

**STATE OF OHIO  
DEPARTMENT OF TRANSPORTATION  
D10 RPM FY2025**

PID No.	<b>109885</b>
FED No.	Non Federal

Latitude: 39°26'28"  
Longitude: -81°27'36"

**Project Description**

**Raised Pavement Markers**

ATH-VAR	MRG-VAR
GAL-VAR	NOB-VAR
HOC-VAR	VIN-VAR
MEG-VAR	WAS-VAR
MOE-VAR	

**INDEX OF SHEETS**


Title Sheet	.....1
General Notes	.....2-3
General Summary	.....4
Subsummary Totals	.....5
Location Maps	.....6-14
Subsummaries	.....15-40

Railroad Involvement - None

**2023 SPECIFICATIONS**

*The standard specifications of the State of Ohio, Department of Transportation, including changes and supplemental specifications listed in the proposal shall govern this improvement.*

*I hereby approve these plans and declare that the making of this improvement will not require the closing to traffic of the highway and that provisions for the maintenance and safety of traffic will be as set forth on the plans and estimates.*

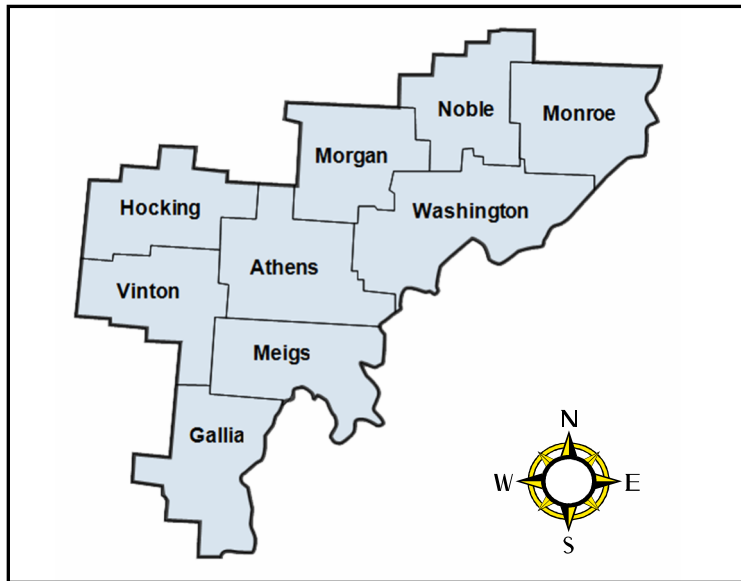

Standard Drawings	Engineer's Seal
TC-65.10 01/17/14	
TC-65.11 01/19/24	
MT-95.30 07/19/19	
MT-95.31 07/19/19	
MT-95.32 04/19/19	
MT-95.60 04/19/19	
MT-97.10 04/19/19	
MT-98.10 01/17/20	
MT-98.11 01/17/20	
MT-98.20 04/19/19	
MT-98.22 01/17/20	
MT-98.28 01/17/20	
MT-105.10 01/17/20	
Supplemental Specifications	
800 - 1/17/2025	
831 - 04/21/2023	
832 - 7/19/2024	
934 - 04/21/2023	



Plan Prepared By:

**District 10  
Capital Programs  
338 Muskingum Dr.  
Marietta, OH 45750**

<b>UNDERGROUND UTILITIES</b>
CONTACT BOTH SERVICES CALL TWO WORKING DAYS BEFORE YOU DIG
Ohio Utilities Protection Service (OUPS) <b>Dial 811 or (800)-362-2764 (toll free)</b> Non-members must be called directly.
Oil & Gas Producers Protective <b>Dial (800)-925-0988</b>

Rich Oster  
District 10 Deputy Director

Pamela Boratyn  
Director, Department of Transportation