


STATE OF OHIO  
DEPARTMENT OF TRANSPORTATION

HAM - 747 - 0.86

CITY OF SPRINGDALE  
HAMILTON COUNTY

PROJECT DESCRIPTION  
FY23 URBAN PAVING PROJECT ON 747 IN  
SPRINGDALE.

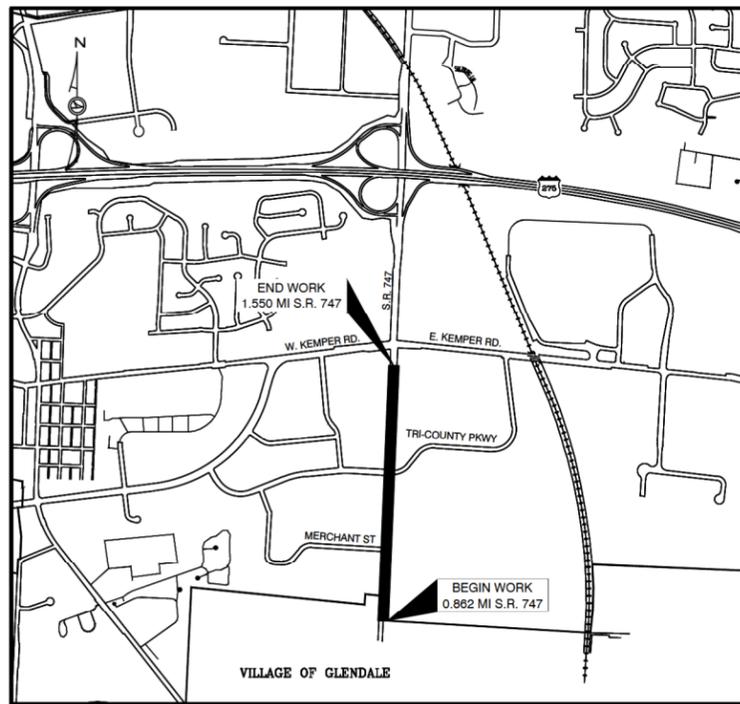

EARTH DISTURBED AREA

PROJECT EDA = 0.0 ACRES  
ESTIMATED CONTRACTOR EDA= 0.0 ACRES  
NOTICE OF INTENT EDA = N/A (NOI NOT REQUIRED)  
PROJECT EDA < 1.0 ACRES.  
NOI NOT SUBMITTED/REQUIRED

2019 SPECIFICATIONS

THE STANDARD SPECIFICATIONS OF THE STATE OF OHIO, DEPARTMENT OF TRANSPORTATION, INCLUDING CHANGES AND SUPPLEMENTAL SPECIFICATIONS LISTED IN THE PROPOSAL SHALL GOVERN THIS IMPROVEMENT.

LOCATION MAP  
LATITUDE: N 39° 16' 54.2" LONGITUDE: W 84° 28' 03.3"  
NO SCALE

PORTION TO BE CONSTRUCTED .....  
CITY STREETS ..... PRINCETON PIKE (SR747)  
STATE & FEDERAL ROUTES .....  
COUNTY & TOWNSHIP ROADS .....  
OTHER ROADS .....

DESIGN DESIGNATION HAM-747-0.86

CURRENT ADT (2023)..... 10,500  
DESIGN YEAR ADT (2035)..... 10,500  
DESIGN HOURLY VOLUME (2035)..... 1,400  
DIRECTIONAL DISTRIBUTION..... 53.2  
TRUCKS (24 HOUR B&C)..... 2%  
DESIGN SPEED..... 35 MPH  
LEGAL SPEED..... 35 MPH

DESIGN FUNCTIONAL CLASSIFICATION  
PRINCIPAL ARTERIAL

DESIGN EXCEPTIONS  
NONE REQUIRED

**UNDERGROUND UTILITIES**

UNDERGROUND UTILITIES  
Contact Two Working Days  
Before You Dig

**OHIO811.org**  
Before You Dig

OHIO811, 8-1-1, or 1-800-382-2764  
(Non-members must be called directly)



Signed: *Shawn Riggs*  
Date: 12/6/2022

INDEX OF SHEETS:

TITLE SHEET.....	1
TYPICAL SECTIONS.....	2
GENERAL NOTES.....	3-4
MAINTENANCE OF TRAFFIC NOTES.....	5-6
GENERAL SUMMARIES.....	7
RAISED PAVEMENT MARKERS QUANTITIES.....	8
PAVEMENT MARKING QUANTITIES.....	9-12
PLAN SHEETS.....	13-15
PAVEMENT MARKING PLAN SHEETS.....	16-18
PAVEMENT PLANING DETAIL.....	19

STANDARD CONSTRUCTION DRAWINGS-ODOT

STANDARD CONSTRUCTION DRAWINGS-ODOT		SUPPLEMENTAL SPECIFICATIONS
MT-95.31	07/19/19	800-2019 4/21/23
MT-95.32	04/19/19	807 01-21-22
MT-97.10	04/19/19	821 04-20-12
MT-97.11	01/20/17	832 10-19-18
MT-99.20	04/19/19	905 04-17-20
MT-105.10	01/17/20	921 04-20-12
MT-110.10	07/19/13	SS 1136 4/21/23
TC-65.10	01/17/14	
TC-65.11	07/21/17	
TC-71.10	07/16/21	
TC-74.10	01-21-22	
TC-82.10	07/19/19	
BP-3.1	01/21/22	

I HEREBY APPROVE THESE PLANS AND DECLARE THAT THE MAKING OF THIS IMPROVEMENT WILL NOT REQUIRE THE CLOSING TO TRAFFIC OF THE HIGHWAY AND THAT PROVISIONS FOR THE MAINTENANCE AND SAFETY FOR TRAFFIC WILL BE AS SET FORTH ON THE PLANS AND ESTIMATES.

**DISTRICT DEPUTY DIRECTOR**  
*Tammy K Campbell* 5-21-23  
**DIRECTOR, DEPARTMENT OF TRANSPORTATION**  
*Jack Madant* 5-21-23



FEDERAL PROJECT NO.  
E191-882

PID NO.  
110406

CONSTRUCTION PROJECT NO.

RAILROAD INVOLVEMENT  
NONE

HAM - 747 - 0.86