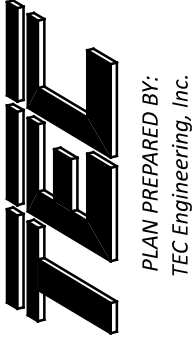


SHEET NUM.										PART.		ITEM	ITEM EXT	GRAND TOTAL	UNIT	DESCRIPTION	SEE SHEET NO.
10	20	21	26	27	28	29	115	119	162	1/STGB	2/NFP						
									33	33		638	98600	33	FT	WATER WORK, MISC.: FURNISHING AND INSTALLING 1" COPPER SERVICE PIPE W/ AQUA SHIELD, CINCINNATI SPEC 1126	162
									15	15		638	98600	15	FT	WATER WORK, MISC.: FURNISHING AND INSTALLING 2" COPPER SERVICE PIPE W/ AQUA SHIELD, CINCINNATI SPEC 1126	162
									205	171	34	638	98600	205	FT	WATER WORK, MISC.: FURNISHING AND INSTALLING 3/4" COPPER SERVICE PIPE W/ AQUA SHIELD, CINCINNATI SPEC 1126	162
									285	30	255	638	98600	285	FT	WATER WORK, MISC.: FURNISHING AND LAYING 16" DUCTILE IRON PIPE AND FITTINGS, CINCINNATI SPEC 1101	162
									36	15	21	638	98600	36	FT	WATER WORK, MISC.: FURNISHING AND LAYING 6" DUCTILE IRON PIPE AND FITTINGS, CINCINNATI SPEC 1101	162
									27			638	98600	27	FT	WATER WORK, MISC.: FURNISHING AND LAYING 8" DUCTILE IRON PIPE AND FITTINGS, CINCINNATI SPEC 1101	162
									LS		LS	SPECIAL	63898100	LS		WATER WORK, MISC.: HAULING WATER WORKS MATERIAL, 1 TON, CINCINNATI SPEC 1102	162
																<b>LIGHTING</b>	
3,175										3,175		625	25411	3,175	FT	CONDUIT, 2", 725.052, AS PER PLAN	10
LS										LS		625	98200	LS		LIGHTING, MISC.: MAINTAIN EXISTING LIGHTING	10
																<b>OTHER UTILITIES</b>	
	44									44		SPECIAL	61199700	44	EACH	GAS VALVE BOX ADJUSTED TO GRADE	9
	12									12		611	99900	12	EACH	DRAINAGE STRUCTURE, MISC.: GAS METER, ADJUSTED TO GRADE	9
	9									9		638	10400	9	EACH	FIRE HYDRANT ADJUSTED TO GRADE	
	101									101		638	10800	101	EACH	VALVE BOX ADJUSTED TO GRADE	
	7									7		638	10900	7	EACH	SERVICE BOX ADJUSTED TO GRADE	
	5									5		638	98000	5	EACH	WATER WORK, MISC.: WATER MANHOLE, ADJUSTED TO GRADE	9
																<b>TRAFFIC CONTROL</b>	
			105	57								630	03100	162	FT	GROUND MOUNTED SUPPORT, NO. 3 POST	
			48	14								630	08520	62	FT	STREET NAME SIGN SUPPORT, NO. 3 POST	
			3	1								630	08600	4	EACH	SIGN POST REFLECTOR	
			1									630	72521	1	EACH	OVERHEAD SIGN SUPPORT, TYPE TC-16.22, DESIGN 7, AS PER PLAN	110
			2			10	5					630	79100	17	EACH	SIGN HANGER ASSEMBLY, MAST ARM	
			7	8								630	79500	15	EACH	SIGN SUPPORT ASSEMBLY, POLE MOUNTED	
			95.6	53.5		82.5	22					630	80100	253.6	SF	SIGN, FLAT SHEET	
			6	2								630	80500	8	EACH	SIGN, DOUBLE FACED, STREET NAME	
				2								630	80510	2	EACH	SIGN, STREET NAME	
			1									630	84511	1	EACH	RIGID OVERHEAD SIGN SUPPORT FOUNDATION, AS PER PLAN	110
			13	14								630	84900	27	EACH	REMOVAL OF GROUND MOUNTED SIGN AND DISPOSAL	
			1									630	85100	1	EACH	REMOVAL OF GROUND MOUNTED SIGN AND REERECTION	
			9	9								630	86002	18	EACH	REMOVAL OF GROUND MOUNTED POST SUPPORT AND DISPOSAL	
			1									630	86010	1	EACH	REMOVAL OF GROUND MOUNTED POST SUPPORT AND REERECTION	
			2	2								630	87400	4	EACH	REMOVAL OF OVERHEAD MOUNTED SIGN AND DISPOSAL	
		1	17	11								630	87500	28	EACH	REMOVAL OF POLE MOUNTED SIGN AND DISPOSAL	
			1									630	97700	1	EACH	SIGNING, MISC.: REMOVAL OF MEIER'S WINE CELLARS SIGN	10
			1									630	97700	1	EACH	SIGNING, MISC.: REMOVAL OF SPAN WIRE	103
			2									630	97700	2	EACH	SIGNING, MISC.: SOLAR POWERED RECTANGULAR RAPID FLASHING BEACON (RRFB)	103
					0.1							644	00200	0.1	MILE	LANE LINE, 4"	
					0.48	0.12						644	00300	0.6	MILE	CENTER LINE	
					400							644	00400	400	FT	CHANNELIZING LINE, 8"	
					152	103						644	00500	255	FT	STOP LINE	
					584	54						644	00630	638	FT	CROSSWALK LINE, 24"	
					215	81						644	00700	296	FT	TRANSVERSE/DIAGONAL LINE	
					36							644	00900	36	SF	ISLAND MARKING	
					1	1						644	01000	2	EACH	RAILROAD SYMBOL MARKING	
					410	496						644	01200	906	FT	PARKING LOT STALL MARKING	
					11	2						644	01300	13	EACH	LANE ARROW	
					3							644	01301	3	EACH	LANE ARROW, AS PER PLAN	103
						230						644	01500	230	FT	DOTTED LINE, 4", DOUBLE YELLOW	
						16						644	30000	16	FT	REMOVAL OF PAVEMENT MARKING	

GENERAL SUMMARY

DESIGN AGENCY  
  
 PLAN PREPARED BY:  
 TEL Engineering, Inc.  
 7288 Central Park Blvd.  
 Mason, OH 45040

DESIGNER  
 KLL

REVIEWER  
 ALH 04/29/26

PROJECT ID  
 116550

SHEET TOTAL  
 018 | 166