


PORTAGE COUNTY
NELSON TOWNSHIP
LOTS 3 AND 5
T5N
R6W



FOR 305-2.43

RIGHT OF WAY PLAN
POR-305-2.35

CALC. BY	REGION	STATE	FEDERAL PROJECT
DATE	5	OHIO	
CHKD. BY			
DATE			

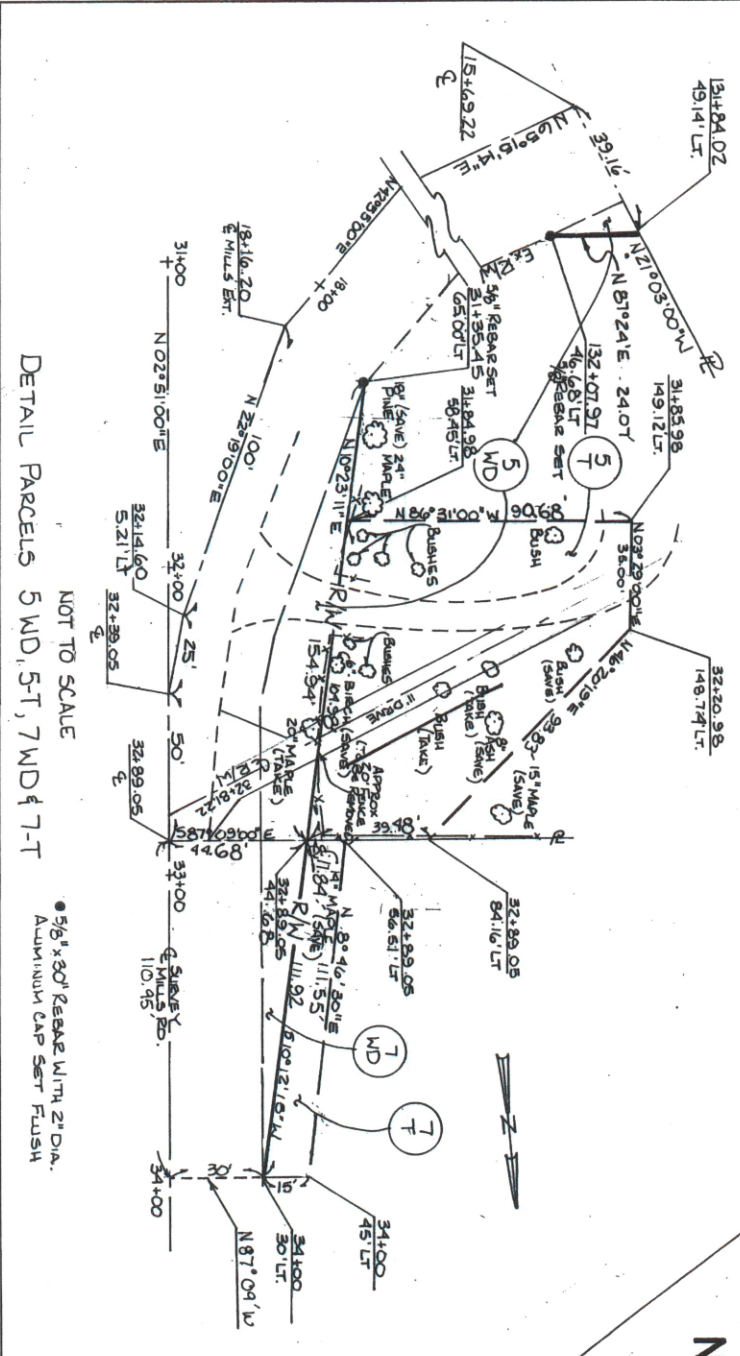

NOT TO SCALE
5/8\"/>

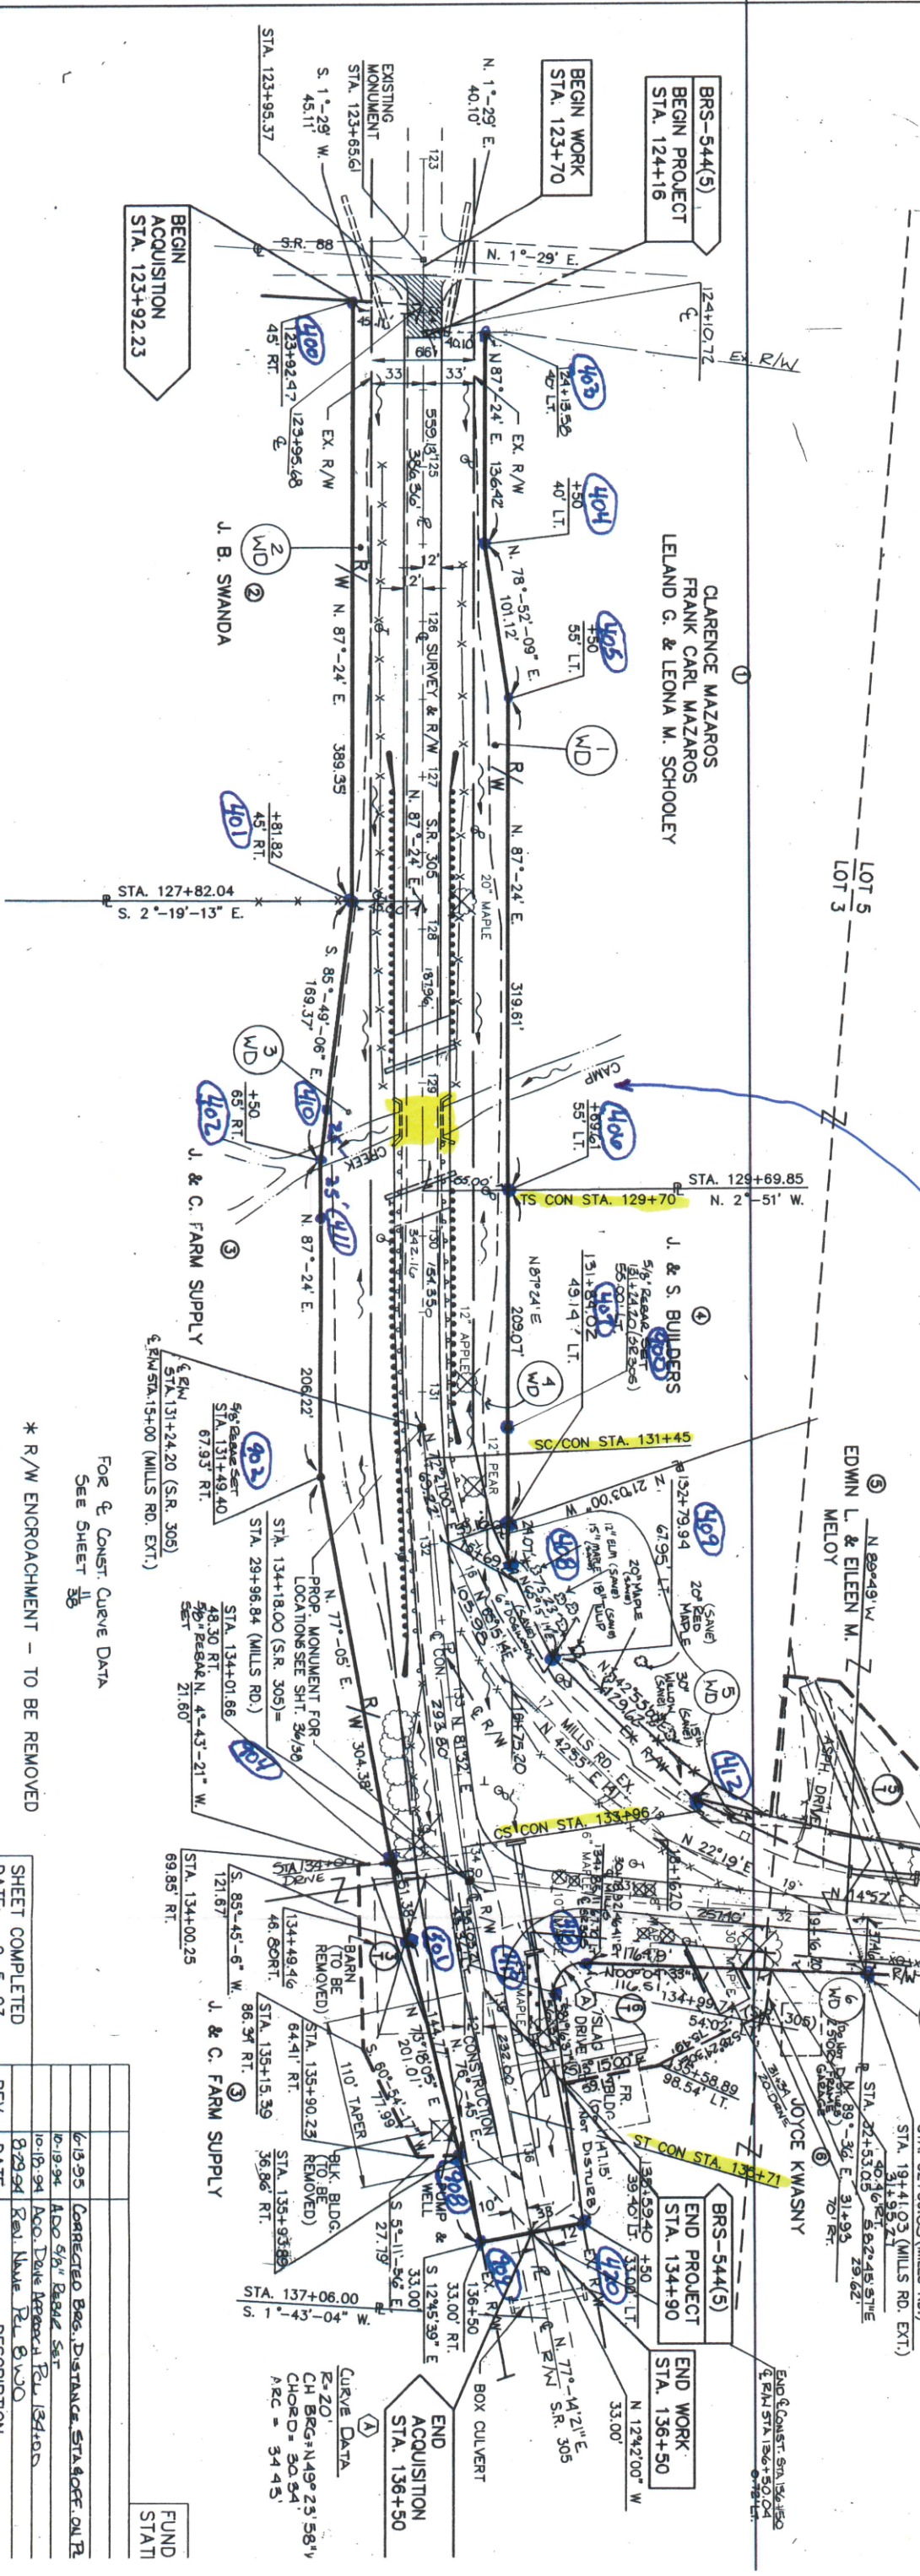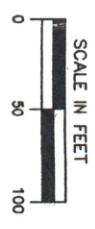

FOR & CONST. CURVE DATA
SEE SHEET 35
* R/W ENCROACHMENT - TO BE REMOVED

SHEET COMPLETED	REV.	DATE	DESCRIPTION
DATE: 2-5-93			
6-15-95			CORRECTED BEG. DISTANCE, STRAIGHT OFF. ON R.
6-19-94			ADO 5/8\"/>
10-19-94			ADO, DEVE APPROVAL, R/W, 134+00
8-29-94			Rev. Name R/W, 134+00

FUND
STATI