

STATE OF OHIO
DEPARTMENT OF HIGHWAYS

I-1105(1)

FED. RD. DIVISION	STATE	PROJECT
2	OHIO	I-1105(1)

271

WAY-1-1.36

CONGRESS TOWNSHIP
WAYNE COUNTY

LIMITED ACCESS

This improvement is especially designed for through traffic and has been declared a limited access highway or freeway by action of the Director of Highways in accordance with the provisions of Section 5511.02 of the Revised Code of Ohio.

WAYNE COUNTY

WAY-1-1.36

MAR 25 1964

GROUND PHOTO LAB

1/1 Return AS-11/11

The standard specifications of the State of Ohio, Department of Highways, including changes and supplemental specifications listed in the proposal shall govern this improvement.

The right of way for this improvement will be provided by the State of Ohio.

I hereby approve these plans and declare that the making of this improvement will not require the closing of the highway to traffic and that provisions for the maintenance and safety of traffic will be as set forth on the plans and estimates.

Approved [Signature]
Date 7-17-57 Chief Engineer, Interstate Projects

Approved [Signature]
Date 7-22-57 Deputy Director, Planning & Programming

Approved [Signature]
Date 7-22-57 Deputy Director, Design & Construction

Approved _____
Date _____ First Assistant Director

Approved [Signature]
Date 7/22/57 Acting Director of Highways

Sheet No. 196 dated 2-24-58 Substituted for original sheet 196

Sheet Nos. 1, 2, 9, 10, 11, 12, 13, 14, 17, 18, 19, 24, 25, 71, 72, 73, 74, 75, 76, 77, 78, 121, 129, 130, 131, 132, 133, 148, 151, 152, 153, 154, 206, 257, 267. Revised 5-5-58.

Sheet Nos. 207-A, 207-B, 207-C, 207-D, 207-E, 207-F. Added 5-5-58.

Sheet Nos. 8, 257, 261, 262 Revised 6-25-58
Sheet No. 262A Added 6-25-58

DEPARTMENT OF COMMERCE
BUREAU OF PUBLIC ROADS

APPROVED

DIVISION ENGINEER

DATE

MAR 25 1964

GROUND PHOTO LAB

Revised 5-5-58.

CONVENTIONAL SIGNS

State Line	-----
County Line	-----
Township Line	-----
Section Line	-----
Center Line	-----
Corporation Line	-----
Fence Line	X X X X X X X X X X
Guard Rail (existing)	=====
Guard Rail (proposed)	=====
Steam Railroad	-----
Power Poles	=====
Telephone Poles	=====
Trees (existing)	=====
Trees or Stumps (to be removed)	=====

INDEX OF SHEETS


Title Sheet	-----	1
Location Map	-----	2
Typical Section	-----	3-5
General Notes	-----	6-7
General Summary	-----	8
Summary of Quantities	-----	9-13
Plan & Profile	-----	14-23
Cross Section	-----	24-120
State Route 301	-----	121-134
Congress Township 40	-----	135-143
Wayne County 409	-----	144-147
Wayne County 503	-----	148-156
Wayne County 102	-----	157-173
Wayne County 36	-----	174-184
Roadside Rest Details	-----	185-199
Detail Sheets	-----	200-207
Structures 20' & Under	-----	208-221
Structures Over 20'	-----	222-255
Right Of Way Sheets	-----	256-271

LINE DATA

Begin Project	Sta. 757+00	
End Project	Sta. 977+77.88	
Gross Length of Project	22,077.88	Lin. Ft.
Deduct for Equation	36.64	Lin. Ft.
Net Length of Project	22,041.24	Lin. Ft. or 4.174 Miles
Net Length of Work	22,356.24	Lin. Ft.
Add for Approaches (See Sheet No. 7)	11,829.36	Lin. Ft.
Total Length of Work	34,185.60	Lin. Ft. or 6.475 Miles

Approved [Signature]
Date 7/1/57 Engineer of Traffic

File No.	WAYNE COUNTY	WAY-1-1.36
Date of Letting	-----	19
Contract No.	-----	

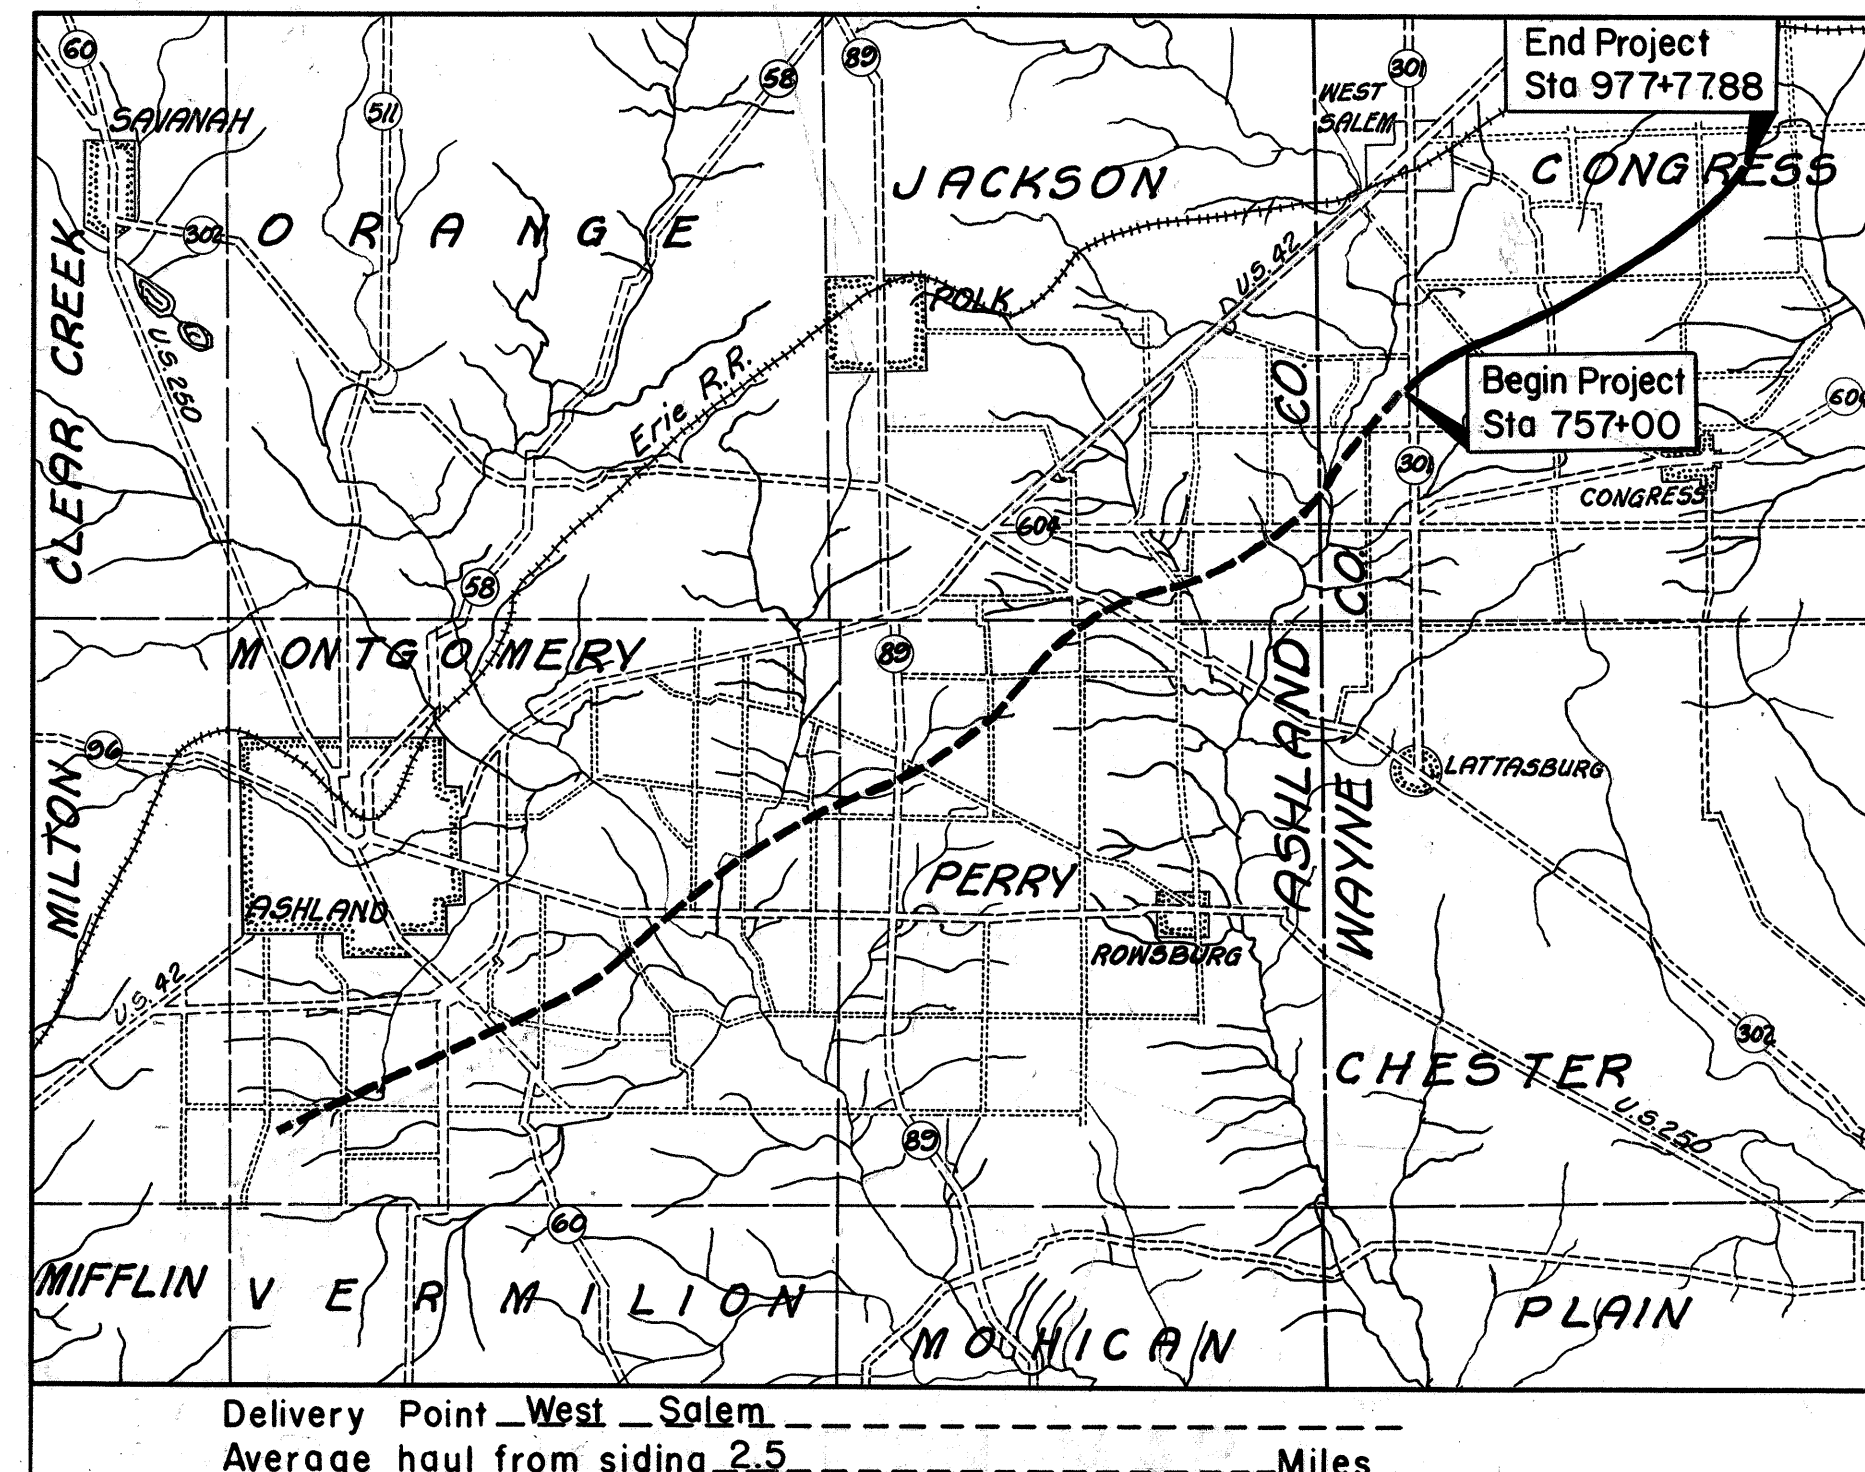

LOCATION MAP

SCALE OF MILES



Portion to be improved
Portion Under Separate Contract
State Roads
Other Roads

SCALE


Plan _____ 1" = 100'
Profile: Horizontal _____ 1" = 100'
Profile: Vertical _____ 1" = 10'

Supplemental Prints of Standard Construction Drawings									
HW-A&B	7-15-57	I-8 CB No. 4	6-1-57	S-27 PC. 4	1-4-54	RP No. 1	7-2-56	AS-1-54	12-1-54
HW-C	7-15-57	I-8 CB No. 5	6-1-57	I-8 I No. 2	12-1-54	RP No. 2	9-14-56	I-8 M.H. No. 2	5-1-52
DR-1	1-3-55	T.J.	5-1-56	I-15 No. 4	12-1-54	RP No. 3	9-14-56		
RI-1	1-3-55	S-27 PC. 3	2-20-45	B-T-50-70-71E. No. 1	10-1-47	RP No. 4A	7-1-57		
T-35	1-2-56	I-1, 2, 3, 4&5	2-20-45	AR-1-57	4-9-57	RP No. 4B	7-1-57		
L-1	4-1-50	I-14G	1-22-52	G-707	6-1-56	RP No. 4C	7-1-57	E-101	1-1-57
L-3	4-1-50	I-15 No. 1	8-1-55	F-1	4-1-57	I-15 No. 2B	6-1-57	B-119	REV. 6-30-56
L-3-A	4-1-50	I-15 No. 2	12-1-54	I-8 CB No. 3A	5-1-52	I-8 M.H. No. 1	5-1-52	5	6-8-55
L.J. No. 1	7-1-55	I-15 No. 2A	7-2-56	I-8 CB 2-2-A&B	1-56	CSB-2-56	Sheets 2 & 3	18	REV. 2-6-57
B-T-71R	3-2-53	I-15 No. 3	12-1-54	SP 53	7-22-53	RB-1-55	3-1-55	S-114	8-30-55

REVISED SHEETS		
ORIGINAL SHEET NO.	REVISED SHEET NO.	REVISION DATE
228	228A	9-18-57
229	229A	9-18-57
231	231A	9-18-57
233	233A	9-18-57
234	234A	9-18-57
235	235A	9-18-57
237	237A	9-18-57
239	239A	9-18-57
240	240A	9-18-57
241	241A	9-18-57
243	243A	9-18-57
247	247A	9-18-57
Sheet No. 8 Revised 3-18-57		
Sheet No. 231A Rev. 10-11-57		

Supplemental Specifications	
E-101	1-1-57
B-119	REV. 6-30-56
5	6-8-55
18	REV. 2-6-57
S-114	8-30-55

Lights, Signs, & Barricades shall be provided & maintained at the intersection of Wayne County 40 & 102 closing 40 to through traffic.

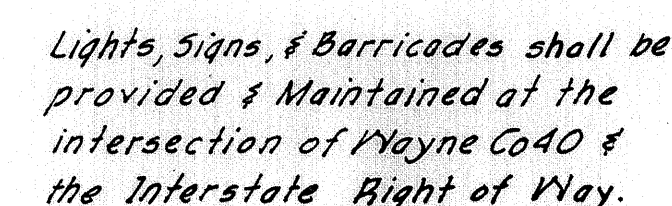


Lights, Signs, & Barricades shall be provided & maintained at the intersection of Wayne County 40 & 503 closing 40 to through traffic.

The Contractor shall provide & maintain Lights, Signs, & Barricades at each location indicated. Barricades shall meet the requirements for movable gate detailed on Standard Construction Drawing No G-707. Lights shall meet the requirements of sec G-707 of the specifications. Standard "ROAD CLOSED" signs shall be 40"x24" size. The Contractor shall furnish, erect, maintain, and remove barricades, lights, and signs, cost of which shall be included in the lump sum bid of Maintaining Traffic.

Lights, Signs, & Barricades will be provided & maintained at the intersection of Wayne County 102 & 503 closing 102 to through traffic.

P. I. 874 + 10.67
 $\Delta = 18^{\circ} 49' 35''$ Lt
 $D = 0^{\circ} 28'$
 $R = 12,277.67'$
 $T = 2035.47'$
 $L = 4034.23'$
 $E = 167.57'$

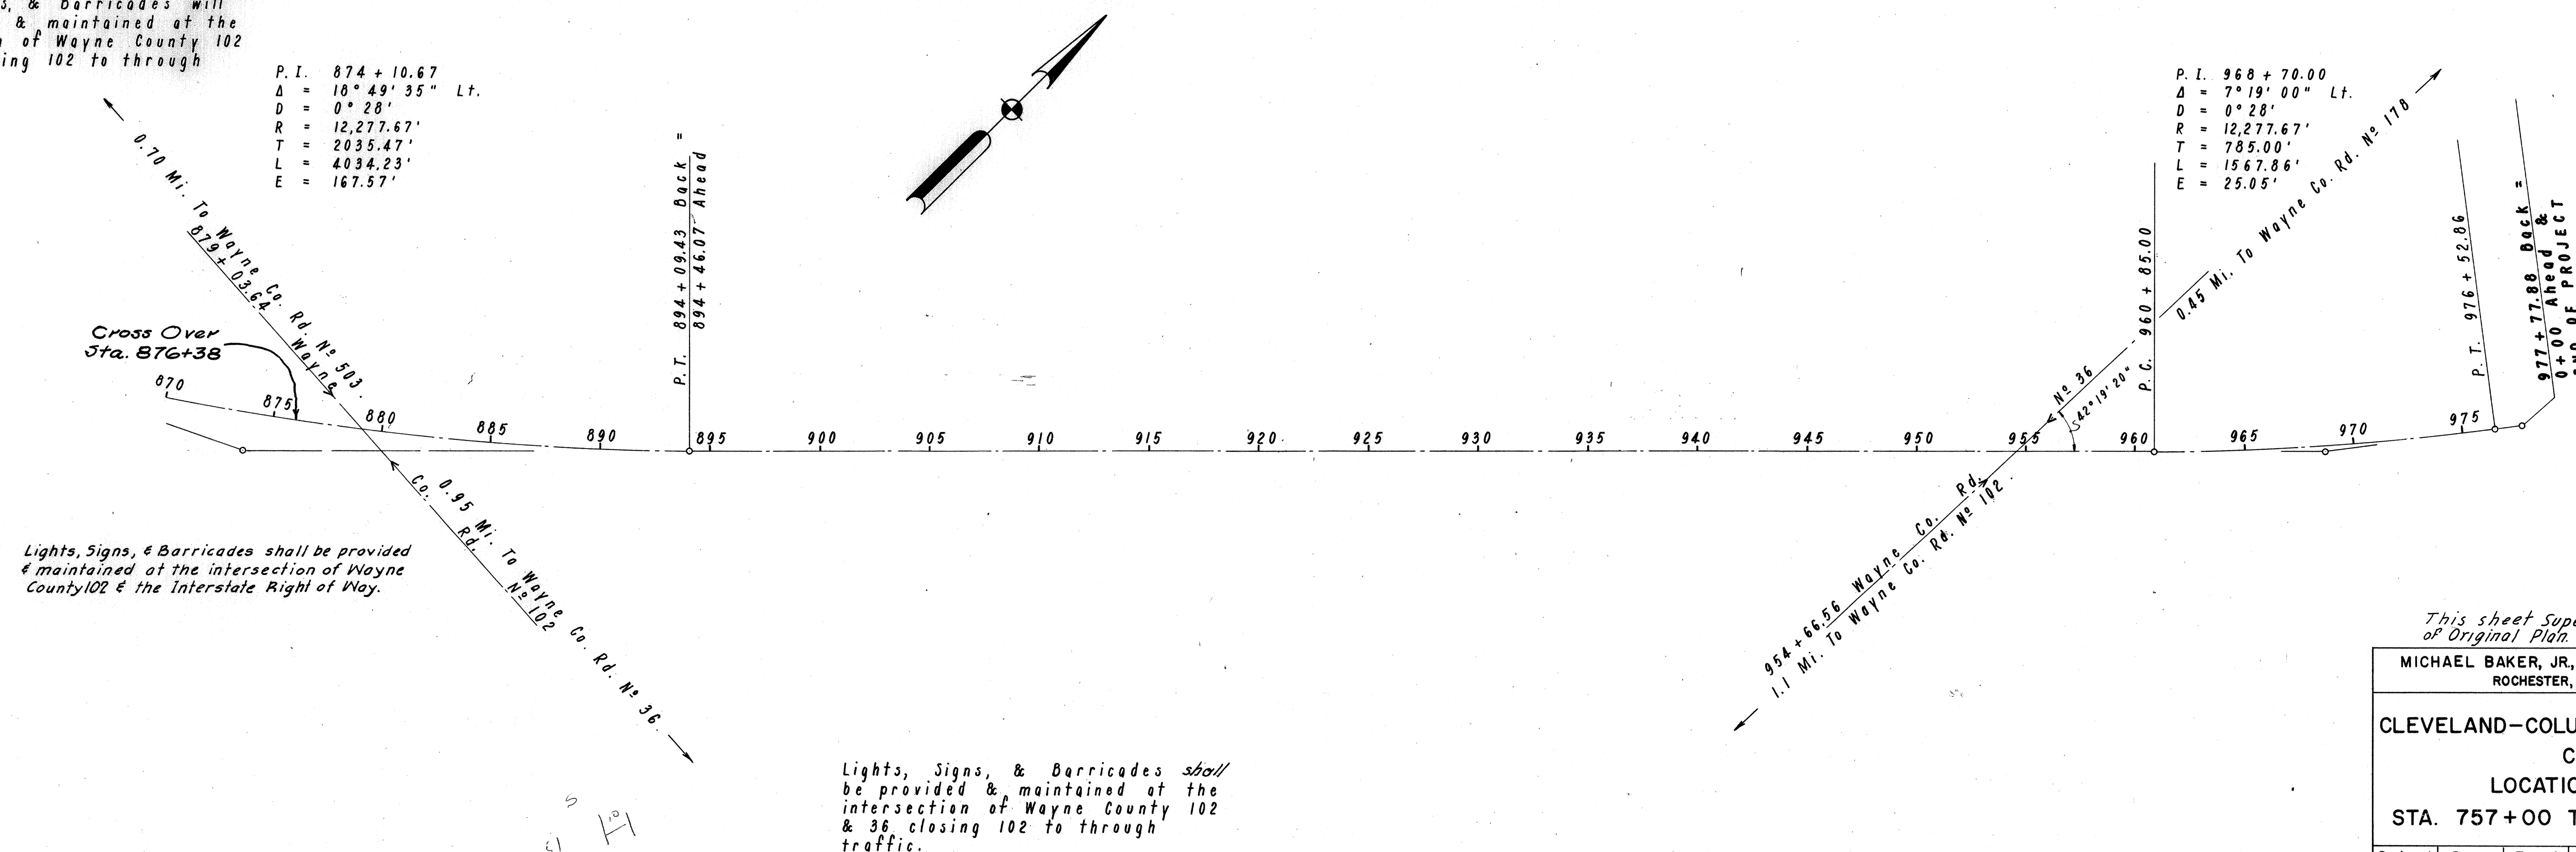

Lights, Signs, & Barricades shall be provided & maintained at the intersection of Wayne County 102 & the Interstate Right of Way.

Lights, Signs, & Barricades shall be provided & maintained at the intersection of Wayne County 102 & 36 closing 102 to through traffic.

P. I. 968 + 70.00
 $\Delta = 7^{\circ} 19' 00''$ Lt
 $D = 0^{\circ} 28'$
 $R = 12,277.67'$
 $T = 785.00'$
 $L = 1567.86'$
 $E = 25.05'$

*This sheet Supercedes Sheet No.2
of Original Plan.*

CLEVELAND-COLUMBUS EXPRESSWAY
C-84
LOCATION PLAN
STA. 757+00 TO STA. 977+7788

Designed	Drawn	Traced	Checked	Reviewed Date	Revised
	F.B.	F.B.	H.T.C.		5-5-51

Revised 5-5-58

Ref. P.I. Sta. 17+19.30

Fence Post


51.5'

52°-36'

35.2'

44°-25'


Survey

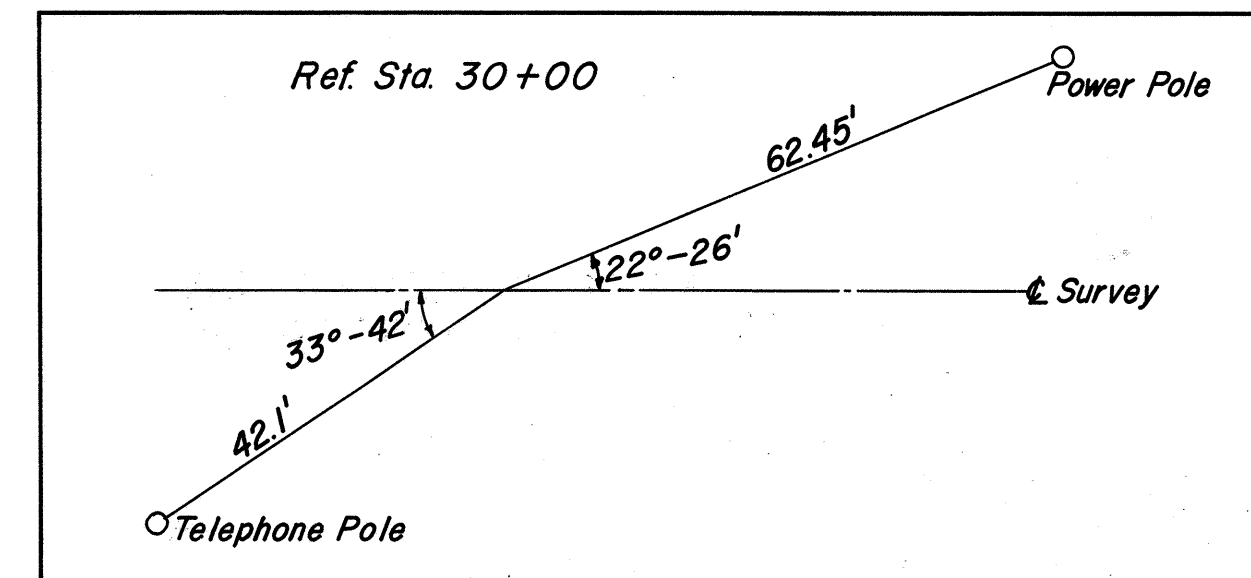

FED. RD. DIVISION	STATE	PROJECT	
2	OHIO	I-1105(1)	


248
271

15.37 MILES NORTH OF ASHLAND
WAYNE COUNTY
WAY - I- 1.36

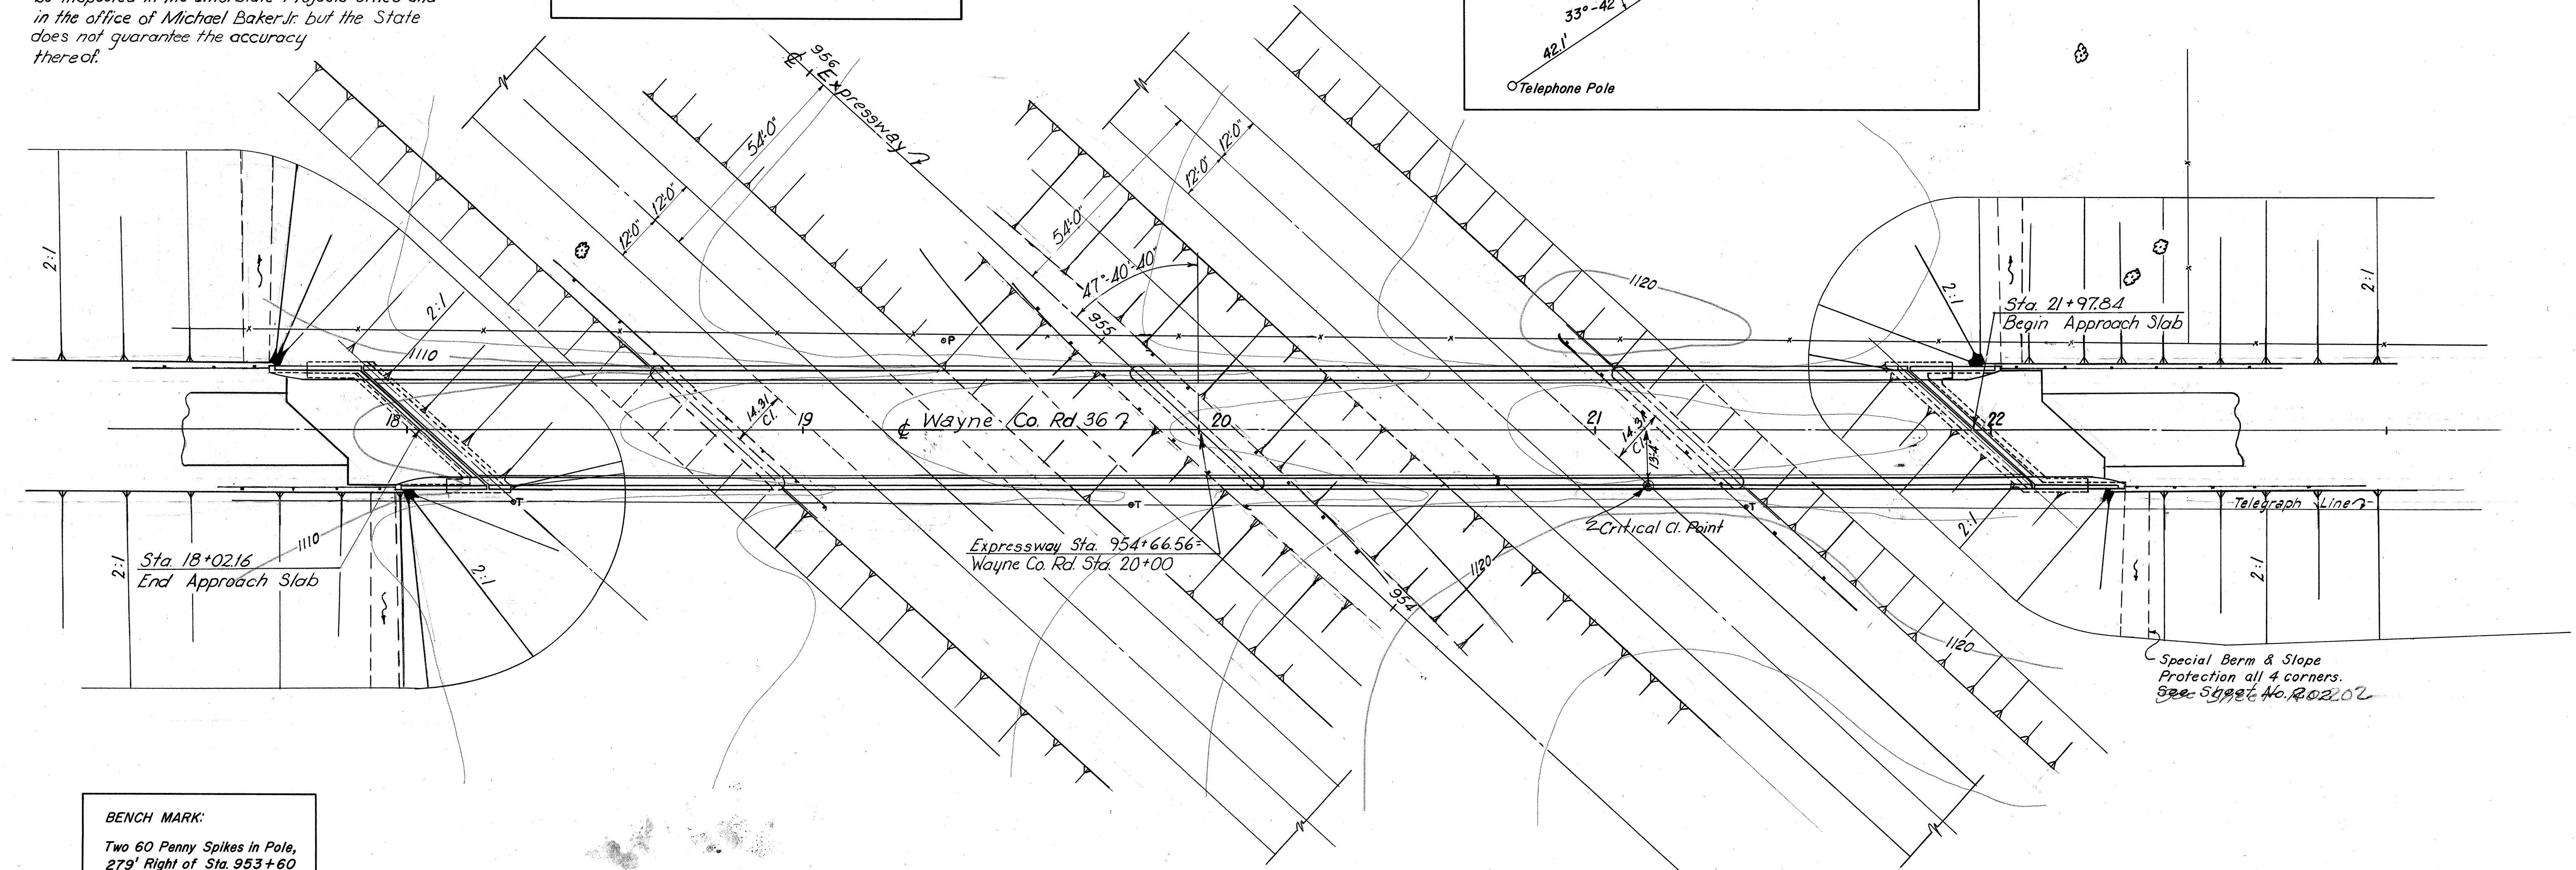

BENCH MARK:
*Two 60 Penny Spikes in Pole,
279' Right of Sta. 953+60
Elevation: 1117.65*

A.V.D. 1975 = 160 Vehicles

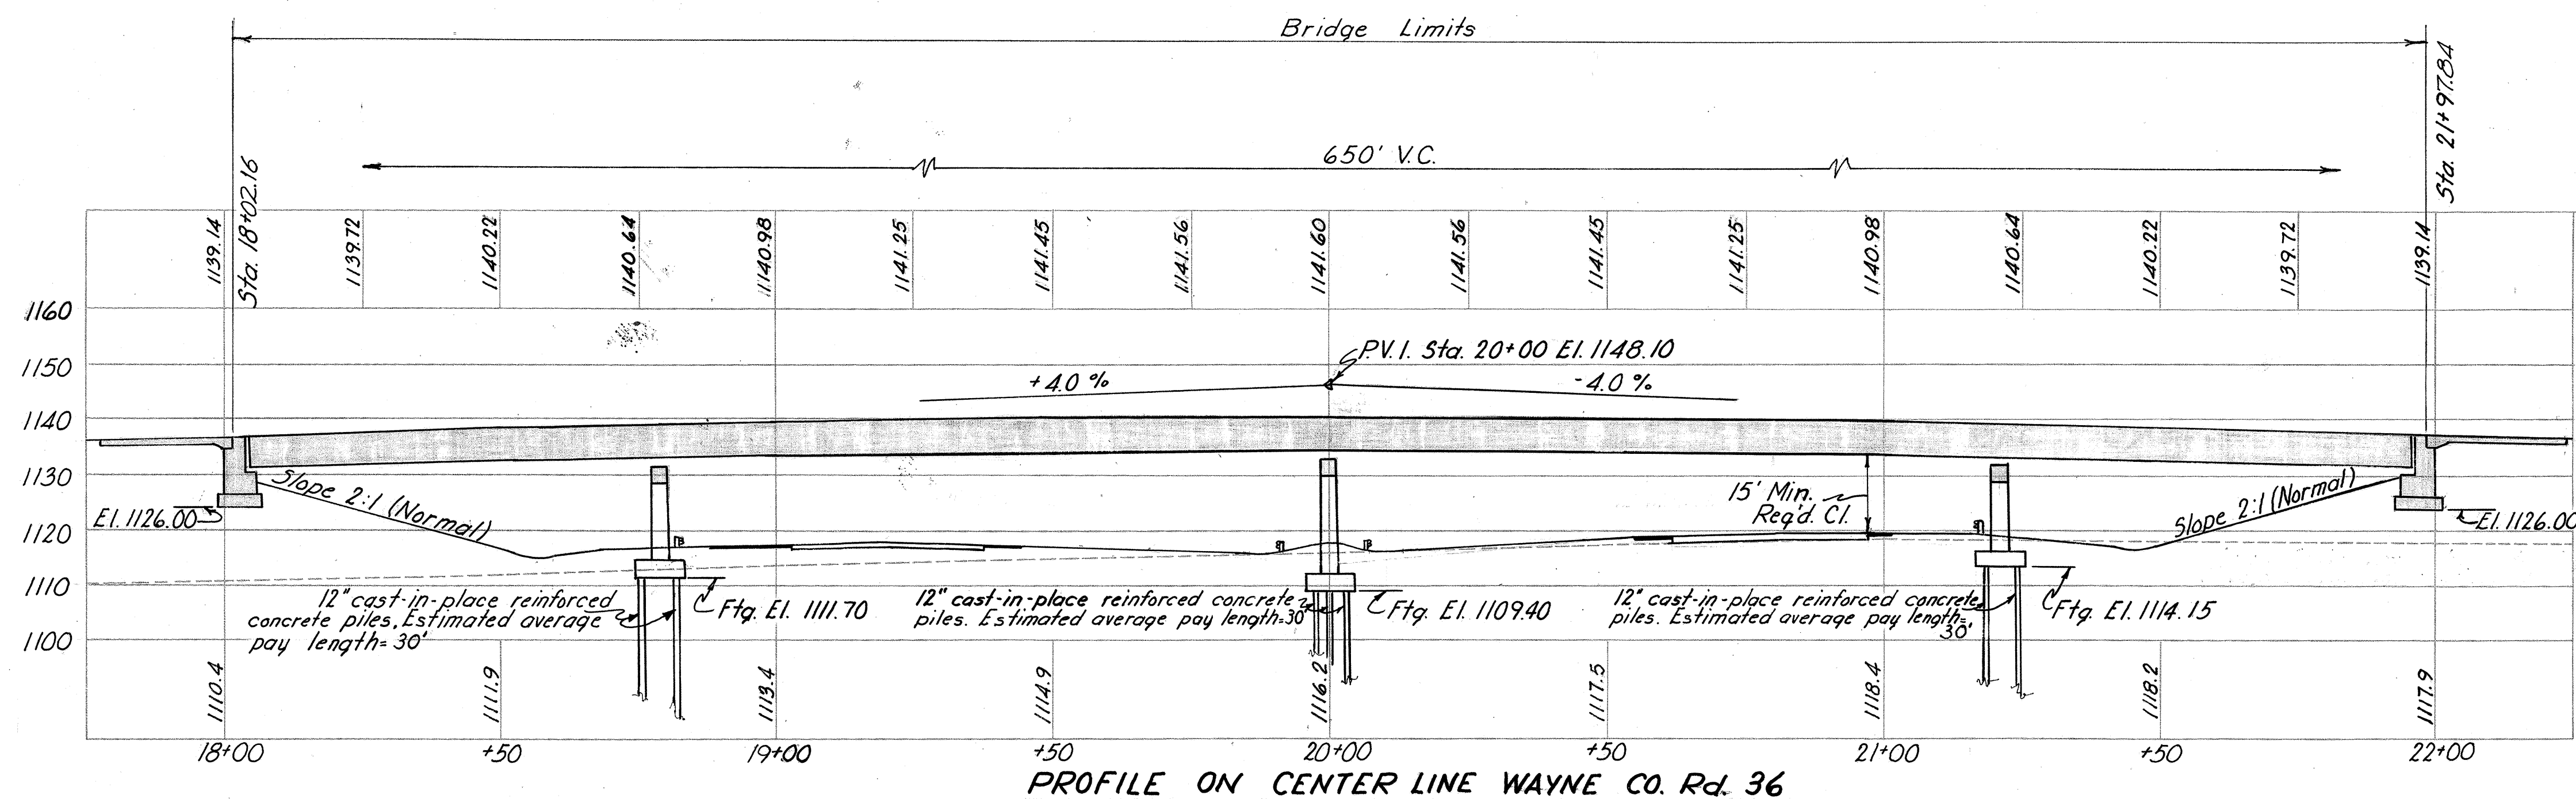

PROPOSED STRUCTURE

Type: Continuous steel girder with reinforced concrete deck and substructure.
Span : 73' -121'6"-121'6"-73' c/c Bearings
Roadway : 24'-0" f/rf 2'-0" Safety Curbs
Load Freq : C.F. = 30 (51)
Wearing Surface : 2" Monolithic Concrete
Approach Slab : 25'-0" long Special Design.
Skew : 47°-40°-40° R/L
Alignment : Tangent

MICHAEL BAKER, JR., CONSULTING ENGINEERS
ROCHESTER, PENNSYLVANIA



SITE PLAN
BRIDGE NO. WAY-1-0511
UNDER COUNTY ROAD NO. 36

WAYNE COUNTY	STA. 954 + 66.56
--------------	------------------

PRESENT TOPOGRAPHY		PROPOSED WORK		
Surveyed	Drawn	Designed J.P.R.	Drawn R.C.	Checked F.W.L.



- *Welding of Structural Steel shall be Class A. Any welds shown as field welds may, at the option of the contractor, be made in the shop.*
- *Porous Drains, one foot thick, shall be provided at each end of bridge, as indicated on General Plan.*
- *Piles shall be driven to a minimum bearing capacity of 30 Tons for the piers.*
- *Excavation Quantity includes the removal of fill material between surface of proposed embankment and bottom of abutment. Backfill behind abutments shall be made with material meeting the requirements of Sec. I-22 and shall be compacted in accordance with requirements for embankment compaction. Payment for backfill shall be included with roadway embankment.*
- *Embankments to be placed to subgrade elevation for a distance of approximately 200 feet beyond the bridge limits as early as practical in the construction procedure and before work is begun on the abutments or Piers 1 and 3. Abutments should be placed as late as practical, with a minimum time lapse of 30 days between completion of the embankment and starting of work on the abutments.*

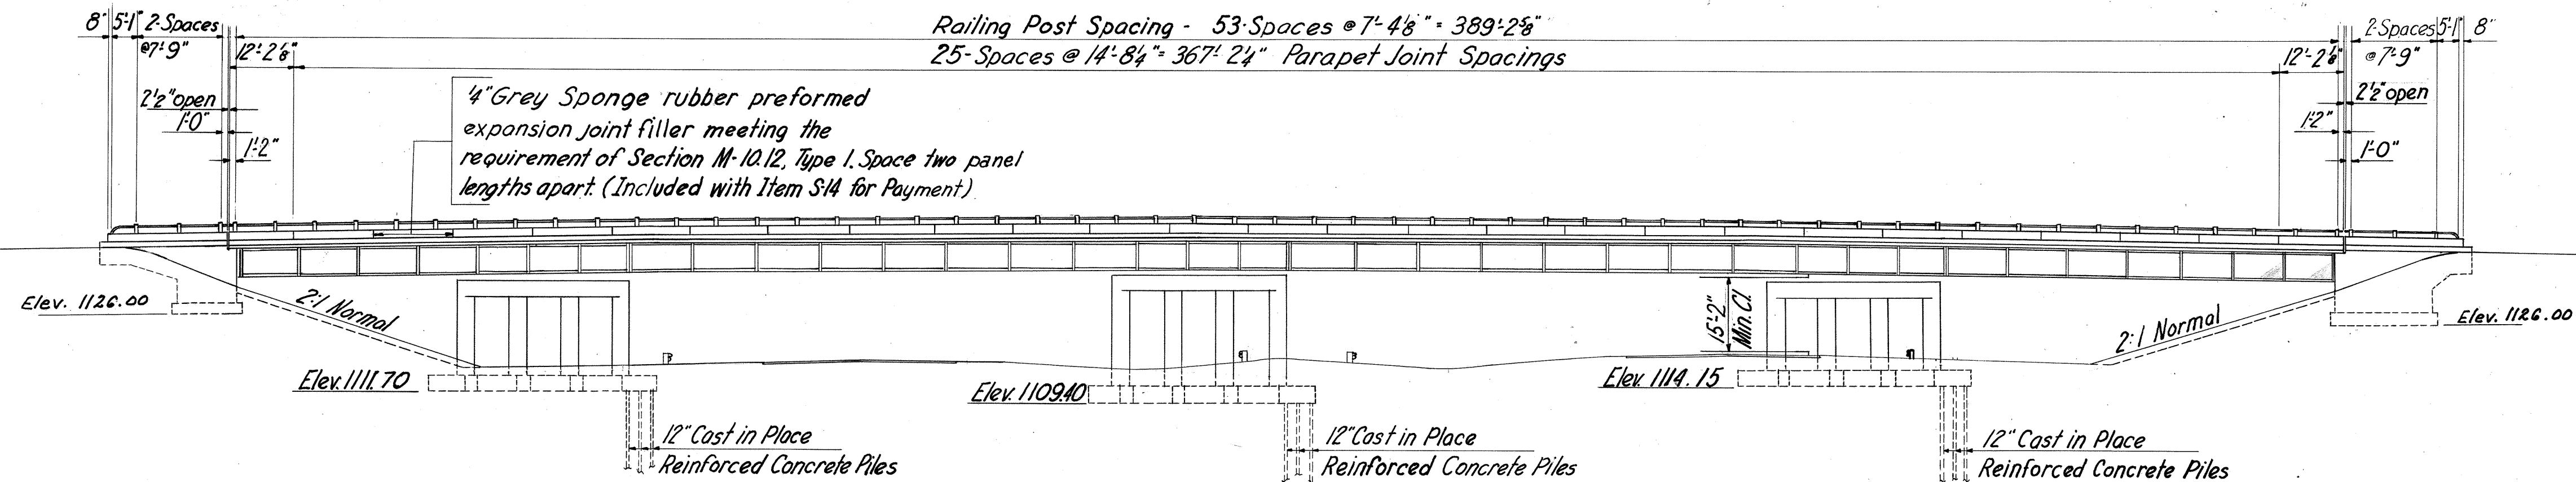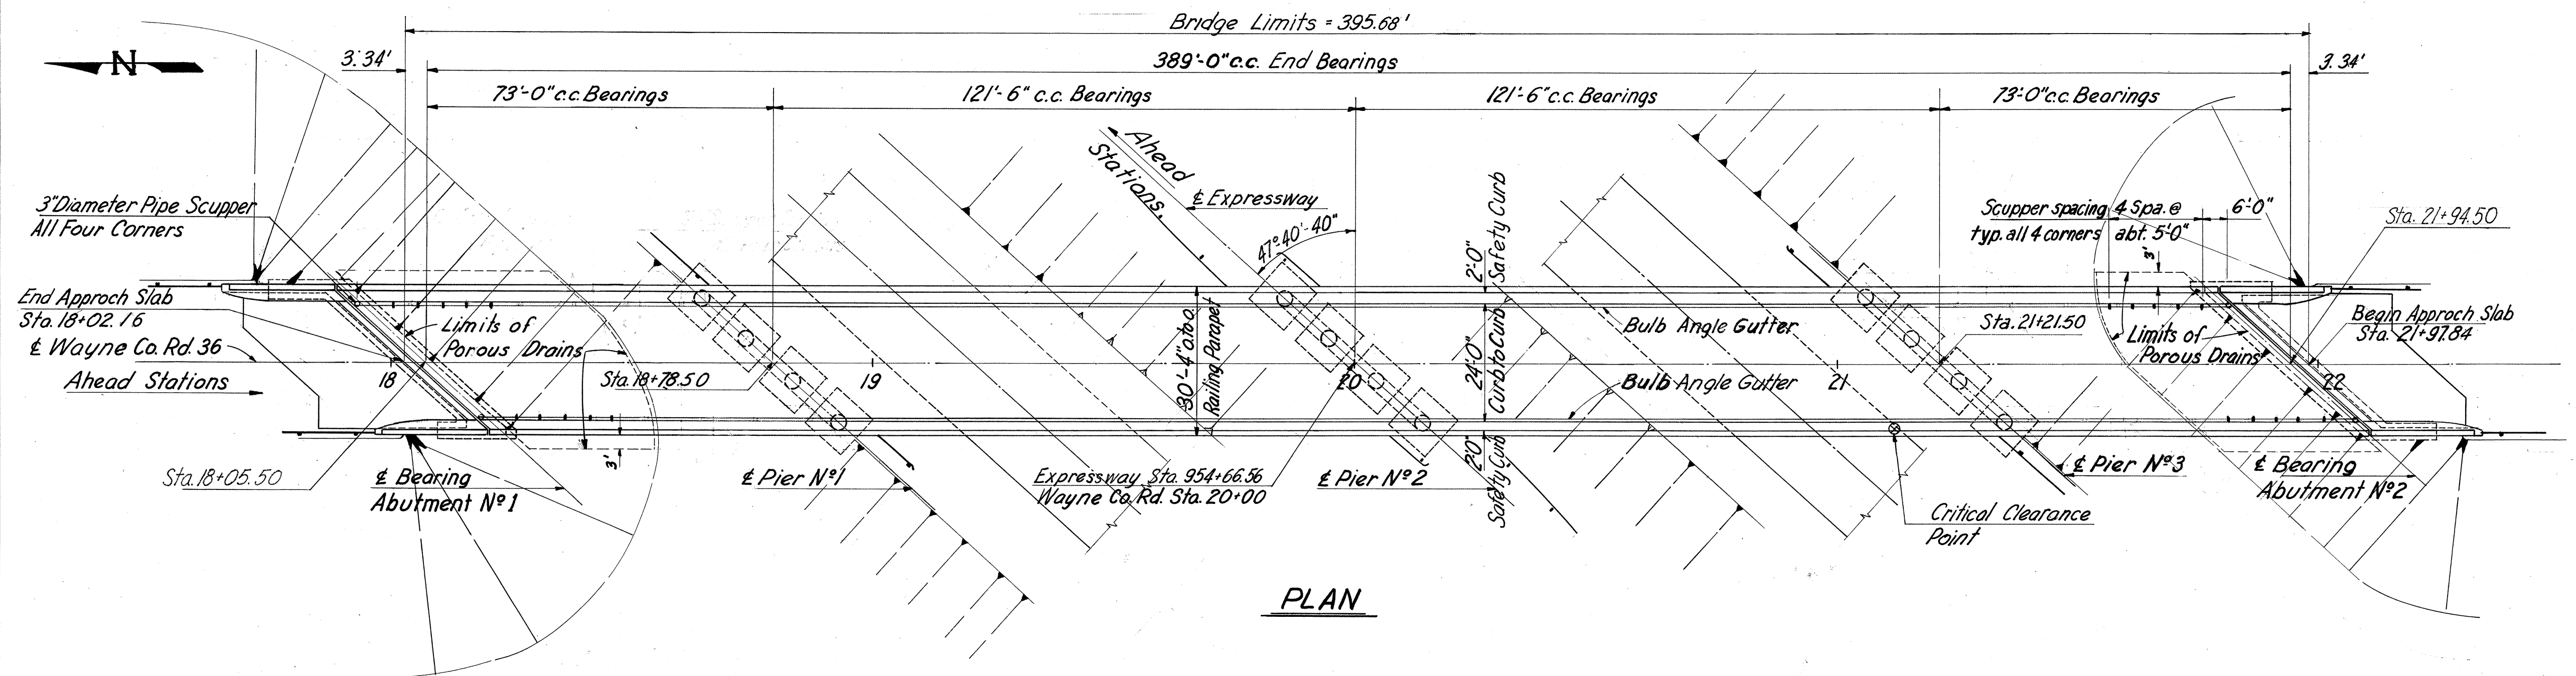ELEVATION

ESTIMATED QUANTITIES									
ITEM	TOTAL	UNIT	DESCRIPTION	SUPERSTR	ABUTMENTS	PIERS	GENERAL	As BUILT	
E-2	555	Cu.Yds.	Unclassified Excavation		265	290		C-15, -41	514
E-2	Lump	Sum	Cofferdams, Cribbs and Sheeting				Lump		
S-1	348	Cu.Yds.	Class "C" Concrete, Superstructure	348					
S-1	93	Cu.Yds.	Class "C" Concrete, Pier Caps & Columns.			93			
S-1	150	Cu.Yds.	Class "E" Concrete, Abutments above Footings		150				
S-1	194	Cu.Yds.	Class "E" Concrete, Footings		62	132			
S-4	129,180	Lbs.	Reinforcing Steel	90,910	12,660	25,610			
S-7	495,000	Lbs.	Structural Steel	495,000				C-9, +9446	504,446
S-8	495,000	Lbs.	Field Painting of Structural Steel	495,000				C-9, +9446	504,446
S-14	873	Lin.Ft.	Railing (Aluminum Rail and Supports, Concrete Parapet.)				873		
S-16	Lump	Sum	First Test Pile				Lump		
S-18	2490	Lin.Ft.	12" Cast-in-Place Reinforced Concrete Piles			2490		C-10, -428	2062
S-29	#5	Cu.Yds.	Porous Backfill		45				
S-29	120	Cu.Yds.	Porous Drains on Embankment Slopes				120		

MICHAEL BAKER, JR., CONSULTING ENGINEERS
ROCHESTER, PENNSYLVANIA

GENERAL PLAN & ELEVATION


BRIDGE NO. WAY-1-0511
UNDER COUNTY ROAD NO. 36

WAYNE COUNTY	STA. 954 + 66.56
--------------	------------------



Designed	Drawn	Traced	Checked	Reviewed-Date	Revised
J.P.R.	R.P.M.	R.P.M.	F.J.K. J.P.R.		

Revised As-Built H.E.R. 2-26-60


WAYNE COUNTY
WAY-1- 136

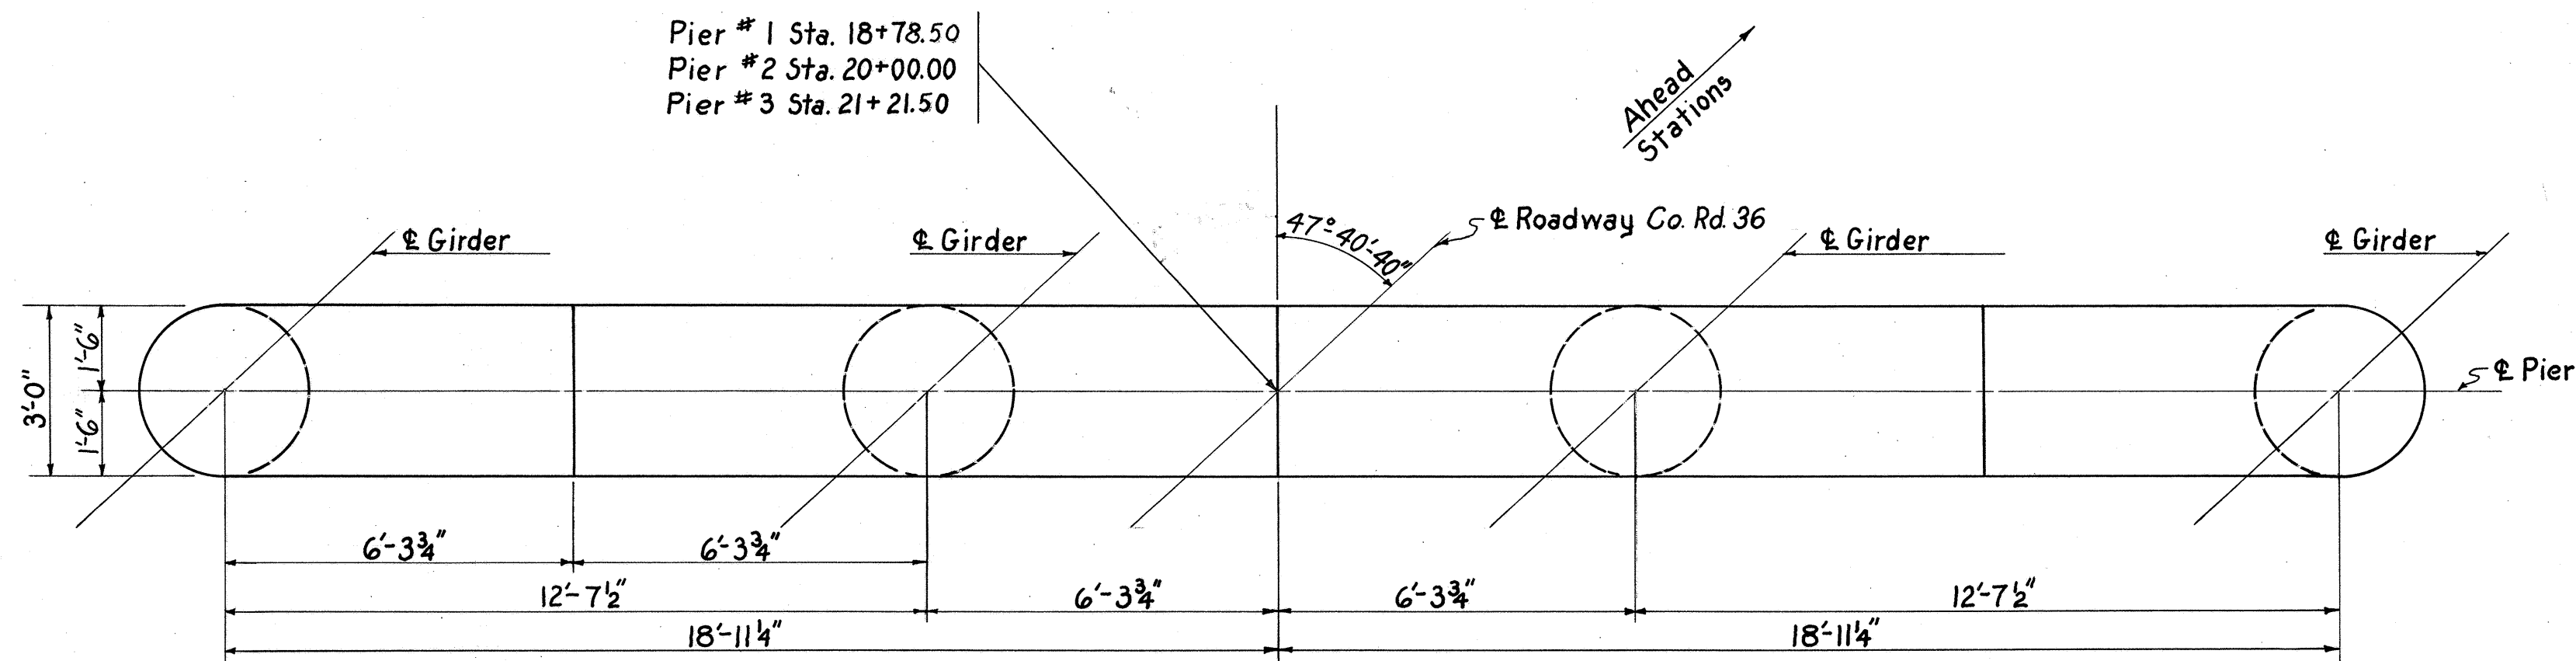


PIER CAP PLAN

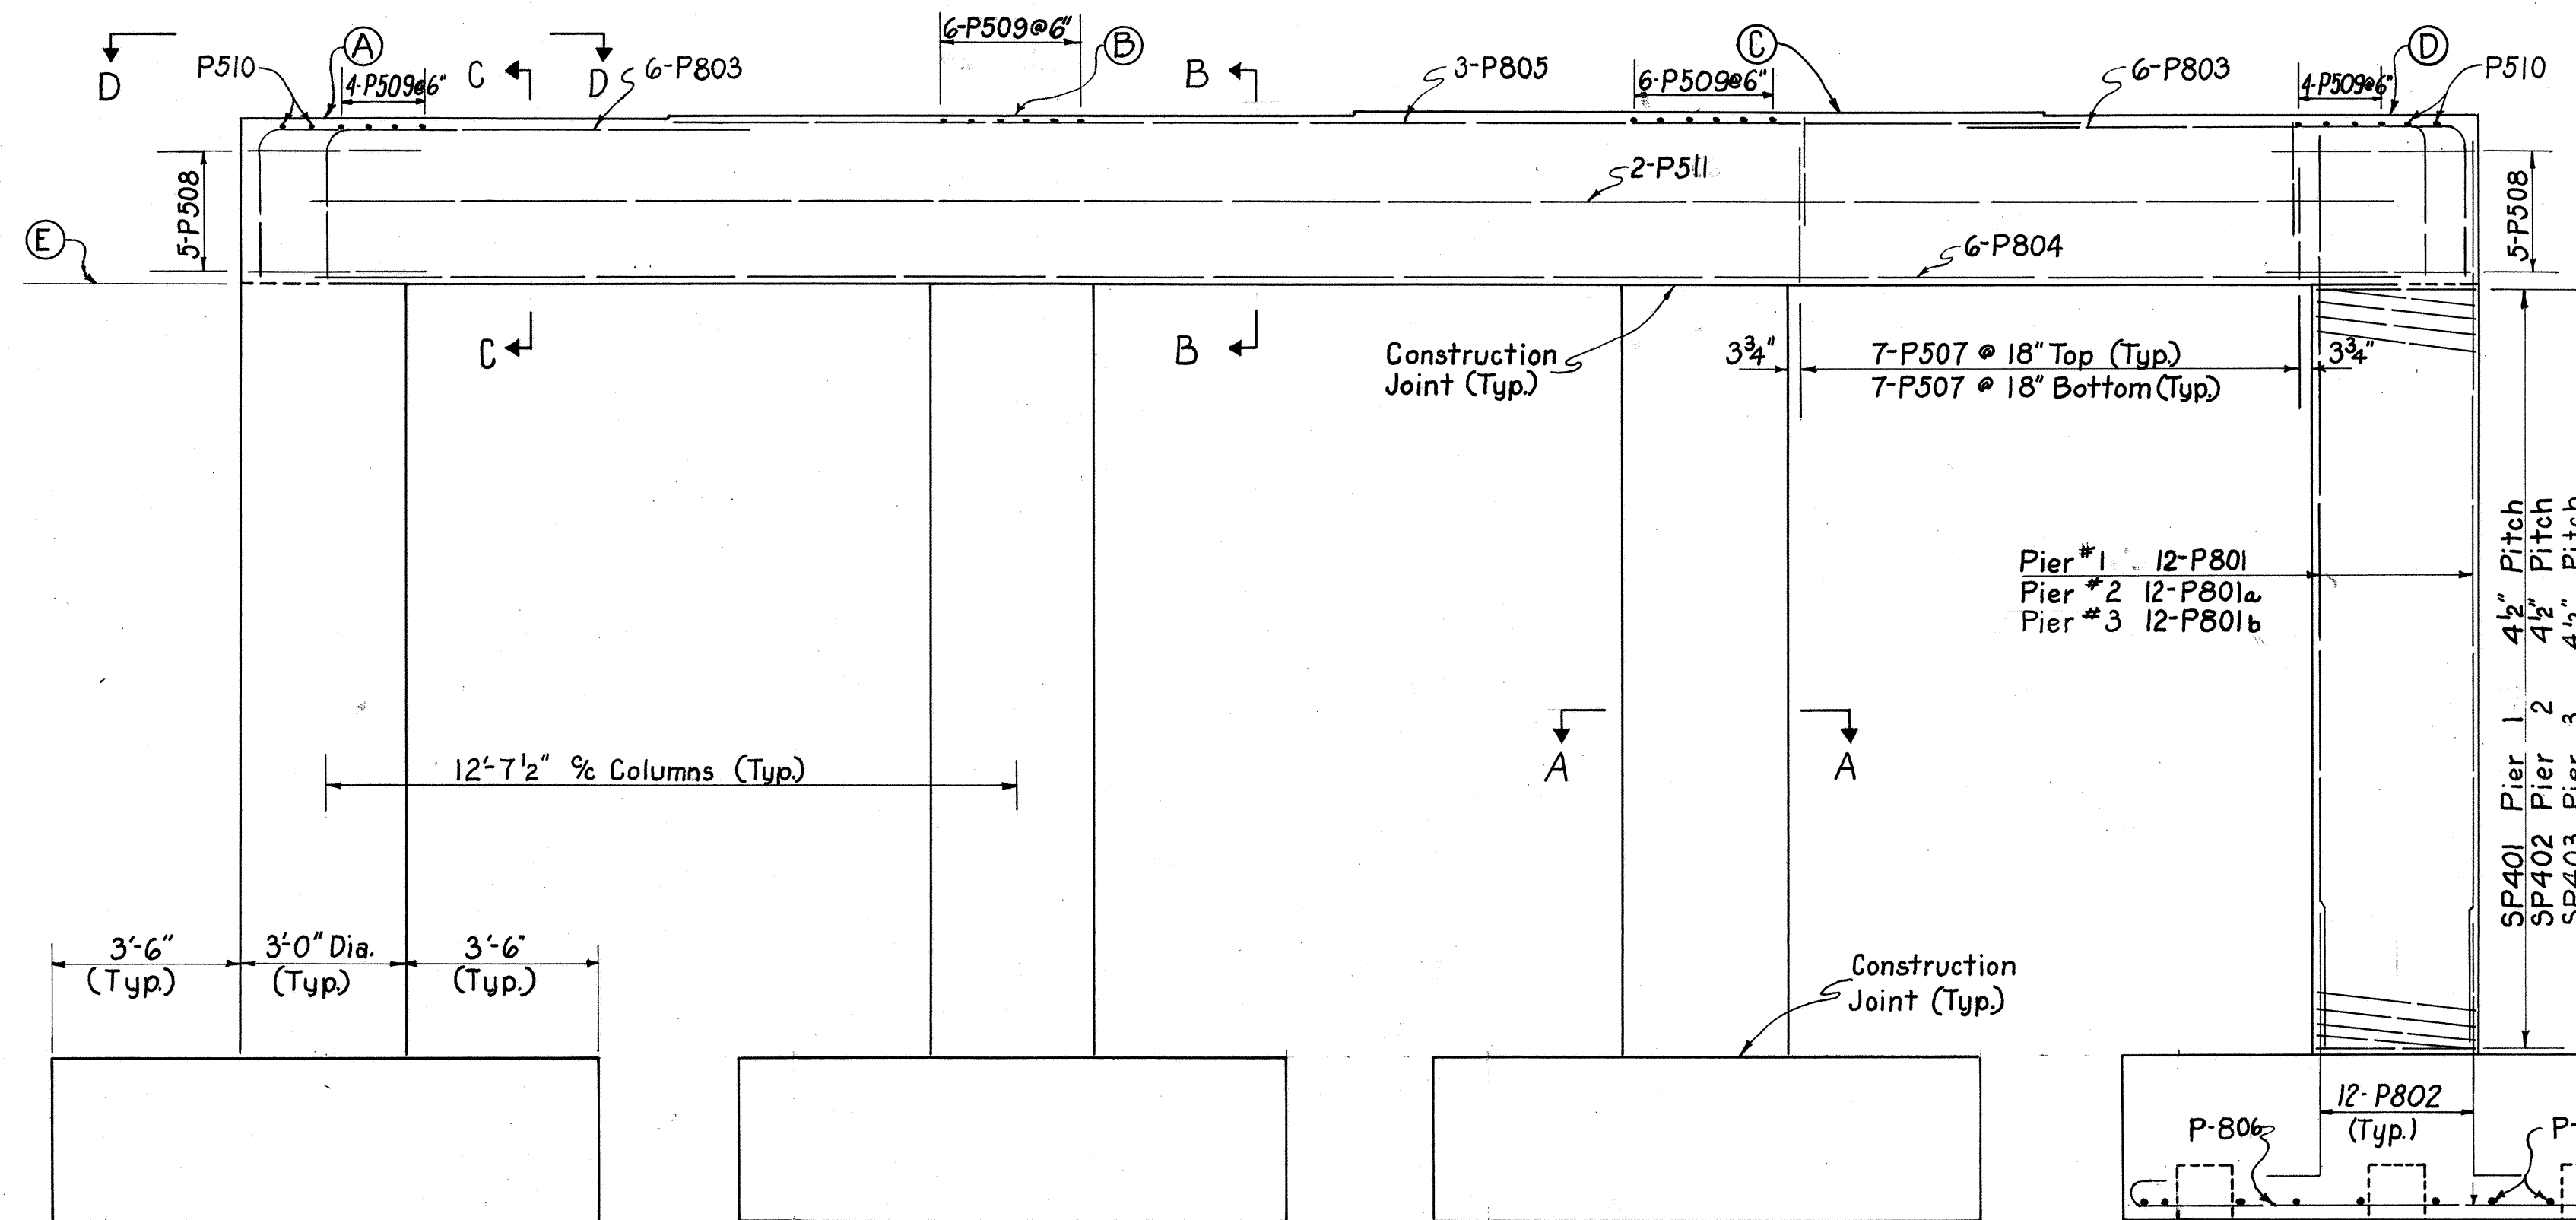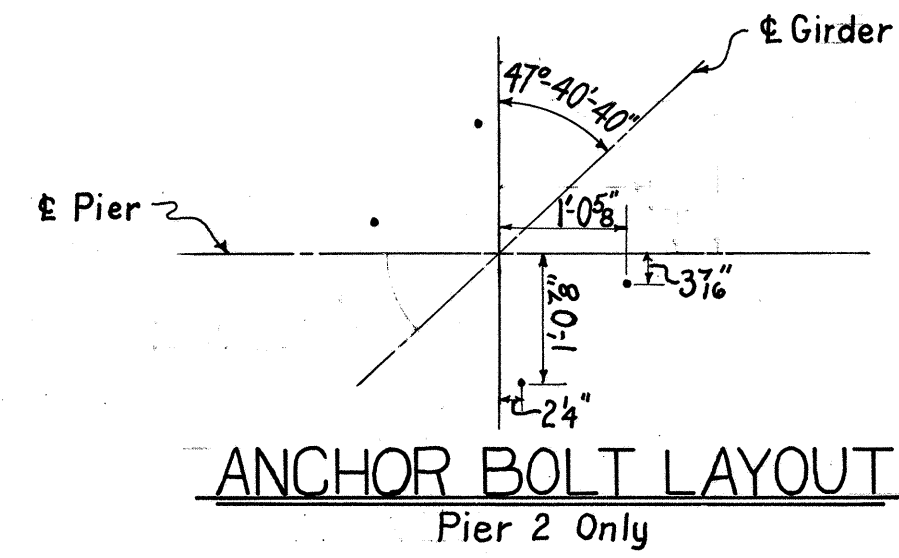


ELEVATION

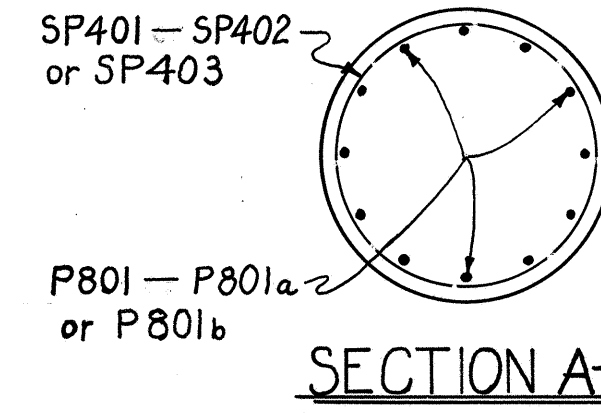


SECTION A-A

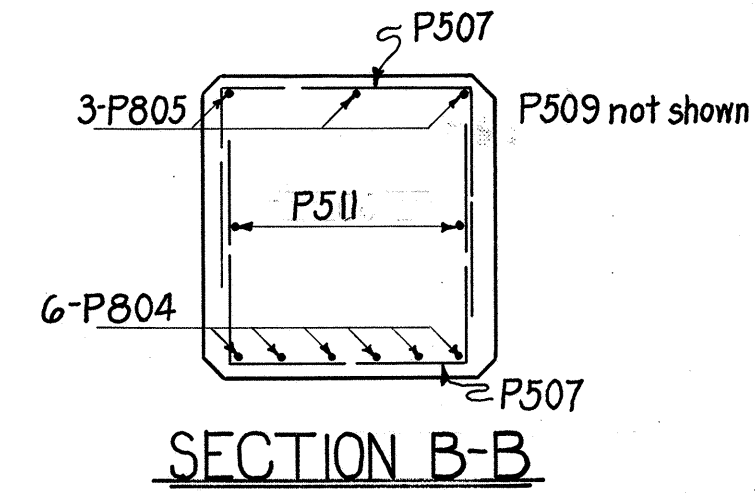

SECTION B-B

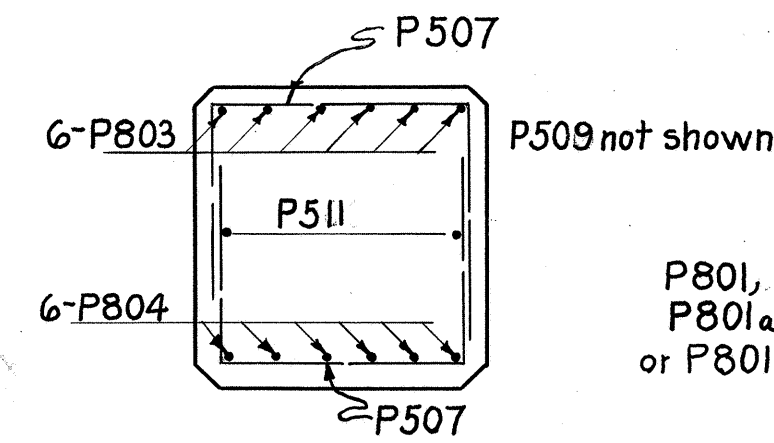


SECTION C-C

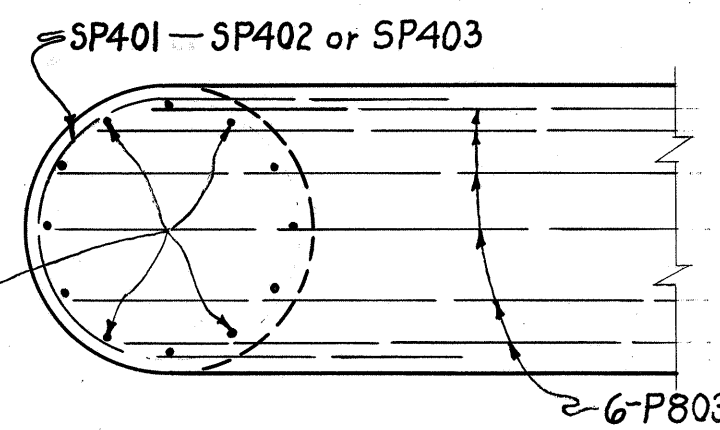


VIEW D-D

PIER ELEVATIONS						
ELEV.	A	B	C	D	E	F
Pier 1	1133.07	1133.36	1133.50	1133.49	1130.07	1111.70
Pier 2	1134.09	1134.23	1134.23	1134.09	1131.09	1109.40
Pier 3	1133.49	1133.50	1133.36	1133.07	1130.07	1114.15

NOTE:
Clearance of reinforcing steel shall be 2" from face of concrete unless otherwise shown.
Special care shall be taken in placing reinforcing steel in the bridge seat so that it will not interfere with the drilling of the Anchor Bolt holes.

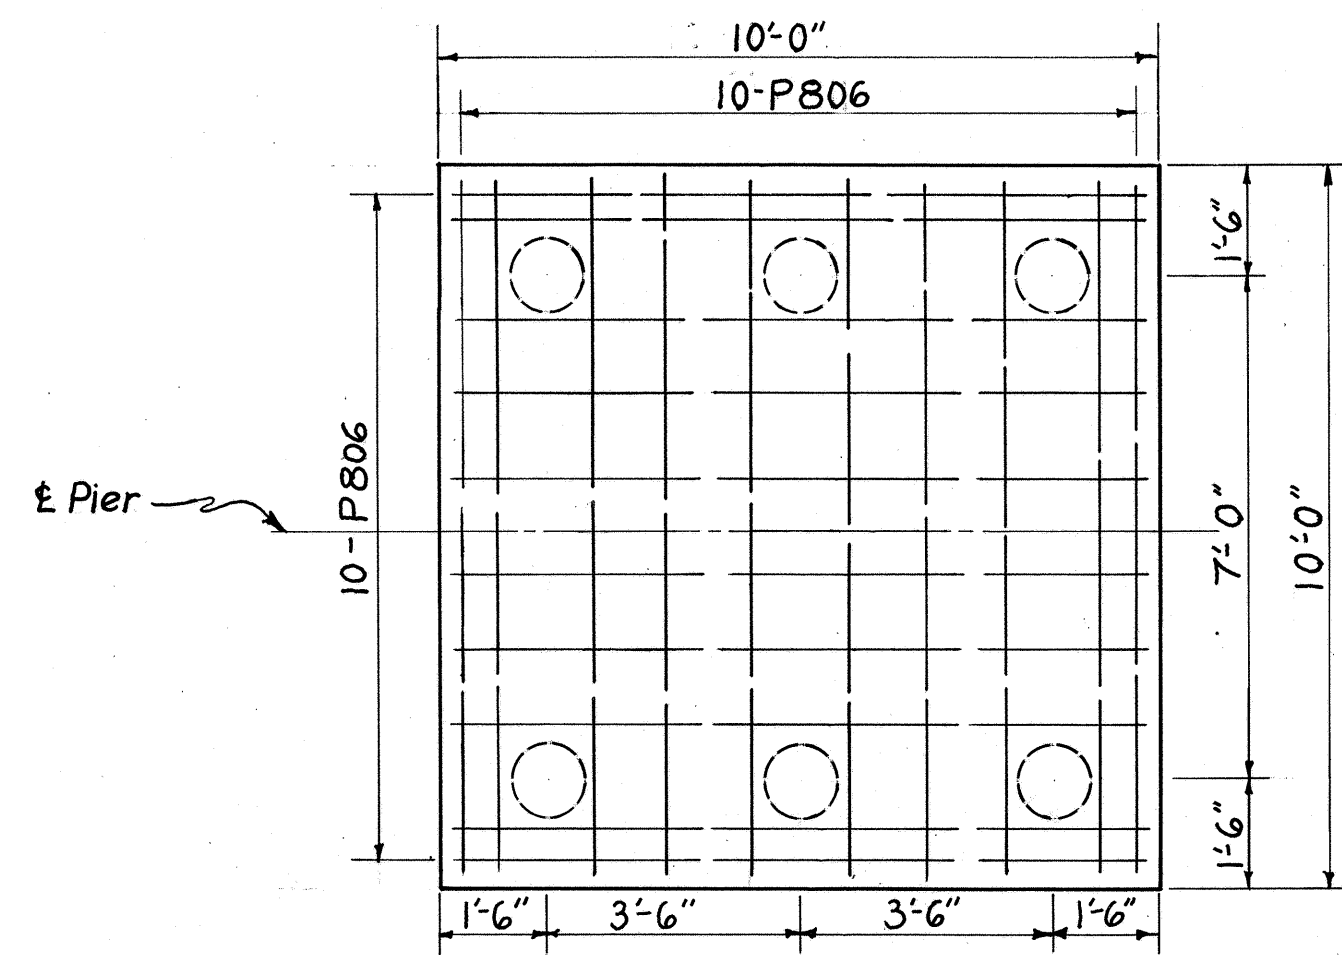

Typical Footing for Piers 1&3

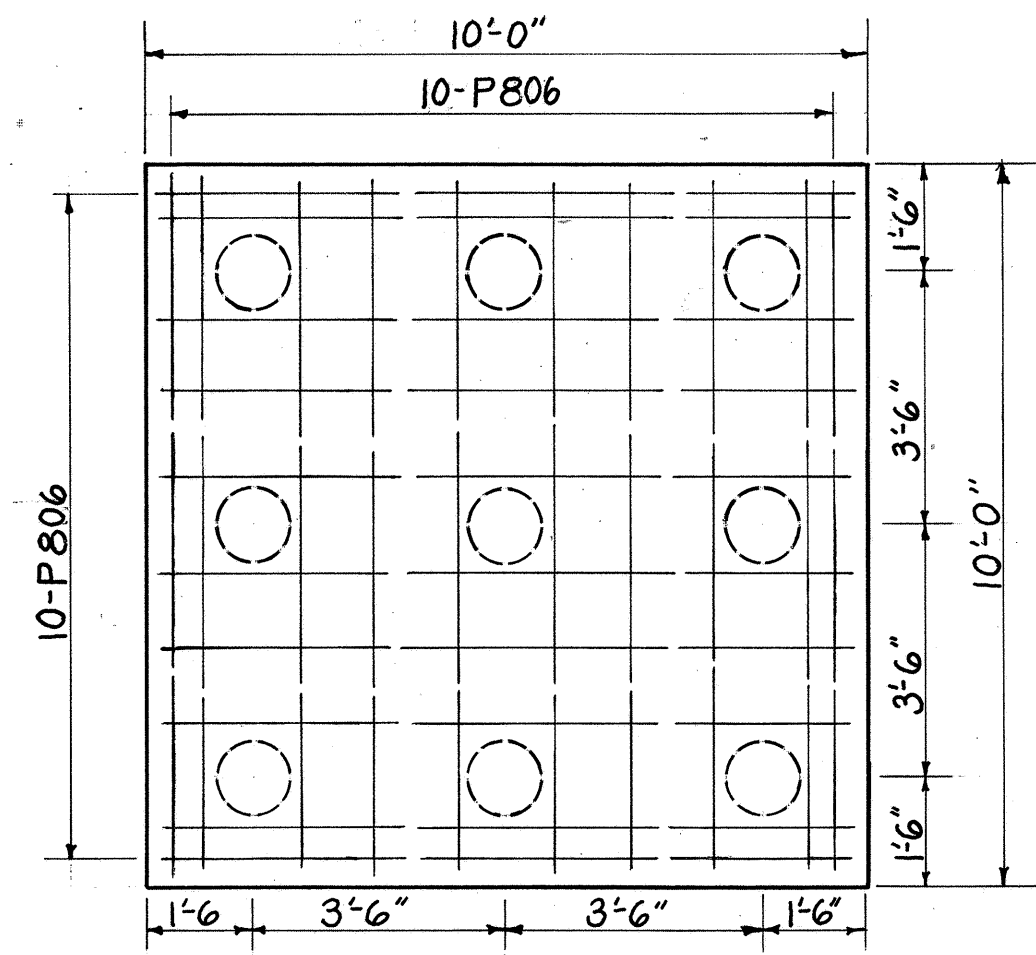

Typical Footing for Pier 2



MICHAEL BAKER, JR., CONSULTING ENGINEERS
ROCHESTER, PENNSYLVANIA


PIERS
BRIDGE NO. WAY-1- 0511
UNDER COUNTY ROAD NO. 36

WAYNE COUNTY STA. 954 + 66.56


Designed	Drawn	Traced	Checked	Reviewed-Date	Revised
F.W.L.	F.W.L.	O.B.	J.P.R.		

WAYNE COUNTY
WAY-1- 136


- NOTES:
- All dimensions are horizontal.
 - All intermediate stiffener $\angle 5 \times 3 \frac{1}{2} \times \frac{3}{8}$
 - All Rivets $\frac{3}{4}$ "
 - All intermediate crossframe $\angle 3 \frac{1}{2} \times 3 \frac{1}{2} \times \frac{5}{16}$
 - End Cross Frame $\angle 4 \times 4 \times \frac{5}{8}$
 - For additional details see END FINISH and DECK PLAN SHEETS.

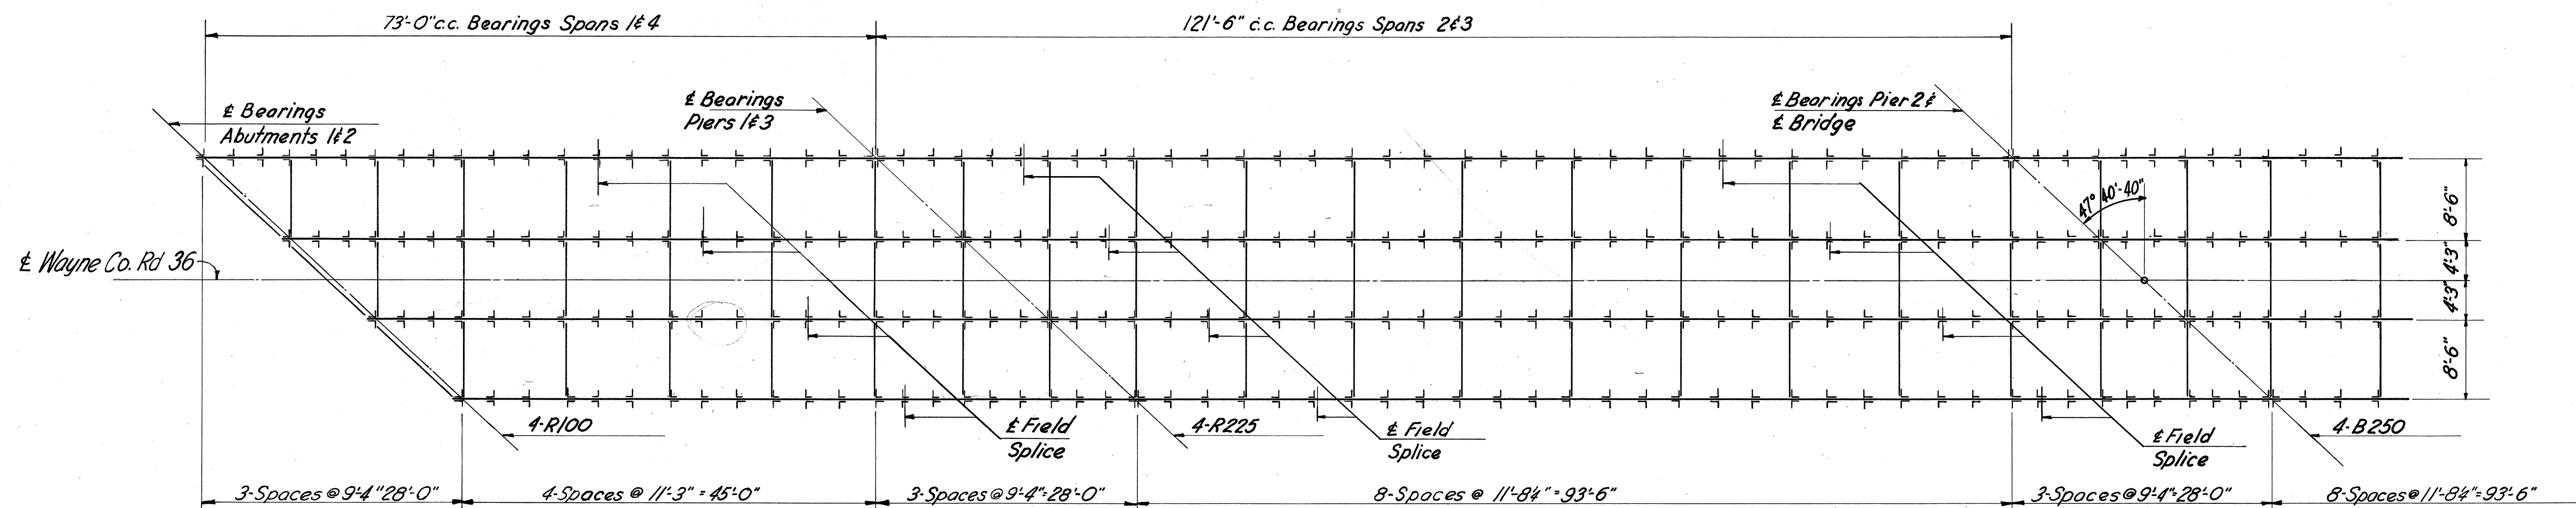


HALF PLAN - STEEL FRAMING

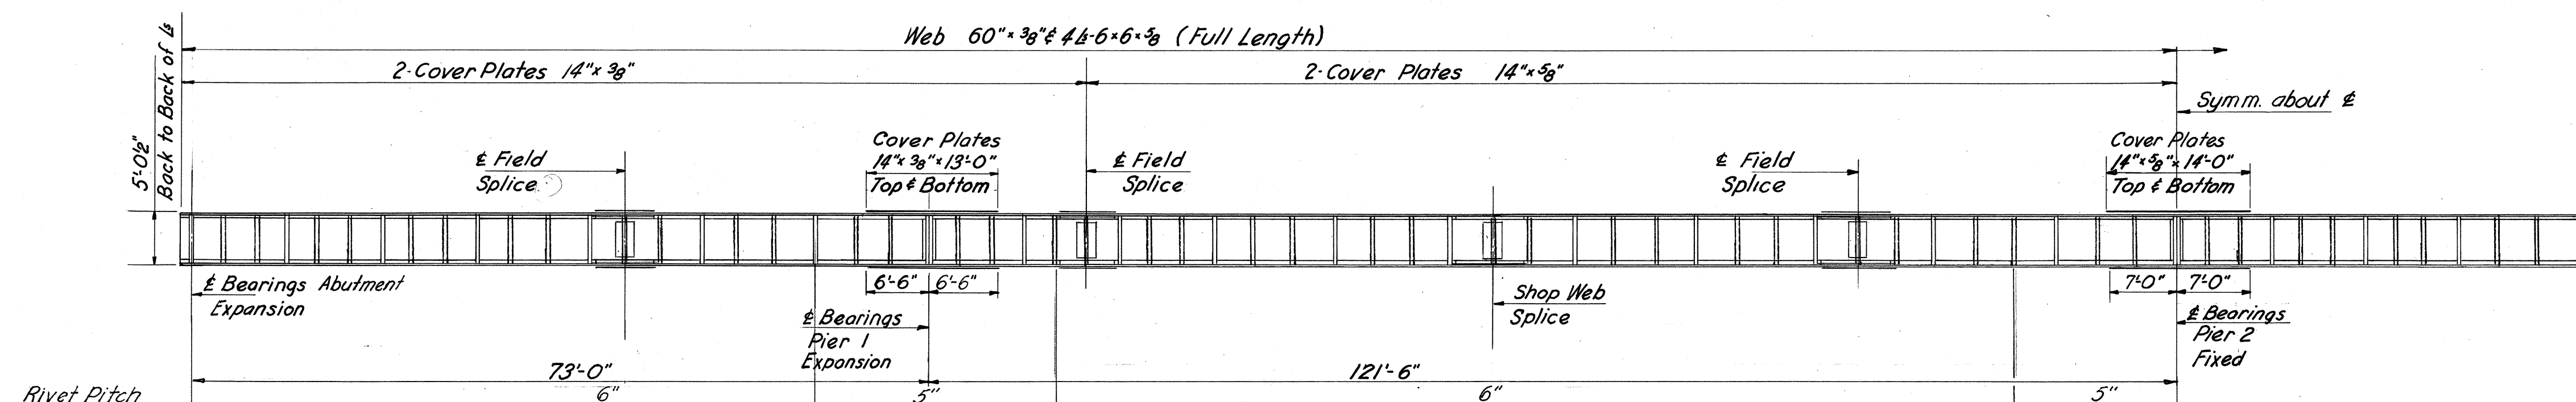

HALF ELEVATION OF EXTERIOR GIRDERS

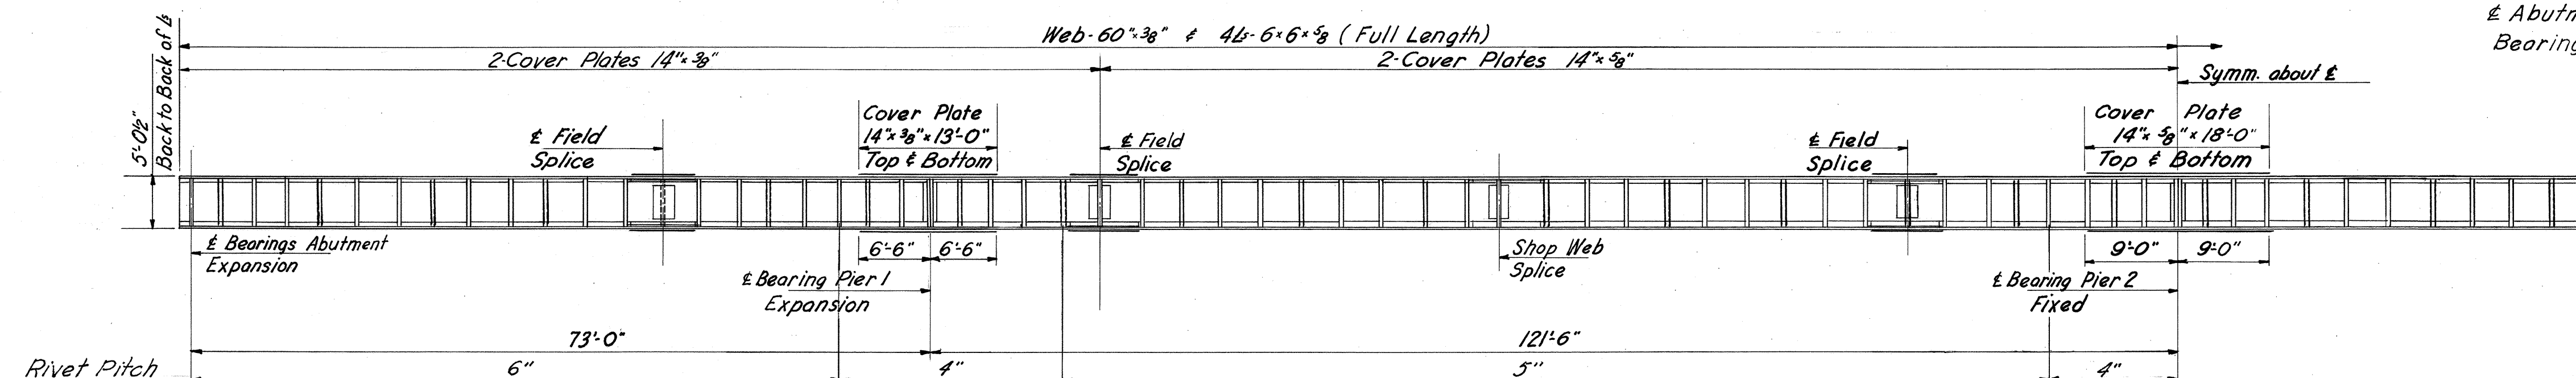


HALF ELEVATION OF INTERIOR GIRDERS

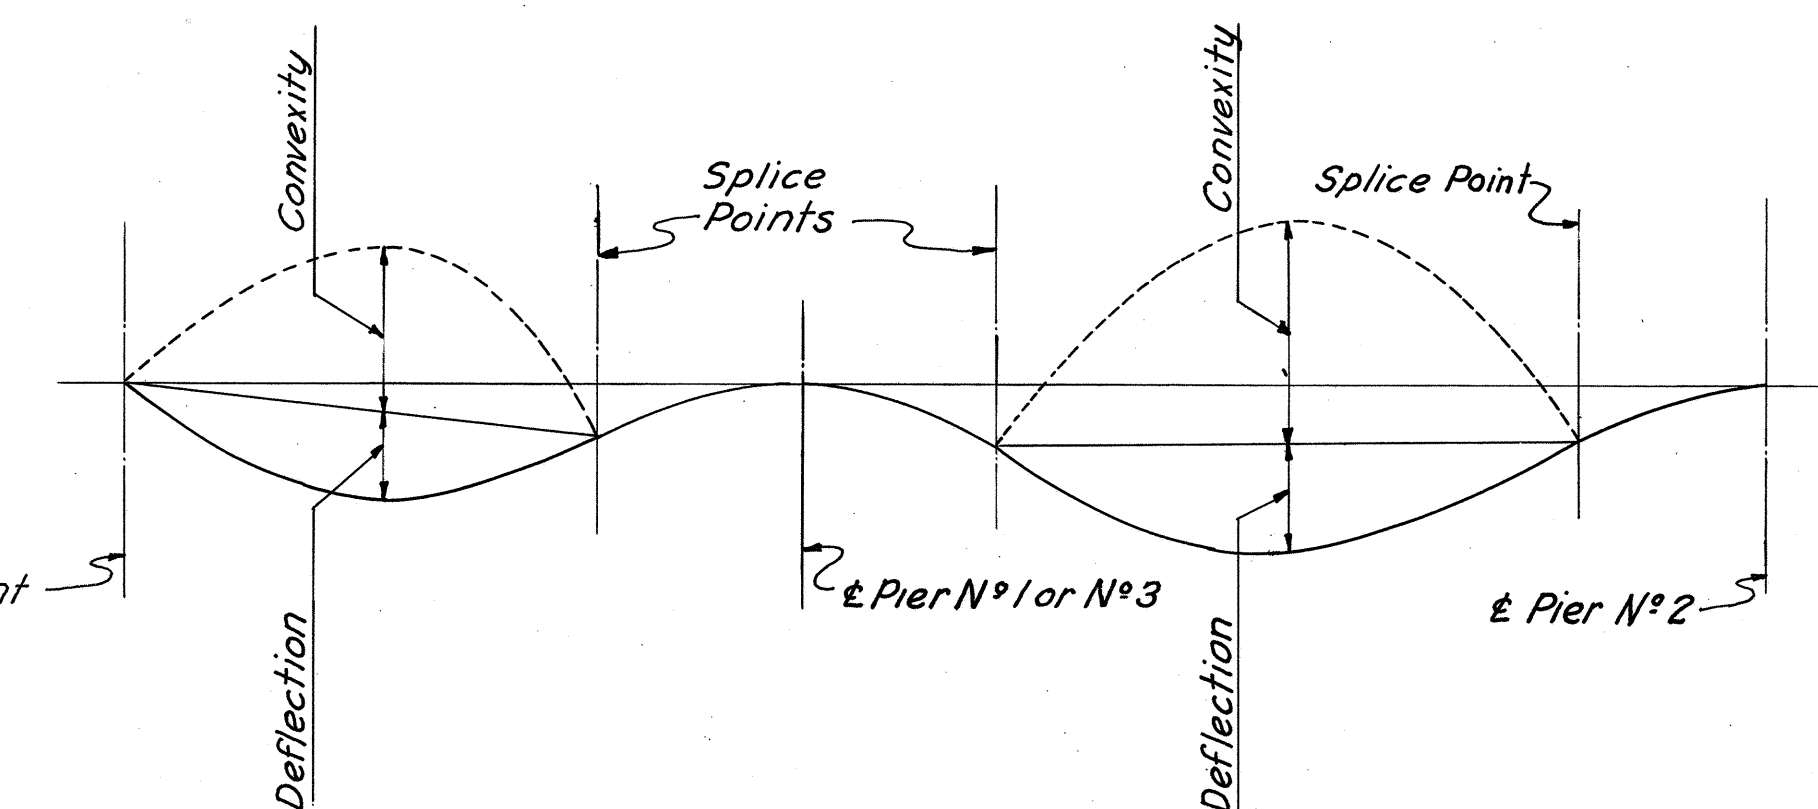

CAMBER DIAGRAM

DEFLECTION & CAMBER

	Outside Girders		Inside Girders	
	End Span	Mid. Span	End Span	Mid. Span
Deflection due to weight of steel	0	$\frac{1}{4}$ "	0	$\frac{3}{16}$ "
Deflection due to remaining dead load	$\frac{1}{8}$ "	$\frac{3}{8}$ "	$\frac{1}{8}$ "	$\frac{1}{16}$ "
Convexity required for Vertical Curve	1"	1"	1"	1"
Sum of Deflection and Convexity	$\frac{1}{8}$ "	$\frac{2}{8}$ "	$\frac{1}{8}$ "	$\frac{1}{8}$ "
Required Camber	$\frac{1}{8}$ "	$\frac{2}{8}$ "	$\frac{1}{8}$ "	$\frac{1}{8}$ "

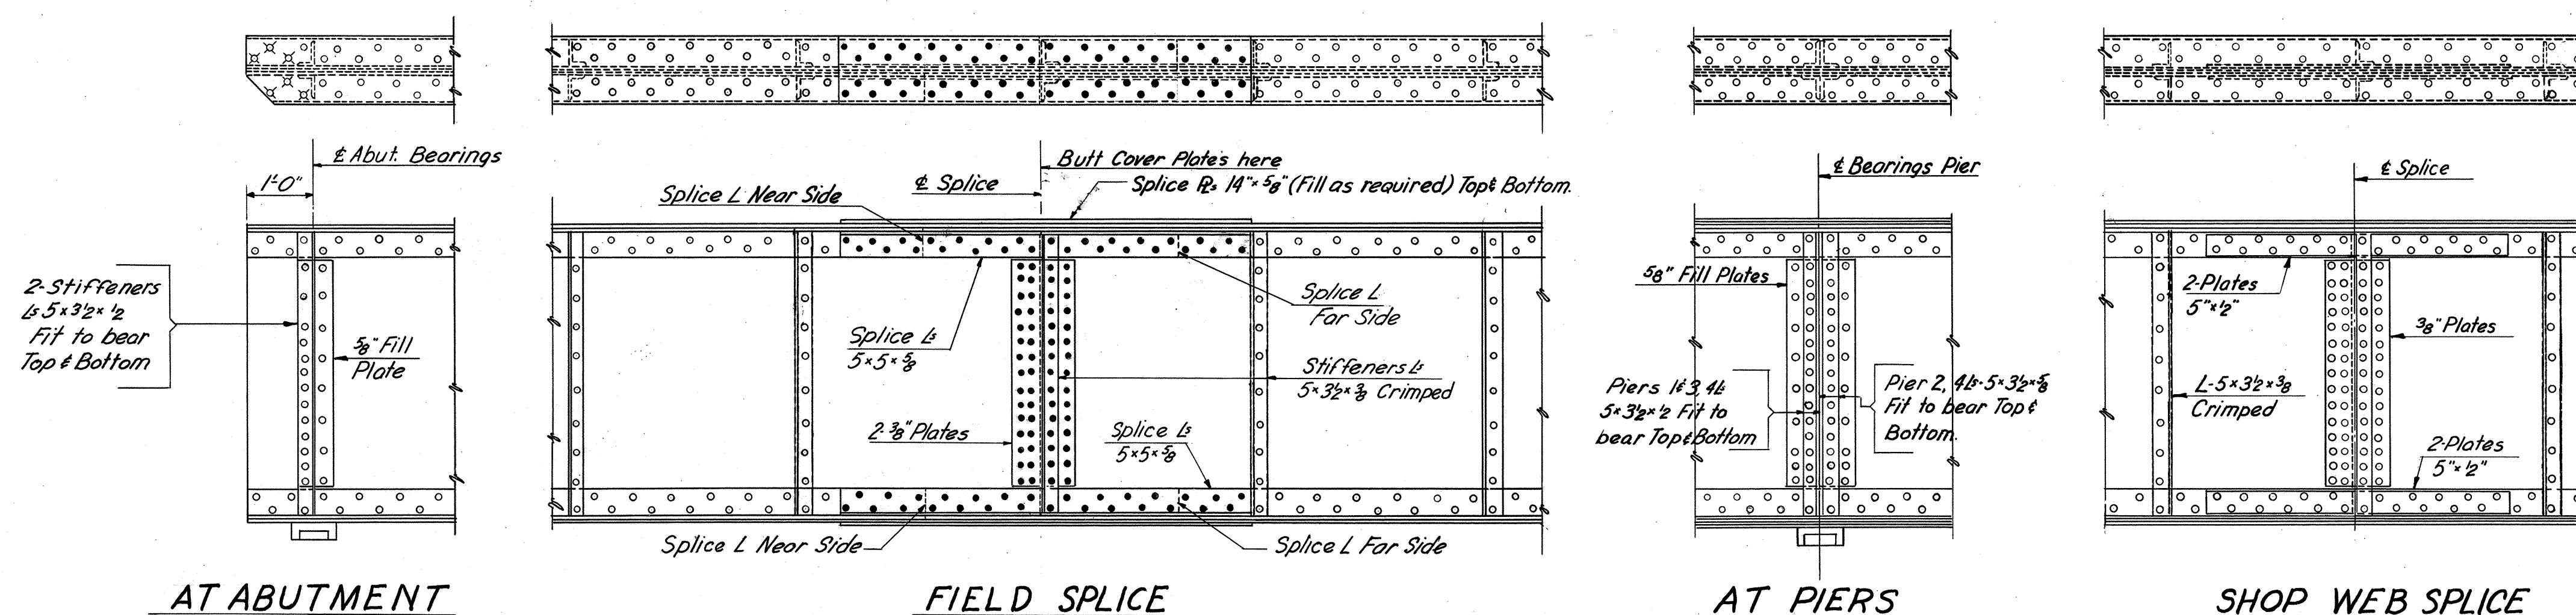

MICHAEL BAKER, JR., CONSULTING ENGINEERS
ROCHESTER, PENNSYLVANIA

STEEL FRAMING

BRIDGE NO. WAY-1-0511
UNDER COUNTY ROAD NO. 36



WAYNE COUNTY STA. 954 + 66.56

Designed	Drawn	Traced	Checked	Reviewed-Date	Revised
J.P.R.	R.M.	R.M.	J.D.		


FED. RD. DIVISION	STATE	PROJECT
2	OHIO	I-1105 (1)

253
271

WAYNE COUNTY
WAY-1-136

DECK CONSTRUCTION PROCEDURE

In order to facilitate water curing of the concrete of the deck slab, the placing of concrete shall progress up grade. The slab may be placed in sections between transverse construction joints which are normal to the centerline of bridge and are located near the center of any span.

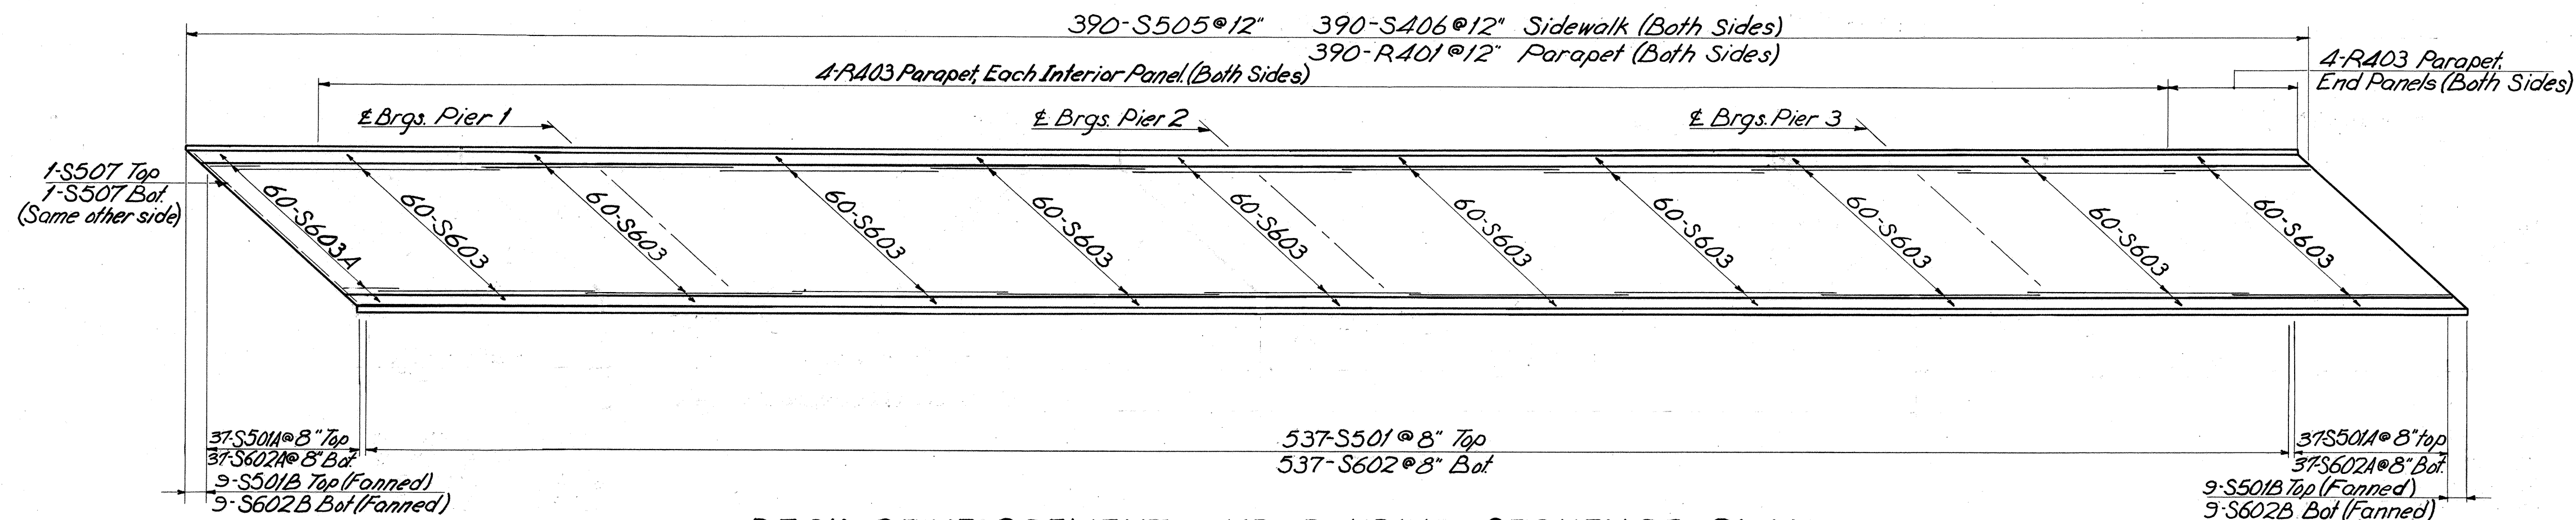

DECK REINFORCEMENT AND POURING SEQUENCE PLAN



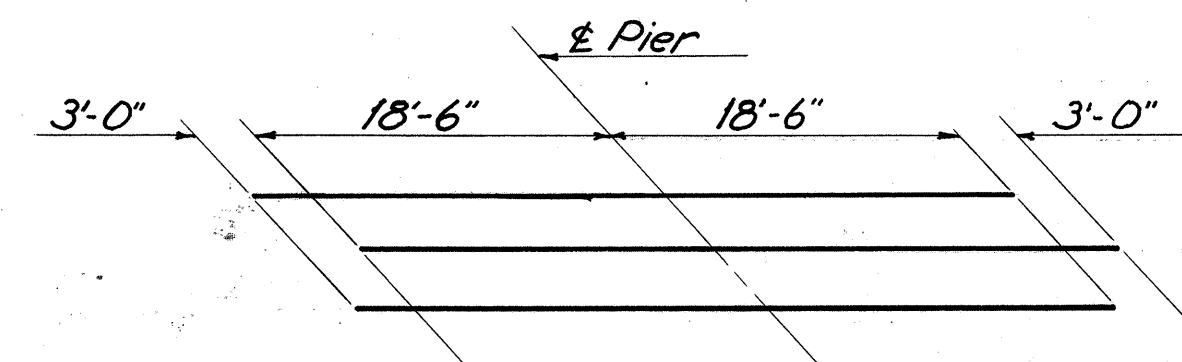


DIAGRAM SHOWING STAGGER OF S604 BARS OVER PIERS

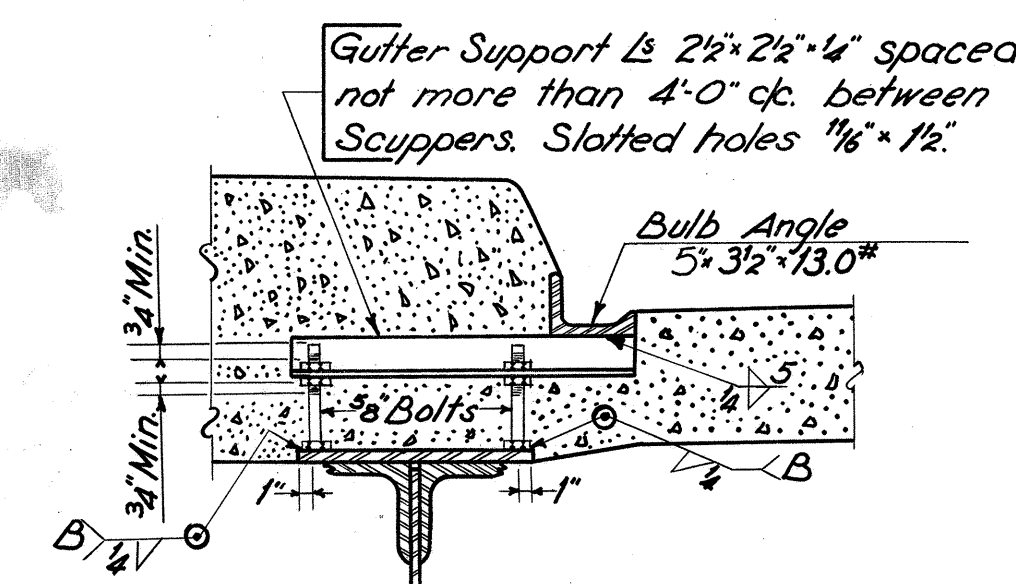


GUTTER SUPPORT

Note: Refer to Standard Drawing CSB-2-56 Sht. 3 of 6 for Gutter Support Spacing details.

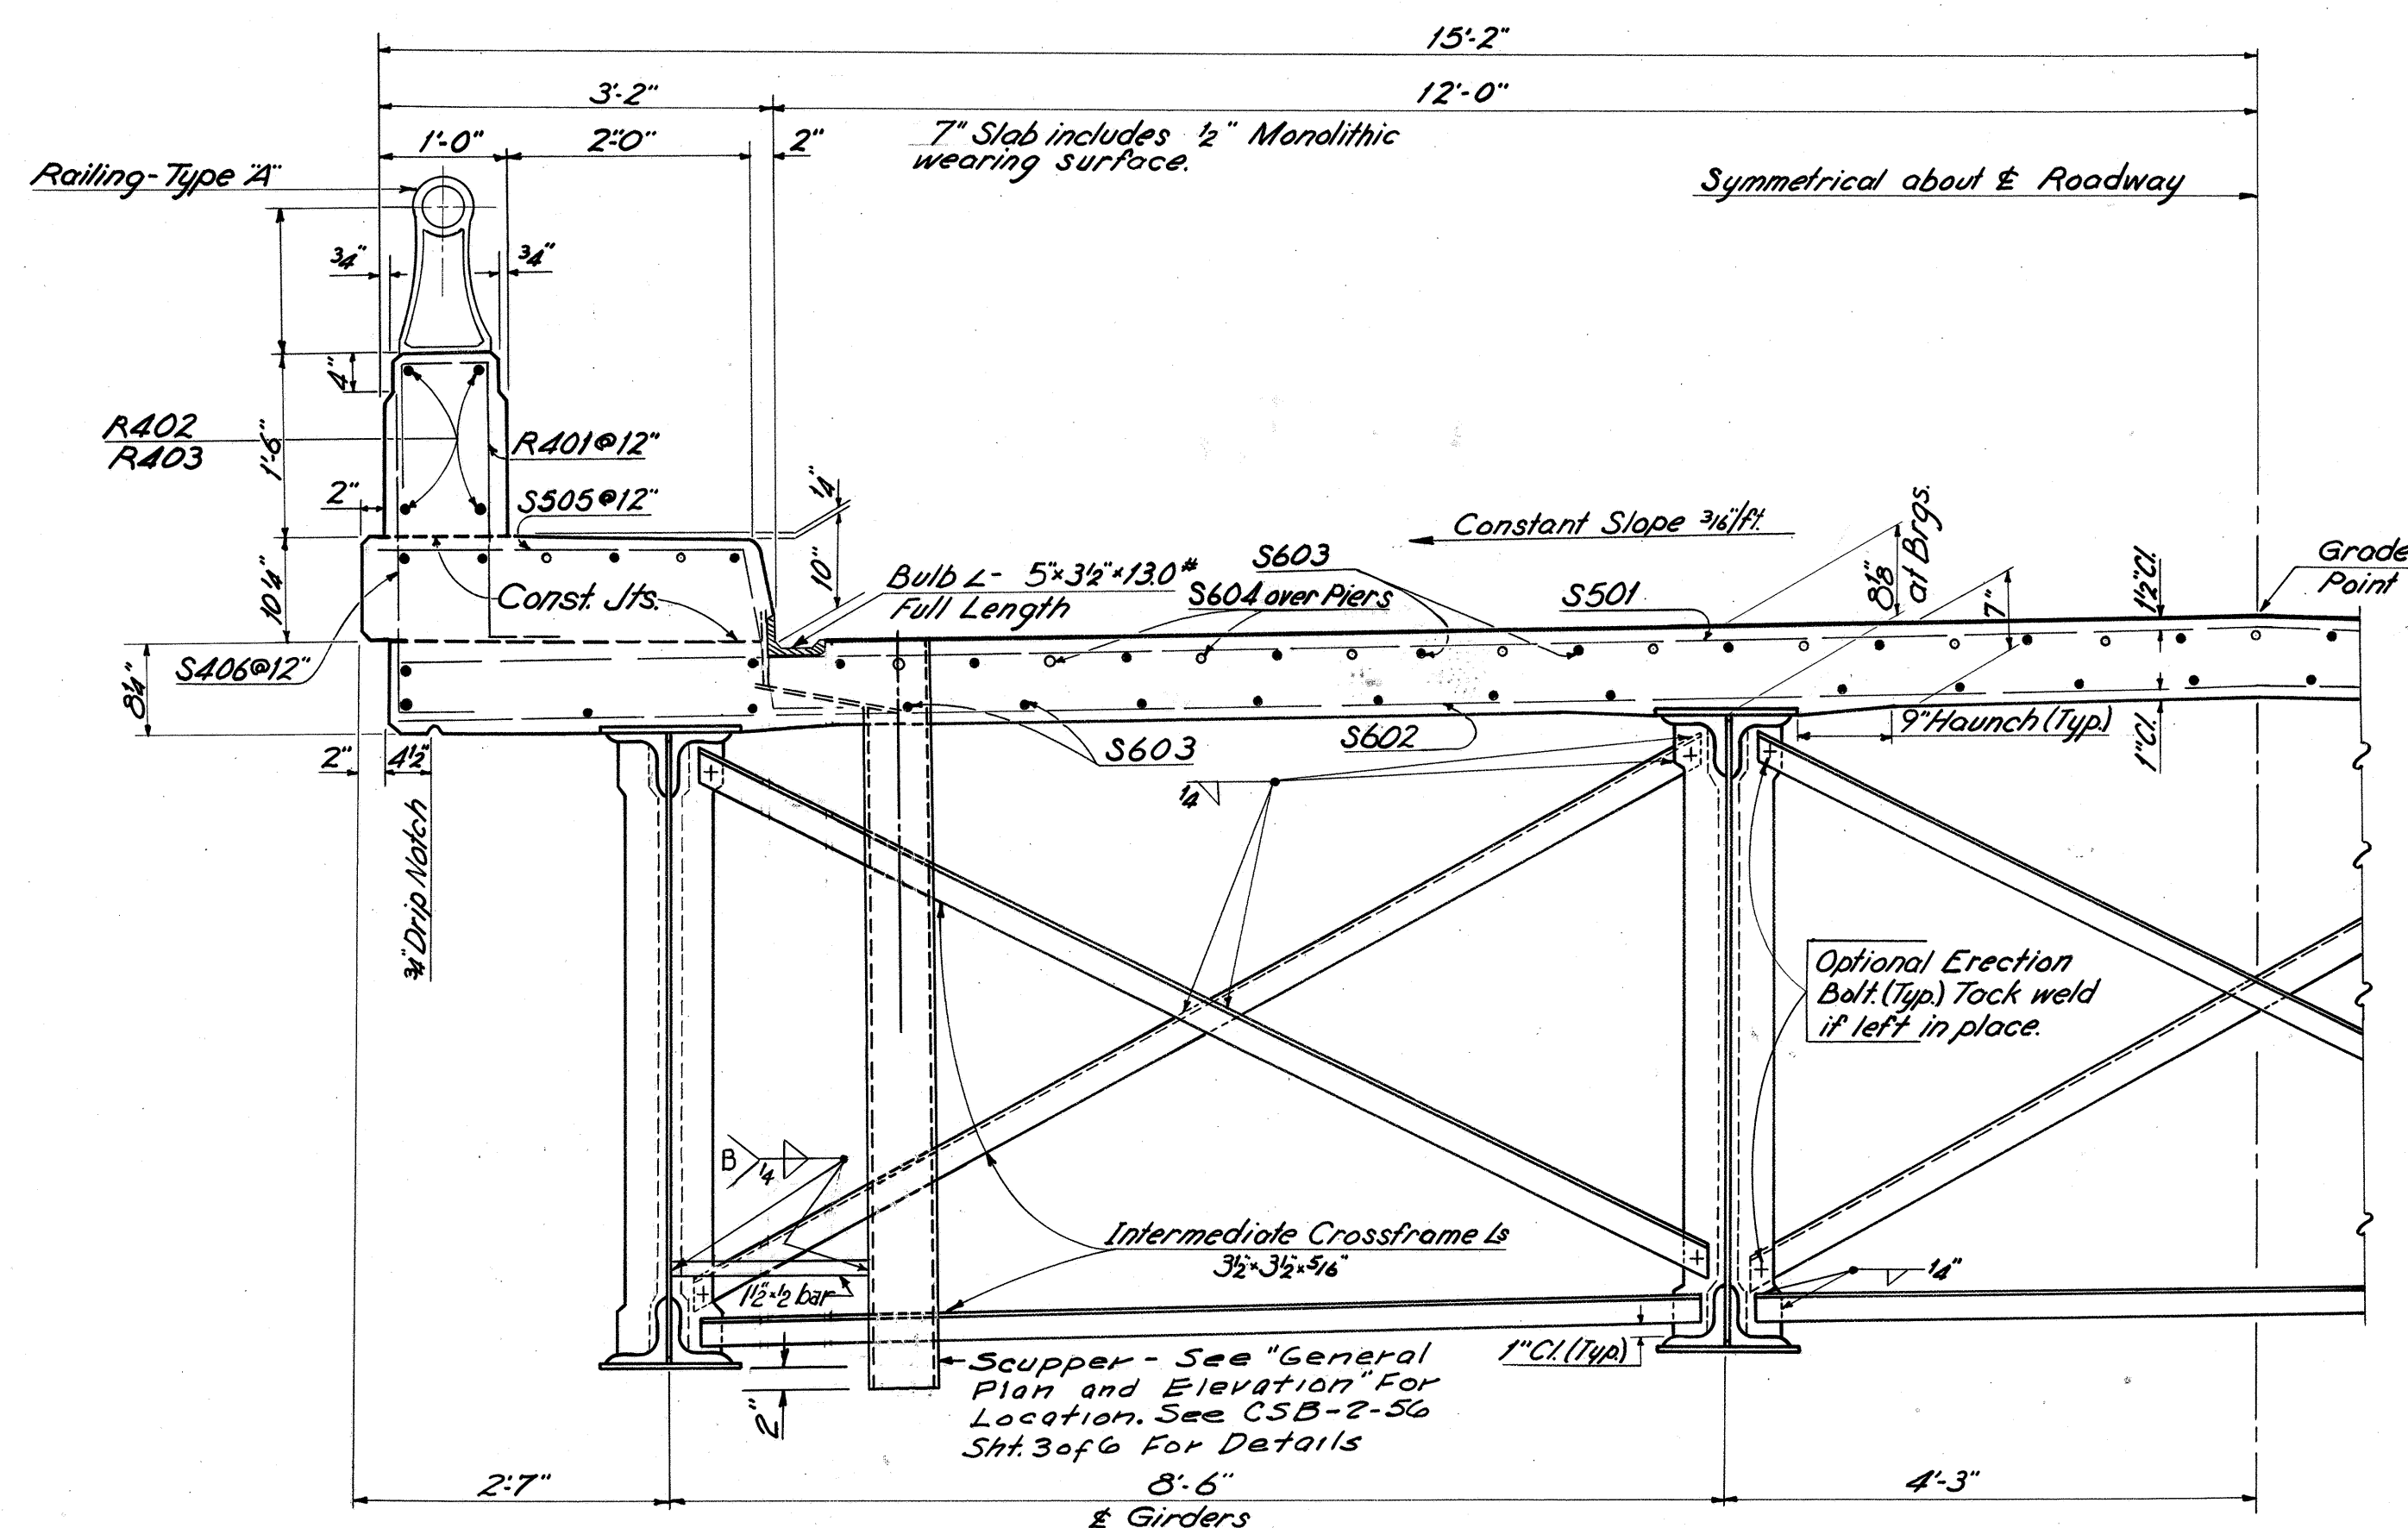

TYPICAL HALF SECTION

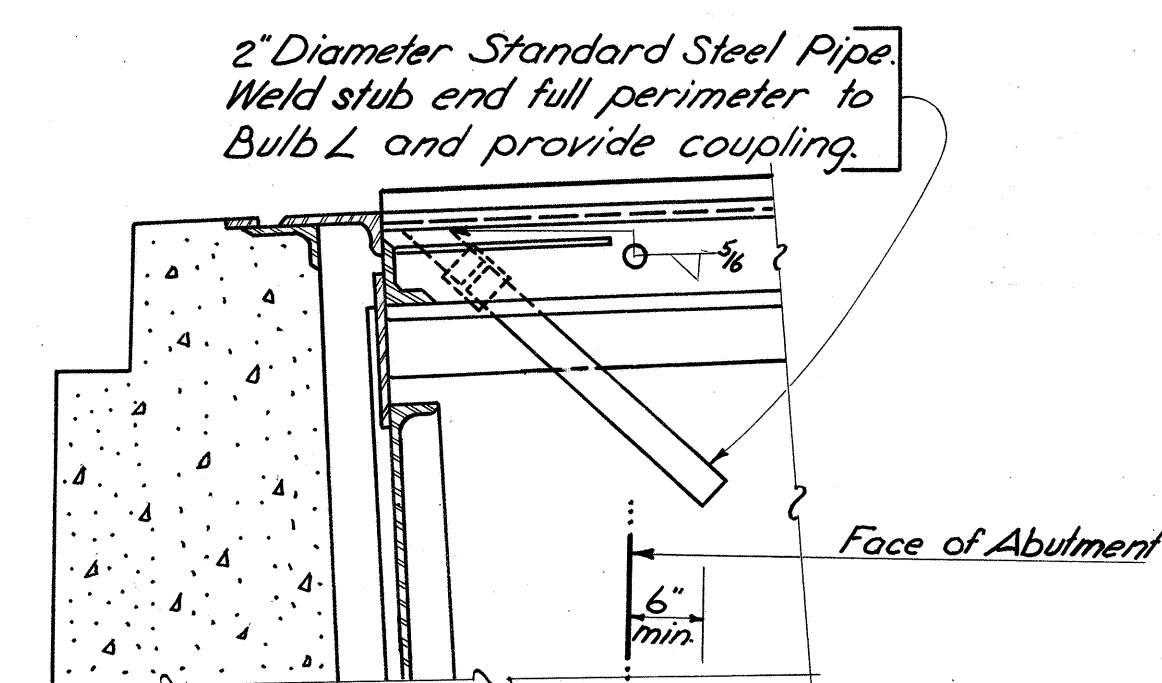


SCUPPER DETAIL AT END FINISH

MICHAEL BAKER, JR., CONSULTING ENGINEERS
ROCHESTER, PENNSYLVANIA

DECK PLAN
BRIDGE NO. WAY-1-0511
UNDER COUNTY ROAD NO. 36

WAYNE COUNTY STA. 954 + 66.56


Designed	Drawn	Traced	Checked	Reviewed-Date	Revised
J.P.R.	EA	EA	J.D.		

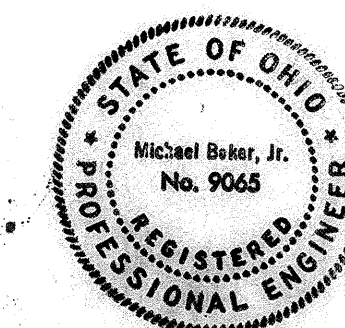

WAYNE COUNTY
WAY-1-136

REINFORCING STEEL BAR SCHEDULE

Bending diagram type - All dimensions are out to out.

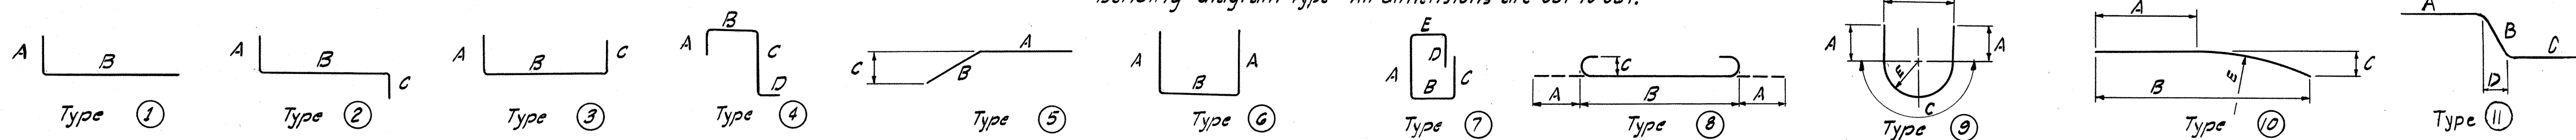

PIERS													
MARK	PIER1	PIER2	PIER3	TOTAL	SIZE	LENGTH	TYPE	A	B	C	D	E	WEIGHT
P801	48	-	-	48	8	18'-2"	Str.						2329
P801a	-	48	-	48	8	21'-6"	Str.						2755
P801b	-	-	48	48	8	15'-9"	Str.						2019
P802	48	48	48	144	8	5'-8"	1	10"	5'-0"				2180
P803	12	12	12	36	8	11'-7"	1	2'-10"	9'-0"				1113
P804	6	6	6	18	8	37'-10"	Str.						1818
P805	3	3	3	9	8	27'-6"	Str.						661
P806	80	80	80	240	8	1'-8"	8	1'-1"	9'-6"	10"			7478
P507	42	42	42	126	5	7'-1"	6	2'-4"	2'-8"				930
P508	10	10	10	30	5	8'-0"	9	1'-11"	2'-8"	4'-2"		1'-4"	250
P509	20	20	20	60	5	4'-1"	6	10"	2'-8"				255
P510	4	4	4	12	5	3'-5" & 3'-11"	6	10"	2'-8" & 2'-6"	(6 each)			46
P511	2	2	2	6	5	37'-10"	Str.						237

SPIRAL BARS										
MARK	PIER 1	PIER 2	PIER 3	TOTAL	SIZE	LENGTH	PITCH	No. of Turns	CORE DIA.	WEIGHT
SP401	4	-	-	4	1/2"	15'-4"	4 1/2"	44	32"	1175
SP402	-	4	-	4	1/2"	18'-8"	4 1/2"	53	32"	1390
SP403	-	-	4	4	1/2"	12'-11"	4 1/2"	37	32"	970

Total Weight 25,610 #

ABUTMENTS												
MARK	TOTAL	SIZE	LENGTH	TYPE	A	B	C	D	E	WEIGHT		
A501	76	5	10'-0"	1	4'-6"	5'-7"				793		
A502	88	5	3'-7"	Str.						329		
A503	88	5	6'-3"	6	1'-5"	3'-8"				573		
A504	80	5	22'-6"	Str.						1877		
A505	74	6	18'-1"	7	8'-0"	1'-5"	6'-6"	2'-0"	10"	2,010		
A506	8	6	20'-6"	7	8'-10"	1'-5"	7'-6"	2'-0"	1'-5"	246		
A507	34	5	17'-6"	6	8'-3"	1'-2"				621		
A508	34	5	16'-2"	6	7'-7"	1'-2"				573		
A509	12	5	19'-6"	Str.						244		
A510	12	5	20'-0"	Str.						250		
A411	16	4	10'-0"	Str.						107		
A412	12	4	9'-4"	Str.						75		
A413	12	4	5'-0"	Str.						40		
A414	12	4	4'-0"	Str.						32		
A515	136	5	6'-9"	Str.						957		
A516	4	5	10'-0"	6	4'-6"	1'-2"				42		
A517	20	5	8'-0"	6	3'-6"	1'-2"				167		
A518	8	5	18'-0"	Str.						150		
A519	16	5	23'-5"	Str.						391		
A420	48	4	6'-5"	3	2'-10"	1'-2"	2'-8"			206		
A421	20	4	23'-6"	Str.						313		
A422	12	4	23'-9"	10	10'-3"	23'-6"	2'-4"		29'-10"	190		
A423	92	4	5'-7"	6	2'-7"	8"				343		
* R424	16	4	22'-0"	Str.								
* R425	48	4	1'-11" to 4'-8"	3	6"	1'-4"	4" to 4'-0" (Dep. Vary by 9")					
A526	12	5	19'-3"	Str.						241		
A527	12	5	18'-9"	Str.						235		
A528	4	5	12'-0"	6	5'-6"	1'-2"				50		
A529	8	5	6'-0"	Str.						50		
A530	136	5	5'-10"	6	1'-5"	3'-2"				827		
A531	16	5	24'-3"	Str.						405		
A532	76	5	3'-0"	Str.						238		
A533	14	5	4'-6"	Str.						66		
A534	6	5	2'-0" to 3'-6"	Str.						17		

* Included with Railing for Payment.

Total Weight 12,660 #

SUPERSTRUCTURE												
MARK	TOTAL	SIZE	LENGTH	TYPE	A	B	C	D	E	WEIGHT		
S501	537	5	29'-8"	Str.						1668		
S501a	74	5	6'-11" to 28'-8"	Str.	(2 each Vary by 7 1/4")						1,373	
S501b	18	5	7'-0"	Str.						131		
S602	537	6	29'-8"	Str.						23,931		
S602a	74	6	6'-11" to 28'-8"	Str.	(2 each Vary by 7 1/4")						1,977	
S602b	18	6	7'-0"	Str.						189		
S603	600	6	40'-0"	Str.						36,048		
S603a	60	6	10'-0"	Str.						901		
S604	69	6	40'-0"	Str.						4,146		
S505	780	5	4'-9"	11	3'-0"	1'-3"	6"	6"		3,864		
S406	780	4	3'-0"	1	6"	2'-7"				1,563		
S507	4	5	40'-0"	Str.						167		
R401	780	4	5'-0"	4	1'-2"	6"	4'-4"	1'-0"		Included with Railing for payment		
R402	200	4	1'-4"	Str.								
R403	16	4	11'-10"	Str.								

Total Weight 90,910 #

SPIRAL NOTES

The 'length' shown in the steel list for the spiral bars is the distance from the top of the footing to the bottom of the pier cap.

The 'No. of Turns' shown in the steel list for the spiral bars is the 'length' divided by the pitch, plus 3 turns (total number of closed coil), expressed as the nearest whole number.

Spiral reinforcing bars shall not have deformations but shall in other respects conform to Item S-4. 1/2 closed coils shall be provided at ends of each spiral unit.

Four steel channel, tee or angle spacers, weighing approximately 0.68 lbs. per lin. ft. of spacer, shall be provided for each spiral unit. They shall be equally spaced along the periphery of the coils. The number of pounds of these spacers, based on 0.68 lbs. per lin. ft., will be paid for as reinforcing steel and is included in the tabulated quantity of spiral bars.

REPLACEMENT BAR

MARK	NO.	SIZE	LENGTH	TYPE	WEIGHT
RE 400	1	4	5'-3"	Str.	
RE 500	2	5	5'-7"	Str.	
RE 600	4	6	5'-11"	Str.	
RE 800	1	8	6'-6"	Str.	

REPLACEMENT BARS:

If reinforcing bars are fabricated from stock which has previously been tested and approved by the Ohio Highway Testing Laboratory, test sample as provided in section S-4.02 need not be furnished and replacement bars will not be required.

BAR SIZE:

Bar size is indicated in the bar mark. The first digit where three digits are used, and the first two digits where four are used, indicate the bar size number. For example, A401 is a no. 4 size bar and A1114 is a no. 11 size bar.



MICHAEL BAKER JR., CONSULTING ENGINEERS
ROCHESTER, PENNSYLVANIA

BAR SCHEDULE

BRIDGE NO. WAY-1-0511
UNDER COUNTY ROAD NO. 36

WAYNE COUNTY STA. 954 + 66.56

Designed	Drawn	Traced	Checked	Reviewed-Date	Revised
-	-	R.M.	J.D. FULL	JPR	