#### LINEAR GRADING

AREAS WHERE THE SHOULDER IS HIGHER THAN THE EDGE OF PAVEMENT WILL BE GRADED TO PROVIDE POSITIVE DRAINAGE. THIS WORK WILL ONLY BE PERFORMED IN AREAS NECESSARY AND WILL NOT BE PERFORMED ON THE ENTIRE PROJECT. AREAS FOR THE WORK WILL BE MARKED BY THE PROJECT ENGINEER. UNDER NO CIRCUMSTANCES WILL THIS WORK BE PERFORMED CONCURRENTLY WITH ANY OTHER OPERATION.

GRADING WILL BE ACCOMPLISHED BY THE REMOVAL OF MATERIAL TO PROVIDE A 0.08 POSITIVE SLOPE. THE GRADED AREAS WILL BE COMPACTED TO A SUFFICIENT DENSITY TO PREVENT EROSION UNTIL SEEDING AND MULCHING IS PERFORMED. ALL EXCESS MATERIAL WILL BE REMOVED FROM THE BERMS AND WILL BE DISPOSED OF OFF THE PROJECT BY THE CONTRACTOR.

THE CONTRACTOR IS REQUIRED TO PLACE ITEM 617 WITHIN A PERIOD NOT TO EXCEED 7 DAYS. REFER TO THE AS PER PLAN NOTE FOR REQUIREMENTS.

**EXPOSED EARTH OUTSIDE OF THE LIMITS OF ITEM 617** ARE REQUIRED TO BE SEEDED AND MULCHED WITHIN 7 DAYS OF PLACEMENT OF ITEM 617. PAYMENT FOR THIS WORK SHALL BE MADE UNDER ITEM 832.

THE QUANTITY OF ITEM 209 IS NOT PERMITED TO BE INCREASED. REDUCTIONS IN QUANTITIES ARE PERMITTED AS DETERMINED BY THE PROJECT ENGINEER.

ALL MATERIALS, LABOR, EQUIPMENT, TOOLS, AND INCIDENTALS NECESSARY TO COMPLETE THIS WORK WILL BE INCLUDED IN THE UNIT PRICE FOR THE PERTINENT BID ITEM. THE FOLLOWING QUANTITIES HAVE BEEN CARRIED TO THE GENERAL SUMMARY: 209, LINEAR GRADING, 134 STA.

## **BARRIER REFLECTORS**

THE FOLLOWING ESTIMATED QUANTITIES HAVE BEEN CARRIED TO THE GENERAL SUMMARY FOR USE AT LOCATIONS DIRECTED BY THE ENGINEER FOR INSTALLING/REPLACING BARRIER REFLECTORS ON ALL EXISTING BARRIER RUNS WITHIN THE PROJECT LIMITS.

202, REMOVAL MISC.: BARRIER REFLECTOR, 21 EACH 626, BARRIER REFLECTOR, TYPE 2 (BIDIRECTIONAL), 103 EACH

#### ITEM 253 - CONCRETE PAVEMENT REPAIR

THIS ITEM WILL BE USED TO REPLACE CONCRETE PAVEMENT AT THE SPECIFIED LOCATIONS BELOW. CONCRETE PAVEMENT WILL BE EXCAVATED AND REPLACED WITH ASPHALT.

SR 7 SLM 23.14 SLM 23.80 SLM 26.97

A QUANTITY OF THIS ITEM SHALL BE PROVIDED FOR USE AS DIRECTED BY THE ENGINEER. THIS ITEM SHALL CONSIST OF REMOVING THE EXISTING CONCRETE PAVEMENT FULL DEPTH AND PLACING 10"-12"± 301 ASPHALT CONCRETE BASE, PG64-22. PAYMENT SHALL BE BASED ON THE ACTUAL NUMBER OF SQUARE YARDS OF PAVEMENT REMOVED AND REPLACED TO THE LIMITS DESIGNATED BY THE ENGINEER. THE FOLLOWING ESTIMATED QUANTITY HAS BEEN CARRIED TO THE GENERAL SUMMARY:

253, PAVEMENT REPAIR, 33 SQ YD


## ITEM 623 - MONUMENT BOX ADJUSTED TO GRADE, AS PER PLAN

IN ADDITION TO THE REQUIREMENTS OF CMS 611.10.D FOR MANHOLES, 623.05 FOR MONUMENT BOXES, OR 638.18 FOR VALVE BOXES, THE CONTRACTOR WILL MAKE A CLEAN CIRCULAR CUT AROUND THE CASTING (48" DIAMETER FOR STORM AND SANITARY MANHOLE CASTINGS, 24"-28" FOR VALVE AND MONUMENT BOXES, AND 2' IN DIAMETER LARGER THAN STANDARD MANHOLES SUCH AS TELECOMMUNICATION MANHOLE CASTINGS) AND REMOVE AND DISCARD THE EXISTING CASTING. INSTALL A NEW CASTING TO GRADE (ACCORDING TO TOLERANCES AS SHOWN ON STANDARD CONSTRUCTION DRAWING BP-3.1) AFTER THE PAVEMENT SURFACE COURSE HAS BEEN REPLACED.

CMS 499 CLASS QCMS CONCRETE (DYE THE CONCRETE SUCH THAT ITS COLOR CLOSELY MATCHES THE COLOR OF THE SURROUNDING PAVEMENT) WILL BE USED FOR BACKFILLING THE FULL PAVEMENT SECTION AND THE JOINT BETWEEN THE ASPHALT AND CONCRETE WILL BE SEALED WITH CMS 702.01 PG BINDER. EPOXY COATED REBAR SHALL BE PLACED IN THE CONCRETE AT 6" MAXIMUM ON CENTER AND A MINIMUM OF 3.5" CLEARANCE FROM THE TOP, BOTTOM AND SIDES. THE CONCRETE WILL BE VIBRATED SUFFICIENTLY TO ELIMINATE AIR POCKETS UNDER THE FRAME.

PAYMENT WILL INCLUDE REMOVAL OF THE EXISTING MATERIAL, INSTALLATION AND FURNISHING OF A NEW CASTING. AND ALL LABOR AND MATERIALS REQUIRED TO COMPLETE THIS ITEM OF WORK AS DESCRIBED.

THE FOLLOWING QUANTITIES HAVE BEEN CARRIED TO THE GENERAL SUMMARY:

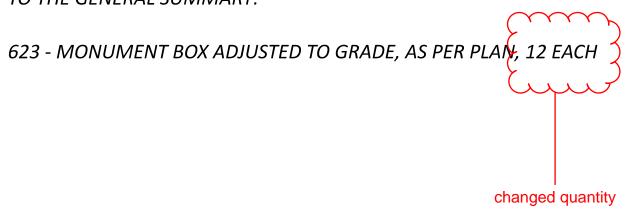

### **ITEM SPECIAL - AS-BUILT CONSTRUCTION DRAWINGS**

| PRIOR TO FINAL ACCEPTANCE OF THE WORK, THE CONTRACTOR SHALL     | TH       |
|---|----------|
| FURNISH THE DEPARTMENT FORMAL AS-BUILT CONSTRUCTION RECORD-     | FIL      |
| DRAWING PLANS. THE FORMAL AS-BUILT CONSTRUCTION RECORD-         | OF       |
| DRAWING FLANS. THE FORMAL AS BOILF CONSTRUCTION RECORD          | CC       |
|   | HI       |
| SHALL BE DENOTED UTILIZING CLOUDING IN MICROSTAION (OR OTHER    |          |
| CAD SOFTWARE) OR CLOUDING IN PDF EDITING SOFTWARE. THE          | CC       |
| AS-BUILT CONSTRUCTION PLANS SHALL HAVE A SIGNED                 | IM       |
| VERIFICATION ON THE TITLE SHEET FROM THE CONTRACTOR INDICATING  | OF       |
| THAT ALL RED-LINED AND FIELD CHANGES HAVE BEEN INCORPORATED     |          |
| NTO AS-BUILT CONSTRUCTION RECORD-DRAWINGS.                      |          |
|   | ST       |
| THE CONTRACTORS VERIFICATION STATEMENT INDICATES ALL            |          |
| KNOWN FIELD MODIFICATIONS MADE HAVE BEEN INCLUDED IN            | TH       |
| THE FORMAL RECORD DRAWING. THE CONTRACTORS                      | ST       |
| VERIFICATION STATEMENT SHALL BE SIGNED BY THE CONTRACTORS       | AS       |
| PROJECT MANAGER (OR ACCEPTABLE REPRESENTATIVE).                 | LIN      |
|   |          |
| N ADDITION TO THE INFORMATION SHOWN ON THE CONSTRUCTION         | Th       |
| PLANS, THE AS-BUILT CONSTRUCTION RECORD-DRAWINGS SHALL SHOW     | M        |
| THE FOLLOWING:  | EA       |
|   | ТС       |
| 1. ALL DEVIATIONS FROM THE ORIGINAL APPROVED CONSTRUCTION       | RE       |
| PLANS WHICH RESULT IN A CHANGE OF LOCATION, MATERIAL,           | FL       |
| TYPE OR SIZE OF WORK.   | OF       |
| 2. ANY UTILITIES, PIPES, WELLHEADS, ABANDONED PAVEMENTS,        | CC       |
| FOUNDATIONS OR OTHER MAJOR OBSTRUCTIONS DISCOVERED AND          | A٨       |
| REMAINING IN PLACE WHICH ARE NOT SHOWN, OR DO NOT CONFORM       |          |
| TO LOCATIONS OR DEPTHS SHOWN IN THE PLANS. UNDERGROUND          | A٨       |
| FEATURES SHALL BE SHOWN AND LABELED ON THE RECORD-DRAWING       | AS       |
|   | AS<br>M  |
| PLAN IN TERMS OF STATION, OFFSET AND ELEVATION.                 | UF       |
| 3. THE FINAL OPTION AND SPECIFICATION NUMBER SELECTED FOR       |          |
| THOSE ITEMS WHICH ALLOW SEVERAL MATERIAL OPTIONS UNDER          | DI.      |
| THE SPECIFICATION (E.G., CONDUIT).                              | CR       |
| 4. CHANGES TO THE PAY ITEMS AND FINAL QUANTITIES AS PAID        |          |
| SHALL BE SHOWN ON THE GENERAL SUMMARY AND SUBSUMMARIES.         | IN       |
| 5. ADDITIONAL PLAN SHEETS MAY BE NEEDED IF NECESSARY TO         | RE       |
| SHOW WORK NOT INCLUDED IN THE CONSTRUCTION PLANS.               | ΕN       |
| IF ADDITIONAL PLAN SHEETS ARE NEEDED, THEY ARE REQUIRED         | LIN      |
| TO BE PREPARED IN CONFORMANCE WITH THE LOCATION AND             |          |
| DESIGN MANUAL, VOLUME 3, SECTION 1200 - PLAN PREPARATION.       | Th       |
|   | LU       |
| NOTATION SHALL ALSO BE MADE OF LOCATIONS AND THE EXTENT OF      | HA       |
| USE OF MATERIALS, OTHER THAN SOIL, FOR EMBANKMENT CONSTRUCTION  | FL       |
| ROCK, BROKEN CONCRETE WITHOUT REINFORCING STEEL, ETC.).         | CC       |
|   | RI       |
| THE PLAN INDEX SHALL SHOW THE PLAN SHEETS WHICH HAVE CHANGES    |          |
| APPEARING ON THEM.  | TH       |
|   | PR       |
| TWO COPIES OF THE AS-BUILT CONSTRUCTION RECORD-DRAWINGS SHALL   | EA       |
| BE DELIVERED TO THE PROJECT ENGINEER FOR APPROVAL UPON          | SH       |
| COMPLETION OF THE PHYSICAL WORK BUT PRIOR TO THE REQUEST FOR    | DA       |
| FINAL PAYMENT. AFTER THE DEPARTMENT HAS APPROVED THE AS-BUILT   | TH       |
| CONSTRUCTION RECORD-DRAWINGS, THE ASSOCIATED ELECTRONIC FILES   | W        |
| SHALL BE DELIVERED TO THE DISTRICT CAPITAL PROGRAMS             | W        |
| ADMINISTRATOR. ACCEPTANCE OF THESE PLANS AND DELIVERY OF THE    | BR       |
| ASSOCIATED ELECTRONIC FILES IS REQUIRED PRIOR TO THE WORK BEING |          |
| ACCEPTED AND THE FINAL ESTIMATE APPROVED.                       | Th       |
|   | ER       |
| PAYMENT FOR ALL THE ABOVE SHALL BE LUMP SUM UPON PROPER         | SH       |
| EXECUTION OF ALL WORK OF THIS ITEM AS DETERMINED BY THE         | US       |
| PROJECT ENGINEER.   | ۵۵<br>۸۸ |
|   | PR       |
|   | ER       |
|   | TH       |
|   |          |

# STREAM/WETLAND AVOIDANCE

HE CONTRACTOR SHALL NOT PLACE TEMPORARY OR PERMANENT LL IN WETLANDS OR BELOW THE ORDINARY HIGH WATER MARK ANY WATERWAY DURING CONSTRUCTION OF THIS PROJECT. THE ONTRACTOR SHALL NOT PLACE EQUIPMENT BELOW THE ORDINARY IGH WATER MARK. IF DEBRIS ENTERS THE WATERWAY DURING ONSTRUCTION, THE CONTRACTOR SHALL REMOVE THE DEBRIS IMEDIATELY UTILIZING EQUIPMENT STAGED ABOVE THE RDINARY HIGH WATER MARK.

## TATE WILD AND SCENIC RIVER PROTECTIONS

HE PROJECT IS LOCATED WITHIN 1000 FEET OF CONNEAUT CREEK, A TATE WILD AND SCENIC RIVER AND THE EAST BRANCH OF THE SHTABULA RIVER IS A STATE SCENIC RIVER WITHIN THE PROJECT MITS.

HE CONTRACTOR SHALL NOT DISCHARGE TOXIC OR HAZARDOUS IATERIALS SUCH AS SEALANTS, PAINT, SOLVENTS, CLEANING AGENTS, ARTHEN MATERIALS, WASTE-WATER, FUELS OR DEBRIS OF ANY KIND O A SCENIC RIVER, ITS TRIBUTARIES, OR DRAINAGE WAYS. IF EFUELING OF IMMOBILE EQUIPMENT IS NECESSARY WITHIN THE LOODPLAIN OR NEAR ANY TRIBUTARY DRAINAGE WAYS, DITCHES, R STREAM. THE CONTRACTOR SHALL PROVIDE SECONDARY ONTAINMENT WITH ENOUGH CAPACITY TO COMPLETELY CONTAIN ND COLLECT ALL POTENTIAL LIQUID WASTES IN THE EVENT OF A SPILL.

NY AND ALL CONSTRUCTION DEBRIS, EARTHEN DEBRIS, EXCESS SPHALT OR CONCRETE, WOOD DEBRIS FROM CLEARING, EXCESS FILL 1ATERIAL, AND TRASH SHOULD BE DISPOSED OF AT AN APPROVED PLAND SITE OR LAND FILL ABOVE FEMA 100-YEAR FLOOD ELEVATIONS. ISPOSAL OF ANY SUCH MATERIALS WITHIN 1000 FEET OF CONNEAUT REEK AND THE EAST BRANCH OF THE ASHTABULA RIVER IS PROHIBITED.

I ACCORDANCE WITH ORC 3750.06, REPORTABLE SPILLS MUST BE EPORTED TO THE LOCAL FIRE DEPARTMENT (911), THE LOCAL MERGENCY COORDINATOR (440-576-3500), AND THE OHIO SPILL NE (800-282-9378).

HE CONTRACTOR SHALL KEEP ALL IDLE EQUIPMENT, FUELS, JBRICANTS, AND ANY STORAGE FOR/OF POTENTIALLY TOXIC OR AZARDOUS MATERIALS OUT OF THE FEMA DESIGNATED SPECIAL LOOD HAZARD AREA AND NOT WITHIN 1000 FEET OF THE ONNEAUT CREEK AND THE EAST BRANCH OF THE ASHTABULA VER.

HE CONTRACTOR SHALL NOTIFY THE PROJECT ENGINEER 40 DAYS RIOR TO WORK WITHIN 1000 FEET OF CONNEAUT CREEK AND THE AST BRANCH OF THE ASHTABULA RIVER. THE PROJECT ENGINEER HALL NOTIFY THE DISTRICT ENVIRONMENTAL COORDINATOR 35 AYS PRIOR TO WORK WITHIN 1000 FEET OF THE SCENIC RIVERS. HE DISTRICT ENVIRONMENTAL COORDINATOR SHALL COORDINATE ITH ODNR SCENIC RIVERS A MINIMUM OF 30 DAYS PRIOR TO ANY *ORK WITHIN 1000 FEET OF CONNEAUT CREEK AND THE EAST* RANCH OF THE ASHTABULA RIVER.

HE CONTRACTOR SHALL DEVELOP AND IMPLEMENT A SEDIMENT AND ROSION CONTROL PLAN BEFORE EARTHWORK COMMENCES. THE PLAN HALL INCLUDE A LIST OF APPLICABLE BMPS, PER SS 832 THAT WILL BE SED THROUGHOUT THE PROJECT, SUCH AS PERIMETER CONTROLS ND/OR SEEDING AND MULCHING, AND MUST BE SUBMITTED TO THE ROJECT ENGINEER FOR REVIEW AND ACCEPTANCE. SEDIMENT AND ROSION CONTROLS SHALL BE PROPERLY INSTALLED AND MAINTAINED HROUGHOUT THE DURATION OF THE PROJECT. STRAW BALES SHALL NOT BE PERMITTED AS A FORM OF SEDIMENT CONTROL. ALL TEMPORARY SEDIMENT AND EROSION CONTROLS SHALL BE REMOVED UPON STABILIZATION OF THE PROJECT AREA. PARTICULAR ATTENTION SHALL BE GIVEN TO ANY DRAINAGE WAYS, UNPROTECTED SLOPES, DITCHES, AND STREAMS THAT COULD CONVEY SEDIMENT LADEN WATERS DIRECTLY TO THE CONNEAUT CREEK AND THE EAST BRANCH OF THE ASHTABULA RIVER.

DESIGN AGENCY



ESIGNER REP REVIEWER MJA 01-07-25 ROJECT ID 100956 HEET TOTAL P.5 12

| DESCRIPTION   | UNIT       | GRAND            | ITEM           | ITEM       | PART.            | 1 | 1     |     |                  | T NUM. | SHEET |          |     |       |  |
|---|------------|------------------|----------------|------------|------------------|---|-------|-----|------------------|--------|-------|----------|-----|-------|--|
| DESCRIPTION   | UNIT       | TOTAL            | EXT            |            | 01/STR/05        |   | 11    | 10  | 9                |        | 7     | 6        | 5   | 4     |  |
| ROADWAY   |            |                  |                |            |                  |   |       |     |                  |        |       |          |     |       |  |
| WEARING COURSE REMOVED  |            | 52               | 23500          | 202        | 52               |   |       |     | 52               |        |       |          |     |       |  |
| REMOVAL MISC.: BARRIER REFLECTOR  | EACH       | 21               | 98100          | 202        | 21               |   |       |     |                  |        |       |          | 21  | 10    |  |
| EXCAVATION (FOR PAVEMENT REPAIR) LINEAR GRADING   | CY<br>STA  | 42<br>134        | 10000<br>60200 | 203<br>209 | 42<br>134        |   |       |     |                  |        |       |          | 134 | 42    |  |
| PREPARING SUBGRADE FOR SHOULDER PAVING  | STA        | 1,200            | 72000          | 209        | 1,200            |   |       |     | 1,200            |        |       |          | 134 |       |  |
| MONUMENT ASSEMBLY ADJUSTED TO GRADE, AS PER PLAN  | FACH       | <u>12</u>        | 39501          | 623        | 12               | ( |       |     |                  |        |       |          | 12  |       |  |
| AS-BUILT CONSTRUCTION PLANS   |            | LS               | 69091000       | SPECIAL    | u jsu            | ( |       |     |                  |        |       |          | LS  |       |  |
| EROSION CONTRO  |            |                  |                |            |                  |   |       |     |                  |        |       |          |     |       |  |
| EROSION CONTROL   | EACH       | 3,000            | 30000          | 832        | 3,000            |   |       |     |                  |        |       |          |     |       |  |
| PAVEMENT  |            |                  |                |            |                  |   |       |     |                  |        |       |          |     |       |  |
| PARTIAL DEPTH PAVEMENT REPAIR (441) (LONGITUDINAL)  |            | 2,750            | 01000          | 251        | 2,750            |   |       |     |                  |        |       |          |     | 2,750 |  |
| PARTIAL DEPTH PAVEMENT REPAIR (441) (TRANSVERSE)  |            | 250              | 01000          | 251        | 250              |   |       |     |                  |        |       |          |     | 250   |  |
| FULL DEPTH PAVEMENT SAWING  |            | 3,375            | 01500          | 252        | 3,375            |   |       |     |                  |        |       |          | 22  | 3,375 |  |
| PAVEMENT REPAIR<br>PAVEMENT PLANING, ASPHALT CONCRETE (T=1.75")   |            | 783<br>161,361   | 01000<br>01000 | 253<br>254 | 783<br>161,361   |   |       |     | 161,361          |        |       |          | 33  | 750   |  |
|   |            |                  | 01000          | 237        |                  |   |       |     |                  |        |       |          |     |       |  |
| PAVEMENT PLANING, ASPHALT CONCRETE (T=2.25")  |            | 46,322           | 01000          | 254        | 46,322           |   |       |     | 46,322           |        |       |          |     |       |  |
| AGGREGATE BASE (FOR PAVEMENT REPAIR)  |            | 42               | 20000          | 304        | 42               |   |       |     | 21 447           |        |       |          |     | 42    |  |
| NON-TRACKING TACK COAT<br>PRIME COAT, AS PER PLAN @0.40 GAL/SY  |            | 21,417<br>10,664 | 20000<br>10001 | 407<br>408 | 21,417<br>10,664 |   |       |     | 21,417<br>10,664 |        |       |          |     |       |  |
| AGGREGATE, SINGLE CHIP SEAL, TYPE A   | SY SAL     | 162,283          | 110001         | 408        | 162,283          |   |       |     | 162,283          |        |       |          |     |       |  |
|   |            |                  |                |            |                  |   |       |     |                  |        |       |          |     |       |  |
| EMULSION, CHIP SEAL @0.40 GAL/SY  |            | 64,914           | 25000          | 422        | 64,914           |   |       |     | 64,914           |        |       |          |     |       |  |
| ASPHALT CONCRETE SURFACE COURSE, TYPE 1, (448), PG70-22M  |            | 8,380            | 50100          | 441        | 8,380            |   |       |     | 8,380            |        |       |          |     |       |  |
| ASPHALT CONCRETE INTERMEDIATE COURSE, TYPE 1, (448)   | CY<br>CY   | 1,262            | 50200          | 441        | 1,262            |   |       |     | 1,262            |        |       |          |     |       |  |
| ASPHALT CONCRETE SURFACE COURSE, TYPE 1, (449), (DRIVEWAYS)<br>COMPACTED AGGREGATE, AS PER PLAN (T=1" AVG.) |            | 26<br>741        | 70500<br>10101 | 441<br>617 | 26<br>741        |   |       |     | 26<br>741        |        |       |          |     |       |  |
|   |            | / +1             | 10101          | 017        | ,                |   |       |     | / +1             |        |       |          |     |       |  |
| RUMBLE STRIPES, EDGE LINE (ASPHALT CONCRETE)  |            | 3                | 41000          | 618        | 3                |   |       |     | 3                |        |       |          |     |       |  |
| RUMBLE STRIPES, CENTER LINE (ASPHALT CONCRETE)  |            | 3                | 43000          | 618        | 3                |   |       |     | 3                |        |       |          |     |       |  |
| LONGITUDINAL JOINT PREPARATION  | FT         | 10,772           | 20000          | 874        | 10,772           |   |       |     | 10,772           |        |       |          |     |       |  |
| TRAFFIC CONTRO  |            |                  |                |            |                  |   |       |     |                  |        |       |          |     |       |  |
| RPM   |            | 753              | 00100          | 621        | 753              |   |       | 753 |                  |        |       |          |     |       |  |
| RAISED PAVEMENT MARKER REMOVED  |            | 605              | 54000          | 621        | 605              |   |       | 605 |                  |        |       |          | 102 |       |  |
| BARRIER REFLECTOR, TYPE 1 (BIDIRECTIONAL)<br>EDGE LINE, 6"  |            | 103<br>22.74     | 00102<br>10010 | 626<br>646 | 103<br>22.74     |   | 22.74 |     |                  |        |       |          | 103 |       |  |
| CENTER LINE   |            | 11.37            | 10010          | 646        | 11.37            |   | 11.37 |     |                  |        |       |          |     |       |  |
|   |            | 62               | 40400          | 646        |                  |   |       |     |                  |        |       |          |     |       |  |
| STOP LINE   | FT         | 62               | 10400          | 646        | 62               |   | 62    |     |                  |        |       |          |     |       |  |
|   |            |                  |                |            |                  |   |       |     |                  |        |       |          |     |       |  |
| LAW ENFORCEMENT OFFICER WITH PATROL CAR FOR ASSISTANCE  |            | 50               | 11110<br>12460 | 614<br>614 | 50               |   |       |     |                  |        | 50    | 1 ን      |     |       |  |
| WORK ZONE MARKING SIGN<br>ASPHALT CONCRETE FOR MAINTAINING TRAFFIC  | EACH<br>CY | 12<br>10         | 12460          | 614<br>614 | 12<br>10         |   |       |     |                  |        |       | 12<br>10 |     |       |  |
| PORTABLE CHANGEABLE MESSAGE SIGN, AS PER PLAN   | SNMT       | 10               | 18601          | 614        | 10               |   |       |     |                  |        | 12    |          |     |       |  |
| WORK ZONE CENTER LINE, CLASS I  | MILE       | 11.37            | 21000          | 614        | 11.37            |   |       |     |                  |        |       | 11.37    |     |       |  |
| WORK ZONE CENTED LINE CLASS III 642 DAINIT  | MILE       | 22.74            | 21550          | 614        | 22.74            |   |       |     |                  |        |       | 22.74    |     |       |  |
| WORK ZONE CENTER LINE, CLASS III, 642 PAINT<br>WORK ZONE EDGE LINE, CLASS III, 6", 642 PAINT                |            | 68.22            | 21550          | 614<br>614 | 68.22            |   |       |     |                  |        |       | 68.22    |     |       |  |
| WORK ZONE STOP LINE, CLASS II, 0 , 042 PAINT  | FT         | 62               | 26000          | 614        | 62               |   |       |     |                  |        |       | 62       |     |       |  |
| WORK ZONE STOP LINE, CLASS III, 642 PAINT   |            | 124              | 26610          | 614        | 124              |   | 1     |     |                  |        |       | 124      |     |       |  |
|   |            |                  |                |            |                  |   |       |     |                  |        |       |          |     |       |  |
| MAINTAINING TRAFFIC   |            | LS               | 11000          | 614        | LS               |   |       |     |                  |        |       |          |     |       |  |
| FIELD OFFICE, TYPE B  |            | 6                | 16010          | 619        | 6                |   | 1     |     |                  |        |       |          |     |       |  |
| CONSTRUCTION LAYOUT STAKES AND SURVEYING  |            | LS               | 10000          | 623        | LS               |   |       |     |                  |        |       |          |     |       |  |
| MOBILIZATION  |            | LS               | 10000          | 624        | LS               |   |       |     |                  |        |       |          |     |       |  |
|   |            |                  |                |            |                  |   |       |     |                  |        |       |          |     |       |  |
|   |            |                  | I              |            |                  |   |       |     | -                | -      |       |          |     |       |  |
|   |            |                  |                |            |                  |   |       |     |                  |        |       |          |     |       |  |

| J        | SEE<br>SHEET<br>NO. |                          |
|----------|---------------------|--------------------------|
|          | 5                   |                          |
|          |                     |                          |
| quantity | 5                   |                          |
|          | 5                   |                          |
| DL       |                     |                          |
|          |                     |                          |
|          |                     |                          |
|          |                     |                          |
|          |                     |                          |
|          |                     | 1AF                      |
|          | 4                   | SUMMARY                  |
|          |                     | L S                      |
|          |                     | GENERAL                  |
|          |                     | U<br>Z                   |
|          | 4                   | ВE                       |
|          |                     |                          |
|          |                     |                          |
|          |                     |                          |
| L        |                     |                          |
|          |                     |                          |
|          |                     |                          |
|          |                     |                          |
|          |                     |                          |
| ΔΓΓΙΟ    |                     |                          |
| AFFIC    |                     |                          |
|          |                     |                          |
|          | 7                   |                          |
|          |                     |                          |
|          |                     |                          |
|          |                     |                          |
|          |                     | DESIGN AGENCY            |
|          |                     |                          |
|          |                     |                          |
|          |                     |                          |
|          |                     |                          |
|          |                     | designer<br>JF           |
|          |                     | REVIEWER<br>MJA 01-07-25 |
|          |                     | PROJECT ID               |
|          |                     | 100956<br>SHEET TOTAL    |
|          |                     | P.8 12                   |