

MAINTENANCE OF TRAFFIC CROSS SECTIONS  
 RAMP 3 - STA. 844+50 TO STA. 845+00

DESIGN AGENCY




DESIGNER  
BEB


REVIEWER  
AKF 6-8-23

PROJECT ID  
113889

Sheet Totals			SHEET	TOTAL
Seeding	Cut	Fill		
0.0	0	0	136	481

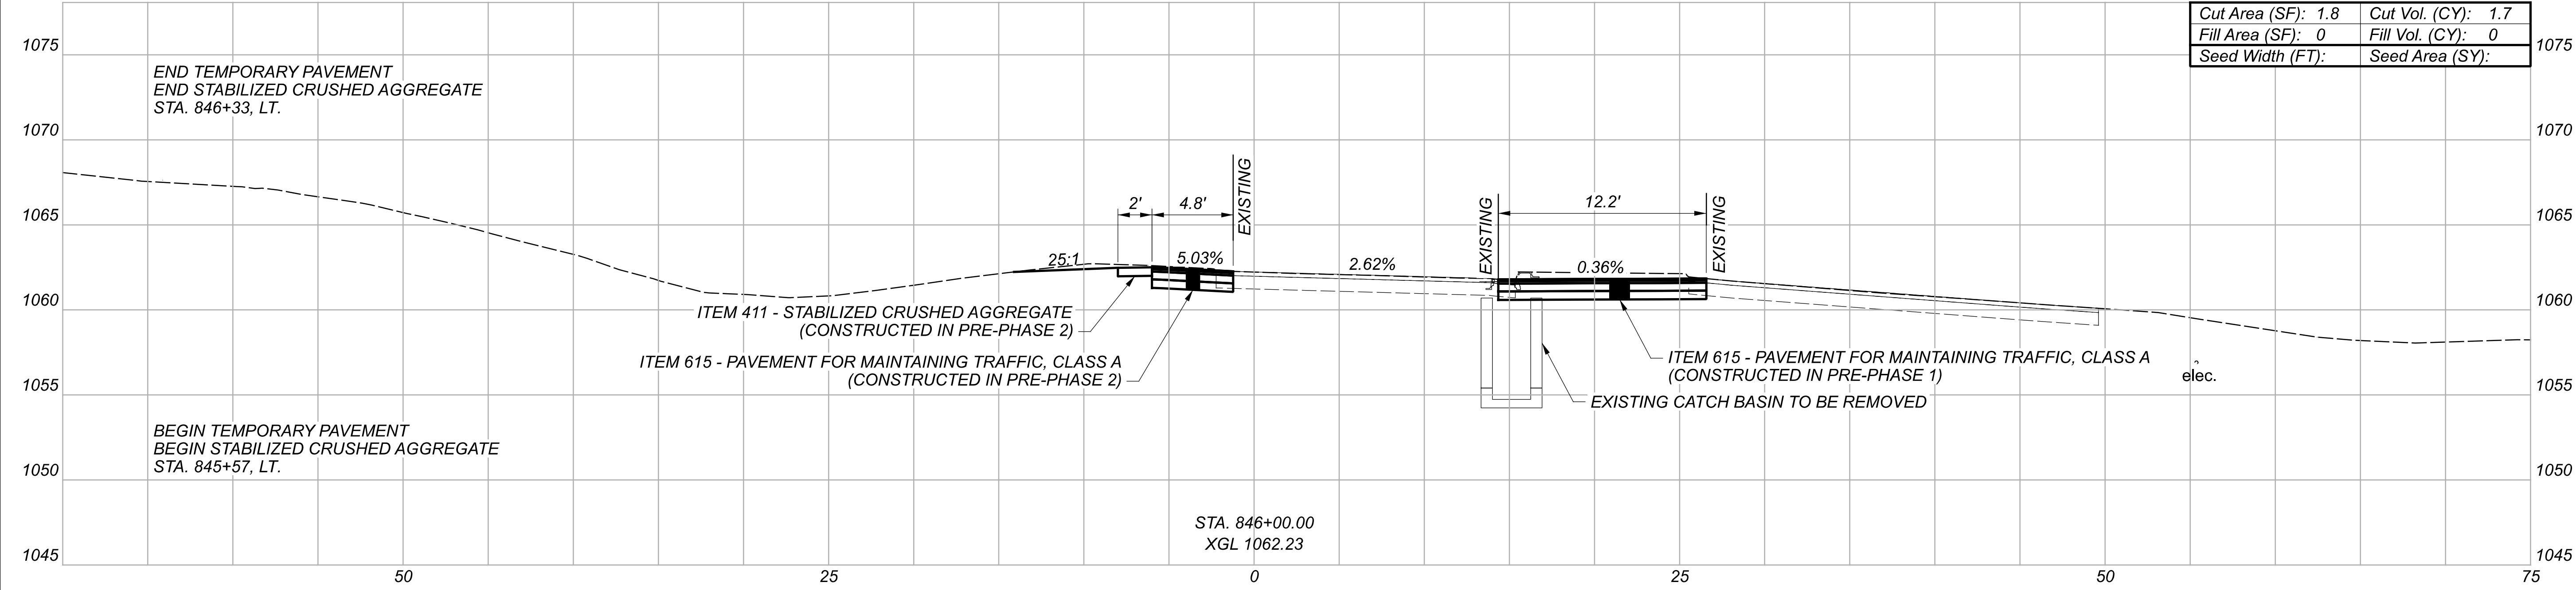

Cut Area (SF): 1.8	Cut Vol. (CY): 1.7
Fill Area (SF): 0	Fill Vol. (CY): 0
Seed Width (FT):	Seed Area (SY):

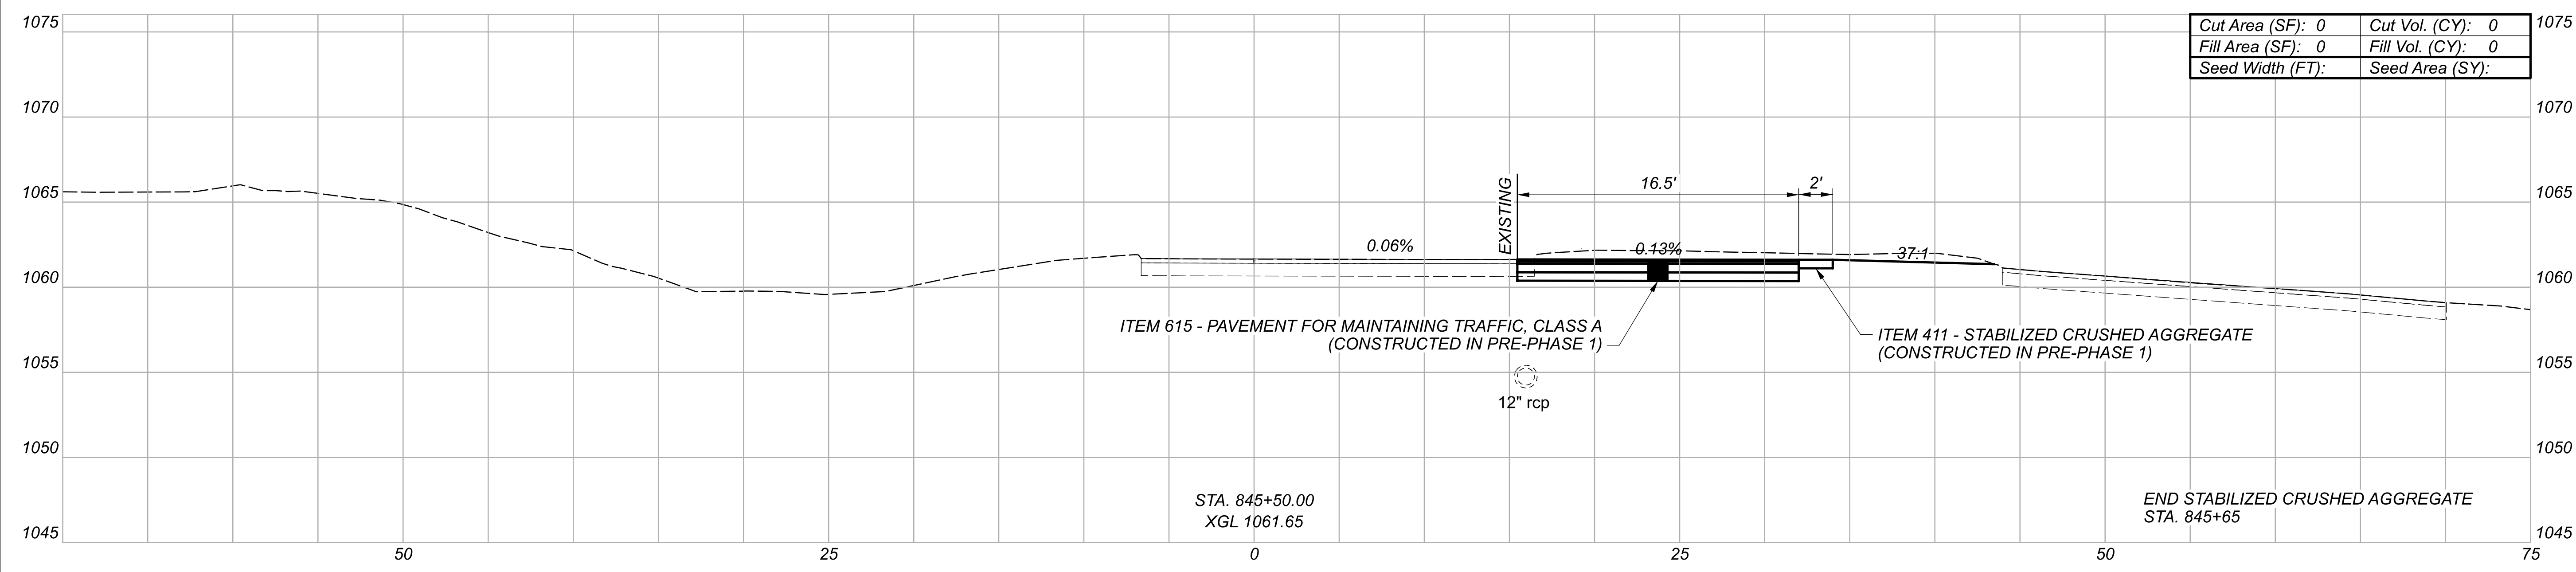

Cut Area (SF): 0	Cut Vol. (CY): 0
Fill Area (SF): 0	Fill Vol. (CY): 0
Seed Width (FT):	Seed Area (SY):

MAINTENANCE OF TRAFFIC CROSS SECTIONS  
 RAMP 3 - STA. 845+50 TO STA. 846+00

DESIGN AGENCY



DESIGNER

BEB



REVIEWER

AKF 6-8-23

PROJECT ID

113889

Sheet Totals			SHEET	TOTAL
Seeding	Cut	Fill	137	481
0.0	1.7	0		

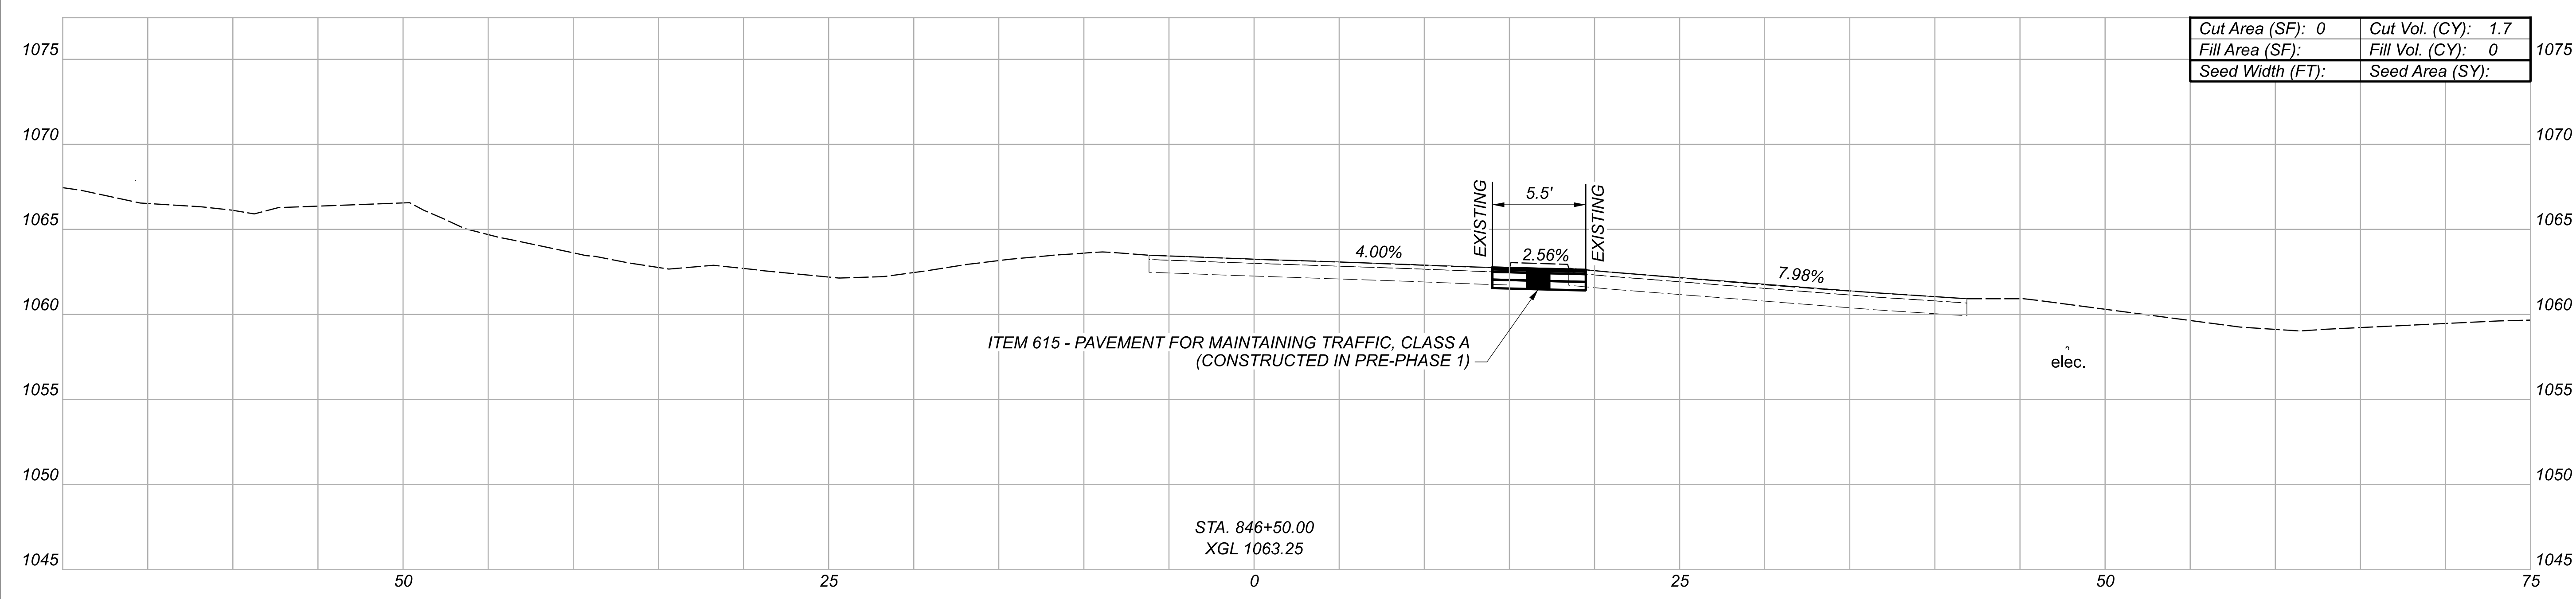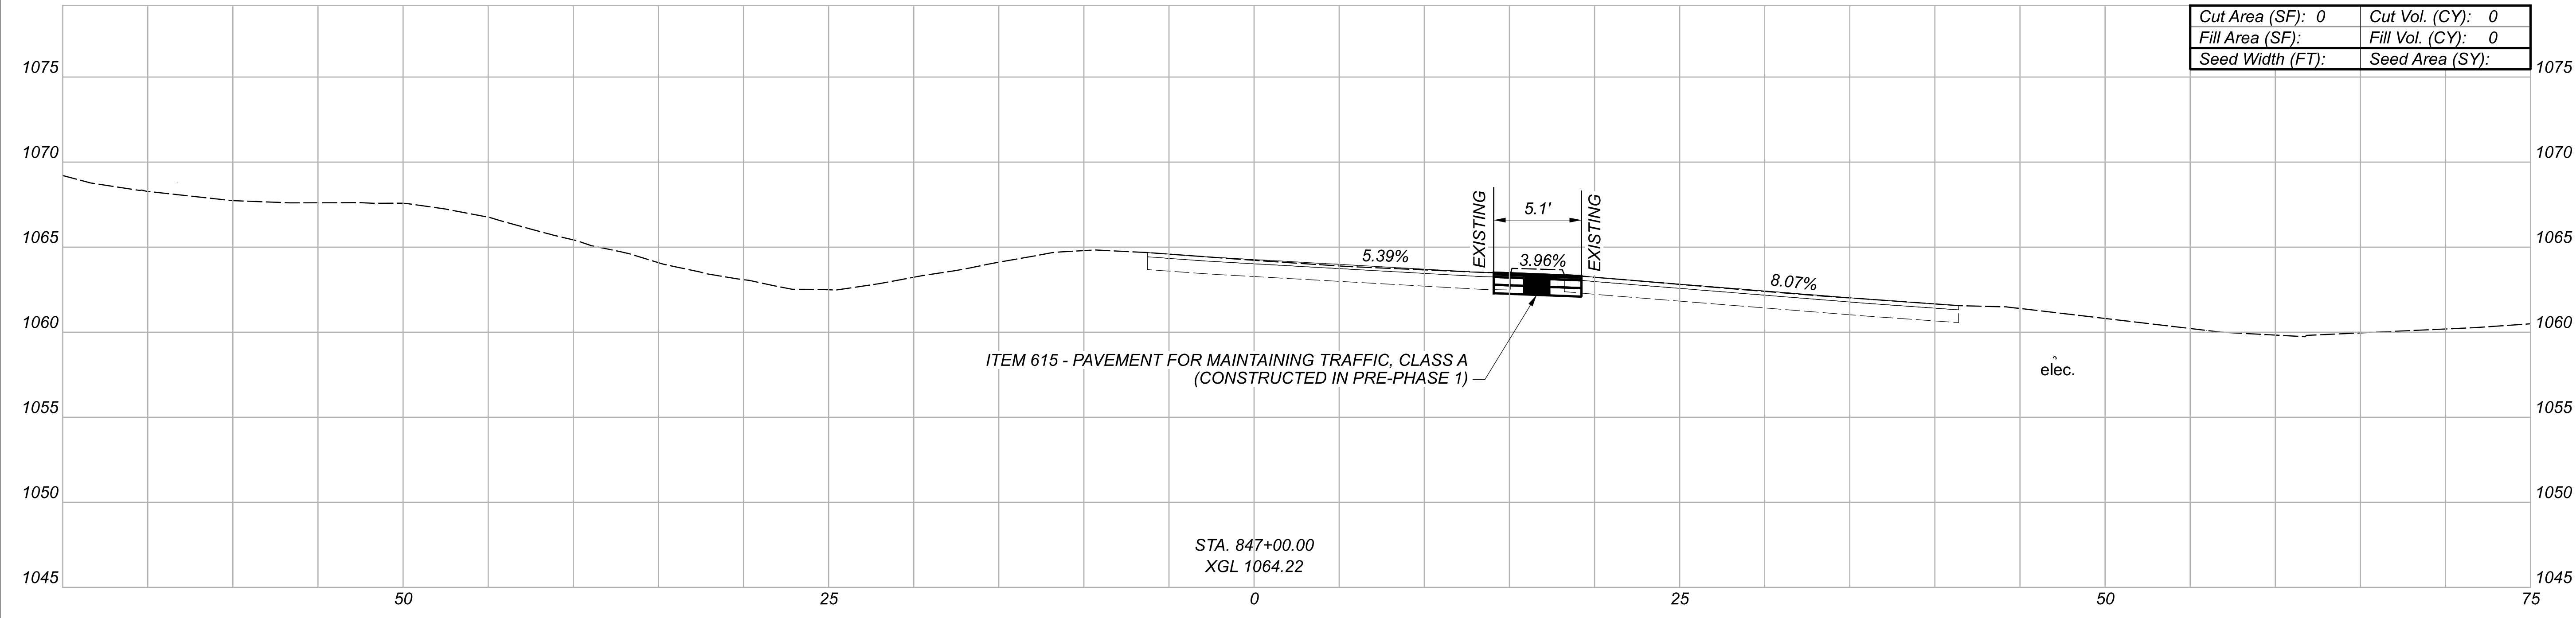

Sheet Totals			SHEET	TOTAL
Seeding	Cut	Fill	138	481
0.0	1.7	0.0		

MAINTENANCE OF TRAFFIC CROSS SECTIONS  
 RAMP 3 - STA. 846+50 TO STA. 847+00

DESIGN AGENCY



DESIGNER


BEB

REVIEWER


AKF 6-8-23

PROJECT ID

113889

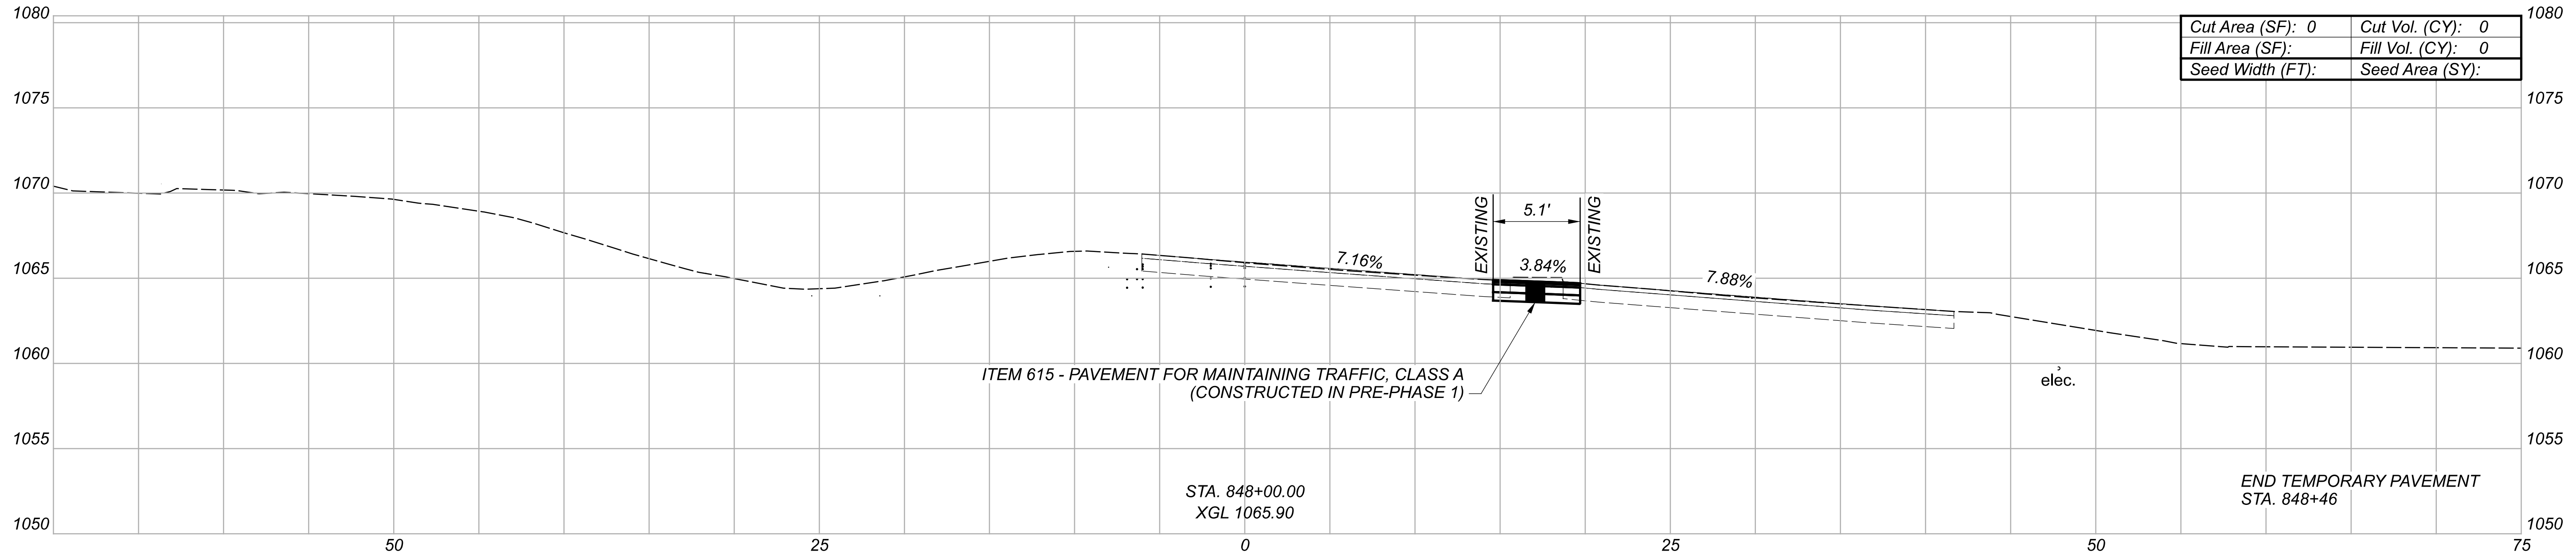

Cut Area (SF): 0	Cut Vol. (CY): 0
Fill Area (SF):	Fill Vol. (CY): 0
Seed Width (FT):	Seed Area (SY):

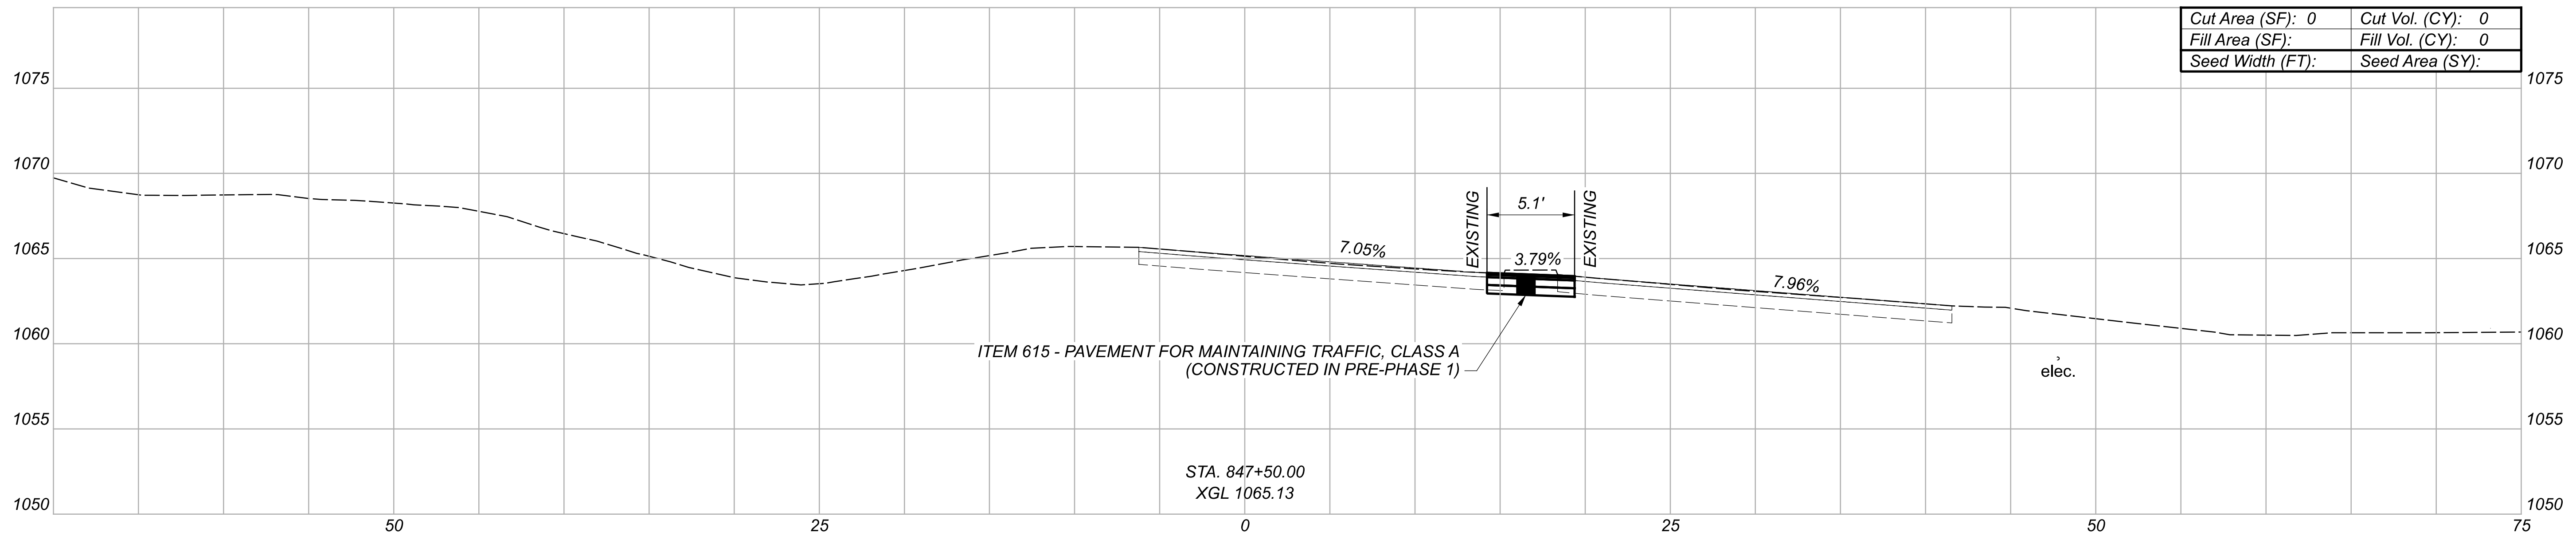

Cut Area (SF): 0	Cut Vol. (CY): 0
Fill Area (SF):	Fill Vol. (CY): 0
Seed Width (FT):	Seed Area (SY):

Sheet Totals			SHEET TOTAL	
Seeding	Cut	Fill	139	481
0.0	0.0	0.0		

MAINTENANCE OF TRAFFIC CROSS SECTIONS  
 RAMP 3 - STA. 847+50 TO STA. 848+00

DESIGN AGENCY



DESIGNER

BEB




REVIEWER

AKF 6-8-23

PROJECT ID

113889



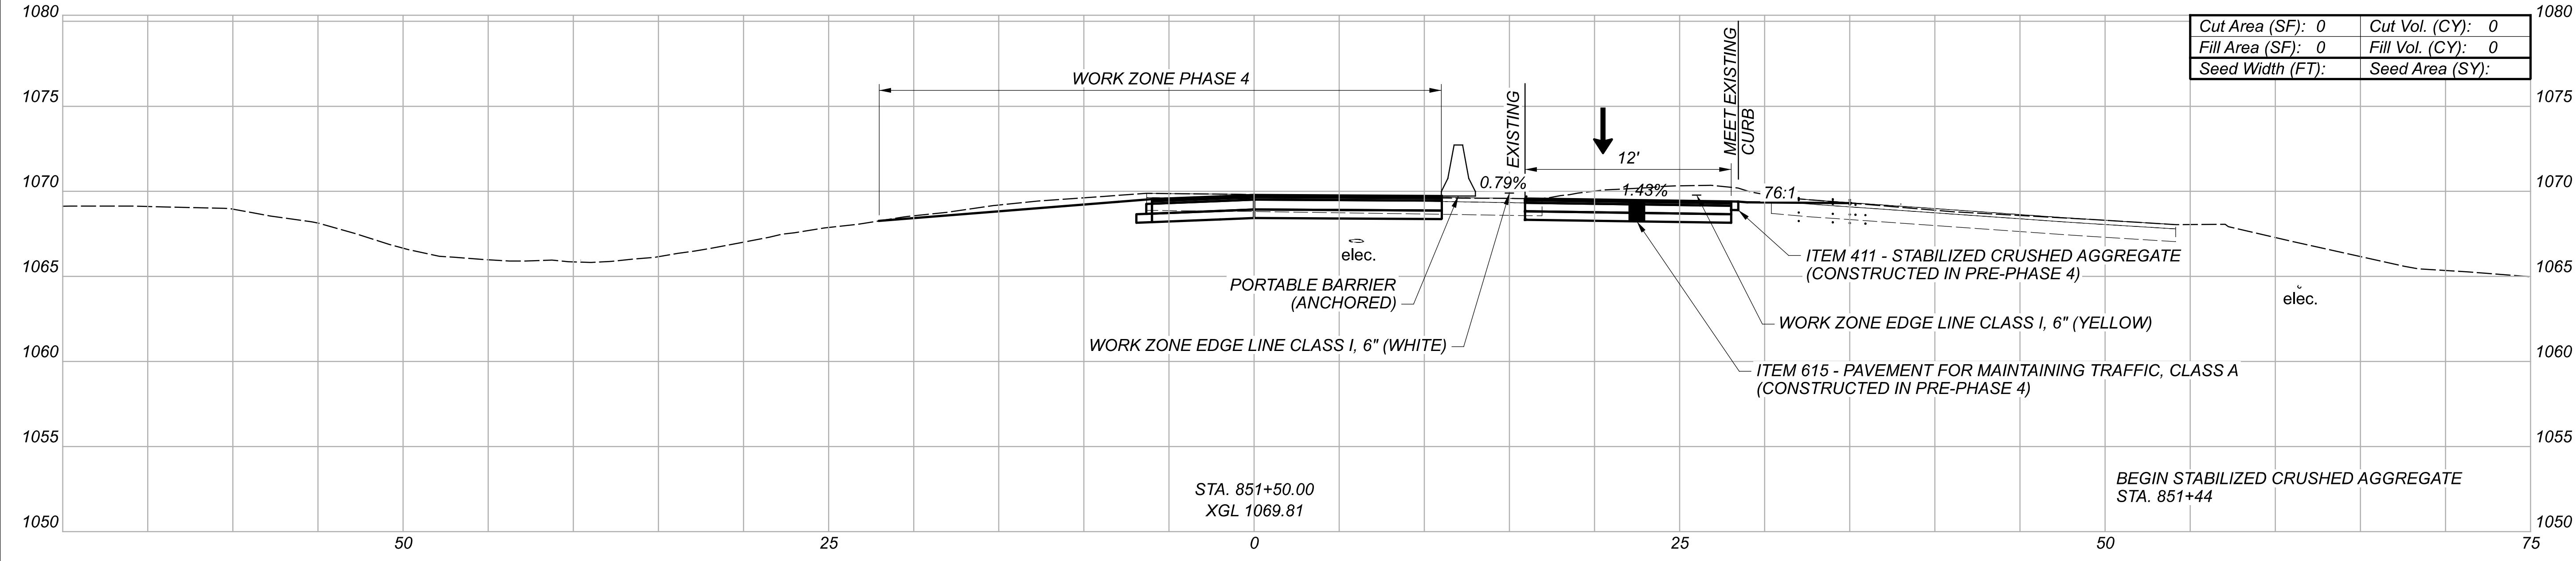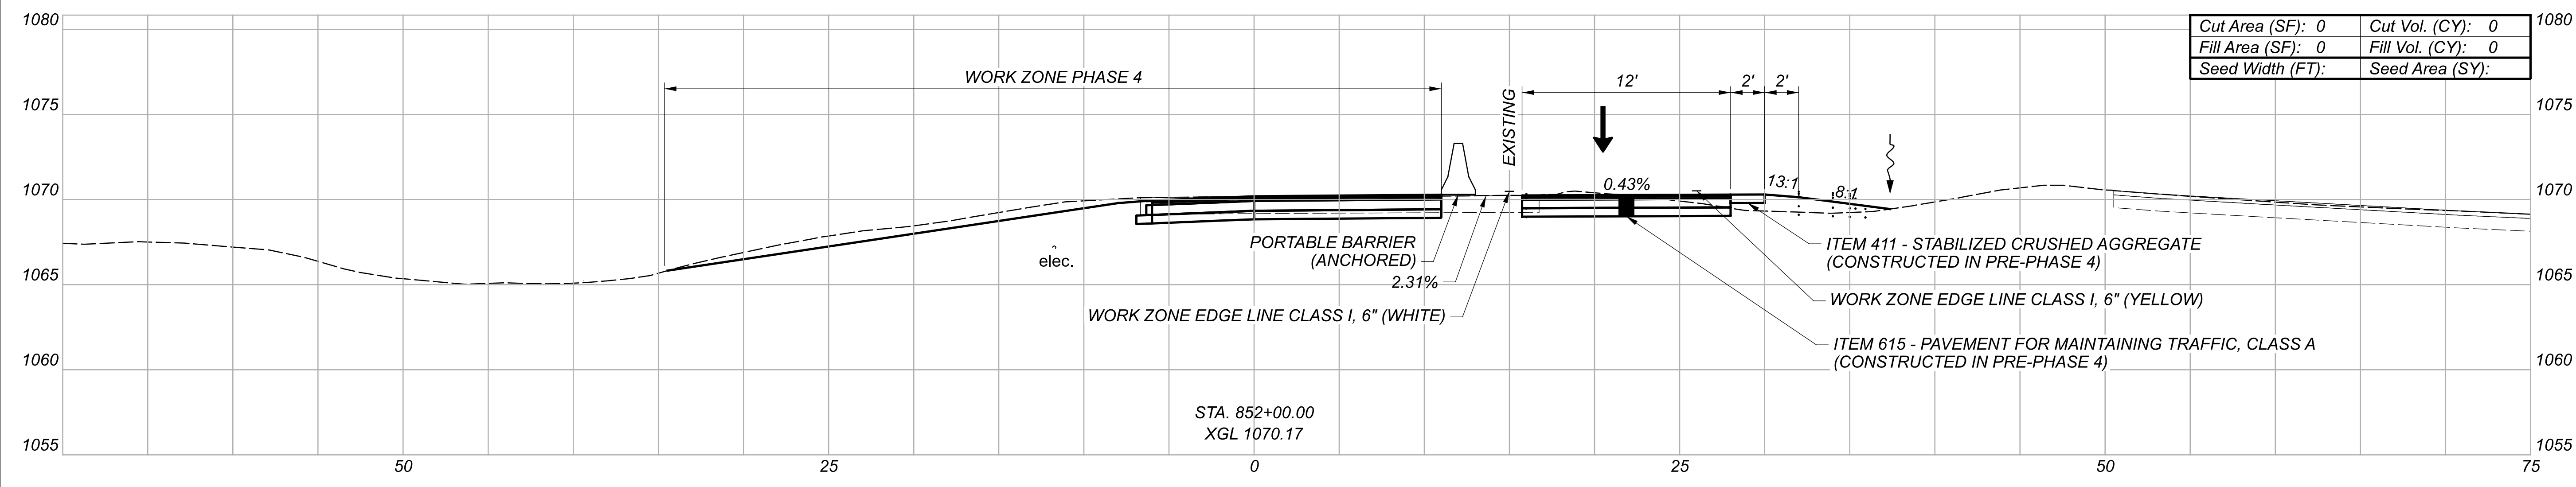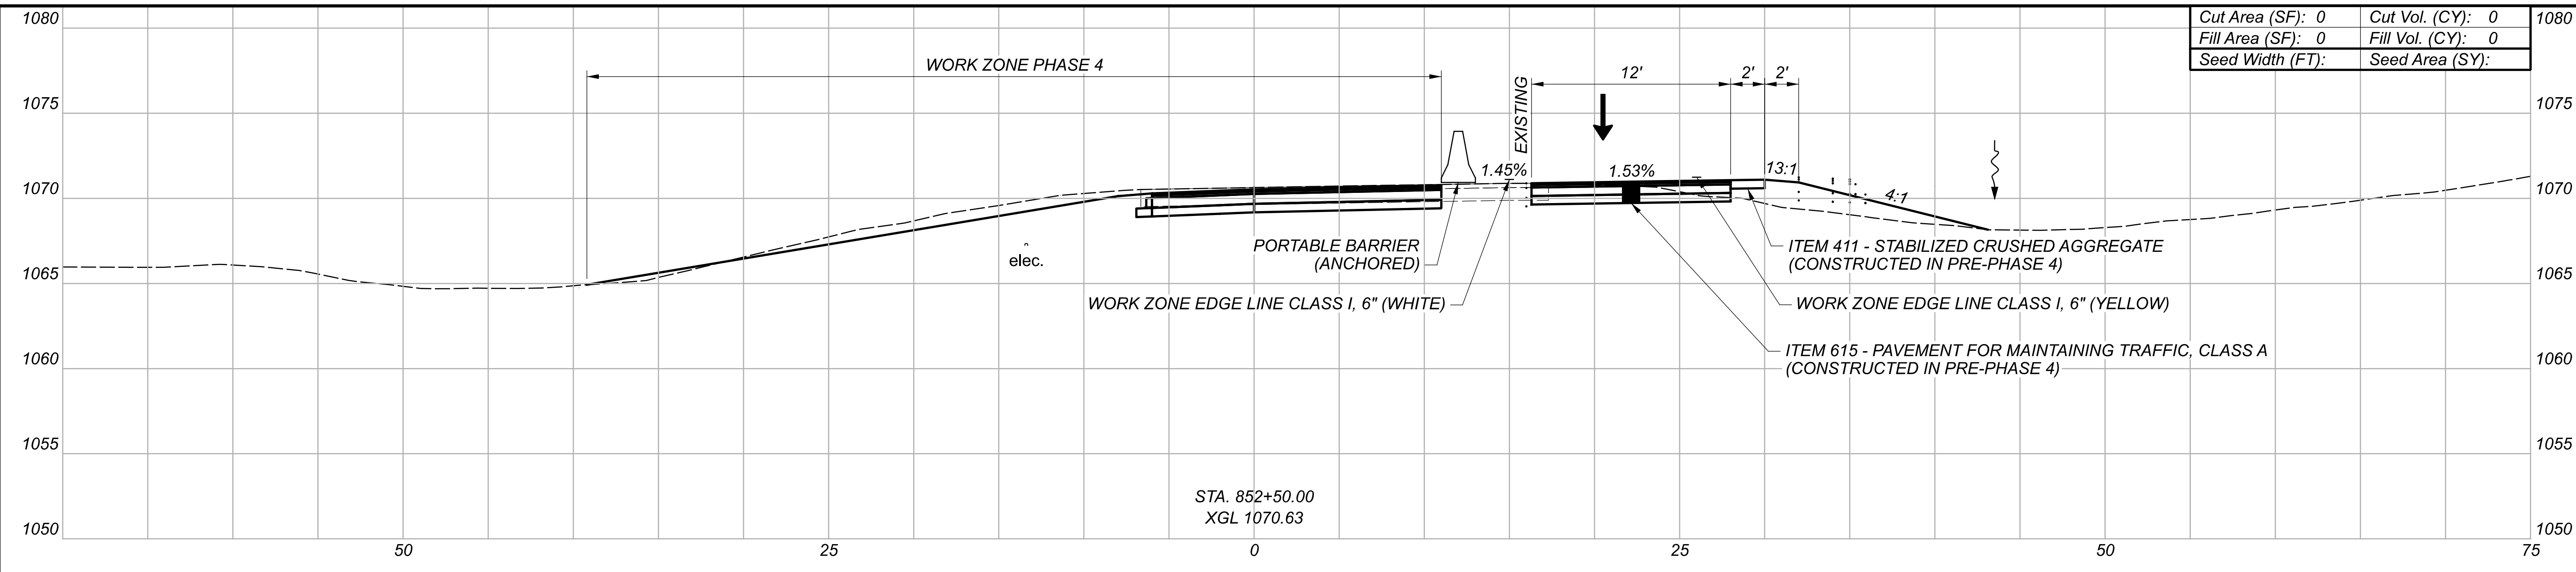

MAINTENANCE OF TRAFFIC CROSS SECTIONS  
 RAMP 3 - STA. 851+50 TO STA. 852+50

DESIGN AGENCY



DESIGNER

BEB


REVIEWER

AKF 6-8-23


PROJECT ID

113889

Sheet Totals			SHEET TOTAL	
Seeding	Cut	Fill	141	481
0.0	0	0		

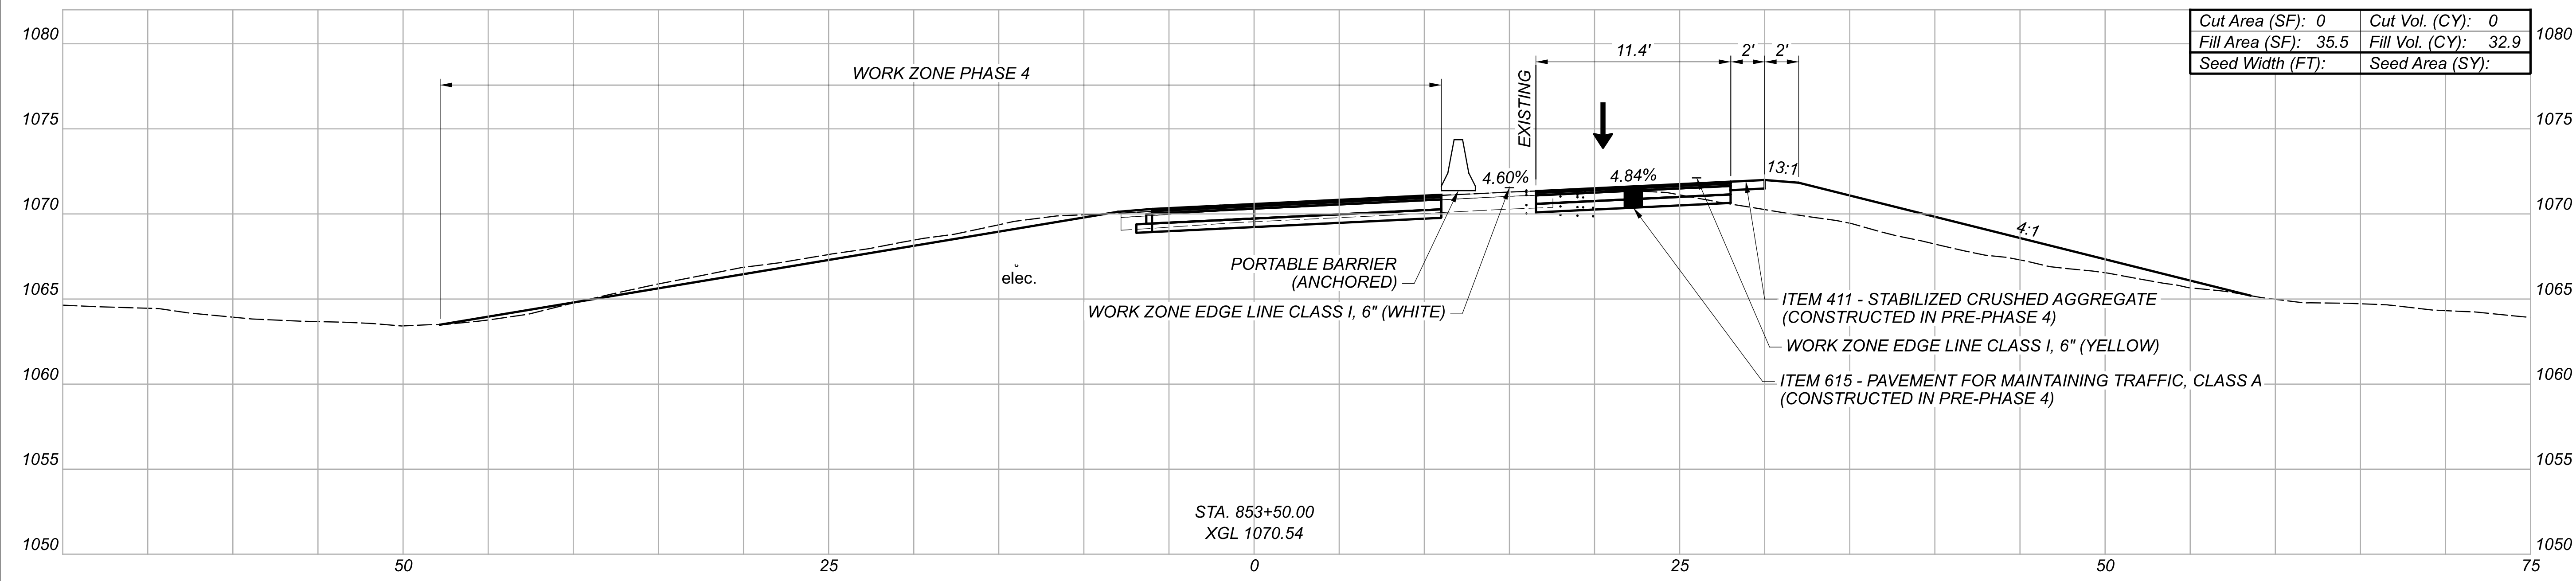

Cut Area (SF): 0	Cut Vol. (CY): 0
Fill Area (SF): 35.5	Fill Vol. (CY): 32.9
Seed Width (FT):	Seed Area (SY):

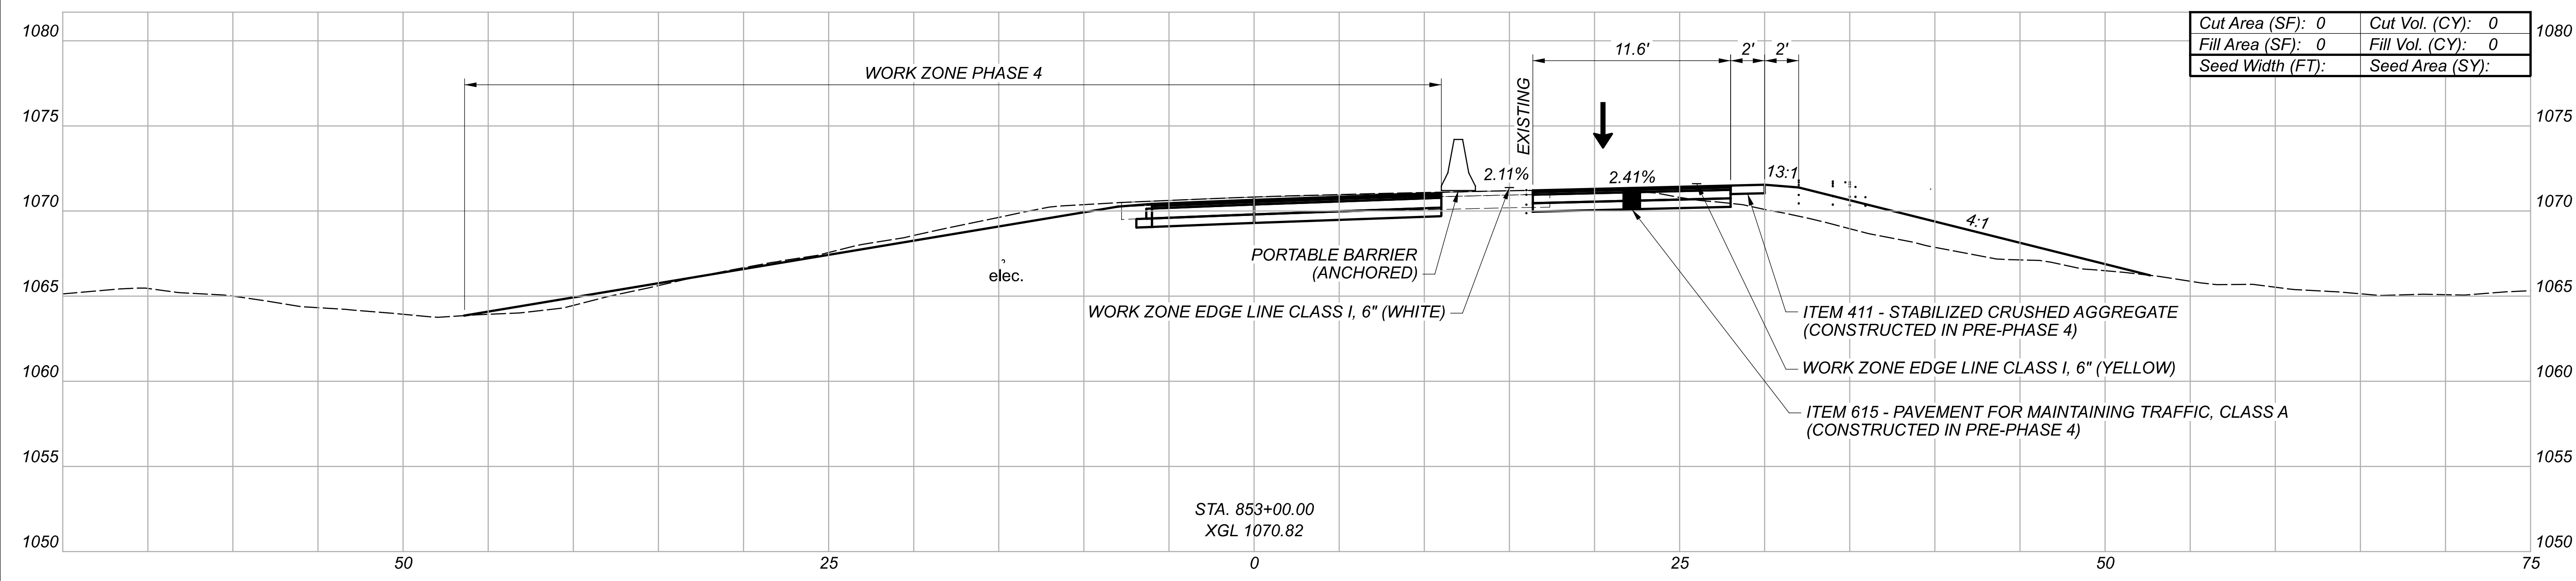

Cut Area (SF): 0	Cut Vol. (CY): 0
Fill Area (SF): 0	Fill Vol. (CY): 0
Seed Width (FT):	Seed Area (SY):

MAINTENANCE OF TRAFFIC CROSS SECTIONS  
 RAMP 3 - STA. 853+00 TO STA. 853+50

DESIGN AGENCY



DESIGNER

BEB

REVIEWER


AKF 6-8-23

PROJECT ID


113889

Sheet Totals			SHEET	TOTAL
Seeding	Cut	Fill		
0.0	0.0	32.9	142	481



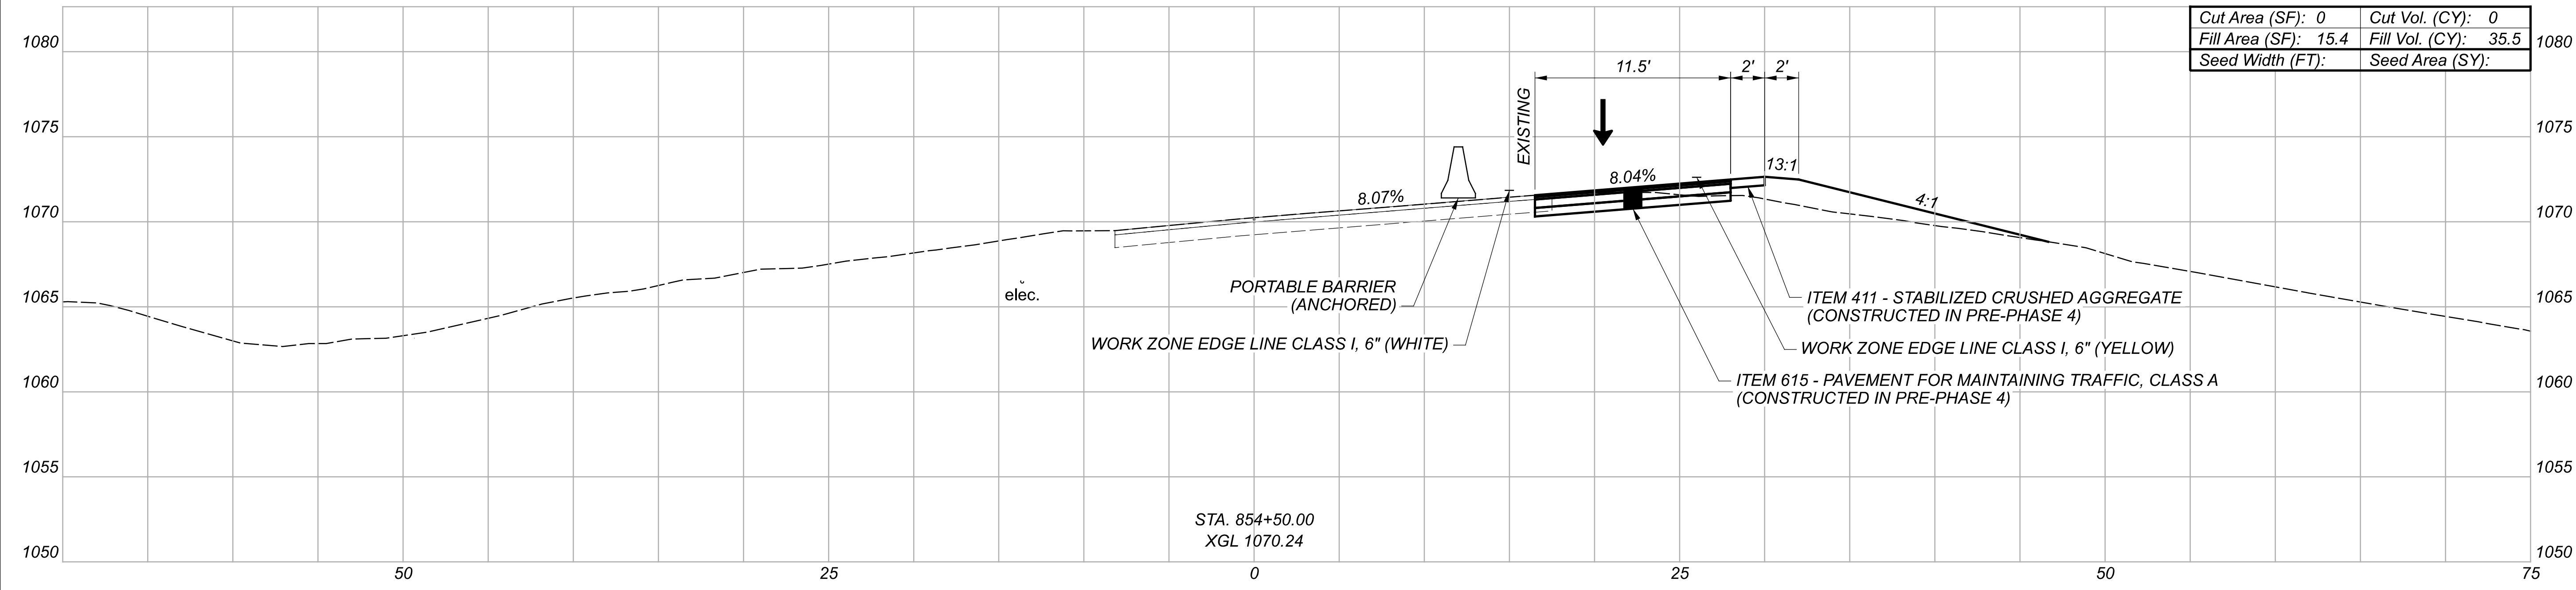

Cut Area (SF):	0	Cut Vol. (CY):	0
Fill Area (SF):	15.4	Fill Vol. (CY):	35.5
Seed Width (FT):		Seed Area (SY):	

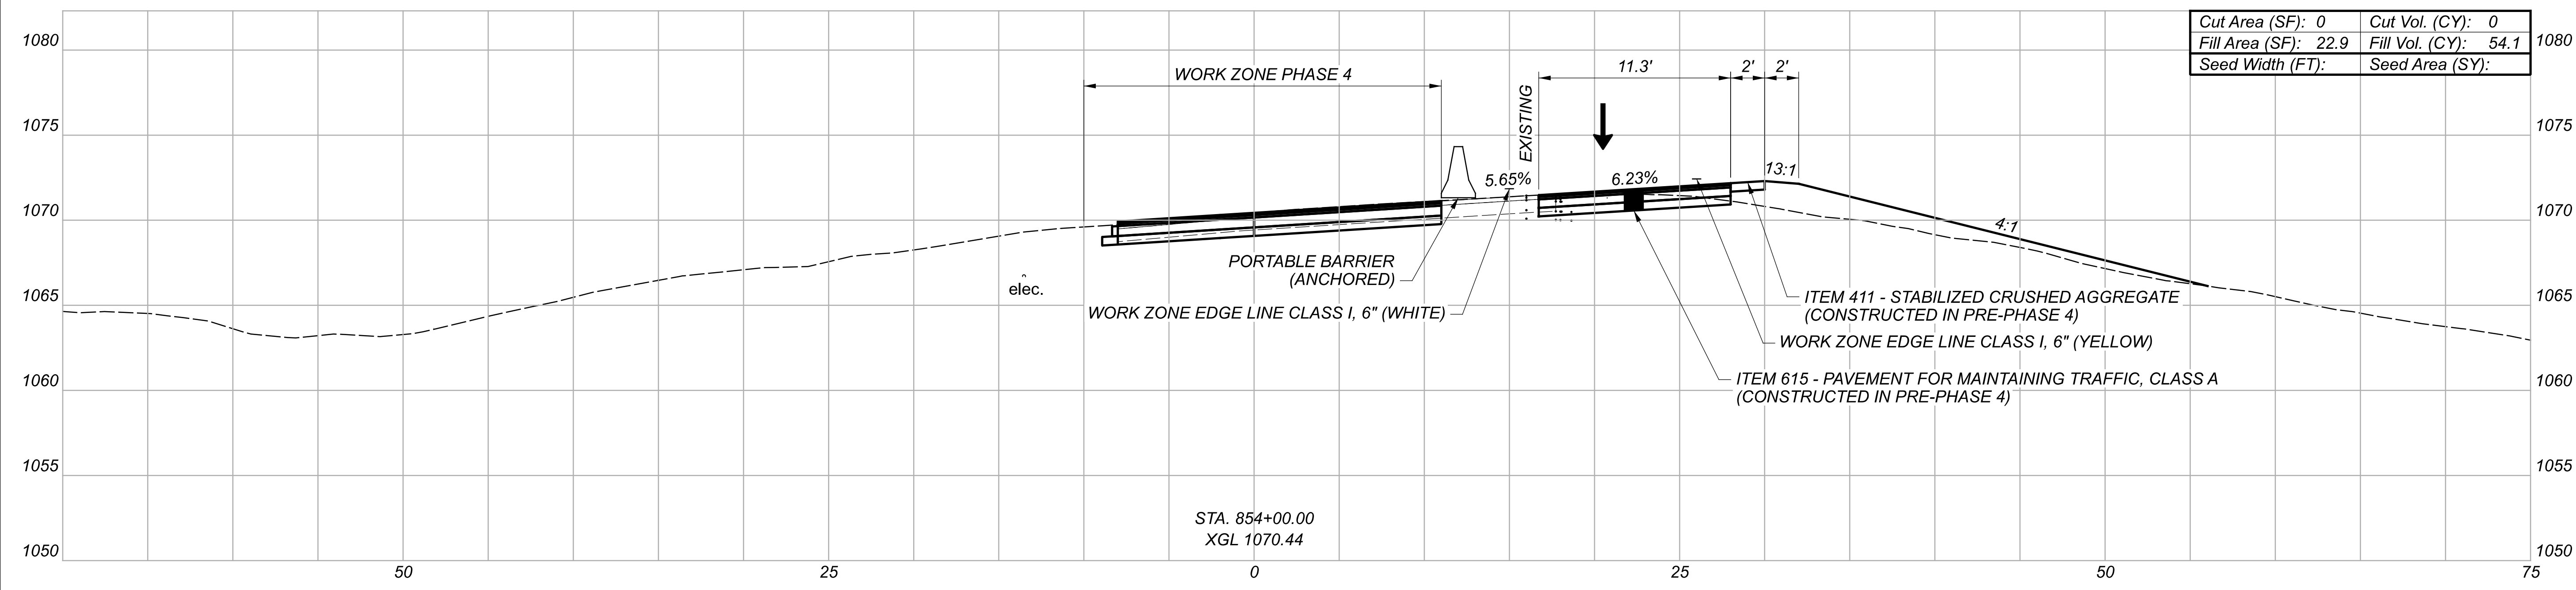

Cut Area (SF):	0	Cut Vol. (CY):	0
Fill Area (SF):	22.9	Fill Vol. (CY):	54.1
Seed Width (FT):		Seed Area (SY):	

MAINTENANCE OF TRAFFIC CROSS SECTIONS  
 RAMP 3 - STA. 854+00 TO STA. 854+50

DESIGN AGENCY



DESIGNER

BEB

REVIEWER


AKF 6-8-23

PROJECT ID


113889

Sheet Totals			SHEET	TOTAL
Seeding	Cut	Fill		
0.0	0.0	89.6	143	481



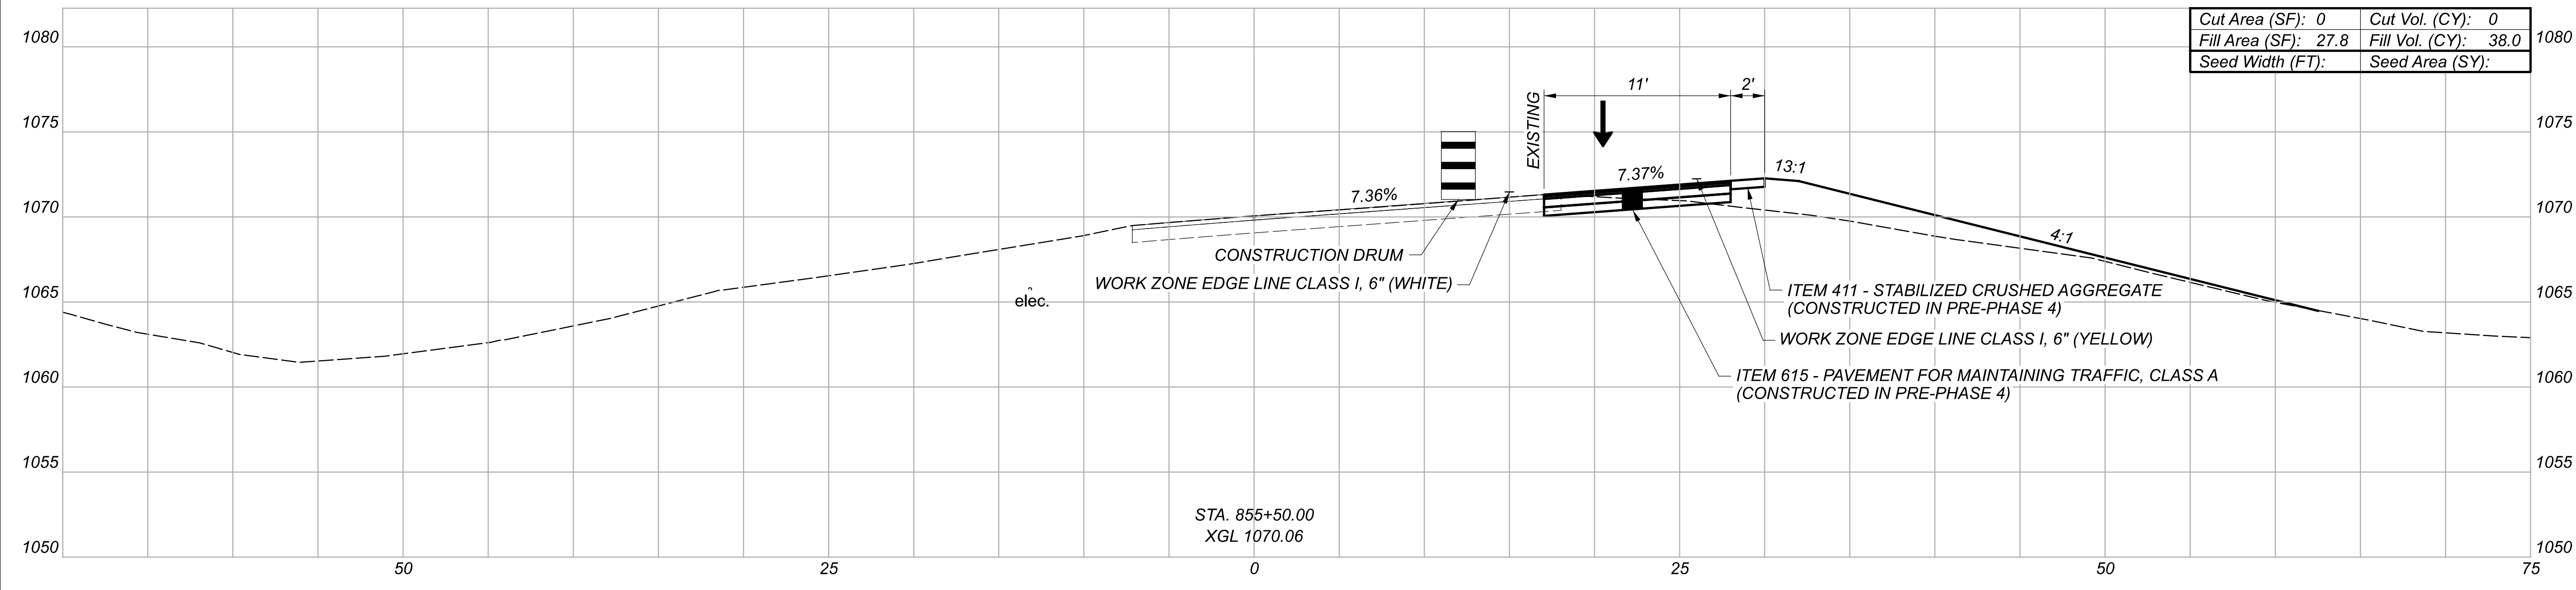

Cut Area (SF): 0	Cut Vol. (CY): 0
Fill Area (SF): 27.8	Fill Vol. (CY): 38.0
Seed Width (FT):	Seed Area (SY):

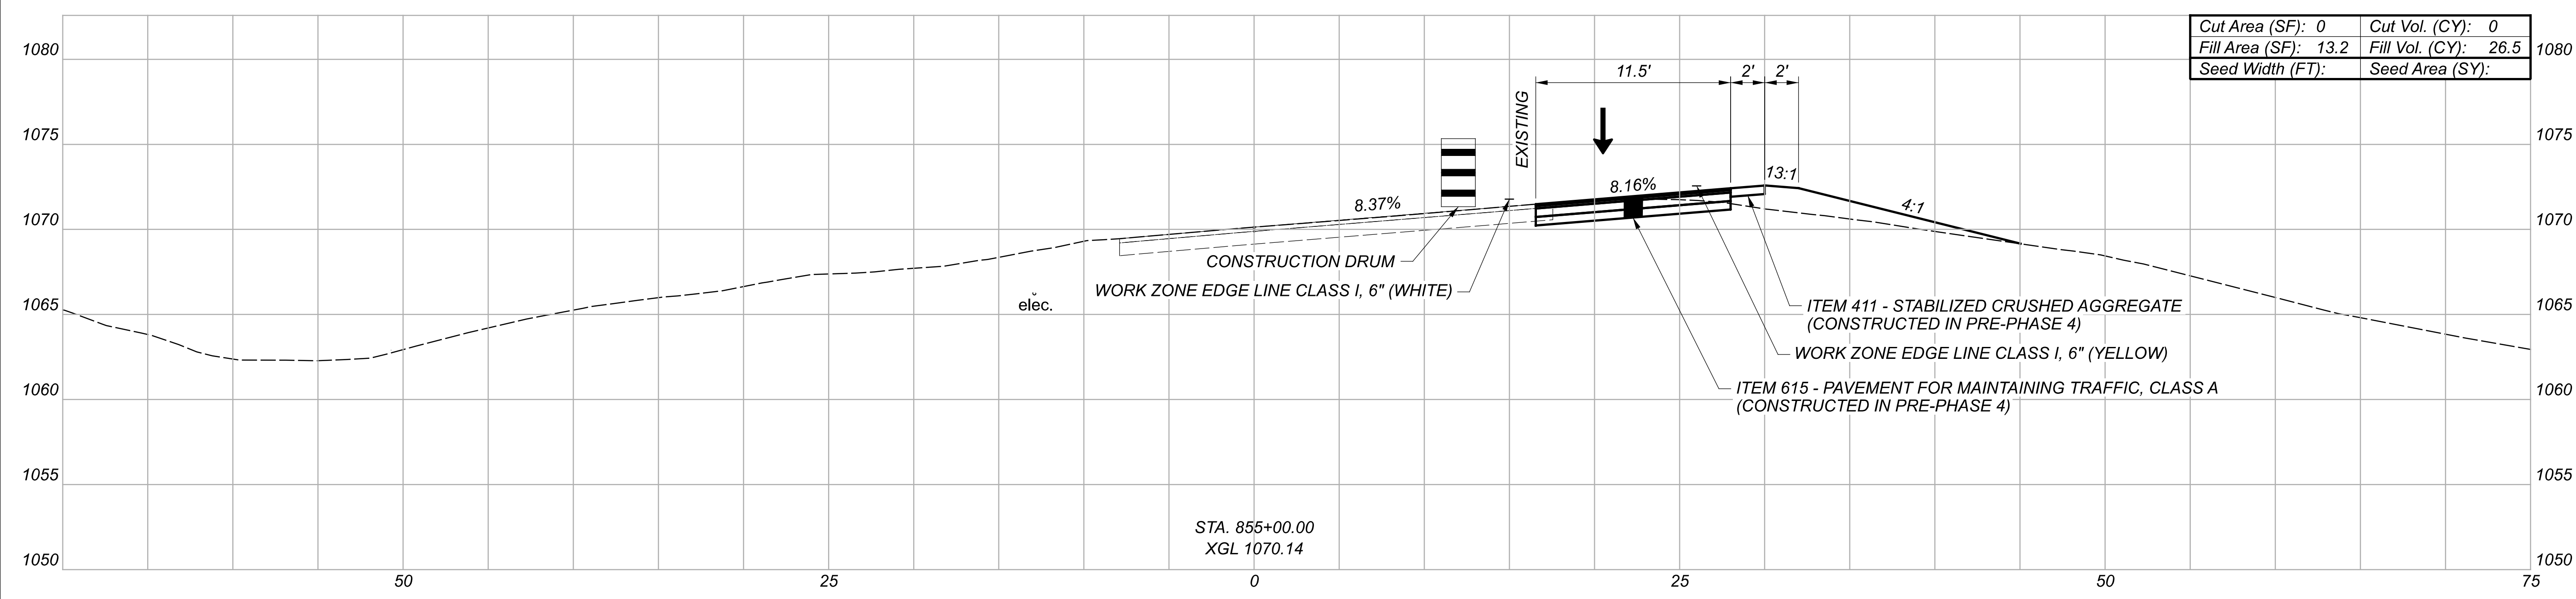

Cut Area (SF): 0	Cut Vol. (CY): 0
Fill Area (SF): 13.2	Fill Vol. (CY): 26.5
Seed Width (FT):	Seed Area (SY):

MAINTENANCE OF TRAFFIC CROSS SECTIONS  
 RAMP 3 - 855+00 TO STA. 855+50

DESIGN AGENCY



DESIGNER

BEB

REVIEWER



AKF 6-8-23

PROJECT ID

113889

Sheet Totals		
Seeding	Cut	Fill
0.0	0.0	64.5

SHEET	TOTAL
144	481

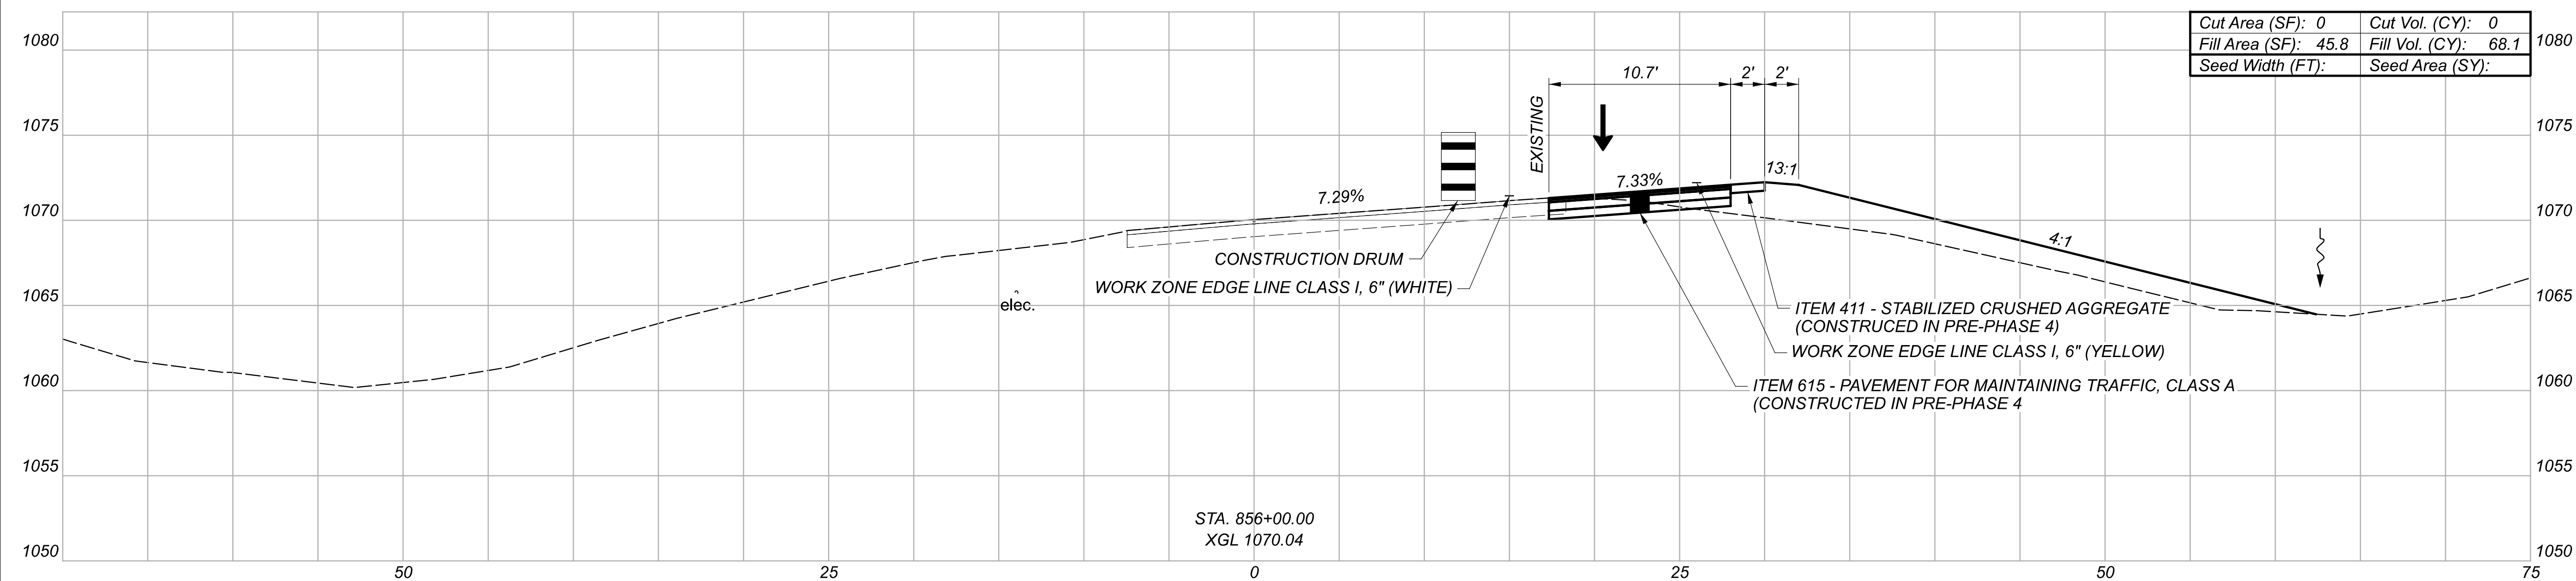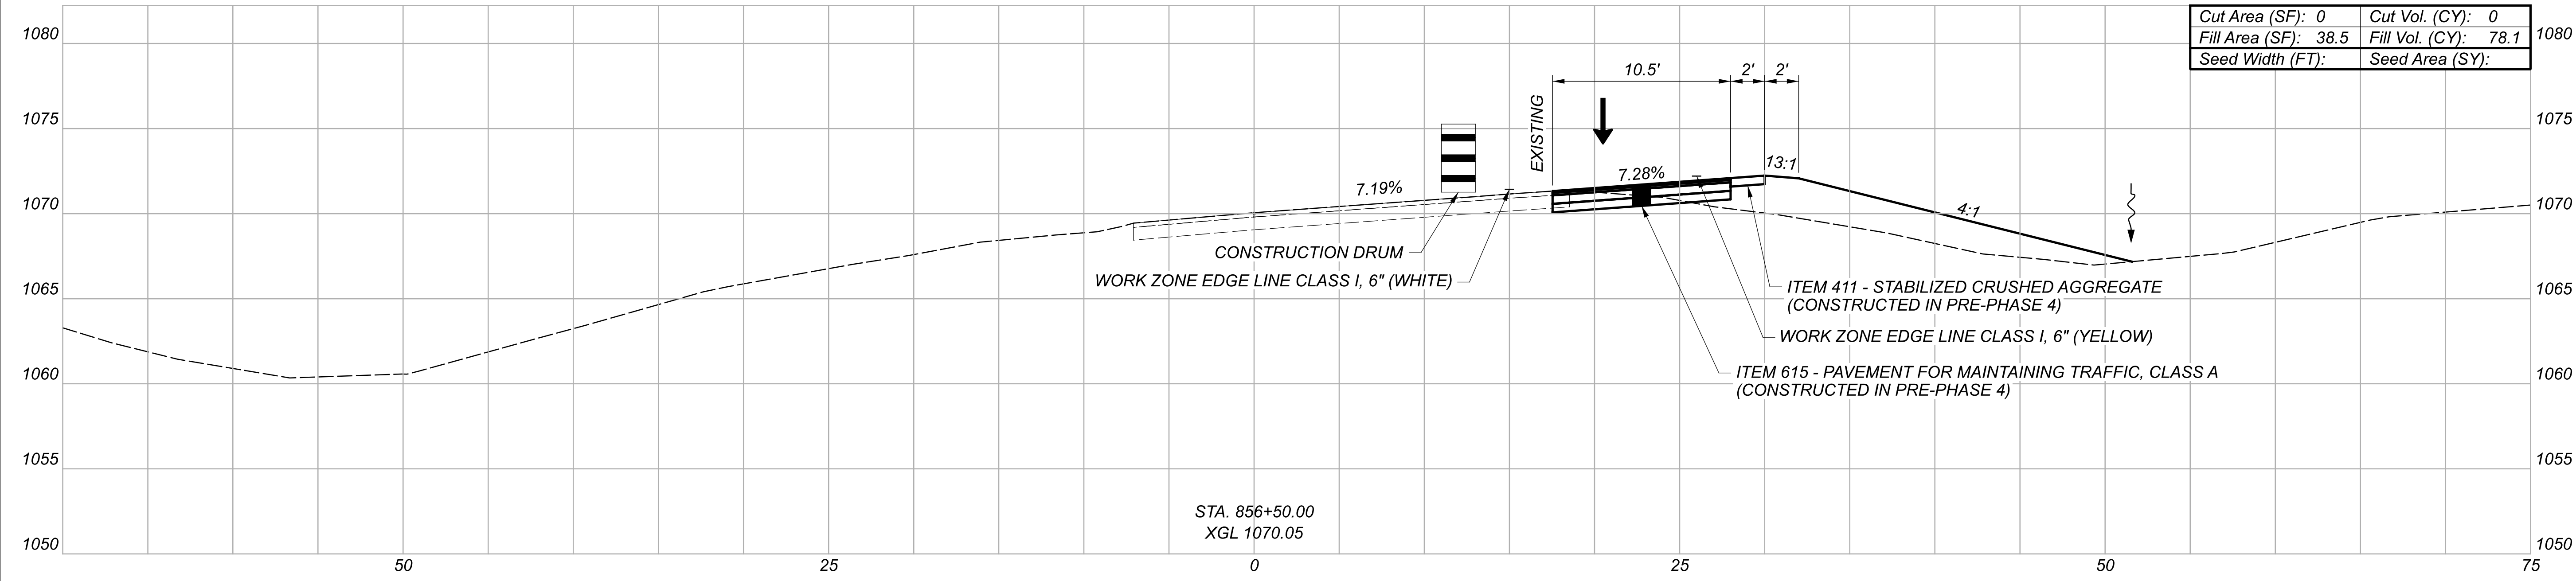

MAINTENANCE OF TRAFFIC CROSS SECTIONS  
 RAMP 3 - STA. 856+00 TO STA. 856+50

DESIGN AGENCY



DESIGNER

BEB



REVIEWER

AKF 6-8-23

PROJECT ID

113889

Sheet Totals			SHEET	TOTAL
Seeding	Cut	Fill		
0.0	0.0	146.2	145	481

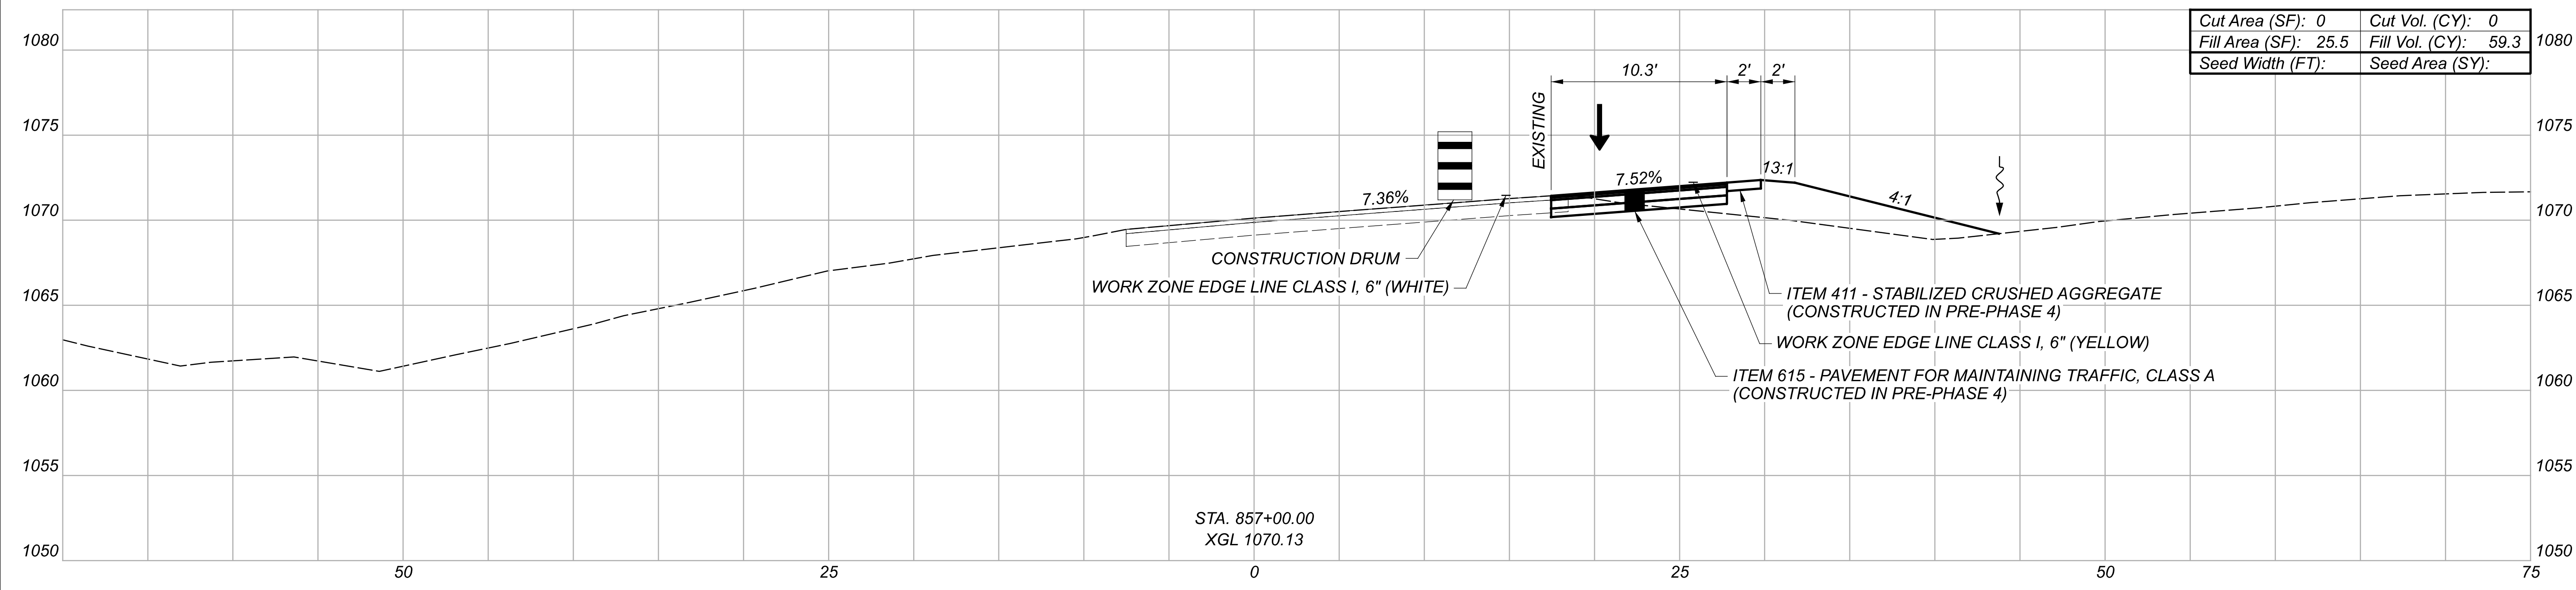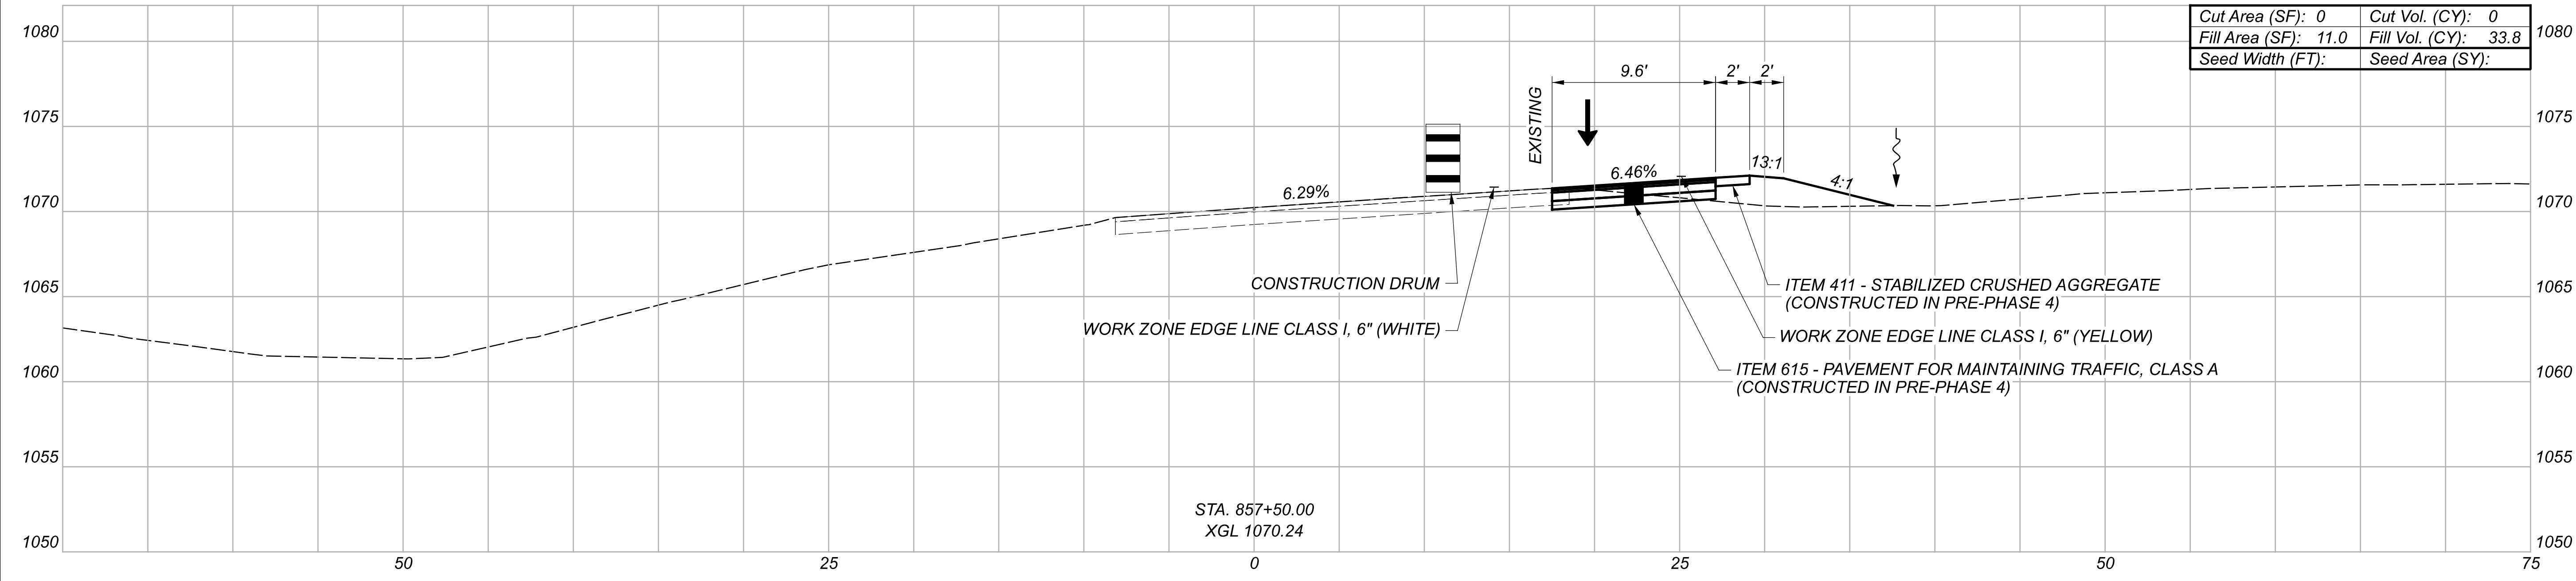

Sheet Totals		
Seeding	Cut	Fill
0.0	0.0	93.7

MAINTENANCE OF TRAFFIC CROSS SECTIONS  
 RAMP 3 - 857+00 TO STA. 857+50

DESIGN AGENCY



DESIGNER

BEB



REVIEWER

AKF 6-8-23

PROJECT ID

113889

SHEET	TOTAL
146	481

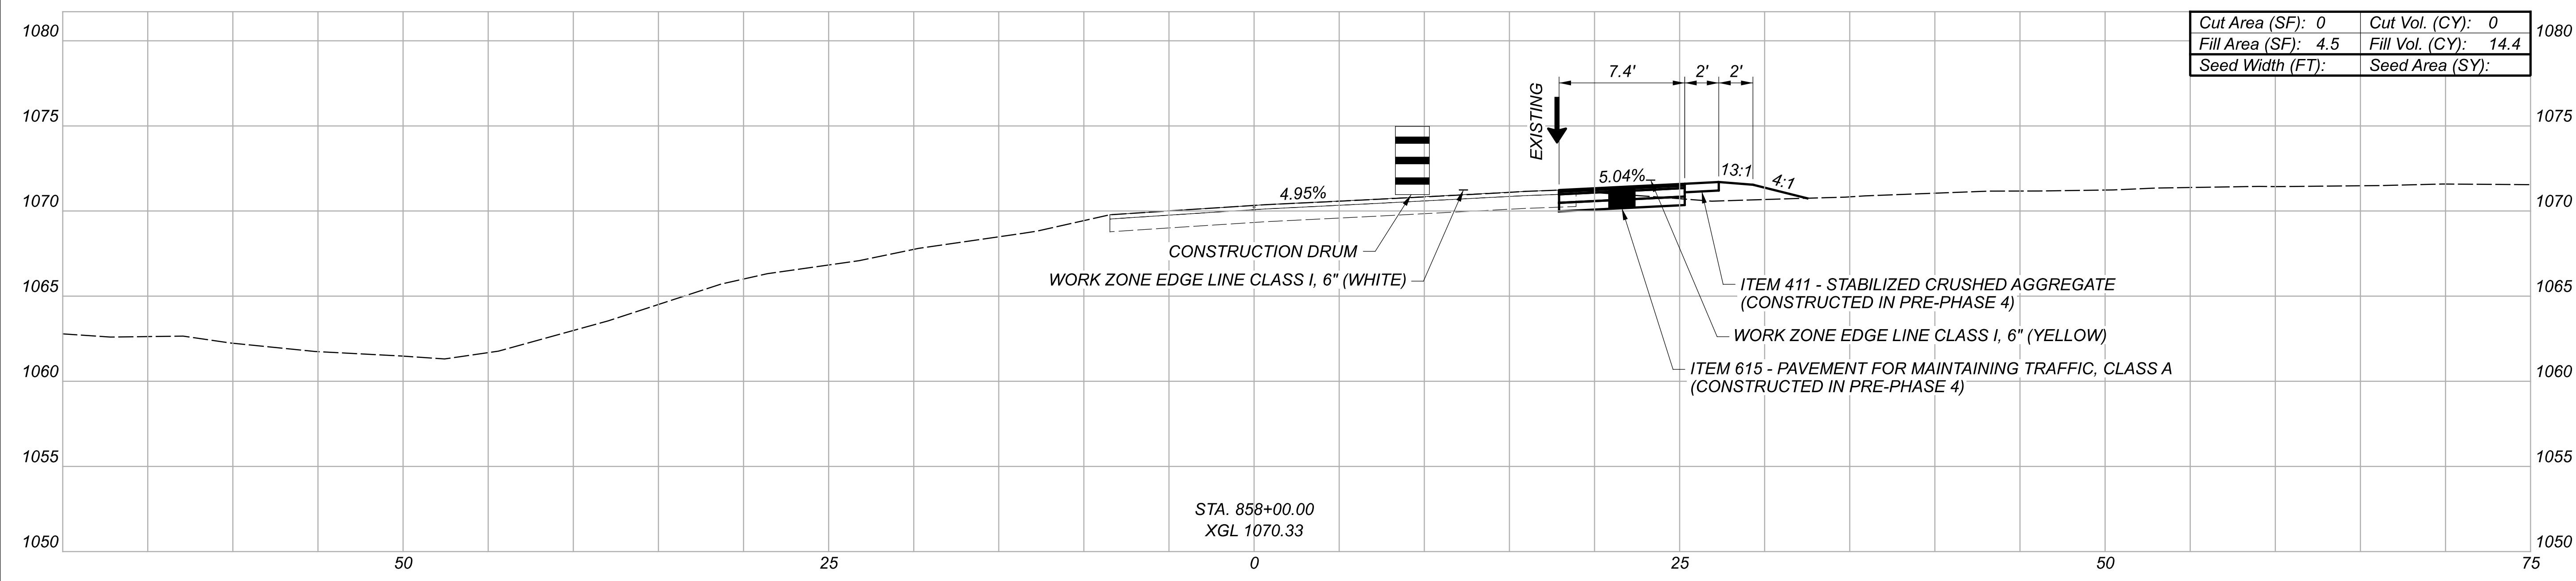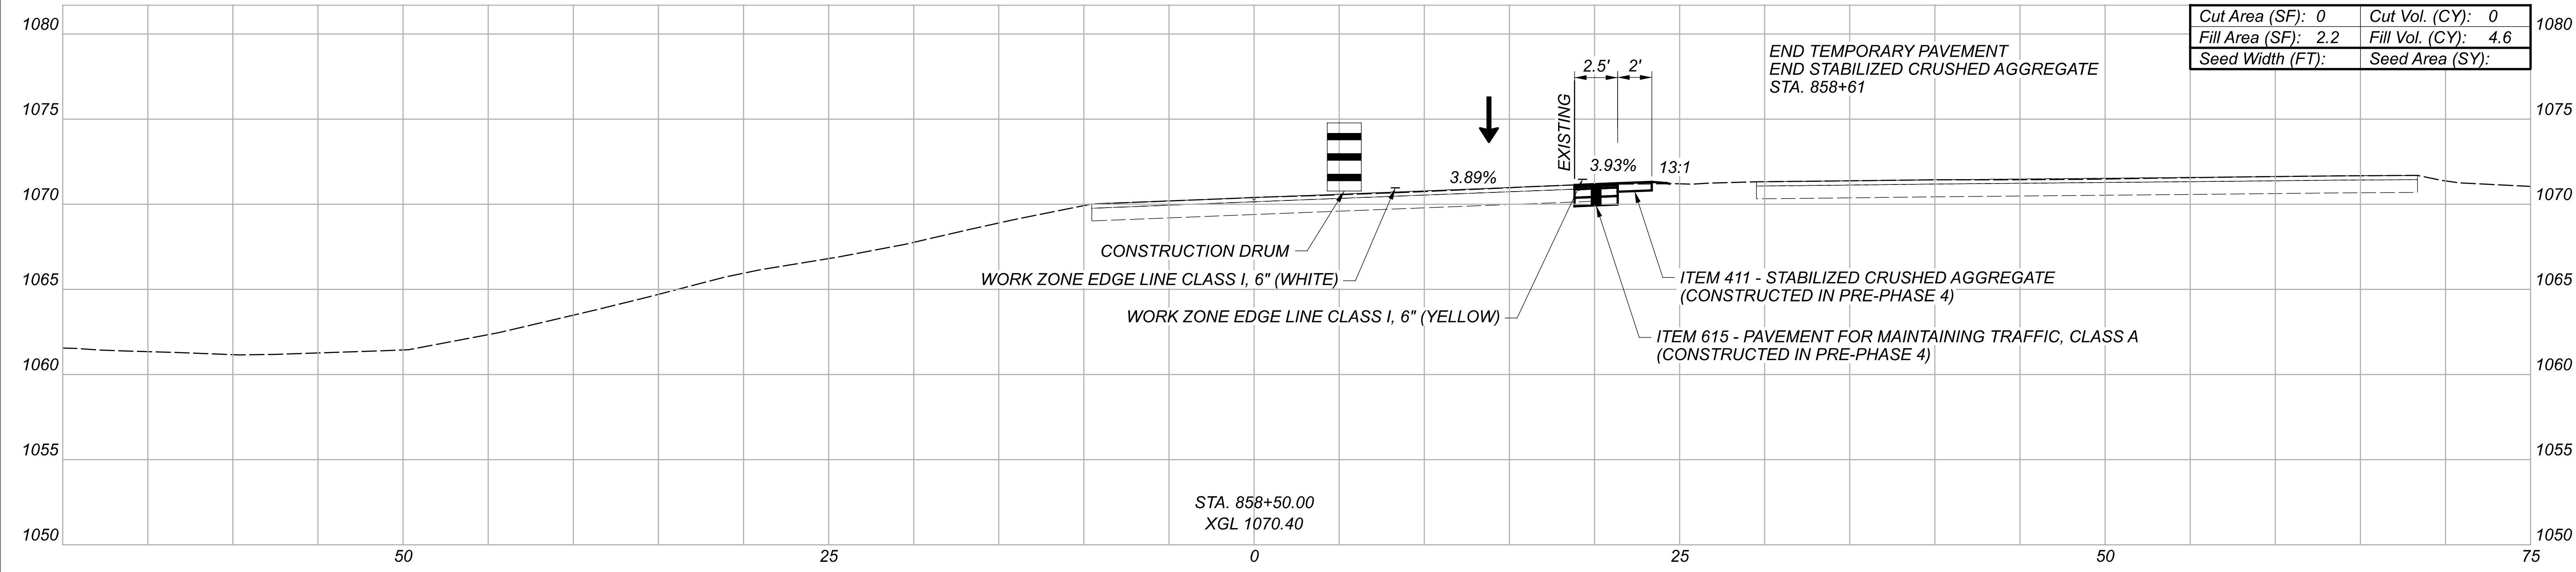

MAINTENANCE OF TRAFFIC CROSS SECTIONS  
 RAMP 3 - STA. 858+00 TO STA. 858+50

DESIGN AGENCY



DESIGNER

BEB

REVIEWER

AKF 6-8-23

PROJECT ID

113889

Sheet Totals			SHEET	TOTAL
Seeding	Cut	Fill	147	481
0.0	0.0	19.0		