

GENERAL (CONTINUED)

BENCHING OF FOUNDATION SLOPES

ALTHOUGH CROSS-SECTIONS INDICATE SPECIFIC DIMENSIONS FOR PROPOSED BENCHING OF THE EMBANKMENT FOUNDATIONS IN CERTAIN AREAS, NO WAIVER OF THE SPECIFICATIONS IS INTENDED. BENCH ALL OTHER SLOPED EMBANKMENT AREAS AS SET FORTH IN SECTION 203.05 OF THE CONSTRUCTION AND MATERIAL SPECIFICATIONS (C&MS). NO ADDITIONAL PAYMENT WILL BE MADE FOR BENCHING REQUIRED UNDER THE PROVISIONS OF SECTION 203.05.

ITEM 204 - PROOF ROLLING

THE FOLLOWING QUANTITY IS PROVIDED IN THE GENERAL SUMMARY TO ADDRESS LOCATIONS REQUIRING PROOF ROLLING.

ITEM 204 - PROOF ROLLING 71 HOUR

ROADWAY

ITEM 203 - EMBANKMENT, AS PER PLAN AND
ITEM 203 - EXCAVATION, AS PER PLAN

ALL PROVISIONS OF 203 APPLY EXCEPT THE METHOD OF MEASUREMENT SHALL NOT USE THE AVERAGE END AREA METHOD. THE DEPARTMENT WILL MEASURE THE TOTAL CUBIC YARDS OF EXCAVATION AND EMBANKMENT BASED ON A COMPARISON BETWEEN THE EXISTING AND FINAL SURFACE DIGITAL TERRAIN MODELS, EXCLUDING ANY AREAS THAT ARE ITEMIZED AND PAID SEPARATELY. ESTIMATED QUANTITIES ARE PROVIDED IN THE EARTHWORK SUBSUMMARY.

CEMENT STABILIZATION

THIS PROJECT REQUIRES SUBGRADE IMPROVEMENTS USING CEMENT STABILIZATION PRIOR TO PAVEMENT CONSTRUCTION. CEMENT STABILIZATION SHALL BE PERFORMED TO A DEPTH OF 12 INCHES EXCEPT AREAS FOUND TO CONTAIN UNSUITABLE SOILS SHALL BE STABILIZED TO A DEPTH OF 14 INCHES PER THE TABLE BELOW.

STATION RANGES OF UNSUITABLE SOILS			
ALIGNMENT	BEGIN STATION	END STATION	LENGTH (FT)
IR 90	742+00.00	746+00.00	400.00
RAMP 117-11	35+50.00	42+52.49	702.49
RAMP 117-12	33+63.90	43+76.68	1,012.78

CHEMICALLY STABILIZE SUBGRADES TO 18 INCHES BEYOND THE EDGE OF THE SURFACE OF PAVEMENT, PAVED SHOULDERS, PAVED MEDIANS AND 18 INCHES BEHIND THE FACE OF NEW CURBS. WHERE CEMENT STABILIZATION IS PERFORMED, ITEM 204 - SUBGRADE COMPACTION SHALL NOT BE PERFORMED.

THE CONTRACTOR SHALL PERFORM THE MIXTURE DESIGN FOR CHEMICALLY STABILIZED SOILS ACCORDING TO 206 OF THE C&MS AND SUPPLEMENT 1120. PAYMENT FOR THE MIX DESIGN SHALL BE PER:

ITEM 206 - MIXTURE DESIGN FOR CHEMICALLY STABILIZED SOILS, LUMP

IN ACCORDANCE WITH SECTIONS 107.10 AND 107.16 OF THE C&MS, THE CONTRACTOR SHALL EXERCISE CAUTION WHEN PERFORMING CEMENT STABILIZATION IN THE VICINITY OF ALL EXISTING AND PROPOSED UTILITY CROSSINGS. THE UTILITY DEPTHS ARE NEAR THE MINIMUM COVER REQUIREMENTS. THE CONTRACTOR SHALL AVOID USING POWER DRIVEN ROTARY MIXERS DIRECTLY ON TOP OF THE UTILITY CROSSINGS.

SUBGRADE EXCAVATION

IN AREAS WHERE SHALLOW ROCK IS ENCOUNTERED IN THE PROPOSED SUBGRADE WITHIN 12 INCHES BELOW THE BOTTOM OF THE PROPOSED PAVEMENT BUILDUP, CEMENT STABILIZATION SHALL NOT BE PERFORMED. THE CONTRACTOR SHALL EXCAVATE TO A DEPTH 6 INCHES BELOW THE FINAL SUBGRADE ELEVATION. THE WIDTH OF THE UPPER 6 INCHES OF AGGREGATE BASE SHALL EXTEND 18 INCHES BEYOND PAVED SHOULDERS. THE ADDITIONAL 6 INCHES BELOW THE BOTTOM OF THE 6 INCH AGGREGATE BASE SHALL BE REPLACED WITH ITEM 304 AGGREGATE BASE AND SHALL EXTEND A MINIMUM OF 12 INCHES BEYOND PAVED SHOULDERS.

THE FOLLOWING LOCATIONS REPRESENT AREAS WHERE SHALLOW ROCK EXISTS BASED ON THE SUBSURFACE INVESTIGATION.

204 - EXCAVATION OF SUBGRADE, AS PER PLAN - SHALLOW ROCK				
ALIGNMENT	BEGIN STA	END STA	LENGTH (FT)	VOLUME (CU YD)
IR 90	563+00.00	659+00.00	9,801.82*	25,969
IR 90	674+00.00	682+00.00	800.00	2,075
IR 90	726+00.00	738+00.00	1,200.00	3,728
RAMP W1	36+39.23	42+13.75	574.52	341
RAMP W2	29+40.99	37+80.90	839.91	438
RAMP 117-5	27+06.36	31+00.00	393.64	197
RAMP 117-8	24+03.19	33+64.10	960.91	569
RAMP 117-9	30+57.77	39+69.36	911.59	431

*STATION EQUATION: STA. 617+61.82 BK R1 = STA. 615+60.00 AH R2

ADDITIONAL LOCATIONS WHERE EXCAVATION AND REPLACEMENT IS REQUIRED AS DESCRIBED ABOVE ARE AS FOLLOWS:

- WB MEDIAN SHOULDER FROM STA 539+50 TO STA 546+10 FOR THE AREA WITHIN THE MAINTENANCE OF TRAFFIC Crossover.
- FULL WIDTH OF THE EASTBOUND AND WESTBOUND PAVEMENT AND SHOULDERS FROM STA 696+30 TO STA 708+00.

204 - EXCAVATION OF SUBGRADE, AS PER PLAN - ADDITIONAL AREAS				
ALIGNMENT	BEGIN STA	END STA	LENGTH (FT)	VOLUME (CU YD)
IR 90	539+50.00	546+10.00	660.00	417
IR 90	696+30.00	708+00.00	1,170.00	3,001

A VOLUME OF ITEM 204 EXCAVATION OF SUBGRADE, AS PER PLAN HAS BEEN INCLUDED IN THE GENERAL SUMMARY FOR THE WORK DESCRIBED ABOVE.

ITEM 304 AGGREGATE BASE IS NOT INCLUDED IN THE COST OF ITEM 204 ABOVE AND WILL BE PAID FOR SEPARATELY AS ITEMIZED IN THE GENERAL SUMMARY.

ITEM 622 - CONCRETE BARRIER END SECTION, TYPE D, AS PER PLAN

CONSTRUCT REFERENCE CB-106 PER STANDARD CONSTRUCTION DRAWING RM-4.5M DATED 6/30/95. IT IS NOT NECESSARY TO TRANSITION THE BACK SIDE OF THE BARRIER TO MATCH THE EXISTING TYPE B NEW JERSEY SHAPE.

TEST HOLES

WHERE PLANS PROVIDE FOR PROPOSED SUBGRADE STABILIZATION, UNDERCUTTING, UNDERDRAIN, LIGHTING CONDUIT OR ITS CONDUIT TO CROSS OVER OR UNDER AN EXISTING UNDERGROUND UTILITY AND THE UTILITY DEPTH IS NOT SHOWN ON THE PLAN, THE CONTRACTOR WILL BE REQUIRED TO PERFORM TEST HOLES TO DETERMINE THE DEPTH OF THE UTILITY AT THE DIRECTION OF THE ENGINEER.

THE CONTRACTOR SHALL HAVE THE UTILITY MARKED USING OHIO 811 AND/OR BY USE OF RADIO FREQUENCY LOCATORS OR OTHER APPROVED METHOD. ONCE LOCATED, THE CONTRACTOR SHALL CAREFULLY HAND AND/OR VACUUM EXCAVATE TO DETERMINE THE DEPTH OF THE EXISTING UTILITY AND PROVIDE THE SURVEYED COORDINATE AND ELEVATION INFORMATION TO THE ENGINEER.

TEST HOLES (CONTINUED)

IF IT IS DETERMINED THAT THE PROPOSED SUBGRADE STABILIZATION, LIGHTING CONDUIT OR ITS CONDUIT WILL BE IN CONFLICT WITH AN EXISTING UNDERGROUND UTILITY IF CONSTRUCTED AS SHOWN ON THE PLAN, NOTIFY THE ENGINEER BEFORE STARTING CONSTRUCTION OF ANY PORTION OF THE PROPOSED WORK WHICH WOULD BE AFFECTED BY THE INTERFERENCE WITH AN EXISTING FACILITY.

THE FOLLOWING QUANTITY IS INCLUDED FOR USE AS DIRECTED BY THE ENGINEER FOR THE UTILITY LOCATION BY USE OF TEST HOLES AS DESCRIBED ABOVE:

ITEM 203 - ROADWAY, MISC.: TEST HOLE 24 EACH

CONNECTION BETWEEN EXISTING AND PROPOSED GUARDRAIL

WHEN IT IS NECESSARY TO SPLICE PROPOSED GUARDRAIL TO EXISTING GUARDRAIL, ONLY THE EXISTING GUARDRAIL SHALL BE CUT, DRILLED, OR PUNCHED. THE CONNECTION SHALL BE MADE USING A W-BEAM, BEAM SPLICE AS SHOWN IN AASHTO M 180-12, EXCEPT THE BEAM WASHERS ARE NOT TO BE USED. PAYMENT SHALL BE INCLUDED IN THE CONTRACT PRICE FOR THE RESPECTIVE GUARDRAIL ITEMS.

ITEM 606 - GUARDRAIL, TYPE MGS, AS PER PLAN
GUARDRAIL, TYPE MGS HALF POST SPACING, AS PER PLAN
GUARDRAIL, TYPE MGS QUARTER POST SPACING, AS PER PLAN

THE POSTS FOR THESE ITEMS SHALL BE STEEL PER 710.15. ALL OTHER PROVISIONS OF 606 SHALL APPLY.

ITEM 606 - ANCHOR ASSEMBLY, MGS TYPE E

THIS ITEM SHALL CONSIST OF FURNISHING AND INSTALLING ONE OF THE MASH 2016 GUARDRAIL END TERMINALS FOR TYPE MGS GUARDRAIL AS LISTED ON ROADWAY ENGINEERING'S WEB PAGE UNDER ROADSIDE SAFETY DEVICES FOR APPROVED GUARDRAIL END TREATMENTS. INSTALLATION SHALL BE AT THE LOCATIONS SPECIFIED IN THE PLANS, IN ACCORDANCE WITH THE MANUFACTURER'S SPECIFICATIONS.

THE FACE OF THE TYPE E IMPACT HEAD SHALL BE COVERED WITH A SHEET OF TYPE G REFLECTIVE SHEETING, PER C&MS 730.19.

REFER TO THE MANUFACTURER'S INSTRUCTIONS REGARDING THE INSTALLATION OF, AND THE GRADING AROUND THE FOUNDATION TUBES AND GROUND STRUT. THE TOP OF ANY FOUNDATION TUBE SHOULD BE LESS THAN 4 INCHES ABOVE THE GROUND. THE PLACEMENT OF THE FOUNDATION TUBES SHOULD BE AN APPROPRIATE DEPTH BELOW THE LEVEL LINE IN ORDER TO MAINTAIN THE FINISHED GUARDRAIL HEIGHT OF 31 INCHES FROM THE EDGE OF THE SHOULDER.

ON-SITE GRADING IS REQUIRED IF THE TOP OF THE FOUNDATION TUBES OR TOP OF THE GROUND STRUT DOES PROJECT MORE THAN 4 INCHES ABOVE THE GROUND LINE.

PAYMENT FOR THE ABOVE WORK SHALL BE MADE AT THE UNIT PRICE BID FOR ITEM 606, ANCHOR ASSEMBLY, MGS TYPE E, EACH, AND SHALL INCLUDE ALL LABOR, TOOLS, EQUIPMENT AND MATERIALS NECESSARY TO CONSTRUCT A COMPLETE AND FUNCTIONAL ANCHOR ASSEMBLY SYSTEM, INCLUDING ALL RELATED TRANSITIONS, REFLECTIVE SHEETING, HARDWARE, GRADING, EMBANKMENT AND EXCAVATION NOT SEPARATELY SPECIFIED, AS REQUIRED BY THE MANUFACTURER.


ITEM 202 - PAVEMENT REMOVED, AS PER PLAN

THIS ITEM INCLUDES THE REMOVAL OF EXISTING PAVEMENT TO THE MAXIMUM DEPTHS AS INDICATED ON THE TYPICAL SECTIONS, INCLUDING THE EXCAVATION AND REMOVAL OF ANY EXISTING EARTH OR SUBGRADE MATERIAL FOUND AT THIS DEPTH IF THE EXISTING PAVEMENT IS THINNER THAN SHOWN IN THE EXISTING TYPICAL SECTIONS.

ITEM 609 - COMBINATION CURB AND GUTTER, TYPE 4, AS PER PLAN

THE FOLLOWING VARIABLE WIDTH GUTTER DETAIL BELOW IS PROVIDED FOR THE LONG-TERM TEMPORARY TRANSITION FROM THE PROPOSED 12 FOOT INSIDE SHOULDER TO THE EXISTING 10 FOOT SHOULDER AT THE FOLLOWING LOCATION:

-STA. 768+85.00 TO STA. 769+18.60 EASTBOUND

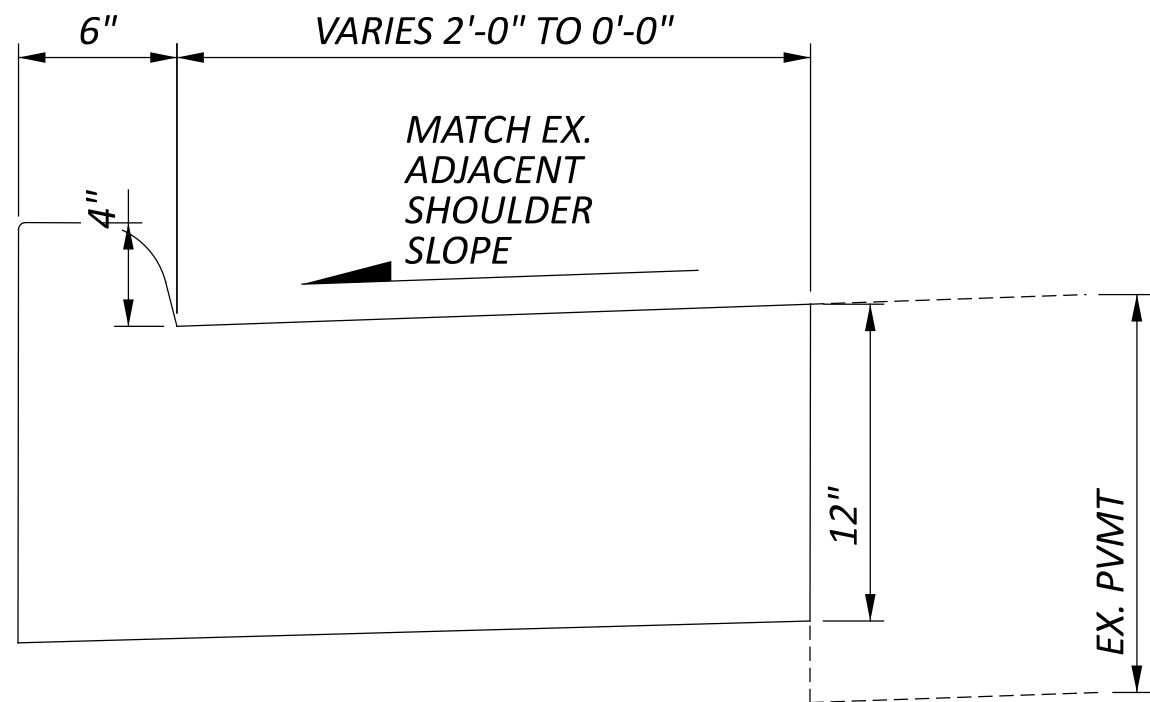

THE CURB HEIGHT SHALL BE A UNIFORM 4 INCHES.

PAYMENT FOR ALL MATERIALS, TOOLS, EQUIPMENT AND LABOR REQUIRED TO COMPLETE THE WORK DESCRIBED ABOVE SHALL BE MADE AT THE UNIT PRICE BID PER FOOT FOR:

ITEM 609 - COMBINATION CURB AND GUTTER, TYPE 4, AS PER PLAN

ITEM 622 - BARRIER, MISC.: PORTABLE BARRIER REMOVED AND RESET

THE CONTRACTOR SHALL REMOVE THE EXISTING PORTABLE CONCRETE BARRIER ON THE EAST SIDE OF W. 140TH ST. NORTH OF RAMP 140-3 TO ALLOW FOR THE RECONSTRUCTION OF THE CURB, CURB RAMP AND SIDEWALK. THE CONTRACTOR MAY STORE THE BARRIER EAST OF THE EXISTING SIDEWALK OR OTHER LOCATION APPROVED BY THE ENGINEER THAT DOES NOT ADVERSELY AFFECT THE SAFETY OF THE PUBLIC. AFTER WORK HAS BEEN COMPLETED IN THIS AREA INCLUDING NECESSARY CONCRETE CURING TIMES, THE CONTRACTOR SHALL RESET THE BARRIER IN ITS ORIGINAL LOCATION AND ORIENTATION.

ITEM 622 - CONCRETE BARRIER, END ANCHORAGE, REINFORCED, TYPE (B1, C1, D), AS PER PLAN

AT LOCATIONS WHERE THE ENTIRE 15 FOOT LENGTH OF END ANCHORAGES CANNOT BE ACHIEVED OR WHERE THERE IS INSUFFICIENT SPACE FOR TWO BACK-TO-BACK END ANCHORAGES REQUIRED PER THE STANDARD CONSTRUCTION DRAWINGS, THE FOLLOWING WILL BE REQUIRED. THE 6-INCH SPACING OF THE Y401 STEEL REINFORCING BARS SHALL BE MAINTAINED UNIFORMLY FOR THE ENTIRE LENGTH OF THE ANCHORAGE(S) EXCEPT AT EACH END WHERE THE FIRST AND LAST Y401 BAR SHALL BE 4 INCHES FROM THE END OF THE END ANCHORAGE OR EXPANSION JOINT.

THE UNIT PRICE BID FOR EACH AS PER PLAN END ANCHORAGE SHALL INCLUDE ALL LABOR, MATERIALS, TOOLS, EQUIPMENT AND INCIDENTALS NECESSARY TO COMPLETE THE WORK DESCRIBED ABOVE AND WILL BE PAID FOR PER EACH FOR THE APPLICABLE ITEM LISTED BELOW:

- ITEM 622 - CONCRETE BARRIER, END ANCHORAGE, REINFORCED, TYPE B1, AS PER PLAN
- ITEM 622 - CONCRETE BARRIER, END ANCHORAGE, REINFORCED, TYPE C1, AS PER PLAN
- ITEM 622 - CONCRETE BARRIER, END ANCHORAGE, REINFORCED, TYPE D, AS PER PLAN

MANHOLES WITHIN PAVEMENT AND PAVED SHOULDERS

WHERE THE PLANS INDICATE THAT A PROPOSED MANHOLE BE PLACED WITHIN THE PAVEMENT LIMITS EXCLUDING MANHOLES INDICATED FOR BOLTED LIDS, THE TOP OF CASTING ELEVATION SHALL BE SET AT THE TOP OF THE COMPACTED ITEM 304 - AGGREGATE BASE. THE LID SHALL BE SOLID WITHOUT HOLES. ONCE EACH MANHOLE IS SET IN PLACE AND PRIOR TO PAVING, THE CONTRACTOR SHALL SURVEY THE CENTER OF THE LID OF EACH BURIED MANHOLE AND FURNISH A LIST OF THE PROJECT GPS COORDINATES (EASTING, NORTHING) TO THE ENGINEER. PAYMENT SHALL INCLUDE ALL LABOR, MATERIALS, EQUIPMENT AND INCIDENTALS NECESSARY TO COMPLETE THE WORK DESCRIBED ABOVE AND WILL BE MADE AT THE UNIT PRICE BID FOR ITEM 611 - MANHOLE, NO. 3, AS PER PLAN.


THE FOLLOWING IS A LIST OF LOCATIONS WHERE BURIED MANHOLES ARE PROPOSED, STATION/OFFSETS SHOWN ARE TO THE CENTER OF THE MANHOLE:

STR. NO.	ALIGNMENT	STATION	OFFSET	SIDE	NORTHING	EASTING	ELEVATION
D64	IR 90	537+48.00	5'	RT			
D26	IR 90	542+75.00	6'	RT			
D31	IR 90	543+25.25	99.25'	LT			
D32	IR 90	543+75.00	94.5'	LT			
D47	RAMP HB	39+85.00	26'	RT			
D29	RAMP HB	42+73.50	2.75'	LT			
D118	IR 90	571+58.00	12'	RT			
D116	IR 90	573+57.00	12'	RT			
D132	IR 90	583+51.00	66'	LT			
D141	IR 90	585+25.00	18'	RT			
D145	IR 90	587+40.00	18'	RT			
D148	IR 90	590+00.00	18'	RT			
D151	IR 90	590+00.00	68'	RT			
D188	IR 90	611+75.00	18'	RT			
D196	IR 90	616+36.00	18'	RT			
D212	IR 90	618+13.00	18'	RT			
D218A	IR 90	620+00.00	16.5'	RT			
D219	IR 90	621+56.00	16'	RT			
D828	IR 90	745+05.00	87'	LT			
D847	RAMP 177-9	36+60.00	2'	RT			

ITEM 611 - INLET, NO. 3C, AS PER PLAN

THE CONTRACTOR SHALL CONSTRUCT THE PROPOSED INLET PER STANDARD CONSTRUCTION DRAWING I-3C, I-3C1 WITH THE EXCEPTION TO THE DIMENSIONS BELOW.

ALL LABOR, MATERIAL, EQUIPMENT, AND INCIDENTALS REQUIRED TO CONSTRUCT THE PROPOSED INLET SHALL BE INCLUDED IN THE UNIT PRICE BID FOR ITEM 611 - INLET, NO. 3C, AS PER PLAN.

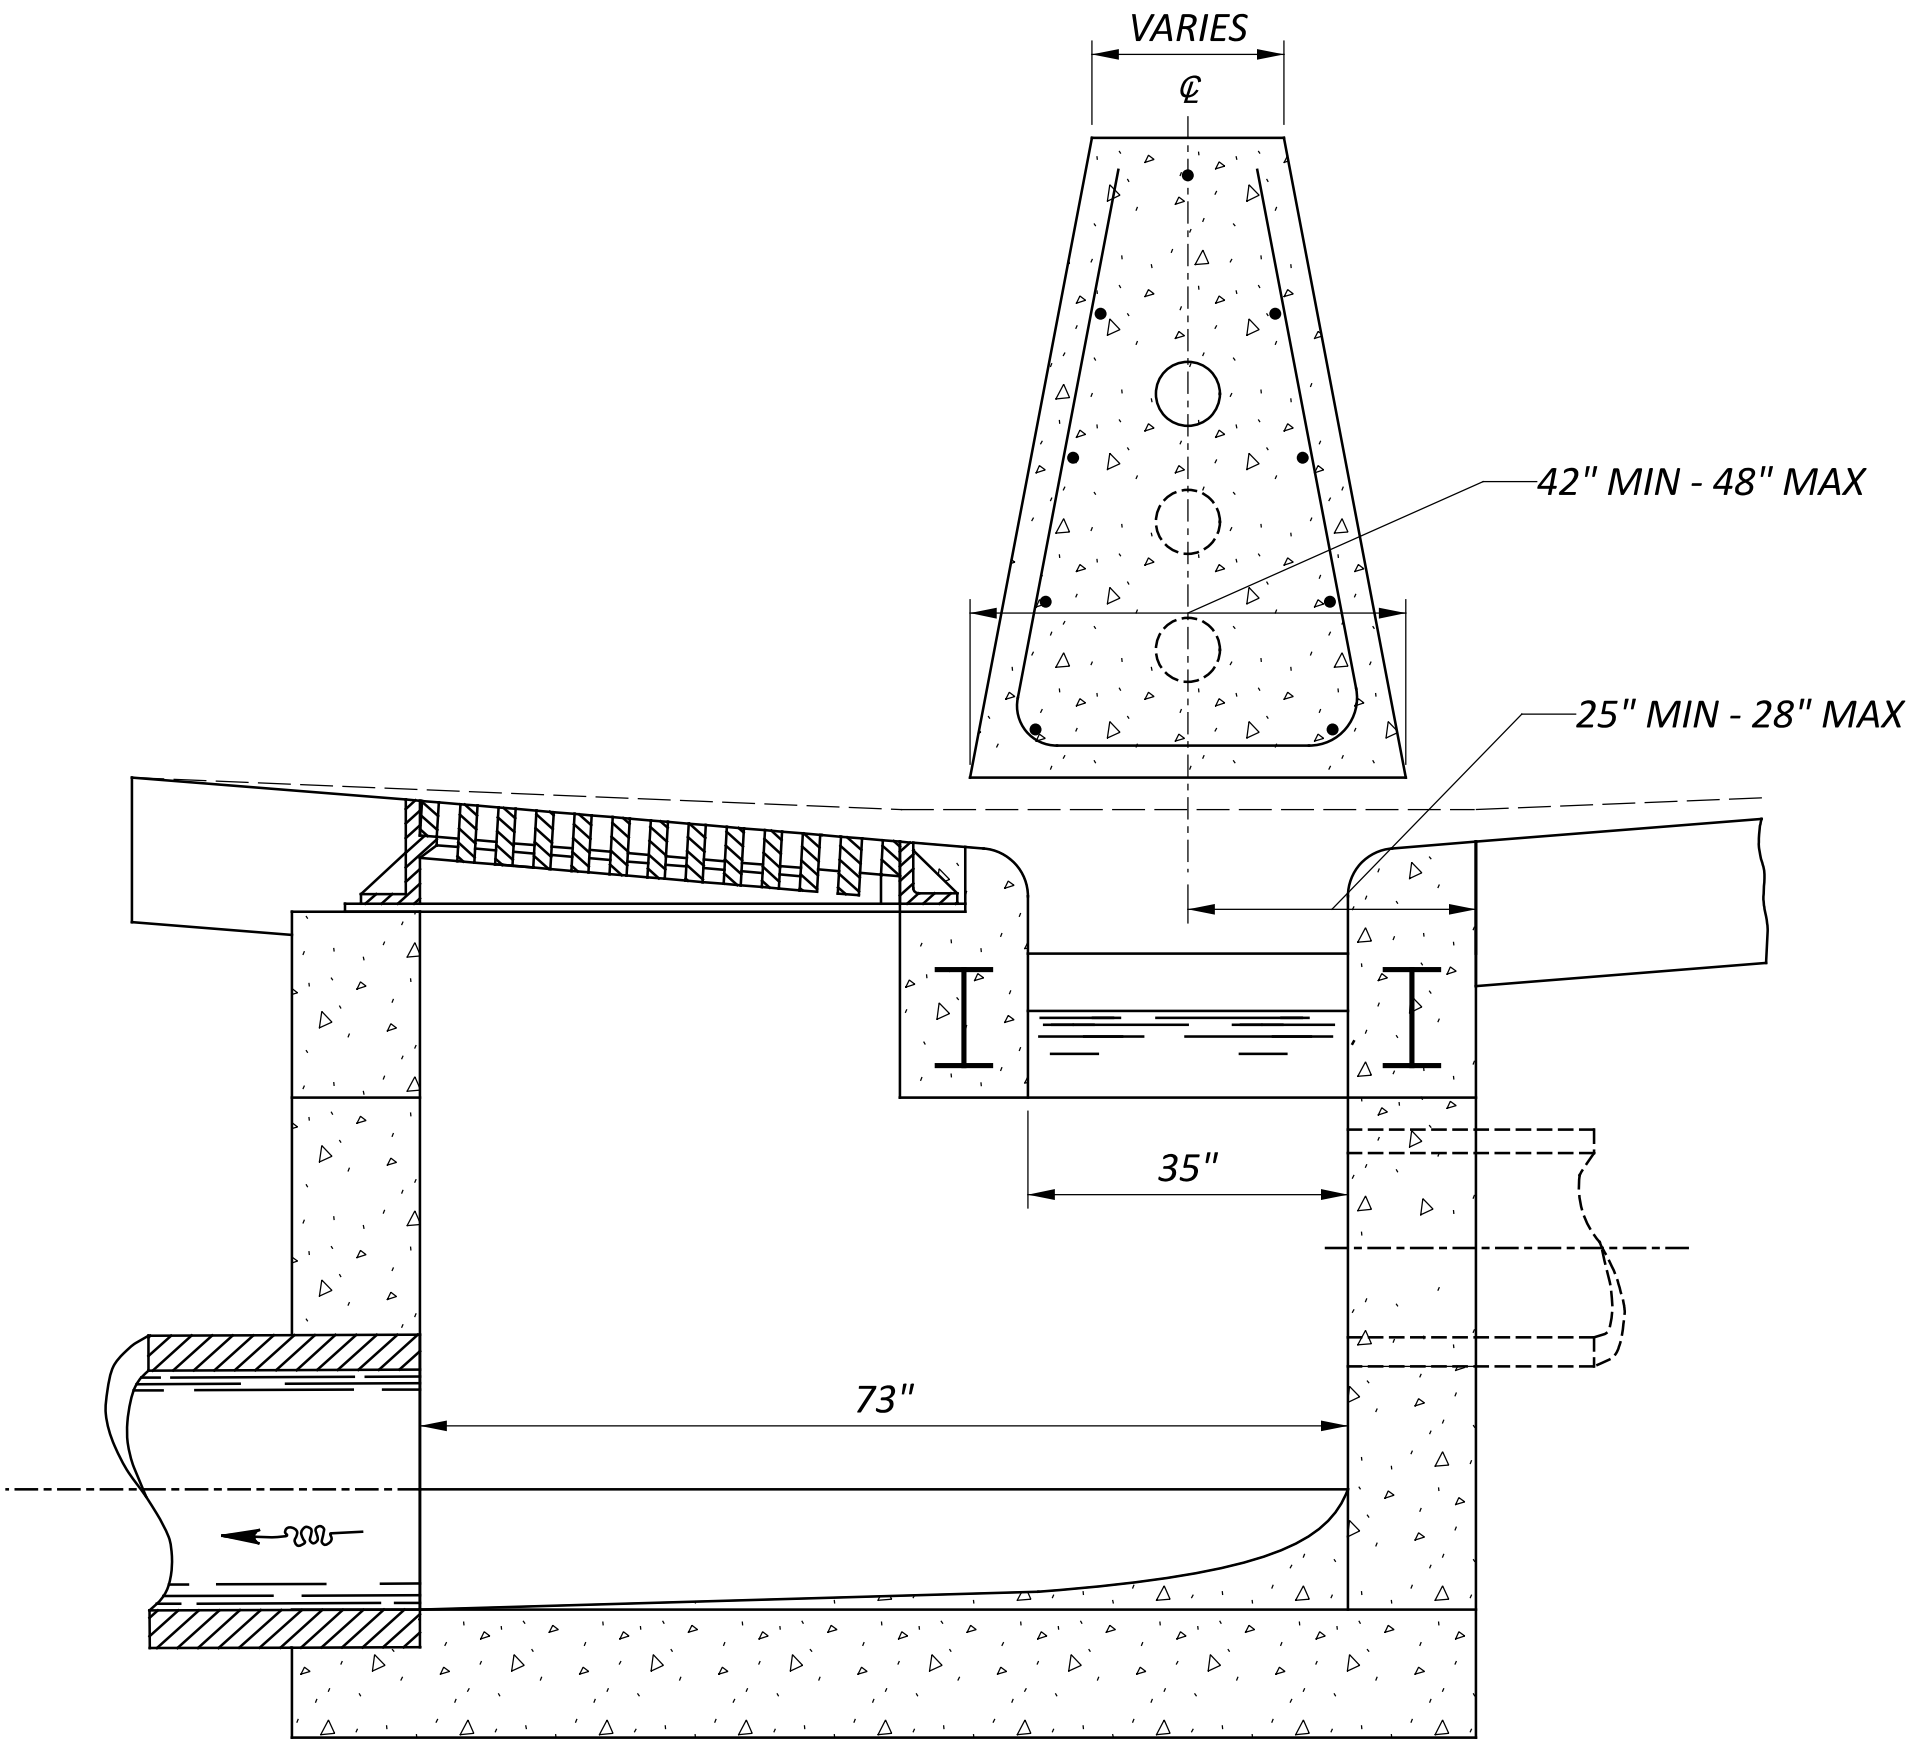

GENERAL NOTES

DESIGN AGENCY

AMERICAN
STRUCTUREPOINT
INC.

DESIGNER

BER

REVIEWER

VDK 08/09/23

PROJECT ID

76779

SHEET

P.0048A

TOTAL

P.1587

GENERAL SUMMARY	
DESIGN AGENCY	
AMERICAN STRUCTUREPOINT INC.	
DESIGNER	
BER	
REVIEWER	
VDK	08/09/23
PROJECT ID	
76779	
SHEET	TOTAL
P.0316	P.1587

SHEET NUM.												PART.			ITEM	ITEM EXT	GRAND TOTAL	UNIT	DESCRIPTION	SEE SHEET NO.
66	346	347									01/IMS/0 4	02/IMS/1 3	03/IMS/1 3							
DRAINAGE CONT.																				
	211										211			611	96601	211	FT	CONDUIT, BORED OR JACKED, AS PER PLAN (2), 42" TYPE C	P.0049	
	156										156			611	96601	156	FT	CONDUIT, BORED OR JACKED, AS PER PLAN (2), 48" TYPE B	P.0049	
	181										181			611	96601	181	FT	CONDUIT, BORED OR JACKED, AS PER PLAN (2), 48" TYPE C	P.0049	
	147										147			611	96601	147	FT	CONDUIT, BORED OR JACKED, AS PER PLAN (2), 54" TYPE B	P.0049	
	155										155			611	96601	155	FT	CONDUIT, BORED OR JACKED, AS PER PLAN (2), 60" TYPE B	P.0049	
	703										703			611	96601	703	FT	CONDUIT, BORED OR JACKED, AS PER PLAN (2), 66" TYPE B	P.0049	
	24										24			611	97400	24	FT	CONDUIT, MISC.: 12" CONDUIT, TYPE B, ROCK CUT	P.0049	
	36										36			611	97400	36	FT	CONDUIT, MISC.: 12" CONDUIT, TYPE C, ROCK CUT	P.0049	
	10,283										10,283			611	97400	10,283	FT	CONDUIT, MISC.: 15" CONDUIT, TYPE B, ROCK CUT	P.0049	
	1,532										1,532			611	97400	1,532	FT	CONDUIT, MISC.: 15" CONDUIT, TYPE C, ROCK CUT	P.0049	
	85										85			611	97400	85	FT	CONDUIT, MISC.: 15" CONDUIT, TYPE F, ROCK CUT	P.0049	
	2,523										2,523			611	97400	2,523	FT	CONDUIT, MISC.: 18" CONDUIT, TYPE B, ROCK CUT	P.0049	
	993										993			611	97400	993	FT	CONDUIT, MISC.: 18" CONDUIT, TYPE C, ROCK CUT	P.0049	
	1,408										1,408			611	97400	1,408	FT	CONDUIT, MISC.: 24" CONDUIT, TYPE B, ROCK CUT	P.0049	
	229										229			611	97400	229	FT	CONDUIT, MISC.: 24" CONDUIT, TYPE C, ROCK CUT	P.0049	
	183										183			611	97400	183	FT	CONDUIT, MISC.: 30" CONDUIT, TYPE B, ROCK CUT	P.0049	
	1,530										1,530			611	97400	1,530	FT	CONDUIT, MISC.: 30" CONDUIT, TYPE C, ROCK CUT	P.0049	
	248										248			611	97400	248	FT	CONDUIT, MISC.: 36" CONDUIT, TYPE B, ROCK CUT	P.0049	
	332										332			611	97400	332	FT	CONDUIT, MISC.: 36" CONDUIT, TYPE C, ROCK CUT	P.0049	
	263										263			611	97400	263	FT	CONDUIT, MISC.: 42" CONDUIT, TYPE B, ROCK CUT	P.0049	
	788										788			611	97400	788	FT	CONDUIT, MISC.: 42" CONDUIT, TYPE C, ROCK CUT	P.0049	
	2,413										2,413			611	97400	2,413	FT	CONDUIT, MISC.: 48" CONDUIT, TYPE B, ROCK CUT	P.0049	
	380										380			611	97400	380	FT	CONDUIT, MISC.: 54" CONDUIT, TYPE B, ROCK CUT	P.0049	
	399										399			611	97400	399	FT	CONDUIT, MISC.: 54" CONDUIT, TYPE C, ROCK CUT	P.0049	
	863										863			611	97400	863	FT	CONDUIT, MISC.: 60" CONDUIT, TYPE B, ROCK CUT	P.0049	
	209										209			611	97400	209	FT	CONDUIT, MISC.: 60" CONDUIT, TYPE C, ROCK CUT	P.0049	
	1,631										1,631			611	97400	1,631	FT	CONDUIT, MISC.: 66" CONDUIT, TYPE B, ROCK CUT	P.0049	
	174										174			611	97400	174	FT	CONDUIT, MISC.: 66" CONDUIT, TYPE C, ROCK CUT	P.0049	
	41										41			611	98150	41	EACH	CATCH BASIN, NO. 3	P.0048	
	1										1			611	98151	1	EACH	CATCH BASIN, NO. 3, AS PER PLAN	P.0048	
	16										16			611	98180	16	EACH	CATCH BASIN, NO. 3A		
	65										65			611	98300	65	EACH	CATCH BASIN, NO. 5		
	1										1			611	98301	1	EACH	CATCH BASIN, NO. 5, AS PER PLAN	P.0048	
1		7									1			611	98301	1	EACH	CATCH BASIN, NO. 5, AS PER PLAN (2)	P.0063	
											7			611	98370	7	EACH	CATCH BASIN, NO. 6		
1											1			611	98371	1	EACH	CATCH BASIN, NO. 6, AS PER PLAN	P.0063	
	1										1			611	98510	1	EACH	CATCH BASIN, NO. 2-3		
	1										1			611	98690	1	EACH	CATCH BASIN, MISC.: CITY OF CLEVELAND CB-1 CATCH BASIN	P.0048	
	1										1			611	98811	1	EACH	INLET, NO. 3C, AS PER PLAN	P.0048A	
	6										6			611	98820	6	EACH	INLET, NO. 3D		
	47										47			611	98840	47	EACH	INLET, NO. 2-A-6		
	35										35			611	98841	35	EACH	INLET, NO. 2-A-6, AS PER PLAN	P.0063	
	25										25			611	98850	25	EACH	INLET, NO. 2-A-8		
	10										10			611	98860	10	EACH	INLET, NO. 2-A-10		
	8										8			611	98870	8	EACH	INLET, NO. 2-A-12		
	2										2			611	98880	2	EACH	INLET, NO. 2-A-14		
	1										1			611	98890	1	EACH	INLET, NO. 2-A-16		
	17										17			611	99000	17	EACH	INLET, NO. 2-A-18		
	7										7			611	99100	7	EACH	INLET, NO. 3 FOR SINGLE SLOPE BARRIER, TYPE B1		
	93										93			611	99110	93	EACH	INLET, NO. 3 FOR SINGLE SLOPE BARRIER, TYPE C1		
	20										20			611	99574	20	EACH	MANHOLE, NO. 3		
	1										1			611	99575	1	EACH	MANHOLE, NO. 3, AS PER PLAN	P.0048A	
	2										2			611	99575	2	EACH	MANHOLE, NO. 3, AS PER PLAN (2)	P.0048	
	1										1			611	99575	1	EACH	MANHOLE, NO. 3, AS PER PLAN (3)	P.0063	
											4			611	99660	4	EACH	MANHOLE RECONSTRUCTED TO GRADE		
											2			611	99660	2	EACH	MANHOLE RECONSTRUCTED TO GRADE		
											1			611	99690	1	EACH	MANHOLE, MISC.: MH-3 MODIFIED	P.0049	

[illegible]

EARTHWORK QUANTITIES				
STATION	IR 90			
	CUT AREA SF	CUT VOLUME CY	FILL AREA SF	FILL VOLUME CY
352+73.44	0		0	
353+23.44	103	0	0	0
353+50.00	112	106	0	0
354+00.00	121	216	0	0
528+50.00	135	141	0	0
529+00.00	151	265	0	0
529+50.00	170	298	0	0
530+00.00	197	340	0	0
530+50.00	198	366	0	0
531+00.00	242	407	0	0
531+50.00	250	455	0	0
532+00.00	248	462	0	0
532+50.00	237	449	0	0
533+00.00	238	440	0	0
533+50.00	227	430	0	0
534+00.00	204	399	0	0
534+50.00	185	360	0	0
535+00.00	188	345	0	0
535+50.00	192	352	0	0
536+00.00	162	329	0	0
536+50.00	159	298	0	0
537+00.00	160	296	0	0
537+50.00	174	309	0	0
538+00.00	189	336	0	0
538+50.00	190	351	0	0
539+00.00	183	346	0	0
539+50.00	177	334	0	0
540+00.00	154	306	0	0
540+50.00	190	319	0	0
541+00.00	185	347	0	0
541+50.00	196	353	0	0
542+00.00	208	374	0	0
542+50.00	194	372	0	0
543+00.00	174	341	0	0
543+50.00	228	372	0	0
544+00.00	215	410	0	0
544+50.00	203	388	0	0
545+00.00	196	370	0	0
545+50.00	186	354	0	0
546+00.00	205	362	0	0
546+50.00	193	369	0	0
547+00.00	232	394	0	0
547+50.00	251	448	0	0
548+00.00	303	513	0	0
548+50.00	297	556	0	0
549+00.00	312	564	0	0
549+50.00	275	543	0	0
550+00.00	284	517	0	0
550+50.00	282	524	0	0
551+00.00	282	522	0	0
551+50.00	272	512	0	0
552+00.00	275	506	0	0
552+50.00	283	517	0	0
553+00.00	270	512	0	0
553+50.00	258	489	0	0
554+00.00	208	431	0	0
554+50.00	208	385	0	0
555+00.00	194	372	0	0
555+50.00	189	354	0	0
556+00.00	178	339	0	0
556+50.00	191	341	0	0
557+00.00	193	356	0	0
557+50.00	190	355	0	0
558+00.00	185	348	0	0
558+50.00	174	332	0	0
559+00.00	172	320	0	0
559+50.00	159	306	0	0
560+00.00	147	283	0	0
560+50.00	145	270	0	0
561+00.00	160	283	0	0
561+50.00	172	308	0	0
TOTALS TO LAST TABLE		25,965		0

EARTHWORK QUANTITIES				
IR 90				
STATION	CUT AREA	CUT VOLUME	FILL AREA	FILL VOLUME
	SF	CY	SF	CY
562+00.00	184	330	0	0
562+50.00	178	335	0	0
563+00.00	176	328	0	0
563+50.00	174	324	0	0
564+00.00	189	335	0	0
564+50.00	208	368	0	0
565+00.00	218	395	0	0
565+50.00	231	416	0	0
566+00.00	231	427	0	0
566+50.00	240	436	0	0
567+00.00	221	427	0	0
567+50.00	318	499	0	0
568+00.00	344	612	0	0
568+50.00	401	690	0	0
569+00.00	382	725	0	0
569+50.00	420	742	0	0
570+00.00	442	798	0	0
570+50.00	484	858	0	0
571+00.00	544	952	0	0
571+50.00	620	1078	0	0
572+00.00	336	885	0	0
572+50.00	437	715	0	0
573+00.00	404	778	0	0
573+50.00	341	690	0	0
574+00.00	205	506	0	0
574+50.00	2	191	0	0
574+65.73	0	0	56	16
582+73.21	0	0	595	
583+00.00	139	69	0	295
583+50.00	233	344	0	0
584+00.00	344	534	0	0
584+50.00	130	439	0	0
585+00.00	105	218	0	0
585+50.00	99	188	0	0
586+00.00	106	189	0	0
586+50.00	85	177	0	0
587+00.00	89	161	0	0
587+50.00	99	174	0	0
588+00.00	146	227	0	0
588+50.00	196	316	0	0
589+00.00	281	441	0	0
589+50.00	339	574	0	0
590+00.00	427	710	0	0
590+50.00	425	789	2	2
591+00.00	376	742	0	2
591+50.00	369	690	0	0
592+00.00	340	657	0	0
592+50.00	303	595	0	0
593+00.00	247	509	0	0
593+50.00	166	383	0	0
594+00.00	136	280	0	0
594+50.00	93	212	0	0
595+00.00	95	174	0	0
595+50.00	92	173	0	0
596+00.00	111	188	0	0
596+50.00	150	242	0	0
597+00.00	173	299	0	0
597+50.00	188	334	0	0
598+00.00	210	368	0	0
598+50.00	216	394	0	0
599+00.00	209	394	0	0
599+50.00	197	376	0	0
600+00.00	202	369	0	0
600+50.00	208	379	0	0
601+00.00	238	0	1	1
601+50.00	436	624	0	1
602+00.00	523	888	0	0
602+50.00	553	997	0	0
603+00.00	603	1070	0	0
TOTALS TO LAST TABLE		31,727		317

EARTHWORK QUANTITIES				
IR 90				
STATION	CUT AREA	CUT VOLUMN	FILL AREA	FILL VOLUMN
	SF	CY	SF	CY
603+50.00	626	1138	0	0
604+00.00	652	1184	0	0
604+50.00	614	1172	0	0
605+00.00	577	1103	0	0
605+50.00	489	987	0	0
606+00.00	402	825	0	0
606+50.00	342	689	0	0
607+00.00	279	575	0	0
607+50.00	215	457	0	0
608+00.00	175	361	0	0
608+50.00	135	287	0	0
609+00.00	107	224	1	1
609+50.00	89	182	0	1
610+00.00	90	166	4	4
610+50.00	113	188	2	6
611+00.00	117	213	0	2
611+50.00	121	221	0	0
612+00.00	184	282	0	0
612+50.00	260	411	0	0
613+00.00	501	706	0	0
613+50.00	398	832	0	0
614+00.00	395	734	0	0
614+50.00	460	791	0	0
615+00.00	475	866	0	0
615+50.00	490	894	0	0
616+00.00	468	887	0	0
616+50.00	408	811	0	0
617+00.00	360	711	0	0
617+50.00	363	669	0	0
616+00.00	379	711	0	0
616+50.00	338	663	0	0
617+00.00	340	628	0	0
617+50.00	346	635	0	0
618+00.00	348	643	0	0
618+50.00	349	646	0	0
619+00.00	342	640	0	0
619+50.00	334	625	0	0
620+00.00	332	616	0	0
620+50.00	358	639	0	0
621+00.00	309	618	0	0
621+50.00	316	579	0	0
622+00.00	262	536	0	0
622+50.00	210	437	0	0
623+00.00	155	338	0	0
623+50.00	116	251	0	0
624+00.00	97	197	0	0
624+50.00	87	170	0	0
625+00.00	88	161	0	0
625+50.00	93	167	0	0
626+00.00	97	176	0	0
626+50.00	105	187	0	0
627+00.00	109	198	0	0
627+50.00	113	206	0	0
628+00.00	94	191	0	0
628+50.00	97	176	0	0
629+00.00	144	223	0	0
629+50.00	83	210	0	0
630+00.00	100	170	0	0
630+50.00	112	197	0	0
631+00.00	124	219	0	0
631+50.00	138	242	0	0
632+00.00	141	258	0	0
632+50.00	147	267	0	0
633+00.00	146	271	0	0
TOTALS TO LAST TABLE		31,658		14

EARTHWORK QUANTITIES				
IR 90 WB				
STATION	CUT AREA	CUT VOLUMN	FILL AREA	FILL VOLUMN
	SF	CY	SF	CY
633+50.00	51	135	0	0
634+00.00	51	95	0	0
634+50.00	57	100	0	0
635+00.00	95	140	0	0
635+50.00	100	180	0	0
636+00.00	116	200	0	0
636+50.00	55	158	0	0
637+00.00	66	112	0	0
637+50.00	77	133	0	0
638+00.00	85	151	0	0
638+50.00	90	162	0	0
639+00.00	84	161	0	0
639+02.72	85	6	0	0
639+50.00	52	122	0	0
640+00.00	228	260	0	0
TOTALS THIS TABLE		2,115		0
TOTALS FROM TABLE 1		25,965		0
TOTALS FROM TABLE 2		31,727		317
TOTALS FROM TABLE 3		31,658		14
TOTALS CARRIED TO SHEET 344		91,466		332

MODEL: Sheet 2 PAPER SIZE: 17x11 (in.) DATE: 4/28/2025 TIME: 12:17:29 AM USER: sstielma
C:\Users\ssstielma\OneDrive\Documents\Projects\2020\0902\676779\400xEngineering\Roadway\Sheets\76776_S0008.dgn

EARTHWORK QUANTITIES				
IR 90 WB				
STATION	CUT AREA	CUT VOLUME	FILL AREA	FILL VOLUME
	SF	CY	SF	CY
40+00.48	47.984	0	0	
40+50.00	56	96	0	0
41+00.00	68	115	0	0
41+50.00	98	153	0	0
42+00.00	140	220	0	0
42+50.00	184	300	0	0
43+00.00	229	382	0	0
43+50.00	204	401	0	0
44+00.00	251	422	0	0
44+50.00	285	496	0	0
45+00.00	285	528	0	0
45+50.00	288	531	0	0
46+00.00	275	521	0	0
46+50.00	292	525	0	0
47+00.00	314	561	0	0
47+50.00	384	646	0	0
48+00.00	421	746	0	0
48+50.00	397	757	0	0
49+00.00	261	609	0	0
49+50.00	249	473	0	0
50+00.00	275	486	0	0
50+50.00	303	535	0	0
51+00.00	335	591	0	0
51+50.00	362	646	0	0
52+00.00	323	635	0	0
52+50.00	277	556	0	0
53+00.00	302	537	0	0
53+50.00	372	625	0	0
54+00.00	419	733	0	0
54+45.37	525	792	0	0
54+50.00	816	70	0	0
55+00.00	921	1608	0	0
55+50.00	966	1748	0	0
56+00.00	981	1803	0	0
56+50.00	979	1815	0	0
57+00.00	951	1788	0	0
57+50.00	958	1768	0	0
58+00.00	947	1763	0	0
58+50.00	919	1727	0	0
59+00.00	863	1650	0	0
59+50.00	695	1442	0	0
60+00.00	551	1153	0	0
60+50.00	530	1001	0	0
61+00.00	505	959	0	0
61+50.00	484	916	0	0
62+00.00	455	869	0	0
62+50.00	441	829	0	0
63+00.00	458	832	0	0
63+50.00	663	1039	0	0
64+00.00	731	1291	0	0
64+50.00	718	1342	2	2
65+00.00	676	1291	1	3
65+50.00	575	1158	0	1
66+00.00	524	1018	4	4
66+50.00	492	940	4	7
67+00.00	431	855	4	7
667+50.00	113	0	9	12
668+00.00	108	204	5	13
668+50.00	108	200	0	5
669+00.00	113	205	0	0
669+50.00	122	218	0	0
670+00.00	120	224	0	0
670+50.00	109	211	0	0
671+00.00	110	203	0	0
671+50.00	104	199	0	0
672+13.34	0	136	106	124
TOTALS TO LAST TABLE		49,087		178

EARTHWORK QUANTITIES				
IR 90 WB				
STATION	CUT AREA	CUT VOLUME	FILL AREA	FILL VOLUME
	SF	CY	SF	CY
674+06.84	4	0	102	
674+50.00	69	49	7	87
675+00.00	77	135	0	6
675+50.00	88	153	0	0
676+00.00	93	167	0	0
676+50.00	97	176	0	0
677+00.00	99	181	0	0
677+50.00	105	0	0	0
678+00.00	106	195	0	0
678+50.00	108	198	0	0
679+00.00	109	201	0	0
679+50.00	107	200	0	0
680+00.00	108	199	0	0
680+50.00	108	200	0	0
681+00.00	99	192	0	0
681+50.00	97	182	0	0
682+00.00	125	205	0	0
682+50.00	122	228	0	0
683+00.00	111	216	0	0
683+50.00	104	199	0	0
684+00.00	98	187	147	136
684+61.77	55	138	855	1146
691+21.31	65	0	90	
692+00.00	66	196	10	146
692+50.00	68	124	5	14
693+00.00	69	127	11	15
693+50.00	66	126	1	11
694+00.00	57	114	0	1
694+50.00	77	124	0	0
695+29.03	8	134	89	130
696+17.61	10	0	15	
696+50.00	41	27	12	16
697+00.00	38	74	4	15
697+50.00	28	61	16	19
698+00.00	19	43	14	28
698+50.00	19	35	17	29
699+00.00	22	38	26	40
699+50.00	20	40	28	50
700+00.00	15	33	36	59
700+50.00	10	23	35	66
701+00.00	28	35	33	63
701+50.00	93	112	38	66
702+00.00	100	178	31	64
702+50.00	100	185	28	55
703+00.00	99	185	28	52
703+50.00	94	179	30	54
704+00.00	99	179	30	56
704+50.00	98	183	28	54
705+00.00	28	117	27	51
705+50.00	17	42	24	47
706+00.00	24	38	18	39
706+50.00	24	44	15	31
707+00.00	32	52	10	23
707+50.00	43	69	3	12
708+00.00	52	88	0	3
708+50.00	61	105	0	0
709+00.00	65	116	0	0
709+50.00	65	120	0	0
710+00.00	68	123	0	0
710+50.00	70	128	0	0
711+00.00	66	127	0	0
711+50.00	69	125	0	0
712+00.00	76	135	0	0
712+50.00	73	138	0	0
713+00.00	70	132	0	0
713+50.00	67	127	0	0
714+00.00	67	124	0	0
TOTALS TO LAST TABLE		8,108		2,684

EARTHWORK QUANTITIES				
IR 90 WB				
STATION	CUT AREA	CUT VOLUME	FILL AREA	FILL VOLUME
	SF	CY	SF	CY
714+50.00	67	124	0	0
715+00.00	66	123	0	0
715+50.00	64	120	0	0
716+00.00	66	120	0	0
716+50.00	66	122	0	0
717+00.00	69	125	0	0
717+50.00	79	137	0	0
718+00.00	70	138	0	0
718+50.00	65	125	0	0
719+00.00	75	130	0	0
719+50.00	77	140	0	0
720+00.00	75	140	0	0
720+50.00	80	143	0	0
721+00.00	80	148	0	0
721+50.00	76	145	0	0
722+00.00	78	143	0	0
722+50.00	73	140	0	0
723+00.00	69	132	0	0
723+50.00	72	131	0	0
724+00.00	81	142	0	0
724+50.00	90	159	0	0
725+00.00	93	169	0	0
725+50.00	87	166	0	0
726+00.00	87	161	0	0
726+50.00	79	154	1	1
727+00.00	116	181	2	3
727+50.00	78	179	0	2
728+00.00	79	145	0	0
728+50.00	89	155	0	0
729+00.00	94	169	0	0
729+50.00	101	180	0	0
730+00.00	105	190	0	0
730+50.00	125	213	0	0
731+00.00	215	315	0	0
731+50.00	239	421	0	0
732+00.00	271	472	0	0
732+50.00	276	507	0	0
733+00.00	302	535	0	0
733+50.00	318	574	0	0
734+00.00	359	627	0	0
734+50.00	311	620	0	0
735+00.00	265	533	0	0
735+50.00	250	477	0	0
736+00.00	171	390	0	0
736+50.00	113	263	0	0
737+00.00	118	214	0	0
737+50.00	101	202	0	0
738+00.00	94	181	0	0
738+50.00	84	165	0	0
739+00.00	81	153	0	0
739+50.00	77	147	0	0
740+00.00	69	135	0	0
740+50.00	66	125	0	0
741+00.00	51	108	0	0
741+50.00	52	95	0	0
742+00.00	56	100	0	0
742+50.00	58	106	0	0
743+00.00	61	110	0	0
743+50.00	85	135	0	0
744+00.00	259	318	0	0
744+50.00	125	356	0	0
745+00.00	111	219	0	0
745+50.00	103	198	0	0
746+00.00	106	193	0	0
TOTALS TO LAST TABLE		13,885		6

EARTHWORK QUANTITIES				
IR 90 WB				
STATION	CUT AREA	CUT VOLUME	FILL AREA	FILL VOLUME
	SF	CY	SF	CY
746+50.00	107	197	0	0
747+00.00	111	202	0	0
747+50.00	93	189	0	0
748+00.00	157	231	0	0
748+50.00	170	302	0	0
749+00.00	174	318	0	0
749+50.00	183	330	0	0
750+00.00	232	384	0	0
750+50.00	117	323	0	0
751+00.00	166	262	0	0
751+50.00	156	298	0	0
752+00.00	159	292	0	0
752+50.00	140	277	0	0
753+00.00	83	206	0	0
753+50.00	75	146	0	0
754+00.00	169	226	0	0
754+50.00	85	149	0	0
755+00.00	104	175	0	0
755+50.00	86	176	0	0
756+00.00	81	155	0	0
756+50.00	161	224	0	0
757+00.00	153	291	0	0
757+50.00	136	268	1	1
758+00.00	131	247	2	3
758+50.00	86	201	3	5
759+00.00	91	164	5	7
759+50.00	153	226	3	7
760+00.00	144	275	8	10
760+50.00	142	264	7	14
761+00.00	101	224	7	13
761+50.00	51	140	8	14
762+00.00	147	184	5	12
762+50.00	65	197	4	8
763+00.00	71	126	0	4
763+50.00	87	146	0	0
764+00.00	87	161	0	0
764+50.00	81	155	0	0
765+00.00	76	145	6	6
765+50.00	80	144	0	6
766+00.00	85	153	0	0
766+50.00	87	159	0	0
767+00.00	87	161	0	0
767+50.00	89	163	0	0
768+00.00	95	170	0	0
768+50.00	91	172	0	0
768+85.00	93	119	0	0
				</

	EARTHWORK QUANTITIES				
	IR 90 EB				
	STATION	CUT AREA SF	CUT VOLUME CY	FILL AREA SF	FILL VOLUME CY
68+50.00	302	560	0		
69+00.00	297	555	0	0	
69+50.00	297	551	0	0	
70+00.00	291	545	0	0	
70+50.00	282	531	0	0	
71+00.00	278	519	0	0	
71+50.00	270	508	0	0	
72+00.00	150	510	64	59	
72+17.61	5	151	312	123	
74+12.15	2		261		
74+50.00	238	2826	1	184	
75+00.00	252	454	1	2	
75+50.00	245	460	1	2	
76+00.00	238	447	0	1	
76+50.00	236	439	0	0	
76+98.67	239	428	0	0	
677+50.00	60	0	0	0	
678+00.00	51	102	2	2	
678+50.00	46	90	2	4	
679+00.00	42	82	2	4	
679+50.00	39	75	3	5	
680+00.00	36	69	4	6	
680+50.00	35	66	3	6	
681+00.00	66	93	4	6	
681+50.00	89	143	0	4	
682+00.00	113	187	1	1	
682+50.00	123	219	0	1	
683+00.00	93	200	0	0	
683+50.00	103	181	0	0	
684+00.00	91	180	0	0	
684+57.56	75	182	1153	1229	
691+17.30	98	0	527		
691+50.00	46	82	0	319	
692+00.00	39	79	0	0	
692+50.00	46	79	0	0	
693+00.00	57	95	0	0	
693+50.00	53	101	0	0	
694+00.00	57	102	5	5	
694+50.00	70	118	1	6	
695+00.00	27	90	0	1	
695+33.09	17	27	1	1	
696+26.89	22	0	46		
697+00.00	55	112	16	84	
697+50.00	61	107	24	37	
698+00.00	64	116	7	29	
698+50.00	74	128	2	8	
699+00.00	102	163	1	3	
699+50.00	96	183	2	3	
700+00.00	96	178	2	4	
700+50.00	91	173	2	4	
701+00.00	98	175	0	2	
701+50.00	150	229	0	0	
702+00.00	167	293	0	0	
702+50.00	164	306	0	0	
703+00.00	161	301	0	0	
703+50.00	151	289	0	0	
704+00.00	154	282	0	0	
704+50.00	151	282	0	0	
705+00.00	98	231	0	0	
705+50.00	65	151	0	0	
706+00.00	54	110	0	0	
706+50.00	44	90	0	0	
707+00.00	31	70	0	0	
707+50.00	21	49	2	2	
708+00.00	16	34	5	6	
708+50.00	15	28	3	7	
709+00.00	16	28	5	7	
TOTALS TO LAST TABLE		16,233		2,167	

EARTHWORK QUANTITIES				
IR 90 EB				
STATION	CUT AREA	CUT VOLUME	FILL AREA	FILL VOLUME
	SF	CY	SF	CY
745+00.00	92	142	0	0
745+50.00	89	168	0	0
746+00.00	69	147	0	0
746+50.00	88	146	0	0
747+00.00	74	150	0	0
747+50.00	94	155	0	0
748+00.00	154	229	0	0
748+50.00	183	312	0	0
749+00.00	147	306	0	0
749+50.00	156	281	0	0
750+00.00	133	268	0	0
750+50.00	109	224	0	0
751+00.00	226	310	0	0
751+50.00	154	352	0	0
752+00.00	156	287	0	0
752+50.00	143	277	0	0
753+00.00	84	210	0	0
753+50.00	84	155	0	0
754+00.00	159	225	0	0
754+50.00	93	163	0	0
755+00.00	112	190	0	0
755+50.00	98	195	0	0
756+00.00	113	195	0	0
756+50.00	197	287	0	0
757+00.00	214	380	0	0
757+50.00	217	399	0	0
758+00.00	220	405	0	0
758+50.00	183	373	0	0
759+00.00	187	343	0	0
759+50.00	232	389	0	0
760+00.00	235	433	0	0
760+50.00	233	434	0	0
761+00.00	199	400	0	0
761+50.00	148	321	0	0
762+00.00	140	267	0	0
762+50.00	143	263	0	0
763+00.00	128	251	0	0
763+50.00	128	236	0	0
764+00.00	109	219	0	0
764+50.00	103	196	0	0
765+00.00	104	192	0	0
765+50.00	106	194	0	0
766+00.00	107	197	0	0
766+50.00	105	197	0	0
767+00.00	102	192	0	0
767+50.00	103	190	0	0
768+00.00	101	188	0	0
768+50.00	94	180	0	0
768+85.00	89	118	0	0
TOTALS THIS TABLE		12,333		0
TOTALS FROM TABLE 1		28,695		0
TOTALS FROM TABLE 2		16,233		2,167
TOTALS FROM TABLE 3		12,389		183
TOTALS THIS SHEET		69,650		2,350
TOTALS FROM SHEET 342		91,466		332
TOTALS FROM SHEET 343		80,800		2,978
TOTALS CARRIED TO SHEET 341		241,916		5,660

ESTIMATED QUANTITIES												ITEM	EXTENSION	GRAND TOTAL	UNIT	DESCRIPTION	SEE SHEET	
Sheet 351	Sheet 352	Sheet 353	Sheet 354	Sheet 355	Sheet 356	Sheet 357	Sheet 358	Sheet 359	Sheet 359A	Sheet 370								
												611	97400	36	FT	CONDUIT, MISC.: 12" CONDUIT, TYPE C, ROCK CUT	P.0049	
												611	97400	10,283	FT	CONDUIT, MISC.: 15" CONDUIT, TYPE B, ROCK CUT	P.0049	
												611	97400	1,532	FT	CONDUIT, MISC.: 15" CONDUIT, TYPE C, ROCK CUT	P.0049	
												611	97400	85	FT	CONDUIT, MISC.: 15" CONDUIT, TYPE F, ROCK CUT	P.0049	
												611	97400	2,523	FT	CONDUIT, MISC.: 18" CONDUIT, TYPE B, ROCK CUT	P.0049	
												611	97400	993	FT	CONDUIT, MISC.: 18" CONDUIT, TYPE C, ROCK CUT	P.0049	
												611	97400	1,408	FT	CONDUIT, MISC.: 24" CONDUIT, TYPE B, ROCK CUT	P.0049	
												611	97400	229	FT	CONDUIT, MISC.: 24" CONDUIT, TYPE C, ROCK CUT	P.0049	
												611	97400	183	FT	CONDUIT, MISC.: 30" CONDUIT, TYPE B, ROCK CUT	P.0049	
												611	97400	1,530	FT	CONDUIT, MISC.: 30" CONDUIT, TYPE C, ROCK CUT	P.0049	
												611	97400	248	FT	CONDUIT, MISC.: 36" CONDUIT, TYPE B, ROCK CUT	P.0049	
												611	97400	332	FT	CONDUIT, MISC.: 36" CONDUIT, TYPE C, ROCK CUT	P.0049	
												611	97400	263	FT	CONDUIT, MISC.: 42" CONDUIT, TYPE B, ROCK CUT	P.0049	
												611	97400	788	FT	CONDUIT, MISC.: 42" CONDUIT, TYPE C, ROCK CUT	P.0049	
												611	97400	2,413	FT	CONDUIT, MISC.: 48" CONDUIT, TYPE B, ROCK CUT	P.0049	
												611	97400	380	FT	CONDUIT, MISC.: 54" CONDUIT, TYPE B, ROCK CUT	P.0049	
												611	97400	399	FT	CONDUIT, MISC.: 54" CONDUIT, TYPE C, ROCK CUT	P.0049	
												611	97400	863	FT	CONDUIT, MISC.: 60" CONDUIT, TYPE B, ROCK CUT	P.0049	
												611	97400	209	FT	CONDUIT, MISC.: 60" CONDUIT, TYPE C, ROCK CUT	P.0049	
												611	97400	1,631	FT	CONDUIT, MISC.: 66" CONDUIT, TYPE B, ROCK CUT	P.0049	
												611	97400	174	FT	CONDUIT, MISC.: 66" CONDUIT, TYPE C, ROCK CUT	P.0049	
												611	98150	41	EACH	CATCH BASIN, NO. 3	P.0048	
												611	98151	1	EACH	CATCH BASIN, NO. 3, AS PER PLAN	P.0048	
												611	98180	16	EACH	CATCH BASIN, NO. 3A		
												611	98300	65	EACH	CATCH BASIN, NO. 5		
												611	98301	1	EACH	CATCH BASIN, NO. 5, AS PER PLAN	P.0048	
												611	98370	7	EACH	CATCH BASIN, NO. 6		
												611	98510	1	EACH	CATCH BASIN, NO. 2-3		
												611	98690	1	EACH	CATCH BASIN, MISC.: CITY OF CLEVELAND CB-1 CATCH BASIN	P.0048	
												611	99100	17	EACH	INLET, NO. 3 FOR SINGLE SLOPE BARRIER, TYPE B1		
												611	98811	1	EACH	INLET, NO. 3C, AS PER PLAN		
												611	99110	7	EACH	INLET, NO. 3 FOR SINGLE SLOPE BARRIER, TYPE C1		
												611	98820	6	EACH	INLET, NO. 3D		
												611	98840	47	EACH	INLET, NO. 2-A-6		
												611	98850	35	EACH	INLET, NO. 2-A-8		
												611	98860	25	EACH	INLET, NO. 2-A-10		
												611	98870	10	EACH	INLET, NO. 2-A-12		
												611	98880	8	EACH	INLET, NO. 2-A-14		
												611	98890	2	EACH	INLET, NO. 2-A-16		
												611	99000	1	EACH	INLET, NO. 2-A-18		
												611	99574	93	EACH	MANHOLE, NO. 3	P.0048A	
												611	99575	20	EACH	MANHOLE, NO. 3, AS PER PLAN	P.0048	
												611	99575	1	EACH	MANHOLE, NO. 3, AS PER PLAN (2)		
												611	99660	2	EACH	MANHOLE RECONSTRUCTED TO GRADE		
												633	99690	1	EACH	MANHOLE, MISC.: MH-3 MODIFIED	P.0048	
												659	00300	1,608	CY	TOPSOIL		
												670	00500	14,216	SY	SLOPE EROSION PROTECTION		
												670	00720	11,691	SY	DITCH EROSION PROTECTION MAT, TYPE B		
												444	836	10000	444	SY	SEEDING AND EROSION CONTROL WITH TURF REINFORCING MAT, TYPE 1	

SHEET NO.	REFERENCE NO.	LOCATION	STATION		SIDE	611	611	611	611	611	611	611	611	611	611	611	611	611	611	611	611	611	611	611	611	611	611	611		
			FROM	TO		12" CONDUIT, TYPE B	15" CONDUIT, TYPE B	15" CONDUIT, TYPE C	24" CONDUIT, TYPE C	36" CONDUIT, TYPE C	42" CONDUIT, TYPE B	42" CONDUIT, TYPE C	60" CONDUIT, TYPE B	CONDUIT, BORED OR JACKED, 15" TYPE B	18" CONDUIT, TYPE B	24" CONDUIT, TYPE B	CONDUIT, BORED OR JACKED, 24" TYPE B	CONDUIT, BORED OR JACKED, 36", TYPE B	CONDUIT, BORED OR JACKED, 36", TYPE C	CONDUIT, BORED OR JACKED, 42", TYPE B	CATCH BASIN, NO. 3	CATCH BASIN, NO. 3A	CATCH BASIN, NO. 5	INLET, NO. 3 FOR SINGLE SLOPE BARRIER, TYPE B1	INLET, NO. 2-A-6	INLET, NO. 2-A-8	INLET, NO. 2-A-10	MANHOLE, NO. 3	MANHOLE, NO. 3, AS PER PLAN	MANHOLE RECONSTRUCTED TO GRADE
						FT	FT	FT	FT	FT	FT	FT	FT	FT	FT	FT	FT	FT	FT	FT	FT	FT	EACH	EACH	EACH	EACH	EACH	EACH	EACH	EACH
OUTFALL A																														
1047/1069	D2	WESTWAY DR	49+48.00	49+52.51	LT	6														1										
OUTFALL AH																														
1048/1068	D3A	HILLIARD BLVD	82+10.38	82+13.00	LT	7																				1				
1048/1068	D4	HILLIARD BLVD	82+13.00	82+32.00	LT	19															1									
OUTFALL B																														
1047/1070	D88	IR 90	530+69.00	530+69.00	LT/RT																1									
1047/1070	D83	IR 90	530+69.00	530+69.00	RT								73		67							1								
1047/1070	D79	IR 90	530+69.00	533+50.00	RT																1									
1048/1070	D75	IR 90	533+50.00	535+20.00	RT												170								1					
1048/1070	D71	IR 90	535+20.00	37+53.40	RT																				1					
1047/1075	D79A	IR 90	353+30.00	530+69.00	RT																						1			
1048/1070	D62	RAMP HA	37+53.40	37+60.00	LT/RT												58								1					
1048/1070	D57	RAMP HA	37+60.00	40+16.00	RT																				1					
1048/1071	D50	RAMP HA	40+16.00	542+89.00	RT																				1					
1048/1071	D21	IR 90	542+89.00	545+10.00	RT																				1					
1049/1072	D19	IR 90	545+10.00	545+54.00	RT								72												1					
1049/1072	D18	IR 90	545+54.00	547+15.00	RT																					1				
1049/1072	D17	IR 90	547+15.00	547+65.00	RT																				1					
1049/1072	D14	IR 90	547+65.00	551+50.00	RT																				1					
1049/1072	D11	IR 90	551+50.00	551+91.86	RT																				1					
1047/1075	D86	IR 90	529+87.00	530+69.00	RT																				1					
1047/1075	D85	IR 90	530+69.00	531+51.00	RT																				1					
1048/1075	D77	RAMP HB	32+51.00	533+50.00	LT																									
1048/1075	D78	IR 90	533+50.00	533+50.00	RT																									
1048/1075	D67	IR 90	535+40.00	535+20.00	RT																									
1048/1075	D72	RAMP HA	35+43.00	535+20.00	LT																									
1048/1075	D73	RAMP HA	35+43.00	35+70.00	LT/RT																									
1048/1075	D74	RAMP HA	35+70.00	35+75.00	RT																									
1048/1075	D66	IR 90	536+65.00	537+48.00	RT																									
1048/1076	D69	IR 90	537+47.00	537+50.00	LT																									
1048/1076	D65	IR 90	537+50.00	537+48.00	LT/RT																									
1048/1076	D64	IR 90	537+48.00	37+53.40	RT																									
1048/1076	D54	RAMP HA	39+68.00	40+16.00	RT																									
1048/1076	D53	RAMP HA	40+16.00	540+58.00	RT																									
1048/1076	D55	RAMP HA	40+16.00	40+16.00	RT																									
1048/1076	D51	RAMP HA	40+16.00	40+16.00	RT																									
1048/1076	D27	IR 90	542+00.00	542+75.00	RT																									
1048/1077	D49	RAMP HB	38+16.00	39+18.00	RT																									
1048/1077	D48	RAMP HB	39+18.00	39+85.00	RT																									
1048/1077	D47	RAMP HB	39+85.00	42+81.00	RT																									
1048/1077	D28	RAMP HB	42+81.00	542+75.00	RT																									
1048/1077	D26	IR 90	542+75.00	542+91.00	RT																									
1048/1077	D25	IR 90	542+91.00	542+89.00	RT																									
1048/1077	D22	IR 90	542+89.00	542+89.00	RT																									
1048/1077	D30	RAMP HB	42+73.50	42+73.50	LT																									
1048/1077	D29	RAMP HB	42+73.50	543+25.25	LT																									
1048/1077	D32	IR 90	543+25.25	543+75.00	LT																									
1048/1077	D33	IR 90	543+75.00	543+75.25	LT																									
1048/1078	D31	IR 90	543+25.25	42+81.00	LT																									
TOTALS CARRIED TO SHEETS 346 & 347																														

DRAINAGE ESTIMATED QUANTITIES

DESIGN AGENCY
AMERICAN
STRUCTUREPOINT
INC.

DESIGNER
BER

REVIEWER
VDK 08/09/23




PROJECT ID
76779

SHEET
P.0351

TOTAL
P.1587

NOTES:

1. FOR LEGEND, SEE SHEET P.1047
2. FOR STORM SEWER PROFILES, SEE SHEETS P.1068 - P.1149
3. ALL CONNECTIONS TO EXISTING STRUCTURES TO BE CORED IN THE FIELD
4. ALL PROPOSED PIPES TO BE CONNECTED TO EXISTING SHALL BE FITTED WITH A MASONRY COLLAR PER SCD DM-1.1. COST INCLUDED IN THE UNIT BID PRICE FOR THE PERTINENT CONDUIT ITEM
5. PROPOSED MANHOLE LID SHALL BE BOLTED DOWN.

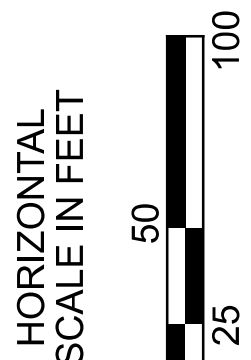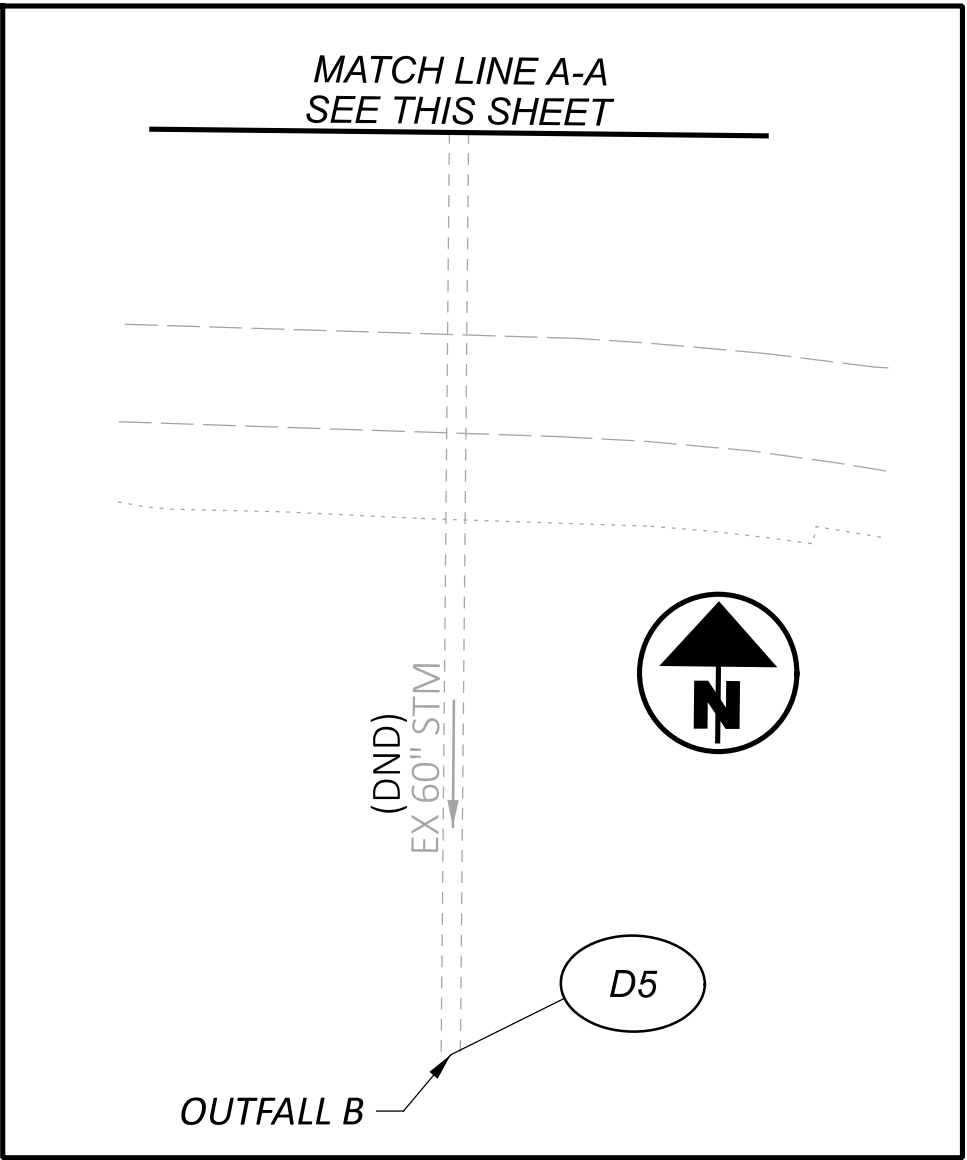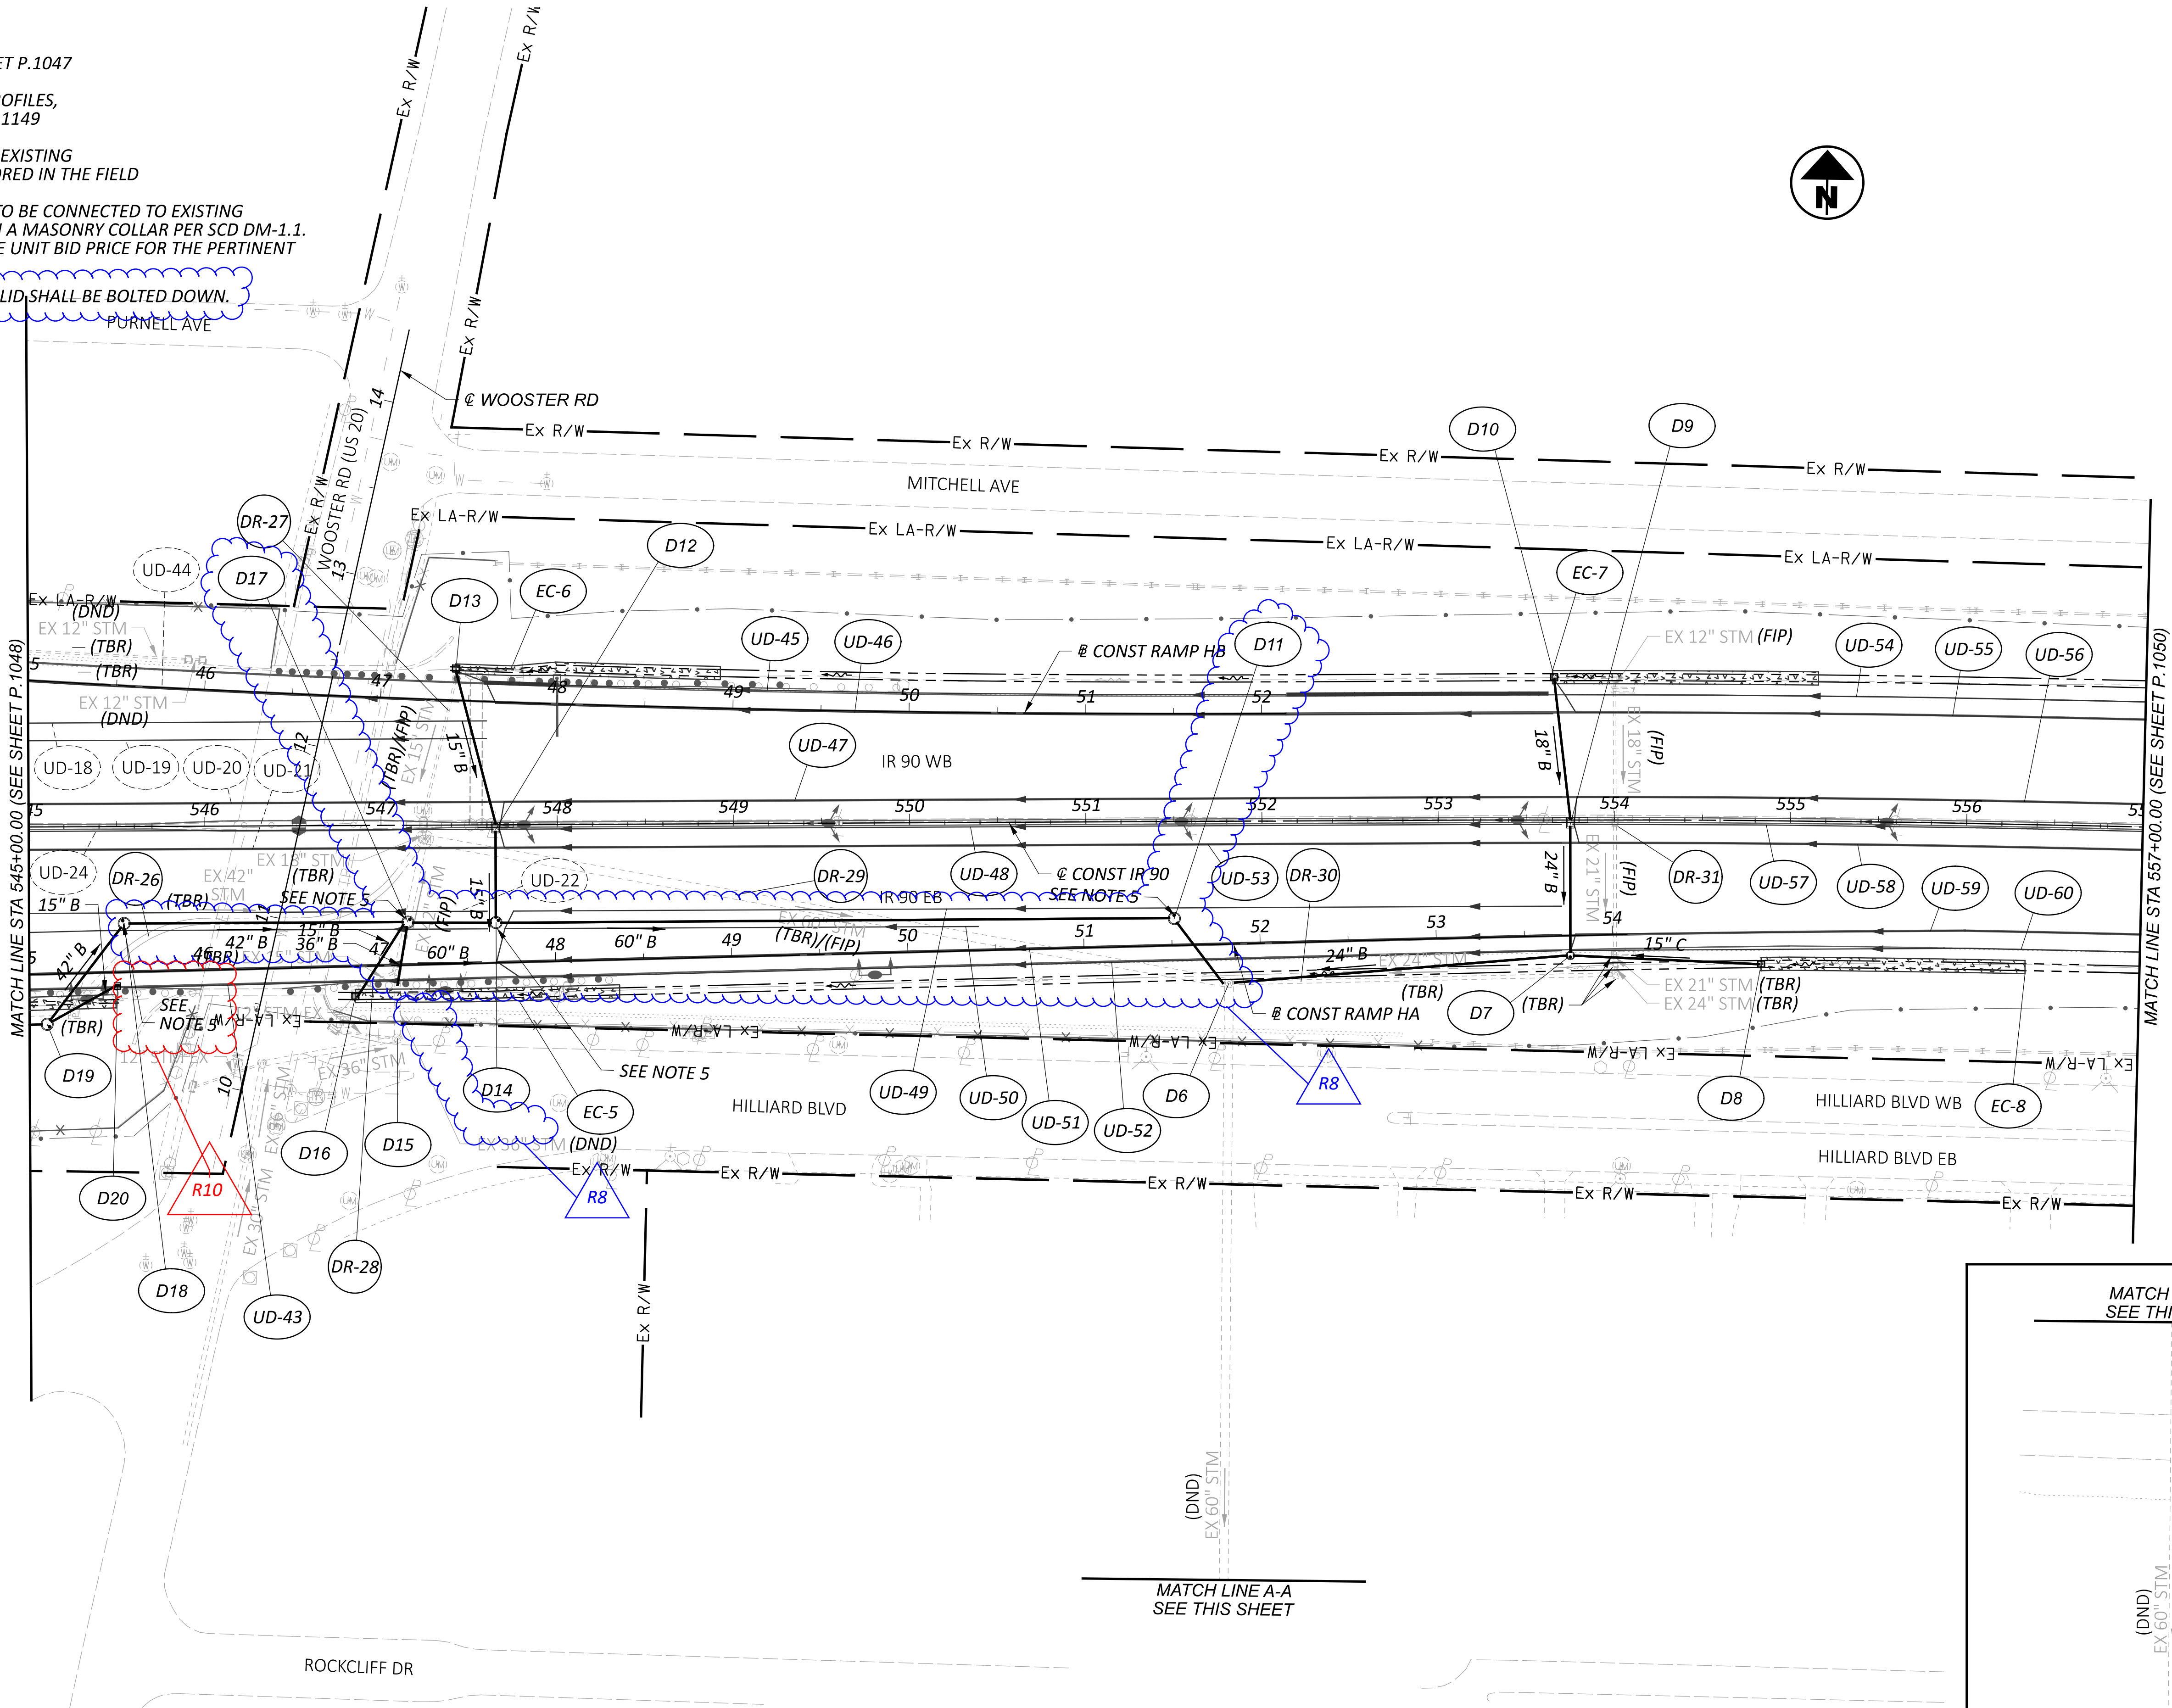

DRAINAGE PLAN SHEET - IR 90
STA 545+00.00 TO STA 557+00.00

DESIGN AGENCY

STRUCTUREPOINT

DESIGNER

AJO

REVIEWER

KEM 08/09/23

PROJECT ID

76779

SHEET


P.1049

TOTAL

P.1587

NOTES:

1. ALL STATIONING TAKEN FROM @ CONST IR 90 UNLESS OTHERWISE NOTED
2. FOR DRAINAGE PLAN SHEETS, SEE SHEET P.1047 - P.1067
3. ALL EXISTING CONNECTIONS TO BE CORED IN THE FIELD
4. ALL PROPOSED PIPES TO BE CONNECTED TO EXISTING SHALL BE FITTED WITH A MASONRY COLLAR PER SCD DM-1.1. COST INCLUDED IN THE UNIT BID PRICE FOR THE PERTINENT CONDUIT ITEM

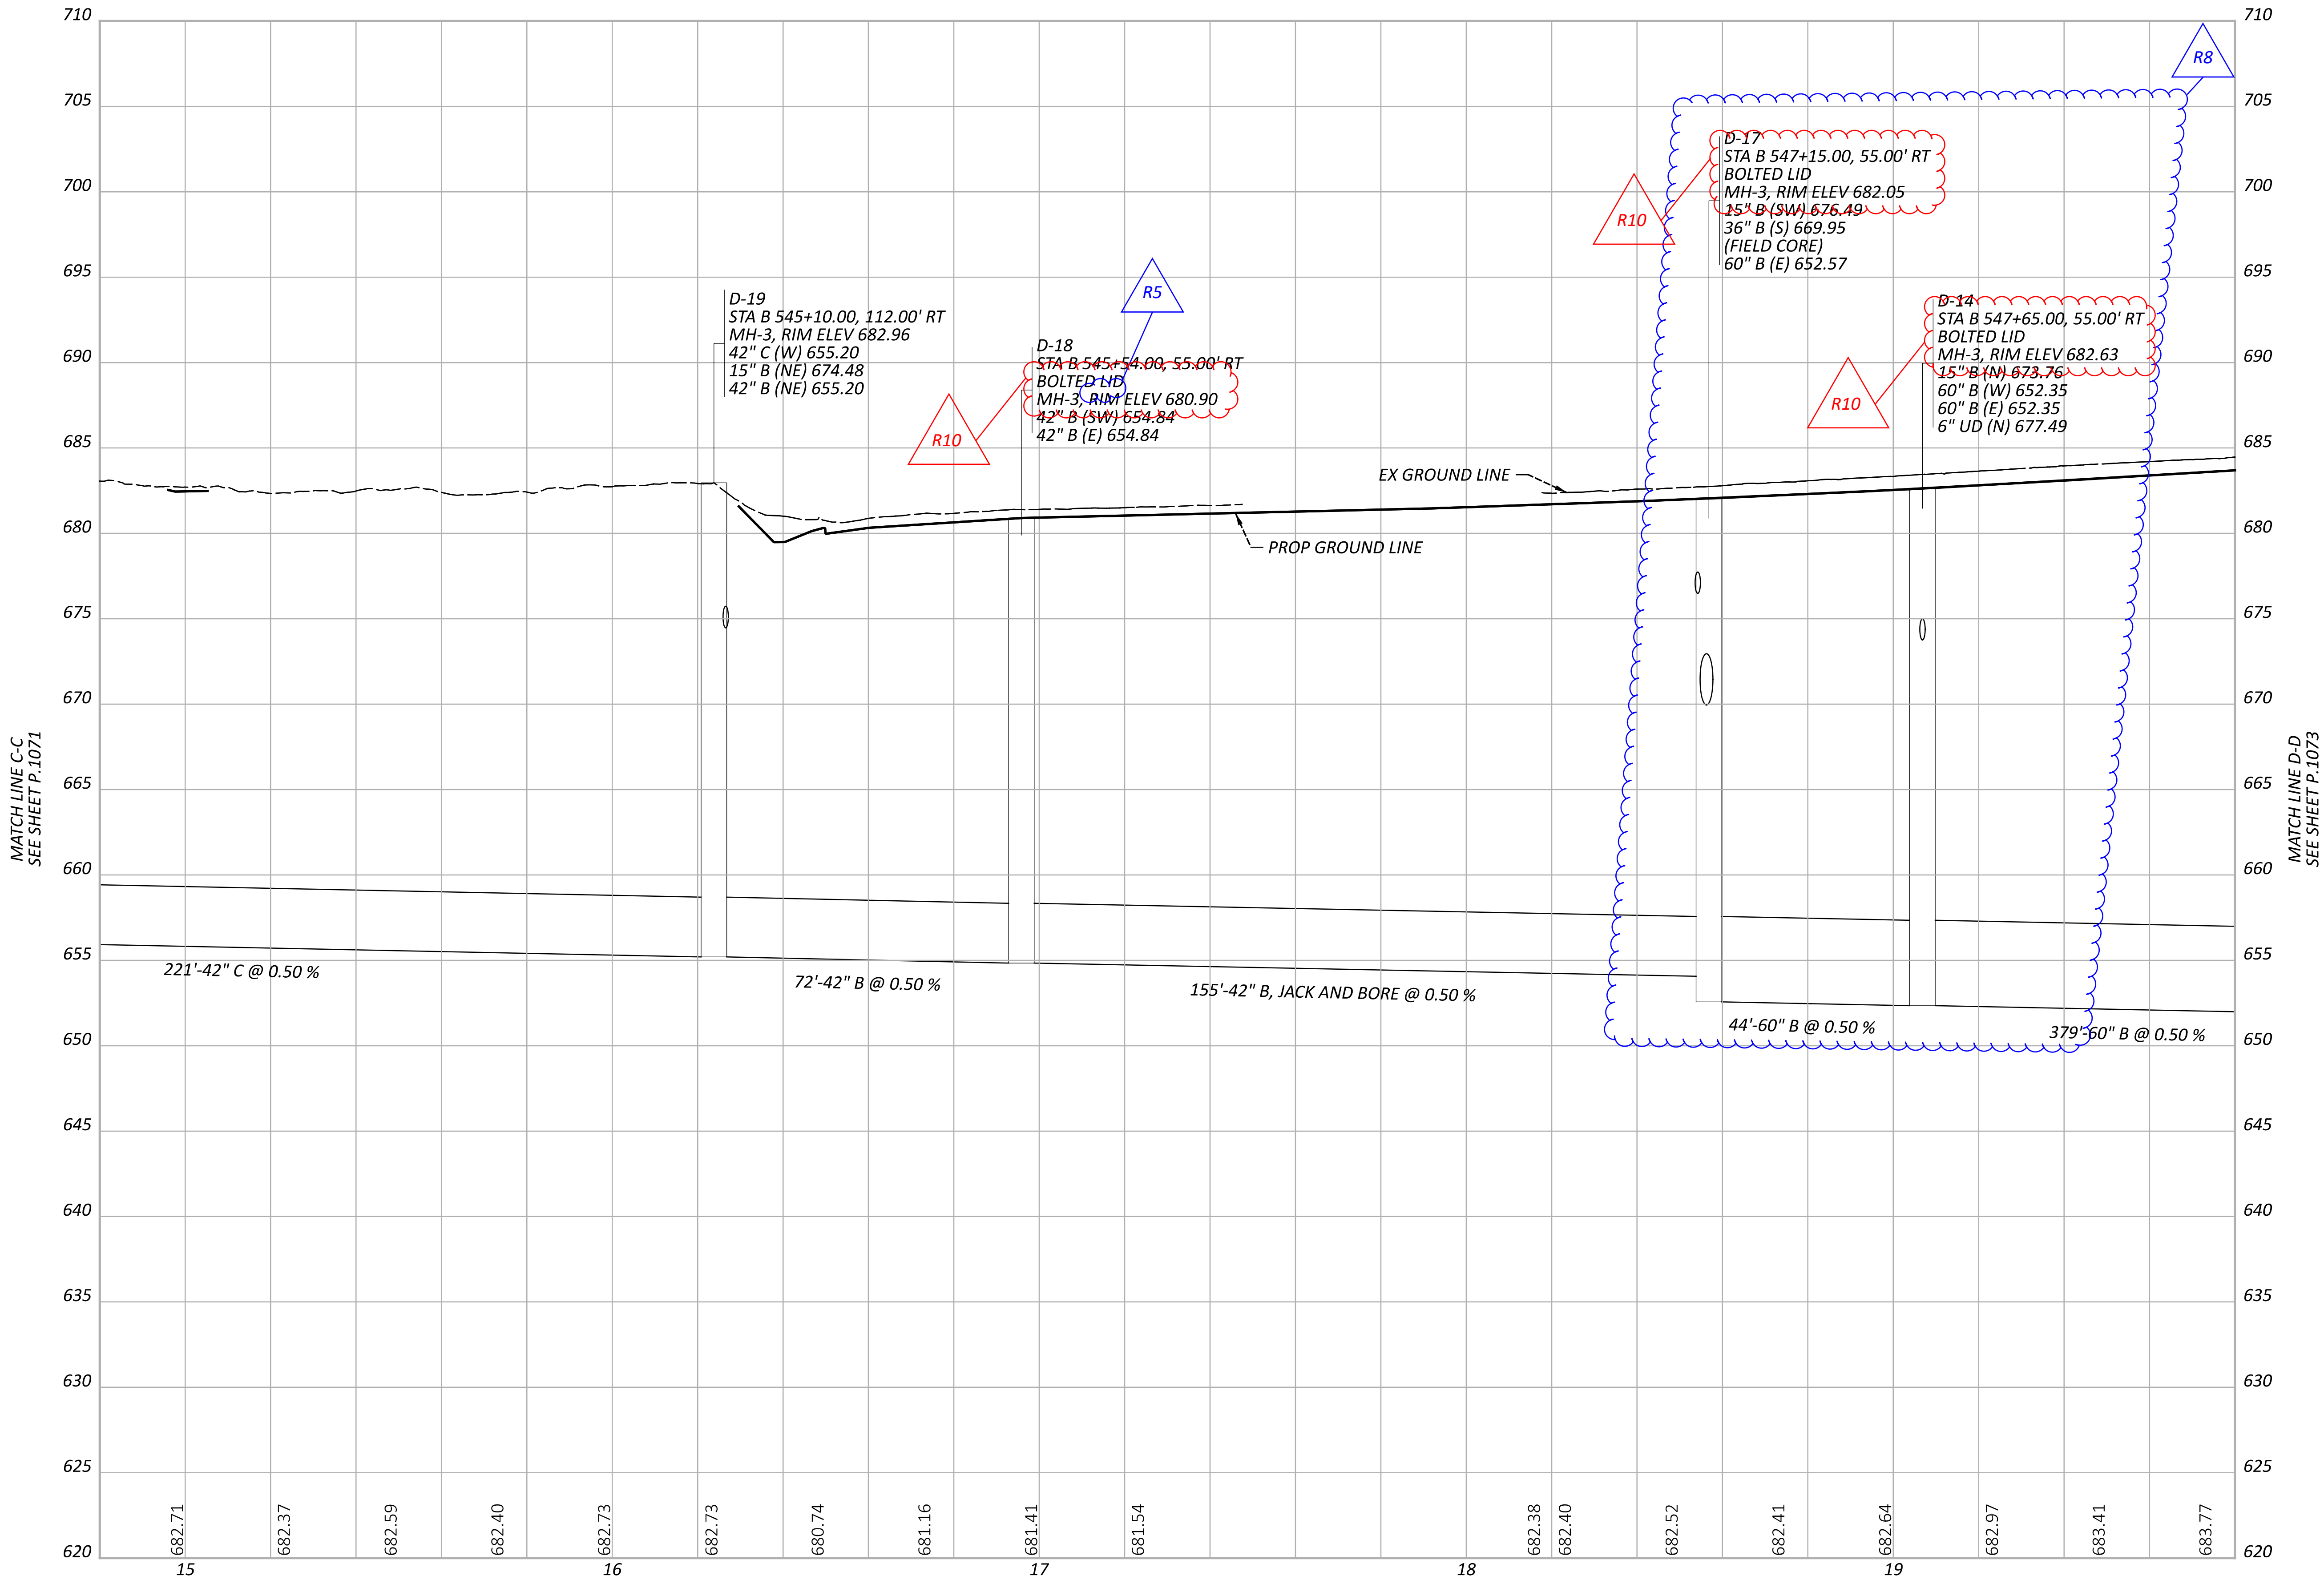


STORM SEWER PROFILES
OUTFALL B

DESIGN AGENCY	
STRUCTUREPOINT	
DESIGNER	
AJO	
REVIEWER	
KEM 08/09/23	
PROJECT ID	
76779	
SHEET	TOTAL
P.1072	P.1587

NOTES:

1. ALL STATIONING TAKEN FROM @ CONST IR 90 UNLESS OTHERWISE NOTED
2. FOR DRAINAGE PLAN SHEETS, SEE SHEET P.1047 - P.1067
3. ALL EXISTING CONNECTIONS TO BE CORED IN THE FIELD
4. ALL PROPOSED PIPES TO BE CONNECTED TO EXISTING SHALL BE FITTED WITH A MASONRY COLLAR PER SCD DM-1.1. COST INCLUDED IN THE UNIT BID PRICE FOR THE PERTINENT CONDUIT ITEM

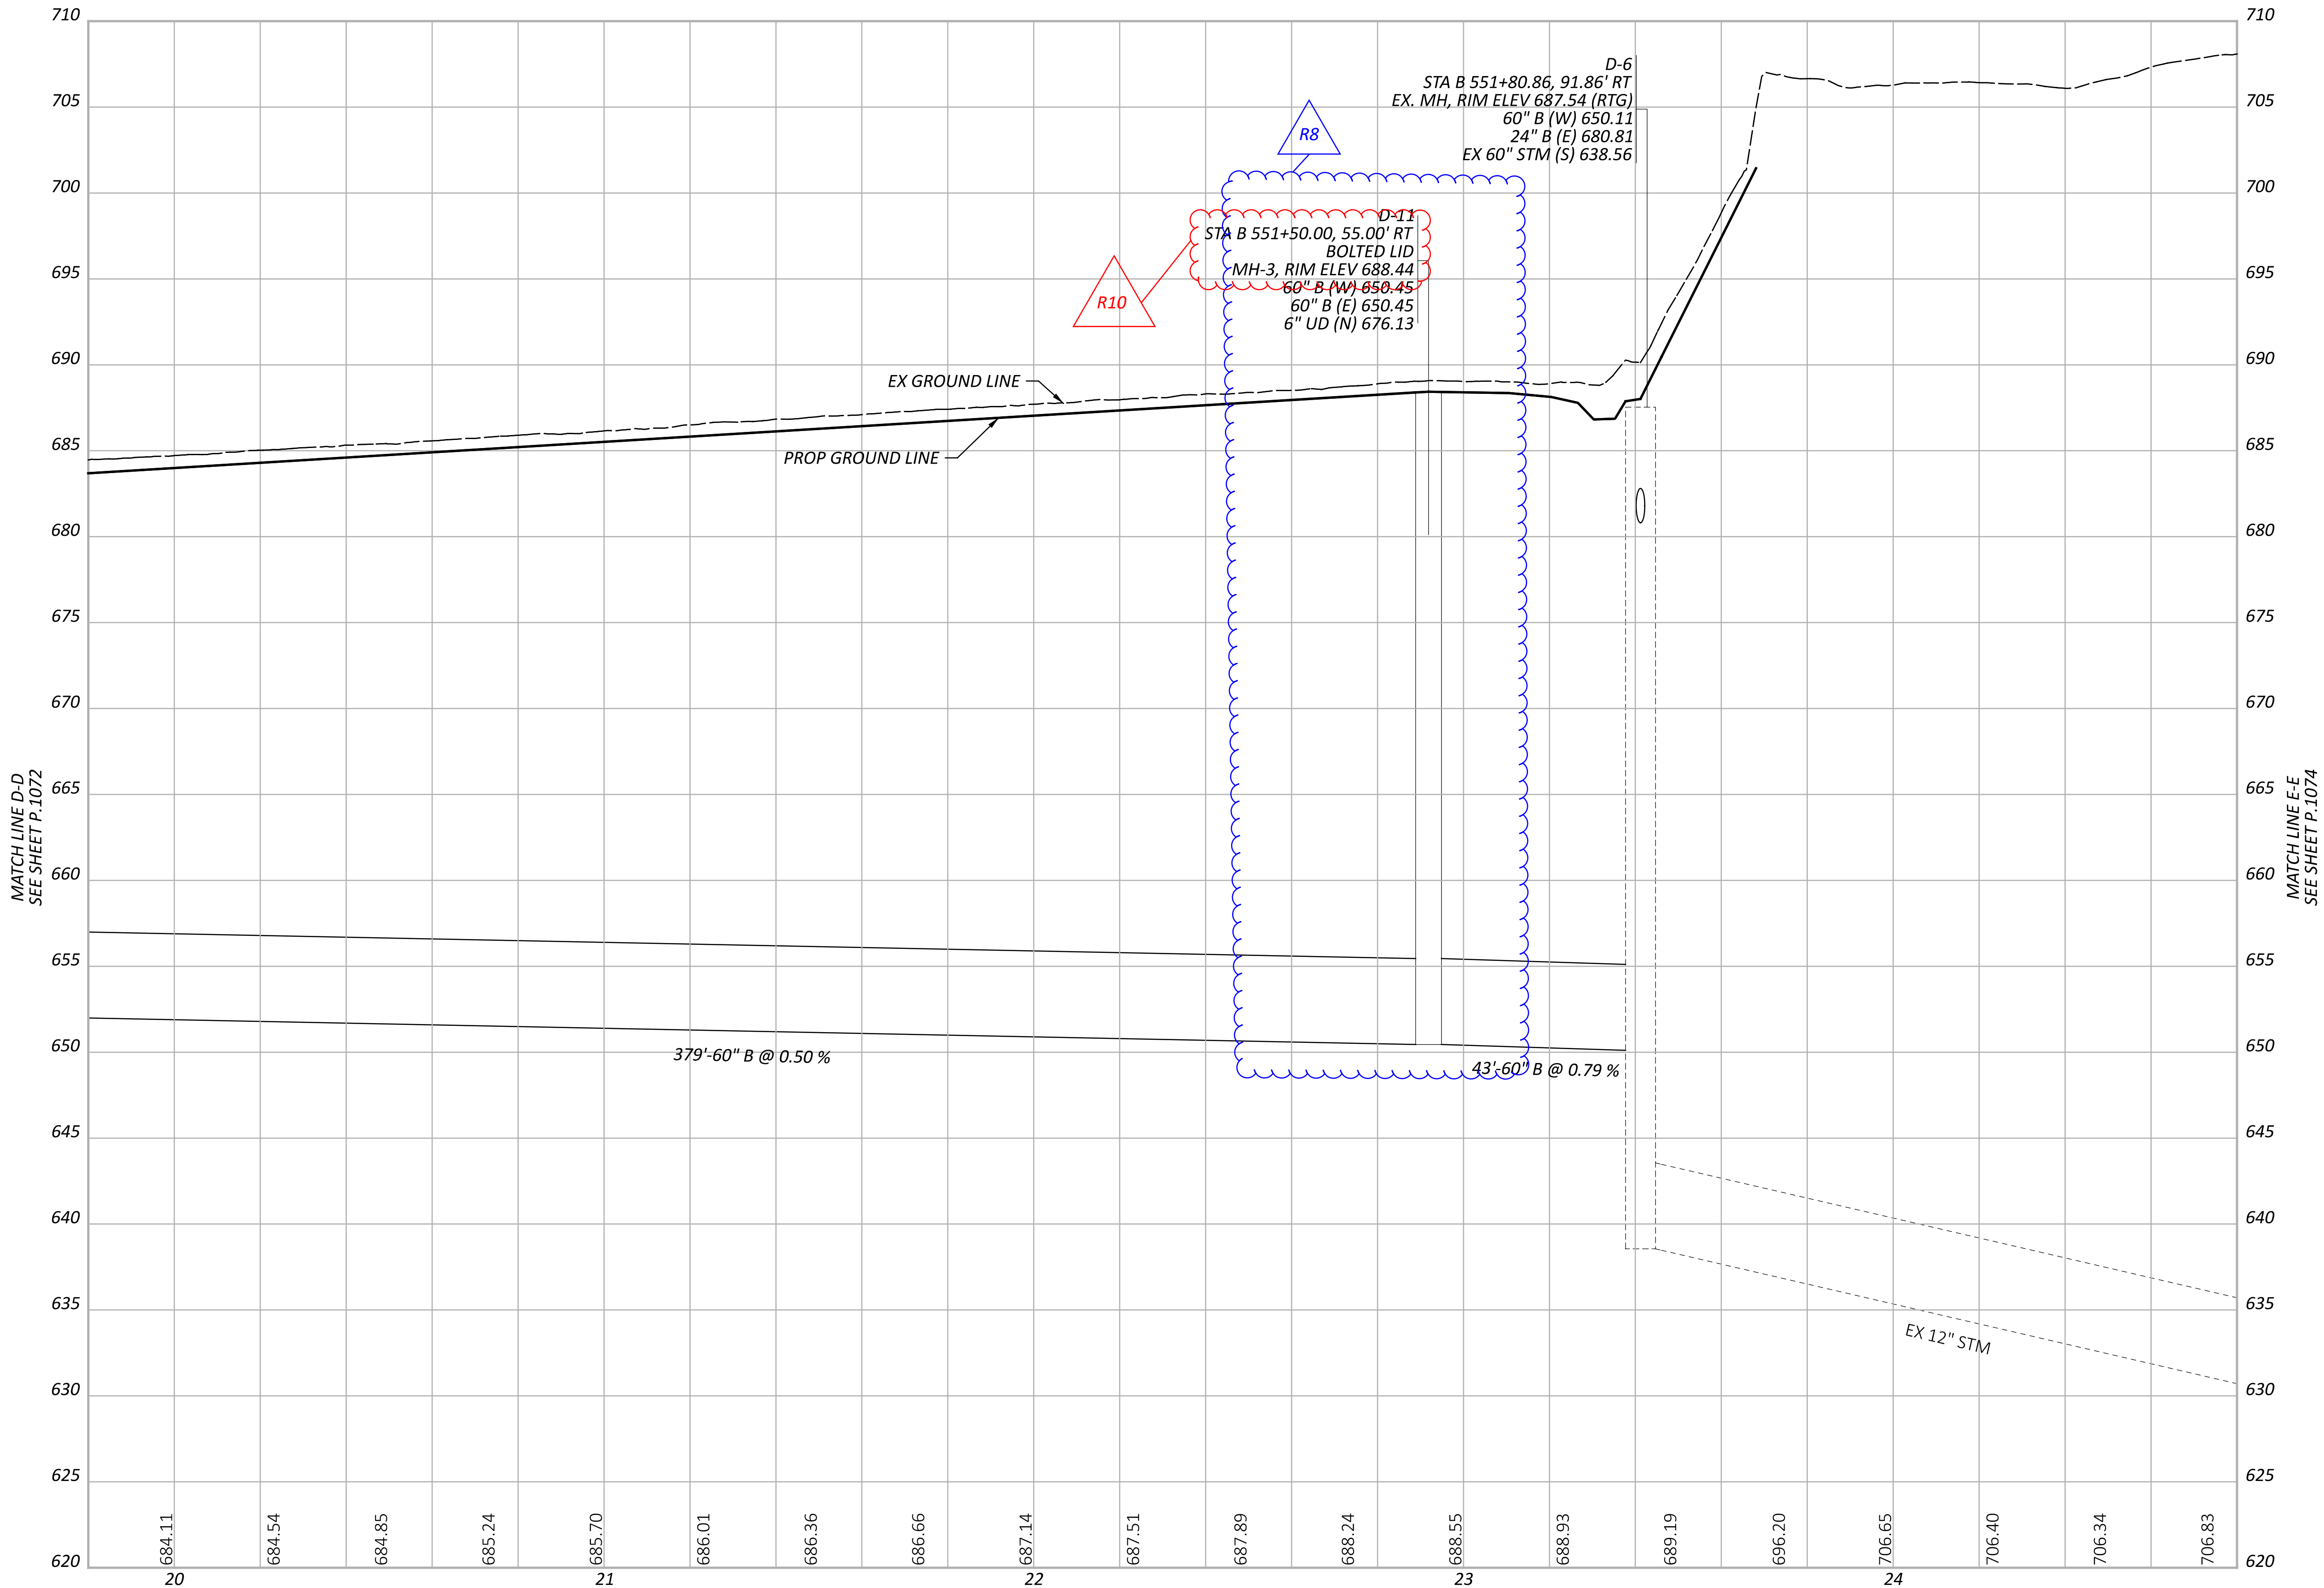

STORM SEWER PROFILES
OUTFALL B

DESIGN AGENCY	
STRUCTUREPOINT	
DESIGNER	
AJO	
REVIEWER	
KEM 08/09/23	
PROJECT ID	
76779	
SHEET	
P.1073	TOTAL
P.1073	P.1587