


WARREN COUNTY

SYCAMORE

SYMMES

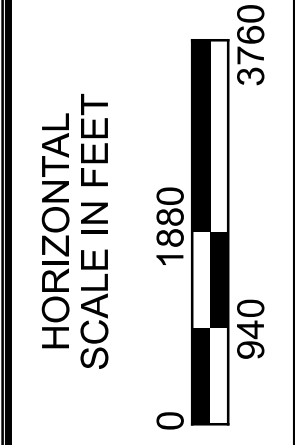

LOCATION MAP
HAM-71/75

DESIGN AGENCY



DESIGNER	NCD
REVIEWER	JDO 08-07-25
PROJECT ID	112574
SHEET	3
TOTAL	34

D08 NOISE WALLS FY2026

MODEL: Sheet PAPER: 34x22 (in.) DATE: 3/13/2026 TIME: 12:37:50 PM USER: ndavis
 p:\vohodo-pw-bentley.com\ohodo-pw-02\Documents\01 Active Projects\District 08_D08\112574\400-Engineering\Roadway\Sheets\112574_REPLACEMENT_NOTES.dgn

ROUTE	PLAN SPLIT	S.L.M					202	202	519	SPECIAL	SPECIAL	SPECIAL	SPECIAL													
		REMOVAL MISC. STEEL POST REMOVAL	REMOVAL MISC. NOISE BARRIER PANEL REMOVAL AND DISPOSAL	PATCHING CONCRETE STRUCTURE AS PER PLAN	NOISE BARRIER (REFLECTIVE) CONCRETE PANEL	NOISE BARRIER PANEL REMOVAL AND REUSE								NOISE BARRIER STEEL POST	NOISE BARRIER FIBERGLASS PANEL											
		REPLACEMENT					EACH	SF		SF	EACH	EACH		SF												
HAM-126	03/NHS	8.24	EB	TO	8.41	EB	3	2592		2592	15	3														
HAM-126	03/NHS	8.74	EB	TO	8.78	EB		192		192	2															
HAM-126	03/NHS	11.11	WB	TO	11.14	WB		384		384	8															
HAM-75	02/IMS	16.84	SB					96		336																
HAM-71	02/IMS	13.15	NB	TO	13.85	NB		1056		1056	26															
GRE-675	02/IMS	6.52	SB	TO	6.90	SB	5	2160			5	2160														
		REHAB																								
HAM-126	03/NHS	8.12	EB	TO	8.34	EB			66																	
HAM-126	03/NHS	8.36	EB	TO	8.43	EB			88																	
HAM-126	03/NHS	8.63	EB	TO	8.78	EB			57																	
HAM-126	03/NHS	9.24	EB	TO	9.24	EB			23																	
HAM-126	03/NHS	11.47	WB	TO	11.10	WB			22																	
HAM-126	03/NHS	8.58	WB	TO	8.56	WB			44																	
BUT-75	02/IMS	2.59	NB	TO	2.64	NB			45																	
BUT-75	02/IMS	4.90	NB						40																	
HAM-71	02/IMS	13.15	NB						2																	
HAM-71	02/IMS	13.20	NB						1																	
HAM-71	02/IMS	13.26	NB						16																	
HAM-71	02/IMS	13.30	NB	TO	13.40	NB			36																	
HAM-71	02/IMS	13.50	NB	TO	13.60	NB			46																	
HAM-71	02/IMS	13.68	NB	TO	13.83	NB			48																	
GRE-675	02/IMS	6.42	NB						20																	
GRE-675	02/IMS	6.58	NB						28																	
GRE-675	02/IMS	6.90	NB						20																	
TOTALS CARRIED TO GENERAL SUMMARY							8	6480	602	4560	51	8	2160													

NOISE WALL SUBSUMMARY

DESIGN AGENCY

 DESIGNER
NCD
 REVIEWER
JDO 08-07-25
 PROJECT ID
112574
 SHEET TOTAL
 11 | 34