

UTILITIES

LISTED BELOW ARE ALL UTILITIES LOCATED WITHIN THE PROJECT CONSTRUCTION LIMITS TOGETHER WITH THEIR RESPECTIVE OWNERS:

ODOT ITS LAB

1606 WEST BROAD STREET
COLUMBUS, OH 43223
614-387-4113
CEN.ITS.LAB@DOT.OHIO.GOV

DUKE ELECTRIC - DISTRIBUTION

139 EAST 4TH STREET, ROOM 467A
CINCINNATI, OHIO 45202
513-514-8209 (CHRIS TEPE)
CHRIS.TEPE@DUKE-ENERGY.COM

DUKE ELECTRIC - TRANSMISSION

139 EAST 4TH STREET, ROOM 552A
CINCINNATI, OHIO 45202
513-287-1266 (TIM MEYER)
TIM.MEYER@DUKE-ENERGY.COM

CINCINNATI METROPOLITAN SEWER DISTRICT

1600 GEST STREET
CINCINNATI, OHIO 45204
513-557-7188 (ROB FRANKLIN)
ROB.FRANKLIN@CINCINNATI-OH.GOV

COGENT COMMUNICATIONS

PAUL BECKER
OVERLAND PARK, KS
815-557-8416
PBECKER@COGENTCO.COM

RAILROAD CONTACT INFORMATION - NORFOLK SOUTHERN RR

ELDRIDGE W. CHAMBERS
SENIOR ENGINEER - PUBLIC IMPROVEMENTS
NORFOLK SOUTHERN CORPORATION
650 PEACHTREE STREET, NW, BOX 45
ATLANTA, GA 30308
(470) 463-6307 (O)
ELDRIDGE.CHAMBERS@NSCORP.COM

CONSTRUCTION NOISE

THIS PROJECT WILL COMPLY WITH ALL LOCAL NOISE ORDINANCES

EXISTING PLANS

EXISTING PLANS ENTITLED HAM-75-9.30 MAY BE INSPECTED IN THE ODOT DISTRICT 8 OFFICE IN LEBANON.

WORK LIMITS

THE WORK LIMITS SHOWN ON THESE PLANS ARE FOR PHYSICAL CONSTRUCTION ONLY. PROVIDE THE INSTALLATION AND OPERATION OF ALL WORK ZONE TRAFFIC CONTROL AND WORK ZONE TRAFFIC CONTROL DEVICES REQUIRED BY THESE PLANS WHETHER INSIDE OR OUTSIDE THESE WORK LIMITS.

CLEARING AND GRUBBING

REMOVE TREES AND ALL VEGETATION WITHIN THE R-O-W LIMITS OF STRUCTURE HAM-75-1192R. SEE SITE PLAN FOR REMOVAL LIMITS. A LUMP SUM QUANTITY IS INCLUDED IN THE GENERAL SUMMARY FOR ITEM 201,CLEARING AND GRUBBING. ALL PROVISIONS ASSET FORTH IN THE SPECIFICATIONS UNDER THIS ITEM ARE INCLUDED IN THE LUMP SUM PRICE BID FOR ITEM 201, CLEARING AND GRUBBING.

DRINKING WATER

THIS PROJECT IS LOCATED IN A DRINKING WATER PROTECTION AREA. IN ORDER TO MINIMIZE THE POTENTIAL FOR CONTAMINATION, THE CONTRACTOR SHALL UTILIZE PROPER CONTAINMENT AND DIKING IN REFUELING AREAS. FUELS, TOXIC/HAZARDOUS MATERIALS, AND CHEMICALS SHALL NOT BE STORED NEAR DRAINAGE WAYS, DITCHES, OR STREAMS. A SPILL KIT IS TO BE MAINTAINED ON-SITE THROUGHOUT CONSTRUCTION ACTIVITIES. THE CONTRACTOR SHALL IMMEDIATELY TAKE STEPS TO MITIGATE ANY EVENT, SUCH AS A SPILL OF FUELS, OILS, OR CHEMICALS, THAT COULD THREATEN TO CONTAMINATE THE DRINKING WATER SUPPLY. ANY SUCH SPILL OR EVENT SHALL BE REPORTED IMMEDIATELY TO THE GREATER CINCINNATI WATER WORKS (513-591-7970). IF THE SPILL IS A REPORTABLE AMOUNT (PER OHIO EPA'S RELEASE REPORTING REQUIREMENTS), THE CONTRACTOR SHALL CONTACT THE LOCKLAND FIRE DEPARTMENT (513-761-2751) OR THE OHIO EPA'S SPILLS HOTLINE (1-800-282-9378) FOR CLEAN-UP OF THE SPILL.

ASBESTOS ABATEMENT

A LICENSED ASBESTOS HAZARD EVALUATION SPECIALIST INSPECTED BRIDGE SFN 3110656 SCHEDULED FOR REHABILITATION; THE ASBESTOS INSPECTION DETERMINED THAT NO ASBESTOS IS PRESENT ON THE BRIDGE STRUCTURE HAM-75-11.92R IN EXCESS OF THE ALLOWABLE REGULATORY LIMITS AND NO ABATEMENT IS REQUIRED.

ELECTRONIC SUBMISSION:

THE CONTRACTOR SHALL SUBMIT ELECTRONICALLY TO OEPA A COMPLETED NOTIFICATION OF DEMOLITION & RENOVATION FORM (NDRF) AND APPLICABLE FEES ALONG WITH THE ASBESTOS SURVEY REPORT. THE COMPLETED NDRF MUST BE SUBMITTED TO OEPA AT LEAST 10 DAYS PRIOR TO ANY DEMOLITION AND RENOVATION ACTIVITY. THE CONTRACTOR IS RESPONSIBLE FOR RETAINING AN ELECTRONIC COPY OF THE NDRF (IN PDF FORM) FOR SUBMISSION TO THE DISTRICT ENVIRONMENTAL STAFF AND ONE HARD COPY TO THE PROJECT ENGINEER.

(GO TO THE OEPA EBUSINESS CENTER AND SUBMIT THE DNRF AND PAYMENT ALONG WITH THE ASBESTOS SURVEY REPORT)

HARD COPY SUBMISSION:

THE CONTRACTOR MAY ELECT TO SUBMIT A HARD COPY OF THE COMPLETED NDRF AND PAYMENT ALONG WITH THE ASBESTOS SURVEY REPORT TO THE FOLLOWING:

ASBESTOS PROGRAM
OHIO EPA, DAPC
P.O. BOX 1049
COLUMBUS, OHIO 43216-1049

OR

ASBESTOS PROGRAM
OHIO EPA, DAPC
50 W TOWN ST, SUITE 700
COLUMBUS, OHIO 43215

IF THE CONTRACTOR ELECTS TO SUBMIT A HARD COPY TO OEPA THEY ARE RESPONSIBLE FOR RETAINING A HARD COPY OF THE NDRF FOR SUBMISSION TO THE DISTRICT ENVIRONMENTAL STAFF AND A HARD COPY TO THE PROJECT ENGINEER.

ITEM 659 - SEEDING AND MULCHING

THIS WORK CONSISTS OF PLACING TOPSOIL, PREPARING THE SEED BED, AND PLACING AND INCORPORATING SEED, AGRICULTURAL LIME, COMMERCIAL FERTILIZER, AND PLACING MULCHING MATERIAL.

PERFORM THIS WORK IN STAGES ACCORDING TO ITEM 207.

PERFORM THIS WORK IN AREAS SHOWN ON THE PLANS FOR SEEDING AND MULCHING. PERFORM SEEDING AND MULCHING AFTER COMPLETING ALL WORK IN THE AREA AND WITHIN 7 DAYS OF OBTAINING FINAL GRADE. IF IT IS ANTICIPATED THAT FUTURE WORK MAY DISTURB AN AREA, PLACE TEMPORARY SEED (CLASS 7), AND PROVIDE MULCH ACCORDING TO ITEM 207 AND PERFORM SEEDING AND MULCHING AFTER ALL WORK IS COMPLETED. IF THE CONTRACTOR DISTURBS A FINAL AREA, THEN THE CONTRACTOR SHALL RESTORE THIS AREA.


USE ALL EXCAVATION MATERIAL IN THE WORK. ALTERNATIVELY LEGALLY USE, RECYCLE, OR DISPOSE OF ALL EXCAVATED MATERIALS ACCORDING TO 105.16 AND 105.17.

ITEM 623 - CONSTRUCTION LAYOUT STAKES AND SURVEYING, AS PER PLAN

PRIOR TO THE START OF ROADWAY OPERATION, THE CONSTRCTOR SHALL REFERENCE THE LENGTH OF THE PROJECT ON BOTH SIDES OF THE ROADWAY, IN A MANNER SATISFACTORY TO THE ENGINEER. THE PAVEMENT SHALL BE REFERENCED IN 500' INCREMENTS, OR IN INCREMENTS ACCEPTABLE TO THE ENGINEER, IN A SEMIPERMANENT CONDITION.

ITEM 253 - PAVEMENT REPAIR

AN ESTIMATED QUANTITY OF 1200 CU YDS OF ITEM 253- PAVEMENT REPAIR HAS BEEN CARRIED TO THE GENERAL SUMMARY TO BE USED AS DIRECTED BY THE ENGINEER. THIS OPERATION SHALL BE PERFORMED BEFORE PAVEMENT PLANING OF ROADWAY.

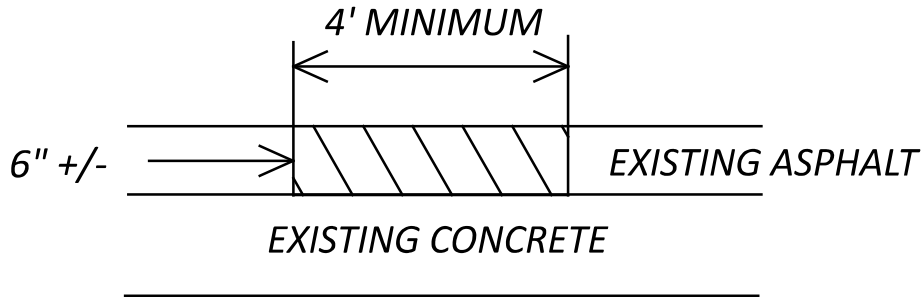

EXISTING DETERIORATED ASPHALT SHALL BE REMOVED TO A DEPTH OF 6" ± (DO NOT DISTURB CONCRETE) OR AS DIRECTED BY THE ENGINEER AND REPLACED WITH ITEM 301, ASPHALT CONCRETE BASE. THE 301 SHALL BE COMPACTED AS PER 401.08E AND IN APPROXIMATELY EQUAL LAYERS. THE LOCATIONS AND SIZE OF THE REPAIRS SHALL BE DETERMINED BY THE ENGINEER.

ITEM 254 - PAVEMENT PLANING

THE PAVEMENT PLANING SHALL BE SCHEDULED SO AS NO TRAFFIC RIDES ON THE PLANED SURFACE. THE COST OF THE ABOVE SHALL BE INCLUDED IN THE UNIT BID PRICE FOR THE RESPECTIVE ITEM. A DISINCENTIVE IN THE AMOUNT OF \$20,000 SHALL BE ASSESSED FOR EACH DAY, OR PORTION THEREOF, A PLANED SURFACE IS OPEN TO TRAFFIC BEYOND THE SPECIFIED TIME LIMIT.

PROFILE AND ALIGNMENT

PLACE THE PROPOSED PAVEMENT TO FOLLOW THE ALIGNMENT AND PROFILE OF THE EXISTING PAVEMENT.

ITEM 621 - RPM REMOVED/REPLACED

I-75
ITEM 621 - RPM 867 EA

THE FOLLOWING QUANTITIES HAVE BEEN CARRIED TO THE GENERAL SUMMARY:

ITEM 621 - RPM 867 EA
ITEM 621 - RPM REMOVED 787 EA

CONTINGENCY QUANTITIES

THE CONTRACTOR SHALL NOT ORDER MATERIALS OR PERFORM WORK LISTED IN THE GENERAL SUMMARY "AS DIRECTED BY THE ENGINEER UNLESS AUTHORIZED BY THE ENGINEER." FOR ITEMS DESIGNATED BY PLAN NOTE TO BE USED. THE ACUTAL WORK LOCATIONS AND QUANTITIES USED AT THE ENGINEER'S DIRECTION SHALL BE MADE A MATTER OF RECORD BY INCORPORATION INTO THE FINAL CHANGE ORDER GOVERNING COMPLETION OF THE PROJECT.

PERMANENT PAVEMENT MARKINGS

THE CONTRACTOR SHALL REFERENCE ALL PAVEMENT MARKINGS INCLUDING AUXILIARY PAVEMENT MARKINGS BEFORE THE START OF THE RESURFACING OPERATION. THIS WILL BE NECESSARY TO ASSURE THE CORRECT PLACEMENT OF MARKINGS IN ORIGINAL LOCATIONS.PAYMENT FOR THIS OPERATION SHALL BE INCLUDED WITH EACHRESPECTIVE PAVEMENT MARKING ITEM.

CURB RAMPS, AS PER PLAN

IN ADDITION TO THE REQUIREMENTS FOR ITEM 608 - CURB RAMP, ALL RESTORATION TO AFFECTED AREAS WITHIN THE CONSTRUCTION LIMITS SHALL BE INCLUDED IN THE UNIT COST INCLUDING ITEM 203, EXCAVATION AND EMBANKMENT AS WELL AS ITEM 659 TOPSOIL, WATER, SEEDING & MULCHING.

CURB RAMP CONSTRUCTION

ALL CURB RAMP WORK INCLUDING THE ASSOCIATED PAVEMENT REPAIRS SHALL BE COMPLETED PRIOR TO RESURFACING

DESIGN AGENCY



DESIGNER

BCP

REVIEWER

JDO 1-17-25

PROJECT ID

120341

SHEET

5

TOTAL

52

ADJACENT PROJECT COORDINATION

PID 117525 (I-75 RECONSTRUCTION) AND PID 120341 (I-75 MILL/FILL WITH BRIDGE REHAB) WILL BE UNDER CONSTRUCTION AT THE SAME TIME. BOTH PRJECTS WILL HAVE LANE CLOSURES EXTENDING INTO THE OTHER ADJACENT PROJECT. THE CONTRACTORS SHALL COORDINATE THEIR WORK AND MOT WITH THE ADJACENT PROJECT; WORK AND MOT ON EACH PROJECT WILL GOVERN AND CONTROL AS DESCRIBED BELOW:

PID 117525 - THE MOT NECESSARY TO PERFORM PRE-PHASE 1 WORK AND IMPLEMENT PHASE 1 MOT TRAFFIC SWITCH IN BOTH DIRECTIONS WILL GOVERN AND CONTROL.

PID 120341 - BEGINNING 14 DAYS AFTER PID 117525 PLACES I-75 TRAFFIC IN PHASE 1 MOT, THE WORK AND MOT ON PID 120341 WILL GOVERN AND CONTROL. THE 14-DAY PERIOD IS TO ALLOW FULL IMPLEMENTATION OF PHASE 1 AND APPLIES TO EACH DIRECTION INDEPENDENTLY. IT IS ANTICIPATED THAT PID 117525 PHASE 1 TRAFFIC SWITCH IS JUNE 2026.

Removed ITEM Special Structures - Consultant for Concrete Quality Control Including Testing and Inspection Note



DESIGN AGENCY

DESIGNER
BCP

REVIEWER
AS 12-20-24

PROJECT ID
120341

SHEET	TOTAL
6	52

GENERAL NOTES

WORK ZONE MARKINGS AND SIGNS

THE FOLLOWING ESTIMATED QUANTITIES HAVE BEEN CARRIED TO THE GENERAL SUMMARY FOR USE AT LOCATIONS IDENTIFIED BY THE ENGINEER FOR WORK ZONE PAVEMENT MARKINGS AND SIGNS PER THE REQUIREMENTS OF C&MS 614.04 AND 614.11.

EXISTING PAVEMENT

ITEM 614, WORK ZONE EDGE LINE, CLASS I, 642 PAINT (WHITE), 0.43 MILES

ITEM 614, WORK ZONE LANE LINE, CLASS I, 642 PAINT, 1.8 MILES

PAVEMENT PATCHING

ITEM 614, WORK ZONE EDGE LINE, CLASS I, 642 PAINT (WHITE), 0.03 MILES

ITEM 614, WORK ZONE LANE LINE, CLASS I, 642 PAINT, 0.03 MILES

SURFACE COURSE RESURFACING

ITEM 614, WORK ZONE EDGE LINE, CLASS I, 642 PAINT (WHITE), 9.45 MILES

ITEM 614, WORK ZONE LANE LINE, CLASS I, 642 PAINT, 7.86 MILES

ITEM 614, WORK ZONE DOTTED LINE, CLASS I, 642 PAINT, 336 FEET

ITEM 614, WORK ZONE TRANSVERSE/DIAGONAL LINE, CLASS I, 642 PAINT, 1293 FEET

ITEM 614, WORK ZONES STOP LINE, CLASS I, 642 PAINT, 69 FEET

TRANSPORTATION MANAGEMENT PLAN - DESIGNATED TRAINED PERSON

TRANSPORTATION MANAGEMENT PLAN – DESIGNATED TRAINED PERSON ACCESS MANAGEMENT FOR DAILY/NIGHTLY WORK OPERATIONS ACCESS MANAGEMENT IS PART OF THE CONTRACTOR’S MEANS AND METHODS. IT IS ANTICIPATED THAT EQUIPMENT WILL BE TRAILERED IN/OUT OF THE WORK AREA OR DRIVEN ACROSS LANES OF TRAFFIC SINCE THE MEDIAN BARRIER RESTRICTS AVAILABLE STAGING AREAS. IF THE CONTRACTOR ELECTS TO CROSS OPEN LANES OF TRAVEL, MT-99.60 IS THE GOVERNING STANDARD EXCEPT AS FOLLOWS:

THE SHORT DURATION CLOSURE IS PERMITTED TO BE PERFORMED BETWEEN 10:00 PM AND 5:00 AM; THE DURATION OF THE CLOSURE SHALL NOT EXCEED 5 MINUTES; AND ALL EQUIPMENT SHALL CROSS PERPENDICULAR TO THE ROAD. REMOVE, TURN, OR COVER ALL SIGNS USED IN THE SHORT-DURATION CLOSURE IF THE NEXT SHORT-DURATION CLOSURE WILL OCCUR MORE THAN 2 HOURS LATER. THIS INCLUDES TURNING OFF OR REVISING THE MESSAGE ON THE PORTABLE CHANGEABLE MESSAGE SIGN. ALL COSTS ASSOCIATED WITH ACCESS MANAGEMENT INCLUDING LAW ENFORCEMENT OFFICERS AND PORTABLE CHANGEABLE MESSAGE SIGNS SHALL BE INCLUDED IN THE LUMP SUM CONTRACT PRICE FOR ITEM 614, MAINTAINING TRAFFIC.

LANE VALUE CONTRACT TABLE

DESCRIPTION OF CRITICAL LANE/RAMP TO BE MAINTAINED	RESTRICTED TIME PERIOD	TIME UNIT	
ALL LANES ON I-75 OPEN TO TRAFFIC (VARIOUS LOCATIONS)	SEE PERMITTED LANE CLOSURE SCHEDULE	1 MINUTE	\$450
ONE LANE TWO-WAY TRAFFIC BY USE OF FLAGGERS ON LOCAL ROADS	NONE	1 MINUTE	\$20
LOCAL RAMPS TO/FROM I-75 (NOT INCLUDING SR 126)	5 AM TO 10 PM	1 MINUTE	\$70
WYOMING AVENUE: ALL LANES OPEN TO TRAFFIC	6 AM TO 8 PM	1 MINUTE	\$40

TRANSPORTATION MANAGEMENT PLAN - DESIGNATED TRAINED PERSON

TRANSPORTATION MANAGEMENT PLAN – DESIGNATED TRAINED PERSON ENSURE ALL INDIVIDUALS CONTRACTED BY, SECURED BY, DIRECTED BY OR EMPLOYED BY THE CONTRACTOR WHOM ARE INVOLVED IN THE DEVELOPMENT, DESIGN, IMPLEMENTATION, OPERATION, INSPECTION AND ENFORCEMENT OF WORK ZONE RELATED TRANSPORTATION MANAGEMENT AND TRAFFIC CONTROL HAVE BEEN TRAINED APPROPRIATE TO THE JOB DECISIONS EACH INDIVIDUAL IS REQUIRED TO MAKE. REPEAT TRAINING IN INTERVALS OF NO MORE THAN 5 YEARS TO REFLECT CHANGING PRACTICES.

DESIGNATE A TRAINED PERSON AT THE PROJECT LEVEL THAT HAS THE PRIMARY RESPONSIBILITY AND SUFFICIENT AUTHORITY FOR IMPLEMENTING AND MAINTAINING THE TRANSPORTATION MANAGEMENT PLAN (TMP) AND OTHER SAFETY AND MOBILITY ASPECTS OF THE PROJECT. FOR INFORMATION AND REQUIREMENTS REGARDING TMPs AND RELATED COMPONENTS SEE ODOT TRAFFIC MANAGEMENT IN WORK ZONES POLICY (21-008(P)) AND STANDARD PROCEDURE (123-001(SPI)). MAINTAIN A 24-HOUR CONTACT FOR THE DESIGNATED TRAINED PERSON AND PROVIDE THIS CONTACT INFORMATION TO THE ENGINEER AT THE PRECONSTRUCTION CONFERENCE. THE DESIGNATED TRAINED PERSON SHALL BE PRESENT ON SITE FOR, AND INVOLVED WITH, EACH TEMPORARY TRAFFIC CONTROL SET UP/TAKE DOWN AND EACH PHASE CHANGE.

THE DUTIES OF THE DESIGNATED TRAINED PERSON ARE AS FOLLOWS:

- BE AVAILABLE ON A 24-HOUR PER DAY BASIS IN ACCORDANCE WITH CMS 614.03.
- BE AWARE OF ALL EXISTING AND PROPOSED TTC OPERATIONS OF THE CONTRACTOR, SUBCONTRACTORS AND SUPPLIERS, AND ENSURE COORDINATION OCCURS BETWEEN THEM TO ELIMINATE CONFLICTING TEMPORARY AND/OR PERMANENT TRAFFIC CONTROL.
- BE PRESENT, ON SITE FOR, AND INVOLVED WITH, EACH TEMPORARY TRAFFIC CONTROL (TTC) SET UP/TAKE DOWN AND EACH PHASE CHANGE IN ACCORDANCE WITH CMS 614.03.
- ENSURE THAT THE TTC ZONE AND ALL RELATED DEVICES ARE INSTALLED, MAINTAINED AND REMOVED IN COMPLIANCE WITH THE CONTRACT DOCUMENTS.
- FACILITATE CORRECTIVE ACTION(S) NECESSARY TO BRING DEFICIENT TTC ZONES AND ALL RELATED DEVICES INTO COMPLIANCE WITH CONTRACT DOCUMENTS IN THE TIMEFRAME DETERMINED BY THE ENGINEER.

THE DEPARTMENT WILL DEDUCT:

A. THE PRORATED DAILY AMOUNT OF ITEM 614 MAINTAINING TRAFFIC FOR ANY DAY IN WHICH THE DESIGNATED TRAINED PERSON FAILS TO PERFORM THE DUTIES SET FORTH ABOVE. THE PRORATED DAILY AMOUNT WILL BE EQUAL TO THE ORIGINAL BID AMOUNT FOR ITEM 614 MAINTAINING TRAFFIC DIVIDED BY THE DIFFERENCE BETWEEN THE ORIGINAL COMPLETION DATE AND THE FIRST DAY OF WORK, IN CALENDAR DAYS.

B. 1% OF THE ORIGINAL BID AMOUNT FOR ITEM 614 MAINTAINING TRAFFIC FOR ANY DAY THAT A TTC ISSUE IS IDENTIFIED IN THE FIELD AND IS NOT CORRECTED IN THE GIVEN TIMEFRAME PER THE ENGINEER. DEDUCTION B SHALL NOT APPLY TO SITUATIONS COVERED BY DEDUCTION C.

C. 1% OF THE ORIGINAL BID AMOUNT FOR ITEM 614 MAINTAINING TRAFFIC FOR ANY DAY THAT A LANE OR RAMP IS BLOCKED (FULLY OR PARTIALLY) WITHOUT TTC, AS DETERMINED BY THE ENGINEER. THIS DEDUCTION SHALL BE IN ADDITION TO ANY OTHER DISINCENTIVES ESTABLISHED FOR UNAUTHORIZED LANE USE. FOR DAYS IN WHICH MORE THAN ONE DEDUCTION LISTED ABOVE OCCUR, THE HIGHEST DEDUCTION AMOUNT WILL APPLY. PAYMENT FOR THE ABOVE REQUIREMENTS, RESPONSIBILITIES AND DUTIES SHALL BE INCLUDED IN THE LUMP SUM PRICE BID FOR ITEM 614, MAINTAINING TRAFFIC.

INTERIM COMPLETION REQUIREMENTS

THE PROJECT HAS AN INTERIM COMPLETION DATE OF 10/1/2025. ALL WORK, INCLUDING PAVEMENT REPAIRS AND RESURFACING, THAT STARTS IN CALENDAR YEAR 2025 SHALL BE COMPLETED WITH THE ENTIRE PAVEMENT WIDTH AND THE ENTIRE PROJECT LENGTH ON/OR BEFORE THE INTERIM COMPLETION DATE. THIS REQUIREMENT APPLIES TO EACH DIRECTION OF I-75 INDIVIDUALLY. ON/OR BEFORE THE INTERIM COMPLETION DATE, THE ROADWAY SHALL BE PLACED IN THE FINAL CONDITION WITH ALL PAVEMENT MARKINGS AND RAISED PAVEMENT MARKERS IN PLACE AND OPEN TO TRAFFIC. THIS INTERIM COMPLETION REQUIREMENT DOES NOT APPLY TO GROOVED RECESSED PAVEMENT MARKINGS.

THE CONTRACTOR SHALL BE ASSESSED A DAILY DISINCENTIVE IN THE AMOUNT OF \$3,500 PER DAY FOR FAILURE TO COMPLETE ALL THE REQUIRED WORK AND ASSOCIATED INCIDENTALS REALTED TO THE WORK. DAILY DISINCENTIVES ARE APPLICABLE TO THE WORK REQUIRED TO THE INTERIM COMPLETION DATE ONLY. THE CONTRACTOR IS STILL SUBJECT TO LIQUIDATED DAMAGES AS OUTLINED IN CMS 108.07 FOR THE REMAINDER OF THE CONTRACT.

DESCRIPTION OF CRITICAL LANE/RAMP TO BE MAINTAINED	COMPLETION DATE	TIME UNIT	DISINCENTIVE \$ PER TIME PERIOD
I-75 IN EITHER DIRECTION: WORK STARTED IN 2025 SHALL BE COMPLETED IN THE ENTIRETY OF THAT DIRECTION INCLUDING RPMs	10/1/2025	DAY	\$3,500

ITEM 900, SPECIAL - RAILROAD FLAGGING SERVICES

FLAGGING FOR WORK ON RAILROAD RIGHT OF WAY SHALL BE COORDINATED, OBTAINED AND PAID FOR BY THE CONTRACTOR. REQUIRED BY THE NORFOLK SOUTHERN SPECIAL PROVISIONS FOR THE PROTECTION OF RAILWAY INTEREST. NORFOLK SOUTHERN SHALL APPROVE THE FLAGGING SERVICE PROVIDER AND THEIR STAFF

NORFOLK SOUTHERN HAS THE SOLE AUTHORITY TO DETERMINE THE NEED FOR PROTECTION SERVICES TO PROTECT ITS OPERATIONS IN GENERAL. THE REQUIREMENTS OF SUCH SERVICES WILL BE WHENEVER THE CONTRACTOR’S PERSONNEL OR EQUIPMENT ARE OR ARE LIKELY TO BE, WORKING ON THE RAILROAD’S RIGHT OF WAY, OR ACROSS, OVER, ADJACENT TO, OR UNDER A TRACK, OR WHEN SUCH WORK HAS DISTURBED OR IS LIKELY TO DISTURB A RAILROAD STRUCTURE OR THE RAILROAD ROADBED OR SURFACE AND ALIGNMENT OF ANY TRACK TO SUCH EXTENT THAT THE MOVEMENT OF TRAINS MUST BE CONTROLLED BY FLAGGING.

THE TOTAL DOLLARS IN THE ESTIMATED QUANTITIES IS BASED UPON AN ESTIMATE OF TOTAL FLAGGING DOLLARS NEEDED TO COMPLETE THE PLANNED WORK.

ONLY THE FOLLOWING CERTIFIED FLAGGING PROVIDERS ARE ACCEPTABLE BY NORFOLK SOUTHERN:

RAILPROS

FIELD SUPPORT TEAM
877-315-0513 (OPTION 1)
NS.INFO@RAILPROS.COM
ADAM BROWN
334-530-2861
ADAM.BROWN@RAILPROS.COM

R&R CONSULTING TEAM

DAVID N. CRAFT
PO BOX 4739
HARRISBURG, PA 17111
717-497-4373 (CELL)
775-521-2495 (E-FAX)
DCRAFT@RRCONSULTINGTEAM.COM
WWW.RRCONSULTINGTEAM.COM

NORTH CAROLINA RAILROAD COMPANY

PP@NCRR.COM
JOHN GASS
JGASS@NCRR.COM; 864-504-0455
HTTPS://WWW.NCRR.COM/

PAYMENT FOR CERTIFIED FLAGGING PROVIDERS WILL BE MADE PER ITEM 900, SPECIAL - RAILROAD FLAGGING SERVICES, EACH BASED UPON THE INVOICES RECEIVED FROM THE FLAGGING SERVICE FOR THE DOLLARS USED, INCLUDING A FIVE PERCENT MARKUP FOR CONRACOTR OVERHEAD FOR ADMINSTERING THE CONTRACT WITH THE FLAGGING SERVICE. AN ESTIMATED QUANTITY OF \$5000 HAS BEEN CARRIED TO THE GENERAL SUMMARY.

IN THE EVENT THE PROJECT IS DELAYED DUE TO RAILROAD FLAGGER AVAILABILITY, THE CONTRACTOR WILL PROVIDE DOCUMENTATION SUPPORTING THEIR EFFORTS TOSCHEDULE A FLAGGER FROM THE FLAGGING SERVICE.

WORK ZONE MARKINGS AND SIGNS

THE FOLLOWING ESTIMATED QUANTITIES HAVE BEEN CARRIED TO THE GENERAL SUMMARY FOR USE AT LOCATIONS IDENTIFIED BY THE ENGINEER FOR WORK ZONE PAVEMENT MARKINGS AND SIGNS PER THE REQUIREMENTS OF C&MS 614.04 AND 614.11.

SURFACE COURSE:
ITEM 614-WZ EDGE LINE, CLASS I, 642 PAINT - 9.41 MILES
ITEM 614-WZ LANE LINE, CLASS I, 6", 642 PAINT - 7.82 MILES
ITEM 614-WZ CHANNELIZING LINE, CLASS I, 12", 642 PAINT - 5125 FEET
ITEM 614-WZ DOTTED LINE, CLASS I, 6", 642 PAINT - 5787 FEET
ITEM 614-WZ STOP LINE, CLASS I, 642 PAINT - 69 FEET
ITEM 614-WZ TRANSVERSE/DIAGONAL LINE, CLASS 1, 642 PAINT - 635 FEET

DESIGN AGENCY



DESIGNER

BCP

REVIEWER

SRK 01-10-25

PROJECT ID

120341

SHEET

9

TOTAL

52

PHASE NO.	SHEET NO.	STATION		SIDE	LENGTH (FEET)	614							621		622
						WORK ZONE GATING IMPACT ATTENUATOR, 24" WIDE HAZARDS (UNI-DIR.)	BARRIER REFLECTOR, TYPE 1 (BI-DIR.)	OBJECT MARKER, ONE-WAY	WORK ZONE EDGE LINE, CLASS I, 642 PAINT (WHITE)	WORK ZONE LANE LINE, CLASS I, 6", 642 PAINT	WORK ZONE DOTTED LINE, CLASS I, 6" , 642 PAINT		RPM		PORTABLE BARRIER, UNANCHORED
		FROM	TO			EACH	EACH	EACH	MILE	MILE	FEET		EACH		FT
1	13-14	195+36	197+25	RT	189	1	4	4	0.04				2		189
1	15	204+00	207+50	RT	350	1	7	7	0.07				3		150
2	16-19	178+65	199+65	LT	2100					0.9	2100		39		
2	16-19	178+65	199+65	RT	2100					0.9	2100		39		
2	16-19	178+65	185+80	LT	715				0.14				6		
2	17	185+50	188+00	LT	250	1	5	5							250
2	18-19	194+75	196+65	LT	190	1	4	4							190
2	17-18	195+65	199+65	LT	400	1			0.08				3		
TOTALS CARRIED TO GENERAL SUMMARY						5	20	20	0.31	1.8	4200		92		779

SHEET NUMBER											PART.			ITEM	ITEM EXT	GRAND TOTAL	UNIT	DESCRIPTION	SEE SHEET NO.
5	8	9	11	22	23	24	29	31	40		01/IMS	02/IMS	03/IMS						
									1		1			832	30000	1	EACH	EROSION CONTROL	
																		EROSION CONTROL	
																		ENVIRONMENTAL / REMEDIATION	
											LUMP			SPECIAL	69071000	LS		ASBESTOS ABATEMENT, SUBMITTAL OF OEPA NOTIFICATION OF DEMOLITION OR REMOVAL FORM	
																		ROADWAY	
											LUMP			201	11000	LS		CLEARING AND GRUBBING	
					442							442		202	30000	442	SF	WALK REMOVED	
					58							58		202	32000	58	FT	CURB REMOVED	
													LUMP	SPECIAL	69098400	LS		CONSULTANT FOR CONCRETE QUALITY CONTROL INCLUDING TESTING AND INSPECTION	
					161							161		608	10000	161	SF	4" CONCRETE WALK	
					249							249		608	52001	249	SF	CURB RAMP, AS PER PLAN	
					57							57		609	26000	57	FT	CURB, TYPE 6	
																		PAVEMENT	
1,200												1,200		253	02000	1,200	CY	PAVEMENT REPAIR	
				2								2		253	02001	2	CY	PAVEMENT REPAIR, AS PER PLAN	
				147,834								147,834		254	01000	147,834	SY	PAVEMENT PLANING, ASPHALT CONCRETE, 1.50"	
				1,488								1,488		254	01600	1,488	SY	PATCHING PLANED SURFACE	
				22,175								22,175		407	20000	22,175	GAL	NON-TRACKING TACK COAT	
				4,345								4,345		441	00100	4,345	CY	ANTI-SEGREGATION EQUIPMENT	
				6,249								6,249		442	10300	6,249	CY	ASPHALT CONCRETE SURFACE COURSE, 12.5 MM, TYPE A (447)	
				10.23								10.23		618	40600	10.23	MILE	RUMBLE STRIPS, SHOULDER (ASPHALT CONCRETE)	
				352								352		617	10100	352	CY	COMPACTED AGGREGATE	
				6,343								6,343		617	20000	6,343	SY	SHOULDER PREPARATION	
				7								7		617	25000	7	MGAL	WATER	
																		TRAFFIC CONTROL	
867			92								92	867		621	00100	959	EACH	RPM	
787			92								92	787		621	54000	879	EACH	RAISED PAVEMENT MARKER REMOVED	
						7						7		644	01360	7	EACH	WRONG WAY ARROW	
						69						69		644	00500	69	FT	STOP LINE	
						1,028						1,028		644	00720	1,028	FT	CHEVRON MARKING	
						6						6		644	01300	6	EACH	LANE ARROW	
						635						635		644	00700	635	FT	TRANSVERSE/DIAGONAL LINE	
						9.41						9.41		807	10010	9.41	MILE	WET REFLECTIVE TRAFFIC PAINT, EDGE LINE, 6"	
						7.82						7.82		807	10110	7.82	MILE	WET REFLECTIVE TRAFFIC PAINT, LANE LINE, 6"	
						5,125						5,125		807	10310	5,125	FT	WET REFLECTIVE TRAFFIC PAINT, CHANNELIZING LINE, 12"	
						5,787						5,787		807	10410	5,787	FT	WET REFLECTIVE TRAFFIC PAINT, DOTTED LINE, 6"	
						17.23						17.23		850	10010	17.23	MILE	GROOVING FOR 6" RECESSED PAVEMENT MARKING, (ASPHALT)	
						10,912						10,912		850	10130	10,912	FT	GROOVING FOR 12" RECESSED PAVEMENT MARKING, (ASPHALT)	
																		MAINTENANCE OF TRAFFIC	
				400							400			614	11110	400	hour	LAW ENFORCEMENT OFFICER WITH PATROL CAR FOR ASSISTANCE	
			5								5			614	12380	5	EACH	WORK ZONE IMPACT ATTENUATOR, 24" WIDE HAZARDS, (UNIDIRECTIONAL)	
			20								20			614	13310	20	EACH	BARRIER REFLECTOR, TYPE 1 (BI-DIRECTIONAL)	
			20								20			614	13360	20	EACH	OBJECT MARKER, TWO WAY	
	10											10		614	18601	10	SNMT	PORTABLE CHANGEABLE MESSAGE SIGN, AS PER PLAN, ASSUMING 2 PCMS	8
		7.82	0.31								0.31	7.82		614	20110	8.13	MILE	WORK ZONE LANE LINE, CLASS I, 6", 642 PAINT	
		9.41	1.8								1.8	9.41		614	22110	11.21	MILE	WORK ZONE EDGE LINE, CLASS I, 6", 642 PAINT	
		5,125										5,125		614	23200	5,125	FT	WORK ZONE CHANNELIZING LINE, CLASS I, 8", 642 PAINT	
		5,787	4,200								4,200	5,787		614	24202	9,987	FT	WORK ZONE DOTTED LINE, CLASS I, 6", 642 PAINT	
		635										635		614	25200	635	FT	WORK ZONE TRANSVERSE/DIAGONAL LINE, CLASS I, 642 PAINT	
		69										69		614	26200	69	FT	WORK ZONE STOP LINE, CLASS I, 642 PAINT	
			779								779			622	41100	779	FT	PORTABLE BARRIER, UNANCHORED	
	10											10		896	00010	10	SNMT	PORTABLE NON-INTRUSIVE TRAFFIC SENSOR, CLASS I, 8 SENSORS	
	10											10		896	00020	10	SNMT	PORTABLE CHANGEABLE MESSAGE SIGN, 2 PCMS	
																		STRUCTURE REPAIR (HAM-IR 75-11.02R)	
								2					2	519	12300	2	SY	PATCHING CONCRETE BRIDGE DECK - TYPE B	31

GENERAL SUMMARY

DESIGN AGENCY



DESIGNER

BCP

REVIEWER

JDO 1-17-25

PROJECT ID

120341


SHEET

20

TOTAL


52

GENERAL SUMMARY



DESIGNER BCP	
REVIEWER AS	12-20-24
PROJECT ID 120341	
SHEET 21	TOTAL 52

- AS PER PLAN

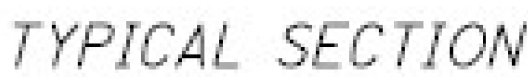

PART	COUNTY-ROUTE	S.L.M.			644	644	644	644	644		807	807	807	807		850	850				
					WRONG WAY ARROW	STOP LINE	CHEVRON MARKING	LANE ARROW	TRANSVERSE/DIAGONAL LINE		WET REFLECTIVE TRAFFIC PAINT, EDGE LINE, 6" *	WET REFLECTIVE TRAFFIC PAINT, LANE LINE, 6"	WET REFLECTIVE TRAFFIC PAINT, CHANNELIZING LINE, 12"	WET REFLECTIVE TRAFFIC PAINT, DOTTED LINE, 6"		GROOVING FOR 6" RECESSED PAVEMENT MARKING, (ASPHALT)	GROOVING FOR 12" RECESSED PAVEMENT MARKING, (ASPHALT)				
					EACH	FT	FT	EACH	FT		MILE	MILE	FT	FT		MILE	FT				
02/IMS	HAM-75 NB	10.15	TO	11.08			224				1.66	1.72	939	1079		3.38	2018				
02/IMS	HAM-75 NB	GALBRAITH RAMP									0.46					0.46					
02/IMS	HAM-75 NB	11.11	TO	11.53			184				0.81	0.81	492	940		1.62	1432				
02/IMS	HAM-75 NB	GALBRAITH RAMP									0.37					0.37					
02/IMS	HAM-75 NB	11.56	TO	11.86			95				0.53	0.64	548	540		1.17	1088				
02/IMS	HAM-75 NB	DAVIS ST. RAMP			2	18					0.3					0.3					
02/IMS	HAM-75 NB	11.88	TO	11.94							0.12	0.12				0.24					
02/IMS	HAM-75 NB	12.4	TO	12.52							0.12	0.12				0.24					
02/IMS	HAM-75 SB	10.15	TO	11.18			448				1.67	2.03	1883	1618		3.7	3501				
02/IMS	HAM-75 SB	RAMP FROM GALBRAITH									0.47					0.47					
02/IMS	HAM-75 SB	RAMP TO GALBRAITH			3	35	77	6			0.27		342			0.27	342				
02/IMS	HAM-75 SB	11.18	TO	12.17							1.61	1.69		1274		3.3	1274				
02/IMS	HAM-75 SB	COOPER AVE. RAMPS			2	16			635		0.36		496			0.36	496				
02/IMS	HAM-75 SB	12.17	TO	12.52							0.66	0.69	425	336		1.35	761				
TOTALS CARRIED TO GENERAL SUMMARY					7	69	1028	6	635		9.41	7.82	5125	5787		17.23	10912				

* WHITE EDGE LINE: 4.50 MILES
YELLOW EDGE LINE: 4.91 MILES

PAVEMENT MARKING SUBSUMMARY

DESIGN AGENCY



DESIGNER

NCD

REVIEWER

JDO 1-17-25

PROJECT ID

120341

SHEET

24

TOTAL

52


Davis St.

West Ramp

Legend

NOT TO SCALE

CURB RAMP DETAILS (DAVIS ST.)

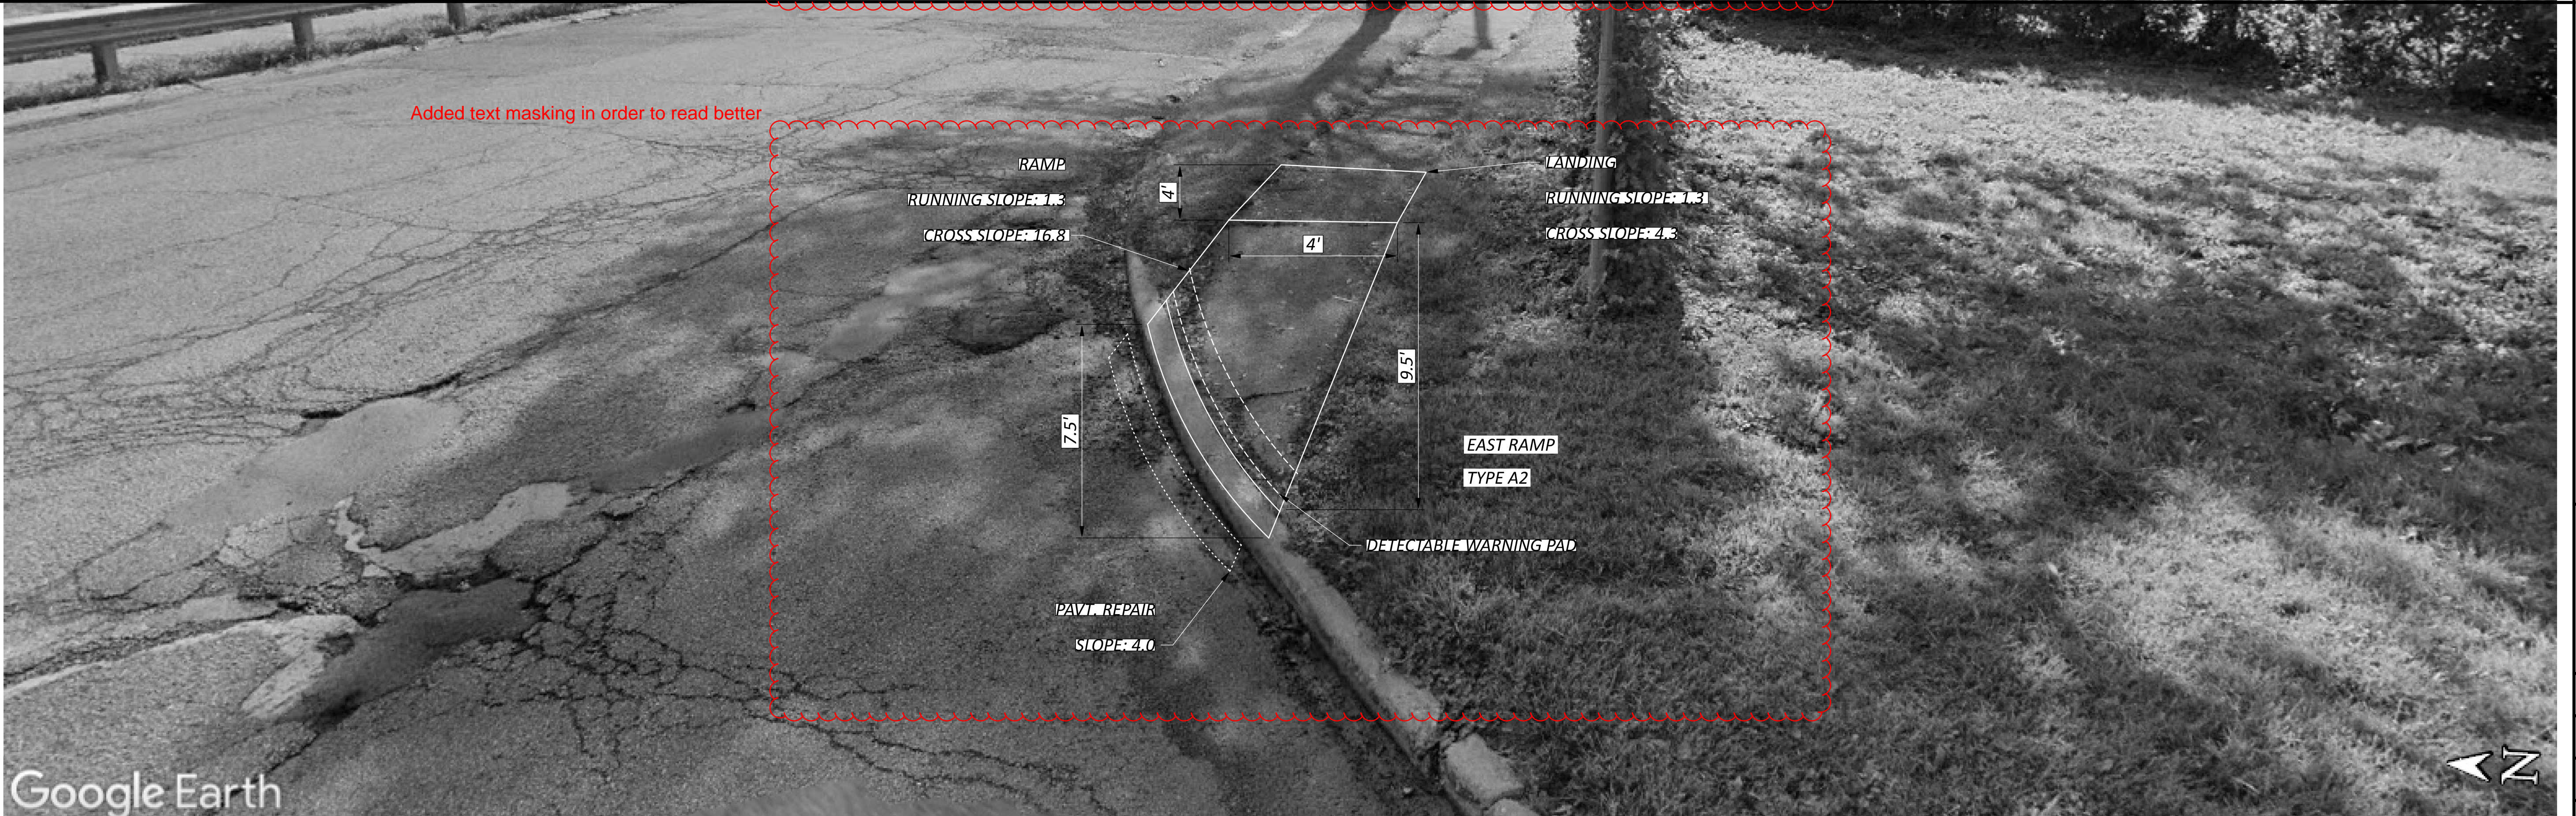

DESIGN AGENCY



DESIGNER

NCD

REVIEWER

JDO 1-17-25

PROJECT ID


120341


SHEET

25

TOTAL

52

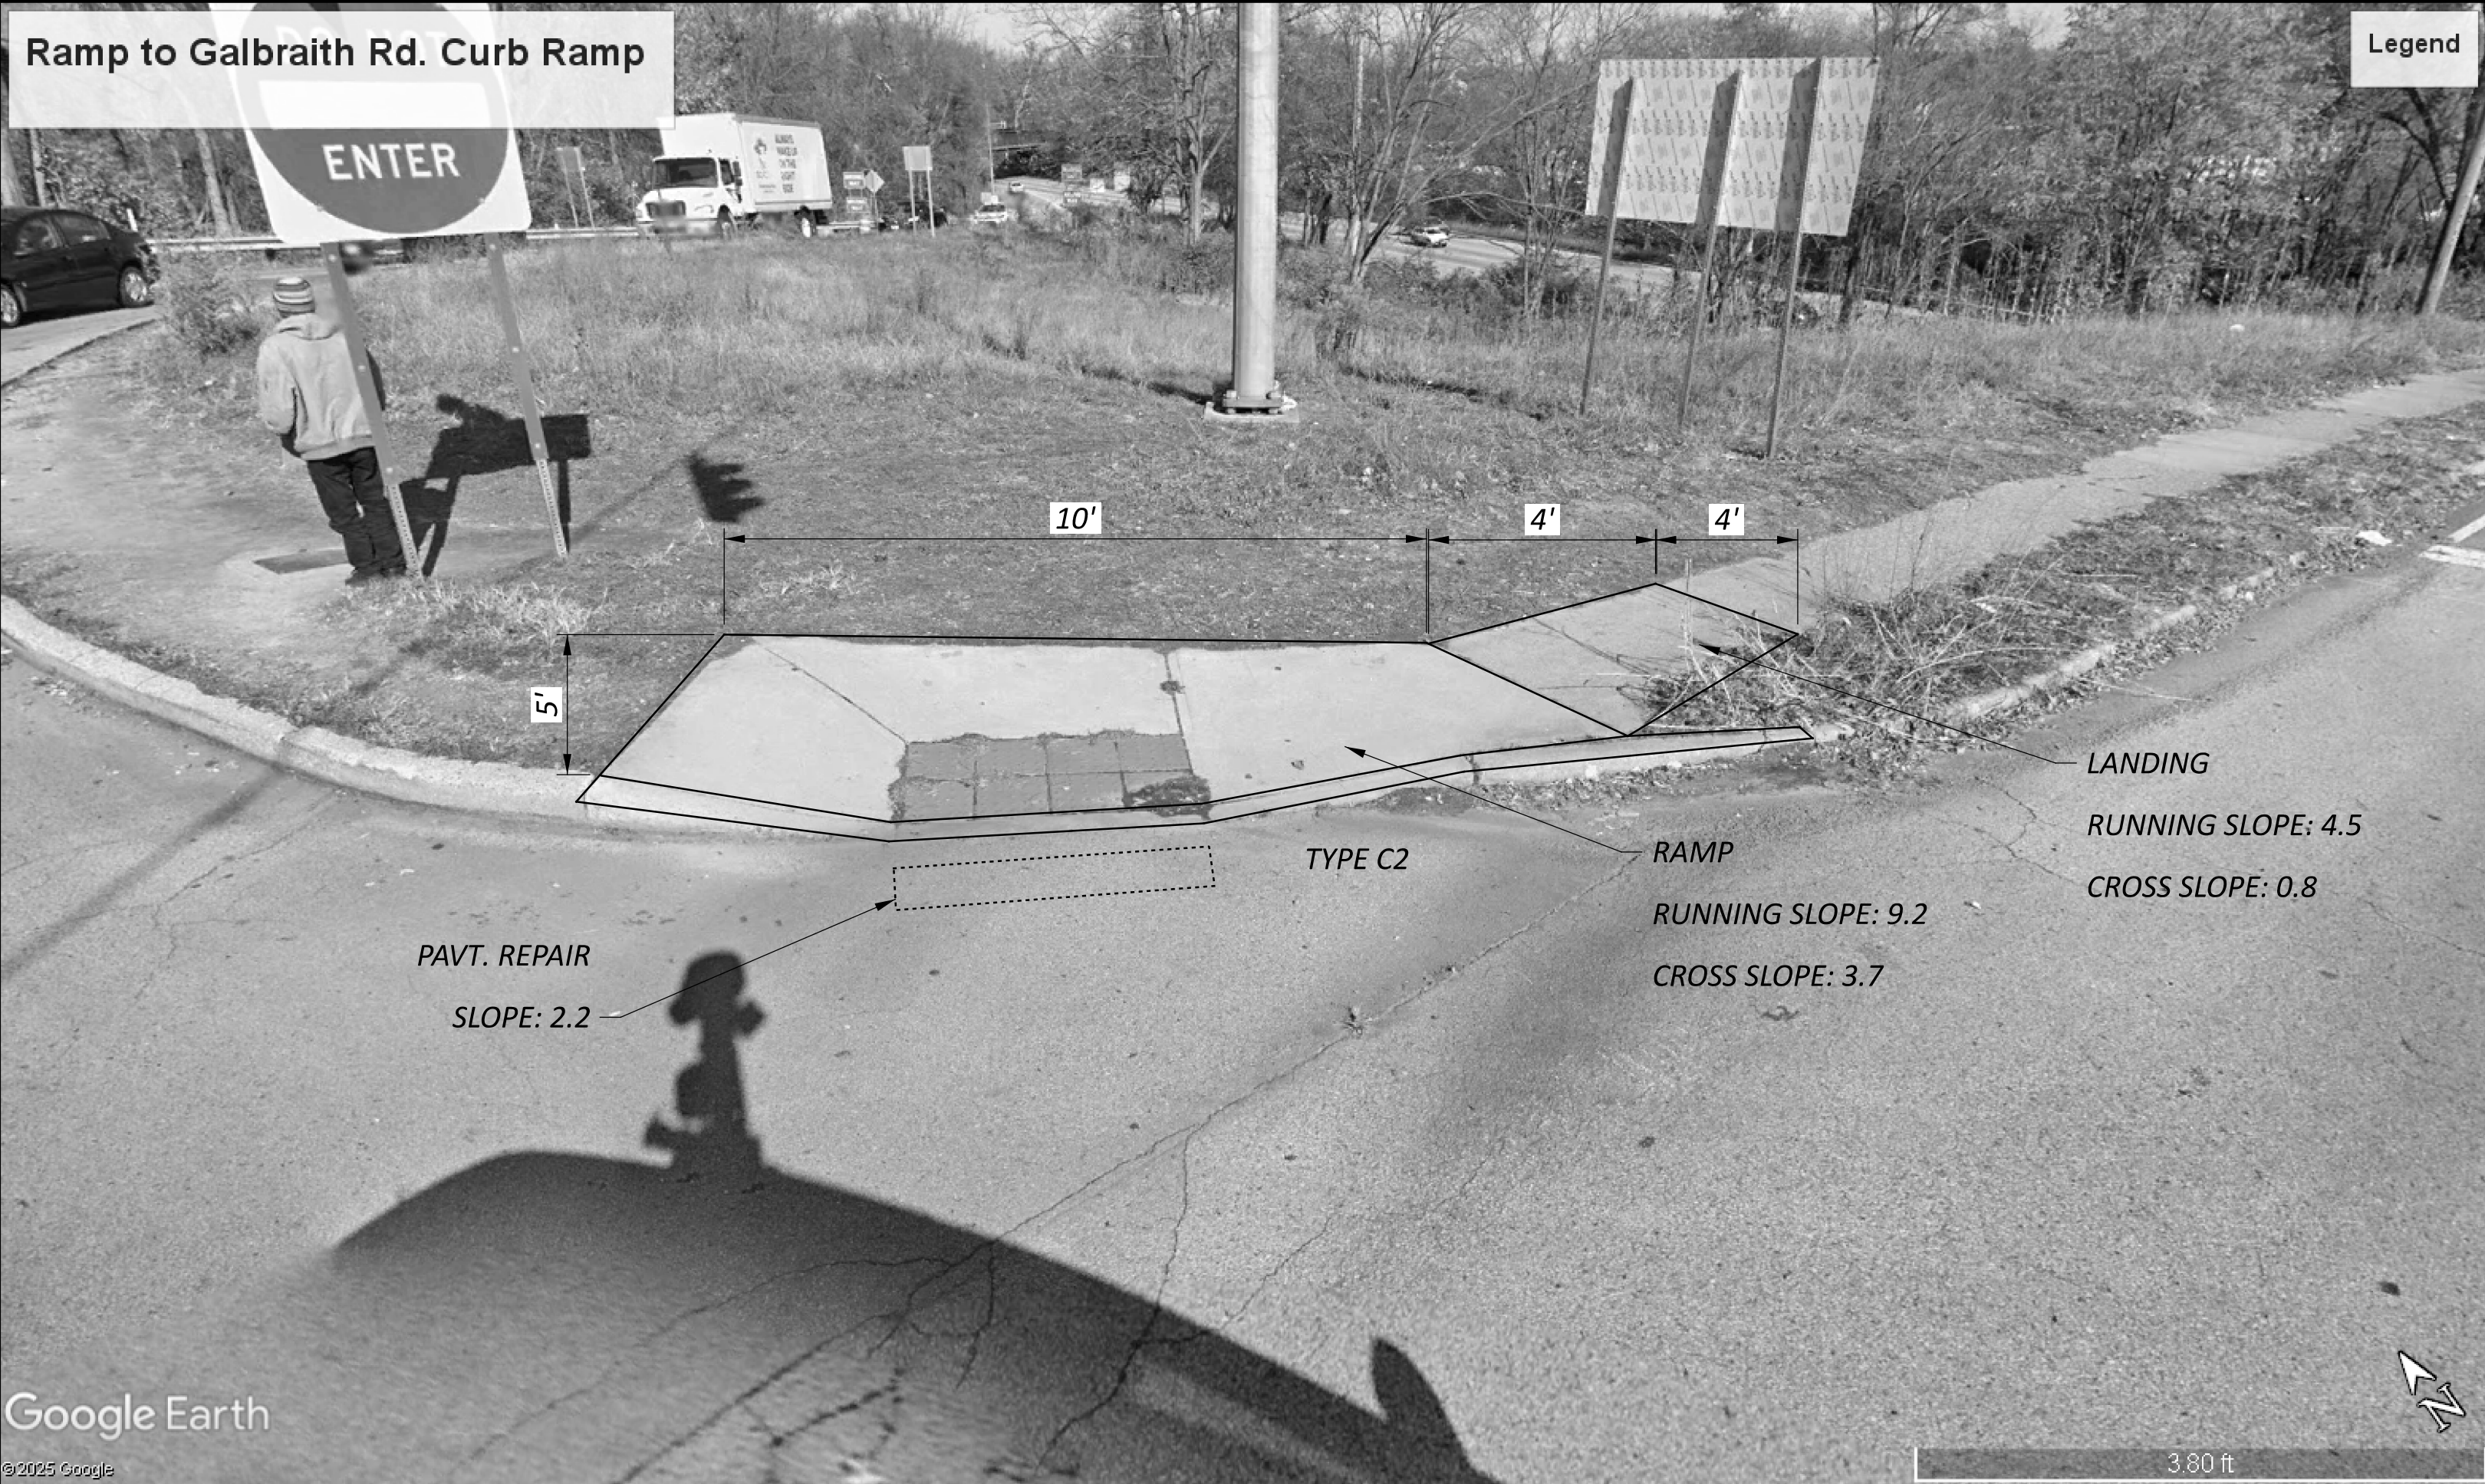

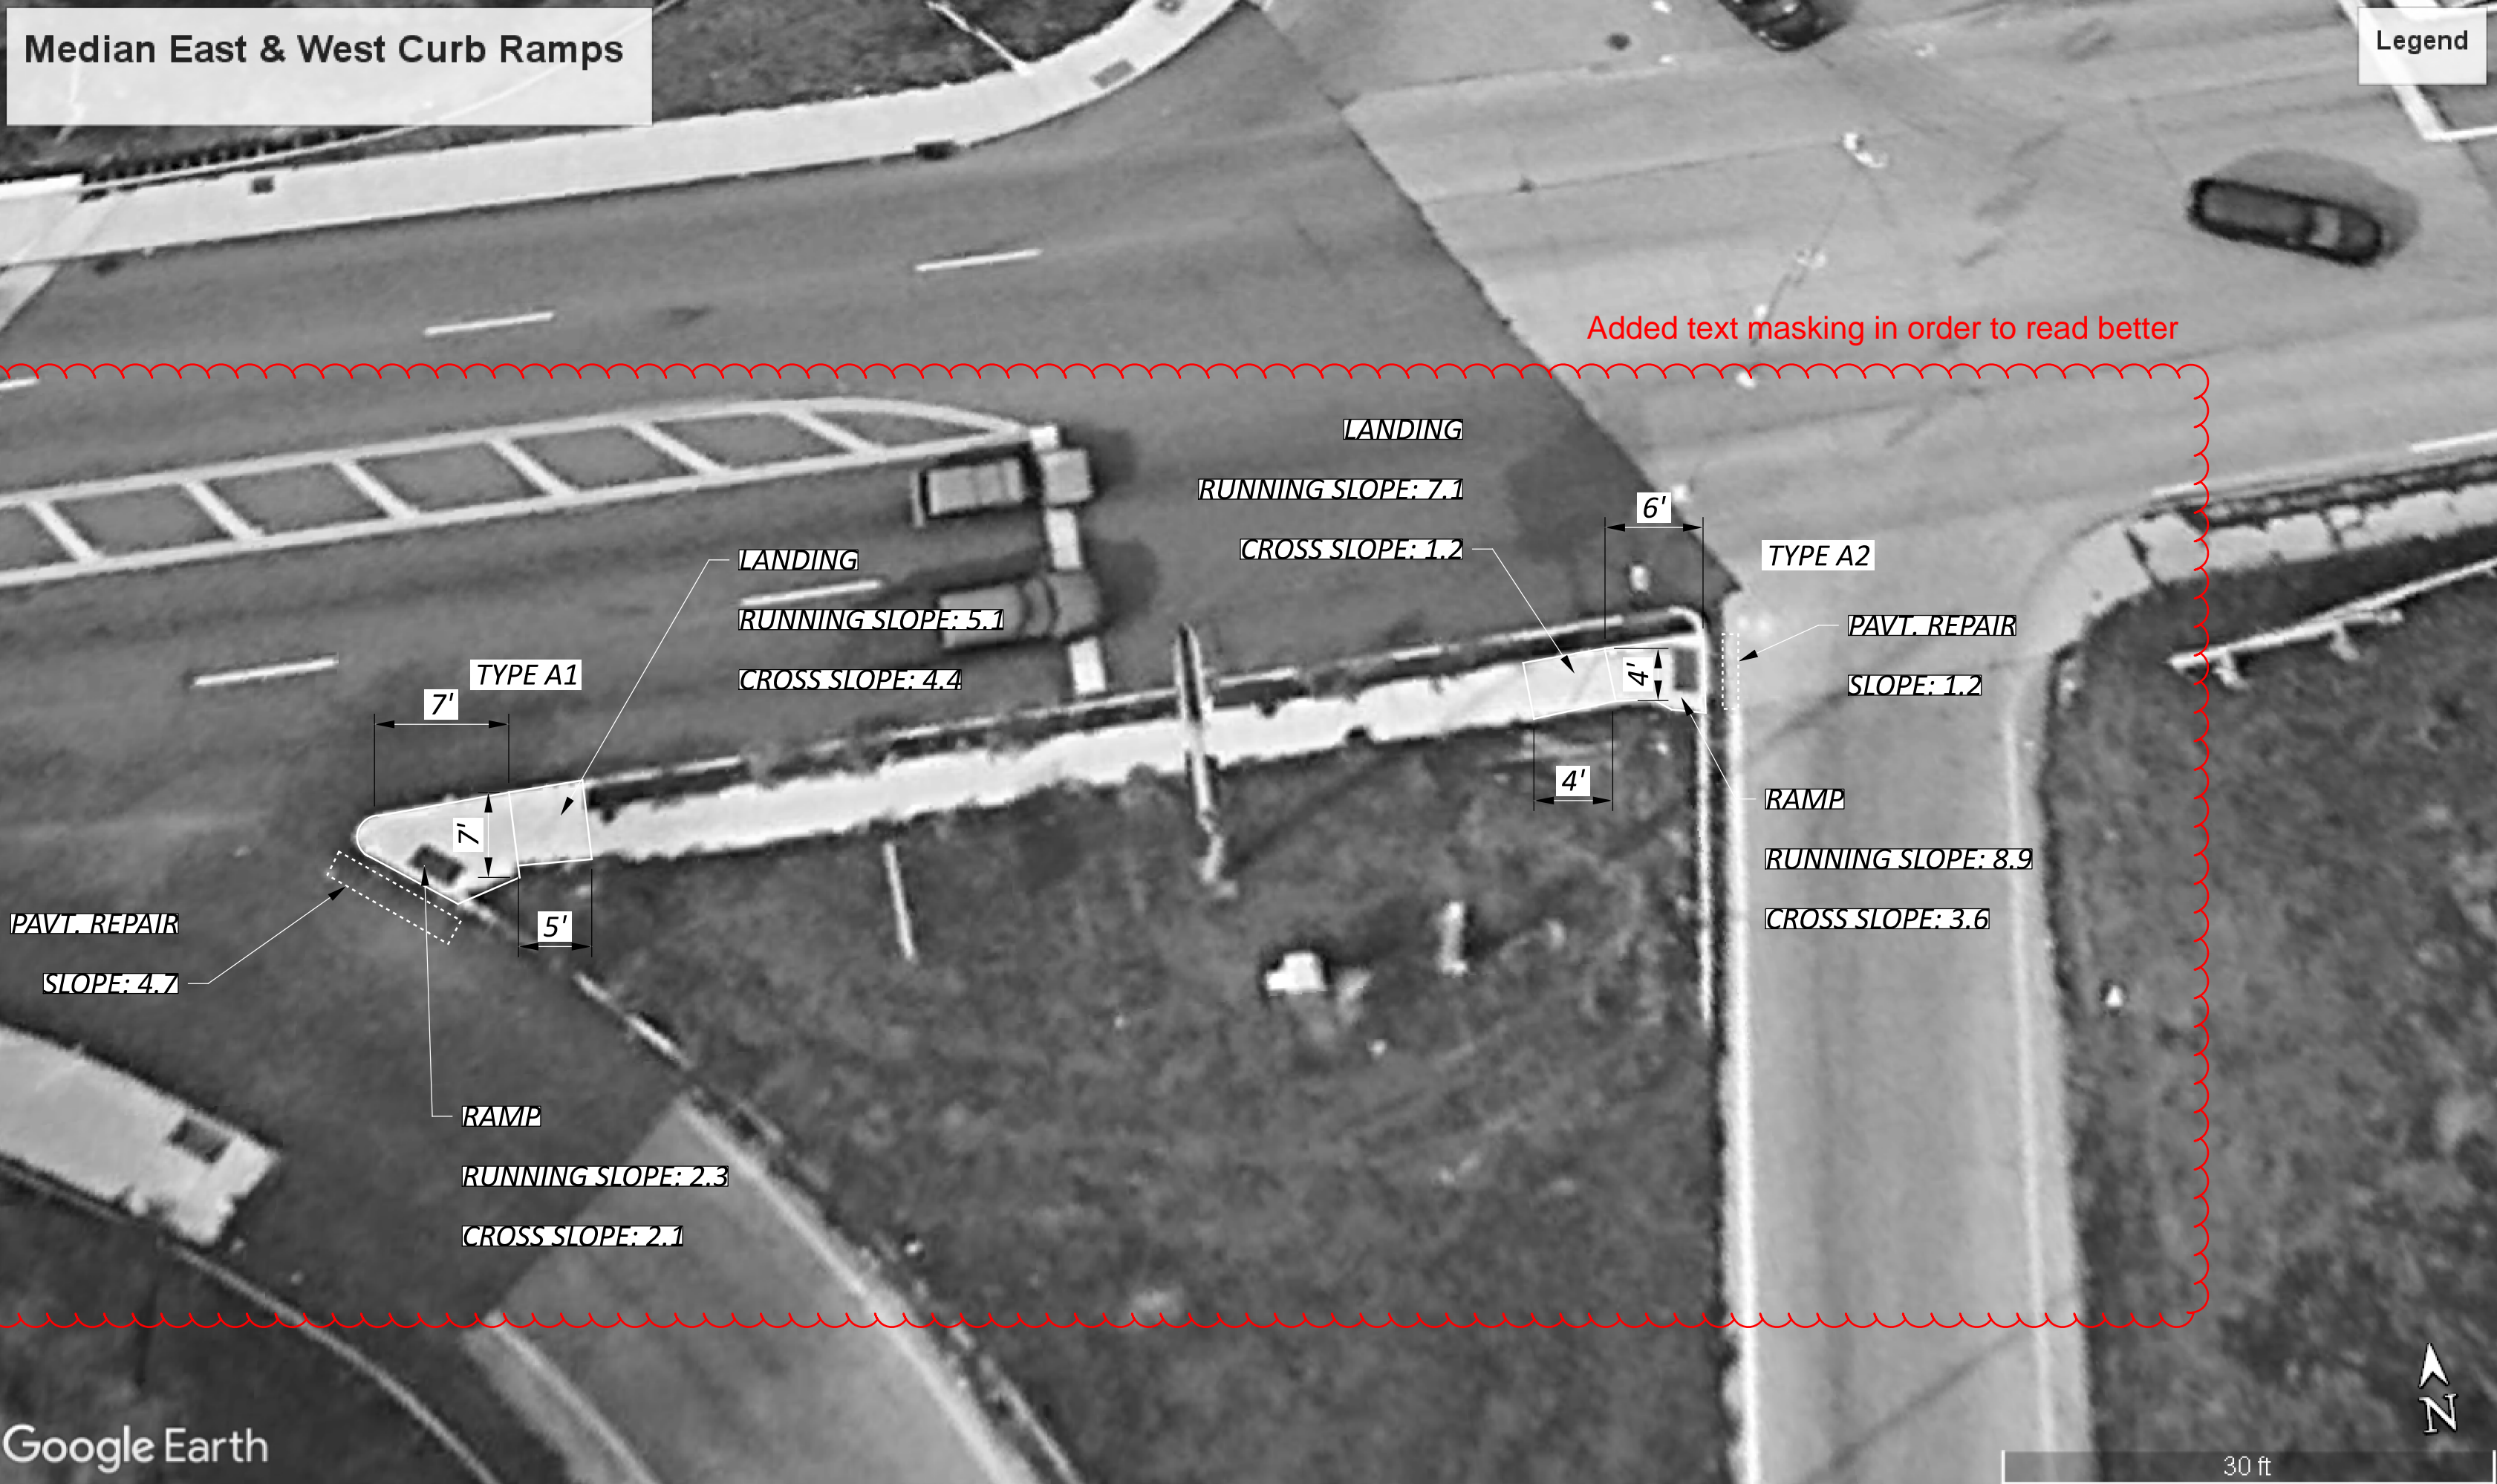

NOT TO SCALE

CURB RAMP DETAILS (RAMPS TO I-75 SOUTH)

DESIGN AGENCY



DESIGNER
NCD

REVIEWER
JDO 4-21-25

PROJECT ID
120341

SHEET
27

TOTAL
52

ITEM 518 - SCUPPER, VERTICAL EXTENSION

THIS WORK CONSISTS OF REMOVING THE HORIZONTAL DRAINAGE PIPES UNDERNEATH THE BRIDGE DECK AND EXTENDING THE SCUPPERS TO BE 8" BELOW THE BOTTOM FLANGE WHERE THE DRAINAGE WILL NOT FALL ON ROADS, SIDEWALKS, PARKING AREAS, OR R/W THAT DOES NOT BELONG TO ODOT. EXSITING VERTICAL SCUPPERS WILL HAVE 8" OF BOTTOM OF DRAINAGE PIPE REMOVED AND EXTENDED TO 8" BELOW BOTTOM FLANGE.

CONSTRUCT SECURE AND WATERTIGHT CONNECTIONS, INCLUDING THE CONNECTIONS TO ADJACENT CONCRETE. PROVIDE CASTINGS, TRUE TO FORM AND DIMENSION. WELD THE JOINTS OF STRUCTURAL STEEL SCUPPERS. GALVANIZE SCUPPERS ACCORDING TO 711.02.

EXISTING STRUCTURE VERIFICATION

DETAILS AND DIMENSIONS SHOWN ON THESE PLANS PERTAINING TO THE EXISTING STRUCTURE HAVE BEEN OBTAINED FROM PLANS OF THE EXISTING STRUCTURE AND FROM FIELD OBSERVATIONS AND MEASUREMENTS. CONSEQUENTLY, THEY ARE INDICATIVE OF THE EXISTING STRUCTURE AND THE PROPOSED WORK BUT THEY SHALL BE CONSIDERED TENTATIVE AND APPROXIMATE. THE CONTRACTOR IS REFERRED TO CMS SECTIONS 102.05 AND 105.02.

BASE CONTRACT BID PRICES UPON A RECOGNITION OF THE UNCERTAINTIES DESCRIBED ABOVE AND UPON A PREBID EXAMINATION OF THE EXISTING STRUCTURE. HOWEVER, THE DEPARTMENT WILL PAY FOR ALL PROJECT WORK UPON ACTUAL DETAILS AND DIMENSIONS THAT HAVE BEEN VERIFIED IN THE FIELD.

PROPOSED WORK

- HAM-75-1102R (SFN 3110443)**
 - PATCH DETERIORATED PORTIONS OF THE SOUTH BACKWALL WITH CONCRETE PROPOSAL NOTE 512, TYPE B PATCH
- HAM-75-1152R (SFN 3110532)**
 - PATCH DETERIORATED PORTIONS OF THE SOUTH BACKWALL WITH CONCRETE PROPOSAL NOTE 512, TYPE B PATCH
- HAM-75-1184R (SFN 3110591)**
 - PATCH DETERIORATED PORTIONS OF THE WEARING SURFACE, INCLUDING CONTIGUOUS UNSOUND AREAS WITH CONCRETE PROPOSAL NOTE 512, TYPE B PATCH. AREAS THAT AREN'T CONTAGIOUS TO A VISIBLE DETERIORATED AREA (POTHOLE) SHALL NOT BE REPAIRED
- HAM-75-1192R (SFN 3110656)**
 - REPAIR OUT-OF-PLANE BENDING CRACKS AT THE TOP OF CROSS -FRAME STIFFENERS
 - WELD THE CROSS FRAME STIFFENER TO THE TOP AND BOTTOM FLANGES TO MITIGATE FURTHER CRACKING AT ALL INTERMEDIATE CROSS FRAME LOCATIONS IN SPANS 4 THROUGH PIER 22
 - PAINT REPAIRED/ DAMAGED AREAS OF PAINT, PER 514
 - REMOVE AND REPLACE THE DETERIORATED PORTIONS OF THE TOP 1' - 7" OF THE BARRIER FACING
 - PATCH DETERIORATED PORTIONS OF THE WEARING SURFACE WITH PROPOSAL NOTE 512, TYPE B PATCH
 - REMOVE HORIZONTAL DRAINAGE PIPES AND EXTEND SCUPPERS TO BE 8" BELOW THE BOTTOM FLANGE. INSTALL TYPE D ROCK CHANNEL PROTECTION WITH FILTER FABRIC UNDER EACH NEW SCUPPER LOCATION TO PREVENT EROSION. CLEAN ALL BRIDGE SCUPPERS AND DRAIN PIPES TO ENSURE POSITIVE DRAINAGE FLOW
 - REMOVE TREES UNDERNEATH AND WITHIN RIGHT OF WAY LIMITS
 - ZONE PAINT STRUCTURAL STEEL WITHIN 10 FEET OF EITHER SIDE OF EACH INTERMEDIATE EXPANSION JOINT (5 LOCATIONS)

ITEM 514 - FIELD PAINTING, MISC.: PAINT REPAIR OF DAMAGED STRUCTURAL STEEL - THREE COAT OZEU SPOT PAINTING

1.0 DESCRIPTION THIS ITEM CONSISTS OF FIELD PAINTING STRUCTURAL STEEL PREVIOUSLY COATED WITH A NEWER EXISTING OZEU OR IZEU PAINT SYSTEM TO REPAIR DAMAGED AREAS FROM CROSSFRAME STIFFENER REPAIR. THIS WORK CONSIST OF PERFORMING SURFACE PREPARATION AND APPLYING A THREE-COAT PAINT SYSTEM TO THE PREPARED STEEL AND FEATHERED REMOVAL AREAS OF EXISTING OZEU OR IZEU PAINT SYSTEMS.

2.0 GENERAL C&MS 514.05 THROUGH 514.10 AND 514.13.D APPLY UNLESS MODIFIED BY THESE NOTES. WORK MAY BE COMPLETED WITH ACCORDANCE FROM PN 090.

3.0 WASHING EXISTING OZEU OR IZEU PAINTED SURFACES CLEAN SURFACES TO BE COATED WITH LOW PRESSURE WATER. REMOVE ALL DIRT, DEBRIS, ANIMAL EXCREMENT, SALT CONTAMINANTS AND OTHER ACCUMULATED FOREIGN MATERIAL IN ACCORDANCE WITH SSPC-SP12 (LP WC), LOW PRESSURE WATER CLEANING. THE PRESSURE WASHER SHALL BE CAPABLE OF ACHIEVING AT LEAST 2000 POUNDS PER SQUARE INCH AT THE NOZZLE. WHEN USING THE POWER WASHING EQUIPMENT, THE NOZZLE SHALL BE MAINTAINED NO MORE THAN 10 INCHES FROM THE SURFACE. SUPPLY AND USE POTABLE WATER. PROVIDE TO THE ENGINEER A LETTER OF WRITTEN ACCEPTANCE FOR ANY BIODEGRADABLE DETERGENTS OR CLEANERS USED IN CONJUNCTION WITH THIS METHOD.

COLLECT AND CONTAIN WATER AND DEBRIS REMOVED DURING WASHING OPERATIONS ABOVE WATER FEATURES IN CONFORMANCE WITH C&MS 514.08 AND C&MS 514.13.D FOR ANY DEBRIS. CREATE SETTLEMENT COLLECTION BASINS AND STRAIN ALL WASH WATER ABOVE LAND FEATURES AS NECESSARY TO PRODUCE VISIBLY CLEAR WATER AND COMPLY WITH C&MS 514.08 AND C&MS 514.13.D FOR ANY DEBRIS.

4.0 SURFACE PREPARATION AFTER THE PRESSURE WASHED SURFACE HAS DRIED, REMOVE EXISTING PAINT COATING TO CONTRACT LIMITS OR AS DIRECTED BY THE ENGINEER ACCORDING TO: SSPC-SP 11, POWER TOOL CLEANING TO BARE METAL, AS SHOWN ON THE PICTORIAL SURFACE PREPARATION STANDARDS FOR PAINTING STEEL SURFACES SHOWN IN SSPC-VIS 3; SSPC SP6, COMMERCIAL BLAST CLEANING, AS SHOWN ON THE PICTORIAL SURFACE PREPARATION STANDARDS FOR PAINTING STEEL SURFACES SHOWN IN SSPC-VIS 1; OR SSPC SP12 UHP WJ-4, ULTRAHIGH-PRESSURE WATER JETTING, AS SHOWN ON THE PICTORIAL SURFACE PREPARATION STANDARDS FOR PAINTING STEEL SURFACES SHOWN IN SSPC-VIS 4. SUPPLY BLAST WATER CONTAINING A COMMERCIALLY AVAILABLE RUST INHIBITOR AT A DOSAGE THAT PREVENTS FLASH RUSTING FOR 12 HOURS AND DOCUMENTED AS ACCEPTABLE TO THE COATING'S MANUFACTURER. THE ENGINEER WILL USE THE SSPC-VIS 1, SSPC-VIS 3 OR SSPC-VIS 4 TO DETERMINE THE ACCEPTANCE OF THE SURFACE PREPARATION. FEATHER THE EXISTING PAINT TO EXPOSE A MINIMUM OF ½ INCH OF EACH COAT. CONTAIN AND DISPOSE OF WASTE GENERATED BY THE CLEANING ACCORDING TO C&MS 514.13.D.

ROUND ALL EXPOSED CORNERS OF MAIN MATERIAL TO BE PAINTED AS NECESSARY TO ACHIEVE A 1/16 INCH RADIUS OR EQUIVALENT FLAT SURFACE AT A 45 DEGREE ANGLE.

5.0 FIELD PAINTING APPLY THE PRIME, INTERMEDIATE AND FINISH COATS OF THE THREE-COAT PAINT SYSTEM SPECIFIED IN C&MS 708.02, ACCORDING TO C&MS 514.15, 514.16, 514.17, 514.19 AND 514.20 TO CONTRACT LIMITS OR AS DIRECTED BY THE ENGINEER. TINT THE FINISH COAT TO APPROXIMATELY THE SAME COLOR AS THE EXISTING FINISH COLOR, OR AS DESIGNATED IN THE CONTRACT. MATCH THE COLOR TO THE ENGINEERS SATISFACTION. THE ENGINEER WILL DETERMINE THE PRIME AND INTERMEDIATE COAT THICKNESS USING A TYPE 2 MAGNETIC GAGE AT SPOT LOCATIONS. THE PRIME, INTERMEDIATE AND FINISH COAT OF PAINT SHALL MEET THE MINIMUM DRY FILM THICKNESS REQUIREMENTS OF C&MS 514.20. APPLY PAINT AS FOLLOWS:

A. APPLY THE PRIME COAT ONLY TO THE PREPARED SURFACE OF THE BARE STEEL AND THE EXISTING PRIME COAT EXPOSED BY FEATHERING. DO NOT APPLY THE PRIME COAT TO THE ADJACENT INTERMEDIATE COAT.

B. APPLY CAULK AFTER PRIMING

C. APPLY THE INTERMEDIATE COAT TO THE NEW PRIME COAT AND TO THE EXISTING INTERMEDIATE COATS THAT ARE EXPOSED BY FEATHERING.

D. APPLY THE FINISH COAT TO THE NEW INTERMEDIATE COAT AND TO THE EXISTING FINISH COATS THAT ARE EXPOSED BY FEATHERING.

AT THE PERIMETER OF THE REPAIR AREA, APPLY THE PRIME, INTERMEDIATE AND FINISH COATS WITH A BRUSH. IN LIEU OF BRUSHING THE CONTRACTOR MAY DOUBLE MASK AREAS NOT TO BE COATED AND SPRAY TO FEATHERED REMOVAL LINES.

BLEND REPAIR AREAS WITH THE ADJACENT COATING TO PROVIDE A FINISHED SURFACE IN THE PATCHED AREAS THAT IS SMOOTH AND HAS AN EVEN PROFILE WITH THE ADJACENT SURFACE.

6.0 MEASUREMENT THE DEPARTMENT WILL MEASURE FIELD PAINTING OF DAMAGED STRUCTURAL STEEL BY THE NUMBER OF STRUCTURAL STEEL LOCATIONS PAINTED (EACH). A MINIMUM PAINT AREA AT EACH CROSSFRAME STIFFENER IS ASSUMED TO BE 24" WIDE (12" TO EACH SIDE OF THE CROSSFRAME) MEASURED ALONG THE GIRDER WEB x THE WEB DEPTH MEASURED FROM FLANGE TO FLANGE.

THE DEPARTMENT WILL DETERMINE THE SURFACE AREA BY TAKING EXACT FIELD MEASUREMENTS OF ALL PAINTED SURFACES AND CALCULATIONS.

7.0 BASIS OF PAYMENT THE DEPARTMENT WILL PAY FOR ACCEPTED QUANTITIES AT THE CONTRACT PRICES AS FOLLOWS: THE DEPARTMENT MAY CONSIDER PAINT AS ELIGIBLE FOR PAYMENT FOR MATERIAL ON-HAND AS SPECIFIED IN 109.10, HOWEVER, ONLY PAINT THAT THE CONTRACTOR CAN PROVE TO THE ENGINEER WILL BE USED DURING THE CONSTRUCTION SEASON IS ELIGIBLE FOR PAYMENT. THE CONTRACTOR SHALL PROVIDE THE ENGINEER CALCULATIONS INDICATING THE TOTAL AREA OF STEEL TO BE PAINTED DURING THE CONSTRUCTION PROJECT. THE CONTRACTOR SHALL ALSO PROVIDE CALCULATIONS SHOWING THE TOTAL NUMBER OF GALLONS REQUIRED.

IF THE CONTRACTOR CAUSES DAMAGE OR INJURY TO PUBLIC OR PRIVATE PROPERTY, THE DEPARTMENT WILL NOT PAY FOR RESTORING THE PROPERTY TO ITS ORIGINAL CONDITION.

THE DEPARTMENT WILL NOT PAY FOR REPAIRING ADJACENT COATINGS DAMAGED DURING THE WASHING, POWER TOOL CLEANING OR BLAST CLEANING OPERATION.

THE DEPARTMENT WILL NOT PAY FOR REMOVING AND REPLACING AN AREA OF COATING BECAUSE A SPOT OR MAXIMUM AVERAGE THICKNESS EXCEEDS THE MAXIMUM SPOT THICKNESS.

THE DEPARTMENT WILL NOT PAY FOR ADDITIONAL TESTING REQUIRED BY ANY HAULER, TREATMENT FACILITY, DISPOSAL FACILITY OR LANDFILL.

THE DEPARTMENT WILL NOT PAY FOR ACCESSING, INSPECTING, AND REPAIRING AREAS THAT ARE NOT FOUND TO BE IN CONFORMANCE WITH THE SPECIFICATIONS AND PERTINENT CONTRACT DOCUMENTS.

ALL OTHER REQUIREMENTS OF THIS FIELD PAINTING SPECIFICATION ARE CONSIDERED INCIDENTAL TO THE WORK.

ITEM	UNIT	DESCRIPTION
514	EACH	FIELD PAINTING, MISC.: PAINT REPAIR OF DAMAGED STRUCTURAL STEEL - THREE COAT OZEU SPOT PAINTING

ITEM 514 - FIELD PAINTING, MISC.: ZONE PAINTING OF STRUCTURAL STEEL NEAR EXPANSION JOINTS

1.0 DESCRIPTION THIS ITEM CONSISTS OF FIELD ZONE PAINTING STRUCTURAL STEEL PREVIOUSLY COATED WITH A NEWER EXISTING OZEU OR IZEU PAINT SYSTEM TO TREAT STRUCTURAL STEEL NEAR THE INTERMEDIATE EXPANSION JOINTS WITH DAMAGED SEALS. THIS WORK CONSIST OF PERFORMING SURFACE PREPARATION AND APPLYING A THREE-COAT PAINT SYSTEM TO THE PREPARED STEEL AND FEATHERED REMOVAL AREAS OF EXISTING OZEU OR IZEU PAINT SYSTEMS.

2.0 GENERAL C&MS 514.05 THROUGH 514.10 AND 514.13.D APPLY UNLESS MODIFIED BY THESE NOTES.

3.0 WASHING EXISTING OZEU OR IZEU PAINTED SURFACES CLEAN SURFACES TO BE COATED WITH LOW PRESSURE WATER. REMOVE ALL DIRT, DEBRIS, ANIMAL EXCREMENT, SALT CONTAMINANTS AND OTHER ACCUMULATED FOREIGN MATERIAL IN ACCORDANCE WITH SSPC-SP12 (LP WC), LOW PRESSURE WATER CLEANING. THE PRESSURE WASHER SHALL BE CAPABLE OF ACHIEVING AT LEAST 2000 POUNDS PER SQUARE INCH AT THE NOZZLE. WHEN USING THE POWER WASHING EQUIPMENT, THE NOZZLE SHALL BE MAINTAINED NO MORE THAN 10 INCHES FROM THE SURFACE. SUPPLY AND USE POTABLE WATER. PROVIDE TO THE ENGINEER A LETTER OF WRITTEN ACCEPTANCE FOR ANY BIODEGRADABLE DETERGENTS OR CLEANERS USED IN CONJUNCTION WITH THIS METHOD.

COLLECT AND CONTAIN WATER AND DEBRIS REMOVED DURING WASHING OPERATIONS ABOVE WATER FEATURES IN CONFORMANCE WITH C&MS 514.08 AND C&MS 514.13.D FOR ANY DEBRIS. CREATE SETTLEMENT COLLECTION BASINS AND STRAIN ALL WASH WATER ABOVE LAND FEATURES AS NECESSARY TO PRODUCE VISIBLY CLEAR WATER AND COMPLY WITH C&MS 514.08 AND C&MS 514.13.D FOR ANY DEBRIS.

4.0 SURFACE PREPARATION AFTER THE PRESSURE WASHED SURFACE HAS DRIED, REMOVE EXISTING PAINT COATING TO CONTRACT LIMITS OR AS DIRECTED BY THE ENGINEER ACCORDING TO: SSPC-SP 11, POWER TOOL CLEANING TO BARE METAL, AS SHOWN ON THE PICTORIAL SURFACE PREPARATION STANDARDS FOR PAINTING STEEL SURFACES SHOWN IN SSPC-VIS 3; SSPC SP6, COMMERCIAL BLAST CLEANING, AS SHOWN ON THE PICTORIAL SURFACE PREPARATION STANDARDS FOR PAINTING STEEL SURFACES SHOWN IN SSPC-VIS 1; OR SSPC SP12 UHP WJ-4, ULTRAHIGH-PRESSURE WATER JETTING, AS SHOWN ON THE PICTORIAL SURFACE PREPARATION STANDARDS FOR PAINTING STEEL SURFACES SHOWN IN SSPC-VIS 4. SUPPLY BLAST WATER CONTAINING A COMMERCIALLY AVAILABLE RUST INHIBITOR AT A DOSAGE THAT PREVENTS FLASH RUSTING FOR 12 HOURS AND DOCUMENTED AS ACCEPTABLE TO THE COATING'S MANUFACTURER. THE ENGINEER WILL USE THE SSPC-VIS 1, SSPC-VIS 3 OR SSPC-VIS 4 TO DETERMINE THE ACCEPTANCE OF THE SURFACE PREPARATION. FEATHER THE EXISTING PAINT TO EXPOSE A MINIMUM OF ½ INCH OF EACH COAT. CONTAIN AND DISPOSE OF WASTE GENERATED BY THE CLEANING ACCORDING TO C&MS 514.13.D.

ROUND ALL EXPOSED CORNERS OF MAIN MATERIAL TO BE PAINTED AS NECESSARY TO ACHIEVE A 1/16 INCH RADIUS OR EQUIVALENT FLAT SURFACE AT A 45 DEGREE ANGLE.

5.0 FIELD PAINTING APPLY THE PRIME, INTERMEDIATE AND FINISH COATS OF THE THREE-COAT PAINT SYSTEM SPECIFIED IN C&MS 708.02, ACCORDING TO C&MS 514.15, 514.16, 514.17, 514.19 AND 514.20 TO CONTRACT LIMITS OR AS DIRECTED BY THE ENGINEER. TINT THE FINISH COAT TO APPROXIMATELY THE SAME COLOR AS THE EXISTING FINISH COLOR, OR AS DESIGNATED IN THE CONTRACT. MATCH THE COLOR TO THE ENGINEERS SATISFACTION. THE ENGINEER WILL DETERMINE THE PRIME AND INTERMEDIATE COAT THICKNESS USING A TYPE 2 MAGNETIC GAGE AT SPOT LOCATIONS. THE PRIME, INTERMEDIATE AND FINISH COAT OF PAINT SHALL MEET THE MINIMUM DRY FILM THICKNESS REQUIREMENTS OF C&MS 514.20. APPLY PAINT AS FOLLOWS:



ITEM 514 - FIELD PAINTING, MISC.: ZONE PAINTING OF STRUCTURAL STEEL NEAR EXPANSION JOINTS, CONT.

A. APPLY THE PRIME COAT ONLY TO THE PREPARED SURFACE OF THE BARE STEEL AND THE EXISTING PRIME COAT EXPOSED BY FEATHERING. DO NOT APPLY THE PRIME COAT TO THE ADJACENT INTERMEDIATE COAT.

B. APPLY CAULK AFTER PRIMING

C. APPLY THE INTERMEDIATE COAT TO THE NEW PRIME COAT AND TO THE EXISTING INTERMEDIATE COATS THAT ARE EXPOSED BY FEATHERING.

D. APPLY THE FINISH COAT TO THE NEW INTERMEDIATE COAT AND TO THE EXISTING FINISH COATS THAT ARE EXPOSED BY FEATHERING.

AT THE PERIMETER OF THE REPAIR AREA, APPLY THE PRIME, INTERMEDIATE AND FINISH COATS WITH A BRUSH. IN LIEU OF BRUSHING THE CONTRACTOR MAY DOUBLE MASK AREAS NOT TO BE COATED AND SPRAY TO FEATHERED REMOVAL LINES.

BLEND REPAIR AREAS WITH THE ADJACENT COATING TO PROVIDE A FINISHED SURFACE IN THE PATCHED AREAS THAT IS SMOOTH AND HAS AN EVEN PROFILE WITH THE ADJACENT SURFACE.

6.0 MEASUREMENT THE DEPARTMENT WILL MEASURE FIELD PAINTING OF STRUCTURAL STEEL BY LUMP SUM. ALL STRUCTURAL STEEL WITHIN 10 FEET OF EACH INTERMEDIATE EXPANSION JOINT WILL BE PAINTED (5 LOCATIONS). THE LOCATIONS OF THE INTERMEDIATE EXPANSION JOINTS ARE AS FOLLOWS:

STA.. 184+28.00
STA. 188+94.00
STA. 191+35.50
STA. 196+70.31
STA. 202+26.00

7.0 BASIS OF PAYMENT THE DEPARTMENT WILL PAY FOR ACCEPTED QUANTITIES AT THE CONTRACT PRICES AS FOLLOWS: THE DEPARTMENT MAY CONSIDER PAINT AS ELIGIBLE FOR PAYMENT FOR MATERIAL ON-HAND AS SPECIFIED IN 109.10, HOWEVER, ONLY PAINT THAT THE CONTRACTOR CAN PROVE TO THE ENGINEER WILL BE USED DURING THE CONSTRUCTION SEASON IS ELIGIBLE FOR PAYMENT. THE CONTRACTOR SHALL PROVIDE THE ENGINEER CALCULATIONS INDICATING THE TOTAL AREA OF STEEL TO BE PAINTED DURING THE CONSTRUCTION PROJECT. THE CONTRACTOR SHALL ALSO PROVIDE CALCULATIONS SHOWING THE TOTAL NUMBER OF GALLONS REQUIRED.

IF THE CONTRACTOR CAUSES DAMAGE OR INJURY TO PUBLIC OR PRIVATE PROPERTY, THE DEPARTMENT WILL NOT PAY FOR RESTORING THE PROPERTY TO ITS ORIGINAL CONDITION.

THE DEPARTMENT WILL NOT PAY FOR REPAIRING ADJACENT COATINGS DAMAGED DURING THE WASHING, POWER TOOL CLEANING OR BLAST CLEANING OPERATION.

THE DEPARTMENT WILL NOT PAY FOR REMOVING AND REPLACING AN AREA OF COATING BECAUSE A SPOT OR MAXIMUM AVERAGE THICKNESS EXCEEDS THE MAXIMUM SPOT THICKNESS.

THE DEPARTMENT WILL NOT PAY FOR ADDITIONAL TESTING REQUIRED BY ANY HAULER, TREATMENT FACILITY, DISPOSAL FACILITY OR LANDFILL.

THE DEPARTMENT WILL NOT PAY FOR ACCESSING, INSPECTING, AND REPAIRING AREAS THAT ARE NOT FOUND TO BE IN CONFORMANCE WITH THE SPECIFICATIONS AND PERTINENT CONTRACT DOCUMENTS.

ALL OTHER REQUIREMENTS OF THIS FIELD PAINTING SPECIFICATION ARE CONSIDERED INCIDENTAL TO THE WORK.

ITEM	UNIT	DESCRIPTION
514	LS	FIELD PAINTING, MISC.: ZONE PAINTING OF STRUCTURAL STEEL NEAR EXPANSION JOINTS

ITEM 518 - STRUCTURE DRAINAGE, MISC.: CLEANING SCUPPERS AND BRIDGE DRAINAGE SYSTEMS

THIS ITEM CONSISTS OF REMOVING ALL DIRT, DEBRIS, AND OTHER OBSTRUCTIONS FROM THE SCUPPERS, DRAIN PIPE DOWNSPOUTS, AND PIPE OUTLETS. THE DRAINAGE SYSTEM SHALL BE CLEANED USING METHODS THAT DO NOT DAMAGE THE COMPONENTS OF THE SYSTEM INCLUDING THE SUPPORTING ATTACHMENTS. ANY COMPONENTS DAMAGED DURING THE CLEANING PROCEDURE SHALL BE REPAIRED OR REPLACED AT THE CONTRACTOR'S EXPENSE. AFTER CLEANING, THE ENTIRE SYSTEM SHALL BE FLUSHED WITH CLEAN WATER TO MAKE CERTAIN THE WATER FLOWS FREELY TO ITS OUTLET. ALL MATERIAL REMOVED FROM THE DRAINAGE SYSTEM SHALL BE PROPERLY DISPOSED OF.

ALL MATERIALS, LABOR, EQUIPMENT AND INCIDENTALS NECESSARY TO CLEAN OUT THE SCUPPERS AND DRAINAGE SYSTEMS, INCLUDING PROVIDING ACCESS TO INSPECT THE ENTIRE DRAINAGE SYSTEM BEFORE AND AFTER CLEANING, SHALL BE PAID FOR AS A LUMP SUM WITH THE FOLLOWING PAY ITEM:

ITEM	UNIT	DESCRIPTION
518	LS	STRUCTURE DRAINAGE, MISC.: CLEANING SCUPPERS AND BRIDGE DRAINAGE SYSTEMS

ITEM 601 - ROCK CHANNEL PROTECTION, TYPE D WITH FILTER, AS PER PLAN

THIS WORK CONSISTS OF INSTALLING TYPE D ROCK CHANNEL PROTECTION WITH FILTER FABRIC WITH DIMENSIONS OF 4' X 4' TO A DEPTH OF 18" THICK UNDER EACH NEW VERTICALLY DRAINING BRIDGE SCUPPER. DIMENSIONS BASED ON STANDARDS FROM L&D VOL. 2 TABLE 1002-4 AND STANDARD DRAWING DM-1.1.

THE DEPARTMENT WILL PAY FOR ACCEPTED QUANTITIES AT THE CONTRACT PRICES AS FOLLOWS:

ITEM	UNIT	DESCRIPTION
601	CY	ROCK CHANNEL PROTECTION, TYPE D WITH FILTER

RAILROAD PROJECT COORDINATION

THE CONTRACTOR SHALL PERFORM ONGOING COORDINATION OF THEIR DESIGN AND CONSTRUCTION ACTIVITIES WITH THE RAILROAD(S) THROUGHOUT THE PROJECT. THE CONTRACTOR SHALL PROVIDE A CURRENT SCHEDULE ON A MONTHLY BASIS INCLUDING ANTICIPATED DATES OF THE FOLLOWING ITEMS:

- CONSTRUCTION SUBMITTALS REQUIRING RAIL REVIEW AND APPROVAL PRIOR TO BEGINNING CONSTRUCTION (PER THE RAIL AGREEMENT(S)).
- CONSTRUCTION START AND END DATES FOR WORK THAT MAY CREATE AN IMPACT TO THE RAIL FACILITY/OPERATIONS.
- ANTICIPATED DATES AND DURATION FOR FLAGGERS.
- ANY OTHER MILESTONES THAT MAY IMPACT RAIL FACILITIES OR OPERATIONS.

MEANS AND METHODS: THE CONTRACTOR SHALL DEVELOP A DETAILED SUBMISSION INDICATING THE PROGRESSION OF WORK WITH SPECIFIC TIMES WHEN TASKS WILL BE PERFORMED FOR WORK ACTIVITIES THAT ARE ON OR IN THE VICINITY OF THE RAILROAD PROPERTY.

THIS SUBMISSION MAY REQUIRE A WALKTHROUGH AT WHICH TIME THE RAILROAD AND/OR THEIR REPRESENTATIVE WILL BE PRESENT. WORK WILL NOT BE PERMITTED TO COMMENCE UNTIL THE CONTRACTOR HAS PROVIDED THE RAILROADS WITH A SATISFACTORY PLAN THAT THE PROJECT WILL BE UNDERTAKEN WITHOUT SCHEDULING, PERFORMANCE, OR SAFETY RELATED ISSUES.

PROVIDE A LISTING OF THE ANTICIPATED EQUIPMENT TO BE USED, THE LOCATION OF ALL EQUIPMENT TO BE USED AND ENSURE A CONTINGENCY PLAN OF ACTION IS IN PLACE SHOULD A PRIMARY PIECE OF EQUIPMENT MALFUNCTIONS. ALL WORK IN THE VICINITY OF THE RAILROAD PROPERTY THAT HAS THE POTENTIAL OF AFFECTING TRAIN OPERATIONS MUST BE SUBMITTED AND APPROVED BY THE RAILROAD PRIOR TO WORK BEING PERFORMED. THIS SUBMISSION WILL ALSO INCLUDE A DETAILED NARRATIVE DISCUSSING THE COORDINATION OF PROJECT SAFETY ISSUES BETWEEN THE CONTRACTOR AND THE RAILROAD AND/OR THEIR REPRESENTATIVE. THE NARRATIVE SHALL ADDRESS PROJECT LEVEL COORDINATION AND DAY TO DAY, SPECIFIC WORK OPERATIONS INCLUDING CRANE AND EQUIPMENT OPERATIONS, ERECTIONS PLANS AND TEMPORARY WORKS. UP TO SIXTY (60) CALENDAR DAYS WILL BE REQUIRED TO REVIEW ALL CONSTRUCTION SUBMISSIONS. UP TO AN ADDITIONAL SIXTY (60) CALENDAR DAYS WILL BE REQUIRED TO REVIEW ANY SUBSEQUENT SUBMISSIONS RETURNED NOT APPROVED.

CONSTRUCTION SCHEDULE: SUBMIT A DETAILED CONSTRUCTION SCHEDULE FOR THE DURATION OF THE PROJECT CLEARLY INDICATING THE TIME PERIODS WHILE WORKING ON AND AROUND THE RAILROADS RIGHT-OF-WAY. AS THE WORK PROGRESSES, THIS SCHEDULE SHALL BE UPDATED MONTHLY AND RESUBMITTED AS NECESSARY TO REFLECT CHANGES IN WORK SEQUENCE, DURATION AND METHOD, ETC.

NOTES FROM NS RR: THE RAILROAD ENGINEER OR HIS FIELD REPRESENTATIVE MAY REQUIRE THE CONTRACTOR TO INSTALL AT-GRADE BALLAST PROTECTION CONSISTING OF FILTER FABRIC AND/OR PLYWOOD TO PREVENT FOULING OF THE BALLAST DURING PAINT REMOVAL/APPLICATION PROCESS. SUCH PROTECTION SHALL STAY IN PLACE FOR THE DURATION OF CONSTRUCTION ACTIVITIES AND BE REMOVED BEFORE DEMOBILIZATION.

THE CONTRACTOR SHALL COMMENCE NO WORK ON RAILROAD RIGHT-OF-WAY UNTIL HE HAS COMPLIED WITH THE CONDITIONS PRESENTED ON NS PUBLIC PROJECTS MANUAL (SEE APPENDIX E, NORFOLK SOUTHERN - SPECIAL PROVISIONS FOR PROTECTION OF RAILWAY INTERESTS). THE CONTRACTOR SHALL SO ARRANGE AND CONDUCT HIS WORK THAT THERE WILL BE NO INTERFERENCE WITH RAILROAD'S OPERATIONS. WHENEVER WORK IS LIABLE TO AFFECT THE OPERATIONS OR SAFETY OF TRAINS, THE METHODS OF DOING SUCH WORK SHALL FIRST BE SUBMITTED TO THE RAILROAD ENGINEER FOR APPROVAL, BUT SUCH APPROVAL SHALL NOT RELIEVE THE CONTRACTOR FROM ANY LIABILITY.

IF REQUIRED, THE CONTRACTOR MUST HIRE AN APPROVED THIRD-PARTY PROVIDER OF PROTECTIVE SERVICES FOR THE PROTECTION OF PERSONNEL WORKING ON OR NEAR THE RAILROAD RIGHT-OF-WAY.

CONSTRUCTION ACCESS

ALL WORK FROM SPANS 1 THROUGH 4 OF THE HAM-75-11.92R BRIDGE ARE TO BE ACCESSED USING THE GATE AT THE EAST END OF PATTERSON AVENUE INTO ODOT'S R-O-W. ALL OTHER SPANS ARE TO BE ACCESSED FROM THE TOP OF THE BRIDGE BY SNOOPER TRUCK OR WORK PLATFORMS WITH SHOULDER CLOSURE IN ACCORDANCE WITH THE PERMITTED LANE CLOSURE SCHEDULE (PLCS).

DESIGN AGENCY



DESIGNER

BCP

REVIEWER

AS 12-20-24

PROJECT ID

120341

SHEET


30

TOTAL

52

ESTIMATED QUANTITIES - STRUCTURE No.: HAM-75-1102R (SFN 3110443)										
ITEM	EXTENSION	TOTAL	UNIT	DESCRIPTION	ABUT.	PIERS	SUPER.	GEN.	SEE SHEET #	
519	12300	2	SY	PATCHING CONCRETE BRIDGE DECKS - TYPE B			2		P.32	
ESTIMATED QUANTITIES - STRUCTURE No.: HAM-75-1152R (SFN 3110532)										
ITEM	EXTENSION	TOTAL	UNIT	DESCRIPTION	ABUT.	PIERS	SUPER.	GEN.	SEE SHEET #	
519	12300	2	SY	PATCHING CONCRETE BRIDGE DECKS - TYPE B			2		P.34	
ESTIMATED QUANTITIES - STRUCTURE No.: HAM-75-1184R (SFN 3110591)										
ITEM	EXTENSION	TOTAL	UNIT	DESCRIPTION	ABUT.	PIERS	SUPER.	GEN.	SEE SHEET #	
519	12300	11	SY	PATCHING CONCRETE BRIDGE DECKS - TYPE B			11		P.35	
ESTIMATED QUANTITIES - STRUCTURE No.: HAM-75-1192R (SFN 3110656)										
ITEM	EXTENSION	TOTAL	UNIT	DESCRIPTION	ABUT.	PIERS	SUPER.	GEN.	SEE SHEET #	
202	11201		LS	PORTIONS OF STRUCTURE REMOVED, AS PER PLAN				LS		
202	75000	130	FT	FENCE REMOVED				130	P.40	
509	20001	142	LB	CONCRETE REINFORCEMENT, REPLACEMENT OF EXISTING CONCRETE REINFORCEMENT, AS PER PLAN			142		P.36, P.38, P.41	
510	10001	10	EACH	DOWEL HOLES WITH NONSHRINK, NONMETALLIC GROUT, AS PER PLAN			10		P.28	
511	34410	21	CY	CLASS QC2 CONCRETE, SUPERSTRUCTURE			21		P.36, P.38, P.41	
513	95030	2590	EACH	STRUCTURAL STEEL, MISC.: WELDING CROSSFRAME STIFFENERS			2590		P.44-P.49	
513	95030	2590	EACH	STRUCTURAL STEEL, MISC.: STEEL PREPARATION, INSPECTION, AND NDT.			2590		P.44-P.49	
513	95030	316	EACH	STRUCTURAL STEEL, MISC.: DRILLING STRUCTURAL STEEL			316		P.44-P.49	
514	27702	316	EACH	FIELD PAINTING, MISC.: FIELD PAINTING OF DAMAGED STRUCTURAL STEEL - THREE COAT OZEU SPOT PAINTING			2590		P.29	
514	27800		LS	FIELD PAINTING, MISC.: ZONE PAINTING OF STRUCTURAL STEEL NEAR EXPANSION JOINTS				LS		
518	12700	59	EACH	SCUPPER, VERTICAL EXTENSION			59		P.36-41	
518	63300		LS	STRUCTURE DRAINAGE, MISC.: CLEANING SCUPPERS AND BRIDGE DRAINAGE SYSTEMS				LS		
519	12300		SY	PATCHING CONCRETE BRIDGE DECKS - TYPE B			5		P.36, P.39-P.41	
601	32300	3	CY	ROCK CHANNEL PROTECTION, TYPE D WITH FILTER				3	P.38	
SPECIAL	900E11000	5000	EACH	SPECIAL - RAILROAD FLAGGING SERVICES				5000	P.9	

DESIGN AGENCY



DESIGNER

BCP

REVIEWER

AS 12-20-24

PROJECT ID



120341

SHEET

31

TOTAL

52

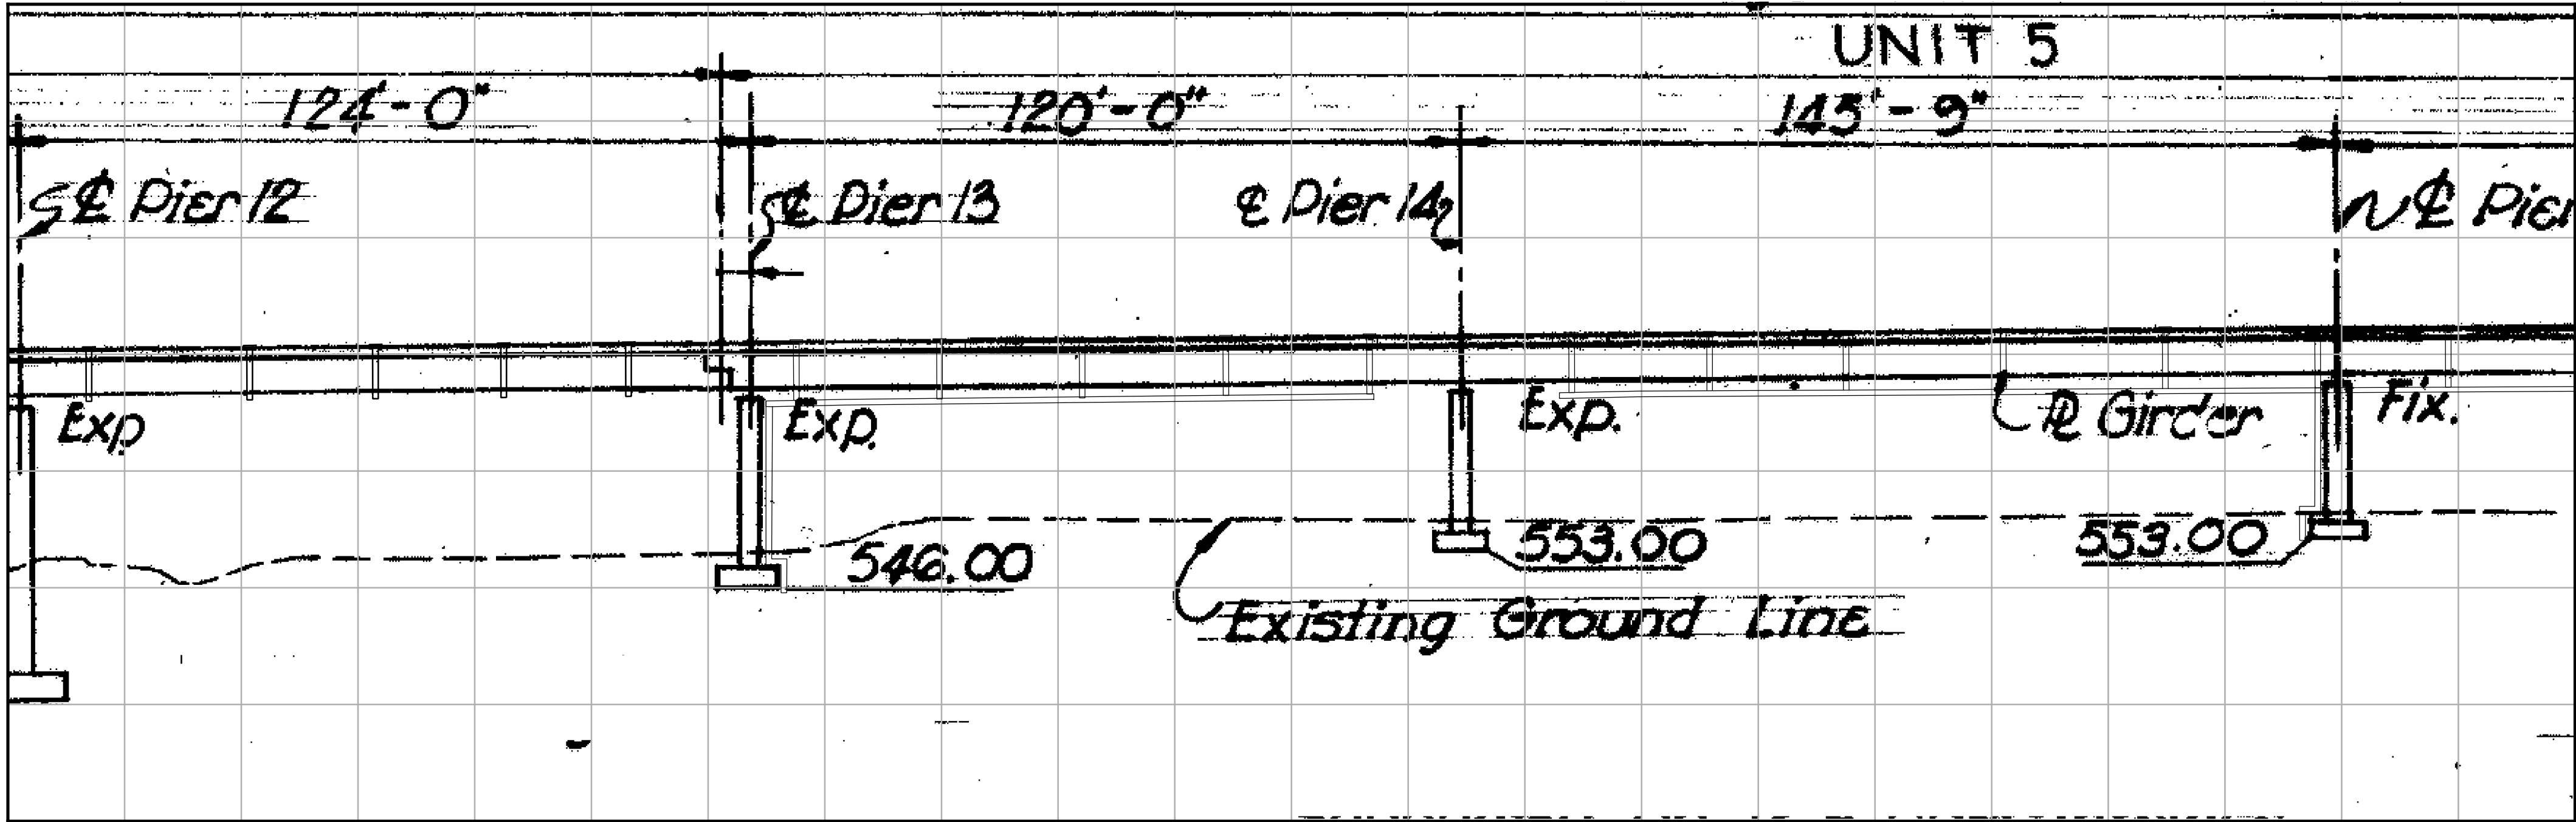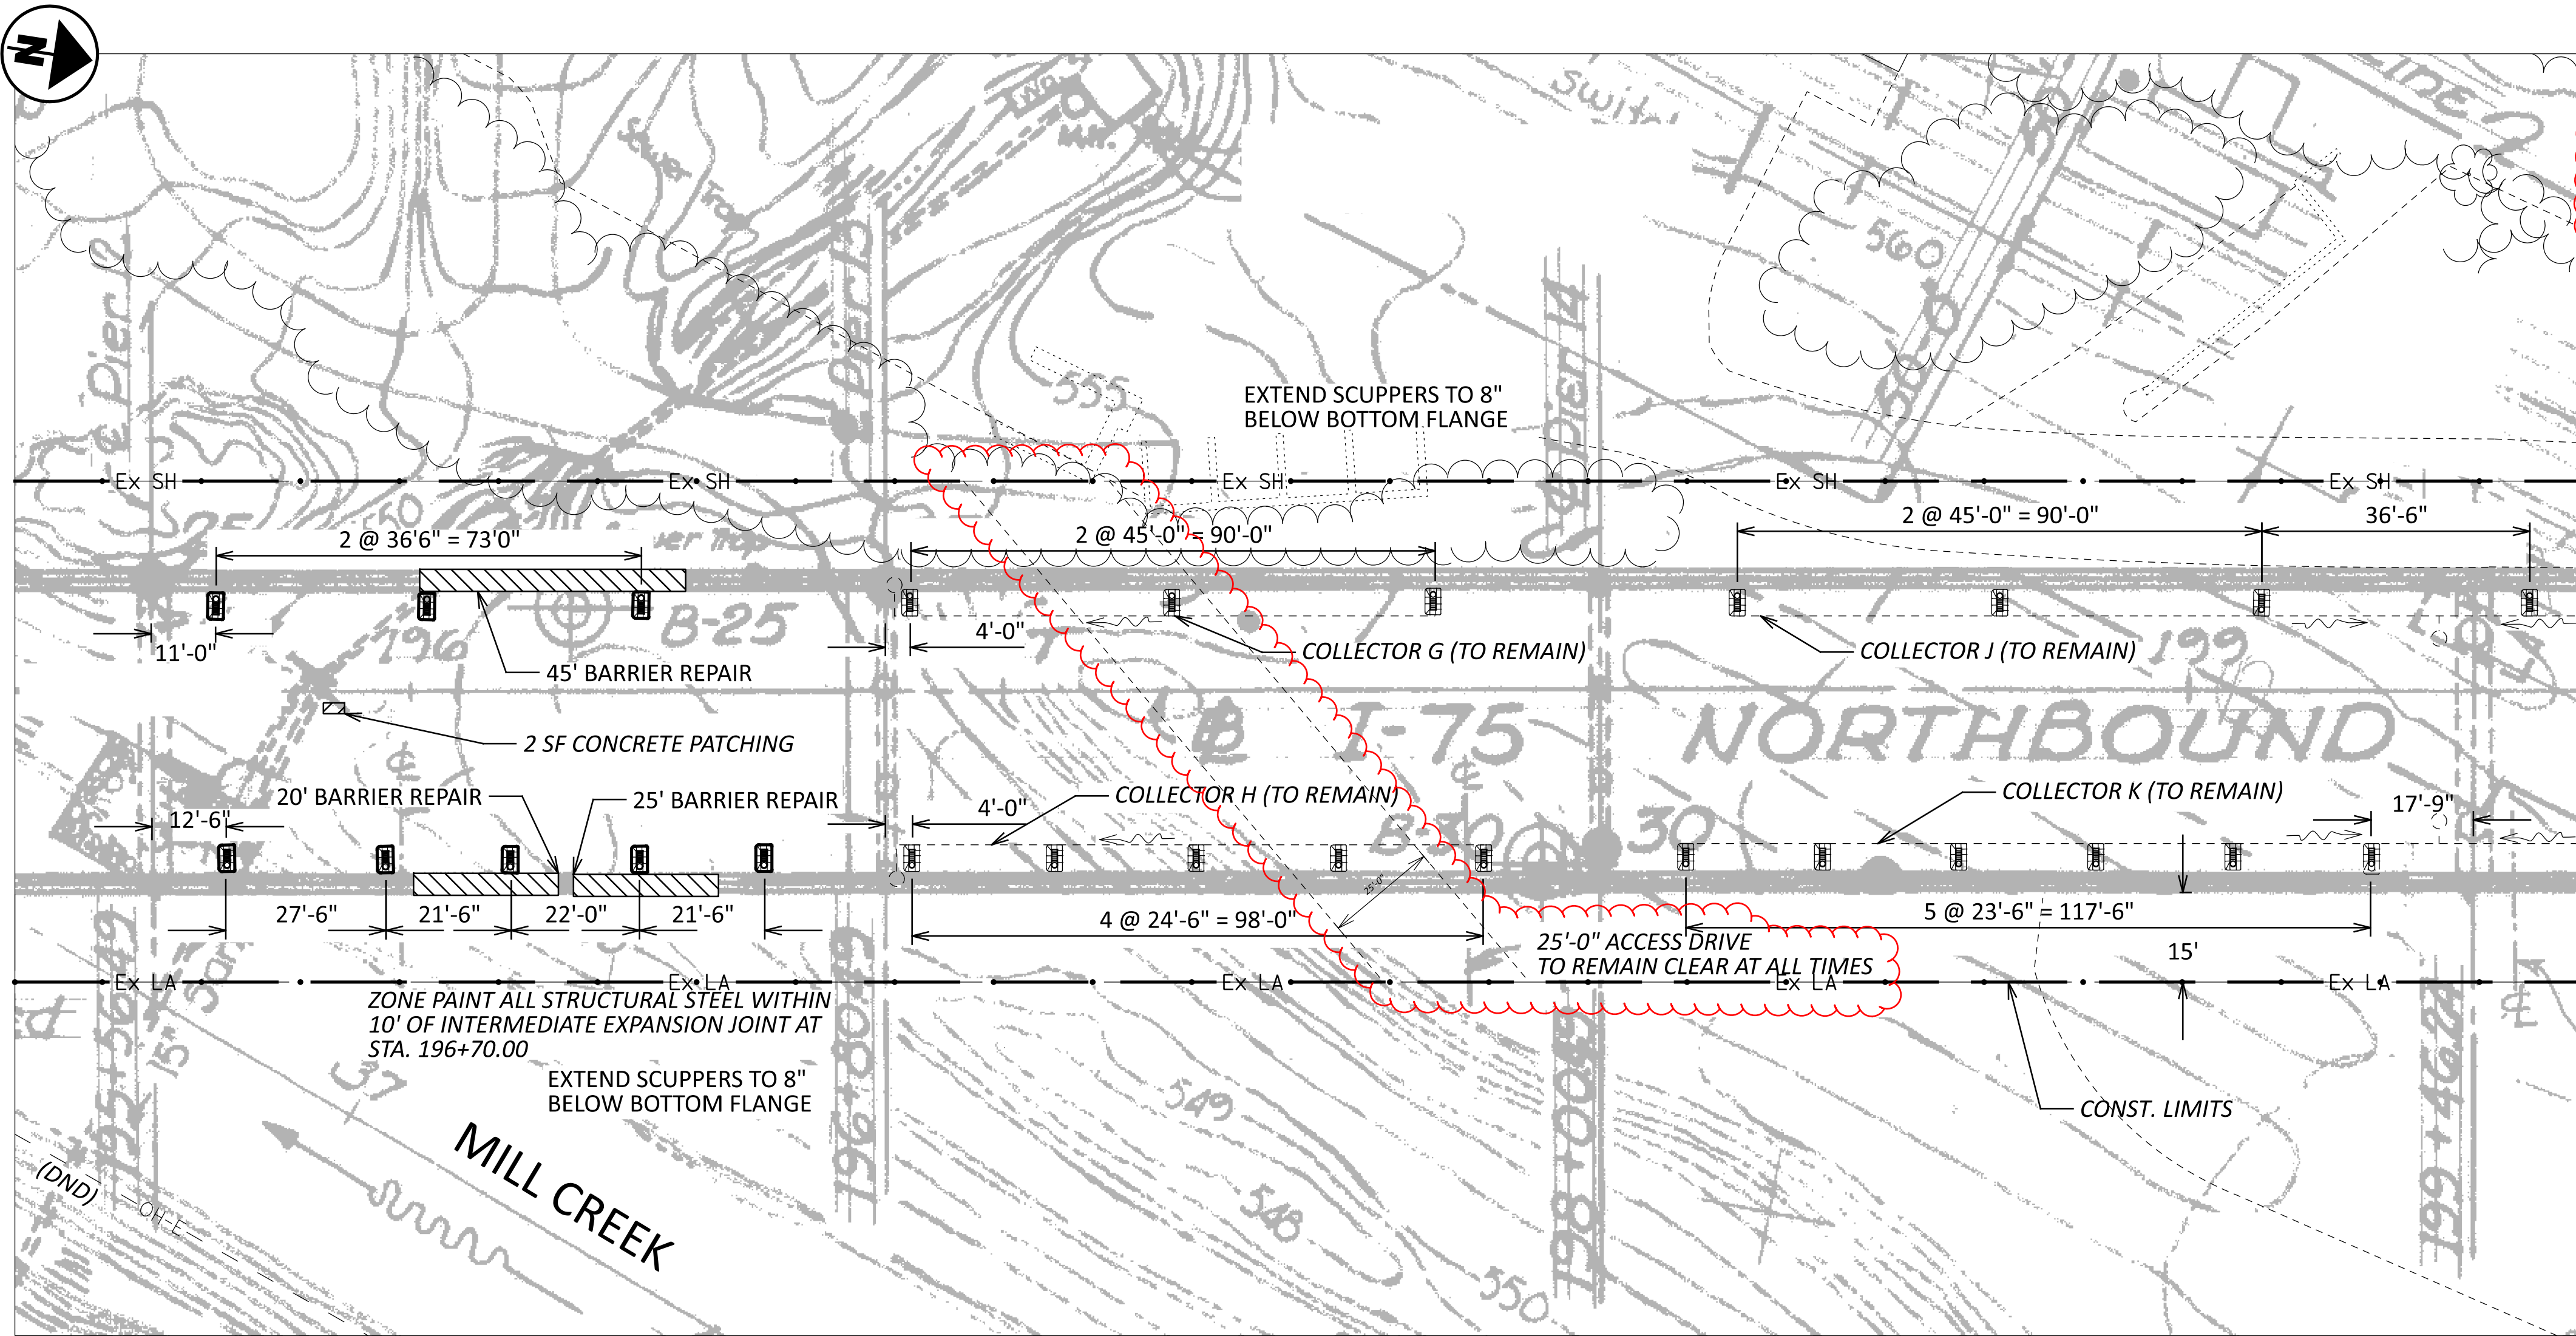

NOTES

- 1) PATCH THE APPROACH SLABS AND DECK PER PROPOSAL NOTE 512, TYPE B
- 2) REMOVE AND REPLACE DETERIORATED PORTIONS OF THE BARRIER
- 3) DETAILS ON THIS SHEET ARE TAKEN FROM EXISTING PLANS AND SHOULD BE USED FOR INFORMATION PURPOSES ONLY

DESIGN TRAFFIC:

HAM-75-1192 (NB)

2026 ADT = 126,000 2038 ADT = 126,000

DHV = 15,500

2024 ADTT = 20,152

DESIGN SPEED = 65 MPH

LEGAL SPEED = 65 MPH

DESIGN FUNCTIONAL CLASSIFICATION: 01-PRINCIPAL ARTERIAL INTERSTATE
NHS ROUTE YES

LEGEND

- TYPE B CONCRETE PATCHING
- REMOVE AND REPLACE THE DETERIORATED PORTIONS OF THE TOP 1'-7" OF THE BARRIER
- REPLACE FACING AND CORE FOR FULL THICKNESS OF BARRIER
- EXISTING BRIDGE SCUPPERS (TO REMAIN)
- BRIDGE SCUPPERS TO BE EXTENDED

EXISTING STRUCTURE

TYPE: CONTINUOUS ROLLED BEAM AND WELDED PLATE GIRDER WITH REINFORCED CONCRETE DECK AND SUBSTRUCTURE

SPANS: 56'-6"-70'-0"-61'-6"; 93'-0"-111'-3"-111'-3"-99'-0"; 113'-6"-113'-6"
126'-0"-145'-9"-156'-0"-124'-0"; 120'-0"-145'-9"-156'-0"-118'-0";
89'-0"-105'-0"-129'-0"-100'-0"-70'-0"

ROADWAY: 50' F/F OF 1'-0" SAFETY CURBS

LOADING: CF = 2000 (57) ADEQUATE FOR AASHTO ALTERNATE LOADING
SKEW: 0°

WEARING SURFACE: MONOLITHIC CONCRETE

APPROACH SLABS: 25'-0" LONG (STD A-1-72)

ALIGNMENT: 1°45' CURVE TO LEFT, 350'-0" SPIRAL TO TANGENT

CROWN: SUPERELEVATED

STRUCTURE FILE NUMBER: 3110656

DATE BUILT: JAN 1985

DISPOSITION: SEE PROPOSED WORK

PROPOSED WORK

- 1) REPAIR OUT-OF-PLANE BENDING CRACKS AT THE TOP OF CROSS-FRAME STIFFENERS
- 2) WELD THE CROSS FRAME STIFFENER TO THE TOP AND BOTTOM FLANGES TO MITIGATE FURTHER CRACKING AT ALL INTERMEDIATE CROSS FRAME LOCATIONS IN SPANS 4 THROUGH SPAN 22
- 3) PAINT REPAIRED/ DAMAGED AREAS OF PAINT, PER 514
- 4) REMOVE AND REPLACE THE DETERIORATED PORTIONS OF THE TOP 1' - 7" OF THE BARRIER FACING THE FULL THICKNESS OF THE BARRIER REFACING
- 5) PATCH DETERIORATED PORTIONS OF THE WEARING SURFACE WITH PROPOSAL NOTE 512, TYPE B PATCH
- 6) REMOVE HORIZONTAL DRAINAGE PIPES AND EXTEND SCUPPERS TO BE 8" BELOW THE BOTTOM FLANGE. INSTALL TYPE D ROCK CHANNEL PROTECTION WITH FILTER FABRIC UNDER EACH NEW SCUPPER LOCATION TO PREVENT EROSION
- 7) REMOVE TREES UNDERNEATH AND WITHIN ROW LIMITS
- 8) ZONE PAINT STRUCTURAL STEEL WITHIN 10 FEET OF EITHER SIDE OF EACH INTERMEDIATE JOINT (5 LOCATIONS)



SITE PLAN - 4

BRIDGE NO: HAM-75-1192R

I-75 NB BRIDGE OVER WEST FORK MILL CREEK, NS RR, & SHEPARD LN

SFN 3110656

DESIGN AGENCY





DESIGNER BCP CHECKER AS

REVIEWER AS 12-20-24

PROJECT ID 120341

SUBSET 4 TOTAL 6

SHEET 39 TOTAL 52

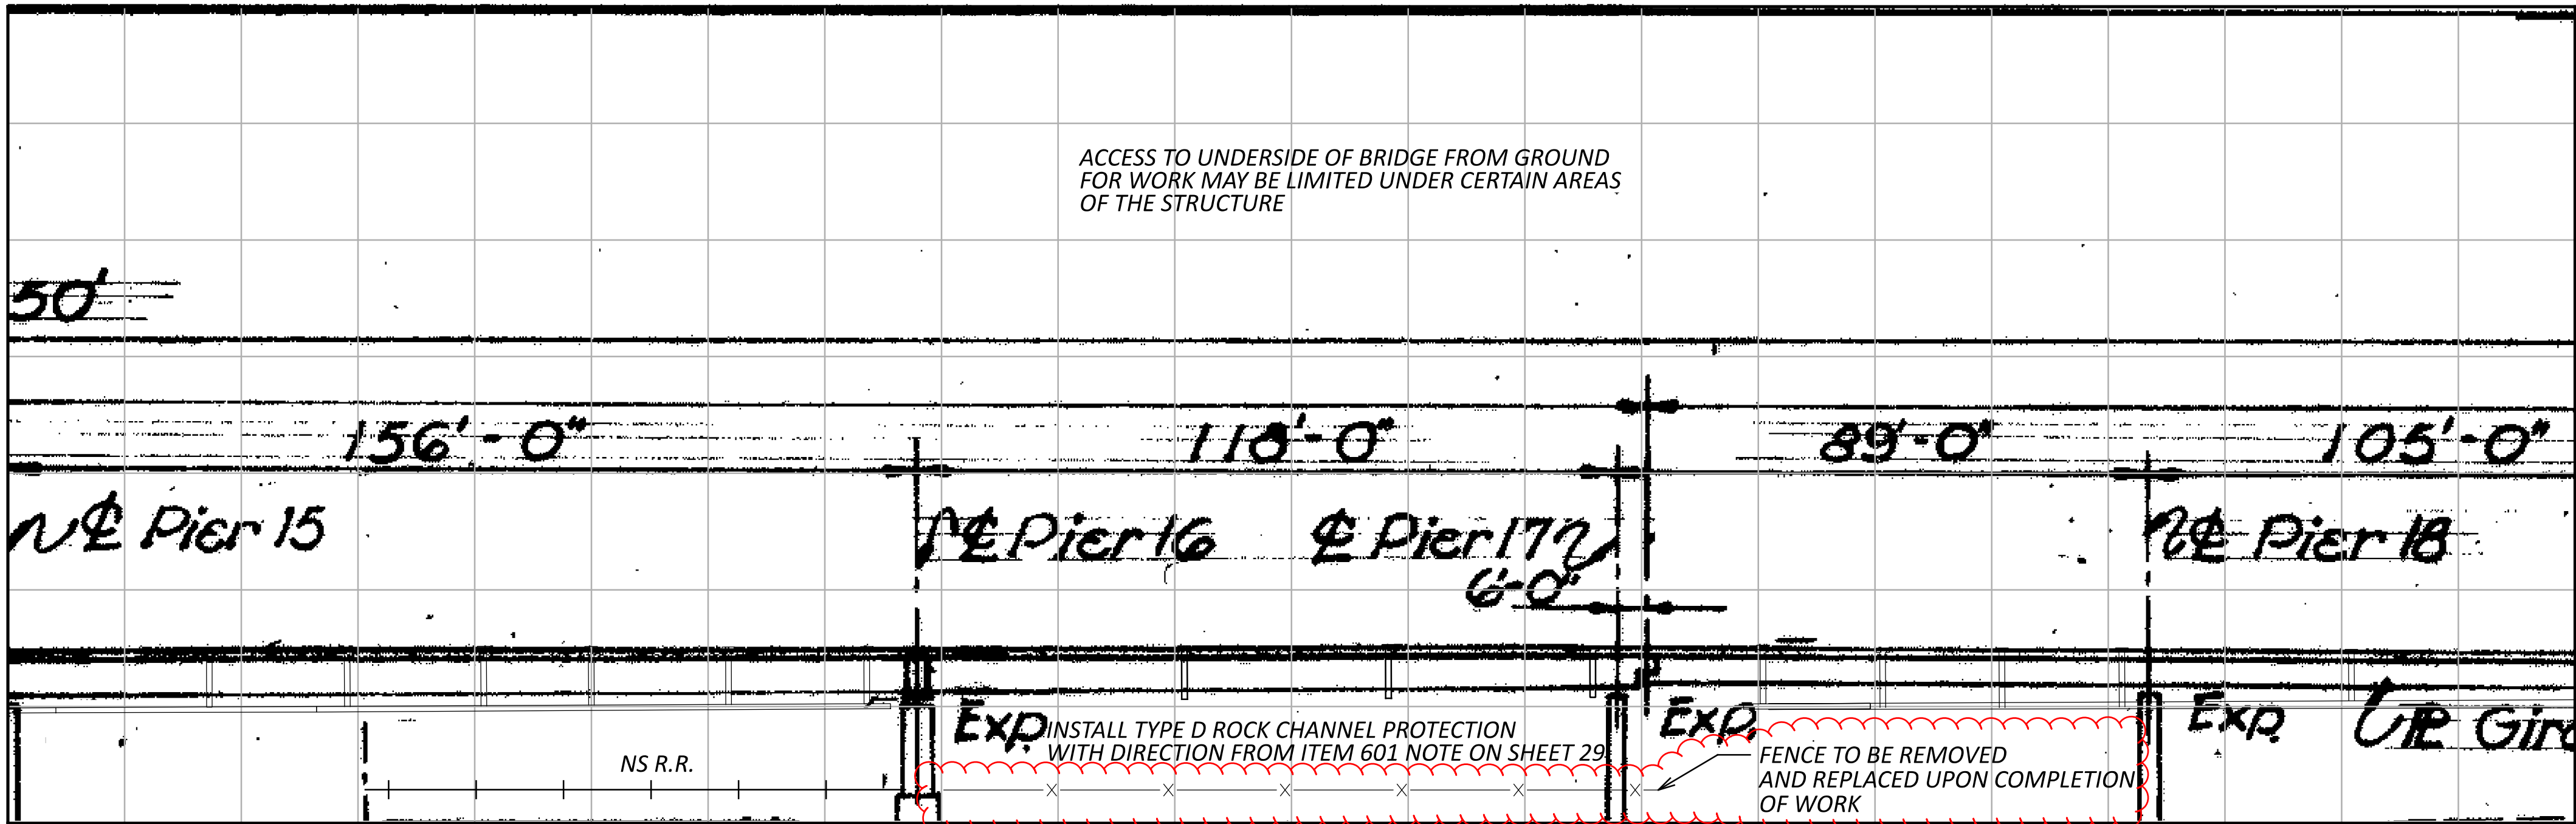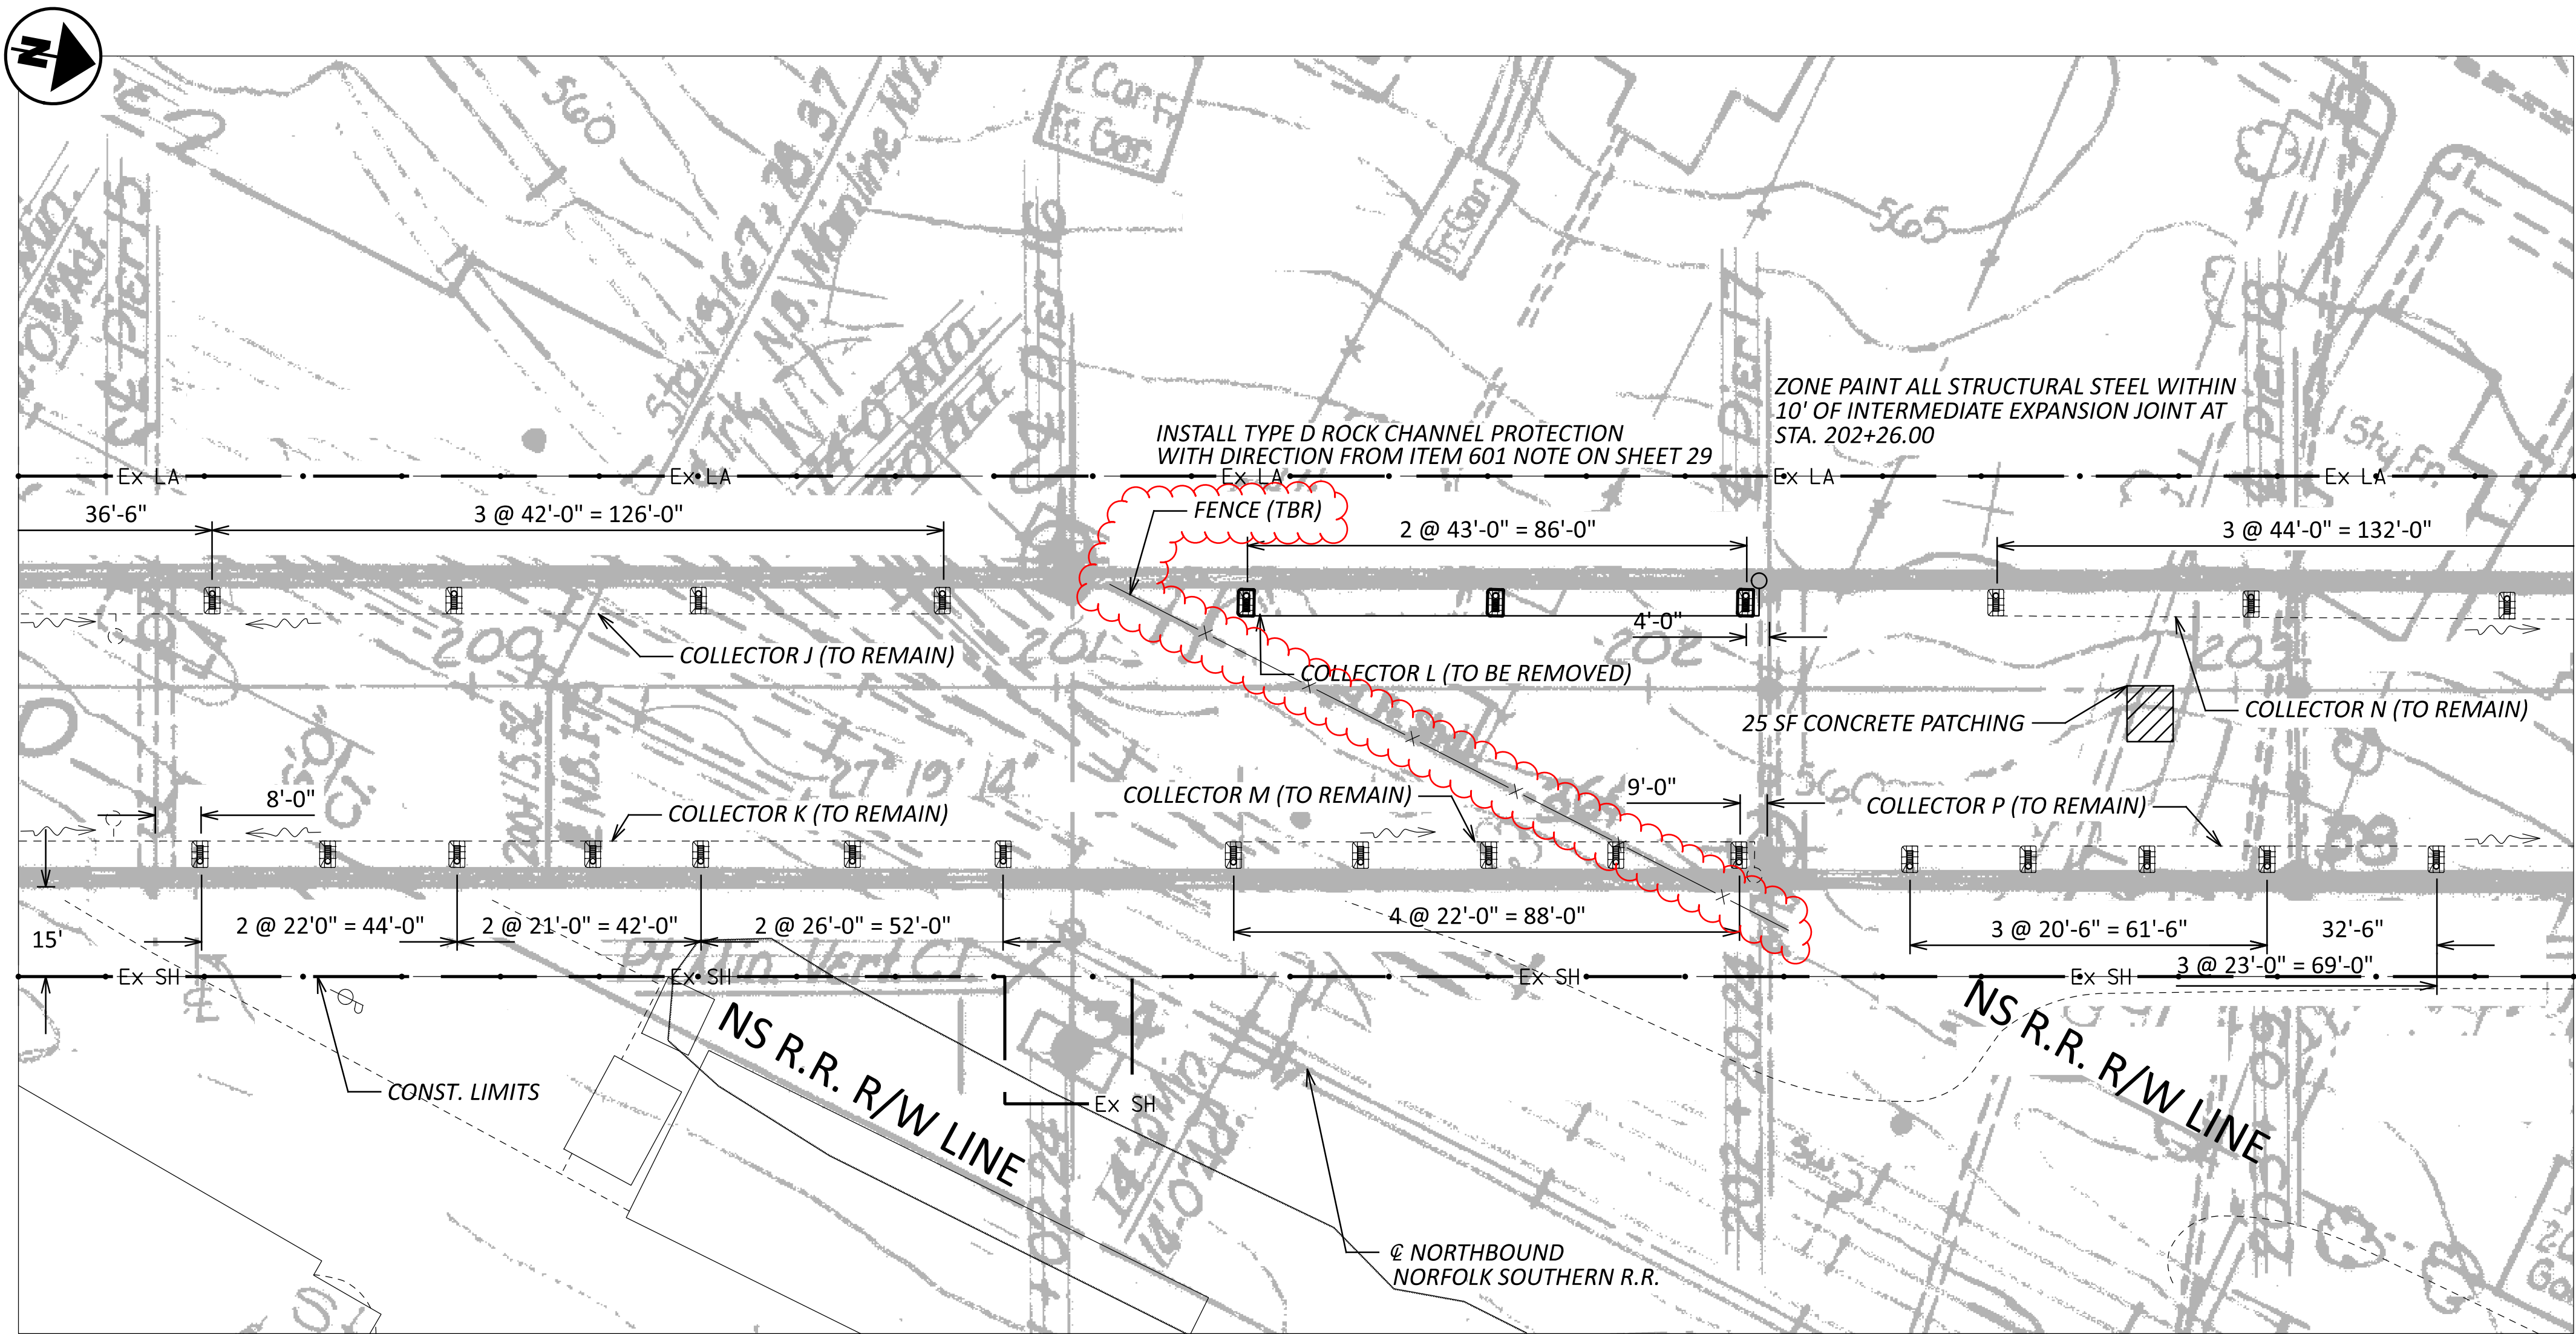

NOTES

- 1) PATCH THE DETERIORATED PORTIONS OF THE WEARING SURFACE PER PROPOSAL NOTE 512, TYPE B
- 2) REMOVE AND REPLACE DETERIORATED PORTIONS OF THE BARRIER
- 3) DETAILS ON THIS SHEET ARE TAKEN FROM EXISTING PLANS AND SHOULD BE USED FOR INFORMATION PURPOSES ONLY

DESIGN TRAFFIC:

HAM-75-1192 (NB)

2026 ADT = 126,000 2038 ADT = 126,000

DHV = 15,000 2024 ADTT = 20,152

DESIGN SPEED = 65 MPH LEGAL SPEED = 65 MPH

DESIGN FUNCTIONAL CLASSIFICATION: 01-PRINCIPAL ARTERIAL INTERSTATE

NHS ROUTE YES

LEGEND

- TYPE B CONCRETE PATCHING
- REMOVE AND REPLACE THE DETERIORATED PORTIONS OF THE TOP 1'-7" OF THE BARRIER
- REPLACE FACING AND CORE FOR FULL THICKNESS OF BARRIER
- EXISTING BRIDGE SCUPPERS (TO REMAIN)
- BRIDGE SCUPPERS TO BE EXTENDED

EXISTING STRUCTURE

TYPE: CONTINUOUS ROLLED BEAM AND WELDED PLATE GIRDER WITH REINFORCED CONCRETE DECK AND SUBSTRUCTURE

SPANS: 56'-6"-70'-0"-61'-6"; 93'-0"-111'-3"-111'-3"-99'-0"; 113'-6"-113'-6"
126'-0"-145'-9"-156'-0"-124'-0"; 120'-0"-145'-9"-156'-0"-118'-0";
89'-0"-105'-0"-129'-0"-100'-0"-70'-0"

ROADWAY: 50' F/F OF 1'-0" SAFETY CURBS

LOADING: CF = 2000 (57) ADEQUATE FOR AASHTO ALTERNATE LOADING

SKEW: 0°

WEARING SURFACE: MONOLITHIC CONCRETE

APPROACH SLABS: 25'0" LONG (STD A-1-72)

ALIGNMENT: 1°45' CURVE TO LEFT, 350'-0" SPIRAL TO TANGENT

CROWN: SUPERELEVATED


STRUCTURE FILE NUMBER: 3110656

DATE BUILT: JAN 1985

DISPOSITION: SEE PROPOSED WORK

PROPOSED WORK

- 1) REPAIR OUT-OF-PLANE BENDING CRACKS AT THE TOP OF CROSS -FRAME STIFFENERS
- 2) WELD THE CROSS FRAME STIFFENER TO THE TOP AND BOTTOM FLANGES TO MITIGATE FURTHER CRACKING AT ALL INTERMEDIATE CROSS FRAME LOCATIONS IN SPANS 4 THROUGH SPAN 22
- 3) PAINT REPAIRED/ DAMAGED AREAS OF PAINT, PER 514
- 4) REMOVE AND REPLACE THE DETERIORATED PORTIONS OF THE TOP 1' - 7" OF THE BARRIER FACING THE FULL THICKNESS OF THE BARRIER REFACING
- 5) PATCH DETERIORATED PORTIONS OF THE WEARING SURFACE WITH PROPOSAL NOTE 512, TYPE B PATCH
- 6) REMOVE HORIZONTAL DRAINAGE PIPES AND EXTEND SCUPPERS TO BE 8" BELOW THE BOTTOM FLANGE. INSTALL TYPE D ROCK CHANNEL PROTECTION WITH FILTER FABRIC UNDER EACH NEW SCUPPER LOCATION TO PREVENT EROSION
- 7) REMOVE TREES UNDERNEATH AND WITHIN ROW LIMITS
- 8) ZONE PAINT STRUCTURAL STEEL WITHIN 10 FEET OF EITHER SIDE OF EACH INTERMEDIATE JOINT (5 LOCATIONS)

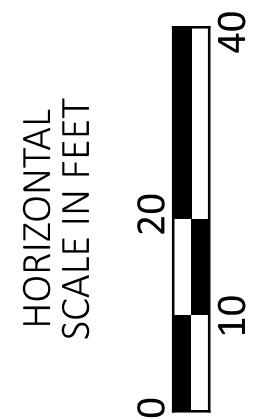

SITE PLAN - 5

BRIDGE NO: HAM-75-1192R

I-75 NB BRIDGE OVER WEST FORK MILL CREEK, NS RR, & SHEPARD LN

SFN
3110656

DESIGN AGENCY



DESIGNER
BCP

CHECKER
AS

REVIEWER
AS





PROJECT ID
120341

SUBSET
5


TOTAL
6

SHEET
40

TOTAL
52

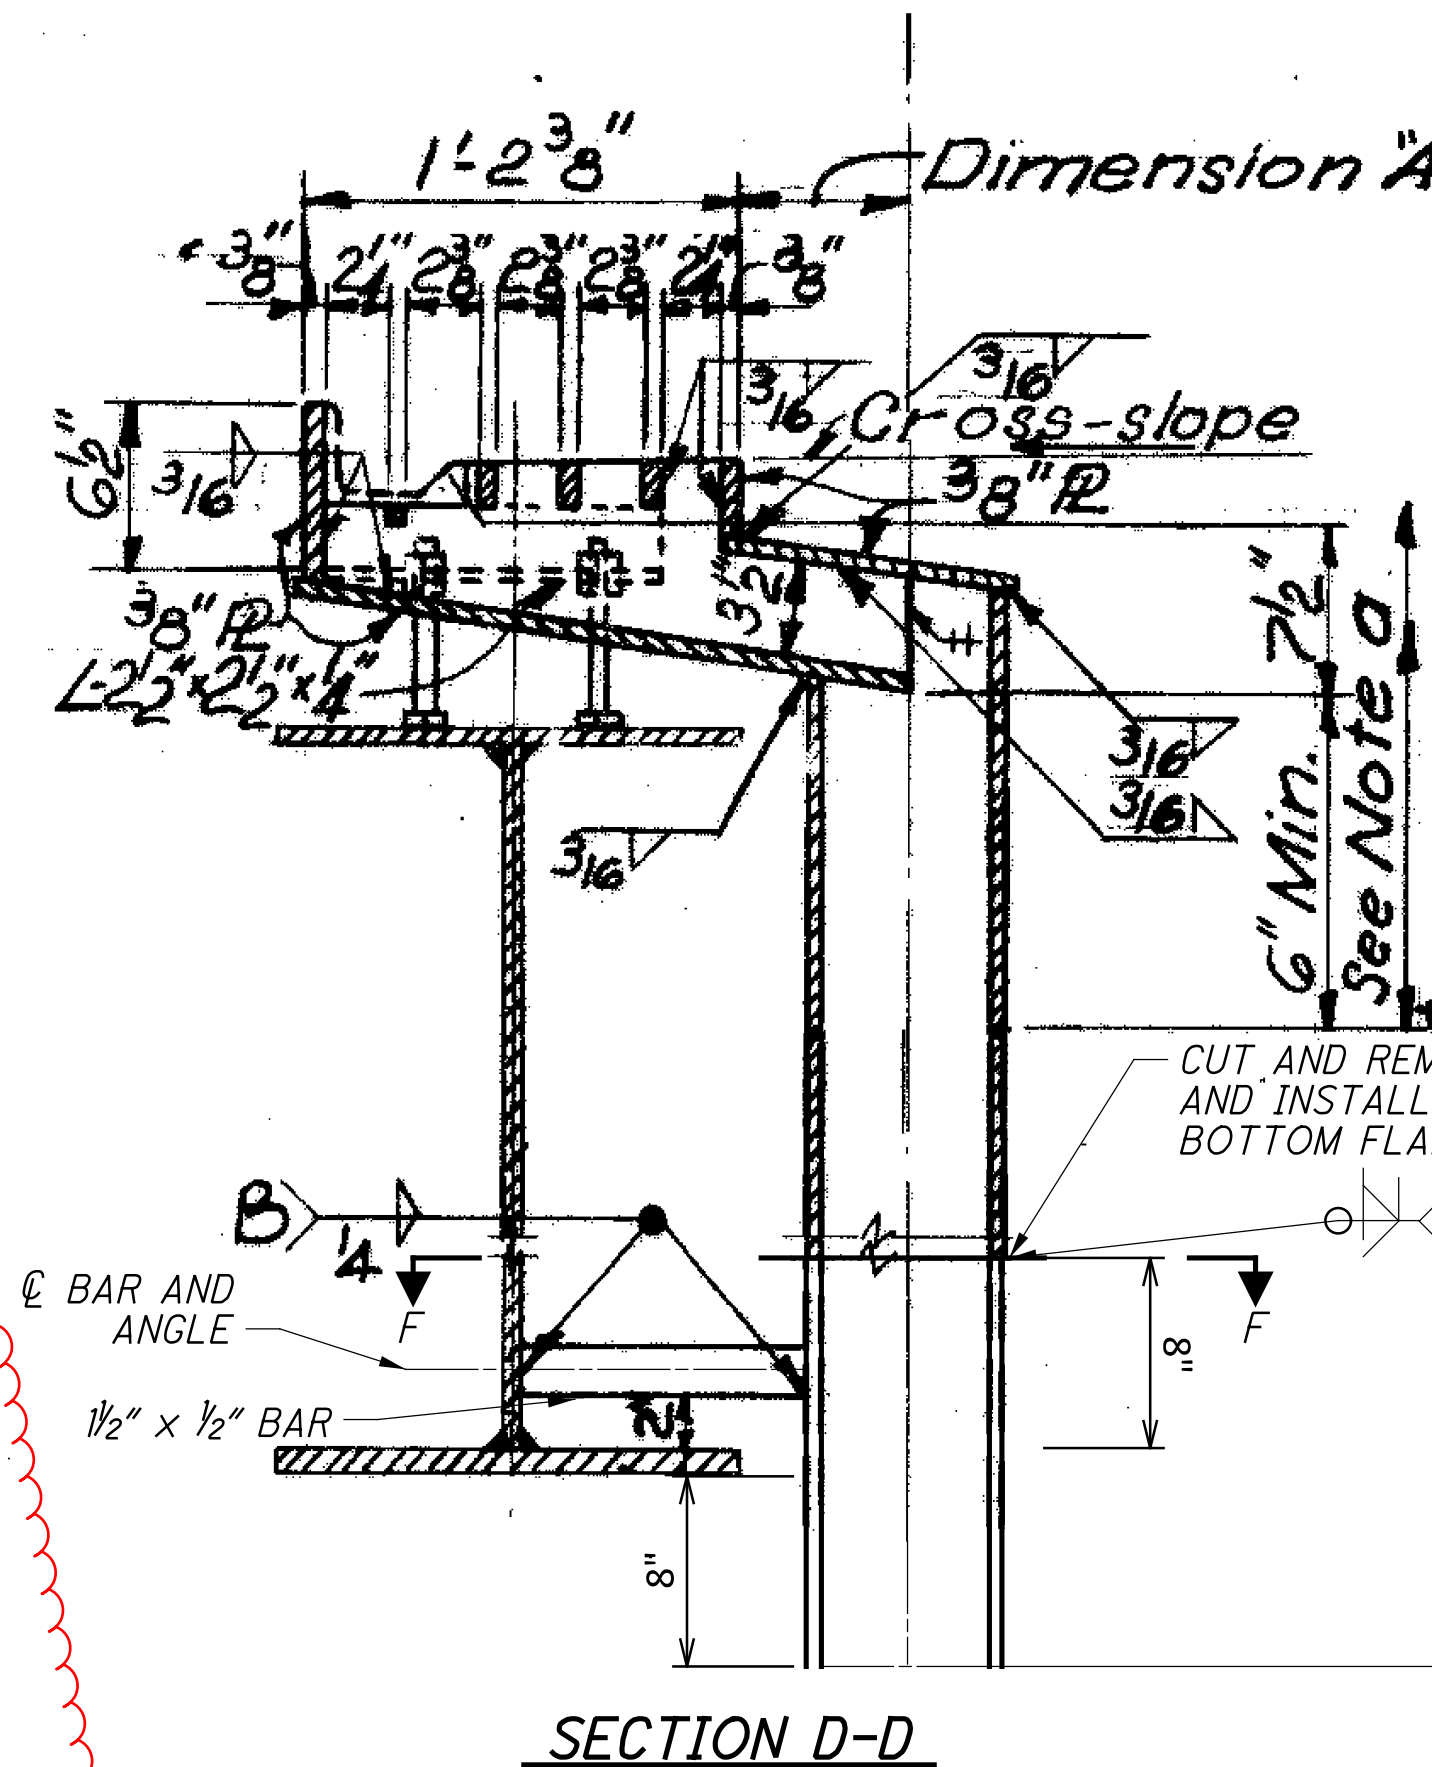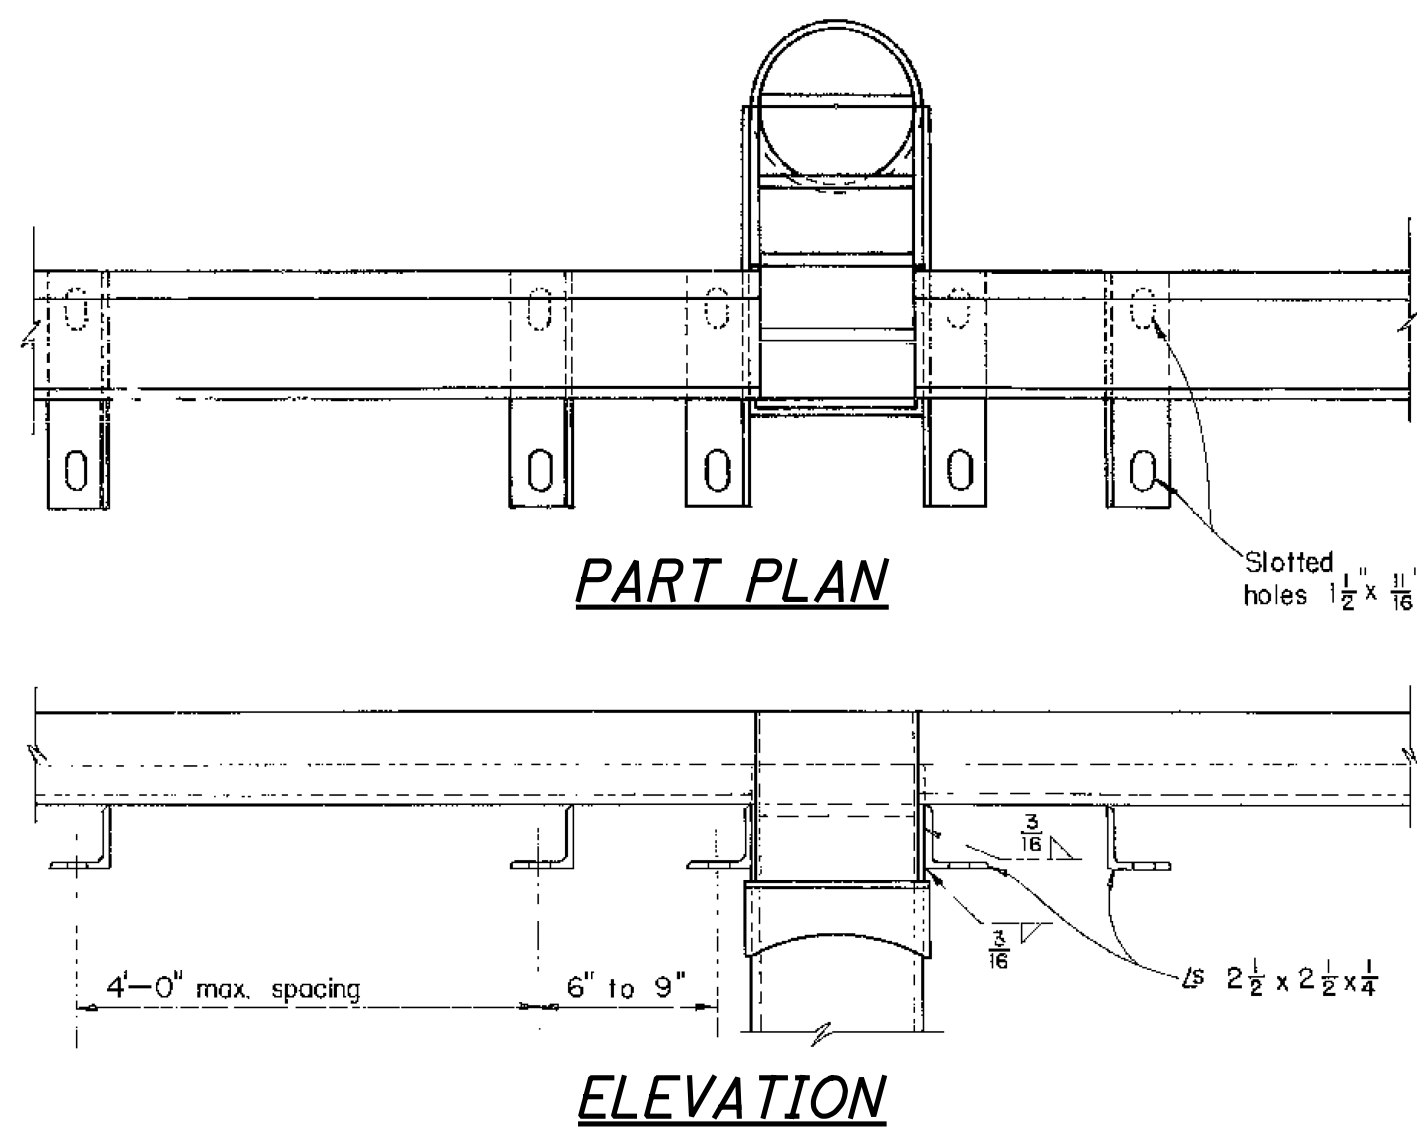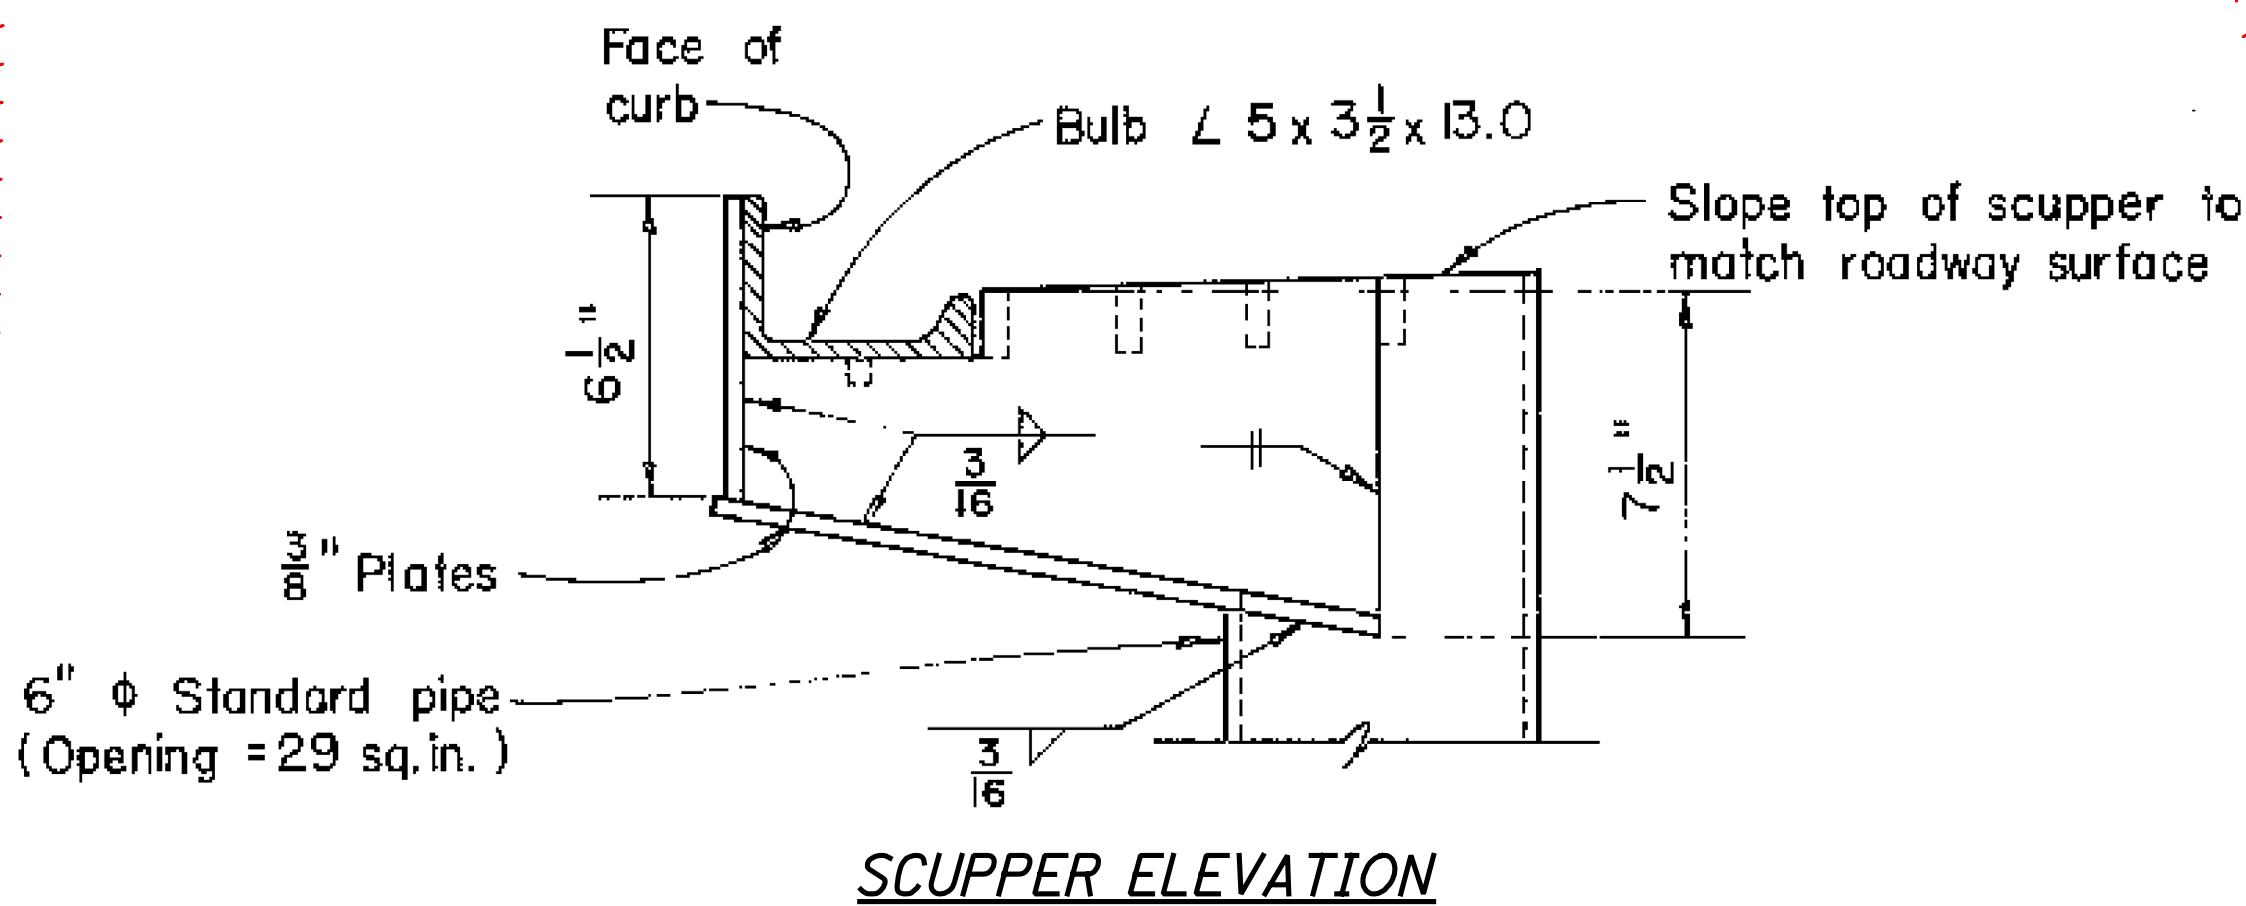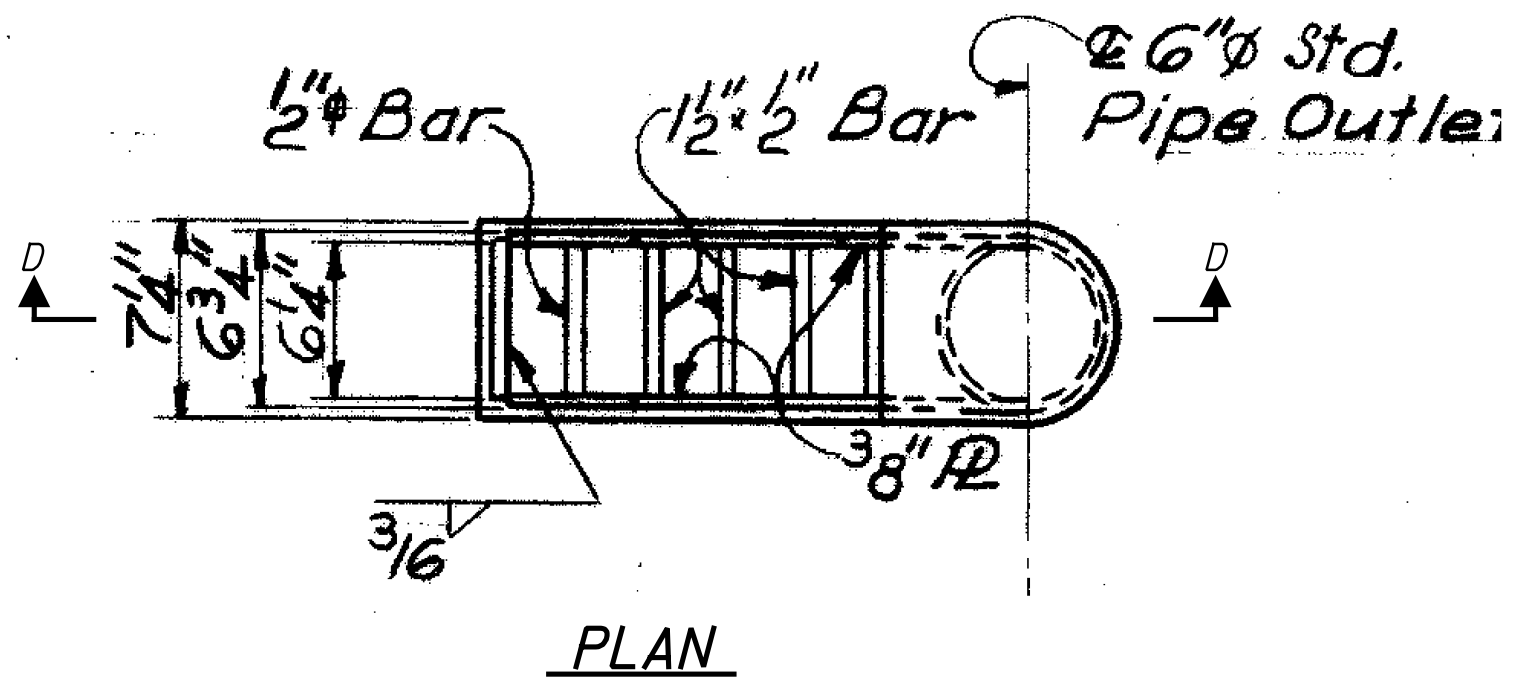

Gutter supports $2\frac{1}{2} \times 2\frac{1}{2} \times \frac{1}{4}$ spaced at not more than 4'-0" centers between scuppers.

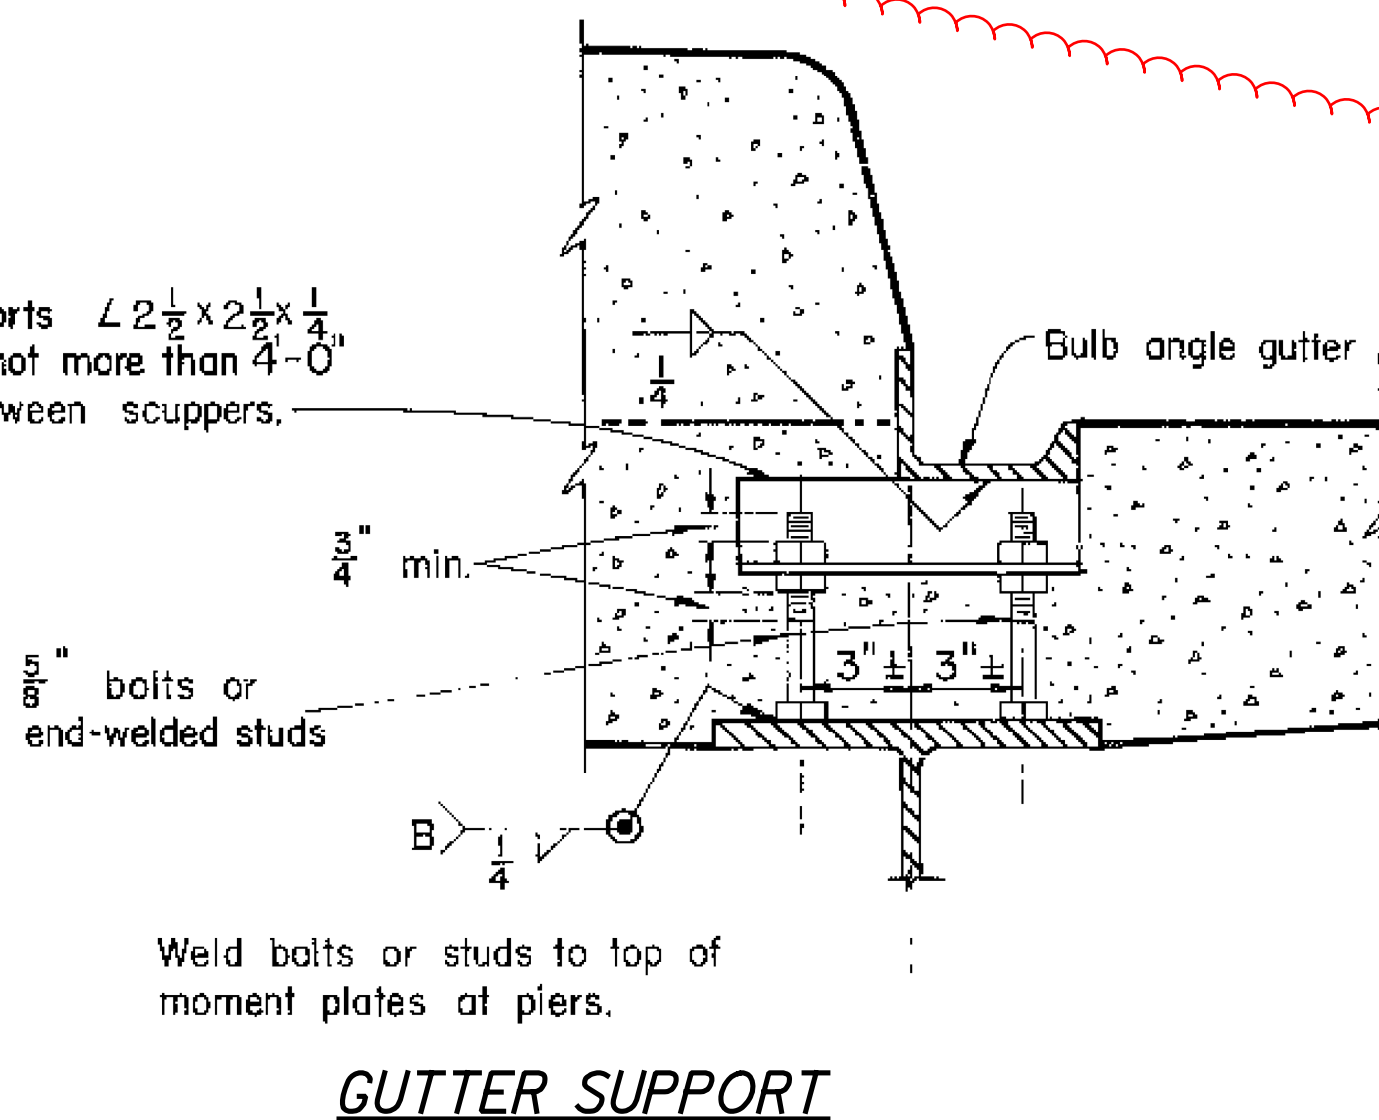

SCUPPER NOTES:

GENERAL:
THE DESIGNER SHALL SHOW THE LOCATION OF THE SCUPPERS IN A PLAN VIEW OF THE BRIDGE DECK ON THE CONTRACT DOCUMENTS.

SUPPLEMENTAL REINFORCEMENT:
REINFORCE THE CONCRETE DECK AT THE TWO SCUPPER CORNERS OPPOSITE THE CURB LINE WITH ONE #4 BAR, 3'-0" LONG ORIENTED AT 45° TO THE LONG AXIS OF THE SCUPPER AND LOCATED JUST BELOW THE TRANSVERSE BARS IN THE TOP MAT OF STEEL.

MATERIAL:
FURNISH STRUCTURAL STEEL TUBING ACCORDING TO C&MS 707.10. TOUGHNESS TESTING IN ACCORDANCE WITH ASTM E436 IS NOT REQUIRED. ALL OTHER MATERIAL SHALL BE ASTM A709 GRADE 36, 50 OR 50W. GALVANIZE SUPPORT ANGLES, BARS, BOLTS, NUTS AND WASHERS IN ACCORDANCE WITH C&MS 711.02

DECK CROWN/SUPERELEVATION:
CUT THE TOP OF THE STEEL TUBING SQUARE FOR CROSS SLOPES $\frac{1}{2}$ " PER FOOT AND LESS. CUT THE TOP OF THE TUBING PARALLEL TO THE DECK SURFACE FOR CROSS SLOPES GREATER THAN $\frac{1}{2}$ " PER FOOT.

FASTENER NOTES:

- THE SIZE OF THE SLOTTED HOLES SHALL BE $\frac{1}{16} \times 1\frac{1}{16}$ ". THE SLOT SHALL BE HORIZONTAL IN THE $3 \times 3\frac{3}{8}$ " BAR AND VERTICAL IN THE ANGLE. BOLTS SHALL BE $\frac{5}{8}$ " DIAMETER A325 TYPE 1, GALVANIZED, WITH HEX NUT AND TWO WASHERS. TIGHTEN ACCORDING TO C&MS 513.
- THE BOLTS SHALL BE $\frac{5}{8}$ " DIAMETER A325 TYPE 1 GALVANIZED FOR GALVANIZED, METALIZED OR PAINTED STRUCTURES OR A325 TYPE 3 FOR BARE WEATHERING STEEL STRUCTURES. EACH ASSEMBLY SHALL INCLUDE A BOLT, NUT AND TWO WASHERS. TIGHTEN ACCORDING TO C&MS 513. FOR WEATHERING STEEL STRUCTURES, PROVIDE A $3\frac{1}{2} \times 3\frac{1}{2} \times \frac{1}{8}$ " PREFORMED BEARING PAD, C&MS 711.21, WITH A $\frac{1}{16}$ " DIAMETER HOLE, BETWEEN THE BEAM WEB AND THE ANGLE. AFTER THE DECK CONCRETE HAS BEEN POURED, FIELD DRILL THE $\frac{1}{16}$ " DIAMETER HOLE IN THE WEB.

BASIS OF PAYMENT:
THE DEPARTMENT WILL PAY FOR THE SUPPLEMENTAL REINFORCEMENT DESCRIBED ABOVE SEPARATELY UNDER ITEM 509.

Special Scupper	Dimension "A"
S-1	2'5"
S-2	2'5"
S-3	1'3"
S-4	10'16"
S-5	4'5 1/16"
S-6	1'6"
S-7	4'4"
S-8	8"
S-9	6'4"
S-10	4'5 1/16"
S-11	4"
S-12	3'3 3/8"
S-13	3"
S-14	2'3 1/4"
S-15	10'8"
S-16	8'8"
S-17	1'5"

SPECIAL SCUPPER "A" DIMENSIONS

*SEE SHEET 50 FOR SPECIAL SCUPPER LOCATIONS