

LEGEND

- (L) STANDARD LONGITUDINAL JOINT PER BP-2.1
 - (C) CONTRACTION JOINT PER BP-2.2
 - (N) CONTRACTION JOINT, TYPE Y PER BP-2.5
 - (W) EXPANSION JOINT PER BP-2.2 WITHOUT DOWEL BARS
 - (Y) EXPANSION JOINT PER BP-2.2 WITHOUT DOWEL BARS AND P.E.J.F. (2" DEEP SAWCUT WITH 705.04 JOINT SEAL)
- CLASS RRCM CONCRETE

- (A) 9" NON-REINFORCED CONCRETE PAVEMENT, CLASS QCI
- (B) 6" AGGREGATE BASE
- (C) TIED LONGITUDINAL JOINT



 0 10 20

 HORIZONTAL

 SCALE IN FEET

 CALCULATED


 TOD

 CHECKED

 PEK

PAVEMENT JOINT DETAIL
THORNWOOD CROSSING

LIC-THORNWOOD CROSSING

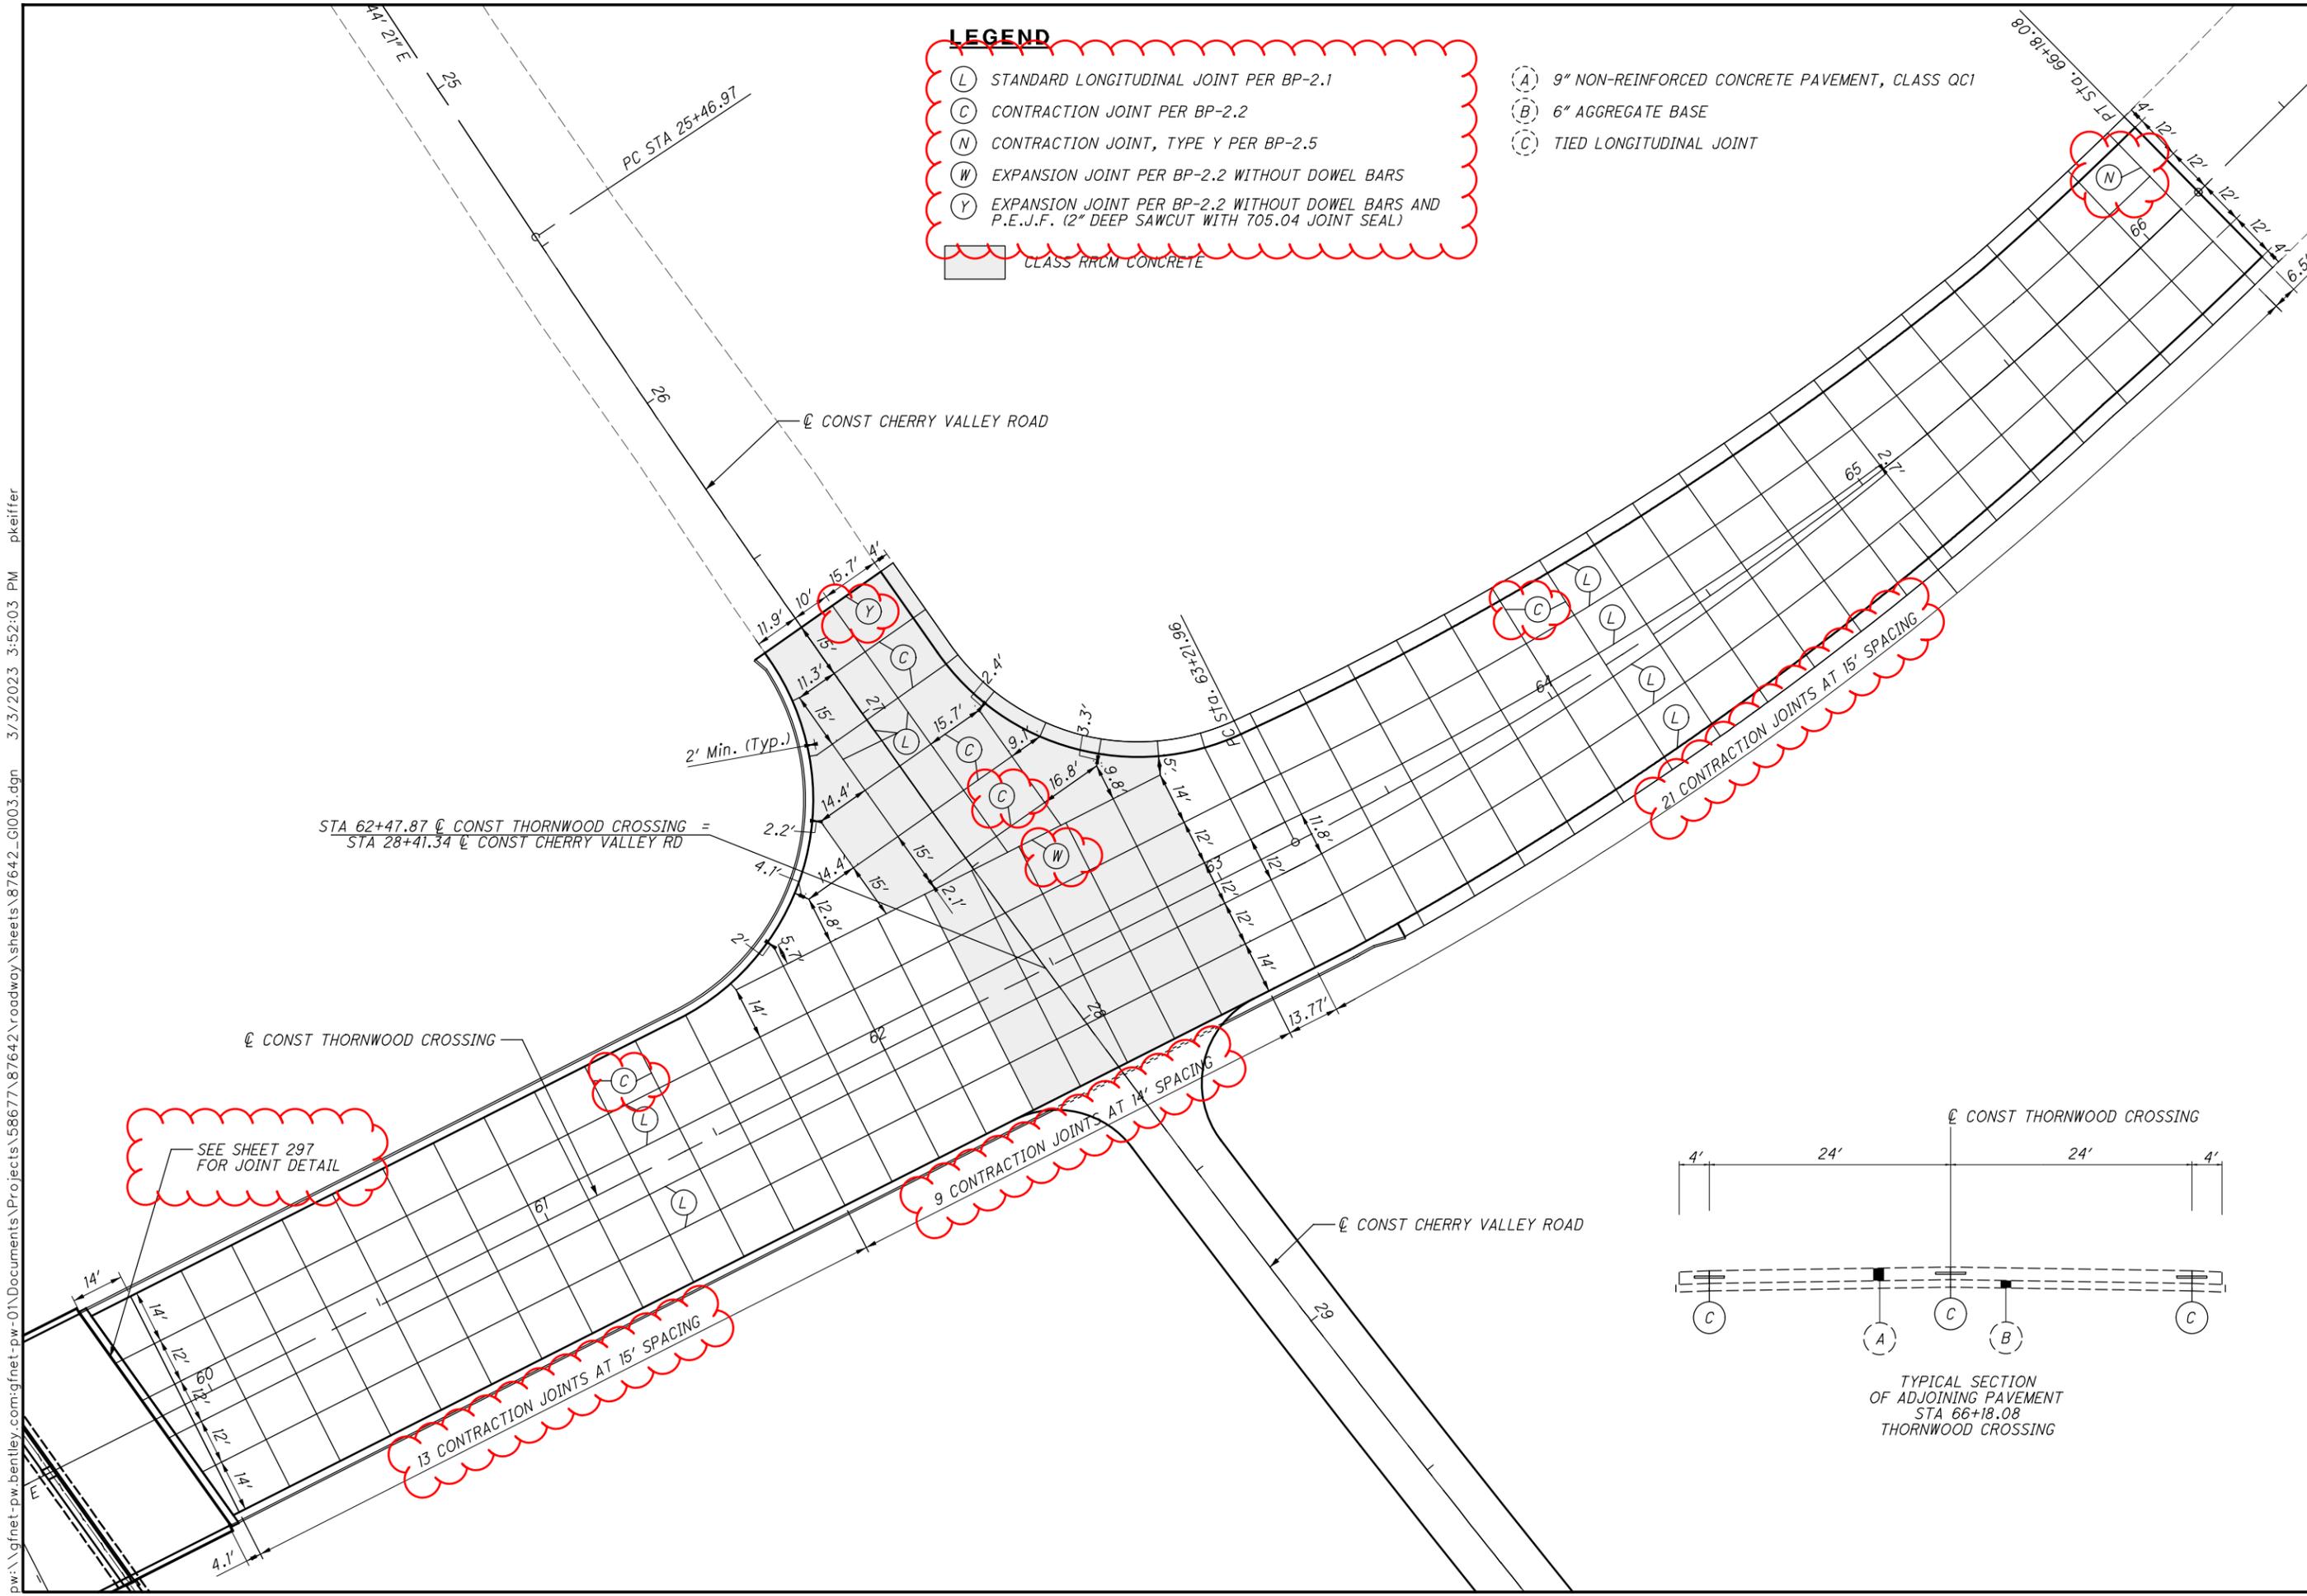


21 CONTRACTION JOINTS AT 15' SPACING

9 CONTRACTION JOINTS AT 14' SPACING

13 CONTRACTION JOINTS AT 15' SPACING

SEE SHEET 297 FOR JOINT DETAIL

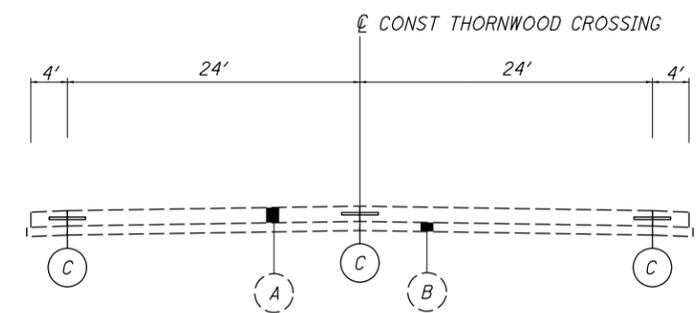

TYPICAL SECTION OF ADJOINING PAVEMENT
STA 66+18.08
THORNWOOD CROSSING

p:\gfn\pw-bentley.com\gfn\pw-01\Documents\Projects\58677\87642\roadway\sheets\87642_G1003.dgn 3/3/2023 3:52:03 PM pkeiffer

ITEM 625, LUMINAIRE, DECORATIVE, AS PER PLAN A (77W, LED, 240V, TYPE III)

IN ADDITION TO THE REQUIREMENTS OF ITEM 625, THIS ITEM INCLUDES FURNISHING AND INSTALLING A DECORATIVE HOLOPHANE LED LUMINAIRE WITH A LIGHTING SYSTEM AS DETAILED ON THIS SHEET.

PROTECT EACH LUMINAIRE ACCODING TO ODOT SUPPLEMENTAL SPECIFICATION 913

PAYMENT SHALL BE MADE AT THE UNIT PRICE BID AND INCLUDE ALL LABOR, EQUIPMENT, MATERIALS, AND INCIDENTALS NECESSARY TO INSTALL THE LUMINAIRE.

ITEM 625, LUMINAIRE, DECORATIVE, AS PER PLAN B (77W, LED, 240V, TYPE III)

IN ADDITION TO THE REQUIREMENTS OF ITEM 625, THIS ITEM INCLUDES FURNISHING AND INSTALLING A DECORATIVE HOLOPHANE LED LUMINAIRE WITHOUT A LIGHTING SYSTEM AS DETAILED ON THIS SHEET.

PROTECT EACH LUMINAIRE ACCODING TO ODOT SUPPLEMENTAL SPECIFICATION 913

PAYMENT SHALL BE MADE AT THE UNIT PRICE BID AND INCLUDE ALL LABOR, EQUIPMENT, MATERIALS, AND ALL INCIDENTALS (EXCEPT ITEMS SEPARATELY ITEMIZED AS SPECIFIED ON THIS SHEET) NECESSARY TO ERECT THE LIGHT POLE.

ITEM 625, LIGHT POLE, DECORATIVE, AS PER PLAN (GROUND MOUNTED)

THIS ITEM INCLUDES FURNISHING AND INSTALLING A GROUND MOUNTED HOLOPHANE DECORATIVE LIGHT POLE WITH BREAKAWAY BASE AS DETAILED ON THIS SHEET.

PROTECT EACH LUMINAIRE ACCODING TO ODOT SUPPLEMENTAL SPECIFICATION 913

PAYMENT SHALL BE MADE AT THE UNIT PRICE BID AND INCLUDE ALL LABOR, EQUIPMENT, MATERIALS, AND ALL INCIDENTALS (EXCEPT ITEMS SEPARATELY ITEMIZED AS SPECIFIED ON THIS SHEET) NECESSARY TO ERECT THE LIGHT POLE.

ITEM 625, LIGHT POLE, DECORATIVE, AS PER PLAN (BRIDGE MOUNTED)

THIS ITEM INCLUDES FURNISHING AND INSTALLING A BRIDGE MOUNTED HOLOPHANE DECORATIVE LIGHT POLE AS DETAILED ON THIS SHEET.

PROTECT EACH LUMINAIRE ACCODING TO ODOT SUPPLEMENTAL SPECIFICATION 913


PAYMENT SHALL BE MADE AT THE UNIT PRICE BID AND INCLUDE ALL LABOR, EQUIPMENT, MATERIALS, AND ALL INCIDENTALS (EXCEPT ITEMS SEPARATELY ITEMIZED AS SPECIFIED ON THIS SHEET) NECESSARY TO ERECT THE LIGHT POLE.

ITEM 625, LIGHT POLE ANCHOR BOLTS ON STRUCTURE

THIS ITEM INCLUDES THE INSTALLATION OF FOUR (4) ANCHOR BOLTS FOR THE BRIDGE MOUNTED DECORATIVE LIGHT POLE. THE ANCHOR BOLTS SHALL BE SET IN THE BRIDGE PARAPET PRIOR TO POURING OF PARAPET CONCRETE. THE ANCHOR BOLTS MAY NEED SHIPPED TO JOB SITE FROM MANUFACTURER SEPARATE FROM REST OF LIGHTING ITEMS.

PAYMENT SHALL BE MADE AT THE UNIT PRICE BID AND INCLUDE ALL INCIDENTALS NECESSARY TO INSTALL THE ANCHOR BOLTS.

**BRIDGE MOUNTED
DECORATIVE LIGHT POLE**

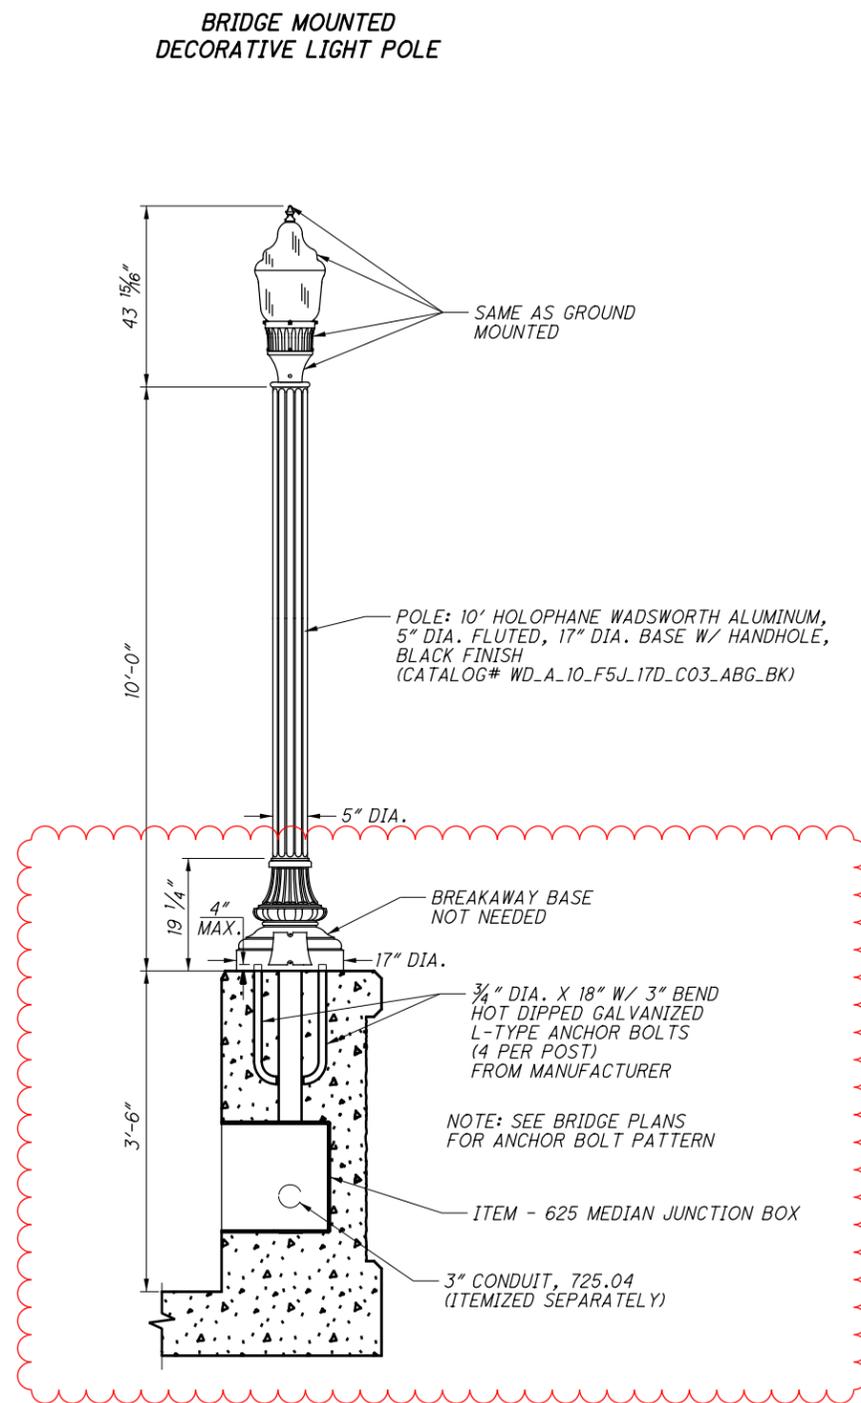

**GROUND MOUNTED
DECORATIVE LIGHT POLE**

