

***SAN-523-3.07***

**INDEX OF SHEETS:**

TITLE SHEET	1
TYPICAL SECTIONS	2
GENERAL NOTES	3
MAINTENANCE OF TRAFFIC NOTES	4
GENERAL SUMMARY	5
SUBSUMMARIES	6
PLAN AND PROFILE	7
CROSS SECTIONS	8-10
STRUCTURES (OVER 20 FT. SPAN)	11-21
SAN-523-0307	

## E200120

NONE

REHABILITATE SAN-523-0307 STRUCTURE OVER  
LITTLE MUDDY CREEK; PERFORM NECESSARY RELATED WORK.

PROJECT EARTH DISTURBED AREA: 0.1 ACRES  
ESTIMATED CONTRACTOR EARTH DISTURBED AREA: 0 ACRES  
NOTICE OF INTENT EARTH DISTURBED AREA: N/A ACRES  
(NOI NOT REQUIRED)

THE STANDARD SPECIFICATIONS OF THE STATE OF OHIO, DEPARTMENT OF TRANSPORTATION, INCLUDING SUPPLEMENTAL SPECIFICATIONS LISTED IN THE PLANS, CHANGES LISTED IN THE PROPOSAL, AND THE SUPPLEMENTAL SPECIFICATION 800 VERSION INDICATED ON THE PROPOSAL SHALL GOVERN THIS IMPROVEMENT.


I HEREBY APPROVED THESE PLAND AND DECLARE THAT THE MAKING OF THIS IMPROVEMENT WILL REQUIRE THE CLOSING OF TRAFFIC OF THE HIGHWAY AND THAT DETOURS WILL BE PROVIDED.

*Pat McColley, PE*  
 Pat McColley, P.E., S.I.  
**DISTRICT 02 DEPUTY DIRECTOR**

  
Pamela Boratyn  
**DIRECTOR, DEPARTMENT OF TRANSPORTATION**

### LOCATION MAP

LATITUDE: 41°26'33" LONGITUDE: -83°4'36"

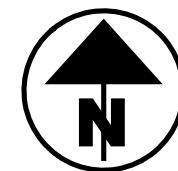

PORTION TO BE IMPROVED	
INTERSTATE HIGHWAY	
FEDERAL ROUTES	
STATE ROUTES	
COUNTY & TOWNSHIP ROADS	
OTHER ROADS	

CURRENT ADT (2025)	500
DESIGN YEAR ADT (2045)	600
DESIGN HOURLY VOLUME (2045)	70
DIRECTIONAL DISTRIBUTION	77%
TRUCKS (24 HOUR B&C)	8%
DESIGN SPEED	60 MPH
LEGAL SPEED	55 MPH
DESIGN FUNCTIONAL CLASSIFICATION:	
RURAL MINOR COLLECTOR	
NHS PROJECT	NO

NONE REQUIRED


NONE REQUIRED

<p><b>UNDERGROUND UTILITIES</b></p> <p>Contact Two Working Days Before You Dig</p>
 <p><b>OHIO811.org</b></p> <p>Before You Dig</p>
<p><b>OHIO811, 8-1-1, or 1-800-362-2764</b></p> <p>(Non members must be called directly)</p>

PLAN PREPARED BY:  
ODOT DISTRICT 2  
317 E POE RD  
BOWLING GREEN, OH 43402

STANDARD CONSTRUCTION DRAWINGS					SUPPLEMENTAL SPECIFICATIONS	SPECIAL PROVISIONS
MGS-1.1	7/16/21				800 1/17/25	ASBESTOS REPORT 3/29/21
MGS-2.1	1/19/18				832 7/15/22	
MGS-3.3	7/16/21					WATERWAY PERMIT 7/30/21
MGS-4.2	7/19/13					
AS-1-15	7/17/15					
AS-2-15	1/18/19					
DS-1-92	7/15/22					
PSBD-2-07	7/20/18					
TST-2-21	7/16/21					
MT-101.60	1/17/20					
MT-105.10	1/17/20					

**ENGINEER'S SEAL**

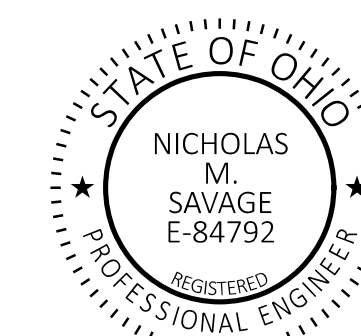

MILE SHEET

DESIGN AGENCY



DESIGNER

IJS

REVIEWER

MS 06-23-25

PROJECT ID

107718

SHEET	TOTAL
1	1

21

**SAN-523-03.07**

MODEL: Sheet PAPER SIZE: 34x22 (in.) DATE: 8/13/2025 TIME: 5:44:18 AM USER: nsavage  
[www.chicodot-pw-bentley.com:chicodot-pw-02/Projects/District 02/Sandusky/107718400-Engineering/Roadway/Sheets/107718\\_GT002.dgn](http://www.chicodot-pw-bentley.com:chicodot-pw-02/Projects/District%20Sandusky/107718400-Engineering/Roadway/Sheets/107718_GT002.dgn)