

7,168,17

AIR SPEED ZONE CERTIFICATION O.D.O.T. DISTRICT 2 SURVEY

PERSONNEL

PID: 88497

SHEET 1 OF 1

NOTES NUHFER

DATE 10-25-2013

ROUTE SEN-224

CALC. NUHFER

WEATHER FAIR

COUNTY SENECA

ROD ROUSOS

TEMP. +43°

BEGIN SLM: 8.16

GPS ROUSOS

END SLM: 9.16

EB X WB X

BEGIN: BETWEEN WERTZ RD. TR#109 NORTH AND SOUTH

END: WEST OF WELLY RD. TR#113

MONUMENTS: SET MAG NAILS ALONG THE NORTH AND SOUTH WHITE LINES


INTERVALS: 1320' APART USING ODOT VRS 2009 DATUM

BEGIN: NORTHING; 523859.515

EASTING; 1756991.041

END: NORTHING; 524802.999

EASTING; 1762186.098

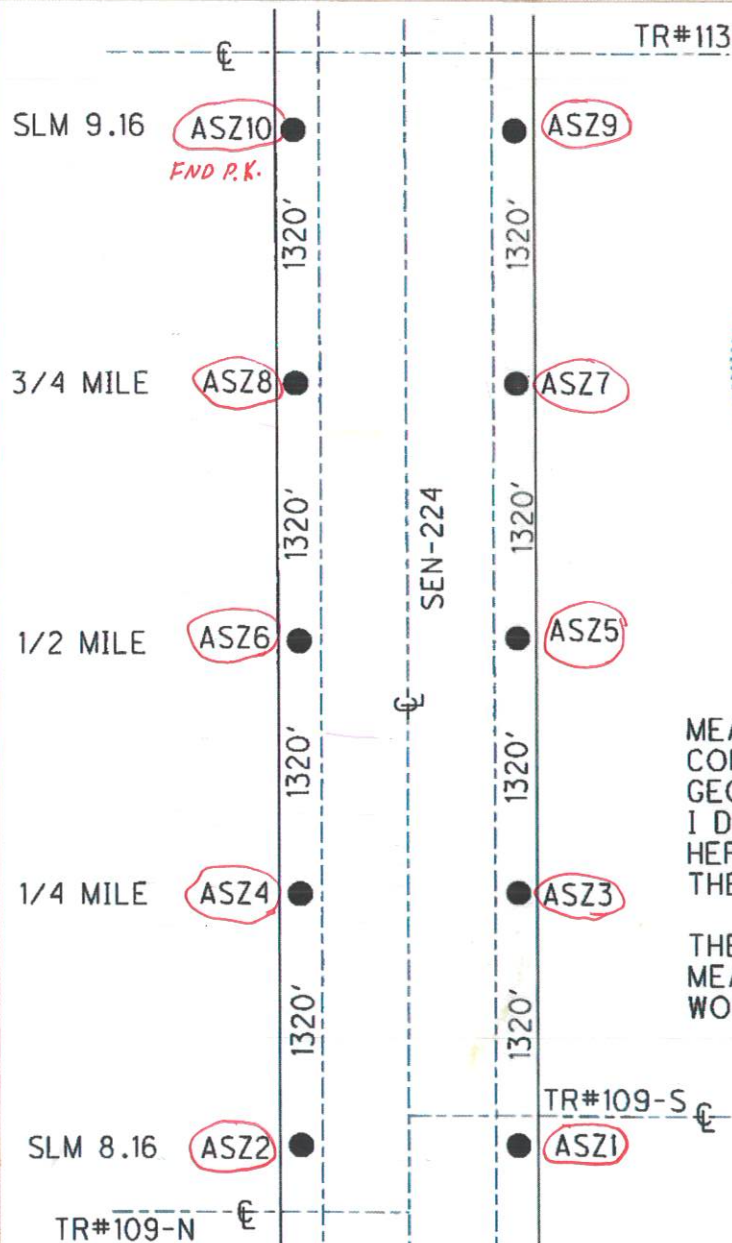

LEGEND:

● =MAG NAILSET

NO SCALE

- Shot as point name circled
- FND Mag Nail unless otherwise noted

ASZ 1-ASZ 2 - 9/10/24
ASZ 3-ASZ 10-9/11/24

MEASUREMENTS OBTAINED USING ODOT VRS
CORS NETWORK, NAD83 (CORS96) DATUM,
GEOID 2009.

I DO HEREBY CERTIFY THAT THE INFORMATION
HEREIN CONTAINED IS TRUE AND CORRECT TO
THE BEST OF MY KNOWLEDGE.

THE WORDS I AND MY AS USED HEREIN ARE TO
MEAN THAT EITHER MYSELF OR SOMEONE
WORKING UNDER MY DIRECT SUPERVISION.

Ryan G. Nuhfer PS 10-28-2013
RYAN G. NUHFER, P.S. # 7877 DATE