


LEGEND

WORK AREA	
DRUMS/CONES	
2-WAY LEFT-TURN MARKING	
DIRECTION OF TRAVEL	

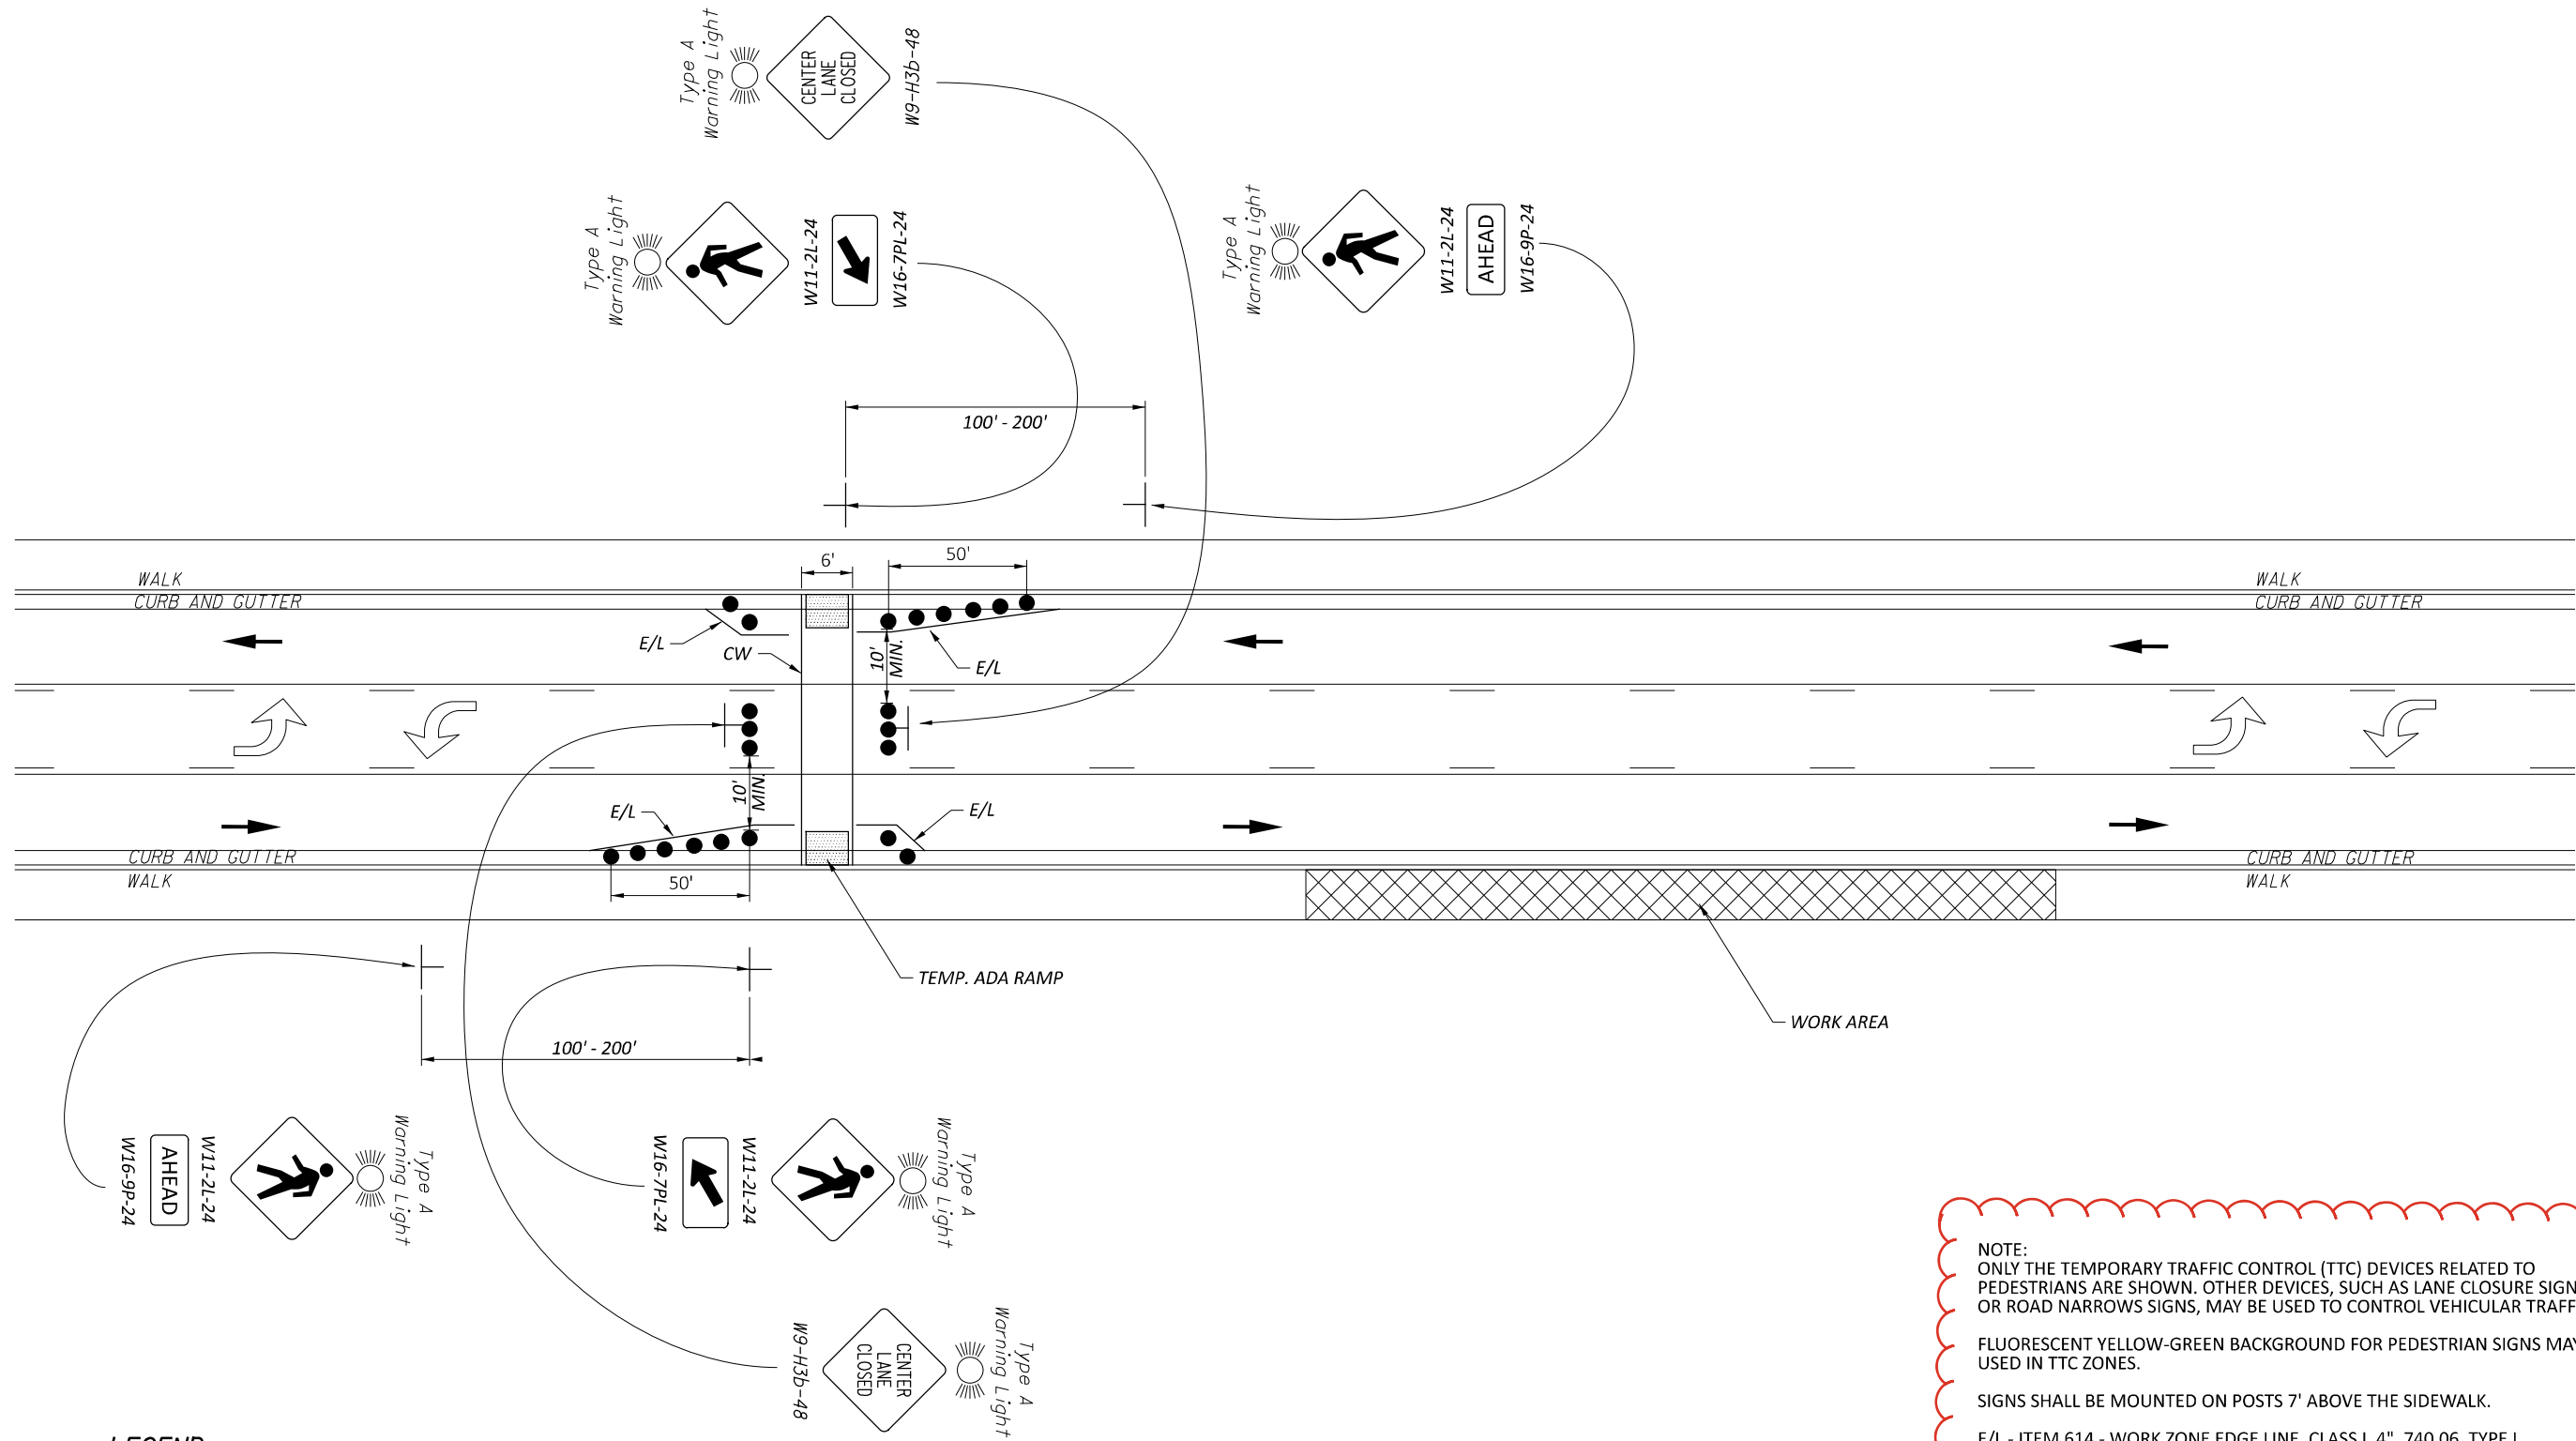

NOTE:
ONLY THE TEMPORARY TRAFFIC CONTROL (TTC) DEVICES RELATED TO PEDESTRIANS ARE SHOWN. OTHER DEVICES, SUCH AS LANE CLOSURE SIGNING OR ROAD NARROWS SIGNS, MAY BE USED TO CONTROL VEHICULAR TRAFFIC.

FLUORESCENT YELLOW-GREEN BACKGROUND FOR PEDESTRIAN SIGNS MAY BE USED IN TTC ZONES.

SIGNS SHALL BE MOUNTED ON POSTS 7' ABOVE THE SIDEWALK.

E/L - ITEM 614 - WORK ZONE EDGE LINE, CLASS I, 4", 740.06, TYPE I
200 FEET / EACH

CW - ITEM 614 - WORK ZONE CROSSWALK LINE, CLASS I, 12", 740.06, TYPE I
72 FT / EACH

TEMPORARY ADA RAMP SHALL BE A PRODUCT DESIGNED FOR TEMPORARY ADA CURB RAMP, BE A MINIMUM OF 4' X 4', BE DETECTABLE AND HAVE ACCESSIBILITY FEATURES, AND BE SECURED TO THE GROUND SUCH THAT IT PREVENTS MOVEMENT OF THE RAMP AND MINIMIZES TRIPPING HAZARD.

PEDESTRIAN DETOURS SHALL UTILIZE EXISTING AND THE TEMPORARY CROSSING TO MINIMIZE THE TOTAL DISTANCE OF THE PEDESTRIAN DETOUR.

INCLUDE ALL MATERIAL, EQUIPMENT, AND WORK REQUIRED TO INSTALL PEDESTRIAN MID BLOCK CROSSINGS IN 614 - MAINTENANCE OF TRAFFIC LUMP SUM.



GENERAL SUMMARY	
DESIGN AGENCY	
	
DESIGNER	
KWK	
REVIEWER	
JDC	06/01/25
PROJECT ID	
116274	
SHEET	TOTAL
9	41