

ADA WAIVER

AN APPROVED ADA DESIGN WAIVER IS REQUIRED ON THIS PROJECT. THE FOLLOWING FEATURES LISTED BELOW CANNOT FEASIBLY BE CONSTRUCTED TO MEET ADA GUIDELINES.

ADA FEATURE	APPROVAL DATE	SHEET NUMBERS
RMP0028846	04/10/2025	P.43
RMP0028847	04/10/2025	P.44

ITEM 253 PAVEMENT REPAIR, AS PER PLAN

THIS ITEM SHALL INCLUDE THE COST OF ALL LABOR, MATERIALS, AND EQUIPMENT NECESSARY TO REMOVE AND REPLACE PAVEMENT FOLLOWING THE INSTALLATION OF PROPOSED DRAINAGE STRUCTURES. SEE SHEET P.22 FOR DETAILS. THE FOLLOWING QUANTITIES, SHOWN FOR REFERENCE ONLY, HAVE BEEN PROVIDED BELOW FOR THE COMPLETION OF THIS WORK. ALL REPAIRED PAVEMENT SHALL BE CONSTRUCTED BASED ON A WIDTH OF TWO FEET AROUND THE PERIMETER OF THE DRAINAGE STRUCTURE AS WELL AS THE FOLLOWING PAVEMENT SECTION.

ITEM 204- SUBGRADE COMPACTION	35 SY.
ITEM 301 - ASPHALT CONCRETE BASE, PG64-22	6 CU. YD.
ITEM 304 - AGGREGATE BASE	6 CU. YD.
ITEM 441 - ASPHALT CONCRETE SURFACE COURSE, TYPE 1, (449), PG64-22	3 CU. YD.
ITEM 407 - NON-TRACKING TACK COAT	6 GAL.

THE ABOVE QUANTITY IS BASED ON THE FOLLOWING PAVEMENT THICKNESSES FOR THE 2-FOOT WIDE PAVEMENT SECTION:

- 1

EXISTING PAVEMENT SURFACE
- 2

ITEM 441 - ASPHALT CONCRETE SURFACE COURSE, TYPE 1, (449), PG64-22 (3.0 INCHES), MAXIMUM 1.5-INCH LIFT
- 3


ITEM 301 - ASPHALT CONCRETE BASE, PG64-22 (6 INCHES), COMPACTED IN TWO LIFTS
- 4

ITEM 304 - AGGREGATE BASE (6 INCHES)
- 5

ITEM 407 - NON-TRACKING TACK COAT (0.06 GAL/SQ. YD.)
- 6

ITEM 204- SUBGRADE COMPACTION

PROVIDE ANY MATERIALS USED OUTSIDE THE LIMITS STATED ABOVE AT NO ADDITIONAL COST.

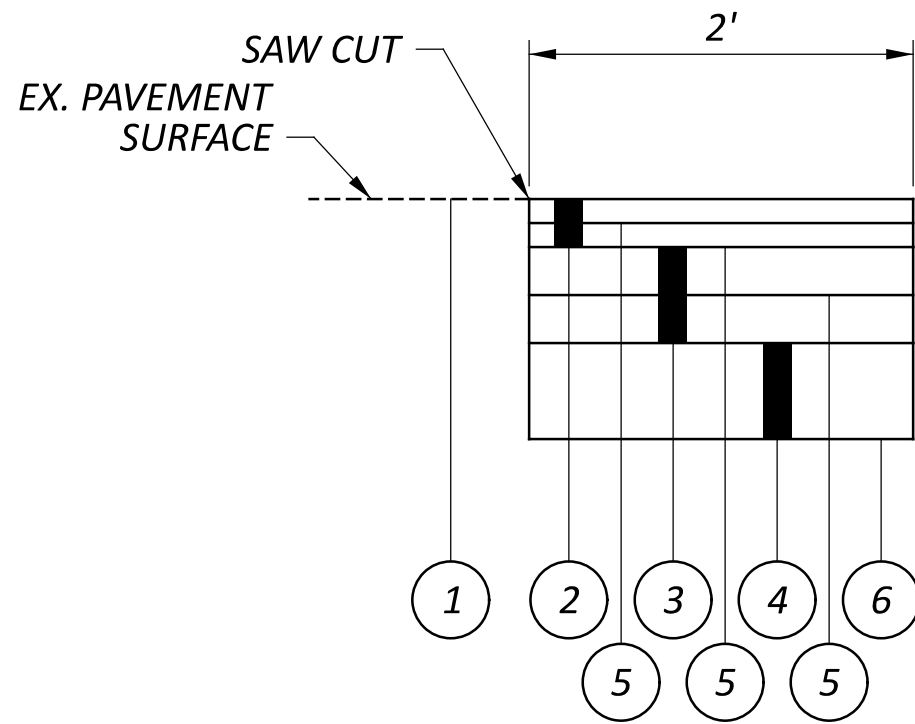

ITEM 253 PAVEMENT REPAIR, AS PER PLAN 15 CY

ITEM 611 - MANHOLE ADJUSTED TO GRADE

THIS WORK SHALL CONSIST OF ADJUSTING MANHOLE TO GRADE PRIOR TO THE APPLICATION OF THE SURFACE COURSE AS DIRECTED BY THE ENGINEER. THE FOLLOWING QUANTITY HAS BEEN CARRIED TO THE GENERAL SUMMARY:

ITEM 611 MANHOLE ADJUSTED TO GRADE 1 EACH

ITEM 611 - GAS VALVE BOX ADJUSTED TO GRADE

THIS WORK SHALL CONSIST OF ADJUSTING GAS VALVE BOX TO GRADE PRIOR TO THE APPLICATION OF THE SURFACE COURSE AS DIRECTED BY THE ENGINEER. THE FOLLOWING QUANTITY HAS BEEN CARRIED TO THE GENERAL SUMMARY:

ITEM 611 GAS VALVE BOX ADJUSTED TO GRADE 1 EACH

ITEM 620 - DELINEATOR (WHITE), POST SURFACE MOUNTED

THIS WORK SHALL CONSIST OF INSTALLING 18 WHITE DELINEATORS ON PROPOSED CONCRETE BUMP-OUTS WHERE SPECIFIED IN SHEETS P.40 - P.42. AN ADDITIONAL 6 WHITE DELINEATORS SHALL BE PROVIDED TO THE VILLAGE OF AMESVILLE FOR POST-CONSTRUCTION MAINTENANCE.

ITEM 620 DELINEATOR, POST SURFACE MOUNTED 6 EACH

ITEM 642 - REMOVAL OF PAVEMENT MARKINGS, AS PER PLAN

THIS ITEM SHALL INCLUDE THE COST OF ALL LABOR, MATERIALS, AND EQUIPMENT NECESSARY TO REMOVE EXISTING PAVEMENT MARKINGS IN LOCATIONS DESIGNATED FOR NEW OR PROPOSED PAVEMENT MARKINGS.

ITEM 642 REMOVAL OF PAVEMENT MARKINGS, AS PER PLAN 45 FT

SEQUENCE OF CONSTRUCTION

TO ALLOW A CAPITAL GAS LINE PROJECT TO BE COMPLETED IN EARLY 2026, THE FOLLOWING WORK SHALL NOT BEGIN UNTIL JUNE 1, 2026.

SR 550
- LT. SIDE, STA. 562+50 TO STA. 569+50

SR 329
- STA. 1+00 TO STA. 4+50

ALL OTHER WORK MAY BEGIN AT THE CONVENIENCE OF THE CONTRACTOR, MINDFUL OF THE SEPTEMBER 1, 2026 PROJECT COMPLETION DATE.

GENERAL NOTES

DESIGN AGENCY



DESIGNER

EME

REVIEWER

SLG 02/05/25

PROJECT ID

119817

SHEET

P.8

TOTAL

45

LIBERTY ST

LIBERTY ST

DESIGN AGENCY

SA

STRAND
ASSOCIATES®

DESIGNER

EME

REVIEWER

SLG 02/05/25

PROJECT ID

119817

SHEET	TOTAL
P.42	45