


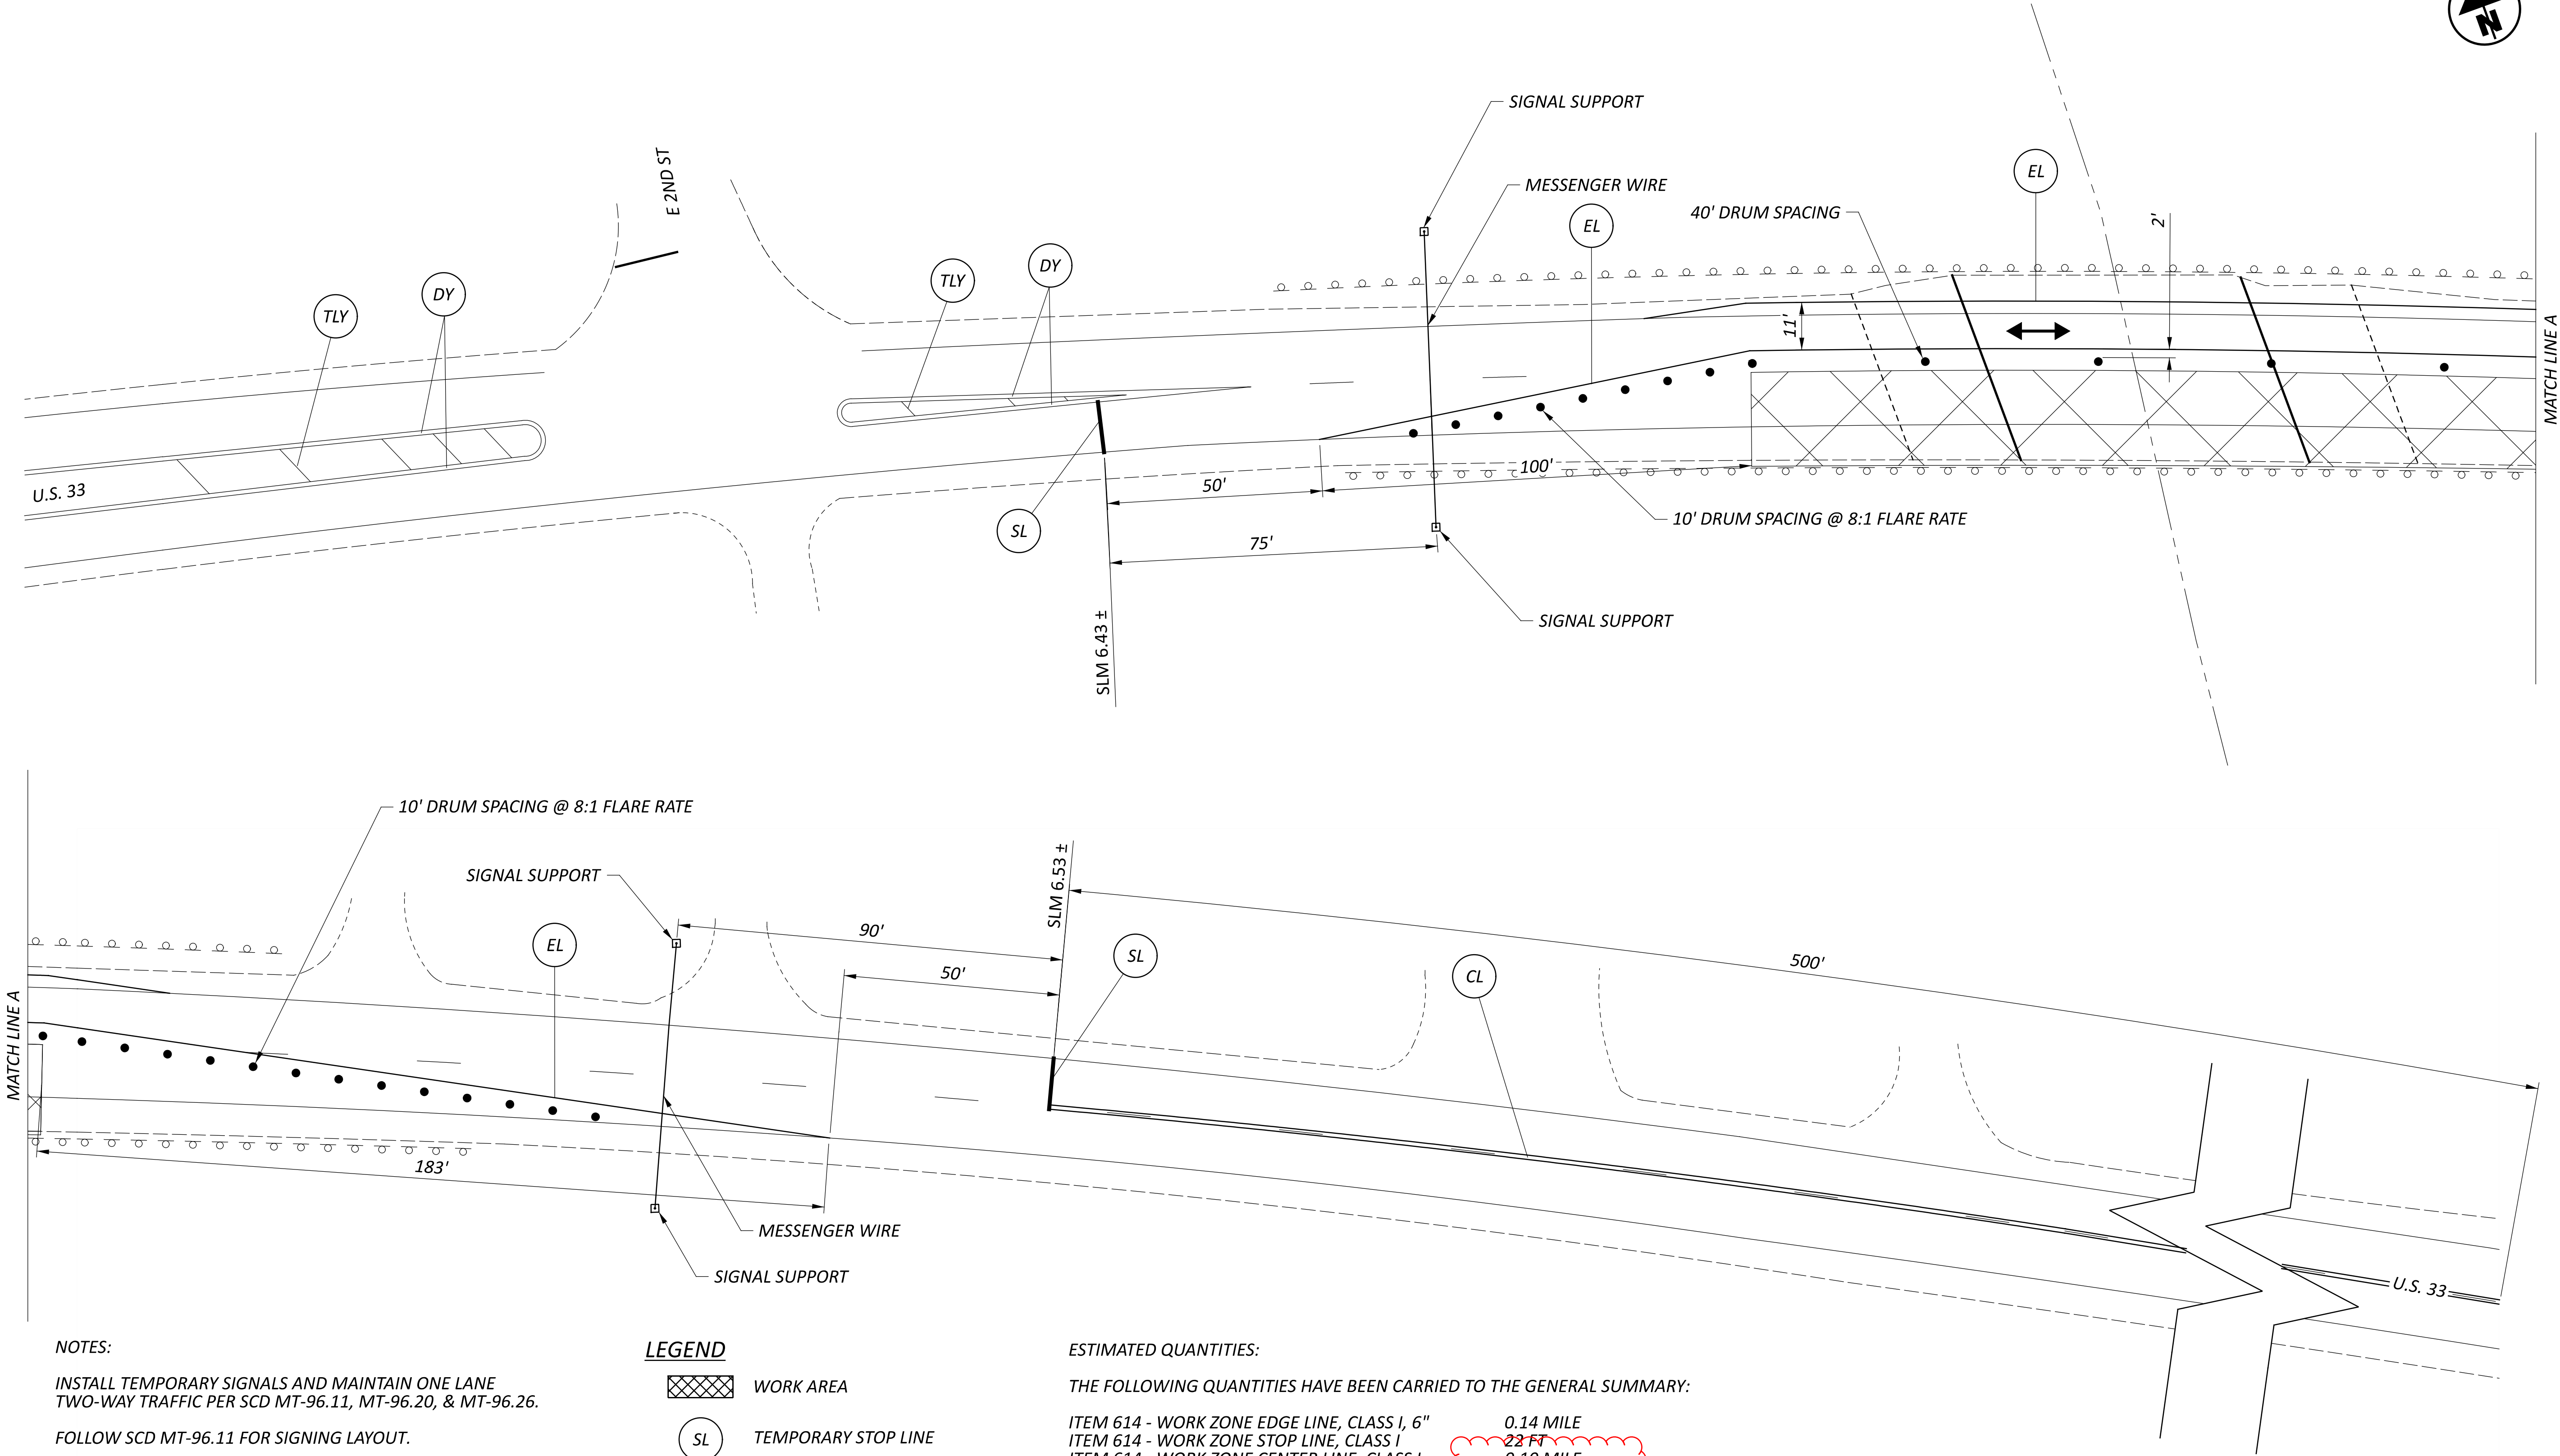

NOTES:

INSTALL TEMPORARY SIGNALS AND MAINTAIN ONE LANE TWO-WAY TRAFFIC PER SCD MT-96.11, MT-96.20, & MT-96.26.

FOLLOW SCD MT-96.11 FOR SIGNING LAYOUT.

LEGEND


- WORK AREA
- TEMPORARY STOP LINE
- TEMPORARY EDGE LINE
- TEMPORARY CENTERLINE
- EX. DOUBLE YELLOW
- EX. TRANSVERSE LINE YELLOW

ESTIMATED QUANTITIES:

THE FOLLOWING QUANTITIES HAVE BEEN CARRIED TO THE GENERAL SUMMARY:

ITEM 614 - WORK ZONE EDGE LINE, CLASS I, 6" 0.14 MILE
ITEM 614 - WORK ZONE STOP LINE, CLASS I 22 FT
ITEM 614 - WORK ZONE CENTER LINE, CLASS I 0.10 MILE

ALL OTHER LABOR, EQUIPMENT, AND MATERIALS ASSOCIATED WITH THE WORK ZONE ARE INCLUDED IN ITEM 614, MAINTAINING TRAFFIC.

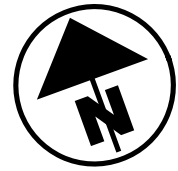

MAINTAINANCE OF TRAFFIC - PHASE 1
MER-33-6.45 BRIDGE

DESIGN AGENCY



DESIGNER

DAV

REVIEWER

BJA 9-04-25

PROJECT ID

101178


SHEET

P.7A

TOTAL

20

HORIZONTAL
SCALE IN FEET

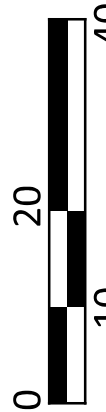

GENERAL SUMMARY	
DESIGN AGENCY	
	
DESIGNER	
TMK	
REVIEWER	
BJA	6-11-25
PROJECT ID	
101178	
SHEET	TOTAL
P.9	20