

STATE OF OHIO  
DEPARTMENT OF HIGHWAYS

F-581 (10)

F-581 (10)

222

# BUT-4-(16.53-19.15)

LEMON TOWNSHIP

# BUTLER COUNTY


GRADE SEPARATION WITH BALTIMORE & OHIO R.R.

## LIMITED ACCESS

This improvement is especially designed for through traffic and has been declared a limited access highway or freeway from Station 555+00 to Station 634+50 by action of the Director of Highways in accordance with the provisions of Sec. 5511.02 of the Revised Code of Ohio.

### CONVENTIONAL SIGNS

- TOWNSHIP LINE
- CORPORATION LINE
- RIGHT-OF-WAY
- CENTER LINE
- PROPERTY LINE
- FENCE
- RAILROAD
- POLES
- GAS
- WATER
- TREES
- HEDGES
- GUARD RAIL
- MANHOLES
- INLETS
- CULVERTS
- DITCHES
- HIGHWAY SIGNS
- MAIL BOX
- WATER VALVE
- SEWER

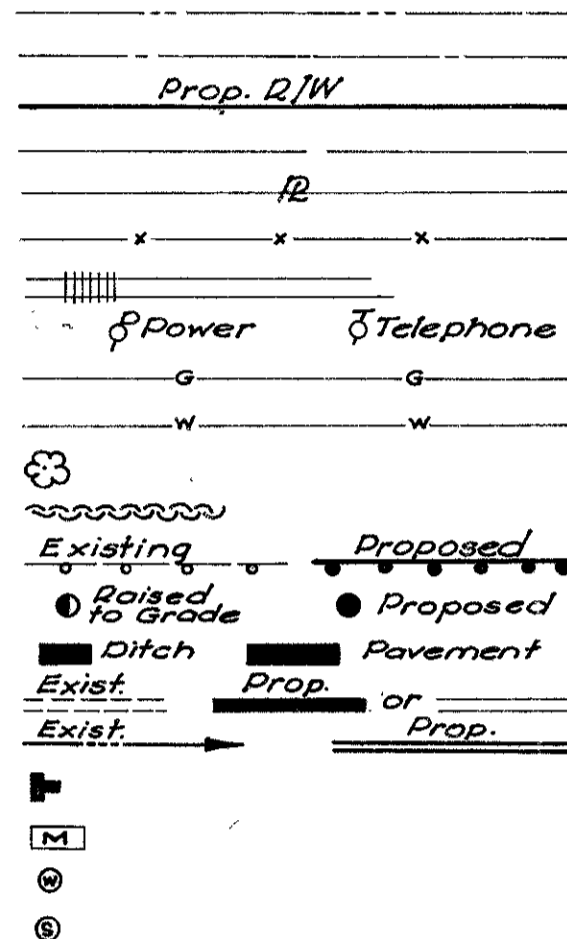

### INDEX OF SHEETS

(NOTE: SHEET No. 144 NOT A PART OF THIS PLAN)

TITLE SHEET	1
TYPICAL SECTIONS	2-17
GENERAL NOTES	18-21
SUMMARY OF QUANTITIES	22-29
GENERAL PLAN	30
PLAN AND PROFILE	31-47
SUPERELEVATION TABLES	48
CROSS SECTIONS	49-143
INTERSECTION DETAILS	145-154
PAVEMENT DETAILS	155-156
DRAINAGE DETAILS	157-171, 163A
STRUCTURES OVER 20 FT. SPAN	172-205
RIGHT-OF-WAY PLAN	206-219
SOIL PROFILE	219A, 220-222
RAILROAD FORCE ACCOUNT WORK	174


### LINE DATA

Length of Project	Sta. 470+50 to Sta. 634+50
Length of Project BUT-4-(16.53-19.15)	16,400.00 lin. ft. = 3.106 Miles
Length of Work	16,400.00 lin. ft.
Add for Approaches	
Todhunter Rd.	= 512.80 lin. ft.
Ramp A	= 4038.00 lin. ft.
Ramp B	= 2414.00 lin. ft.
Route 73	= 1592.00 lin. ft.
Length of Work	5,556.80 lin. ft.
Length of Work	21,956.80 lin. ft. = 4.158 Miles

DELIVERY POINTS - B&O R.R. AVE. HAUL  
5 CAR COMPANY TRACK AT LE SOURSVILLE, OHIO - 3 MI.  
4 CAR COMPANY TRACK AT NORTH EXCELLO, OHIO - 1 MI.  
2 CAR COAL YARD AT EXCELLO, OHIO - 1 MI.  
10 CAR TEAM TRACK AT MIDDLETOWN, OHIO - 3 MI.

REVIEWED & APPROVED *H. J. Wagner*  
DATE *10-26-55* ENGINEER OF TRAFFIC

\*\* SUBMITTED TO B.P.R. FOR APPROVAL

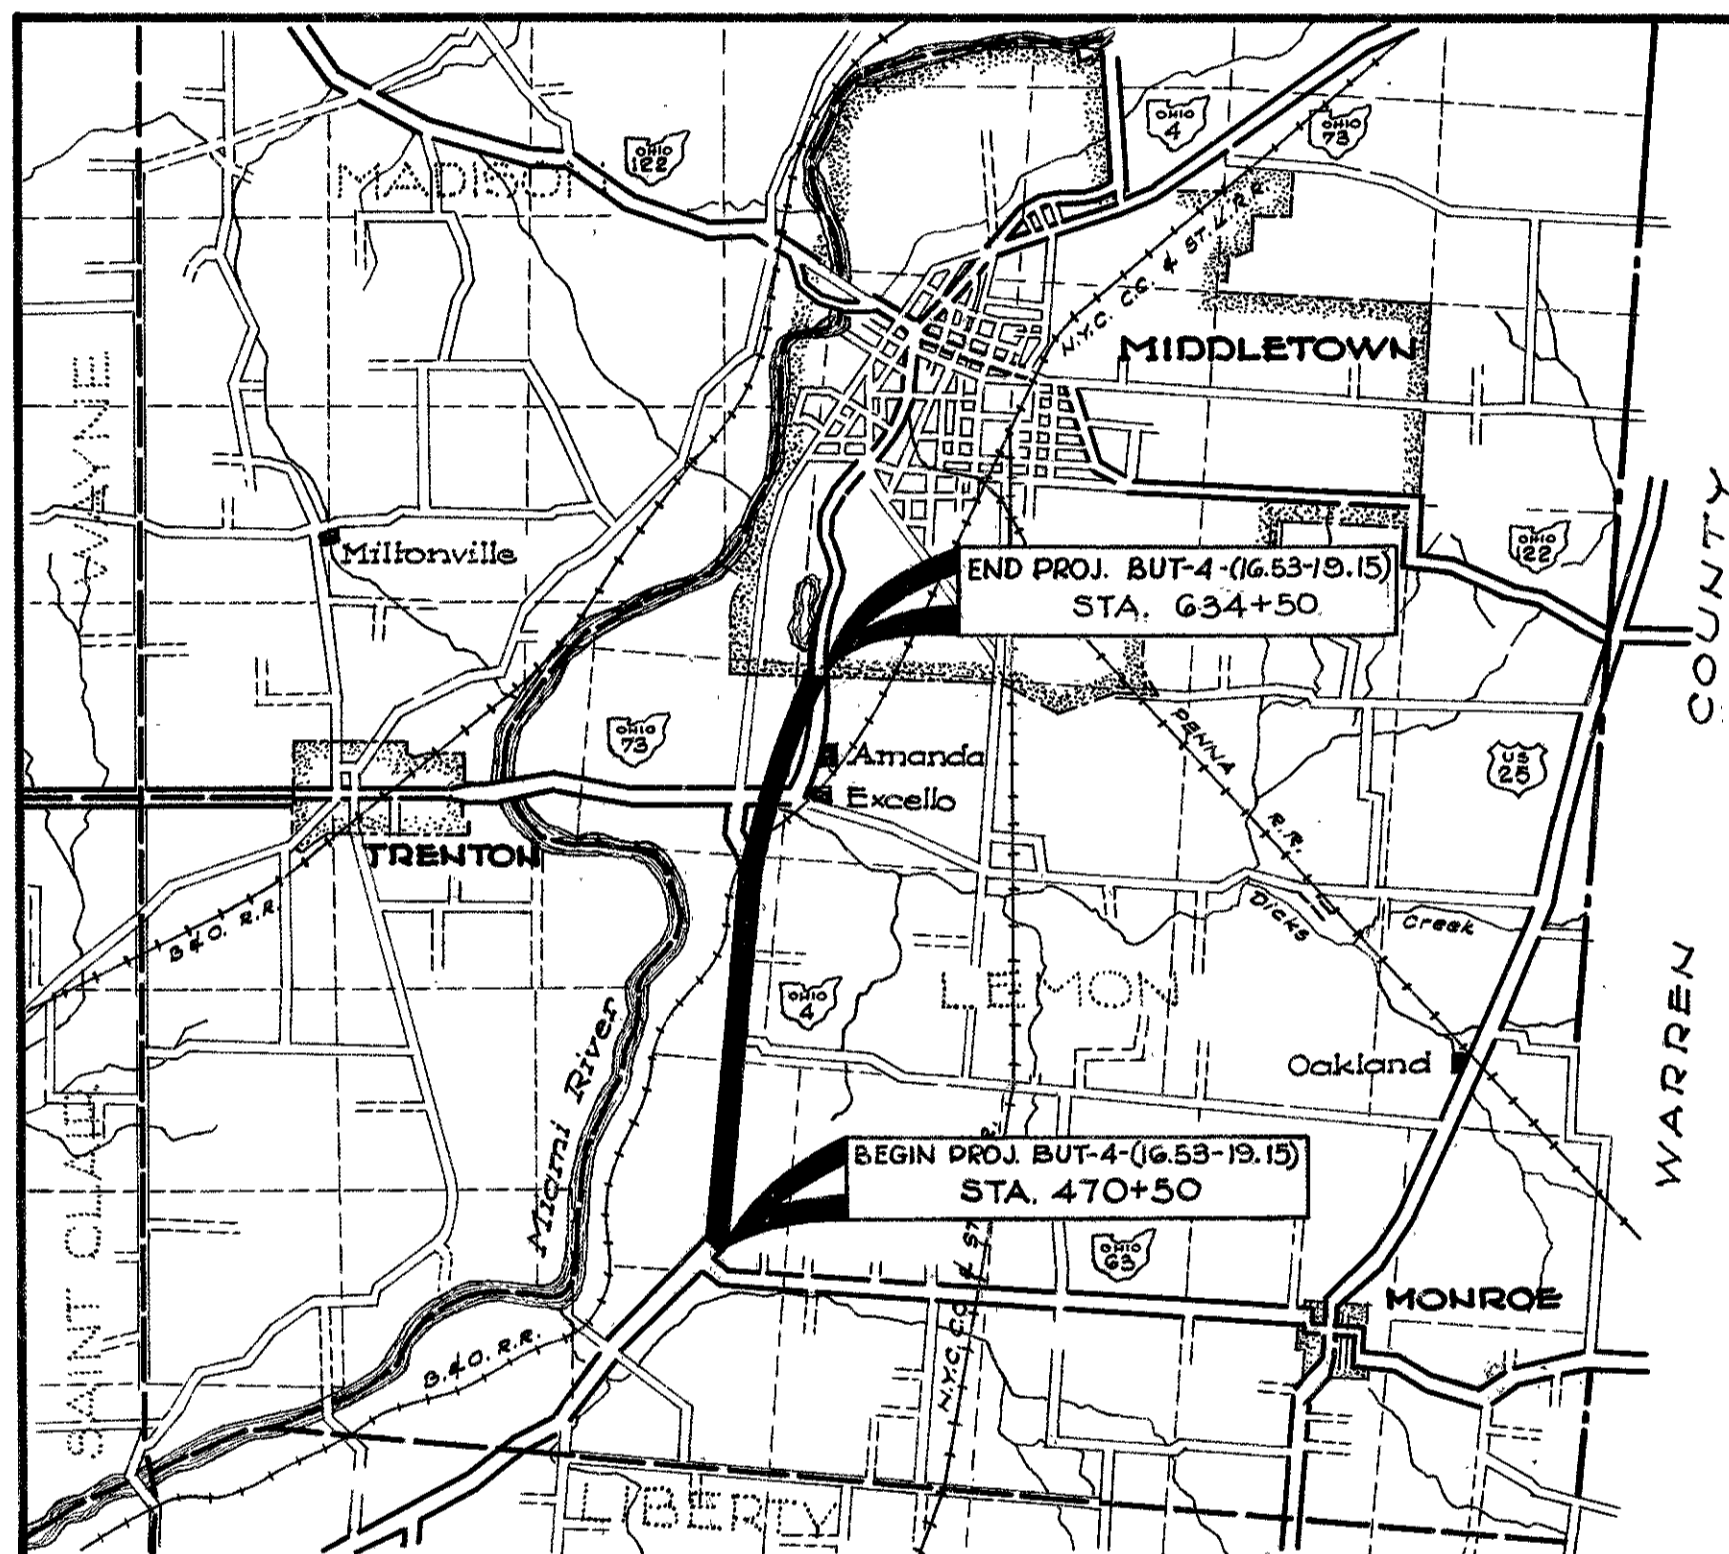

LOCATION PLAN



### SCALES

PLAN	1" = 50'
PROFILE-HORIZONTAL	1" = 50'
PROFILE-VERTICAL	1" = 10'
CROSS SECTIONS	1" = 10'
APPROACHES & INTERSECTIONS	1" = 20'

The Standard Specifications of The State of Ohio, Department of Highways including changes and Supplemental Specifications listed in the proposal shall govern this improvement.

I hereby approve these plans and declare that the making of this improvement will not require the closing of traffic of the highway and that provisions for maintenance and safety of traffic will be as set forth in these plans and estimates.

The right of way for this improvement will be provided by The State of Ohio.

- Approved *J. S. Patton*  
Date *10-4-55* Division Deputy Director
- Approved *John J. Heurley*  
Date *10-20-55* Deputy Director of Planning & Programming
- Approved *E. S. Weston*  
Date *10-19-55* Engineer of Location & Design
- Approved *Richard Orth*  
Date *10-12-55* Engineer of Bridges
- Approved *W. J. Gould*  
Date *10-19-55* Deputy Director of Design & Construction
- Approved *L. H. Schaubert*  
Date *10-21-55* First Assistant Director
- Approved *J. H. Smith*  
Date *10-20-55* Director of Highways
- Approved *K. J. WAGNER*  
Date *10-26-55* Chief Engineer, Baltimore and Ohio Railroad Company

CONSTRUCTION BUREAU  
FEB 11 1960  
GROUND PHOTO LAB

PREPARED BY  
VOGT, IVERS, SEAMAN & ASSOCIATES  
ENGINEERS ARCHITECTS  
CINCINNATI OHIO

DEPARTMENT OF COMMERCE  
BUREAU OF PUBLIC ROADS

APPROVED: \_\_\_\_\_  
DISTRICT ENGINEER \_\_\_\_\_ DATE \_\_\_\_\_

STANDARD DRAWINGS			
L-1	4-1-50	L-3-A	4-1-50
L-3	4-1-50	S-27 P.C.3	2-20-45
RT-1	1-3-55	I-3 I No. 2	12-1-54
T-35	10-1-52	S-27 P.C.4	1-4-54
B-T-71R	3-2-55	I-1,2,3,4,5	2-20-45
**L.J. No. 1	7-1-55	I-8 C.B. 1,2A & B	5-1-52
**L.J.	7-1-55	I-8 C.B. 2-2A & B	5-1-52
DR-1	1-3-55	I-8 C.B. 1-3 & 1-4	5-1-52
**OS-1	7-1-55	**T-15 No. 1	8-1-52
**OS-2	7-1-55	T-14-B	1-22-52
I-8 C.B. 2-3 & 2-4	5-1-52	I-8 M.H. No. 3	5-1-52
I-8 C.B. 2-5 & 2-6	5-1-52	I-8 M.H. No. 3-A	5-1-52
I-8 C.B. No. 3	5-1-52	I-8 M.H. No. 2	5-1-52
I-8 C.B. No. 3-A	5-1-52	I-12	7-1-54
I-8 C.B. No. 6	5-1-52	I-15 No. 2	12-1-54
I-8 C.B. No. 7	5-1-52	G-7.07	1-2-53
I-8 M.H. No. 1	5-1-52	B-T-50-70-71E No. 1	10-1-47
I-8 M.H. No. 1-A	1-3-55	I-21-23	12-1-54
AS-1-54	12-1-54		

SUPPLEMENTAL SPECIFICATIONS	
5	6-8-55
B-119	REV. 12-1-54
L-209.12	7-17-54
M-106.6(d)	11-30-54
M-110.27	9-9-52
M-109.23	REV. 5-28-54
S-114	8-30-55


FILE NO. 372



# TYPICAL SECTIONS

TYPE T-71

SCALE: 1/4" = 1'-0"

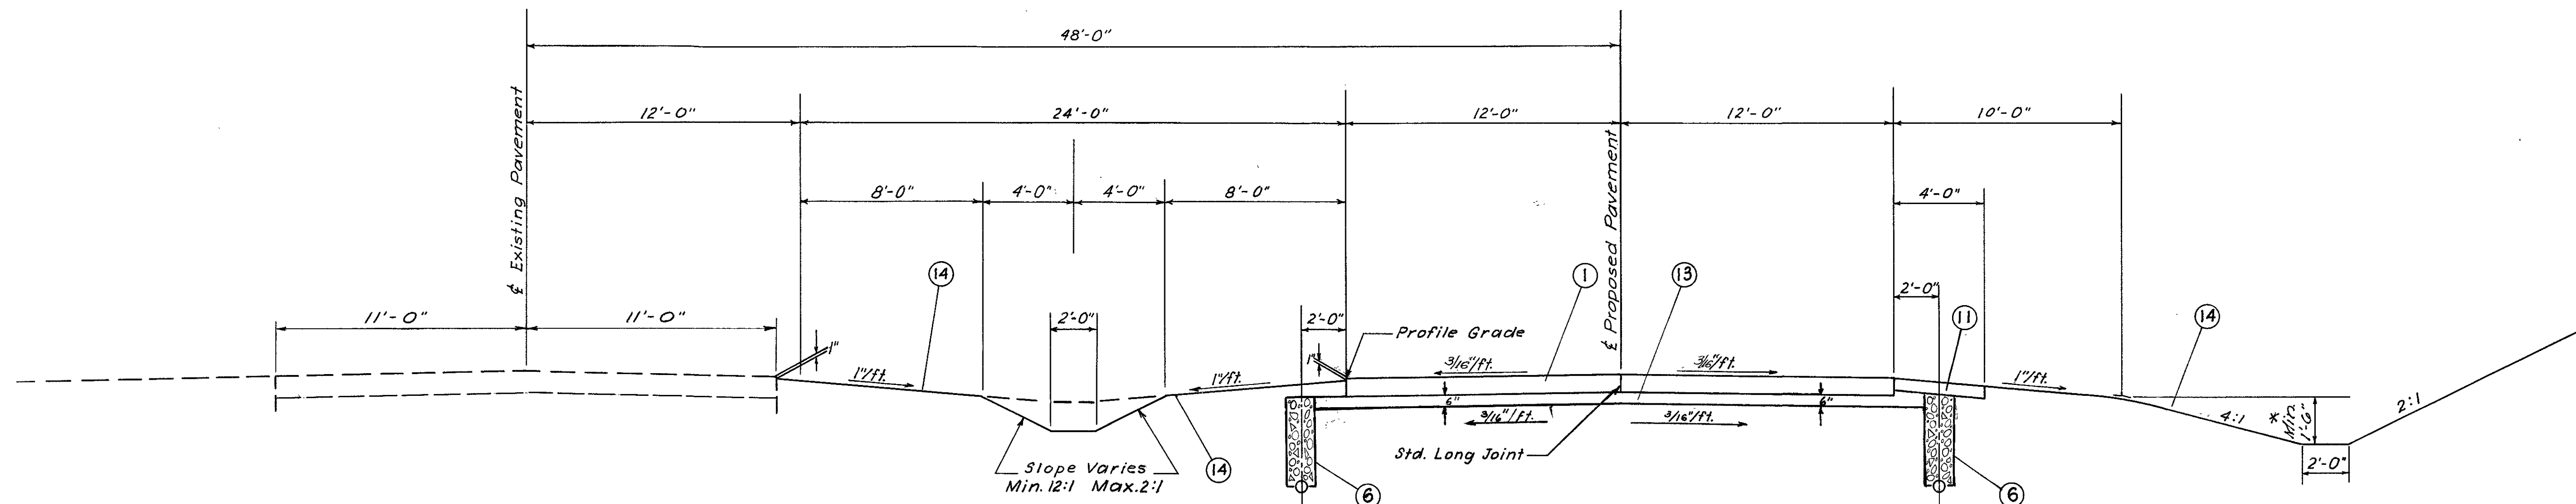


## TYPICAL NORMAL SECTION C

Sta. 483+25.0 - 492+00.0 = 875.00 Lin. Ft.

Notes:


1. See Sheet 4 for Legend

\*2. Minimum depth of side ditches is as indicated on Typical Sections unless shown otherwise on Cross Sections or Plan & Profile

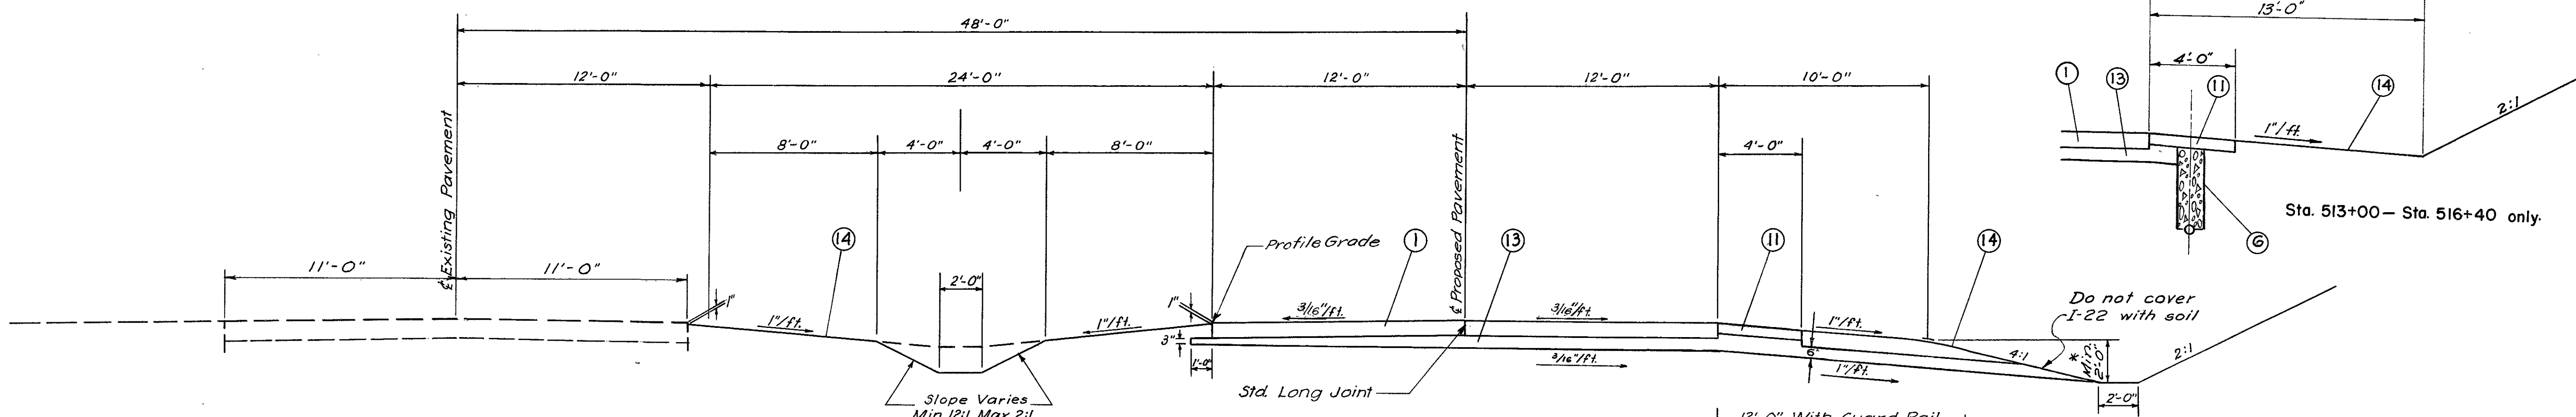

## TYPICAL NORMAL SECTION D



Sta. 492+00.0 - 514+00.0 = 2200.00 Lin. Ft.  
Sta. 522+00.0 - 535+75.0 = 1375.00 Lin. Ft.

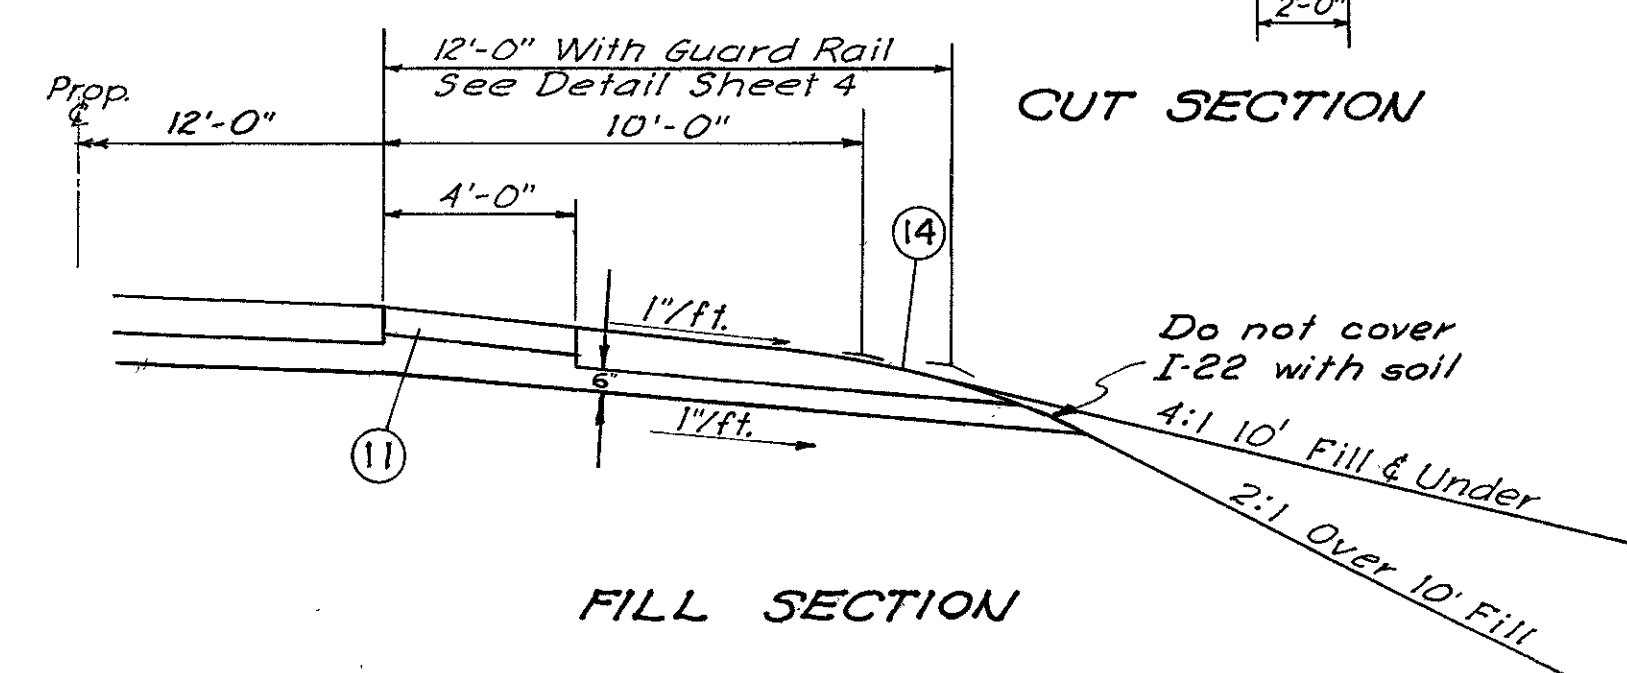


# TYPICAL SECTIONS

## TYPE T-71


SCALE: 1/4" = 1'-0"

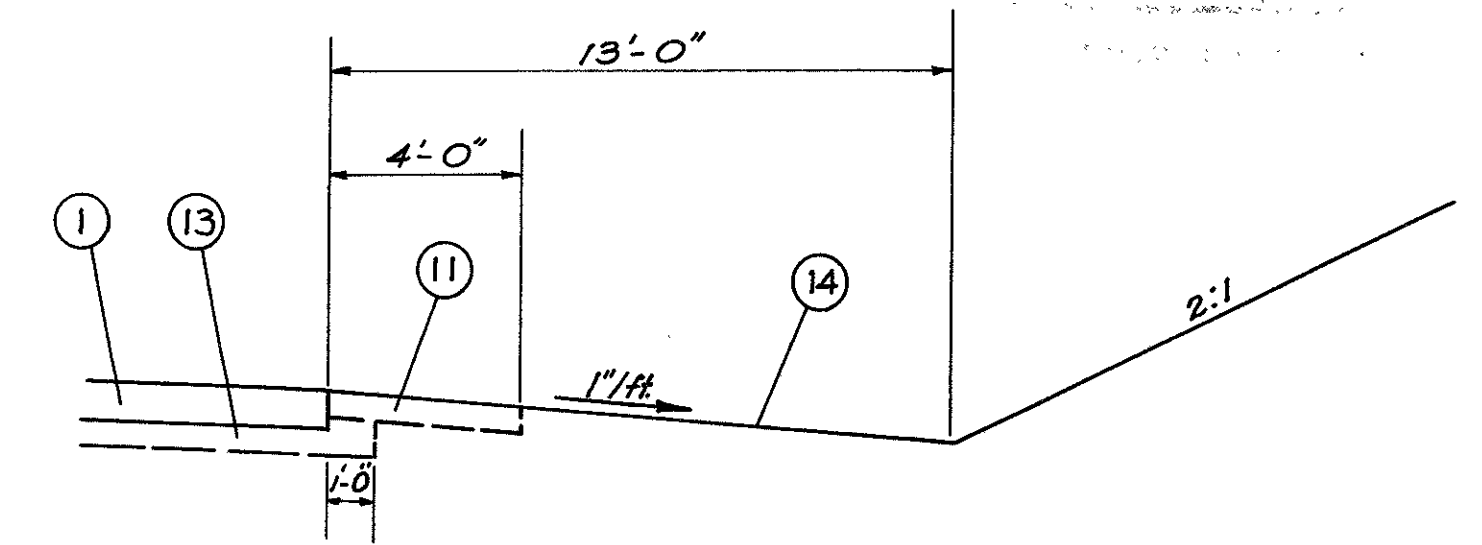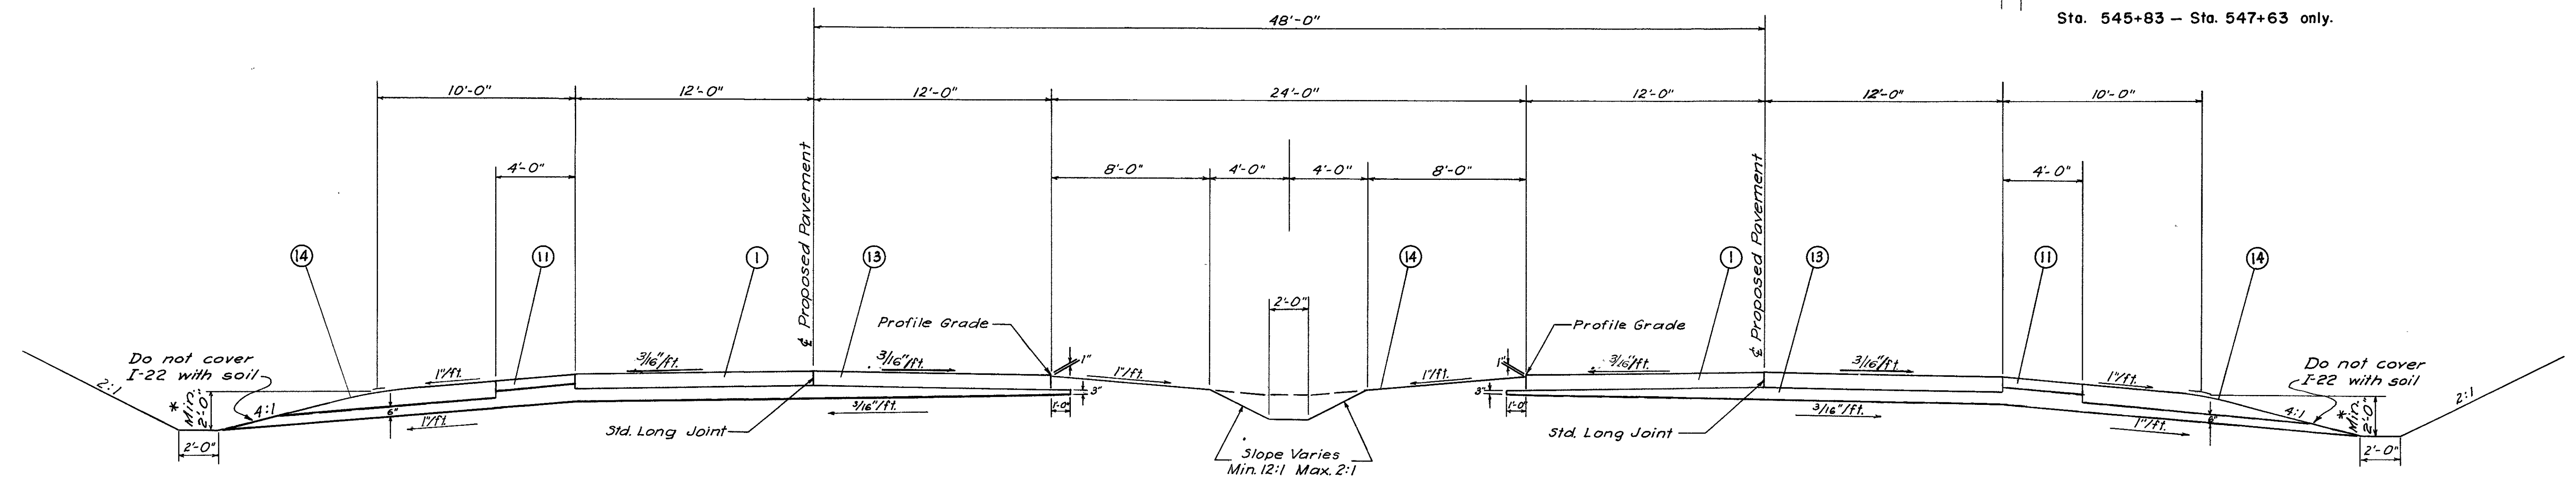

### CUT SECTION

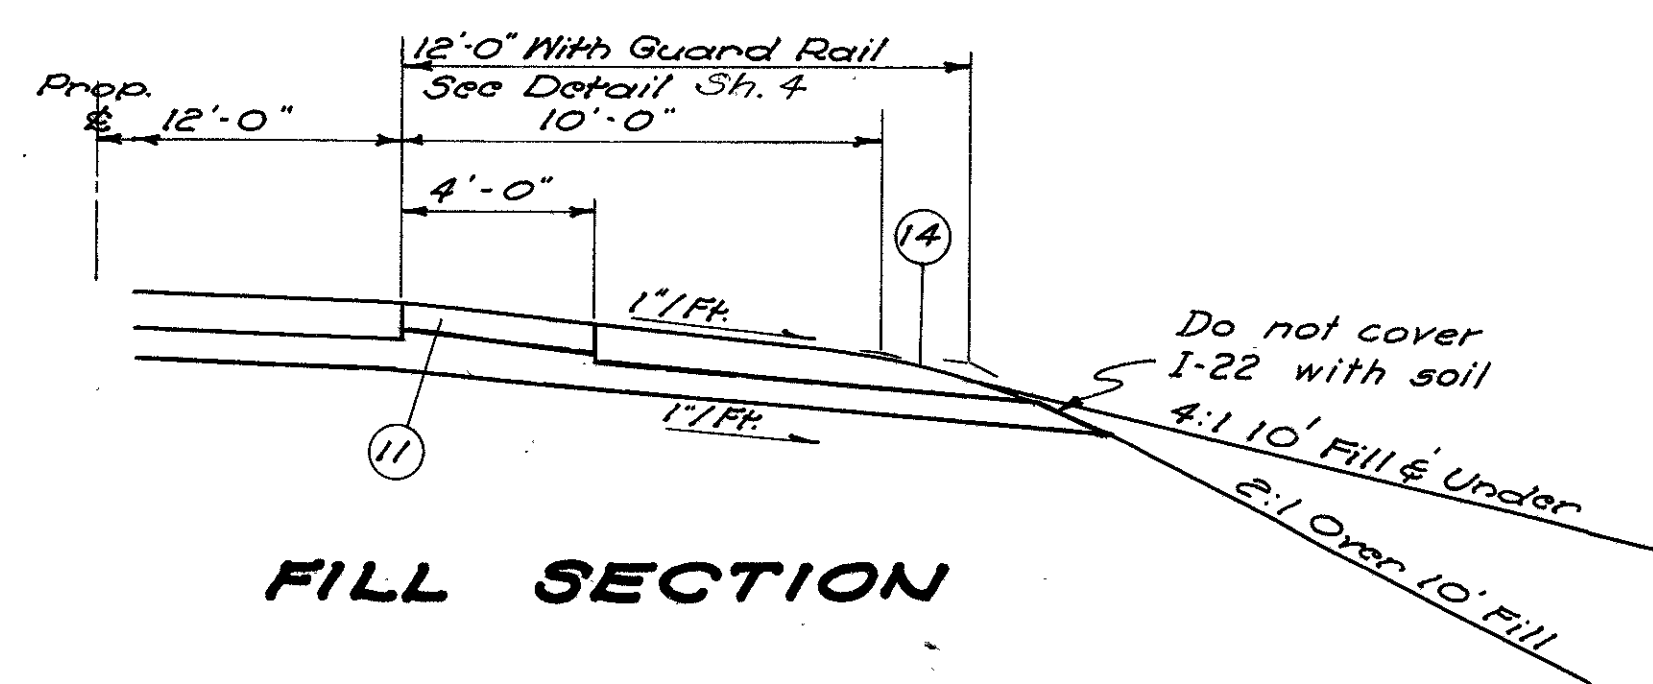

### FILL SECTION

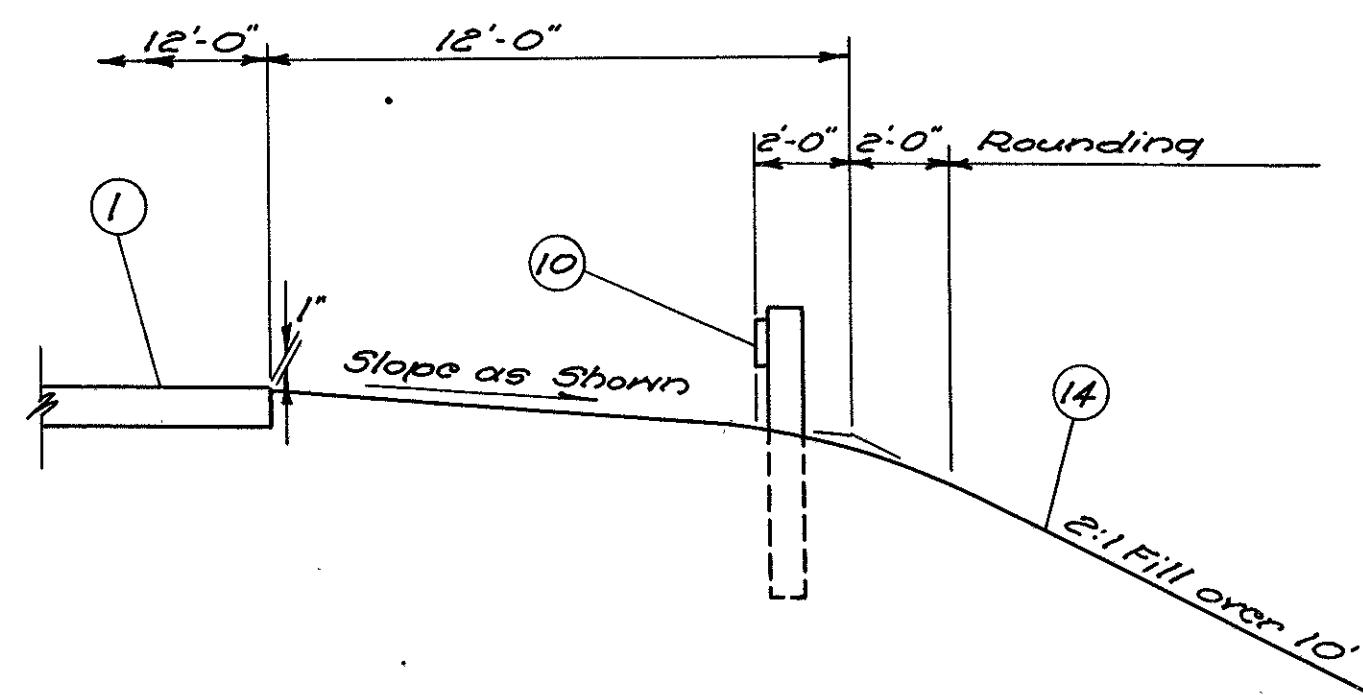

### GUARD RAIL DETAIL

### TYPICAL NORMAL SECTION E

Sta. 514+00.0 - 522+00.0 = 800.00 Lin. Ft.  
Sta. 543+75.0 - 549+68.67 = 593.67 Lin. Ft.  
Sta. 564+34.50 - 566+90.13 = 255.63 Lin. Ft.

#### Notes:

\*1. Minimum depth of side ditches is as indicated on Typical Section unless shown otherwise on Cross Sections or Plan & Profile


### LEGEND

- ① Item T-71 9" Reinforced Portland Cement Concrete Pavement
- ② Item T-35 1 1/4" Asphaltic Concrete Surface Course Type "C" (60-70)
- ③ Item B-35 1 1/4" Asphaltic Concrete Leveling Course (60-70)
- ④ Item B-35 3" Asphaltic Concrete Base Course (60-70)
- ⑥ Item I-4 6" Pipe Underdrains
- ⑦ Item I-9 Stone Underdrain No.2
- ⑧ Item I-12 Type 2A Portland Cement Concrete Curb
- ⑨ Item I-13 4" Portland Cement Concrete Sidewalk
- ⑩ Item I-15 Deep Steel Beam Guard Rail
- ⑪ Item I-18 6" Stabilized Crushed Aggregate Shoulders
- ⑫ Item I-21 4" Type 1 Portland Cement Concrete Median Pavement
- ⑬ Item I-22 Subbase Type A, B, C, or D
- ⑭ Item L-9 Seeding & Protecting
- ⑯ Item I-23 Precast White Portland Cement Concrete Traffic Dividers
- ⑰ Item T-30 Bituminous Tack Coat, Sec. M-5.5 M5-2 or RS-1, or Sec. 52 RC-1 or RC-2 applied at the rate of 0.10 Gal. per Sq. Yd. (See Note in Proposal)
- ⑱ Item B-70 3" Portland Cement Concrete Base Course

# TYPICAL SECTIONS

TYPE T-71

SCALE: 1/4" = 1'-0"

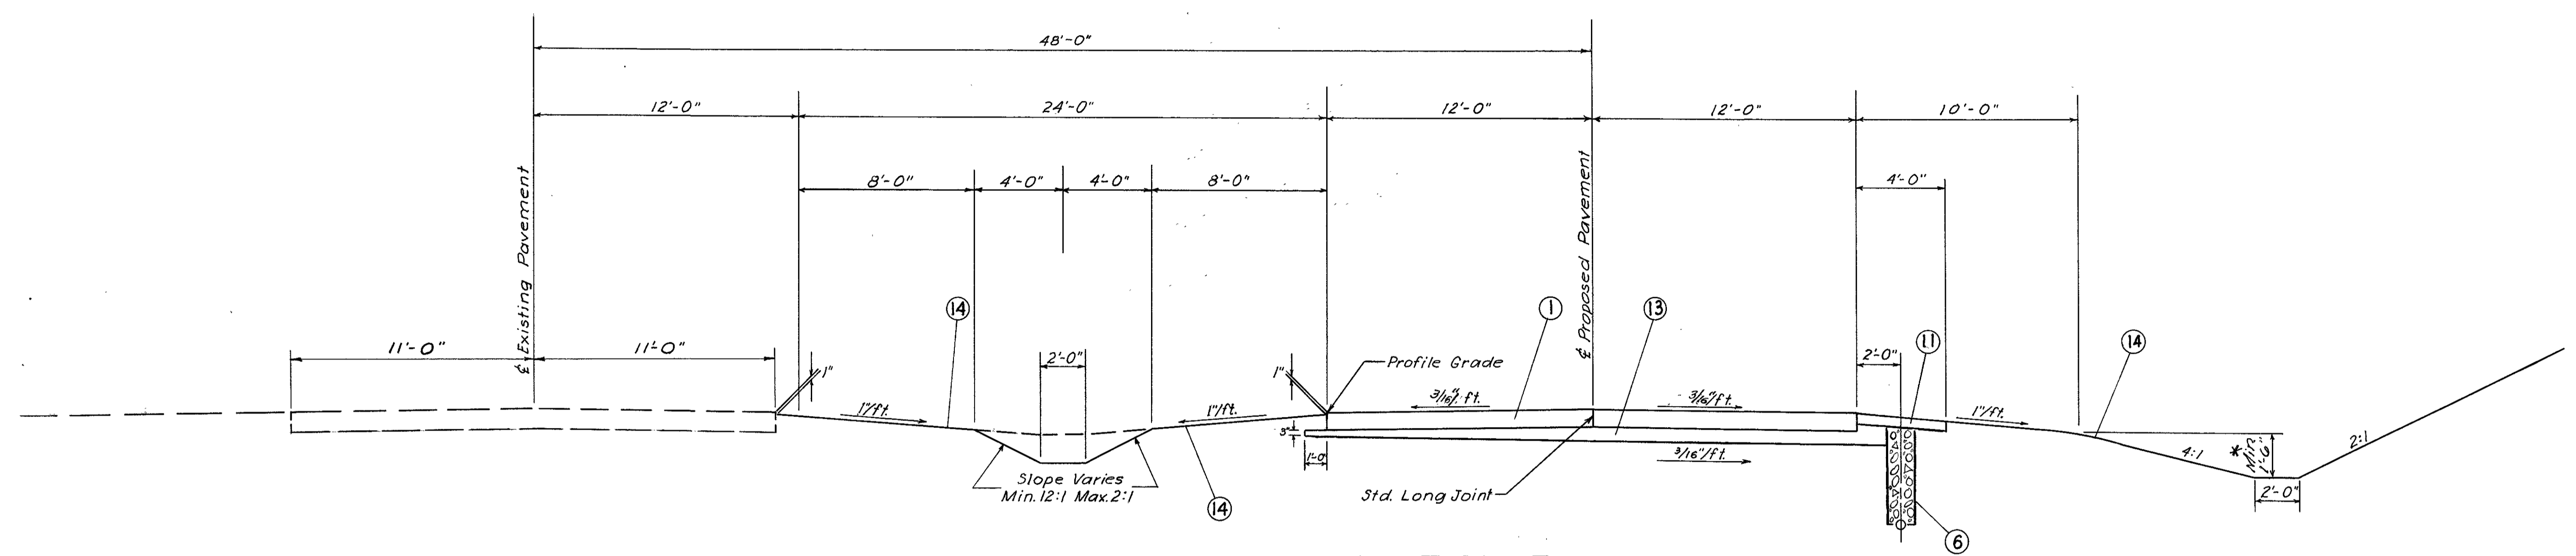


TYPICAL NORMAL SECTION F

Sta. 535+75.0 - 537+75.0 = 200.00 Lin. Ft.

Notes:

1. See Sheet 4 for Legend.

\*2. Minimum depth of side ditches is as indicated on Typical Sections unless shown otherwise on Cross Sections or Plan & Profile

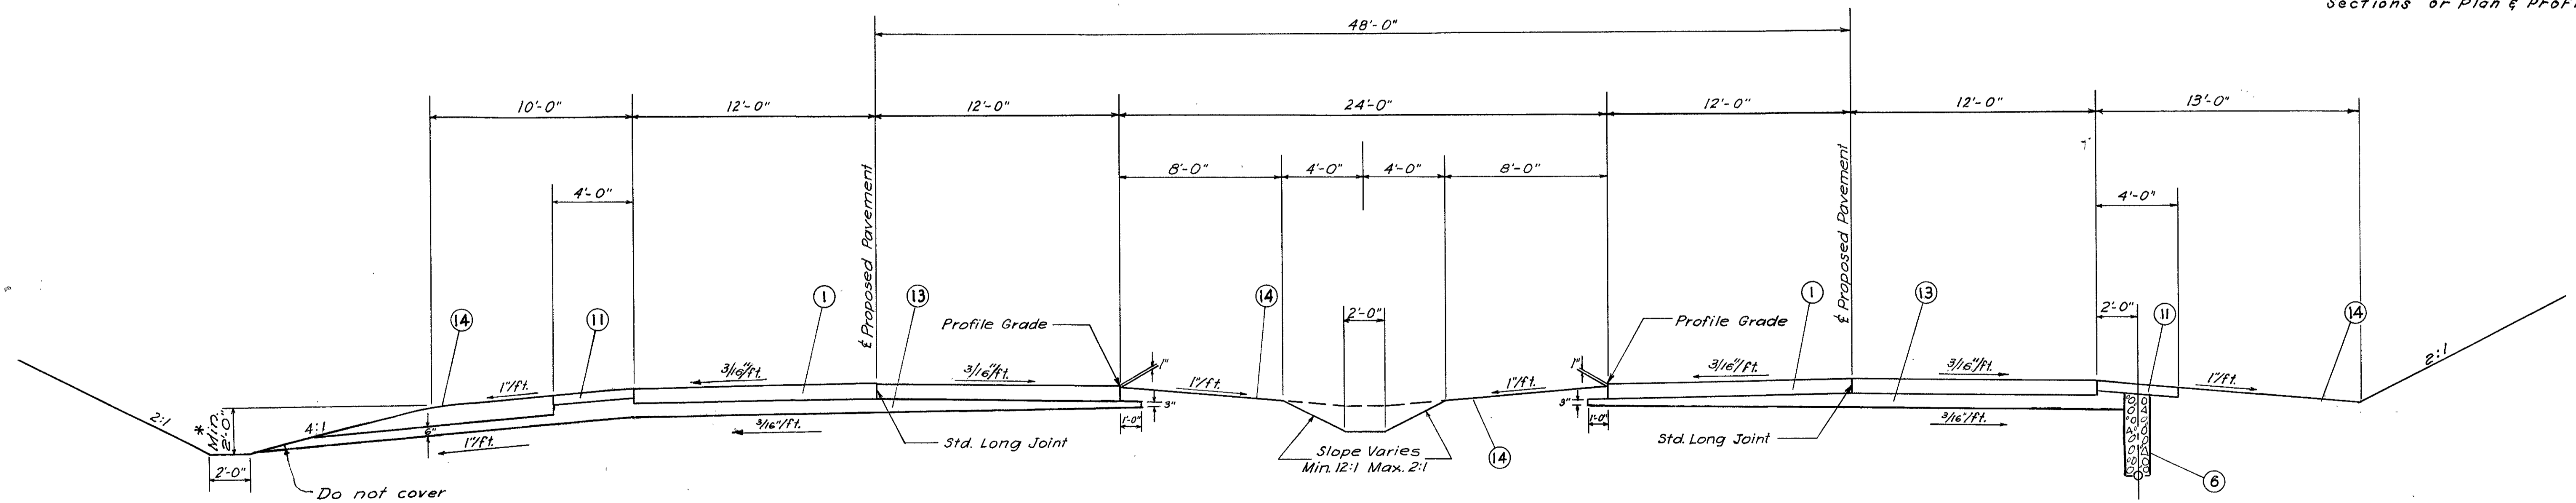


TYPICAL NORMAL SECTION G

Sta. 537+75.0 - 543+75.0 = 600.00 Lin. Ft.

# TYPICAL SECTIONS TYPE T-71

SCALE: 1/4" = 1'-0"

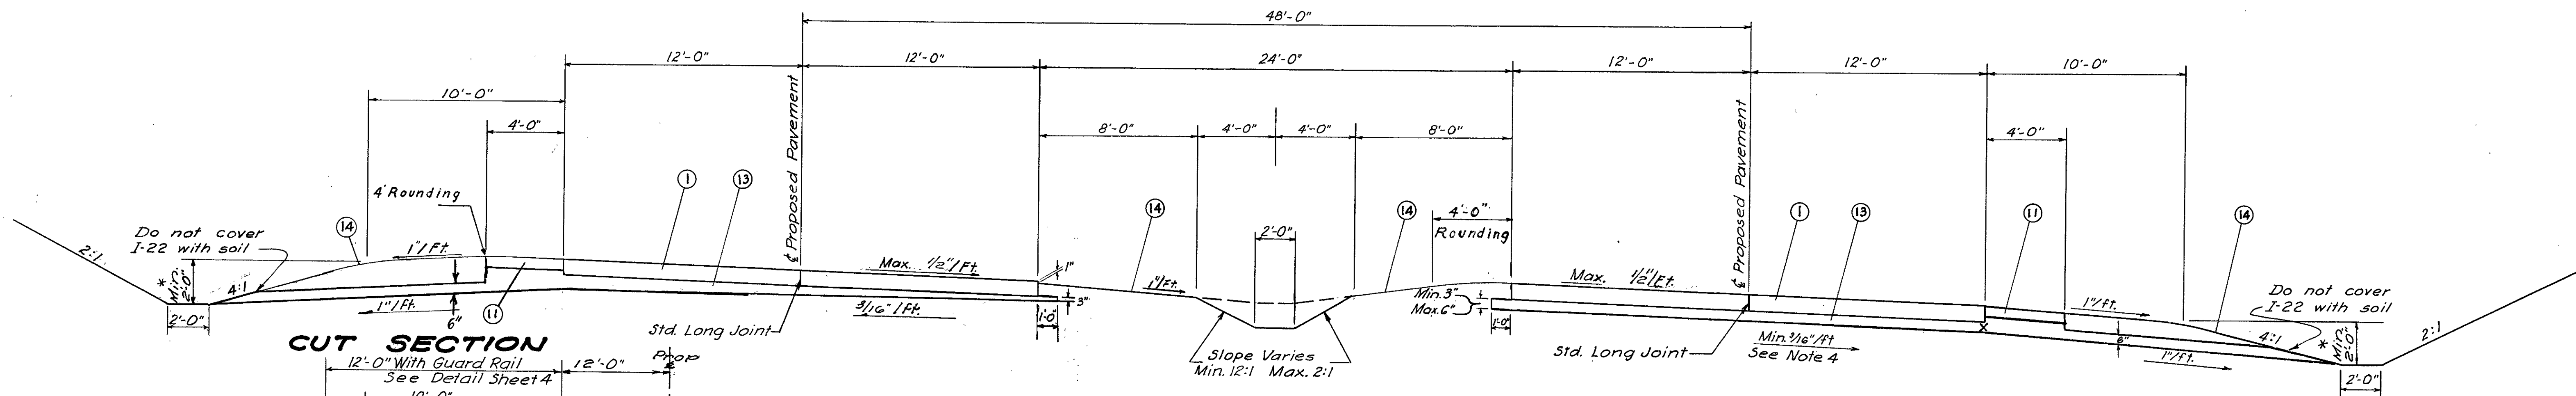

## SUPERELEVATED TYPICAL SECTION H


Sta. 549+68.67 - 550+75.0 = 106.33 Lin. Ft.  
 Sta. 561+82.20 - 564+34.50 = 252.30 Lin. Ft.  
 Sta. 566+90.13 - 569+00.0 = 209.87 Lin. Ft.

Notes:

1. See Sheet 4 for Legend.
- \* 2. Minimum depth of side ditches is as indicated on Typical Sections unless shown otherwise on Cross Sections or Plan & Profile.
3. Subbase on high side of superelevated pavement section follows pavement slope when super-elevation is more than 1/2"/ft. Where super-elevation is 1/2"/ft. or less, subbase slopes to outer edge as shown on Super-elevated Typical Section H.
4. In a transition between a normal and a super-elevated pavement section maintain a constant 3/16"/ft cross-slope on the subbase while dimension "X" decreases at a constant rate to a minimum of 6" and pavement cross-slope increases to .016"/ft. Subbase then parallels pavement slope thru remainder of super-elevation at constant thickness of 6".
5. See Sheet 10 for pavement details of Acceleration and Deceleration Lanes.




## FILL SECTION

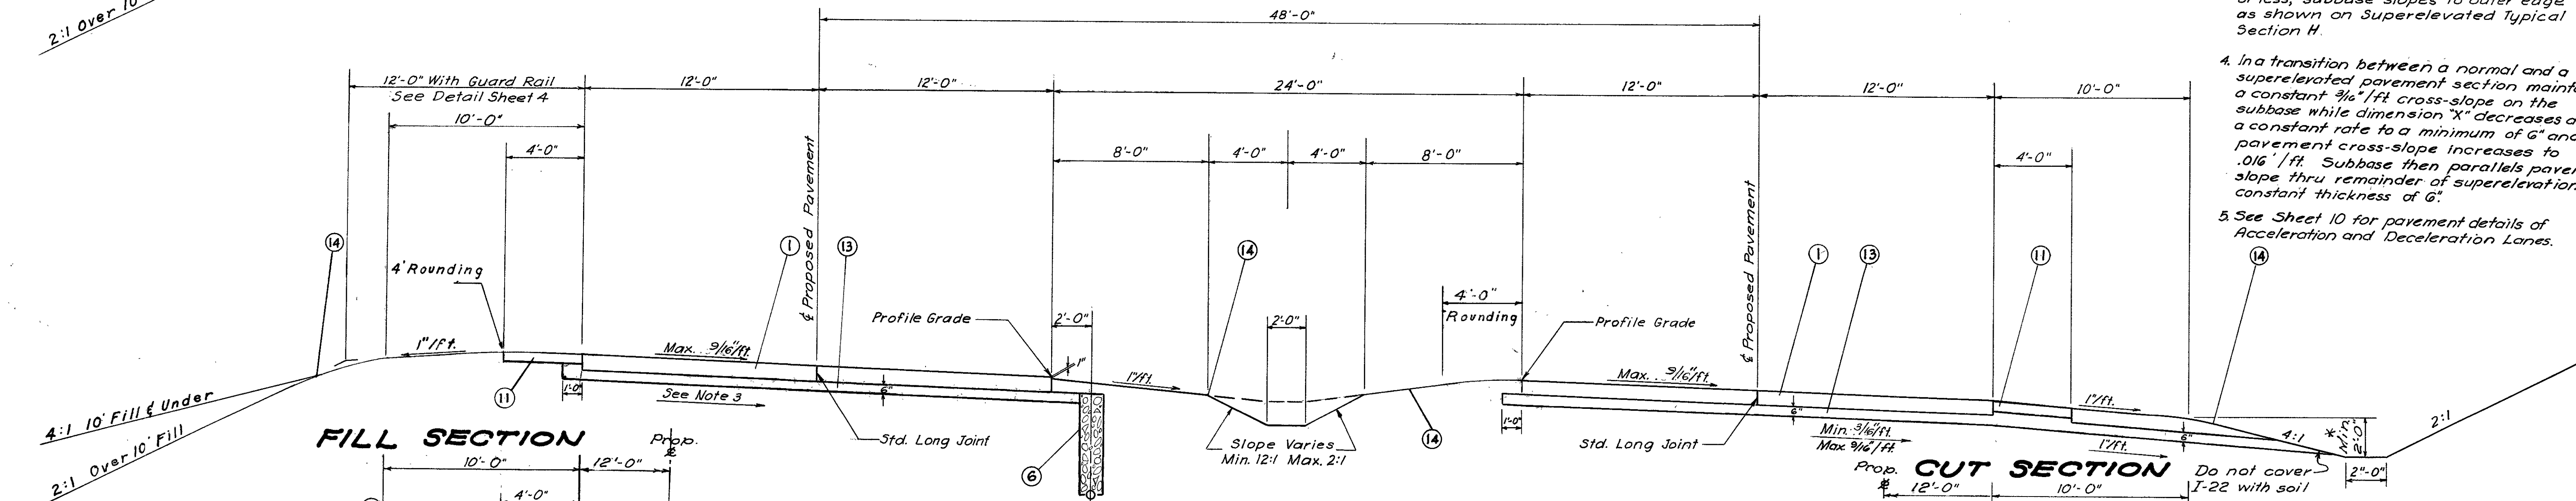


## SUPERELEVATED TYPICAL SECTION I

Sta. 550+75.0 - 555+00.0 = 425.00 Lin. Ft.  
 Sta. 559+86.0 - 561+82.20 = 196.20 Lin. Ft.

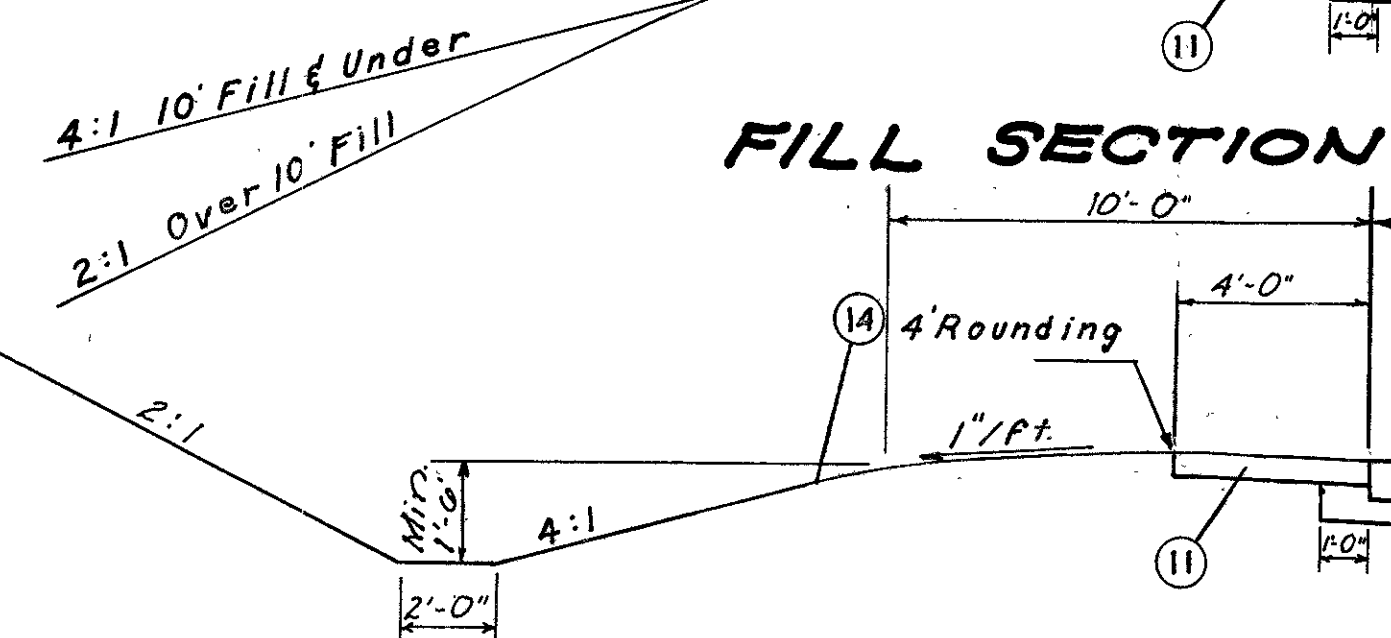

## CUT SECTION

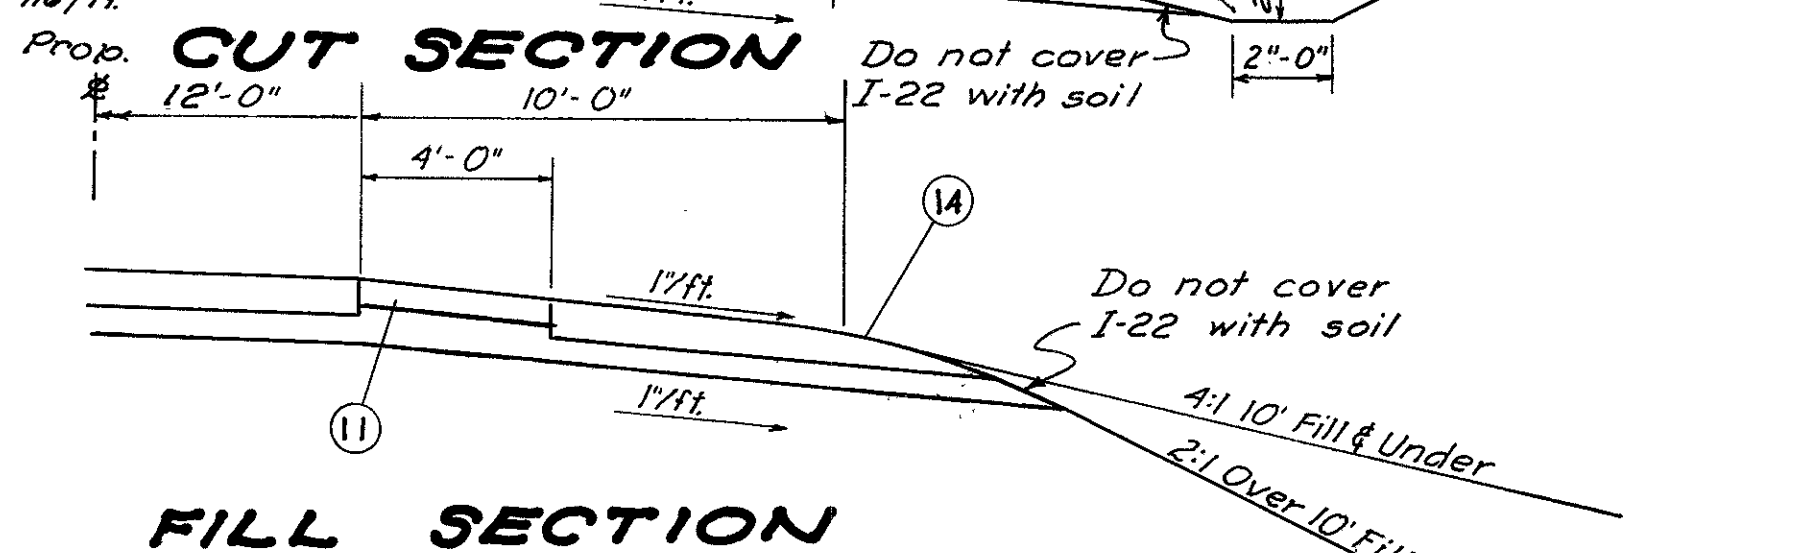


## FILL SECTION

# TYPICAL SECTIONS

TYPE T-71


SCALE: 1/4" = 1'-0"

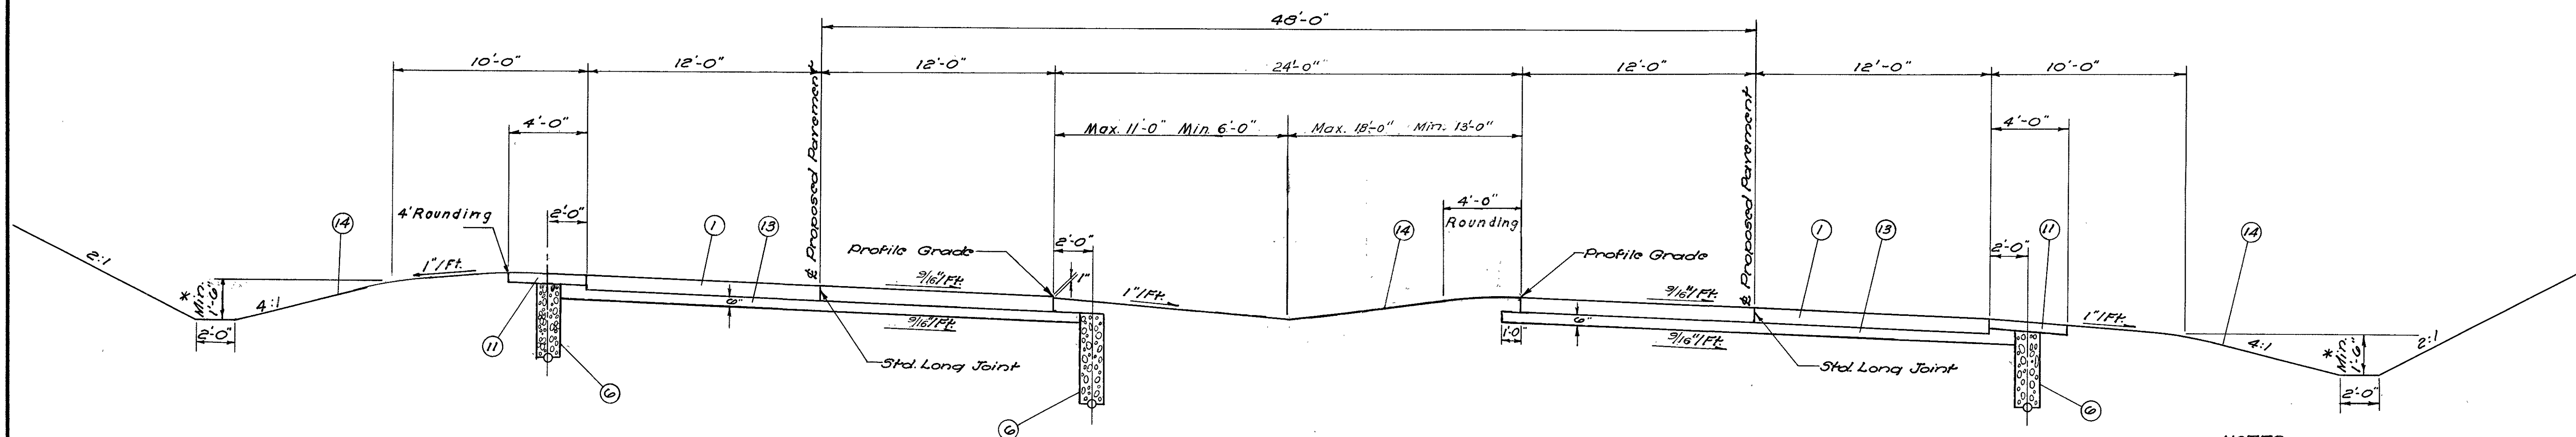

## SUPERELEVATED TYPICAL SECTION J

Sta. 555+00.0-559+86.0 = 486.00 Lin. Ft.


### CUT SECTION

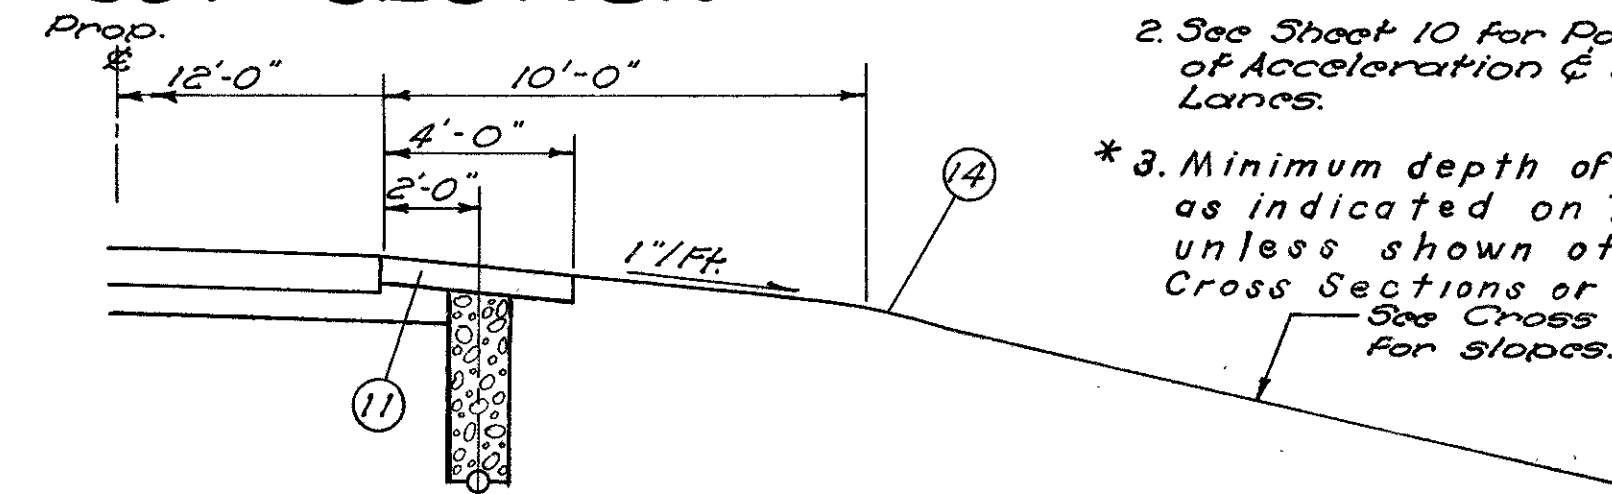

### FILL SECTION

#### NOTES:

1. See Sheet 4 For Legend
2. See Sheet 10 For Pavement Details of Acceleration & Deceleration Lanes.
- \* 3. Minimum depth of side ditches is as indicated on Typical Sections unless shown otherwise on Cross Sections or Plan & Profile. See Cross Sections for slopes.

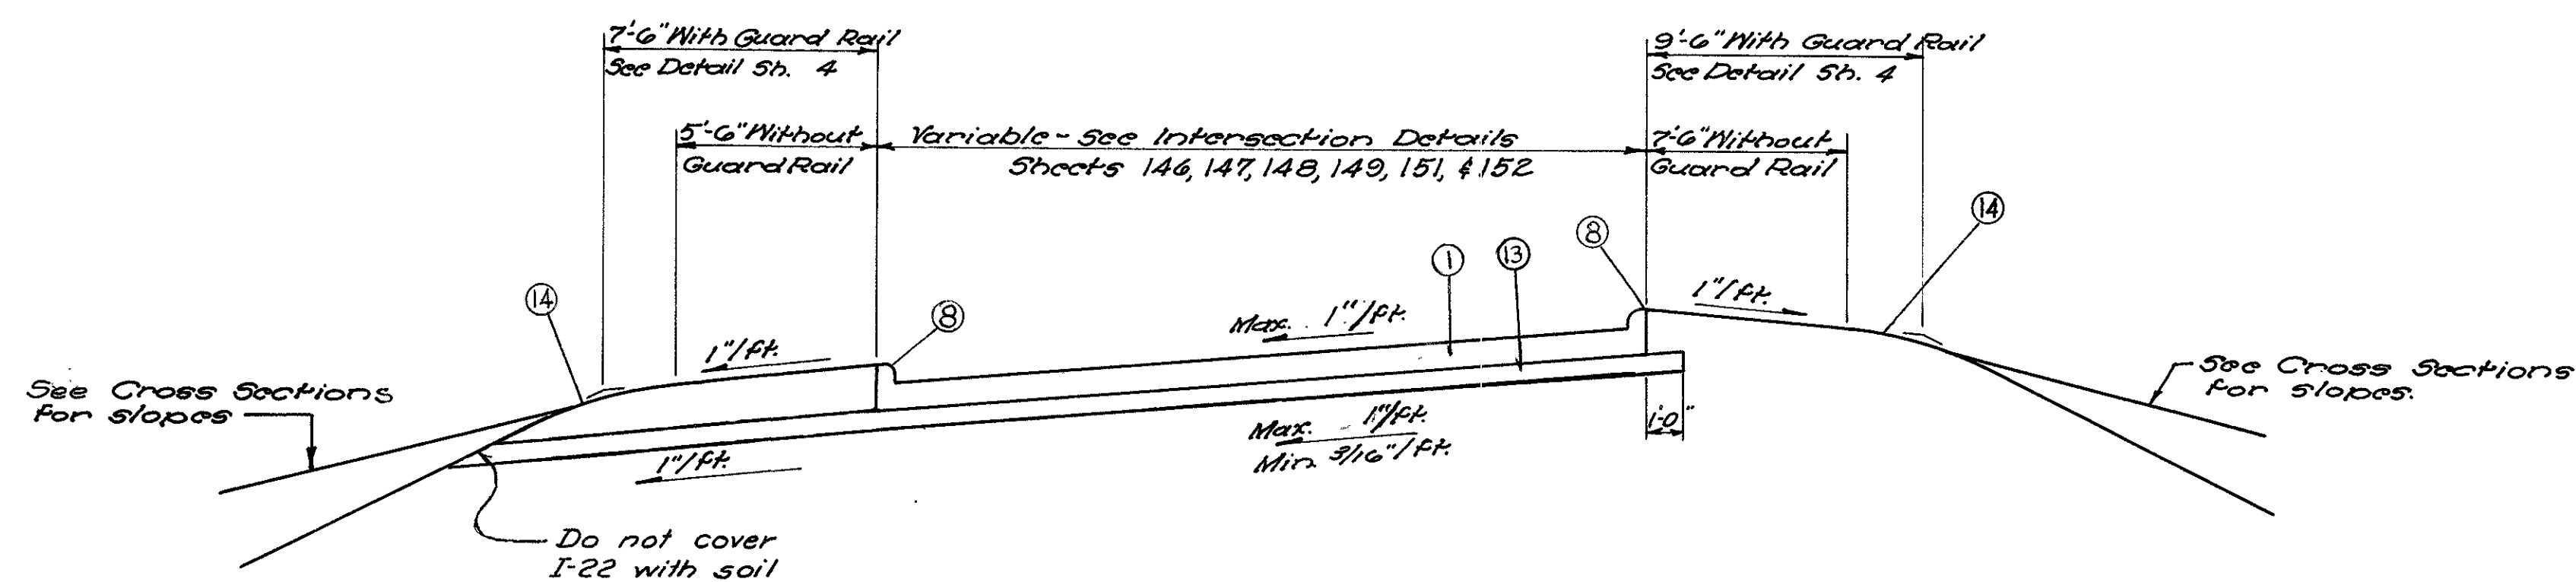


## TYPICAL RAMP SECTION

# TYPICAL SECTIONS


## TYPE T-71

SCALE: 1/4" = 1'-0"

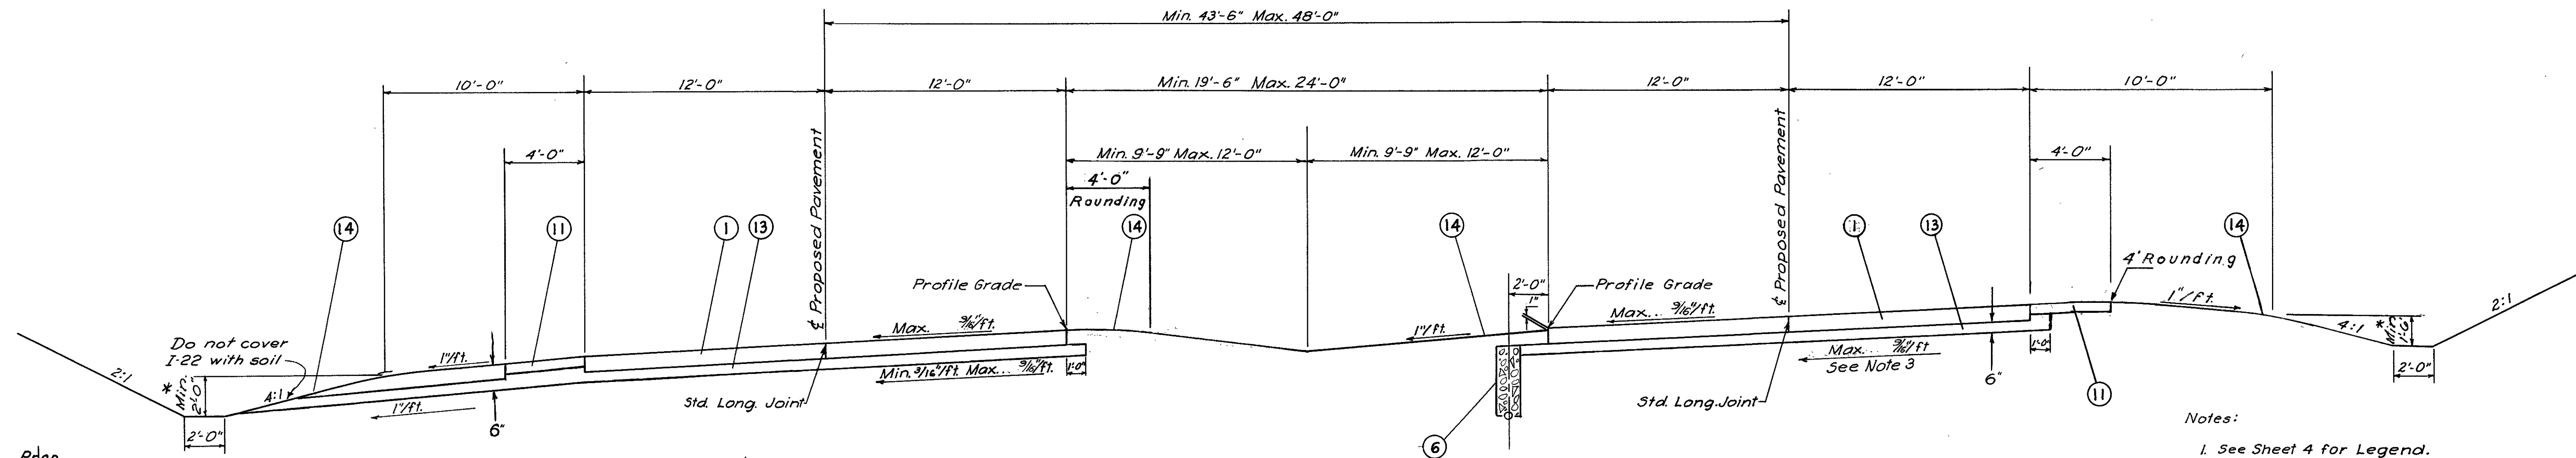


### SUPERELEVATED TYPICAL SECTION K

Sta. 569+00.0-571+75.0 = 275.00 Lin. Ft.

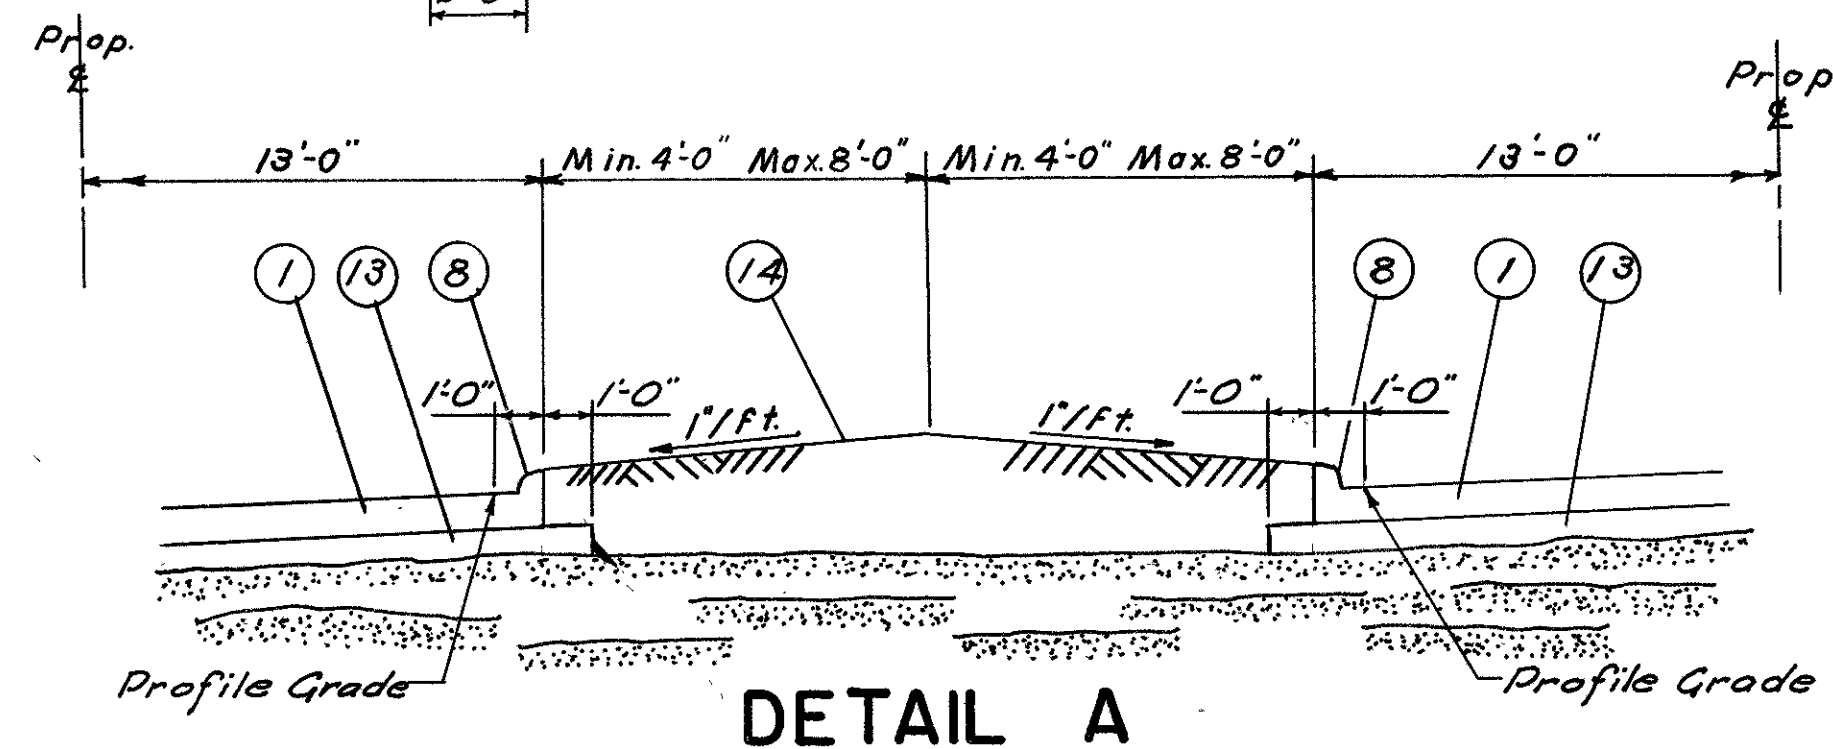

DETAIL A

- Notes:
1. See Sheet 4 for Legend.
  2. Rock shoulders on high side of superelevated sections to follow pavement slope as shown on Superelevated Typical Section M when transverse pavement slope is more than 1/16 ft. When transverse pavement slope is 1/16 ft. or less, rock shoulders are shaped as indicated.
  3. Subbase on high side of superelevated pavement section follows pavement slope when superlevation is more than 1/2 ft. Where superlevation is 1/2 ft. or less, subbase slopes to outer edge as shown on Superelevated Typical Section B.
  - \*4. Minimum depth of side ditches is as indicated on Typical Sections unless shown otherwise on Cross Sections or Plan & Profile.
  5. 1-9 Stone Underdrains (No.1) to be spaced 50' on center longitudinally. Exact location to be determined in field. Trench to be a minimum of 1'-0" wide by 1'-0" deep below bottom of subbase.

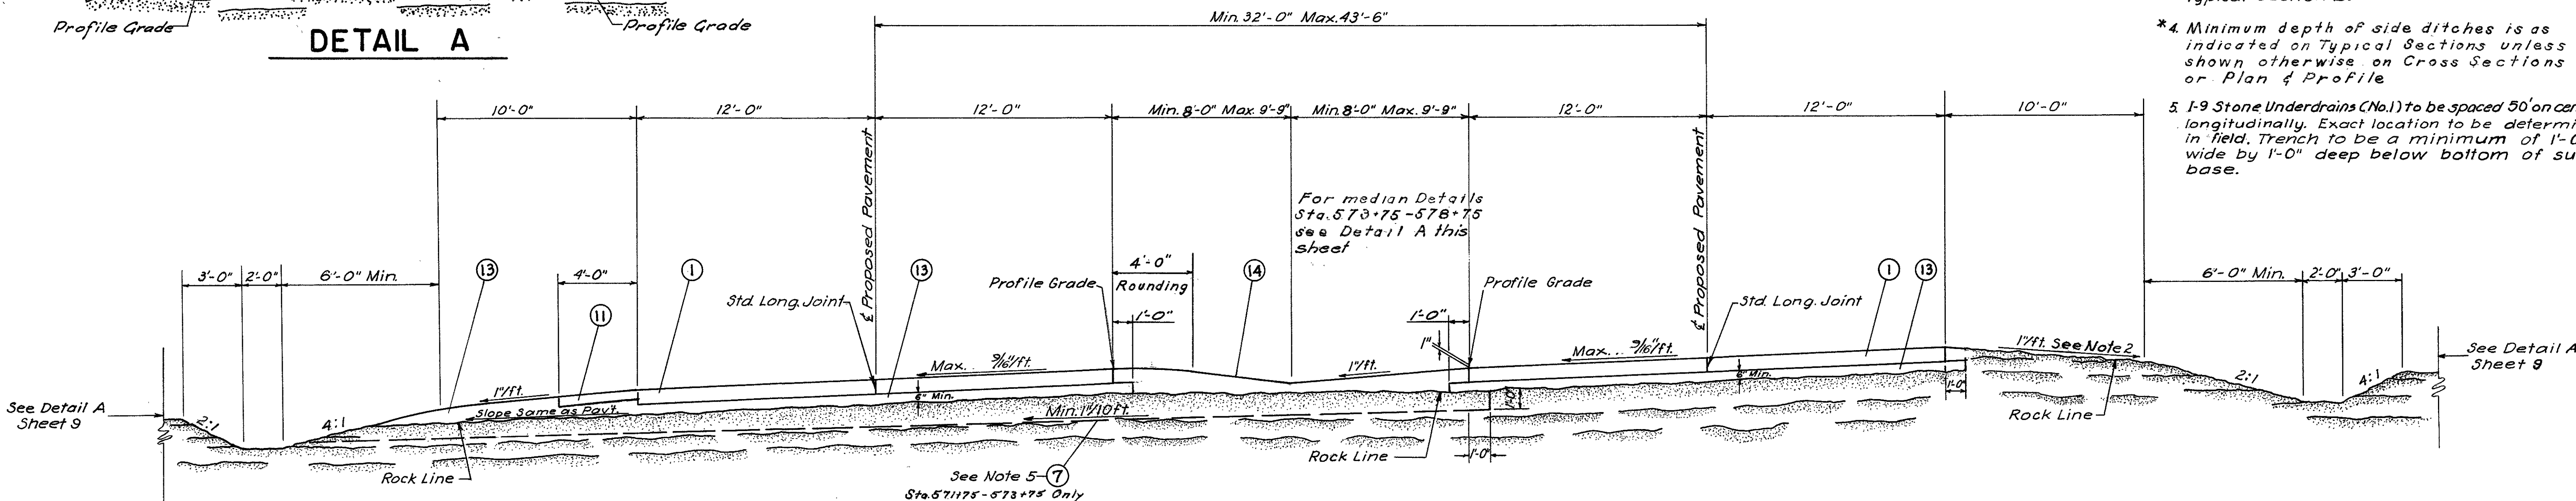

### SUPERELEVATED TYPICAL SECTION L

Sta. 571+75.0-578+75.0 = 700.00 Lin. Ft.

See Detail A Sheet 9


See Detail A Sheet 9



# TYPICAL SECTIONS

## TYPE T-71

SCALE: 1/4" = 1'-0"

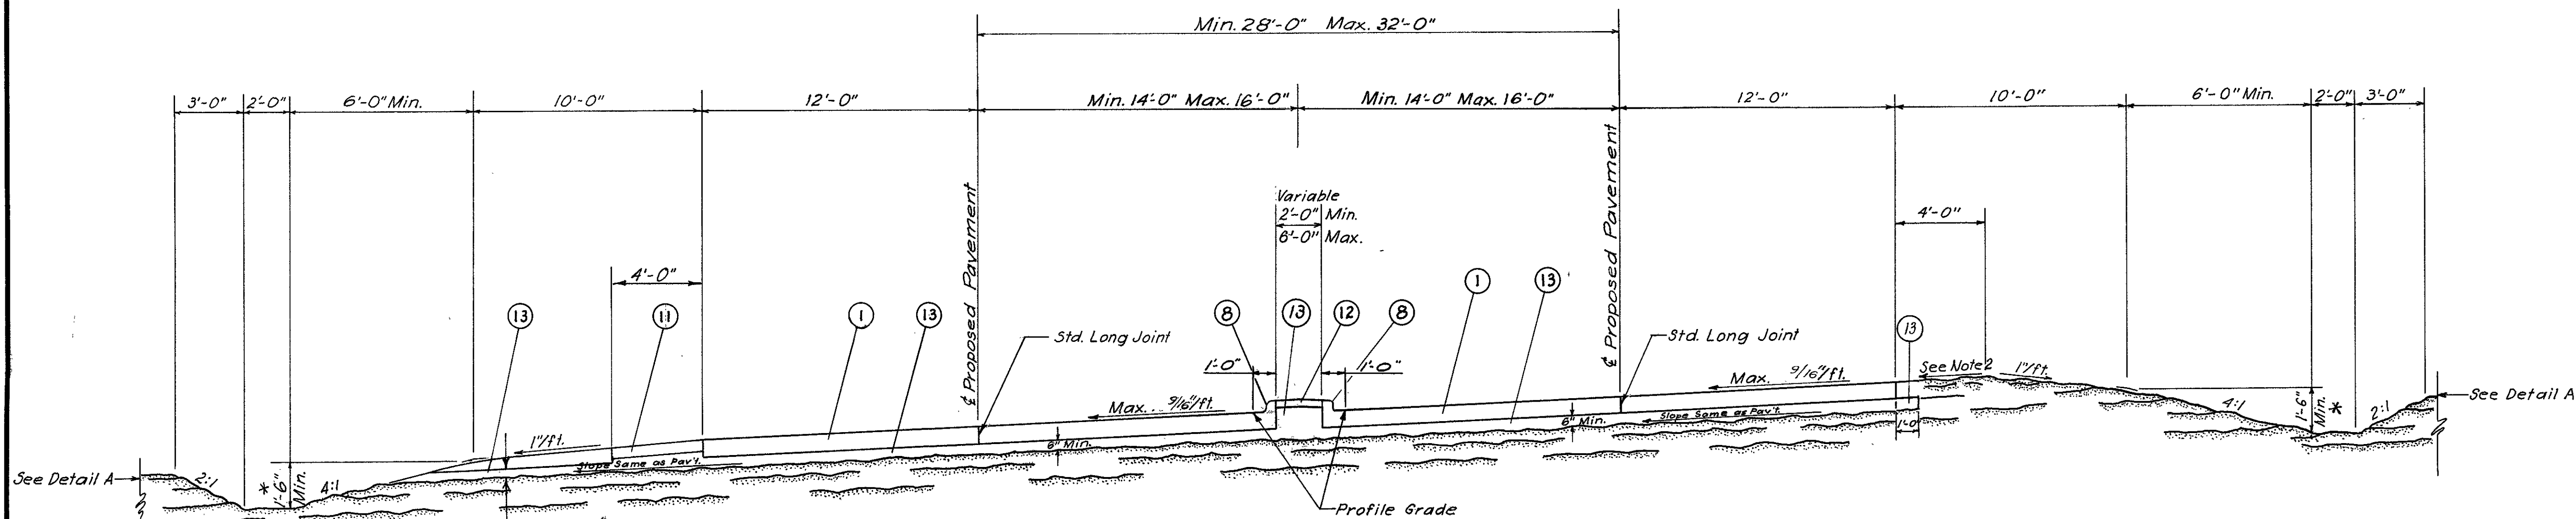


### SUPERELEVATED TYPICAL SECTION M

Sta. 578+75.0N - 580+56.97N = 181.97 Lin. Ft.


Notes:

1. See Sheet 4 for Legend.
2. Rock shoulders on high side of super-elevated sections to follow pavement slope as indicated when transverse pavement slope is more than 1/2'ft.
3. See Std. Drwg. I-21-23 Item I-21 Type I for details of concrete median.
4. See Sheet 10 for Pavement Details of Deceleration Lane.
- \* 5. Minimum depth of side ditches is as indicated on Typical Sections unless shown otherwise on Cross Sections or Plan & Profile

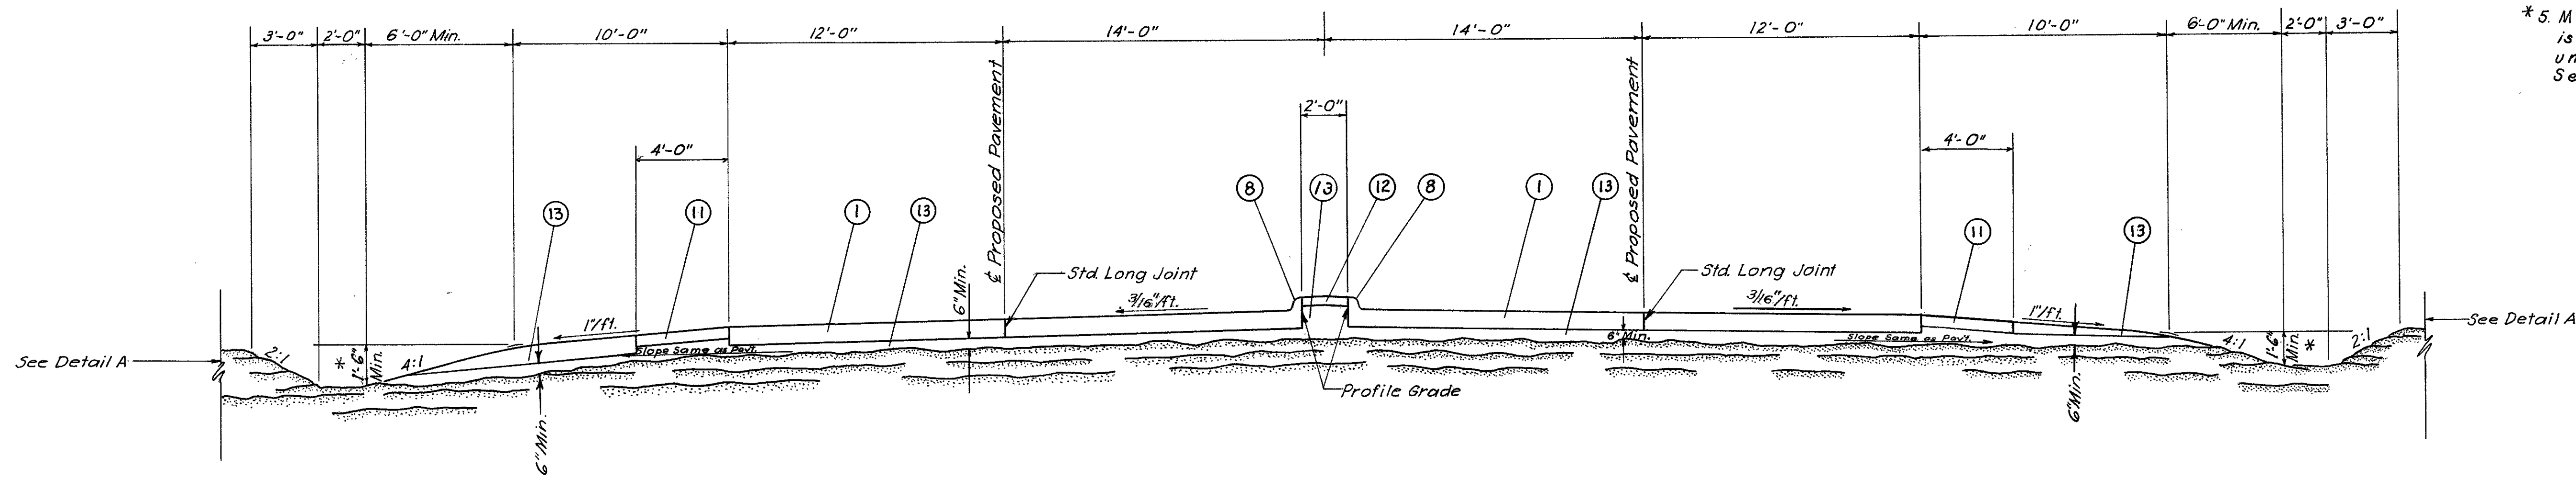

### TYPICAL NORMAL SECTION N

Sta. 582+89.04N - 585+64.78 = 275.74 Lin. Ft.

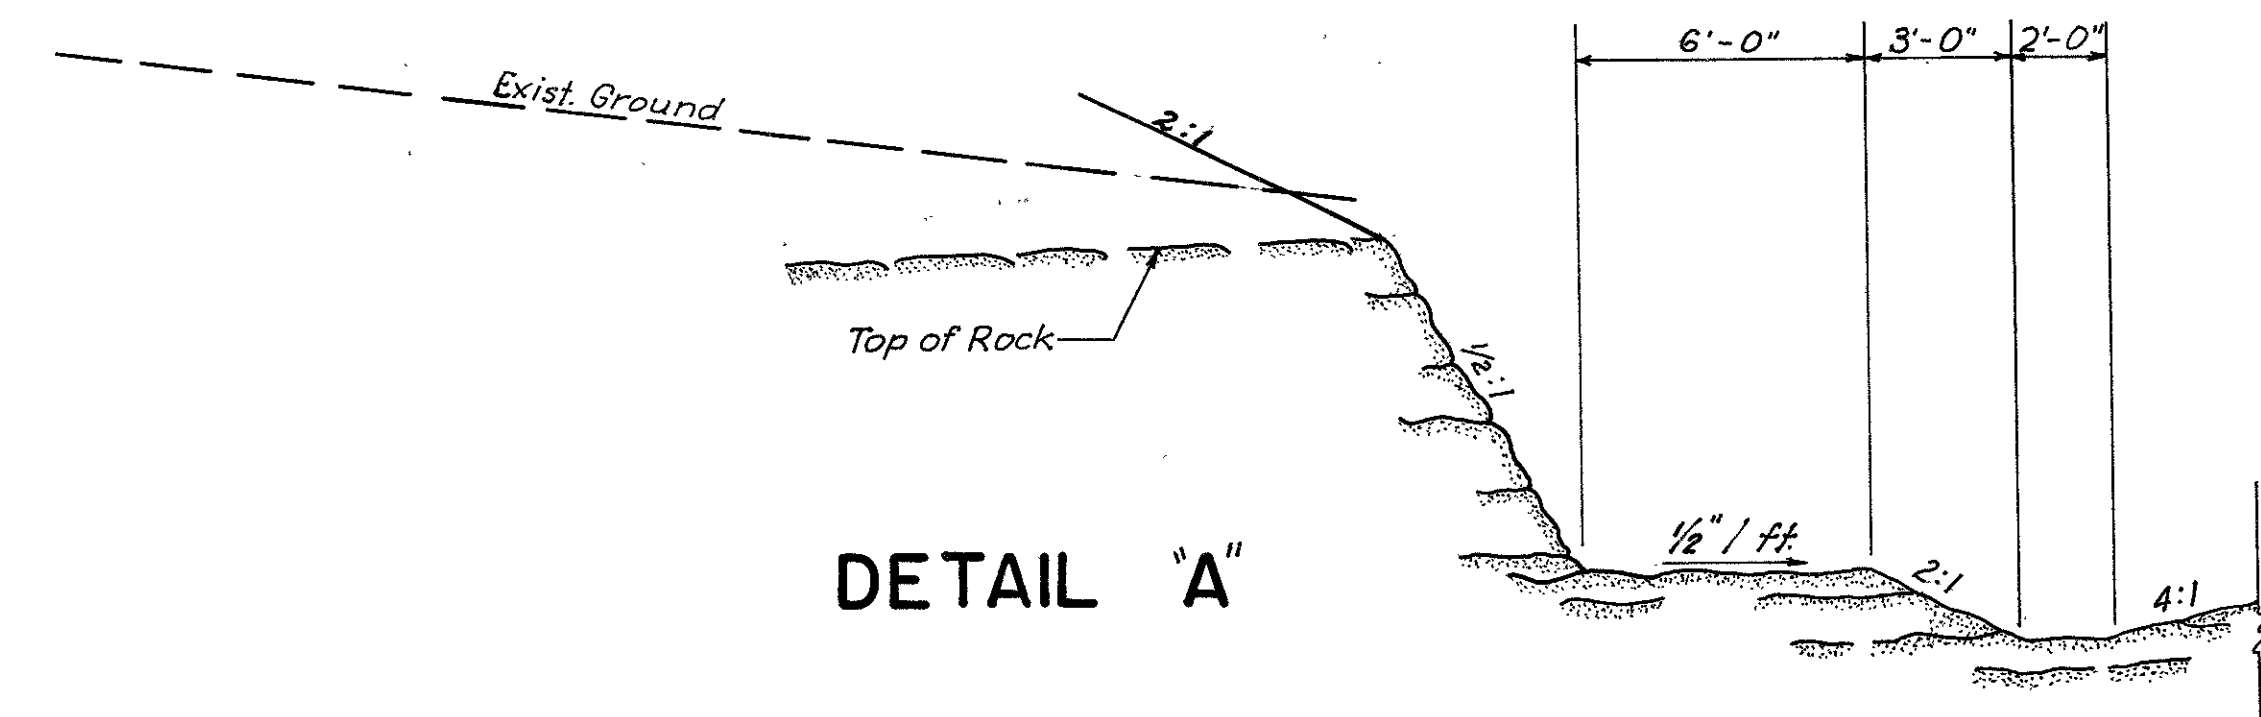


DETAIL "A"



# TYPICAL SECTIONS


## TYPE T-71

SCALE: 1/4" = 1'-0"

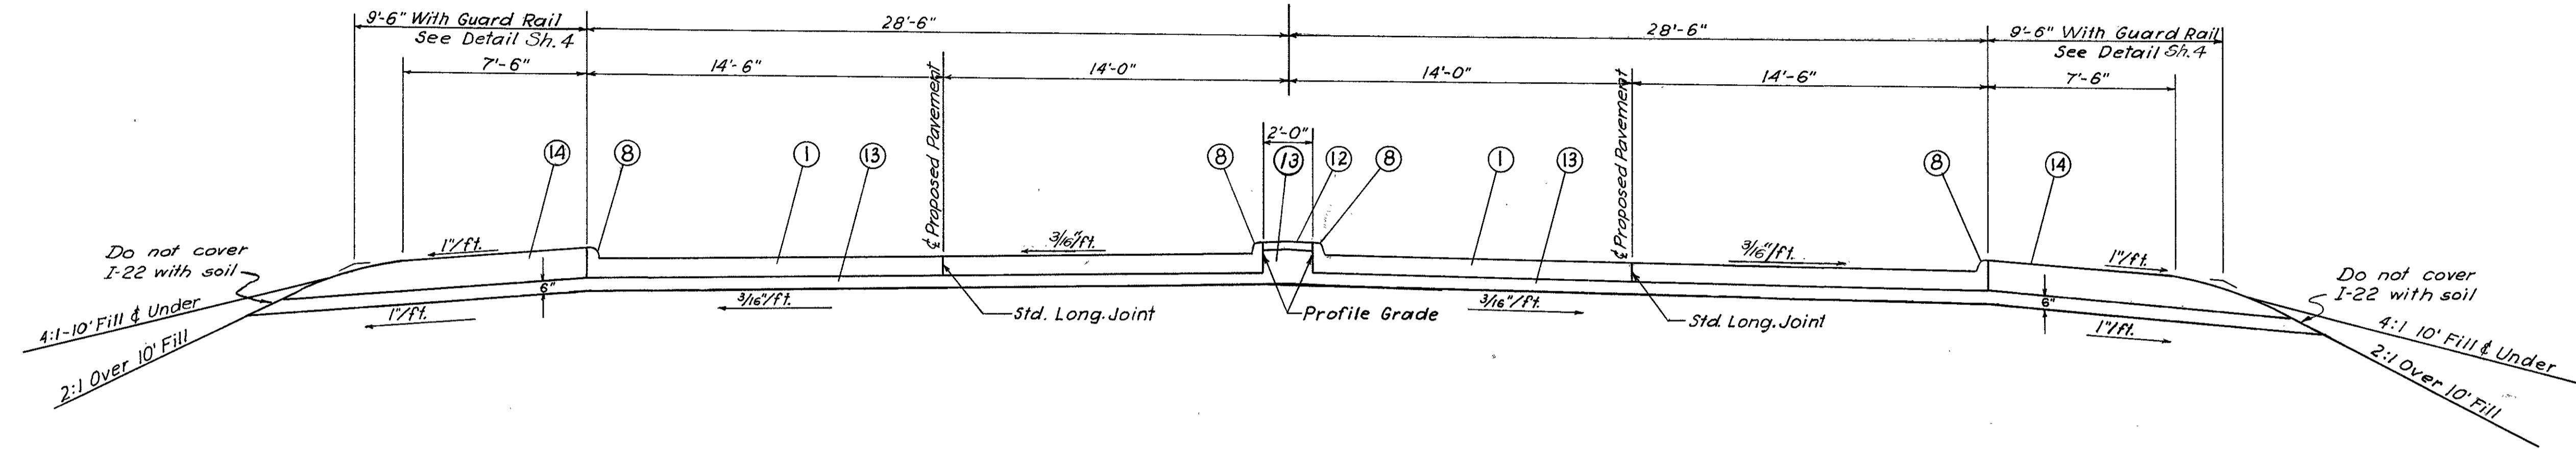

### TYPICAL NORMAL SECTION P

Sta. 590+17.54 - 594+28.63 = 411.09 Lin. Ft.

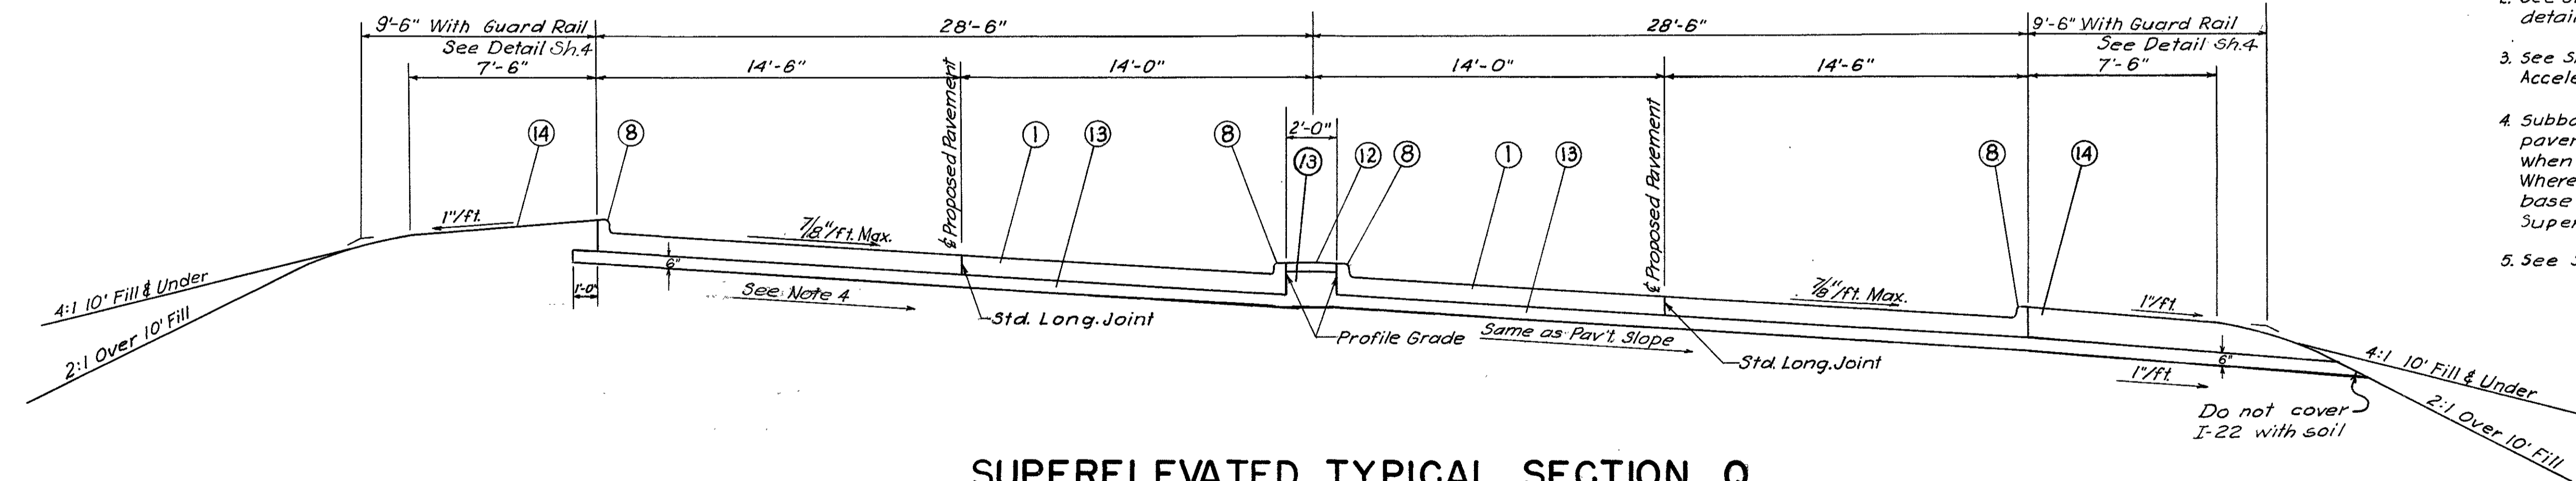

### SUPERELEVATED TYPICAL SECTION Q


Sta. 596+37.23 - 601+50.00 = 512.77 Lin. Ft.

Notes:

1. See Sheet 4 for Legend.
2. See Std. Drwg. I-21-23 Item I-21 Type 1 for details of concrete median.
3. See Sheet 10 for pavement details of Acceleration and Deceleration Lanes.
4. Subbase on high side of superelevated pavement section follows pavement slope when superelevation is more than 3/16'ft. Where superelevation is 3/16'ft. or less, subbase slopes to outer edge as shown on Superelevated Typical Section O.
5. See Sheet 4 for Guard Rail Details.

# TYPICAL SECTIONS TYPE T-71


SCALE: 1/4" = 1'-0"

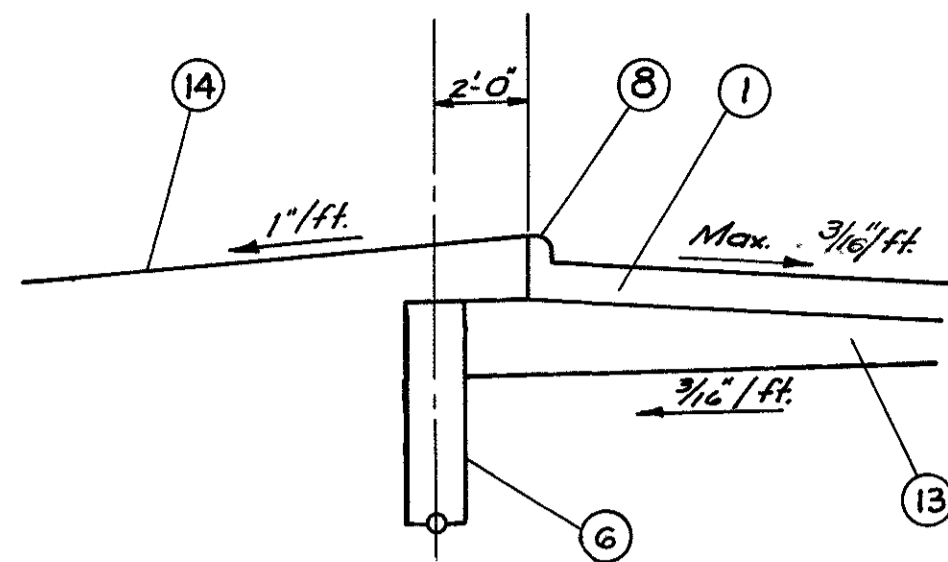

Sta. 608+00 - Sta. 610+35.57 only.

**Notes:**


1. See Sheet 4 for Legend.
2. See Std. Drwg. I-21-23 Item E-21 Type I for details of concrete median.
3. Subbase on high side of super-elevated pavement section follows pavement slope when super-elevation is more than 3/16'/ft. Where super-elevation is 3/16'/ft. or less, subbase slopes to outer edge as shown on Super-elevated Typical Section O.
4. See Sheet 4 for Guard Rail Details.
- \*5. Minimum depth of side ditches is as indicated on Typical Sections unless shown otherwise on Cross Sections or Plan & Profile

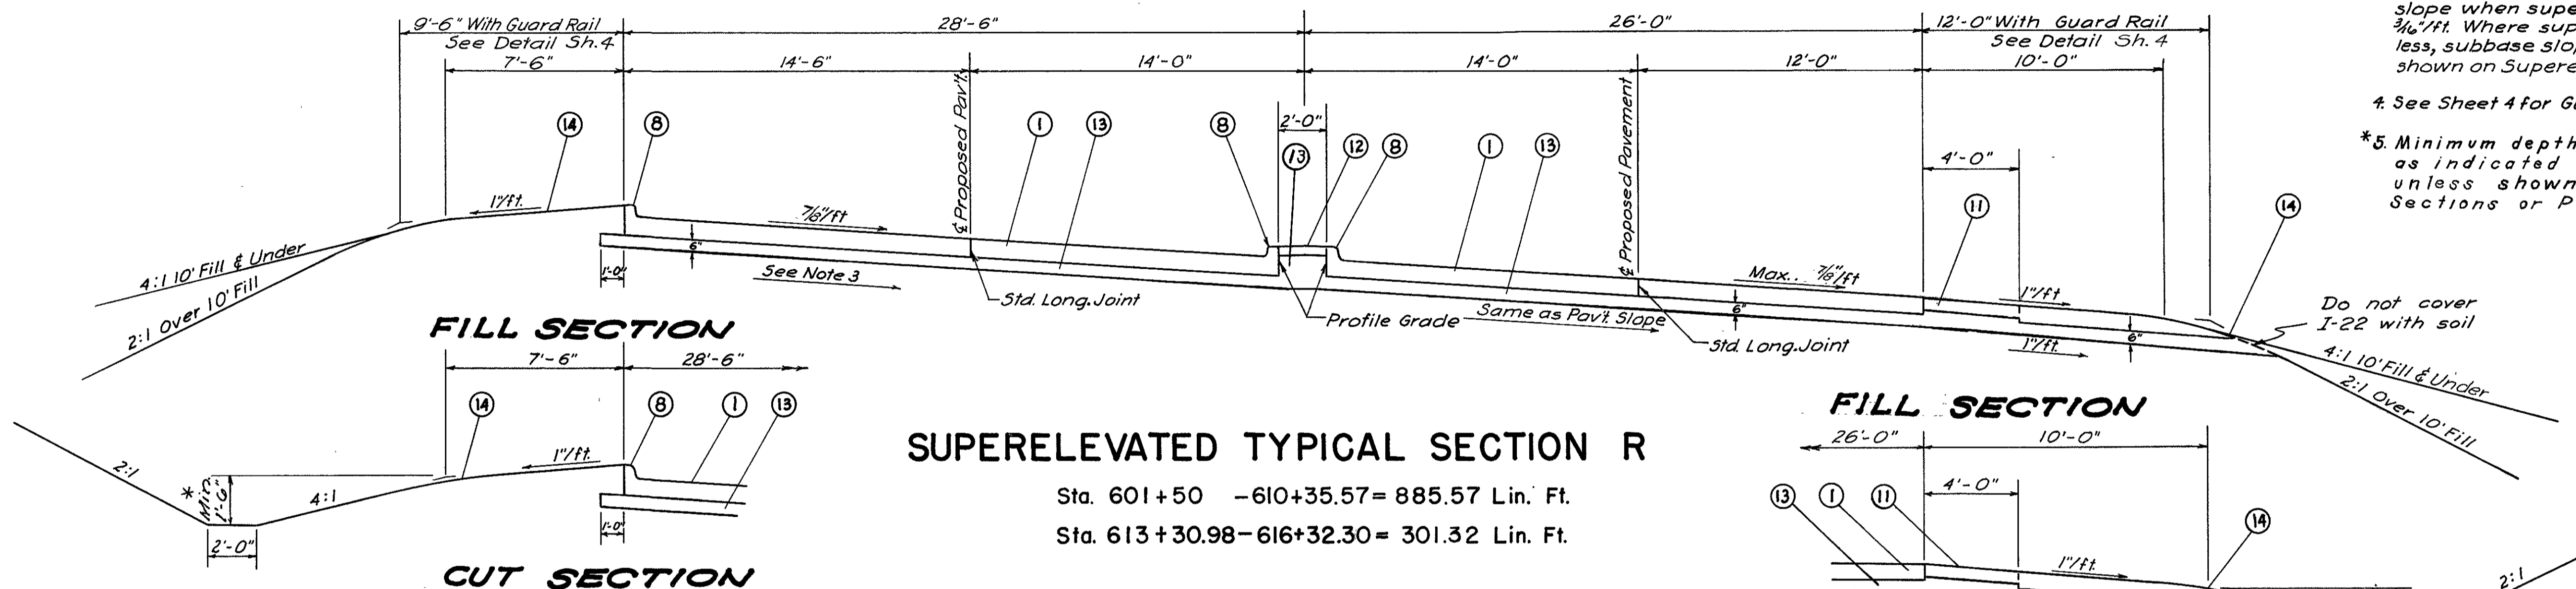


## SUPERELEVATED TYPICAL SECTION R

Sta. 601+50 - 610+35.57 = 885.57 Lin. Ft.  
Sta. 613+30.98 - 616+32.30 = 301.32 Lin. Ft.


### FILL SECTION

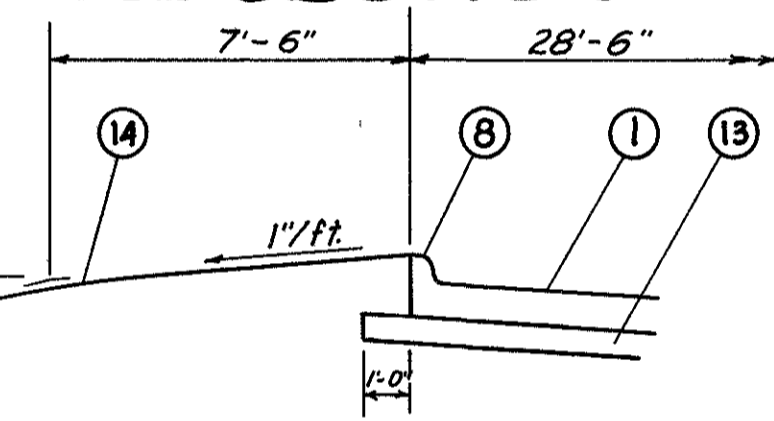

### CUT SECTION

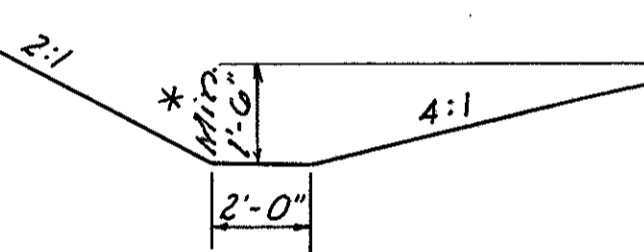


### FILL SECTION

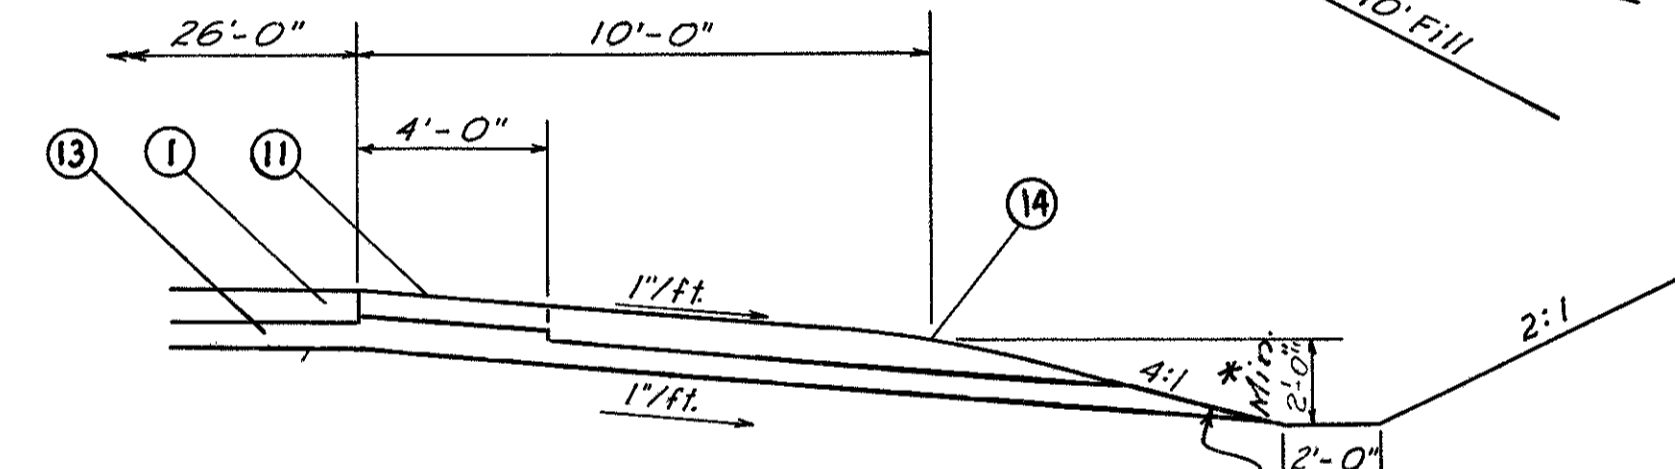

### CUT SECTION

Do not cover I-22 with soil

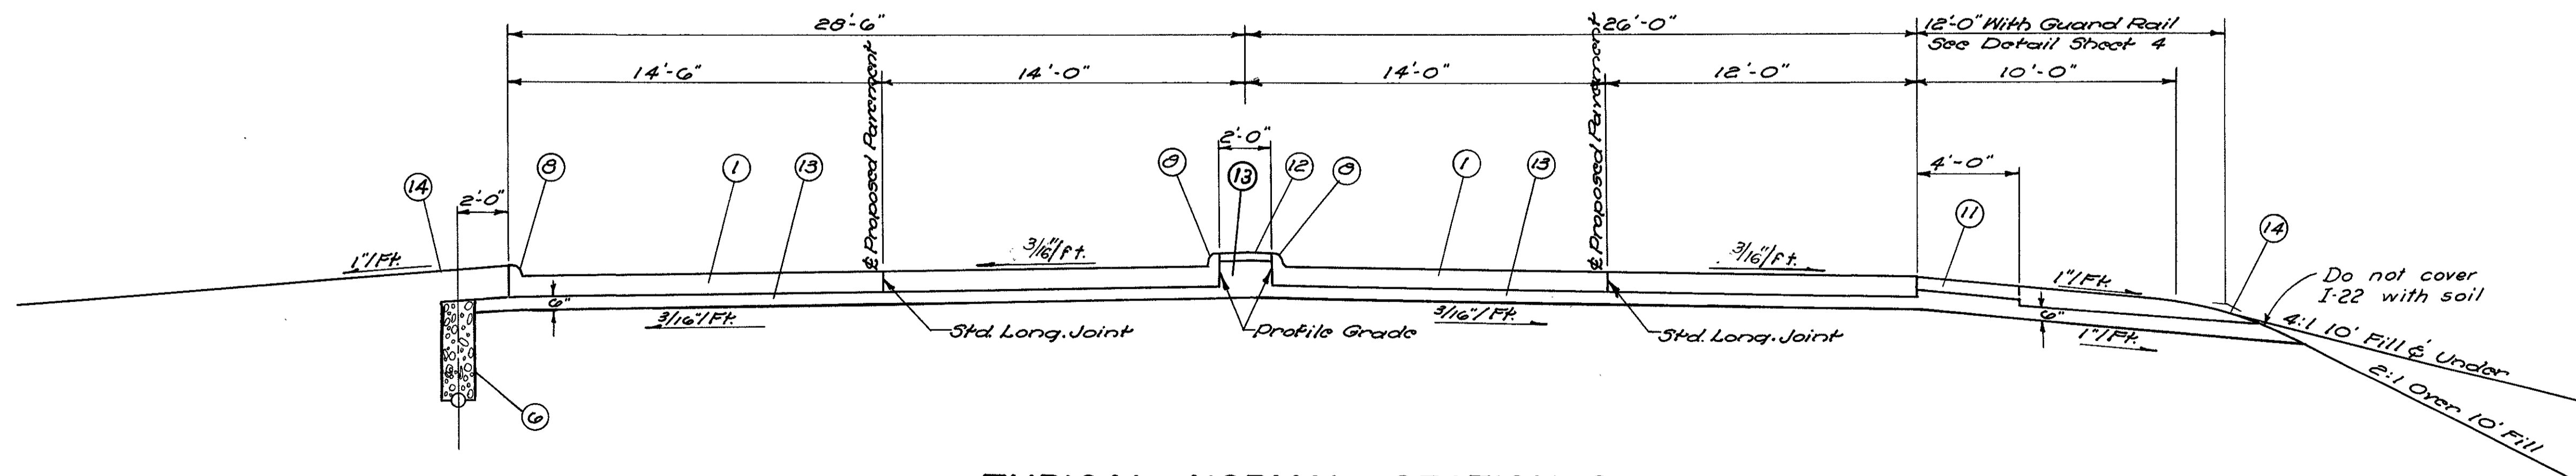


## TYPICAL NORMAL SECTION S

Sta. 610+35.57 - 613+30.98 = 295.41 Lin. Ft.

# TYPICAL SECTIONS

## TYPE T-71


SCALE 1/4" = 1'-0"

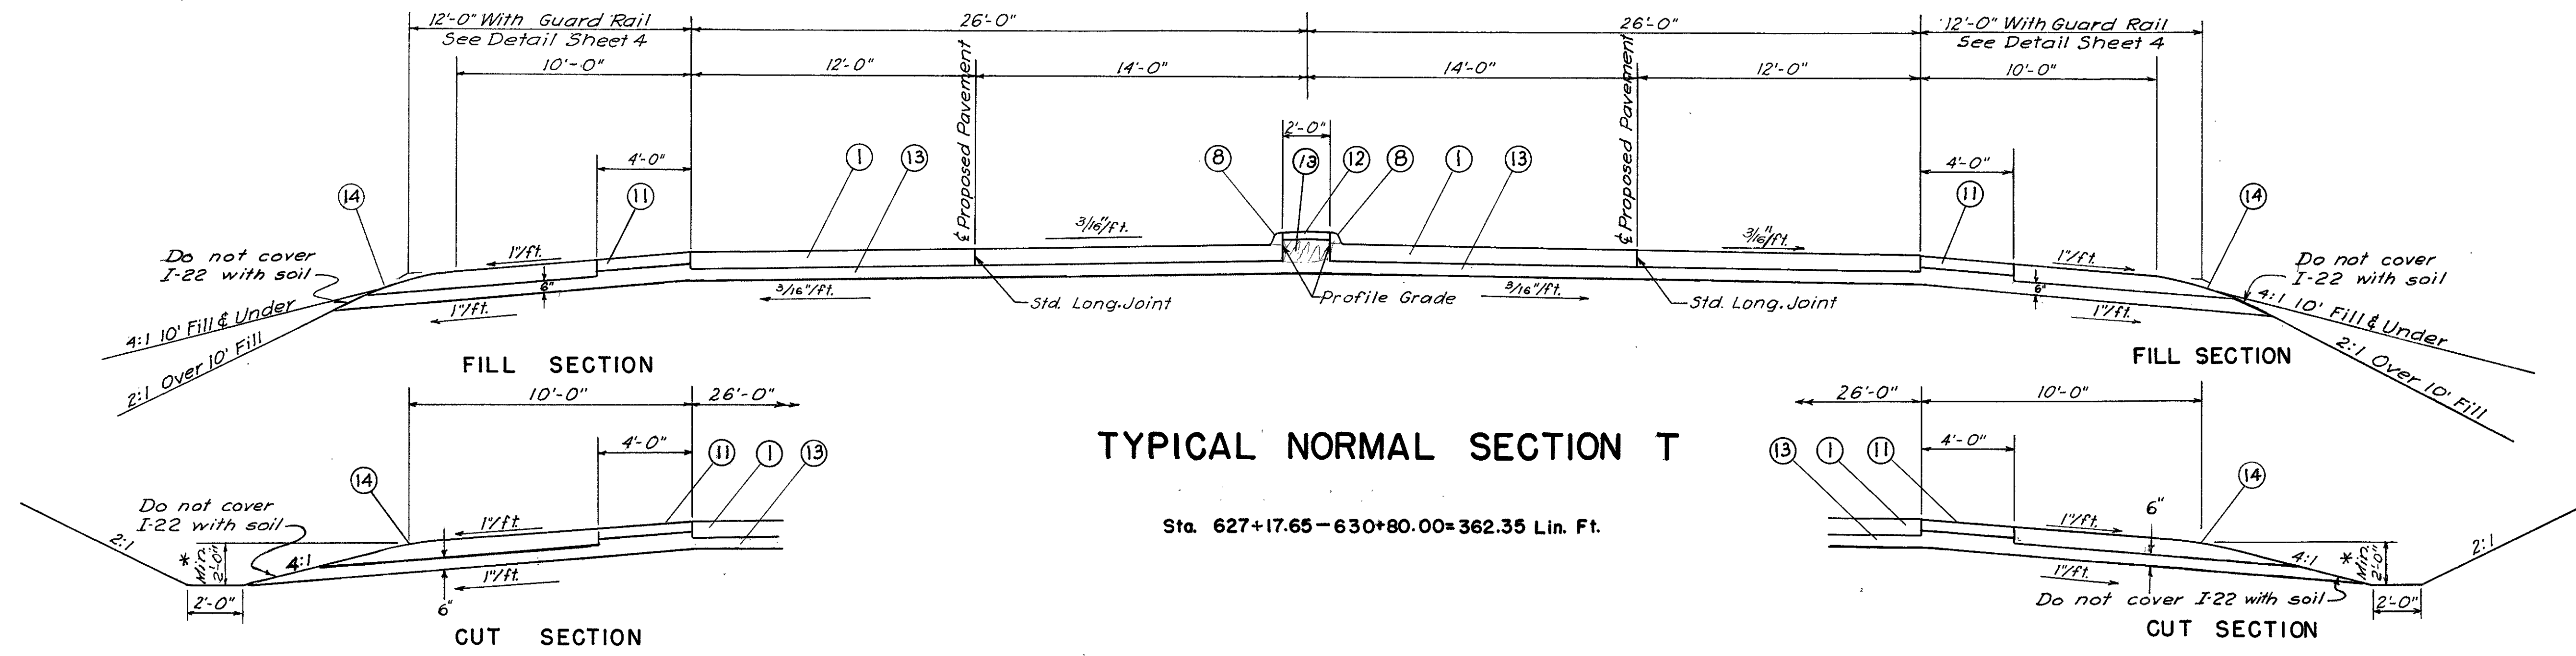

### TYPICAL NORMAL SECTION T

Sta. 627+17.65 - 630+80.00 = 362.35 Lin. Ft.

- Notes:
1. See Sheet 4 for Legend.
  2. See Std. Drwg. I-21, -23, Item I-21, Type 1 for details of concrete median.
  3. Subbase on high side of superelevated pavement section follows pavement slope when superlevation is more than 3/16"/ft. Where superlevation is 3/16"/ft or less, subbase slopes to outer edge as shown on Superelevated Typical Section O.
  4. See Sheet 4 for Guard Rail Details.
  - \*5. Minimum depth of side ditches is as indicated on Typical Sections unless shown otherwise on Cross Sections or Plan & Profile.

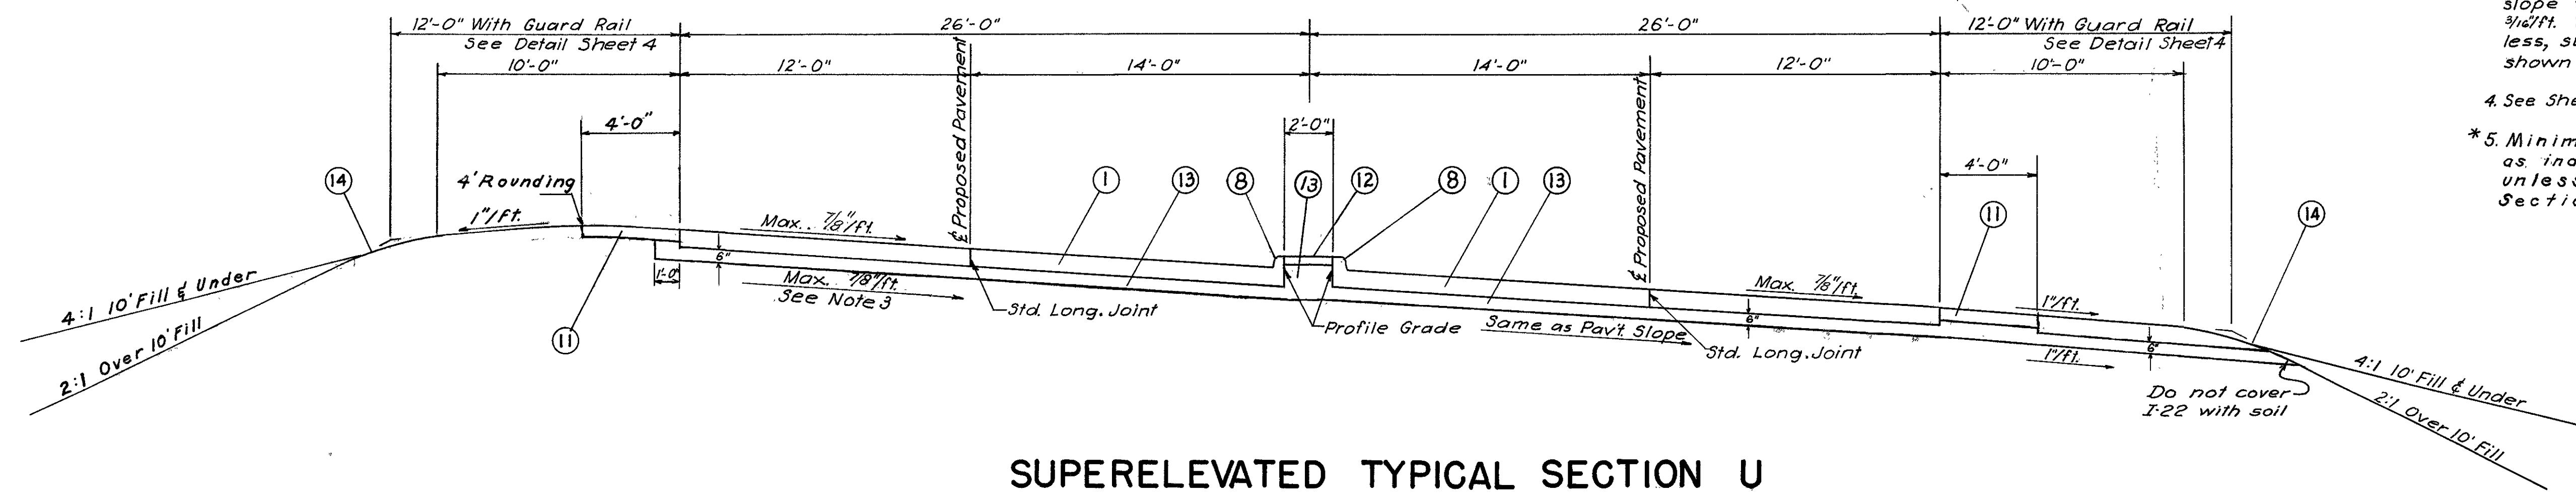


### SUPERELEVATED TYPICAL SECTION U

Sta. 616+32.30 - 627+17.65 = 1085.35 Lin. Ft.

# TYPICAL SECTIONS TYPE T-71

SCALE 1/4"=1'-0"

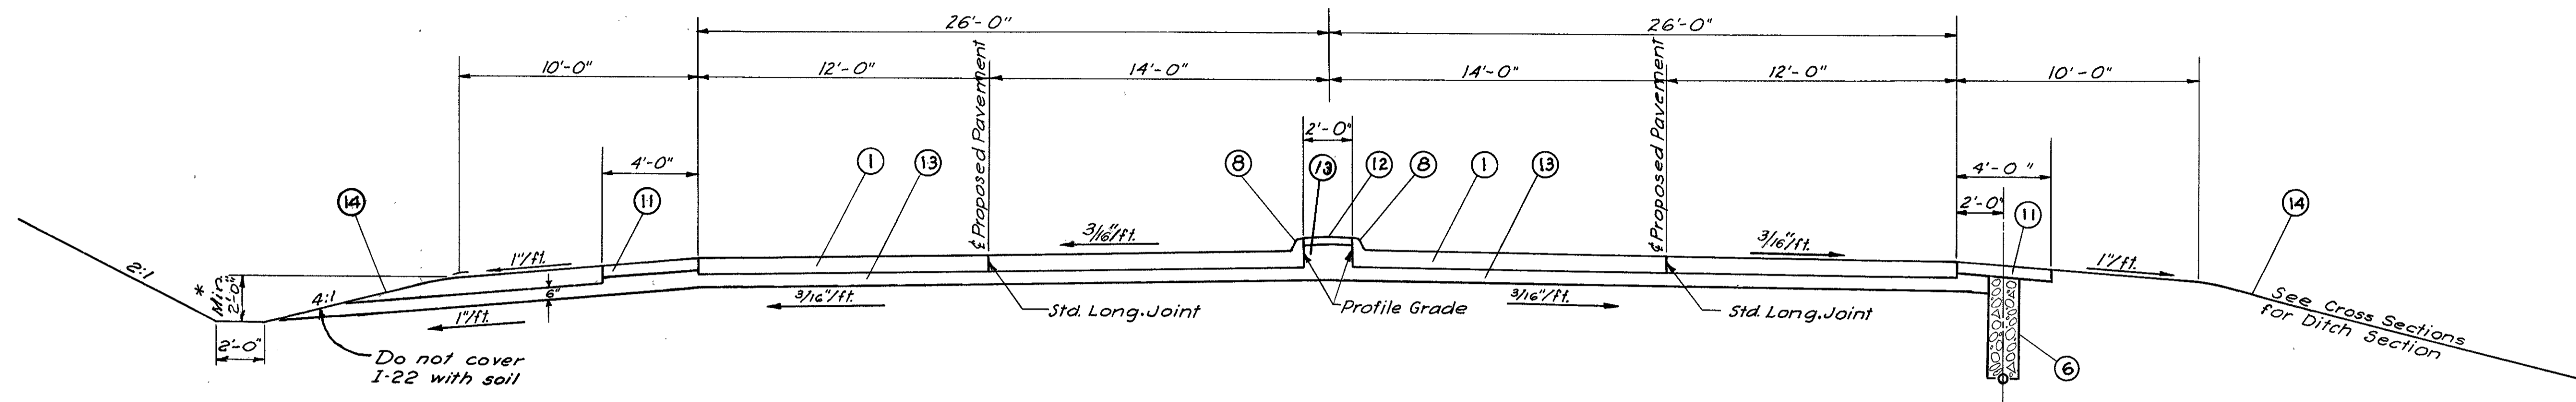


## TYPICAL NORMAL SECTION V

Sta. 630+80.00-632+40.00=160.00 Lin. Ft.



**Notes:**

- 1. See Sheet 4 for Legend.
- 2. See Std. Drwg. I-21, 23, Item I-21, Type 1 for details of concrete median.
- 3. See Sheet 4 for Guard Rail Details
- \*4. Minimum depth of side ditches is as indicated on typical sections unless shown otherwise on Cross Sections or Plan & Profile.

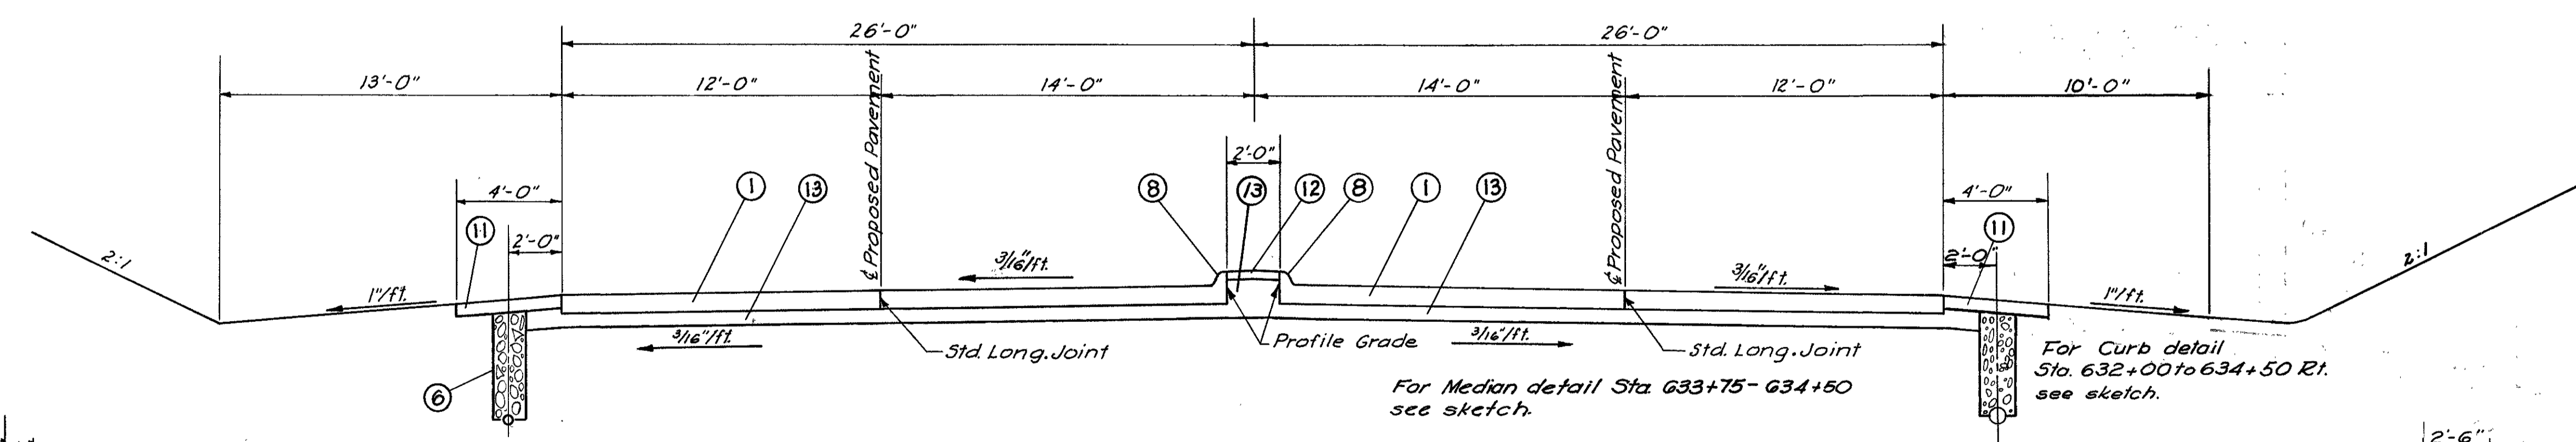

## TYPICAL NORMAL SECTION W


Sta. 632+40.00-634+50.00=210.00 Lin. Ft.

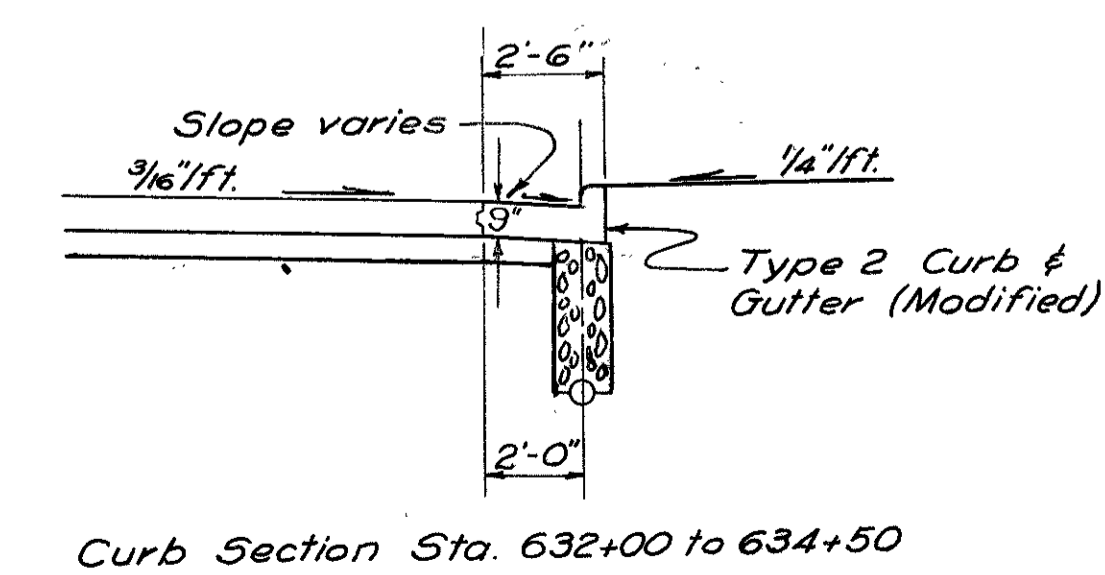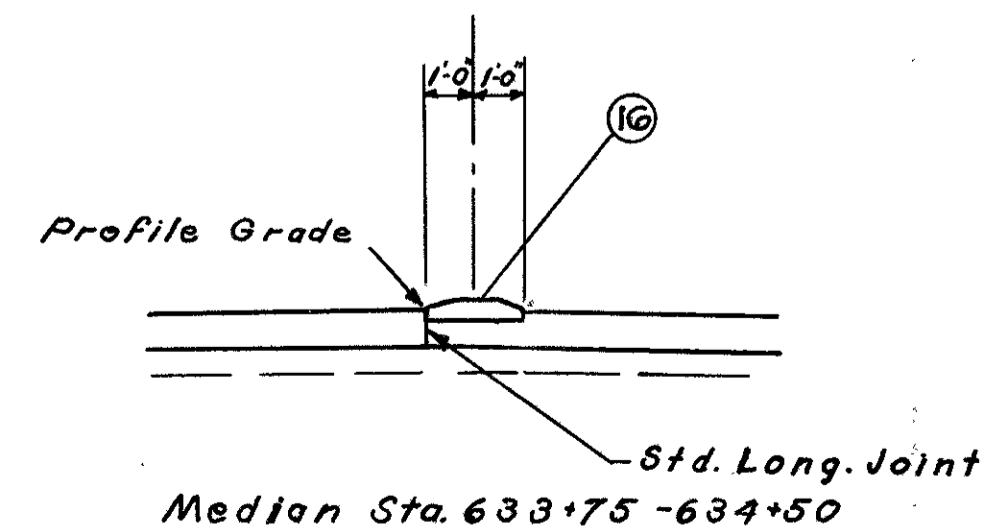




# TYPICAL SECTIONS TYPE T-71


SCALE: 1/4" = 1'-0"

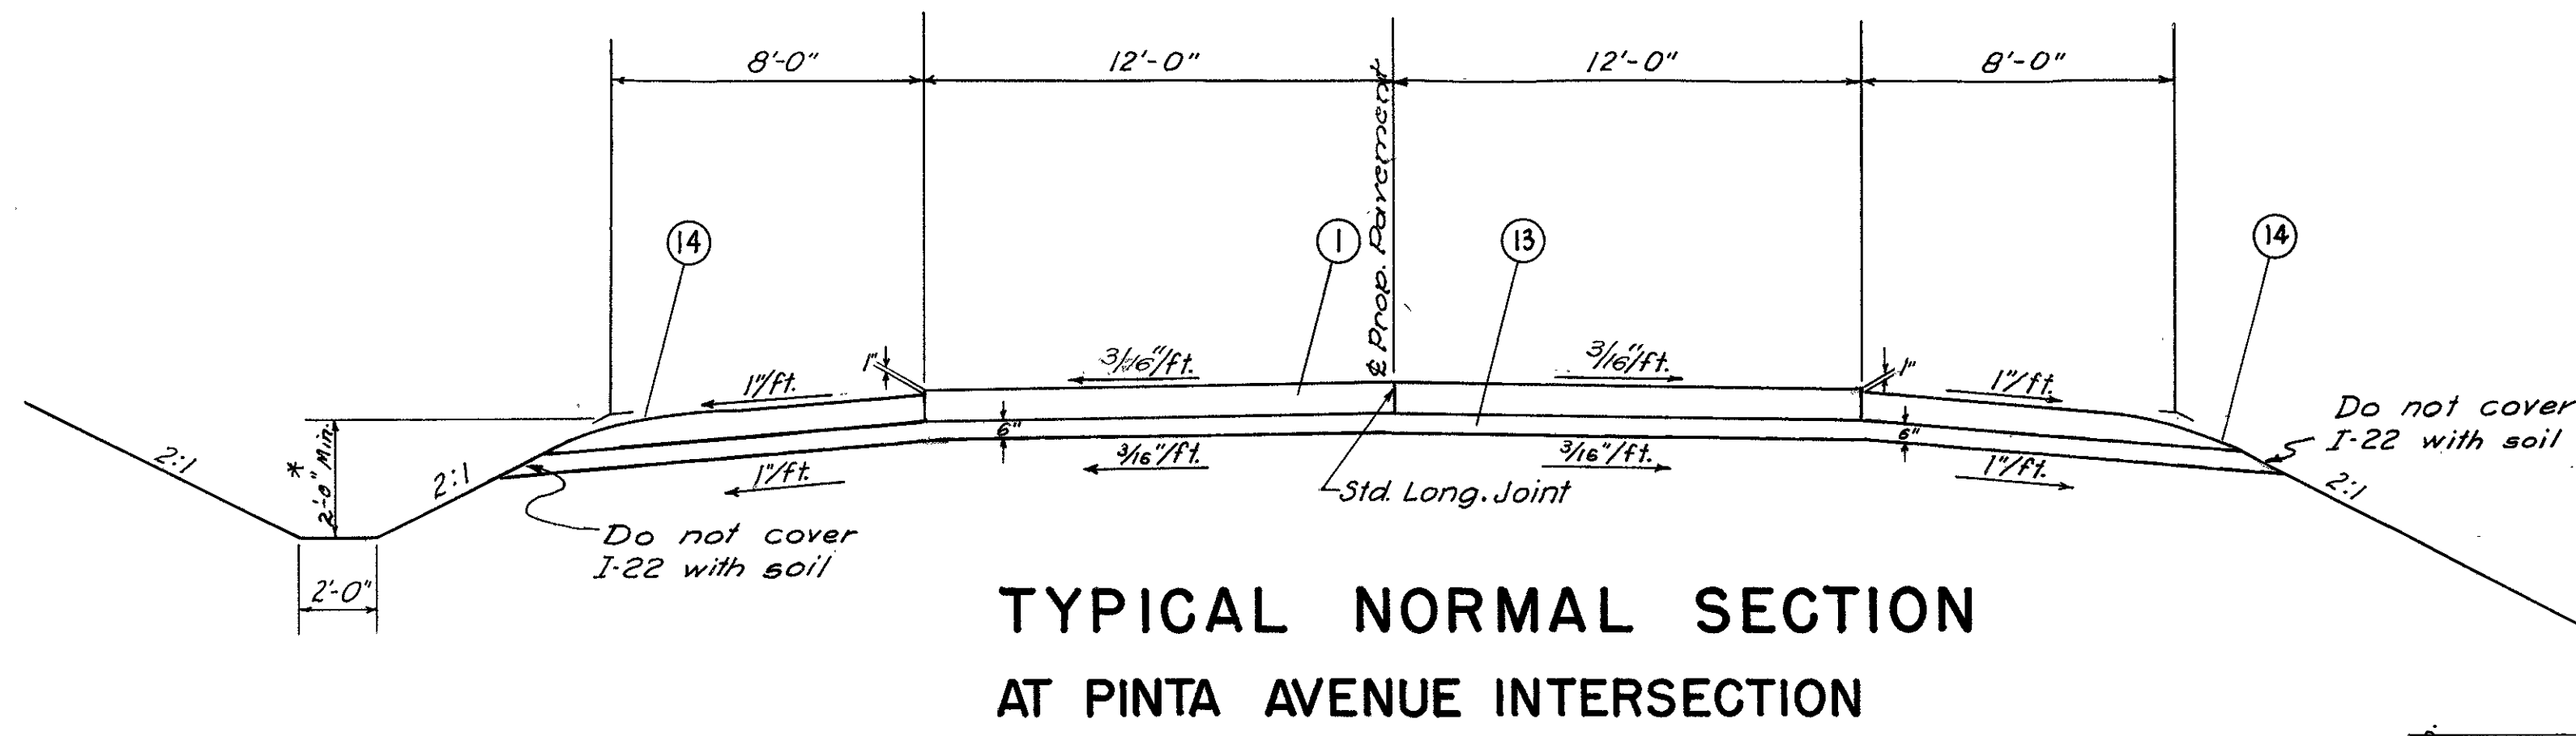

TYPICAL NORMAL SECTION  
AT PINTA AVENUE INTERSECTION

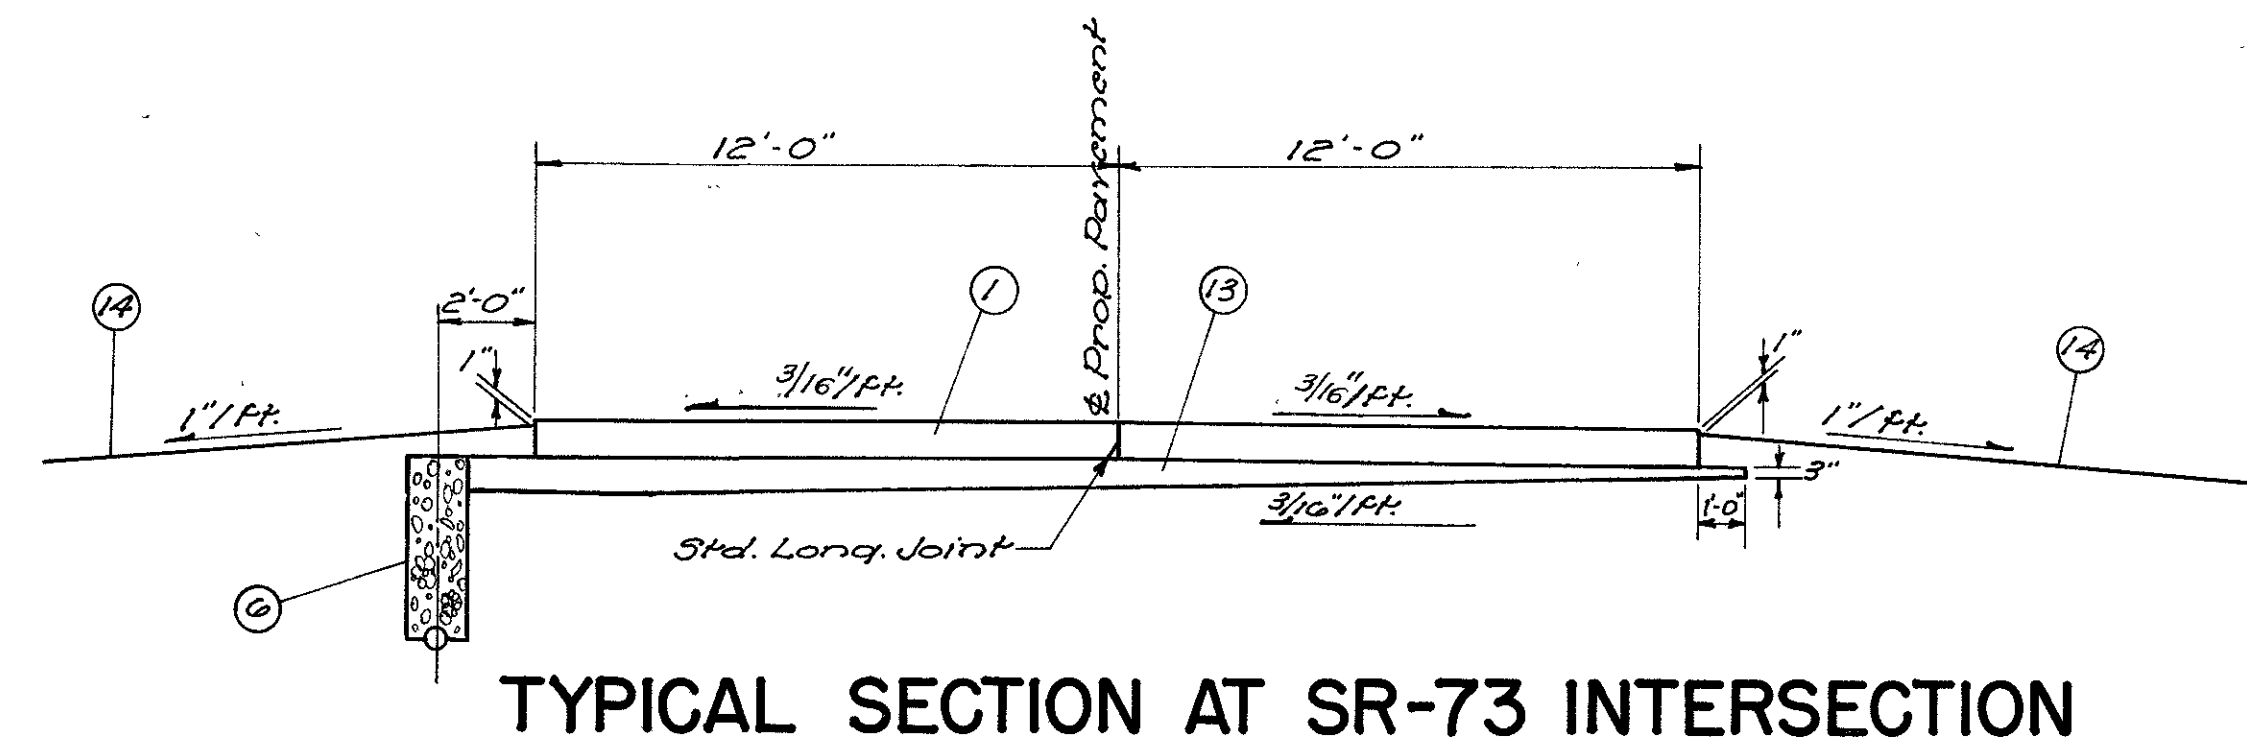


TYPICAL SECTION AT SR-73 INTERSECTION

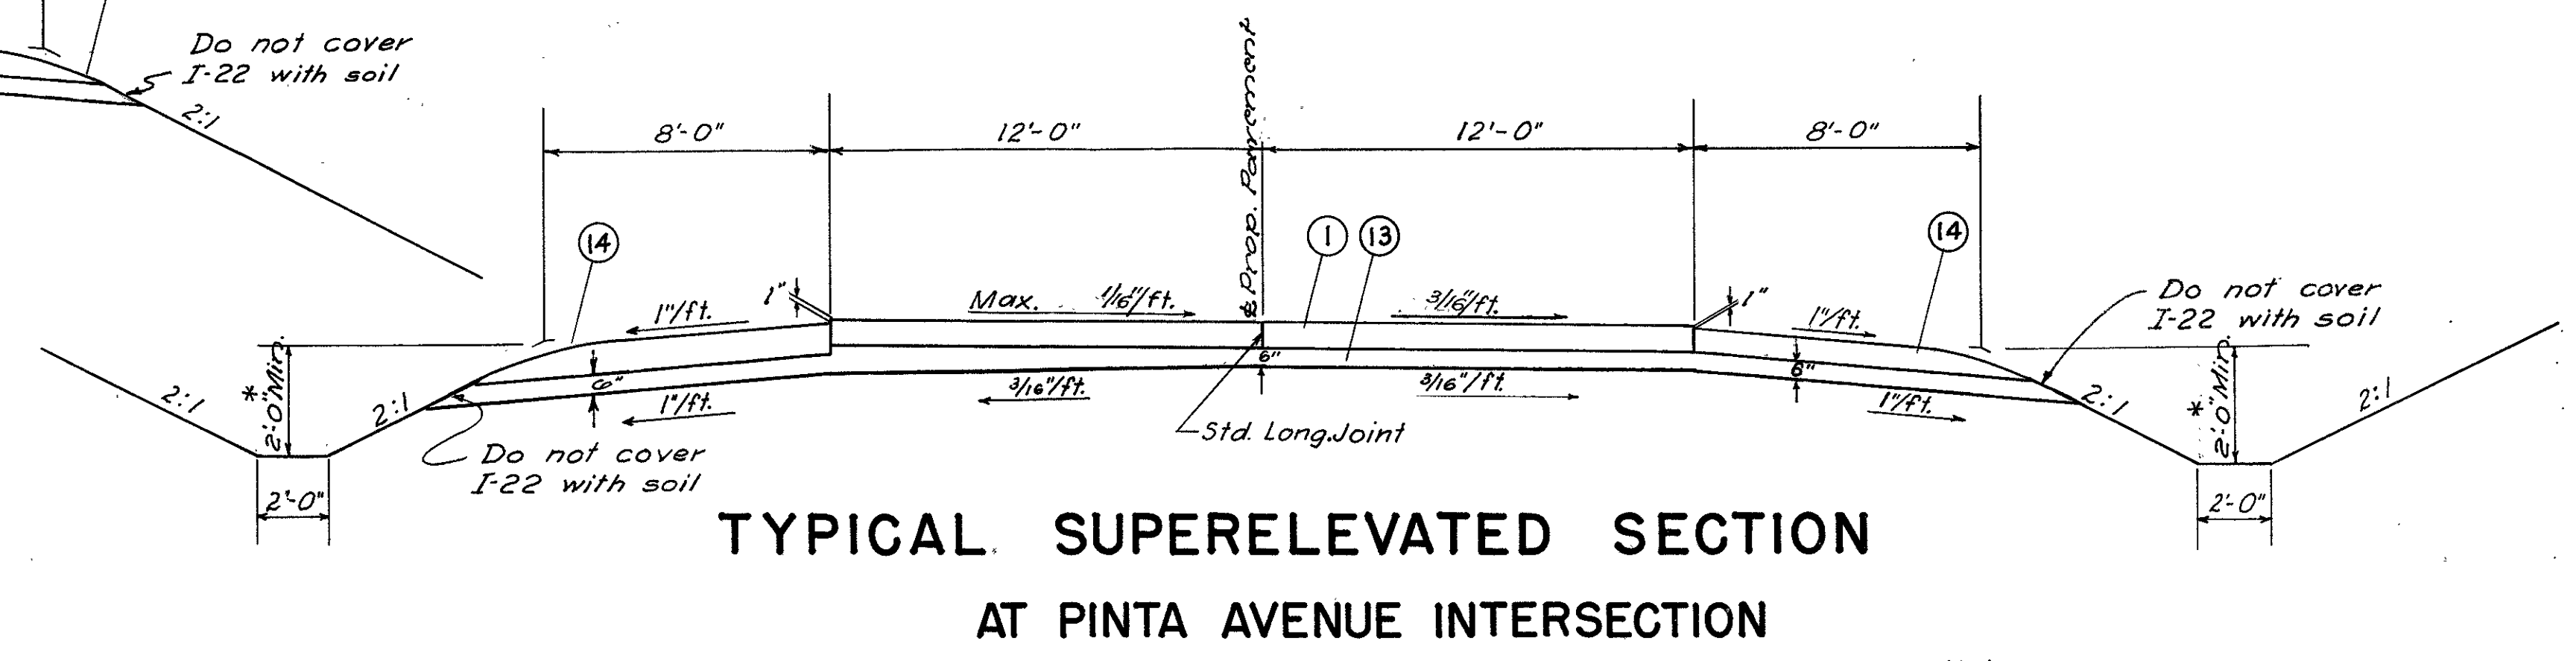


TYPICAL SUPERELEVATED SECTION  
AT PINTA AVENUE INTERSECTION

## VERITY PARKWAY

- Notes:
1. See Sheet 4 for Legend.
  2. See Intersection Detail Sheets
  - \*3. Minimum depth of side ditches is as indicated on Typical Sections unless shown otherwise on Cross Sections or Plan & Profile

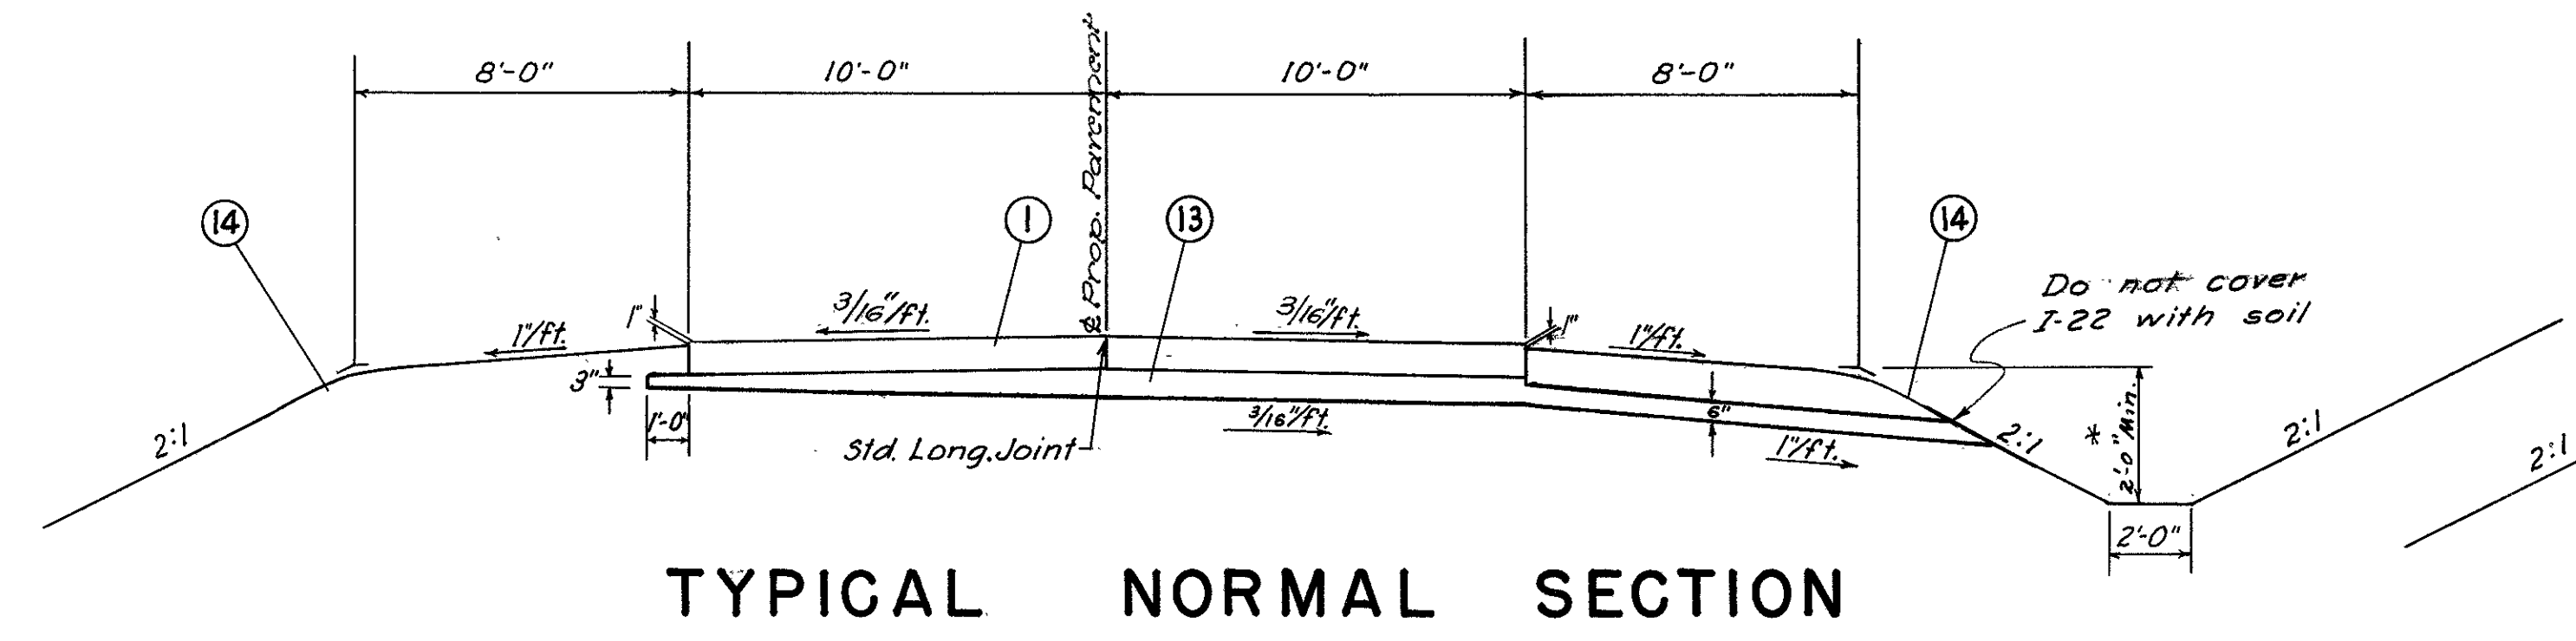

TYPICAL NORMAL SECTION

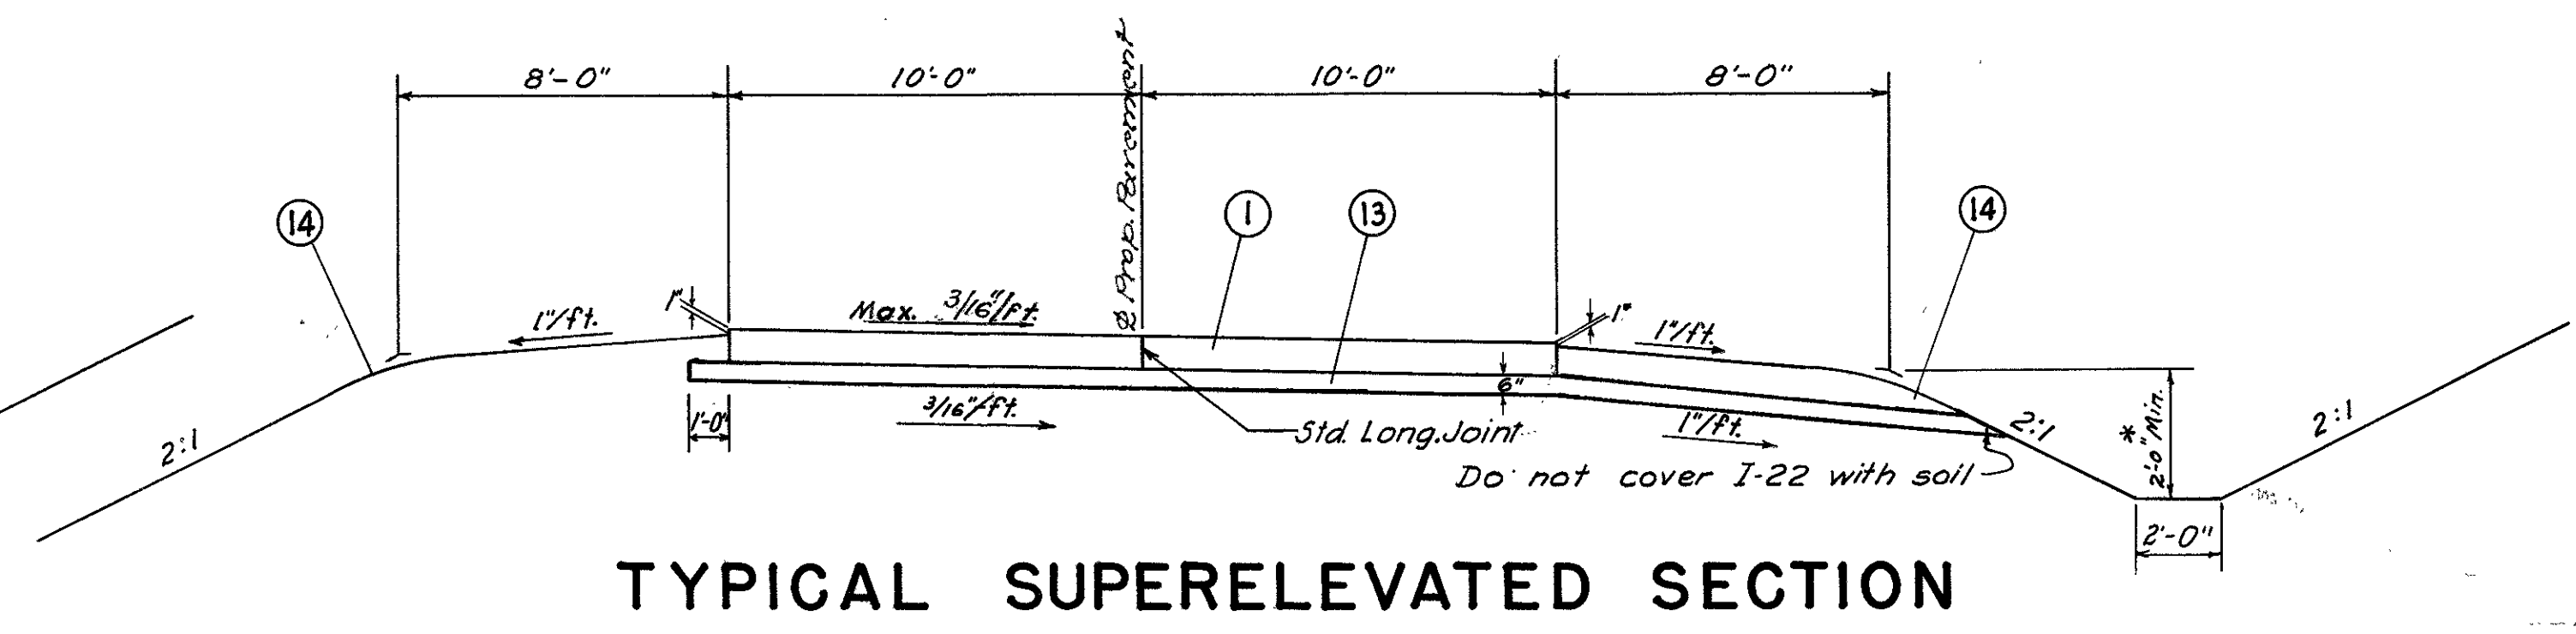

TYPICAL SUPERELEVATED SECTION


## TODHUNTER ROAD




# TYPICAL SECTIONS

## TYPE T-71

SCALE: 1/4" = 1'-0"

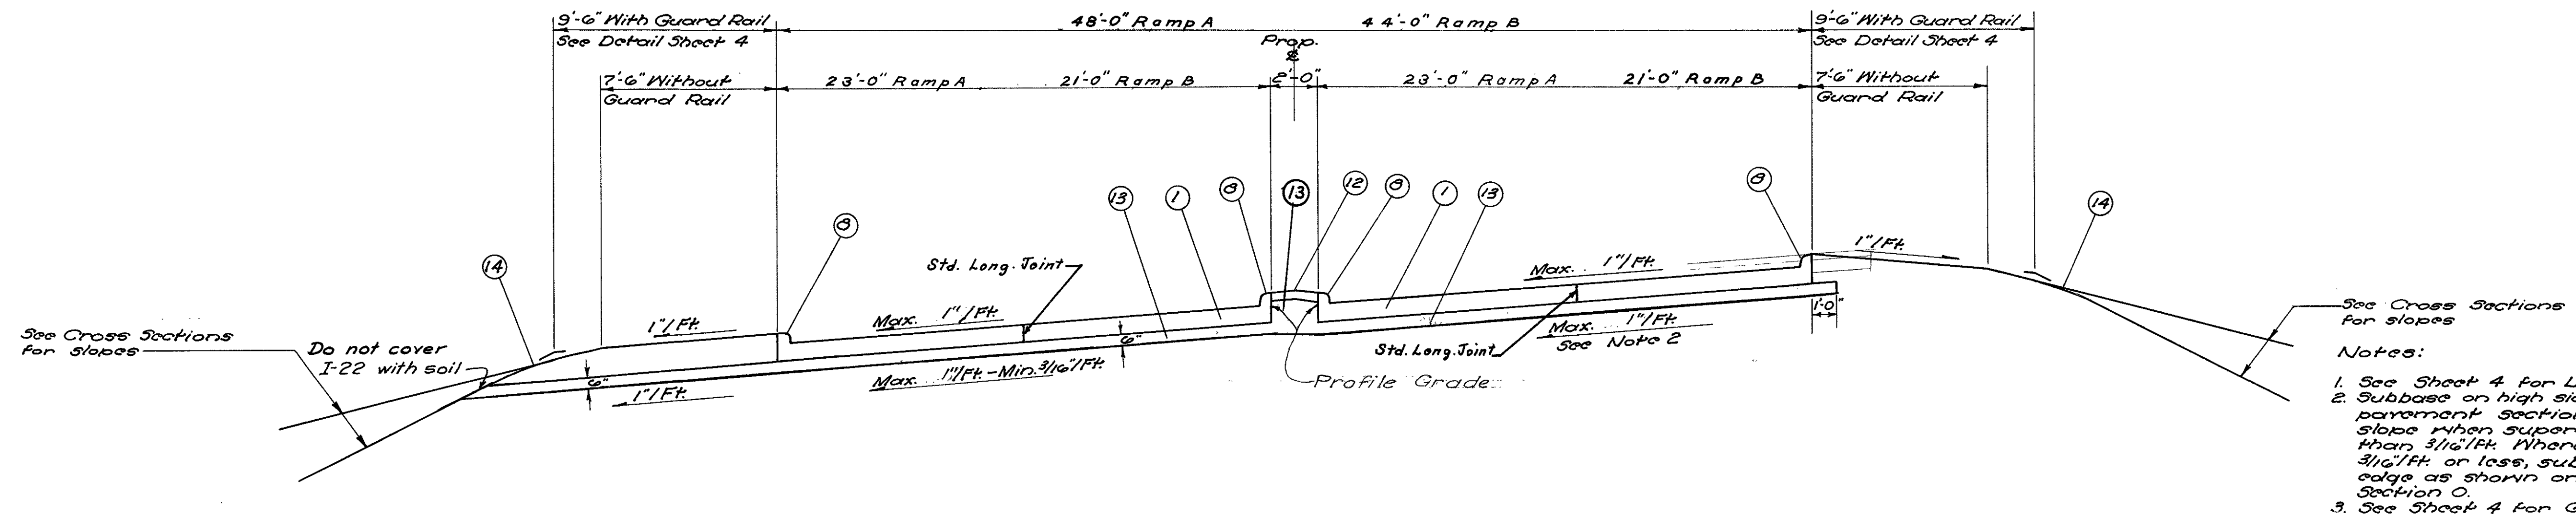

SUPERELEVATED TYPICAL RAMP SECTION

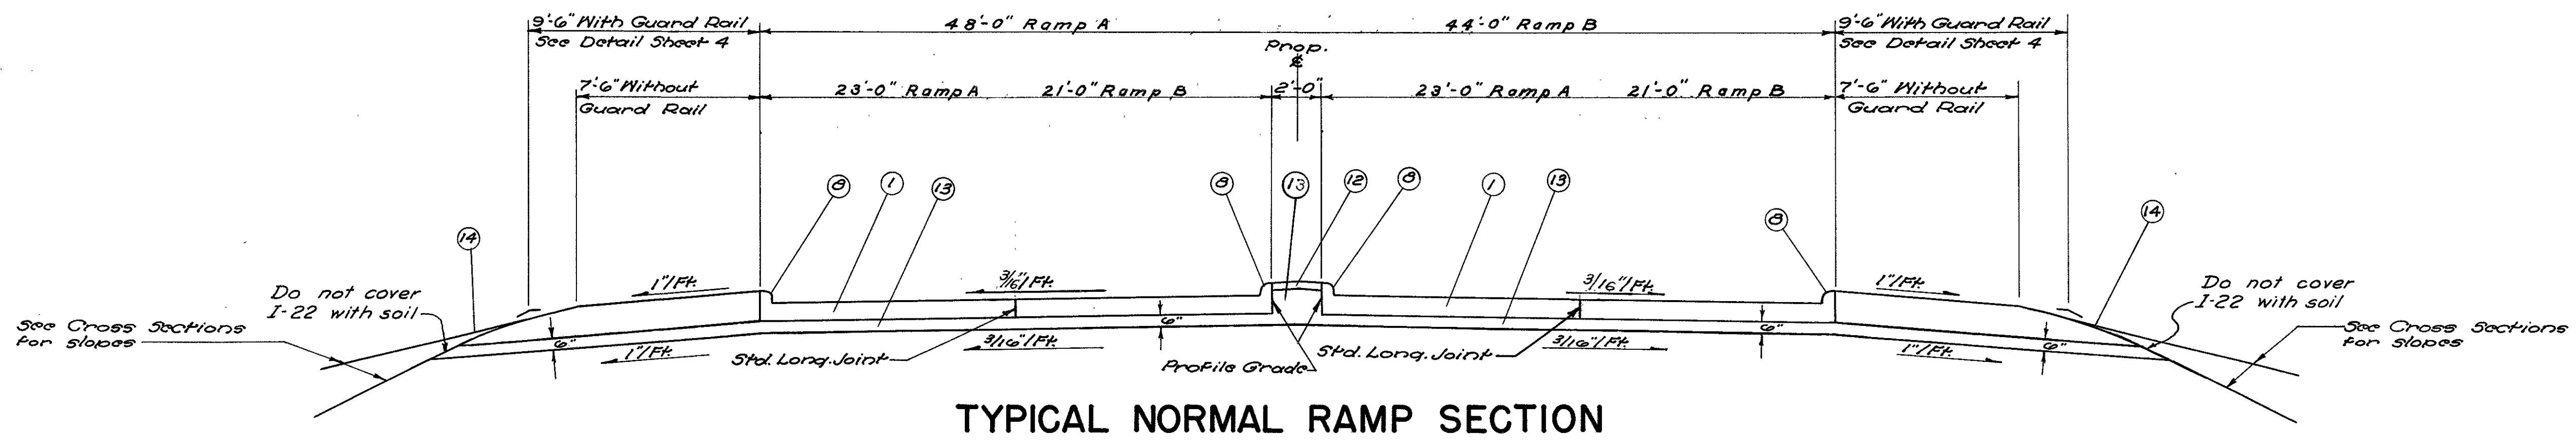

TYPICAL NORMAL RAMP SECTION

# GENERAL NOTES

## GENERAL

### DESIGN SPEED

Design speed on this project is 50 M. P. H., however the design speed on the northbound lane is 60 M.P.H. and on the southbound lane 50 M.P.H.

### FIELD OFFICE

The contractor shall provide a suitable field office in accordance with Section S-0.01 (b), Structures General, having a minimum floor area of 500 sq. ft. The contractor shall have a telephone installed and maintained during the construction of this project.

### DATUM

All elevations are referred to U. S. C. & G. S. Datum.

### STATIONING

In general, stationing indicated on the Plans is along the centerline of the new lane, regardless of the direction of flow of traffic. In locations where the two lanes are not concentric, both lanes are stationed individually. The northbound lane is indicated by the suffix "N" and the southbound lane by the suffix "S" after the stationing.

### TRAFFIC

At least ten (10) days before any interruption of the normal flow of traffic within the project limits, the contractor shall submit to the Director in writing his proposed methods and procedures planned for the maintenance of traffic throughout the life of the contract.

The Contractor, to the satisfaction of the Director, shall plan and conduct his operations so that two way traffic, without detours, shall be maintained at all times consistent with the requirements of Sec. T-35.23 and as set forth below.

The Contractor shall provide temporary cross-overs between new and existing pavement as required to maintain traffic. Suitable access shall be provided to all driveways and side roads at all times, as approved by the Engineer.

Aggregate and chloride used for maintaining local traffic shall be applied on temporary roadways as directed and in the amounts requested by the Engineer (see General Summary for quantities) and shall be paid for at the unit price bid for Item S-15, Furnishing and Placing Aggregate for Traffic Bound Surface Course and Item S-15 Furnishing and Applying Calcium Chloride or Calcium Magnesium Chloride. The hardness and soundness requirements of the Construction and Material Specifications shall be waived for the traffic bound surface course.

### HISTORICAL AND MEMORIAL MONUMENTS AND MARKERS

Historical and memorial monuments and markers shall be carefully removed, stored and reset where and as directed by the Engineer, in accordance with the provisions of Section G-7.09 of the Construction and Material Specifications.

### RAILROAD TRAFFIC

See Special clauses in proposal as to protection of railroad traffic.

### CONSTRUCTION LAYOUT STAKES

See note in Proposal describing work included in this Lump Sum pay item.

## ROADWAY

### REMOVAL AND DISPOSAL OF UNSUITABLE MATERIAL

It is anticipated that certain areas will be encountered where the existing material is unsuitable for use as embankment or to support embankment. The Contractor shall make explorations for, and removal of, unsuitable material as directed by the Engineer. The Contractor is referred to Item E-1, Roadway Excavation, for basis of payment, method of disposal, etc. When approved by the Engineer, unsuitable embankment material may be wasted within the limits of the R/W, but outside roadway construction limits, providing it is covered with at least one foot of earth and left in a slightly condition. All materials so removed shall be measured and paid for as Item E-1, Roadway Excavation.

### REMOVALS (MISCELLANEOUS)

Building foundations, steps, walls, aqueduct structures, or other similar structures shall be excavated to a depth of three feet (3') below the proposed subgrade, or twelve inches (12") below finished surface if located outside the pavement limits but within the R/W or easement lines.

The removal of existing rigid concrete pavement either with or without surface courses shall be paid for at the contract unit price bid per square yard for Item E-8, Removal and Disposal of Existing Pavement. The removal of existing flexible pavement without rigid base shall be paid for at the contract unit price bid per cubic yard for Item E-1, Roadway Excavation. Wherever a portion of pavement remains in place, the cutting and trimming shall be neat and to the line shown on the drawings. No extra payment shall be made for cutting and trimming.

Removal of existing sidewalk when replaced by new sidewalk shall be paid for in the unit price bid for the new sidewalk, I-13. Removal of the existing sidewalk not to be replaced by new sidewalk shall be paid for as E-8, Removal and Disposal of Existing Sidewalk.

Wherever the proposed concrete sidewalk adjoins or abuts an existing sidewalk the existing walk shall be cut and trimmed to a neat line as shown on the Plans. Payment for cutting and trimming shall be included with sidewalks and shall be paid for at the contract unit prices bid for Items I-13, Sidewalks and Concrete Steps.

The contents of all existing privies or septic tanks, upon which embankment is to be placed, shall be removed and the empty pit backfilled with material meeting the requirements of Section E-1.08. The cost of removing and disposing of contents shall be paid for at the unit price bid per cu. yd. of "Roadway Excavation, Item E-1".

The removal and disposal of any existing pavement, sidewalk, head walls, pipe curbs, foundations, retaining walls, concrete or masonry posts, wells, septic tanks, curb drains or other masonry, street railway rails and ties, guardposts, flagpoles, fences, billboards, or other similar items, lying within or below the limits of the Roadway Excavation, Item E-1, Excavation for Structures, Item E-2, and not specifically paid for under a separate item are classified as excavation and are paid for as additional excavation under the excavation item of which they are a part.

### REMOVAL OF TREES AND STUMPS

Trees or stumps, shall be removed or preserved as indicated on the Plans by the following symbols:

Trees or stumps to be removed . . . .  
Trees to be preserved . . . . .



## ROADWAY (CONT'D)

The number of trees or stumps to be removed, as indicated by the above symbol, is approximate and the State of Ohio reserves the right to order the removal of additional trees or stumps, even though these trees or stumps are not indicated on the Plans or are indicated to be preserved.

Payment for the removal of these additional trees or stumps is included in the lump sum bid for the Removal of Trees and Stumps, Item E-9.

### SUBBASE ITEM I-22

All 9" T-71 pavement throughout the job shall have a subbase of I-22 as shown on the Typical Sections. The I-22 shall be either Grade, A, B, C or D.

### ROUNDING OF CORNERS ON CROSS SECTIONS

The rounded corners, shown on Standard Drawing RT-1 apply to all cross sections even though otherwise shown in these Plans.

### SIDEWALK EXPANSION JOINTS

In addition to the expansion joints specified in Section I-13.06 of the Construction and Material Specifications, 1/2" of premo lded expansion joint shall be provided wherever the sidewalks or median pavement abut longitudinal curbs or other permanent structures. One layer of 1/2" material may be used in lieu of the two 1/4" layers specified in Section I-13.06. Payment for the 1/2" premo lded expansion joint material is included in the price bid per square foot for Item I-13, Sidewalks, or when used for median pavement, payment is included in the price bid per square yard for Item I-21, Portland Cement Concrete Median Pavement.

Existing street signs, traffic markers, and other similar objects within the limits of the construction shall be removed and stock piled as directed by the Engineer. Payment for removal and stock piling of these items shall be included in the contract price bid per cubic yard for Item E-1, Roadway Excavation.

### FILLING OF BASEMENTS, WELLS, ETC.

All basements, wells, cisterns, holes resulting from the removal of storage tanks, etc. located wholly or partly within the right-of-way limits of this project except in excavation areas shall be filled to the contour of the surrounding ground and compacted as per Item E-1.08. This work shall be done as soon as possible in order not to leave an unsightly and dangerous condition any longer than is absolutely necessary. Payment for the above work is included in Item E-1 Roadway Excavation.

### FERTILIZING AREAS TO BE SEEDED OR SODDED

All areas to be seeded, under Item L-9, or sodded, under Item L-10 shall have commercial fertilizer (10-6-4) applied at the rate of twenty (20) pounds per 1000 square feet.

### PLACING SOD

Sod shall be placed so that the top of the sod coincides with the finished surface as shown on the cross sections. All earthwork necessary to accomplish the above is included in the contract unit bid per square yard of sod.

### SUBGRADE COMPACTION FOR DRIVES AND CROSSOVERS

The subgrade under drives and crossovers having a crushed aggregate base, Item B-119, or paved with 7" or 8" of T-70s shall be compacted to a depth of six (6) inches to the density requirements of Table III, Item E-1. Payment for subgrade compaction as specified above shall be included in the unit price bid for Item E-1, Roadway Excavation.

# GENERAL NOTES (CONT'D)

NO.	STATE	PROJECT
2	OHIO	

19  
222

BUT-4-(16,53-19.15)

## ROADWAY (CONT'D)

### SEEDING QUANTITIES

Quantities for seeding are calculated for the soil areas between lines ten feet (10') outside the construction limits as shown on the cross sections or to the R/W line if such line is less than ten feet from the construction limits. All areas outside these limits where the vegetative growth has been injuriously disturbed or destroyed by the contractor, shall be restored and seeded in accordance with the provisions of Item L-9 by the contractor at his own expense.

The mixture of seed to be used in rural areas shall be as specified under Item L-9.

The seed mixture for urban and residential areas as designated by the Engineer, shall be as follows:

- 20% Kentucky Bluegrass (*Poa pratensis*)
- 20% Kentucky 31 Fescue
- 40% Creeping Red Fescue (*Festuca rubra*)
- 15% Red Top (*Agrostis alba*)
- 5% White Dutch Clover (*Trifolium repens*)

### GUARD RAIL

Guard rail shall be flared to meet bridge railing in such a manner that the change in alignment of the guard rail will not exceed one (1) foot in 10 feet.

The removal of any guard rail or guard rail posts lying within the limits of roadway excavation or embankment (and not specifically paid for under a separate item) is included in the Contract Unit Price per cubic yard bid for Item E-1, Roadway Excavation. All resulting materials shall become the property of the Contractor and shall be disposed of by him at no extra cost to the State, except steel rail on all existing steel beam type guard rail shall be stored on the right-of-way at the disposal of the State Maintenance Forces.

## PAVEMENT

### SUPERELEVATION

Superelevated curves shall be built without crown. The crown shall be worked out of the pavement in accordance with the elevations shown in the Super-elevation Tables.

### PLACING AND FINISHING ASPHALTIC CONCRETE

The requirements under Sec. T-35, 18 for mechanical equipment for placing and finishing asphaltic concrete are hereby waived for areas less than 5 feet in width or where surface is deformed; and the asphaltic concrete may be spread and finished by acceptable hand methods. Dump boards will be required if spread and finished by hand method.

The requirements under Sec. T-35, 19 for rollers are hereby waived to permit the use of but one (1) roller, meeting the requirements of the specifications.

### ITEM T-30 BITUMINOUS TACK COAT

For tack coat bituminous materials see note in proposal.

## PAVEMENT (CONT'D)

### ASPHALTIC CONCRETE BASE COURSE

Asphaltic Concrete base course may be constructed of Type "A" surface course composition, at no additional cost to the State.

### SUBBASE COURSE

In the final finishing of slopes and ditches, care shall be exercised to assure that the exposed edge of the subbase course will be left free of earth cover that would impede free drainage.

### HAND FINISHING

Hand finishing will be permitted as per Section T-71, 211 for the reinforced Portland cement concrete pavement on this project at the following locations:

1. Intersections and cross-overs.
2. Sections where the sharp curvature prevents the use of finishing machine.
3. Sections where the maintenance of traffic requires hand finishing.
4. Variable width lanes which in the opinion of the Engineer requires hand finishing.

### EXPANSION AND CONTRACTION JOINTS

Where transverse joints are located closer than 10 feet to the regular block-out joints around catch basins, manholes and water valves, the blockout joints shall be continued to the transverse joint. Similarly where longitudinal joints are located closer than 2 feet to the regular blockout joints around catch basins, manholes and water valves, the blockout joints shall be continued to the longitudinal joints.

### TREATMENT OF EXISTING PAVEMENT AT END OF NEW PAVEMENT

At terminal points between new and existing pavements any difference in grade between the two pavements shall be corrected by filling with T-35, Type C, as approved by the Engineer. Where the new pavement is above the existing pavement the difference shall be corrected by filling over the existing pavement as indicated on the Plans. Where the new pavement is below the existing pavement the existing pavement shall be removed to a depth at least 1 1/4 inches below the new pavement.

Removal of existing pavement as described above shall be paid for at the contract unit price for Item E-8, Removal and Disposal of Existing Wearing Course. An estimated quantity of 300 sq yds is included in the General Summary.

Filling shall be paid for at the contract unit price for Item T-35 Asphaltic Concrete Surface Course.

existing pavement, the cost of sealing the resulting joint shall be included for payment in the price bid for Item T-35, Asphaltic Concrete Surface Course, as per Item T-35, 18 of the Construction and Material Specifications.

### CONTRACTION JOINTS

In addition to the pavement joints detailed for approaches and intersections the maximum distance between contraction joints shall in all cases be in accordance with Standard Drawing T.J.

## PAVEMENT (CONT'D)

### RESURFACING

Where crushed aggregate is used as a wedge course to build up the shoulder to meet the edge of the new pavement, compaction of the subgrade under the crushed aggregate shoulder as specified under Sec. I-18, 03 is hereby waived on this project.

The contraction joints in the pavement shall extend through the curb. The contraction joints in the curb shall be of the premolded type, 3/8" thick in lieu of the kind that is in the pavement, and shall be cut to conform to the contour of the curb before being placed. Extreme care shall be used in placing this material at the proper alignment with the contraction joint in the pavement.

Premolded expansion joint material shall meet the requirement of Sec. M-10, 02 or Sec. M-10, 03, and poured joint seal material shall meet the requirements of Sec. M-10, 23 or Section M-10, 26. Payment for expansion and contraction joints in pavement shall be included in contract unit price bid per square yard for Item T-71, Reinforced Concrete Pavement.

### FLEXIBLE FORMS

Approved flexible forms shall be used for construction of circular pavement edges having a radius of 100 ft. or less, circular concrete curbs and concrete curb transitions of short radii.

## SEWERS

### SEWAGE

The Contractor shall conduct his operations so as to maintain any authorized sanitary sewage flow uninterrupted throughout the construction period. Any unauthorized sanitary sewers shall be sealed as described below.

Any additional costs involved in maintaining this flow, by pumping or by any other approved method which is necessary for construction of the project, shall be included in the contract unit price bid per linear foot of pipe.

### LOCATION AND SIZE OF EXISTING PIPE

The location, type, depth and size of all existing pipe and house connections affected by this project are shown as nearly exact as available information will permit. The State of Ohio will not be responsible for any variations found during construction.

### INLETS, MANHOLES AND PIPES

The proposed elevations and locations of inlets, manholes and pipes and the estimated lengths of pipe may be adjusted by the Engineer during construction.

### ITEM SPECIAL - Furnishing and Installing 24" Cast Iron Pipe

The 24" Cast Iron pipe shall conform to the specification requirements of the American Standards Association A-21.2 Class A. Method of measurement and basis of payment shall be in accordance with Sec. I-2.08 and Sec. I-2.09 of the Construction and Material Specifications.

### ITEM I-3 Roadway Drainage With Porous Backfill

If corrugated Metal Pipe, Sec. M-64(c), is furnished for Roadway Drainage with porous backfill, it shall be perforated in accordance with Sec. M-64(b).

# GENERAL NOTES (CONT'D)

## SEWERS (CONT'D)

### SEALING OF PIPE

All pipes entering or leaving existing manholes, catch basins, inlets or culverts which are indicated to be abandoned, sealed, removed, filled or otherwise made inoperative shall be sealed at both ends if practicable, unless otherwise indicated on the Plans. Payment for this work to be included in the pertinent item involved.

Wherever any existing pipes, regardless of their nature, which are inactive or are to be abandoned are encountered in construction operations, they shall be sealed on both sides where broken into. In any case if the inlet or outlet ends of such pipes are presently exposed, they shall be sealed prior to backfill or construction of embankment. Payment for this work shall be included in the contract unit price bid for Item E-1, Roadway Excavation.

Sealing of pipes shall be accomplished by the proper installation of a suitable precast concrete plug, or the construction of a bulkhead of brick or concrete masonry with a minimum thickness of 12".

### UNRECORDED CONNECTIONS

Any unrecorded active connections to the sewer through existing catch basins or manholes to be removed or abandoned encountered in construction shall be reconnected to the sewer as the Engineer may direct. Payment for this work shall be included in the contract unit price bid per linear foot for Item I-2, Storm Sewer.

### CONCRETE COLLARS

Concrete collars as required by the Plans or requested by the Engineer shall be constructed of Class "C" Concrete and shall be not less than 6" in least dimension from any exterior surface involved. Payment shall be included in the contract unit price bid for the pertinent pipe item involved.

### DISPOSAL OF CASTINGS

Castings of manholes, inlets, or catch basins which are to be relocated, abandoned or removed shall be removed in accordance with the Provisions of Item I-16. Castings of manholes which are to be adjusted to grade shall be removed, stored and reset by the Contractor.

All existing castings which are removed shall be stored on the right-of-way at the disposal of the State of Ohio.

## SEWERS (CONT'D)

### SEWER HOUSE DRAINS

Existing House Drains. All existing house drains, which includes yard, roof, basement or other similar pipe drains, now in use which are disturbed because of the Highway Improvement shall be replaced by the Contractor. Where an existing house is to be removed, the upgrade end of the existing house connection shall be plugged and accurately referenced if the existing house connection remains satisfactory for future use. Payment for plugging is included in the unit price bid for Item E-1, Roadway Excavation. Estimated quantities of I-3 pipe to be used for reconnecting disturbed drains are included in the summaries.

Proposed House Connections. The State of Ohio will notify property owners in advance of construction that if they contemplate new house connections to the proposed sewer, the property owner must furnish, at his sole cost, tees of the proper size and material to the Contractor. The Contractor will then install the tees as he proceeds with laying the sewer and payment for the work involved will be at the same rate as though he were furnishing and laying straight pipe.

To obtain a house connection to either an existing sewer that is to remain or to a proposed sewer, the property owner or his agent, at his sole cost, shall furnish all material and labor required to install the house connection from the carrier sewer to a point beyond the limits of roadway construction.

### COOPERATION BETWEEN CONTRACTOR AND PROPERTY OWNER

The Contractor must cooperate with the property owner or his agent to give said property owner or his agent ample opportunity for extending said sewer connection from the tee branch or existing sewer to a point beyond roadway construction limits. The necessary house connections shall be installed by the property owner or his agent at no cost to the Contractor, other than the cost of cooperation in scheduling his work which said cost shall be assumed by the Contractor and shall be included in the unit prices bid for the various sewer items.

### REMOVAL OF EXISTING HOUSE DRAINS

The removal of all existing house connections, which includes sanitary, yard, roof, basement or other similar pipe drains within the roadway excavation limits shall be classified and paid for as Item E-1, Roadway Excavation.

### STORM SEWER UNDER RAILROAD

To carry storm sewage under the tracks of the Baltimore and Ohio Railroad, 75 feet of 48" tunnel liner plate will be installed under the tracks by the Railroad, at no cost to the Contractor. The Contractor shall cooperate with the Railroad in every way to permit the work to proceed as expeditiously as possible.

## MISCELLANEOUS

### DUMPED ROCK FILL FOR CHANNEL PROTECTION

The masonry material used for the Dumped Rock Fill shall be obtained from the Removal of Existing Structures, Item S-24 or Item S-22 or from Item E-8, Removal of Existing Pavement. Larger size material than that which is specified in the Construction and Material Specifications may be used providing a reasonable smooth and continuous surface conforming to the lines shown on the Plans is obtained. All dumped rock used at the outlet of culverts shall be uniformly placed so that at least fifty percent (50%) of the pieces will weigh at least 75 pounds.

Dumped Rock Fill shall be placed as shown on the Dick's Creek Channel Relocation drawing.

The excavation required to place Dumped Rock Fill along the proposed channel shall be paid for as Channel Excavation, Item E-3. Payment for all other work involved in obtaining and placing the Dumped Rock Fill shall be included in the price bid for Dumped Rock Fill as per Plan, Item I-10.

### FILL FOR DICK'S CREEK CHANNEL RELOCATION

All fill material placed in connection with the realignment of the existing Dick's Creek Channel shall meet the specification requirements for embankment as set forth under Item E-1, Roadway Excavation.

### RIGHT-OF-WAY MONUMENTS, FEDERAL PROJECT MARKERS & SECTION MARKERS

Existing Right-of-Way Monuments, Bench Marks, Federal Project and Section Markers that will be removed by construction, shall be protected by the contractor as per Section G-7.09 of the Construction and Material Specifications until they can be witnessed, referenced and reset by the Construction Field Crews.

## UTILITIES

### GAS AND WATER LINES

All work required for removing, relocating, or constructing new facilities for private or public utilities and appurtenances as shown on the plans will be done by and at the expense of the respective owners unless otherwise noted on the plans.

### UTILITY POLES

All work required for removing or relocating utility poles and towers as required by the construction of the roadway and appurtenant facilities will be done by others. The Contractor must cooperate and coordinate his work with the other contractors to allow their work to proceed with a minimum of delay and cost.

# GENERAL NOTES (CONT'D)

## WATER LINES

### GENERAL

The work of installing the water mains shall be accomplished in accordance with all the applicable provisions of the State of Ohio Department of Highways - Construction and Material Specifications - and these specifications together with the drawings. In general these specifications cover materials and items of work which are peculiar to the work of installing water mains. Items of work which are described in detail in the Ohio Department of Highway Specifications shall be adhered to unless otherwise specified.

### WORK TO BE DONE

The installation of the water mains shall include all material, labor, equipment, services, and accessories necessary to complete the work as shown on the drawings and here specified. The major items of work are on S. R. #73 and include (1) Relocate 8" water main between Station 8+87 and Station 16+70. (2) Relocate 2" water main and meter from Station 15+20 to Station 13+89. (3) Relocate fire hydrant from Station 13+92 rt to Station 13+97 lt. (4) Relocate various house service curb boxes and meters.

### MATERIALS

Water pipe shall be mechanical joint cast iron pipe centrifugally cast, Class 150, in accordance with Federal Specification WW-P-421 Type I or II. Joints shall conform to A. S. A. Specification A21. 11.

Fittings for mechanical joint pipe shall be suitable for the type and class of pipe with which they are being used.

Bolts for flanged joints shall be stainless steel.

Pipe and fitting used with water shall be tar coated inside and outside.

Casing pipe shall be butt or spiral welded in accordance with A. S. T. M. 139.

Joints for steel pipe shall be field welded.

Steel casing pipe shall have metal thickness of not less than 1/4".

Valves shall be in accordance with AWWA Standard Specifications C 500 - 52 T for gate valves for ordinary water work service. Valves shall be for 150 p. s. i., working pressure, cast iron body, bronze mounted, parallel seat, double disc non-rising stem, nut operated.

Corporation cocks for water service connections shall be 3/4" size and fitted for flared copper connection. Corporation cocks shall be Mueller or equal.

Curb stops shall be 3/4" size for water fitted for flared copper connections for water. Curb stops shall be Mueller or equal.

Curb boxes shall be 2-1/2" diameter and adjustable height between 30" and 42". Cover shall have in raised letters the word "WATER". Curb box shall be Clow-National F2450 with F2494 cover or equal.

### LAYING OF PIPE

(1) Care shall be taken not to damage the tar coatings. Pipe shall be laid upon an undisturbed foundation giving uniform bearing with the holes dug for the joints.

Ends of pipes in trenches shall be closed when pipe is not being laid. Water main shall be installed 3 feet deep and in general shall follow the contour of the finished grade. (2) Joints for mechanical joint pipe shall be made up in accordance with the recommendation of the manufacturer. (3) Backfilling shall be done in accordance with the Ohio Department of Highway Specifications Section E-2.08

(4) Care of other services. All underground sewers, drainage, water, gas, electric, or telephone services which are encountered shall be cared for and maintained as part of this work. If any such services are injured or disturbed this contractor shall arrange for their restoration by the respective owners at no additional cost to the contract.

All known underground services and structures are shown for the convenience of the contractor. No assurance can be given as to the completeness or correctness of such underground features. (5) Fire hydrants and curb stops shall be blocked suitably supported. (6) The installation of all water mains shall be placed into service with the minimum of interruption to the normal service. All water mains shall be installed, tested, chlorinated and filled with potable water before service taps are made. The contractor shall work with the Butler County Engineer in placing the mains and service connections into normal operating service.

### TESTING

The water mains shall be tested under a pressure of 150 p. s. i., in accordance with the AWWA Standard Specification for laying cast iron pipe modified for mechanical joint pipe. The pipe lines shall satisfactorily pass the pressure test before service connections are made.

### CHLORINATION

After satisfactory installation and testing of the water mains they shall be chlorinated in accordance with the AWWA Specification.

Backfilled trenches shall have the surface restored as soon as possible. The restoration of the surface shall be such as to match the surrounding surfaces.

Clean up of work area shall consist of the removal of surplus material in order to leave the entire site free and clear and in good condition.

# QUANTITIES

DRIVEWAYS & MAIL BOX TURNOUTS									
Station	Side	5" Portland cement concrete pavement Item T-7D	7" Portland cement concrete pavement Item T-7C	6" Stabilized crushed aggregate Item I-7E	6" Stabilized crushed aggregate Item I-7E	Removal & disposal of existing pavement Item E-8	5" Crushed Aggregate Base Course Item B-119	2" Asphaltic Concrete Surface Course Type C Item T-3E	Remarks
		Sq. Yd.	Sq. Yd.	Cu. Yd.	Cu. Yd.	Sq. Yd.	Cu. Yd.	Cu. Yd.	
472+83	Rt.		55.6	3.7					Drive
473+72	Rt.		32.5	2.0					Drive
474+81.5	Rt.		35.6						Drive
477+32.5	Rt.		51.7						Drive
486+87	Rt.				16.2				Drive
489+74.5	Rt.		48.7	4.1					Drive
491+00	Rt.				13.4				Drive
494+19	Rt.		59.5	2.2					Drive
496+65	Rt.		53.6	2.6					Drive
499+27.5	Rt.		66.9	5.4					Drive
501+47	Rt.		62.5	2.7					Drive
509+80	Rt.				15.4				Drive
506+16	Rt.		59.9						Drive
514+40	Lt.		30.8						M.B. Turnout
516+50	Rt.		63.3		21.1				Drive
519+84.5	Lt.		72.5						Drive & M.B. Turnout
521+37.5	Lt.		35.9						Drive
0+92, Todhunter Ed.	Lt.		77.9						Drive
528+12	Rt.		108.3						Drive
528+36	Rt.		72.2						Drive
529+13	Rt.		85.3		15.6				Drive
530+35.5	Rt.		105.6		26.7				Drive
536+00.5	Rt.		47.9						Drive
538+42.5	Lt.		61.9						Drive & M.B. Turnout
538+54	Rt.		29.3						Drive
538+71	Lt.		37.3						Drive
540+33.5	Rt.		38.1	6.1					Drive
541+23	Lt.		96.4	2.5					Drive & M.B. Turnout
541+43	Rt.		37.5	4.4					Drive
543+56.5	Lt.		81.1	2.2					Drive & M.B. Turnout
543+62	Rt.		60.0	4.5					Drive
543+97	Lt.		48.9						Drive
545+35	Lt.		64.2	2.6					Drive & M.B. Turnout
549+10.5	Rt.		90.6						Drive
549+80	Lt.		34.8						M.B. Turnout
550+61.5	Rt.		78.3						Drive
551+88	Lt.		71.9	6.9					Drive & M.B. Turnout
552+10	Lt.				11.6				Drive
557+54	Lt.		36.2						M.B. Turnout
559+00	Rt.		83.9	5.3					Drive
559+40	Rt.		77.3	3.4					Drive
1+52.7A, Exist S.R.4	-		54.2						Drive
561+02.5	Rt.		79.0						Drive
564+46	Rt.		56.5						Drive
3+24.7, S.R. 73	Lt.				4.2	1.7			Drive
3+62, S.R. 73	Rt.				5.3	2.1			Drive
3+75, S.R. 73	Lt.				4.0	1.6			Drive
4+26.2, S.R. 73	Lt.				5.2	2.1			Drive
4+60, S.R. 73	Rt.				4.9	2.0			Drive
4+79, S.R. 73	Lt.				4.9	2.0			Drive
5+28, S.R. 73	Lt.				51.4	2.3			Drive
5+40, S.R. 73	Rt.				6.6	2.7			Drive
6+70, S.R. 73	Rt.		45.8						Drive
8+21, S.R. 73	Rt.		60.3						Drive
8+50, S.R. 73	Rt.		20.0		103.7				Access Ed.
11+89, S.R. 73	Lt.		49.6	3.9					Drive
13+38, S.R. 73	Lt.		46.8	3.9					Drive
1+66, Verity Pkwy @ SR3	Lt.	47.8							Drive
Verity Pkwy @ SR3 Inter	Rt.	558.3							Service Sta. Dr.
17+13, S.R. 73	Rt.				5.9	2.4			Drive
18+16, S.R. 73	Rt.				4.1	1.7			Drive
Totals to Gen Summary		606.1	2664.3	686	181.4	93.7	50.7	20.6	

MISC. REMOVALS											
Station	Side	Removal of Existing Structures, Item S-24								Concrete	Masonry
		Pipe Removal Item E-12 Lin. Ft.									
		6"	9"	12"	15"	18"	21"	24"	30"		
471+95	Rt.	50									
472+83	Lt.				25						Lump
473+72	Lt.			18							
474+81.5	Lt.			24							Lump
477+32.5	Lt.			26							Lump
480+13	Lt.			60							Lump
486+87	Lt.			24							
489+74.5	Lt.			24							Lump
494+19	Lt.			14							
496+10	Lt.			14							
496+65	Lt.			26							
499+27.5	Lt.			20							
501+47	Lt.			27							
503+60	Lt.	41		60							Lump
506+16	Lt.			18							
512+34	Lt.					62					Lump
514+00	Lt. & Rt.			120							Lump
530+35.5	Lt.			20							
533+20	Lt.					59					Lump
536+00.5	Lt.			39							
538+54	Lt.			38							
550+61.5	Rt.			70							
552+25	Lt.										Lump
553+80	Lt.										Lump
558+30	Lt.			25							Lump
558+70	Lt.			15							Lump
569+00	Rt.							16			
569+40	Rt.					*65					
560+70	Lt.					35					Lump
6+50, S.R. 73	Lt.										Lump
7+00, S.R. 73	Lt.										Lump
7+50, S.R. 73	Lt.										Lump
8+00, S.R. 73	Lt.										Lump
8+50, S.R. 73	Lt.										Lump
893+90	Rt.										Lump
5+60, Ramp A	Rt.										Lump
11+80, S.R. 73	Lt.										Lump
15+10, S.R. 73	Rt.										Lump
15+45, S.R. 73	Rt.										Lump
15+96, S.R. 73	Rt.										Lump
16+25, S.R. 73	Rt.										Lump
16+80, S.R. 73	Rt.										Lump
16+85, S.R. 73	Rt.										Lump
17+25, S.R. 73	Rt.			10							
17+45, S.R. 73	Rt.			40							
602+00	Rt.				26						
6+80, Ramp B	Lt.										Lump
602+50	Lt.										Lump
603+75	Lt.										Lump
626+10	Lt.										Lump
626+65	Lt.										Lump
627+10	Lt.										Lump
628+75	Lt.										Lump
629+20	Lt.										Lump
629+55	Lt.										Lump
1+25, Verity Pkwy	Lt. & Rt.	60									
G32+46	Lt. & Rt.		78								
593+70	Lt.										Lump
4+11A -5+10 AL	Lt.					.50					
1+43.5, Pinta Ave.	Lt.	40									
Totals by pipe size		91	120	805	51	62	85	59	16		
Totals to Gen Summary		1067					222	*65		Lump	Lump

\* Remove for storage (For disposal by property owner.)

TEMPORARY RUN-AROUNDS Item S-15	
Station	Quantity
480+13	Lump Sum
503+60	Lump Sum
512+20	Lump Sum
533+20	Lump Sum

Aggregate and Chloride for Temporary Run Arouns are included in the quantities on the General Summary

STEPS			
Station	Side	Concrete Steps Item I-13 Width 3'-0"	
		6" Eiser 12" Tread Lin. Ft.	7 1/2" Eiser 12" Tread Lin. Ft.
519+50	Lt.	15	
541+36	Rt.	24	
12+85, State Route #73	Lt.		15
551+05	Lt.		15
Totals to General Summary		39	30

CONCRETE REFERENCE MONUMENTS	
Concrete Reference Monuments cast in place as per Plan. Item I-8	See Sheet
Each	
78	206

REMOVAL OF TREES & STUMPS	
Item E-9	
Lump Sum	









# QUANTITIES

OUT-4-(16.53-19.15)

## PAVEMENT

Station to Station	Side	9" Reinf. Portland Cement Concrete Pavement Item T-71 Sq. Yds.	Sub-base Item I-22 Cu. Yds.	Concrete Curb Item I-12		Asphaltic Concrete Surface Course Type "C" Item T-35		1 1/4" Asphaltic Conc. Leveling Course Item B-95 Cu. Yds.	3" Asphaltic Conc. Base Course Item B-95 Cu. Yds.	8" Portland Cement Concrete Base Course Item B-70 Sq. Yds.	Bituminous Tack Coat Item T-90 Gal.	6" Stabilized Crushed Aggregate Shoulders Item I-18 Cu. Yds.	9" Stabilized Crushed Aggregate Item I-18 Cu. Yds.	4" Concrete Sidewalks Item I-19 Sq. Ft.	Removal & Disposal of Existing Pavement Item E-8 Sq. Yds.	Removal & Disposal of Existing Sidewalk Item E-8 Sq. Ft.	Rein. F. Concrete Approach Slab Item I-7 Sq. Yds.	Precast White Portland Cement Concrete Traffic Dividers, Item I-23 Ea.	4" Portland Cement Concrete Median Pavement Item I-21 Sq. Yds.	Removing & Re-setting Historical Monument Item Special Lump	Type 2 Curb & Gutter Modified Item I-12 Lin. Ft.	
				Type 2A Curb Lin. Ft.	Type 6 Curb Lin. Ft.	Minimum 1/4"	1 1/4"															
470+50-492+00		5,928.0	1,145.4				2.0	2.0		60.0	5.9	438.0										
492+00-514+00		5,866.7	1,891.0				1.0	6.3	6.3		185.0	18.1	457.1									
514+00-522+00		4,266.7	1,305.3											18	1,955.6							
522+00-537+75		4,356.4	1,437.3				2.0	2.7	2.7	80.0	7.8	303.9							34			
525+37	Rt.	1,121.7	314.8	137			0.6	0.5	0.5													
537+75-563+00		15,047.7	3,832.4	144									956.9		5096.7						Lump	
559+47	Lt.	1,294.7	267.2	865			0.8															
563+00-585+79.78		12,227.1	3,555.2	2,380									805.9									
589+92.54-594+53.63		2,781.7	812.1	1,520																		
Ramp A		4,570.2	1,211.6	3,475																		
S.E. 773 (Including Verity Parkway & Harrison St.)		7,128.1	1,661.9	2,532	65	19.9	54.1	54.1	257.7			50.8		8,477		898						
596+12.23-616+32.30		13,709.6	3,228.7	6,156									329.4									
Ramp B		10,445.9	2,751.4	8,204									807.9						6			250
616+32.30-634+50		10,121.7	2,588.4	3,285																		
Pinto Ave. (Including Verity Parkway & Minnesota Avenue)		1,372.5	379.9	408			0.9						213.4									
Totals to Gen. Summary		100,838.7	26,382.6	29,106	65	25.2	65.6	65.6	262.5	325.0	31.8	4,466.2	213.4	8,495	7,859.0	898	595.4 *120.3	40	1,642.4	Lump	250	

φ (T-13")  
\* (T-10")

## CROSS-OVERS

Station to Station	2" Asphaltic Conc. Surface Course Type C Item T-35	5" Crushed Aggregate Base Course Item B-119	Precast White Portland Cement Concrete Traffic Dividers-Item I-23
	Cu. Yd.	Cu. Yd.	Each
472+31-475+25	39.8	98.3	38
467+72-477+68	9.9	25.4	
480+75-481+65	9.0	22.2	
486+42-487+45	10.9	27.0	
489+30-490+18	8.7	21.4	
490+55-491+45	9.0	22.2	
493+75-494+67	8.7	21.4	
496+21-497+10	8.8	21.8	
498+50-499+72	14.4	35.7	
501+03-501+94	8.8	21.8	
505+35-506+61	14.4	35.6	
508+74-509+63	8.8	21.8	
516+05-516+95	8.9	21.9	
519+40-520+28	8.6	21.2	
520+93-521+81	8.6	21.2	
522+16-523+04	8.7	21.4	
527+46-529+58	27.4	67.7	26
530+99-531+89	9.0	22.2	
532+06-532+96	9.0	22.2	
532+96-533+85	8.8	21.8	
534+60-535+48	8.7	21.4	
535+56-536+46	9.0	22.2	
537+98.5-539+15	12.9	31.8	
539+94.5-541+87	24.4	60.2	22
543+11-544+41.5	15.0	37.0	
545+51-546+39	8.6	21.2	
548+63-549+58	9.6	23.8	
550+15.5-551+07.5	9.2	22.6	
551+41-552+55	12.5	30.9	
560+54-561+50	9.8	24.1	
563+94-564+92	10.1	24.9	
Totals to Gen. Summary	370.0	914.3	86

## GUARD RAIL

Station to Station	Side	Guard Rail Steel Beam Type (Deep) Item I-15		Guard Rail Removed & Stored Item I-15
		Guard Rail	Guard Rail	
		Lin. Ft.	Lin. Ft.	
551+00-553+88	Lt.		288	
560+35-568+47.5	Lt.	812.5		
564+00	Lt.	25.0		
585+39-585+76.5	Rt.	37.5		
589+90-594+40	Lt.	450.0		
1+85 Lt. Ramp A-590+15	Rt.	625.0		
1+93 Rt. Ramp A-594+50	Rt.	587.5		
10+39 Lt. SB 73-606+67	Lt.	1,787.5		
596+12-606+62	Lt.	1,050.0		
596+30-601+05	Rt.	475.0		
601+93	Rt.	25.0		
1+25 Verity Pkwy@Pinto	Lt.	25.0		
627+74.5-628+62,185	Rt.	87.5		
628+15	Lt.	25.0		
632+27	Lt.	25.0		
16+00, S.R. 73	Rt.		25	
603+55	Rt.	25.0		
Totals to Gen. Summary		6,062.5	313	

## EXCAVATION & EMBANKMENT

Station to Station	Roadway Excavation			Embankment	Embankment + 15%
	Item E-1	Cu. Yd.	Cu. Yd.		
Sta. 470+50-480+00	1734	2095	2409		
480+00-490+00	6347	365	420		
490+00-500+00	6786	353	406		
500+00-510+00	7789	479	551		
510+00-520+00	10599	907	1043		
520+00-530+00	2694	8486	9757		
530+00-540+00	2641	6151	7074		
540+00-550+00	23766	360	414		
550+00-560+00	20375	8834	10159		
560+00-570+00	2448	25781	29648		
570+00-580+00	118325	381	438		
580+00-590+11	144686	8564	9849		
590+11-600+00	37583	176063	202472		
600+00-610+00	18105	18000	20700		
610+00-620+00	5221	17740	20401		
620+00-630+00	2078	31345	36046		
630+00-634+50	995	1261	1450		
Totals to Gen. Summary	412172	307165	353239		

## EARTHWORK CALCULATIONS

Item	Quantity
	Cu. Yd.
E-1 Excavation	412,172
Embankment	307,165
Embankment + 15%	353,239
Excess Excavation	58,933

## SODDING

Station to Station	Sodding Item L-10	Commercial Fertilizer (10-6-4 Mix) 20*per1000
		Sq. Ft. Item L-9
	Sq. Yd.	Ton
470+50-481+00	317.8	.029
481+00-495+00	1,053.6	.095
495+00-509+00	427.3	.038
509+00-523+00	679.9	.061
523+00-537+00	654.8	.059
Todhunter Rd.	324.0	.029
537+00-551+00	910.5	.082
551+00-565+50	1,415.4	.127
565+50-579+00	400.2	.036
593+00-607+00	176.7	.016
State Route 73	321.9	.029
607+00-621+00	37.2	.003
621+00-634+50	348.5	.031
Pinto Ave.	47.0	.004
Totals to Gen. Summary	7,113.8	.639

## OVERHEAD SIGN ASSEMBLIES

STA.	SHEET No.	OS-1 TYPE "A" EACH	OS-2 TYPE "A" EACH
591+30	41	1	
621+00	46		1
Total		1	1

## WATER CALCULATIONS

Item	Cu. Yd.	Rate: Gal. per Cu. Yd.	Water Item E-11 M. Gals.
Roadway Embankment	307,165	5	1,535,825
Channel Embankment	5,132	5	25,660
Sub-base	26,383	5	131,915
I-18 & B-119	5,895	5	29,475
Totals to Gen. Summary			1,722,875

## SEEDING CALCULATIONS

	Sq. Yd.	Sq. Yd.
Gross Area Between Seeding Limits		260,459
Deductions		
Pavement & Sidewalks	106,751	
Stabilized Shoulders & Approaches	27,651	
Gutters	237	
Sod Area	7,114	
Channel Protection	1,314	
Driveway & Mailbox Turnouts	6,906	
Cross-overs	6,660	
Total Area to be Deducted	156,633	156,633
Net Area to be Seeded & Protected, Item L-9		103,826
Commercial Fertilizer (10-6-4) @ 20*per1000sqft. Item L-9		Ton 9.344

# QUANTITIES

SUT-4-10 50-12-15)

8" & 12" WATER MAIN STATE ROUTE No. 73															
Station	Cast Iron Water Pipe			90° Bend		Tee			Reducer	Valve		16" Dia. Casing pipe	Manhole for Water Valves & Meters	Relocate Fire Hydrant	Remove exist. M.; F.H. Valves
	12"	8"	6"	12"	8"	12"x12"x12"	8"x8"x6"	8"x8"x4"	12"x8"	8"	6"				
	Lin. ft.	Lin. ft.	Lin. ft.	Ea.	Ea.	Ea.	Ea.	Ea.	Ea.	Ea.	Ea.				
8+87 Rt. to 16+10 Rt.		827													
8+87 Rt.					1										
8+98 Rt. to 9+12 Lt.											75				
9+13 Lt.					1										
9+22 Rt.														1	
13+97 Lt.								1							
13+98 Lt.			3				1			1			1		
14+02															2
14+05 Lt.							1			1		1			
14+10.73 to 14+95.73 Lt.											75				
15+20															* 1
16+10															* 2
16+10							* 1		* 1	* 1			* 1		
16+10 Lt. to 16+73 Rt. * 109															
16+59.59 to 16+94.59 Lt.											* 75				
16+73 Lt.					* 1										
16+73 Rt.					* 1										
18+30 Rt.			* 5											* 1	
To Water Main S.R. 4			8												
To Service Conn.															
To General Summ. * 109		827		2	2	1	2	1	1	1	2	225	2	2	6

6" & 12" WATER MAIN STATE ROUTE No. 4								
Station	Adjust to Grade		Manhole for Water Valves & Meters	Cast Iron Water Pipe 6"	22 1/2° Bend 6"	11 1/4° Bend 6"	Air Relief Valve 1"	Lower exist. 12" Water Main
	M.H.	F.H.						
	Ea.	Ea.						
0+39 M Lt.	1							
1+10 P Lt.	1							
1+57 P Rt.		1						
628+11 Rt.			1				1	
628+15 Rt.				107	4			
629+70 Rt.					1	2		
632+00 Lt.	1							
632+40 Lt.								80
To Service Conn.			1					
From W.M. 6.R. 73				8				
To General Summ.	3	1		115	5	2	1	80

WATER MAIN SERVICE CONNECTIONS													
Station	Copper Water Pipe 2"	90° Bend 2"	2" Coupling	Valve 2"	Reducer 4"x2"	Curb stop 3/4"	3/4" Corp. Cock	Manhole for Water Valves & Meters	Relocate		Install 3'-0" 3/4" copper conn. in place of removed Water Meter	Close Corp. Cock.	Adjust curb box to grade
									Water Meter	Curb box			
									Ea.	Ea.			
3+59 Lt.						1			1	1	1		
4+10 Lt.						1			1	1	1		
4+42 Lt.						1			1	1	1		
5+17 Lt.						1			1	1	1		
5+38 Lt.						1			1	1	1		
5+87 Rt.											1		
6+60 Rt.											1		
6+85 Rt.											1		
7+40 Rt.											1		
7+97 Rt.											1		
8+30 Rt.											1		
8+55 Rt.											1		
12+90 Lt.						1	1		1	1			
13+90 Lt.	50	2	1	1	1			1	1				
16+82 Rt.											* 1		
16+88 Lt.													* 1
17+40 Lt.						* 1			* 1	* 1			
17+42 Lt.						* 1							
17+92 Rt.						* 1							
From S.R. 73								2					
From S.R. 4								1					
To General Sum.	50	2	1	1	1	9	1	4	8	9	6	8	1

SEWERS & MANHOLES									
Station to Station	Side	Sewers Item I-2			Manholes Item I-8 Each			Manholes Abandoned Item I-16 Each	Removal of Pipe Item I-12 Lin. Ft.
		Lin. Ft.			Standard				
		M-6.6(a)	M-6.6(b)	M-10.6.6(d)	N=1	Adjusted to Grade Method			
3+43A to 4+23A	Rt.			74	1				
3+50A to 4+13A	Rt.	53			1				
4+11A to 4+60A	Lt.		60						65
13+98	Rt.							1	
14+00	Lt.							1	
16+22	Lt.							* 1	
18+50	Lt.							* 1	
4+15 A	Lt.								1
4+22A	Lt.								1
4+26A	Lt.								1
Totals to General Summ.		53	60	74	2	2	2	3	65

**\* NOTE:**  
 The cost of all water main, service connection, sewer and manhole items listed on this sheet between station 14+78 and station 18+92.6 shall be participated in by state and federal funds.  
 The cost of all other items listed on this sheet shall have no state or federal participation.

# GENERAL SUMMARY



TYPE CODE 7221

ITEM	QUANTITY	NO STATE OR FEDERAL PARTICIPATION	TOTAL	UNIT	DESCRIPTION
E-1	412,172	—	412,172	Cu.Yd.	Roadway Excavation, as per plan
E-1	91,693	—	91,693	Sq.Yd.	Compacted Subgrade
E-8	300	—	300	Sq.Yd.	Removal and Disposal of Existing Wearing Course
E-8	7,953	—	7,953	Sq.Yd.	Removal and Disposal of Existing Pavement
E-8	898	—	898	Sq.Ft.	Removal and Disposal of Existing Sidewalk
F-9	Lump	—	Lump	Lump	Removal of Trees and Stumps
F-11	1723	—	1723	M.Gal.	Water
S-24	Lump	—	Lump	Lump	Removal of Existing Structures
I-8	78	—	78	Each	Concrete Reference Monuments
I-13	39	—	39	Lin.Ft.	Concrete Steps, 6" Riser, 12" Tread
I-13	30	—	30	Lin.Ft.	Concrete Steps, 7 1/2" Riser, 12" Tread
I-13	8,495	—	8,495	Sq.Ft.	4" Concrete Sidewalk, as per plan
I-15	313	—	313	Lin.Ft.	Guard Rail, Removed and Stored
I-15	6062.50	—	6062.50	Lin.Ft.	Guard Rail, Steel Beam Type (Deep)
I-15	4,930	—	4,930	Cu.Yd.	Stabilized Crushed Aggregate Shoulders and Approaches
L-9	103,827	—	103,827	Sq.Yd.	Seeding and Protecting, as per Plan
L-9	9,98	—	9,98	Ton	Commercial Fertilizer (10-6-4)
L-10	7,113	—	7,113	Sq.Yd.	Sodding
S-15	Lump	—	Lump	Lump	Temporary Run-Arounds
S-15	90	—	90	Ton	Furnishing and Applying Calcium Chloride or Calcium Magnesium Chloride
S-15	3000	—	3000	Cu.Yd.	Furnishing and Placing Aggregate For Traffic Bound Surface Course
S-15	1500	—	1500	Cu.Yd.	Furnishing and Placing Aggregate For Traffic Bound Surface Course using Size No 2 Material
Special	1	—	1	Each	Single Pole Overhead Sign Assembly, Type "A"
Special	1	—	1	Each	Bridge Type Overhead Sign Assembly, Type "A" (Span = 20')
Special	Lump	—	Lump	Lump	Removing and Resetting Historical Monument
I-1	160	—	160	Lin. Ft.	12" Pipe for Driveways, Sec. M-6.4(c)
I-1	130	—	130	Lin. Ft.	15" Pipe for Driveways, Sec. M-6.4(c)
I-1	146	—	146	Lin. Ft.	18" Pipe for Driveways, Sec. M-6.4(c)
I-1	90	—	90	Lin. Ft.	24" Pipe for Driveways, Sec. M-6.4(c)
I-1	40	—	40	Lin. Ft.	27" Pipe for Driveways
I-2	96	—	96	Lin. Ft.	18" Storm Sewer, Class "A"
I-2	72	—	72	Lin. Ft.	24" Storm Sewer, Class "A"
I-2	198	—	198	Lin. Ft.	24" Storm Sewer, Class "A" Under Pavement or Approaches, Sec. M-6.6(a) or Sec. M-6.8(b)
I-2	176	—	176	Lin. Ft.	18" Storm Sewer, Class "B", Sec. M-6.4(c)
I-2	36	—	36	Lin. Ft.	12" Storm Sewer, Class "A" Under Pavement or Approaches
I-2	1,690	—	1,690	Lin. Ft.	12" Storm Sewer, Class "B"
I-2	354	—	354	Lin. Ft.	24" Storm Sewer, Class "A", Sec. M-6.3(a) or Sec. M-6.8(c)
I-2	21	—	21	Lin. Ft.	15" Storm Sewer, Class "B"
I-2	47	—	47	Lin. Ft.	18" Storm Sewer, Class "B"
I-2	4,688	—	4,688	Lin. Ft.	12" Storm Sewer, Class "B" Under Pavement or Approaches
I-2	346	—	346	Lin. Ft.	15" Storm Sewer, Class "B" Under Pavement or Approaches
I-2	274	—	274	Lin. Ft.	18" Storm Sewer, Class "B" Under Pavement or Approaches
I-2	112	—	112	Lin. Ft.	24" Storm Sewer, Class "B" Under Pavement or Approaches
I-3	100	—	100	Lin. Ft.	4" Roadway Drainage
I-3	4	—	4	Lin. Ft.	4" Roadway Drainage Under Pavement or Approaches, Sec. M-6.8(a)
I-3	100	—	100	Lin. Ft.	6" Roadway Drainage
I-3	100	—	100	Lin. Ft.	8" Roadway Drainage
I-3	712	—	712	Lin. Ft.	12" Roadway Drainage
I-3	248	—	248	Lin. Ft.	15" Roadway Drainage
I-3	100	—	100	Lin. Ft.	15" Roadway Drainage
I-3	284	—	284	Lin. Ft.	18" Roadway Drainage Under Pavement or Approaches, Sec. M-6.5(b) or Sec. M-6.8(b)
I-3	28	—	28	Lin. Ft.	6" Outlets for Roadway Drainage, Sec. M-6.4(h), without Perforations
I-3	50	—	50	Lin. Ft.	15" Outlets for Roadway Drainage, Sec. M-6.4(c)
I-4	9,226	—	9,226	Lin. Ft.	6" Underdrains
I-4	126	—	126	Lin. Ft.	6" Outlets for Underdrains, Sec. M-6.4(h), without Perforations
I-5	7	—	7	Each	6" Pipe Specials for Underdrains
I-5	1	—	1	Each	4" Pipe Specials for Roadway Drainage Under Pavement or Approaches, Sec. M-6.8(c)
I-5	1	—	1	Each	12" Pipe Specials for Roadway Drainage Under Pavement or Approaches
I-5	2	—	2	Each	24" Pipe Specials for Roadway Culverts, Sec. M-6.6(b) or Sec. M-6.8(b)
I-5	1	—	1	Each	27" Pipe Specials for Roadway Culverts, Sec. M-6.6(b) or Sec. M-6.8(b)
I-5	2	—	2	Each	30" Pipe Specials for Roadway Culverts, Sec. M-6.6(b) or Sec. M-6.8(b)
I-2	86	—	86	Lin. Ft.	24" Class "A" Storm Sewer, Sec. M-6.6(b)
I-2	152	—	152	Lin. Ft.	24" Class "A" Storm Sewer Under Pavement or Approaches, Sec. M-106.6(c)
I-3	1	—	1	Each	24" Paved Bituminous Coated Carrieway for 1/2" Pipe Special, Sec. M-6.4(c), for Storm Sewers.
I-8	34	—	34	Each	Catch Basins Std. No. 1-2-A
I-8	2	—	2	Each	Catch Basins Std. No. 1-3
I-8	1	—	1	Each	Catch Basins Std. No. 1-4
I-8	8	—	8	Each	Catch Basins Std. No. 2-2-A
I-8	1	—	1	Each	Catch Basins Std. No. 2-3
I-8	1	—	1	Each	Catch Basins Std. No. 2-4
I-8	8	—	8	Each	Catch Basins Std. No. 3
I-8	32	—	32	Each	Catch Basins Std. No. 3-A
I-8	1	—	1	Each	Catch Basins Std. No. 6
I-8	2	—	2	Each	Side Ditch Catch Basin, Std. No. 7
I-8	6	—	6	Each	Inlets Std. No. 2-6
I-8	7	—	7	Each	Inlets Std. No. 2-10
I-8	2	—	2	Each	Inlets Std. No. 2-14
I-8	10	—	10	Each	Manholes Std. No. 1
I-8	2	—	2	Each	Manholes Adjusted to Grade Method "B"
I-8	1	—	1	Each	Manholes Std. No. 2 Modified as per Plan
I-8	5	—	5	Each	Combination Inlet Manhole Std. No. 3
I-8	3	—	3	Each	Combination Inlet Manhole Standard No. 3-A
I-8	3	—	3	Each	Manholes Adjusted to Grade Method "A"
I-9	329	—	329	Lin. Ft.	Stone Underdrains - No. 1
I-10	308	—	308	Cu. Yd.	Dumped Rock Fill
I-14	47	—	47	Lin. Ft.	Paved Gutters, Type A
I-14	167	—	167	Lin. Ft.	Paved Gutters, Type 1 Modified as per Plan
I-8	2	—	2	Each	Catch Basins, Std. No. 2 Modified as per Plan
I-16	4	—	4	Each	Catch Basins Abandoned
F-2	736	—	736	Cu. Yd.	Excavation for Structures, Dry
F-2	73	—	73	Cu. Yd.	Excavation for Structures, Wet
F-3	425	—	425	Cu. Yd.	Channel Excavation
S-1	32	—	32	Cu. Yd.	Concrete for Structures, Class "C"
S-1	31.8	—	31.8	Cu. Yd.	Concrete for Structures, Class "E"
S-4	930	—	930	Lb.	Reinforcing Steel
S-27	98	—	98	Lin. Ft.	12" Pipe for Roadway Culverts, Sec. M-6.6(b) or Sec. M-6.8(b)
F-12	65	—	65	Lin. Ft.	24" Pipe Removed for Storage
S-27	242	—	242	Lin. Ft.	18" Pipe for Roadway Culverts, Sec. M-6.6(b) or Sec. M-6.8(b)
S-27	126	—	126	Lin. Ft.	21" Pipe for Roadway Culverts, Sec. M-6.6(b) or Sec. M-6.8(b)
S-27	542	—	542	Lin. Ft.	24" Pipe for Roadway Culverts, Sec. M-6.6(b) or Sec. M-6.8(b)
S-27	202	—	202	Lin. Ft.	27" Pipe for Roadway Culverts, Sec. M-6.6(b) or Sec. M-6.8(b)
S-27	308	—	308	Lin. Ft.	30" Pipe for Roadway Culverts, Sec. M-6.6(b) or Sec. M-6.8(b)
S-27	106	—	106	Lin. Ft.	42" Pipe for Roadway Culverts, Sec. M-6.6(b)
I-16	—	3	3	Each	Manholes Abandoned
I-8	1	—	1	Each	Manholes, Special

# GENERAL SUMMARY



TYPE CODE 7221

ITEM	QUANTITY	NO. STATE OR FEDERAL PARTICIPATION	TOTAL	UNIT	DESCRIPTION
I-8	1	—	1	Each	Gate Chamber and Flood Gates, As per Plan
Special	9	—	9	Lin. Ft.	Furnishing and Installing 24" Cast Iron Pipe
I-2	145	53	198	Lin. Ft.	12" Sewer, Sec. M.G.G.(c)
I-2	55	60	115	Lin. Ft.	21" Sewer, Sec. M.G.G.(b)
I-2	455	—	455	Lin. Ft.	24" Sewer, Sec. M.G.G.(b)
I-2	458	—	458	Lin. Ft.	30" Sewer, Sec. M.G.G.(b)
E-12	1,067	—	1,067	Lin. Ft.	Pipe Removed, 15" and Under
E-12	222	65	287	Lin. Ft.	Pipe Removed, Over 15"
I-2	125	74	199	Lin. Ft.	24" Sewer Under Pavement or Approaches, Sec. M.106.6(c)
B-35	263	—	263	Cu. Yd.	PAVEMENT Asphaltic Concrete Base Course (60-70)
B-35	66	—	66	Cu. Yd.	Asphaltic Concrete Leveling Course (60-70)
B-70	325	—	325	Sq. Yd.	8" Portland Cement Concrete Base Course
B-119	965	—	965	Sq. Yd.	Crushed Aggregate Base
F-80	32	—	32	Gal.	Bituminous Tack Coat, As per Plan
F-85	482	—	482	Cu. Yd.	Asphaltic Concrete Surface Course, Type C (60-70)
F-70	2,665	—	2,665	Sq. Yd.	7" Portland Cement Concrete Pavement
F-70	606	—	606	Sq. Yd.	8" Portland Cement Concrete Pavement
F-71	100,839	—	100,839	Sq. Yd.	9" Reinforced Portland Cement Concrete Pavement
I-7	120	—	120	Sq. Yds.	Reinforced Concrete Approach Slabs (7-10')
I-7	596	—	596	Sq. Yd.	Reinforced Concrete Approach Slabs (7-13')
I-2	29,106	—	29,106	Lin. Ft.	Standard Concrete Curb, Type 2A, As Per Plan
I-2	65	—	65	Lin. Ft.	Standard Concrete Curb, Type G
I-21	1,643	—	1,643	Sq. Yd.	Portland Cement Concrete Median Pavement, Standard Type 1
F-22	26,383	—	26,383	Cu. Yd.	Sub-base
I-23	120	—	120	Each	Precast White Portland Cement Concrete Traffic Dividers
I-2	250	—	250	Lin. Ft.	Std. Type 2 Combination Curb and gutter, Modified as per plan
STRUCTURES OVER 20 FT. SPAN					
For Quantities, See Sheet No. 173					
For Quantities, See Sheet No. 192					
Lump	Lump	Lump	Lump	Lump	Construction Layout Stakes
WATER MAINS					
Special	109	—	109	Lin. Ft.	12" Cast Iron Pipe
Special	—	827	827	Lin. Ft.	8" Cast Iron Pipe
Special	3	110	115	Lin. Ft.	6" Cast Iron Pipe
Special	75	150	225	Lin. Ft.	16" Dia. Casing Pipe
Special	—	50	50	Lin. Ft.	2" Copper Pipe
Special	—	1	1	Each	2" Coupling
Special	1	—	1	Each	12" x 8" Reducer
Special	—	1	1	Each	4" x 2" Reducer
Special	1	—	1	Each	12" x 12" x 12" Tee
Special	—	2	2	Each	8" x 8" x 4" Tee
Special	—	1	1	Each	8" x 8" x 4" Tee
Special	—	2	2	Each	6" x 1 1/4" Bend
Special	—	5	5	Each	6" x 2 1/2" Bend
Special	2	—	2	Each	12" x 90° Bend
Special	—	2	2	Each	8" x 90° Bend
Special	—	2	2	Each	2" x 90° Bend
Special	1	—	1	Each	8" Valve
Special	—	2	2	Each	2" Valve
Special	—	1	1	Each	1" Air Relief Valve
Special	—	1	1	Each	3/4" Corporation Cock
Special	1	7	8	Each	Close Corporation Cock
Special	3	6	9	Each	3/4" Curb Stop
Special	1	3	4	Each	Manhole for Water Valves and Meters
Special	1	7	8	Each	Relocate Water Meter
Special	3	6	9	Each	Relocate Curb Box
Special	1	—	1	Each	Adjust Curb Box to Grade
Special	1	1	2	Each	Relocate Fire Hydrant
Special	—	1	1	Each	Adjust Fire Hydrant to Grade
Special	3	3	6	Each	Remove Existing Manhole and Fire Hydrant Valves
Special	—	80	80	Lin. Ft.	Lower Existing 12" Water Main
Special	1	5	6	Each	Install 3" O.D., 3/4" Copper Connection in Place of Removed Water Meter

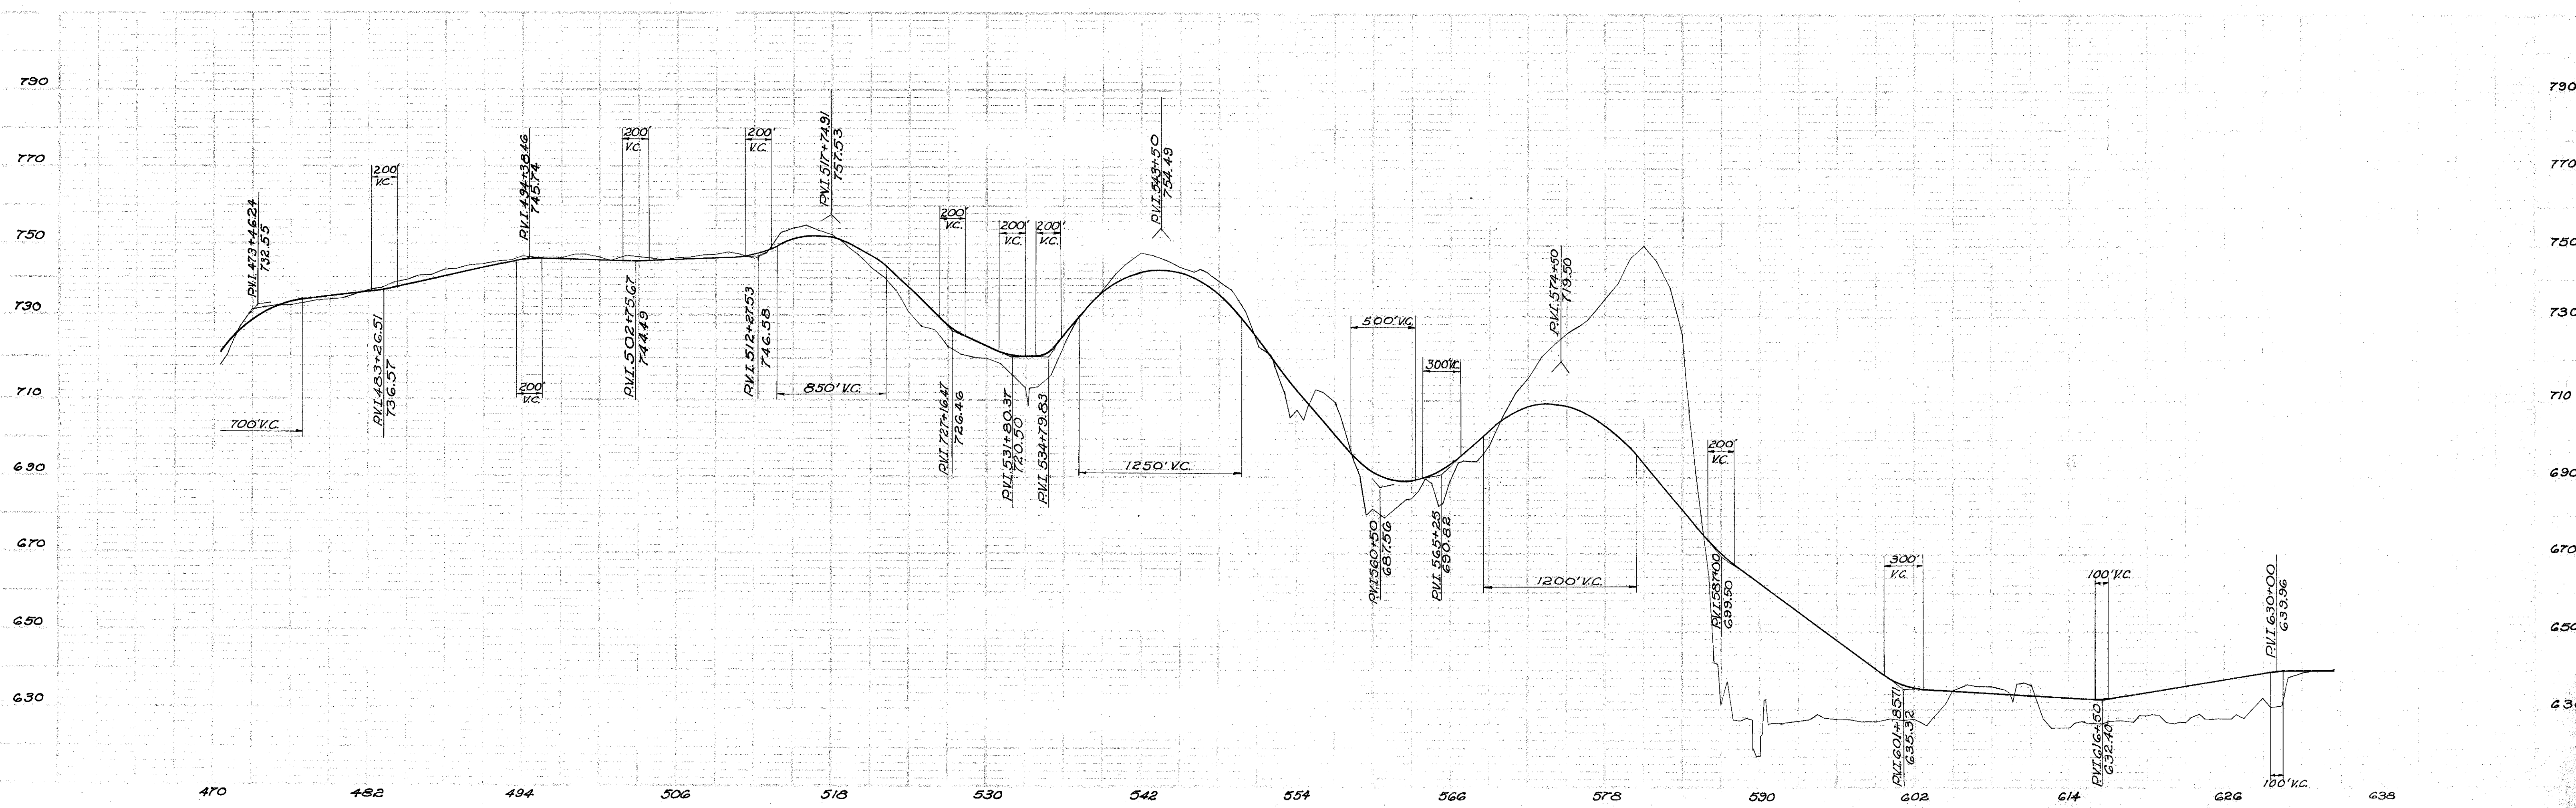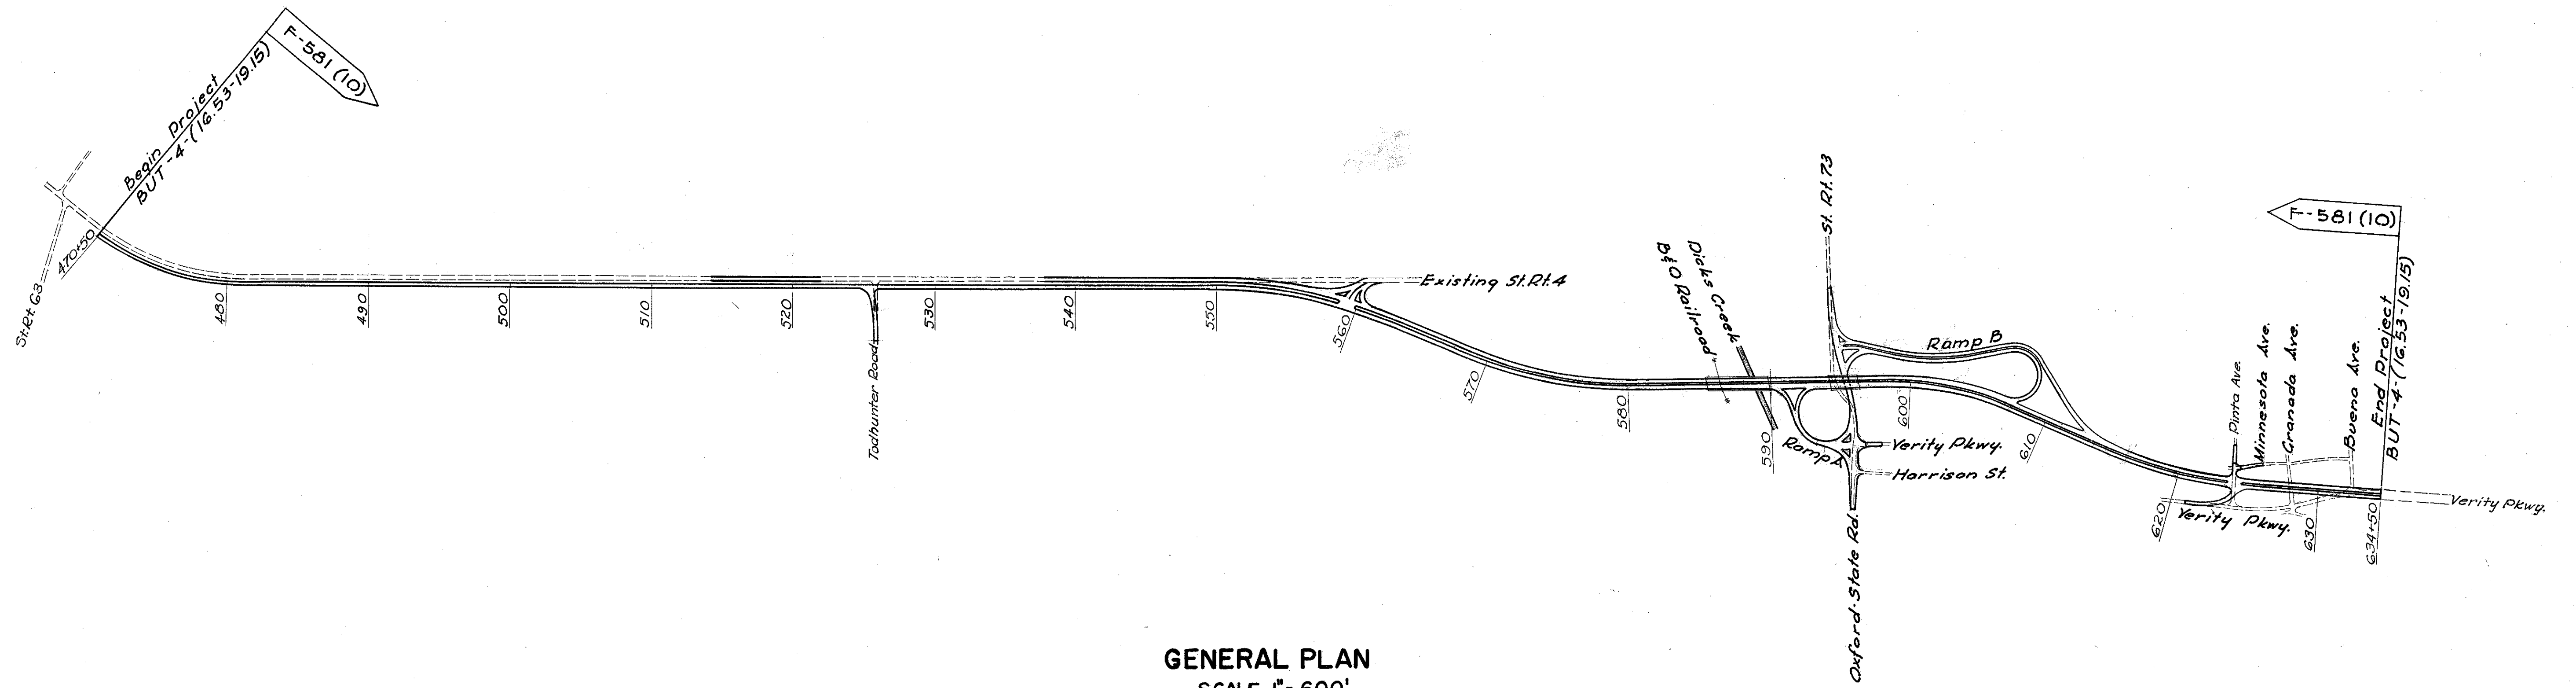

**UTILITIES**

Utility	Owner	Address
Gas	Cincinnati Gas & Electric Co.	4th. & Main Sts. Cincinnati 2, Ohio
Gas	Texas Eastern Transmission Corp.	108 W. Second St. Seymour, Indiana
Light & Power	Cincinnati Gas & Electric Co.	4th. & Main Sts. Cincinnati 2, Ohio
Water	Butler Co.	Butler County Court House Hamilton, Ohio
Sewer	Butler Co.	Butler County Court House Hamilton, Ohio
Telephone	Ohio Bell Telephone Co.	Dayton, Ohio
Telegraph	Western Union Telegraph Co. (On B. & O. R.R. R.W.)	Consult Baltimore and Ohio Railroad 54'-0" Cincinnati, Ohio

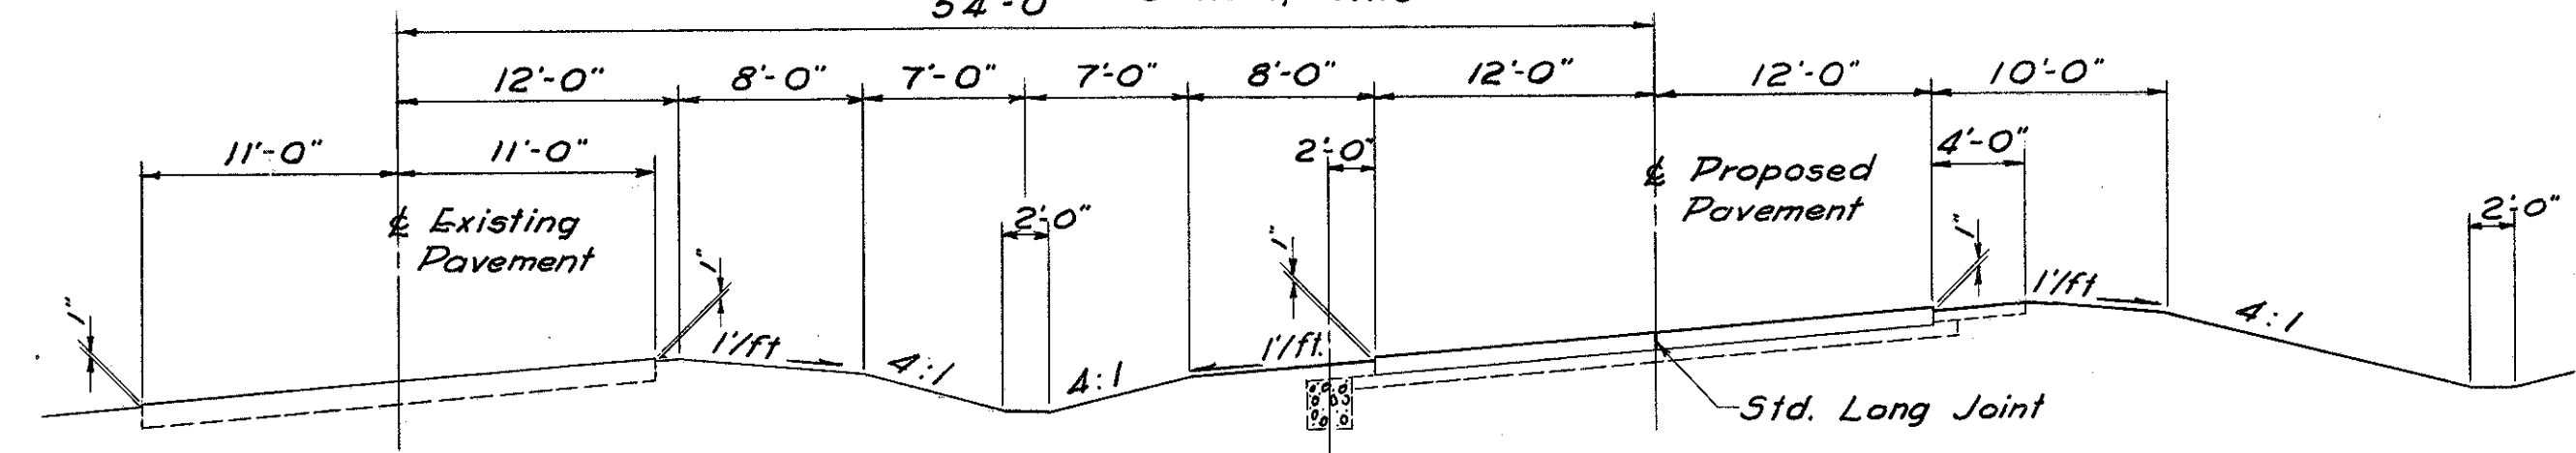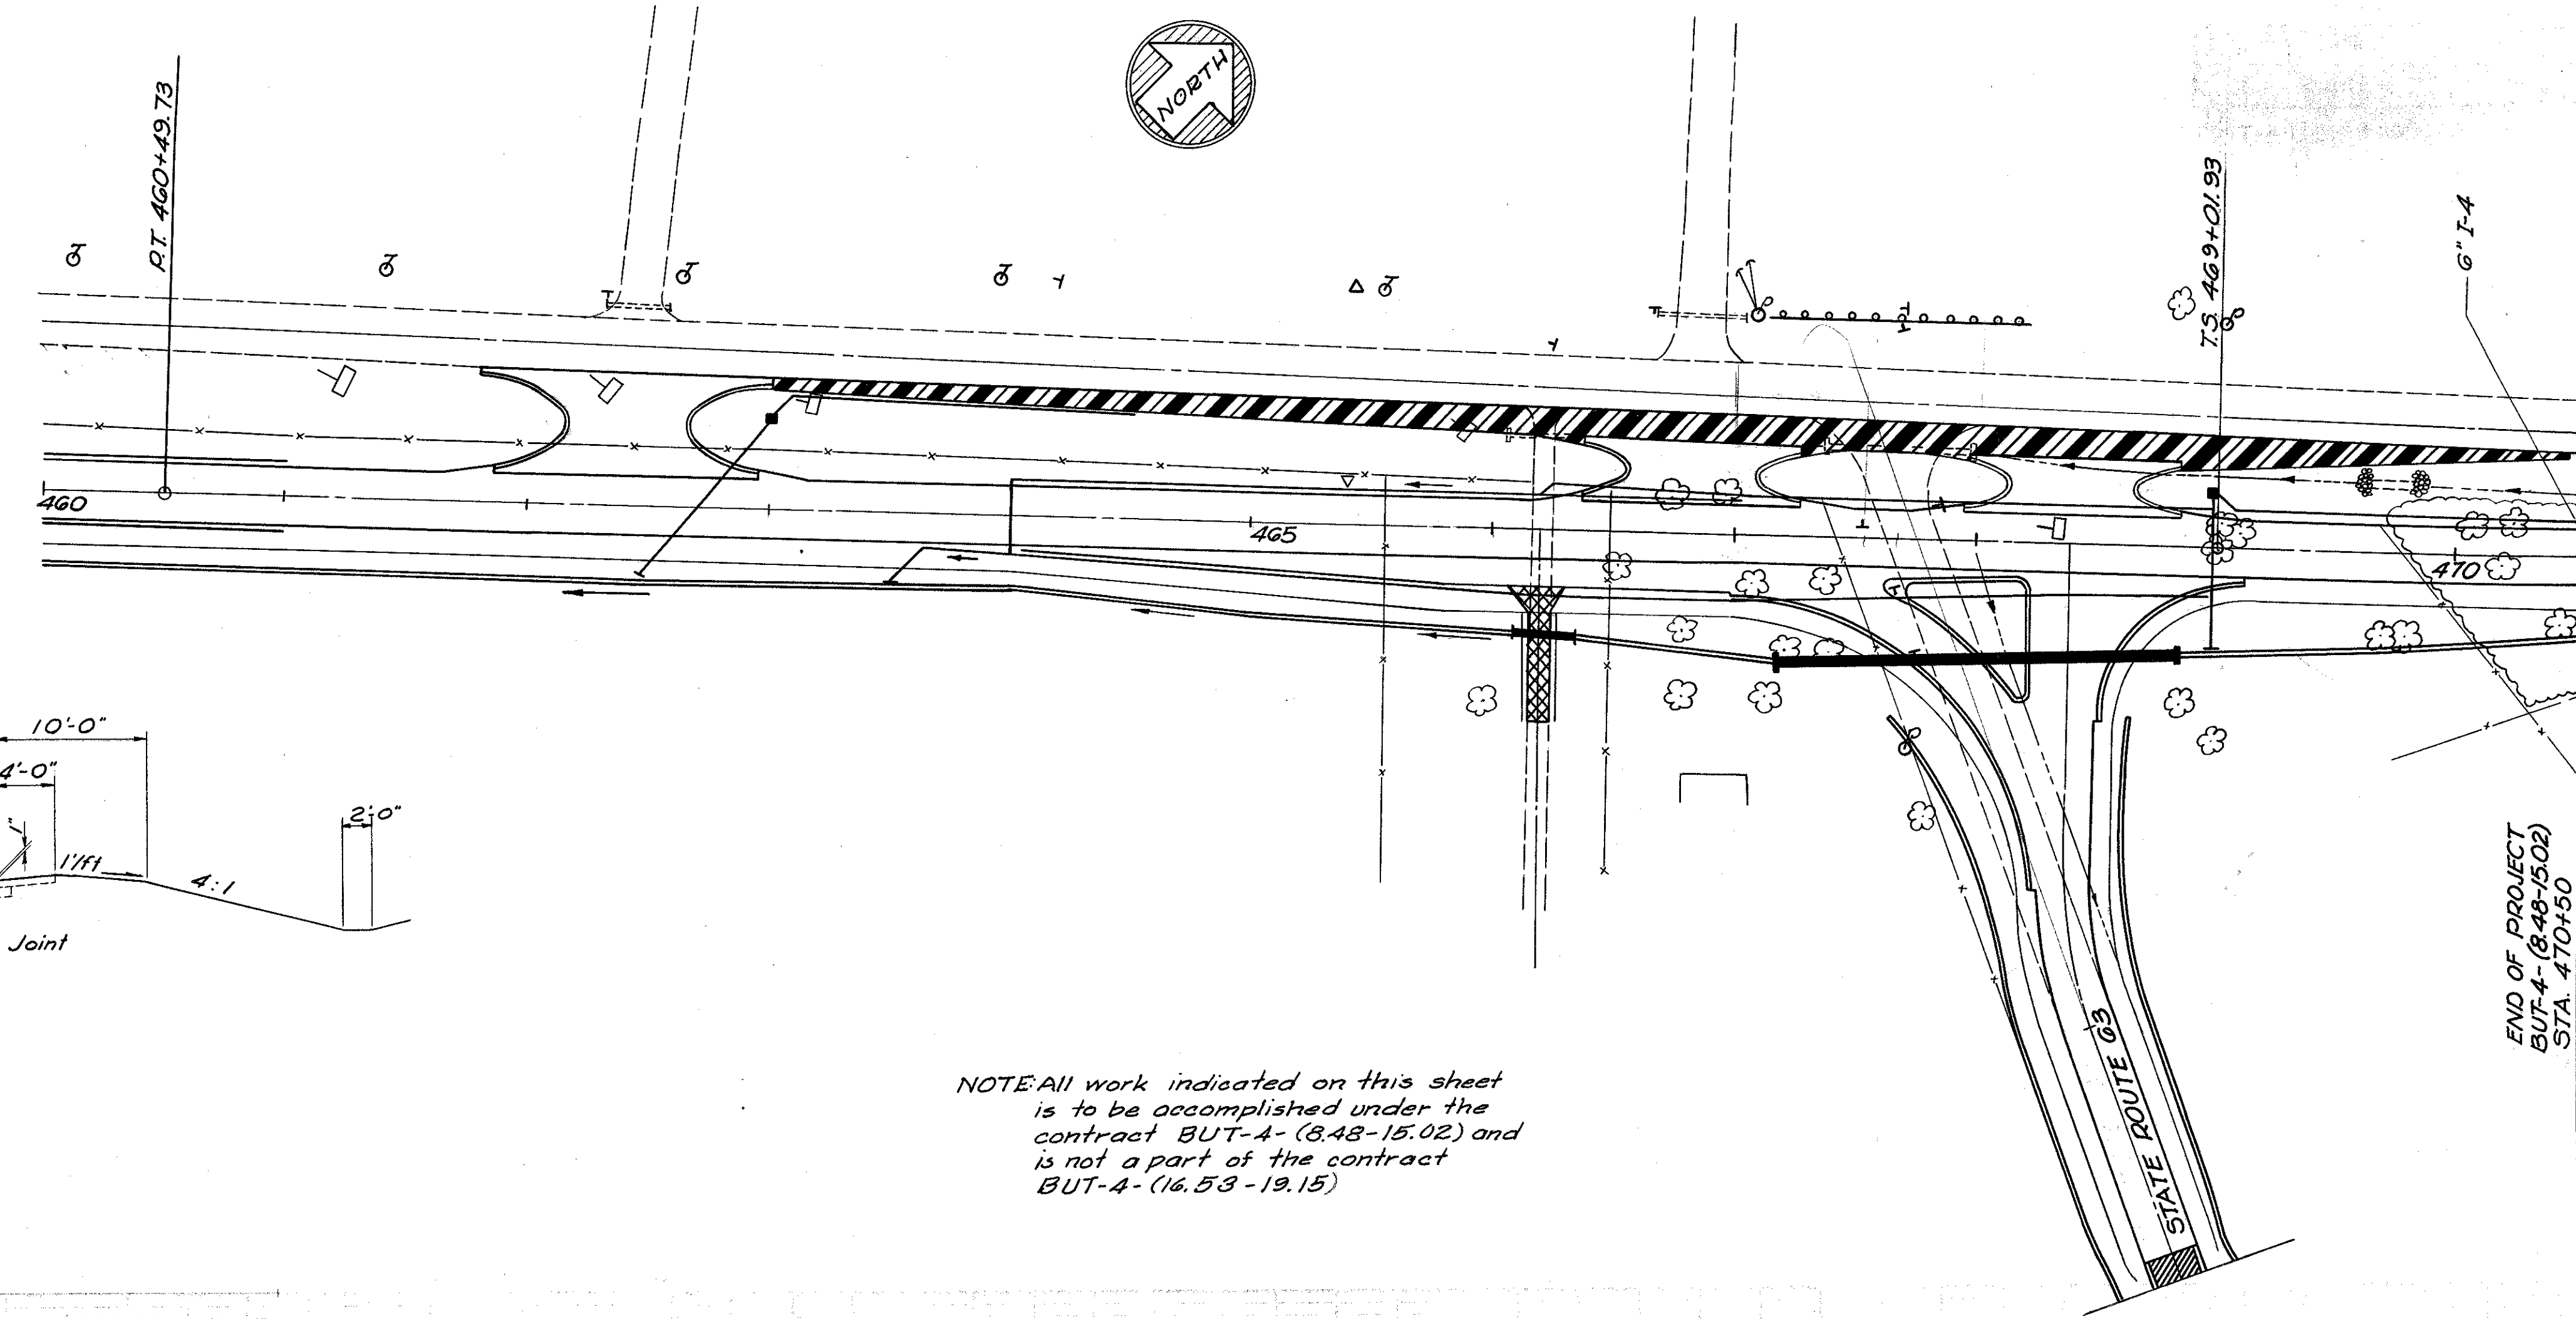


**CROSS SECTION AT END OF PROJECT**  
 BUT. 4 (8.48-15.02)  
 Scale: 1/8" = 1'-0"

NOTE: All work indicated on this sheet is to be accomplished under the contract BUT-4- (8.48-15.02) and is not a part of the contract BUT-4- (16.53-19.15)

END OF PROJECT  
 BUT-4- (8.48-15.02)  
 STA. 470+50  
 BEGIN PROJECT  
 BUT-4- (16.53-19.15)

F-581(10)

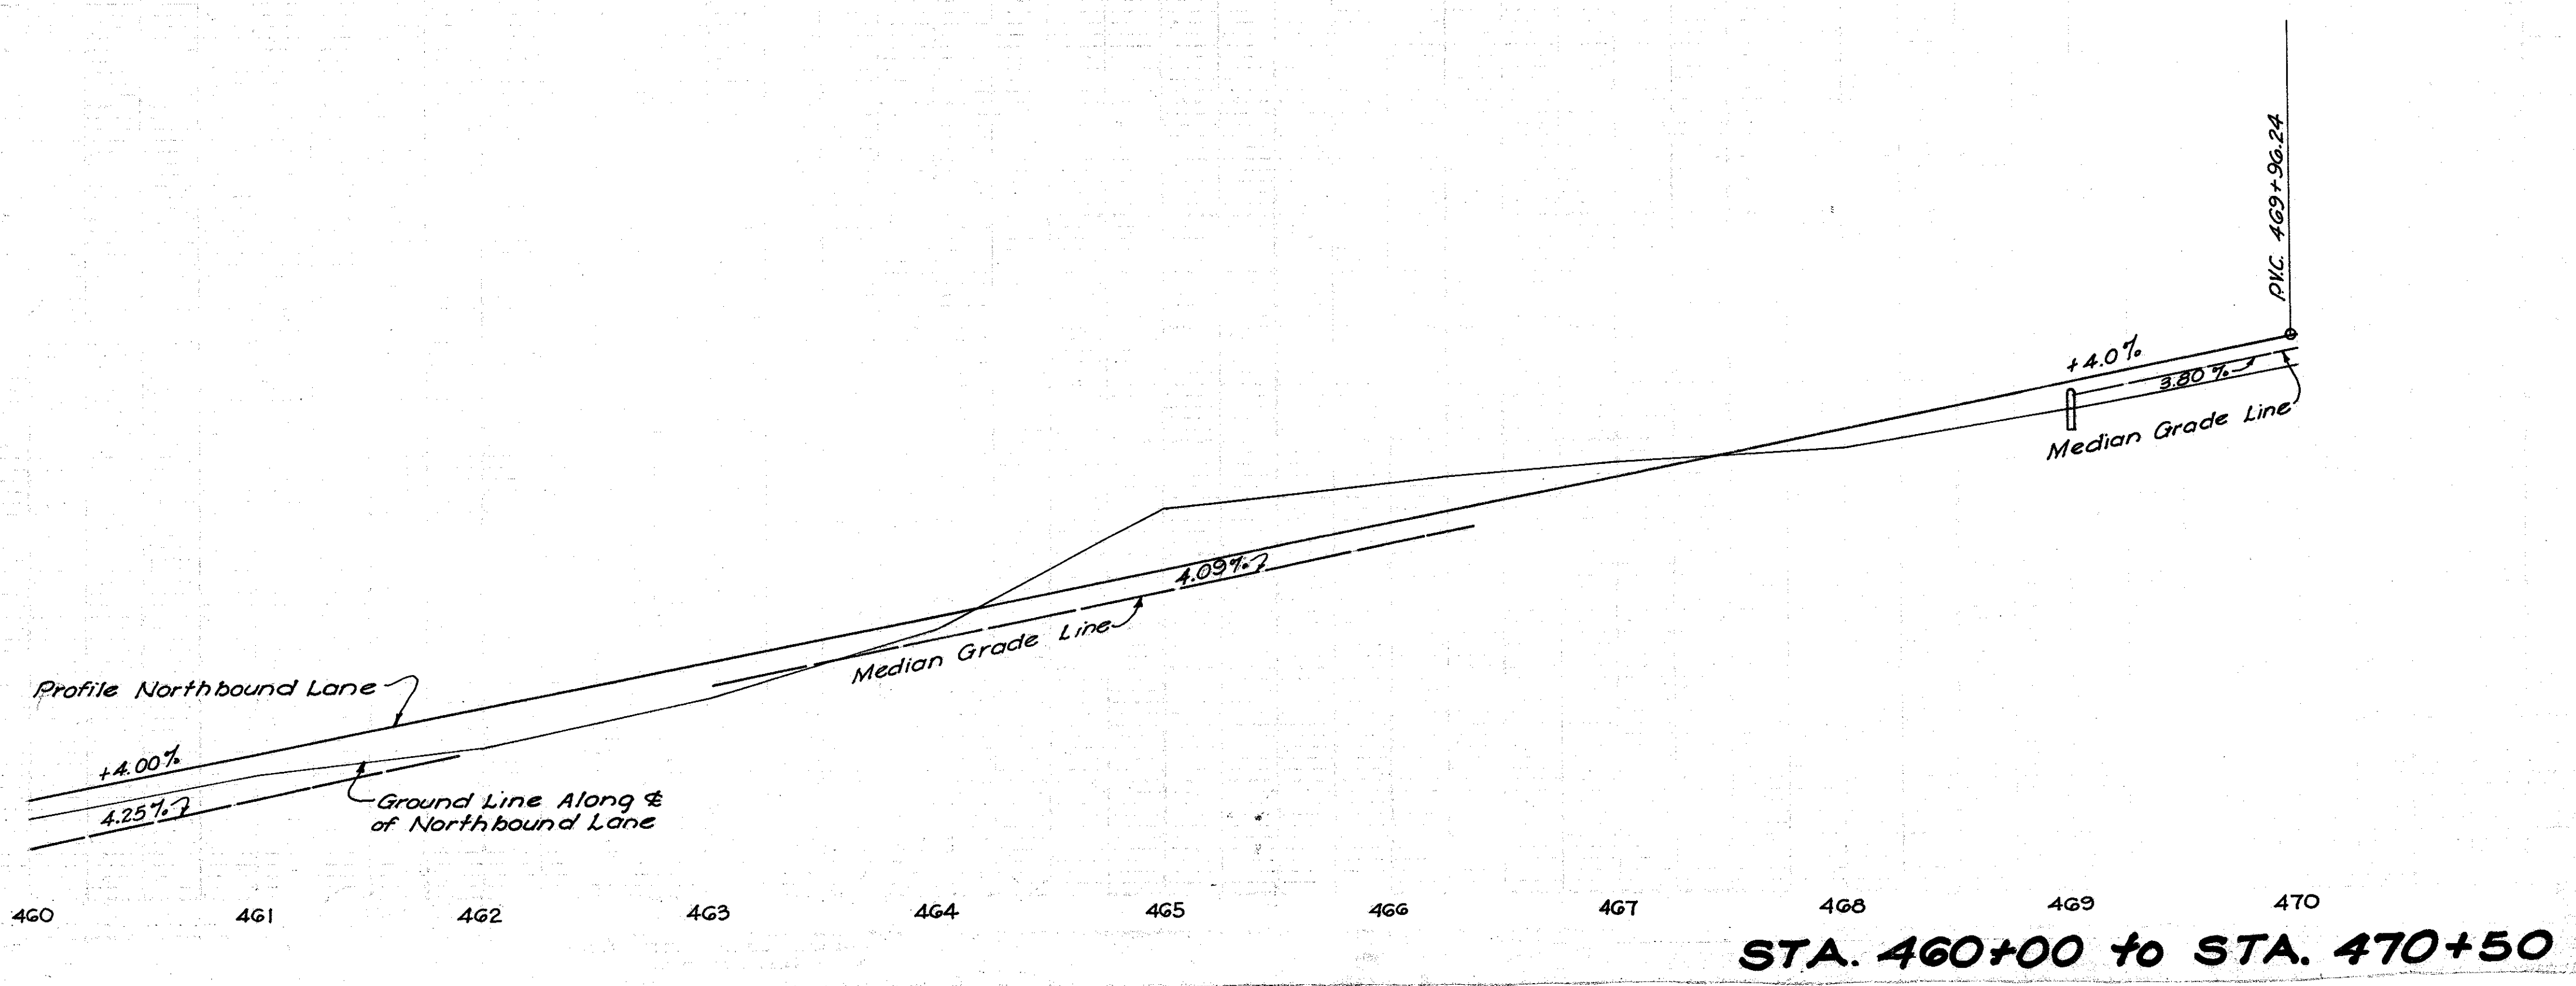

**STA. 460+00 to STA. 470+50**

B.M.#43 E1.733.501


**CURVE DATA**

P.I. = 475+95.53  
 $\Delta$  = 37°55'-22"  
 D = 4°00'-00"  
 R = 1432.39'  
 Ls = 400.00'  
 Lc = 548.07'  
 Ts = 693.60'  
 Es = 87.15'  
 Superelev. = 1' / ft.


N.W. corner of lower porch step to res. of Wm. B. Saunders. (Sta. 475+50-100:R)

Should Contract But 4 (16.53-1915) be constructed before But 4-(8.48-15.02), this cross-over shall be used to transfer traffic from existing road to proposed NB Lane & properly marked & controlled by the Ohio State Hwy Safety Dept.

Note:  
 If Contract BUT-4 (8.48-15.02) has not progressed to Sta. 470+50, provide temporary outlet for proposed side ditch & 6" I-4 to existing ditch @ Sta. 470+00 as shown.

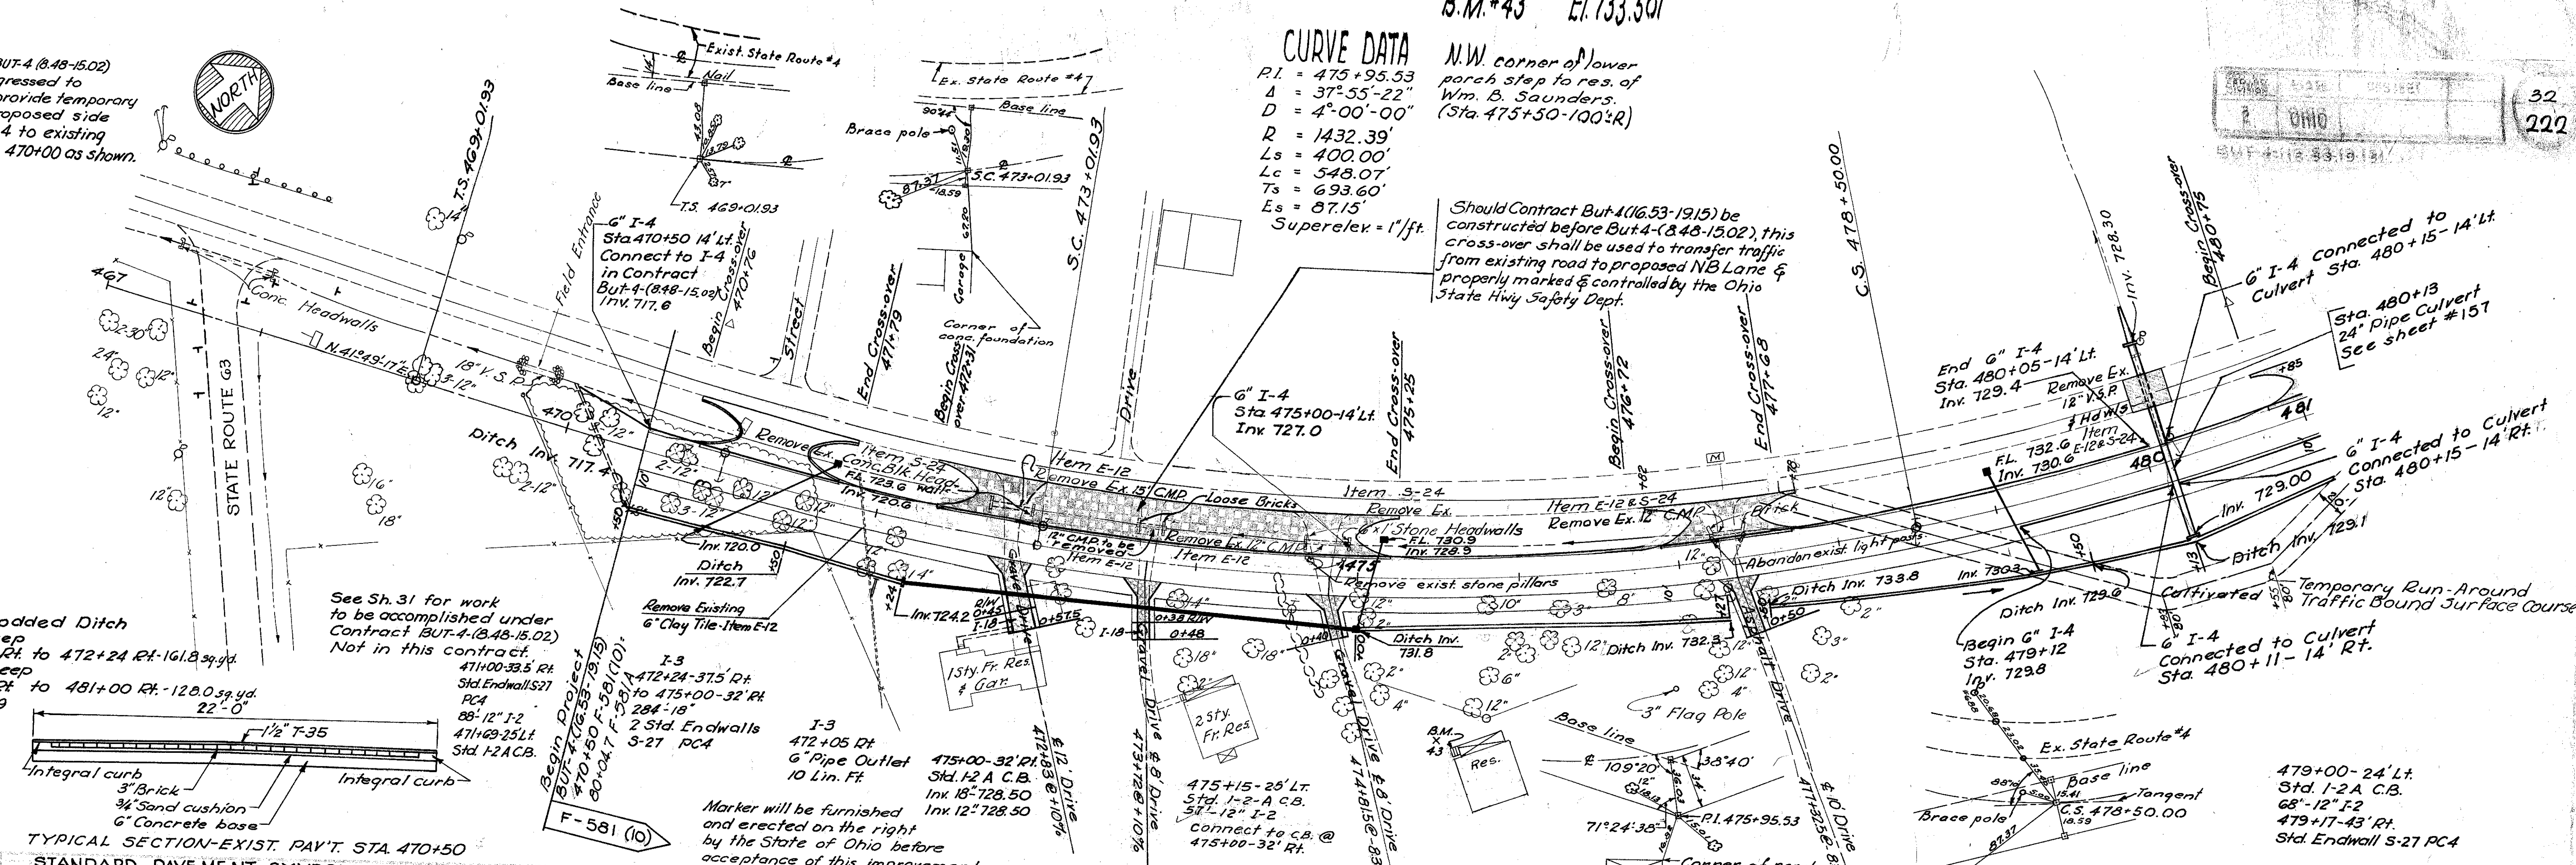


L-10 Sodded Ditch  
 1' Deep  
 470+50 Rt. to 472+24 Rt. - 161.8 sq. yd.  
 1.5' Deep  
 480+00 Rt. to 481+00 Rt. - 128.0 sq. yd.  
 See sh. 169

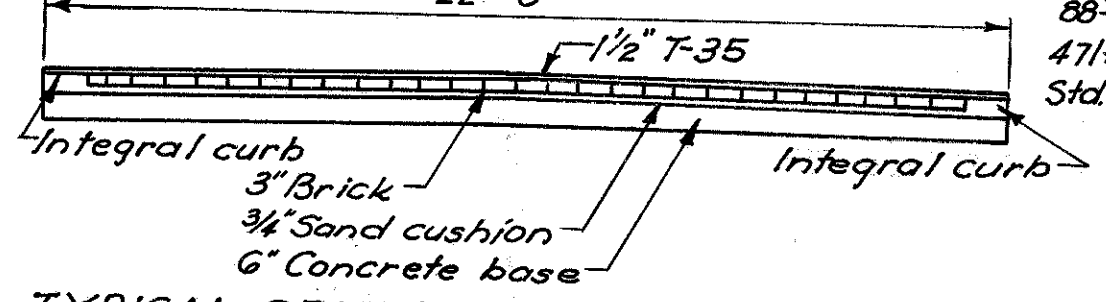

TYPICAL SECTION-EXIST. PAV'T. STA. 470+50

**STANDARD PAVEMENT SYMBOLS**

- 8' Reinforced Portland Cement Concrete Pavement.
- 8' Plain Portland Cement Concrete Pavement.
- 7' Plain Portland Cement Concrete Pavement.
- 4' Concrete Sidewalk.
- T-35 Surface Course-Type C Minimum 1/4.
- 1/2 T-35 Surface Course-Type C 1/4 B-35 Leveling Course 7-30 Bit Tack Coat-0.10 Gal./sq. Y. 8-35 Base Course I-22 Sub-base Variable thickness to meet bottom of exist. sub-base Minimum 6
- 1-18 1-18 Field Drives - 6" Residence drives beyond R/W-8" Business drives beyond R/W-9
- 2" T-35 Surface Course-Type C 5" B119 Base Course

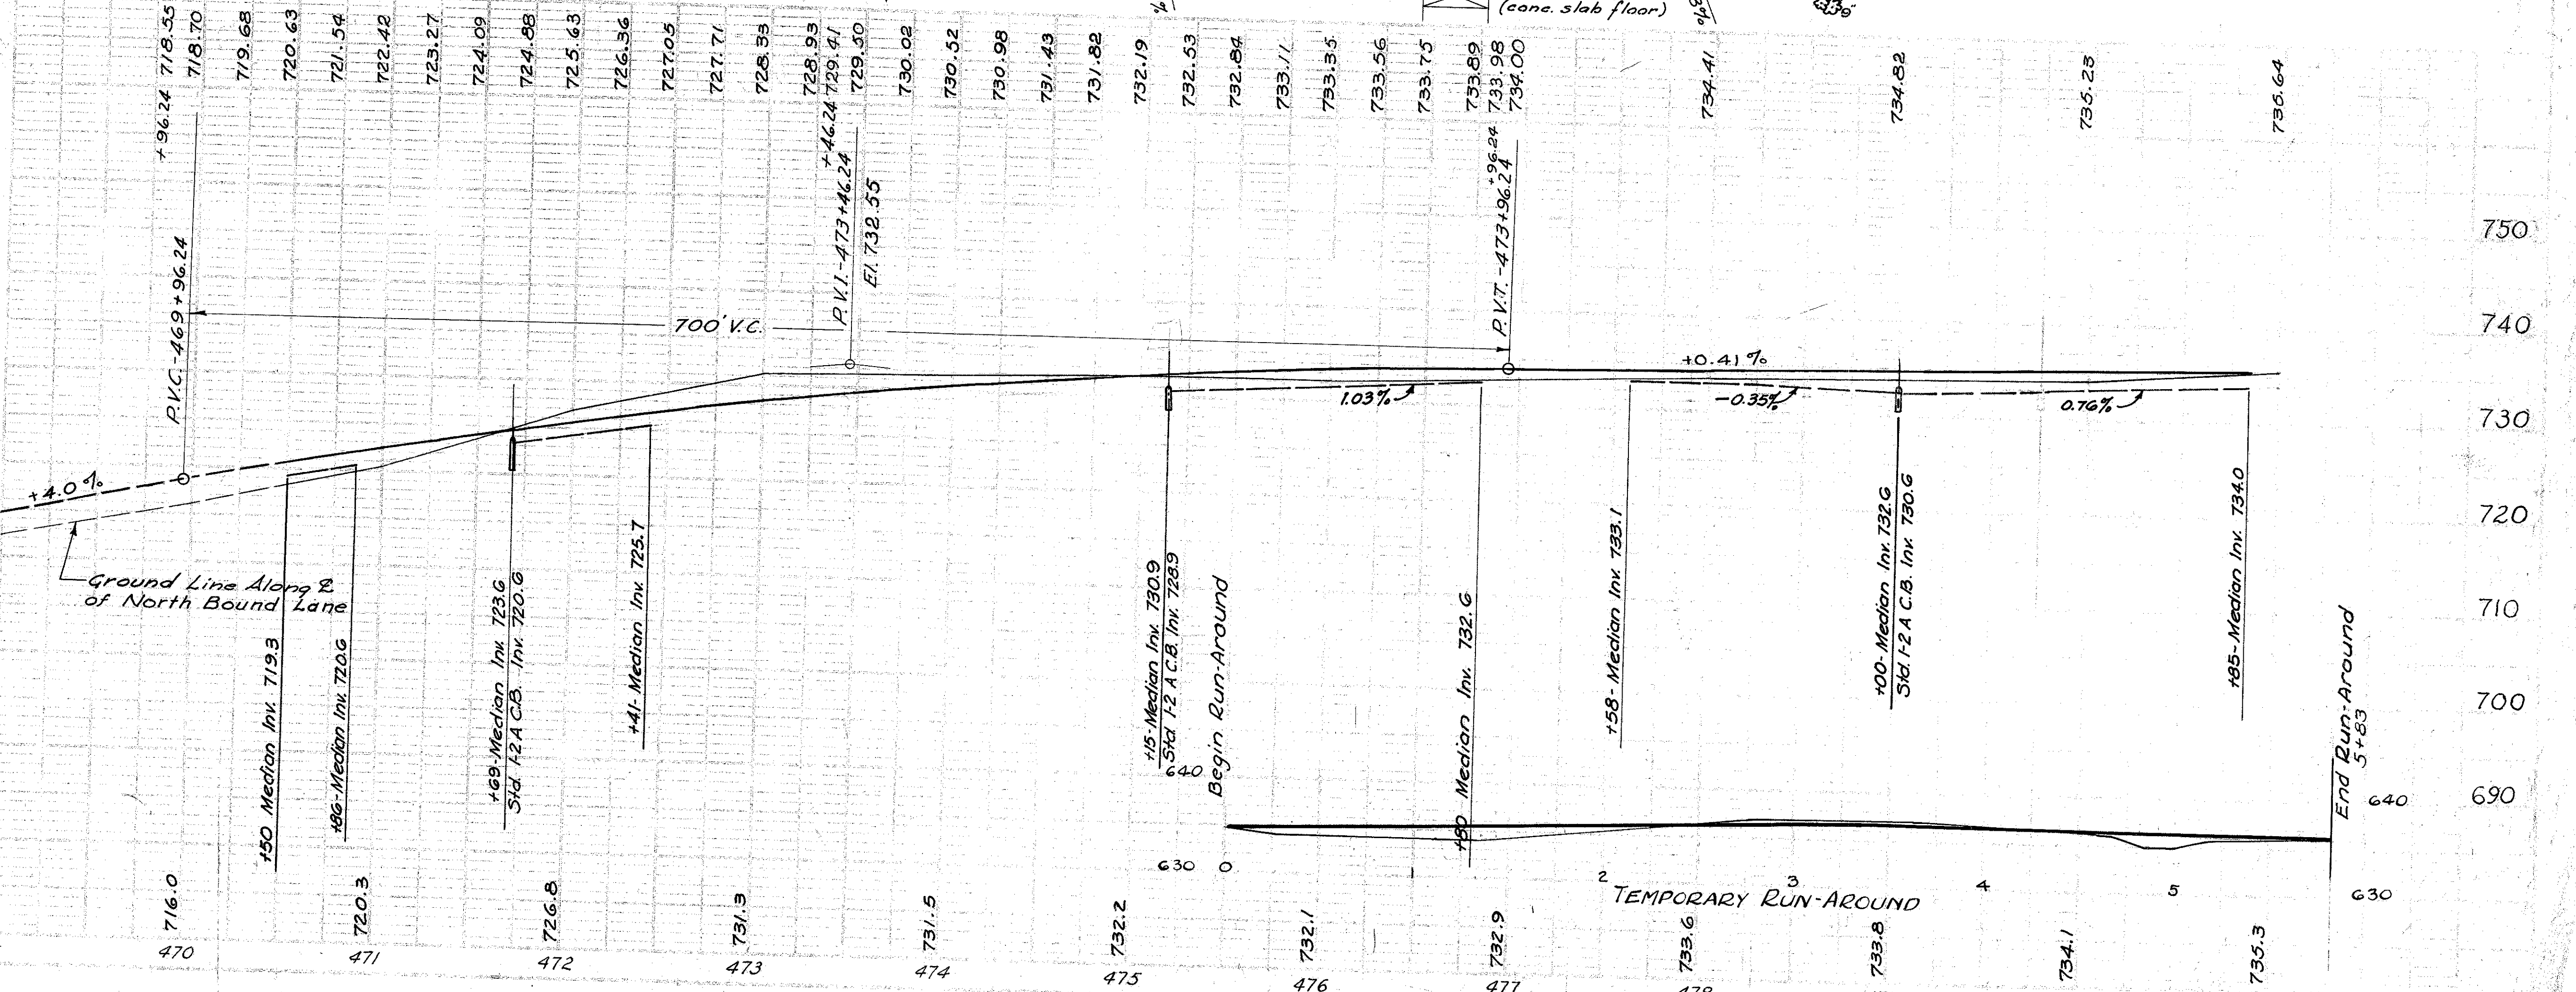


Marker will be furnished and erected on the right by the State of Ohio before acceptance of this improvement.

TEMPORARY RUN-AROUND





B.M. #44 El. 739.316  
Top of pipe @ end of  
walk W. side of Rte. #4  
in front of Blunt res.  
(Sta. 488+30.70' ± L)

CURVE DATA  
PI = 475+95.53  
Δ = 37°-55'-22"  
D = 4°-00'-00"  
R = 1432.39  
L = 400.00  
E<sub>1</sub> = 548.07'  
E<sub>2</sub> = 693.60'  
E<sub>3</sub> = 87.15'  
Superelev = 1"/ft

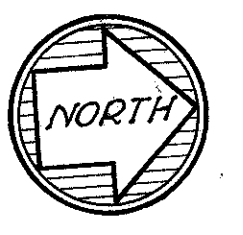

L-10  
Sodded Ditch  
1.5' Deep  
481+00 Rt. to 486+71 Rt. - 730.9 sq. yd.  
1.0' Deep  
487+03 Rt. to 489+59 Rt. - 238.1 sq. yd.  
489+95 Rt. to 490+76 Rt. - 24.6 sq. yd.  
See sh. 169

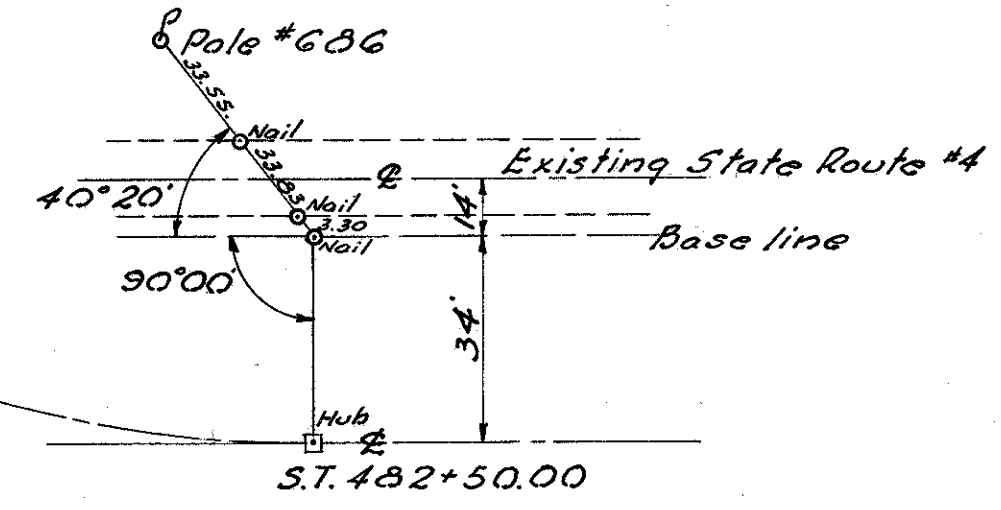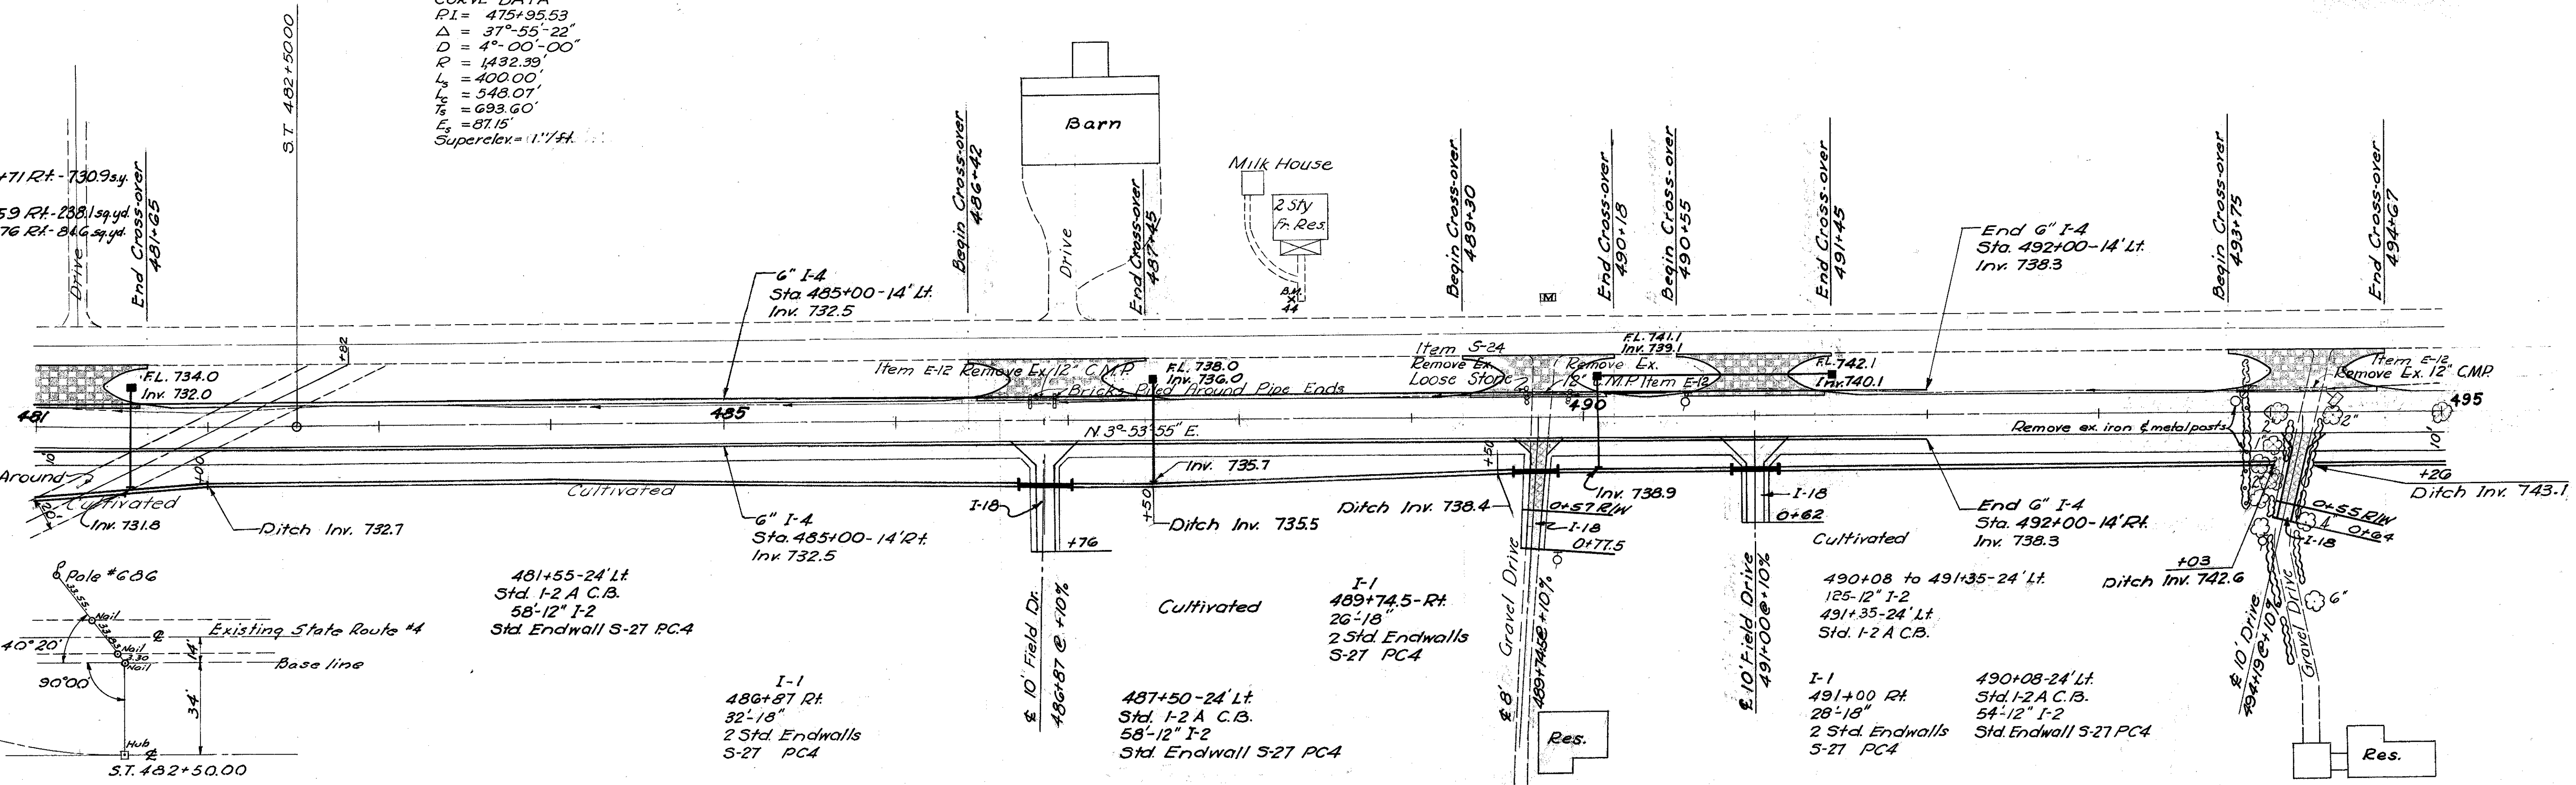

481+55-24' Lt.  
Std. I-2 A C.B.  
58'-12" I-2  
Std. Endwall S-27 PC4


I-1  
486+87 Rt.  
32'-18"  
2 Std. Endwalls  
S-27 PC4

487+50-24' Lt.  
Std. I-2 A C.B.  
58'-12" I-2  
Std. Endwall S-27 PC4

490+08 to 491+35-24' Lt.  
125'-12" I-2  
491+35-24' Lt.  
Std. I-2 A C.B.




I-1  
491+00 Rt.  
28'-18"  
2 Std. Endwalls  
S-27 PC4

490+08-24' Lt.  
Std. I-2 A C.B.  
54'-12" I-2  
Std. Endwall S-27 PC4

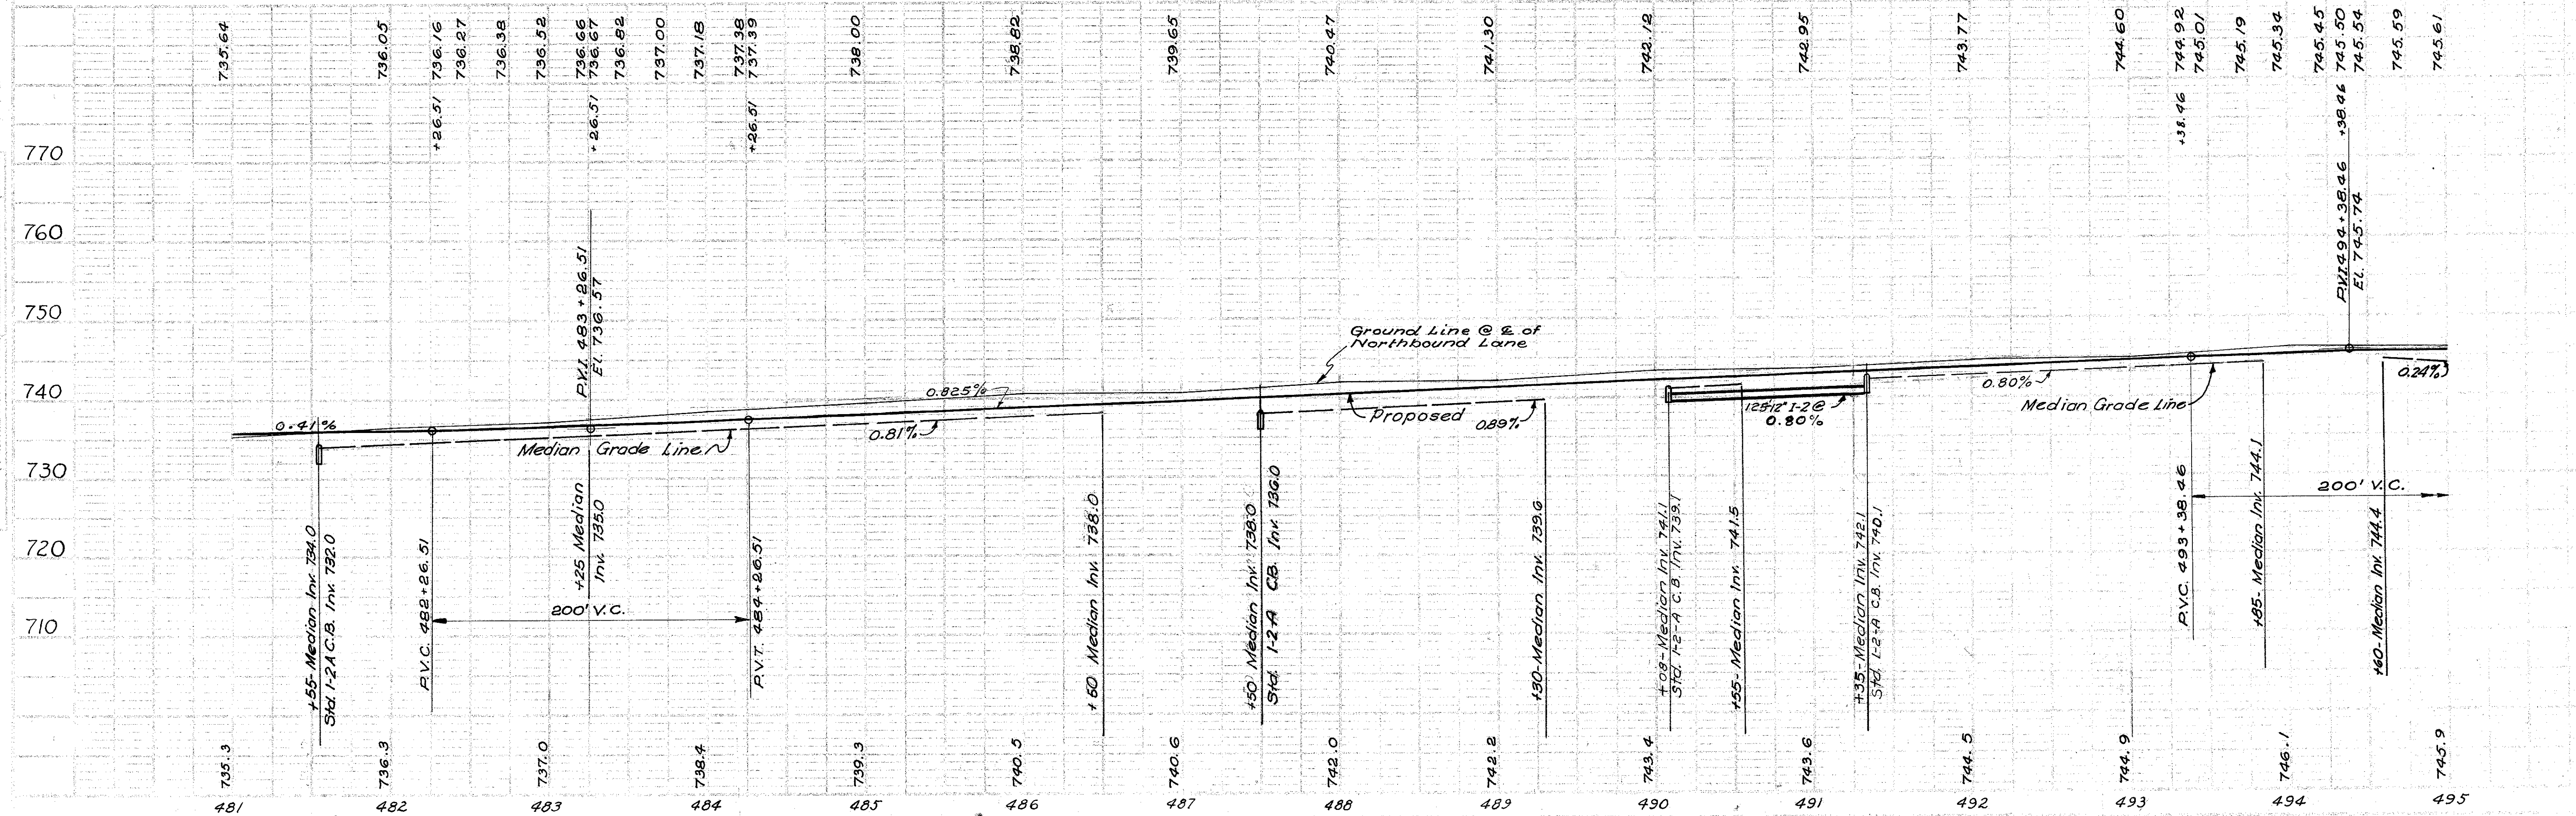



STA. 481+00 to STA. 495+00

B.M. #45 El. 745.758  
 Nail in 8" x 6" W side of  
 Rte #4 in front of Van Guelpen  
 & Williams res.  
 (Sta. 493+80-100 ± L)

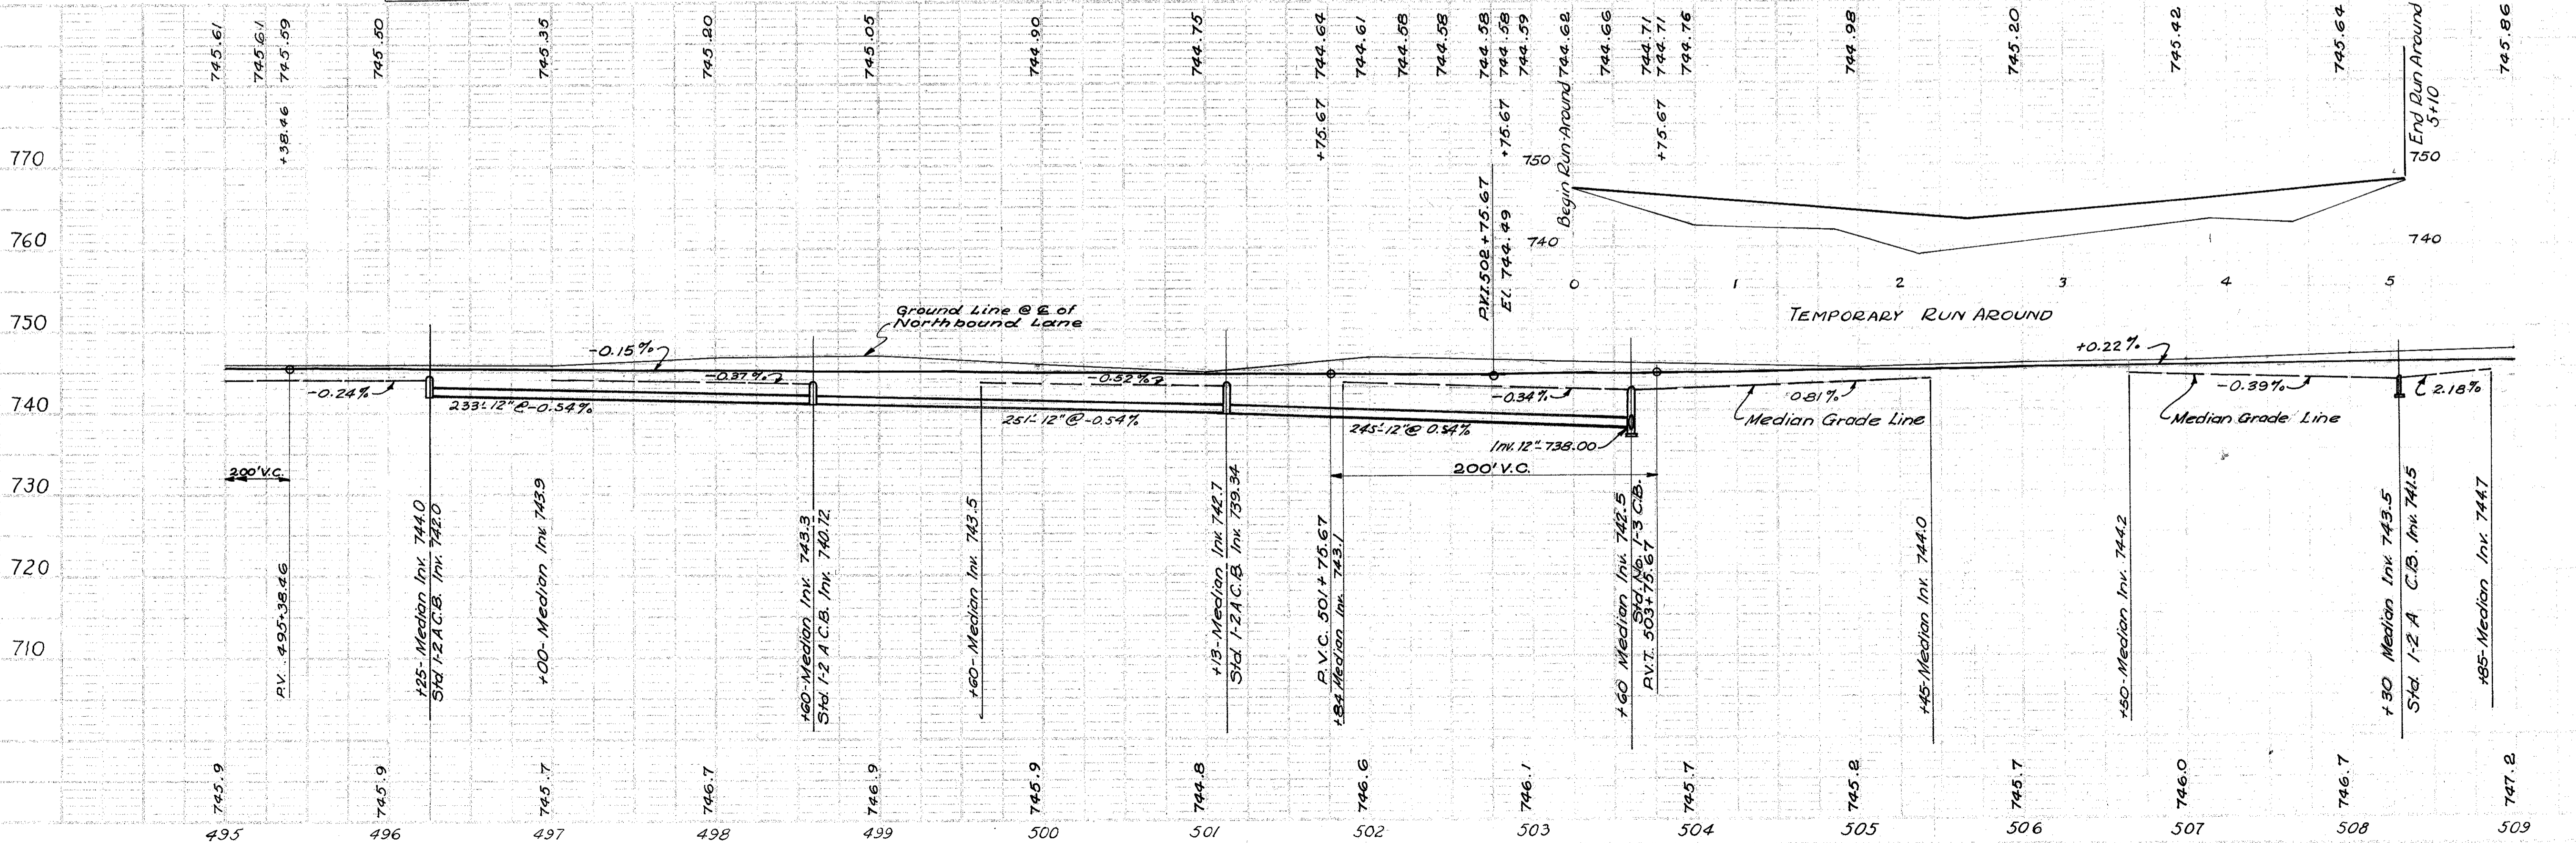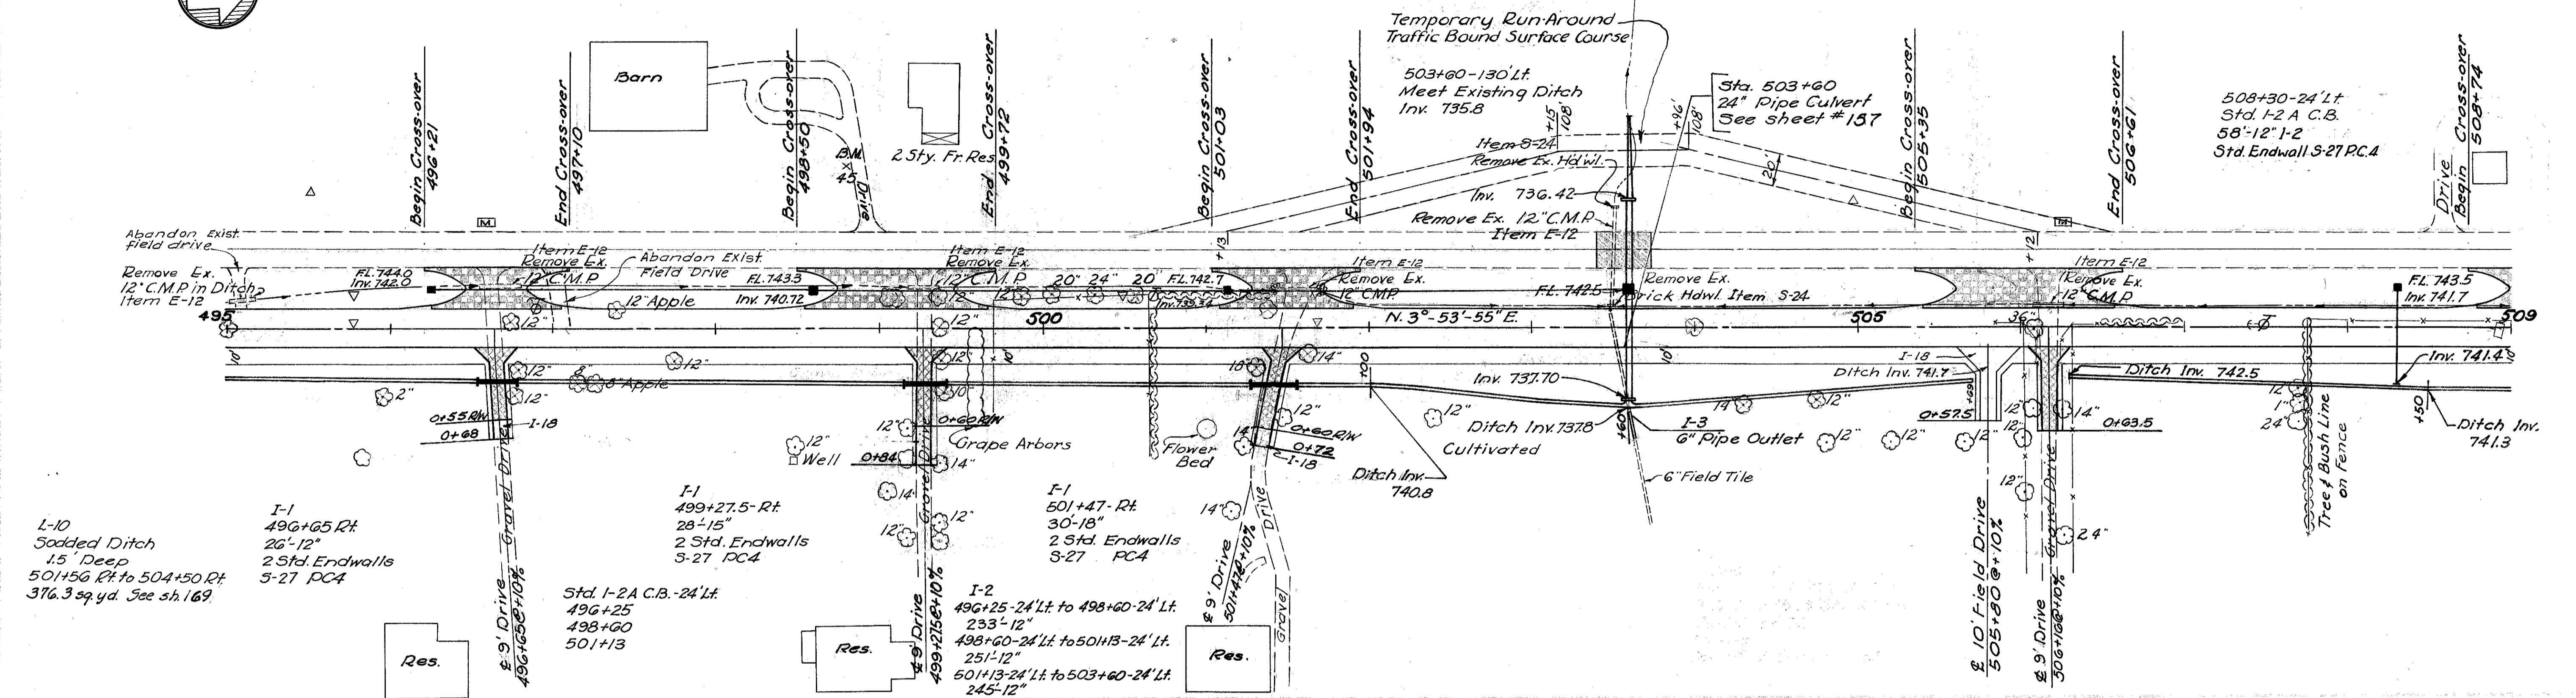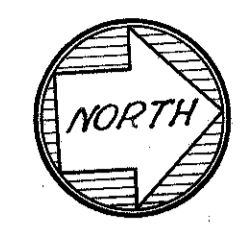

STA. 495+00 to STA. 509+00



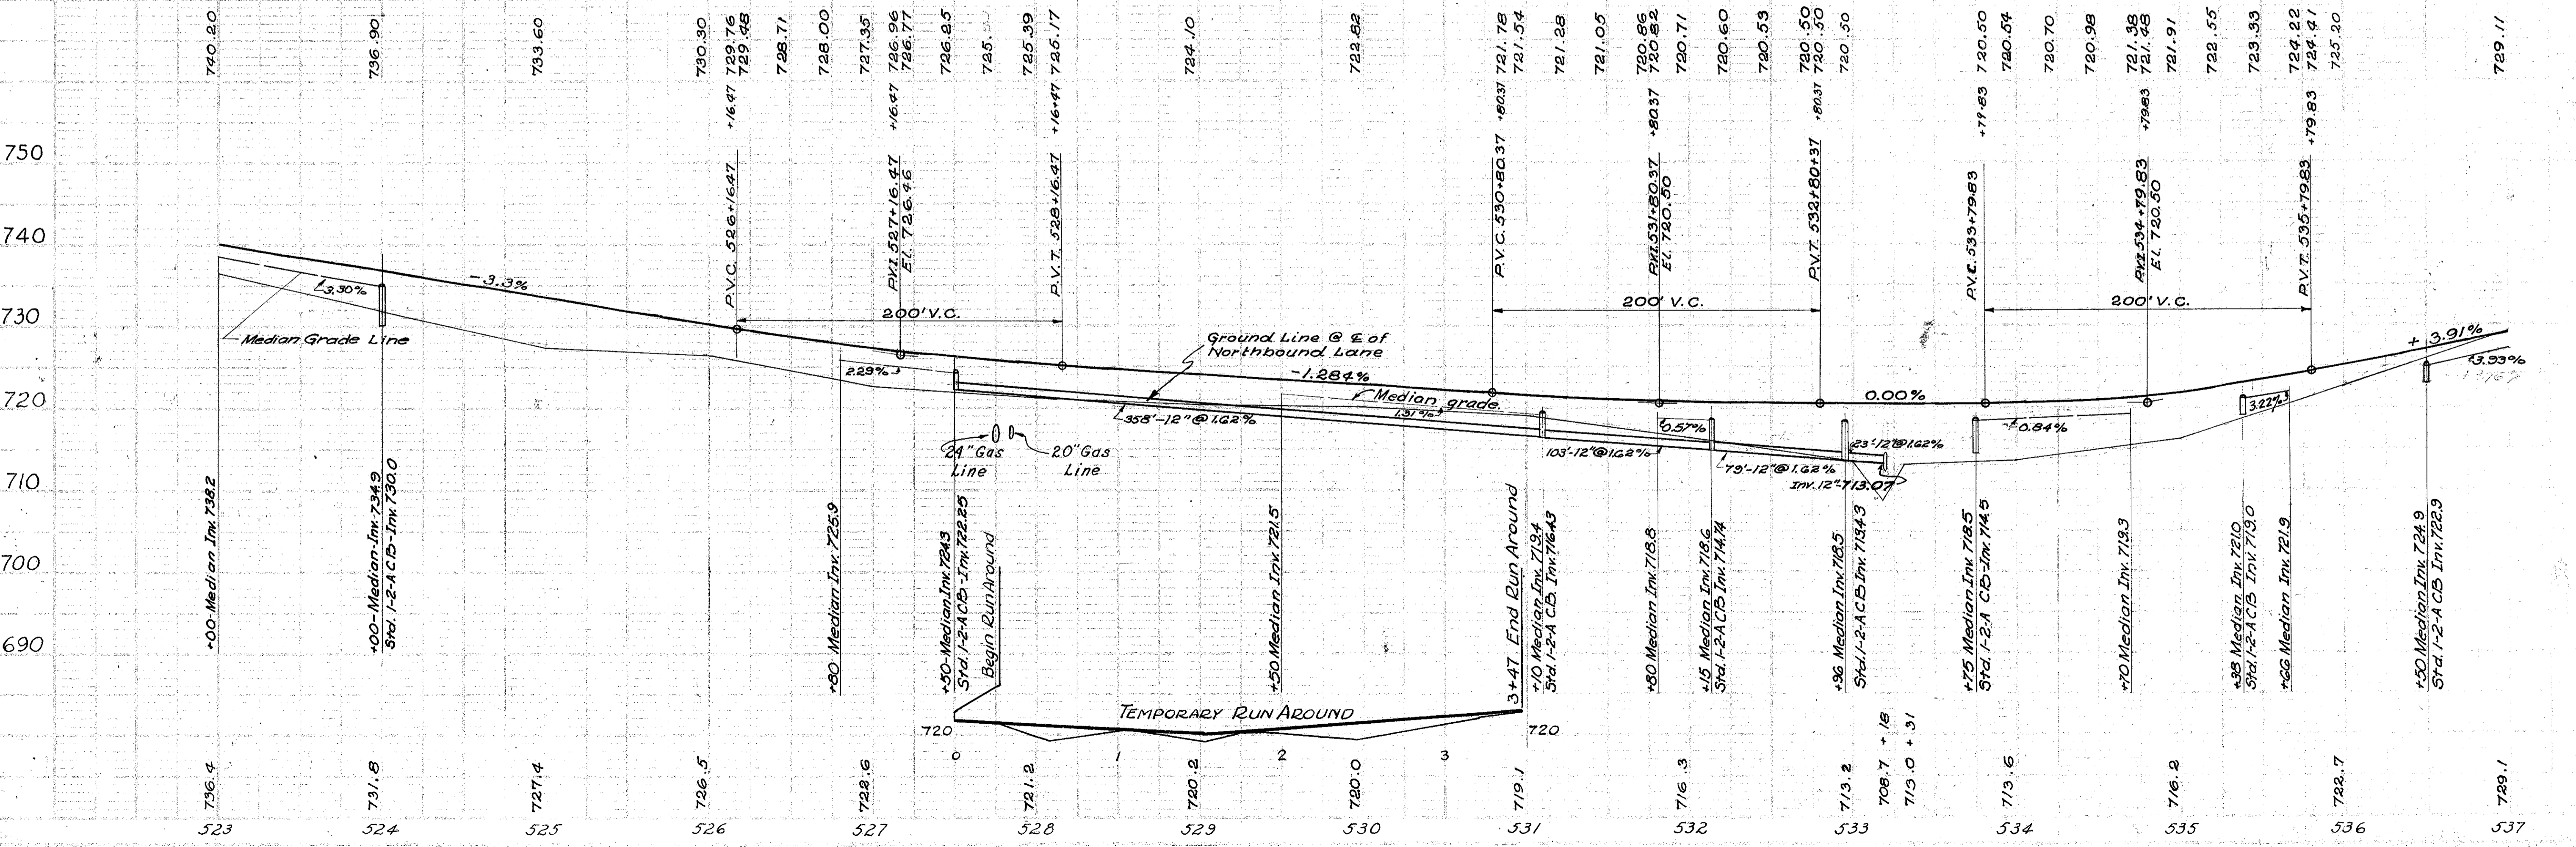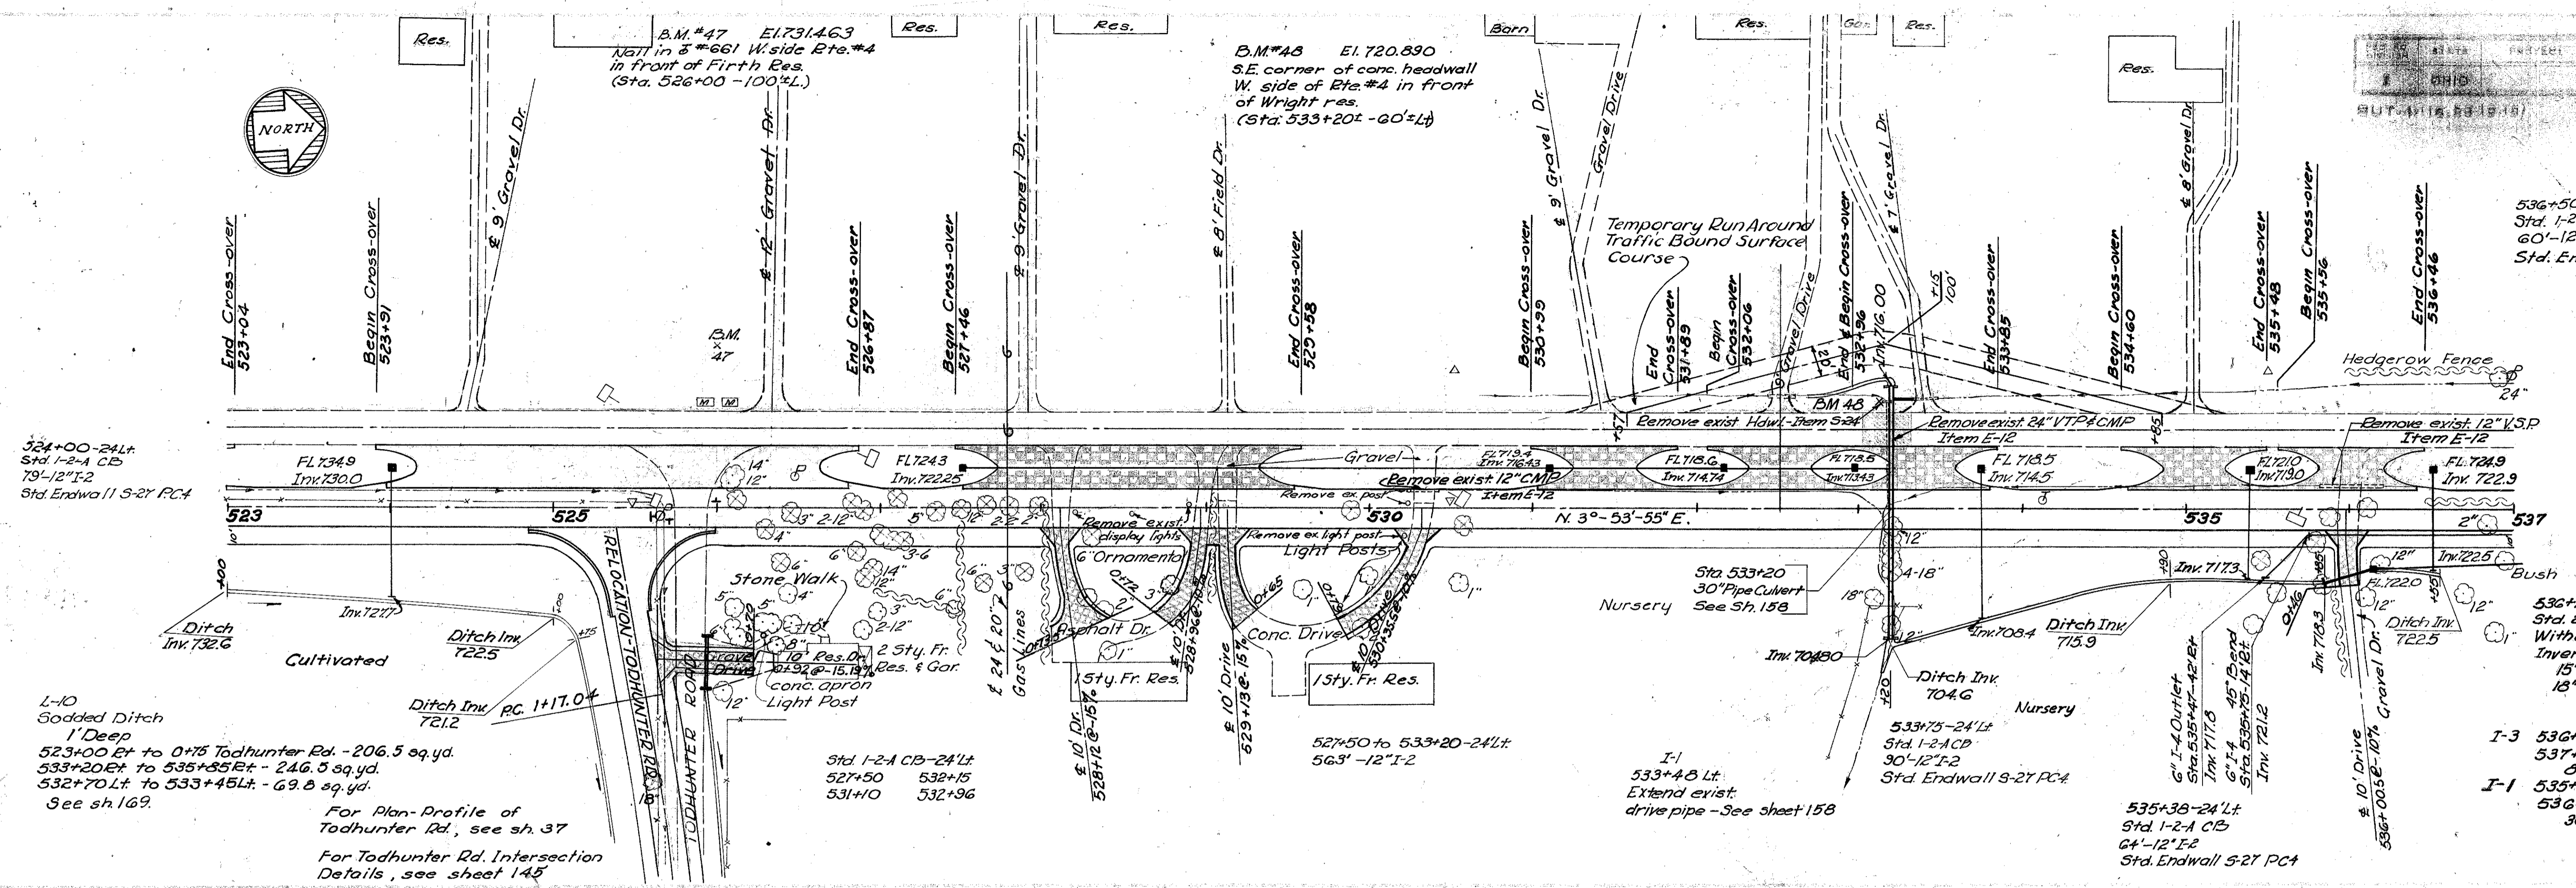

STA. 523+00 to STA. 537+00

524+00-24Lt  
Std. 1-2-A CB  
79'-12" I-2  
Std. Endwall 11 S-27 PCA

L-10  
Sodded Ditch  
1' Deep  
523+00 Et to 0+75 Todhunter Rd. - 206.3 sq. yd.  
533+20 Et to 535+45 Et - 246.3 sq. yd.  
532+70 Lt to 533+45 Lt - 69.0 sq. yd.  
See sh. 169.

For Plan-Profile of  
Todhunter Rd., see sh. 37  
For Todhunter Rd. Intersection  
Details, see sheet 145



Std. 1-2-A CB-24Lt  
527+50 532+15  
531+10 532+96

I-1  
533+48 Lt.  
Extend exist.  
drive pipe - See sheet 158


535+38-24Lt  
Std. 1-2-A CB  
64'-12" E-2  
Std. Endwall 5-27 PCA

I-3 536+15-35' Et. to  
537+00-31.5' Et.  
34'-15"  
I-1 535+85-45' Et. to  
536+15-35' Et.  
30'-18"

536+50-24Lt  
Std. 1-2-A CB  
60'-12" I-2  
Std. Endwall 5-27 PCA

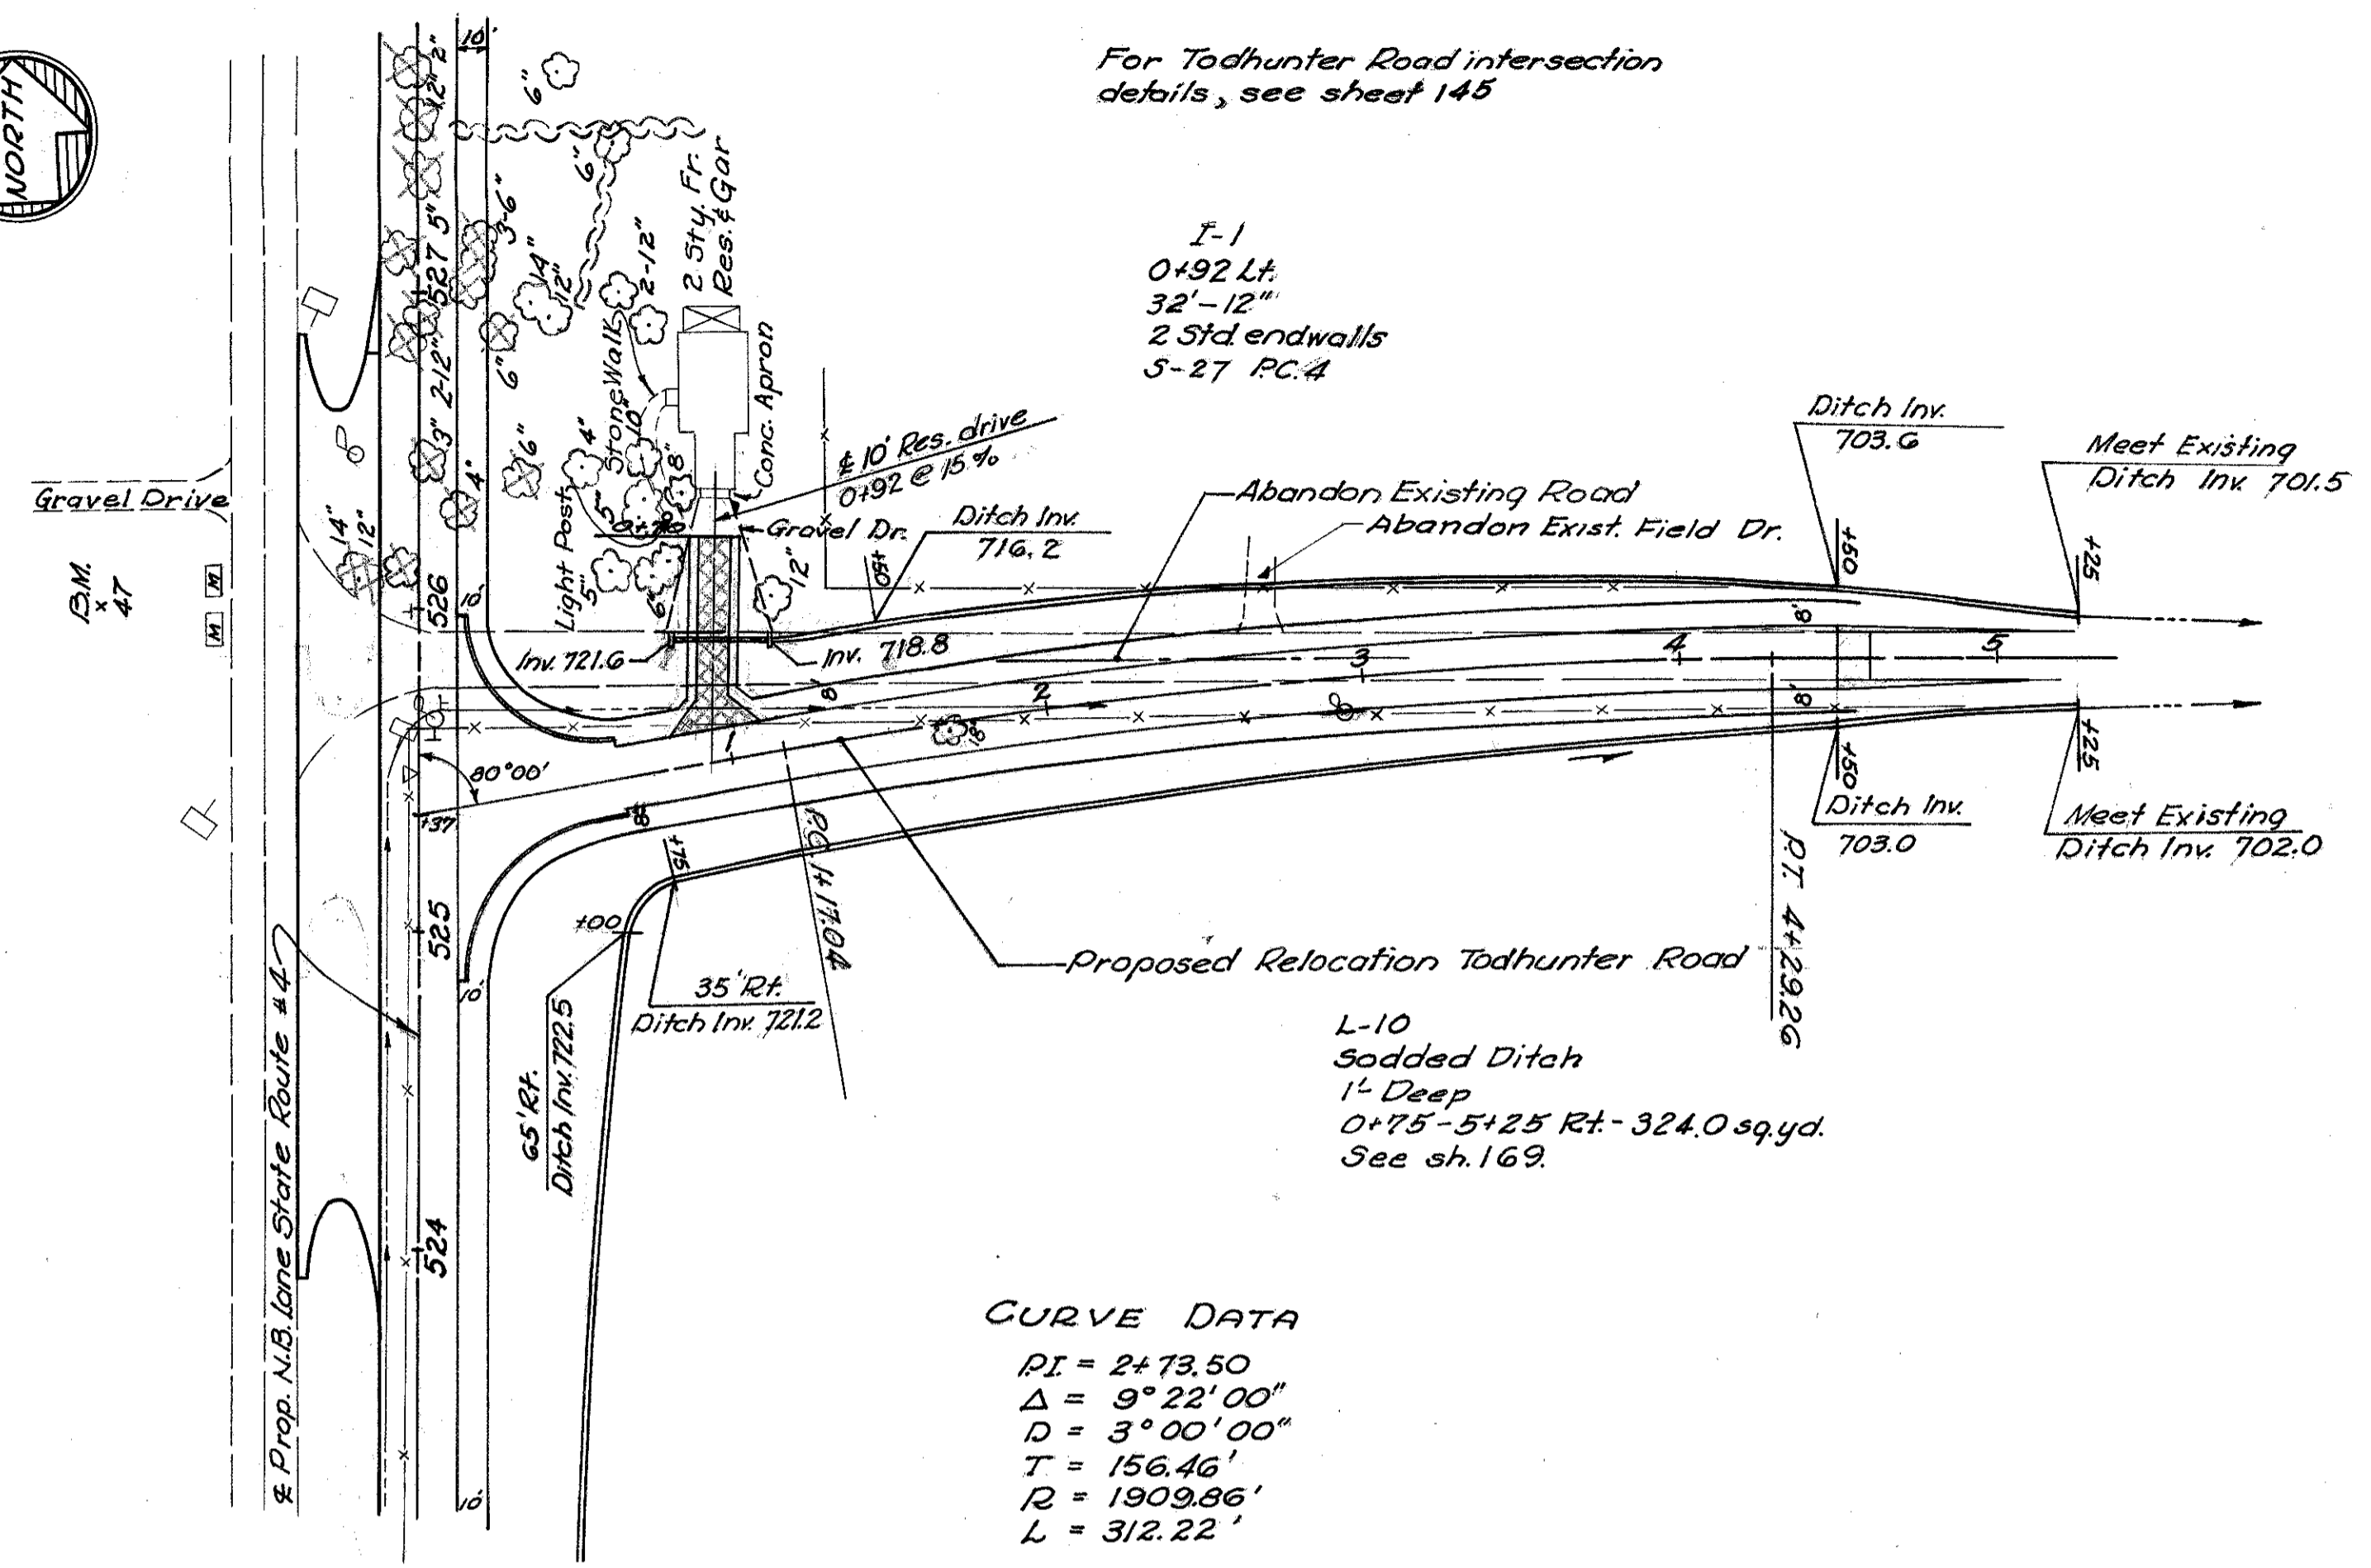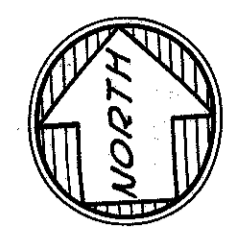

**CURVE DATA**  
 PI = 2+73.50  
 Δ = 9° 22' 00"  
 D = 3° 00' 00"  
 T = 156.46'  
 R = 1909.86'  
 L = 312.22'

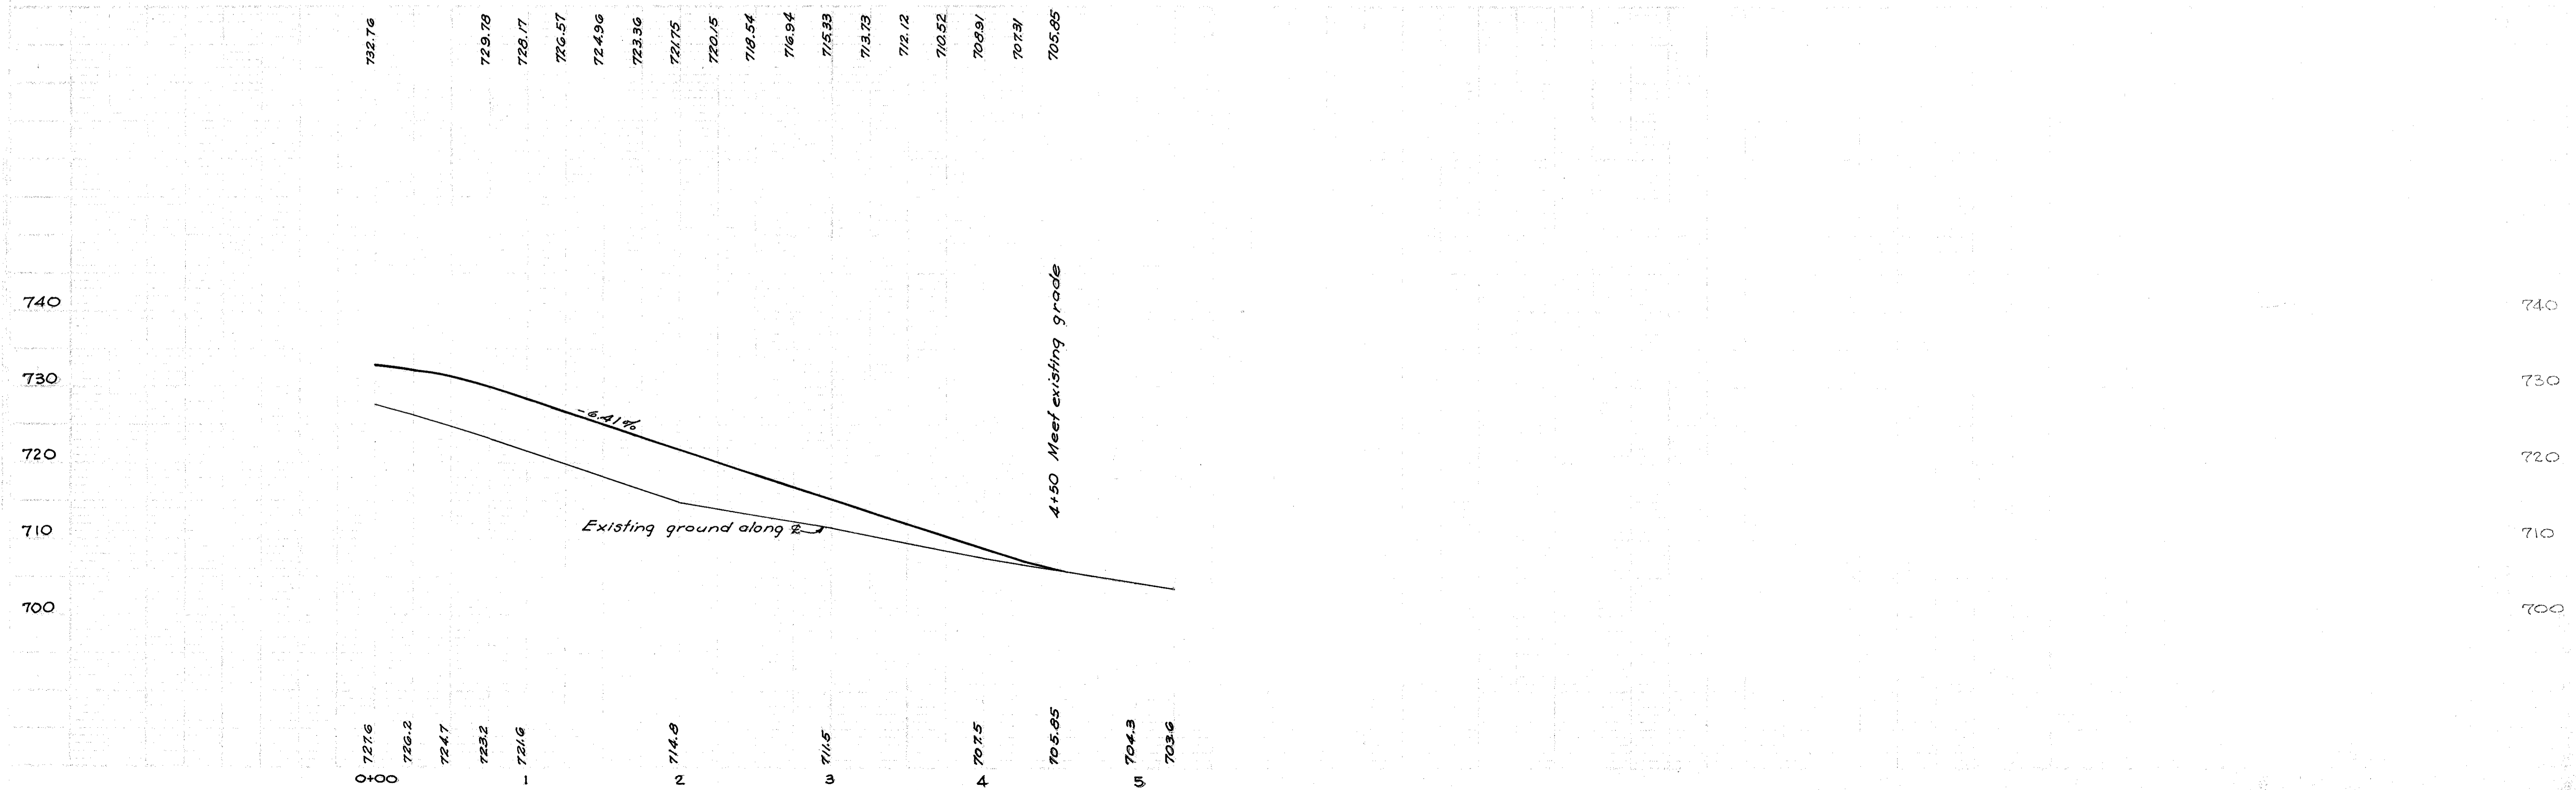


















6"-I-4  
 6+08 Lt. to 8+50 Lt.  
 Inv. 6" @ 6+08 Lt. - 624.8  
 Inv. 6" @ 8+50 Lt. - 624.5  
 Connect to No. 3-A CB @ 8+50 Lt.  
 6+96 Lt. - 6" 6" Tee  
 0+20 B Rt. to 0+73 B Rt. Tee  
 0+20 B Lt. - Connect 6"-I-4 to Tee  
 0+73 B Lt. - Inv. 6" I-4 - 625.0  
 0+20 B Rt. to 1+92 B Rt.  
 Inv. 6" @ 0+20 B Rt. - 625.0 Connect to Inlet-MH  
 Inv. 6" @ 1+92 B Rt. - 625.0 Connect to Inlet-MH  
 Inv. 6" @ 0+73 B Rt. (Inlet-MH) - 624.8  
 8+25 to 9+38 - 29.5' Lt.  
 Inv. 6" I-4 @ 8+25 Rt. - 625.0  
 Inv. 6" I-4 @ 9+38 Rt. (C.B.) - 624.8

STA.	TYPE
8+00 Lt.	*3-A Catch Basin
8+50 Lt.	*3-A Catch Basin
1+50 B Lt.	*3-A Catch Basin
0+50 B Rt.	*3-A Catch Basin
0+75 B Rt.	*3-A Inlet Manhole
1+75 B Rt.	*3-A Inlet Manhole
1+75 B Lt.	*3-A Catch Basin
2+50 B Rt.	*3-A Catch Basin
6+10.45 Lt.	*3-A Catch Basin
6+90.36 Lt.	*3-A Catch Basin

For drives @ Sta. 3+75, 4+26.2, 4+79, 5+28 on the left see sheet no. 156  
 Water services to houses # 603, 605, 607, 609, 611 shall have curb boxes and water meters relocated to property line.  
 Abandon water service branch at houses # 615, 701, 703, 705, 707 and Sta. 8+60 - 78' Rt.; Sta. 9+15 - 85' Rt.; Sta. 9+65 - 95' Rt.  
 Corp. cocks on water service branches to be closed.  
 Abandon Fire Hydrant Sta. 9+20 - 86' Rt. See Sh. 149 for relocated water & gas lines.

I-2  
 8+50 Lt. to 9+40 Rt.  
 99'-15"  
 Inv. @ 8+50 Lt. - 623.28  
 Inv. @ 9+40 Rt. - 623.85  
 8+00 Lt. to 8+50 Lt.  
 48'-12"  
 Inv. @ 8+00 Lt. - 626.55  
 Inv. @ 8+50 Lt. - 626.39  
 8+50 Lt. to 1+75 B Rt.  
 88'-15"  
 Inv. @ 8+50 Lt. - 623.18  
 Inv. @ 1+75 B Rt. - 622.64  
 1+50 B Lt. to 1+75 B Lt.  
 22'-12"  
 Inv. @ 1+50 B Lt. - 626.02  
 Inv. @ 1+75 B Lt. - 626.00  
 1+75 B Lt. to 0+75 B Rt.  
 59'-12"  
 Inv. @ 1+75 B Lt. - 625.90  
 Inv. @ 0+75 B Rt. - 625.84  
 6+10.45 Lt. to 6+90.36 Lt.  
 78'-12"  
 Inv. @ 6+10.45 Lt. - 626.80  
 Inv. @ 6+90.36 Lt. - 626.40

I-2  
 0+50 B Rt. to 0+75 B Rt.  
 21'-12"  
 Inv. @ 0+50 B Rt. - 625.60  
 Inv. @ 0+75 B Rt. - 624.60  
 0+75 B Rt. to 1+75 B Rt.  
 86'-12"  
 Inv. @ 0+75 B Rt. - 624.50  
 Inv. @ 1+75 B Rt. - 622.89  
 1+75 B Rt. (Inlet MH) to 1+75 B Rt. (Endwall)  
 21'-18"  
 Inv. @ 1+75 B Rt. (Inlet MH) - 622.54  
 Inv. @ 1+75 B Rt. (Endwall) - 621.1  
 1+75 B Lt. to 2+50 B Rt.  
 70'-12"  
 Inv. @ 1+75 B Lt. - 626.50  
 Inv. @ 2+50 B Rt. - 626.30  
 2+50 B Rt. (C.B.) to 2+50 B Rt. (Endwall)  
 26'-12"  
 Inv. @ 2+50 B Rt. (C.B.) - 626.20  
 Inv. @ 2+50 B Rt. (Endwall) - 621.2  
 6+90.36 Lt. to 0+50 B Rt.  
 58'-12"  
 Inv. @ 6+90.36 Lt. - 626.30  
 Inv. @ 0+50 B Rt. - 625.70

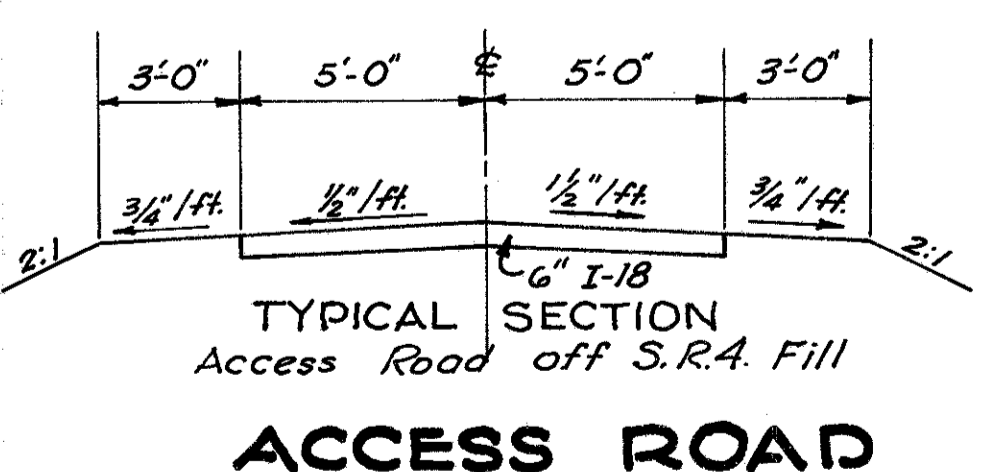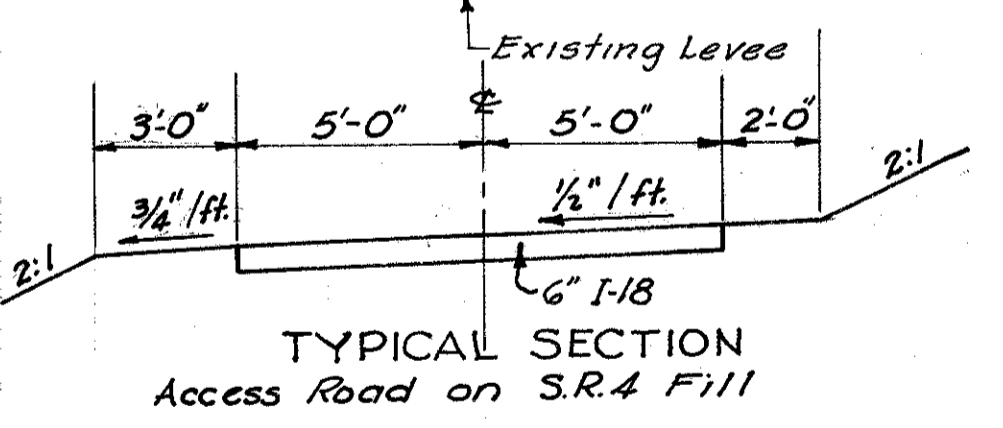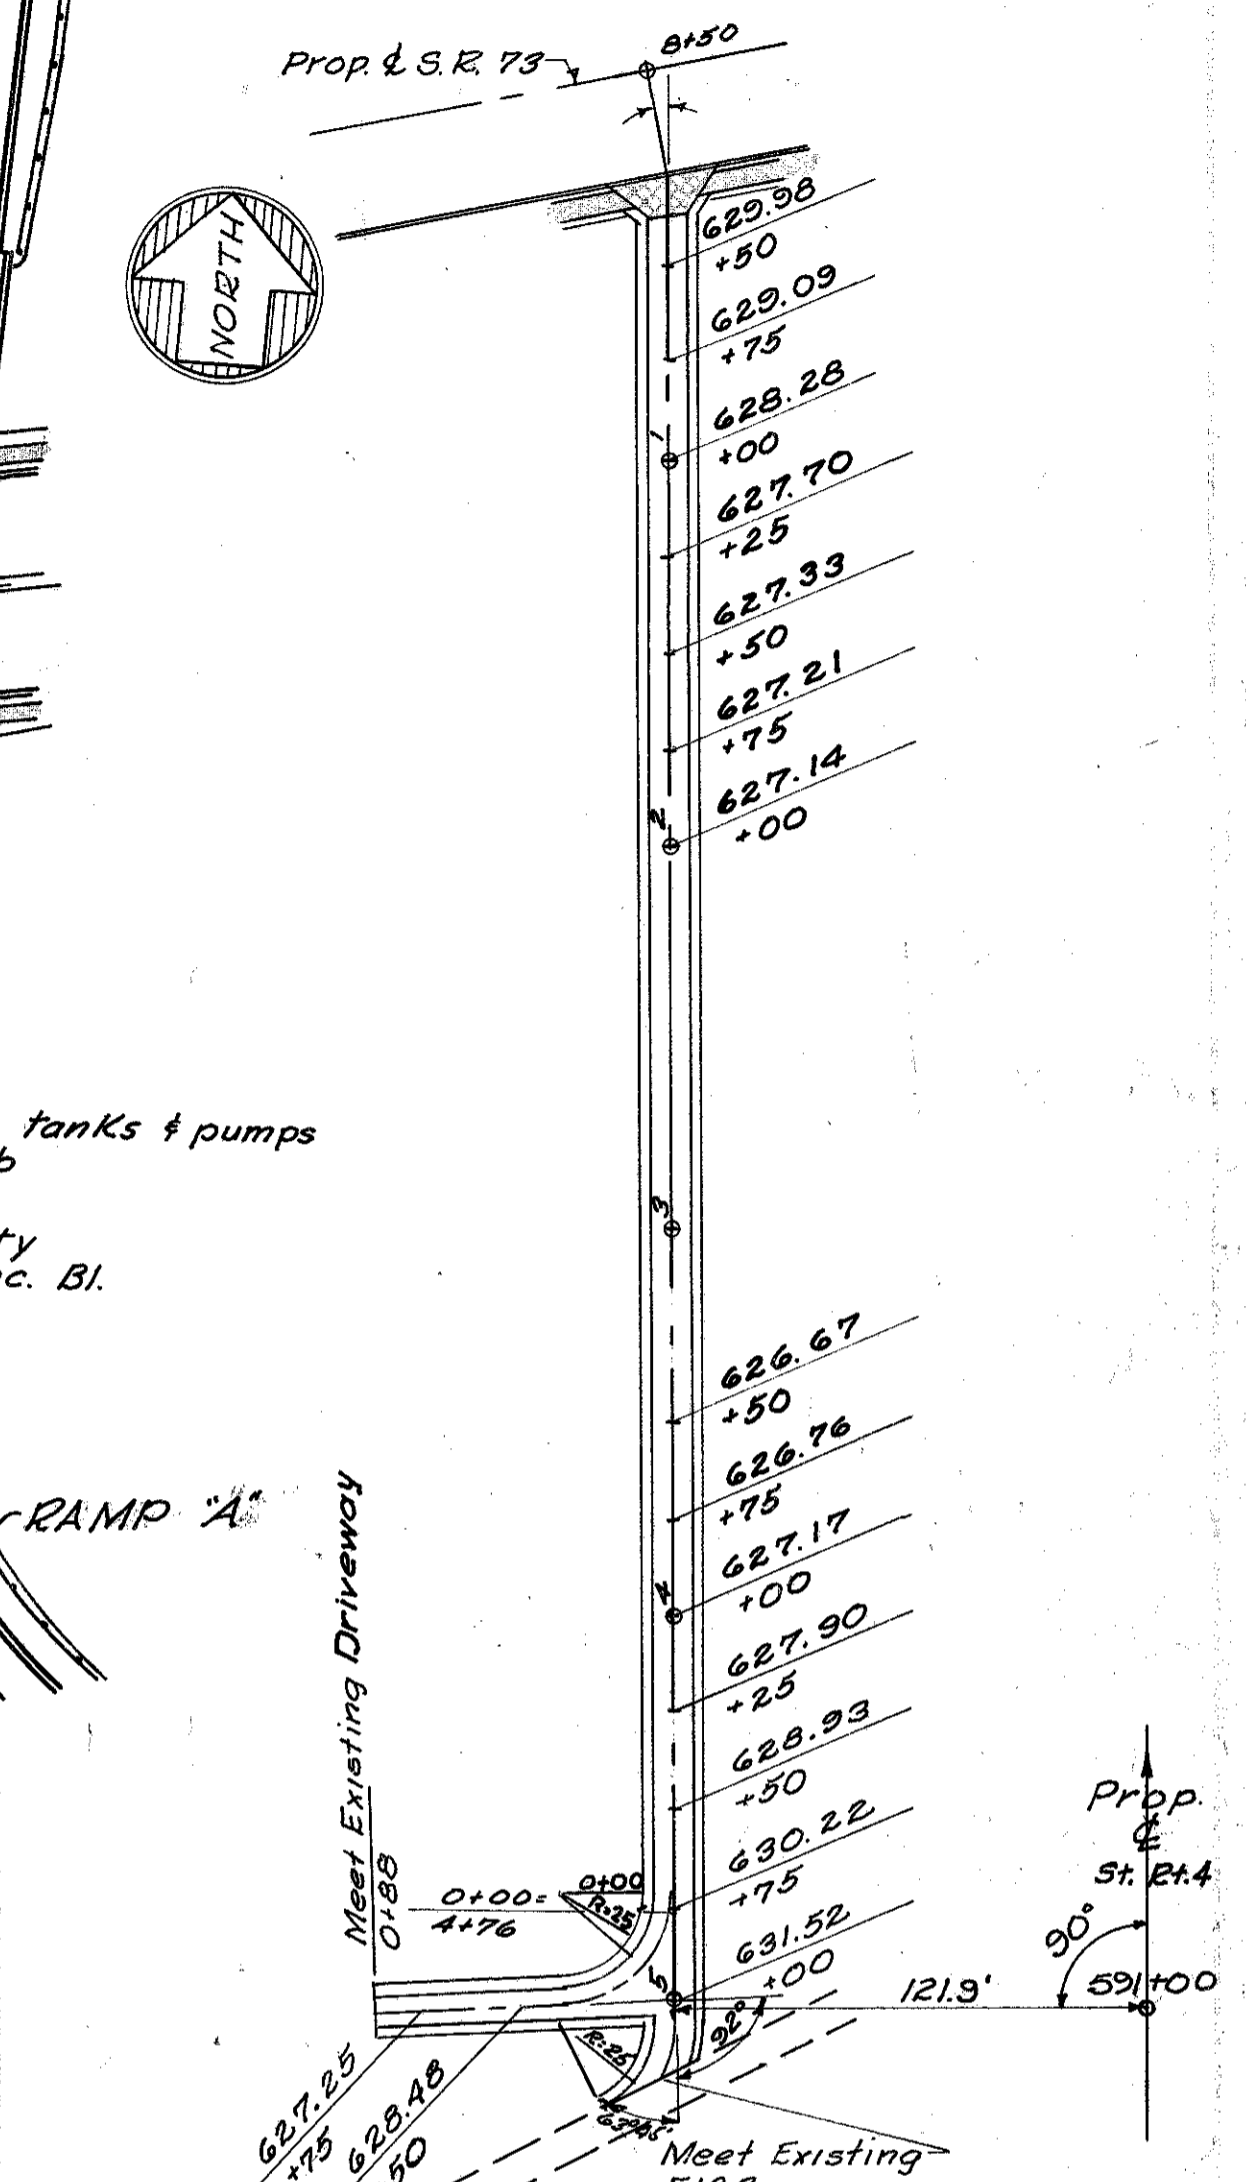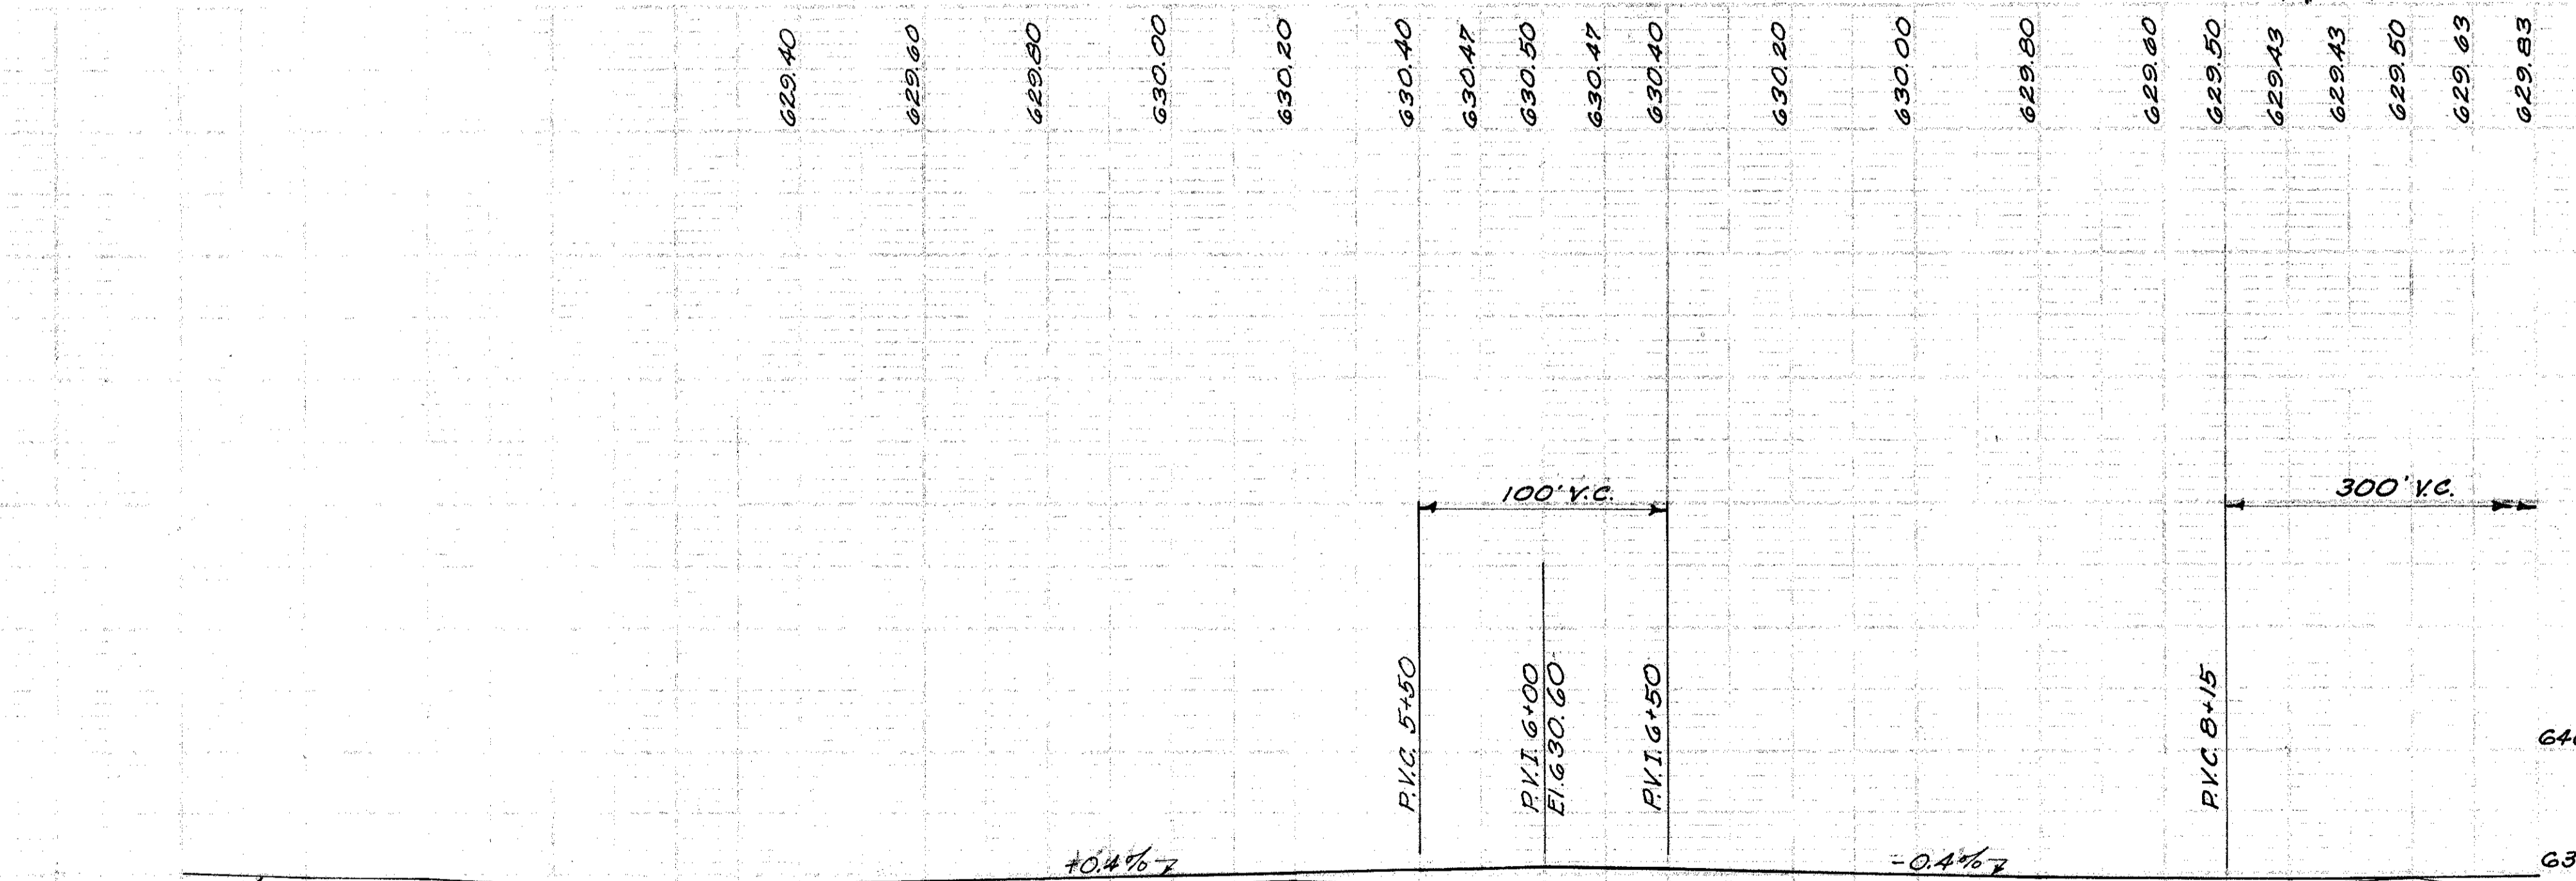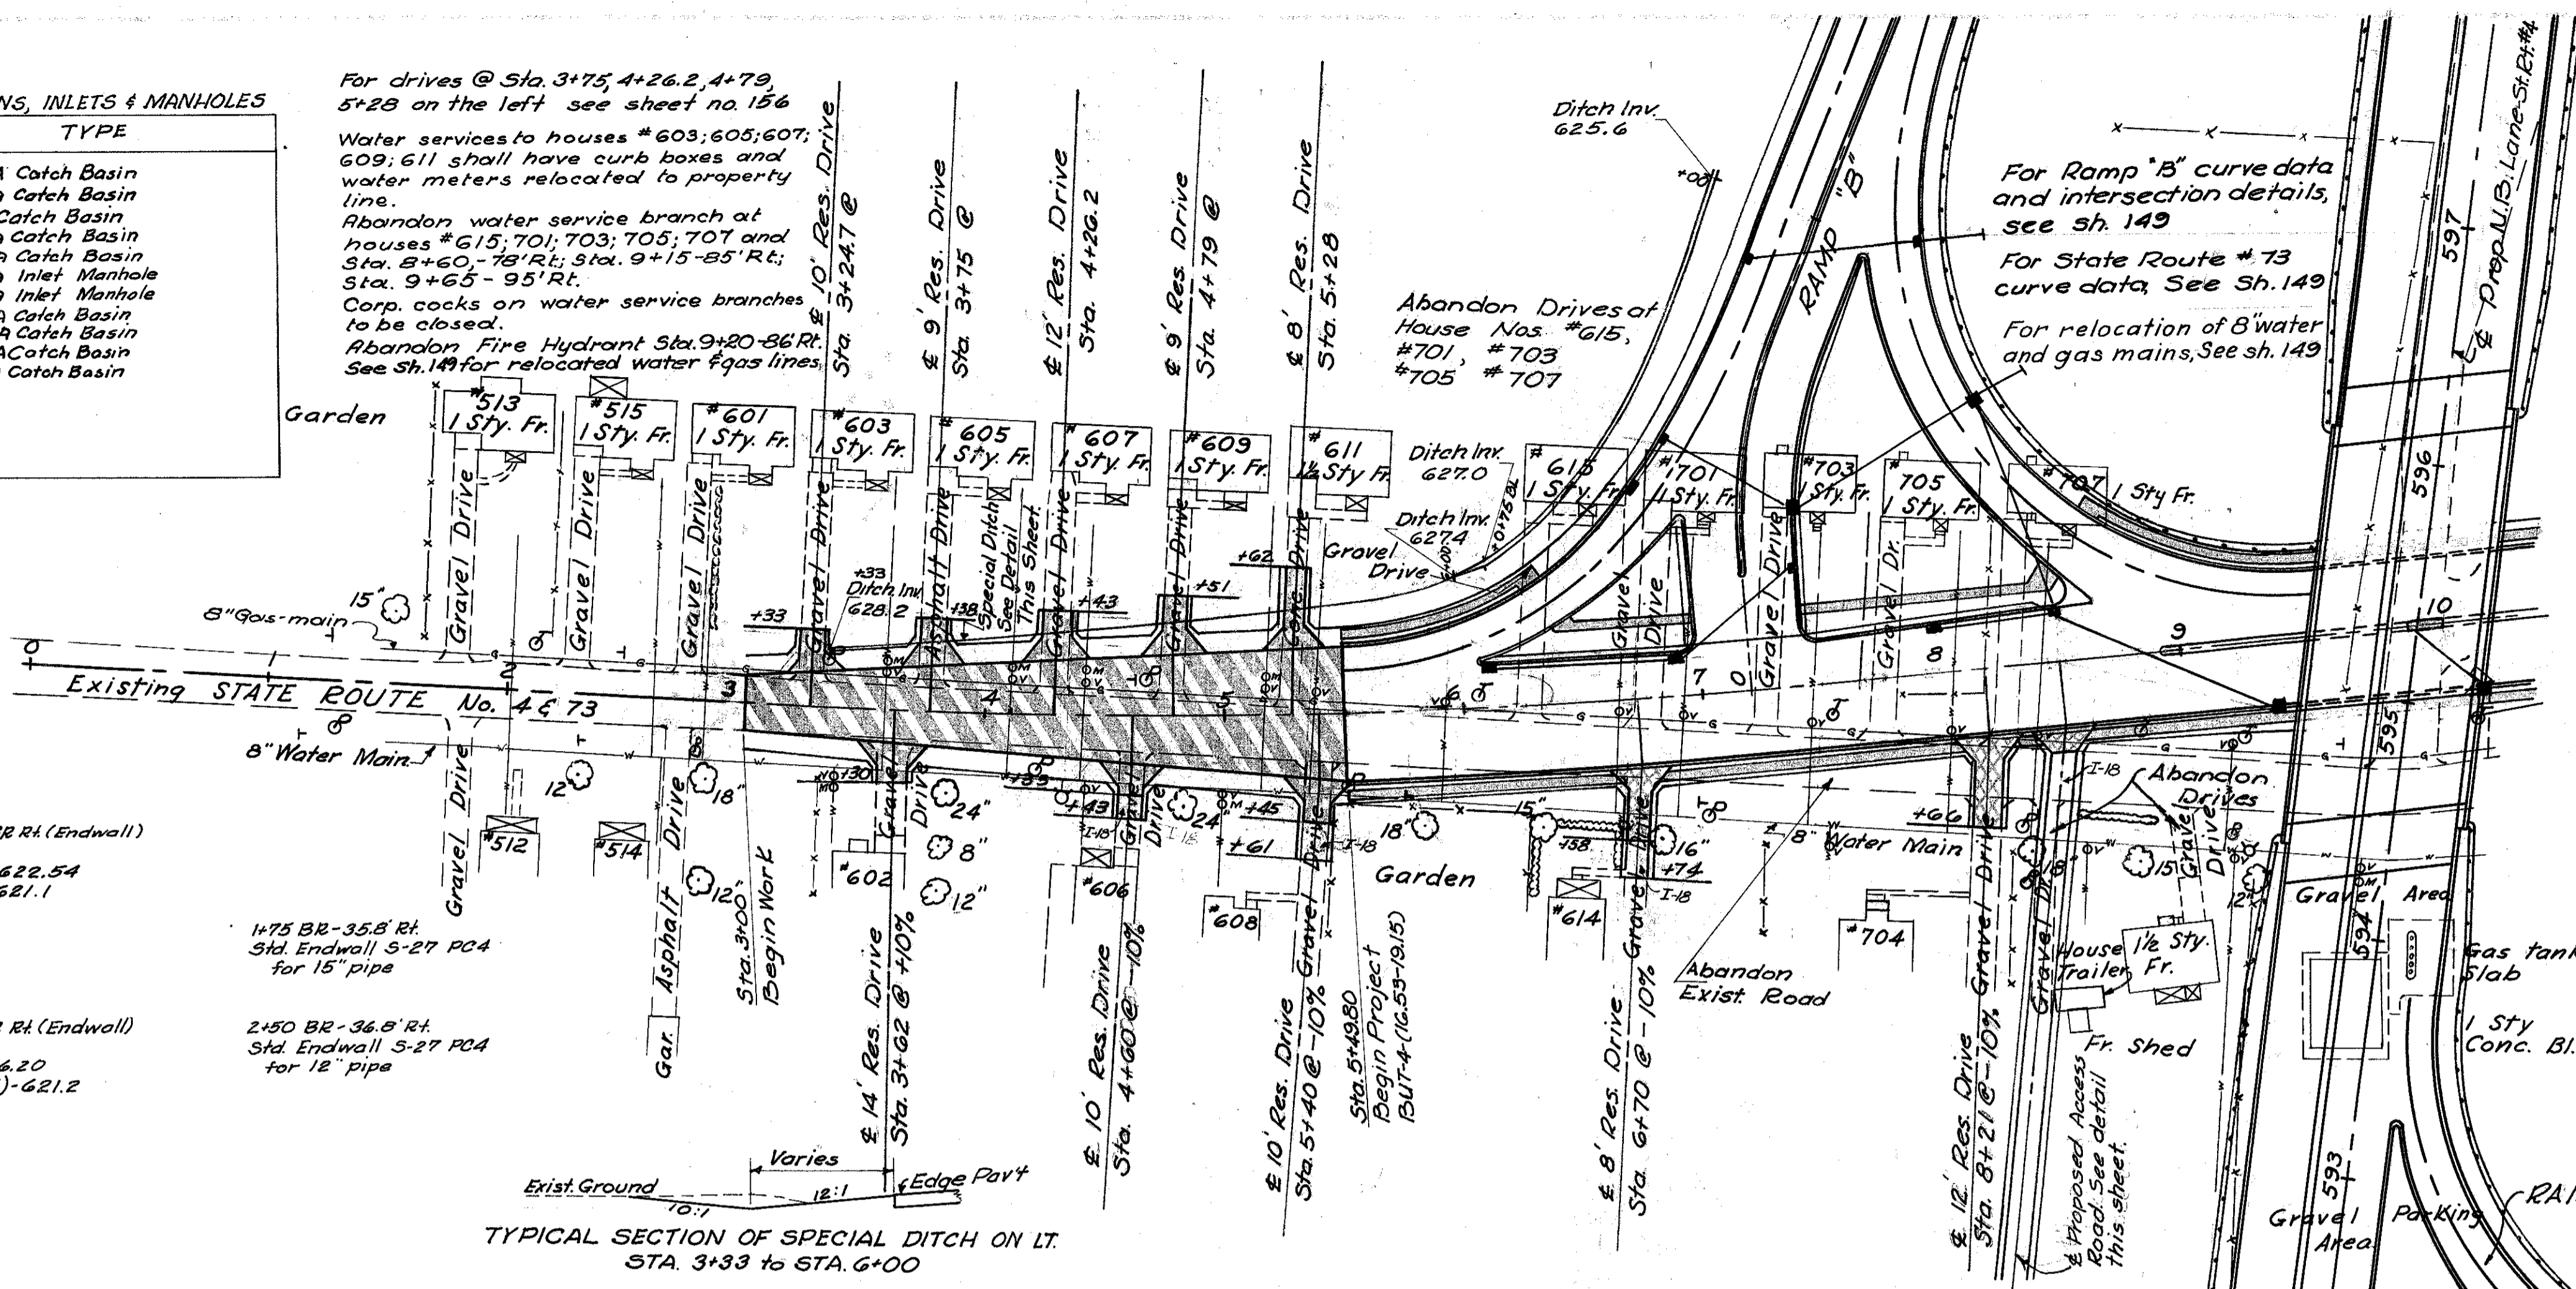



CATCH BASINS, INLETS & MANHOLES

STATIONS	TYPE
16+63 Rt	#3 Inlet Manhole
15+50 Rt	#3 Inlet Manhole
13+71 Rt	#3-A Catch Basin
12+50 Rt	#3 Inlet Manhole
10+25 Rt	#3 Inlet Manhole
10+00 E	#2-14 Inlet
9+40 Rt	#3 Inlet Manhole
0+50 ARt	#3 Catch Basin
0+30 A Lt	#3 Catch Basin - See Sh. #164
0+78A-15 Lt	#1 Manhole
1+55 AR Rt	#3-A Catch Basin
2+25 A E	#2-14 Inlet
2+25A-55 Rt	#1 Manhole Dim El. 640.97
2+25 A- Rt	#3-A Catch Basin
5+10 AL- Lt	#3-A Catch Basin
7+10 AL- Lt	#3-A Catch Basin
593+23 Rt	#3-A Catch Basin
594+10.8 Lt	#3-A Catch Basin
594+25.5 Rt	#3-A Catch Basin
17+65 - Lt	#2-2A C.B. without side inlets
6+00 AL-16 Lt	#1 Manhole Dim El. 656.3
4+10 A - Lt	#2 MH on prop. 28. See sh. #164
0+46H - Rt	#6 Catch Basin
17+35-24.5 Rt	#7 Catch Basin
2+12 E Rt	#2-2-A C.B. without side inlets

Manholes Adjusted to Grade See sheet 164  
14+00 Lt. 3+65A Lt.

16+22 Lt. 18+50 E

For relocation of 8" water and gas mains and fire hydrants See sh. 147

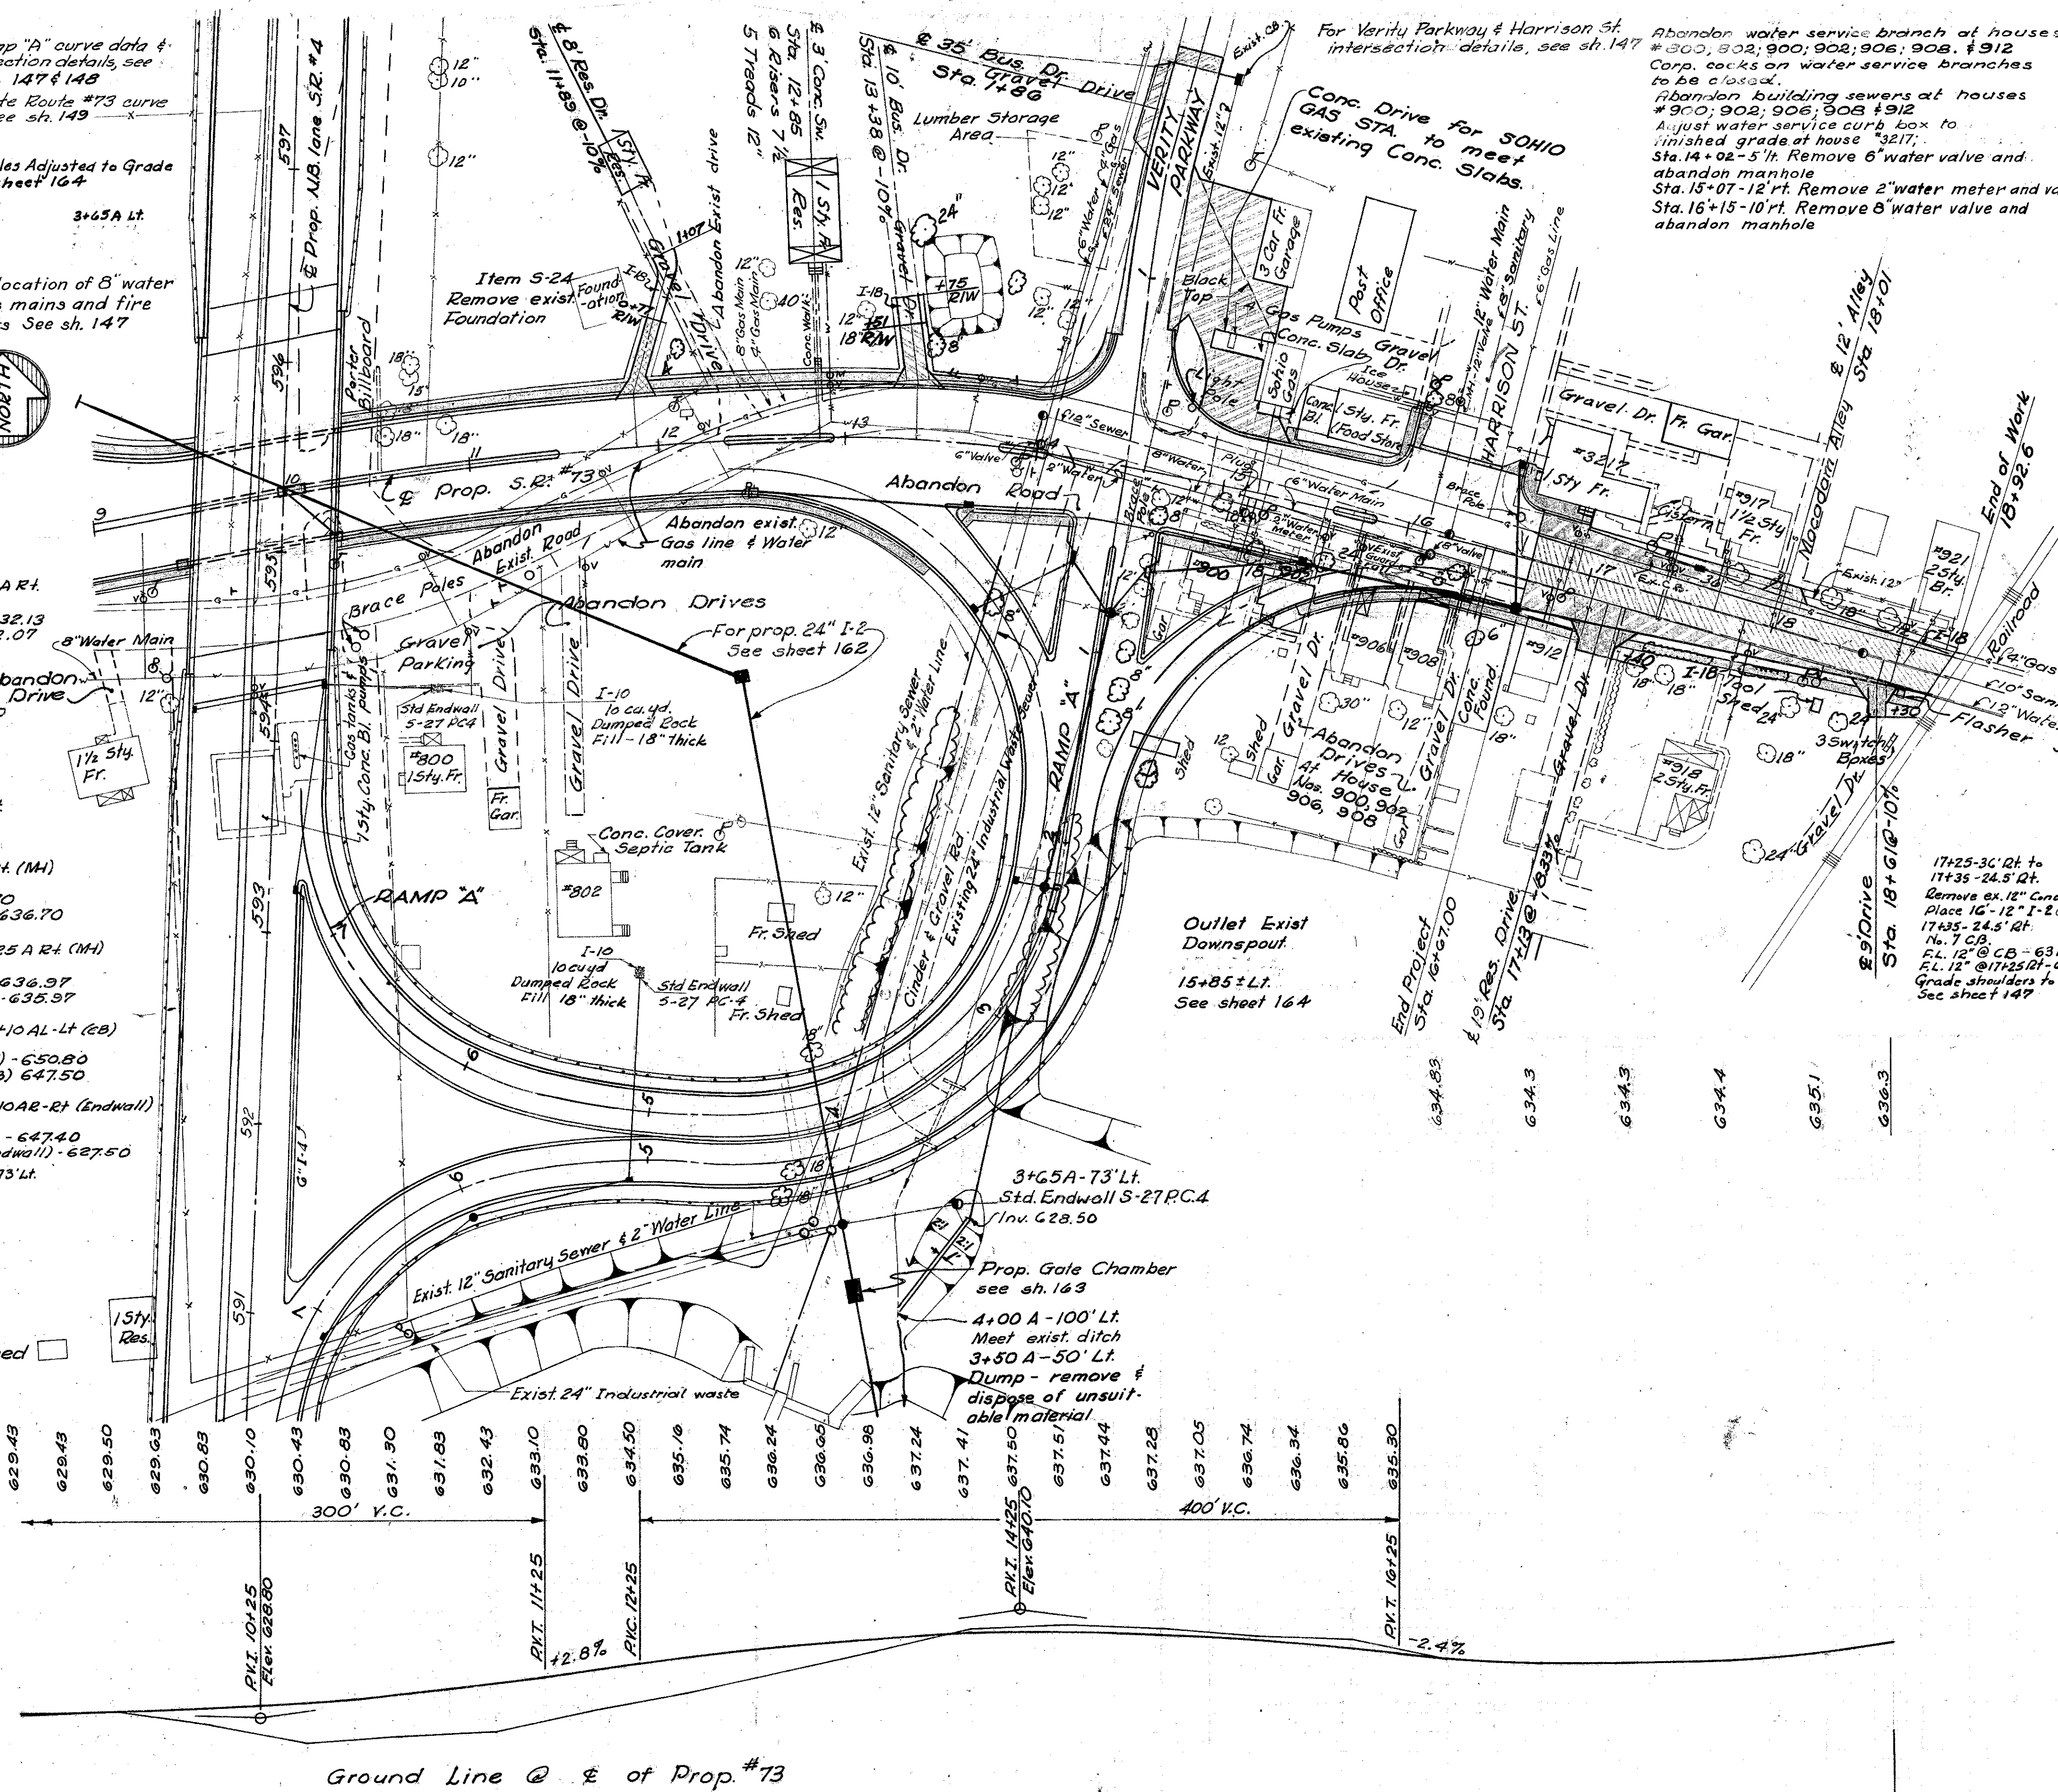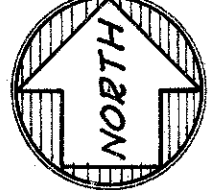

I-2

9+40 Rt to 10+25 Rt  
80'-15"  
Inv. @ 9+40 Rt - 624.10  
Inv. @ 10+25 Rt - 624.80

10+00 E to 10+25 Rt  
35'-12"  
Inv. @ 10+00 E - 625.00  
Inv. @ 10+25 Rt - 624.90

10+25 Rt to 12+50 Rt  
21'-12"  
Inv. @ 10+25 Rt - 624.90  
Inv. @ 12+50 Rt - 631.00

12+50 Rt to 13+71 Rt  
113'-12"  
Inv. @ 13+71 Rt - 633.07  
Inv. @ 12+50 Rt - 631.13

15+50 Rt to 16+63 Rt  
107'-12"  
Inv. @ 15+50 Rt - 631.11  
Inv. @ 16+63 Rt - 631.52

594+25.5 Rt (CB) to Endwall Rt  
58'-12" M 6.4c (16 Ga.)  
Inv. @ 594+25.5 Rt (CB) - 627.00  
Inv. @ Endwall Rt - 628.00

7+10 AL- Lt (CB) to 6+00 AL- Lt (MH)  
36'-12"  
Inv. @ 7+10 AL- Lt (CB) - 656.60  
Inv. @ 6+00 AL- Lt (MH) - 651.00

593+23 Rt to 594+25.5 Rt  
107'-12"  
Inv. @ 593+23 Rt - 630.20  
Inv. @ 594+25.5 Rt - 627.10

594+10.5 Lt to 594+25.5 Rt  
85'-12"  
Inv. @ 594+10.5 Lt - 629.50  
Inv. @ 594+25.5 Rt - 627.10

1+55 AR Rt to 0+50 ARt  
56'-12"  
Inv. @ 1+55 AR Rt - 632.13  
Inv. @ 0+50 ARt - 632.07

15+50 Rt to 0+50A Lt  
71'-12"  
Inv. @ 15+50 Rt - 631.11  
Inv. @ 0+50A Lt - 630.70

0+50 A Lt to 0+78 A Lt  
31'-12"  
See Sheet #164

0+50 ARt to 0+78 A Lt  
34'-12"  
See Sheet #164

2+25 A E to 2+25 A Rt (MH)  
3'-12"  
Inv. @ 2+25 E - 637.70  
Inv. @ 2+25 Rt (MH) - 636.70

2+25 A Rt. (C.B.) to 2+25 A Rt (MH)  
14'-12"  
Inv. @ 2+25 Rt (C.B.) - 636.37  
Inv. @ 2+25 A Rt (MH) - 635.97

6+00 AL- Lt (MH) to 5+10 AL- Lt (CB)  
83'-12"  
Inv. @ 6+00 AL- Lt (MH) - 650.80  
Inv. @ 5+10 AL- Lt (CB) - 647.50

5+10 AL- Lt (CB) to 5+10 AR- Rt (Endwall)  
108'-12"  
Inv. @ 5+10 AL- Lt (CB) - 647.40  
Inv. @ 5+10 AR- Rt (Endwall) - 627.50

0+78A-15 Lt. to 3+65A-73 Lt.  
321'-18" I-2  
Inv. @ 0+78A - 630.20  
Inv. @ 3+65A - 628.50

0+46H Rt to 16+63 Rt  
74'-12"  
Inv. @ 0+46H Rt - 631.82  
Inv. @ 16+63 Rt - 631.52

See sheet 162 for additional drainage

640  
630  
620

Ground Line @ E of Prop. #73

629.43  
629.43  
629.50  
629.63  
630.83  
630.10  
630.43  
630.83  
631.30  
631.83  
632.43  
633.10  
633.60  
634.50  
635.16  
635.74  
636.24  
636.65  
636.98  
637.24  
637.41  
637.50  
637.51  
637.44  
637.28  
637.05  
636.74  
636.34  
635.86  
635.30

300' V.C.  
400' V.C.

PVT. 11+25  
+2.8%

PVI. 12+25  
PVI. 12+25

PVT. 16+25  
-2.4%

629.0  
629.5  
630.0  
630.2  
630.7  
630.7  
630.5  
631.4  
633.5  
633.8  
638.1  
638.4  
638.0  
637.2  
635.7  
634.7  
634.2  
634.2  
634.3  
635.0  
636.3 +.95

Abandon water service branch at houses #300, 302, 900, 902, 906, 908. #912 Corp. cocks on water service branches to be closed.

Abandon building sewers at houses #900, 902, 906, 908 #912 Adjust water service curb box to finished grade at house #327. Sta. 14+02-5 ft. Remove 6" water valve and abandon manhole Sta. 15+07-12 ft. Remove 2" water meter and valve Sta. 16+15-10 ft. Remove 8" water valve and abandon manhole

13+75 Rt to 15+53 Rt  
Inv. 6" I-4 @ 13+75 Rt - 632.0  
Inv. 6" I-4 @ 15+53 Rt (C.B.) - 631.5

0+32 A Lt to 0+50 A Lt  
Inv. 6" I-4 @ 0+32 A Lt - 631.5  
Inv. 6" I-4 @ 0+50 A Lt (C.B.) - 631.2

0+50 A Lt to 0+99 A Lt  
Inv. 6" I-4 @ 0+50 A Lt (C.B.) - 631.2  
Inv. 6" I-4 @ 0+99 A Lt - 632.0

0+32 A Rt to 0+50 A Rt  
Inv. 6" I-4 @ 0+32 A Rt - 632.6  
Inv. 6" I-4 @ 0+50 A Rt (C.B.) - 632.5

0+50 A Rt to 1+06 A Rt  
Inv. 6" I-4 @ 0+50 A Rt (C.B.) - 632.5  
Inv. 6" I-4 @ 1+06 A Rt - 634.7

9+42 to 10+22-27.5 Rt  
Inv. 6" I-4 @ 9+42 Rt (C.B.) - 624.8  
Inv. 6" I-4 @ 10+22 Rt - 625.0

10+21 to 12+47-27.5 Rt  
Inv. 6" I-4 @ 10+21 Rt (C.B.) - 625.0  
Inv. 6" I-4 @ 12+47 Rt - 629.1

0+50 E Lt to 2+12 E Lt  
Inv. 6" I-4 @ 0+50 Lt - 635.0  
Inv. 6" I-4 @ 2+12 Lt - 634.5 (90° bend)  
Connect 6" I-4 to Prop. 2-2-A C.B. Sta. 2+12 Rt with 36" G" Outlet for I-4  
Inv. @ C.B. - 634.0

2+12 E - 23 Rt  
Abandon Exist. Catch Basin Item 1-16. Build No. 2-2-A C.B. without side inlets on existing 12" Pipe Item E-12. Build Std. No. 22A. C.B. without side inlets on exist. 12" @ 17+65. Inv. 12" - 629.6. Grade shoulders to prop C.B. See sheet 147. Remove exist 4" CI Pipe


17+24 to 17+65 Lt. Abandon exist. C.B. Remove exist 12" Pipe Item E-12. Build Std. No. 22A. C.B. without side inlets on exist. 12" @ 17+65. Inv. 12" - 629.6. Grade shoulders to prop C.B. See sheet 147. Remove exist 4" CI Pipe

17+25-30 Rt to 17+35-24.5 Rt.  
Remove ex. 12" Conc. Pipe Item E-12. Place 16" 12" I-2 (No. 4-16).  
17+35-24.5 Rt.  
16" 7 C.B.  
FL. 12" @ CB - 631.7  
FL. 12" @ 17+25 Rt - 631.3  
Grade shoulders to drain. See sheet 147


6" I-4  
591+18 Rt to 593+23 Rt  
Inv. 6" I-4 @ 591+18 Rt - 635.2  
Inv. 6" I-4 @ 593+23 Rt (C.B.) - 630.7

For drainage in Interchange Area  
(Sta. 607+00 to 617+00) see sheets 166, 167, & 168

CURVE DATA  
 PI = 620+28.49  
 Δ = 13°-40'-00" Lt  
 D = 2°-30'-00"  
 R = 2291.83'  
 Ls = 300.00'  
 Lc = 486.67'  
 Ts = 541.51'  
 Es = 35.83'  
 Superelev = 1/40' / ft.


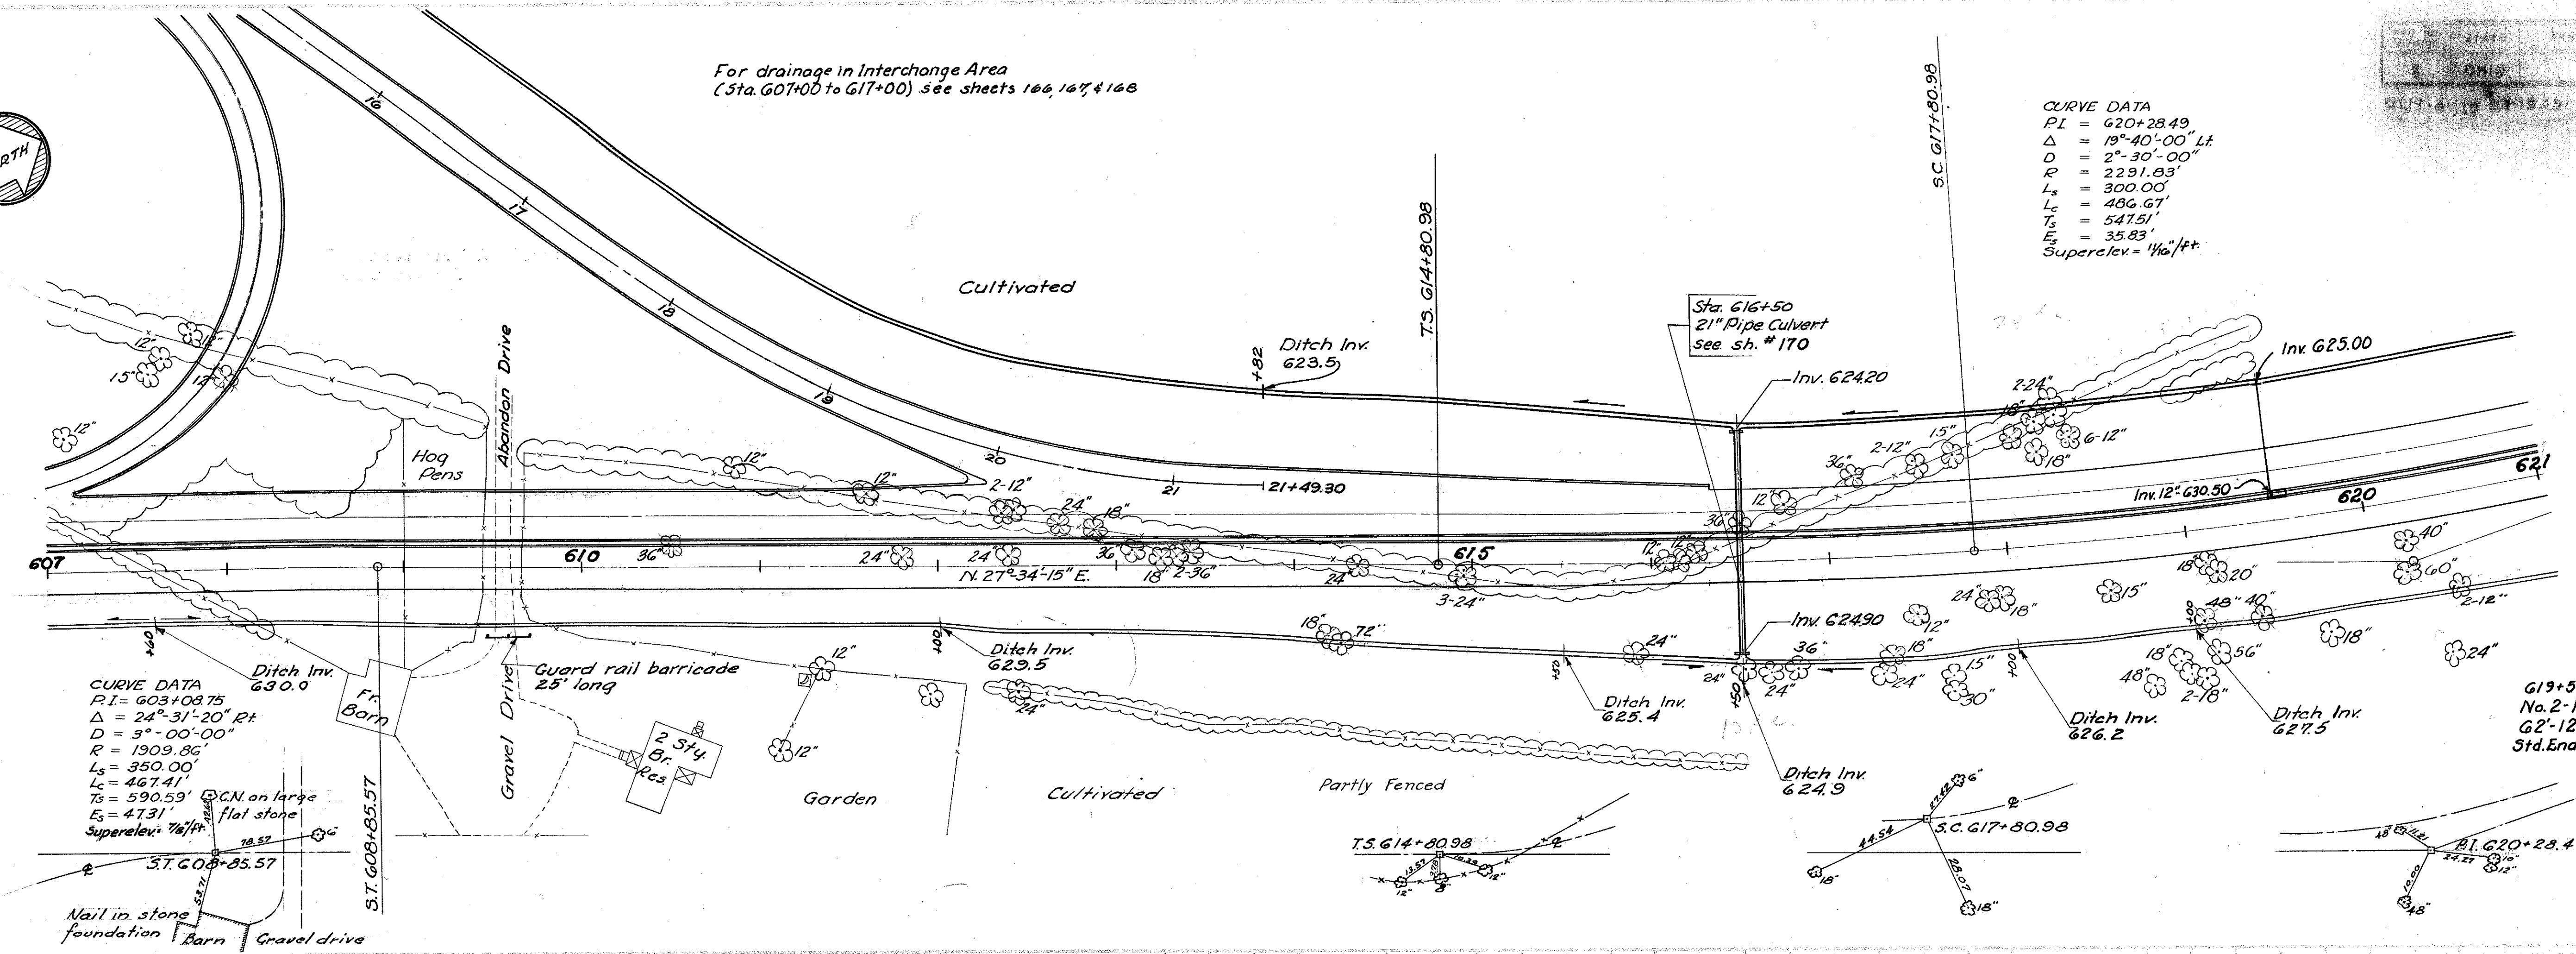


CURVE DATA  
 PI = 603+08.75  
 Δ = 24°-31'-20" Rt  
 D = 3°-00'-00"  
 R = 1909.86'  
 Ls = 350.00'  
 Lc = 467.41'  
 Ts = 590.59'  
 Es = 473.1'  
 Superelev = 7/80' / ft.  
 C.M. on large flat stone

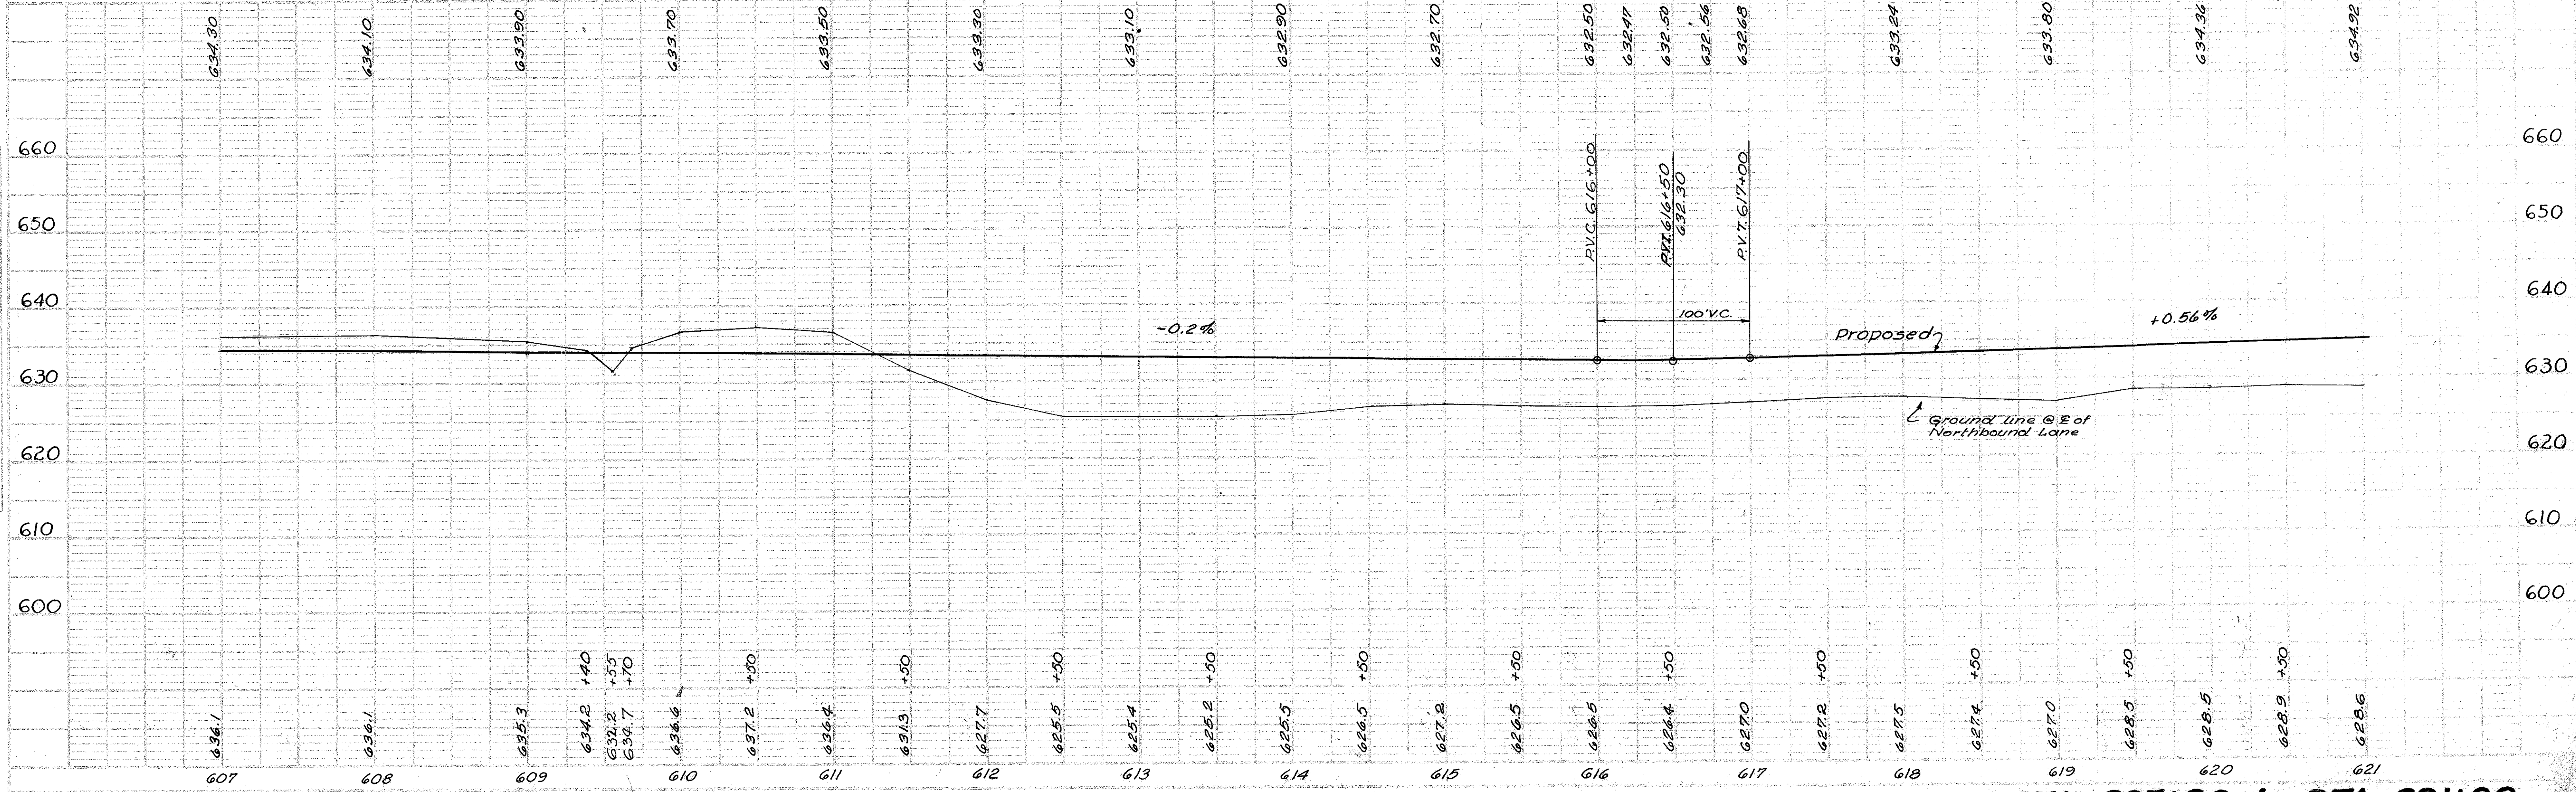



STA. 607+00 to STA. 621+00



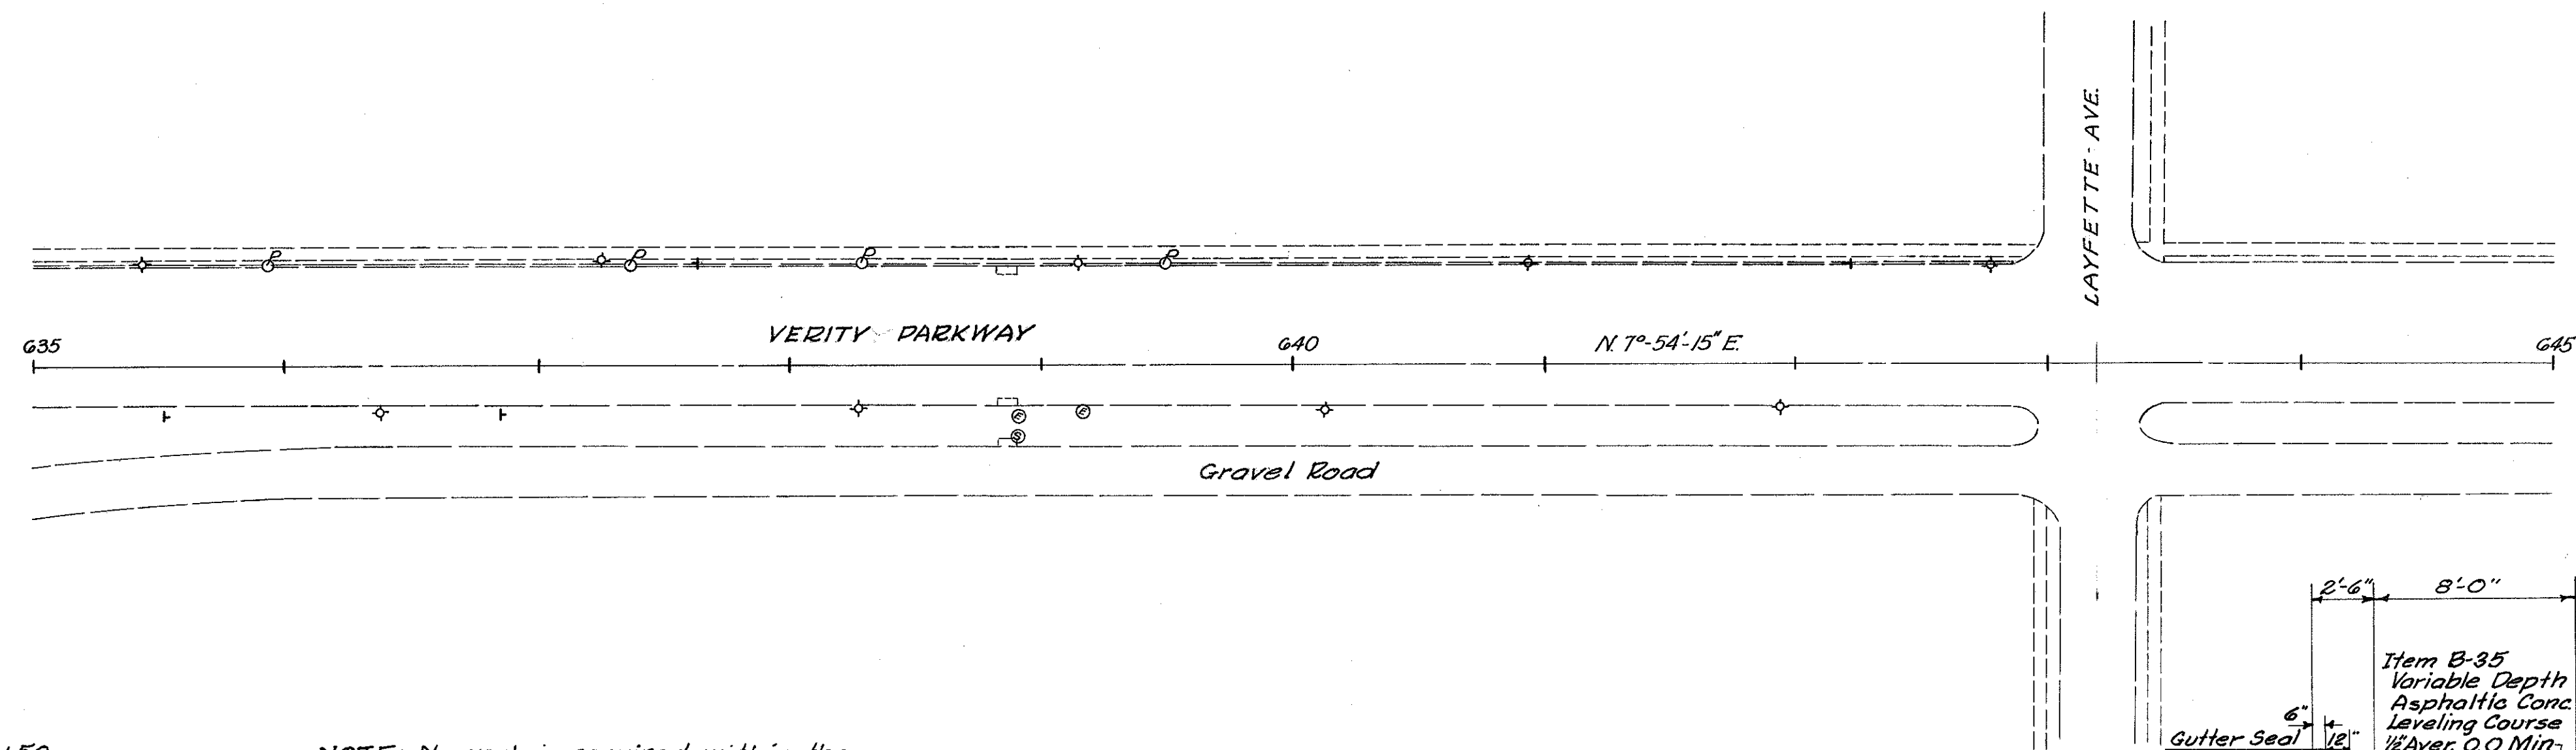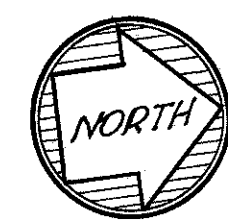

End Project Sta. 634+50  
 BUT-4-(16.53-19.15)  
 See sheet 46

NOTE: No work is required within the  
 limits shown on this sheet under  
 Contract BUT-4-(16.53-19.15)

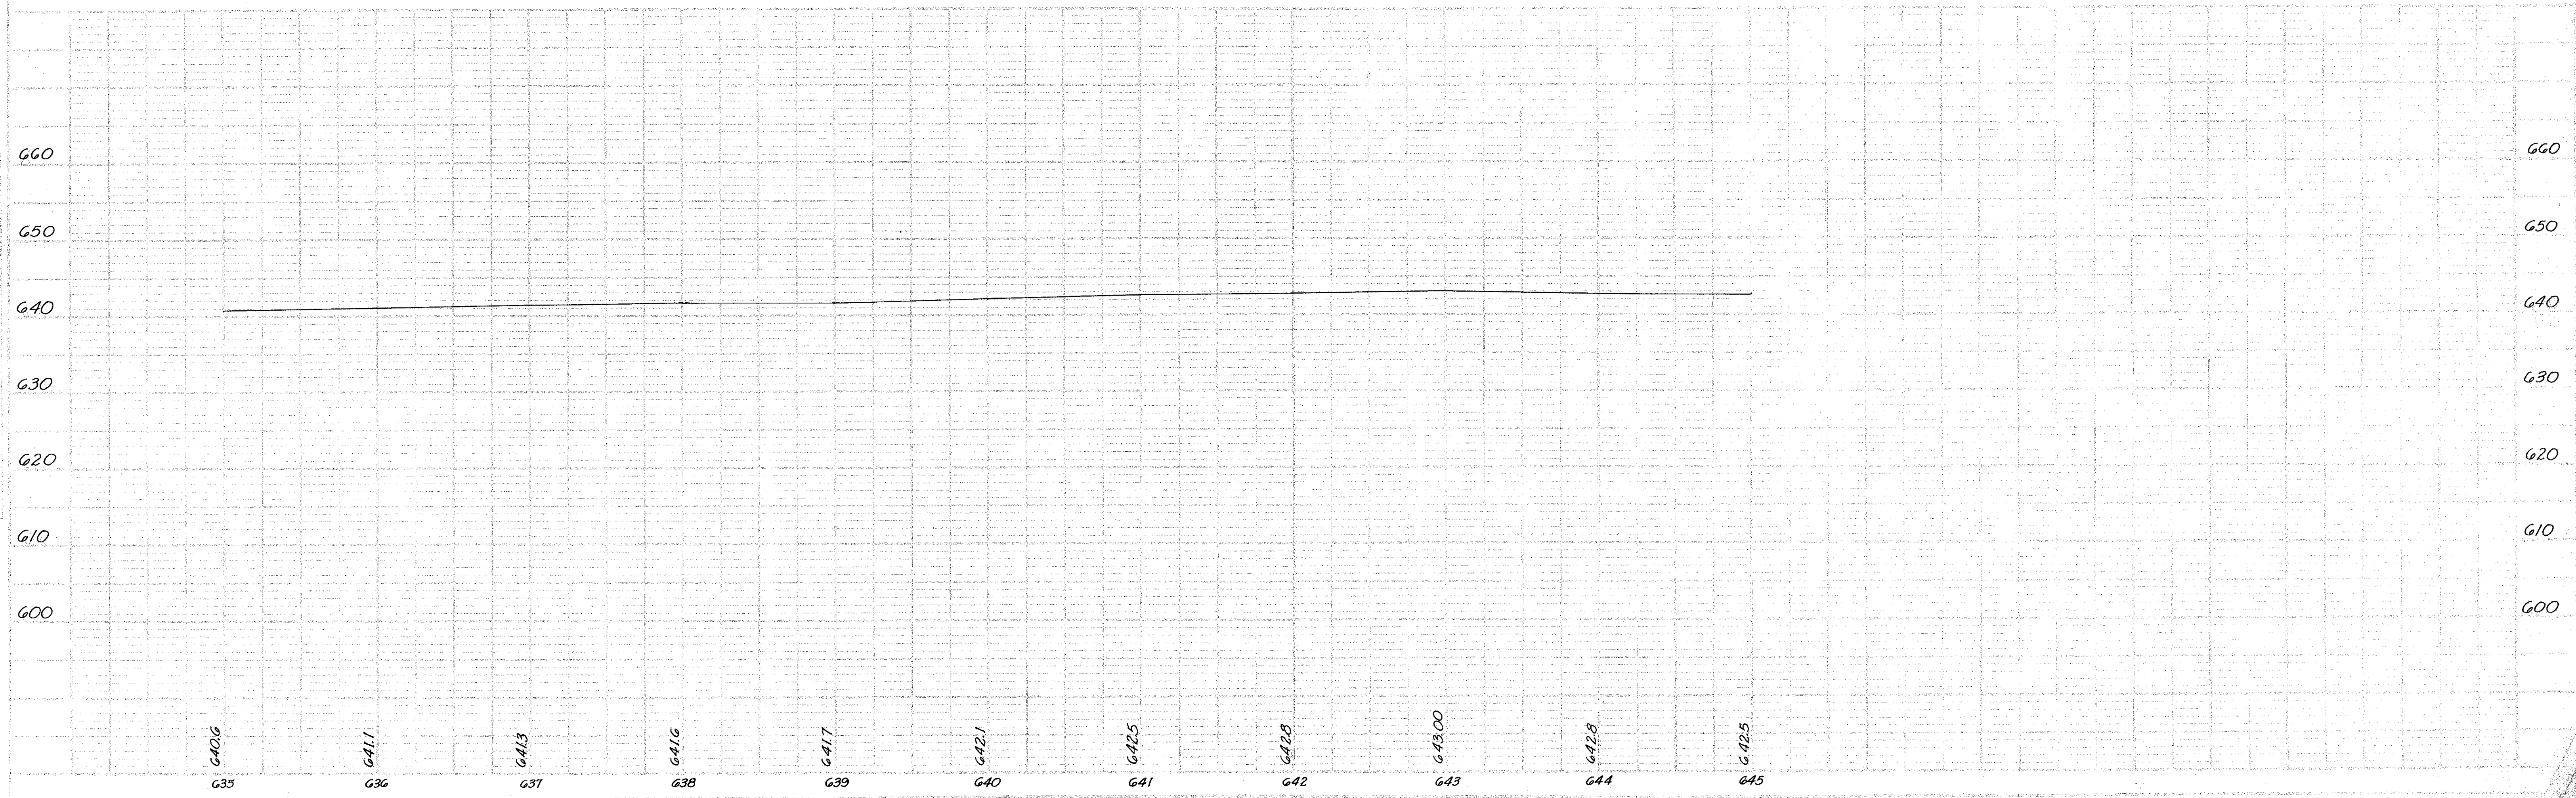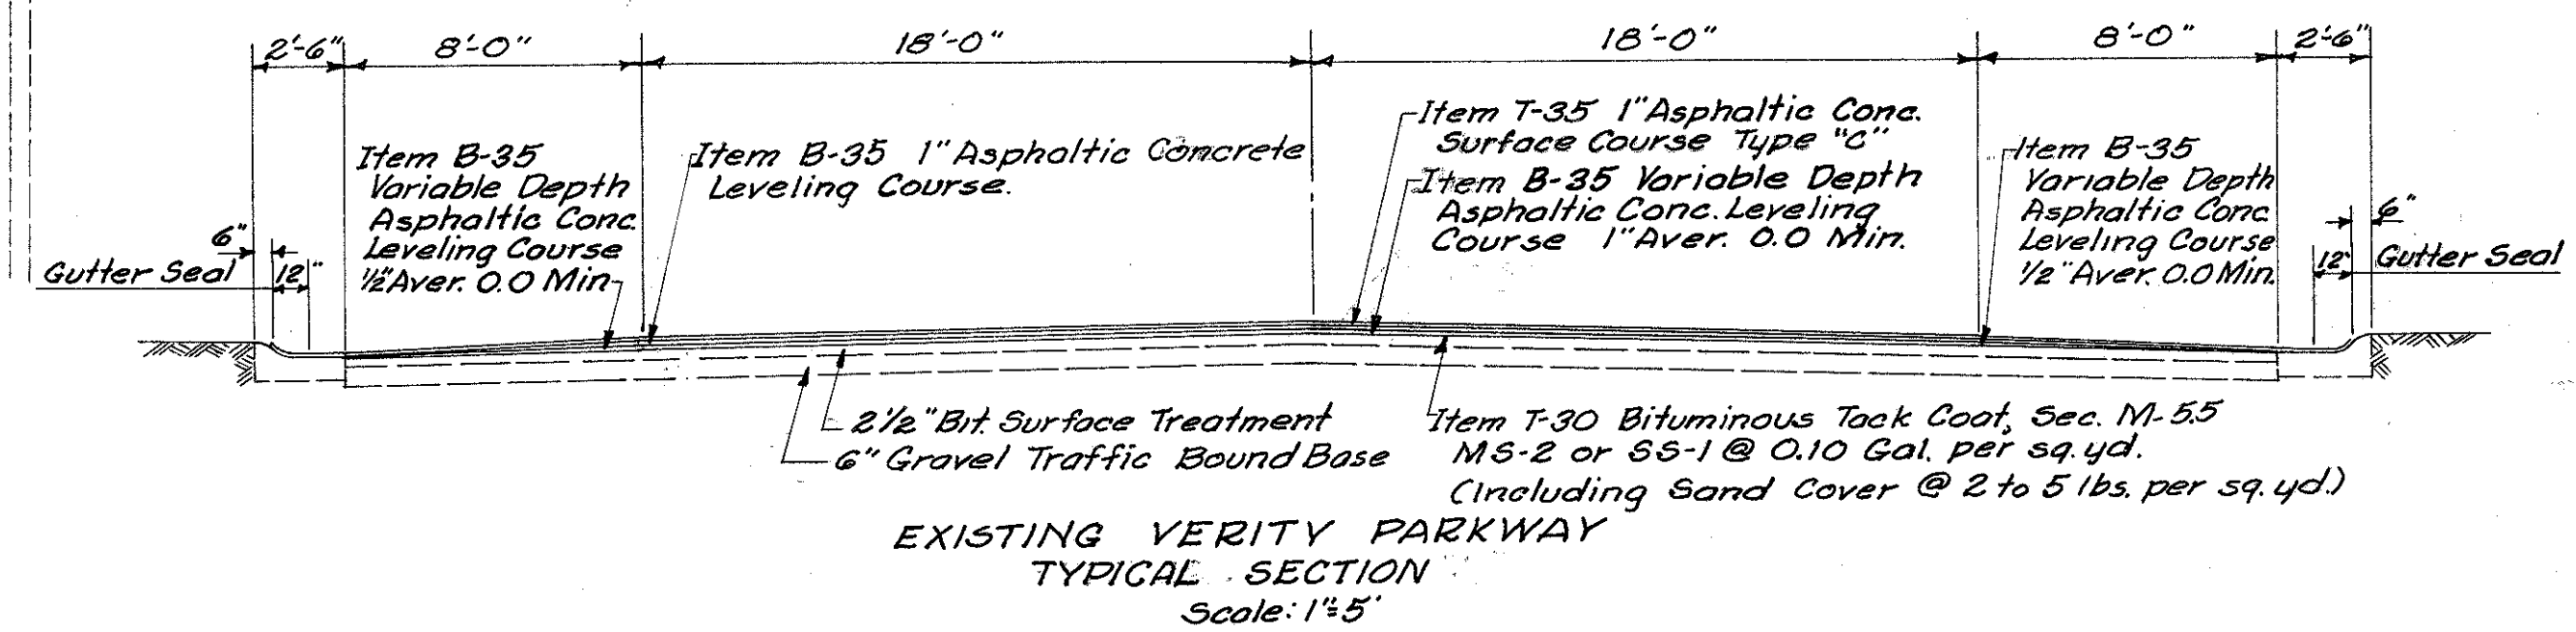

STA. 635+00 to STA. 645+00

# SUPERELEVATION TABLES

TS = 469+01.93      D = 4°00' Lt			
SC = 473+01.93      S = 1 1/4% Ft			
CS = 478+50.00			
ST = 482+50.00			
Station	Inner Edge N.B. Lane	℄ N.B. Lane	Outer Edge N.B. Lane
470+50	720.63	721.06	721.49
+75	721.54	722.03	722.51
471+00	722.42	722.96	723.51
+25	723.27	723.87	724.47
+50	724.09	724.75	725.40
+75	724.88	725.59	726.30
472+00	725.63	726.40	727.17
+25	726.36	727.19	728.01
+50	727.05	727.93	728.81
+75	727.71	728.65	729.59
473+00	728.33	729.33	730.32
5C.473+01.93	728.41	729.41	730.41
+25	729.33	729.93	730.93
+50	729.50	730.50	731.50
+75	730.02	731.02	732.02
474+00	730.52	731.52	732.52
+25	730.98	731.98	732.98
+50	731.43	732.43	733.43
+75	731.82	732.82	733.82
475+00	732.19	733.19	734.19
+25	732.53	733.53	734.53
+50	732.84	733.84	734.84
+75	733.11	734.11	735.11
476+00	733.35	734.35	735.35
+25	733.56	734.56	735.56
+50	733.75	734.75	735.75
+75	733.89	734.89	735.89
477+00	734.00	735.00	736.00
+25	734.10	735.10	736.10
+50	734.20	735.20	736.20
+75	734.31	735.31	736.31
478+00	734.41	735.41	736.41
+25	734.51	735.51	736.51
CS.478+50.00	734.61	735.61	736.61
+75	734.72	735.66	736.61
479+00	734.82	735.71	736.59
+25	734.92	735.75	736.58
+50	735.02	735.79	736.57
+75	735.13	735.85	736.56
480+00	735.23	735.89	736.55
+25	735.33	735.93	736.54
+50	735.43	735.93	736.52
+75	735.54	736.03	736.52
481+00	735.64	736.07	736.51
+25	735.74	736.12	736.49
+50	735.84	736.16	736.48
+75	735.95	736.21	736.48
482+00	736.05	736.26	736.46
+25	736.15	736.34	736.45
ST.482+50.00	736.27	736.46	736.46
+75	736.38	736.57	736.50
483+00	736.52	736.71	736.58
483+25.00	736.66	736.85	736.66

T.S. = 550+43.67      D = 2°00' Rk					
S.C. = 552+43.67      S = 3/16% Ft					
C.S. = 561+59.50					
S.T. = 563+59.50					
Station	Outer Edge S.B. Lane	℄ S.B. Lane	Inner Edge Both Lanes	℄ N.B. Lane	Outer Edge N.B. Lane
549+68.67	730.13	730.32	730.13	730.32	730.13
+75	729.91	730.03	729.89	730.06	729.87
550+00	729.93	729.09	729.90	729.01	728.82
+25	729.06	728.11	727.92	727.97	727.78
TS.550+43.67	727.37	727.37	727.13	727.13	726.99
+50	727.15	727.12	726.93	726.91	726.72
+75	726.29	726.14	725.95	725.96	725.67
551+00	725.41	725.19	724.96	724.80	724.61
+25	724.55	724.26	723.93	723.75	723.52
+50	723.69	723.34	723.00	722.70	722.40
+75	722.82	722.41	722.01	721.64	721.27
552+00	721.95	721.49	721.03	720.59	720.15
+25	721.08	720.56	720.04	719.53	719.02
5C.552+43.67	720.44	719.87	719.31	718.75	718.18
+50	720.19	719.62	719.06	718.50	717.93
+75	719.20	718.63	718.07	717.51	716.94
553+00	718.22	717.65	717.09	716.53	715.96
+25	717.23	716.66	716.10	715.54	714.97
+50	716.25	715.68	715.12	714.56	713.99
+75	715.27	714.70	714.14	713.58	713.01
554+00	714.28	713.71	713.15	712.59	712.02
+25	713.30	712.73	712.17	711.61	711.04
+50	712.31	711.74	711.18	710.62	710.05
+75	711.33	710.76	710.20	709.64	709.07
555+00	710.34	709.77	709.21	708.65	708.08
+25	709.36	708.79	708.23	707.67	707.10
+50	708.38	707.81	707.25	706.69	706.12
+75	707.39	706.82	706.26	705.70	705.13
556+00	706.41	705.84	705.28	704.72	704.15
+25	705.42	704.85	704.29	703.73	703.16
+50	704.44	703.87	703.31	702.75	702.18
+75	703.45	702.88	702.32	701.76	701.19
557+00	702.47	701.90	701.34	700.78	700.21
+25	701.49	700.92	700.36	699.80	699.23
+50	700.50	699.93	699.37	698.81	698.24
+75	699.52	698.95	698.39	697.83	697.26
558+00	698.53	697.96	697.40	696.84	696.27
+25	697.55	697.01	696.45	695.89	695.32
+50	696.58	696.11	695.55	694.99	694.42
+75	695.64	695.27	694.71	694.15	693.58
559+00	694.66	694.49	693.93	693.37	692.80
+25	694.33	693.76	693.20	692.64	692.07
+50	693.67	693.10	692.54	691.98	691.41
+75	693.06	692.49	691.93	691.37	690.80
560+00	692.51	691.94	691.38	690.78	690.25
+25	692.01	691.44	690.88	690.32	689.75
+50	691.53	691.01	690.45	689.89	689.32
+75	691.20	690.63	690.07	689.51	688.94
561+00	690.88	690.31	689.75	689.19	688.62
+25	690.62	690.05	689.49	688.93	688.36
+50	690.42	689.85	689.29	688.73	688.16
CS.561+59.50	690.36	689.79	689.23	688.67	688.10
+75	690.20	689.67	689.14	688.62	688.10
562+00	689.99	689.52	689.05	688.60	688.15
+25	689.84	689.43	688.92	688.64	688.26
+50	689.75	689.40	688.95	688.74	688.43
+75	689.72	689.44	689.14	688.90	688.66
563+00	689.75	689.51	689.28	689.11	688.91
+25	689.80	689.64	689.45	689.35	689.17
+50	689.85	689.81	689.62	689.59	689.41
ST.563+59.50	689.88	689.88	689.69	689.69	689.50
+75	689.95	689.98	689.79	689.83	689.64
564+00	690.08	690.13	689.99	690.09	689.90
+25	690.25	690.42	690.23	690.39	690.20
564+34.50	690.34	690.53	690.34	690.53	690.34

T.S. = 567+65.13      D = 2°00' Lt				
S.C. = 569+65.13      S = 3/16% Ft				
C.S. = 579+23.46				
S.T. = 581+23.46				
Station	Inner Edge N.B. Lane	℄ N.B. Lane	Outer Edge N.B. Lane	
566+90.13	695.94	696.13	695.94	
567+00	696.25	696.44	696.27	
+25	697.03	697.22	697.12	
+50	697.80	697.99	697.95	
TS.567+65.13	698.27	698.46	698.46	
+75	698.53	698.77	698.81	
568+00	699.35	699.54	699.70	
+25	700.13	700.36	700.60	
+50	700.90	701.19	701.49	
+75	701.66	702.01	702.36	
569+00	702.39	702.79	703.20	
+25	703.06	703.53	704.00	
+50	703.70	704.23	704.76	
5C.569+65.13	704.08	704.64	705.21	
+75	704.32	704.88	705.45	
570+00	704.89	705.44	706.01	
+25	705.42	705.98	706.55	
+50	705.92	706.48	707.05	
+75	706.38	706.94	707.51	
571+00	706.80	707.36	707.93	
+25	707.19	707.75	708.32	
+50	707.54	708.10	708.67	
+75	707.86	708.42	708.99	
572+00	708.13	708.69	709.26	
+25	708.37	708.93	719.50	
+50	708.57	709.13	719.70	
+75	708.74	709.30	719.87	
573+00	708.86	709.42	719.99	
+25	708.96	709.52	710.09	
+50	709.00*	709.56	710.13	
+75	708.98*	709.59	710.16	
574+00	708.95*	709.56	710.13	
+25	708.90*	709.51	710.08	
+50	708.80*	709.41	709.98	
+75	708.67*	709.28	709.85	
575+00	708.50*	709.11	709.68	
+25	708.30*	708.91	709.48	
+50	708.05*	708.66	709.23	
+75	707.78*	708.39	708.96	
576+00	707.46*	708.07	708.64	
+25	707.11*	707.72	708.29	
+50	706.72*	707.33	707.90	
+75	706.29*	706.90	707.47	
577+00	705.83*	706.44	707.01	
+25	705.33*	705.94	706.51	
+50	704.79*	705.40	705.97	
+75	704.21*	704.82	705.39	
578+00	703.60*	704.21	704.78	
+25	702.95*	703.56	704.13	
+50	702.27*	702.88	703.45	
+75	701.54*	702.15	702.72	
579+00	700.78*	701.39	701.96	
CS.579+23.46	700.04*	700.65	701.22	
+25	699.99*	700.60	701.16	
+50	699.16*	699.69	700.18	
+75	698.29*	698.75	699.17	
580+00	697.40*	697.73	698.13	
+25	696.46*	696.76	697.04	
+50	695.48*	695.71	695.91	
+75	694.49*	694.64	694.77	
581+00	693.49*	693.57	693.63	
ST.581+23.46	692.56*	692.56	692.56	
+25	692.50*	692.50	692.50	
+50	691.50*	691.47	691.43	
+75	690.50*	690.43	690.37	
582+00	689.50*	689.40	689.30	
+25	688.50*	688.37	688.24	
+50	687.50*	687.34	687.17	
582+73.46	686.56*	686.36	686.17	


T.S. = 568+06.135      D = 2°00' Lt			
S.C. = 570+06.135      S = 3/16% Ft			
C.S. = 579+64.465			
S.T. = 581+64.465			
Station	Outer Edge S.B. Lane	℄ S.B. Lane	Inner Edge S.B. Lane
567+31.13	697.23	697.42	697.23
+50	697.76	697.95	697.81
+75	698.47	699.06	698.53
568+00	699.19	699.38	699.36
TS.568+06.135	699.33	699.57	699.57
+25	699.95	700.14	700.19
+50	700.62	700.81	700.93
+75	701.31	701.51	701.70
569+00	701.89	702.16	702.42
+25	702.47	702.80	703.14
+50	703.01	703.41	703.82
+75	703.50	703.97	704.45
570+00	703.91	704.45	705.00
+25	704.40	704.97	70



150 140 130 120 110 100 90 80 70 60 50 40 30 20 10 0 10 20 30 40 50 60 70 80 90 100 110 120 130 140 150

19  
222


DATE: 10-18-53 BY: BLS

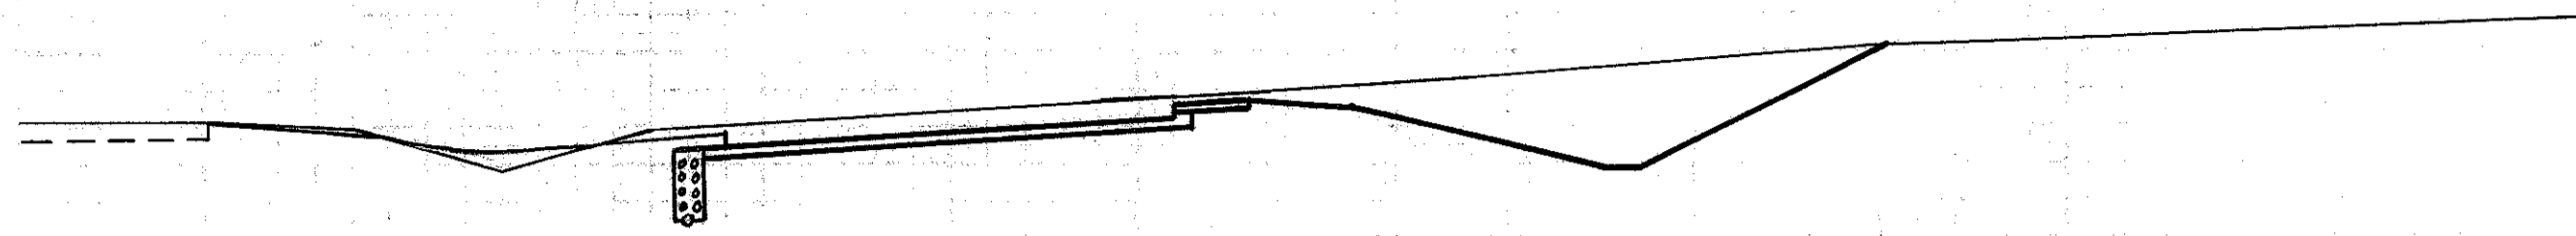

725.63  
472+00  
726.8



722.42  
471+00  
720.3

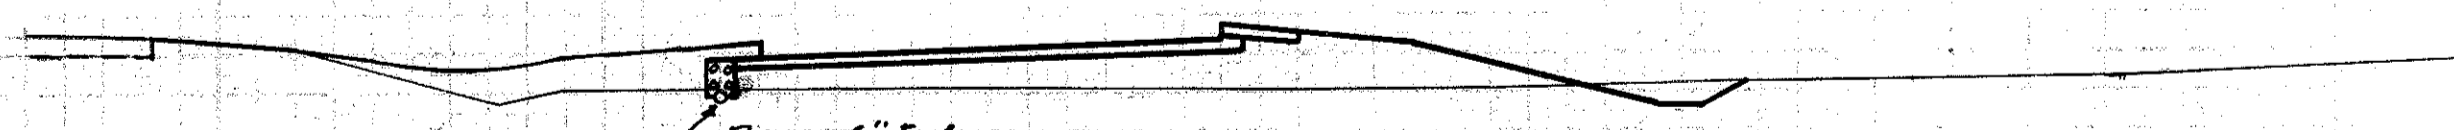





C Prop. 6" I-4

720.63  
470+50  
718.2

End Area		Cu. Yds.	
Cut	Fill	Cut	Fill
130	4		
		248	165
4	85		
		9	162
6	90		

150 140 130 120 110 100 90 80 70 60 50 40 30 20 10 0 10 20 30 40 50 60 70 80 90 100 110 120 130 140

STA. 470+50 TO 472

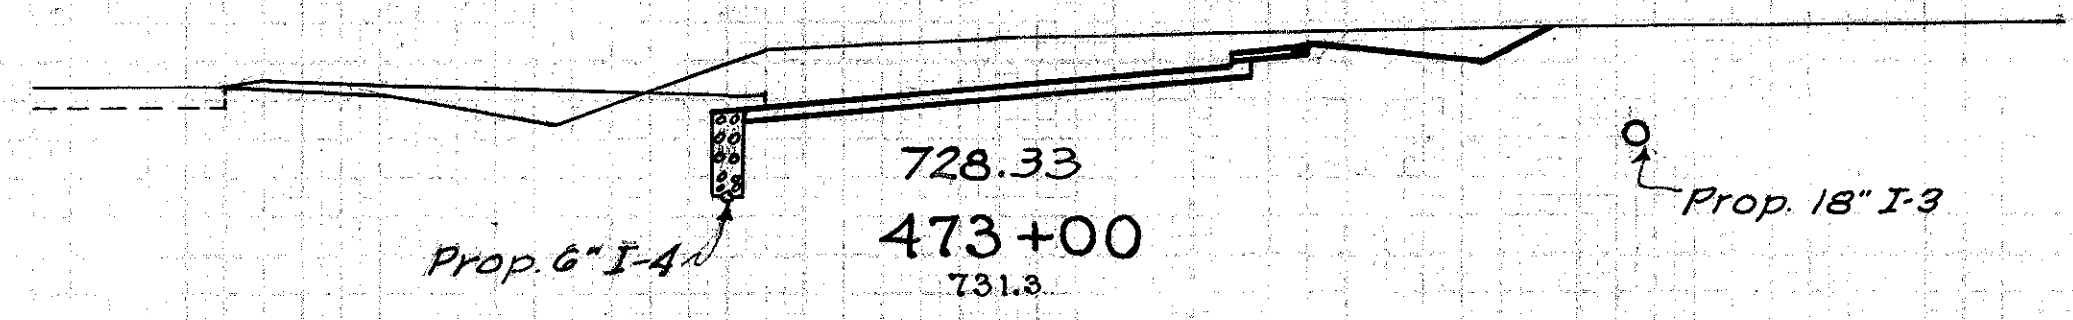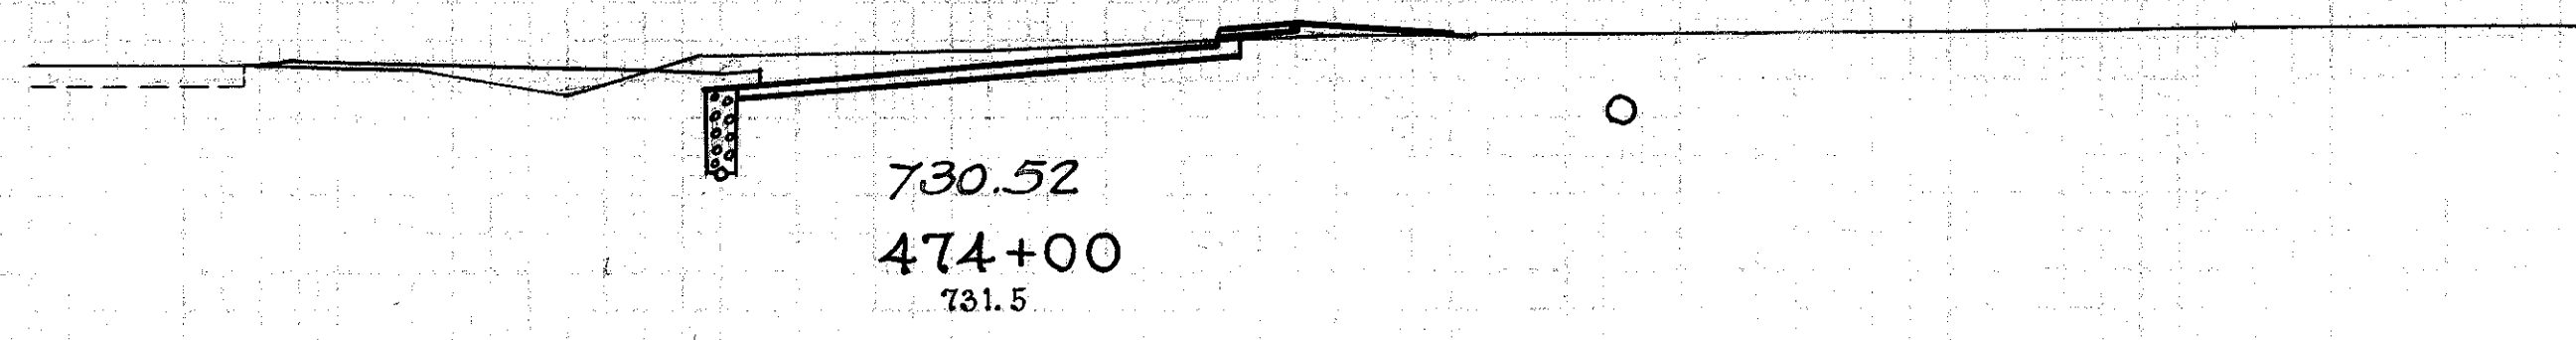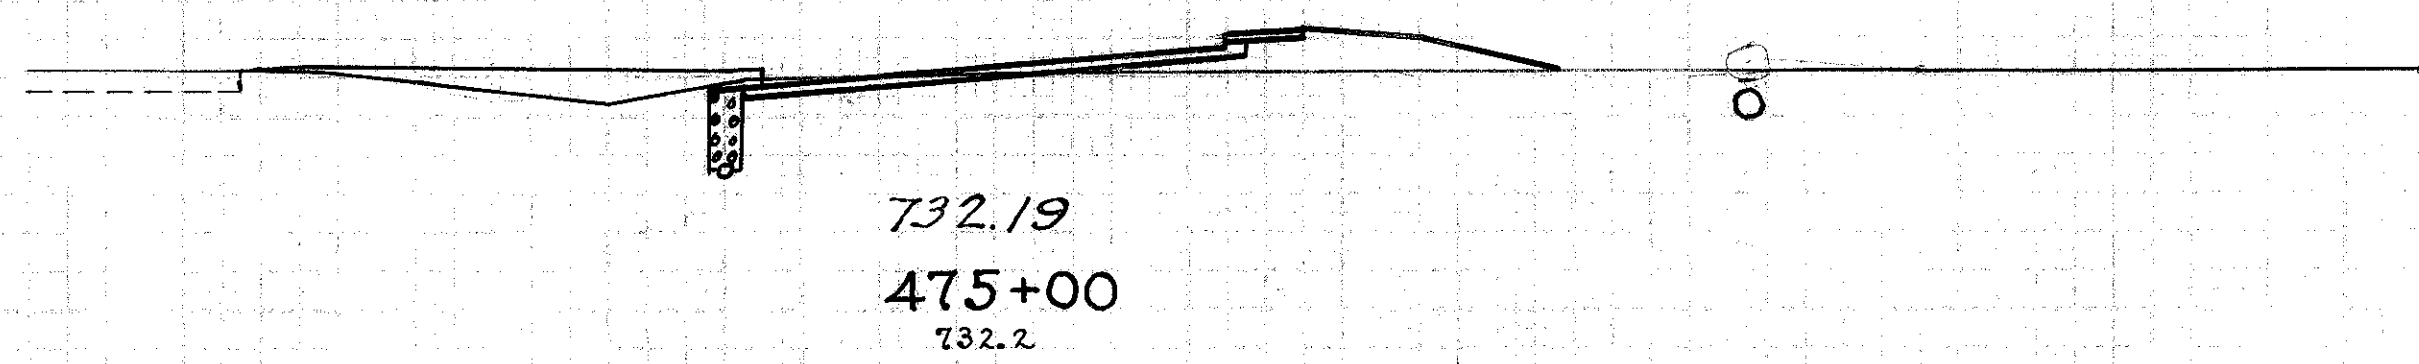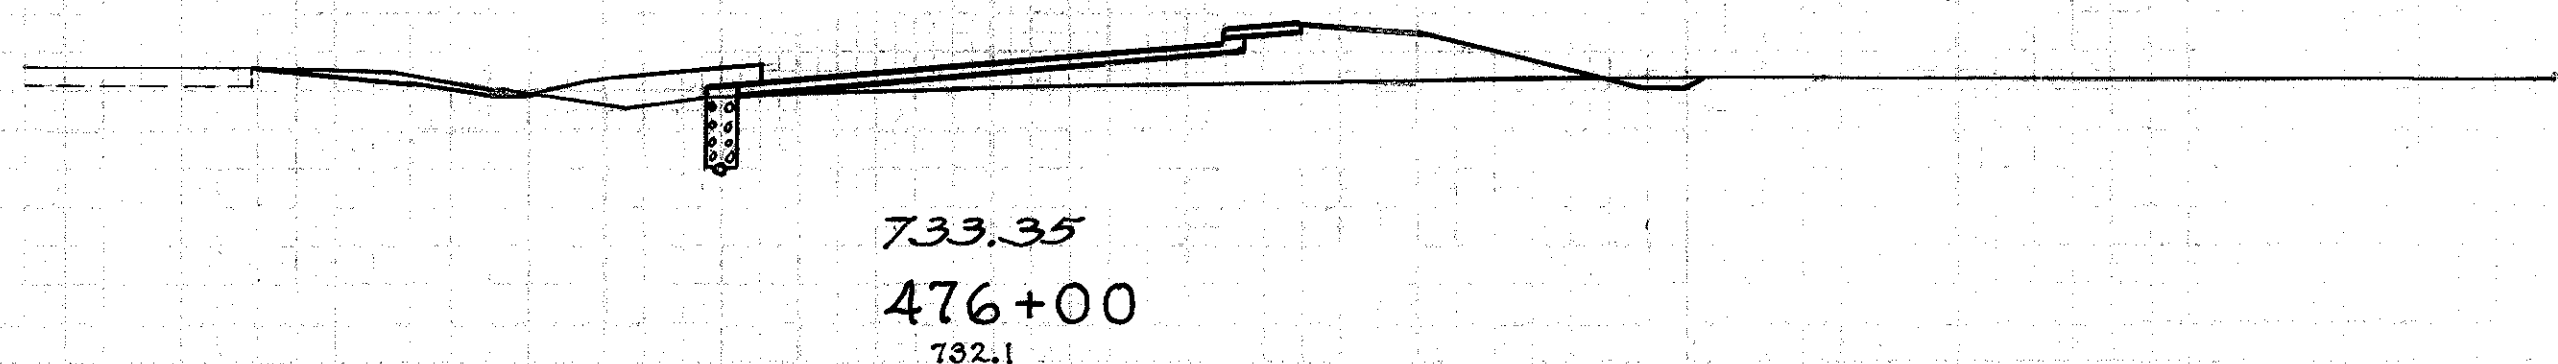


Note: Drive Rt. Sta. 474+81.5

Note: Drive Rt. Sta. 473+72

Note: Drive Sta. 472+83

Station	End Area		Cu. Yds.	
	Cut	Fill	Cut	Fill
476+00	7	66		
475+00			28	226
474+00			100	130
473+00			46	14
472+00			274	57
471+00			30	
470+00			102	17
469+00			19	
468+00			430	39

150 140 130 120 110 100 90 80 70 60 50 40 30 20 10 0 10 20 30 40 50 60 70 80 90 100 110 120 130 140 150

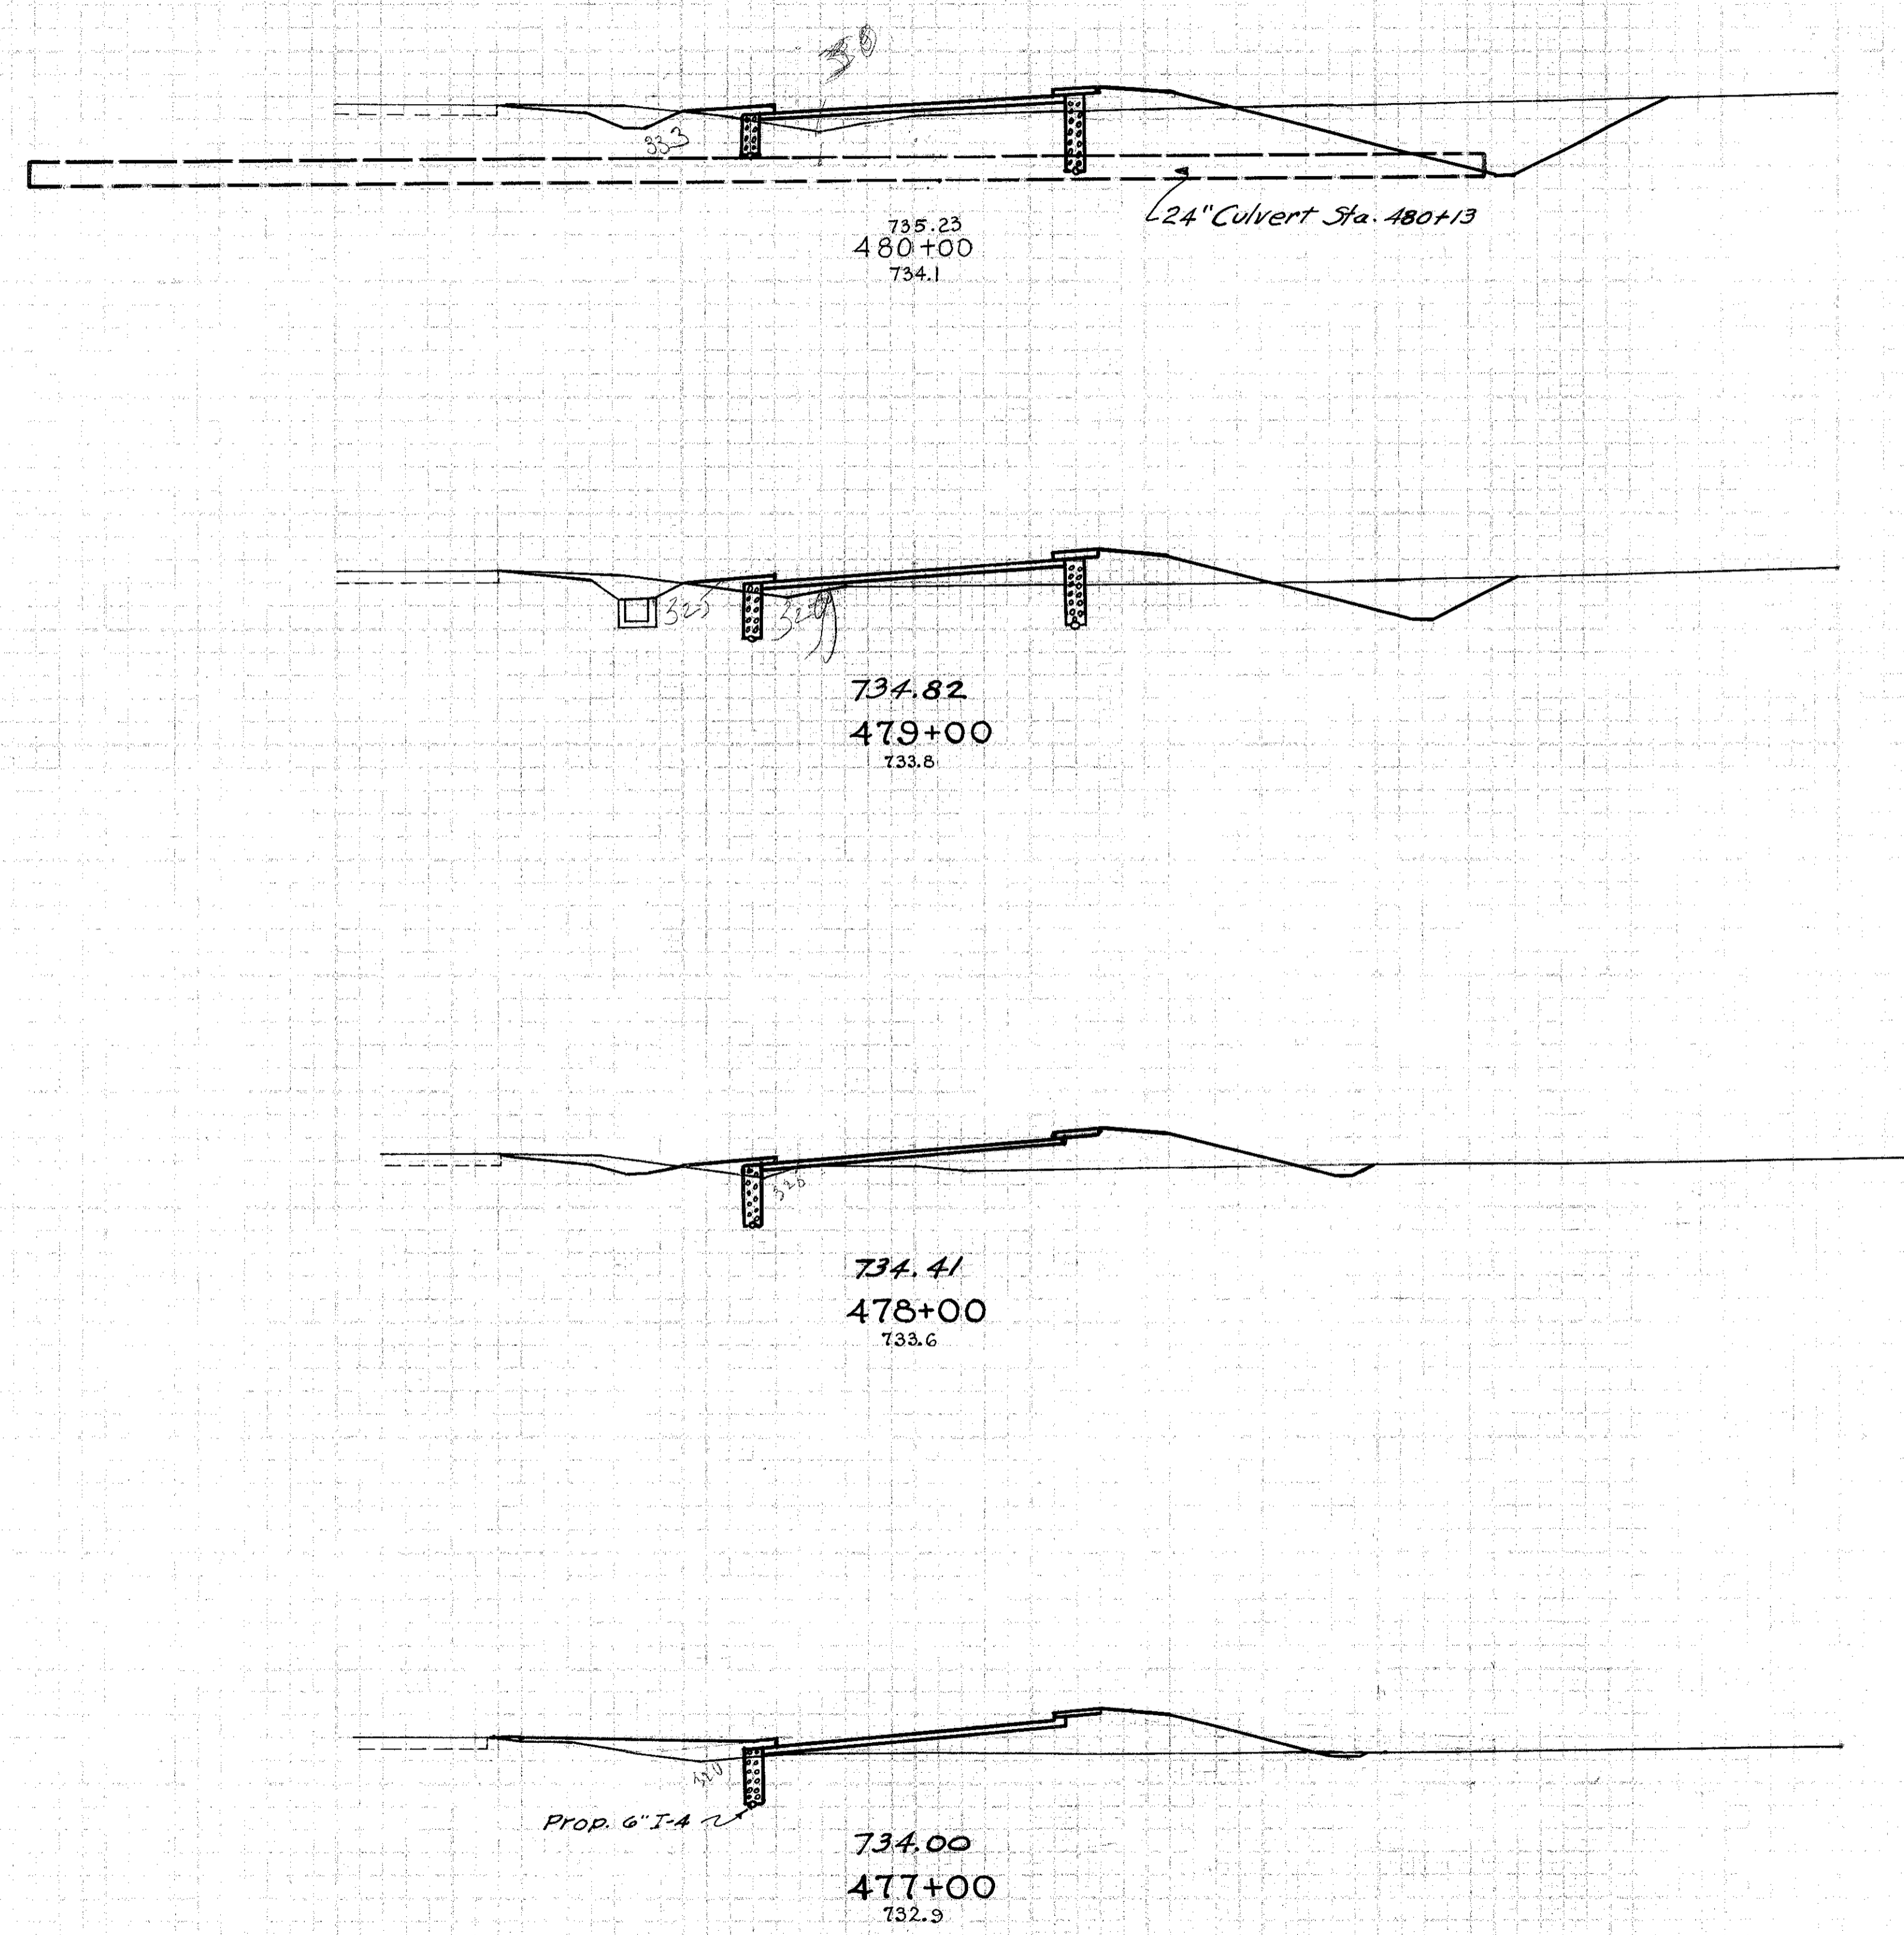

End Area		Cu. Yds.	
Cut	Fill	Cut	Fill
156	48		
		404	235
62	79		
		141	298
14	82		
		32	393
			12
3	130		
		19	363





Note:  
Drive Rt. Sta. 477+31

Sta. 470+50 to Sta. 480+00  
 E-1  
 Embankment +15% 2409 Cu. Yds.

150 140 130 120 110 100 90 80 70 60 50 40 30 20 10 0 10 20 30 40 50 60 70 80 90 100 110 120 130 140

STA. 477+00 TO 480+00

150 140 130 120 110 100 90 80 70 60 50 40 30 20 10 0 10 20 30 40 50 60 70 80 90 100 110 120 130 140 150

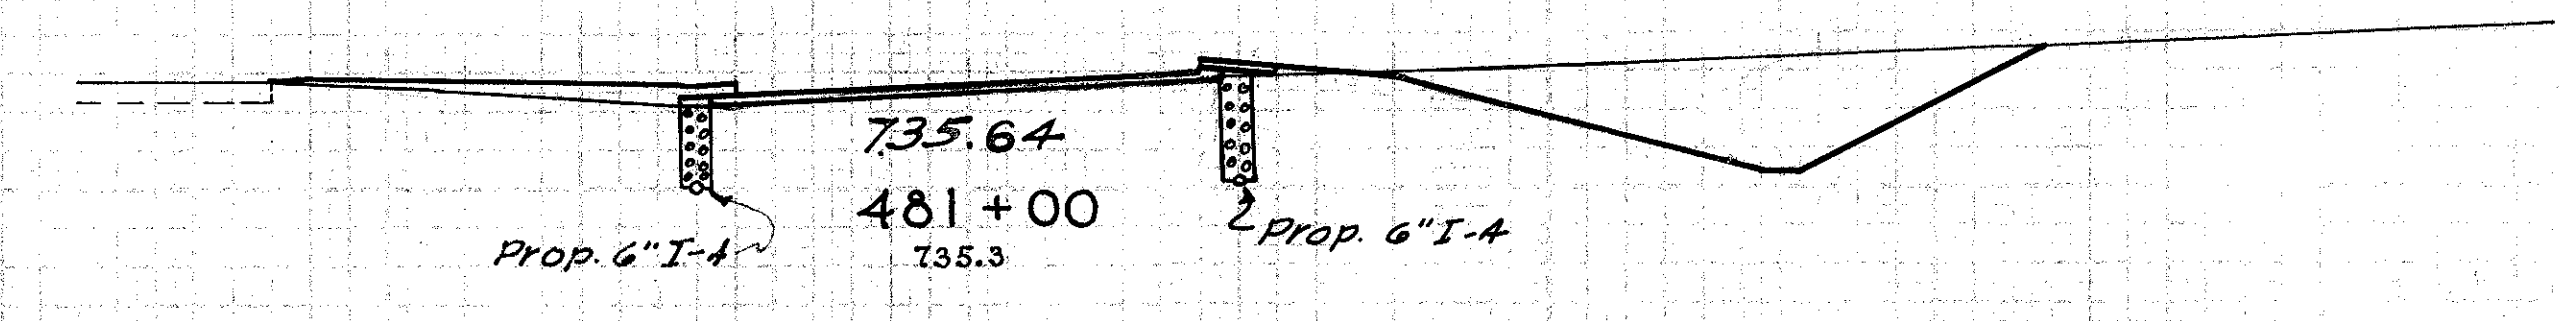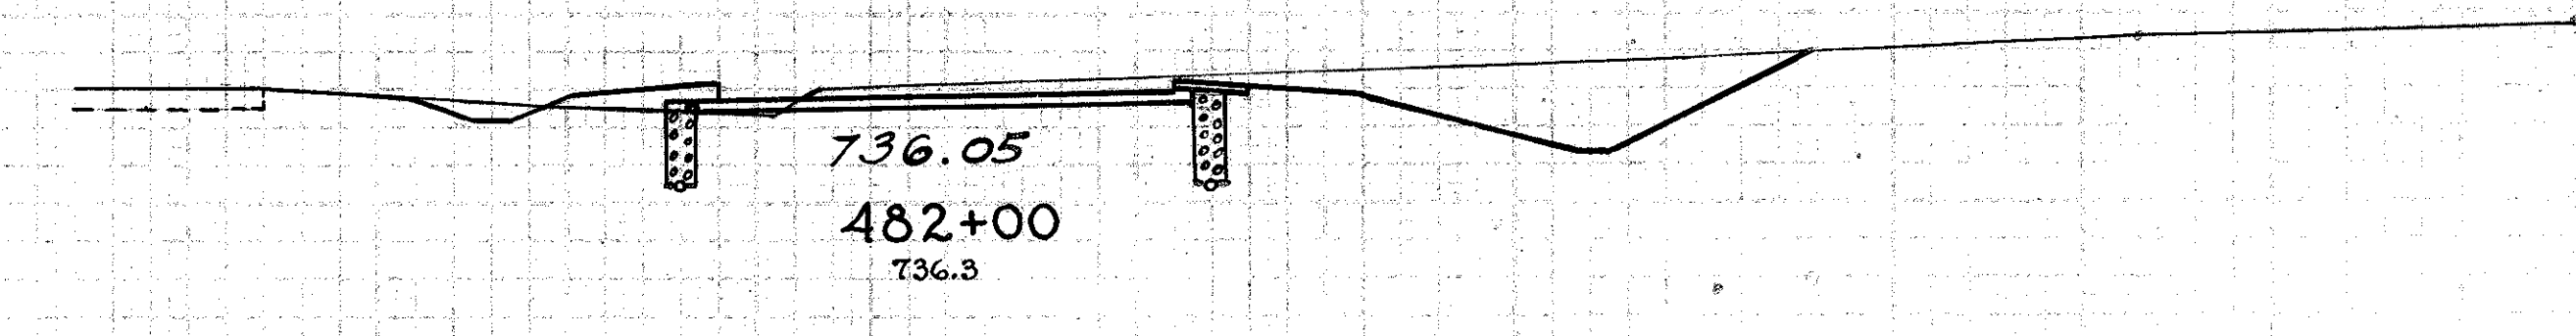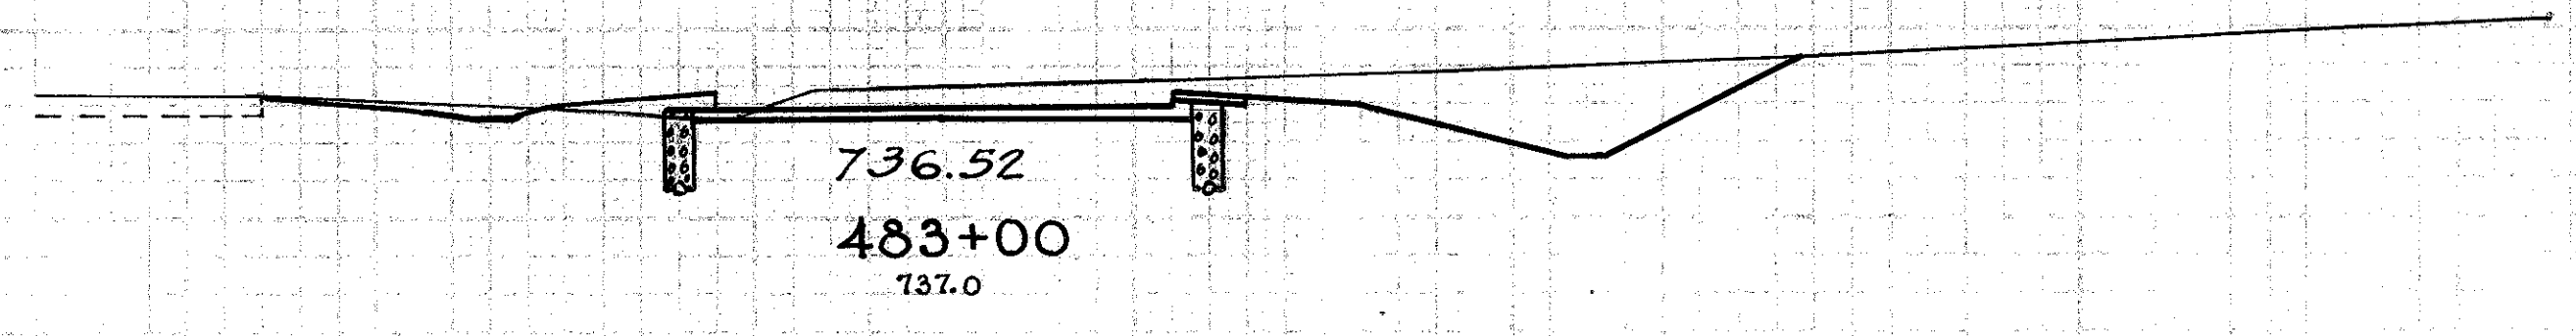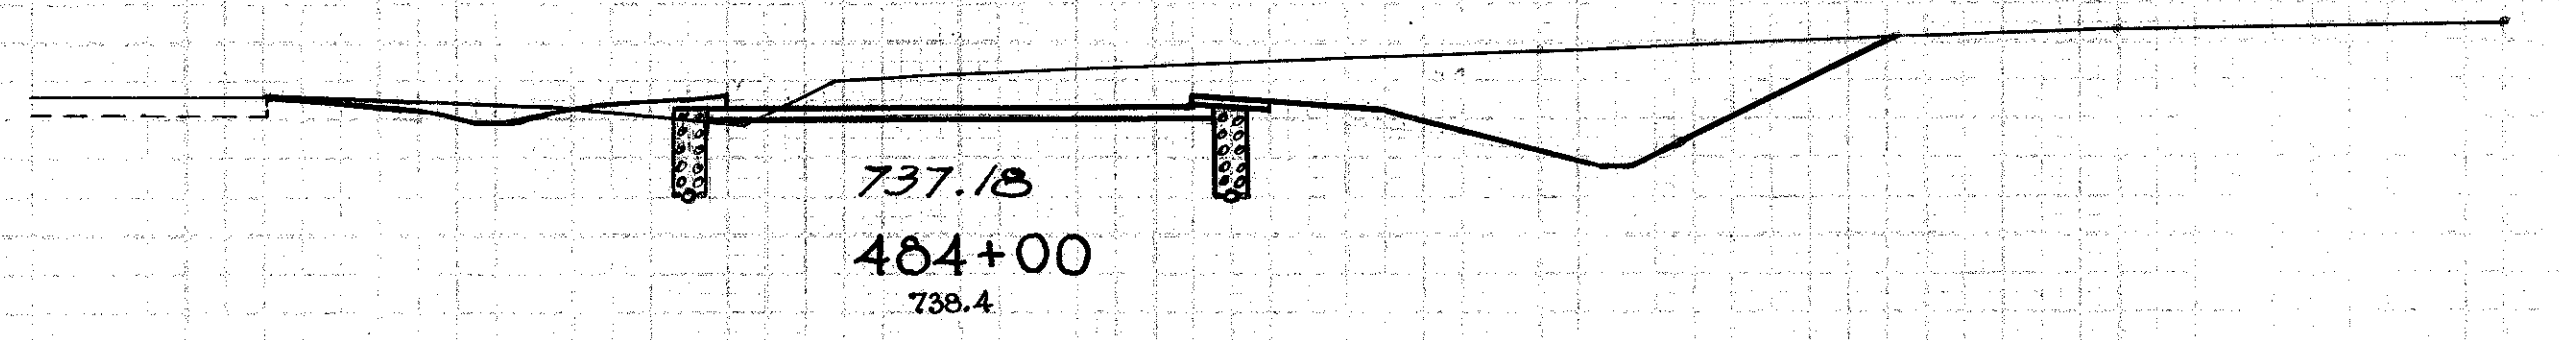


End Area	C u. Yds.	
	Cut	Fill
176	5	
		599 19
126	5	
		428 22
105	7	
		406 54
114	22	
		500 130



150 140 130 120 110 100 90 80 70 60 50 40 30 20 10 0 10 20 30 40 50 60 70 80 90 100 110 120 130 140

150 140 130 120 110 100 90 80 70 60 50 40 30 20 10 0 10 20 30 40 50 60 70 80 90 100 110 120 130 140 150

53  
222

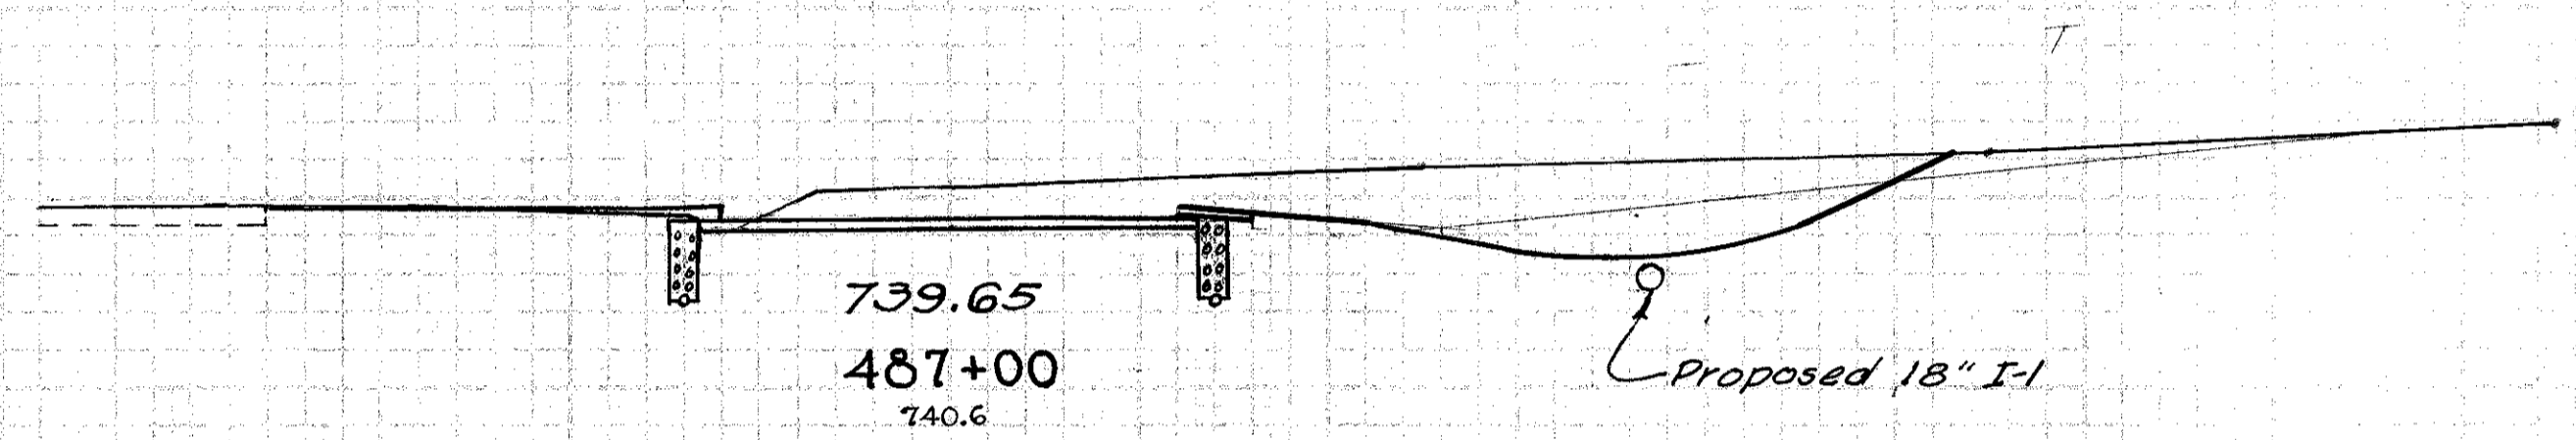


Note:  
Field Drive Rt. Sta. 486+87

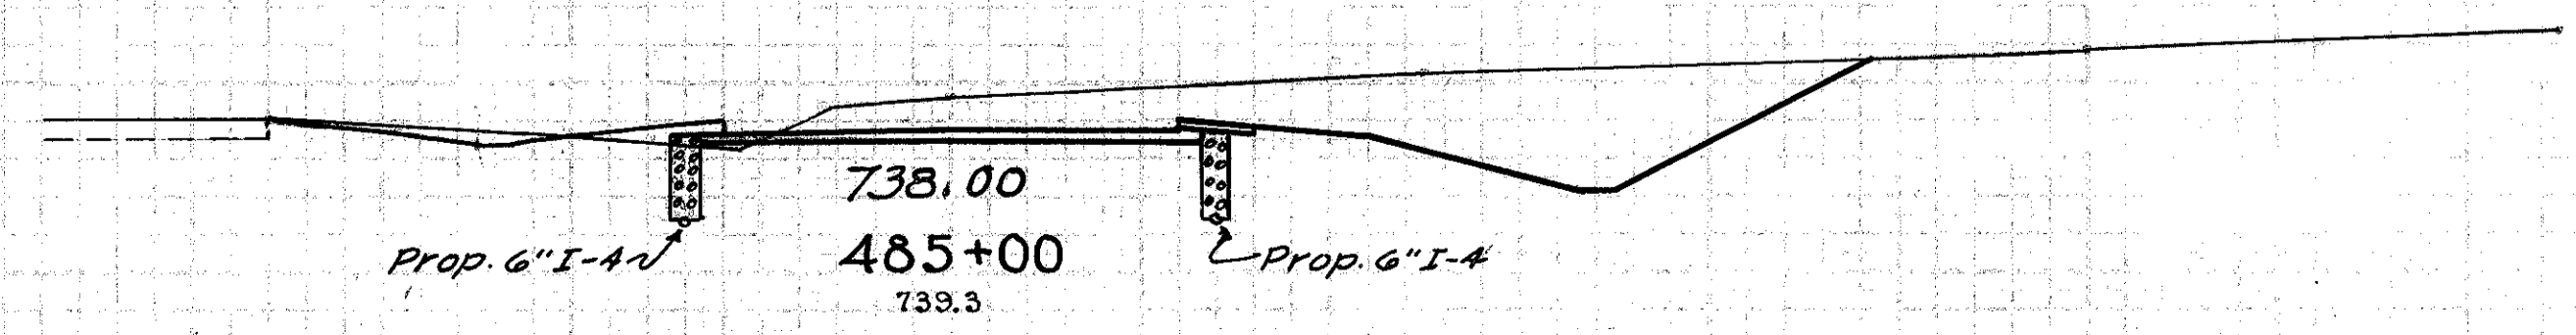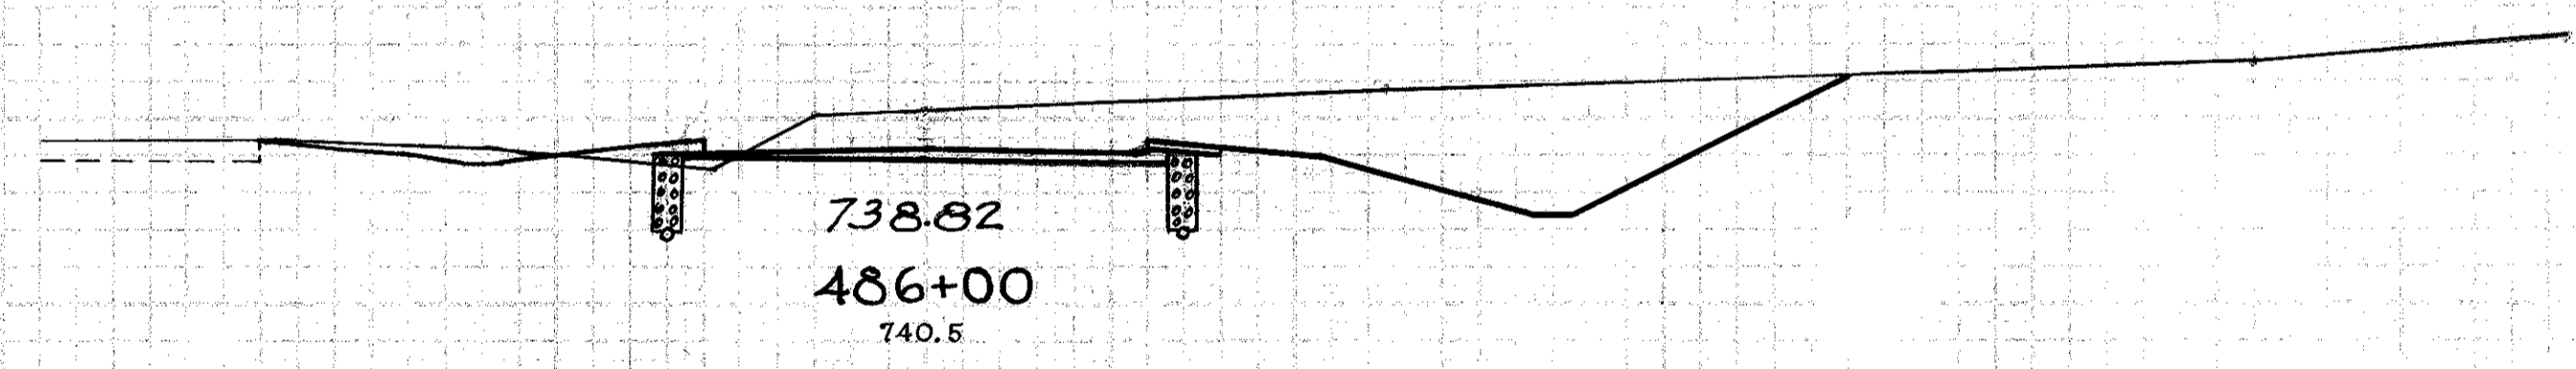


Sta.	End Area		Cu. Yds.	
	Cut	Fill	Cut	Fill
487+00	191	1	9	25
486+00	772	11		
485+00	226	5		
484+00	774	20		
483+00	192	6		
482+00			682	20

150 140 130 120 110 100 90 80 70 60 50 40 30 20 10 0 10 20 30 40 50 60 70 80 90 100 110 120 130 140



STA. 485+00 TO 487+00

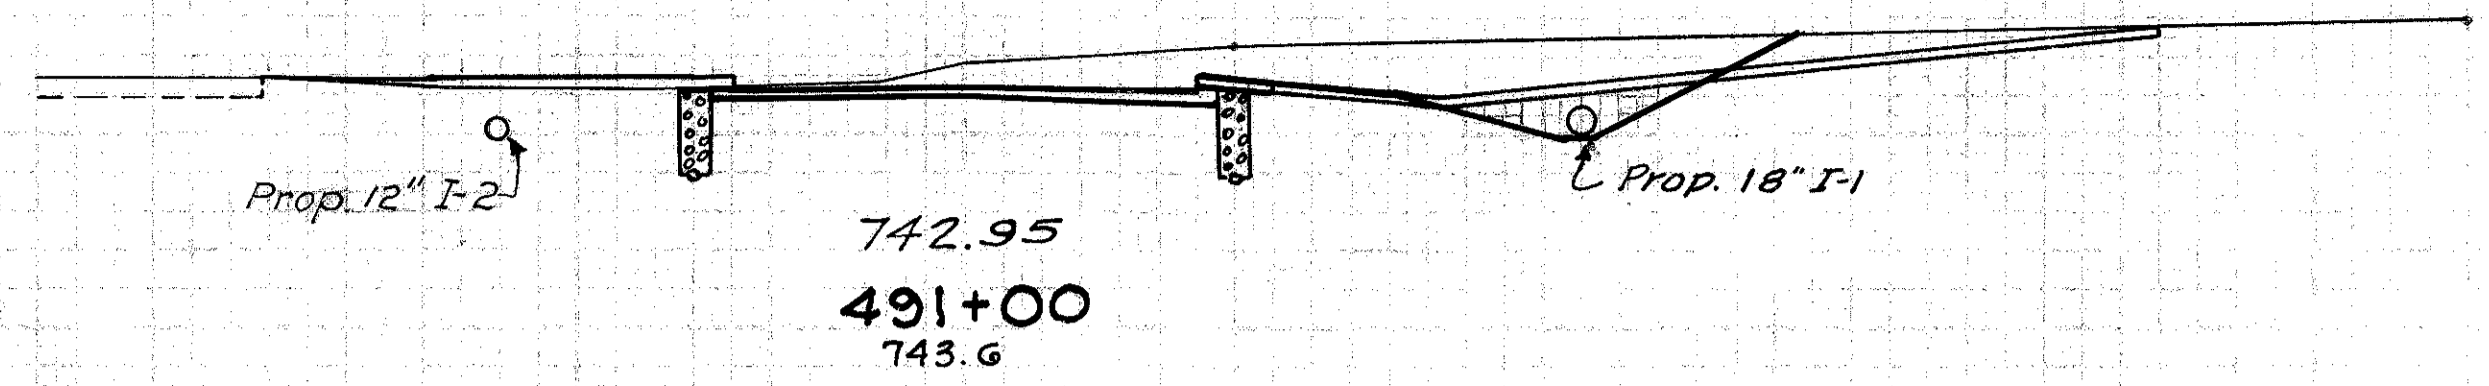

Note:  
Field Drive Sta. 491+00

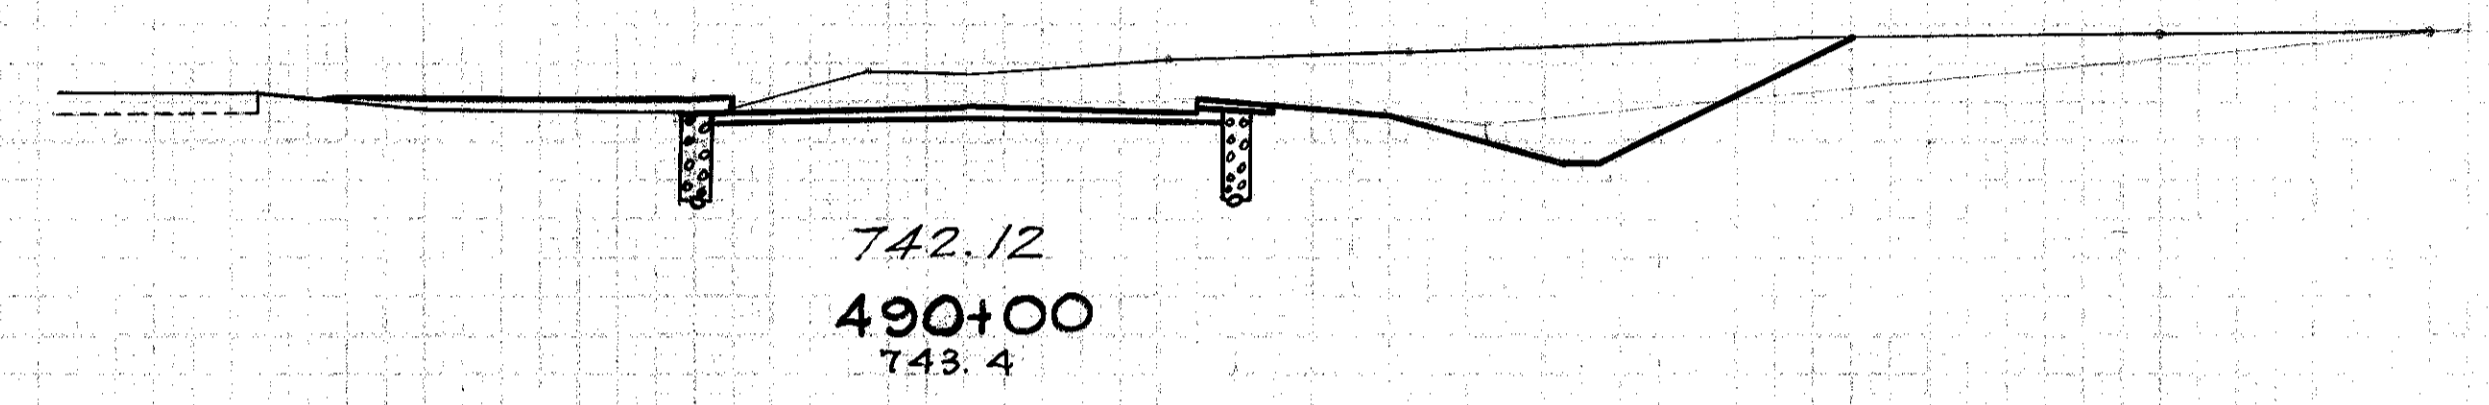

Note:  
Drive Rt. Sta. 489+75

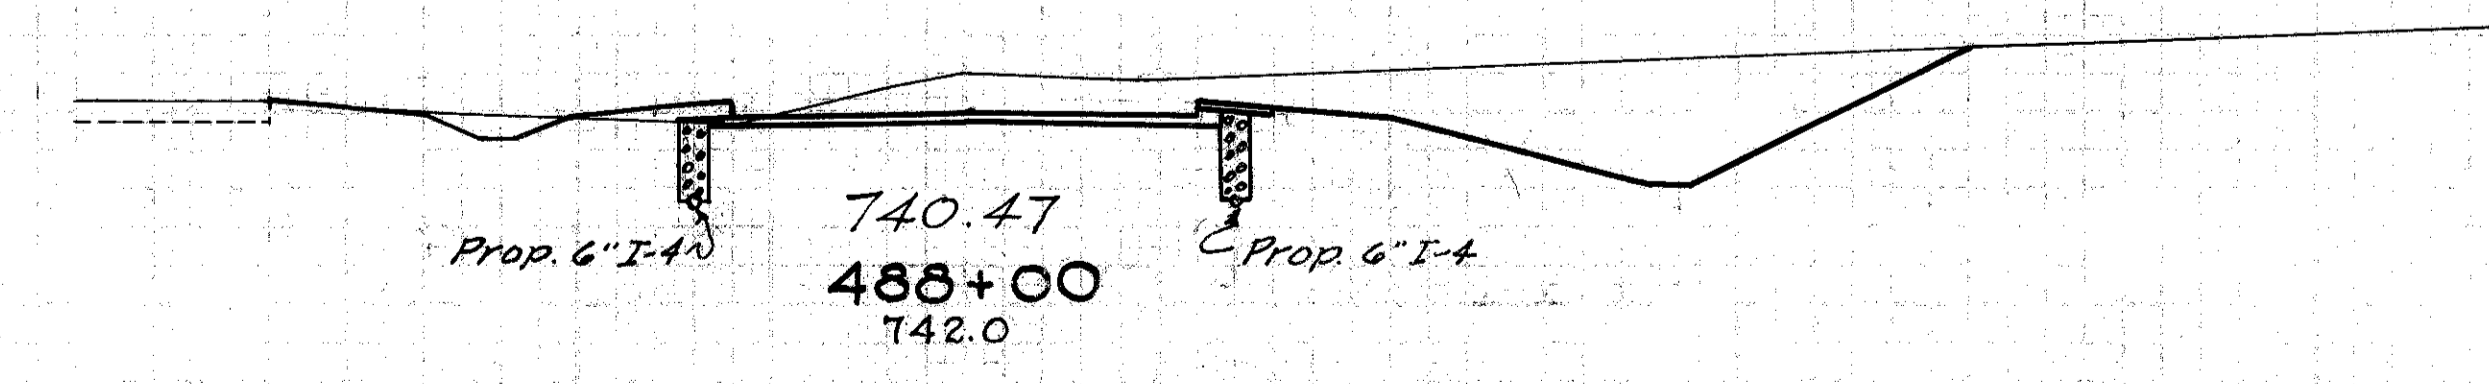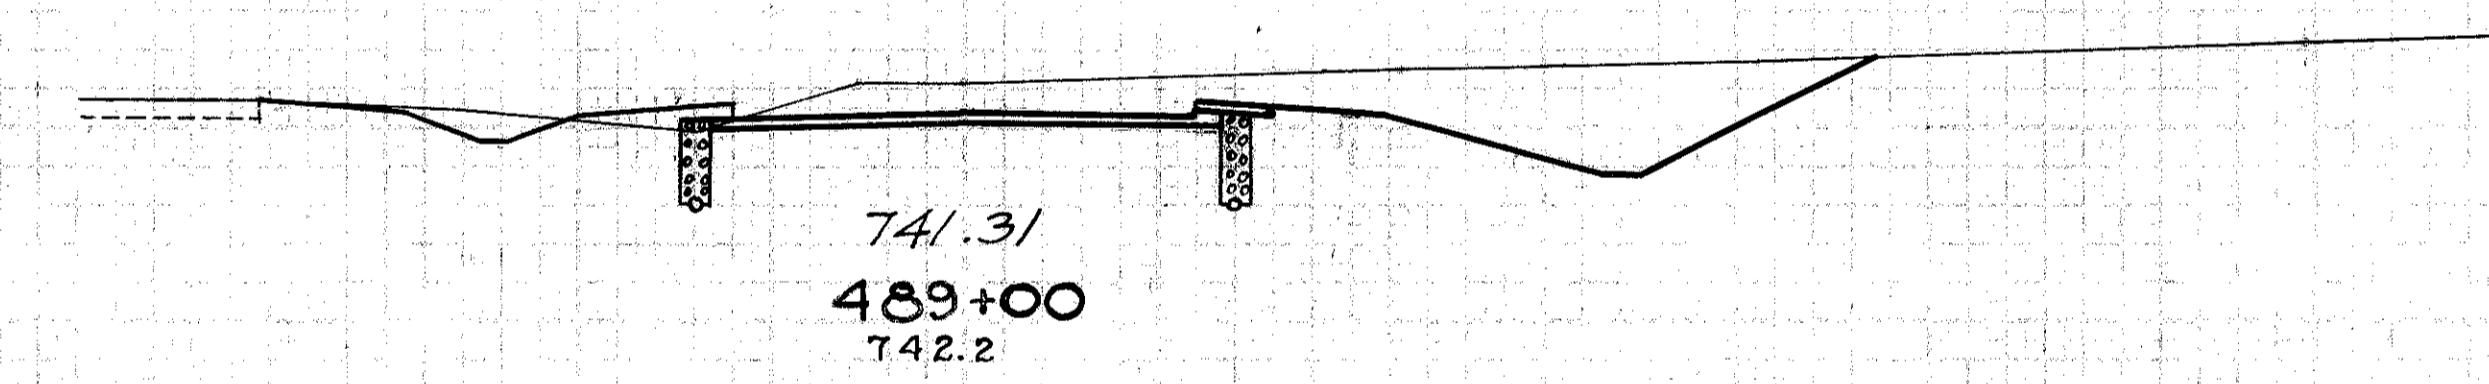


Sta.	End Area		Cu. Yds.	
	Cut	Fill	Cut	Fill
491+00			9	12
490+00	138	3	630	13
489+00	202	4	700	20
488+00	176	7	26	11
487+00			732	22
486+00	219	5	759	11


Sta. 480+00 to Sta. 490+00  
E-1  
Embankment 6347 Cu. Yds.  
Embankment +15% 365 Cu. Yds.  
Embankment 420 Cu. Yds.

150 140 130 120 110 100 90 80 70 60 50 40 30 20 10 0 10 20 30 40 50 60 70 80 90 100 110 120 130 140

55  
222  
BUT-4-116 53-18 13

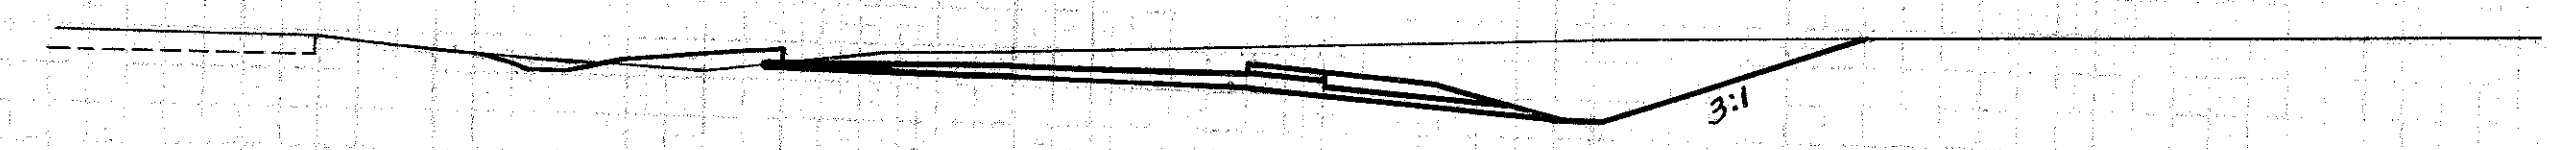


745.61  
495+00  
745.9

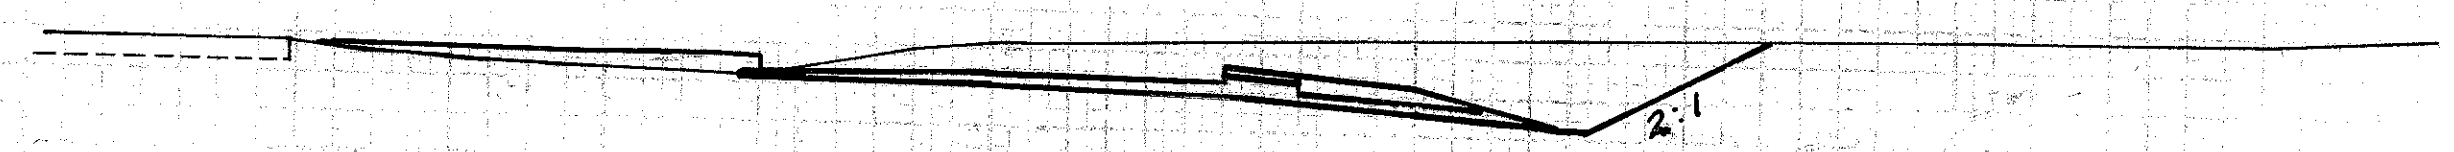


745.34  
494+00  
746.1

Note:  
Drive Rt. Sta. 494+19

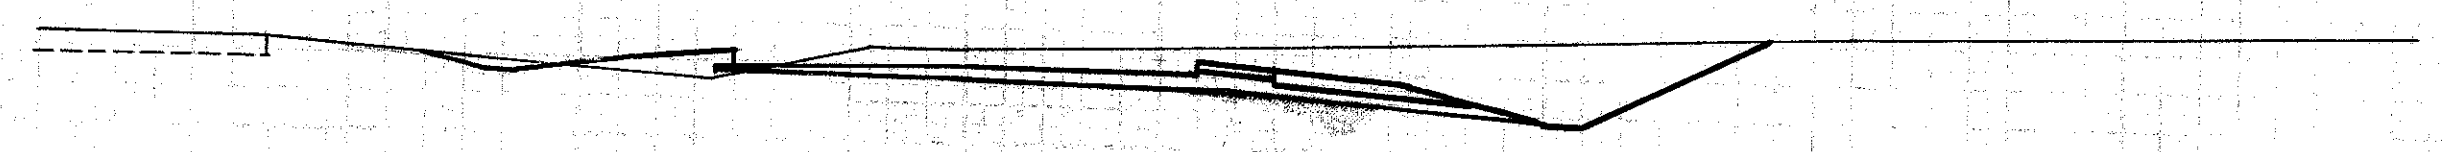

744.60  
493+00  
744.9

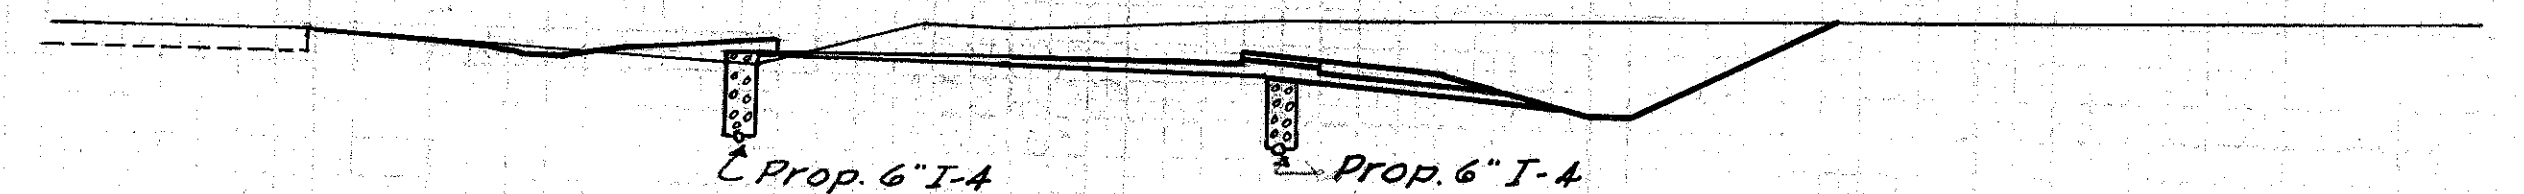

Prop. 6" I-4      Prop. 6" I-4


743.77  
492+00  
744.5

140 130 120 110 100 90 80 70 60 50 40 30 20 10 0 10 20 30 40

End Area		Cu. Yds.	
Cut	Fill	Cut	Fill
142	12		
		559	43
		17	8
160	11		
		559	43
		550	43
137	12		
		559	46
165	13		
		561	30


150 140 130 120 110 100 90 80 70 60 50 40 30 20 10 0 10 20 30 40 50 60 70 80 90 100 110 120 130 140

56  
222  
DATE: 4-18-59  
BY: [Signature]

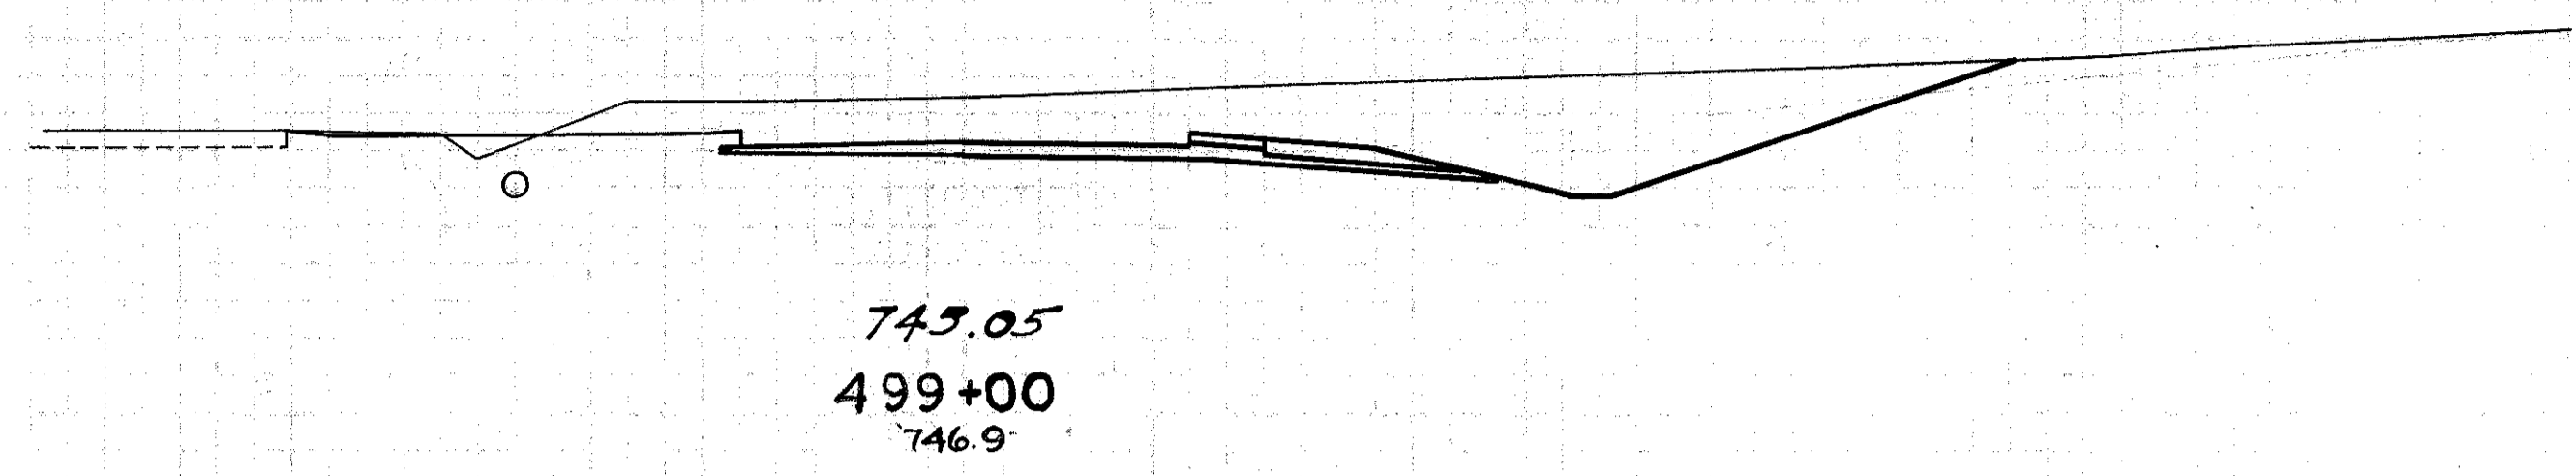


745.05  
499+00  
746.9

Note:  
Drive Sta. 499+27 Rt.

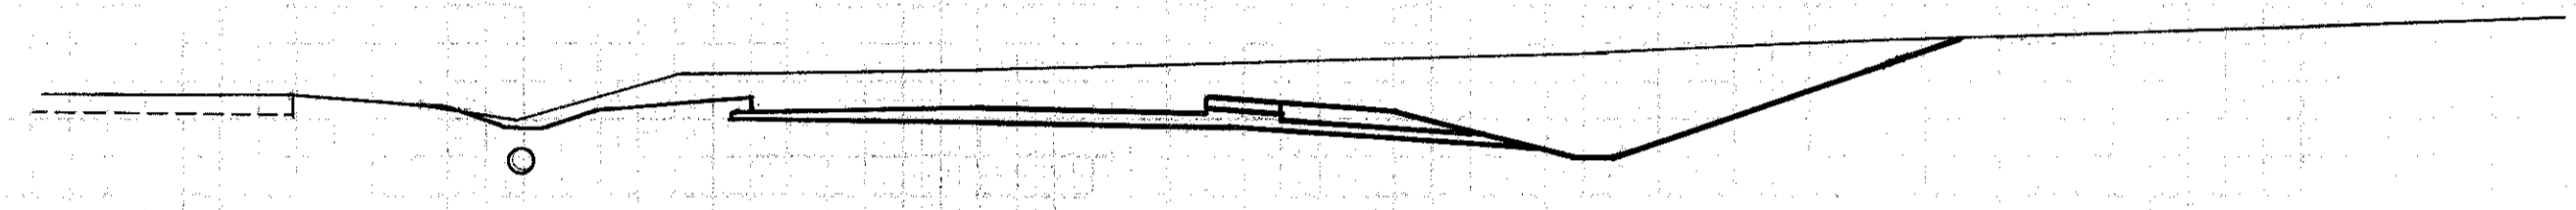


745.20  
498+00  
746.7

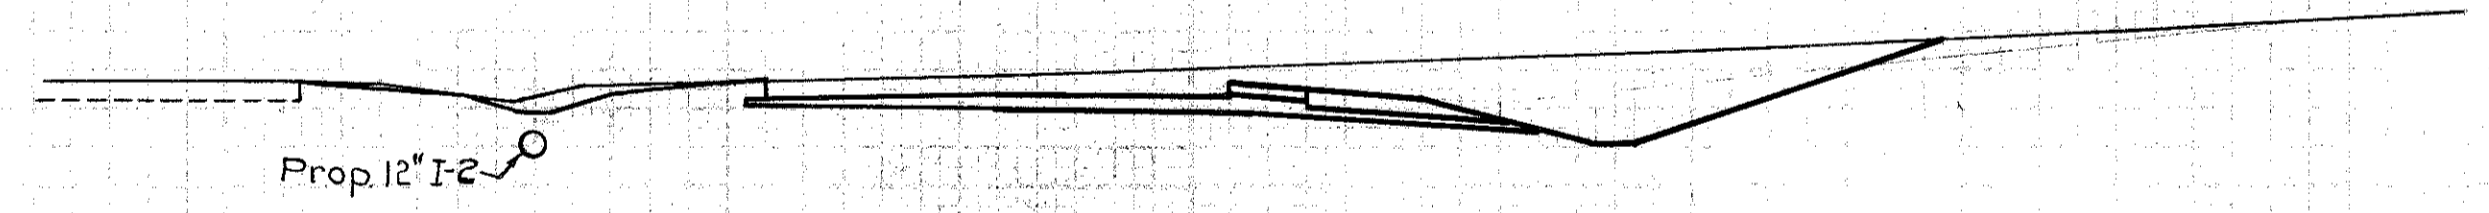

745.35  
497+00  
745.7

Note:  
Drive Rt. Sta. 496+64

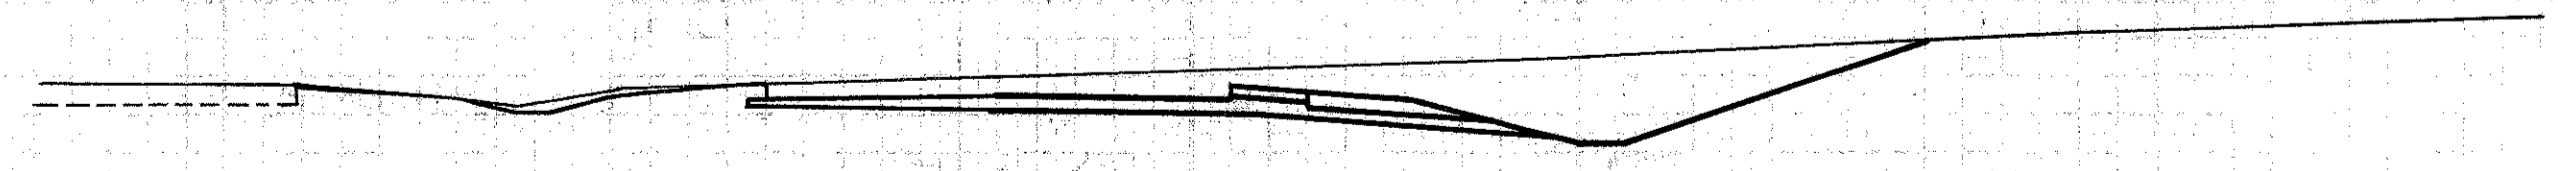

745.50  
496+00  
745.9

End Area		Cu. Yds.	
Cut	Fill	Cut	Fill
			15 26
225	4		
		1009	19
250	6		
		770	22
166	6		
		598	22
		7	17
157	6		
		554	33

150 140 130 120 110 100 90 80 70 60 50 40 30 20 10 0 10 20 30 40 50 60 70 80 90 100 110 120 130 140





STA. 496+00 TO 499+00



150 140 130 120 110 100 90 80 70 60 50 40 30 20 10 0 10 20 30 40 50 60 70 80 90 100 110 120 130 140 150

PL. 140  
 DATE: 1-17-1915  
 SHEET: 2  
 SHEET: 222  
 RUT. 4 (19.53-18.15)

57  
 222

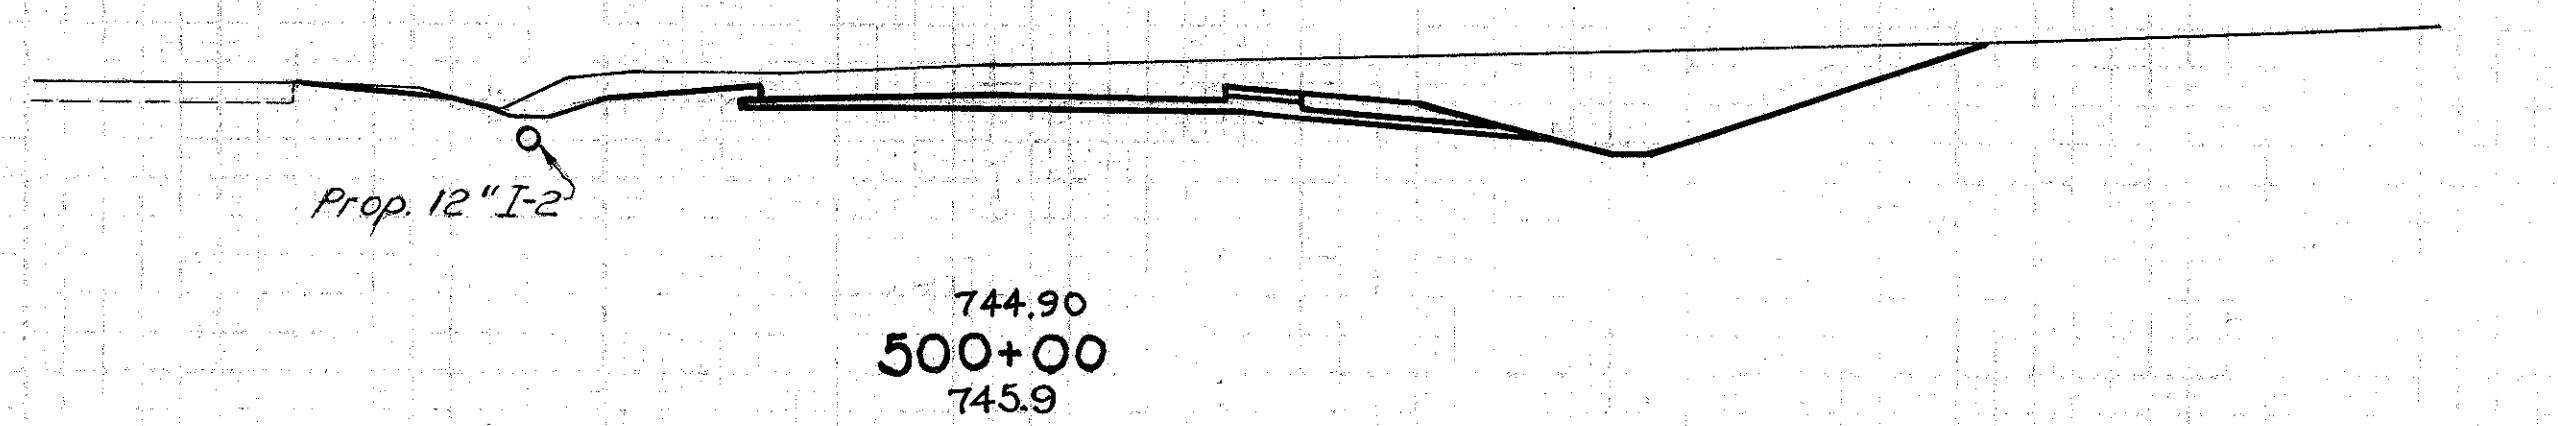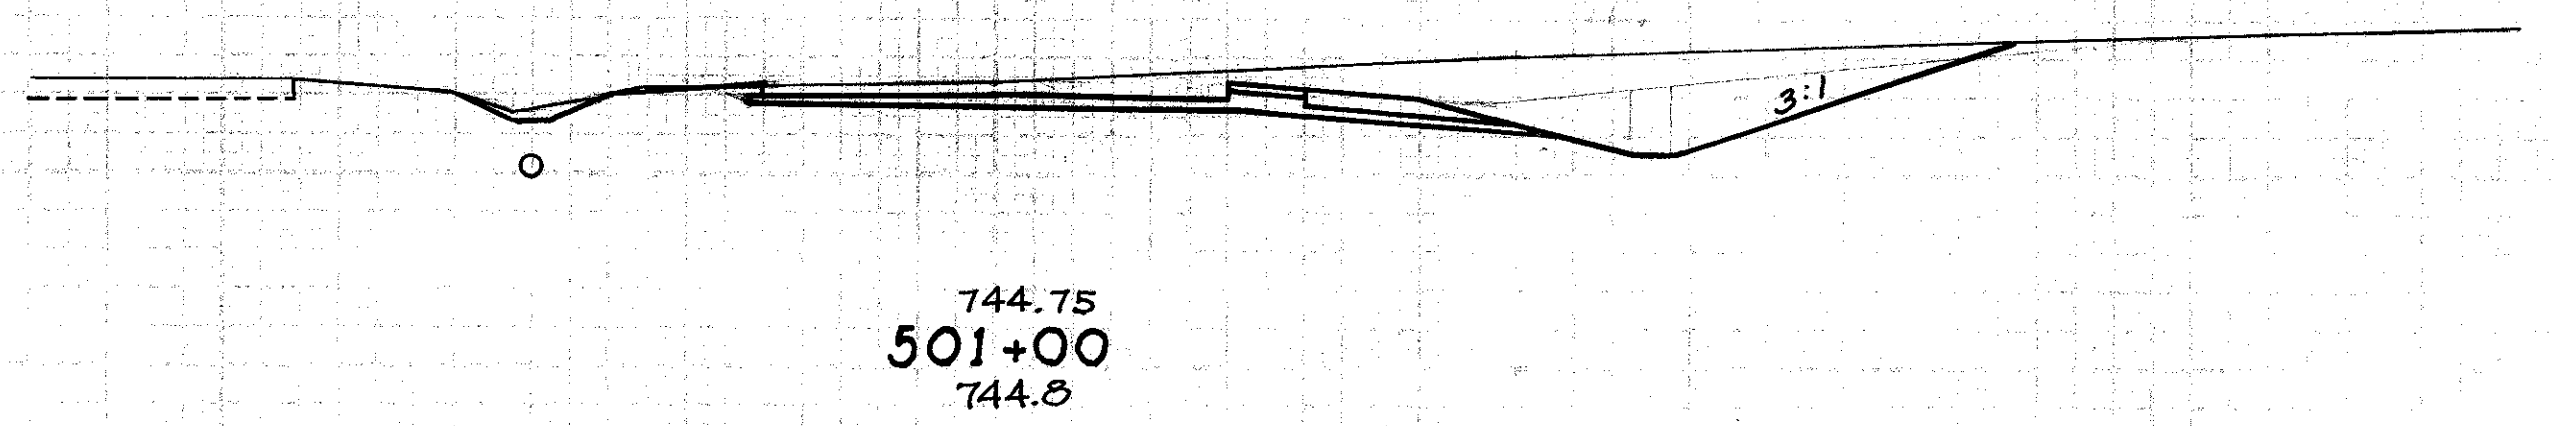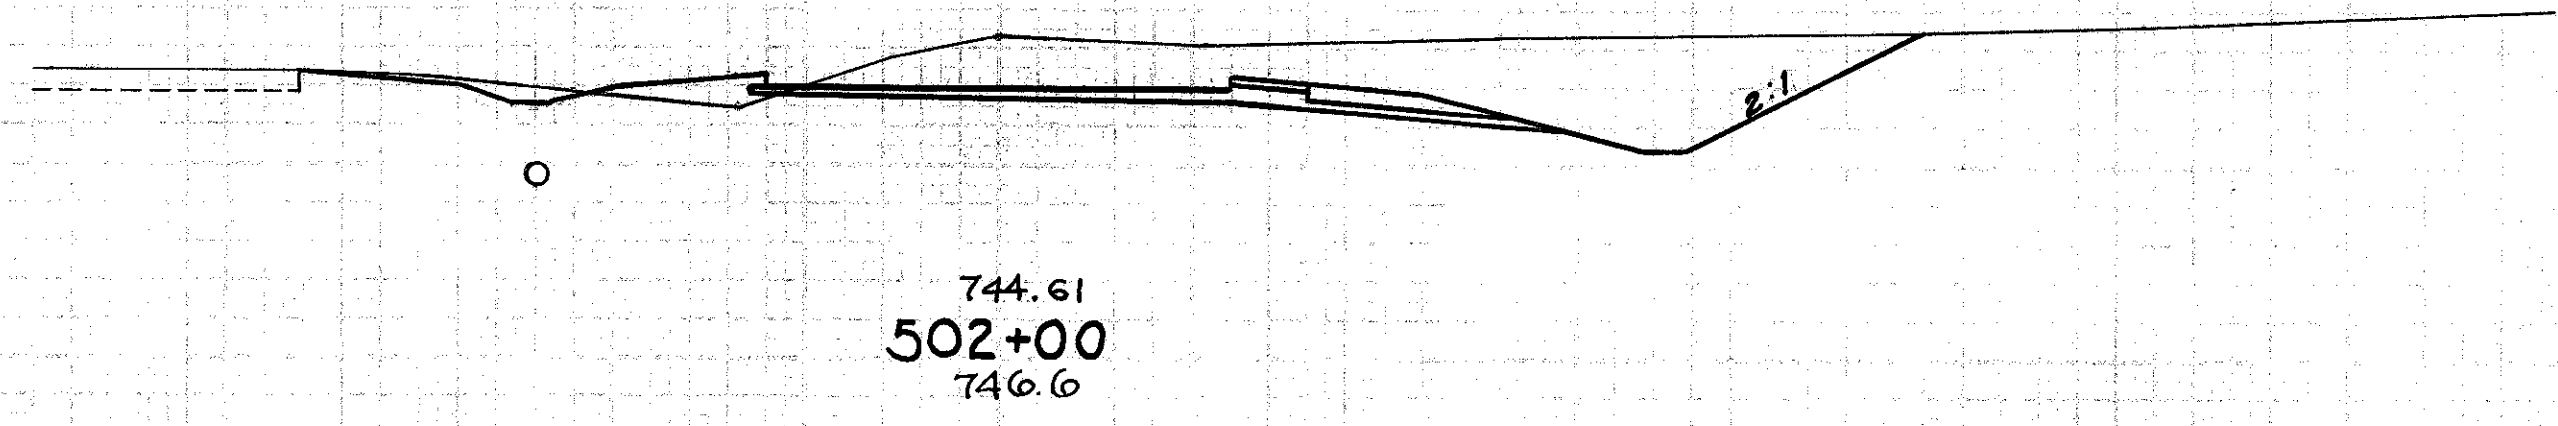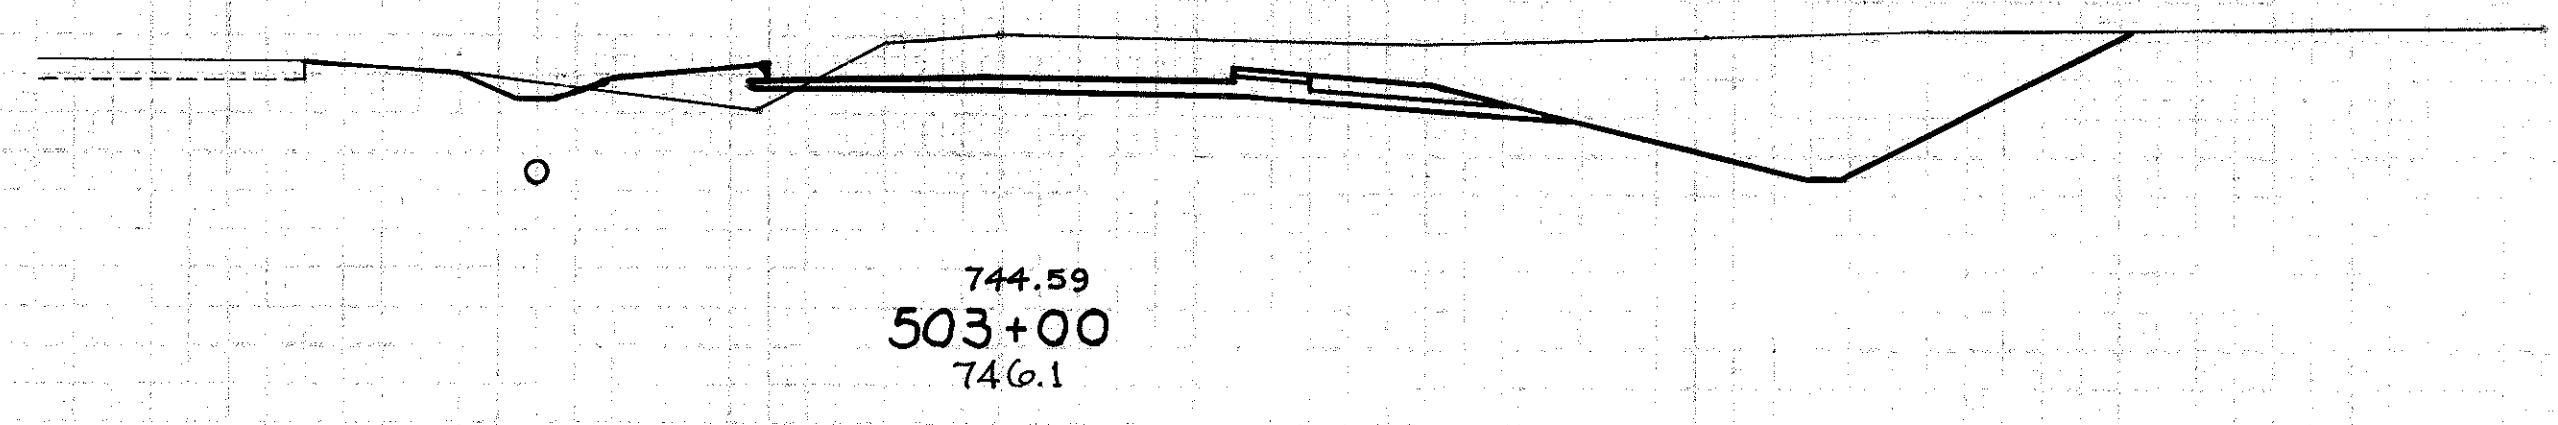

Note:  
 Drive Rt. Sta. 501+47

End Area		Cu. Yds.	
Cut	Fill	Cut	Fill
279	20		
		894	67
204	16		
		4	25
		706	41
177	6		
		730	22
217	6		
		948	19


Sta. 490+00 to Sta. 500+00  
 E-1  
 Embankment +15%  
 6786 Cu. Yds.  
 383 Cu. Yds.  
 406 Cu. Yds.

150 140 130 120 110 100 90 80 70 60 50 40 30 20 10 0 10 20 30 40 50 60 70 80 90 100 110 120 130 140


STA. 500+00 TO 503+00

150 140 130 120 110 100 90 80 70 60 50 40 30 20 10 0 10 20 30 40 50 60 70 80 90 100 110 120 130 140 150


58  
222  
BUT-4-16-53-18-15

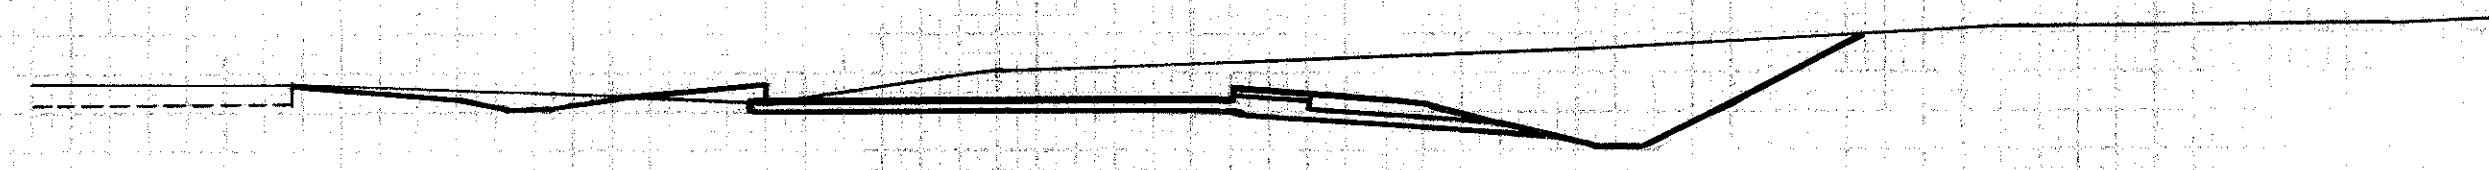


745.42  
507+00  
746.0

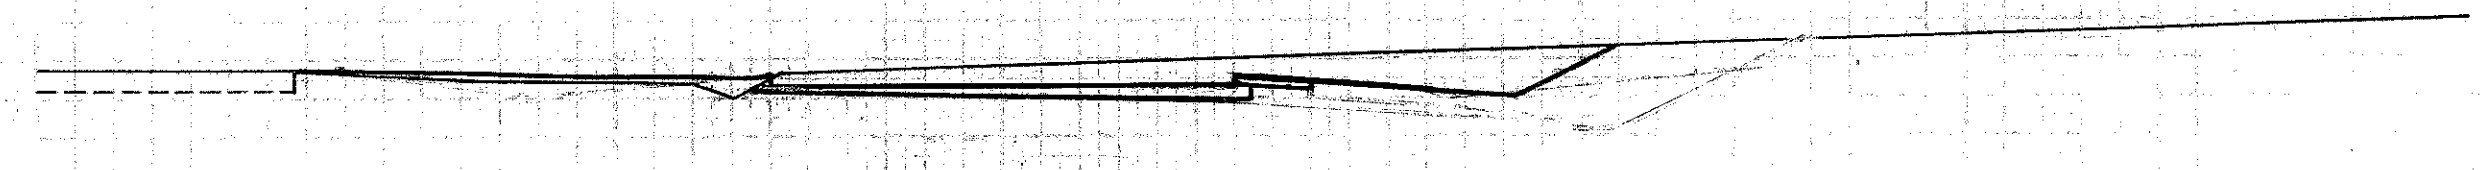

745.20  
506+00  
745.7

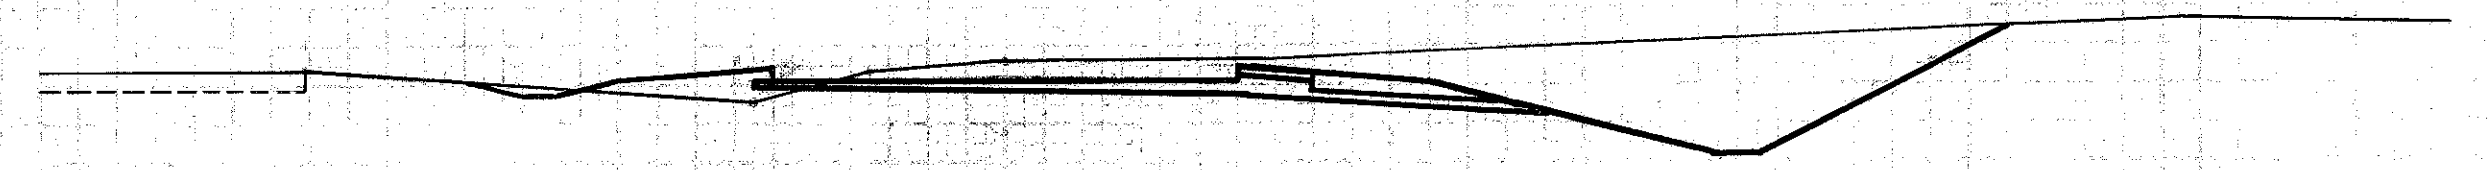

744.98  
505+00  
745.2

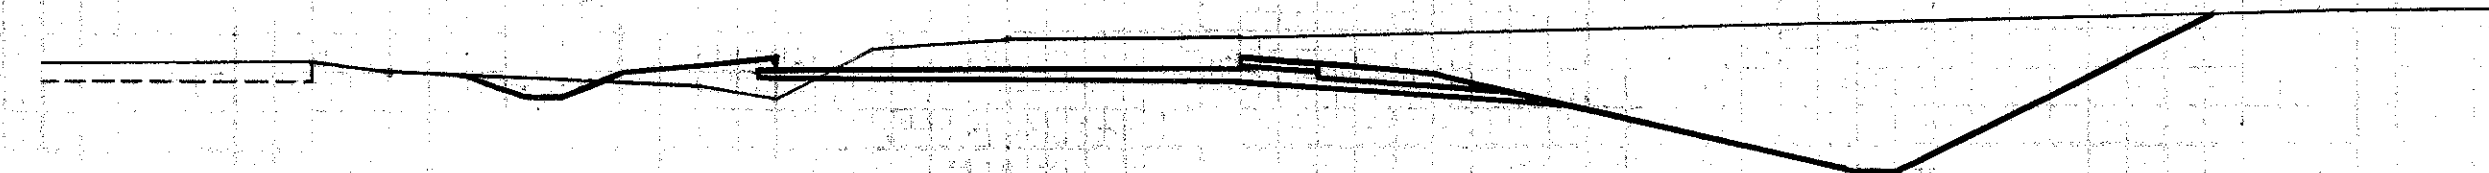

744.76  
504+00  
745.7

Note:  
Drive Rt. Sta. 506+18

End Area		Cu. Yds.	
Cut	Fill	Cut	Fill
180	9		
		463	32
		22	
70	8		
		446	43
172	15		
		833	61
278	18		
		1032	70

150 140 130 120 110 100 90 80 70 60 50 40 30 20 10 0 10 20 30 40 50 60 70 80 90 100 110 120 130 140


STA. 504+00 TO 507+0

150 140 130 120 110 100 90 80 70 60 50 40 30 20 10 0 10 20 30 40 50 60 70 80 90 100 110 120 130 140 150


FED. DIVISION	STATE	PROJECT
2	OHIO	

59  
222


BUT-4-(18.53-19.15)

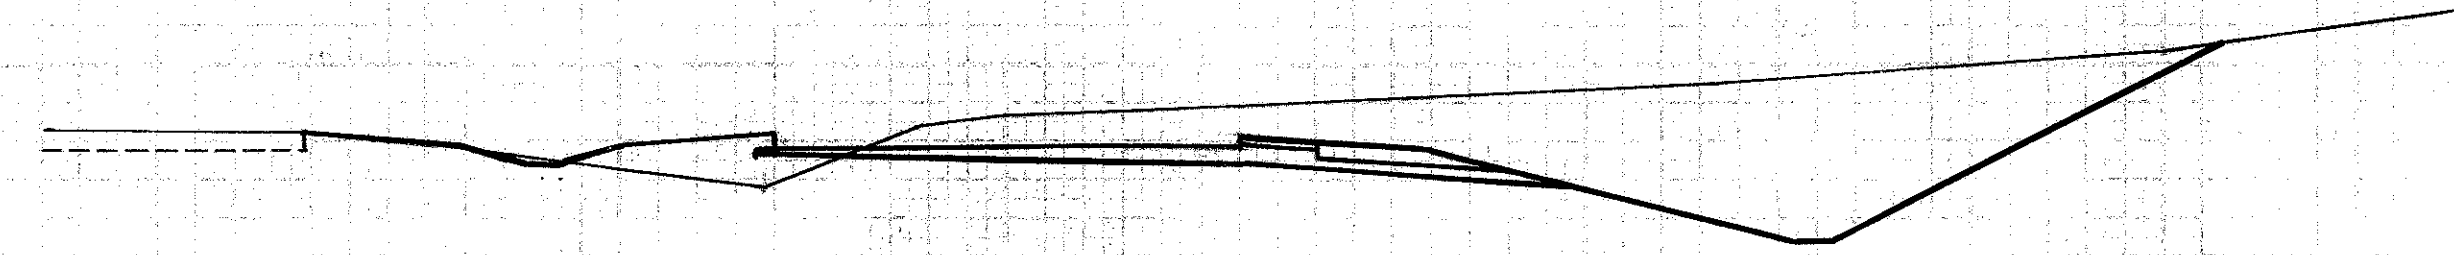


746.30  
511+00  
747.2

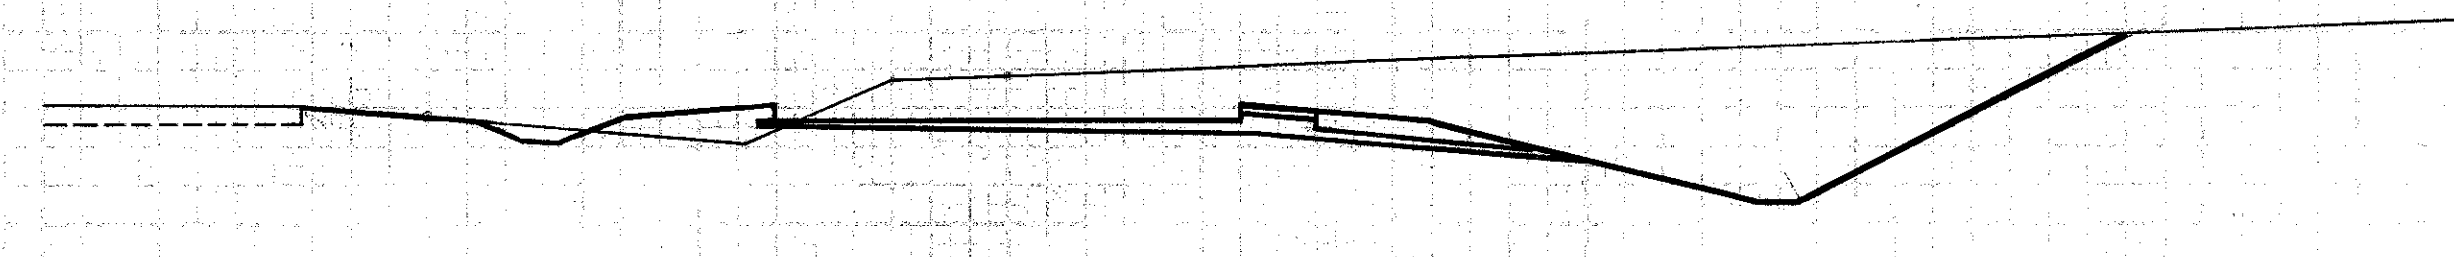

746.08  
510+00  
747.8

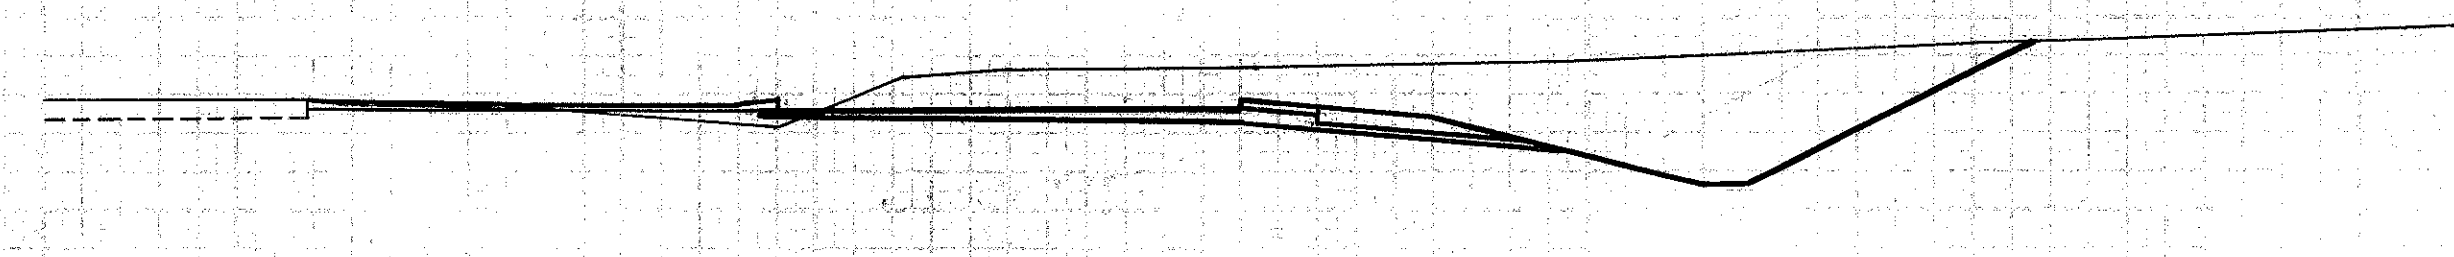

745.86  
509+00  
747.2

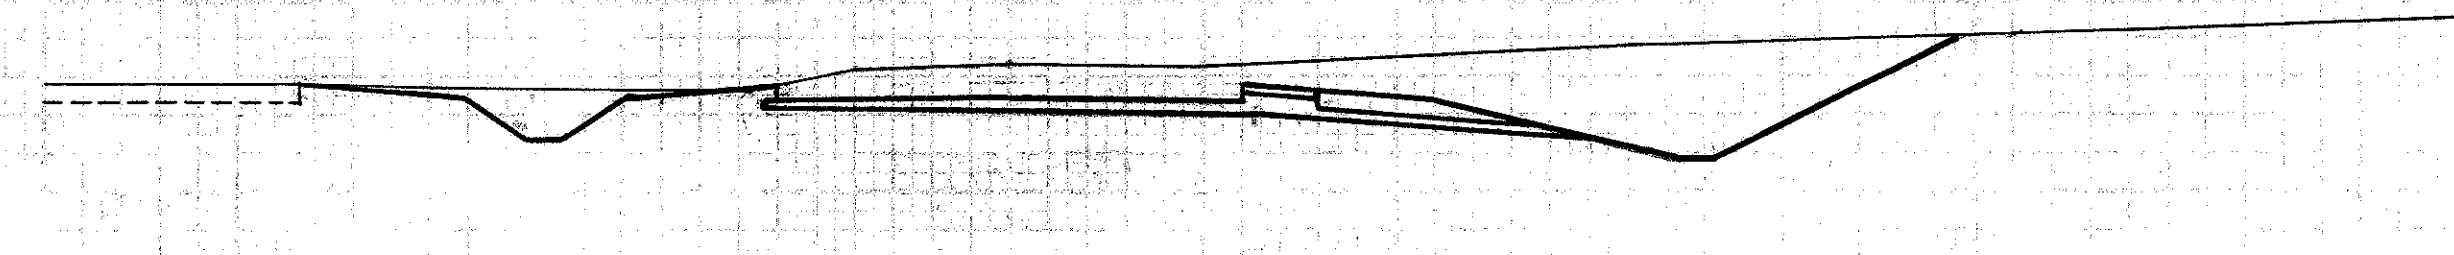

745.64  
508+00  
746.7

End Area		Cu. Yds.	
Cut	Fill	Cut	Fill
325	30		
		1174	91
309	19		
		998	57
230	12		
		876	33
243	6		
		783	28


Sta 500+00 to Sta 510+00  
Embankment 7789 Cu. Yds.  
Excavation 479 Cu. Yds.  
Embankment 15% 551 Cu. Yds.

150 140 130 120 110 100 90 80 70 60 50 40 30 20 10 0 10 20 30 40 50 60 70 80 90 100 110 120 130 140

STA. 508+00 TO 511+0

150 140 130 120 110 100 90 80 70 60 50 40 30 20 10 0 10 20 30 40 50 60 70 80 90 100 110 120 130 140 150

60  
222  
SHEET 4-116 5-3-18

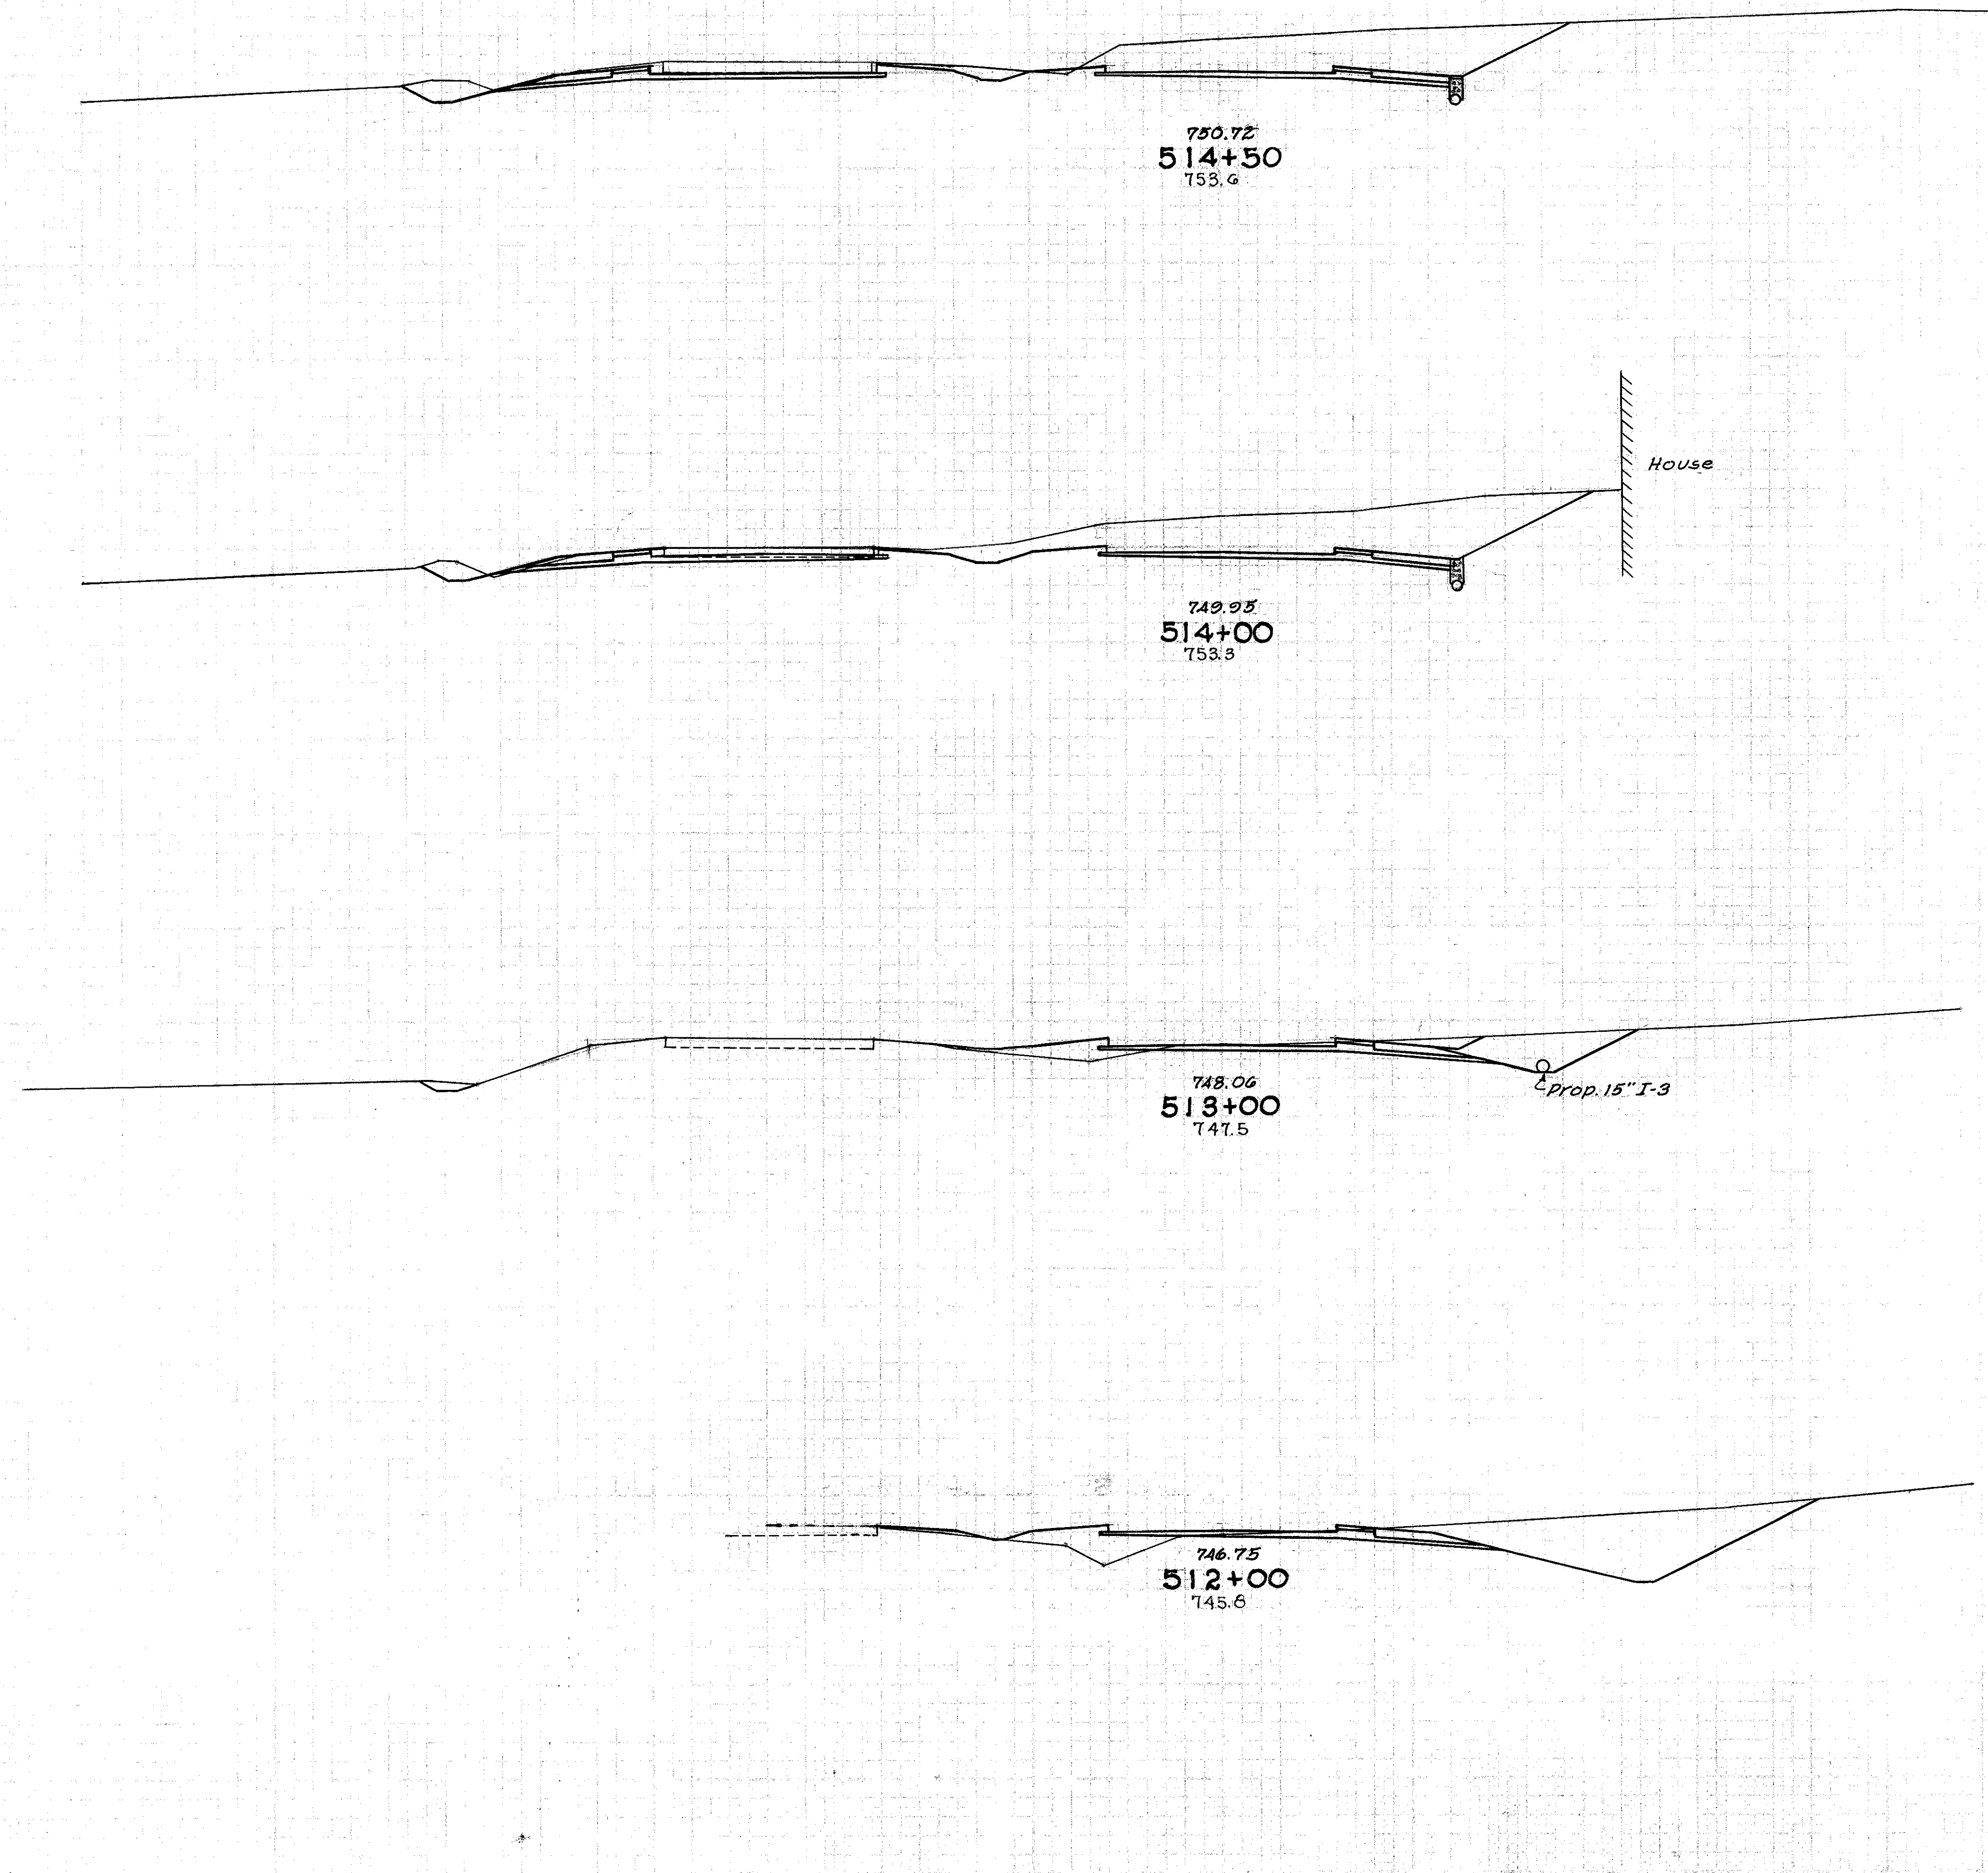

House


Ahead  
Back

End Area		Cu. Yds.	
Cut	Fill	Cut	Fill
316	13		
		588	24
			93
319	13		
		604	69
7	24		
65	24		
		485	119
197	40		
		967	130

150 140 130 120 110 100 90 80 70 60 50 40 30 20 10 0 10 20 30 40 50 60 70 80 90 100 110 120 130 140

STA. 512+00 TO 514+50

150 140 130 120 110 100 90 80 70 60 50 40 30 20 10 0 10 20 30 40 50 60 70 80 90 100 110 120 130 140 150

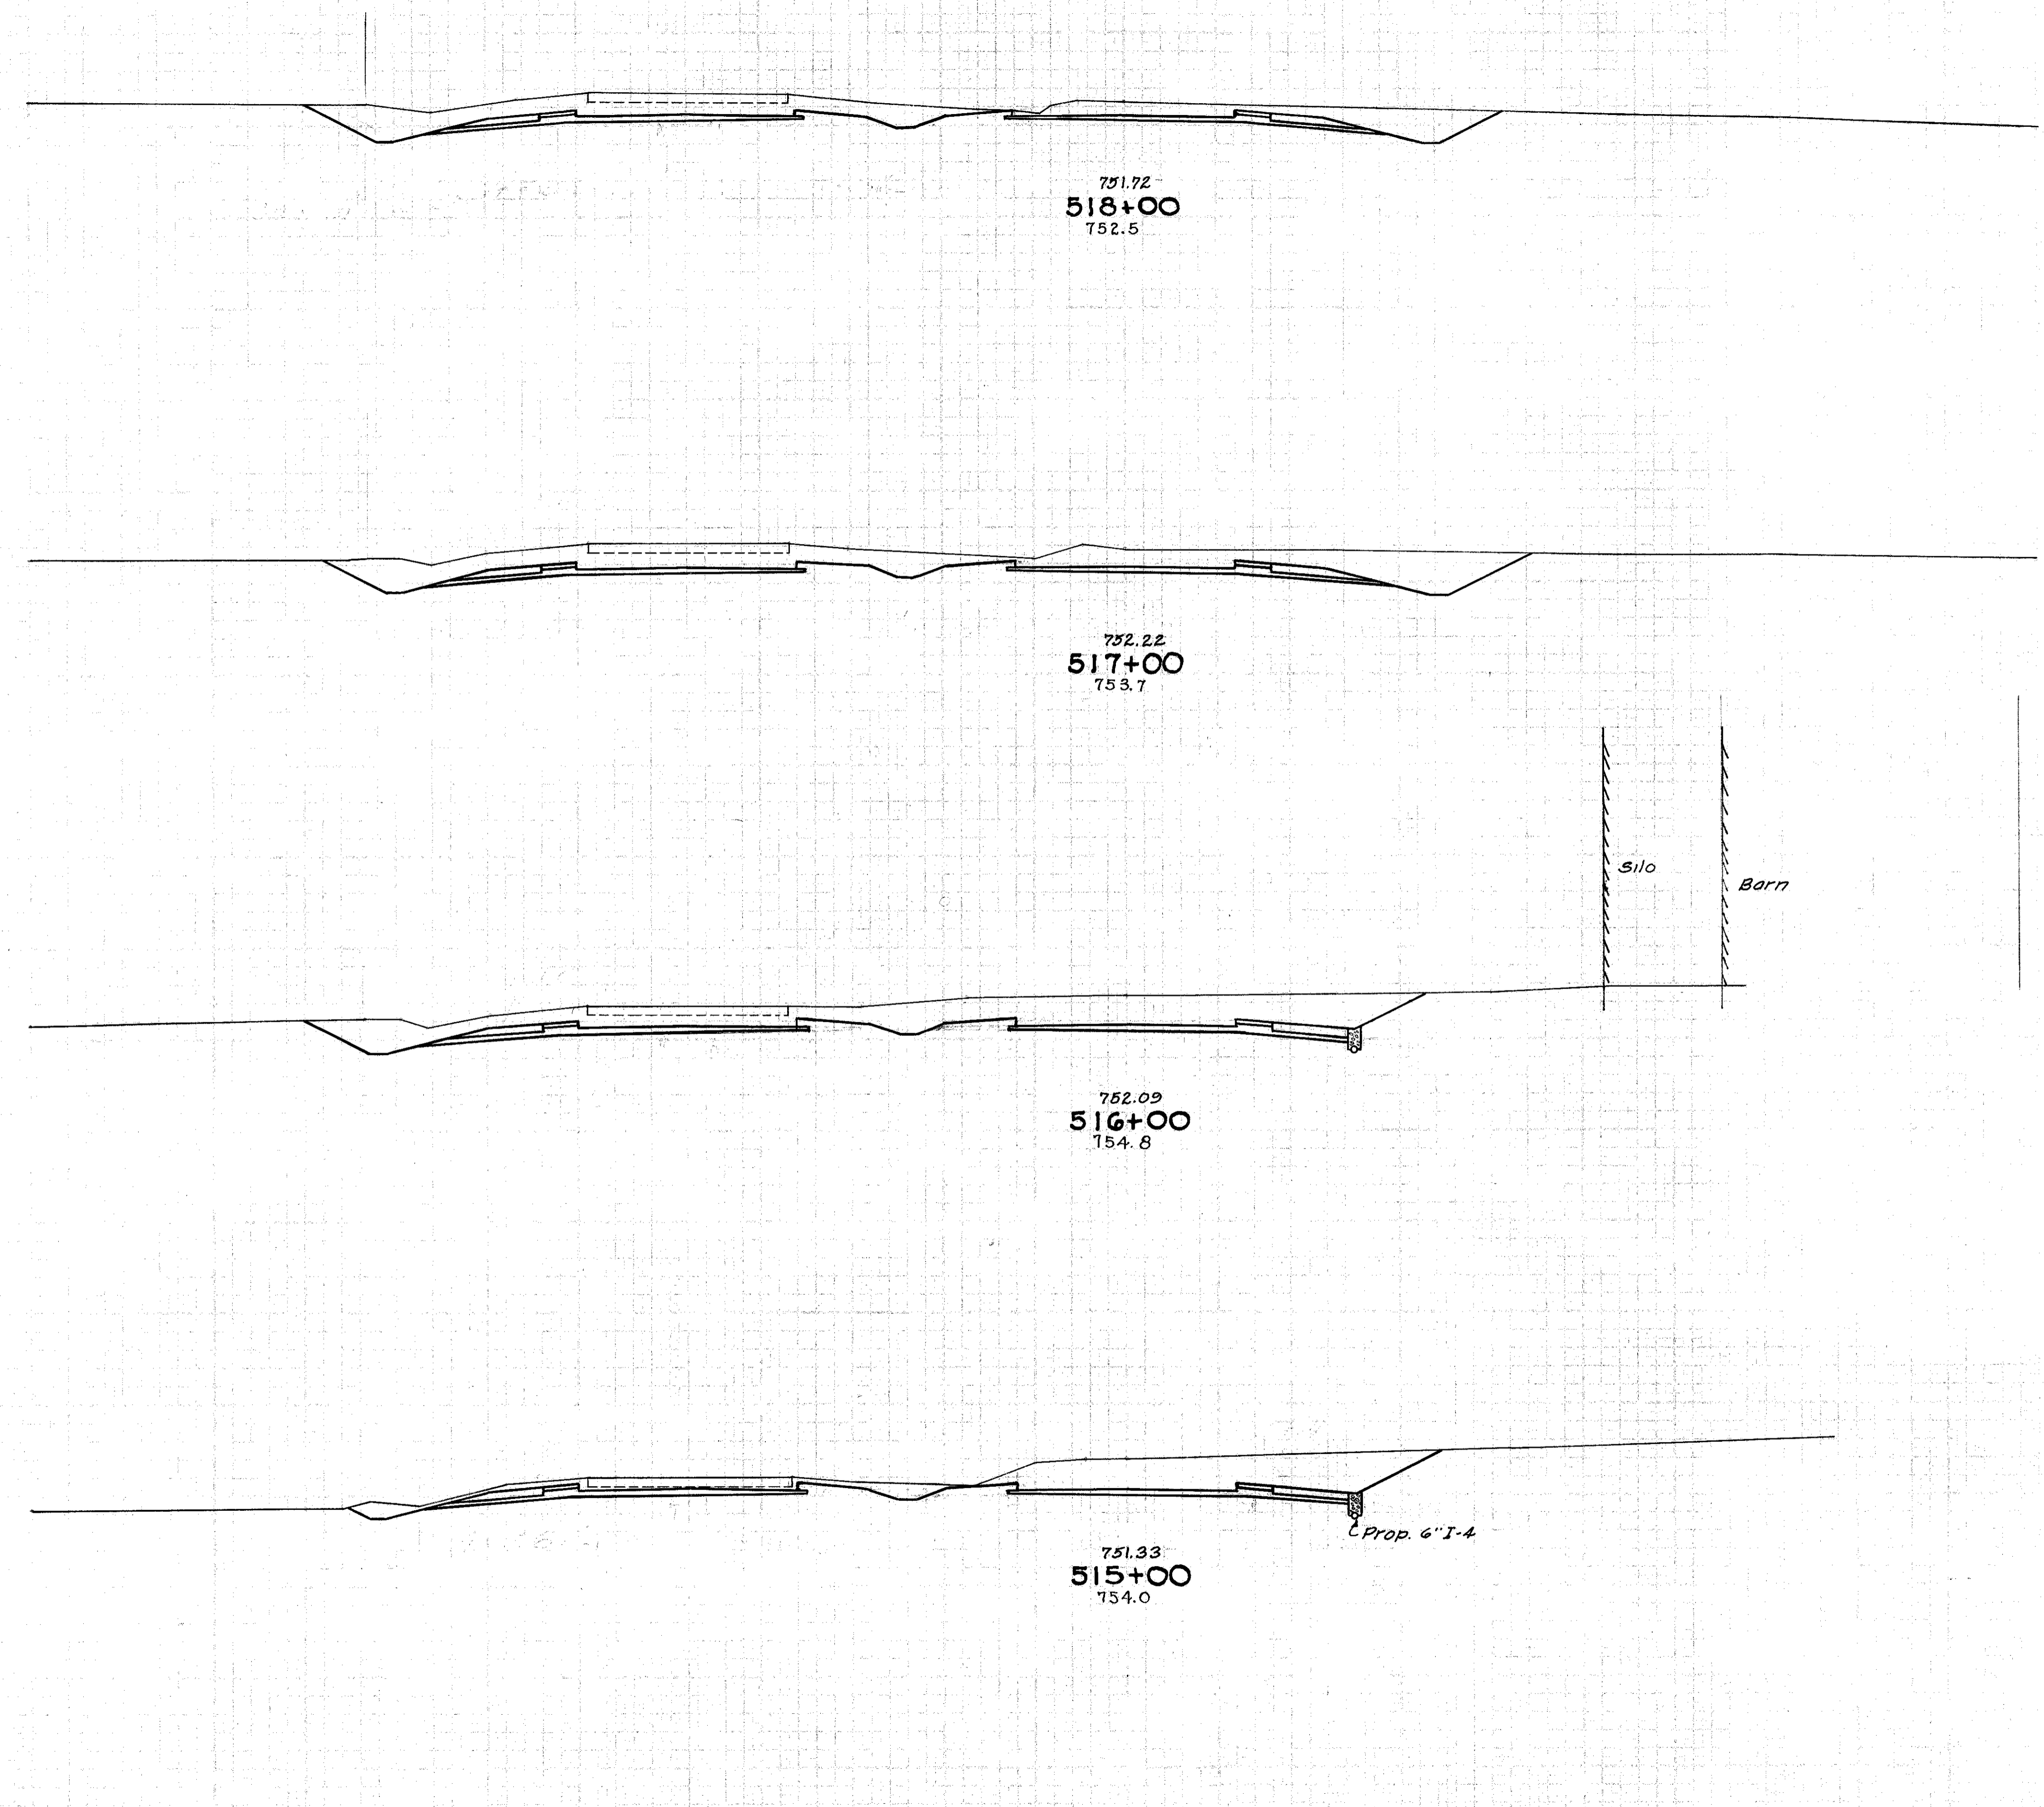


End Area		Cu. Yds.	
Cut	Fill	Cut	Fill
314	12		
		1278	44
376	12		
		1528	48
449	14		
		1385	48
		58	
299	12		
		1139	46

Note:  
Drive Rt Sta 515+68.5

150 140 130 120 110 100 90 80 70 60 50 40 30 20 10 0 10 20 30 40 50 60 70 80 90 100 110 120 130 140

150 140 130 120 110 100 90 80 70 60 50 40 30 20 10 0 10 20 30 40 50 60 70 80 90 100 110 120 130 140 150

PRO. NO.	STATE	PROJECT
222	OHIO	
SUT-4-118 5-3-18 15		

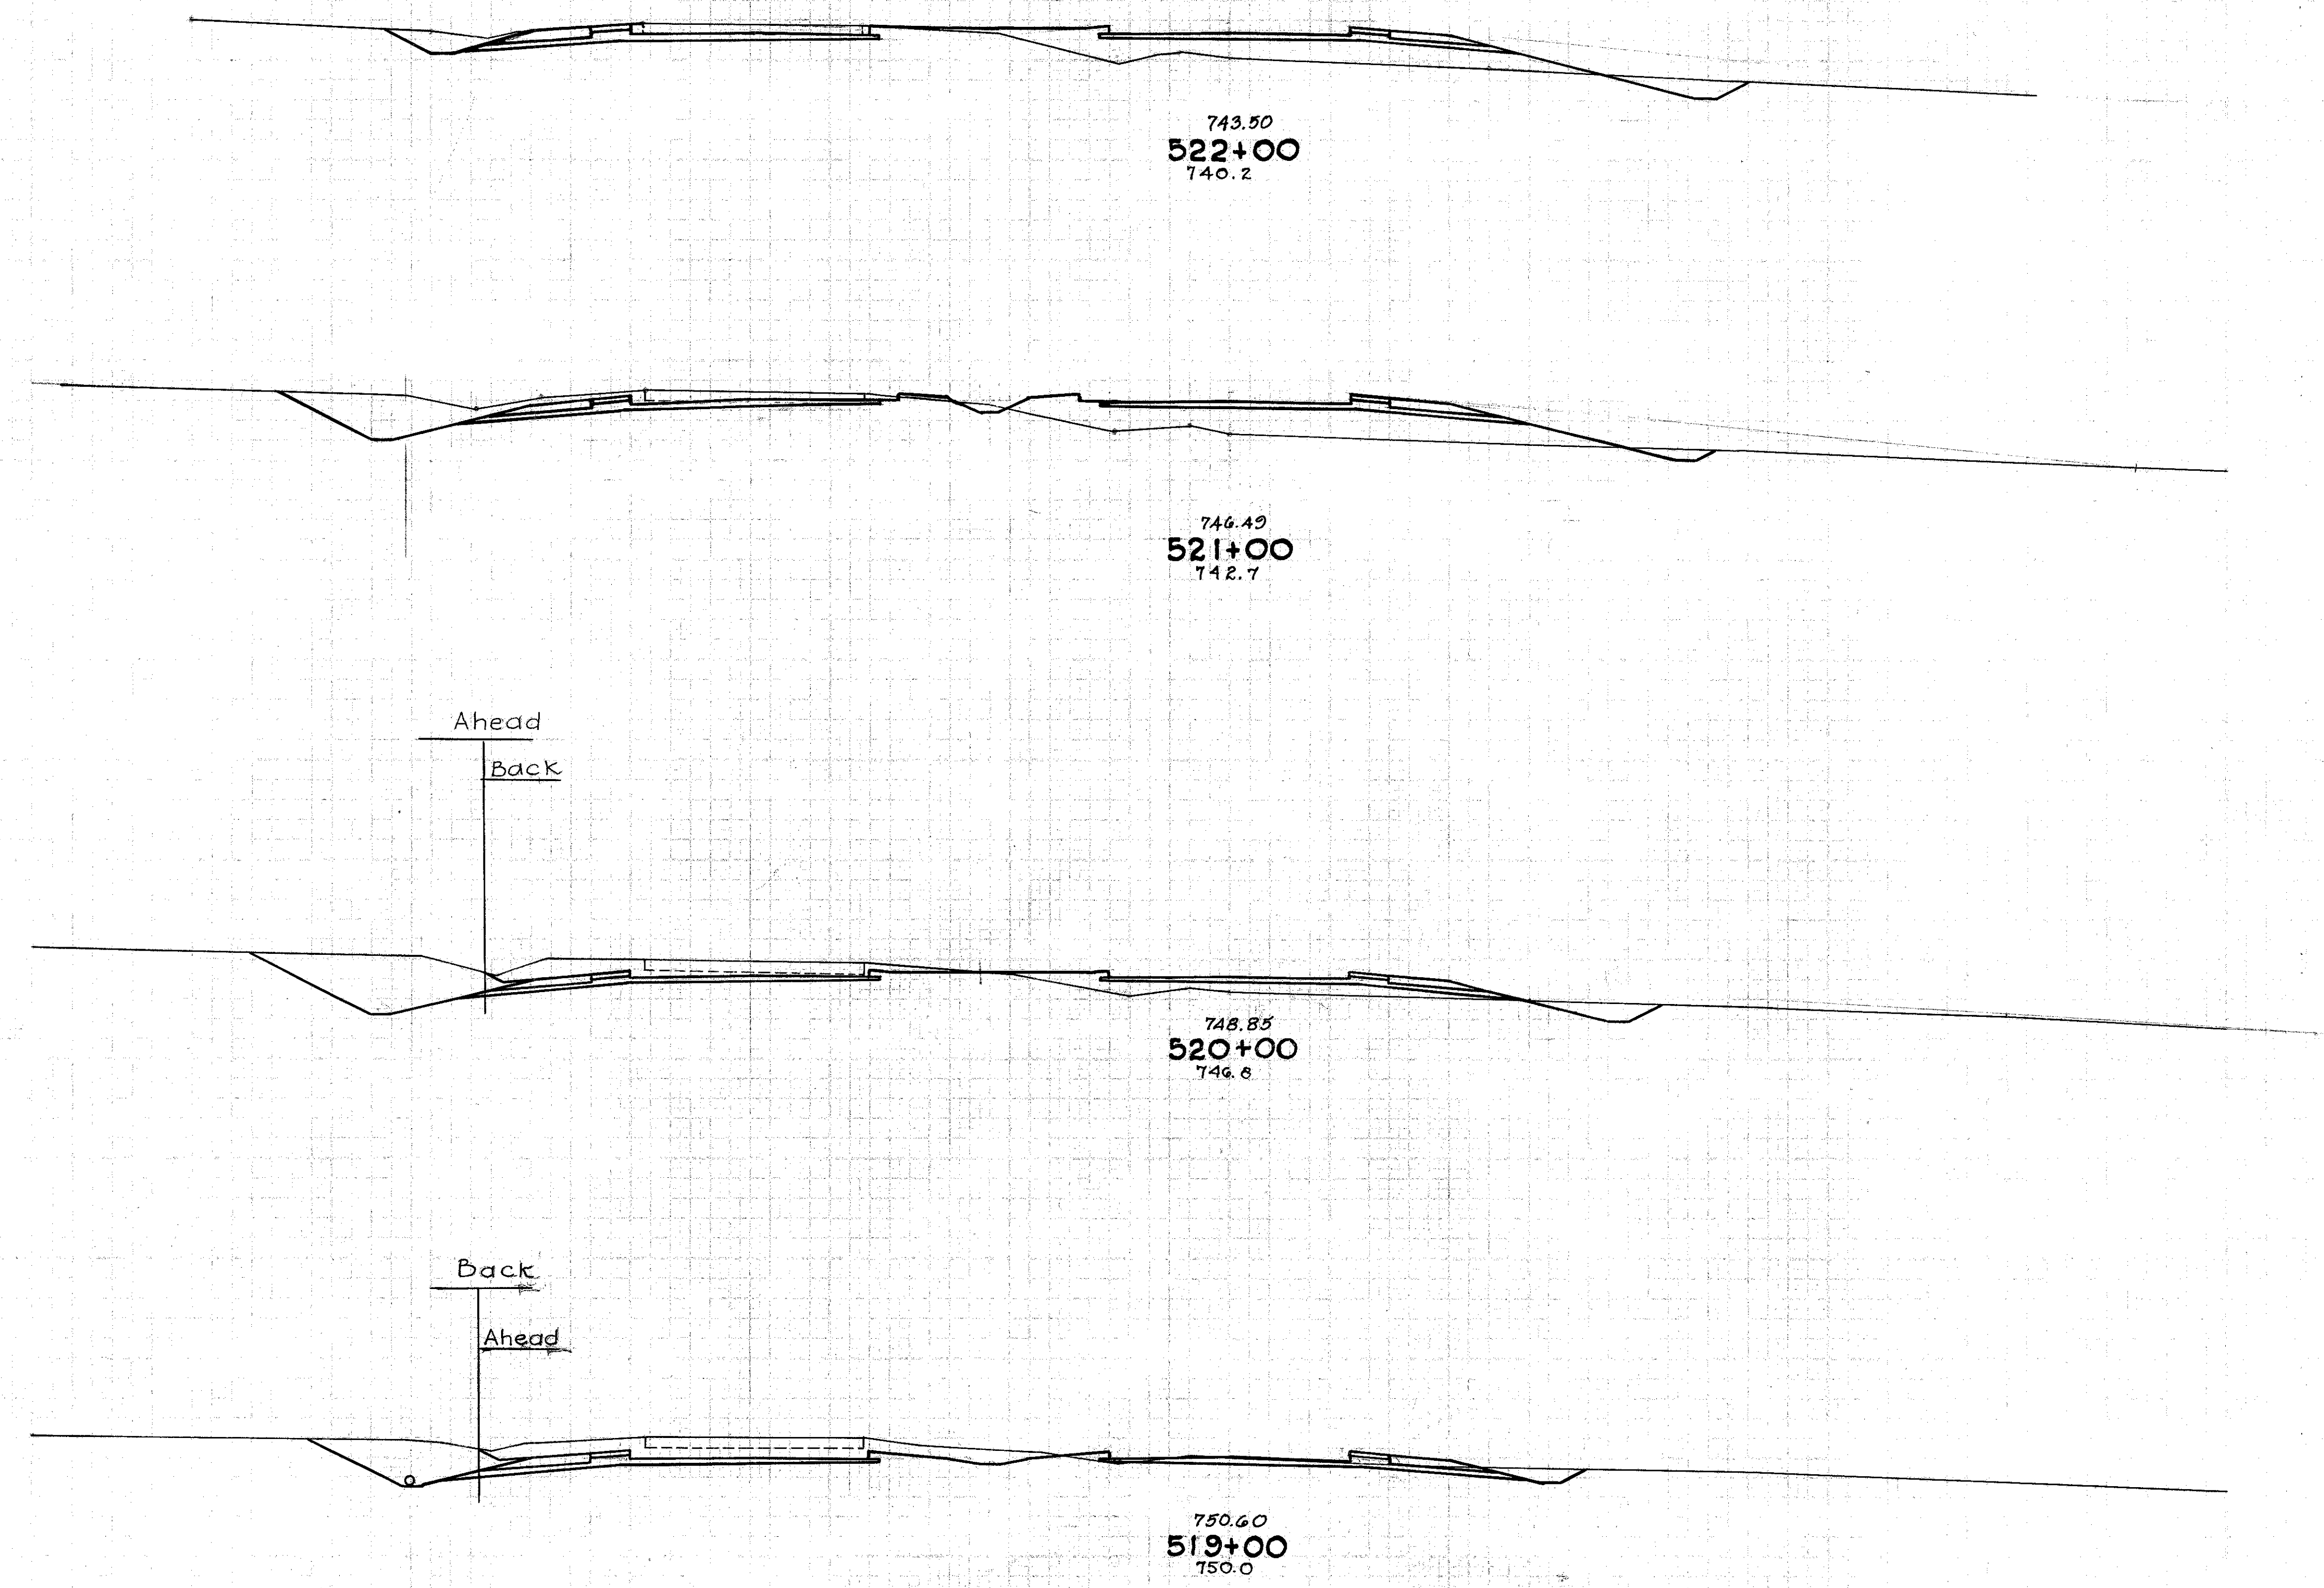

Note:  
Drive Lt. Sta. 521+39

Ahead  
Back

Ahead  
Back

Back  
Ahead

Note:  
Drive Lt. Sta 519+85





End Area		Cu. Yds.	
Cut	Fill	Cut	Fill
203	12	857	44
260	12	850	133
199	60	424	119
140	10	969	52
209	16		
		24	

Sta. 510+00 to Sta. 520+00  
Embankment +15%  
10 599 Cu. Yds.  
907 Cu. Yds.  
1043 Cu. Yds.

150 140 130 120 110 100 90 80 70 60 50 40 30 20 10 0 10 20 30 40 50 60 70 80 90 100 110 120 130 140

STA. 519+00 TO 522+00


150 140 130 120 110 100 90 80 70 60 50 40 30 20 10 0 10 20 30 40 50 60 70 80 90 100 110 120 130 140 150

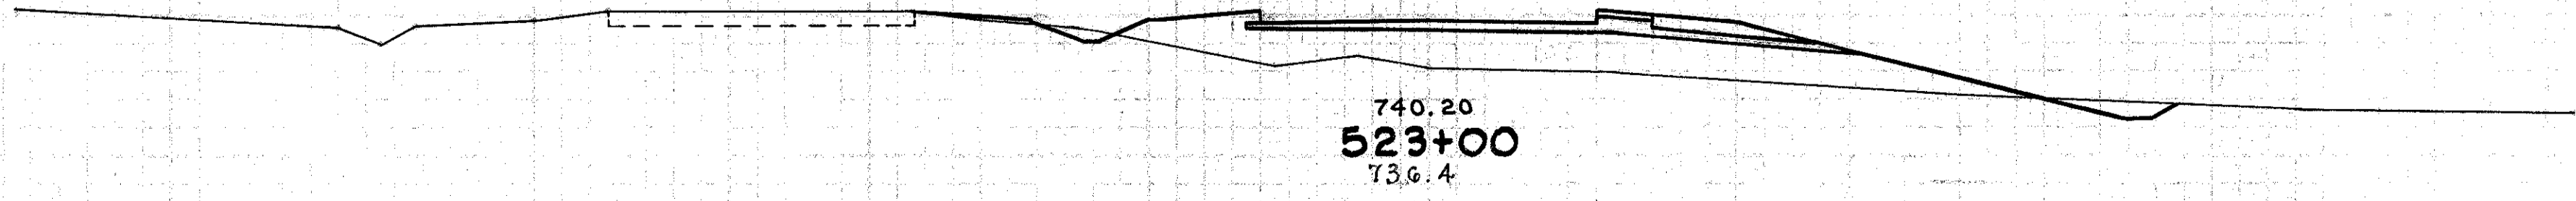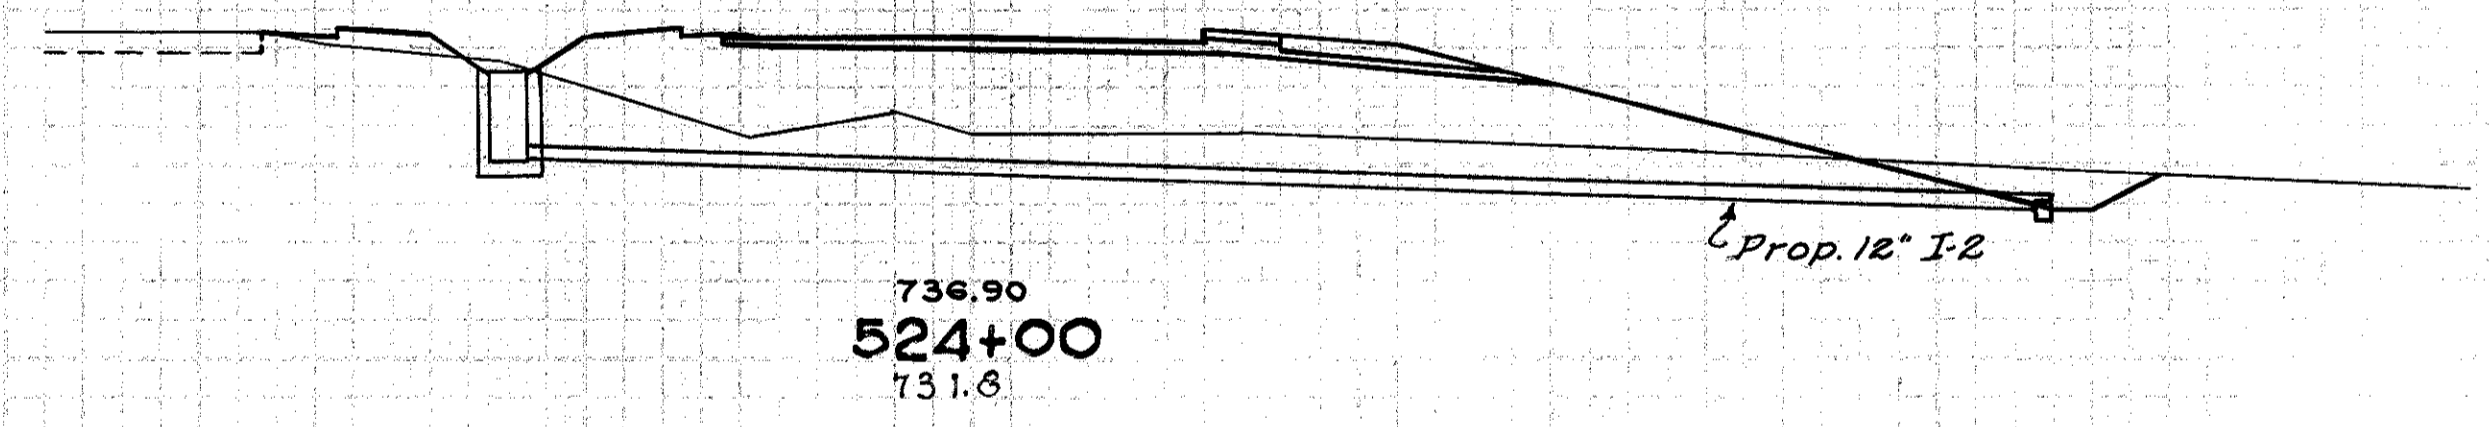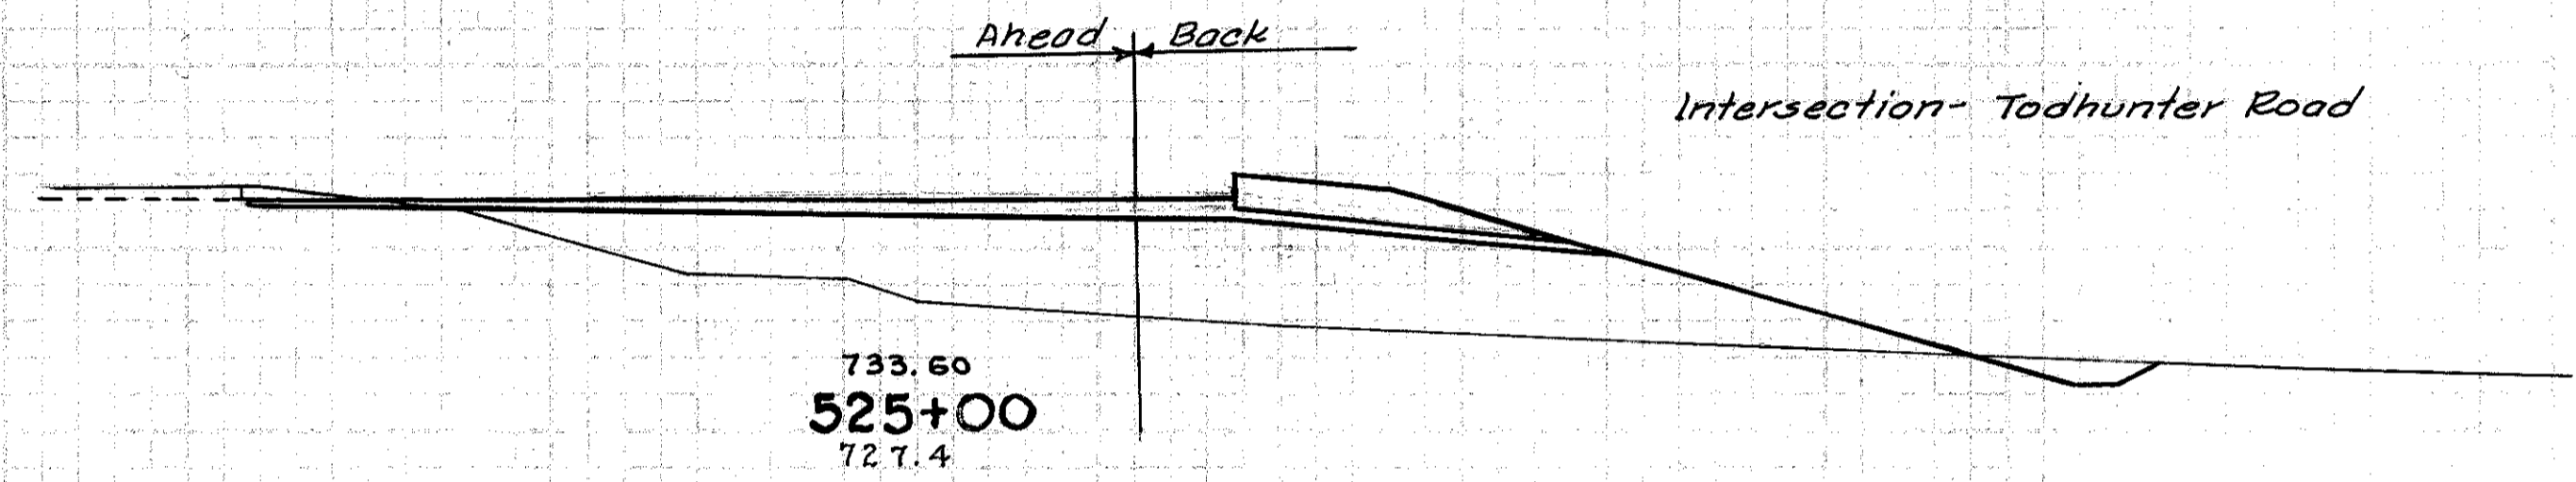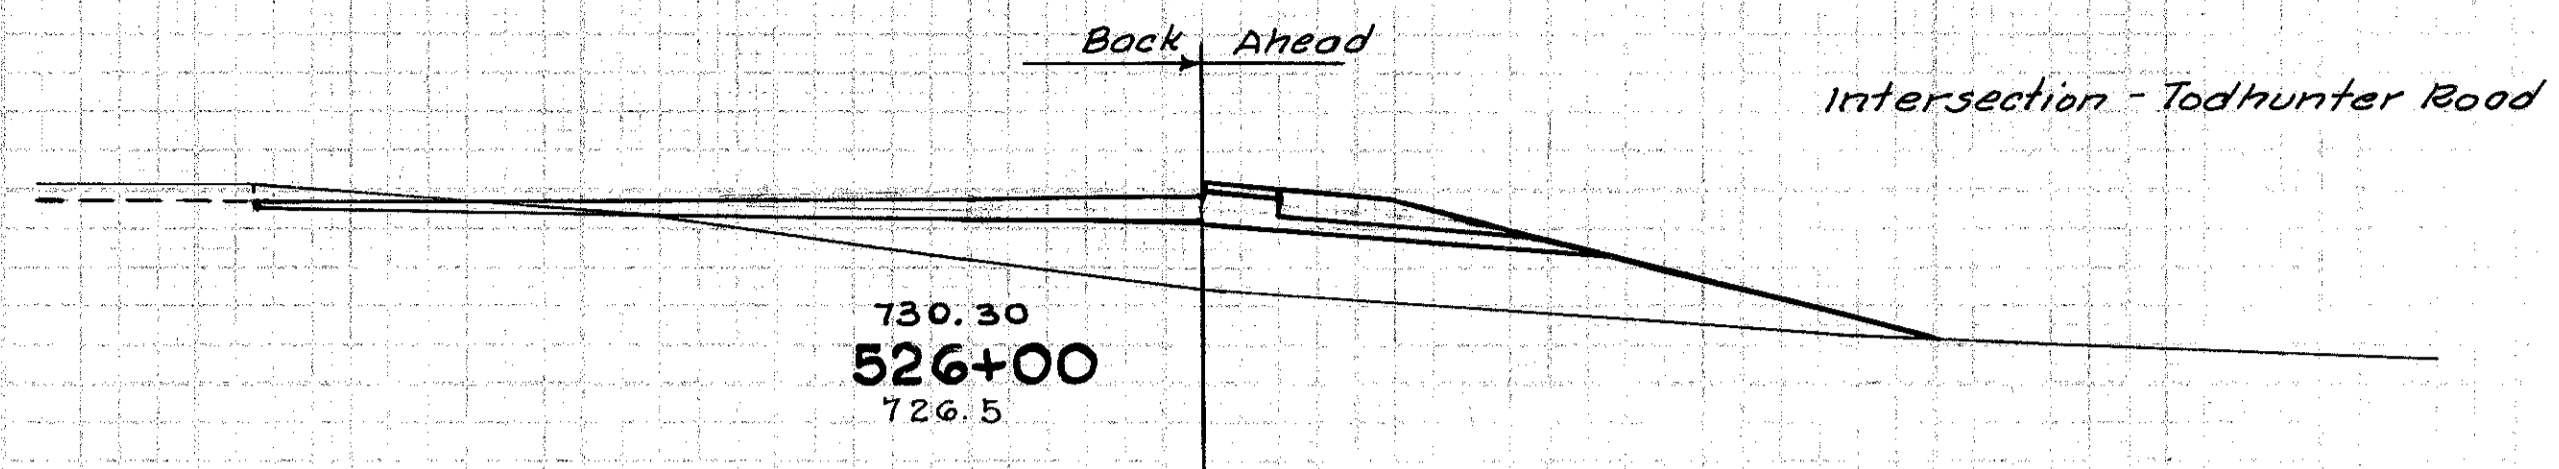

	End Area		Cu. Yds.	
	Cut	Fill	Cut	Fill
Back	11	43		
Ahead	11	170		
30 570				
401 2941				
Ahead	5	138		
Back	14	333		
63 1076				
	20	248		
54 769				
	9	167		
393 832				


150 140 130 120 110 100 90 80 70 60 50 40 30 20 10 0 10 20 30 40 50 60 70 80 90 100 110 120 130 140

STA. 523+00 TO 526+00

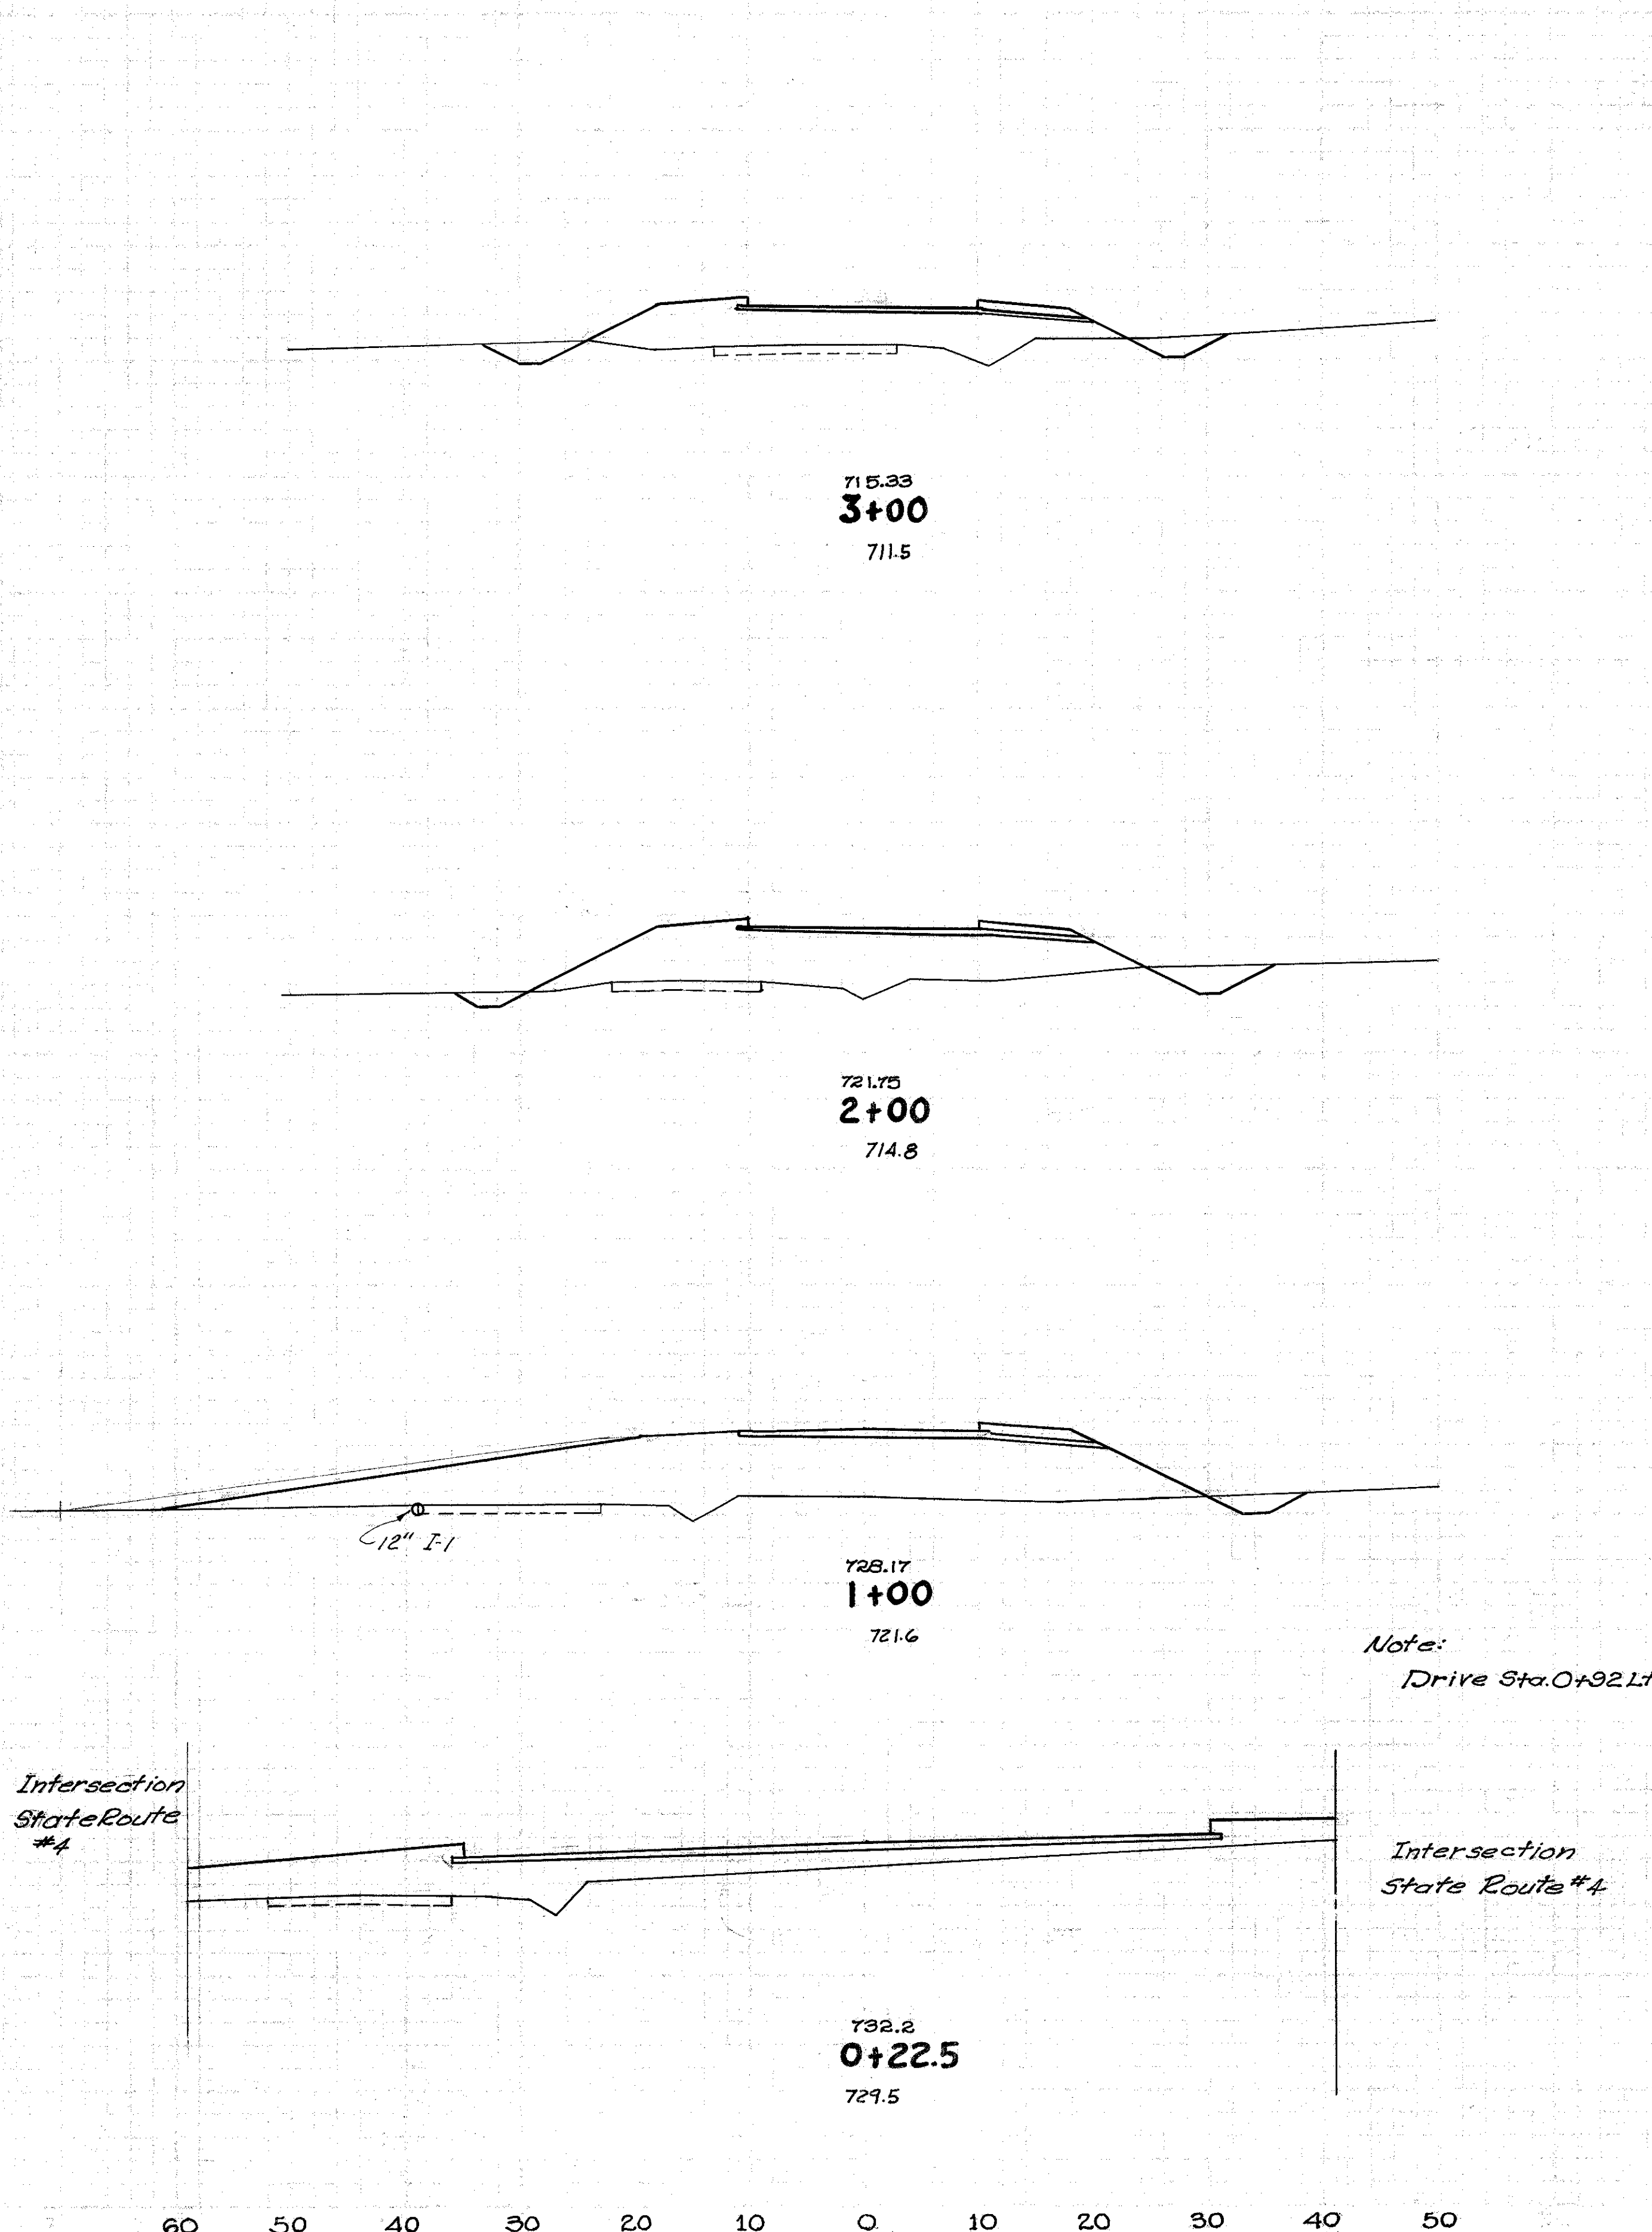

End Area		Cu. Yds.	
Cut	Fill	Cut	Fill
21	140		
		80	637
22	204		
		57	1069
9	373		
		26	854
			15
0	444		

Note:  
Drive Sta. 0+92.1 ft.

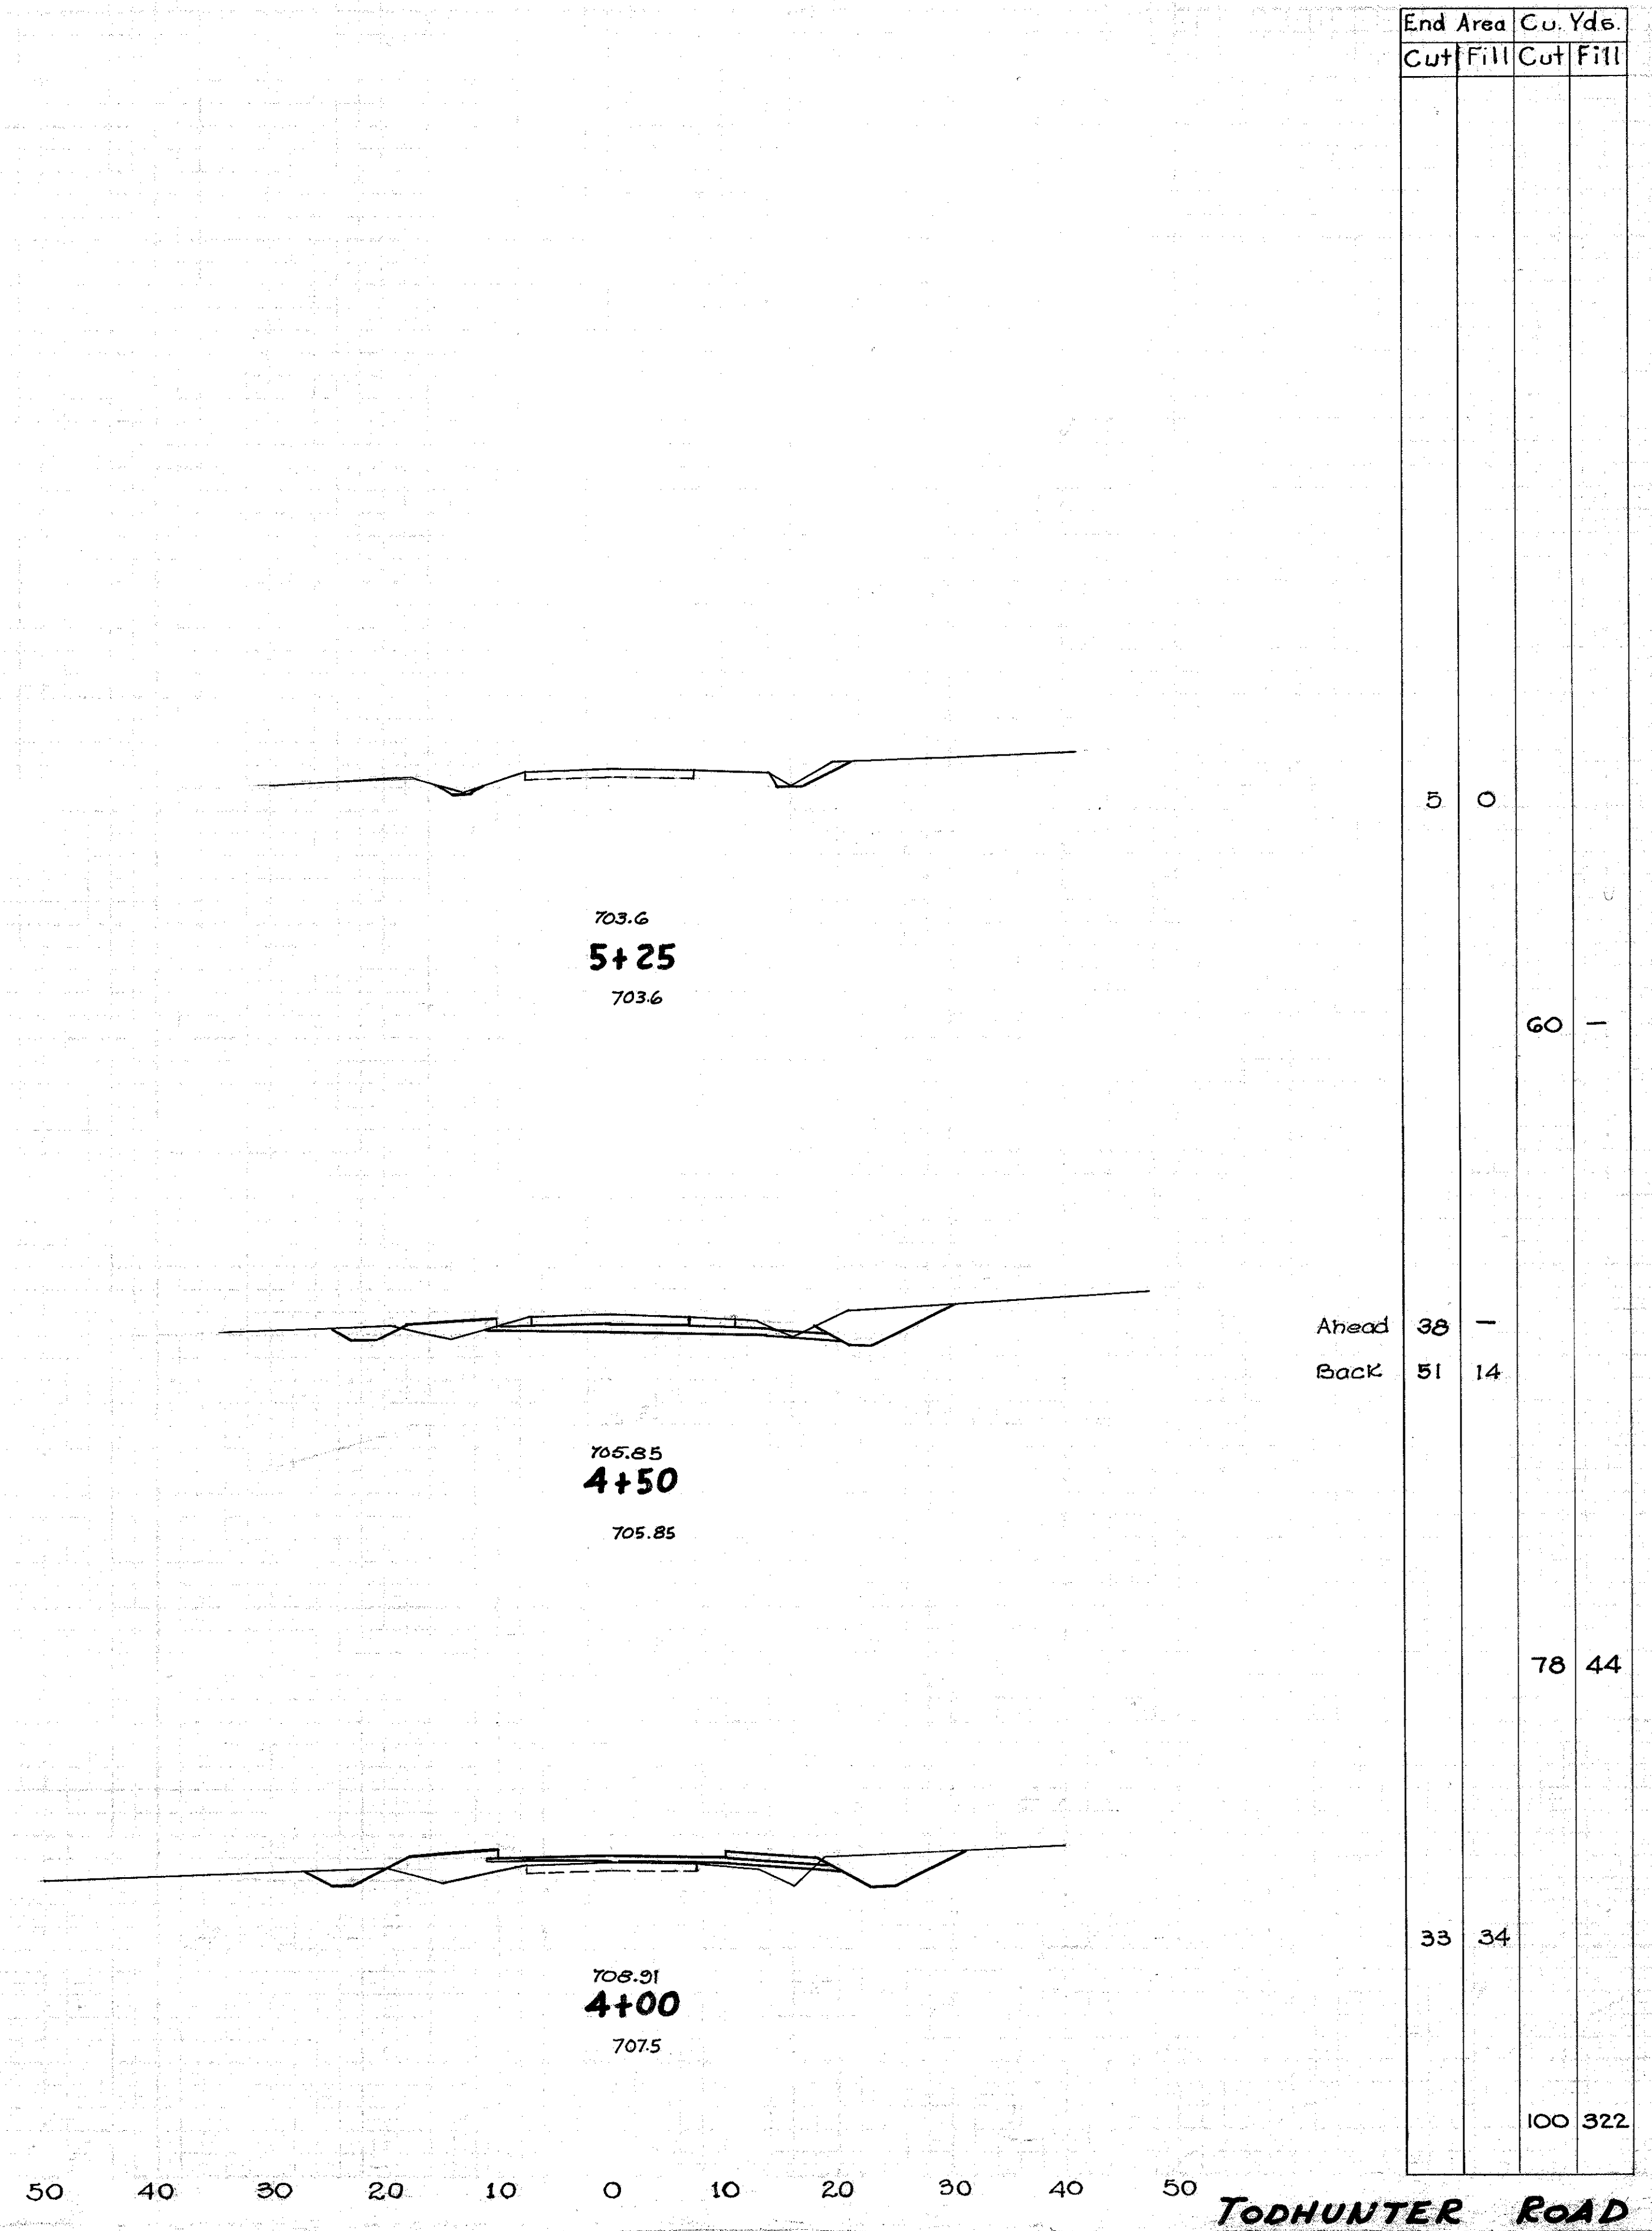


End Area		Cu. Yds.	
Cut	Fill	Cut	Fill
		5	0
			60
Ahead	38		
Back	51		14
			78
			44
		33	34
			100
			322



150 140 130 120 110 100 90 80 70 60 50 40 30 20 10 0 10 20 30 40 50 60 70 80 90 100 110 120 130 140 150


65  
222

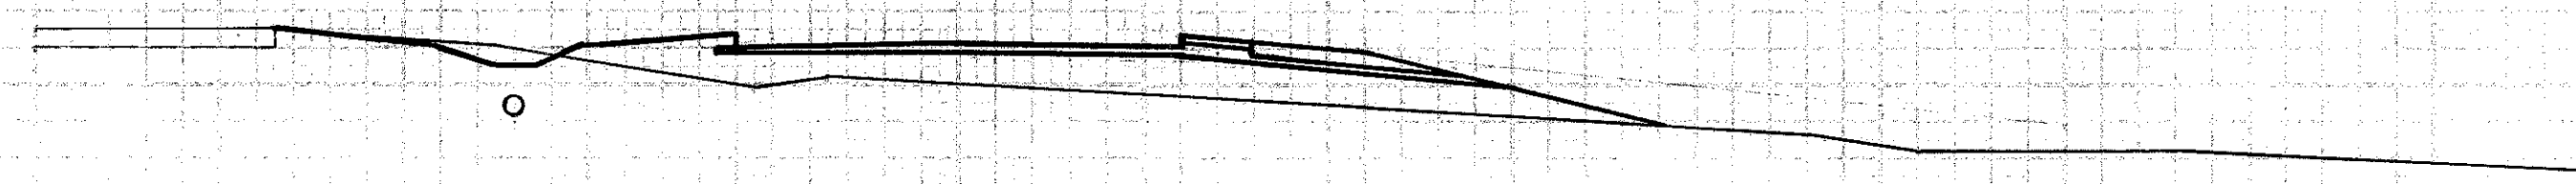

722.82  
**530+00**  
120.0


House

Note:  
Drive Rt. Sta. 530+32

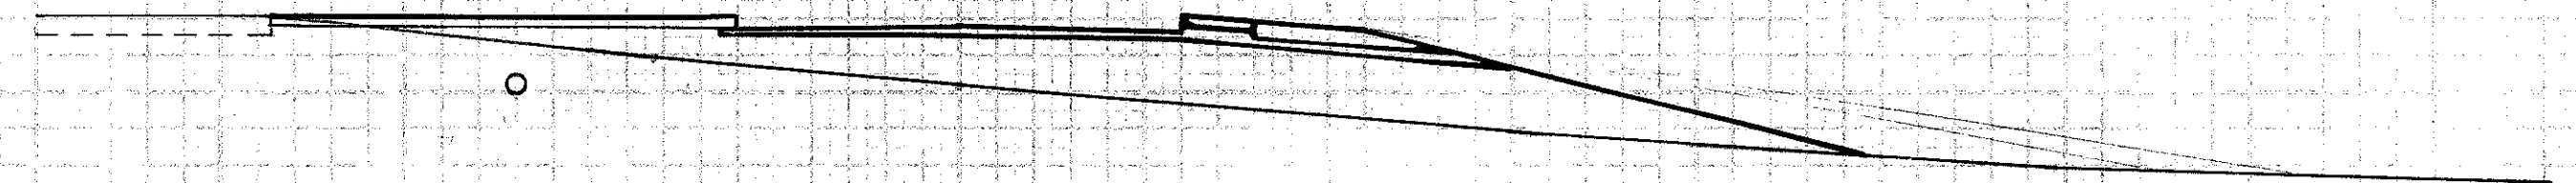


724.10  
**529+00**  
720.2

Note:  
Drive Rt. Sta. 529+12

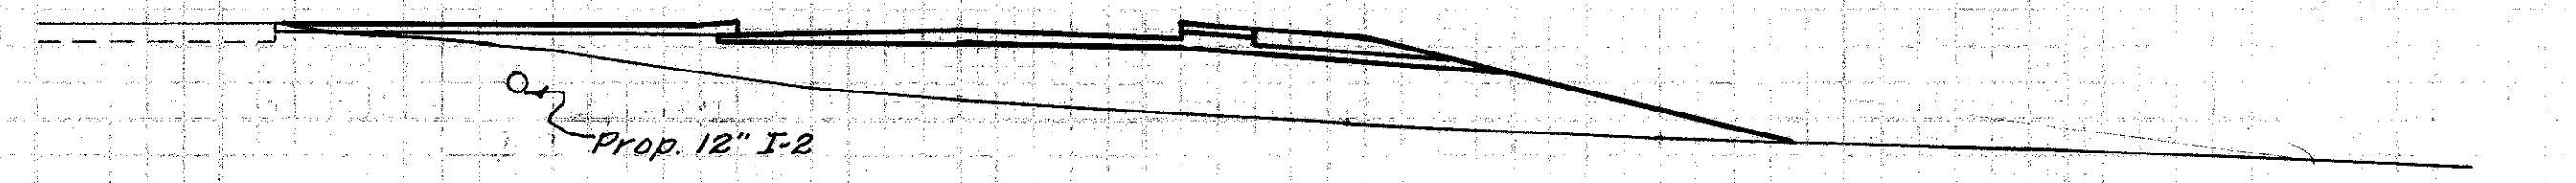

725.39  
**528+00**  
721.2

Note:  
Drive Rt. Sta. 528+37

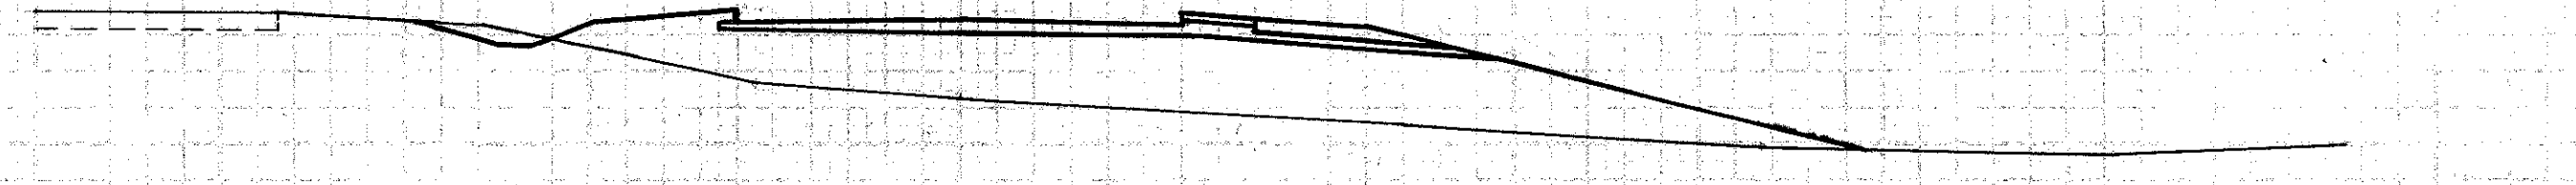

727.35  
**527+00**  
722.6

Note:  
Drive Rt. Sta. 528+12


End Area		Cu. Yds.	
Cut	Fill	Cut	Fill
			33
4	112		
		7	646
			25
0	237		
			39
		-	444
			40
0	203		
		9	844
5	253		
		30	530

Sta. 520+00 to Sta. 530+00  
E-1  
Embankment 2694 Cu. Yds.  
Embankment 8456 Cu. Yds.  
Embankment +15% 9759 Cu. Yds.


STA. 527+00 TO 530+00

150 140 130 120 110 100 90 80 70 60 50 40 30 20 10 0 10 20 30 40 50 60 70 80 90 100 110 120 130 140


150 140 130 120 110 100 90 80 70 60 50 40 30 20 10 0 10 20 30 40 50 60 70 80 90 100 110 120 130 140 150

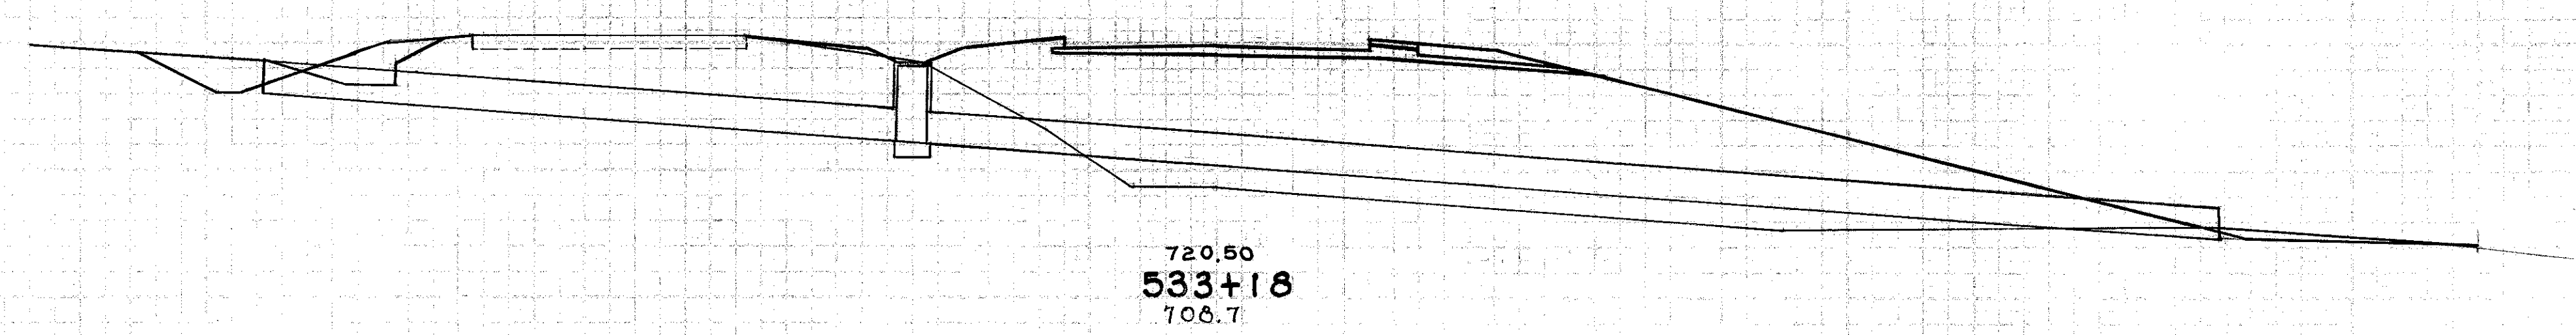


720.50  
**533+18**  
706.7

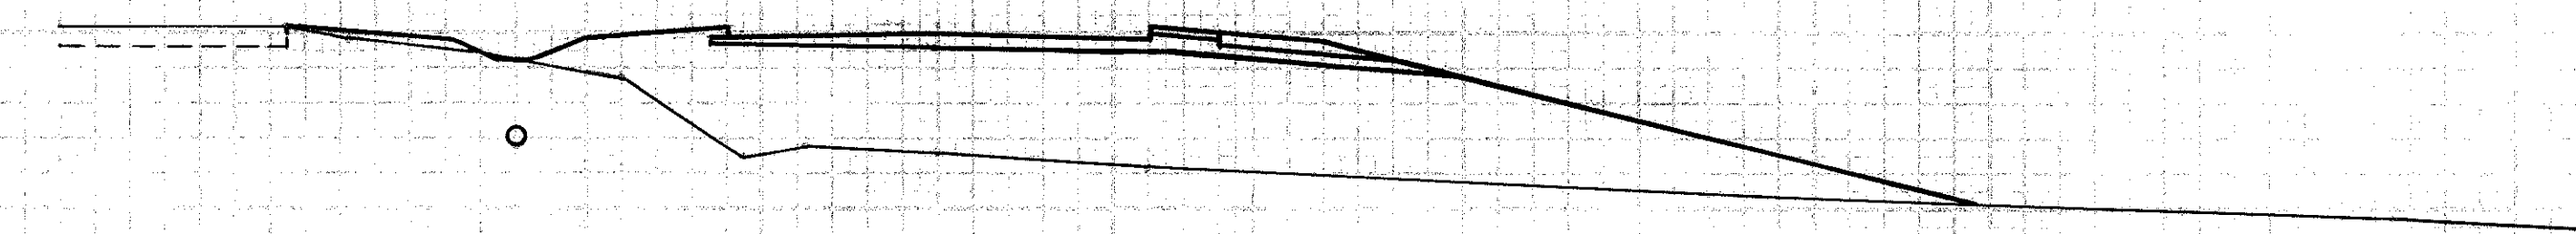

720.50  
**533+00**  
713.2

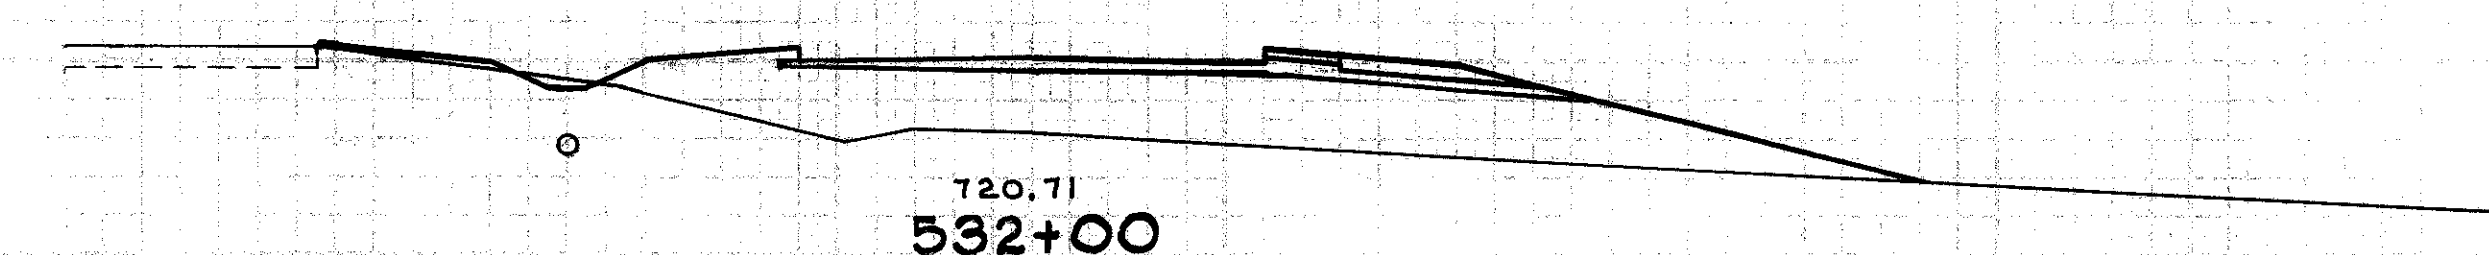

720.71  
**532+00**  
716.3

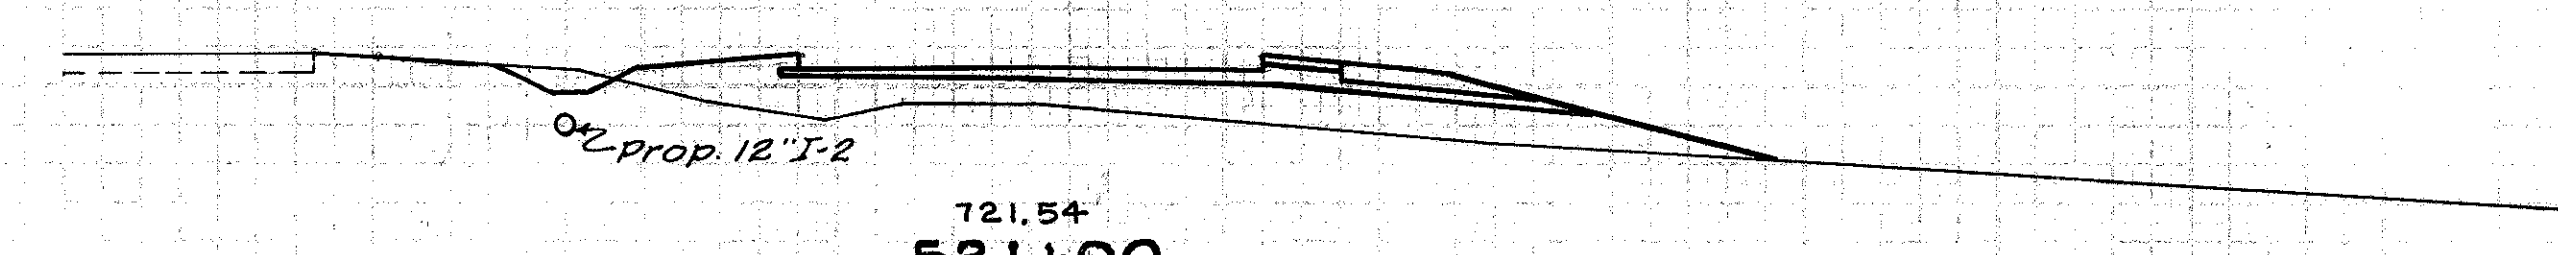


721.54  
**531+00**  
719.1




Sta.	End Area		Cu. Yds.	
	Cut	Fill	Cut	Fill
7	797			
3			410	
0	433			
2			1233	
7	233			
11			682	
5	135			
17			457	

150 140 130 120 110 100 90 80 70 60 50 40 30 20 10 0 10 20 30 40 50 60 70 80 90 100 110 120 130 140

150 140 130 120 110 100 90 80 70 60 50 40 30 20 10 0 10 20 30 40 50 60 70 80 90 100 110 120 130 140 150

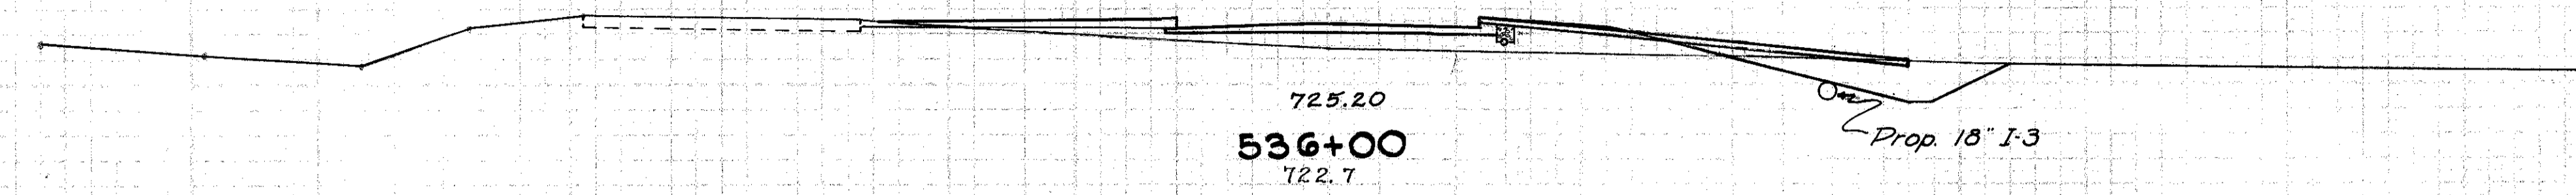

Note:  
Drive Rt. Sta. 535+99

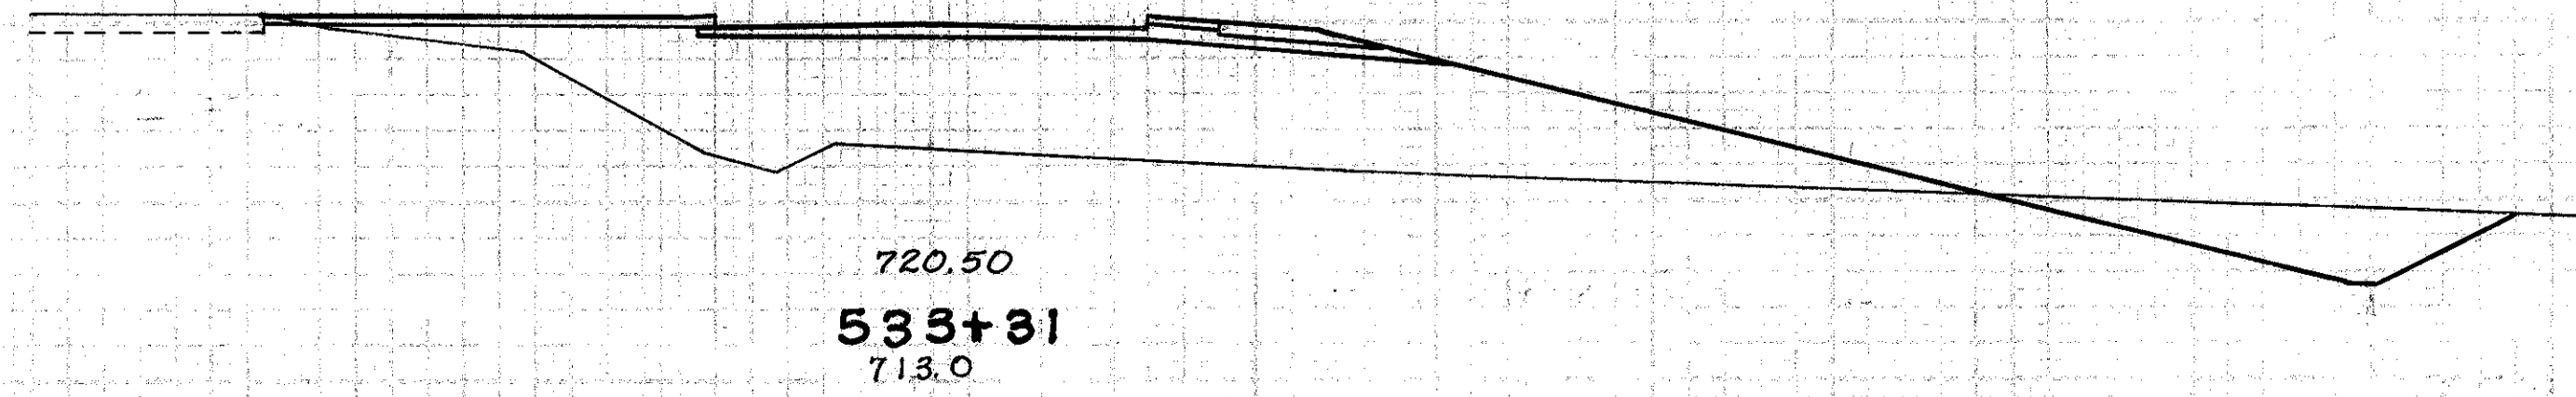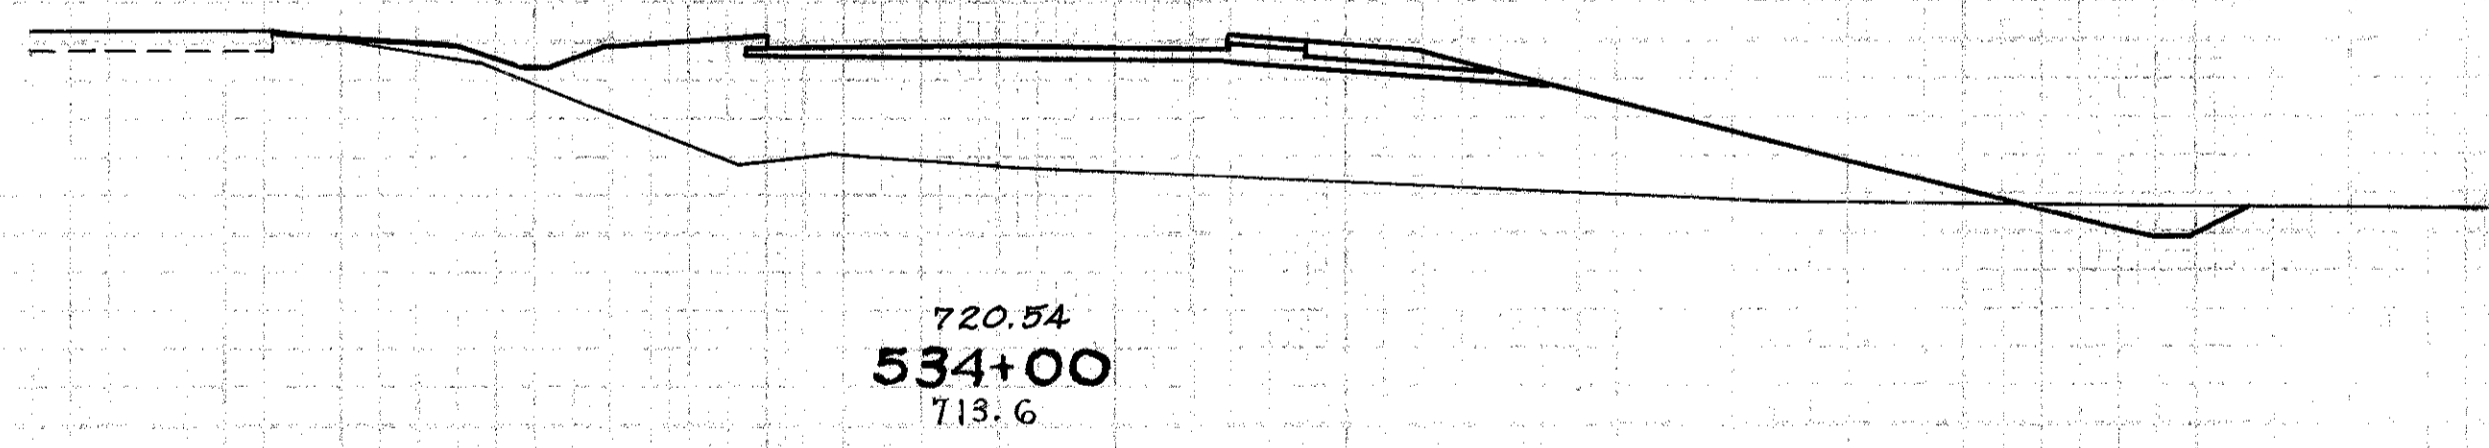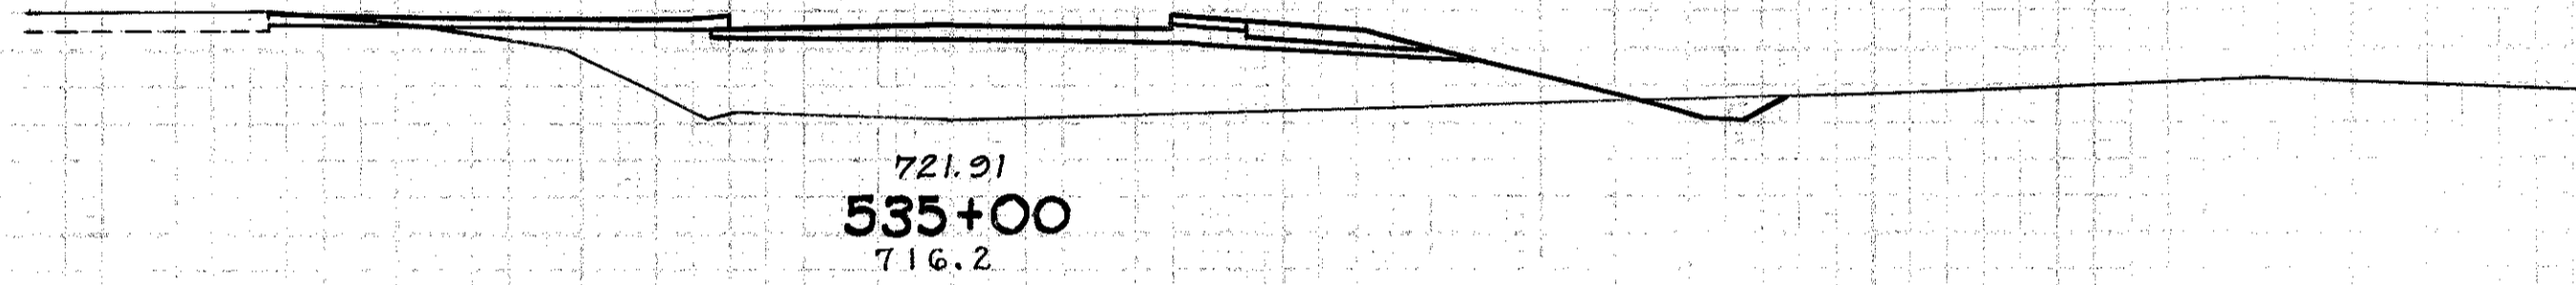


Sta.	End Area		Cu. Yds.	
	Cut	Fill	Cut	Fill
536+00	4	48		2
535+00			17	509
534+00	5	227		
533+31			28	1143
533+00	10	390		
532+00			37	1086
531+00	66	460		
530+00			18	303

150 140 130 120 110 100 90 80 70 60 50 40 30 20 10 0 10 20 30 40 50 60 70 80 90 100 110 120 130 140

STA. 533+31 TO 536+00

150 140 130 120 110 100 90 80 70 60 50 40 30 20 10 0 10 20 30 40 50 60 70 80 90 100 110 120 130 140 150

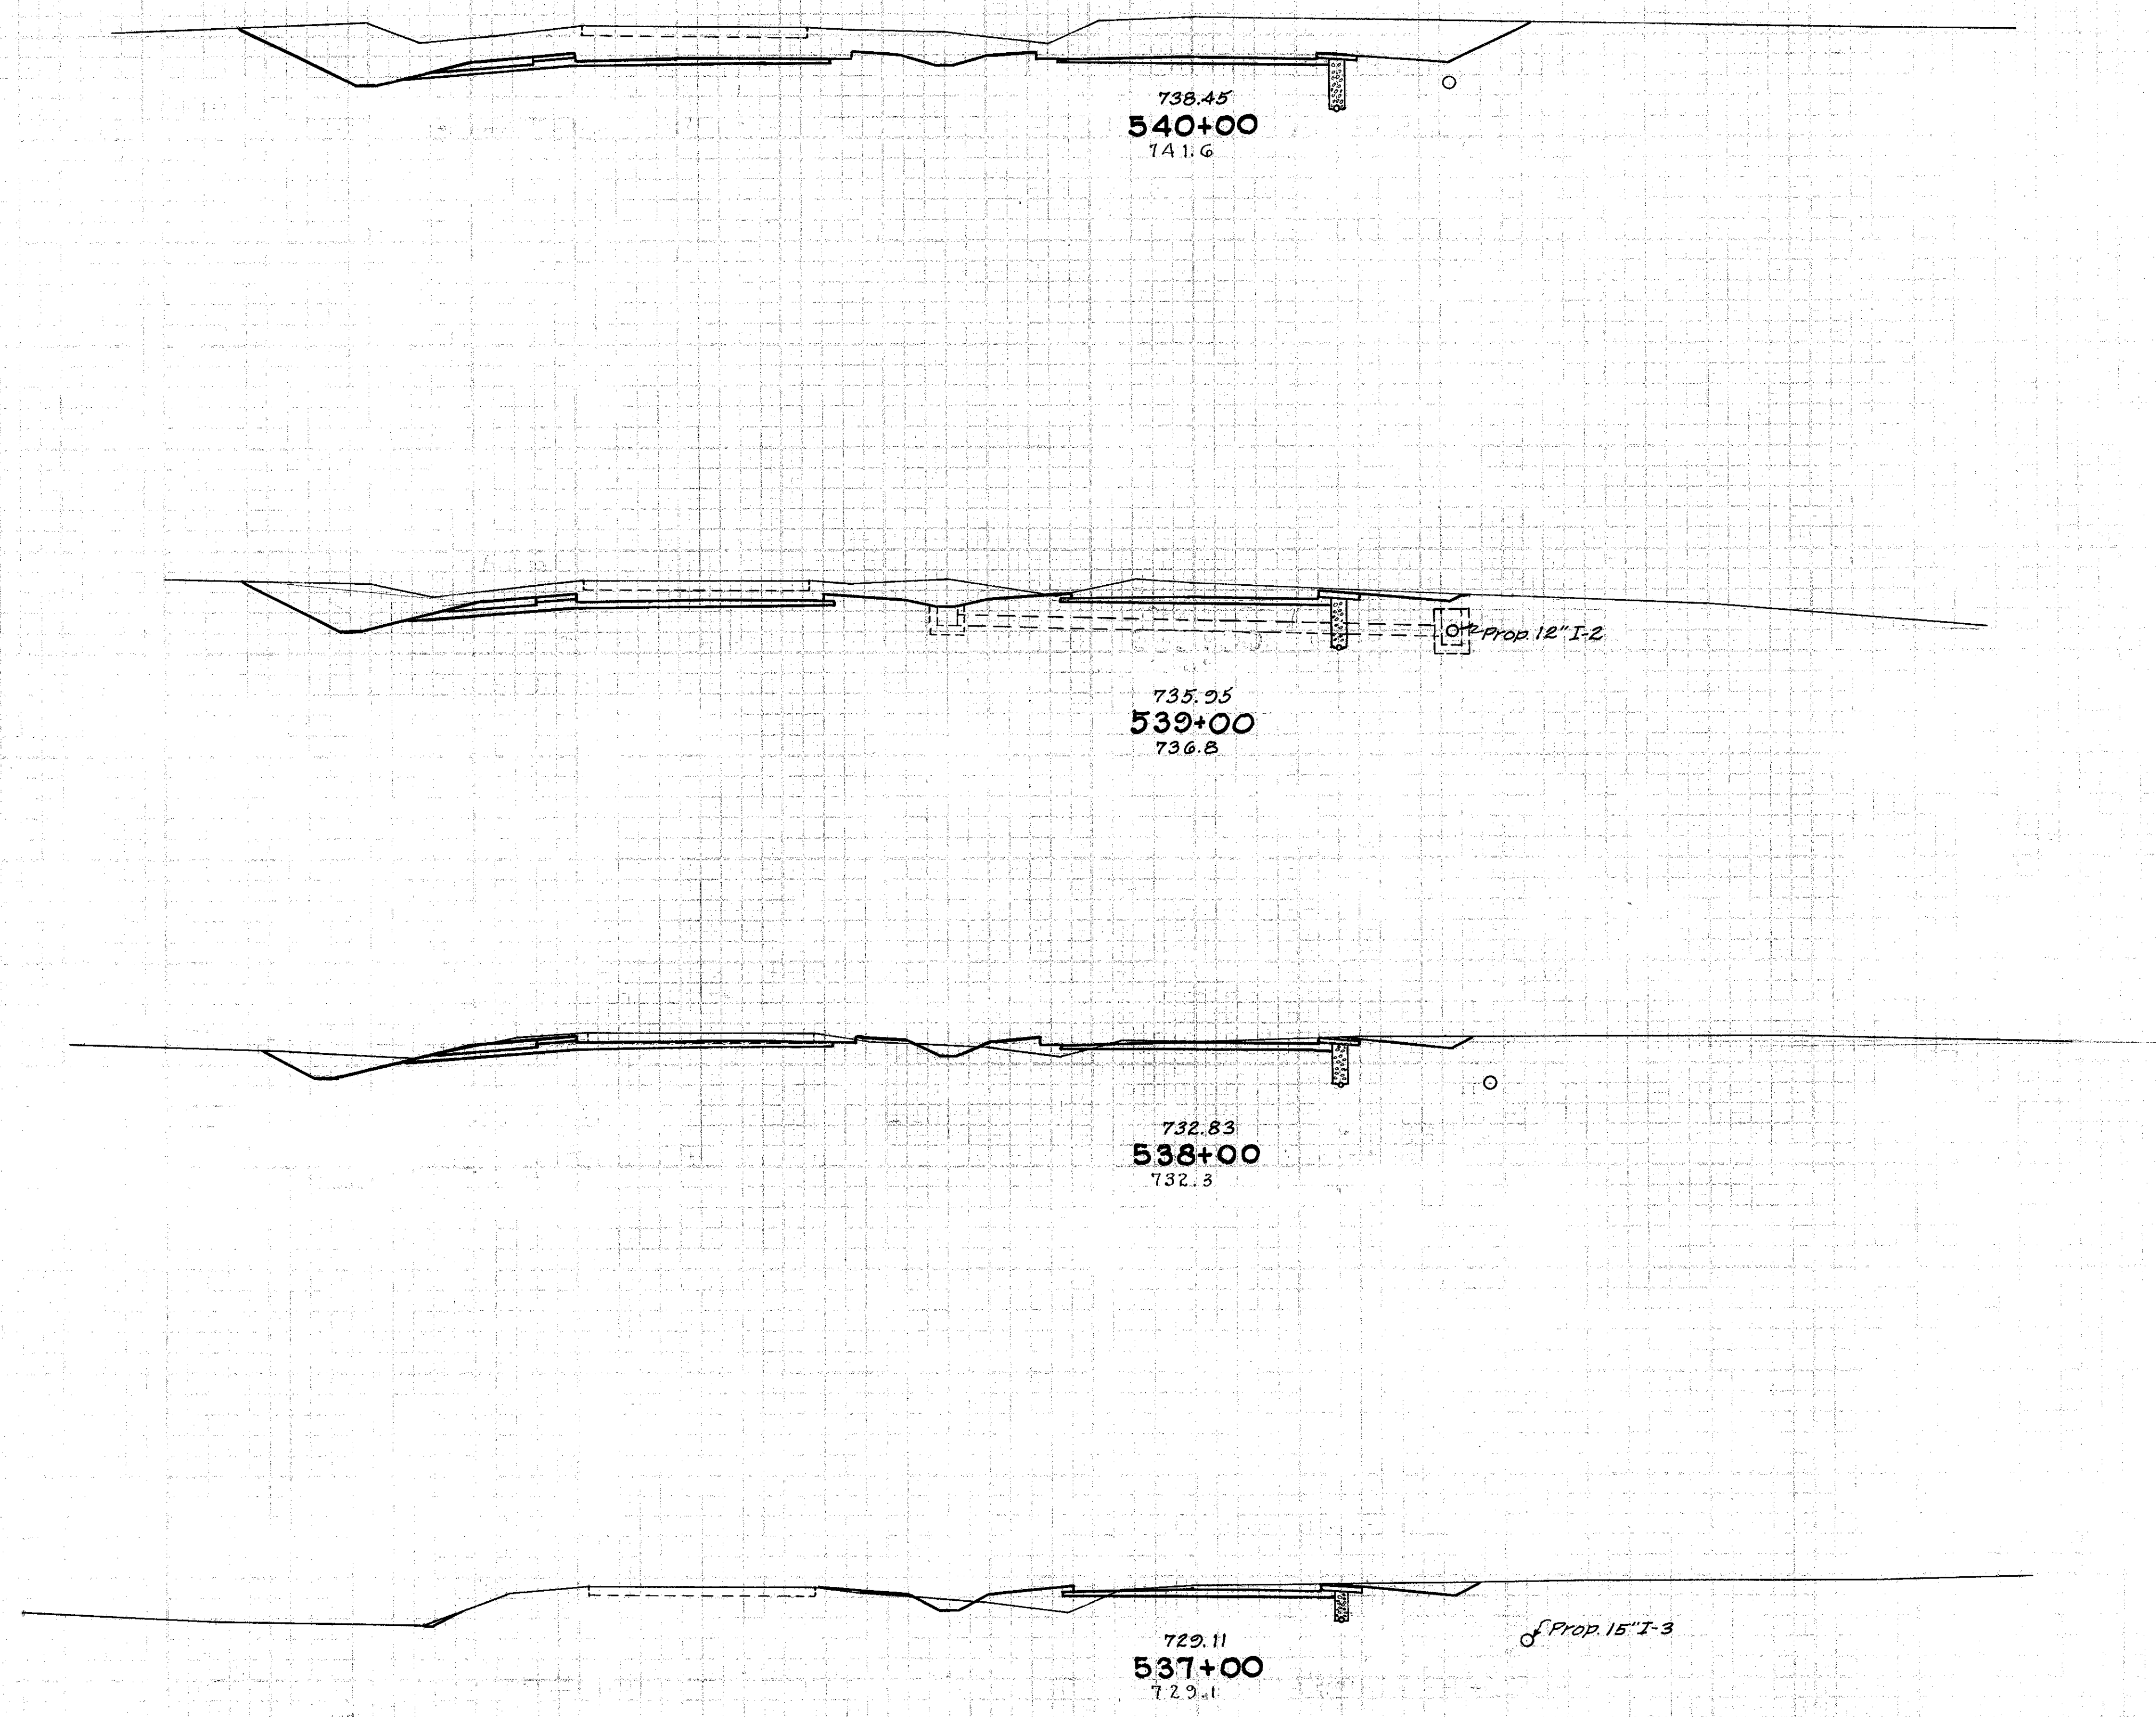

Note:  
Drive Rt. Sta. 540+37


Note:  
Drive Rt. Sta. 538+54  
Drive Lt. Sta. 538+37  
Drive Lt. Sta. 538+67

End Area		Cu. Yds.	
Cut	Fill	Cut	Fill
		8	6
166	6		
		134	22
261	6		
		48	20
		25	
		689	37
111	14		
		28	
		282	63
41	20		
		83	126


Sta 530+00 to Sta 540+00  
E-1  
Embankment 6151 Cu. Yds.  
Embankment +15% 7074 Cu. Yds.

150 140 130 120 110 100 90 80 70 60 50 40 30 20 10 0 10 20 30 40 50 60 70 80 90 100 110 120 130 140


STA. 537+00 TO 540+00

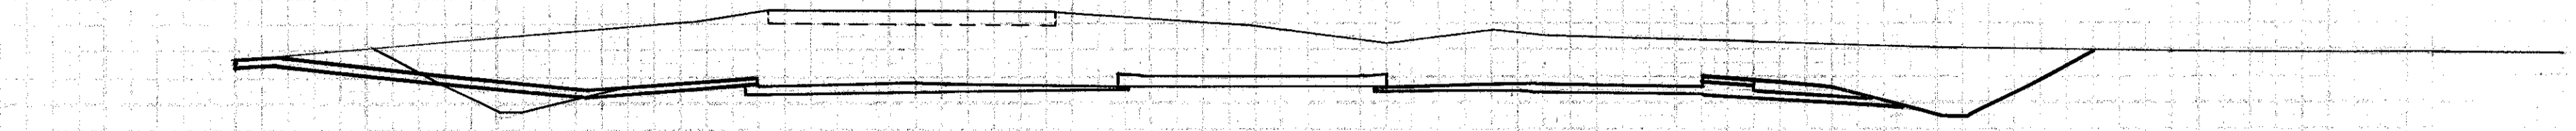


742.15  
**544+00**  
 745.1

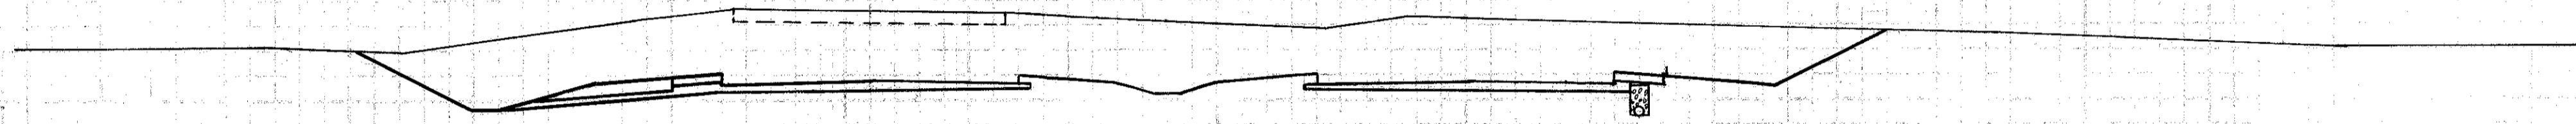

742.17  
**543+00**  
 746.6

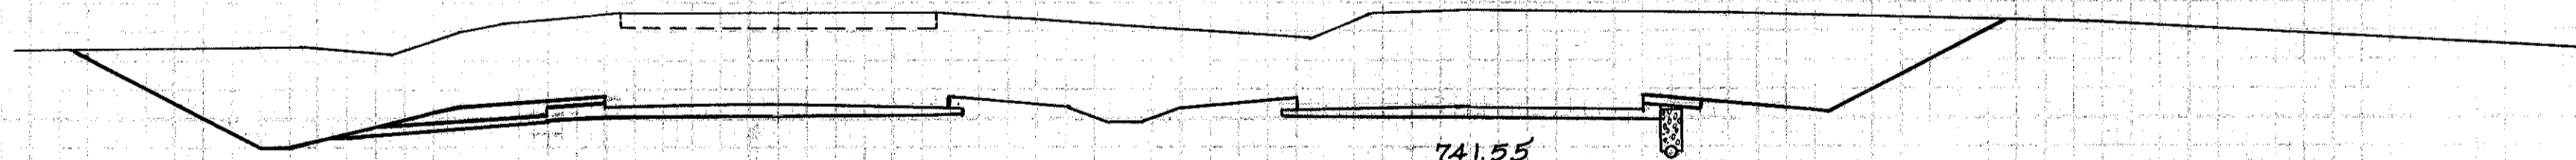

741.55  
**542+00**  
 747.5

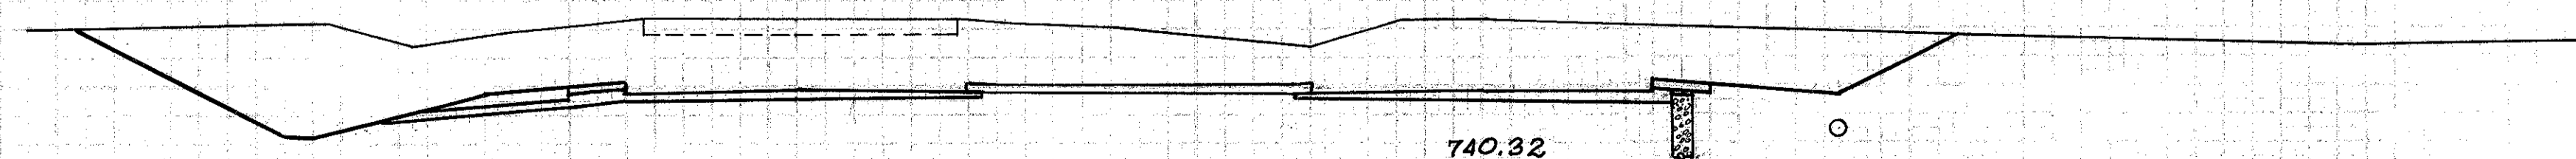

740.32  
**541+00**  
 744.6

Note:  
 Drive Lt. Sta. 543+97  
 Drive Rt. Sta. 543+56  
 Drive Lt. Sta. 543+62


Note:  
 Drive Rt. Sta. 541+42  
 Drive Lt. Sta. 541+22

End Area		Cu. Yds.	
Cut	Fill	Cut	Fill
630	6		
		2390	22
		8	6
		3	13
		8	6
661	6		
		2763	22
		831	6
		2732	22
		45	26
644	6		
		2056	22

150 140 130 120 110 100 90 80 70 60 50 40 30 20 10 0 10 20 30 40 50 60 70 80 90 100 110 120 130 140 150

70  
222  
BLT-4-15.53-19.15

Note:  
Drive Lt. Sta 545+95

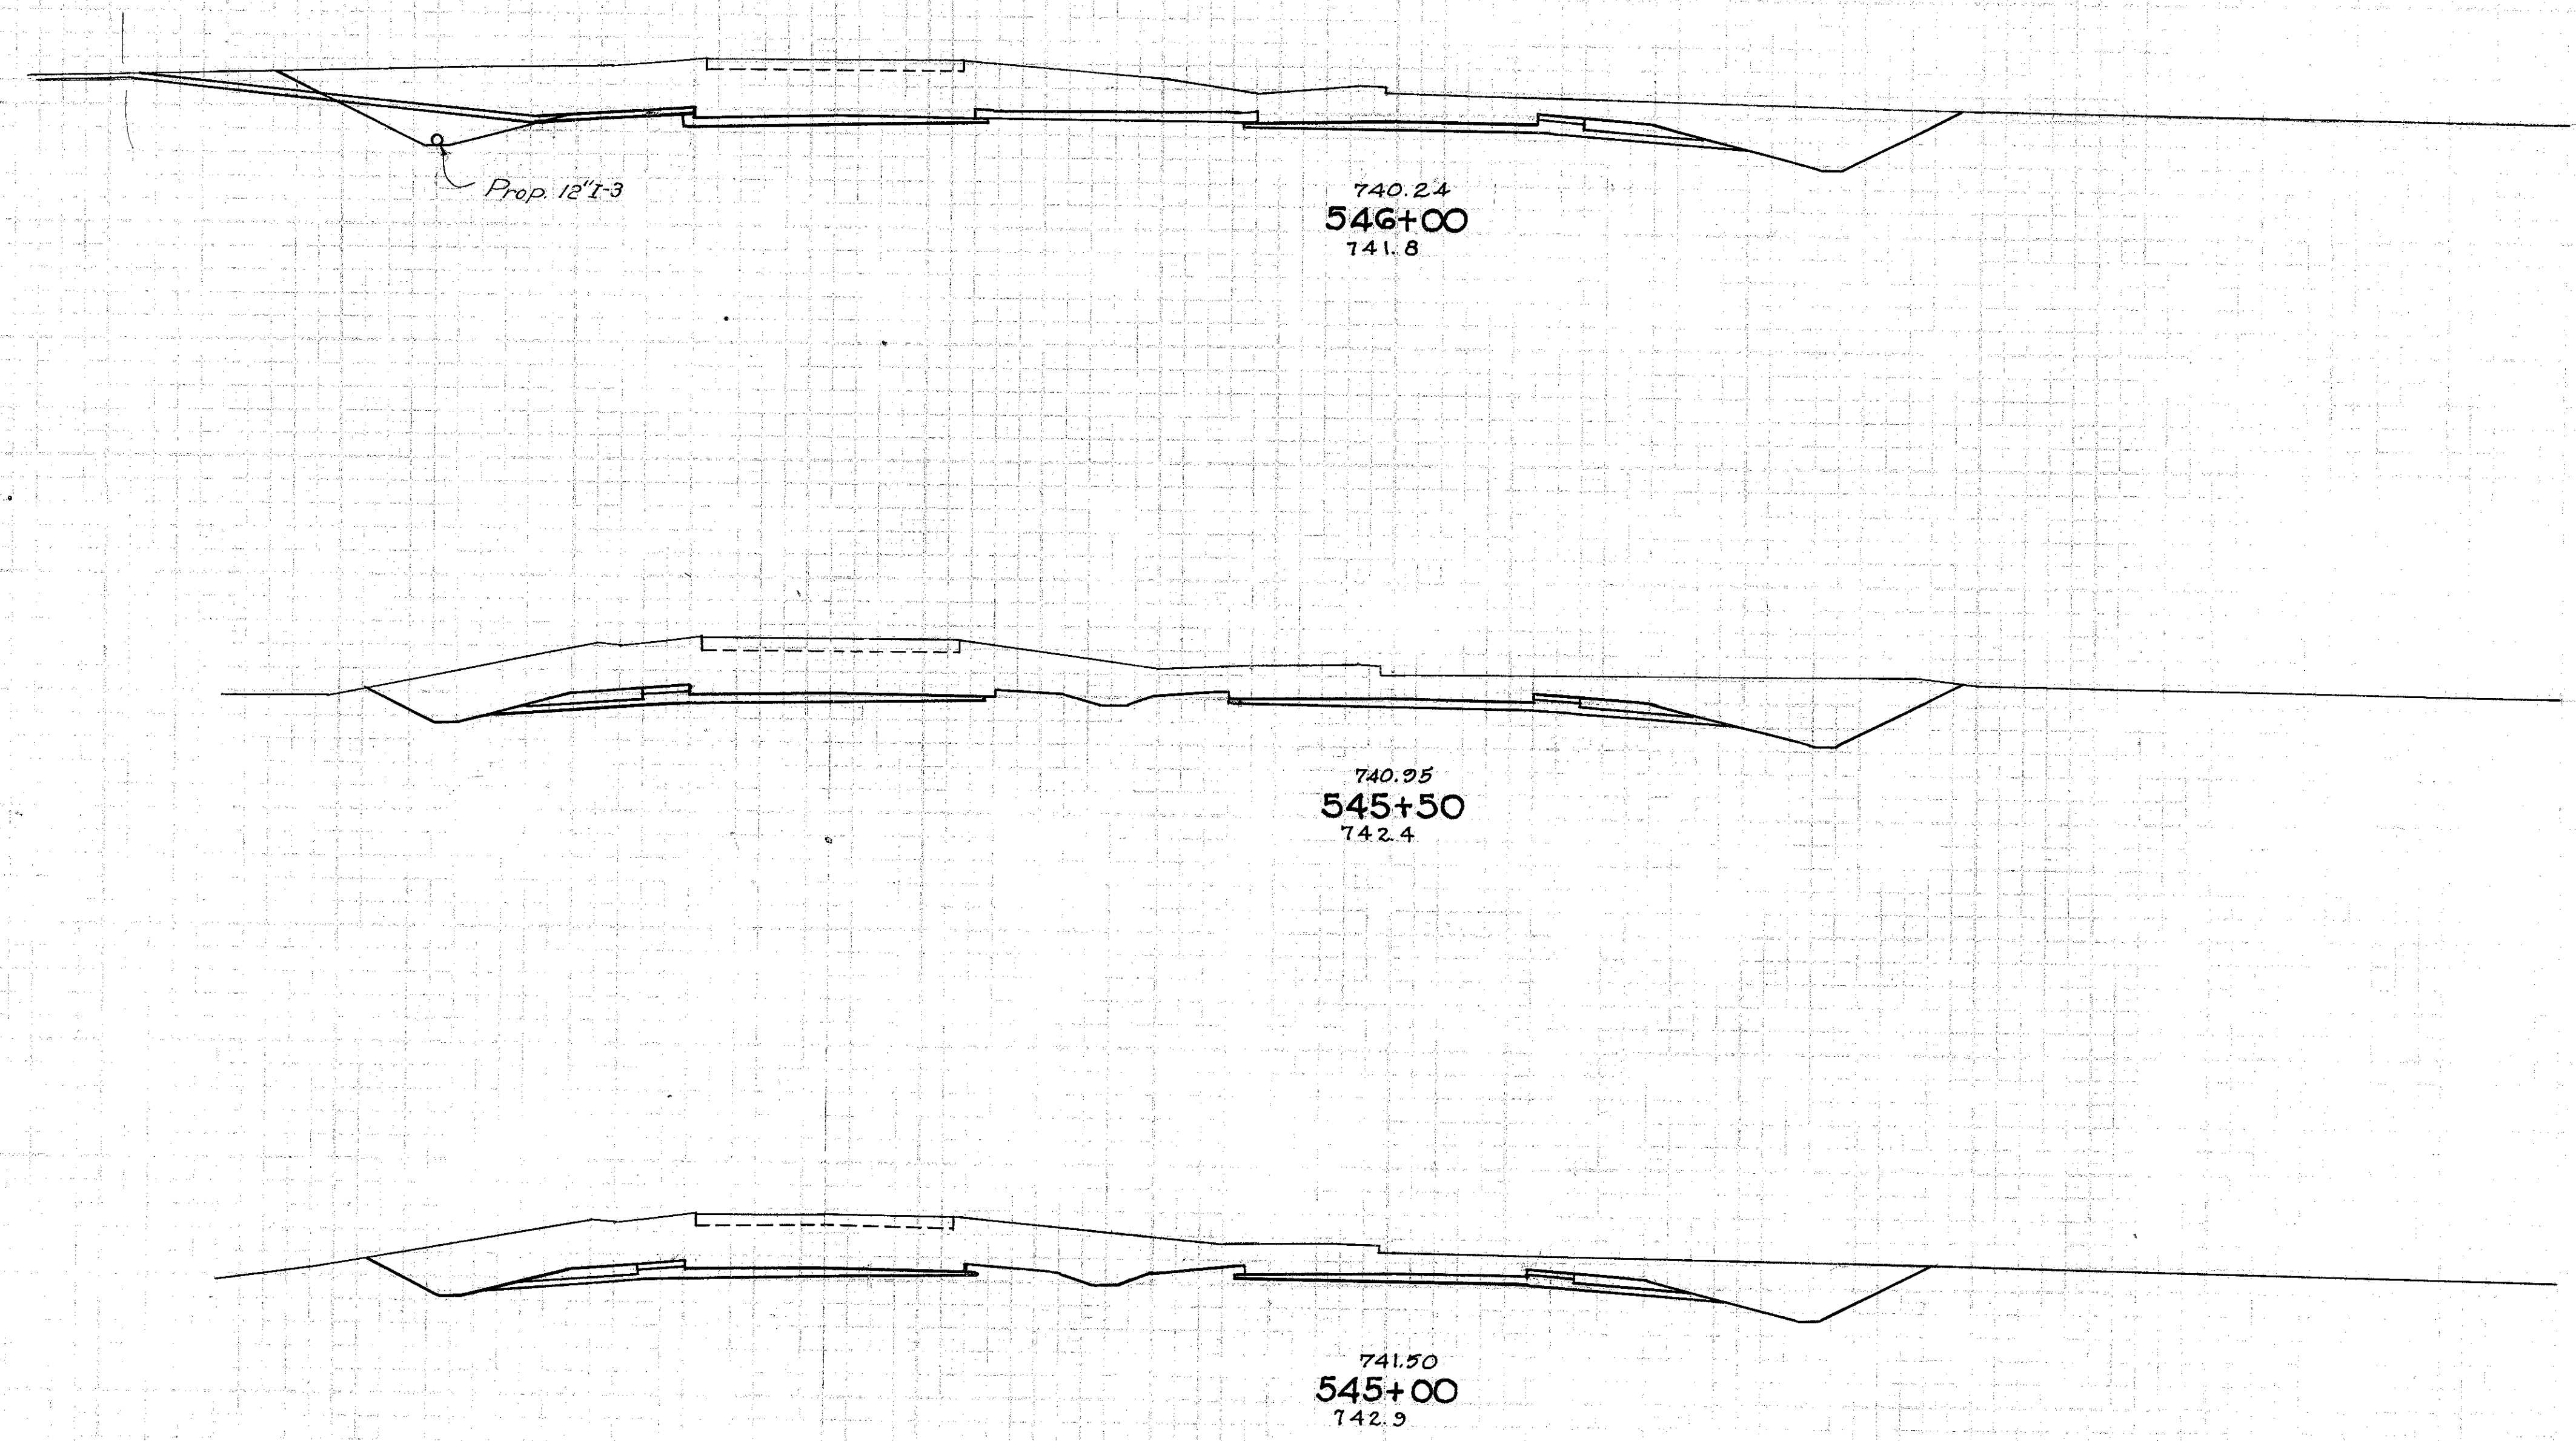


End Area		Cu. Yds.	
Cut	Fill	Cut	Fill
		26	19
630	6		
		1108	17
567	12		
		1017	22
531	12		
		2150	33


150 140 130 120 110 100 90 80 70 60 50 40 30 20 10 0 10 20 30 40 50 60 70 80 90 100 110 120 130 140

150 140 130 120 110 100 90 80 70 60 50 40 30 20 10 0 10 20 30 40 50 60 70 80 90 100 110 120 130 140 150


71  
222  
OHIO  
MAY 16 1915

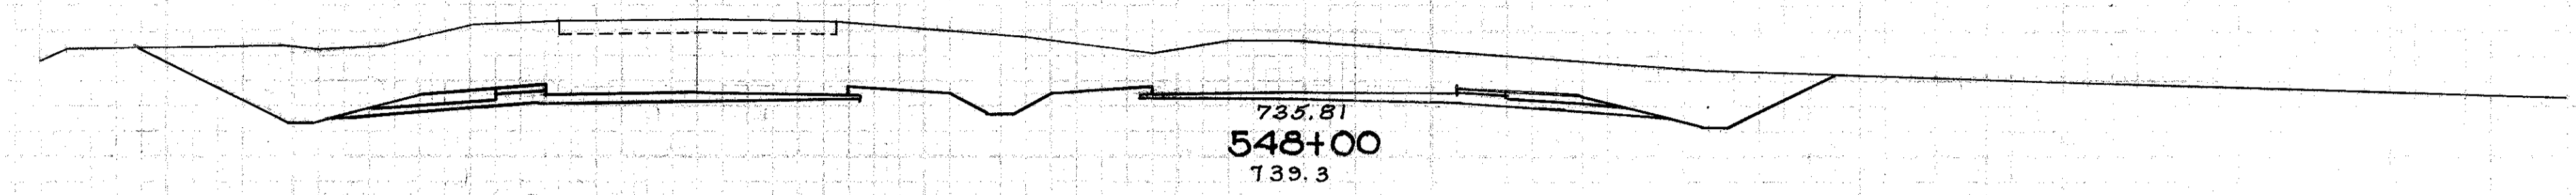


735.81  
548+00  
739.3

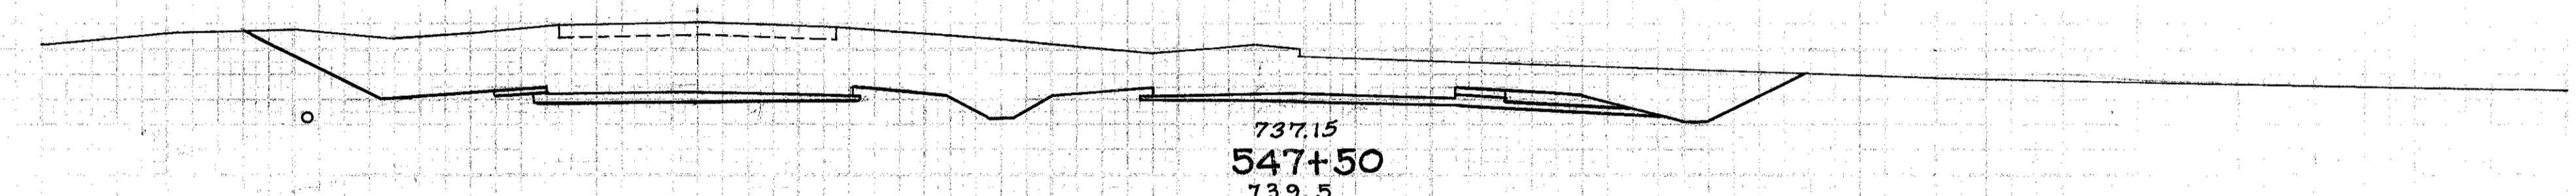

737.15  
547+50  
739.5

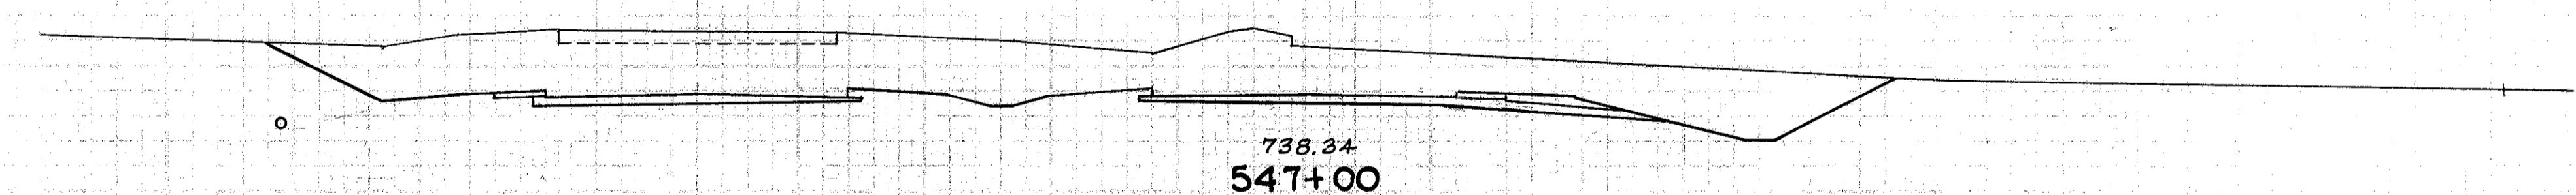

738.34  
547+00  
741.8

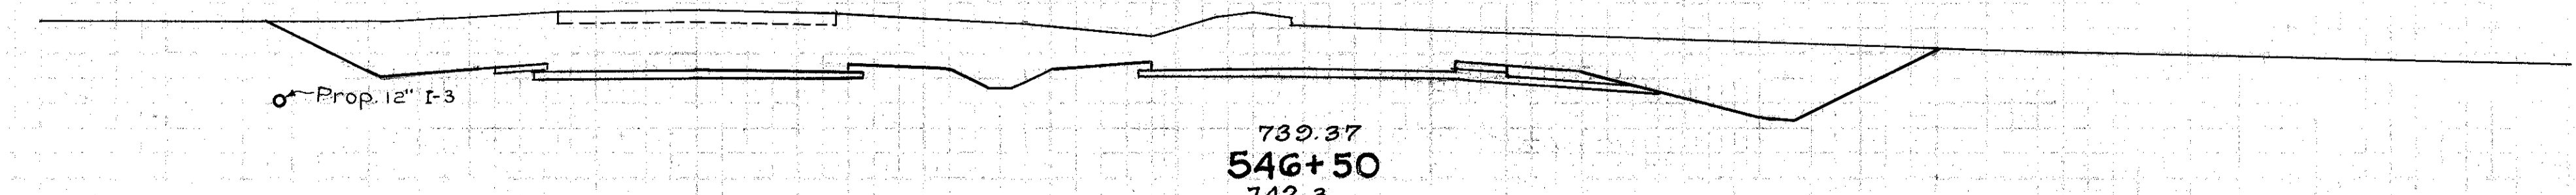





739.37  
546+50  
742.3

End Area		Cu. Yds.	
Cut	Fill	Cut	Fill
682	12		
		1138	17
547	6		
		1019	11
553	6		
		1138	11
573	6		
		1207	11

150 140 130 120 110 100 90 80 70 60 50 40 30 20 10 0 10 20 30 40 50 60 70 80 90 100 110 120 130 140

STA. 546+50 TO 548+00

150 140 130 120 110 100 90 80 70 60 50 40 30 20 10 0 10 20 30 40 50 60 70 80 90 100 110 120 130 140 150

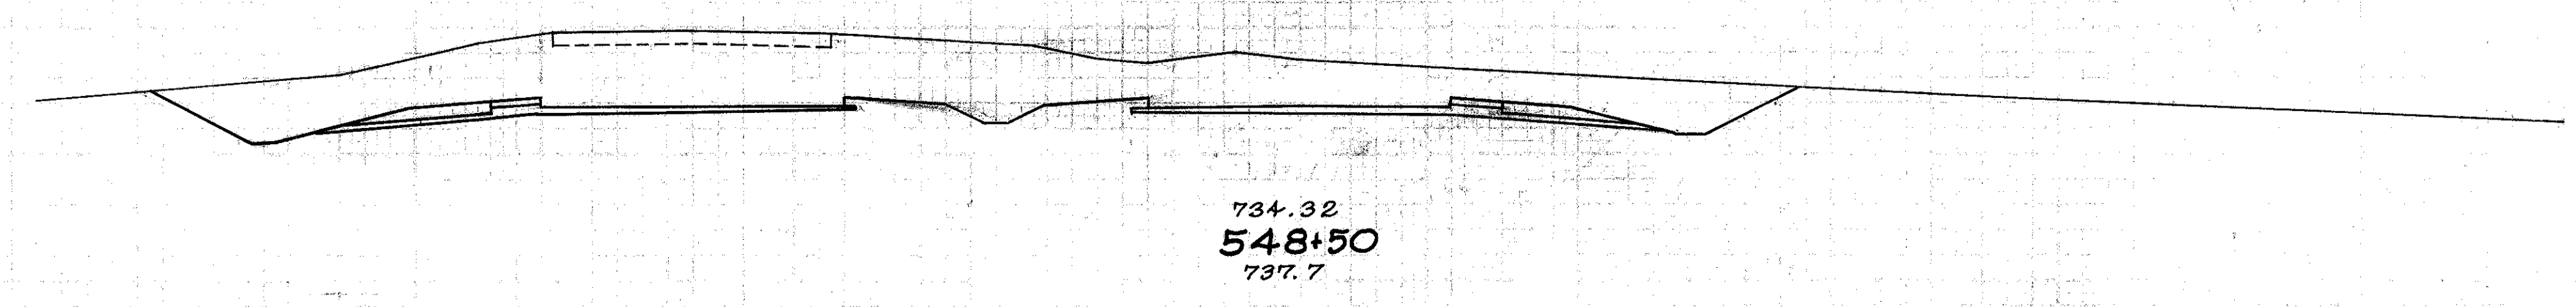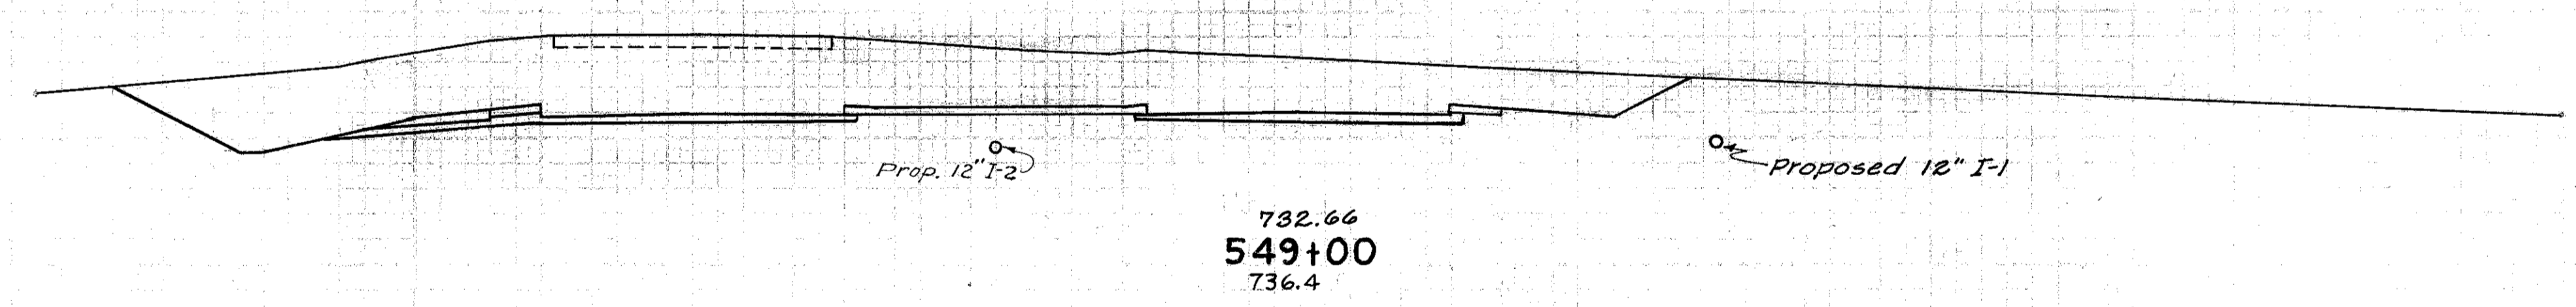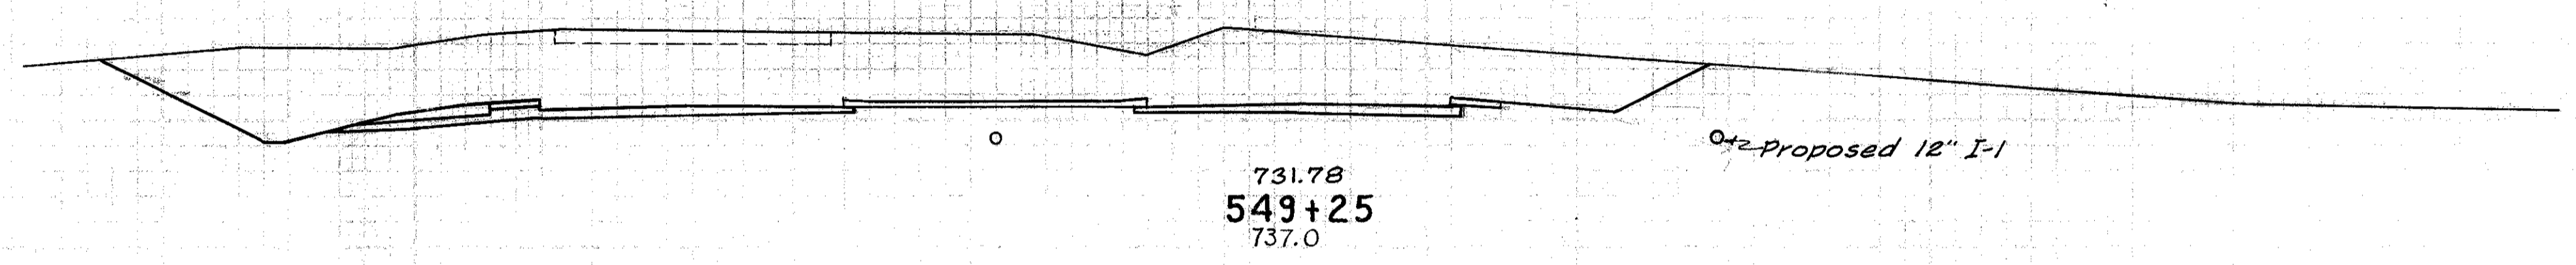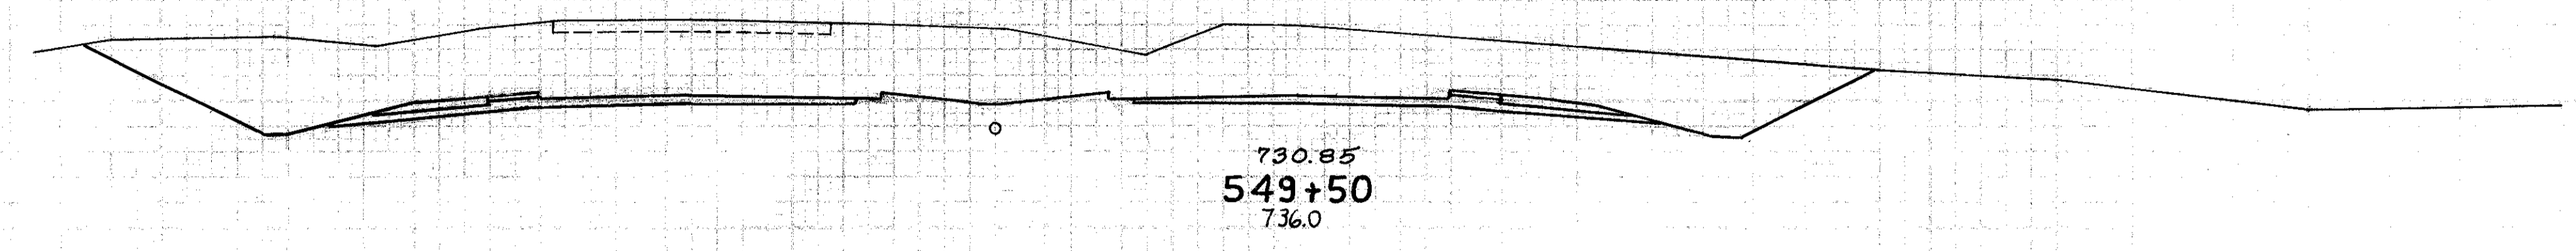

Note:  
Drive Rt. Sta. 549+11





End Area		Cu. Yds.	
Cut	Fill	Cut	Fill
803	12		
		686	8
733	6		
		642	6
654	6		
		46	
		1181	17
621	12		
		1207	32

150 140 130 120 110 100 90 80 70 60 50 40 30 20 10 0 10 20 30 40 50 60 70 80 90 100 110 120 130 140



150 140 130 120 110 100 90 80 70 60 50 40 30 20 10 0 10 20 30 40 50 60 70 80 90 100 110 120 130 140 150

73  
222

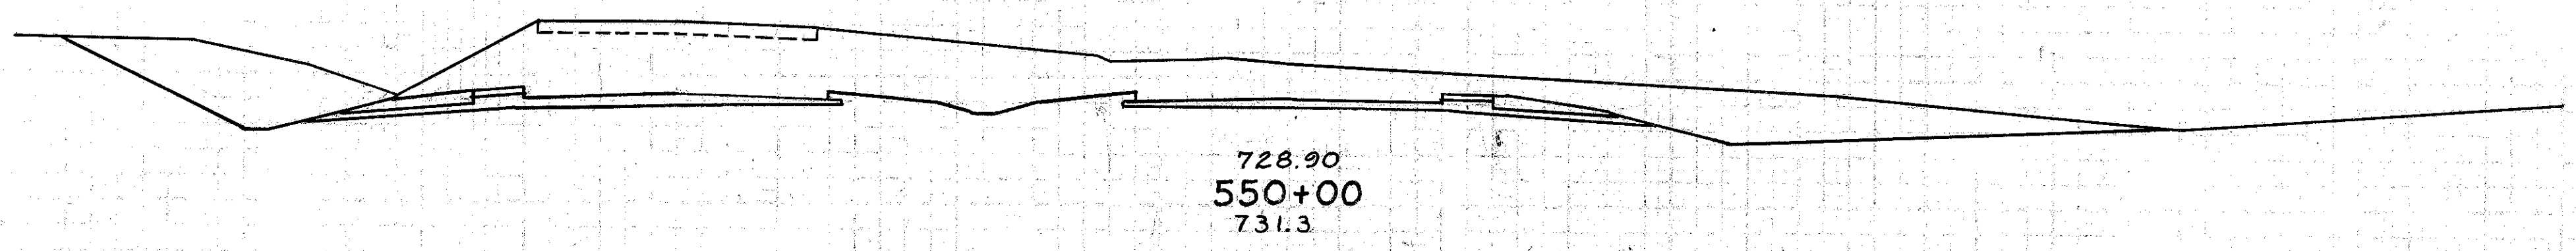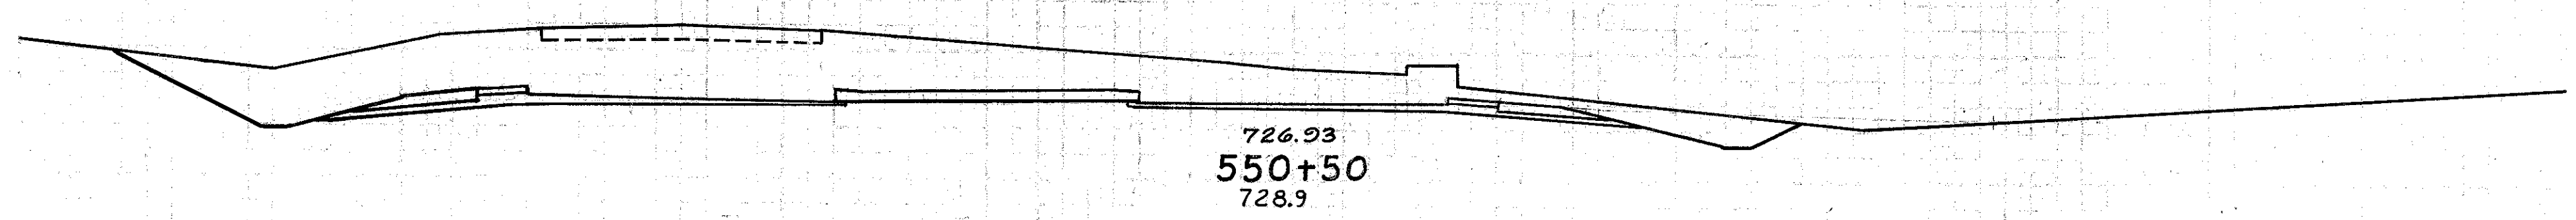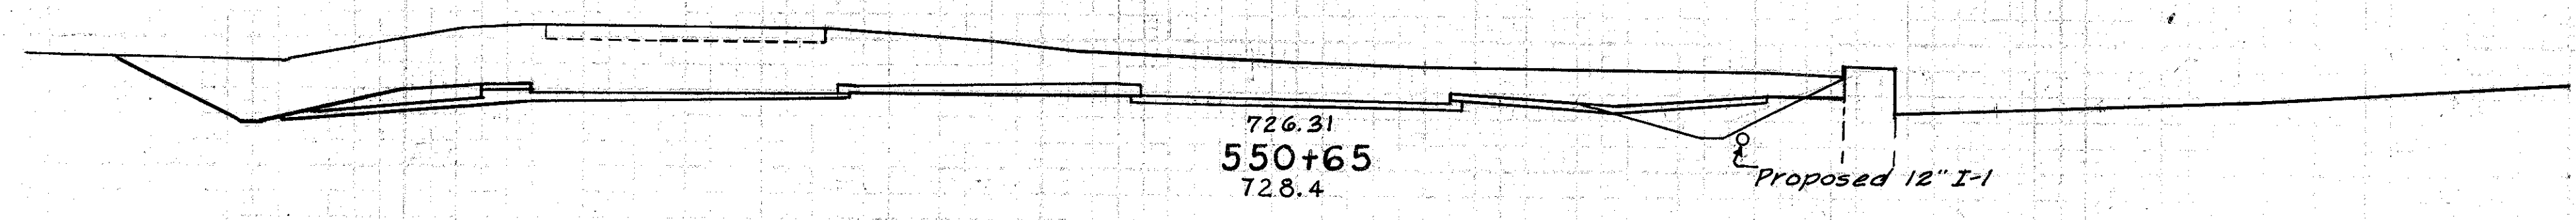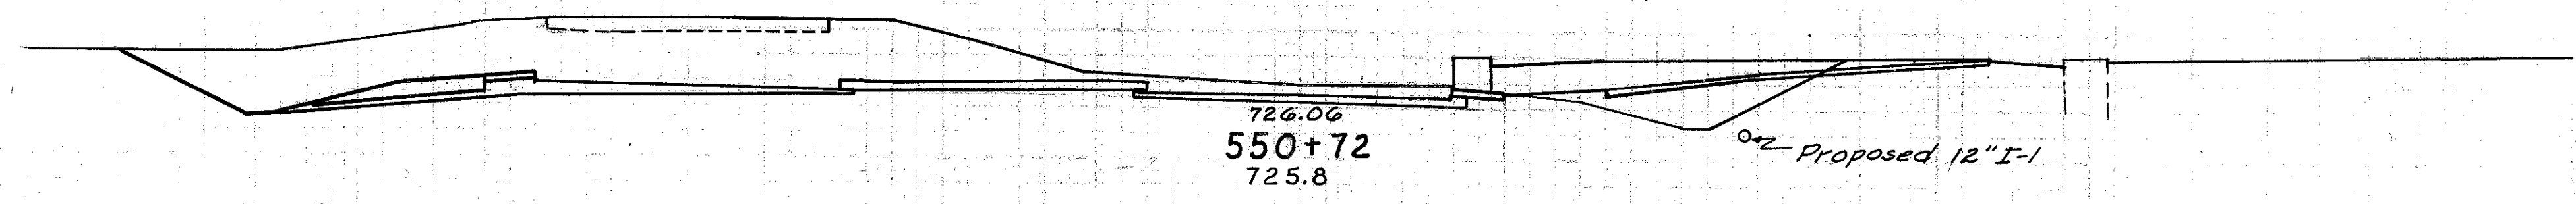

Note  
Drive Sta. 550+60 Rt

End Area		Cu. Yds.	
Cut	Fill	Cut	Fill
514	15		
		6	33
		143	3
537	10		
		317	6
555	12		
		1142	22
673	12		
		1371	22


Sta 540+00 to Sta. 550+00  
E-1  
Embankment 360 Cu.Yds.  
Embankment +15% 414 Cu.Yds.

150 140 130 120 110 100 90 80 70 60 50 40 30 20 10 0 10 20 30 40 50 60 70 80 90 100 110 120 130 140


STA. 550+00 TO 550+77

150 140 130 120 110 100 90 80 70 60 50 40 30 20 10 0 10 20 30 40 50 60 70 80 90 100 110 120 130 140 150



74  
222  
DATE: 4-18-53 15-57

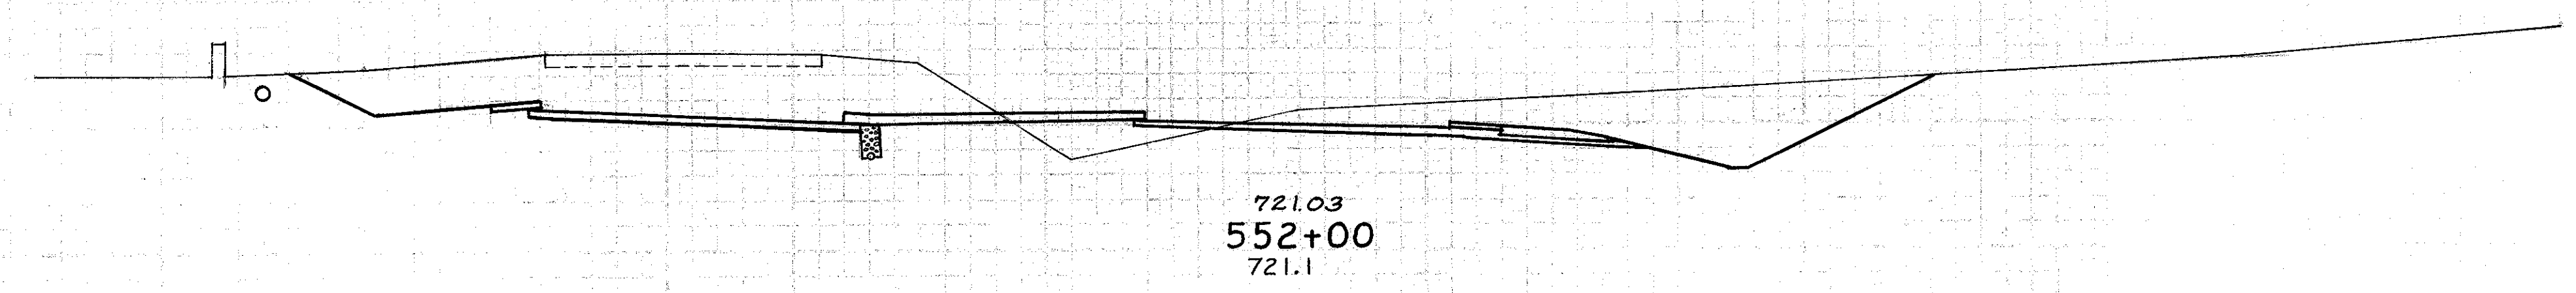

Note:  
Field Drive Lt. Sta. 552+10

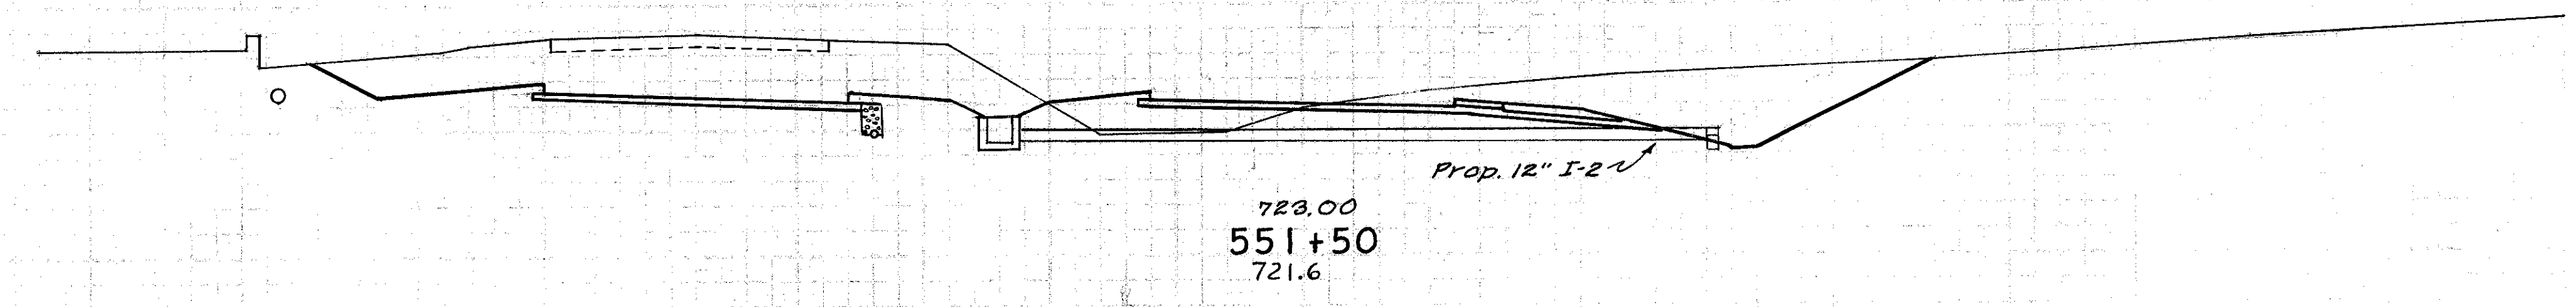

Note:  
Drive Lt. sta. 551+86

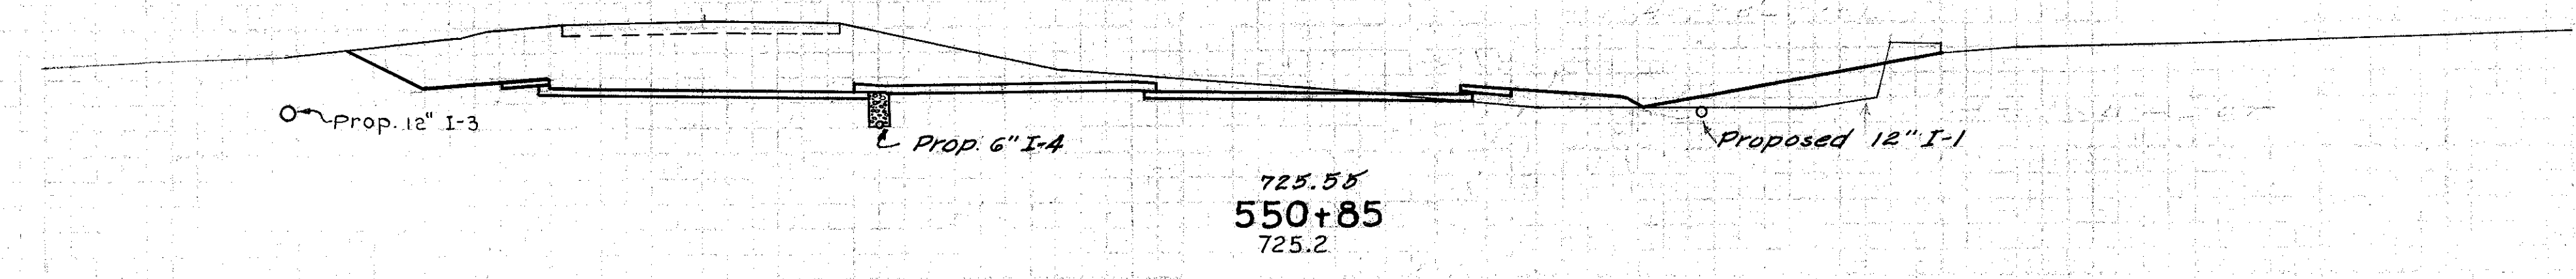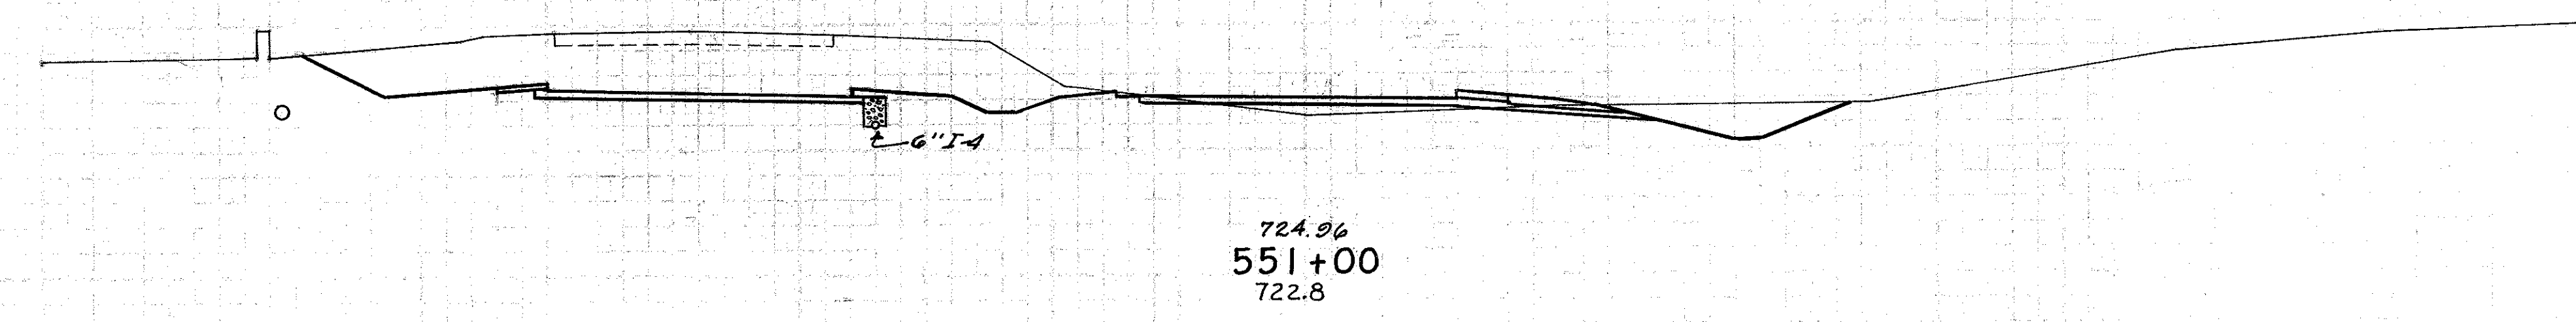


End Area		Cu. Yds.	
Cut	Fill	Cut	Fill
			20
449	35		
			25
		797	76
412	47		
			682
			57
324	14		
			180
			15
324	41		
			202
			13

150 140 130 120 110 100 90 80 70 60 50 40 30 20 10 0 10 20 30 40 50 60 70 80 90 100 110 120 130 140

STA. 550+85 TO 552+0

150 140 130 120 110 100 90 80 70 60 50 40 30 20 10 0 10 20 30 40 50 60 70 80 90 100 110 120 130 140 150




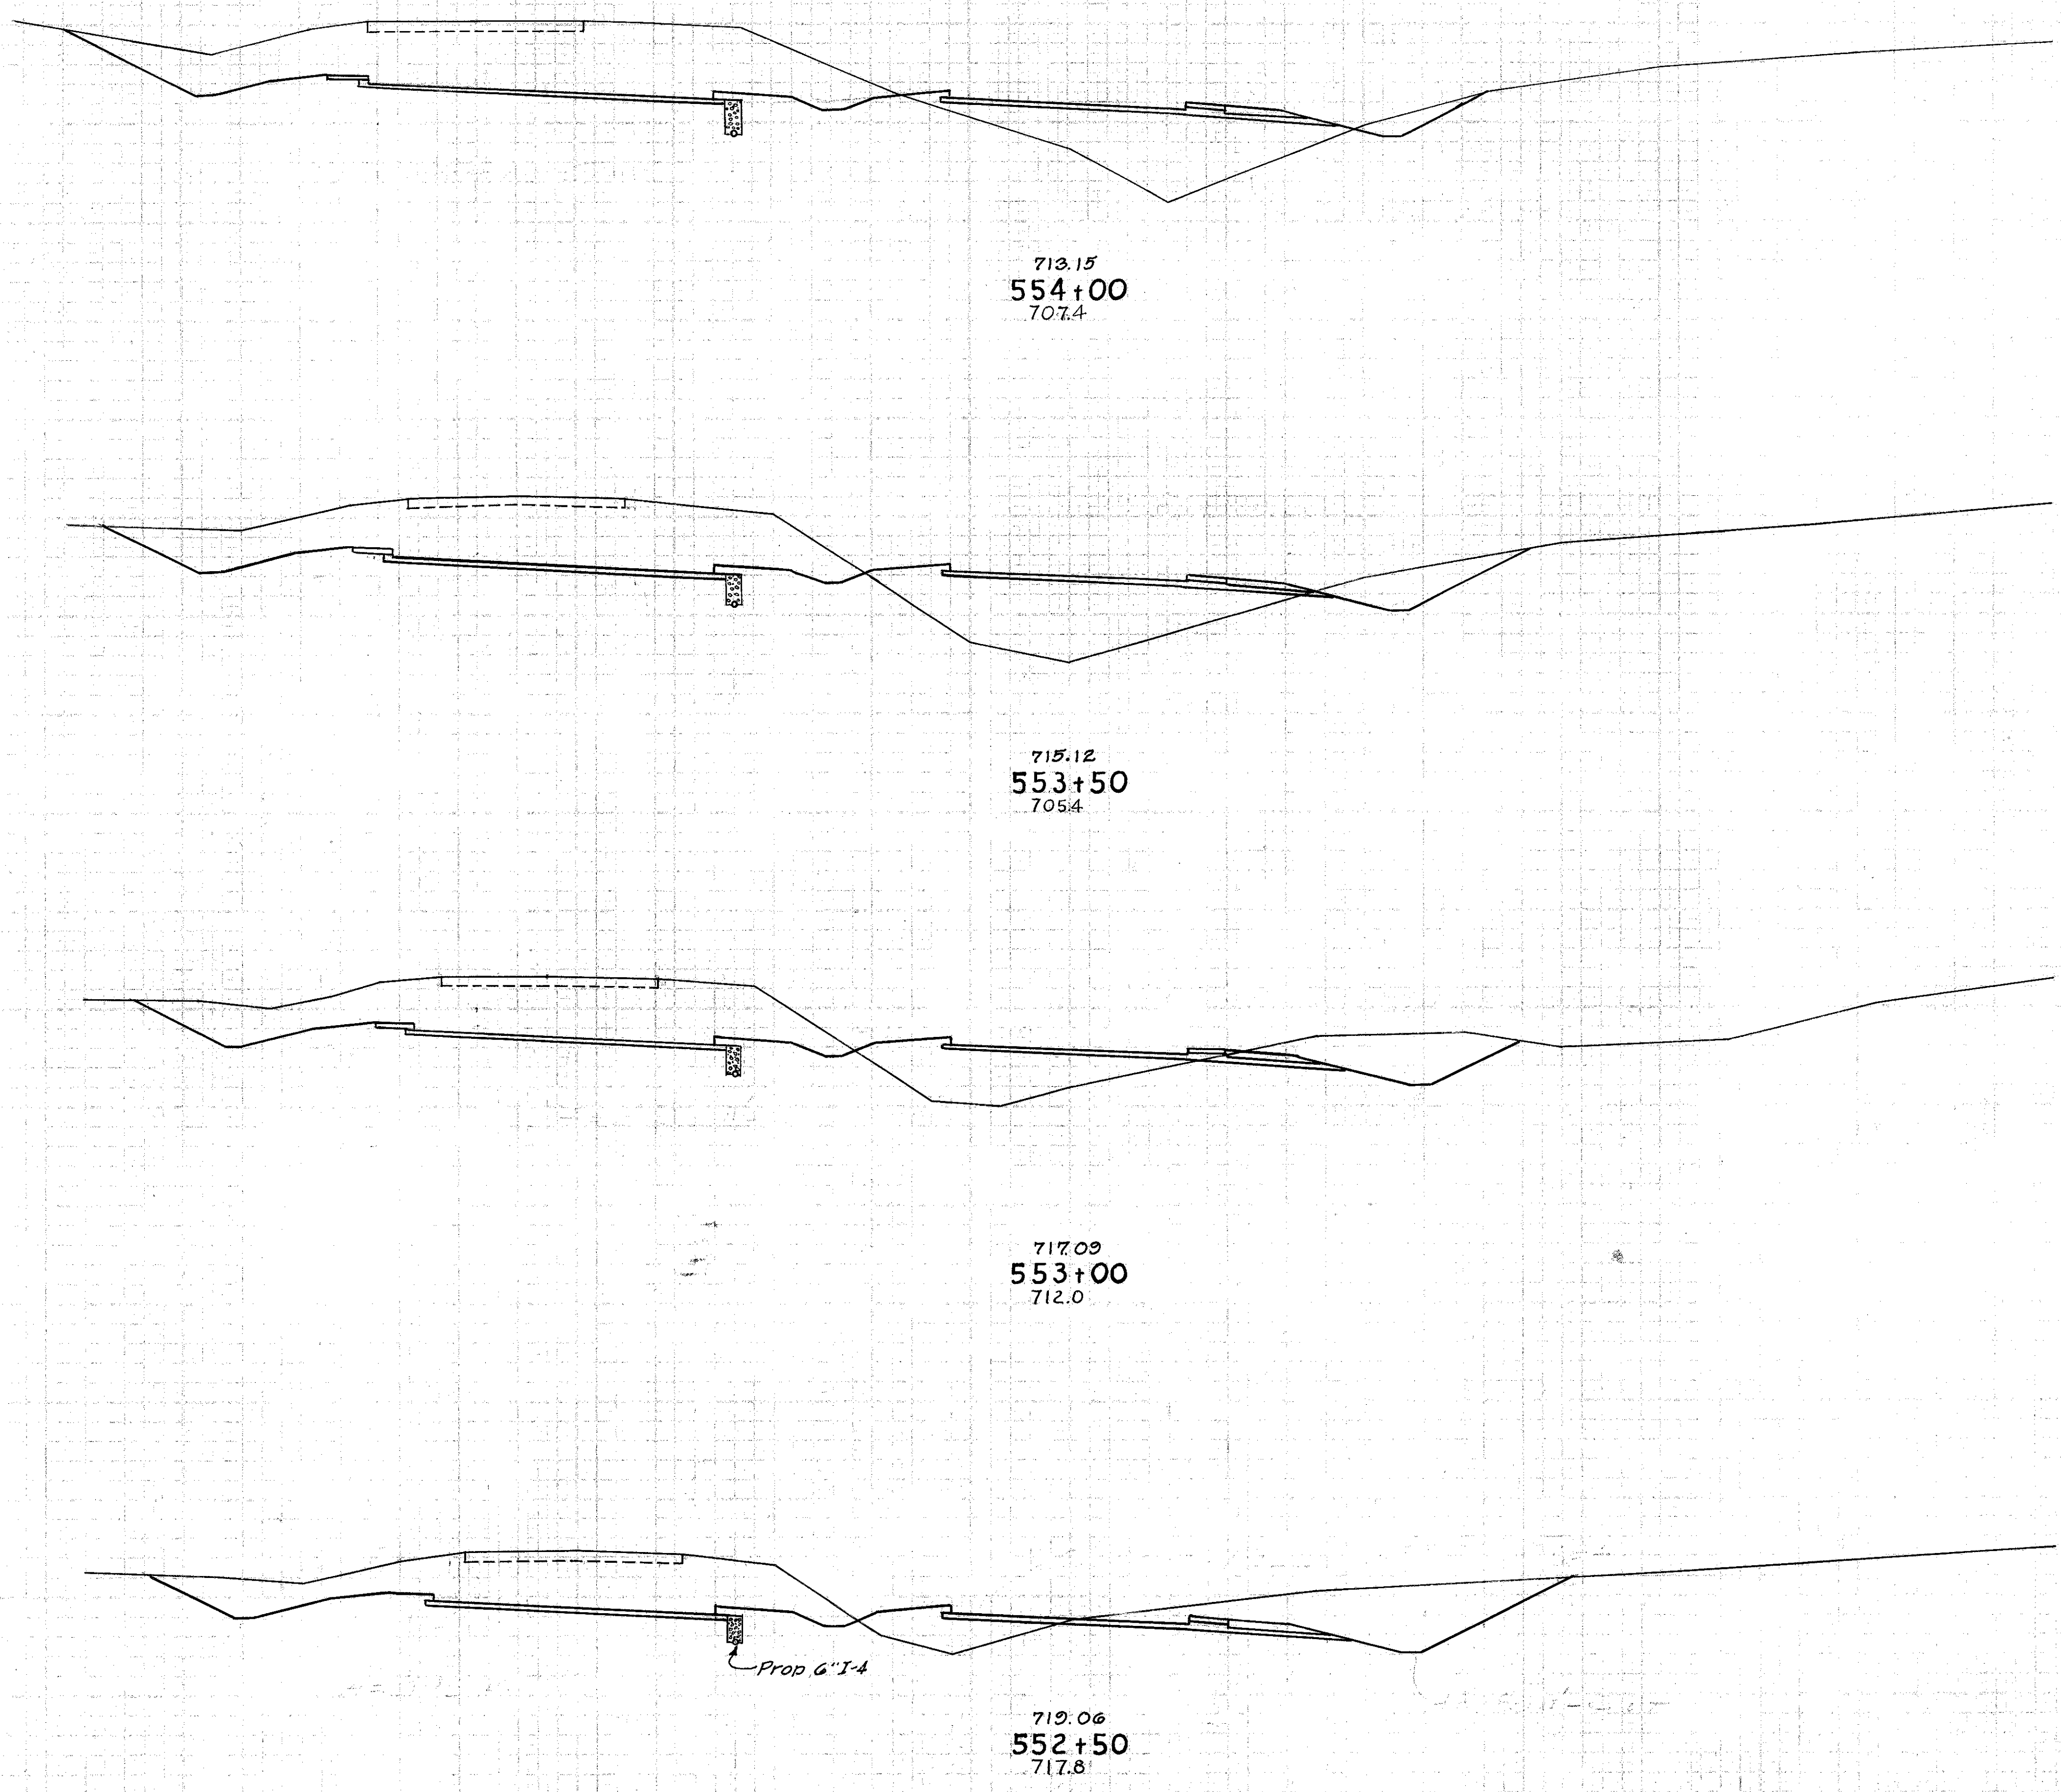


End Area		Cu. Yds.	
Cut	Fill	Cut	Fill
487	191		
		881	377
464	216		
		839	316
442	125		
		862	166
489	54		
		869	82

150 140 130 120 110 100 90 80 70 60 50 40 30 20 10 0 10 20 30 40 50 60 70 80 90 100 110 120 130 140

STA. 552+50 TO 554+0

150 140 130 120 110 100 90 80 70 60 50 40 30 20 10 0 10 20 30 40 50 60 70 80 90 100 110 120 130 140 150

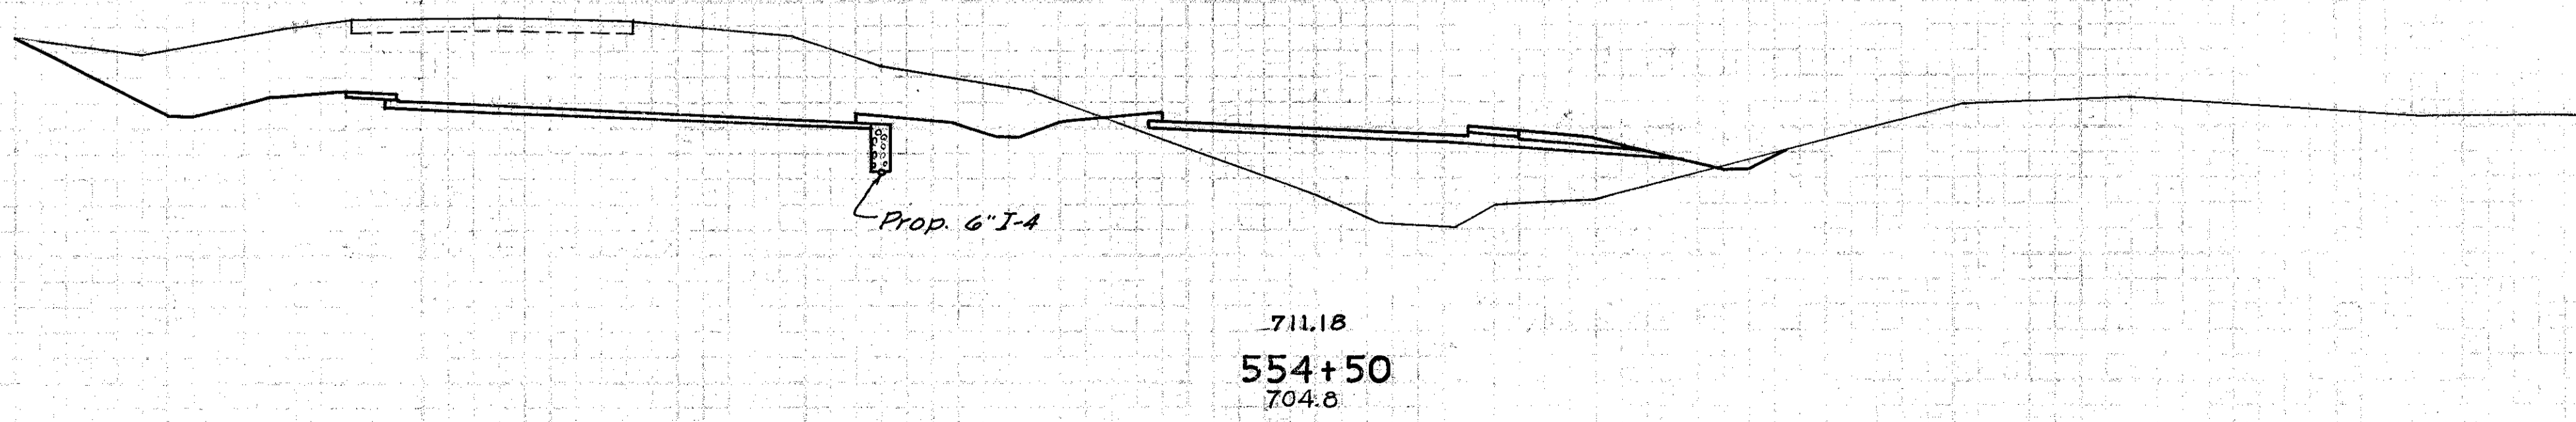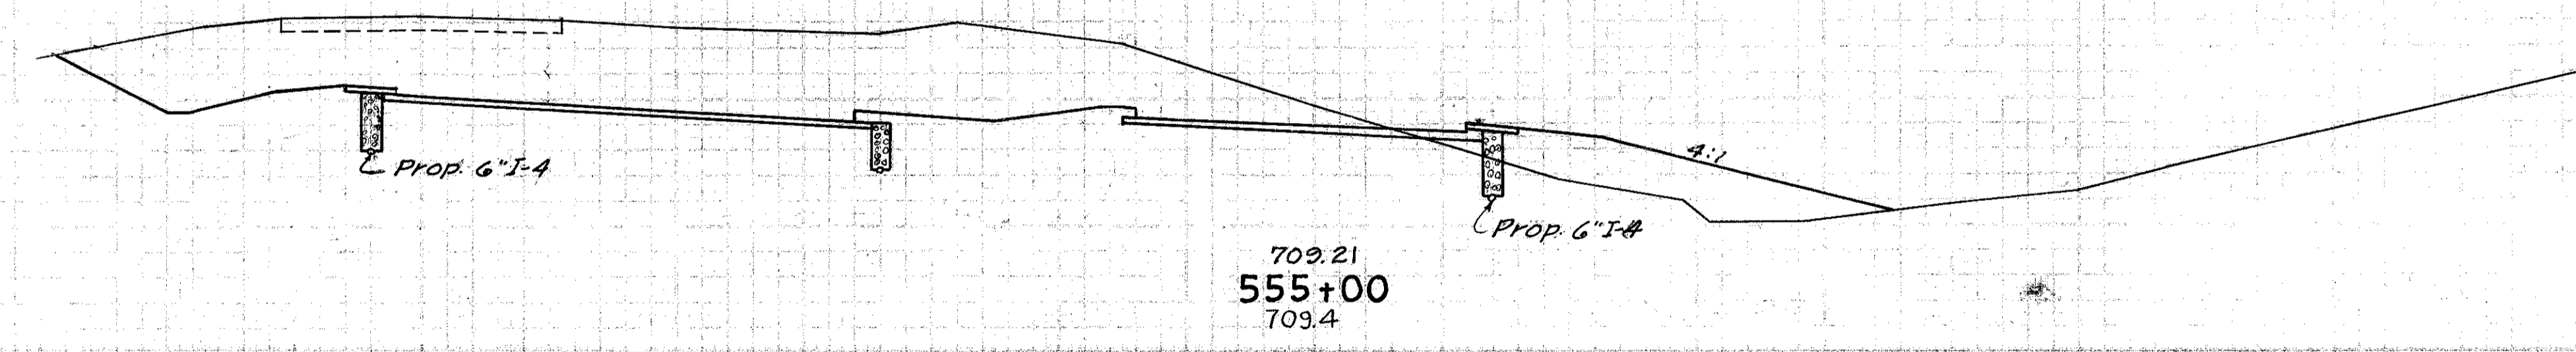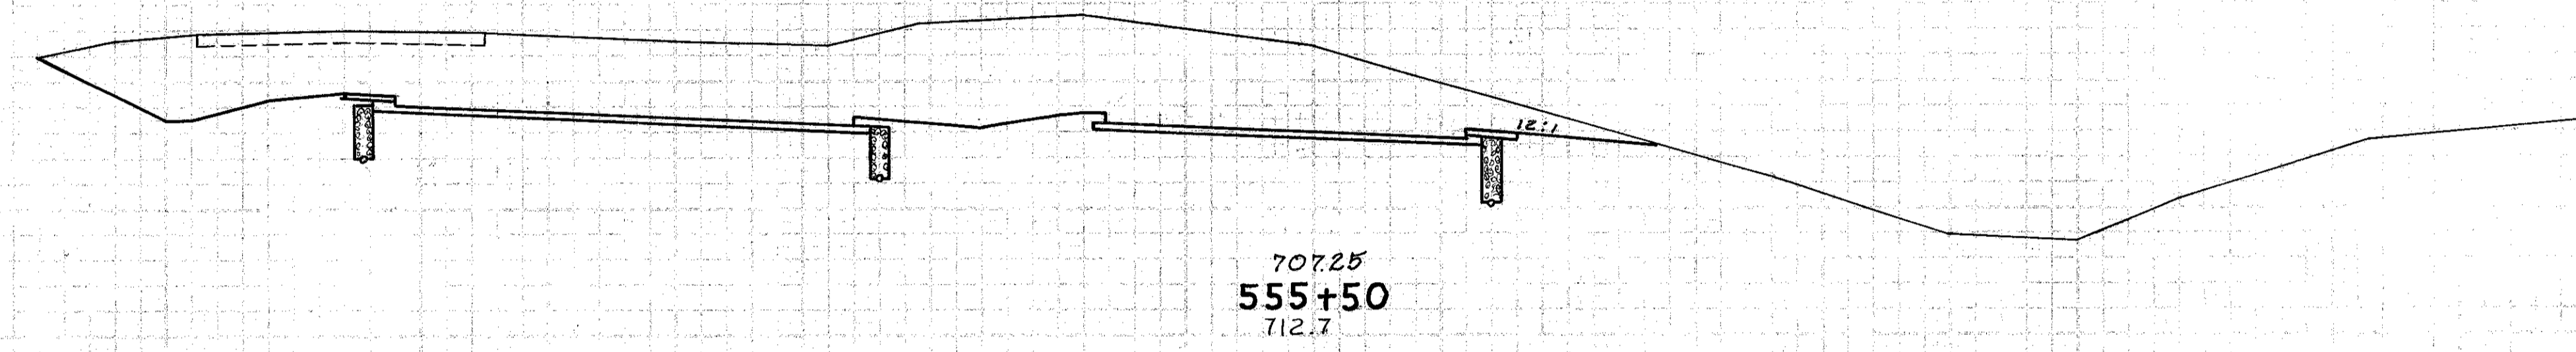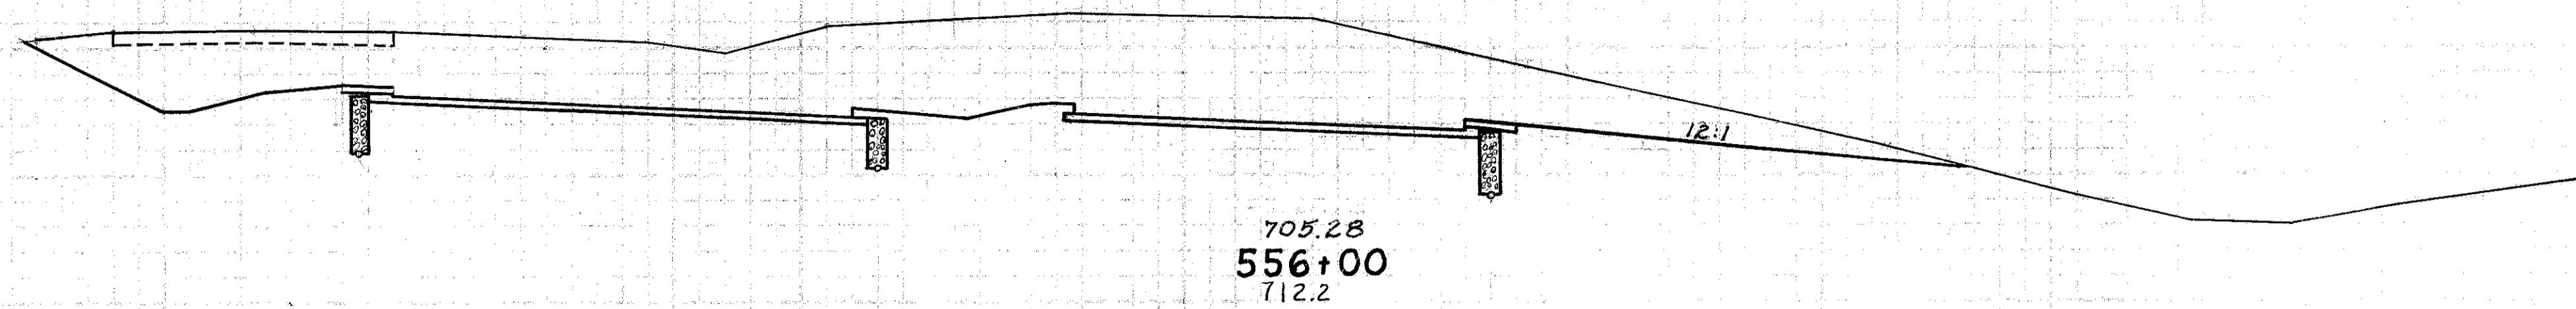


End Transition  
std. 555+50  
Side Slope 12:1

Begin Transition  
std. 550+00  
Side Slope 4:1

End Area		Cu. Yds.	
Cut	Fill	Cut	Fill
871	-		
		1551	-
804	-		
		1321	88
620	95		
		1007	255
467	180		
		883	344

150 140 130 120 110 100 90 80 70 60 50 40 30 20 10 0 10 20 30 40 50 60 70 80 90 100 110 120 130 140

150 140 130 120 110 100 90 80 70 60 50 40 30 20 10 0 10 20 30 40 50 60 70 80 90 100 110 120 130 140 150

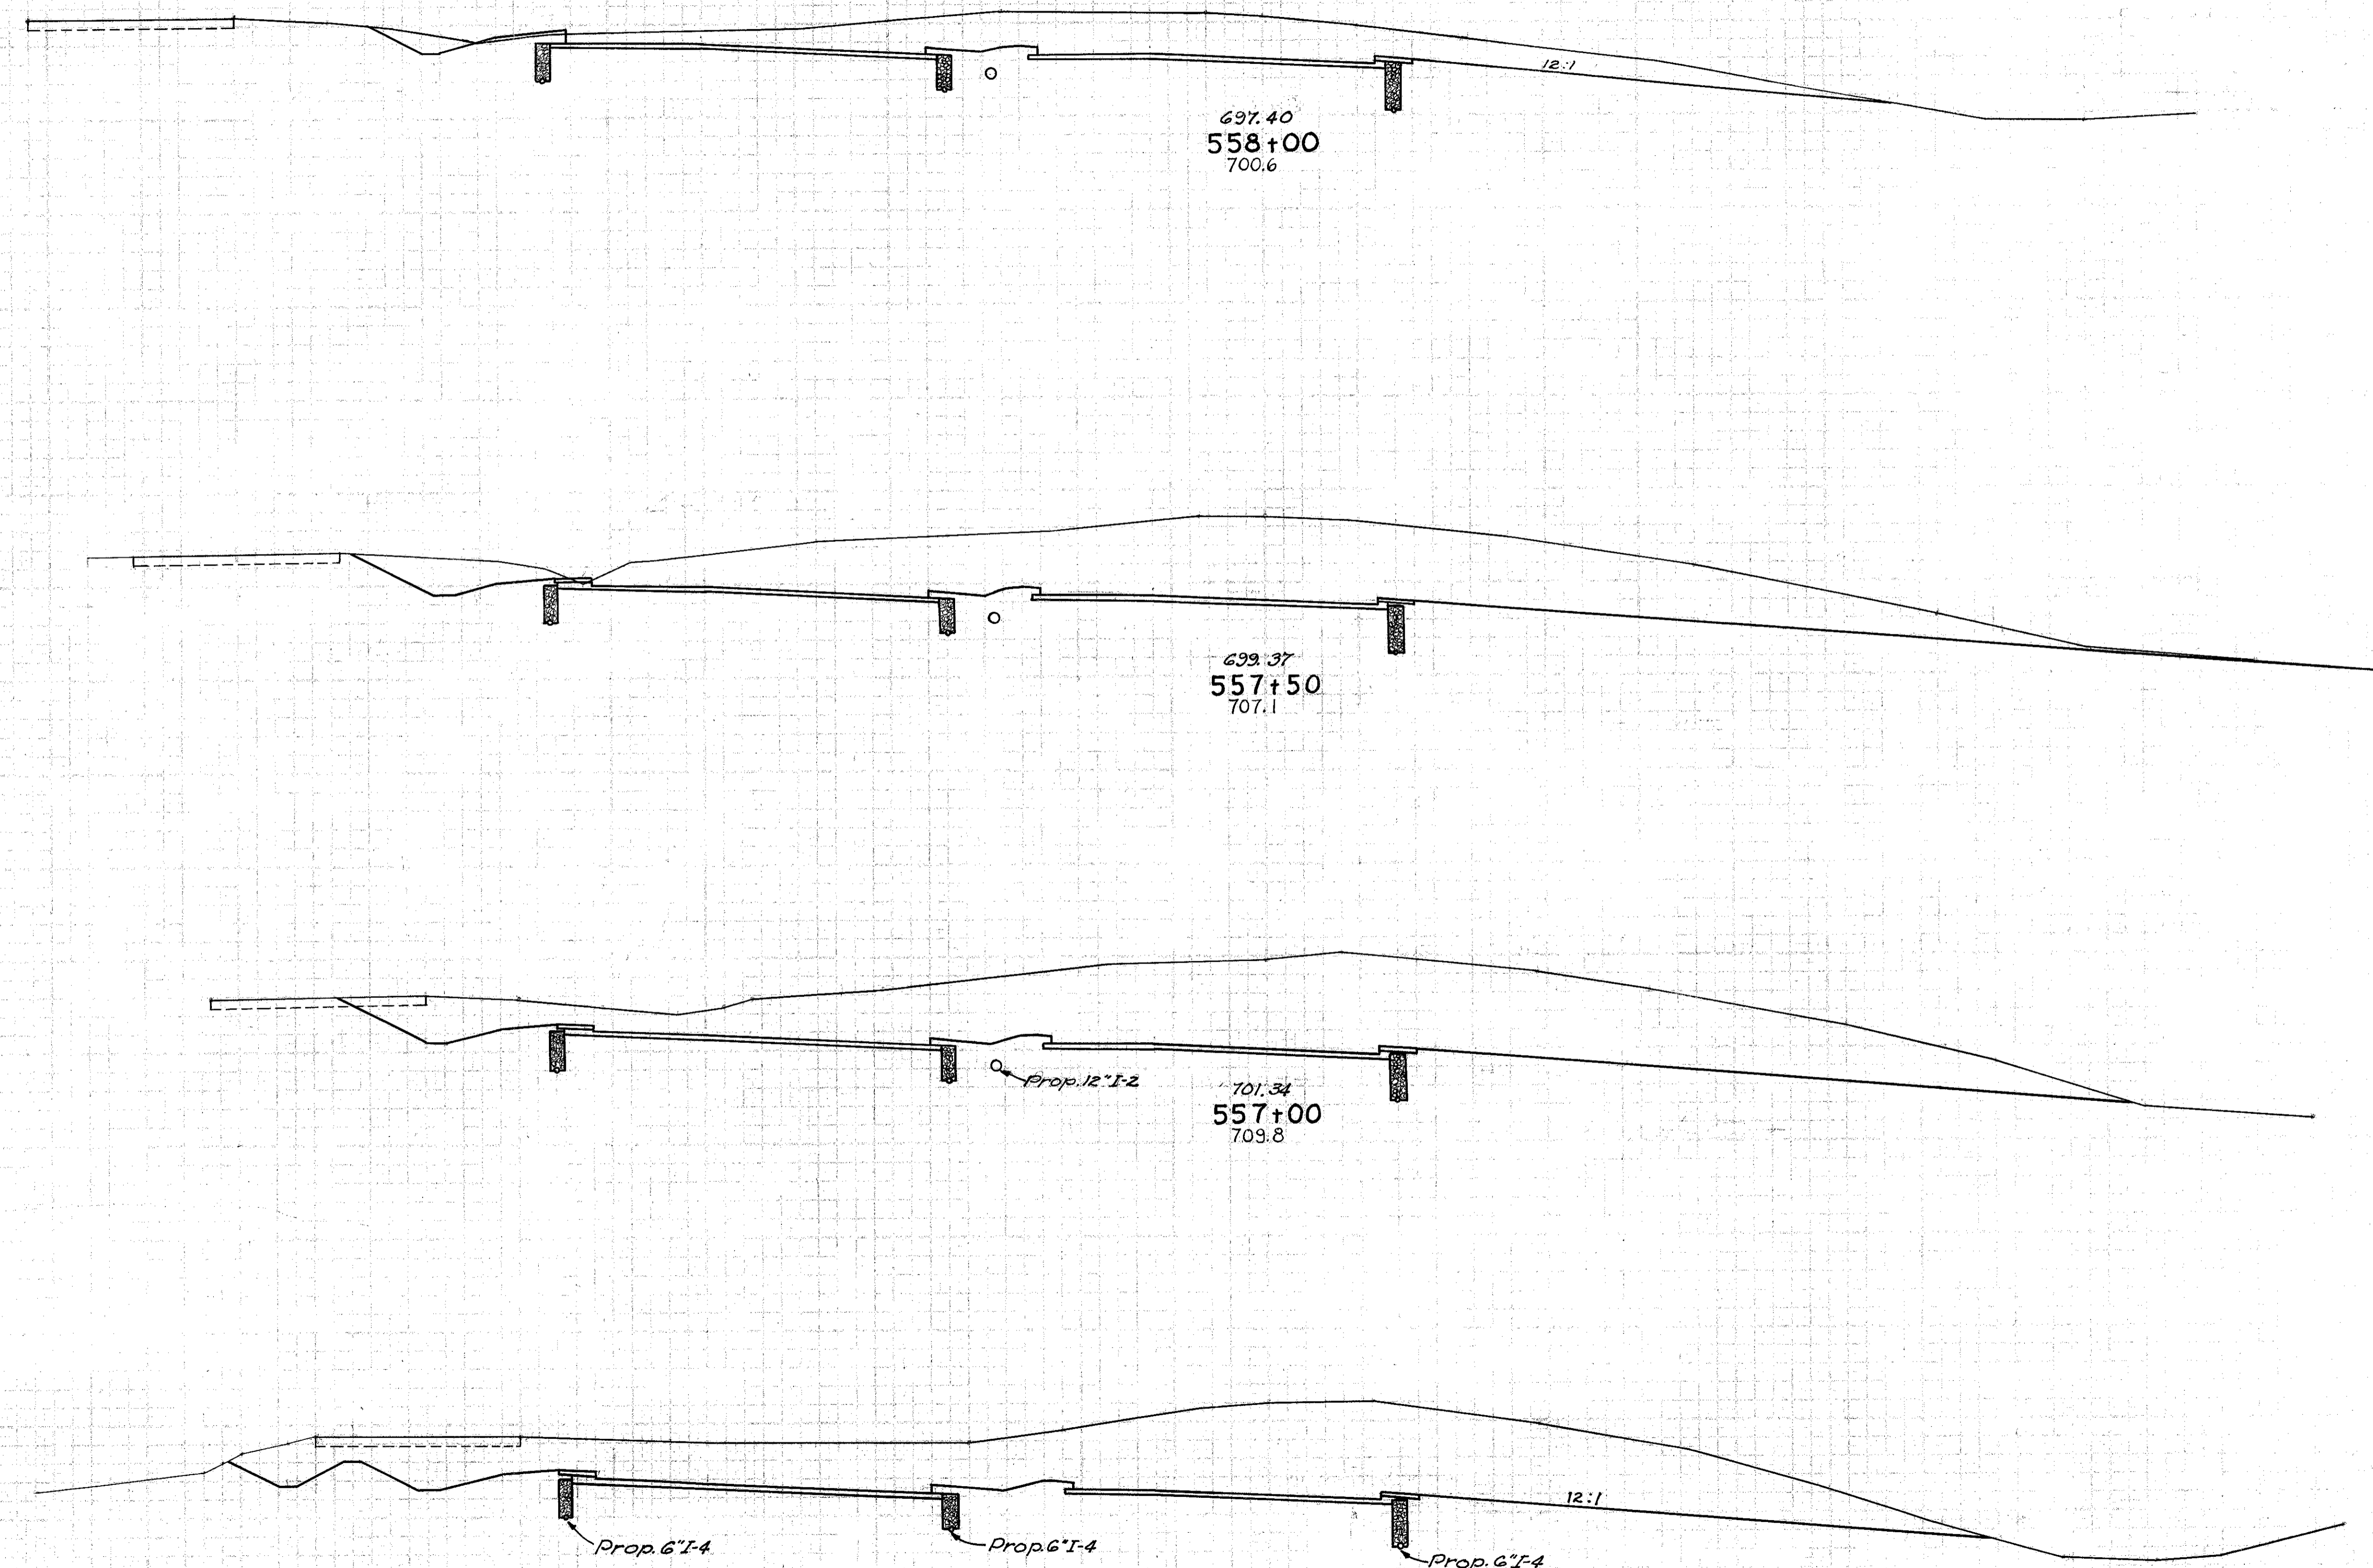

Begin Transition  
Sta. 558+00  
Side Slope 12:1


End Area		Cu. Yds.	
Cut	Fill	Cut	Fill
456	3		
		1407	3
1063	1		
		2151	2
1260	1		
		1418	1
1148	-		
		1870	-

150 140 130 120 110 100 90 80 70 60 50 40 30 20 10 0 10 20 30 40 50 60 70 80 90 100 110 120 130 140

150 140 130 120 110 100 90 80 70 60 50 40 30 20 10 0 10 20 30 40 50 60 70 80 90 100 110 120 130 140 150

See Sheets 79 & 80  
 For Relocation Exist. S.R.#4 & Exist. Pavement  
 For Pavement Removal See Item E-8

78  
 222  
 DATE: 11-13-13

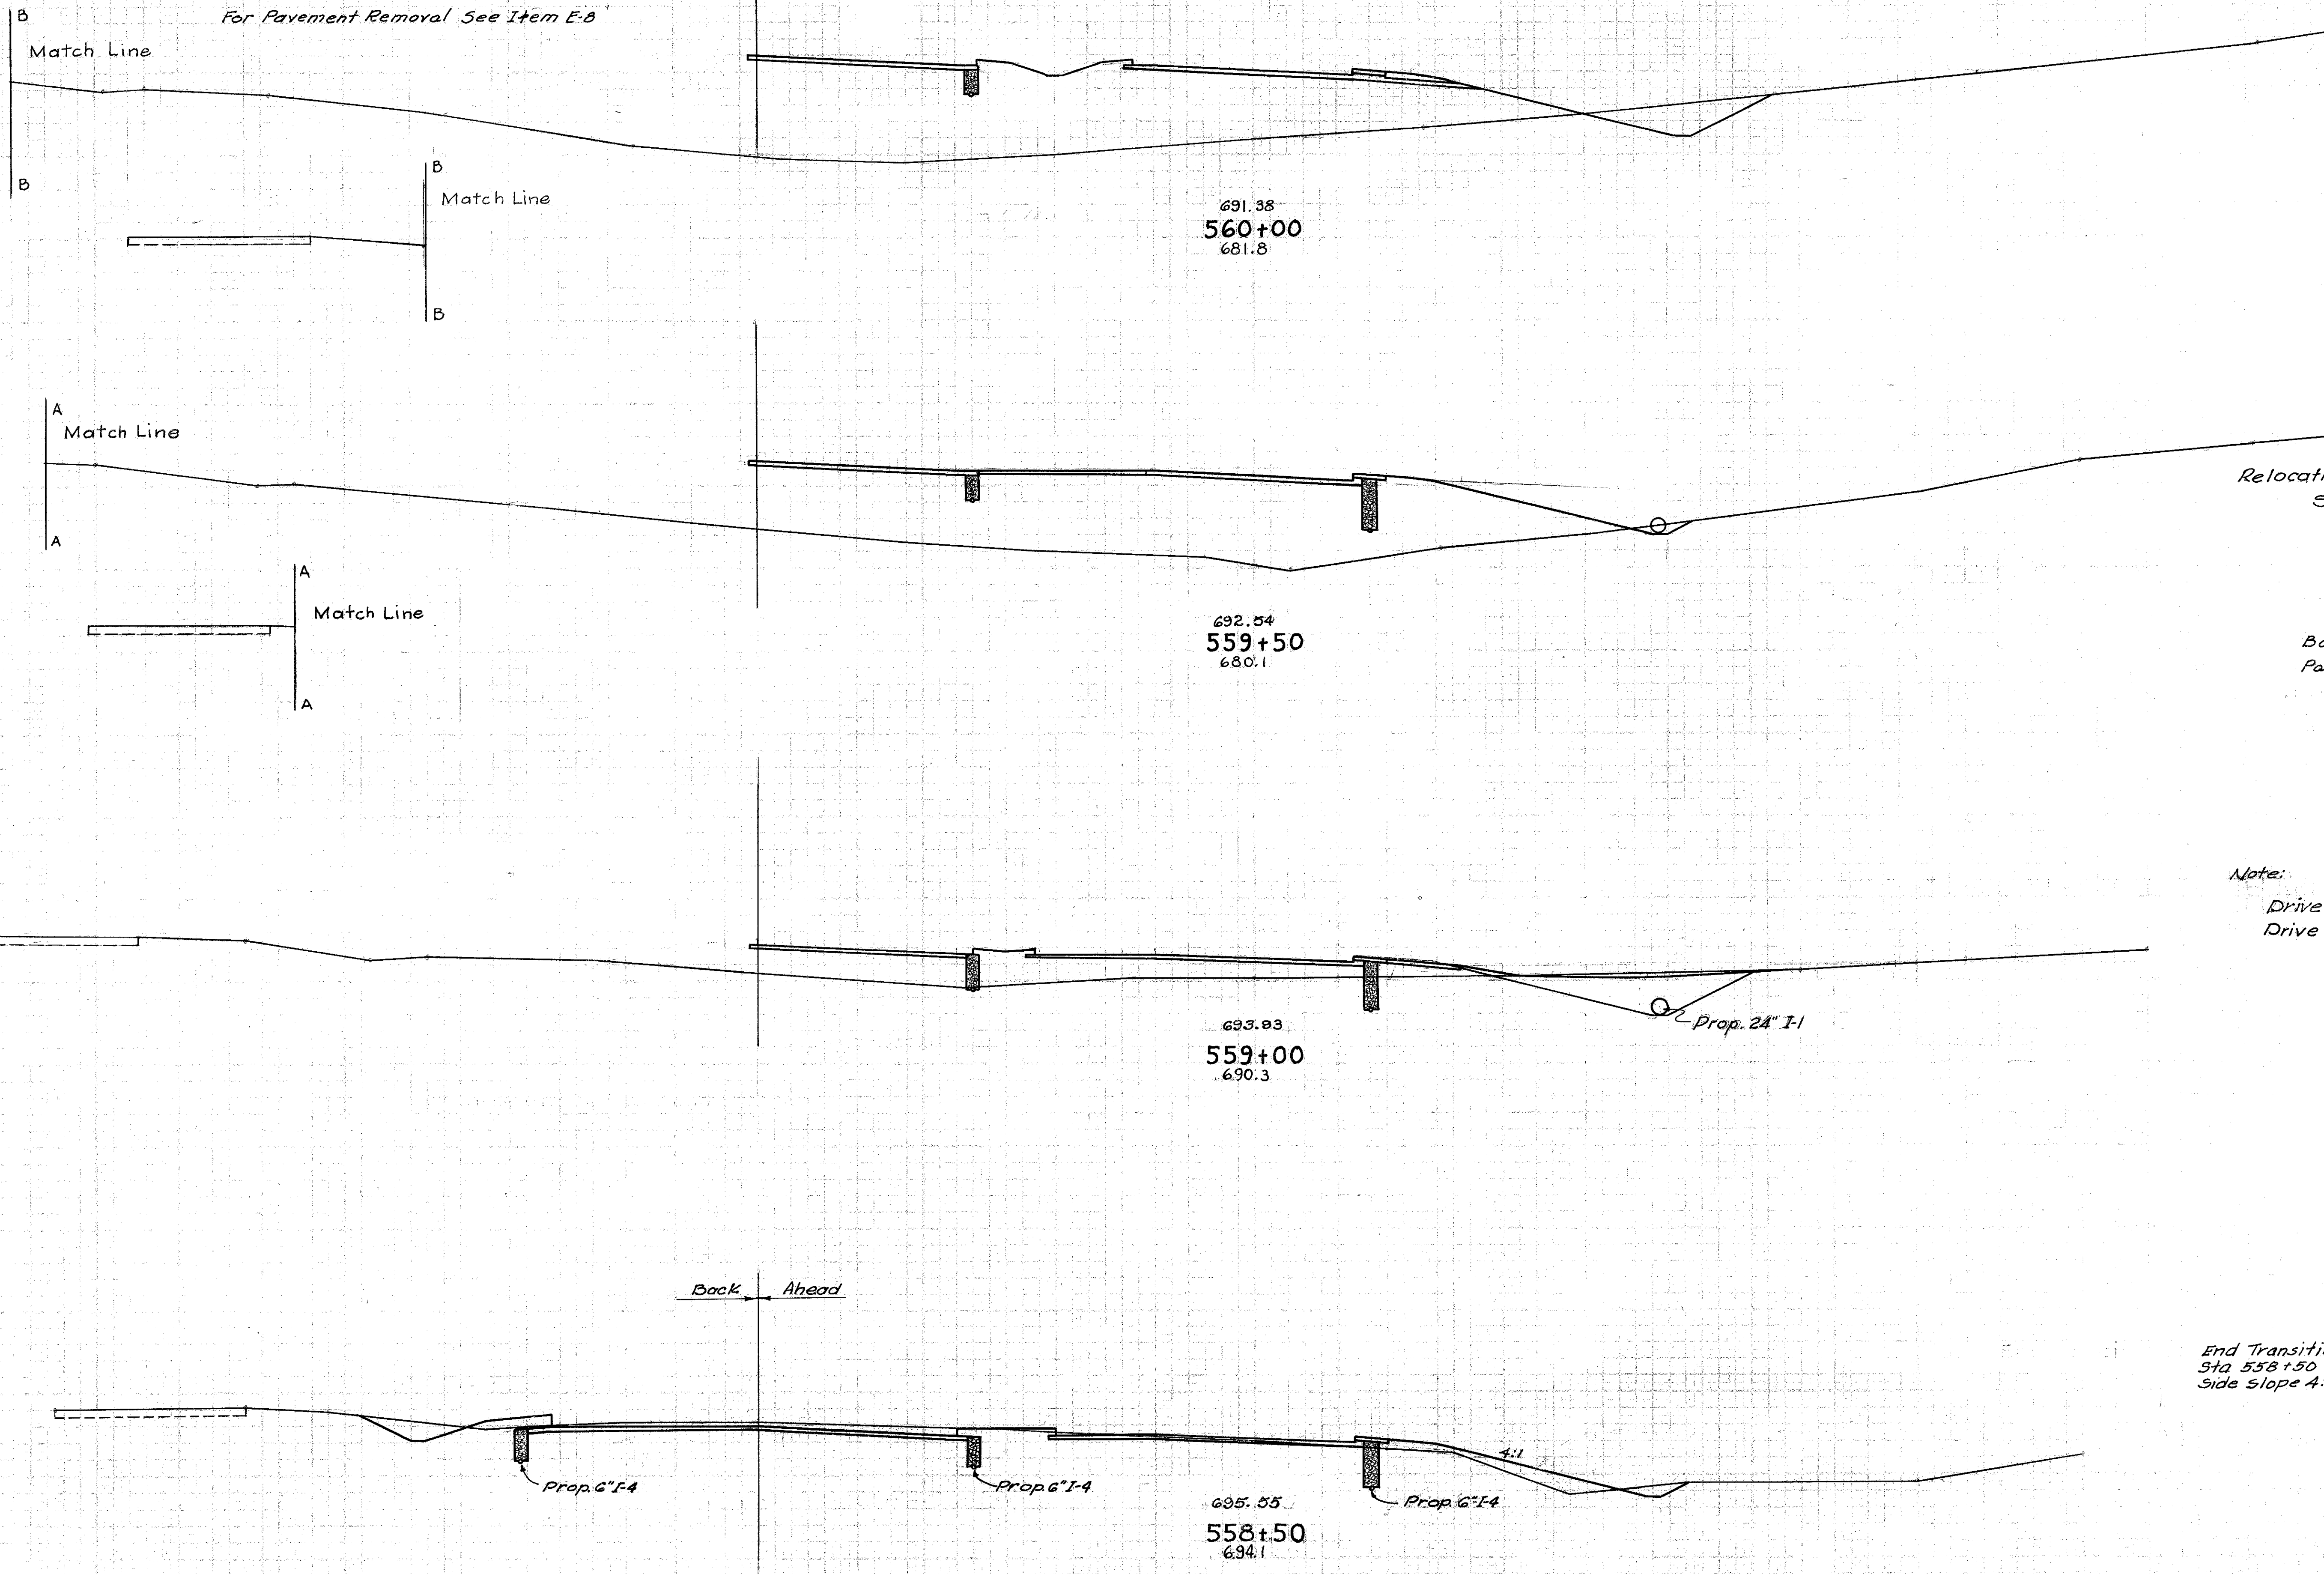

End Area		Cu. Yds.	
Cut	Fill	Cut	Fill
62	856		
		61	1609
		226	3591
4	882		
			322
		89	1033
			49
			71
92	234		
		120	254
Ahead	37	40	
Back	75	47	
		494	46

Relocation Exist.  
 State Route #4

Backfill for  
 Pavement Removal

Note:  
 Drive Rt. Sta. 559+00  
 Drive Rt. Sta. 559+40

End Transition  
 Sta. 558+50  
 Side Slope 4:1

Sta. 550+00 to Sta. 560+00  
 F-1  
 Embankment 8834 Cu. Yds.  
 Embankment +15% 12,159 Cu. Yds.

150 140 130 120 110 100 90 80 70 60 50 40 30 20 10 0 10 20 30 40 50 60 70 80 90 100 110 120 130 140


STA. 558+50 TO 560+00

150 140 130 120 110 100 90 80 70 60 50 40 30 20 10 0 10 20 30 40 50 60 70 80 90 100 110 120 130 140

FE. DIVISION	STATE	PROJECT
2	OHIO	

79  
222

BUT-4-(16.53-19.15)

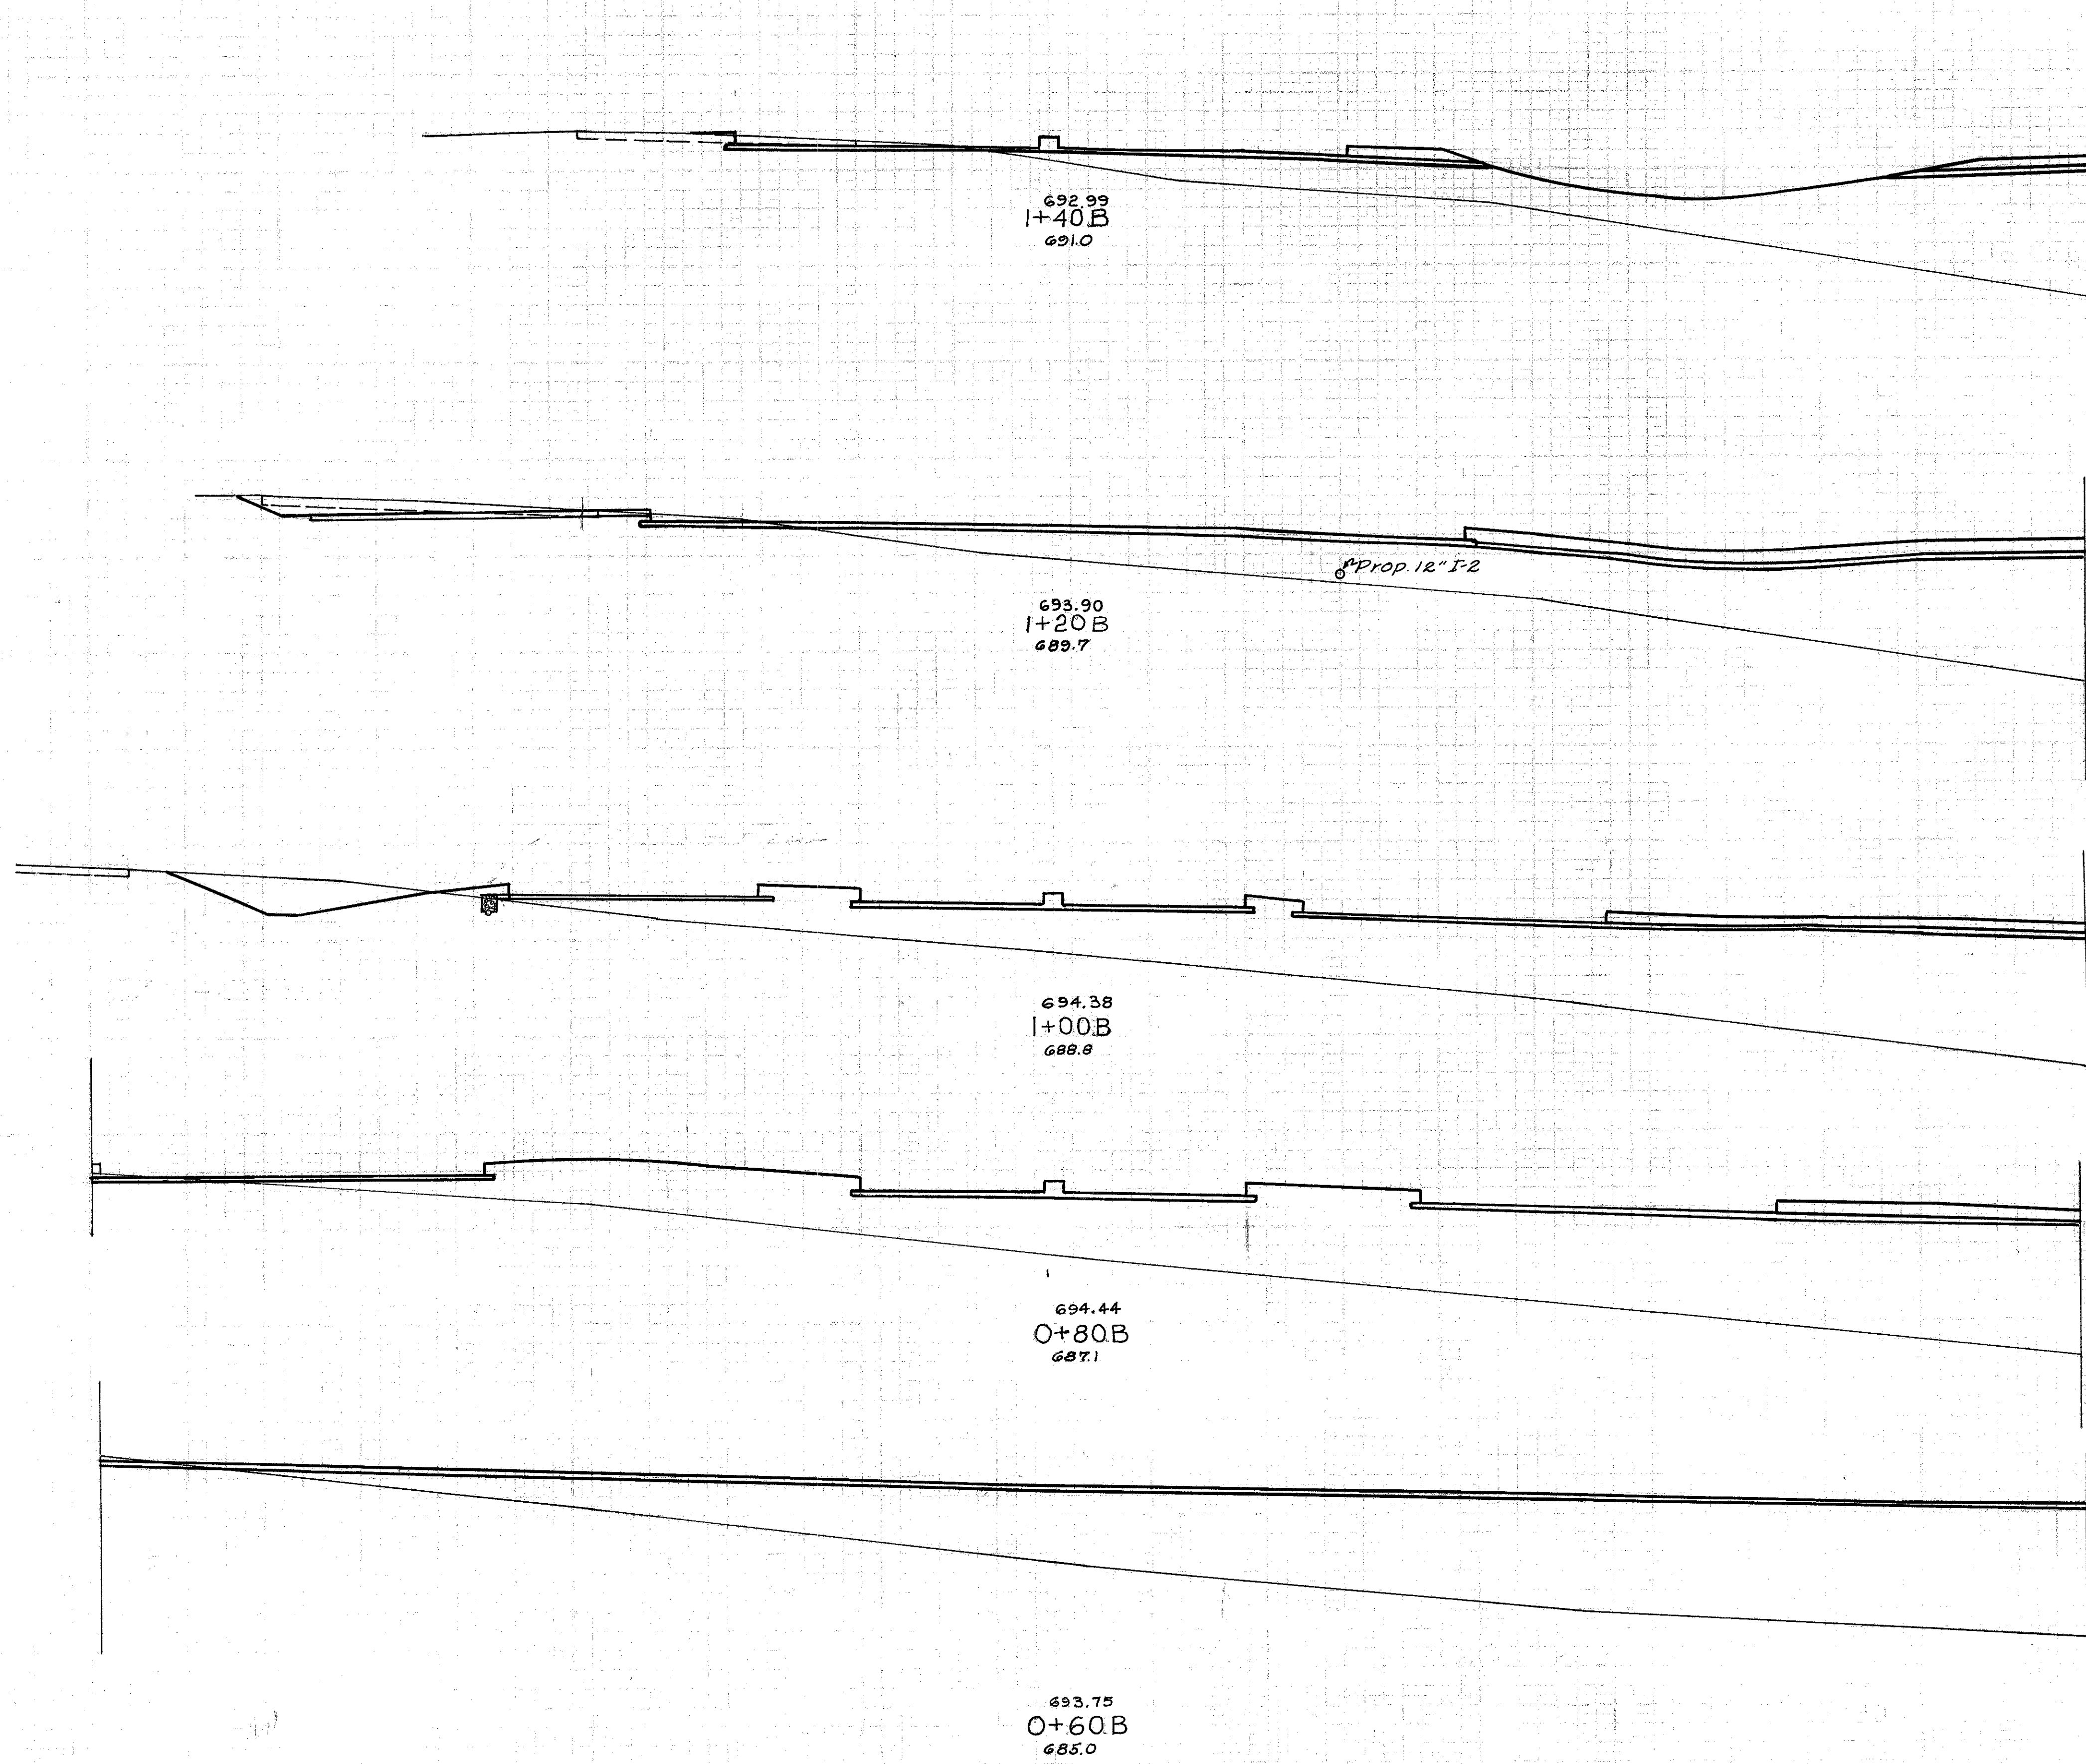

Note:  
Drive Sta. 1+52.7A  
= Sta. 1+20B

Station	End Area		Volume	
	cut	fill	cut	fill
28		643		
			42	544
15		827		
			7	
			56	736
67		1161		
			28	971
9		1461		
			6	1024
7		1305		


150 140 130 120 110 100 90 80 70 60 50 40 30 20 10 0 10 20 30 40 50 60 70 80 90 100 110 120 130 140  
RELOCATION EXISTING STATE ROUTE

150 140 130 120 110 100 90 80 70 60 50 40 30 20 10 0 10 20 30 40 50 60 70 80 90 100 110 120 130 140

DIST.	STATE	PROJECT
2	OHIO	

80  
222

CUT-4-(16.53-19.15)

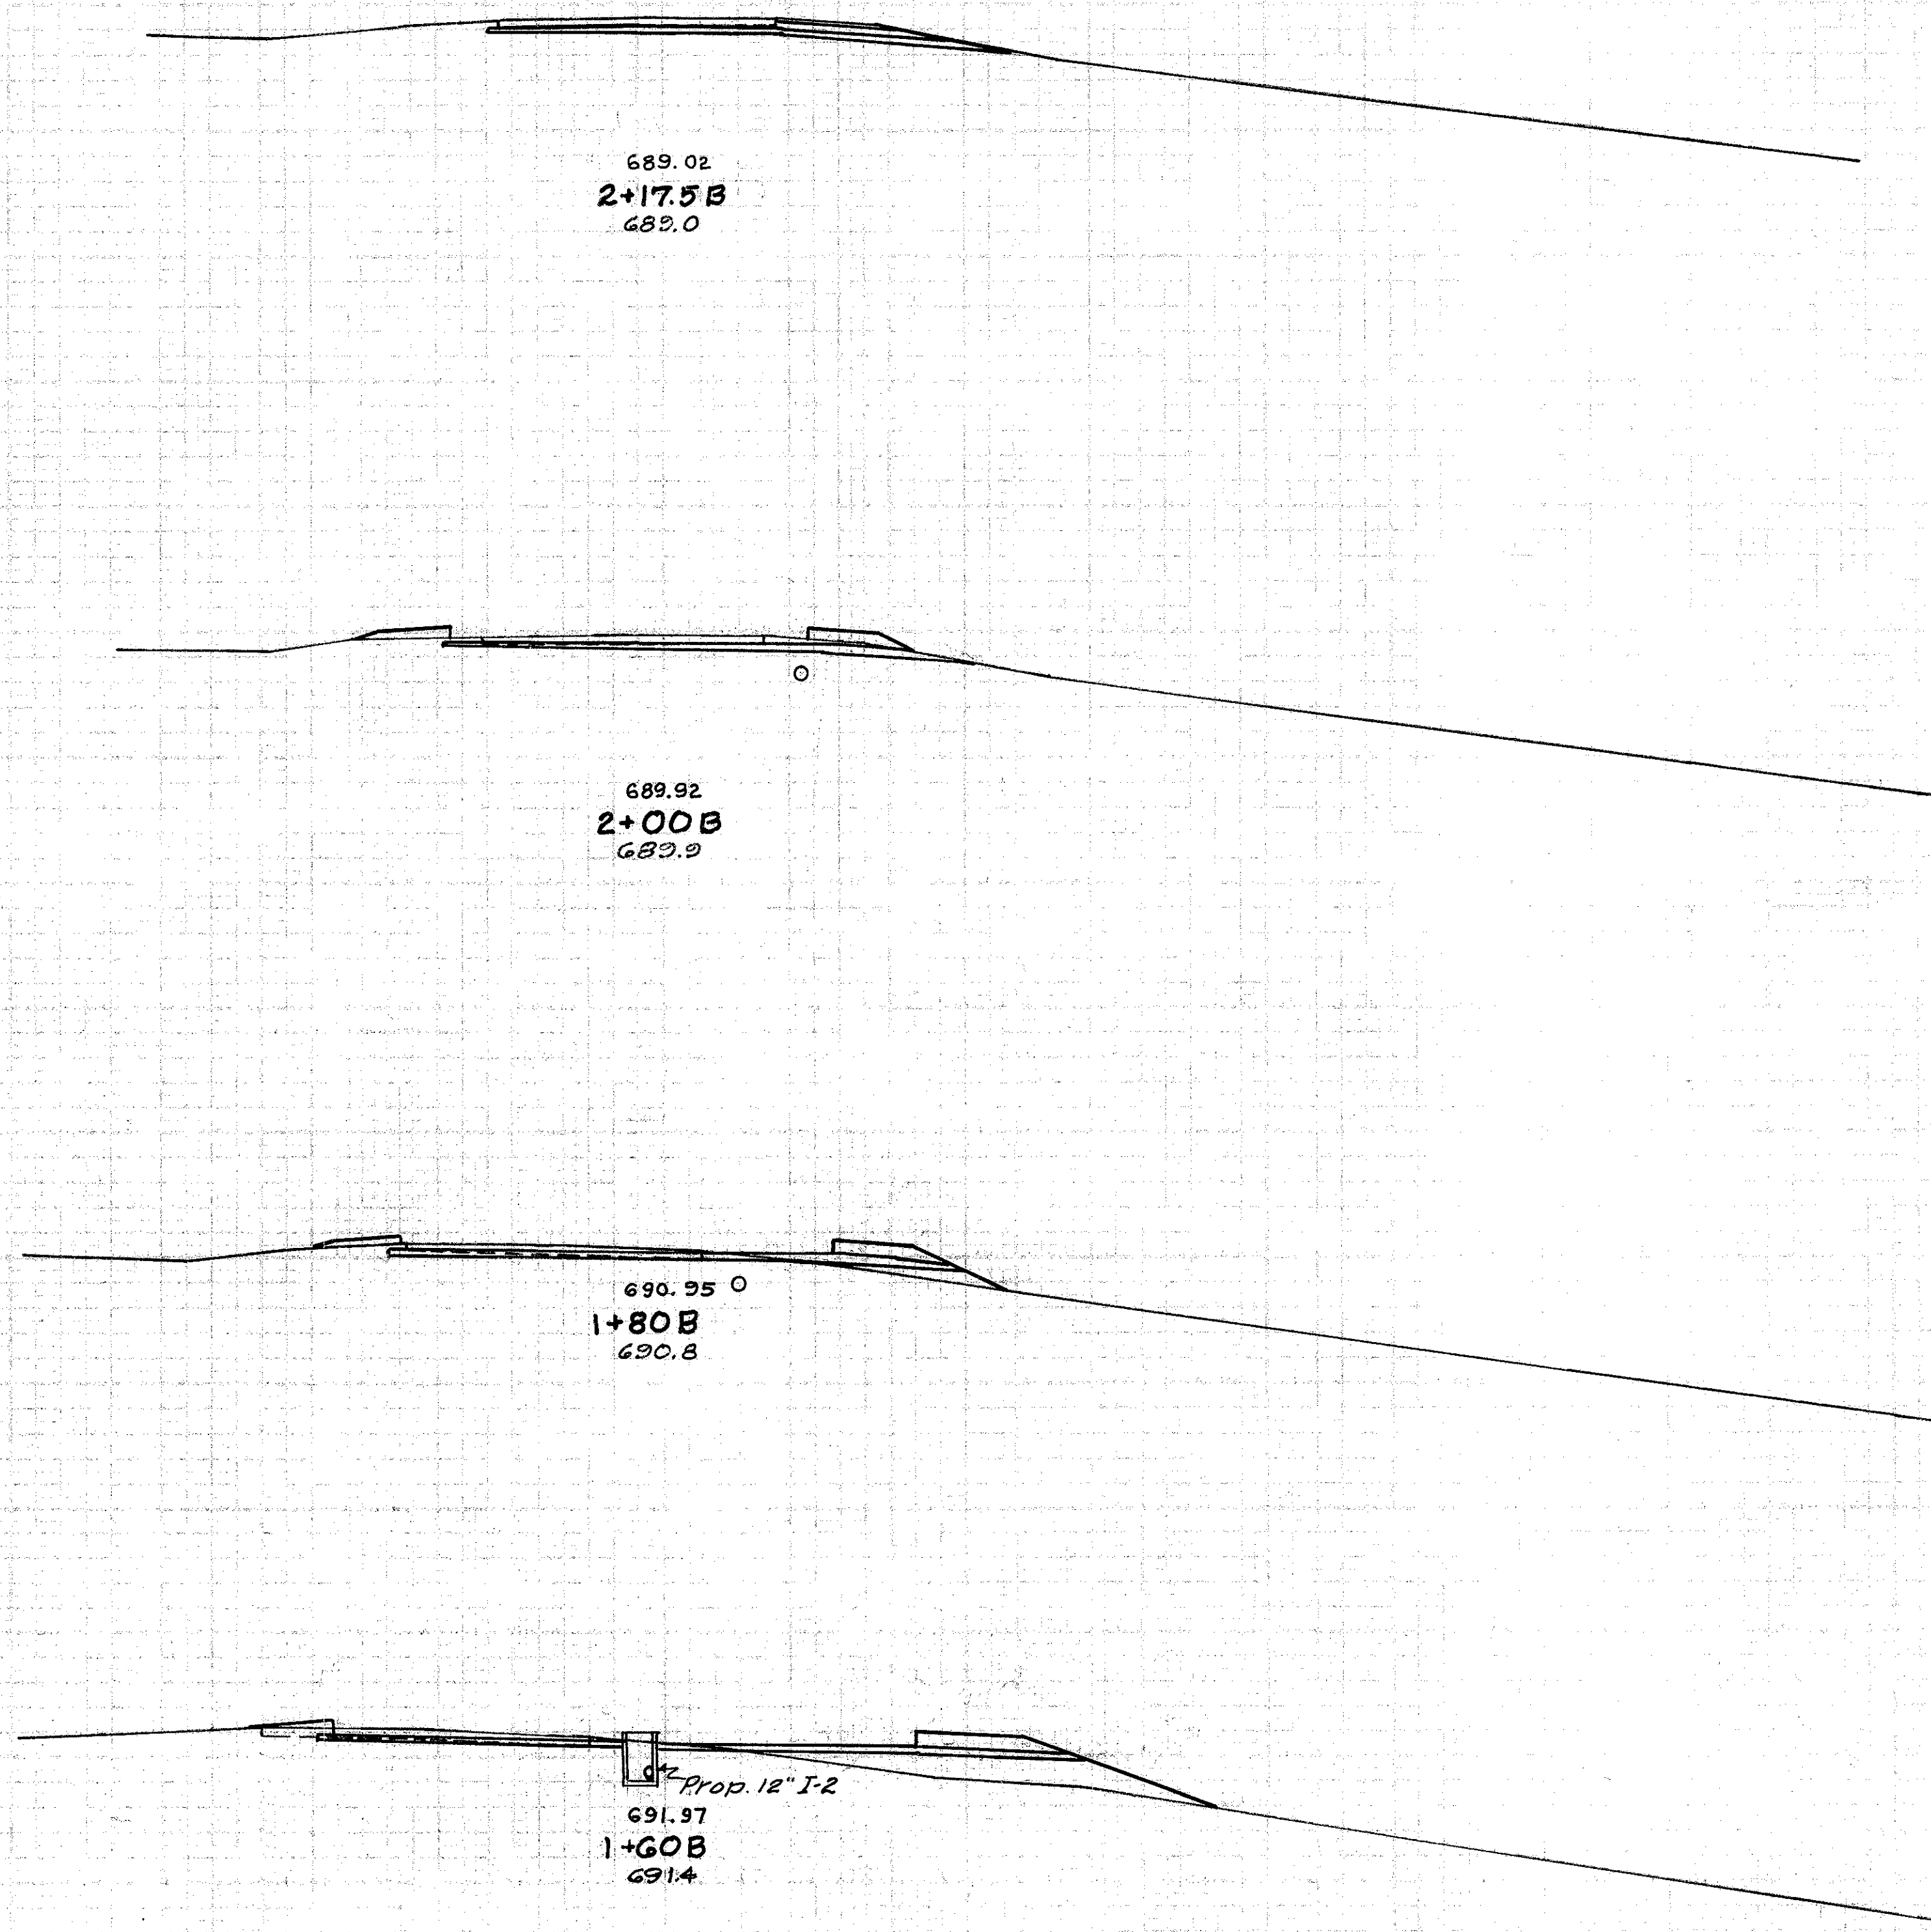


END-AREA		CU. YDS.	
CUT	FILL	CUT	FILL
40	9		
		26	7
40	14		
		24	12
25	19		
		18	33
23	71		
		19	264

150 140 130 120 110 100 90 80 70 60 50 40 30 20 10 0 10 20 30 40 50 60 70 80 90 100 110 120 130 140

RELOCATION EXISTING STATE ROUTE #4



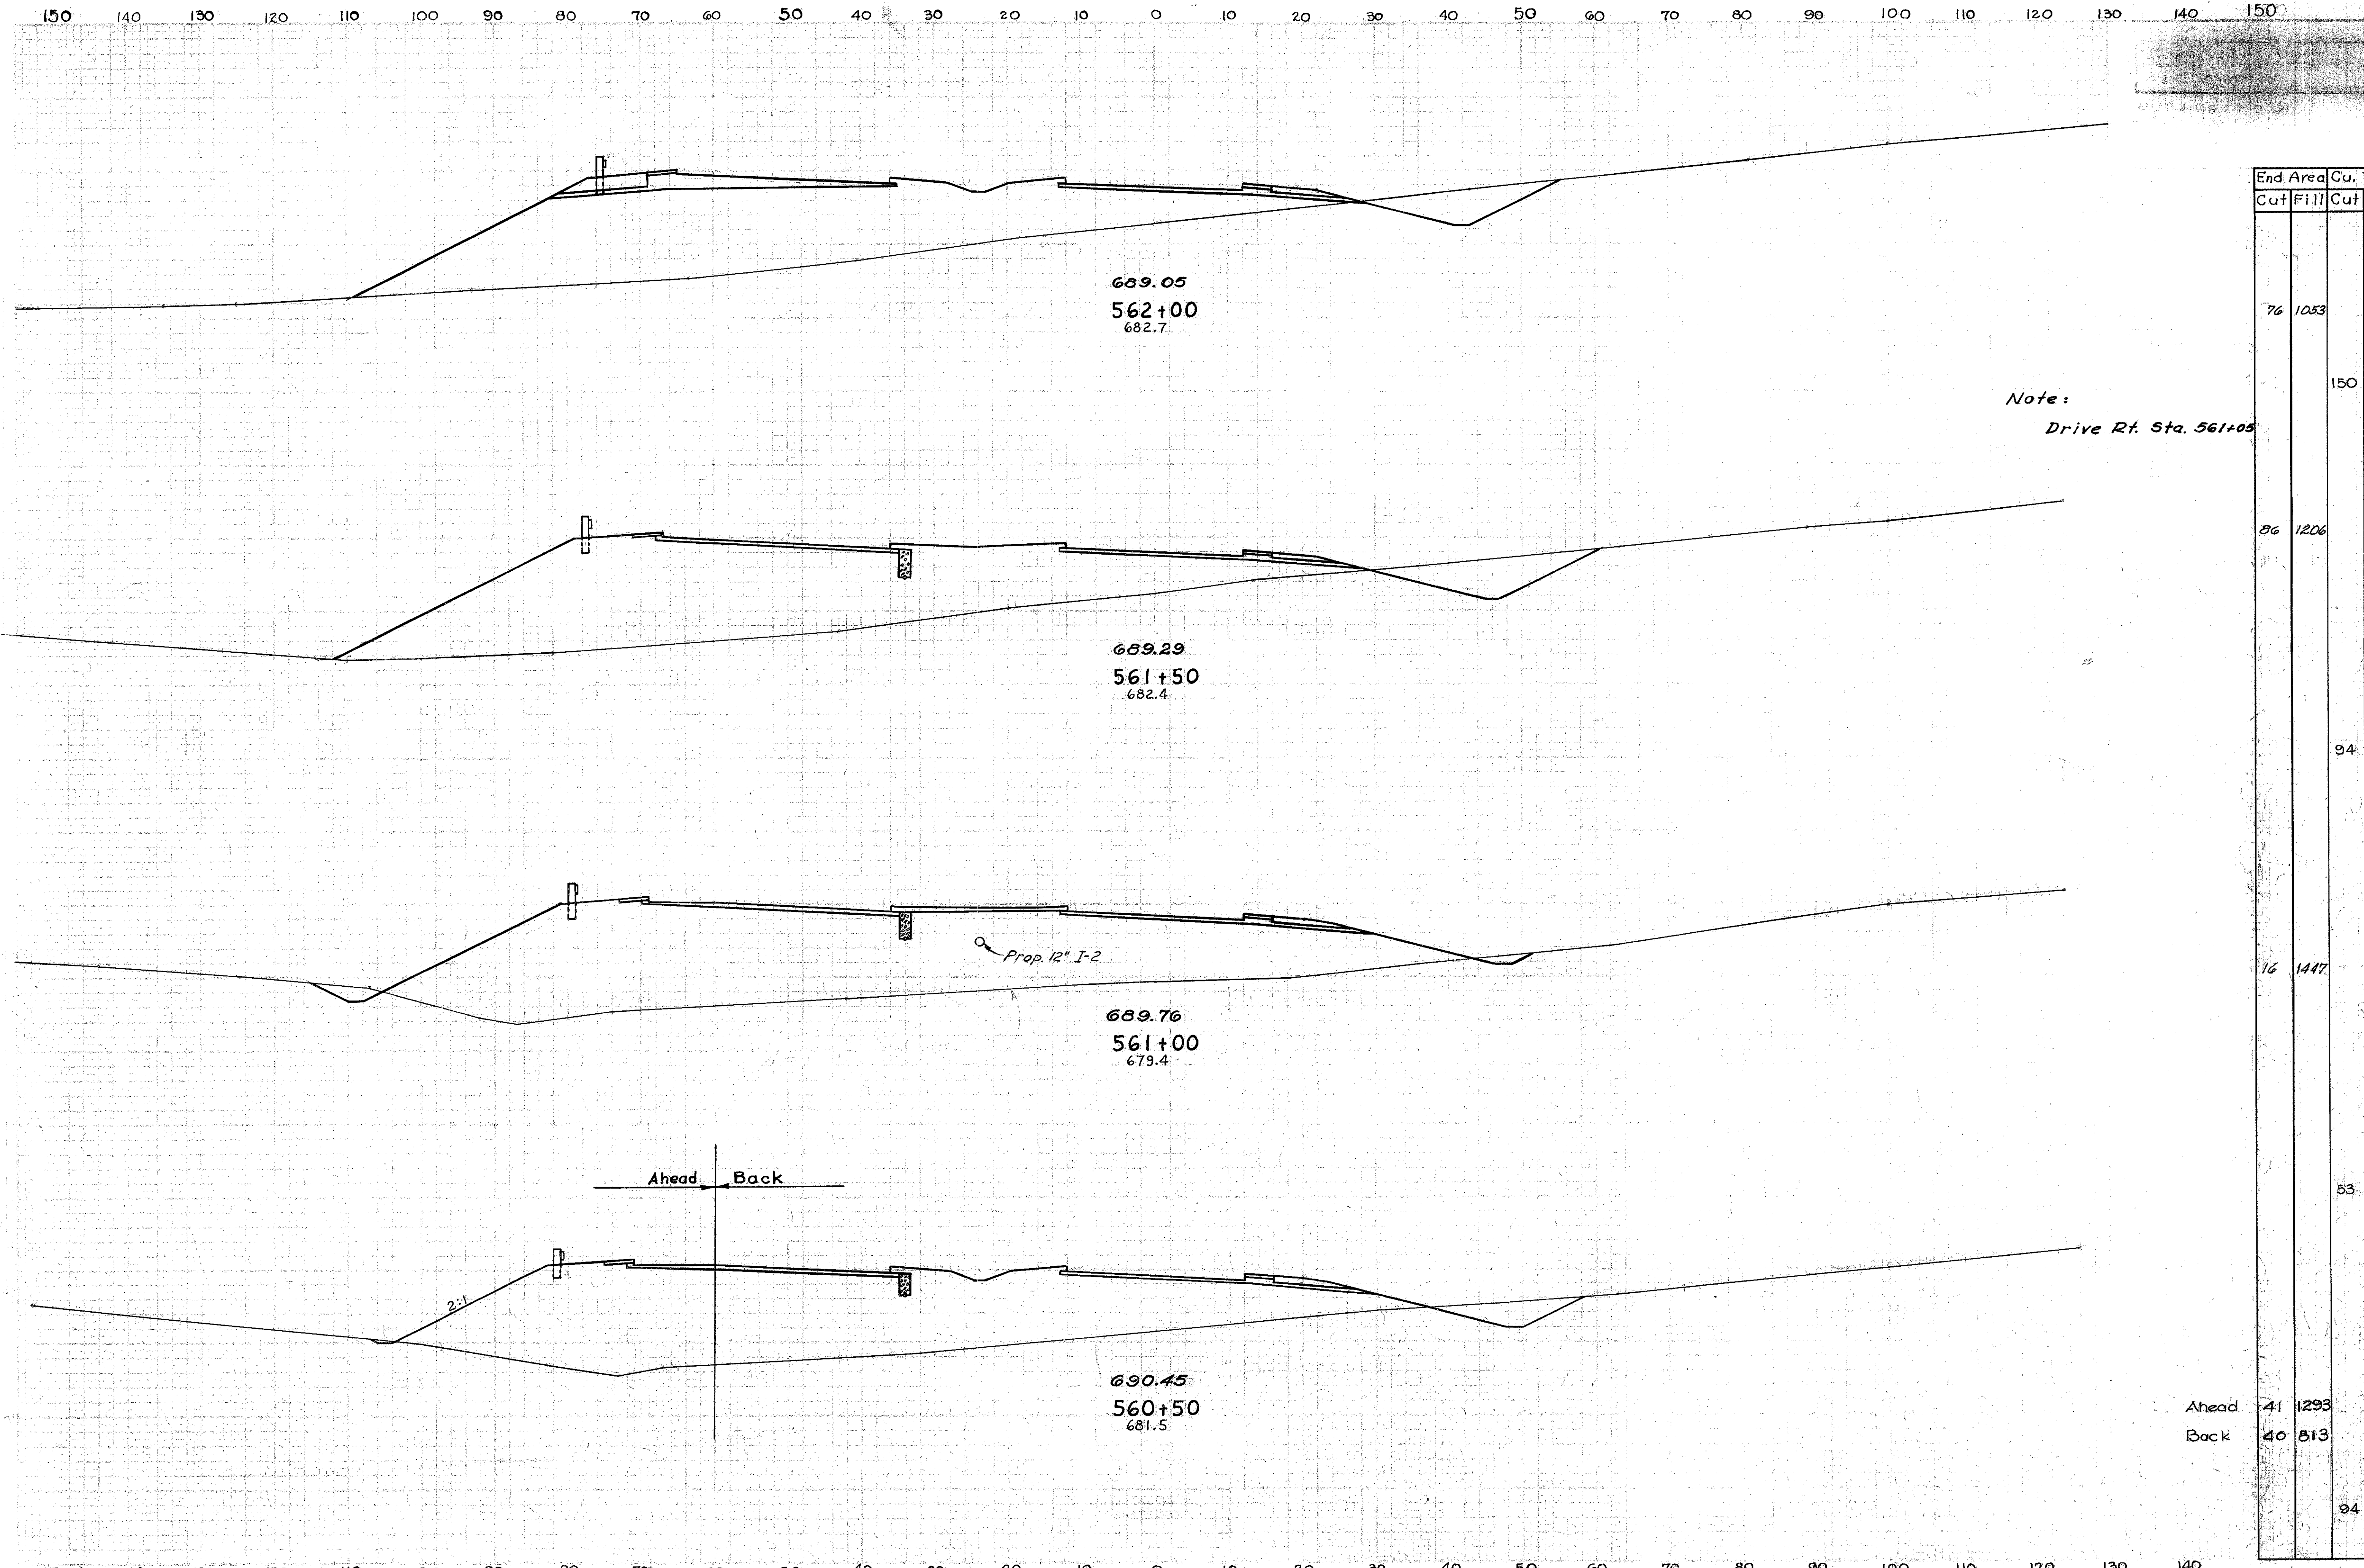





Note:  
Drive Rt. Sta. 561+05

End Area		Cu. Yds.	
Cut	Fill	Cut	Fill
76	1053	150	2092
86	1206	94	2457
16	1447	53	2537
41	1293	94	1545
40	813		

Ahead  
Back

150 140 130 120 110 100 90 80 70 60 50 40 30 20 10 0 10 20 30 40 50 60 70 80 90 100 110 120 130 140 150

82  
222  
80+4 14 5 15

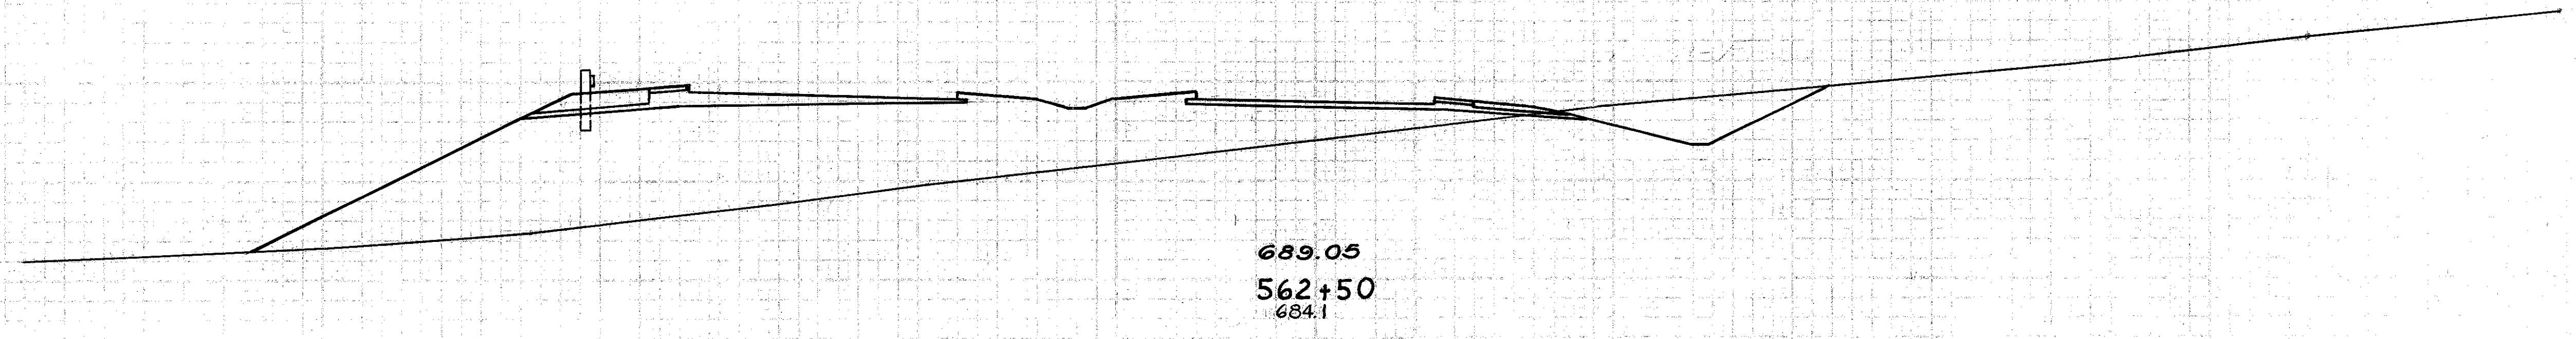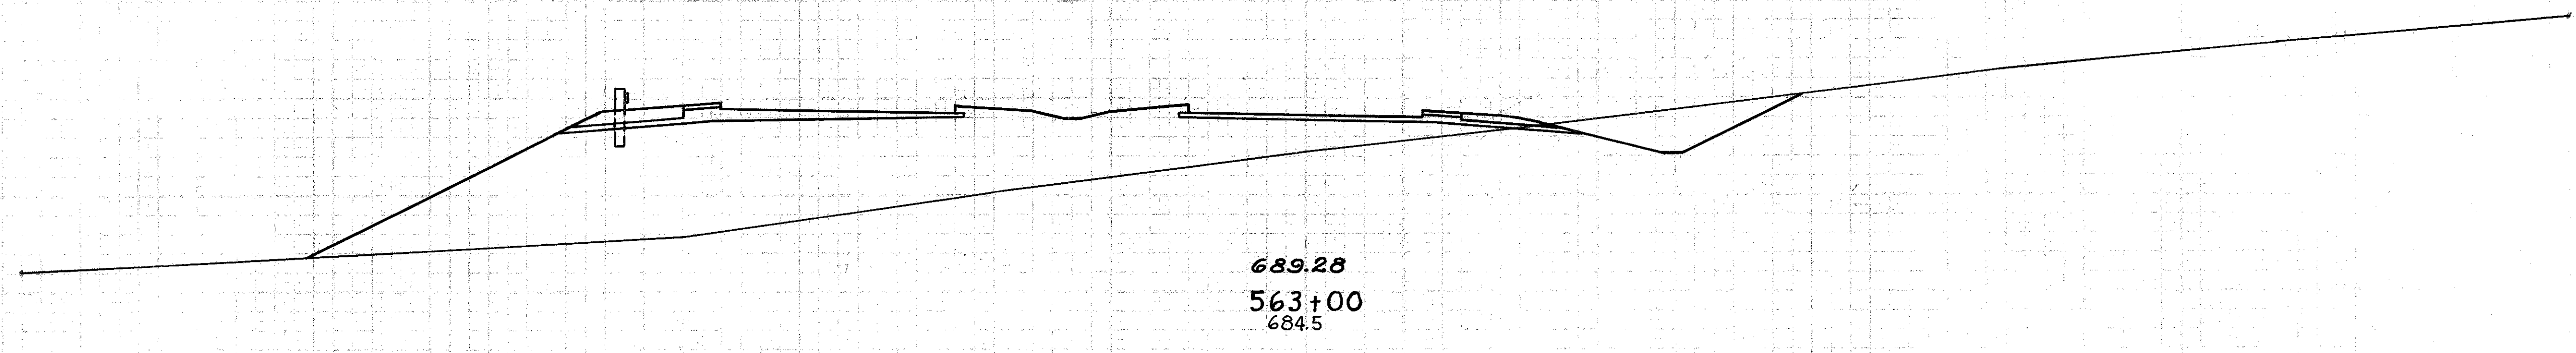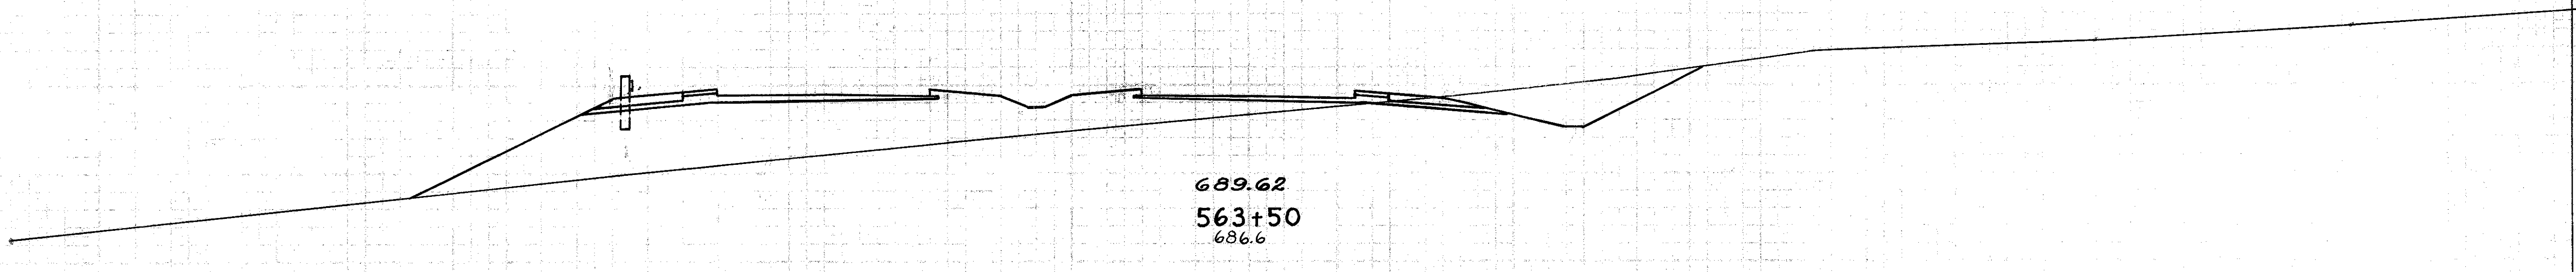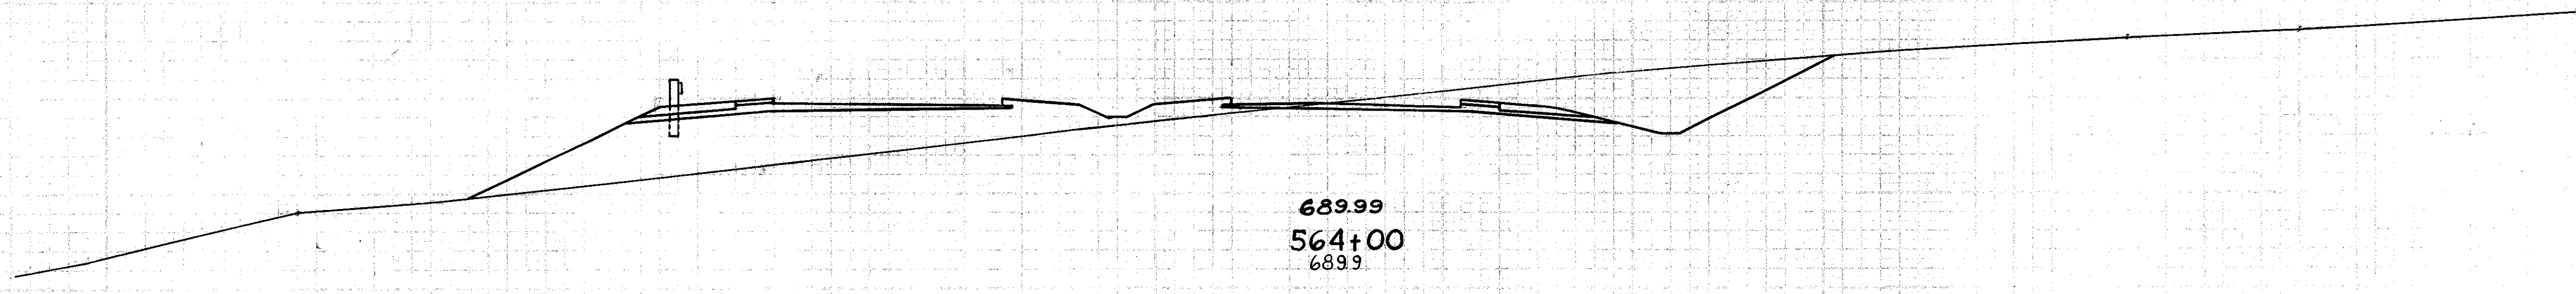

End Area		Cu. Yds.	
Cut	Fill	Cut	Fill
170	316		
		244	747
94	491		
		151	1284
69	896		
		137	1684
73	923		
		138	1830

150 140 130 120 110 100 90 80 70 60 50 40 30 20 10 0 10 20 30 40 50 60 70 80 90 100 110 120 130 140

STA. 562+50 TO 564+00

150 140 130 120 110 100 90 80 70 60 50 40 30 20 10 0 10 20 30 40 50 60 70 80 90 100 110 120 130 140 150

83  
222  
FUT 4/16/53 (10/5)

End Area		Cu. Yds.	
Cut	Fill	Cut	Fill

46	330		
		67	1002
26	752		
		79	
		29	1601
5	977		
		18	1504
		31	
14	647		
		171	892

693.38  
566+00  
689.0

692.23  
565+50  
683.7

691.28  
565+00  
682.4

690.54  
564+50  
688.5

Dump Sta 565+60

Drive Sta 564+46

150 140 130 120 110 100 90 80 70 60 50 40 30 20 10 0 10 20 30 40 50 60 70 80 90 100 110 120 130 140

STA. 564+50 TO 566

150 140 130 120 110 100 90 80 70 60 50 40 30 20 10 0 10 20 30 40 50 60 70 80 90 100 110 120 130 140 150

DATE: 11/16/53  
 SHEET: 222  
 PROJECT: 4-116-53-18-15

End Transition  
 Sta. 568+50  
 Side Slope 4:1

700.90  
 568+50  
 696.2

699.35  
 568+00  
 694.1

Begin Transition  
 Sta. 567+50  
 Side Slope 2:1

696.25  
 567+00  
 694.2

694.73  
 566+50  
 693.8


End Area		Cu. Yds.	
Cut	Fill	Cut	Fill
6	772		
		13	1476
8	822		
		104	2126
48	326		
		176	369
142	72		
		174	372

150 140 130 120 110 100 90 80 70 60 50 40 30 20 10 0 10 20 30 40 50 60 70 80 90 100 110 120 130 140

STA. 566+50 TO 568+50

150 140 130 120 110 100 90 80 70 60 50 40 30 20 10 0 10 20 30 40 50 60 70 80 90 100 110 120 130 140 150

2 DIFF  
 85  
 222  
 BUT-W-48-53-18-15

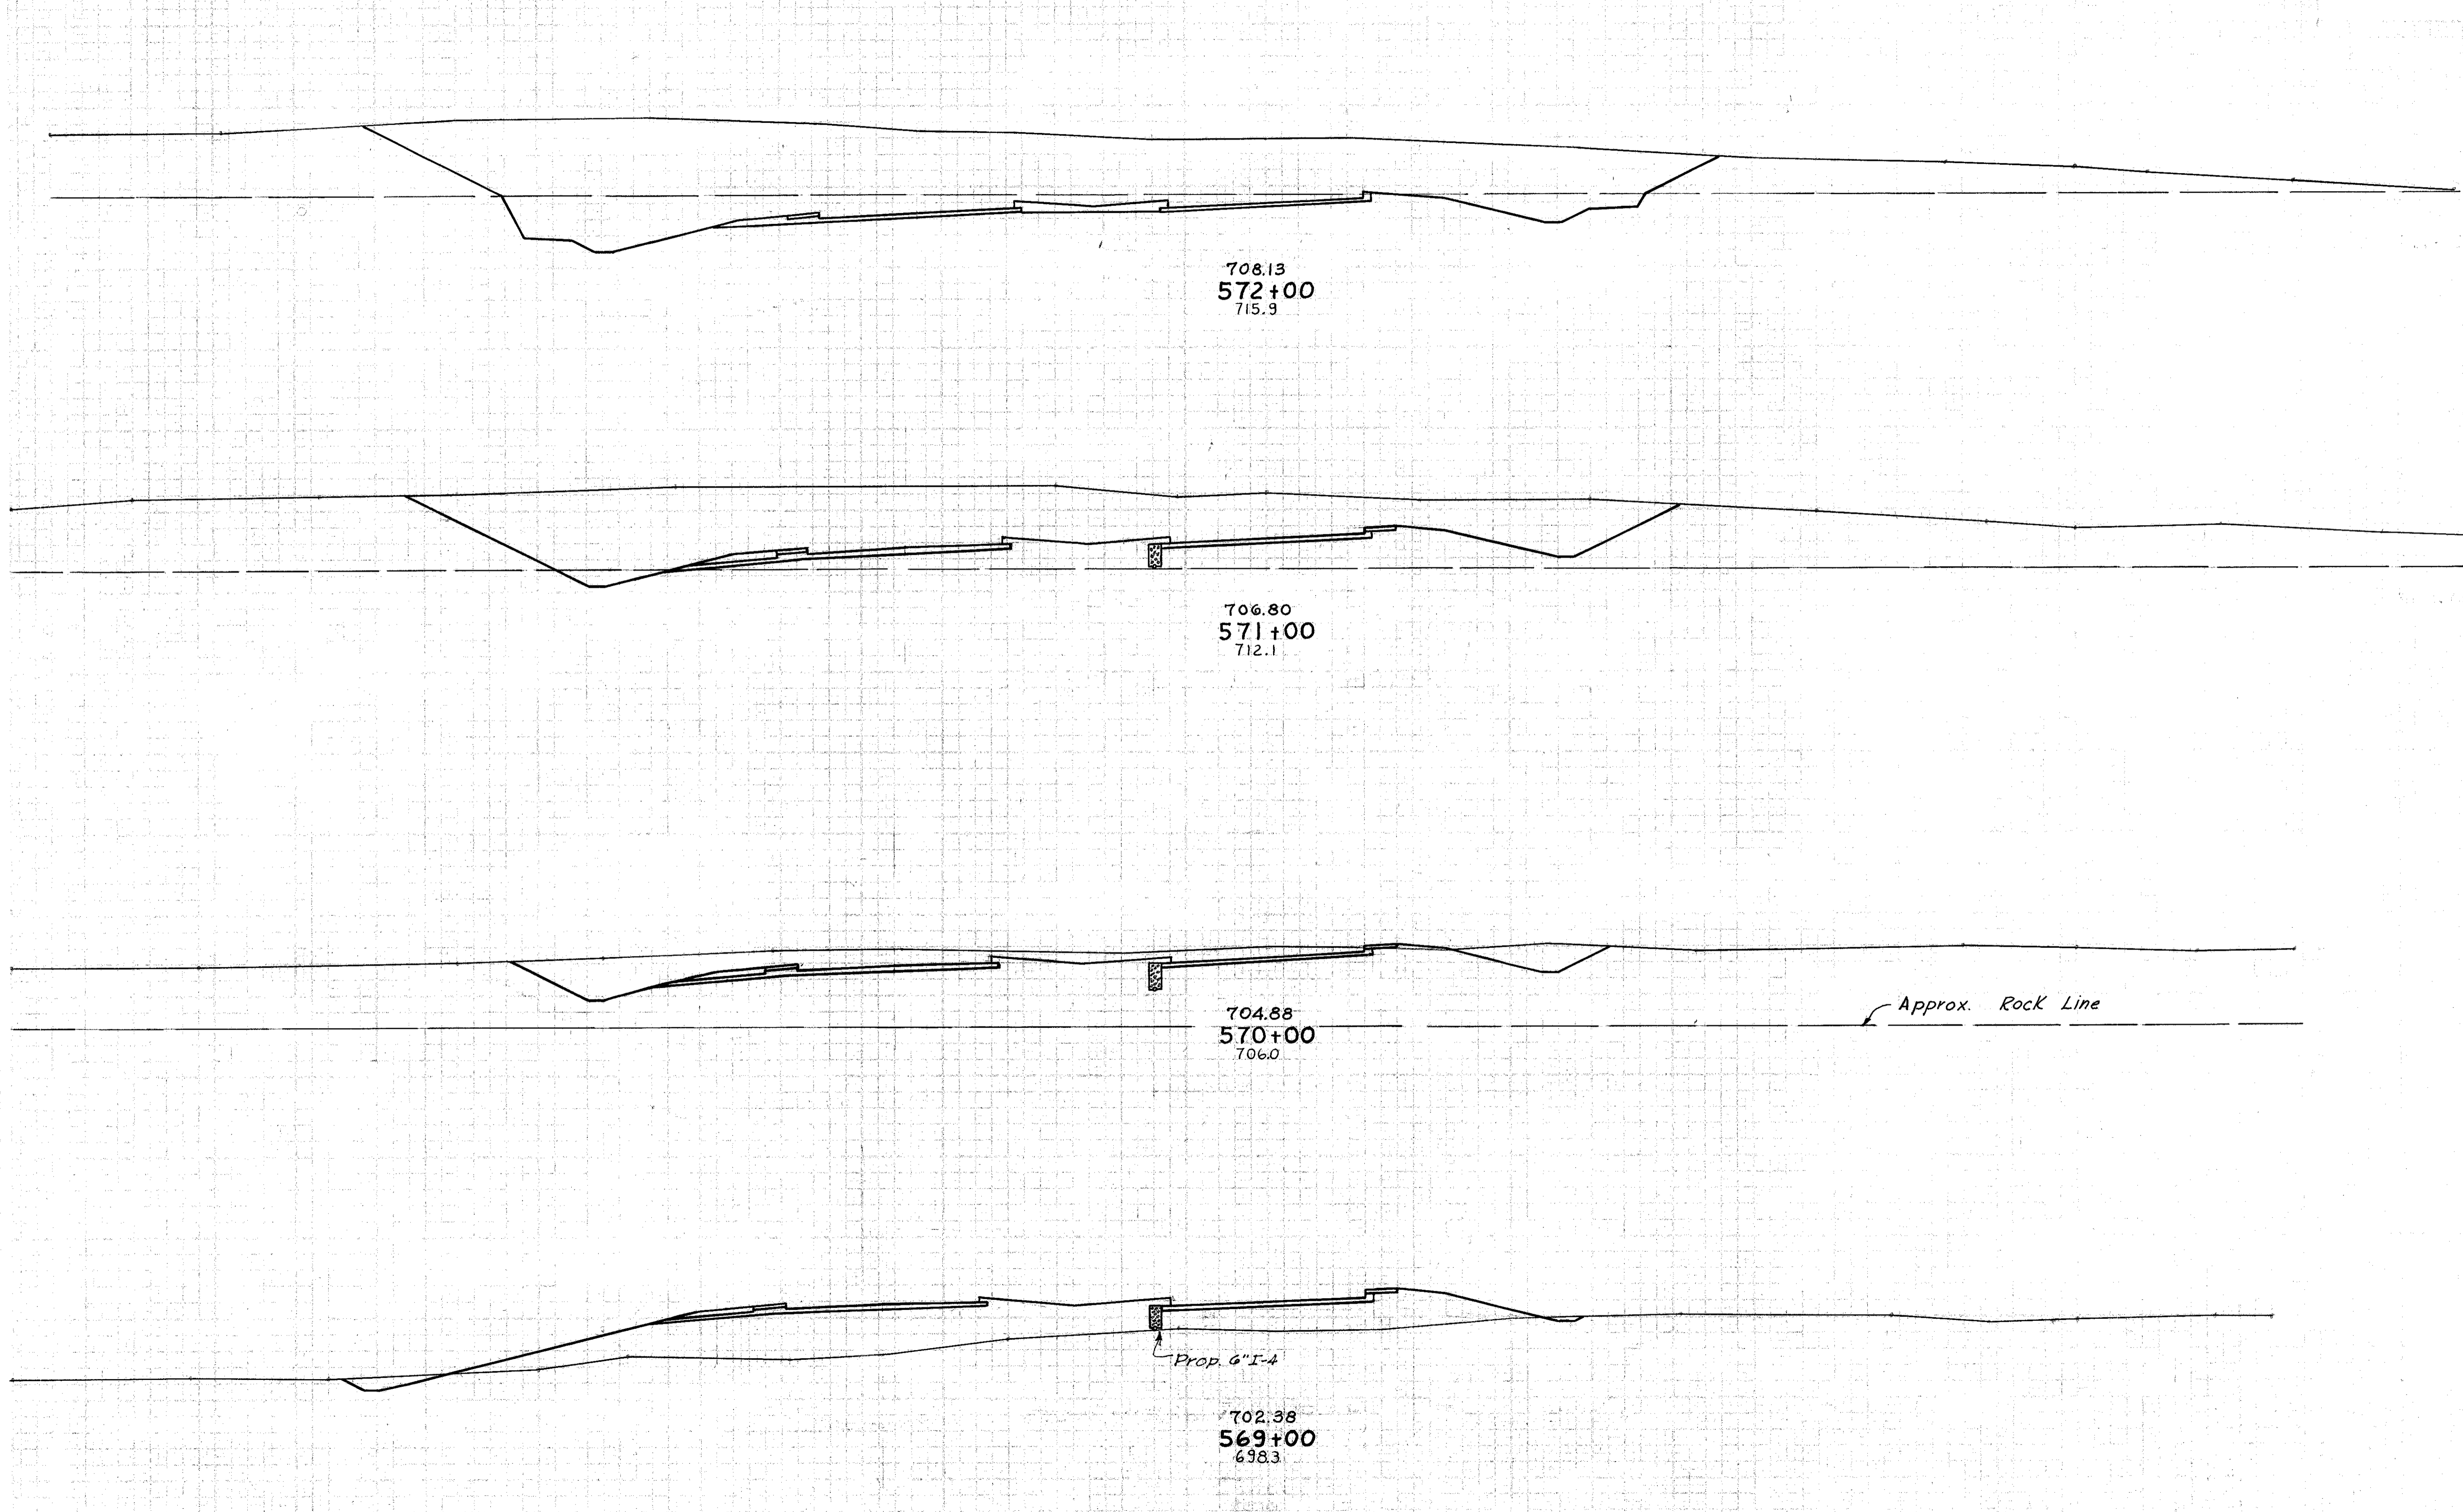

End Area		Cu. Yds.	
Cut	Fill	Cut	Fill
1594	20		
		4985	48
1098	6		
		2511	28
258	9		
		506	1006
15	534		
		19	1209


Sta 560+00 to Sta 570+00  
 E-1 Embankment 2448 Cu. Yds.  
 Embankment 25781 Cu. Yds.  
 Embankment + 15% 29640 Cu. Yds.

150 140 130 120 110 100 90 80 70 60 50 40 30 20 10 0 10 20 30 40 50 60 70 80 90 100 110 120 130 140

STA. 569+00 TO 572+00

150 140 130 120 110 100 90 80 70 60 50 40 30 20 10 0 10 20 30 40 50 60 70 80 90 100 110 120 130 140 150

86  
222  
CHIO  
901.4-016-53-19-15

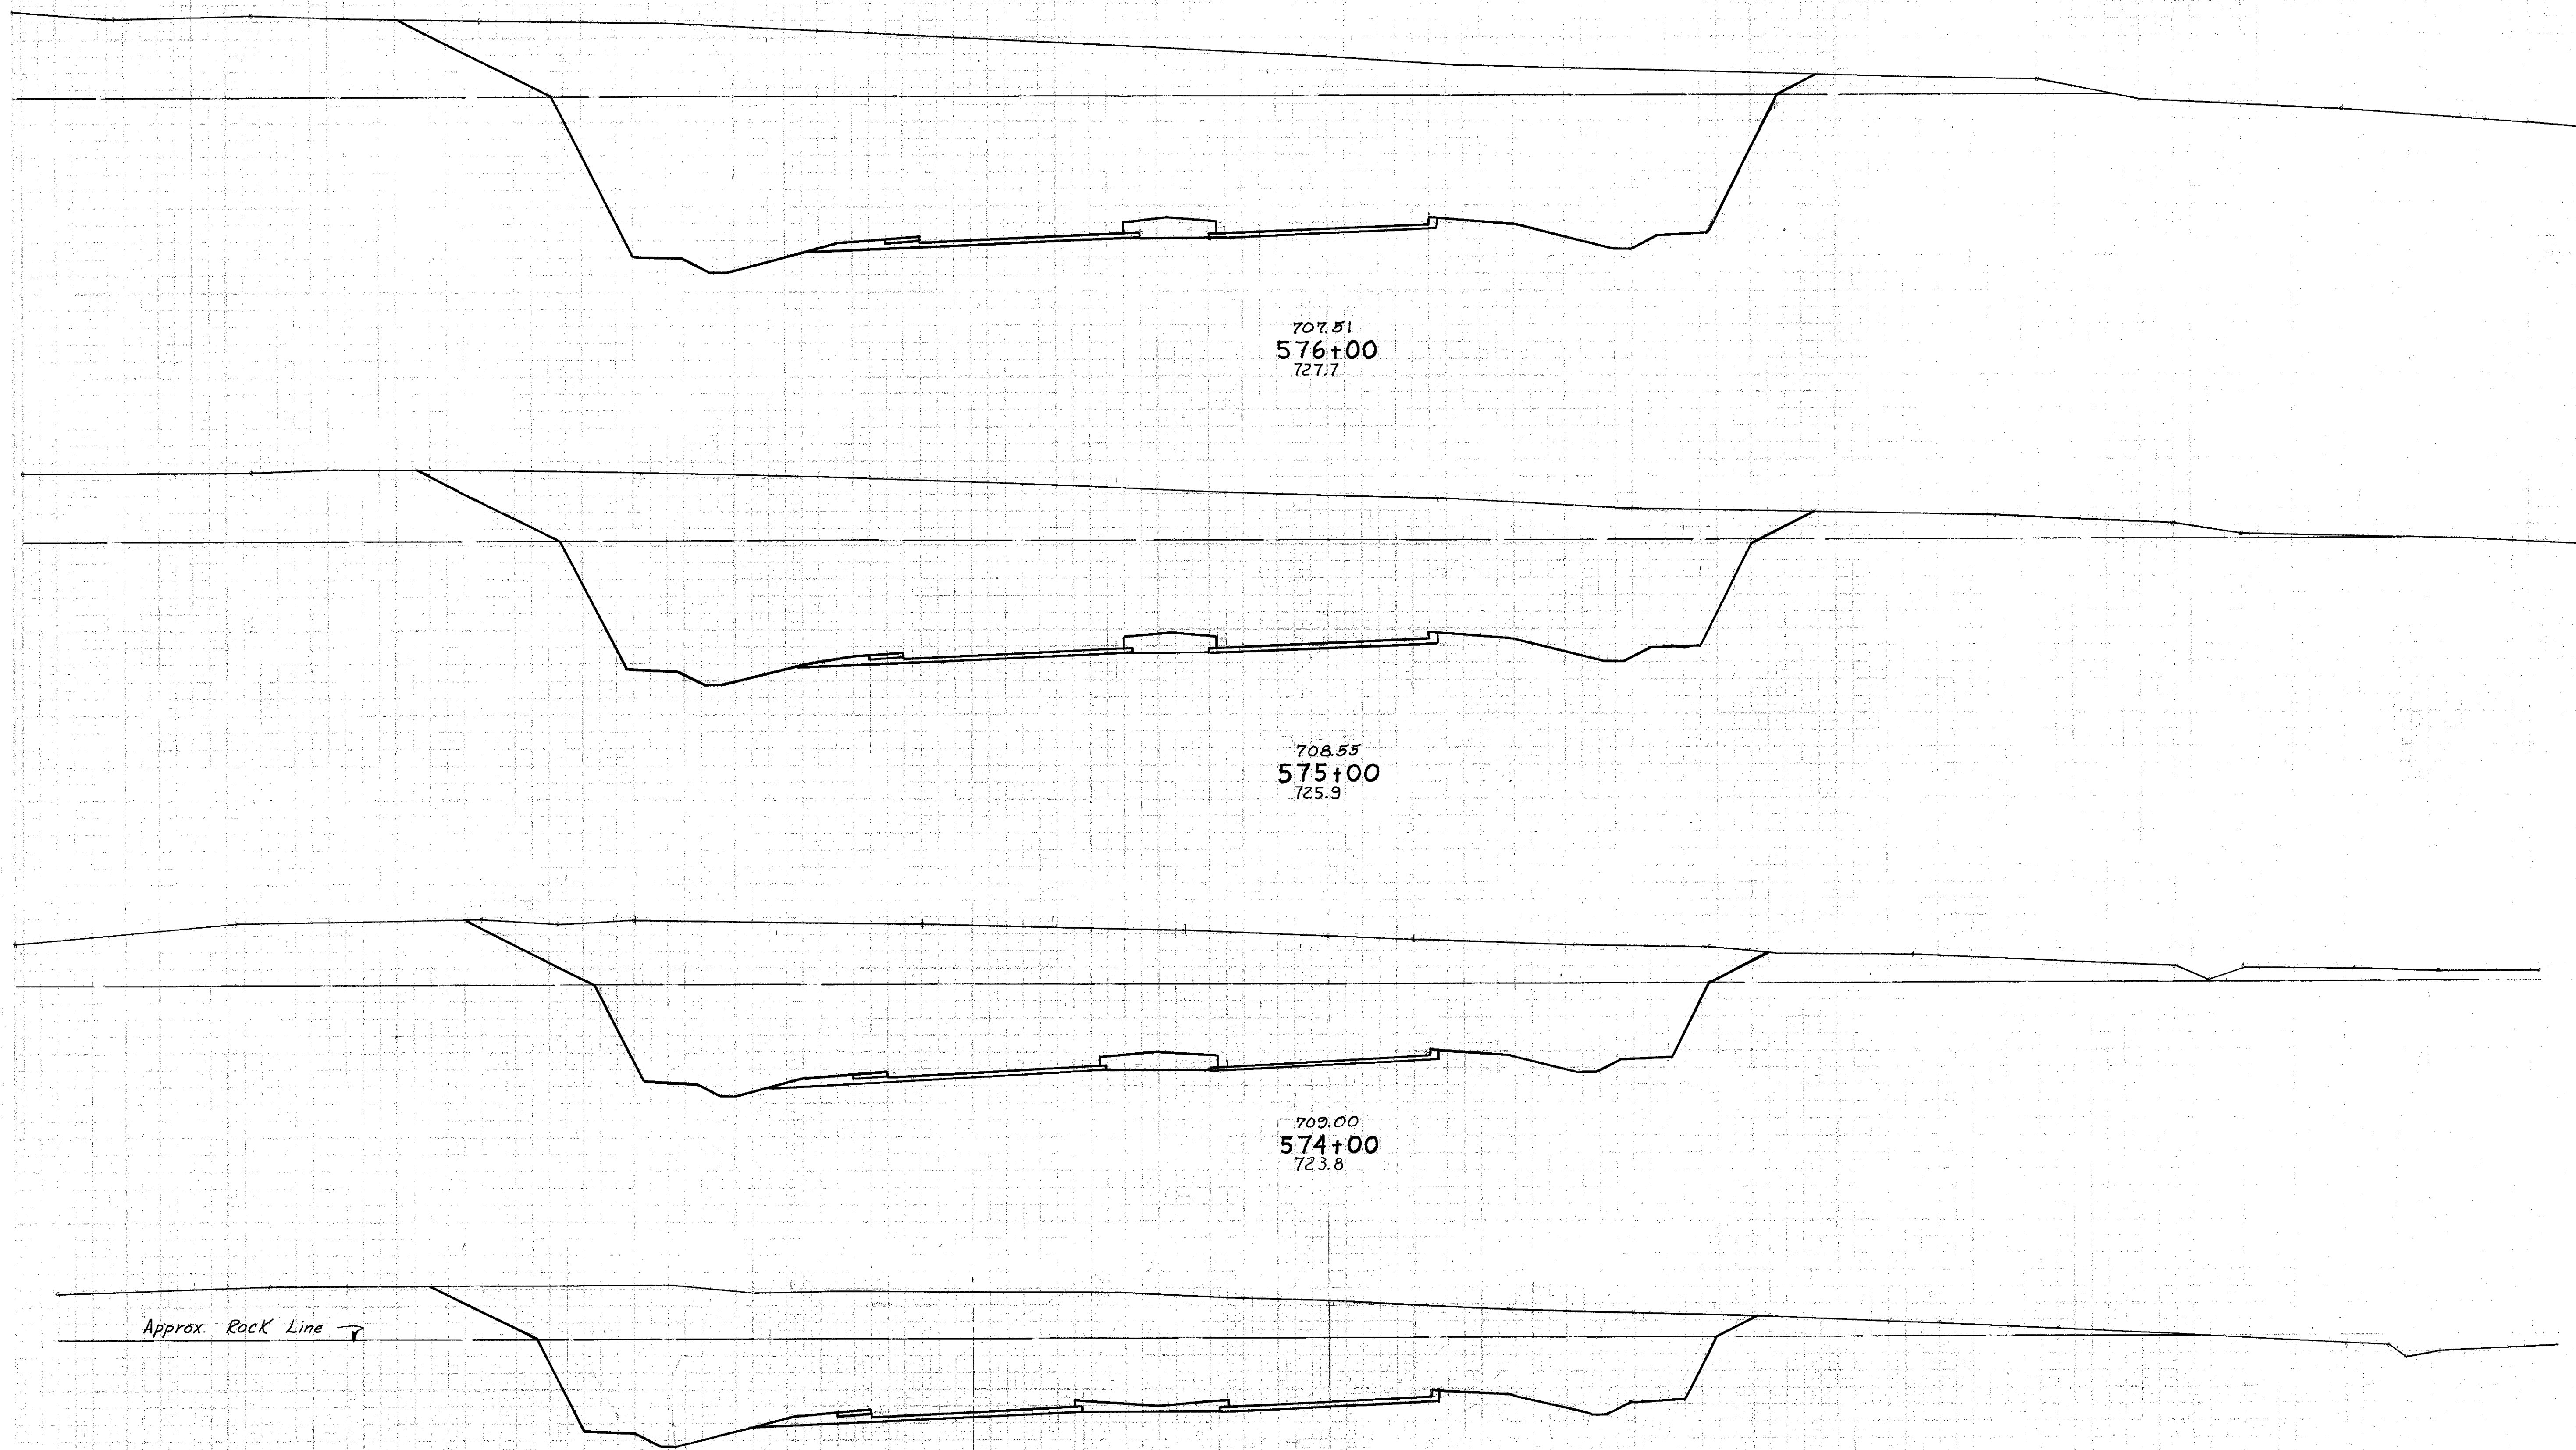

End Area		Cu. Yds.	
Cut	Fill	Cut	Fill
3310	-	11263	43
2772	-	9147	48
2167	-	7546	56
1908	-	6485	67

707.51  
576+00  
727.7

708.55  
575+00  
725.9

709.00  
574+00  
723.8

708.86  
573+00  
720.4


Approx. Rock Line

150 140 130 120 110 100 90 80 70 60 50 40 30 20 10 0 10 20 30 40 50 60 70 80 90 100 110 120 130 140

STA. 573+00 TO 576+00

150 140 130 120 110 100 90 80 70 60 50 40 30 20 10 0 10 20 30 40 50 60 70 80 90 100 110 120 130 140 150

PROJECT: STATE: DISTRICT:  
 2 OHIO  
 BUT-4-(16.53-19.15)  
 87  
 222

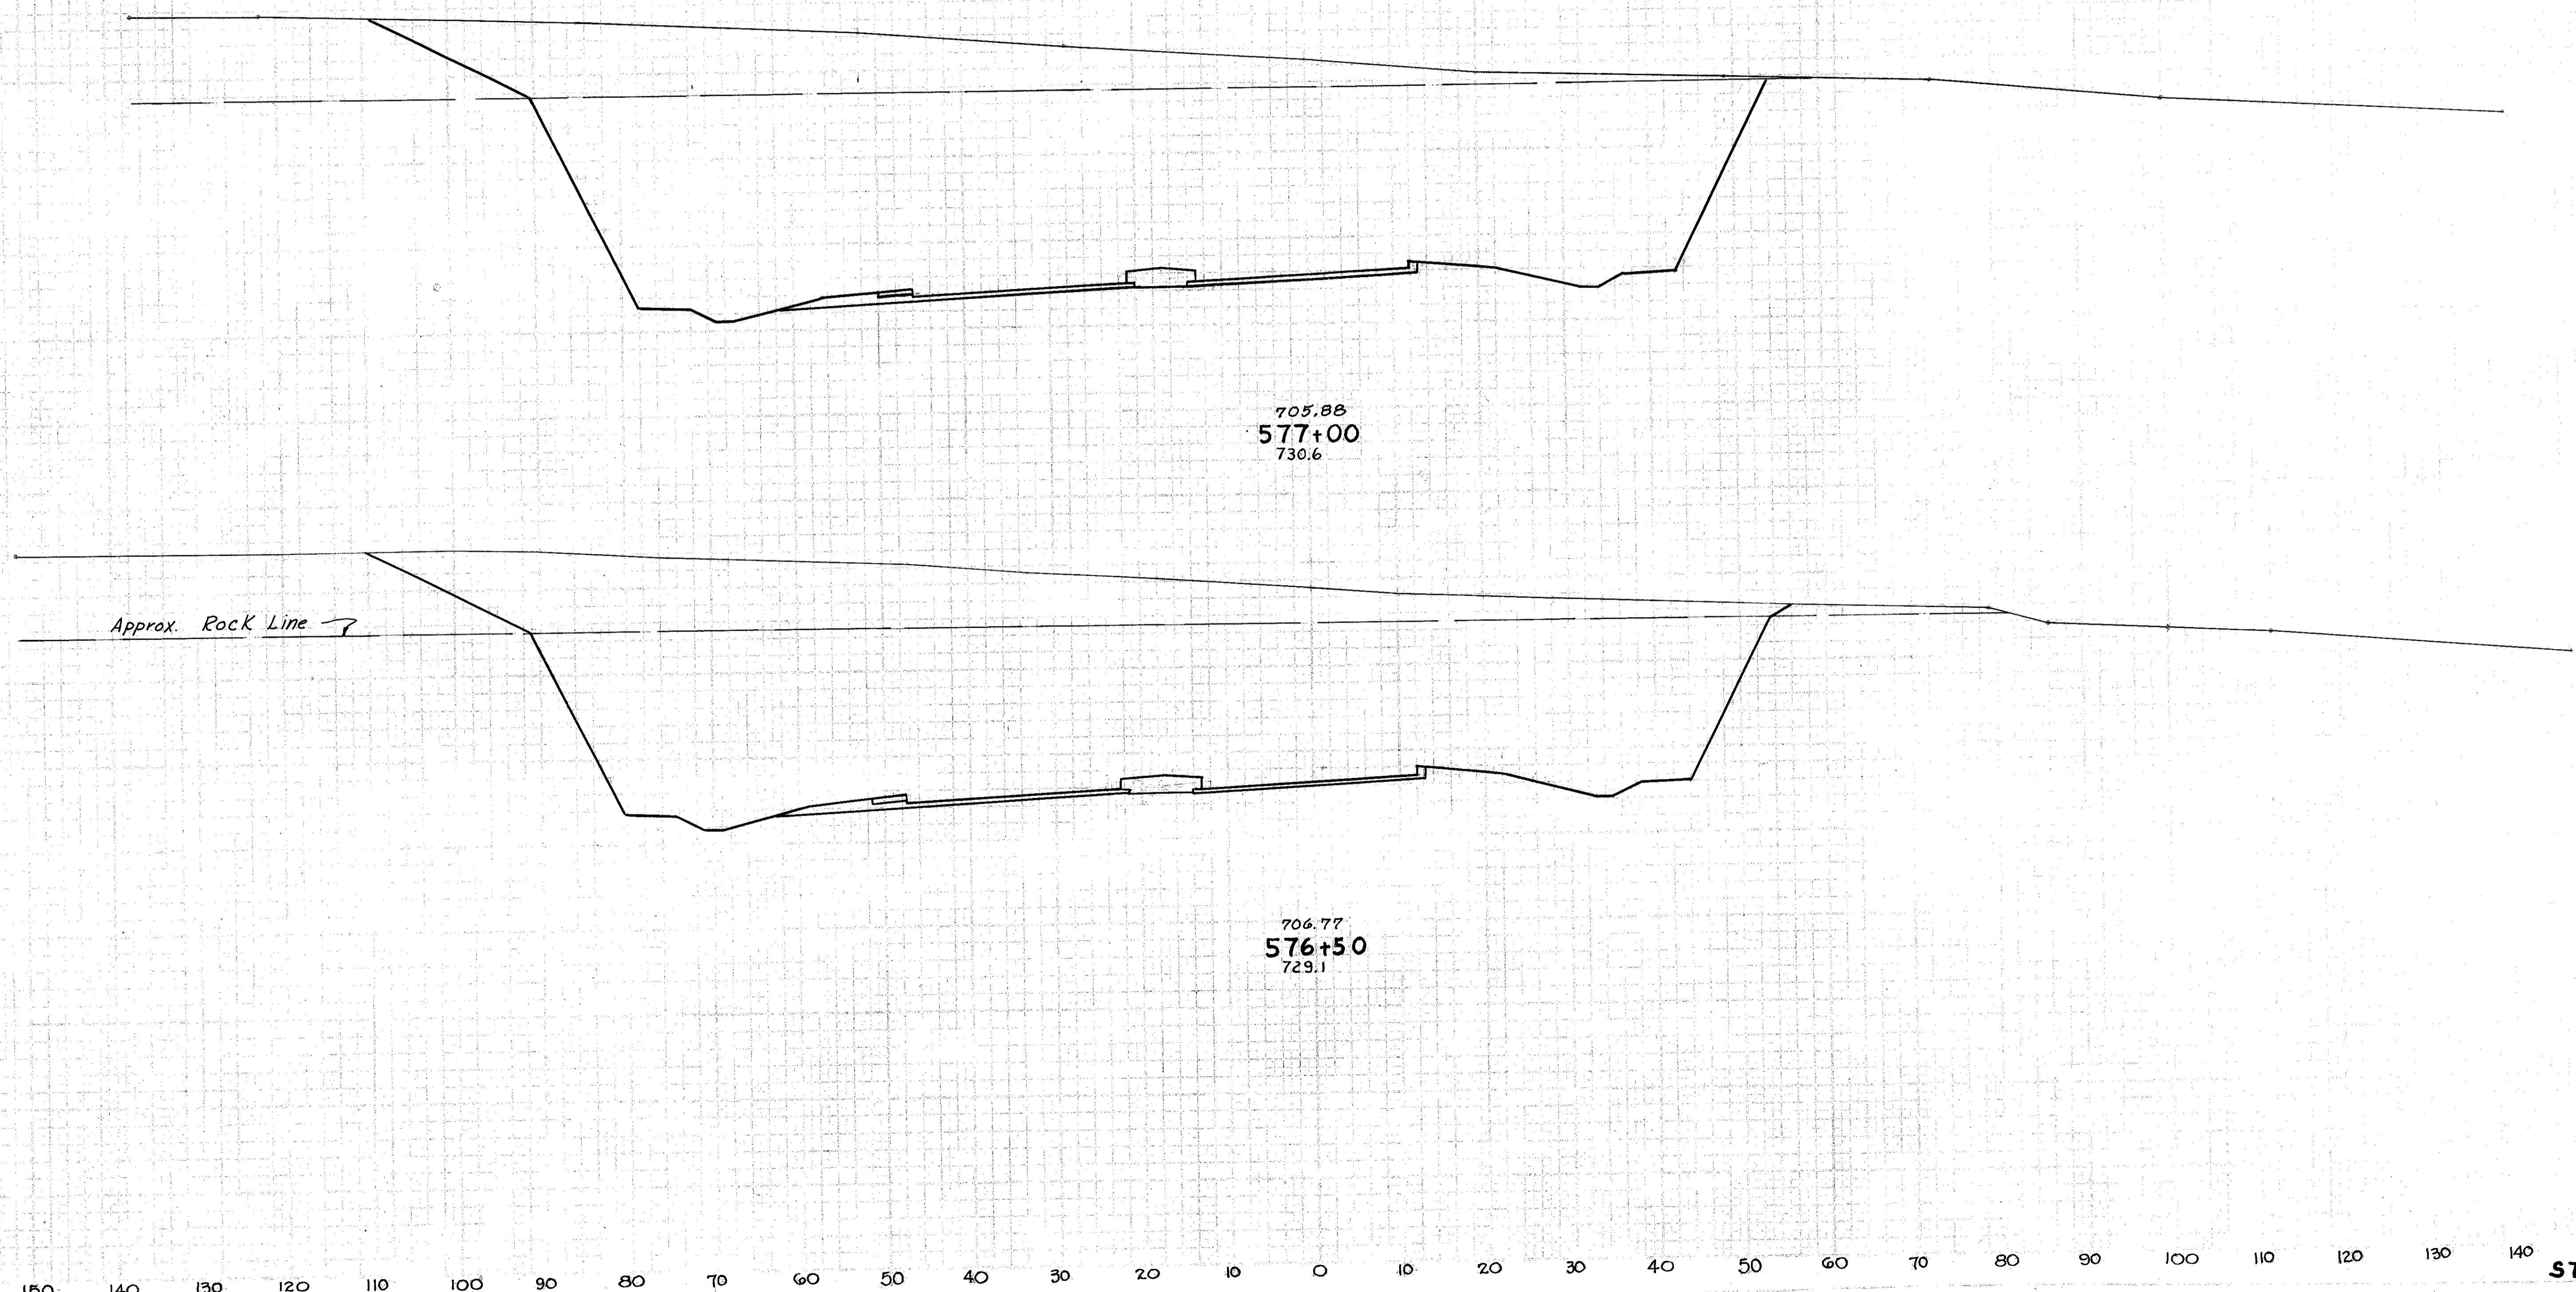


End Area		Cu. Yds.	
Cut	Fill	Cut	Fill
2852	10	5830	49
3353	10	6354	20

STA. 576+50 TO 577+00

150 140 130 120 110 100 90 80 70 60 50 40 30 20 10 0 10 20 30 40 50 60 70 80 90 100 110 120 130 140

150 140 130 120 110 100 90 80 70 60 50 40 30 20 10 0 10 20 30 40 50 60 70 80 90 100 110 120 130 140 150

2 OHIO  
 BLT-4-15-53-13  
 88  
 222

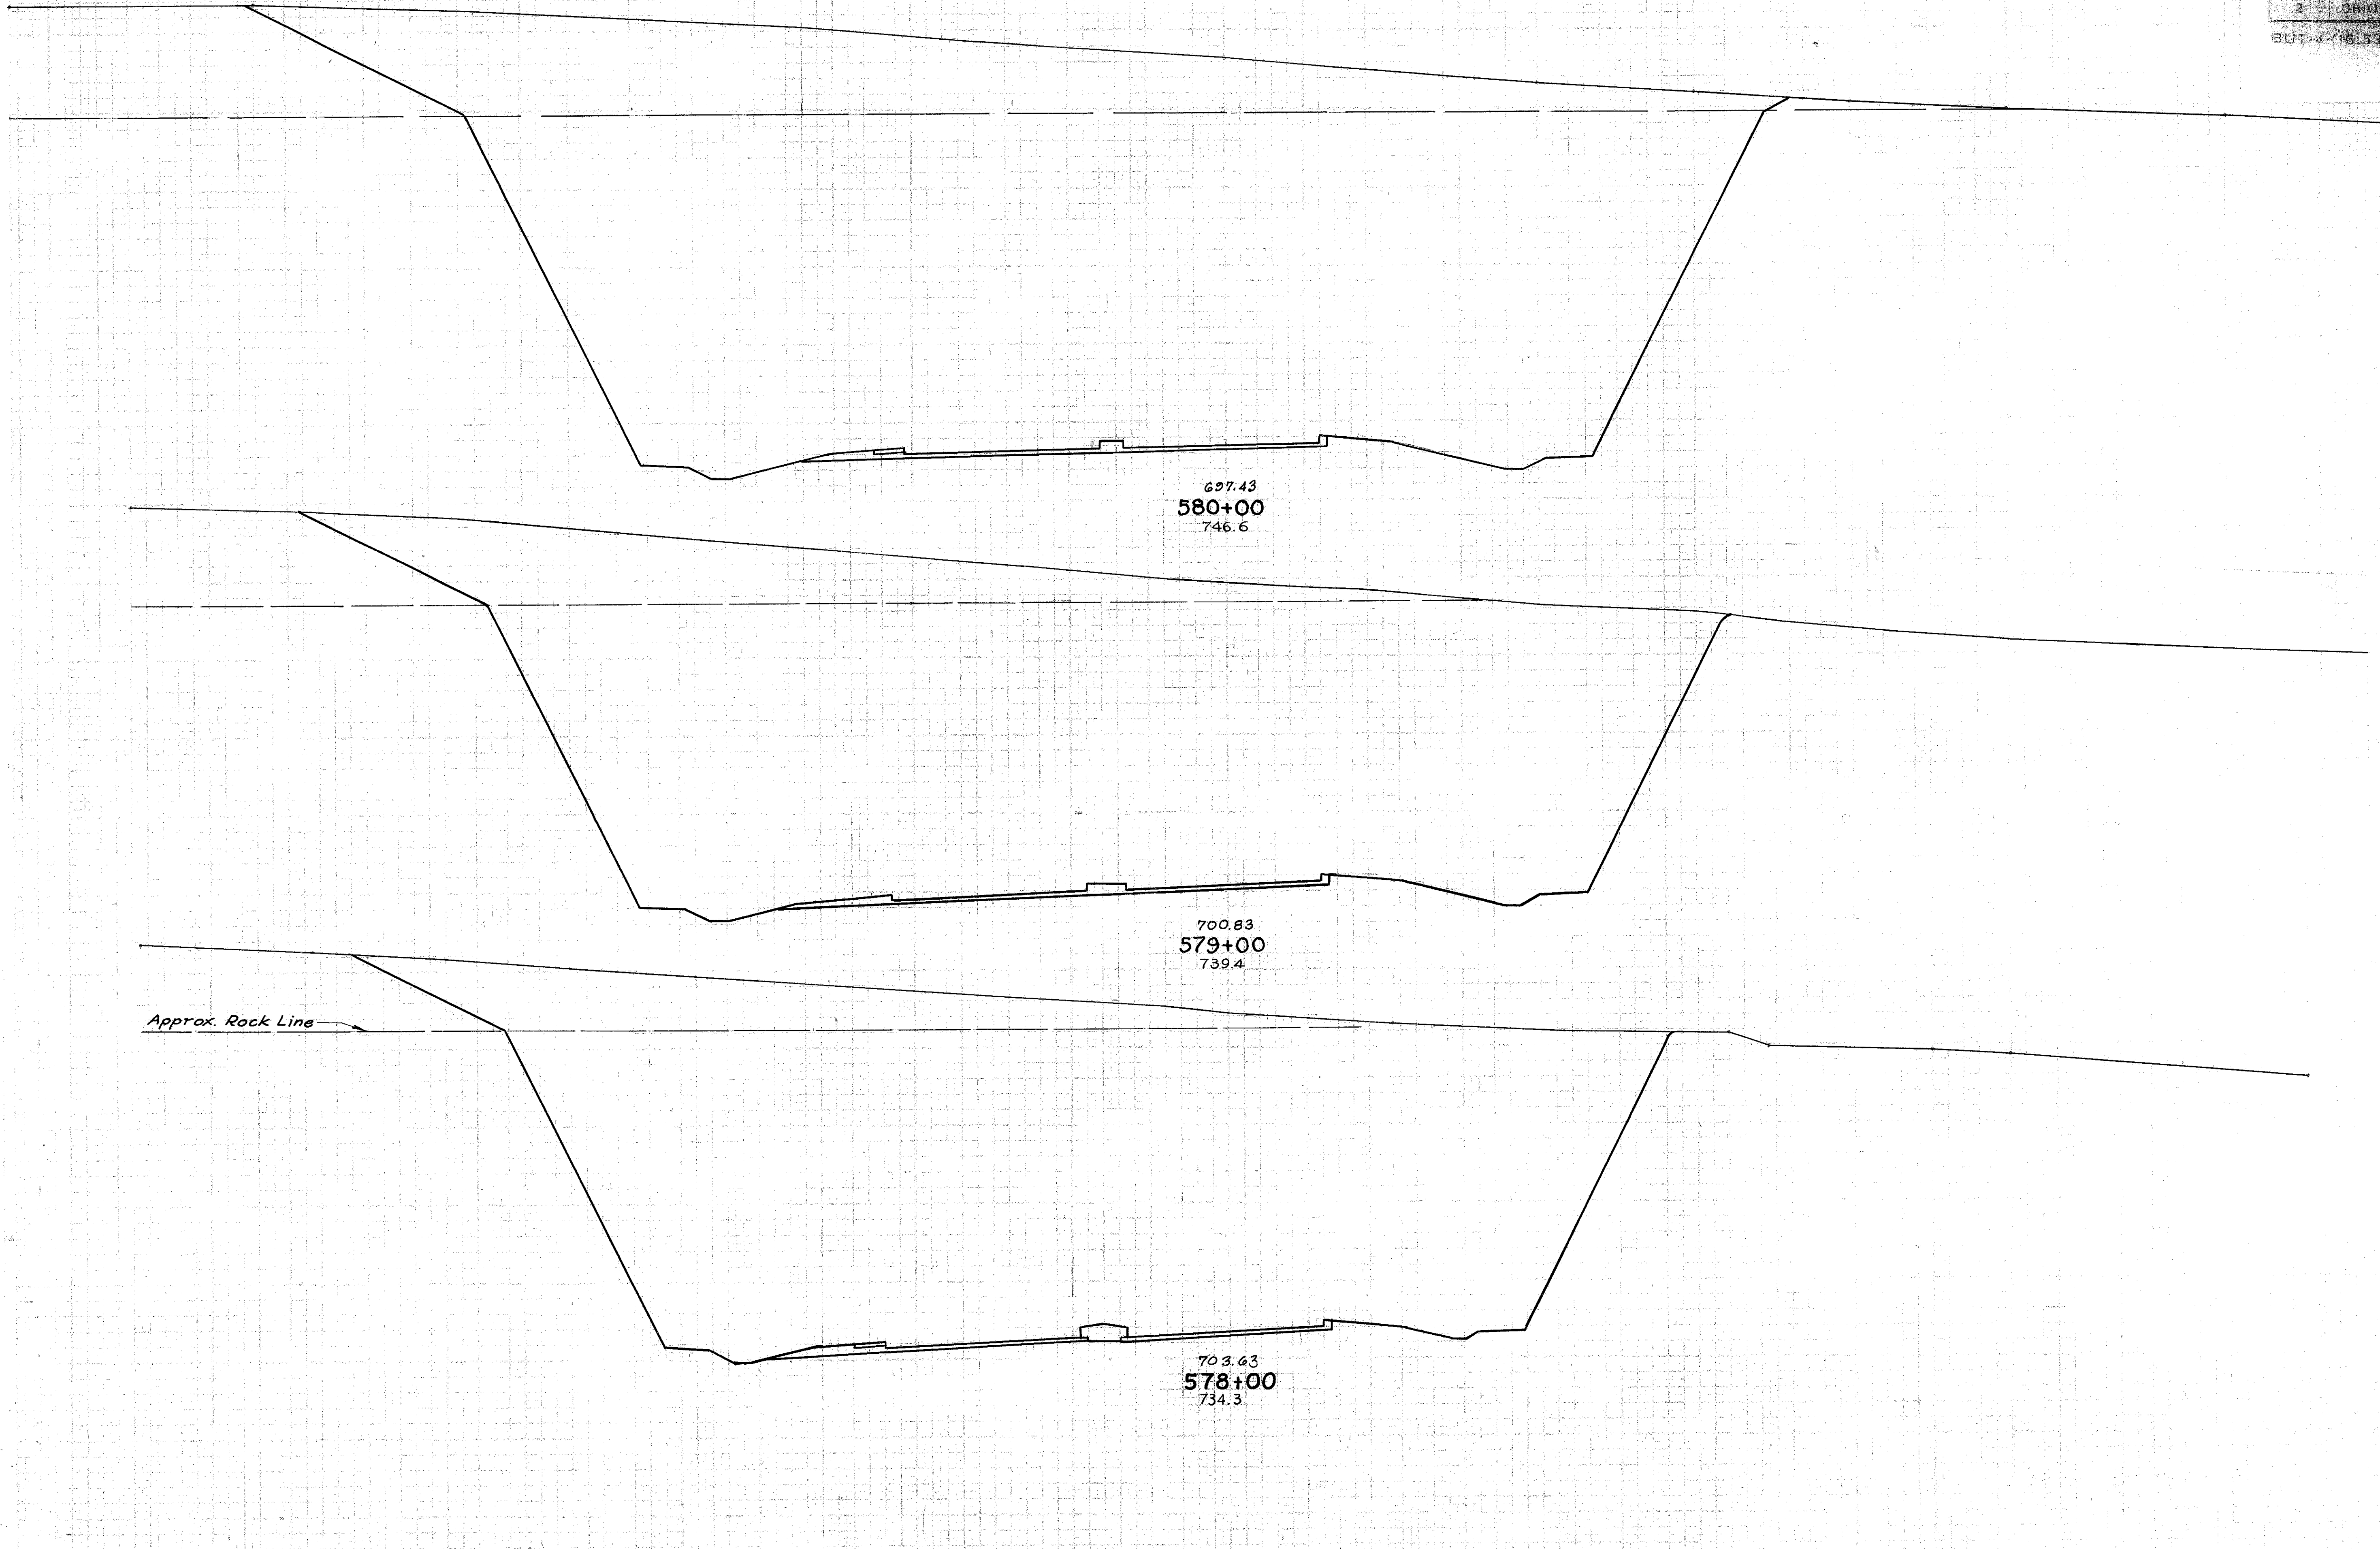

End Area		Cu. Yds.	
Cut	Fill	Cut	Fill
7906			
		25956	
6110			
		22191	17
5873			9
		16057	35

697.43  
**580+00**  
 746.6

700.83  
**579+00**  
 739.4

703.63  
**578+00**  
 734.3

Approx. Rock Line

Sta. 570+00 to Sta. 580+00  
 F-1  
 Embankment 118,325 Cu. Yds.  
 Embankment +15% 438 Cu. Yds.


150 140 130 120 110 100 90 80 70 60 50 40 30 20 10 0 10 20 30 40 50 60 70 80 90 100 110 120 130 140

STA. 578+00 TO 580+00



150 140 130 120 110 100 90 80 70 60 50 40 30 20 10 0 10 20 30 40 50 60 70 80 90 100 110 120 130 140 150

2 OHIO  
 BUT 4-118,51-19,157  
 89  
 222

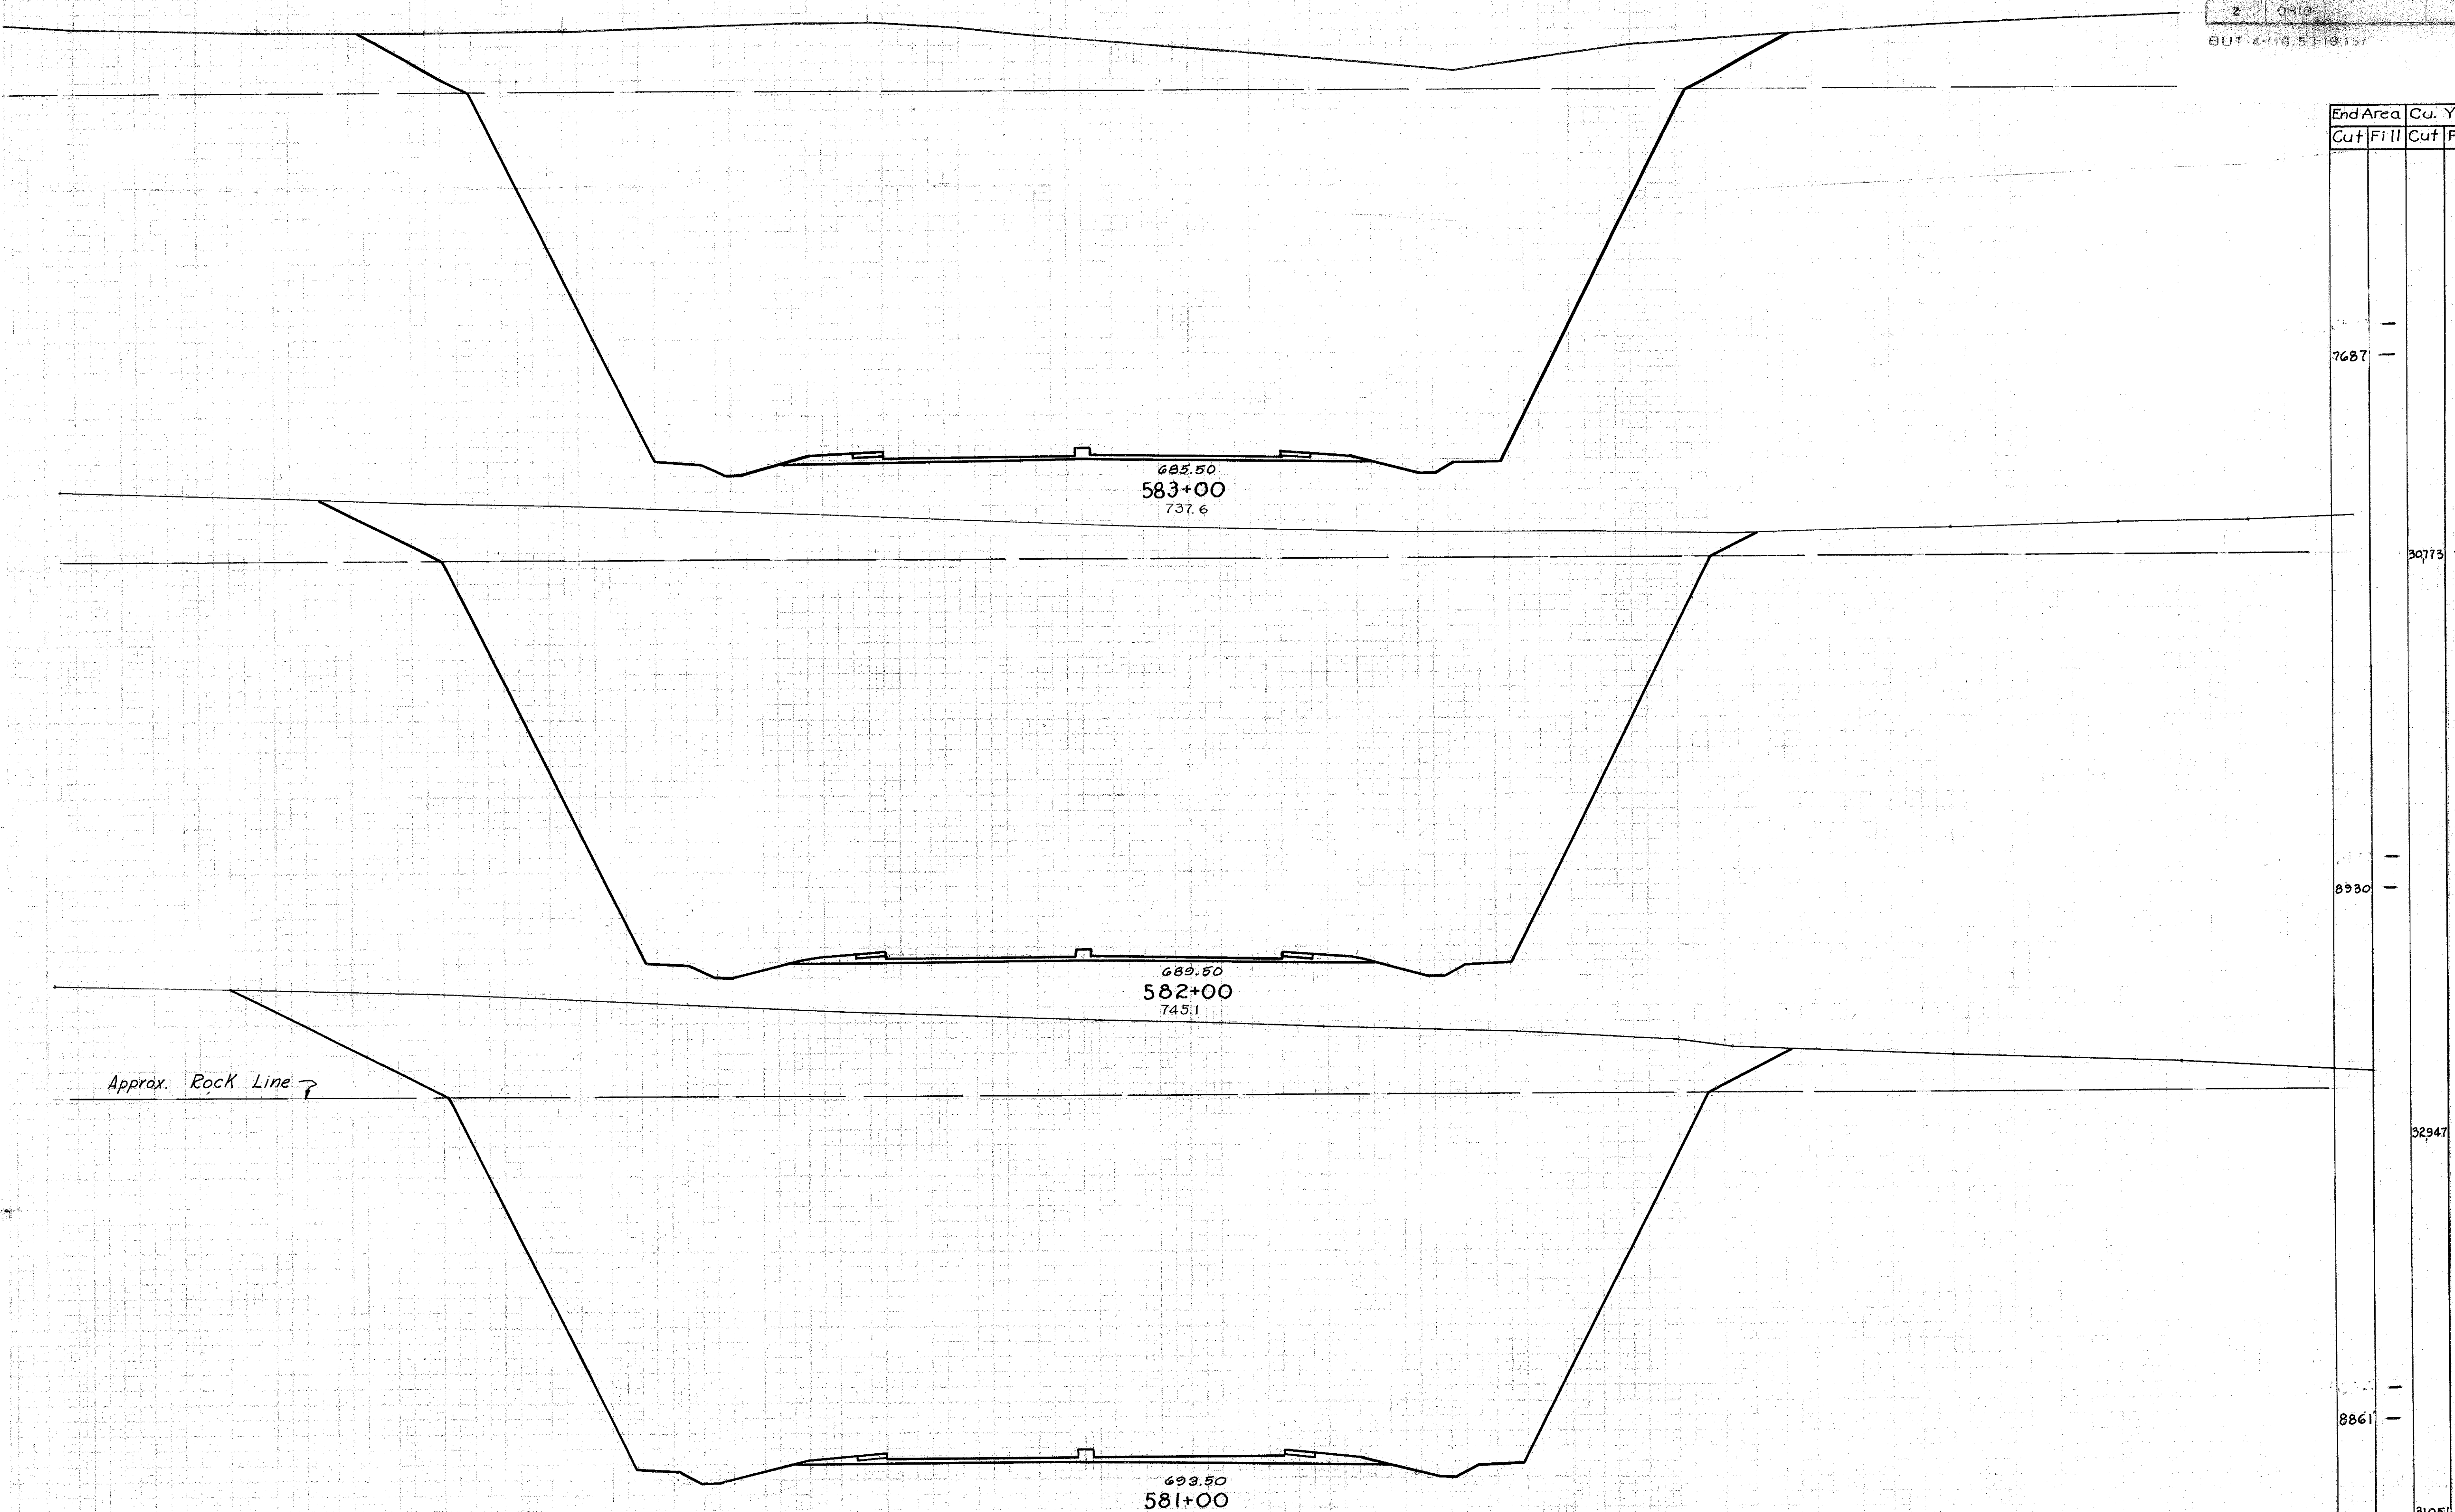


End Area		Cu. Yds.	
Cut	Fill	Cut	Fill
7687	-	-	-
-	-	30773	-
8930	-	-	-
-	-	32947	-
8861	-	-	-
-	-	31051	-

150 140 130 120 110 100 90 80 70 60 50 40 30 20 10 0 10 20 30 40 50 60 70 80 90 100 110 120 130 140

STA. 581+00 TO 583+00

150 140 130 120 110 100 90 80 70 60 50 40 30 20 10 0 10 20 30 40 50 60 70 80 90 100 110 120 130 140 150

90  
222  
PLOT-4-114-585 (9-13)

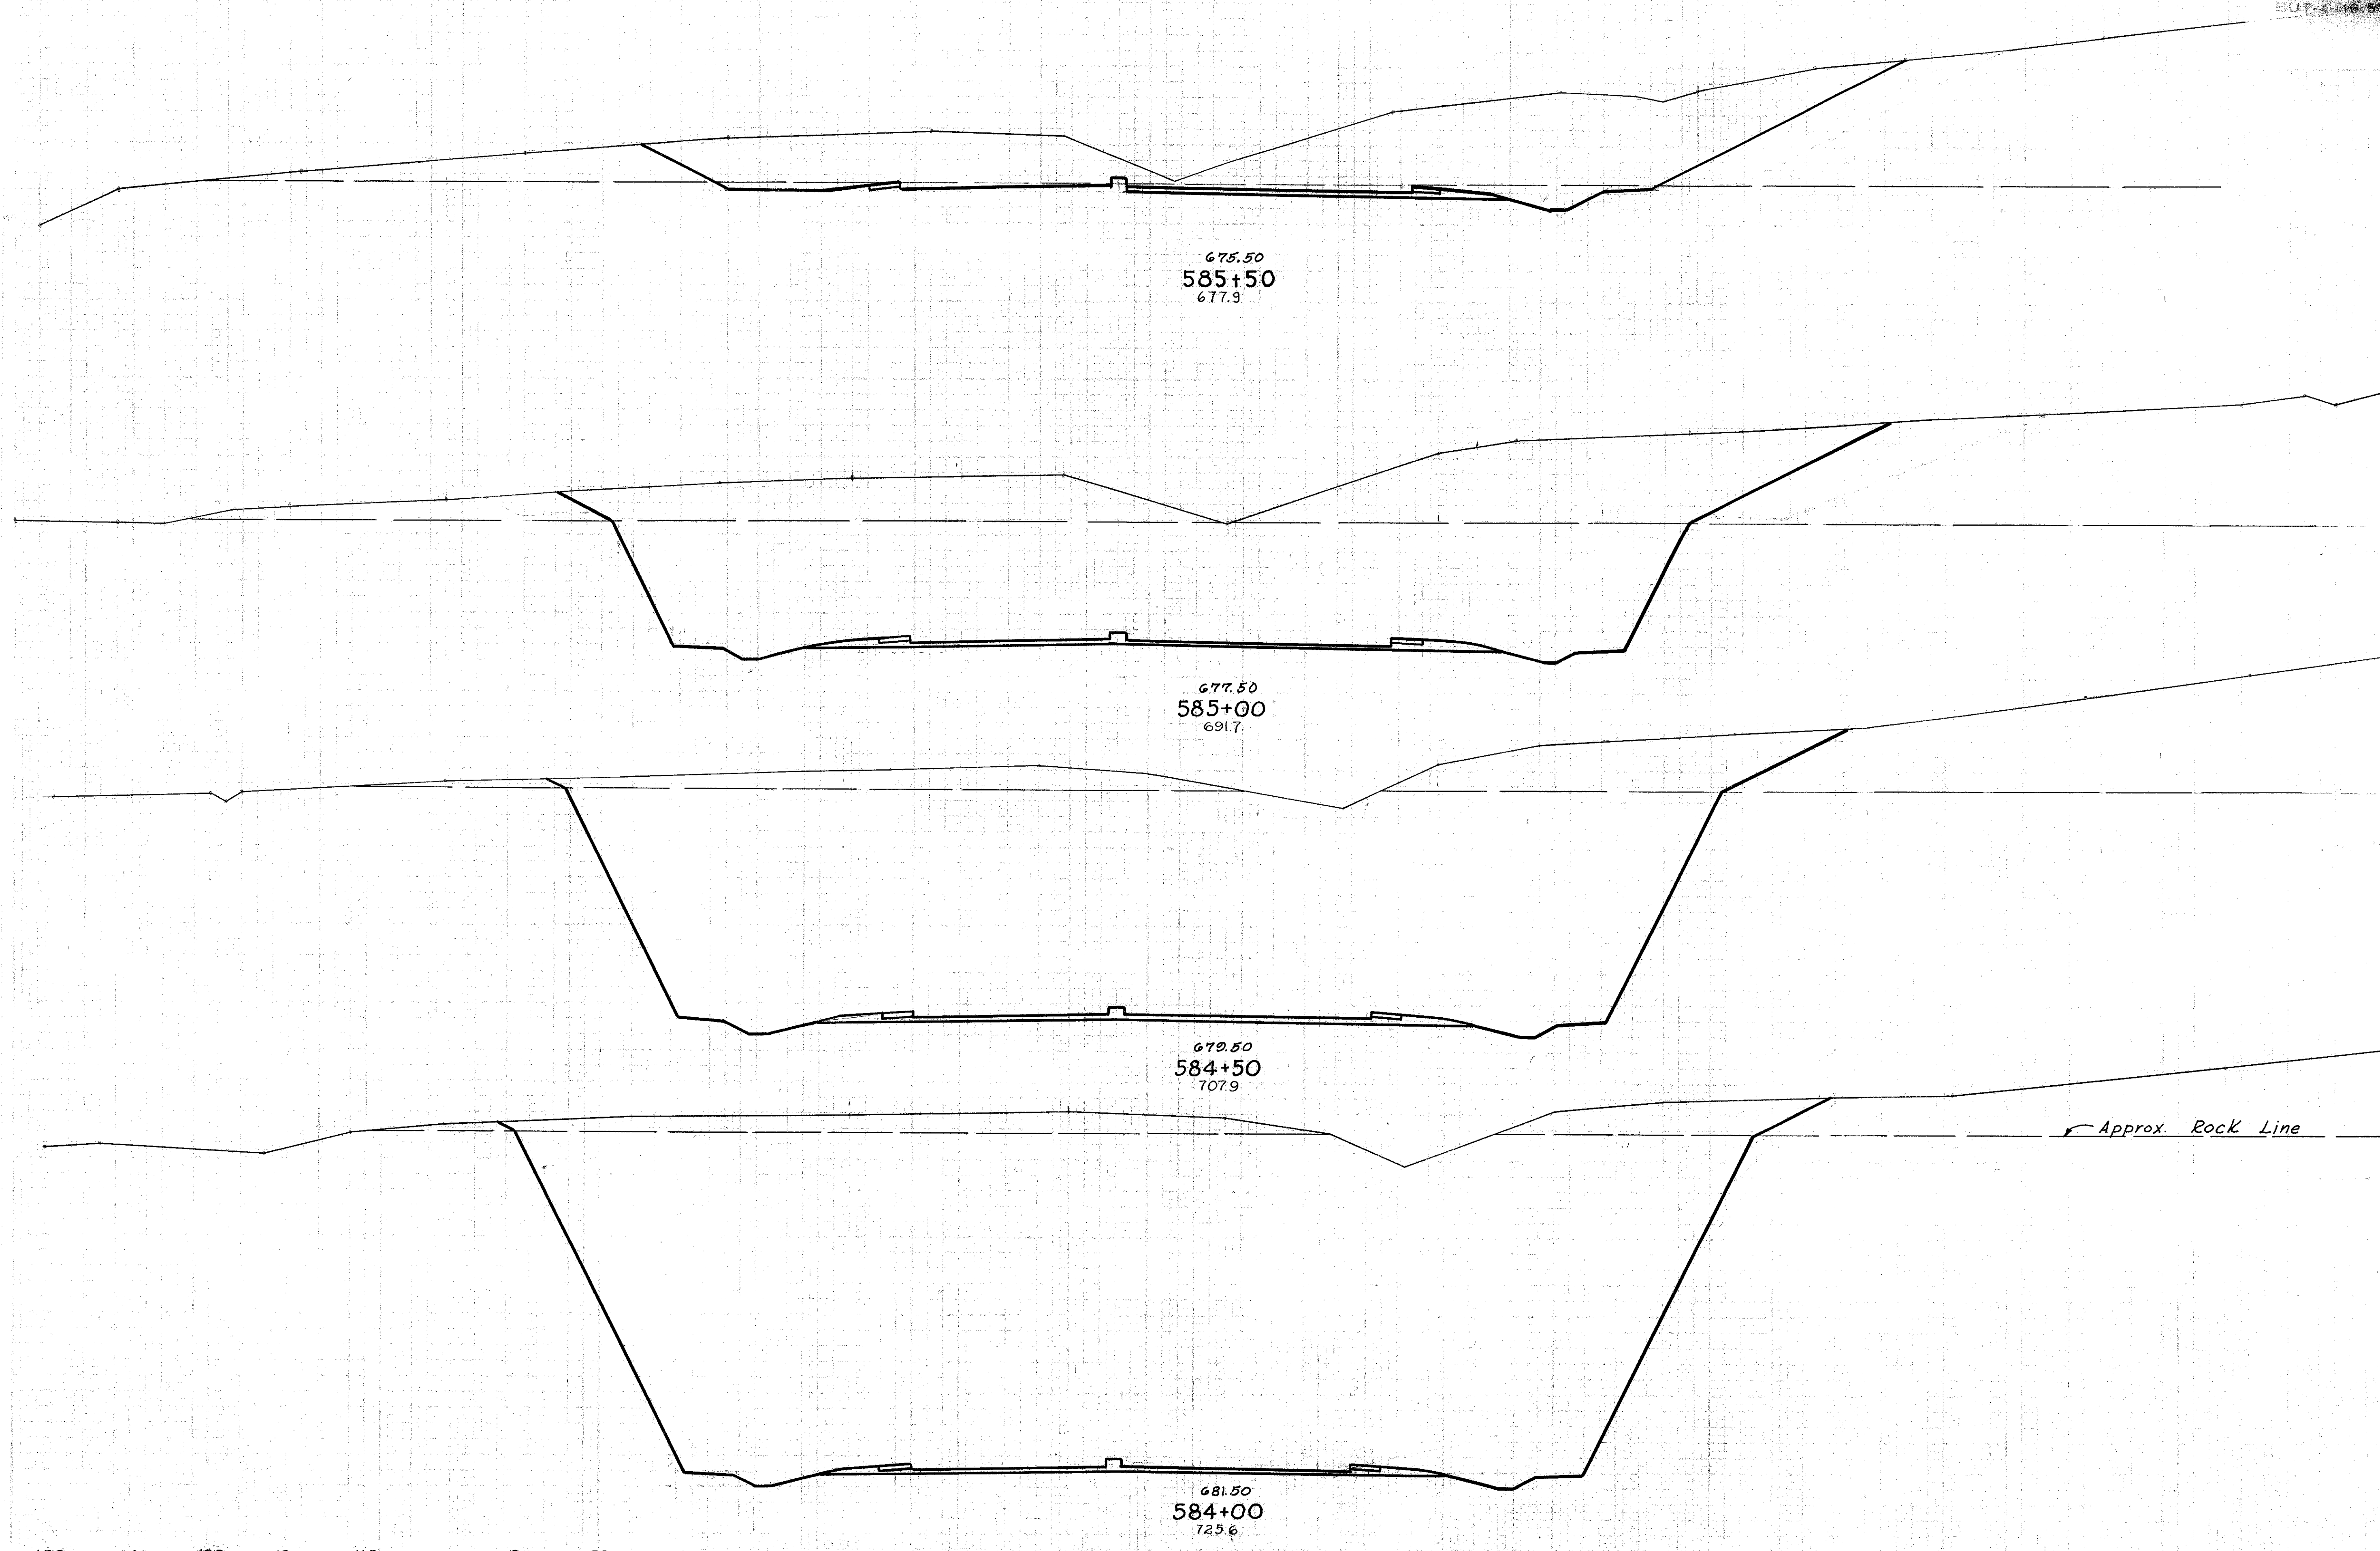

End Area		Cu. Yds.	
Cut	Fill	Cut	Fill
1365	-		
		4134	-
3106	-		
		6742	-
4504	-		
		10071	-
6373	-		
		26238	-


STA. 584+00 TO 585+50

160 150 140 130 120 110 100 90 80 70 60 50 40 30 20 10 0 10 20 30 40 50 60 70 80 90 100 110 120


PROJECT NO.	STATE	DATE
2	OHIO	

9/  
222

BUT-4-(16.53-19.15)

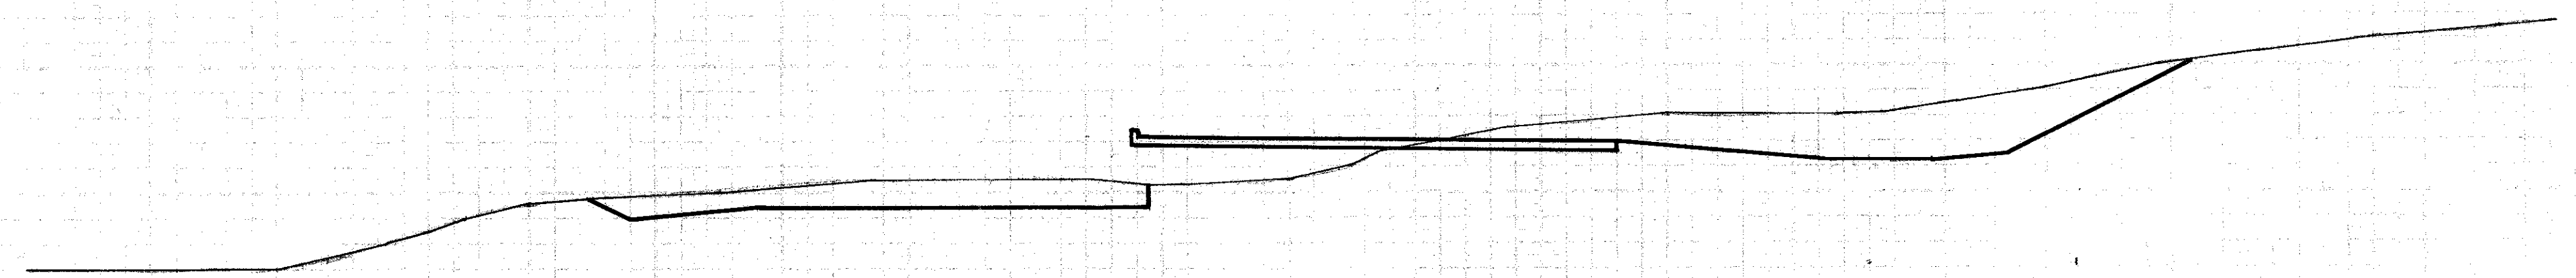

674.34  
**585+79**  
671.0

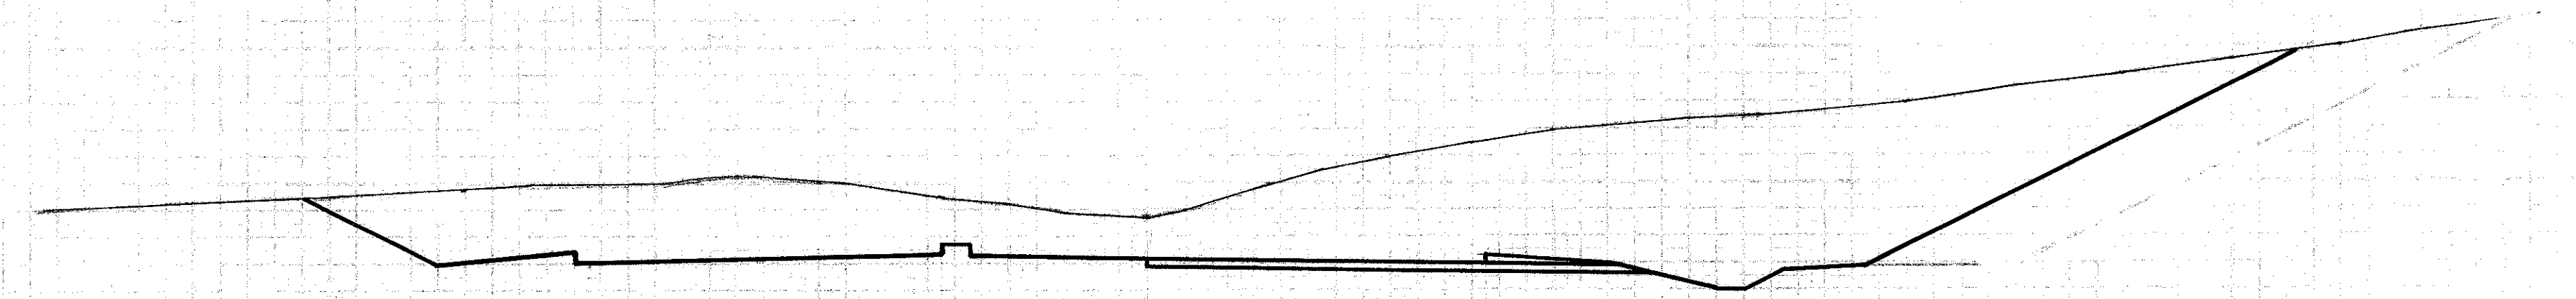

675.30  
**585+55**  
677.5

End Area		Cu. Yds.	
Cut	Fill	Cut	Fill
251	-		
		716	1
1360	3		
		253	1

160 150 140 130 120 110 100 90 80 70 60 50 40 30 20 10 0 10 20 30 40 50 60 70 80 90 100 110 120 130 140  
STA. 585+55 TO STA. 585+




150 140 130 120 110 100 90 80 70 60 50 40 30 20 10 0 10 20 30 40 50 60 70 80 90 100 110 120 130 140 150

2 OHIO

93  
222

4-16-53-19-131

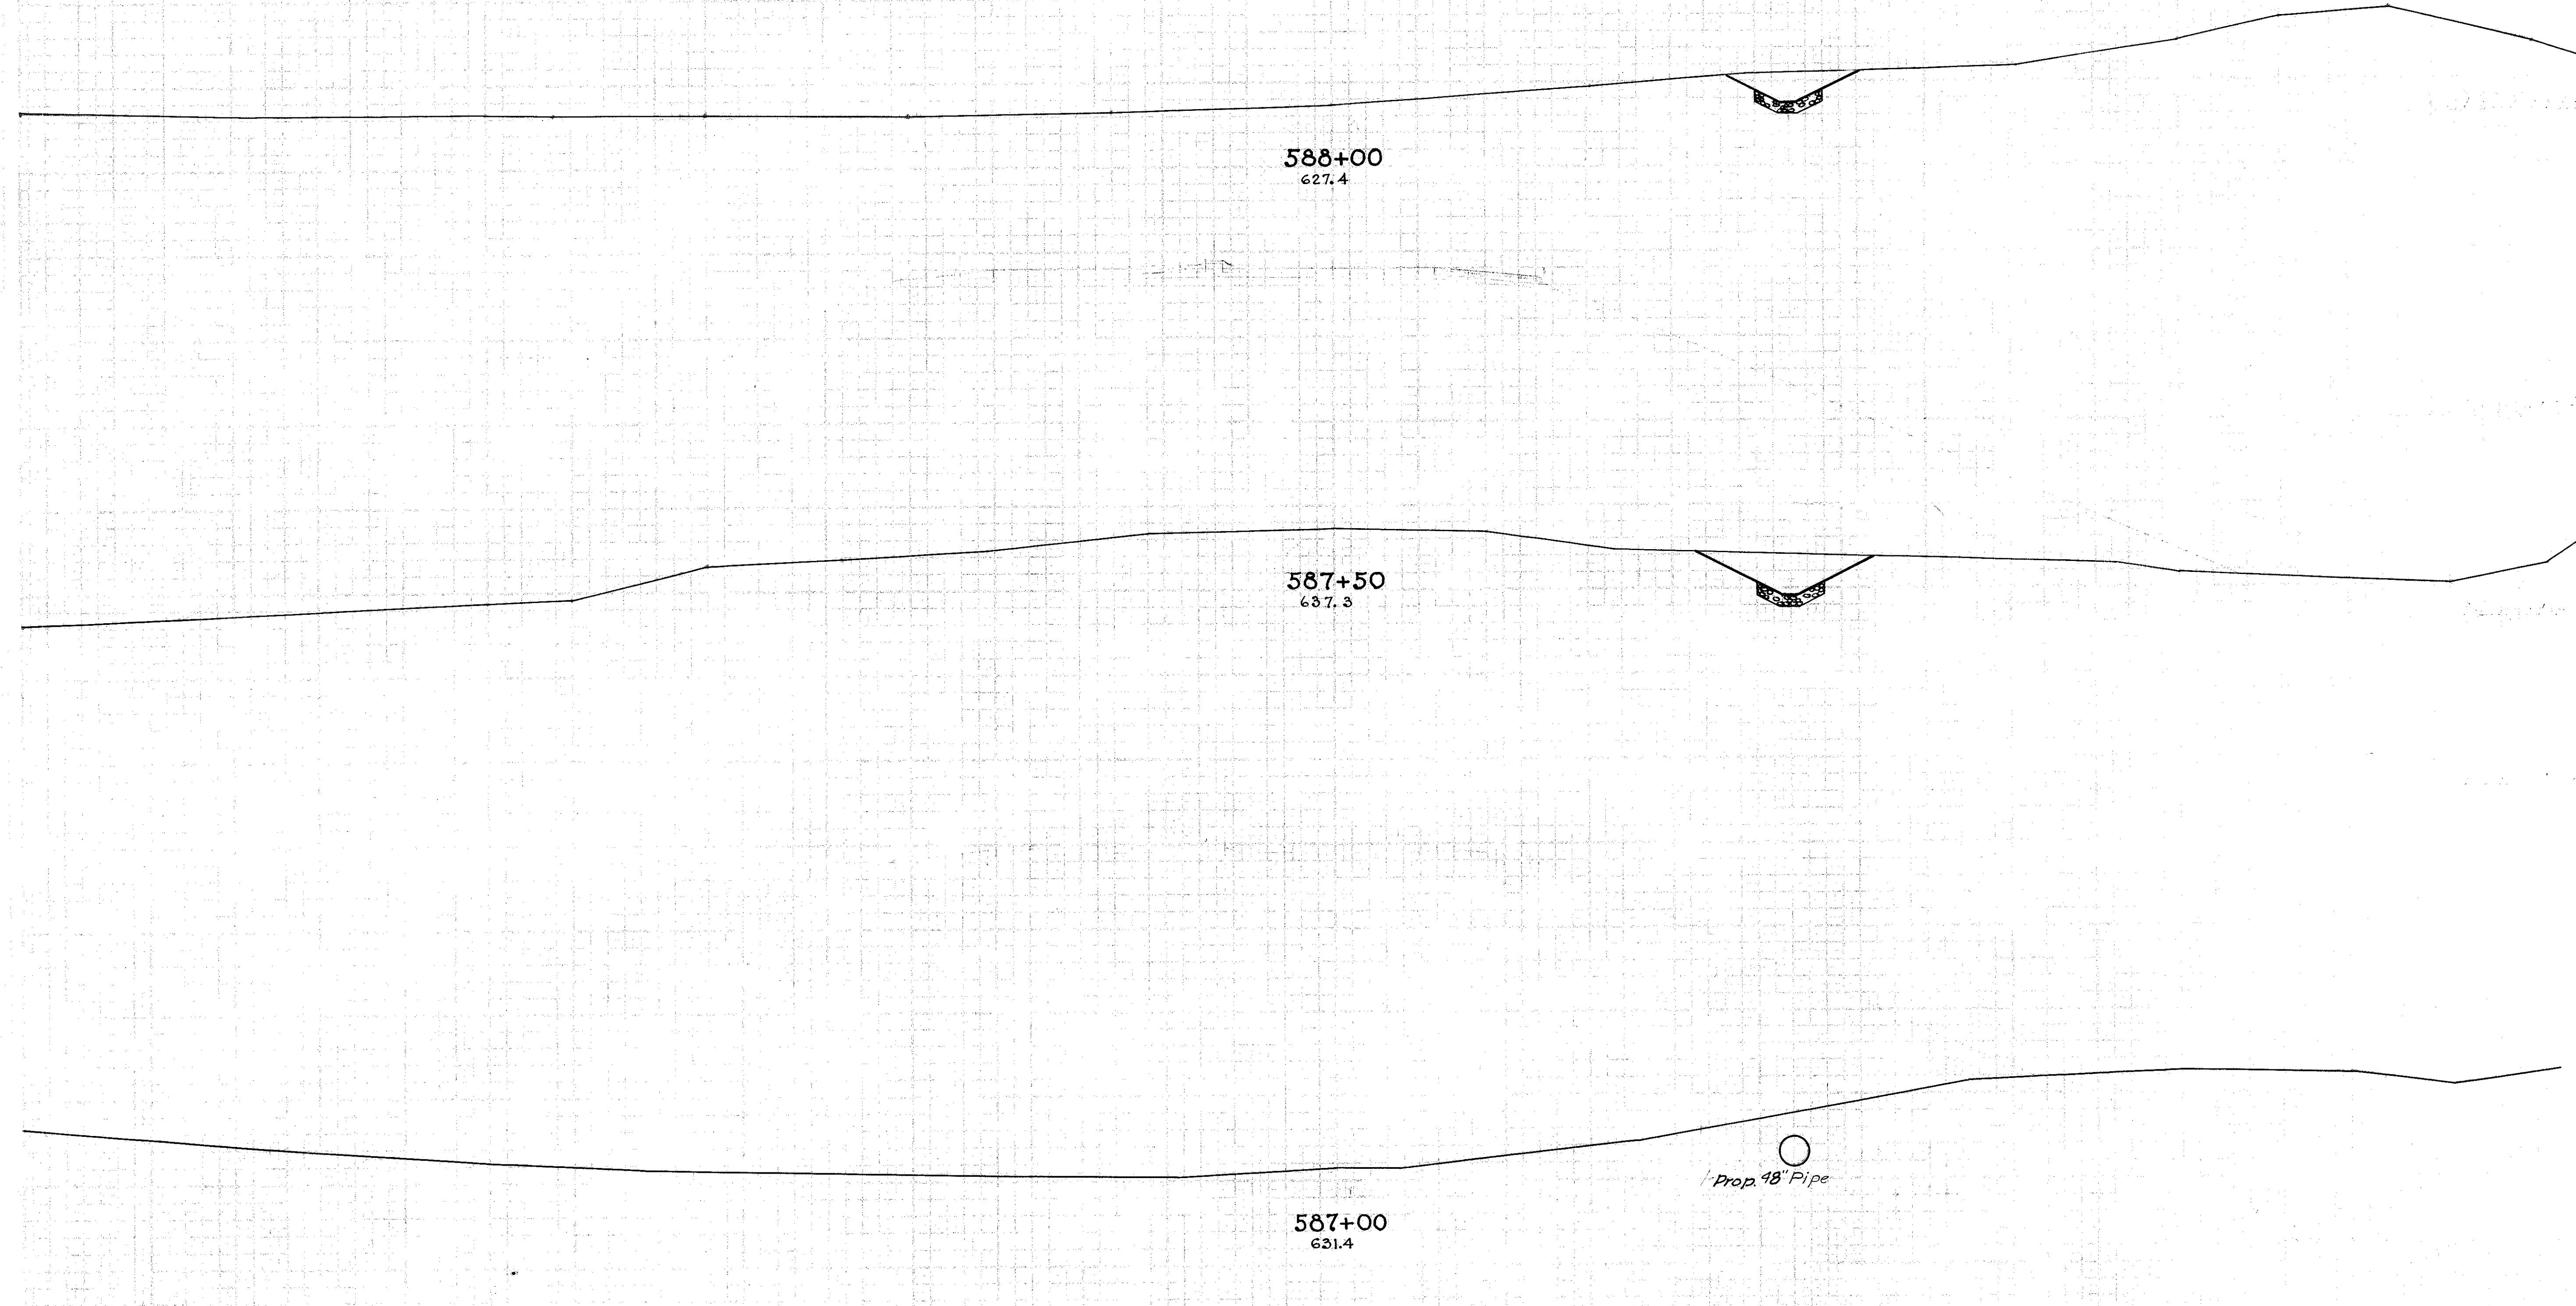

588+00  
627.4

587+50  
637.3

587+00  
631.4

Prop. 18" Pipe

End Area		Cu. Yds.	
Cut	Fill	Cut	Fill
35	-	-	-
-	-	86	-
58	-	-	-
-	-	71	-
-	-	-	-

150 140 130 120 110 100 90 80 70 60 50 40 30 20 10 0 10 20 30 40 50 60 70 80 90 100 110 120 130 140

STA. 587+00 TO 588+00


150 140 130 120 110 100 90 80 70 60 50 40 30 20 10 0 10 20 30 40 50 60 70 80 90 100 110 120 130 140 150

Dist. No.	STATE	PROJECT
2	OHIO	

94  
222

BUT-4-(16.53-19.15)

End Area		Cu. Yds.	
Cut	Fill	Cut	Fill

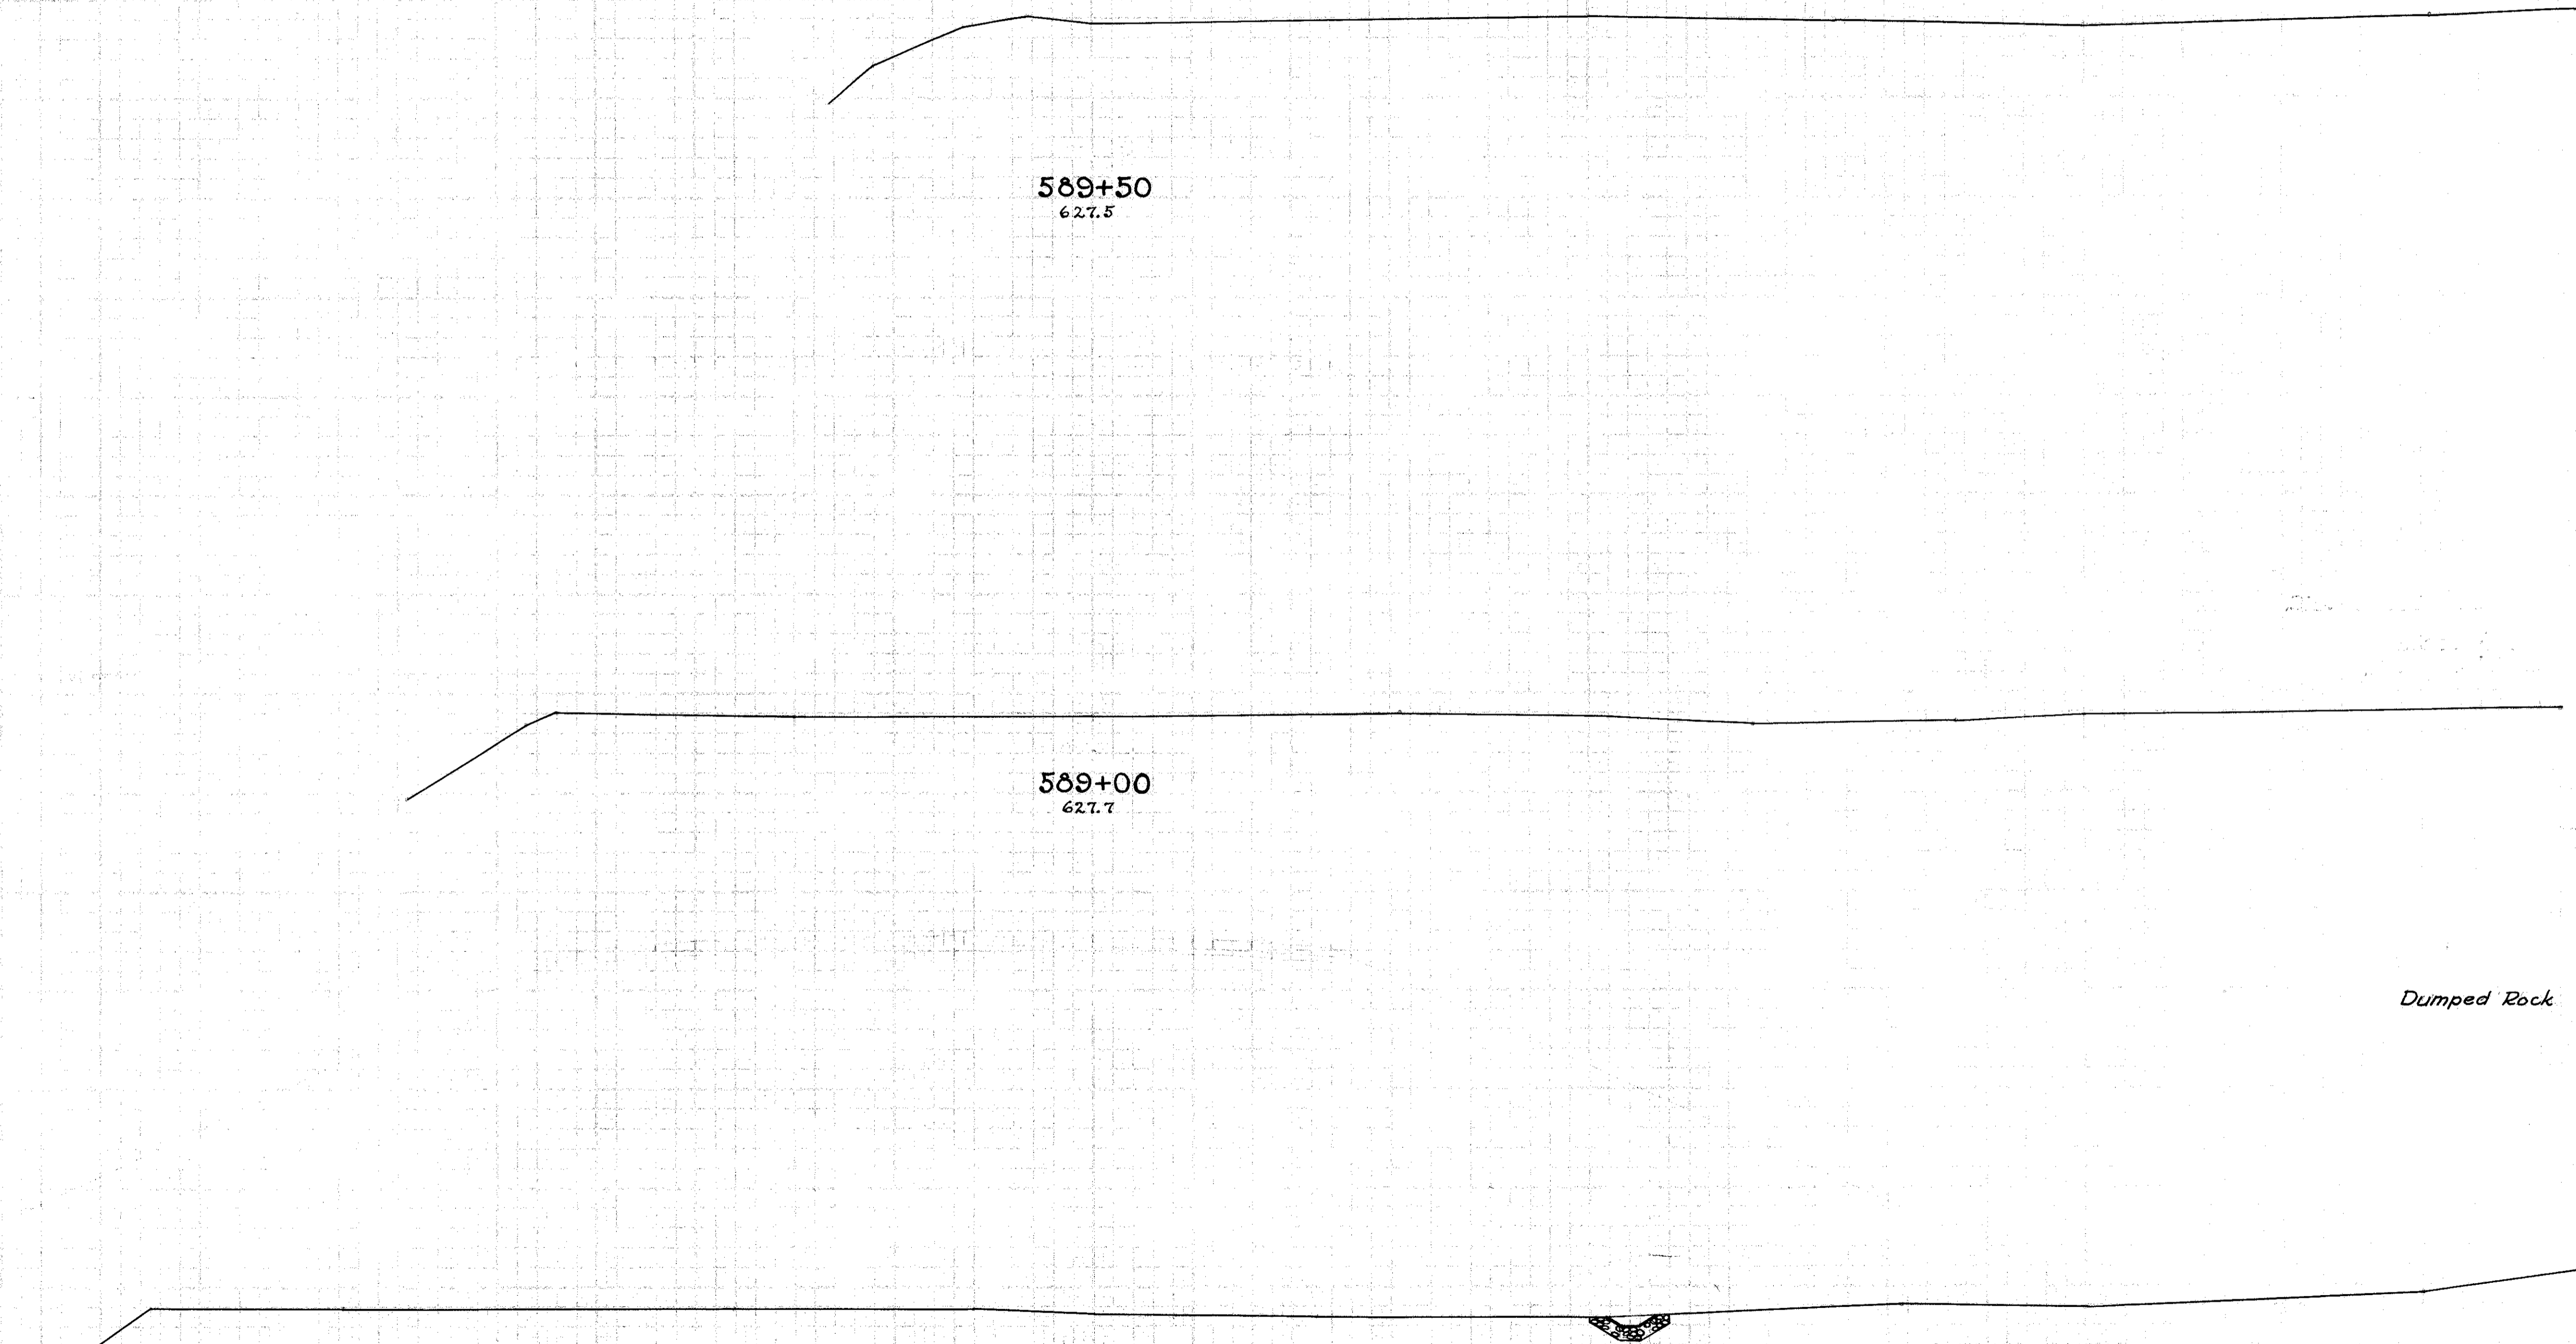

589+50  
627.5

589+00  
627.7

588+50  
627.2

*Dumped Rock*

		-	-
		47	84
7	-	39	-

150 140 130 120 110 100 90 80 70 60 50 40 30 20 10 0 10 20 30 40 50 60 70 80 90 100 110 120 130 140


STA. 588+50 TO 589+50

160 150 140 130 120 110 100 90 80 70 60 50 40 30 20 10 0 10 20 30 40 50 60 70 80 90 100 110 120

DATE	PROJECT
2	OHIO

95  
222

BUT-4-(16.53-19.15)

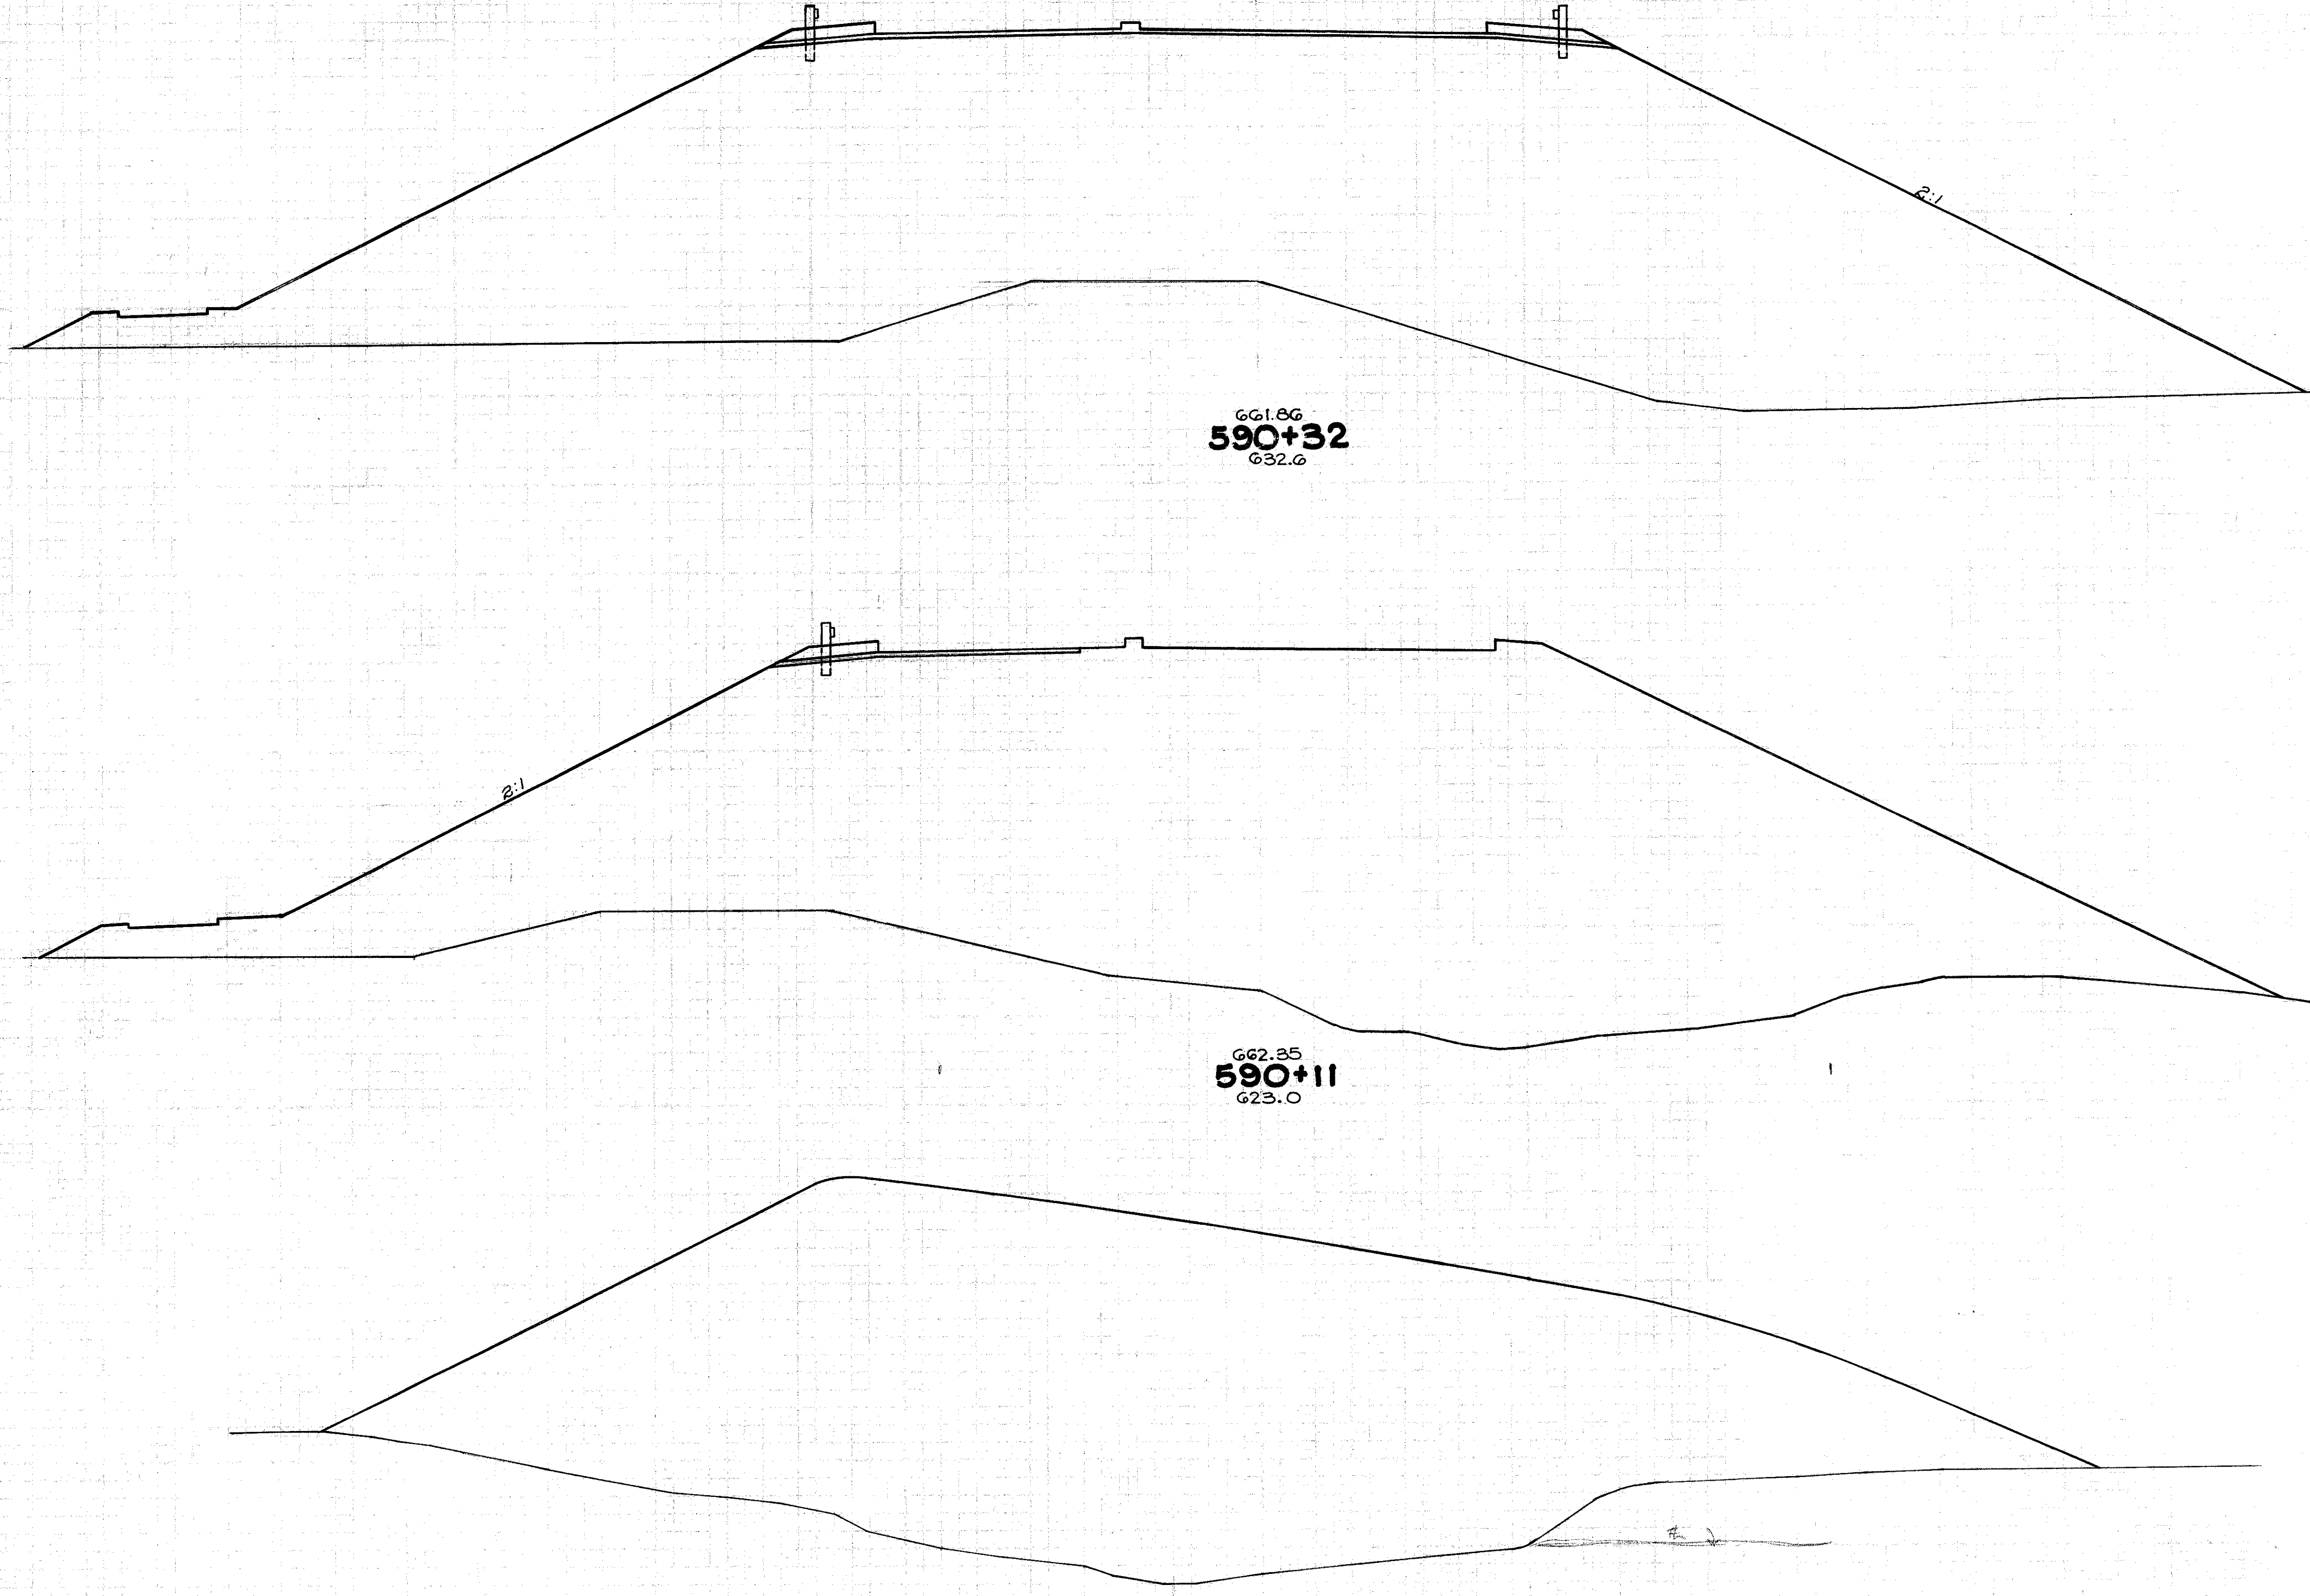

661.86  
**590+32**  
632.6

662.35  
**590+11**  
623.0

662.92  
**589+86**  
617.0


End Area	Cu. Yds.	
	Cut	Fill
5913		
4687		
6139		
5157		
5107		
3405		

Sta 589+00 to Sta 590+11  
E-1  
Embankment +14% 8564 Cu. Yds.  
Embankment +15% 9849 Cu. Yds.

160 150 140 130 120 110 100 90 80 70 60 50 40 30 20 10 0 10 20 30 40 50 60 70 80 90 100 110 120 130 140  
STA. 589+86 TO 590+32

150 140 130 120 110 100 90 80 70 60 50 40 30 20 10 0 10 20 30 40 50 60 70 80 90 100 110 120 130 140 150

96  
222

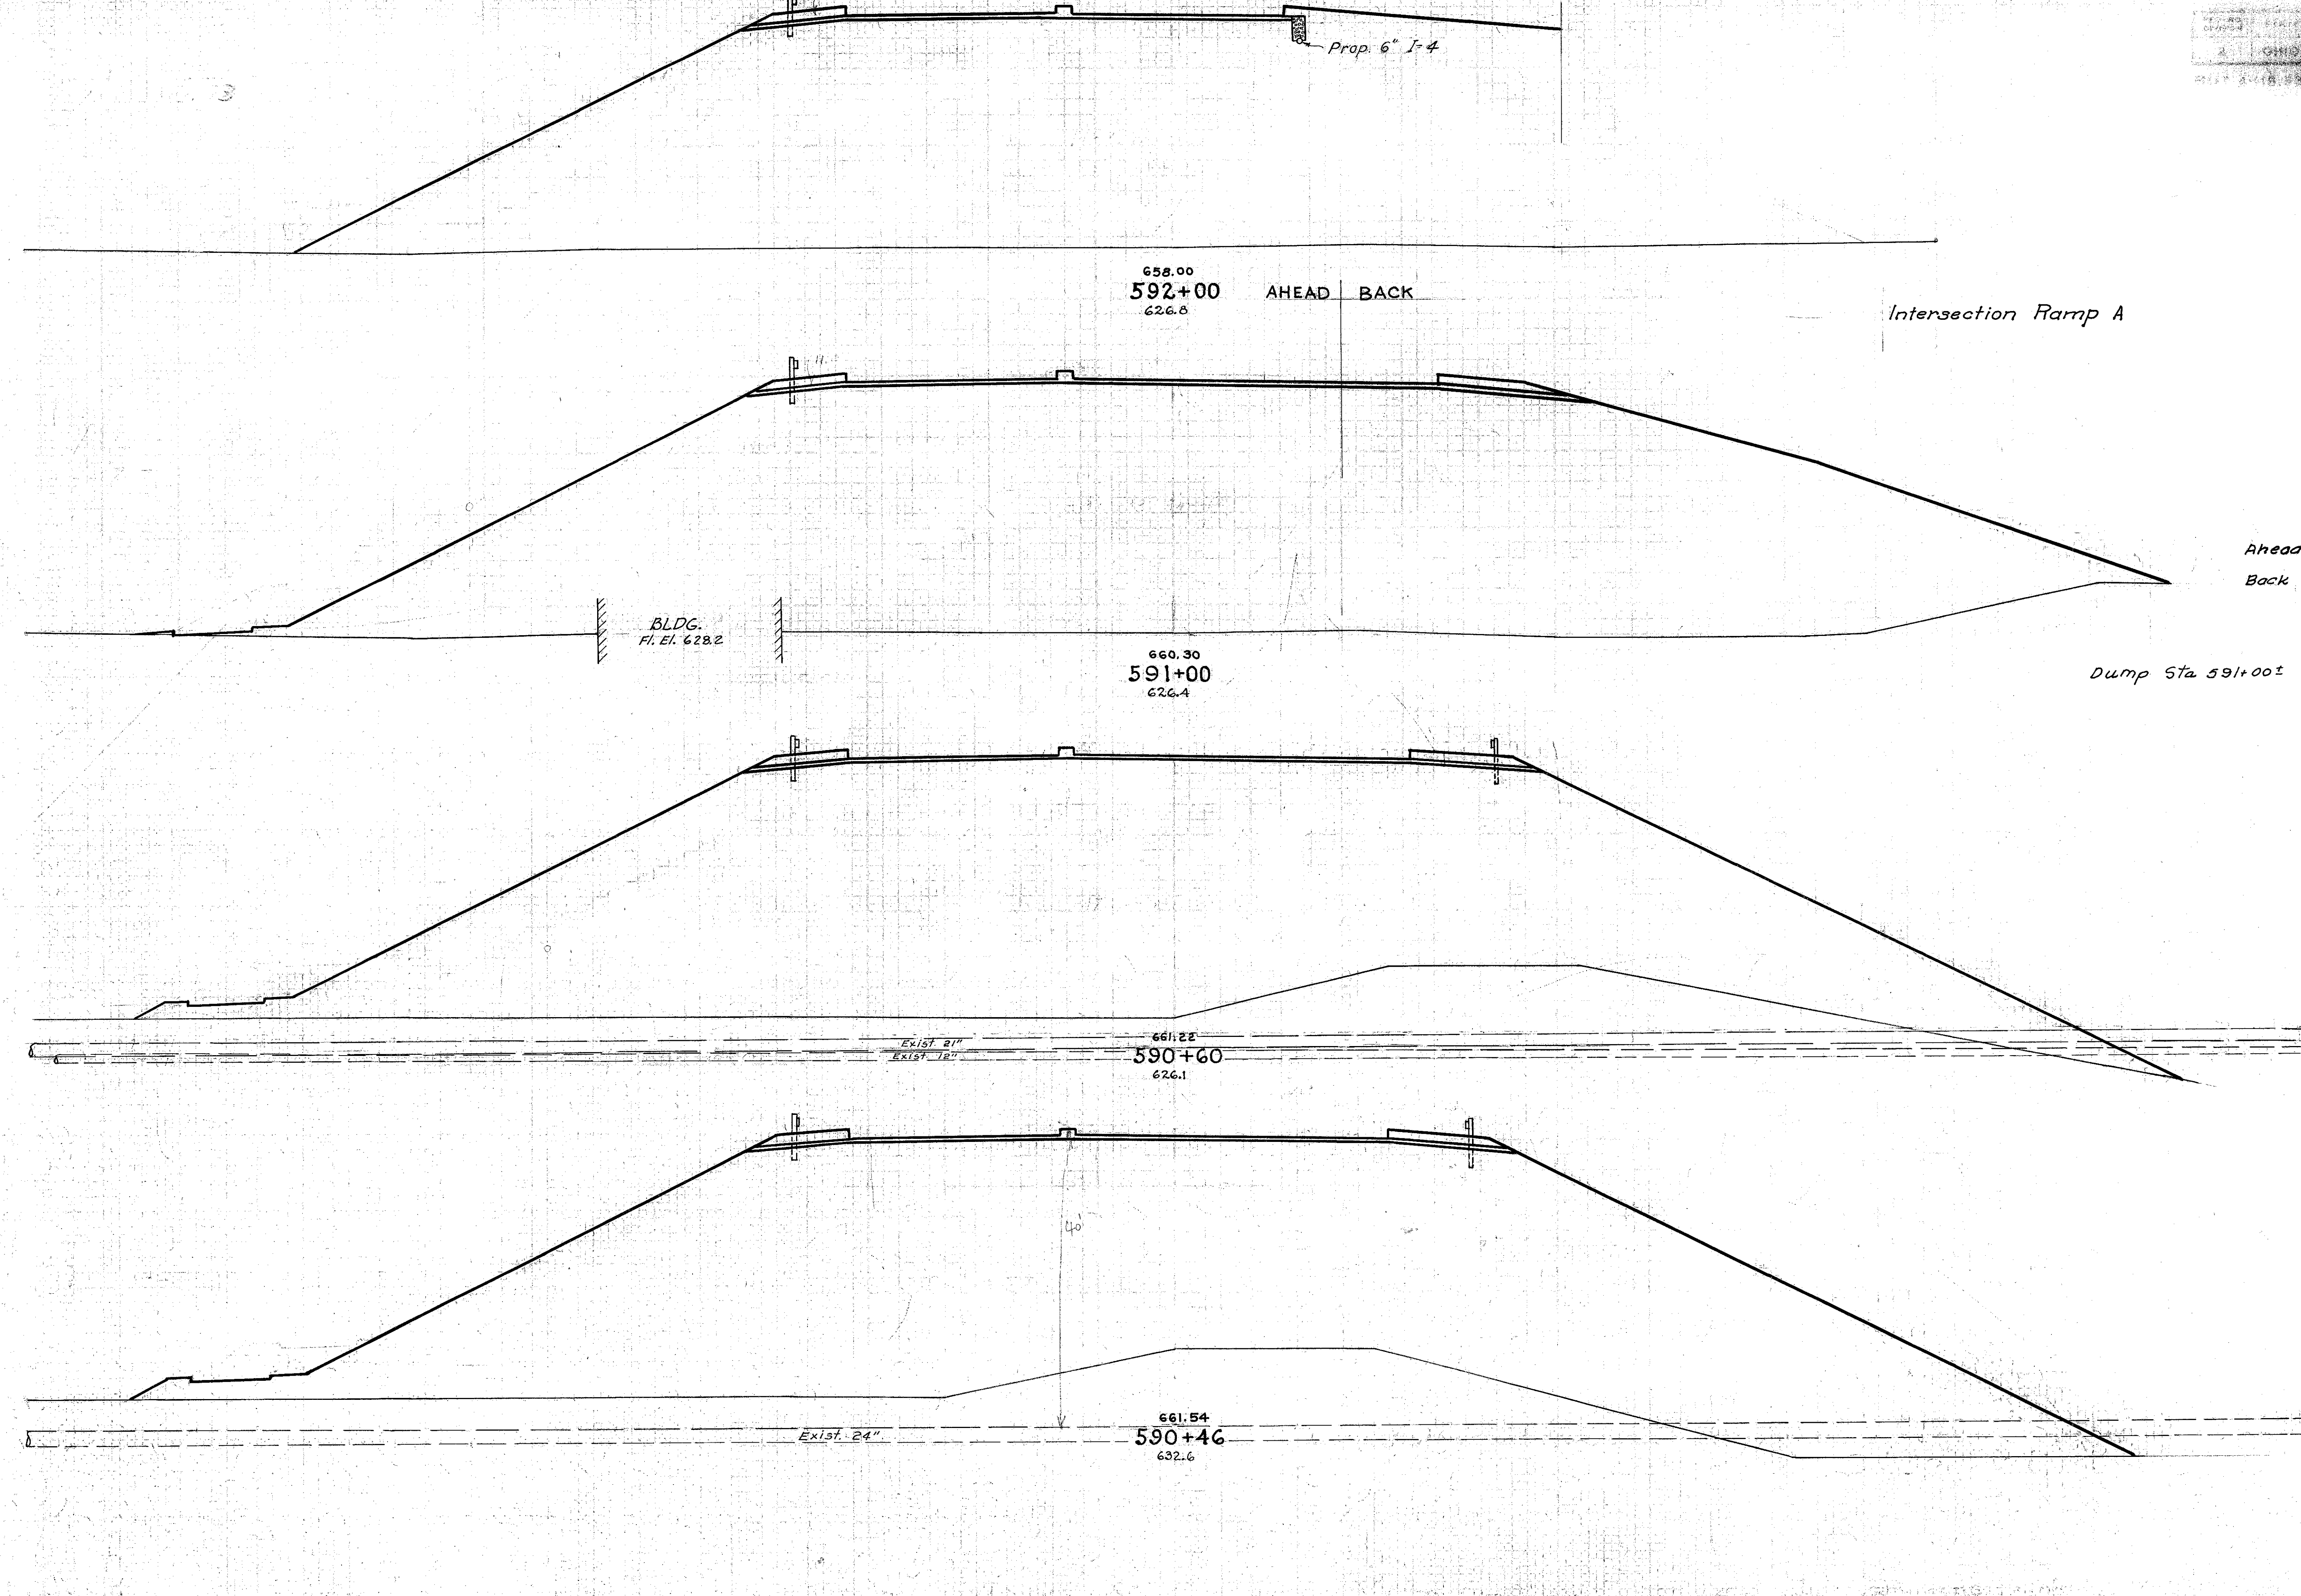


End Area		Cu. Yds.	
Cut	Fill	Cut	Fill
-	4106		
			12378
Ahead	- 2580		
Back	- 2378		
		2622	2622
	5358		
		4052	5785
	5471		
	- 5431		
		1418	2894
	- 5721		
			3019

150 140 130 120 110 100 90 80 70 60 50 40 30 20 10 0 10 20 30 40 50 60 70 80 90 100 110 120 130 140


STA. 590+46 TO 592+00




150 140 130 120 110 100 90 80 70 60 50 40 30 20 10 0 10 20 30 40 50 60 70 80 90 100 110 120 130 140 150

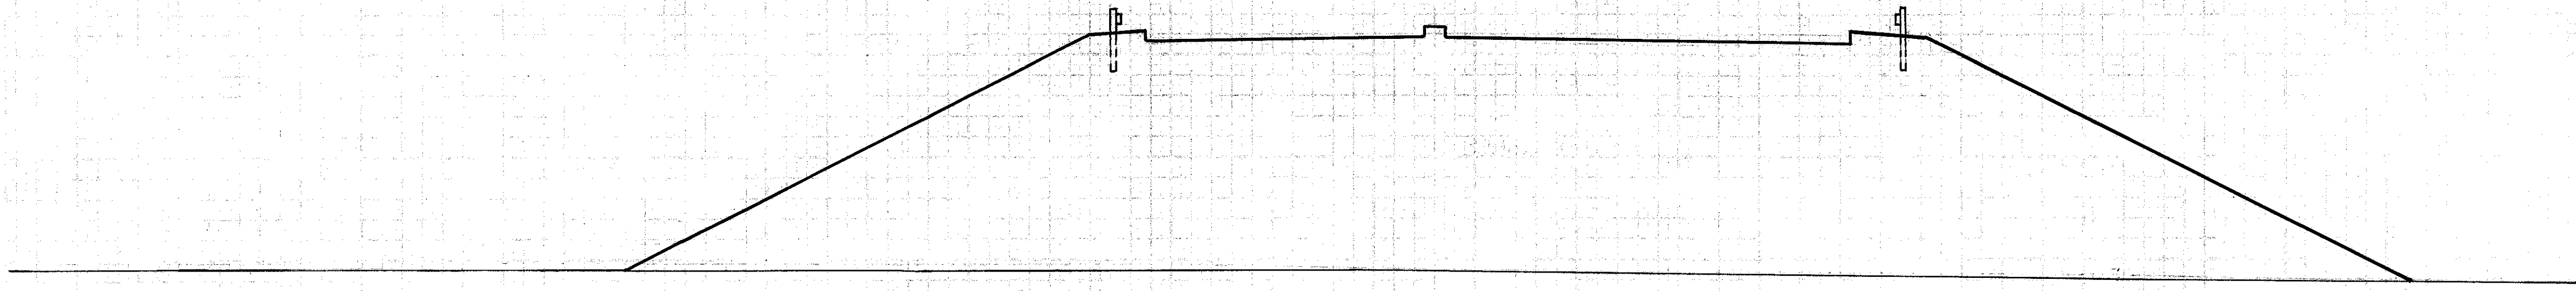


652.53  
**594+38**  
 628.7

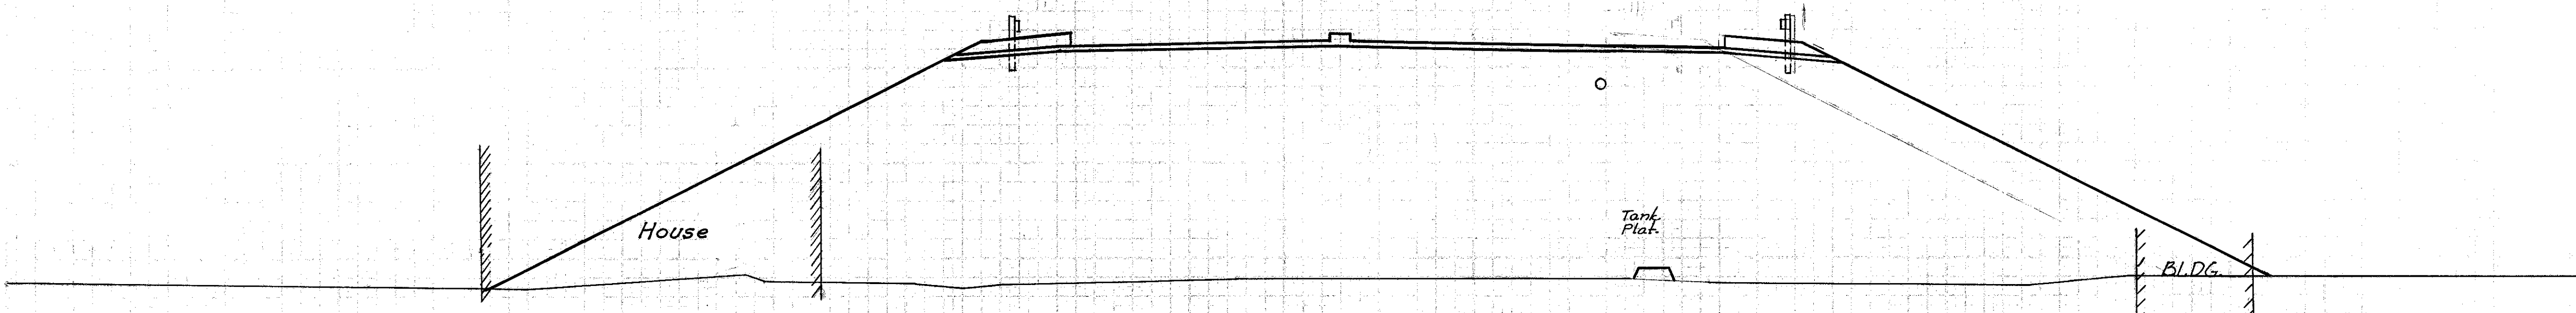

653.40  
**594+00**  
 627.8

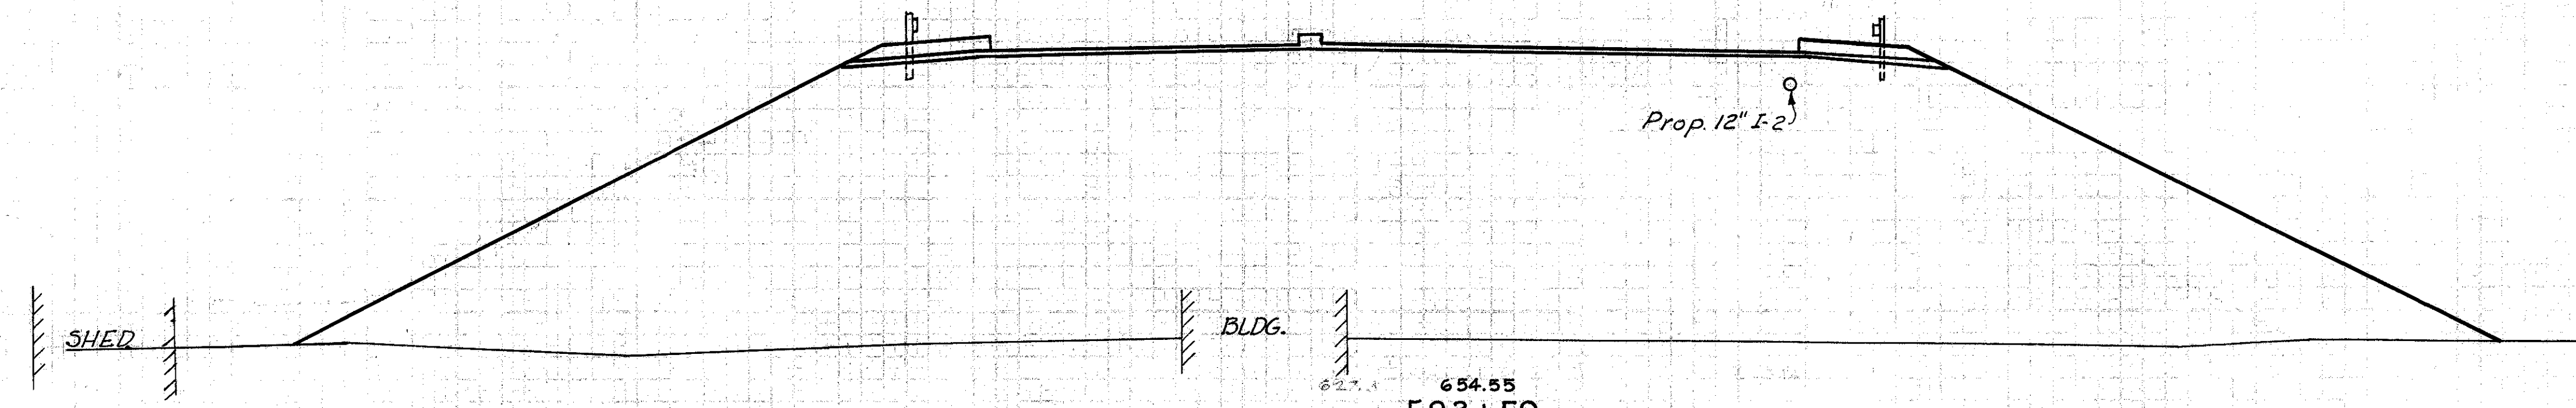

654.55  
**593+50**  
 627.5

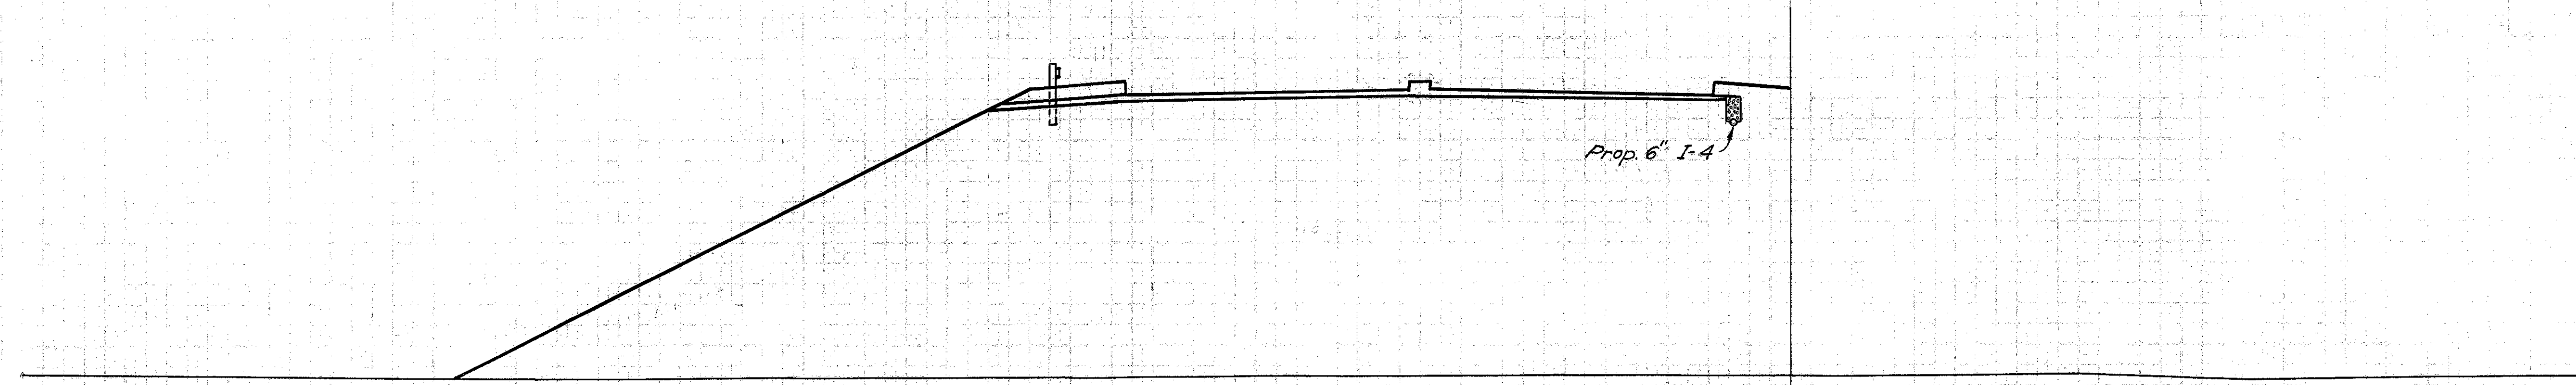


655.70  
**593+00**  
 627.1

End Area		Cu. Yds.	
Cut	Fill	Cut	Fill
-	3043	-	4574
-	3457	-	6726
-	3807	-	6170
-	2856	-	12889

150 140 130 120 110 100 90 80 70 60 50 40 30 20 10 0 10 20 30 40 50 60 70 80 90 100 110 120 130 140

150 140 130 120 110 100 90 80 70 60 50 40 30 20 10 0 10 20 30 40 50 60 70 80 90 100 110 120 130 140 150

98  
222  
EUT APR 19 1919

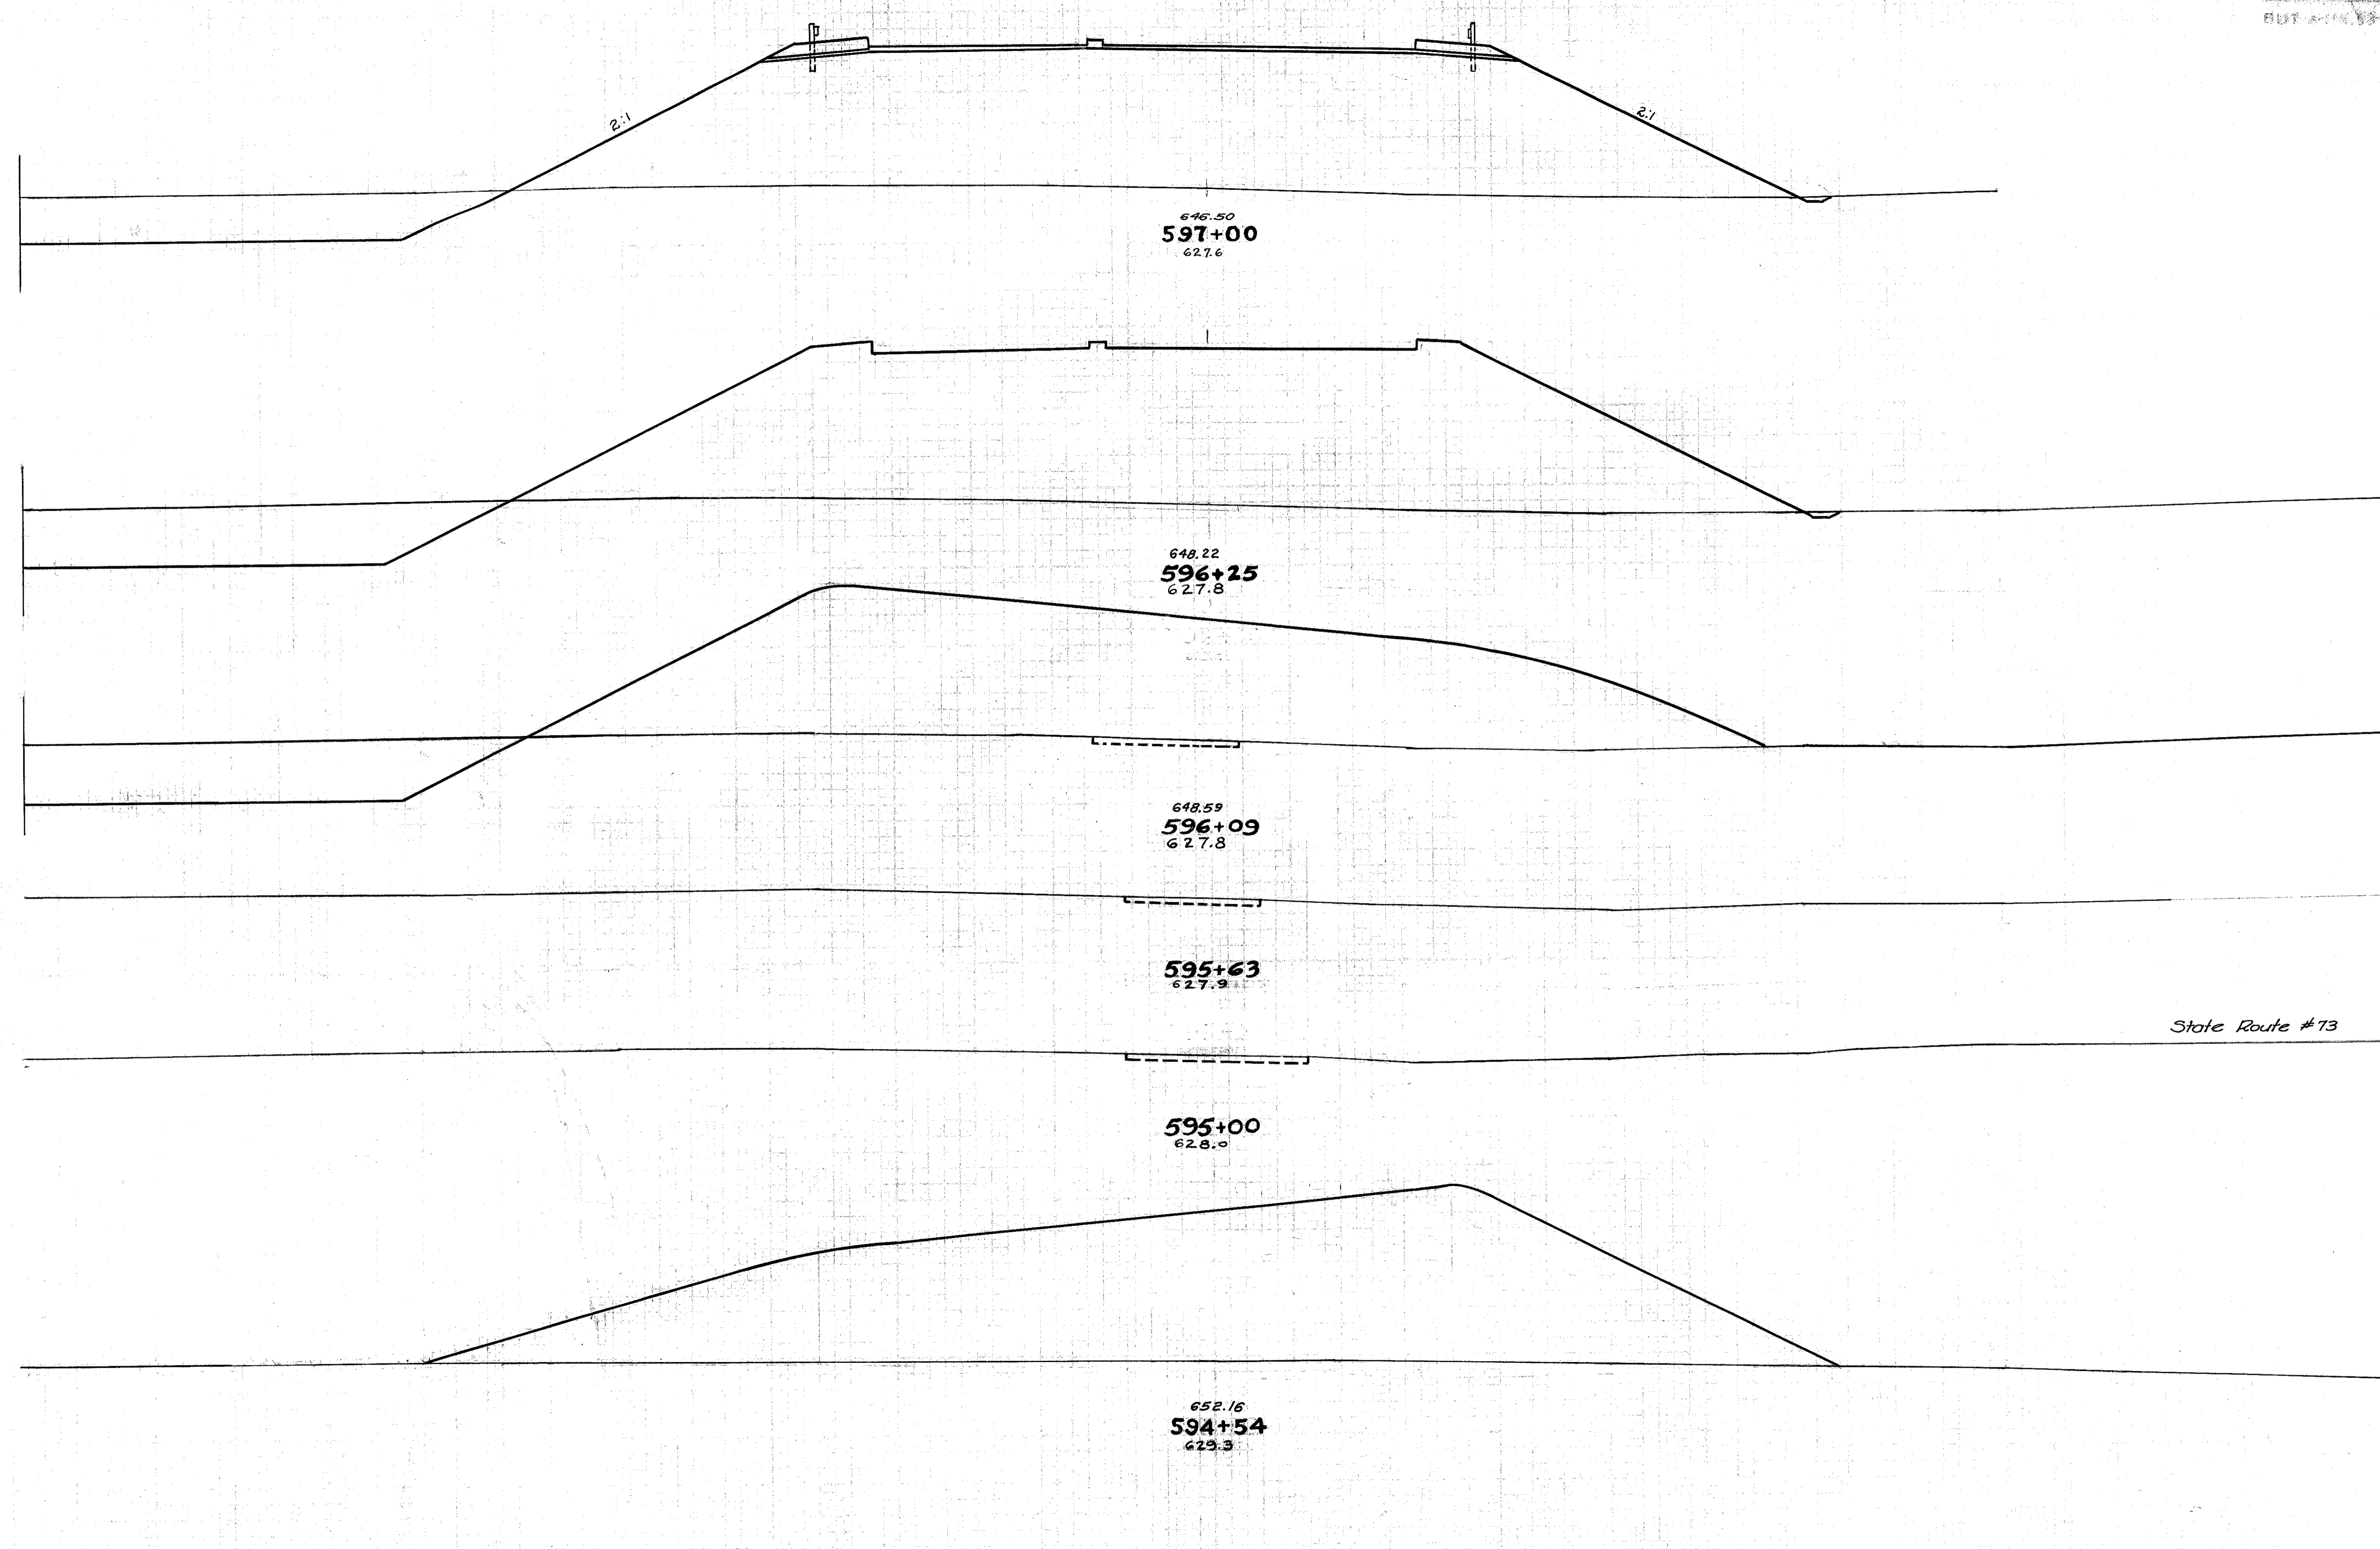

End Area		Cu. Yds.	
Cut	Fill	Cut	Fill
386	2296		
		1085	6697
395	2526		
		91	1351
424	2039		
		361	1632
-	-	-	-
		23064	81403
-	-	-	-
		2365	
-	2776		
		-	1724


150 140 130 120 110 100 90 80 70 60 50 40 30 20 10 0 10 20 30 40 50 60 70 80 90 100 110 120 130 140

STA. 594+54 TO 597


150 140 130 120 110 100 90 80 70 60 50 40 30 20 10 0 10 20 30 40 50 60 70 80 90 100 110 120 130 140 150

222


Begin Transition  
Sta. 600+00  
Side Slope 2:1

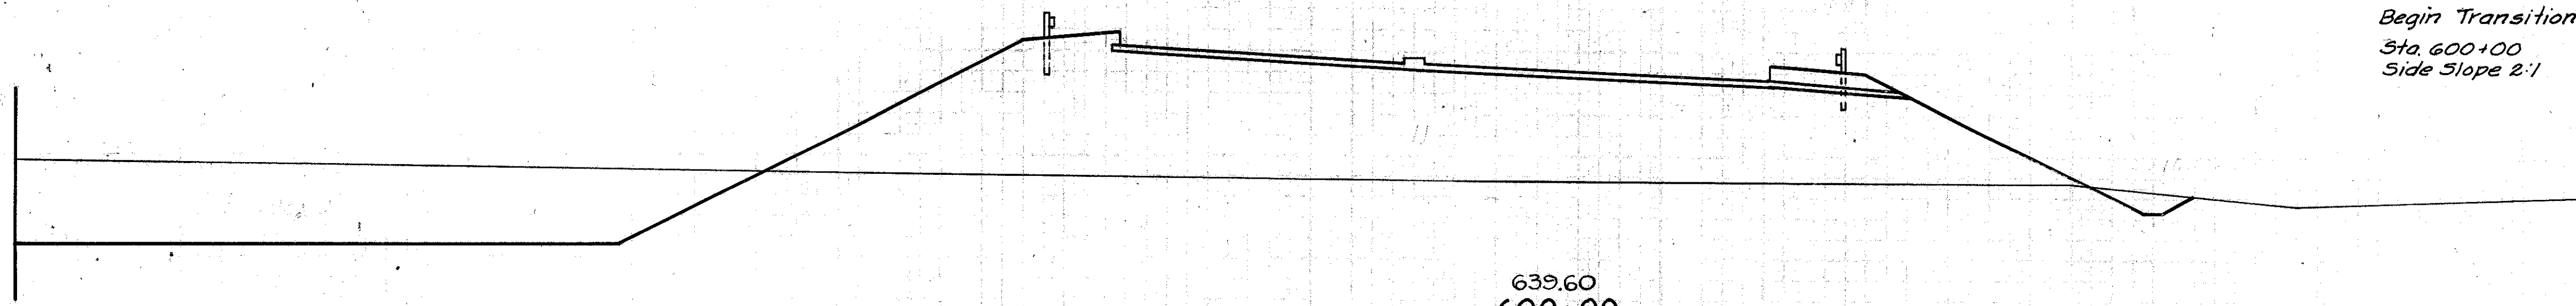


639.60  
600+00  
627.6

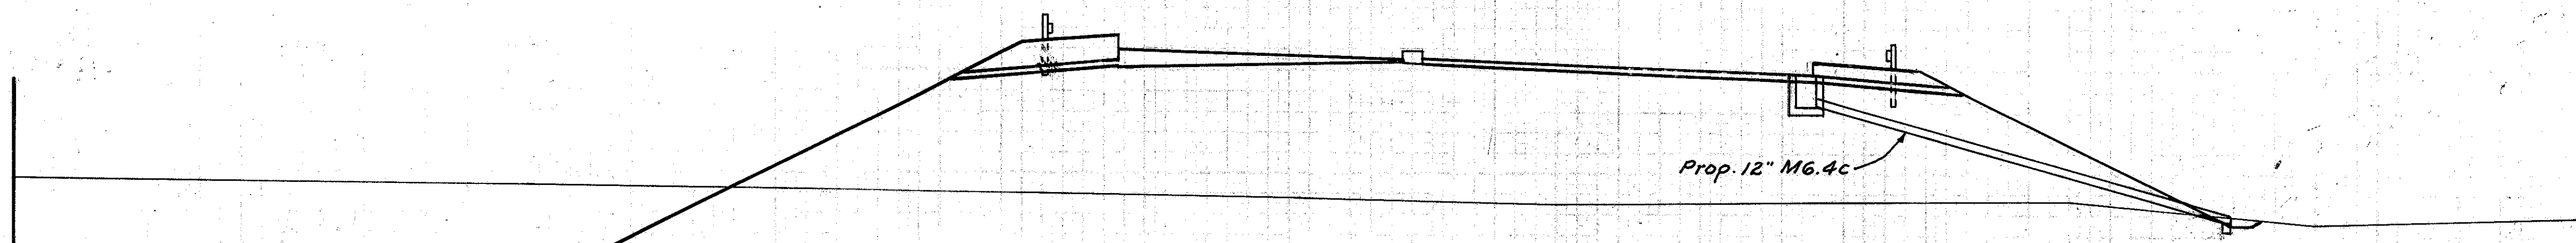

641.90  
599+00  
627.0

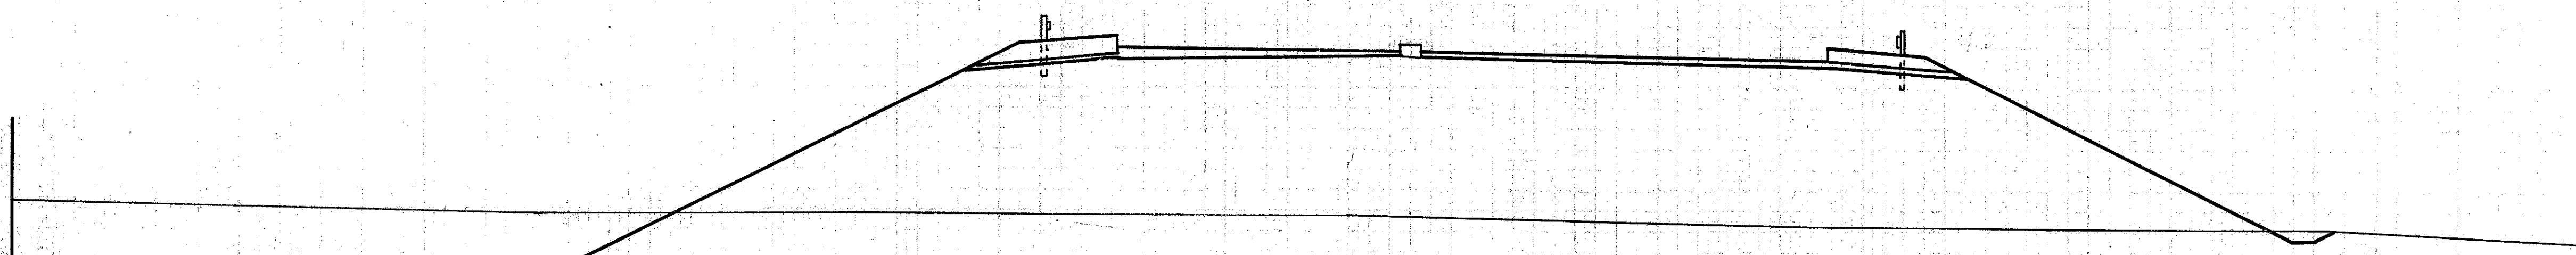

644.20  
598+00  
627.1

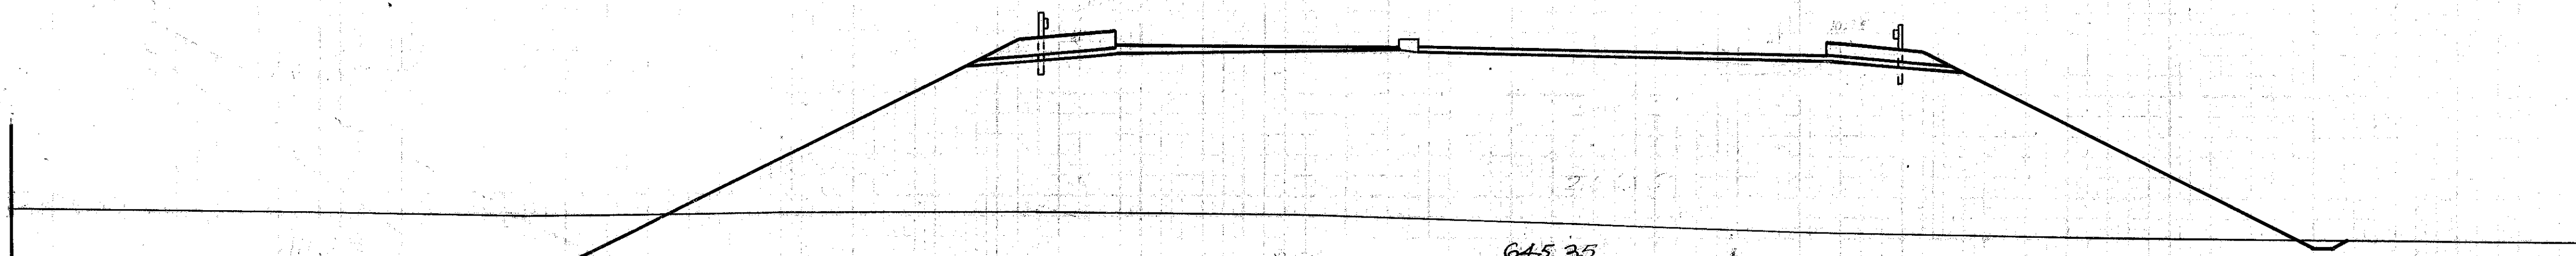

645.35  
597+50  
627.6

End Area		Cu. Yds.	
Cut	Fill	Cut	Fill
500	1168		
		1791	4967
467	1514		
		1606	6419
400	1952		
		753	3721
413	2067		
		740	4040

Sta. 590+11 to Sta. 600+00  
E-1  
Embankment 17% 0.63 Cu. Yds.  
Embankment +15% 202.412 Cu. Yds.


150 140 130 120 110 100 90 80 70 60 50 40 30 20 10 0 10 20 30 40 50 60 70 80 90 100 110 120 130 140

STA. 597+50 TO 600+00

150 140 130 120 110 100 90 80 70 60 50 40 30 20 10 0 10 20 30 40 50 60 70 80 90 100 110 120 130 140 150




100  
222

100-200 8 BLACK

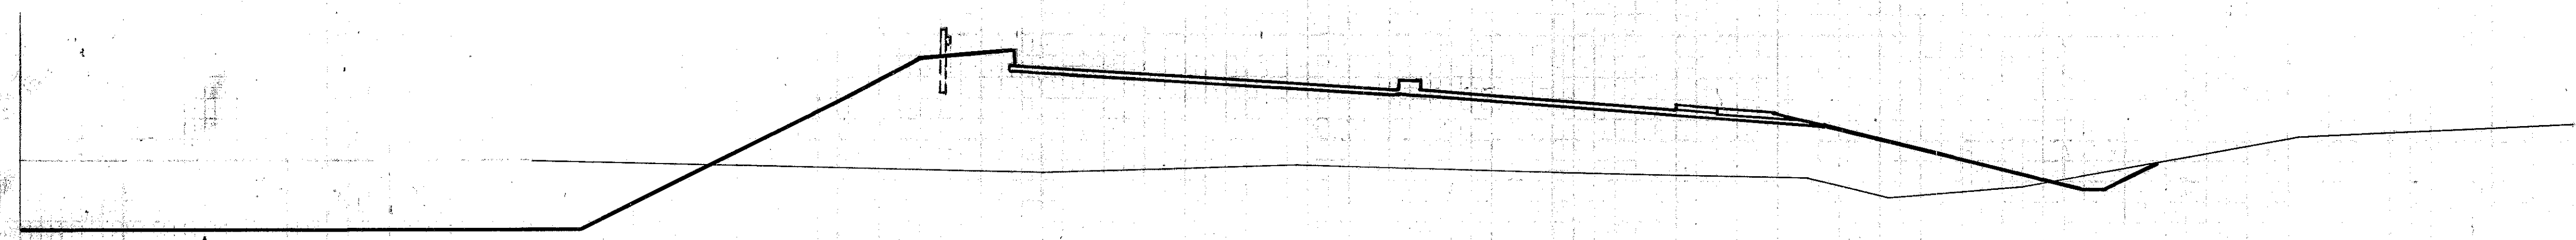

Gas Tanks  
Bob's Truck Serv.

20

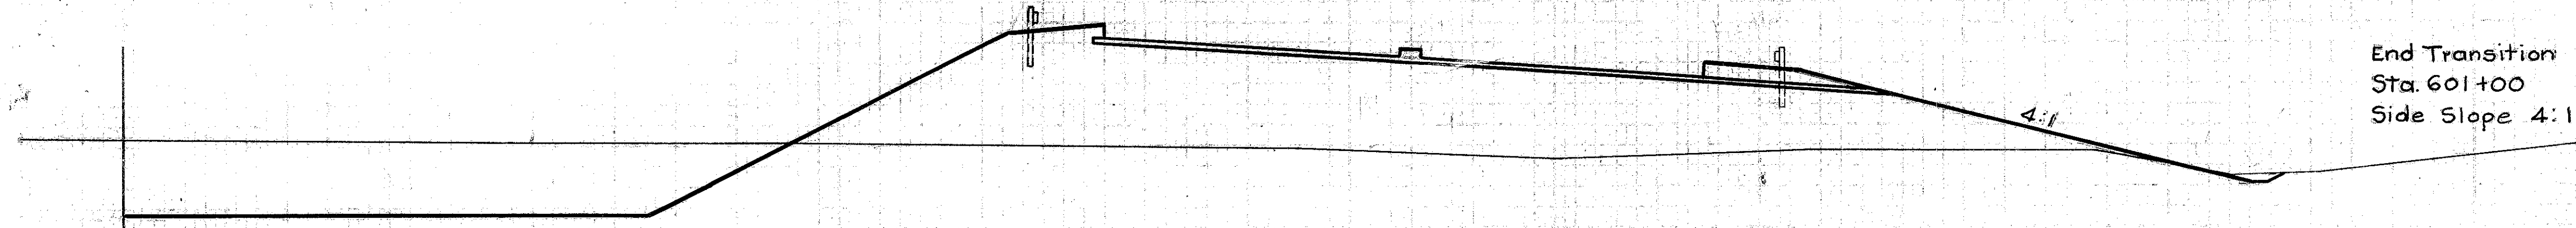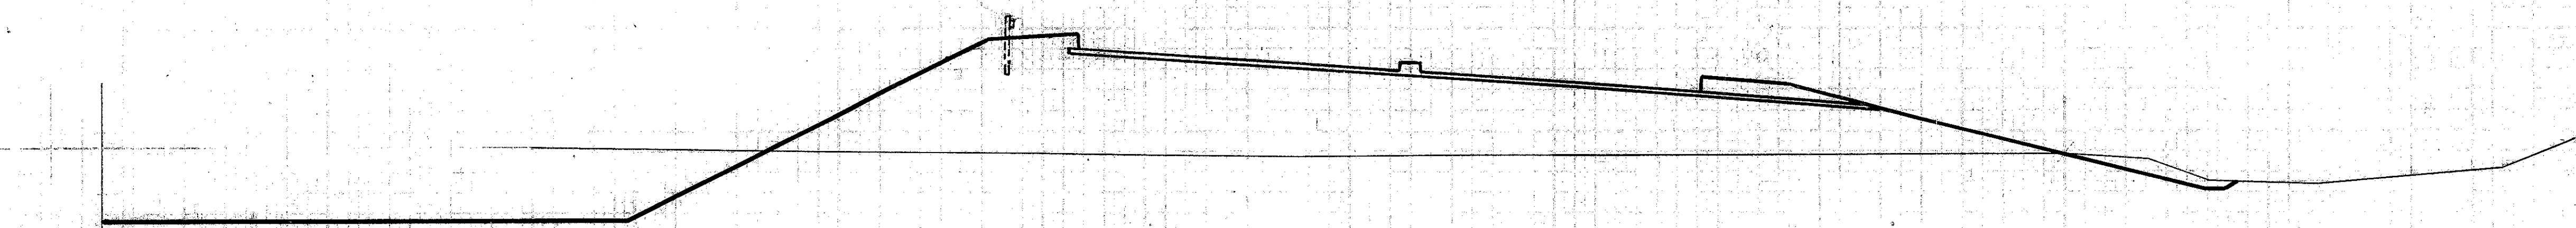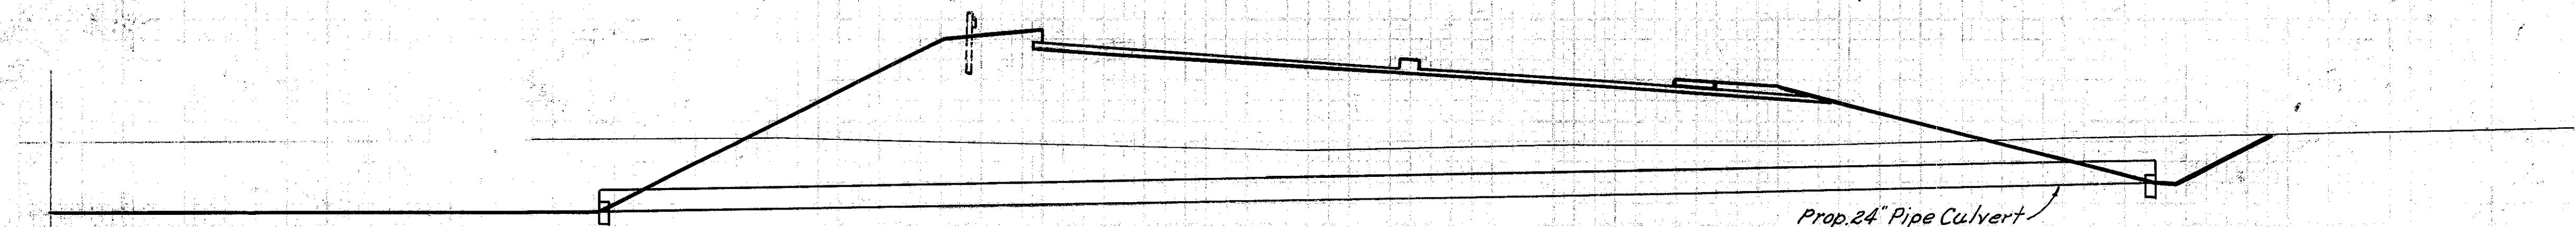

End Area		Cu. Yds.	
Cut	Fill	Cut	Fill
438	934		
			20
		869	1619
500	809		
		869	1546
438	861		
		845	1671
475	944		
		1806	3911


150 140 130 120 110 100 90 80 70 60 50 40 30 20 10 0 10 20 30 40 50 60 70 80 90 100 110 120 130 140

STA 601+00 TO 602+50

150 140 130 120 110 100 90 80 70 60 50 40 30 20 10 0 10 20 30 40 50 60 70 80 90 100 110 120 130 140 150

Black  
3

101  
222  
101-200

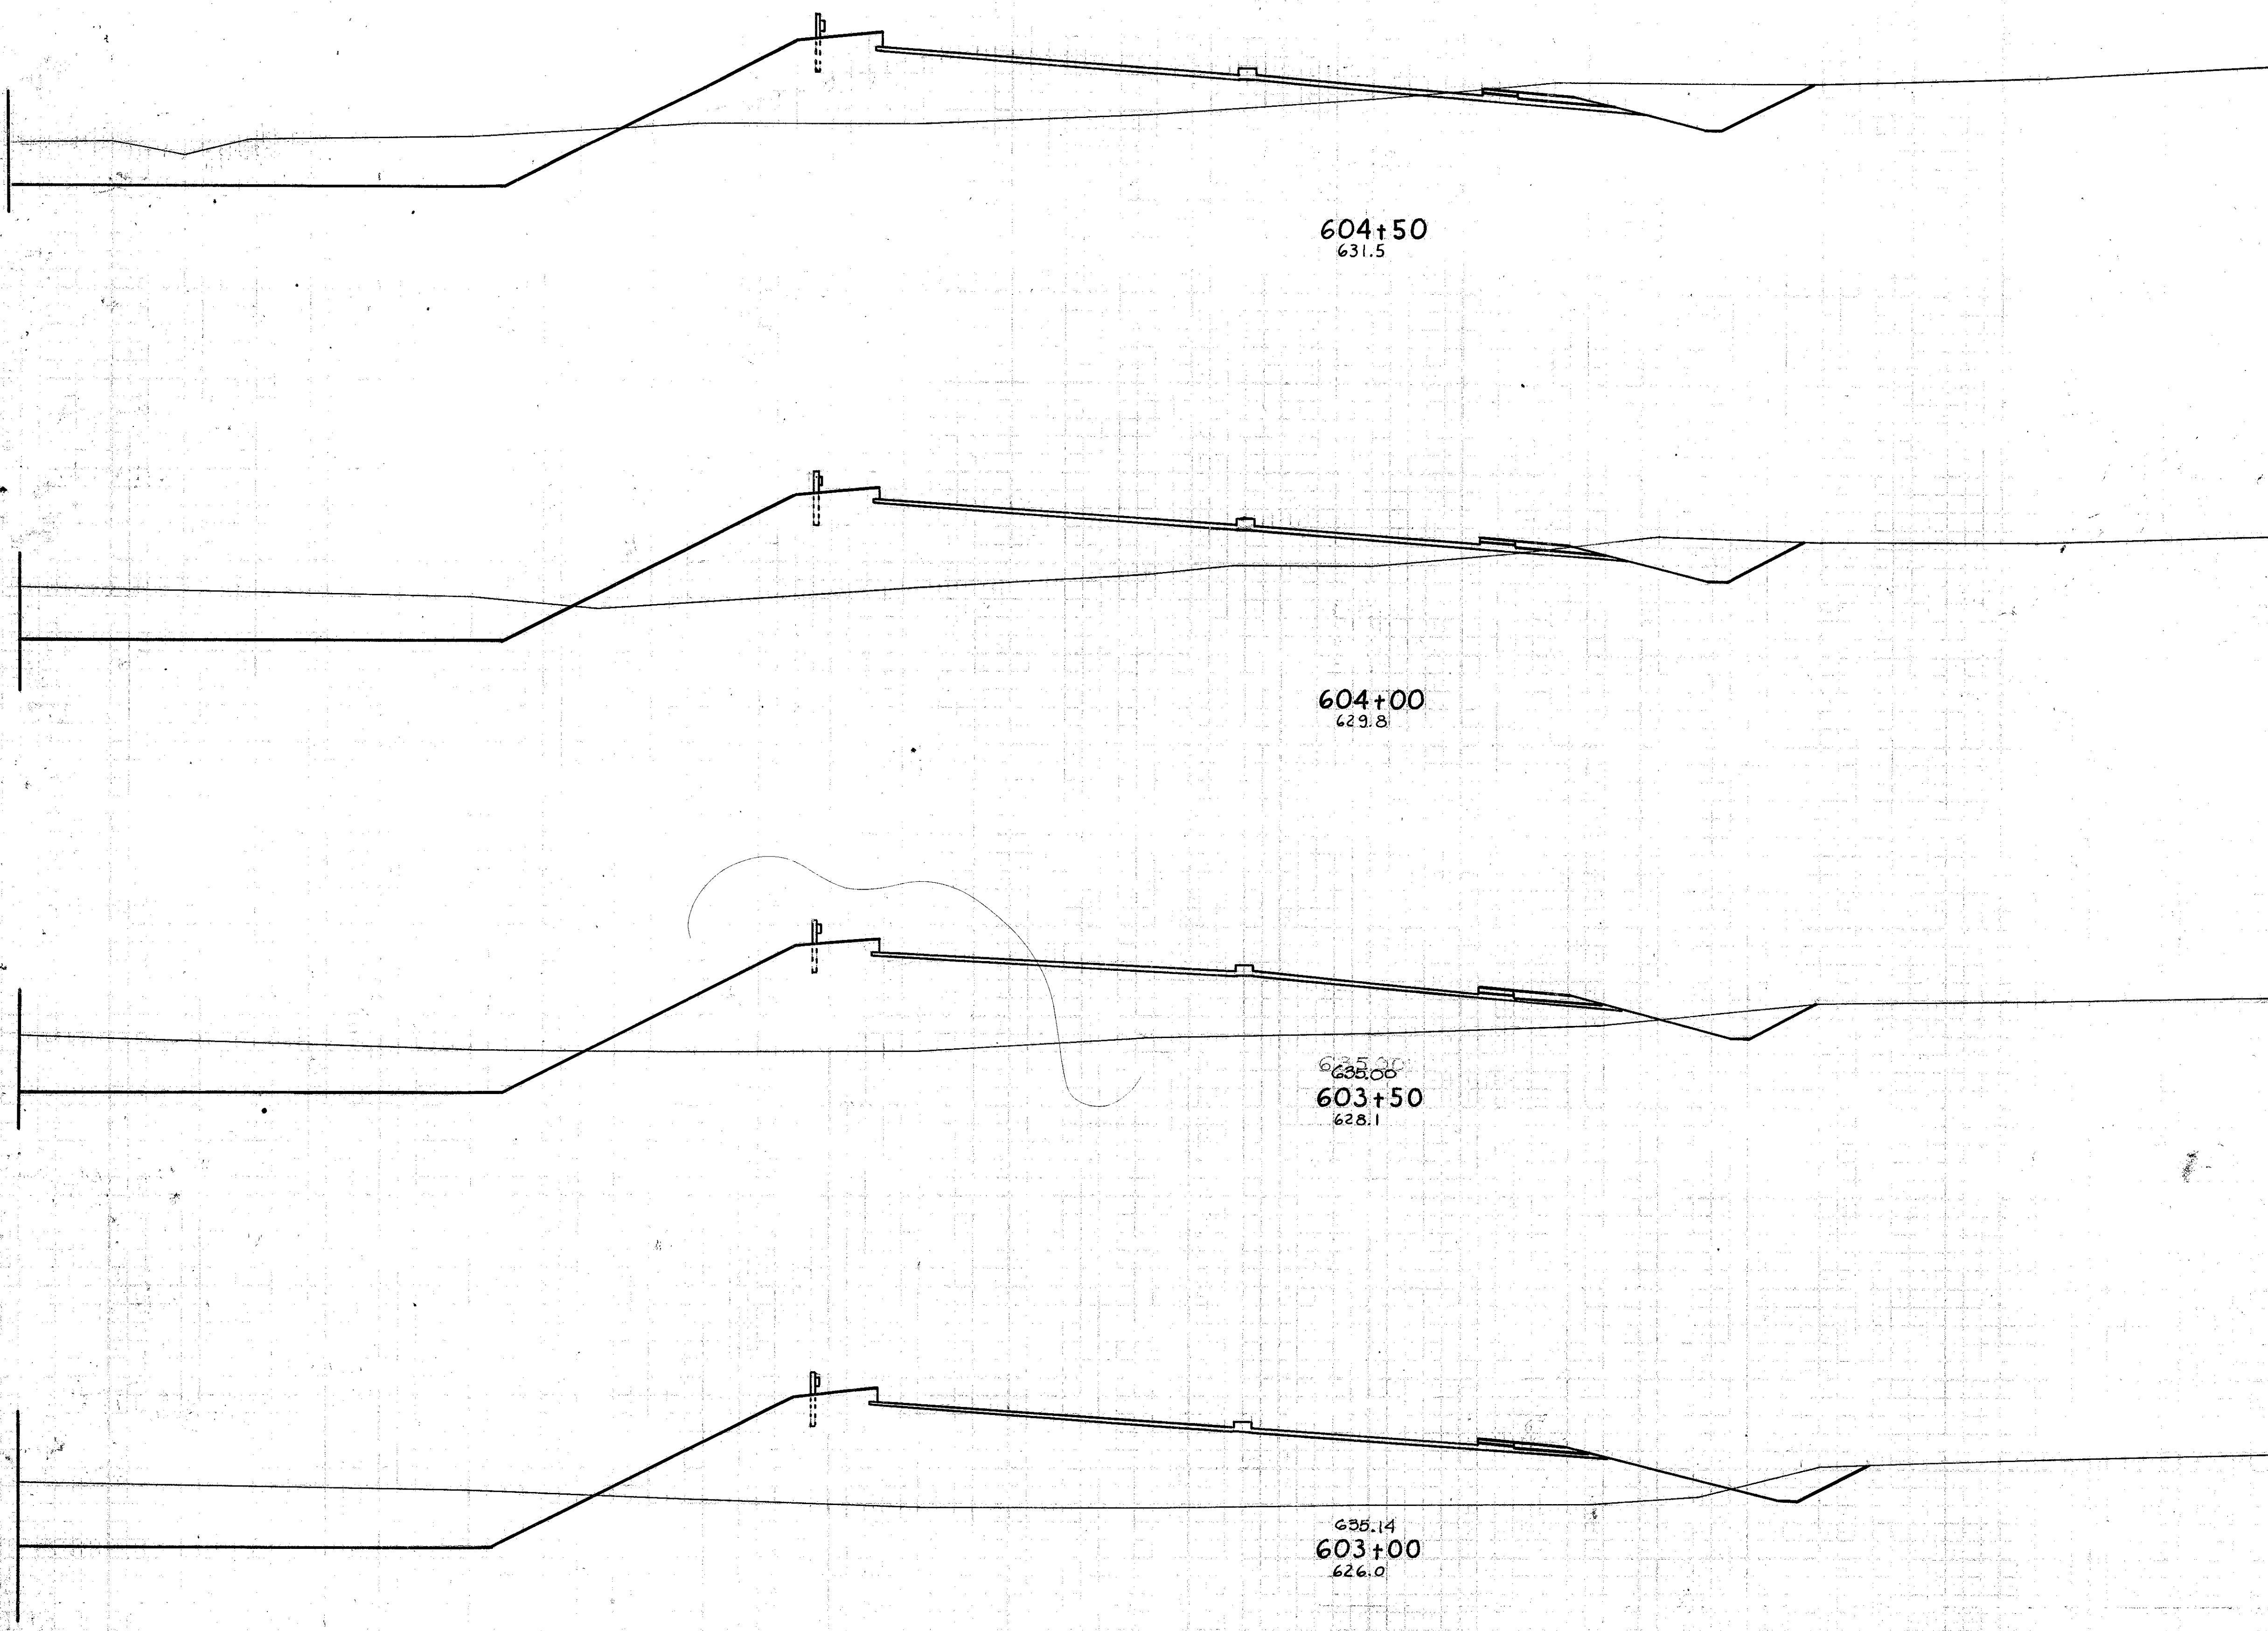

Office Bob's  
Truck Service


End Area		Cu. Yds.	
Cut	Fill	Cut	Fill
443	458		
		762	1009
			30
380	632		
		672	1334
346	809		
		709	1662
420	986		
		794	1778

150 140 130 120 110 100 90 80 70 60 50 40 30 20 10 0 10 20 30 40 50 60 70 80 90 100 110 120 130 140

STA. 603+00 TO 604+50

150 140 130 120 110 100 90 80 70 60 50 40 30 20 10 0 10 20 30 40 50 60 70 80 90 100 110 120 130 140 150


102  
222  
CHIC  
CUT 2-15-1918

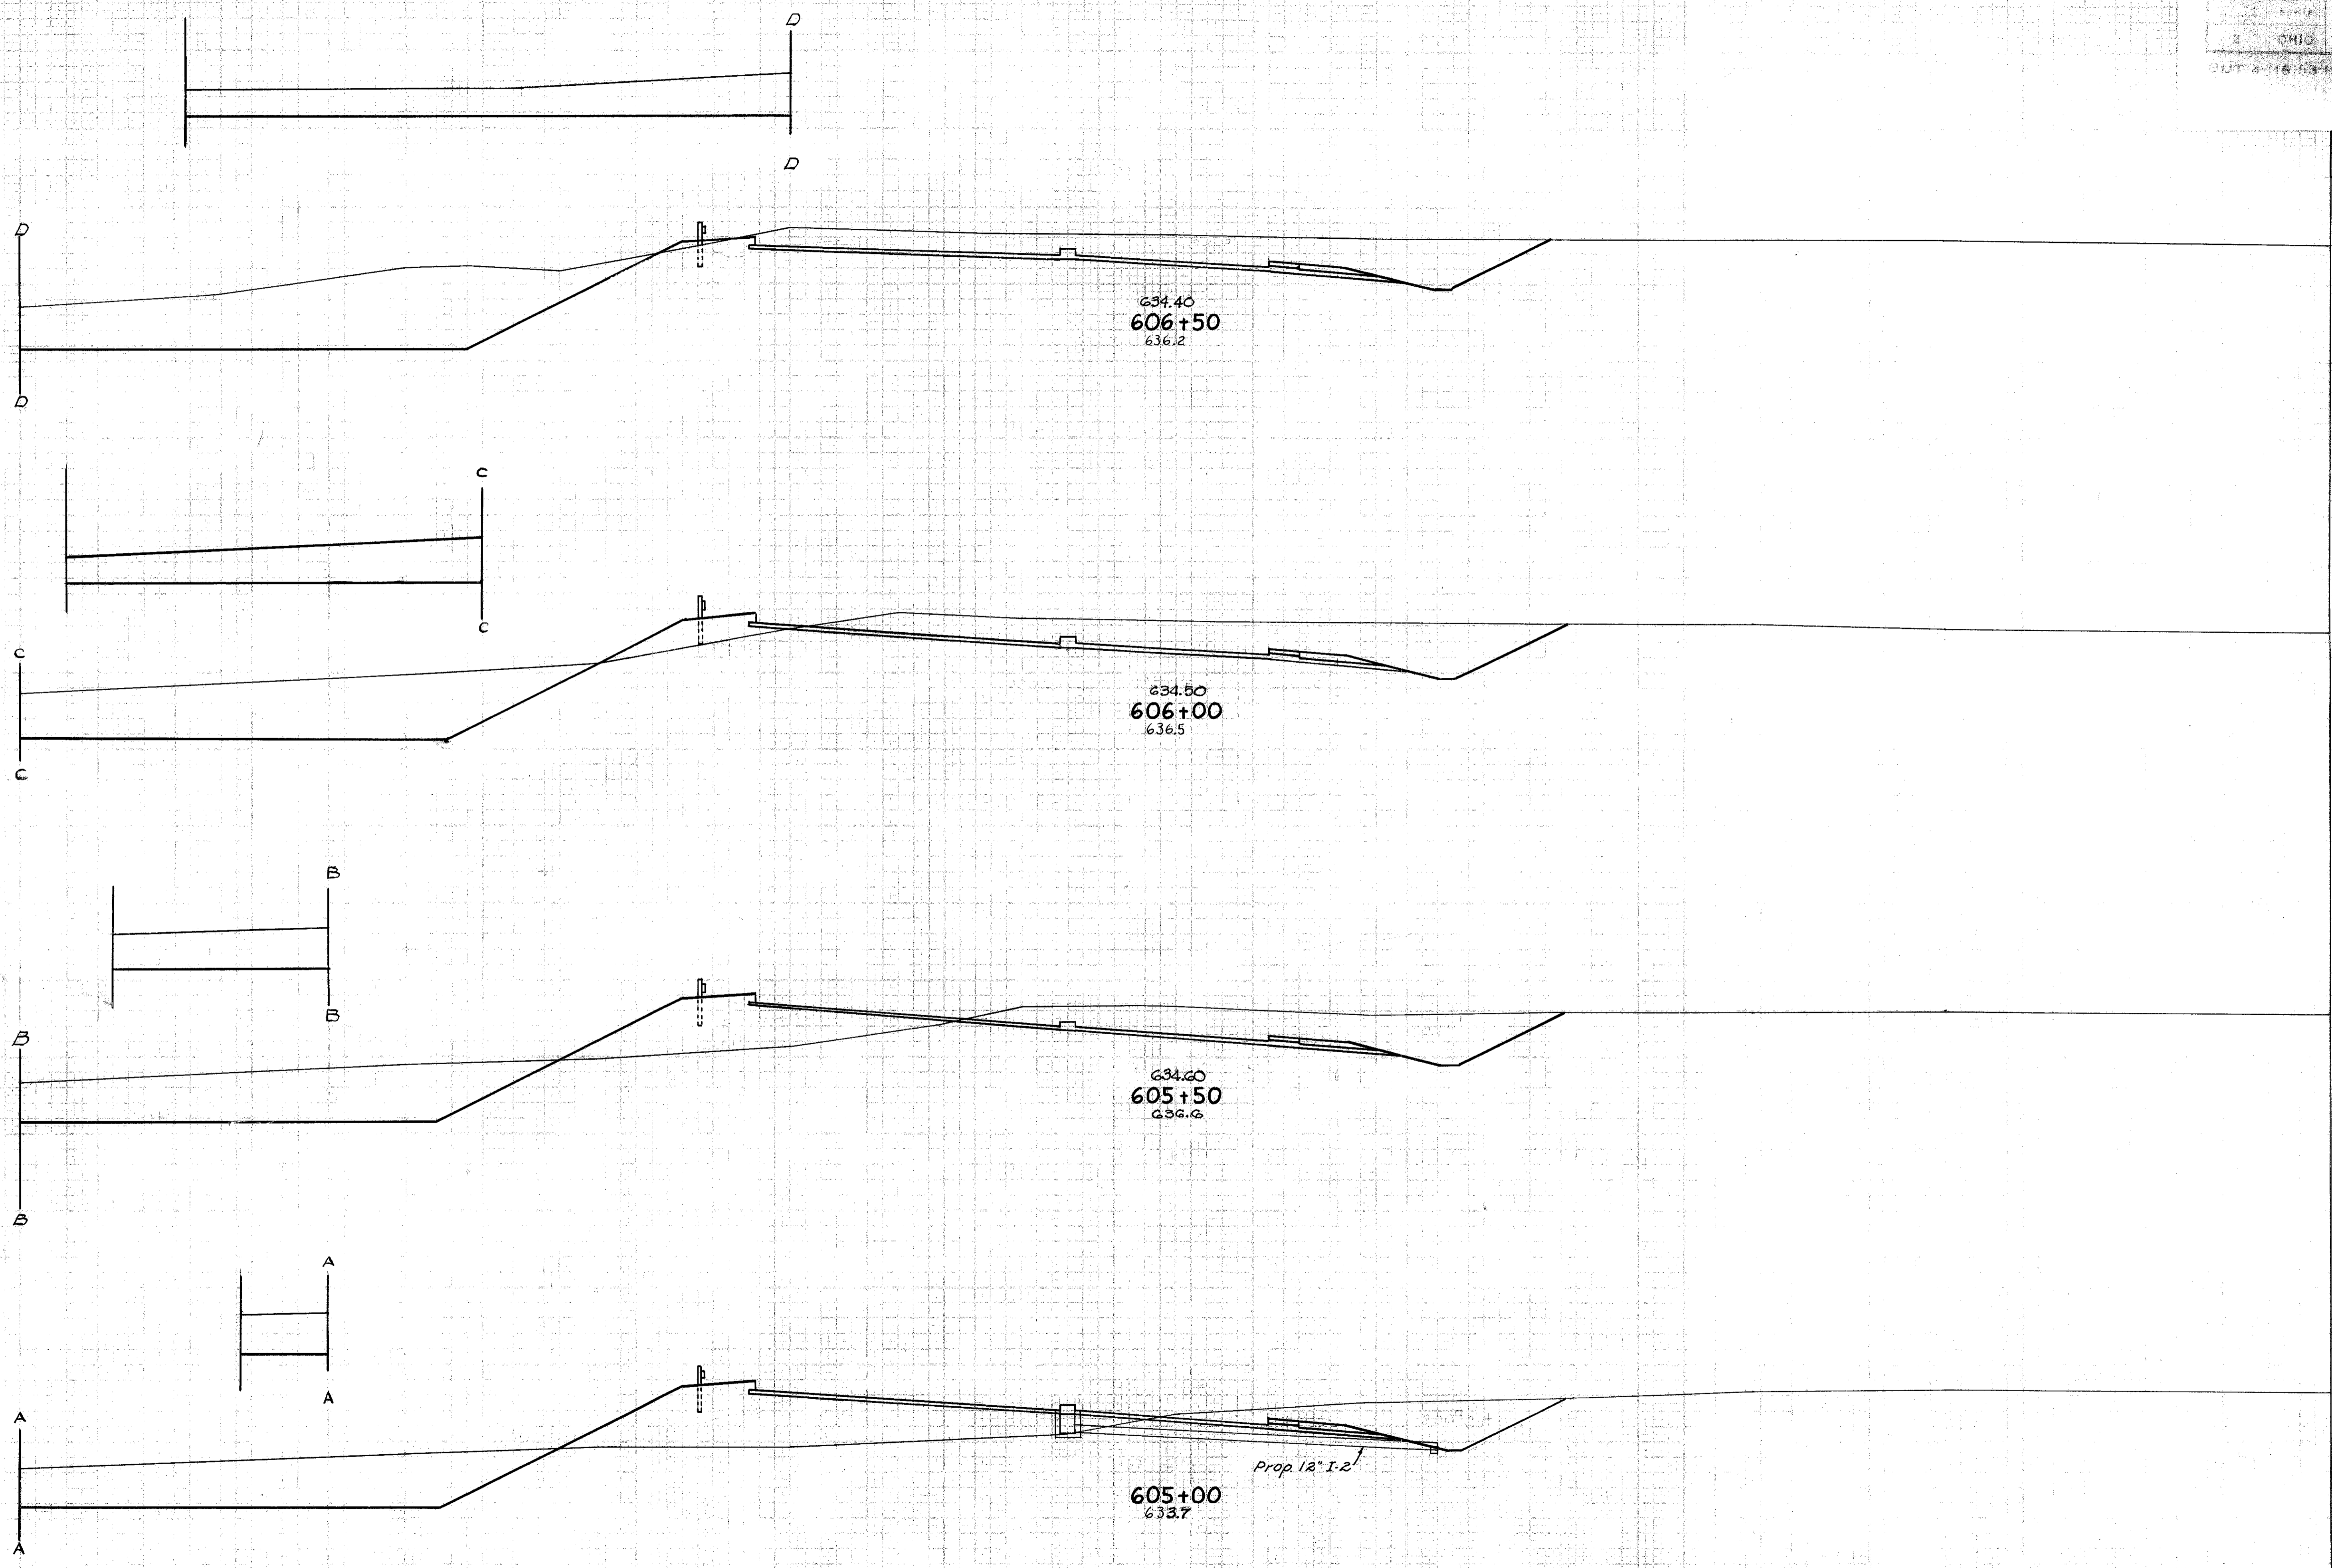

End Area		Cu. Yds.	
Cut	Fill	Cut	Fill
1229	10		
	2247	71	
1198	67		
	965	269	
866	223		
	1416	550	
663	371		
	1024	768	

STA. 605+00 TO 606+50

150 140 130 120 110 100 90 80 70 60 50 40 30 20 10 0 10 20 30 40 50 60 70 80 90 100 110 120 130 140 150

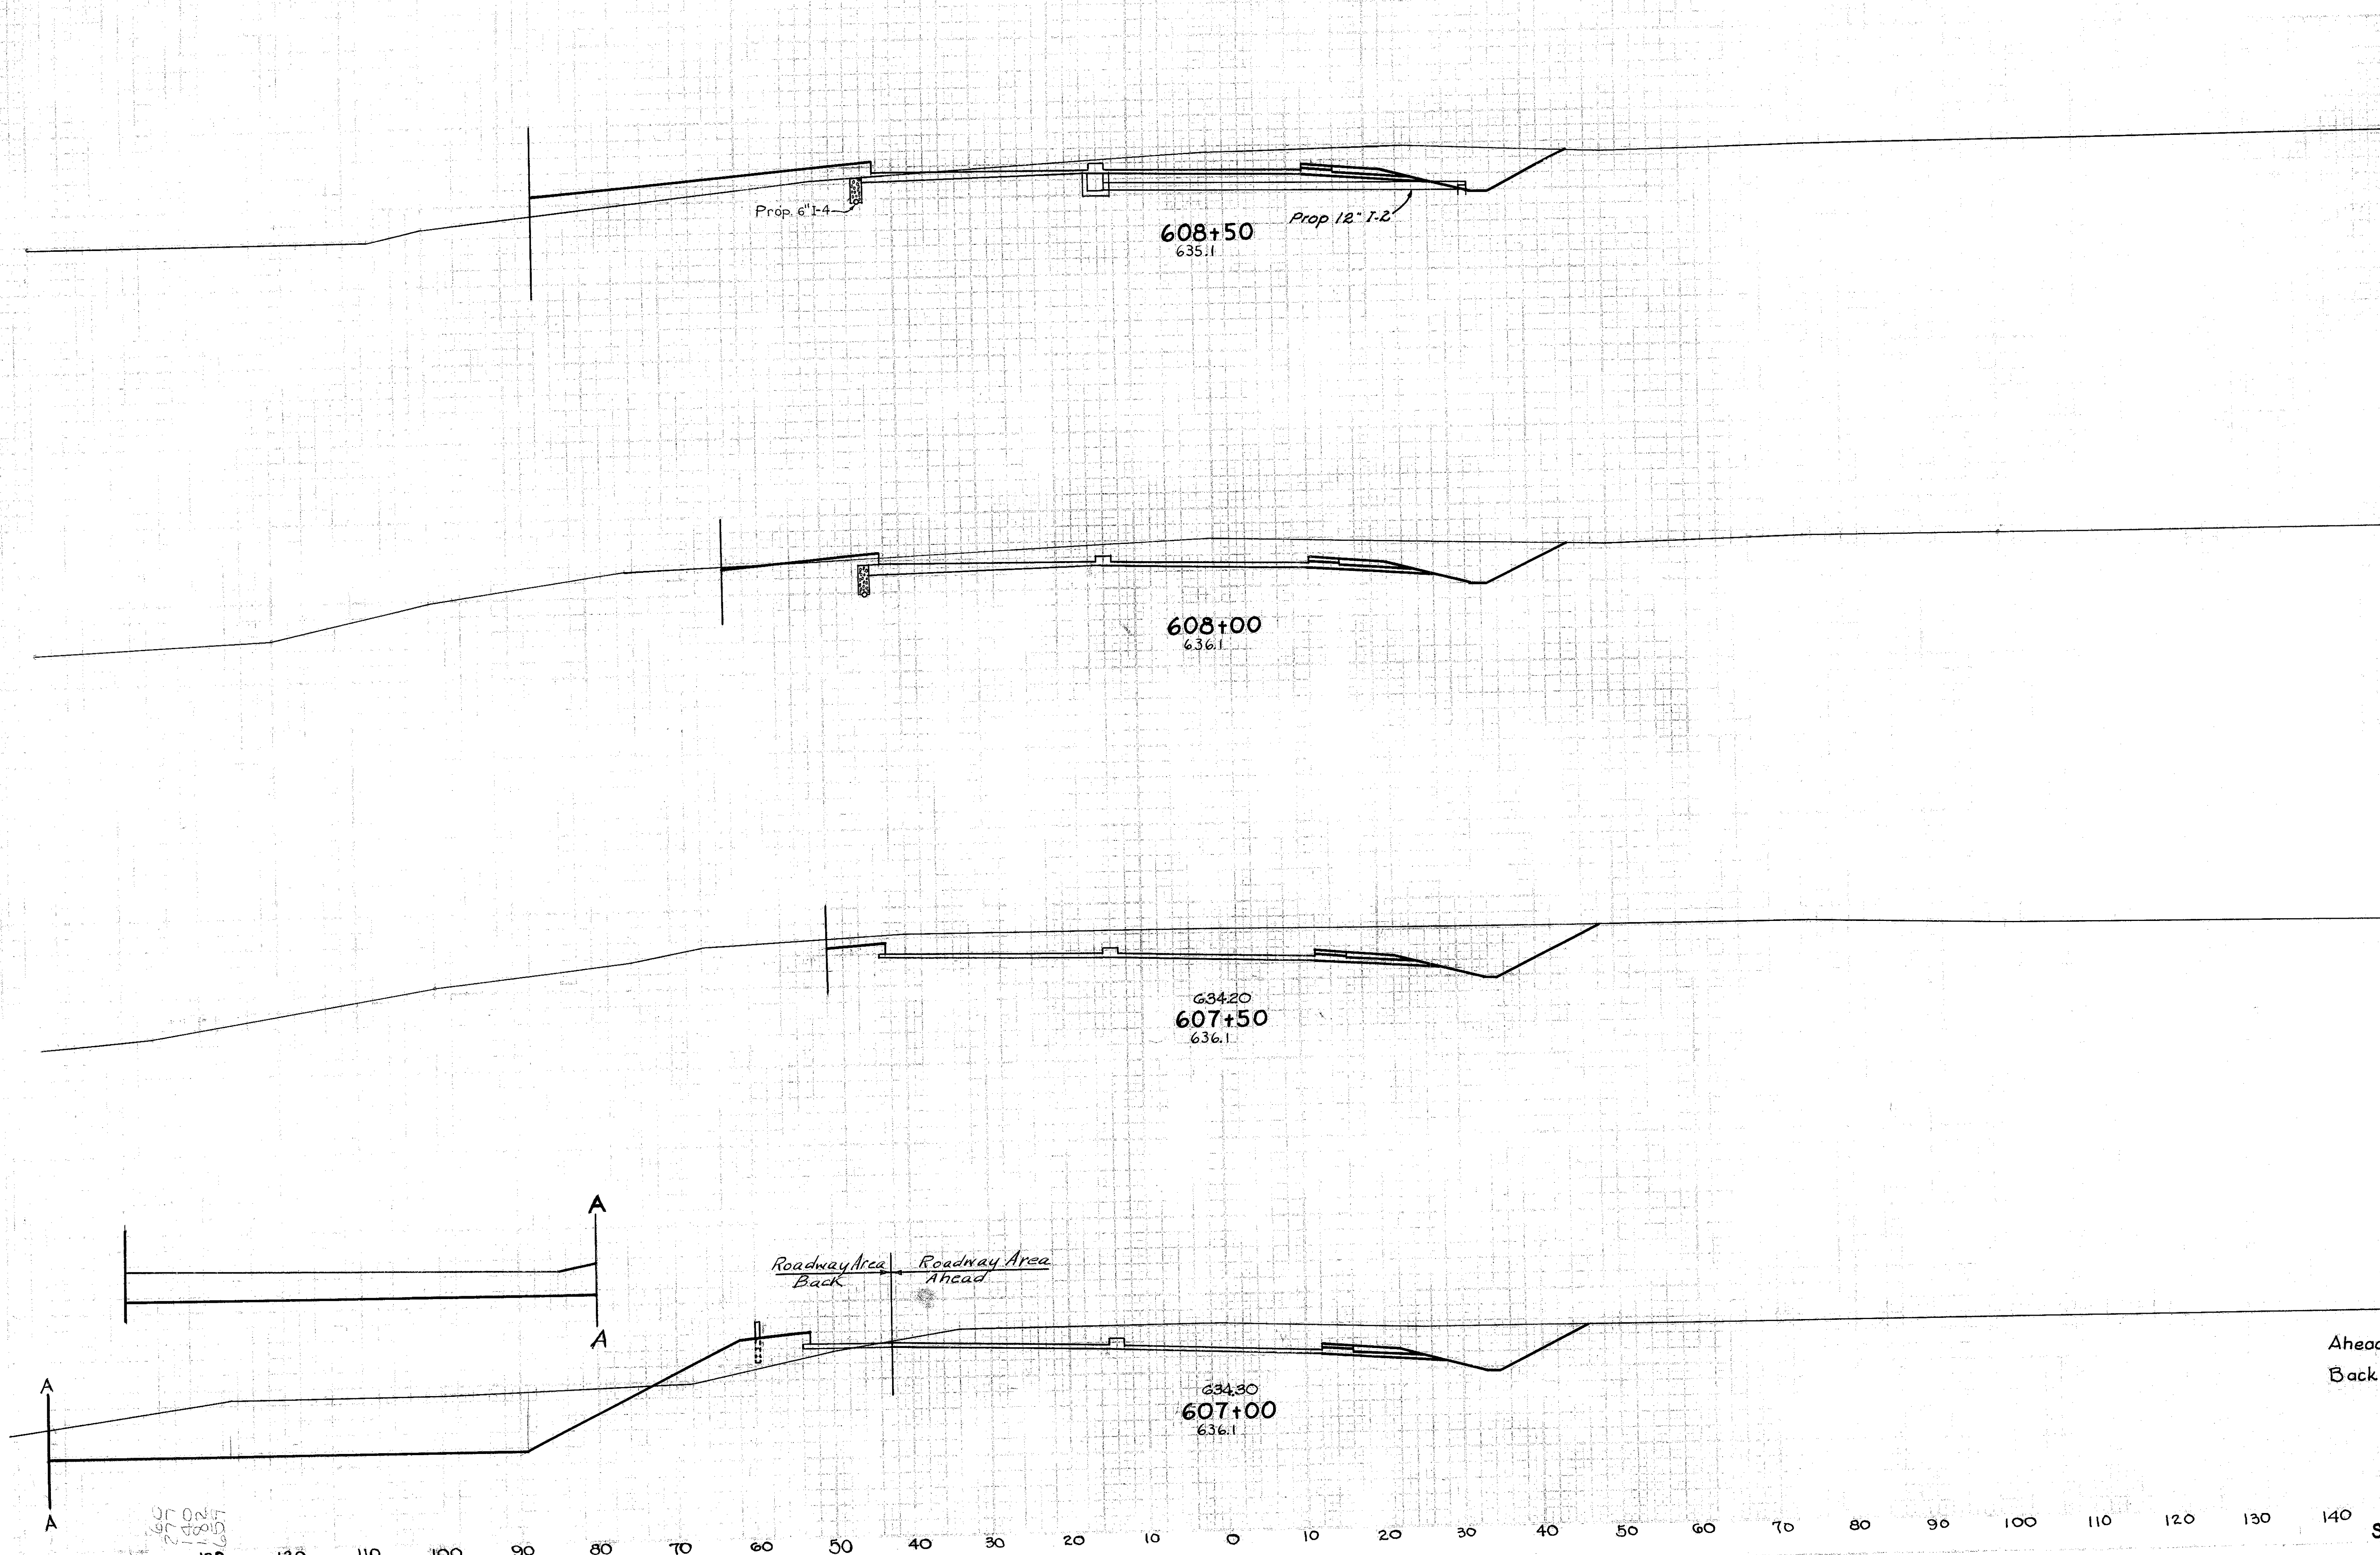





STA. 607+00 TO 608+50

150 140 130 120 110 100 90 80 70 60 50 40 30 20 10 0 10 20 30 40 50 60 70 80 90 100 110 120 130 140

OR ONLY  
FOR ROAD

150 140 130 120 110 100 90 80 70 60 50 40 30 20 10 0 10 20 30 40 50 60 70 80 90 100 110 120 130 140 150

104  
222

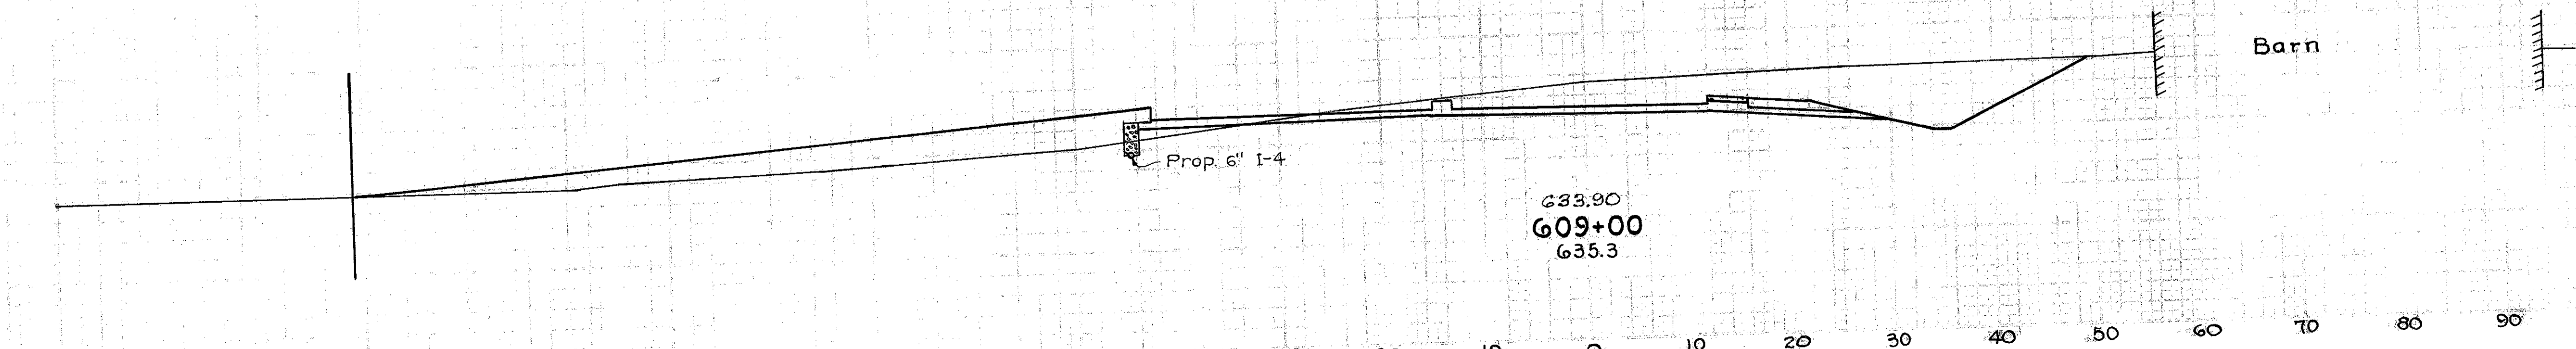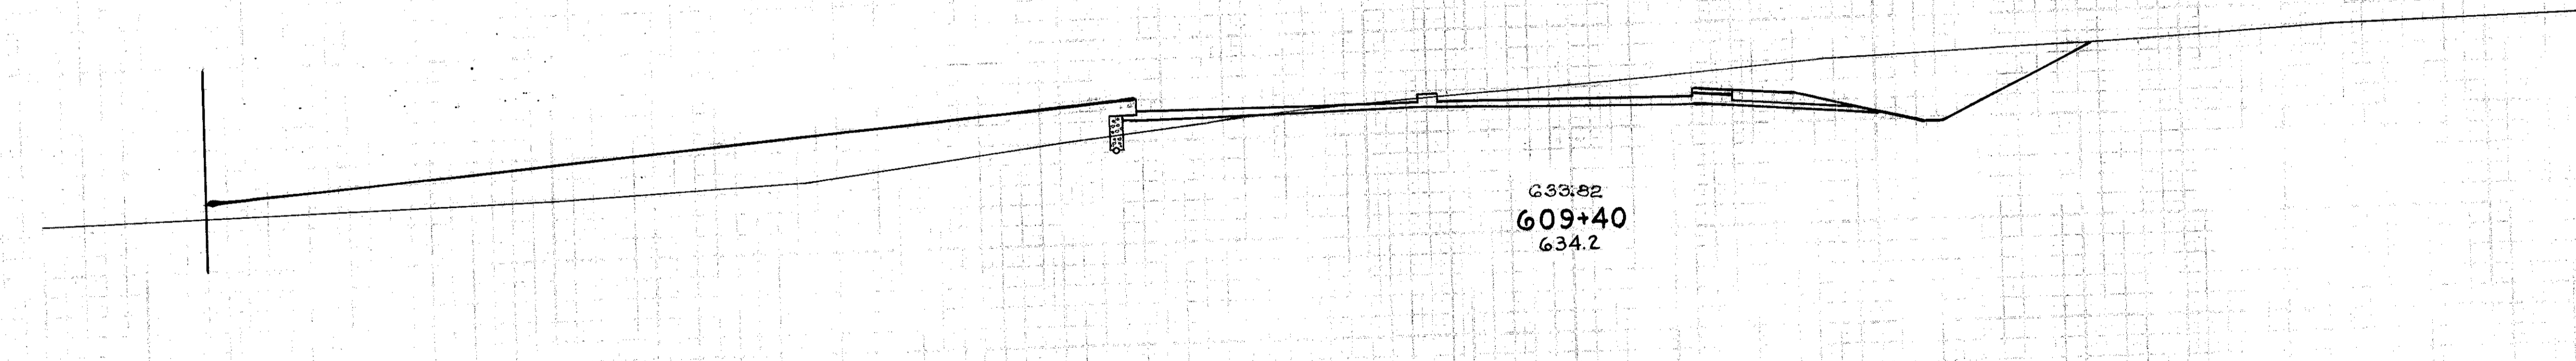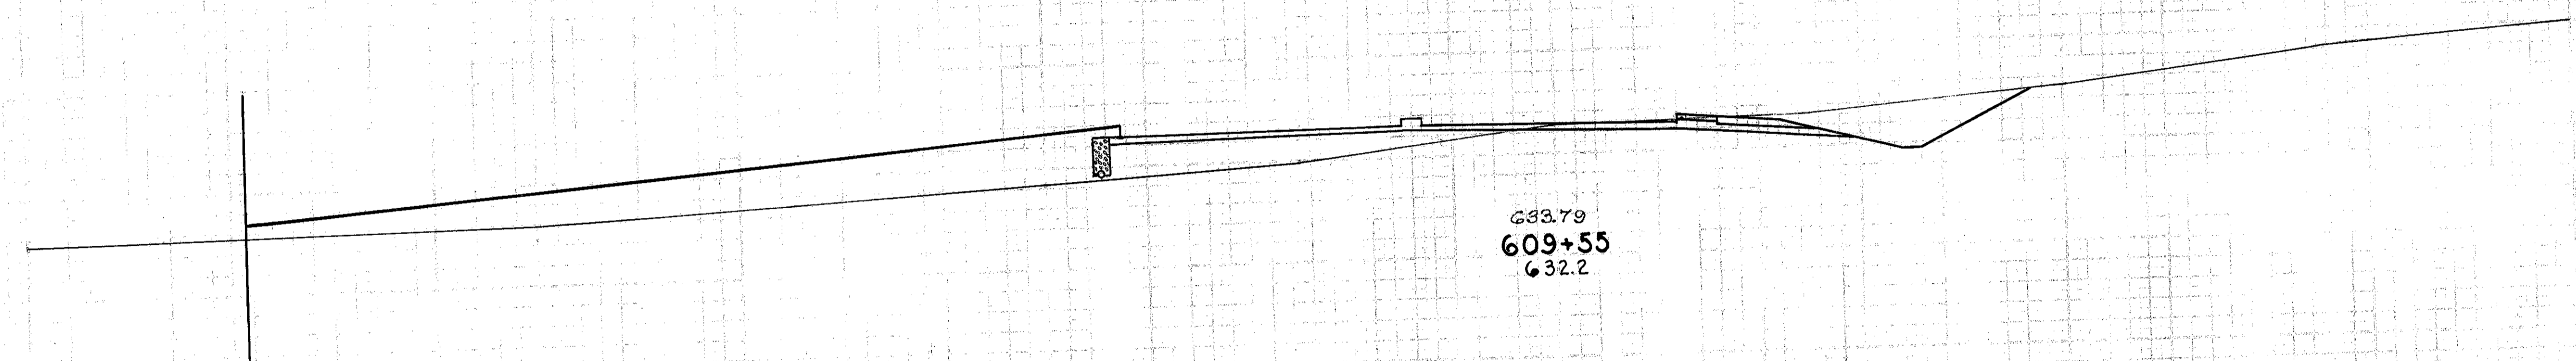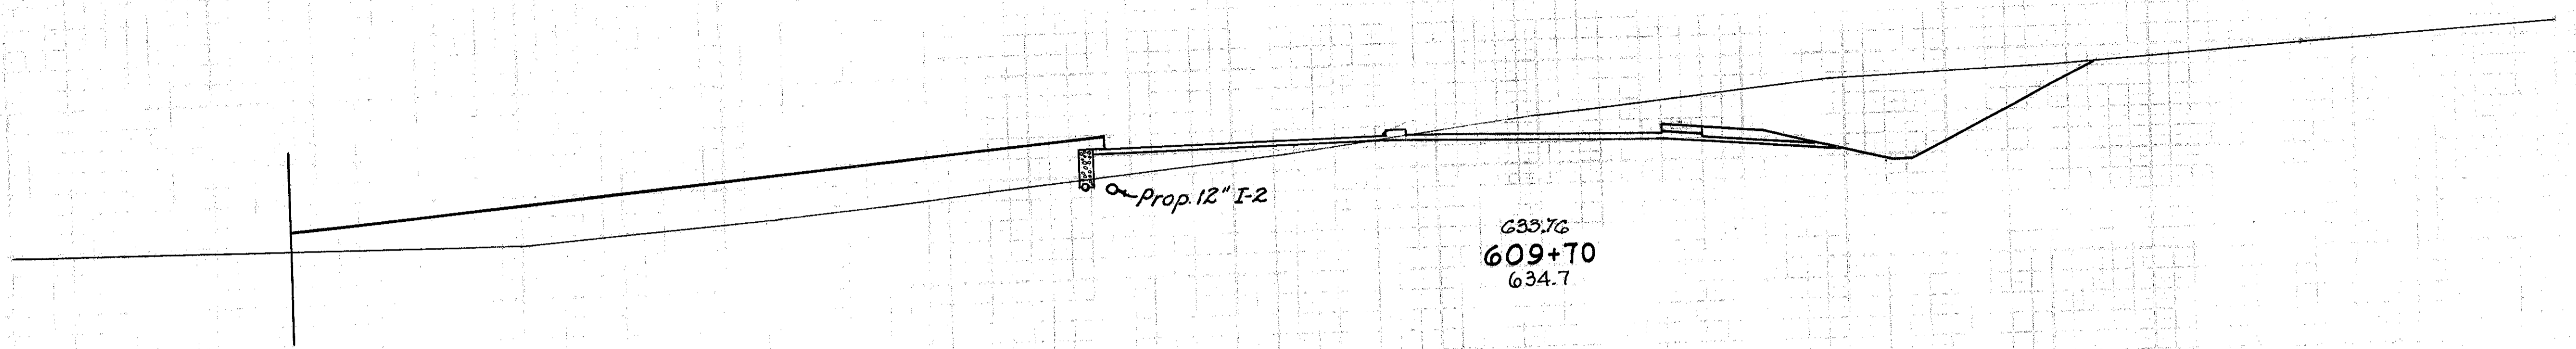

End Area		Cu. Yds.	
Cut	Fill	Cut	Fill
307	383		
		114	222
102	417		
		99	216
254	362		
		385	421
266	206		
		475	275

STA. 609+00 TO 609+70


150 140 130 120 110 100 90 80 70 60 50 40 30 20 10 0 10 20 30 40 50 60 70 80 90 100 110 120 130 140




150 140 130 120 110 100 90 80 70 60 50 40 30 20 10 0 10 20 30 40 50 60 70 80 90 100 110 120 130 140 150

FED. ROAD DISTRICT	STATE	PROJECT
5	OHIO	105 122


DATE: 11-16-53

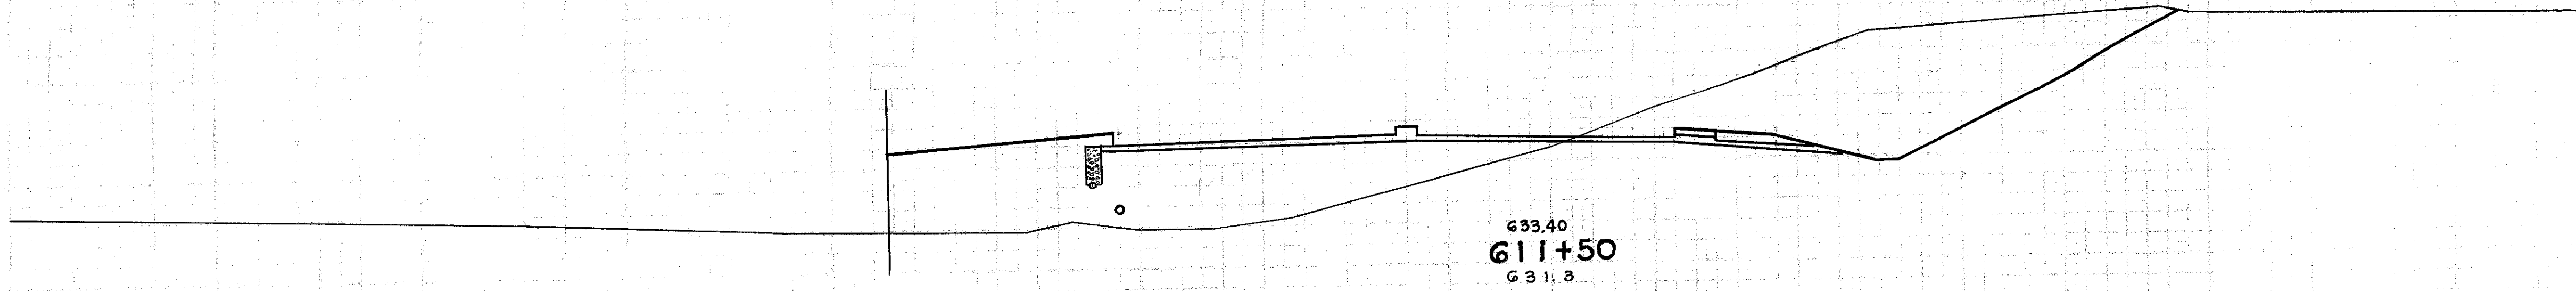


633.40  
**611+50**  
631.8

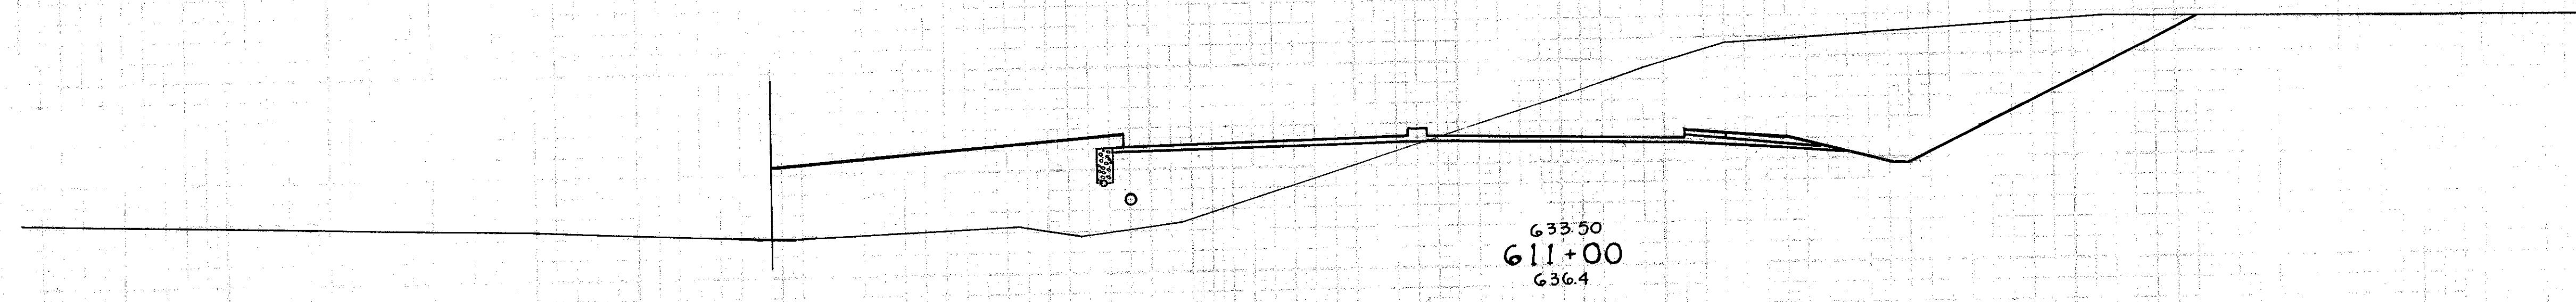

633.50  
**611+00**  
636.4

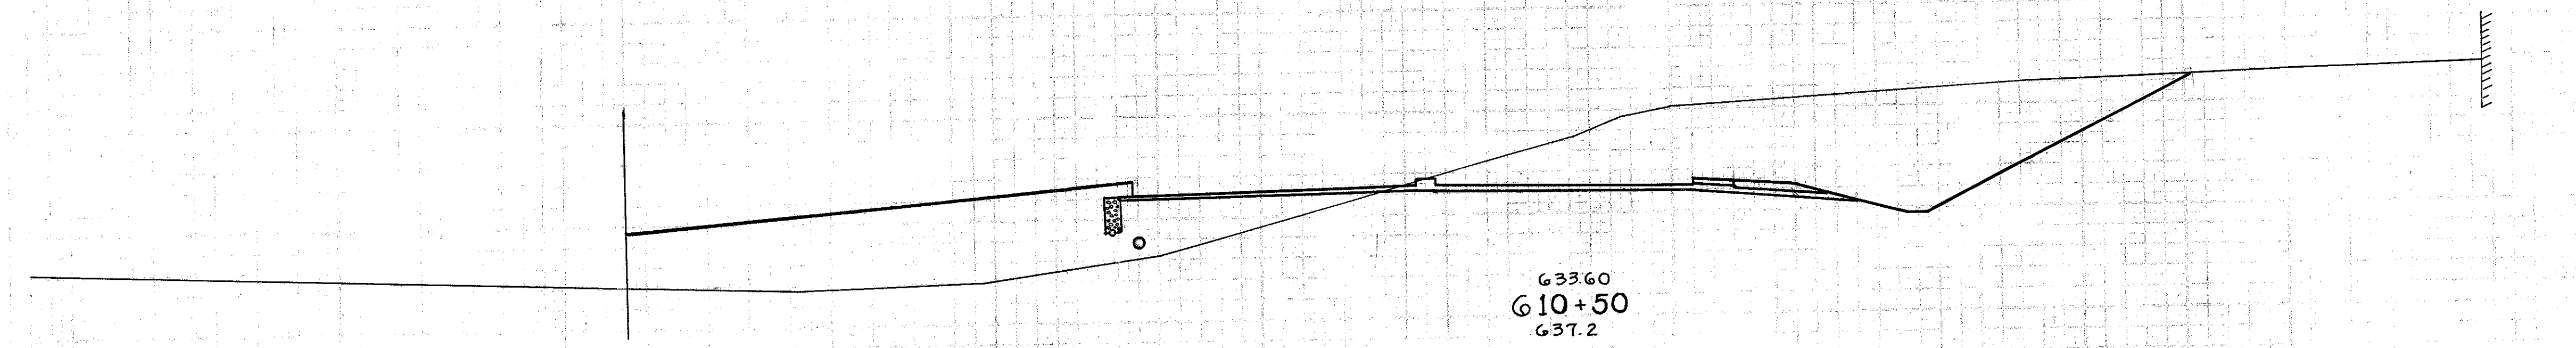

633.60  
**610+50**  
637.2

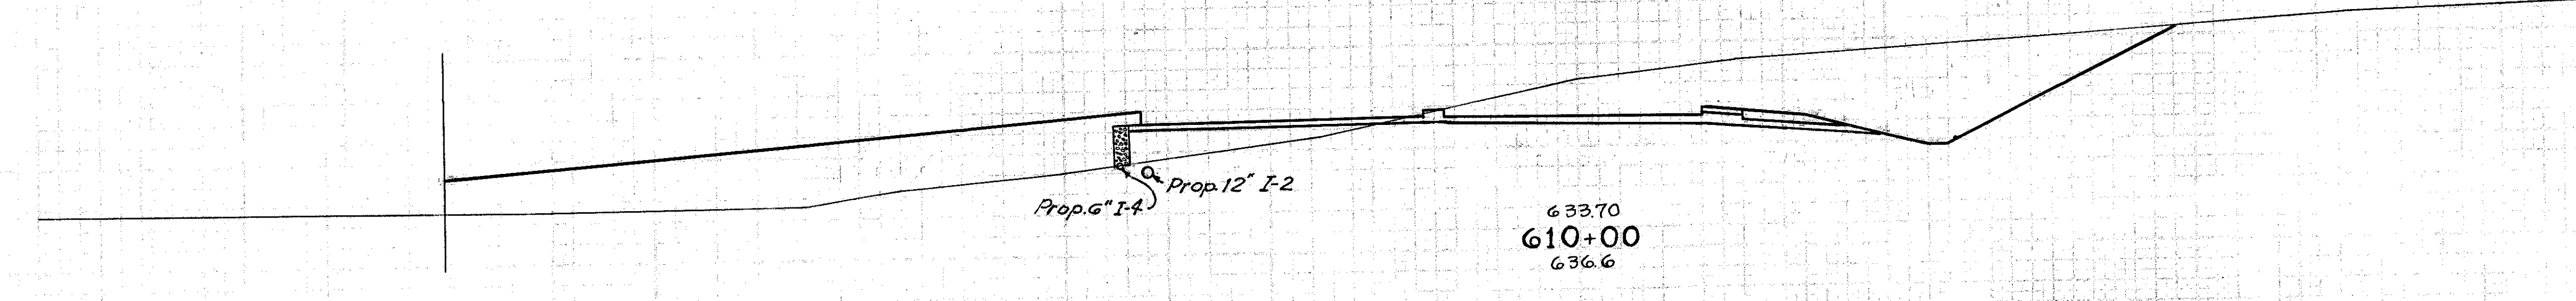

Prop. 6" I-4  
Prop. 12" I-2

633.70  
**610+00**  
636.6

End Area		Cu. Yds.	
Cut	Fill	Cut	Fill
368	468		
		854	802
554	398		
		1021	773
549	437		
		896	782
419	407		
		403	439

Sta. 600+00 to Sta. 610+00  
18105 Cu. Yds.  
Embankment  
Embankment + 15% 20700 Cu. Yds.


150 140 130 120 110 100 90 80 70 60 50 40 30 20 10 0 10 20 30 40 50 60 70 80 90 100 110 120 130 140

STA. 610+00 TO 611+50

150 140 130 120 110 100 90 80 70 60 50 40 30 20 10 0 10 20 30 40 50 60 70 80 90 100 110 120 130 140 150

106  
222  
2 0110  
Date: 11-16-53 (18 15)

Ahead Back

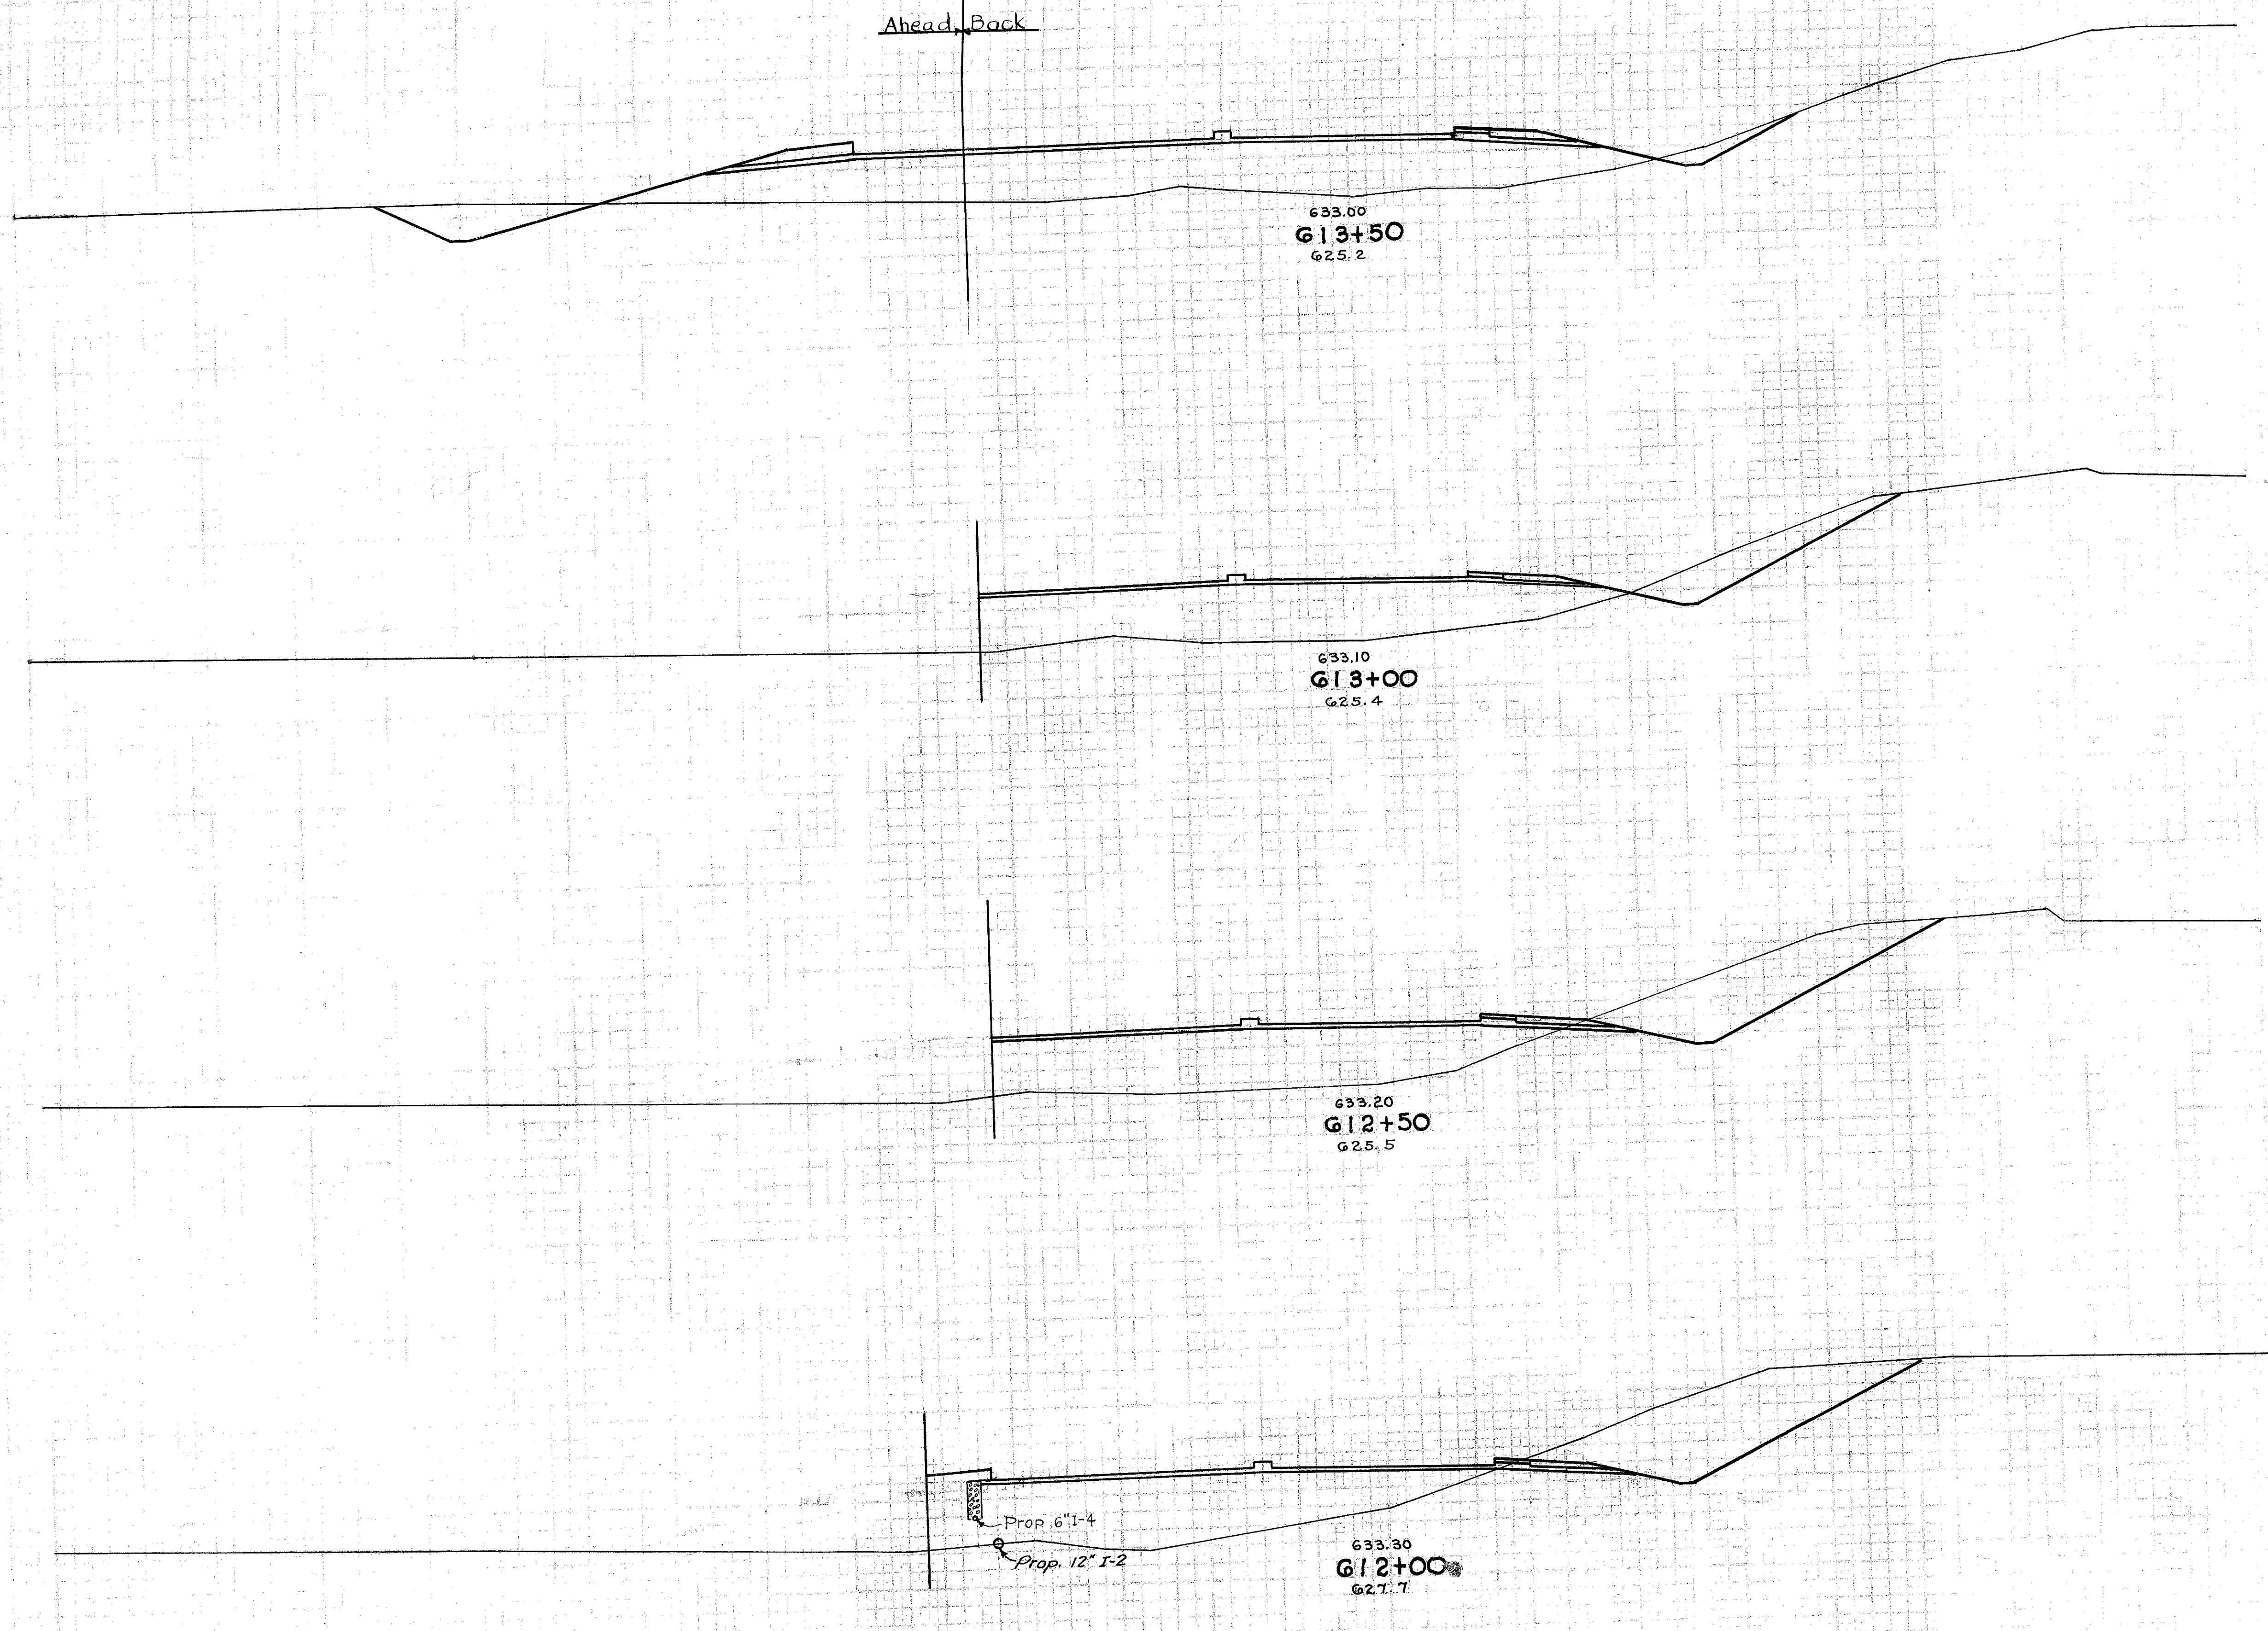


	End Area		Cu. Yds.	
	Cut	Fill	Cut	Fill
Ahead	76	568		
Back	15	403		
			92	756
	84	413		
			264	732
	201	378		
			430	758
	263	408		
			589	811

STA. 612+00 TO 613+50


150 140 130 120 110 100 90 80 70 60 50 40 30 20 10 0 10 20 30 40 50 60 70 80 90 100 110 120 130 140

150 140 130 120 110 100 90 80 70 60 50 40 30 20 10 0 10 20 30 40 50 60 70 80 90 100 110 120 130 140 150


107  
222

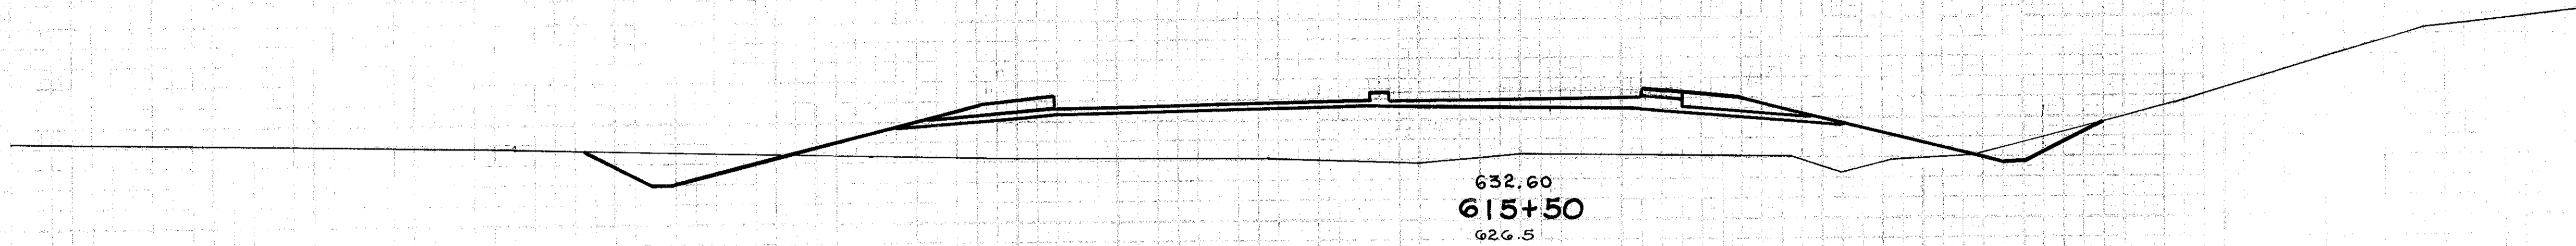


632.60  
**615+50**  
626.5

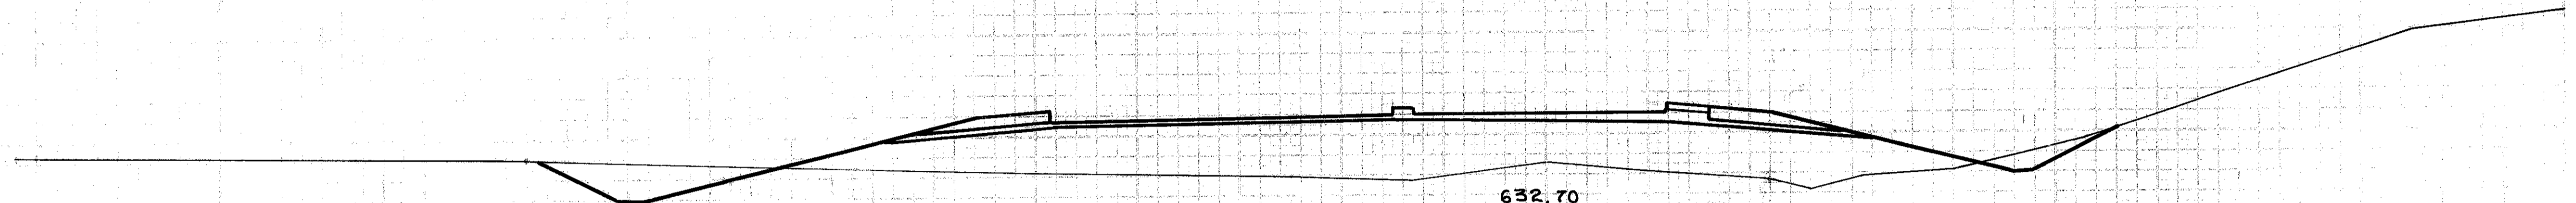

632.70  
**615+00**  
627.2

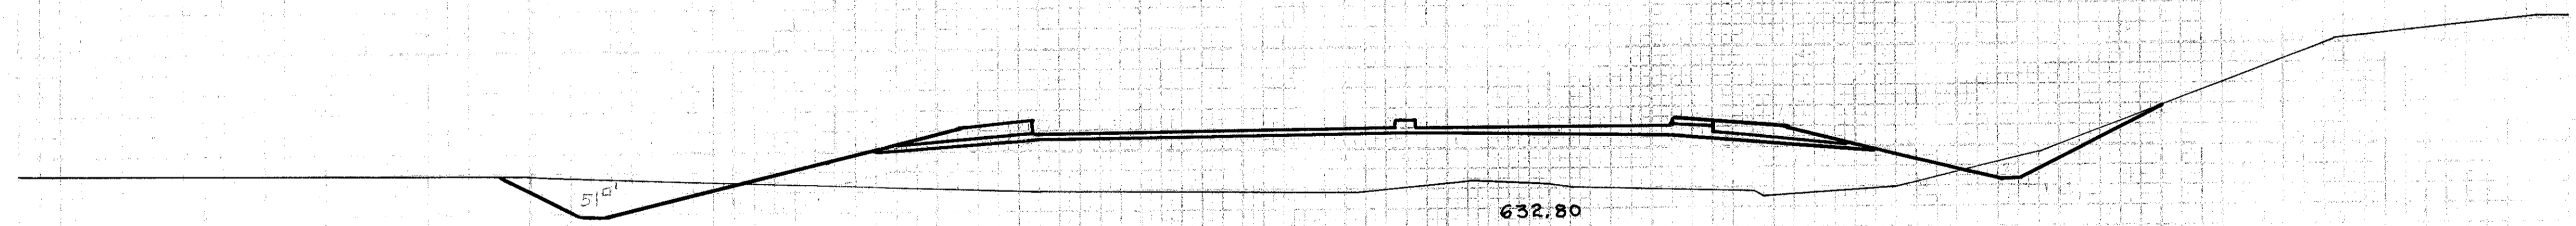

632.80  
**614+50**  
626.5

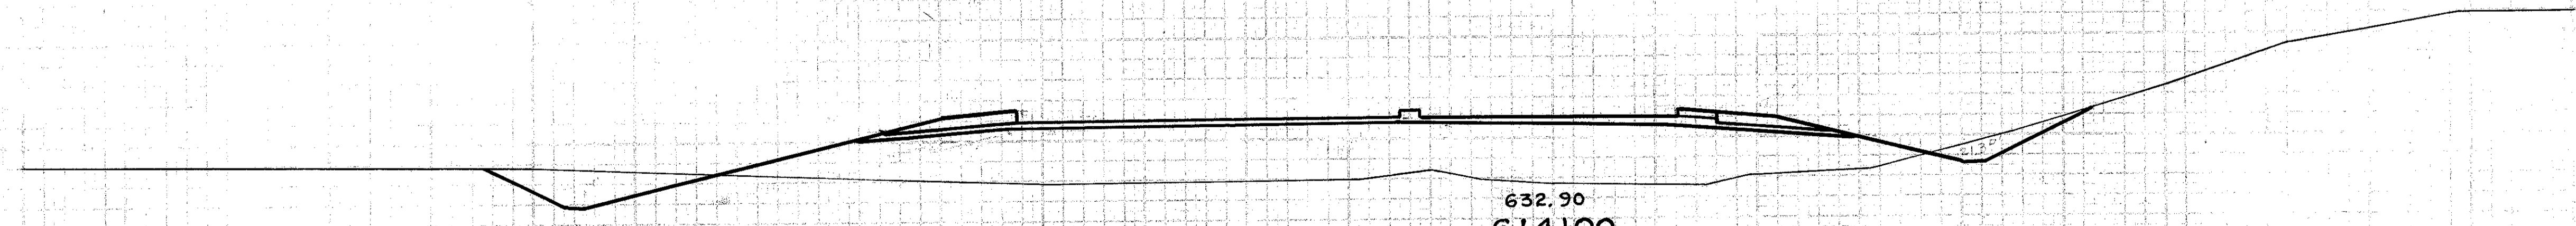

632.90  
**614+00**  
625.5





End Area		Cu. Yds.	
Cut	Fill	Cut	Fill
49	490		
		108	957
68	543		
		131	1050
73	591		
		132	1089
69	585		
		134	1068

150 140 130 120 110 100 90 80 70 60 50 40 30 20 10 0 10 20 30 40 50 60 70 80 90 100 110 120 130 140

STA. 614+00 TO 615+50

150 140 130 120 110 100 90 80 70 60 50 40 30 20 10 0 10 20 30 40 50 60 70 80 90 100 110 120 130 140 150

108  
222  
1947-4-15

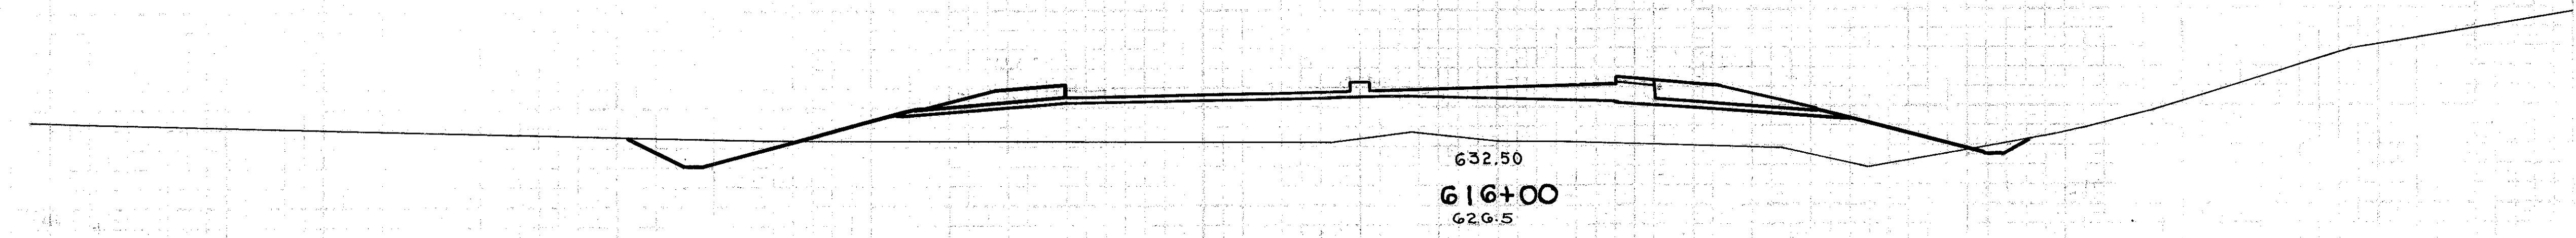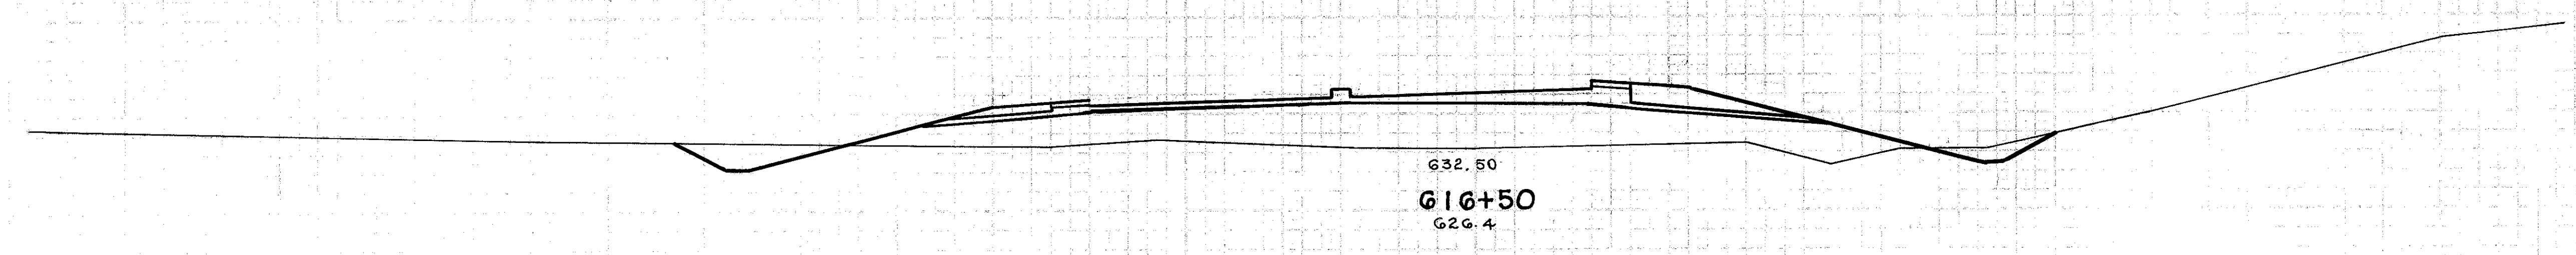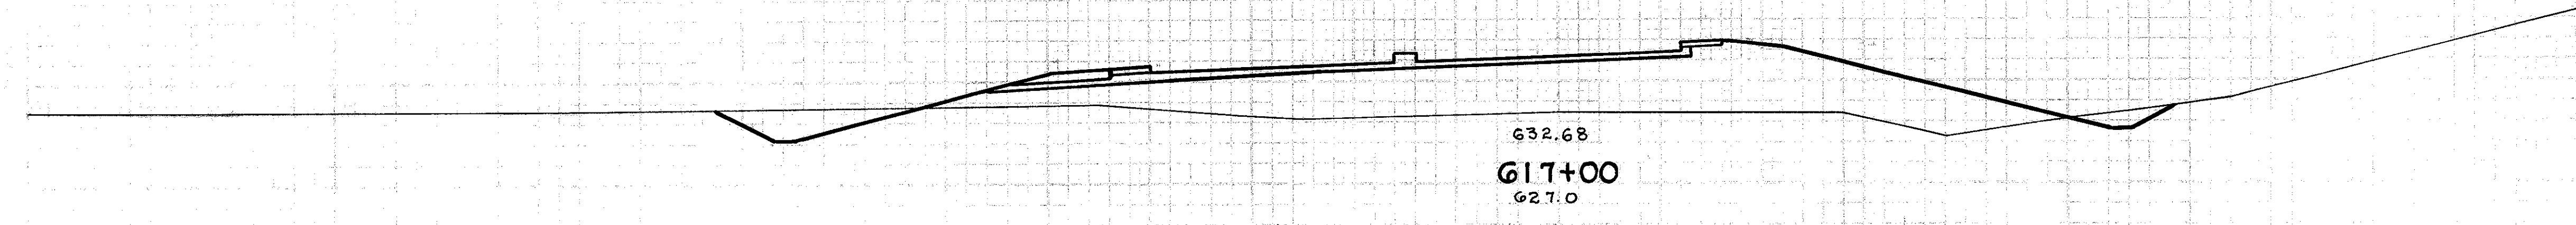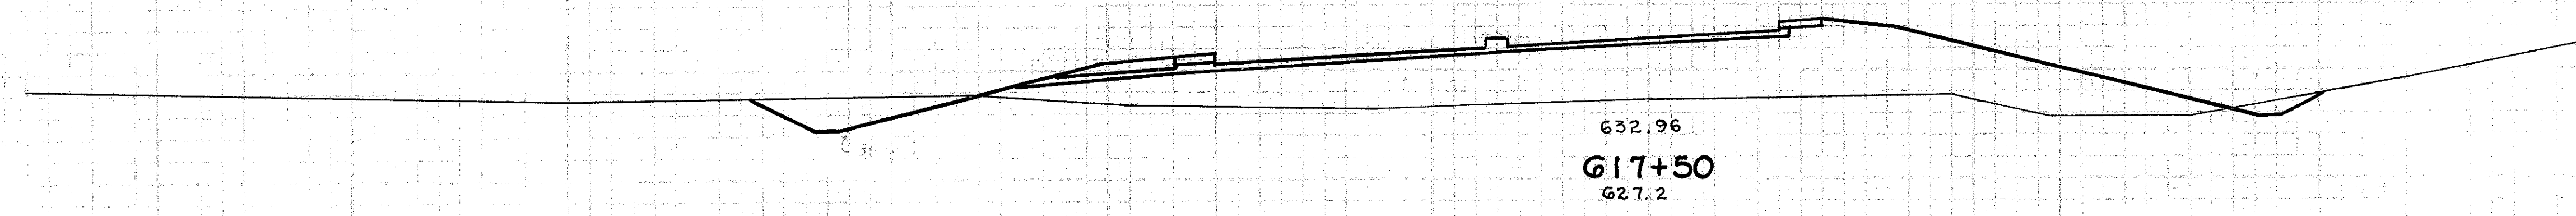


End Area		Cu. Yds.	
Cut	Fill	Cut	Fill
39	492		
		76	882
43	466		
		74	824
37	424		
		59	835
27	478		
		70	896

150 140 130 120 110 100 90 80 70 60 50 40 30 20 10 0 10 20 30 40 50 60 70 80 90 100 110 120 130 140


STA. 616+00 TO 617+50

150 140 130 120 110 100 90 80 70 60 50 40 30 20 10 0 10 20 30 40 50 60 70 80 90 100 110 120 130 140 150


109  
222

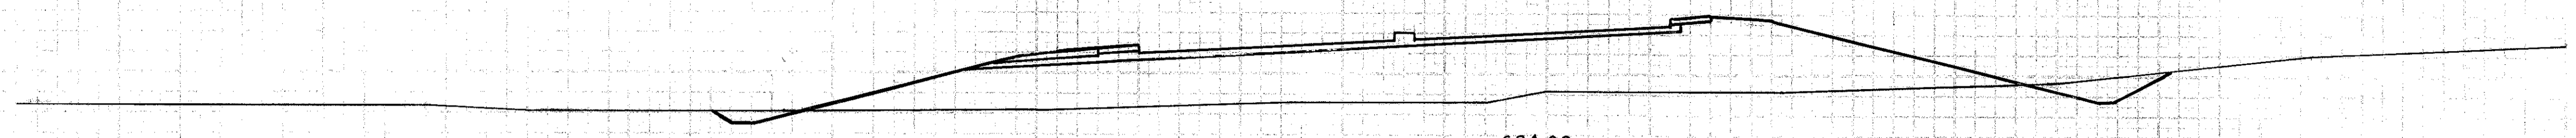


634.08  
619+50  
628.5

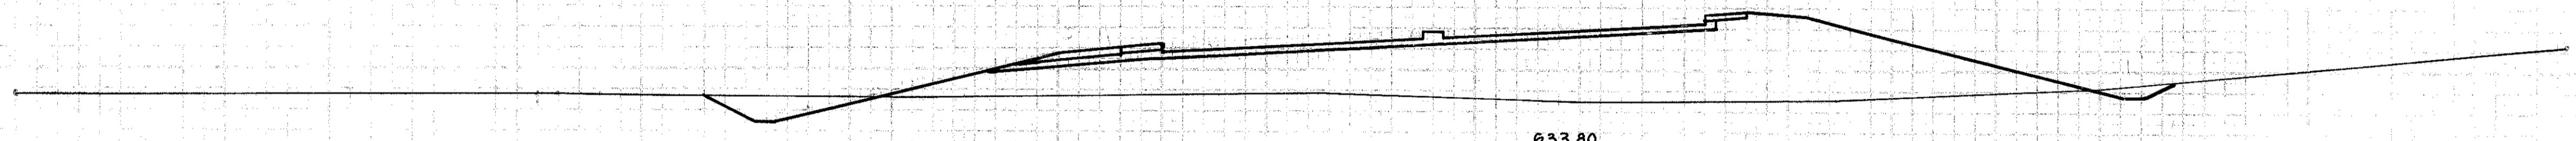

633.80  
619+00  
627.0

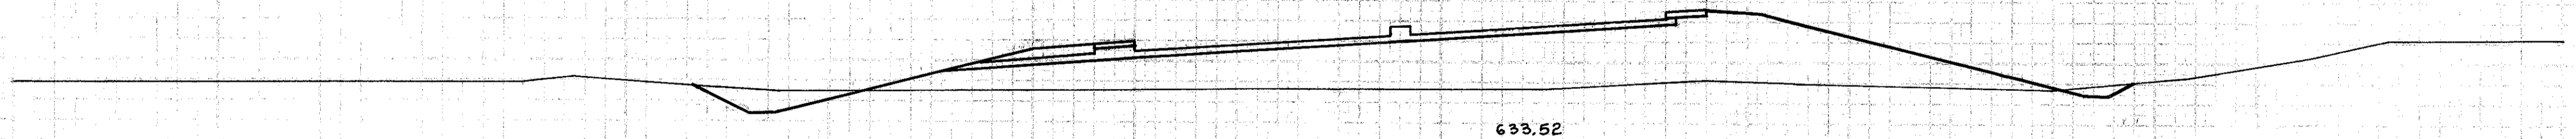

633.52  
618+50  
627.4

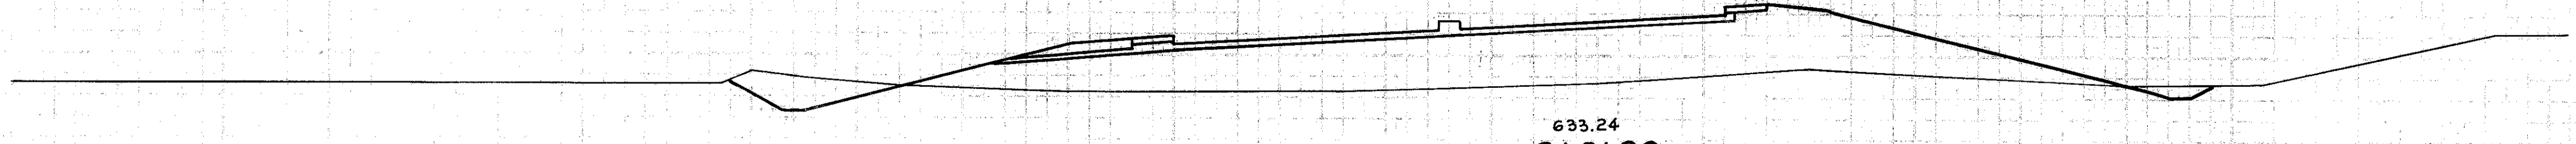

633.24  
618+00  
627.5


End Area	Cut Yds.		Fill Yds.	
	Cut	Fill	Cut	Fill
27	555			
		53	1003	
30	528			
		53	920	
27	466			
		58	874	
36	478			
		62	898	

150 140 130 120 110 100 90 80 70 60 50 40 30 20 10 0 10 20 30 40 50 60 70 80 90 100 110 120 130 140

STA. 618+00 TO 619+50

150 140 130 120 110 100 90 80 70 60 50 40 30 20 10 0 10 20 30 40 50 60 70 80 90 100 110 120 130 140 150

110  
222

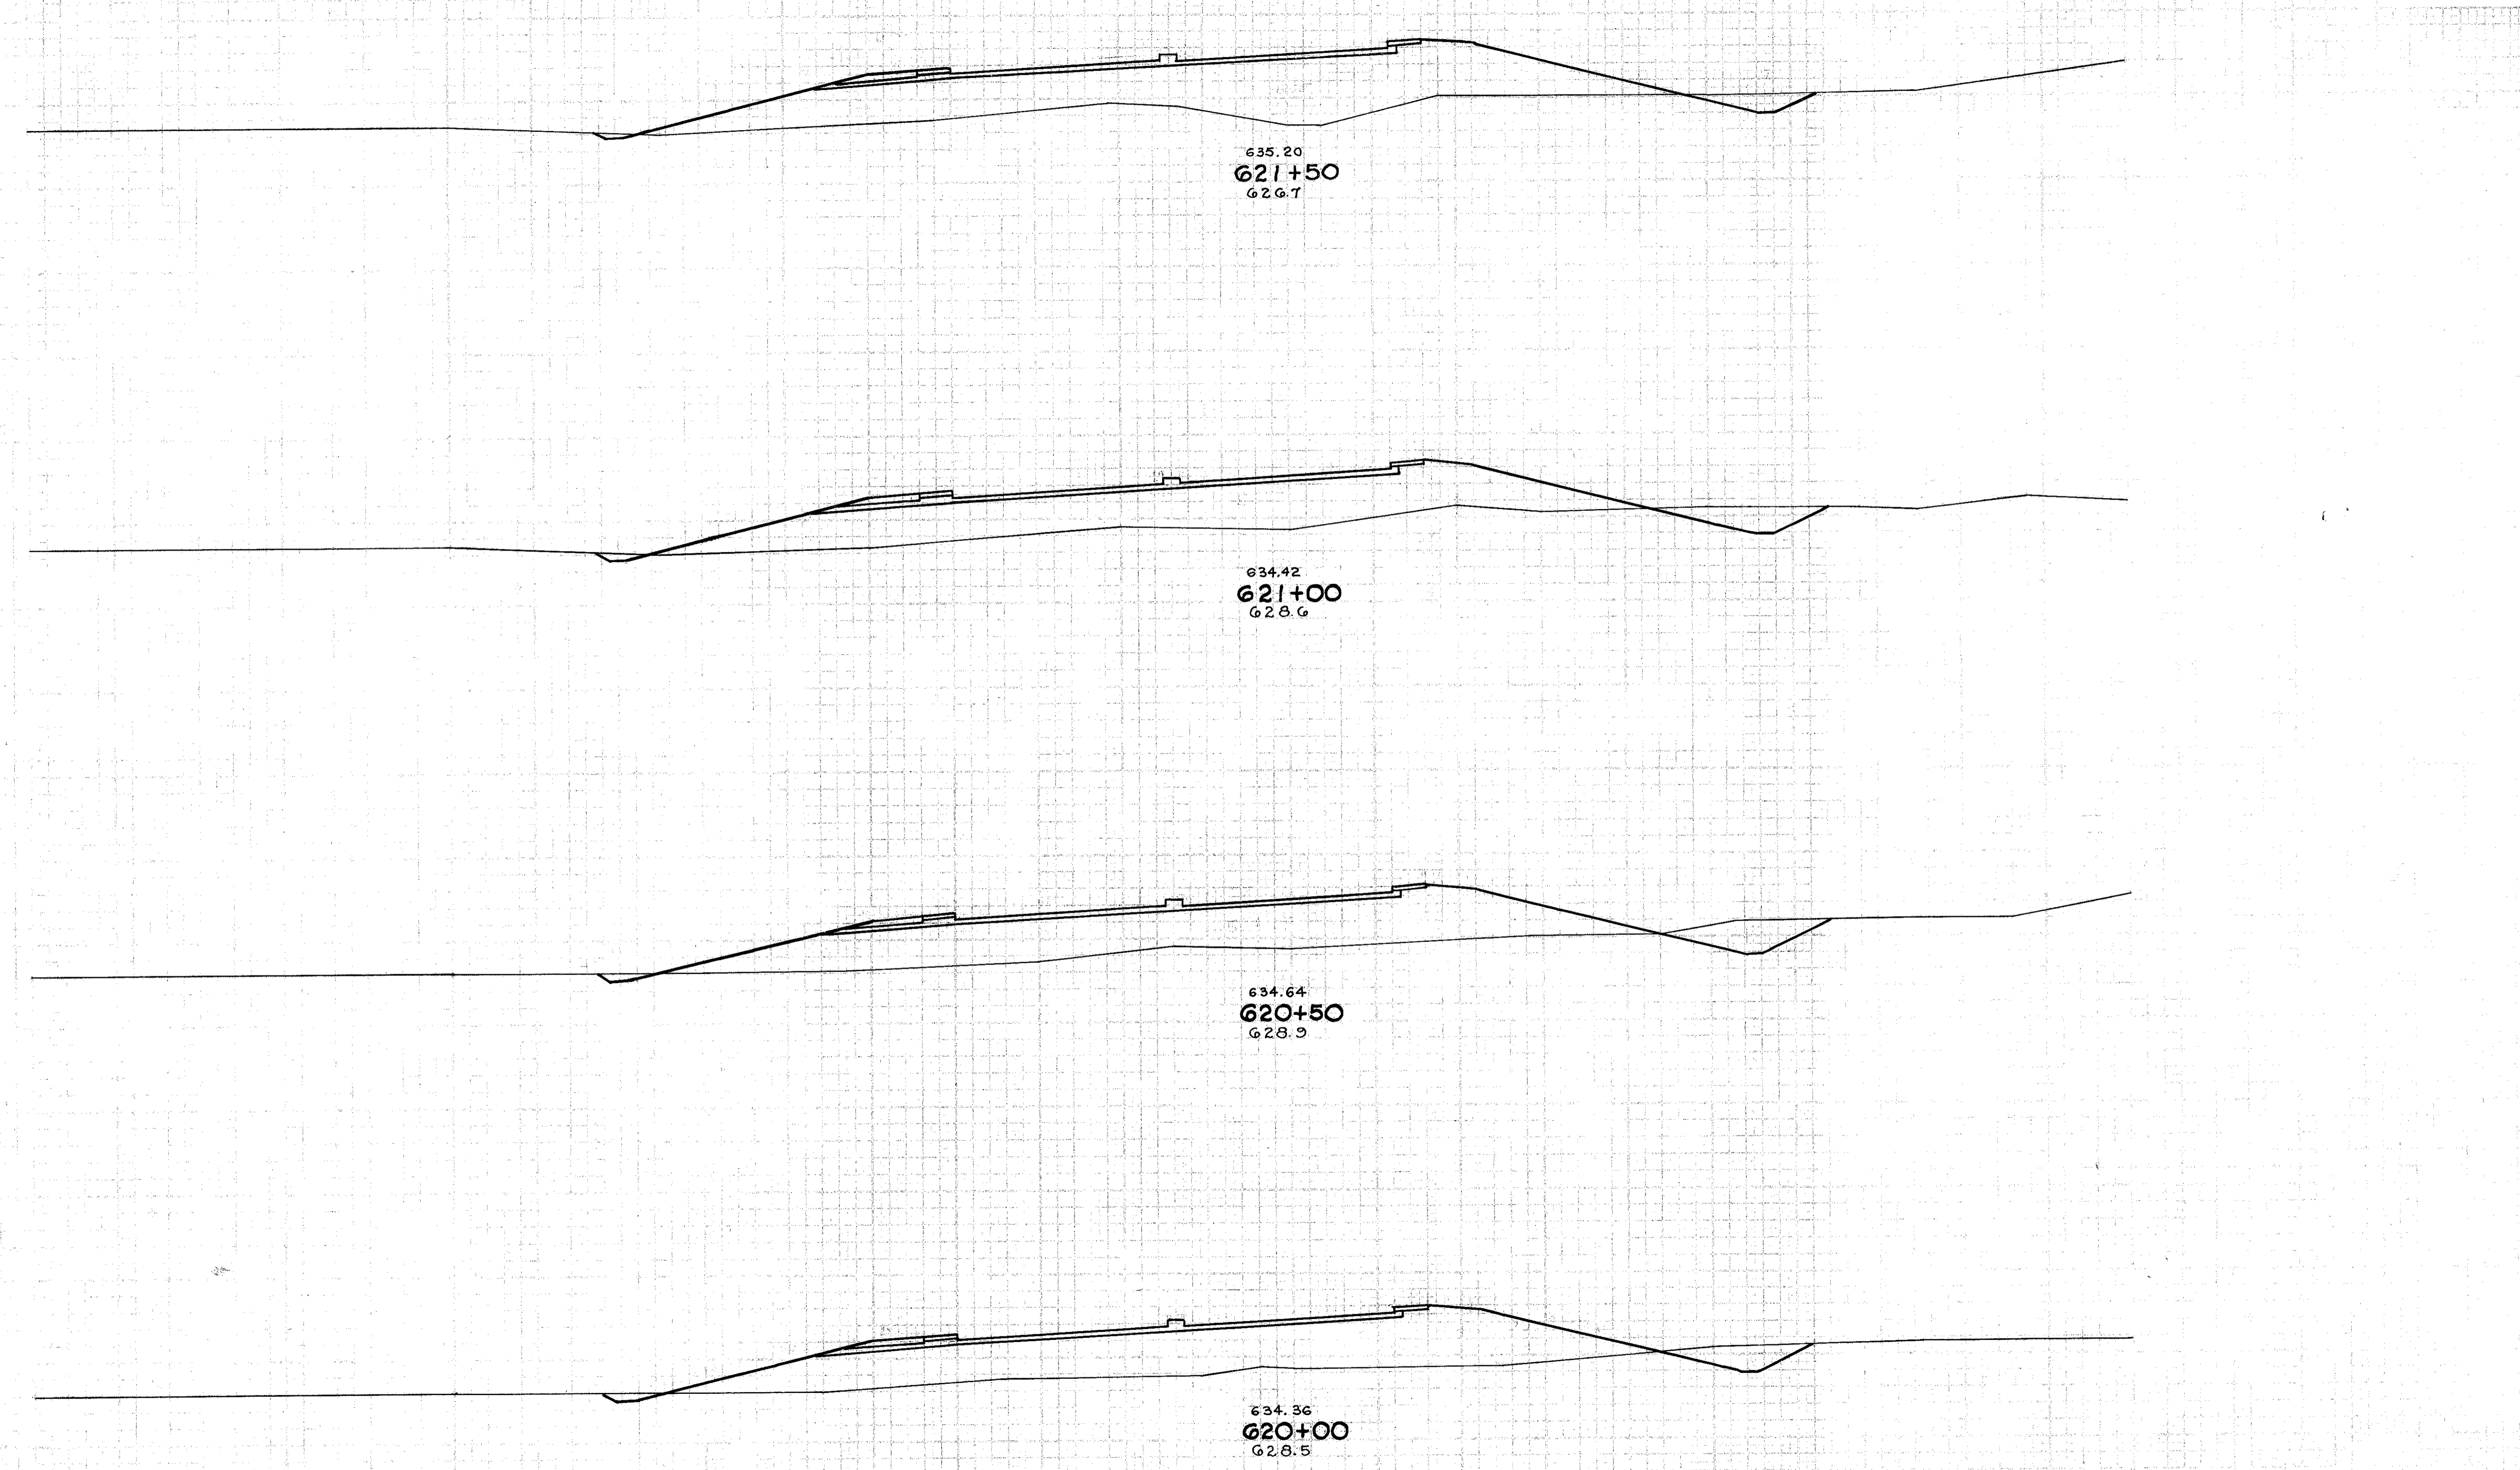

635.20  
**621+50**  
626.7

634.42  
**621+00**  
628.6

634.64  
**620+50**  
628.9

634.36  
**620+00**  
628.5

End Area		Cu. Yds.	
Cut	Fill	Cut	Fill
19	611		
		57	1042
13	514		
		84	976
13	540		
		78	1016
36	557		
		58	1030


Sta 610+00 to Sta 620+00  
Embankment 5221 Cu. Yds.  
Embankment 17740 Cu. Yds.  
Embankment +15% 20401 Cu. Yds.

150 140 130 120 110 100 90 80 70 60 50 40 30 20 10 0 10 20 30 40 50 60 70 80 90 100 110 120 130 140

STA. 620+00 TO 621+5

150 140 130 120 110 100 90 80 70 60 50 40 30 20 10 0 10 20 30 40 50 60 70 80 90 100 110 120 130 140 150

111  
222

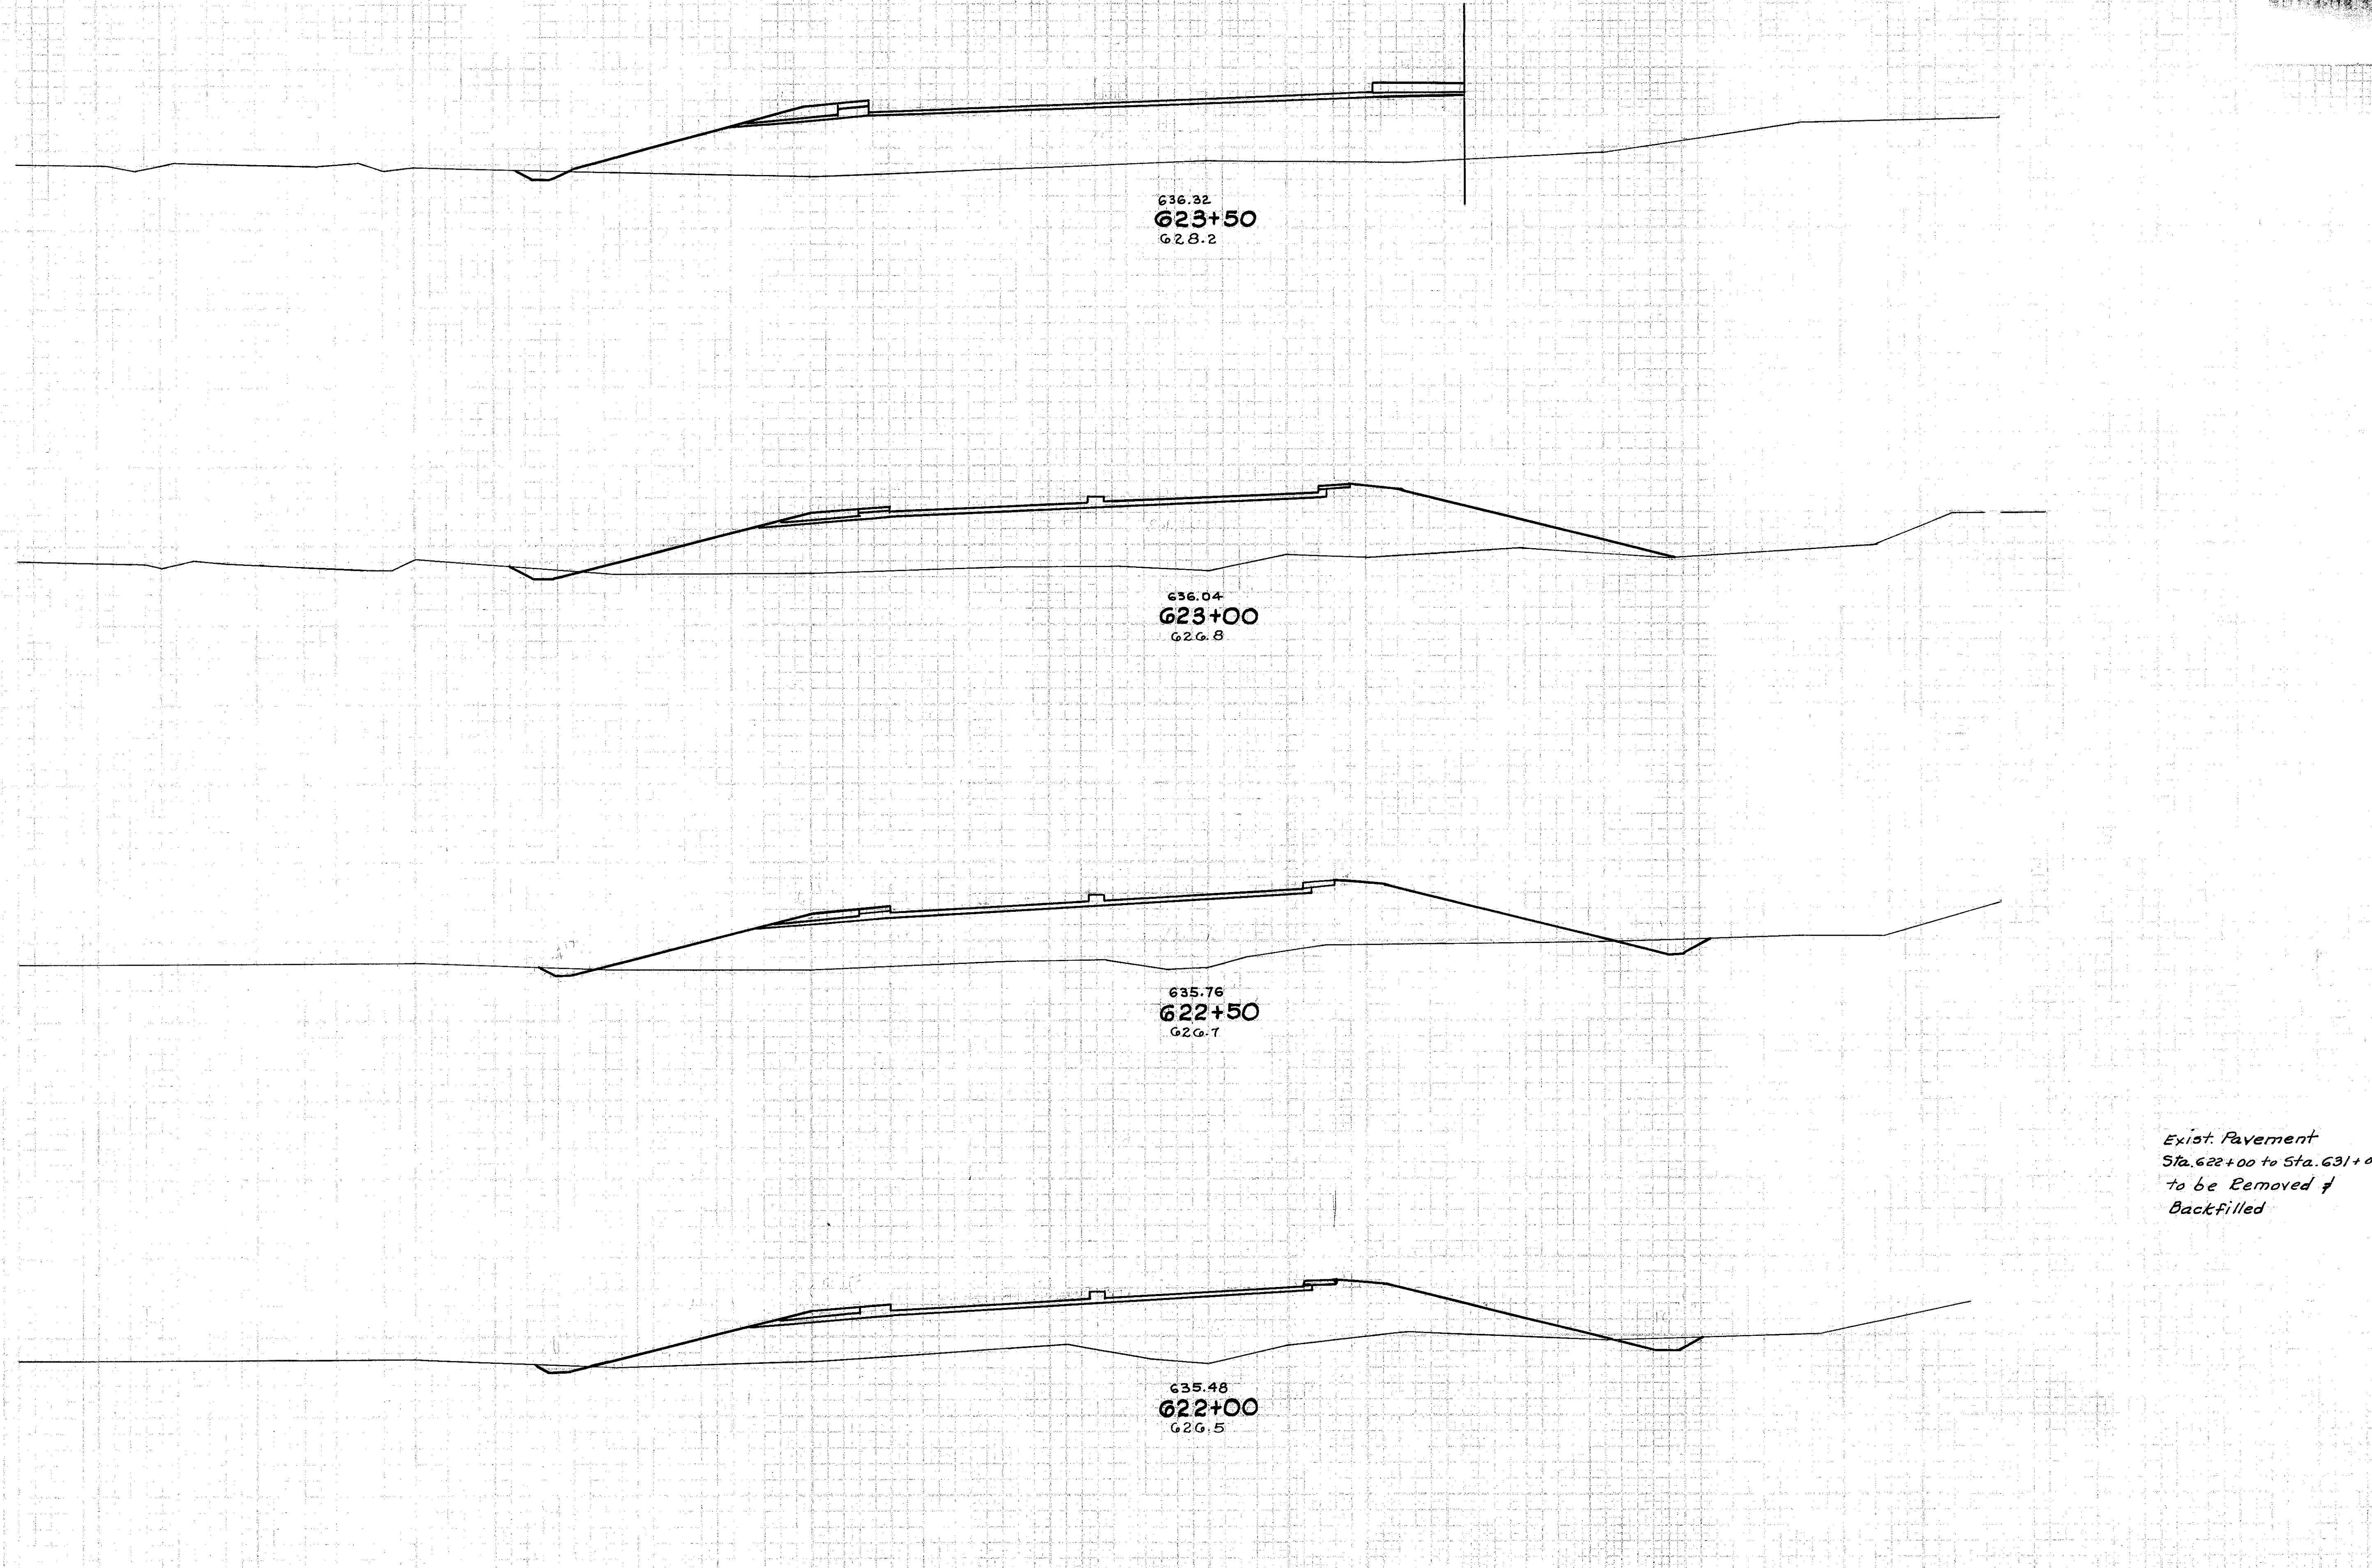

Sta.	End Area		Cu. Yds.	
	Cut	Fill	Cut	Fill
5	774			
10			1464	
6	807			
20			1420	
16	727			
23			1259	
			435	435
14	633			
31			1152	


Exist. Pavement  
Sta. 622+00 to Sta. 631+00  
to be Removed &  
Backfilled

150 140 130 120 110 100 90 80 70 60 50 40 30 20 10 0 10 20 30 40 50 60 70 80 90 100 110 120 130 140


STA. 622+00 TO 623+50

150 140 130 120 110 100 90 80 70 60 50 40 30 20 10 0 10 20 30 40 50 60 70 80 90 100 110 120 130 140 150

112  
222  
11.2.11.93.18.15

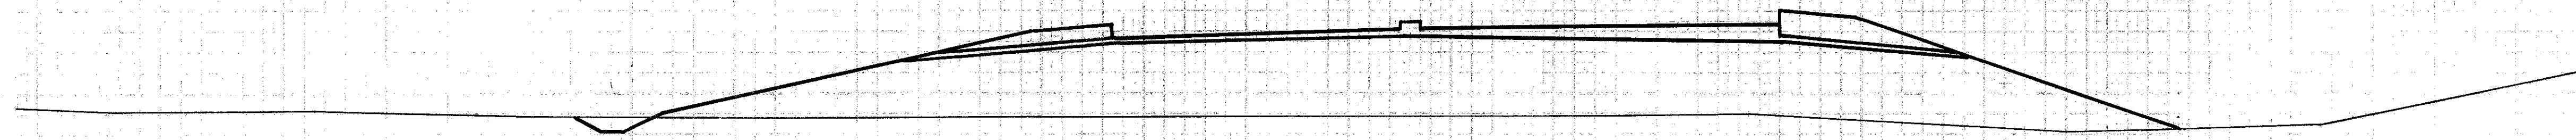


636.88  
624+50  
627.9

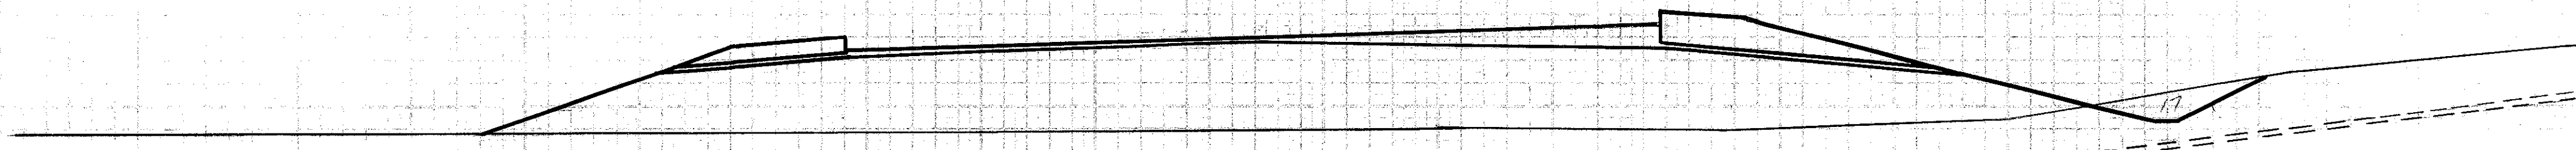


Exist. 6" Water Main

636.77  
624+30  
628.1

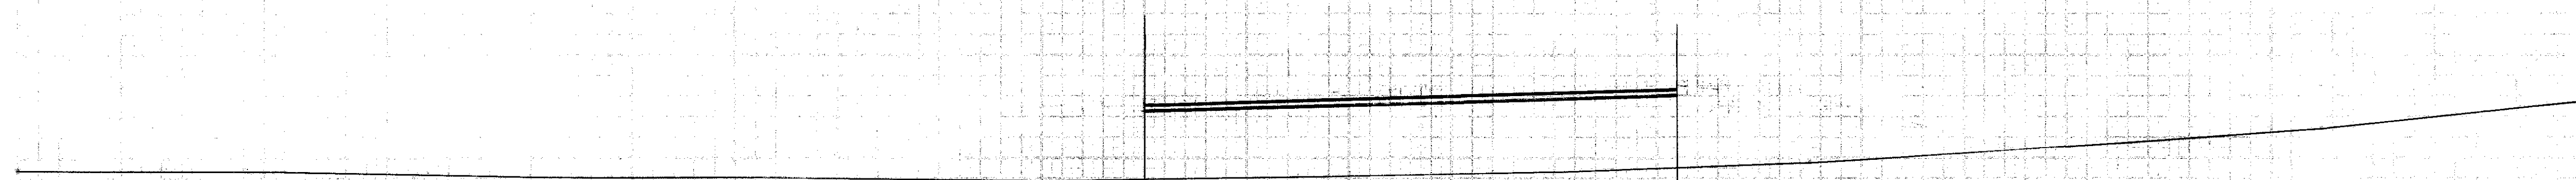

636.60  
624+00  
628.8

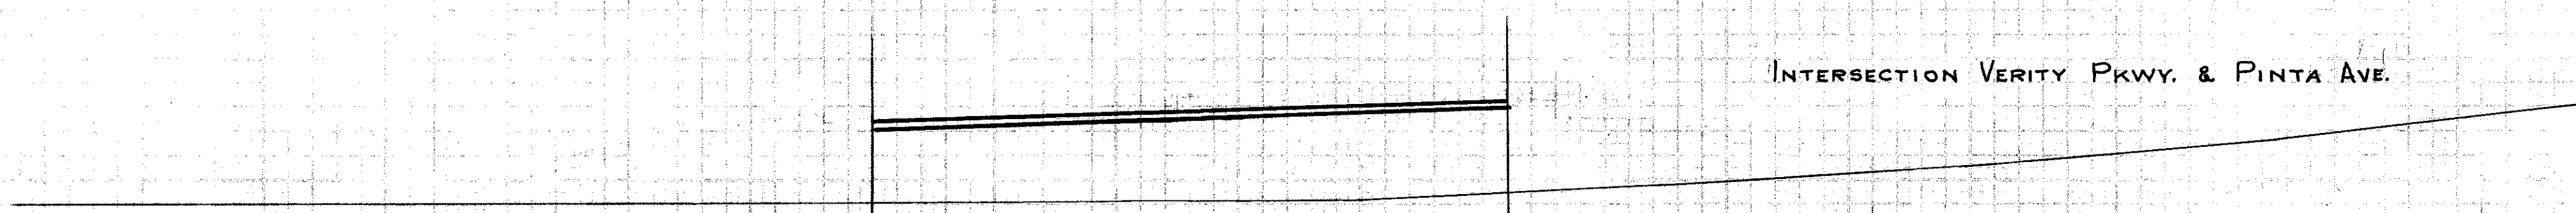

636.43  
623+70  
628.5

INTERSECTION VERITY PKWY. & PINTA AVE.

Verity Pkwy.  
Minnesota Ave.  
Pinta Ave.

End Area		Cu. Yds.	
Cut	Fill	Cut	Fill
8	974		
		9	700
17	917		
		9	719
-	377		
		624	2137
		65	552
		71	1821
-	407		
-	358		
		2	419





150 140 130 120 110 100 90 80 70 60 50 40 30 20 10 0 10 20 30 40 50 60 70 80 90 100 110 120 130 140

STA. 623+70 TO 624+5



150 140 130 120 110 100 90 80 70 60 50 40 30 20 10 0 10 20 30 40 50 60 70 80 90 100 110 120 130 140 150

113  
222

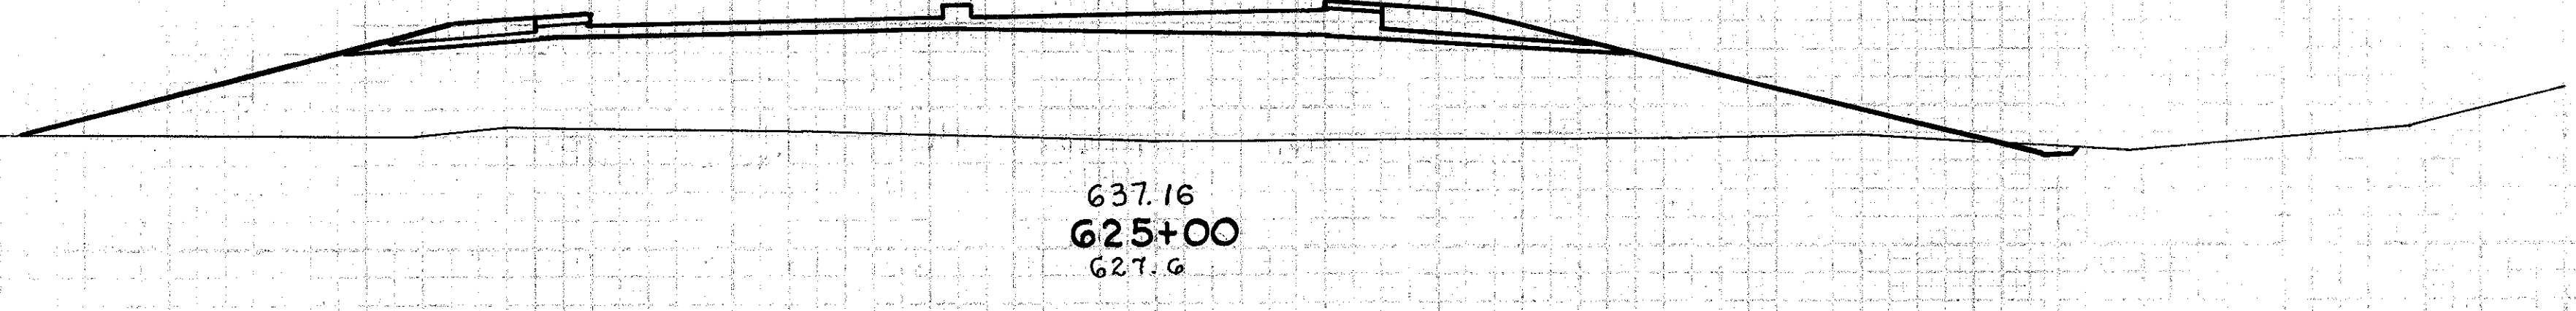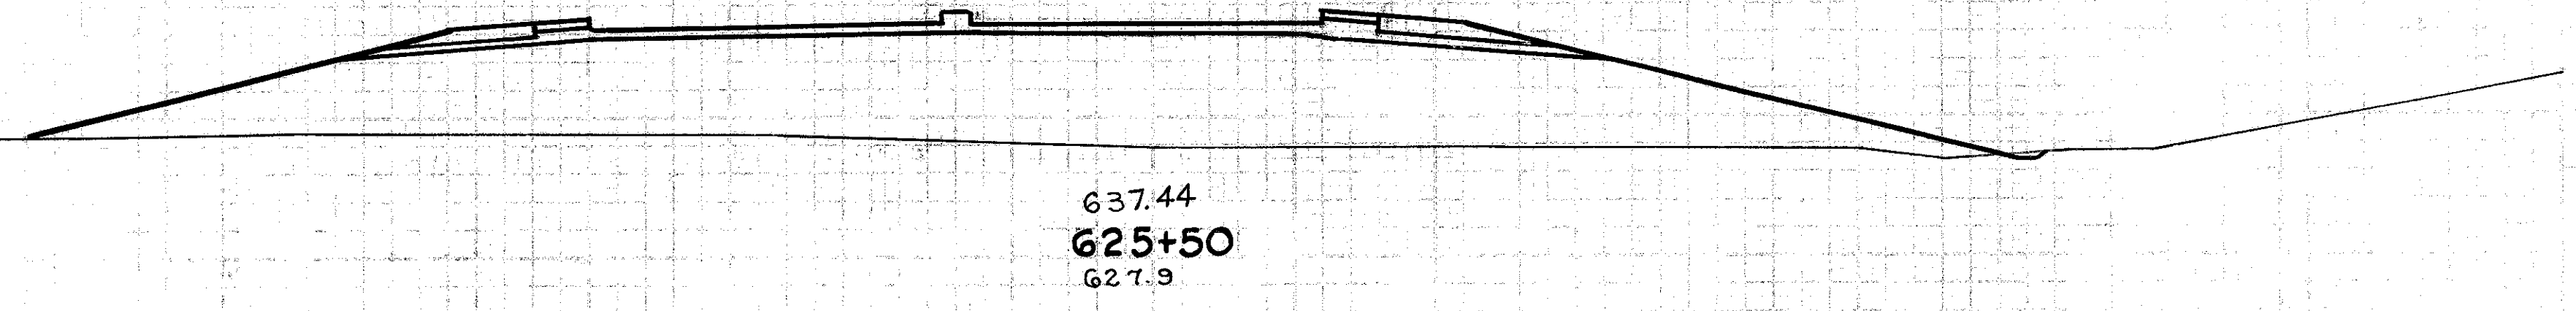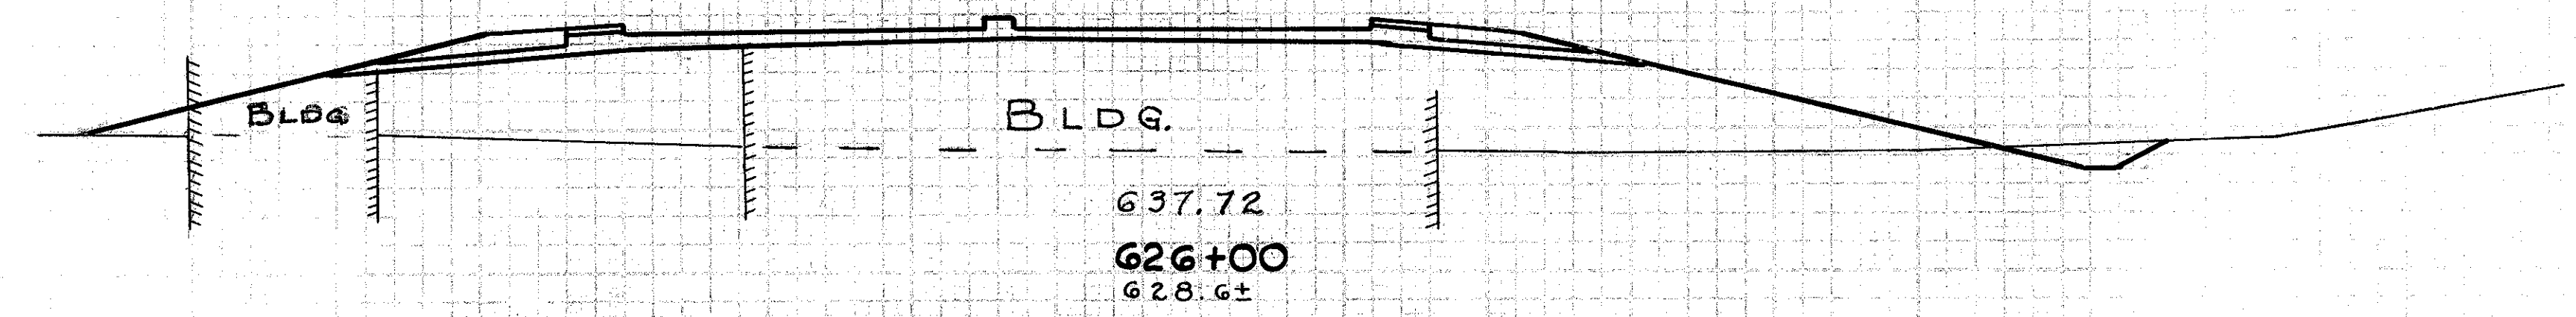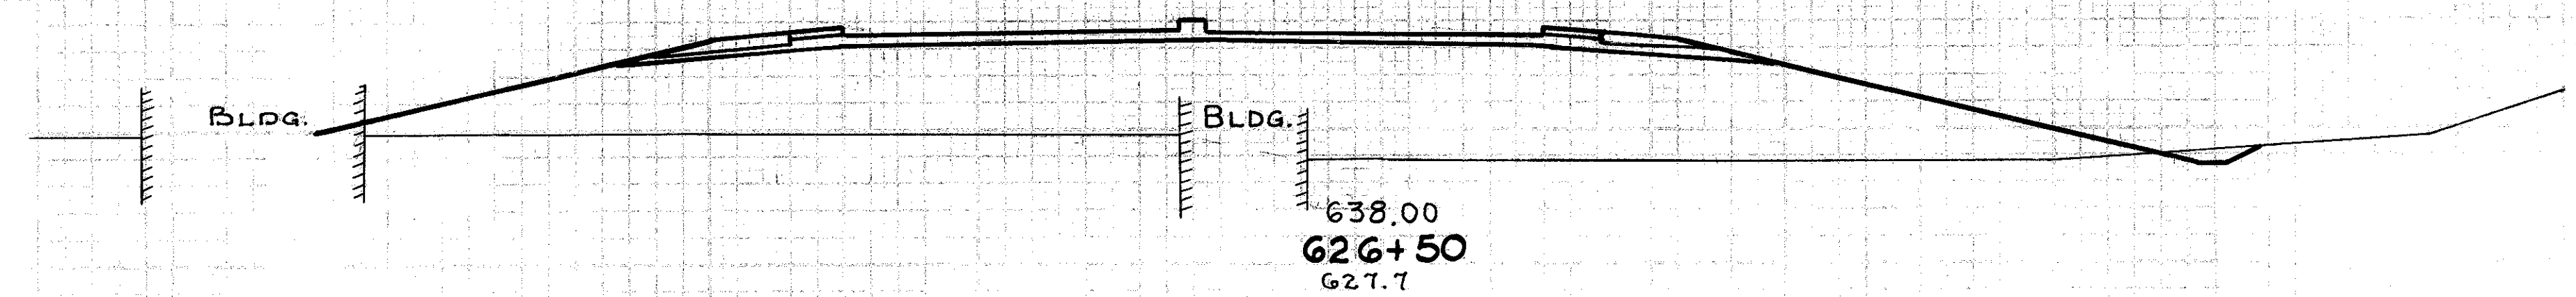

Houses #2801  
#2805


Sta.	End Area		Cu. Yds.	
	Cut	Fill	Cut	Fill
6		839		
11		782		
1		820		
2		846		
			134	138
			16	1501
			11	1483
			3	1357
			9	1685

150 140 130 120 110 100 90 80 70 60 50 40 30 20 10 0 10 20 30 40 50 60 70 80 90 100 110 120 130 140


STA. 625+00 TO 626+50

150 140 130 120 110 100 90 80 70 60 50 40 30 20 10 0 10 20 30 40 50 60 70 80 90 100 110 120 130 140 150


114  
222  
DATE: 4-7-18, 8:30 AM

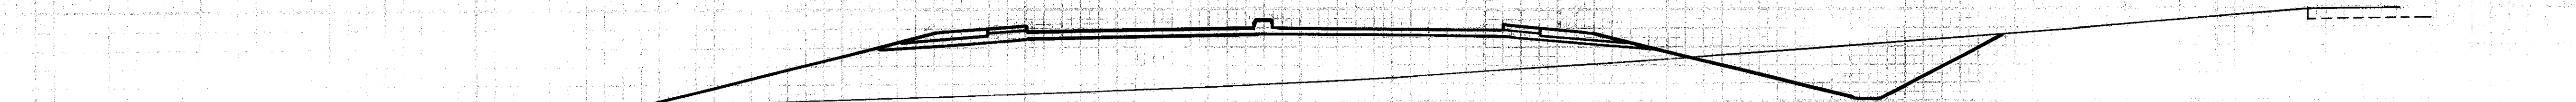


638.87  
**628+05**  
632.6

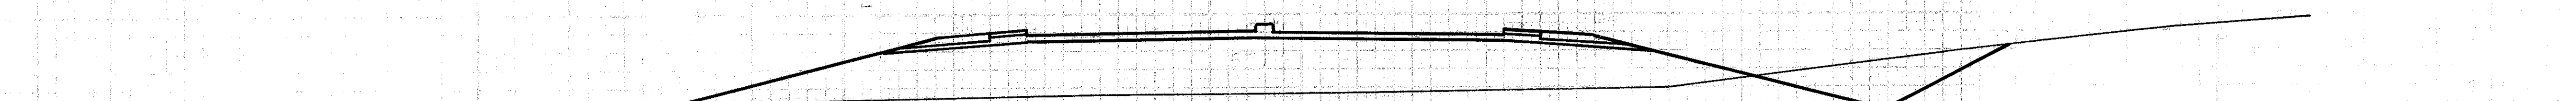


638.84  
**628+00**  
631.5

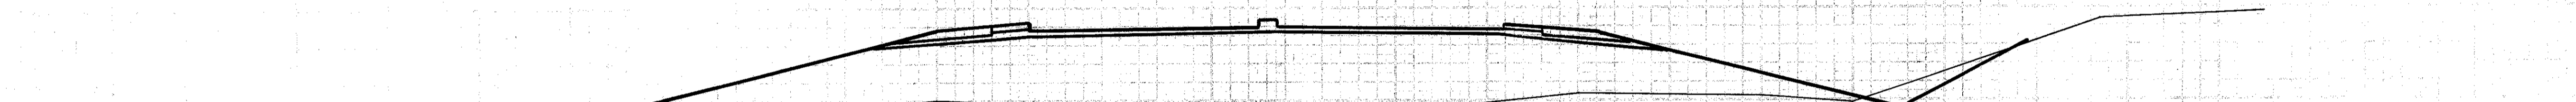

638.76  
**627+85**  
628.8

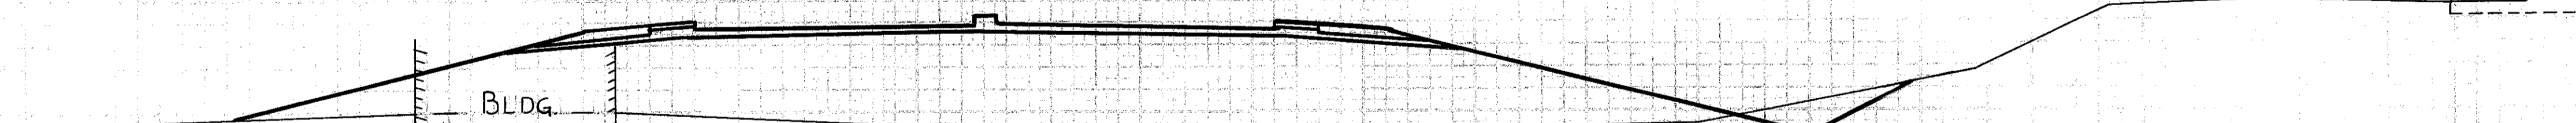

638.56  
**627+50**  
627.9

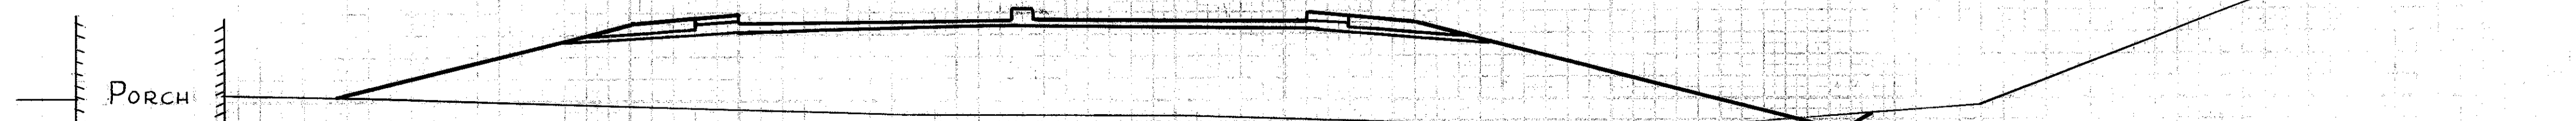

638.28  
**627+00**  
628.7


House #2509

End Area		Cu. Yds.	
Cut	Fill	Cut	Fill
121	515		
		18	102
74	589		
		27	404
22	866		
		36	1068
34	882		
		35	1703
			148
4	957		
		9	1663


150 140 130 120 110 100 90 80 70 60 50 40 30 20 10 0 10 20 30 40 50 60 70 80 90 100 110 120 130 140

STA. 627+00 TO 628+05


150 140 130 120 110 100 90 80 70 60 50 40 30 20 10 0 10 20 30 40 50 60 70 80 90 100 110 120 130 140 150

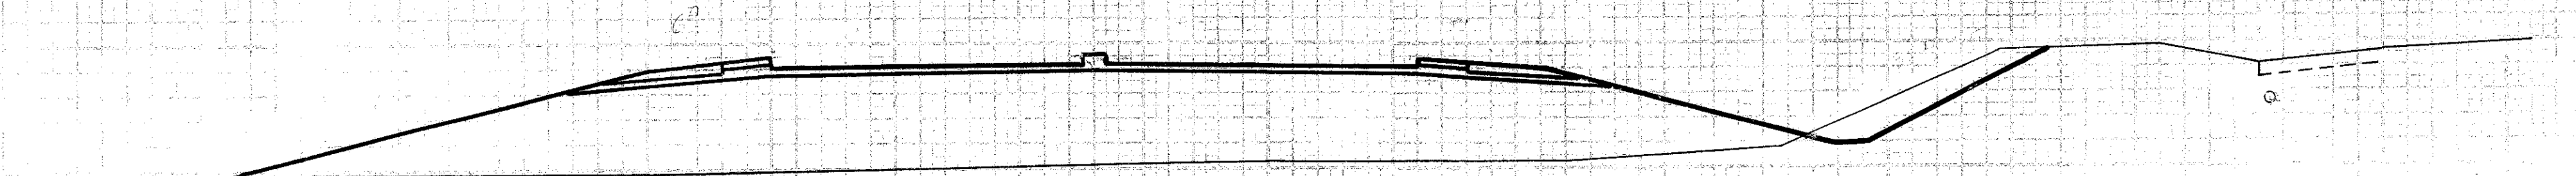


639.12  
**G28+50**  
630.5

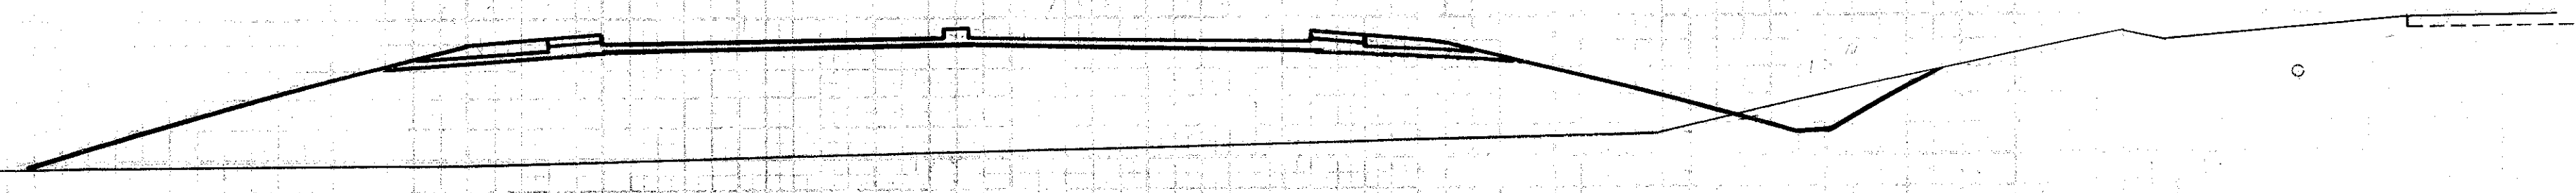

639.06  
**G28+40**  
630.6

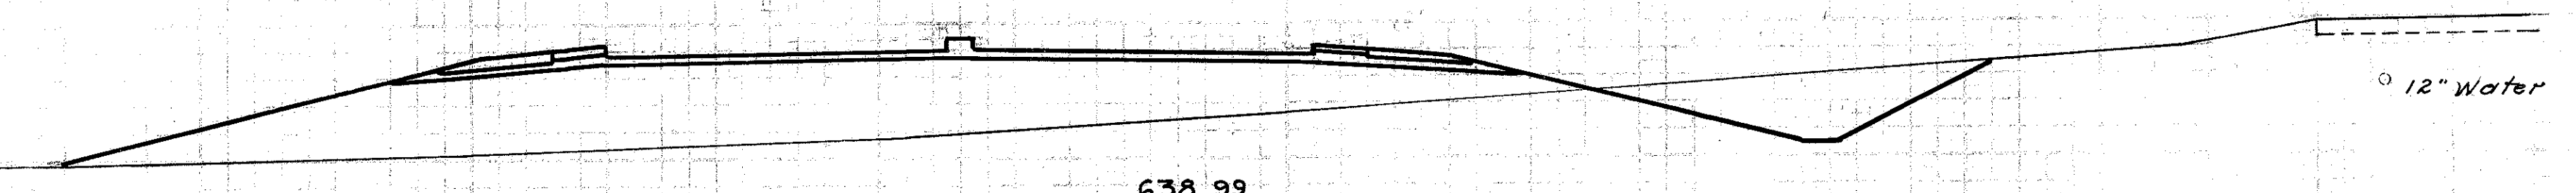

638.99  
**G28+20**  
632.7

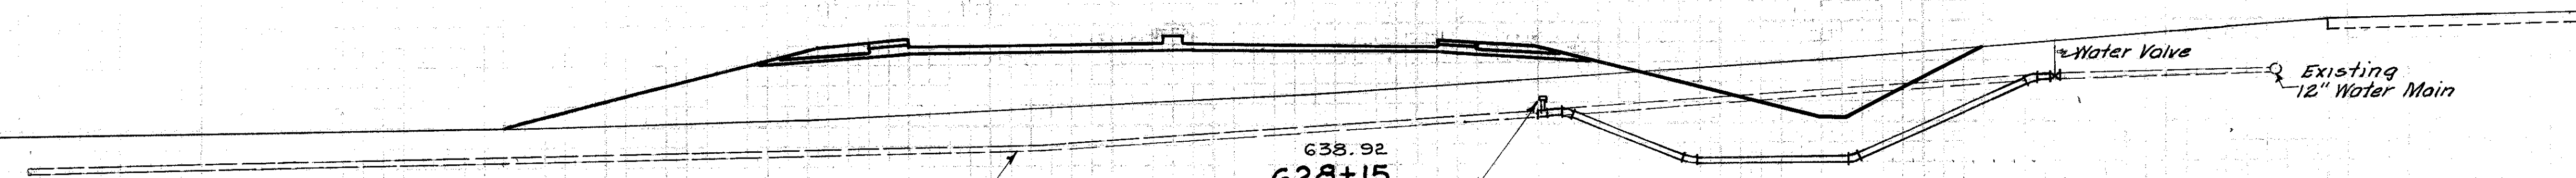

638.92  
**G28+15**  
632.9


End Area		Cu. Yds.	
Cut	Fill	Cut	Fill
32	793		
		8	284
12	752		
		24	331
82	525		
		32	169
111	491		
		43	186

150 140 130 120 110 100 90 80 70 60 50 40 30 20 10 0 10 20 30 40 50 60 70 80 90 100 110 120 130 140


STA. G28+15 TO G28+50

150 140 130 120 110 100 90 80 70 60 50 40 30 20 10 0 10 20 30 40 50 60 70 80 90 100 110 120 130 140 150


116  
222  
DATE 4-15-53

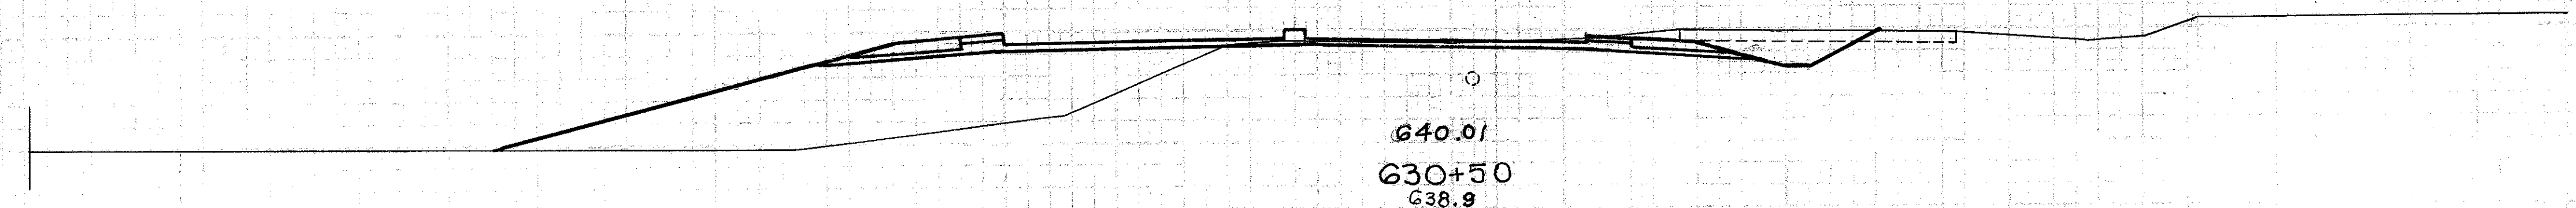


640.01  
630+50  
638.9

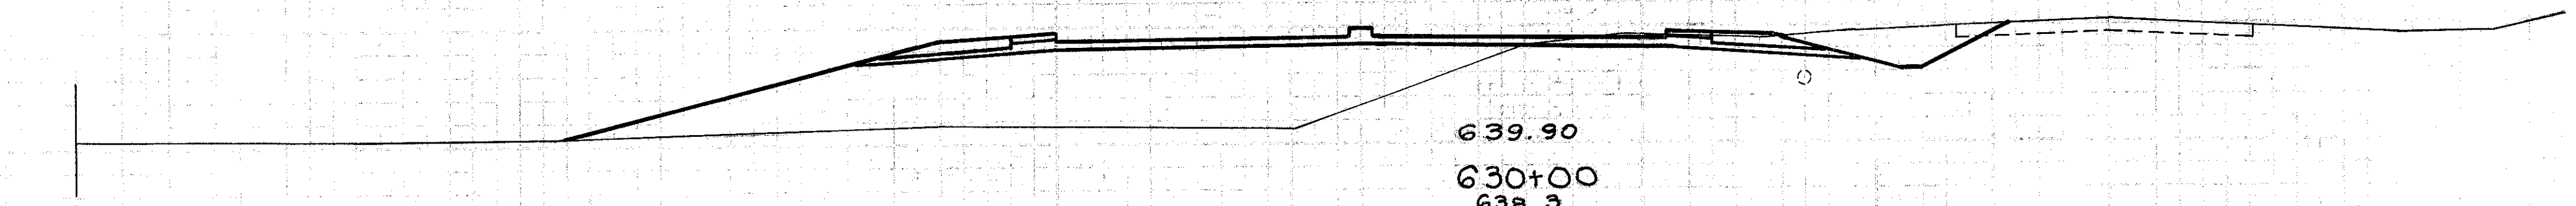

639.90  
630+00  
638.9

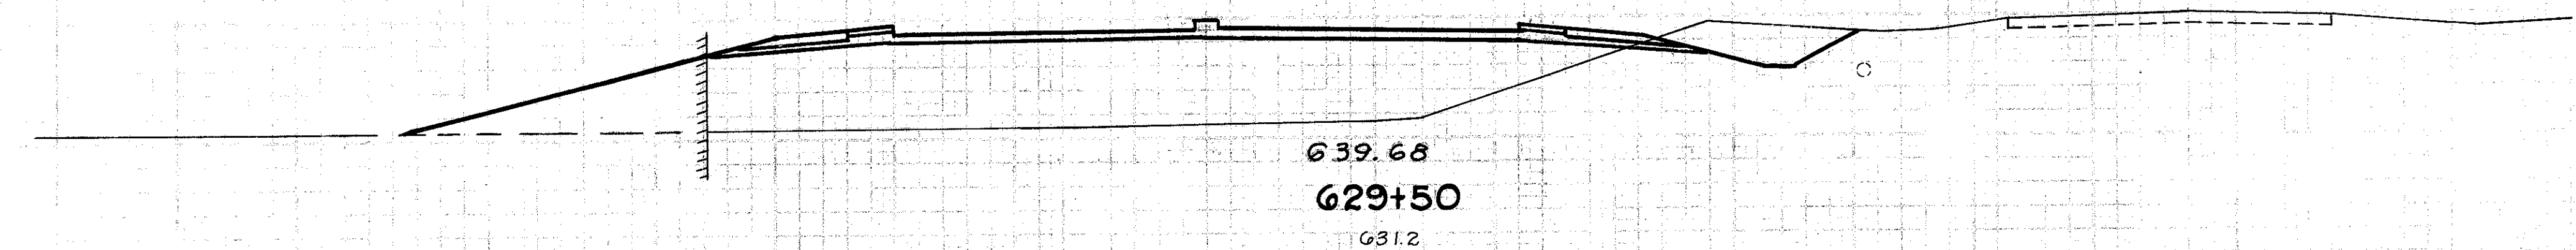

639.68  
629+50  
631.2

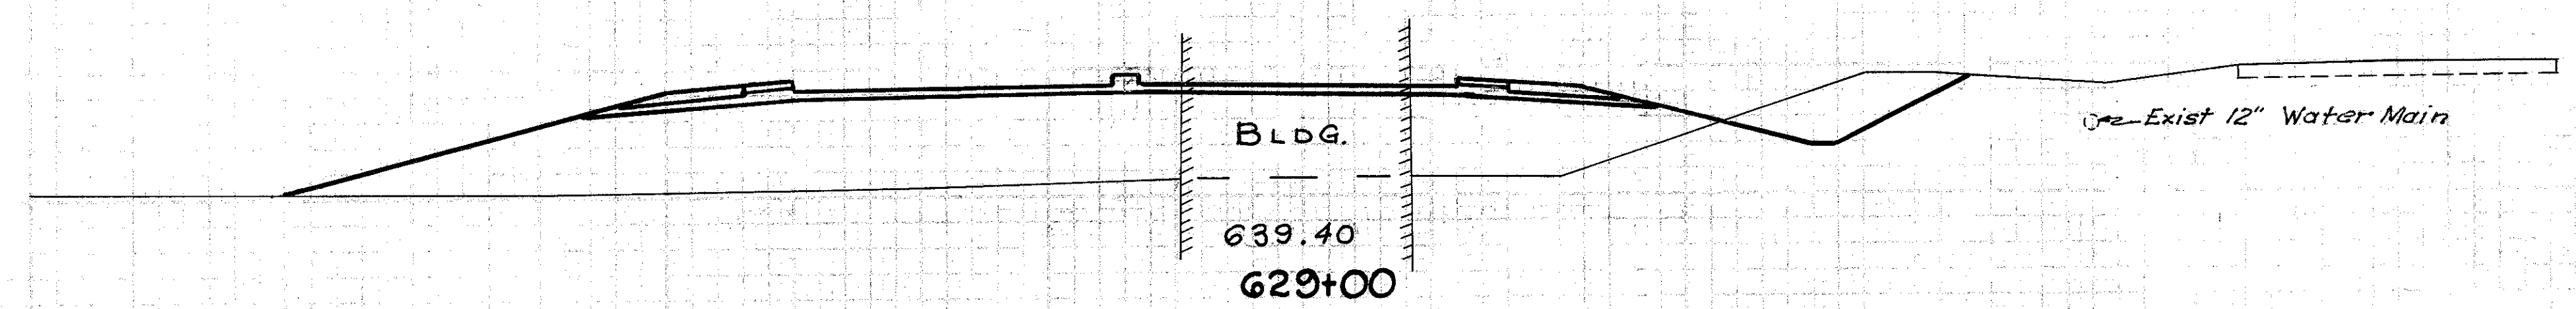

BLDG.  
639.40  
629+00

Exist 12" Water Main

End Area		Cu. Yds.	
Cut	Fill	Cut	Fill
75	316		
		141	671
77	414		
		114	945
46	607		
		94	1181
55	668		
		81	1344


Sta. 629+00 to Sta. 630+00  
E-1  
Embankment 2078 Cu. Yds.  
Embankment 31345 Cu. Yds.  
Embankment +15% 36046 Cu. Yds.

150 140 130 120 110 100 90 80 70 60 50 40 30 20 10 0 10 20 30 40 50 60 70 80 90 100 110 120 130 140

STA. 629+00 TO 630+00


150 140 130 120 110 100 90 80 70 60 50 40 30 20 10 0 10 20 30 40 50 60 70 80 90 100 110 120 130 140 150

117  
222  
DATE: 11.5.53 19.15

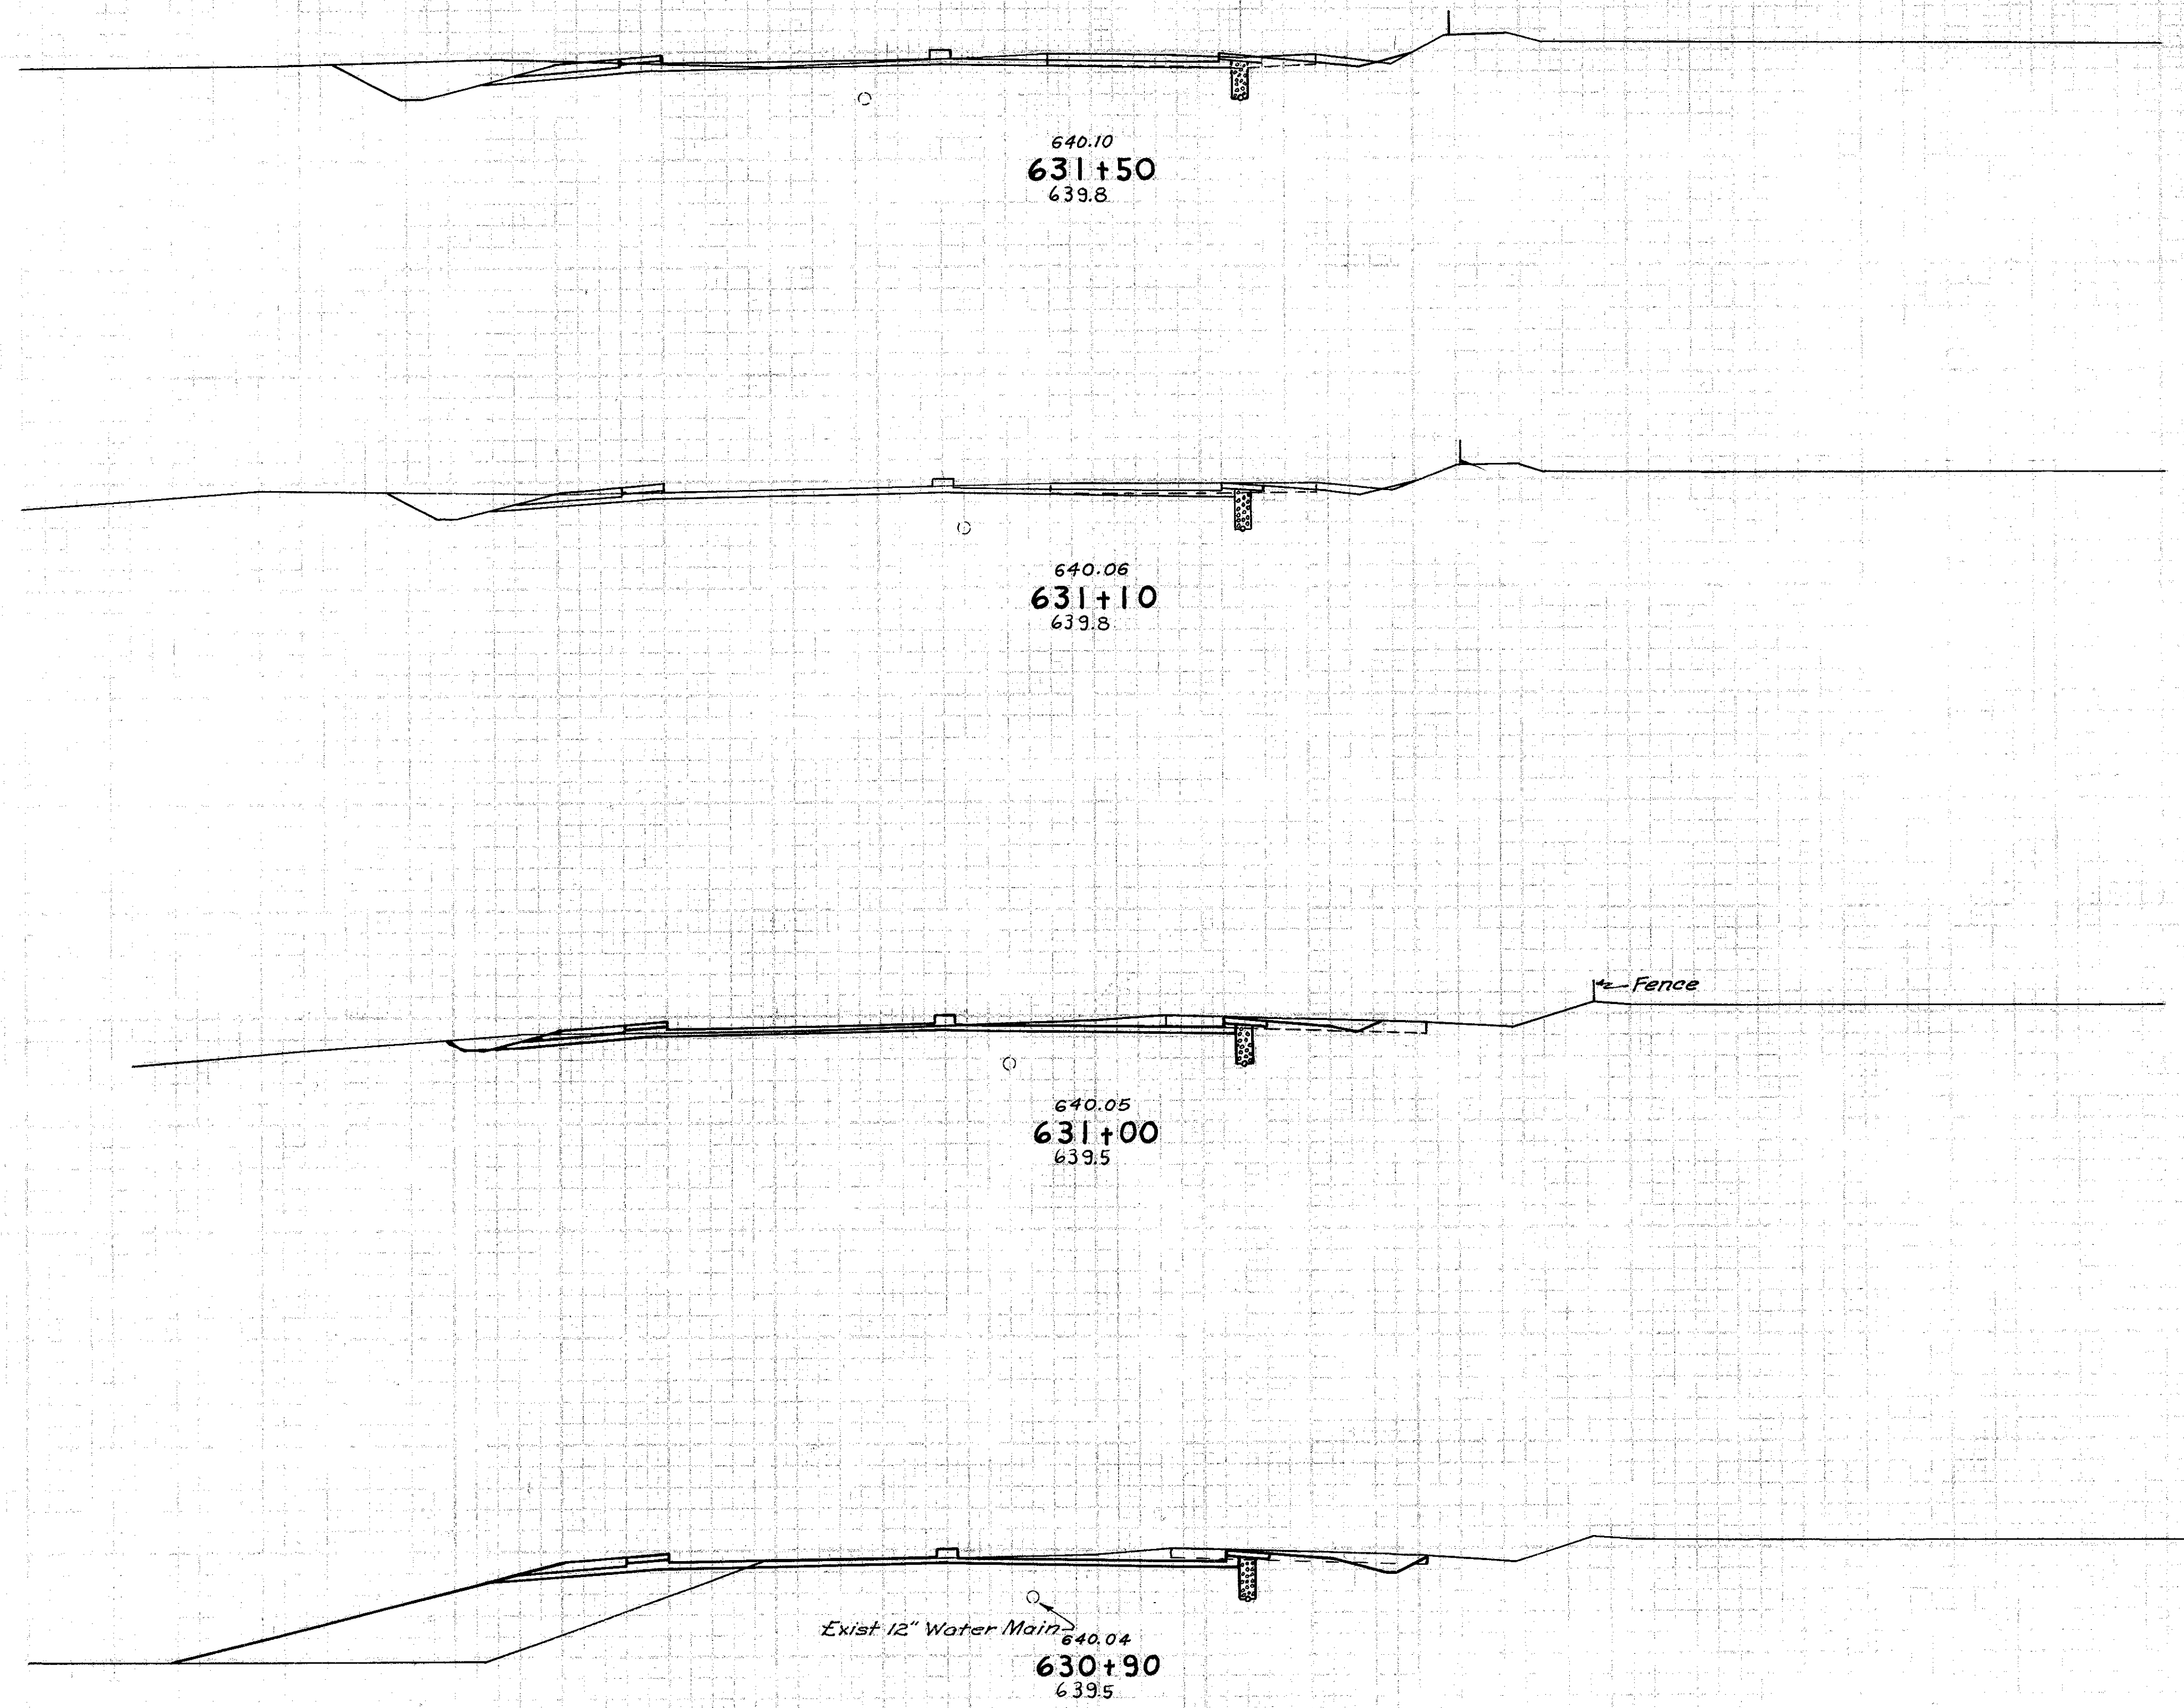

End Area		Cu. Yds.	
Cut	Fill	Cut	Fill
106	8		
		147	12
92	8		
		25	3
45	6		
		18	41
51	216		
		93	394

150 140 130 120 110 100 90 80 70 60 50 40 30 20 10 0 10 20 30 40 50 60 70 80 90 100 110 120 130 140 STA. 630+90 TO 631+50

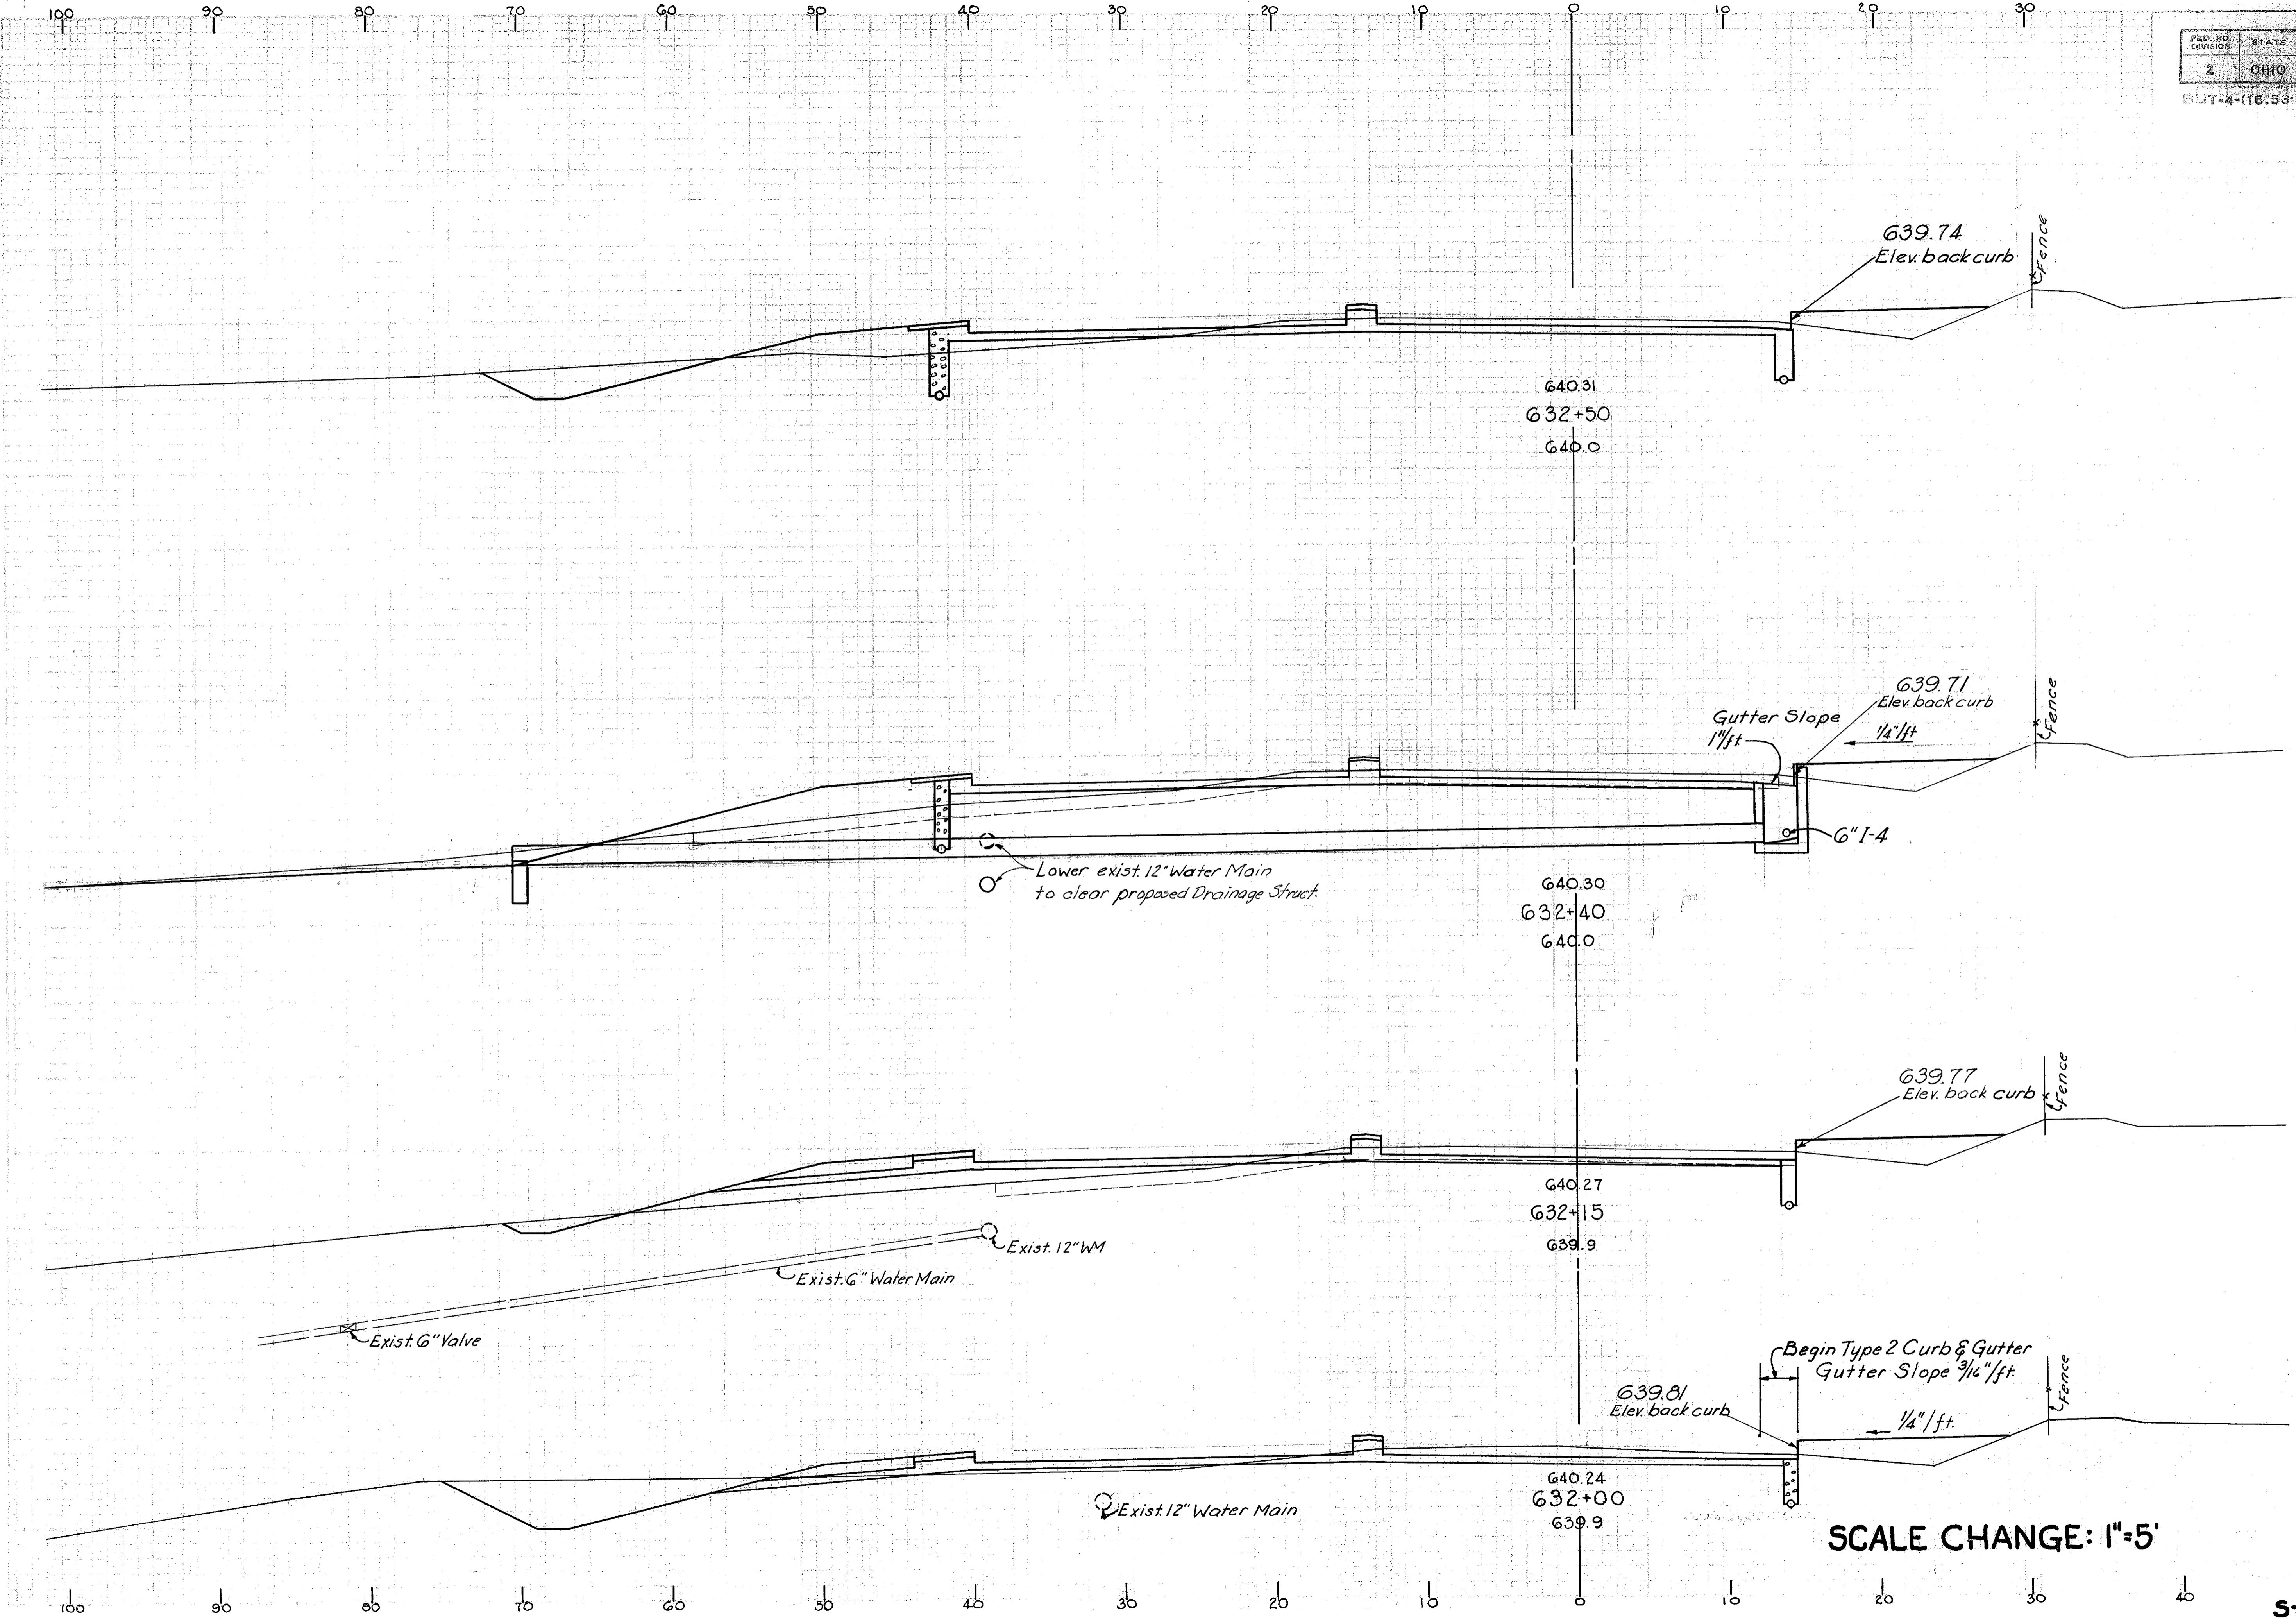


End Area		Cu. Yds.	
Cut	Fill	Cut	Fill
62	17		
		19	12
43	48		
		37	49
36	55		
		29	19
68	14		
		98	20

SCALE CHANGE: 1"=5'

STA. 632+00 TO 632+50

100 90 80 70 60 50 40 30 20 10 0 10 20 30 40

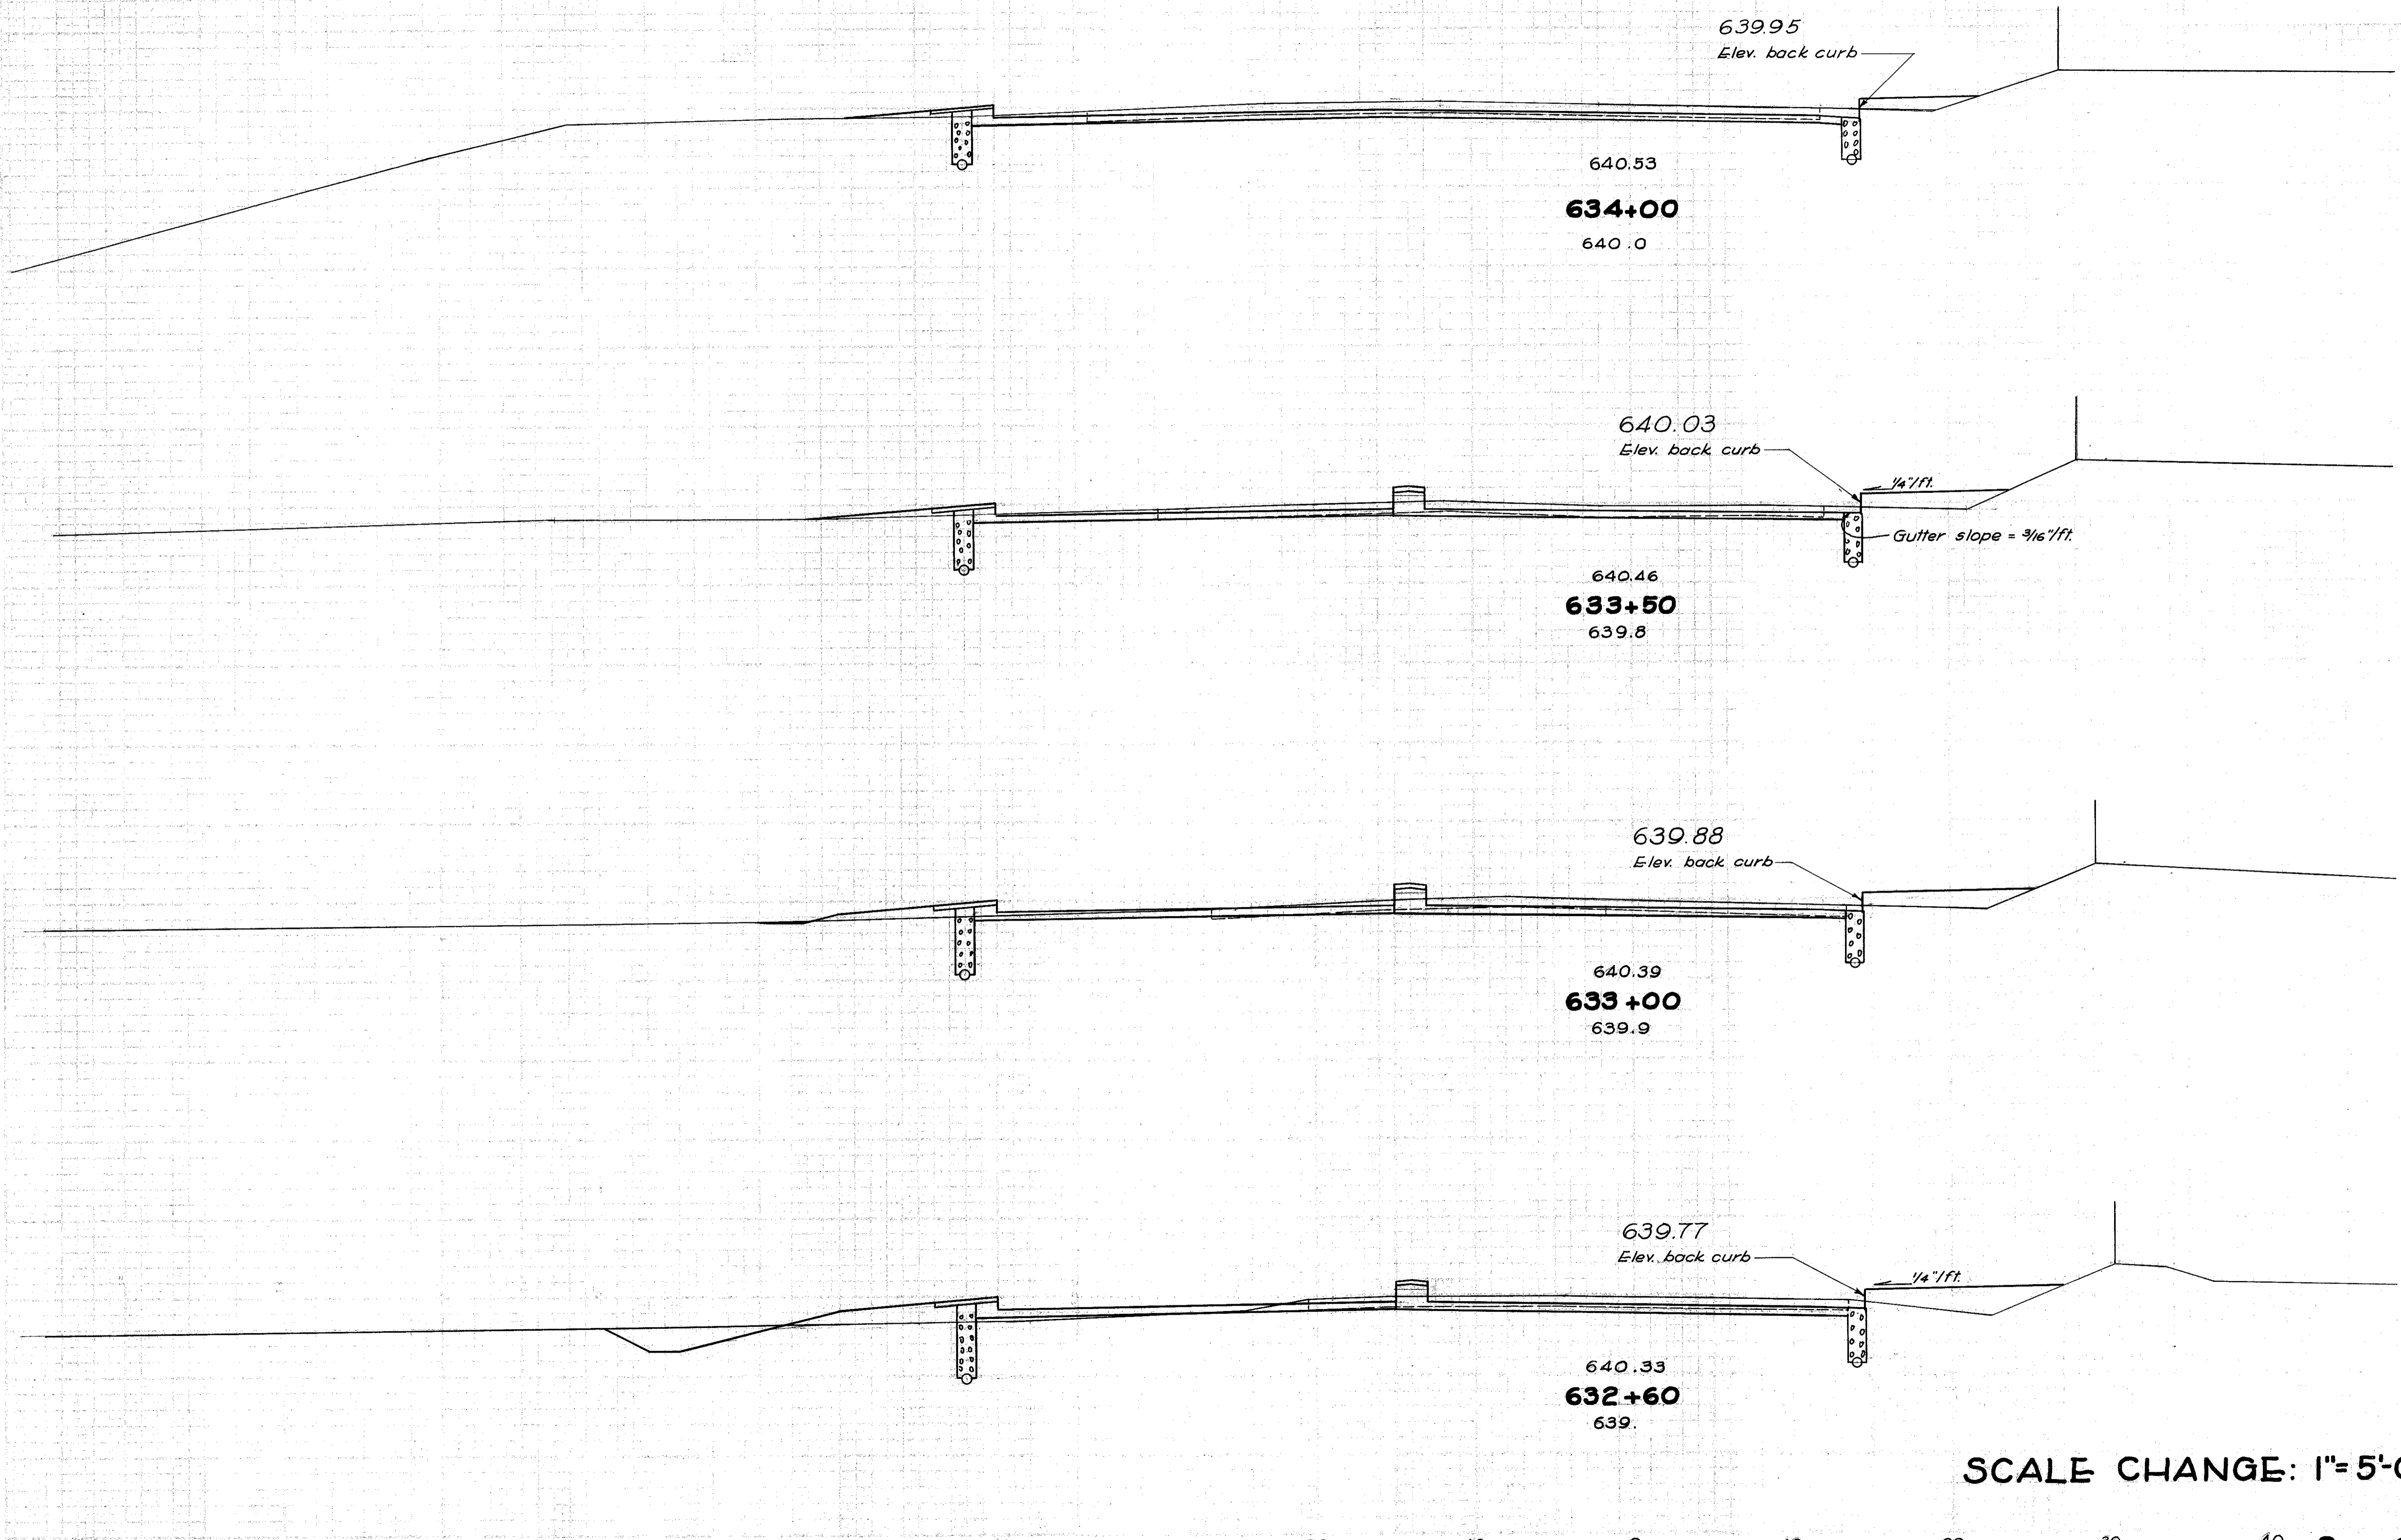

Sta.	End Area		Cu. Yds.	
	Cut	Fill	Cut	Fill
634+00	61	—	—	—
633+50	47	—	100	—
633+00	39	2	79	2
632+60	48	36	64	28
			20	10

SCALE CHANGE: 1"=5'-0"


STA. 632+60 TO 634+00

100 90 80 70 60 50 40 30 20 10 0 10 20 30 40

FED. RES. DIVISION	STATE	PROJECT	
2	OHIO		120 222

UT-4-(16.53-19.15)

End Area	Cu. Yds.	
Cut	Fill	Fill

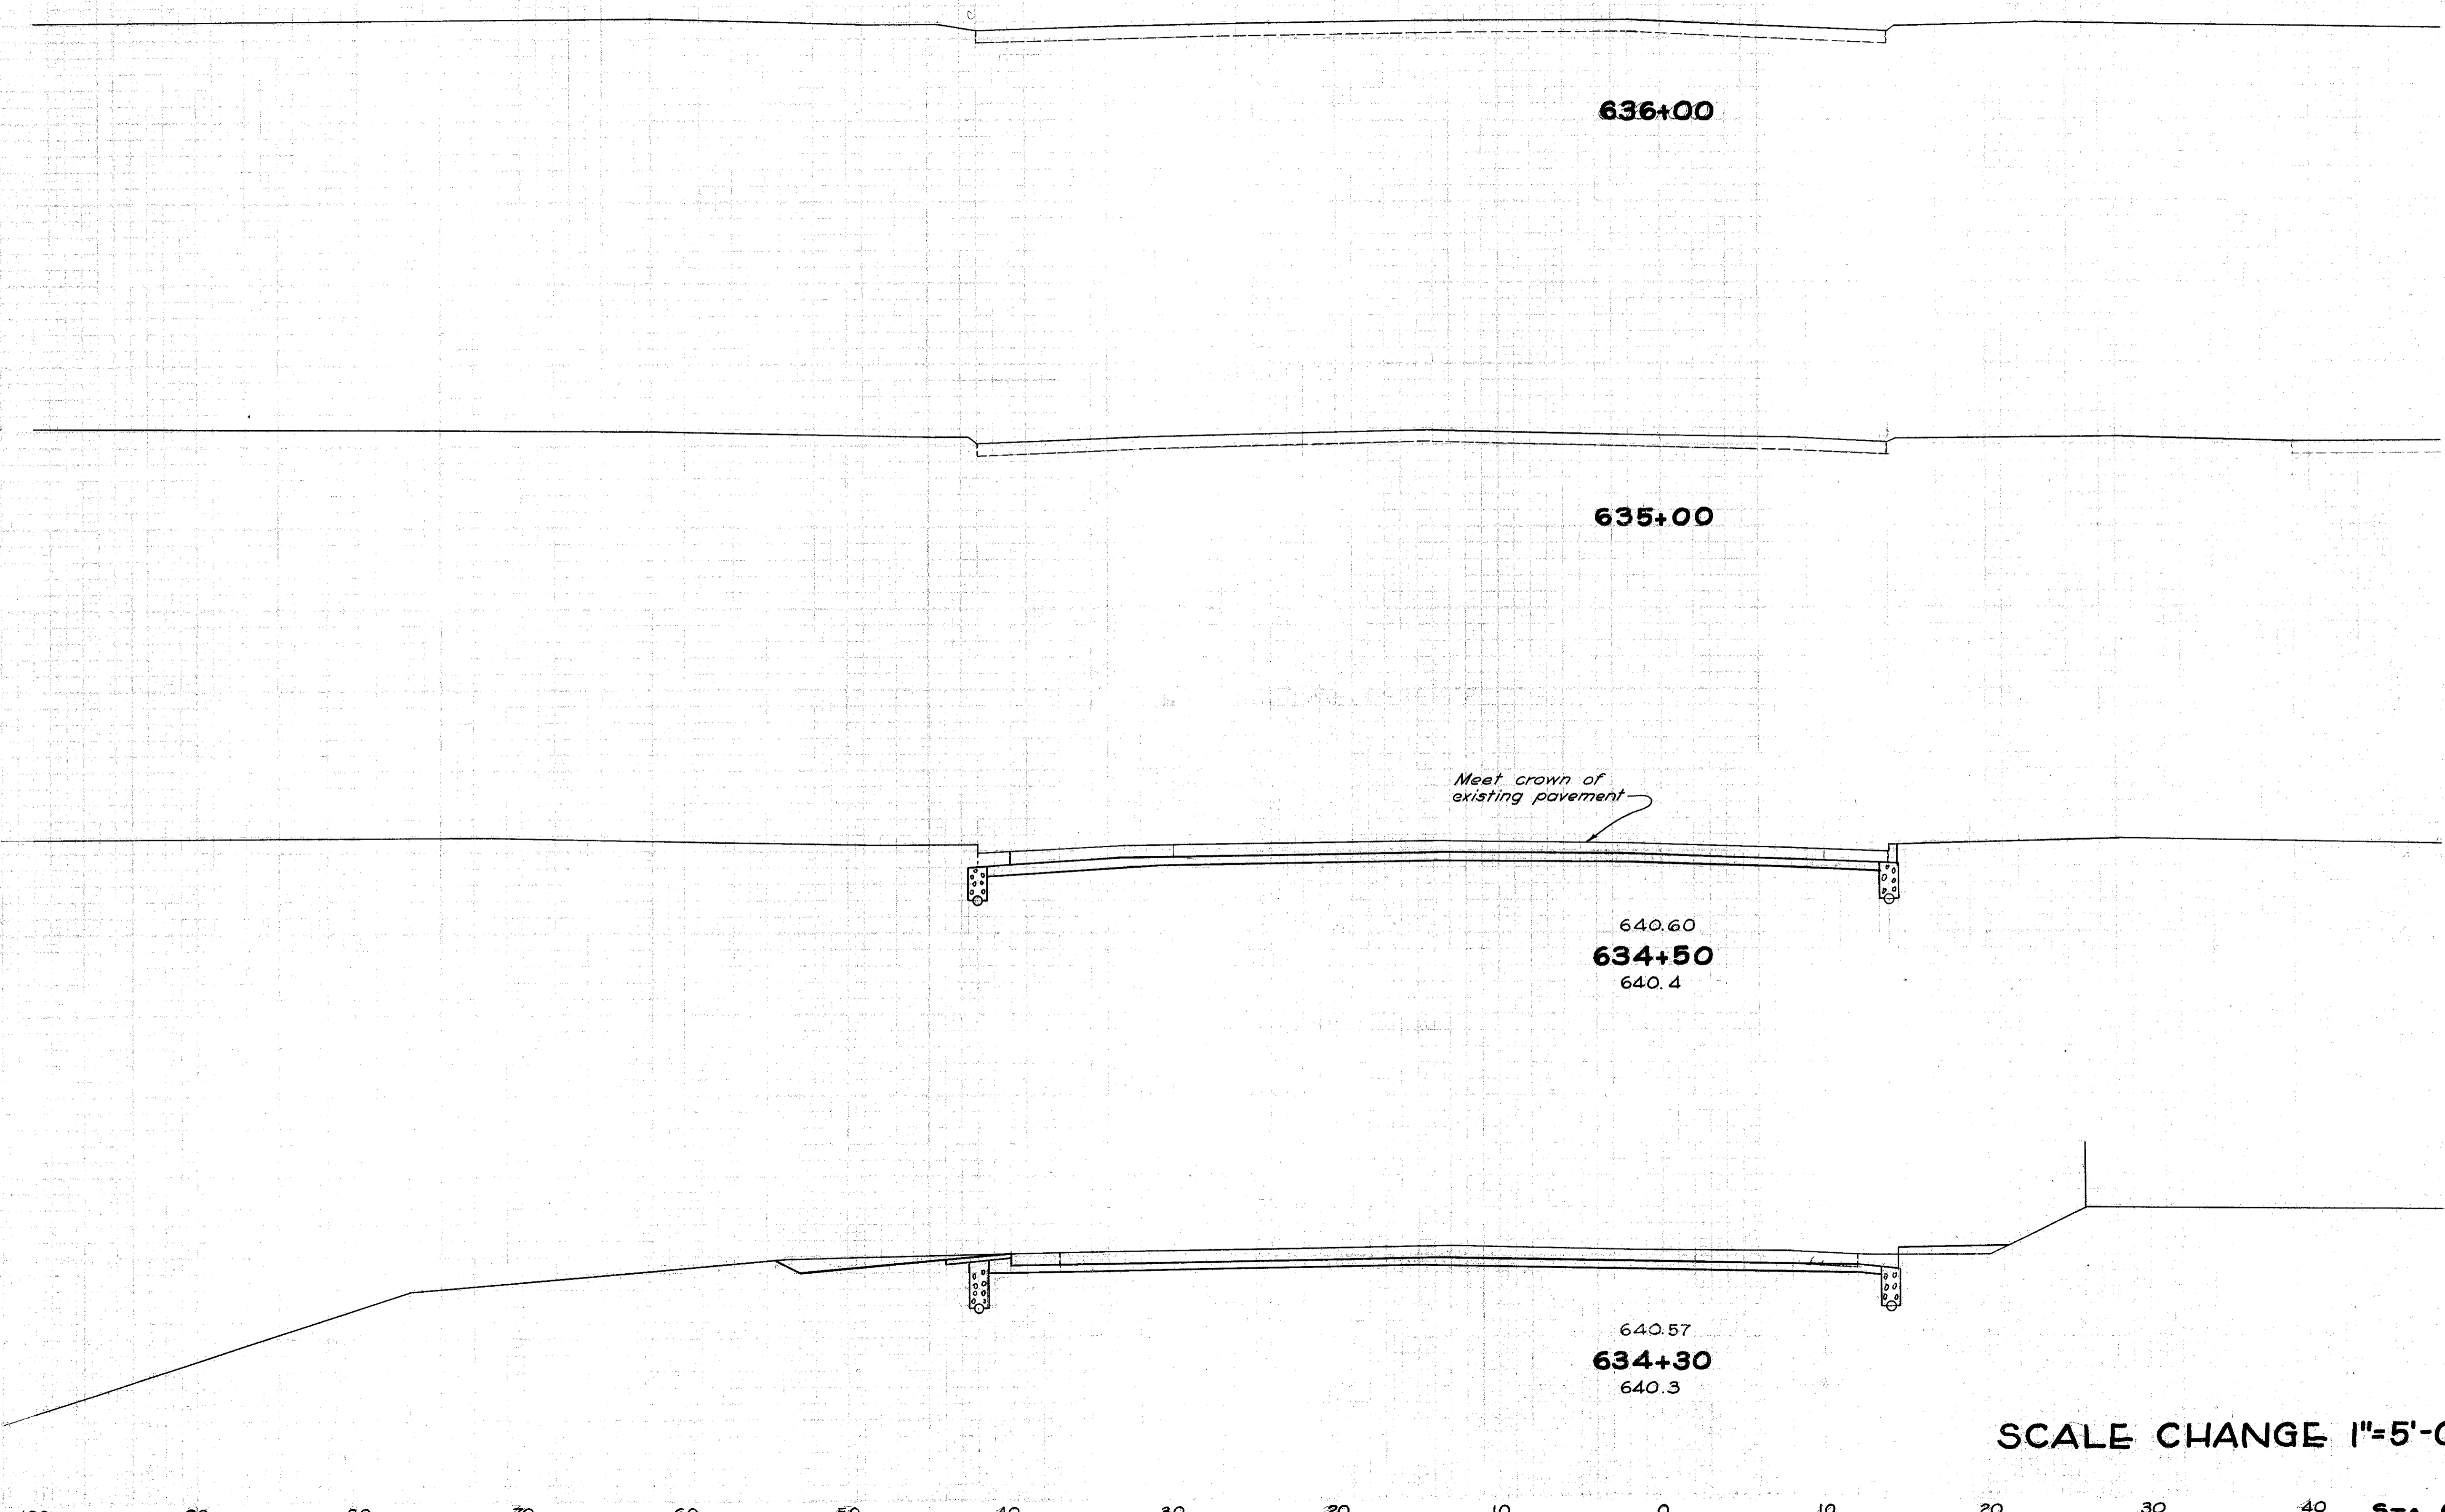

SCALE CHANGE 1"=5'-0"

Sta. 630+00 to Sta. 634+50  
 Embankment 126.1 Cu. Yds.  
 Embankment +15% 145.0 Cu. Yds.

76			
53			
68			
72			


100 90 80 70 60 50 40 30 20 10 0 10 20 30 40 STA. 634+30 TO 636+00



160 150 140 130 120 110 100 90 80 70 60 50 40 30 20 10 0 10 20 30 40 50 60 70 80 90 100 110 120

3UT-4 (16.53-19.15)

Back Ahead

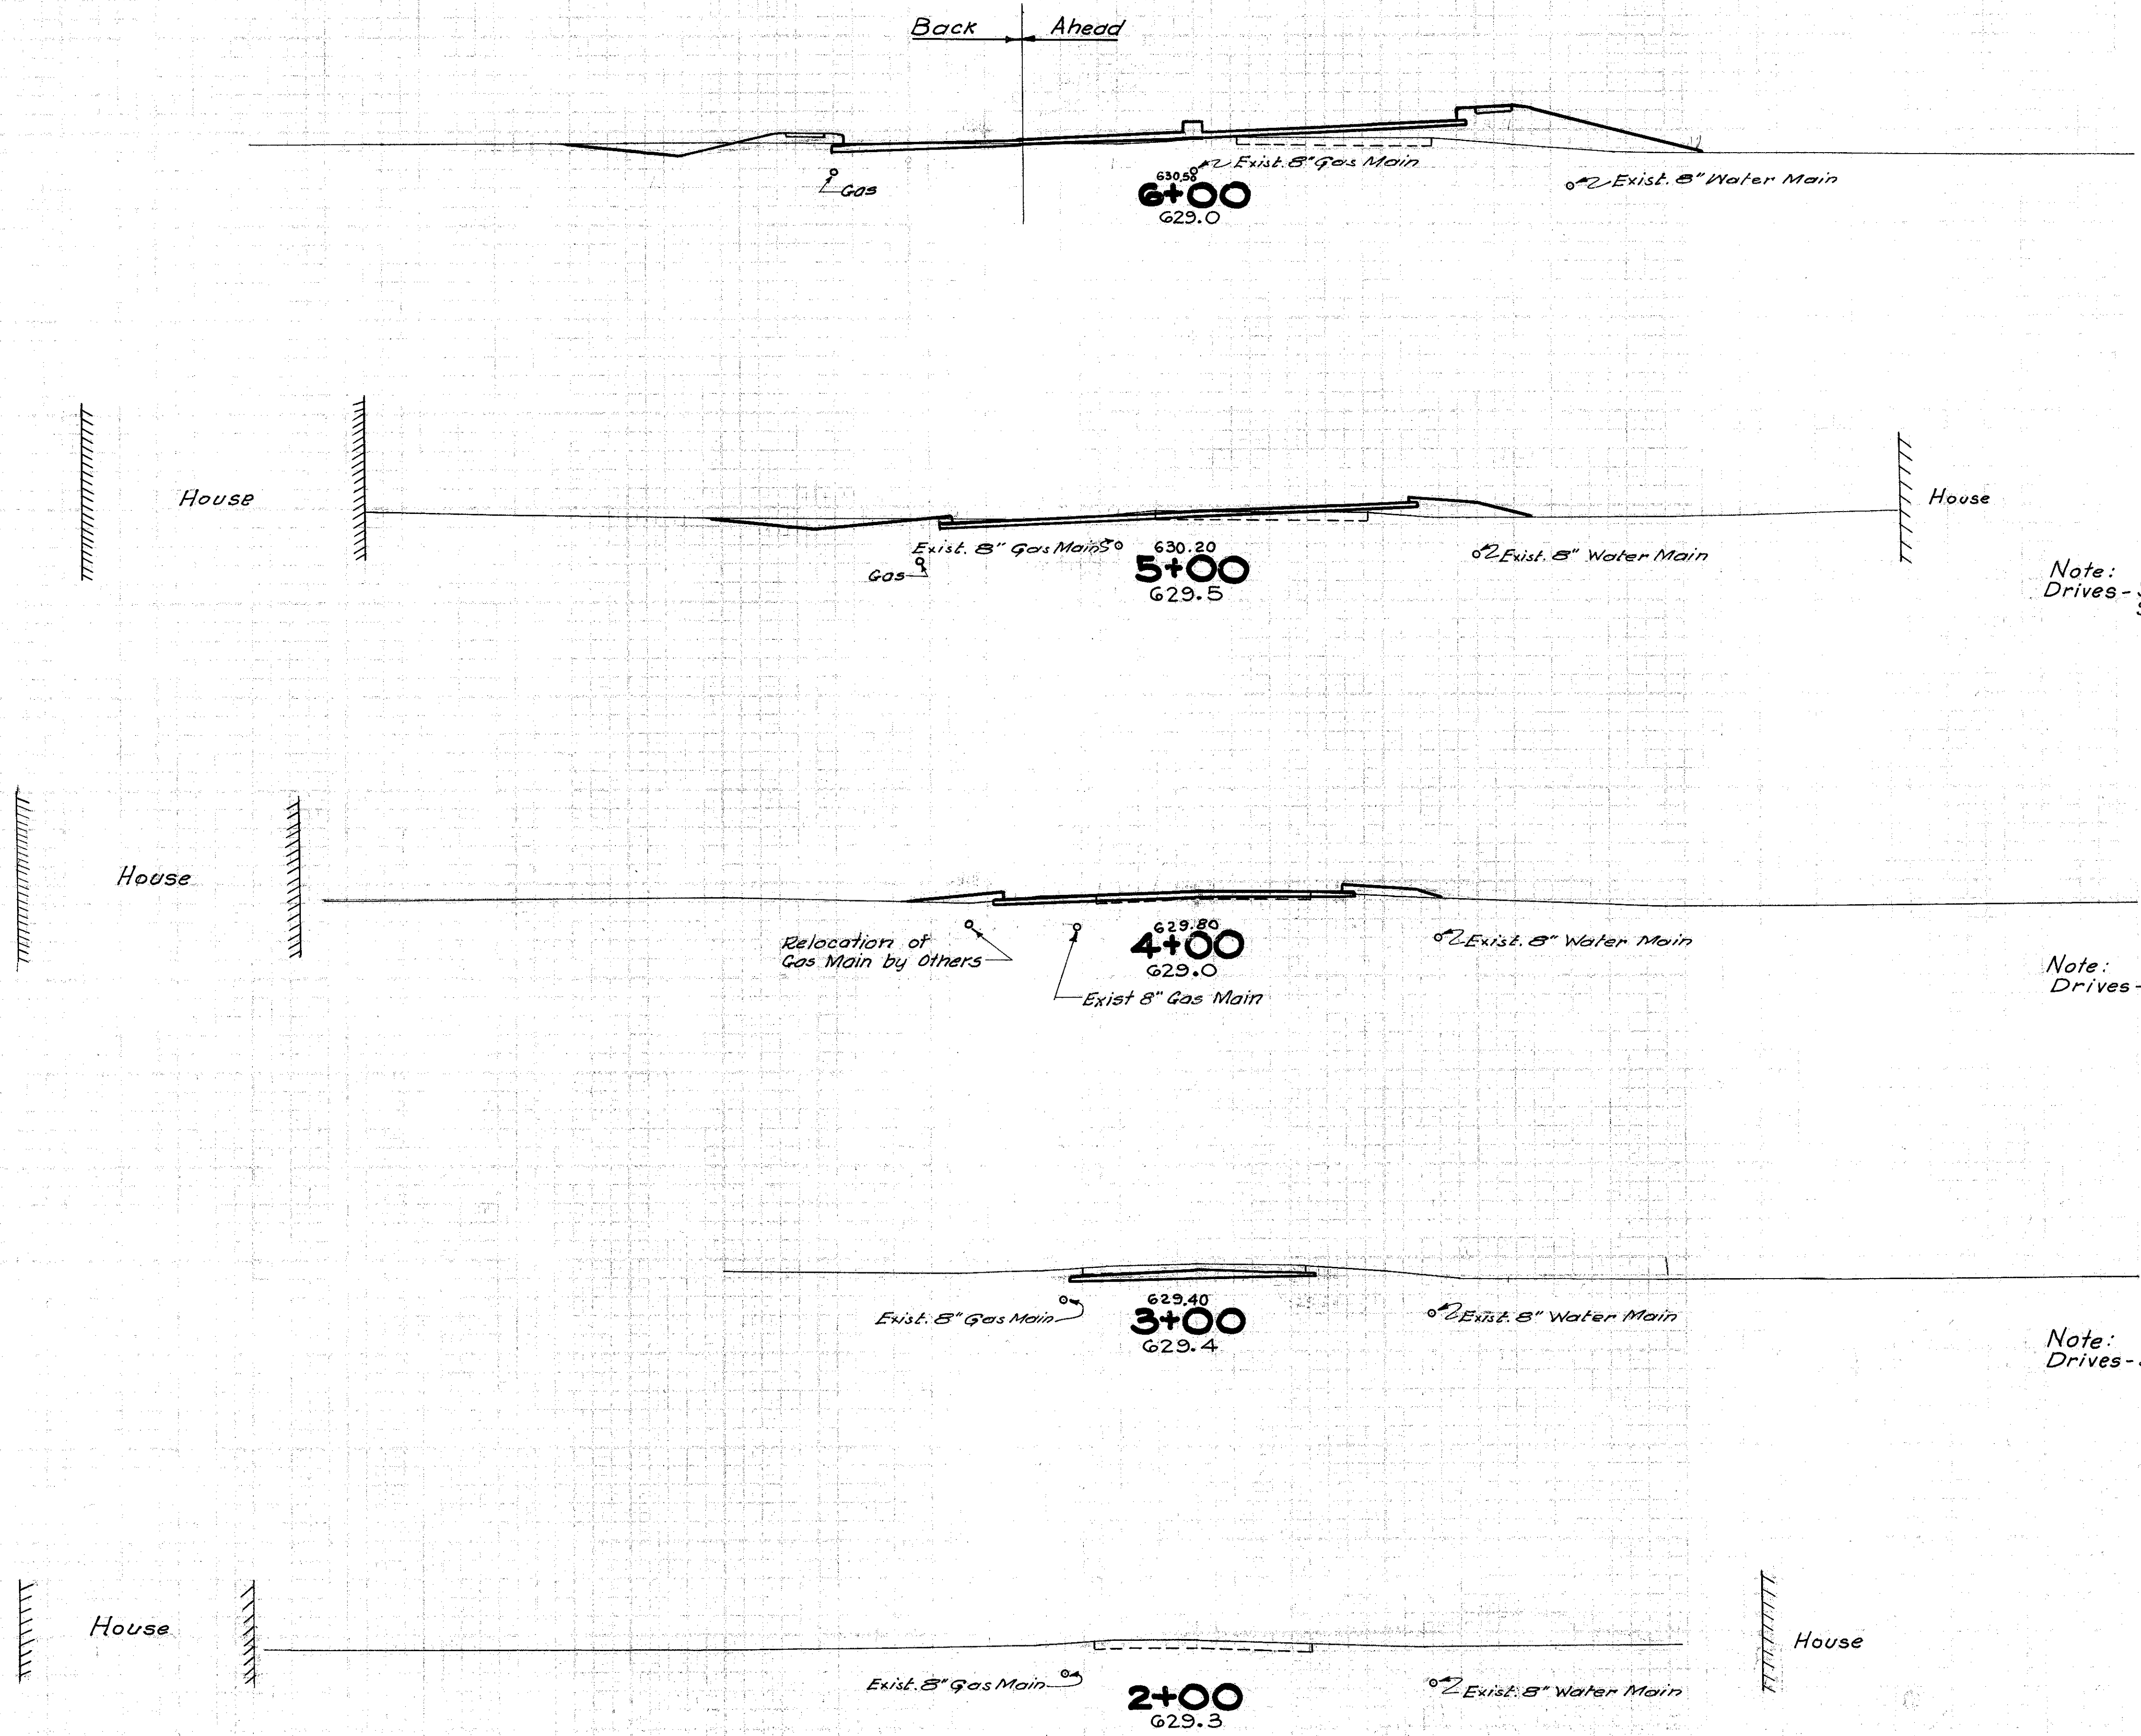


Note:  
Drives - Sta. 5+28 Lt.  
Sta. 5+40 Rt.

Note:  
Drives - Sta. 4+26 Lt.  
" 4+60 Rt.  
" 4+79 Lt.

Note:  
Drives - Sta. 3+24.75 Lt.  
" 3+75.00 Lt.  
" 3+62.00 Rt.

	End Area		Cu. Yds.	
	Cut	Fill	Cut	Fill
Ahead		89		
Back	24	34		
			109	215
	35	22	18	3
			100	63
	19	12	9	3
			89	22
	29	-	7	7
			54	

160 150 140 130 120 110 100 90 80 70 60 50 40 30 20 10 0 10 20 30 40 50 60 70 80 90 100 110 120

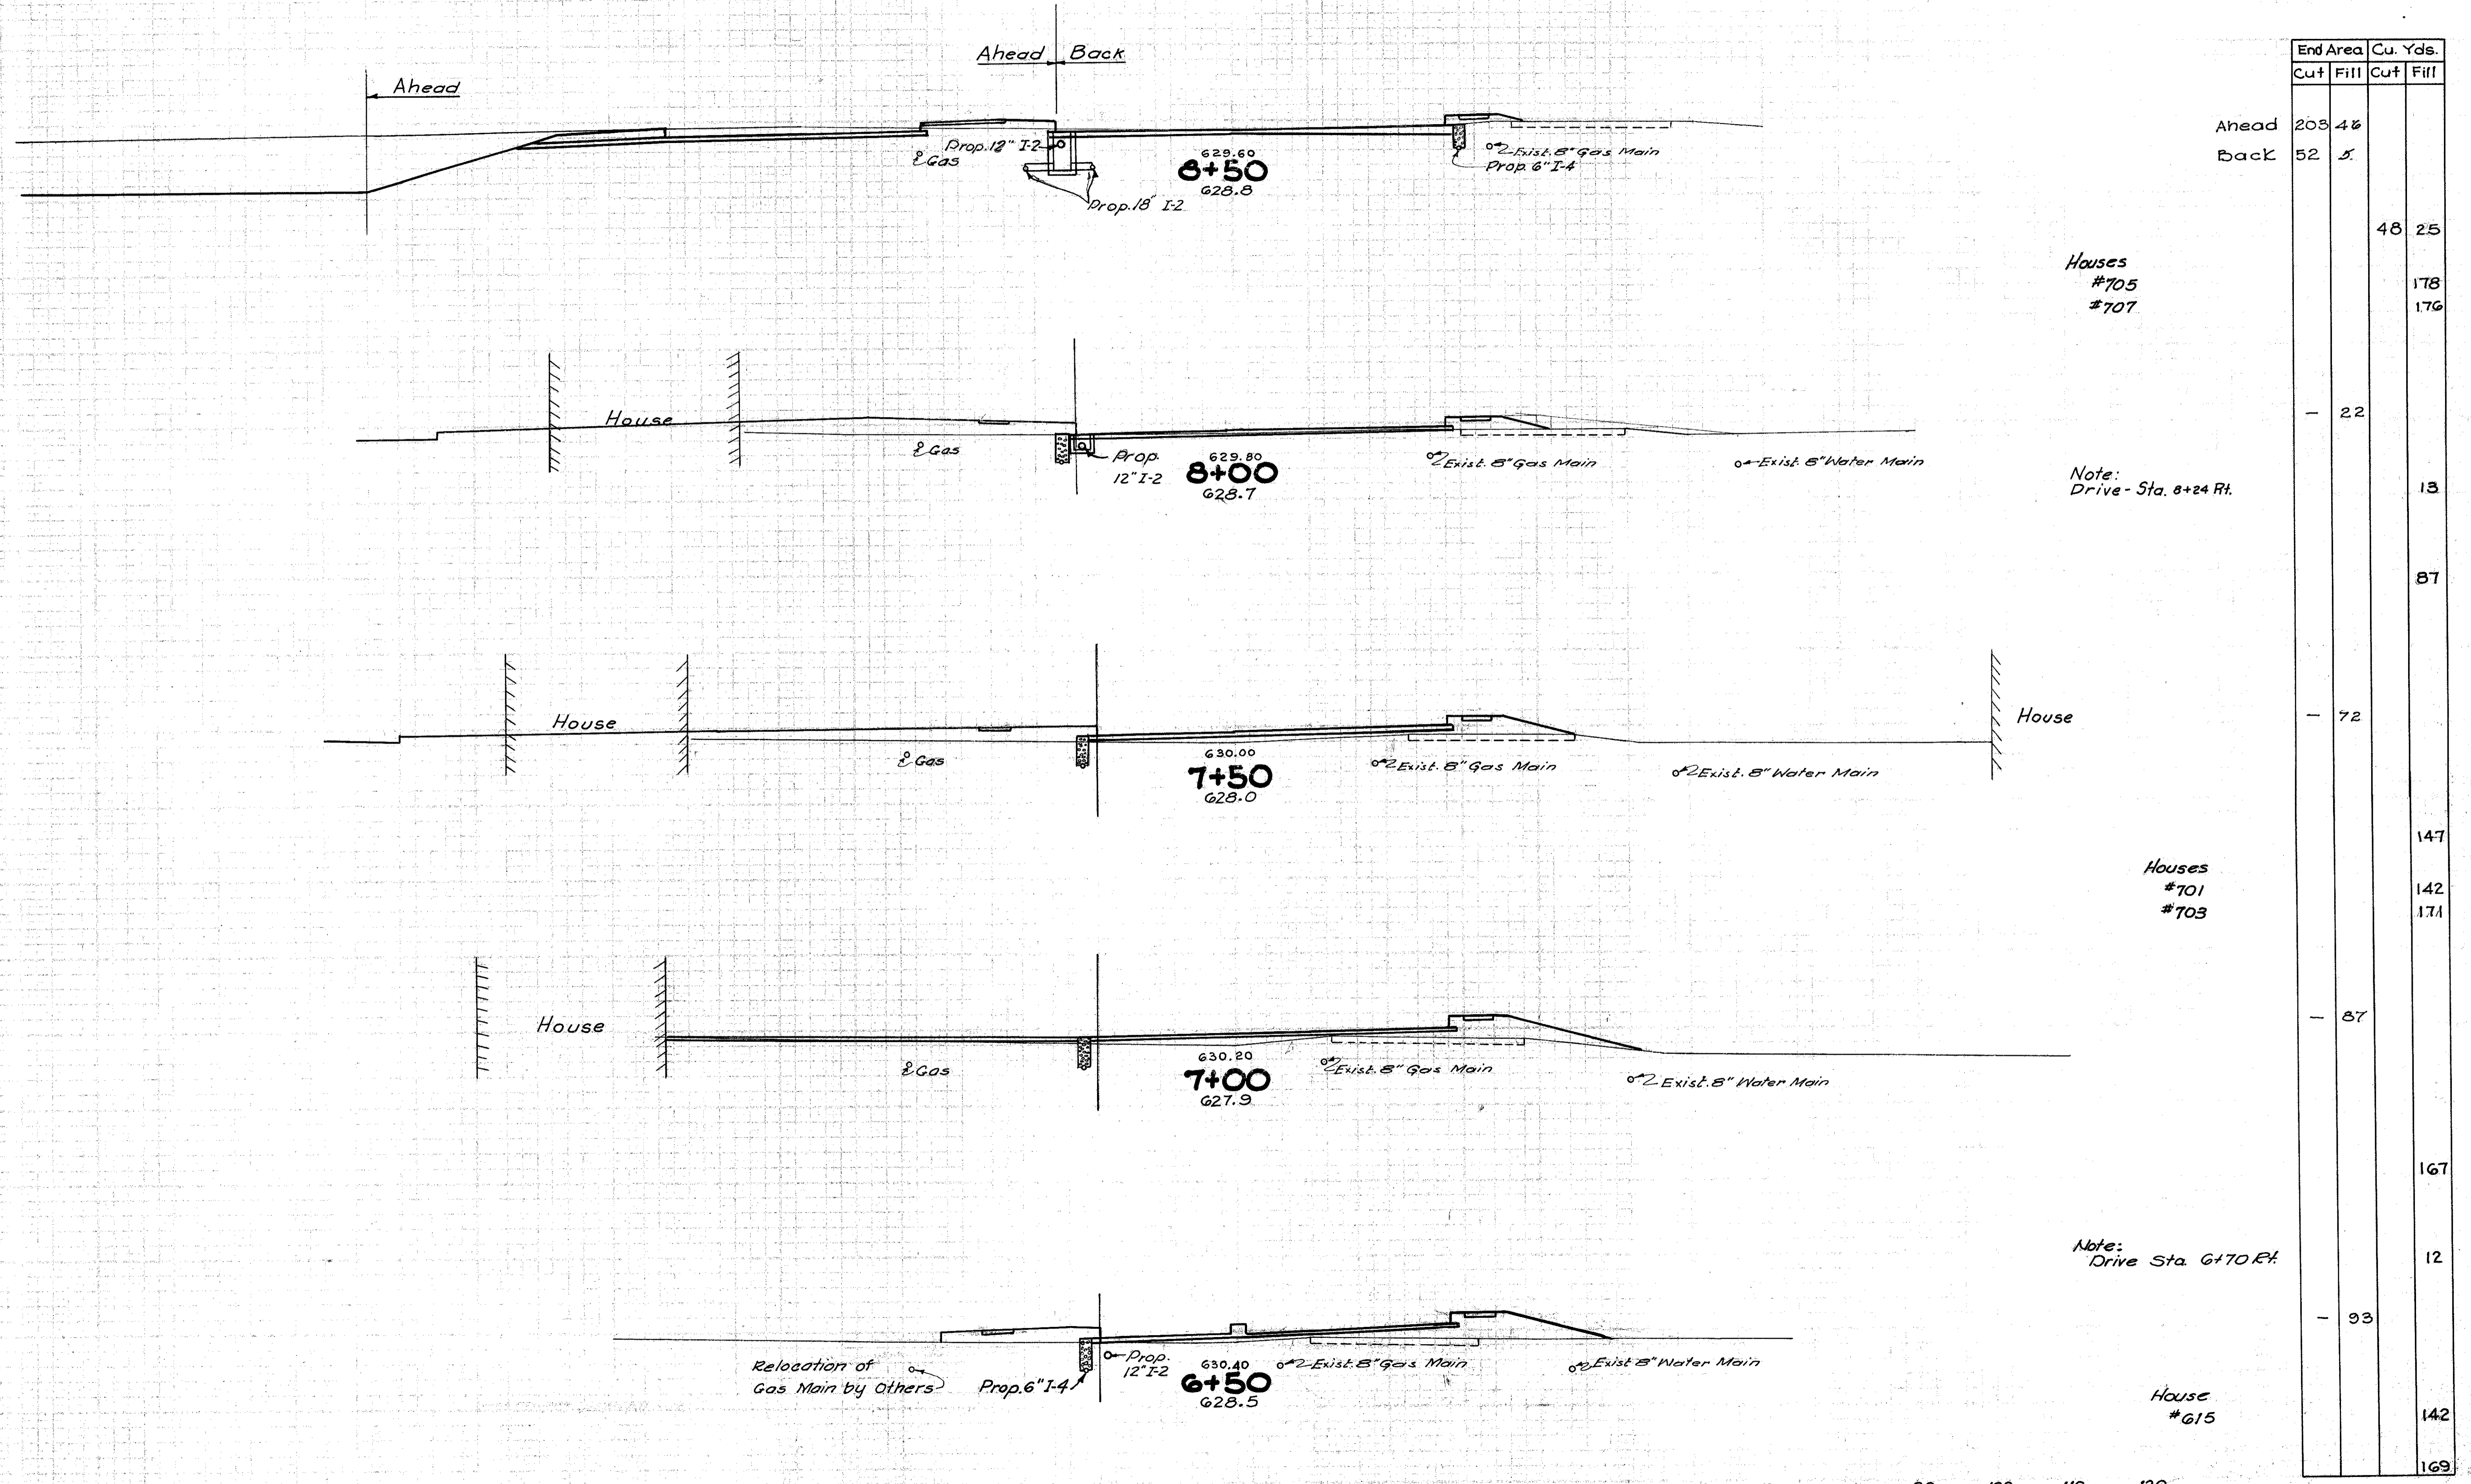


	End Area		Cu. Yds.	
	Cut	Fill	Cut	Fill
Ahead	203	46		
Back	52	5		
			48	25
Houses #705 #707				178
				176
		22		
Note: Drive - Sta. 8+24 Rt.				13
				87
		72		
				147
Houses #701 #703				142
				171
				87
				167
Note: Drive Sta. 6+70 Rt.				12
		93		
House #615				142
				169

160 150 140 130 120 110 100 90 80 70 60 50 40 30 20 10 0 10 20 30 40 50 60 70 80 90 100 110 120

SECTION	DATE	PROJECT
2	OHIO	

123  
222






BLT-4-16-53-19-15

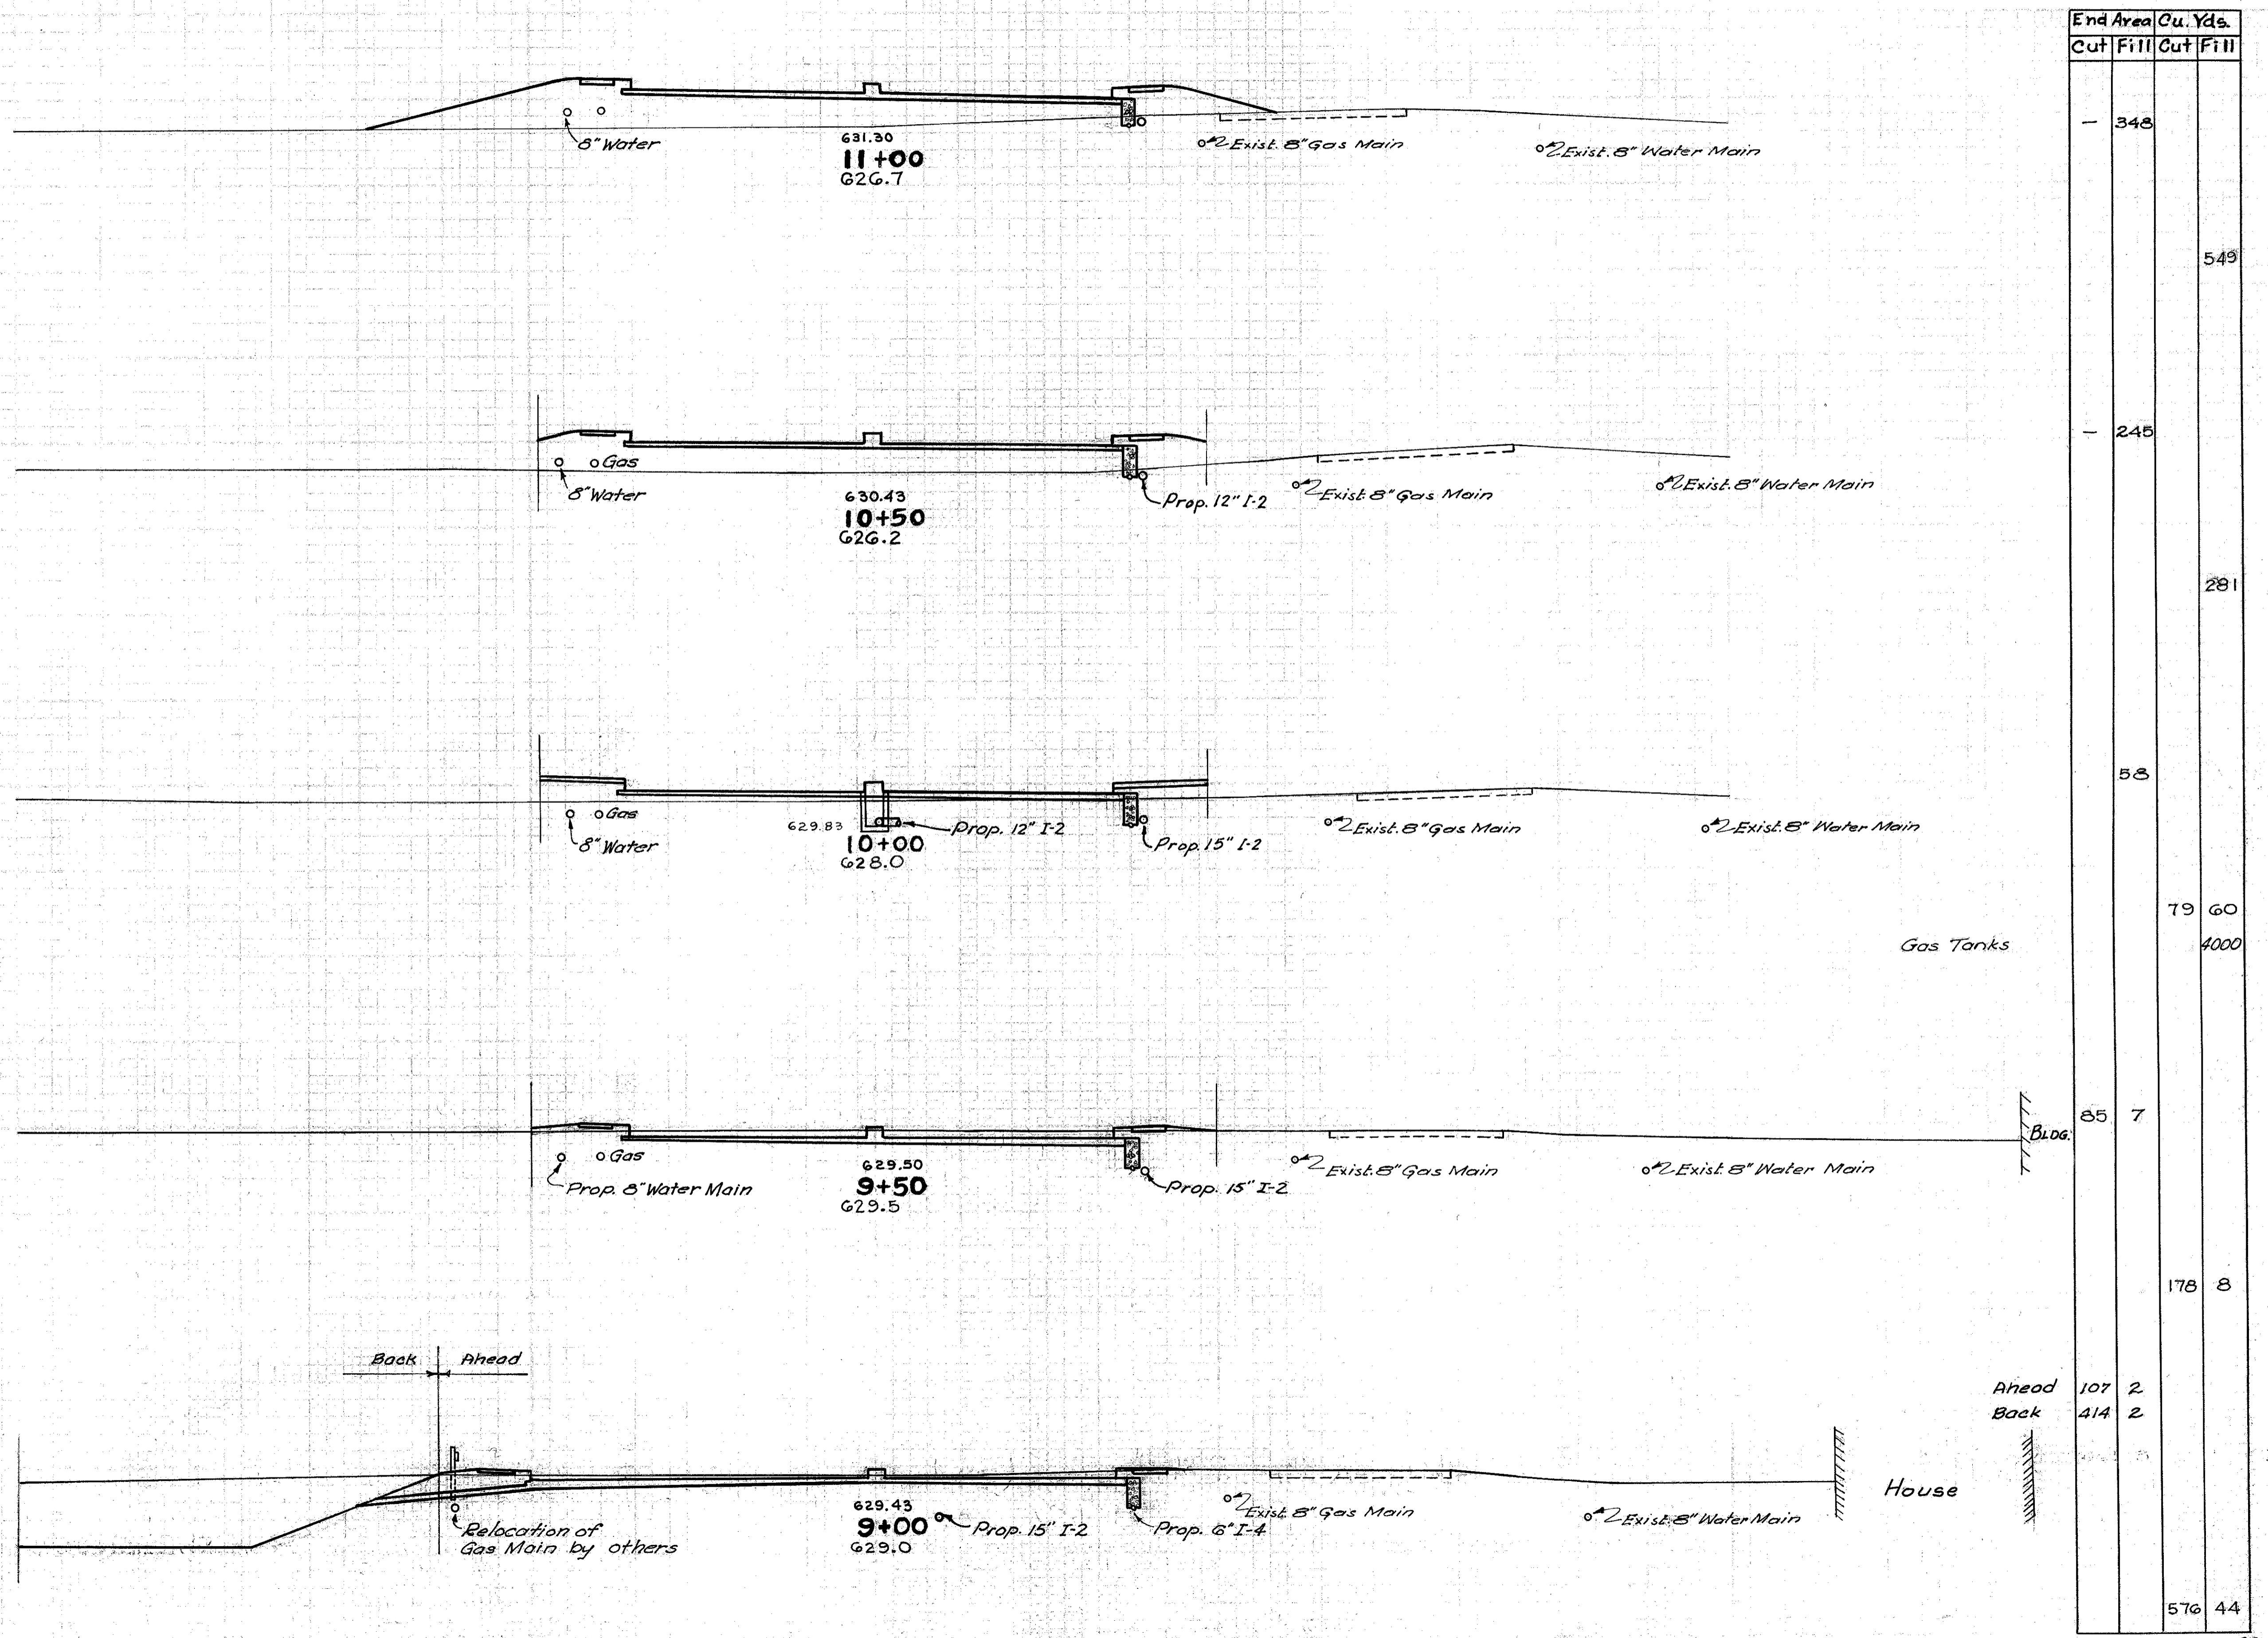

End Area		Cu. Yds.	
Cut	Fill	Cut	Fill
-	348		549
-	245		281
	58		
	79	60	
	4000		
85	7		
	178	8	
Ahead	107	2	
Back	414	2	
	576	44	

160 150 140 130 120 110 100 90 80 70 60 50 40 30 20 10 0 10 20 30 40 50 60 70 80 90 100 110 120 130 STATE ROUTE 73

160 150 140 130 120 110 100 90 80 70 60 50 40 30 20 10 0 10 20 30 40 50 60 70 80 90 100 110 120

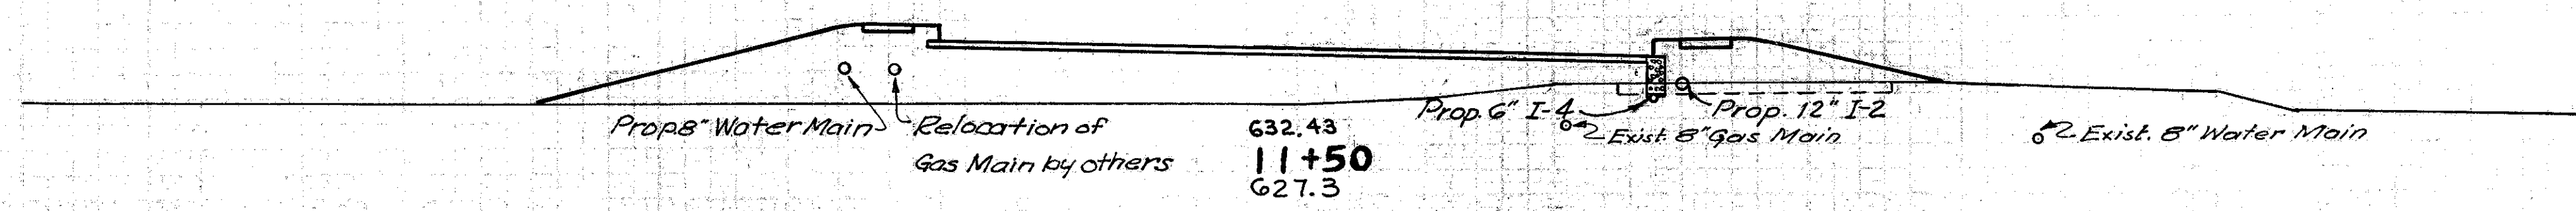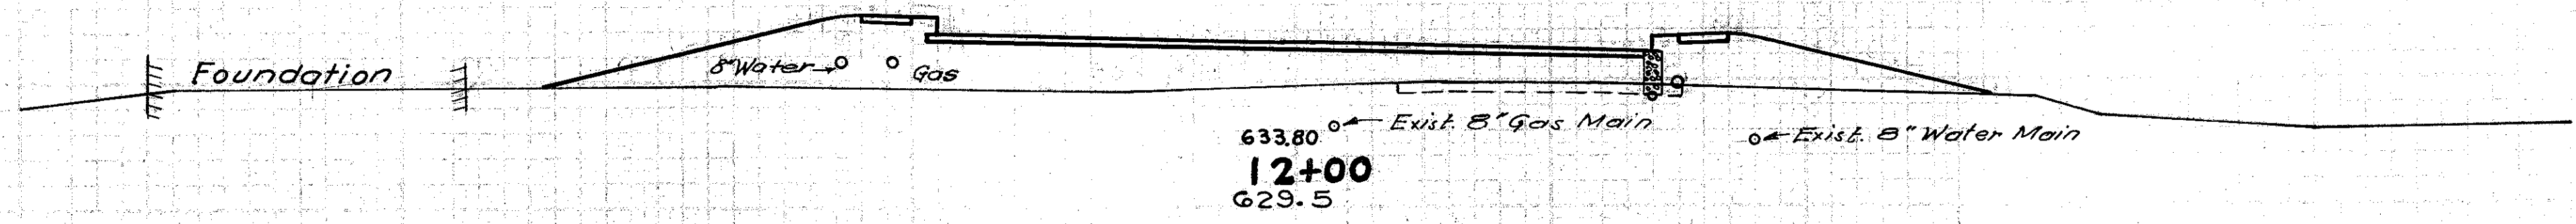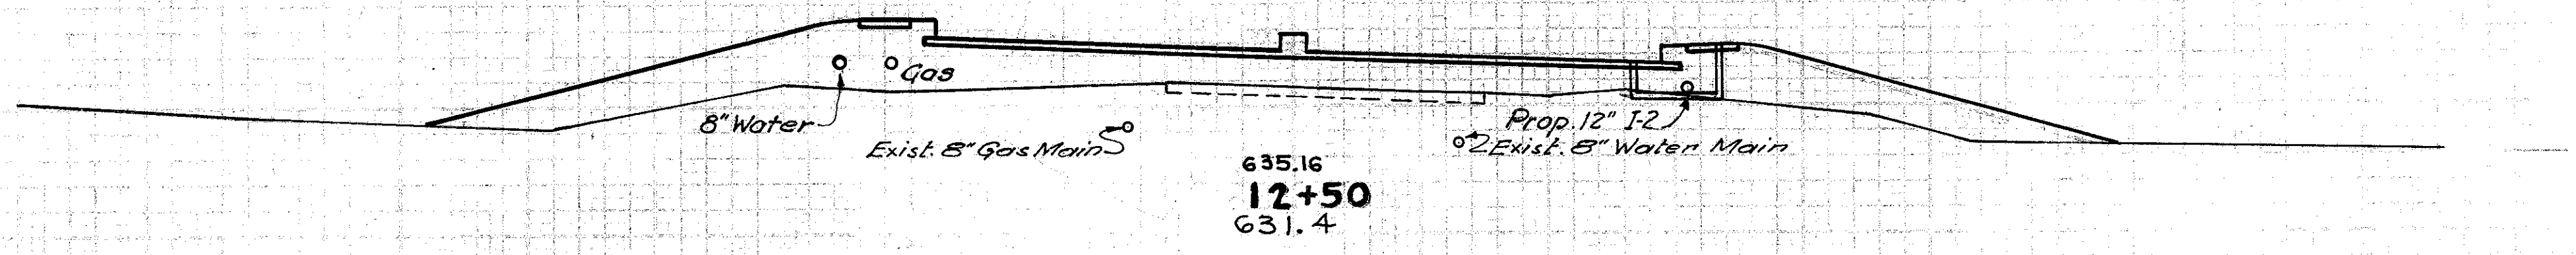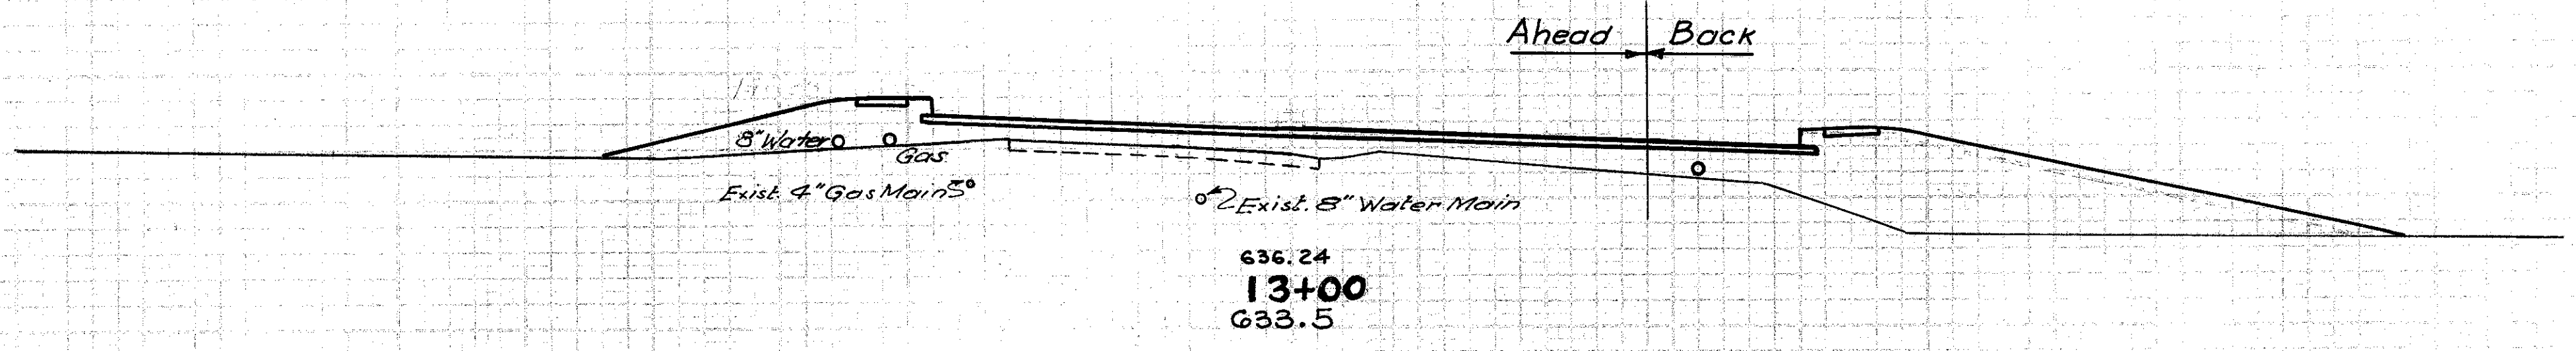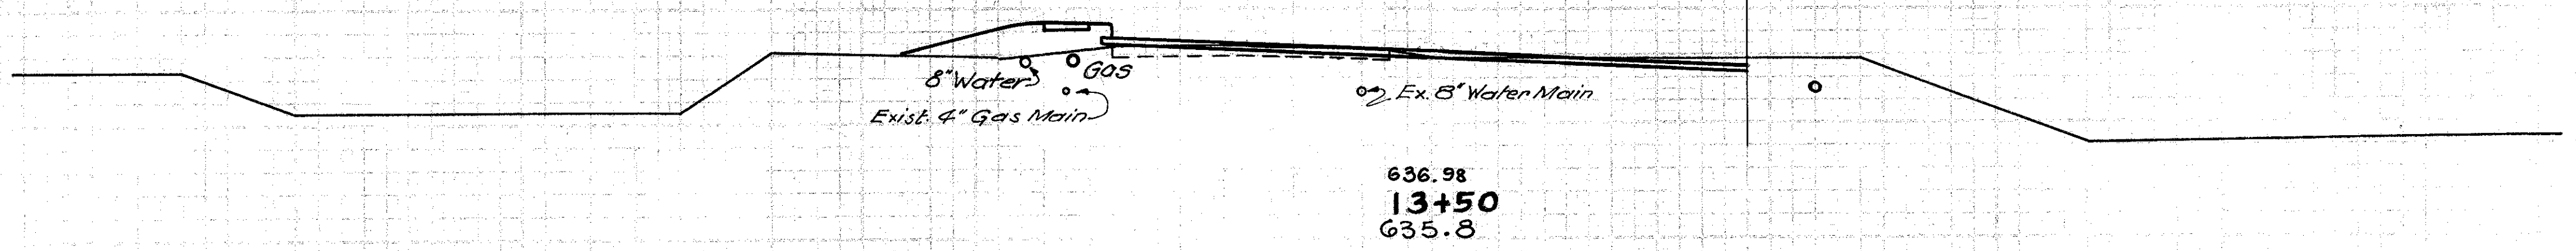






Note: Drive - Sta. 13+38

Note: Drive Sta. 11+89

Sta.	End Area		Cu. Yds.	
	Cut	Fill	Cut	Fill
13+50				
13+00	27	31		
12+50			25	166
12+00				
11+50				
Ahead	-	148		
Back	-	359		
				15
				688
				384
				685
				356
				10
				682
				580
				674

160 150 140 130 120 110 100 90 80 70 60 50 40 30 20 10 0 10 20 30 40 50 60 70 80 90 100 110 120 130 STATE ROUTE 73


160 150 140 130 120 110 100 90 80 70 60 50 40 30 20 10 0 10 20 30 40 50 60 70 80 90 100 110

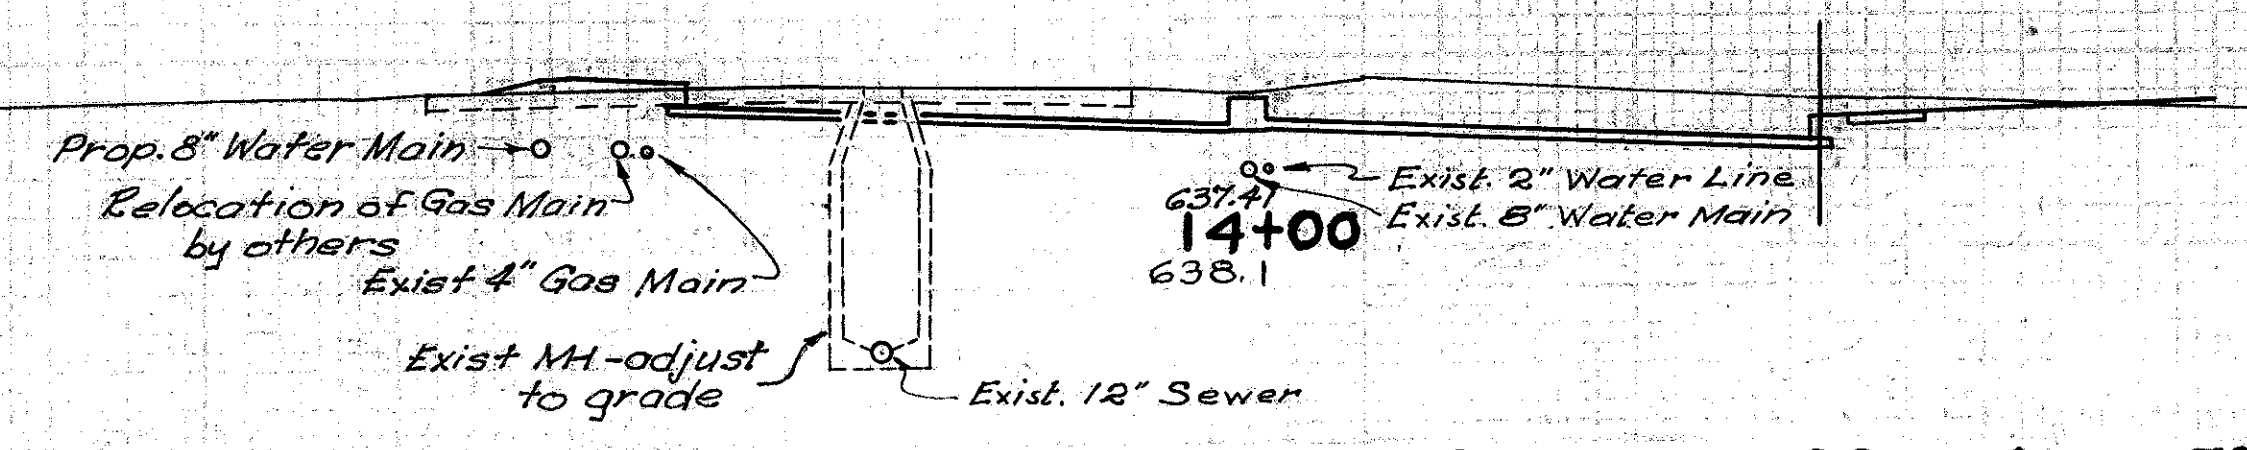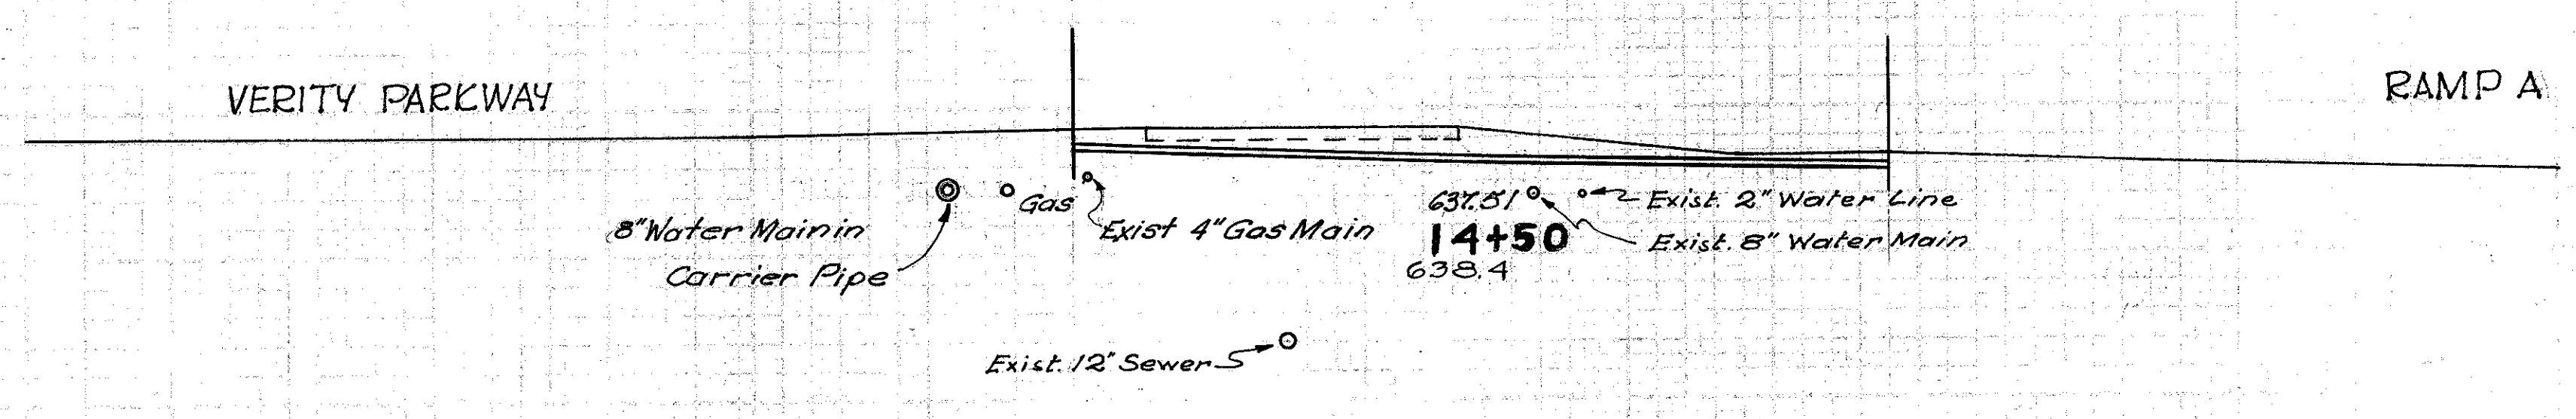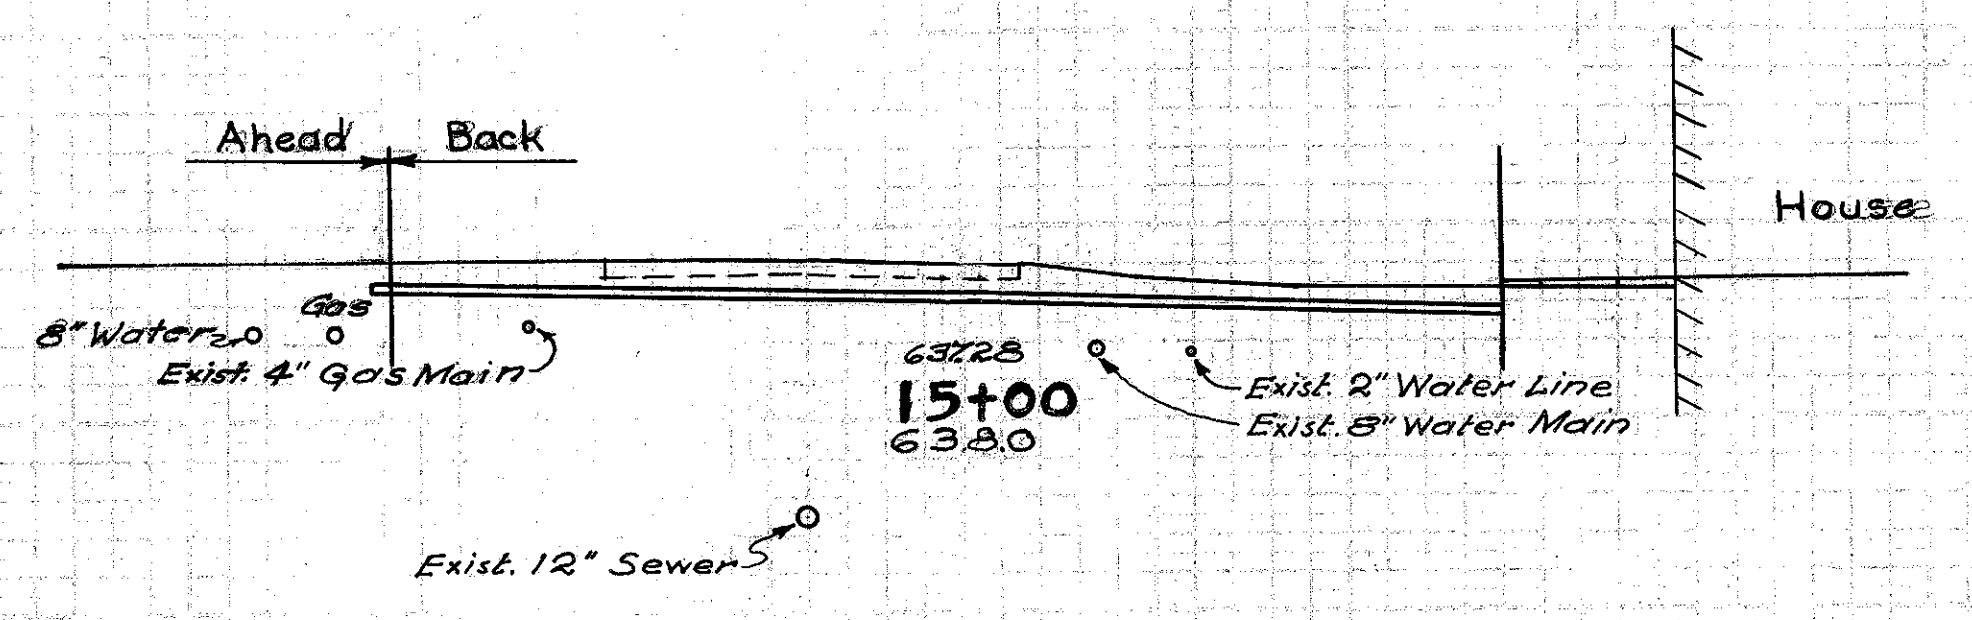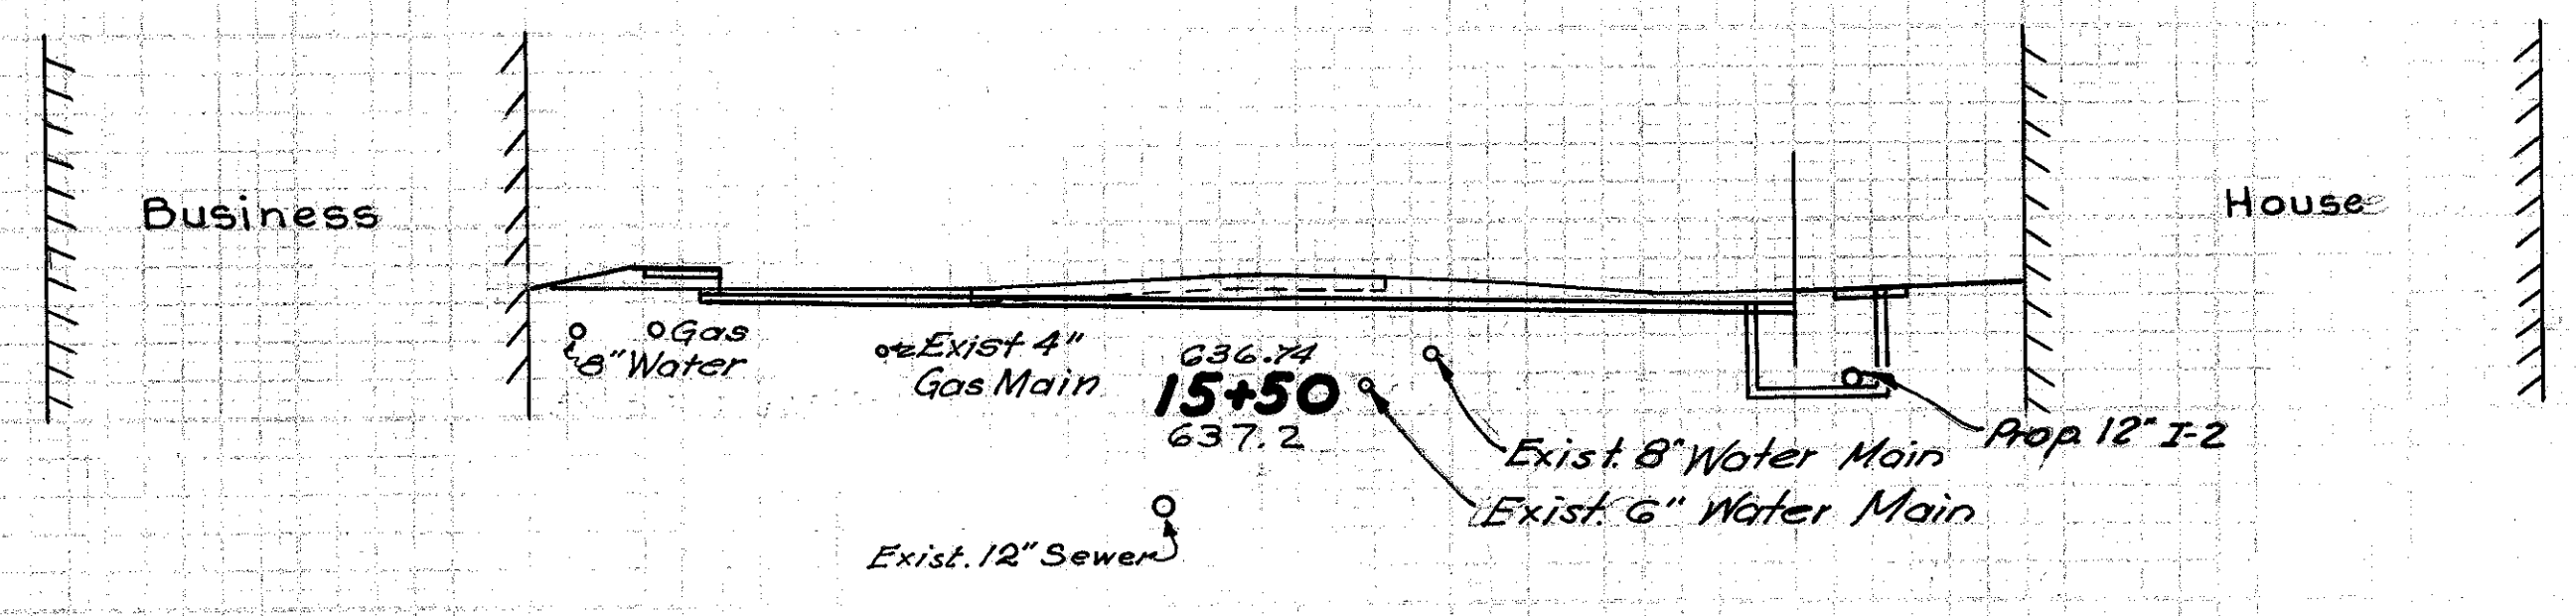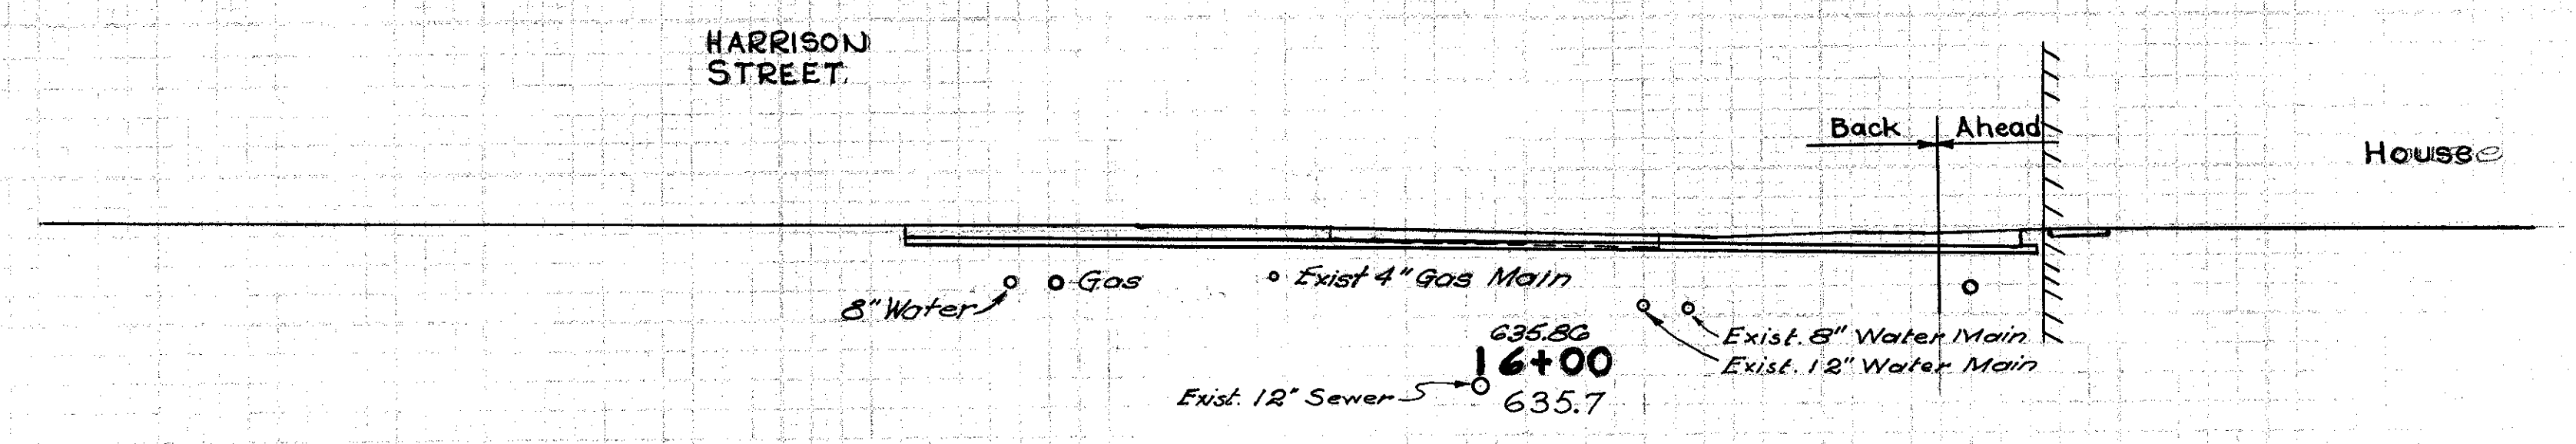

160 150 140 130 120 110 100 90 80 70 60 50 40 30 20 10 0 10 20 30 40 50 60 70 80 90 100 110 120 STATE ROUTE 73

	End Area		Cu. Yds.	
	Cut	Fill	Cut	Fill
Ahead	110	-		
Back	93	-		
			153	6
House #906				181
	72	6		
			151	7
Houses #900				116
#902				116
Ahead	91	1		
Back	91	-		
			164	-
	86	-		
			203	5
	133	5		
			149	33

160 150 140 130 120 110 100 90 80 70 60 50 40 30 20 10 0 10 20 30 40 50 60 70 80 90 100 110

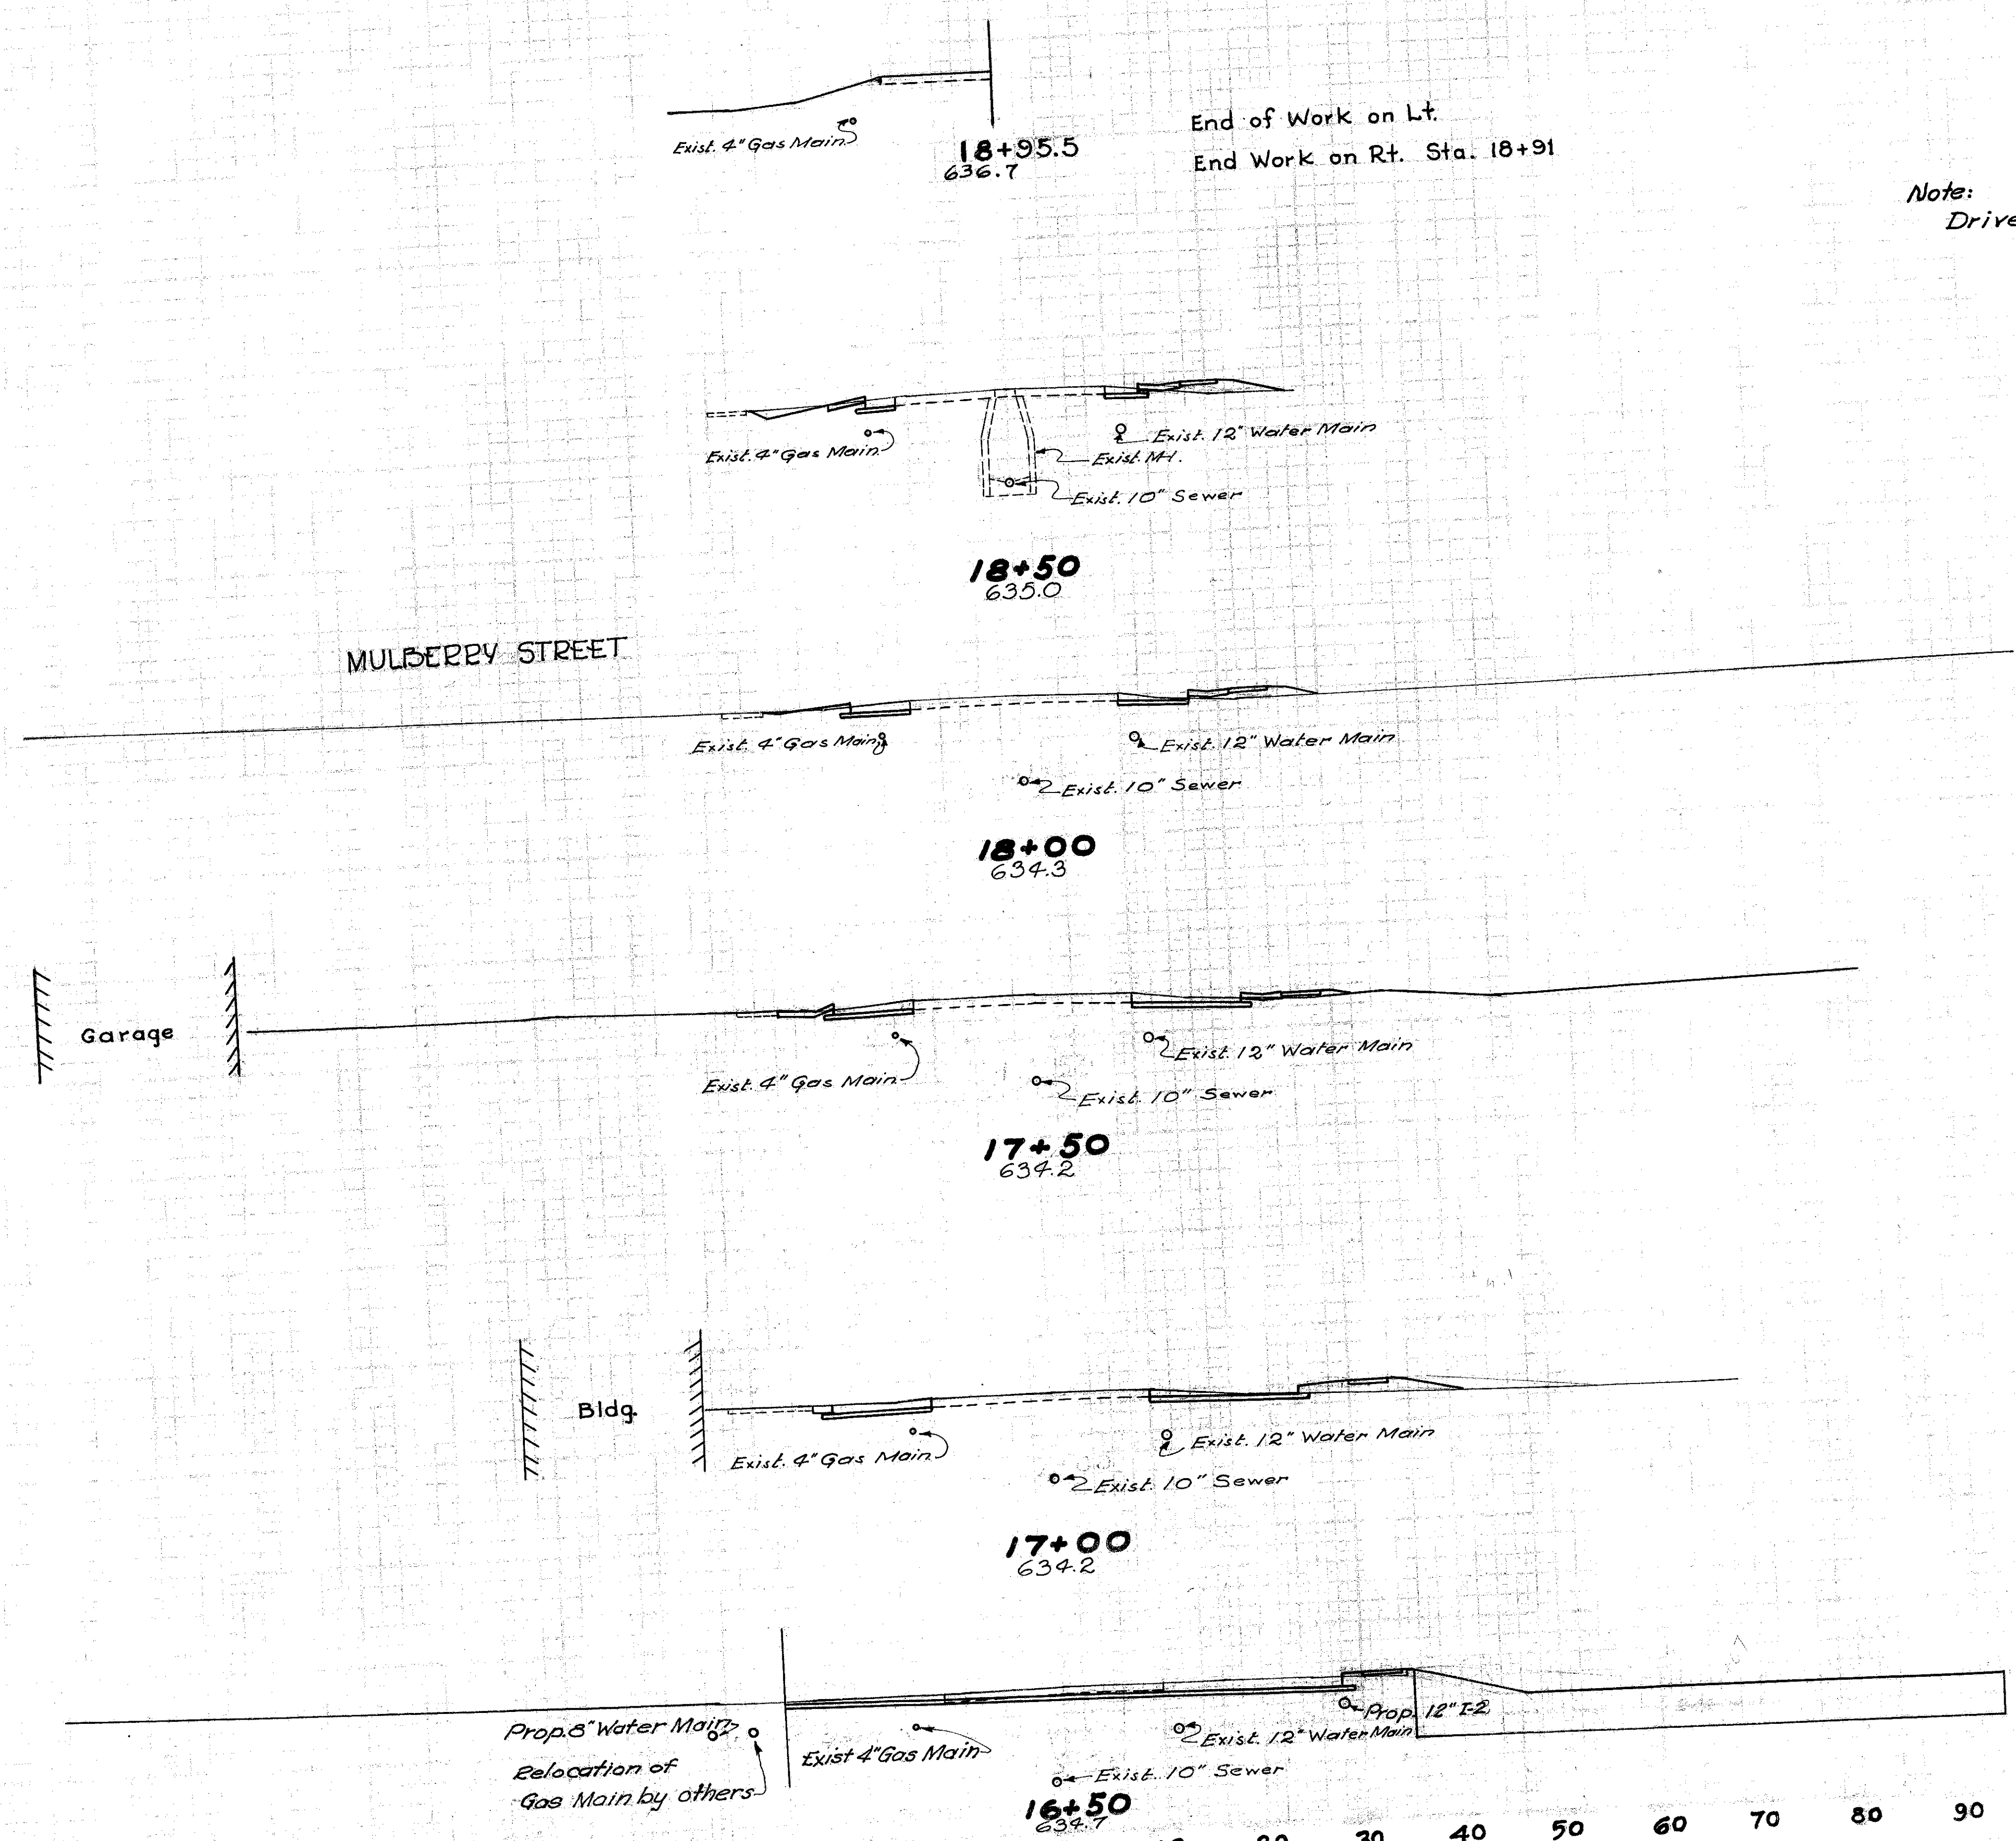

Rt. Lt.	End Area		Cu Yds.	
	Cut	Fill	Cut	Fill
				6
			5	5
	9	2	21	13
	14	8		
			34	10
	23	3		
			33	26
	18	25		
			70	25
				139
				189
	64	2		
				195
			161	2

Note:  
Drive Sta 17+13 Rt.

House  
# 912  
# 910

House  
# 908


STATE ROUTE 73

160 150 140 130 120 110 100 90 80 70 60 50 40 30 20 10 0 10 20 30 40 50 60 70 80 90 100 110 120

150 140 130 120 110 100 90 80 70 60 50 40 30 20 10 0 10 20 30 40 50 60 70 80 90 100 110 120 130 140 150



PROJECT: OHIO  
 DATE: JUN-4-16 8:30 AM

127  
 222

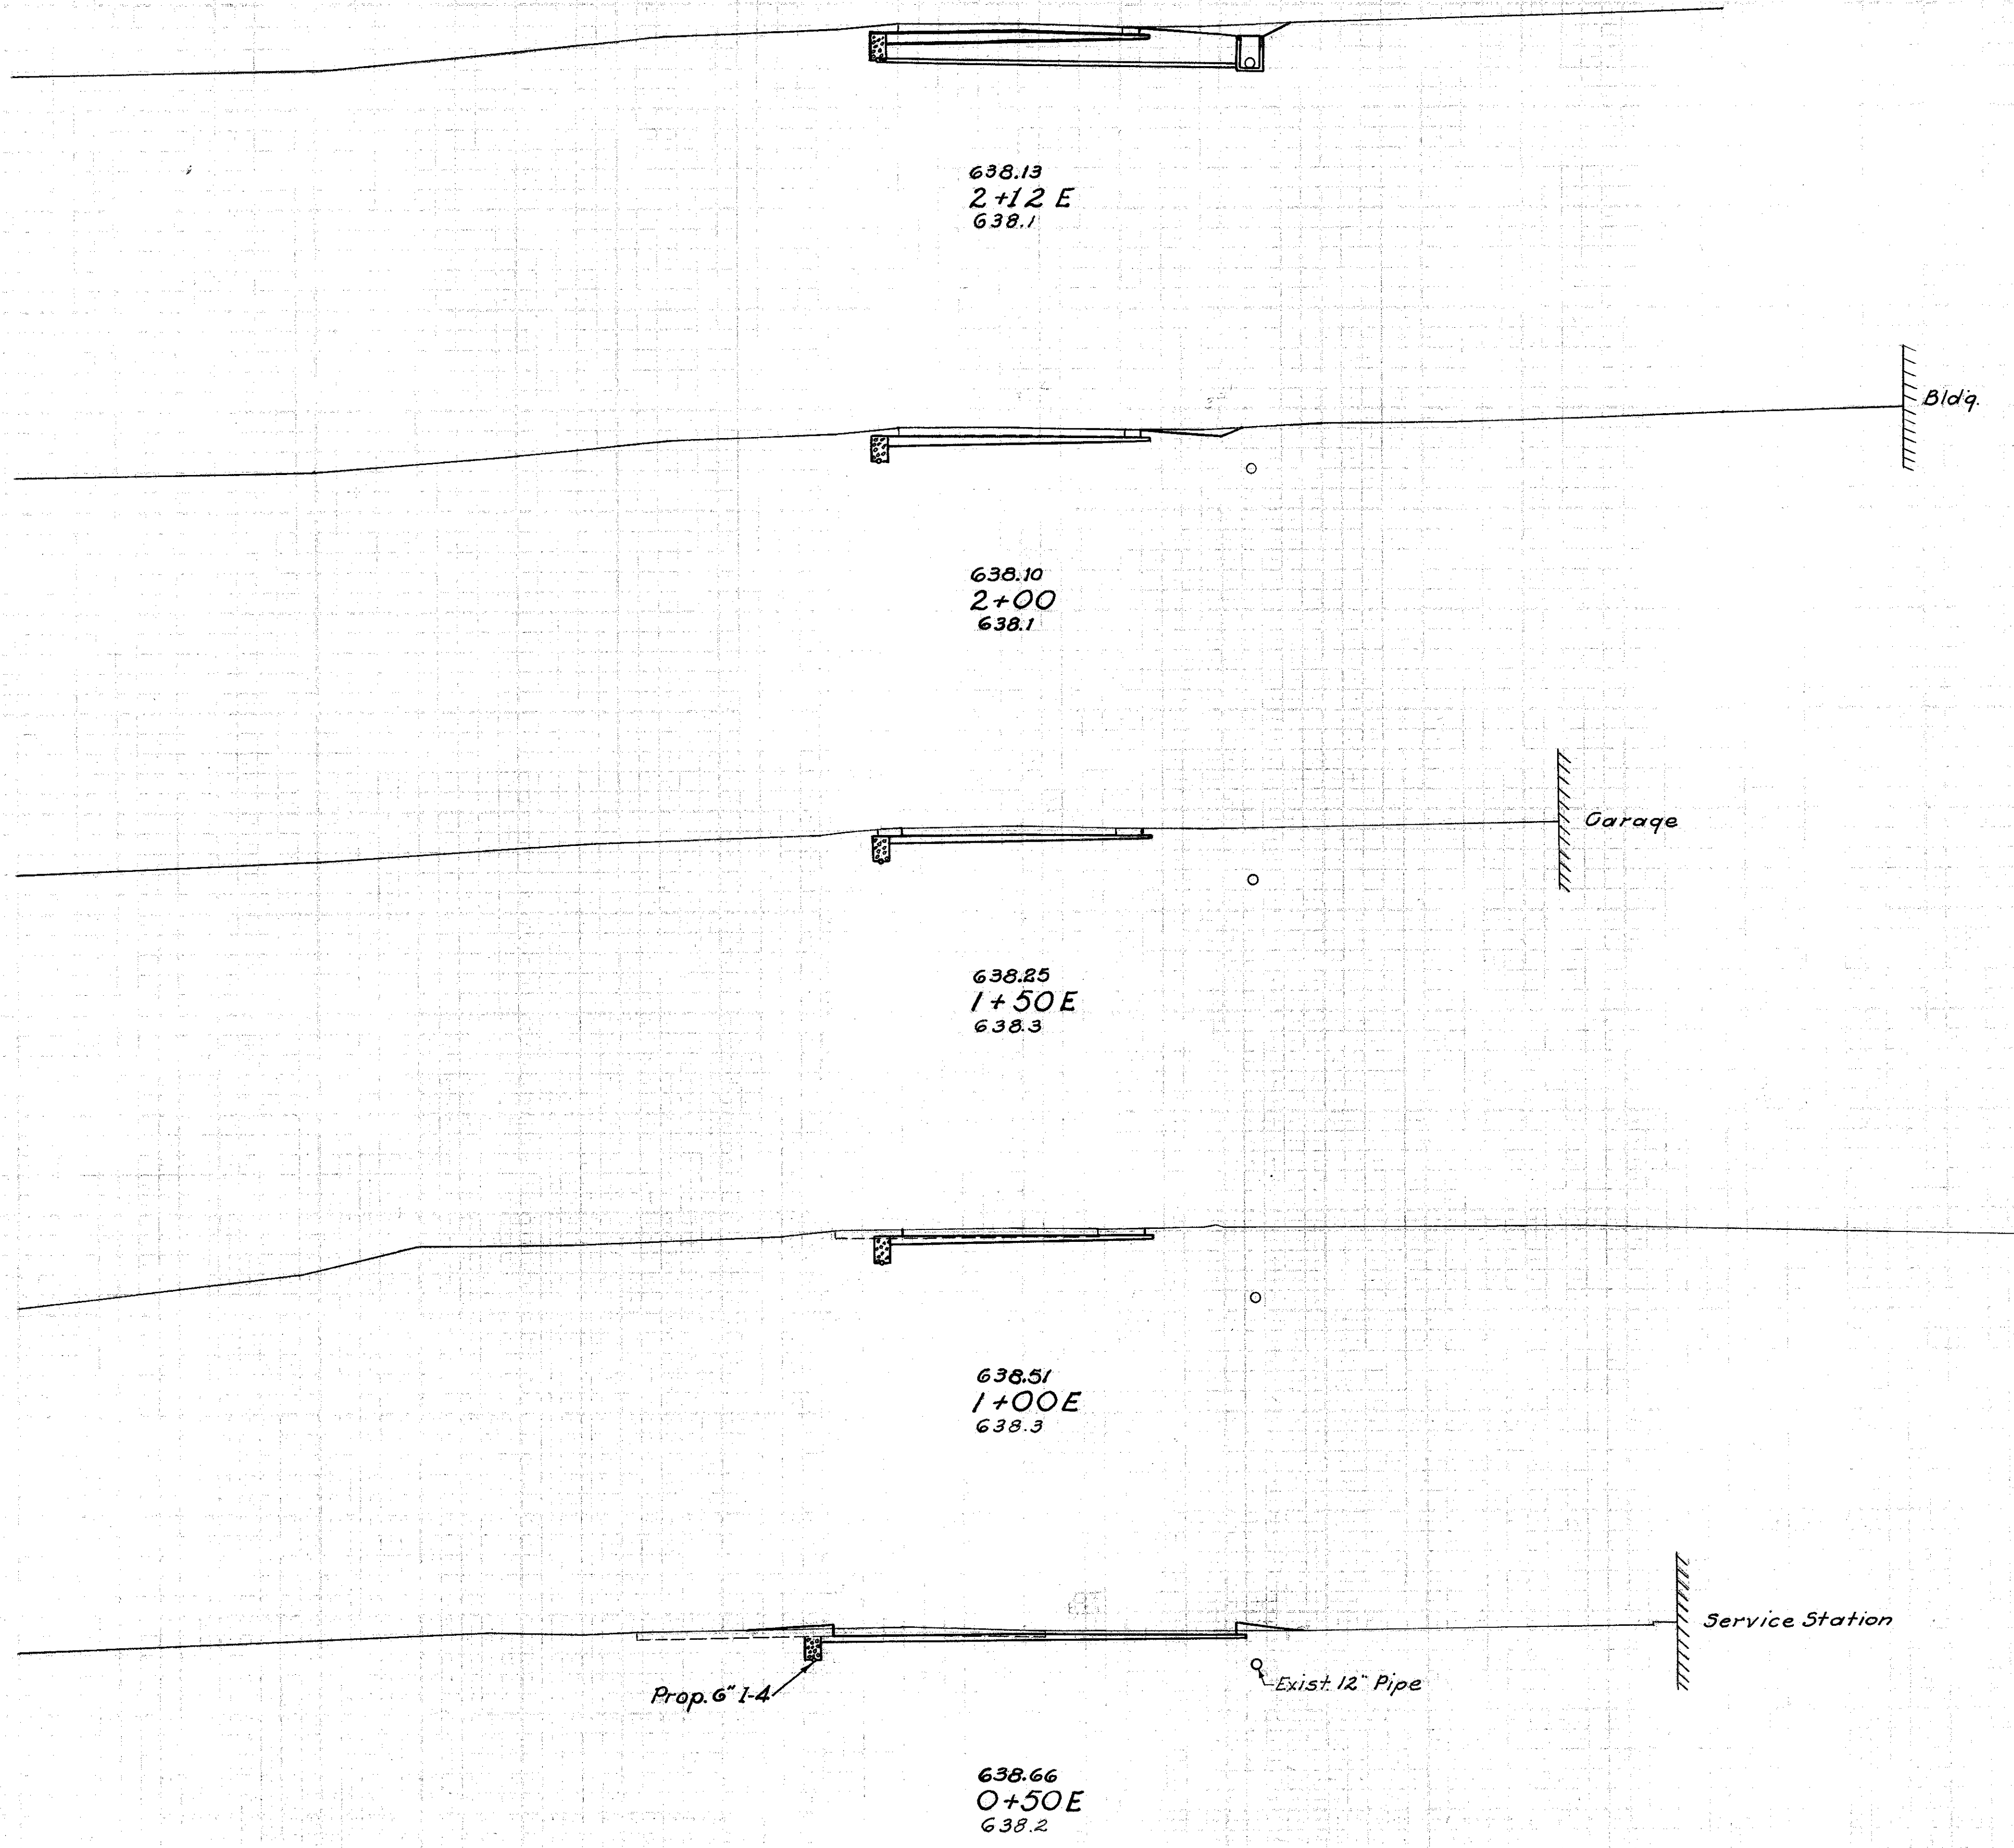

End Area		Cu. Yds.	
Cut	Fill	Cut	Fill
51	-	18	-
28	-	53	-
29	-	58	-
34	-	79	4
51	4	65	4

150 140 130 120 110 100 90 80 70 60 50 40 30 20 10 0 10 20 30 40 50 60 70 80 90 100 110 120 130 140 150  
 VERITY PARKWAY STA. 0+50E TO STA. 2+12 E

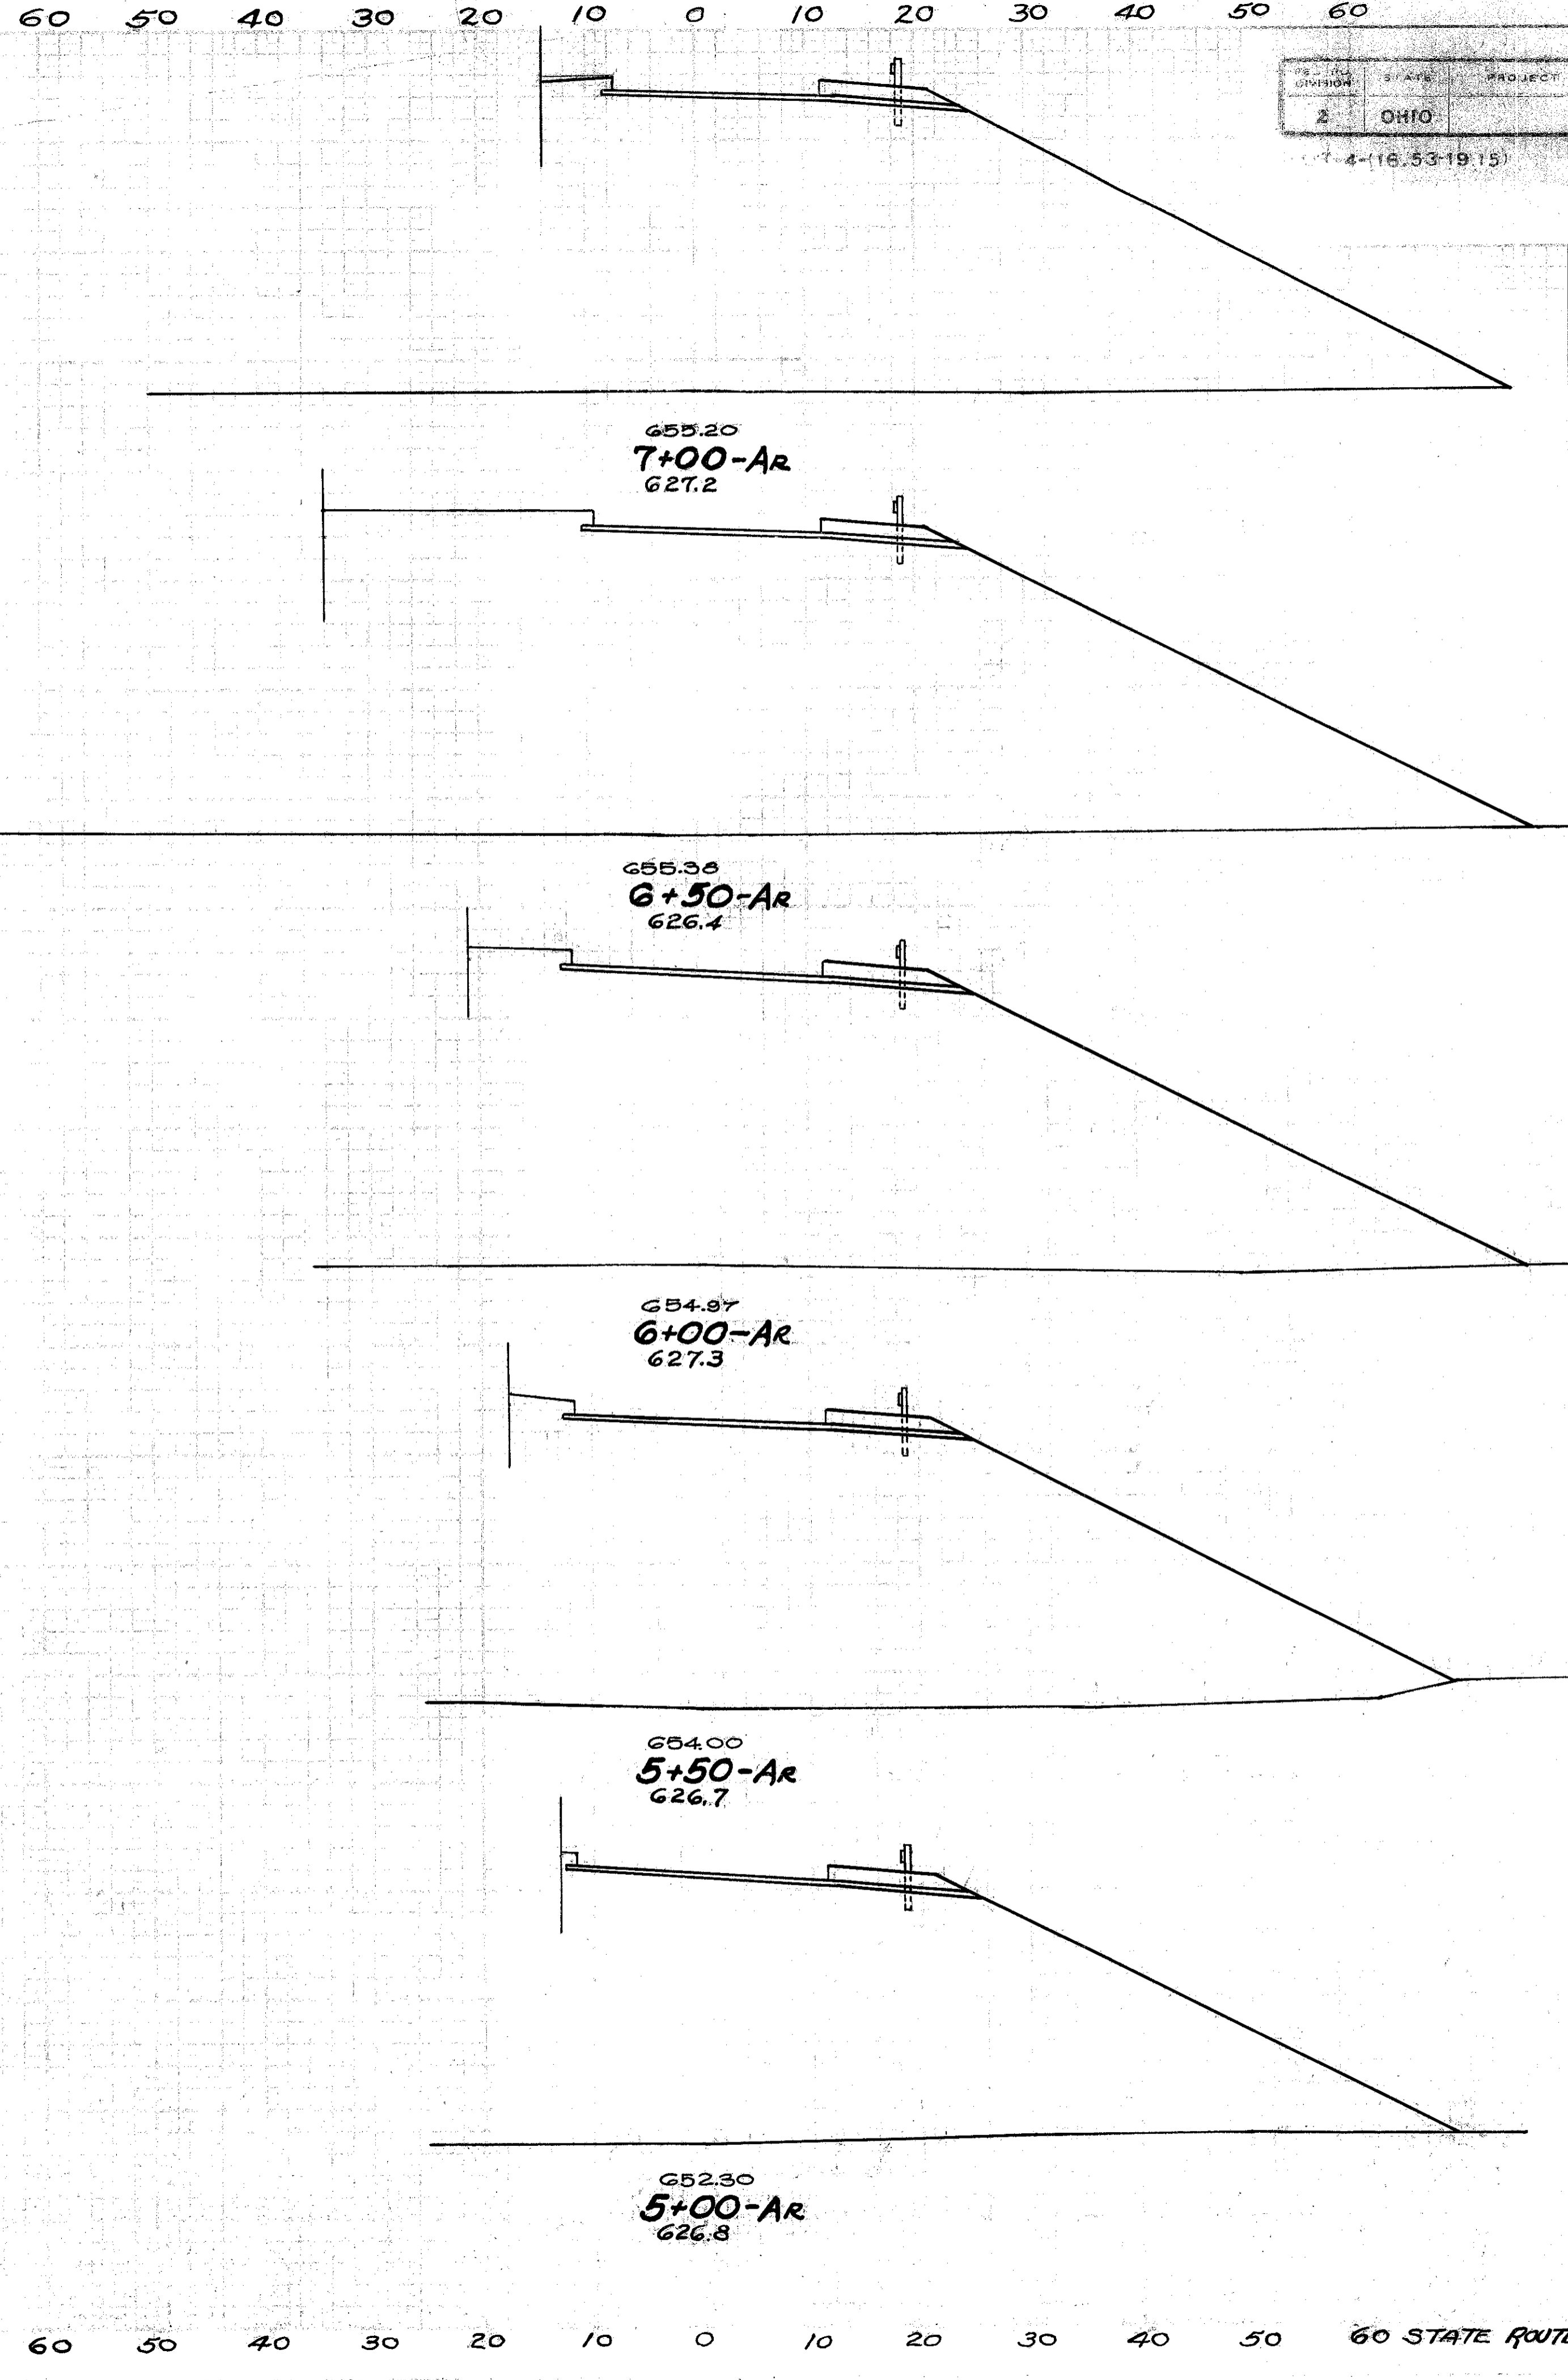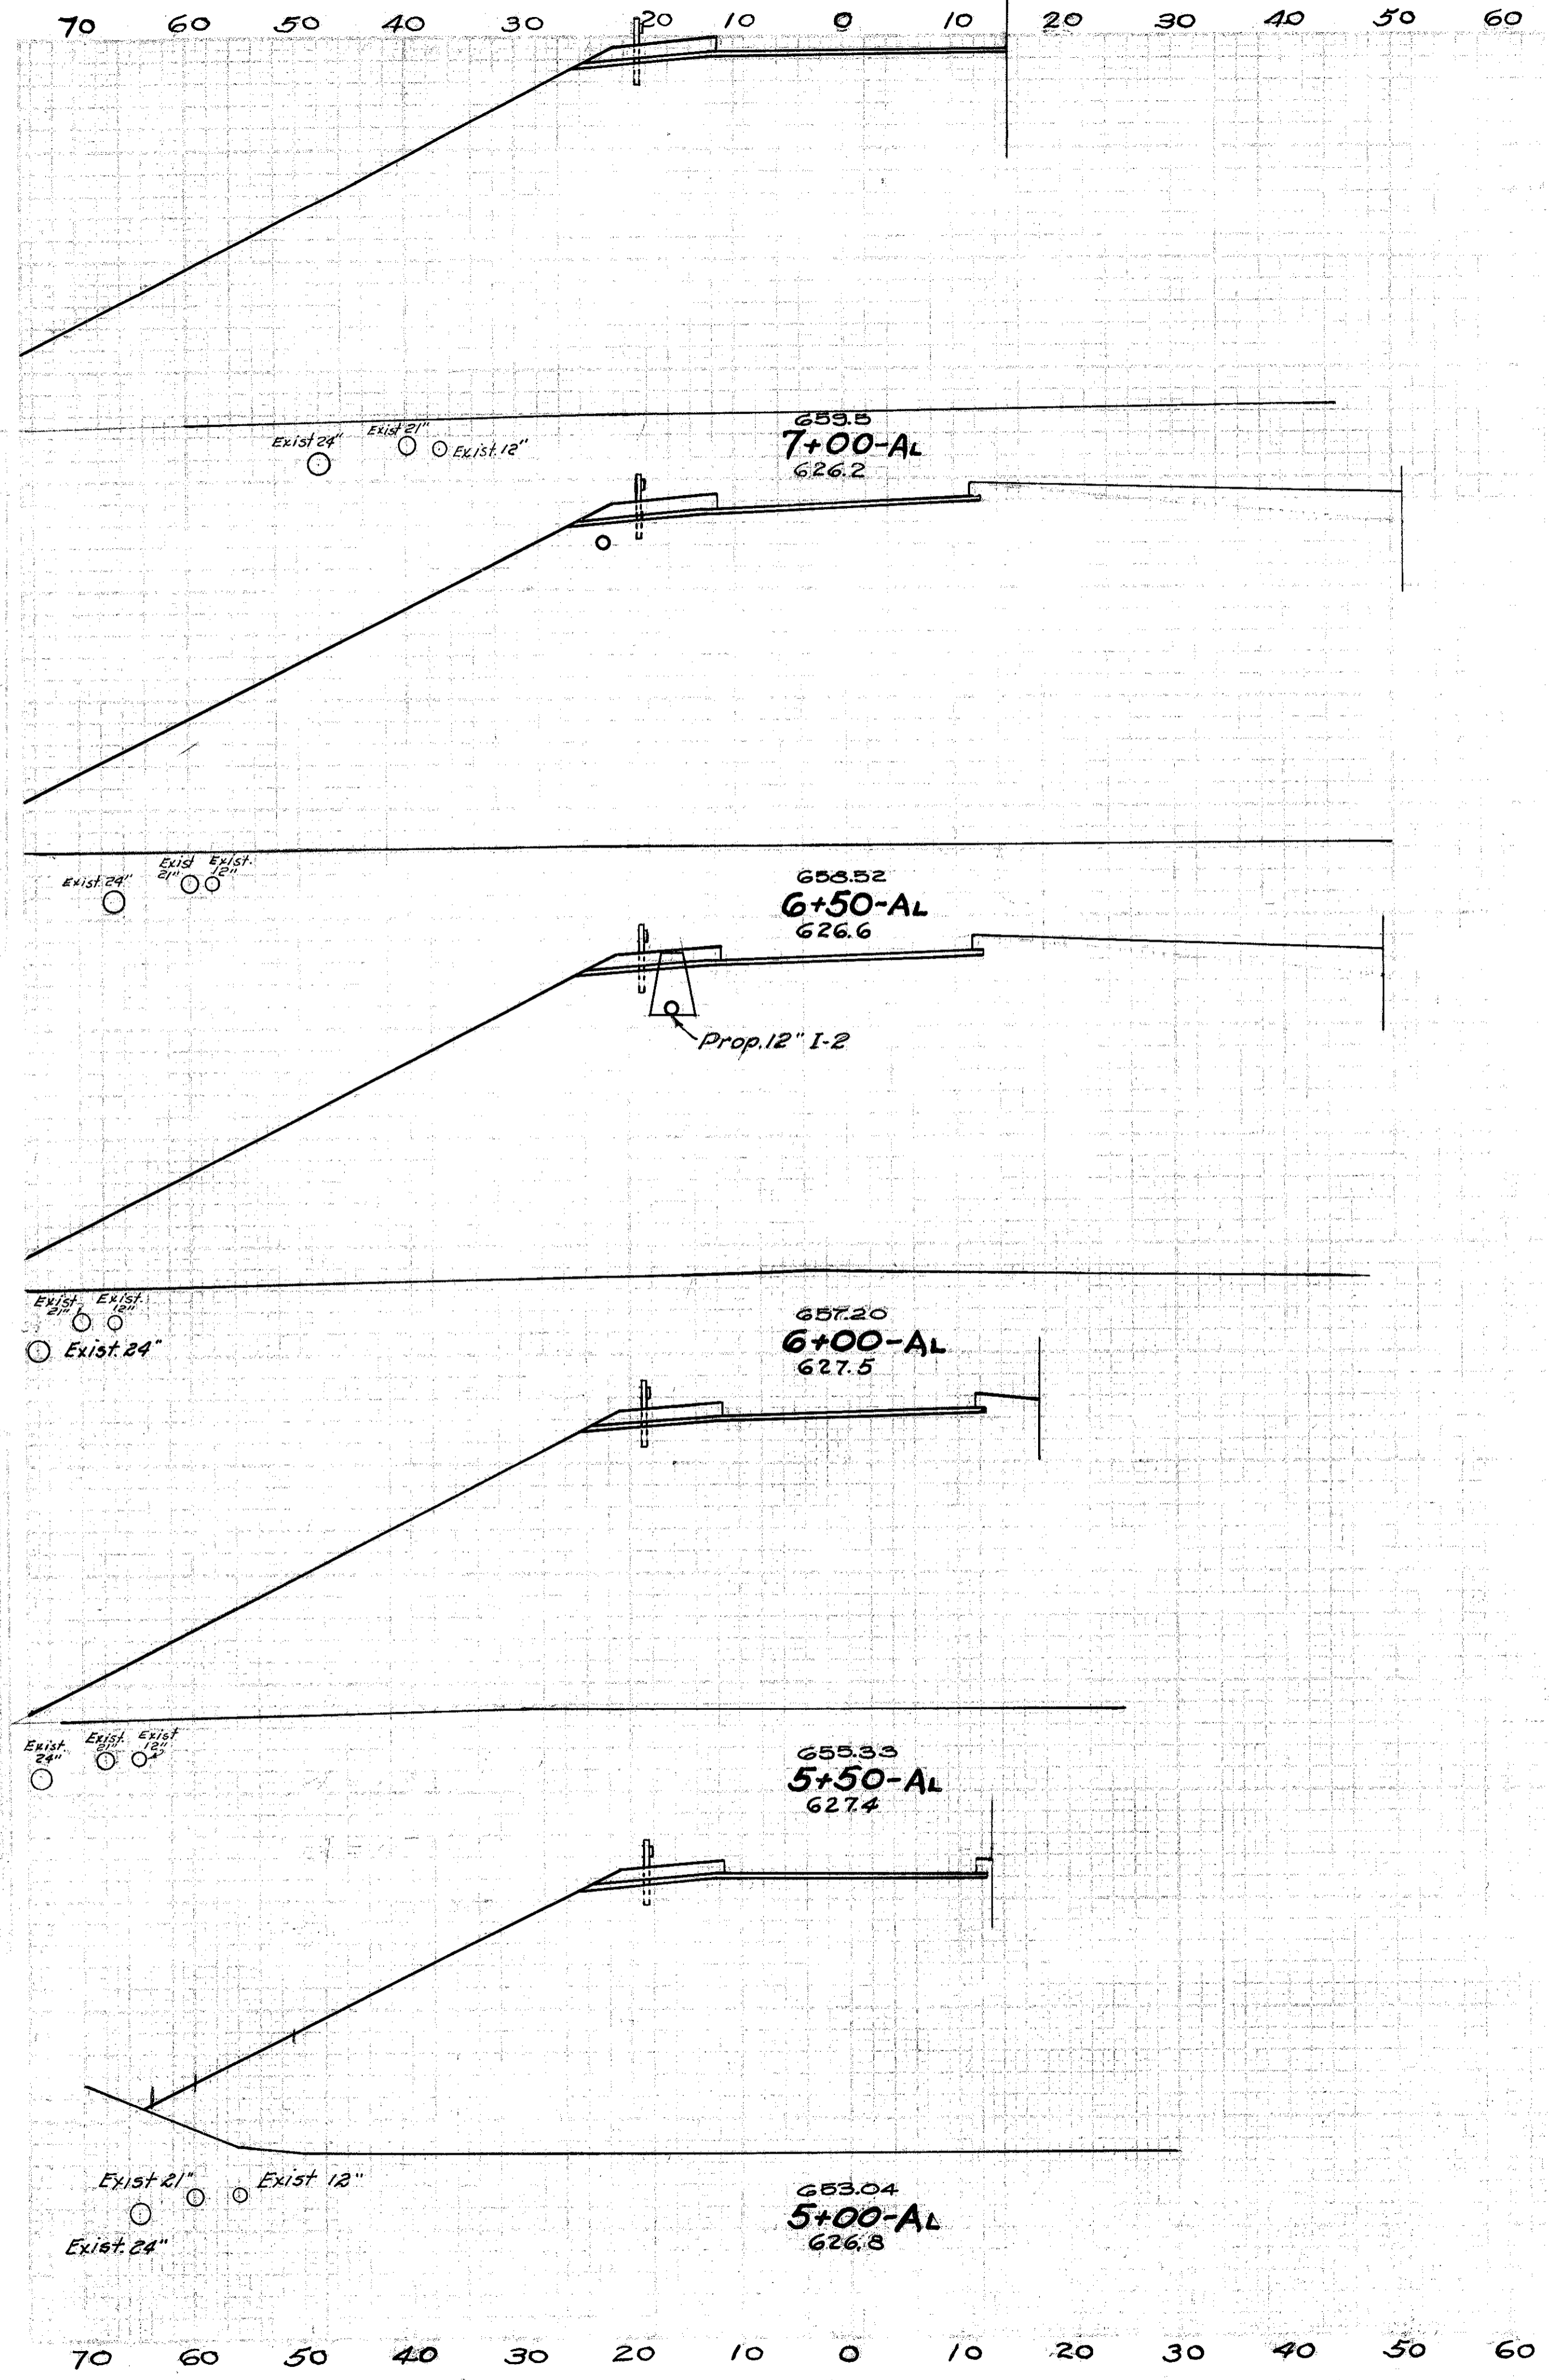


End Area	Cu. Yds.	
	Cut	Fill
- 2347		
	- 5221	
- 3292		
	- 4888	
- 1987		
	- 3541	
- 1837		
	- 3106	
- 1517		

End Area	Cu. Yds.	
	Cut	Fill
- 1737		
	- 3824	
- 2393		
	- 4002	
- 1929		
	- 3405	
- 1745		
	- 2920	
- 1406		



140 130 120 110 100 90 80 70 60 50 40 30 20 10 0 10 20 30 40 50 60 70 80 90 100 110 120 130 140


Begin transition  
Sta. 1+85-A  
Side Slope 4:1

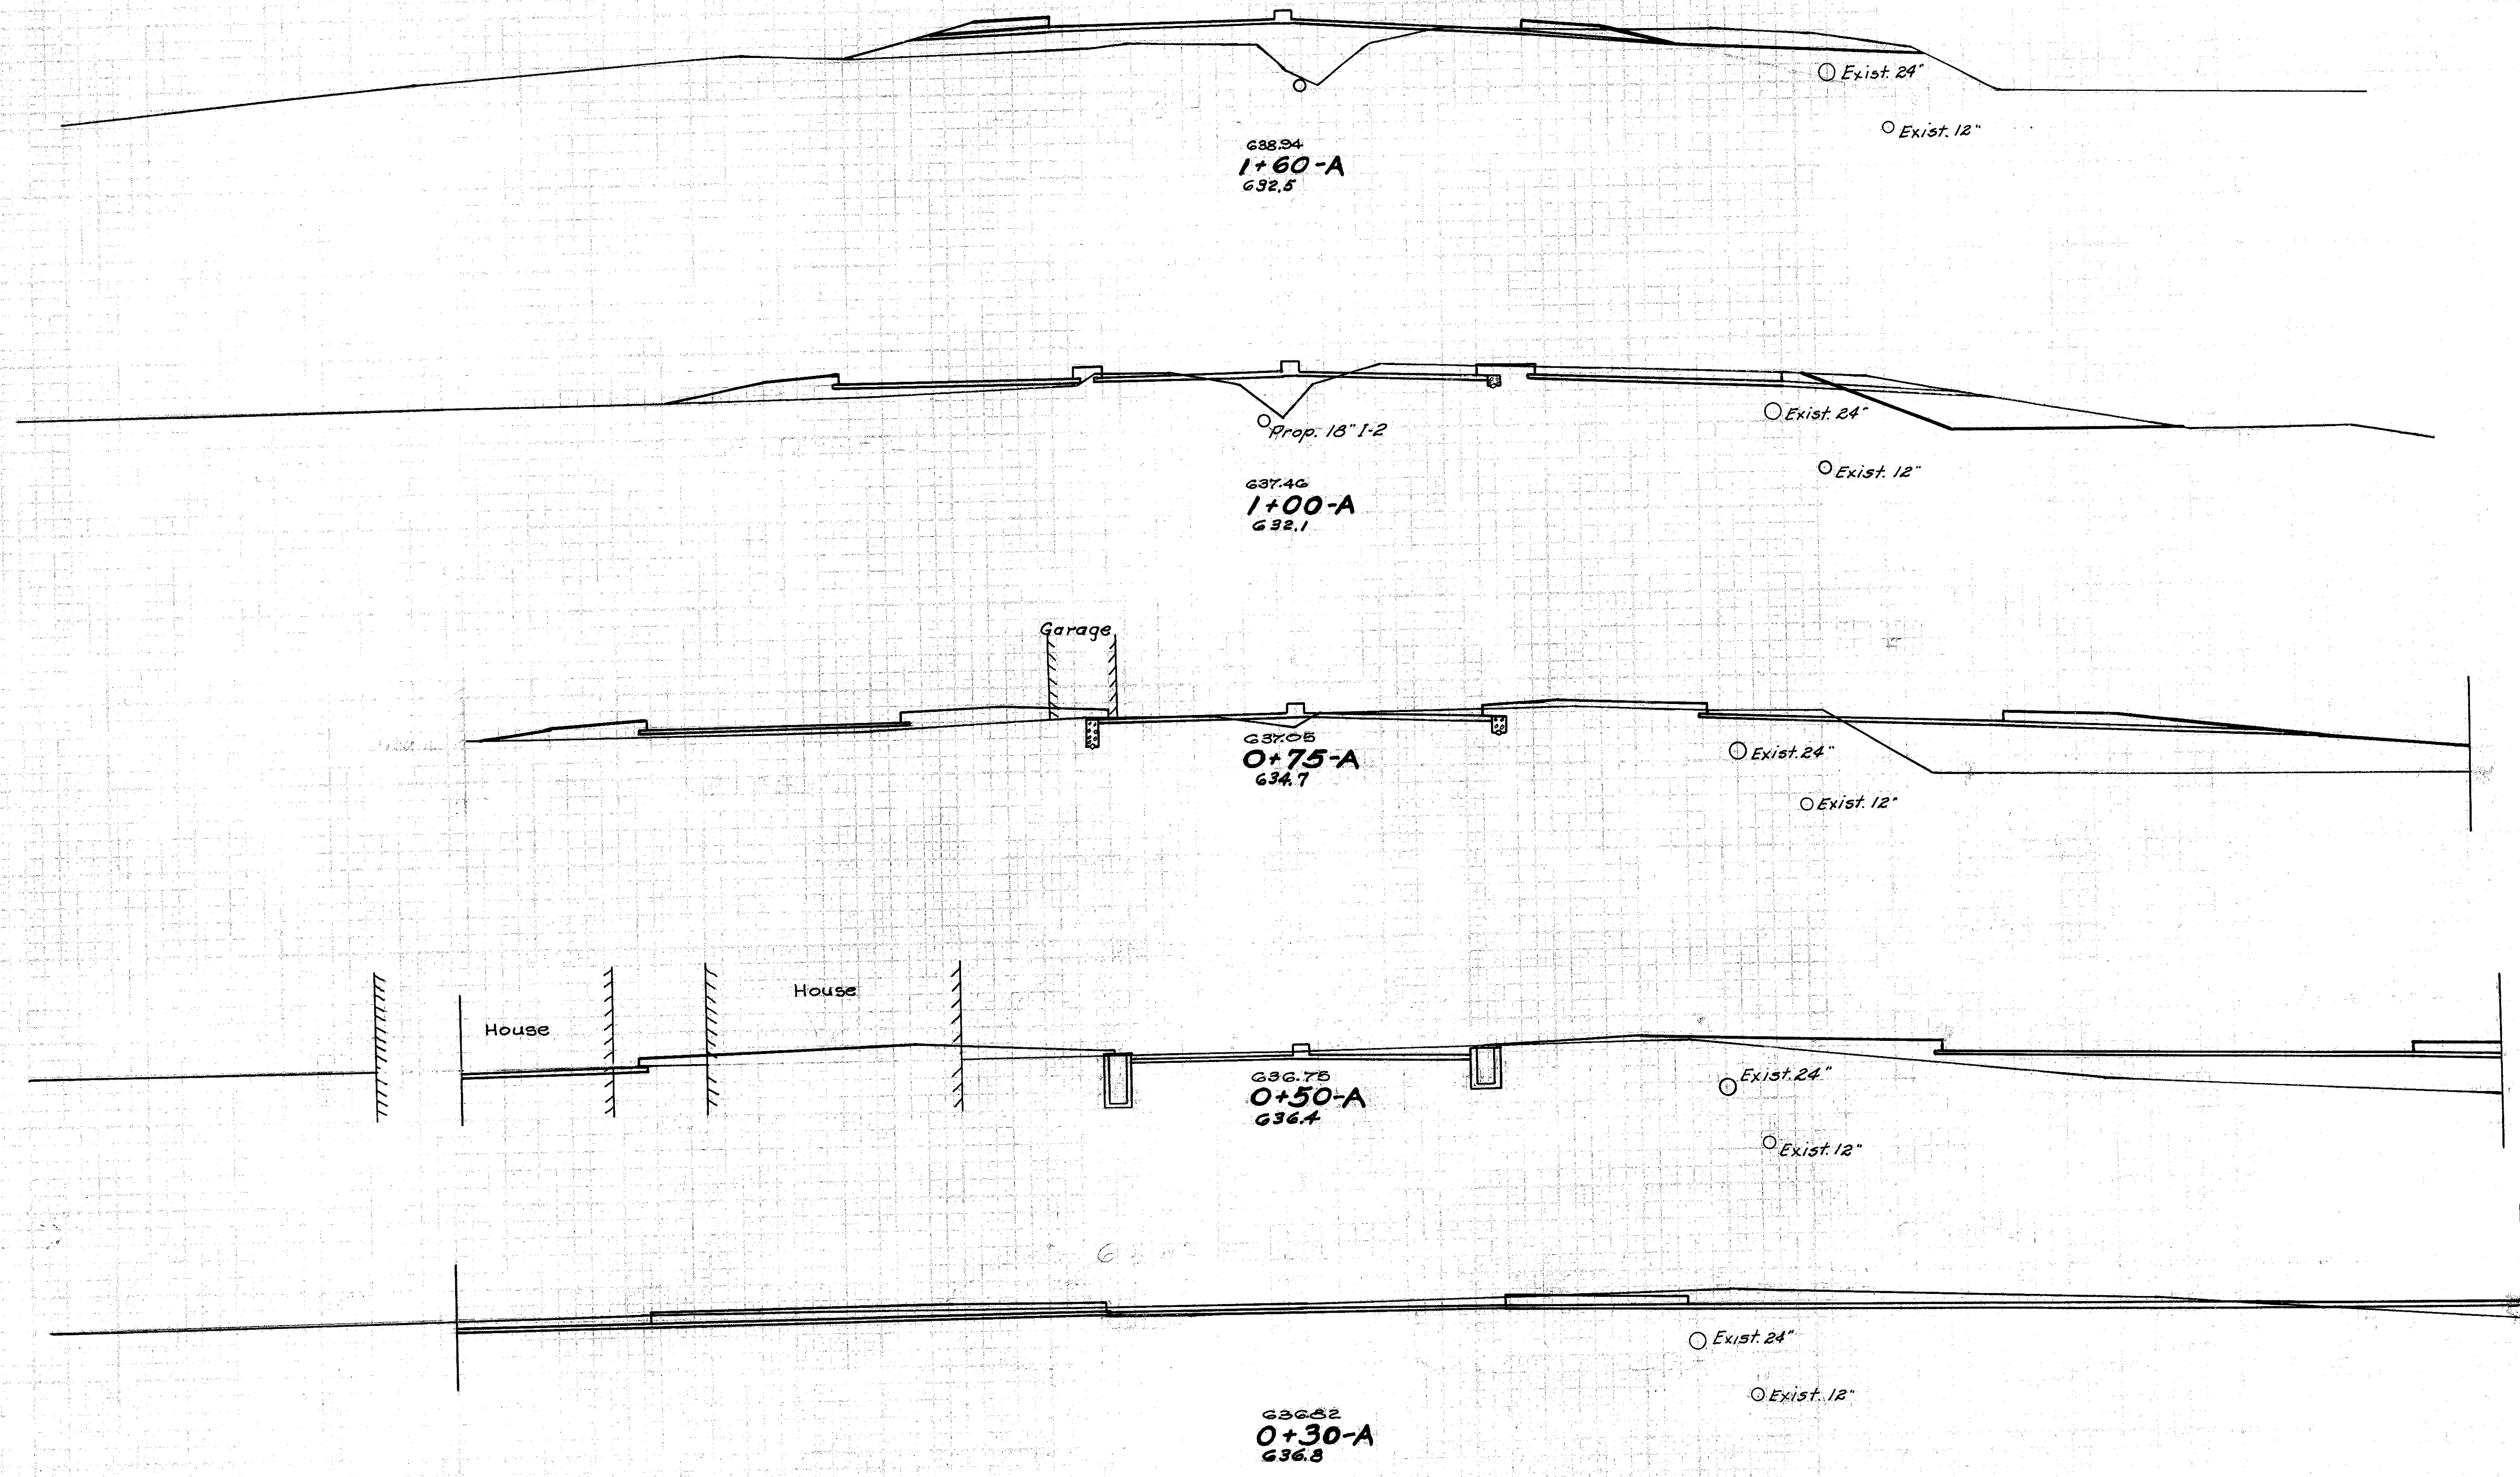

End Area	Cu. Yds.	
	Cut	Fill
111	220	
	376	361
227	105	
	130	274
53	486	
	65	389
87	354	
	170	173
371	112	

150 140 130 120 110 100 90 80 70 60 50 40 30 20 10 0 10 20 30 40 50 60 70 80 90 100 110 120 130 140 STATE ROUTE #4 RAMP-A


150 140 130 120 110 100 90 80 70 60 50 40 30 20 10 0 10 20 30 40 50 60 70 80 90 100 110 120 130 140 150

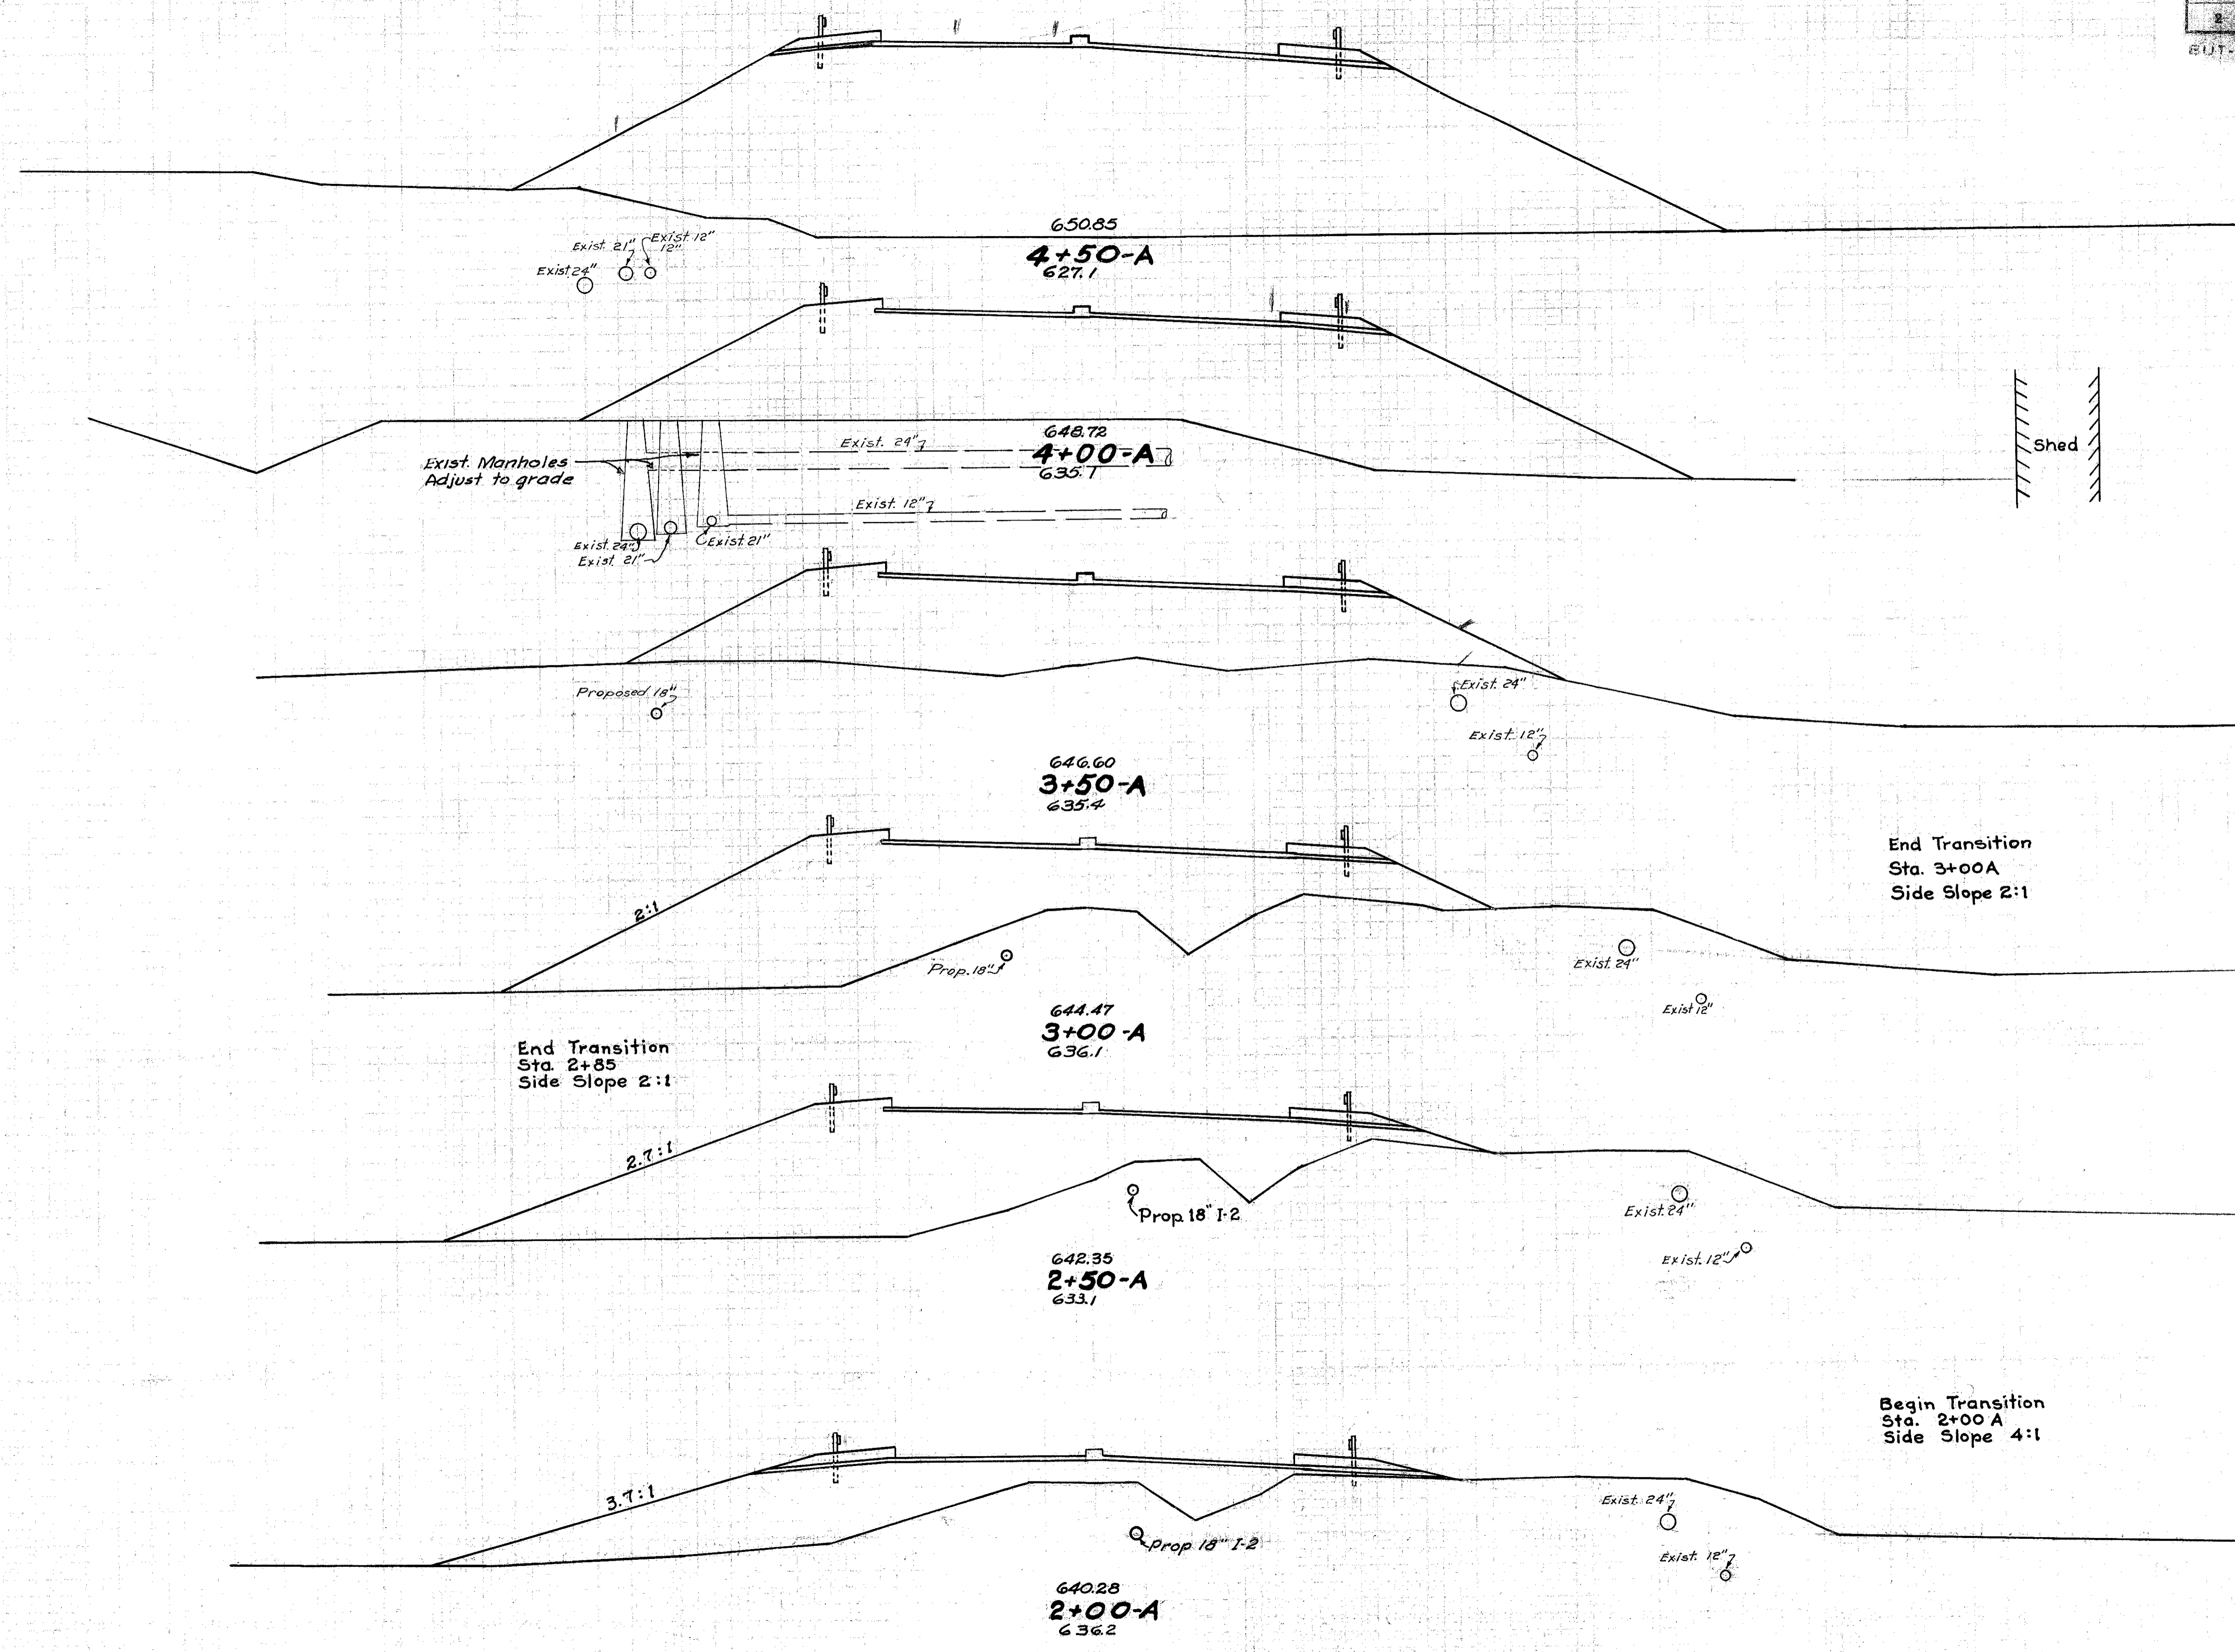

End Area	Cu. Yds.	
CuF	Fill	CuF
-	4952	
-	2425	
-	3617	
-	1481	
-	2237	
-	935	
-	1880	
-	1095	
-	2013	
-	1079	
-	1567	
-	613	
-	82	617

150 140 130 120 110 100 90 80 70 60 50 40 30 20 10 0 10 20 30 40 50 60 70 80 90 100 110 120 130 140 STATE ROUTE #4 RAMP-

140 130 120 110 100 90 80 70 60 50 40 30 20 10 0 10 20 30 40 50 60 70 80 90 100 110 120 130 140

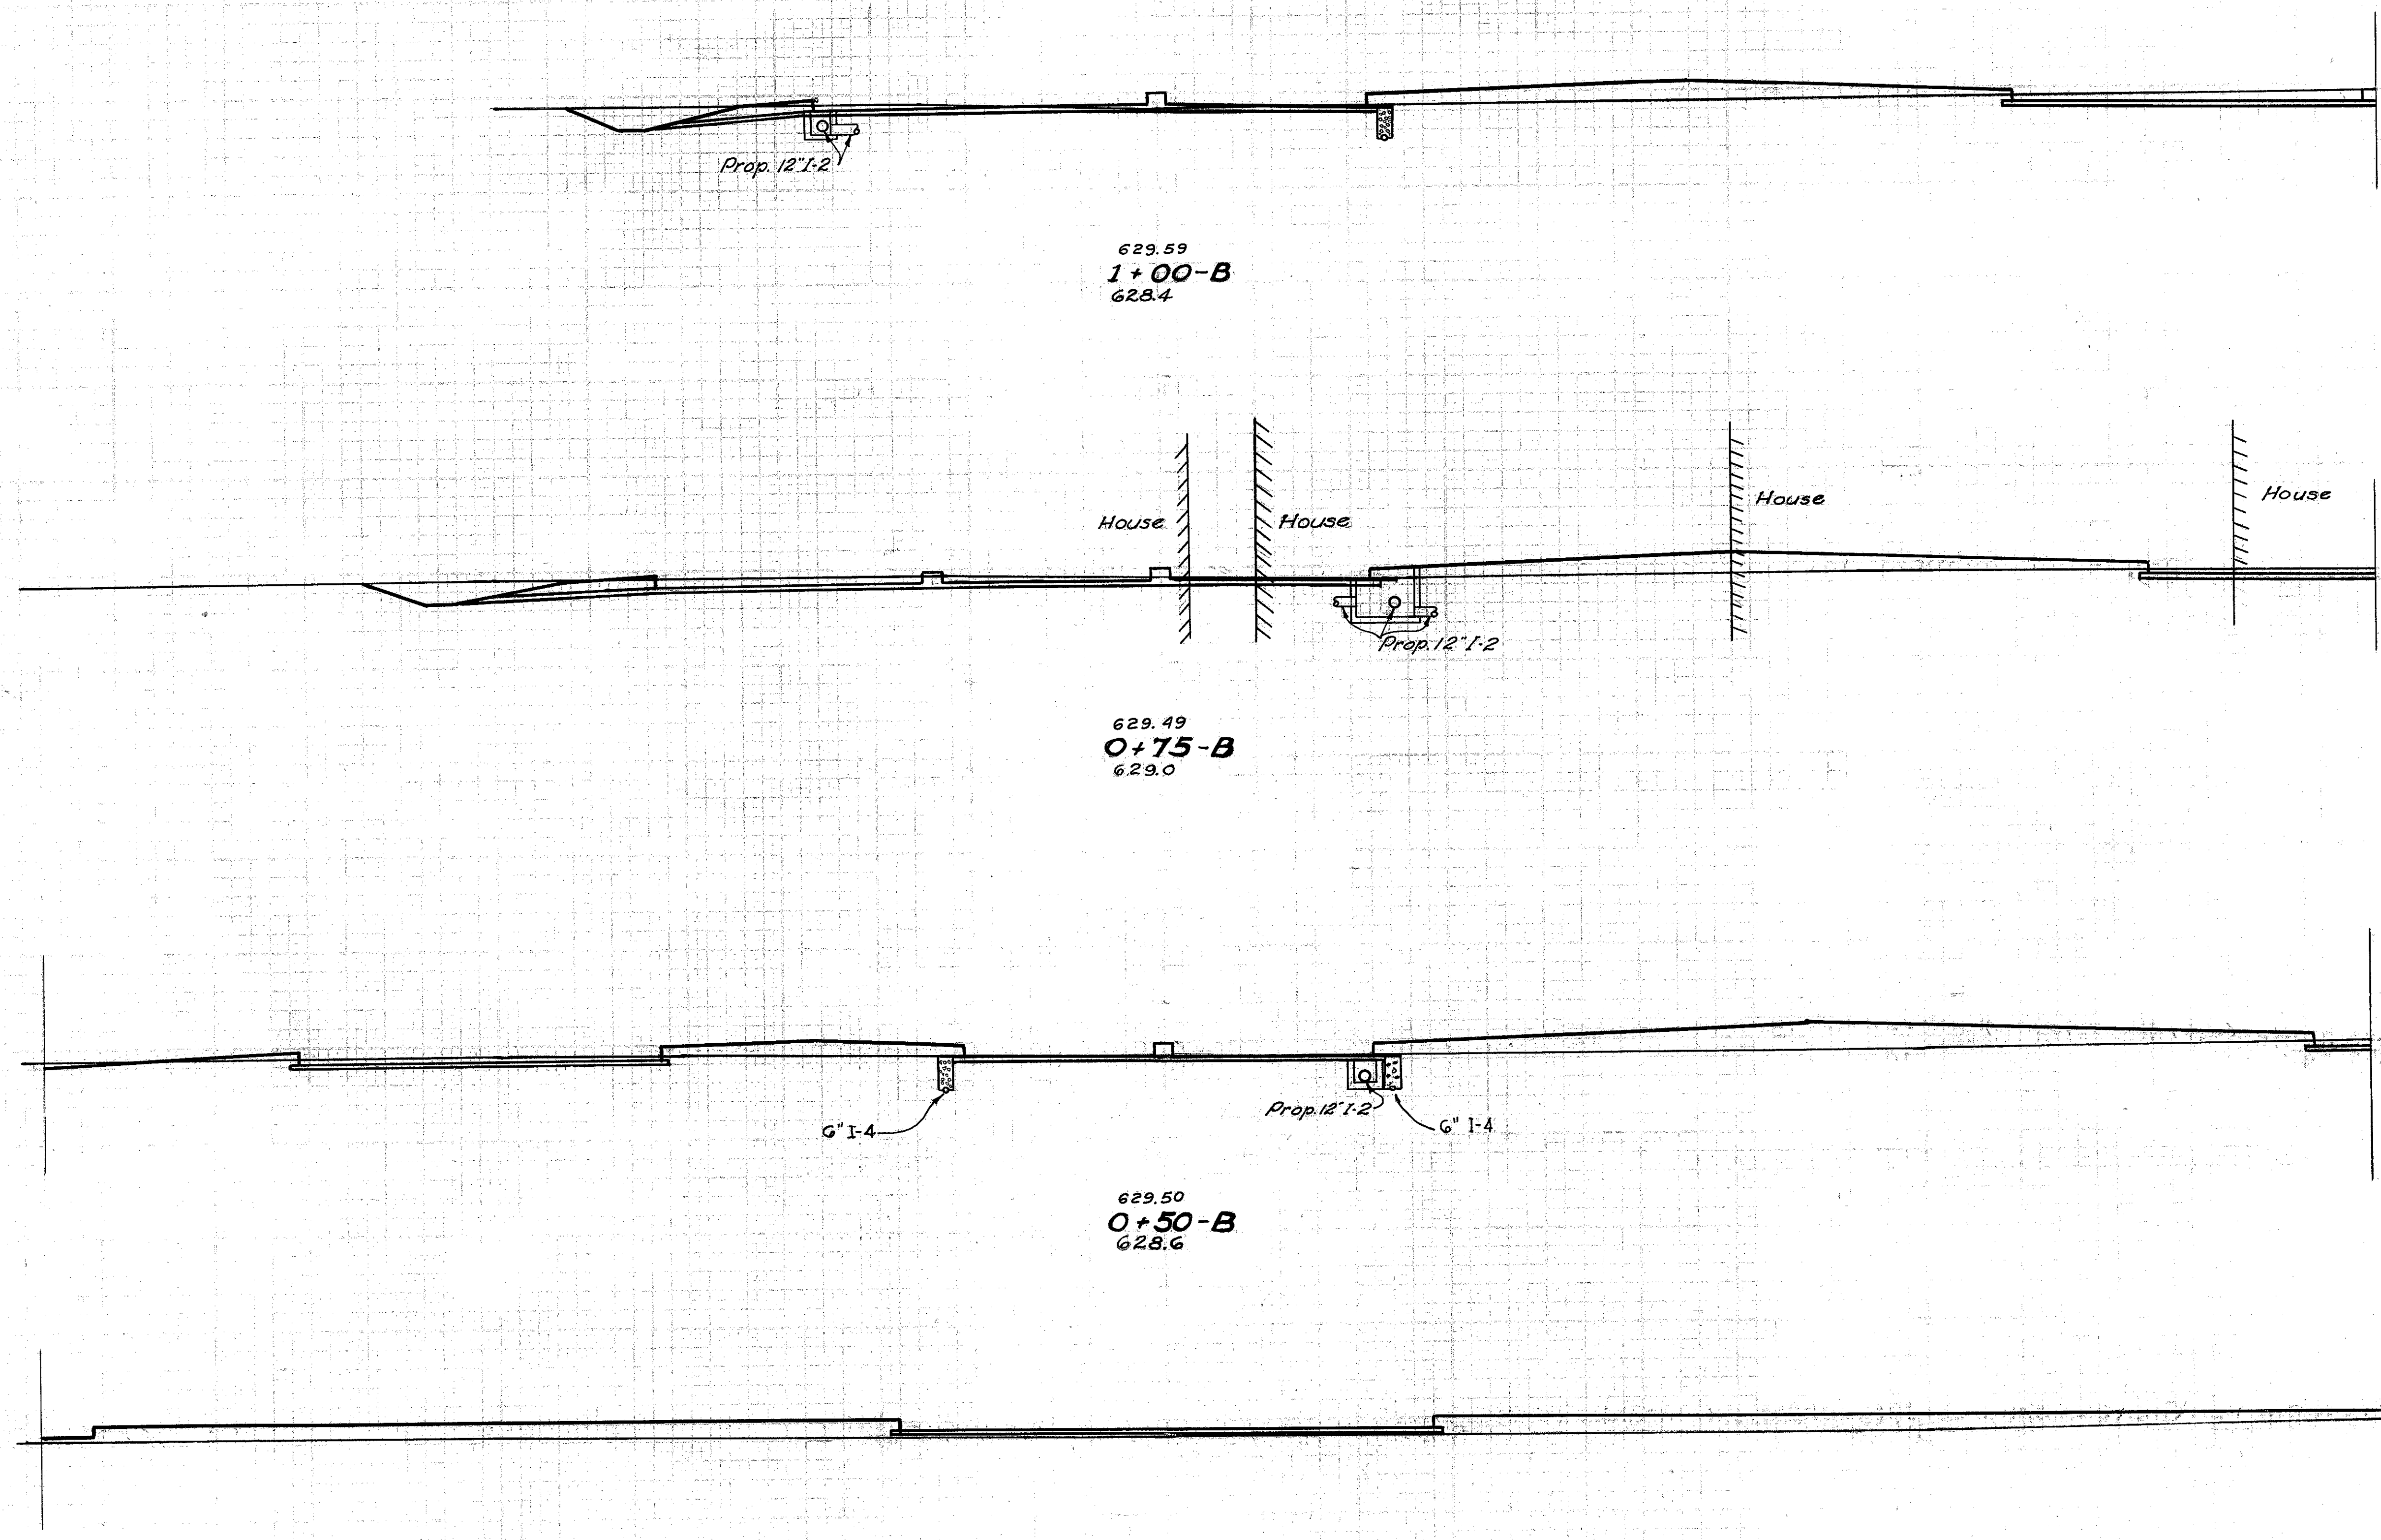

End Area		Cu. Yds.	
Cut	Fill	Cut	Fill
140	135		
		148	126
180	137		
		106	189
48	272		
		254	161
381	-		


140 130 120 110 100 90 80 70 60 50 40 30 20 10 0 10 20 30 40 50 60 70 80 90 100 110 120 130 140 STATE ROUTE #73 - RAMP - "B"

140 130 120 110 100 90 80 70 60 50 40 30 20 10 0 10 20 30 40 50 60 70 80 90 100 110 120 130 140

FED. RD. DISTRICT	STATE	PROJECT
2	OHIO	

132  
222


BLT-4-(16.53-18.15)

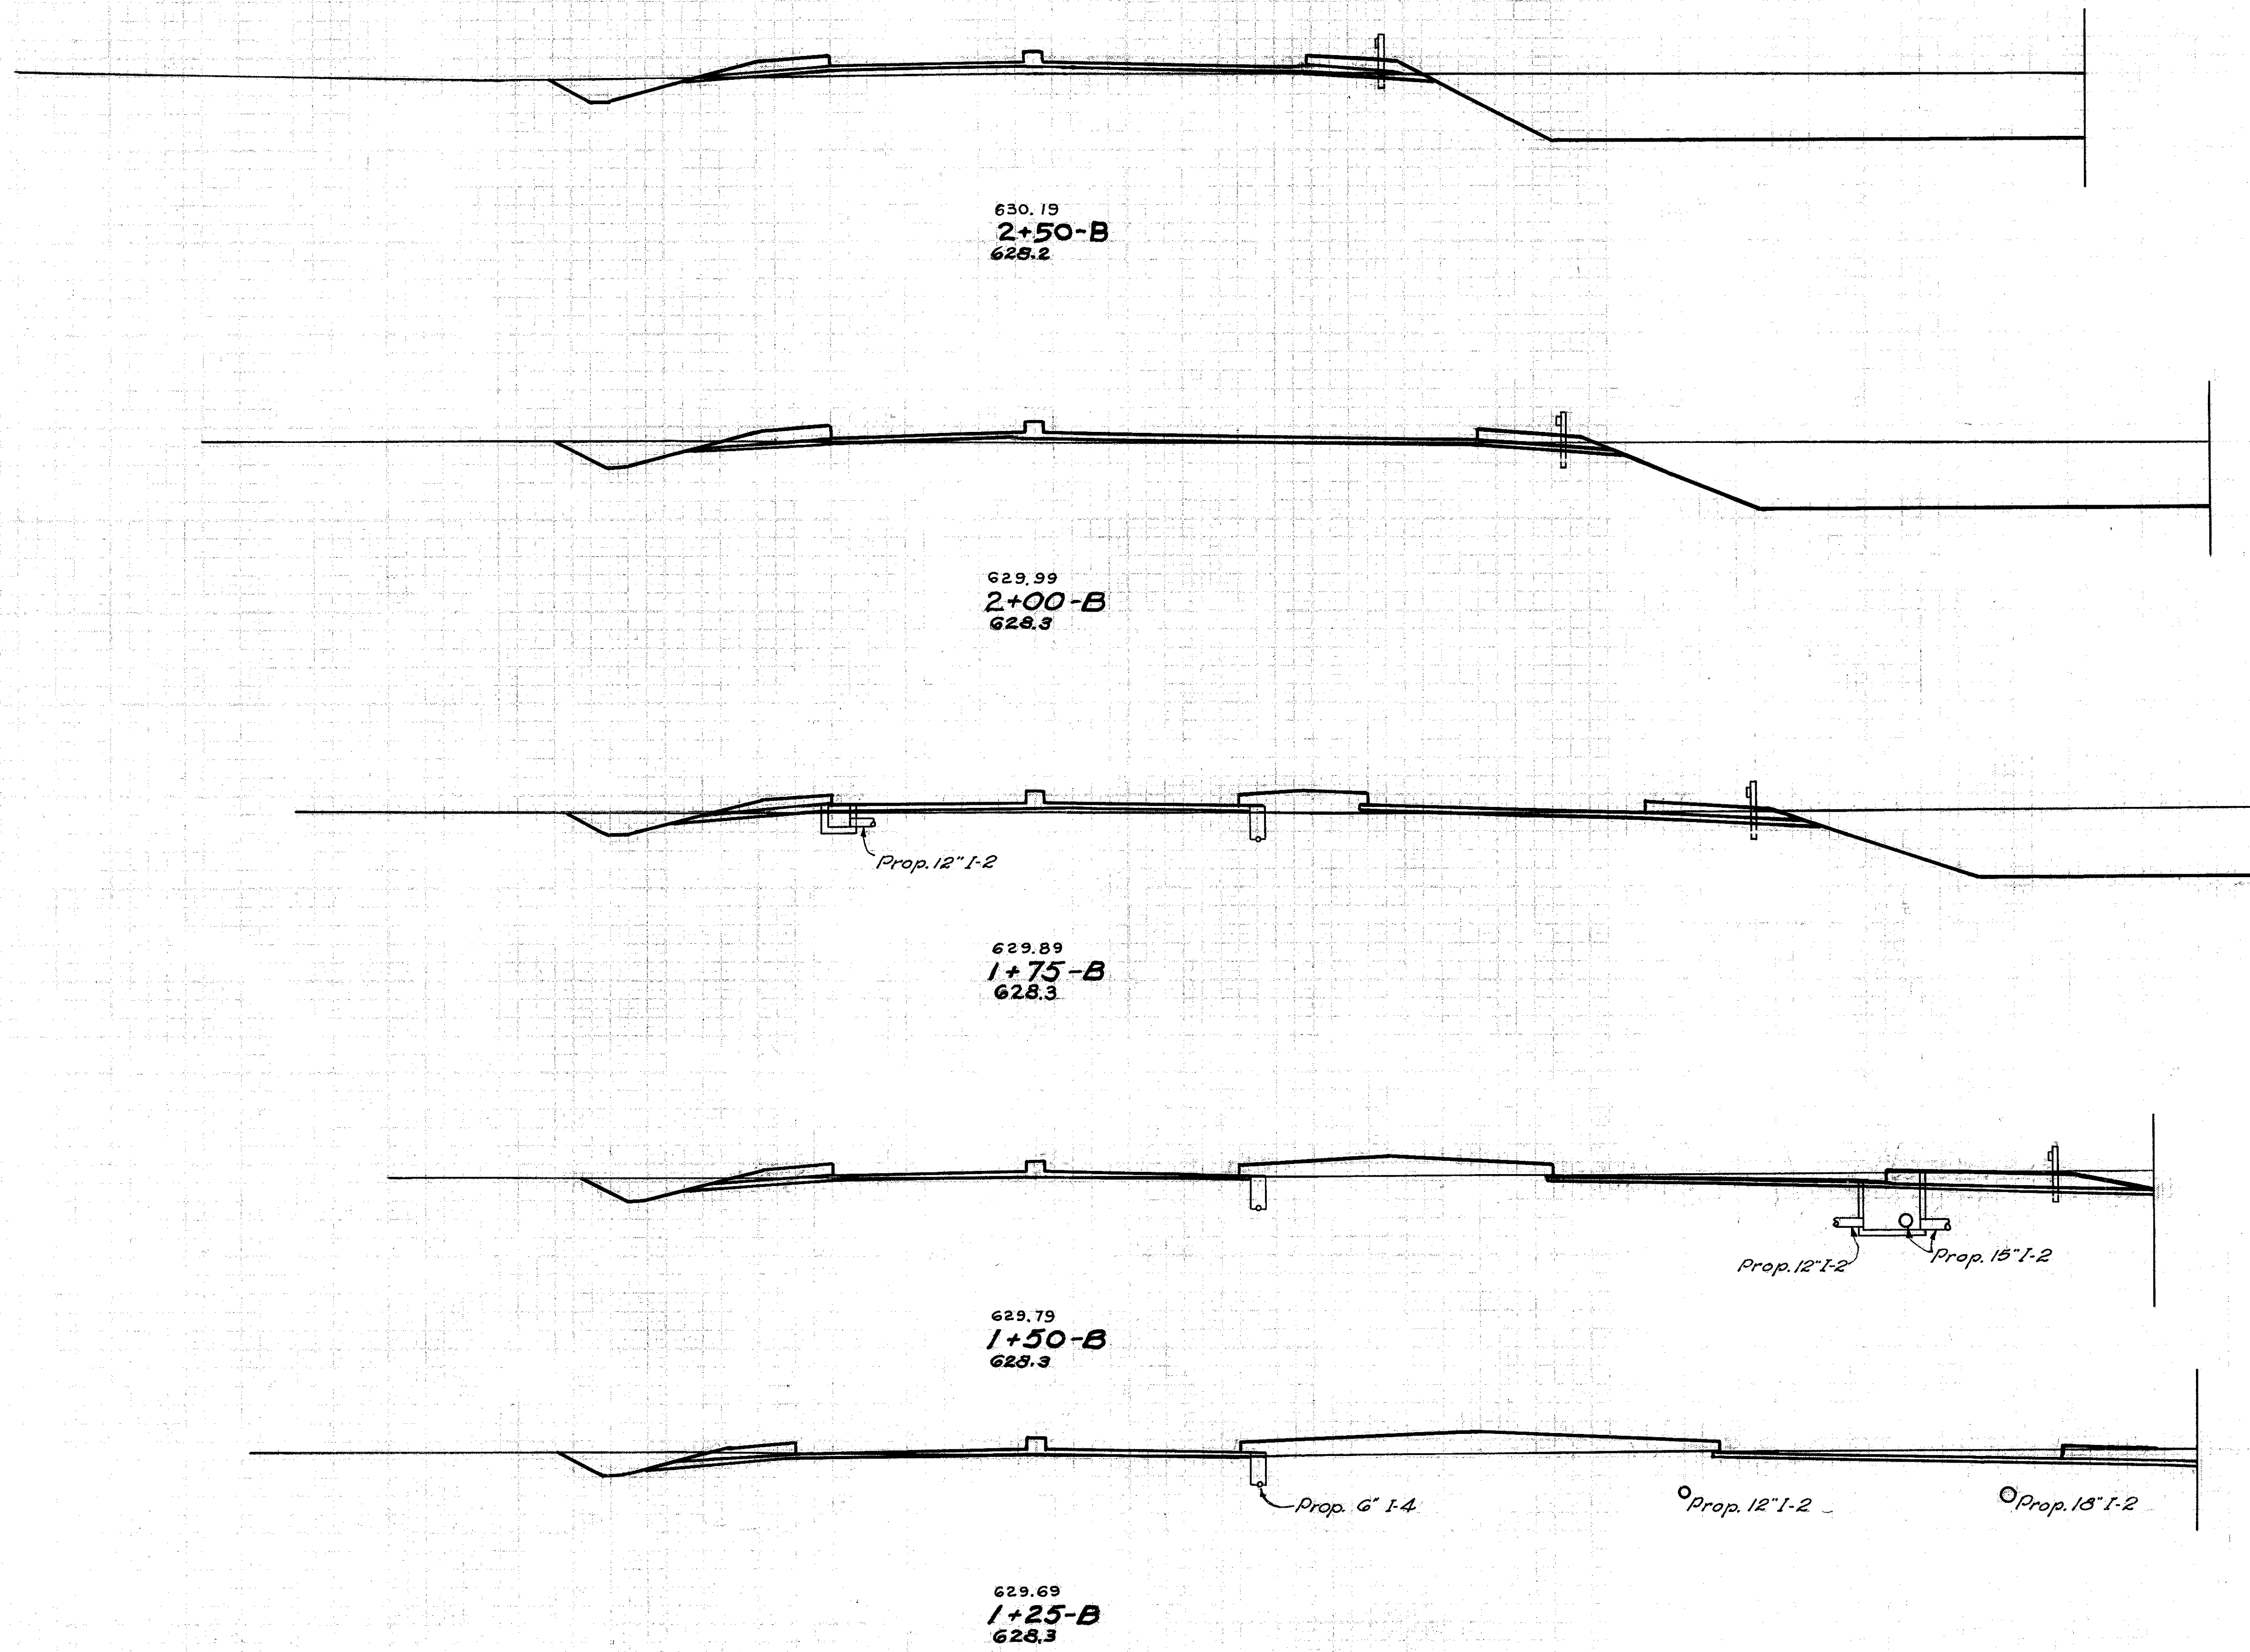

End Area		Cu. Yds.	
Cut	Fill	Cut	Fill
523	81		
		932	115
483	43		
		398	49
376	62		
		232	80
125	111		
		115	119
124	146		
		122	130

140 130 120 110 100 90 80 70 60 50 40 30 20 10 0 10 20 30 40 50 60 70 80 90 100 110 120 130 140 STATE ROUTE #73 RAMP - B

160 150 140 130 120 110 100 90 80 70 60 50 40 30 20 10 0 10 20 30 40 50 60 70 80 90 100 110 120

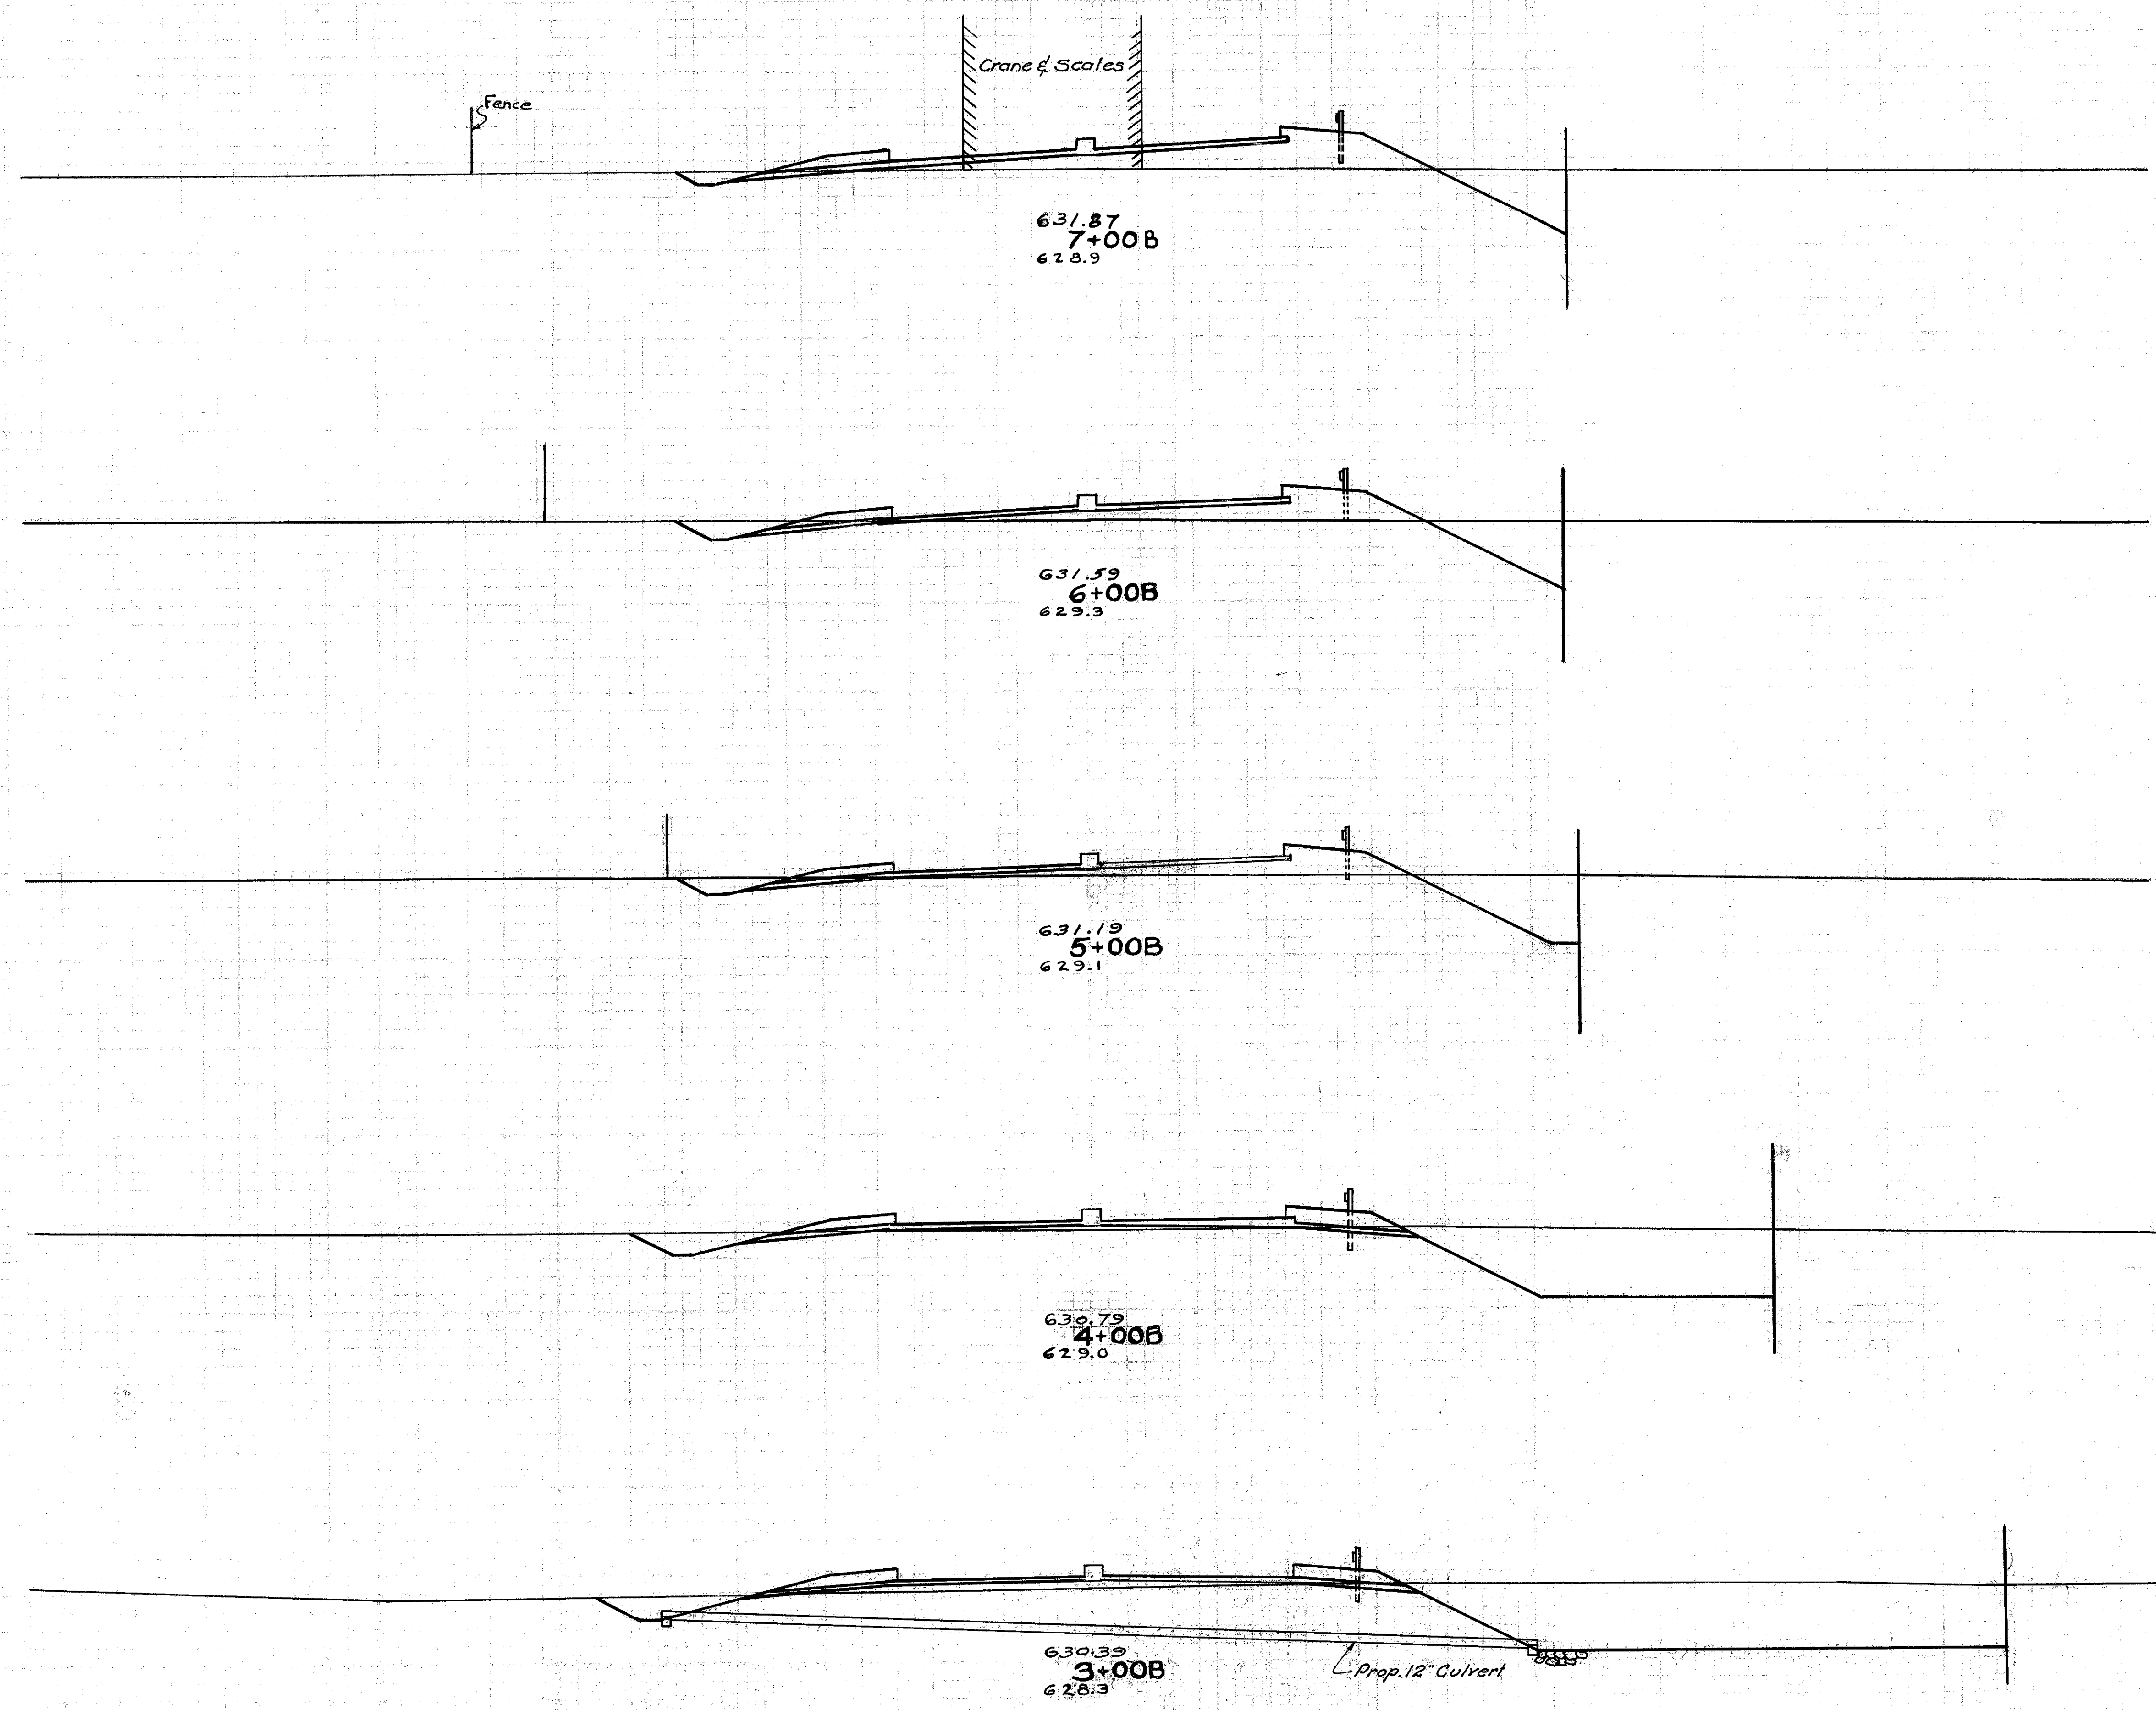


End Area		Cu. Yds.	
Cut	Fill	Cut	Fill
73	151		
		298	513
88	126		
		365	437
109	110		
		776	280
310	41		
		1437	222
466	79		
		916	148

160 150 140 130 120 110 100 90 80 70 60 50 40 30 20 10 0 10 20 30 40 50 60 70 80 90 100 110 120 130 140 RAMP B

160 150 140 130 120 110 100 90 80 70 60 50 40 30 20 10 0 10 20 30 40 50 60 70 80 90 100 110 120 130 140

FED. DIVISION	STATE	PROJECT
2	OHIO	

134  
222

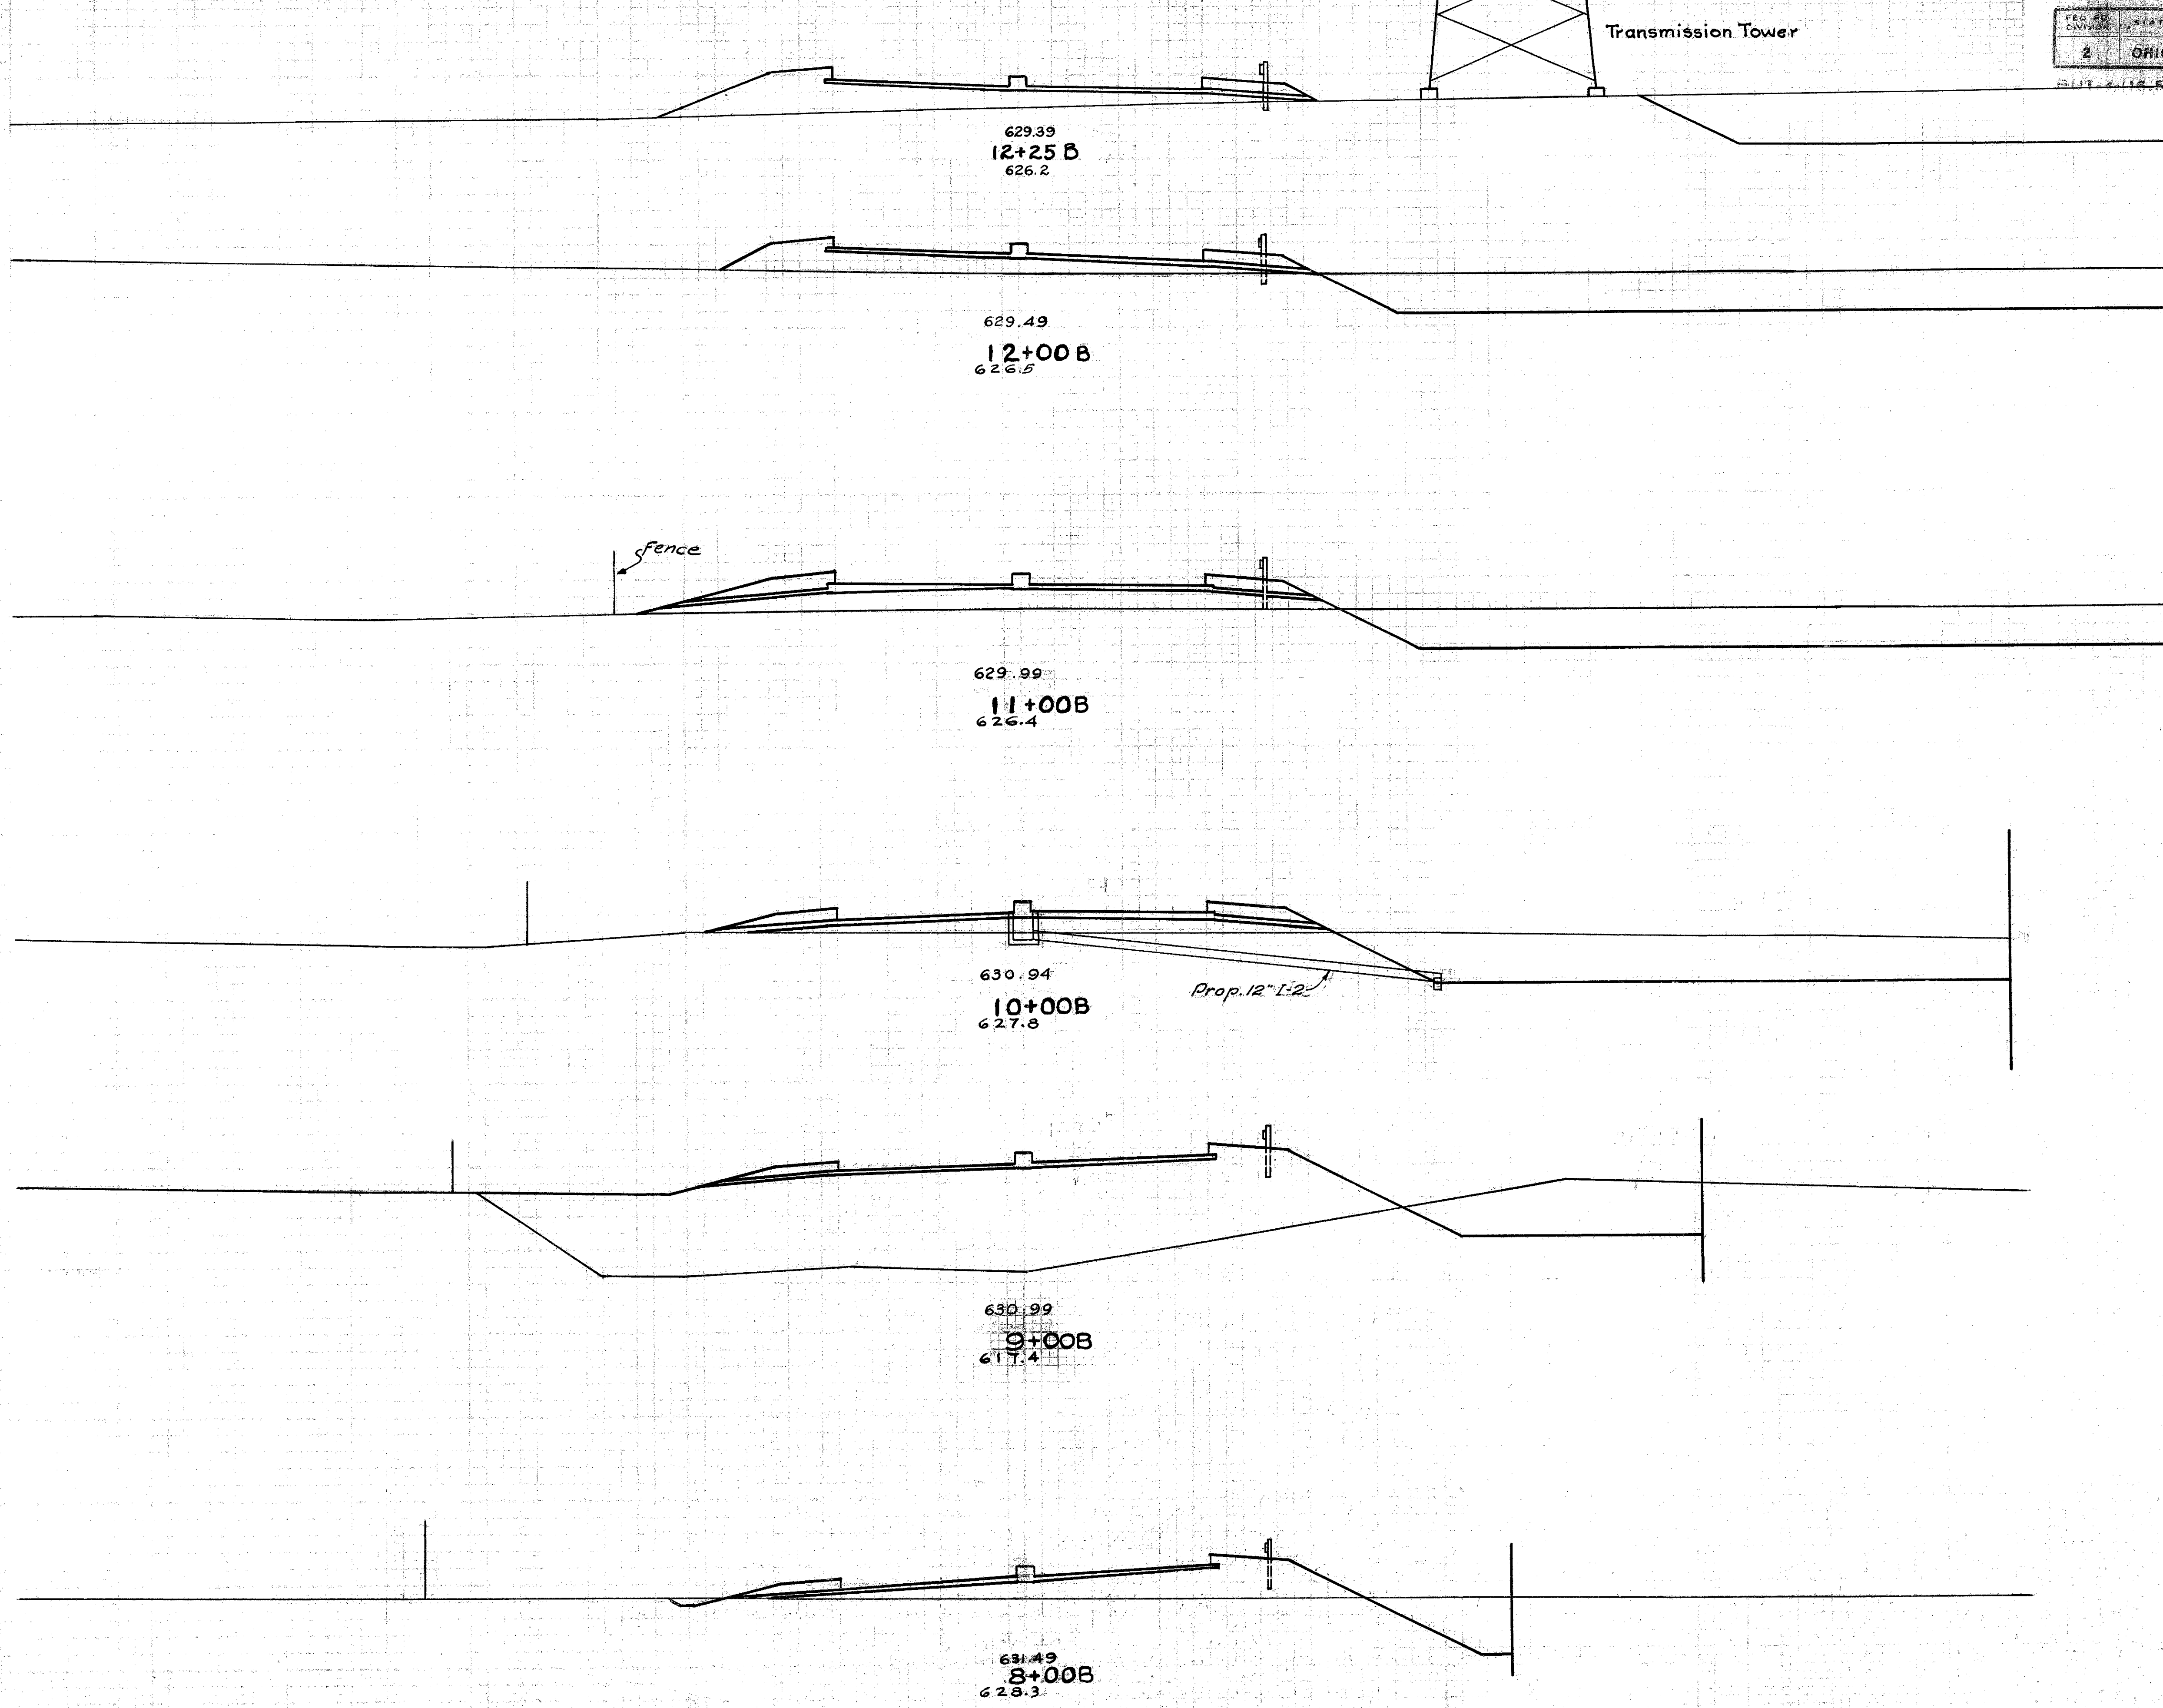


End Area		Cu Yds	
Cut	Fill	Cut	Fill
348	195		
		369	159
448	148		
		1498	630
461	192		
		1659	582
435	122		
		1196	2248
211	1092		
		541	2417
81	213		
		285	674

160 150 140 130 120 110 100 90 80 70 60 50 40 30 20 10 0 10 20 30 40 50 60 70 80 90 100 110 120 130 140 RAMP B

160 150 140 130 120 110 100 90 80 70 60 50 40 30 20 10 0 10 20 30 40 50 60 70 80 90 100 110 120

135  
222

End Area		Cu Yds.	
Cut	Fill	Cut	Fill

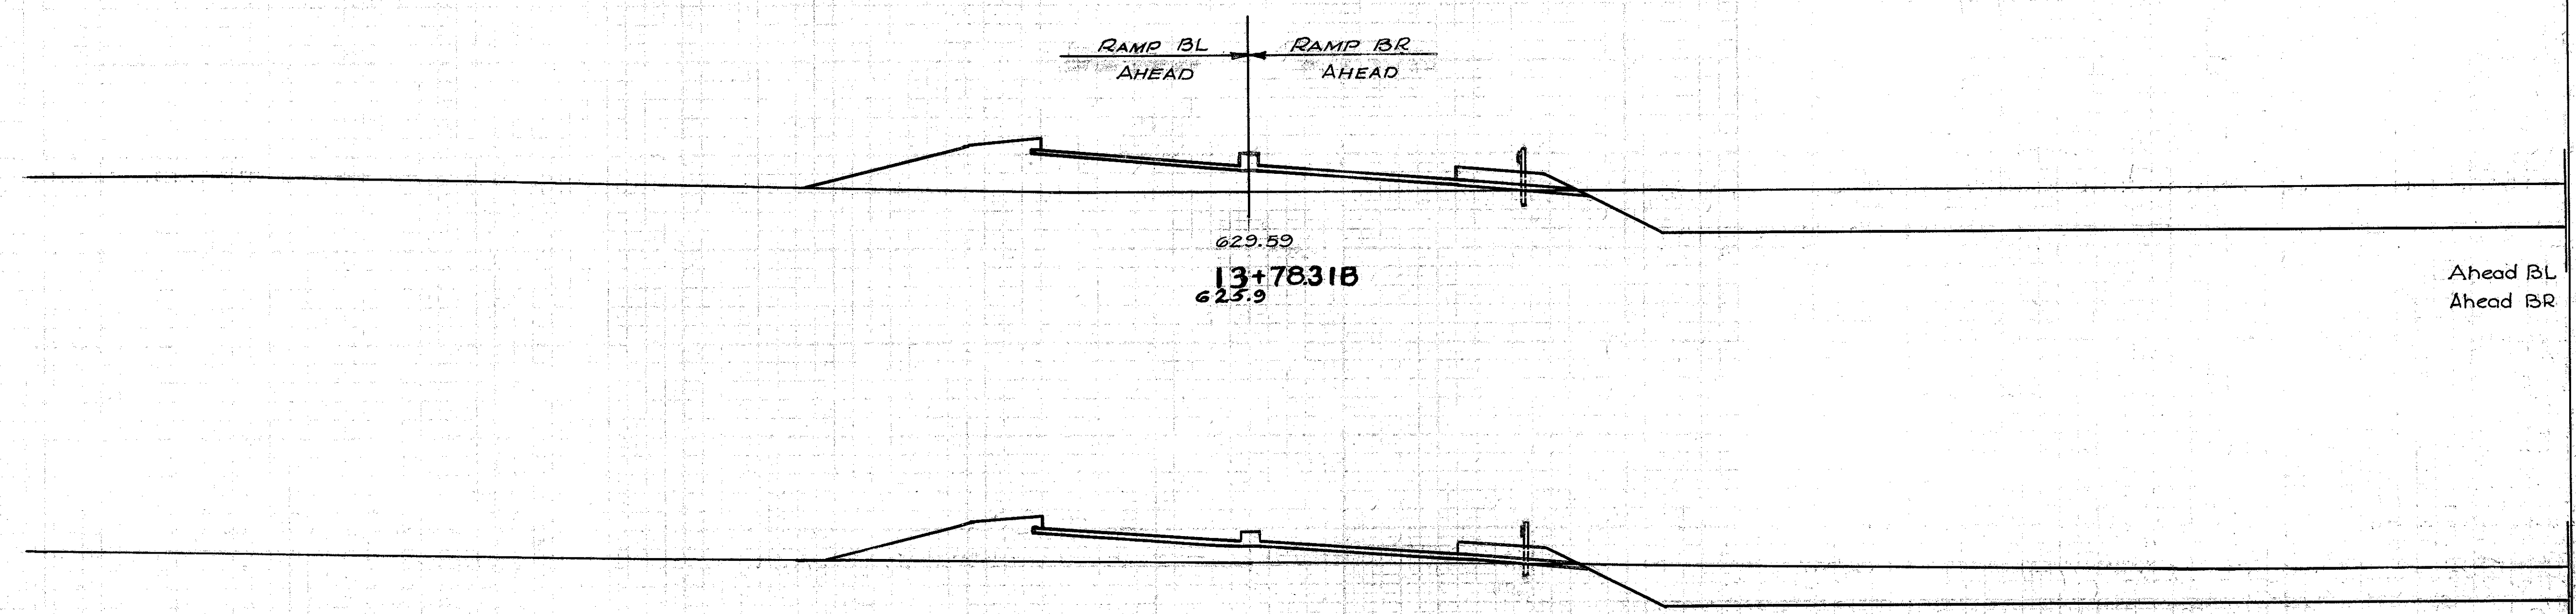

RAMP BL  
AHEAD

RAMP BR  
AHEAD

629.59  
**13+7831B**  
625.9

Ahead BL - 162  
Ahead BR 455 42

1234 599

**13+00B**  
626.3

396 209


298 187

160 150 140 130 120 110 100 90 80 70 60 50 40 30 20 10 0 10 20 30 40 50 60 70 80 90 100 110 120 130 140 RAMP B

160 150 140 130 120 110 100 90 80 70 60 50 40 30 20 10 0 10 20 30 40 50 60 70 80 90 100 110 120

2 OHIO

136  
222

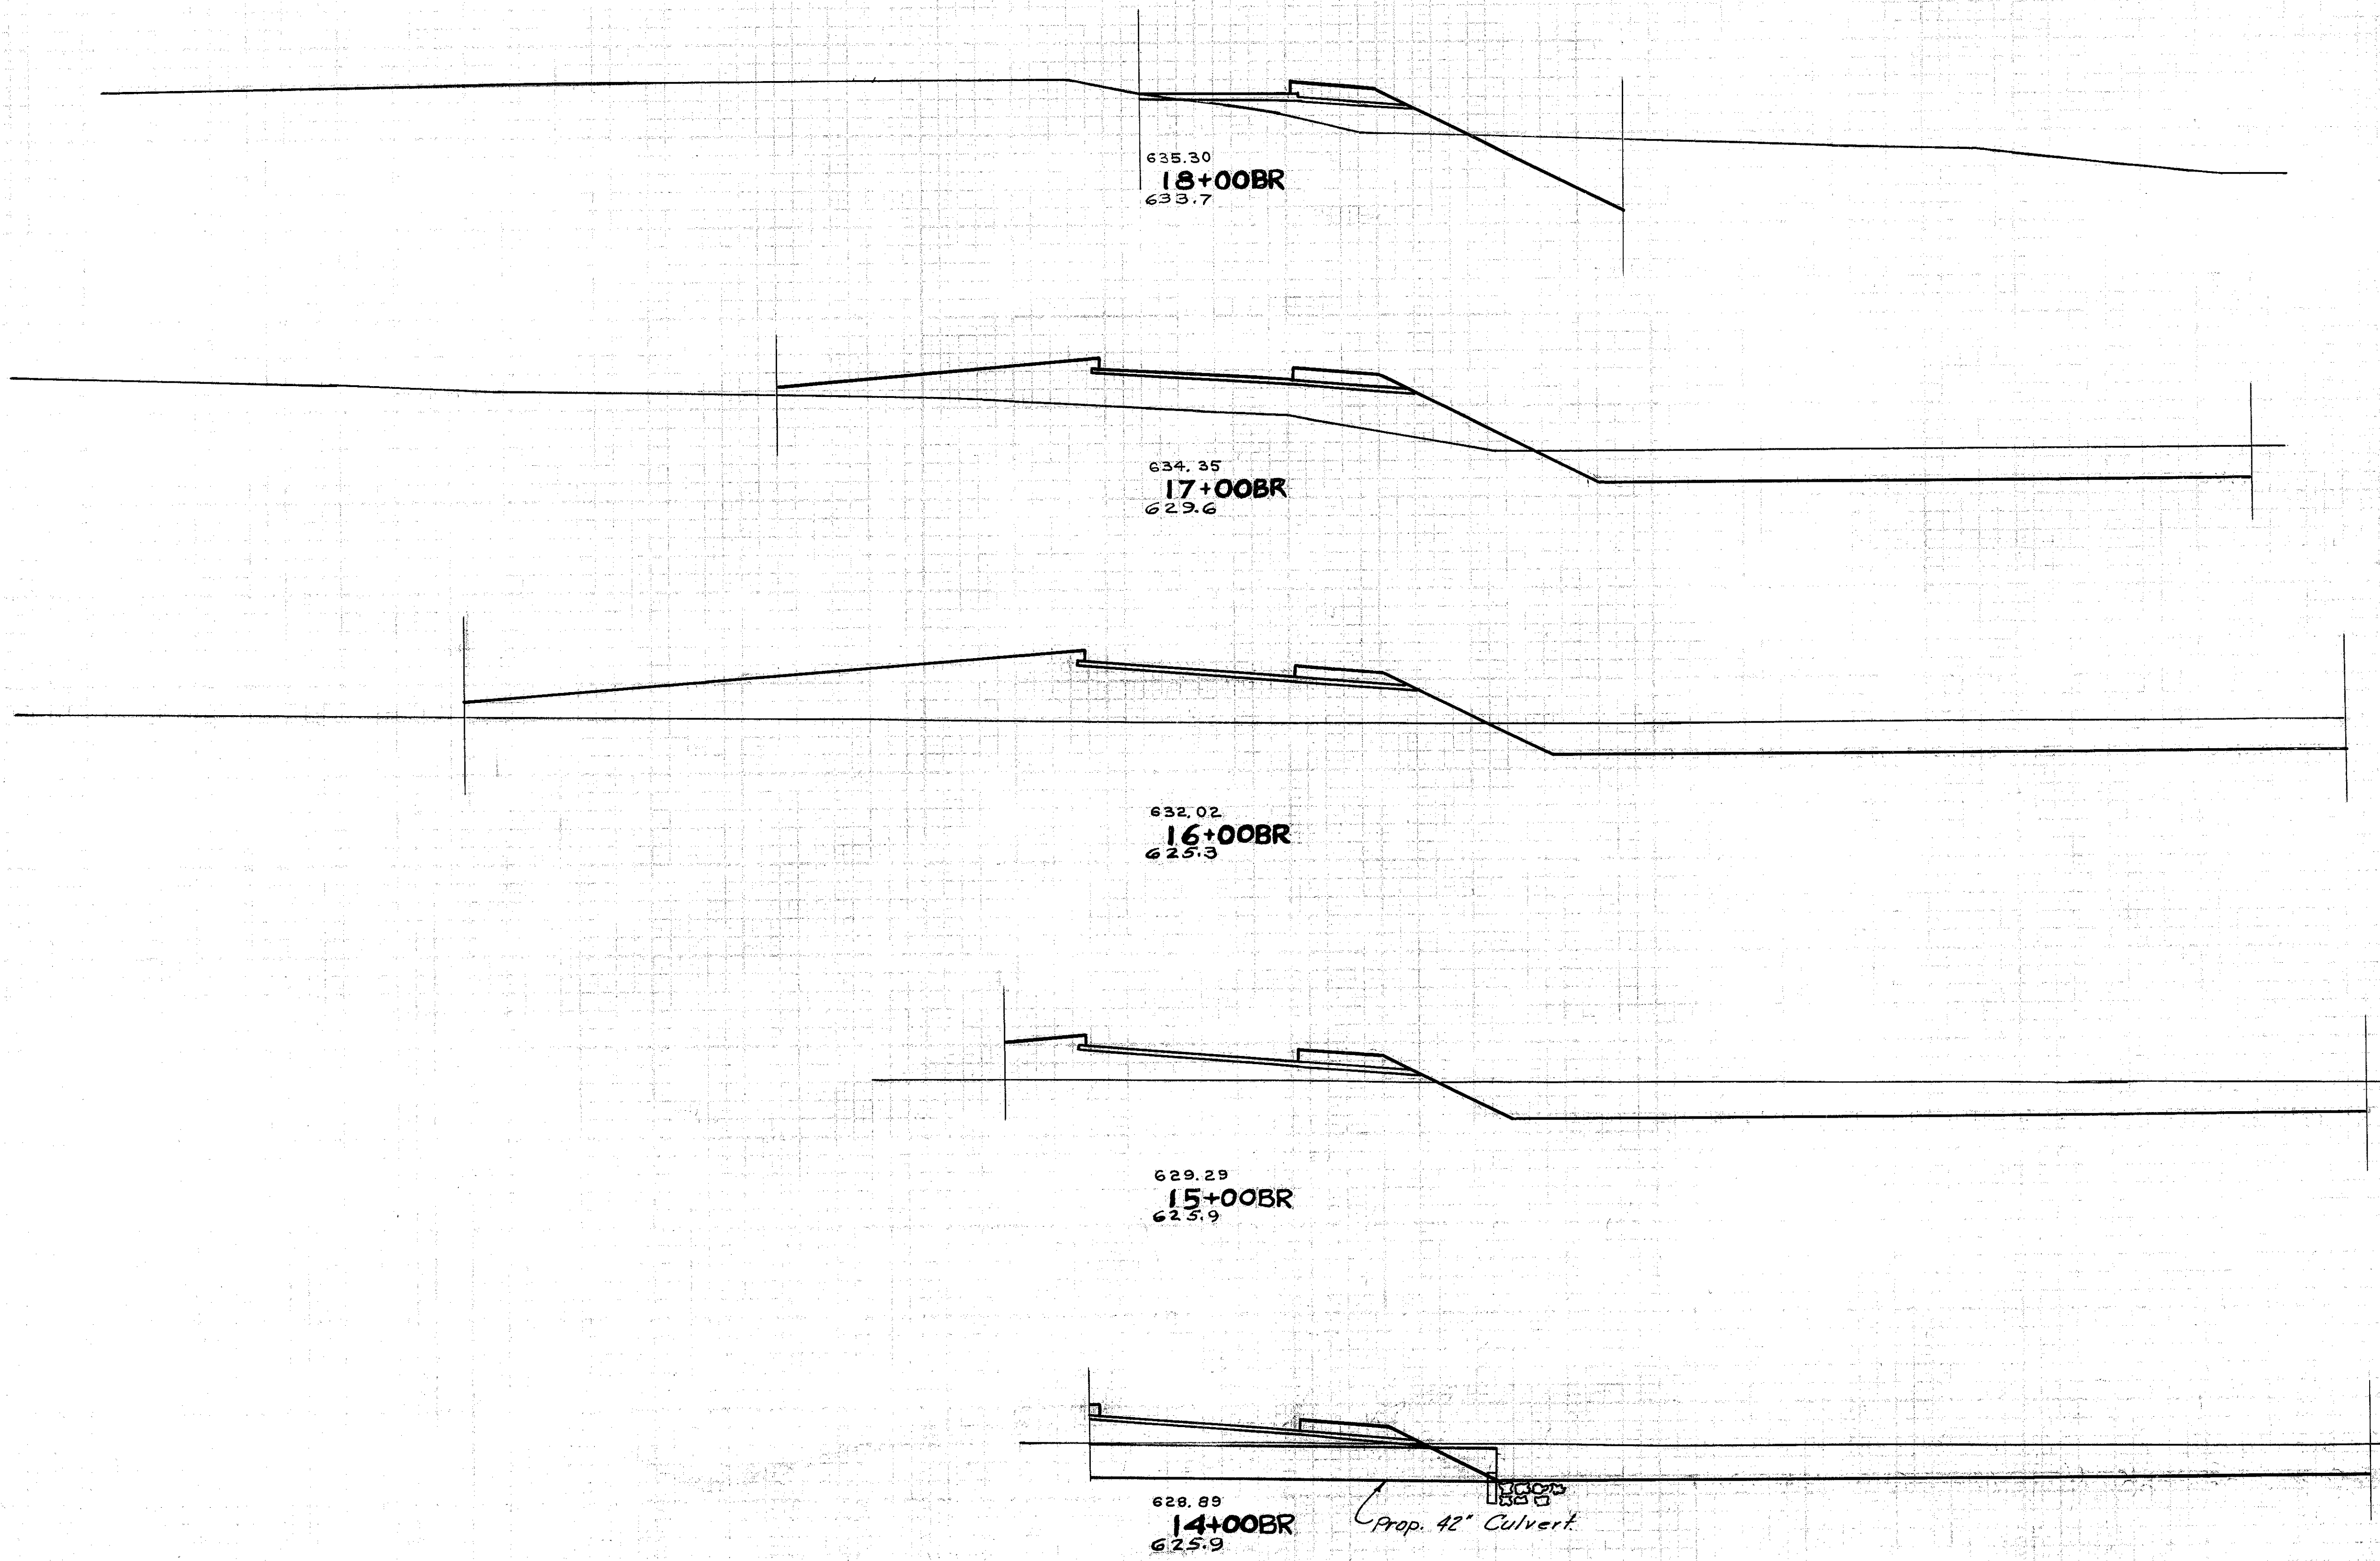


End Area		Cu. Yds.	
Cut	Fill	Cut	Fill
68	79		
		619	694
266	296		
		1107	1557
332	545		
		1578	1269
412	140		
		1483	354
389	51		
		339	37

160 150 140 130 120 110 100 90 80 70 60 50 40 30 20 10 0 10 20 30 40 50 60 70 80 90 100 110 120 130 140 RAMP B R



160 150 140 130 120 110 100 90 80 70 60 50 40 30 20 10 0 10 20 30 40 50 60 70 80 90 100 110 120

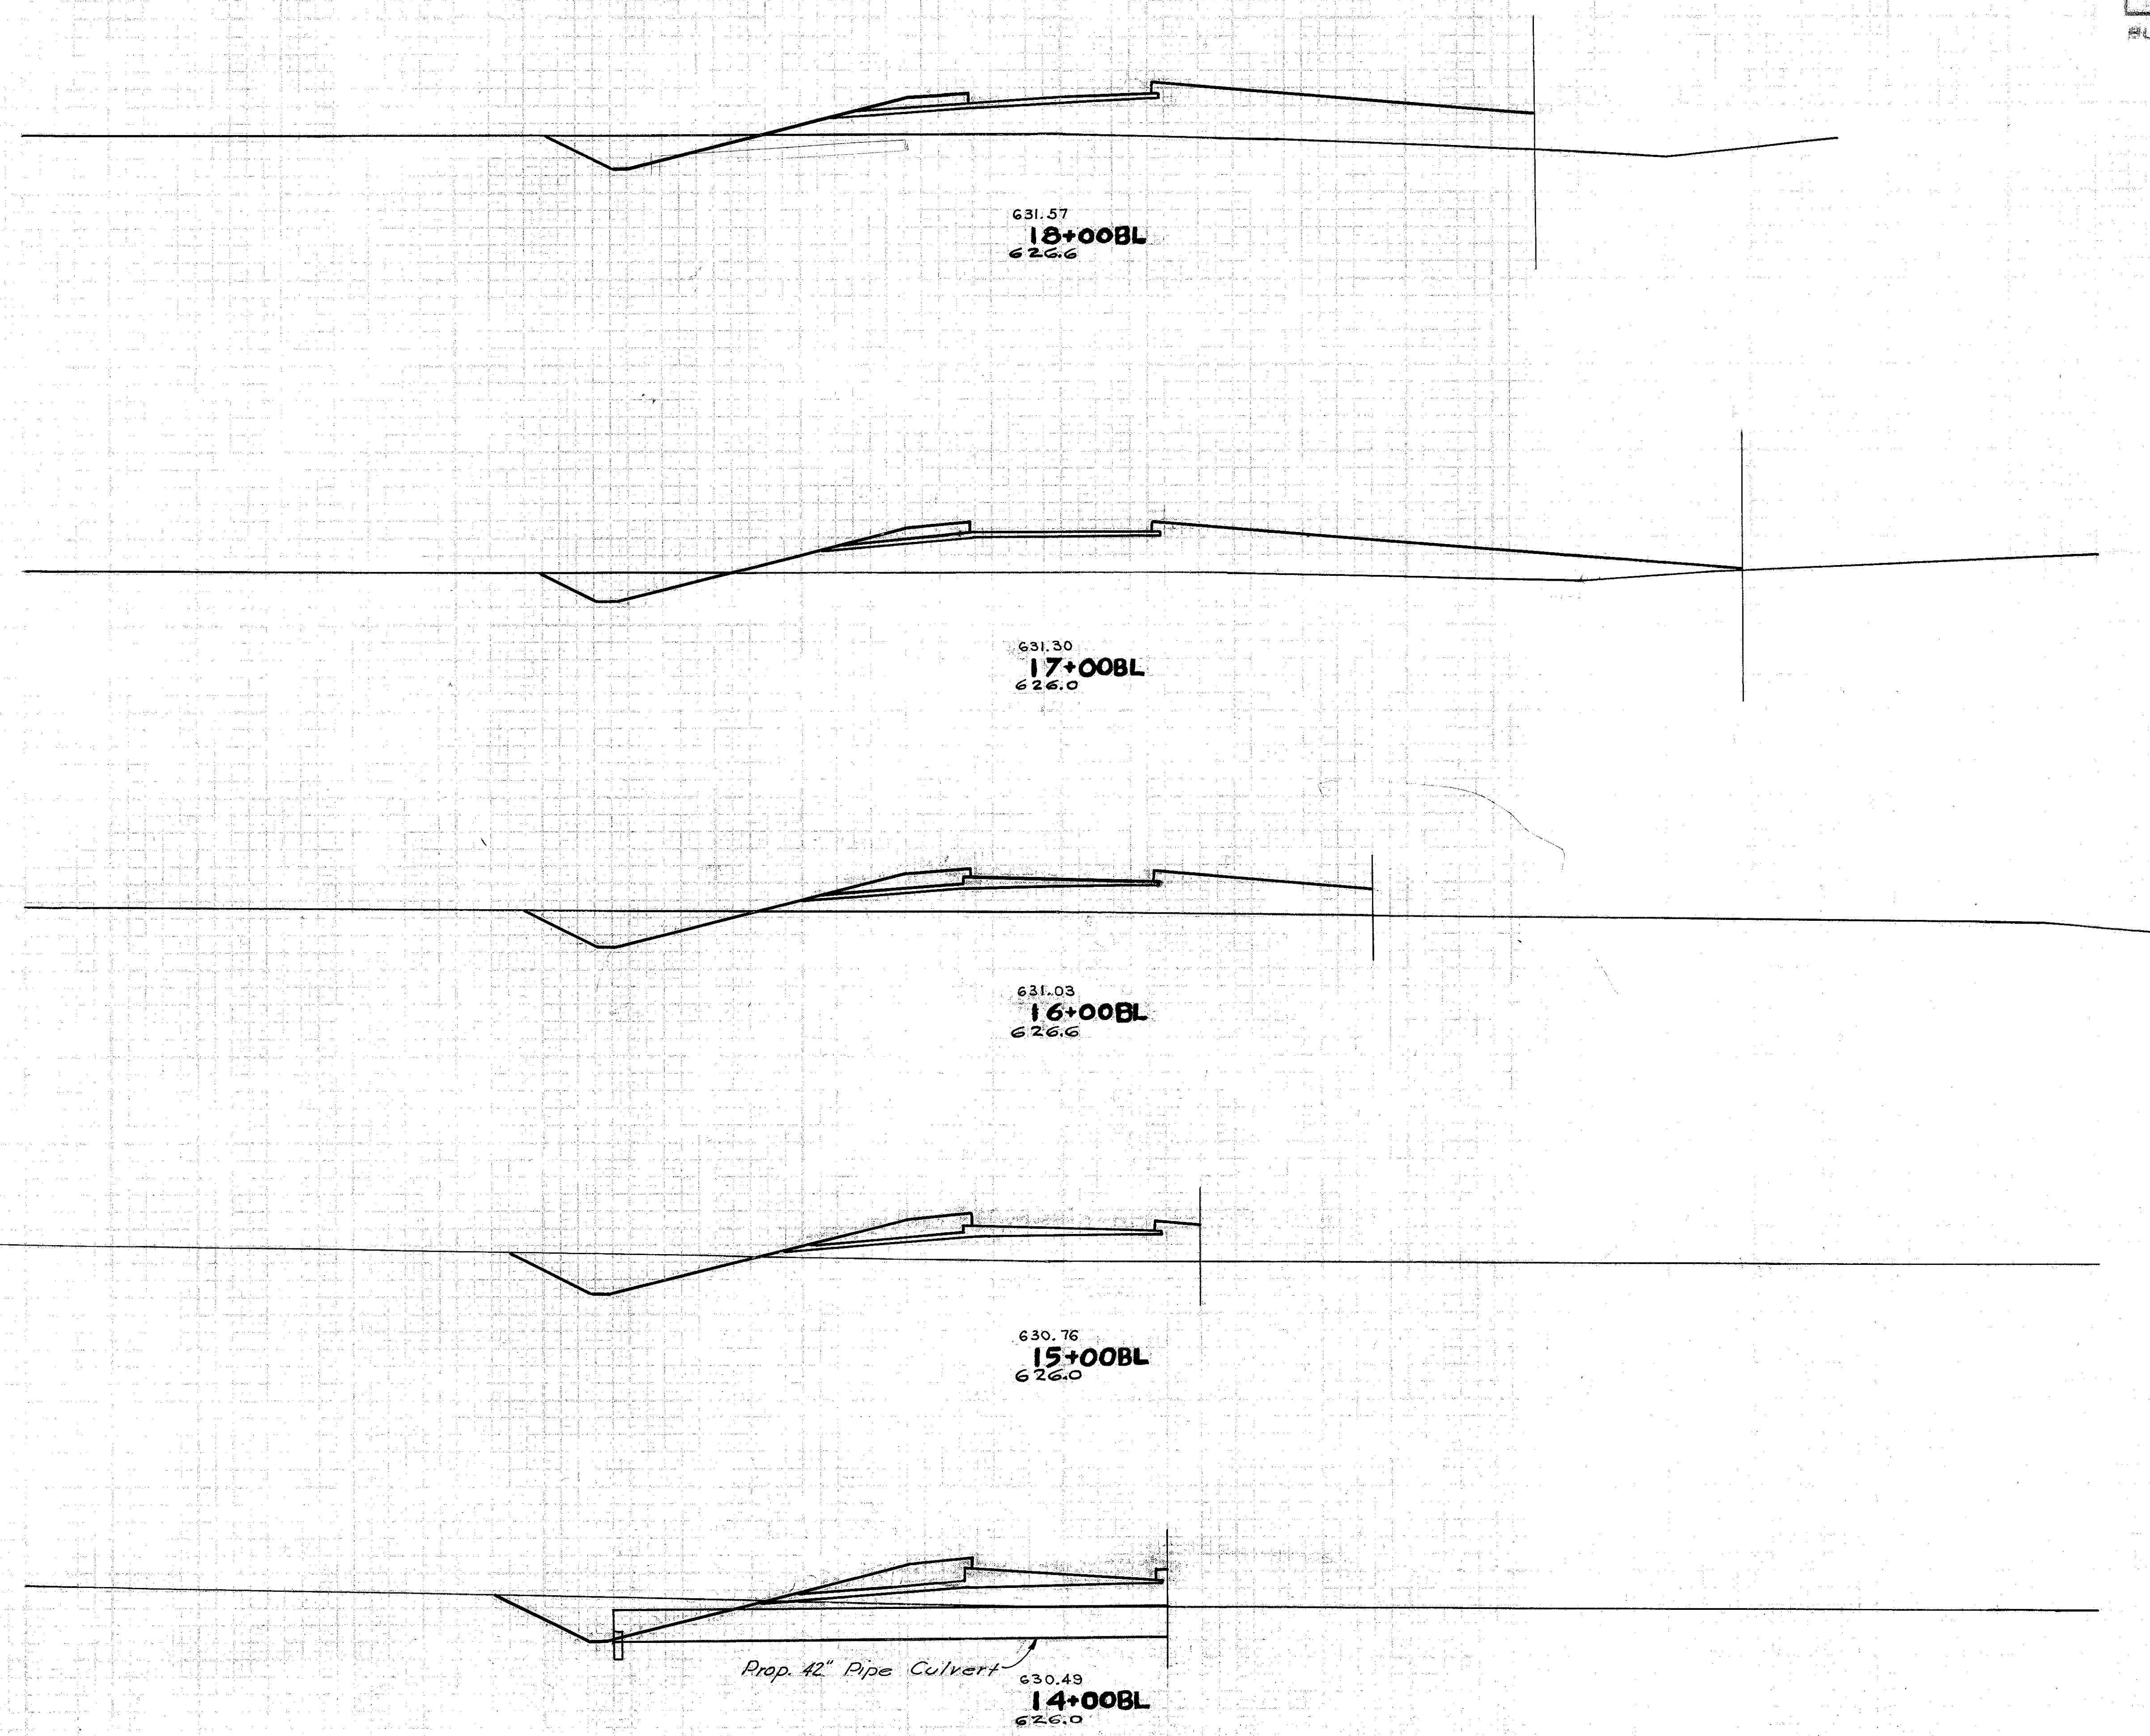


End Area		Cu Yds.	
Cut	Fill	Cut	Fill
58	338		
		193	1533
46	430		
		193	1235
58	237		
		241	733
72	161		
		307	467
94	91		
		38	102

160 150 140 130 120 110 100 90 80 70 60 50 40 30 20 10 0 10 20 30 40 50 60 70 80 90 100 110 120

RAMP B L

160 150 140 130 120 110 100 90 80 70 60 50 40 30 20 10 0 10 20 30 40 50 60 70 80 90 100 110 120

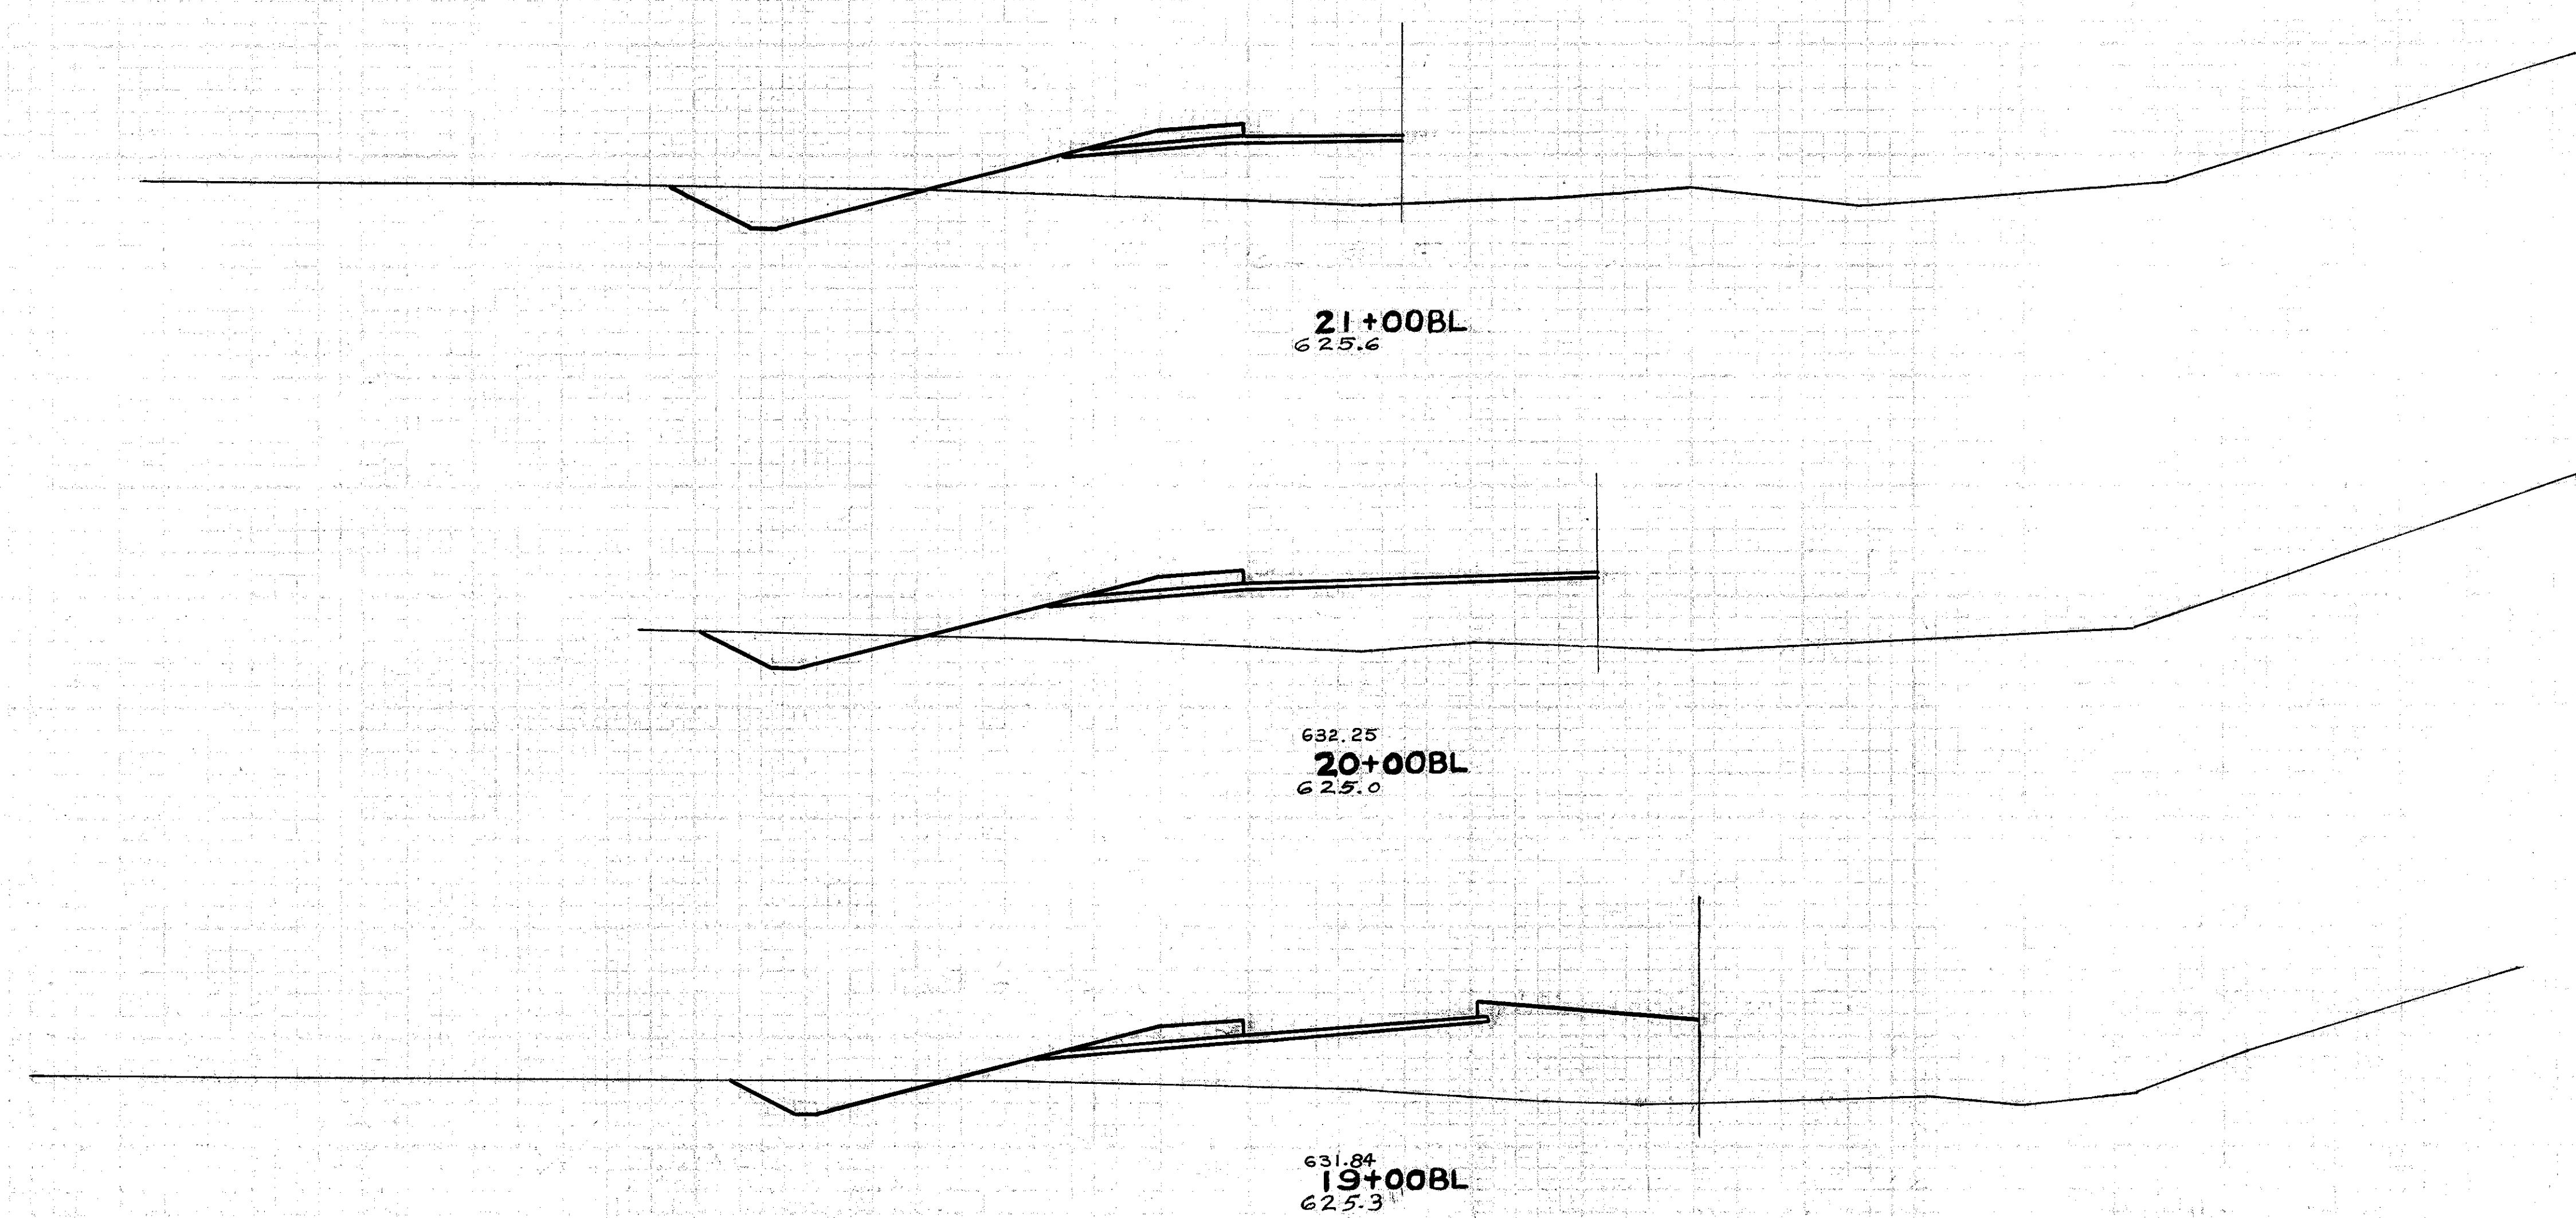

End Area		Cu Yds.	
Cut	Fill	Cut	Fill
53	199		
		170	341
39	309		
		130	1256
31	389		
		165	1457


160 150 140 130 120 110 100 90 80 70 60 50 40 30 20 10 0 10 20 30 40 50 60 70 80 90 100 110 120 130

RAMP B L


60 50 40 30 20 10 0 10 20 30 40 50 60

60 50 40 30 20 10 0 10 20 30 40 50 60

BLT-4-(16.53-19.15)

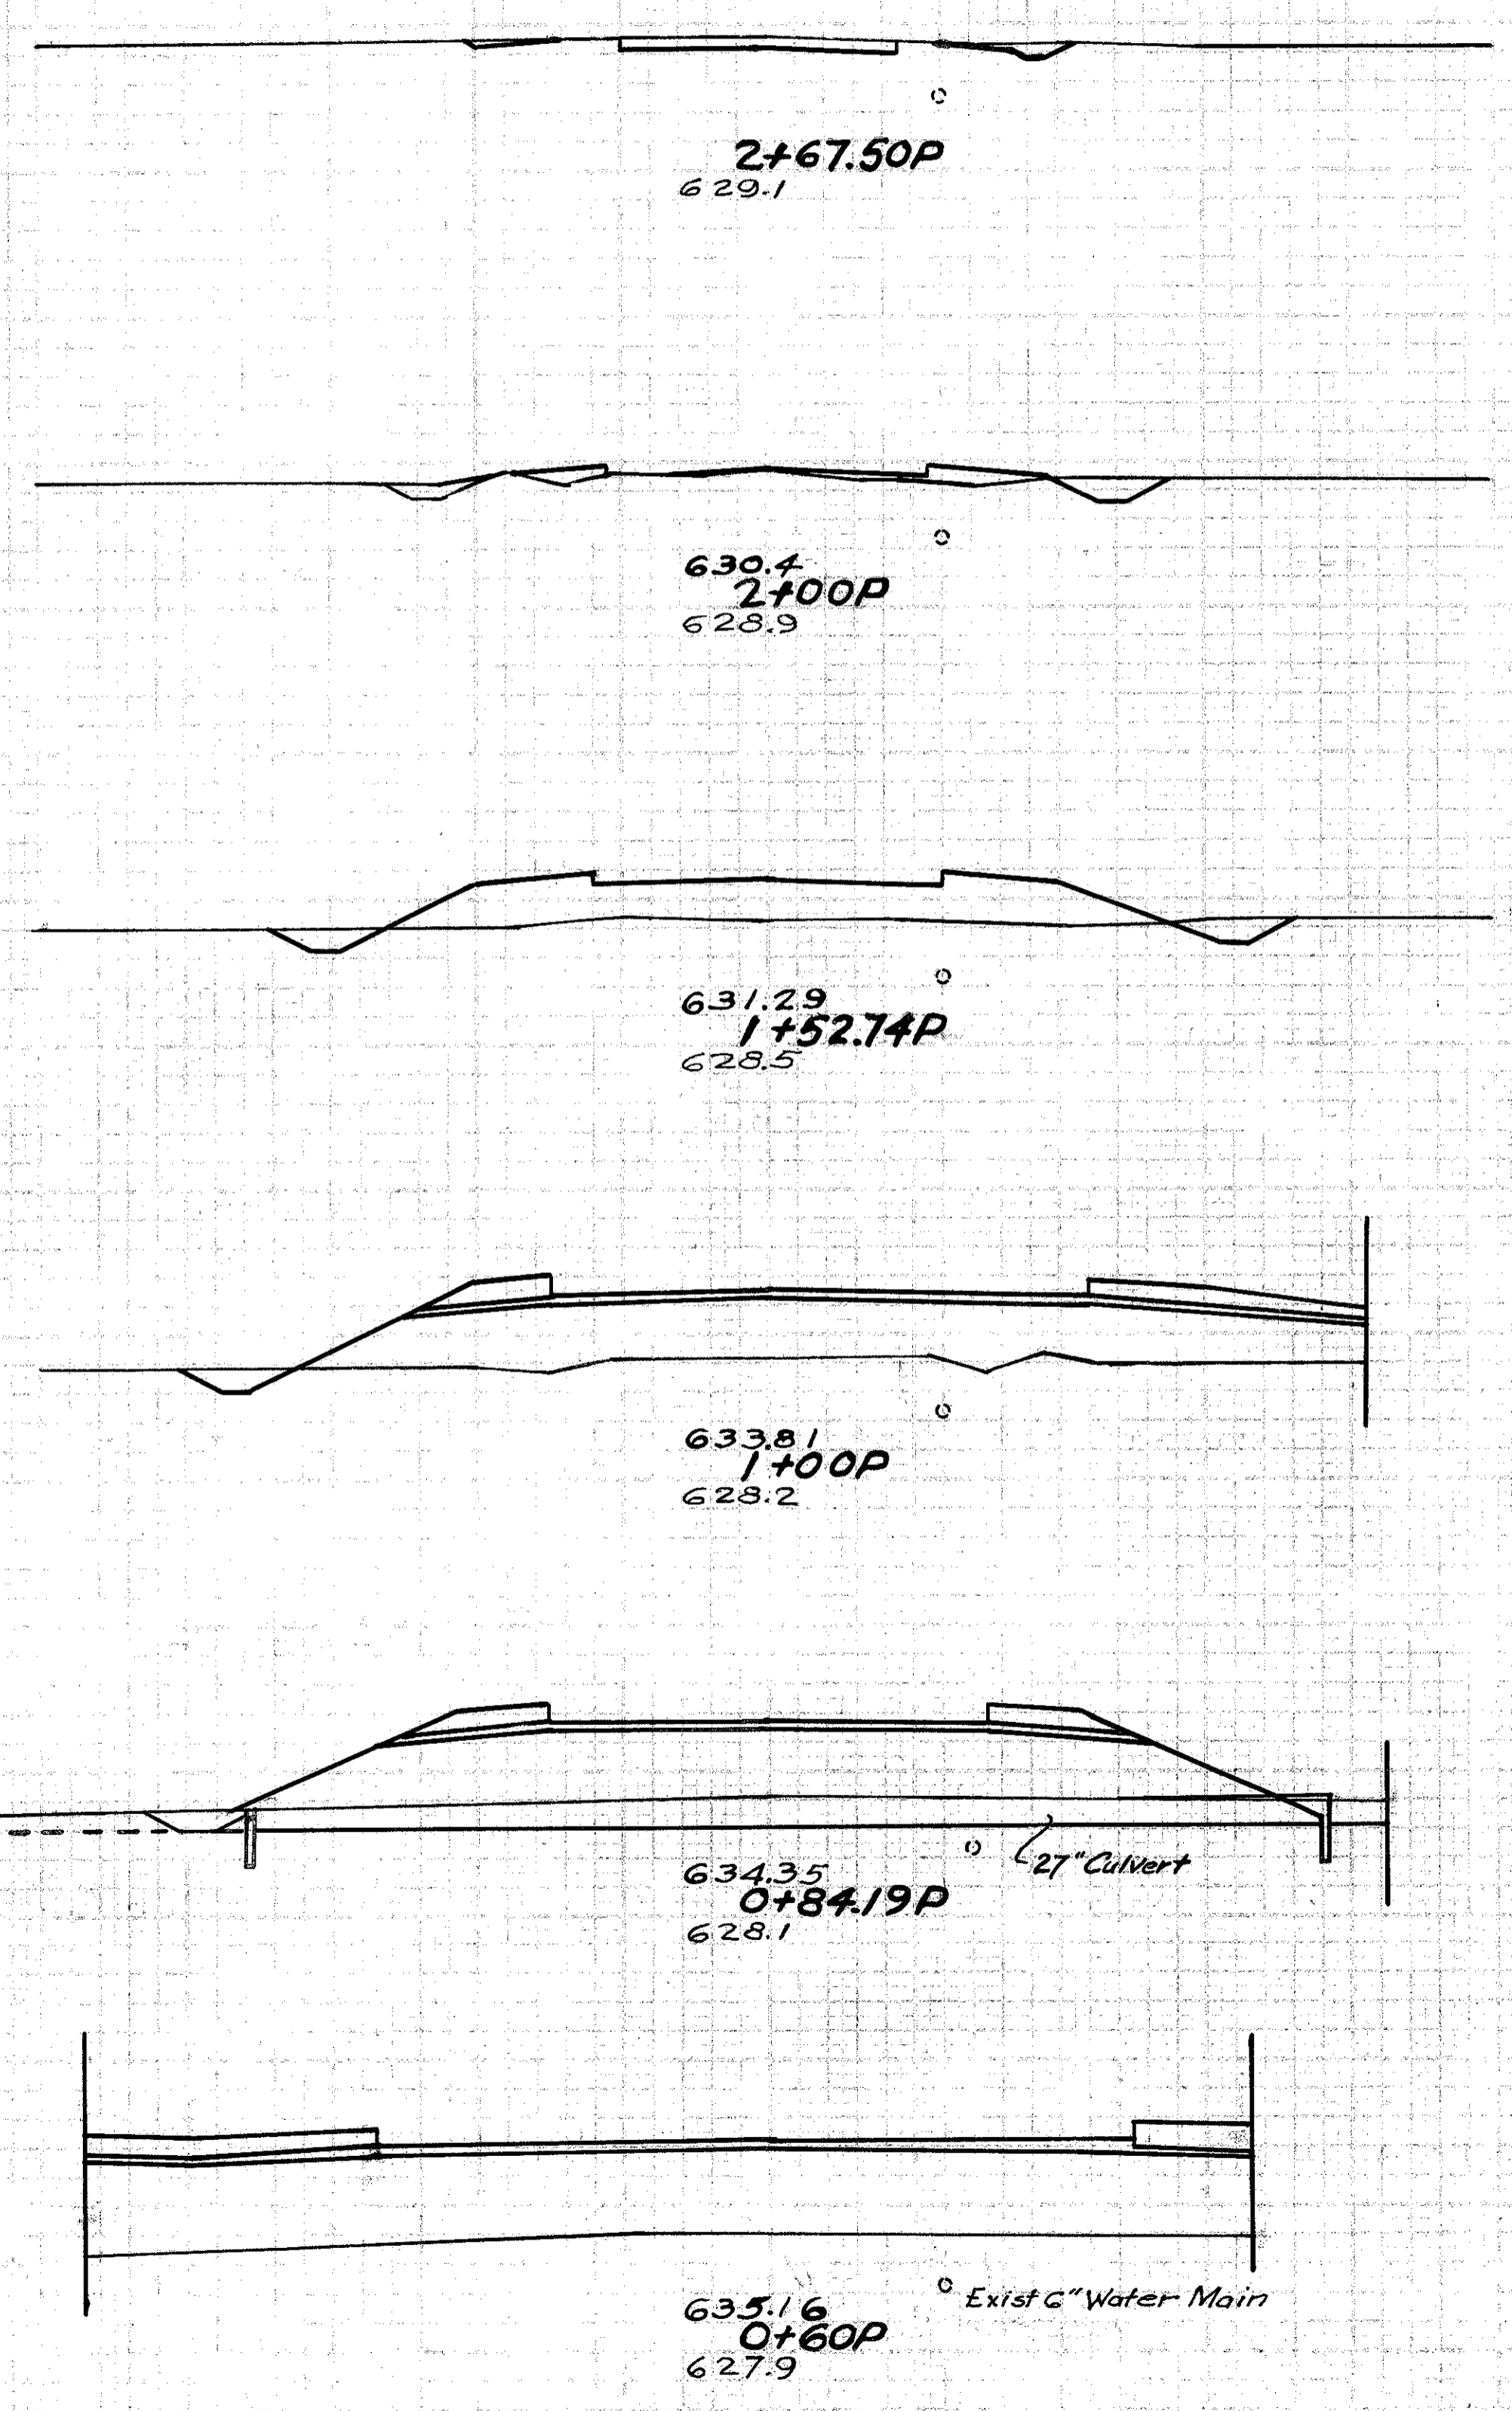


End Area	Cu. Yds.	
	Cut	Fill
5	-	16 29
8	23	22 150
17	148	25 451
9	314	5 183
7	311	3 367
-	509	- 641

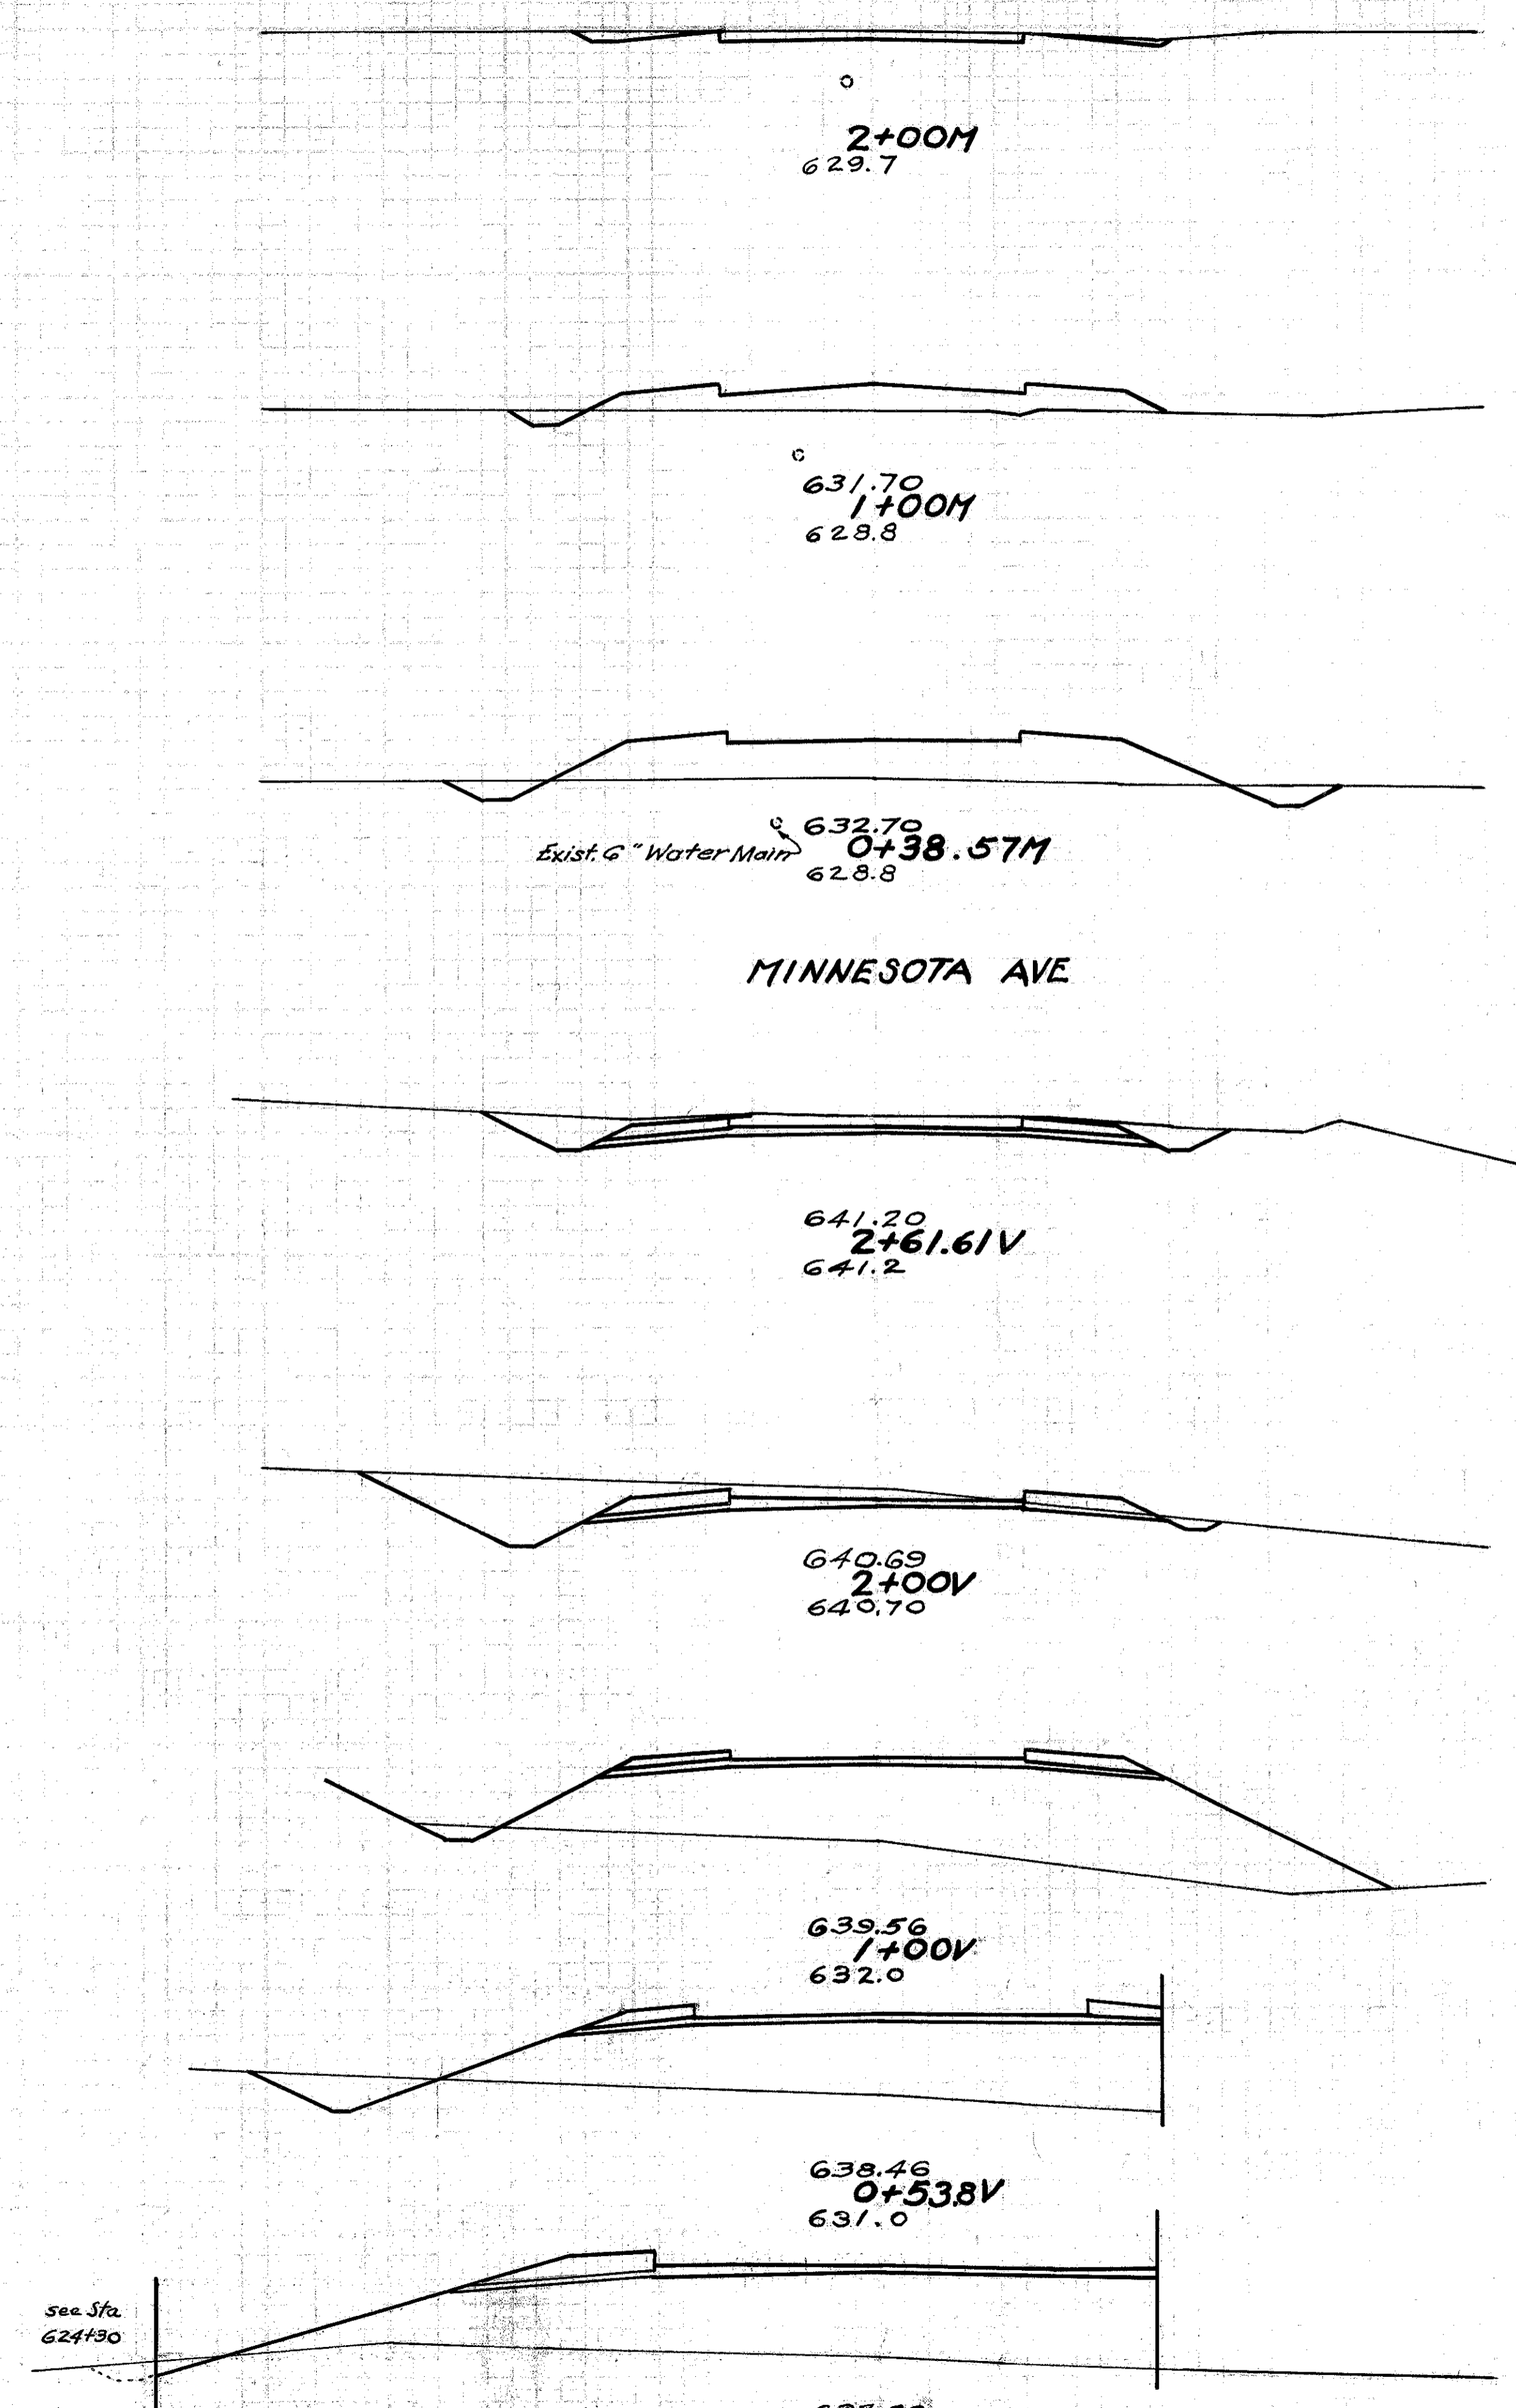

End Area	Cu. Yds.	
	Cut	Fill
8	-	26 81
6	87	24 300
15	177	15 171
113	14	295 33
146	15	283 824
7	430	29 661
27	343	14 344
4	437	3 275

60 50 40 30 20 10 0 10 20 30 40 50 PINTA AVE

60 50 40 30 20 10 0 10 20 30 40 50 VERITY PARKWAY

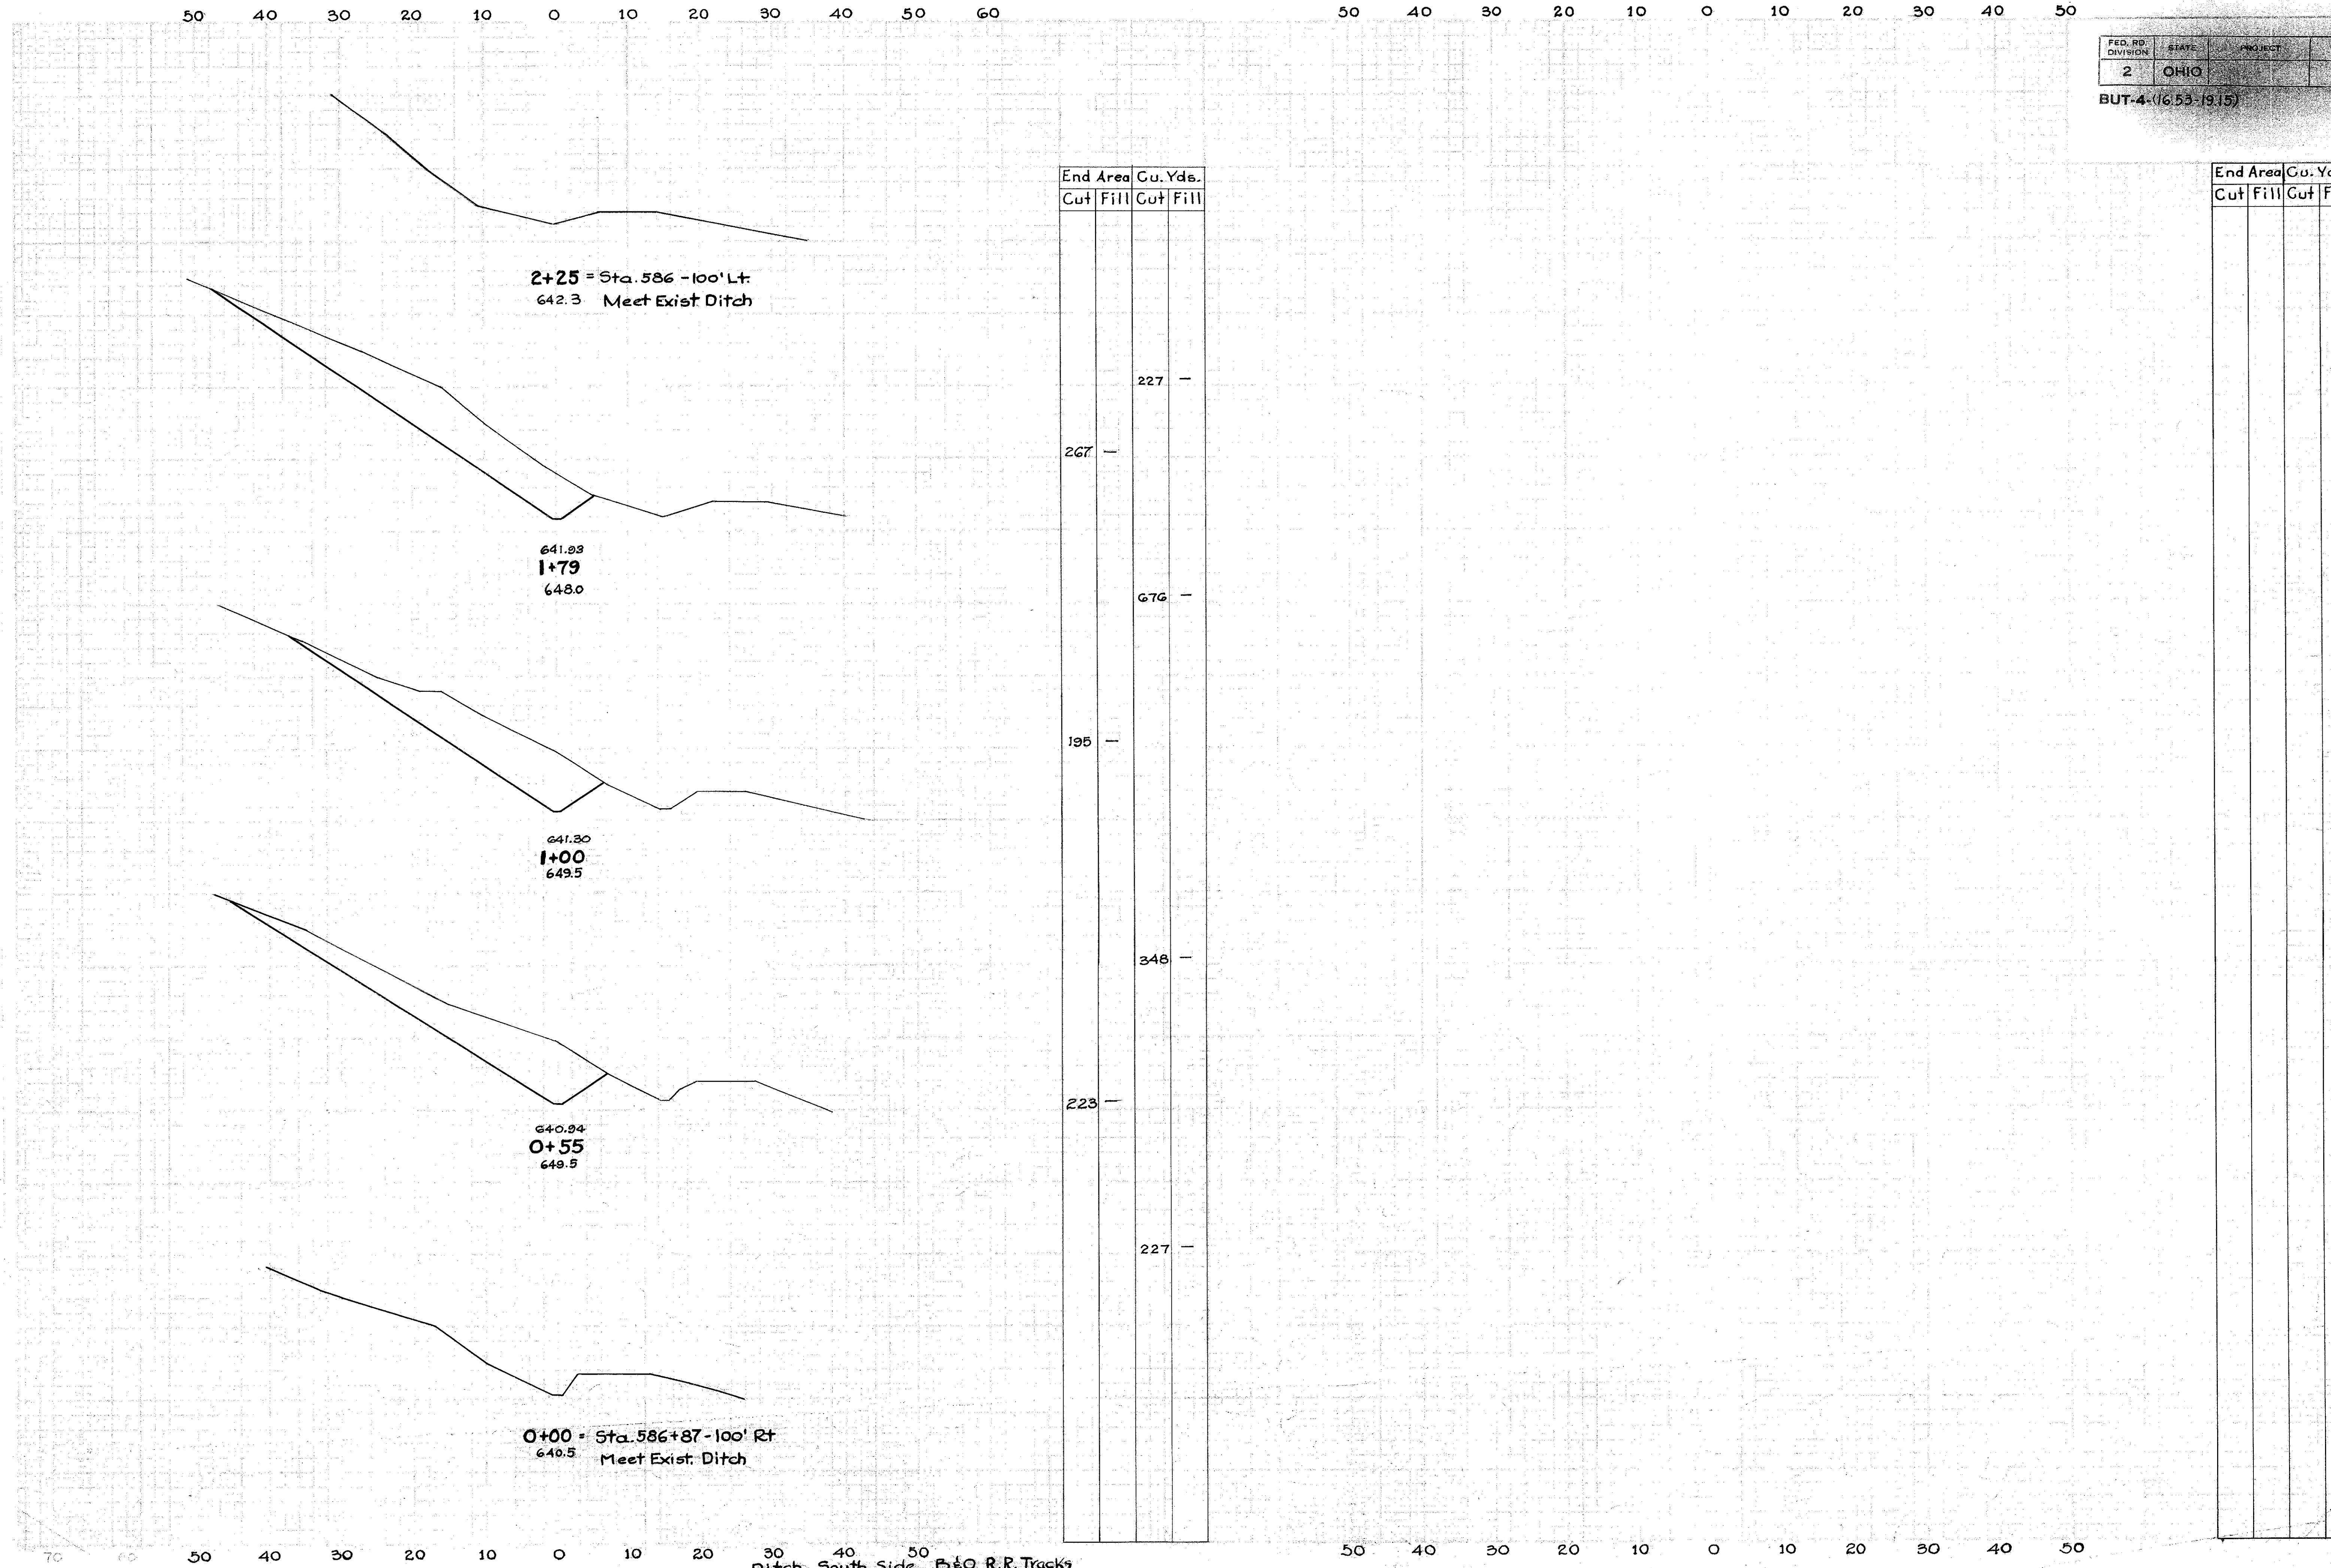

2+25 = Sta. 586 - 100' Lt.  
642.3 Meet Exist Ditch

641.93  
1+79  
648.0

641.30  
1+00  
649.5


640.94  
0+55  
649.5

0+00 = Sta. 586+87 - 100' Rt.  
640.5 Meet Exist Ditch

End Area		Cu. Yds.	
Cut	Fill	Cut	Fill
		227	-
267	-		
		676	-
195	-		
		348	-
223	-		
		227	-


End Area		Cu. Yds.	
Cut	Fill	Cut	Fill

120 110 100 90 80 70 60 50 40 30 20 10 0 10 20 30 40 50 60 70 80 90 100 110 120 130 140 150

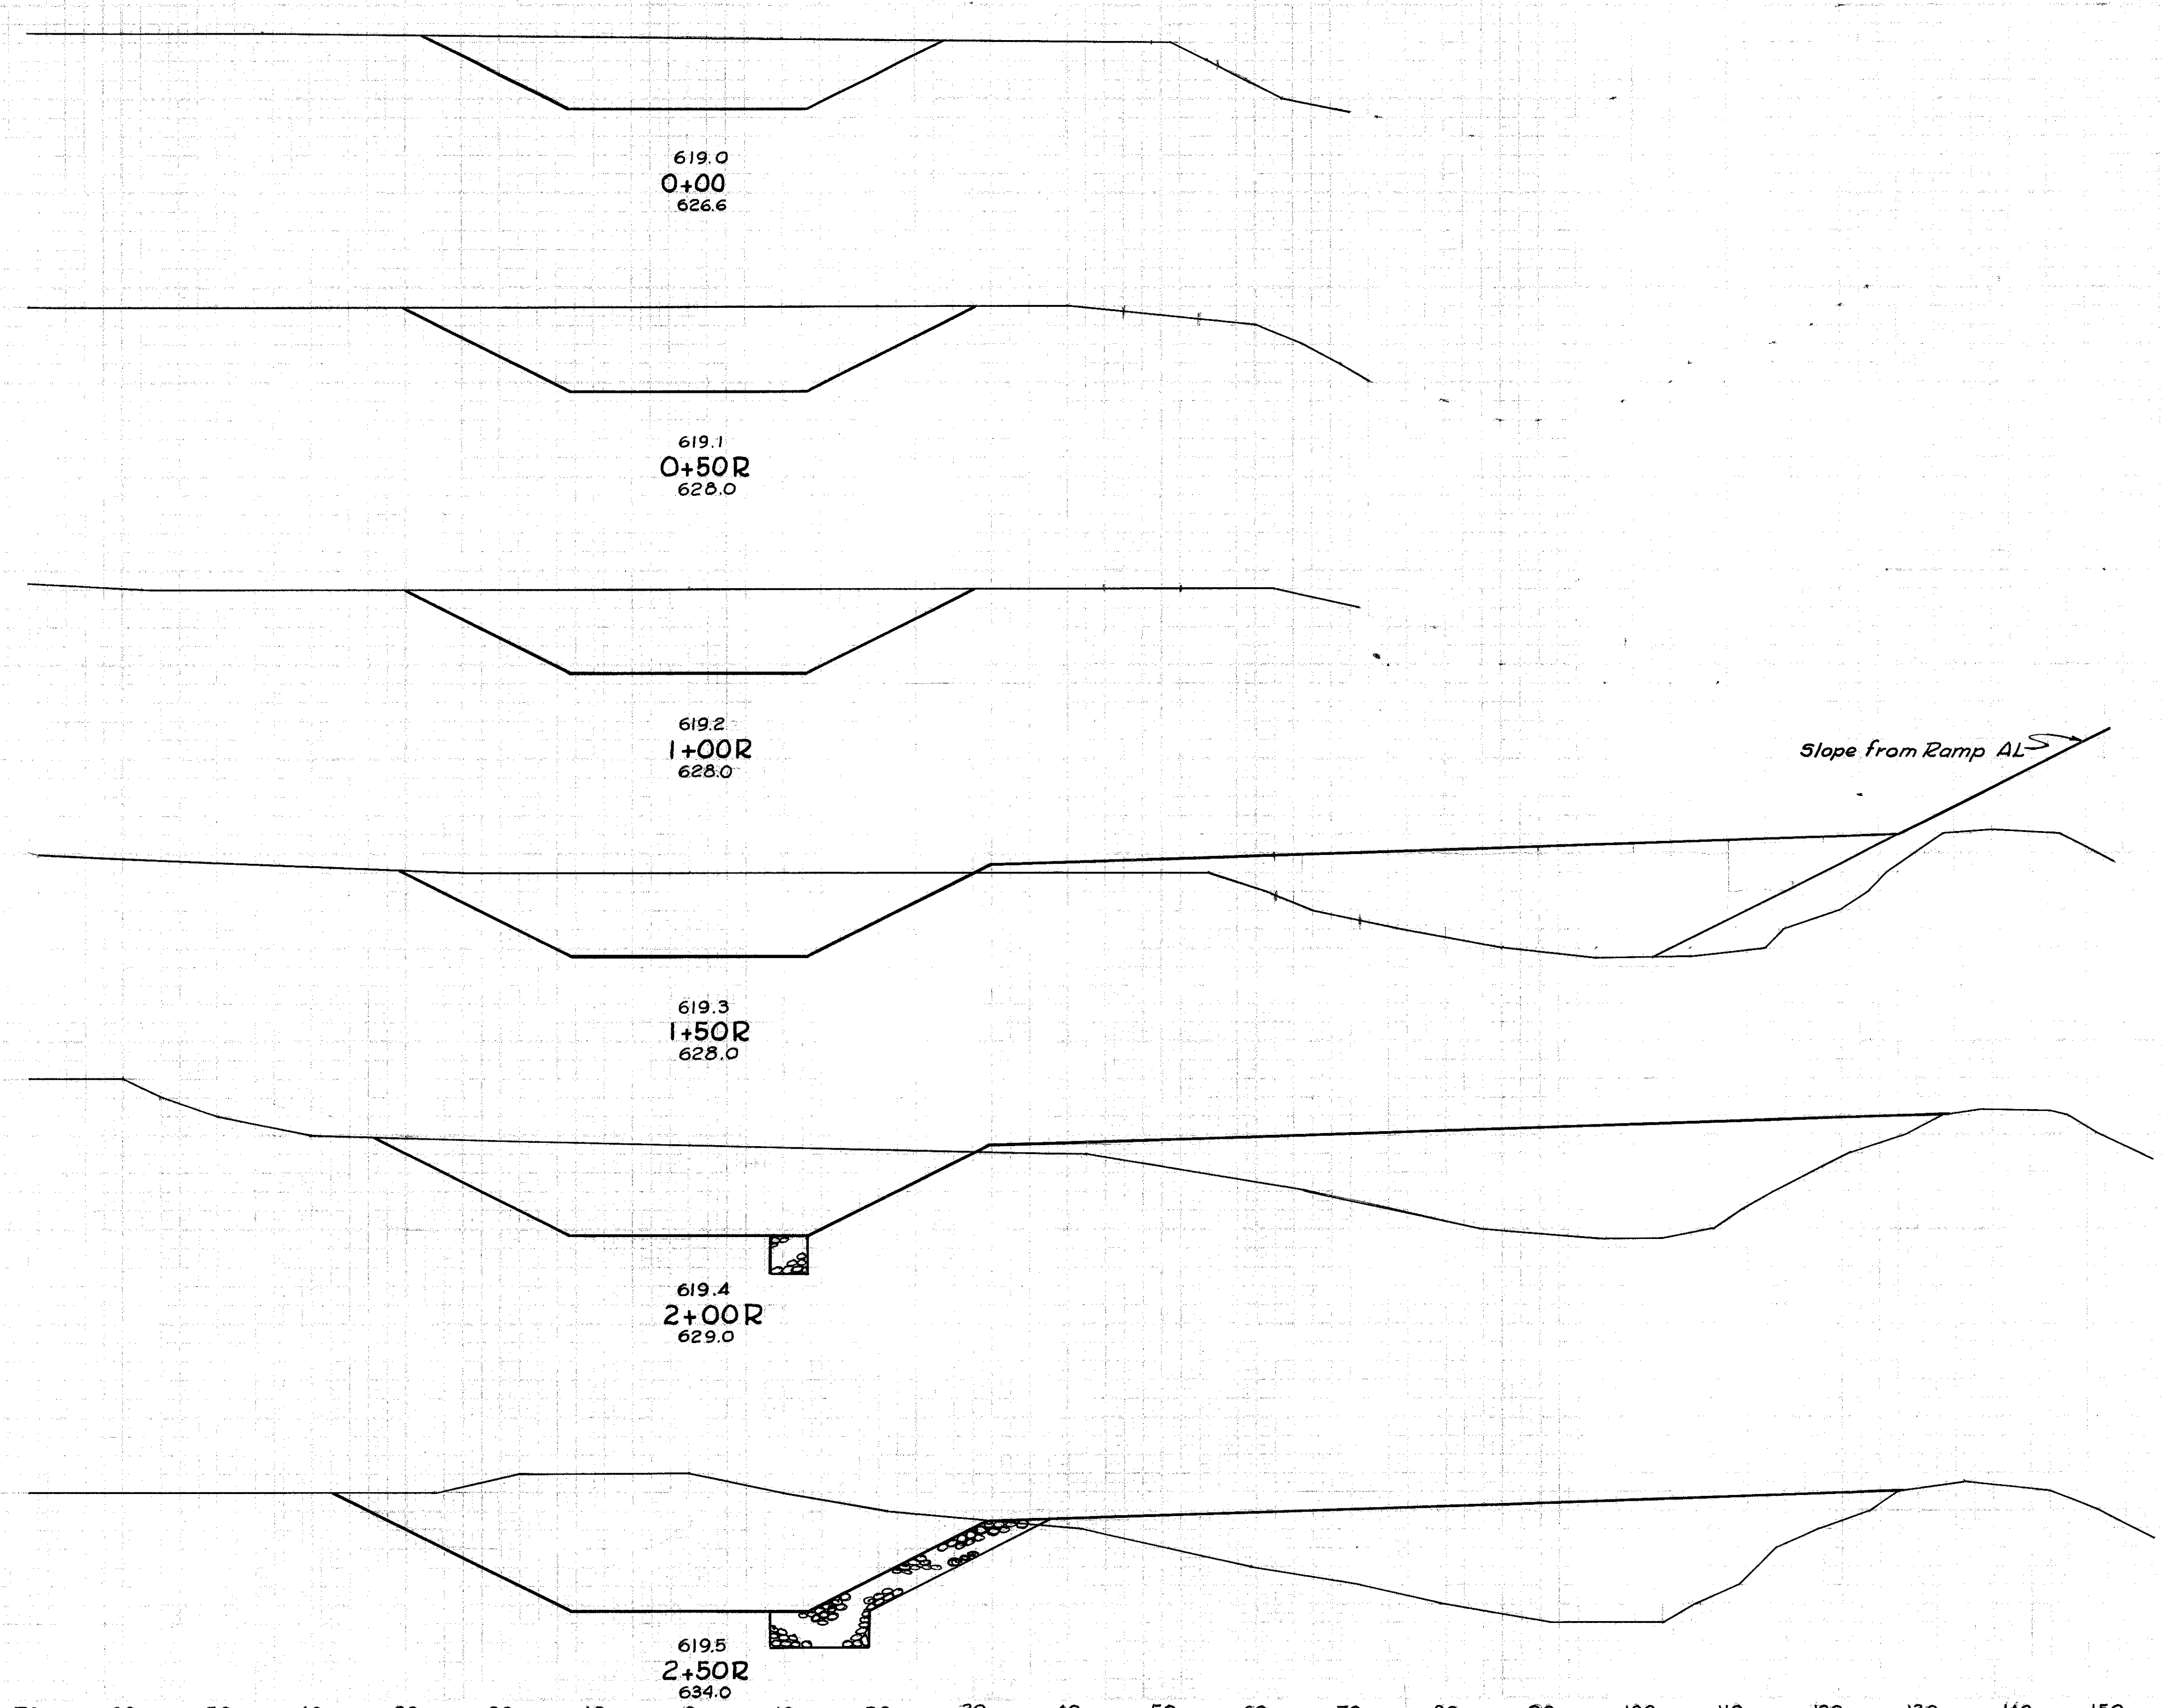

Station <th colspan="2">End Area</th> <th colspan="2">Cu. Yds.</th>	End Area		Cu. Yds.	
	Cut	Fill	Cut	Fill
0+00	304			
0+50R	378			
1+00R	374			
1+50R	374	587		
2+00R	425	670		16
2+50R	746	689		107


120 110 100 90 80 70 60 50 40 30 20 10 0 10 20 30 40 50 60 70 80 90 100 110 120 130 140 150 Dick's Creek Channel Relocation

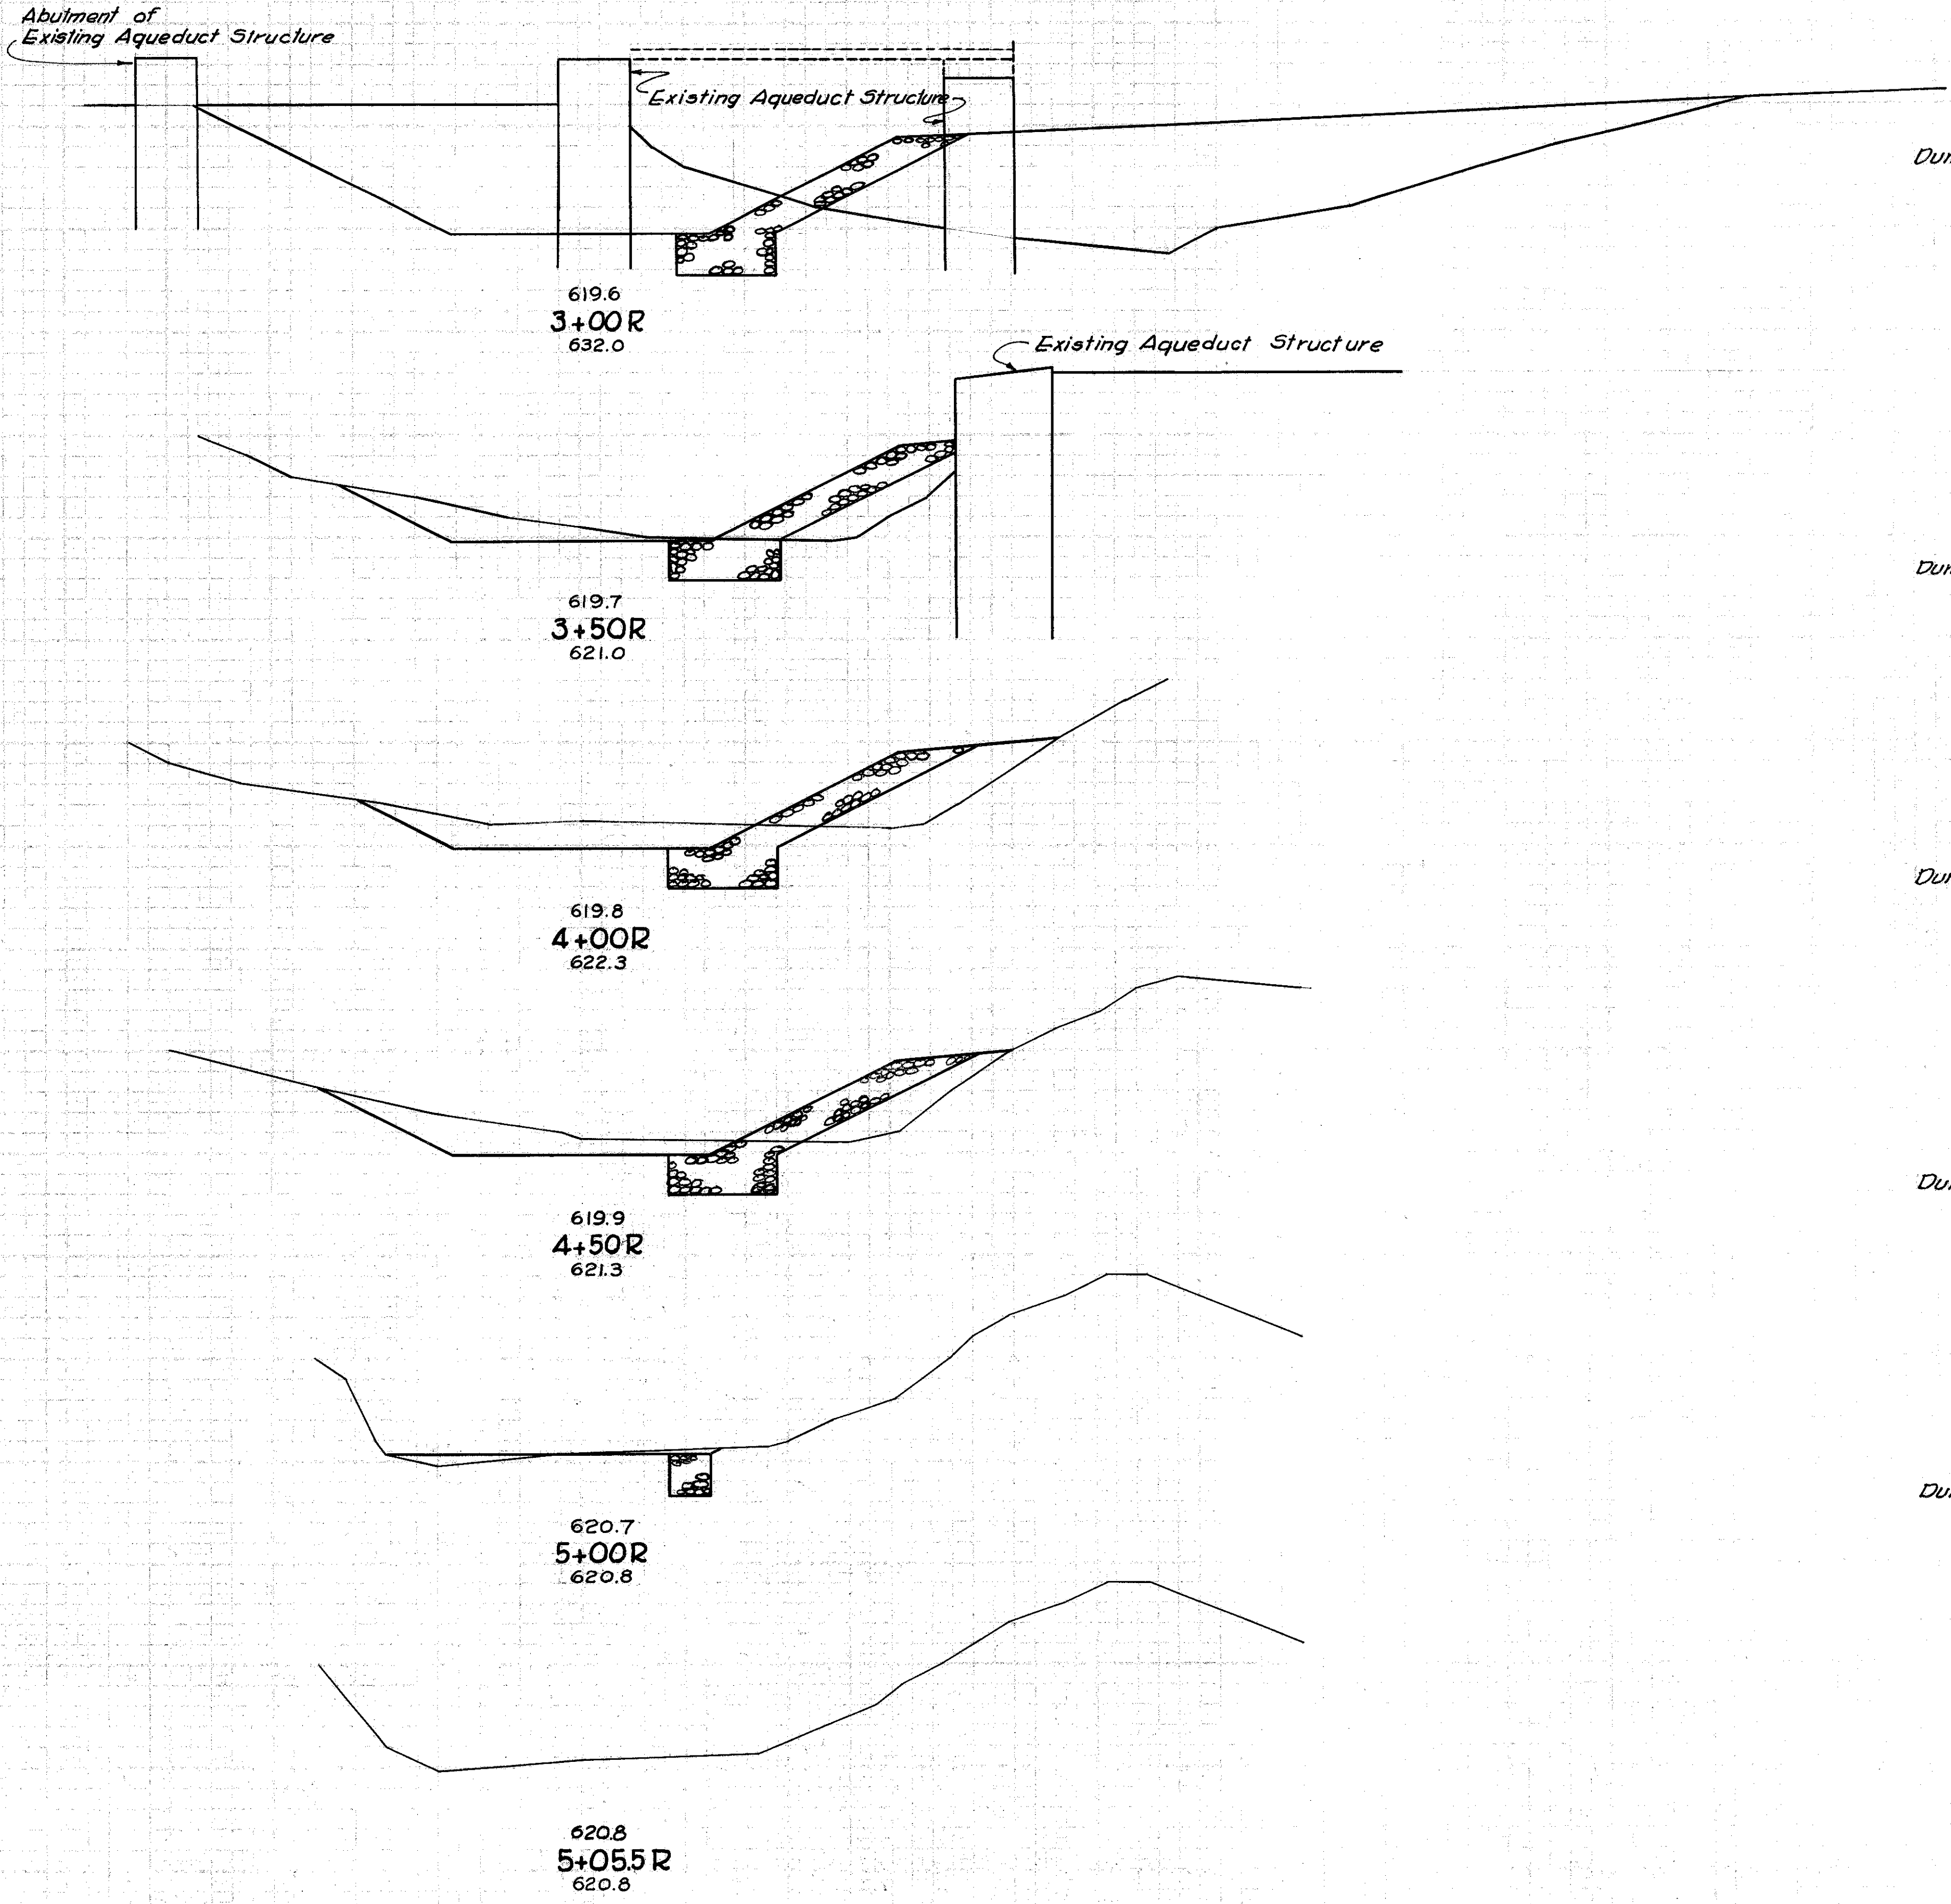


	End Area		Cu. Yds.	
	Cut	Fill	Cut	Fill
Dump rock fill	425	637		
		126		
Dump rock fill	104	41		
		105		
Dump rock fill	142	72		
		105		
Dump rock fill	131	41		
		107		
Dump rock fill	20	9		
		16		

120 110 100 90 80 70 60 50 40 30 20 10 0 10 20 30 40 50 60 70 80 90 100 110 120 130 140 150


143  
222  
DATE: 10.23.1915

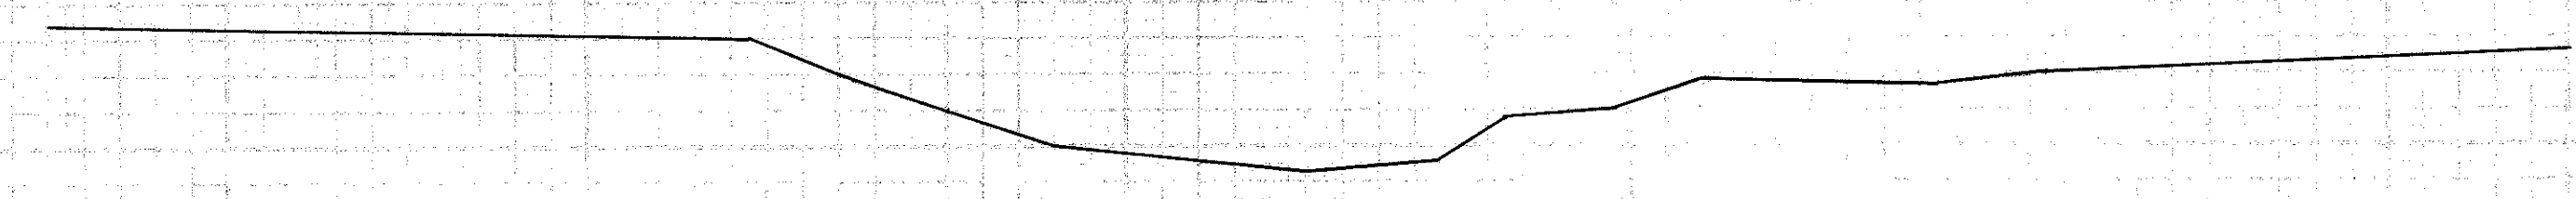


618.6  
2+00L  
618.6

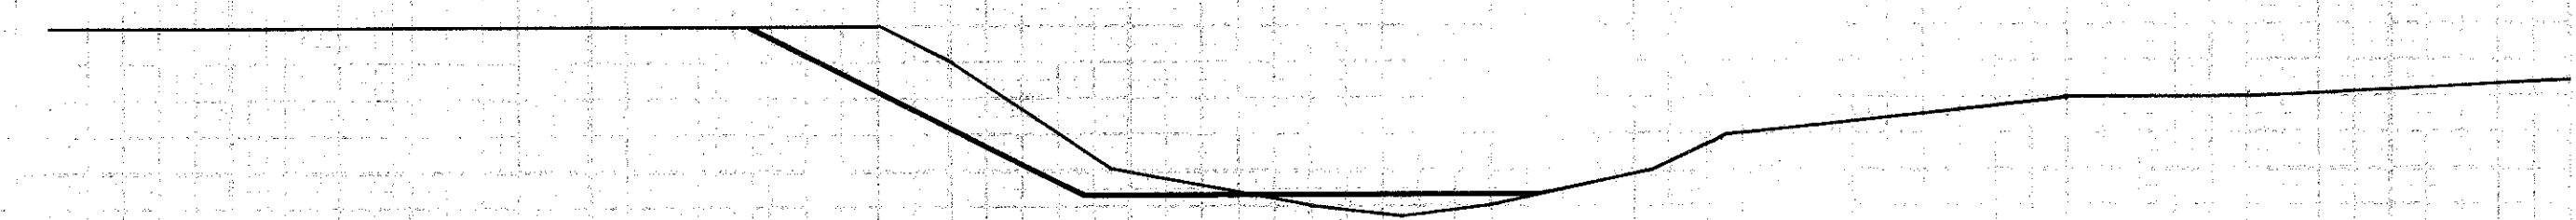

618.7  
1+50L  
618.0

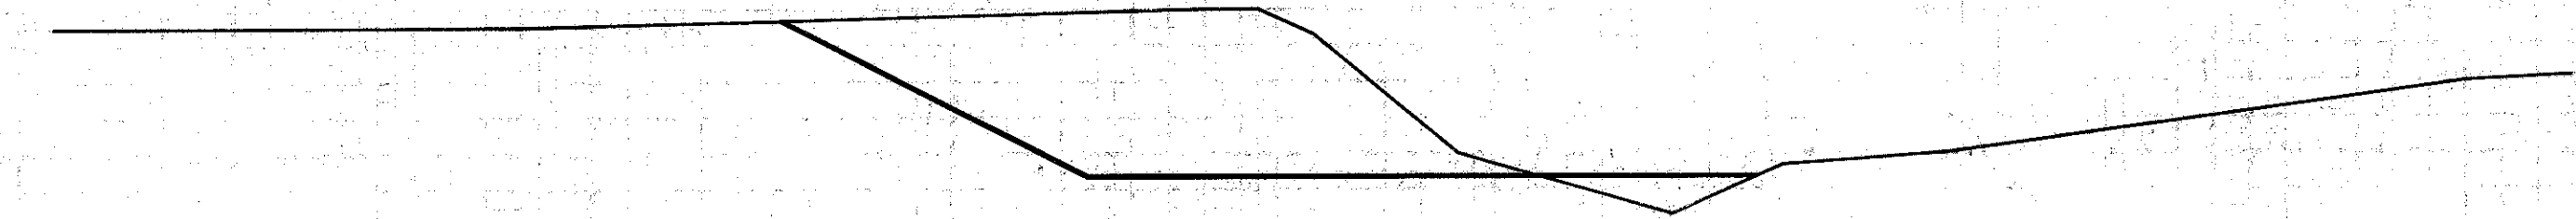

618.8  
1+00L  
626.5


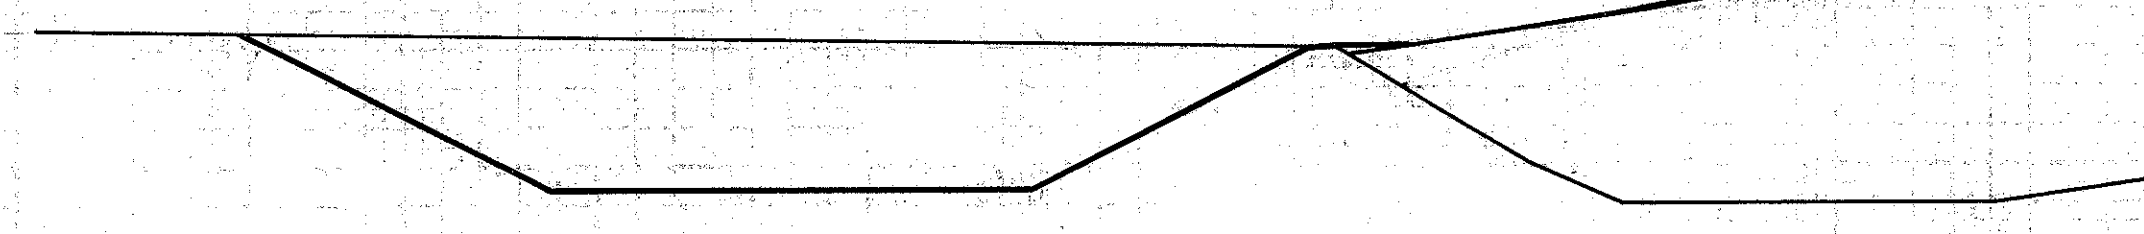


618.9  
0+50L  
626.4

Slope of fill from Highway


End Area		Cu. Yds.	
Cut	Fill	Cut	Fill
60	10		
237	11		
300	2		

120 110 100 90 80 70 60 50 40 30 20 10 0 10 20 30 40 50 60 70 80 90 100 110 120 130 140 150 Dick's Creek Channel Relocation

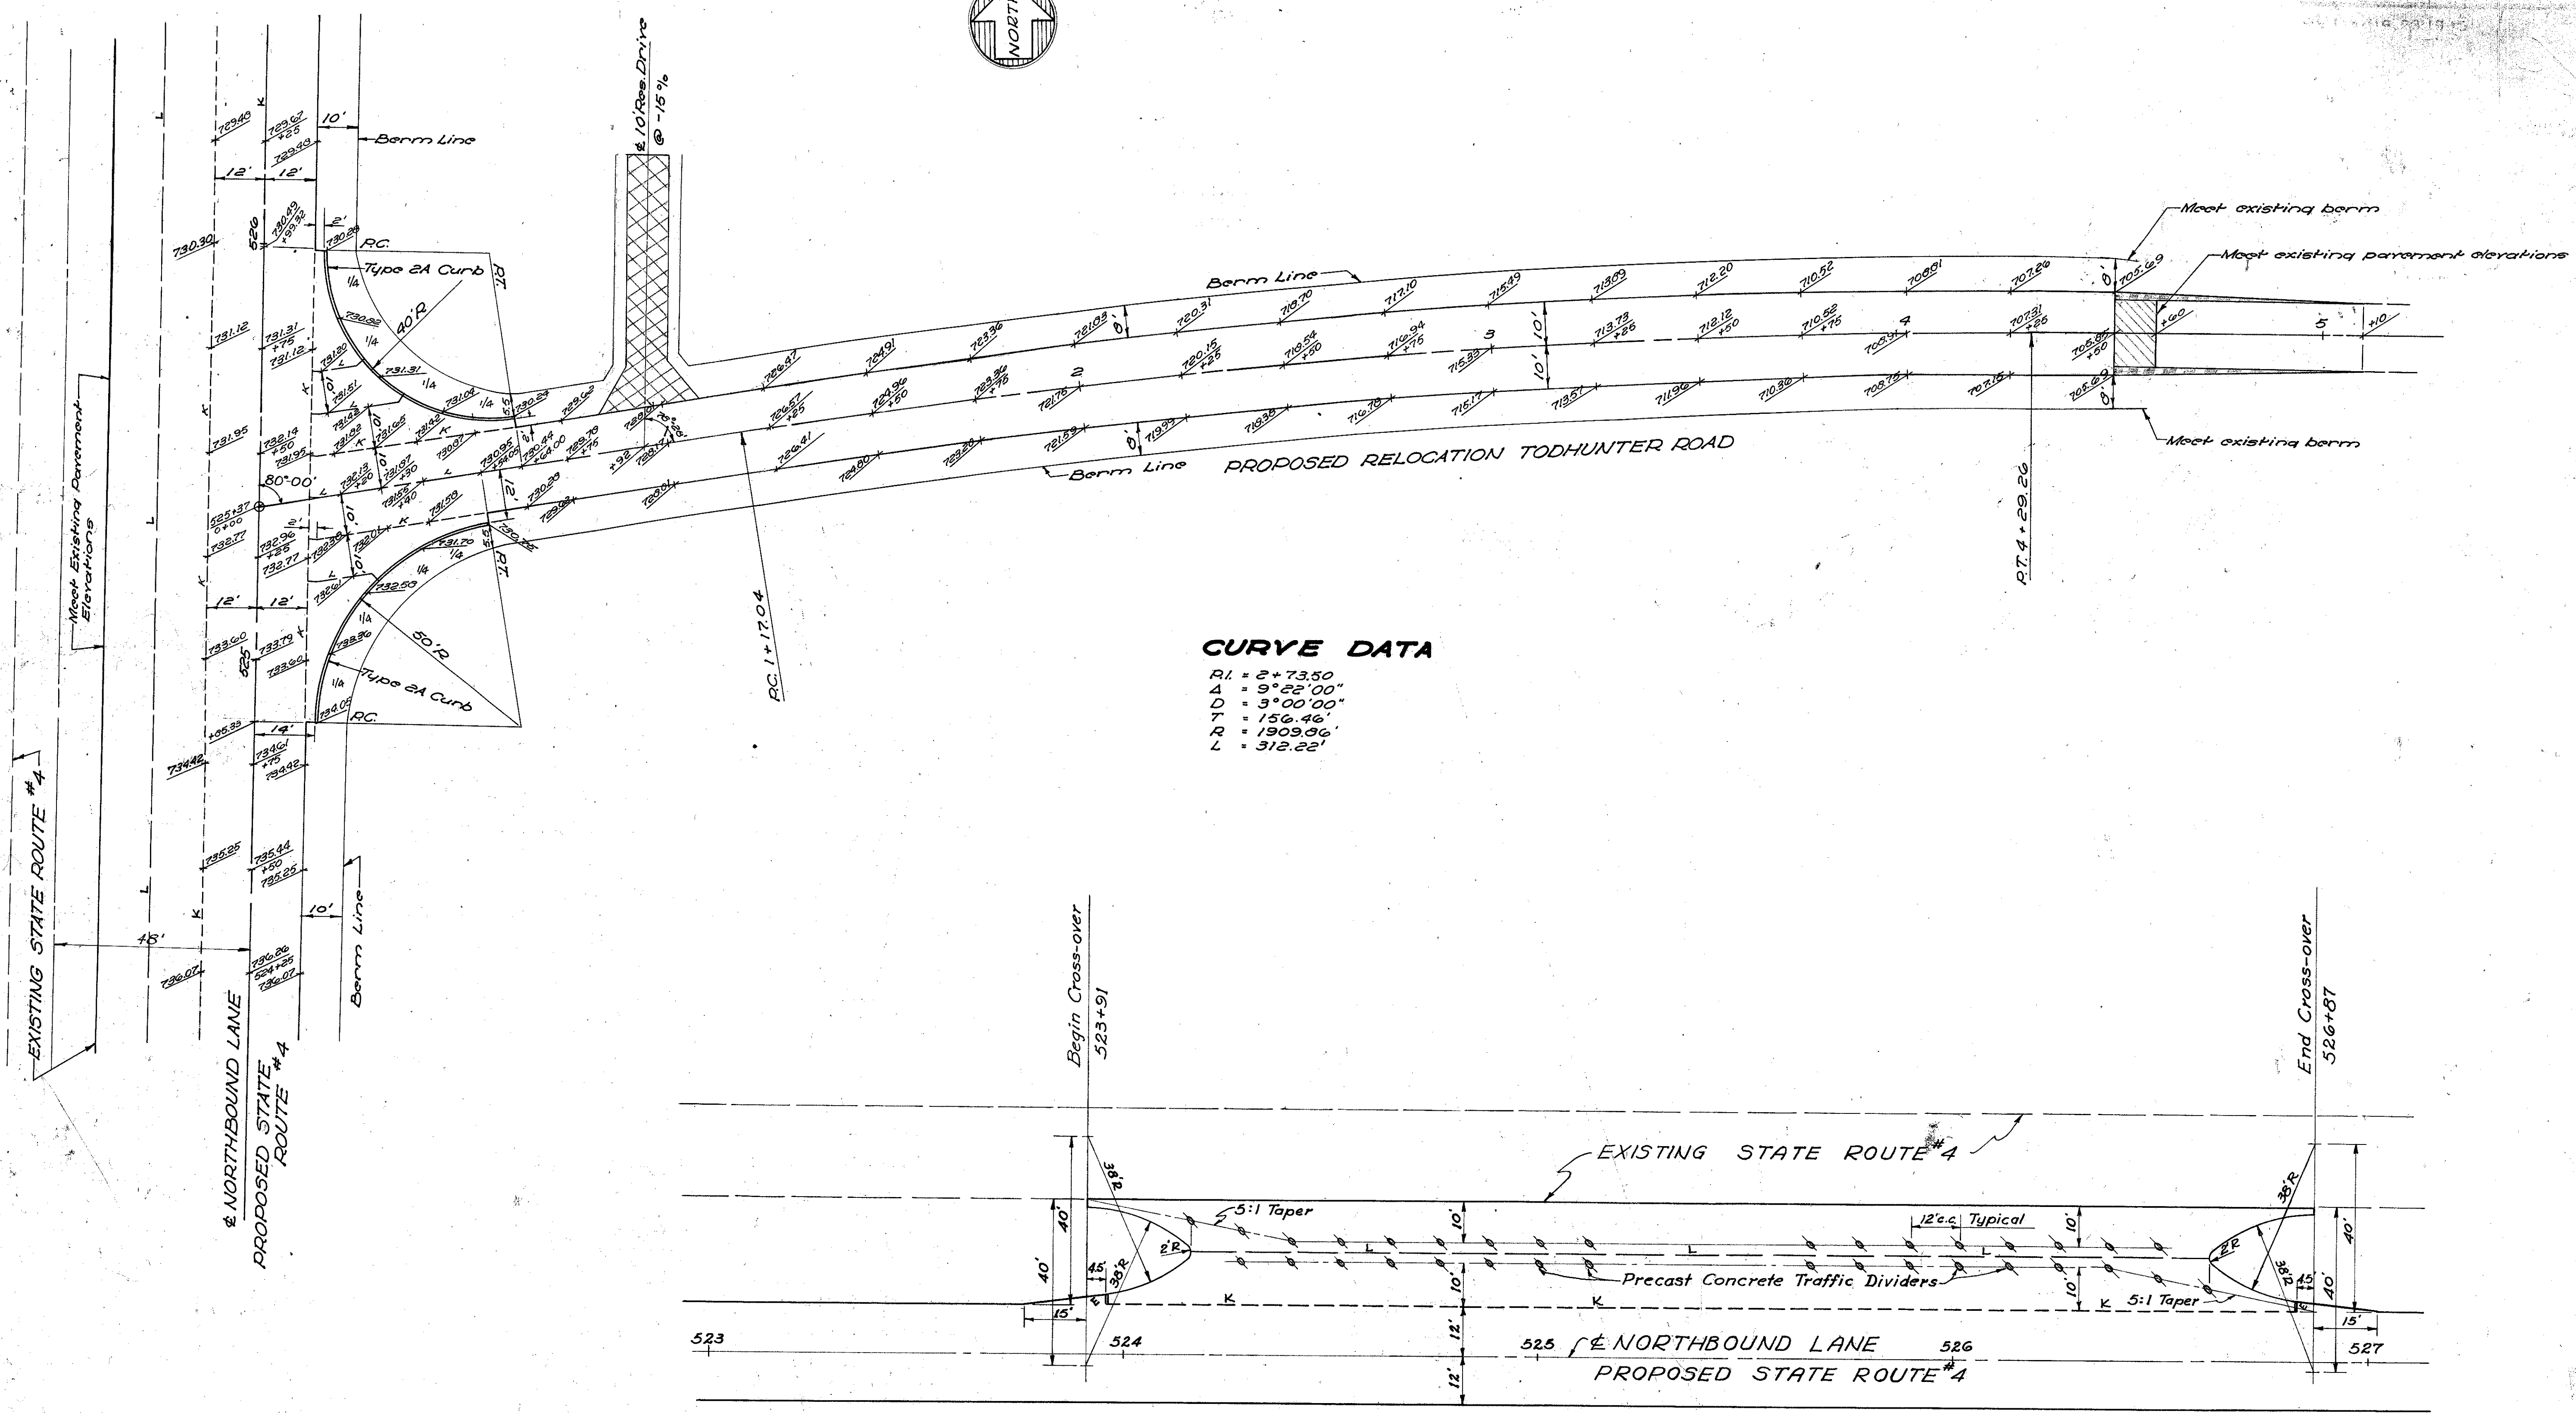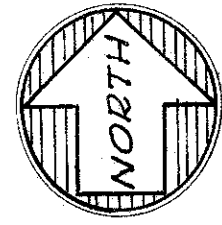


**CURVE DATA**

- RI = 2 + 73.50
- Δ = 9° 22' 00"
- D = 3° 00' 00"
- T = 156.46'
- R = 1909.86'
- L = 312.22'

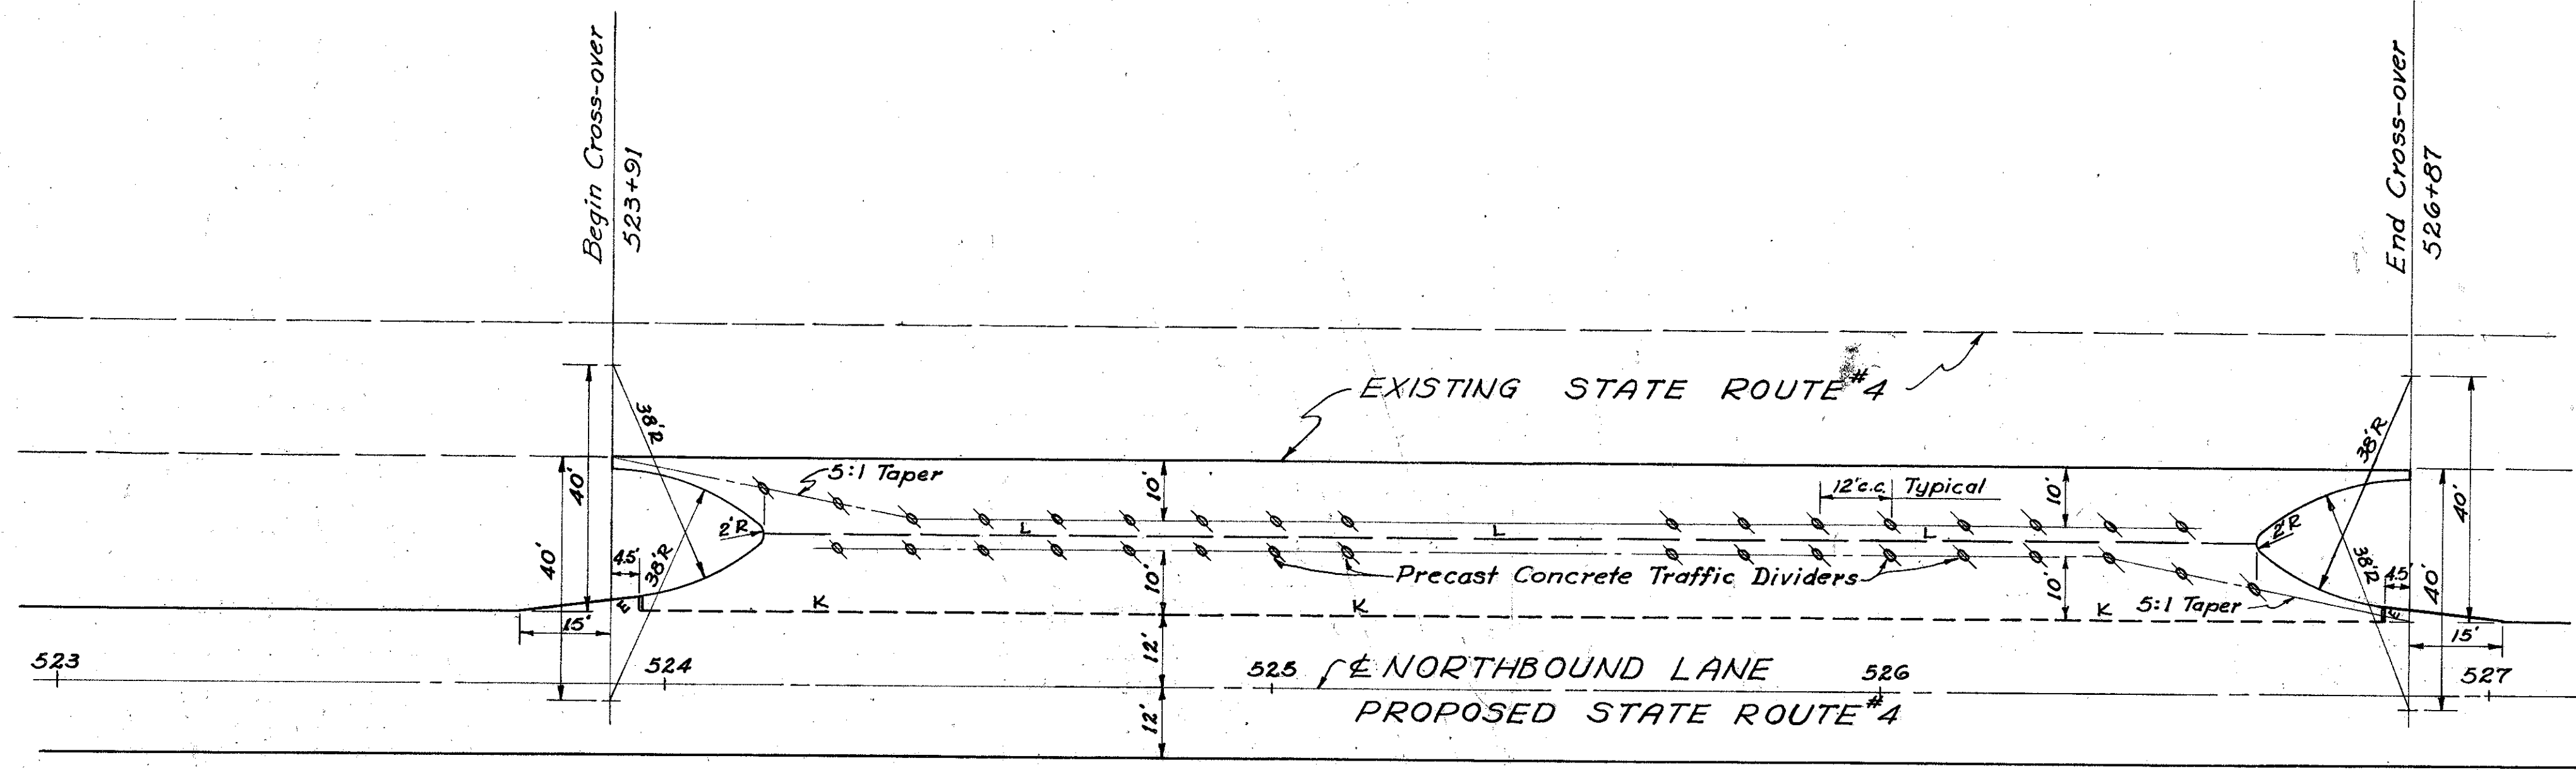

**CROSS-OVER DETAIL**  
**PROPOSED RELOCATION TODHUNTER ROAD**



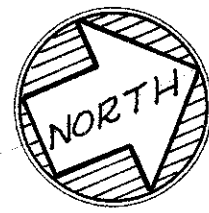


Curve Data, Line 'A'  
 P.I. - 0+73.52 A  
 Δ - 45° 00'  
 R - 177.5'  
 Lc - 139.41'  
 T - 73.52

Curve Data, Line 'A'  
 P.I. - 1+98.55 A  
 Δ - 32° 52'  
 R - 200.5'  
 Lc - 115.01'  
 T - 59.14'


Curve Data, Line 'B'  
 P.I. - 1+57.91 B  
 Δ - 75° 00'  
 R - 110.0'  
 Lc - 144.0'  
 T - 84.41'

For driveways  
 see sheet 35.

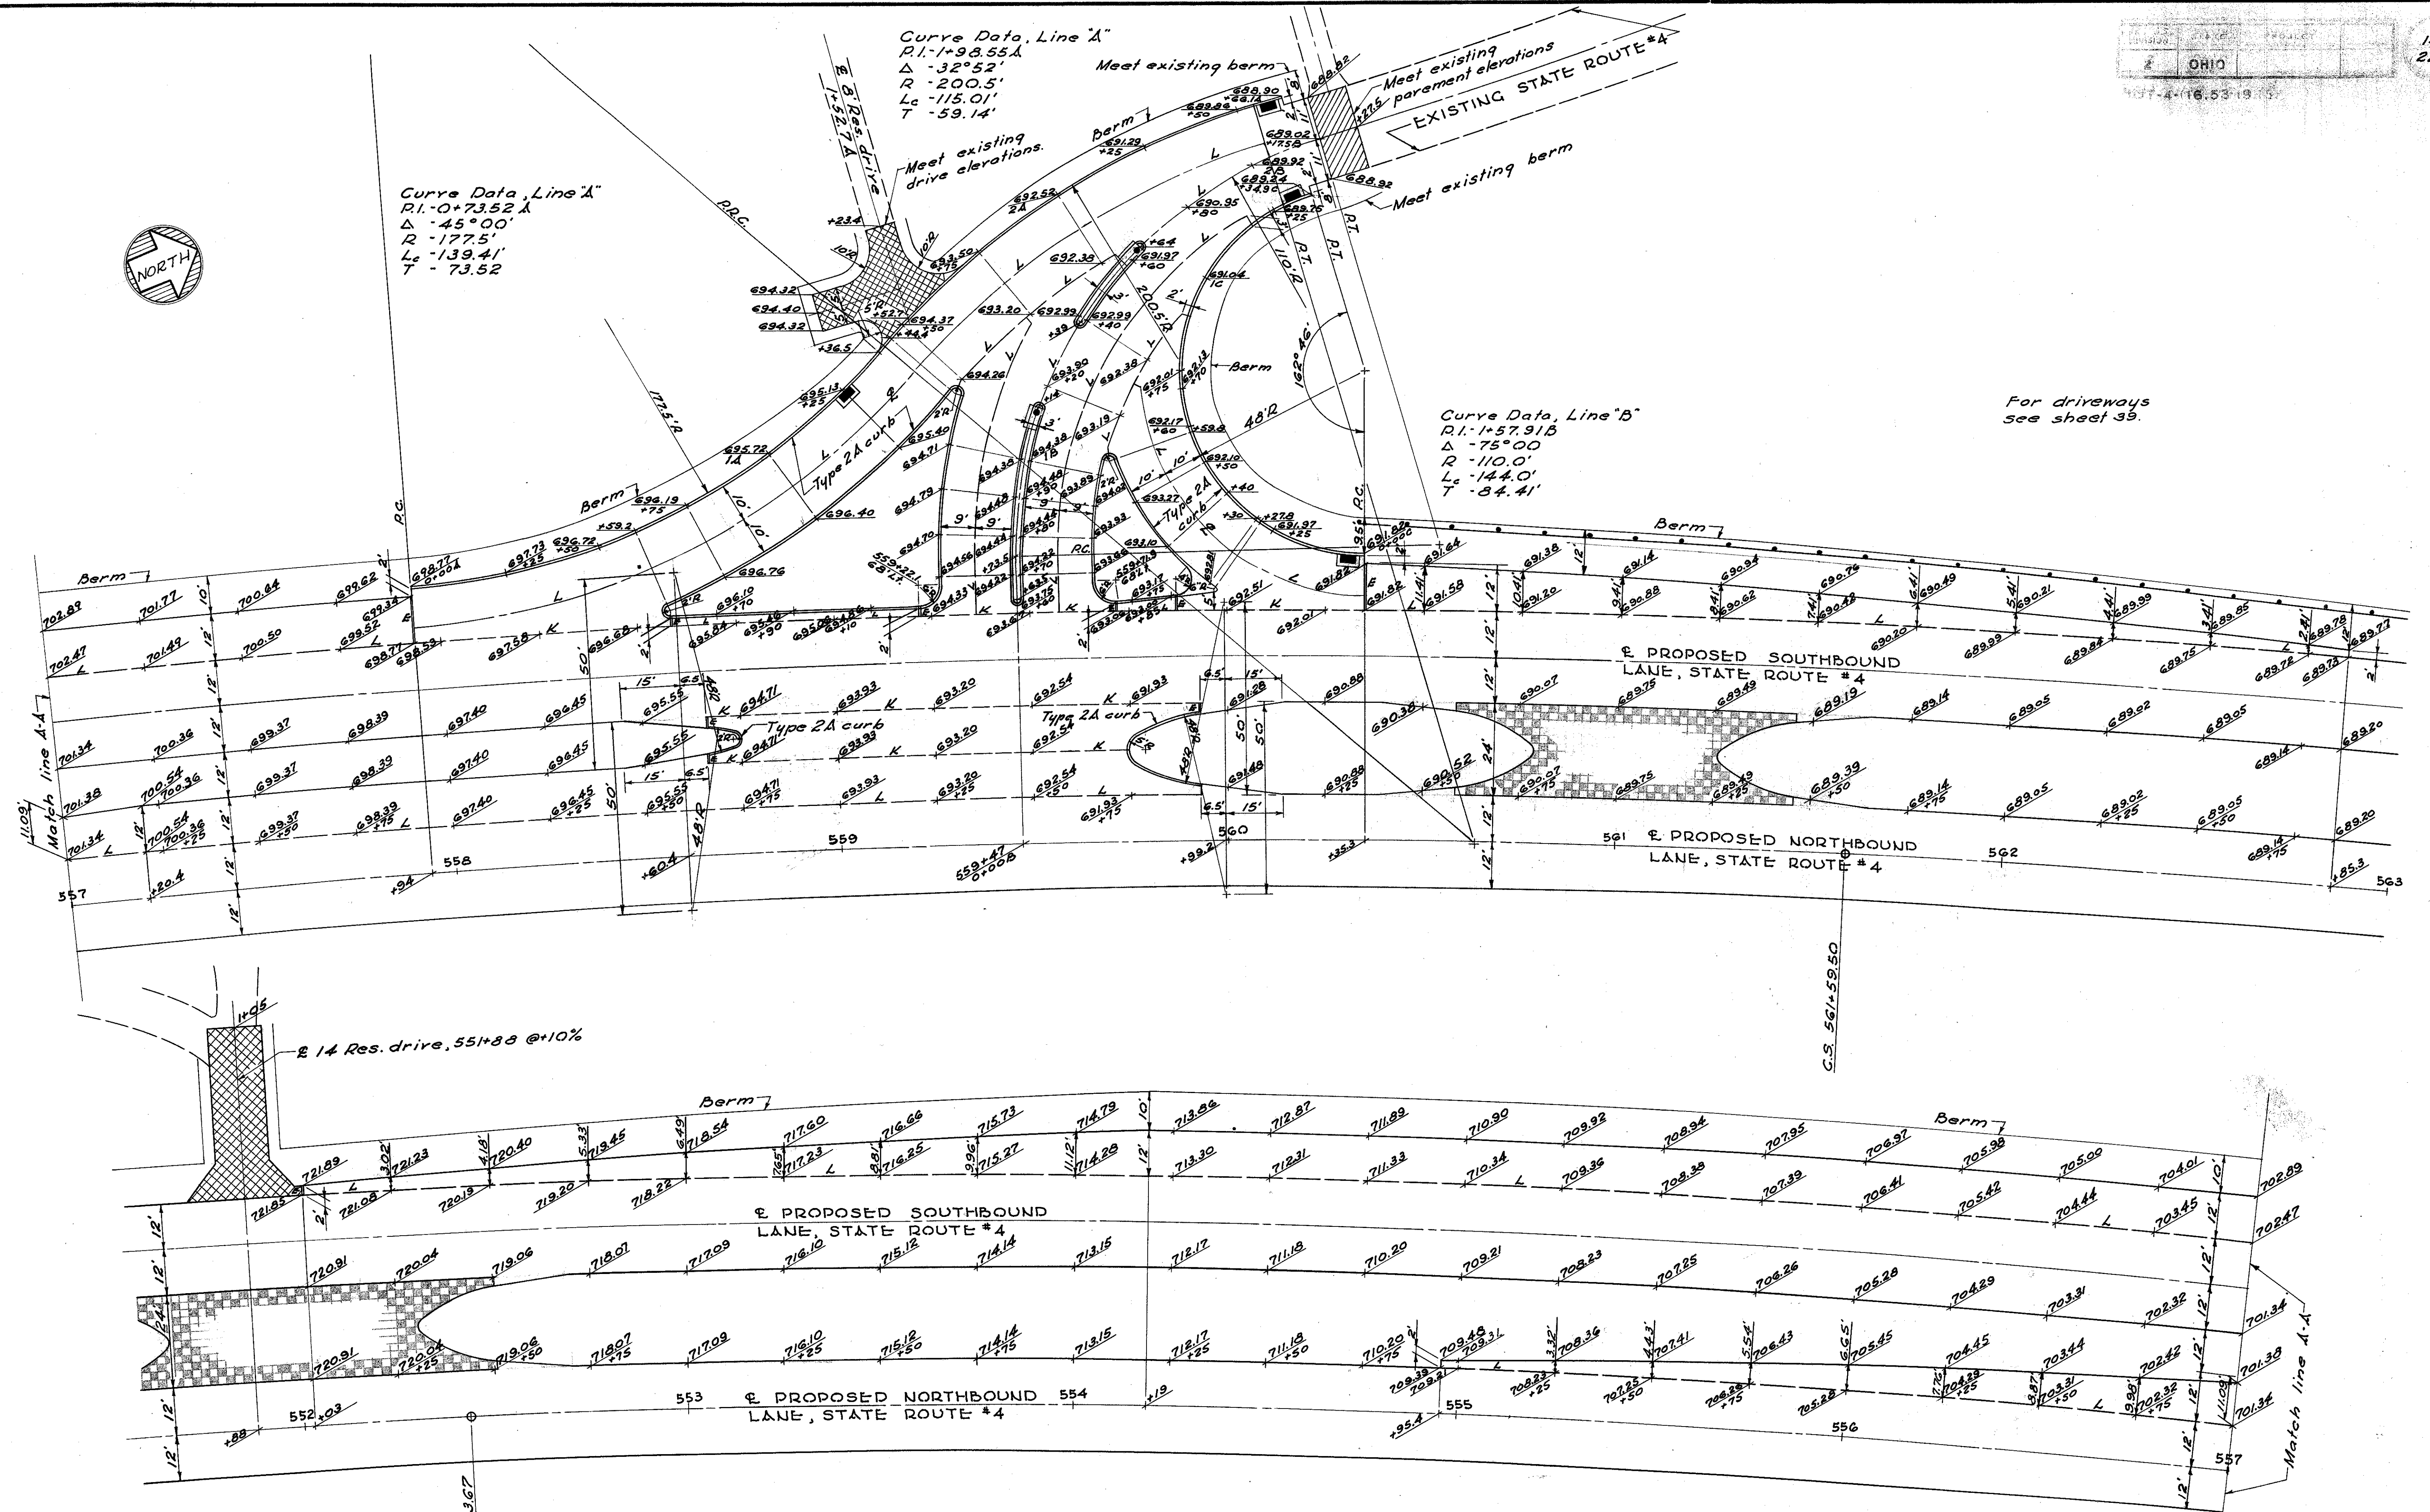

**PROPOSED RELOCATION EXISTING STATE ROUTE #4**

See Sheet 44  
for Driveways and Topo.  
See Sheet 44  
for existing water and gas mains  
and service connections.

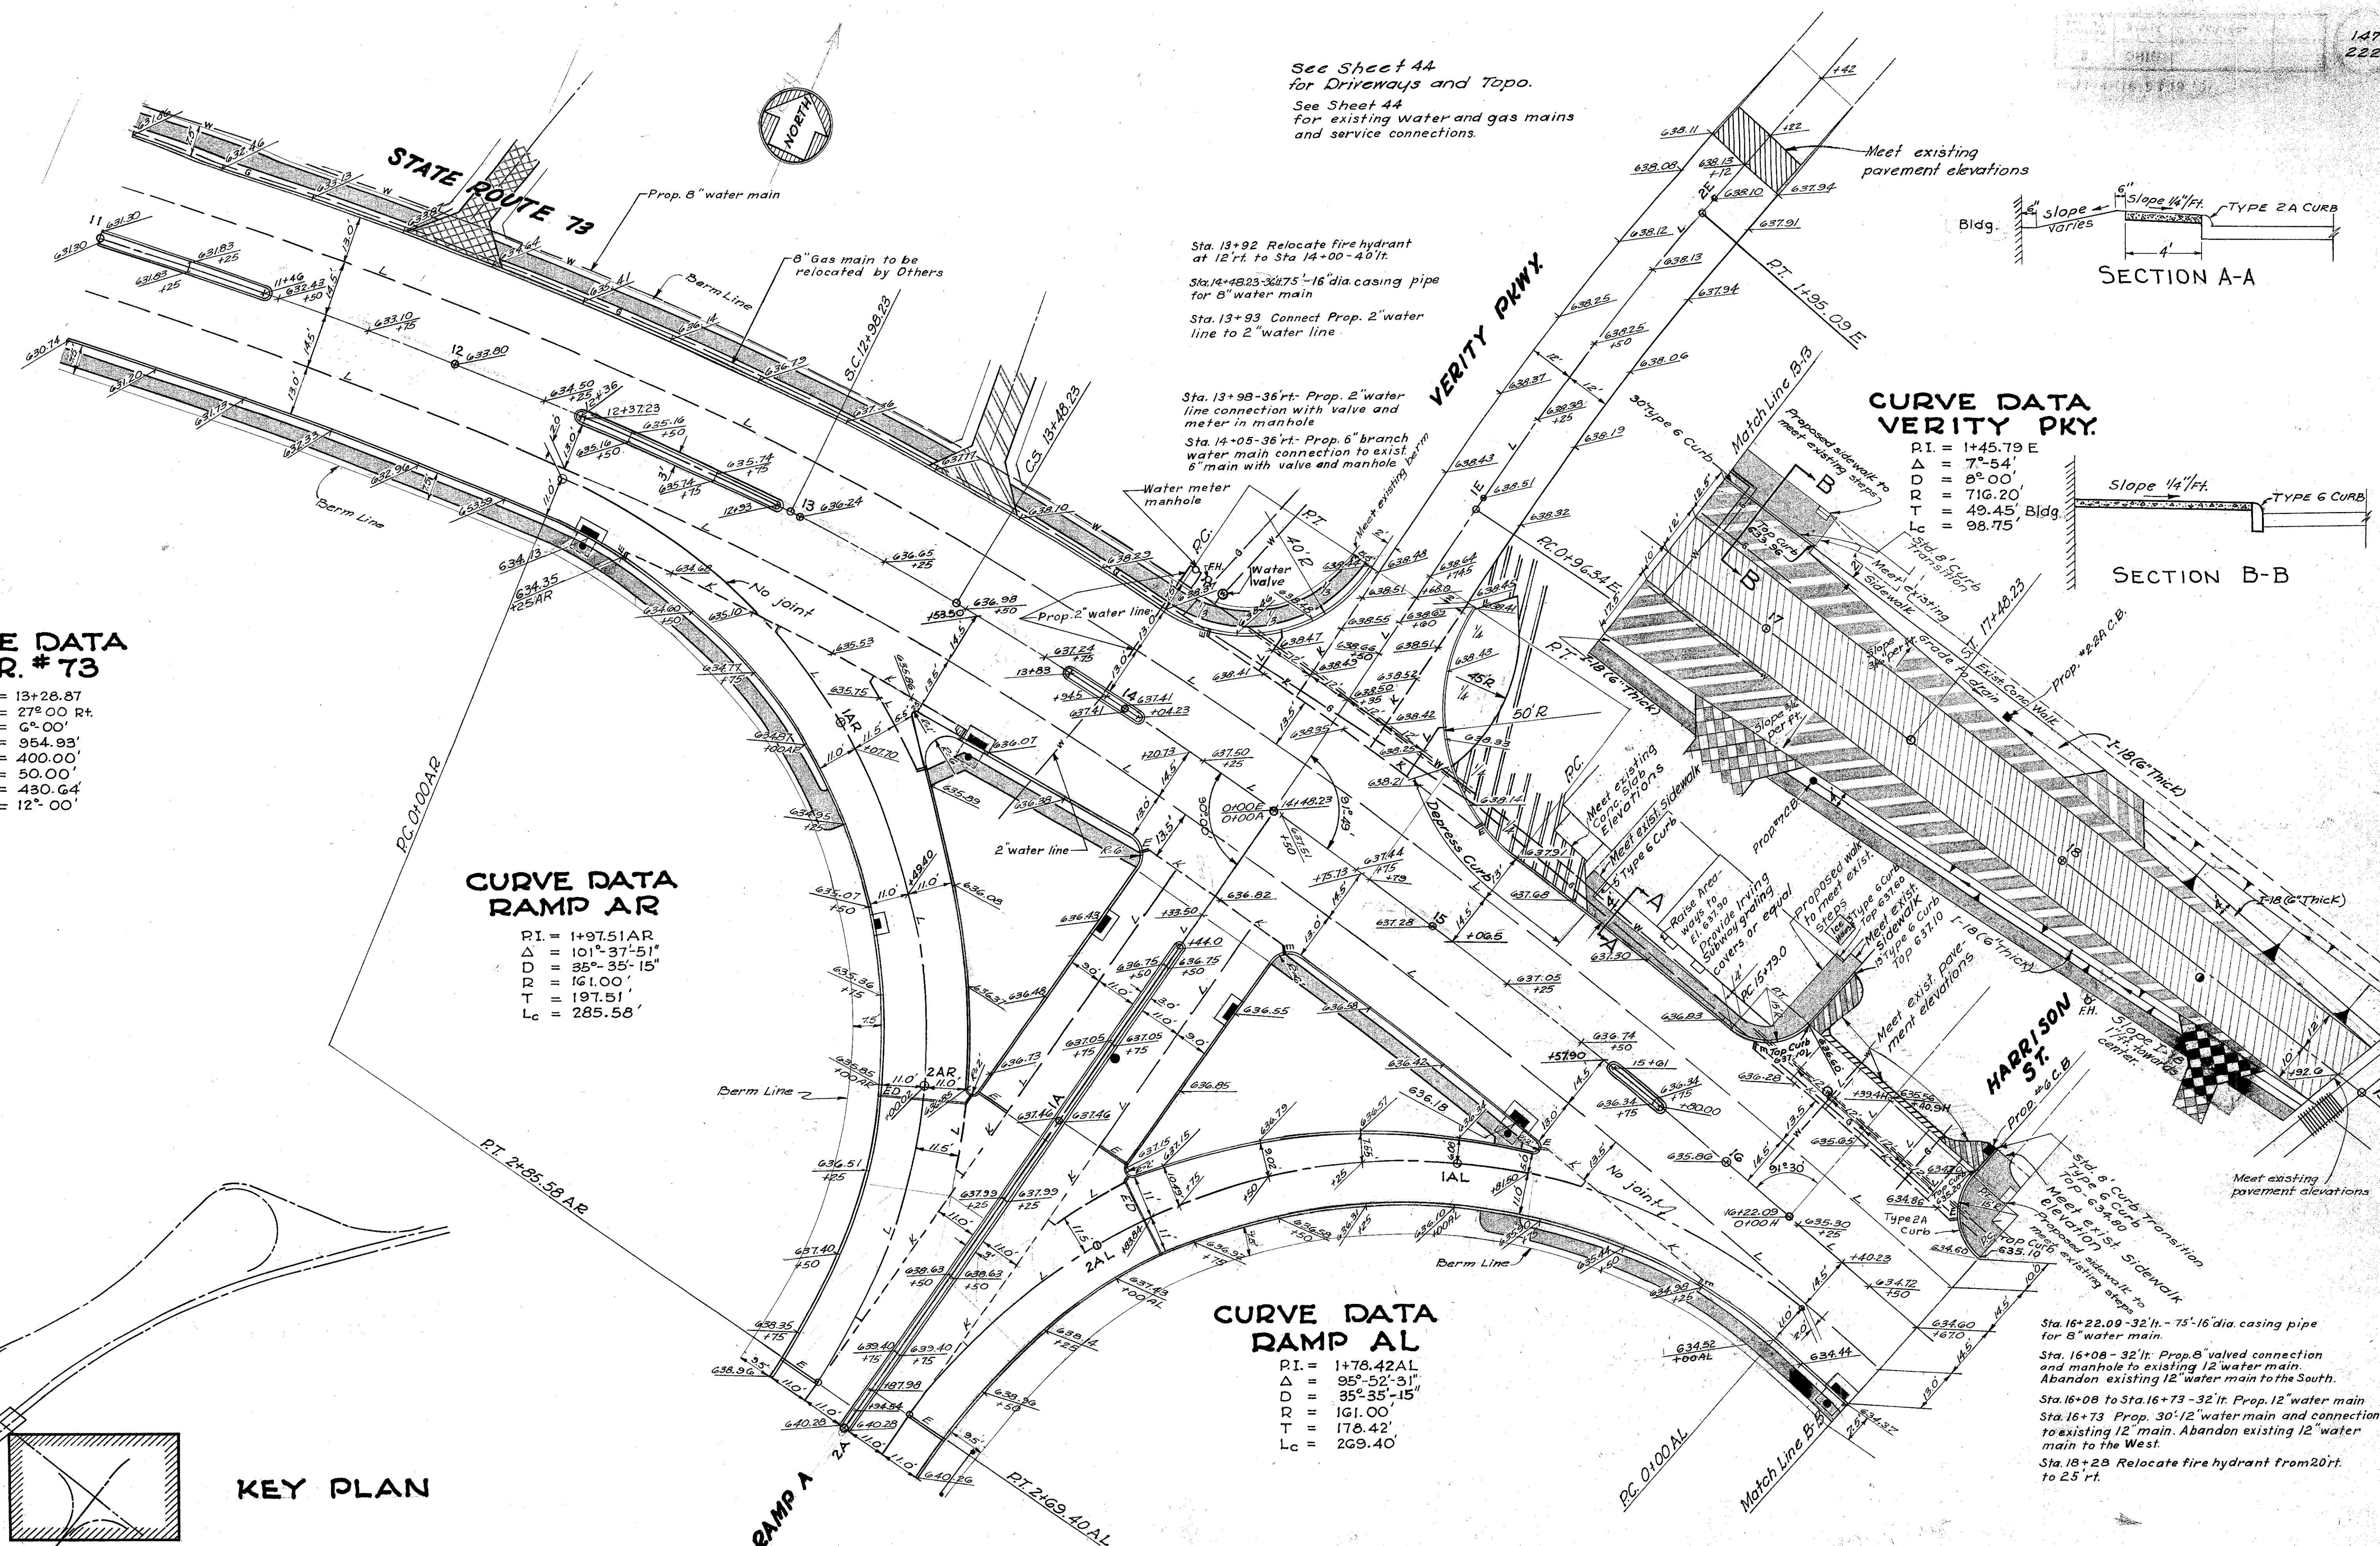

**CURVE DATA  
SR. # 73**

PI.	= 13+28.87
Δ	= 27° 00' Rt.
D	= 6° 00'
R	= 954.93'
L <sub>s</sub>	= 400.00'
L <sub>c</sub>	= 50.00'
T <sub>s</sub>	= 430.64'
Θ <sub>s</sub>	= 12° 00'

**CURVE DATA  
RAMP AR**




PI.	= 1+97.51AR
Δ	= 101° 37' 51"
D	= 35° 35' 15"
R	= 161.00'
T	= 197.51'
L <sub>c</sub>	= 285.58'

**CURVE DATA  
RAMP AL**

PI.	= 1+78.42AL
Δ	= 95° 52' 31"
D	= 35° 35' 15"
R	= 161.00'
T	= 178.42'
L <sub>c</sub>	= 269.40'



**CURVE DATA  
VERITY PKY.**

PI.	= 1+45.79 E
Δ	= 7° 54'
D	= 8° 00'
R	= 716.20'
T	= 49.45' Bldg.
L <sub>c</sub>	= 98.75'

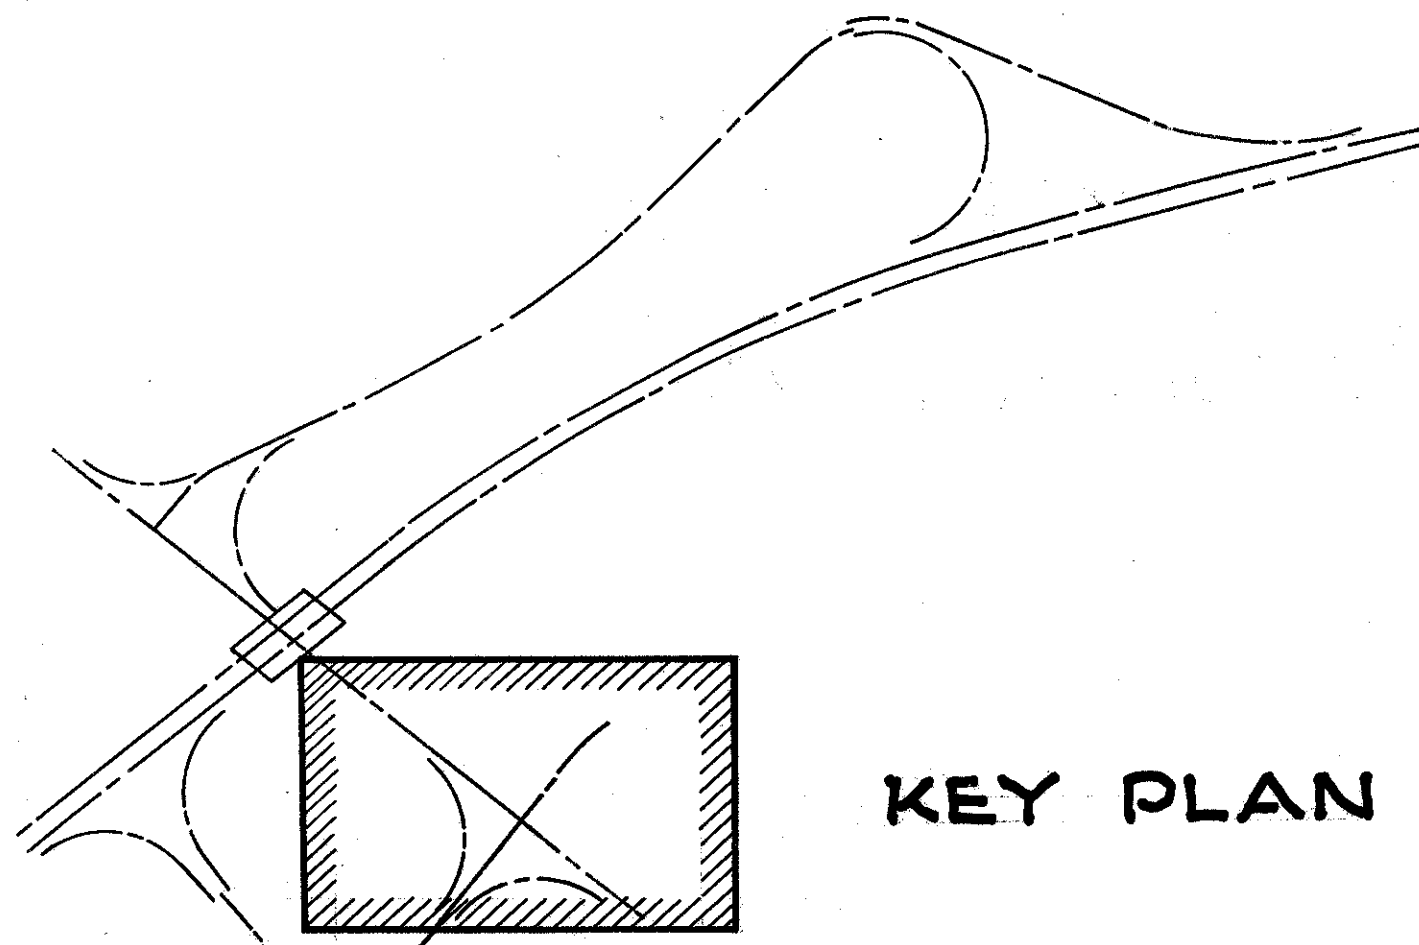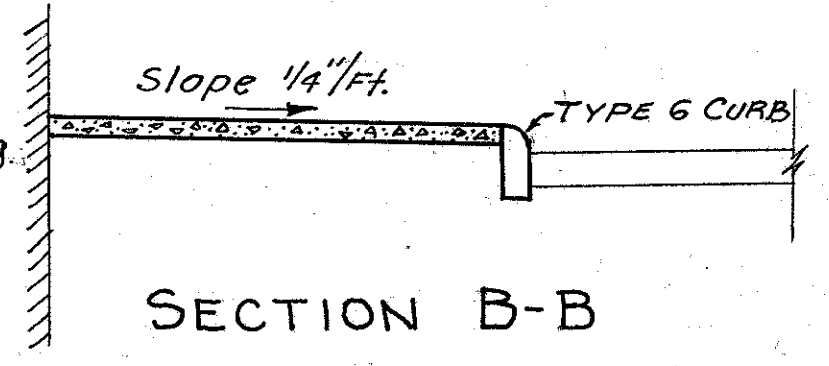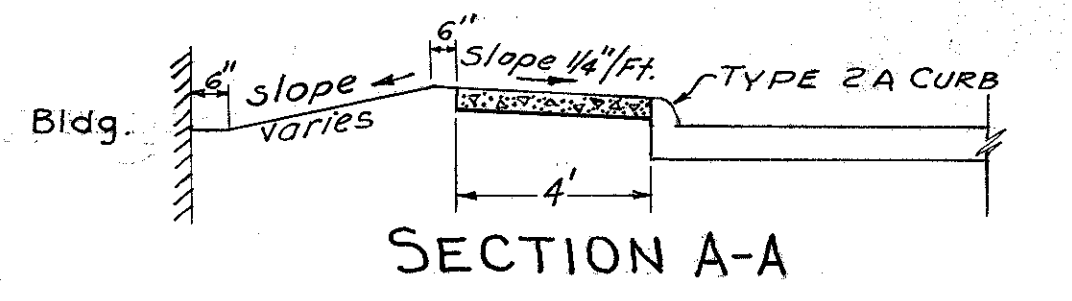

Sta. 16+22.09 - 32' h. - 75' - 16' dia. casing pipe for 8" water main.  
Sta. 16+08 - 32' h. Prop. 8" valved connection and manhole to existing 12" water main. Abandon existing 12" water main to the South.  
Sta. 16+08 to Sta. 16+73 - 32' h. Prop. 12" water main. Sta. 16+73 Prop. 30' 1/2" water main and connection to existing 12" main. Abandon existing 12" water main to the West.  
Sta. 18+28 Relocate fire hydrant from 20' rt. to 25' rt.


Transition curb from 6" to 9" height in length of 8' at approach slab of bridge.

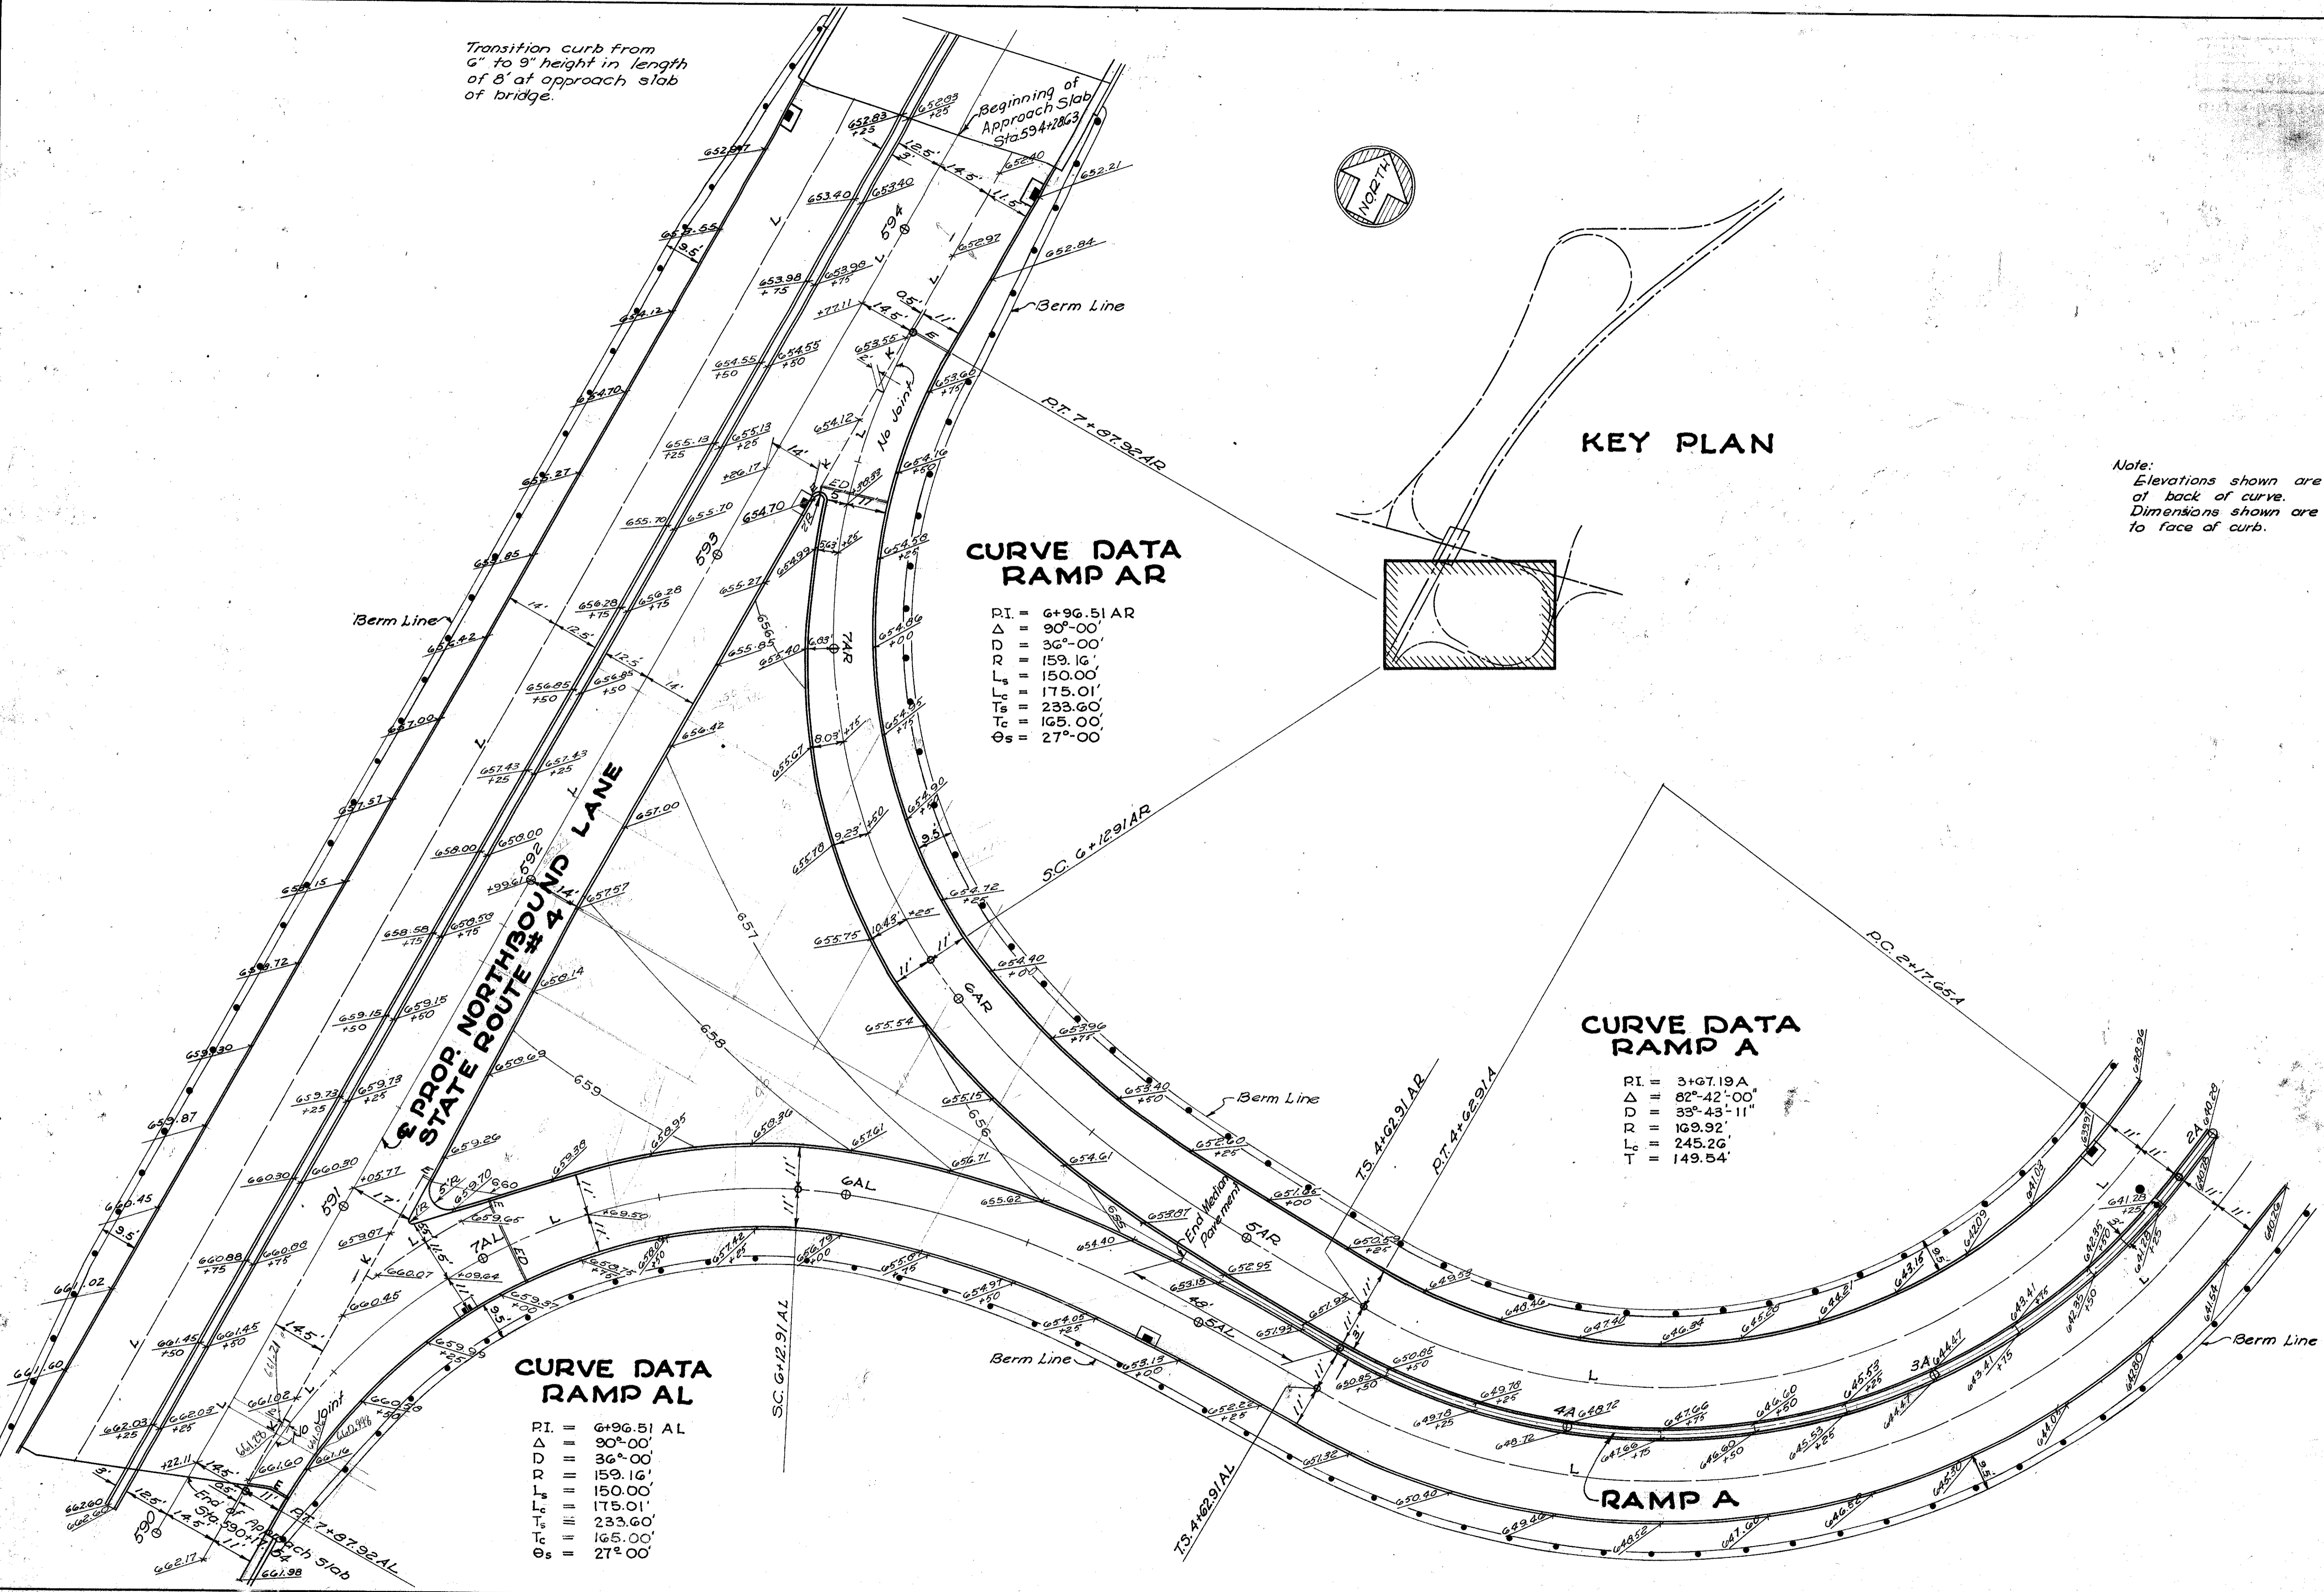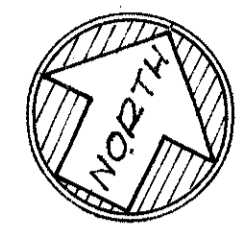

**CURVE DATA  
RAMP AR**

- PI = 6+96.51 AR
- Δ = 90°-00'
- D = 36°-00'
- R = 159.16'
- L<sub>s</sub> = 150.00'
- L<sub>c</sub> = 175.01'
- T<sub>s</sub> = 233.60'
- T<sub>c</sub> = 165.00'
- Θ<sub>s</sub> = 27°-00'

**KEY PLAN**

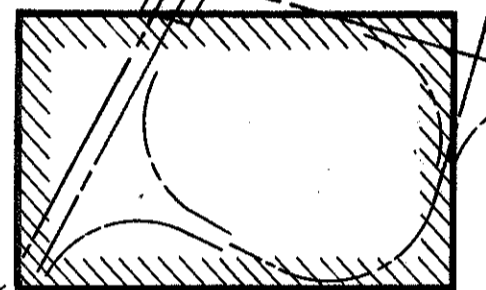

Note:  
Elevations shown are  
of back of curve.  
Dimensions shown are  
to face of curb.


**CURVE DATA  
RAMP A**

- PI = 3+67.19 A
- Δ = 82°-42'-00"
- D = 33°-43'-11"
- R = 169.92'
- L<sub>s</sub> = 245.26'
- T<sub>s</sub> = 149.54'

**CURVE DATA  
RAMP AL**

- PI = 6+96.51 AL
- Δ = 90°-00'
- D = 36°-00'
- R = 159.16'
- L<sub>s</sub> = 150.00'
- L<sub>c</sub> = 175.01'
- T<sub>s</sub> = 233.60'
- T<sub>c</sub> = 165.00'
- Θ<sub>s</sub> = 27°-00'

For driveway details  
see sheet 155

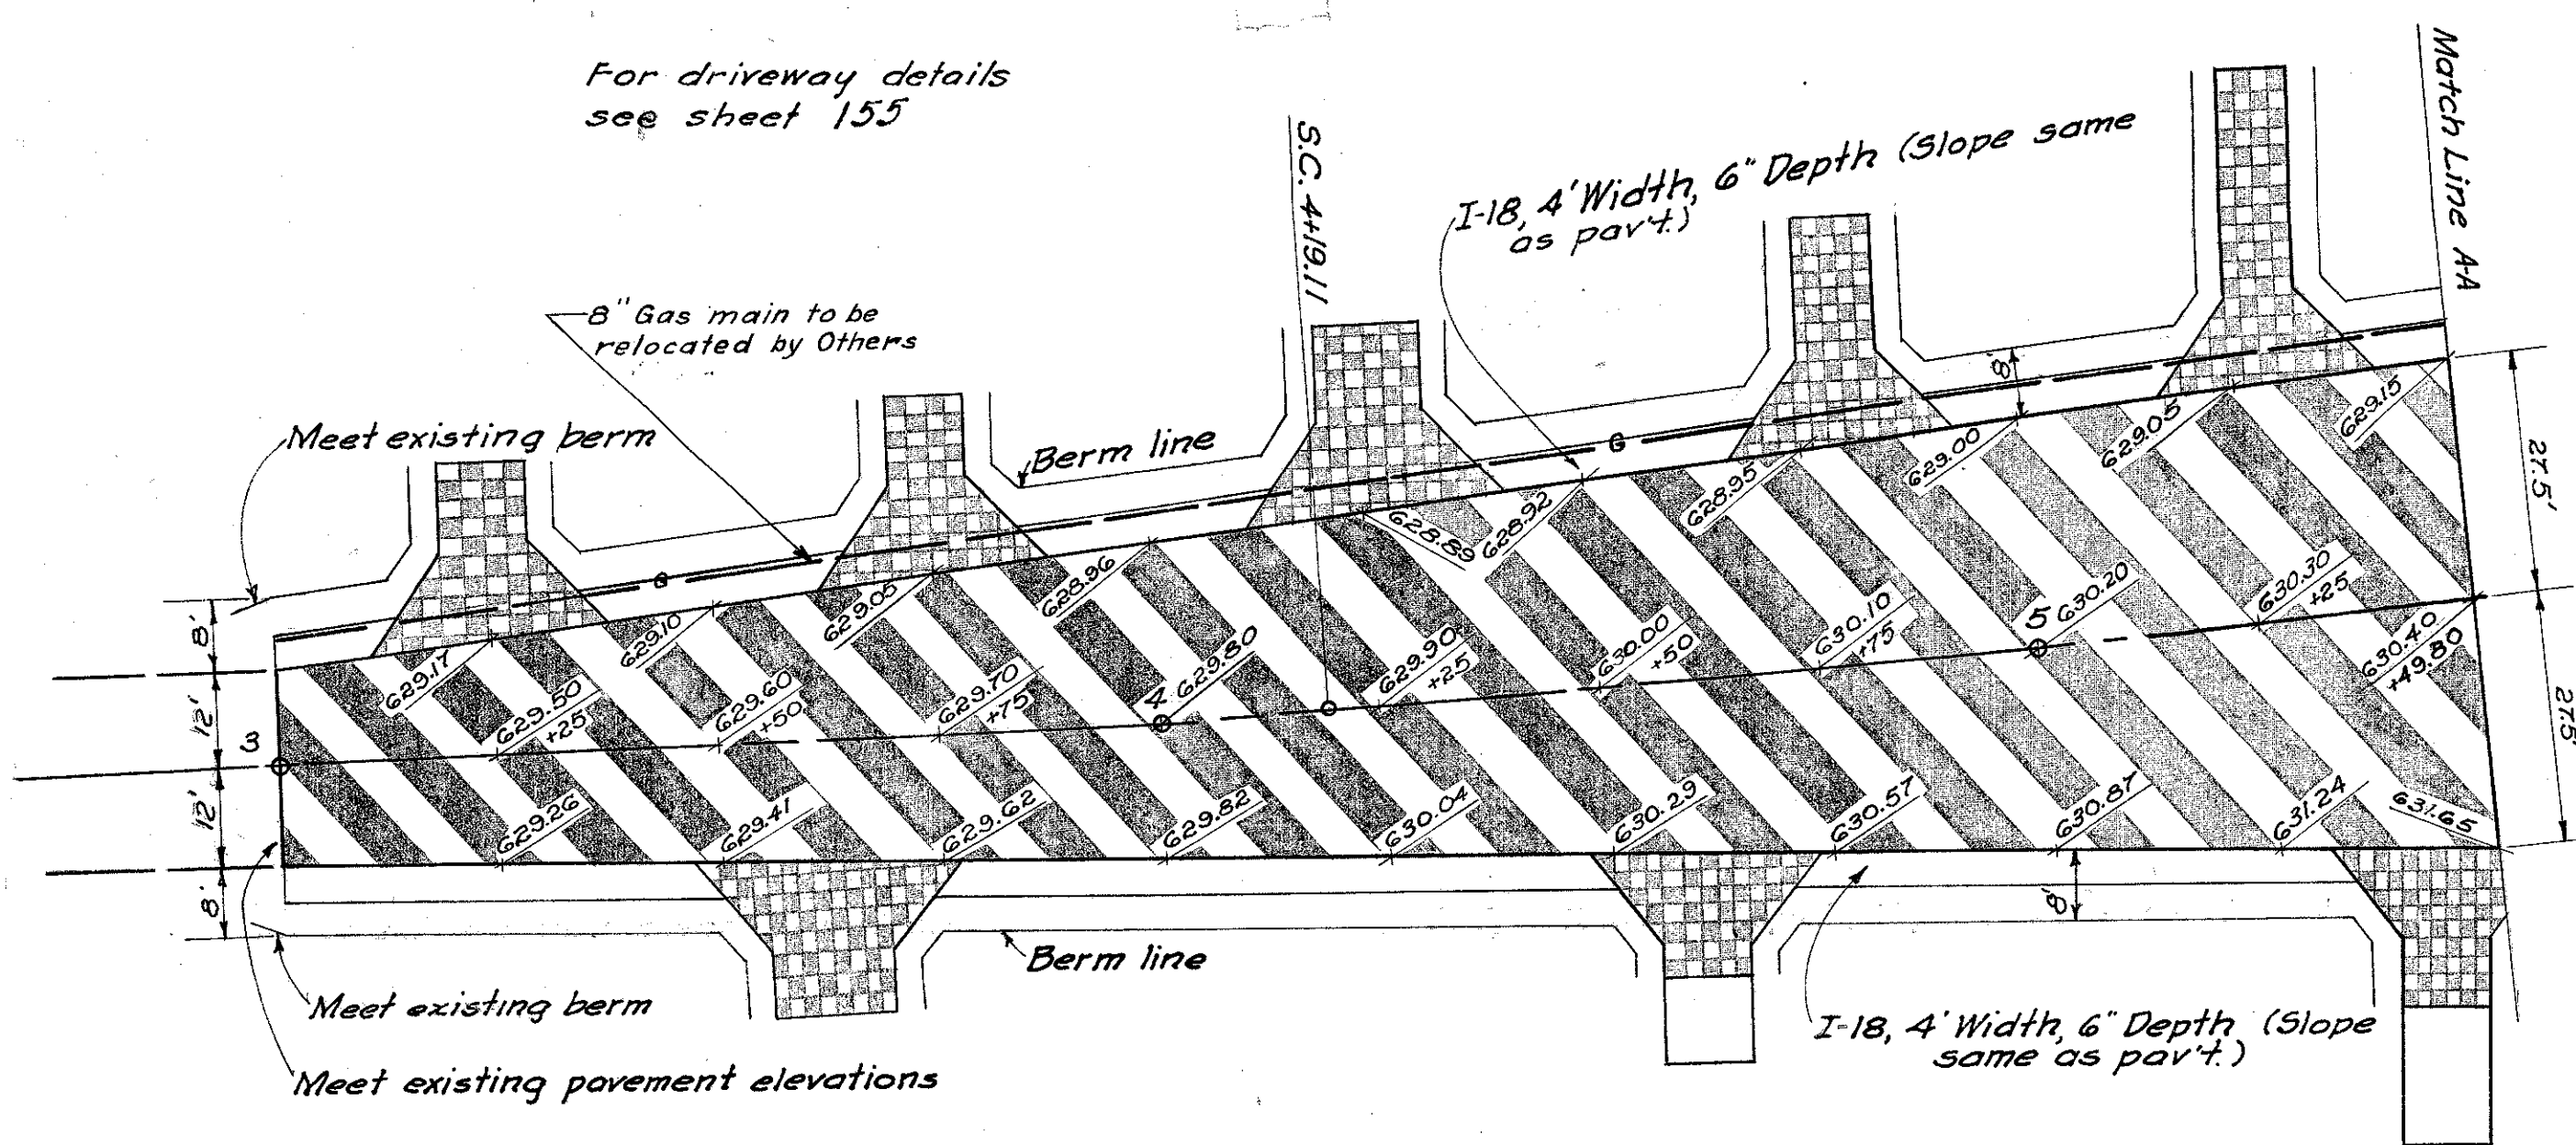

### CURVE DATA S.R. #73

- PI = 5+43.80
- Δ = 8°-57' Lt
- D = 2°-00'
- R = 2864.79'
- Ls = 200.00'
- Lc = 247.50'
- Ts = 324.25'
- Os = 2°-00'

### CURVE DATA RAMP BL

- PI = 1+1189.13L
- Δ = 67°-06'-19"
- D = 36°-00'
- R = 159.15'
- Ls = 150.00'
- Lc = 111.40'
- Ts = 177.53'
- Os = 111.89'
- Os = 27°-00'

### CURVE DATA RAMP B

- PI = 1+0659.3
- Δ = 26°-16'
- D = 28°-00'
- R = 204.63'
- T = 47.74'
- Lc = 93.81'

### CURVE DATA S.R. #73


- PI = 13+28.87
- Δ = 27°-00' Rt
- D = 6°-00'
- R = 954.93'
- Ls = 400.00'
- Lc = 50.00'
- Ts = 430.64'
- Os = 12°-00'

Note: Only Prop. water and gas mains  
shown on this sheet. See sheet 43  
for modifications to existing water  
services.


### CURVE DATA RAMP BR

- PI = 2+69.64 BR
- Δ = 117°-39'-03"
- D = 36°-00'
- R = 159.15'
- Ls = 150.00'
- Lc = 251.80'
- Ts = 340.56'
- Os = 269.64'
- Os = 27°-00'

### TIE BETWEEN SR#4 & SR#73

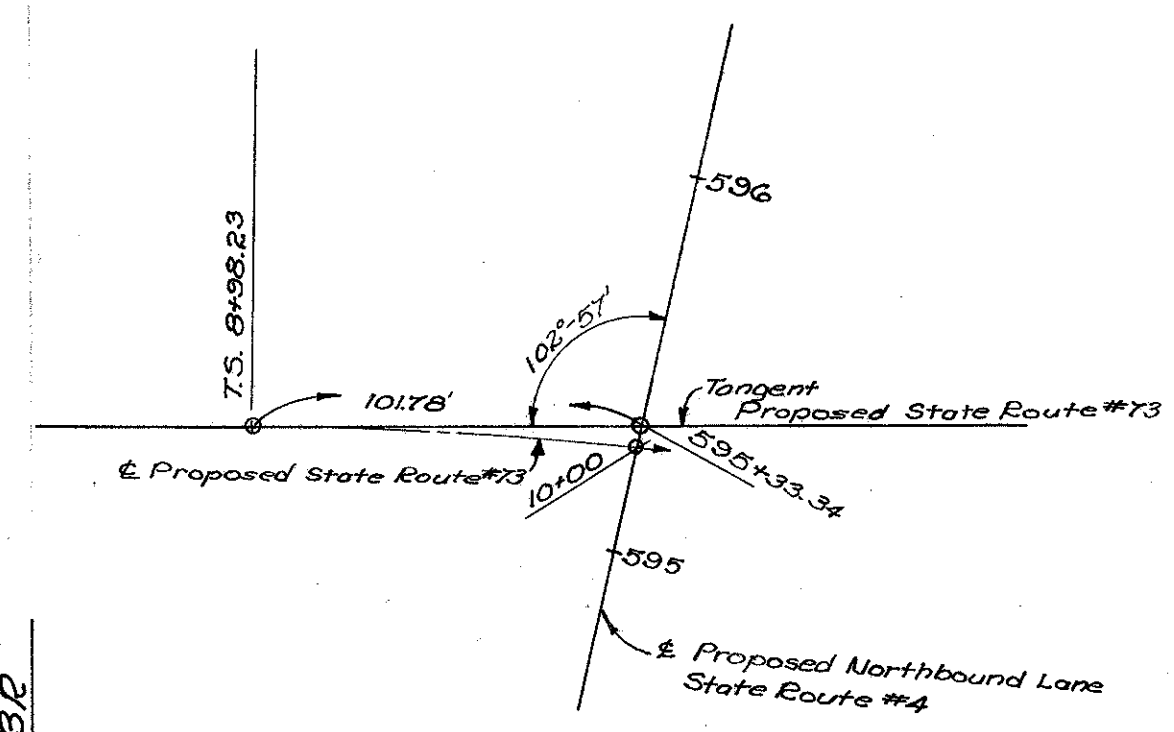


### PROPOSED S.R.#73

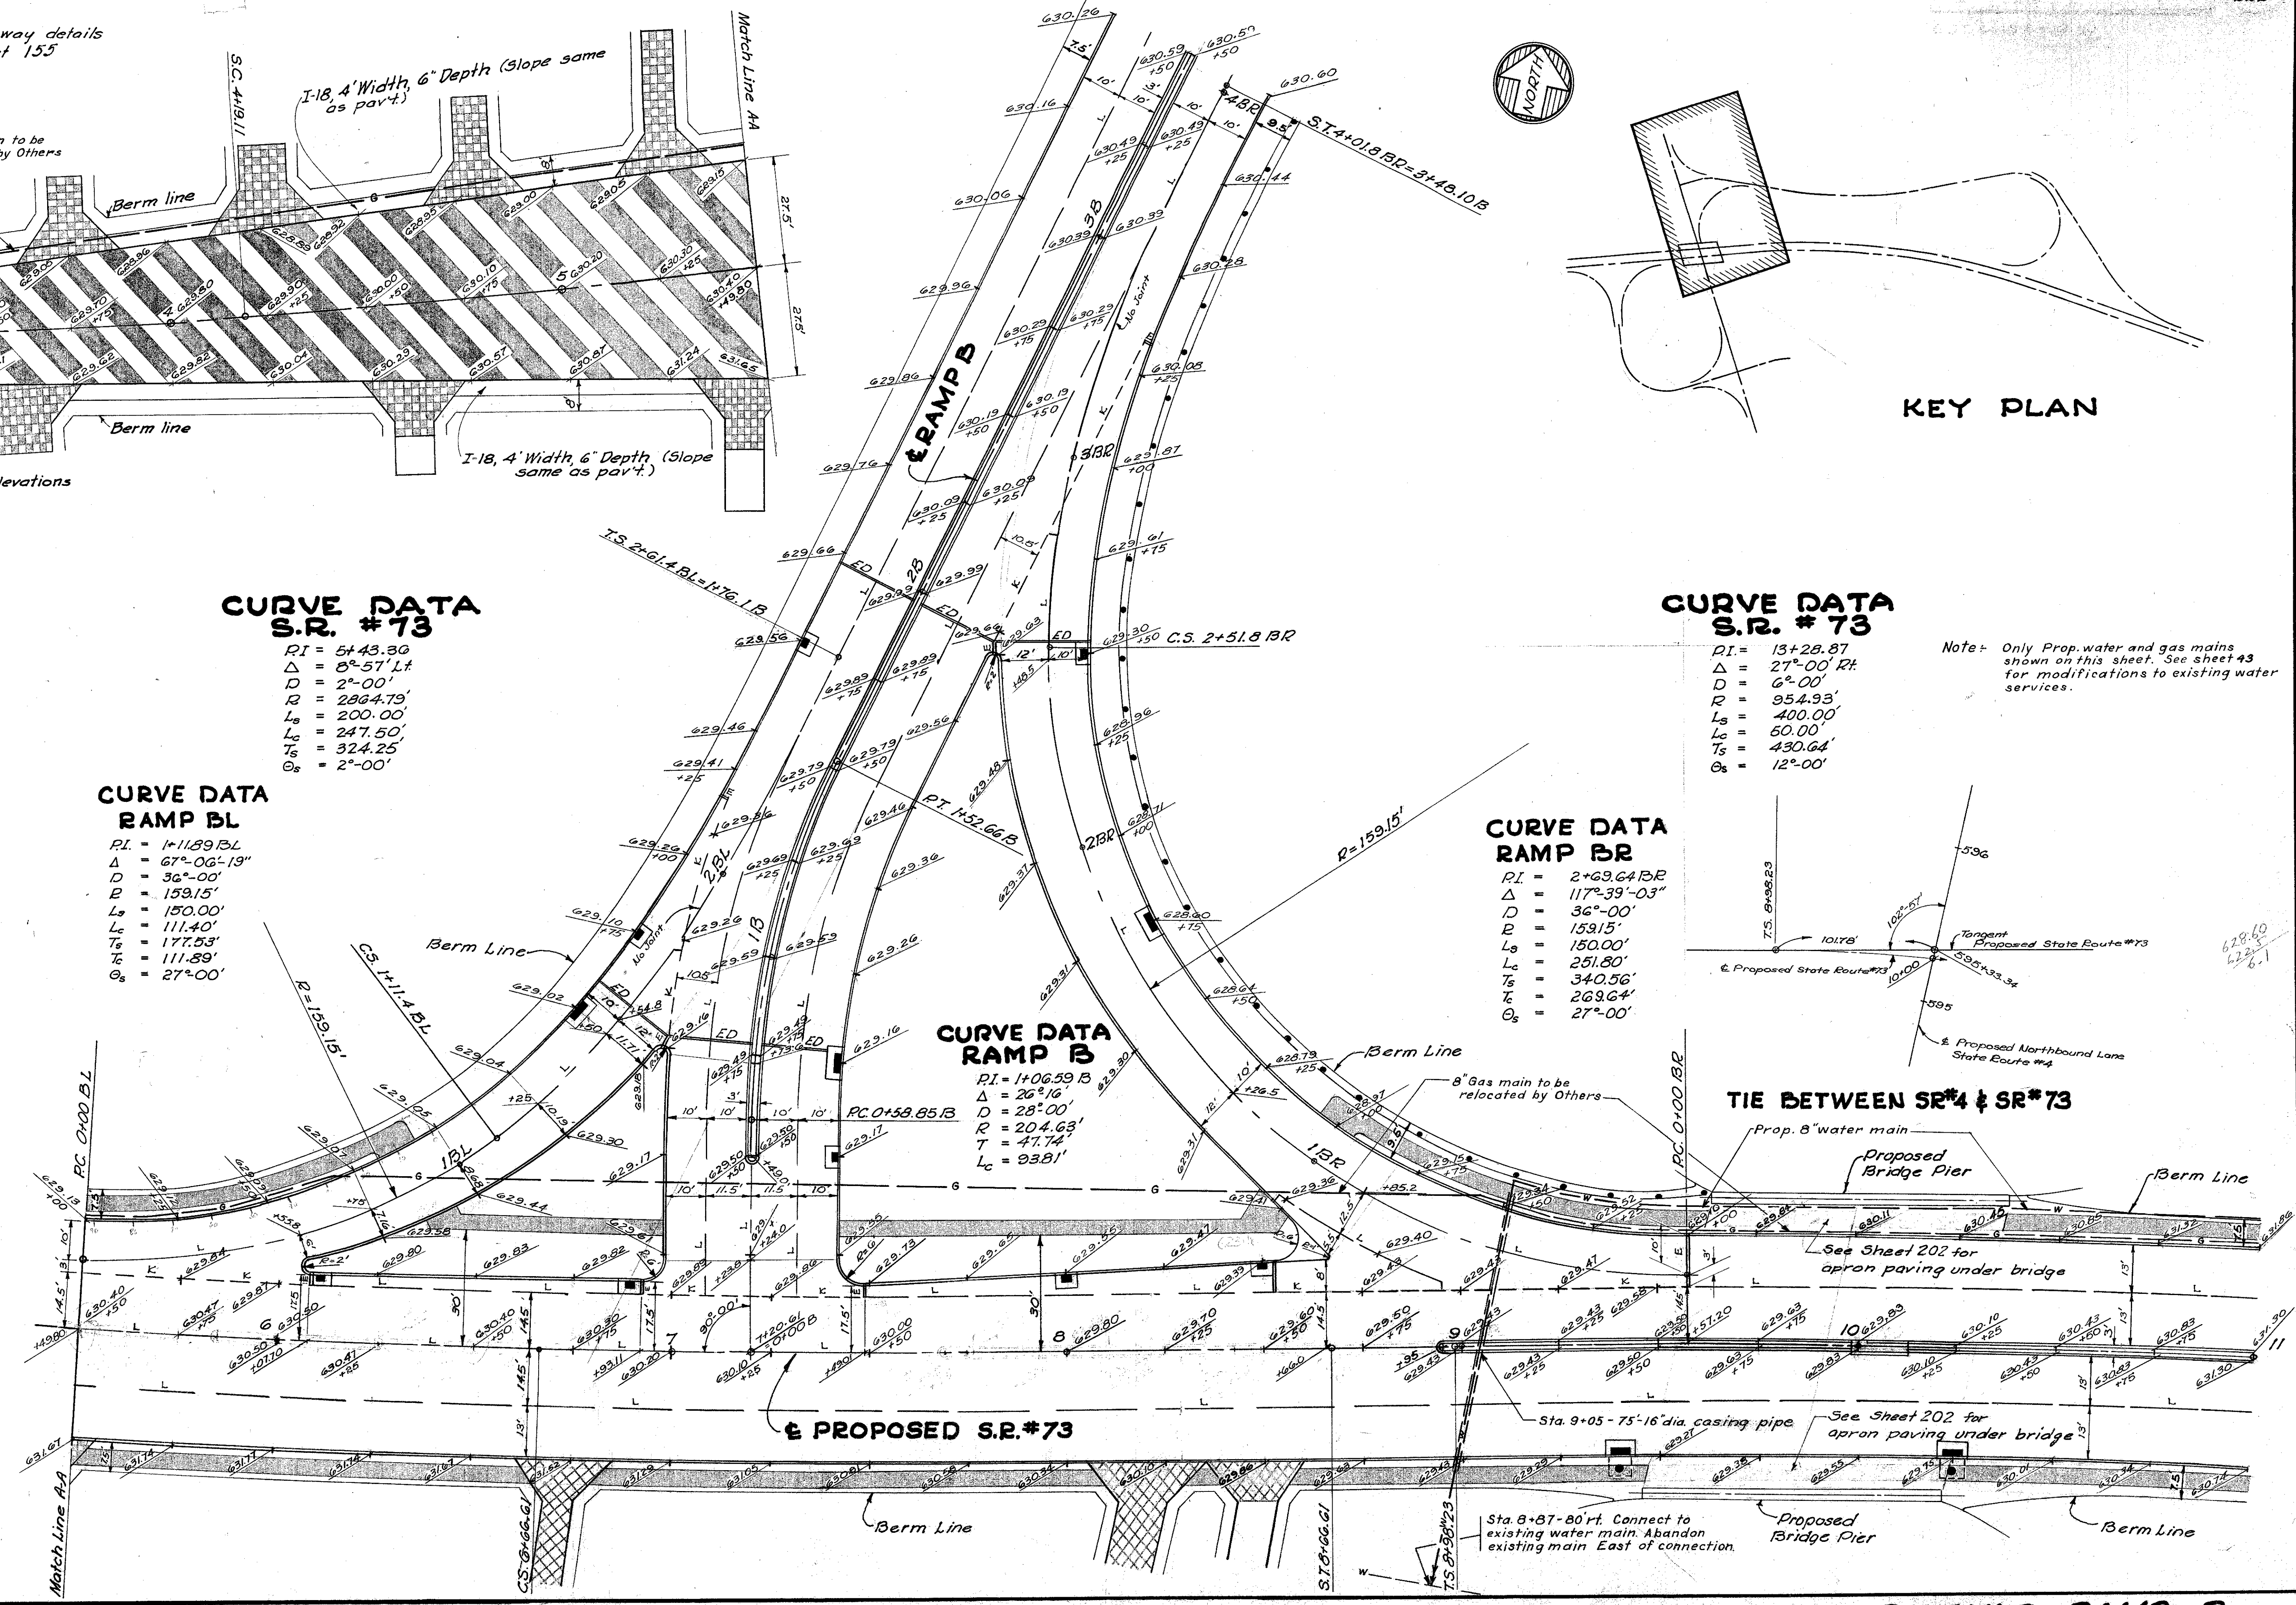


### INTERSECTION DETAILS- RAMP B

**CURVE DATA  
RAMP B**

P.I. = 6+82.73.13  
 Δ = 19°20'34"  
 D = 3°30'  
 R = 1,637.02'  
 Lc = 552.65'  
 T = 278.98'  
 Superelev. = 3/4"/ft.

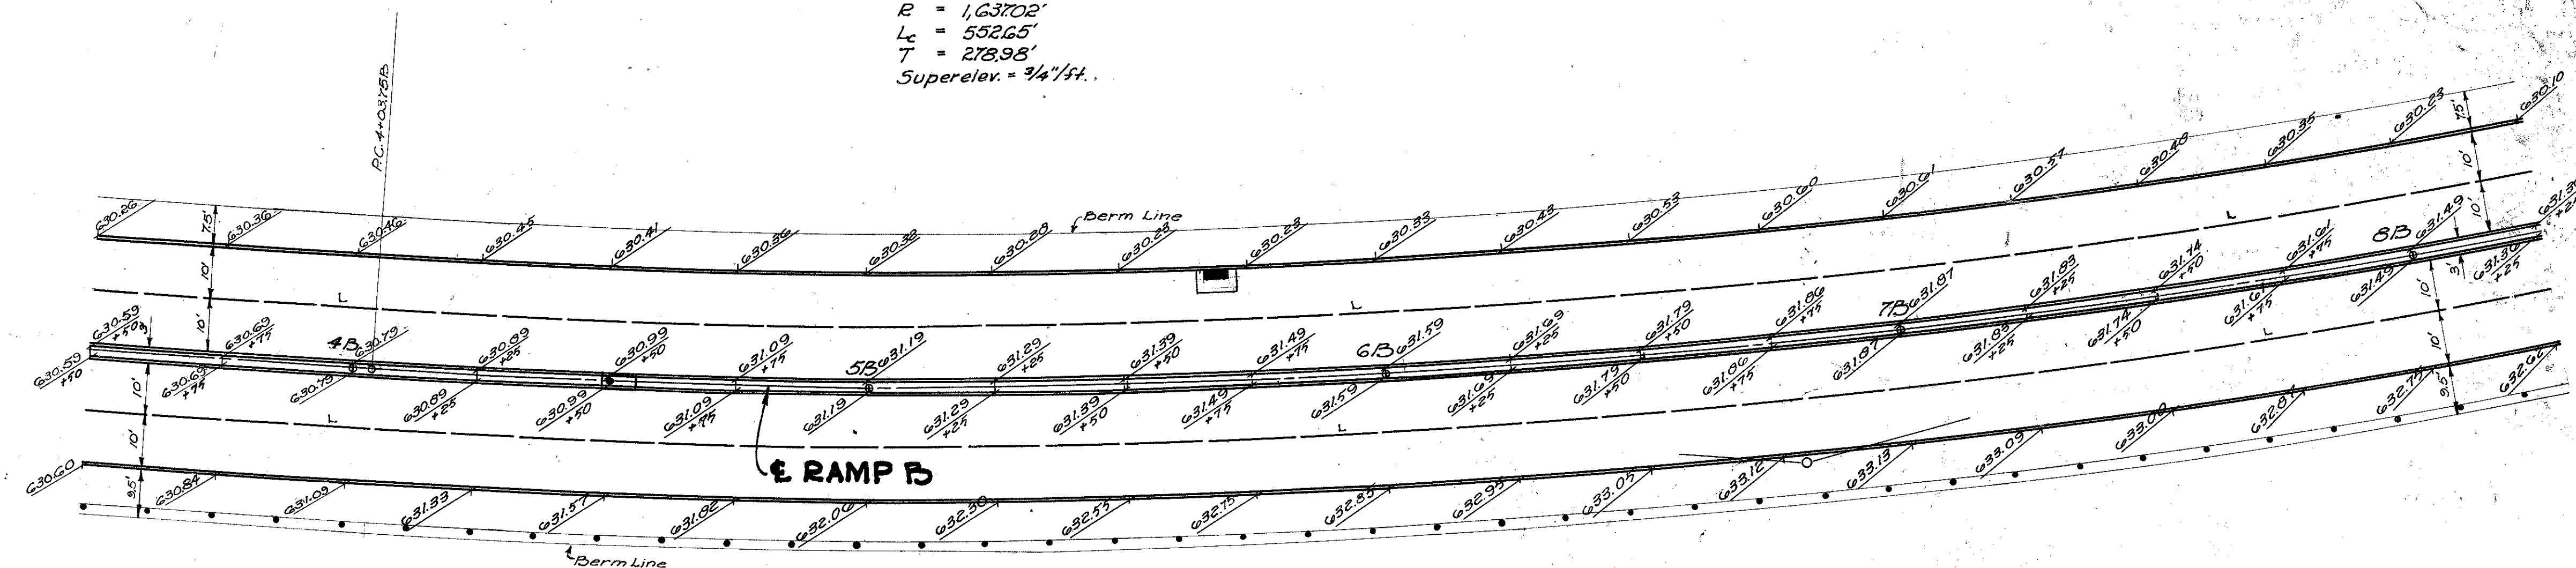


Note:  
Elevations shown are  
at back of curb.  
Dimensions shown are  
to face of curb.

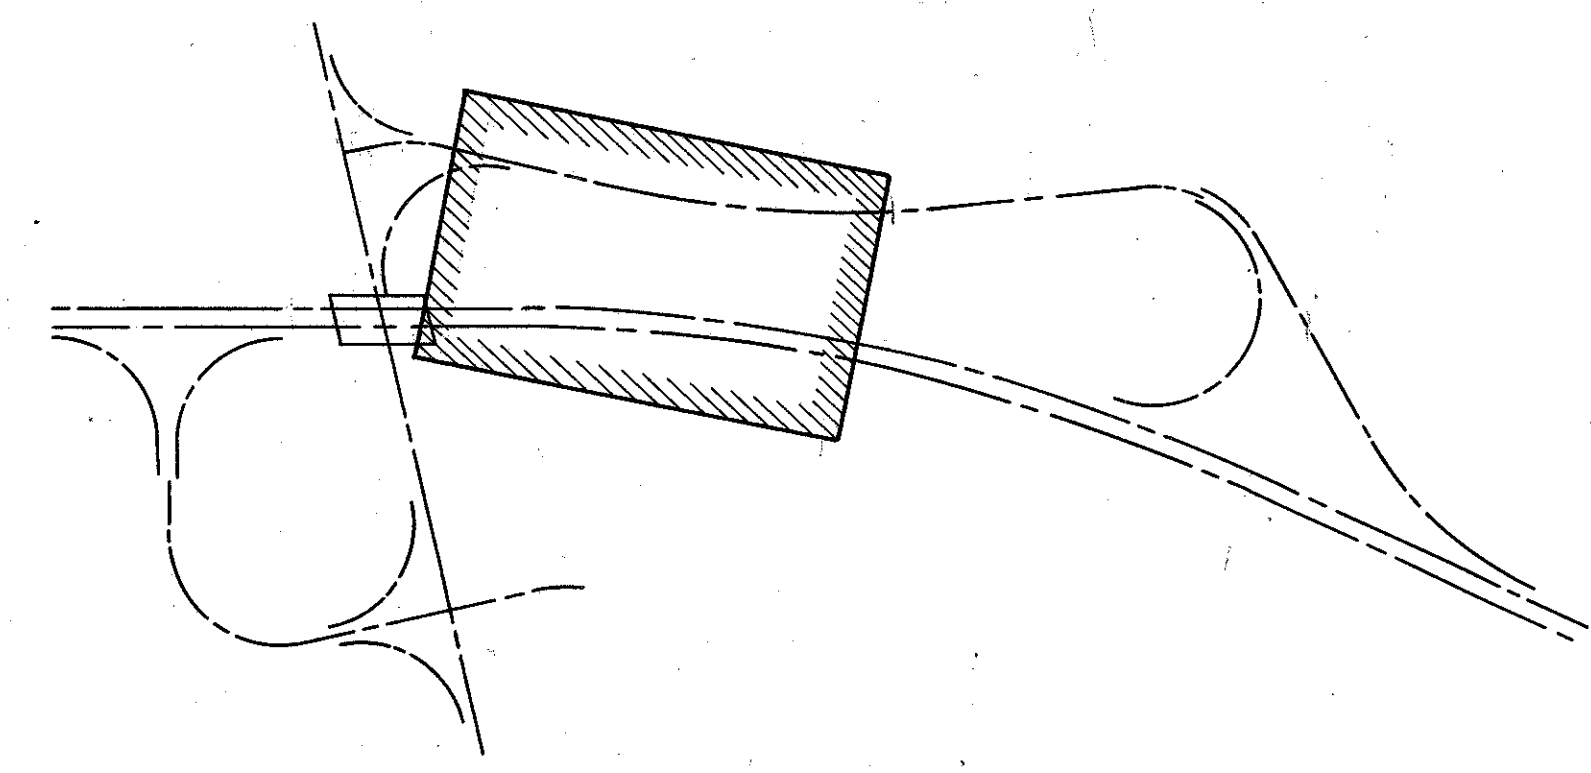

**KEY PLAN**

Transition curb from  
6" to 9" height in length  
of 8' of approach slab  
of bridge.

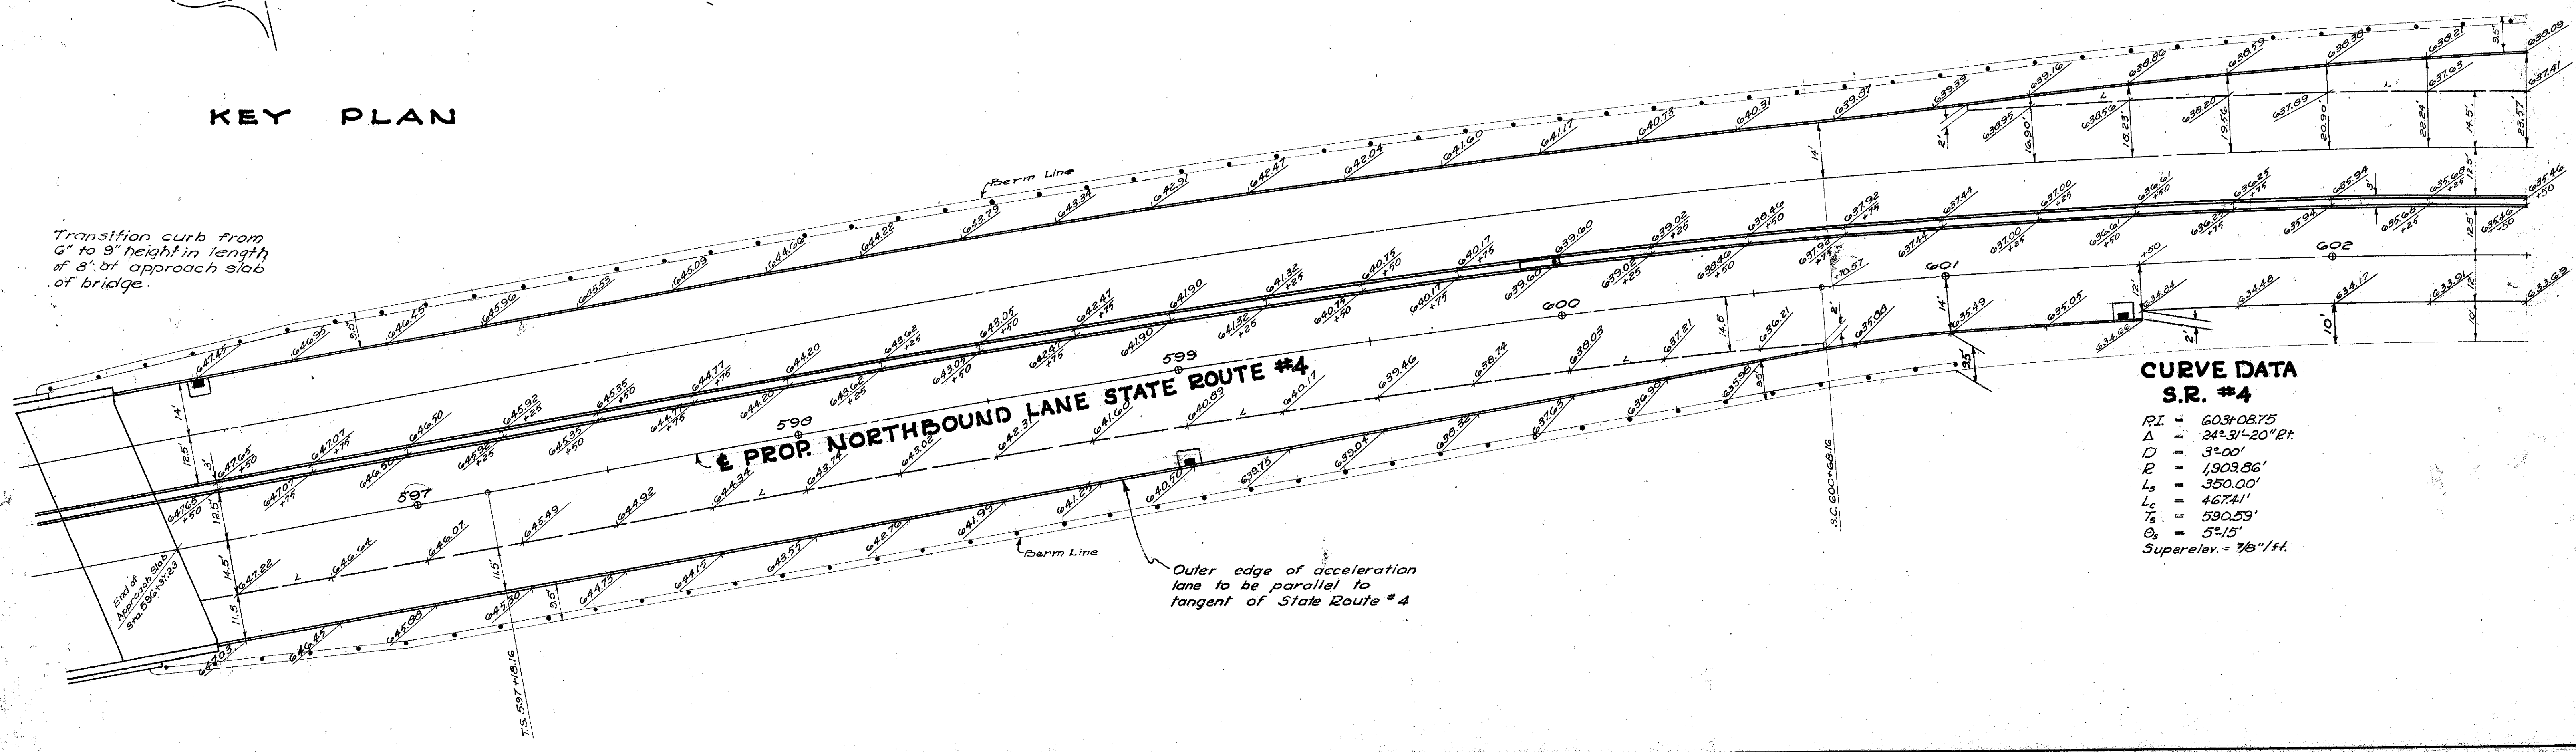


**CURVE DATA  
S.R. #4**

P.I. = 603+08.75  
 Δ = 24°31'20" 21"  
 D = 3°00'  
 R = 1,903.86'  
 Lc = 350.00'  
 Ls = 467.41'  
 Ts = 530.53'  
 Os = 5°15'  
 Superelev. = 7/8"/ft.

**CURVE DATA  
RAMP B**

PI. = 6+82.73B  
Δ = 19°20'34"  
D = 3°30'  
R = 1,637.02'  
Ls = 552.65'  
T = 278.98'  
Superelev. = 3/4"/ft.

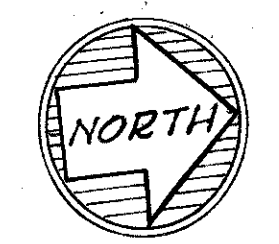

**CURVE DATA  
RAMP BL**

PI. = 14+20.15BL  
Δ = 23°52'14"  
D = 3°45'39"  
R = 180.00'  
Ls = 150.00'  
Os = 23°52'14"  
Superelev. = 1/4"/ft.



**CURVE DATA  
RAMP B**

PI. = 13+132.67B  
Δ = 41°36'38"  
D = 34°00'  
R = 168.52'  
Ls = 150.00'  
Lc = 47.33'  
Ts = 132.33'  
Os = 25°30'  
Superelev. = 1/4"/ft.

**CURVE DATA  
RAMP BR**


Δ = 165°53'22"  
D = 36°29'22"  
R = 157.02'  
Lc = 454.62'  
Superelev. = 1/4"/ft.

Note:  
Elevations shown are  
at back of curb.  
Dimensions shown are  
to face of curb.

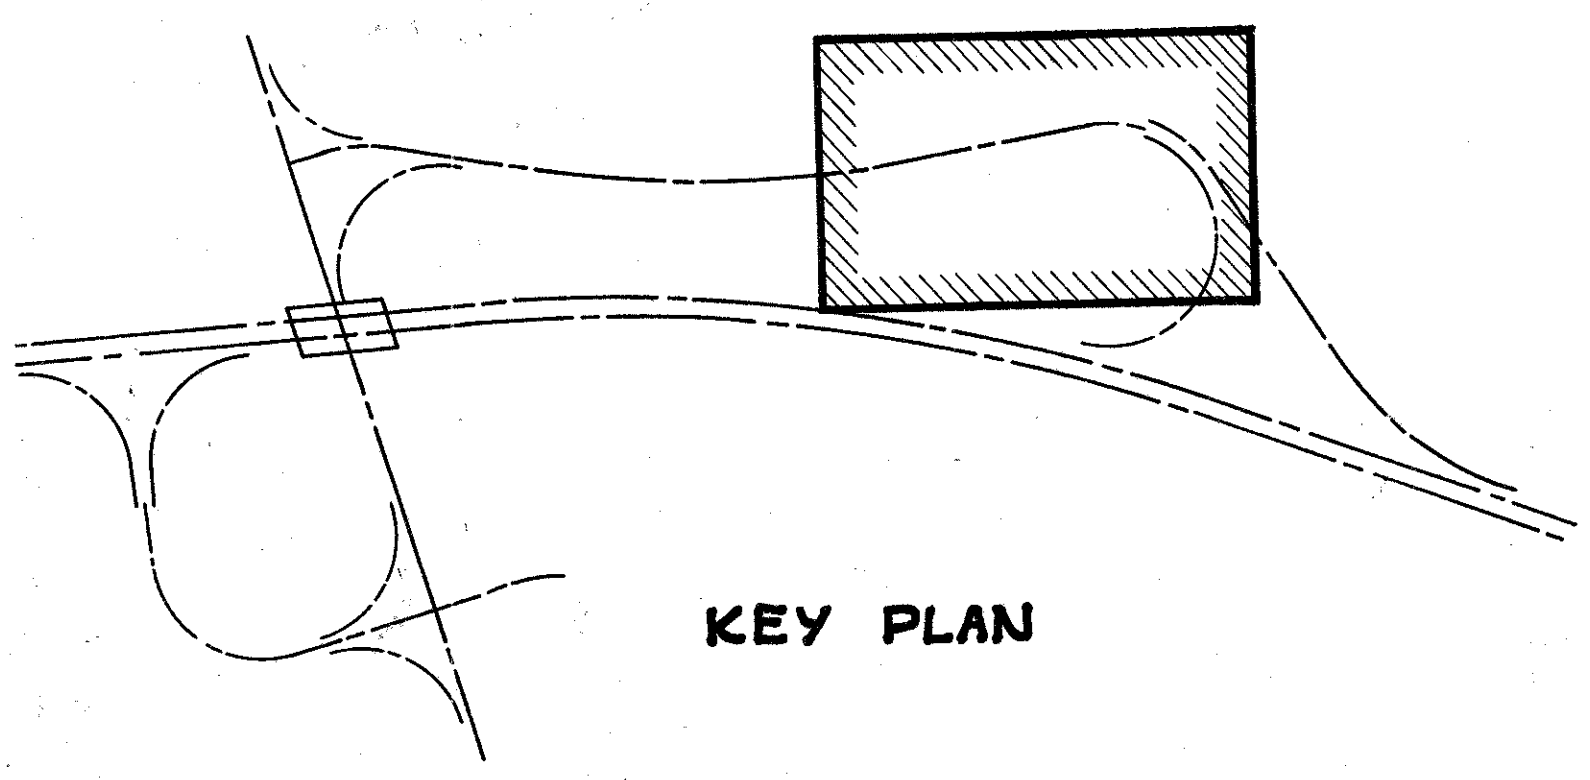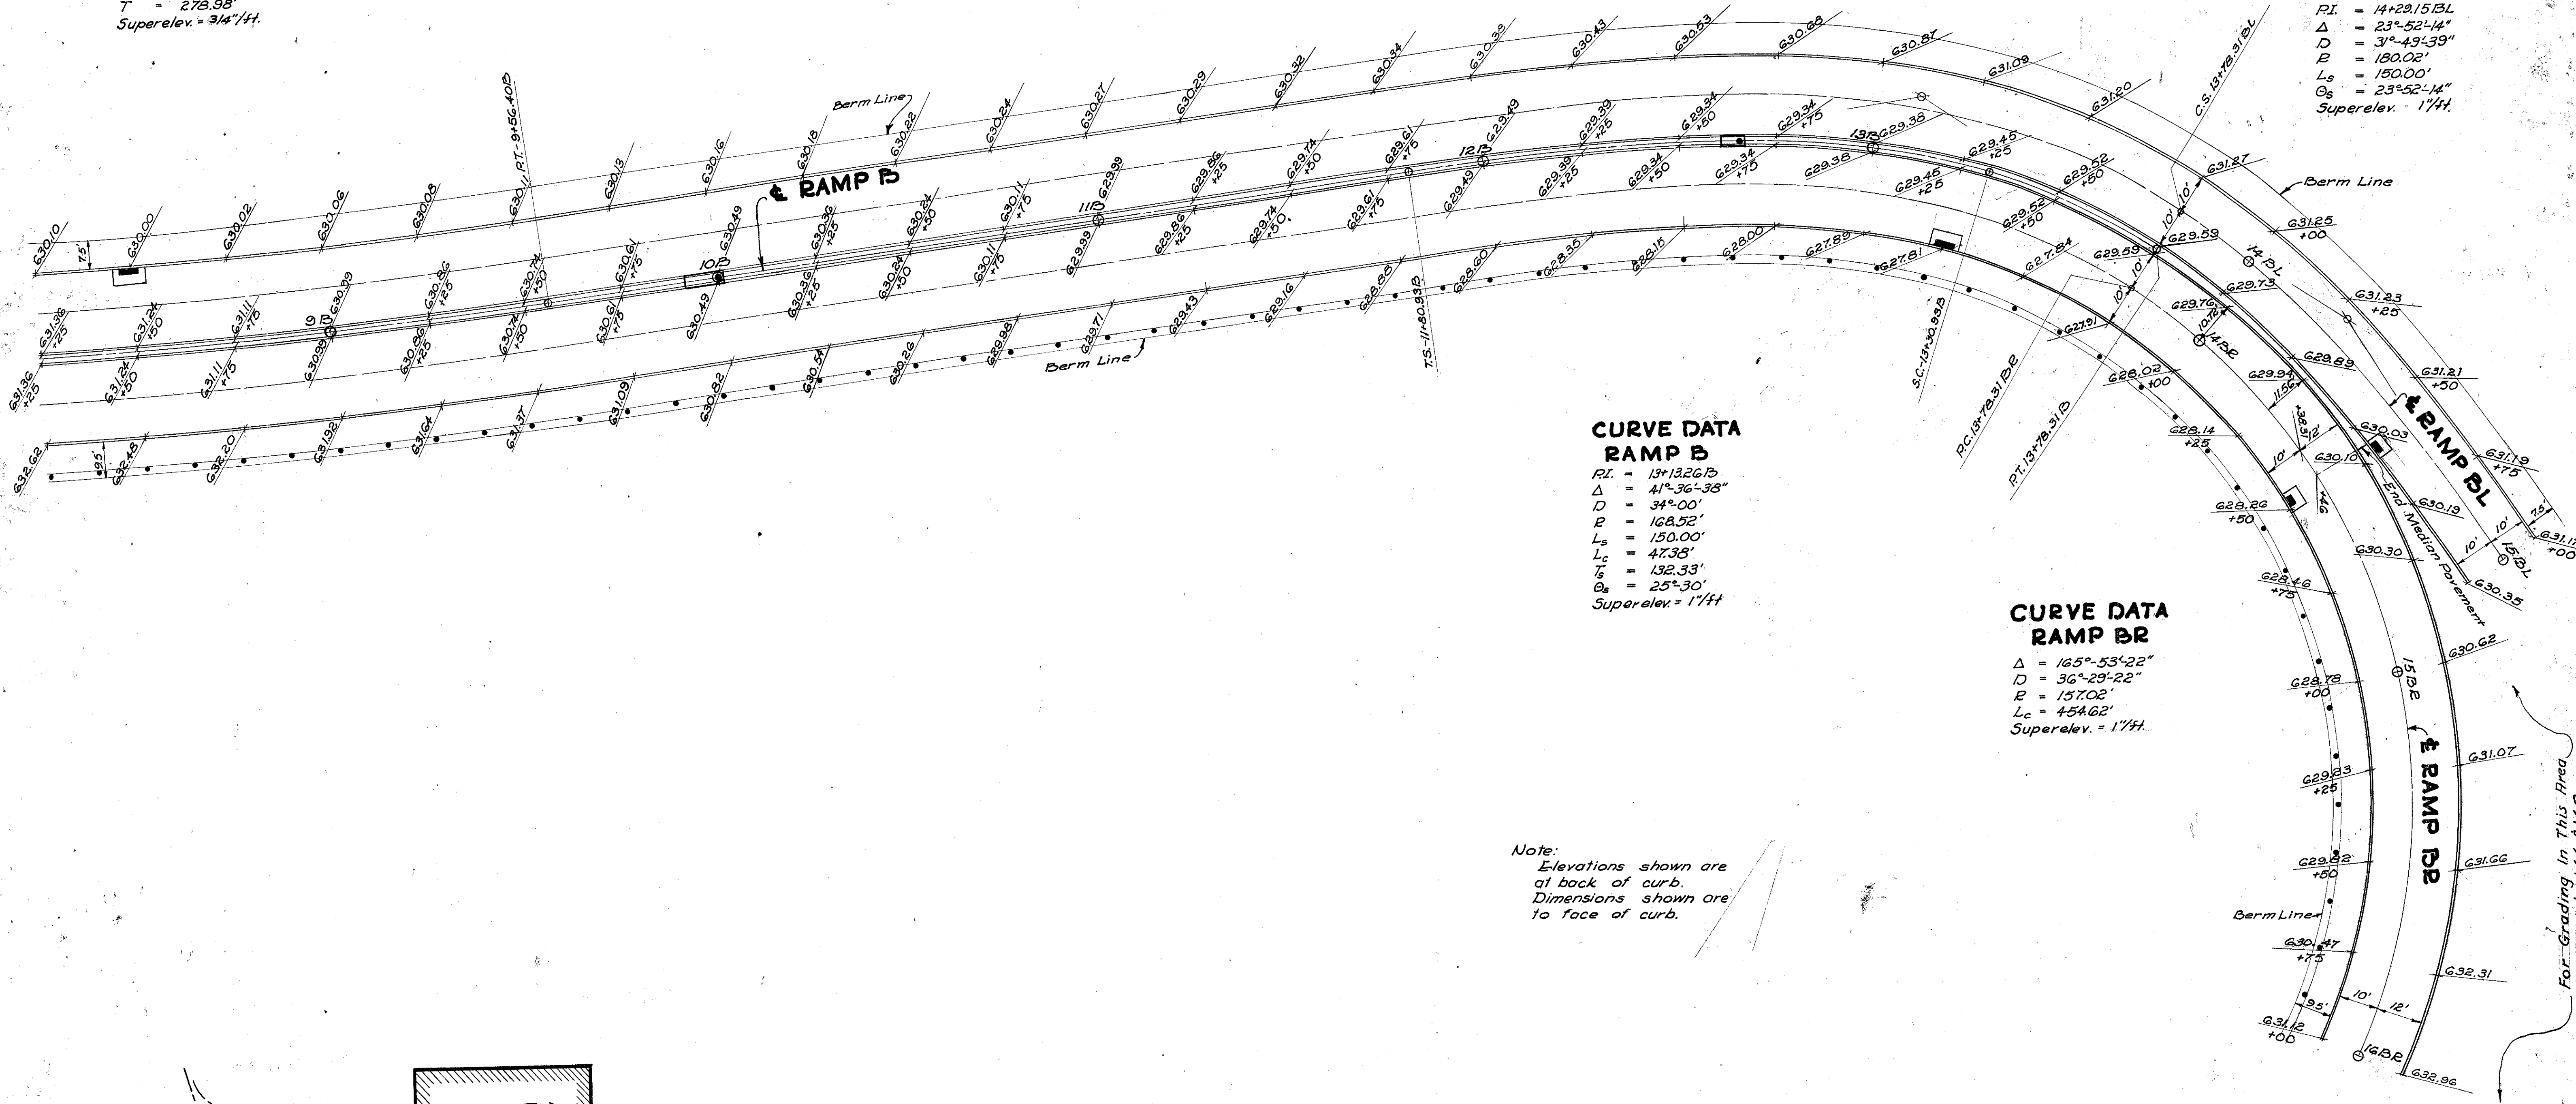


**KEY PLAN**

For Grading in This Area  
See Sheets 166 & 168

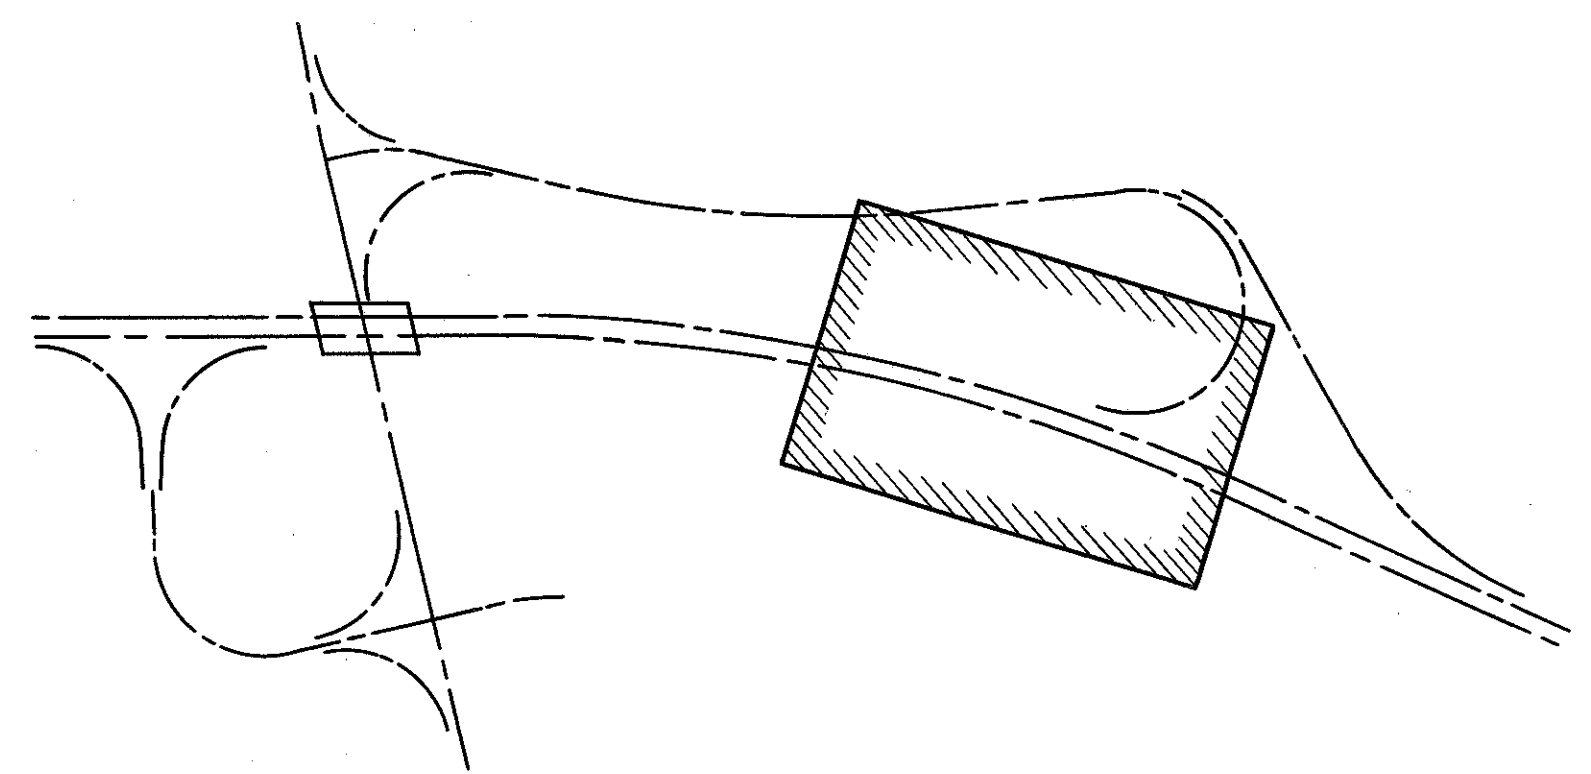


KEY PLAN

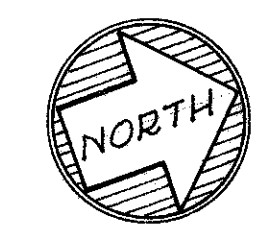

NOTE: Elevations shown are at back of curb  
Dimensions shown are to face of curb.

**CURVE DATA  
RAMP BR**

$\Delta = 165^\circ-53'-22''$   
 $D = 36^\circ-29'-22''$   
 $R = 157.02'$   
 $L_c = 454.62'$   
 $Superelev. = 1/4\%$

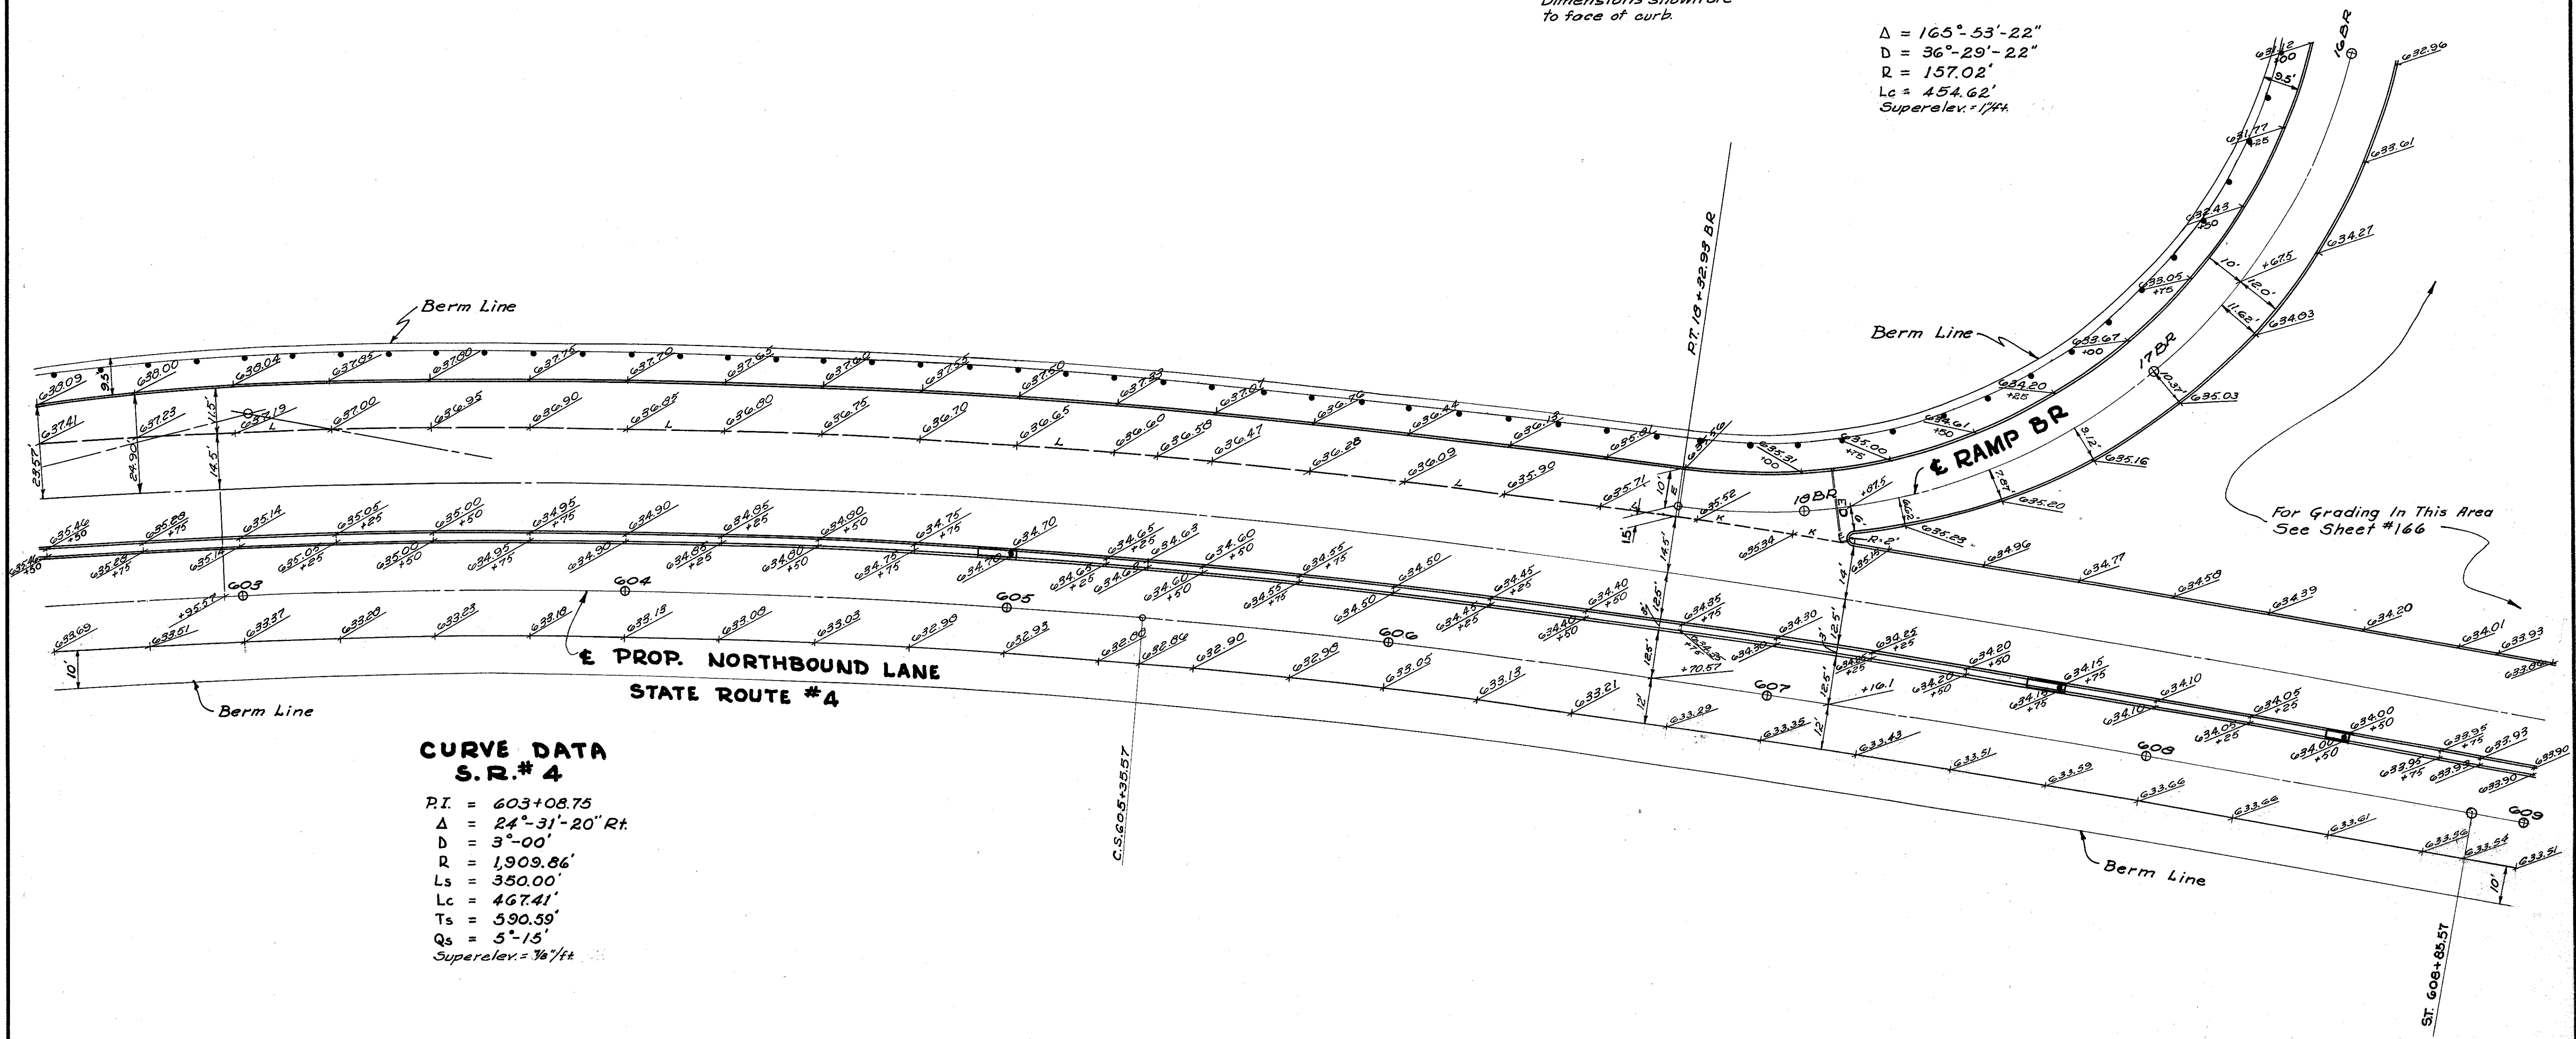



**CURVE DATA  
S.R.# 4**

$P.I. = 603+08.75$   
 $\Delta = 24^\circ-31'-20'' \text{ Rt.}$   
 $D = 3^\circ-00'$   
 $R = 1,909.86'$   
 $L_s = 350.00'$   
 $L_c = 467.41'$   
 $T_s = 590.59'$   
 $Q_s = 5^\circ-15'$   
 $Superelev. = 1/4\%$

For Grading In This Area  
See Sheet #166



**KEY PLAN**

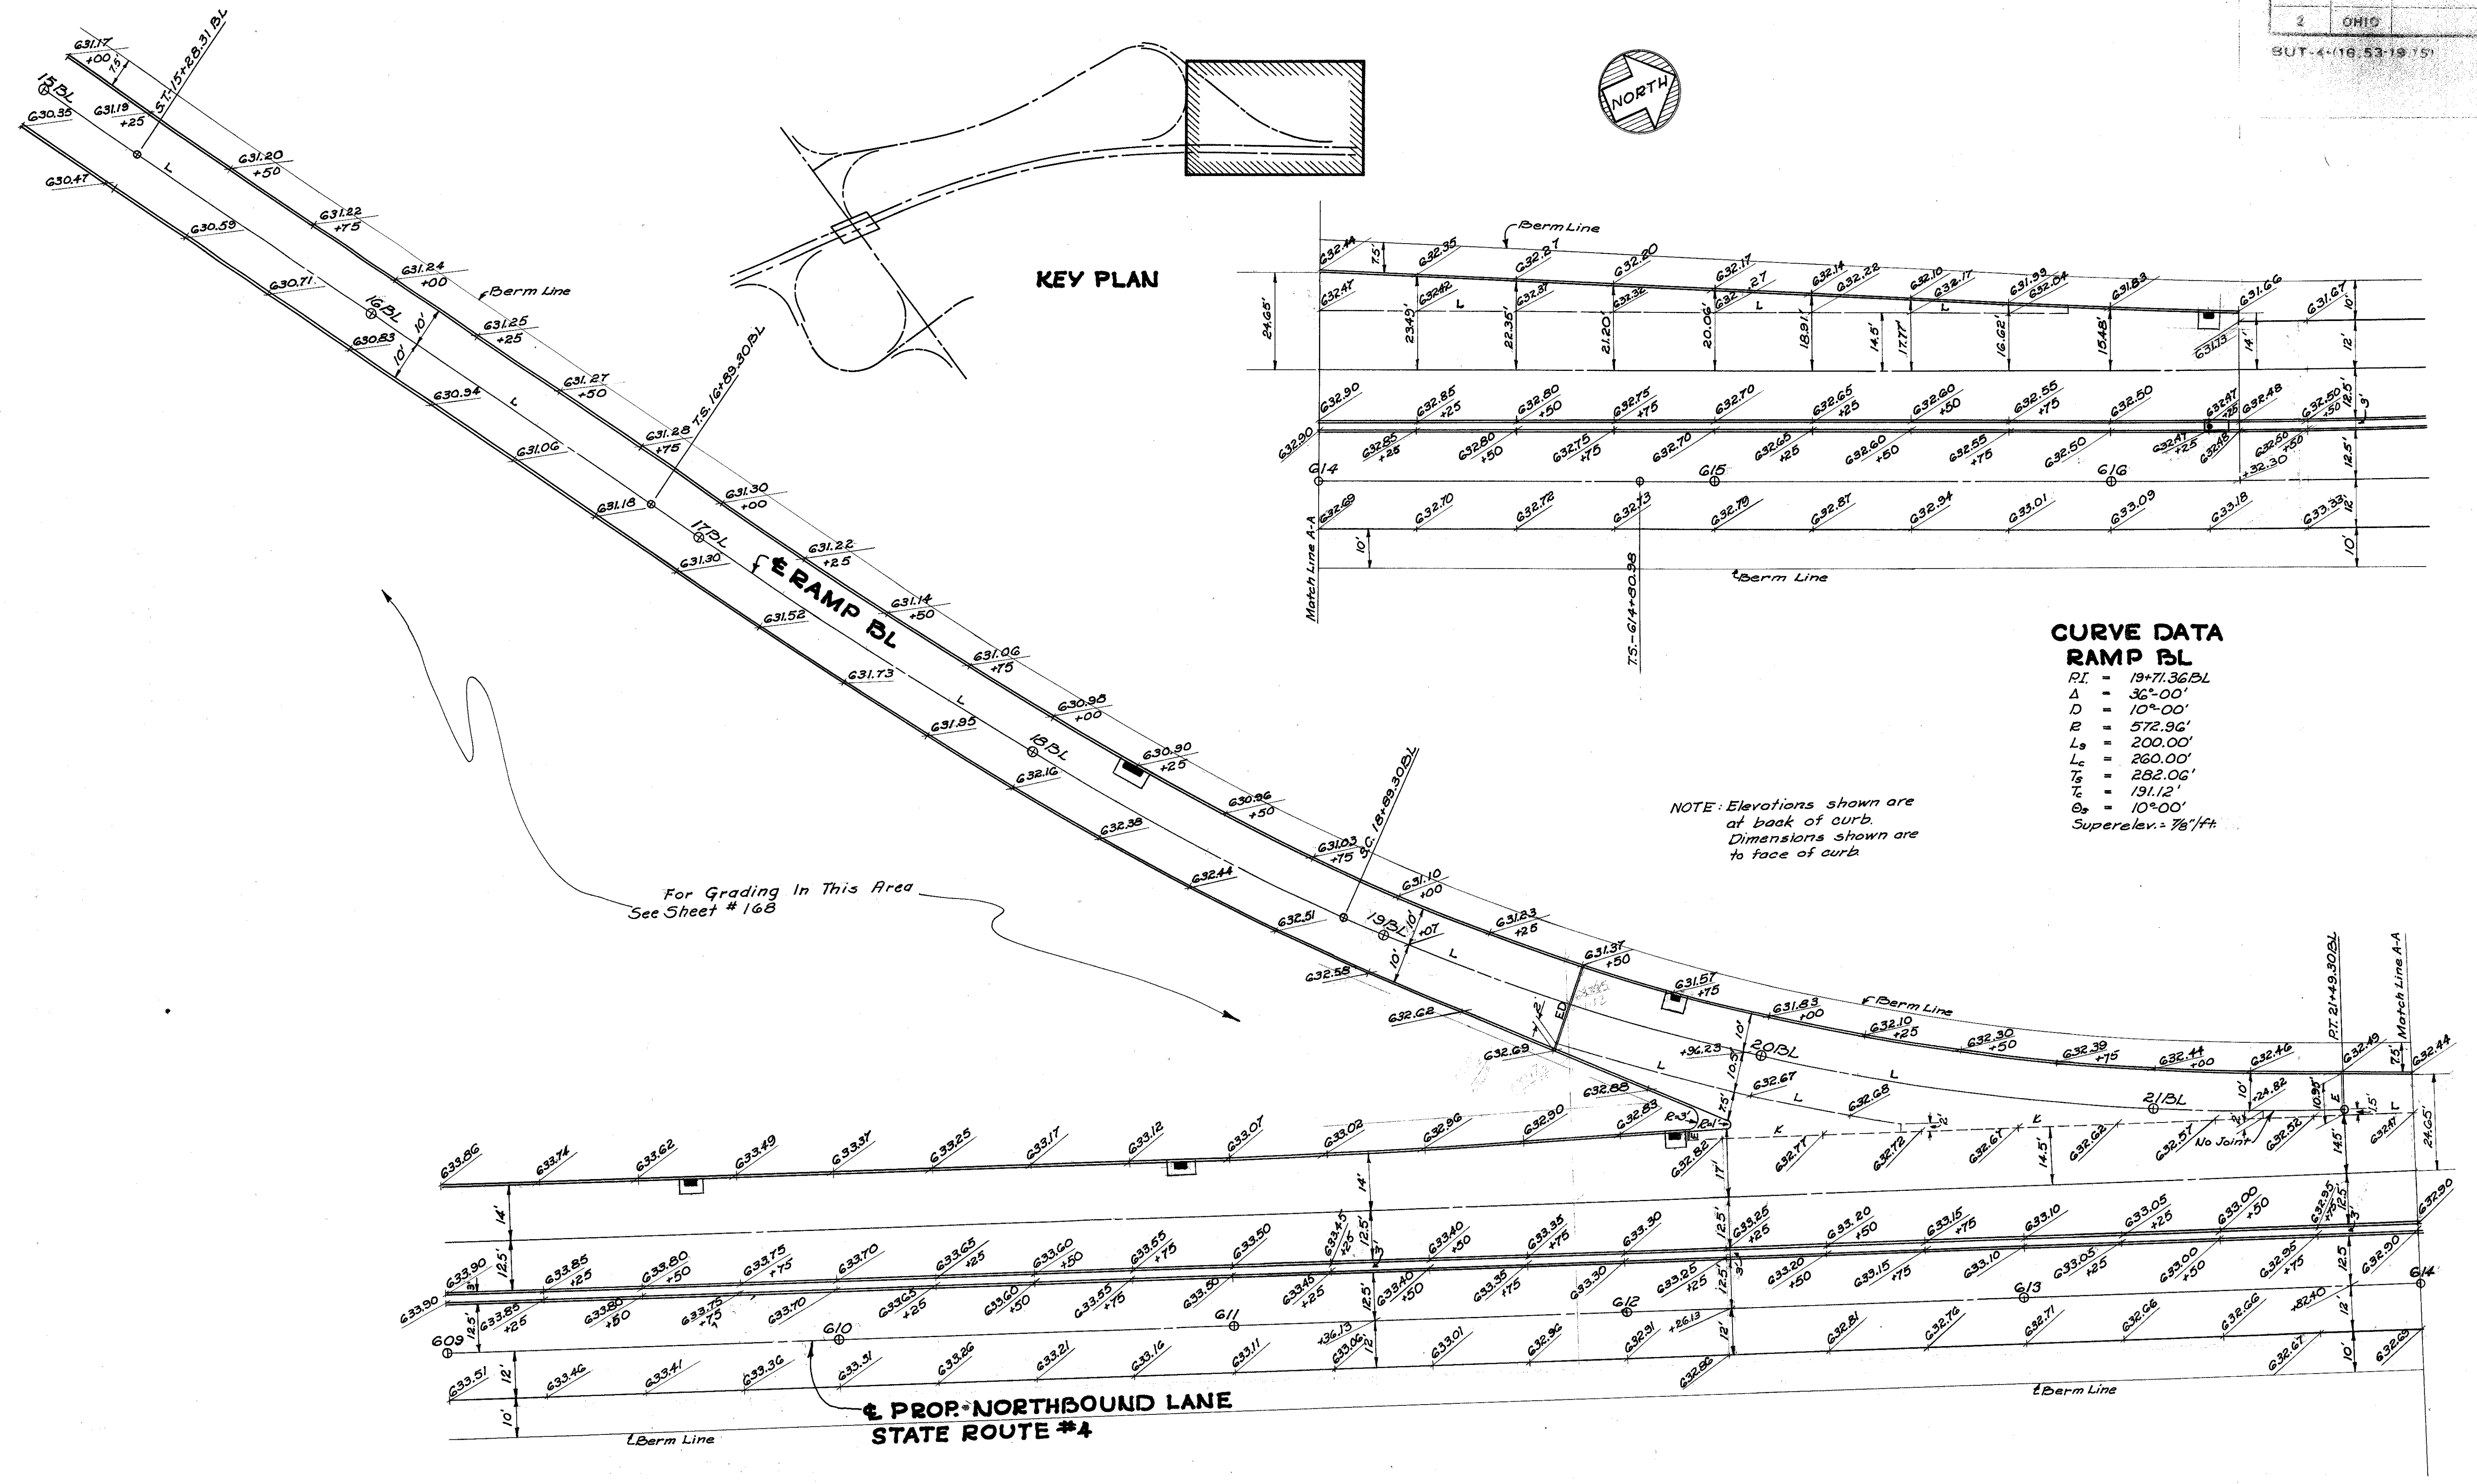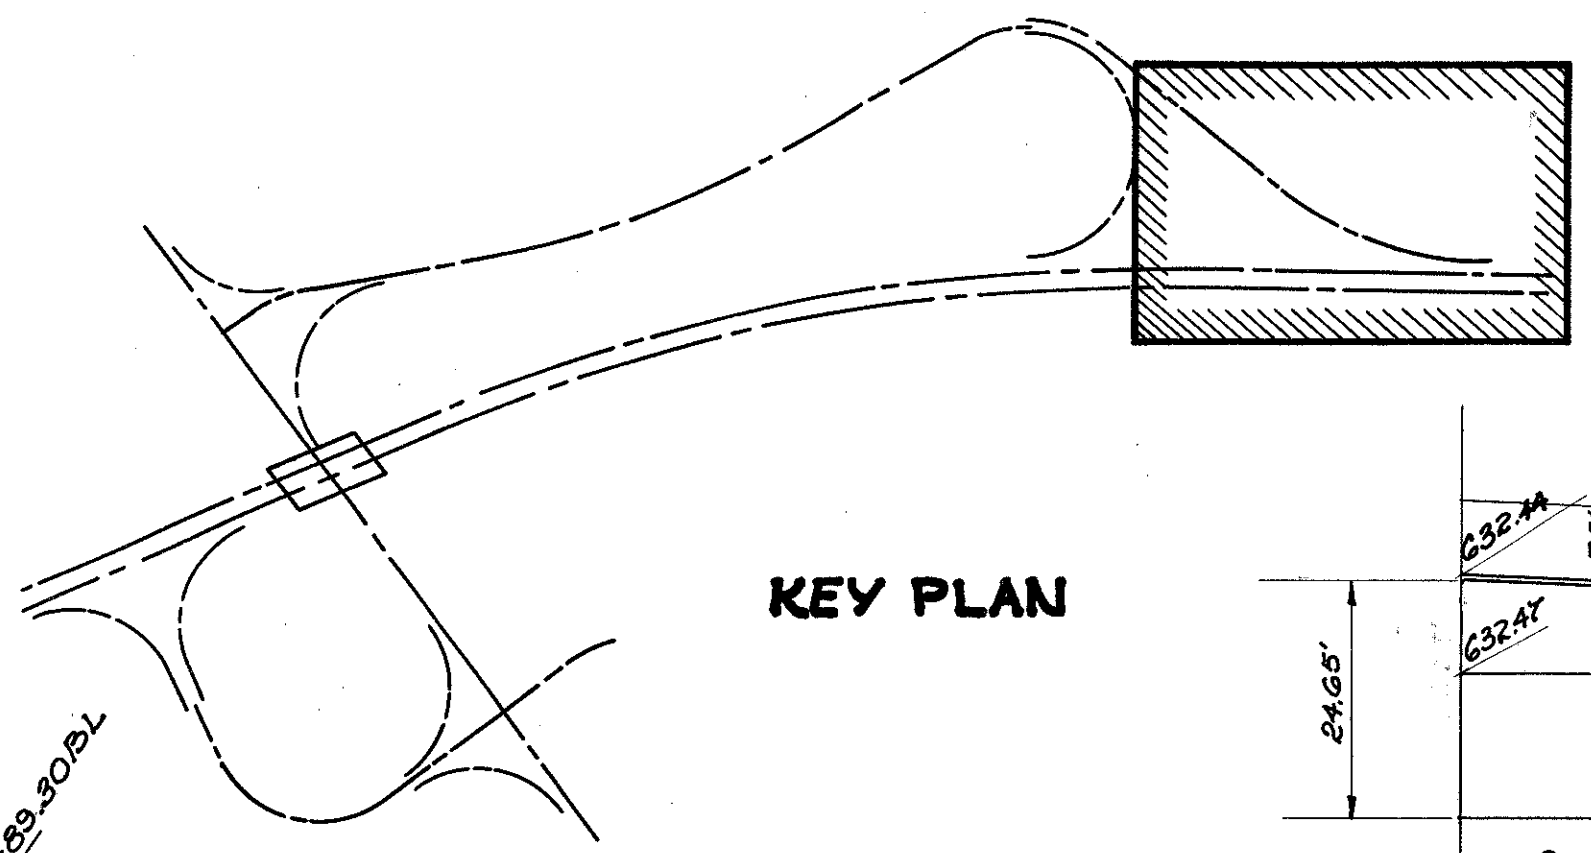

**CURVE DATA  
RAMP BL**

- RI = 19+71.36 BL
- Δ = 36°-00'
- D = 10°-00'
- B = 572.96'
- L<sub>s</sub> = 200.00'
- L<sub>c</sub> = 260.00'
- T<sub>s</sub> = 282.06'
- T<sub>c</sub> = 191.12'
- Δ<sub>s</sub> = 10°-00'
- Superelev. = 7/8" ft.


NOTE: Elevations shown are at back of curb.  
Dimensions shown are to face of curb

For Grading In This Area See Sheet # 168



**PROP. NORTHBOUND LANE  
STATE ROUTE #4**







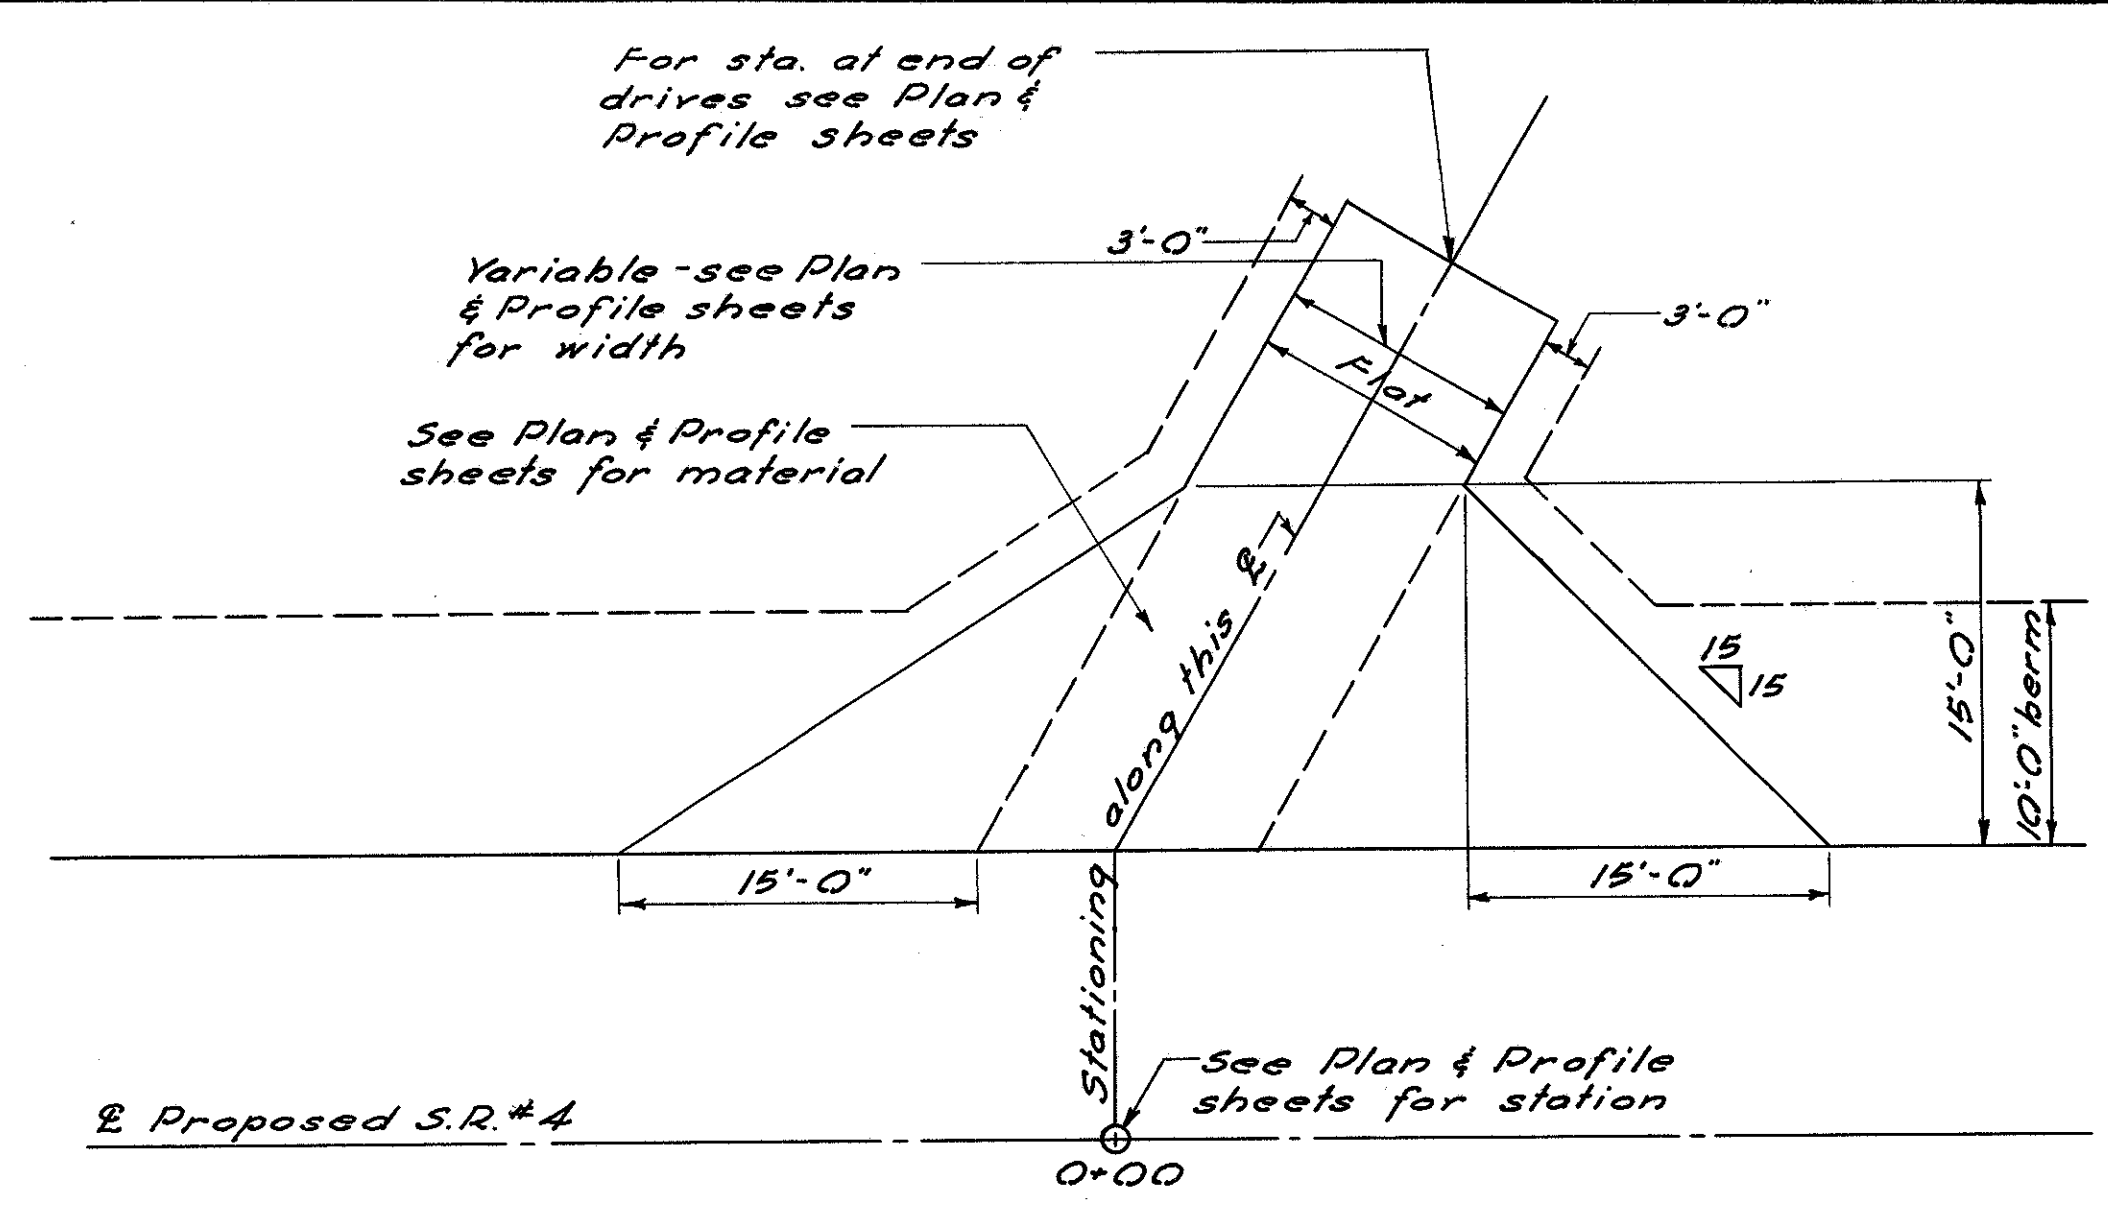

**TYPICAL FIELD DRIVE**  
Scale: 1/8" = 1'-0"

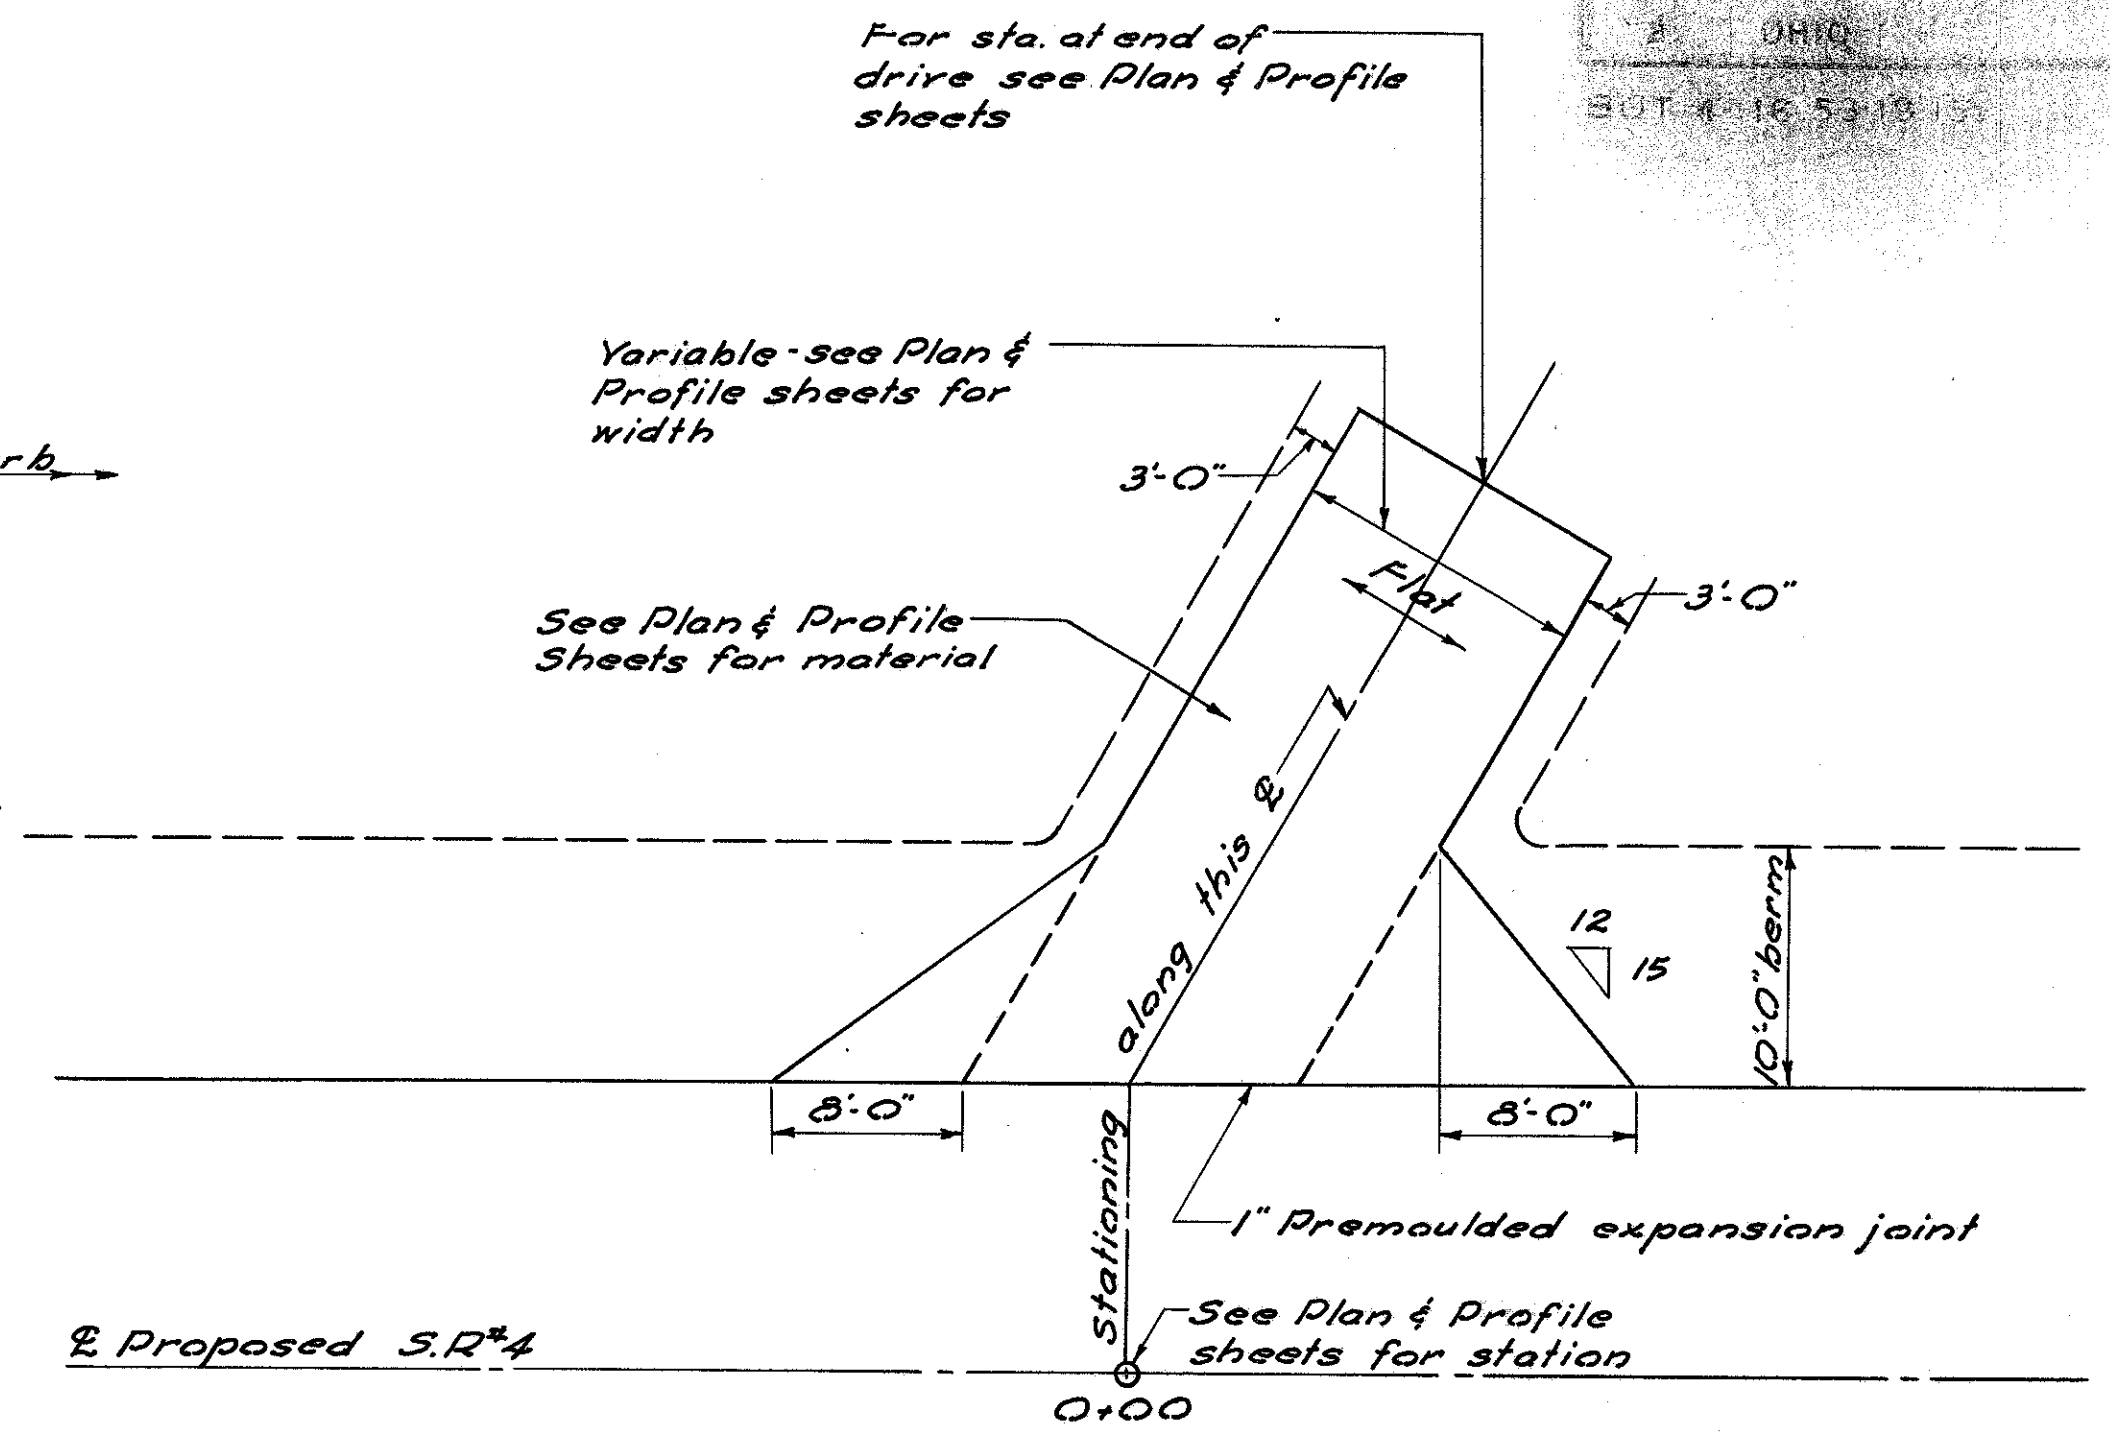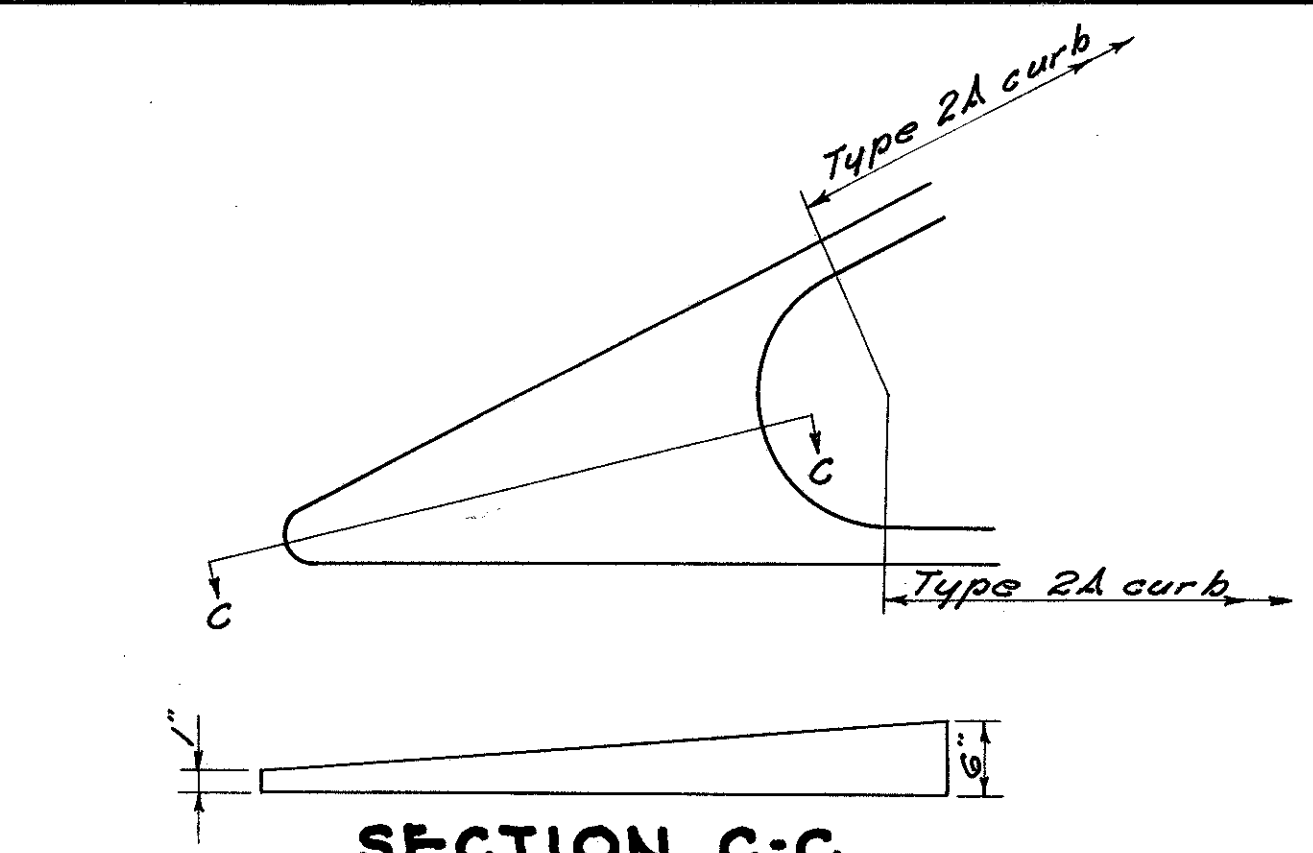

**TYPICAL RESIDENTIAL OR BUSINESS DRIVE**  
Scale: 1/8" = 1'-0"

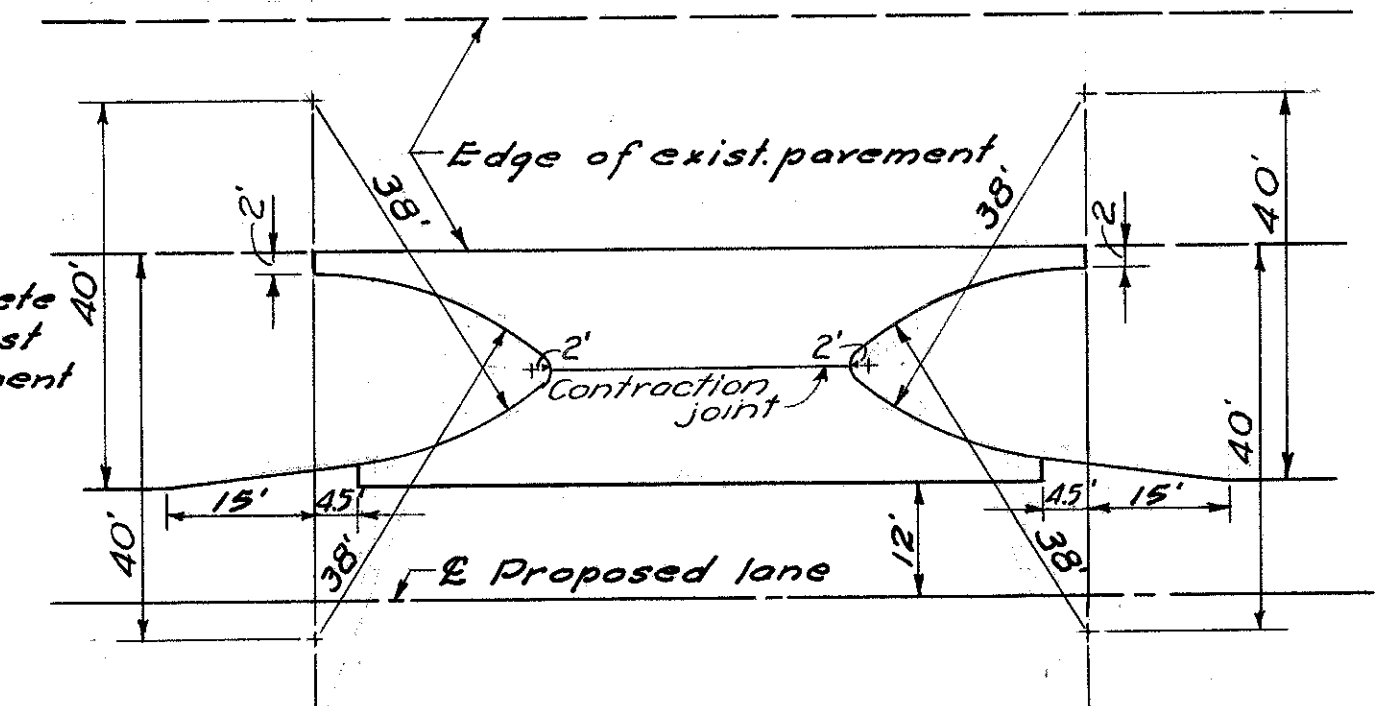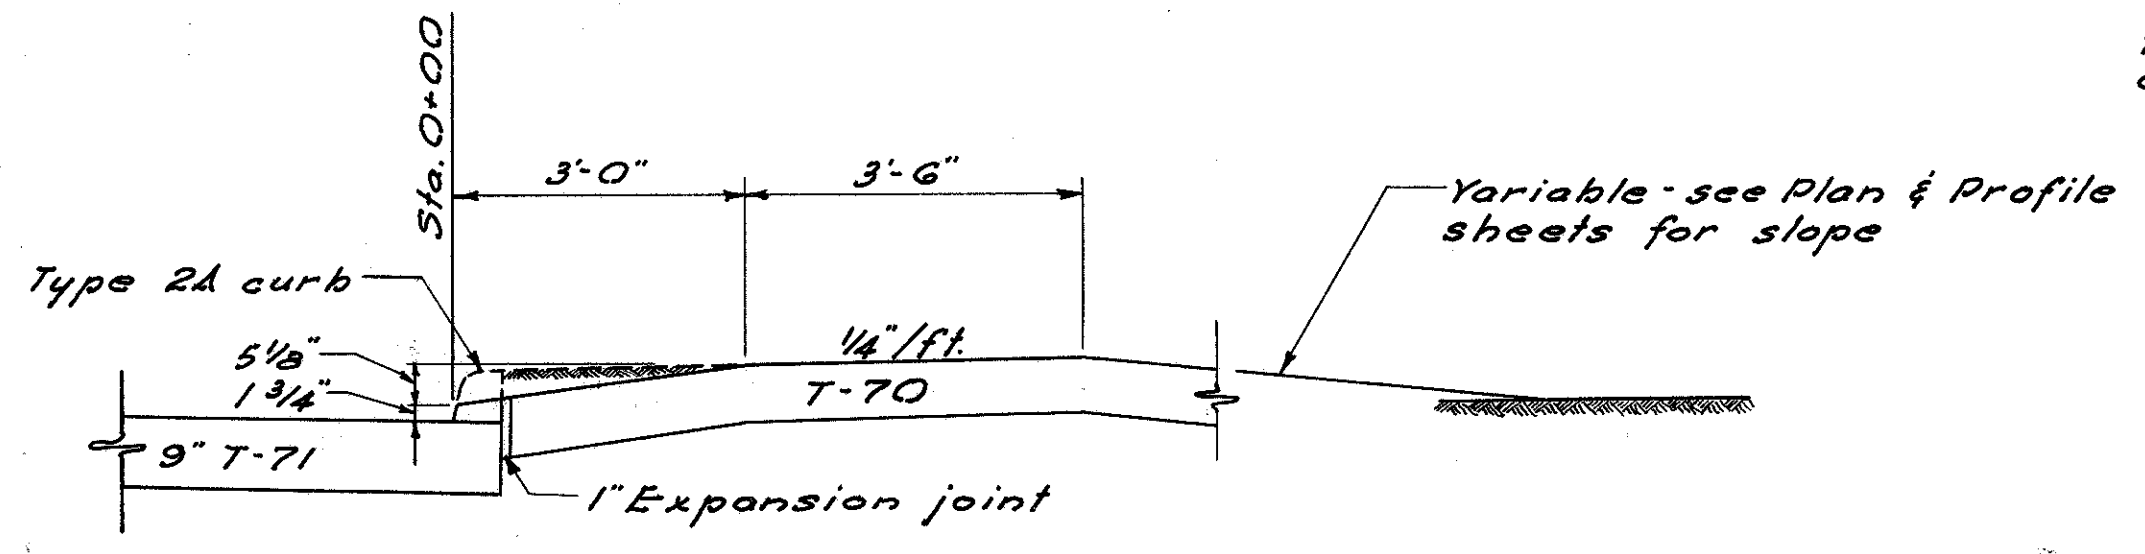


**TYPICAL CROSS-OVER, TYPE A**  
No Scale

Note: Cross-overs to consist of 5" Crushed Aggregate Base Course B-119, & 2" Asphaltic Conc. Surface Course T-35 Type C.

Begin cross-over Station: (as indicated on PLANS)

End cross-over Station: (as indicated on PLANS)

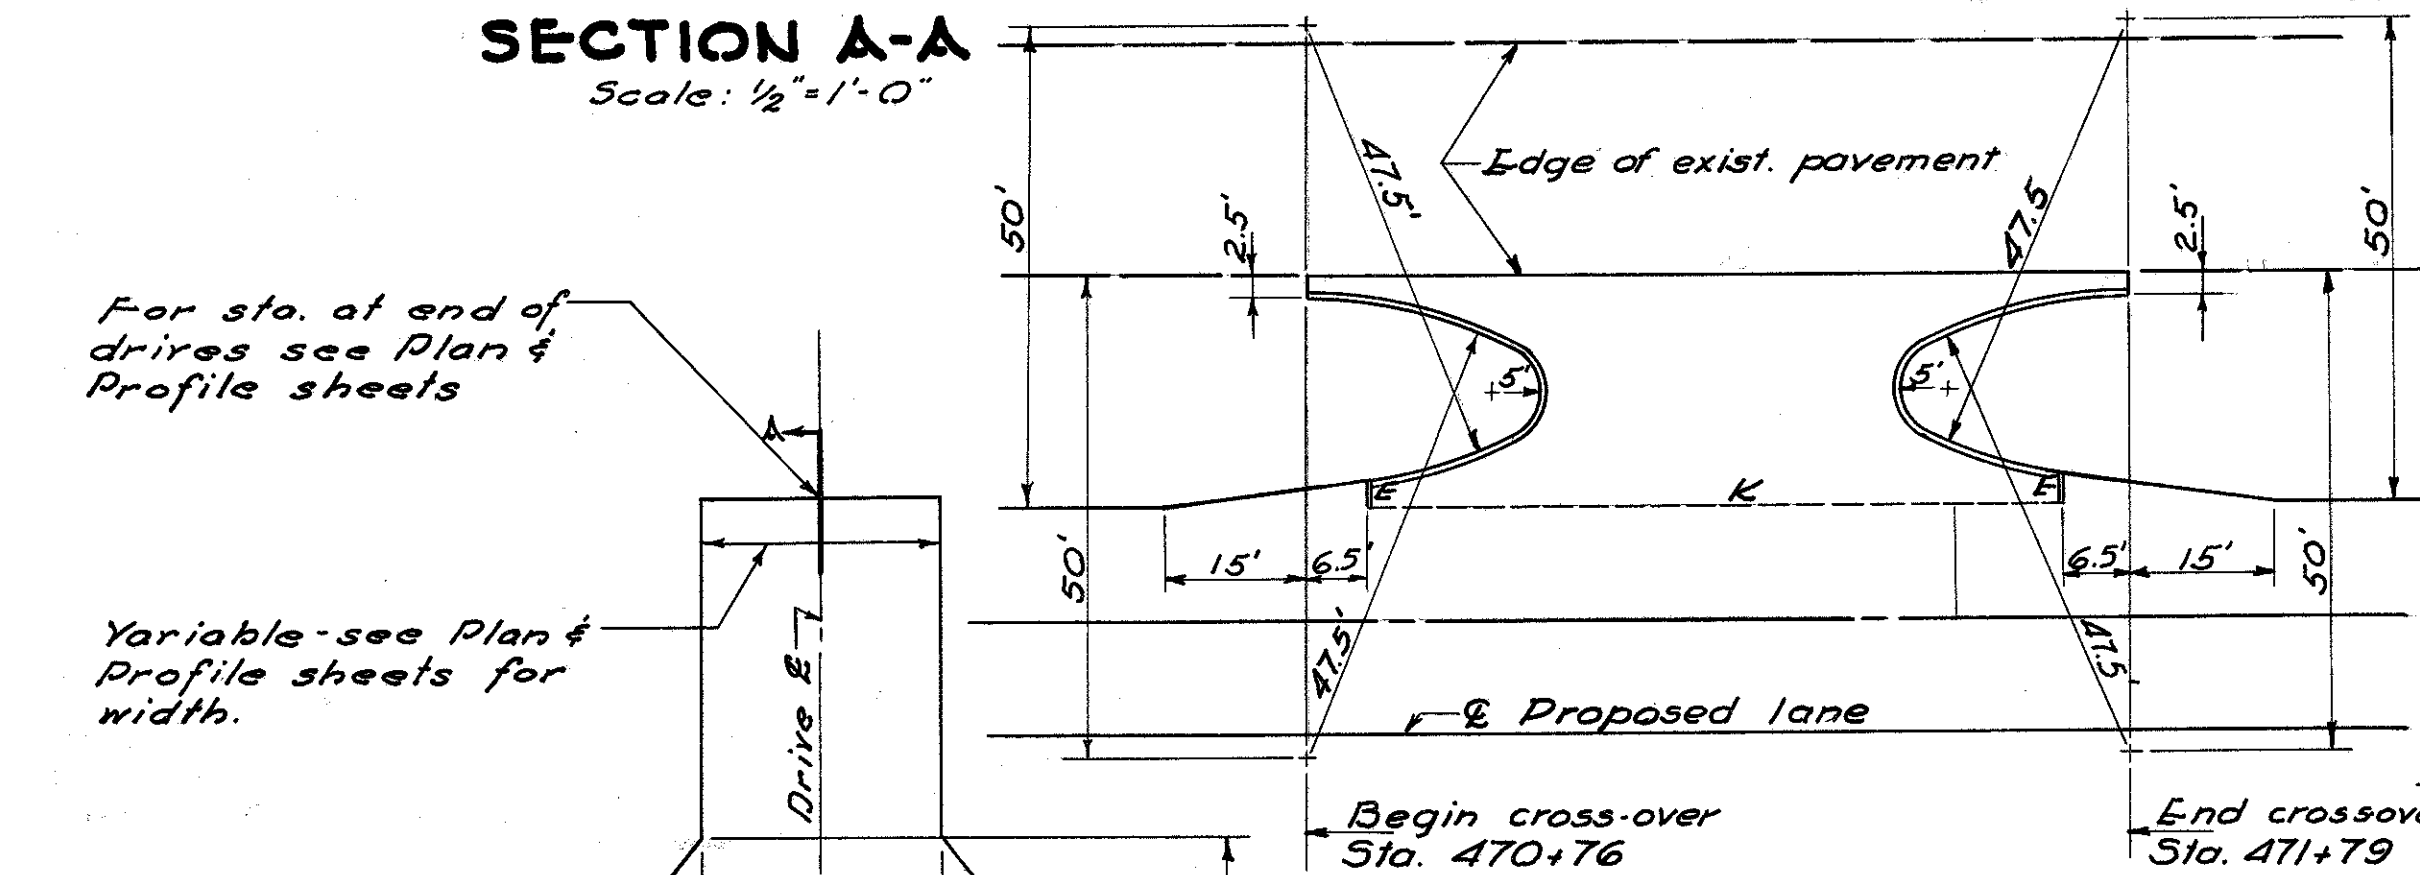


**CROSS-OVER STA. 470+76 TO STA. 471+79 TYPE C**  
No Scale

Note: Cross-overs to consist of 5" Crushed Aggregate Base Course B-119, & 2" Asphaltic Conc. Surface Course T-35 Type C.

Begin cross-over Station: (as indicated on PLANS)

End cross-over Station: (as indicated on PLANS)

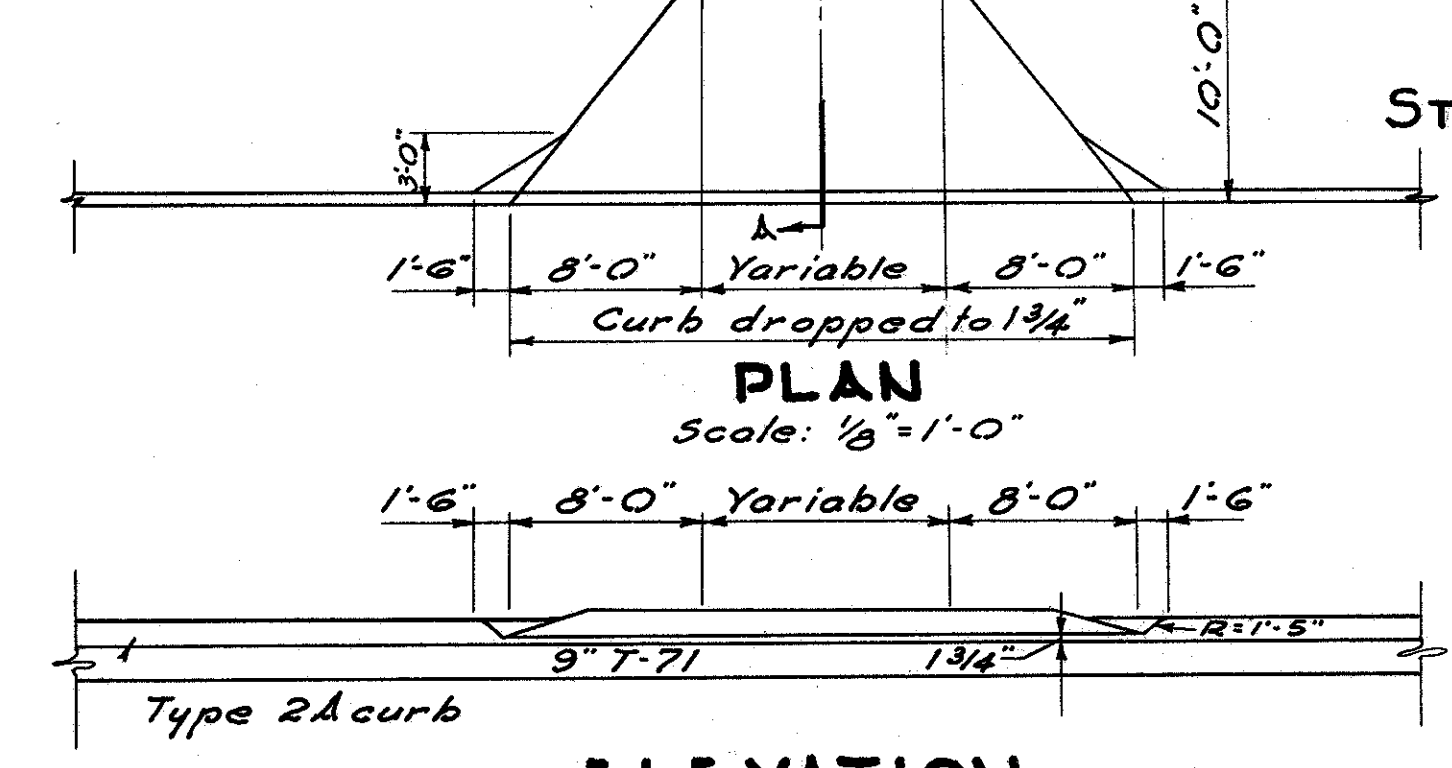

**TYPICAL DRIVE AT SIDEWALK**

**CROSS-OVER DATA**


BEGIN CROSS-OVER STA.	END CROSS-OVER STA.	CROSS-OVER TYPE	BEGIN CROSS-OVER STA.	END CROSS-OVER STA.	CROSS-OVER TYPE	BEGIN CROSS-OVER STA.	END CROSS-OVER STA.	CROSS-OVER TYPE
470+76	471+79	C	508+74	509+63	A	537+98.5	539+15	B
472+31	475+25	A	516+05	516+95	B	539+94.5	541+87	B
476+82	477+78	A	519+40	520+28	B	543+11	544+41.5	B
480+75	481+65	A	520+93	521+81	B	545+51	546+39	B
486+42	487+45	A	522+16	523+04	A	548+63	549+58	B
489+30	490+18	A	527+46	529+58	A	550+15.5	551+07.5	B
493+75	494+67	A	530+99	531+89	A	551+41	552+55	B
496+21	497+10	A	532+06	532+96	A	560+54	561+50	B
498+50	499+72	A	532+96	533+85	A	563+94	564+92	B
501+03	501+94	A	534+60	535+48	A	490+55	491+35	A
505+35	506+61	A	535+56	536+46	A			

**TYPICAL CROSS-OVER, TYPE B**  
No Scale


Note: Cross-overs to consist of 5" Crushed Aggregate Base Course B-119, & 2" Asphaltic Conc. Surface Course T-35 Type C.

Begin cross-over Station: (as indicated on PLANS)


End cross-over Station: (as indicated on PLANS)

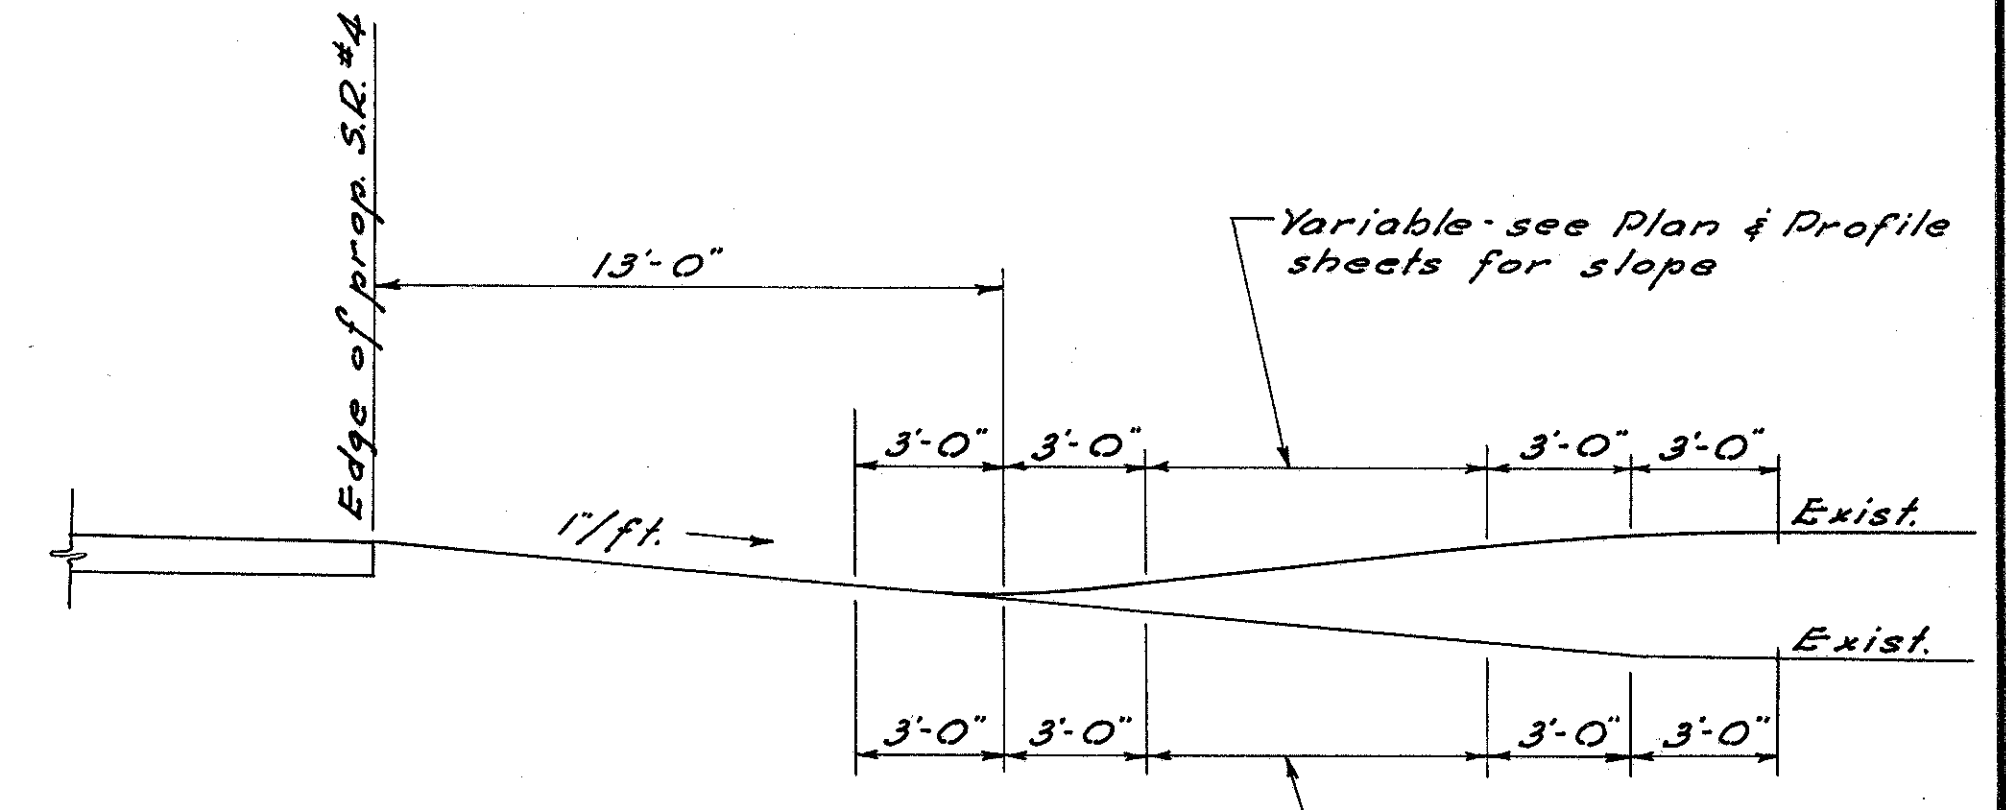


**TYPICAL DRIVE PROFILE**  
Scale: 1/4" = 1'-0"

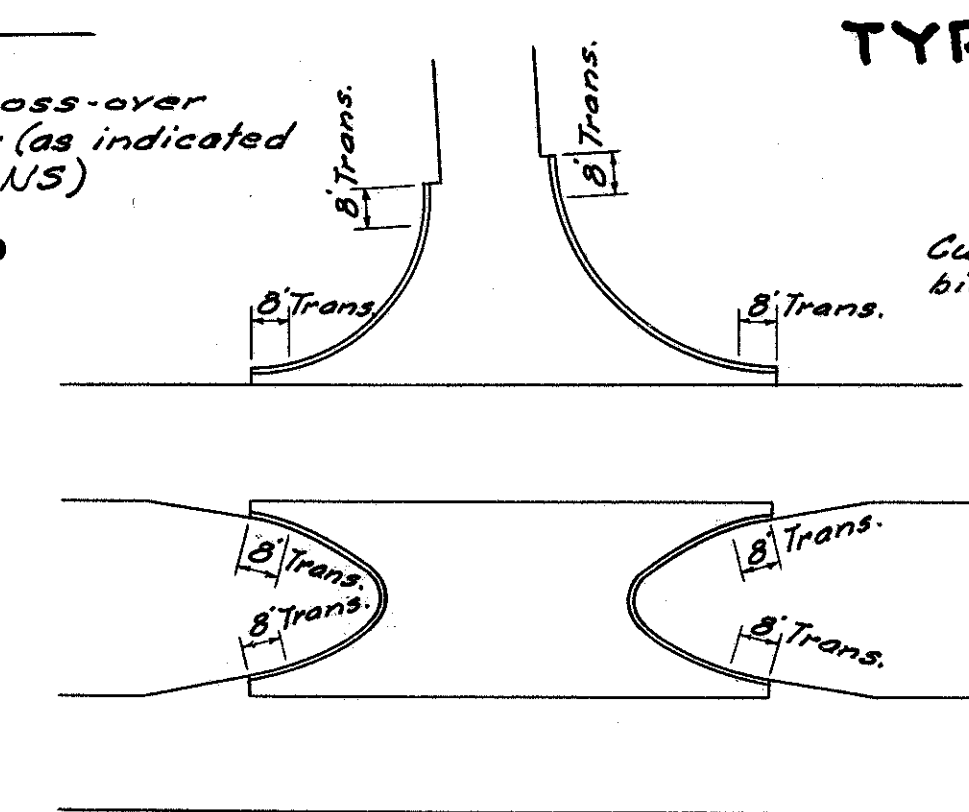

**TYPICAL CURB TRANSITION**  
No Scale

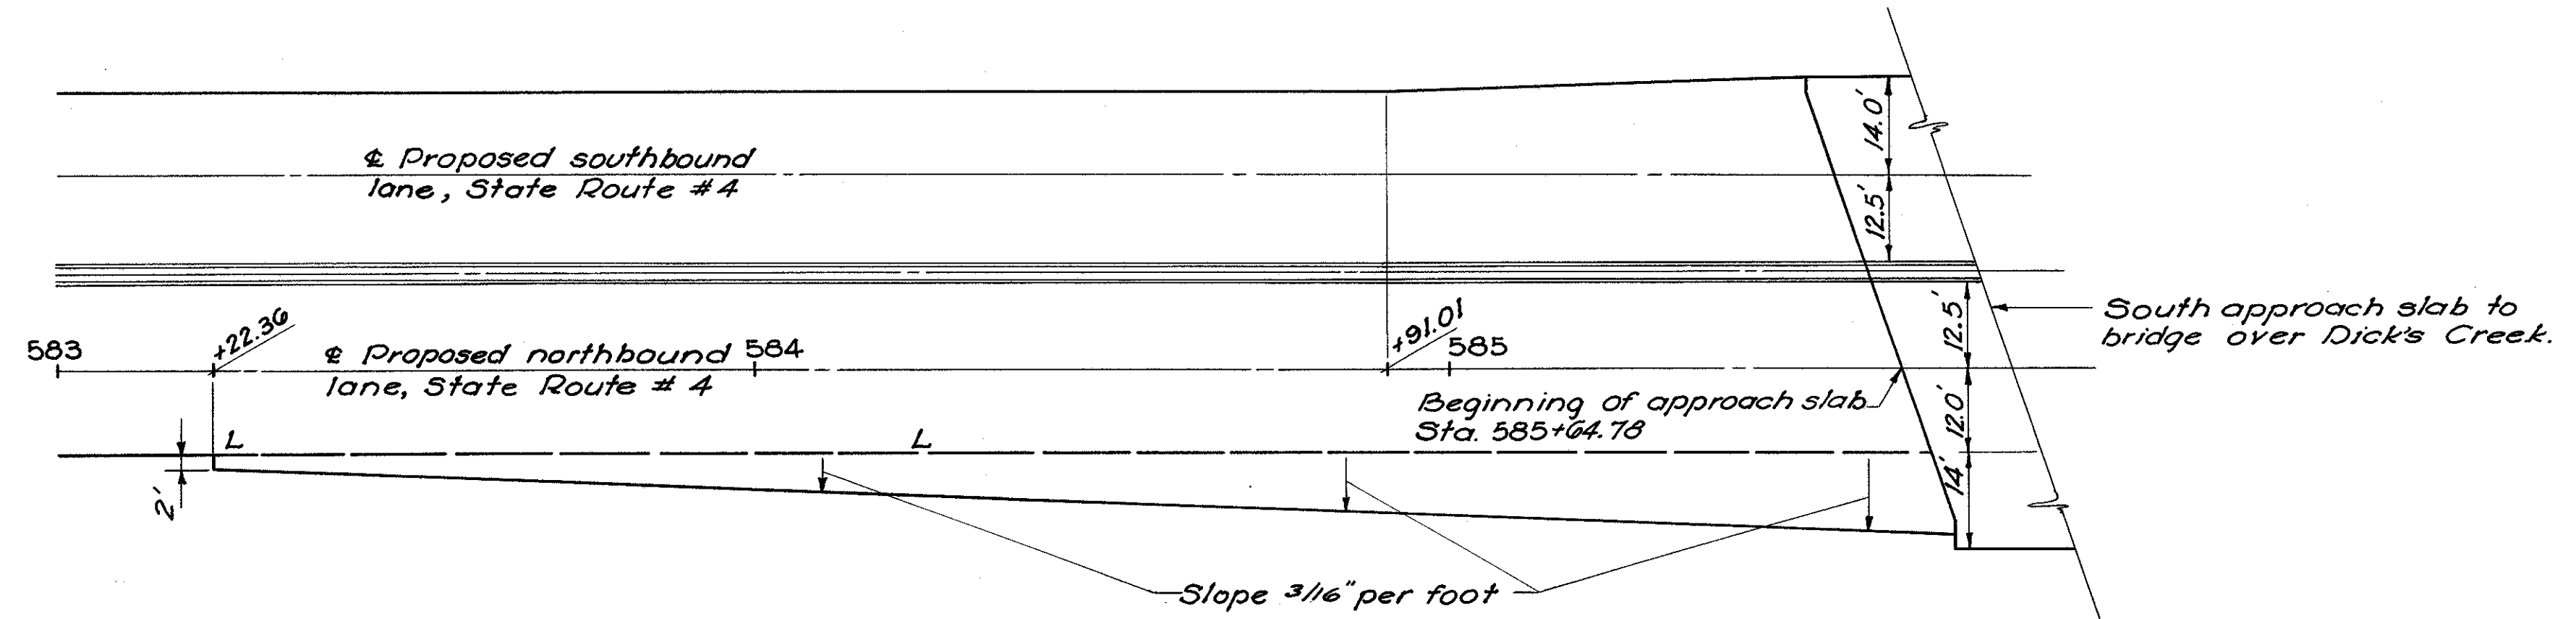


**DECELERATION LANE-STA. 583+22.36 TO STA. 585+72.36**

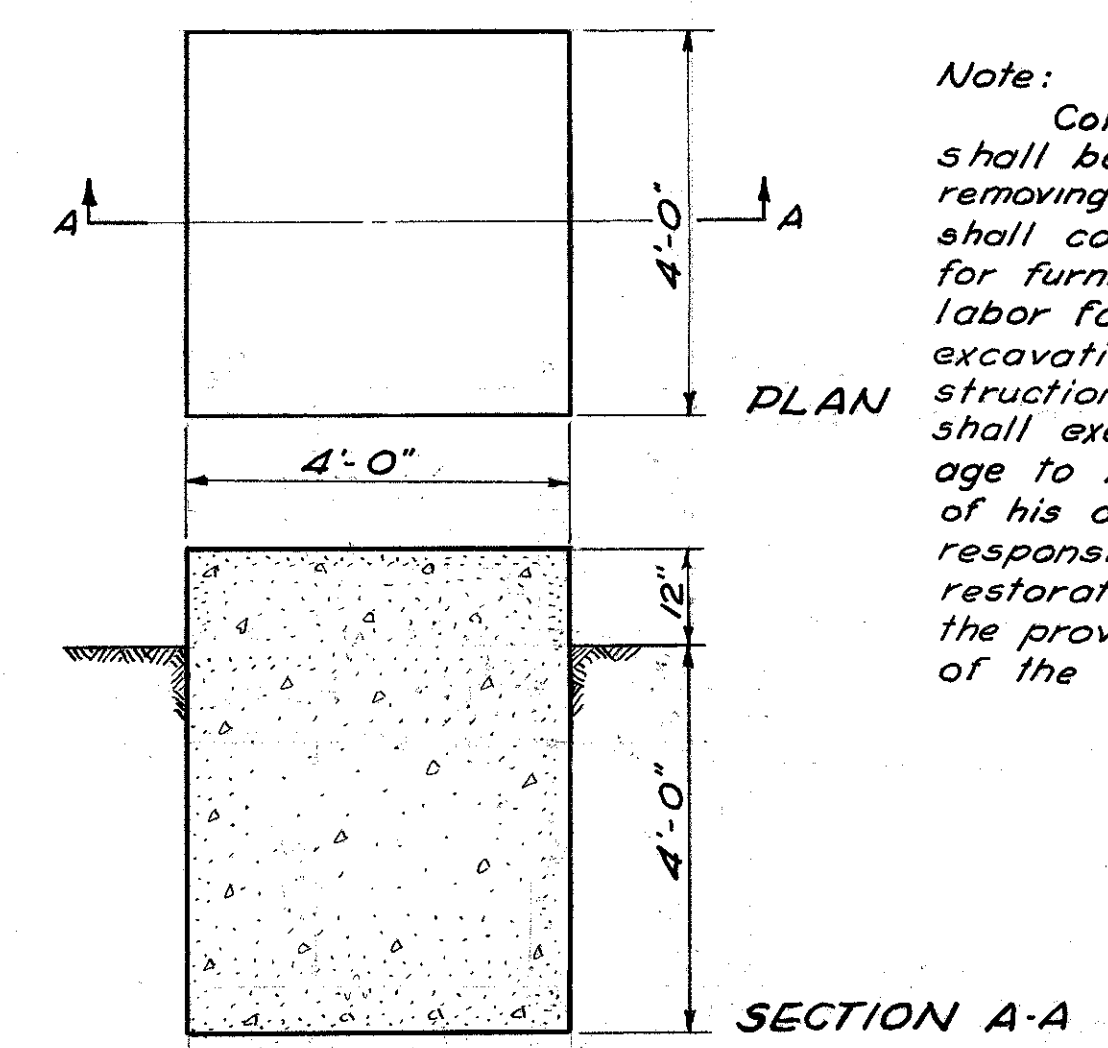

Note: Concrete for monument footing shall be Class "E". Payment for removing and resetting monument shall constitute full compensation for furnishing all materials and labor for this item, including all excavation and backfill and construction of footing. The Contractor shall exercise care to avoid damage to the monument during any of his operations and shall be responsible for preservation and restoration, in accordance with the provisions of Sec. G-709 of the Specifications.

**FOOTING FOR REMEMBRANCE MONUMENT STATION 554+50**

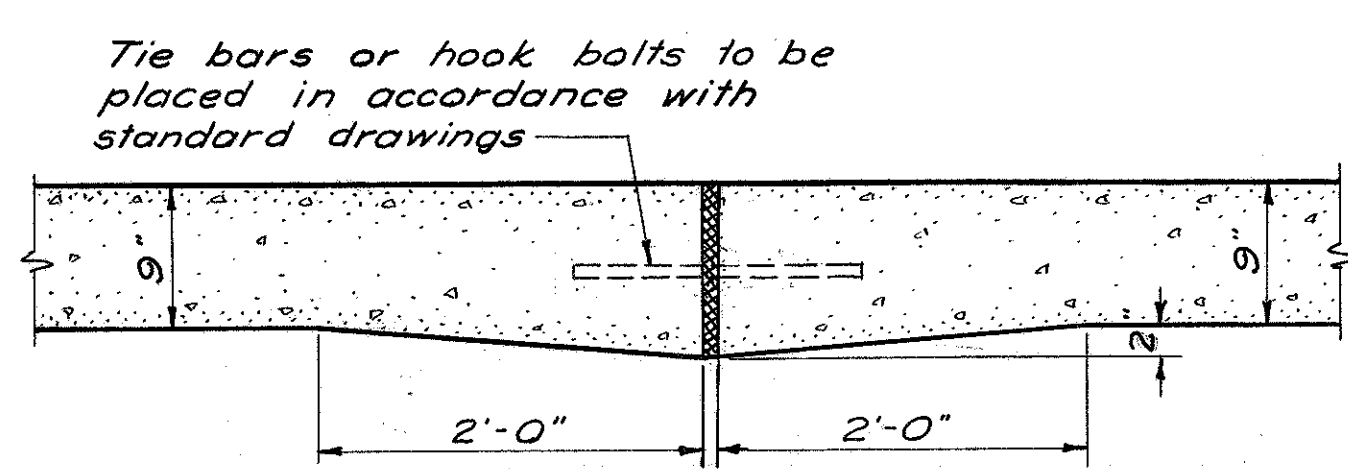





Note: Payment for extra concrete due to thickened edge included in price bid per sq. yd. of pavement. (nominal thickness.) Joint without dowels not thickened.

**EXP. JOINT-THICKENED EDGE**

Scale: 1" = 1'-0"



**TYPICAL JOINT LEGEND**

- L Standard Longitudinal Joint.
- K Standard Key Joint Without Tie Bars.
- E Expansion Joint Without Dowels.
- ED Expansion Joint With Dowels, thickened edge.

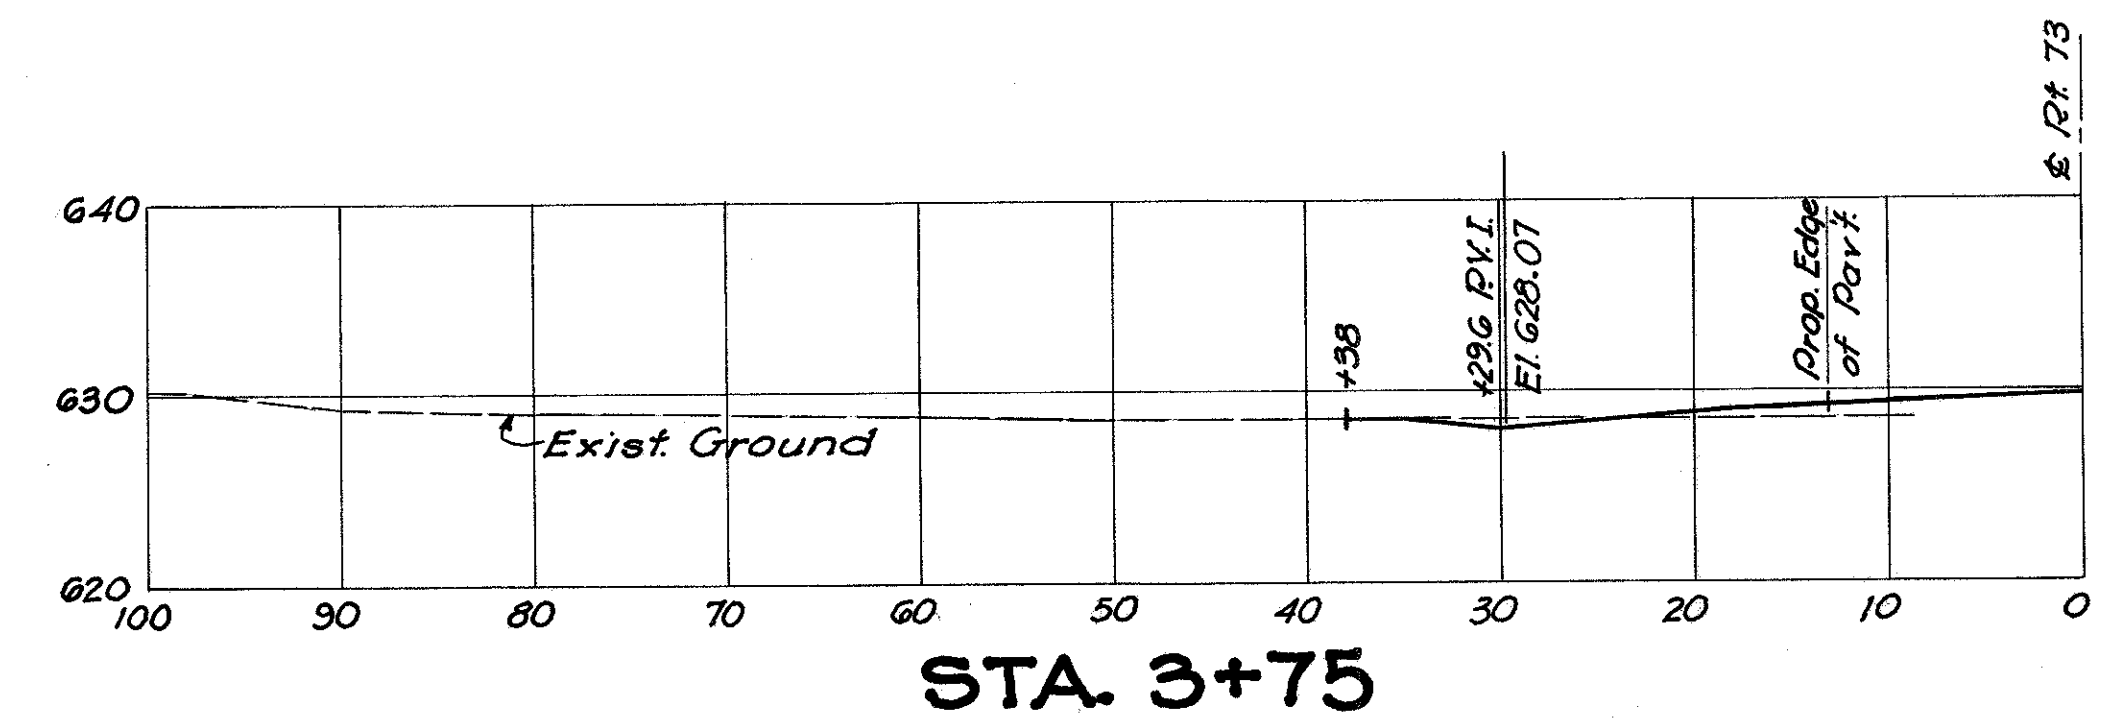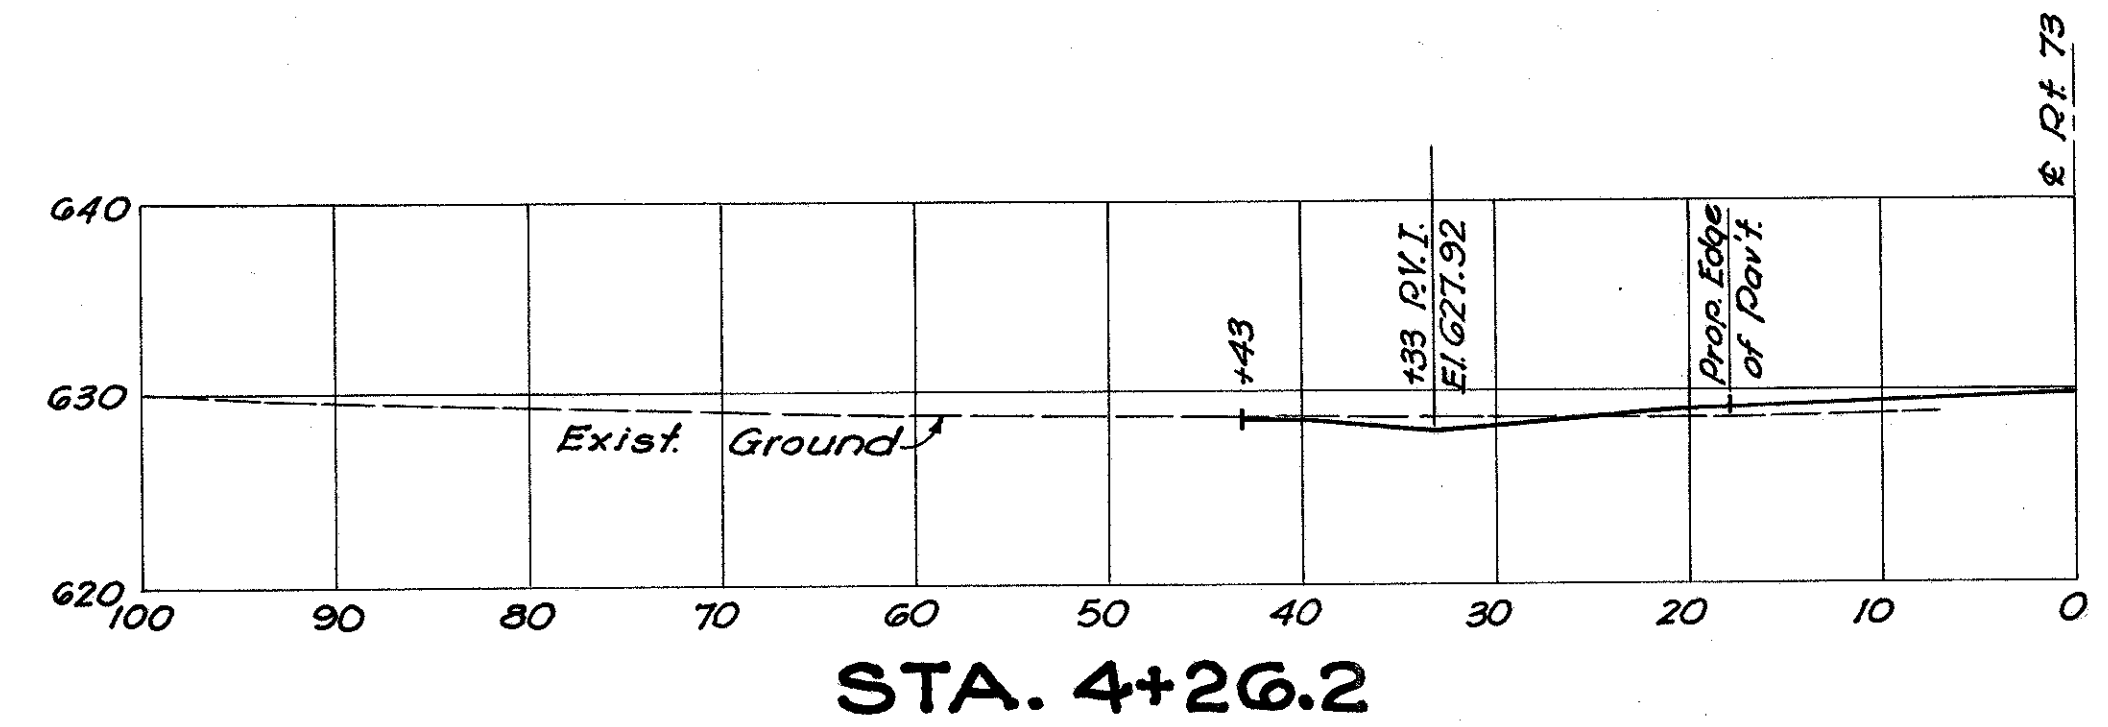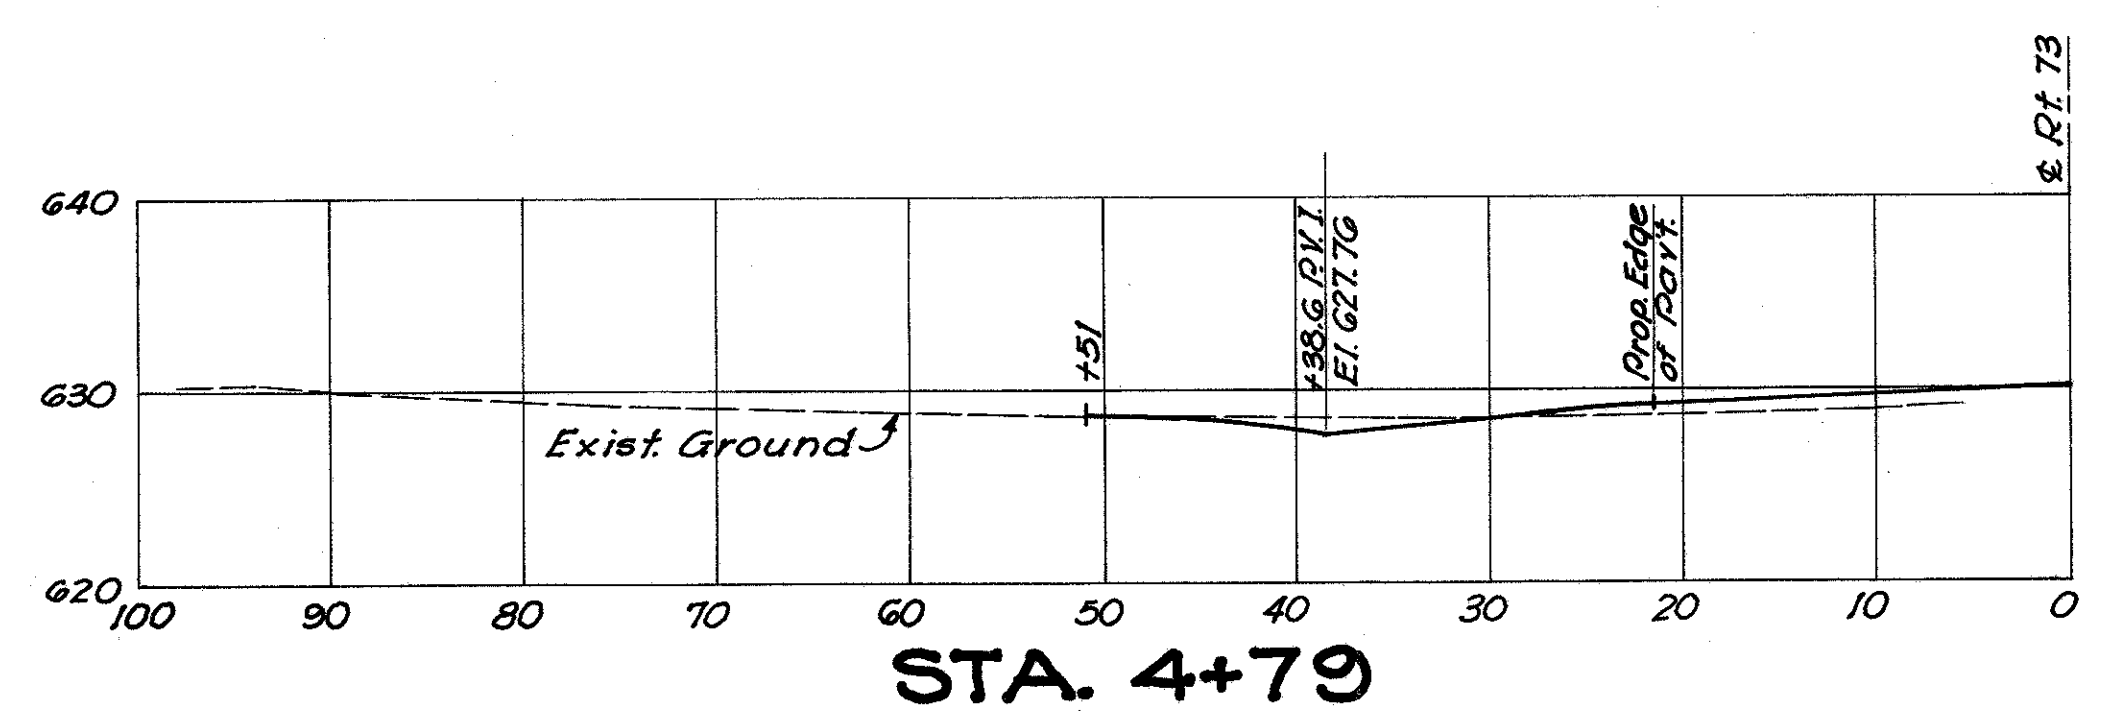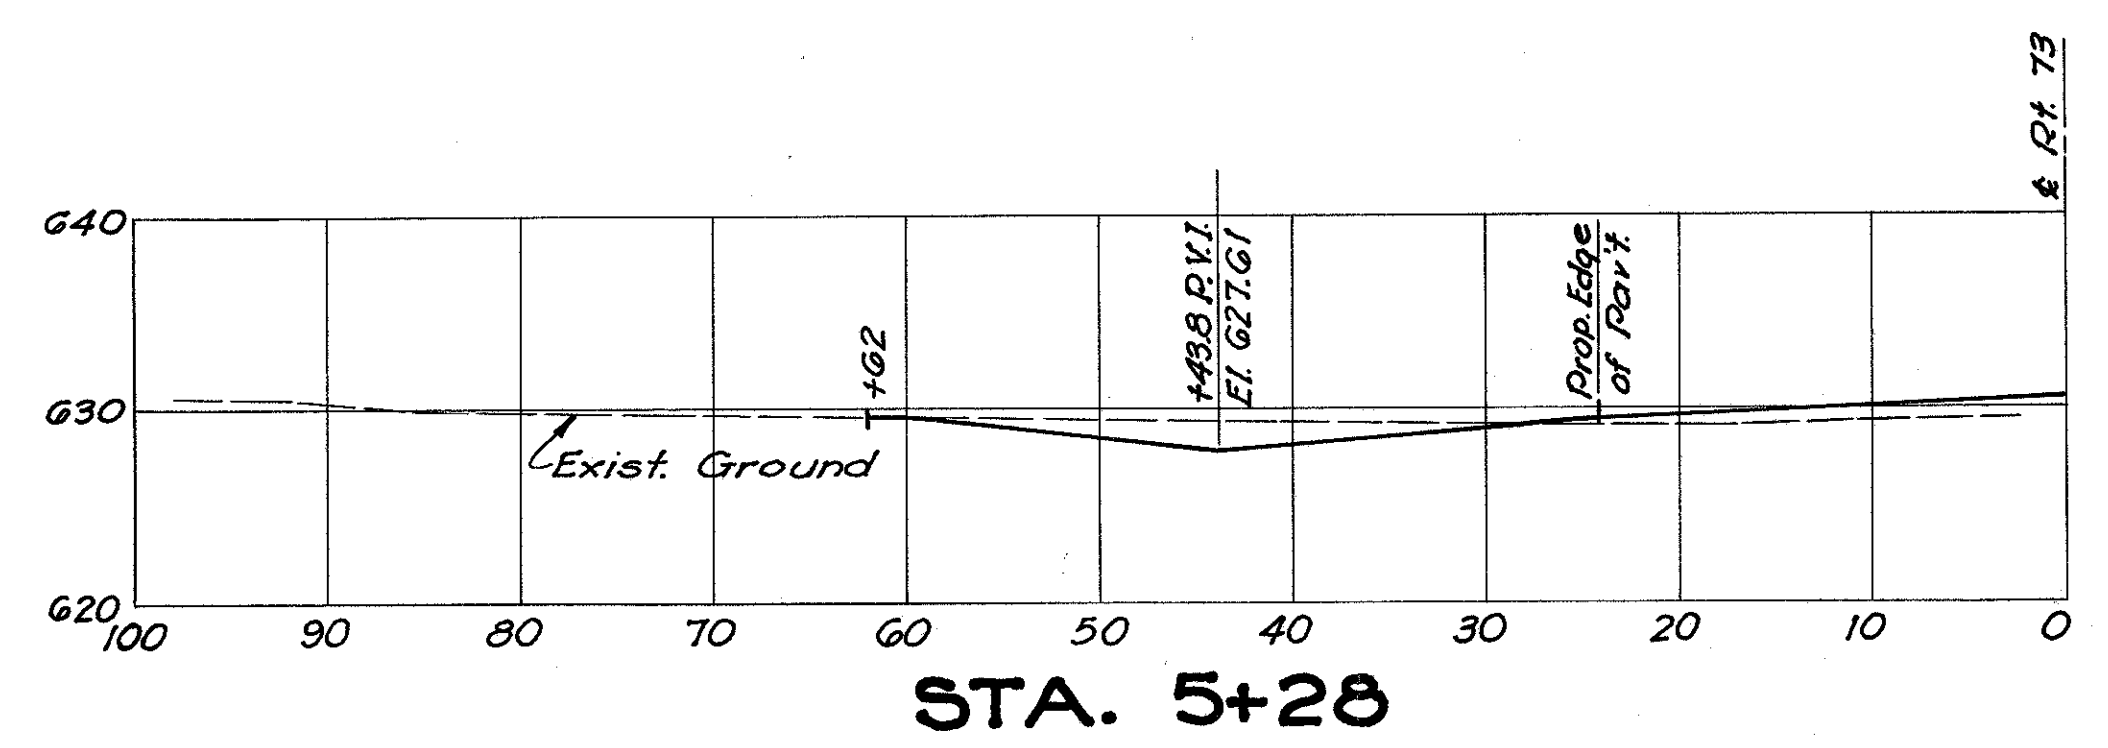

**DRIVEWAY PROFILES-STATE ROUTE 73**



Note: For driveways not shown here see Sheets

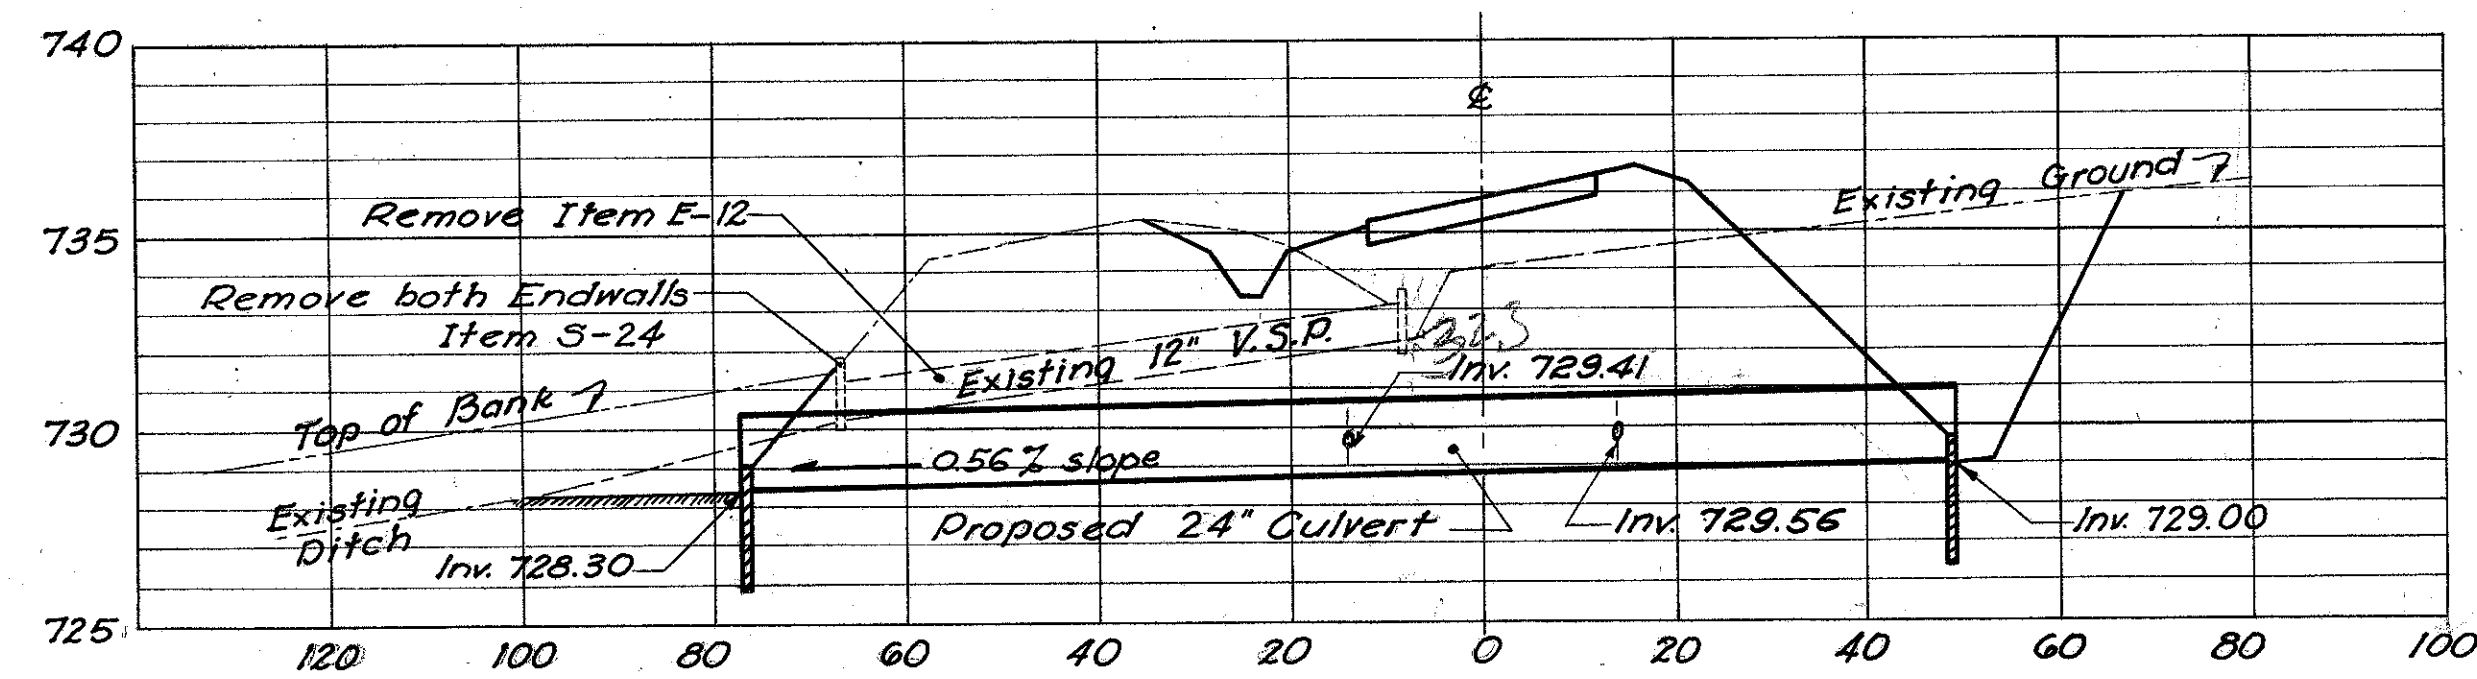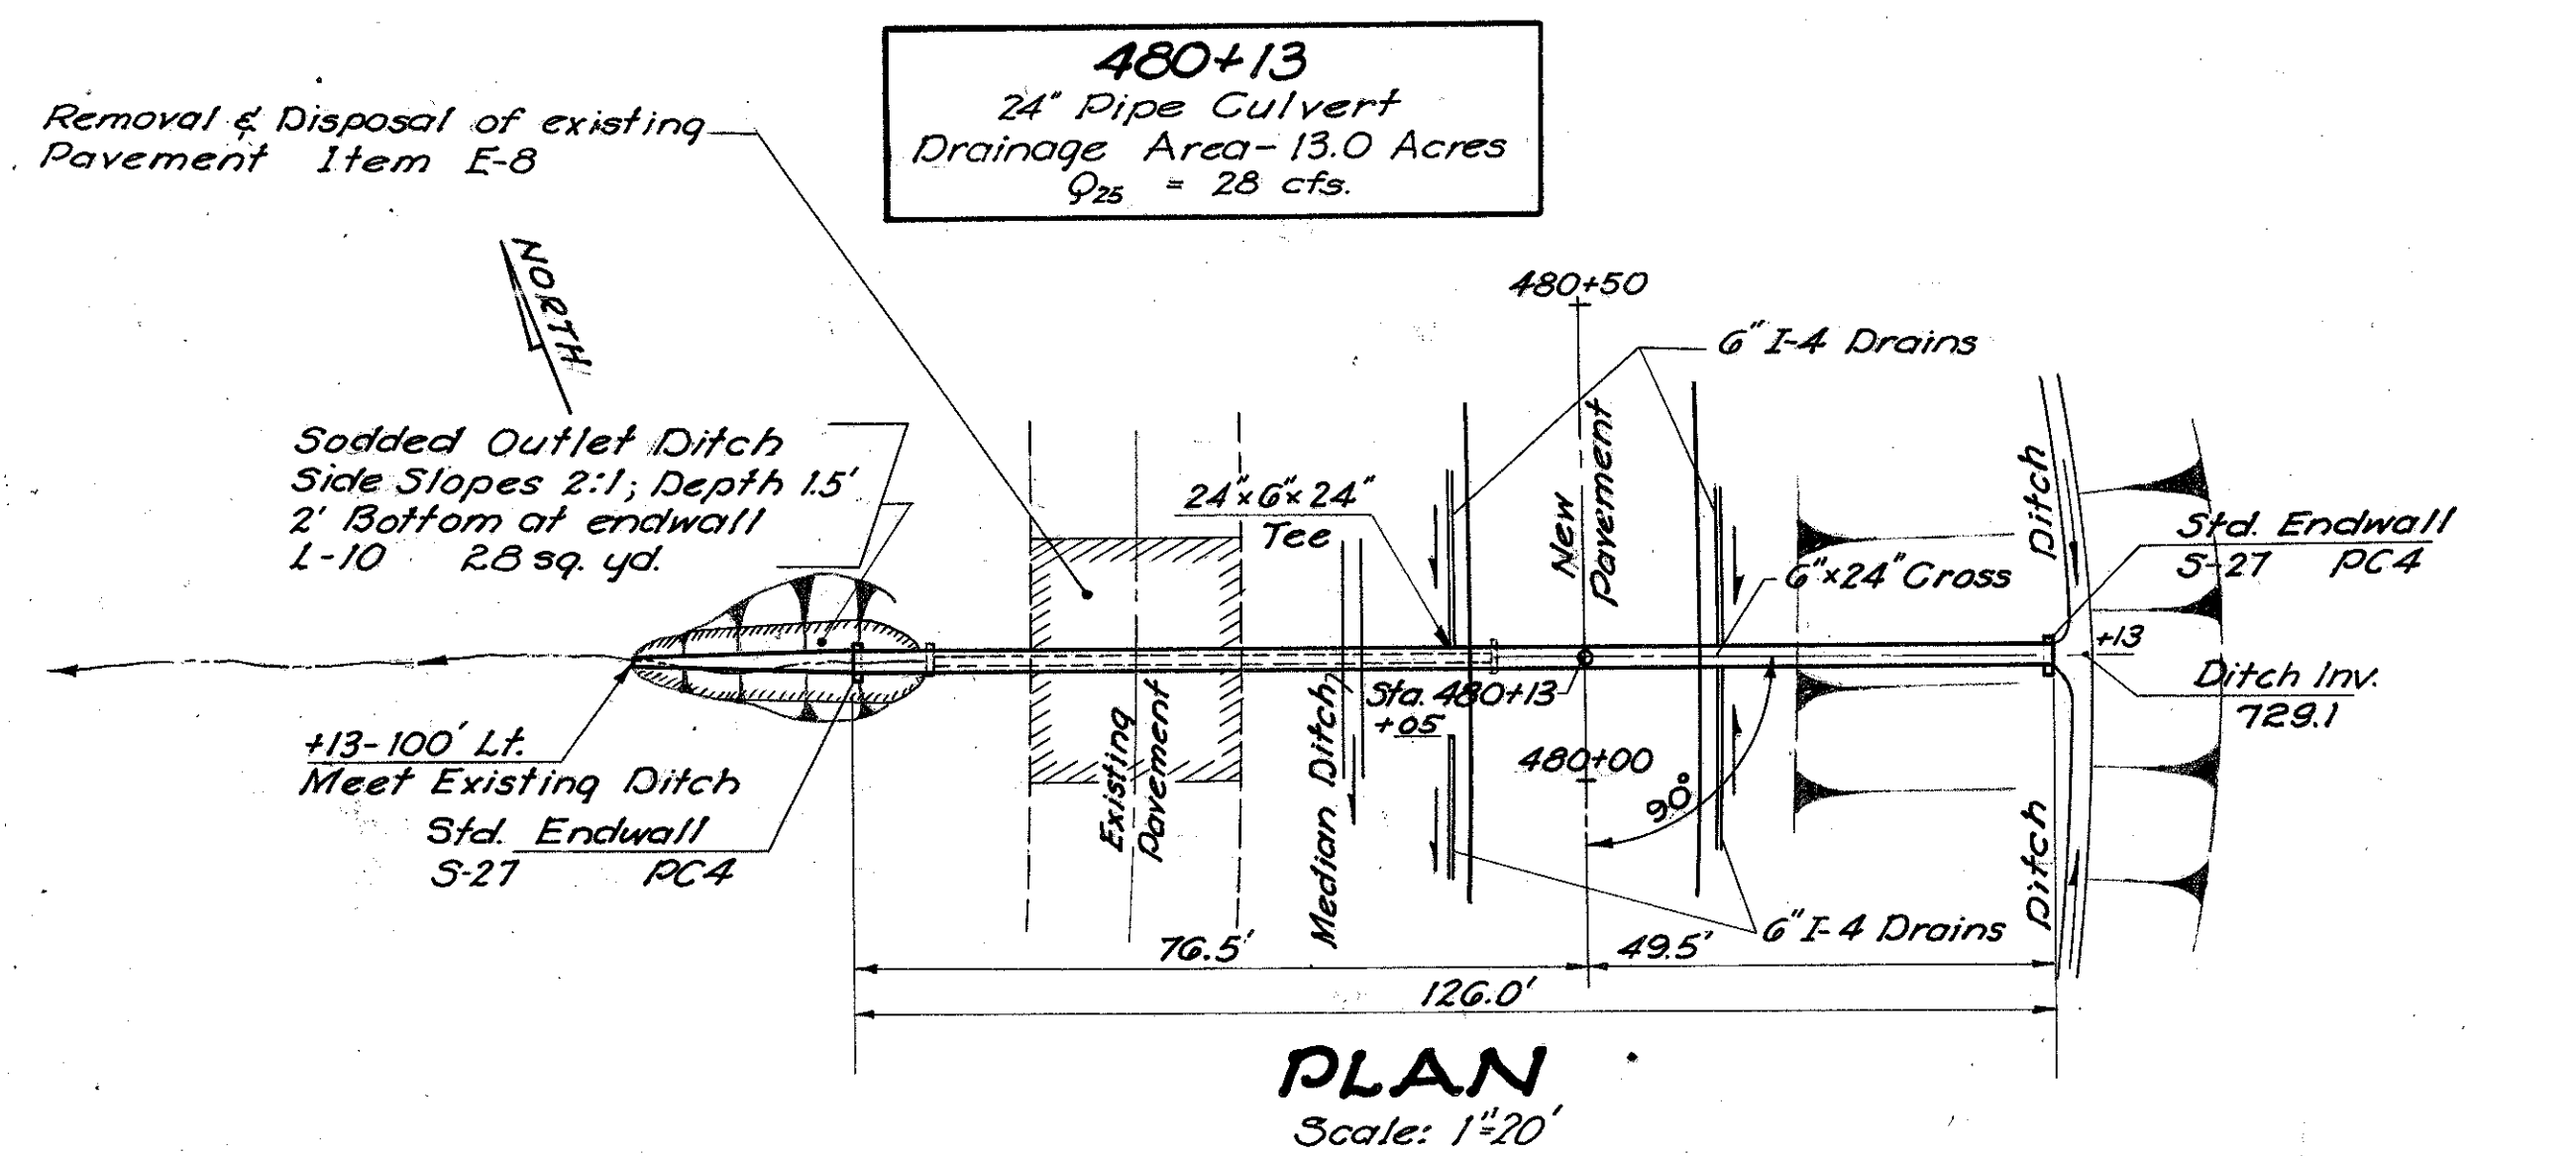

**CULVERT STA. 480+13**

**ESTIMATE OF QUANTITIES**

DESCRIPTION	ITEM	QUANTITY
Excavation for structures (Dry)	E-2	54.5 cu. yd.
Channel Excavation	E-3	31.4 cu. yd.
Removal of Pipe - 12"	E-12	60 lin. ft.
Concrete for Structures - Class E	S-1	0.8 cu. yd.
Pipe for Roadway Culverts - 24"	S-27	118 lin. ft.
Removal of Existing Structures	S-24	Lump Sum
Pipe Specials 24"x6"x24" Tee	I-5	1 each
Pipe Specials 6"x24" Cross	I-5	1 each
Sodding	L-10	2.8 sq. yd.

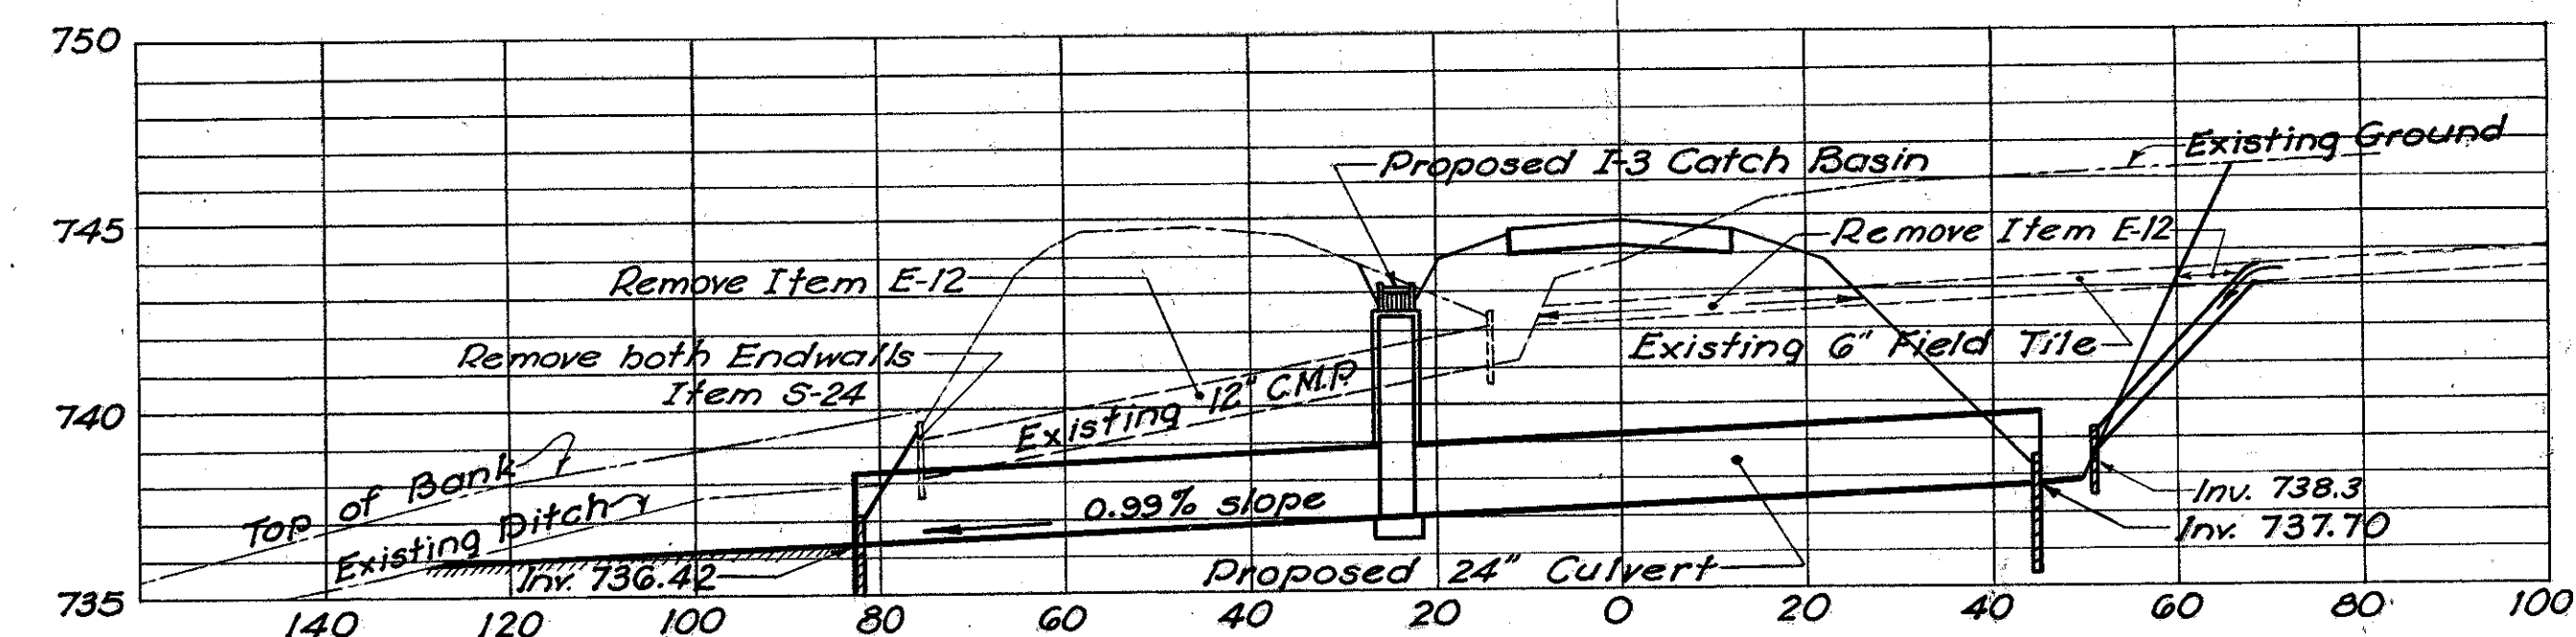
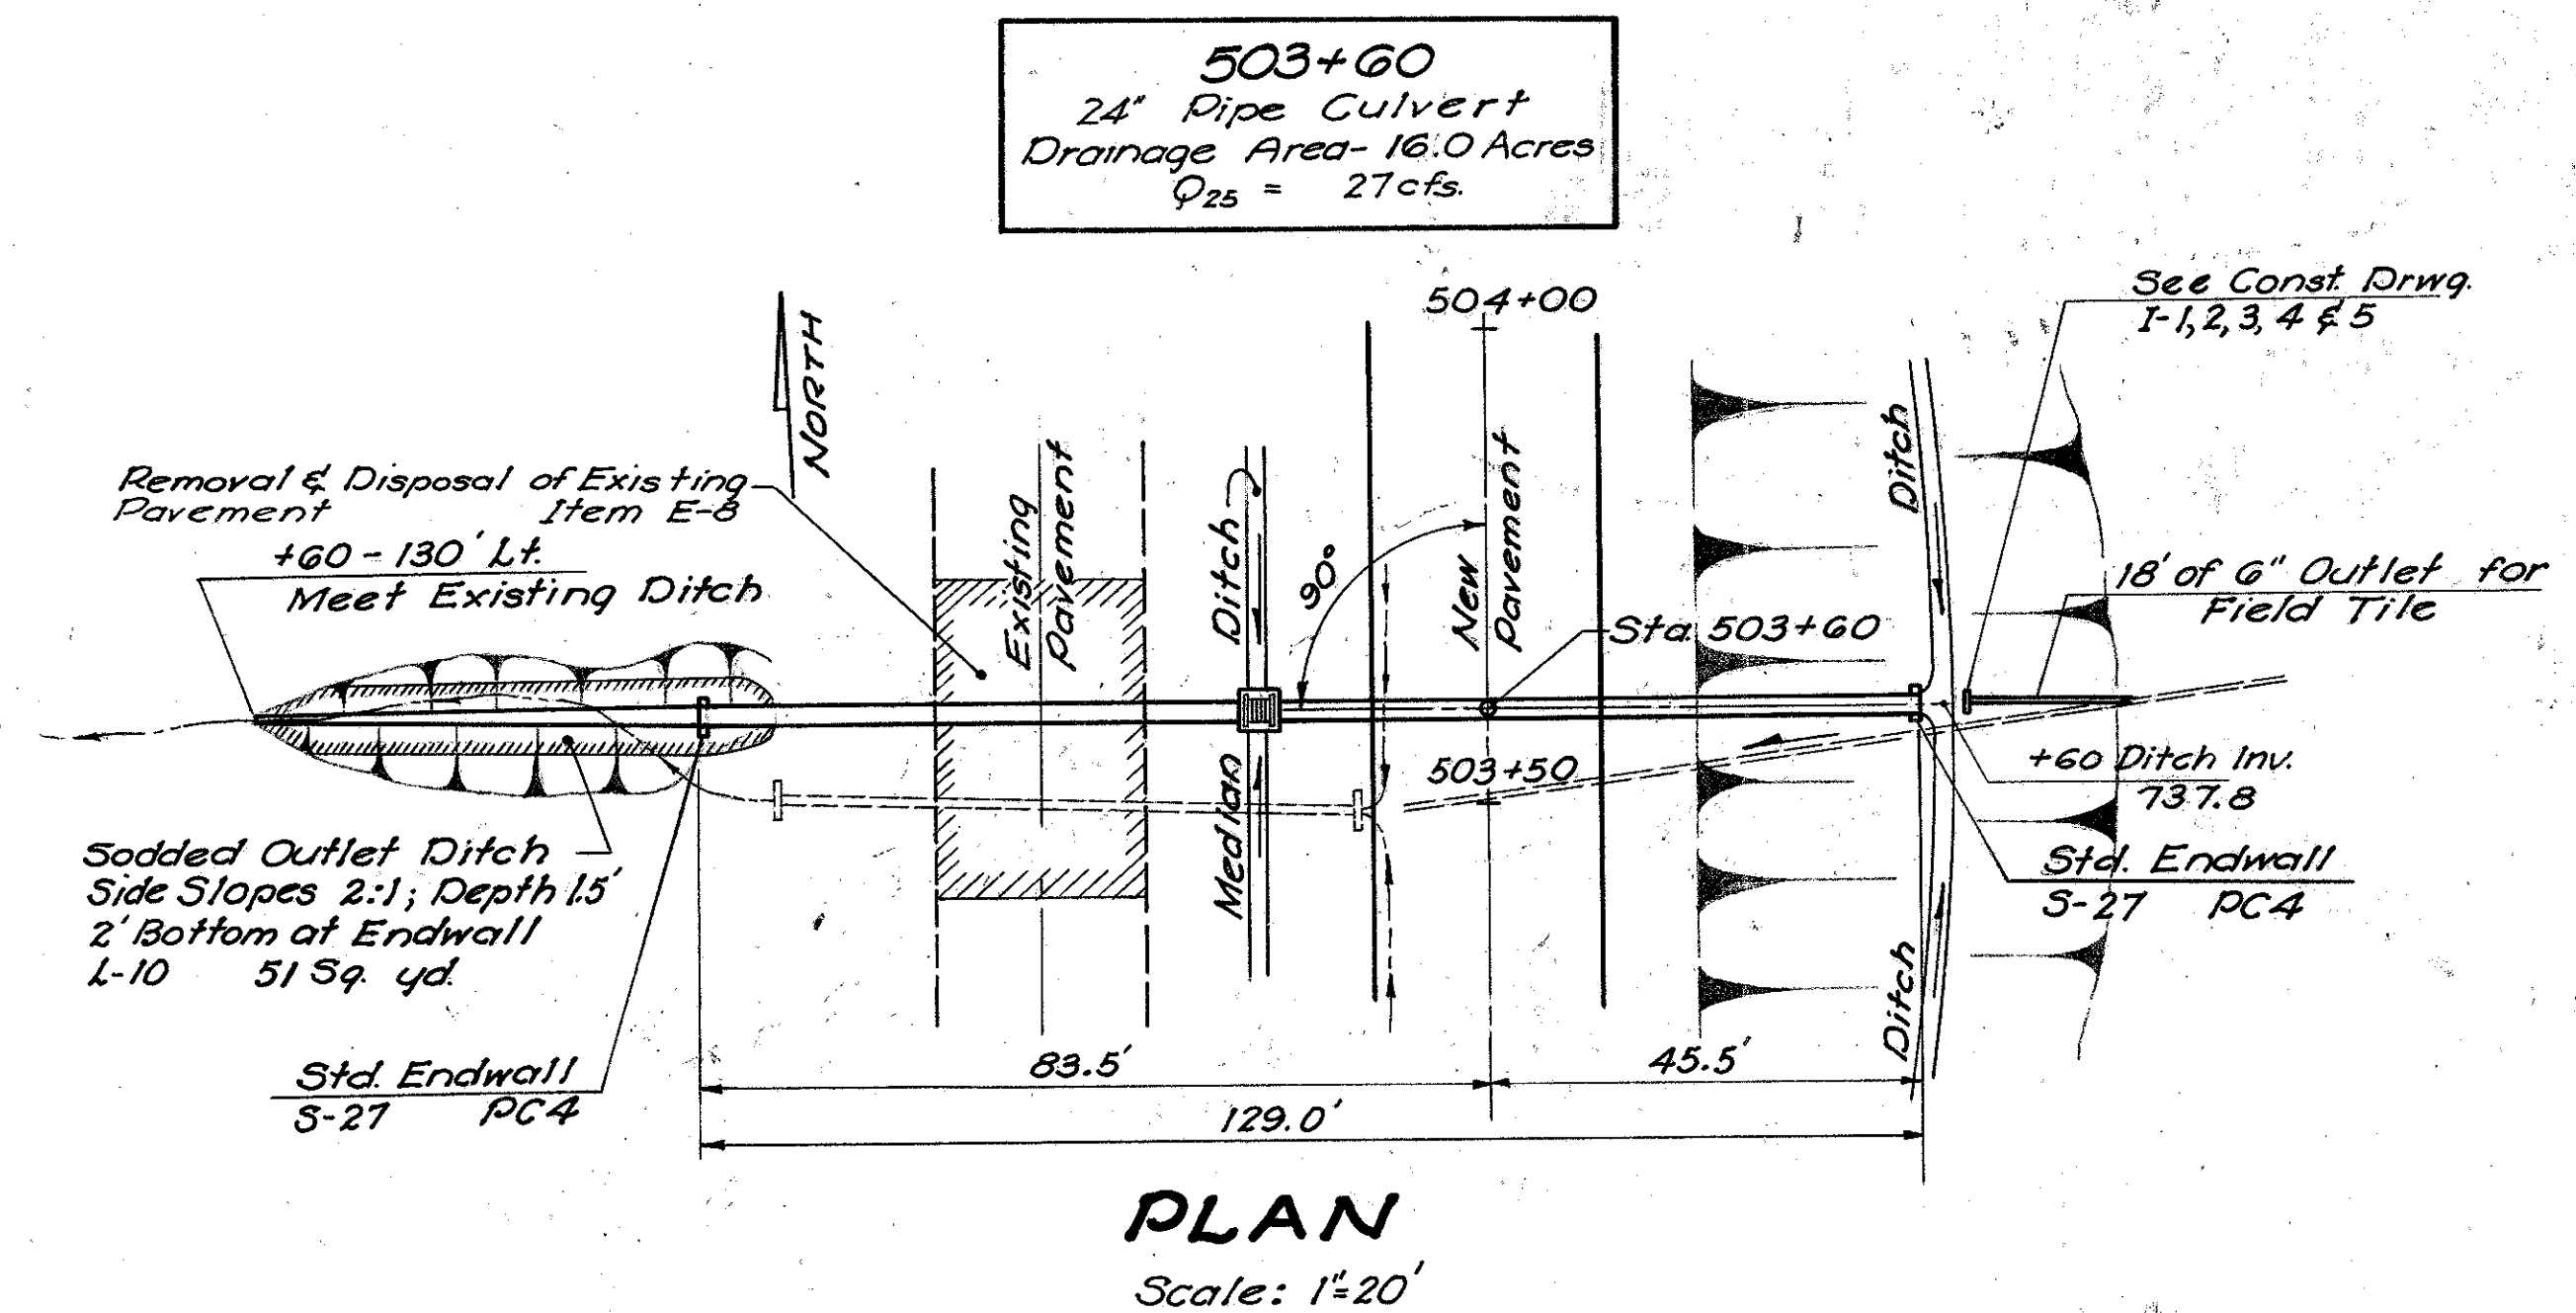


**CULVERT STA. 503+60**

**ESTIMATE OF QUANTITIES**

DESCRIPTION	ITEM	QUANTITY
Excavation for Structures (Dry)	E-2	79.5 cu. yd.
Channel Excavation	E-3	14.5 cu. yd.
Removal of Pipe - 12"	E-12	62 lin. ft.
Removal of Pipe - 6"	E-12	41 lin. ft.
Concrete for Structures - Class E	S-1	0.8 cu. yd.
Pipe for Roadway Culverts - 24"	S-27	126 lin. ft.
Removal of Existing Structures	S-24	Lump Sum
Pipe Outlets for Roadway Drainage - 6"	I-3	18 lin. ft.
Catch Basins No. 1-3	I-8	1 each
Sodding	L-10	51 sq. yd.

**512+20**  
27" Pipe Culvert  
Drainage Area - 13.0 Acres  
Q25-27cfs

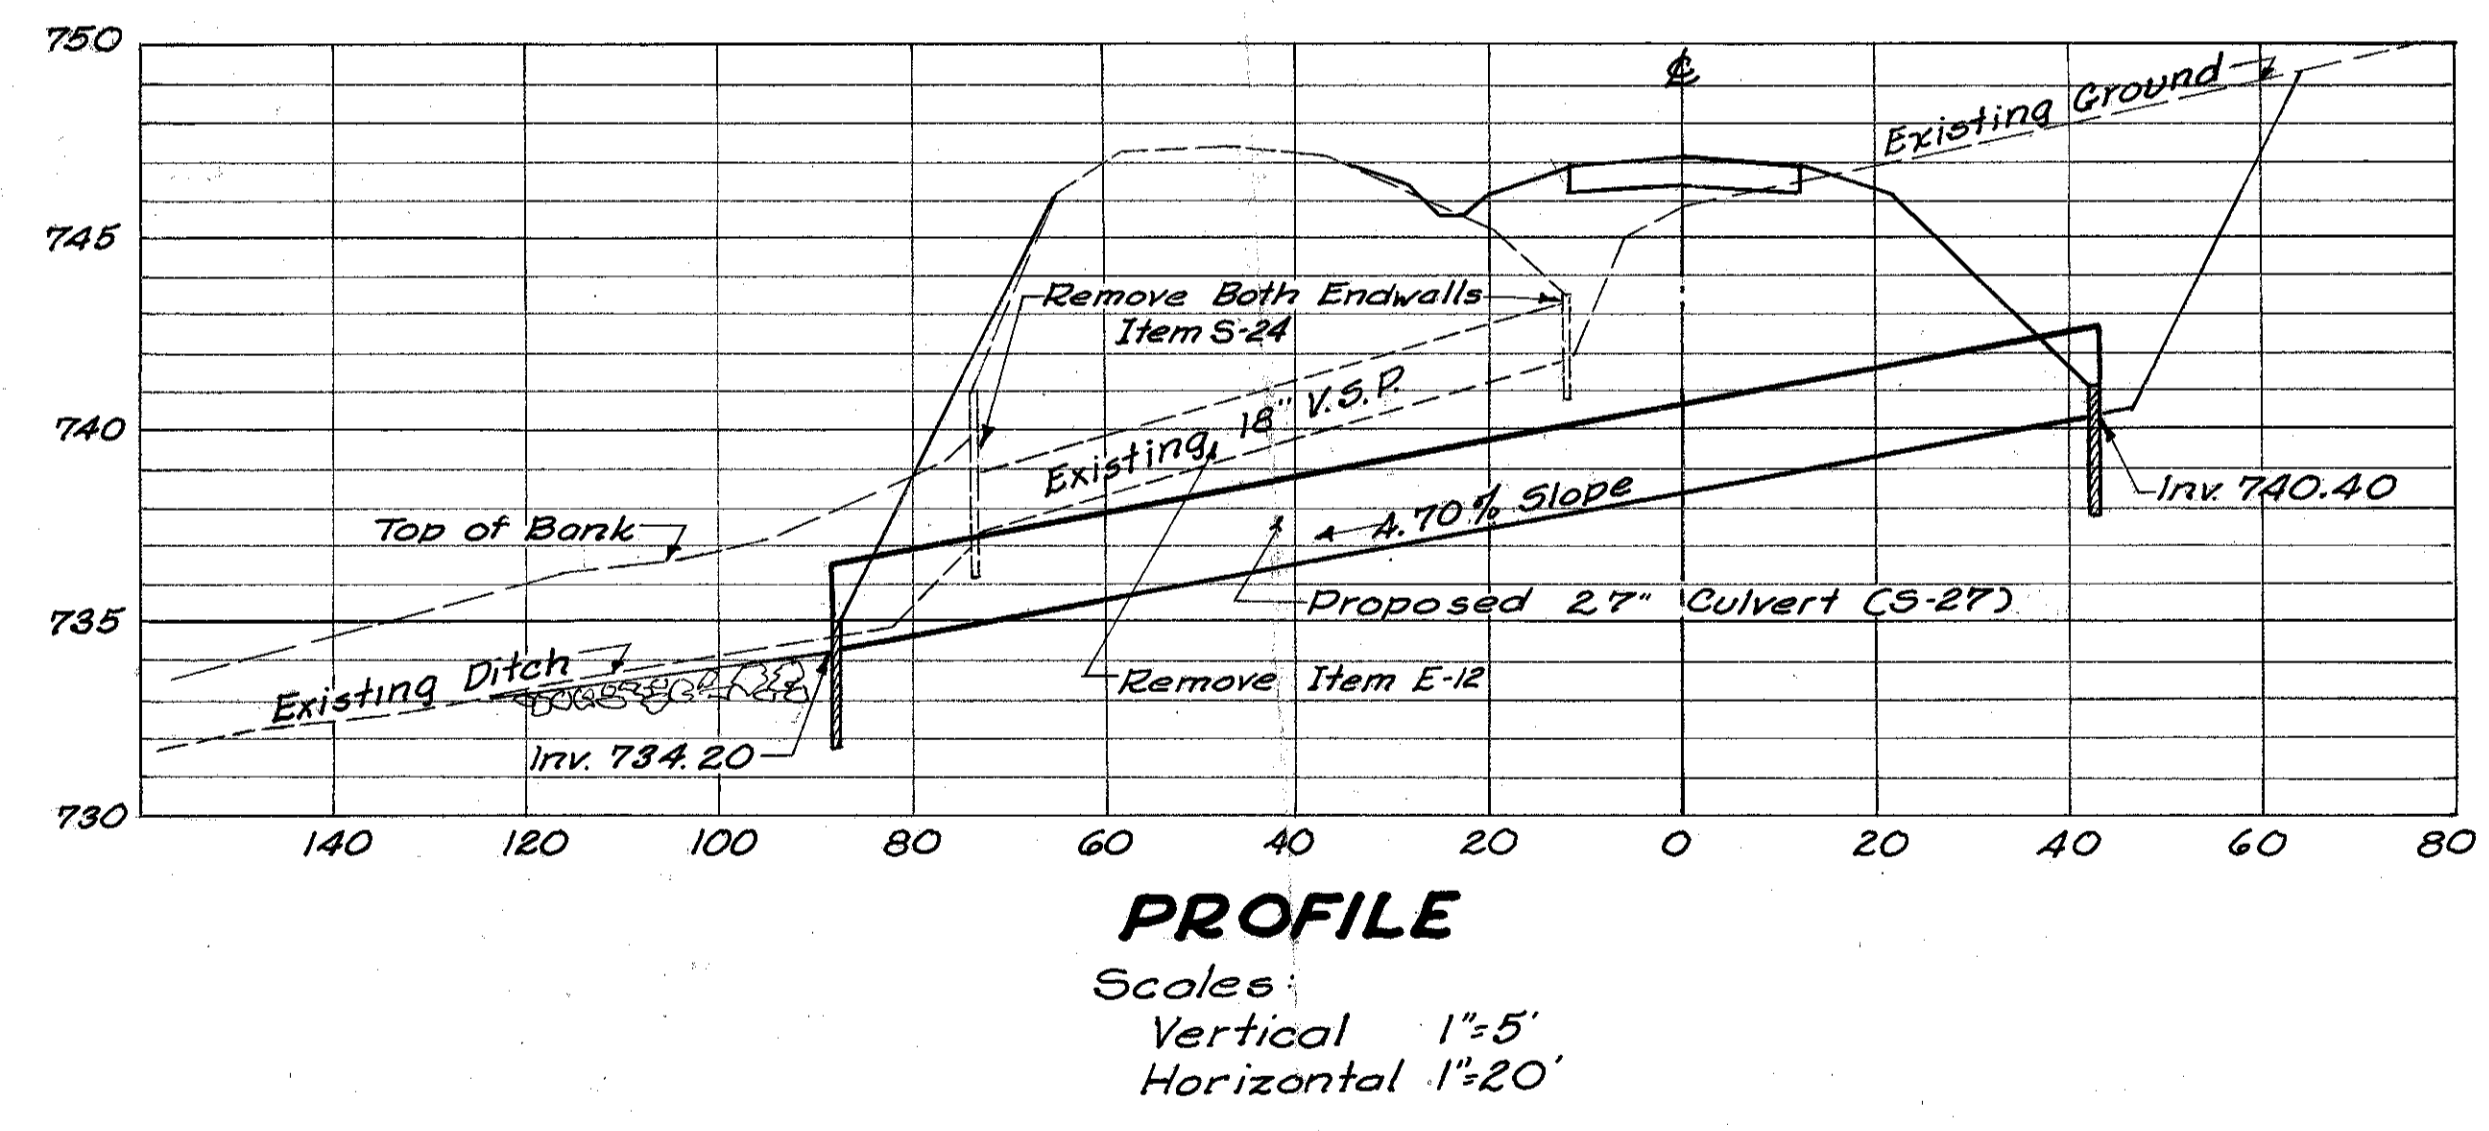
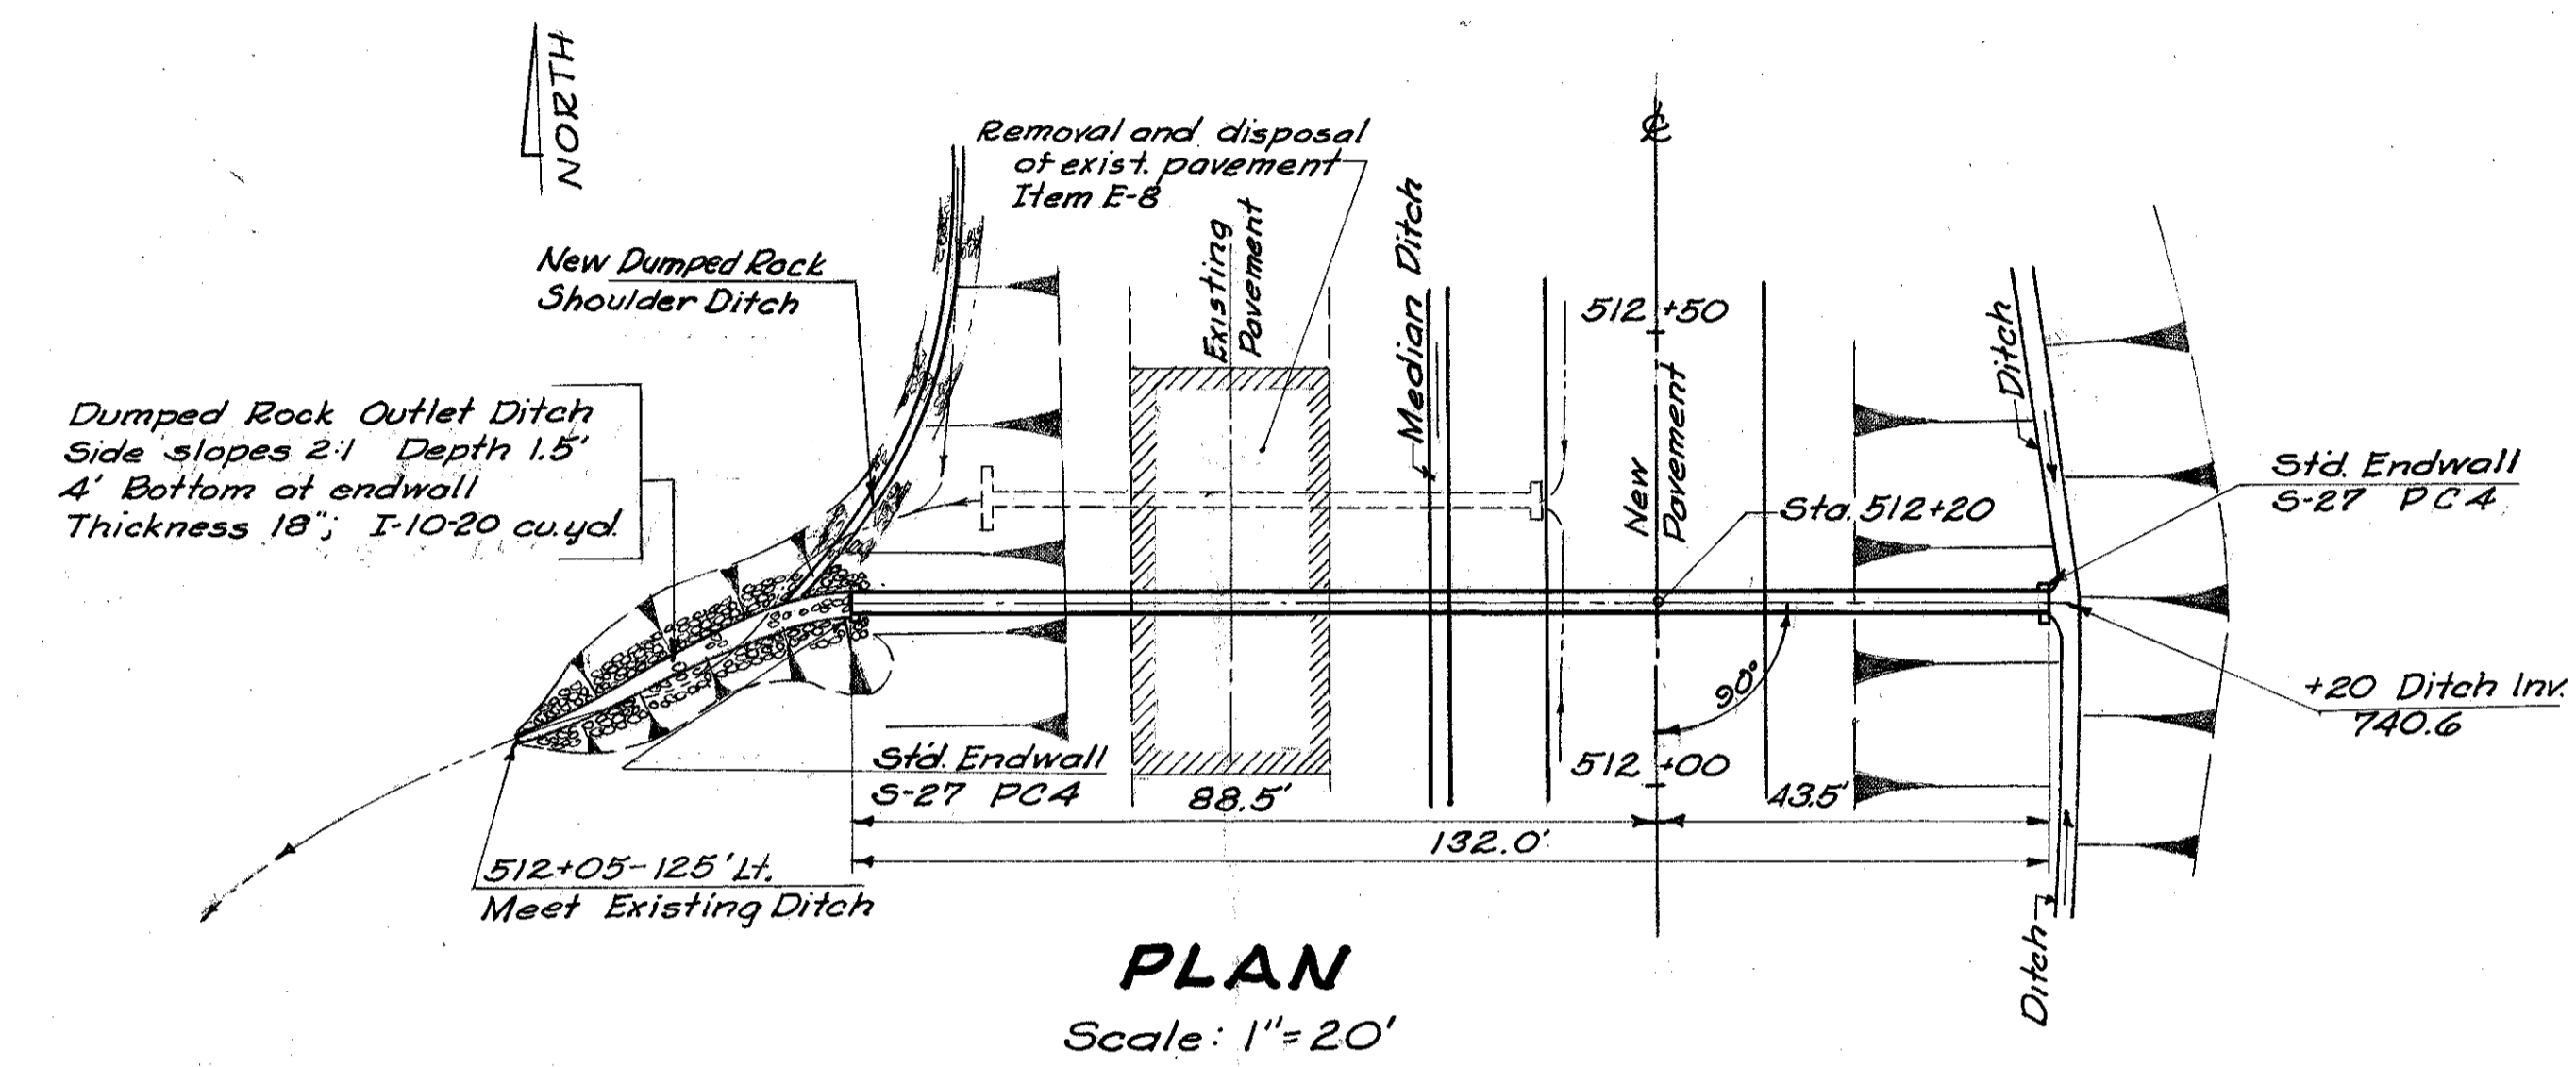


**CULVERT STA. 512+20**

**ESTIMATE OF QUANTITIES**

DESCRIPTION	ITEM	QUANTITY
Excavation for structures (dry)	E-2	140.0 cu.yd.
Channel Excavation	E-3	43.0 cu.yd.
Removal of pipe	E-12	62 lin. ft.
Concrete for structures-Class E	S-1	1.0 cu.yd.
Pipe for Roadway Culverts-27"	S-27	132 lin. ft.
Dumped Rock Fill	I-10	20.0 cu.yd.
Removal of Existing Structures	S-24	Lump Sum

**533+20**  
30" Pipe Culvert  
Drainage Area - 34.0 Acres  
Q25 - 36 cfs

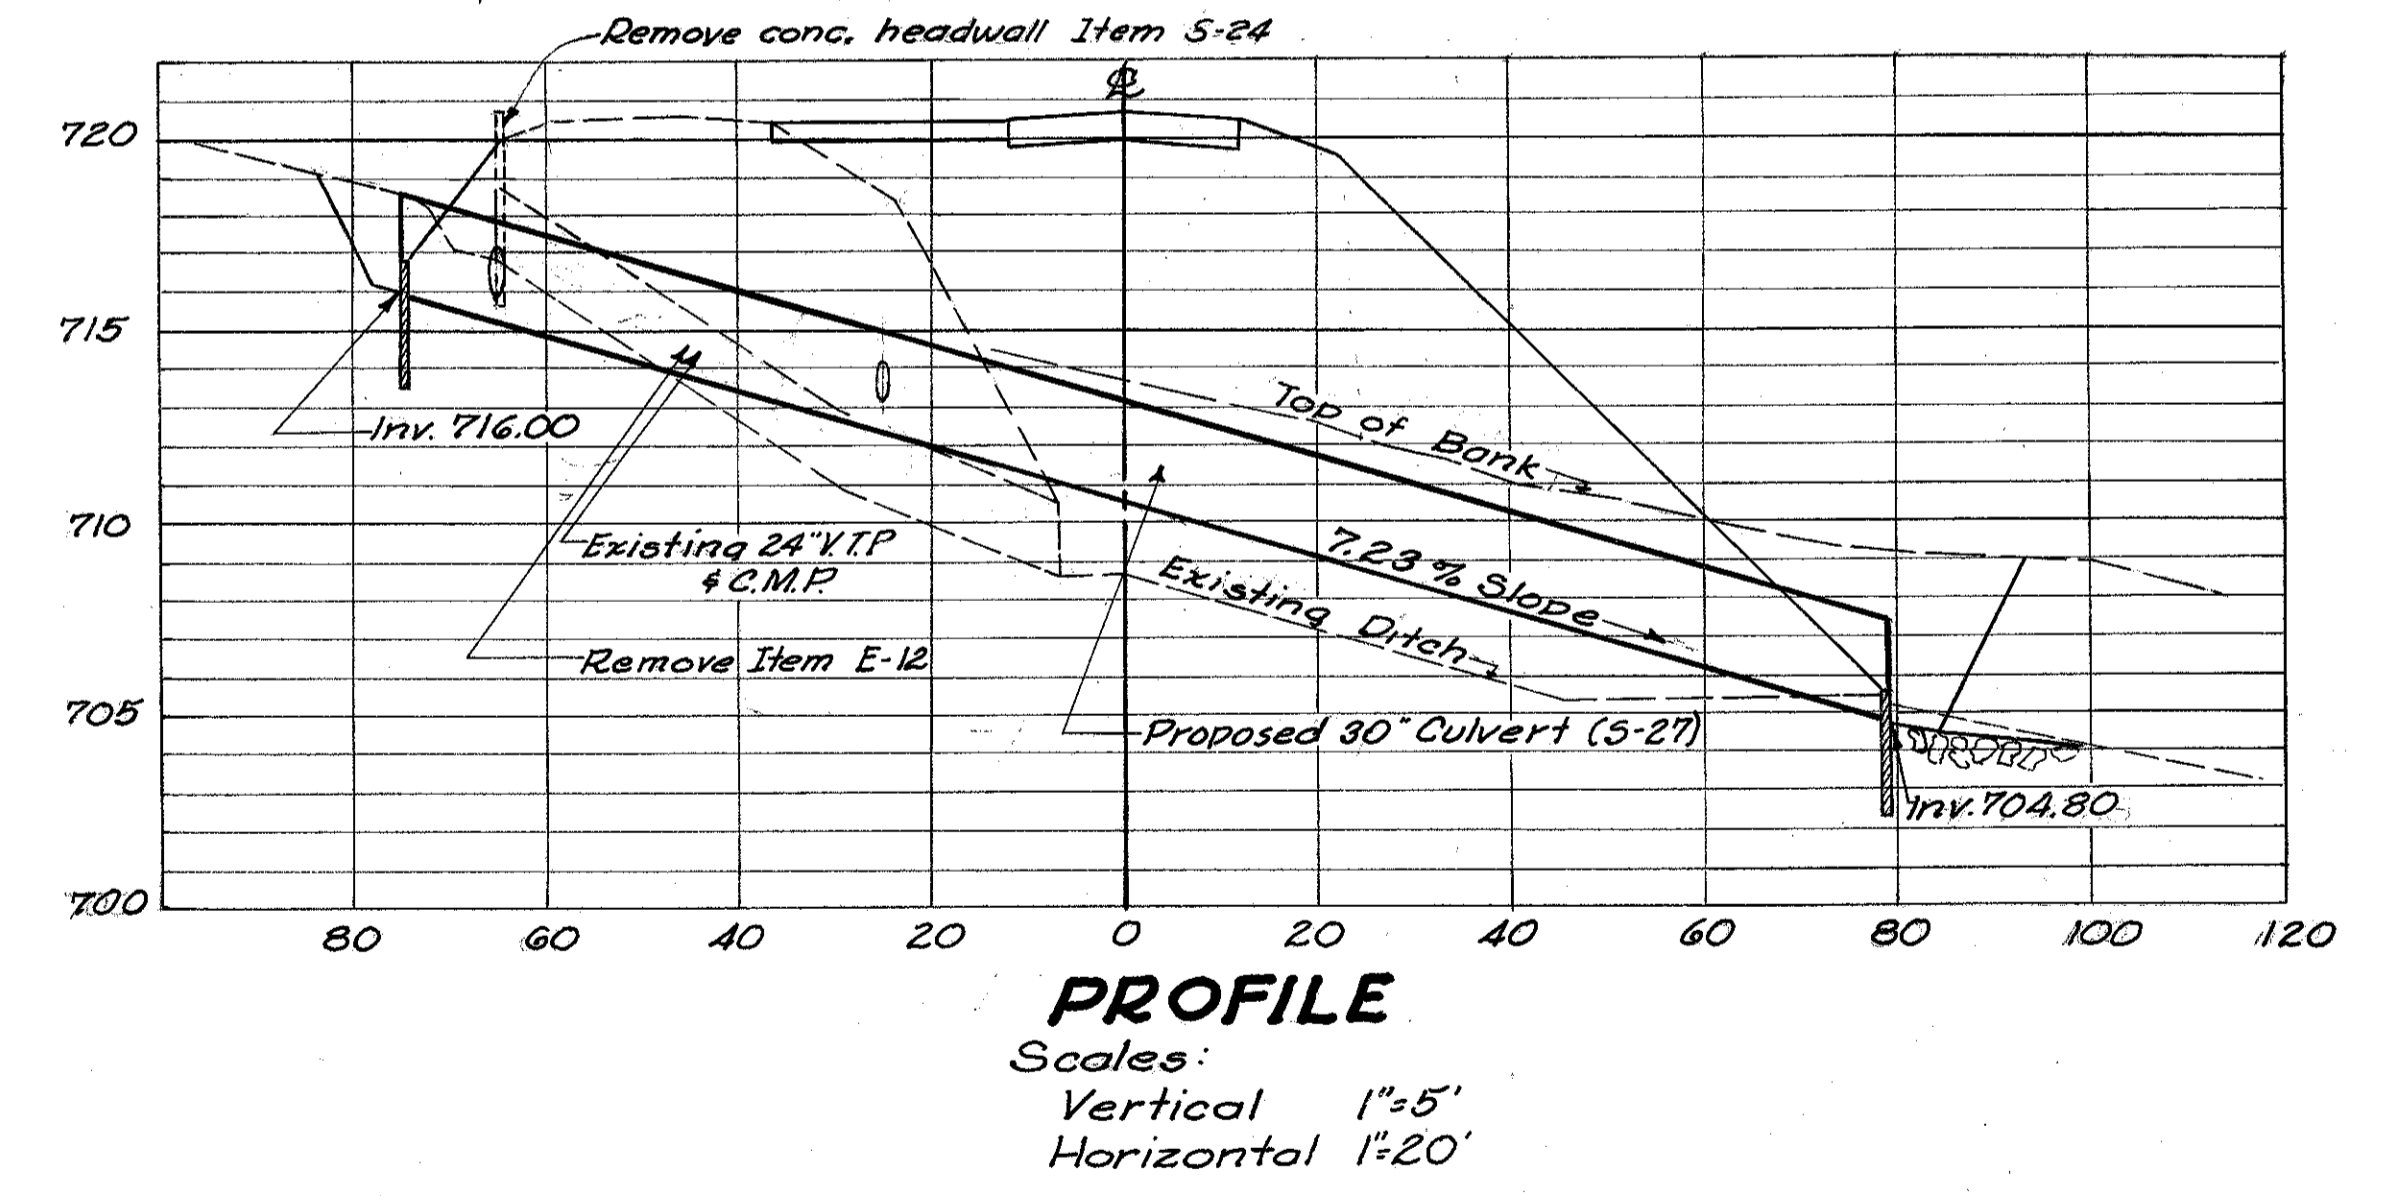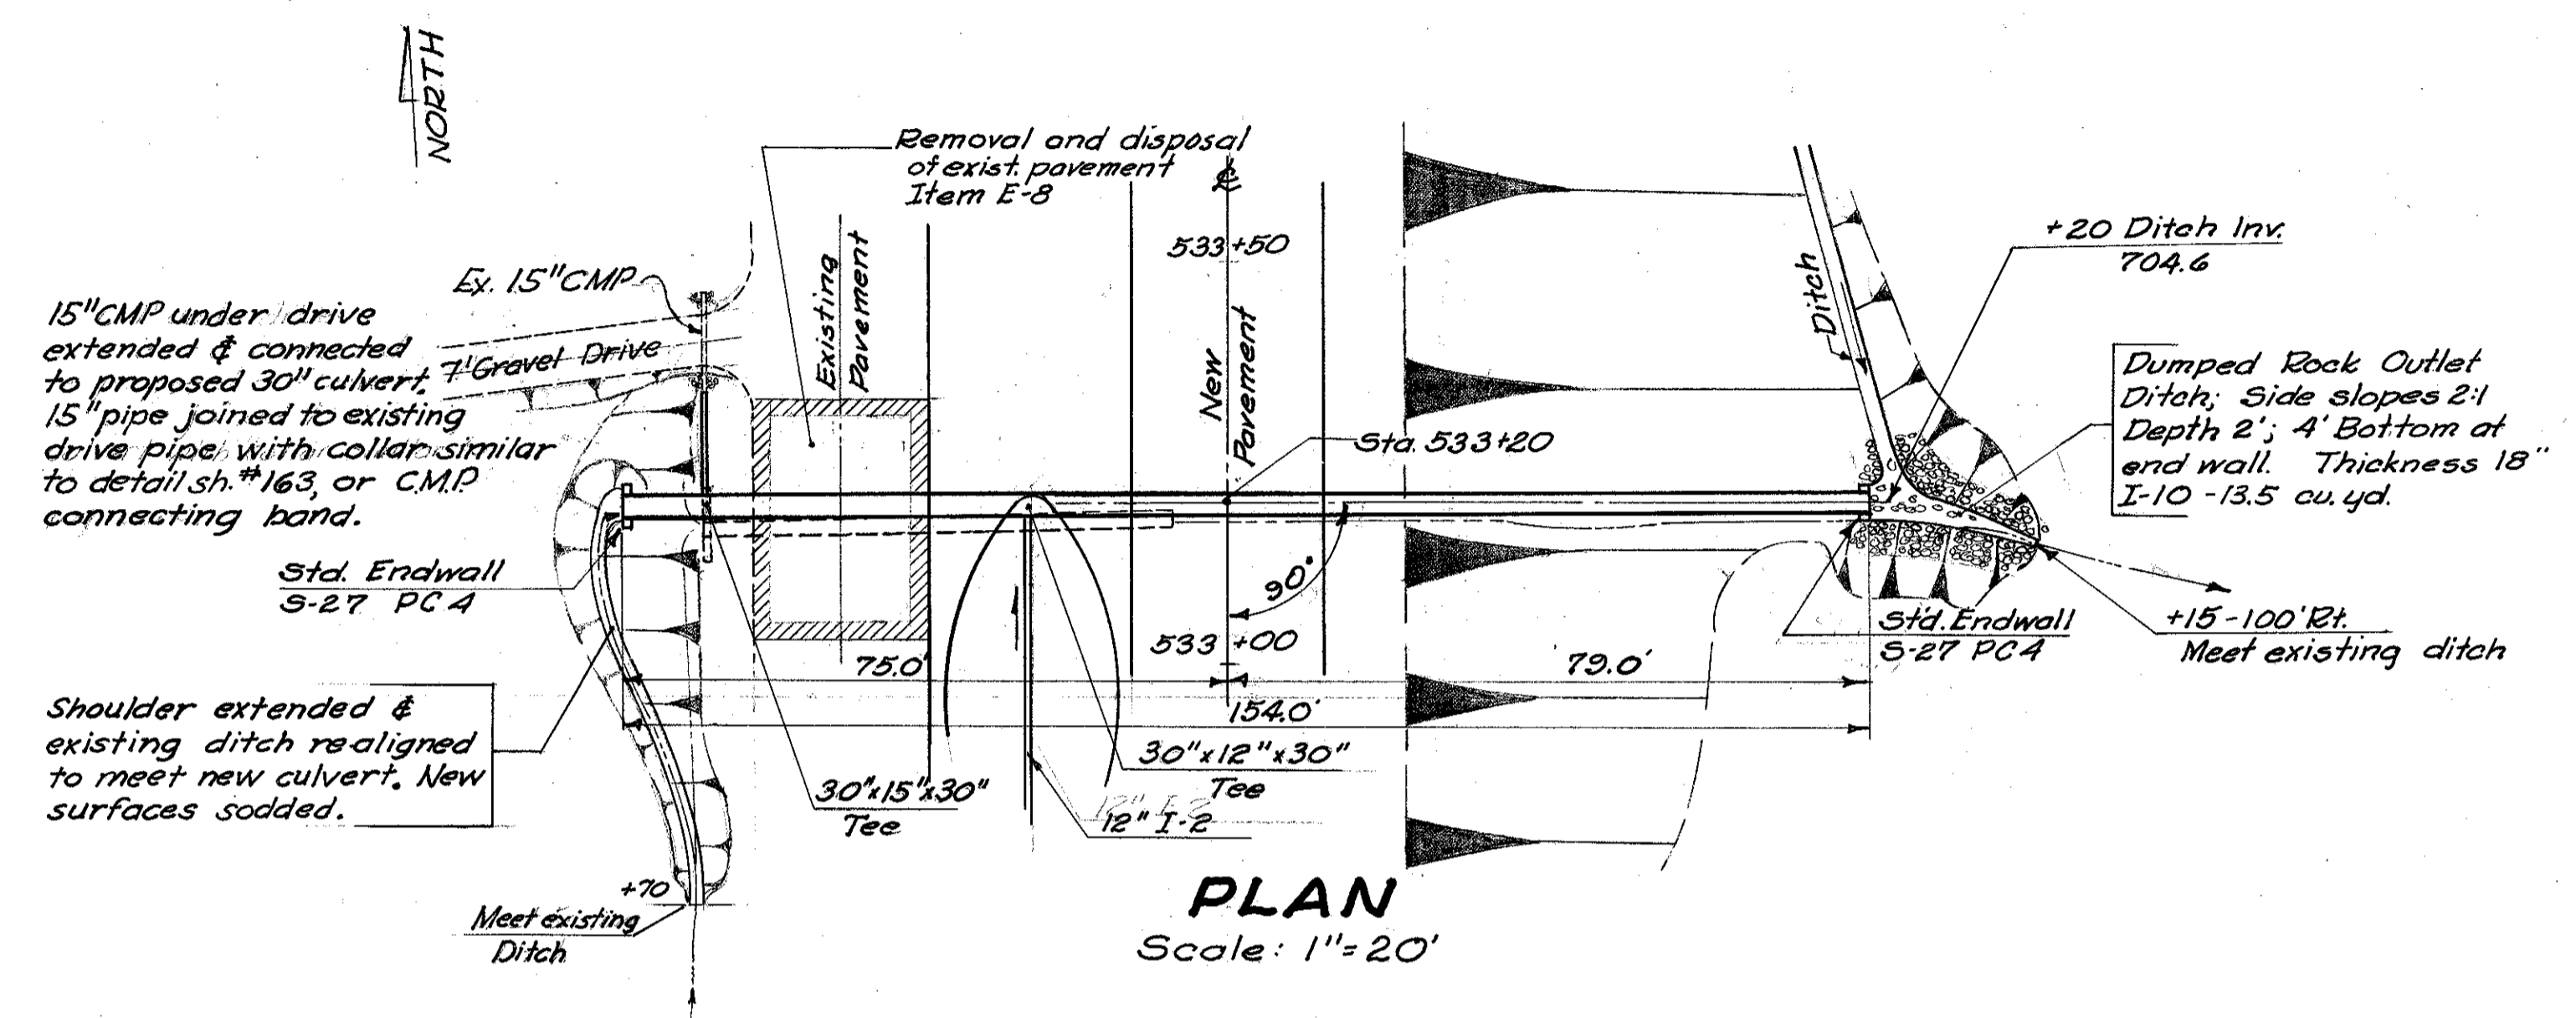

**CULVERT STA. 533+20**

**ESTIMATE OF QUANTITIES**


DESCRIPTION	ITEM	QUANTITY
Excavation for structures (dry)	E-2	61.6 cu.yd.
Channel Excavation	E-3	29.5 cu.yd.
Removal of pipe	E-12	59 lin. ft.
Concrete for structures-Class E	S-1	1.0 cu.yd.
Pipe for Roadway Culverts-30"	S-27	146 lin. ft.
Pipe Specials 30"x15"x30" Tee	I-5	1 each
Dumped Rock Fill	I-10	13.5 cu.yd.
Sodding	L-10	132 sq.yd.
Pipe for Driveways - 15"	I-1	12 lin. ft.
Pipe Specials 30"x12"x30" Tee	I-5	1 each
Removal of existing structures	S-24	Lump Sum

**ESTIMATE OF QUANTITIES**


DESCRIPTION	ITEM	QUANTITY
Excavation for Structures (Dry)	E-2	53.6 Cu.Yd.
Channel Excavation	E-3	14.4 Cu.Yd.
Concrete for Structures	S-1	1.0 Cu.Yd.
Pipe for Roadway Culverts 30"	S-27	162 lin. ft.
Catch Basins No. 1-4	I-8	1 each
Dumped Rock Fill	I-10	7.9 Cu.Yd.

**ESTIMATE OF QUANTITIES**


DESCRIPTION	ITEM	QUANTITY
Excavation for Structures (Dry)	E-2	33.5 Cu.Yd.
Channel Excavation	E-3	8.9 Cu.Yd.
Concrete for Structures	S-1	0.6 Cu.Yd.
Pipe for Roadway Culverts 18"	S-27	178 lin. ft.
Catch Basins No. 1-3	I-8	1 each
Dumped Rock Fill	I-10	5.4 Cu.Yd.

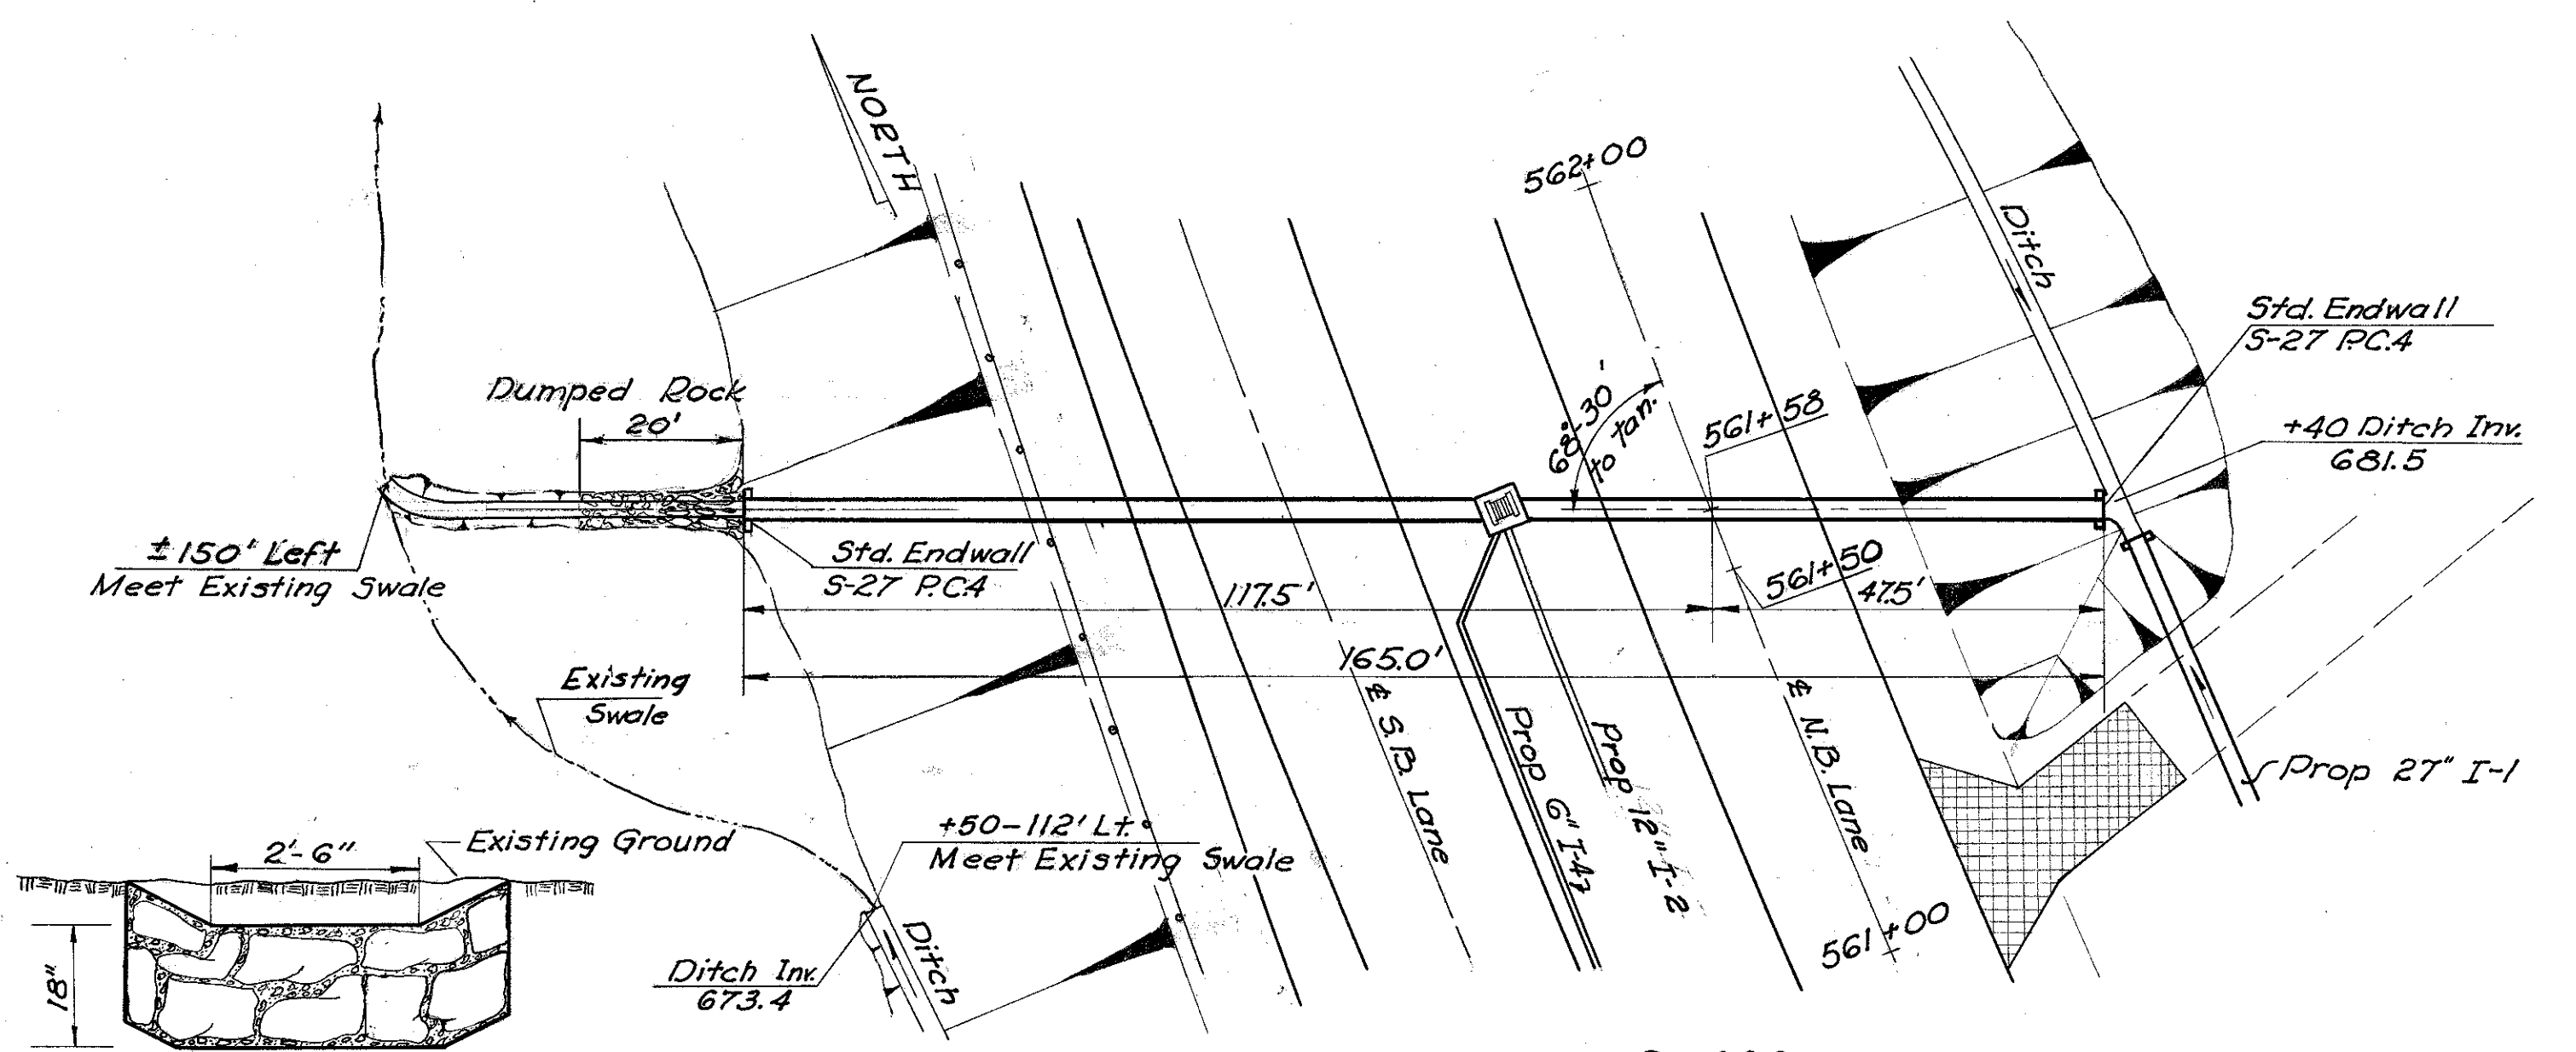


**PLAN**  
Scale 1"=20'

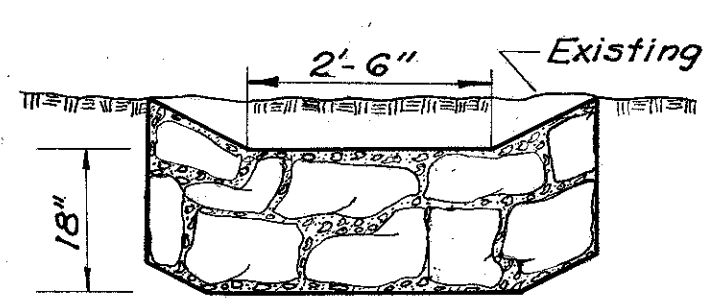


**SECTION THRU  
OUTLET DITCH**  
Scale 1/2"=1'-0"

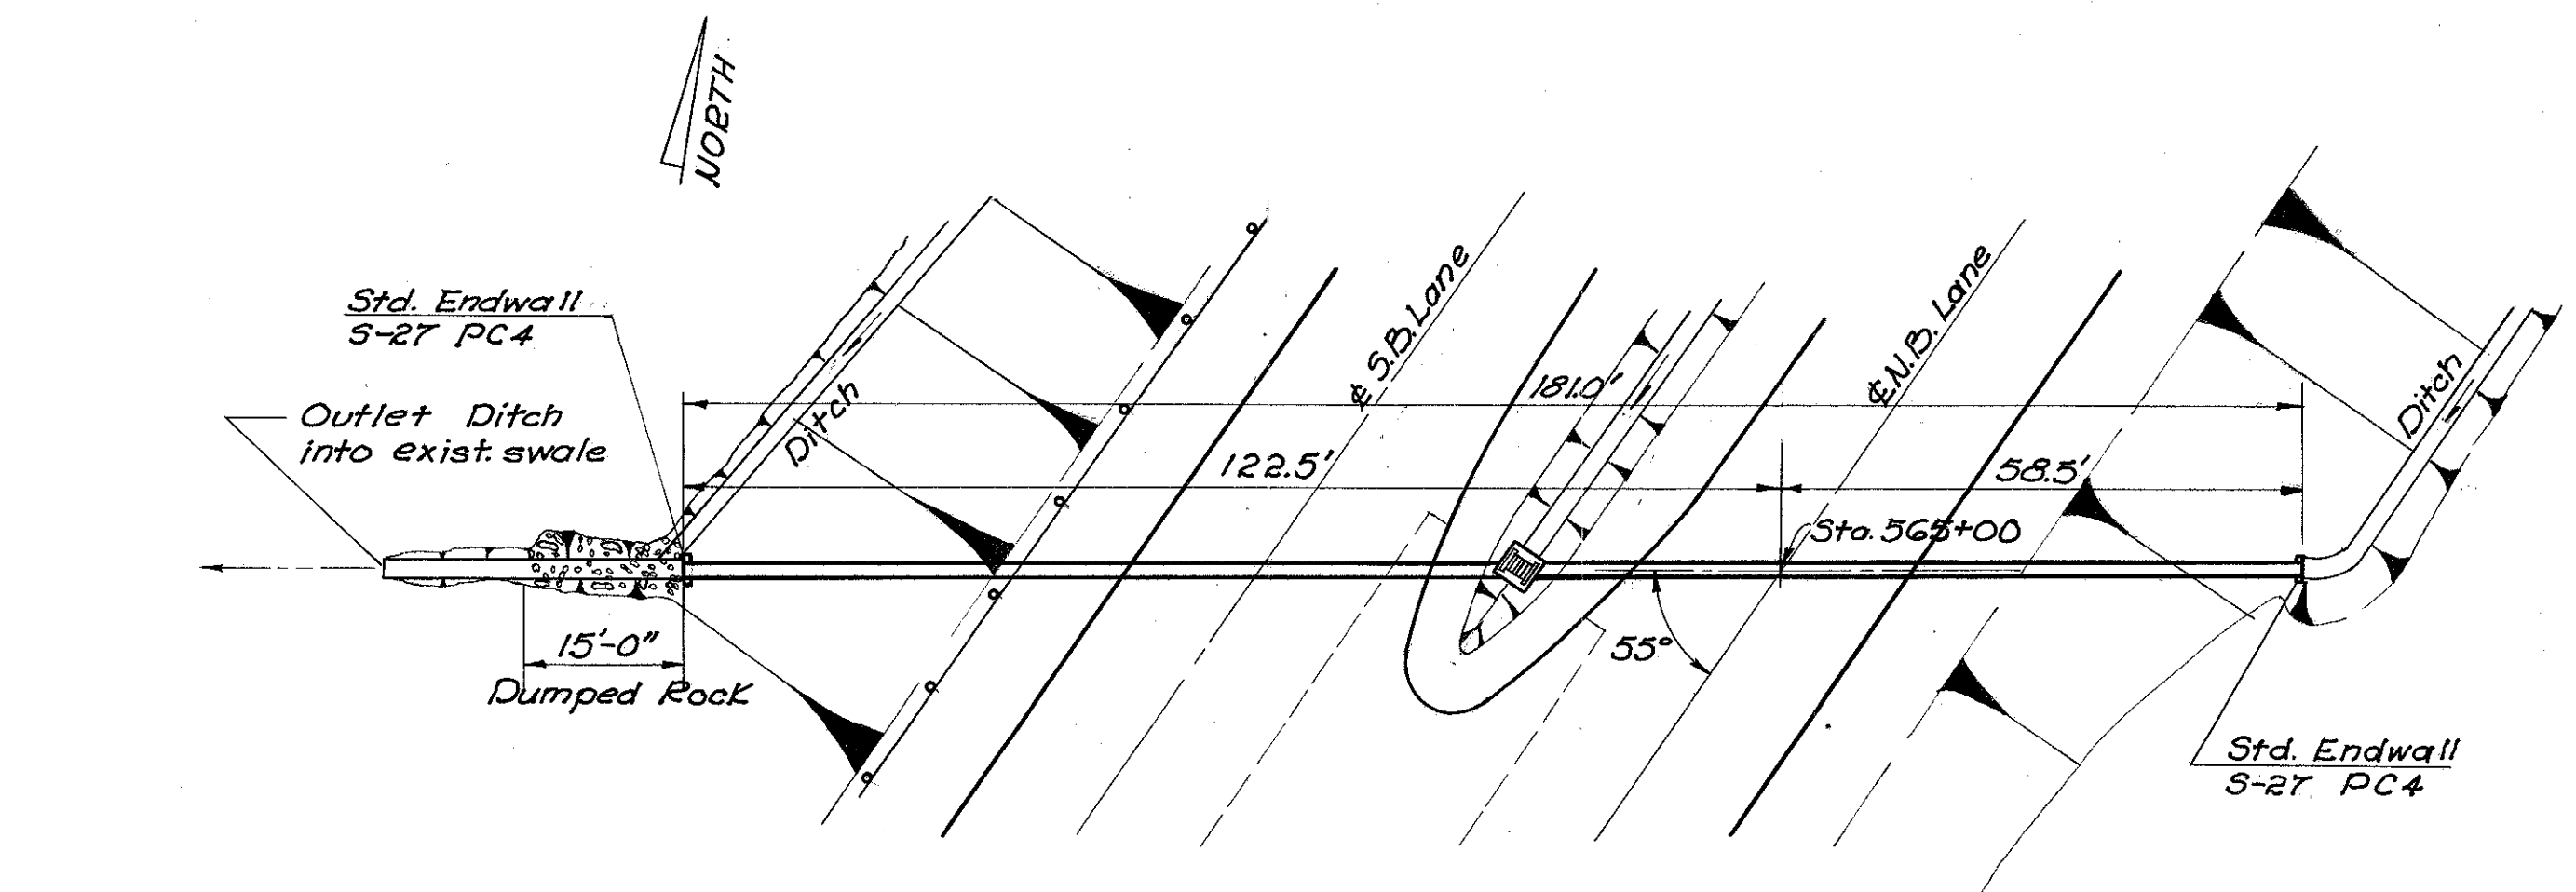

**PLAN**  
Scale 1"=20'

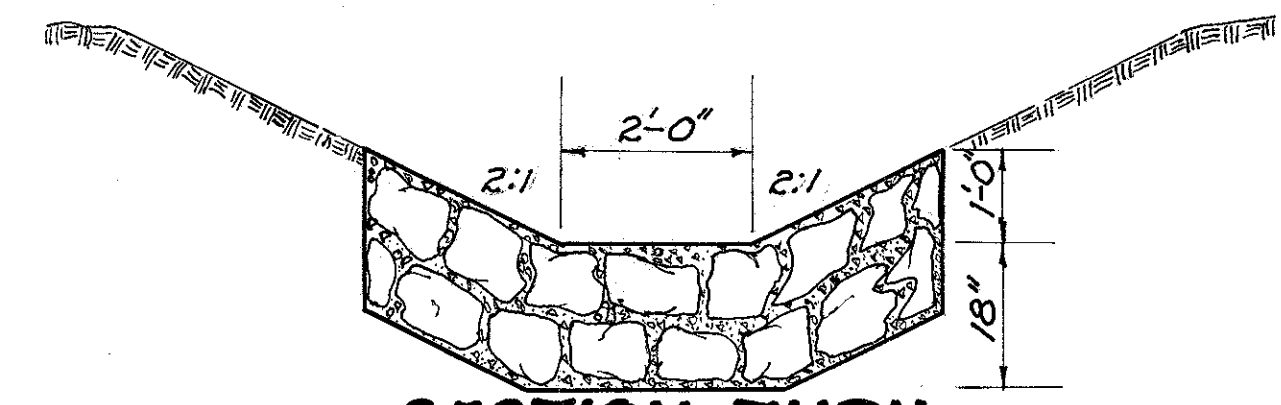

**SECTION THRU  
DUMPED ROCK DITCH**  
Scale 1/2"=1'-0"

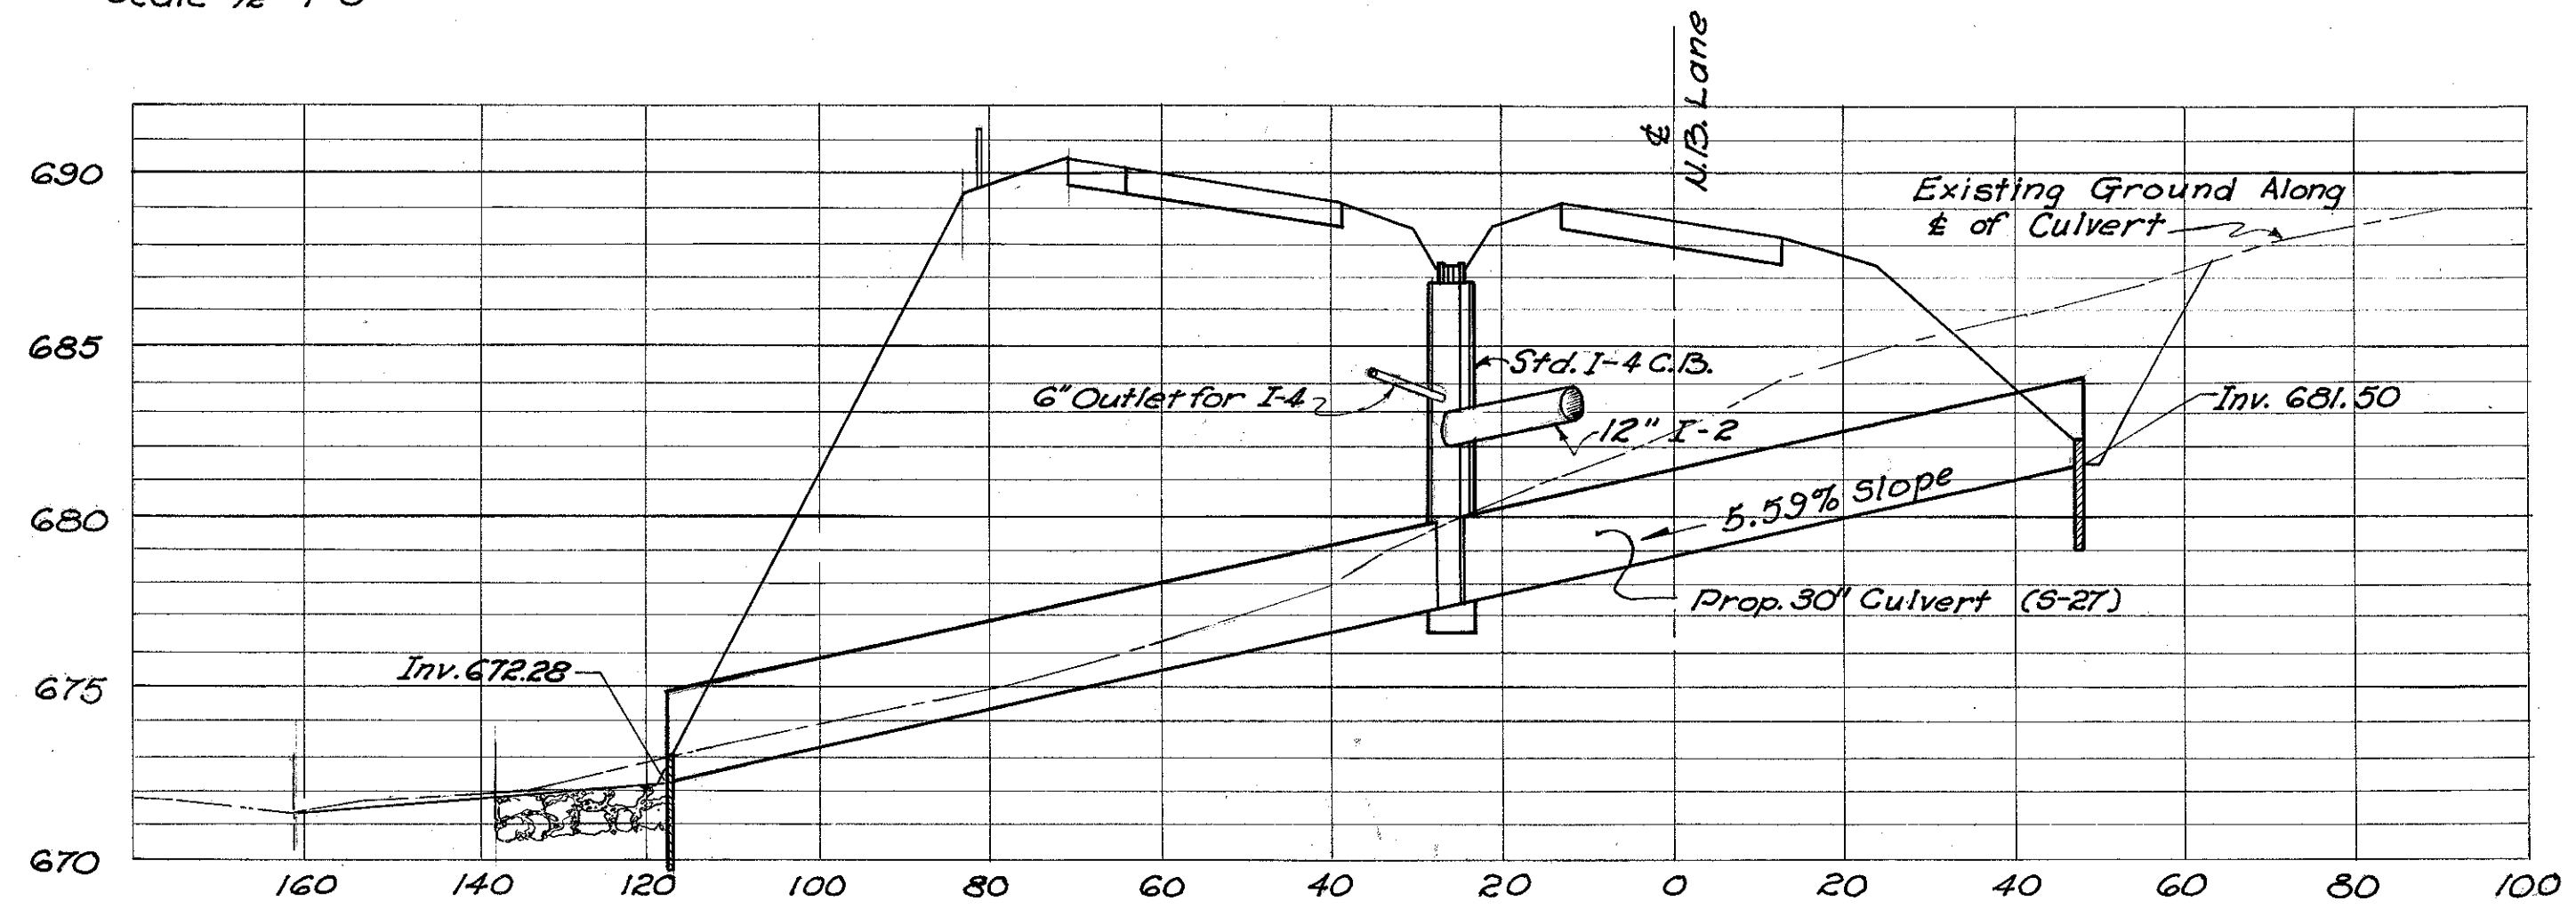


**561+58**  
30" PIPE CULVERT  
DRAINAGE AREA - 17.5 ACRES  
Q<sub>25</sub> - 25 cfs.

**PROFILE**

Scales:  
Horizontal 1"=20'  
Vertical 1"=5'

**CULVERT STA. 561+58**



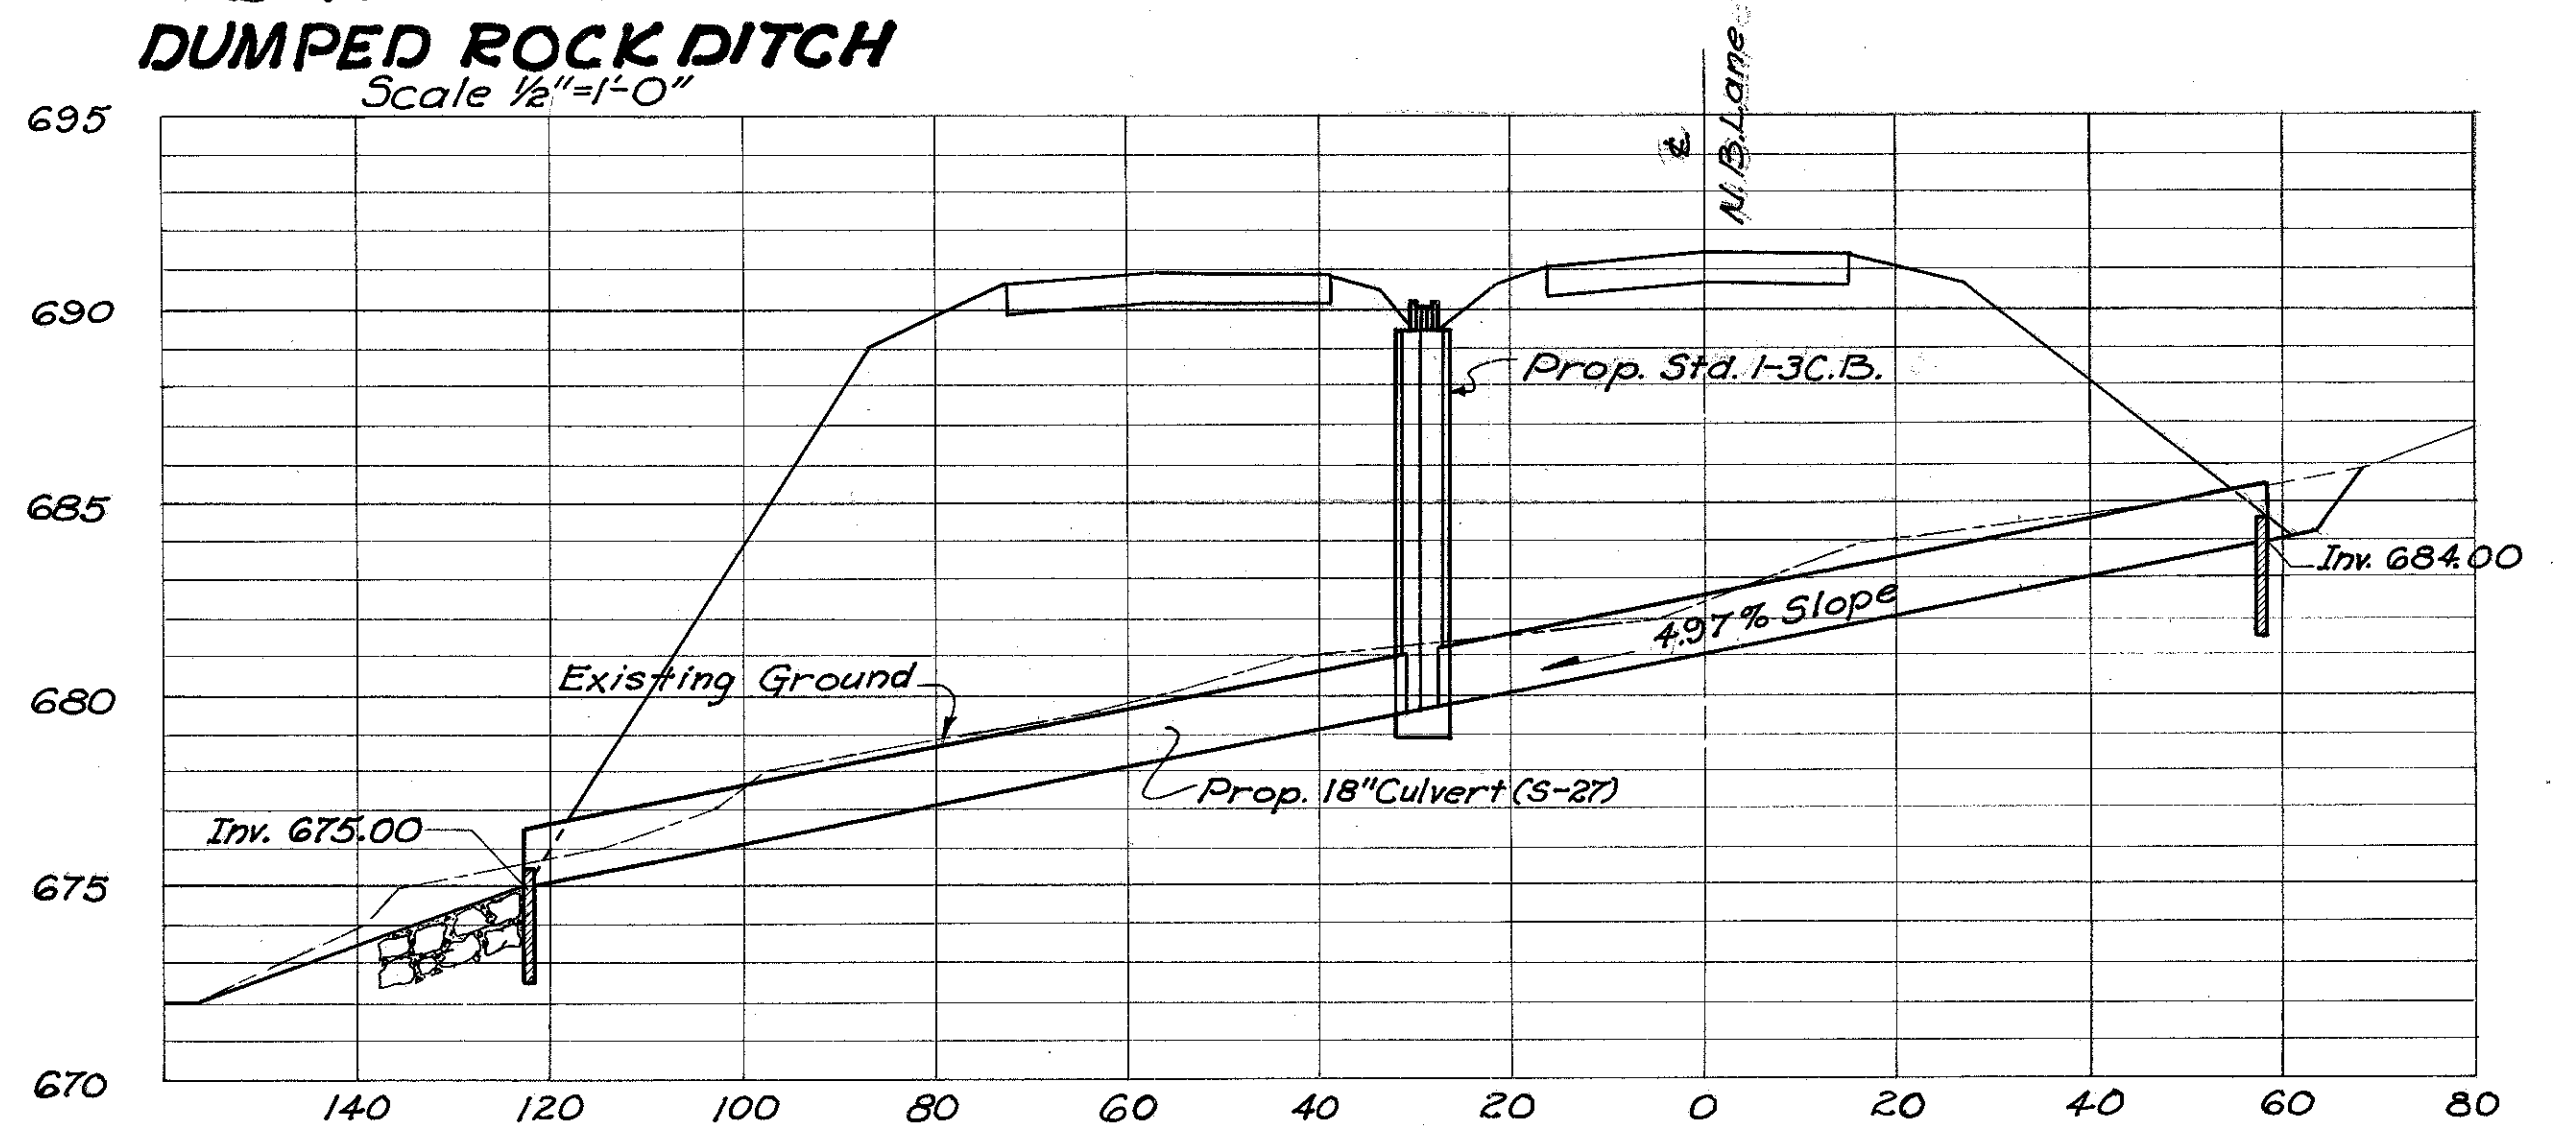


**565+00**  
18" PIPE CULVERT  
DRAINAGE AREA - 4.0 ACRES  
Q<sub>25</sub> - 15 cfs.

**PROFILE**

Scales:  
Horizontal 1"=5'  
Vertical 1"=20'

**CULVERT STA. 565+00**


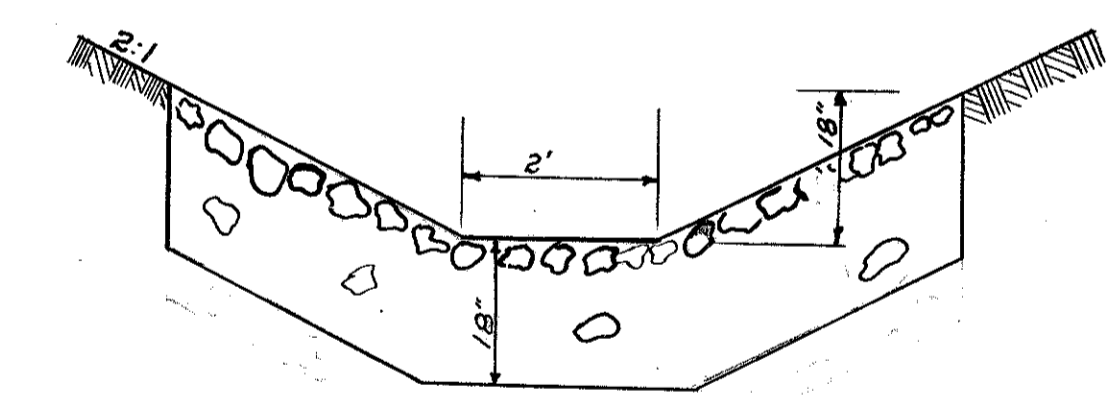
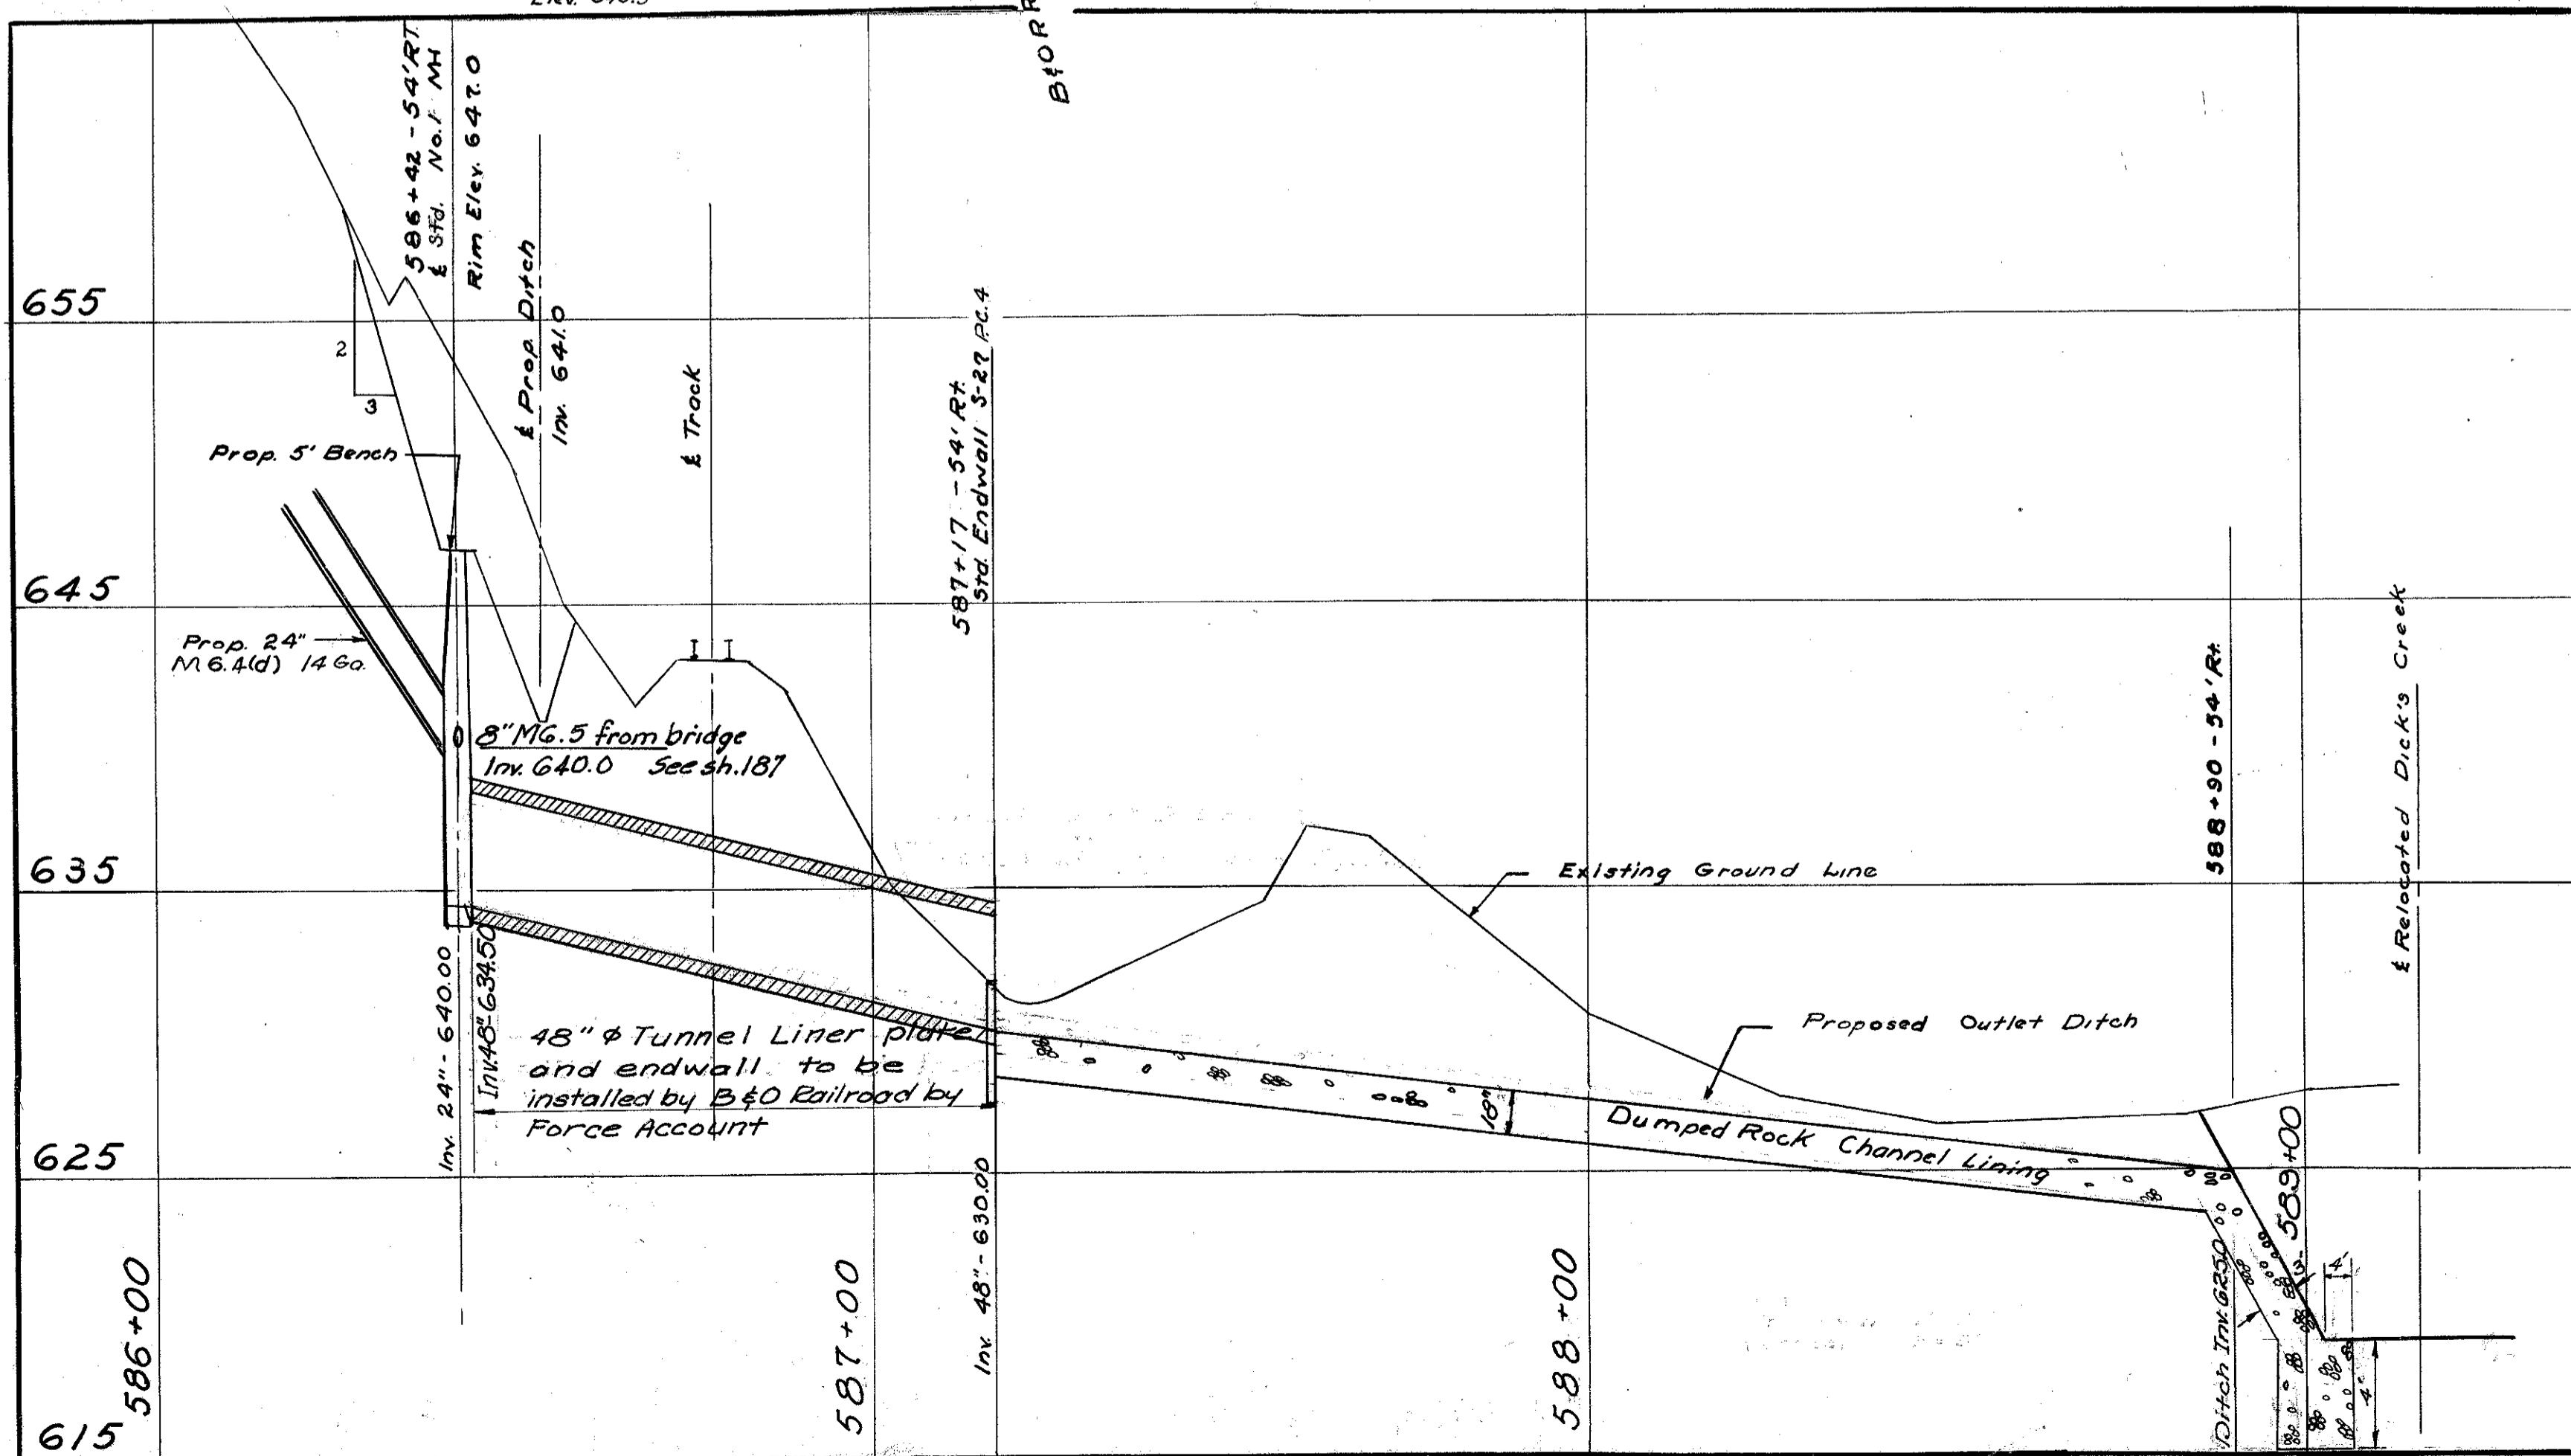
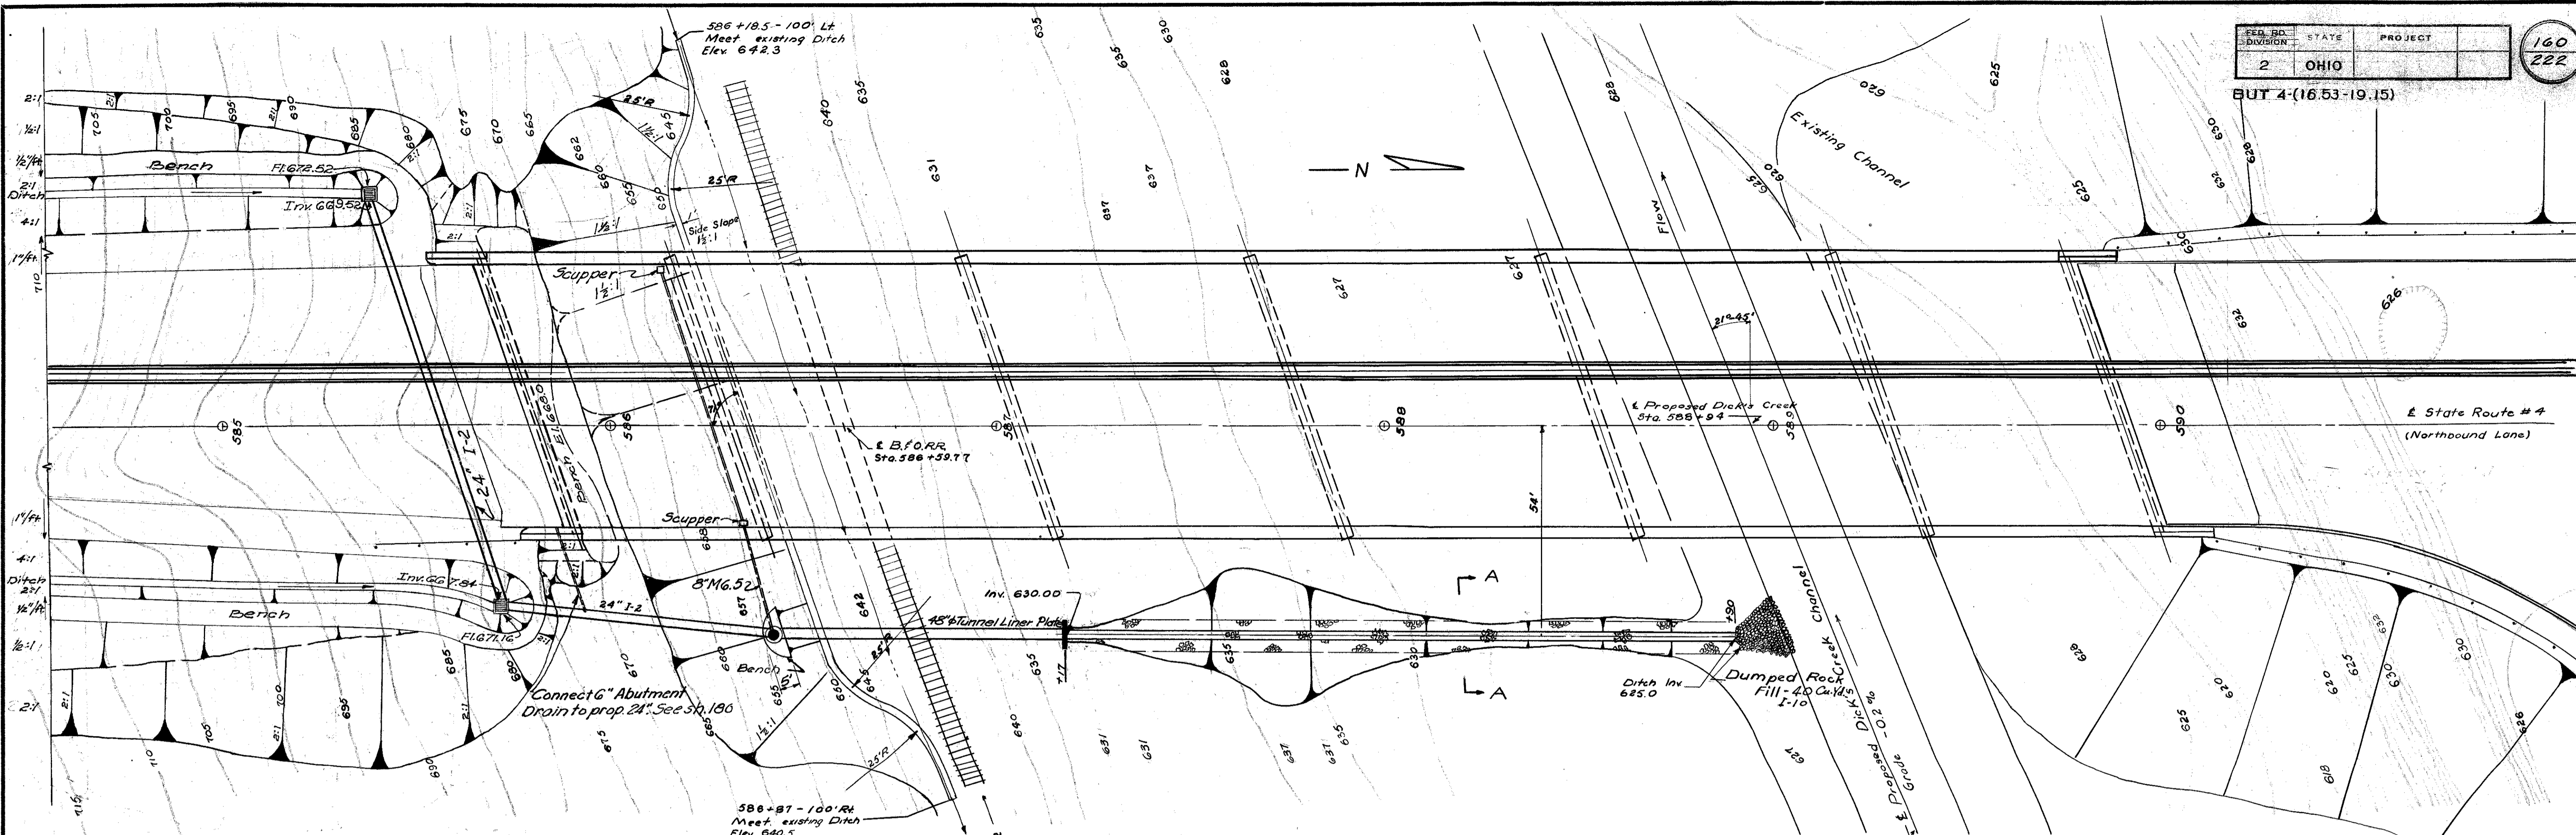


Scales:  
Horizontal: 1" = 20'  
Vertical: 1" = 5'

DRAINAGE AREA  
DICK'S CREEK  
30.60 SQ. MILES


**CHANNEL CURVE DATA**

$\Delta = 44^\circ-17'$   
 $R = 160'$   
 $L = 123.7$   
 $T = 65.1$   
 $P.I. = \text{Sta. } 3+75.2$

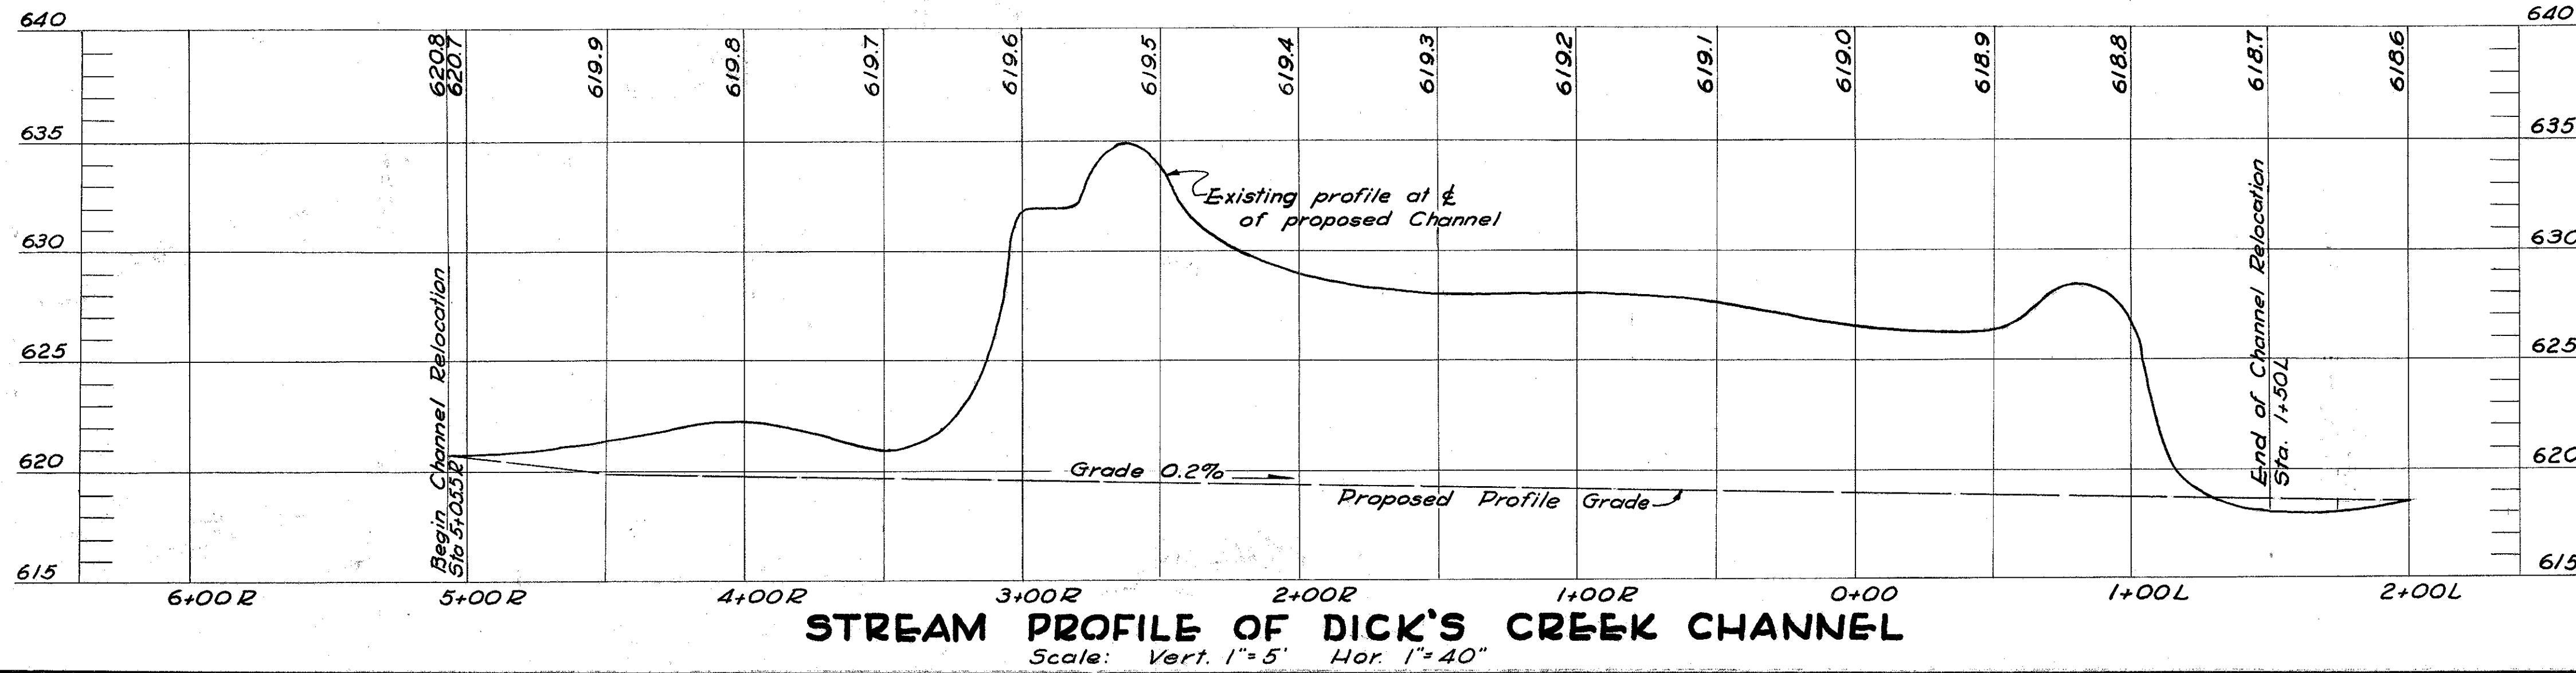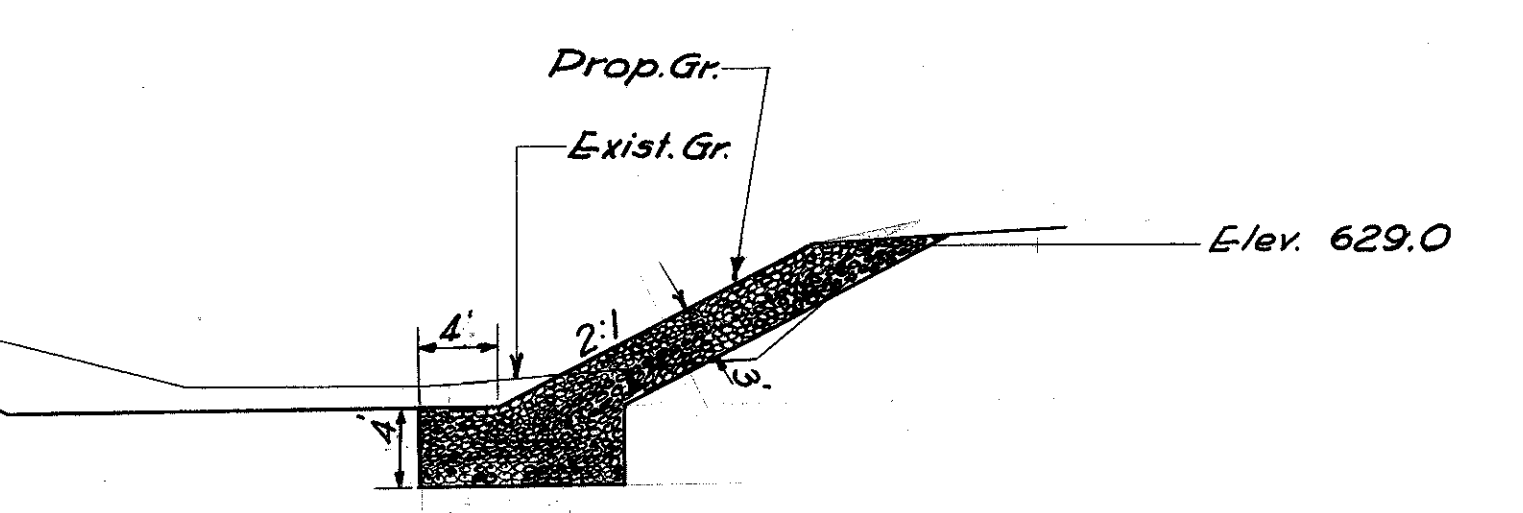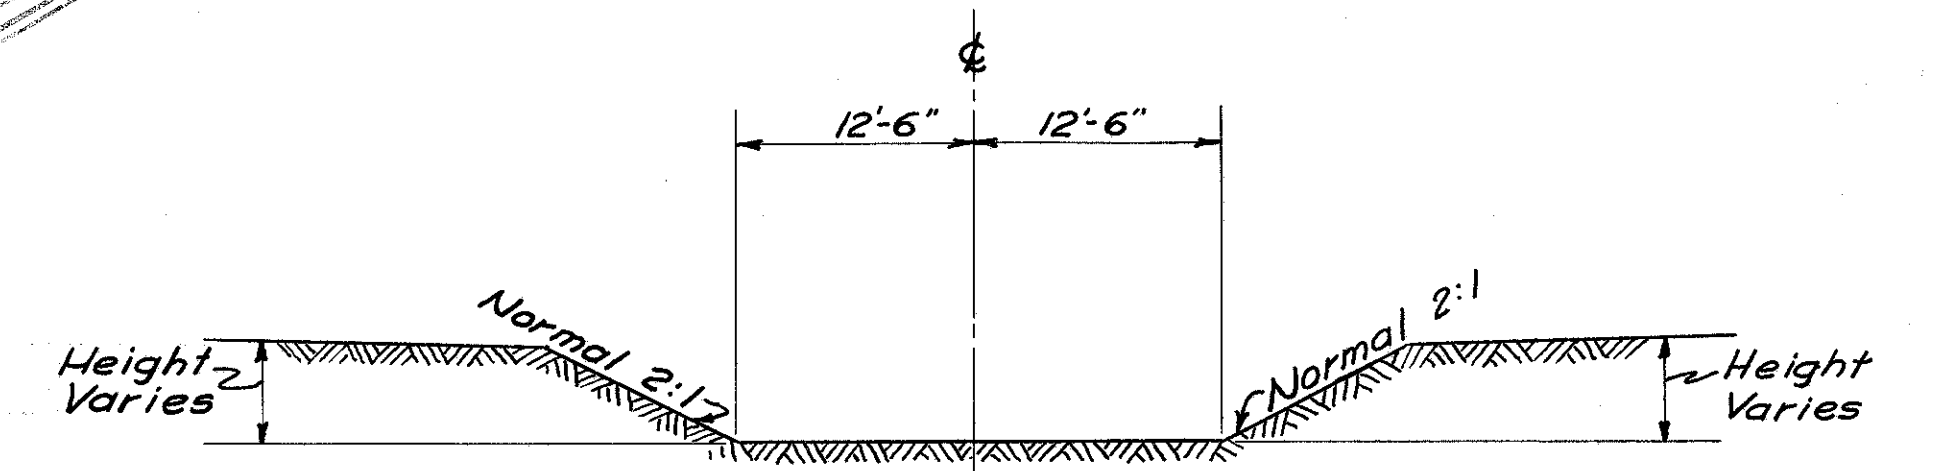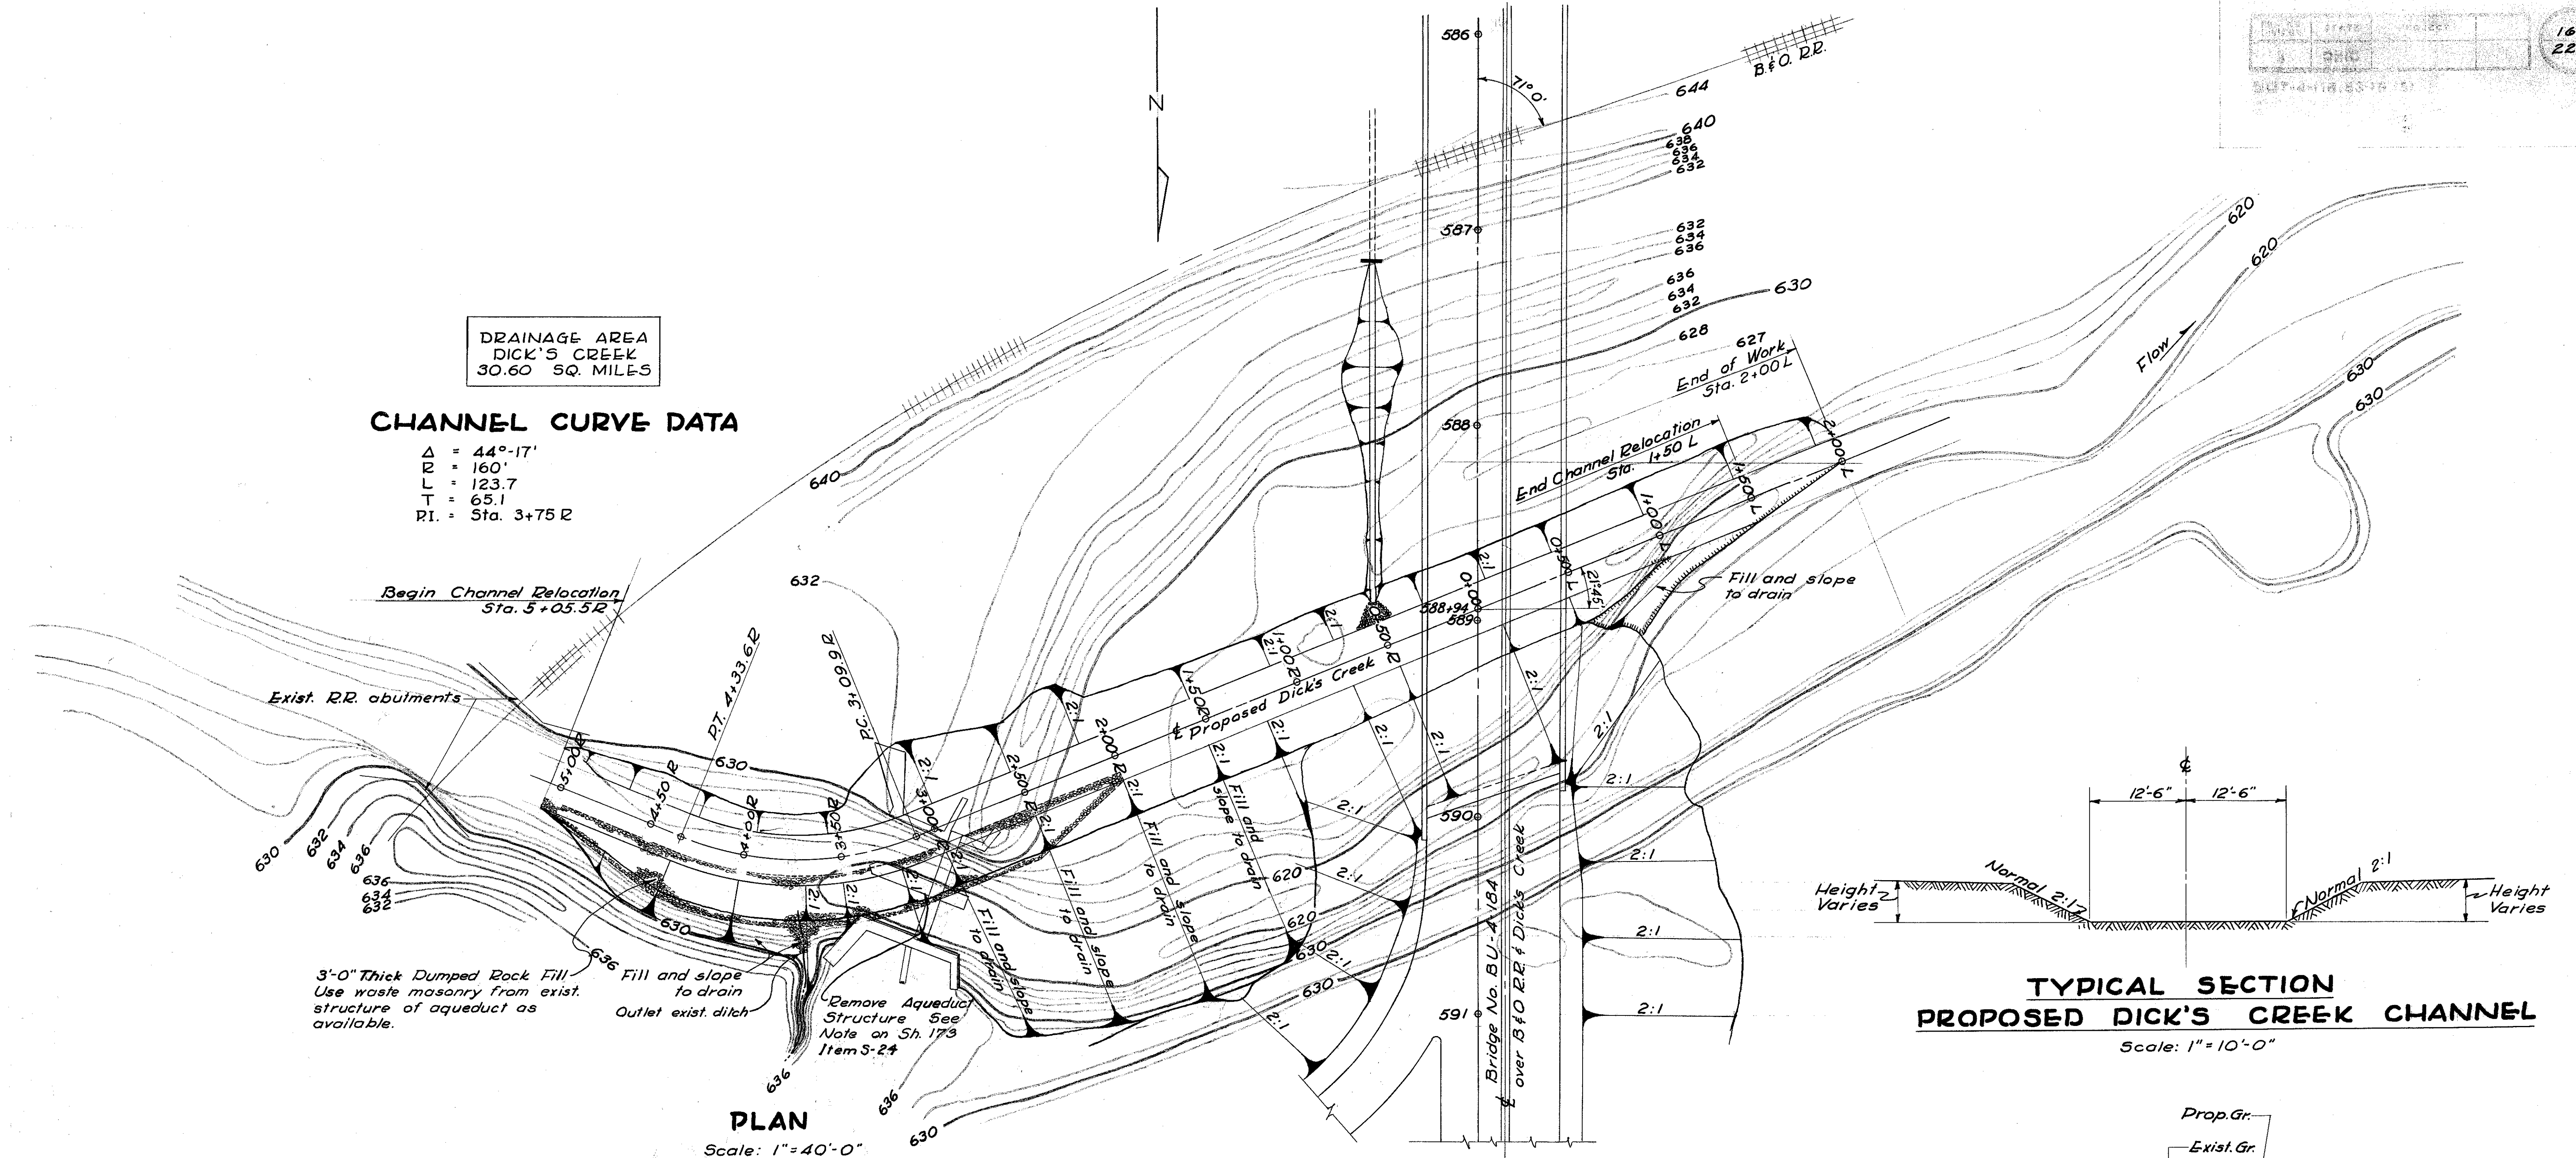


For quantities for Dick's Creek Channel Relocation See Sh. 173



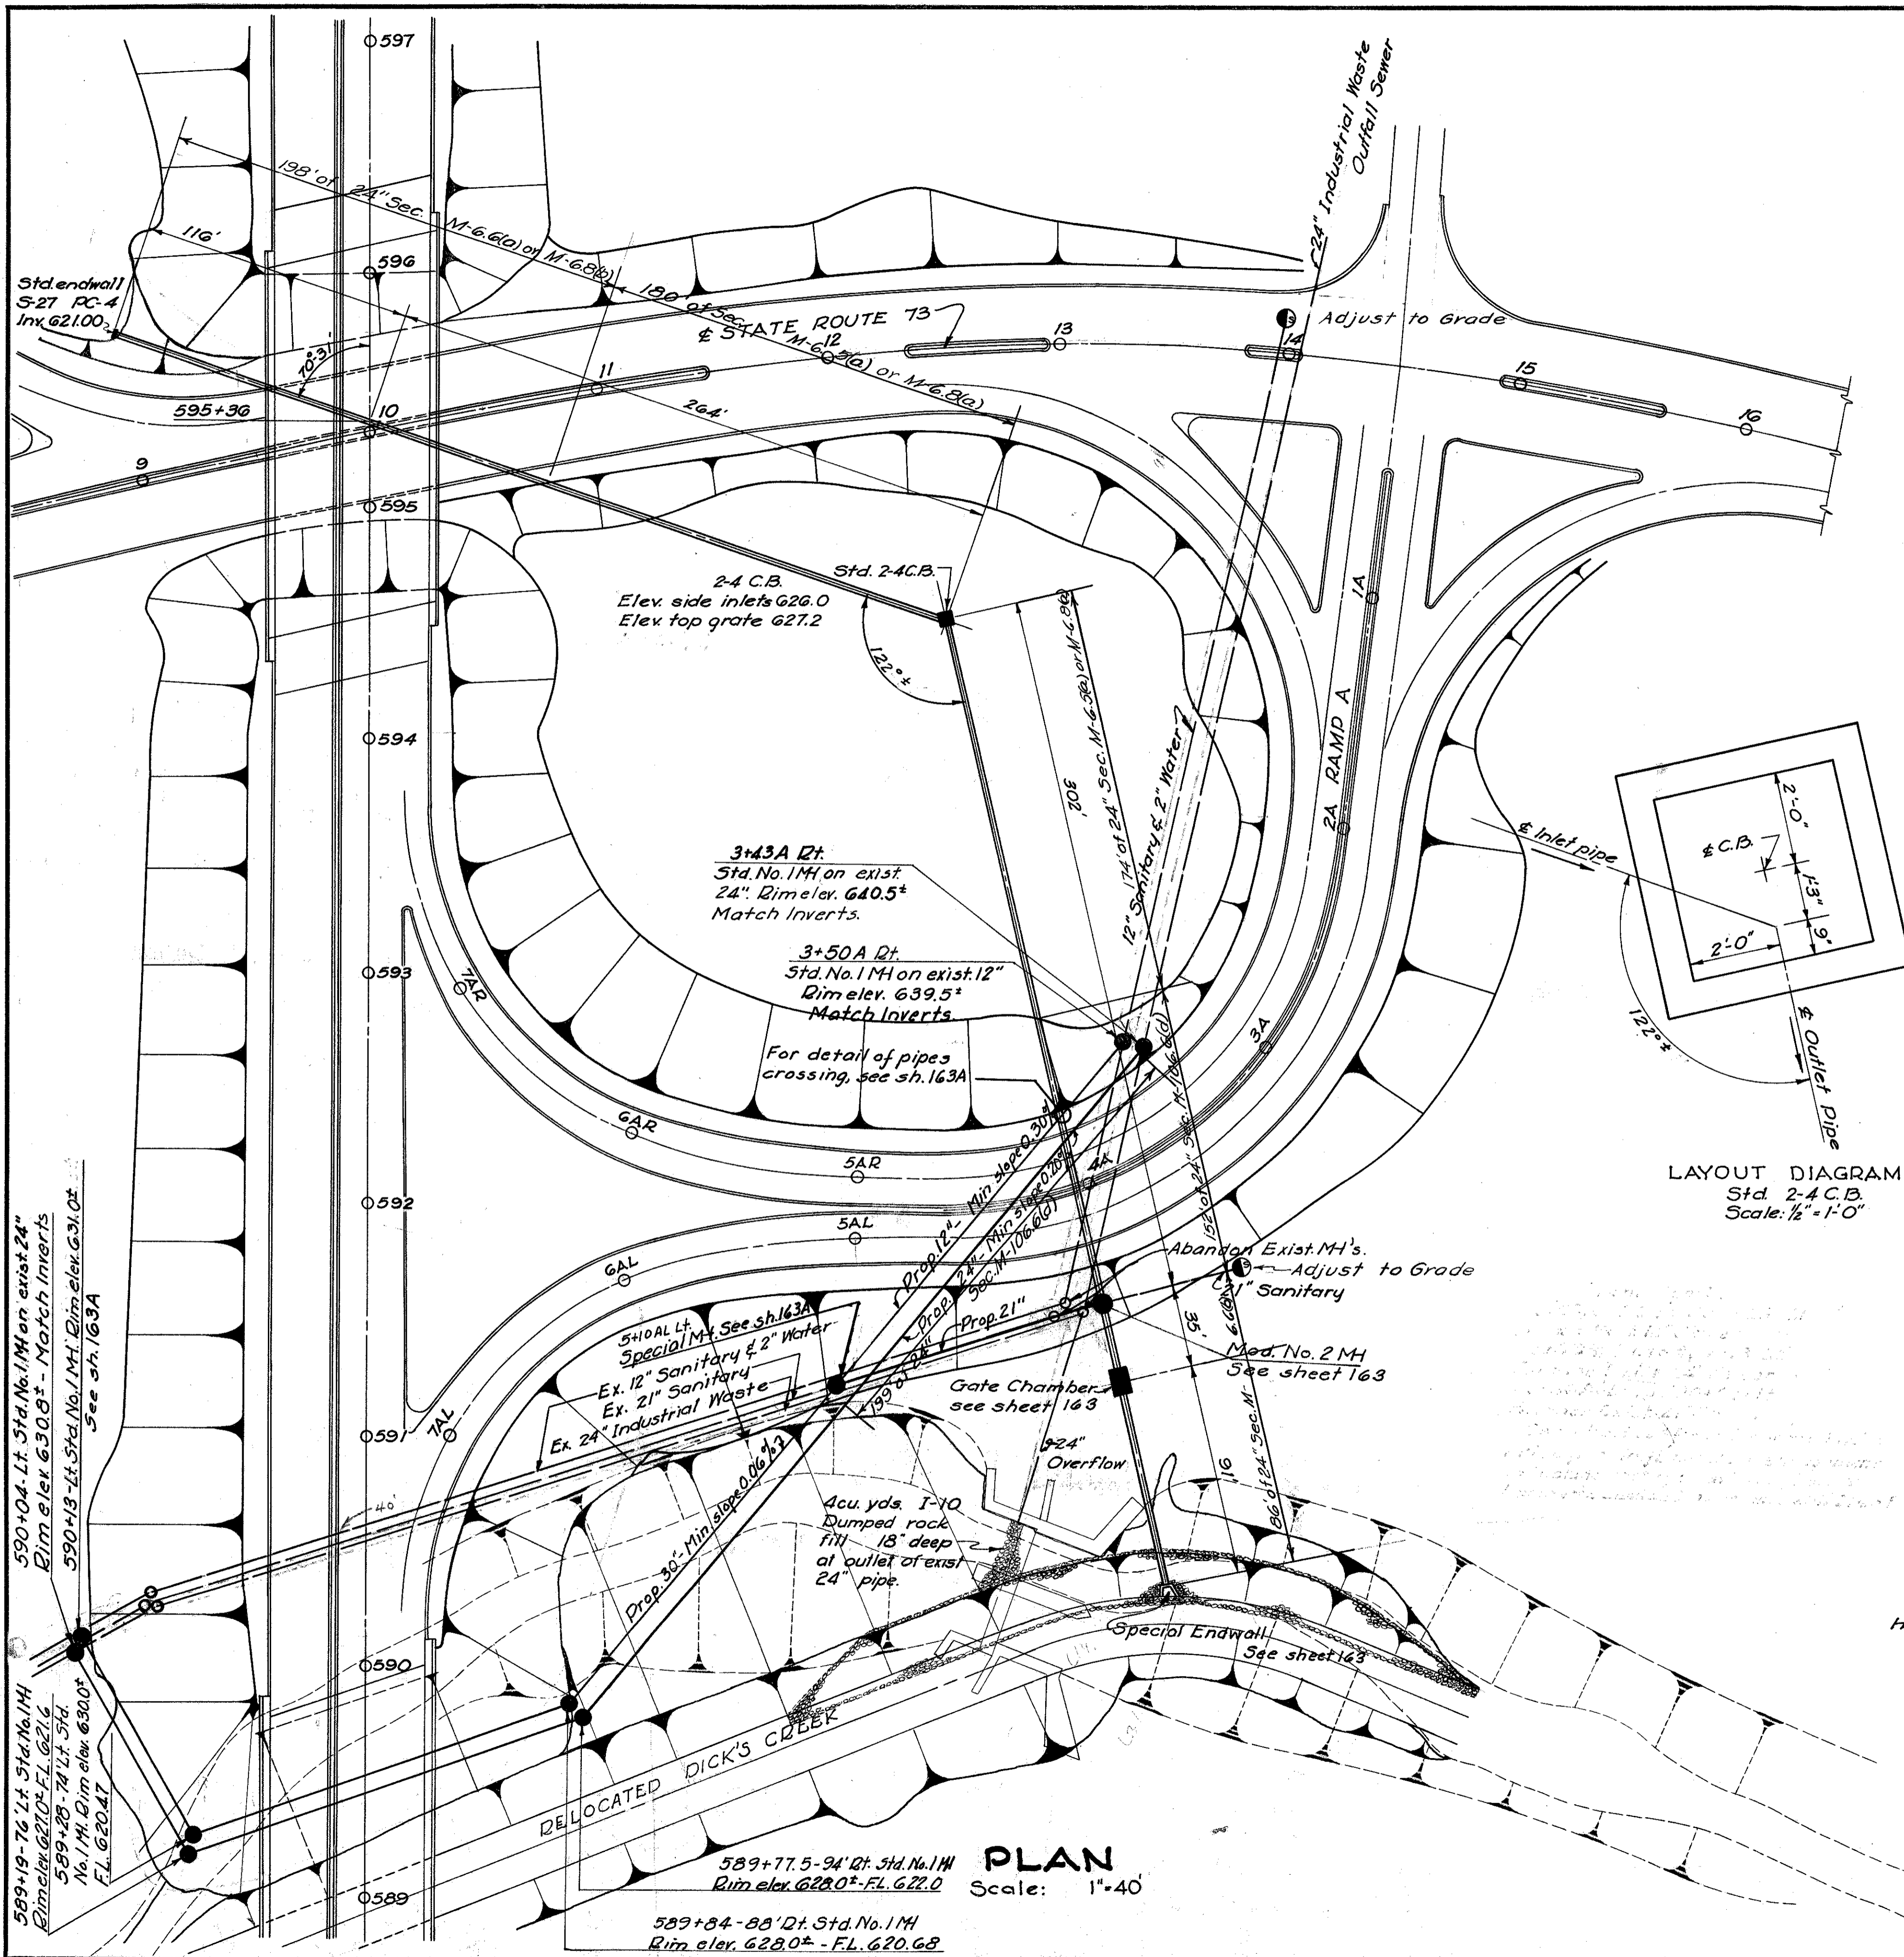

LAYOUT DIAGRAM  
Std. 2-4 C.B.  
Scale: 1/2" = 1'-0"

PLAN  
Scale: 1" = 40'

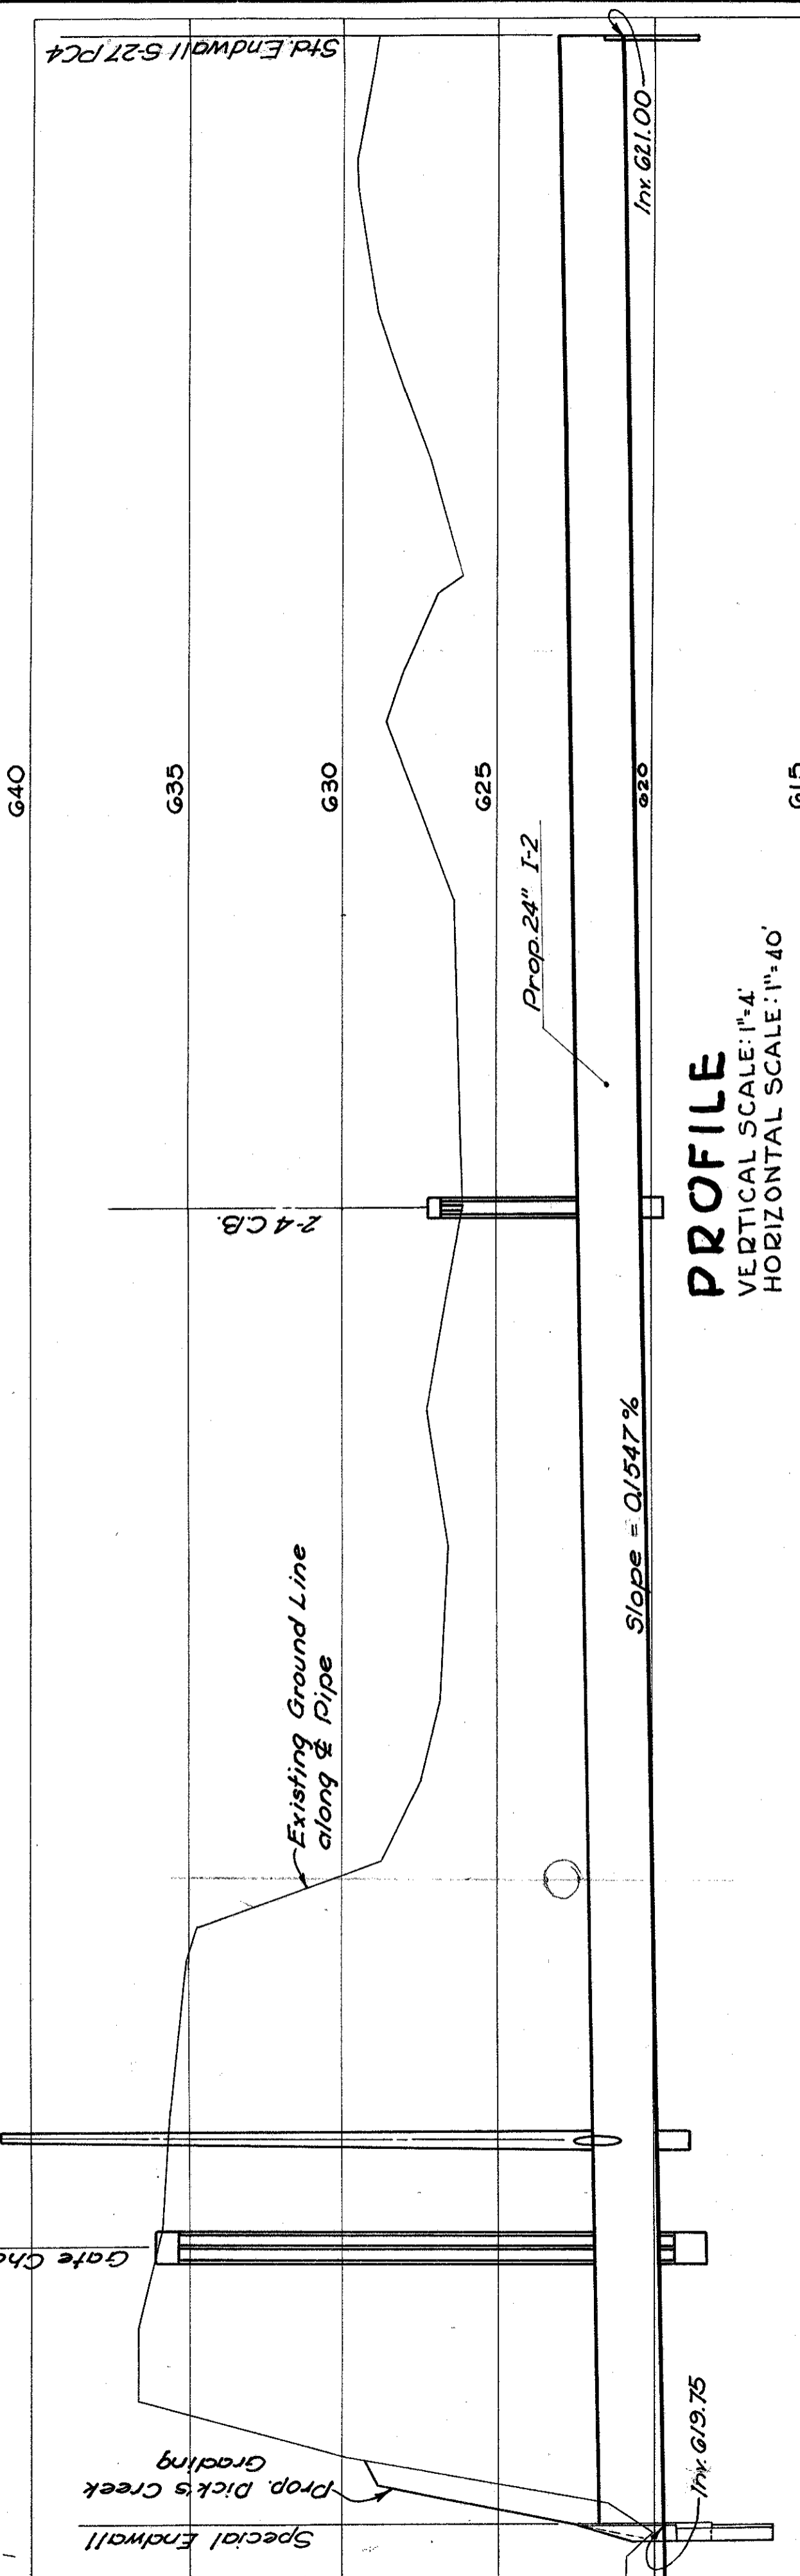


PROFILE  
VERTICAL SCALE: 1" = 4'  
HORIZONTAL SCALE: 1" = 40'

- SUGGESTED INSTALLATION PROCEDURE FOR PROPOSED SEWER RELOCATIONS**
- Step 1: Block exist 24" Outlet Pipe in exist. MH @ Sta. 4+15 A Lt. so that flow will go thru exist. over flow pipe to Dick's Creek.
  - Step 2: Build prop. MH on exist. 24" @ Sta. 3+43A Rt. but do not open exist. pipe.
  - Step 3: Build prop. 24" Sewer & MH's between 3+43A Rt. & 590+04 Lt.
  - Step 4: Break exist. pipe in new MH @ 3+43A Rt. & divert flow through new sewer. Seal old 24" pipe where it leaves new MH. Crystal Tissues Co. shuts down on certain Sundays. Step 4 can be accomplished on those days.
  - Step 5: Build part of proposed 24" Storm Sewer between Mod. No. 2 MH & Dick's Creek.
  - Step 6: Outlet exist. 21" sewer to prop. No. 2 MH & divert flow to Dick's Creek.
  - Step 7: Build prop. MH @ 3+50A Lt. on exist. 12" sewer but do not open exist. pipe.
  - Step 8: Remove exist. 21" between Mod. No. 2 MH & Sta. 5+10A Lt. & build prop. 21" sewer from Mod. No. 2 MH to a point near prop. special MH @ 5+10A Lt. Do not build special MH. Abandon exist. MH on 21".
  - Step 9: Build prop. 12" sewer from MH @ 3+50A Lt. to a point near special MH @ 5+10A Lt. Do not build special MH. Do not break exist. 12" in MH @ 3+50A Lt.
  - Step 10: Build MH on exist. 21" @ Sta. 590+13 Lt. Provide 12" stub in MH to connect to exist. 12" sewer at a later time. Seal upstream end of exist. 21".
  - Step 11: Build prop. 30" sewer from Sta. 590+13 Lt. to a point near prop. special MH @ 5+10A Lt.
  - Step 12: Build special MH @ 5+10A Lt., connect prop. 12", 21", & 30" sewers. Break exist. 12" sewer in MH @ 3+50A Lt. & divert flow through new 12". Seal existing 12" pipe where it leaves new MH.
  - Step 13: Connect exist. 12" to new MH @ Sta. 590+13 Lt.
  - Step 14: Connect exist. 21" sewer to new 21" sewer through Mod. No. 2 MH with 24" C.I.P.
  - Step 15: Abandon exist. MH's on exist. 12" & 24" sewers @ 4+15 A Lt. & 4+22 A Lt. Seal ends of exist. pipes.



The above is merely a suggested sequence of operations. The Contractor may deviate from this method if he wishes, as approved by the Engineer.

All locations & elevations are approximate only & are from the best available information. The existing 2" Water Line is to remain in place. All existing sewers that remain in place but are not to function after the new work is completed shall be sealed in the manner set aside under Item I-16 wherever they are encountered. Payment for sealing the pipes will be included in the other pertinent items in the work. Extreme caution must be exercised while installing the sewers through the existing levee. The Contractor will be held responsible for any flood damage caused by opening up the levee. The following minimum grades shall hold:  
 12" Sanitary - 0.30%  
 21" Sanitary - 0.12%  
 24" Indust. Waste - 0.20%  
 Flow must be maintained at all times. The cost of any pumping which may be required to maintain flow shall be included in the unit cost of the various items in the contract. Flow of sanitary sewage into Dick's Creek will not be permitted for a period in excess of 24 hours.

**24" STORM SEWER TO DICK'S CREEK**

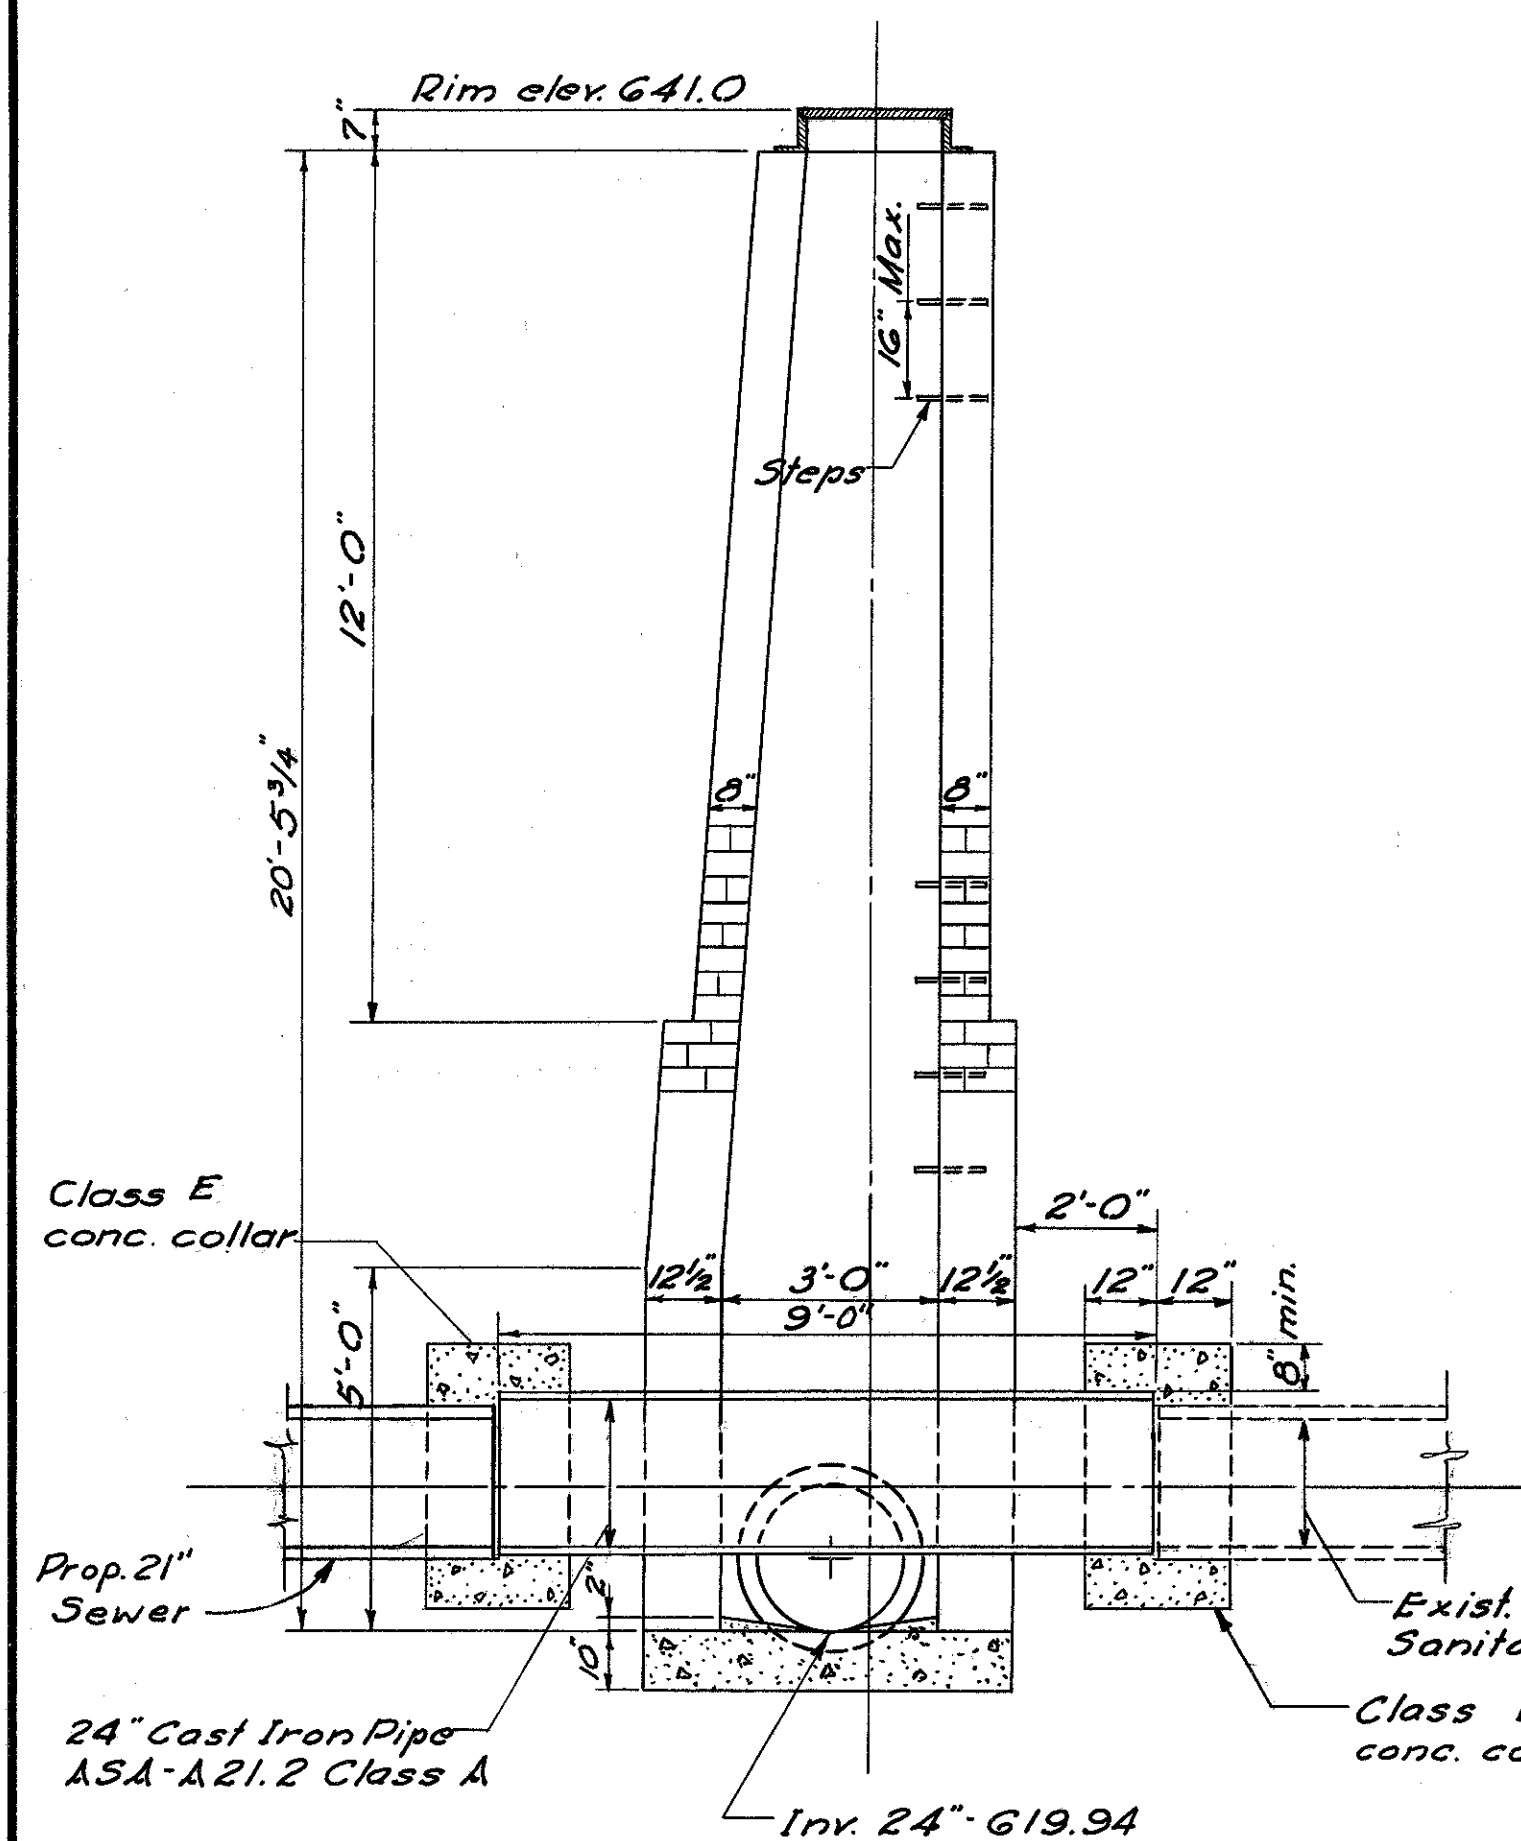






**MOD. No. 2 MANHOLE**  
ON PROPOSED 24" STORM SEWER  
Scale 3/8"=1'-0"

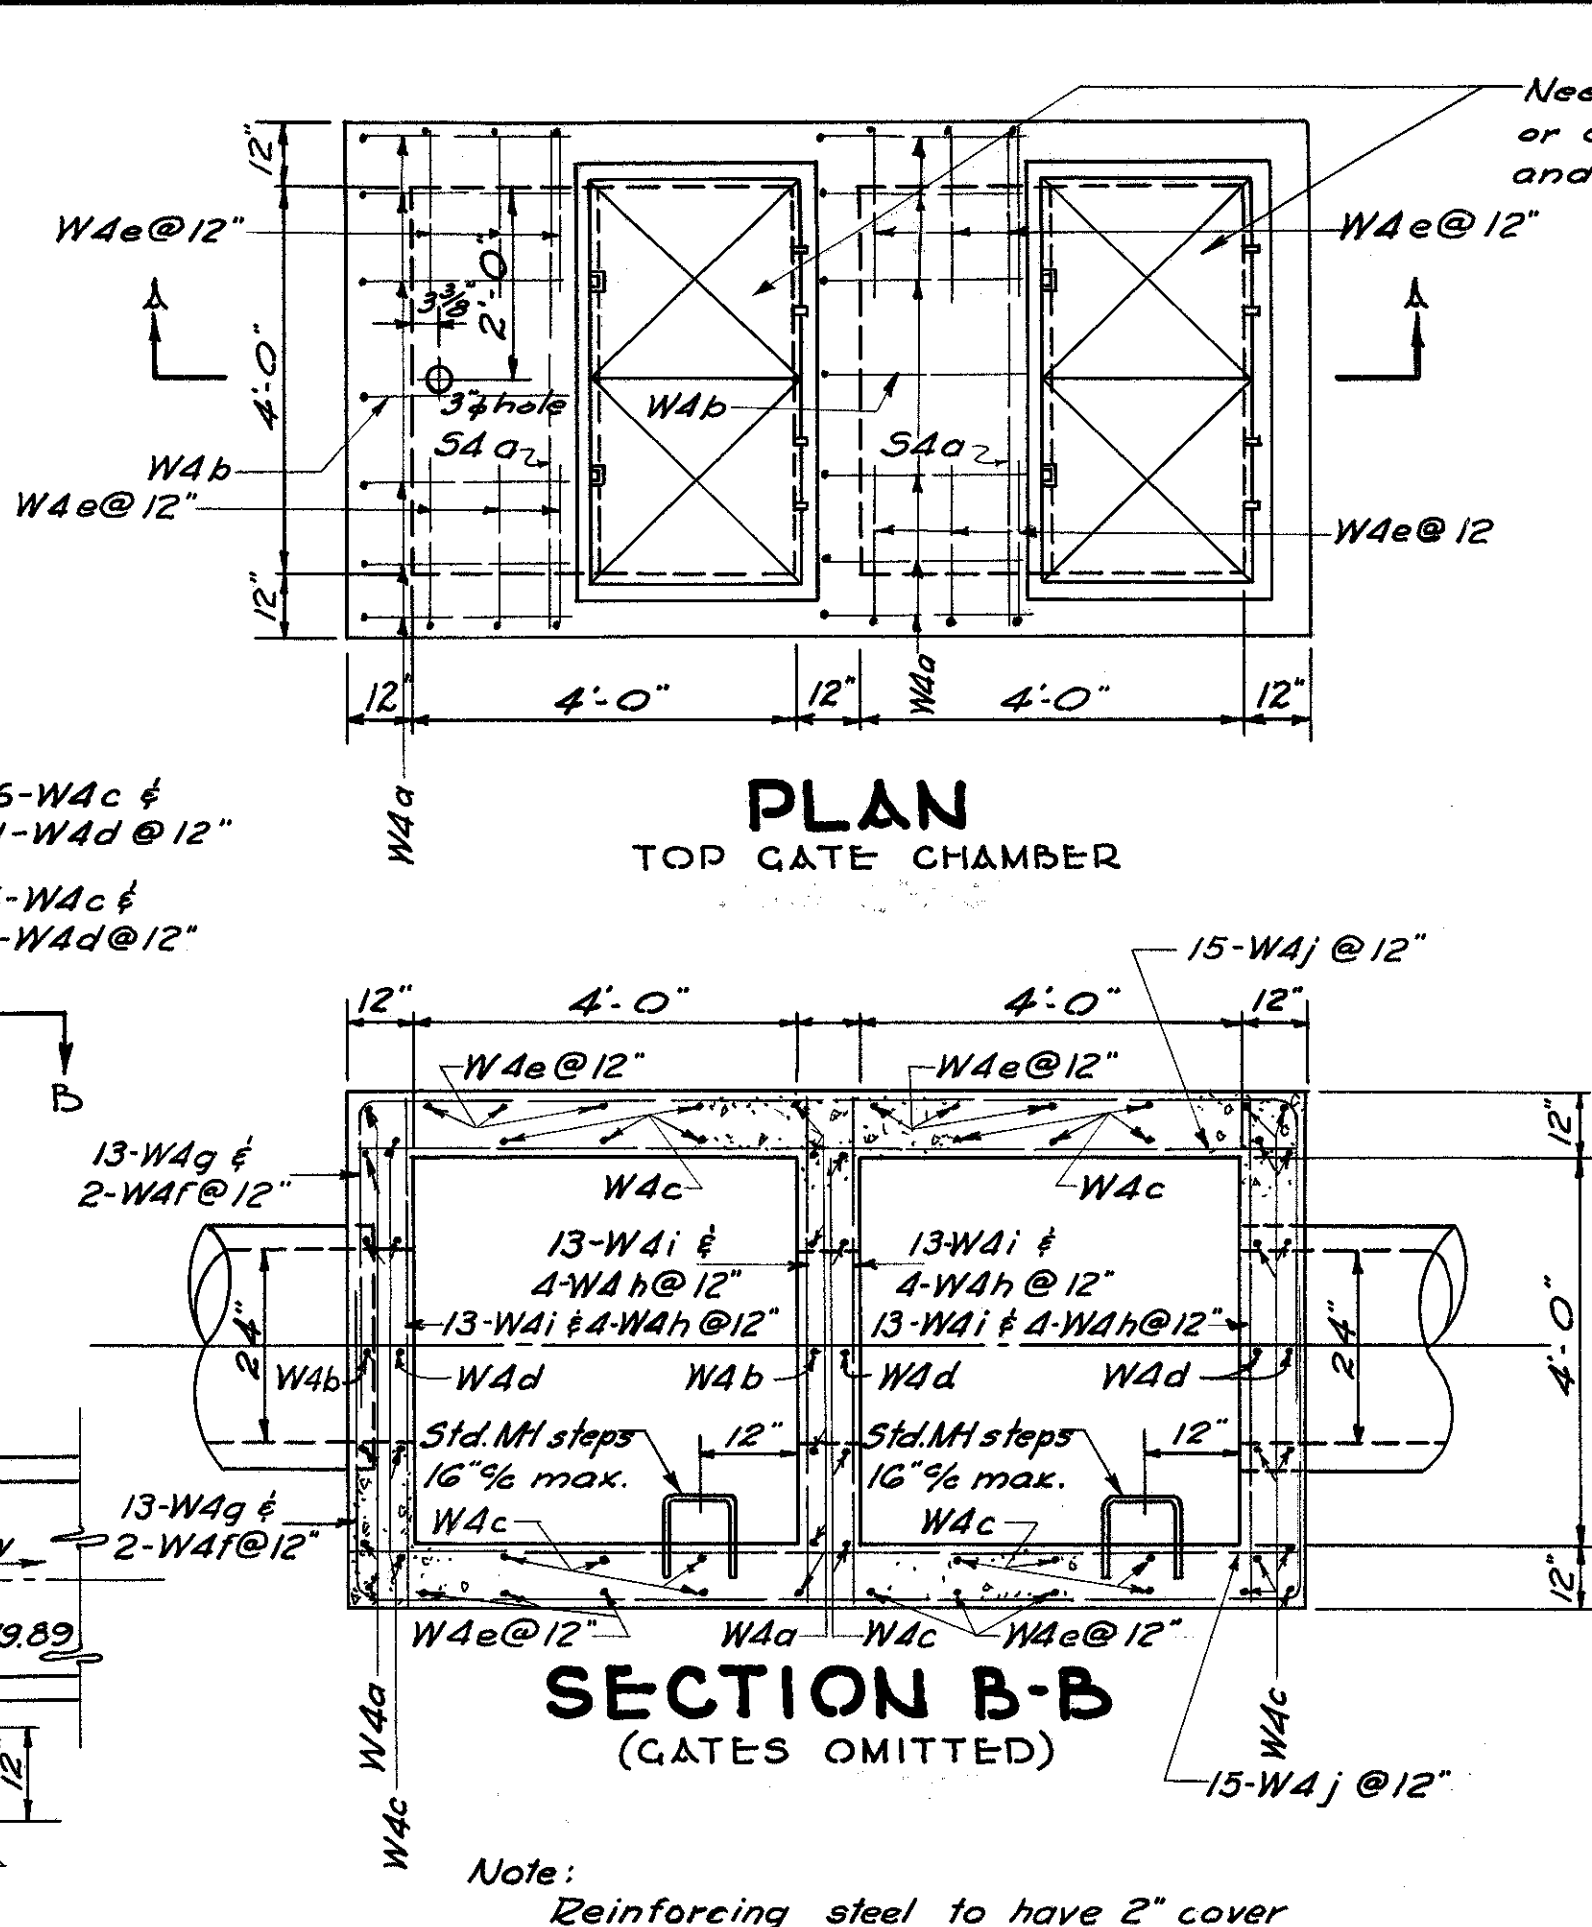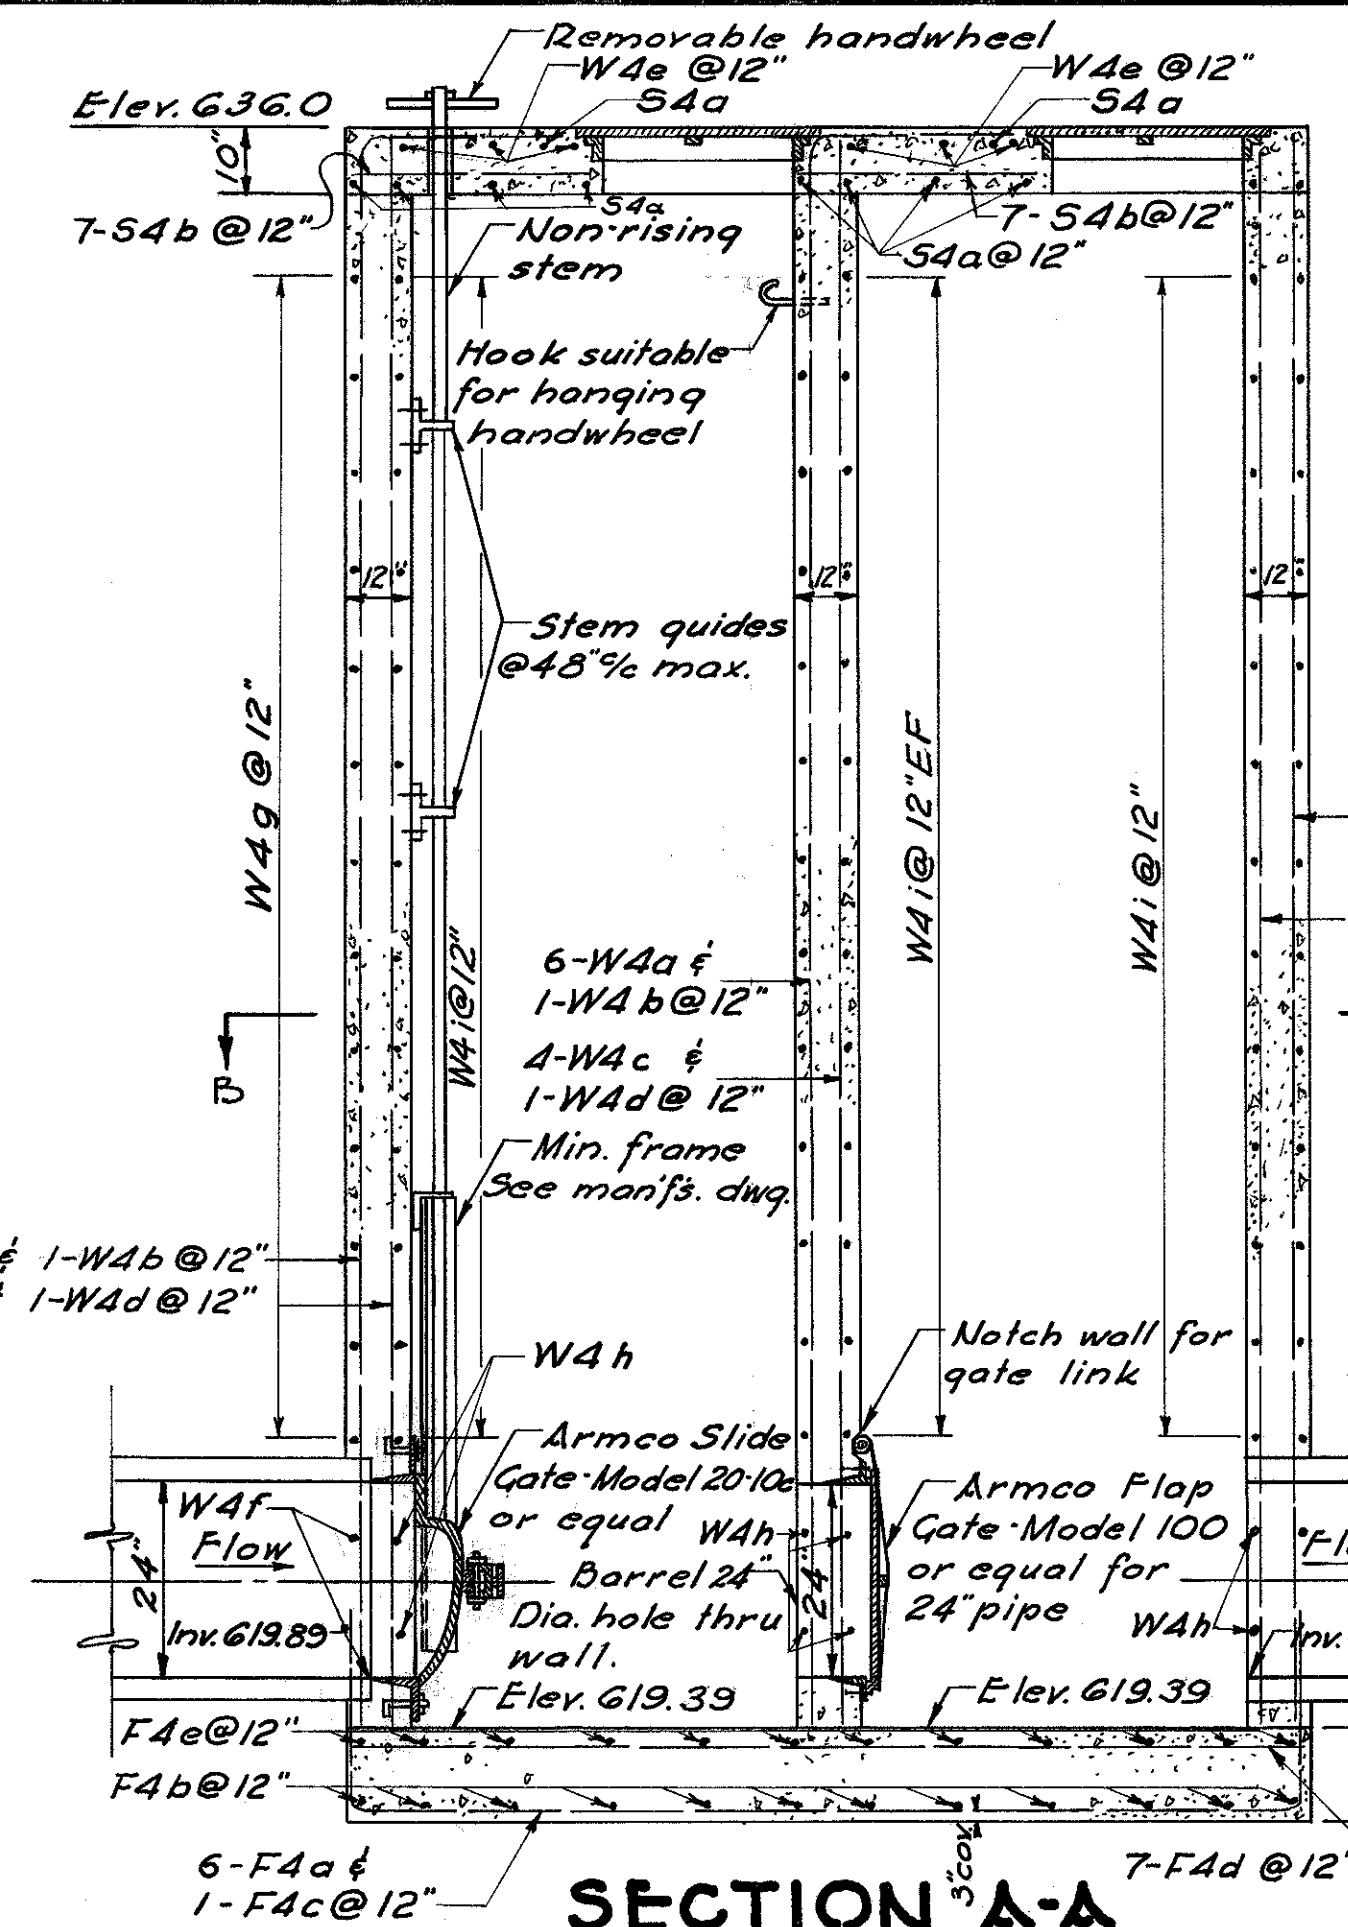

Note:  
Reinforcing steel to have 2" cover  
Except footings where 3" is required.

**GATE CHAMBER**  
ON PROPOSED 24" STORM SEWER

GATE CHAMBER					
MARK	NO.	LENGTH	WEIGHT	SHAPE	BENDING DIAGRAM
F4a	6	14'-7"	58	Bt.	
F4b	12	9'-7"	77	Bt.	
F4c	1	12'-5"	8	Bt.	
F4d	7	10'-8"	50	Str.	
F4e	12	5'-8"	45	Str.	
W4a	12	18'-11"	152	Bt.	
W4b	2	16'-2"	22	Bt.	
W4c	36	16'-5"	395	Str.	
W4d	4	13'-8"	37	Str.	
W4e	12	18'-6"	149	Bt.	
W4f	4	13'-7"	36	Bt.	
W4g	26	17'-7"	305	Bt.	
W4h	16	1'-6"	16	Str.	
W4i	52	5'-8"	197	Str.	
W4j	30	10'-8"	214	Str.	
S4a	10	5'-8"	39	Str.	
S4b	14	2'-8"	25	Str.	

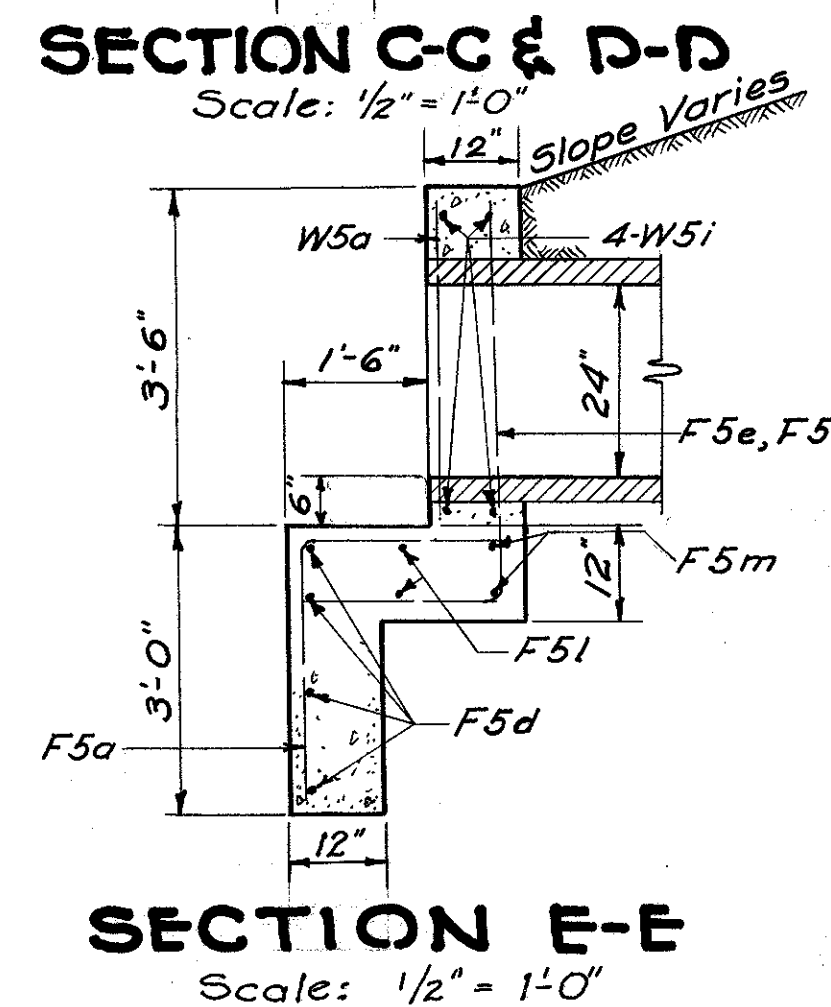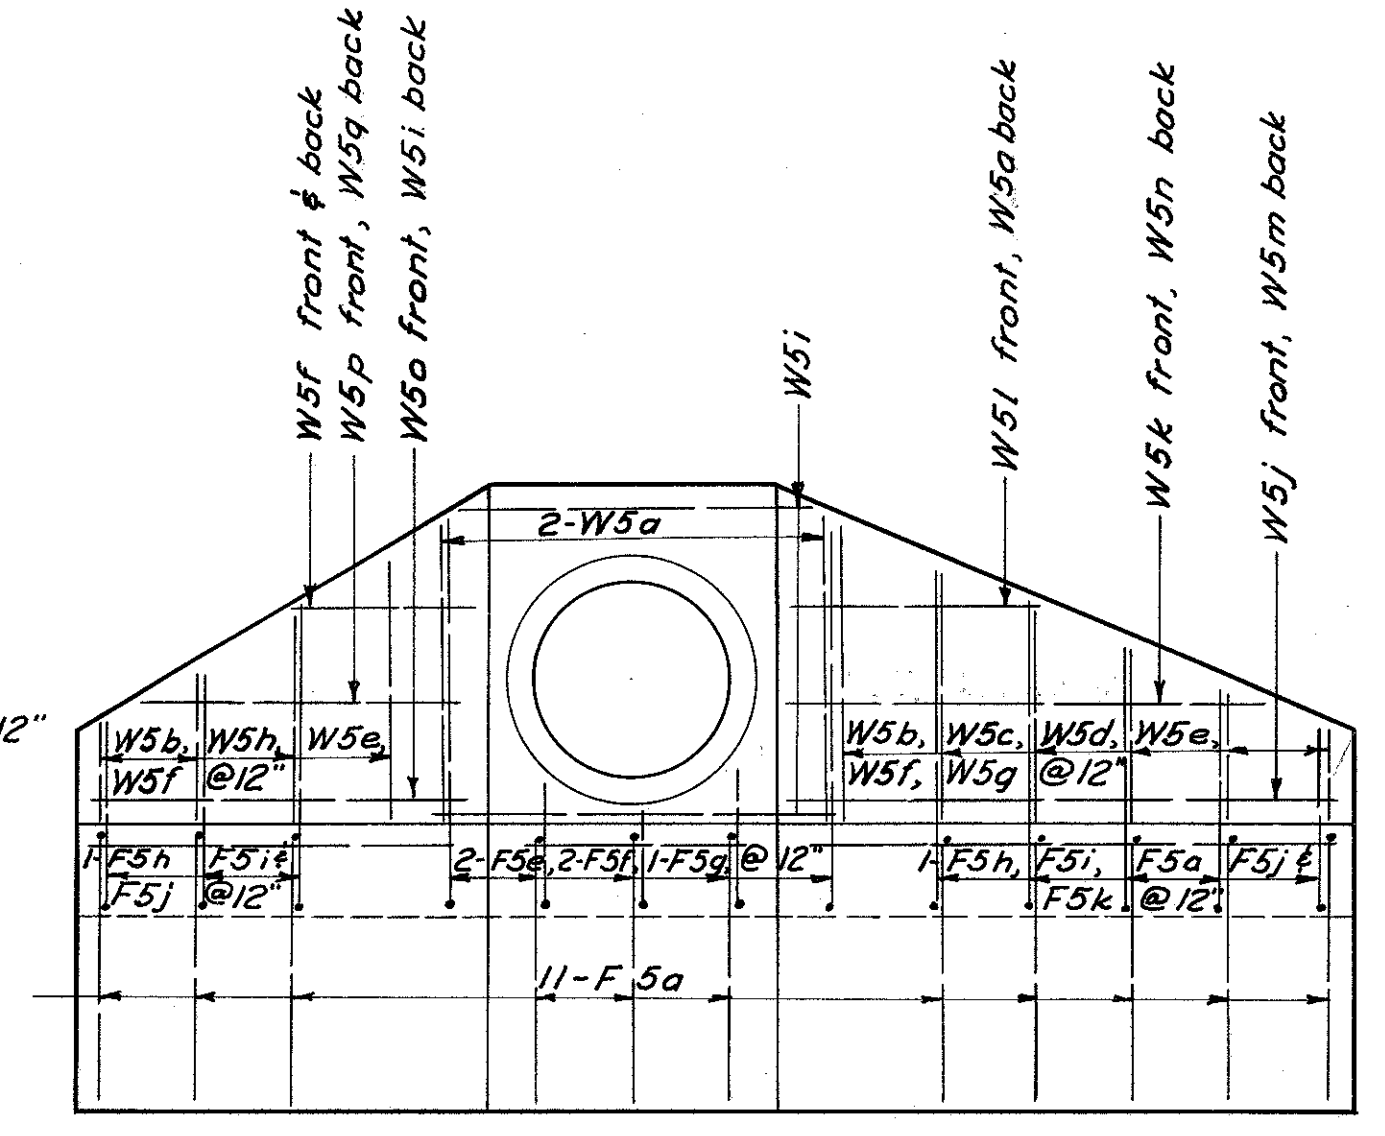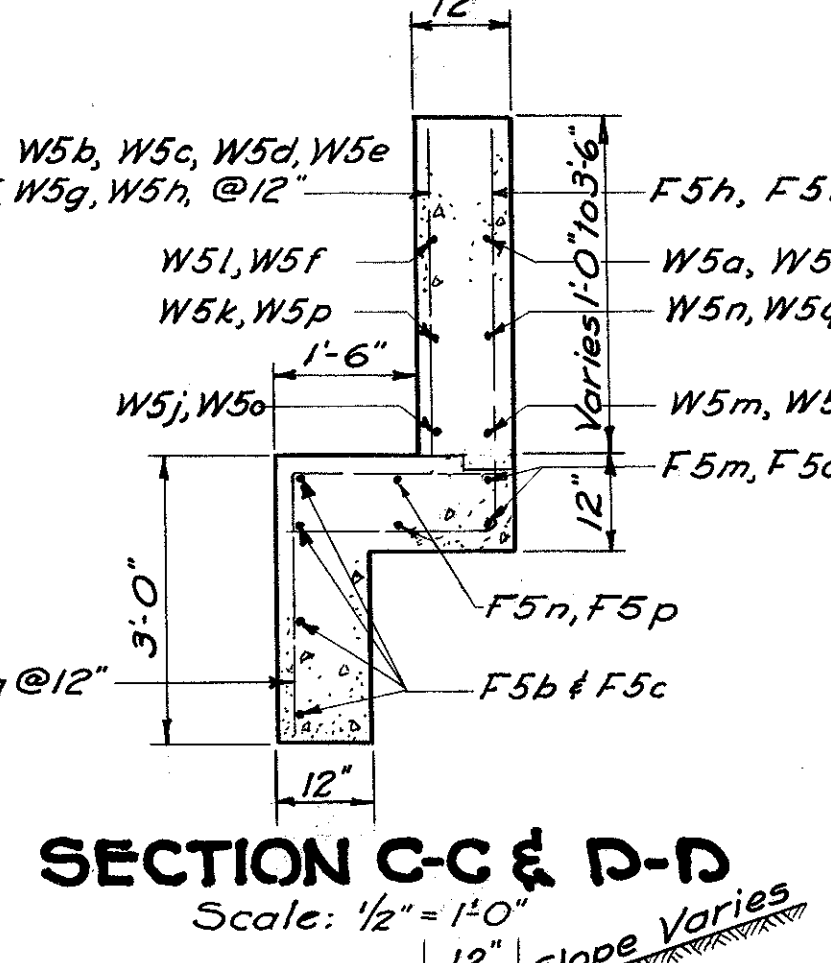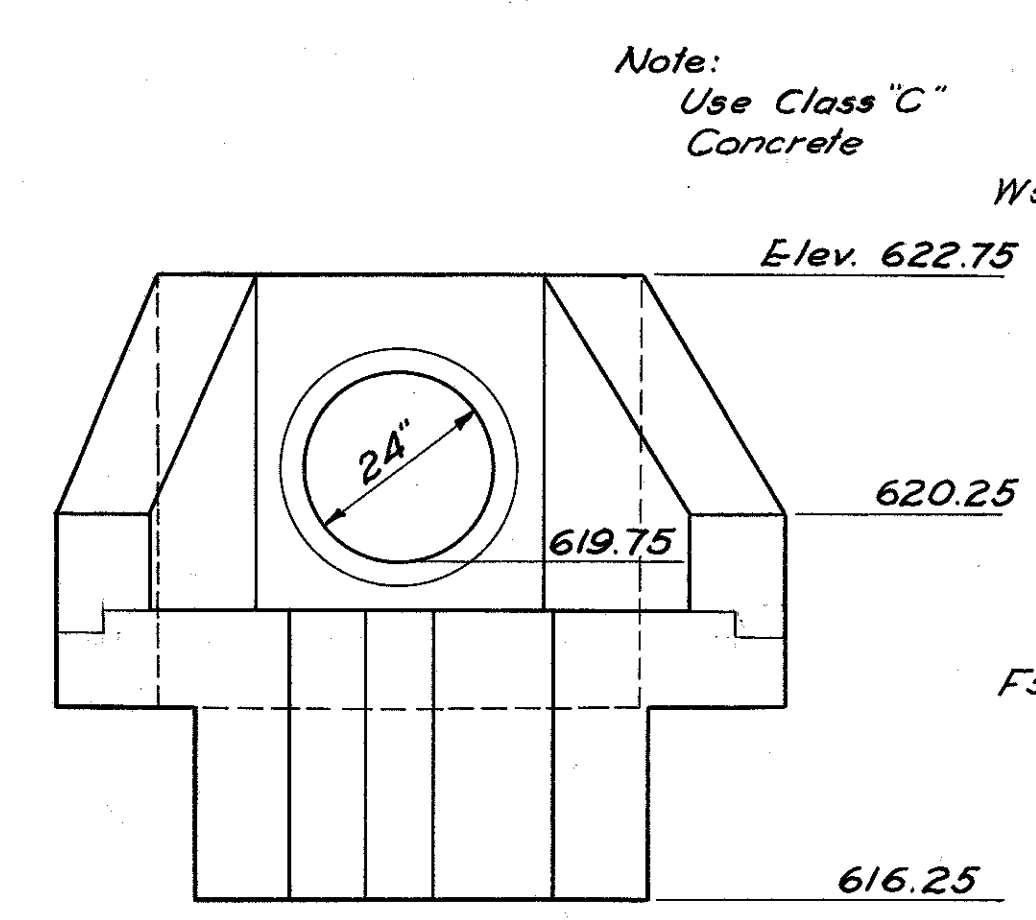
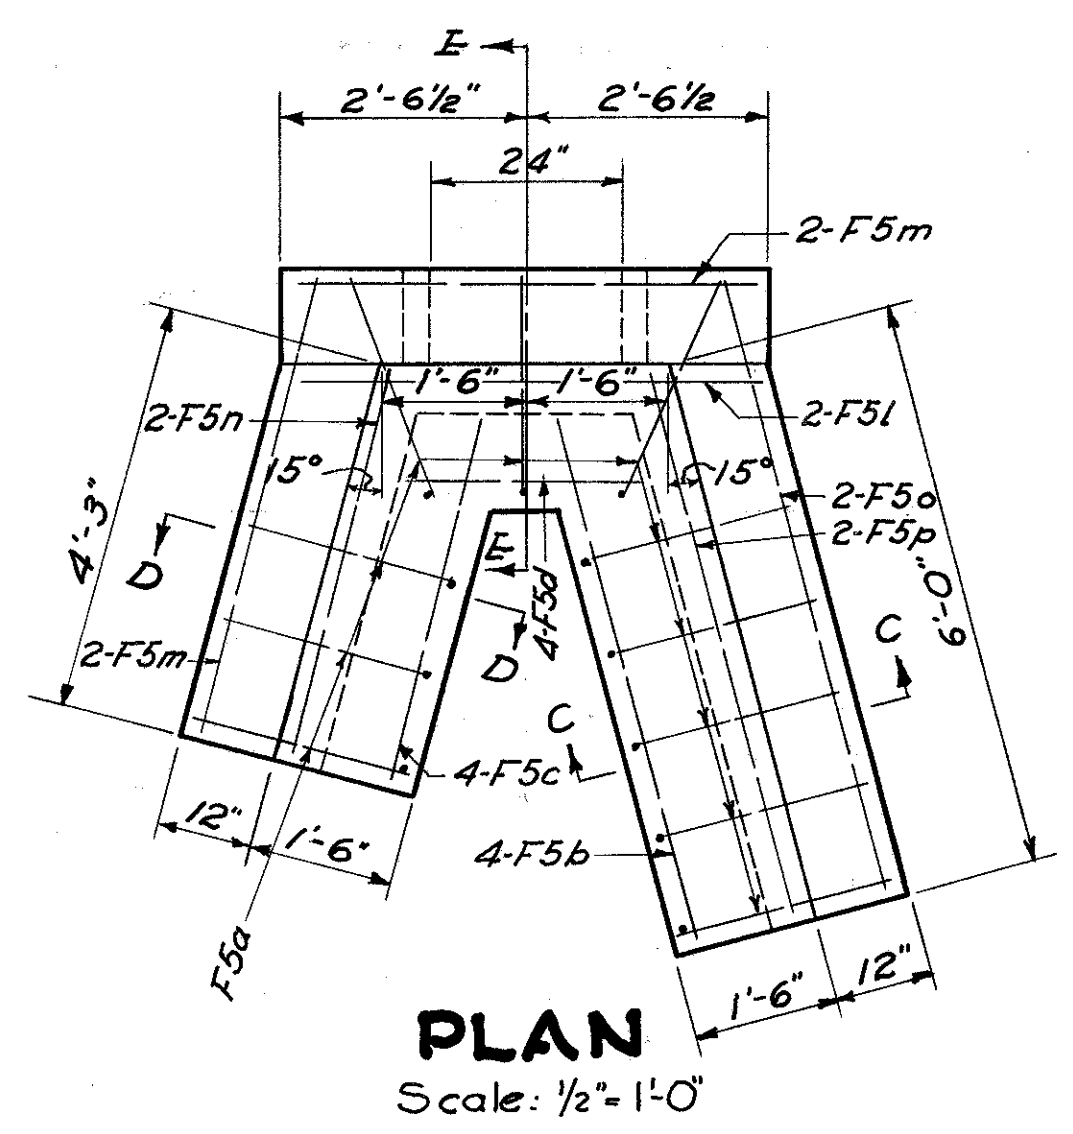


SPECIAL ENDWALL					
MARK	NO.	LENGTH	WEIGHT	SHAPE	BENDING DIAGRAM
F5a	12	4'-8"	58	Bt.	
F5b	4	5'-5"	23	Str.	
F5c	4	3'-9"	16	Str.	
F5d	4	2'-3"	9	Str.	
F5e	2	6'-2"	13	Bt.	
F5f	2	3'-4"	7	Bt.	
F5g	1	3'-0"	3	Bt.	
F5h	2	3'-9"	8	Bt.	
F5i	2	4'-4"	9	Bt.	
F5j	2	5'-0"	10	Bt.	
F5k	1	5'-5"	6	Bt.	
F5l	2	4'-11"	10	Str.	
F5m	4	4'-9"	20	Str.	
F5n	2	3'-11"	8	Str.	
F5o	2	6'-5"	13	Str.	
F5p	2	5'-8"	12	Str.	
W5a	3	3'-4"	10	Str.	
W5b	2	0'-11"	2	Str.	
W5c	1	1'-4"	1	Str.	
W5d	1	1'-10"	2	Str.	
W5e	2	2'-3"	5	Str.	
W5f	4	2'-8"	11	Str.	
W5g	1	3'-1"	3	Str.	
W5h	1	1'-7"	2	Str.	
W5i	4	4'-9"	25	Str.	
W5j	5	6'-7"	7	Str.	
W5k	1	5'-11"	6	Str.	
W5l	1	3'-7"	4	Str.	
W5m	1	6'-5"	7	Str.	
W5n	1	5'-9"	6	Str.	
W5o	1	4'-11"	5	Str.	
W5p	1	4'-5"	5	Str.	
W5q	1	4'-3"	4	Str.	


ESTIMATE OF QUANTITIES

Description	Item	Quantity
Excavation for Structures E-2		12.4 Cu. Yd. (Wet)
Concrete for Structures (Class C)	S-1	3.2 Cu. Yd.
Reinforcing Steel	S-4	330 Lb.




See sheet 162 for Structure locations

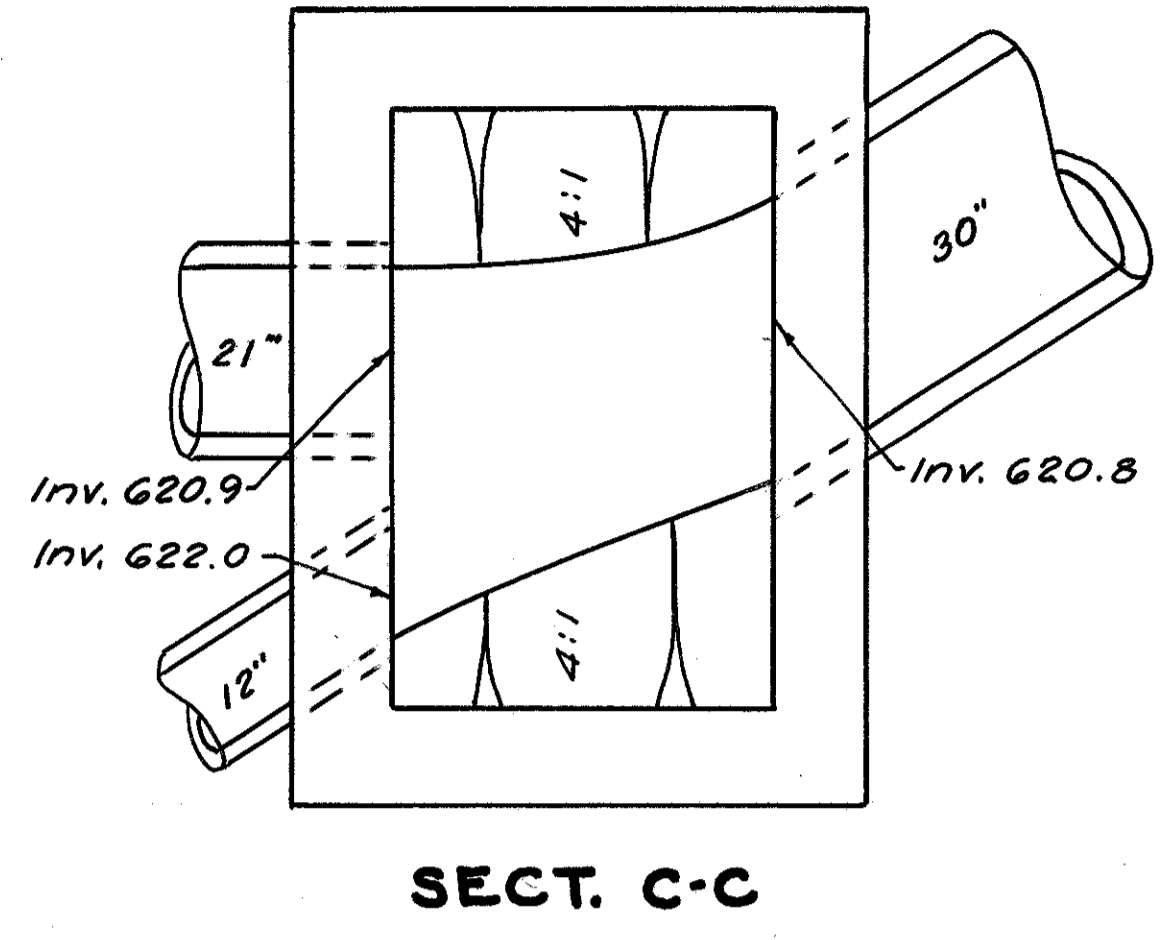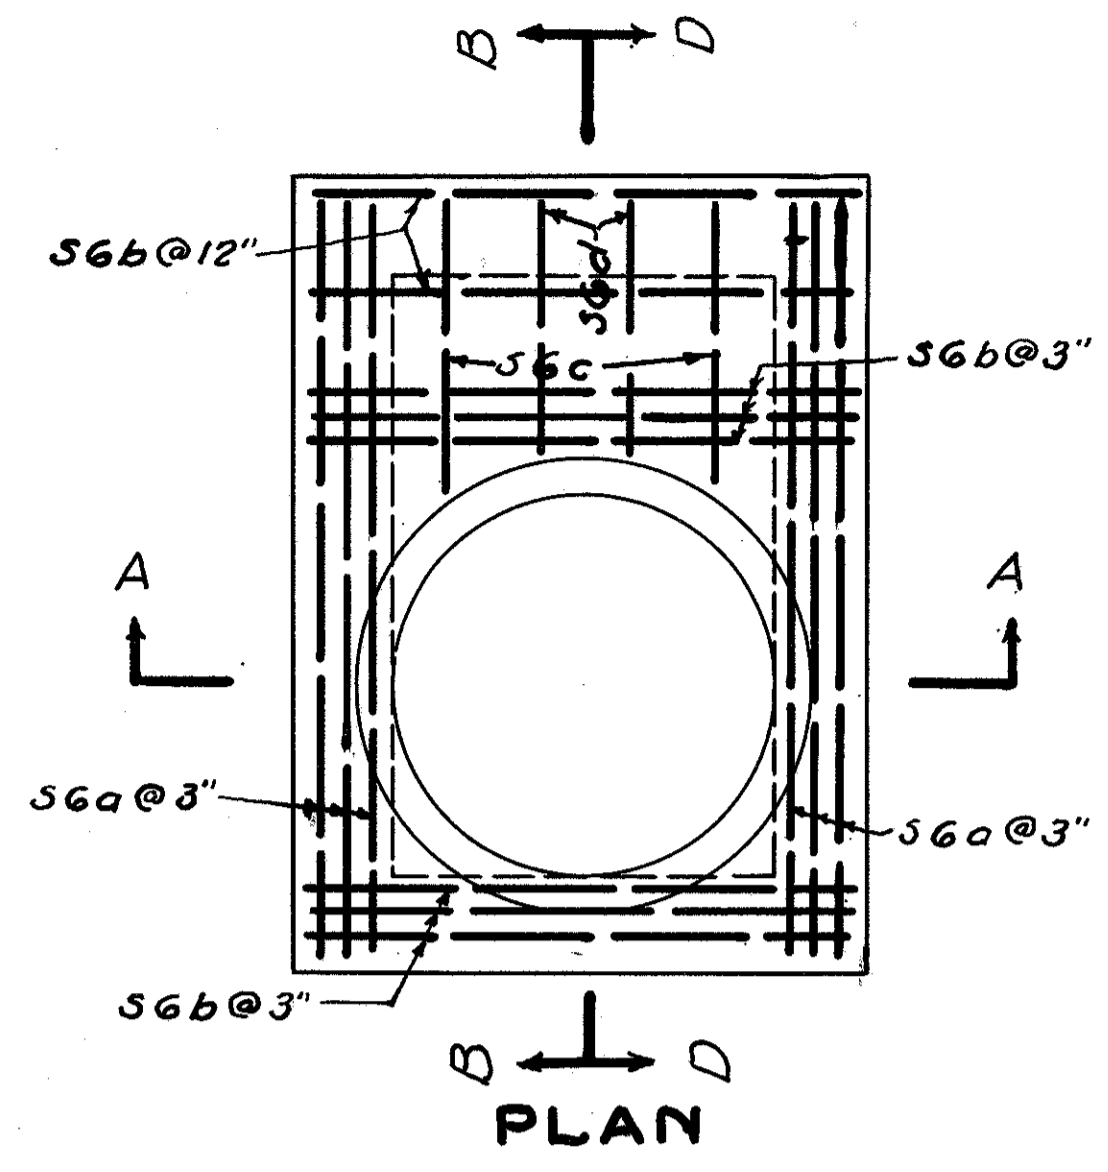


REINFORCING STEEL DETAILS					
MARK	NO	LENGTH	WEIGHT	SHAPE	REMARKS
FGa	18	5'-8"	153	Str.	
FGb	12	7'-11"	143	Str.	
WGa	19	5'-9"	164	Str.	
WGb	10	5'-8"	85	Str.	
WGc	3	2'-6"	11	Str.	
WXd	1	3'-6"	5	Str.	
WGe	7	7'-11"	83	Str.	
Wf	3	2'-0"	9	Str.	
WGg	1	1'-3"	2	Str.	
S6a	6	7'-11"	71	Str.	
S6b	8	5'-8"	68	Str.	
S6c	2	3'-0"	9	Str.	
S6d	2	2'-9"	8	Str.	

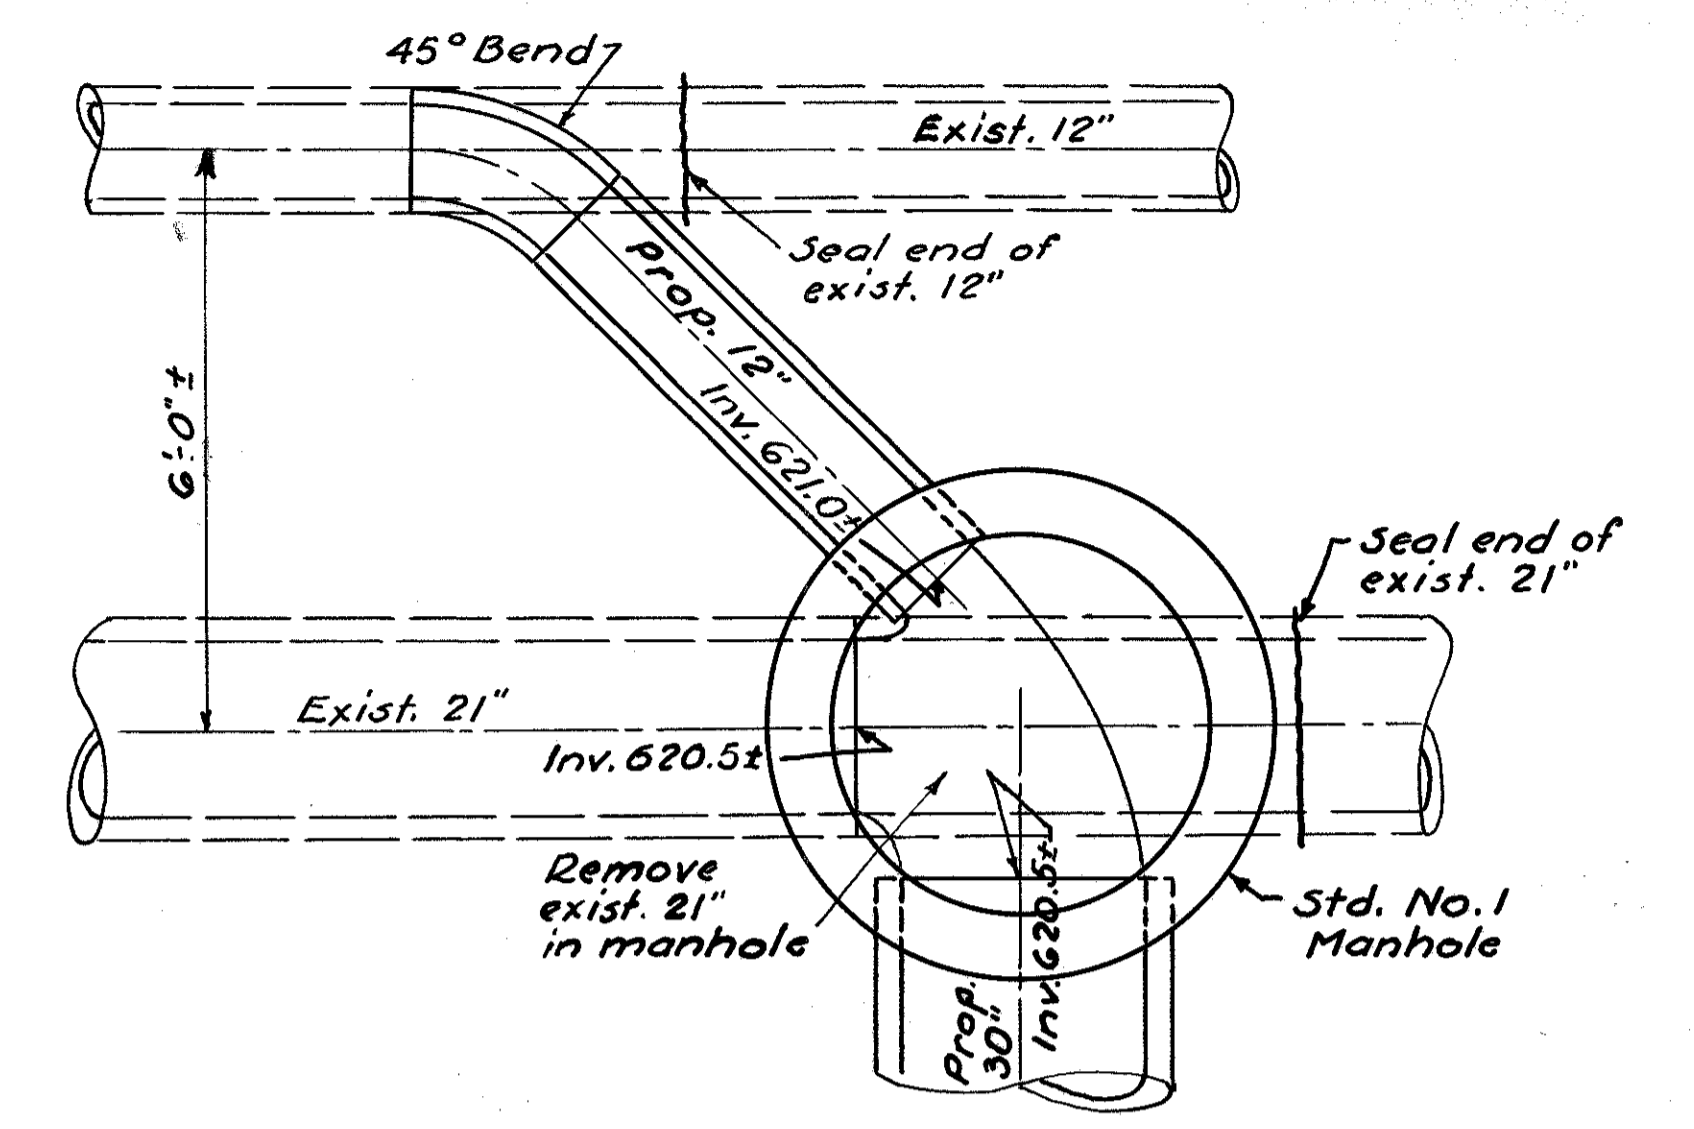


PLAN SHOWING CONNECTIONS  
IN MANHOLE - STA. 590+13 Lt.  
SCALE: 1/2" = 1'-0"

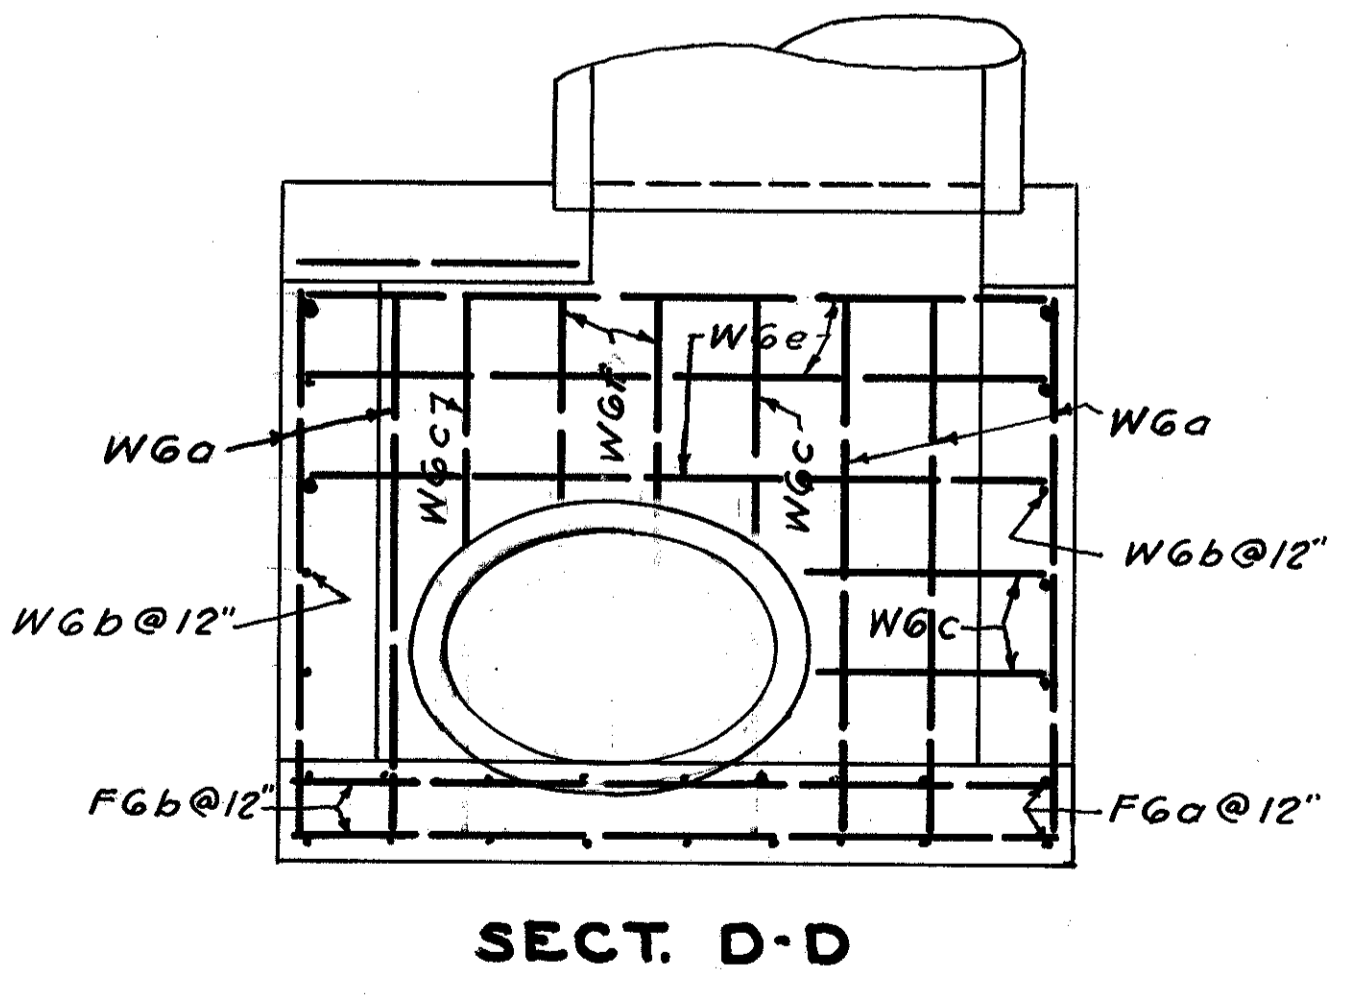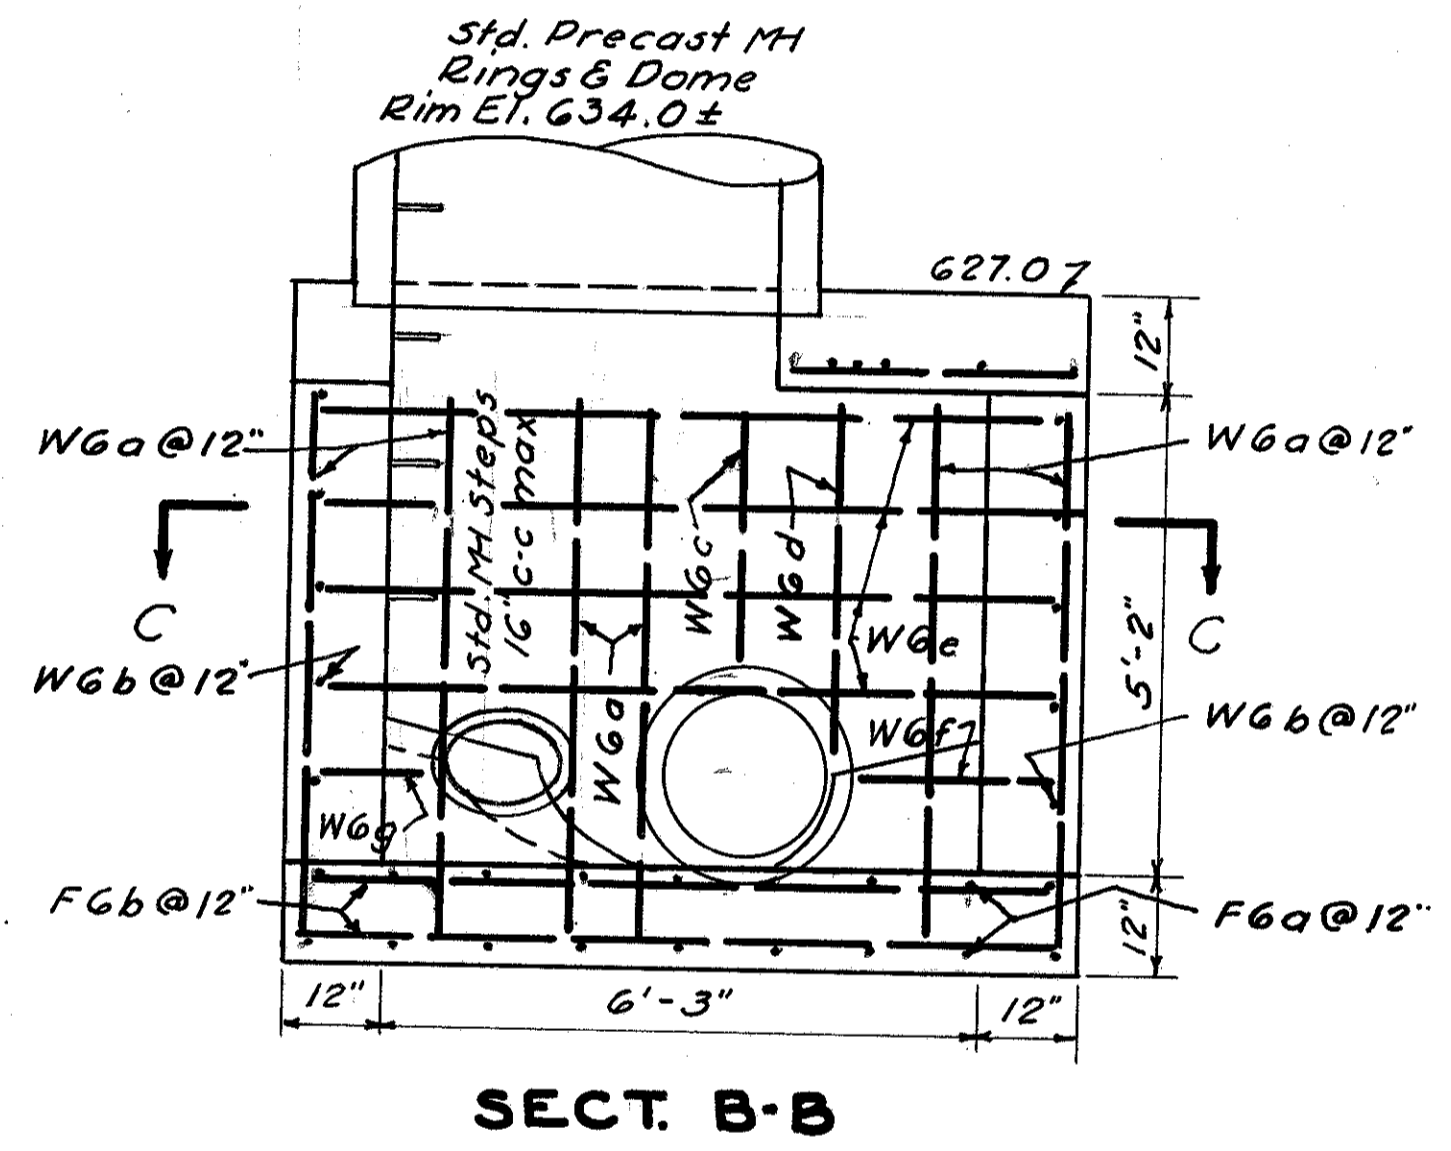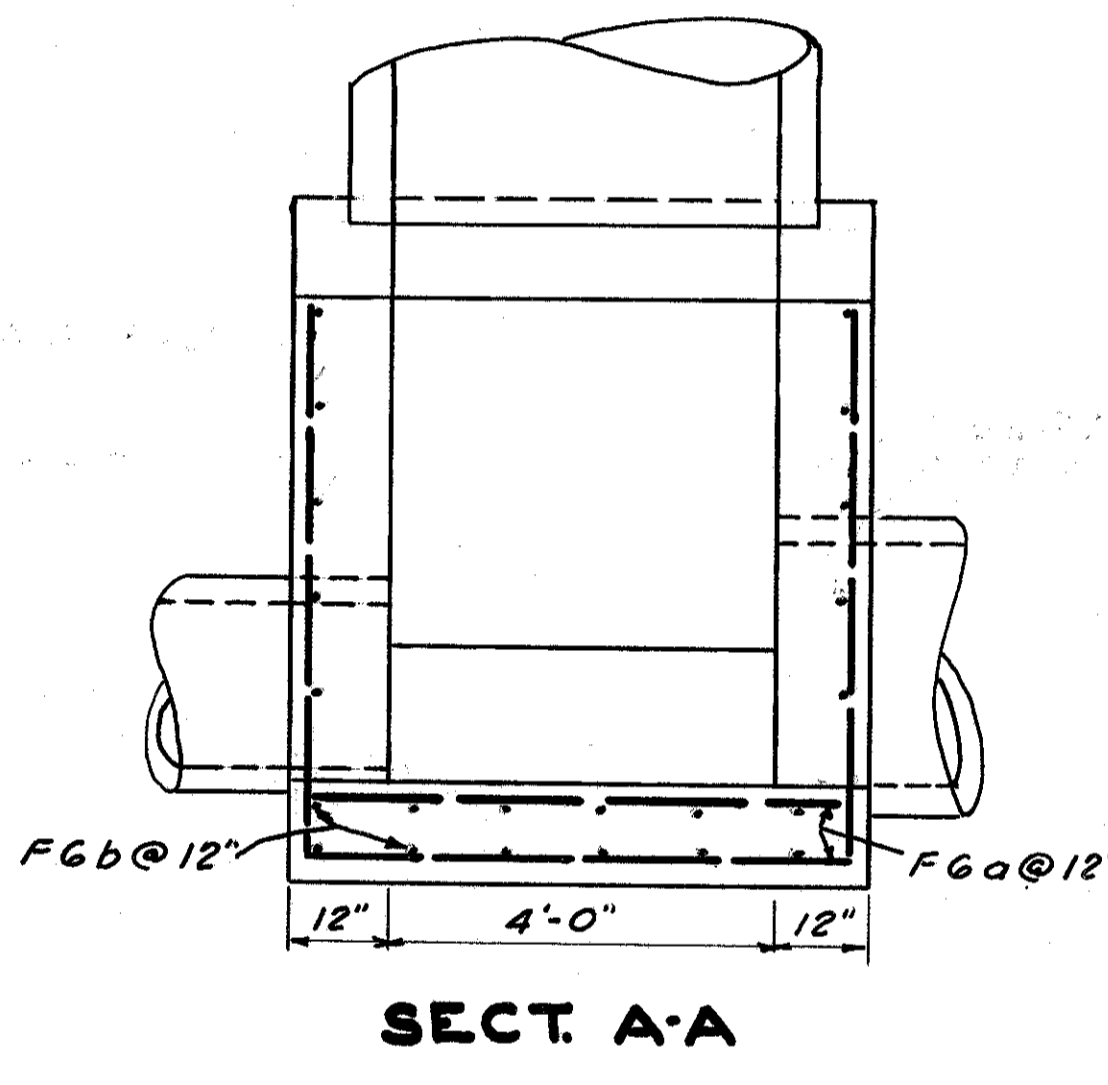


SPECIAL MANHOLE  
STA. 5+10AL Lt.  
SCALE: 1/2" = 1'-0"

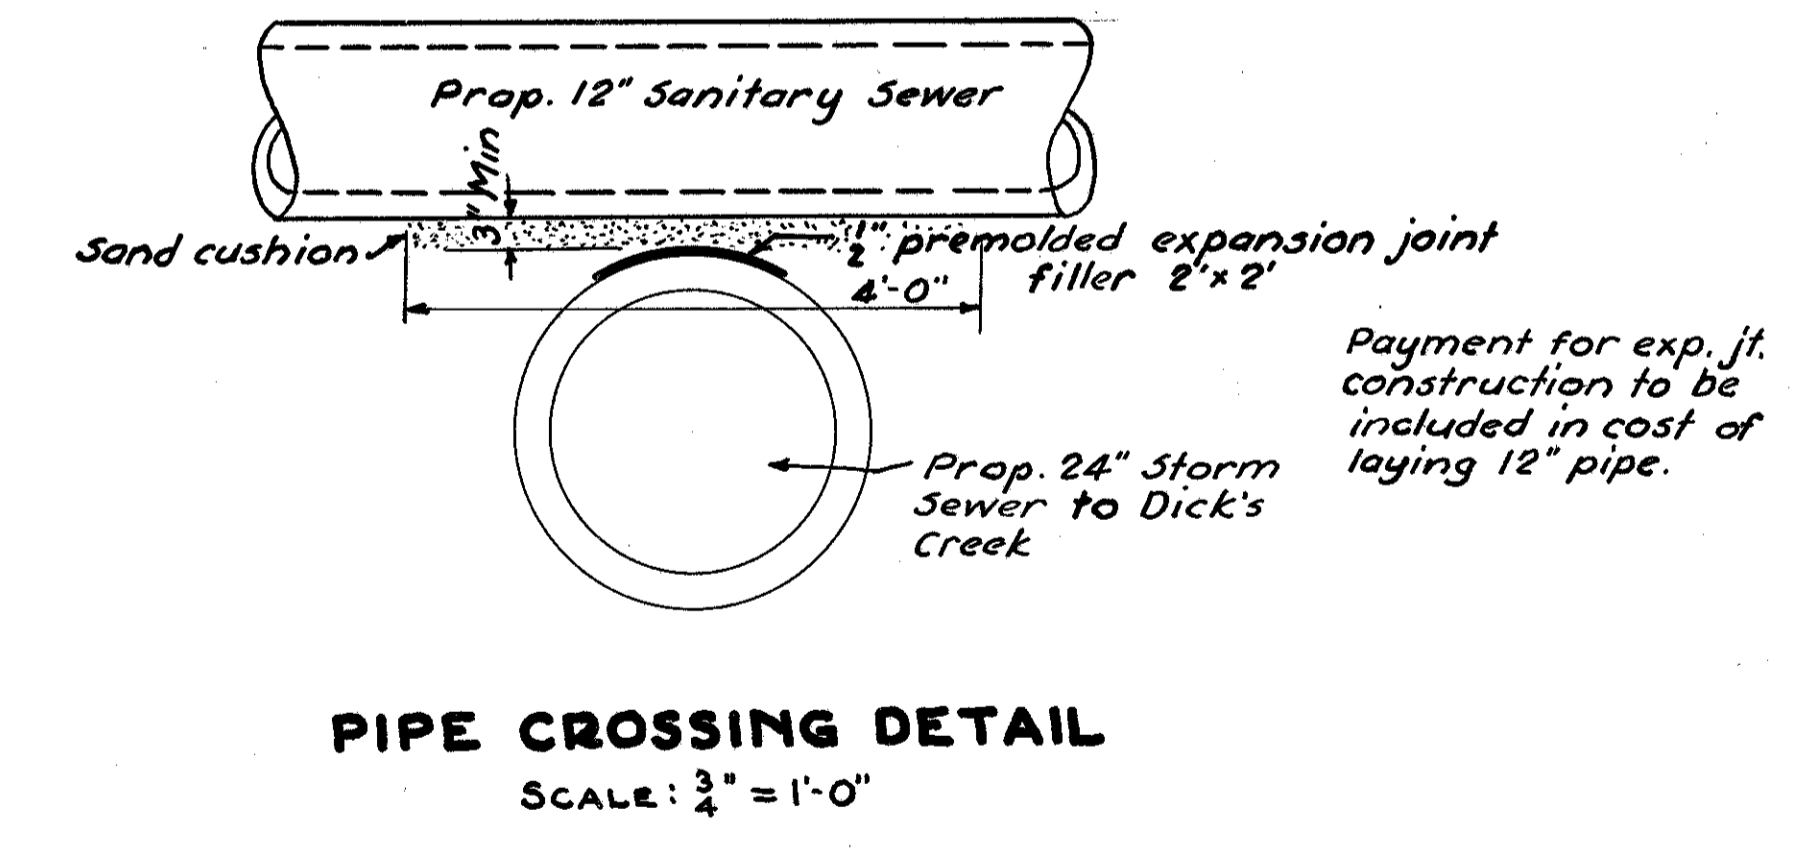

PIPE CROSSING DETAIL  
SCALE: 3/4" = 1'-0"

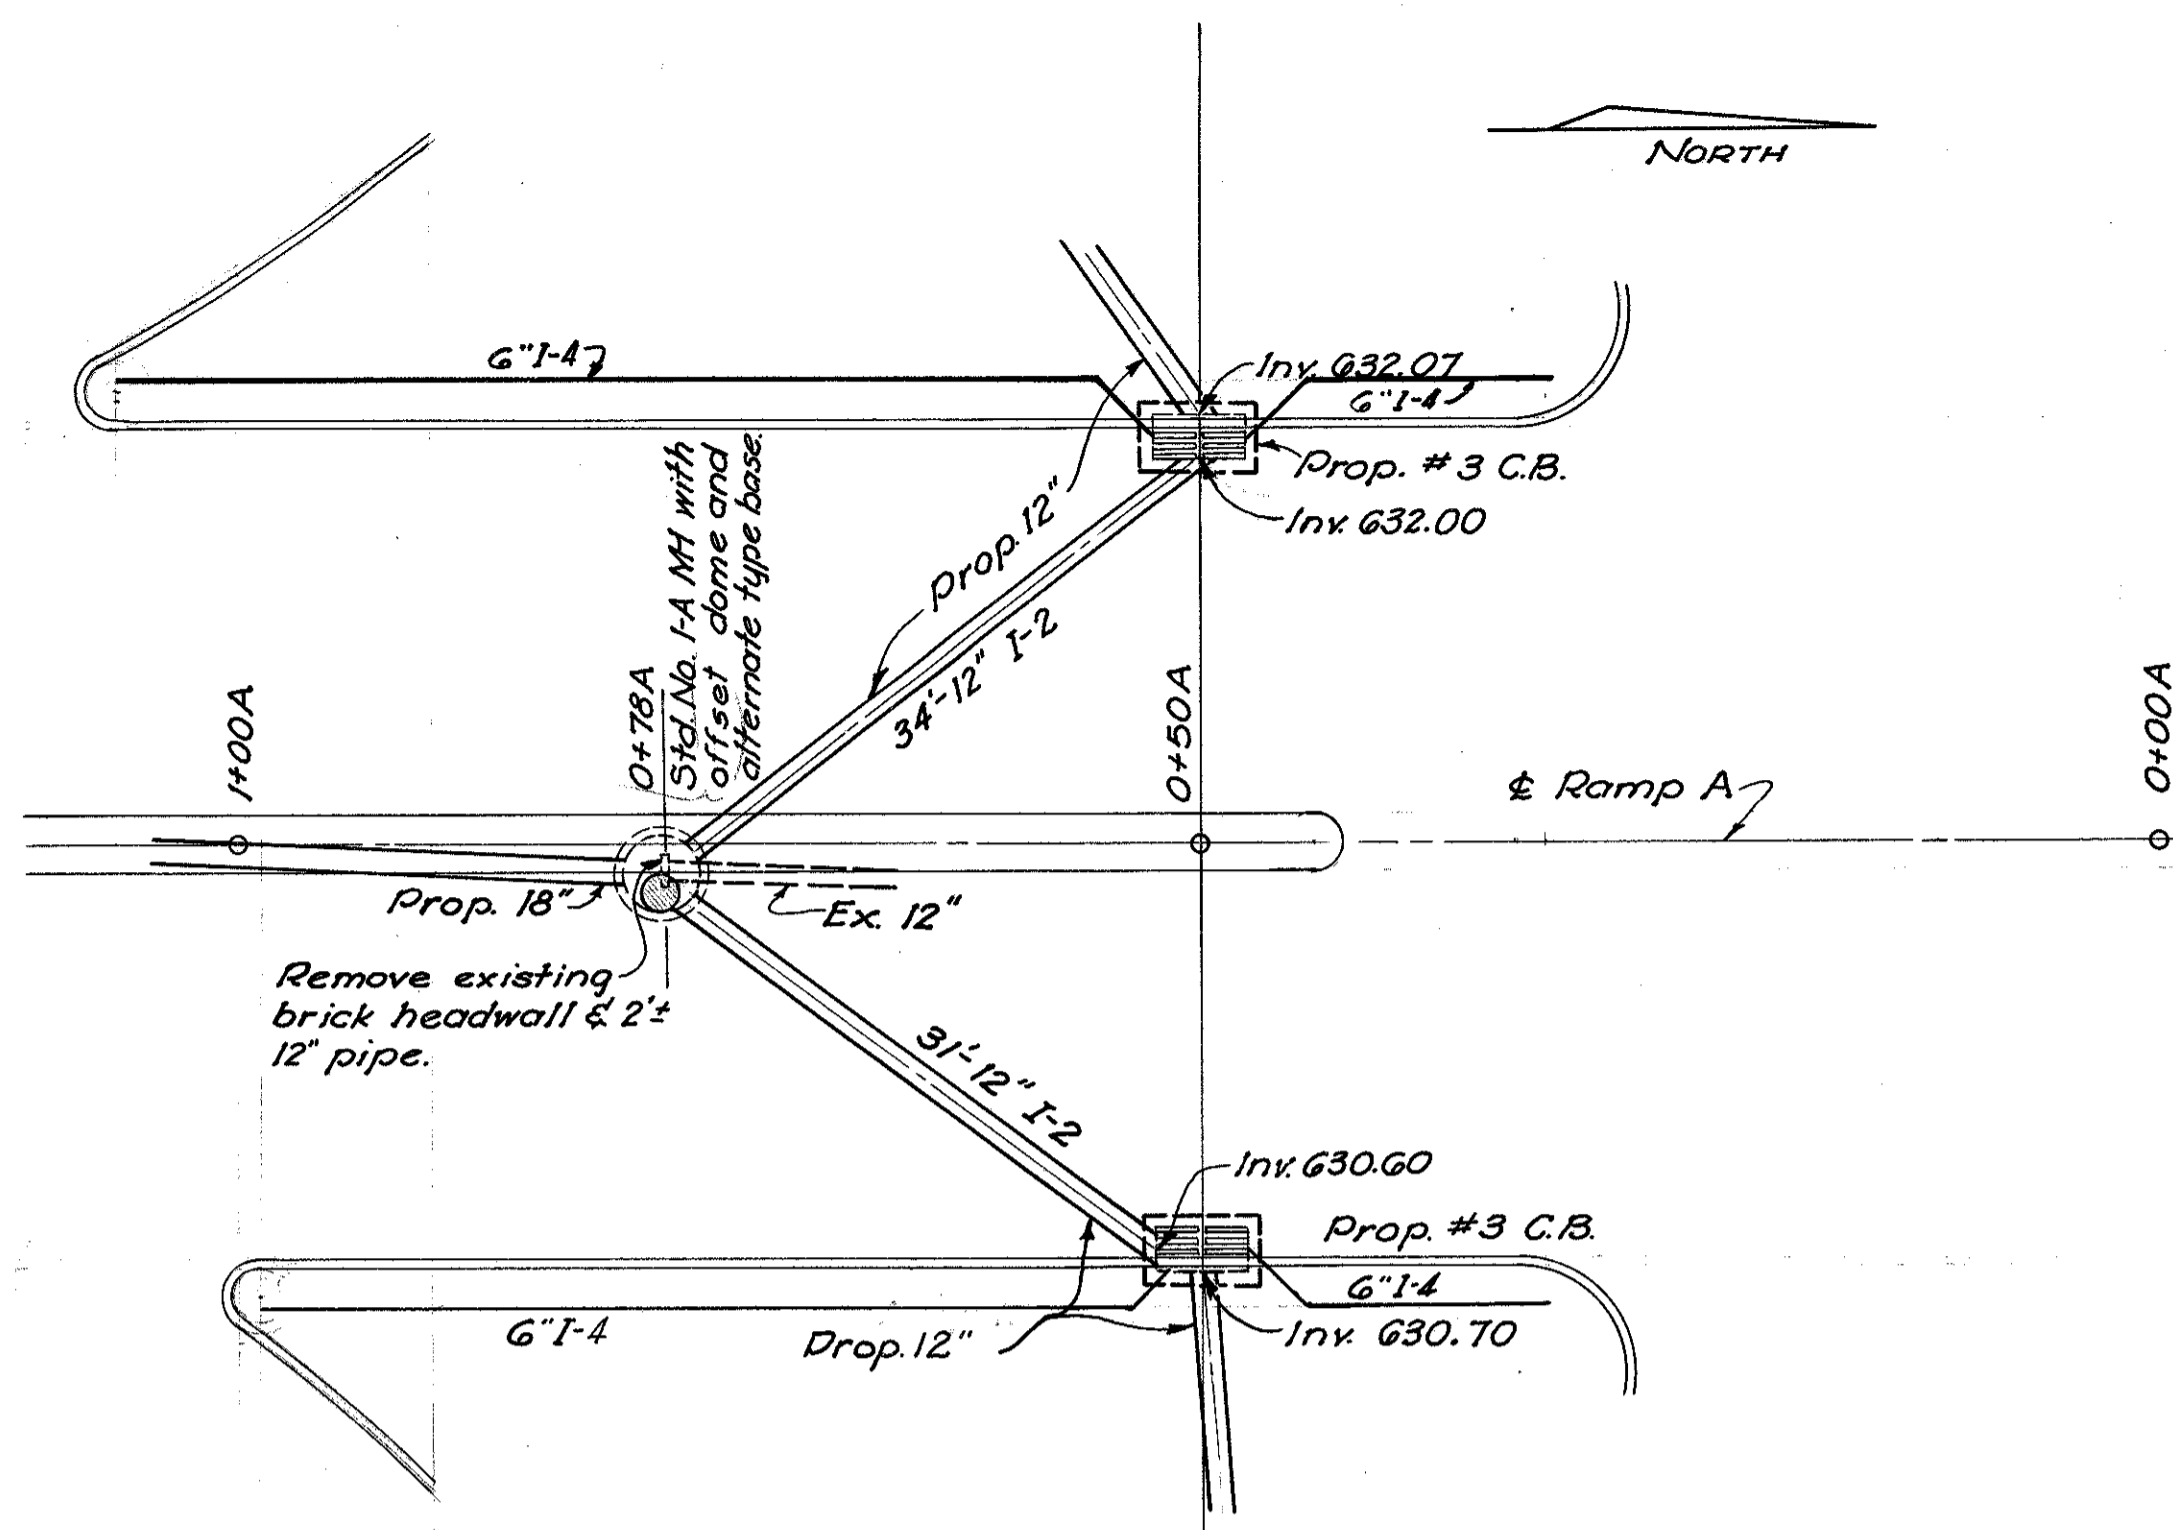


**DRAINAGE PLAN**  
STATION O+78A - RAMP A  
Scale: 1" = 10'

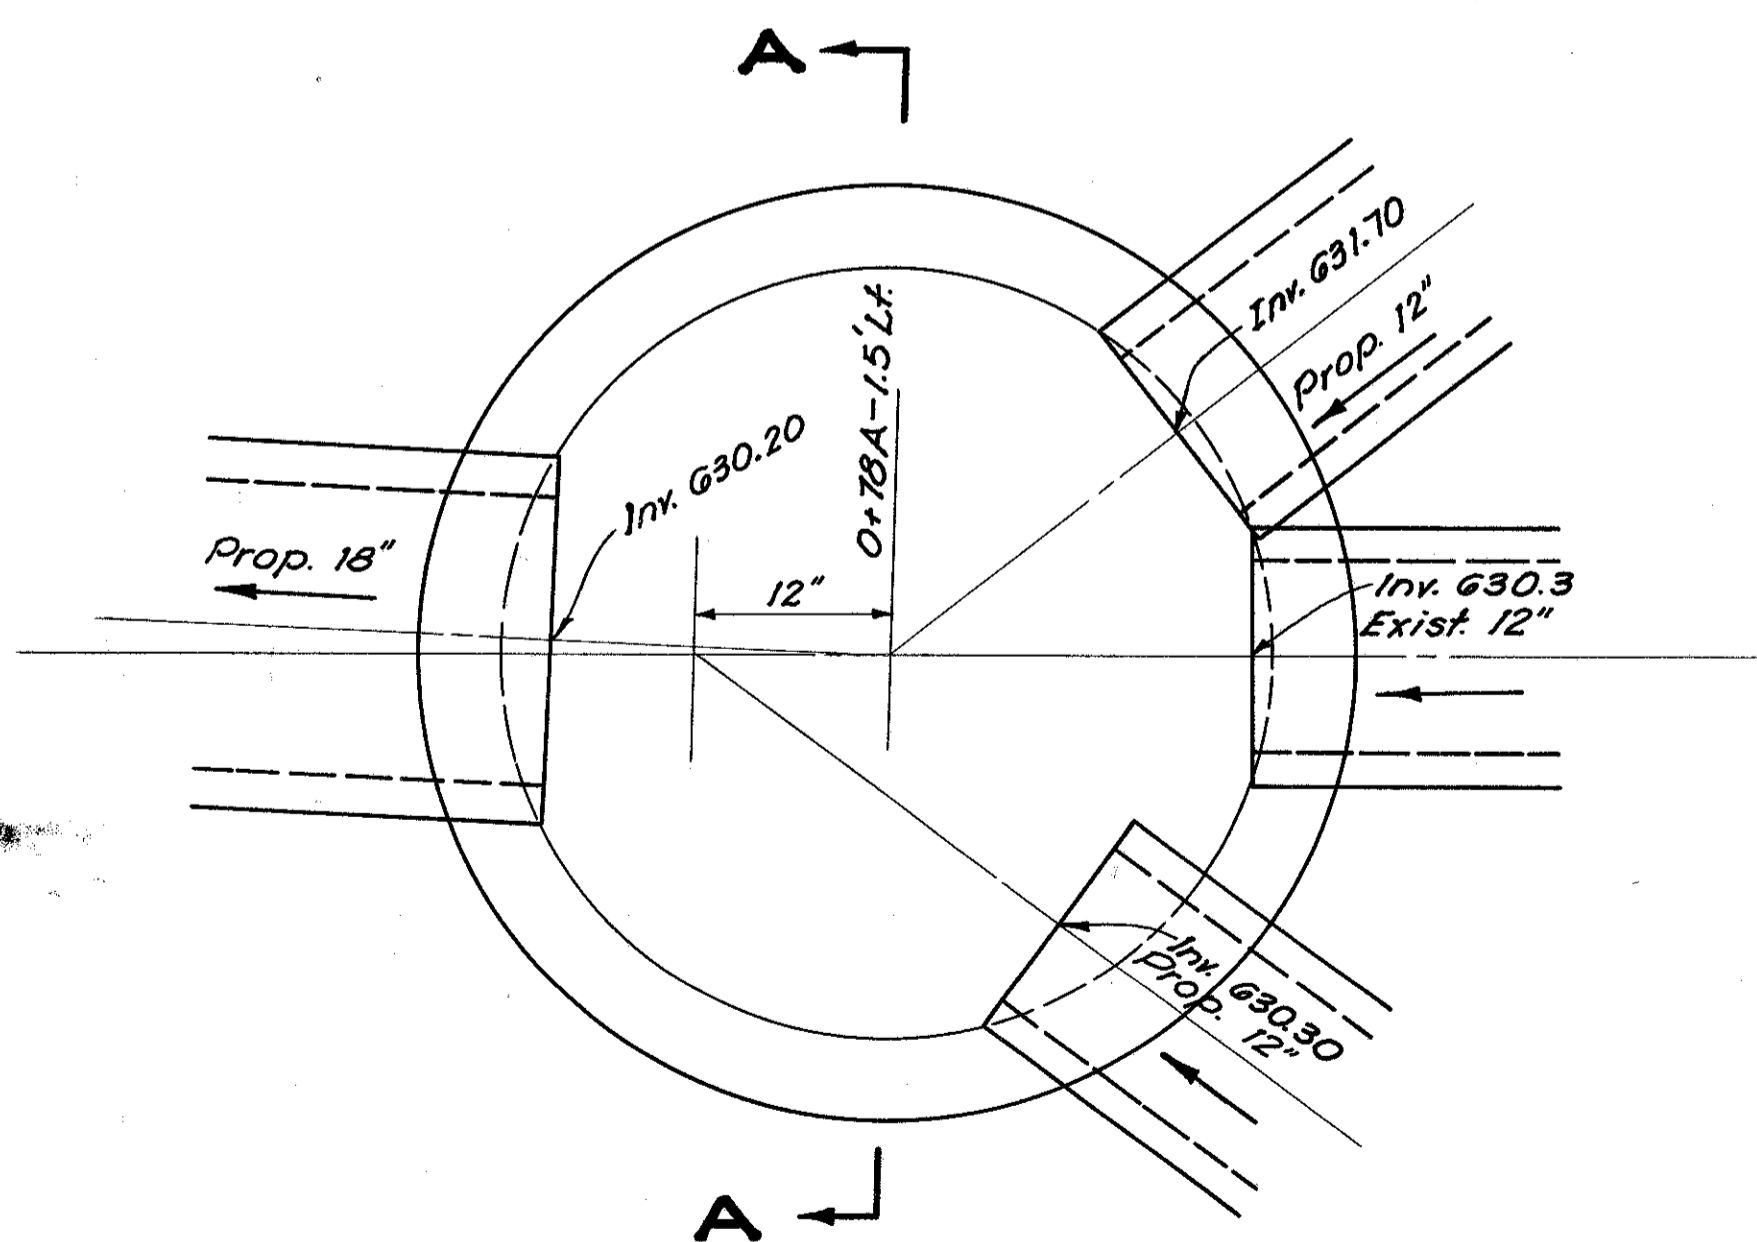

**PLAN**  
SHOWING PIPES ENTERING  
AND LEAVING MANHOLE @  
O+78A - 1.5' LT.  
Scale: 1" = 1'-0"


**METHOD A**

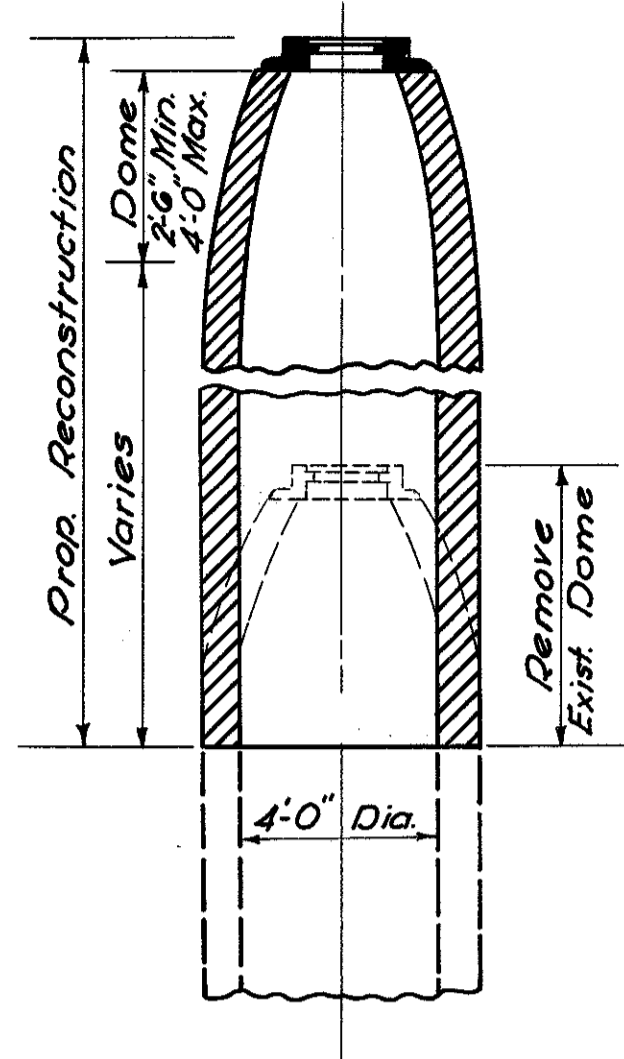


METHOD A is to be used where the existing casting is to be raised an amount exceeding 12" or lowered more than 6".

METHOD B is to be used where the existing casting is to be raised an amount less than 12" or lowered less than 6". Sufficient brick or concrete shall be removed to permit a minimum thickness of concrete of 3".


**METHOD B**

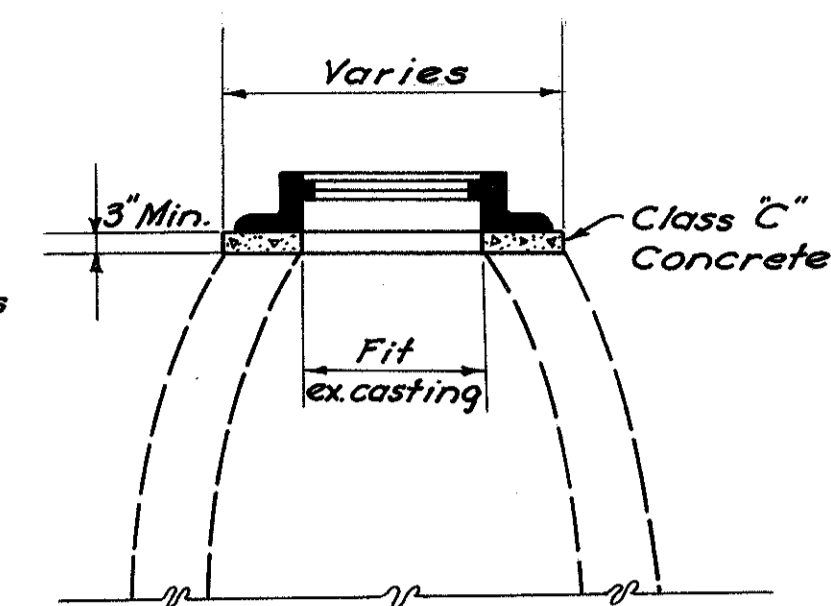

**MANHOLE ADJUSTED TO GRADE**  
No Scale

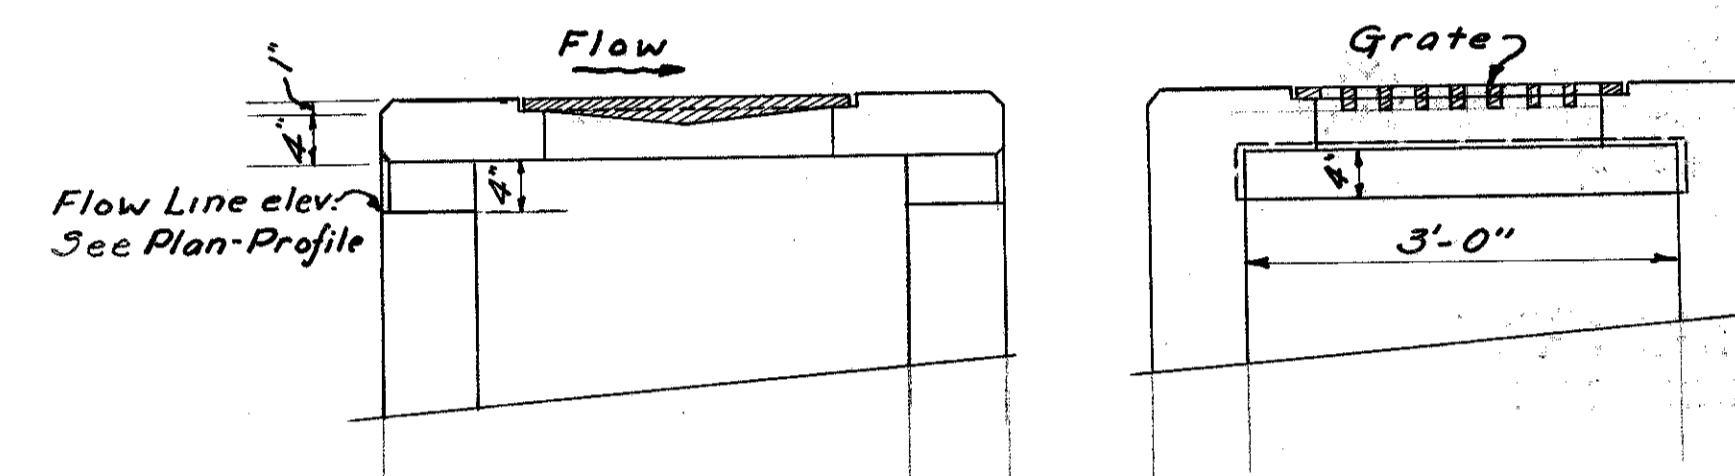


**PART SECTIONS**  
MOD. NO. 2-3 CATCH BASIN

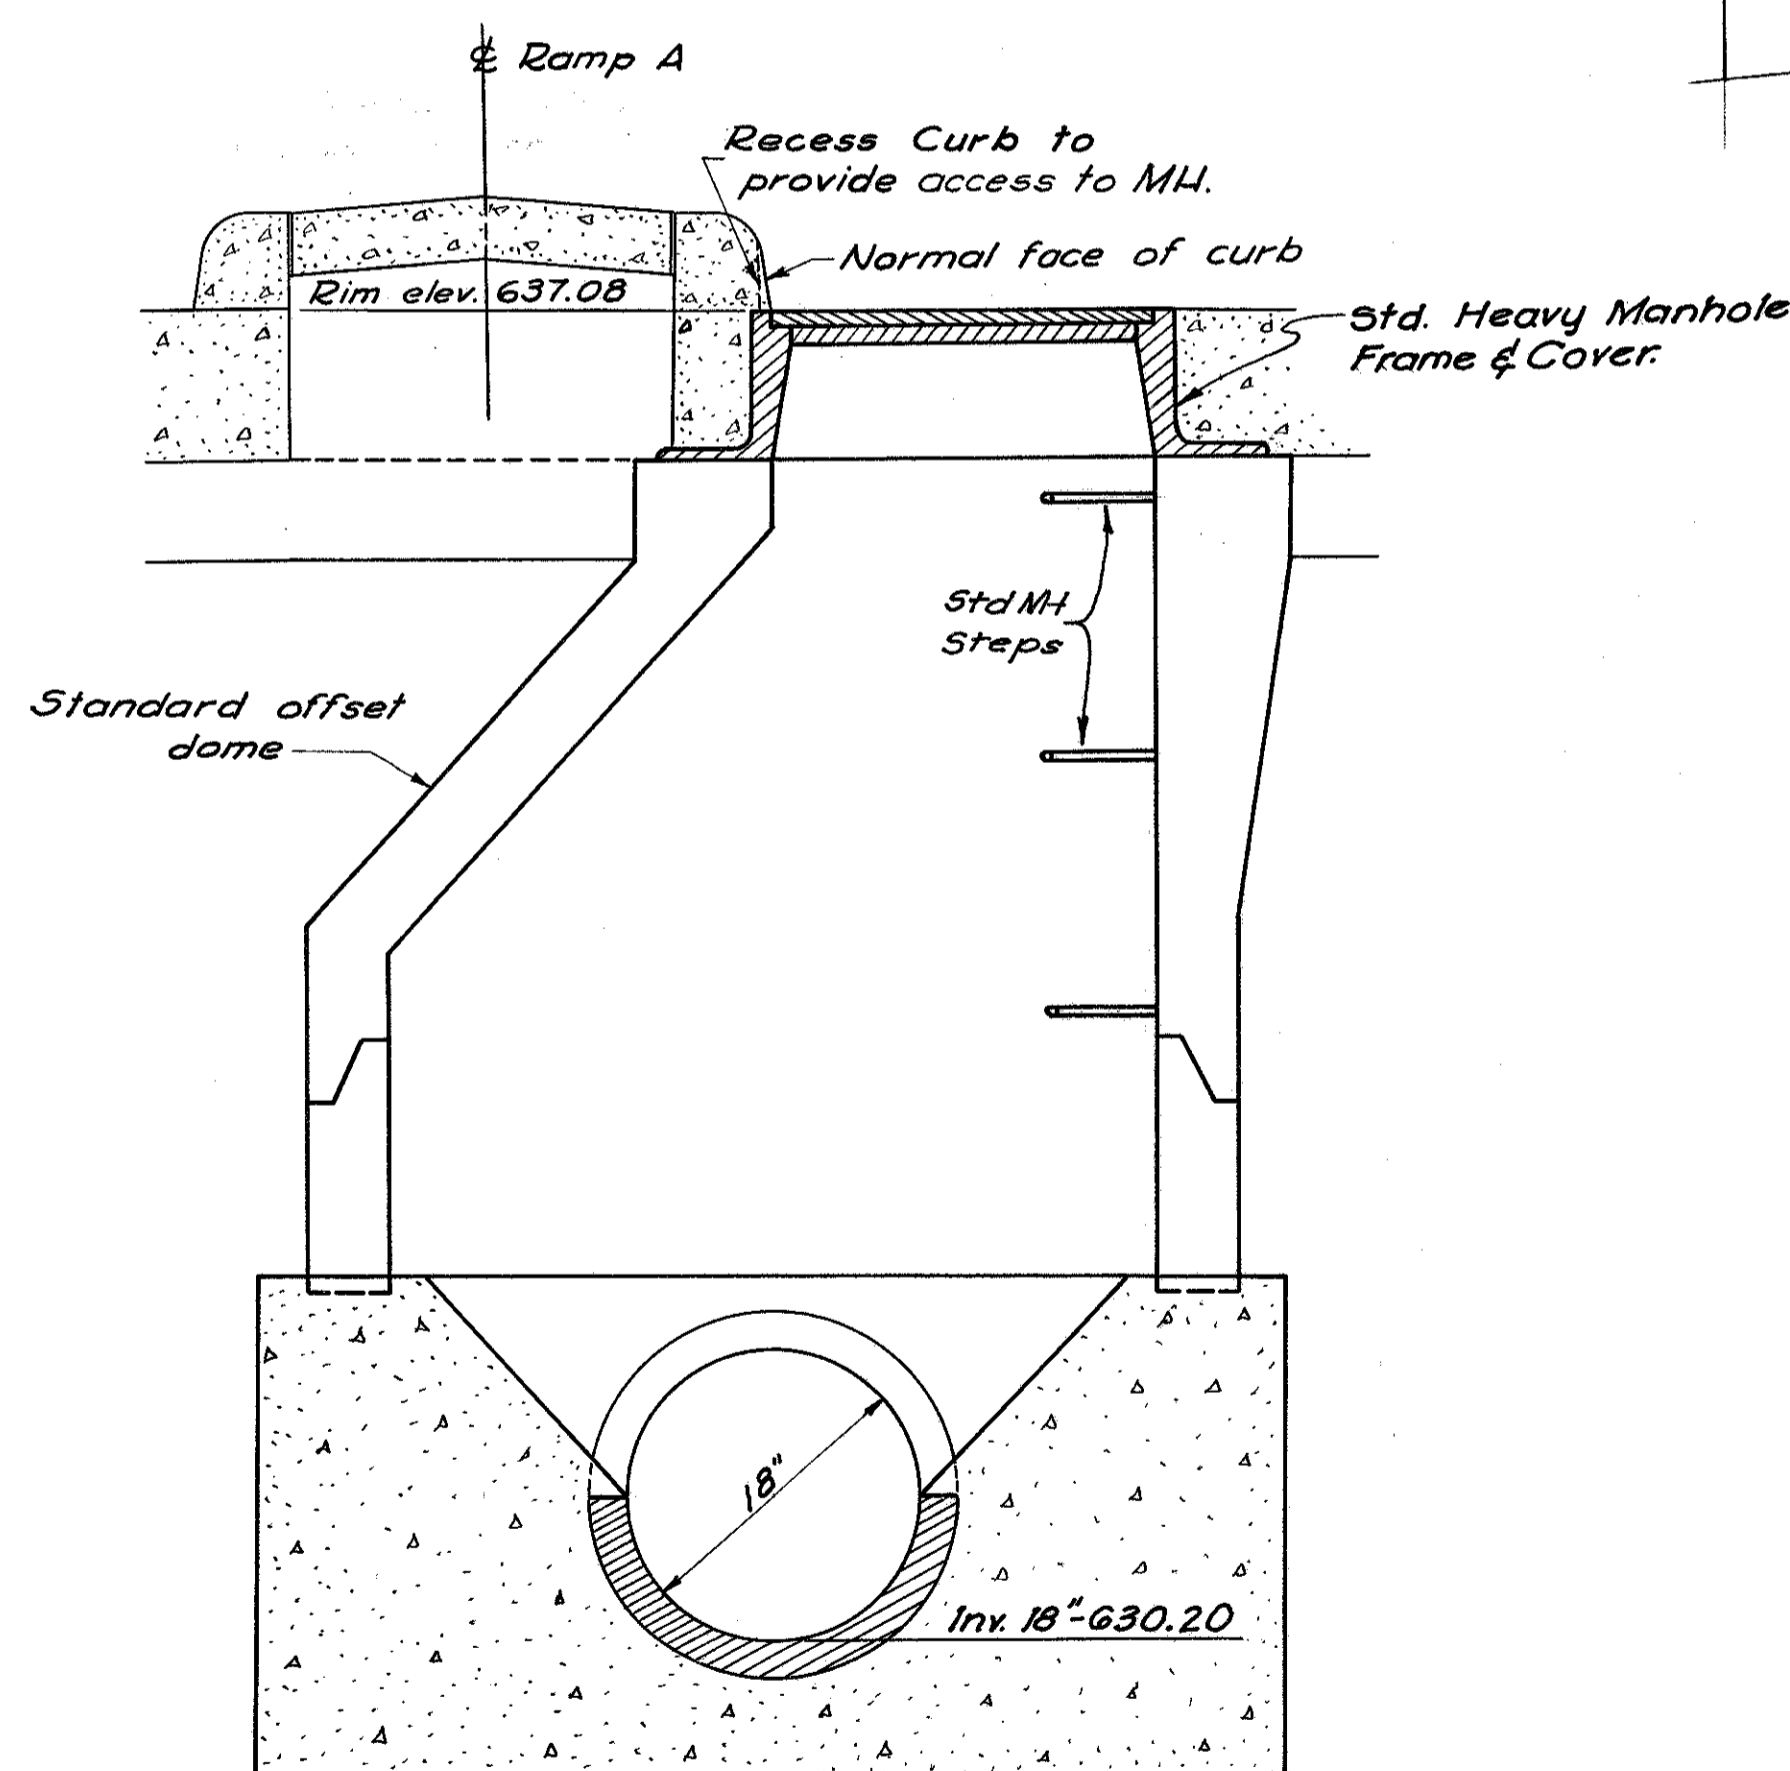

**SECTION A-A**  
STANDARD NO. 1-A MANHOLE  
STATION O+78A 1.5' RT.  
Scale: 1" = 1'-0"


Note: Precast reinforced concrete manholes as detailed above and on Standard Drawing I-8 M.H. No. 1-A may be used in lieu of the design shown on Standard Drawing I-8 M.H. No. 1.

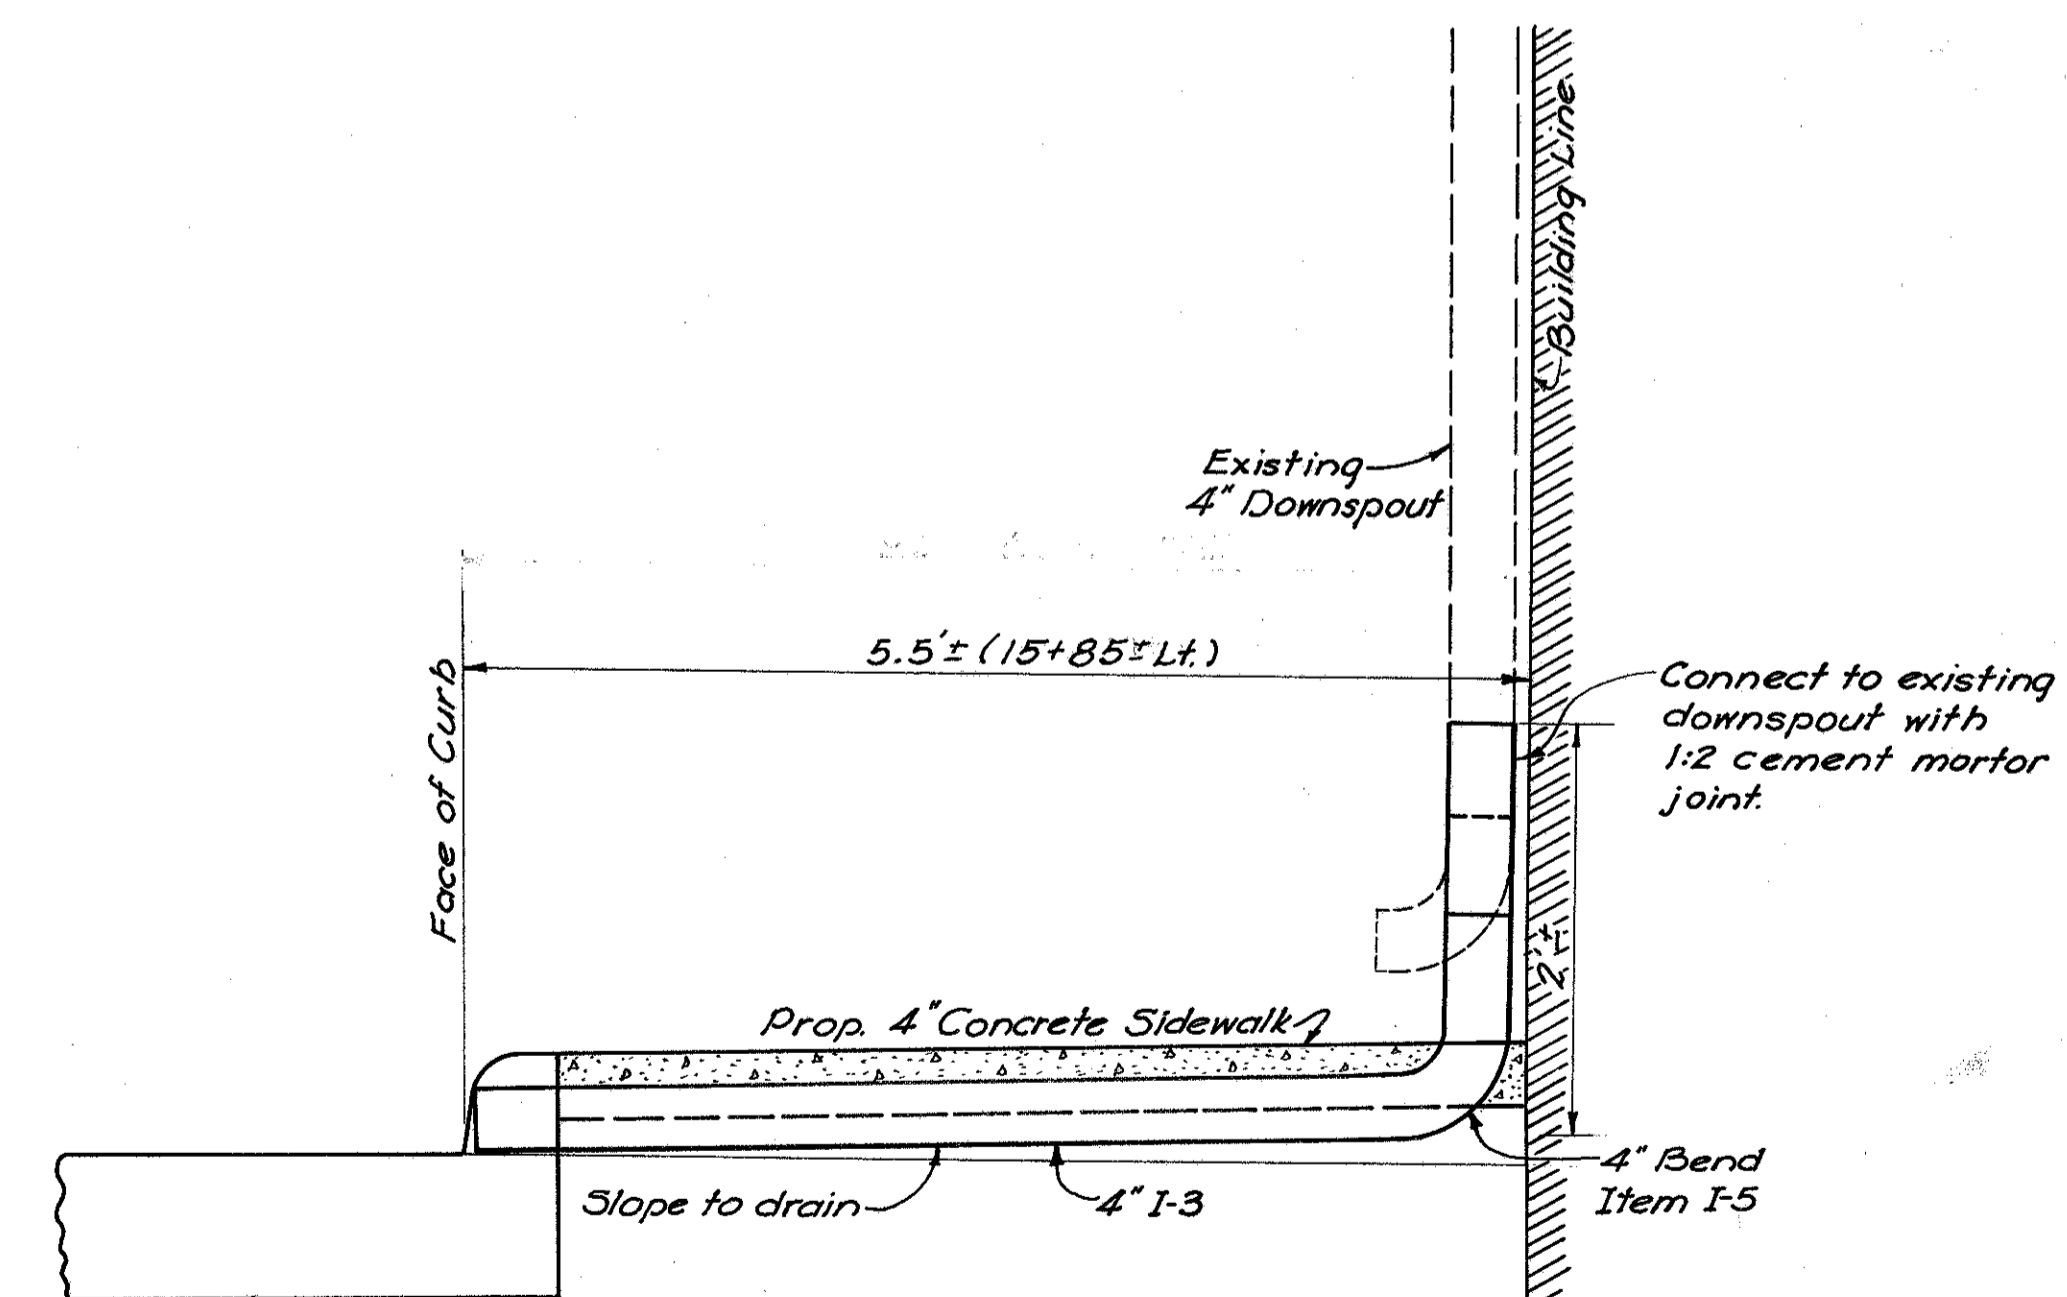

**OUTLET FOR 4" DOWNSPOUT**  
STATION 15+85±LT. (ROUTE 73)

ESTIMATE OF QUANTITIES:  
4'-4" I-3 Under Pavement  
1-4" 90° Bend Item I-5


### KEY PLAN

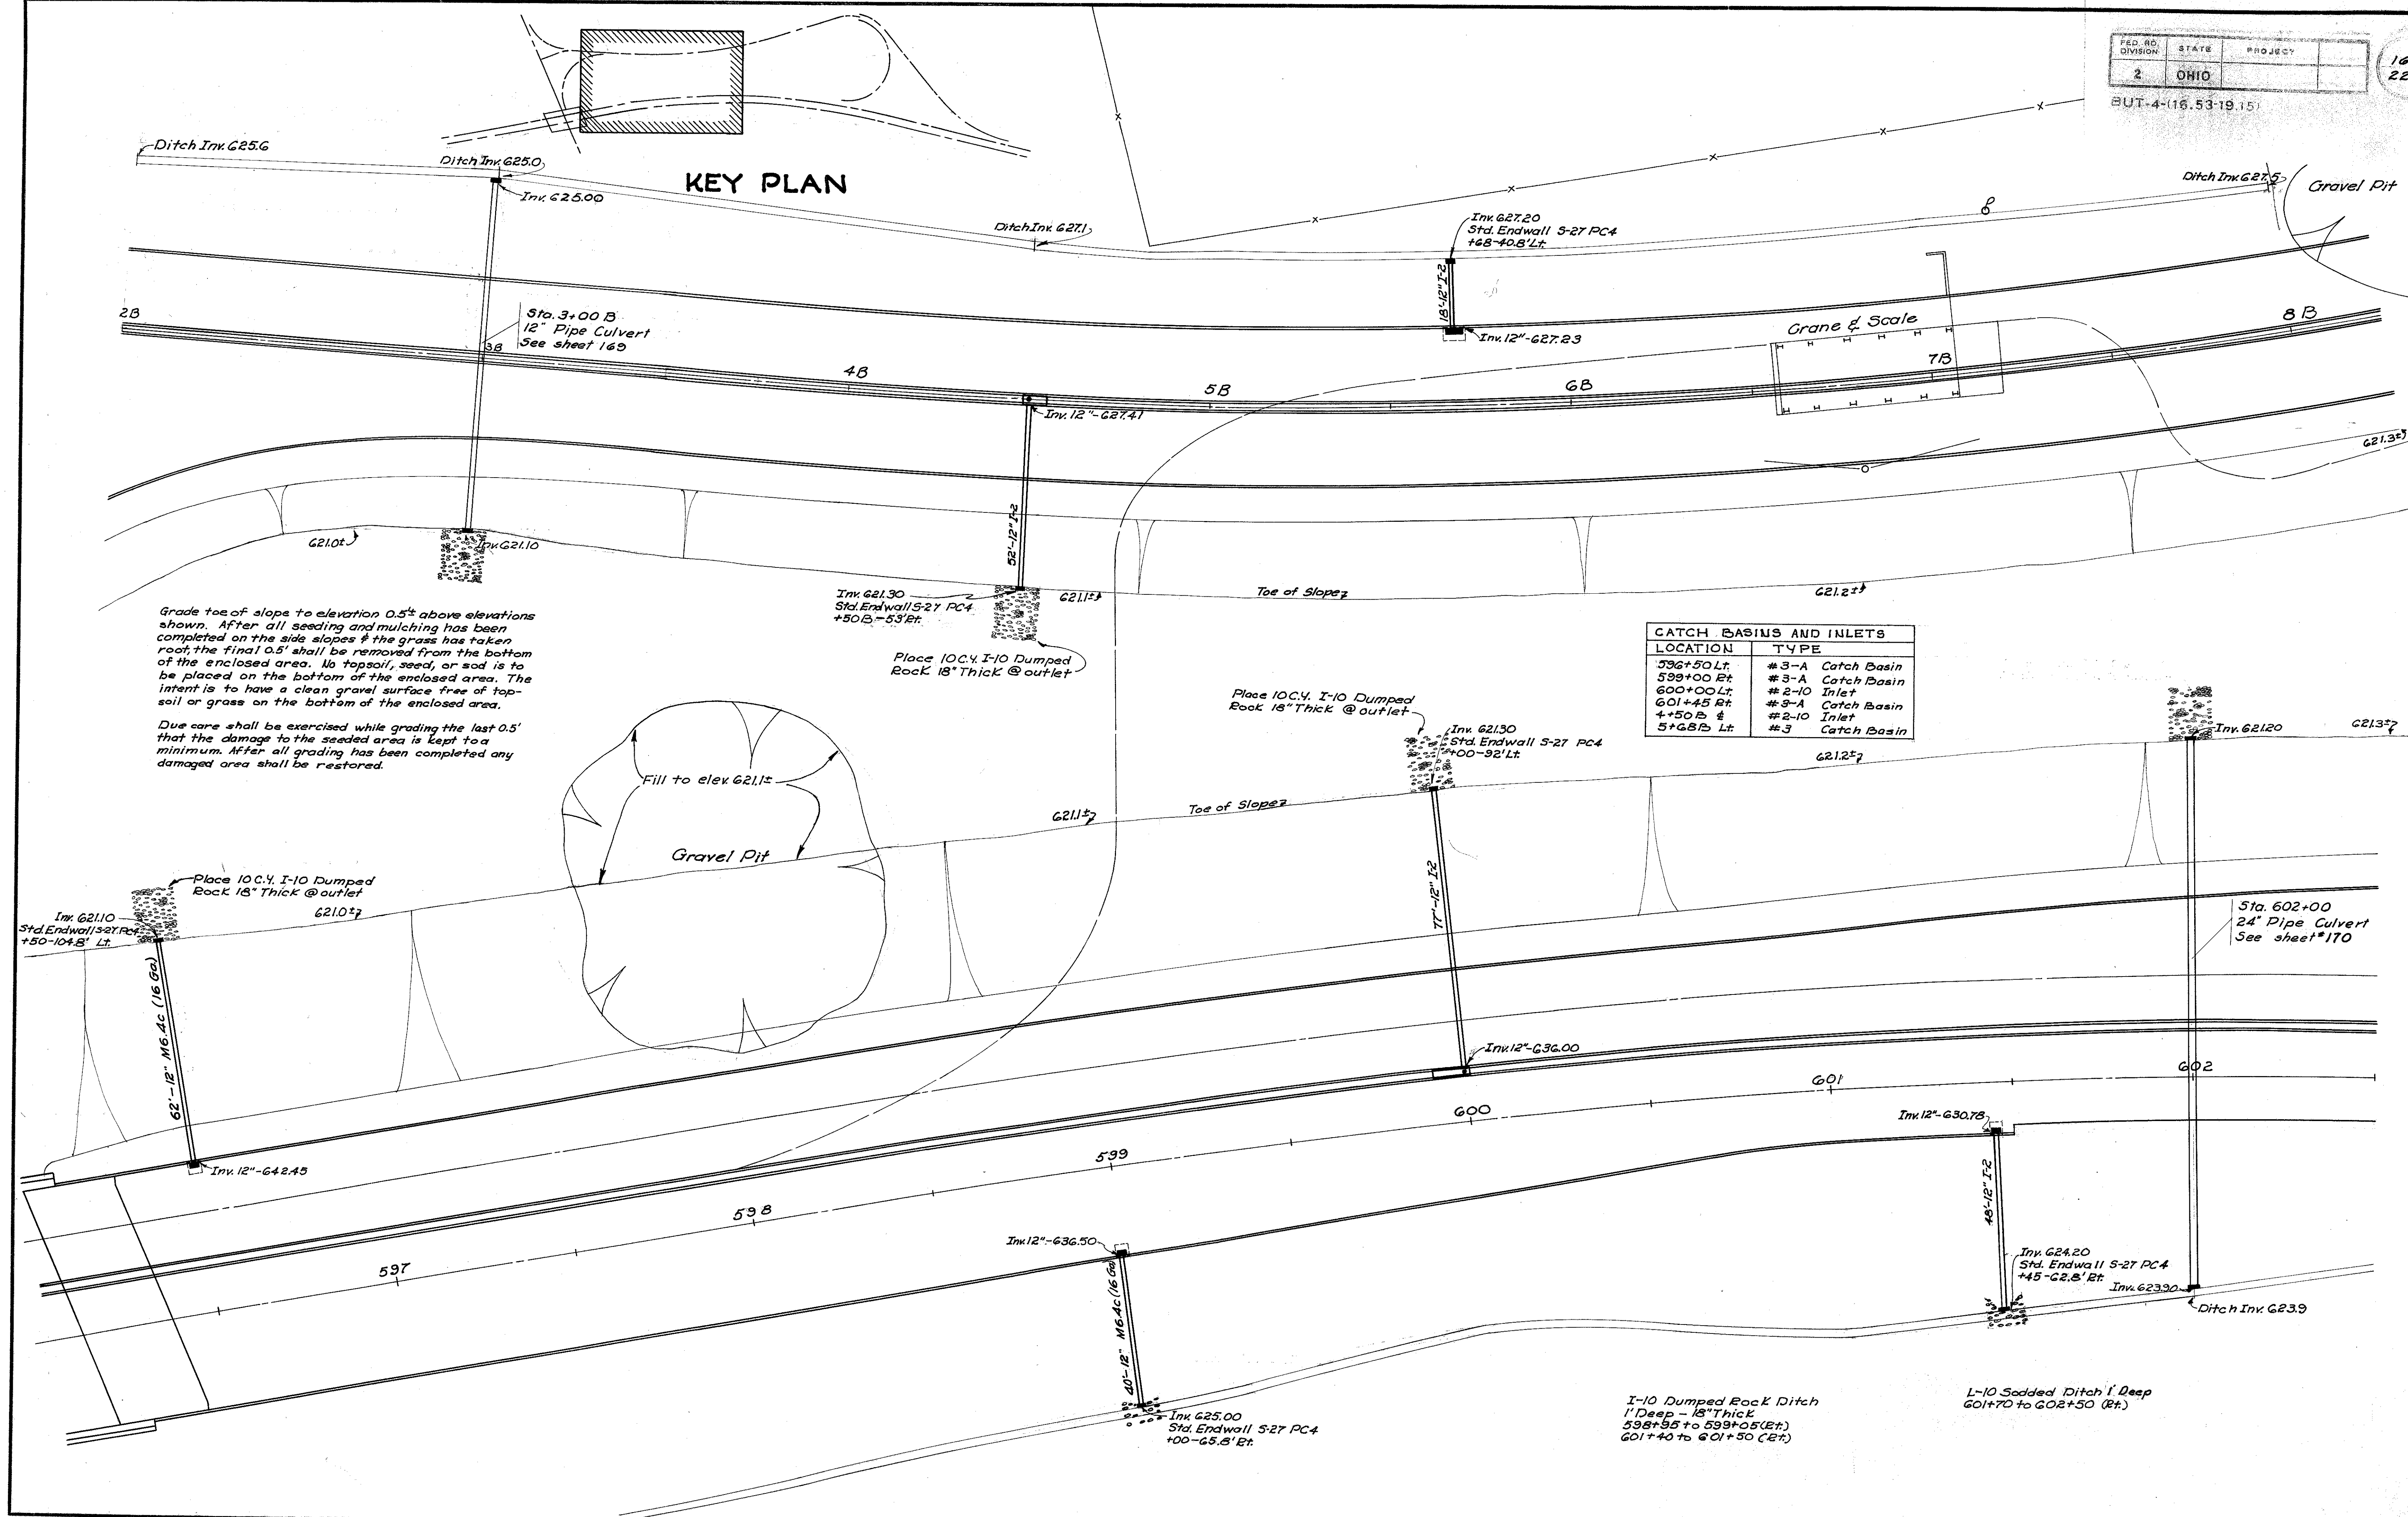

Grade toe of slope to elevation 0.5' above elevations shown. After all seeding and mulching has been completed on the side slopes & the grass has taken root, the final 0.5' shall be removed from the bottom of the enclosed area. No topsoil, seed, or sod is to be placed on the bottom of the enclosed area. The intent is to have a clean gravel surface free of topsoil or grass on the bottom of the enclosed area.

Due care shall be exercised while grading the last 0.5' that the damage to the seeded area is kept to a minimum. After all grading has been completed any damaged area shall be restored.

LOCATION	TYPE
596+50 Lt.	#3-A Catch Basin
599+00 Rt.	#3-A Catch Basin
600+00 Lt.	#2-10 Inlet
601+45 Rt.	#3-A Catch Basin
4+50 B &	#2-10 Inlet
5+68 B Lt.	#3 Catch Basin

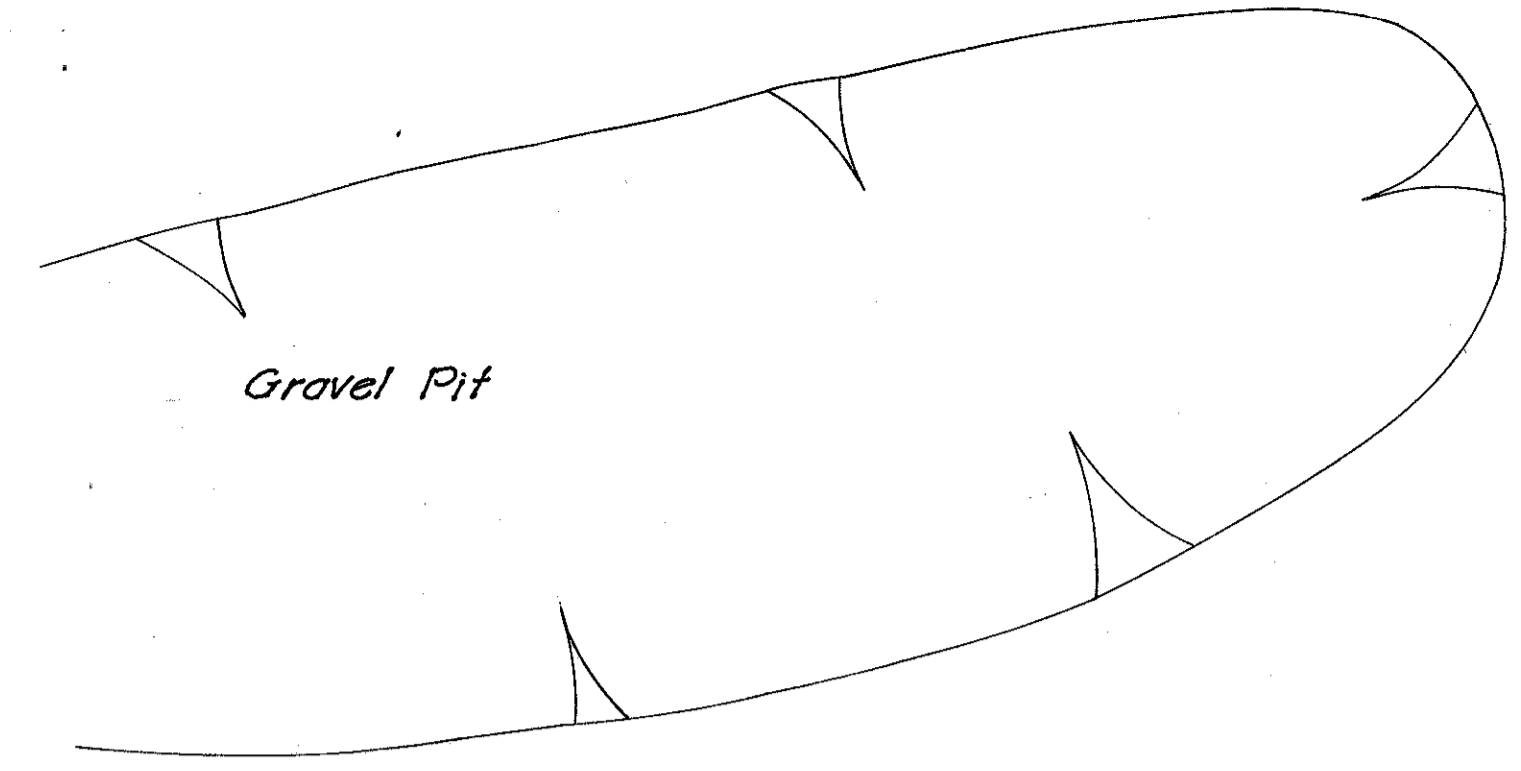


Gravel Pit


INLETS	
LOCATION	TYPE
605+00 Lt.	#2-10
607+75 Lt.	#2-10
608+50 Lt.	#2-6

See note sheet 165 for grading enclosed area.


For additional Topo see Sheets 42 & 45

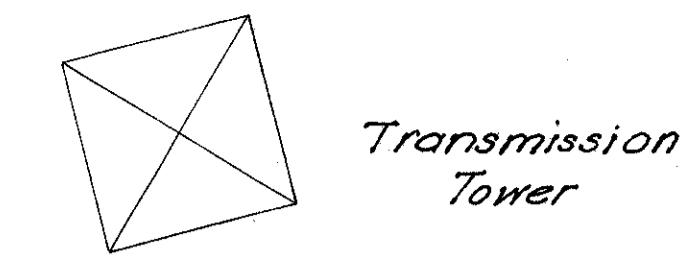


Transmission Tower

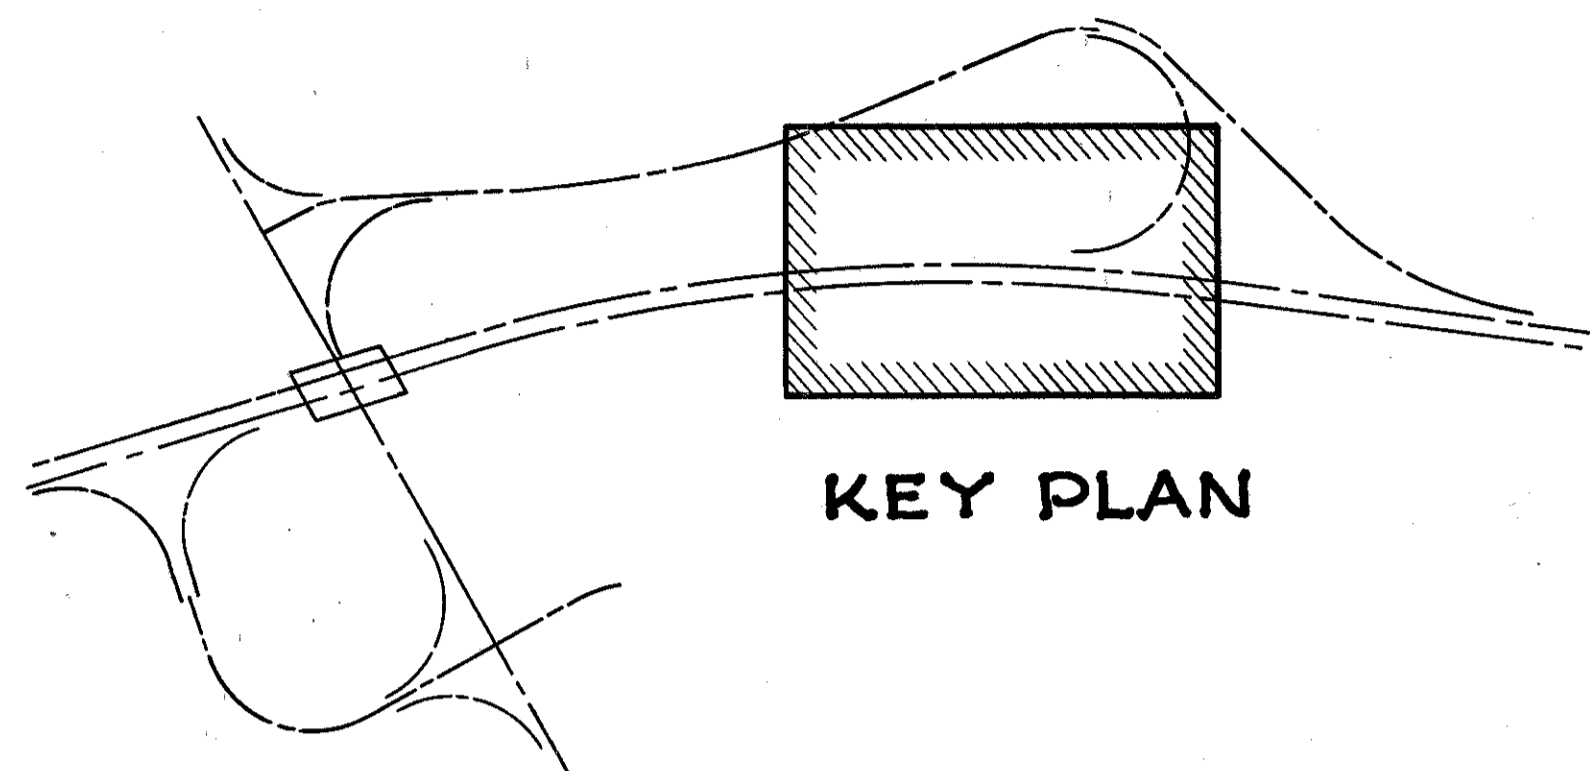

KEY PLAN

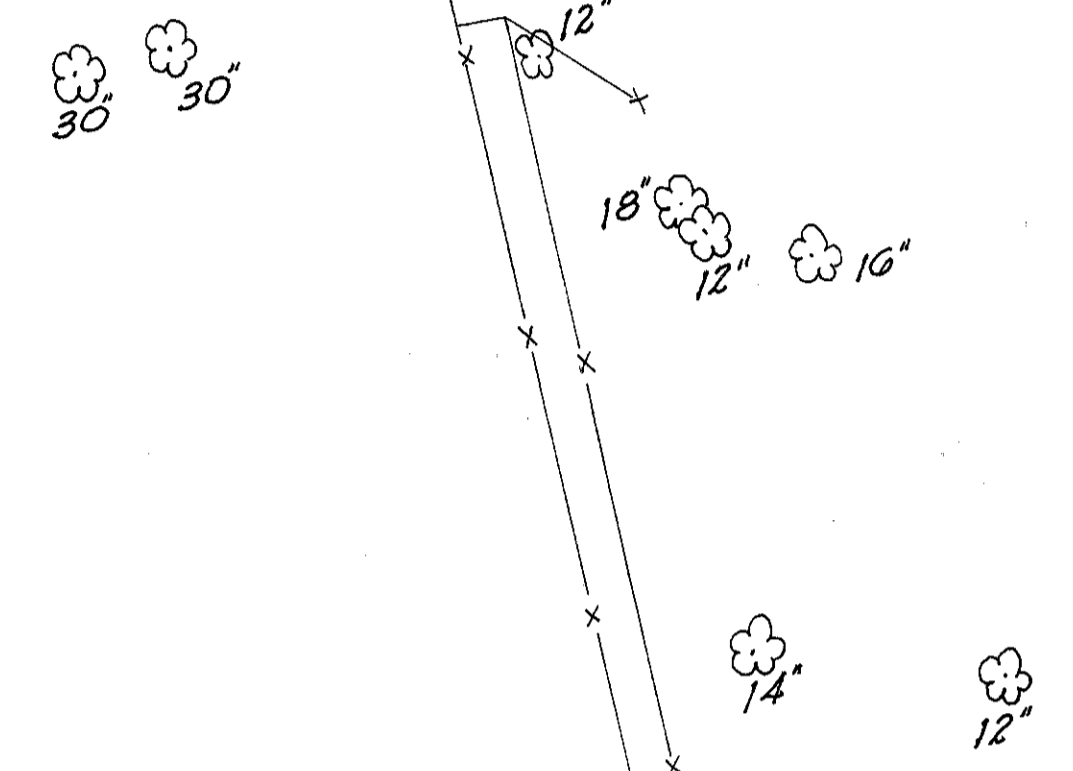

Pig Pen

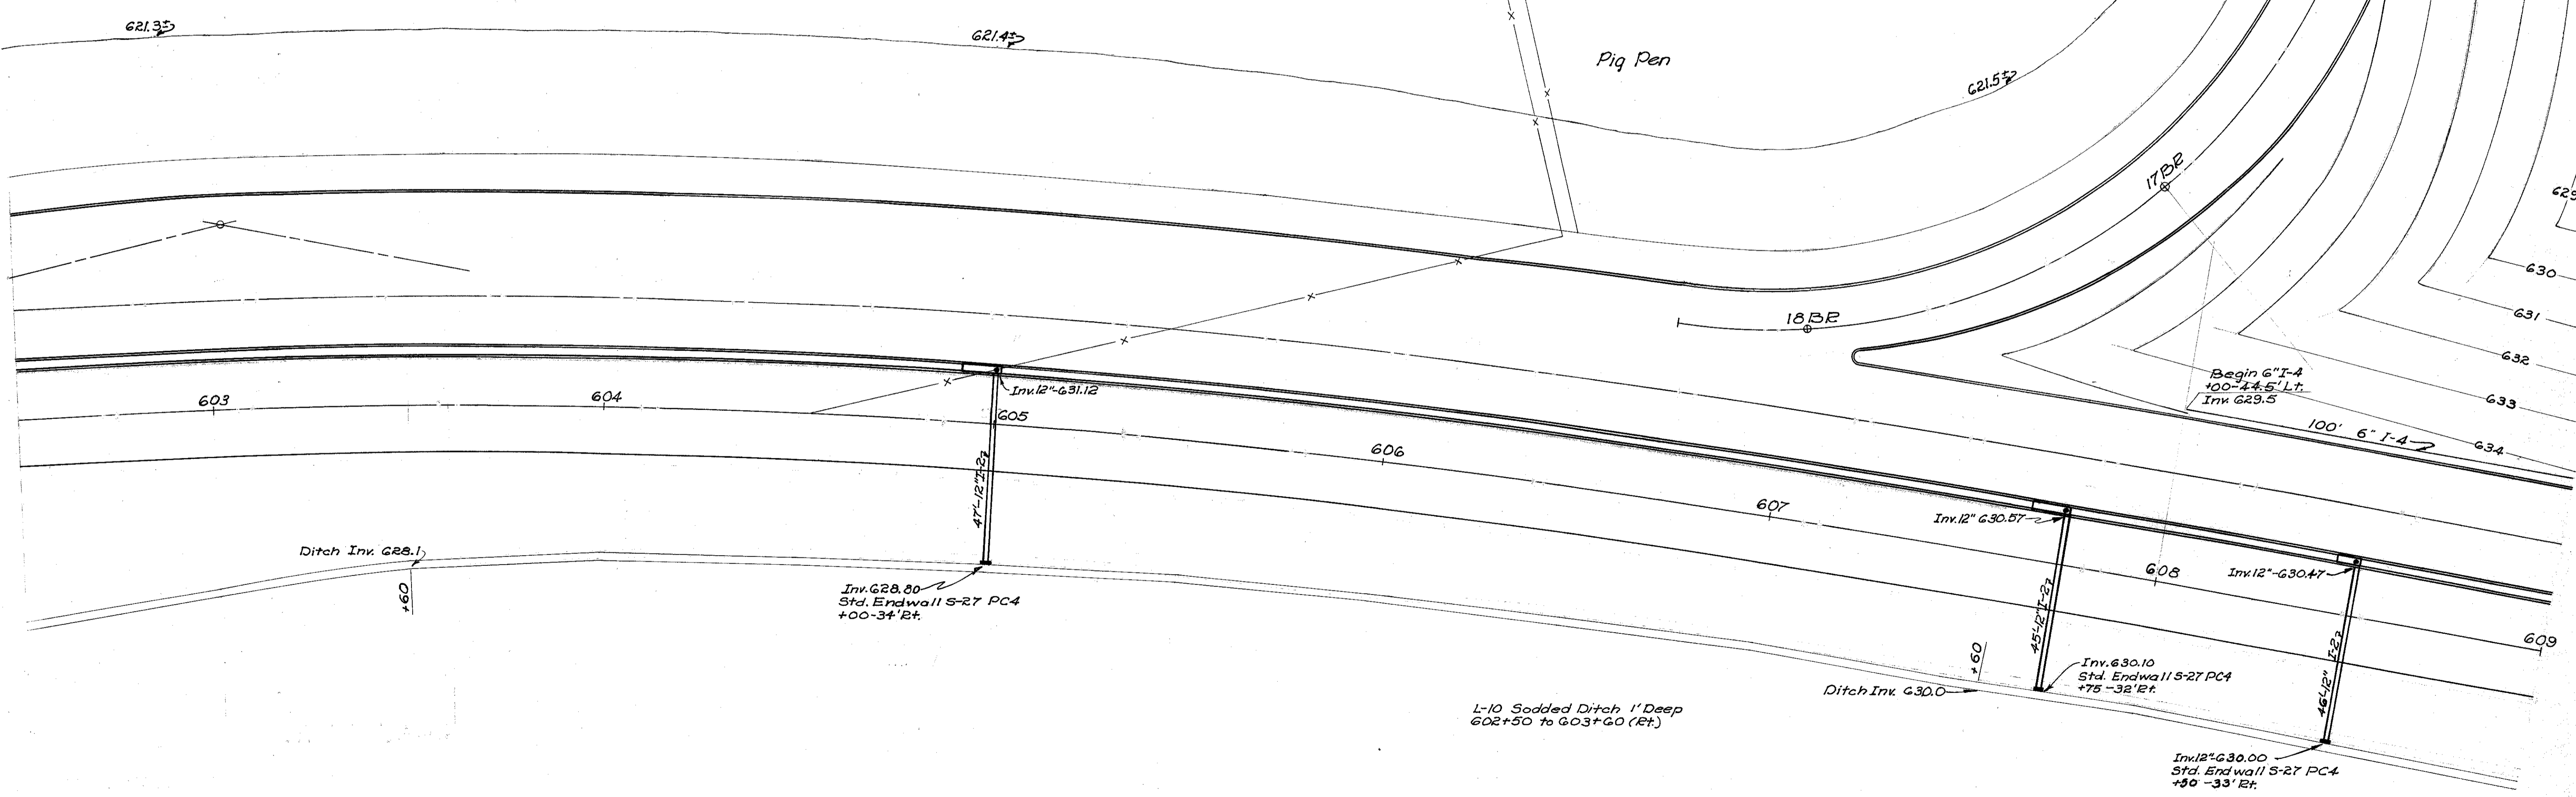

Inv. 628.80  
Std. Endwall S-27 PC4  
+00-34' Et.


L-10 Sodded Ditch 1' Deep  
602+50 to 603+60 (Et.)

Inv. 630.10  
Std. Endwall S-27 PC4  
+75-32' Et.

Inv. 630.00  
Std. Endwall S-27 PC4  
+30-33' Et.

Begin 6" I-4  
+00-44.5' Lt.  
Inv. 629.5


DRAINAGE RAMP B

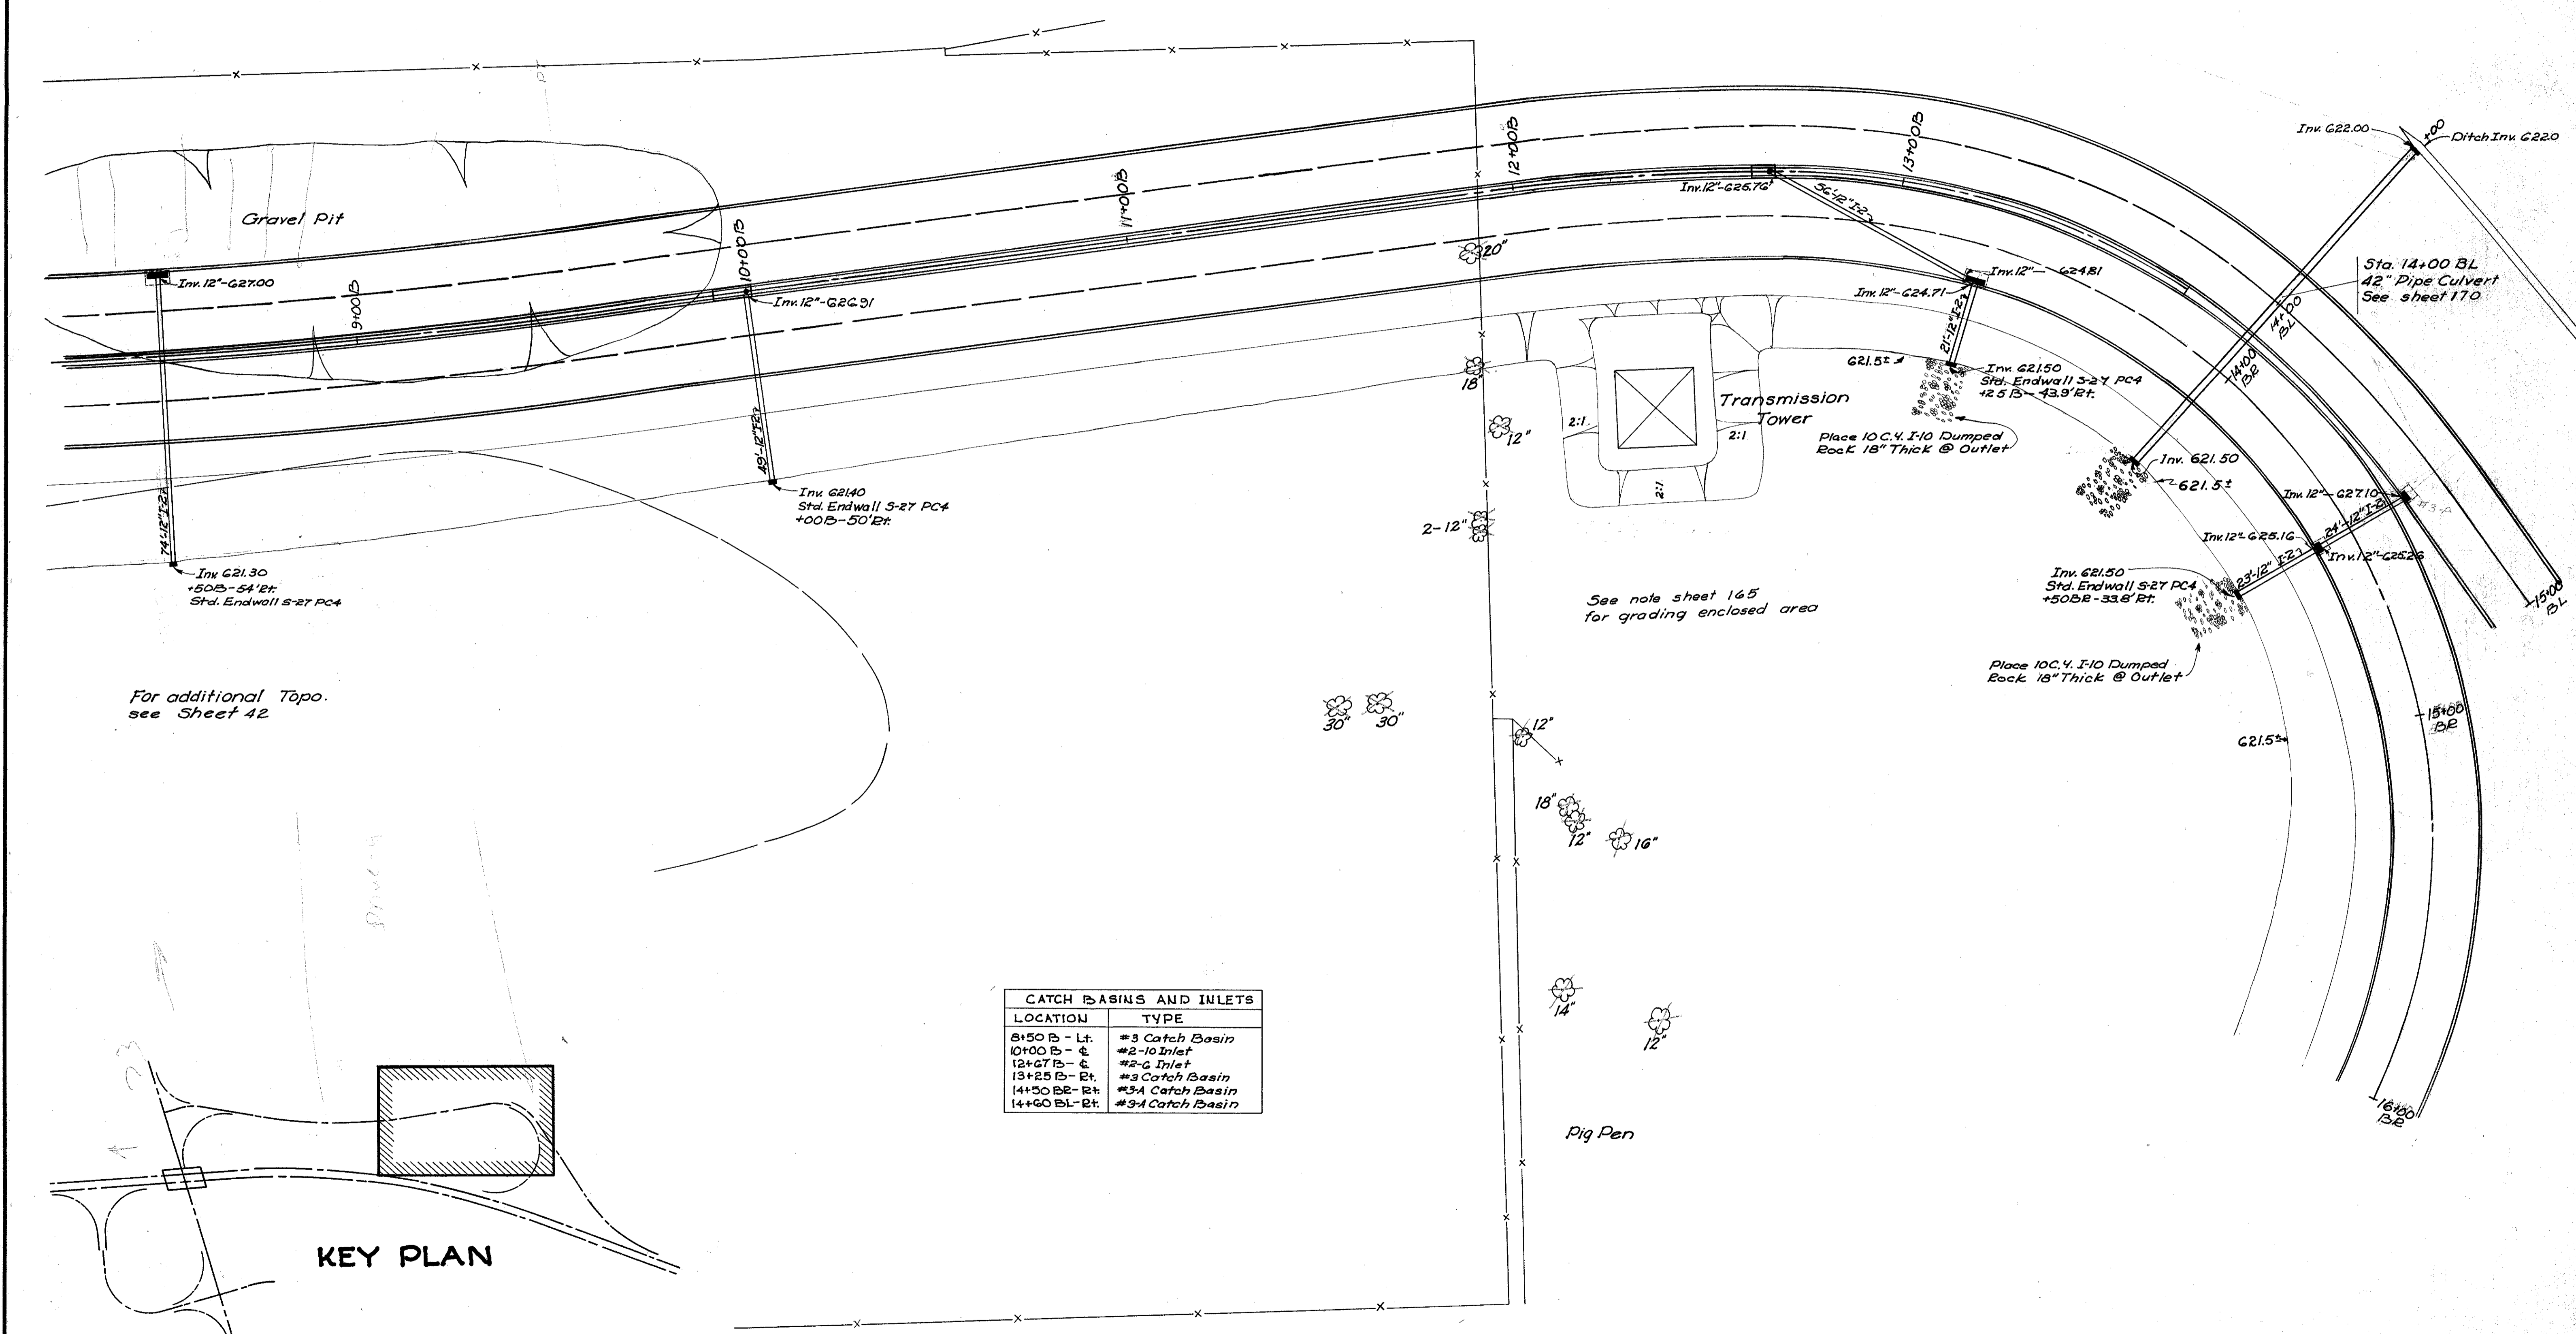

For additional Topo. see Sheet 42

See note sheet 165 for grading enclosed area


CATCH BASINS AND INLETS	
LOCATION	TYPE
8+50 B - Lt.	#3 Catch Basin
10+00 B - C	#2-10 Inlet
12+00 B - C	#2-6 Inlet
13+25 B - Rt.	#3 Catch Basin
14+50 B - Rt.	#3A Catch Basin
14+60 B - Rt.	#3A Catch Basin

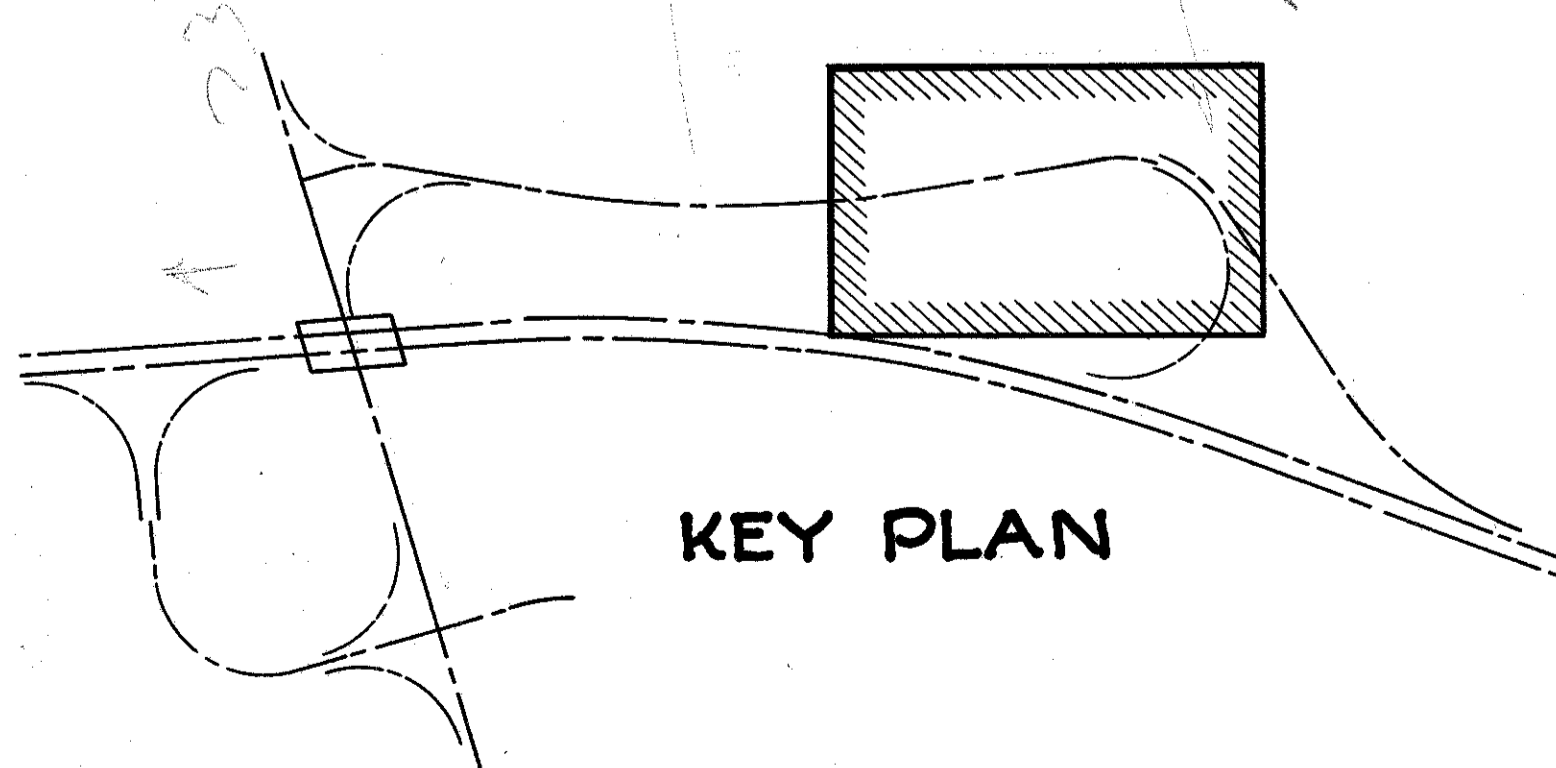

L-10 Sodded Ditch-1' Deep  
G16+40 to G16+60 (Et.)  
G16+40 to G16+60 (Lt.)

I-10 Dumped Rock Ditch  
1' Deep-18" Thick  
G16+20 to G16+30(Lt.)



### KEY PLAN

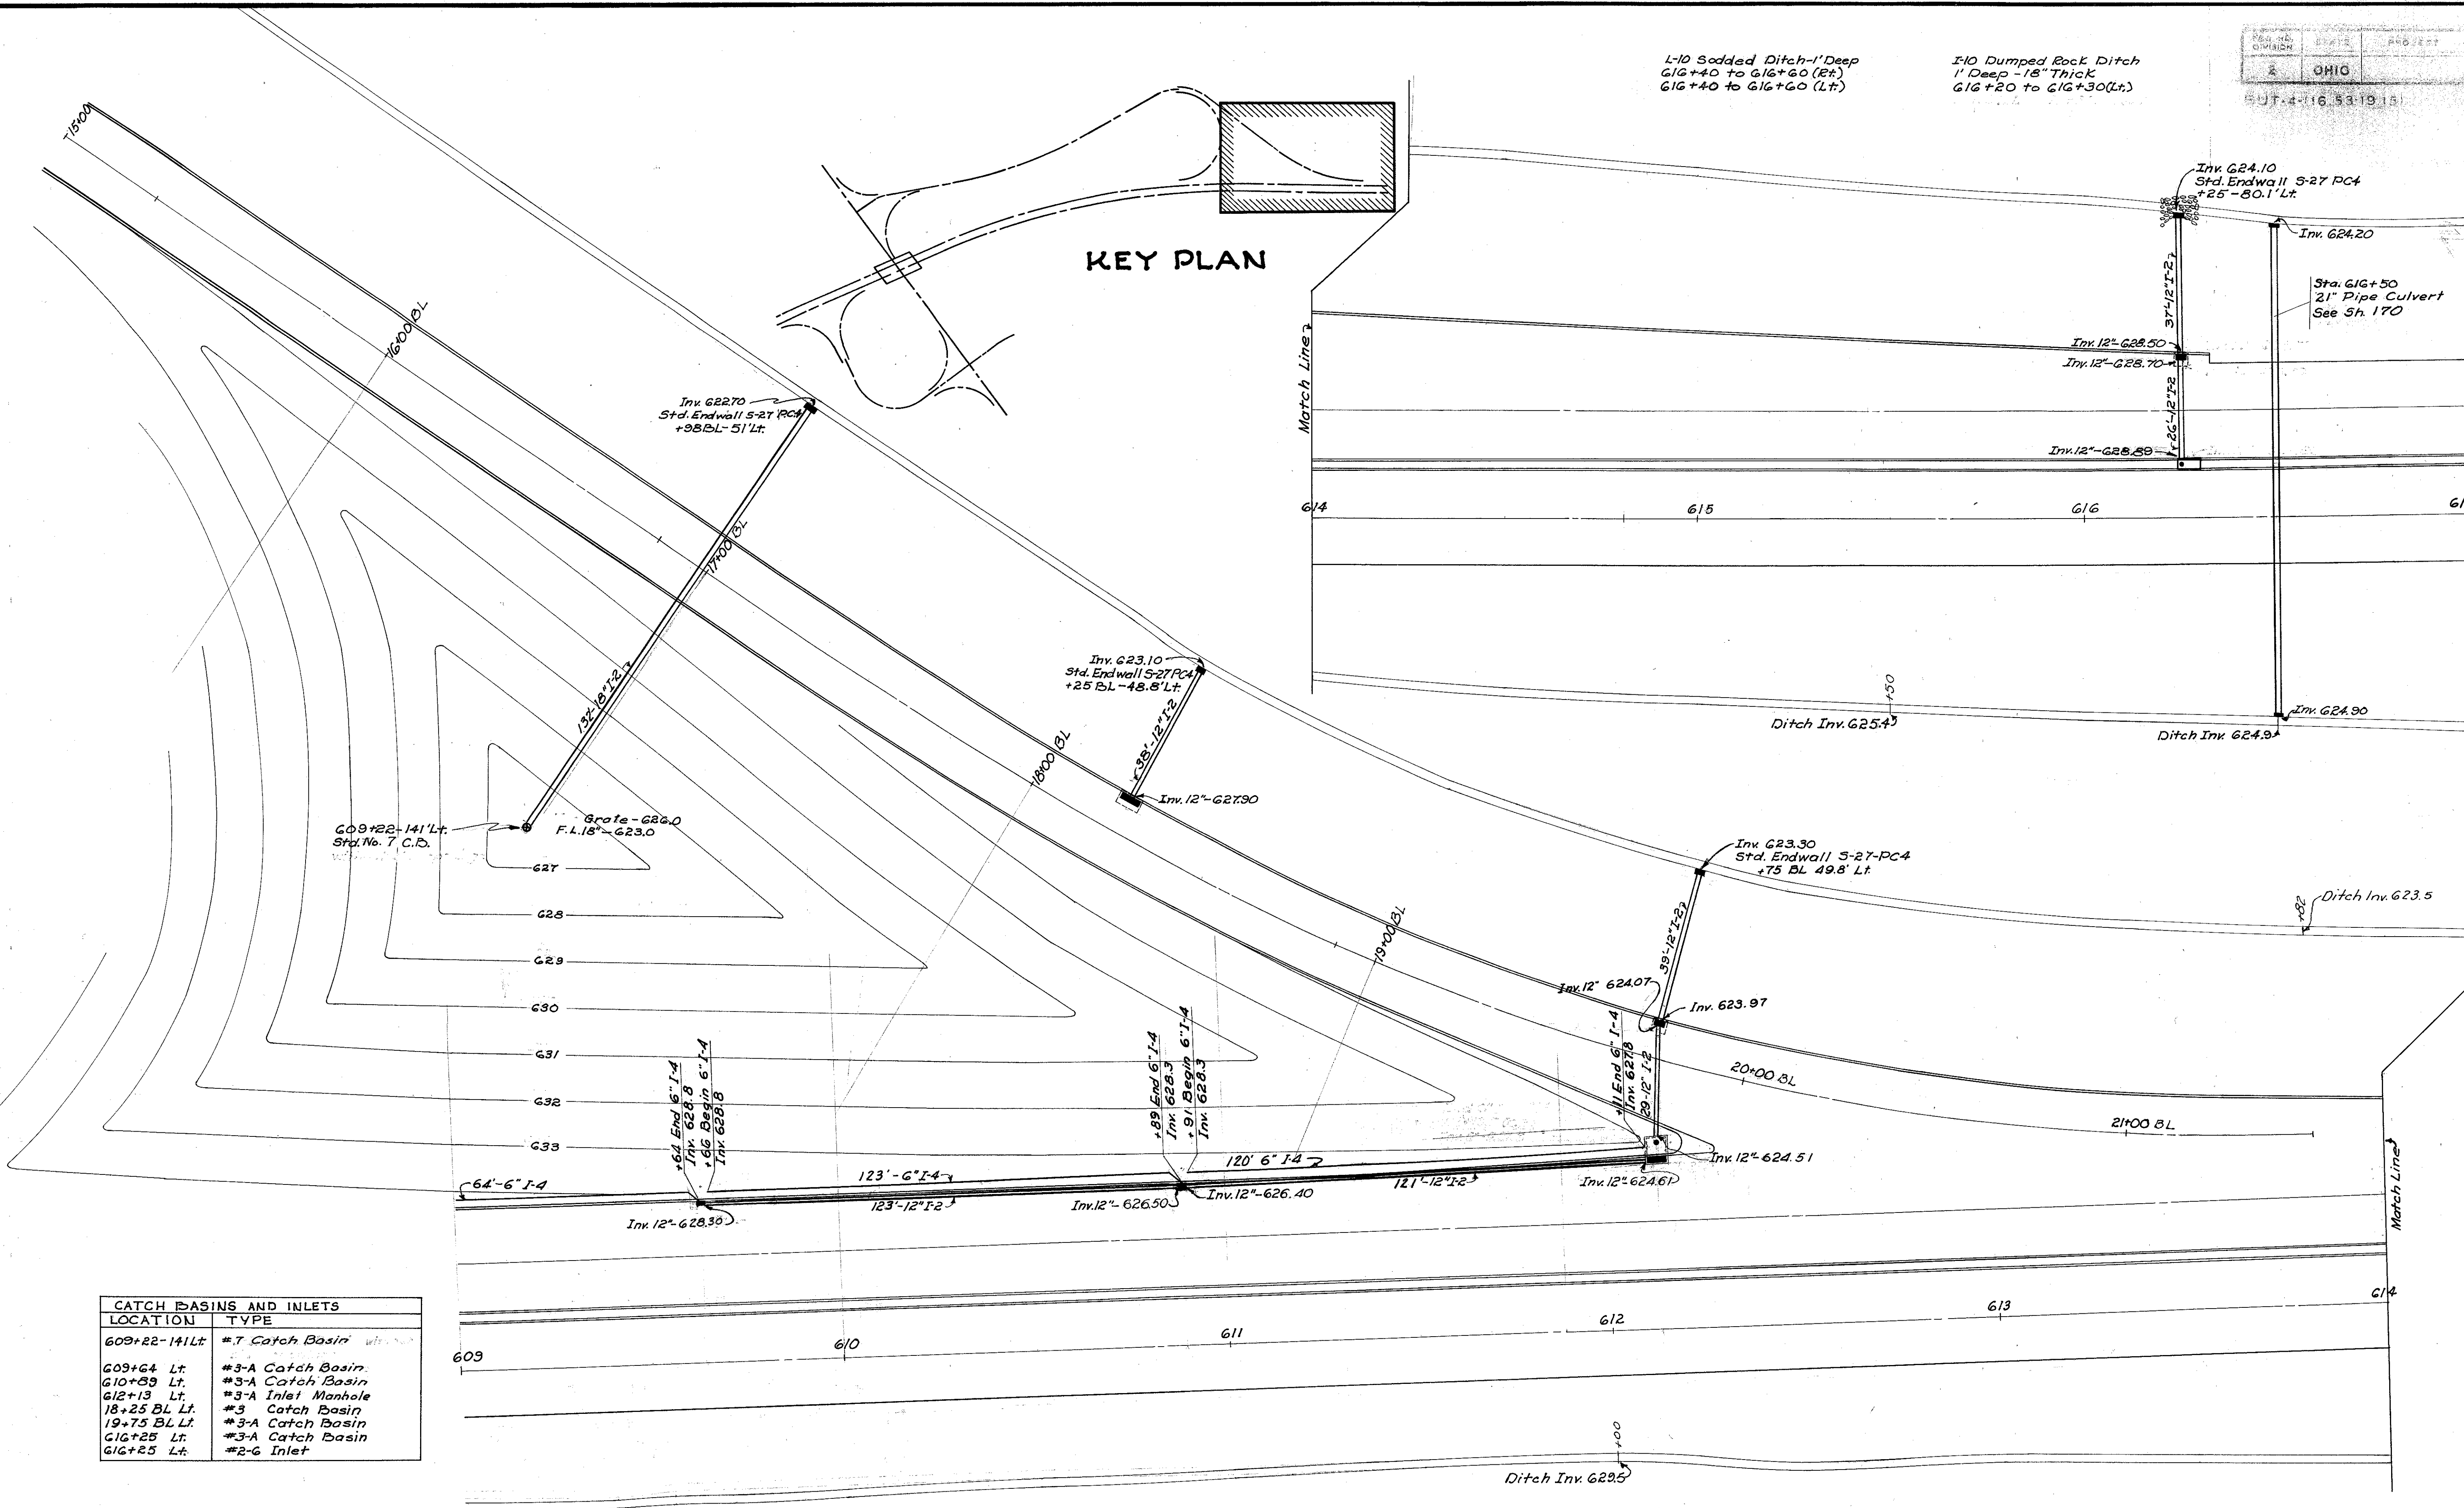

CATCH BASINS AND INLETS	
LOCATION	TYPE
609+22-141 Lt.	#7 Catch Basin
609+64 Lt.	#3-A Catch Basin
610+39 Lt.	#3-A Catch Basin
612+13 Lt.	#3-A Inlet Manhole
18+25 BL Lt.	#3 Catch Basin
19+75 BL Lt.	#3-A Catch Basin
G16+25 Lt.	#3-A Catch Basin
G16+25 Lt.	#2-G Inlet






**3+00B**  
12" Pipe Culvert  
Drainage Area = 2 Acres  
Q25-4.2cfs

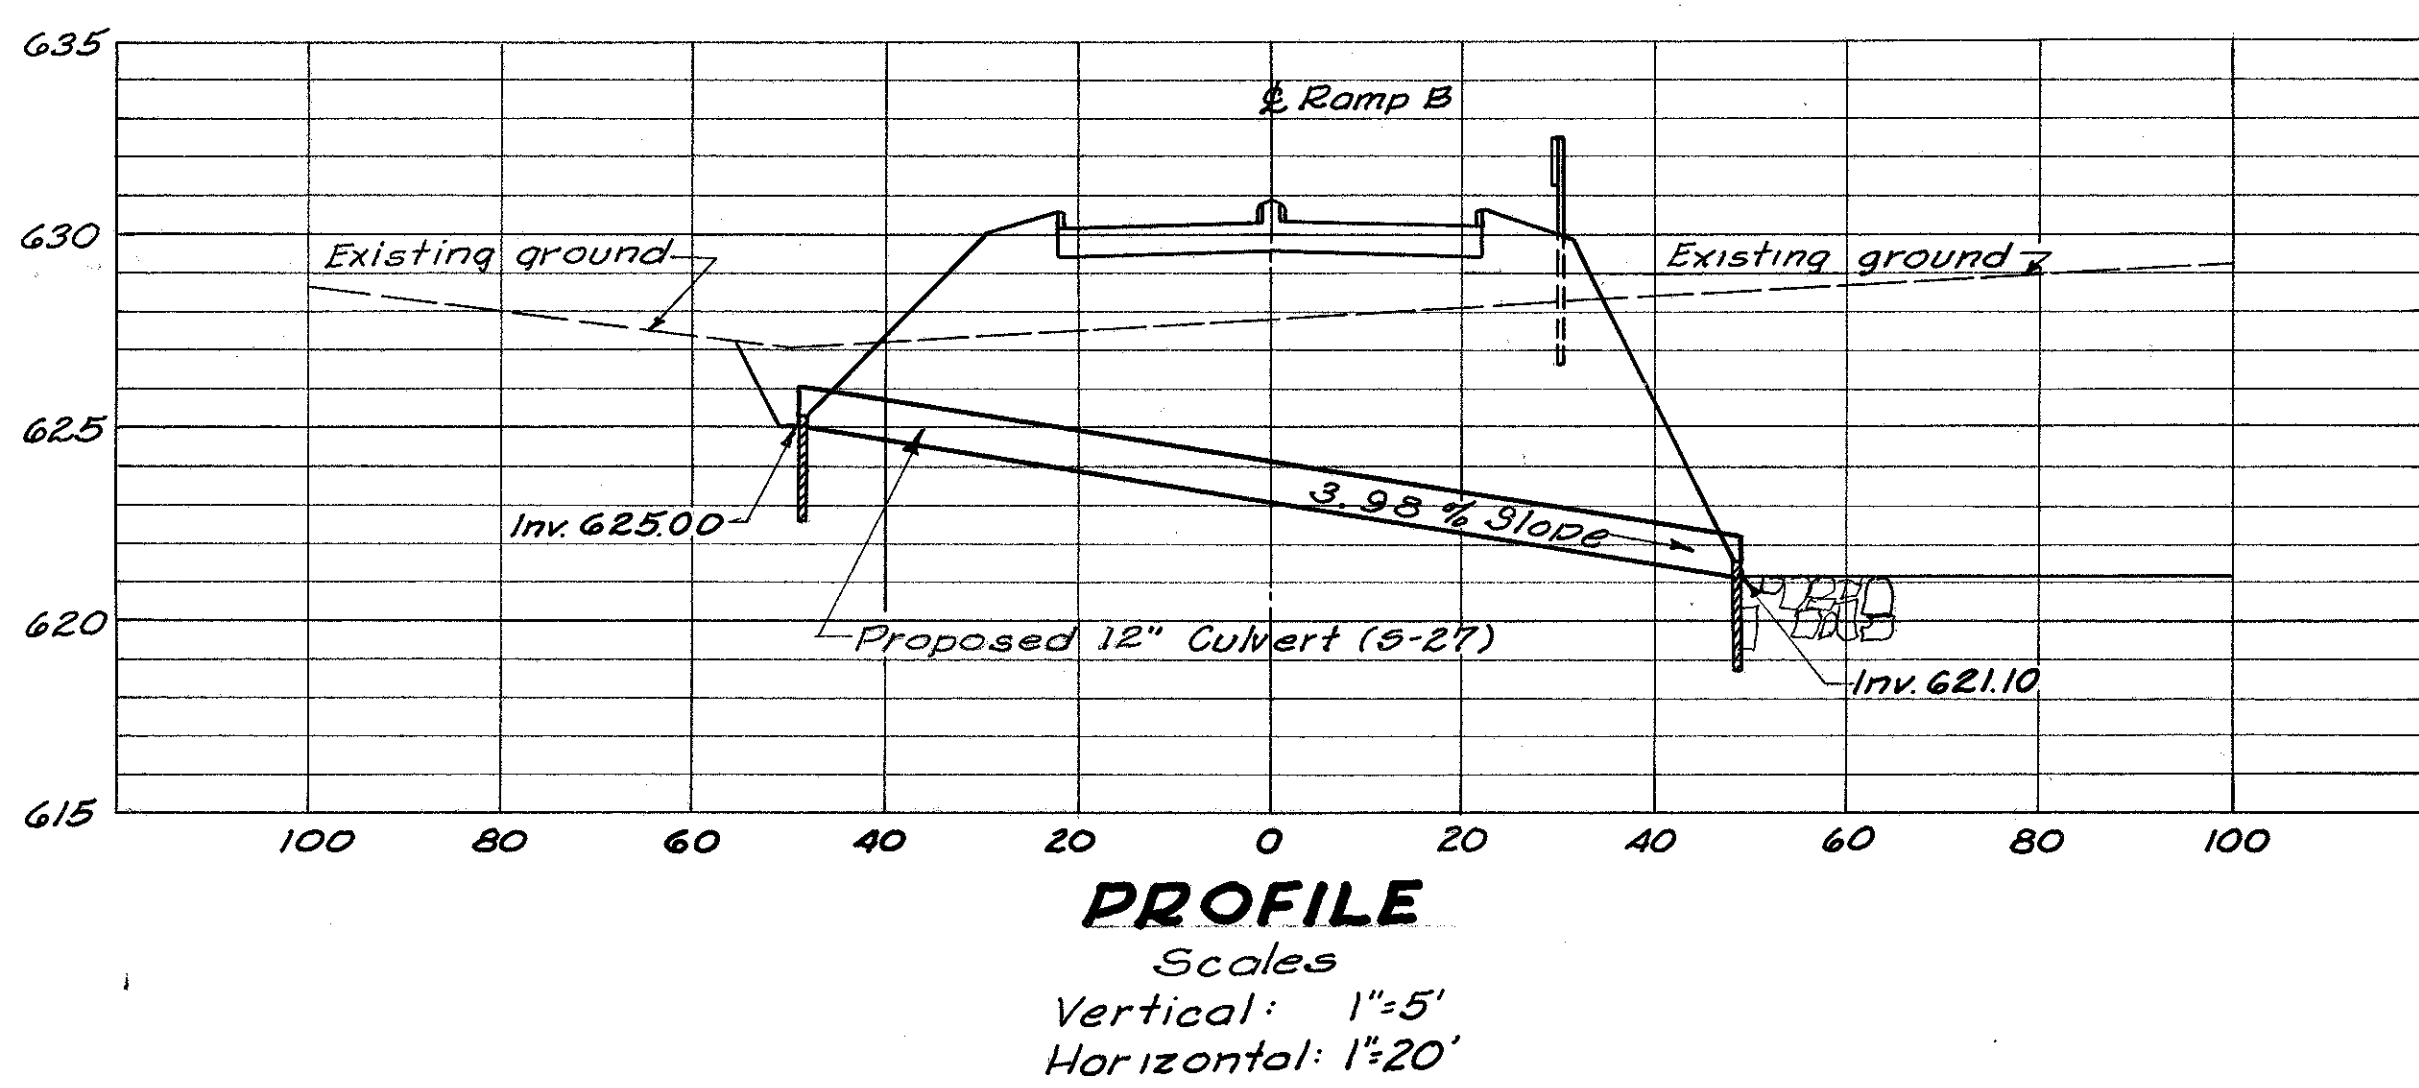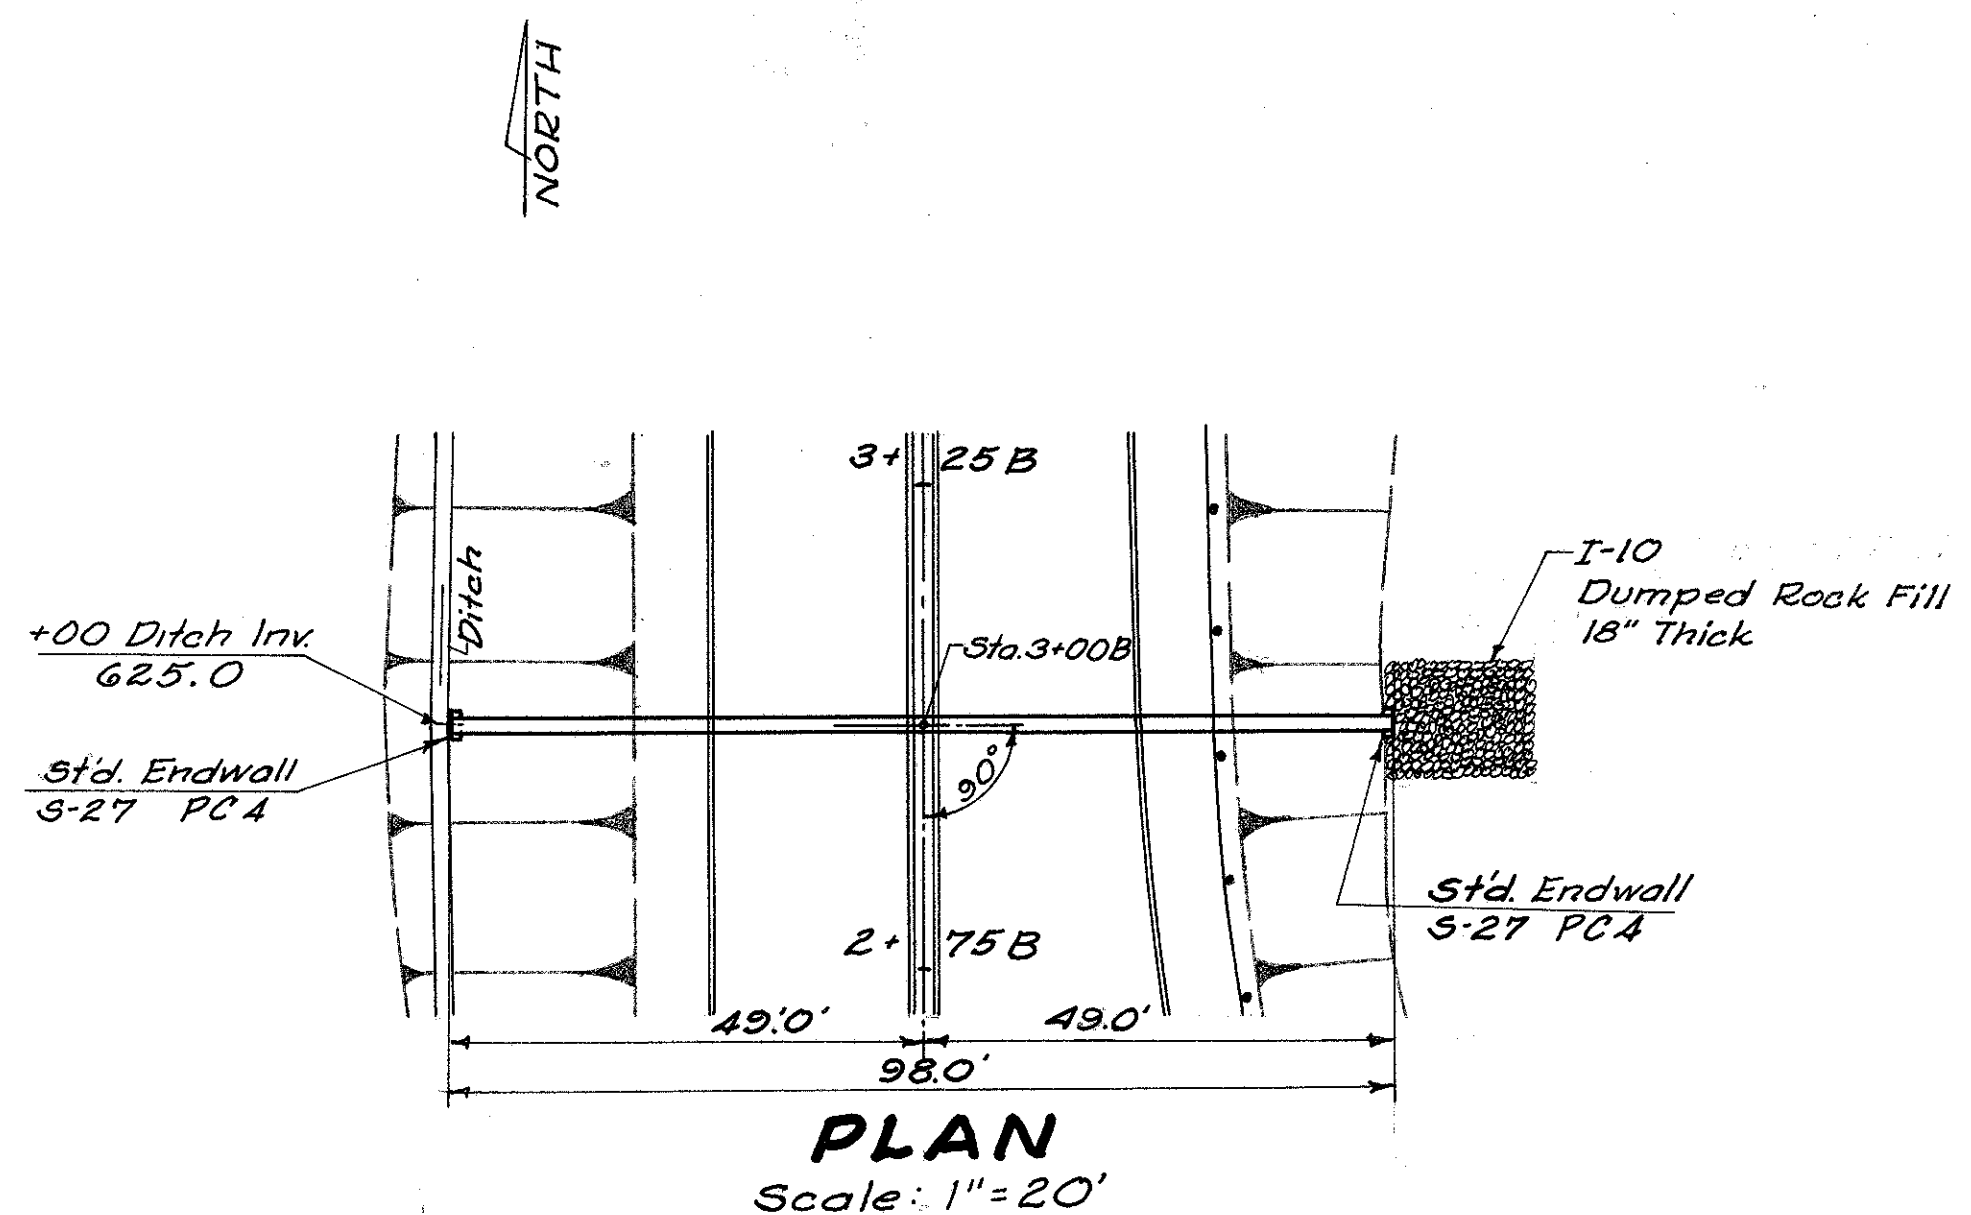

**CULVERT STA. 3+00B**

**ESTIMATE OF QUANTITIES**

DESCRIPTION	ITEM	QUANTITY
Excavation for Structures	E-2	32.0 cu.yds.
Channel Excavation	E-3	10.0 cu.yds.
Concrete for Structures (Class E)	S-1	0.5 cu.yds.
Pipe for Roadway Culverts - 12"	S-27	98 lin. ft.
Dumped Rock Fill	I-10	10.0 cu.yds.

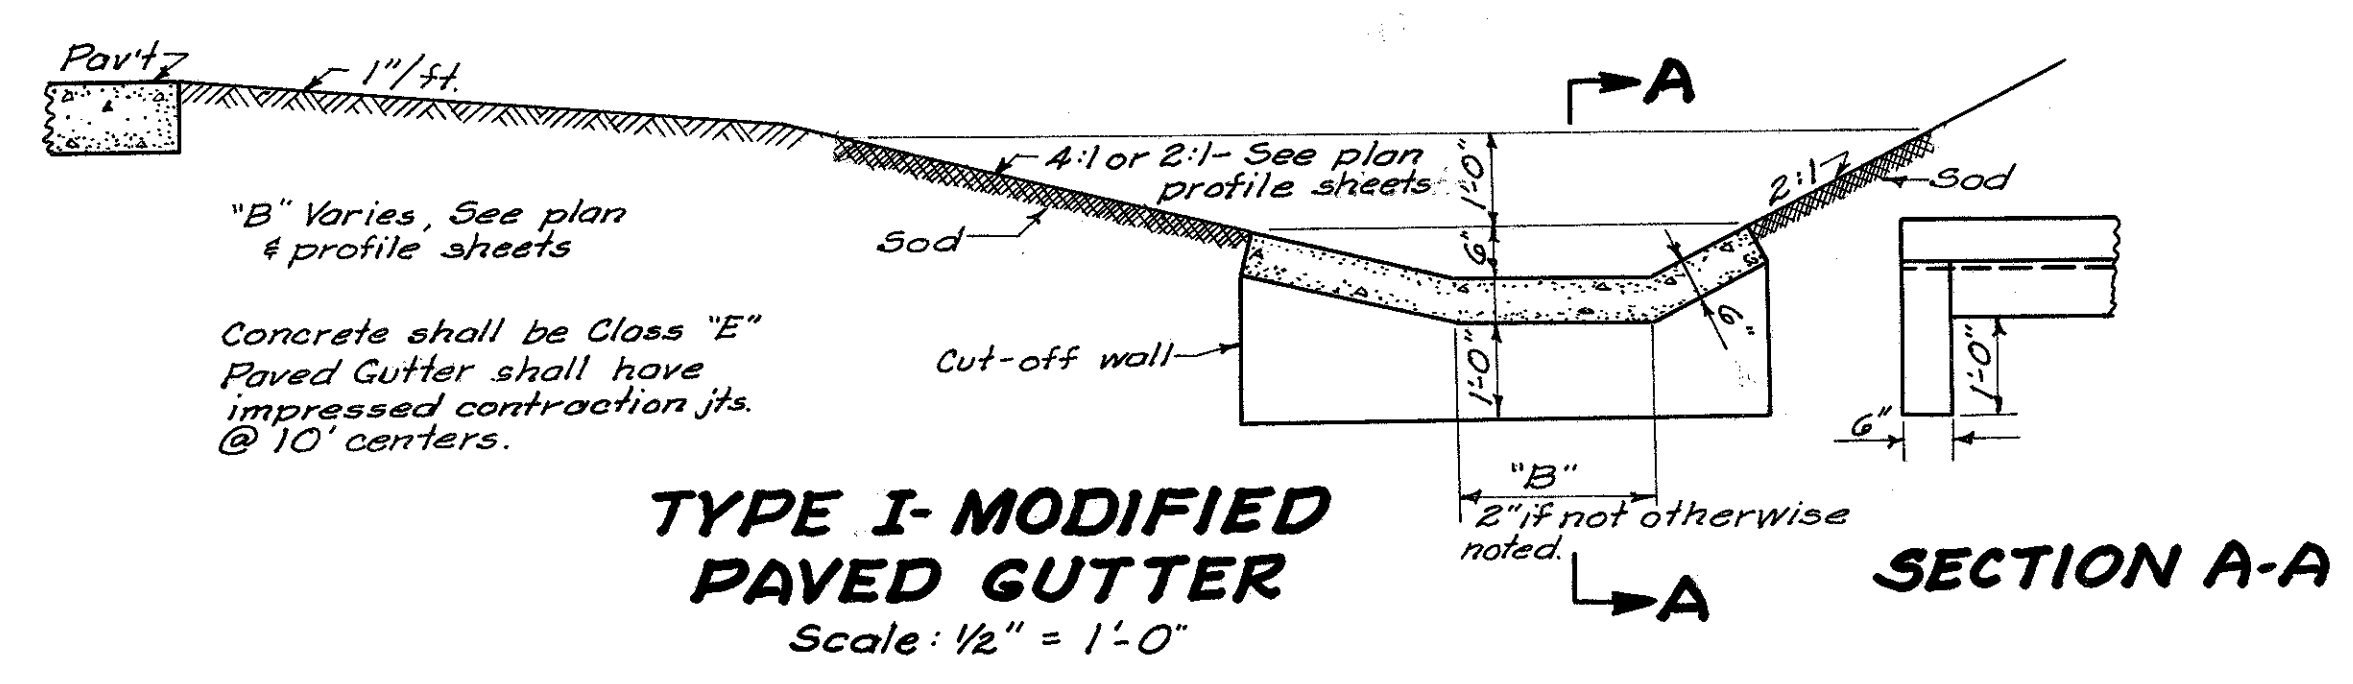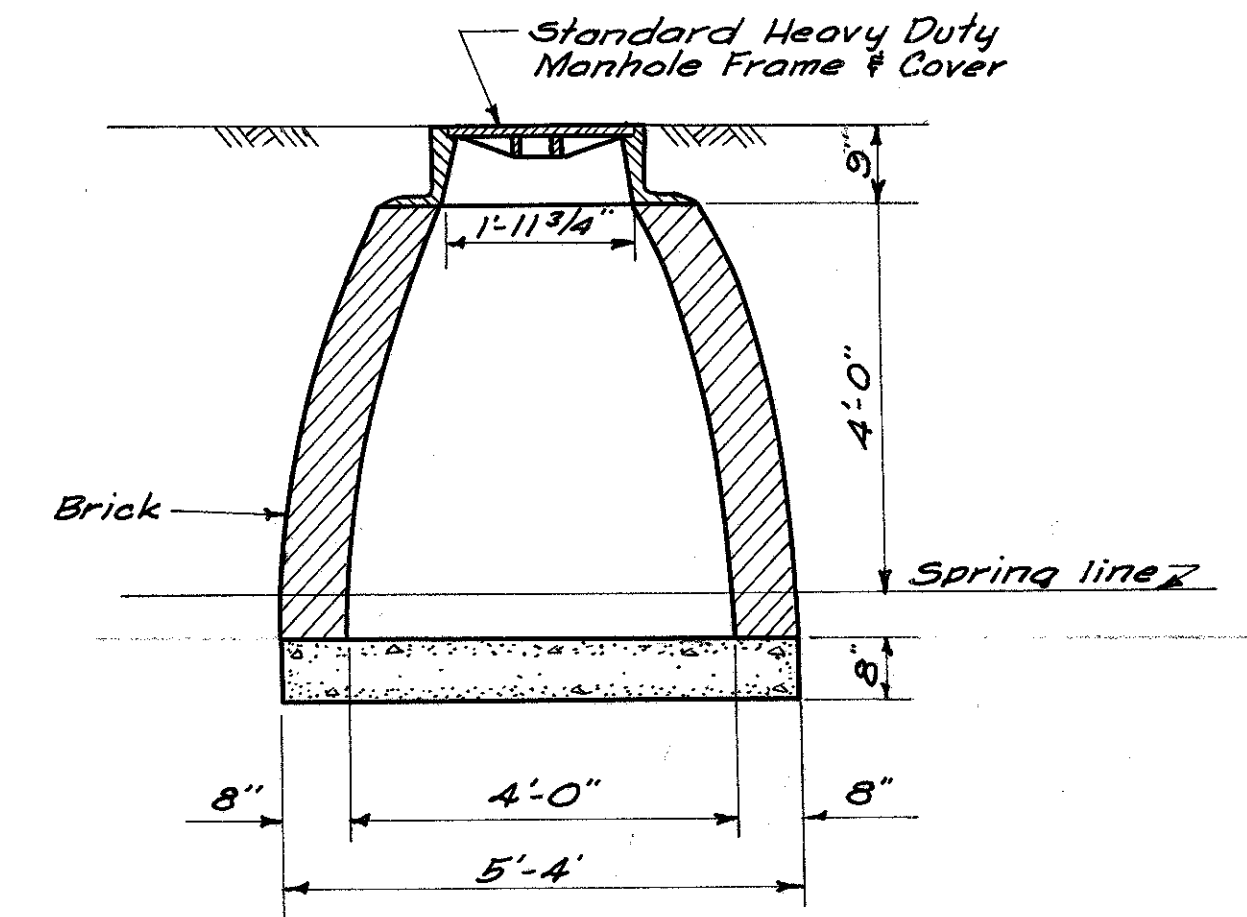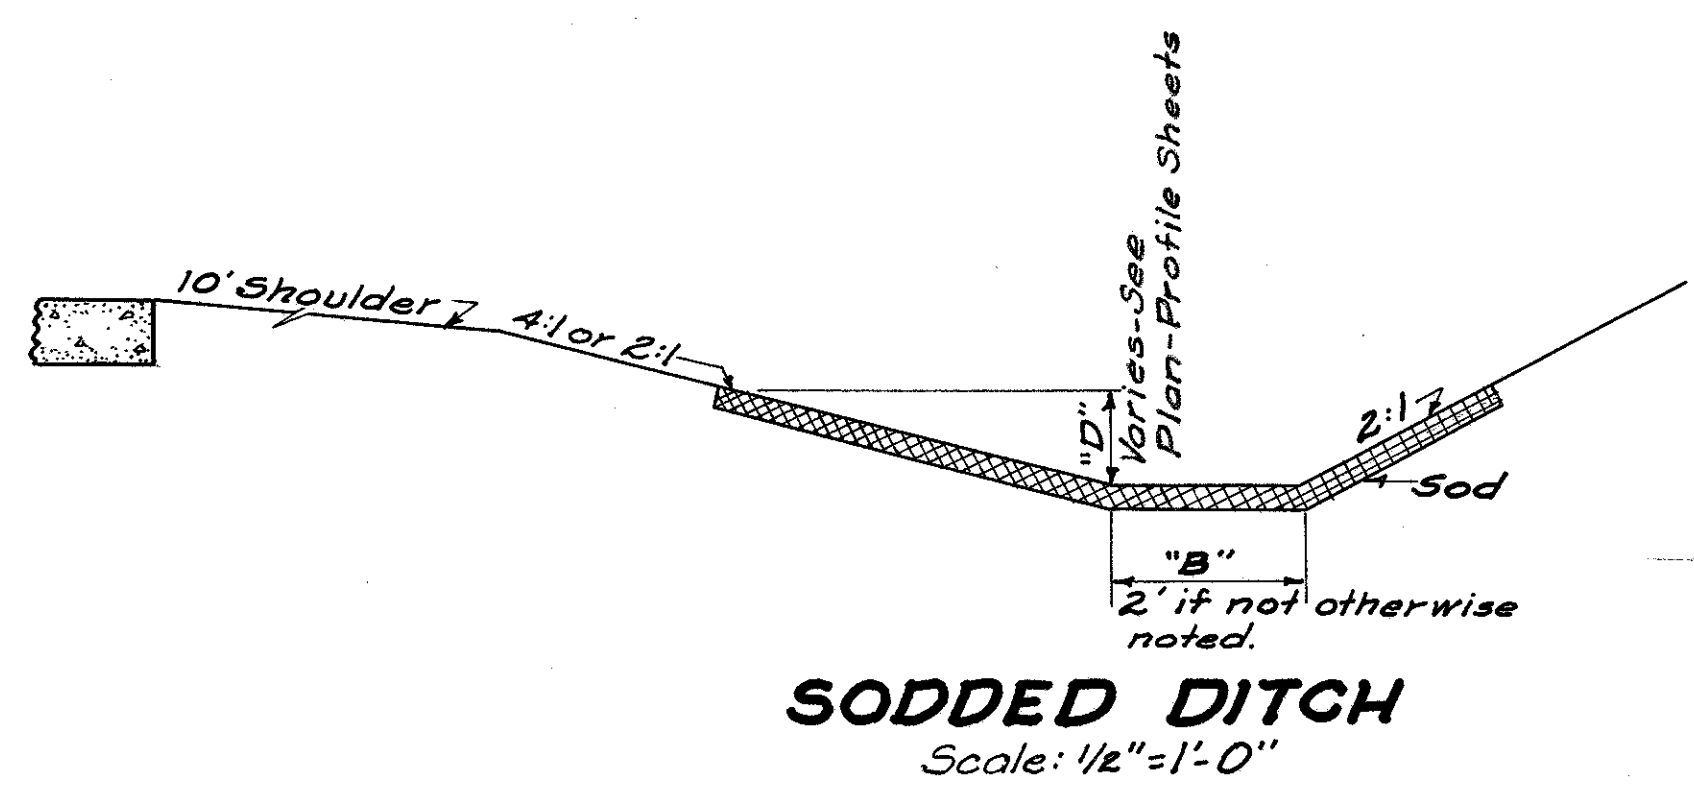




**ROADWAY DITCH DETAILS**

Sheet 170  
Sheet 158

**14+00 BL**  
 42" Pipe Culvert  
 Drainage Area: 30. Acres  
 Q25 - 42cfs

**602+00**  
 24" Pipe Culvert  
 Drainage Area: 13.0 Acres  
 Q25 - 28cfs




**616+50**  
 21" Pipe Culvert  
 Drainage Area: 10.0 Acres  
 Q25 - 14.5cfs

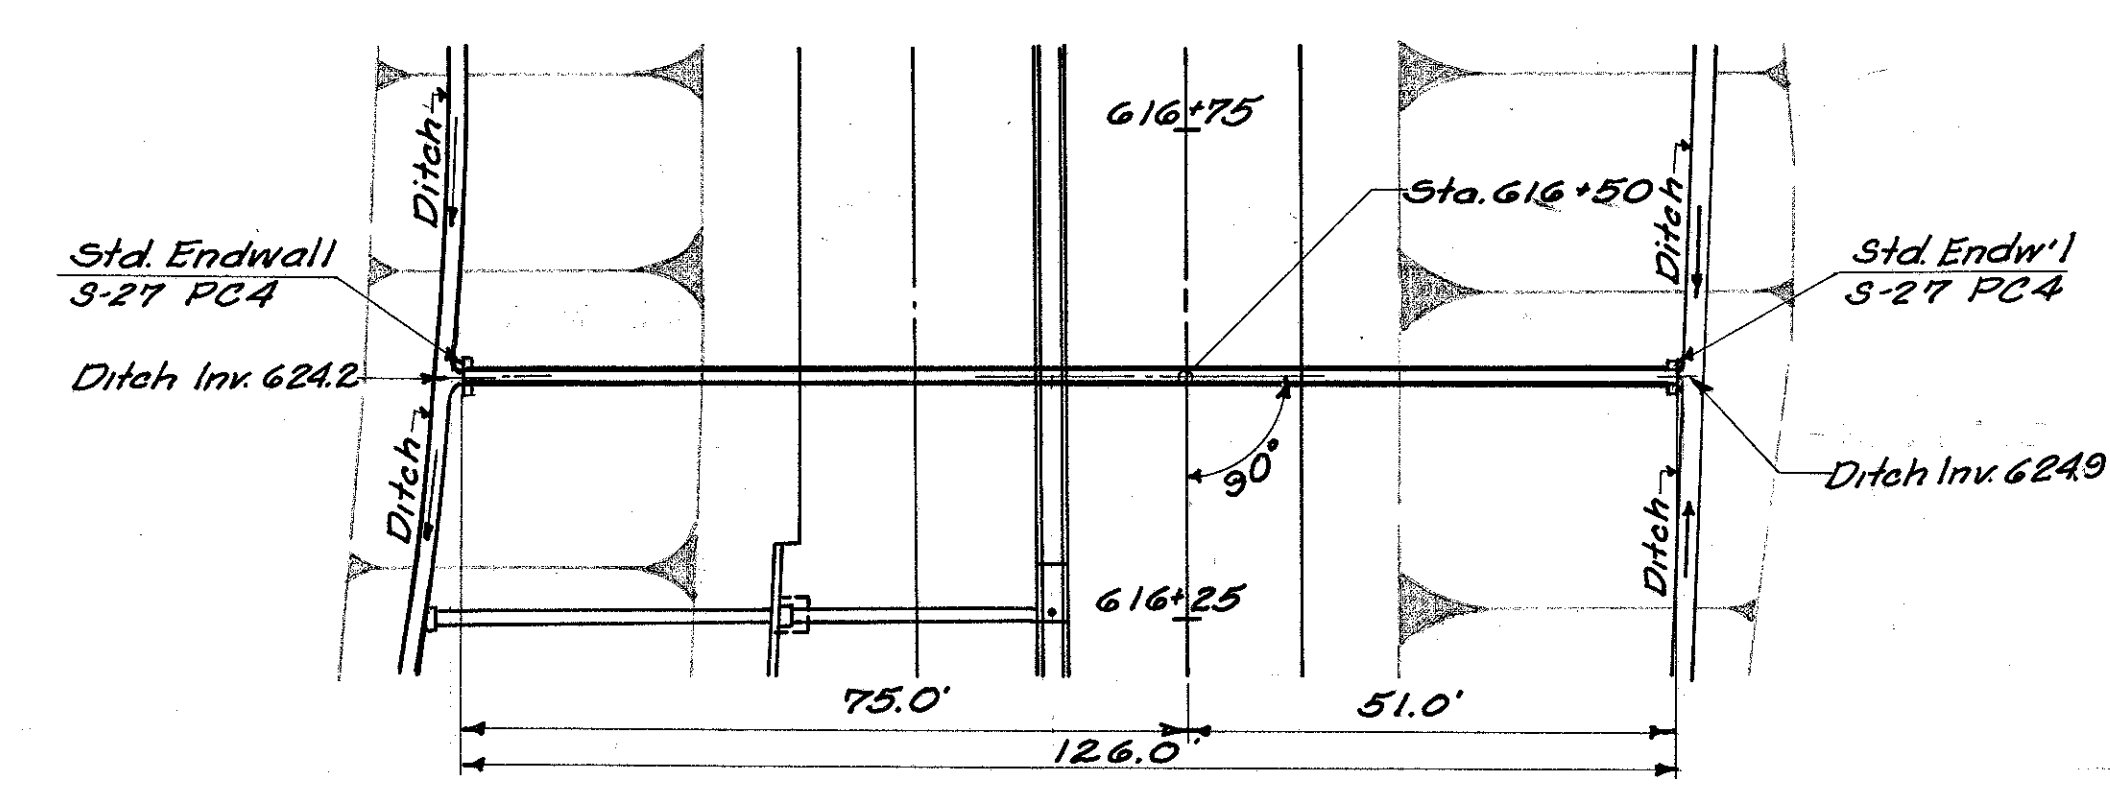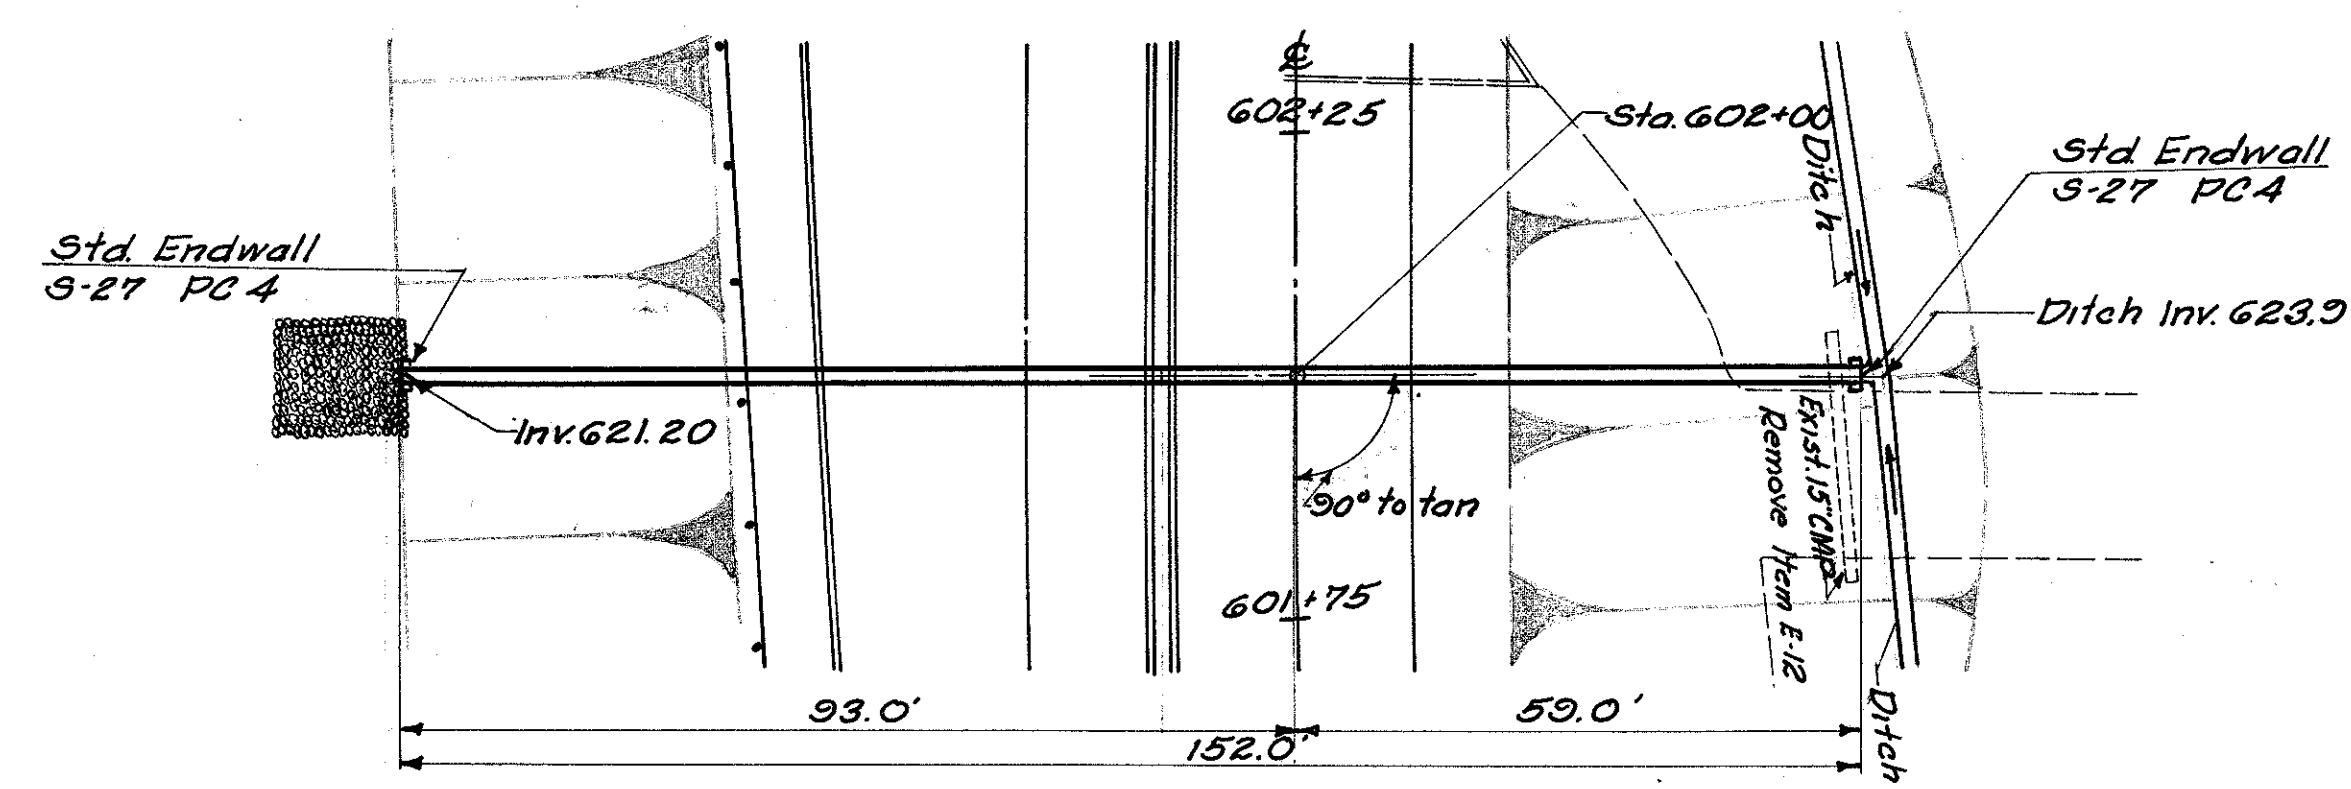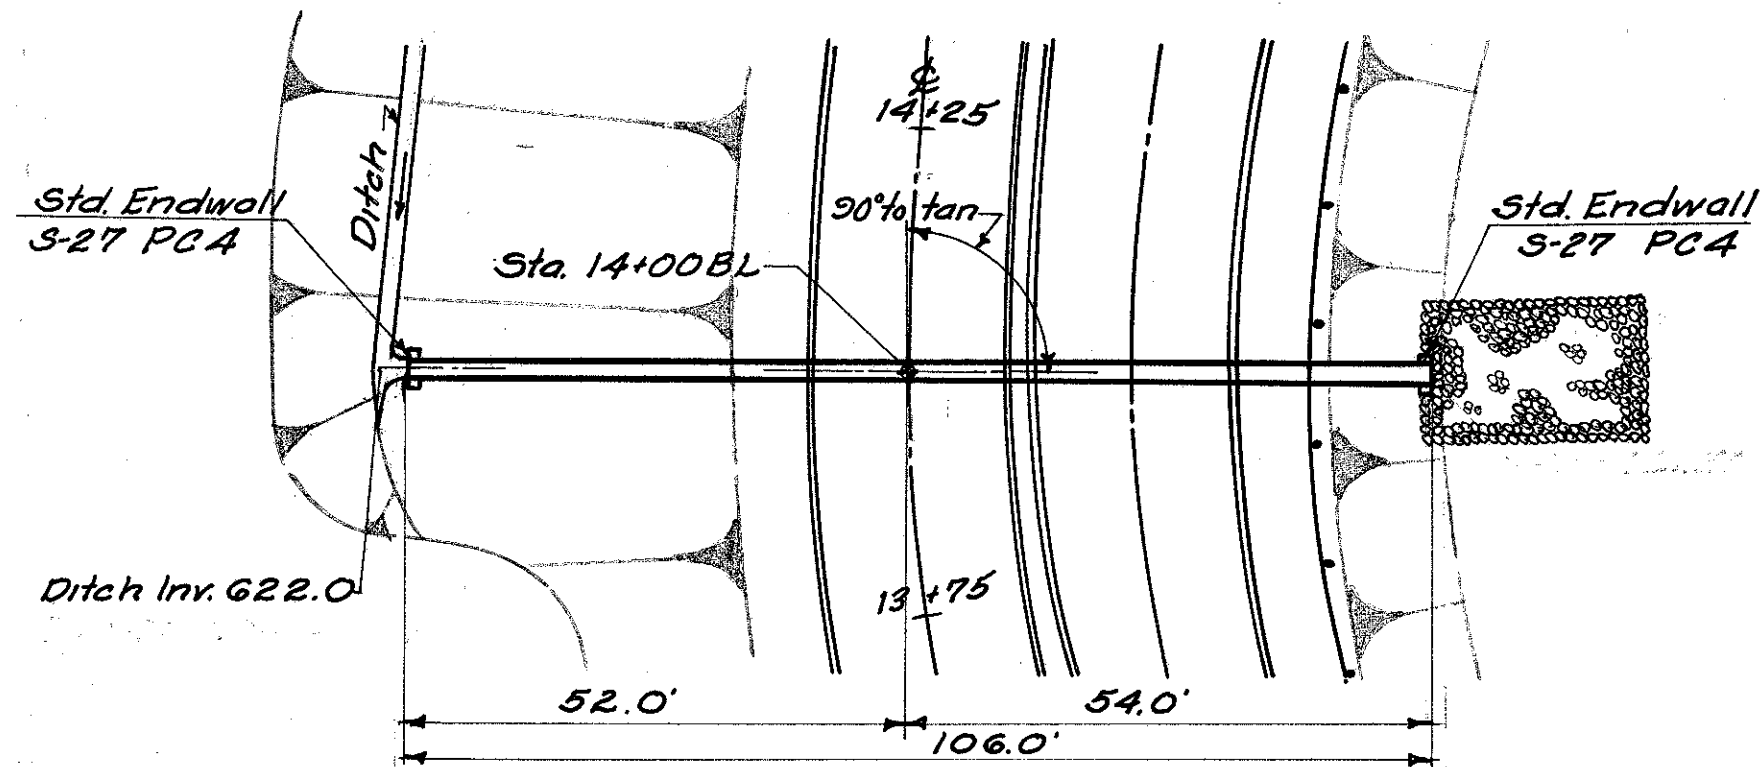

**PLAN**  
 Scale: 1"=20'

**PLAN**  
 Scale: 1"=20'

**PLAN**  
 Scale: 1"=20'

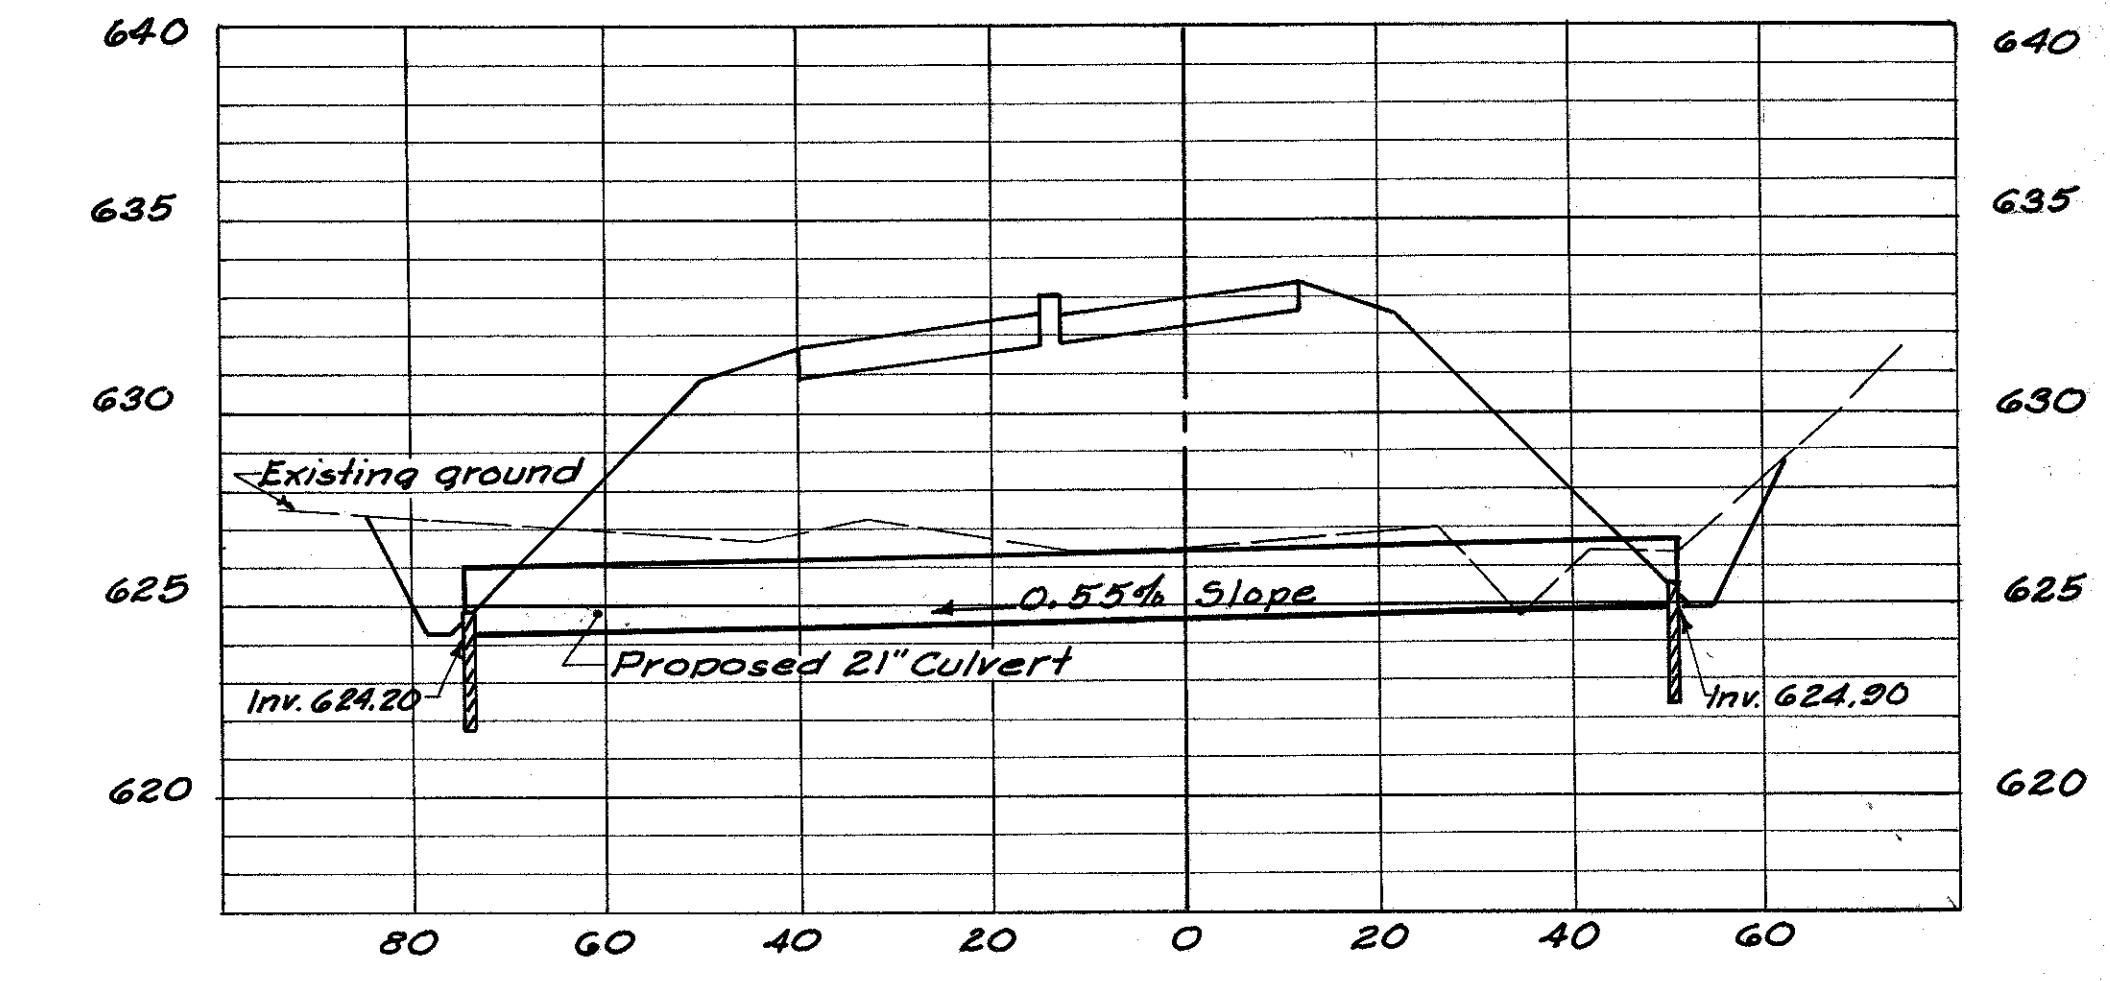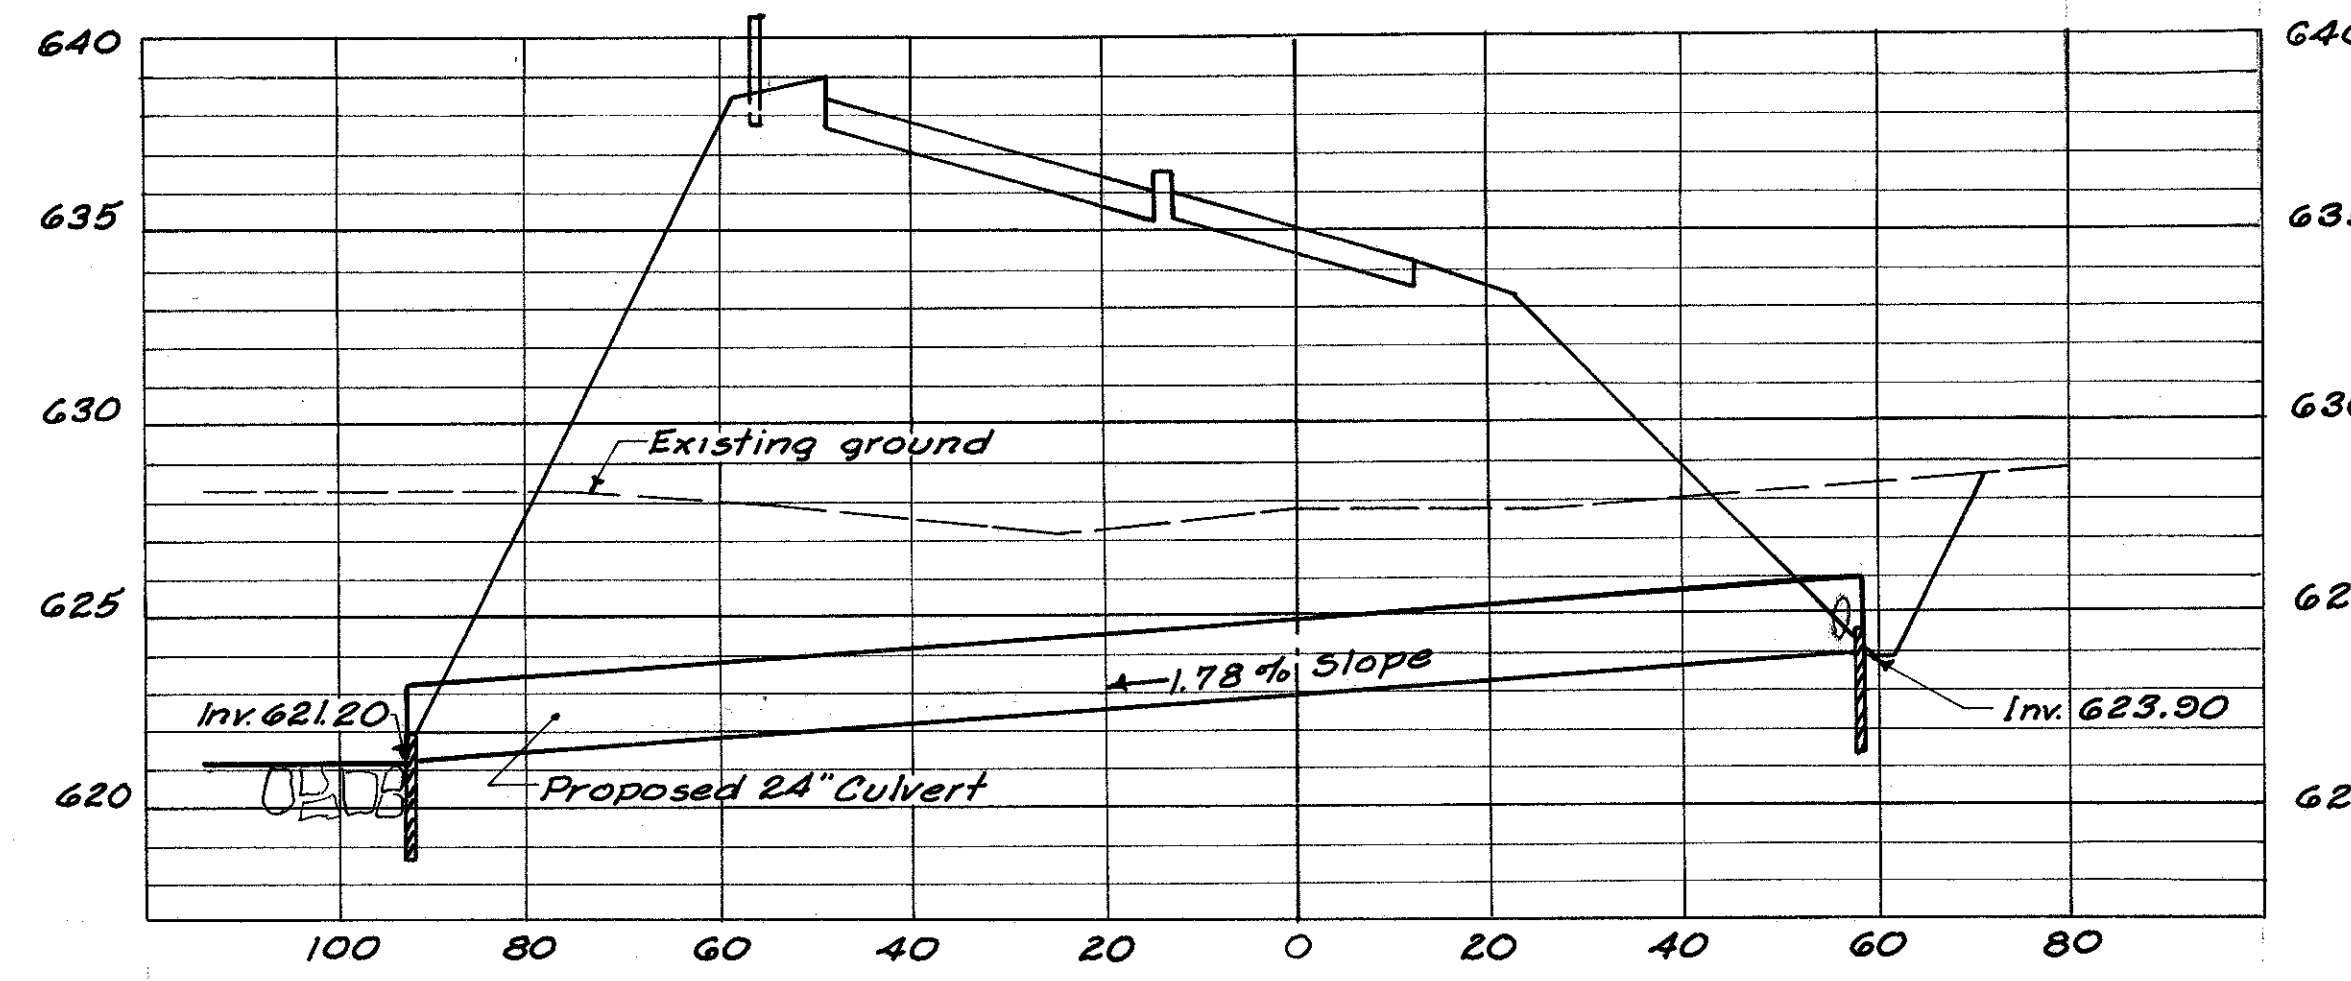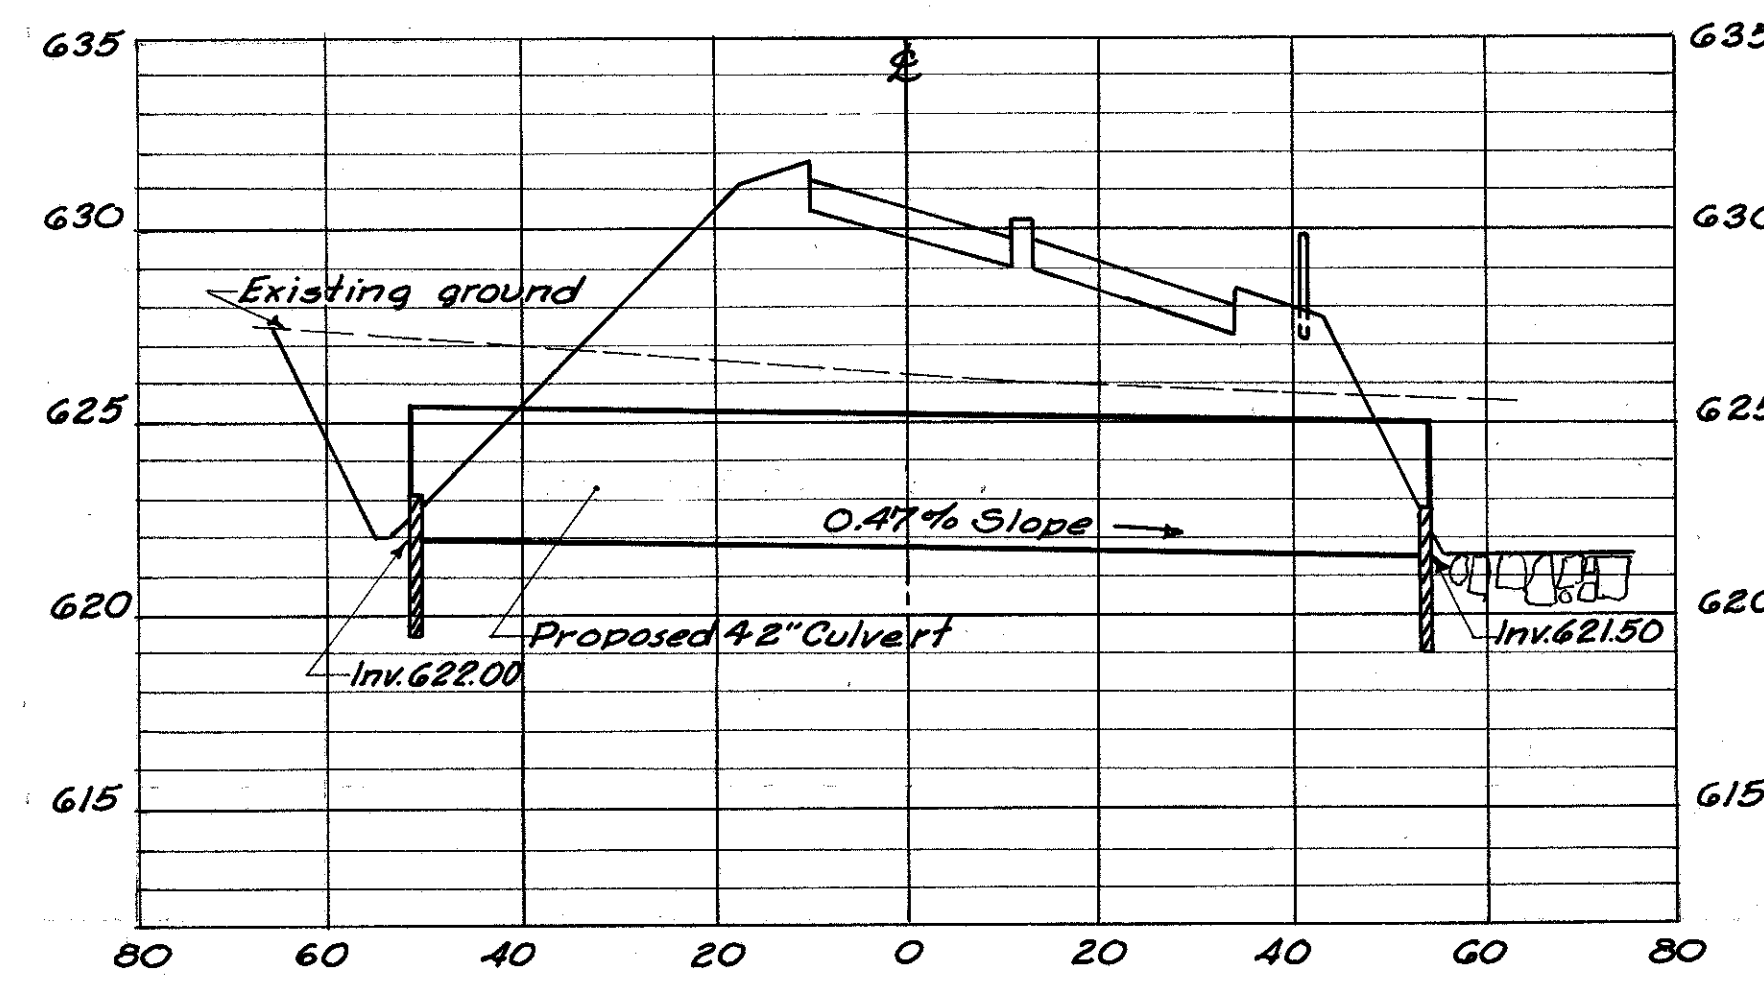

**PROFILE**  
 Scales:  
 Vertical 1"=5'  
 Horizontal 1"=20'

**PROFILE**  
 Scales:  
 Vertical 1"=5'  
 Horizontal 1"=20'

**PROFILE**  
 Scales:  
 Vertical 1"=5'  
 Horizontal 1"=20'

**CULVERT STA. 14+00 BL  
 RAMP B**

**CULVERT STA. 602+00**

**CULVERT STA. 616+50**

**ESTIMATE OF QUANTITIES**


DESCRIPTION	ITEM	QUANTITY
Excavation for Structures (Dry)	E-2	92.0 cu. yd.
Channel Excavation	E-3	20.0 cu. yd.
Concrete for Structures - Class E	S-1	1.5 cu. yd.
Pipe for Roadway Culverts - 42"	S-27	106 lin. ft.
Dumped Rock Fill	I-10	20.0 cu. yd.

**ESTIMATE OF QUANTITIES**

DESCRIPTION	ITEM	QUANTITY
Excavation for Structures	E-2	84.0 cu. yd.
Channel Excavation	E-3	10.0 cu. yd.
Concrete for Structures - Class E	S-1	0.8 cu. yd.
Pipe for Roadway Culverts - 24"	S-27	152 lin. ft.
Dumped Rock Fill	I-10	10.0 cu. yd.
Removal of Pipe	E-12	26 lin. ft.







**ESTIMATE OF QUANTITIES**

DESCRIPTION	ITEM	QUANTITY
Excavation for Structures	E-2	24.0 cu. yd.
Concrete for Structures - Class E	S-1	0.7 cu. yd.
Pipe for Roadway Culverts - 21"	S-27	126 lin. ft.

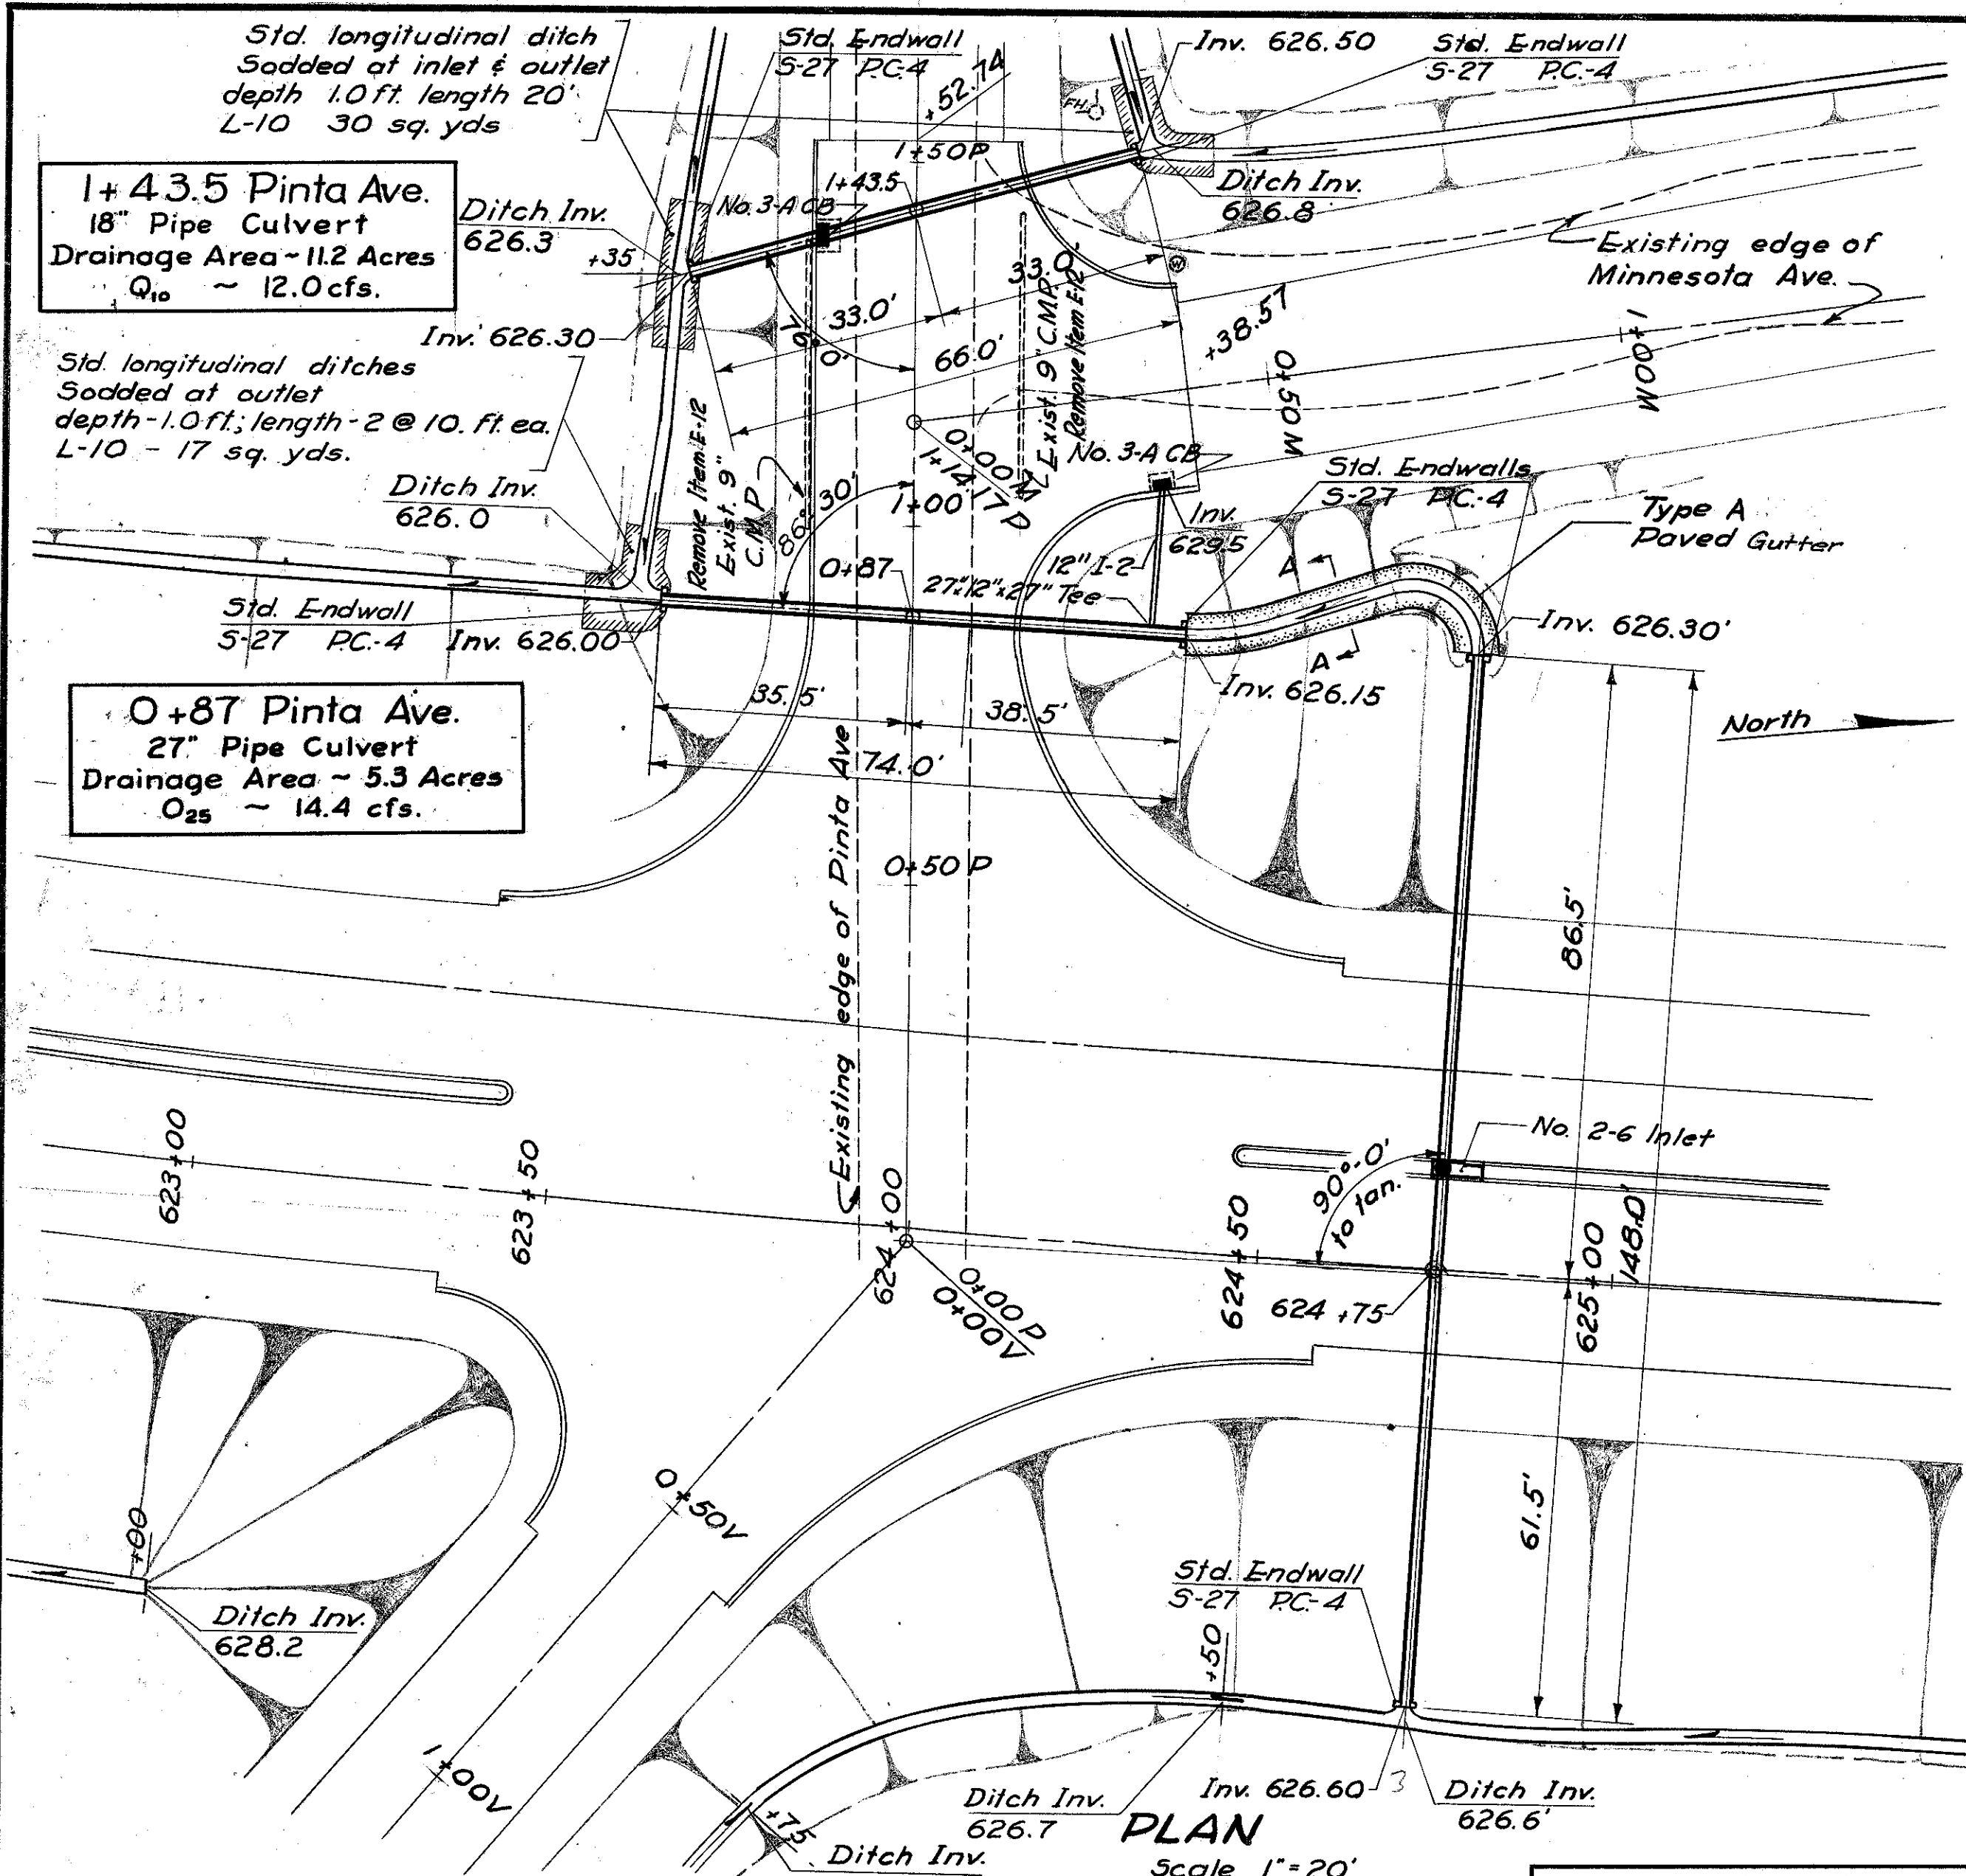


### ESTIMATE OF QUANTITIES

DESCRIPTION	ITEM	QUANTITY
<b>CULVERT STA. 0+87 PINTA AVE.</b>		
Excavation for structures (Dry)	E-2	23.6 cu.yd.
Concrete for structures (Class E)	S-1	1.0 cu.yd.
Pipe for roadway culverts - 27"	S-27	70 lin.ft.
Storm Sewers 12" Class B	I-2	18 lin.ft.
Pipe Specials 27"x12"x27" Tee	I-5	1 each
Catch Basin No. 3-A	I-8	1 each
Sodding	L-10	17.0 sq.yd.
<b>CULVERT STA. 1+43.5 PINTA AVE.</b>		
Excavation for structures (Dry)	E-2	12.2 cu.yds.
Concrete for structures (Class E)	S-1	0.6 cu.yds.
Pipe for roadway culverts - 18"	S-27	64.0 lin.ft.
Sodding	L-10	30.0 sq.yds.
Removal of pipe	E-12	40.0 lin.ft.
Catch Basin No. 3-A	I-8	1 each
<b>CULVERT STA. 624+75</b>		
Excavation for structures (Dry)	E-2	24.6 cu.yds.
Channel excavation	E-3	24.7 cu.yds.
Concrete for structures (Class E)	S-1	0.8 cu.yds.
Pipe for roadway culverts - 24"	S-27	146.0 lin.ft.
Paved outlet gutter Type A	I-14	47.0 lin.ft.
Inlet - No. 2-6 on 24" Culvert	I-8	1 each
<b>CULVERT STA. 632+40</b>		
Excavation for structures (Dry)	E-2	31.2 cu.yds.
Channel excavation	E-3	2.7 cu.yds.
Removal of pipe	E-12	80.0 lin.ft.
Concrete for structures (Class E)	S-1	0.3 cu.yds.
Catch Basins Abandoned	I-16	1 each
Pipe for roadway culverts - 15"	S-27	86.0 lin.ft.
Catch Basin No. 1-2-A	I-8	1 each
Sodding	L-10	23.0 sq.yds.
Pipe Specials 15"x6"x15" Tee	I-5	1 each
Pipe Specials 15"x6" Cross	I-5	1 each

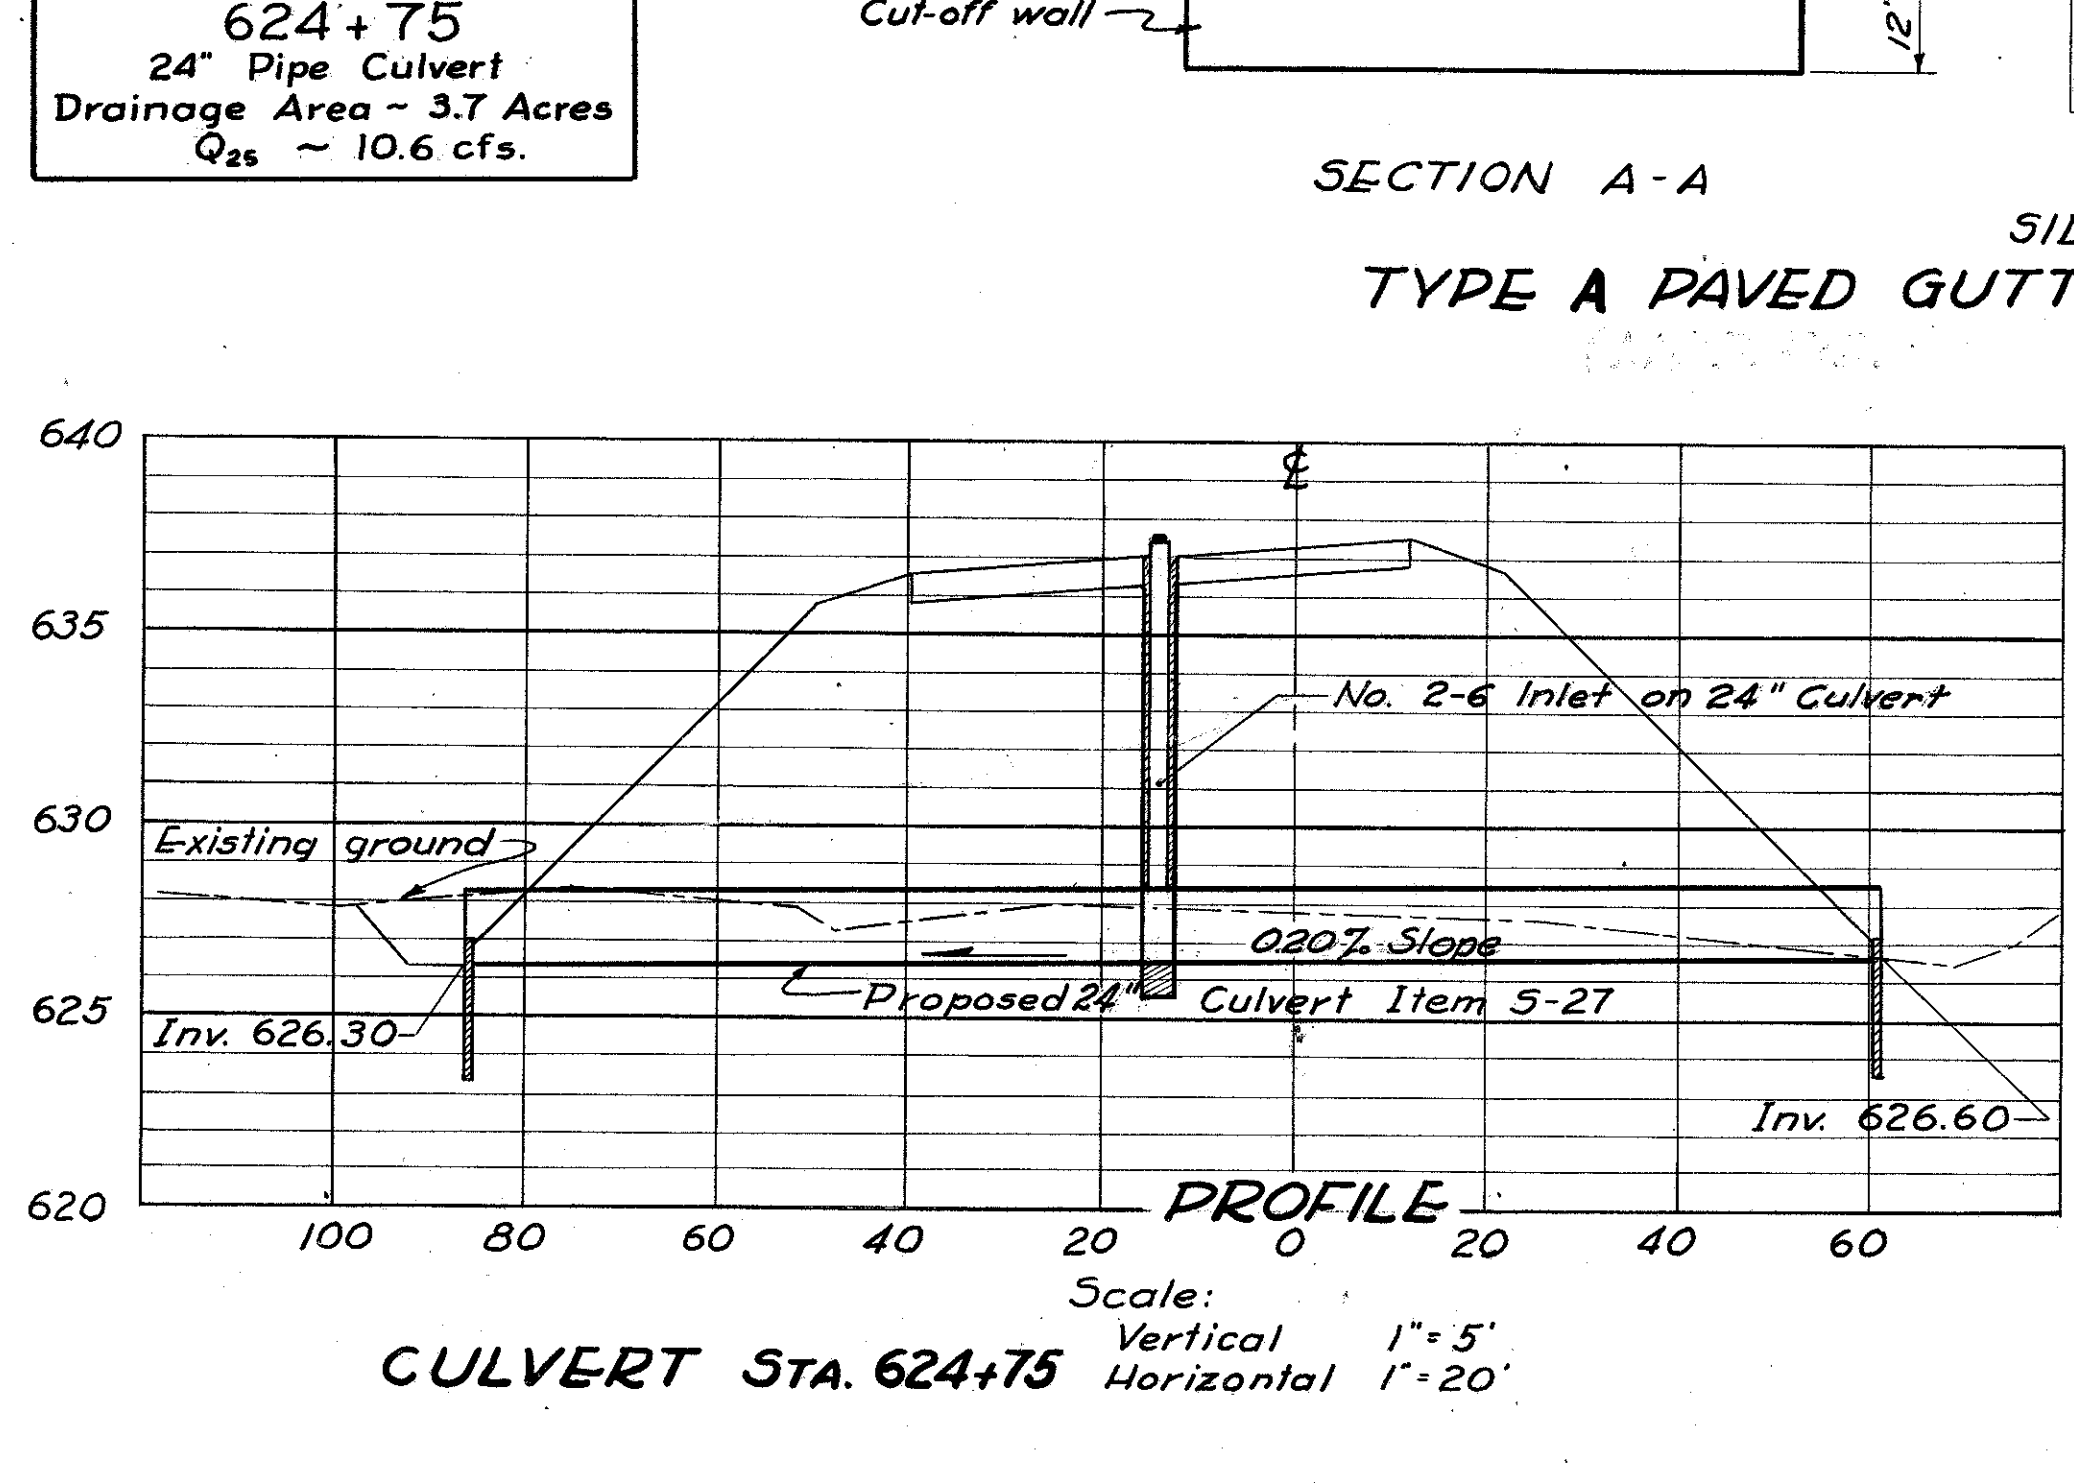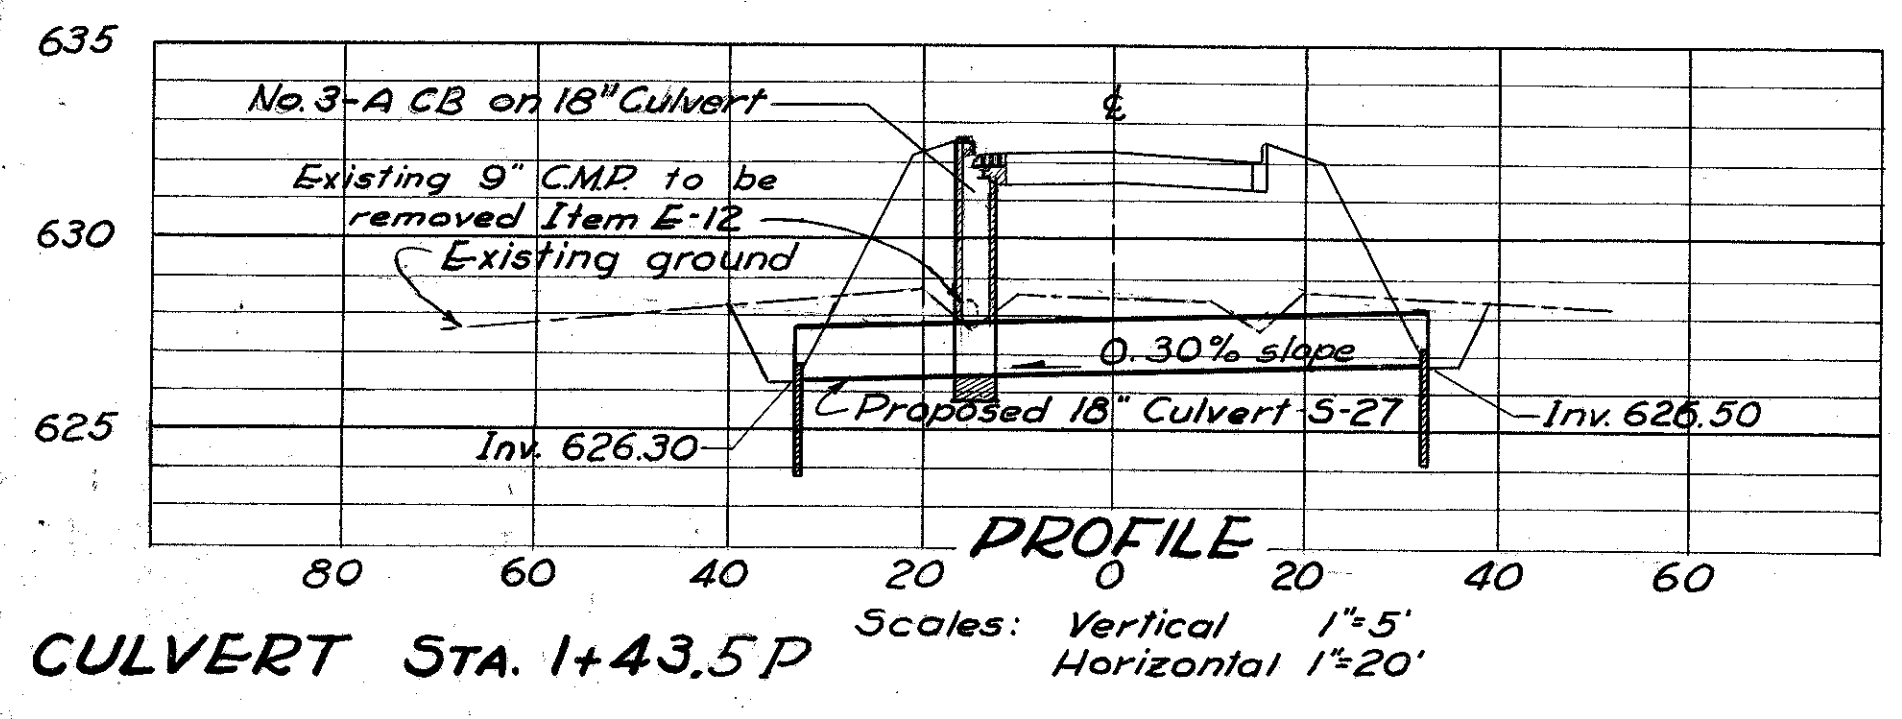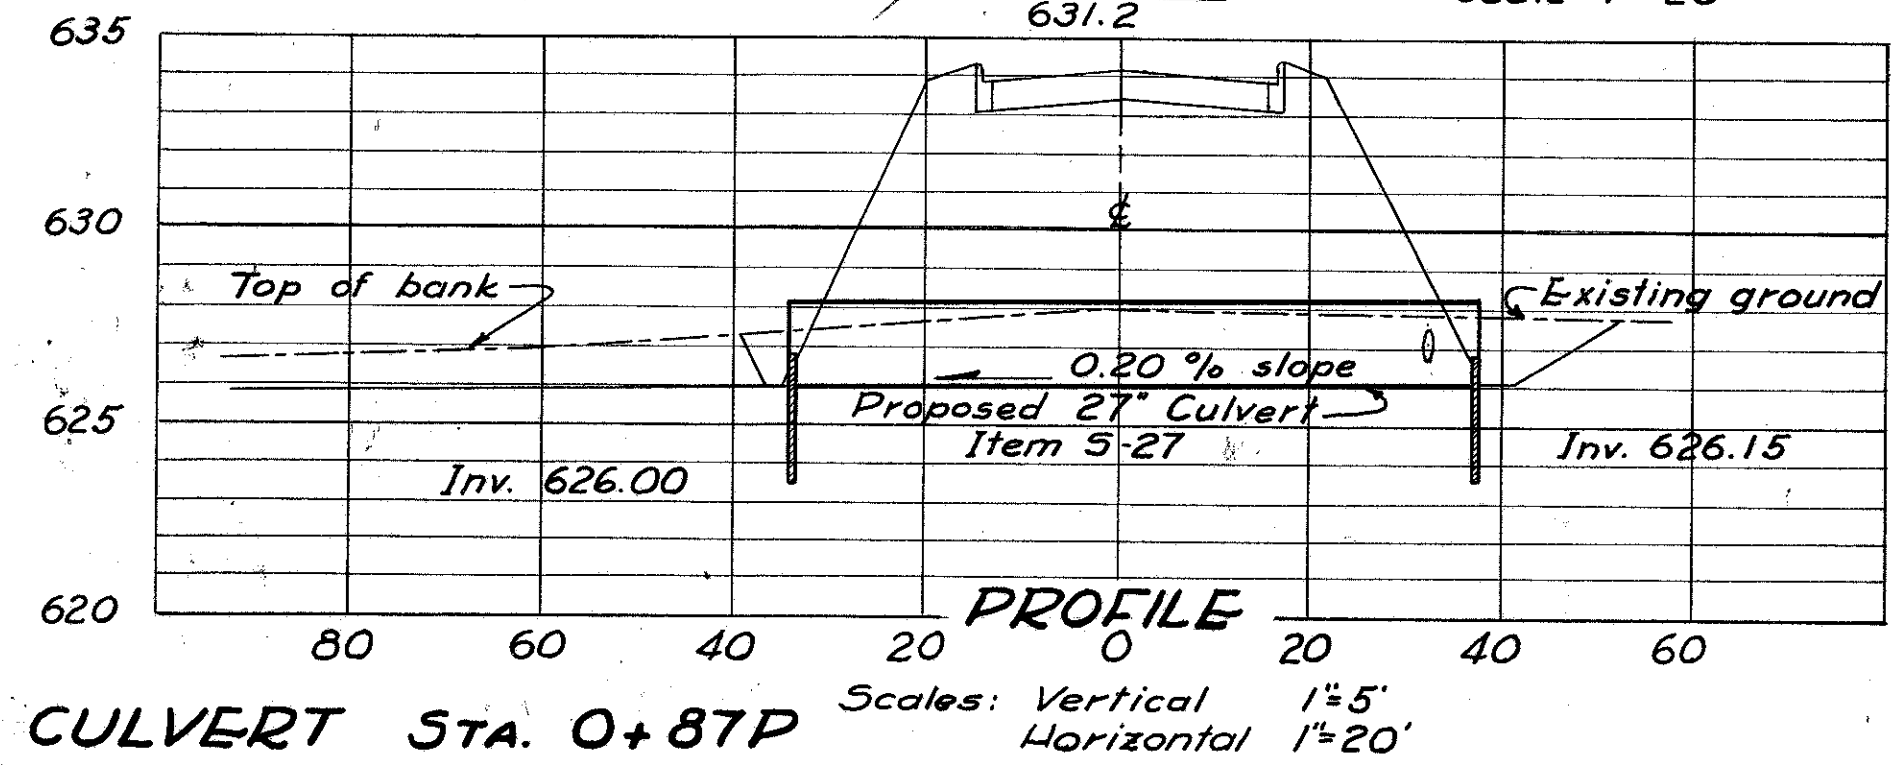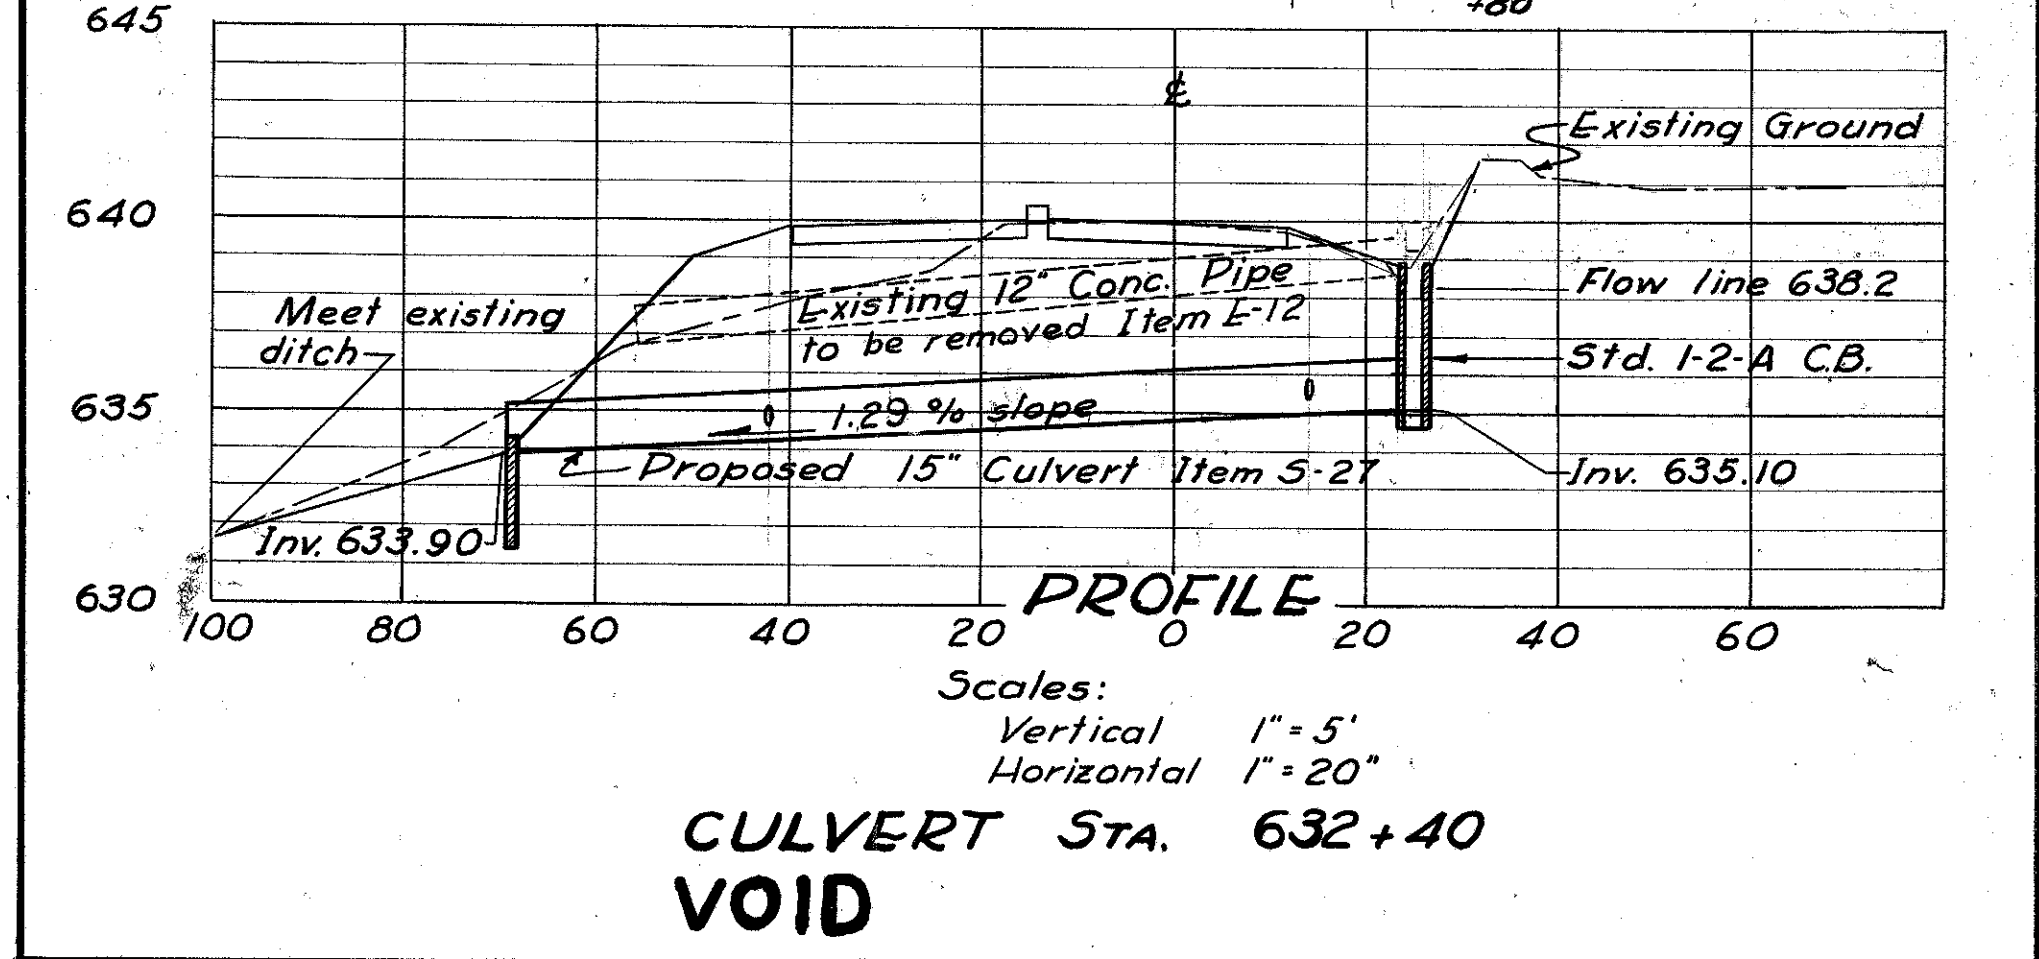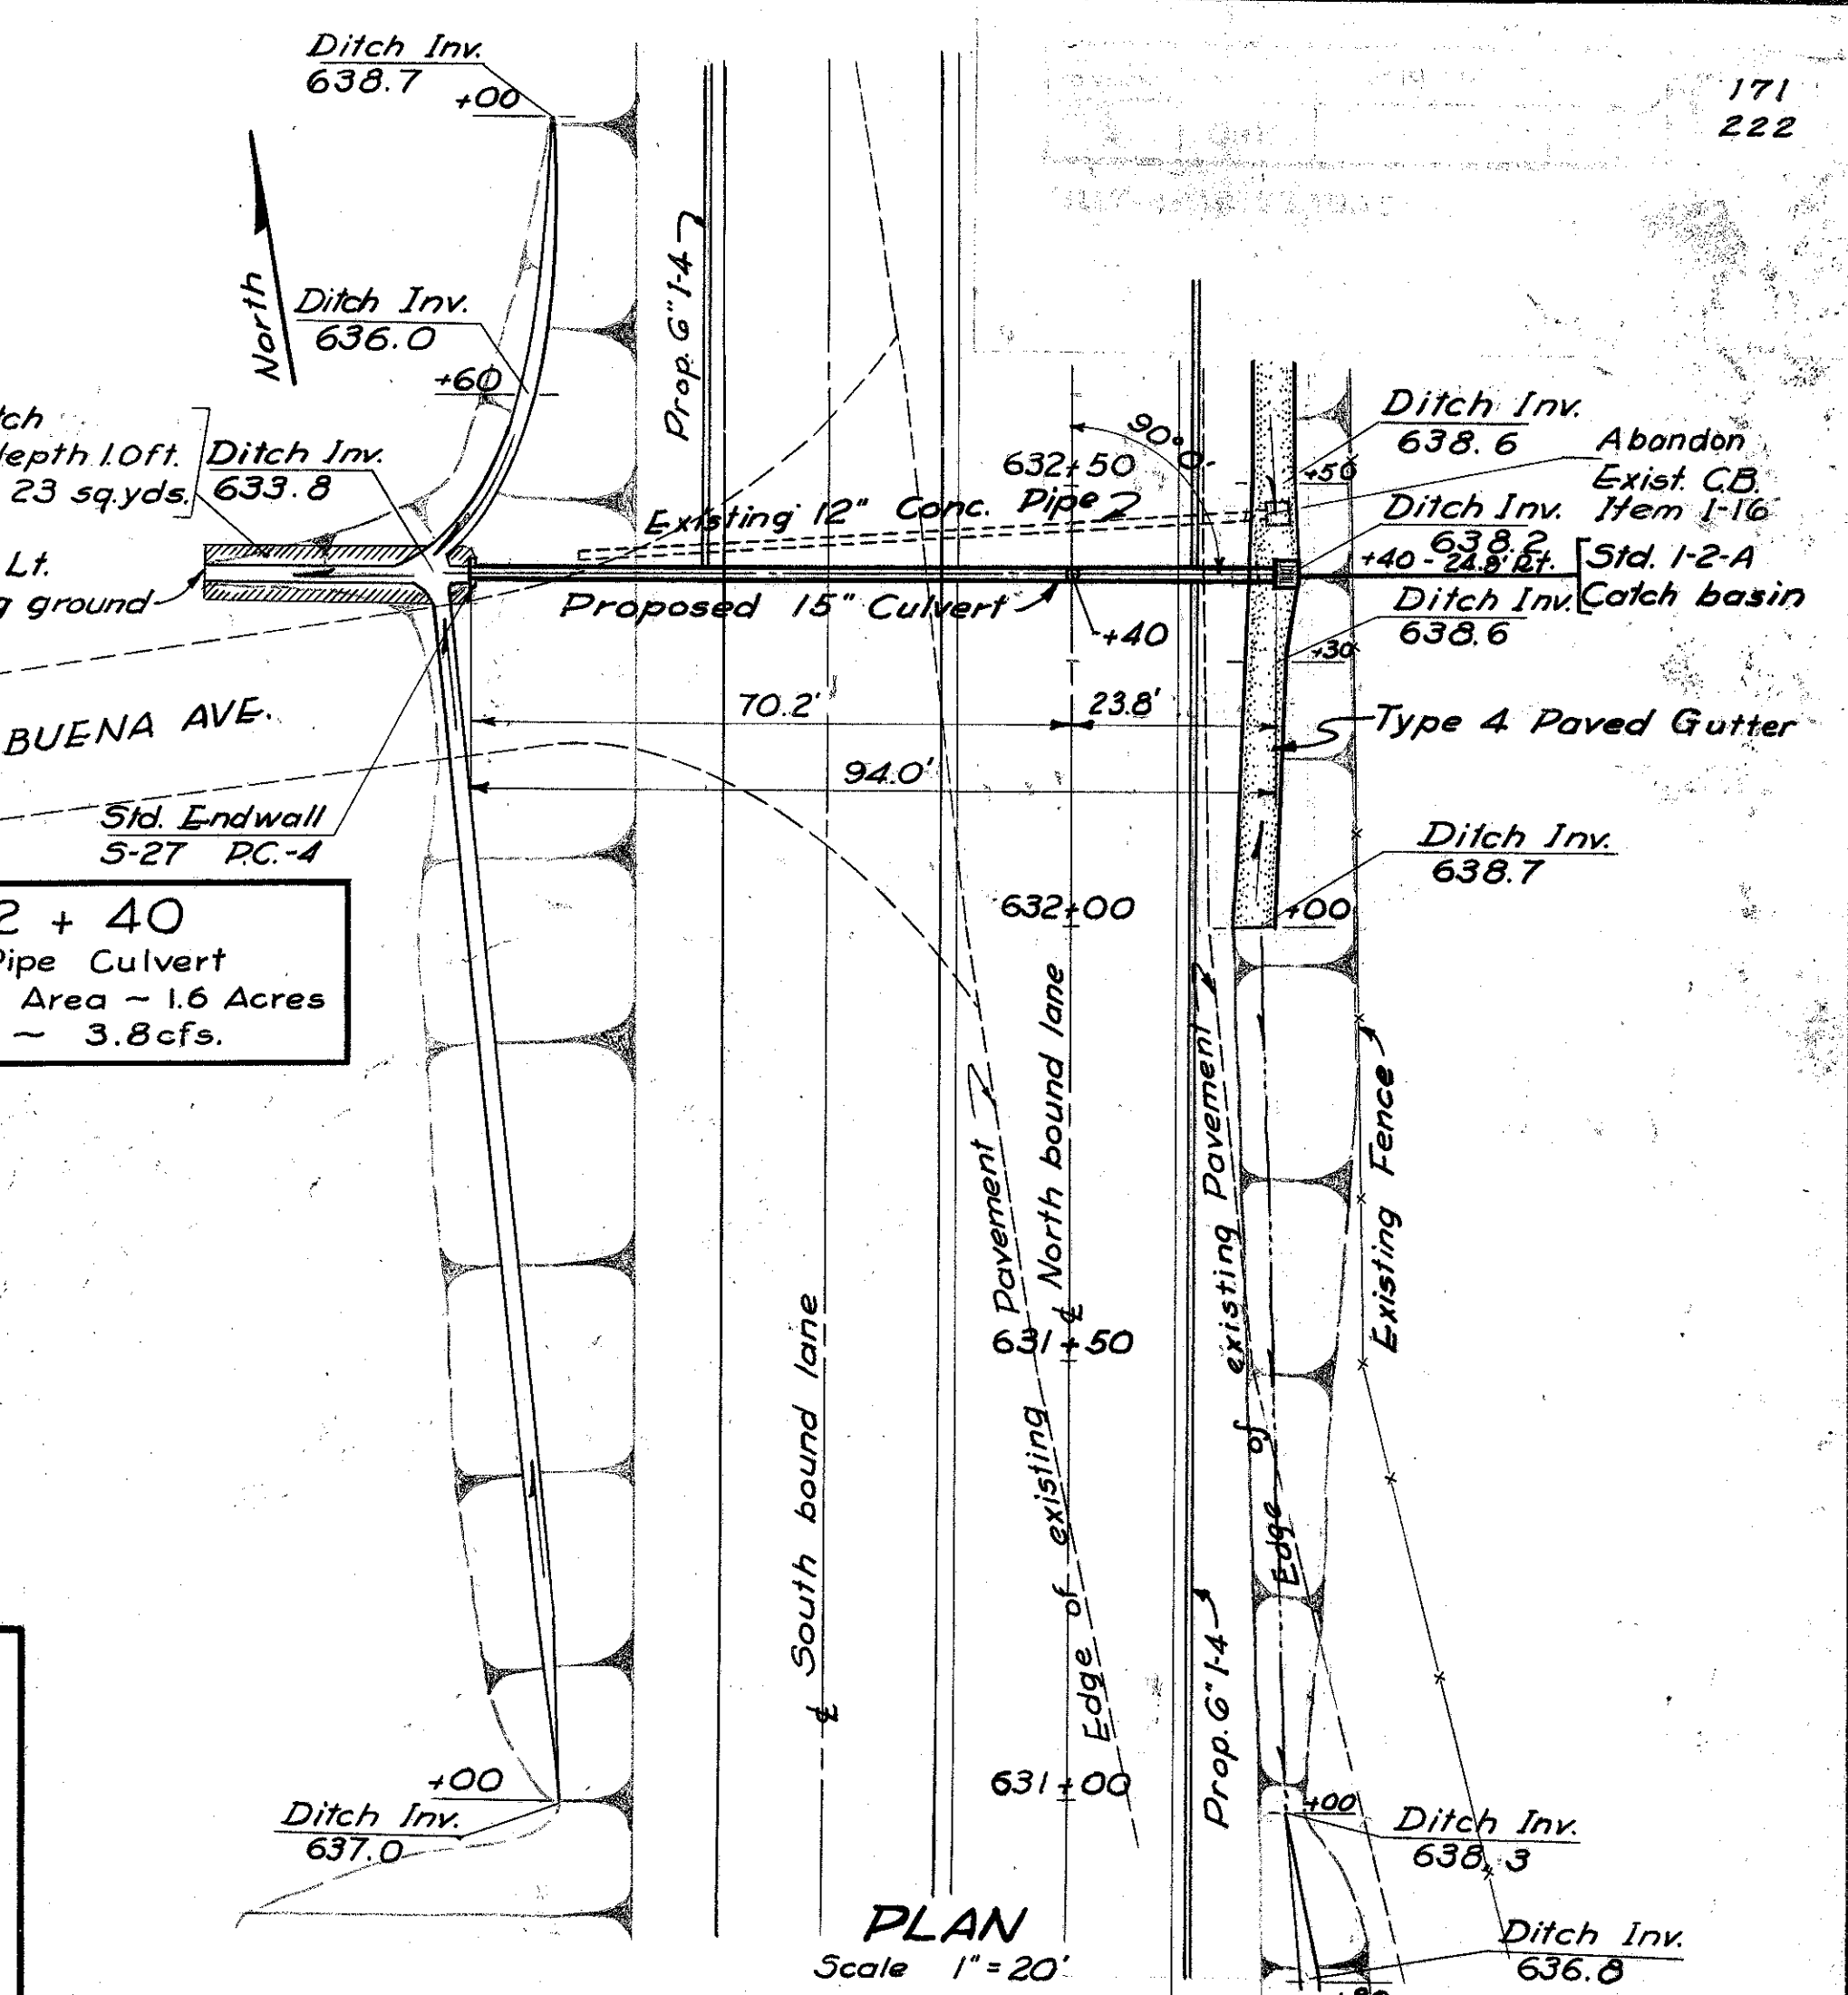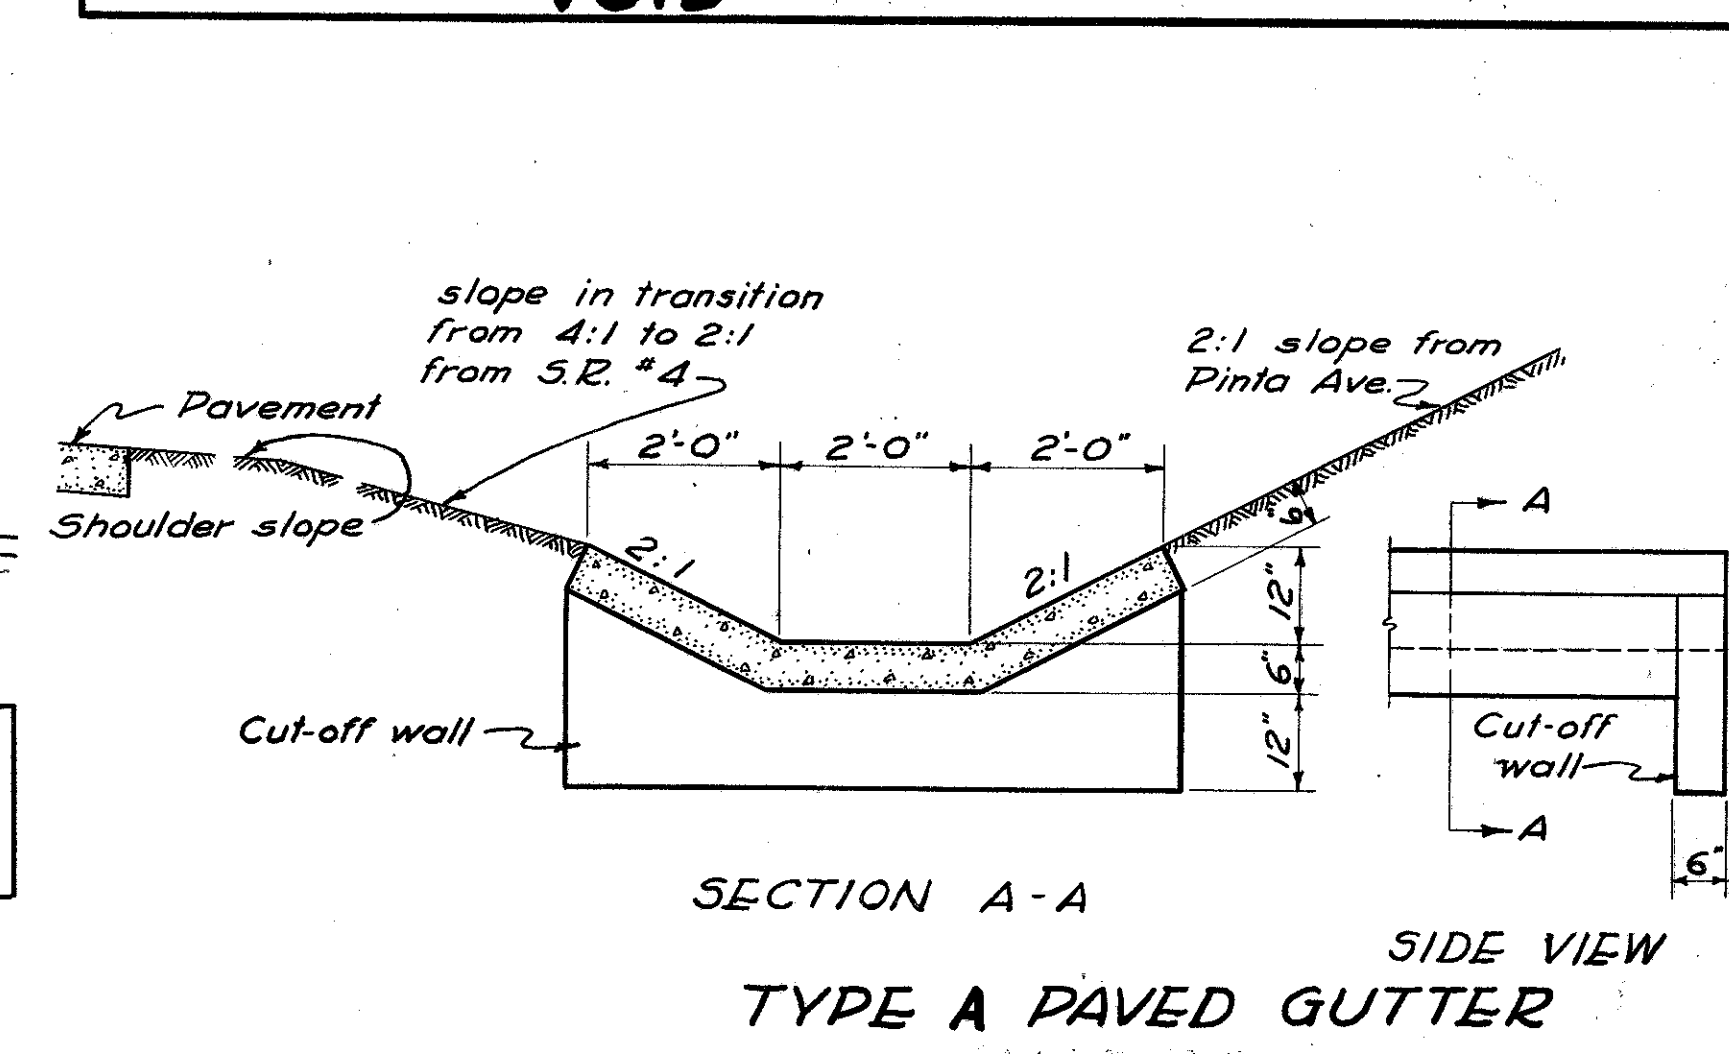

BUT-4-(1G.53-19.15)

**DRAINAGE AREA  
DICK'S CREEK  
30,60 SQ. MILES**

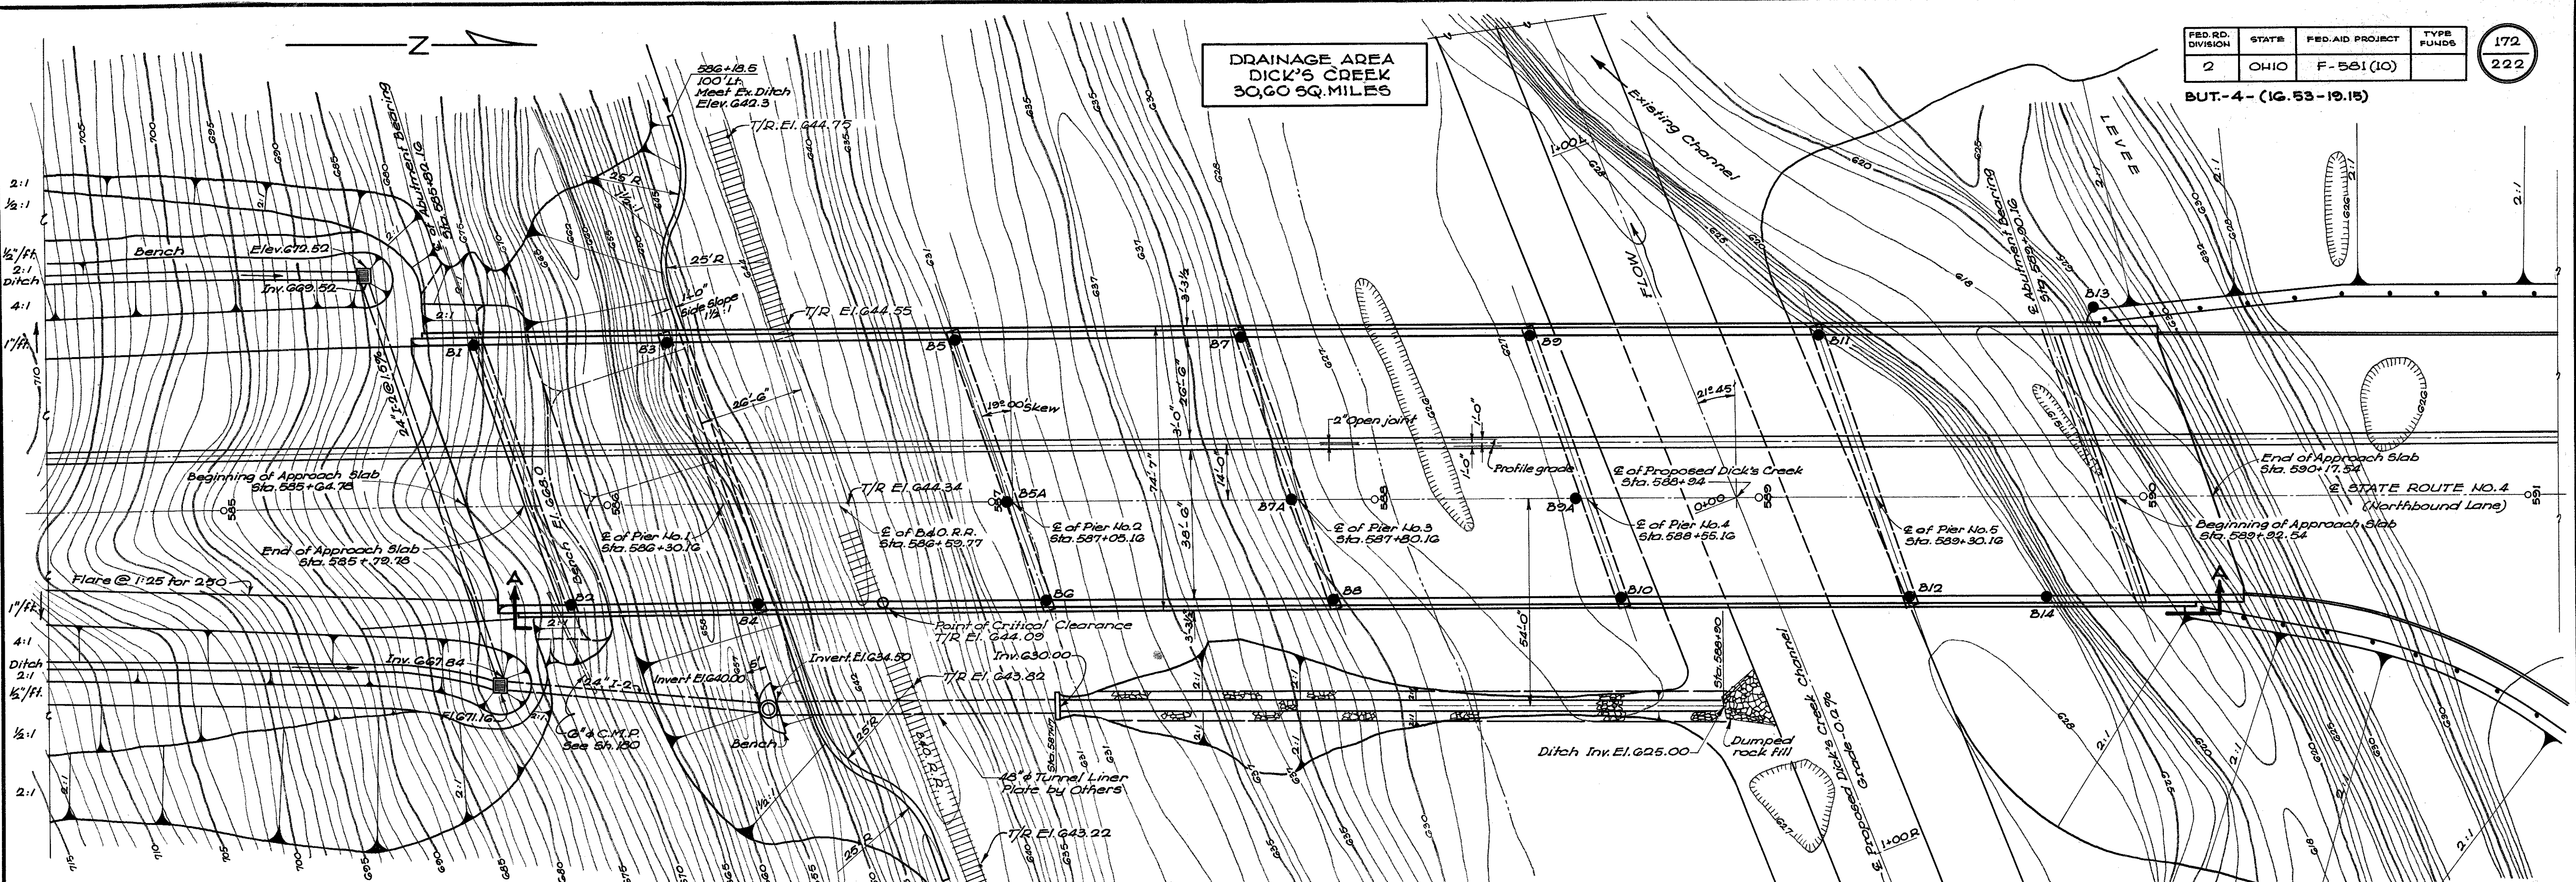

**PLAN**  
Scale: 1" = 20'


For relocation of Dick's Creek Channel see Sheet No. 161

**PROPOSED STRUCTURE**


TYPE: Continuous rolled beam with reinforced concrete deck and substructure.  
 SPANS: 43'-0", 75'-0", 75'-0", 75'-0", 60'-0" c.c. bearings  
 SKEW: 13°-00'  
 WEARING SURFACE: 1" monolithic concrete.  
 SAFETY CURBS: 2 @ 2'-0"  
 ROADWAY: 68'-0" curb to curb  
 APPROACH SLABS: South 15'-0" & North 25'-0" long  
 LOADING: Standard lane loading as per State of Ohio Design Specifications for Highway Structures October 1, 1951 with revisions dated July 15, 1952 and April 1, 1954.  
 CR = 400  
 VERTICAL CLEARANCE: 22'-6" minimum required.

**NOTES**

- Symbol denotes drill hole. See Sheet No. 114 for test boring data.
- Foundation design and foundation quantities are based on a study of test borings and soil samplings made at the site. This sounding information may be inspected in the Office of the Bureau of Bridges in Columbus or in an abridged form in the Division office, but the State assumes no responsibility for the accuracy thereof.
- The minimum construction clearances over the railroad are: 13'-0" vertical and 8'-0" horizontal.
- See Sheet No. 41 for trees and existing structures.

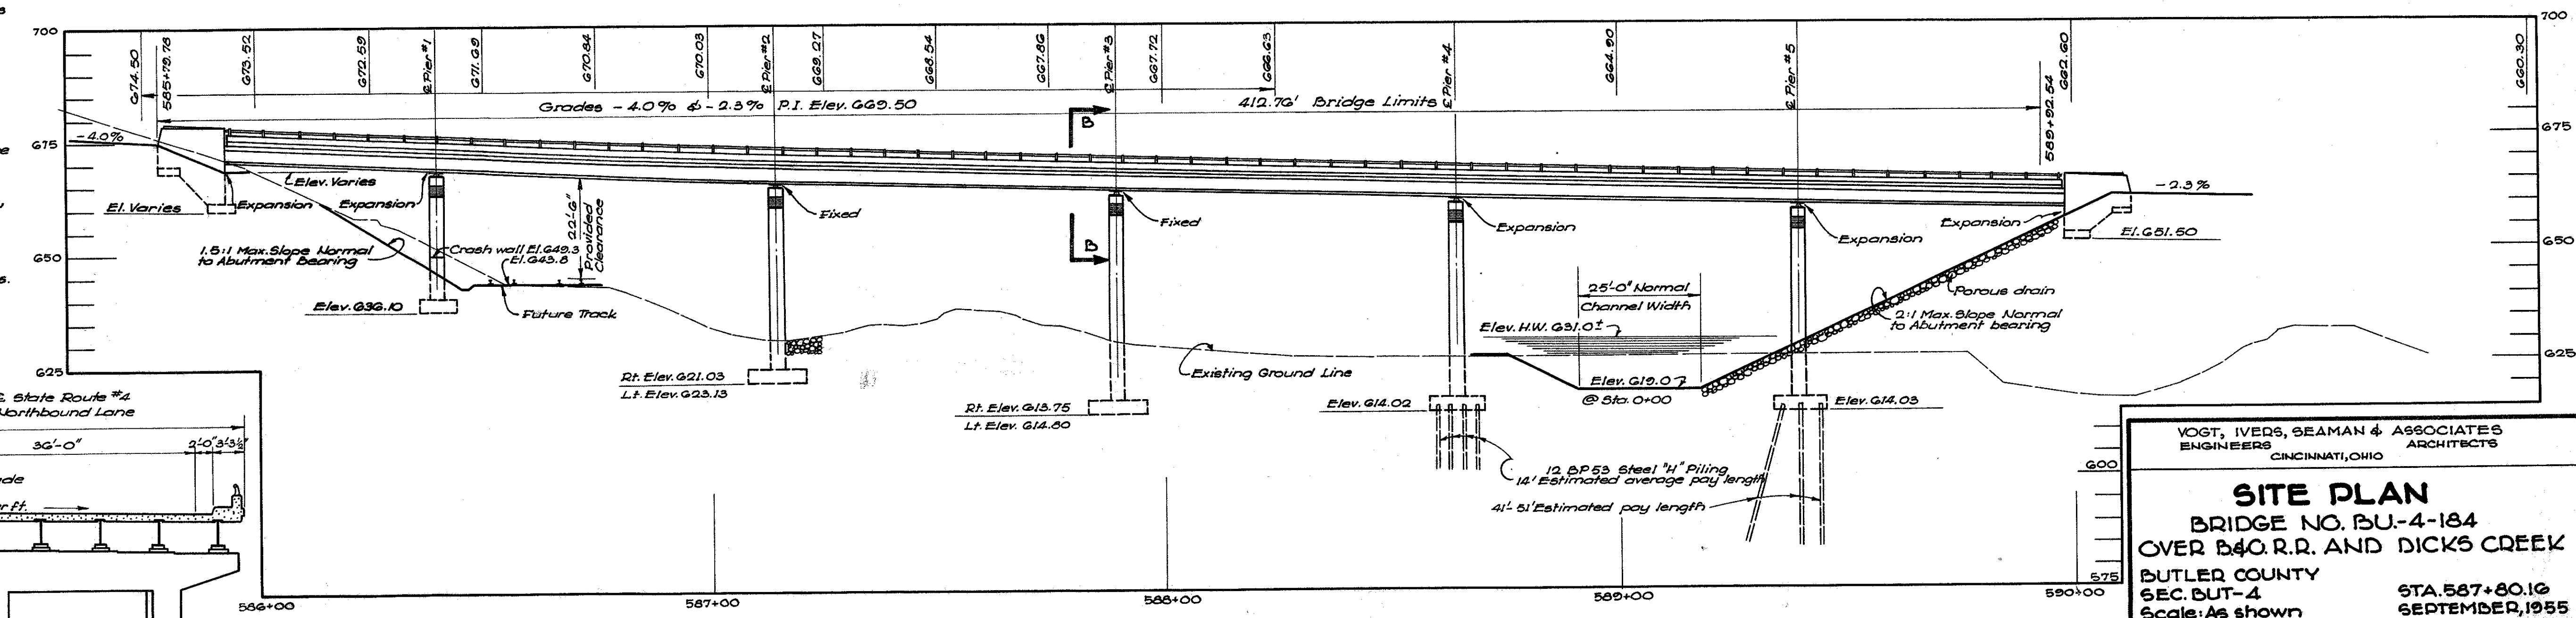

**ELEVATION A-A**  
Scale: 1" = 20'

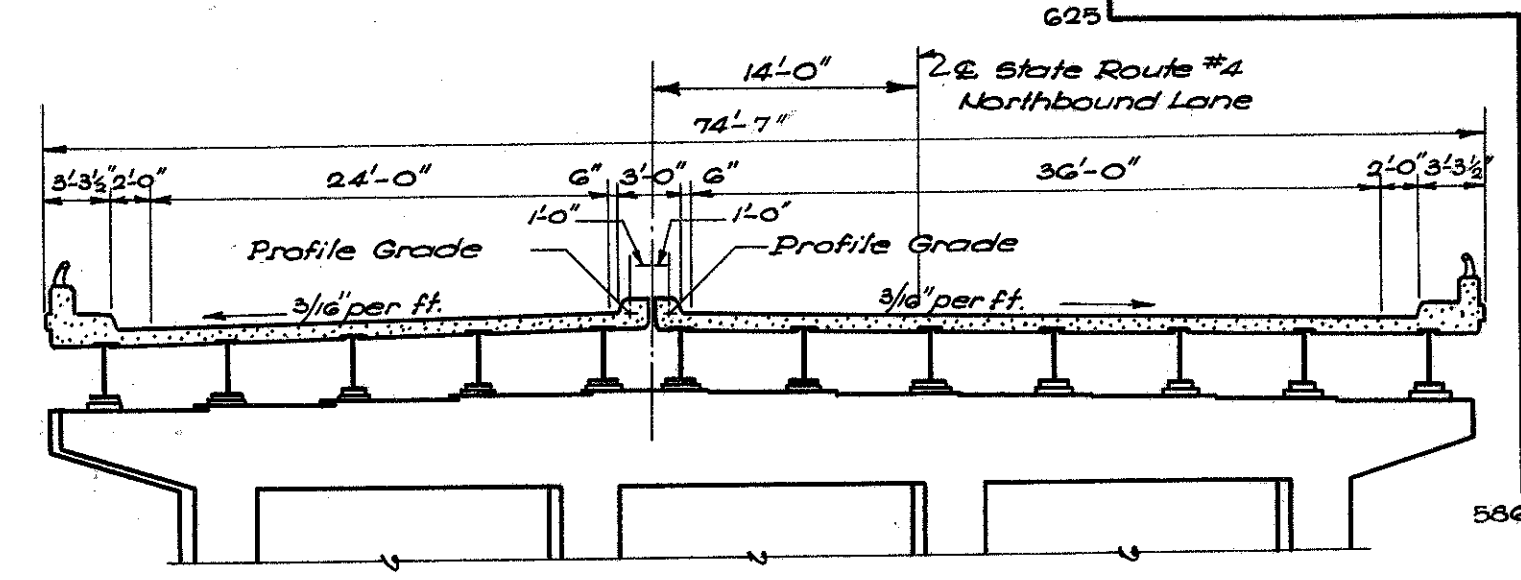


**SECTION B-B**  
Scale: 1" = 10'

VOGT, IVERS, SEAMAN & ASSOCIATES  
ENGINEERS ARCHITECTS  
CINCINNATI, OHIO

**SITE PLAN**  
BRIDGE NO. BU-4-184  
OVER B&O R.R. AND DICKS CREEK  
BUTLER COUNTY  
SEC. BUT-4  
Scale: As shown  
STA. 587+80.16  
SEPTEMBER, 1955

PRESENT TOPOGRAPHY		PROPOSED WORK		
SURVEYED	DRAWN	DESIGNED	DRAWN	CHECKED
J.O.W.	B.G.E.	R.G.H.	R.G.H.	R.J.L.
REVISIONS				

BUT-4-(16.53-19.15)

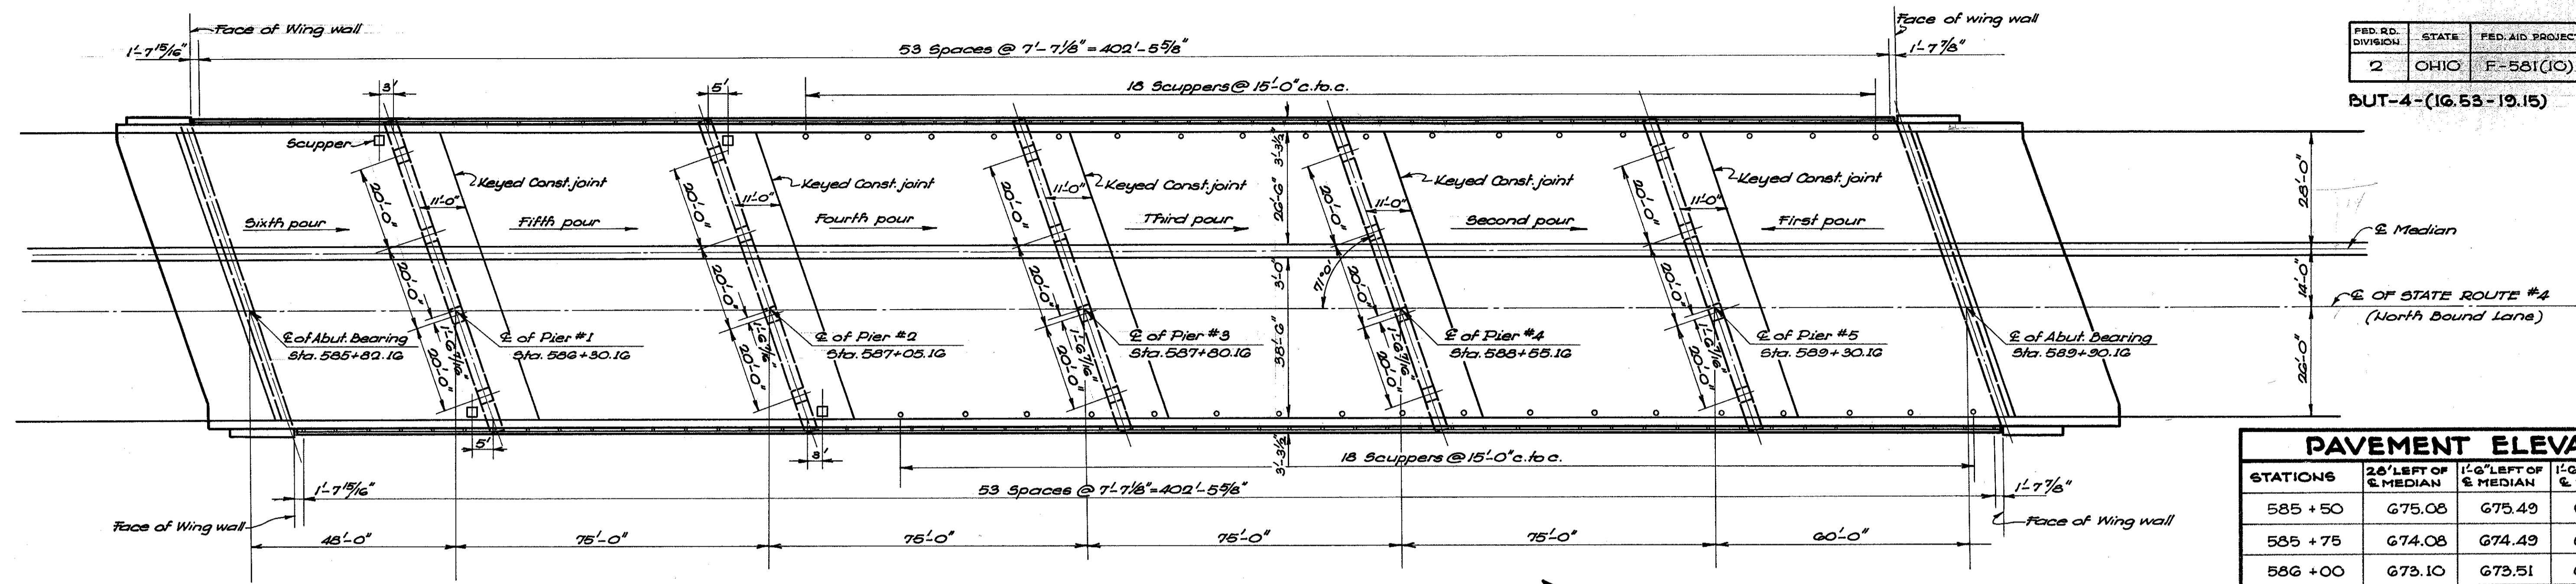


**GENERAL PLAN**  
Scale: 1"=20'

For bridge drainage details and scupper details see sheet No. 187

For railing details see sheet No. 184

For deflection joint details see sheet No. 186

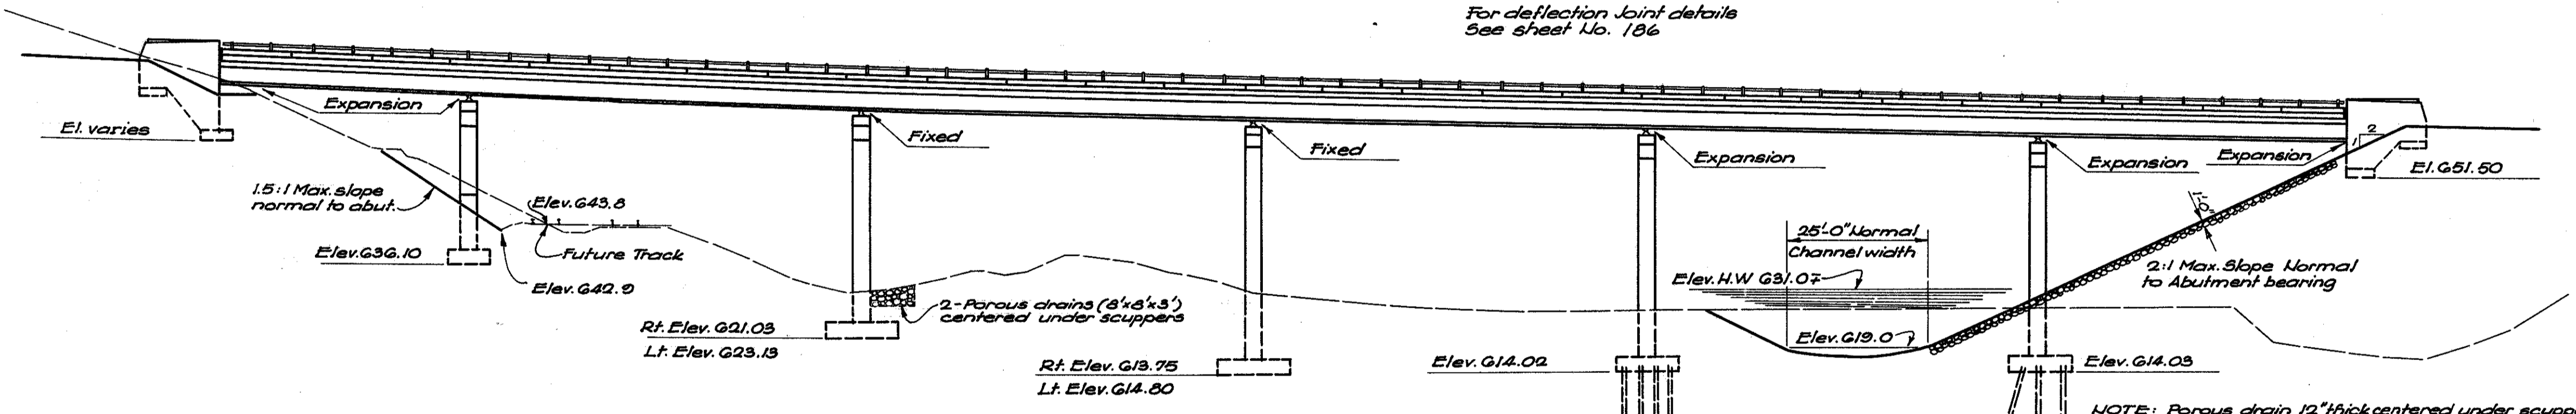

**ELEVATION**  
Scale: 1"=20'

**GENERAL NOTES**

**DECK PLACING PROCEDURE:** Deck slab shall be placed in sections between transverse construction joints, in the numerical order and in the direction indicated on the drawings.

**WELDING:** Welding shall be Class "A" unless otherwise shown on plans. Any weld shown as field weld may be welded in the shop at the option of the contractor. Class "B" welds are shown with the letter "B" in the tail of the weld symbol.

**BEARING PILES:** Piles for pier number four shall be driven to firm contact with rock. This shall be considered as attained when the capacity according to the formula in Sec. 5-18.05 is at least 45 tons per pile if a 7000# steam hammer is used or 35 tons per pile if a steam hammer or drop hammer of 15000# or greater energy is used and if the length of penetration is approximately equal to the depth to rock according to the bridge foundation investigation report. If the energy rating of the hammer is between these values, the required formula capacity shall be determined by interpolation. The design load is 24 tons per pile. Piles for pier number five shall be driven to a minimum bearing capacity of 40 tons and preferably to firm contact with rock.

**PAINT:** One additional field coat of paint, of the same kind as the shop coat, shall be put on the structural steel in the span over the Railroad track, with the exception of the steel in contact with concrete.

**FOOTINGS:** Footings of rear abutment and of piers Nos. 1, 2 & 3 shall extend a minimum of 3' into solid rock or to the elevation shown, whichever is lower.

**EXCAVATION:** Roadway embankment at north abutment shall be placed and compacted to the elevation at which the embankment slope intersects the face of the abutment. Excavation shall then be made for abutment footings. Quantities for excavation includes removal of fill material between the above described elevation and bottom of abutment footings.

**REMOVAL OF EXISTING STRUCTURES:** That portion of the old abandoned aqueduct structure (see sheet No. 181) that interferes with the relocated Dick's Creek channel shall be removed to the proposed grade of the channel. Waste masonry may be disposed of as bank protection as directed by the Engineer. Cost of this removal shall be included in the lump sum price bid Item 5-24.

**SURFACE FINISH OF CONCRETE:** Curb faces and fascias of deck shall receive a rubbed surface finish. All other exposed surfaces shall be governed by the provisions of Item 5-1.

**GRAVEL:** If used as a coarse aggregate, shall be according to Sec. M-3.93 instead of M-3.91 for Class "C" concrete in the superstructure. Gravel meeting the requirements of Sec. M-3.93 may also be used for other concrete in this structure.

**TRAFFIC:** Adequate protection and maintenance of railway traffic shall be provided at all times.

**EMBANKMENT:** The approach embankment to the North abutment to be placed and brought to the planned subgrade elevation, from the forward bridge limit to about station 592+00 (200 ft.) during the initial stage of work at this structure. The above shall be completed before any work will be permitted for the construction of Pier No. 5. Provisions shall be made for and periodic checks made of the elevation of the approach embankment at the North abutment immediately following the placement of the embankment to the planned subgrade elevation. Such periodic observations shall be continued until the existence, degree and nature of any subsidence due to the consolidation of the subsoil has been established.

**ADDITIONAL NOTES:** For additional notes see sheet No. 172

PAVEMENT ELEVATIONS				
STATIONS	2'-6" LEFT OF & MEDIAN	1'-6" LEFT OF & MEDIAN	1'-6" RIGHT OF & MEDIAN	4'-0" RIGHT OF & MEDIAN
585 + 50	675.08	675.49	675.49	674.89
585 + 75	674.08	674.49	674.49	673.89
586 + 00	673.10	673.51	673.51	672.91
586 + 25	672.10	672.58	672.58	671.98
586 + 50	671.27	671.68	671.68	671.08
586 + 75	670.42	670.83	670.83	670.23
587 + 00	669.61	670.02	670.02	669.42
587 + 25	668.84	669.26	669.26	668.66
587 + 50	668.12	668.53	668.53	667.93
587 + 75	667.44	667.85	667.85	667.25
588 + 00	666.80	667.21	667.21	666.61
588 + 25	666.20	666.62	666.62	666.02
588 + 50	665.63	666.04	666.04	665.44
588 + 75	665.05	665.47	665.47	664.87
589 + 00	664.48	664.89	664.89	664.29
589 + 25	663.90	664.32	664.32	663.72
589 + 50	663.33	663.74	663.74	663.14
589 + 75	662.75	663.17	663.17	662.57
590 + 00	662.18	662.59	662.59	661.99
590 + 25	661.60	662.02	662.02	661.42

ESTIMATED QUANTITIES													
ITEM	TOTAL	UNIT	DESCRIPTION	SOUTH ABUT.	#1 PIER	#2 PIER	#3 PIER	#4 PIER	#5 PIER	NORTH ABUT.	SUPER STRUCT.	GENERAL	AS BUILT
E-2	4761	Cu. Yds.	Unclassified Excavation	148	74	215	392	378	308	182			C-6, +6 1707
E-2	395	Cu. Yds.	Rock Excavation	108	164	41	82						
E-2		Lump Sum	Cofferdams, Cribbs & Sheeting									Lump	
E-3	7466	Cu. Yds.	Channel Excavation									7466	C-6, +43 7511
S-1	658	Cu. Yds.	Class "C" Concrete - Superstructure		91	108	119	115	111			858	
S-1	544	Cu. Yds.	Class "C" Concrete - Pier Caps & Columns										
S-1	401	Cu. Yds.	Class "E" Concrete - Pier & Abut. Footings	38	60	66	72	75	56	34			C-6, +6 407
S-1	189	Cu. Yds.	Class "E" Concrete - Abut. & Wing walls	100						89			
S-1	66	Cu. Yds.	Class "E" Concrete - Crashwall		66								
S-4	427610	Lbs.	Reinforcing Steel	6956	22921	45604	45494	25394	26014	7466	245285	456	C-6, -5081 423,529
S-7	911049	Lbs.	Structural Steel								911,049		C-6, +993 912,042
S-8	911049	Lbs.	Field Painting of Structural Steel								911,049		C-6, +993 912,042
S-9	297	Sq. ft.	1" Premolded Exp. Joint filler	40	216					41			
S-14	811	Lin. ft.	Railing (aluminum rail and supports and concrete parapet)								811		
S-16		Lump Sum	First test pile										
S-18	2832	Lin. ft.	Steel piling (12-BS53)					840	2024				C-6, -32 2832
S-24		Lump Sum	Removal of exist. structures										
S-29	98	Cu. Yds.	Porous Backfill	68						30			
S-29	59	Cu. Yds.	Porous Drains		14							45	
S-29	66	Lin. ft.	6" Wrought Iron Pipe incl. specials								66		95
S-29	95	Lin. ft.	6" Plain Concrete Pipe										
S-29	36	Each	Scuppers (6" φ W.I.)								36		
S-29	4	Each	Scuppers (Large C.I.)								4		
S-29	30	Lin. ft.	6" Corrugated Metal Pipe	30									
I-9	30	Lin. ft.	Stone Under Drain (Fr. Dr.)							30			
I-10	1048	Cu. Yds.	Dumped Rock Fill								1048		

NOTE: Materials in approach slabs are not included in the above estimated quantities.


VOGT, IVERS, SEAMAN & ASSOCIATES  
ENGINEERS ARCHITECTS  
CINCINNATI, OHIO

**GENERAL PLAN, ELEVATION  
NOTES & QUANTITIES**  
BRIDGE NO. BU-4-184  
OVER B.&O.R.R. AND DICKS CREEK


BUTLER COUNTY  
SEC. BUT.-4  
Scale: As shown

STA. 587+80.10  
SEPTEMBER 1955


DESIGNED	DRAWN	TRACED	CHECKED	REVIEWED DATE	REVISED
O.L.A.	D.G.B.	J.H.W.	R.J.L.	W.J.I. 10.11.1955	

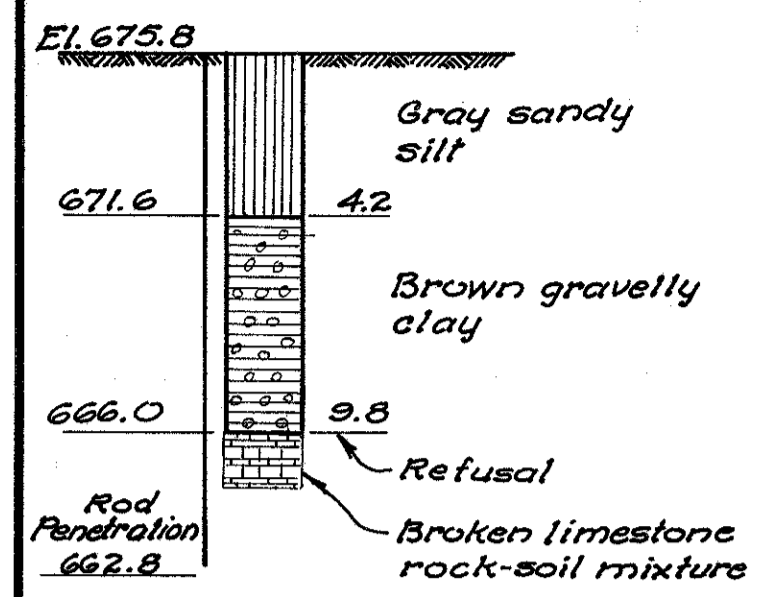


**BORING NO. 1**  
Scale: 1" = 5'-0"

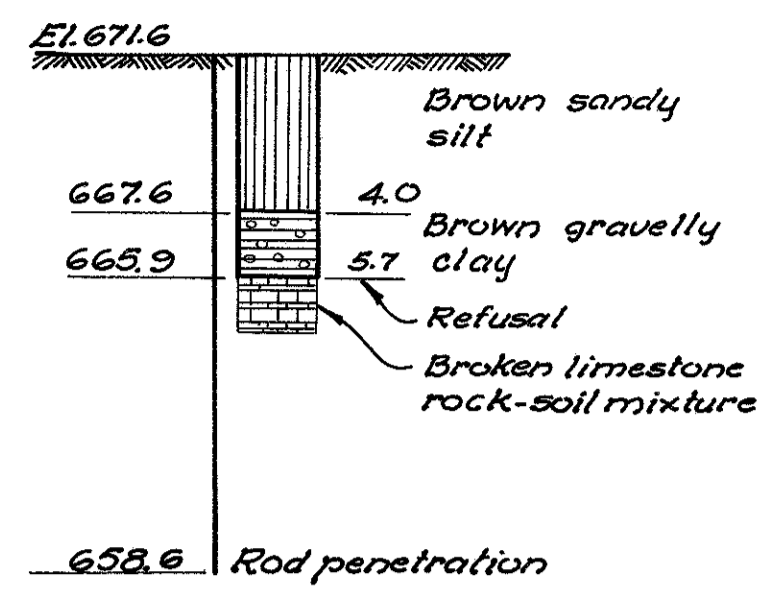


**BORING NO. 2**  
Scale: 1" = 5'-0"

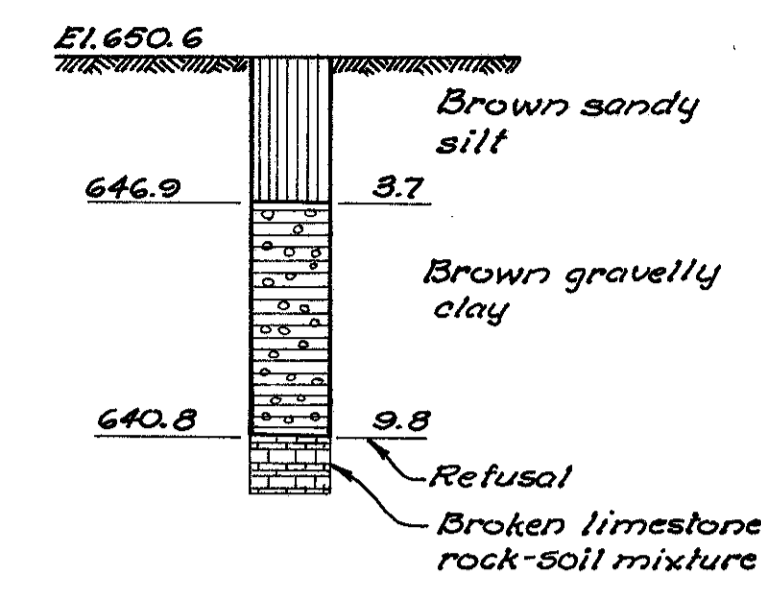


**BORING NO. 3**  
Scale: 1" = 5'-0"

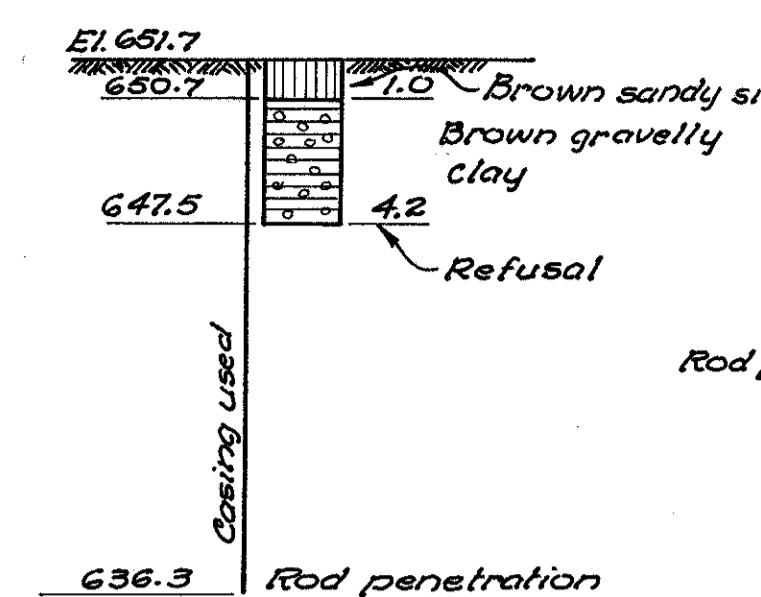


**BORING NO. 4**  
Scale: 1" = 5'-0"

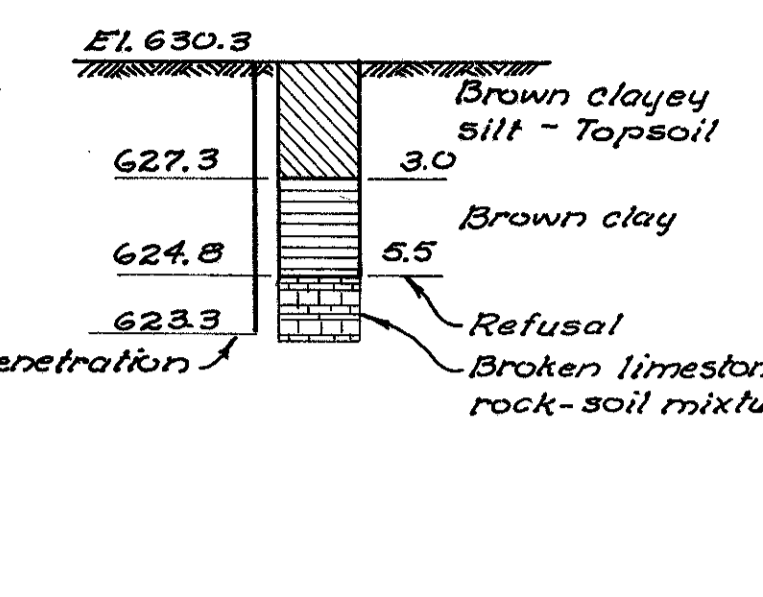


**BORING NO. 5**  
Scale: 1" = 5'-0"

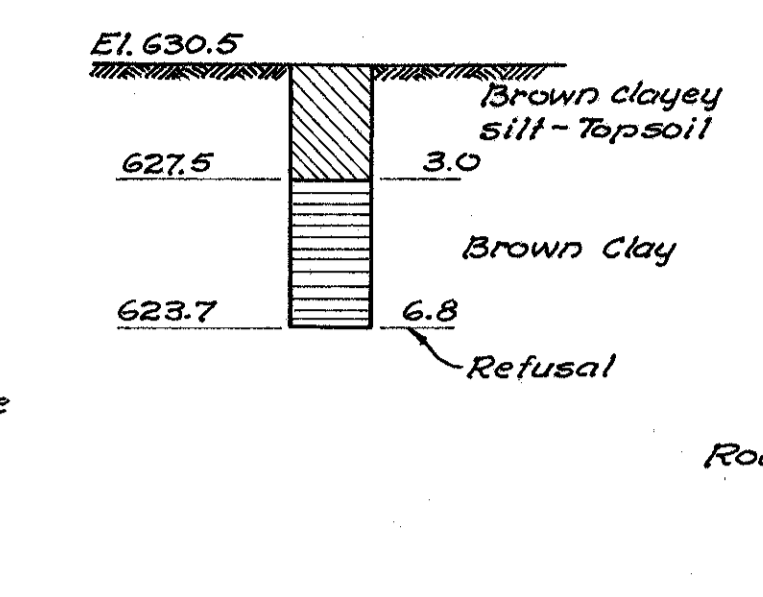


**BORING NO. 5A**  
Scale: 1" = 5'-0"

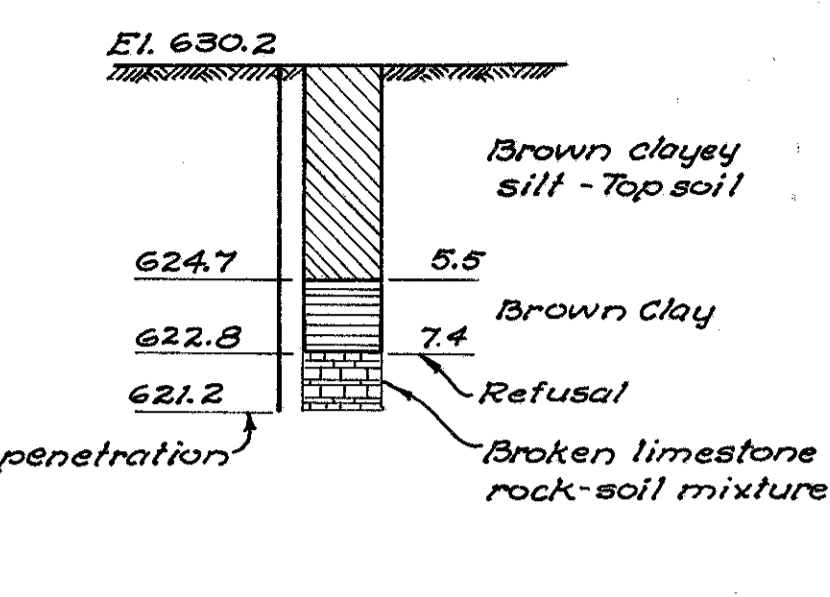


**BORING NO. 6**  
Scale: 1" = 5'-0"

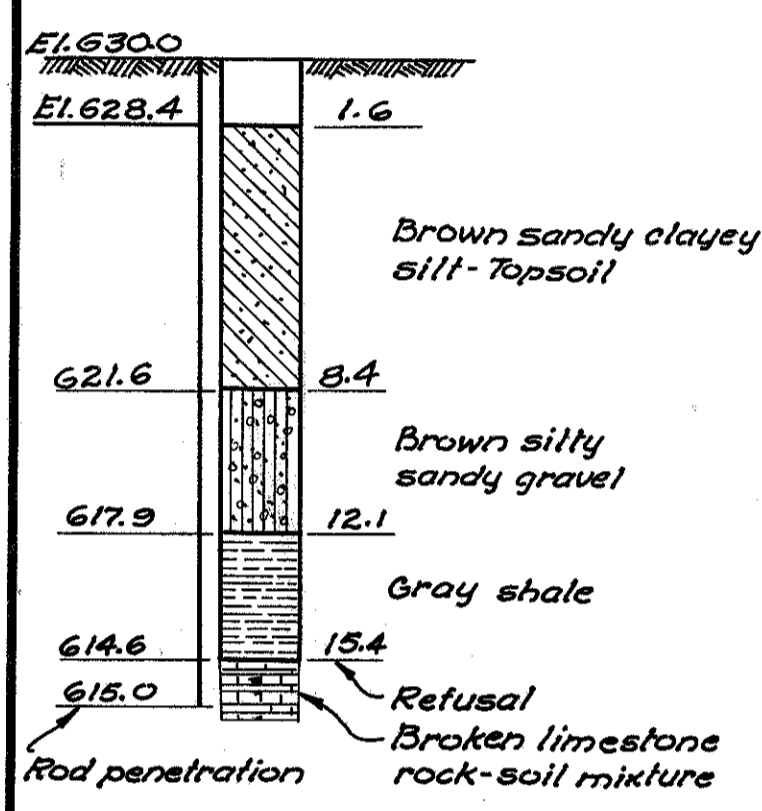


**BORING NO. 7**  
Scale: 1" = 5'-0"

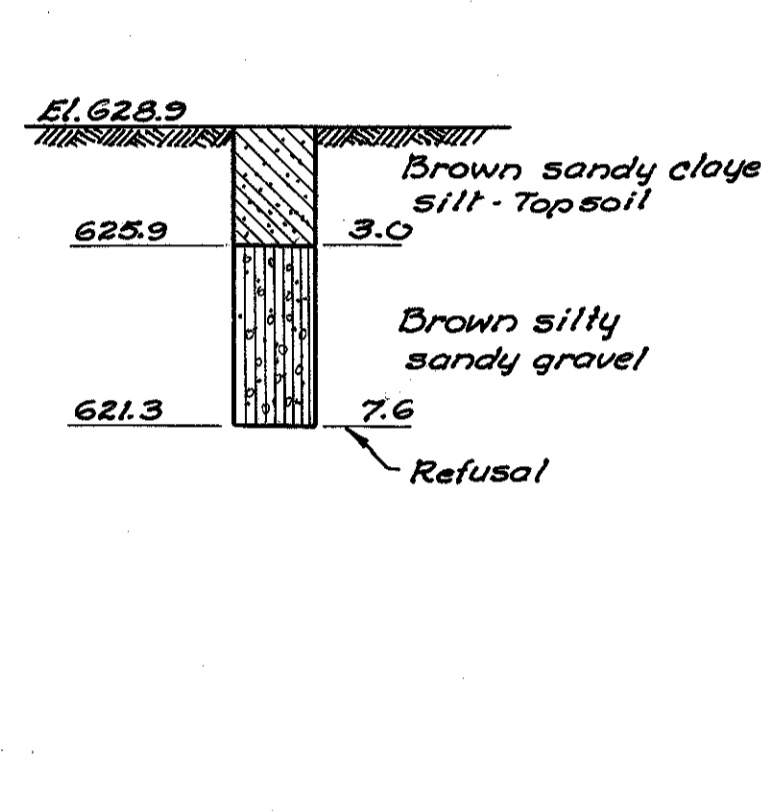


**BORING NO. 7A**  
Scale: 1" = 5'-0"

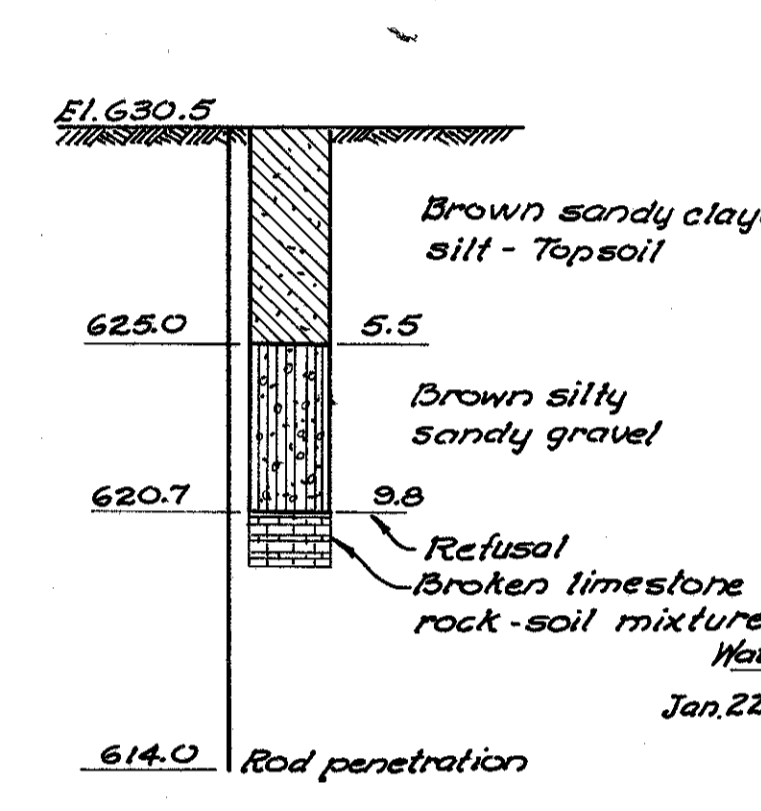


**BORING NO. 8**  
Scale: 1" = 5'-0"

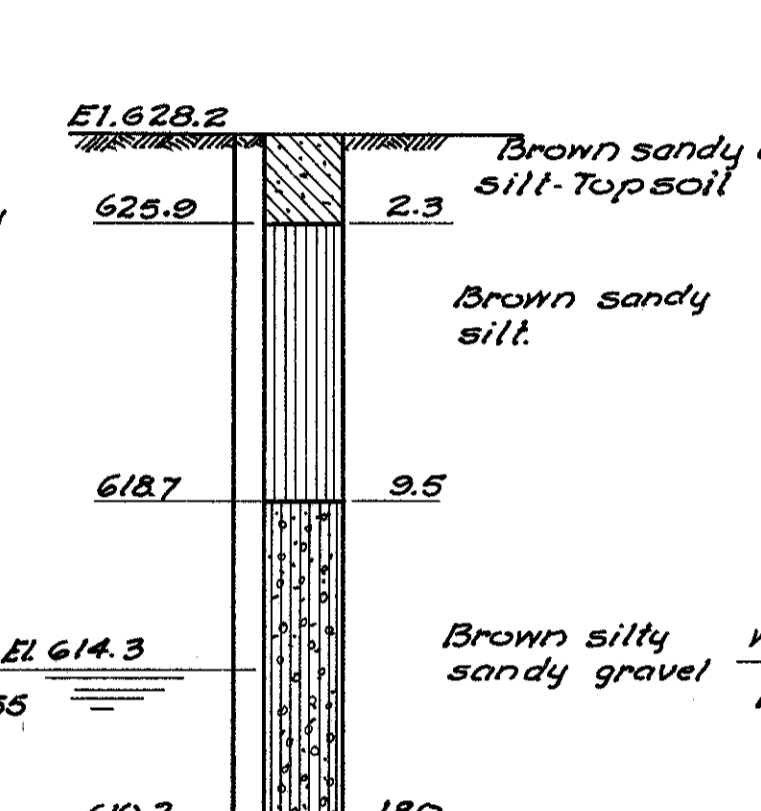


**BORING NO. 9**  
Scale: 1" = 5'-0"

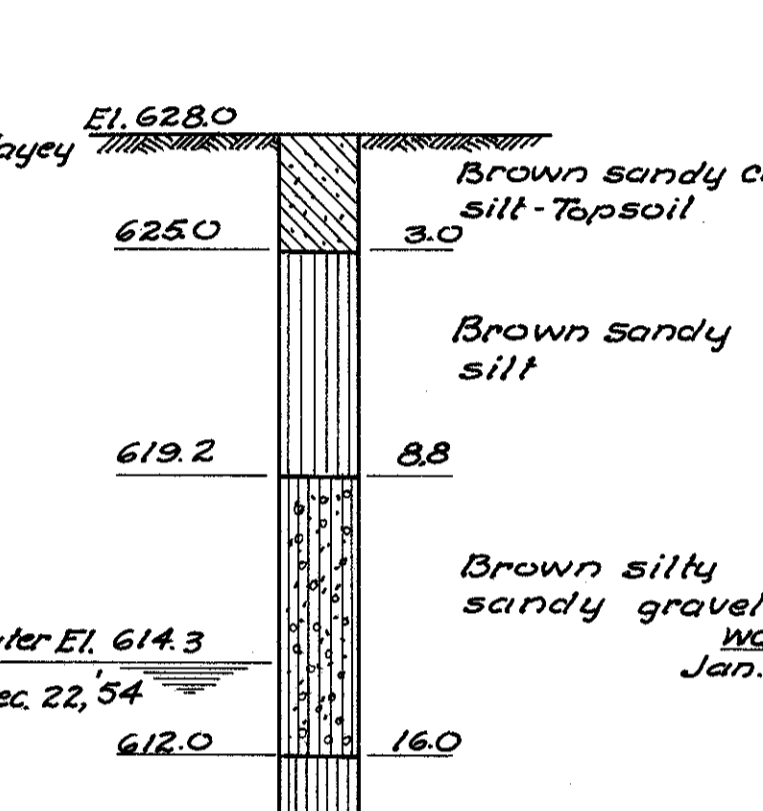


**BORING NO. 9A**  
Scale: 1" = 5'-0"

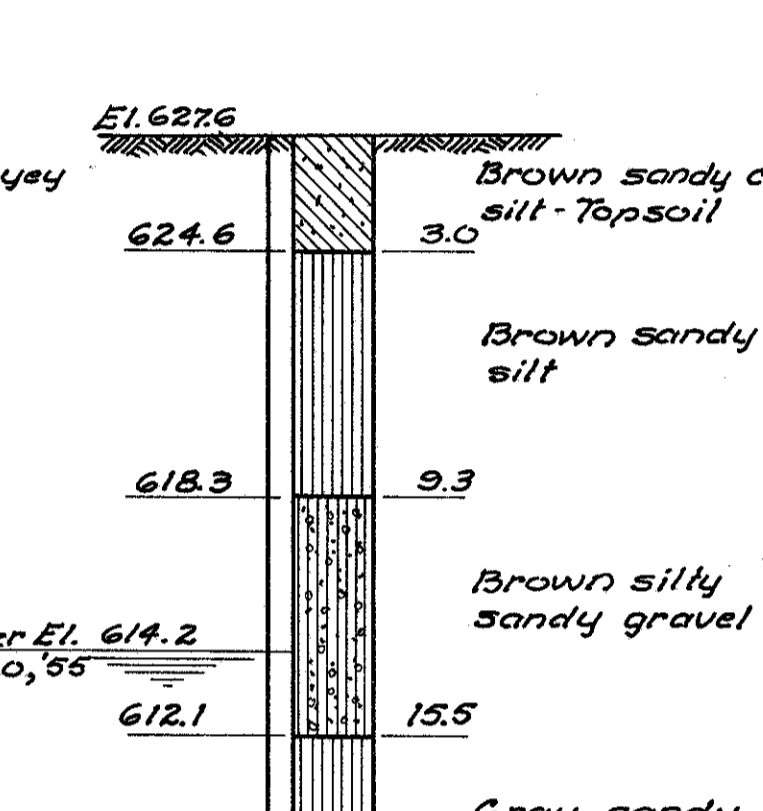


**BORING NO. 10**  
Scale: 1" = 5'-0"

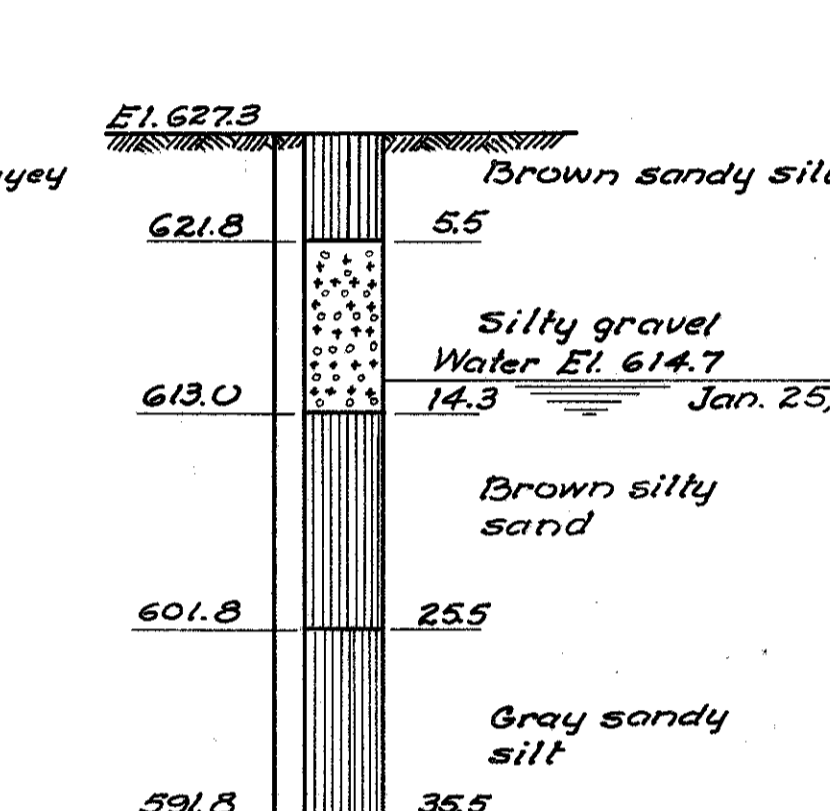


**BORING NO. 11**  
Scale: 1" = 10'-0"

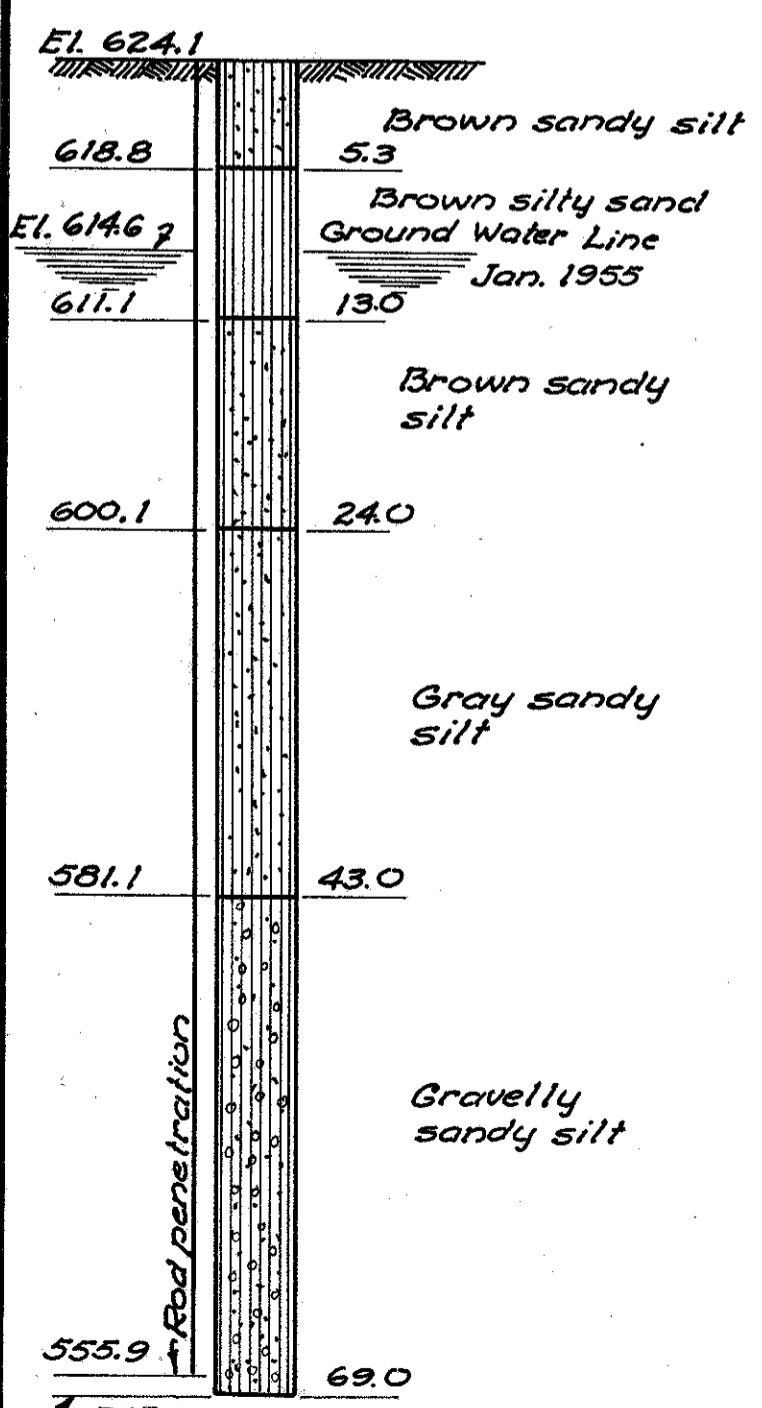


**BORING NO. 13**  
Scale: 1" = 10'-0"

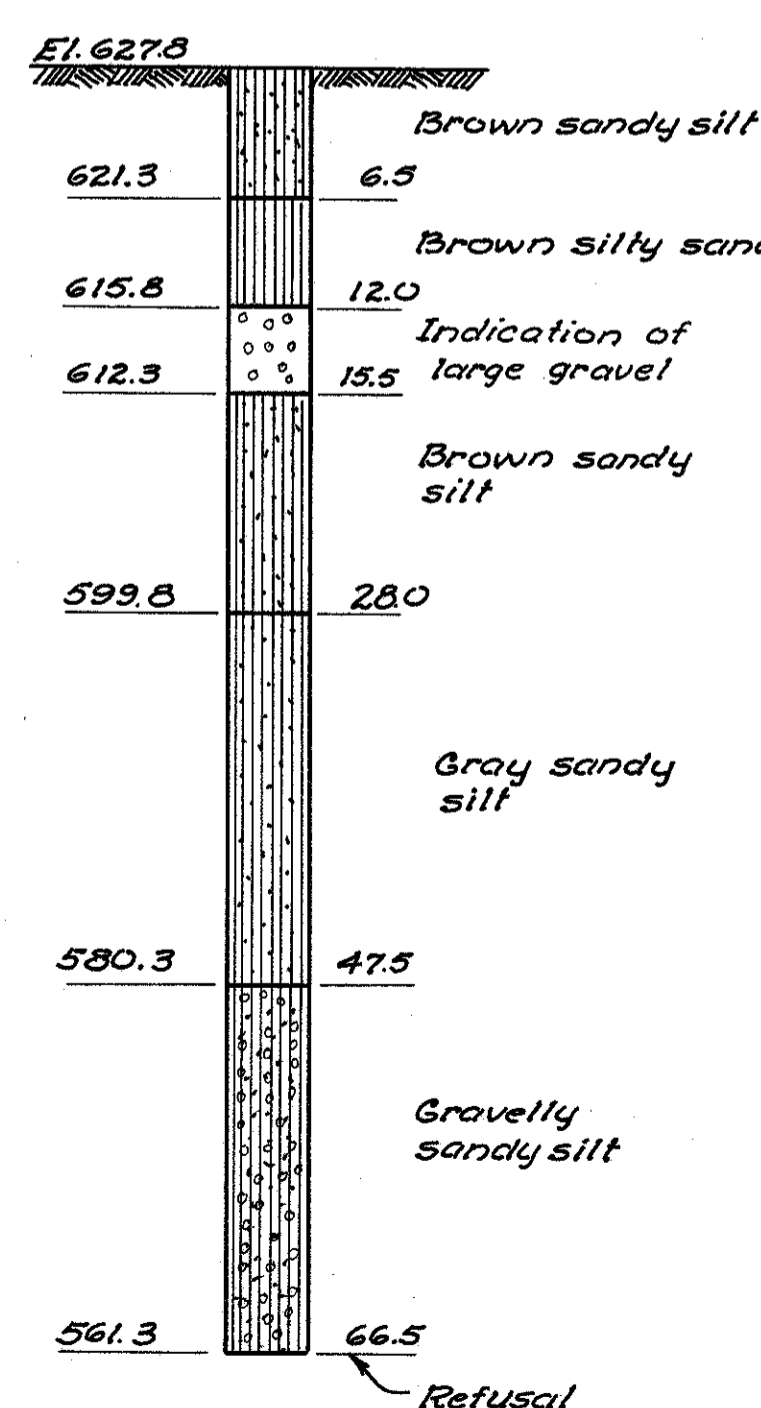

**BORING NO. 14**  
Scale: 1" = 10'-0"

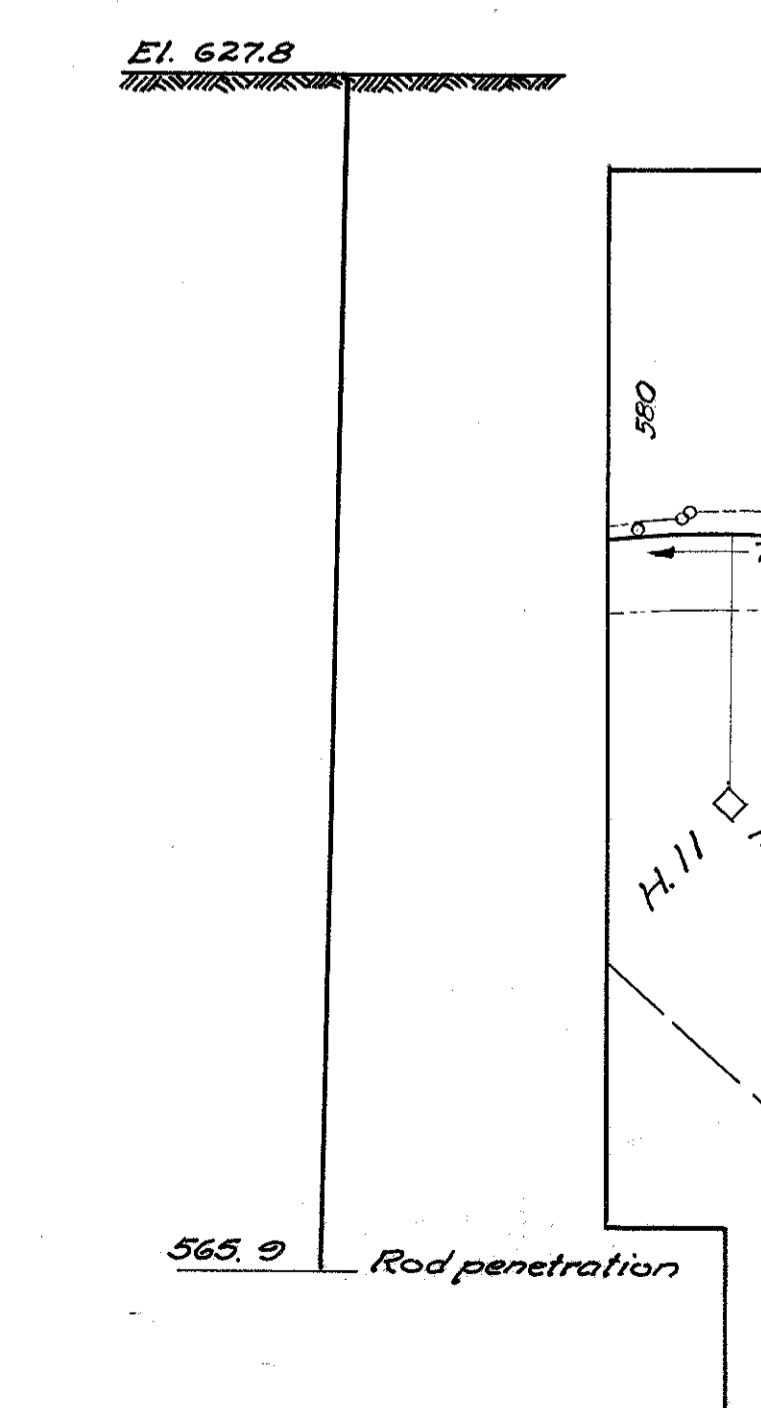

**BORING NO. 12**  
Scale: 1" = 10'-0"

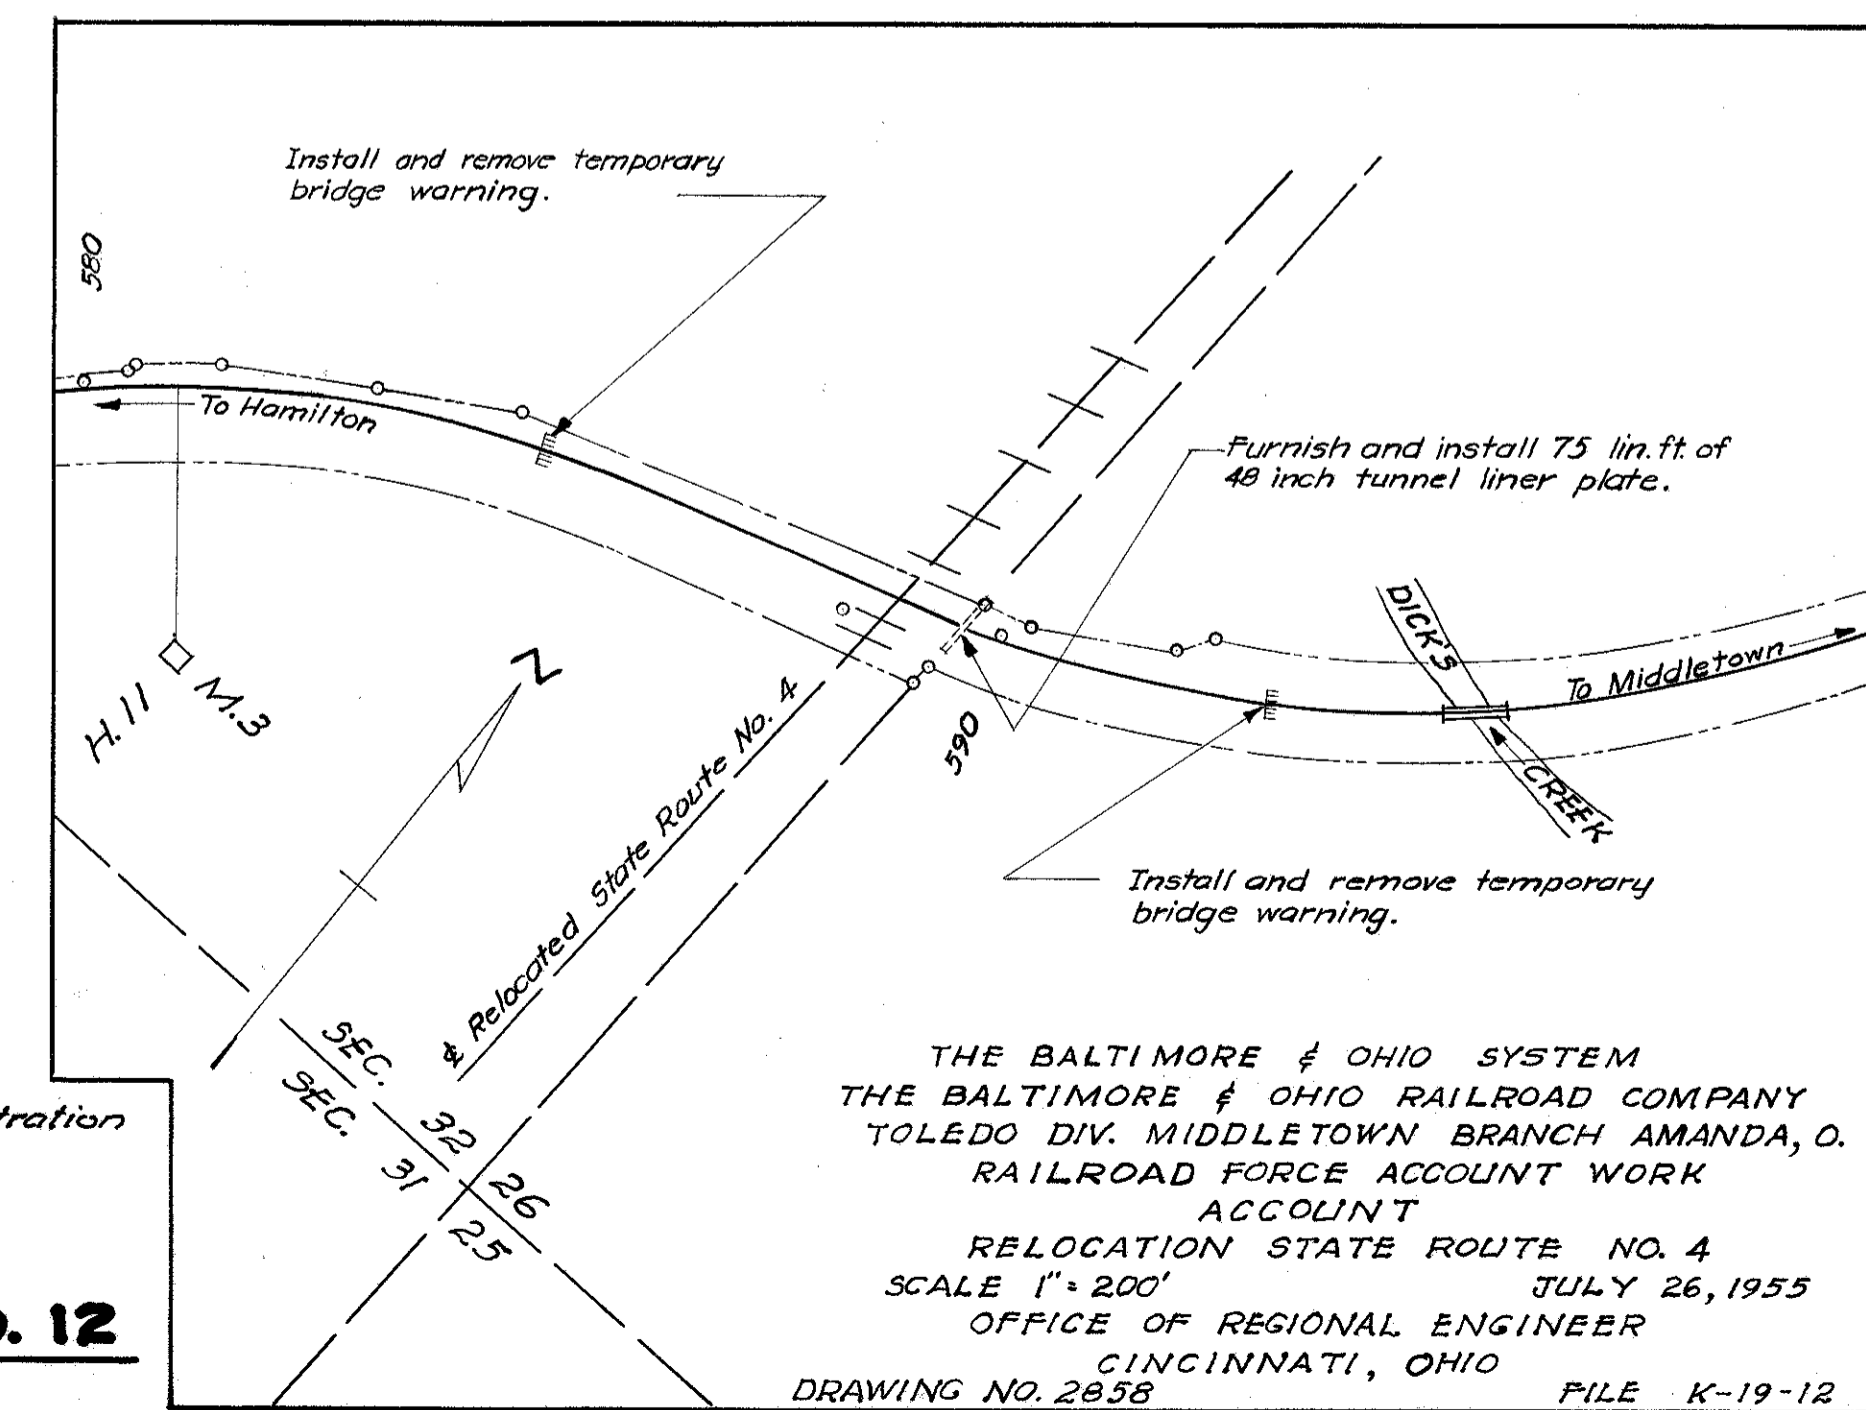


**NOTES:**  
1. Soil auger borings and rod penetration tests were made between Dec. 22, 1954 & Jan. 25, 1955 with a 3" continuous flight auger.  
2. The structure site is generally located on the South edge of a Deep Stage Stream Valley. Overburden at the rear abutment and rear pier consists of residual soil and fragmental rock. Glacial outwash occurs at the location of the remaining piers and the forward abutment. The outwash is composed of somewhat granular material with occasional limestone floaters, for this reason it is believed that the rod penetration tests are the more accurate inasmuch as they penetrated to a lower elevation at some test locations. Refusal of the soil auger borings at a higher elevation at the same test location probably is caused by encounter with floaters.

**FORCE ACCOUNT WORK**  
by  
The Baltimore and Ohio Railroad Company


Inspection During Construction.  
Install and Remove Temporary Bridge Warnings.  
Furnish and Install Tunnel Liner Plate Under Track.

THE BALTIMORE & OHIO SYSTEM  
THE BALTIMORE & OHIO RAILROAD COMPANY  
TOLEDO DIV. MIDDLETOWN BRANCH AMANDA, O.  
RAILROAD FORCE ACCOUNT WORK  
ACCOLINT  
RELOCATION STATE ROUTE NO. 4  
SCALE 1" = 200' JULY 26, 1955  
OFFICE OF REGIONAL ENGINEER  
CINCINNATI, OHIO  
DRAWING NO. 2838 FILE K-19-12


VOGT, IVERS, SEAMAN & ASSOCIATES ENGINEERS ARCHITECTS CINCINNATI, OHIO						
<b>RAILROAD FORCE ACCOUNT WORK &amp; BORINGS</b>						
BRIDGE NO. BU-4-184 OVER B.&O.R.R. & DICKS CREEK						
BUTLER COUNTY SEC. BUT.-4 Scale: As shown				STA. 587+80.16 Sept. 1955		
DESIGNED	DRAWN	TRACED	CHECKED	REVIEWED	DATE	REVISED
R.G.H.	KL.	ALI.	W.J.I.	10-11-55		

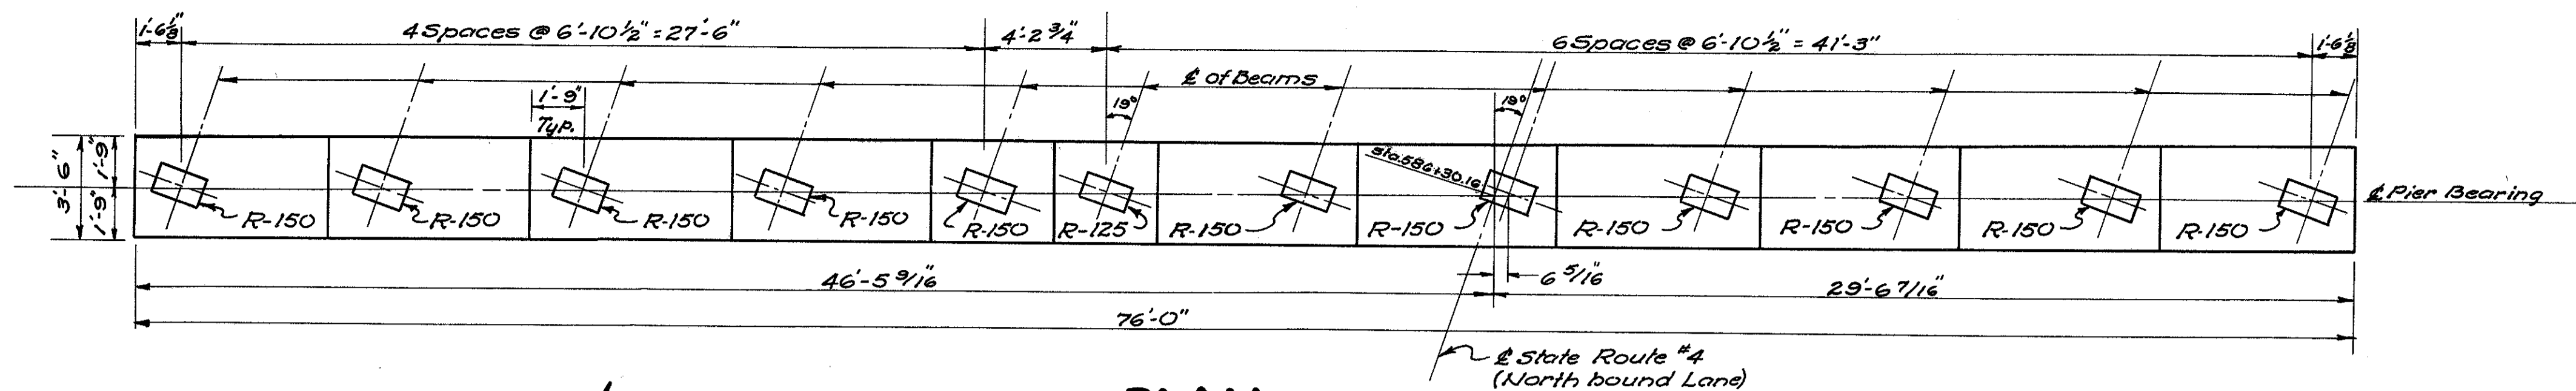


**PLAN**  
Scale: 1/4" = 1'-0"

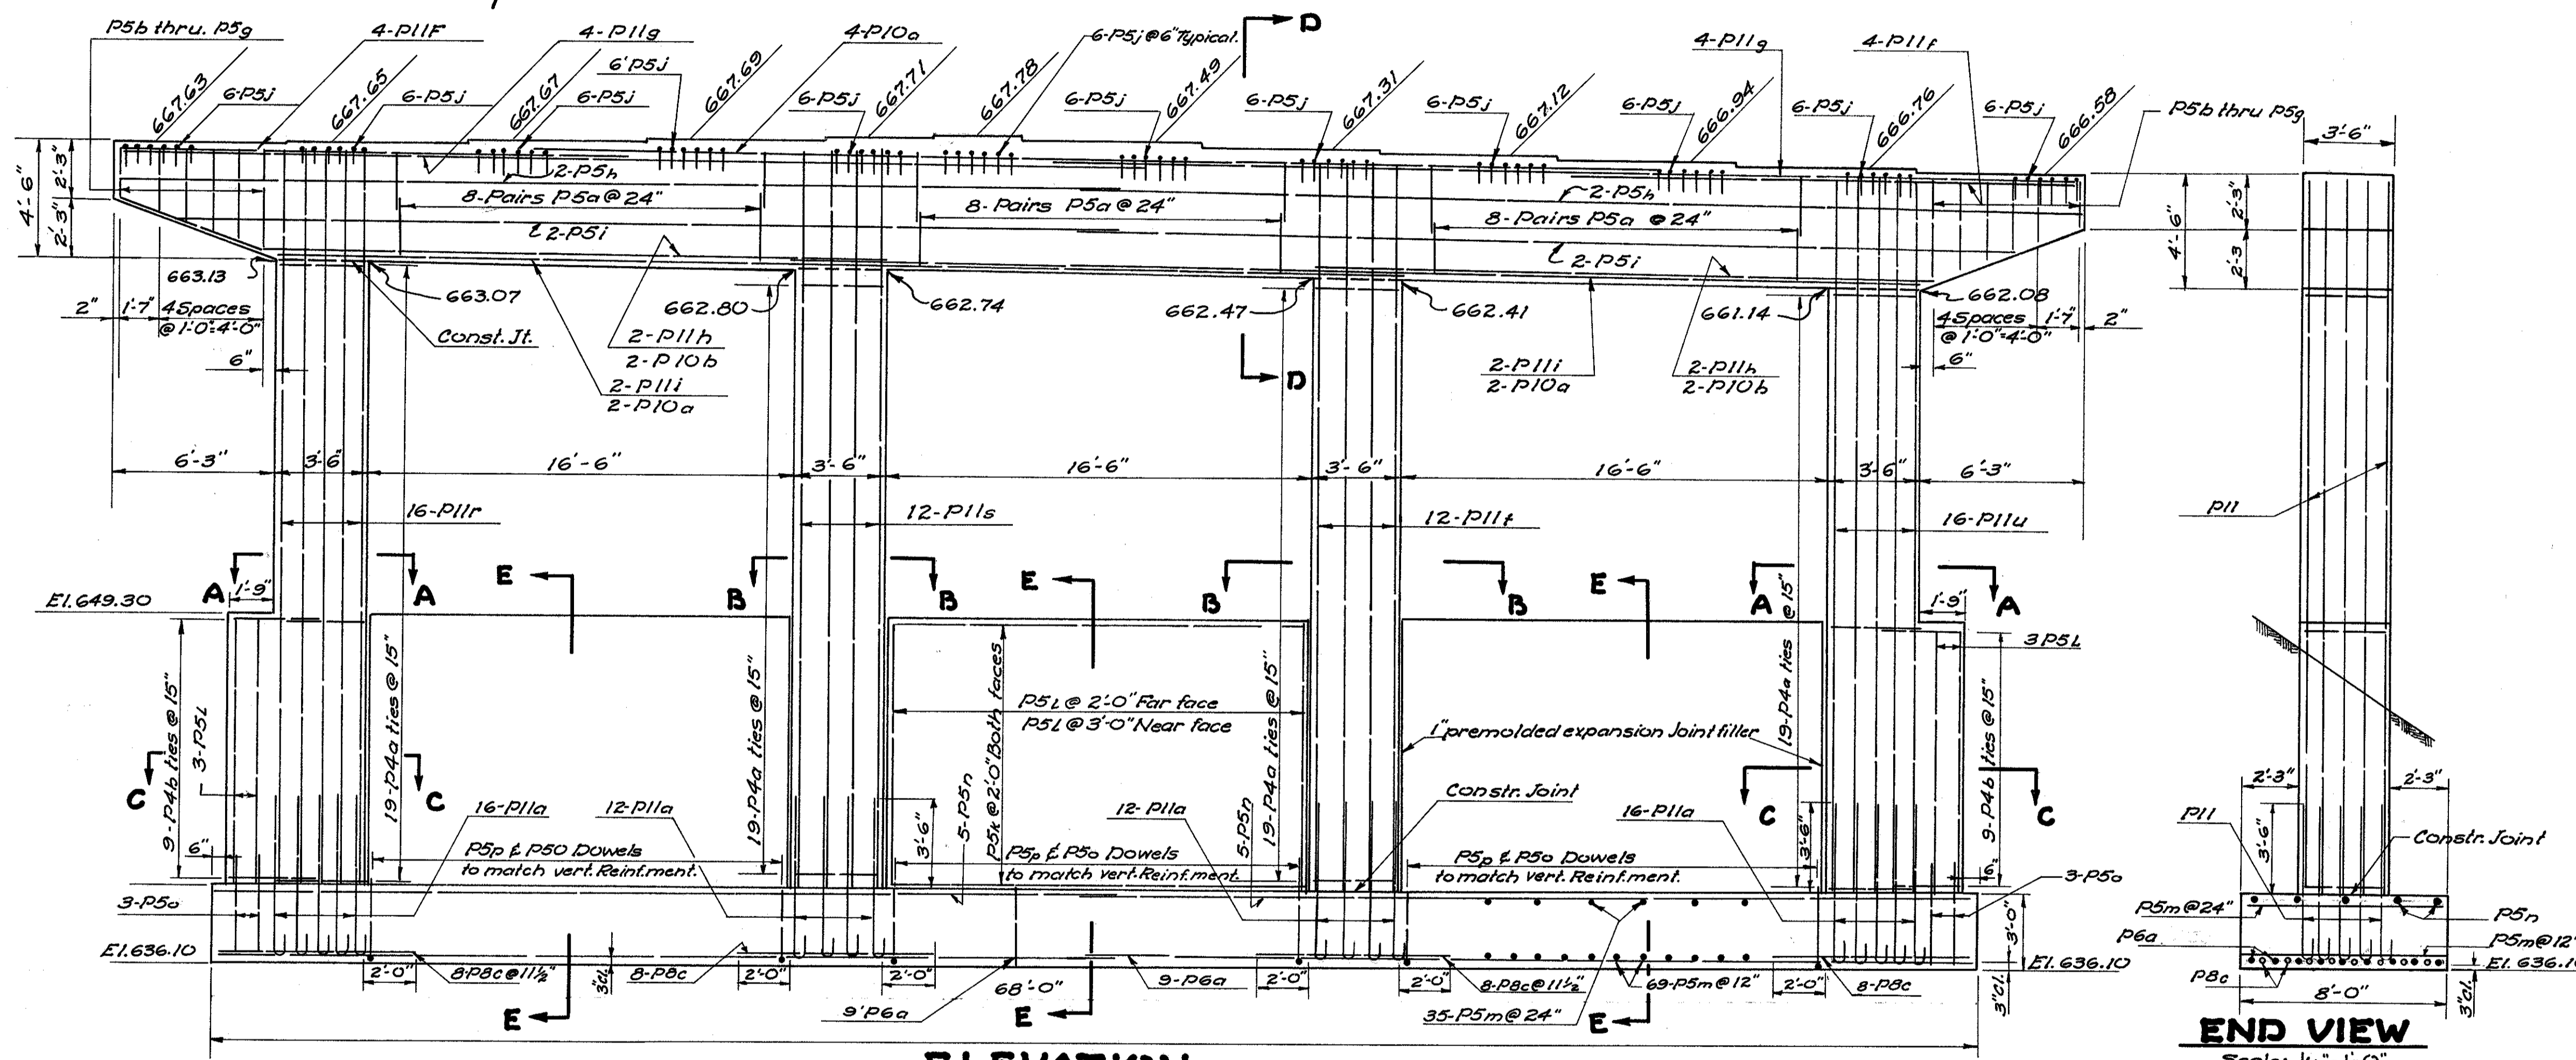


**ELEVATION**  
Scale: 1/4" = 1'-0"

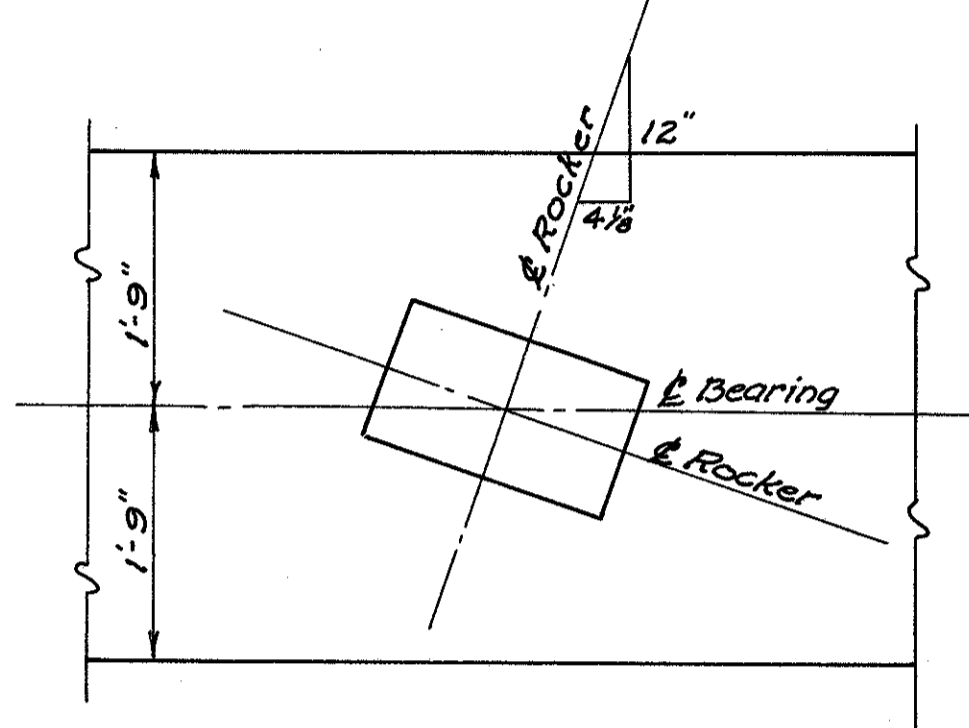


**ROCKER LAYOUT**  
Scale: 3/4" = 1'-0"

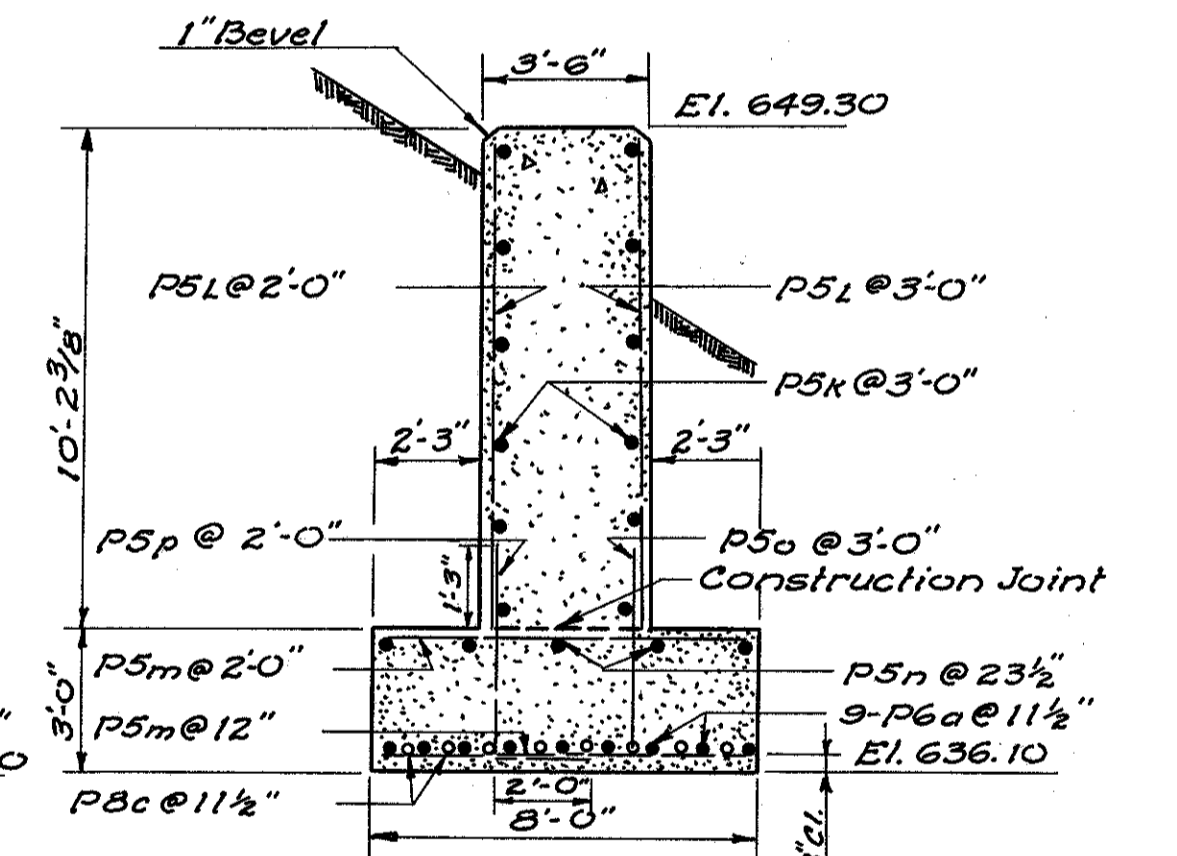


**SECTION E-E**  
Scale: 1/4" = 1'-0"

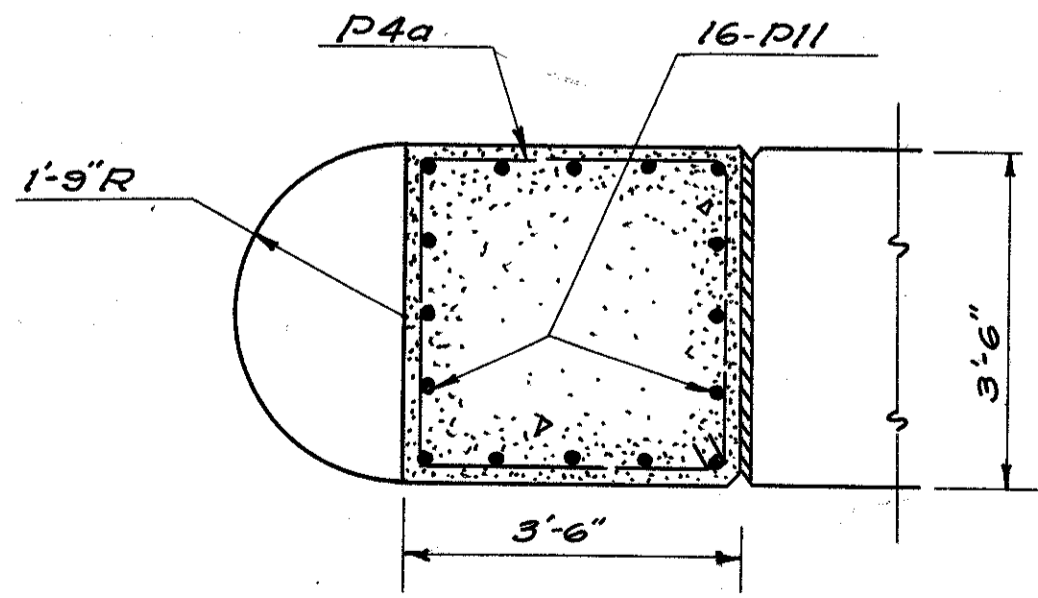


**SECTION A-A**  
Scale: 1/2" = 1'-0"

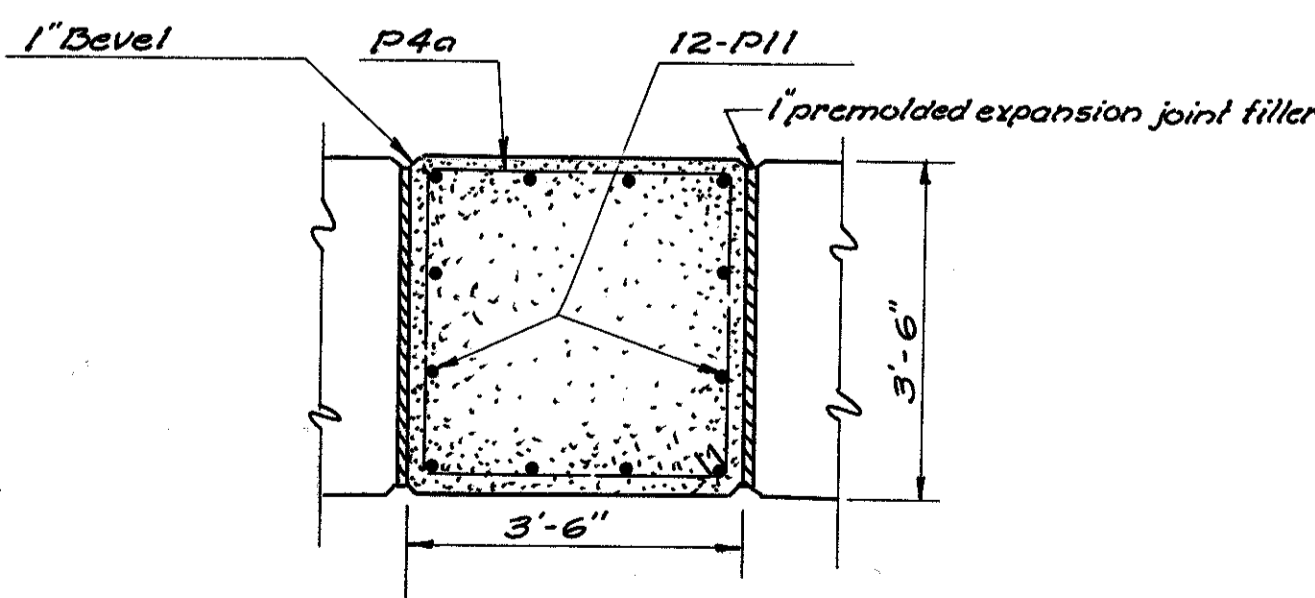

**SECTION B-B**  
Scale: 1/2" = 1'-0"

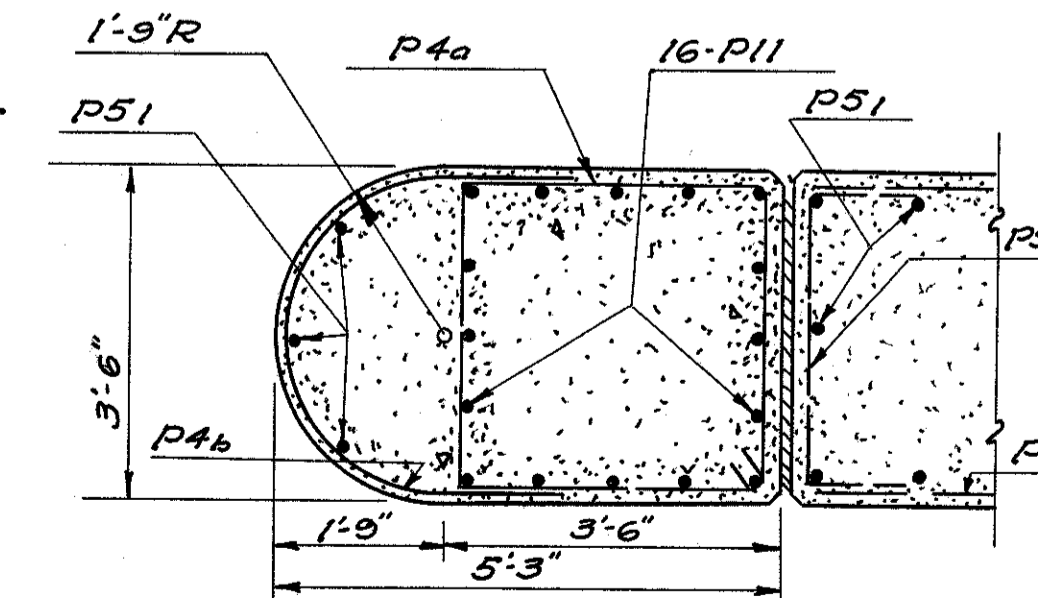

**SECTION C-C**  
Scale: 1/2" = 1'-0"

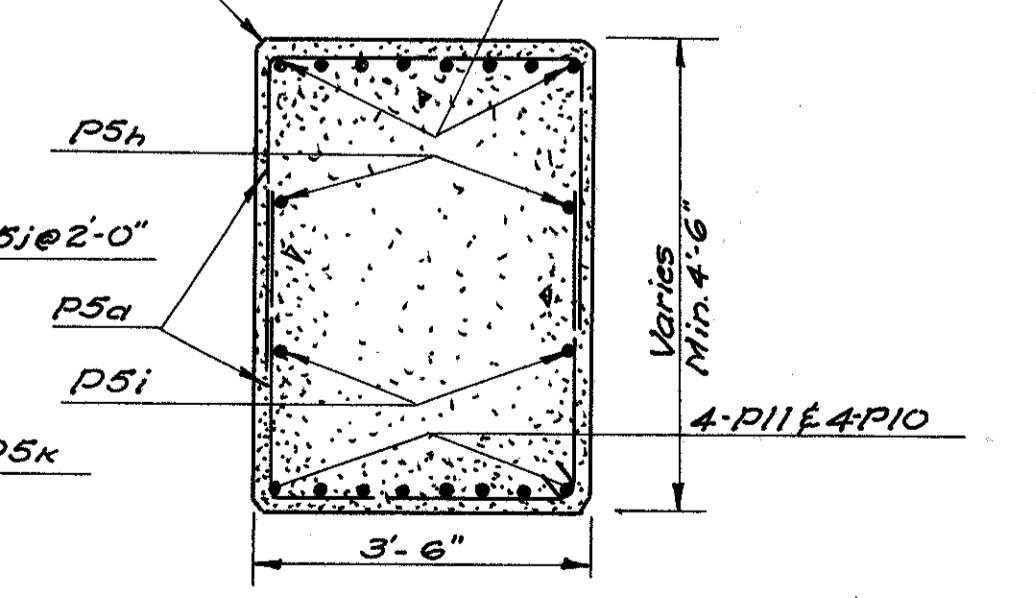

**SECTION D-D**  
Scale: 1/2" = 1'-0"

**END VIEW**  
Scale: 1/4" = 1'-0"

- NOTES:**
1. Place dowels in footings to insure correct placing of main column steel.
  2. All main reinforcing steel to have 2" cover unless otherwise noted.
  3. Pier footing to be class 'E' concrete. Pier Cap & Columns to be class 'C' concrete.

VOGT, IVERS, SEAMAN & ASSOCIATES  
ENGINEERS ARCHITECTS  
CINCINNATI, OHIO


**PIER NO. 1**  
BRIDGE NO. BU.-4-184  
OVER B&O.R.R. & DICKS CREEK

BUTLER COUNTY  
SEC. BUT.-4  
Scale: As shown

STA. 587+80.10  
SEPTEMBER, 1955


DESIGNED	DRAWN	TRACED	CHECKED	REVIEWED	DATE	REVISED
V.D.	ALI	KL.	O.L.A.	W.J.I.	10-11-55	

BUT-4-(16.53-19.15)

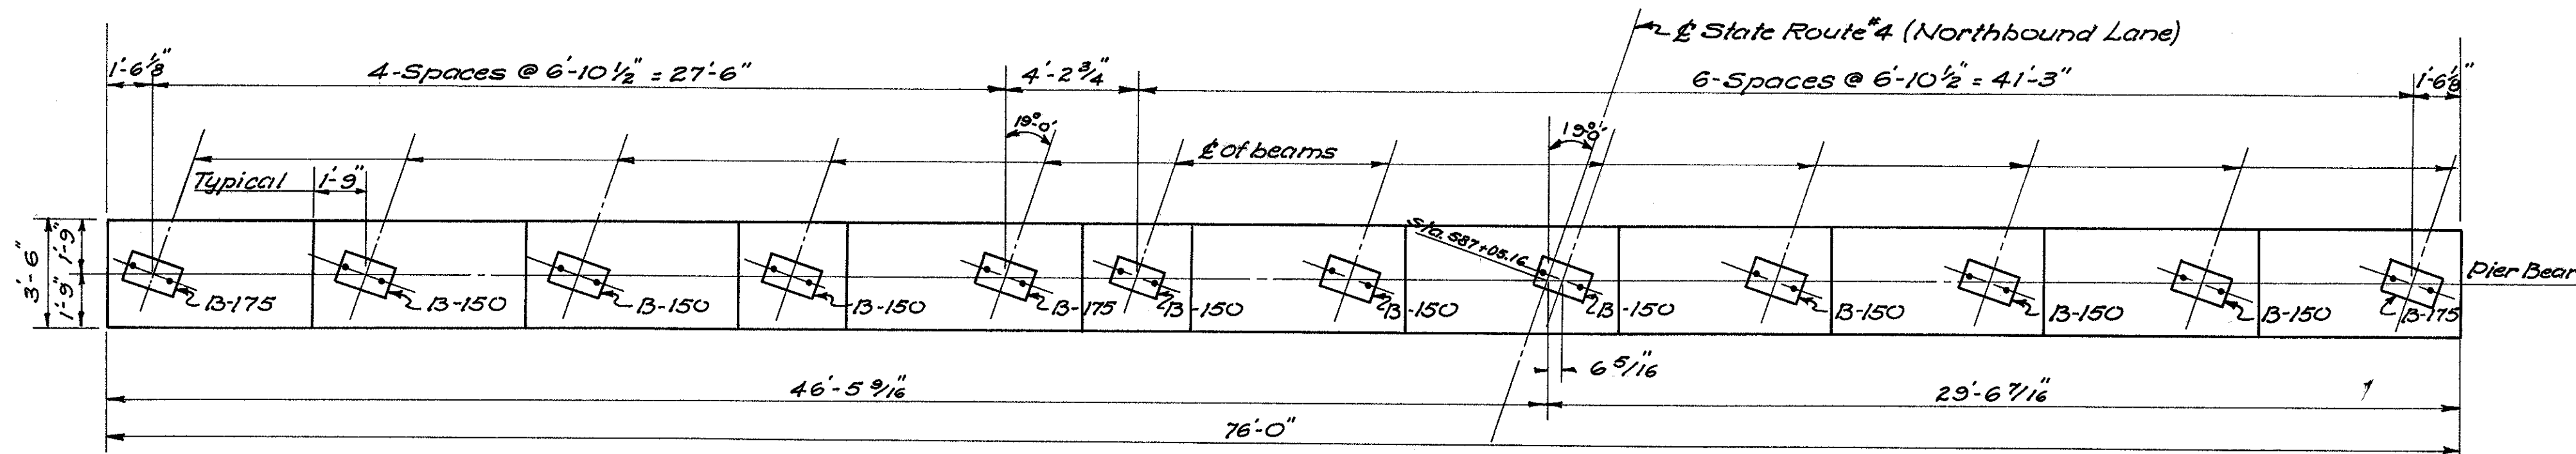


**PLAN**  
Scale: 1/4" = 1'-0"


BOLSTER	A	B	C
B-150	8 1/2"	8 1/2"	2 3/4"
B-175	9"	8 1/2"	2 13/16"

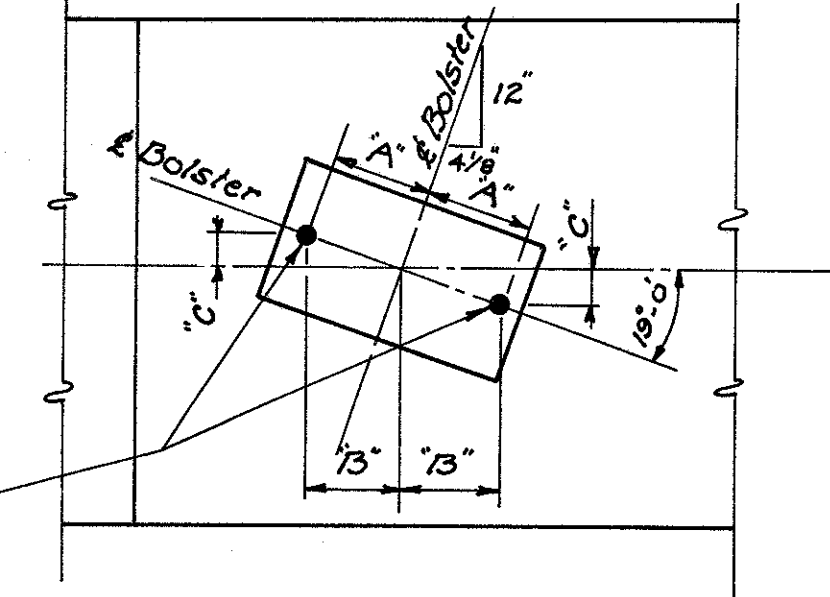


**BOLSTER LAYOUT**  
Scale: 3/4" = 1'-0"

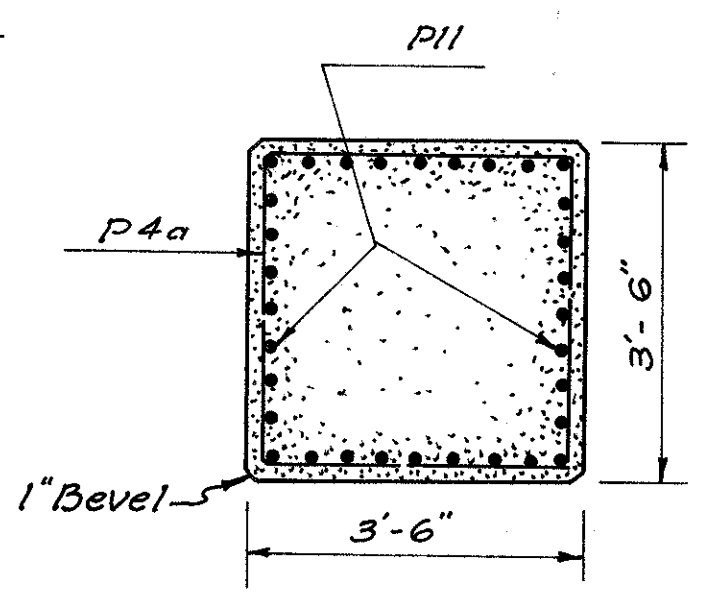


**SECTION A-A**  
Scale: 1/2" = 1'-0"

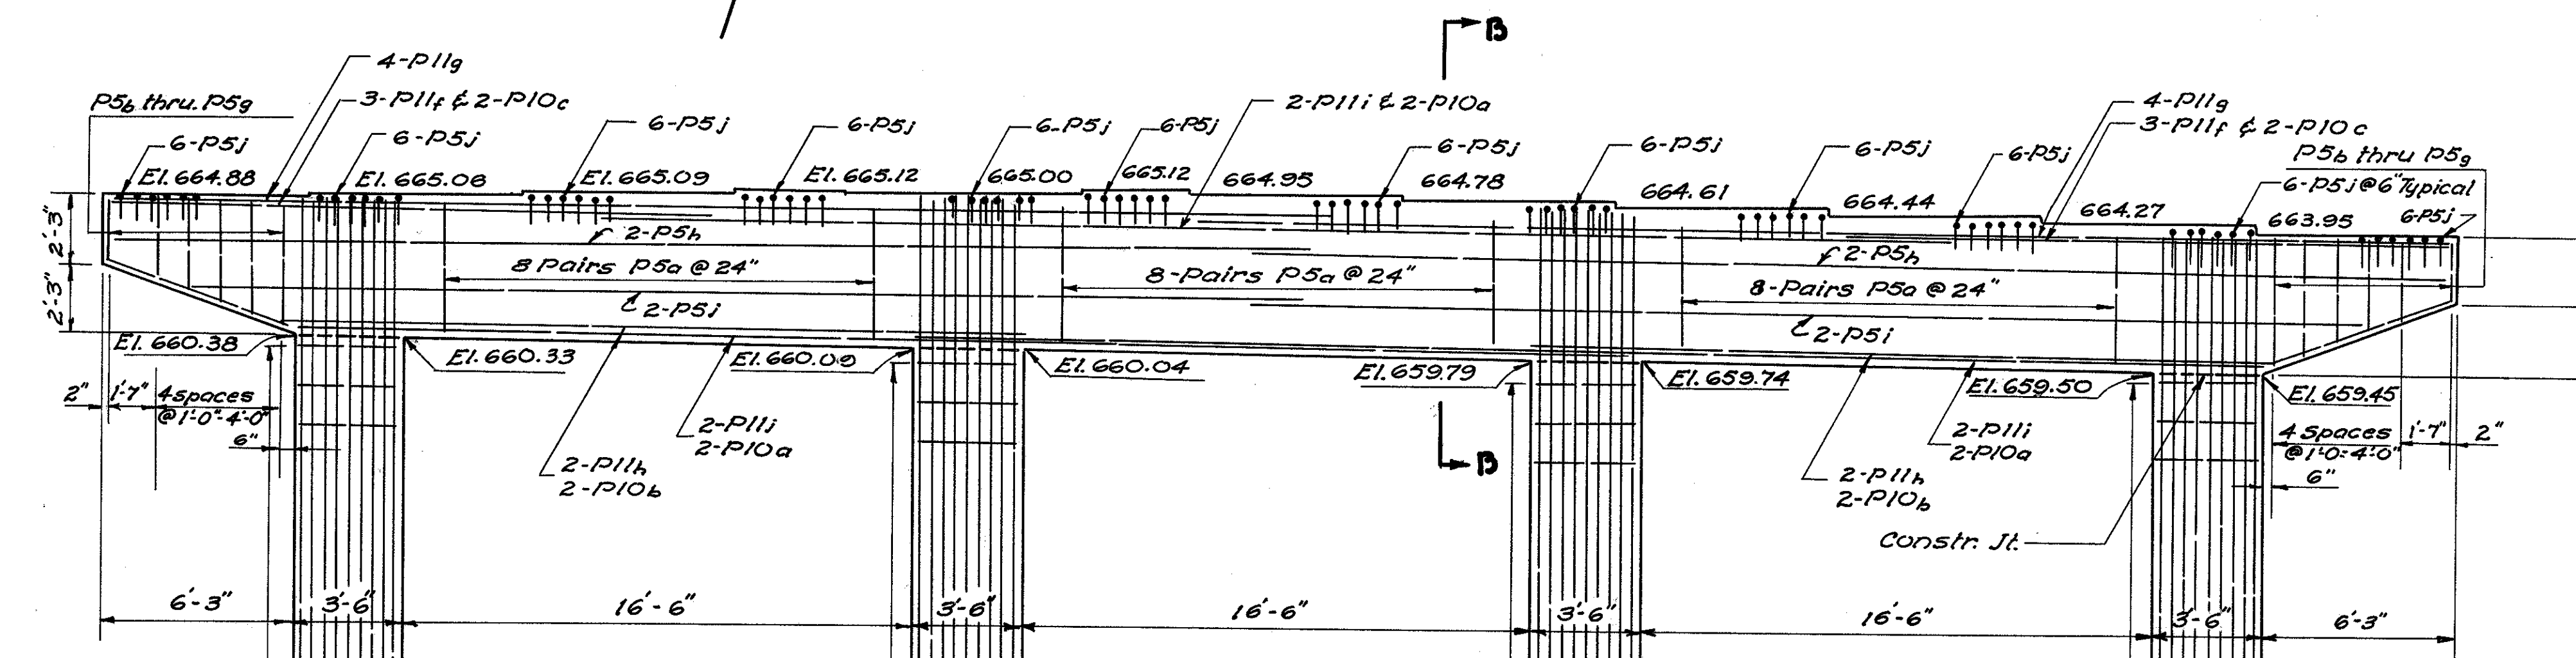


**ELEVATION**  
Scale: 1/4" = 1'-0"

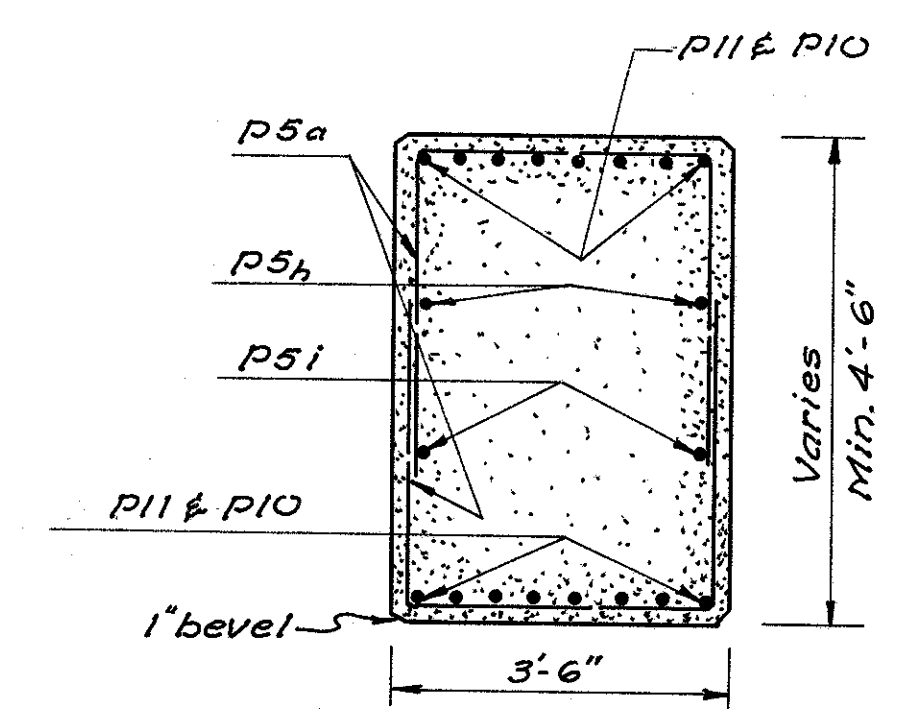

**SECTION B-B**  
Scale: 1/2" = 1'-0"

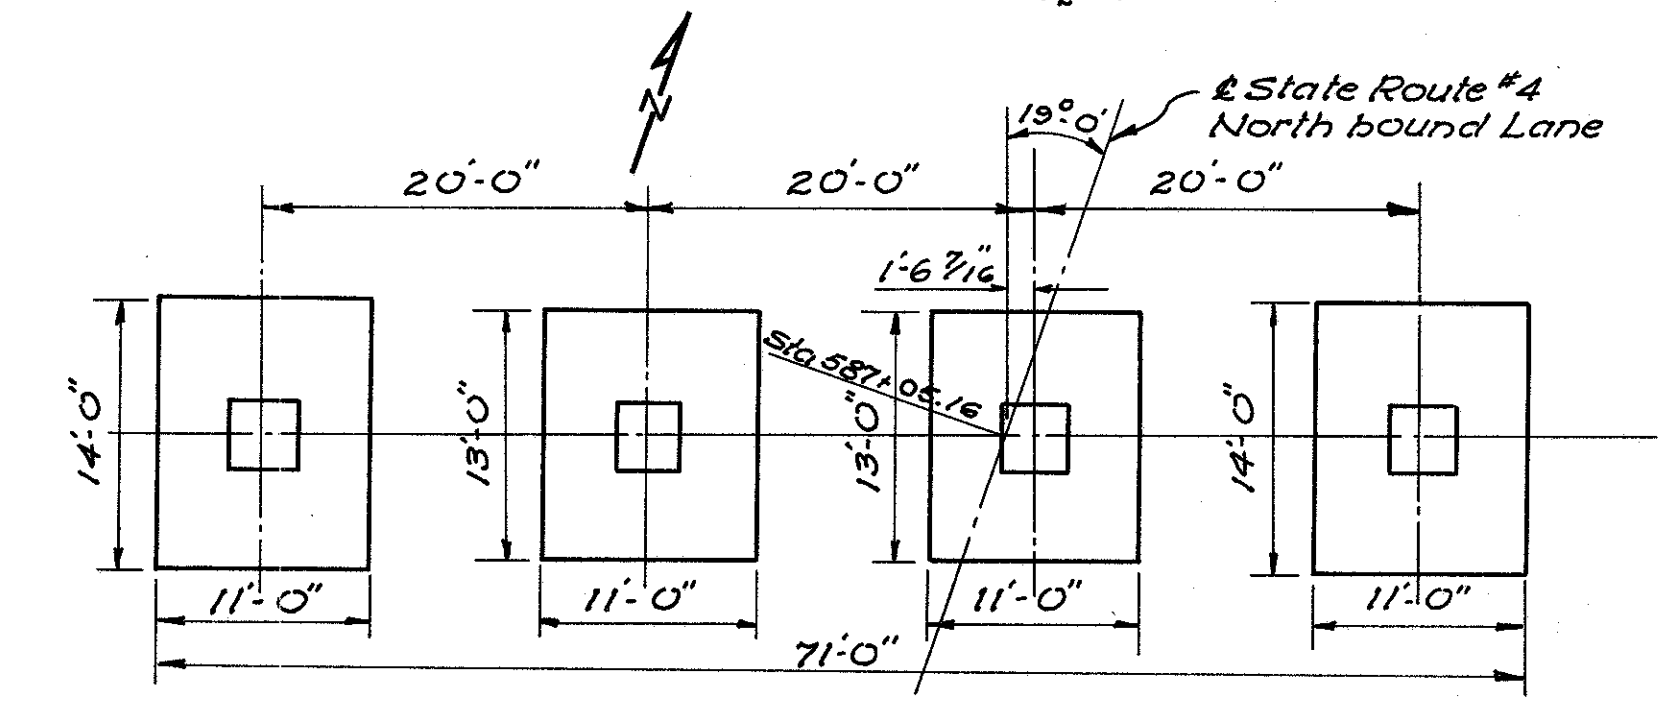

**FOOTING PLAN**  
Scale: 1" = 10'

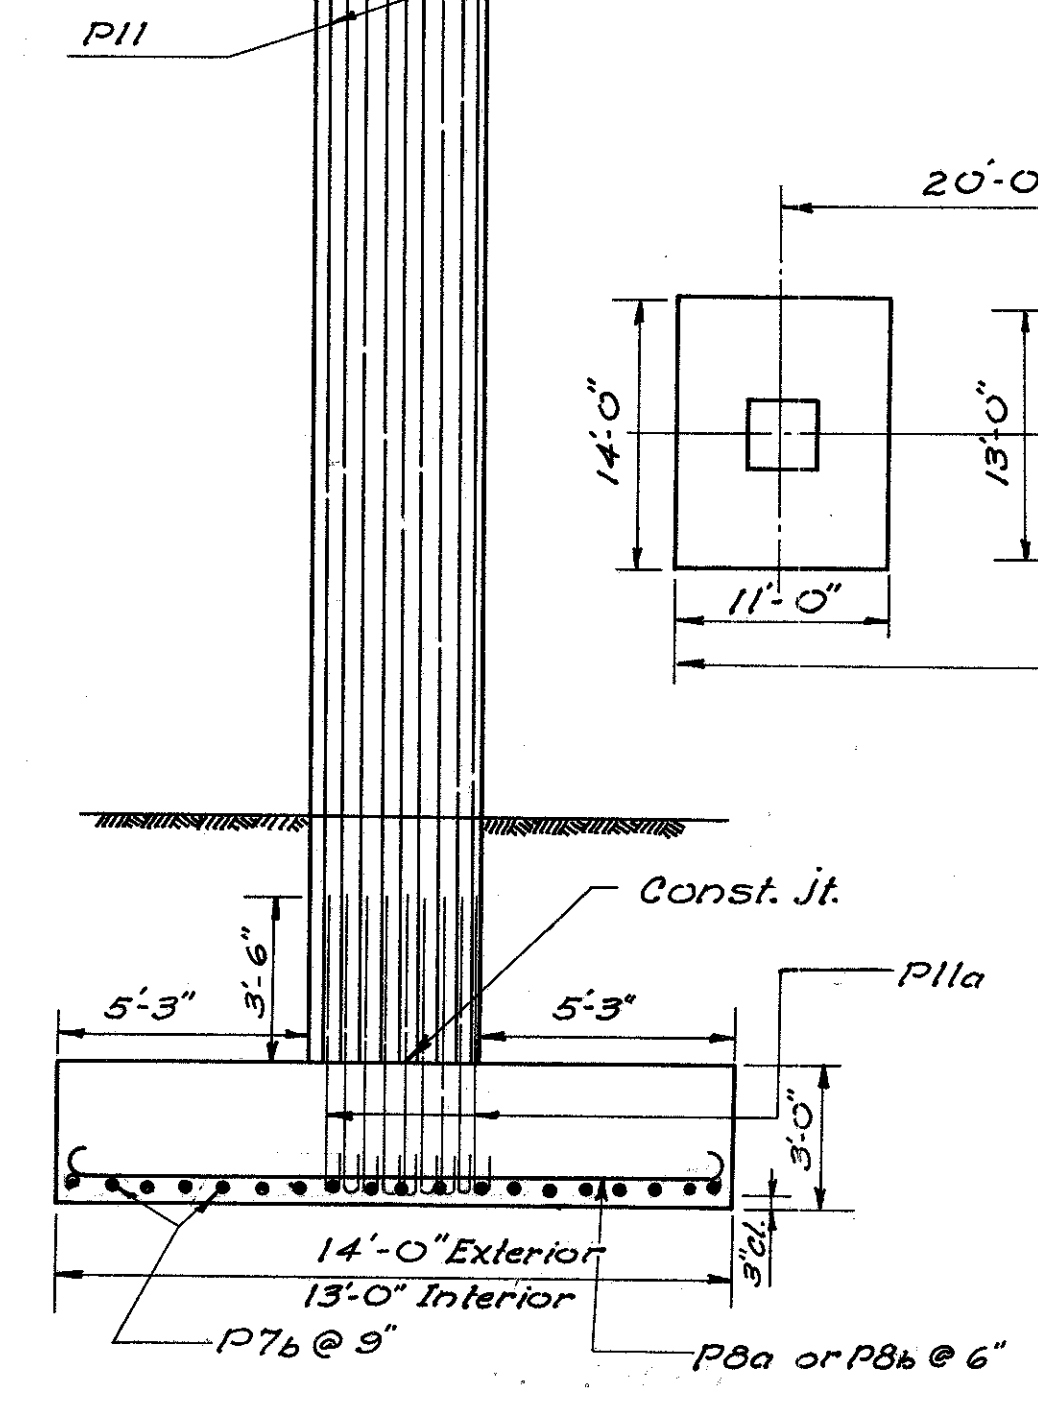

**END VIEW**  
Scale: 1/4" = 1'-0"

- NOTES:
- 1- Place pier cap reinforcement to clear anchor bars
  - 2- Place dowels in footings to insure correct placing of main column steel.
  - 3- All main reinforcing steel to have 2" cover unless otherwise noted.





VOGT, IVERS, SEAMAN & ASSOCIATES  
ENGINEERS ARCHITECTS  
CINCINNATI, OHIO

**PIER NO. 2**  
BRIDGE NO. BU-4-184  
OVER B.&O. R.R. & DICKS CREEK


BUTLER COUNTY  
SEC. BUT-4  
Scale: As shown  
STA. 587+80.16  
SEPTEMBER, 1958

DESIGNED	DRAWN	TRACED	CHECKED	REVIEWED	DATE	REVISED
D.G.E.	B.G.E.	KL	Q.L.A.	W.J.I.	10-11-55	



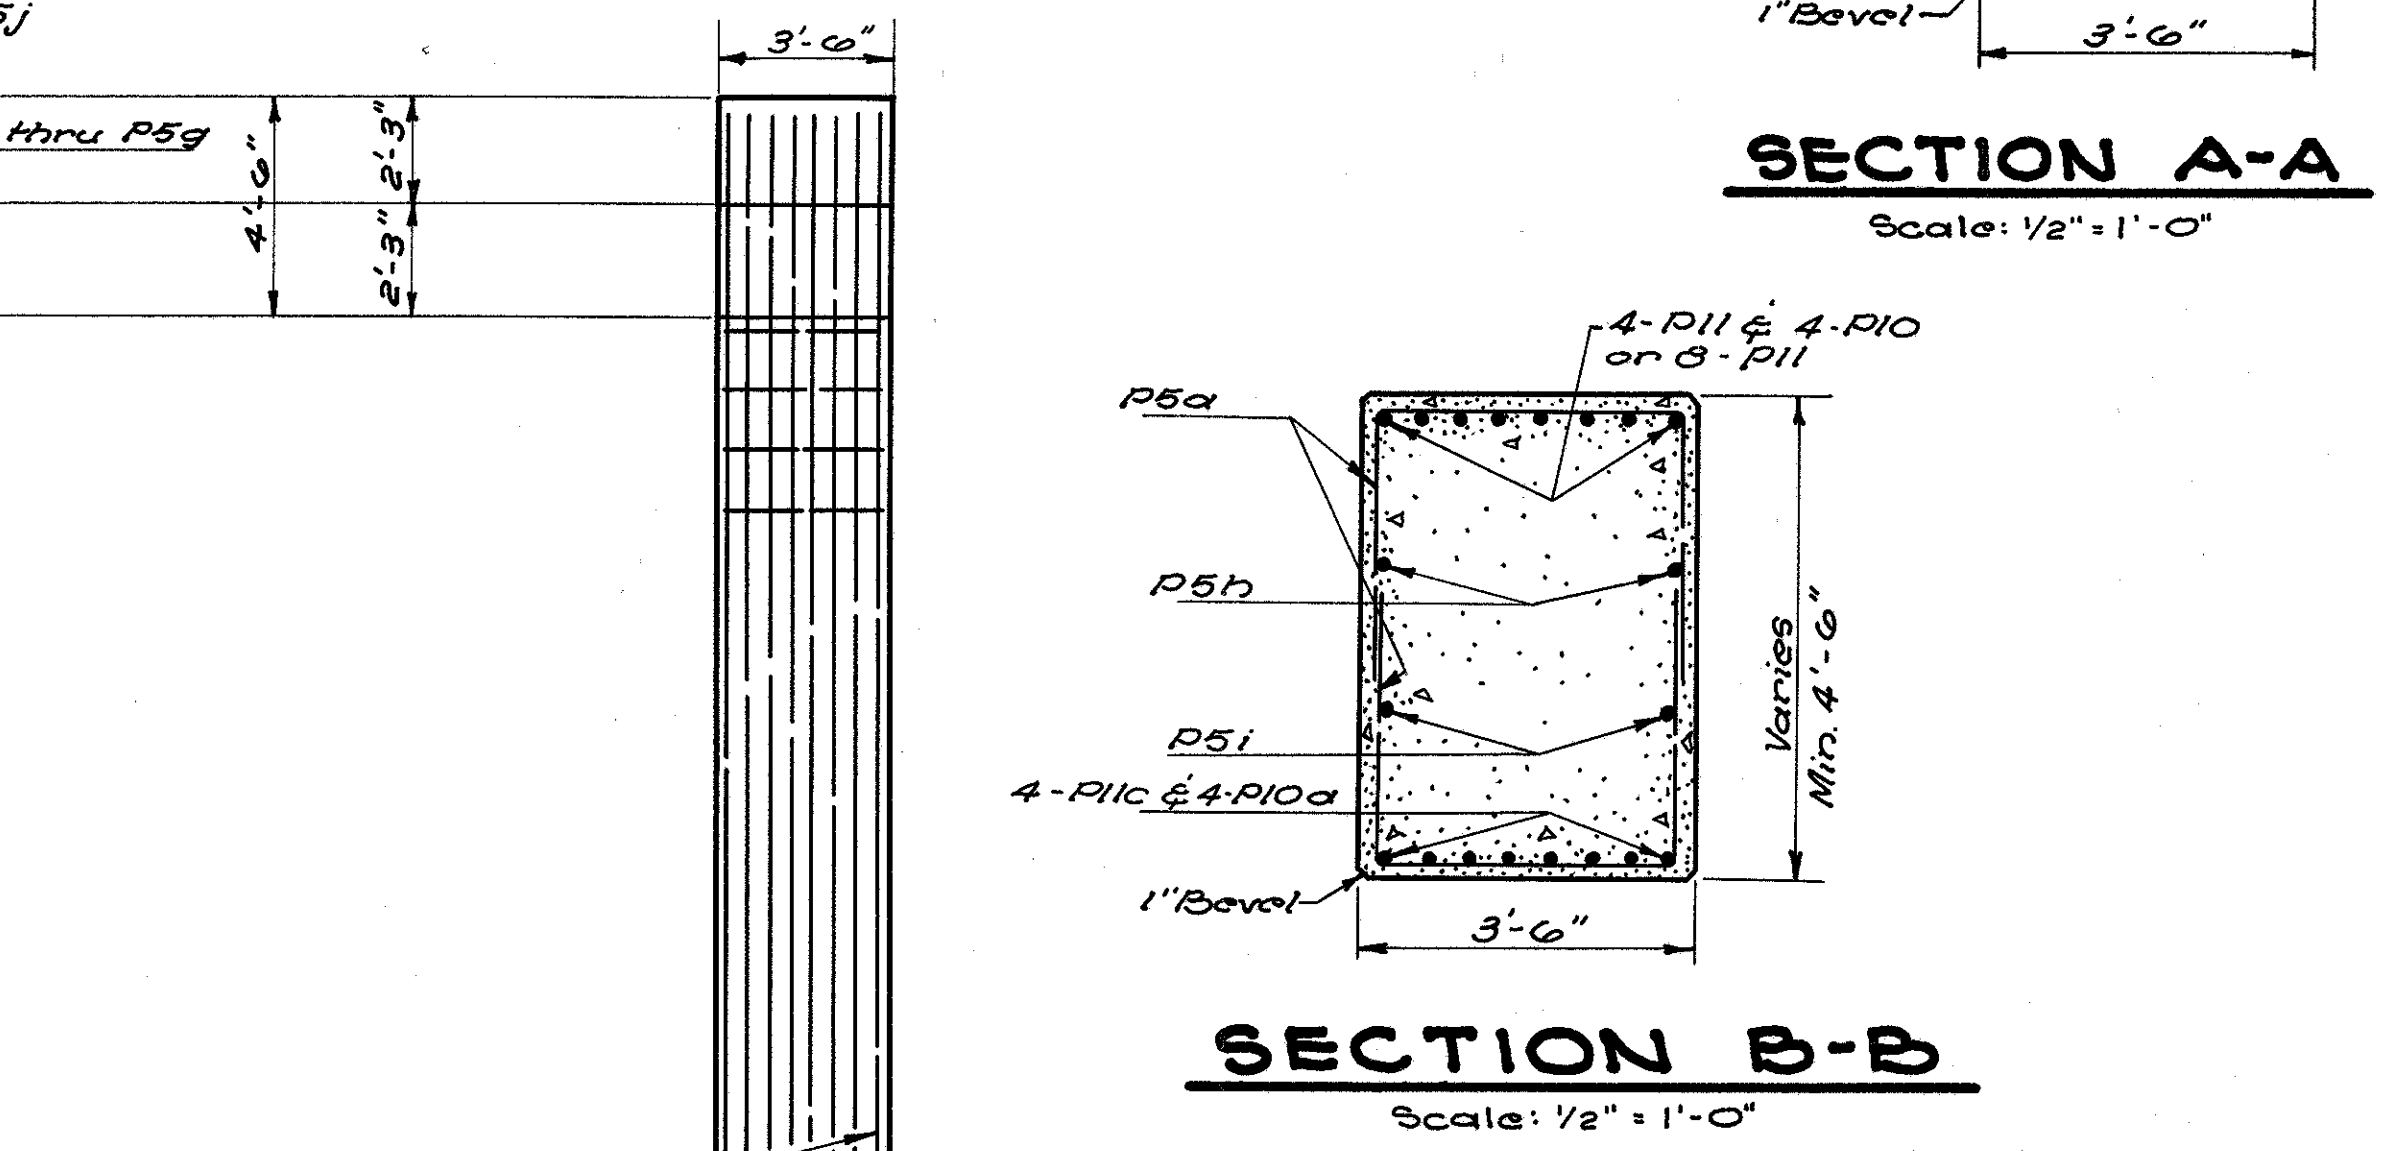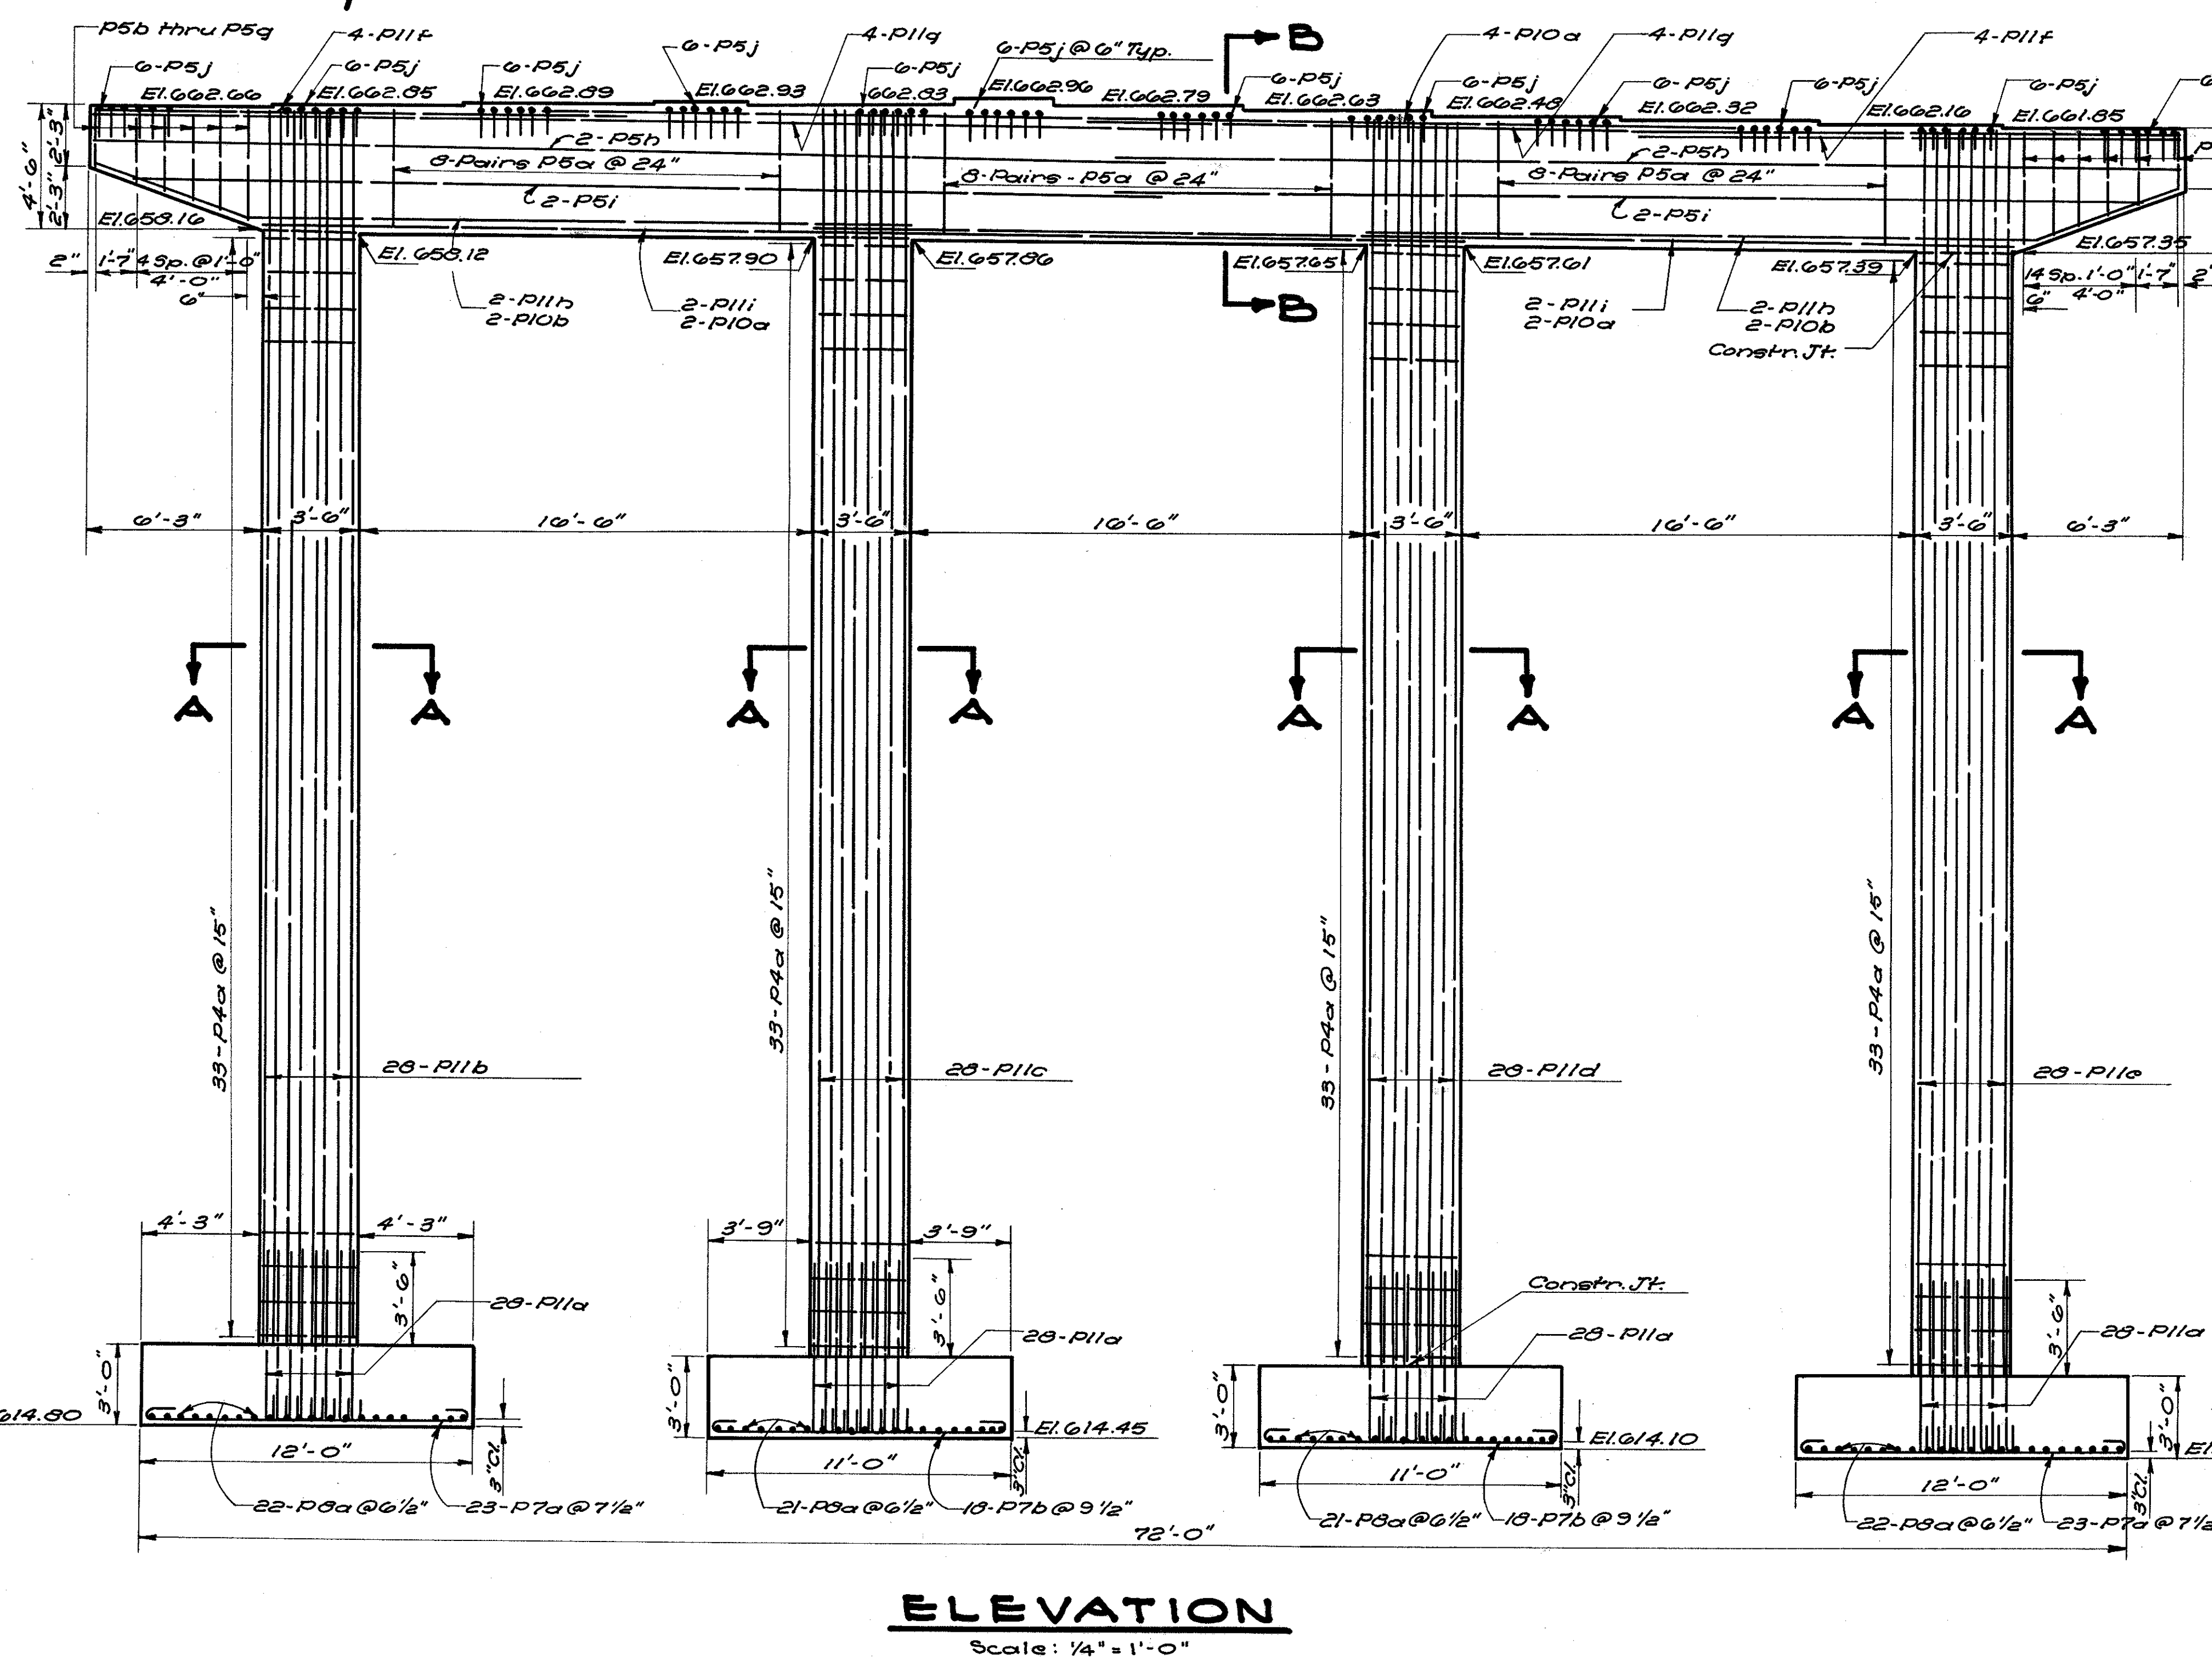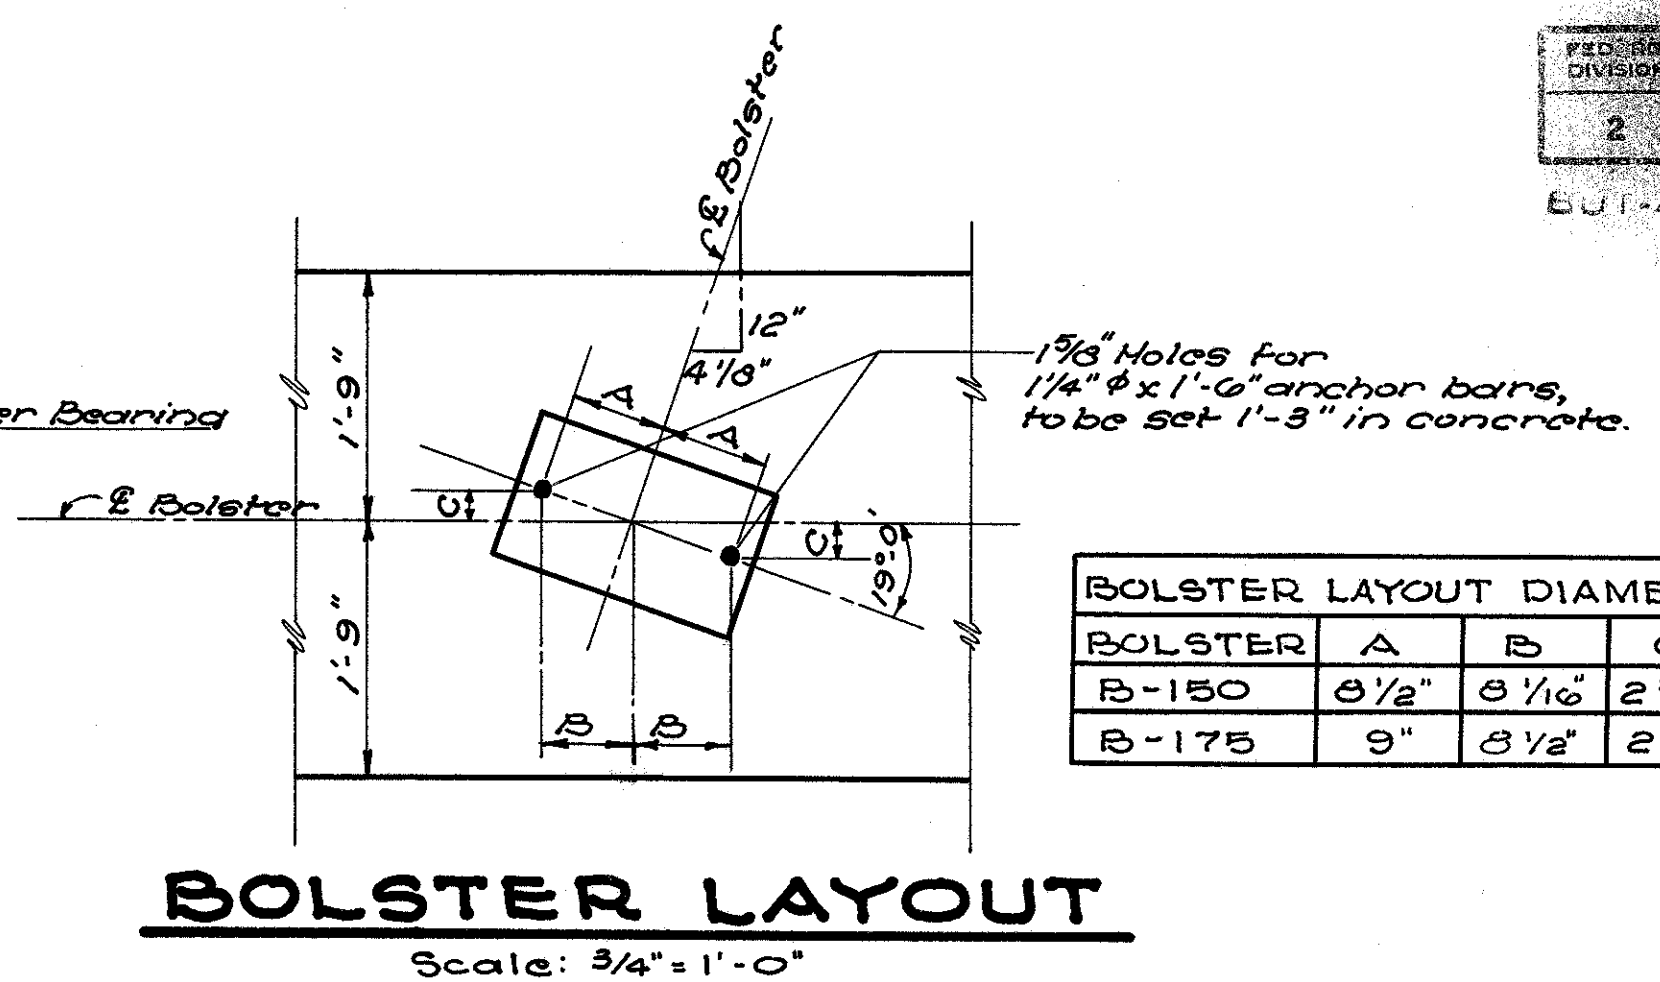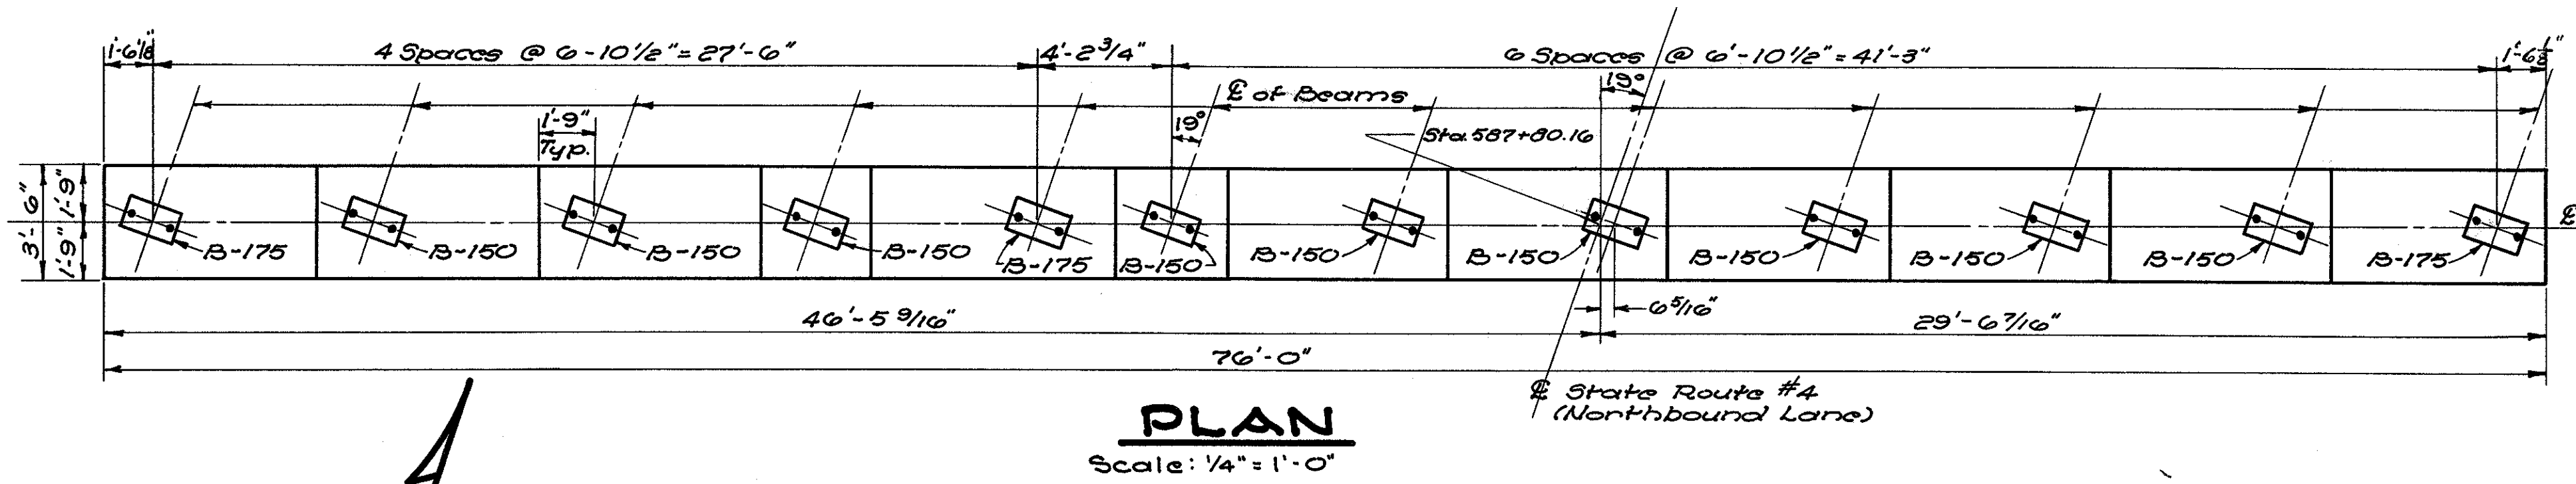







- NOTES:**
- Place pier cap reinforcement to clear anchor bolts.
  - Place dowels in Footings to insure correct placing of main column steel.
  - All main reinforcing steel to have 2" cover unless otherwise noted.

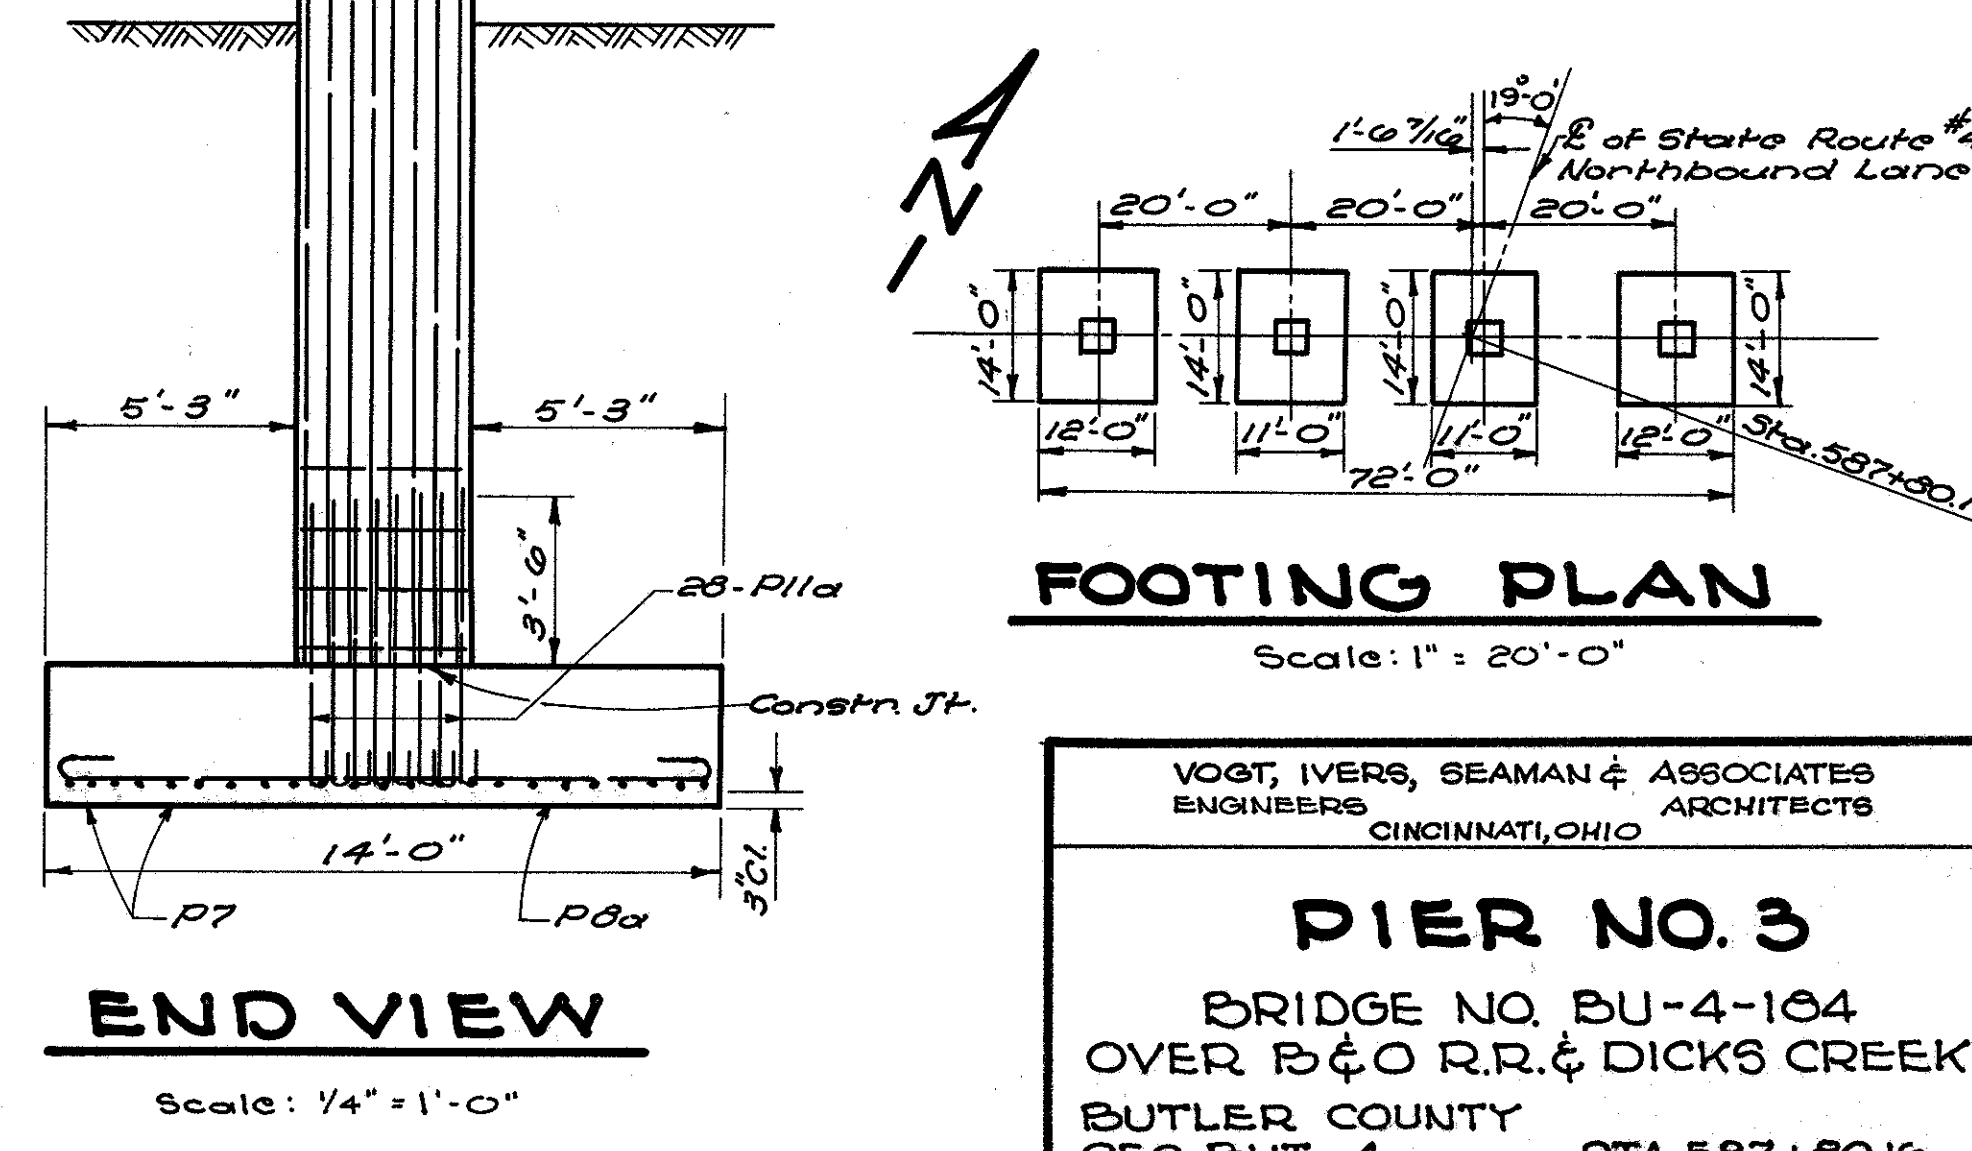

VOGT, IVERS, SEAMAN & ASSOCIATES  
ENGINEERS ARCHITECTS  
CINCINNATI, OHIO

**PIER NO. 3**  
BRIDGE NO. BU-4-104  
OVER B & O R.R. & DICKS CREEK  
BUTLER COUNTY  
SEC. BUT.-4 STA. 587+80.16  
Scale: As shown Sept. 1955

DESIGNED	DRAWN	TRACED	CHECKED	REVIEWED	DATE	REVISED
O.L.A.	ALI	N.B.	O.L.A.	W.J.I.	10-11-55	

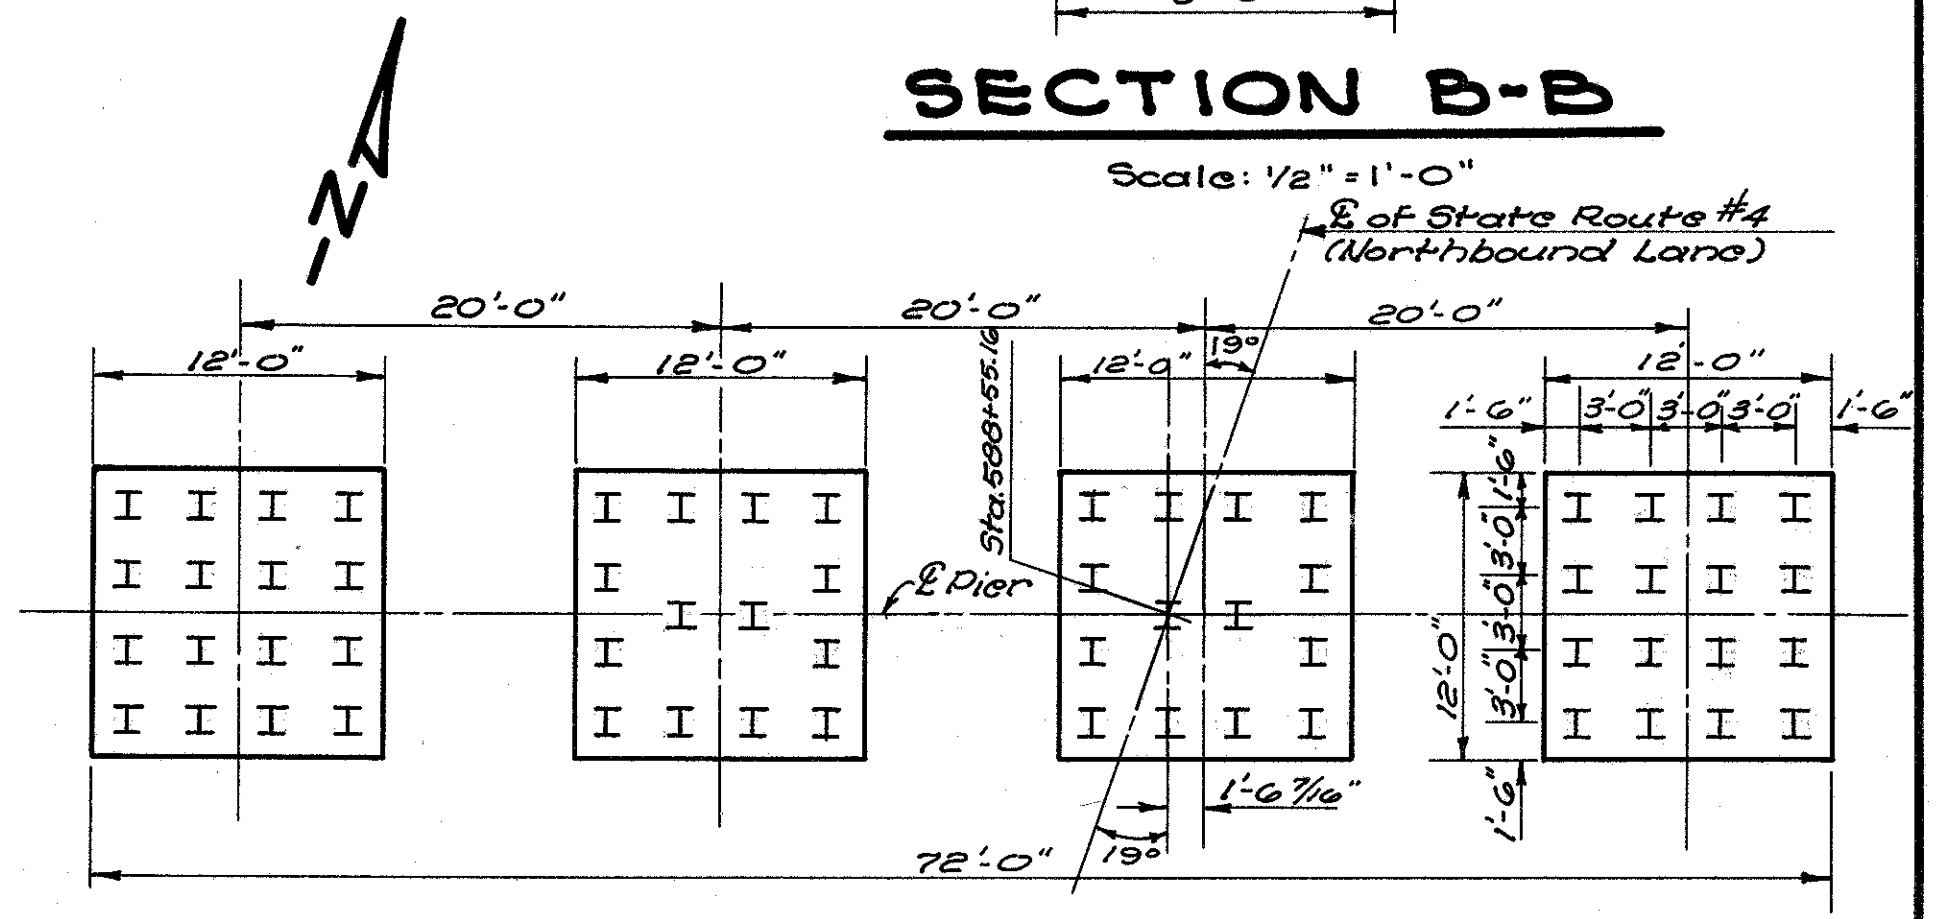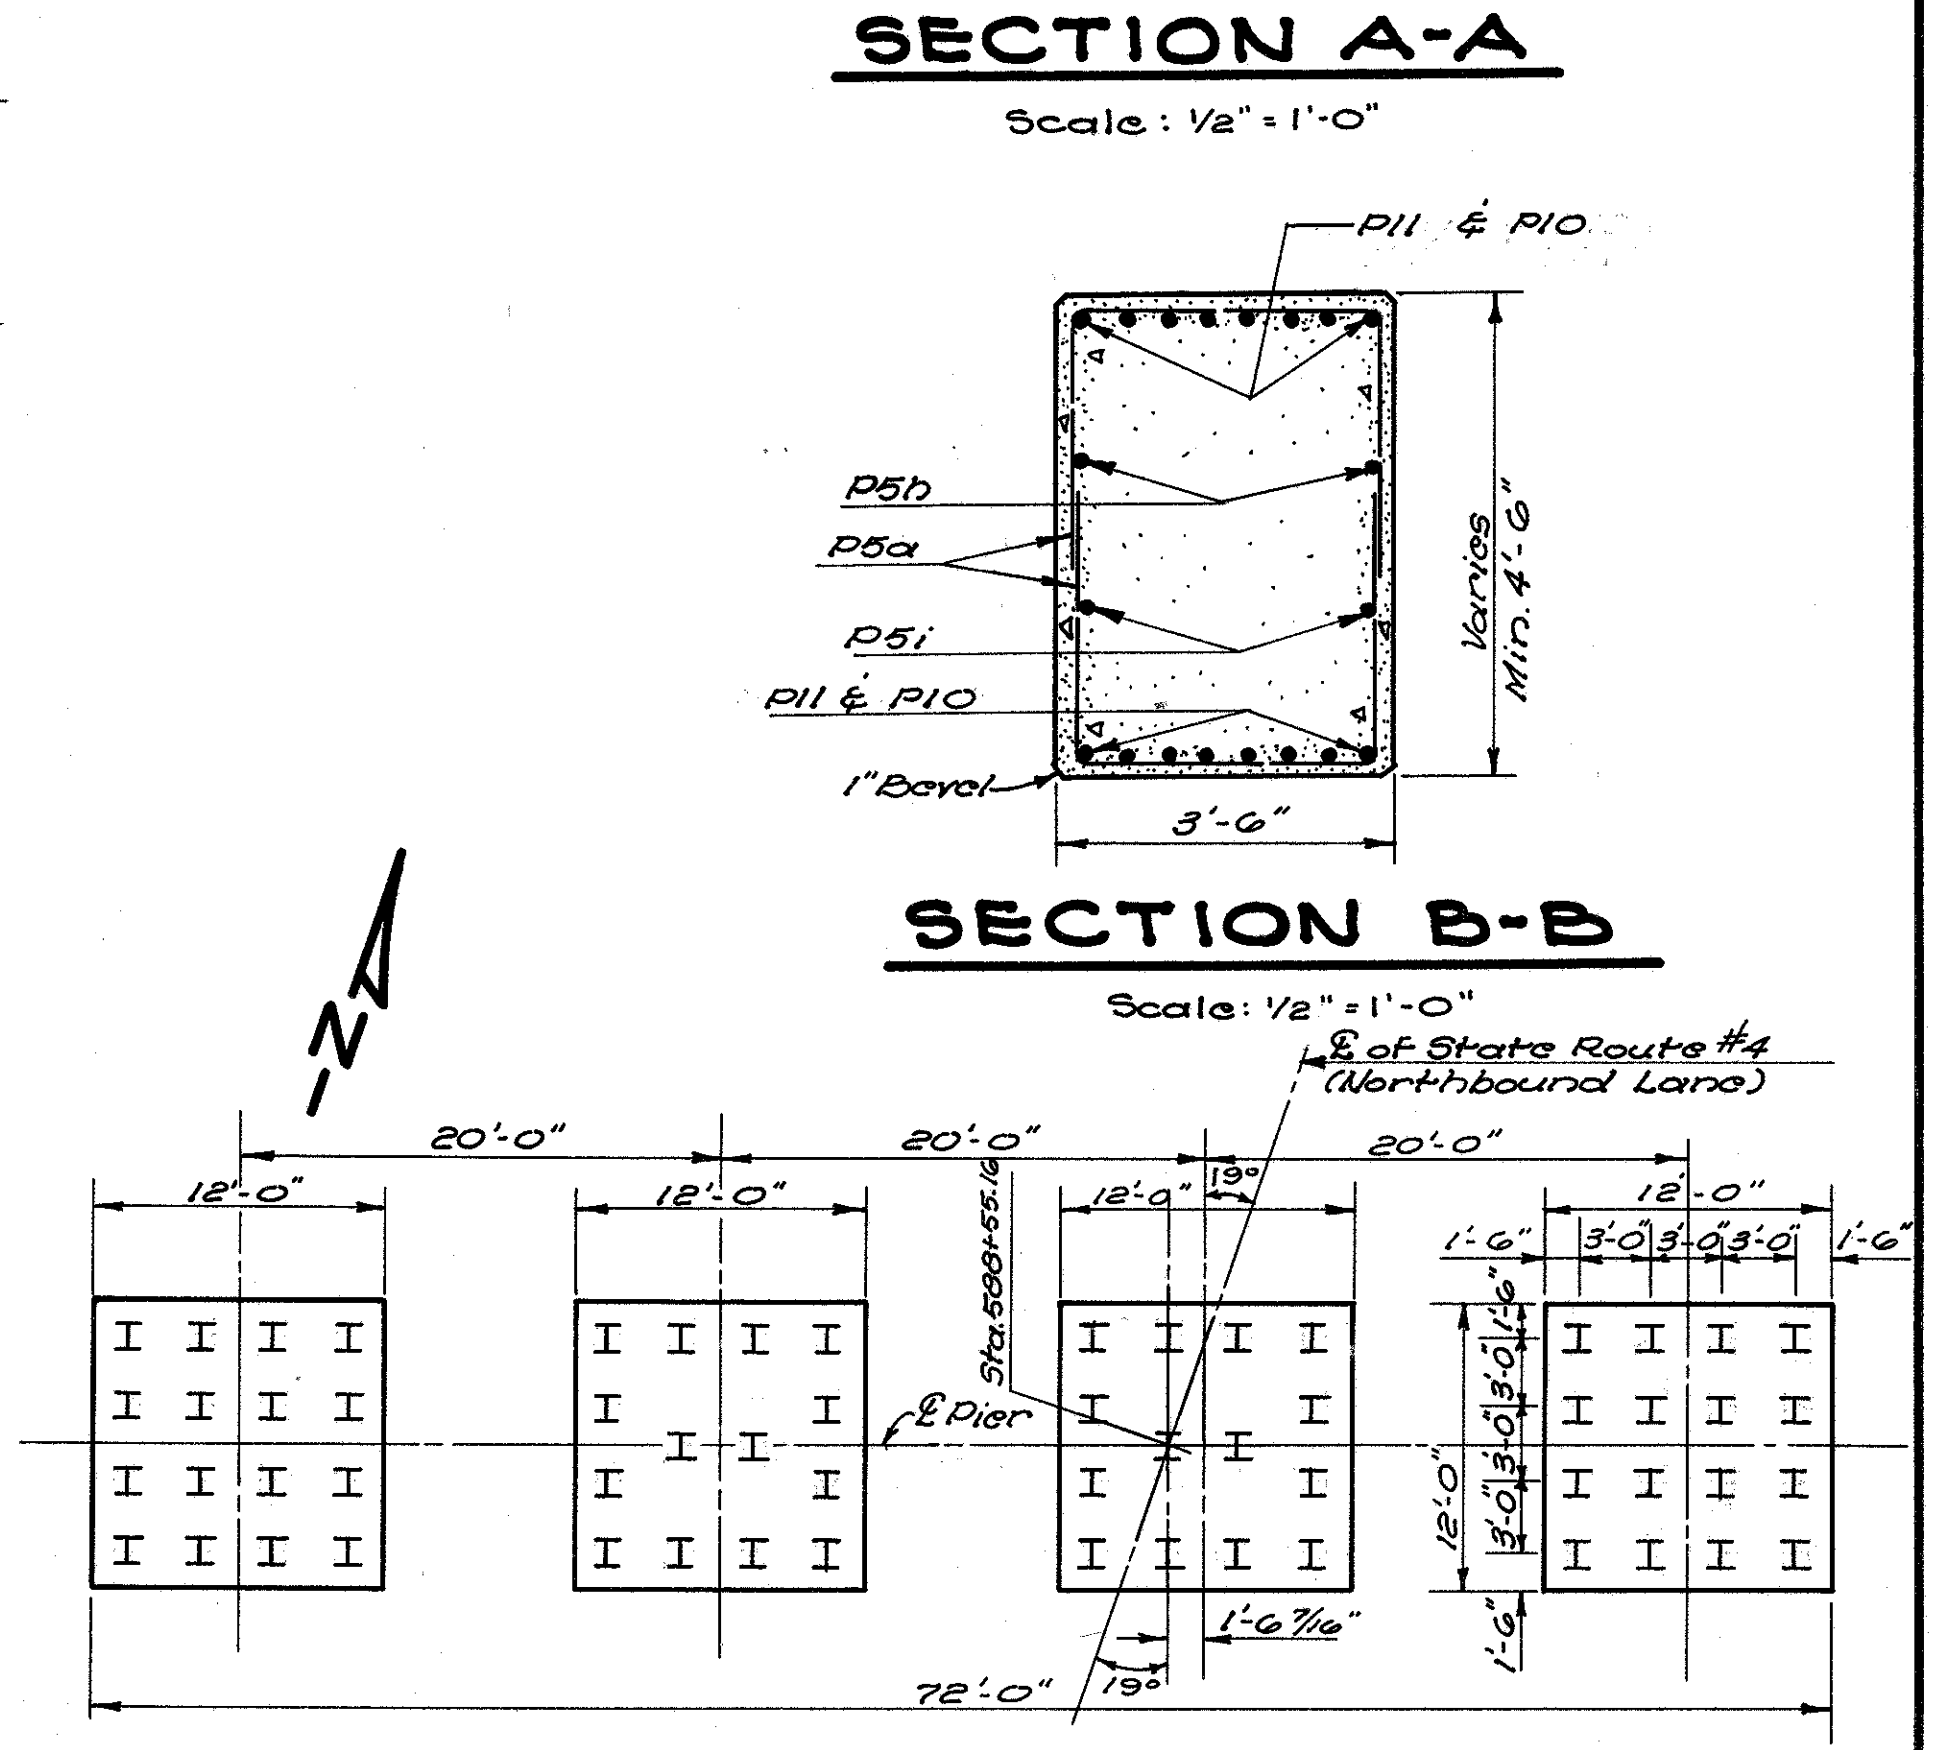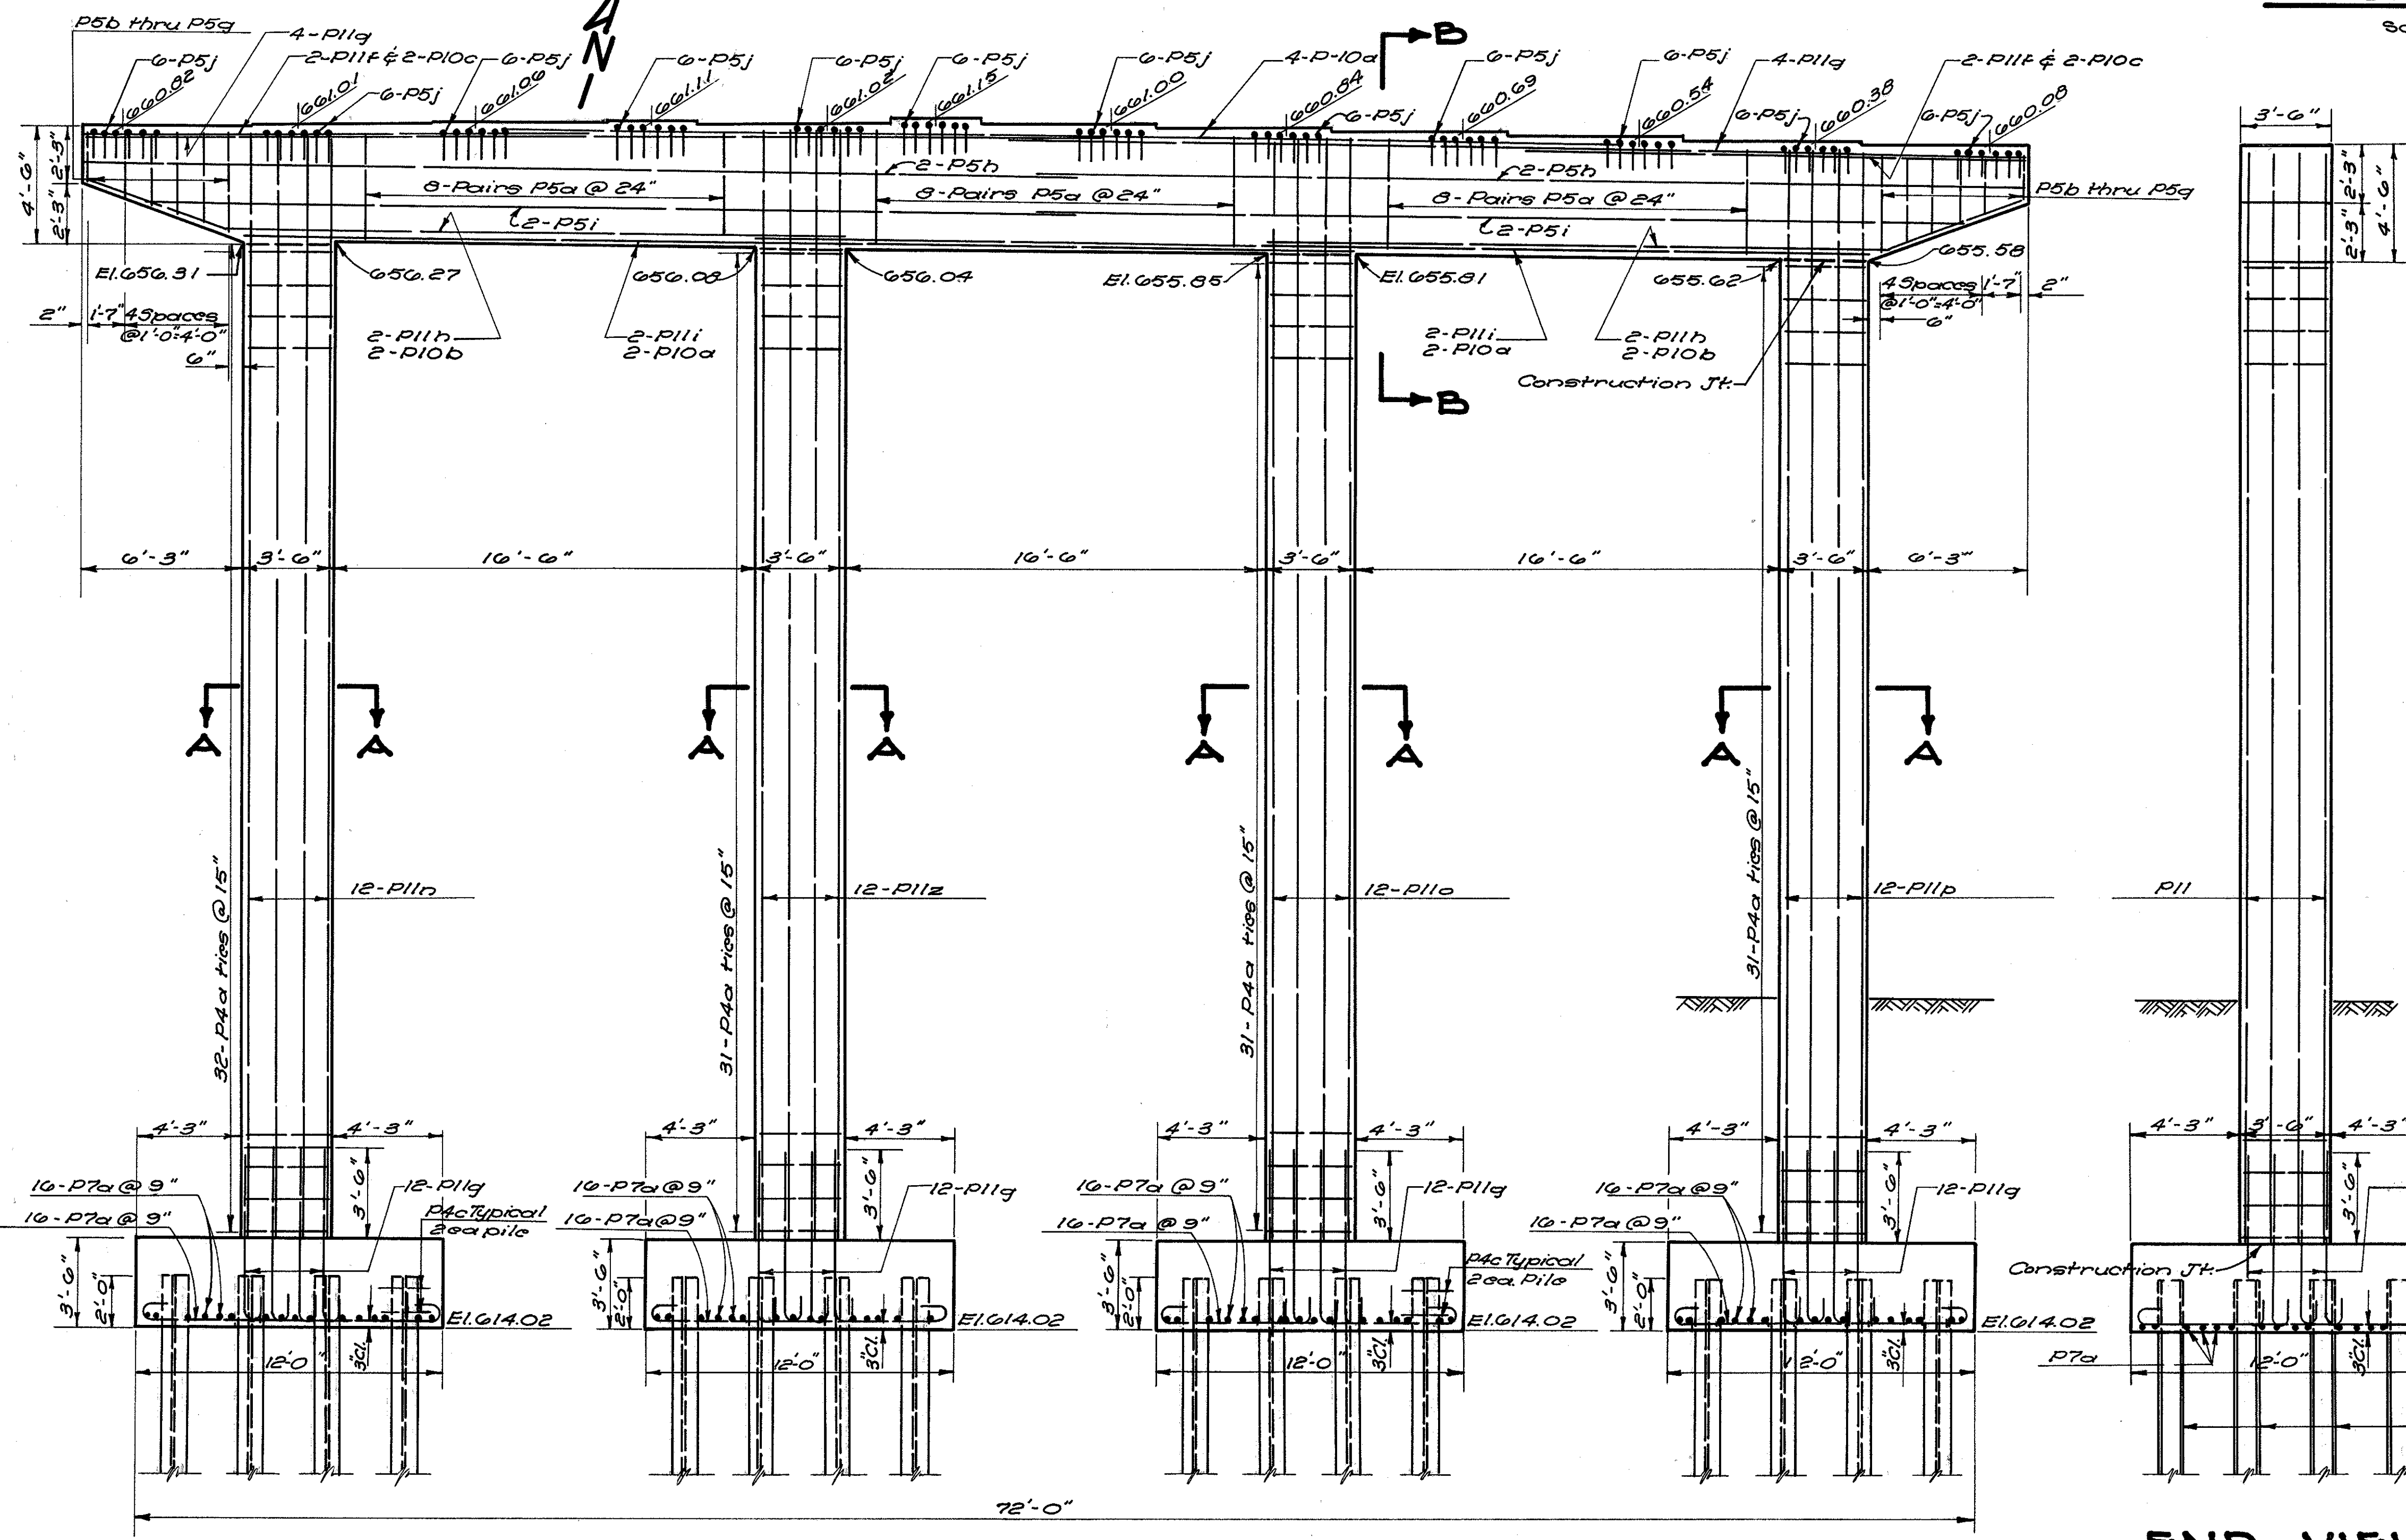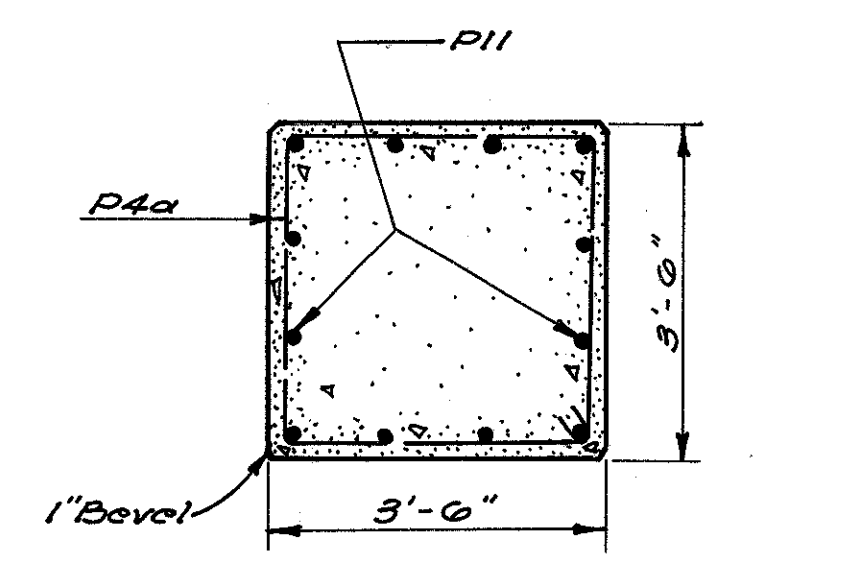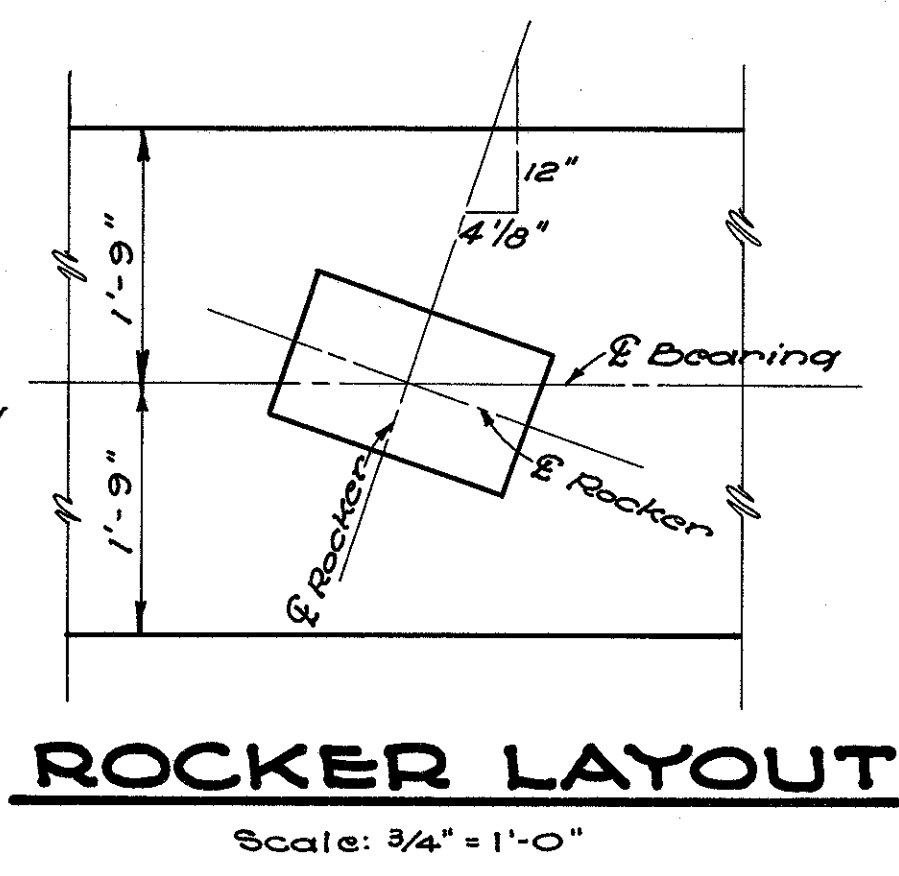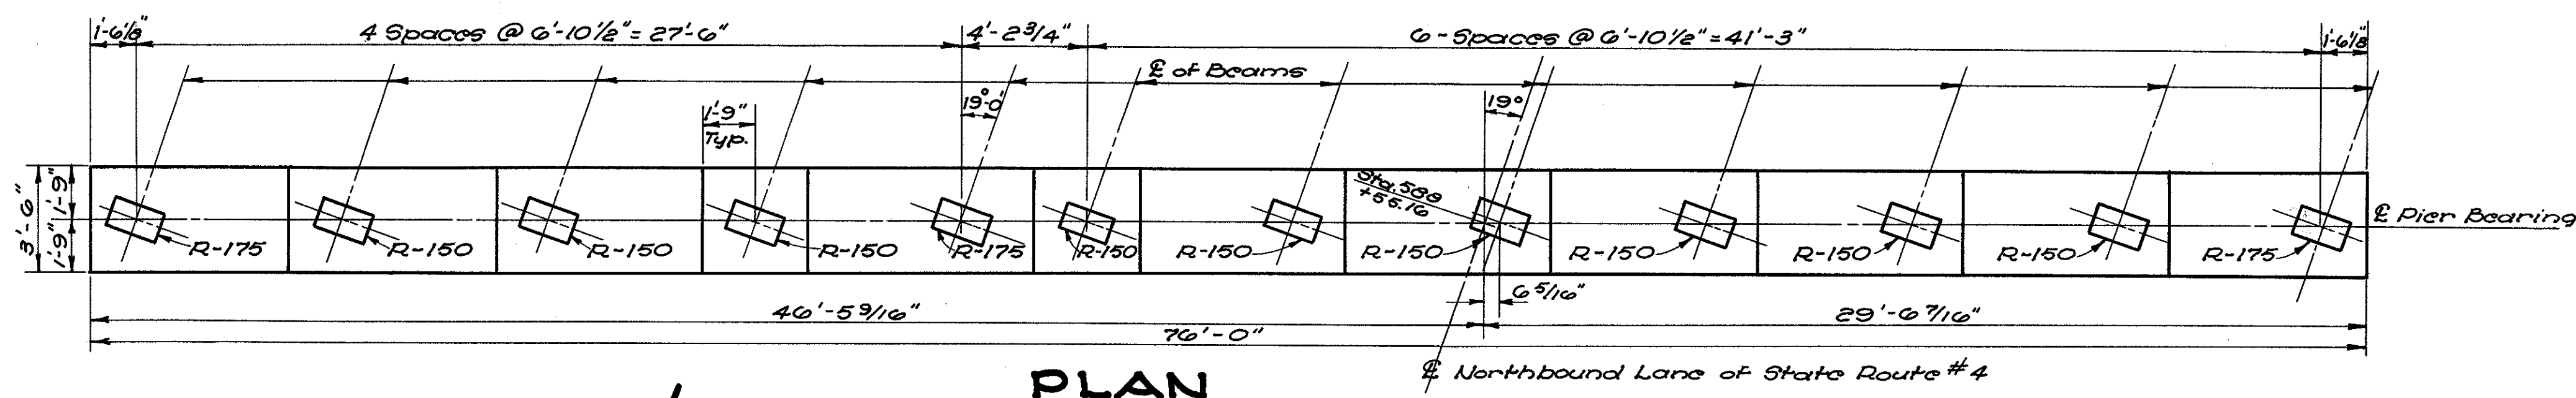








- NOTES:
1. Place donuts in footings to insure correct placing of main column steel.
  2. All main reinforcing steel to have 2" cover unless otherwise noted.



VOGT, IVERS, SEAMAN & ASSOCIATES  
ENGINEERS ARCHITECTS  
CINCINNATI, OHIO

**PIER NO. 4**  
BRIDGE NO. BU-4-184  
OVER B & O R.R. & DICKS CREEK  
BUTLER COUNTY  
SEC. BUT.-4 STA. 537+80.16  
Scale: As shown SEPT. 1955

DESIGNED	DRAWN	TRACED	CHECKED	REVIEWED	DATE	REVISED
V.D.	ALI	N.B.	O.L.A.	W.J.I.	10-11-55	

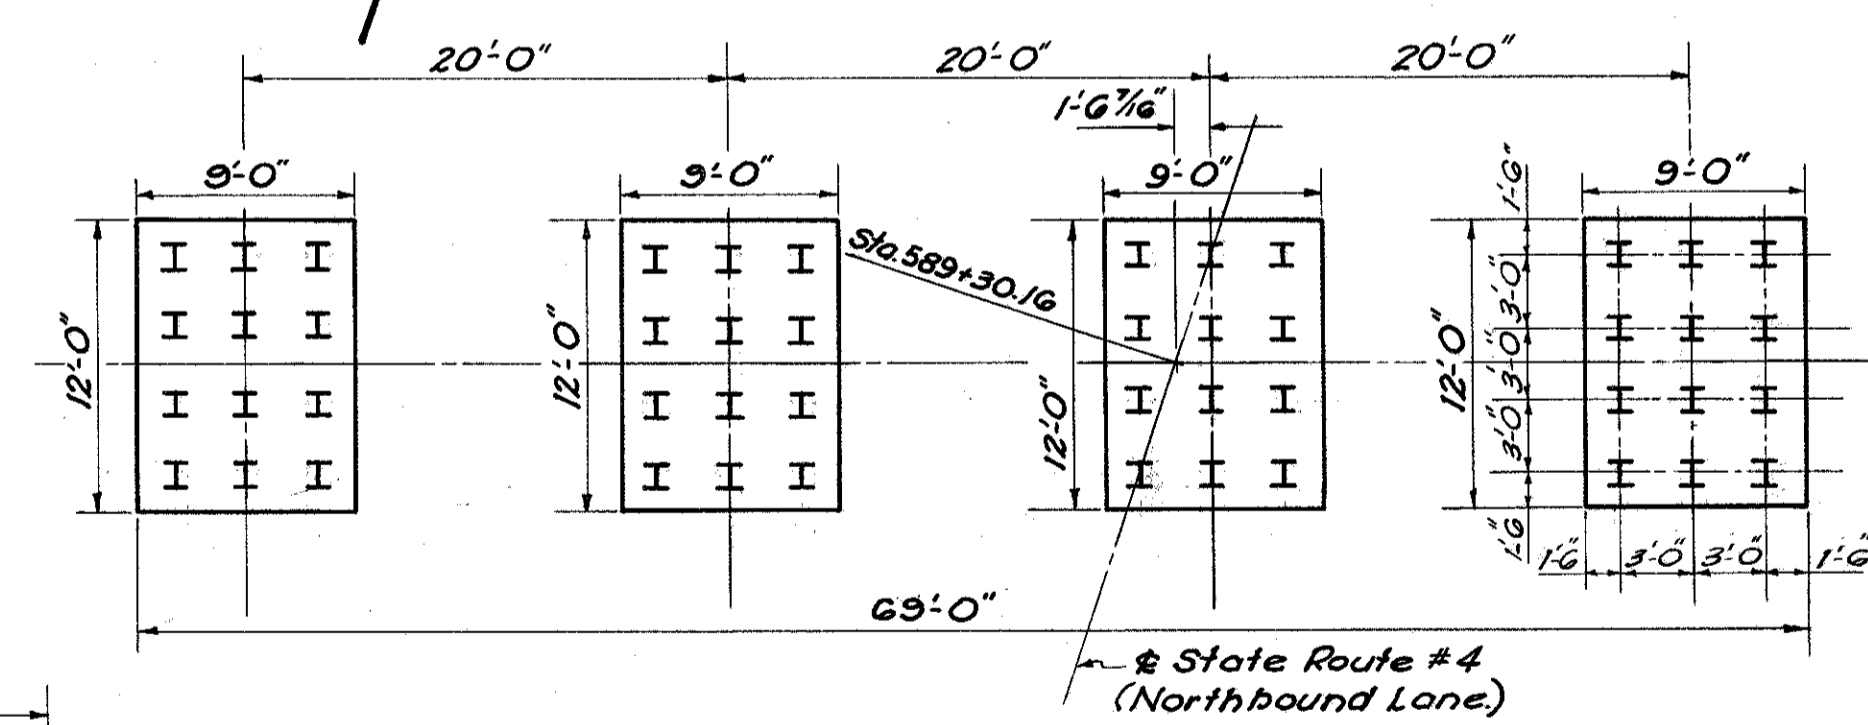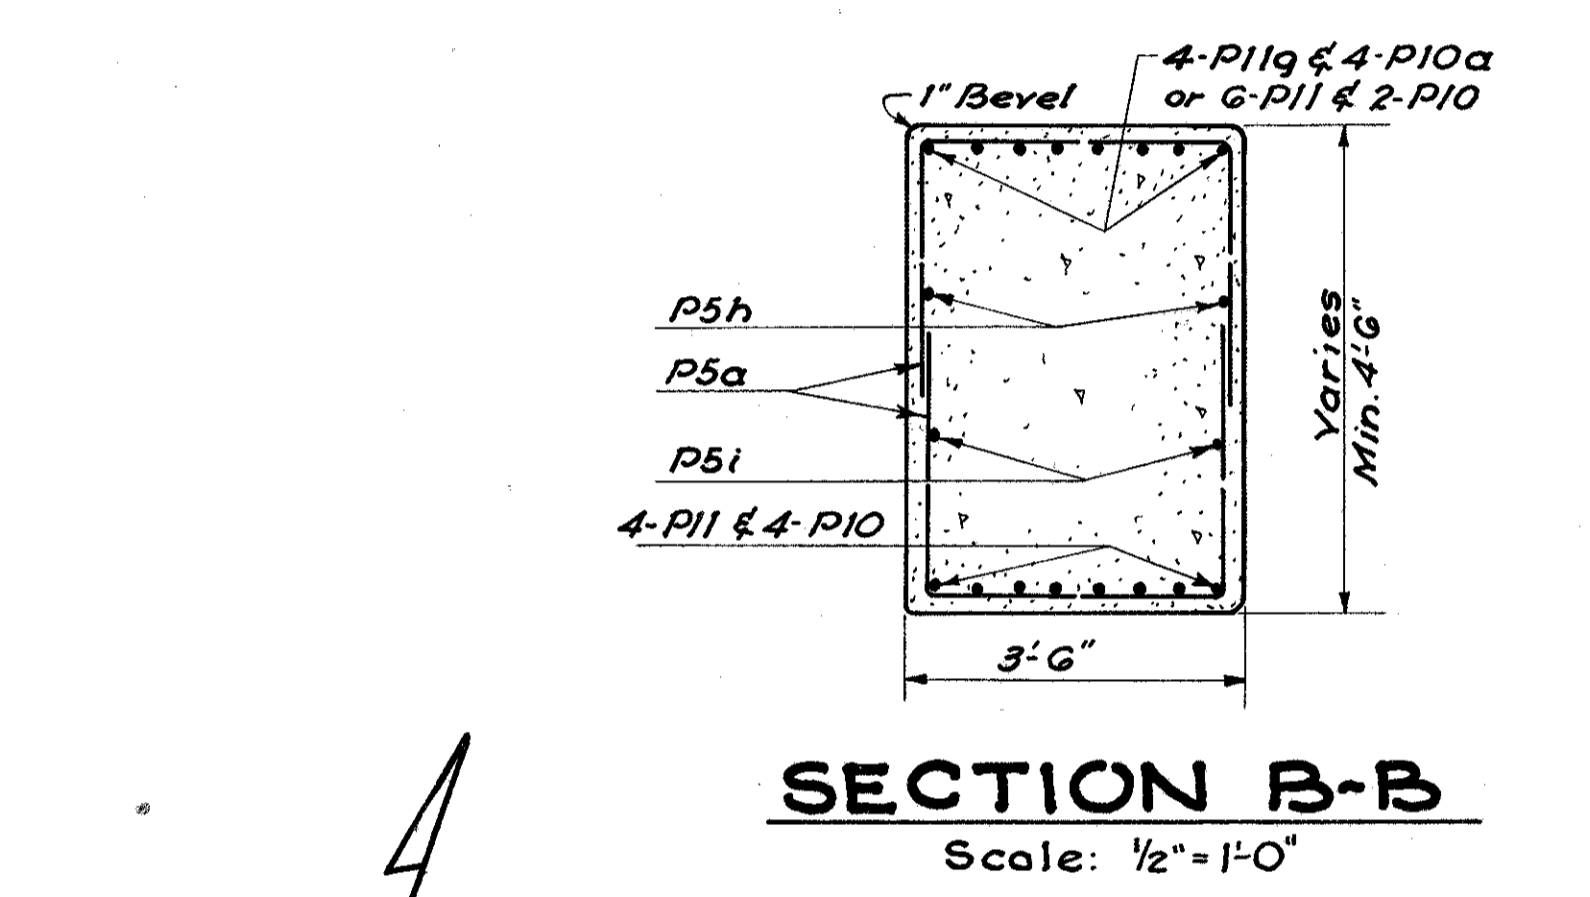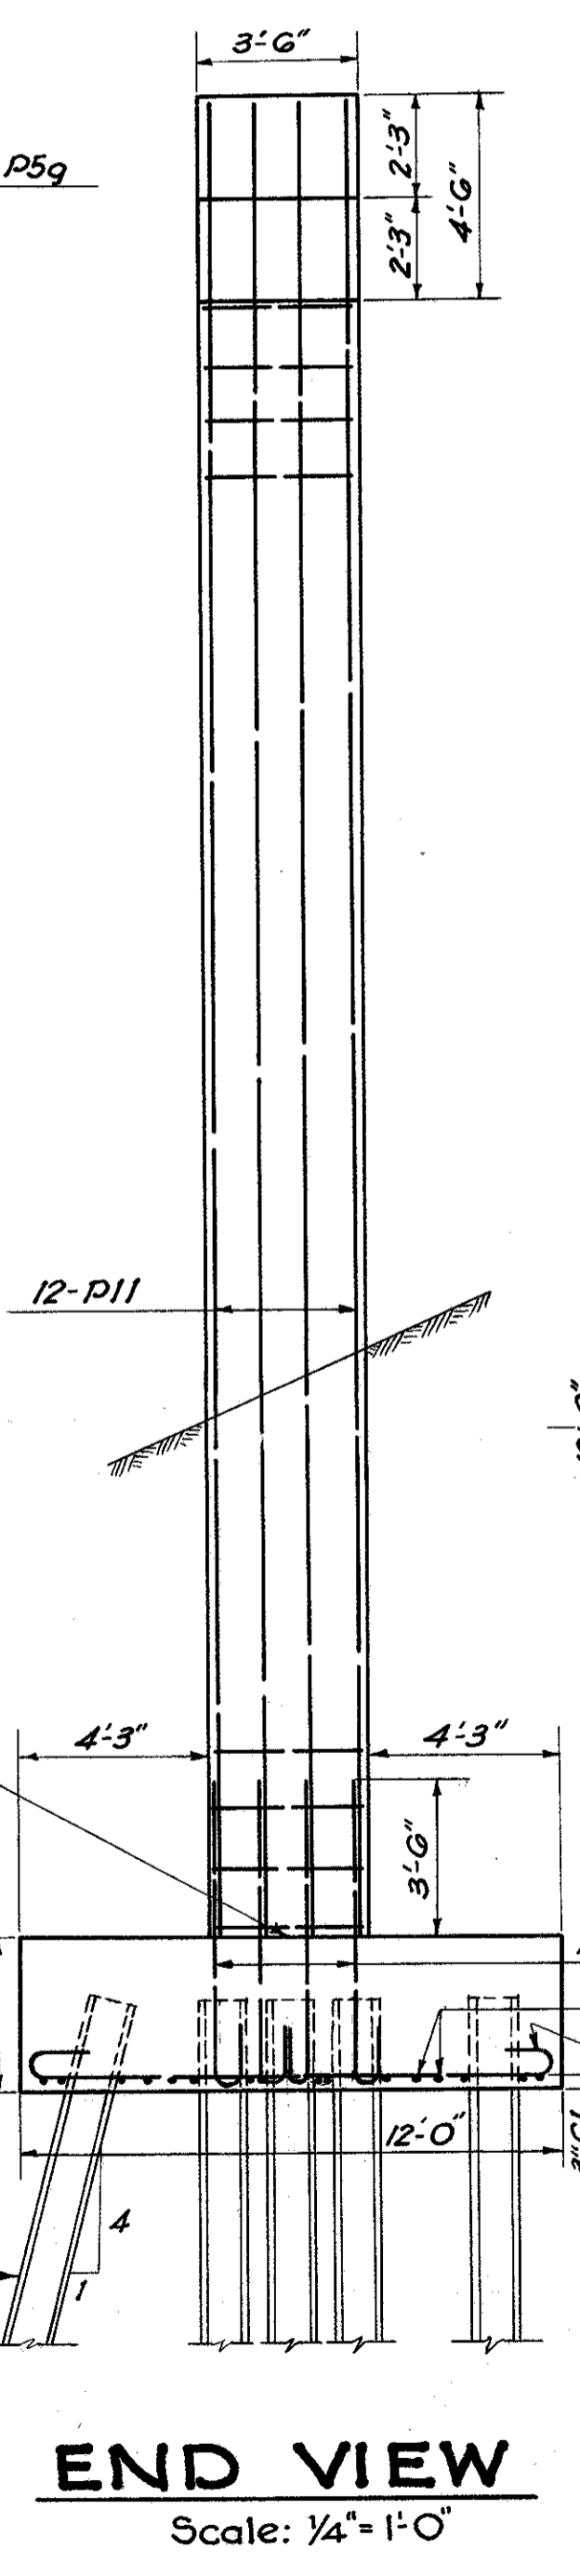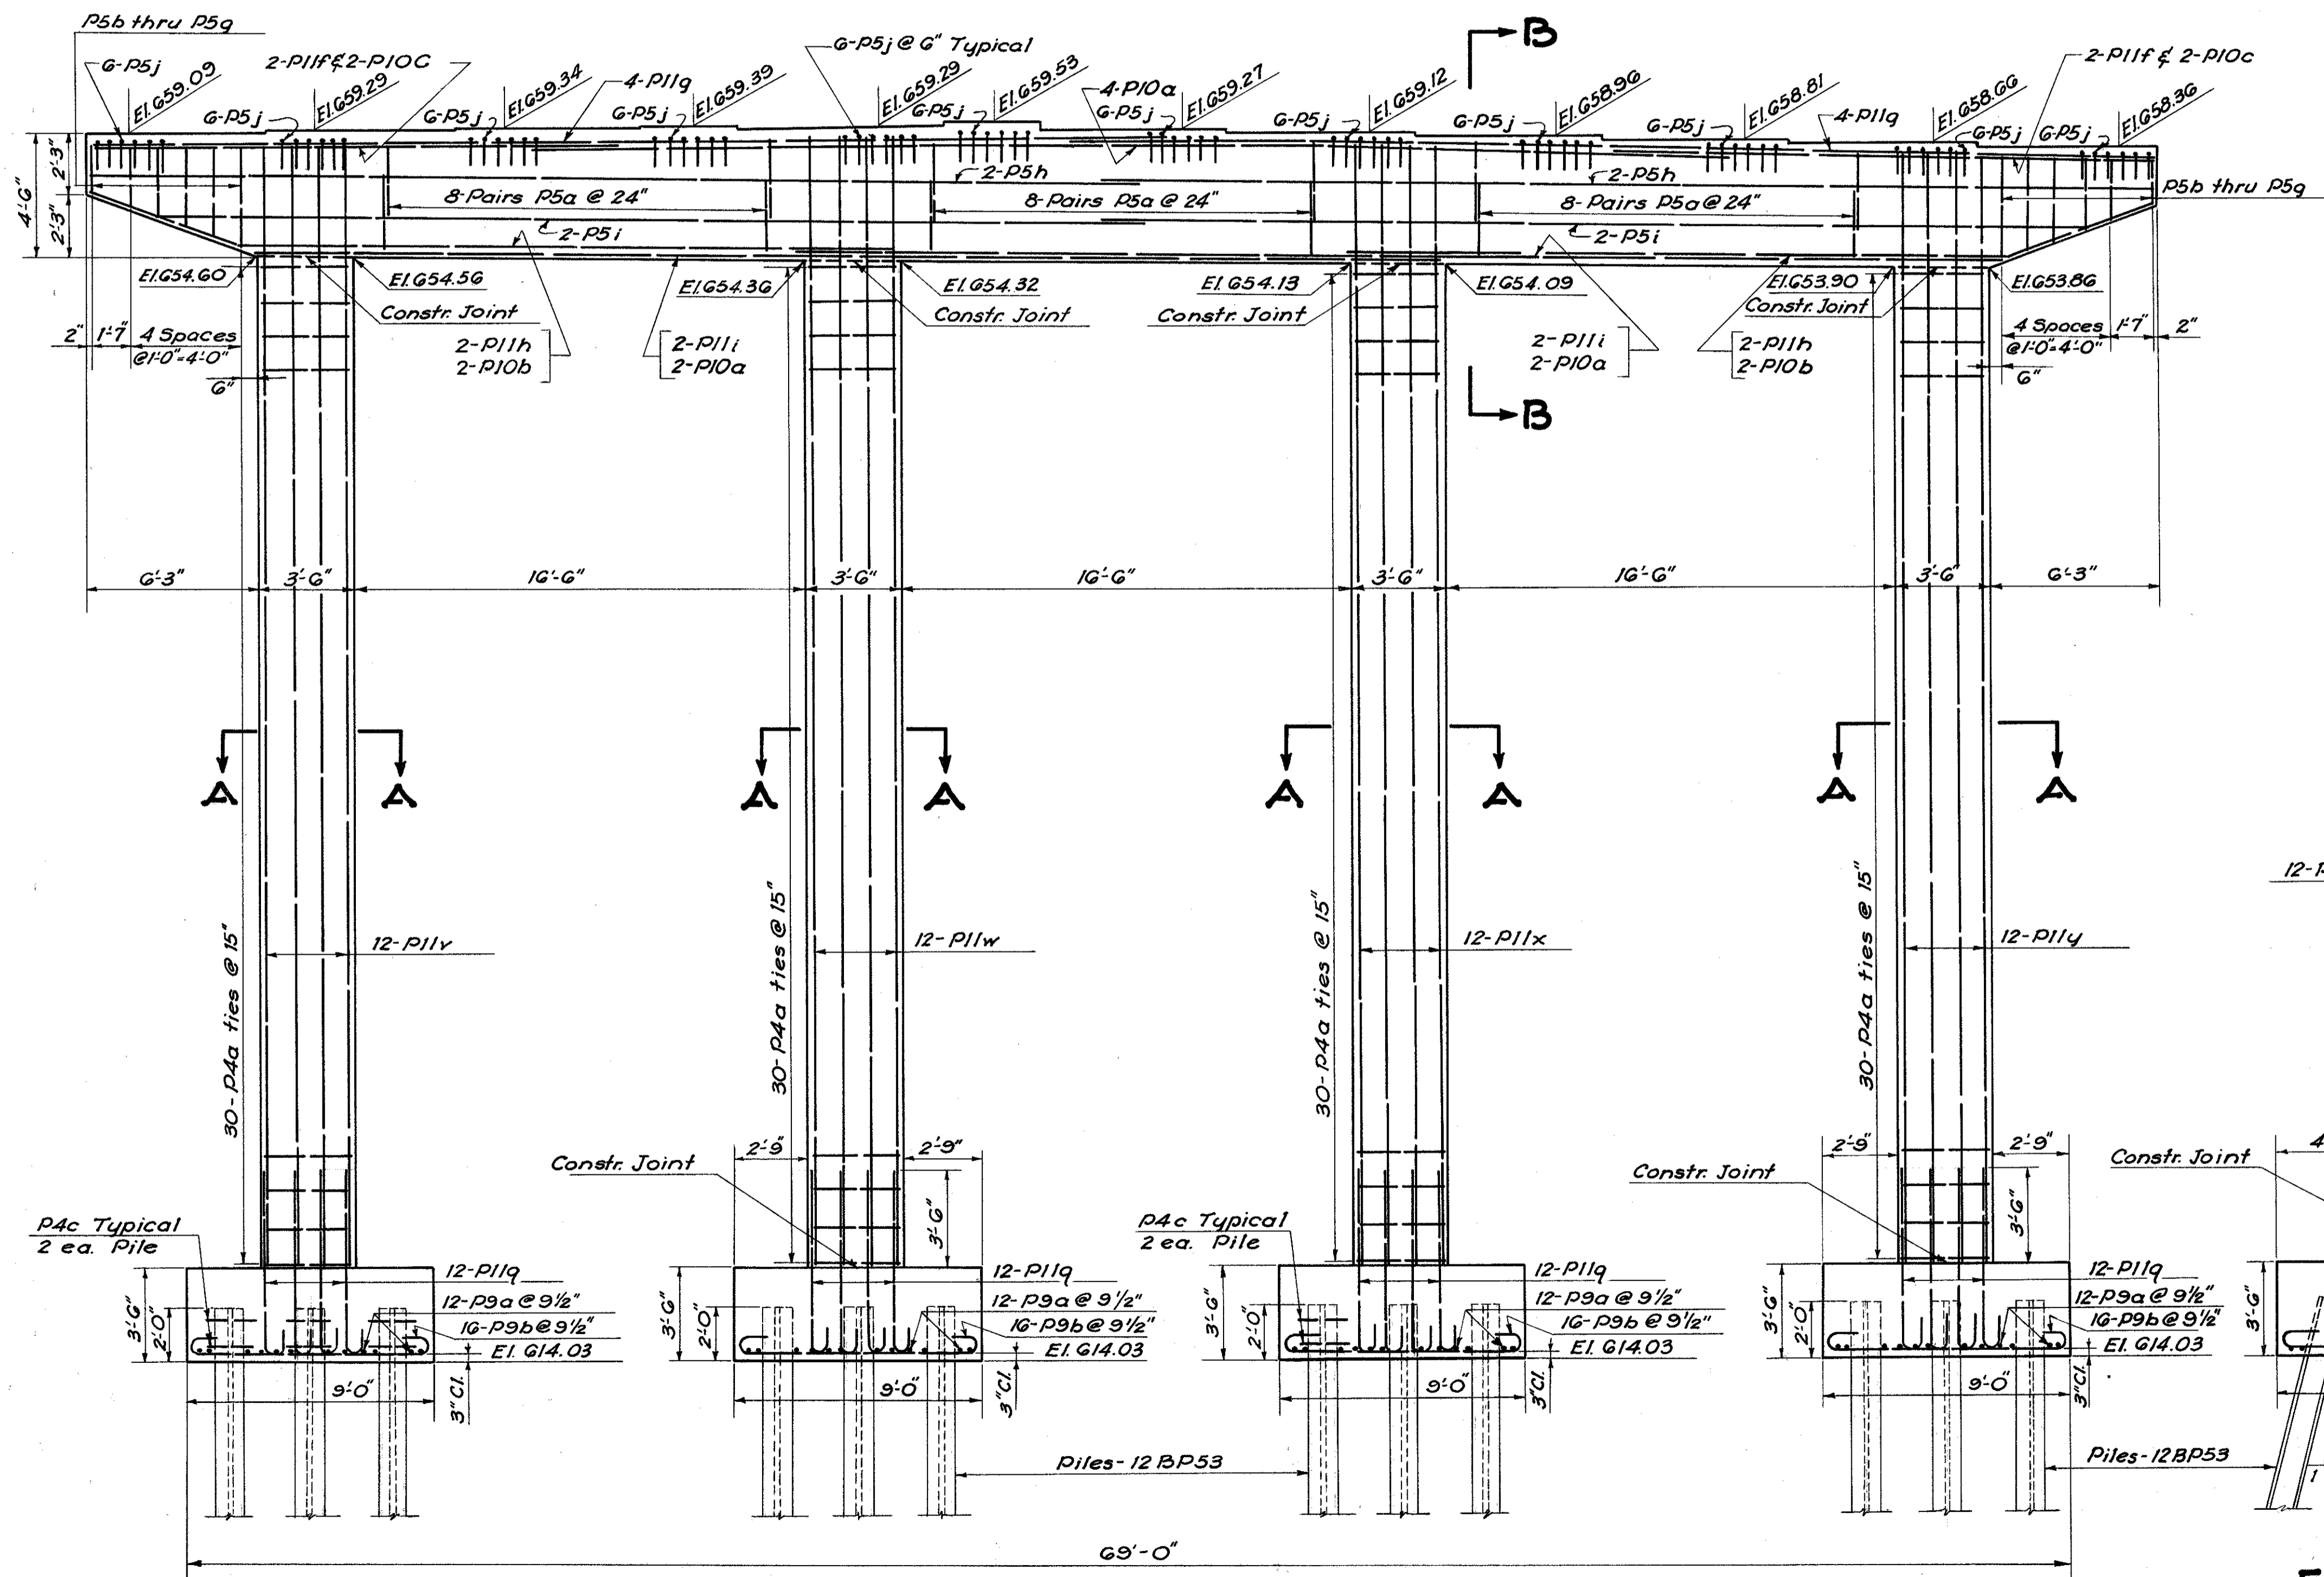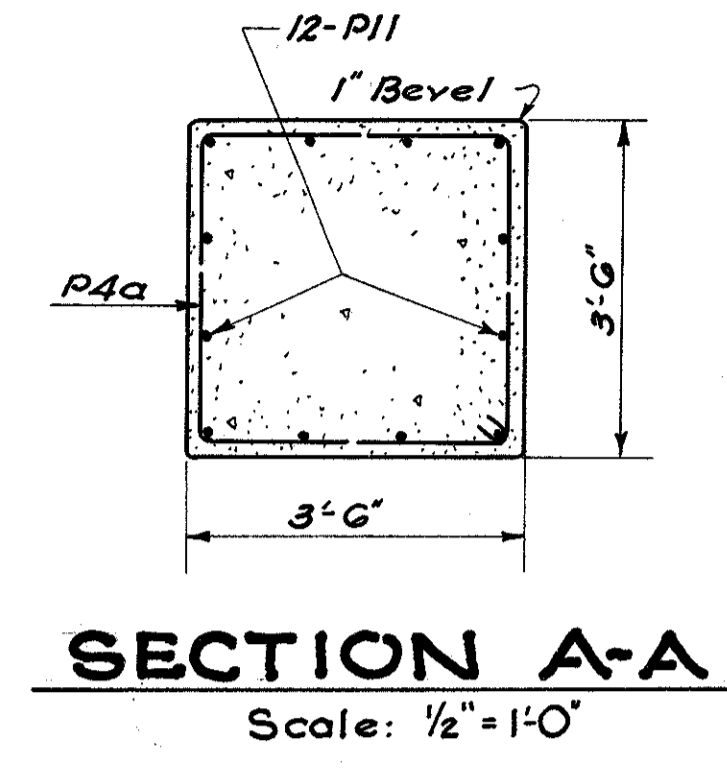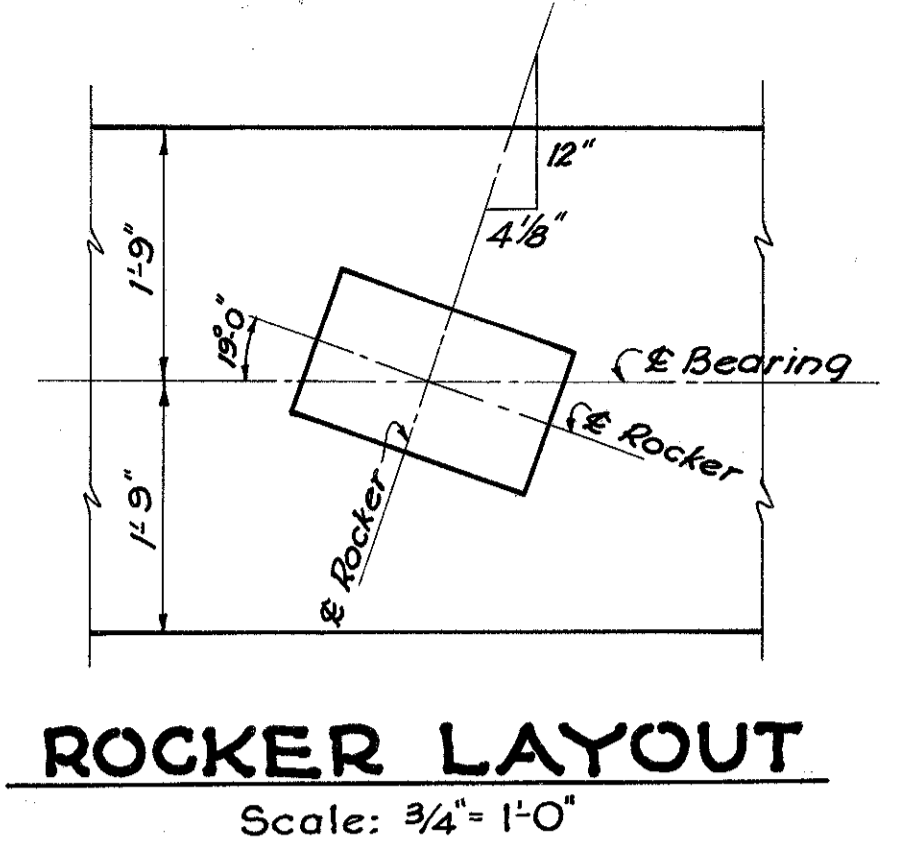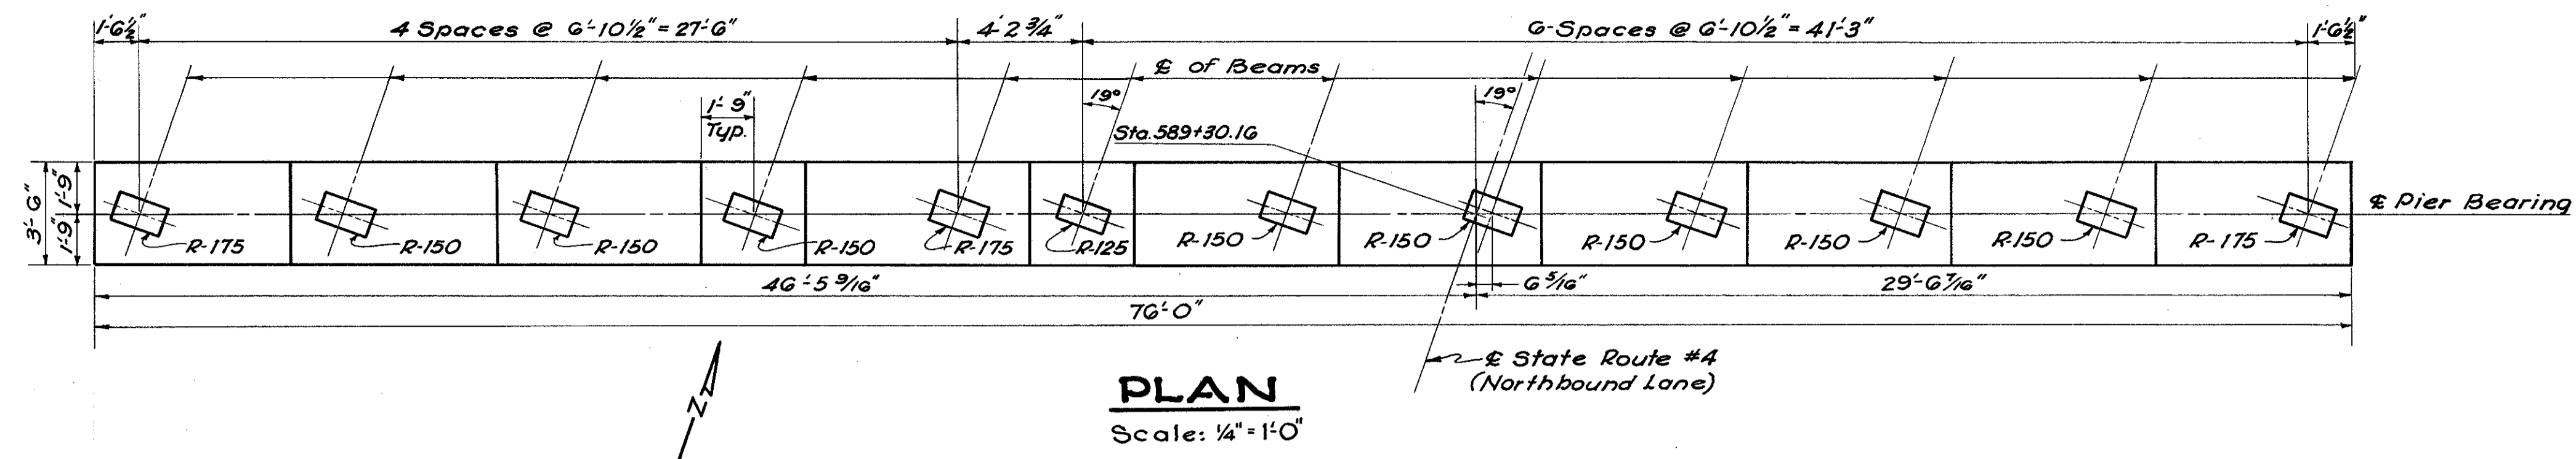

Note:  
1. Place dowels in footing to insure correct placing of main column steel.  
2. All main reinforcing steel to have 2" cover unless otherwise noted.









VOGT, IYERS, SEAMAN & ASSOCIATES  
ENGINEERS ARCHITECTS  
CINCINNATI, OHIO

**PIER NO. 5**  
BRIDGE NO. BU-4-184  
OVER B.&O. R.R. & DICKS CREEK

BUTLER COUNTY  
SEC. BUT. - 4  
Scale: As shown

STA. 587+80.16  
SEPT. 1955

DESIGNED	DRAWN	TRACED	CHECKED	REVIEWED	DATE	REVISED
V.D.	V.D.	S.J.B.	O.L.A.	W.J.I.	10-11-55	

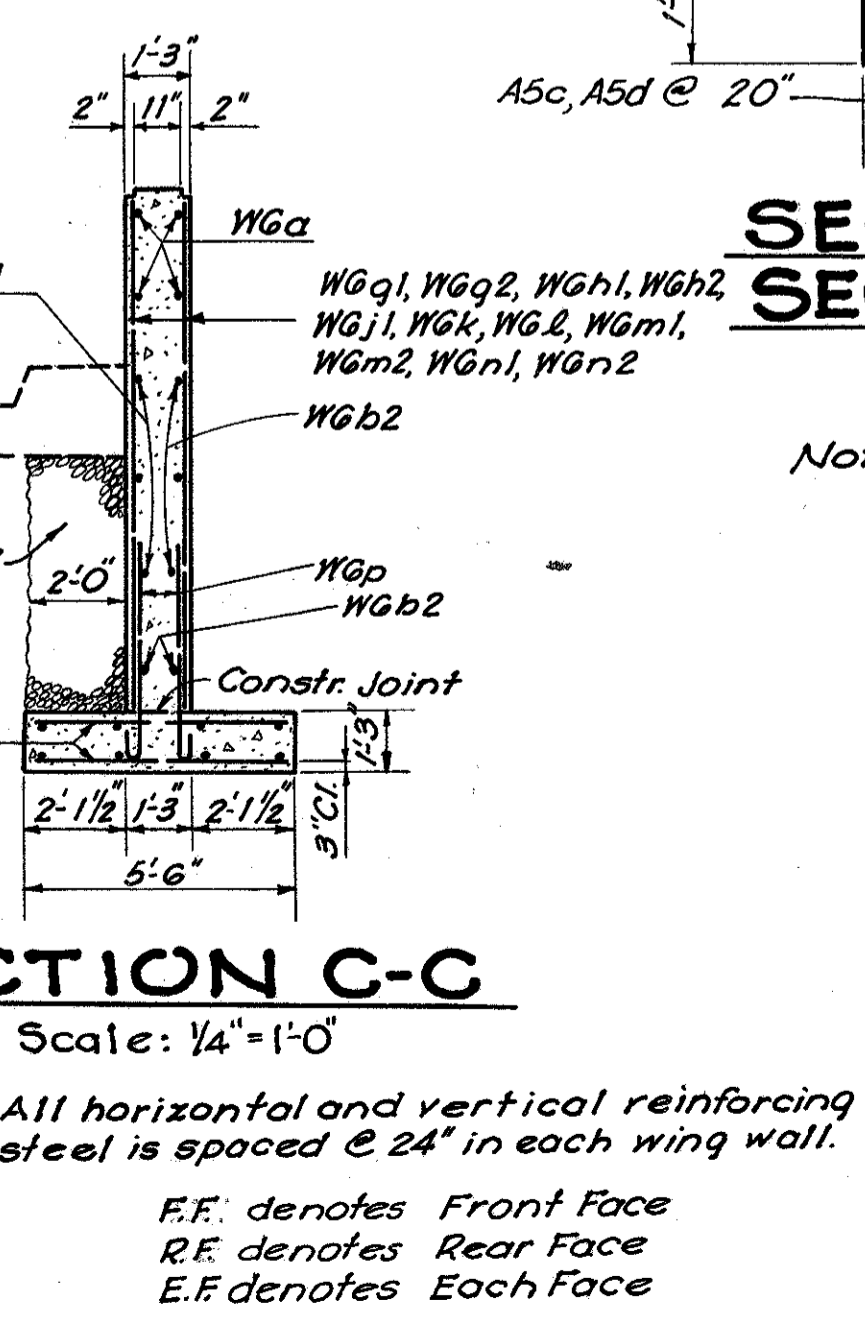
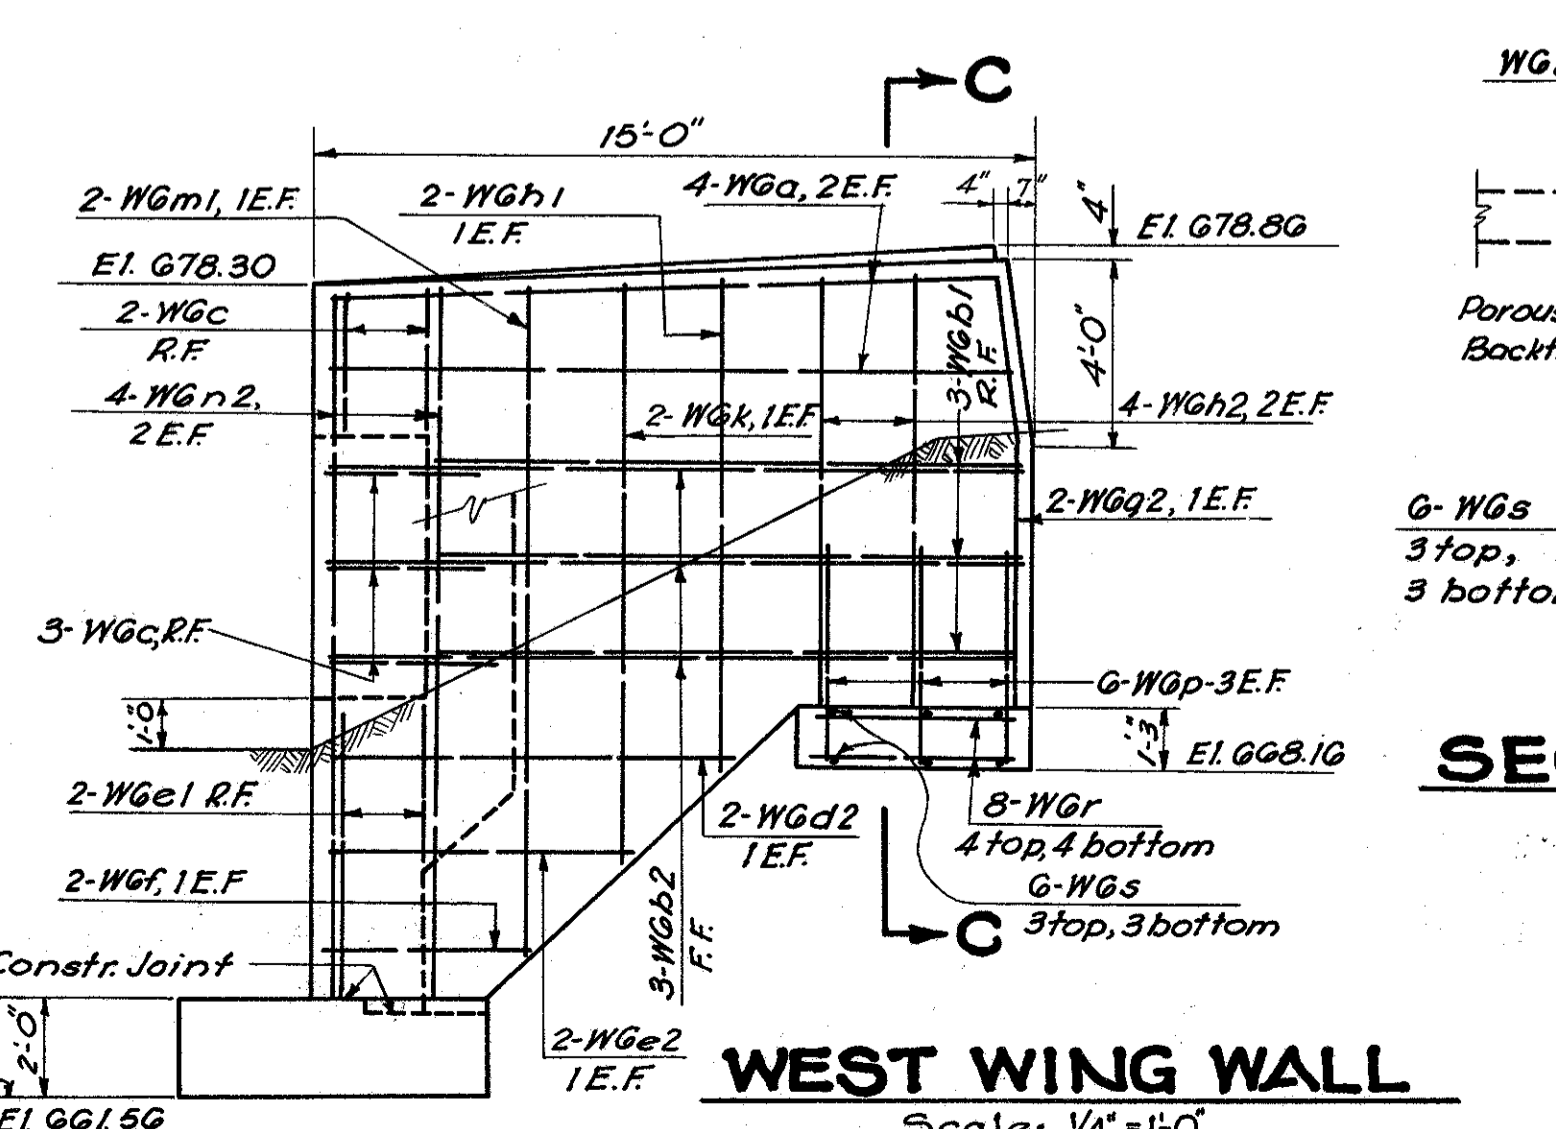
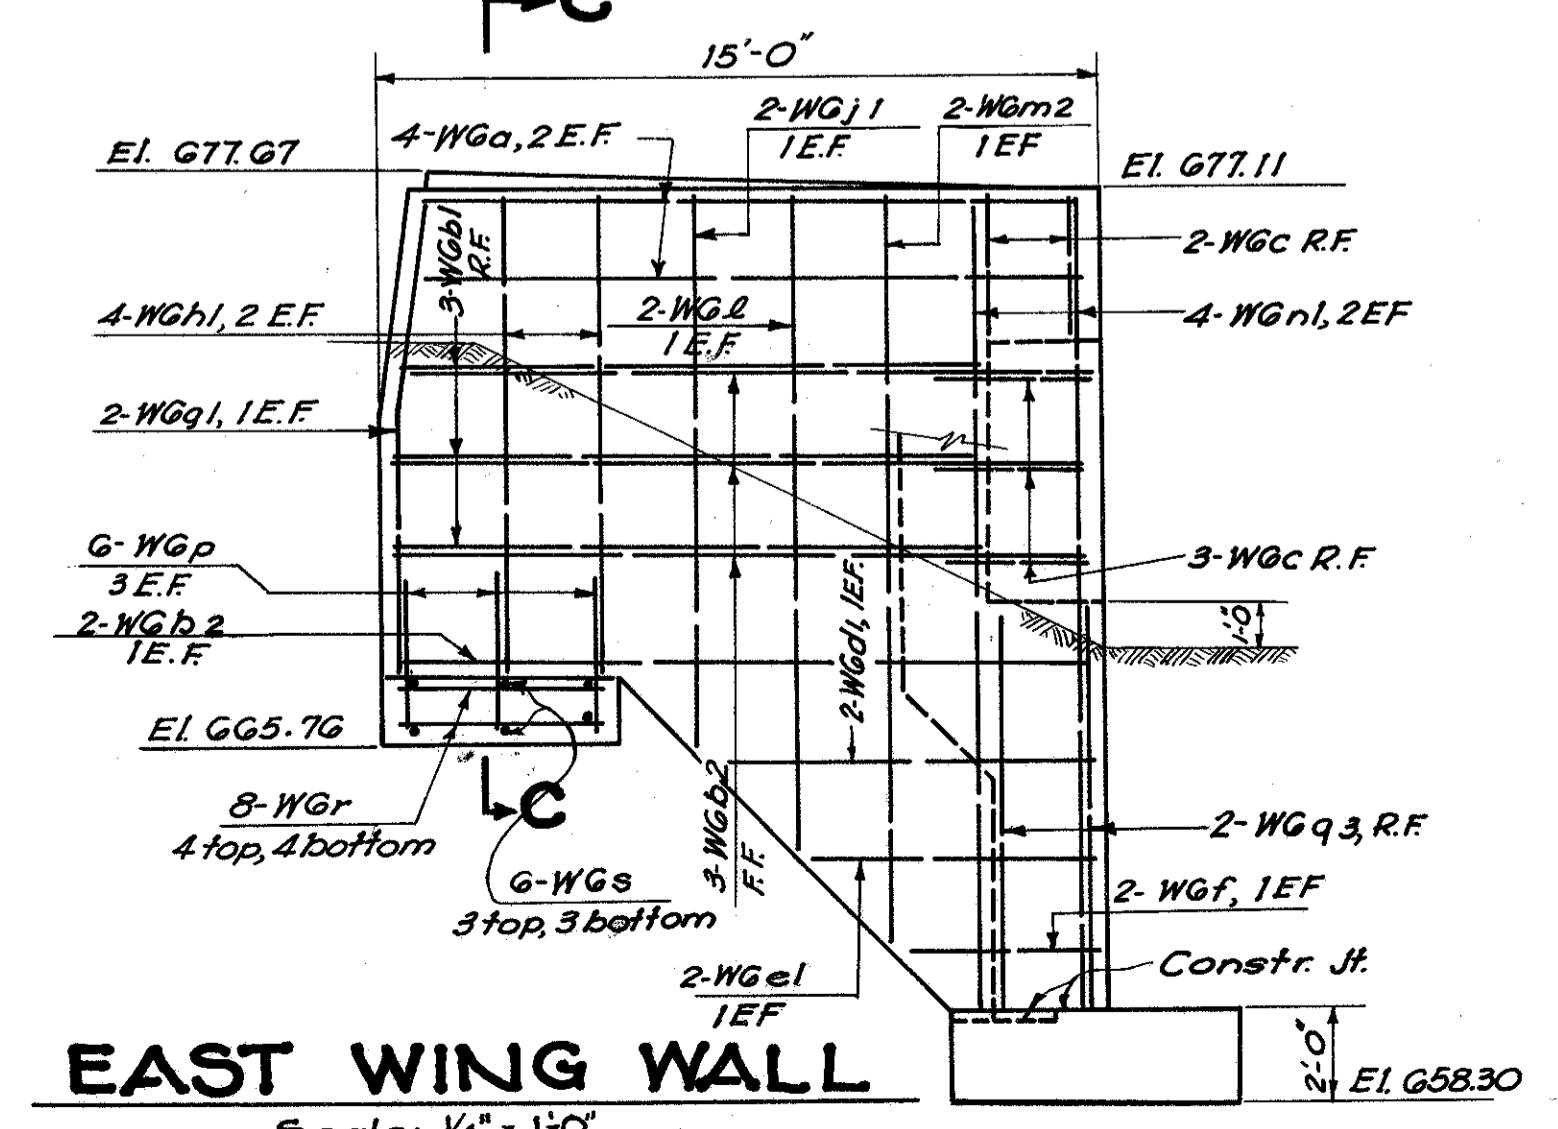
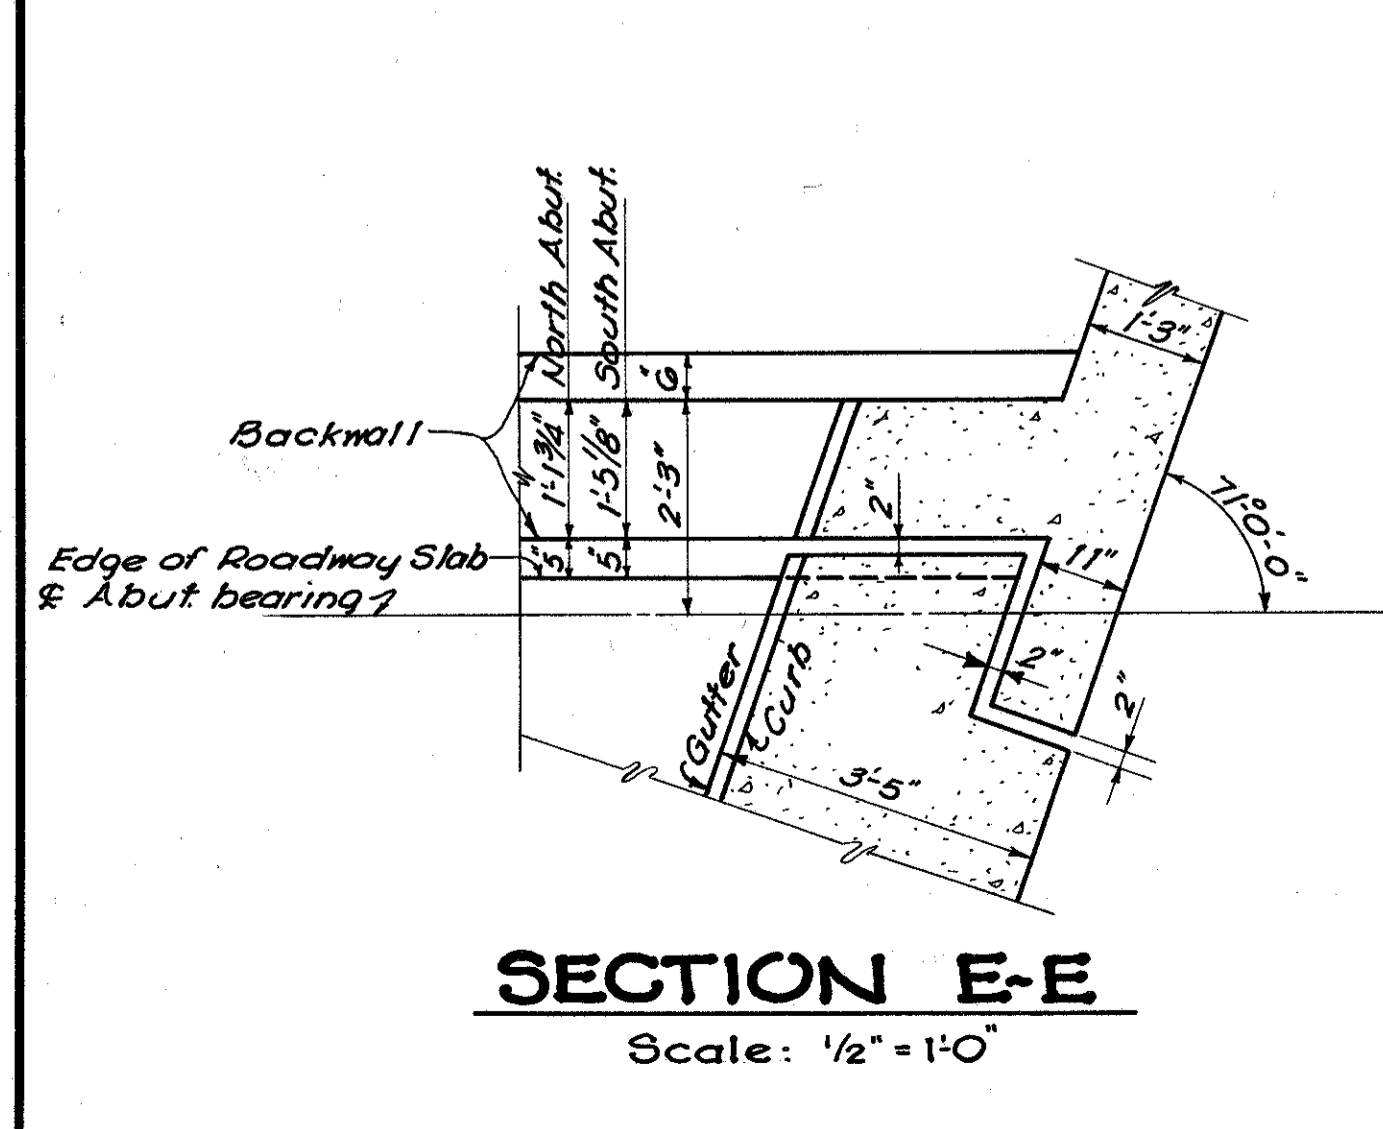
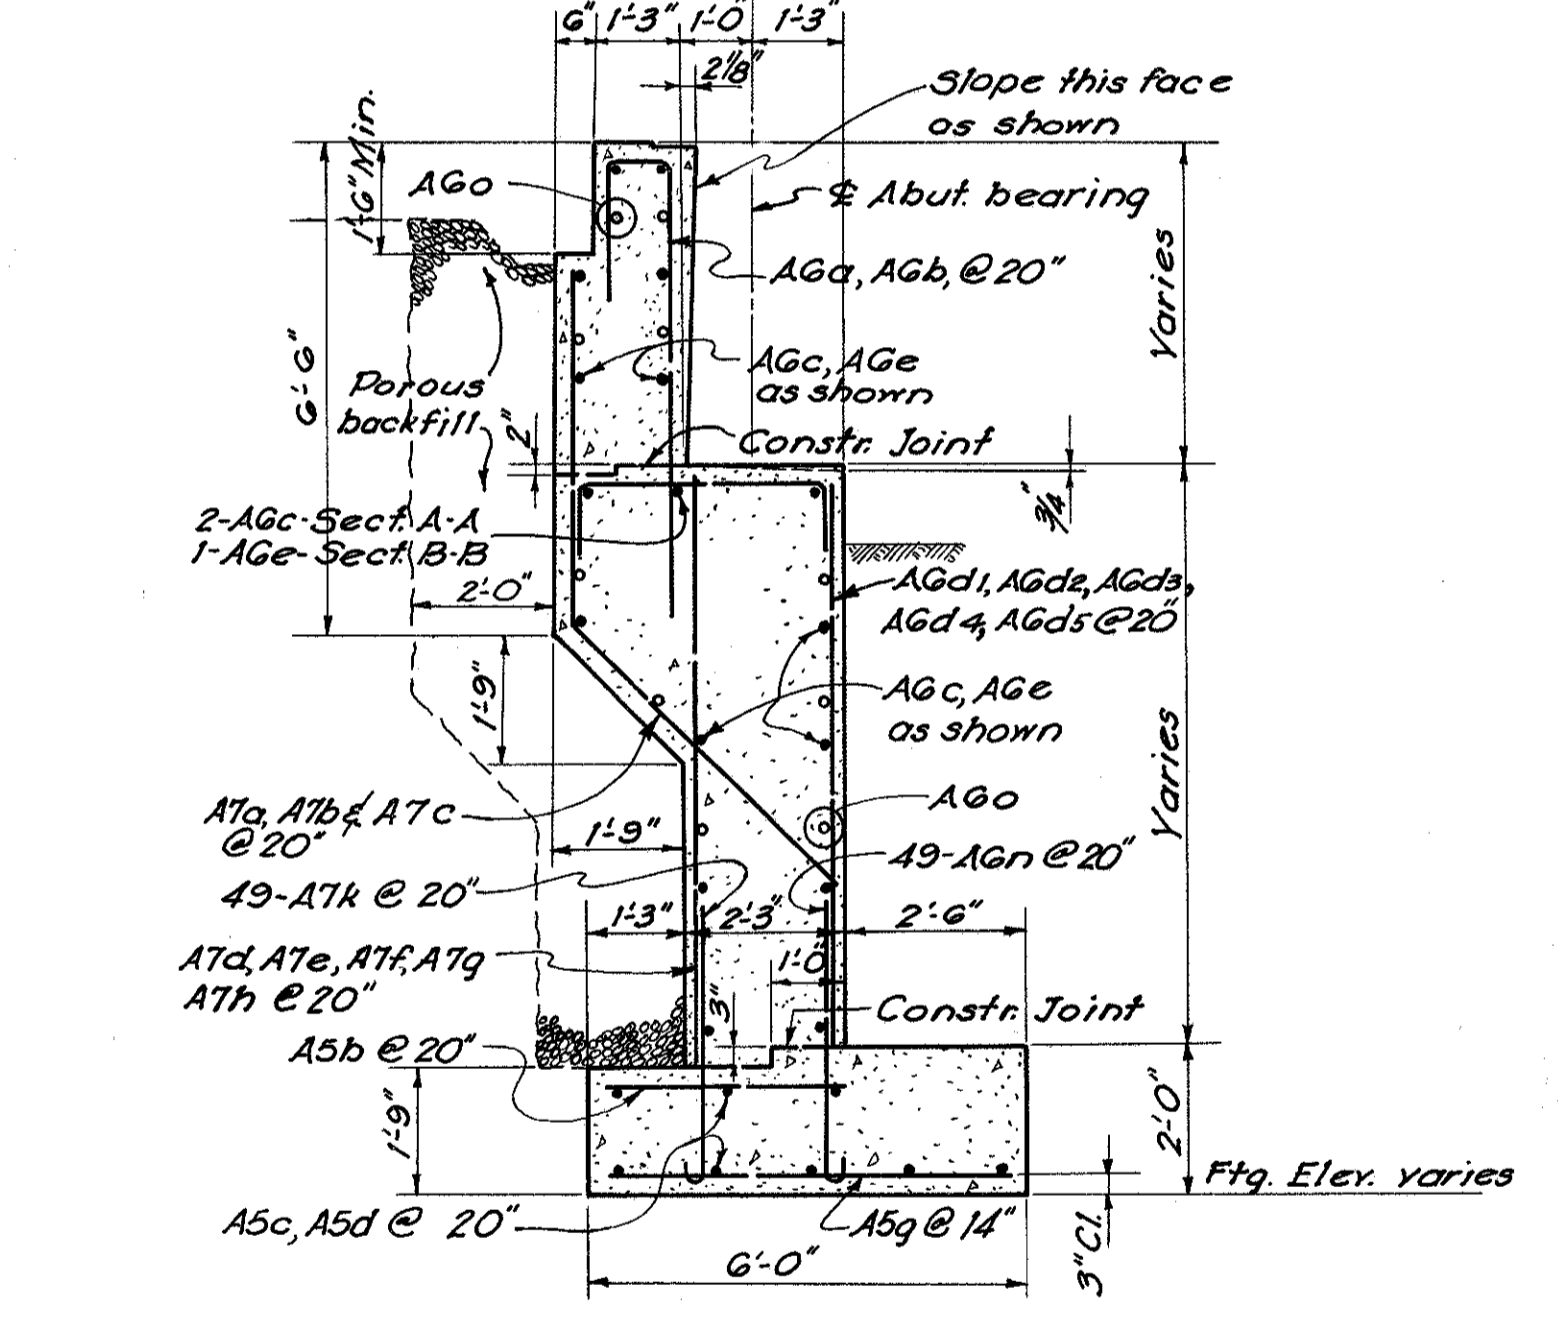
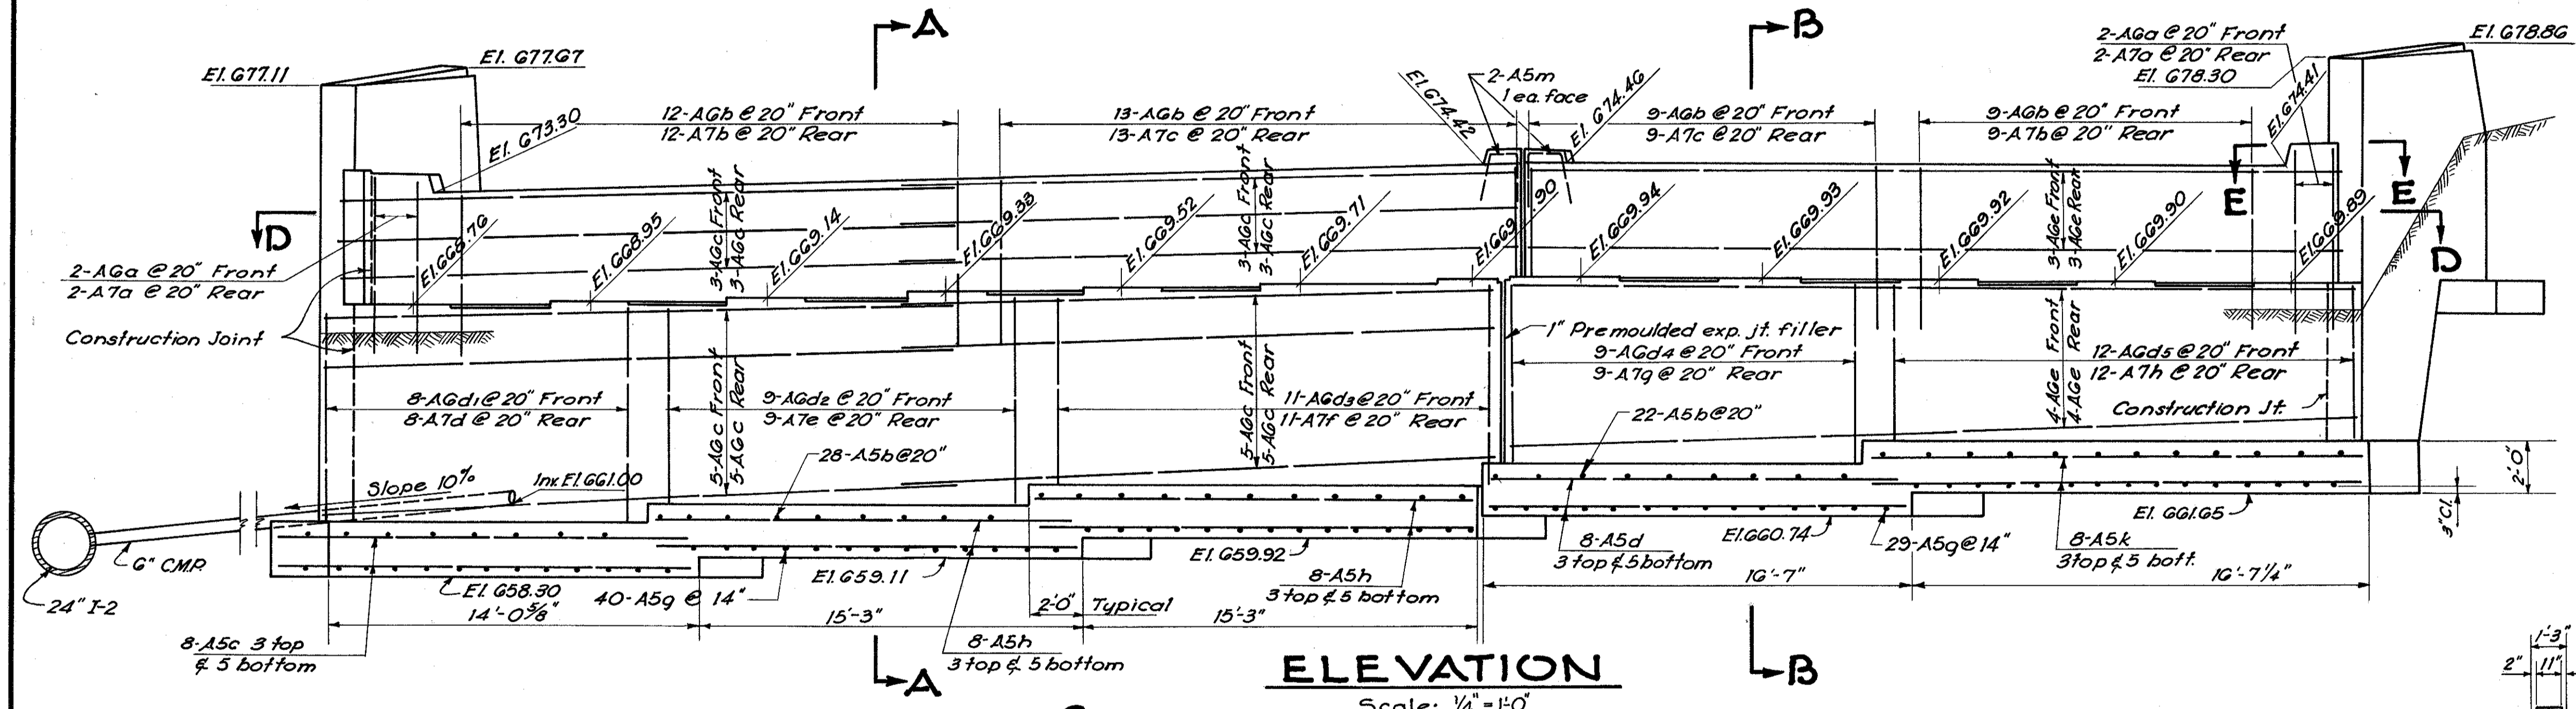
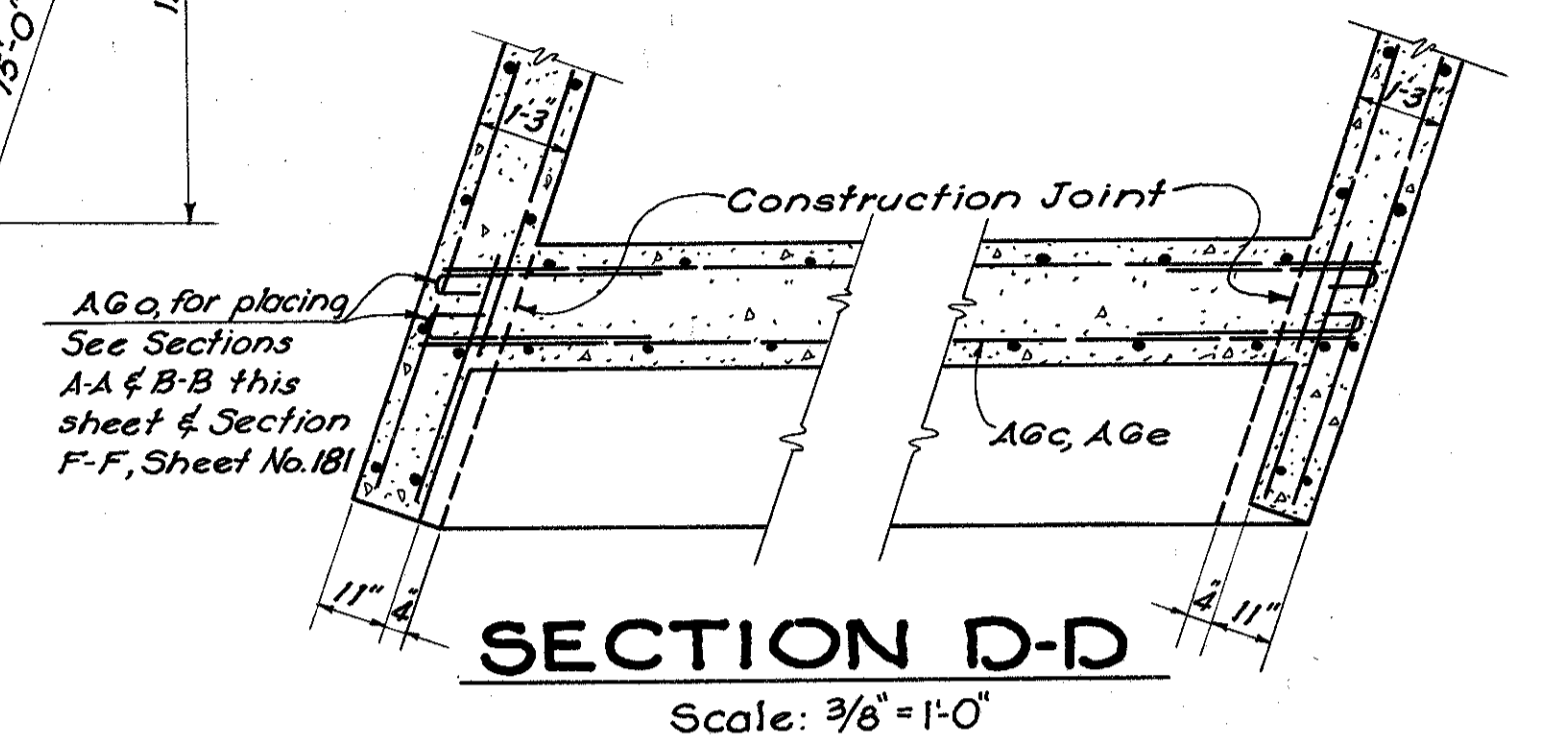
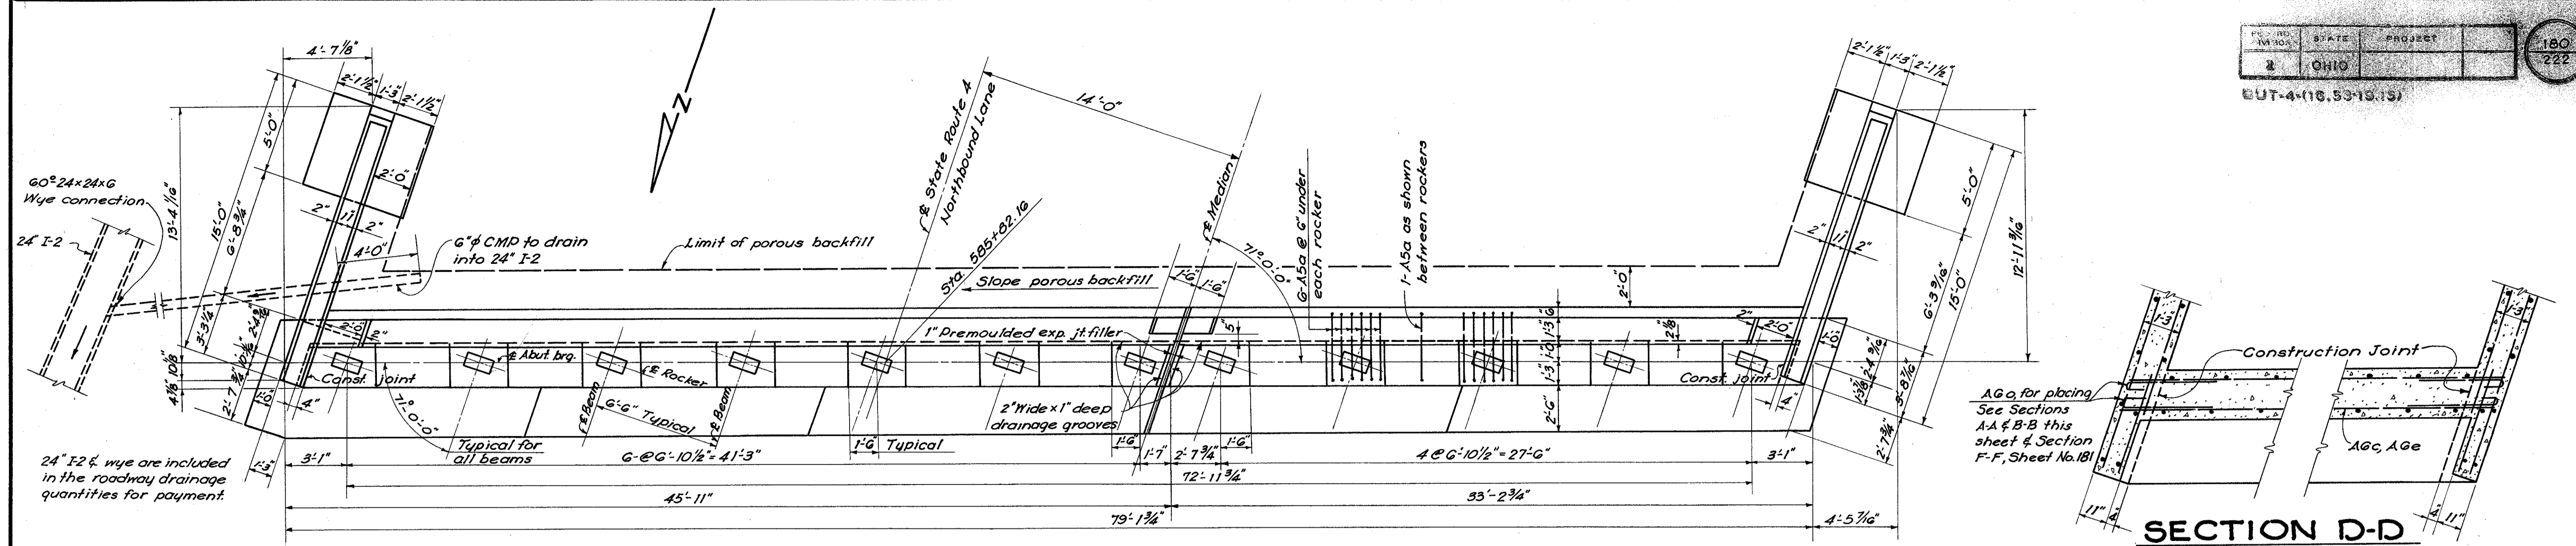


**Notes:**  
All main reinforcing steel to have 2" cover unless otherwise noted. For approach slab details, see Sheet No. 189. Concrete above the bridge seat construction joint shall not be placed until after structural steel work is erected. Steel end finish shall be used as a template for top of backwall.

VOGT, IVERS, SEAMAN & ASSOCIATES  
ENGINEERS ARCHITECTS  
CINCINNATI, OHIO

**SOUTH ABUTMENT**  
BRIDGE NO. BU-4-184  
OVER B.&O. R.R. & DICKS CREEK  
BUTLER COUNTY  
SEC. BU-4  
Scale: As shown  
STA. 587+80.16  
SEPT. 1955

DESIGNED	DRAWN	TRACED	CHECKED	REVIEWED	DATE	REVISED
Y.K.	Y.K.	S.J.B.	V.D.	W.J.I.	10-11-55	

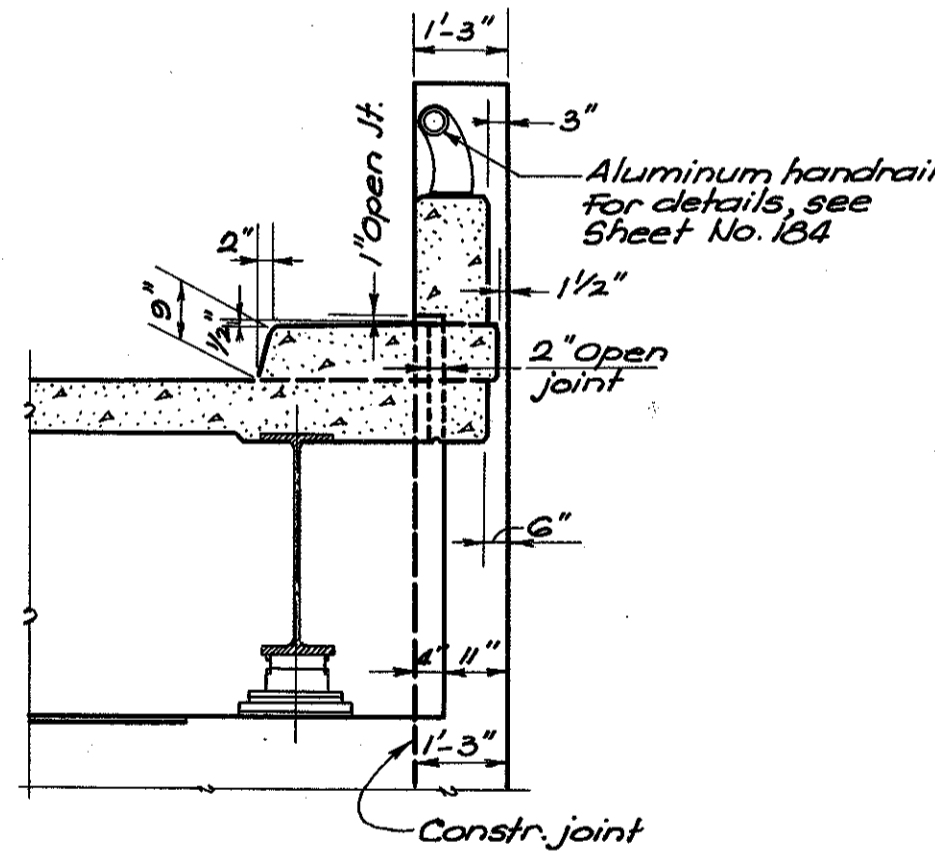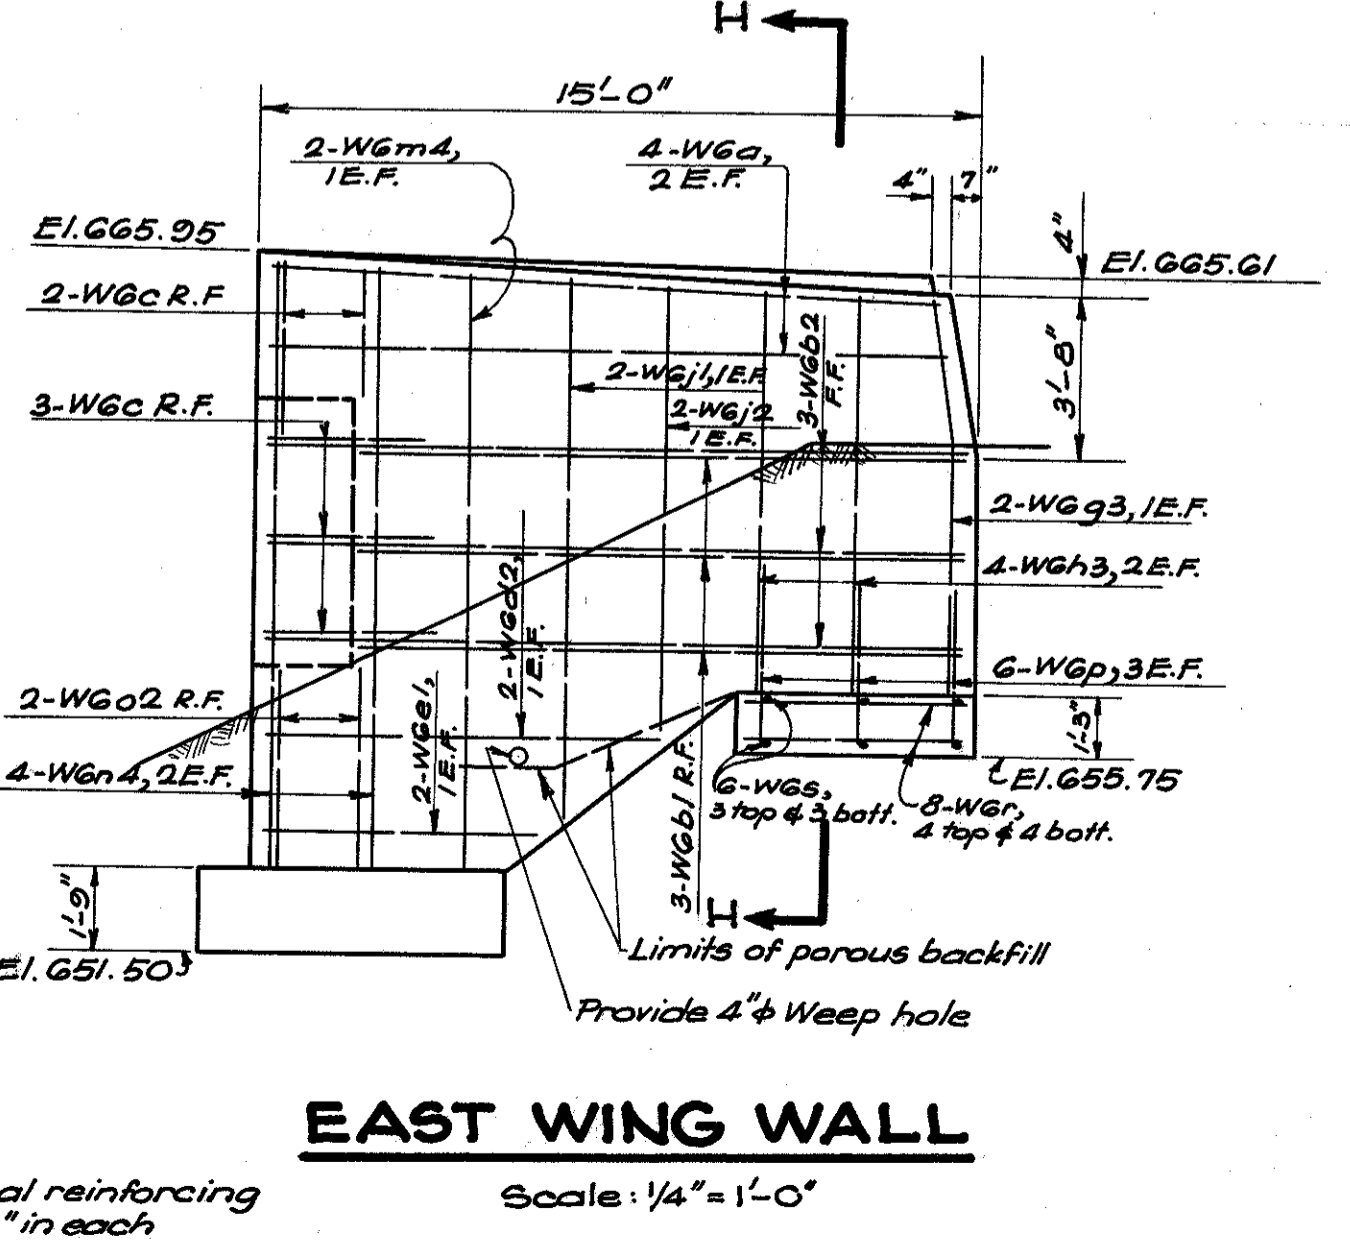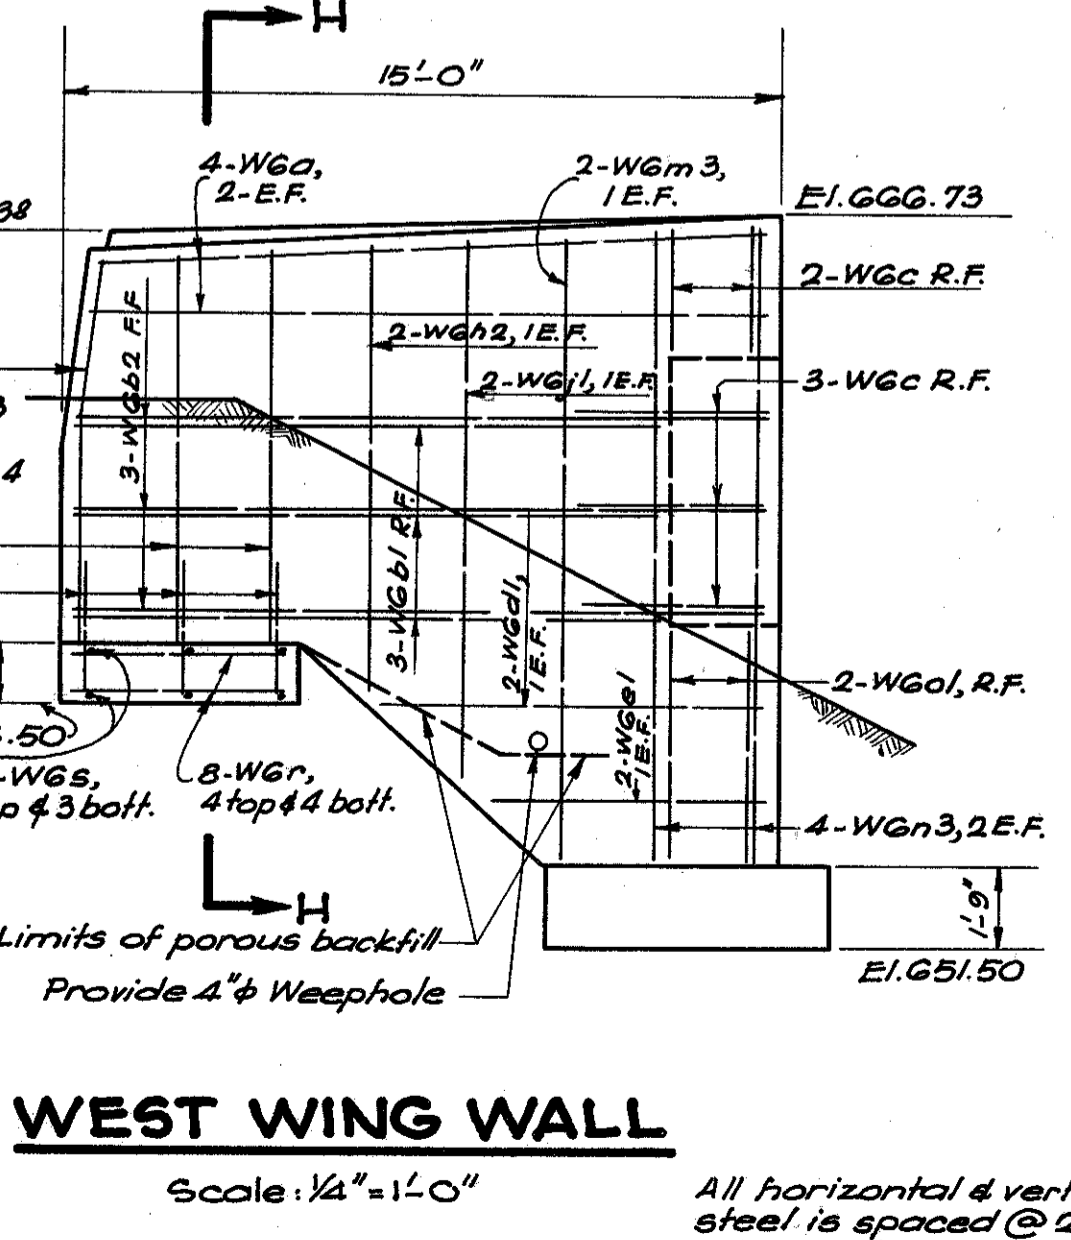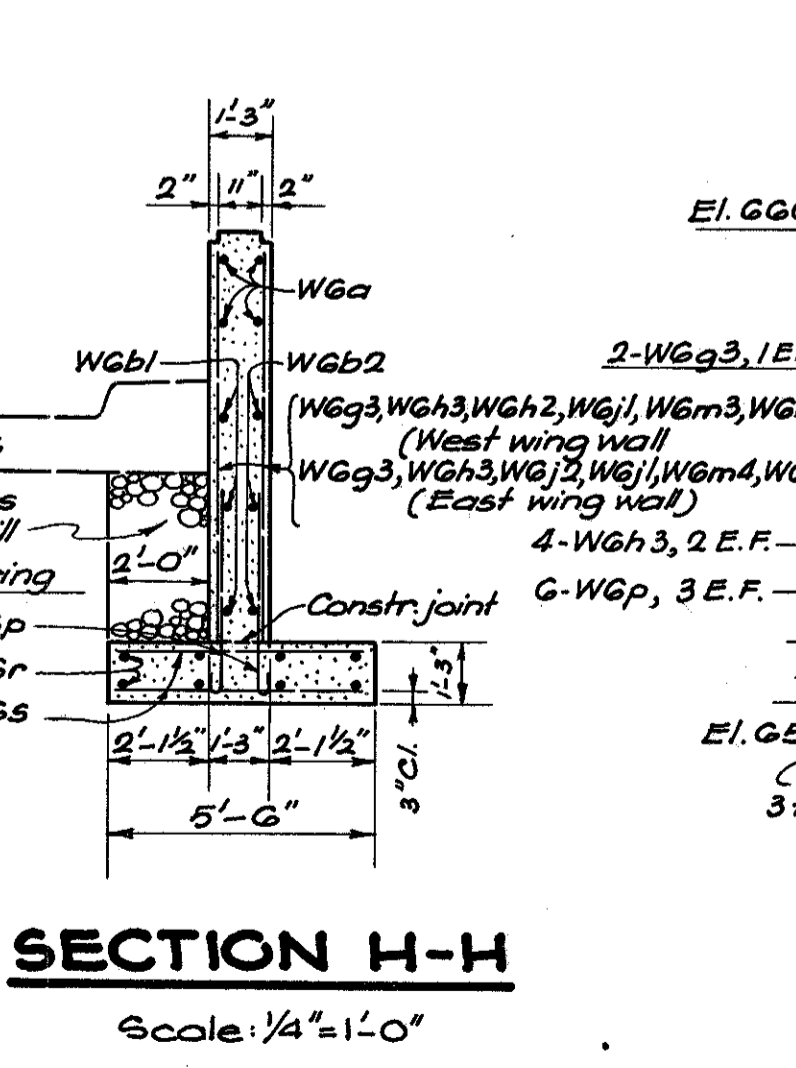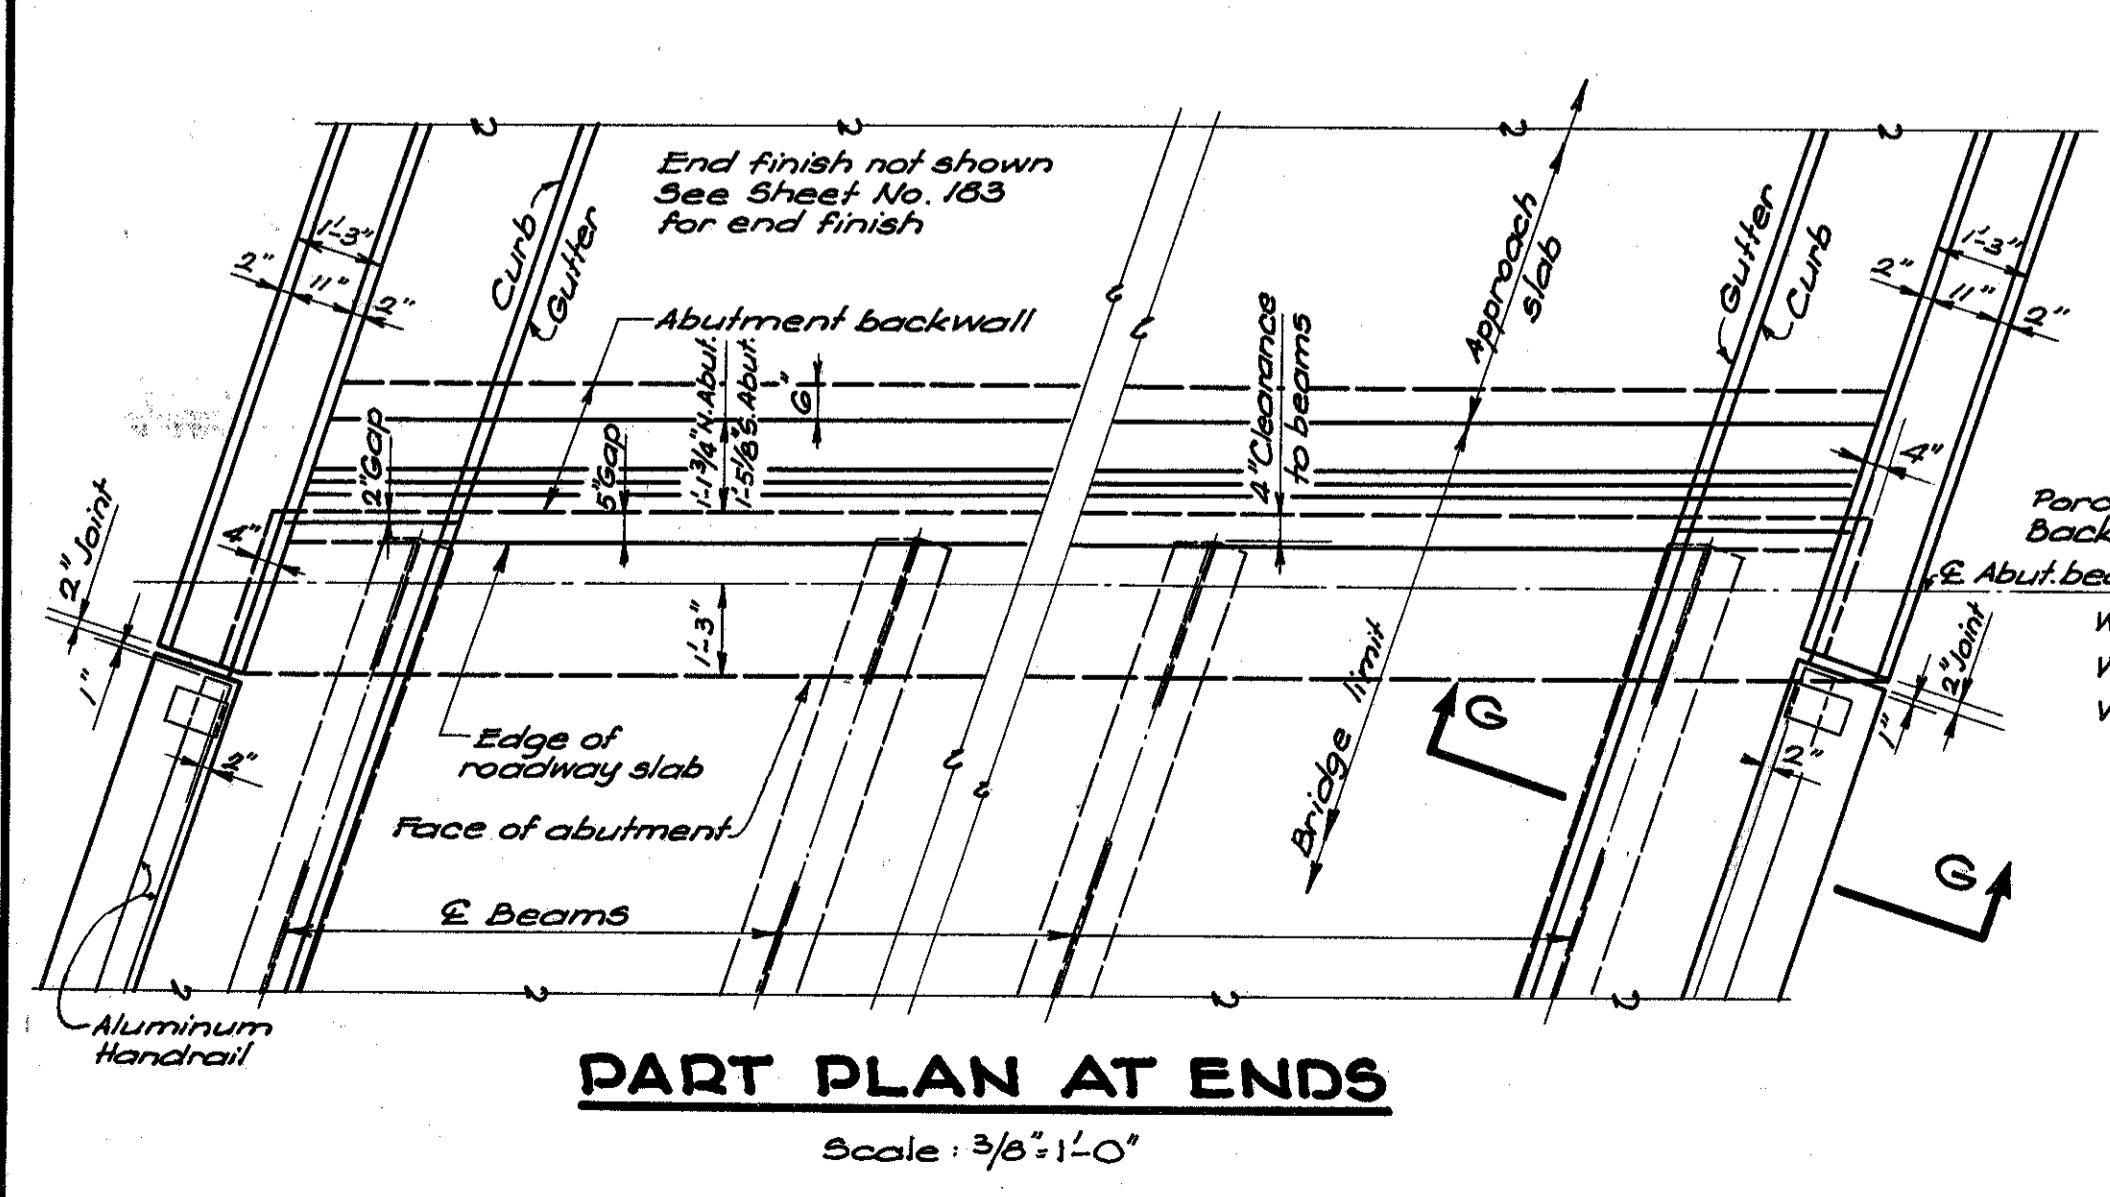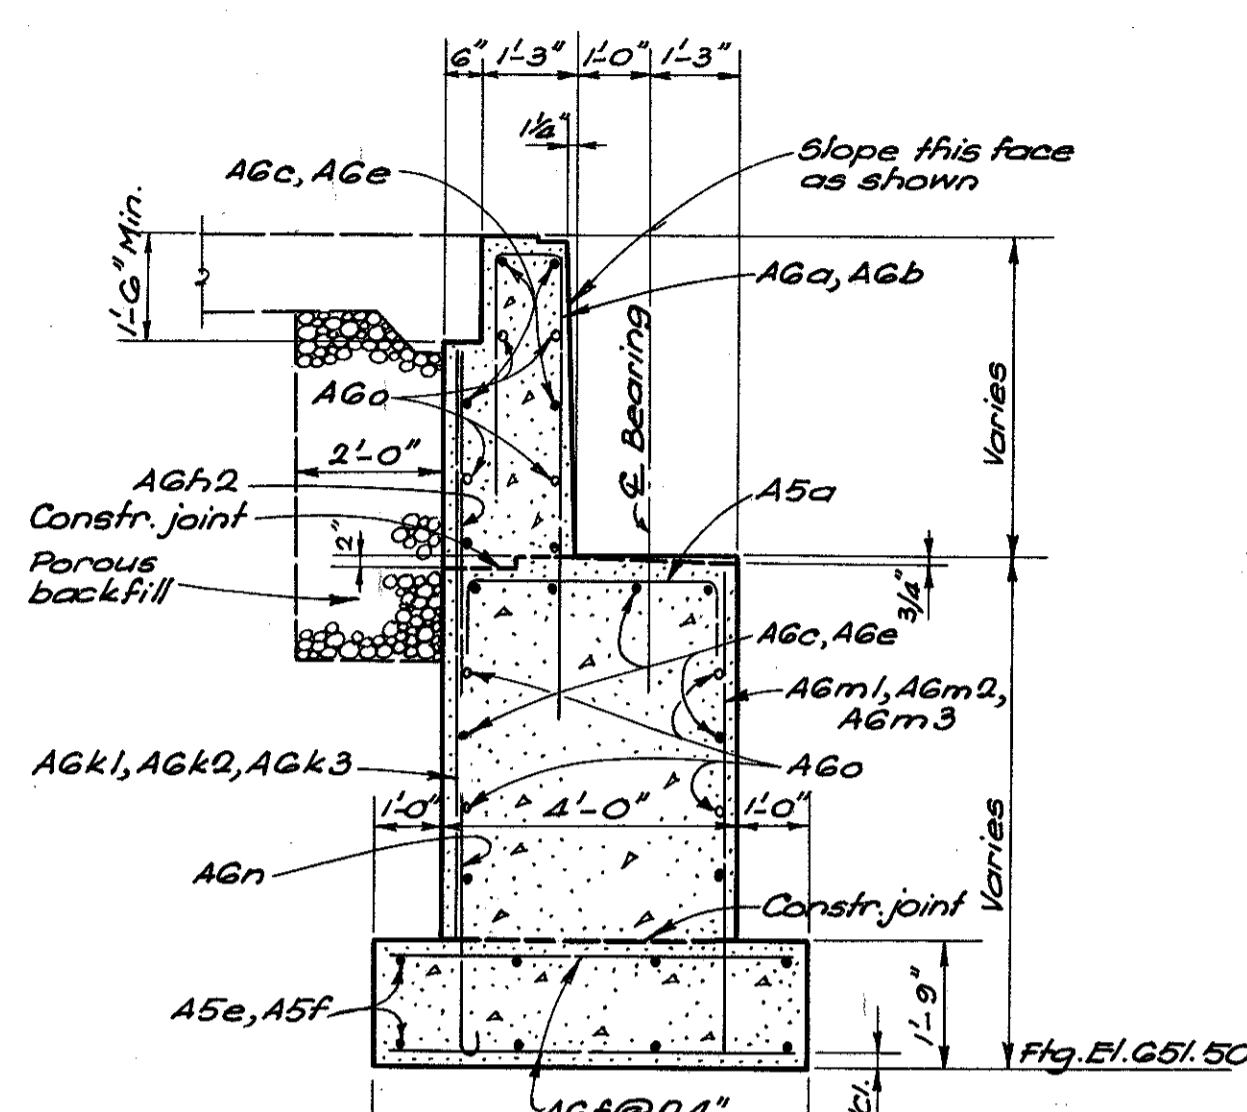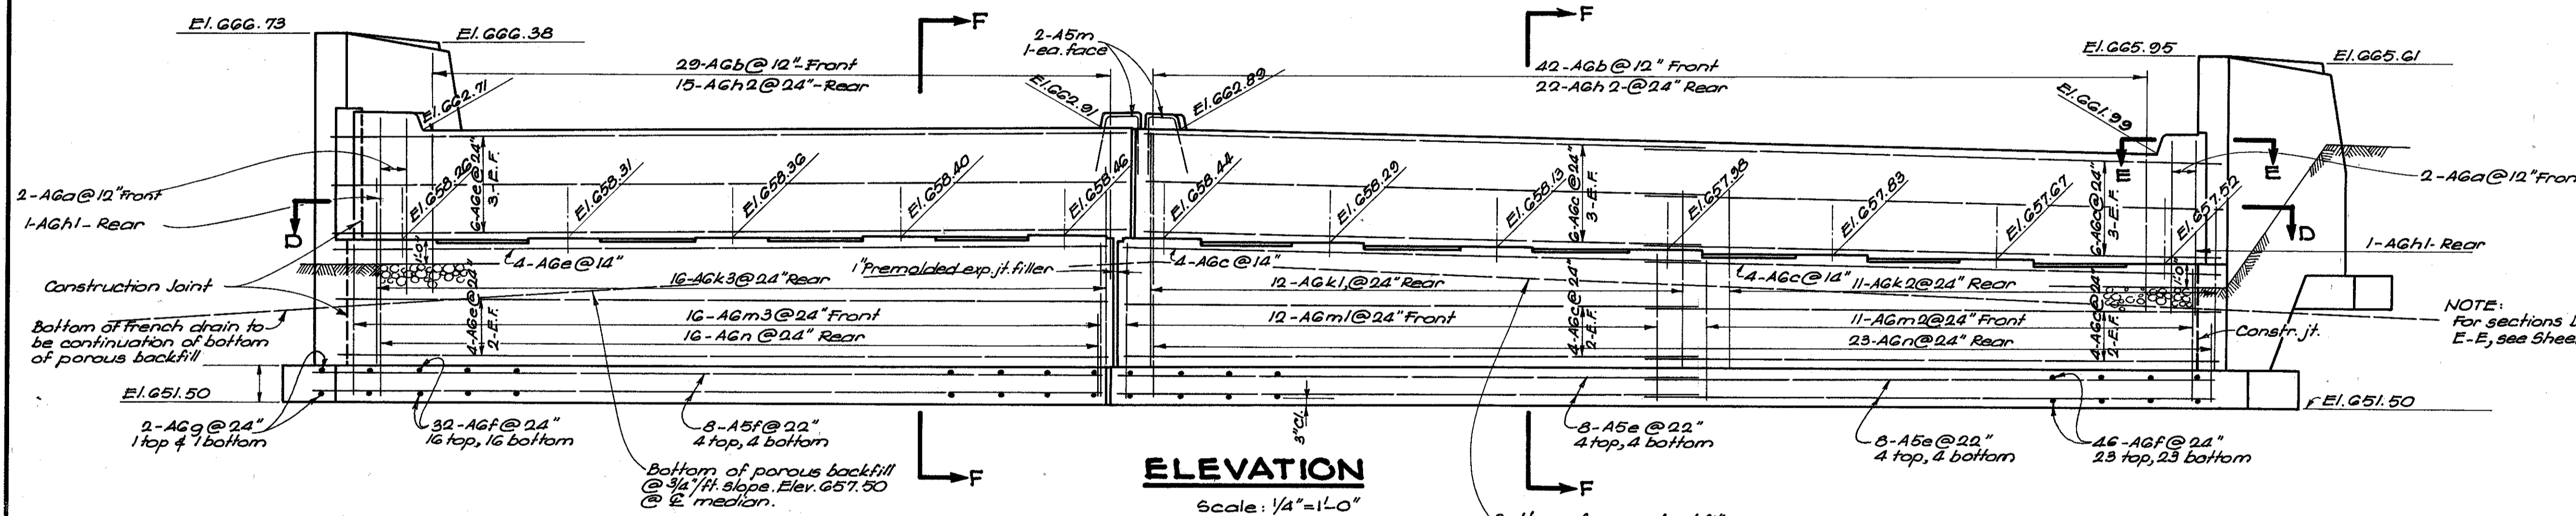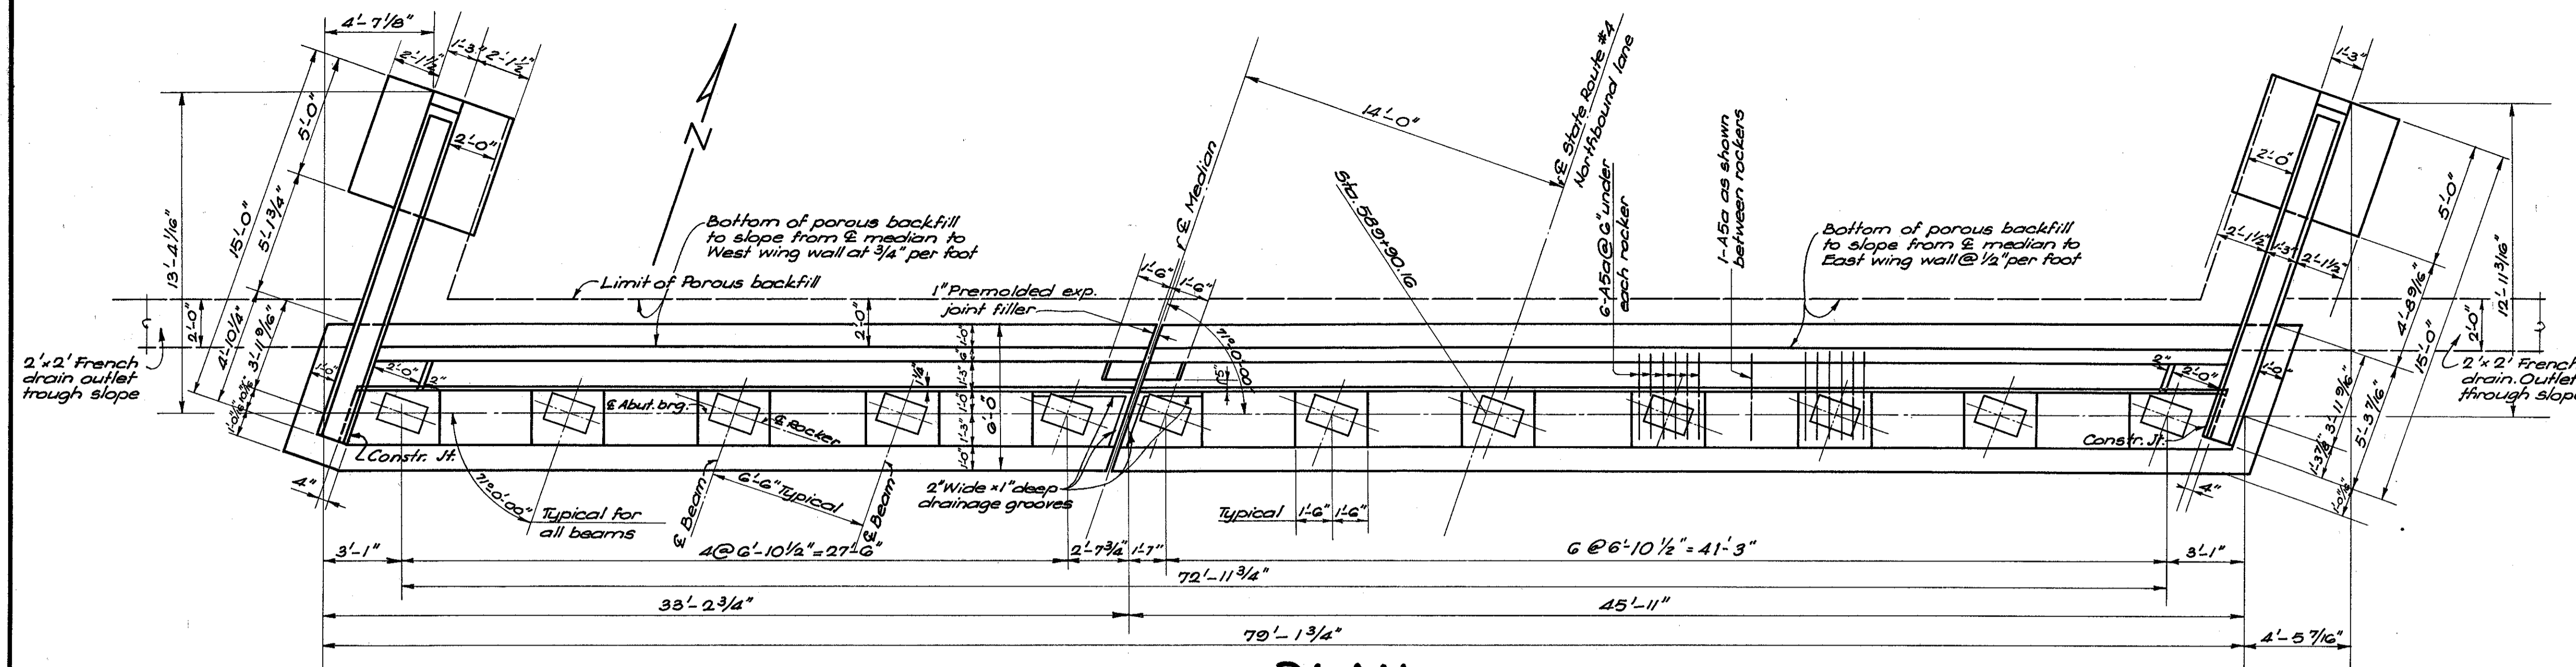

NOTE:  
All main reinforcing steel to have 2" cover unless otherwise noted. For approach slab details, see Sheet No. 180. Concrete above the bridge seat construction joint shall not be placed until after structural steel work is erected. Steel and finish shall be used as a template for top of backwall.

VOGT, IVERS, SEAMAN & ASSOCIATES  
ENGINEERS ARCHITECTS  
CINCINNATI, OHIO


**NORTH ABUTMENT**  
BRIDGE NO. BU-4-184  
OVER B.&O. R.R. AND DICKS CREEK

BUTLER COUNTY  
SEC. BUT-4  
Scale: As shown

STA: 587+80.10  
SEPT. 1955

DESIGNED	DRAWN	TRACED	CHECKED	REVIEWED	DATE	REVISED
V.K.	V.K.	J.H.K.	V.D.	W.J.T.	10-11-55	

All horizontal & vertical reinforcing steel is spaced @ 24" in each wing wall.  
F.F. denotes front face  
R.F. denotes rear face  
E.F. denotes each face

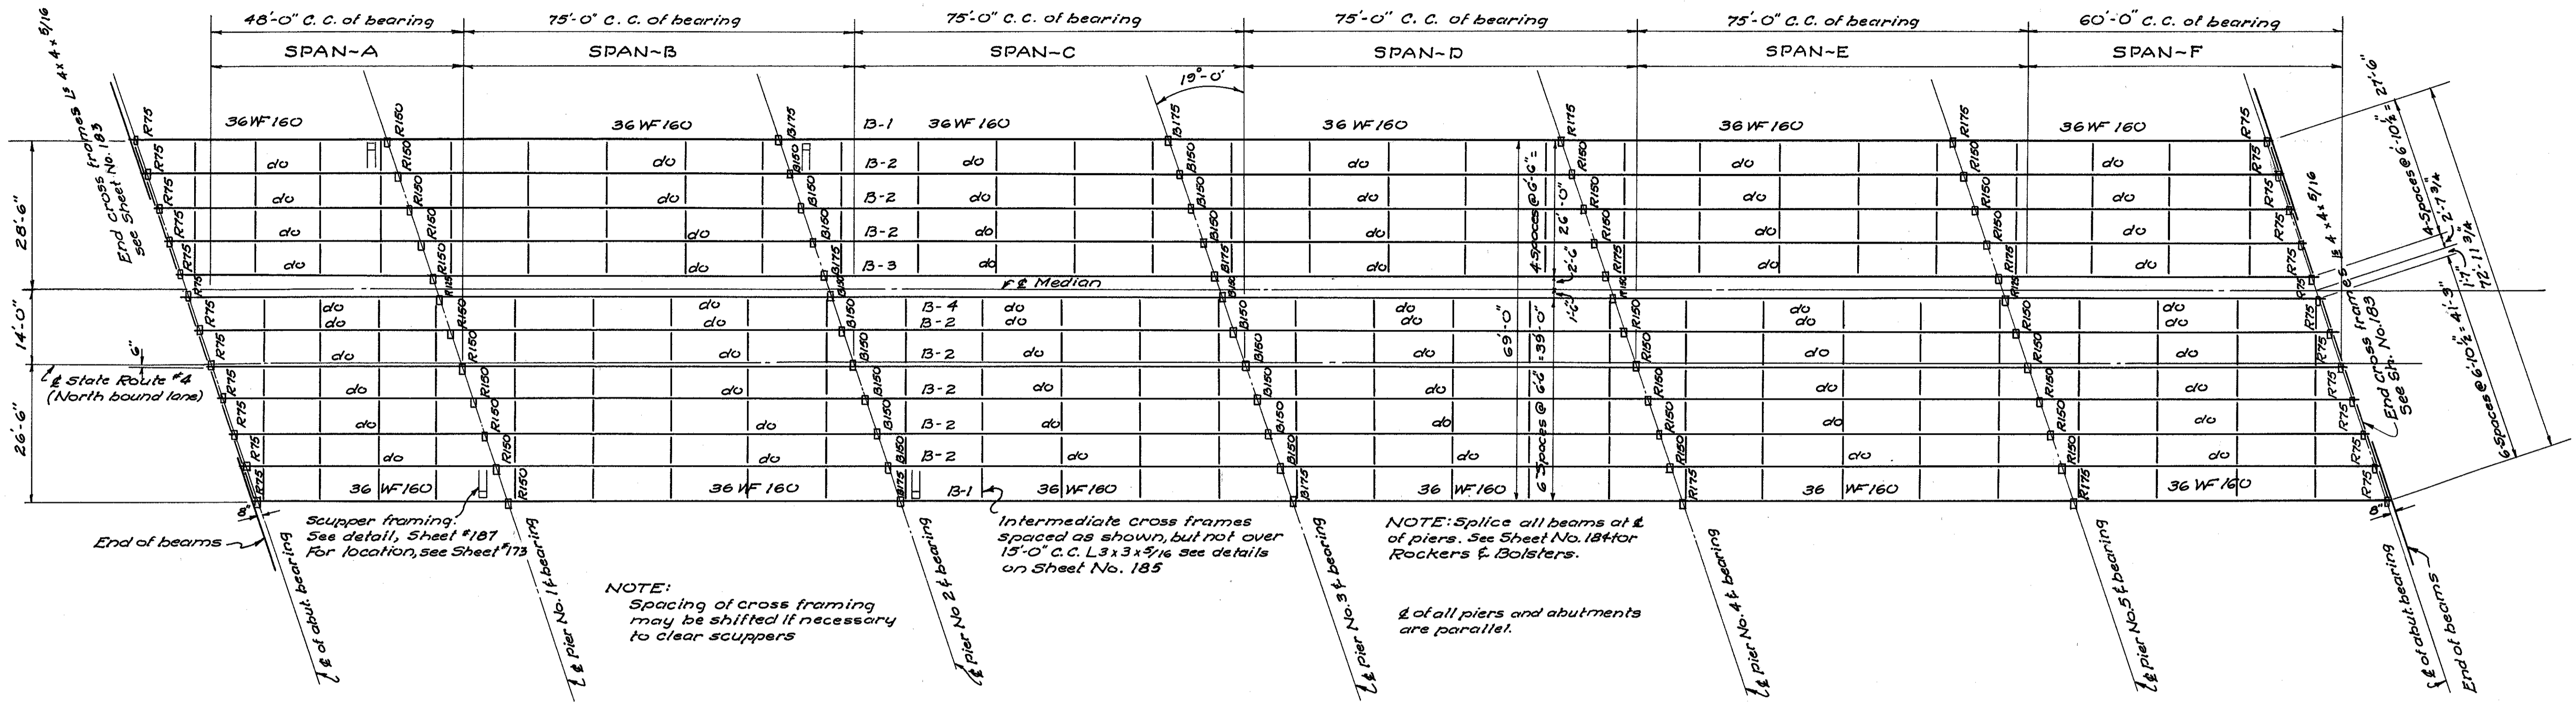



**DEFLECTION & CAMBER**

Beams	B-1					B-2					B-3					B-4									
	Span	A	B	C	D	E	F	A	B	C	D	E	F	A	B	C	D	E	F	A	B	C	D	E	F
Deflection due to weight of steel	0"	1/8"	1/16"	1/16"	1/16"	1/16"	0"	1/8"	1/16"	1/16"	1/16"	1/16"	1/16"	0"	1/8"	1/16"	1/16"	1/16"	1/16"	0"	1/8"	1/16"	1/16"	1/16"	1/16"
Deflection due to remaining dead load	1/8"	7/8"	11/16"	3/4"	3/4"	9/16"	1/16"	9/16"	7/16"	1/2"	1/2"	3/8"	1/16"	1/2"	7/16"	7/16"	3/8"	1/16"	7/16"	3/8"	3/8"	3/8"	3/8"	5/16"	
Summation of deflection	1/8"	1"	3/4"	13/16"	13/16"	5/8"	1/16"	11/16"	1/2"	9/16"	9/16"	7/16"	1/16"	5/8"	1/2"	7/16"	1/16"	1/16"	9/16"	7/16"	7/16"	7/16"	7/16"	3/8"	
Required shop camber	0	1"	1"	1"	1"	0	0	0	0	0	0	0	0	0	0	0	0	0	0	0	0	0	0	0	

NOTE: Where no Cambering is required the beams shall be so fabricated that any curved beams will be placed with the convex flange up.

**BEAM SPLICE WELDING PROCEDURE**

- At pier #3 weld bottom flange splice plates to beams spanning between piers #3 & #4.
- Raise ends of beams @ pier #2, 2 3/16"
- Weld beam flanges & webs @ pier #3.
- Weld top flange splice plates @ pier #3 (both sides of joint).
- Complete welding of bottom flange splice plates @ pier #3.
- Lower end of beams @ pier #2.
- Repeat steps 1 thru 5 @ piers #2 & #4 by raising ends of beams, 1 1/2" @ pier #1 & 1 1/2" @ pier #5.
- Lower ends of beams @ piers #1 & #5.
- Repeat steps 1 thru 5 @ pier #1 & #5 by raising ends of beams, 1 1/2" @ south abutment & 1 1/2" @ north abutment.
- Lower ends of beams @ both abutments.

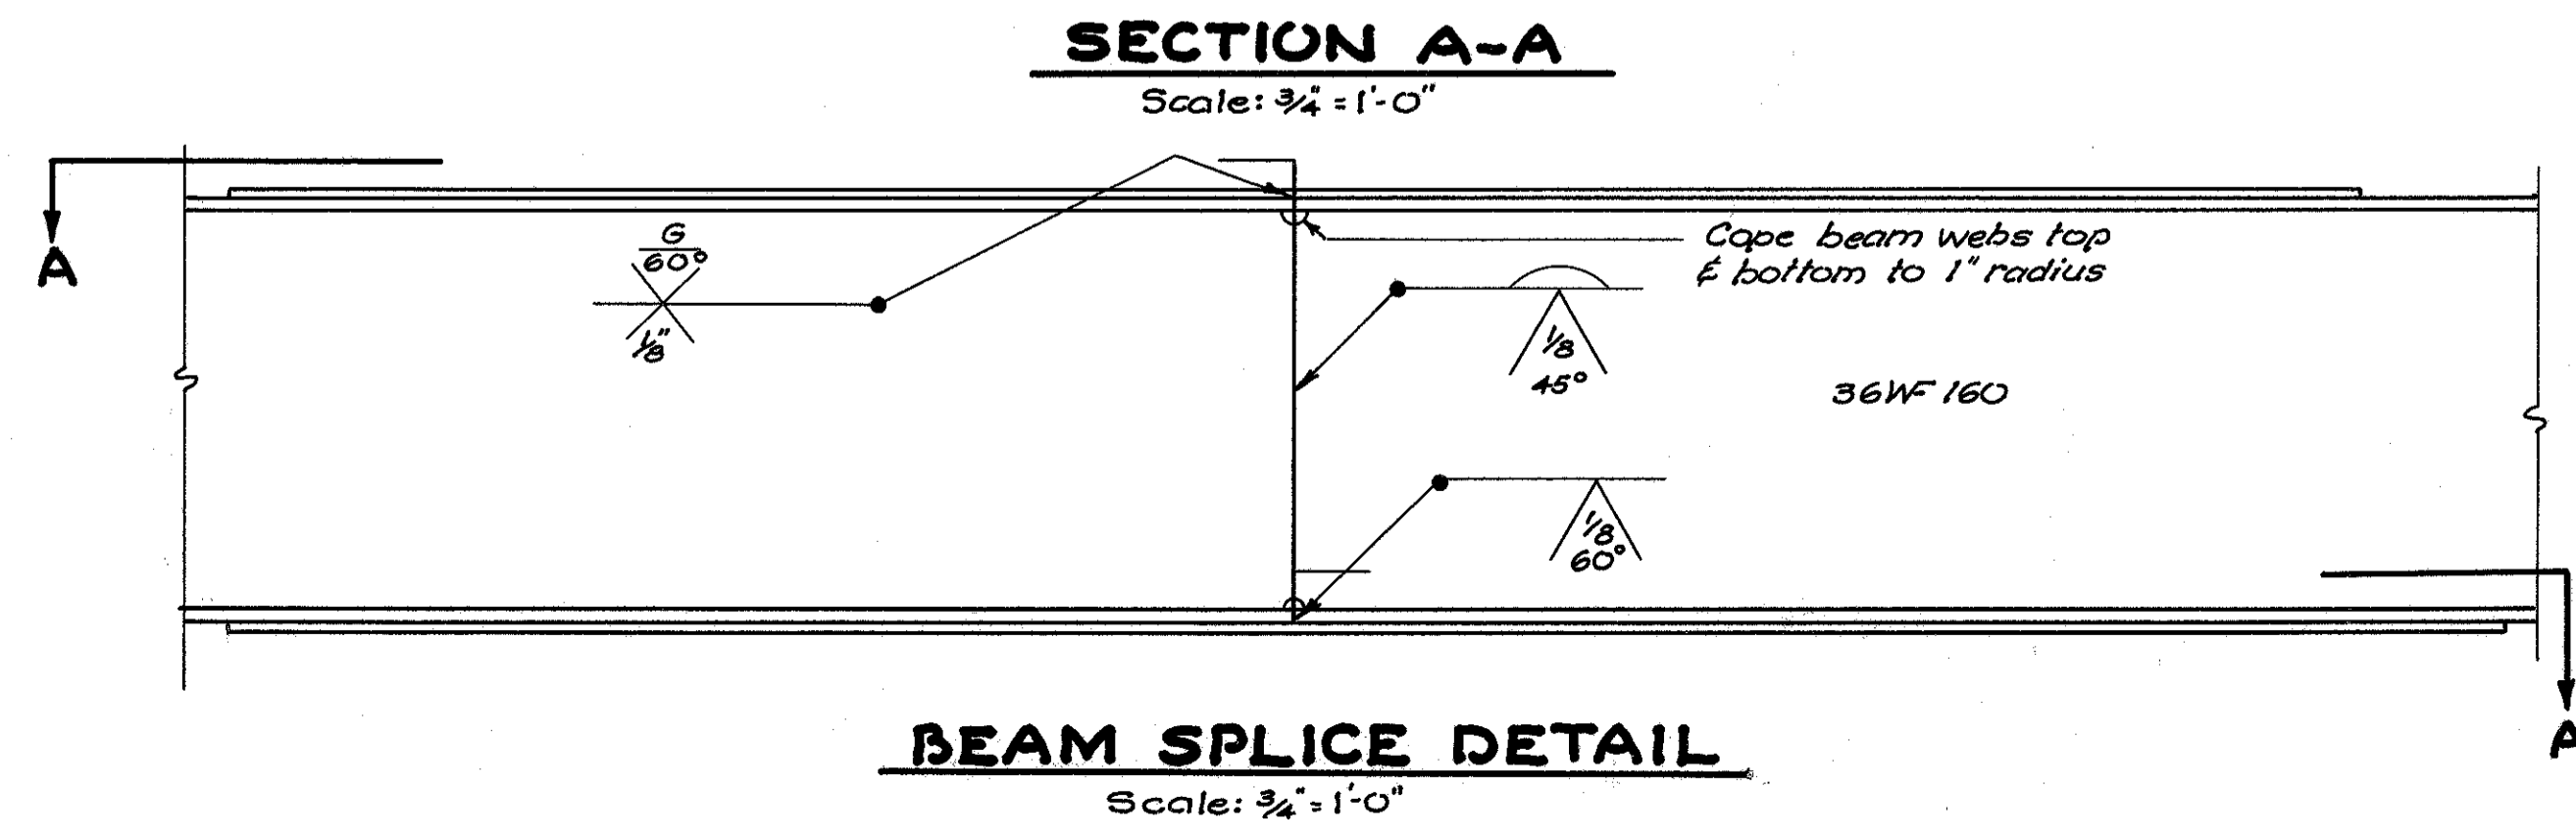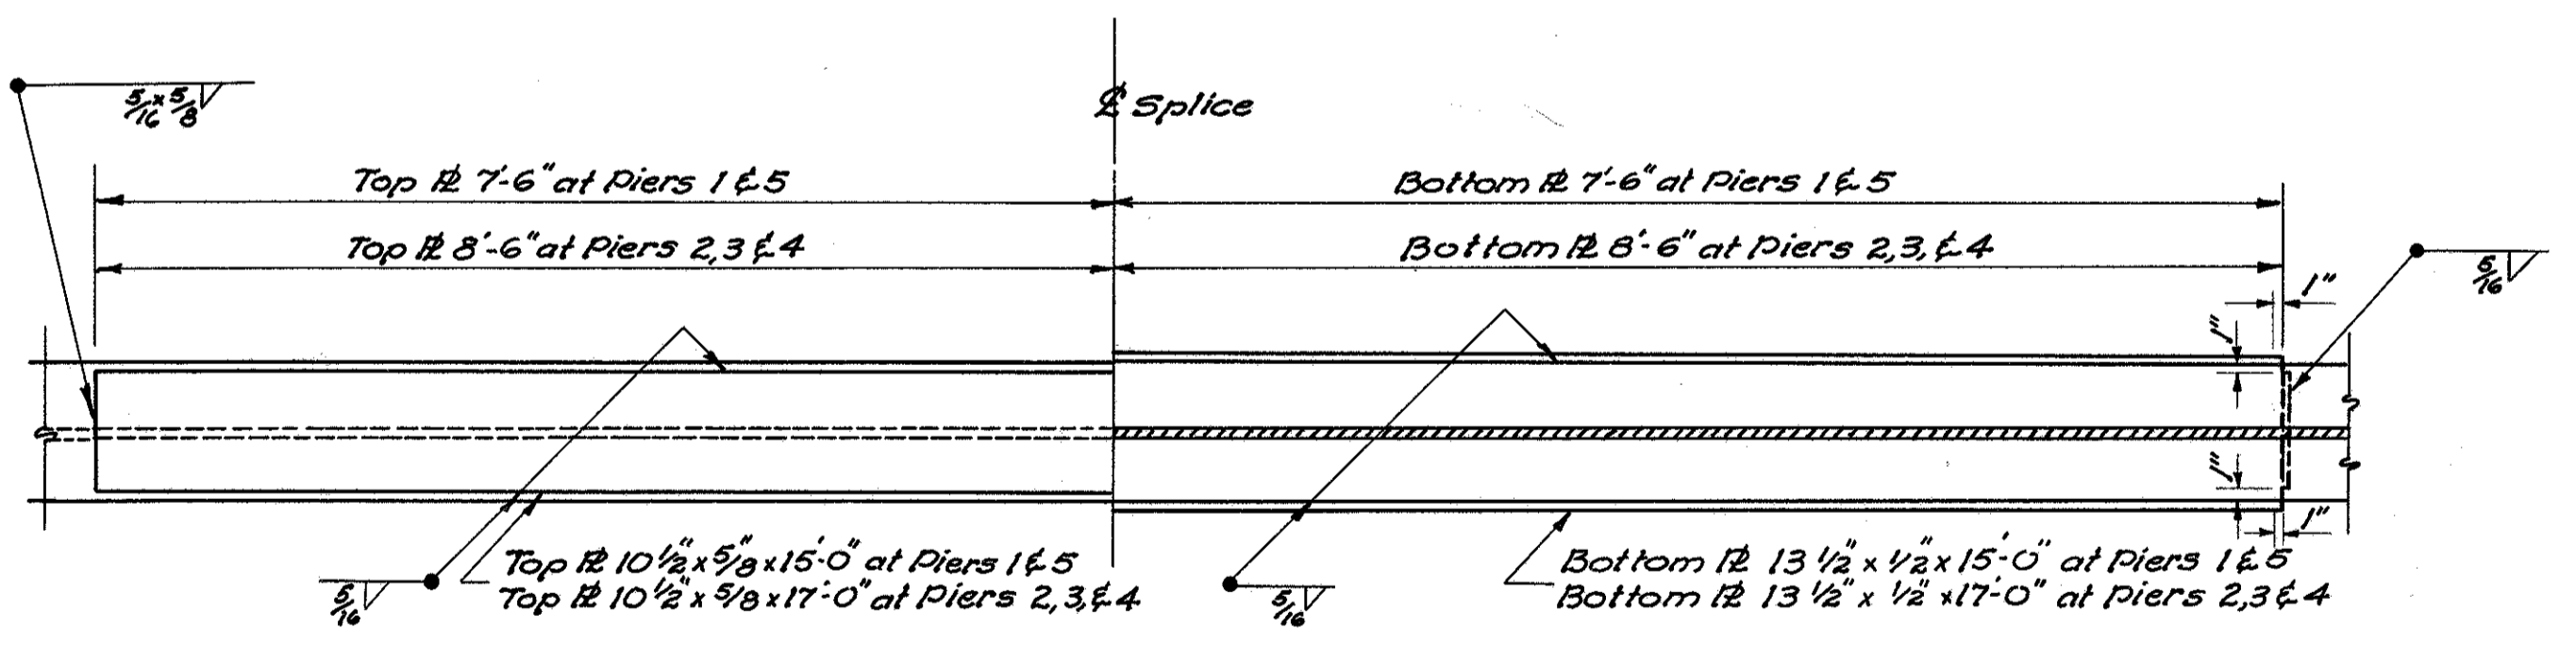


VOGT, IVERS, SEAMAN & ASSOCIATES  
ENGINEERS ARCHITECTS  
CINCINNATI, OHIO

**SUPERSTRUCTURE  
STEEL FRAMING PLAN**

BRIDGE NO. BU-4-184  
OVER B.&O. R.R. AND DICK'S CREEK  
BUTLER COUNTY  
SEC. BU-4  
Scale: As Shown



STA. 587+80.16  
SEPT. 1955

DESIGNED	DRAWN	TRACED	CHECKED	REVIEWED	DATE	REVISED
O.L.A.	B.G.E.	K.L.	O.L.A.	W.J.I.	10-11-55	

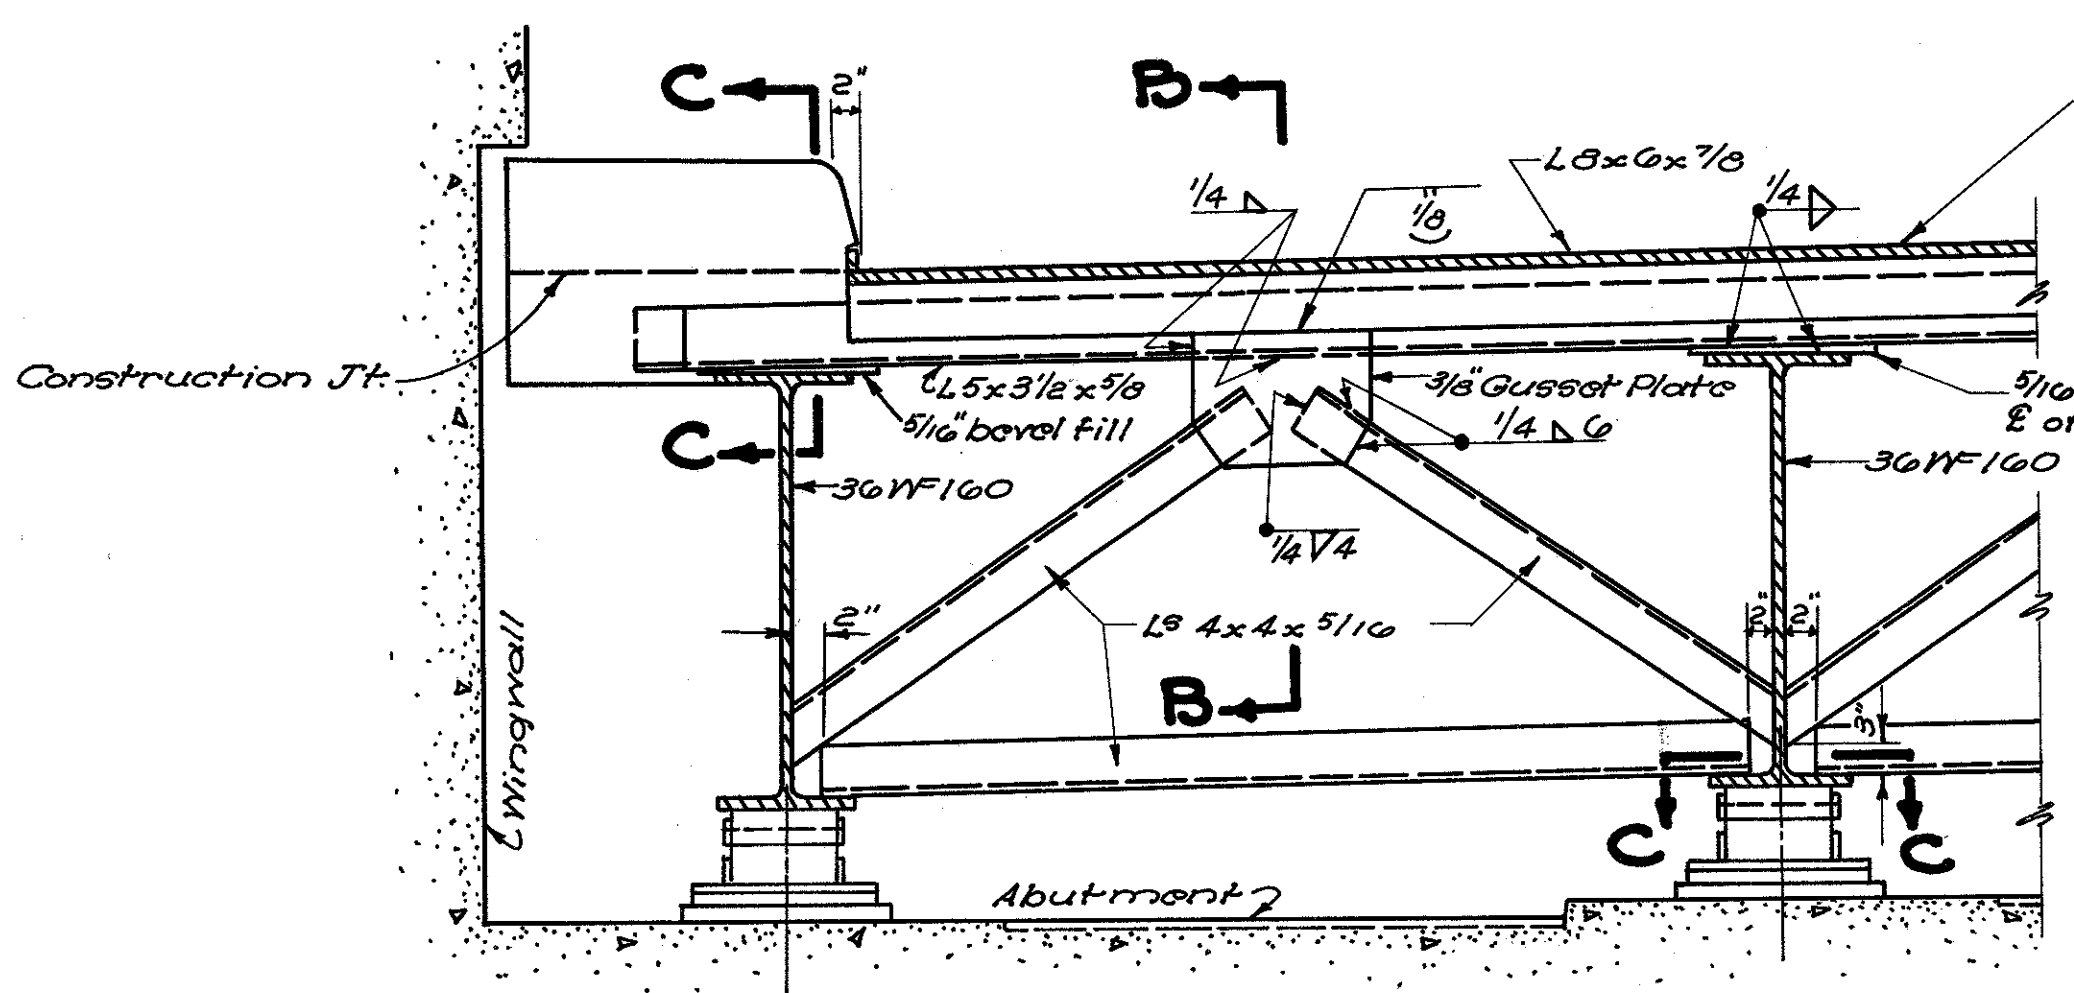


Roadway end finish angle flush with roadway surface.


A welded butt joint will be permitted in the superstructure portion of the end finish over a beam near the midpoint of each half of deck. The abutment portion of the end finish shall be furnished in lengths of angle and bar not under 6'-0" nor over 20'-0".

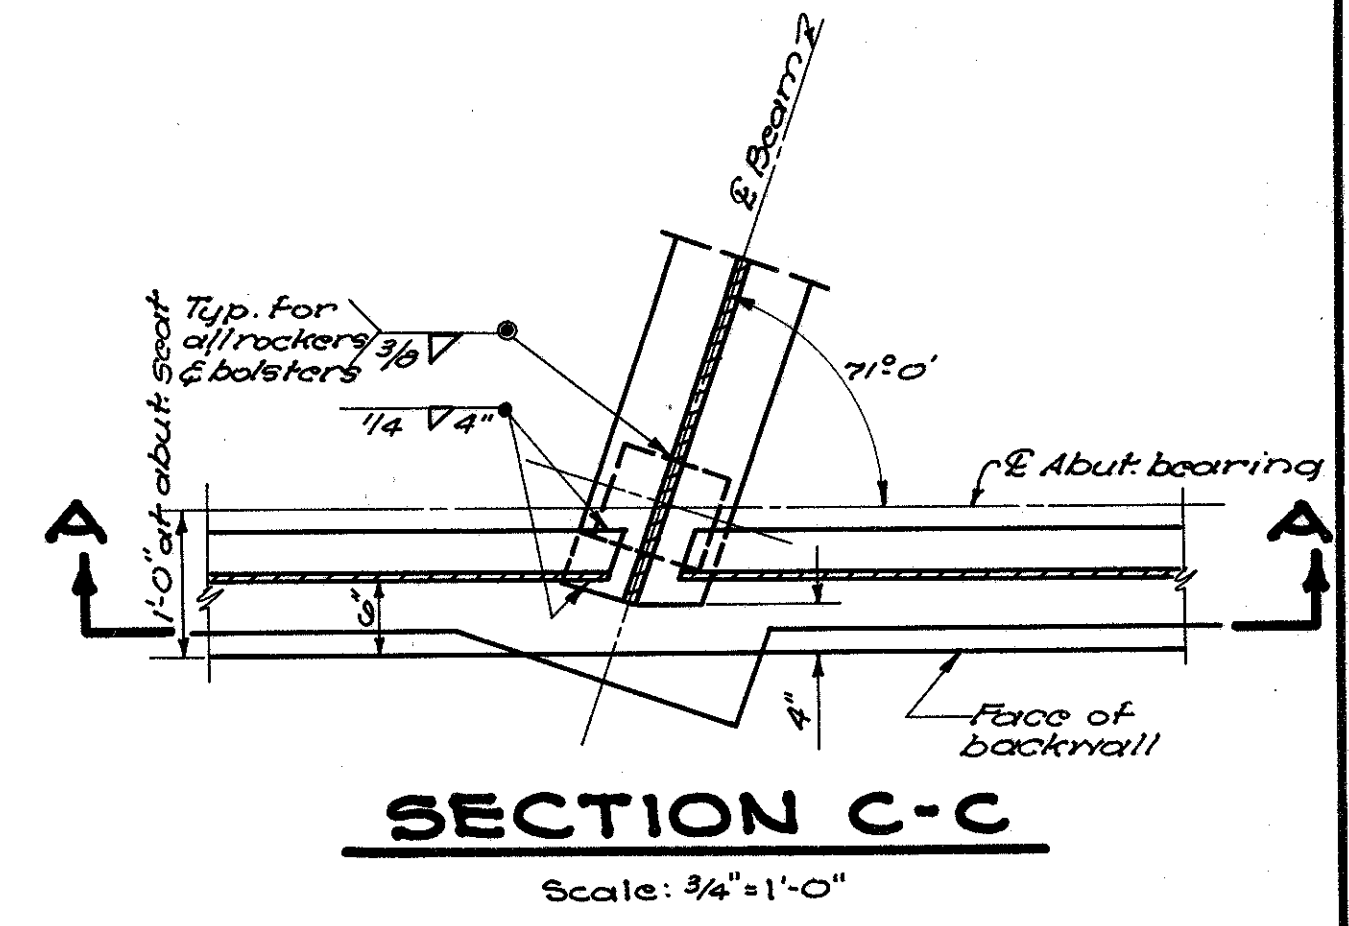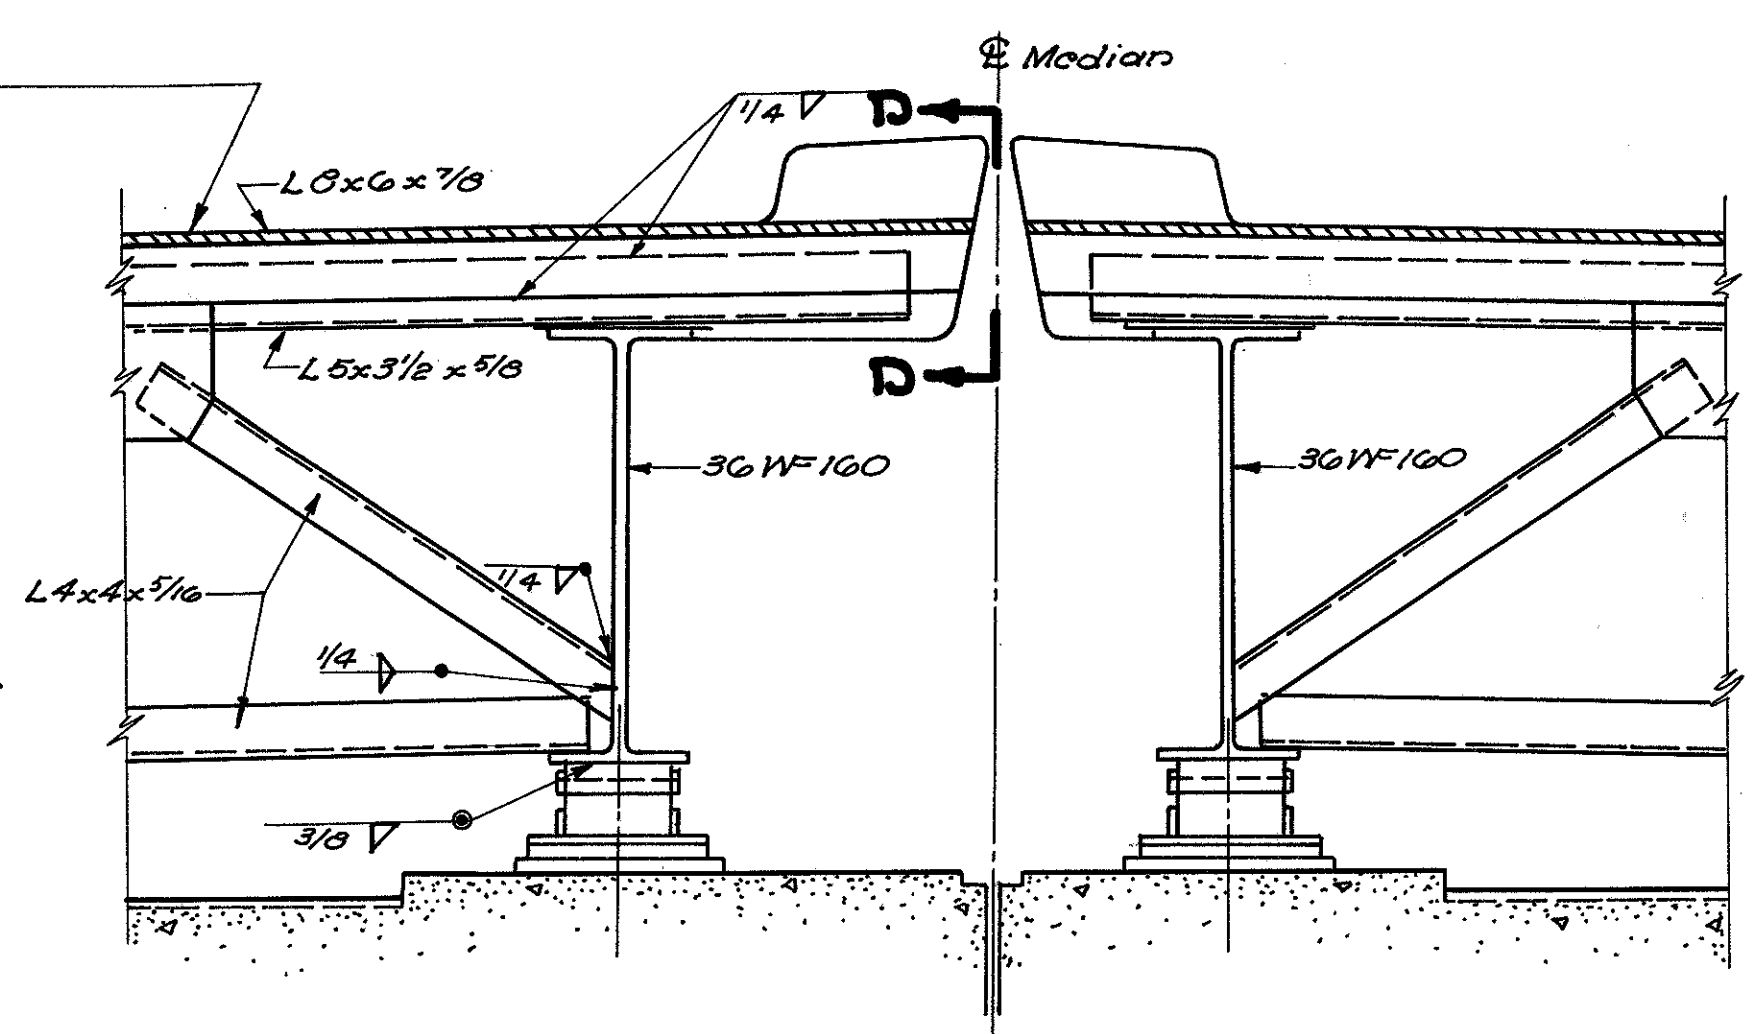


**SECTION A-A**  
**SHOWING END BRIDGING**  
**END FRAMING & END FINISH DETAILS**  
 Scale: 3/4" = 1'-0"

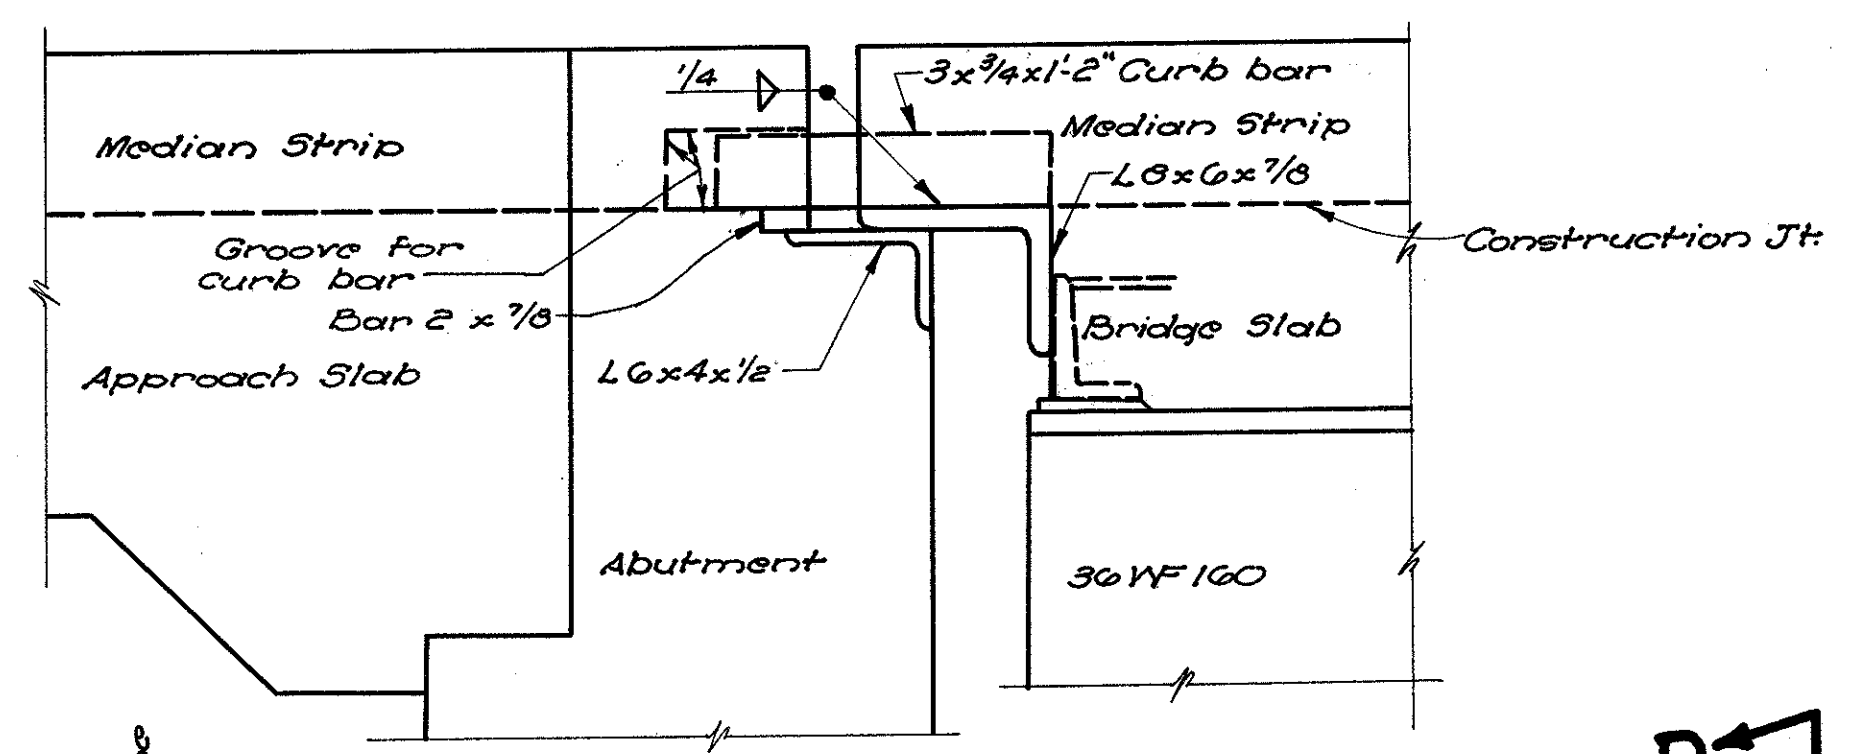


**SECTION D-D**  
 Scale: 1/2" = 1'-0"

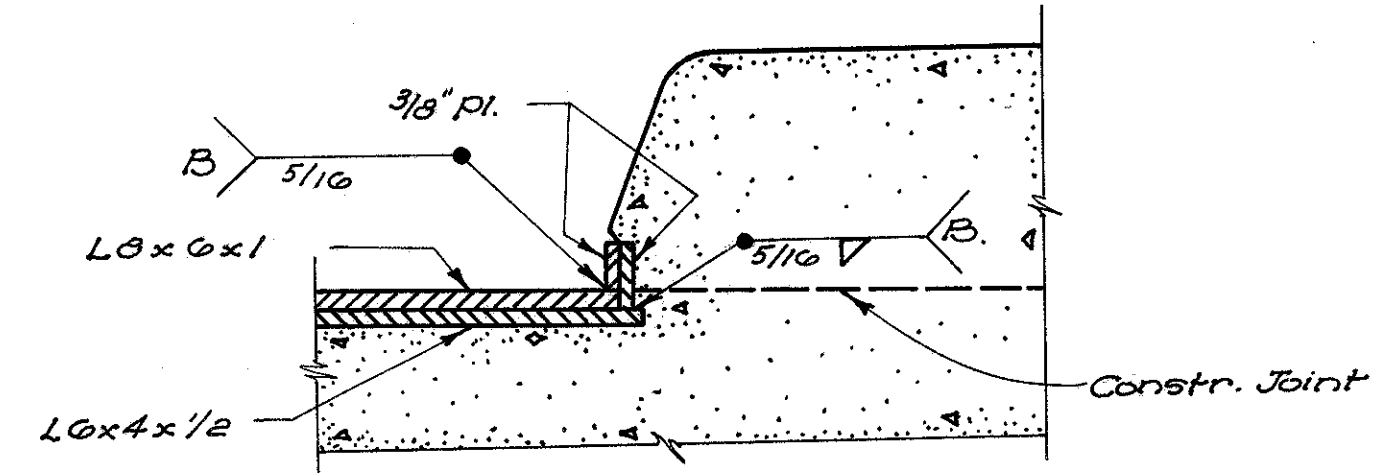


**SECTION G-G**

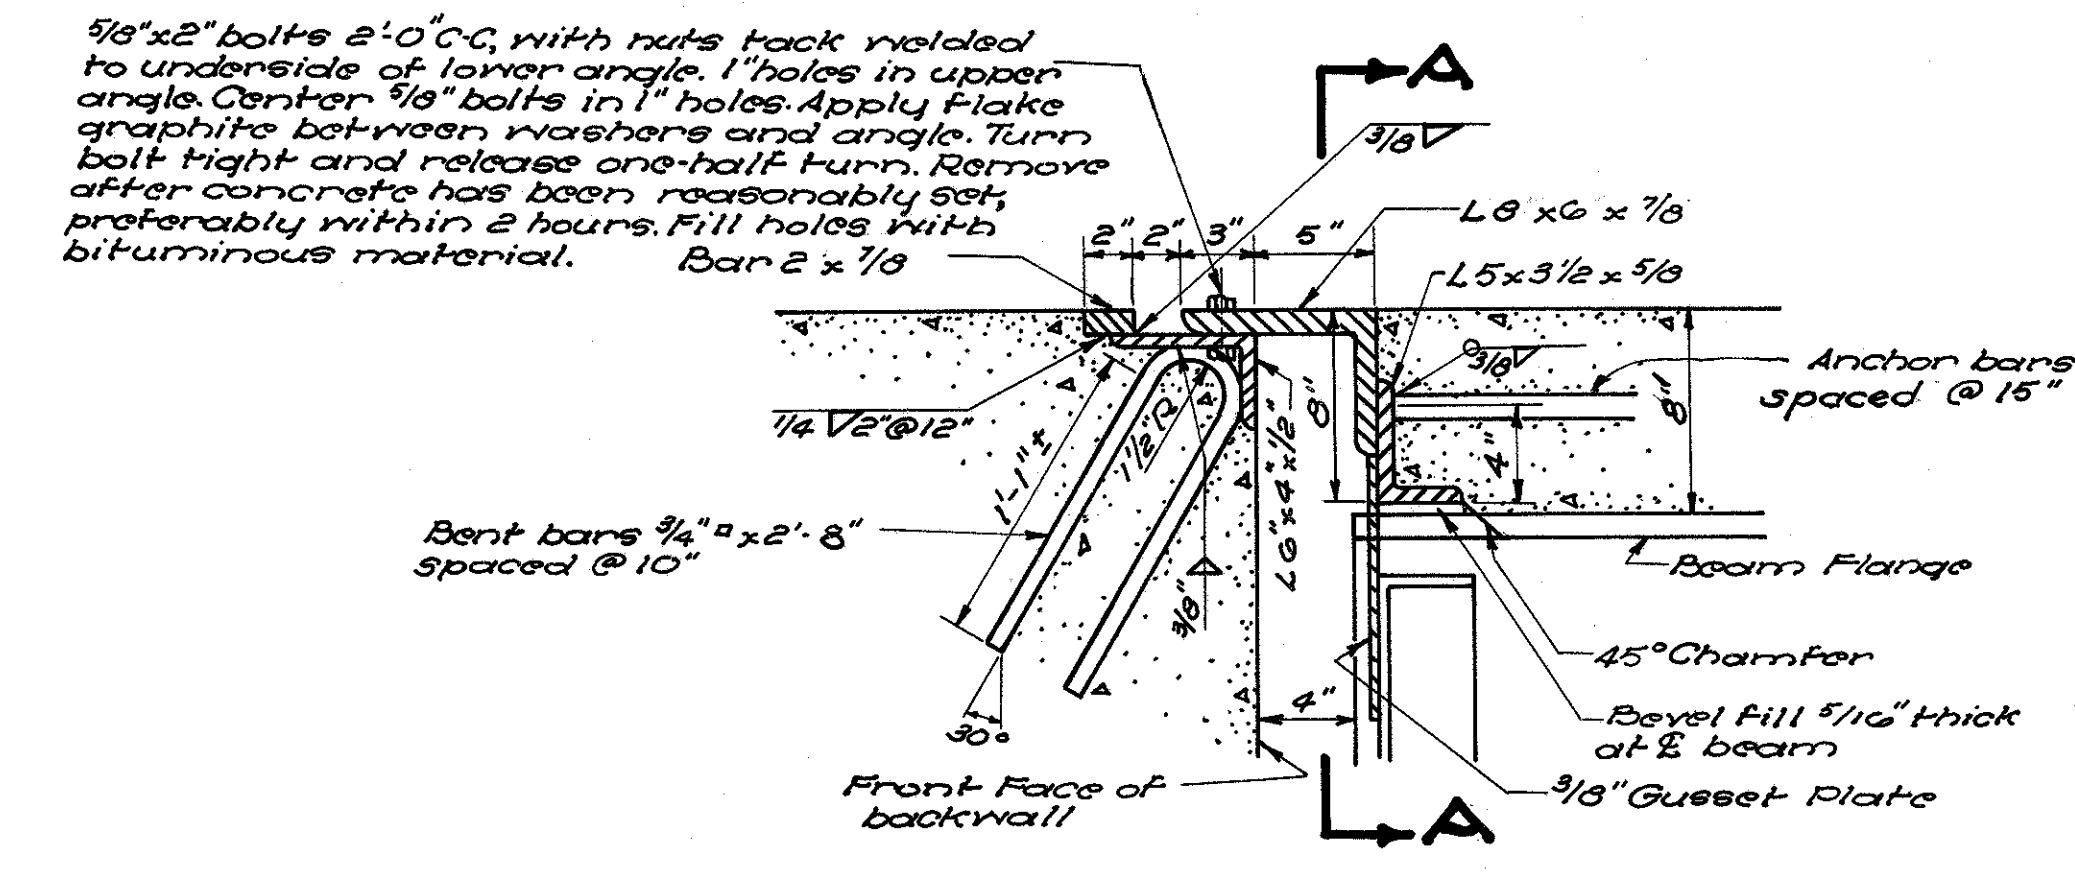


**SECTION B-B**  
 Scale: 1/2" = 1'-0"

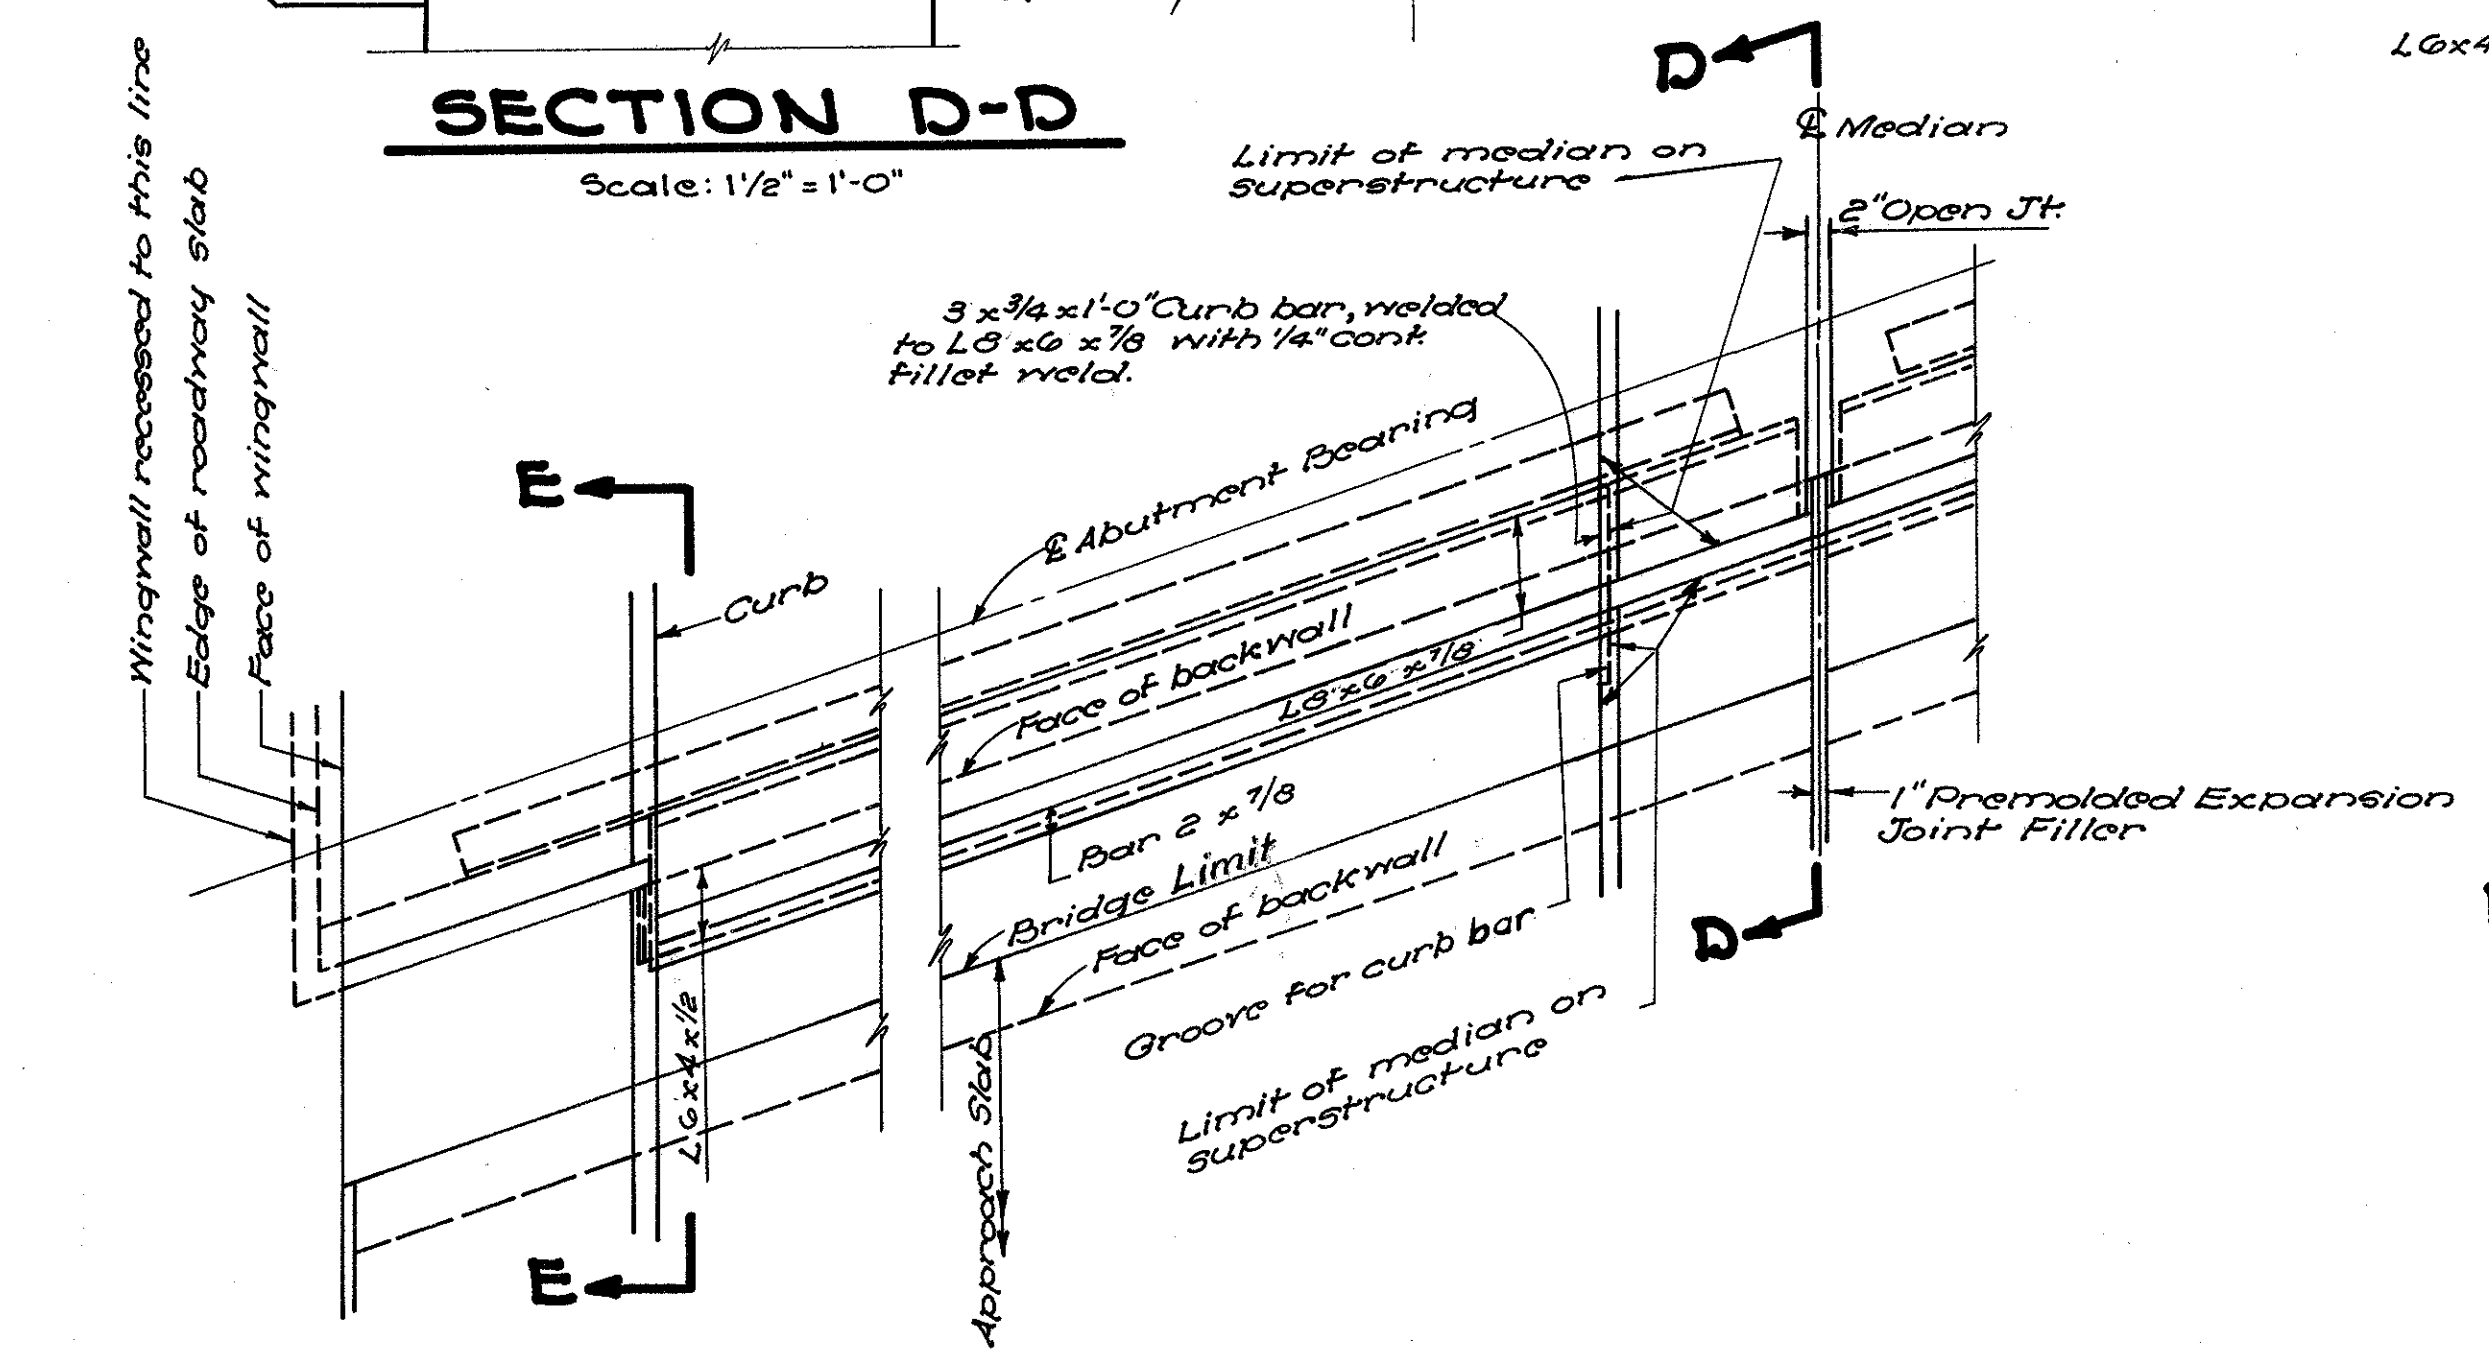

**PARTIAL PLAN OF END FINISH**  
**SOUTH ABUT. SHOWN, NORTH ABUT. SIMILAR**  
 Scale: 3/4" = 1'-0"

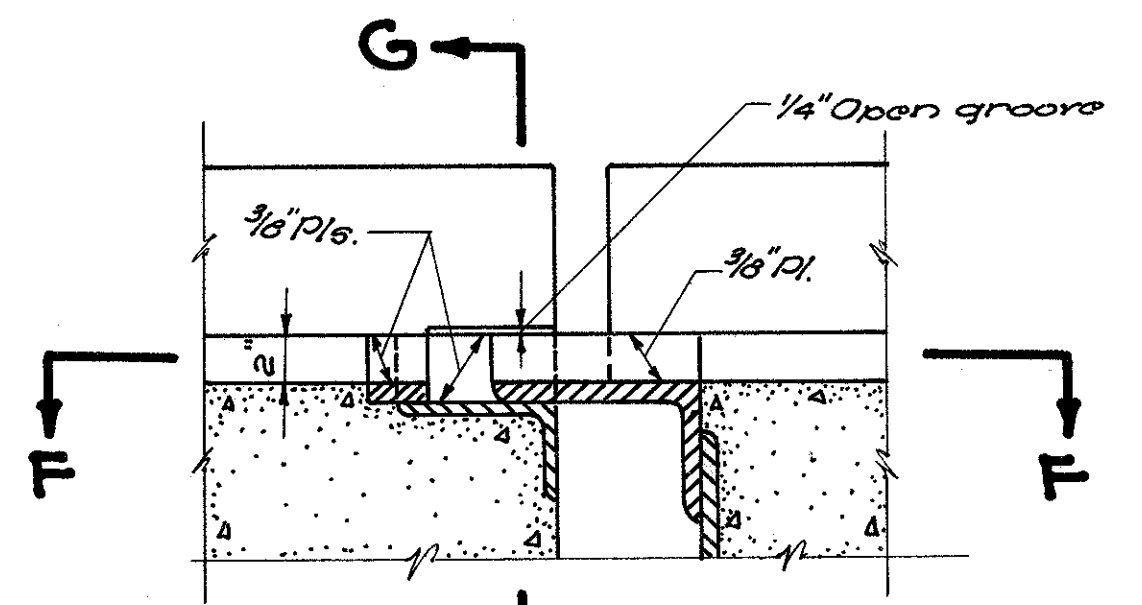

**SECTION E-E**

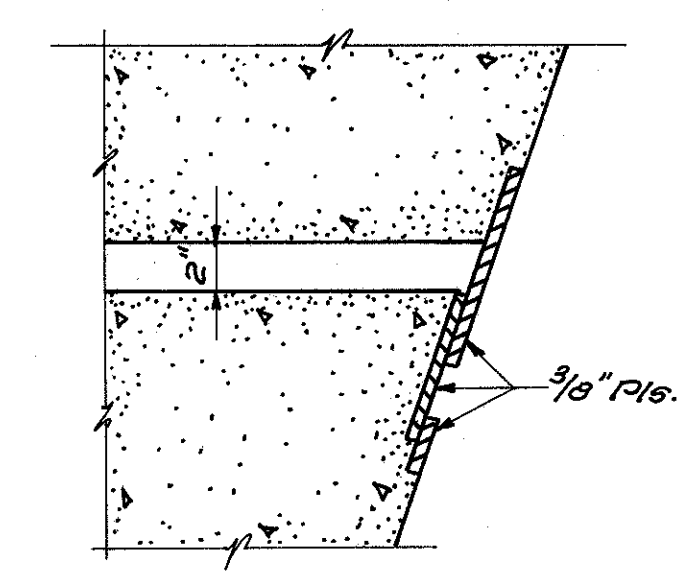


**SECTION F-F**

**CURB PLATE DETAILS**  
 Scale: 1/2" = 1'-0"


VOGT, IVERS, SEAMAN & ASSOCIATES ENGINEERS ARCHITECTS CINCINNATI, OHIO			
<b>SUPERSTRUCTURE</b> <b>END FINISH &amp; END BRIDGING</b>			
BRIDGE NO. BU-4-104 OVER B & O R.R. & DICKS CREEK			
BUTLER COUNTY SEC. BUT-4 Scale: As shown		STA. 587+80.16 Sept. 1955	
DESIGNED	DRAWN	TRACED	CHECKED
O.L.A.	V.D.	N.B.	O.L.A.
DATE		REVISED	
10-11-55			





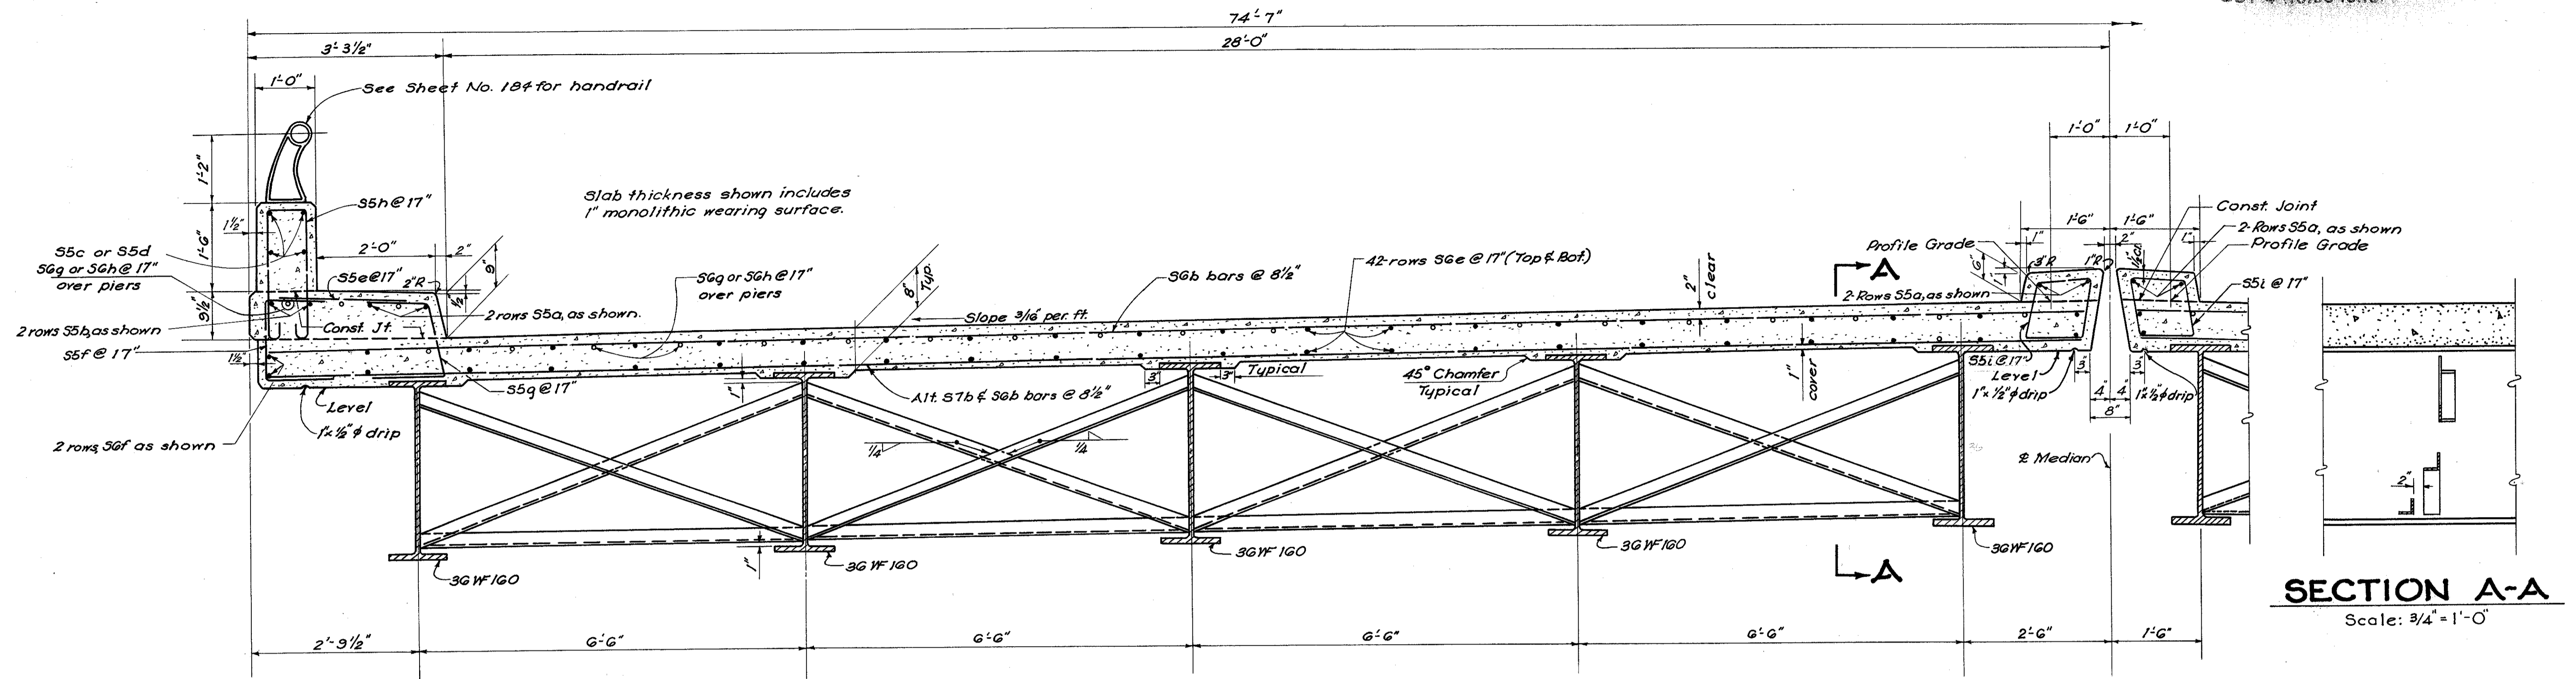

**SECTION A-A**  
Scale: 3/4" = 1'-0"

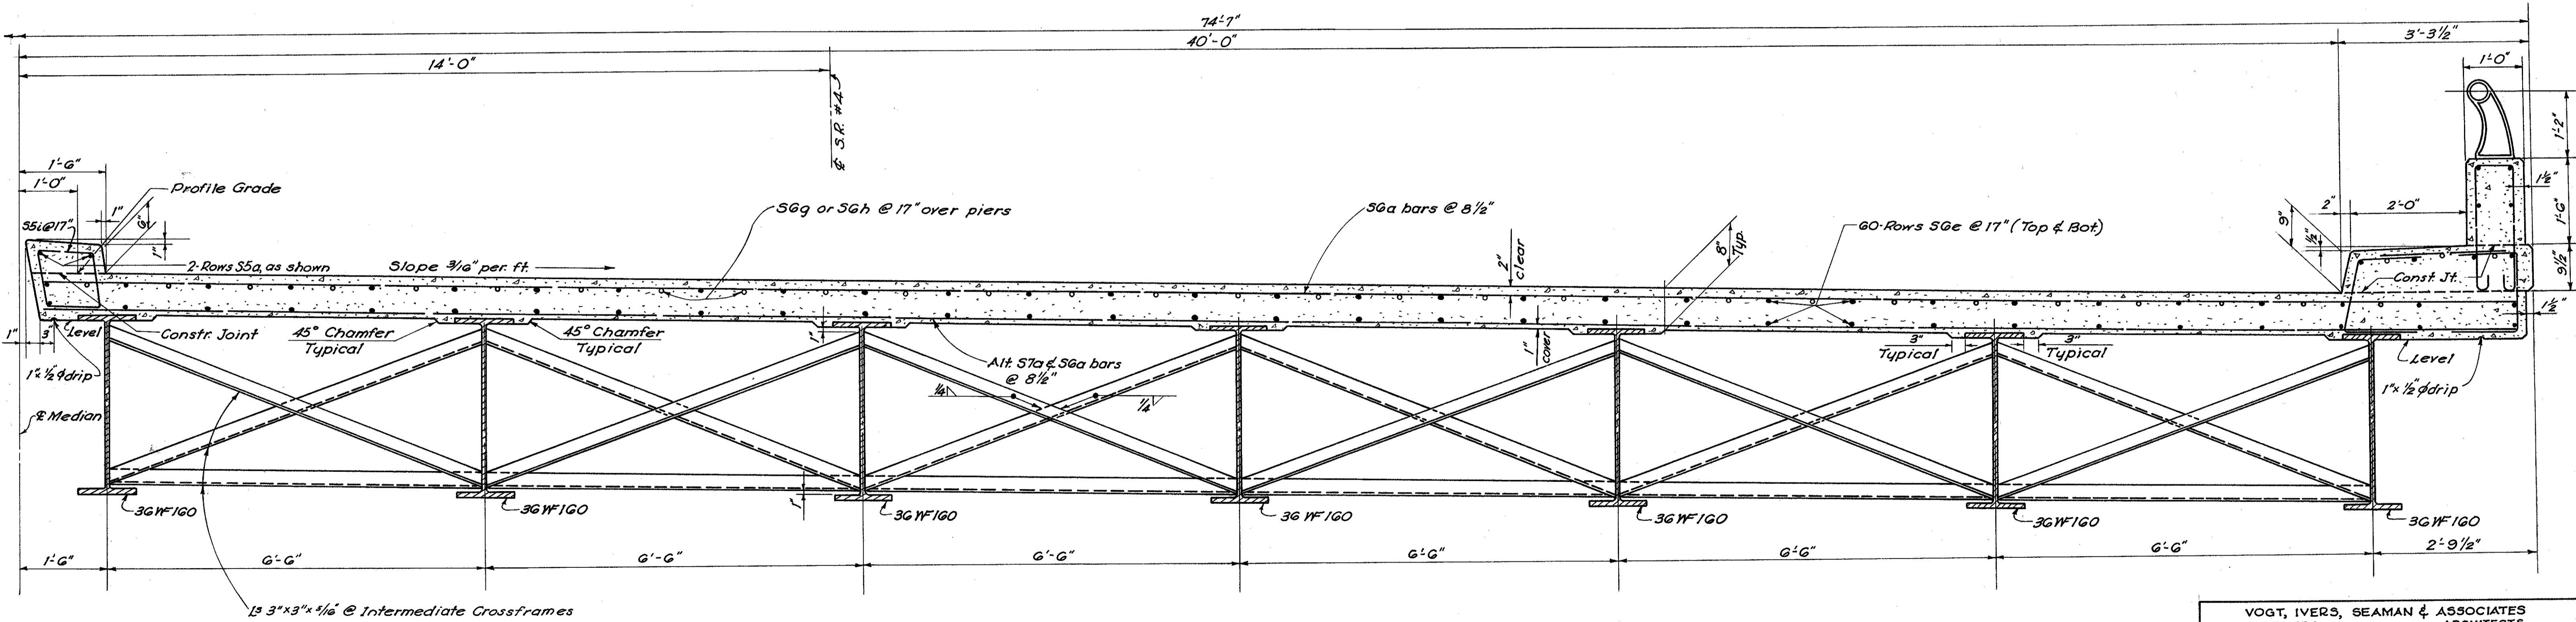

13 3"x3"x 1/4" @ Intermediate Crossframes

Weld both sides of vertical leg & top side of horizontal leg to beam web with 1/4 cont. fillet weld.



**TYPICAL TRANSVERSE SECTION THRU ROADWAY**

Scale: 3/4" = 1'-0"

VOGT, IVERS, SEAMAN & ASSOCIATES  
ENGINEERS ARCHITECTS  
CINCINNATI, OHIO


**SUPERSTRUCTURE  
ROADWAY SLAB**  
BRIDGE NO. BU-4-184  
OVER B.&O. R.R. AND DICK'S CREEK  
BUTLER COUNTY  
SEC. BUT-4 STA. 587+80.16  
Scale: As shown SEPT. 1955

DESIGNED	DRAWN	TRACED	CHECKED	REVIEWED	DATE	REVISED
O.L.A.	V.D.	S.J.B.	O.L.A.	W.J.I.	10-11-55	

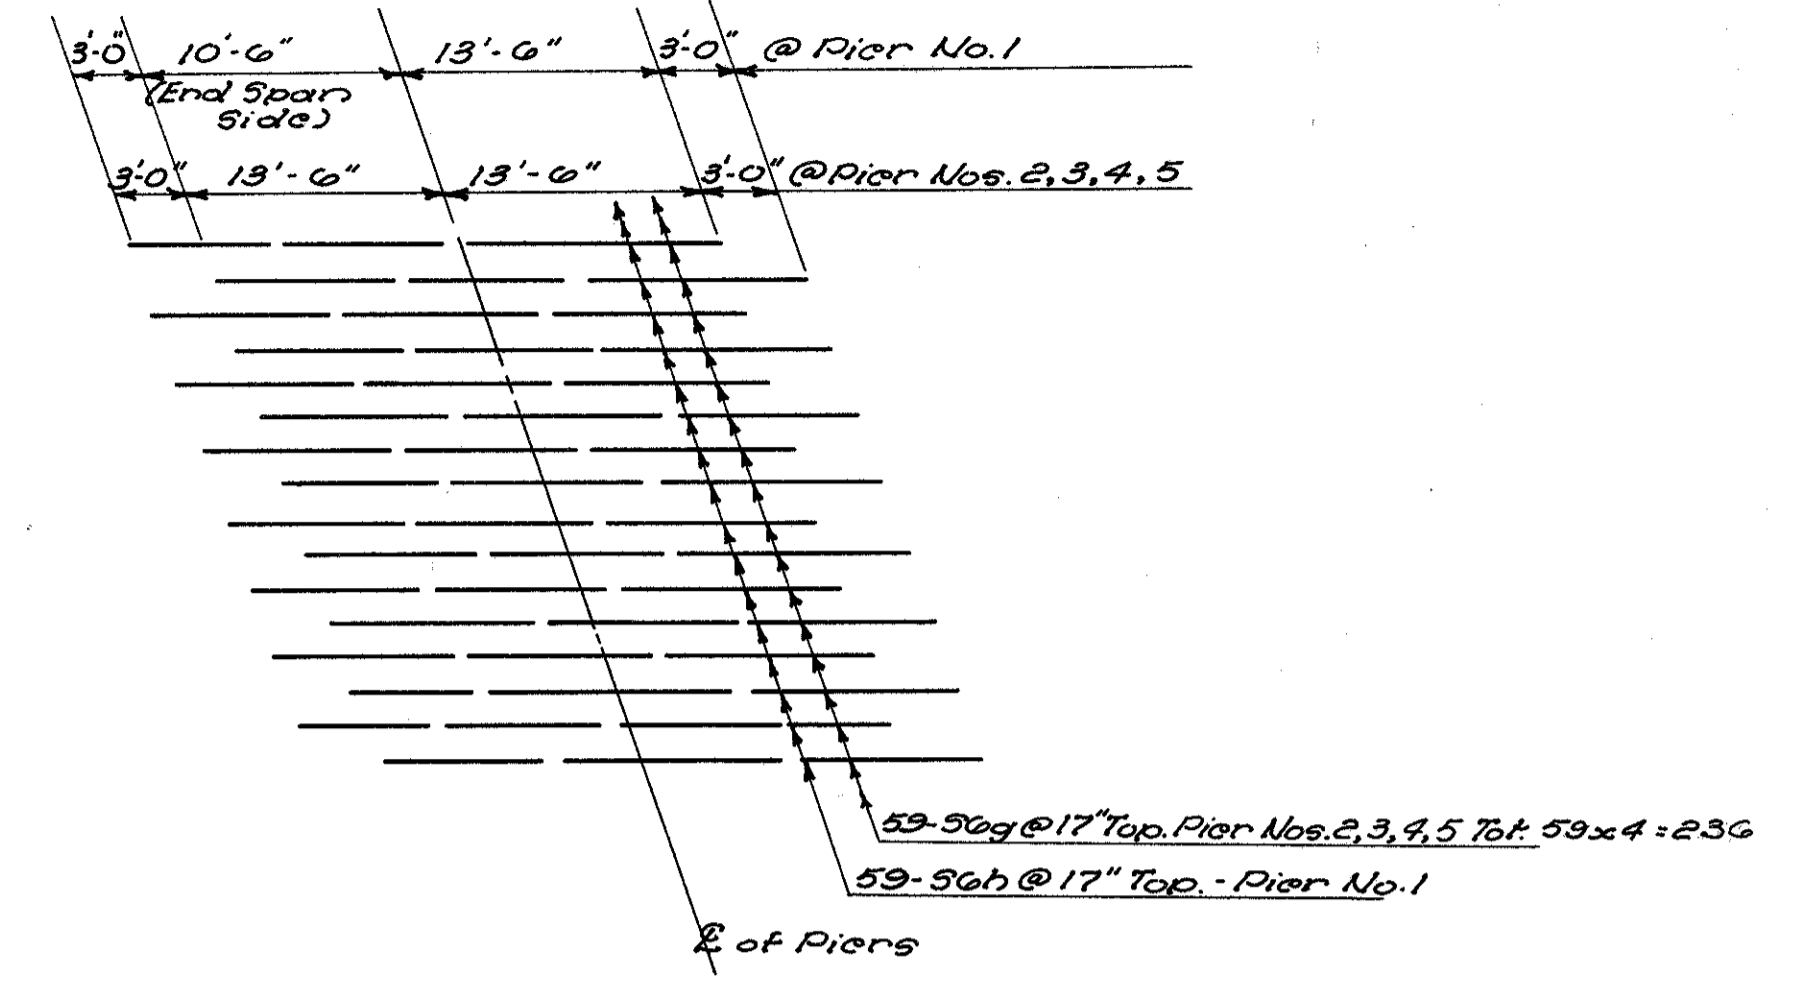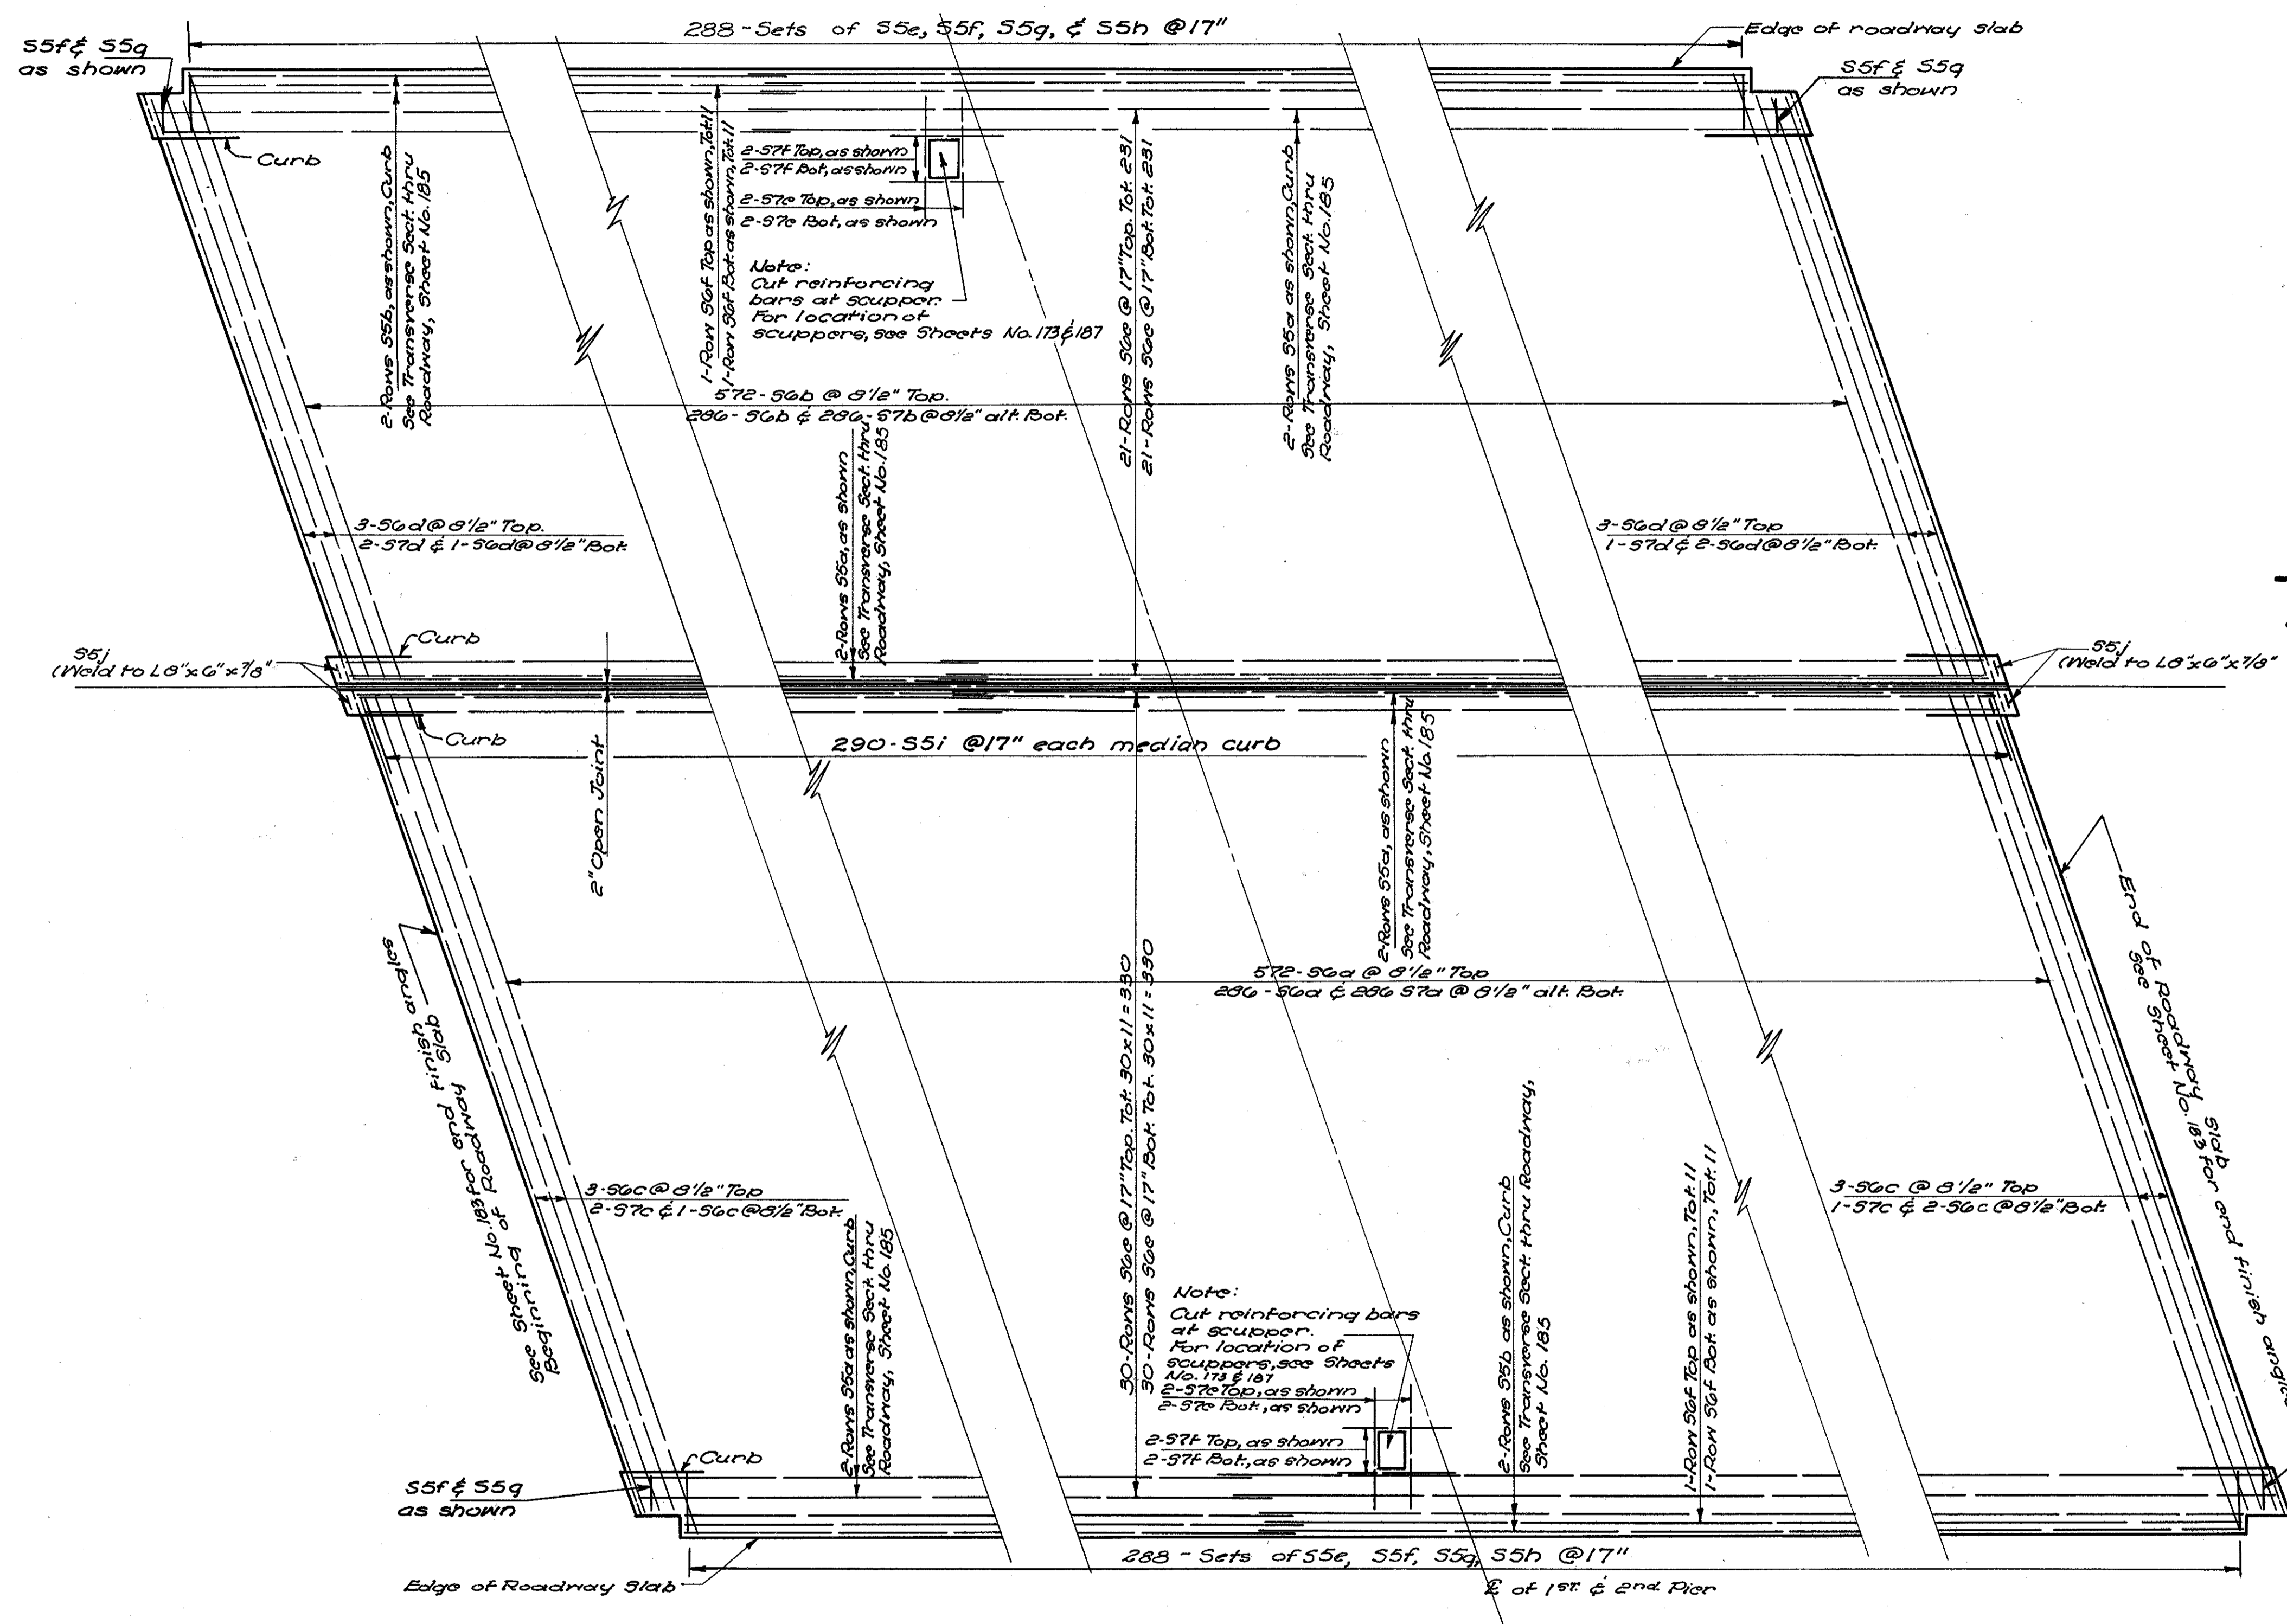

**PLAN OF ADDITIONAL SLAB REINFORCING AT PIERS**

No Scale

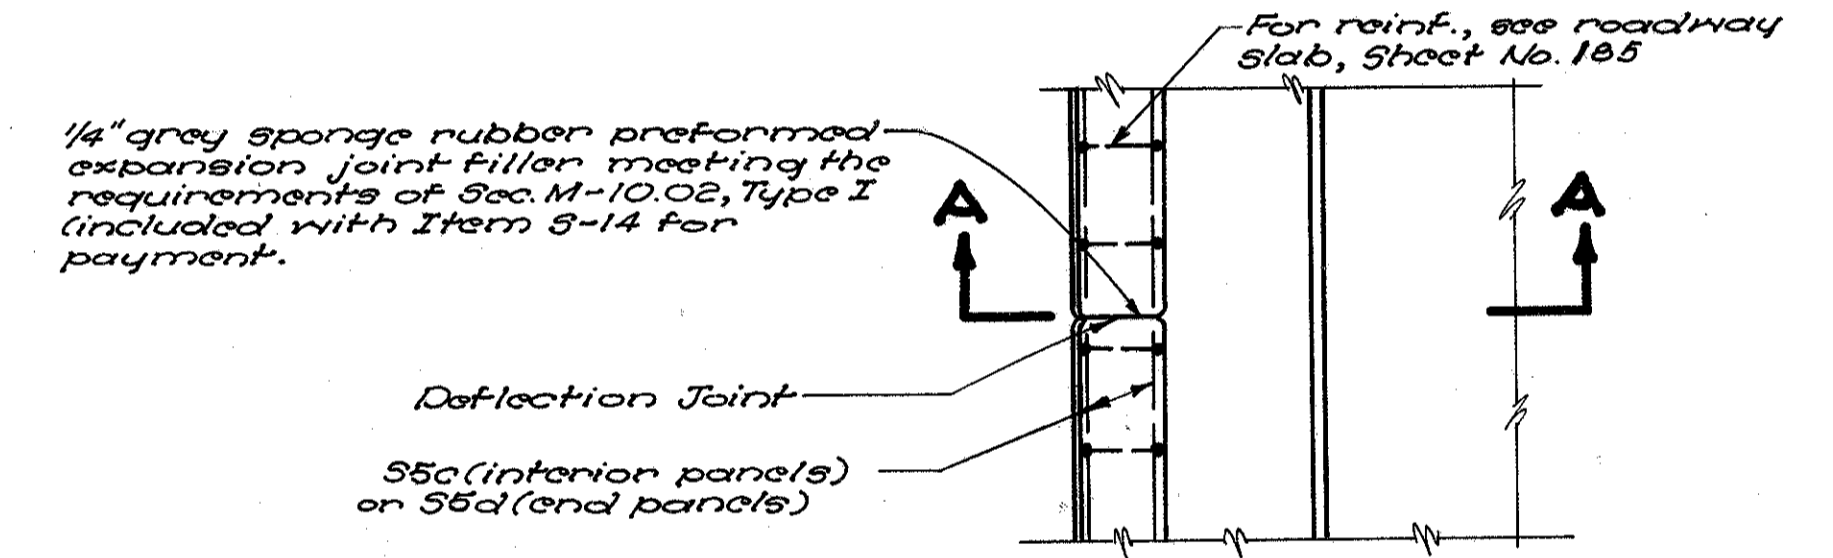

**SECTION A-A**

**PARAPET DEFLECTION JOINT DETAIL**

Scale: 3/8" = 1'-0"

**PLAN SHOWING REINFORCING FOR ROADWAY & SIDEWALK SLABS**

Scale: 3/16" = 1'-0"


VOGT, IVERS, SEAMAN & ASSOCIATES  
ENGINEERS ARCHITECTS  
CINCINNATI, OHIO

**SUPERSTRUCTURE ROADWAY SLAB**  
BRIDGE NO. BU-4-184  
OVER B & O R.R. & DICKS CREEK





RUTLEDGE COUNTY  
SEC. BUT-4  
Scale: As Shown

STA. 587+80.16  
SEPT. 1955



DESIGNED	DRAWN	TRACED	CHECKED	REVIEWED	DATE	REVISED
O.L.A.	V.D.	N.B.	O.L.A.	W.J.I.	10-11-55	

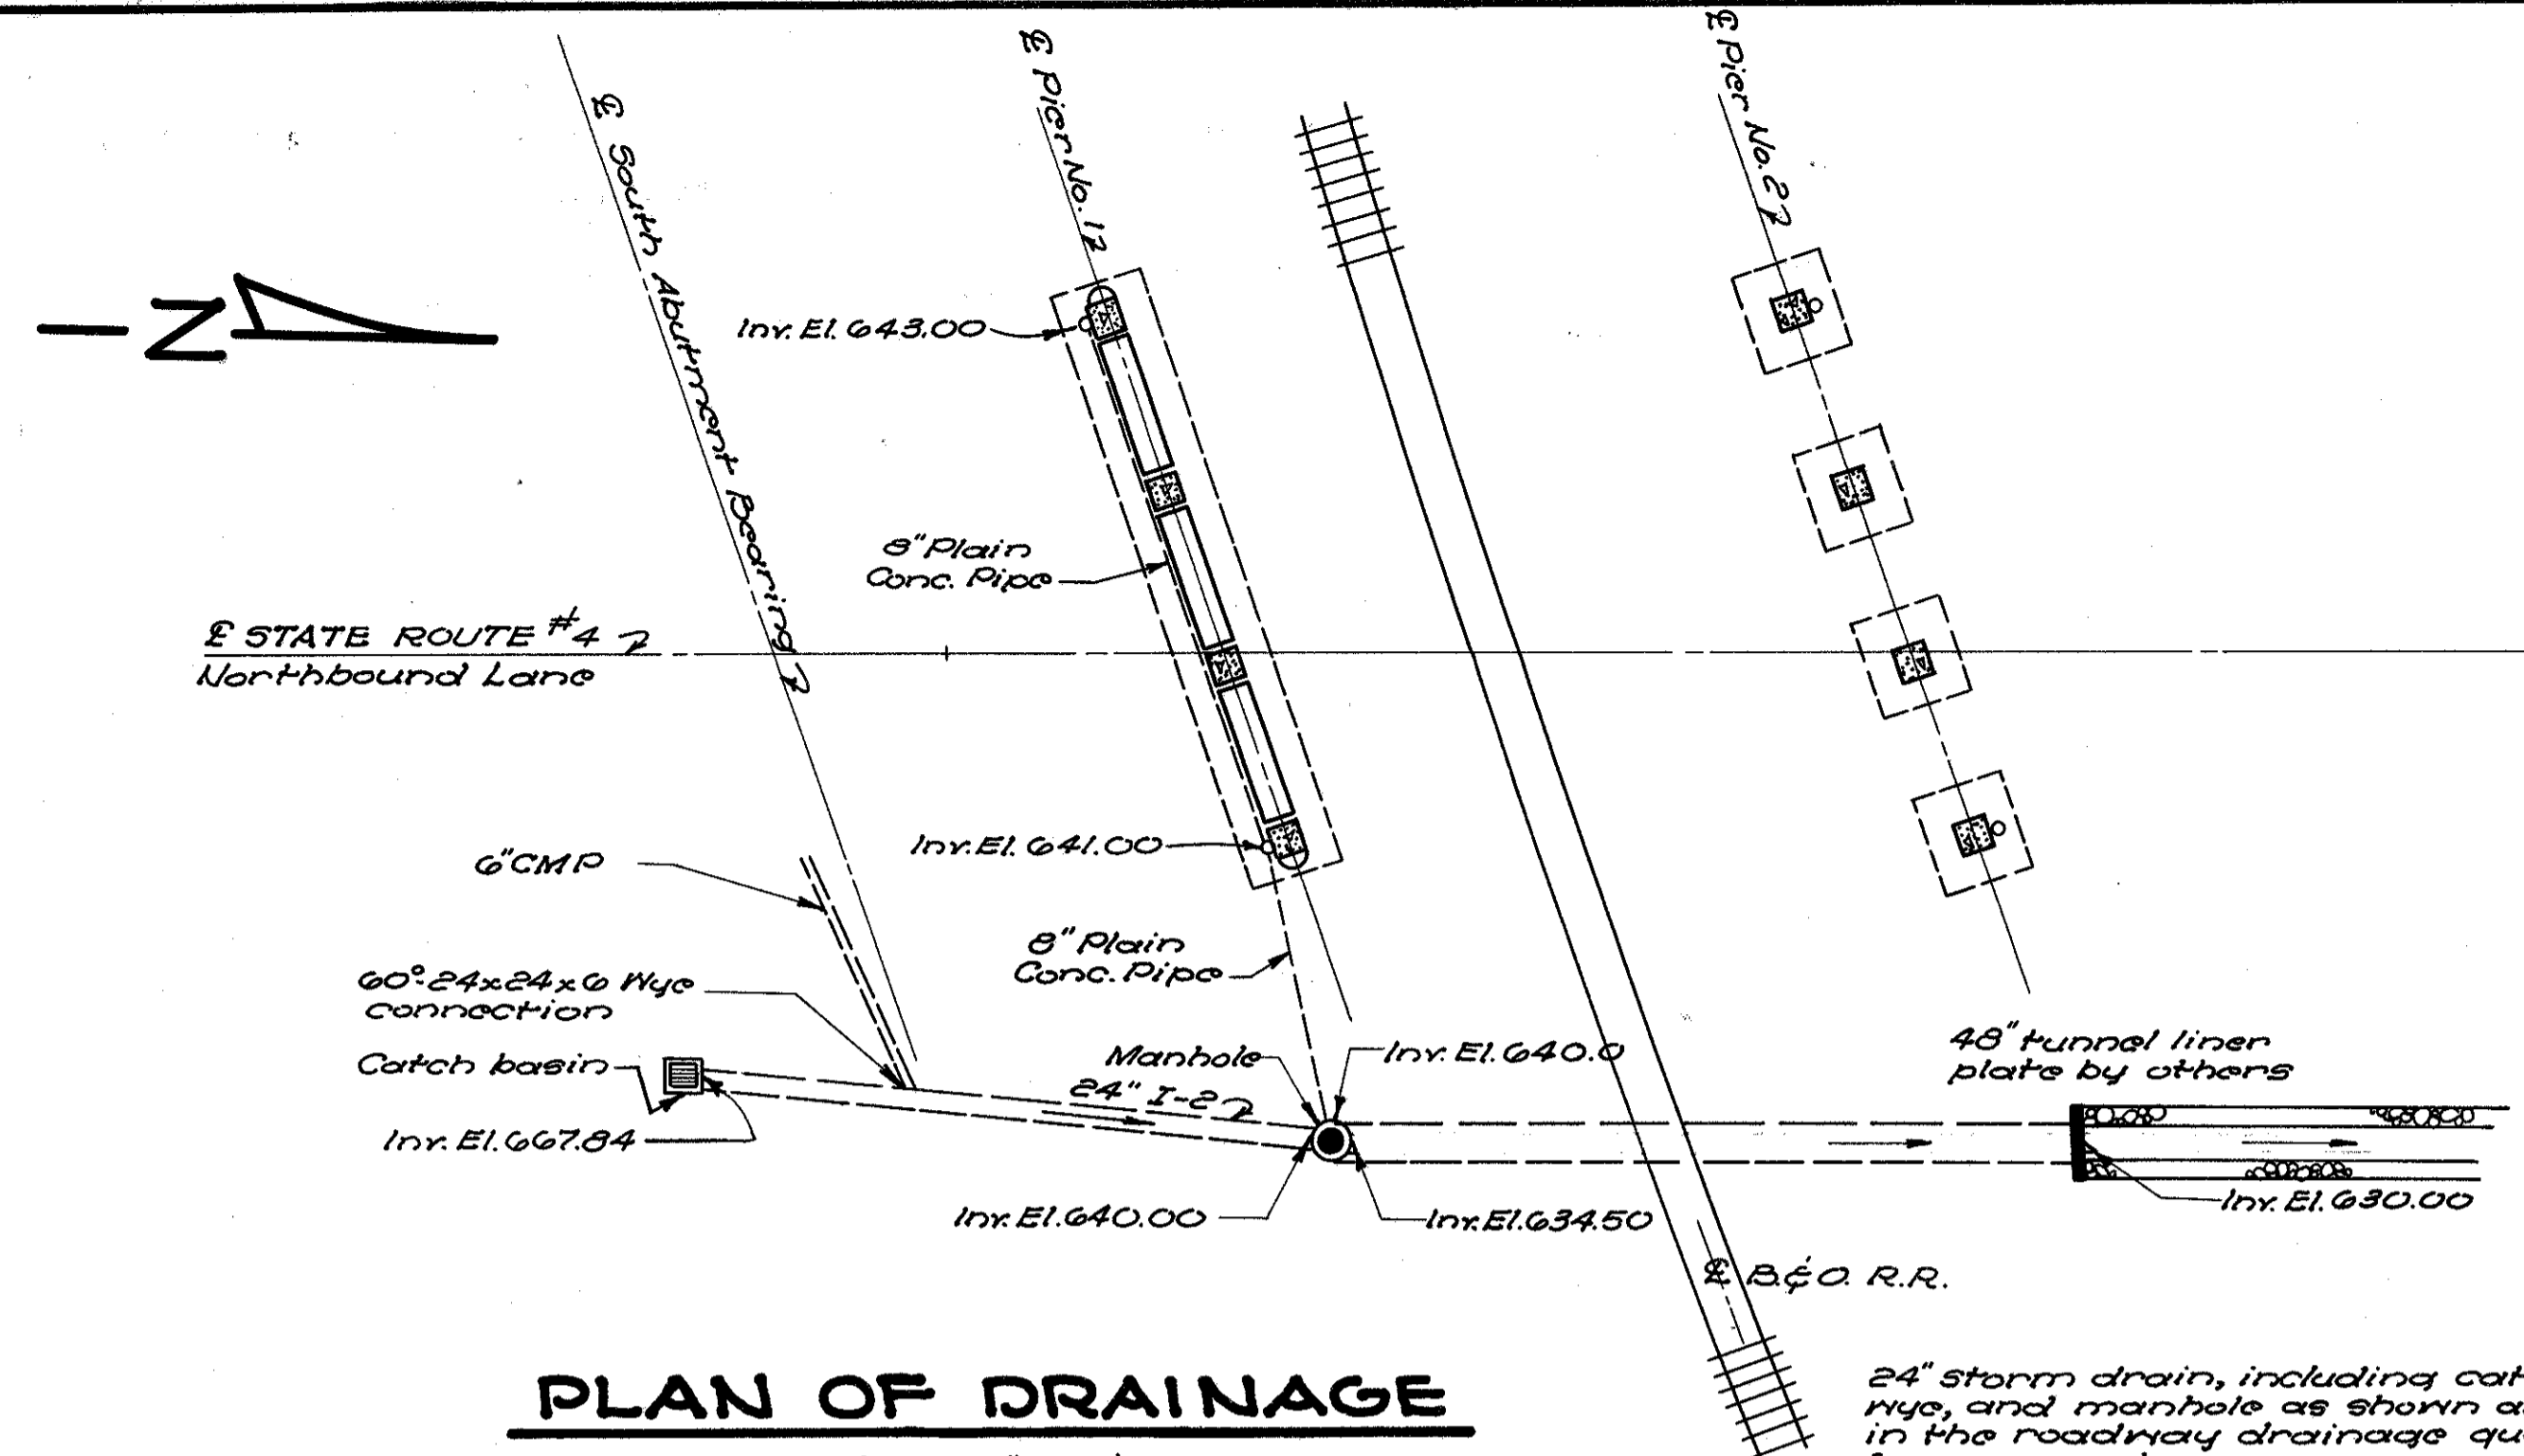

24" storm drain, including catch basin, wye, and manhole as shown are included in the roadway drainage quantities for payment.

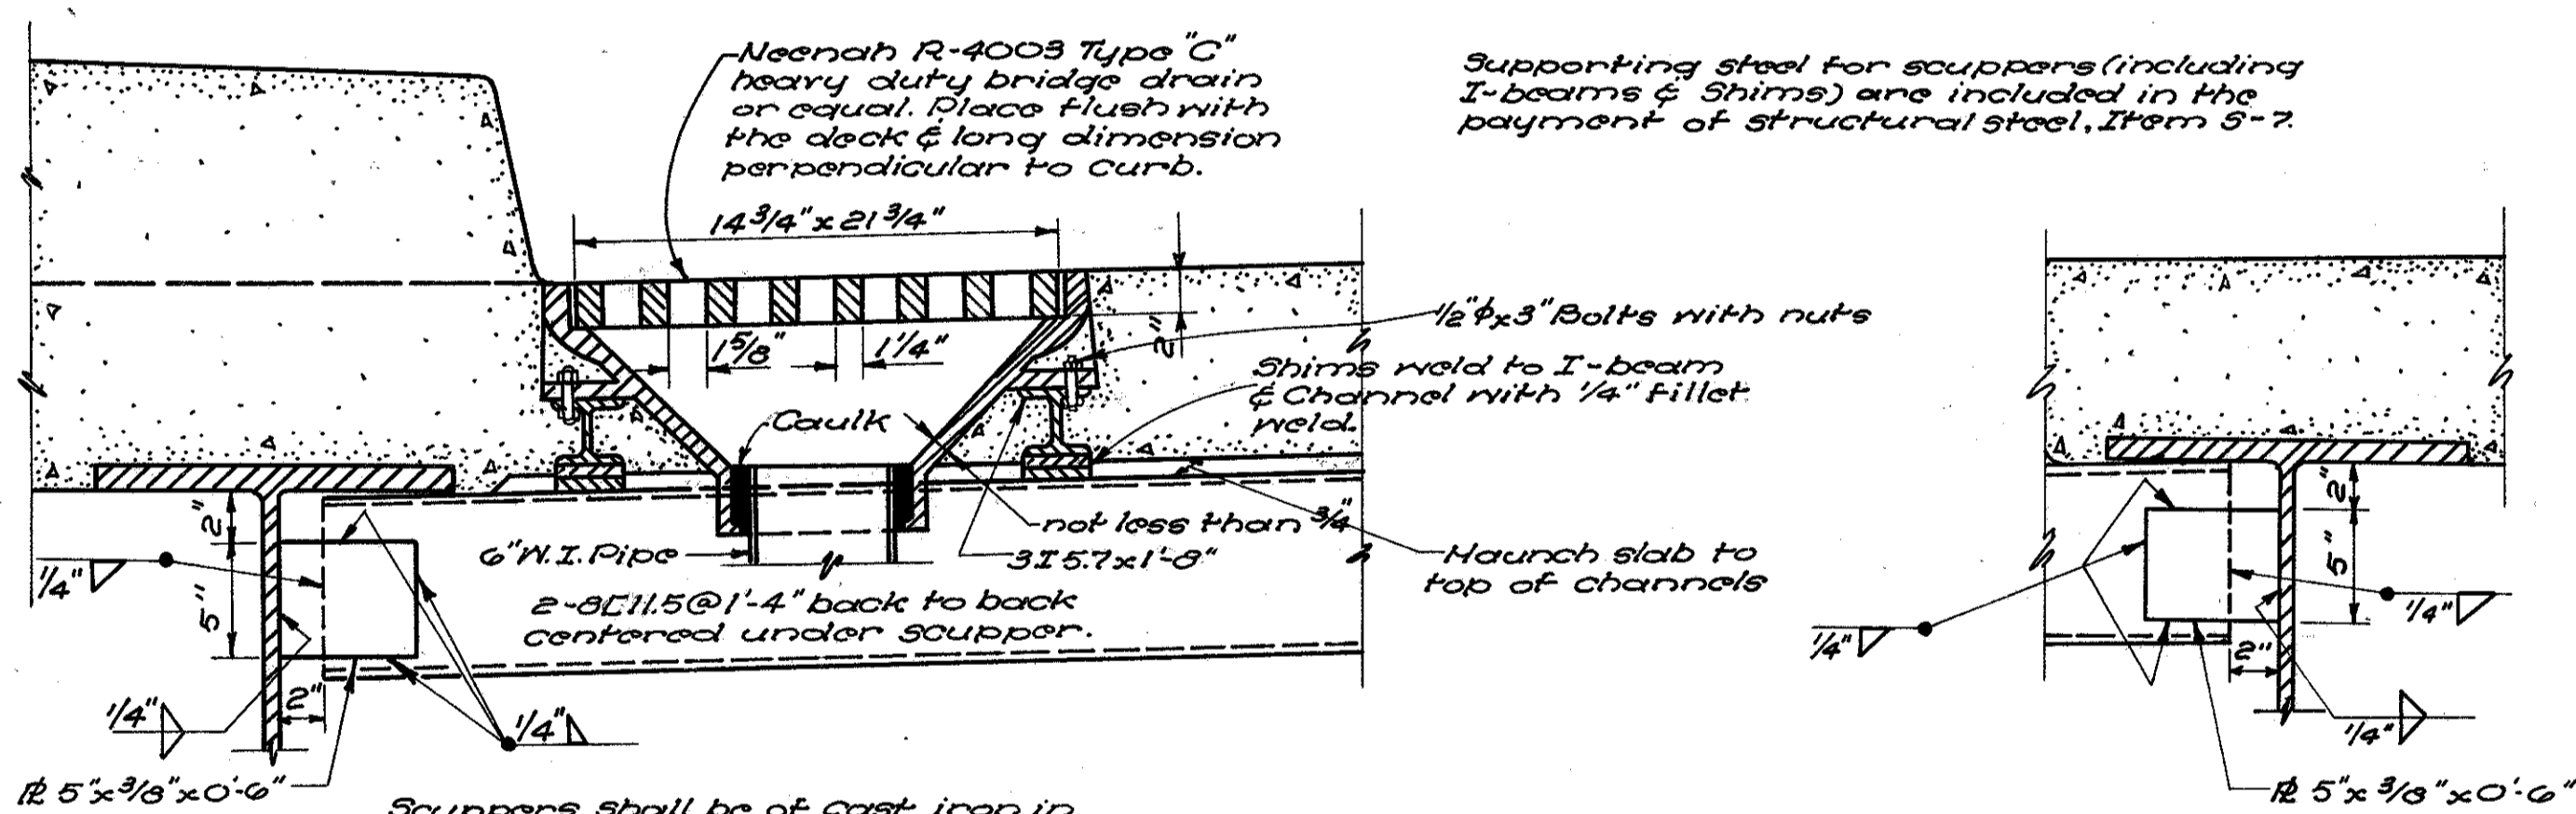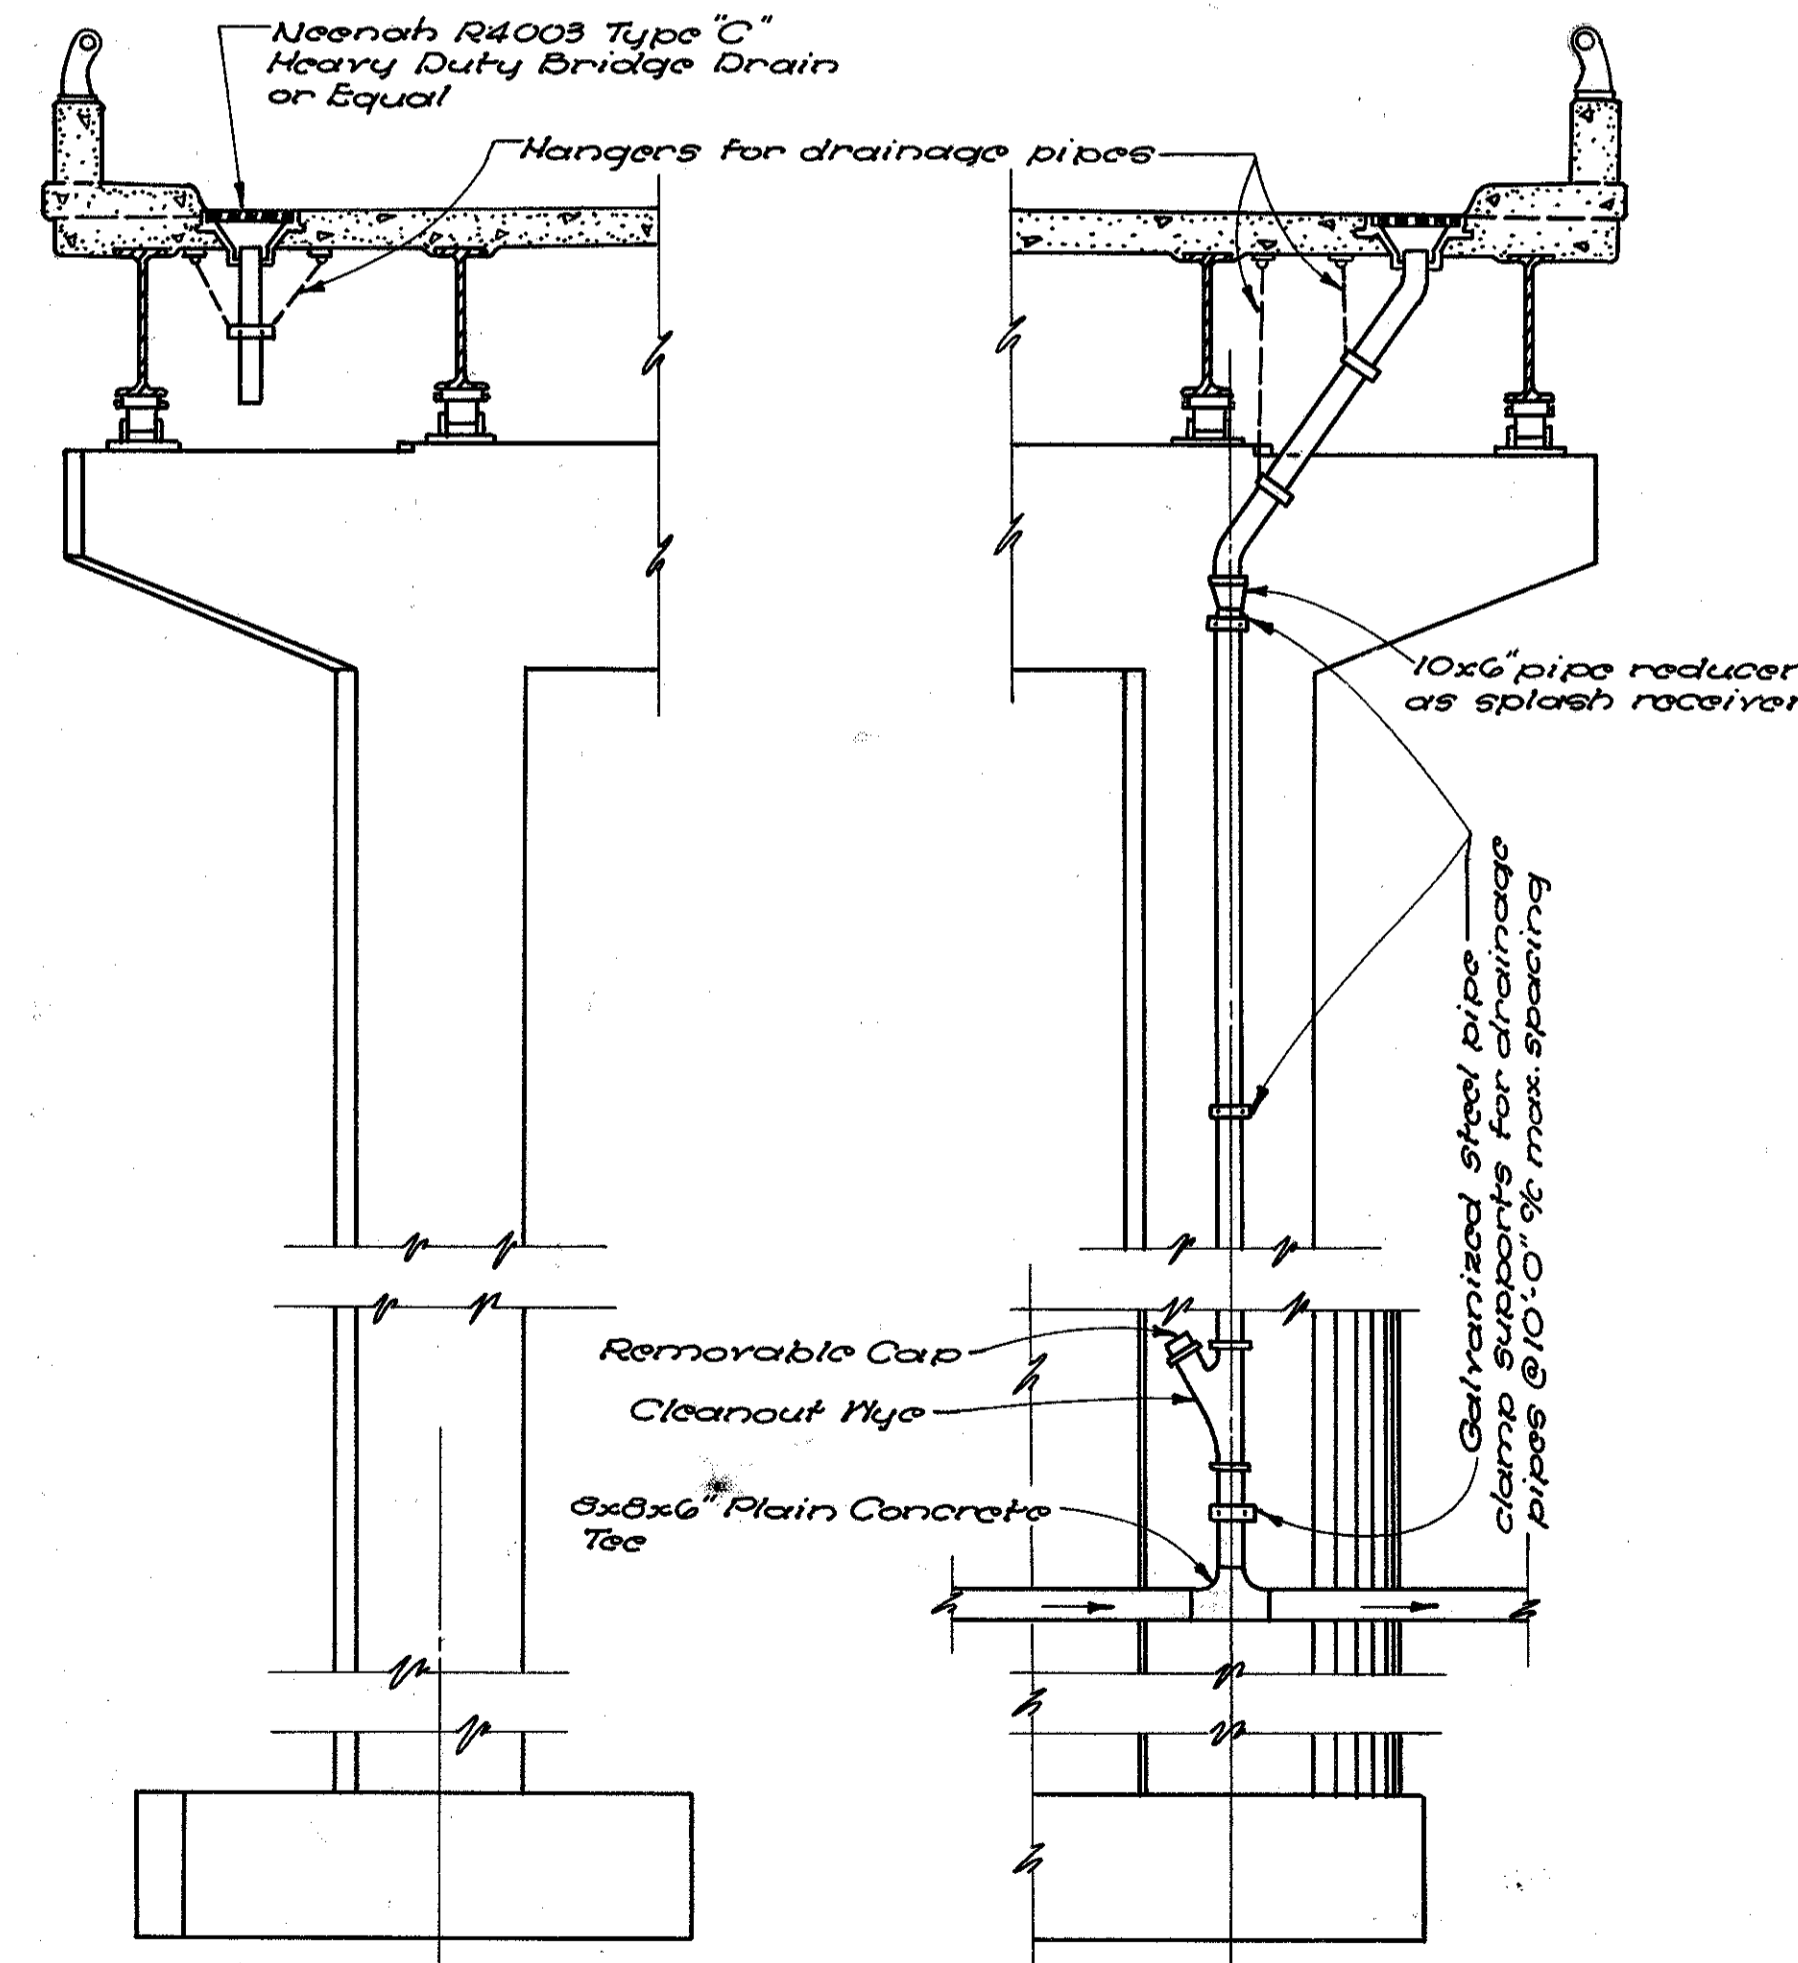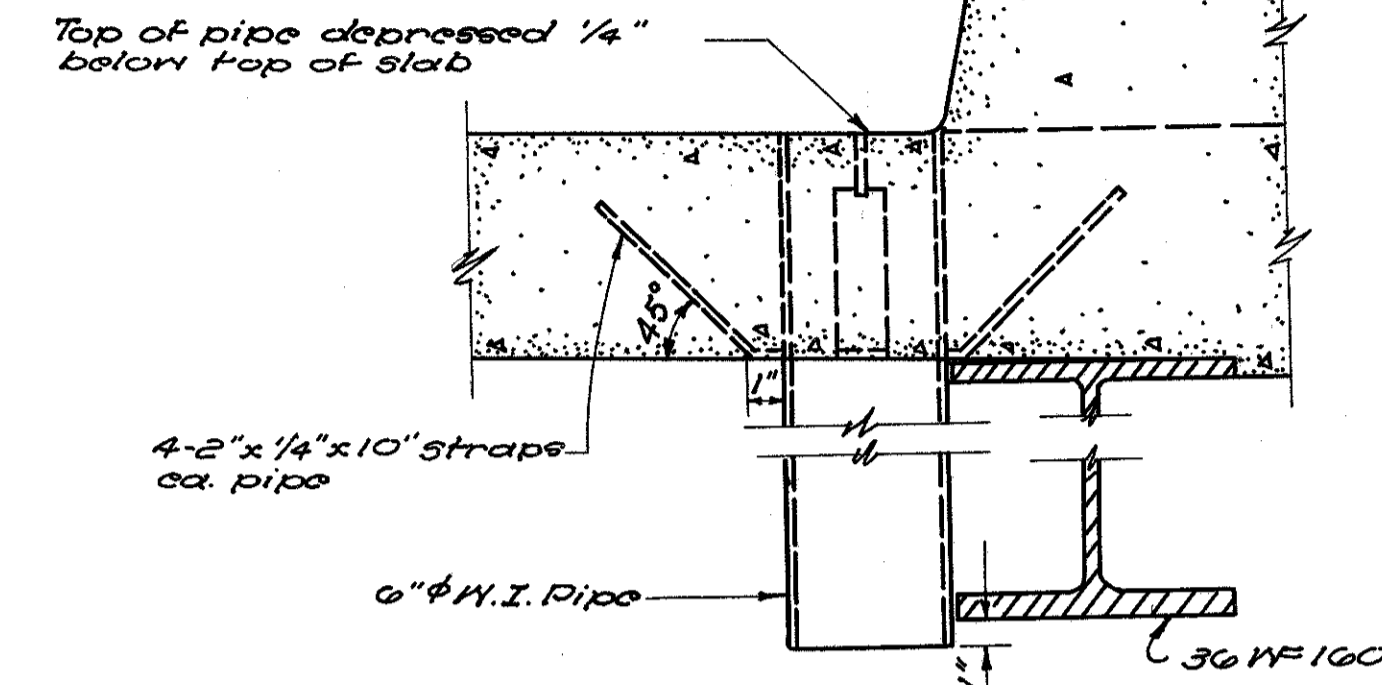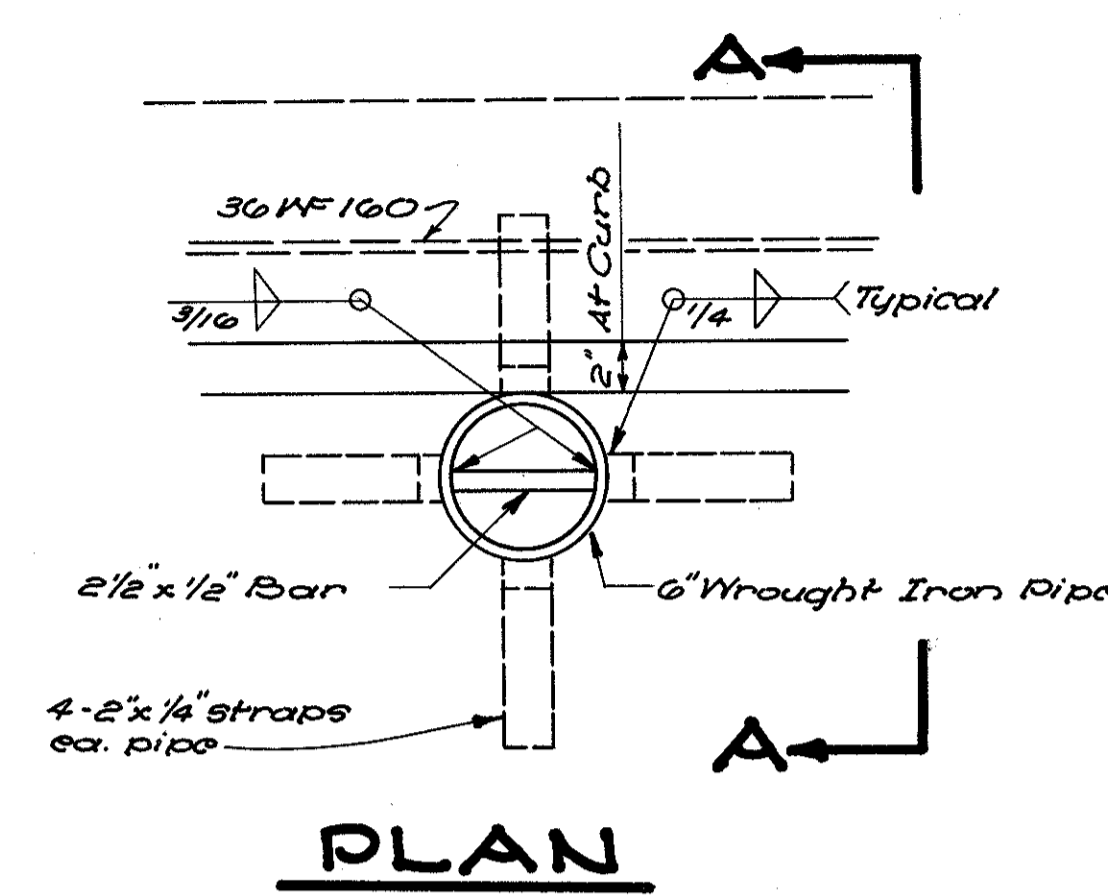

Scuppers shall be of cast iron in accordance with Sec. I-0.02 of the Specs., and shall be essentially of the dimensions shown herein.

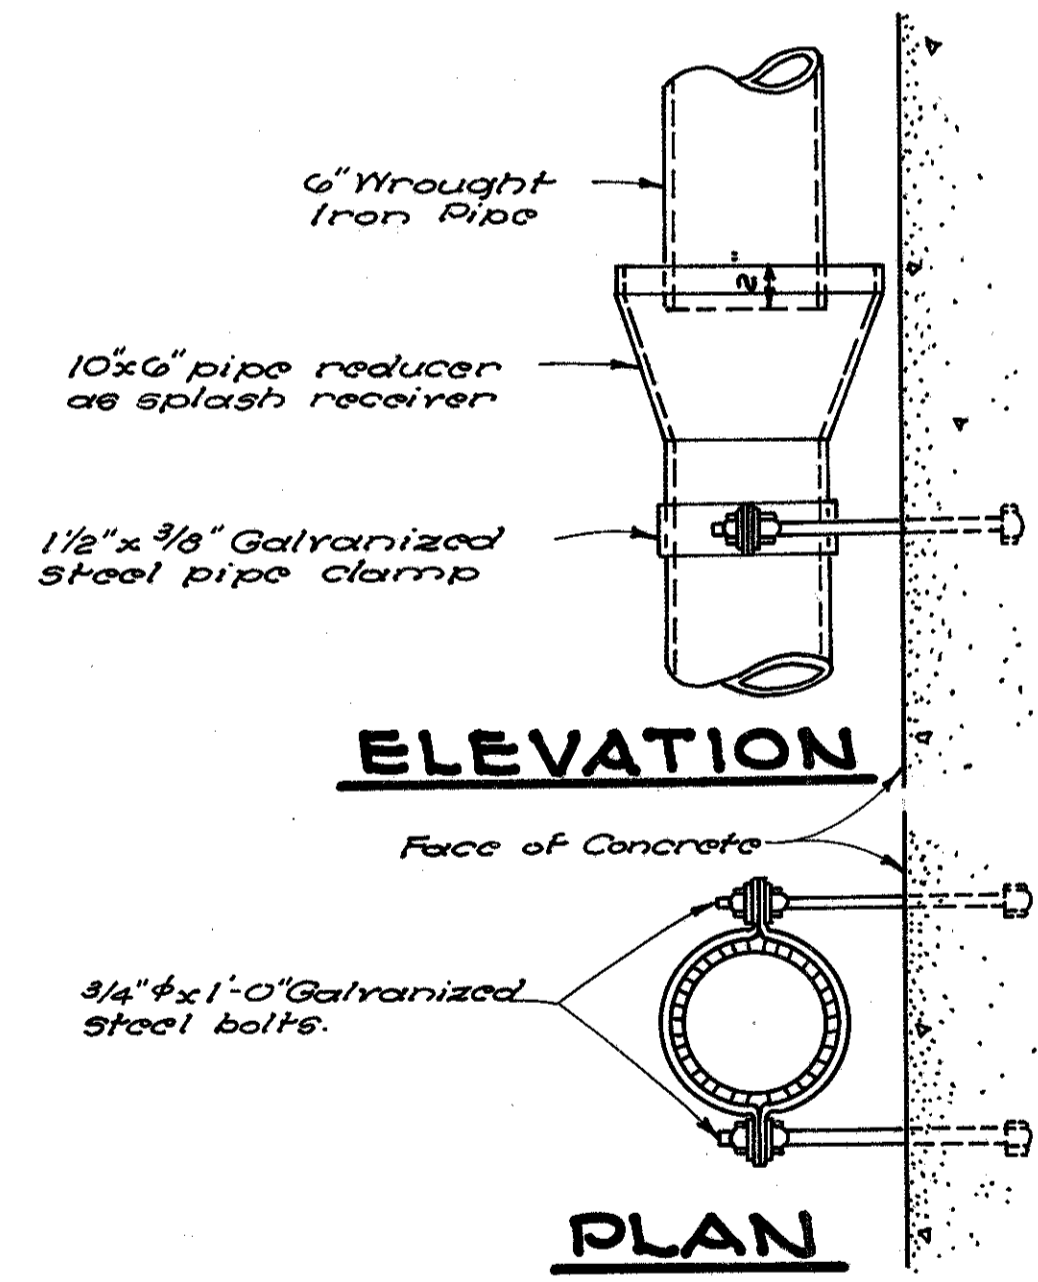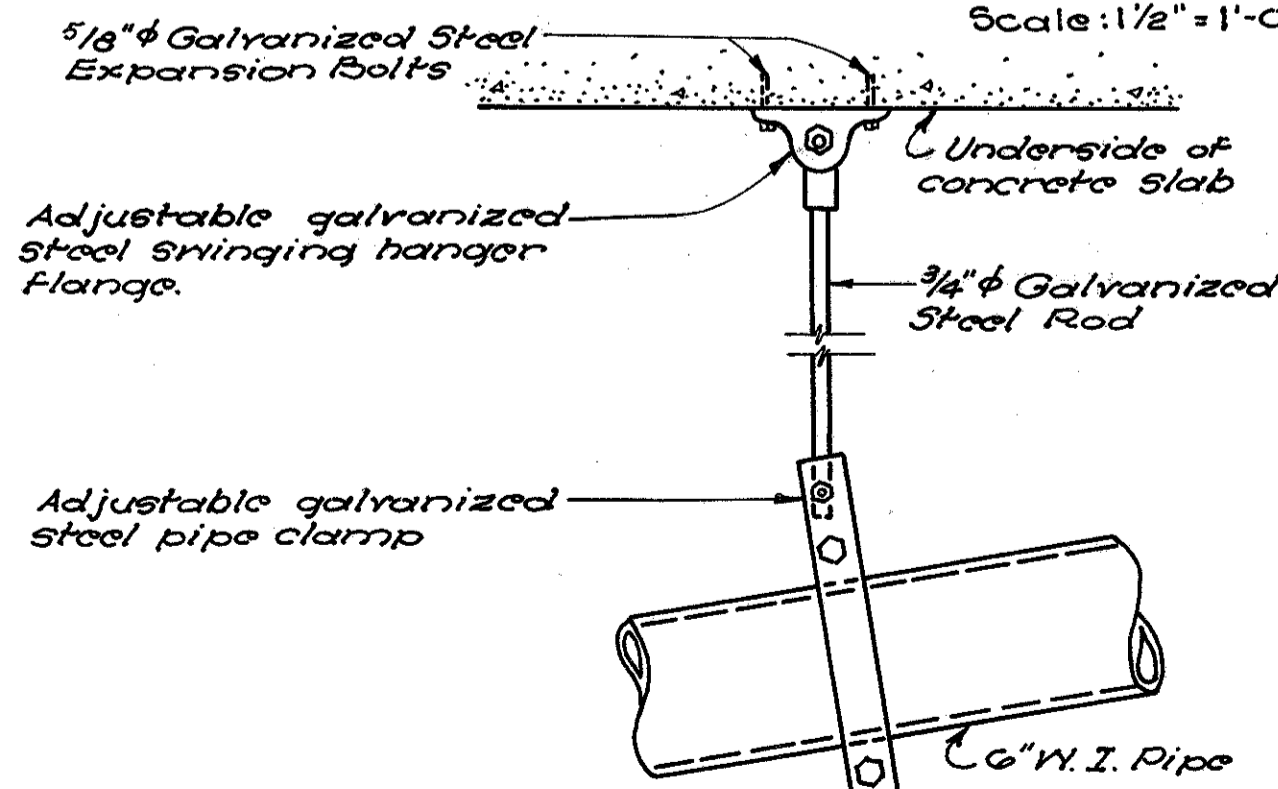





**DETAIL-SUPPORTS FOR VERTICAL DRAINAGE PIPES**  
Scale: 1/2" = 1'-0"

VOGT, IVERS, SEAMAN & ASSOCIATES  
ENGINEERS  
CINCINNATI, OHIO

**DRAINAGE DETAILS**  
BRIDGE NO. BU-4-184  
OVER B & O R.R. & DICKS CREEK  
BUTLER COUNTY  
SEC. BUT-4  
Scale: As shown  
STA. 567+80.16  
SEPT. 1955



DESIGNED	DRAWN	TRACED	CHECKED	REVIEWED	DATE	REVISED
R.G.H.	R.G.H.	N.B.	O.L.A.	W.J.I.	10-11-55	




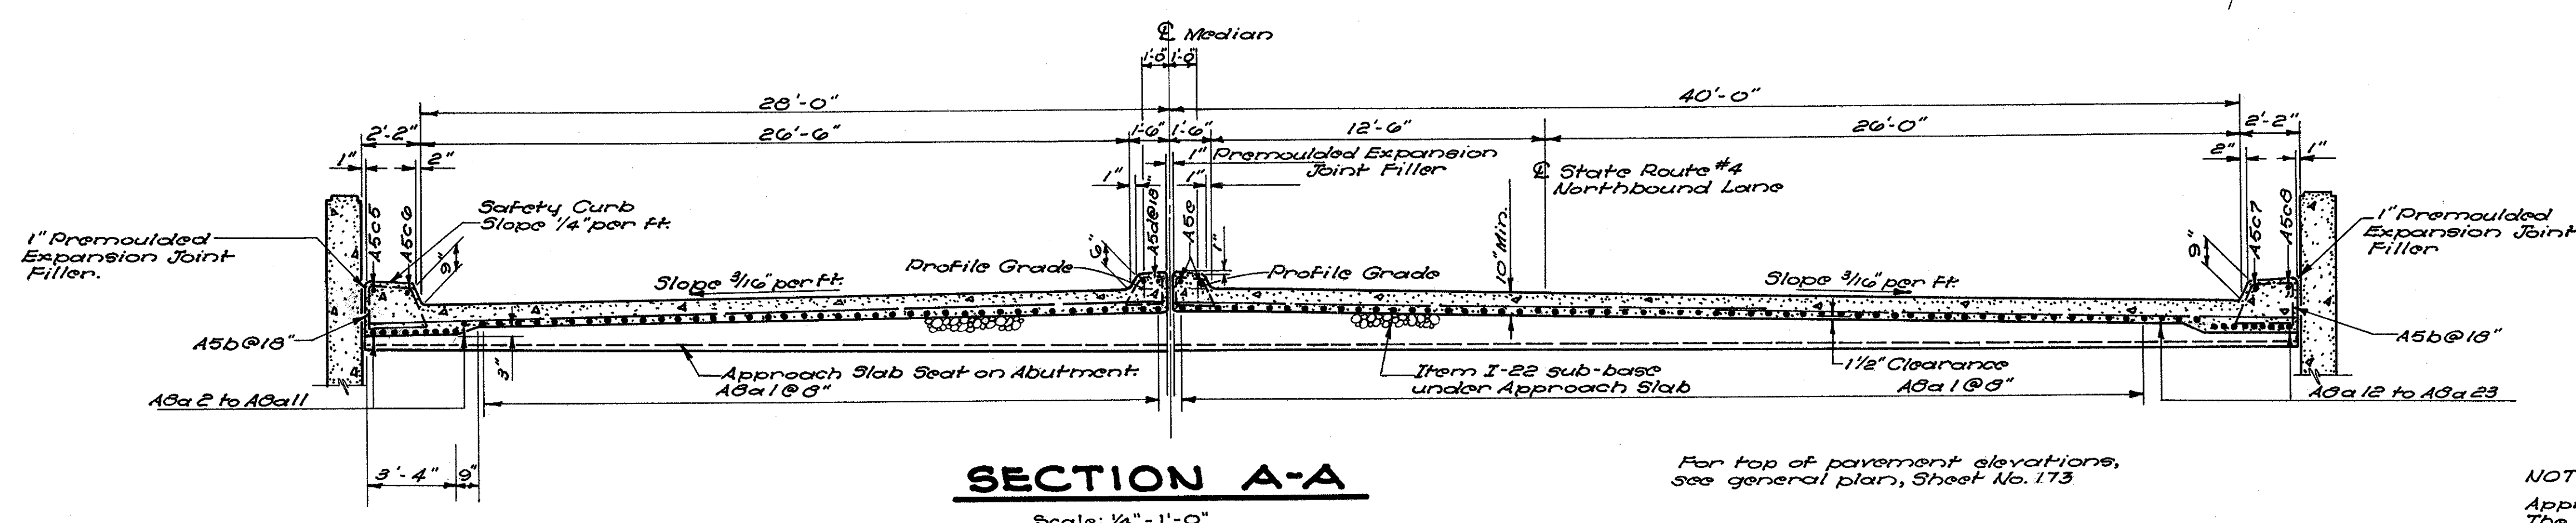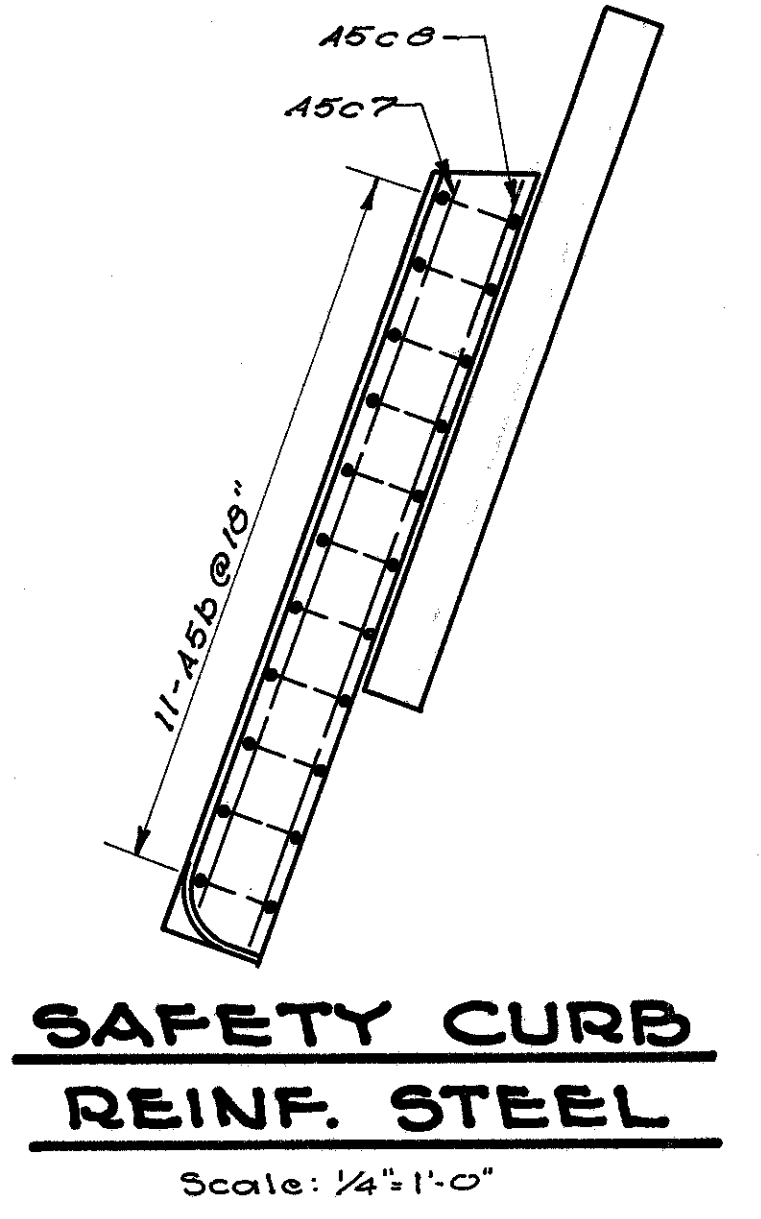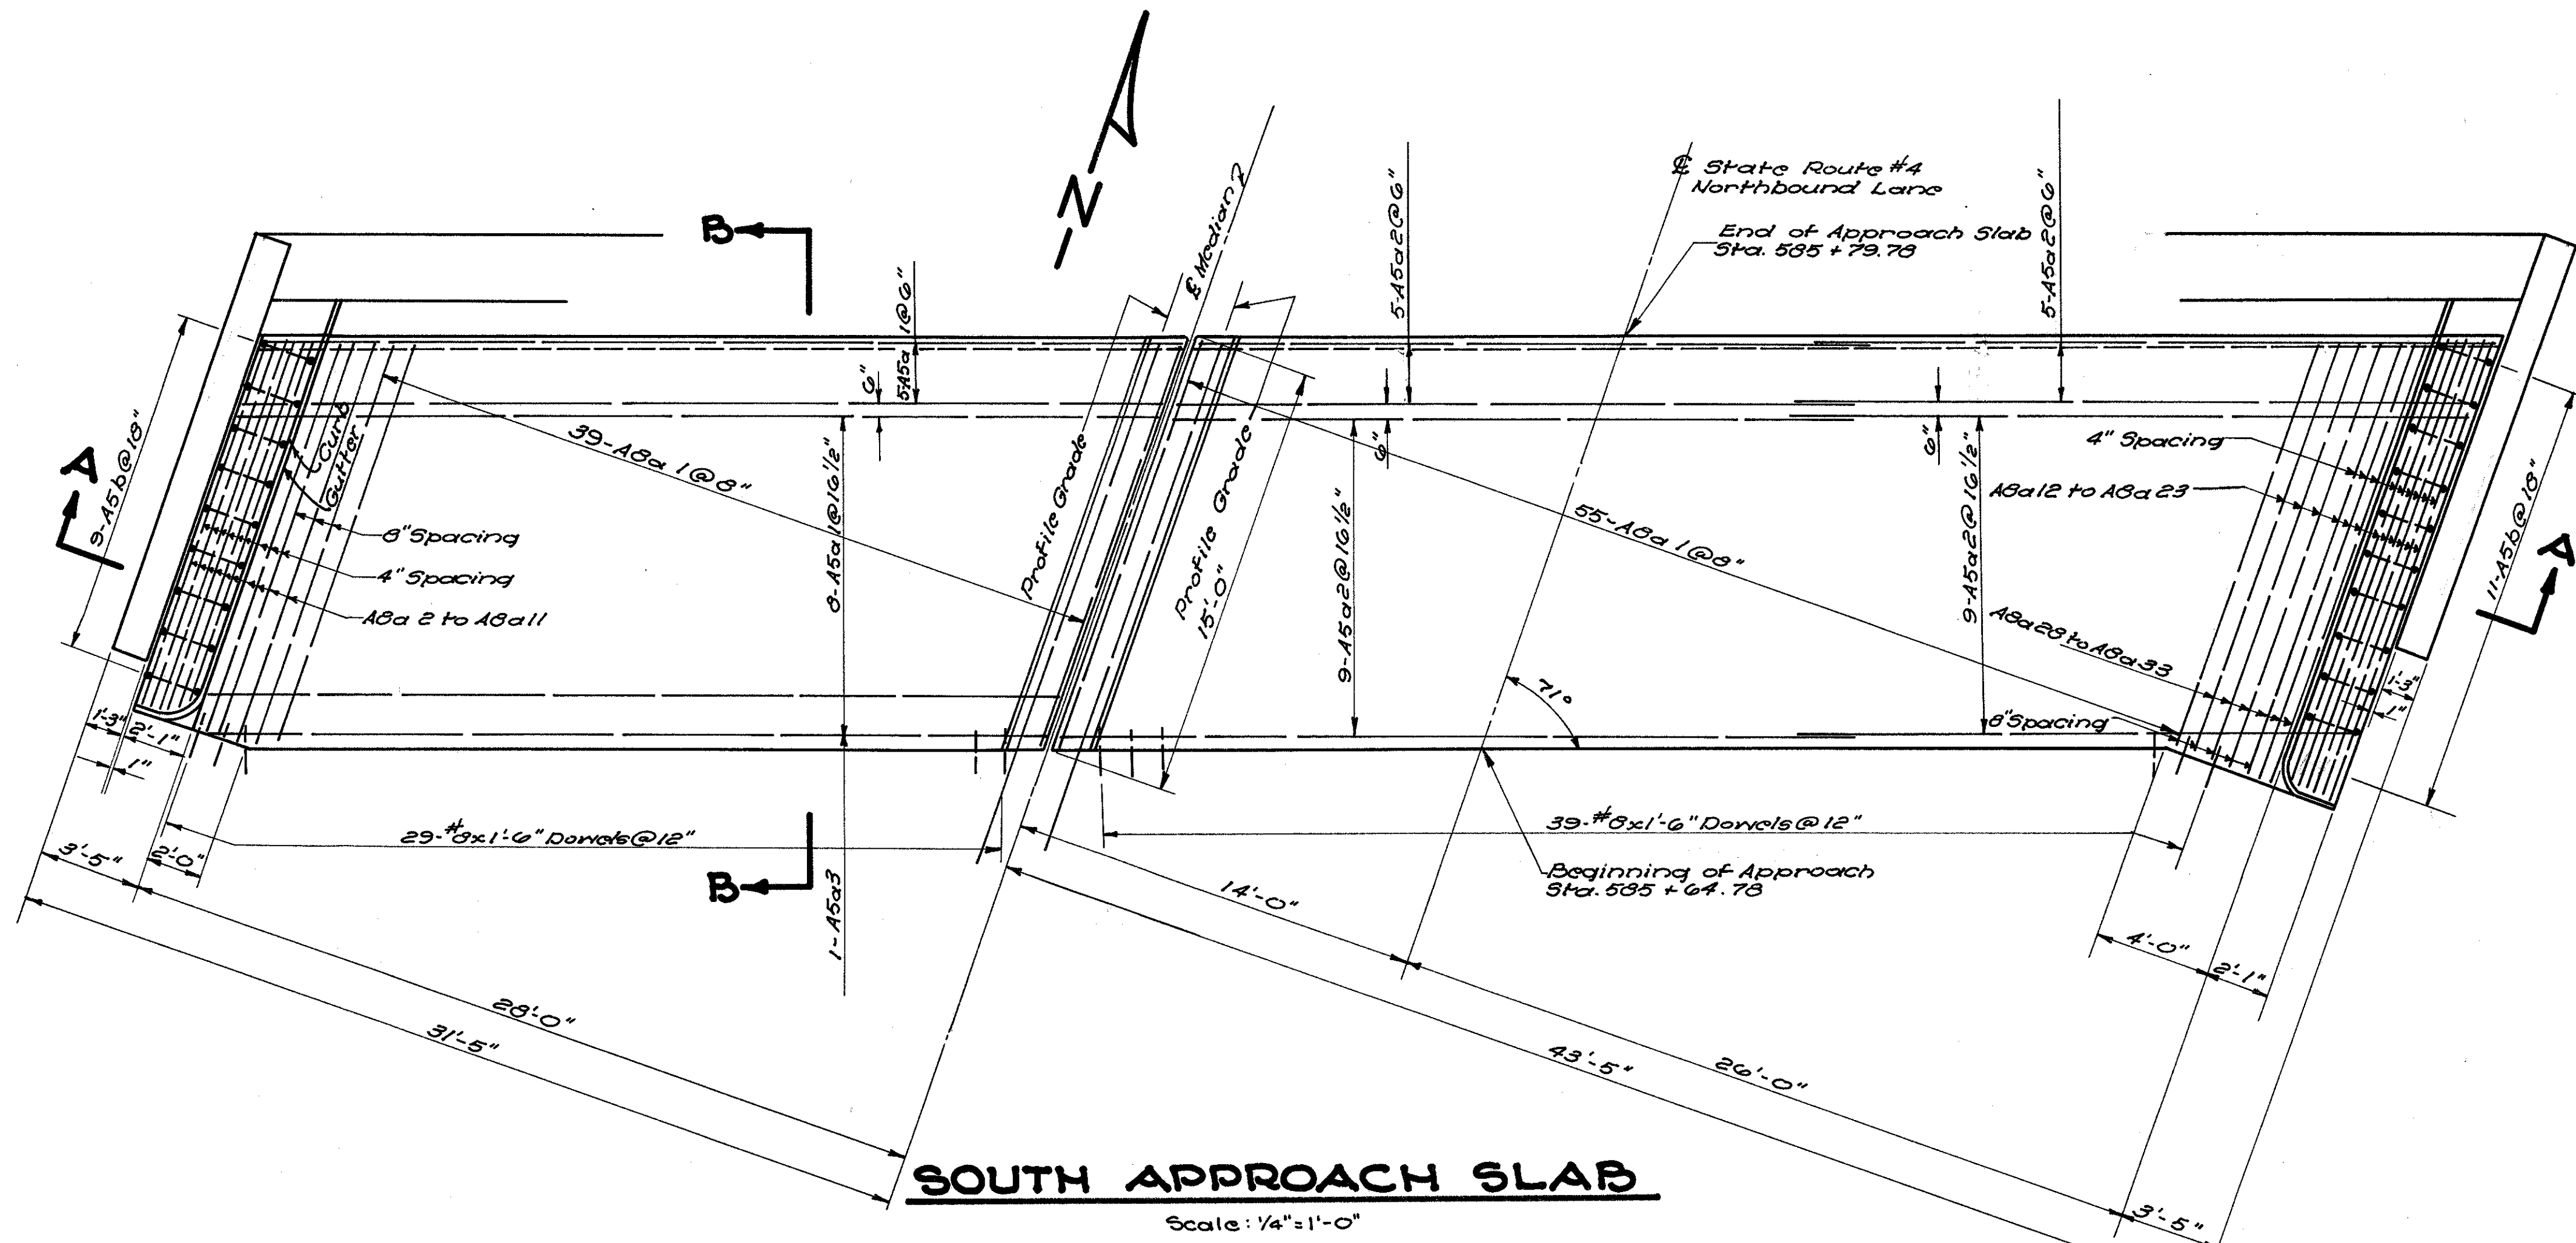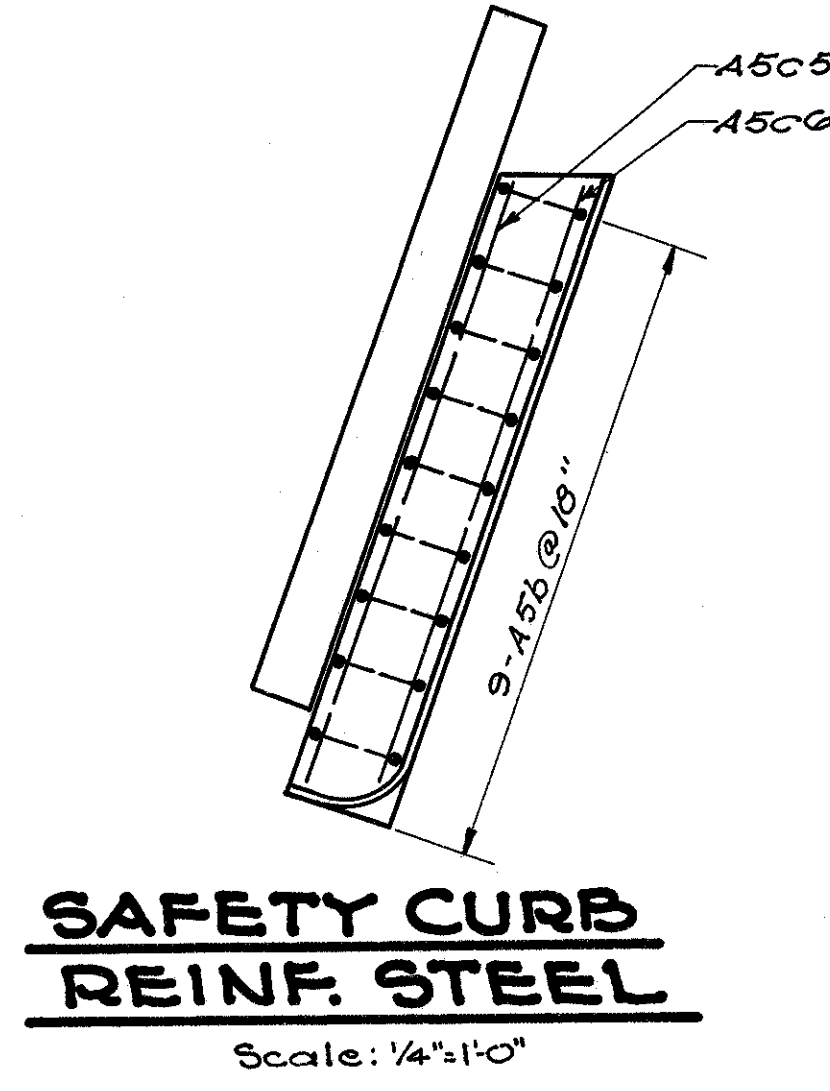

For top of pavement elevations, see general plan, Sheet No. 173

**NOTE:**  
Approach Slab to be Class "C" Concrete. The price bid for Item I-7 for the approach slab shall include Safety Curb & 1" Premoulded Expansion Joint Filler. For location of expansion joints in the approach pavement adjacent to the bridge. See Standard Drawing T.J. No. 1 dated 3-2-53. See Sheet No. 188 for reinforcing steel list. Payment for the construction joints, including dowel bars, is included in the price per sq. yd. bid for the approach pavement.

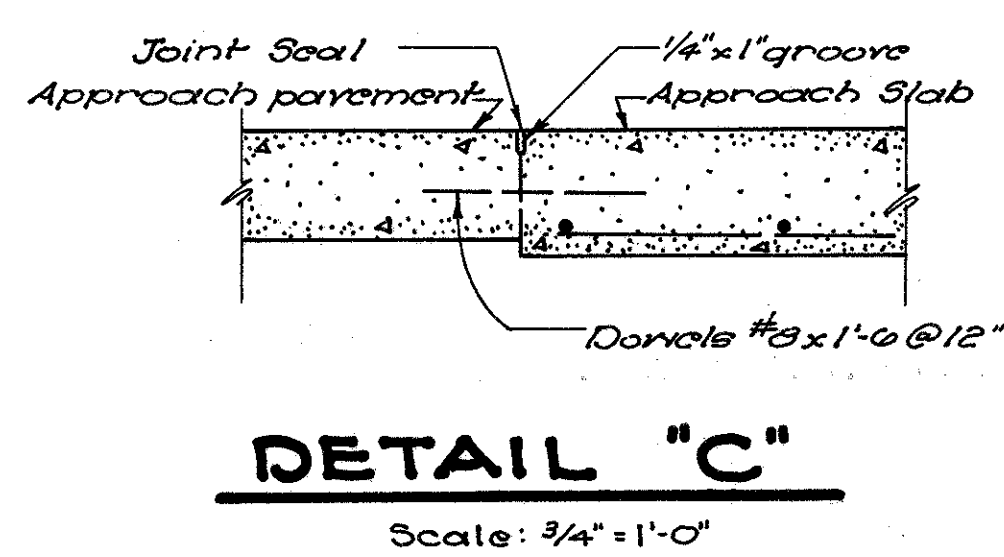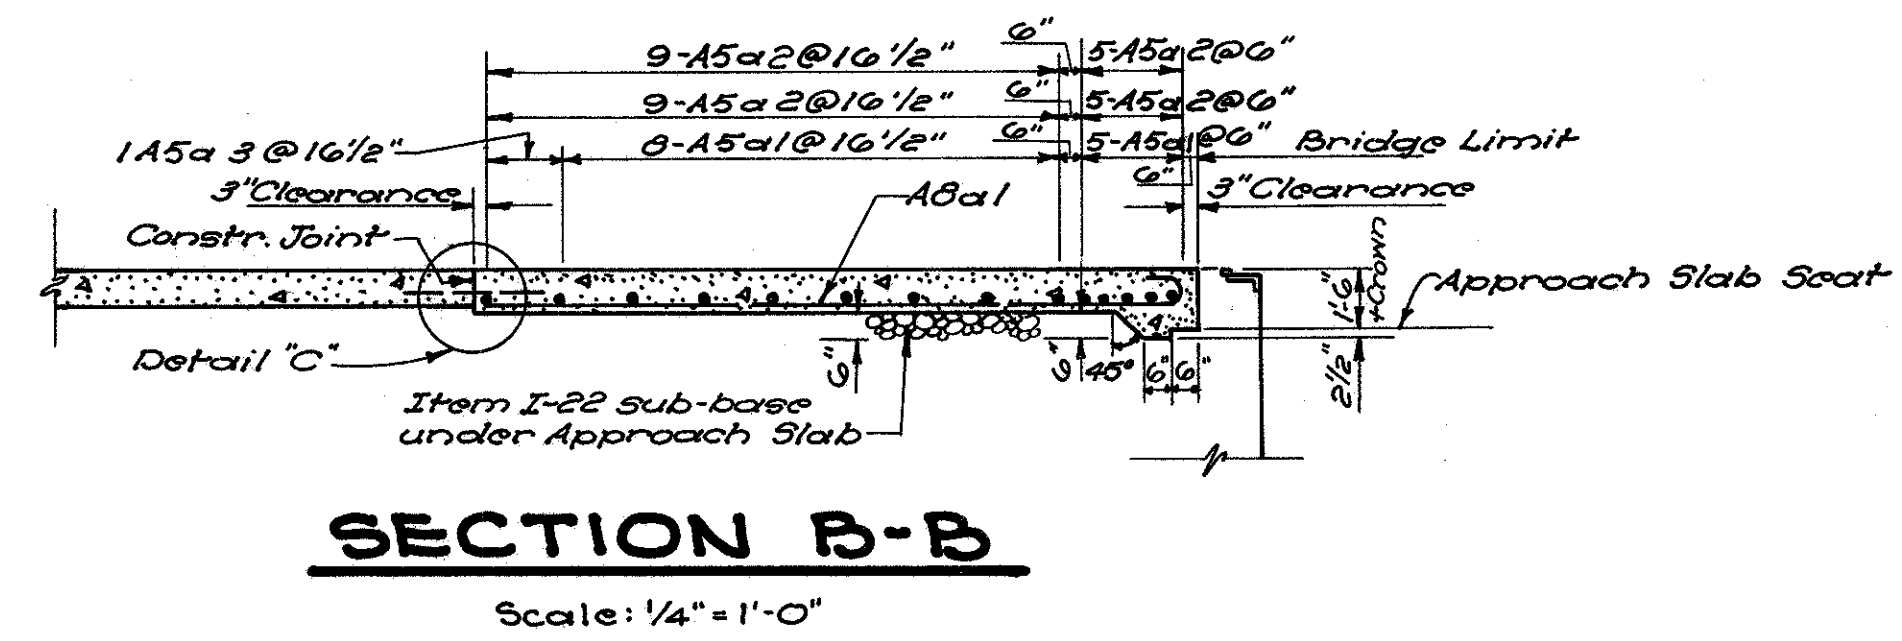

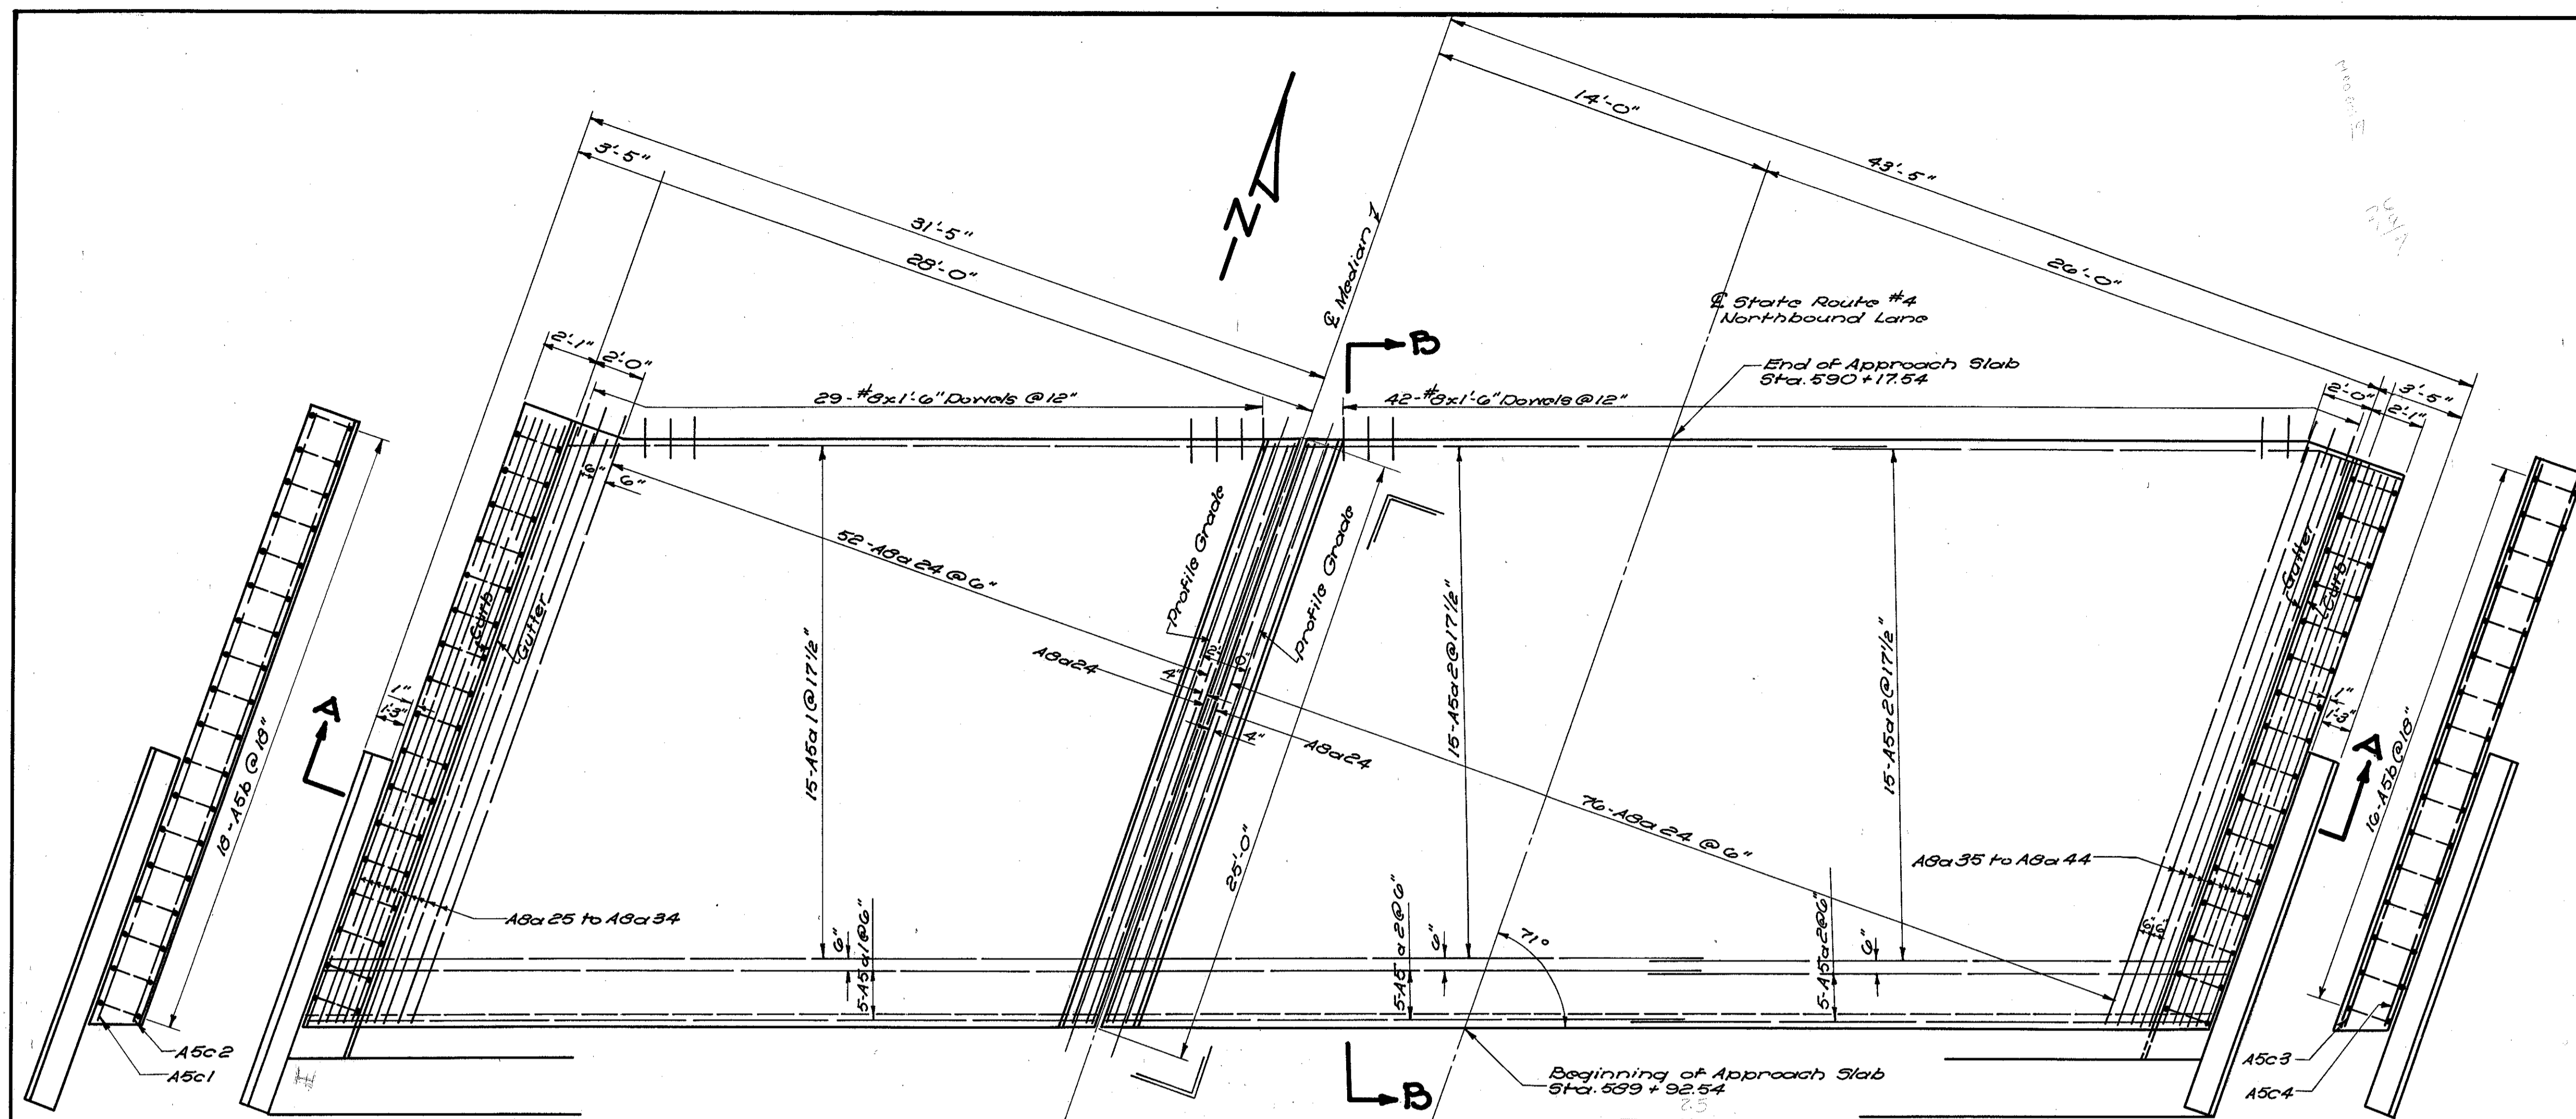


**SAFETY CURB REINF. STEEL**  
Scale: 1/4" = 1'-0"

**NORTH APPROACH SLAB**  
Scale: 1/4" = 1'-0"


**SAFETY CURB REINF. STEEL**  
Scale: 1/4" = 1'-0"

**REINFORCING STEEL LIST**


MARK	LENGTH	NUMBER	TOT. WT.	SHAPE	BENDING DIAGRAM
A5a1	31'-4"	33	1078	Str.	
A5a2	22'-10"	68	1619	Str.	
A5a3	29'-2"	1	30	Str.	
A5b	6'-0"	54	366	Bt.	
A5c1	25'-9"	1	27	Str.	
A5c2	25'-4"	1	26	Str.	
A5c3	23'-11"	1	25	Str.	
A5c4	23'-3"	1	24	Str.	
A5c5	13'-3"	1	12	Str.	
A5c6	13'-9"	1	14	Str.	
A5c7	16'-2"	1	17	Str.	
A5c8	16'-8"	1	17	Str.	
A5d	4'-7"	54	258	Bt.	
A5e	14'-0"	4	60	Str.	
A5f	24'-0"	4	102	Str.	
A6a1	15'-7"	94	3911	Bt.	
A6a2	14'-5"	1	39	Bt.	
A6a3	14'-6"	1	39	Bt.	
A6a4	14'-7"	1	39	Bt.	
A6a5	14'-9"	1	39	Bt.	
A6a6	14'-10"	1	40	Bt.	
A6a7	14'-11"	1	40	Bt.	
A6a8	15'-0"	1	40	Bt.	
A6a9	15'-1"	1	40	Bt.	
A6a10	15'-3"	1	41	Bt.	
A6a11	15'-5"	1	41	Bt.	
A6a12	17'-9"	1	47	Bt.	
A6a13	17'-8"	1	47	Bt.	
A6a14	17'-6"	1	47	Bt.	
A6a15	17'-5"	1	47	Bt.	
A6a16	17'-4"	1	46	Bt.	
A6a17	17'-3"	1	46	Bt.	
A6a18	17'-0"	1	45	Bt.	
A6a19	16'-9"	1	45	Bt.	
A6a20	16'-6"	1	44	Bt.	
A6a21	16'-3"	1	43	Bt.	
A6a22	16'-0"	1	43	Bt.	
A6a23	15'-9"	1	42	Bt.	
A6a24	25'-7"	130	6380	Bt.	
A6a25	27'-1"	1	72	Bt.	
A6a26	27'-0"	1	72	Bt.	
A6a27	26'-10"	1	72	Bt.	
A6a28	26'-9"	1	71	Bt.	
A6a29	26'-7"	1	71	Bt.	
A6a30	26'-3"	1	70	Bt.	
A6a31	26'-2"	1	70	Bt.	
A6a32	26'-0"	1	69	Bt.	
A6a33	25'-11"	1	69	Bt.	
A6a34	25'-9"	1	69	Bt.	
A6a35	24'-3"	1	65	Bt.	
A6a36	24'-4"	1	65	Bt.	
A6a37	24'-6"	1	65	Bt.	
A6a38	24'-7"	1	66	Bt.	
A6a39	24'-9"	1	66	Bt.	
A6a40	24'-10"	1	66	Bt.	
A6a41	24'-11"	1	67	Bt.	
A6a42	25'-1"	1	67	Bt.	
A6a43	25'-2"	1	67	Bt.	
A6a44	25'-6"	1	68	Bt.	

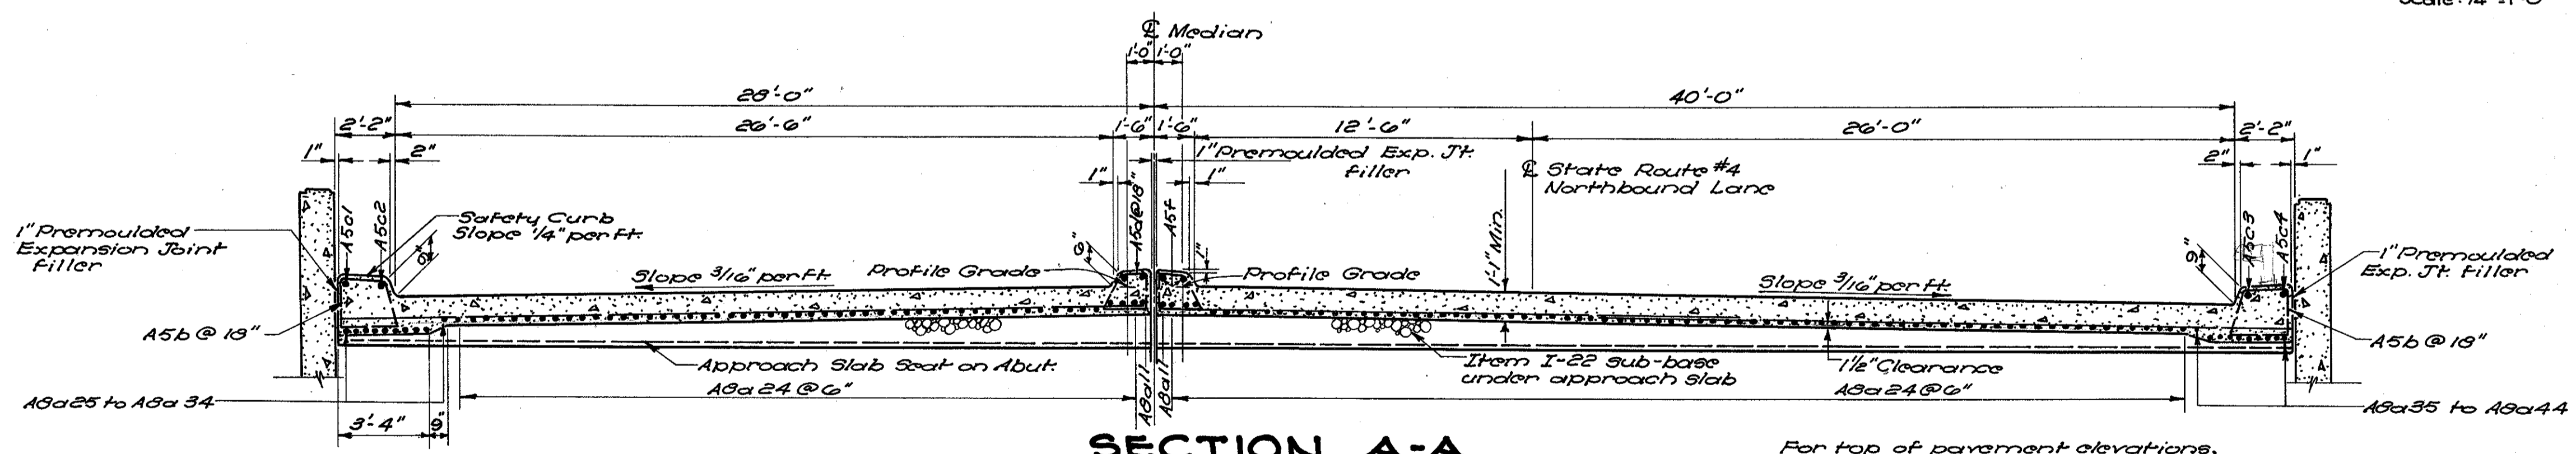

**SECTION A-A**  
Scale: 1/4" = 1'-0"

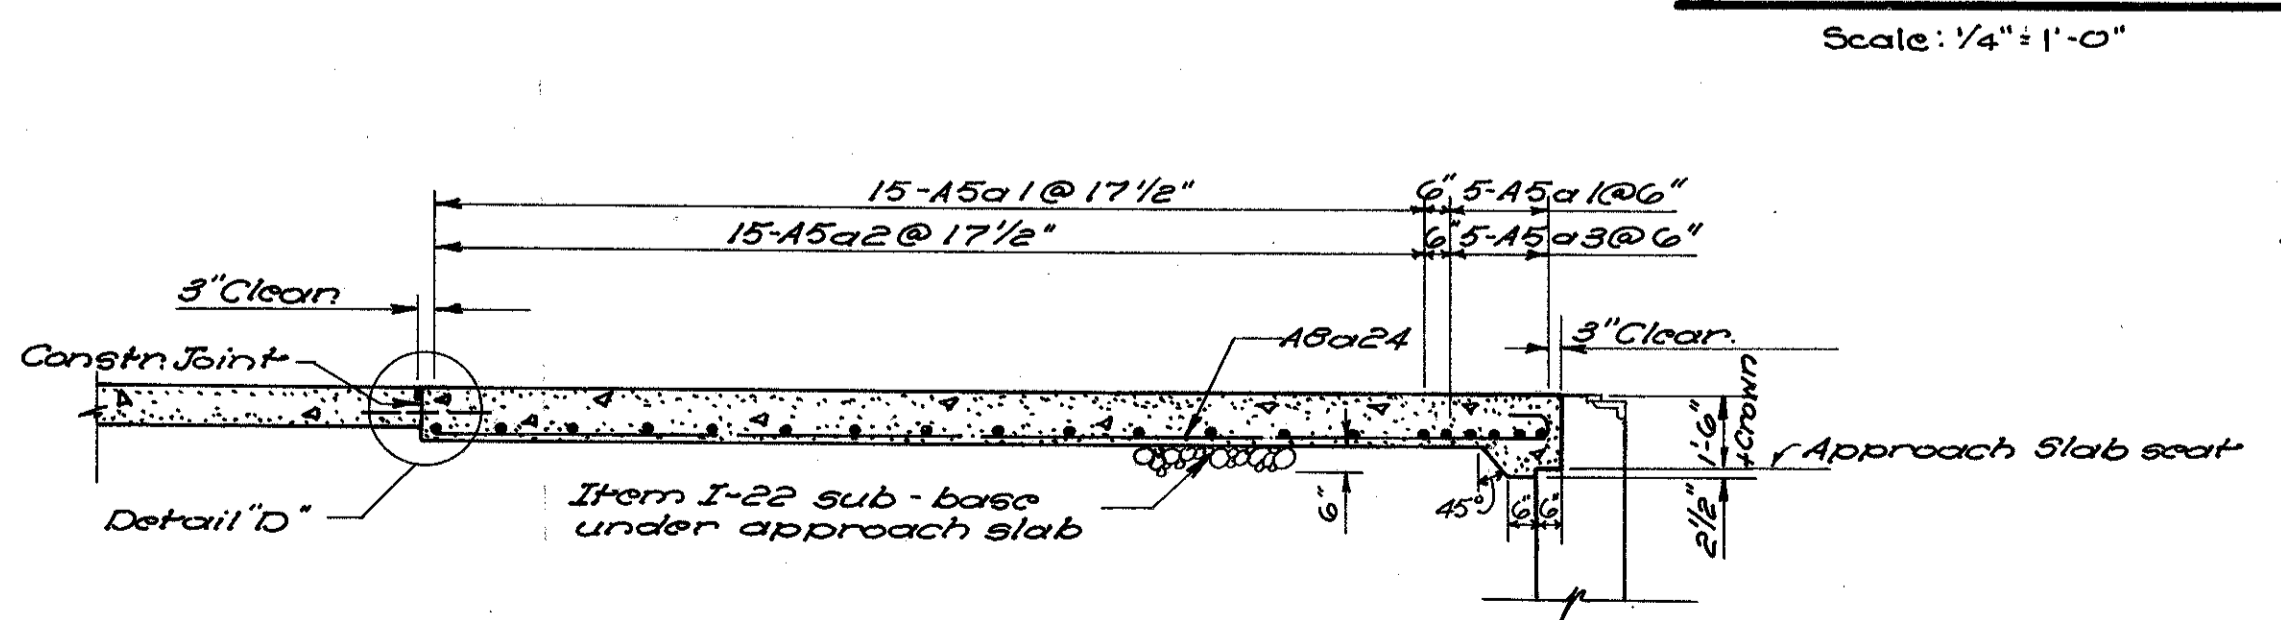


**SECTION B-B**  
Scale: 1/4" = 1'-0"

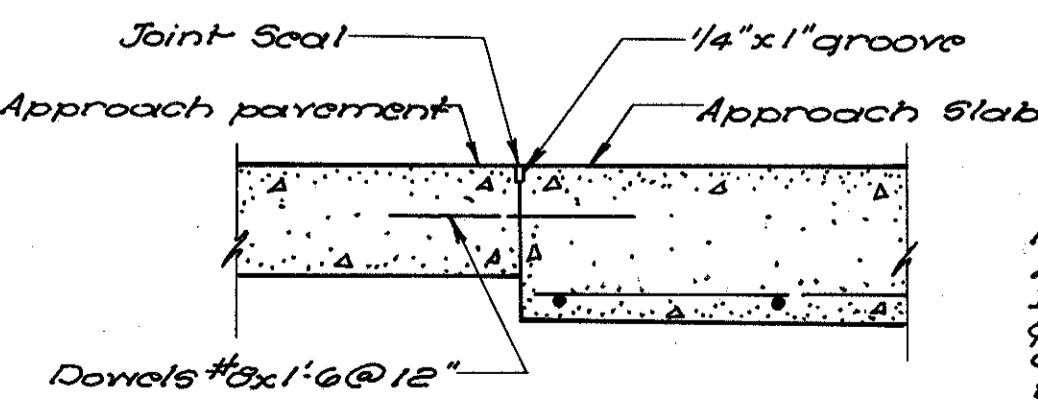


**DETAIL "D"**  
Scale: 3/4" = 1'-0"

**NOTE:**  
Approach Slabs to be Class "C" Concrete. The price bid for Item I-7 for the approach slab shall include safety curb 5" precast expansion joint filler. For location of expansion joints in the approach pavement adjacent to the bridge, see standard drawing T.J. No. 1 dated 3-2-53. Payment for the construction joints, including dowel bars, is included in the price per sq. yd. bid for the approach pavement.

BUT.-4-(10.53-10.15)

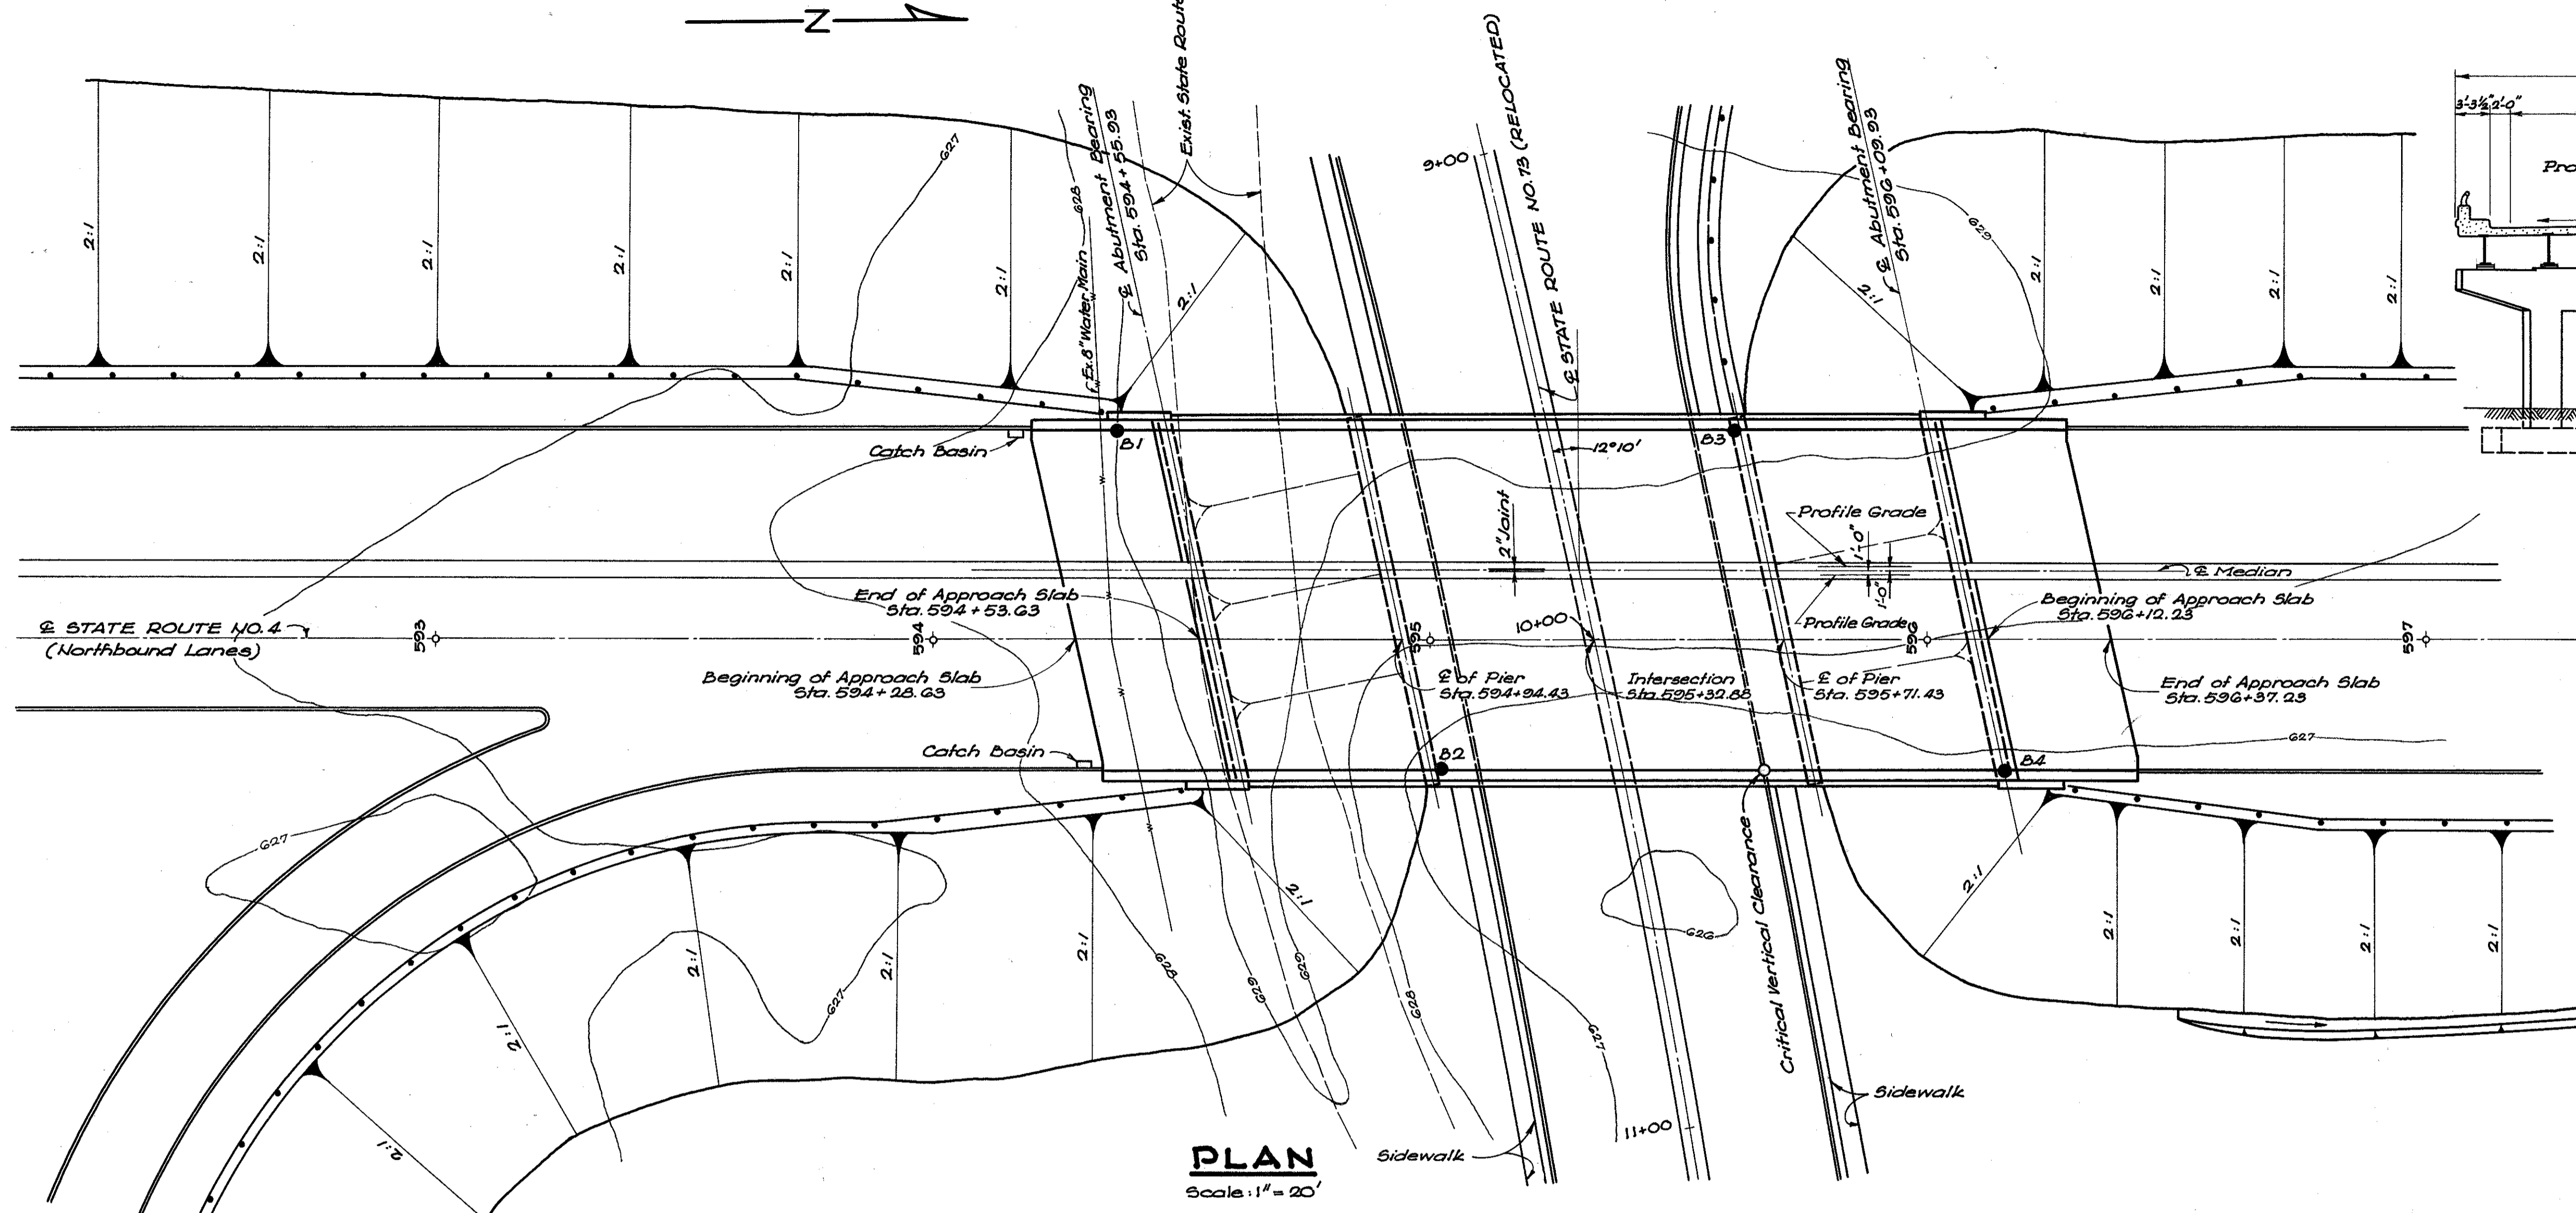

**PLAN**  
Scale: 1" = 20'

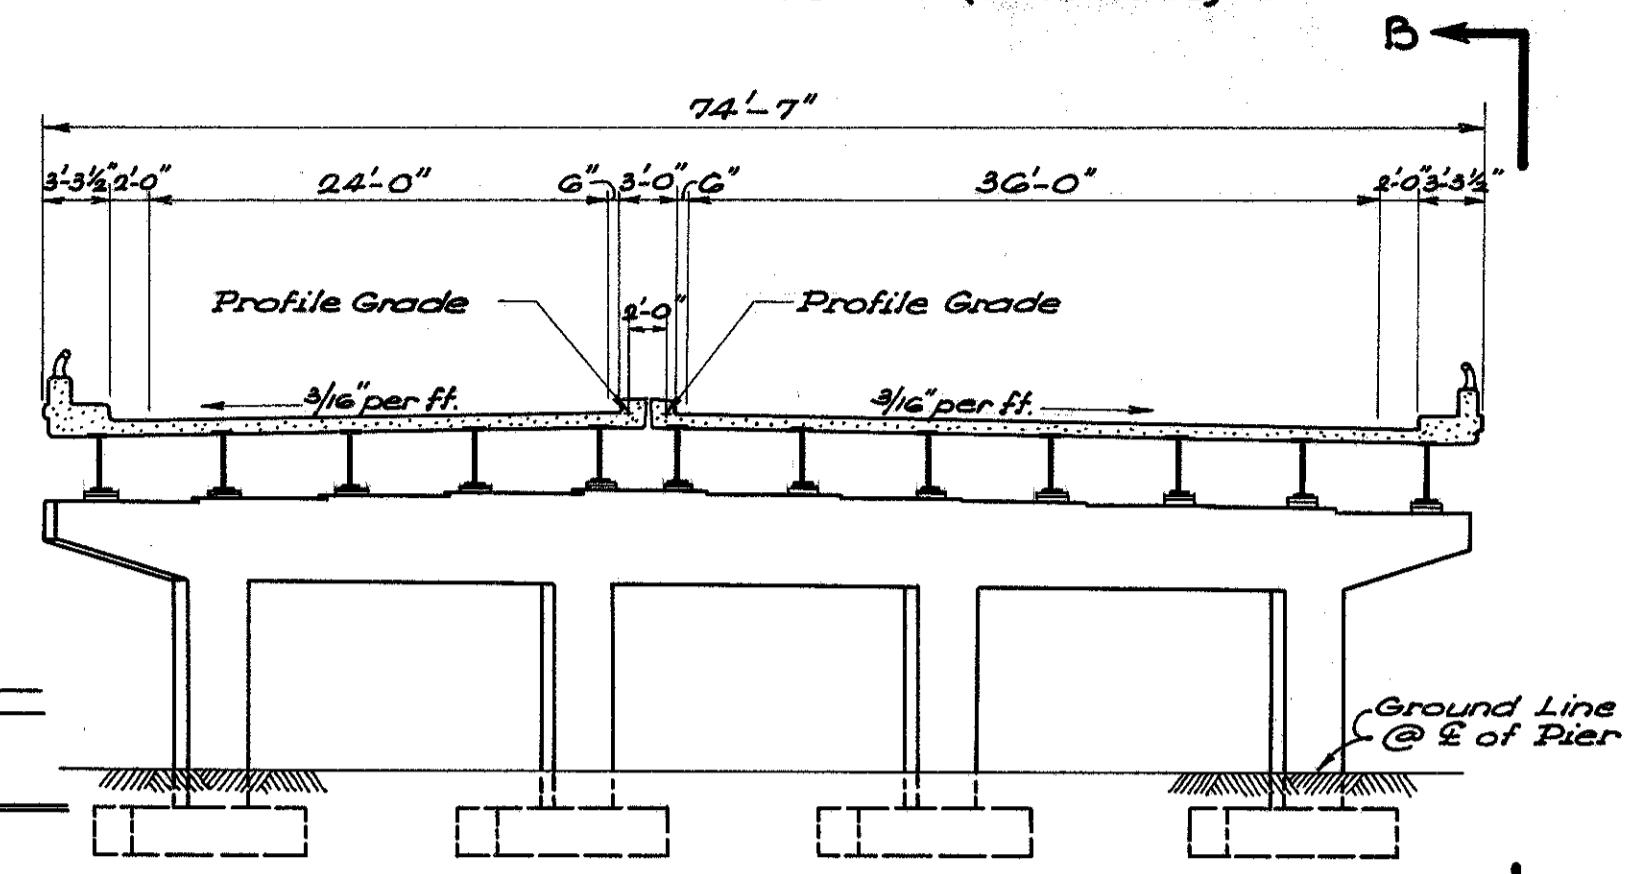


**SECTION A-A**  
Scale: 1" = 10'

**PROPOSED STRUCTURE**

**TYPE:** Continuous rolled beam with reinforced concrete deck and substructure.  
**SPANS:** 36'-0" - 77'-0" - 38'-0" c. to c. bearings  
**SKEW:** 10°-10"  
**WEARING SURFACE:** 1" monolithic concrete.  
**SAFETY CURBS:** 2 @ 2'-0"  
**ROADWAY:** 6'-0" curb to curb  
**APPROACH SLABS:** 25'-0" Long  
**LOADING:** Standard lane loading as per State of Ohio Design Specifications for Highway Structures, October 1, 1951 with revisions dated July 15, 1952 and April 1, 1954.  
 CF = 400


**NOTES**

- Symbol denotes drill hole  
See Sheet No. 195 for test boring data
- Foundation design and foundation quantities are based on a study of test borings and soil samplings made at the site. This sounding information may be inspected in the Office of the Bureau of Bridges in Columbus or in an abridged form in the Division office, but the State assumes no responsibility for the accuracy thereof.
- See Sheet No. 42 for trees and existing structures.

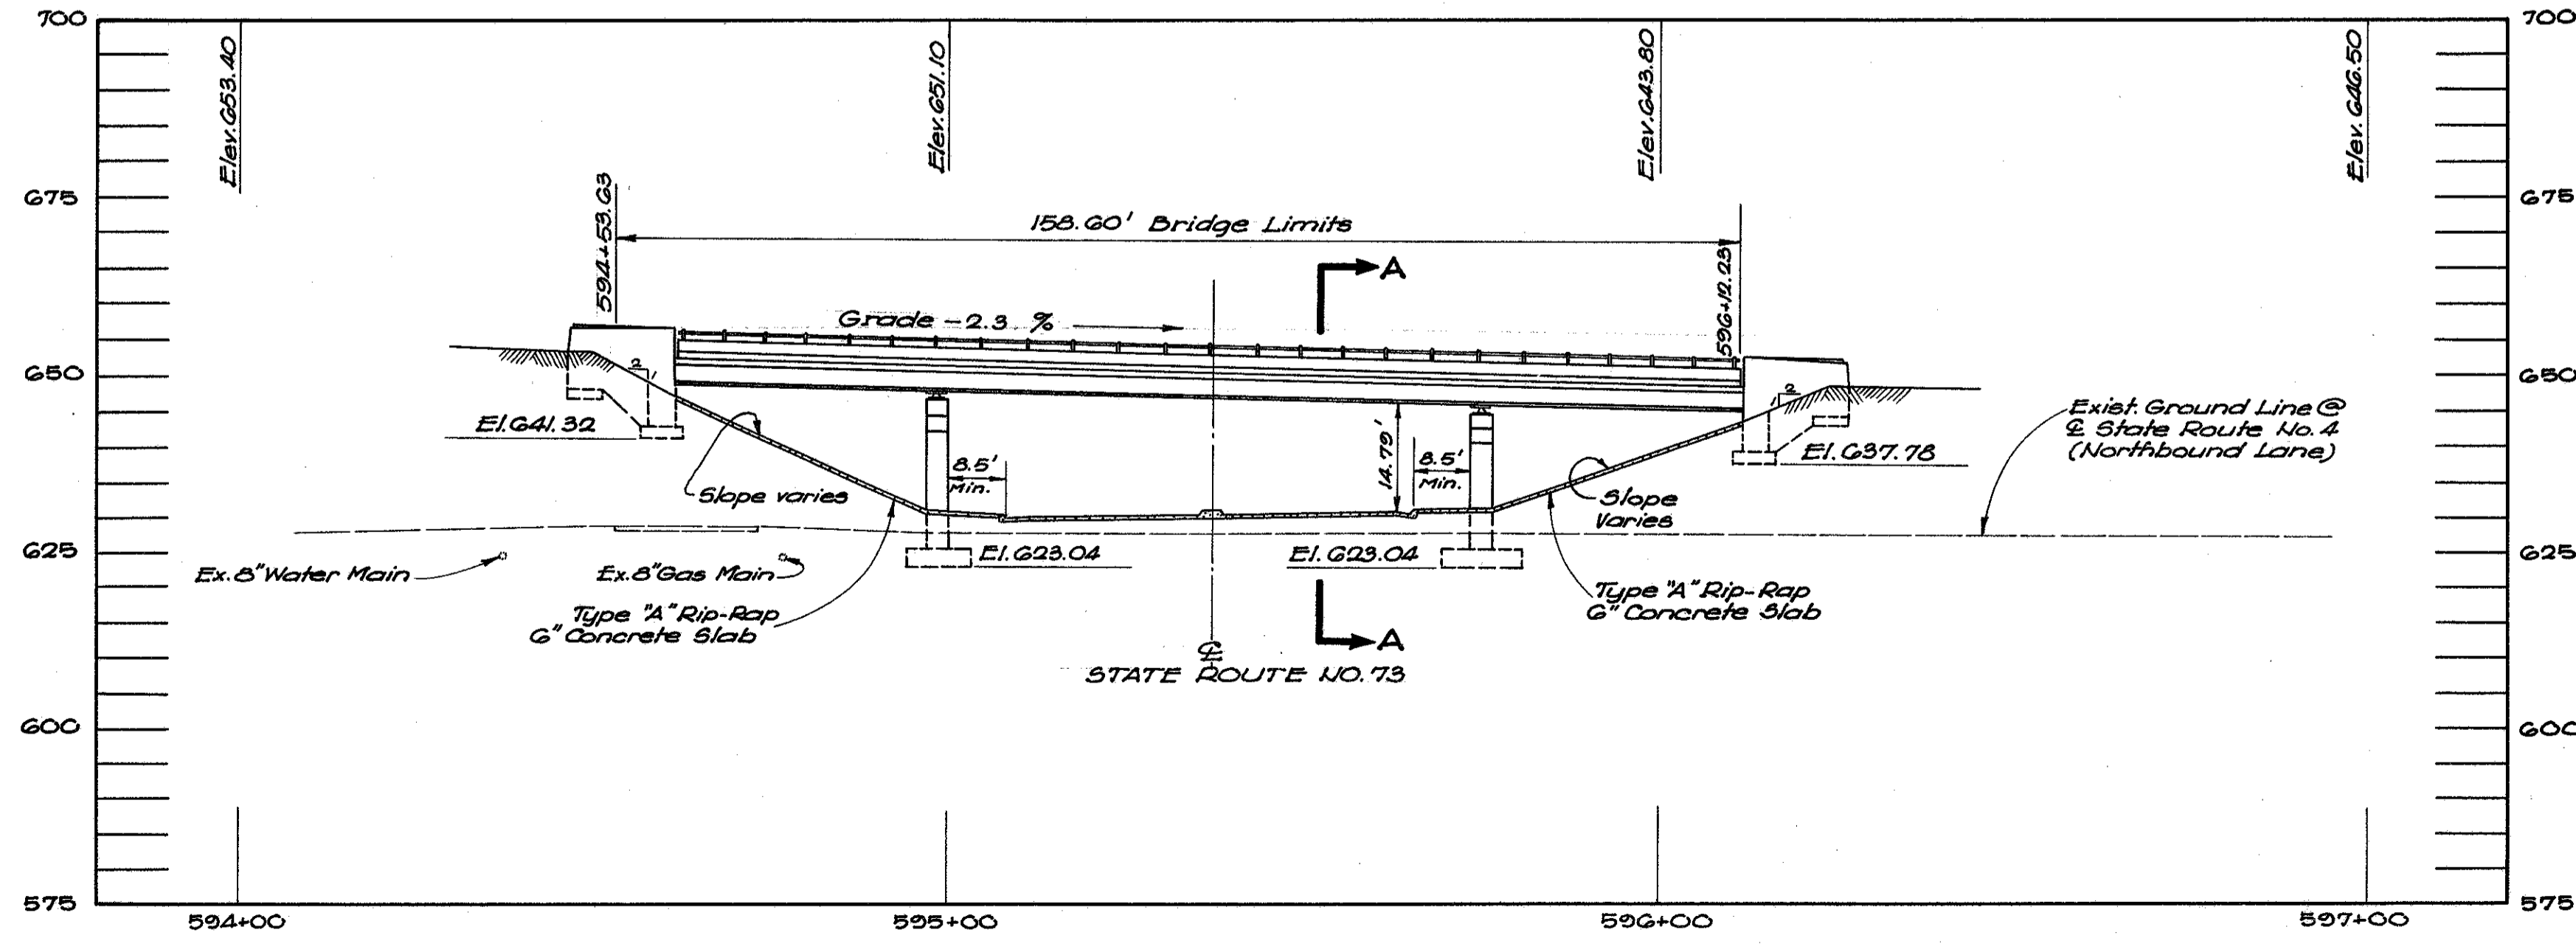

**ELEVATION B-B**  
Scale: 1" = 20'

VOGT, IVERS, SEAMAN & ASSOCIATES ENGINEERS CINCINNATI, OHIO ARCHITECTS					
<b>SITE PLAN</b>					
BRIDGE NO. BU.-4-180 OVER STATE ROUTE 73 (RELOCATED)					
BUTLER COUNTY			STA. 595+32.88		
SEC. BUT.-4			SEPTEMBER, 1955		
Scale: As shown					
PRESENT TOPOGRAPHY		PROPOSED WORK			
SURVEYED	DRAWN	DESIGNED	DRAWN	CHECKED	REVISIONS
J.C.W.	B.G.E.	G.V.	R.G.H.	R.J.L.	

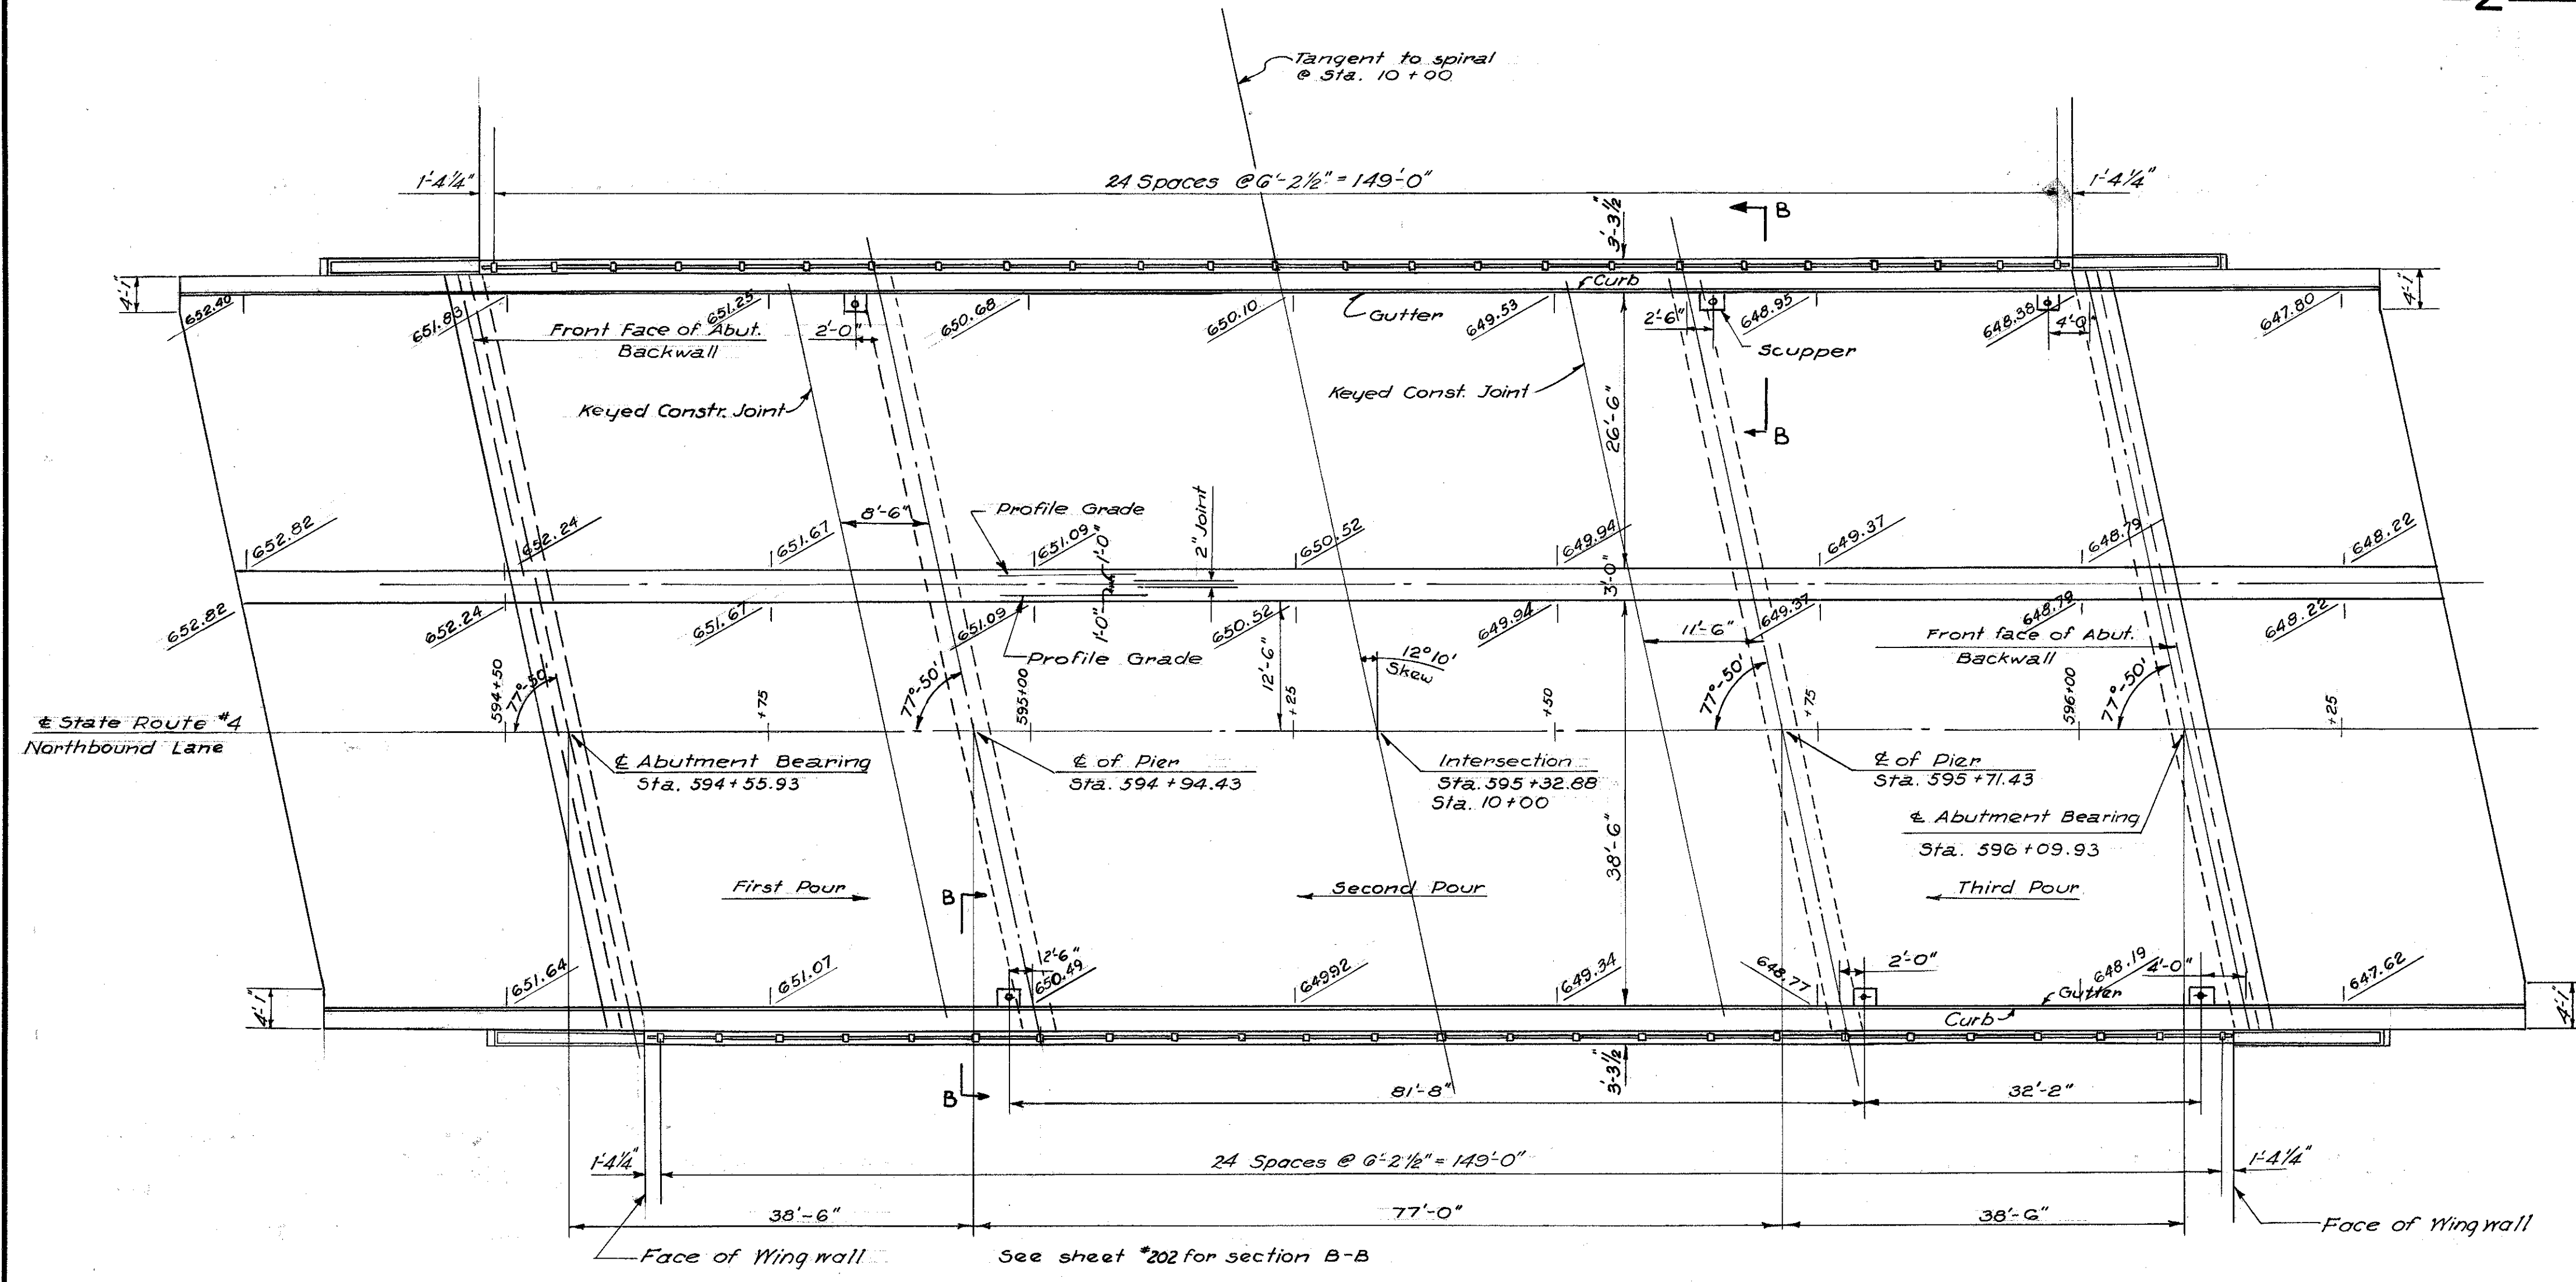

**GENERAL PLAN**  
Scale: 3/32" = 1'-0"

Note: For bridge drainage details & scupper details see sh #202

Note: Elevations shown on plan view are top of pavement elevations.

ESTIMATED QUANTITIES									
ITEM	TOTAL	UNIT	DESCRIPTION	NORTH ABUT.	NORTH PIER	SOUTH PIER	SOUTH ABUT.	SUPER STRUCTURE	GENERAL
E-2	484	Cu.Yds.	Unclassified Excavation	143	107	91	143		
S-1	325	"	Class "C" Concrete-Superstructure					325	
S-1	110	"	Class "C" Concrete-Pier Capst/Col's		54	56			
S-1	133	"	Class "E" Concrete - Pier & Abut. Foot's	33	37	30	33		
S-1	161	"	Class "E" Concrete - Abut & Wing Walls	80			81		
S-4	136,971	Pounds	Reinforcing Steel	7080	10459	19039	7112	84095	186
S-7	356,270	"	Structural Steel					356270	
S-8	356,270	"	Field Painting of Structural Steel					356270	
S-9	238	Sq. Ft.	1" Premolded Expansion Jt. Filler						238
S-14	303	Lin. Ft.	Railing Aluminum rail & supports, and conc. parapet					303	
S-29	62	Cu. Yds.	Porous Backfill	31			31		
S-29	115	Lin. Ft.	6" Wrought Iron Pipe						115
S-29	252	Lin. Ft.	8" Plain Concrete Pipe, incl. Specials						252
S-29	6	Each	Scuppers						6
S-29	1	Each	Concrete Junction Box						1
I-9	50	Lin. Ft.	Stone Underdrain (French drain)	25			25		
I-10	800	Sq. Yds.	Type "A" Riprap, 6" concrete slab						800

Note: Materials in approach slabs are not included in the above estimated quantities.

**GENERAL NOTES**

**DECK PLACING PROCEDURE:** Deck slab shall be placed in sections between transverse construction joints, in the numerical order and in the direction indicated on the drawings.

**WELDING:** Welding shall be Class A unless otherwise shown on plans. Any weld shown as field weld may be welded in the shop at the option of the contractor. Class B welds are shown with the letter "B" in the V-tail of the weld symbol.

**EXCAVATION:** Roadway embankment at abutments shall be placed and compacted to the bridge seat elevation. Excavation shall then be made for the abutment footings. Quantities for excavation includes removal of fill material between the above described elevation and bottom of the abutment footings.


**SURFACE FINISH OF CONCRETE:** Curb faces, fascias of deck and exposed surfaces of piers, abutments, and wing walls shall receive a rubbed surface finish. All other exposed surfaces shall be governed by the provisions of Item S-1.

**GRAVEL:** If used as a coarse aggregate, shall be according to Sec. M-3.93 instead of M-3.91 for Class C concrete in the superstructure. Gravel meeting the requirements of Sec. M-3.93 may also be used for other concrete in this structure.

**TRAFFIC:** Adequate protection and maintenance of two-way traffic on existing or relocated State Route No. 73 shall be provided at all times.

**ADDITIONAL NOTES:** For additional notes, see Sheet No. 19)

**EMBANKMENT:** Approximately 200 ft. of approach embankment at each end of the bridge to be placed and brought to the planned subgrade elevation during the initial stage of work at this structure. The above shall be completed before any work will be permitted on the construction of piers. Provisions shall be made for, and periodic checks made of the elevation of the approach embankments immediately following the placement of the embankment to the planned subgrade elevation. Such periodic observations shall be continued until the existence, degree and nature of any subsidence due to the consolidation of the subsoil has been established.

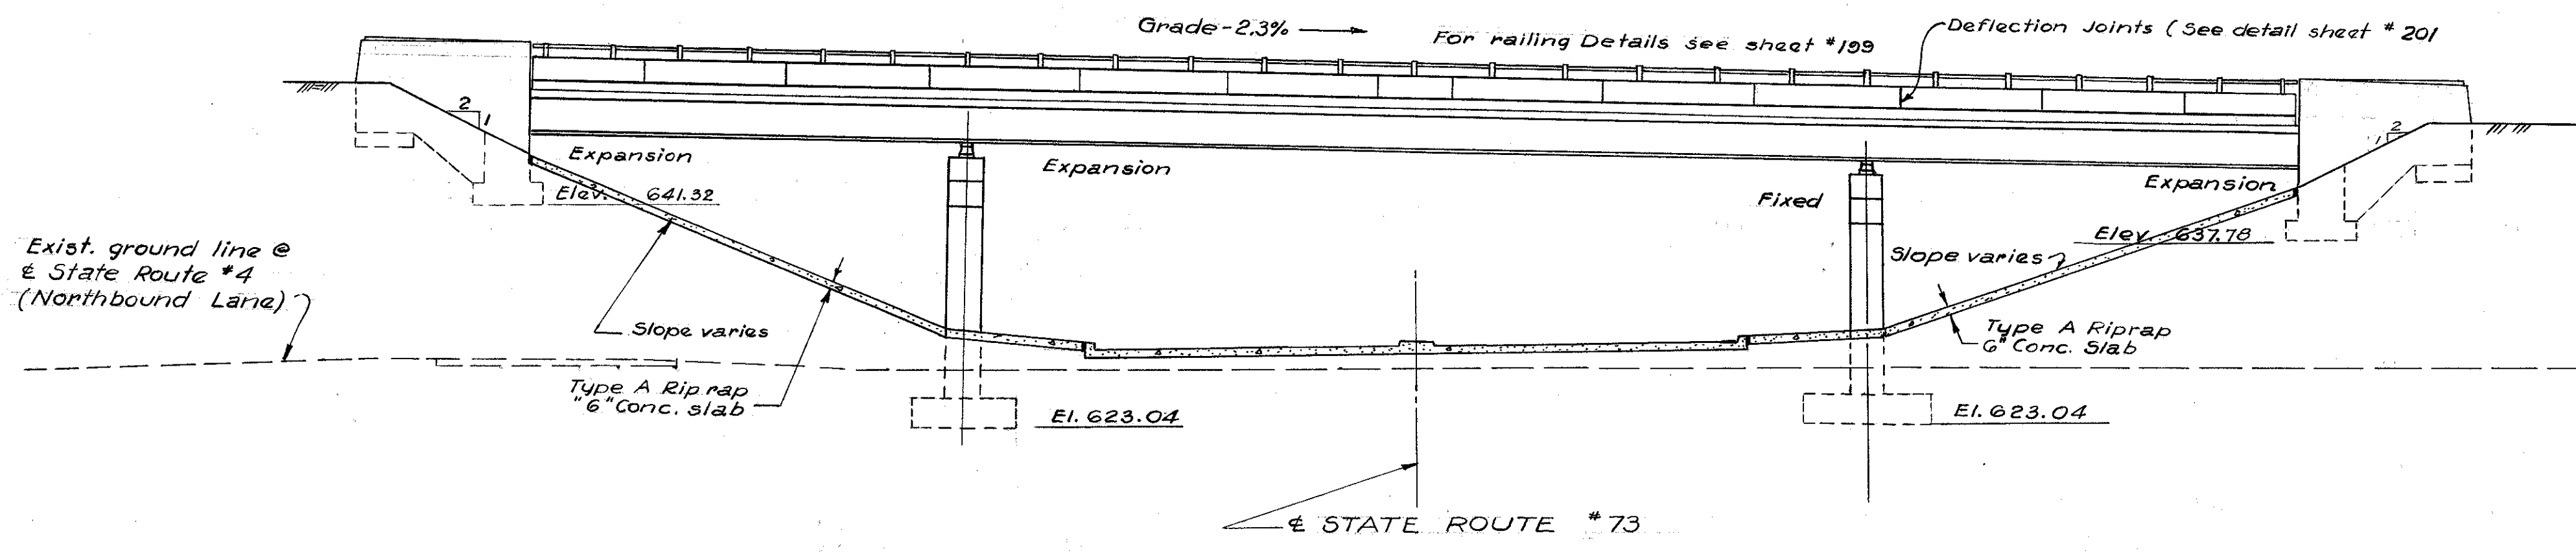

**ELEVATION**  
Scale: 3/32" = 1'-0"

VOGT, IVERS, SEAMAN & ASSOCIATES  
ENGINEERS ARCHITECTS  
CINCINNATI, OHIO


**GENERAL PLAN, ELEVATION NOTES & QUANTITIES**

BRIDGE NO. BU-4-186  
OVER STATE ROUTE 73 (RELOCATED)


BUTLER COUNTY  
SEC. BUT. - 4 STA. 595+32.88  
Scale: As shown Sept. 1955

DESIGNED	DRAWN	TRACED	CHECKED	REVIEWED	DATE	REVISED
G.V.	M.A.A.	G.I.	G.V.	W.J.I.	10-11-55	




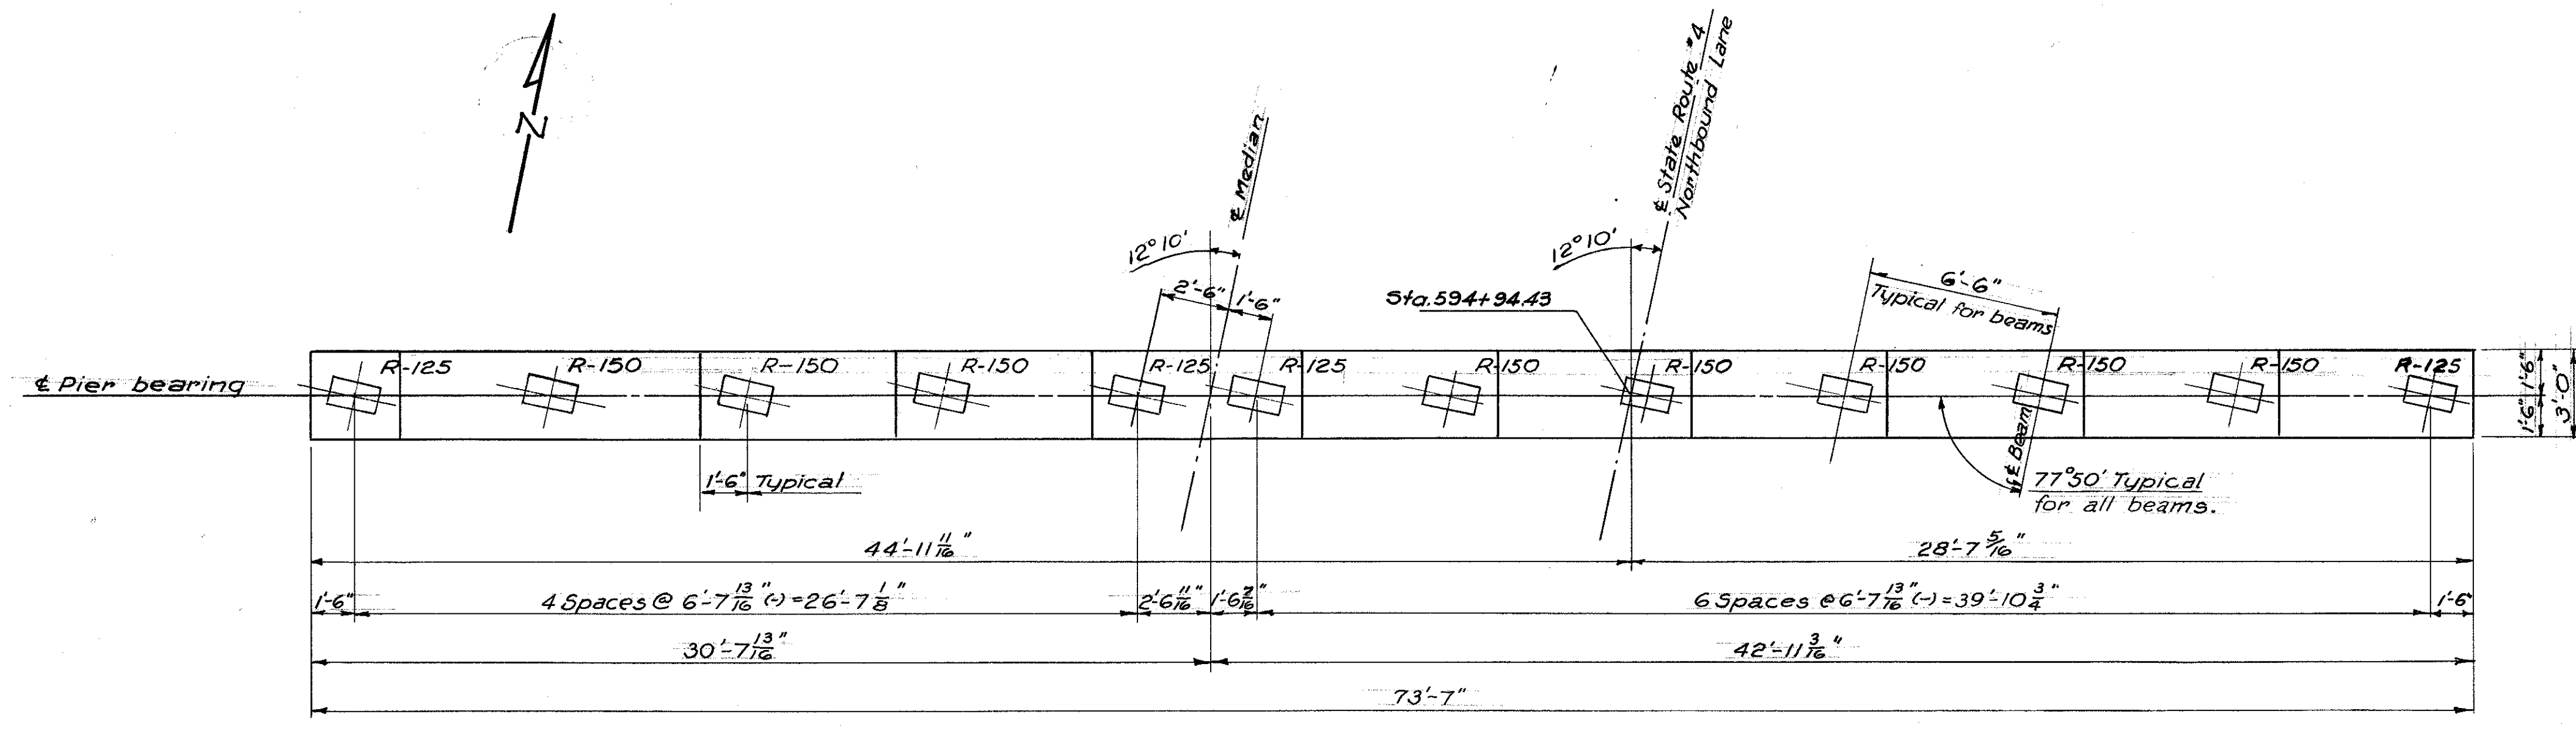


**PLAN**  
Scale: 1/4" = 1'-0"

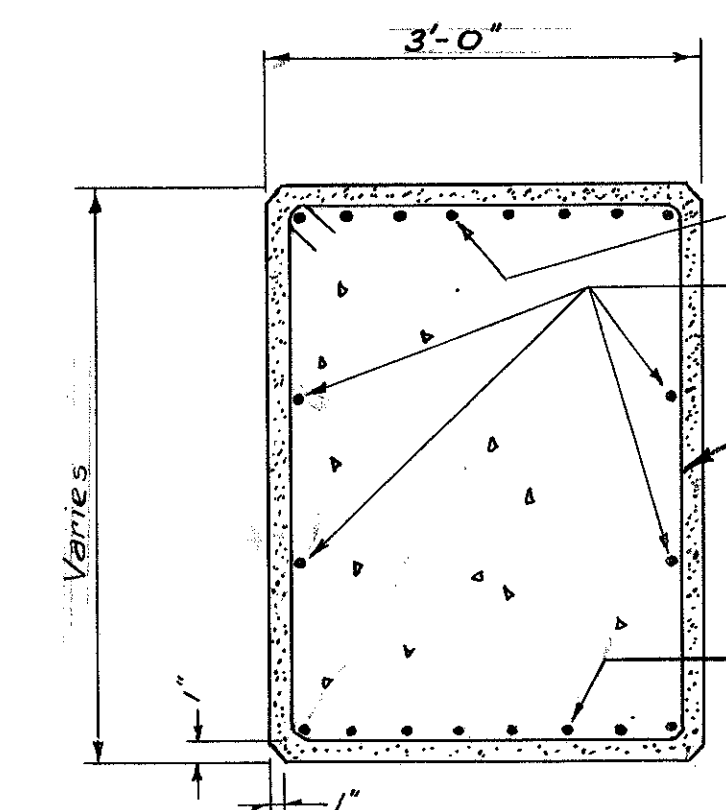


**SECTION C-C**  
Scale: 3/4" = 1'-0"

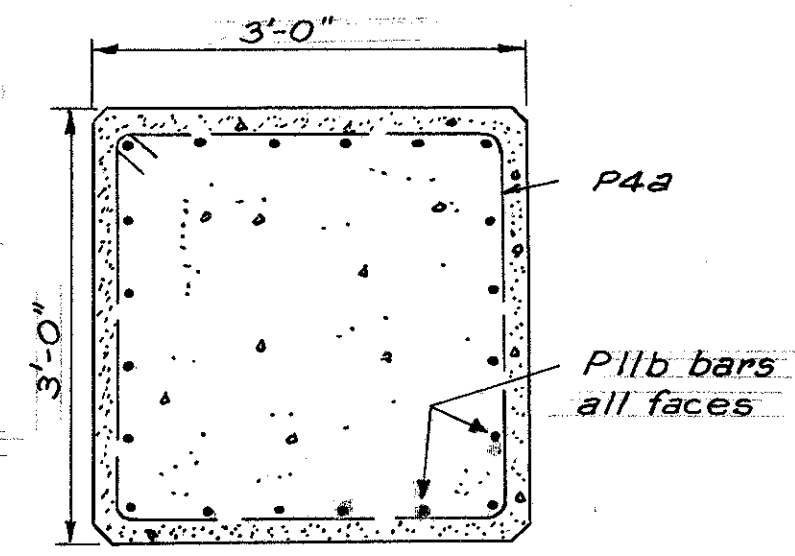


**SECTION A-A**  
Scale: 3/4" = 1'-0"

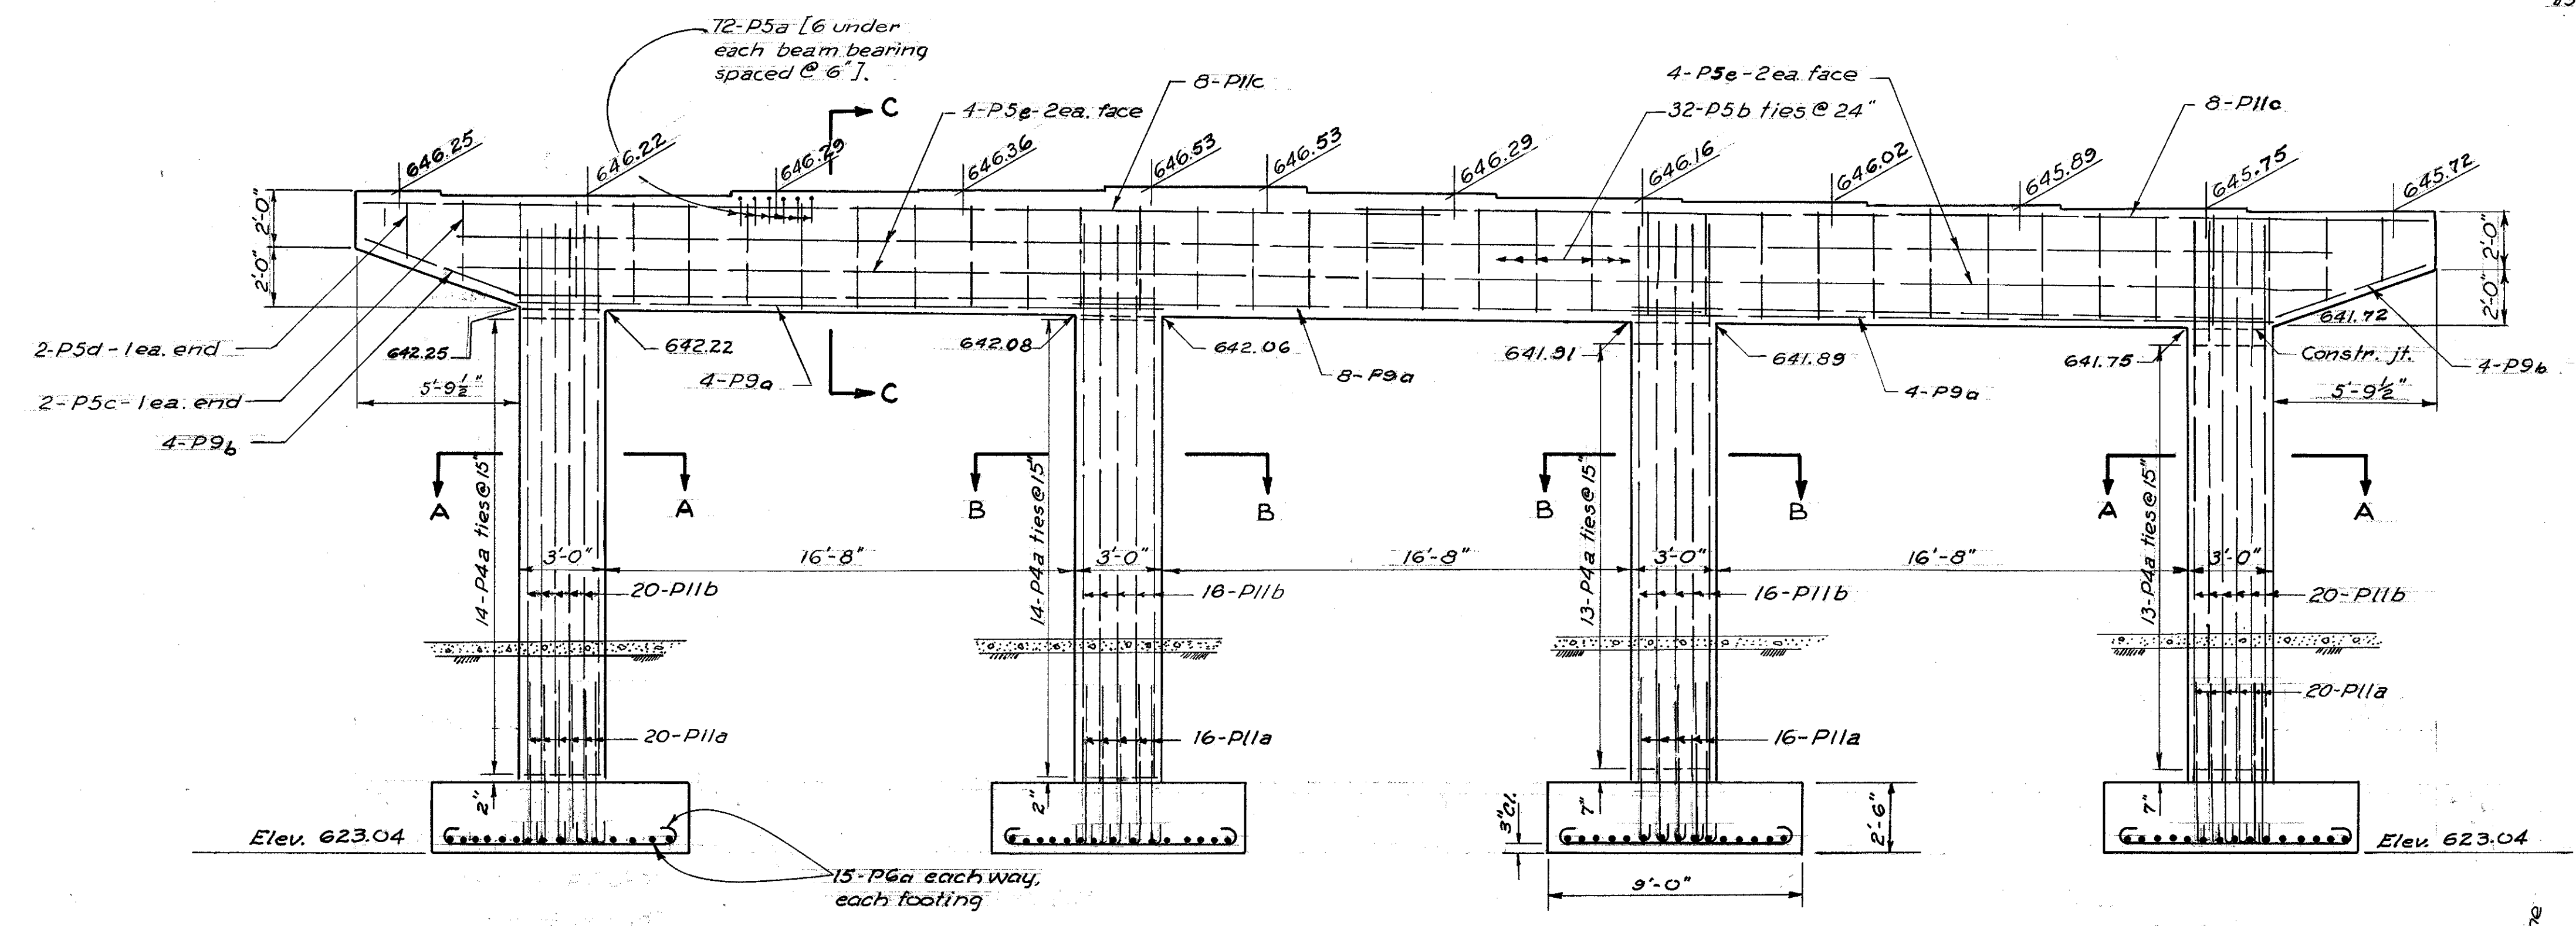

**ELEVATION**  
Scale: 1/4" = 1'-0"

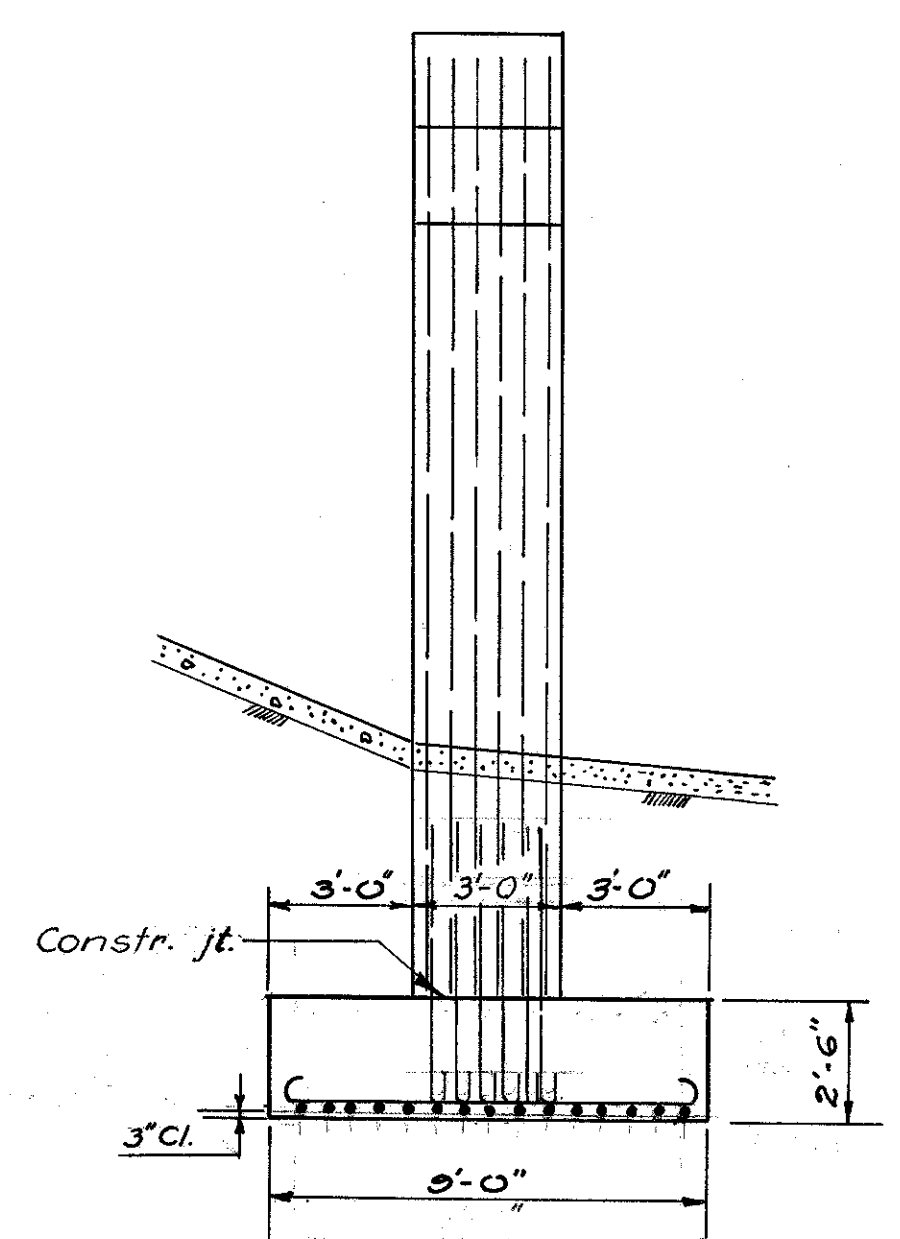


**END VIEW**  
Scale: 1/4" = 1'-0"

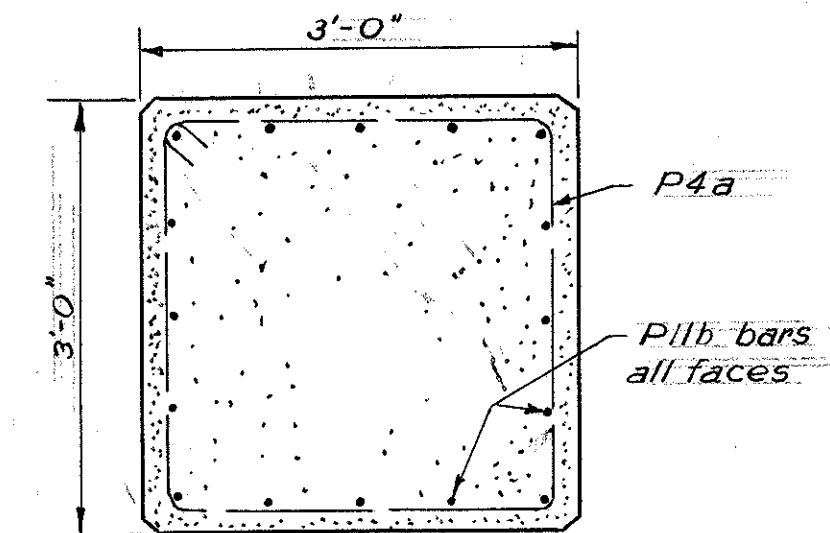

**SECTION B-B**  
Scale: 3/4" = 1'-0"

Notes:  
Place dowels in footings to insure correct placing of main column steel  
All main reinforcing steel to have 2" cover unless otherwise noted.

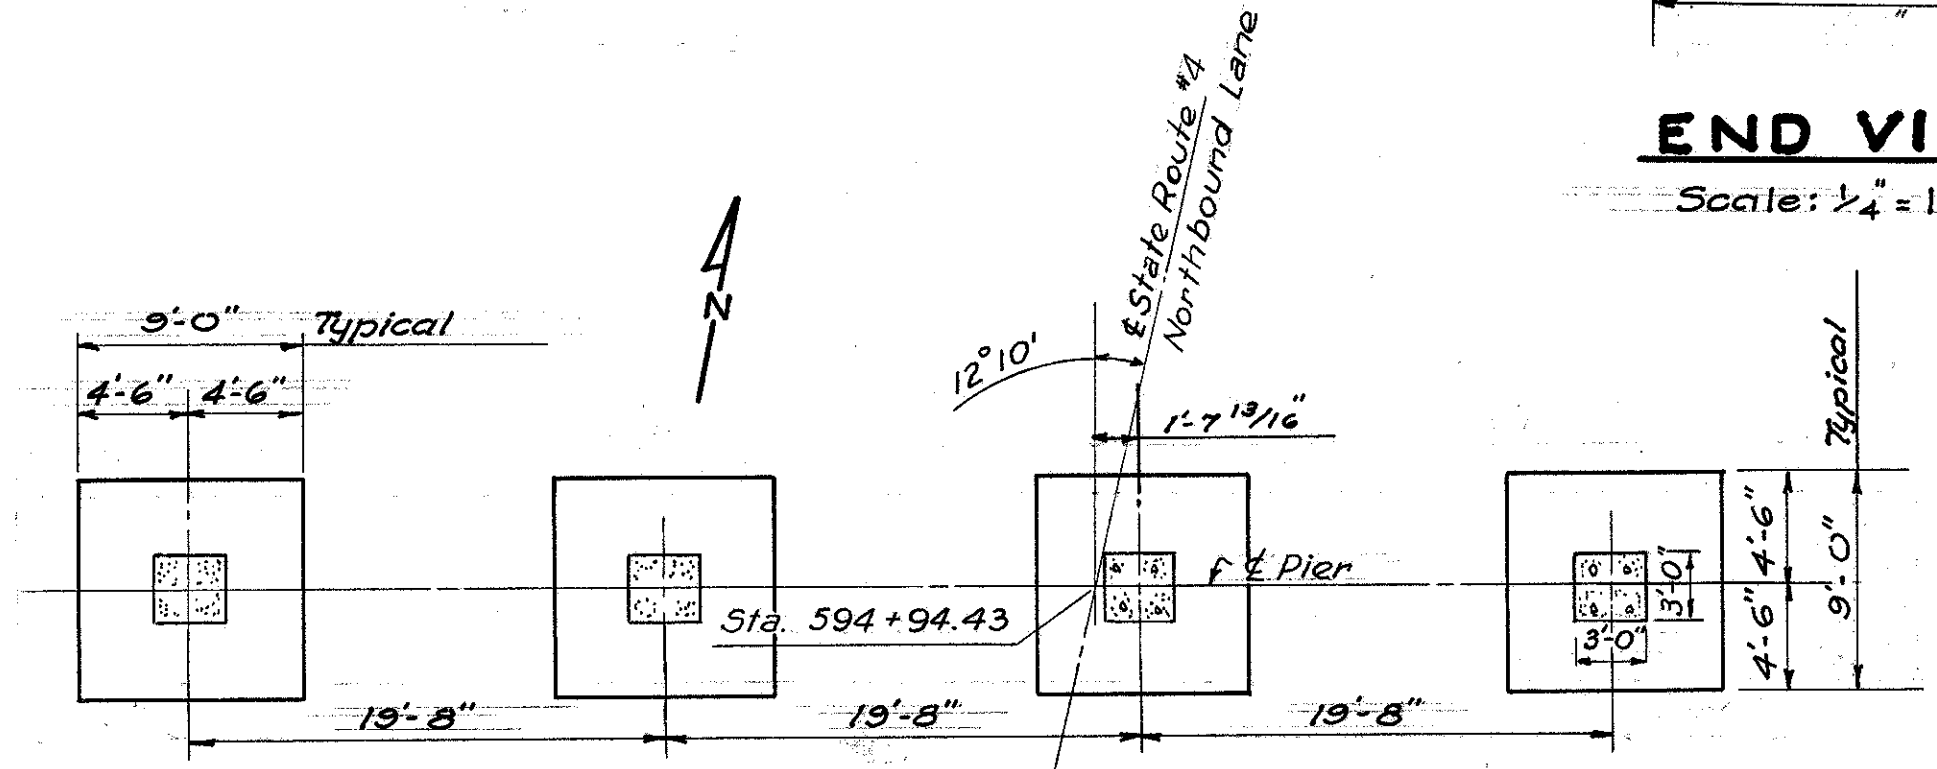

**FOOTING PLAN**  
Scale: 1/8" = 1'-0"

VOGT, IVERS, SEAMAN & ASSOCIATES  
ENGINEERS ARCHITECTS  
CINCINNATI, OHIO




**SOUTH PIER**  
BRIDGE NO. BU-4-186  
OVER STATE ROUTE 73(RELOCATED)

BUTLER COUNTY  
SEC. BUT-4  
Scale: As shown



STA. 595 + 32.88  
SEPT. 1955

DESIGNED	DRAWN	TRACED	CHECKED	REVIEWED	DATE	REVISED
G.V.	R.L.S.	C.I.	G.V.	W.J.I.	10-11-55	


BUT.-4-(16.53-19.15)

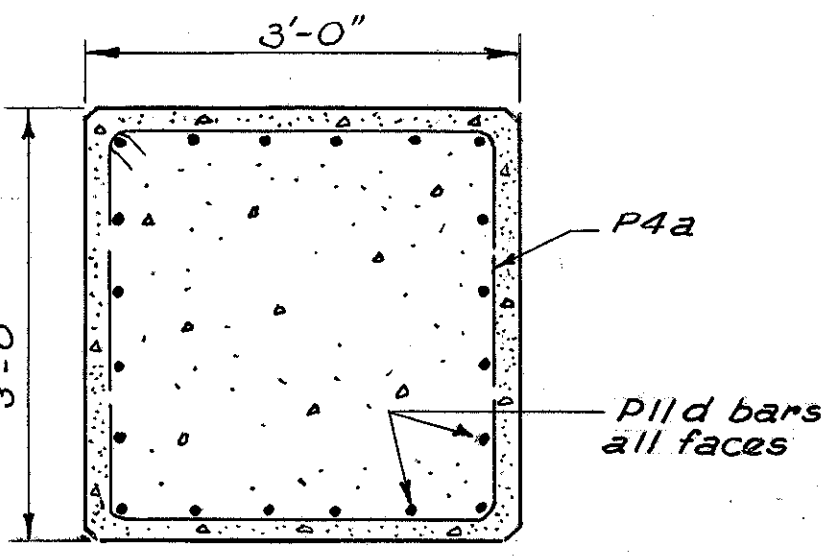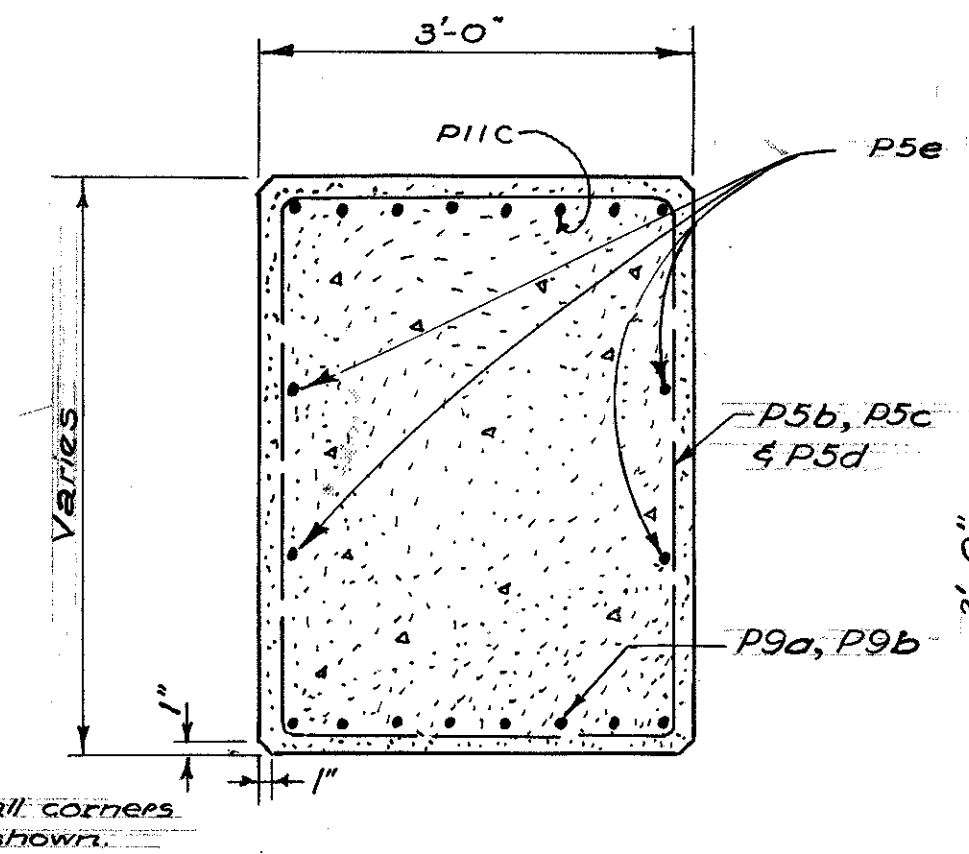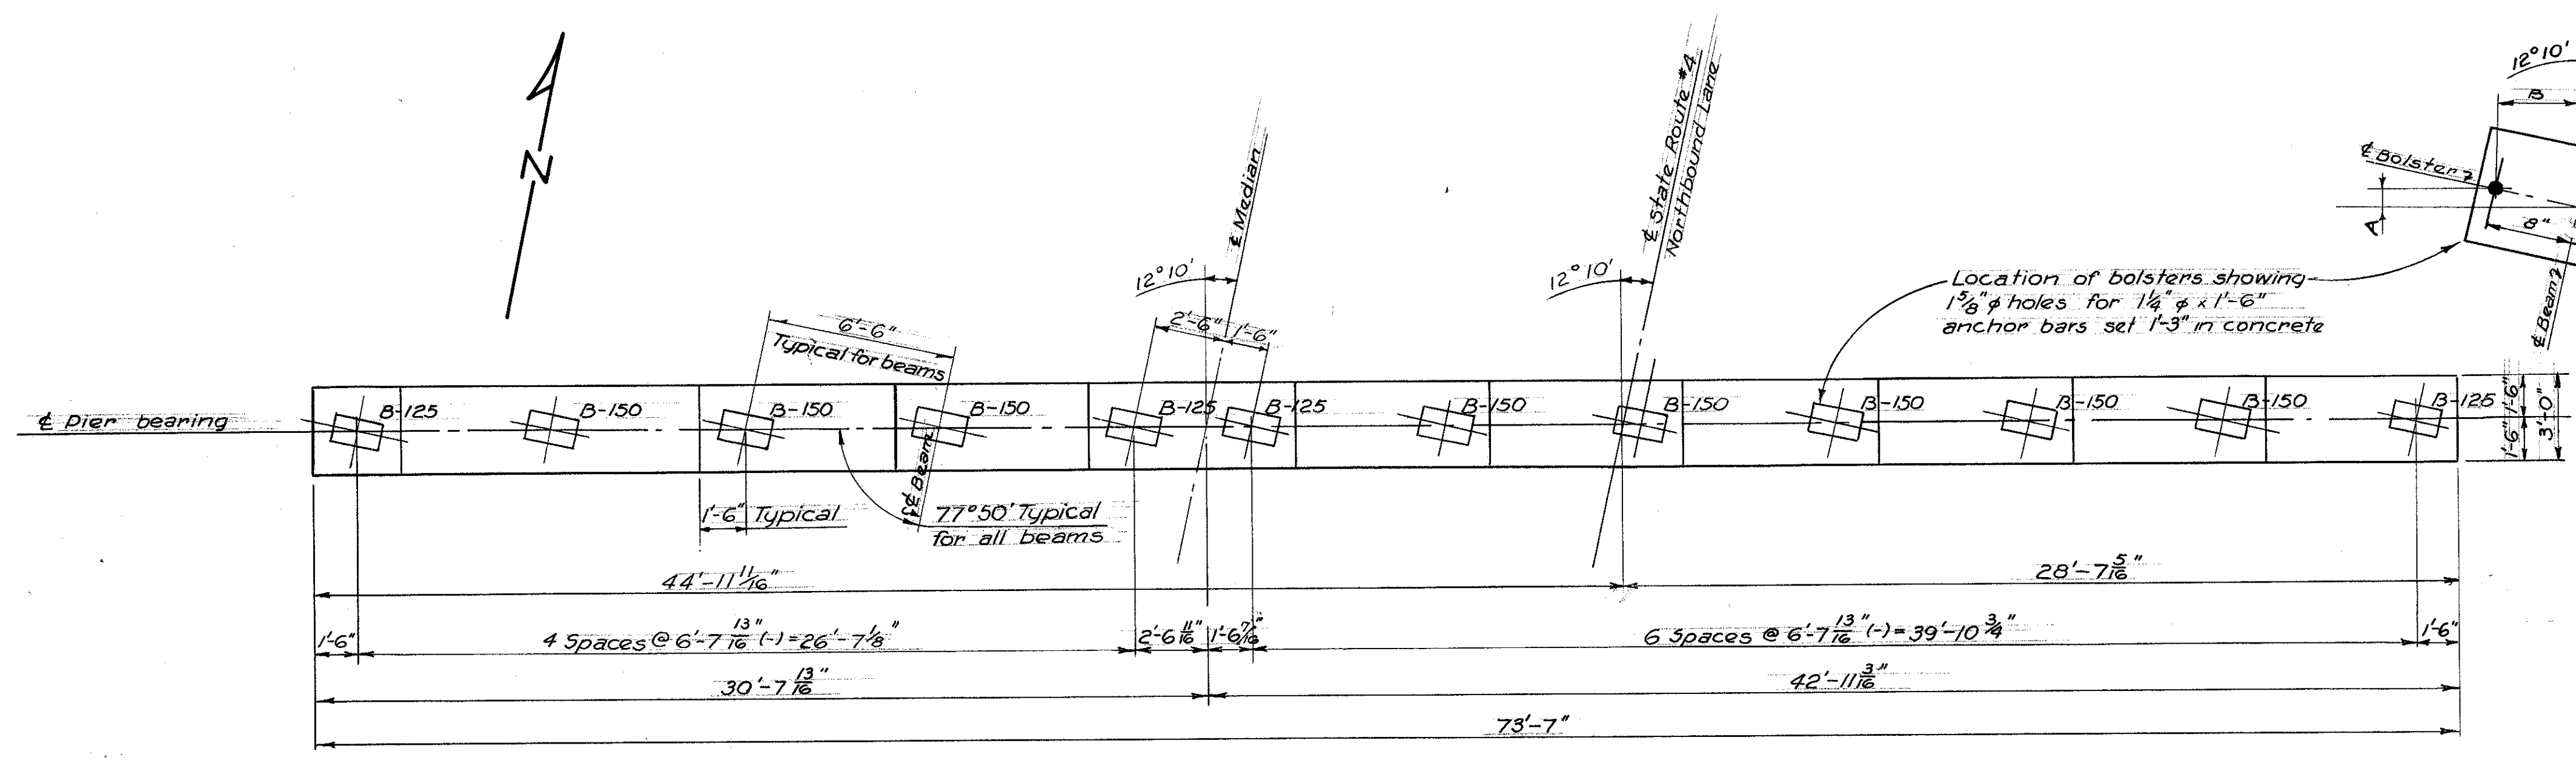

Note:  
Place pier cap reinforcement to clear anchor bars.

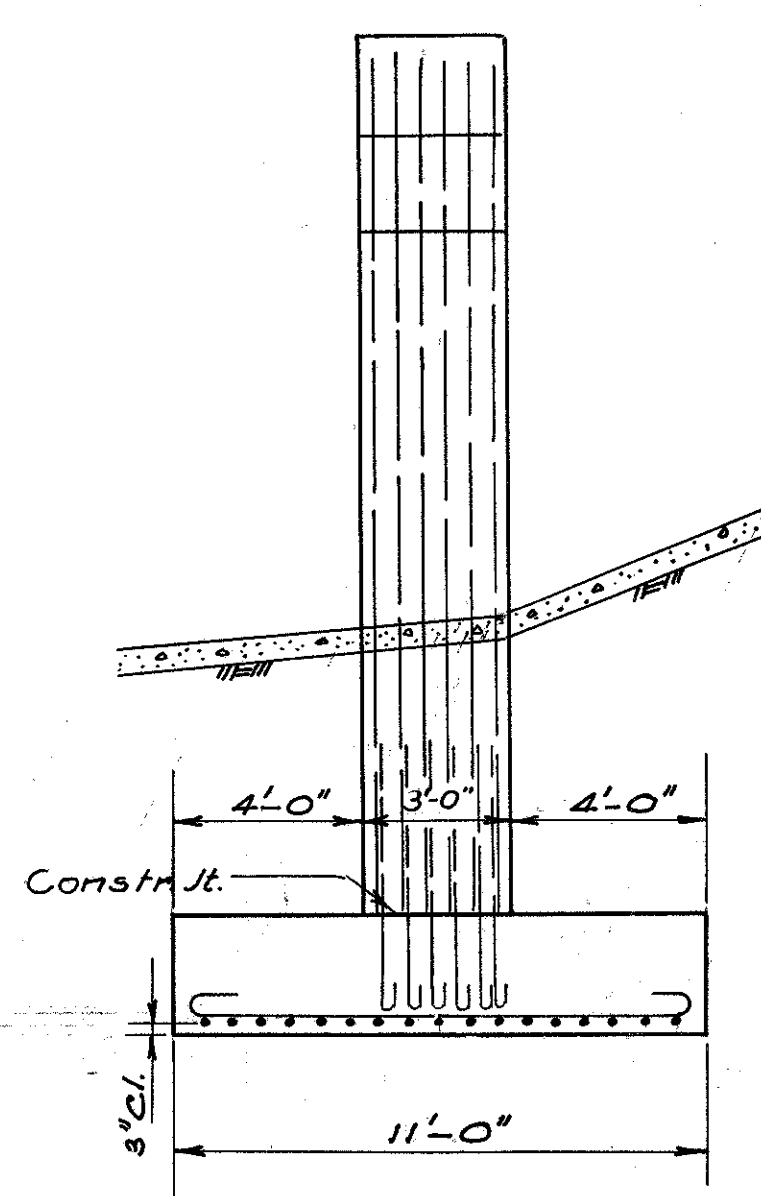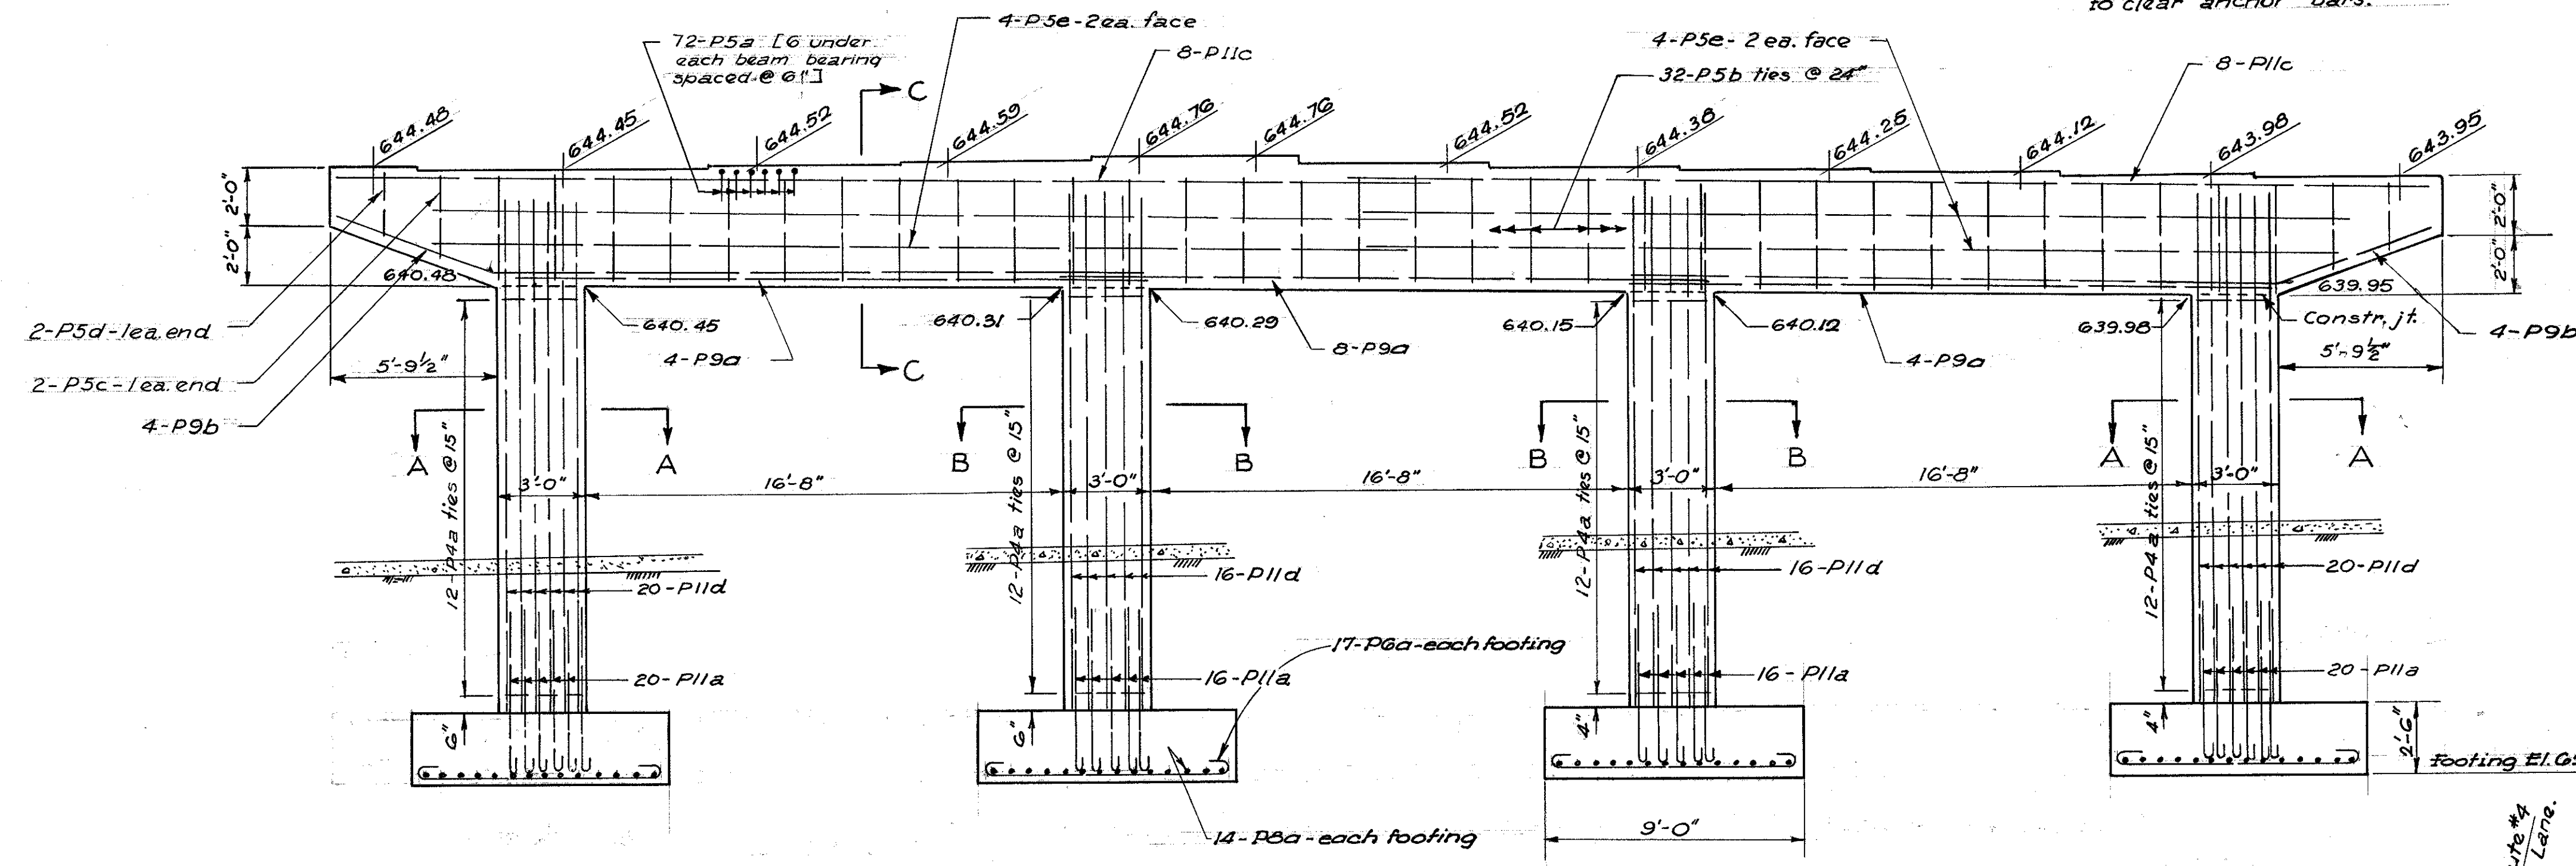

Note:  
Place dowels in footings to insure correct placing of main column steel. All main reinforcing steel to have 2" cover unless otherwise noted.

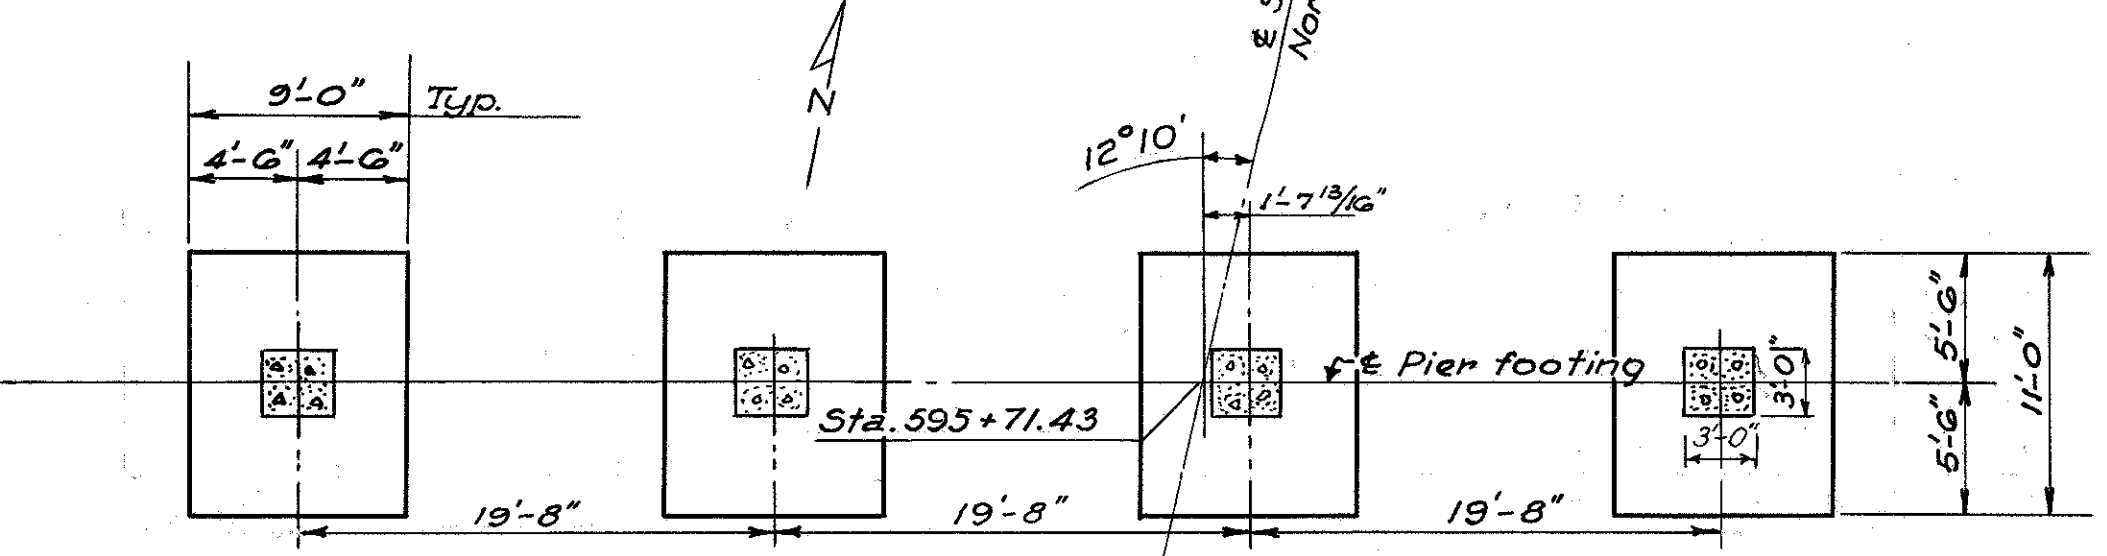

VOGT, IVERS, SEAMAN & ASSOCIATES  
ENGINEERS ARCHITECTS  
CINCINNATI, OHIO



**NORTH PIER**  
BRIDGE NO. BU-4-186  
OVER STATE ROUTE 73 (RELOCATED)

BUTLER COUNTY  
SEC. BUT-4  
Scale: As shown

STA. 595+32.88  
SEPT. 1955


DESIGNED	DRAWN	TRACED	CHECKED	REVIEWED	DATE	REVISED
G.V.	R.L.S.	C.I.	G.V.	W.J.I.	10-11-55	

**NOTES:**  
 For approach slab details, see Sheet No. 204.  
 All reinforcing steel to have 2" clearance, except bottom of footings where 3" is required.  
 For sections not shown on this sheet, see Sheet No. 196.

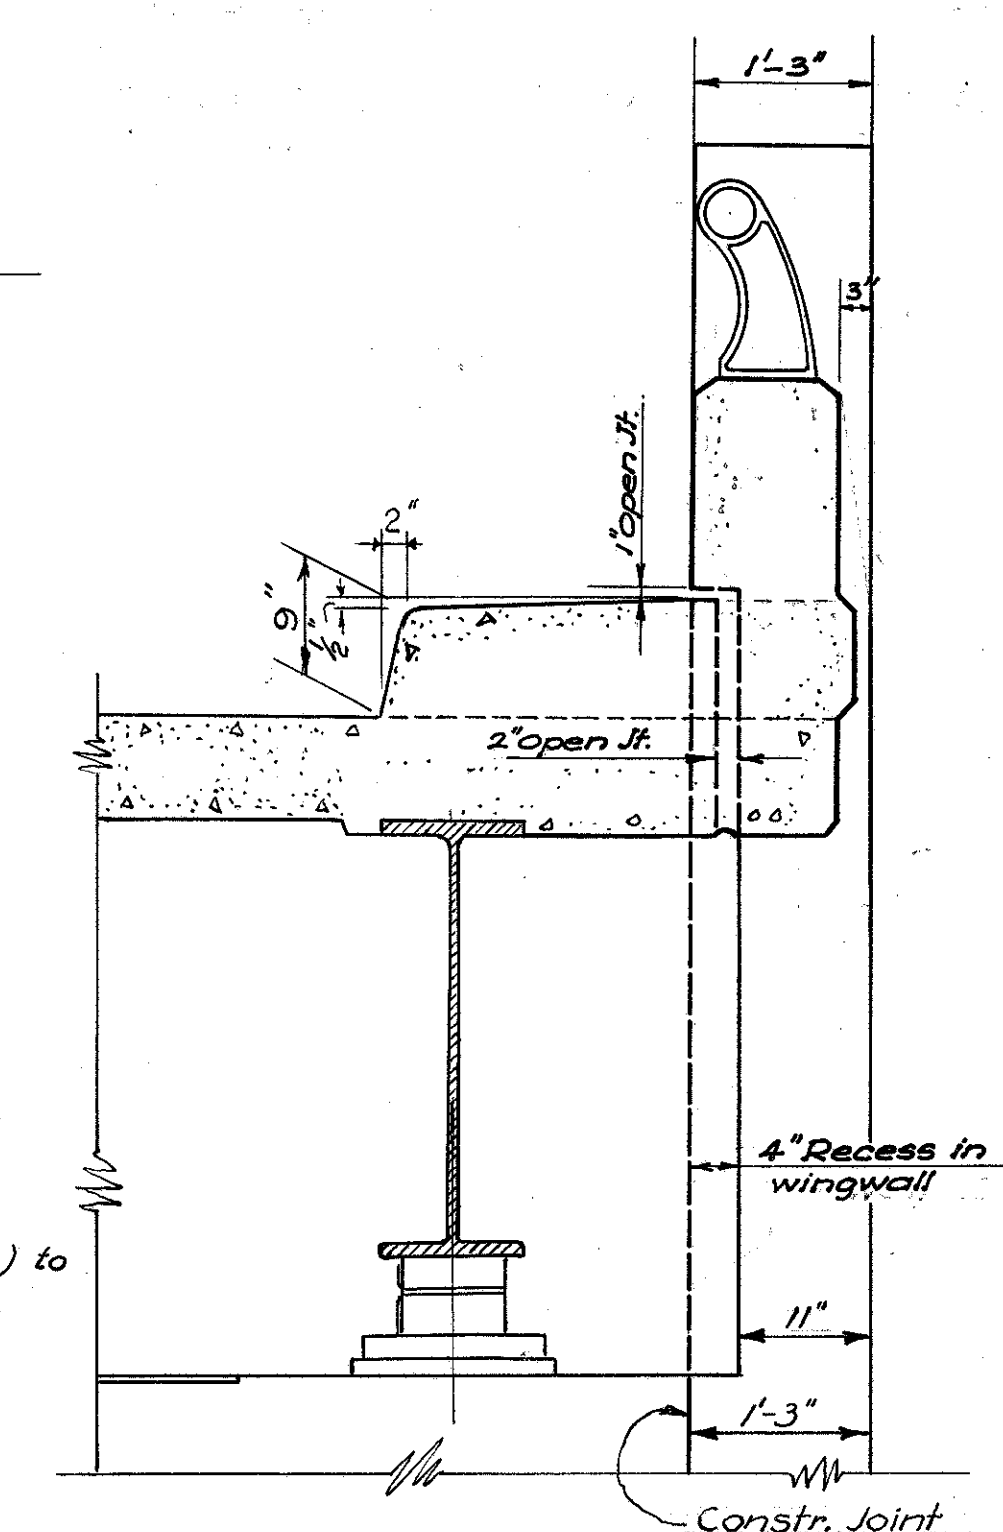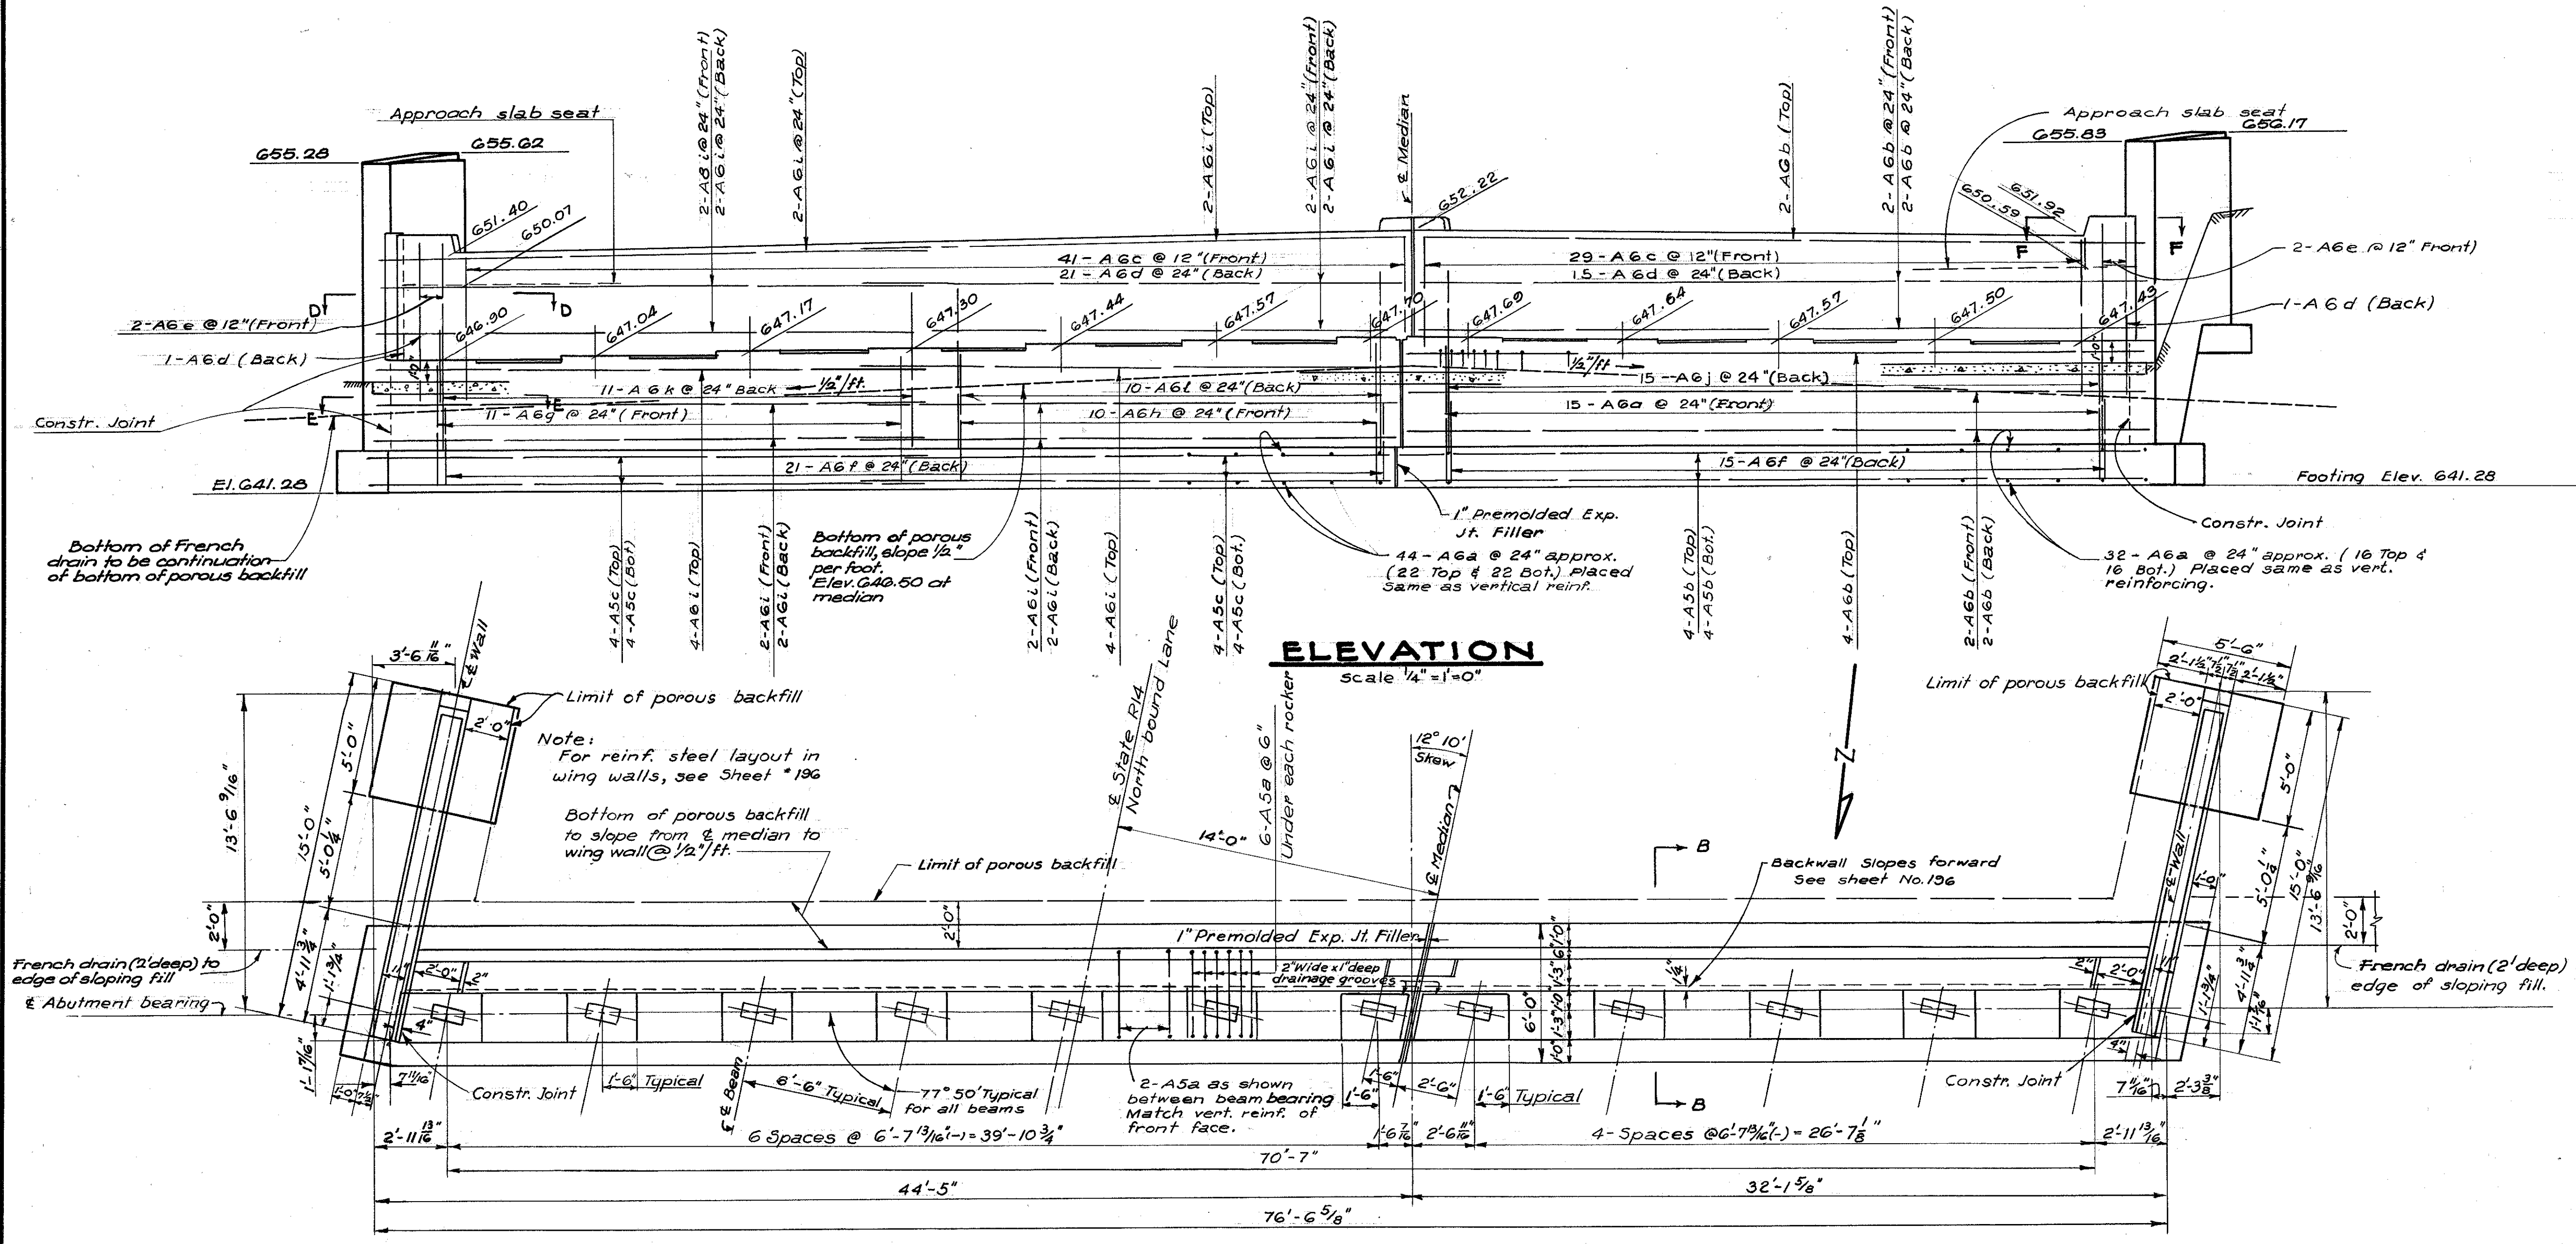

**SECTION A-A**  
 Scale: 3/4" = 1'-0"

**PLAN**  
 Scale: 1/4" = 1'-0"

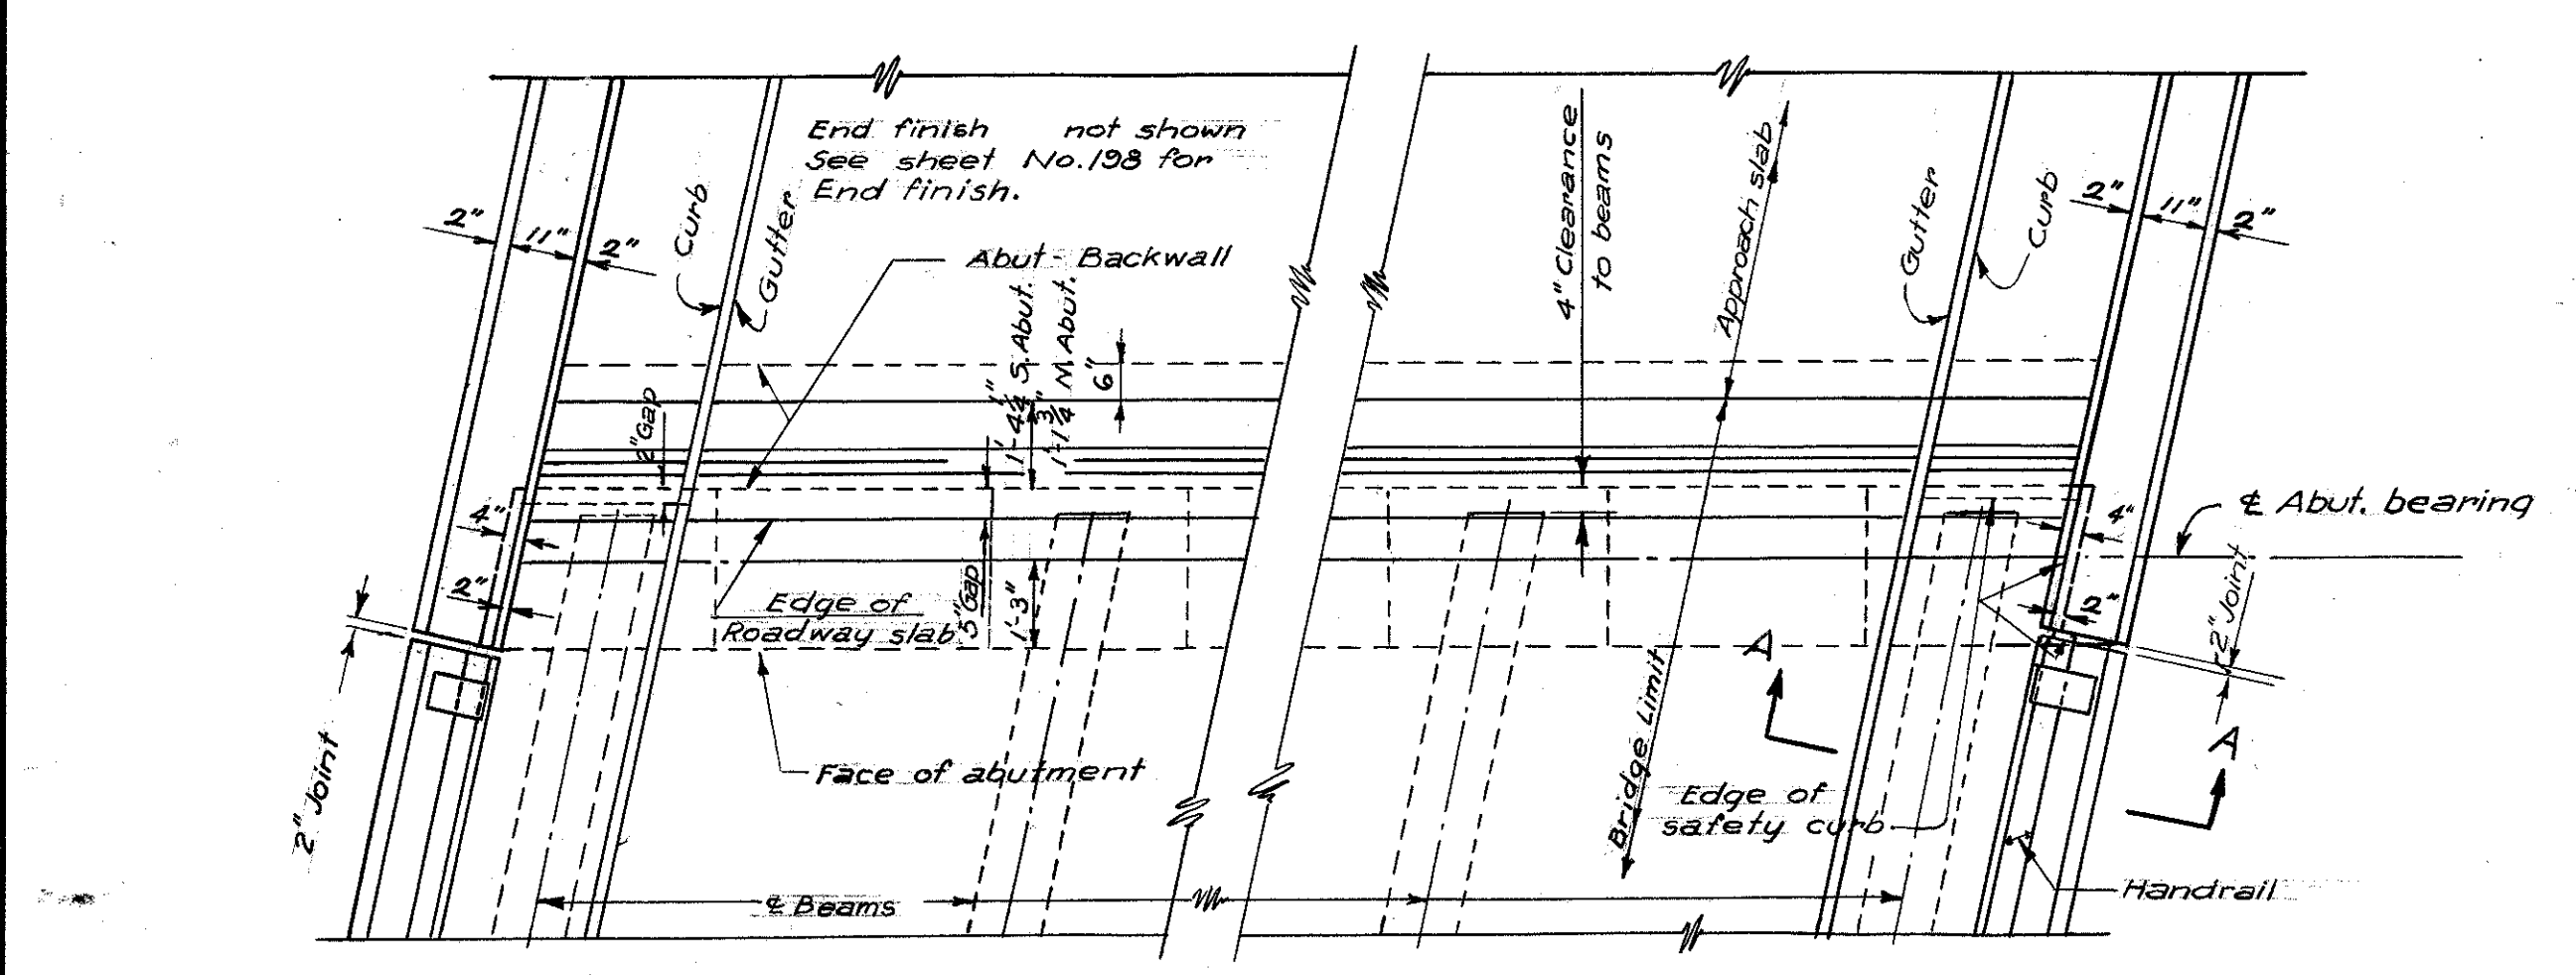

**PART PLAN OF ENDS**  
 Scale: 3/8" = 1'-0"

**NOTE:**  
 The structure site is located in an area of drift covering a Deep Stage Valley. The drift is composed of relative granular material. In no case did the soundings penetrate to bedrock. All depths were limited only by the capacity of the equipment.

BORING B-1	BORING B-2	BORING B-3	BORING B-4
El. 628.8 Gravel, Brown Sand & silt & some clay	El. 626.8 Gravel, Brown Sand & silt & some clay	El. 629.1 Gravel, Brown Silt With Some Sand	El. 626.7 Gravel, Brown Sand & Silt & Some Clay
622.0 6.8	618.8 8.0	615.1 14.0	622.3 4.4
612.8 16.0	Brown Sand With Silt & some clay	611.6 15.1	611.6 15.1
601.2 27.6	598.6 28.4	599.5 29.6	597.6 29.1
583.1 45.7	576.2 50.6	583.5 45.6	579.8 46.9
568.8 60.0	566.8 60.0	569.1 60.0	566.7 60.0

**BORING B-1**      **BORING B-2**      **BORING B-3**      **BORING B-4**

Test borings were made between Jan. 5th & Jan. 12th 1955. See Sheet No. 191 for location of borings. Soil borings were made with 3" Continuous flight auger.


VOGT, IVERS, SEAMAN & ASSOCIATES  
 ENGINEERS ARCHITECTS  
 CINCINNATI, OHIO

**SOUTH ABUTMENT**  
 BRIDGE NO. BU-4-186  
 OVER STATE ROUTE 73 (RELOCATED)

BUTLER COUNTY  
 SEC. BUT.-4  
 Scale: As shown


STA. 595+32.88  
 SEPTEMBER, 1955

DESIGNED	DRAWN	TRACED	CHECKED	REVIEWED	DATE	REVISED
G.V.	ALI	C.I.	R.L.S.	W.J.I.	10-11-55	

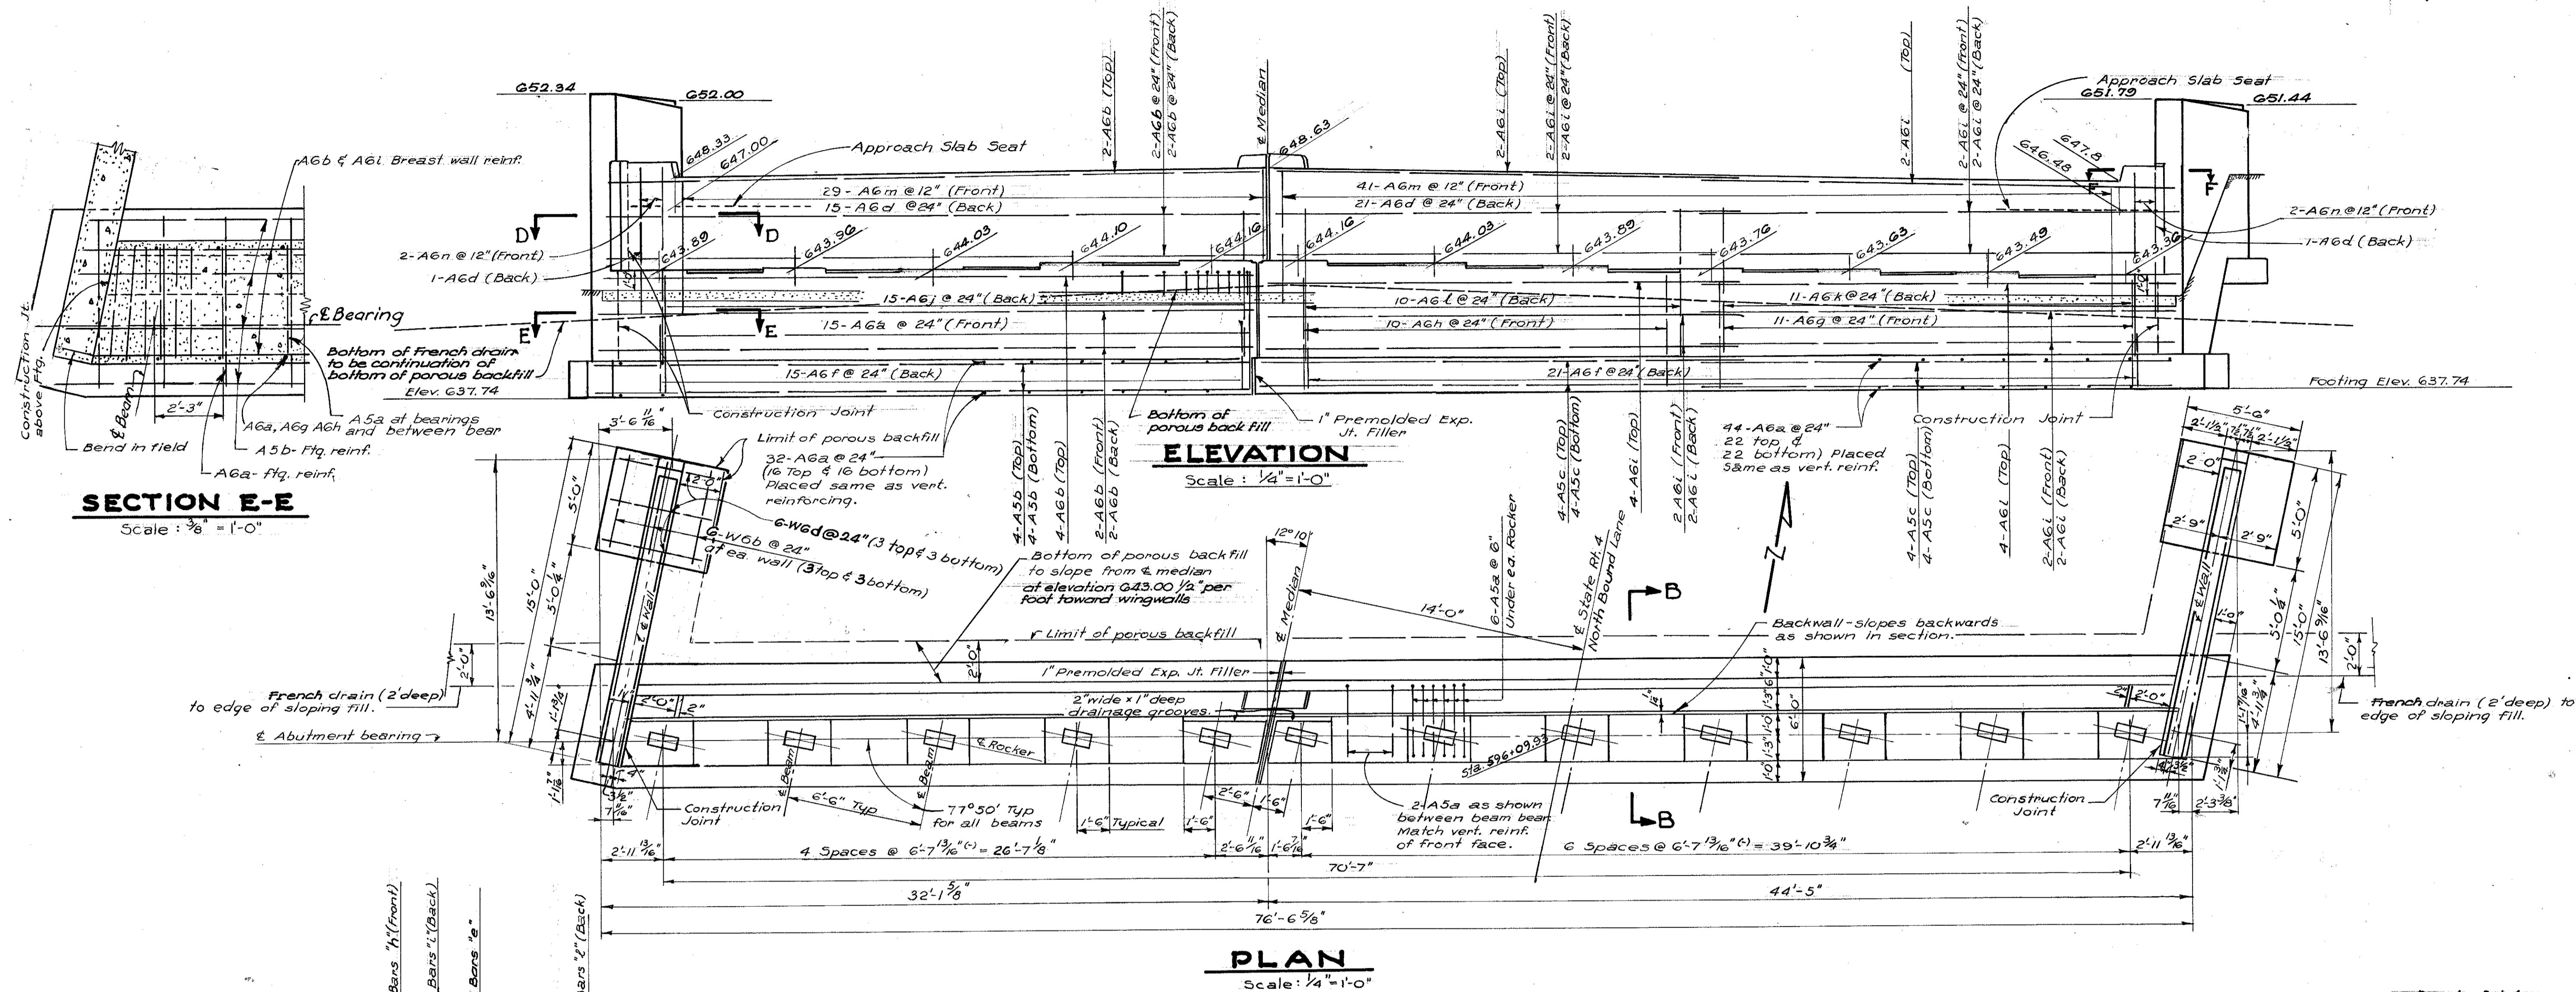

**SECTION E-E**  
Scale: 3/8" = 1'-0"

**PLAN**  
Scale: 1/4" = 1'-0"

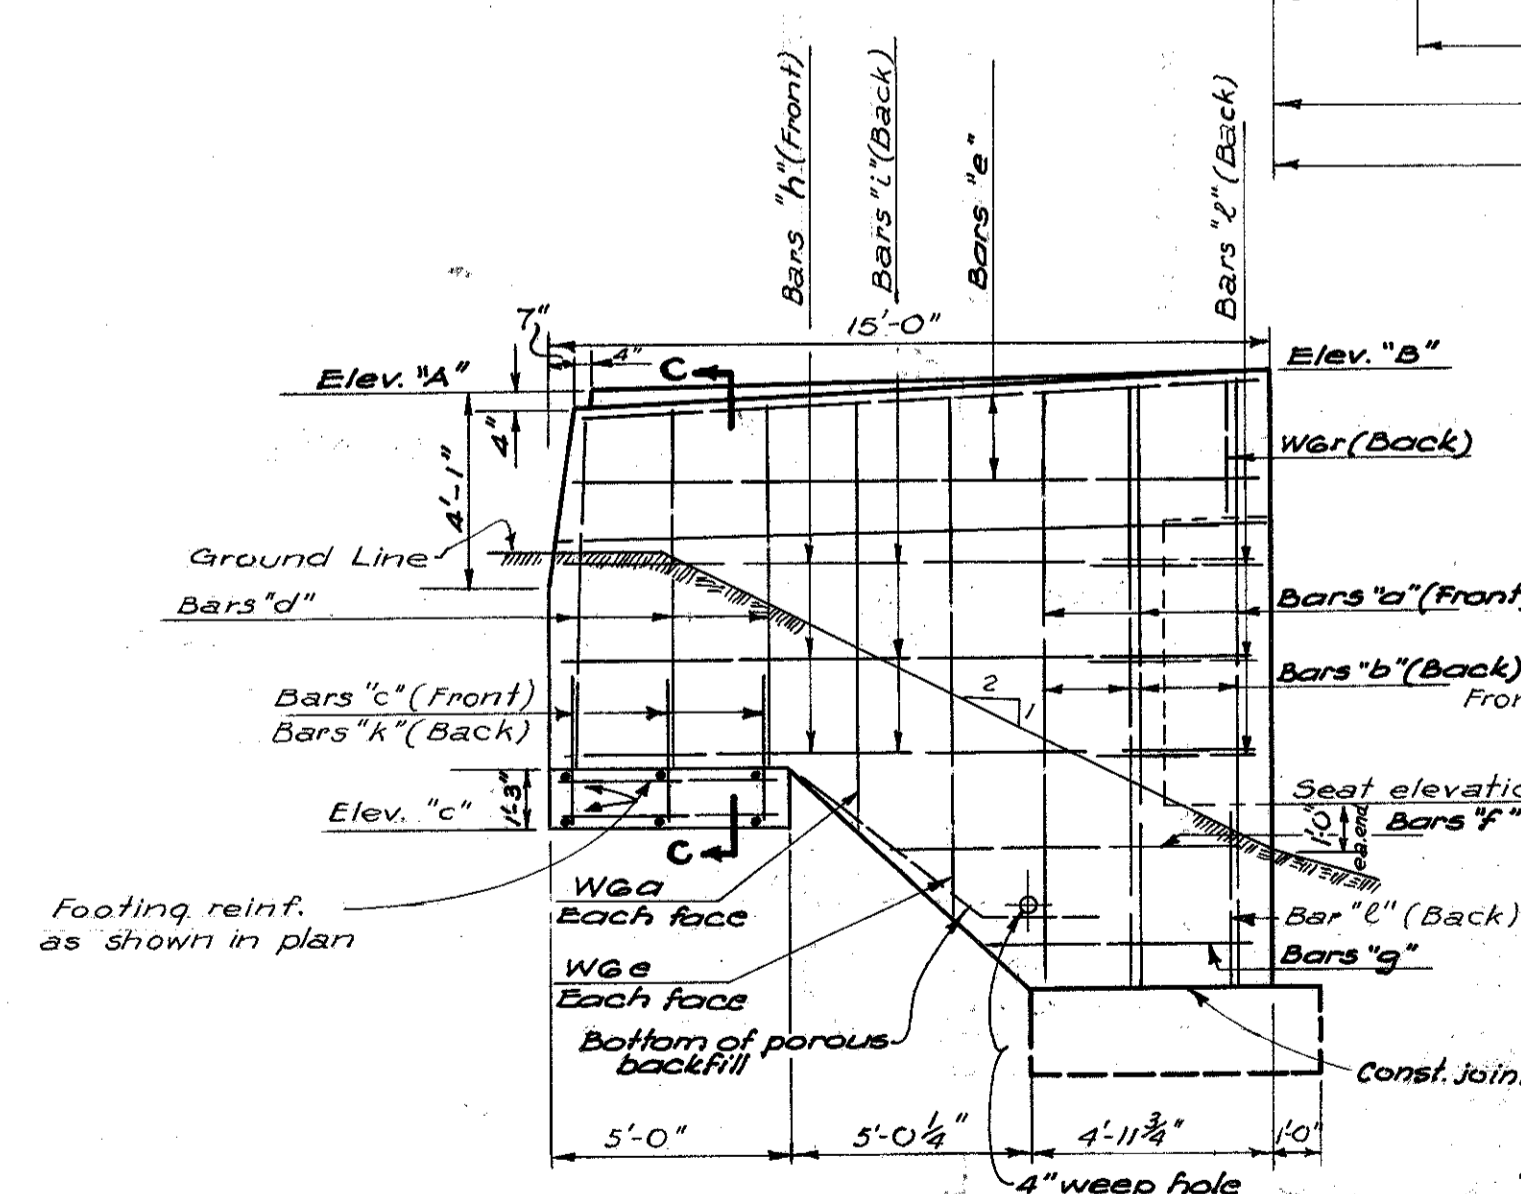

**SECTION C-C**  
Scale: 1/4"

**SECTION D-D**  
Scale: 3/8" = 1'-0"

**BACKWALL SLOPE**

**SECTION F-F**  
Scale: 1/2" = 1'-0"

**SECTION B-B**  
Scale: 3/8" = 1'-0"

**Notes**  
Concrete above the bridge seat construction joint shall not be placed until after structural steel work is erected. Steel end finish shall be used as a template for top of backwall.  
For approach slab details, see Sheet # 205  
All reinforcing steel to have 2" clearance except bottom of footings where 3" is required


DIMENSIONS		WING WALLS																									
Elev. "A"	Elev. "B"	Elev. "C"	Bars "a"	Bars "b"	Bars "c"	Bars "d"	Bars "e"	Bars "f"	Bars "g"	Bars "h"	Bars "i"	Bars "k"	Bars "l"														
			Mk.	No.	Mk.	No.	Mk.	No.	Mk.	No.	Mk.	No.	Mk.	No.													
<b>NORTH ABUTMENT</b>																											
E. WALL	651.44	651.79	642.86	Wgf	3	Wgf	4	Wgh	3	Wgi	6	Wgc	4	Wgg	2	Wgl	2	Wgm	3	Wgn	3	Wgo	4	Wgp	3	Wgq	4
W. WALL	652.00	652.34	643.39	Wgr	3	Wgr	4	Wgh	3	Wgi	6	Wgc	4	Wgg	2	Wgl	2	Wgm	3	Wgn	3	Wgo	4	Wgr	3	Wgq	4
<b>SOUTH ABUTMENT</b>																											
E. WALL	655.62	655.28	646.39	Wgp	3	Wgp	4	Wgh	3	Wgj	6	Wgc	4	Wgg	2	Wgl	2	Wgm	3	Wgn	3	Wgo	4	Wgp	3	Wgq	4
W. WALL	656.17	655.83	646.93	Wgl	3	Wgl	4	Wgh	3	Wgj	6	Wgc	4	Wgg	2	Wgl	2	Wgm	3	Wgn	3	Wgo	4	Wgl	3	Wgq	4

VOGT, IVERS, SEAMAN & ASSOCIATES  
ENGINEERS ARCHITECTS  
CINCINNATI, OHIO

**NORTH ABUTMENT**  
BRIDGE NO. BU-4-186  
OVER STATE ROUTE 73 (RELOCATED)

BUTLER CO.  
SEC. BUT. - 4  
Scale: As shown  
DESIGNED DRAWN TRACED CHECKED REVIEWED DATE REVISED  
G.V. G.V. C.I. R.L.S. W.J.I. 10-11-55

Sta. 595 + 32.88  
SEPTEMBER, 1955

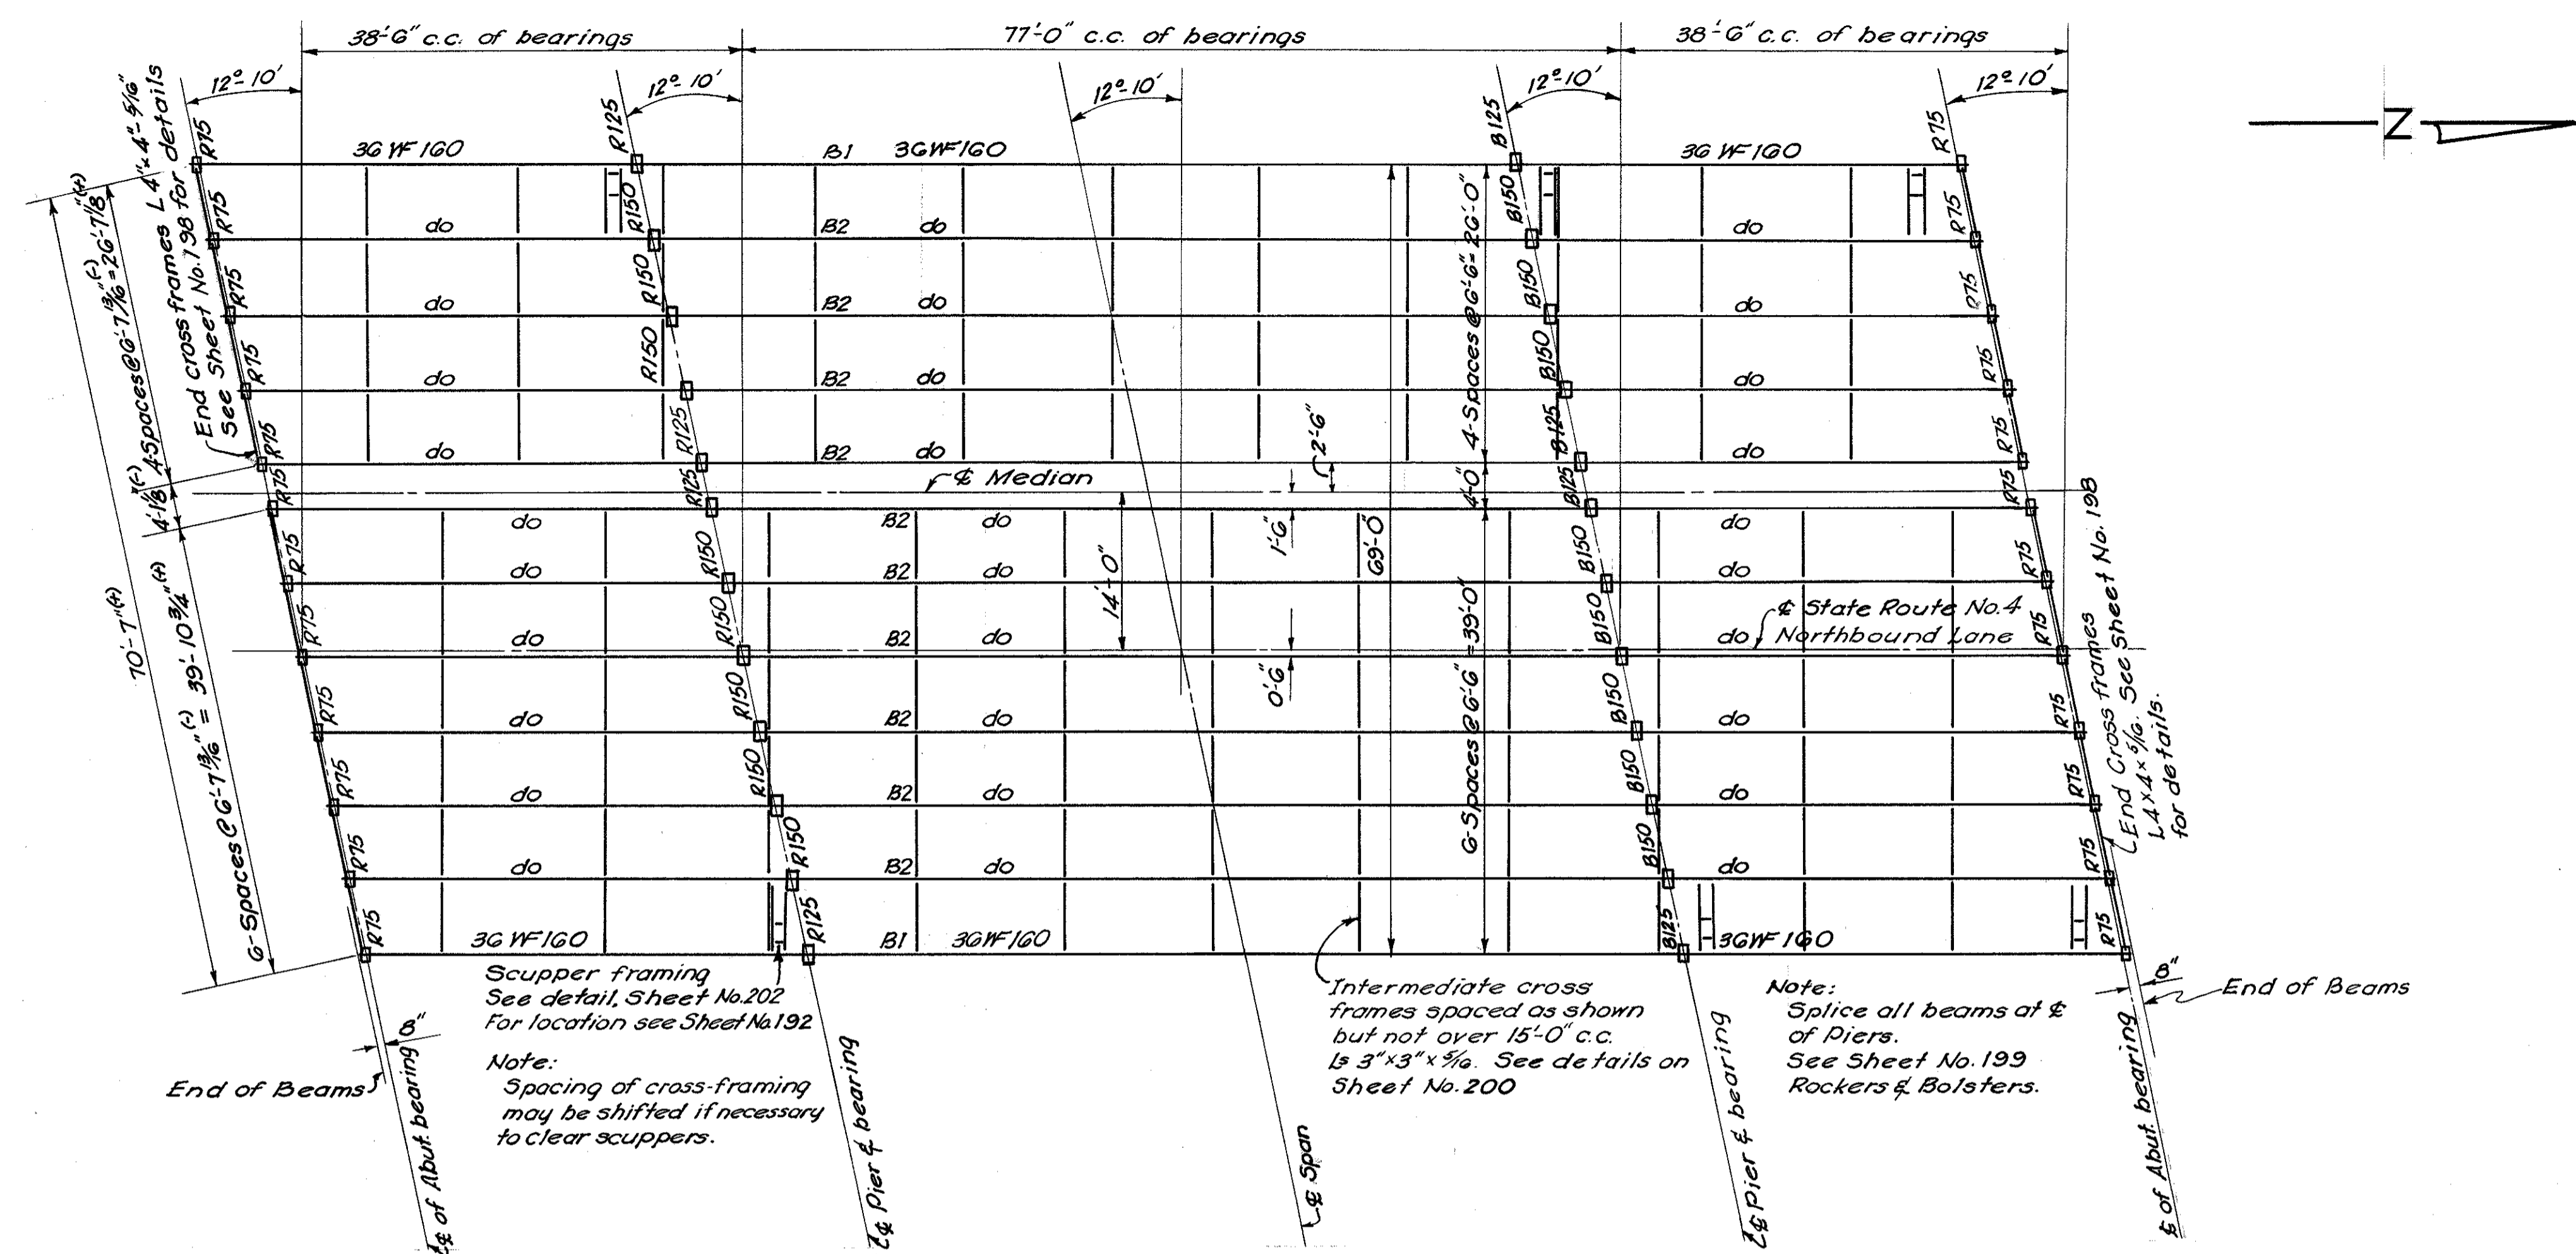


**STEEL FRAMING PLAN**  
Scale: 3/32" = 1'-0"

Location	B-1		B-2	
	End Span	Middle Span	End Span	Middle Span
Deflection due to weight of steel	0"	5/32"	0"	5/32"
Deflection due to remaining dead load	-3/32"	13/16"	-15/32"	1/16"
Sum of deflections	-3/32"	1 1/32"	-15/32"	2 1/32"
Required shop camber	0"	1 3/8"	0"	1"


*Note:* No cambering of beams is required for the end spans, but the beams shall be so fabricated that any curved beam will be placed with the convex flange "down". For center spans camber as shown in table.

**BEAM SPLICE WELDING PROCEDURE**

1. At first Pier, weld bottom flange splice plate to beam on middle span side of joint only.
2. Raise end of beam at first abutment 7/8".
3. Weld beam flanges and web at first pier.
4. Weld top flange splice plate at first pier (both sides of joint).
5. Complete welding of bottom flange splice plate at first pier.
6. Repeat steps 1 to 5 inclusive at second pier by raising of second abutment.
7. Lower ends of beams at both abutments.

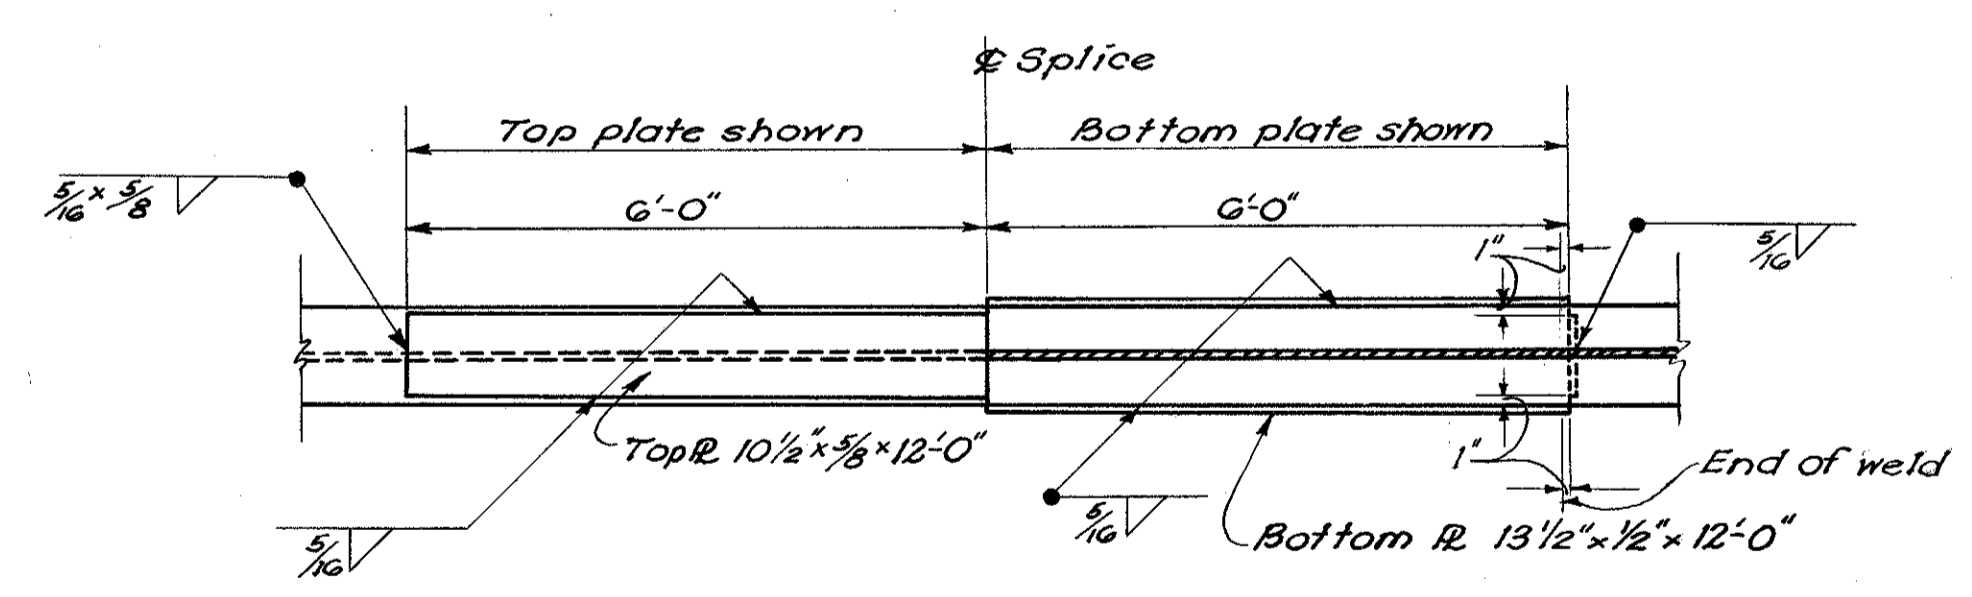

**SECTION A-A**

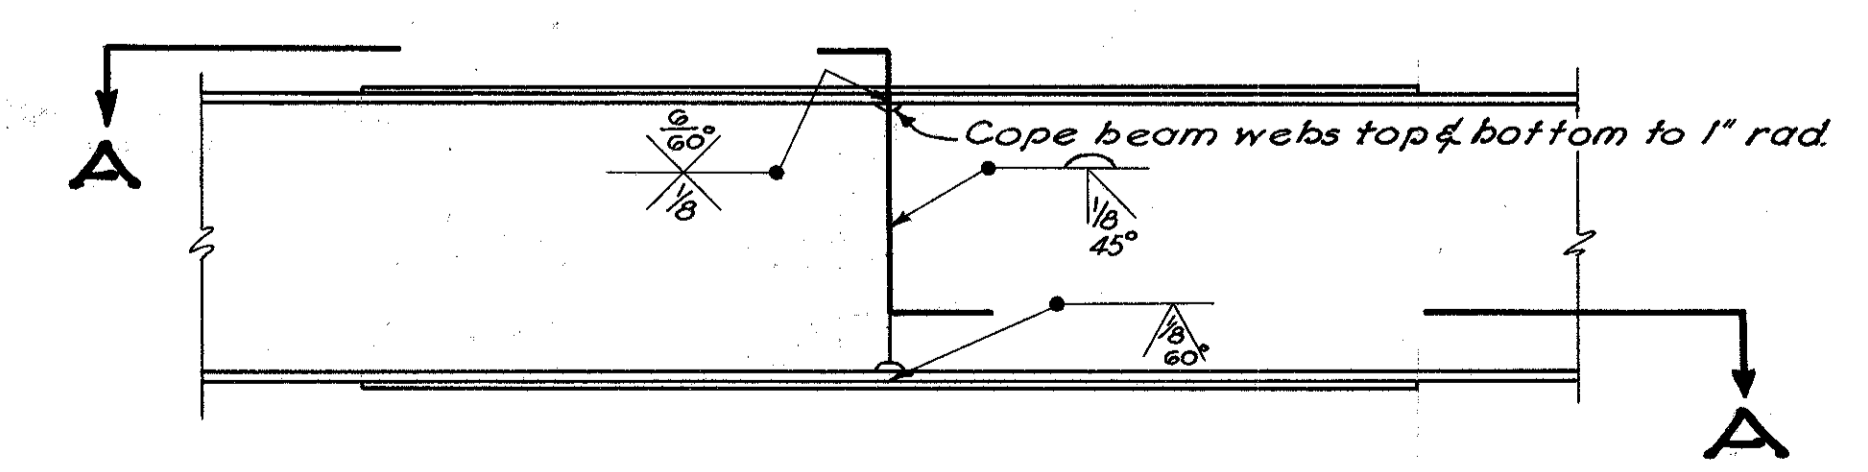

**BEAM SPLICE DETAIL**  
Scale: 1/2" = 1'-0"

VOGT, IVERS, SEAMAN & ASSOCIATES  
ENGINEERS ARCHITECTS  
CINCINNATI, OHIO

**SUPERSTRUCTURE  
STEEL FRAMING PLAN**

BRIDGE NO. BU-4-186  
OVER STATE ROUTE 73 (RELOCATED)




BUTLER COUNTY  
SEC. BUT-4  
Scale: As shown

STA. 595+32.88  
SEPT. 1955

DESIGNED	DRAWN	TRACED	CHECKED	REVIEWED	DATE	REVISED
G.V.	B.G.E.	S.J.B.	R.J.L.	W.J.I.	10-11-55	




BUT-4-(16 53:10.13)

A welded butt joint will be permitted in the superstructure portion of the end finish over a beam near the midpoint of each half of the deck. The abutment portion of the end finish shall be furnished in lengths of angle and bar not under 6'-0" nor over 20'-0". These shall not be welded.

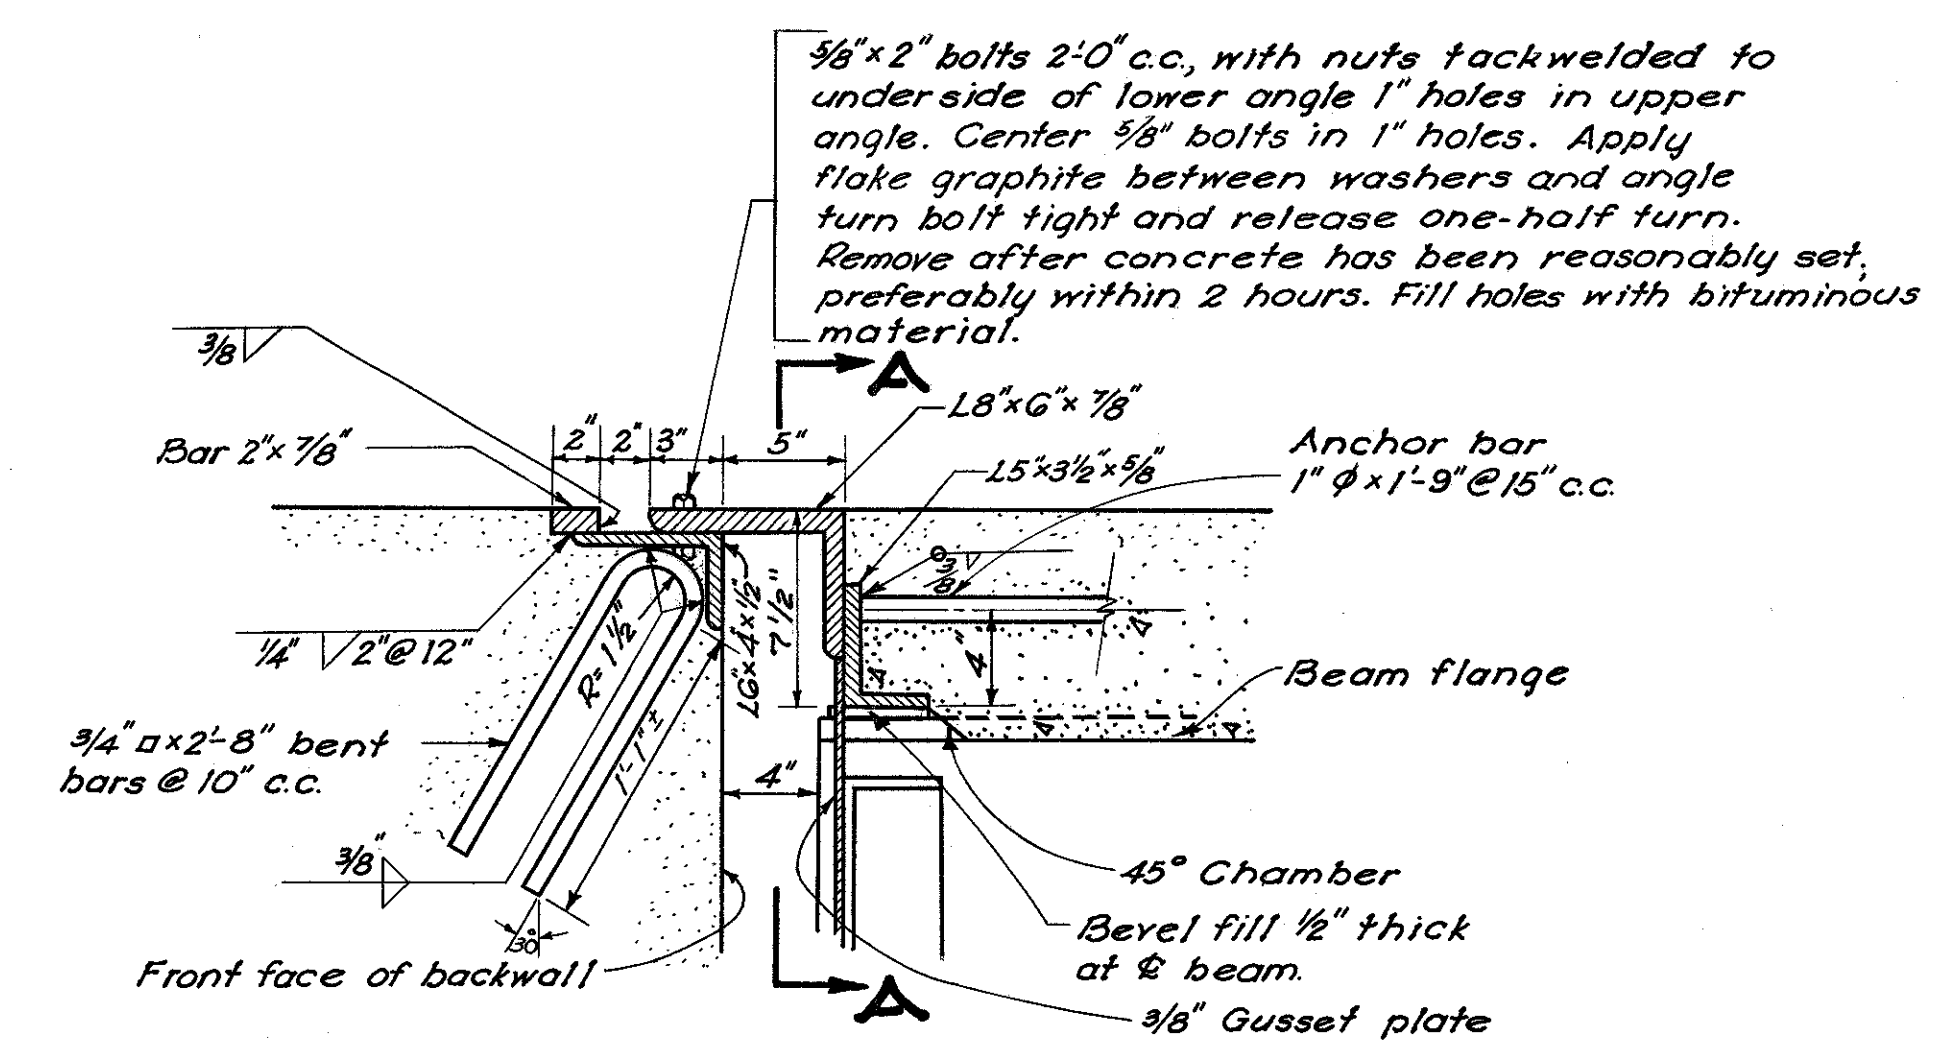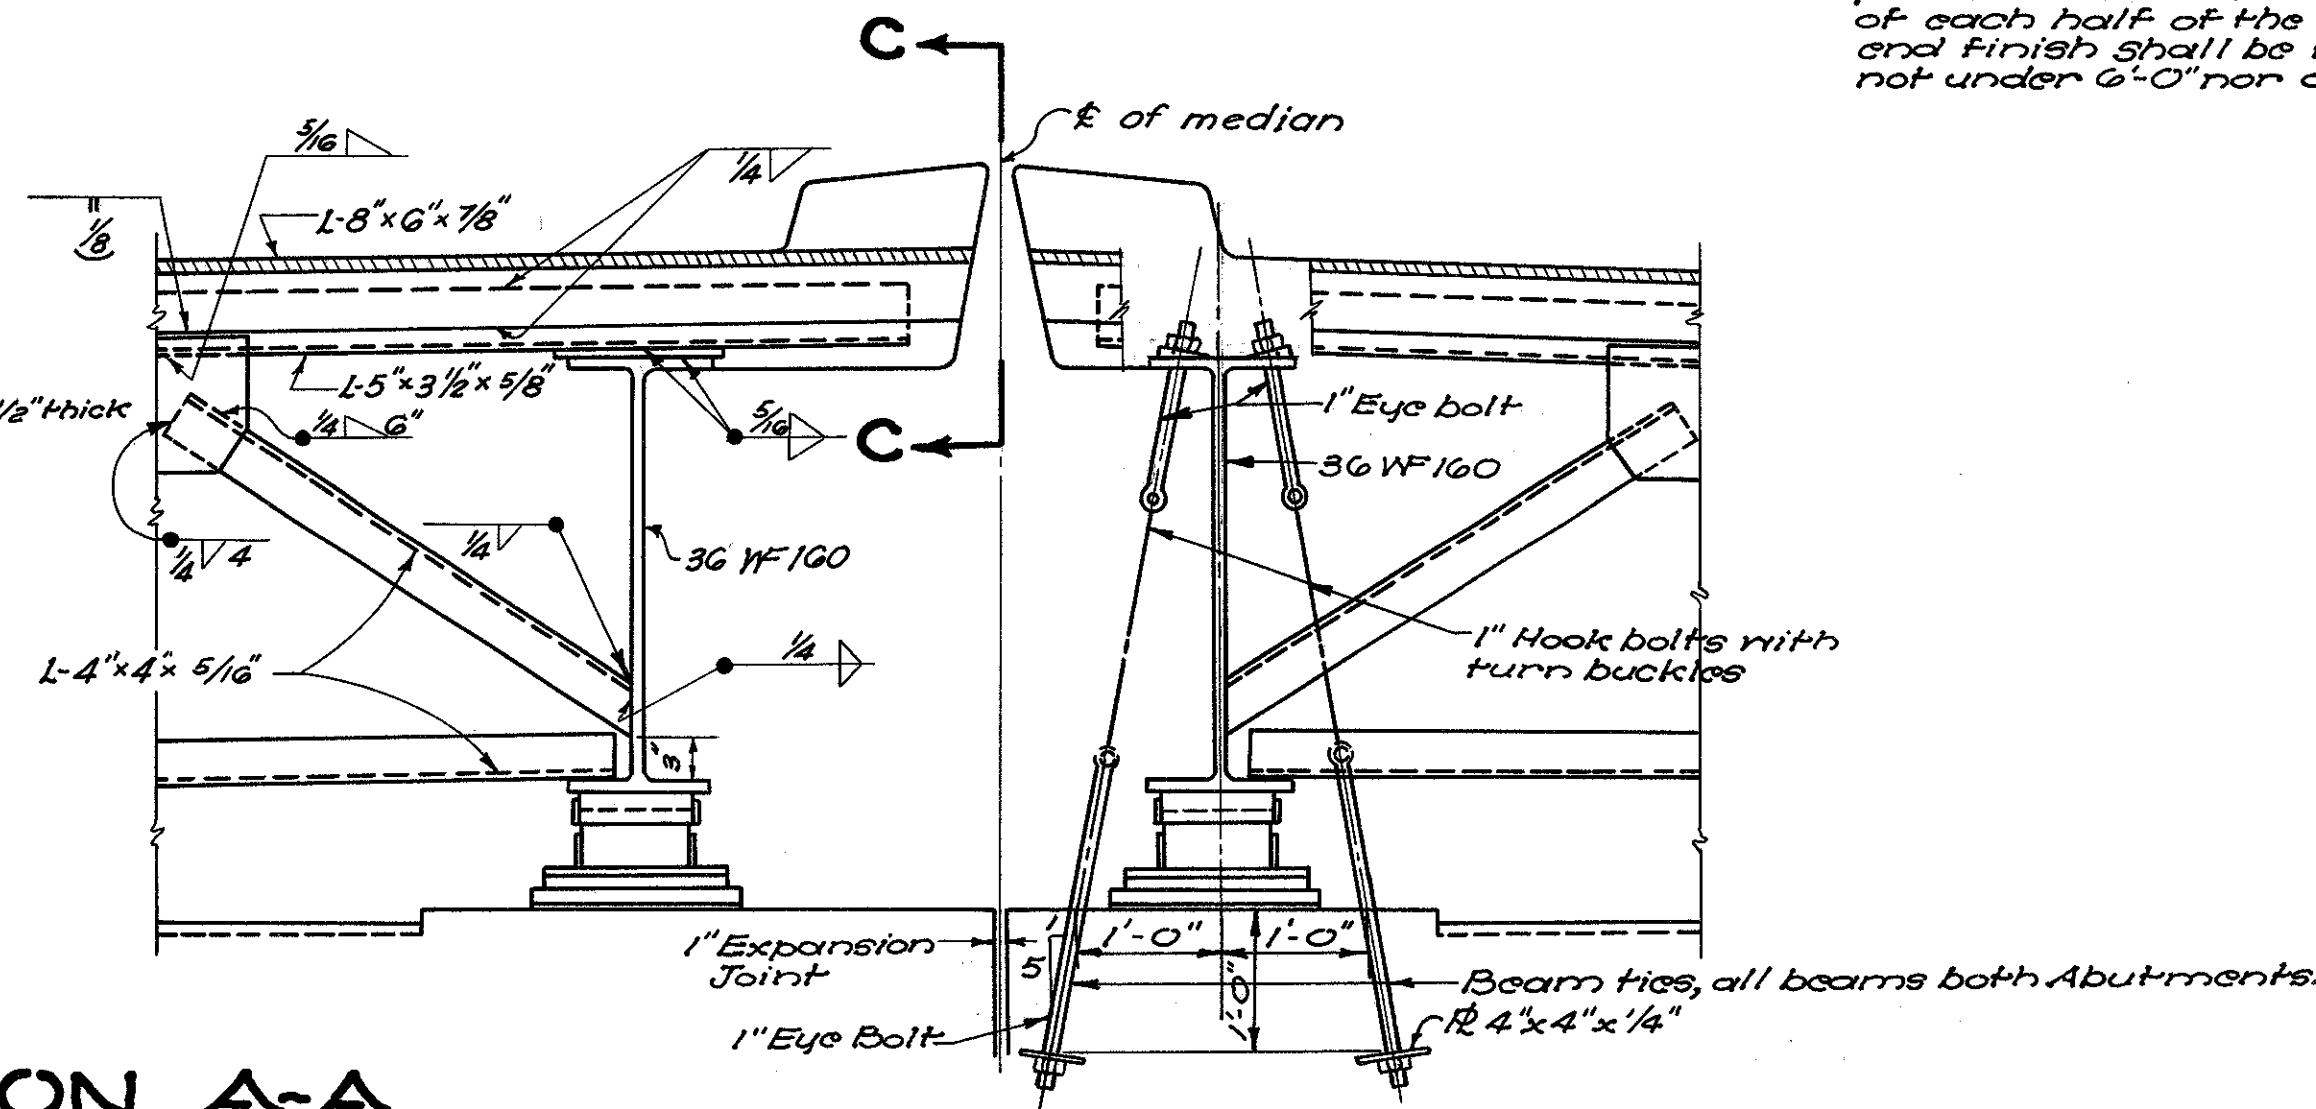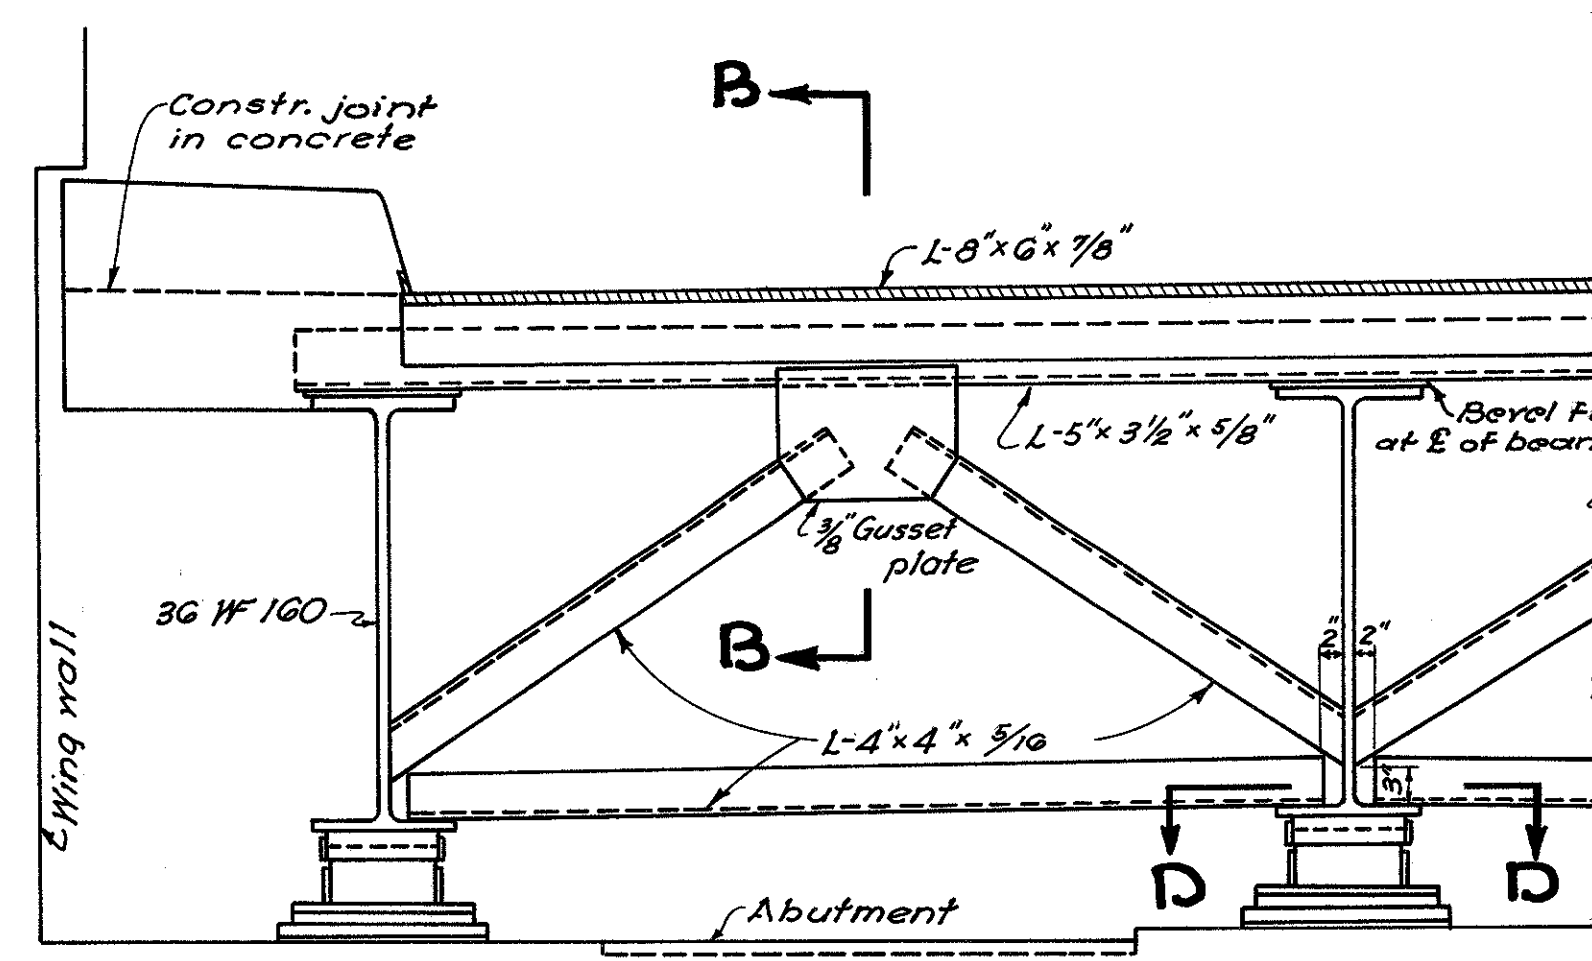

**SECTION A-A**  
**SHOWING END BRIDGING**  
**END FRAMING & END FINISH DETAILS**  
Scale: 3/4" = 1'-0"




**SECTION B-B**  
Scale: 1 1/2" = 1'-0"

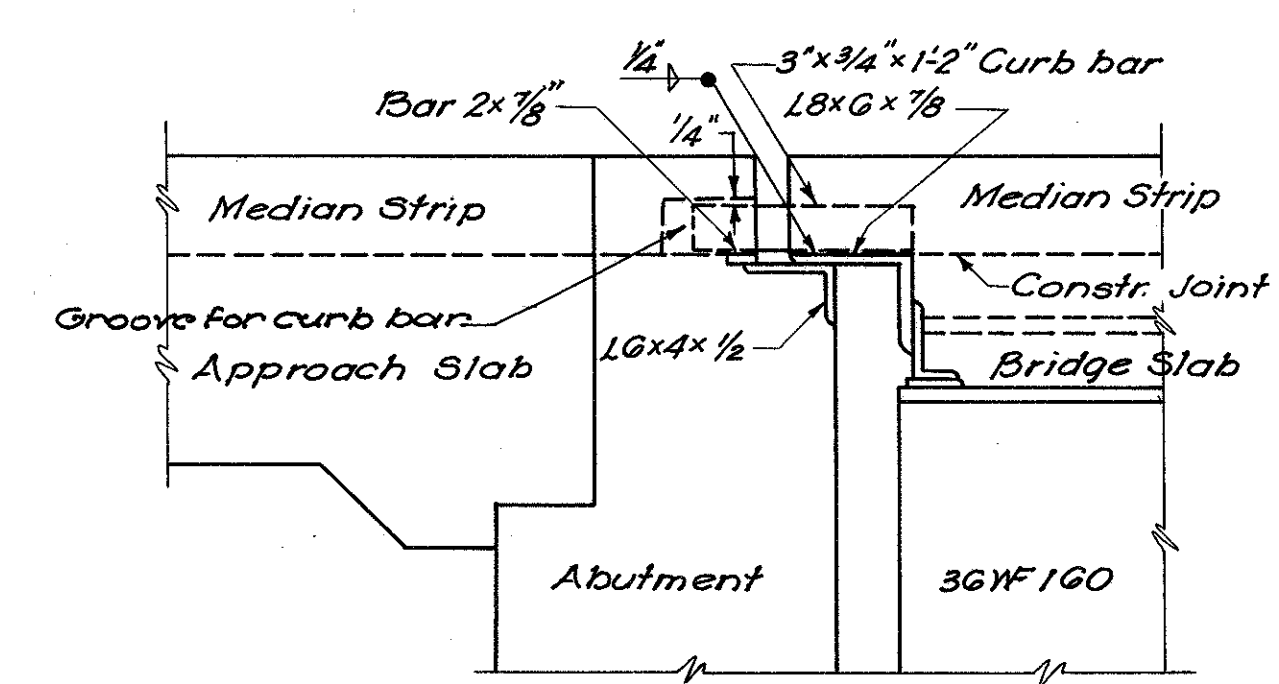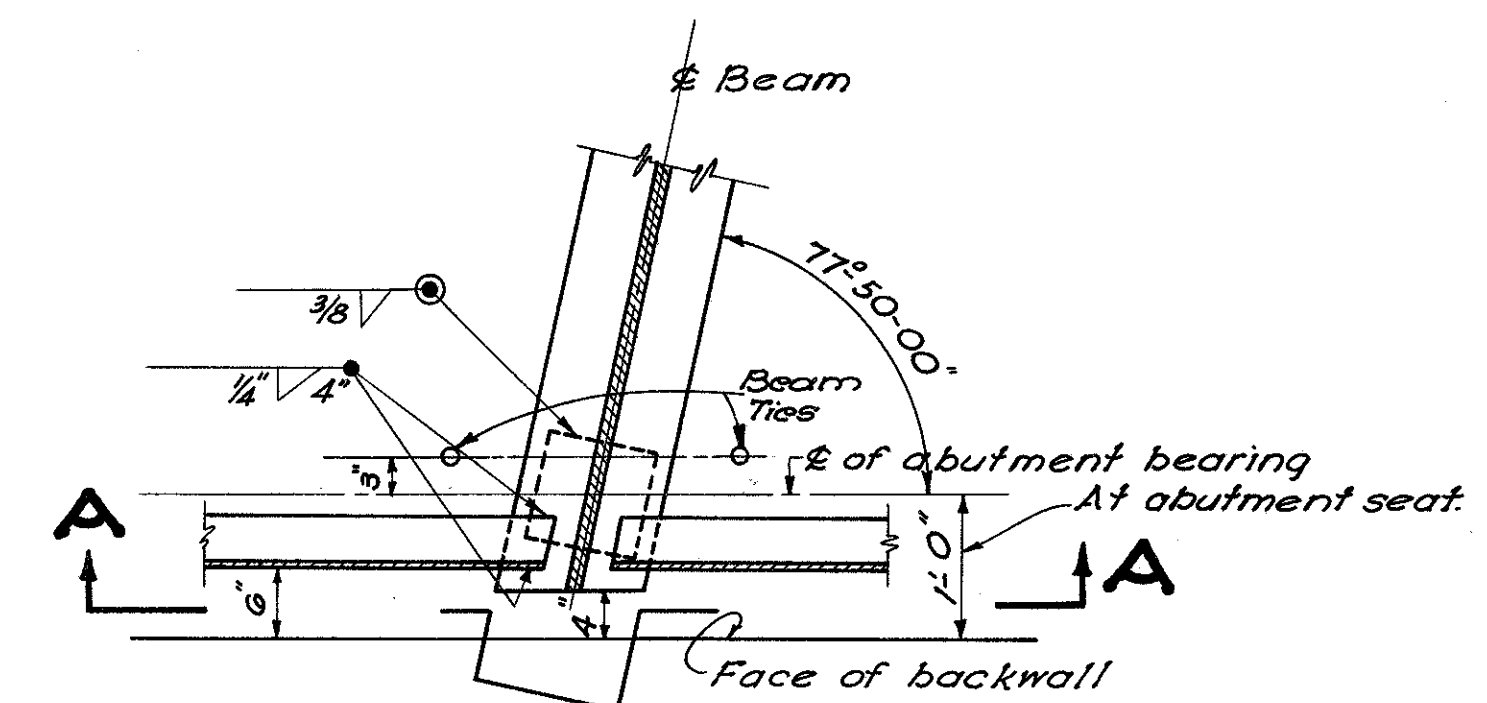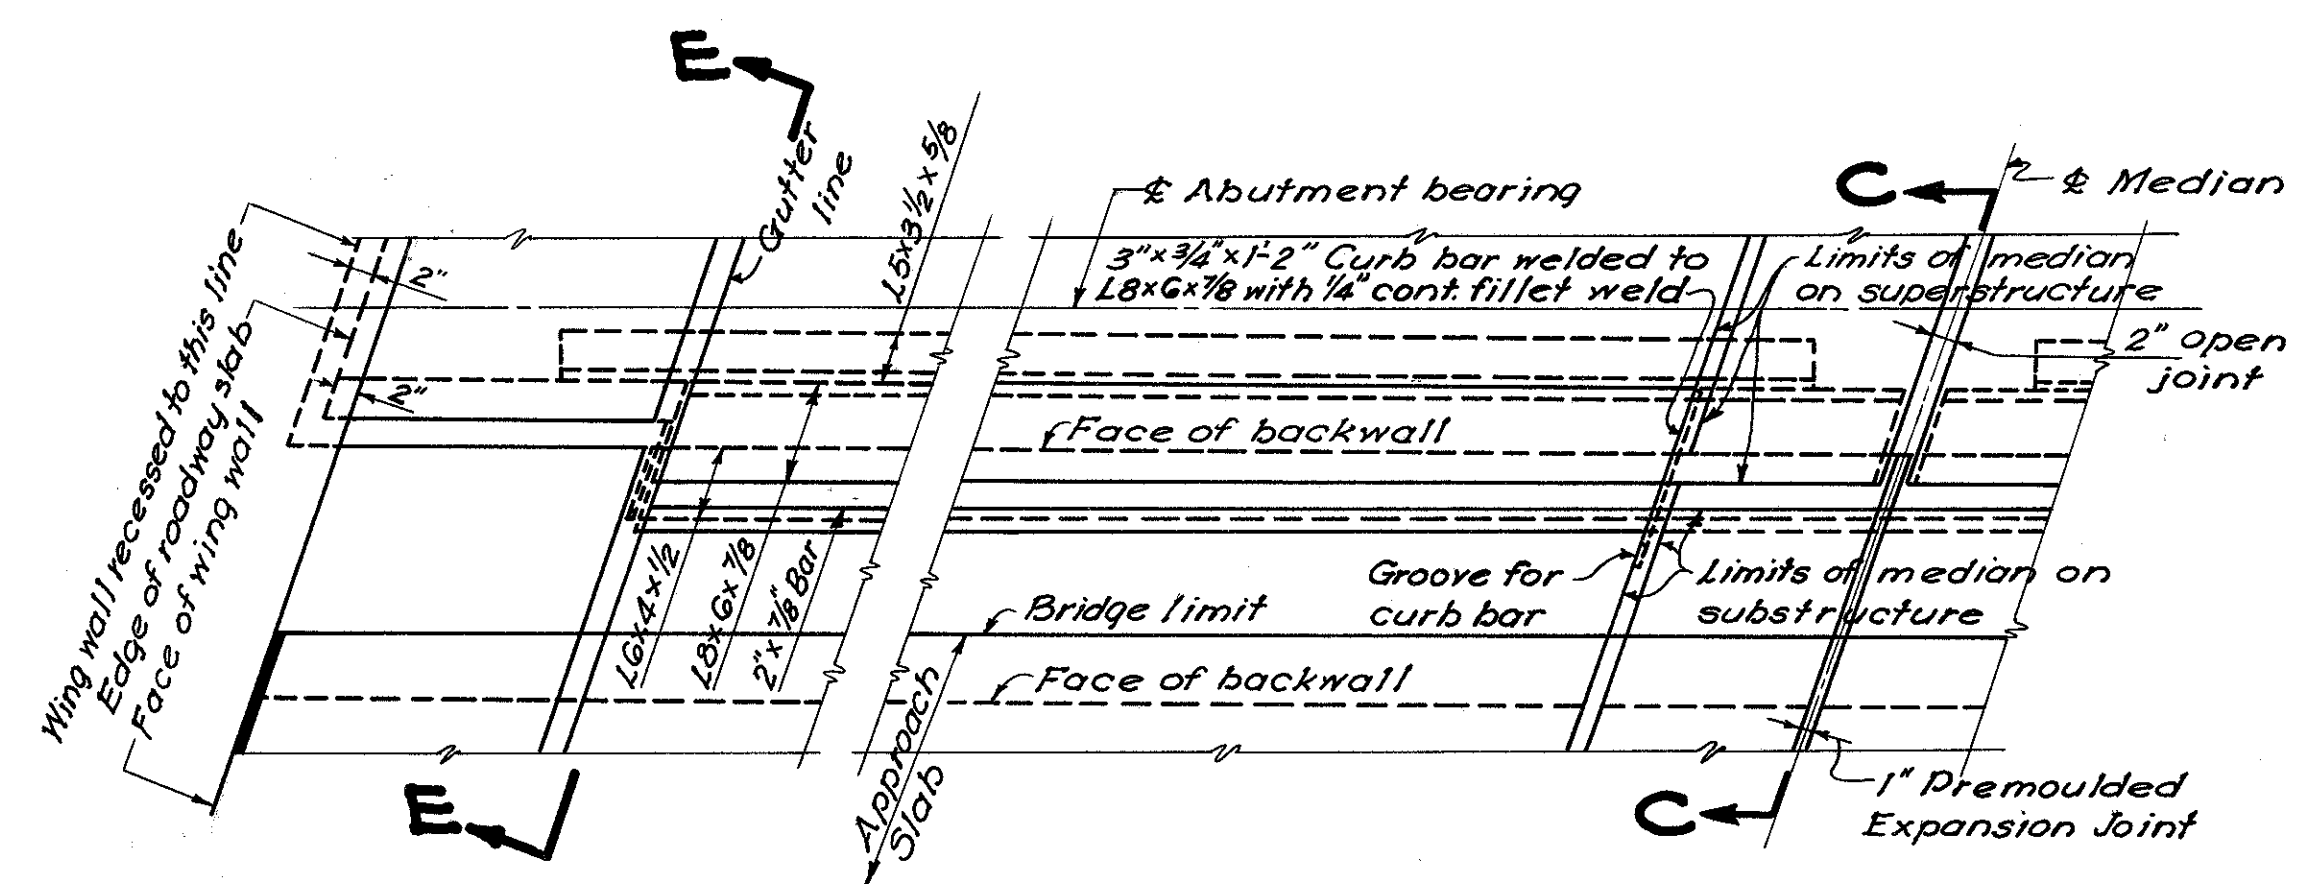

**PARTIAL PLAN OF END FINISH**  
**SOUTH ABUTMENT SHOWN, NORTH ABUTMENT SIMILAR**  
Scale: 3/4" = 1'-0"

**SECTION D-D**  
Scale: 3/4" = 1'-0"

**SECTION C-C**  
Scale: 1" = 1'-0"

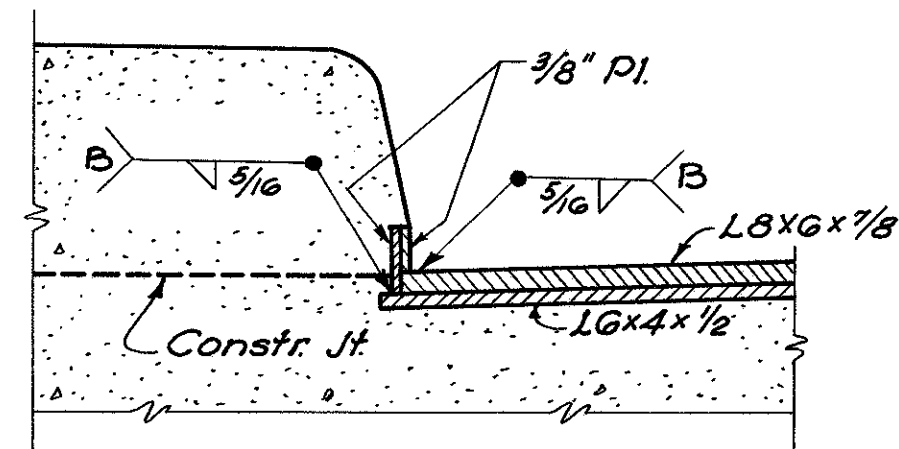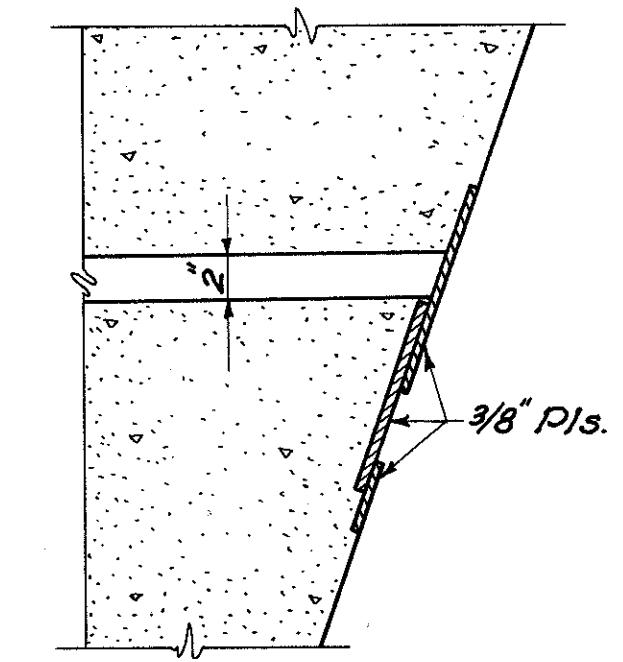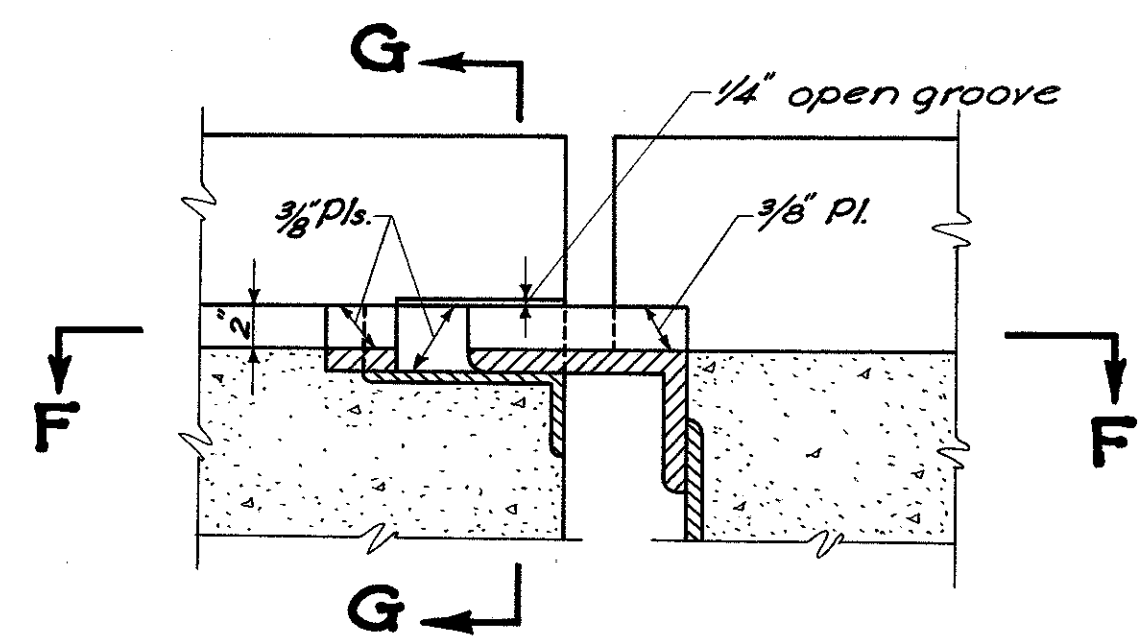

**SECTION E-E**  
**SECTION F-F**  
**SECTION G-G**  
**CURB PLATE DETAILS**  
Scale: 1 1/2" = 1'-0"



VOGT, IVERS, SEAMAN & ASSOCIATES  
ENGINEERS ARCHITECTS  
CINCINNATI, OHIO

**SUPERSTRUCTURE**  
**END FINISH & END BRIDGING**  
BRIDGE NO. BU-4-18G  
OVER STATE ROUTE 73 (RELOCATED)  
BUTLER COUNTY  
SEC. BUT-4  
Scale: As shown

STA. 595+32.88  
SEPT. 1955

DESIGNED	DRAWN	TRACED	CHECKED	REVIEWED	DATE	REVISED
G.V.	B.G.E.	S.J.B.	G.Y.	W.J.I.	10-11-55	



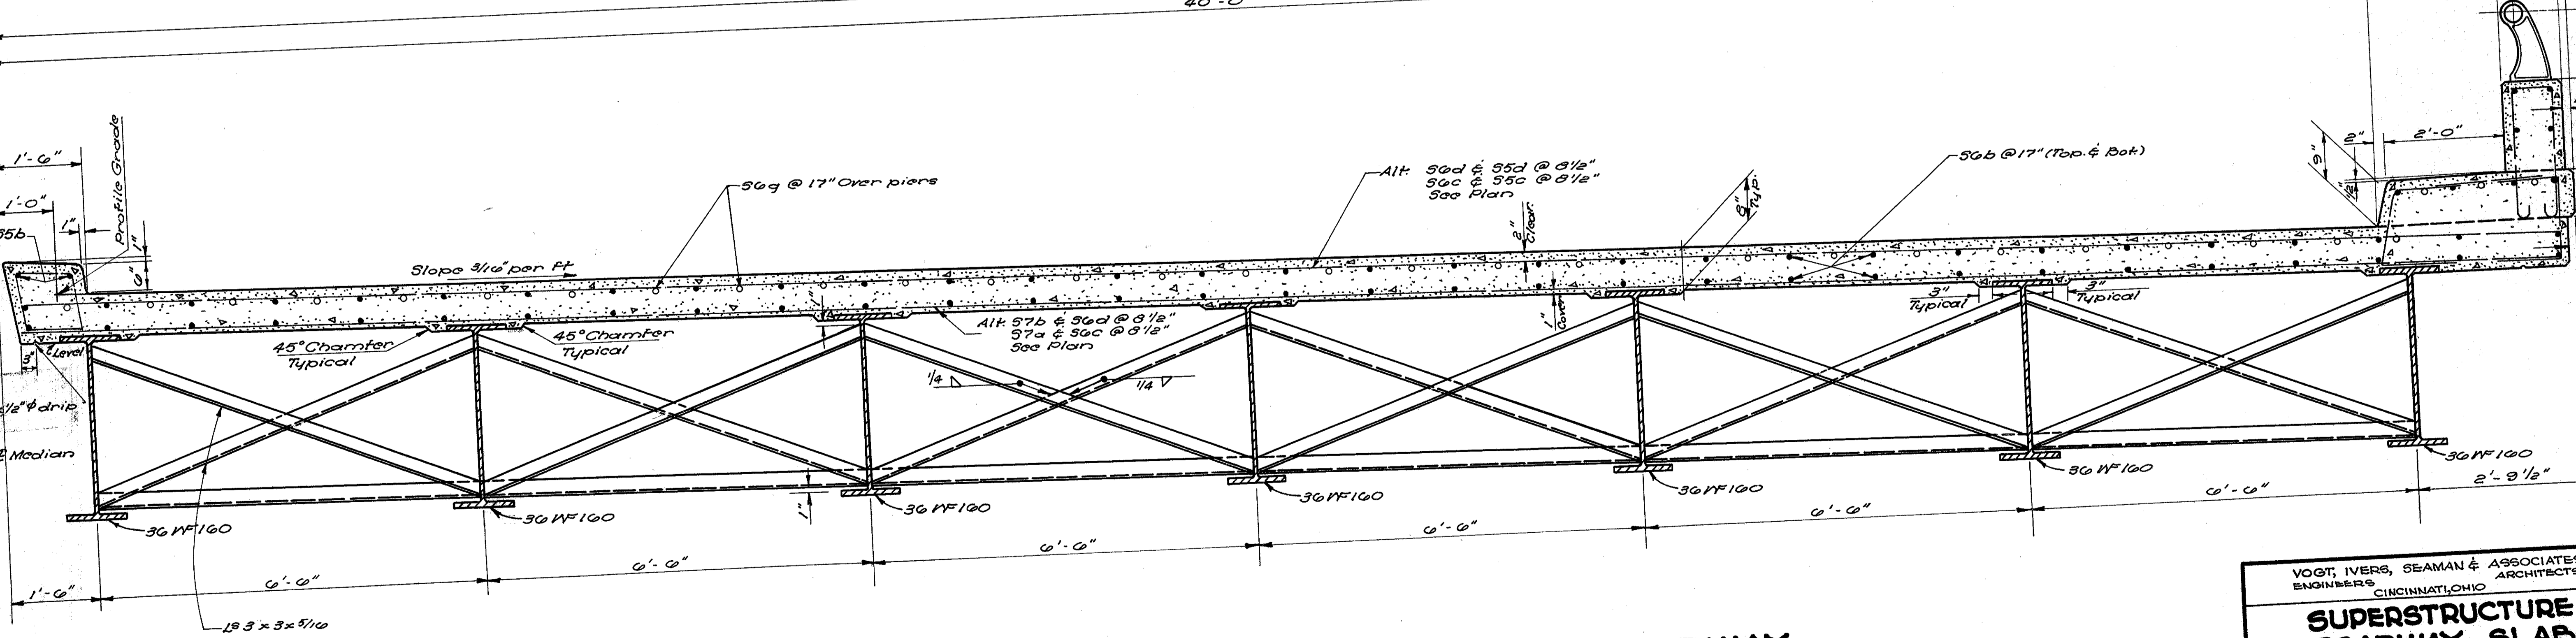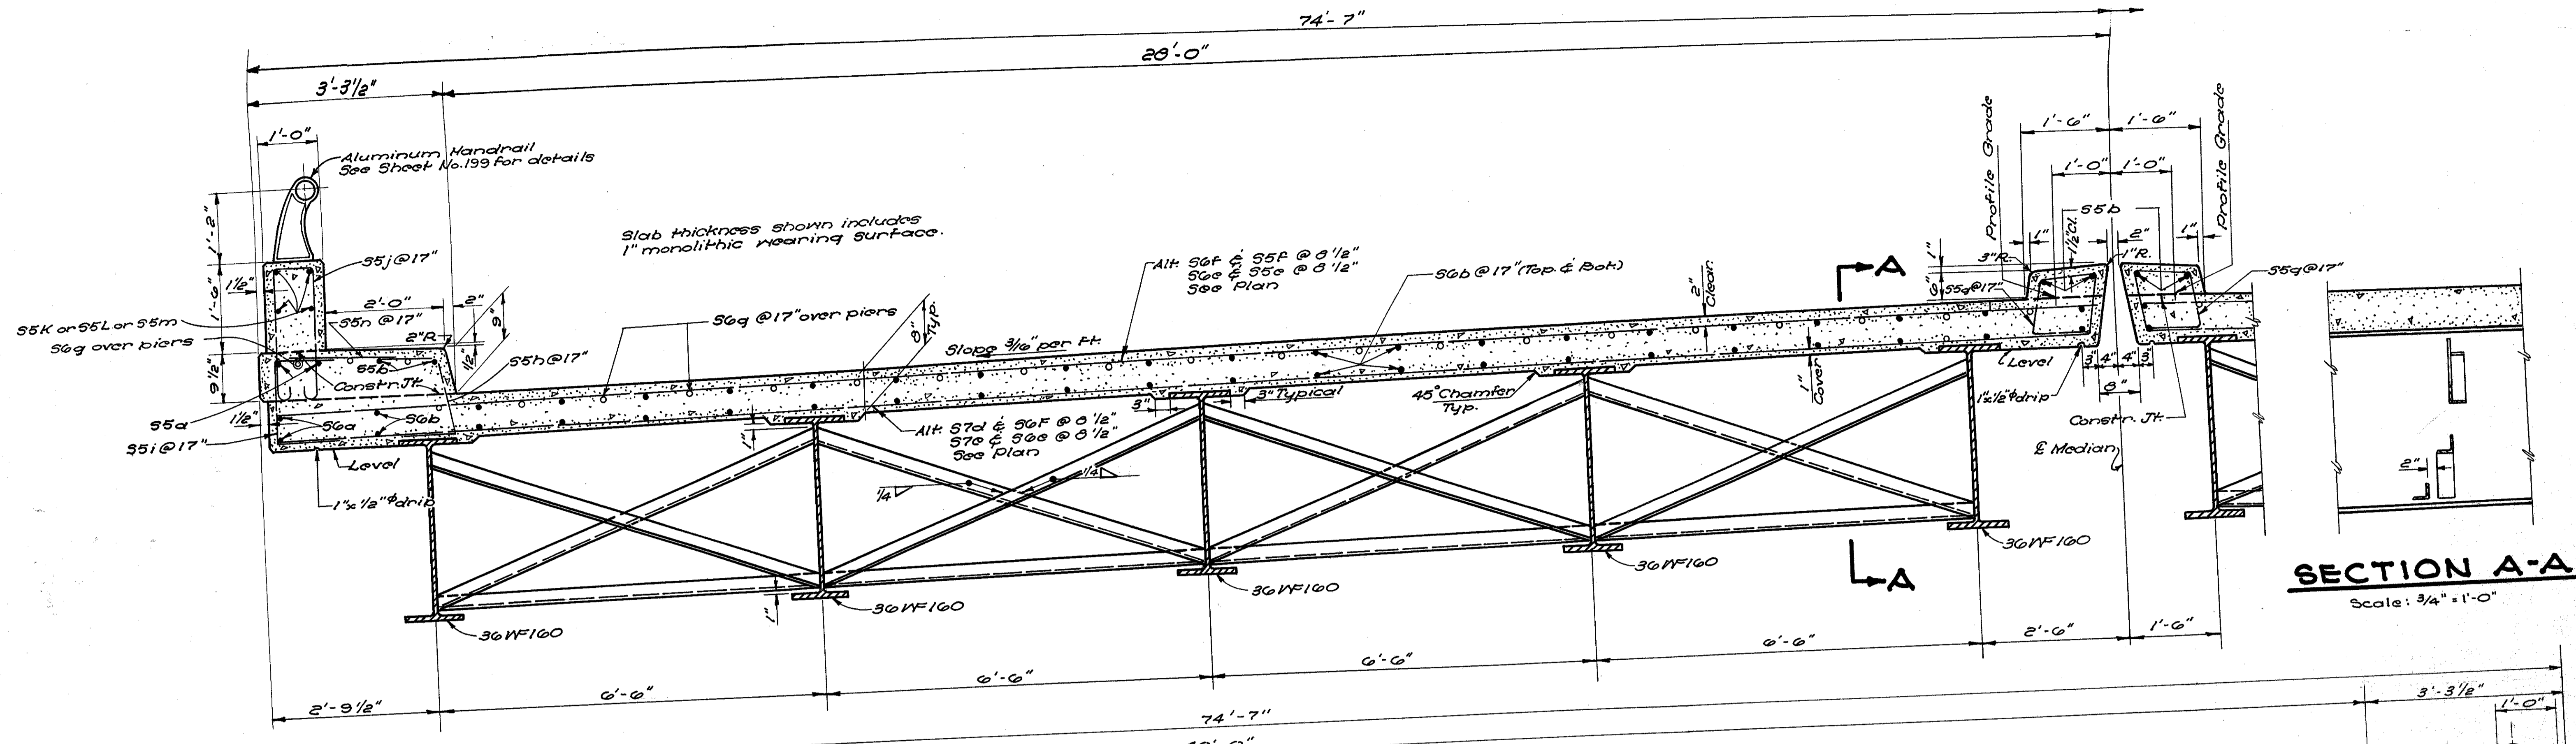

Weld both sides of vert. leg & top side of horizontal leg to beam web with 1/4" cont. fillet weld.

VOGT, IVERS, SEAMAN & ASSOCIATES  
ENGINEERS ARCHITECTS  
CINCINNATI, OHIO



**SUPERSTRUCTURE  
ROADWAY SLAB**  
BRIDGE NO. BU-4-186  
OVER STATE RT. 73 (RELOCATED)

BUTLER COUNTY  
SEC. BUT.-4  
Scale: As shown

STA. 595+32.8  
Sept. 1955


DESIGNED	DRAWN	TRACE	CHECKED	REVIEWED	DATE	REVISE
C.V.	ALI	N.B.	C.V.	W.J.I.	10-11-55	



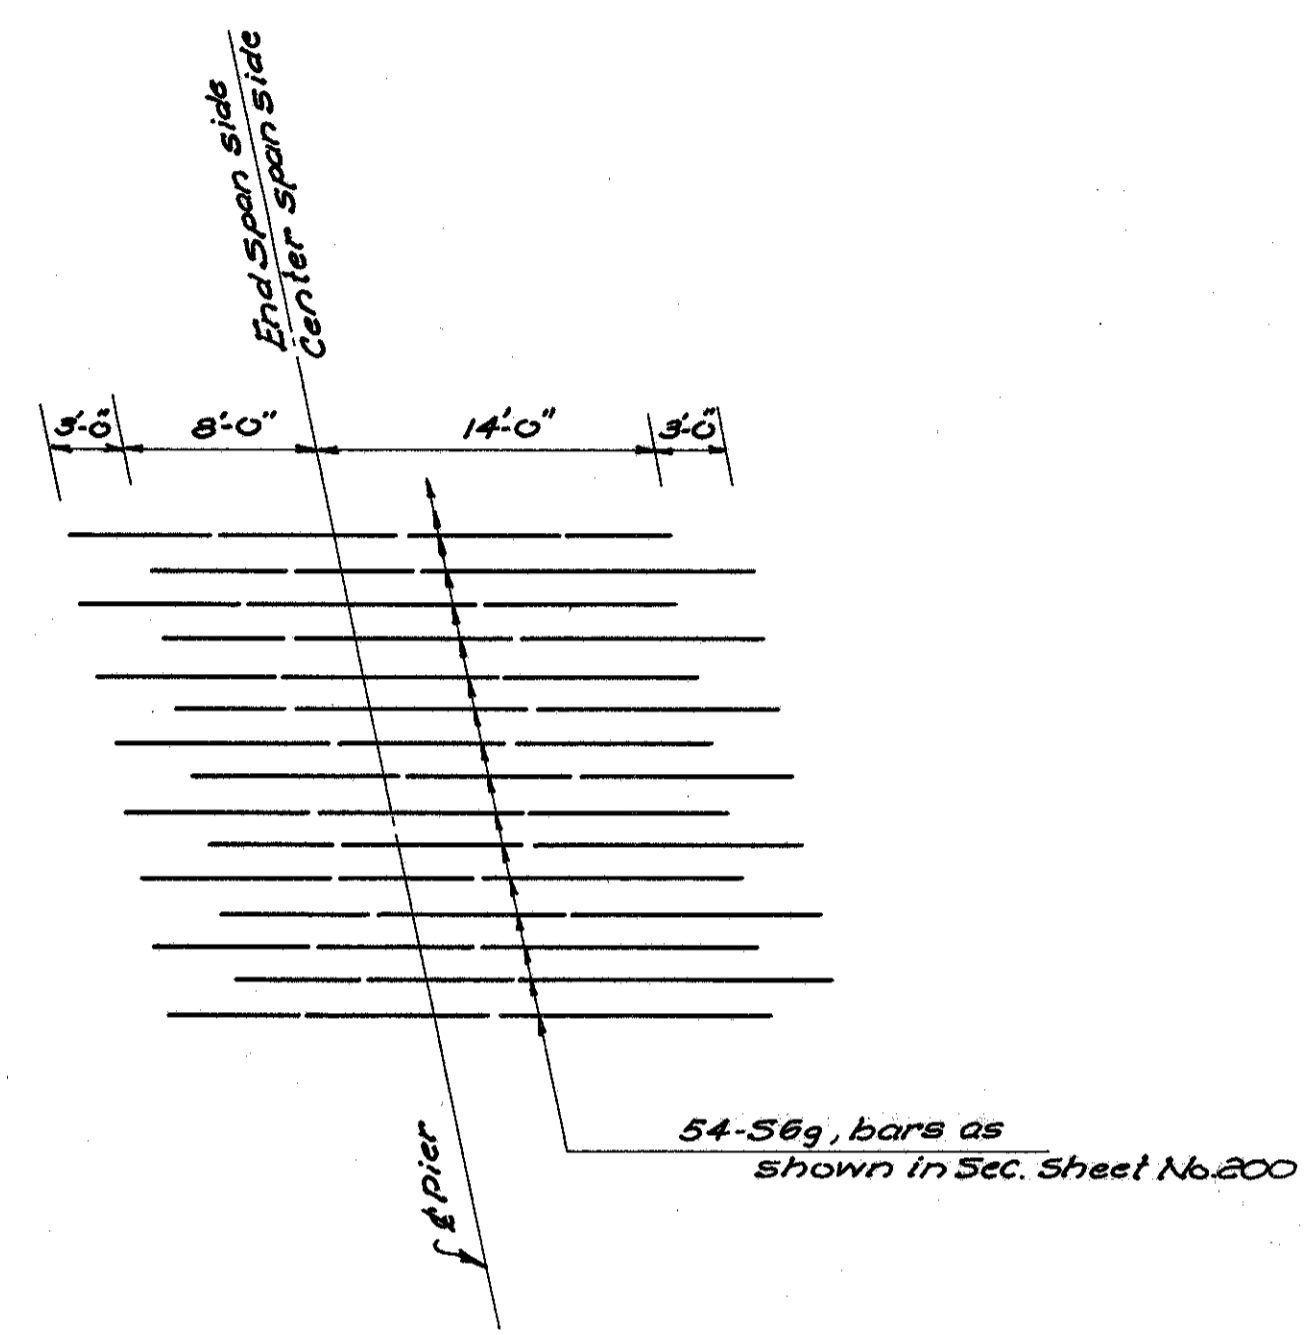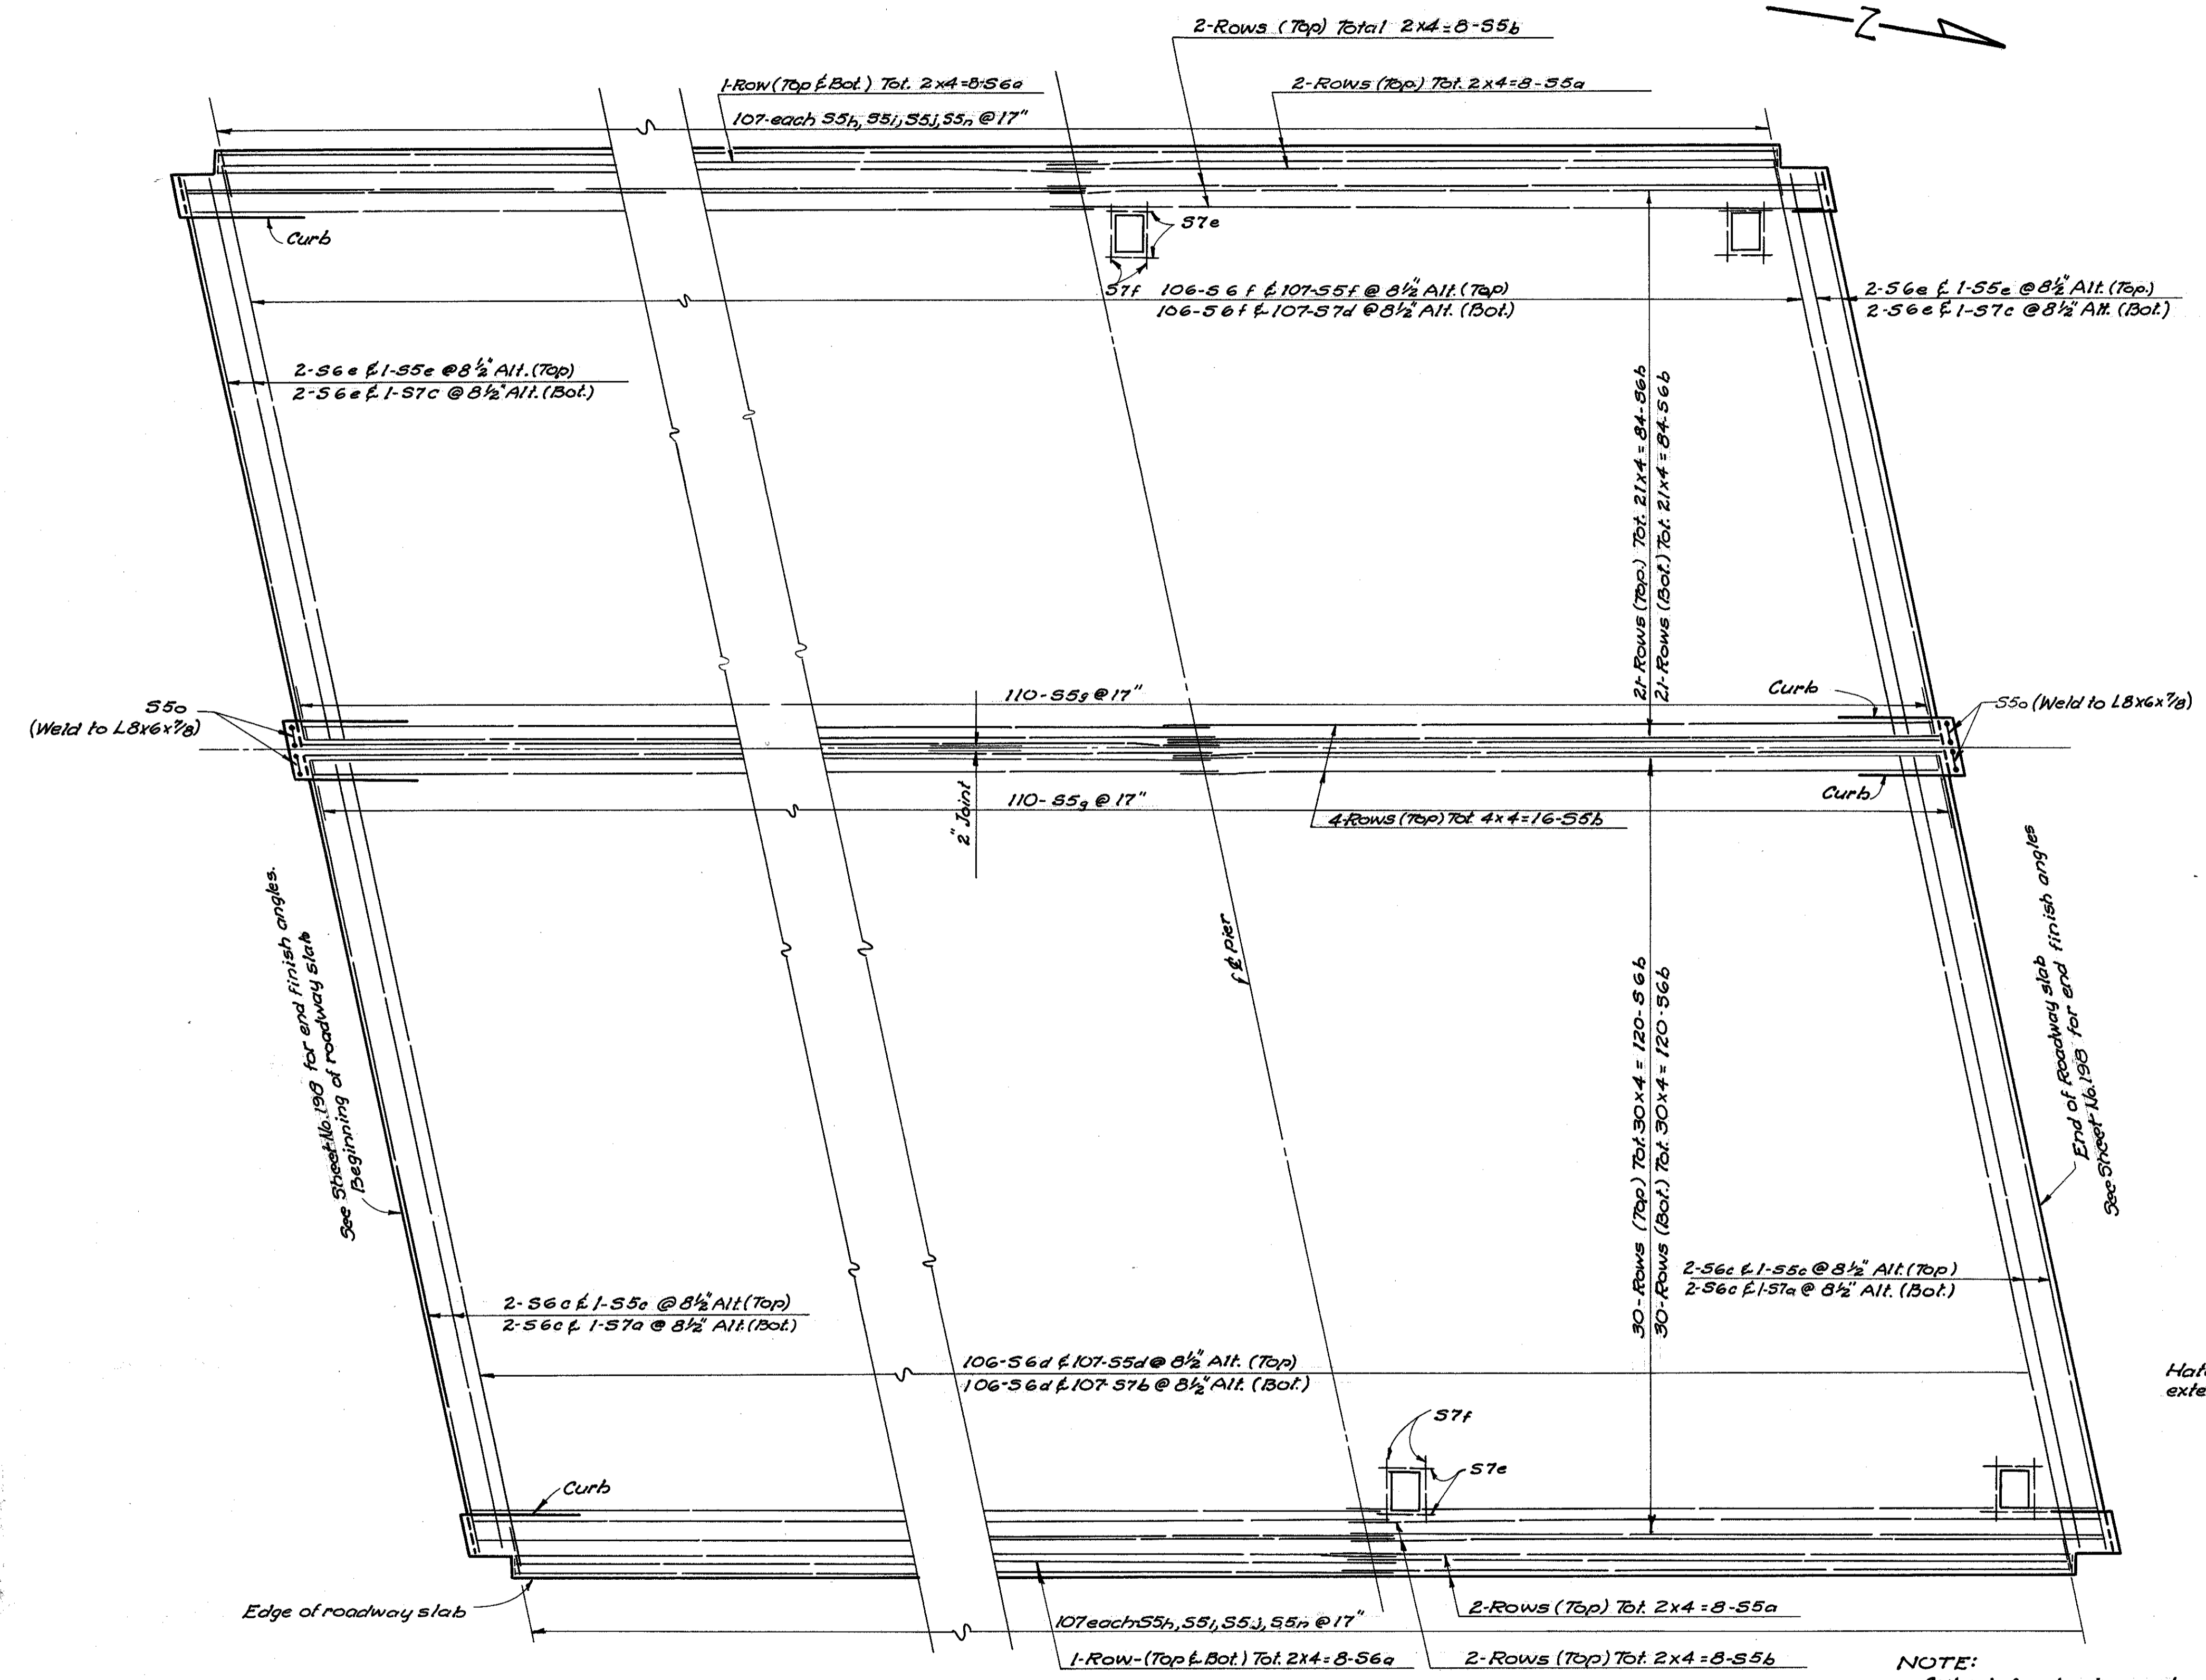

**PLAN OF ADDITIONAL SLAB REINFORCING AT PIERS**  
Scale: 1/8" = 1'-0"

1/4" grey sponge rubber preformed expansion joint filler meeting the requirements of Sec. M-10.02, Type 1. Included in item S-14 for payment.

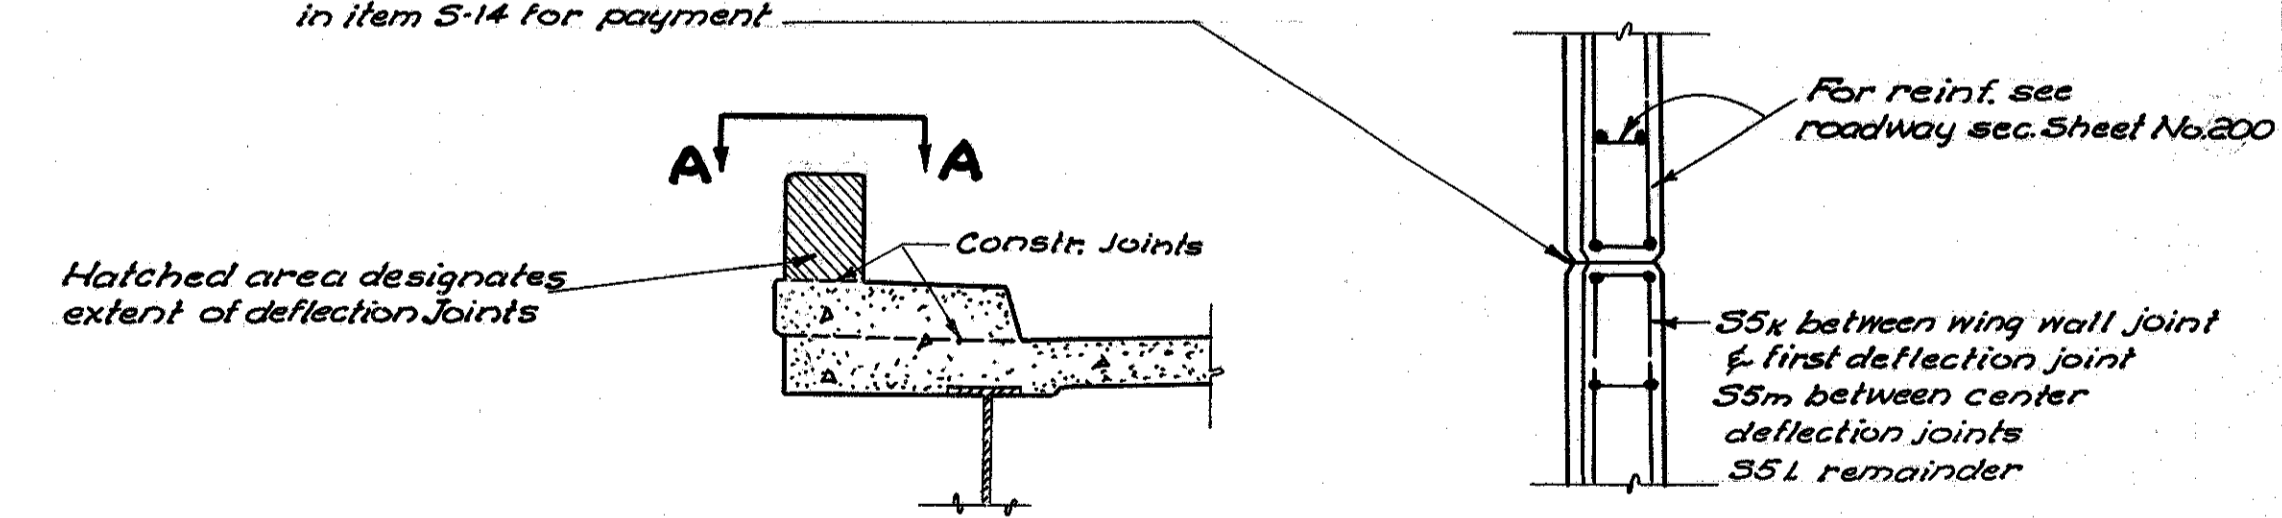

**DEFLECTION JOINT DETAIL VIEW A-A**  
Scale: 3/8" = 1'-0"

NOTE: For location see elevation view on general plan.

NOTE:  
Cut reinforcing bars at scuppers as required.  
For location of scuppers see Sheet No. 192

**PLAN SHOWING REINFORCING FOR ROADWAY & SIDEWALK SLABS**  
Scale: 3/16" = 1'-0"

VOGT, IVERS, SEAMAN & ASSOCIATES  
ENGINEERS ARCHITECTS  
CINCINNATI, OHIO

**SUPERSTRUCTURE ROADWAY SLAB**  
BRIDGE NO. BU-4-186  
OVER STATE ROUTE 73 (RELOCATED)


BUTLER COUNTY  
SEC. BUT.-4  
Scale: As shown

STA. 595+32.88  
SEPTEMBER, 1955

DESIGNED	DRAWN	TRACED	CHECKED	REVIEWED	DATE	REVISED
G.V.	ALI	K.L.	G.V.	W.J.I.	10-11-55	


**TABLE OF SPECIALS**

- A - 8"x6" Concrete elbow
  - B - 8" Concrete Wye (Y)
  - C - 8" Concrete double tee (T)
  - D - 8"x8"x8" Concrete tee (T)
  - E - Concrete Junction Box
- (See Detail This Sheet)

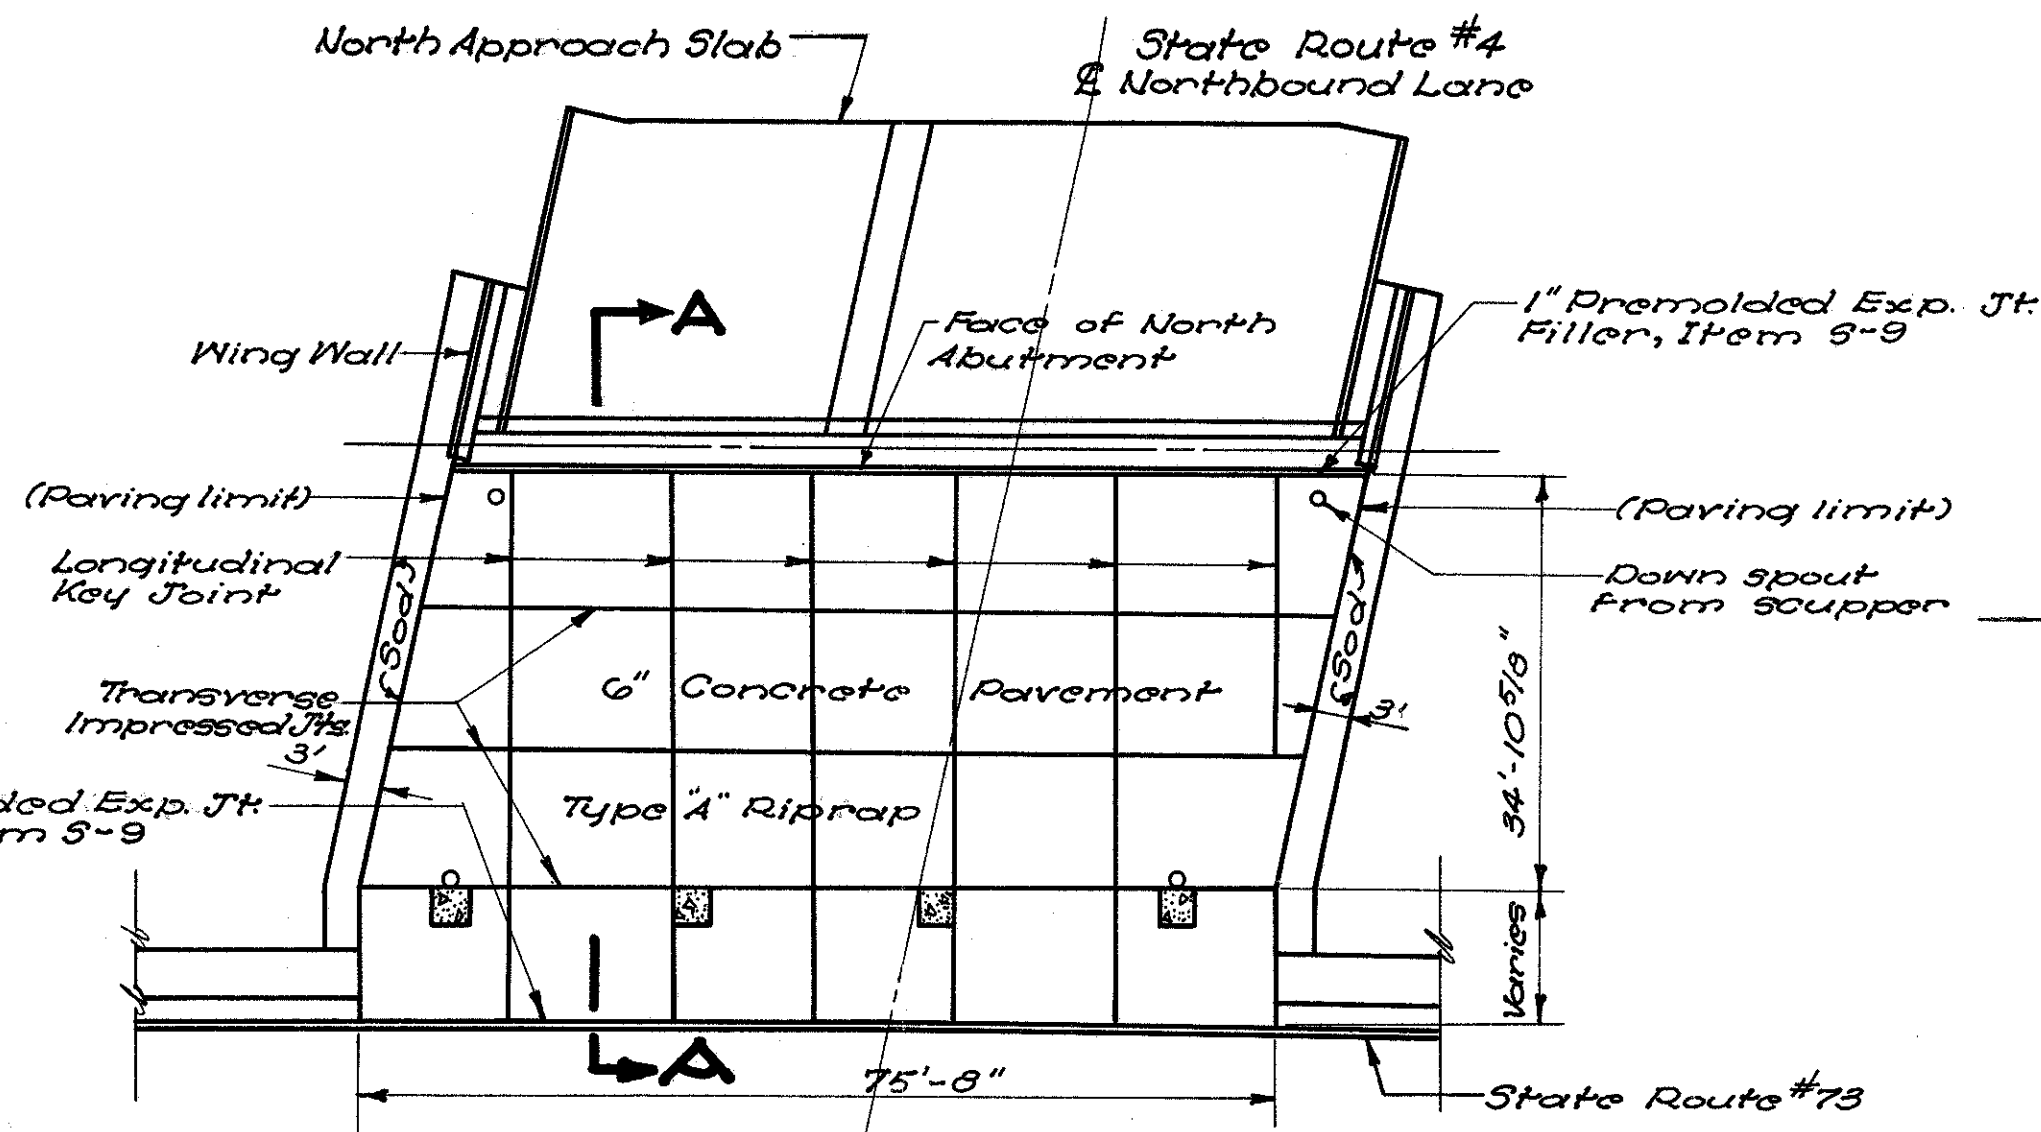


**PLAN OF UNDERGROUND DRAINAGE**  
Scale: 1" = 80'

**SLOPE PROTECTION - NORTH END**

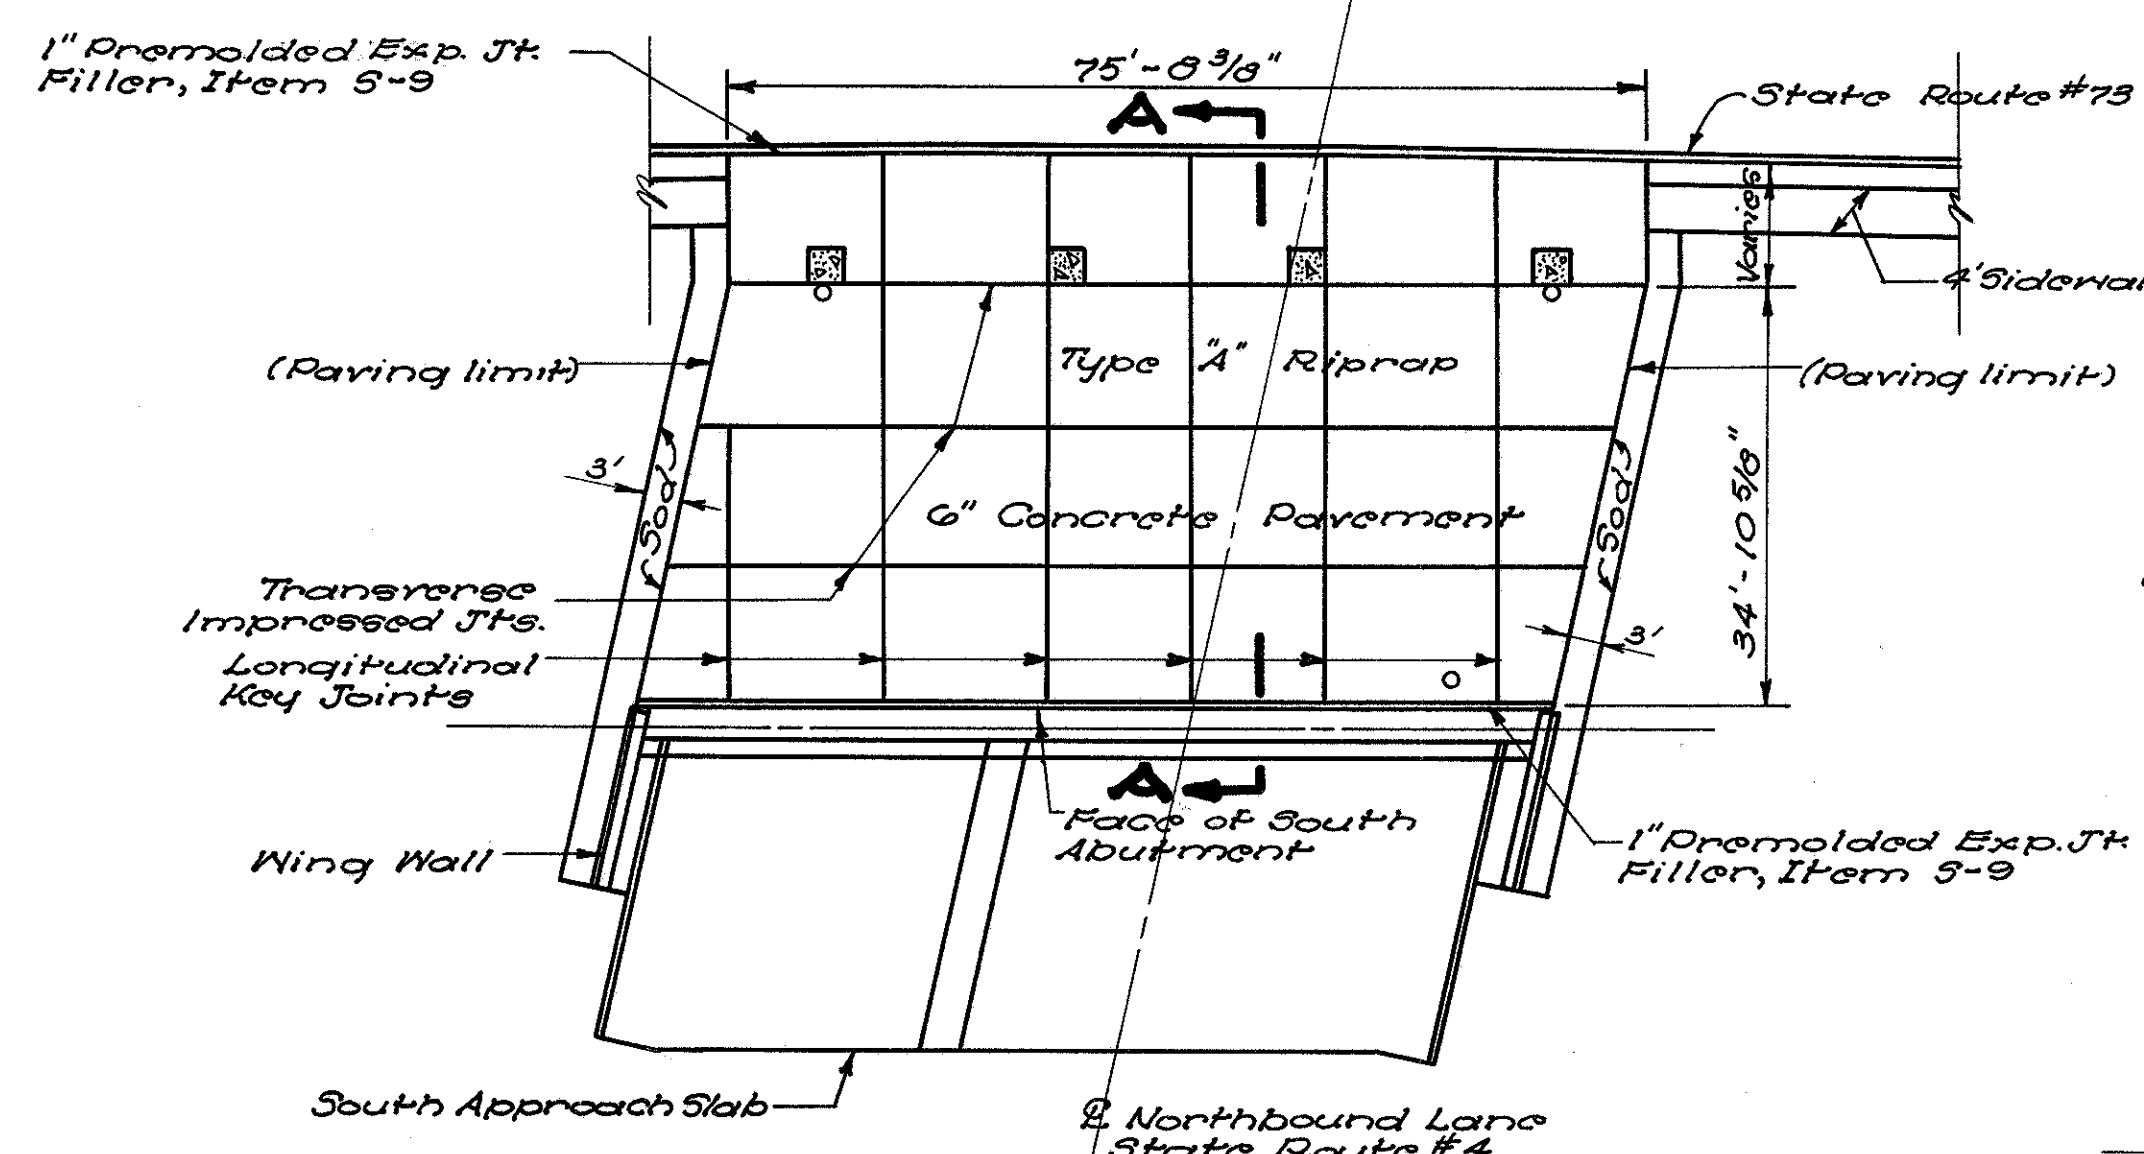


**SLOPE PROTECTION - SOUTH END**

Scale: 1/16" = 1'-0"

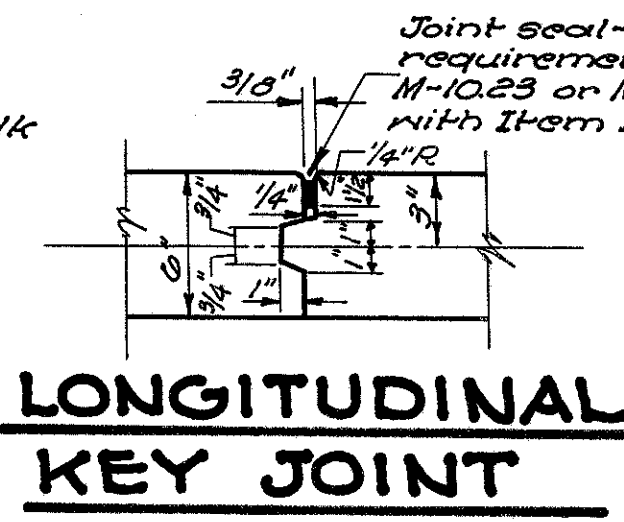


**LONGITUDINAL KEY JOINT**  
Scale: 1/2" = 1'-0"

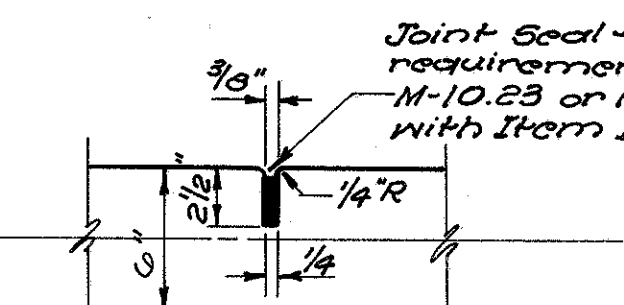


**TRANSVERSE IMPRESSED JOINT**  
Scale: 1/2" = 1'-0"

Slope Protection Glass 'E' Concrete. Reinforce in accordance with Item I-10 of the specifications. Continue reinforcement through joints.

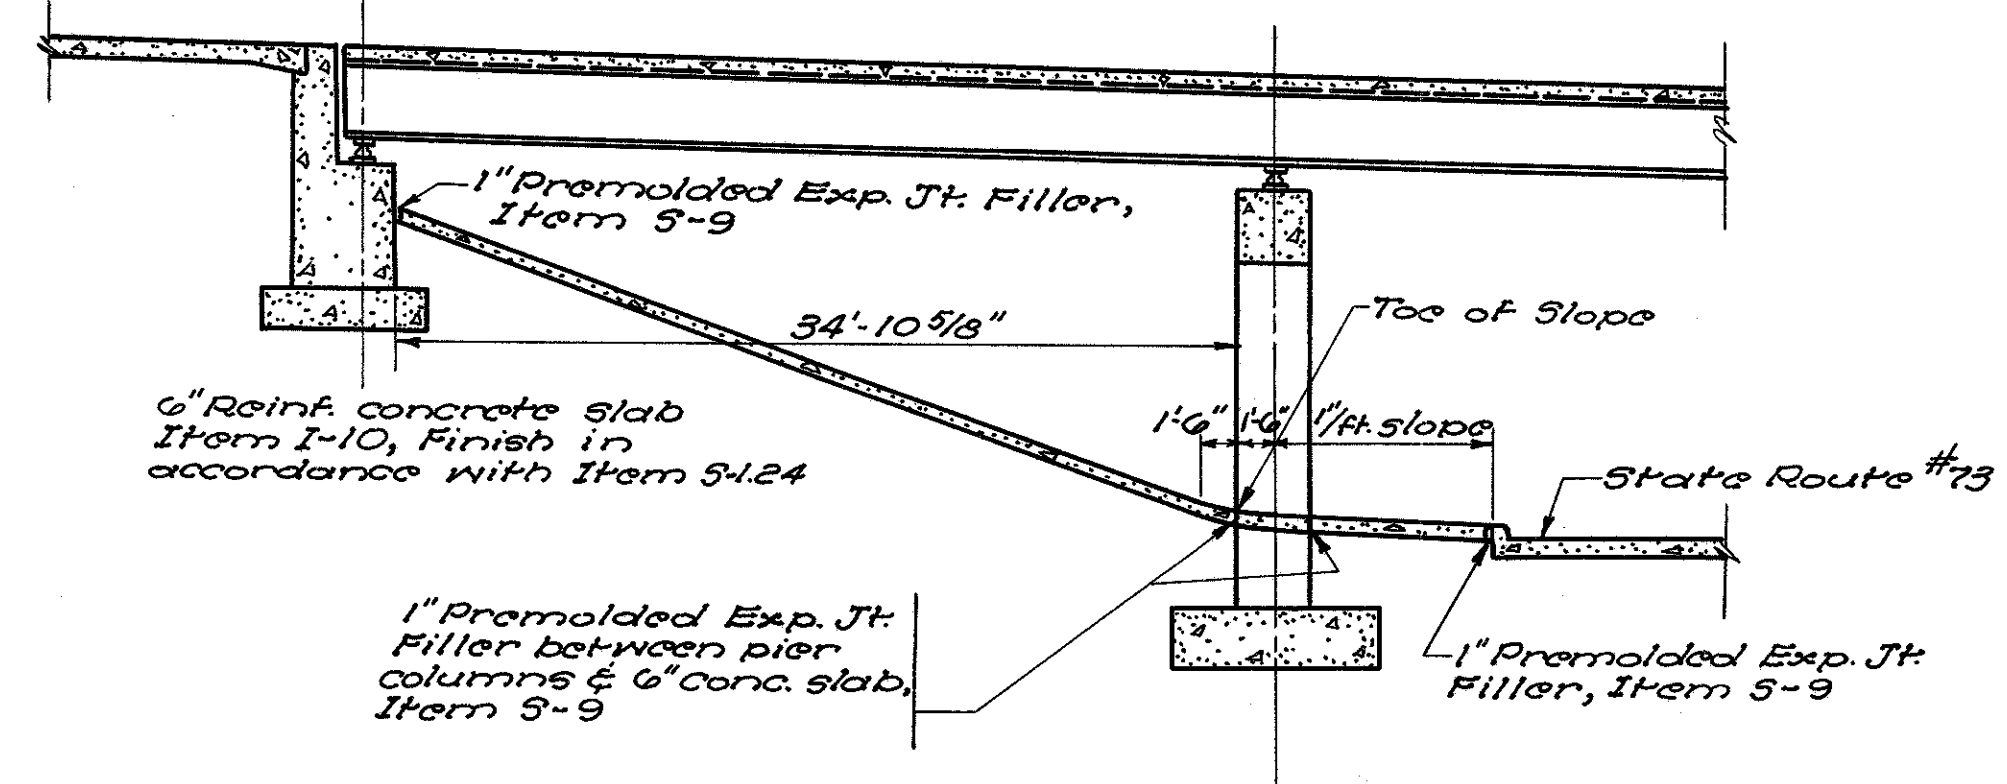

**SECTION A-A**

Scale: 1/8" = 1'-0"

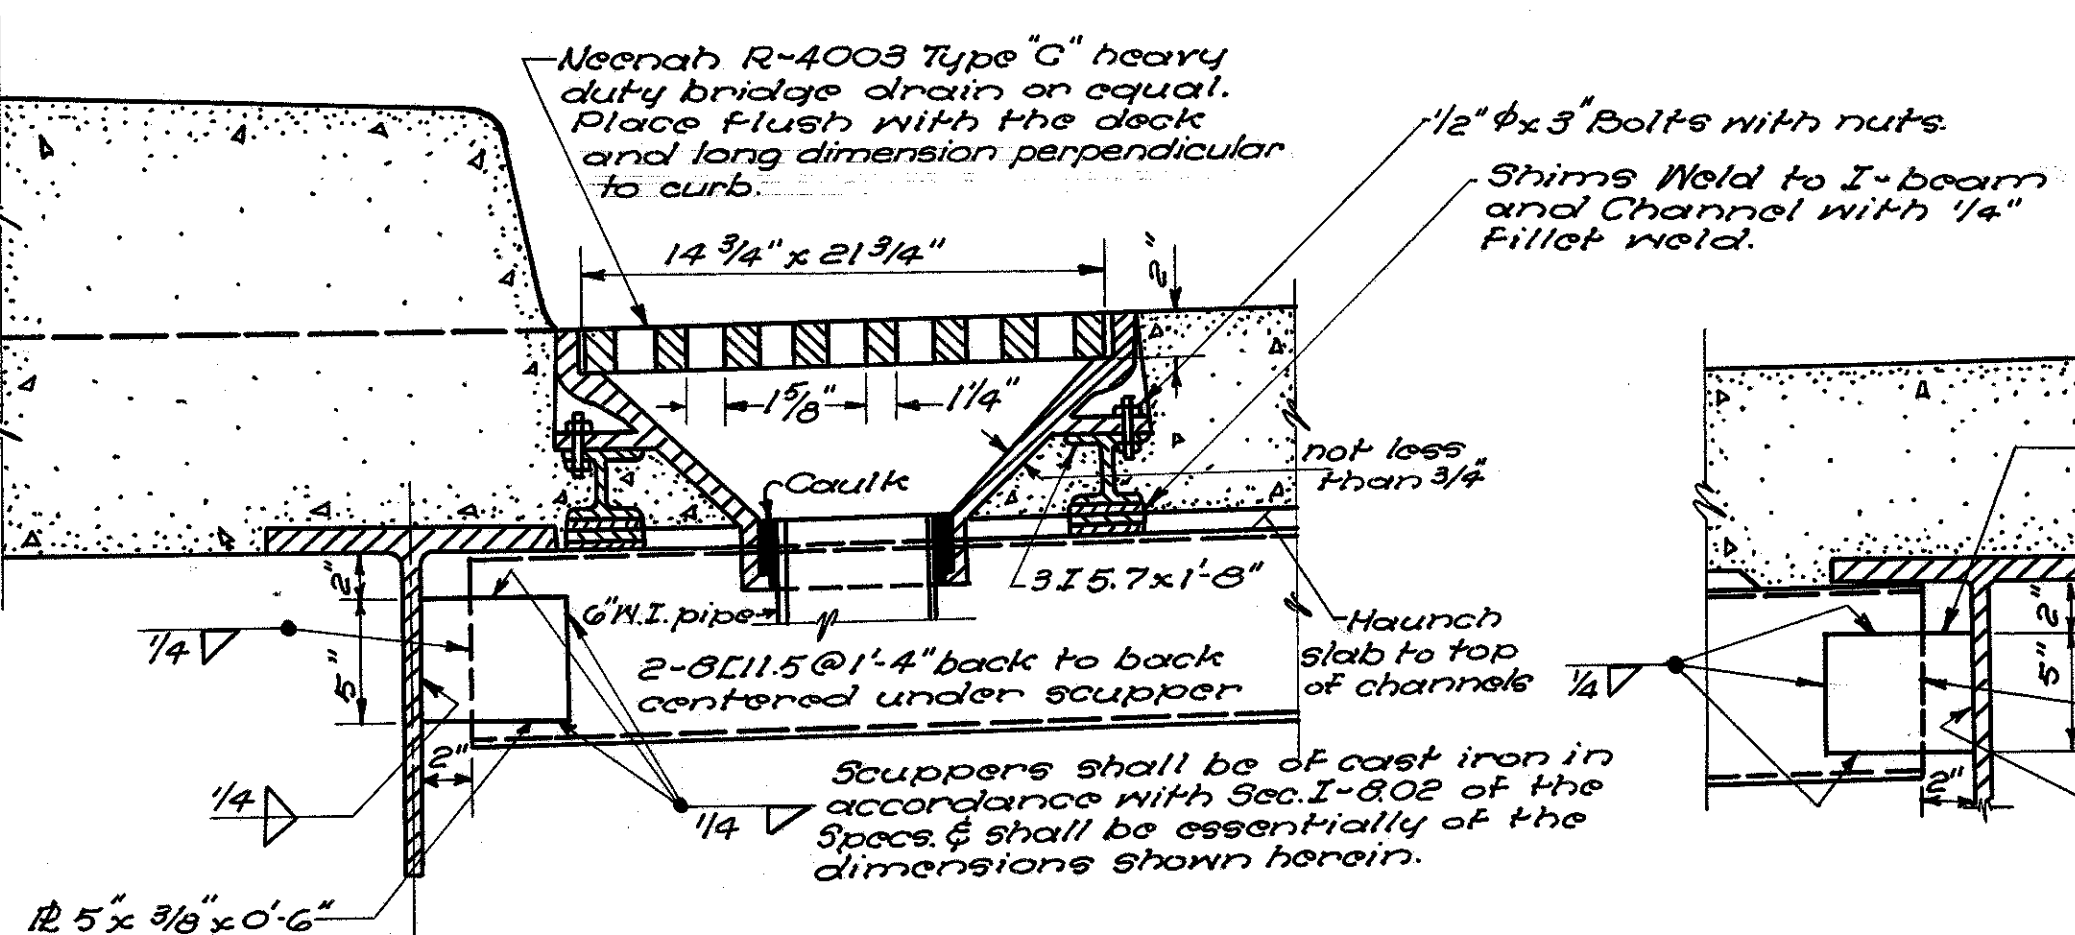

**TYPICAL SCUPPER DETAILS**


Scale: 1/2" = 1'-0"

**SECTION A-A CONCRETE JUNCTION BOX**

Scale: 3/4" = 1'-0"


**DETAIL - HANGER FOR DRAINAGE PIPE**

Scale: 1/2" = 1'-0"

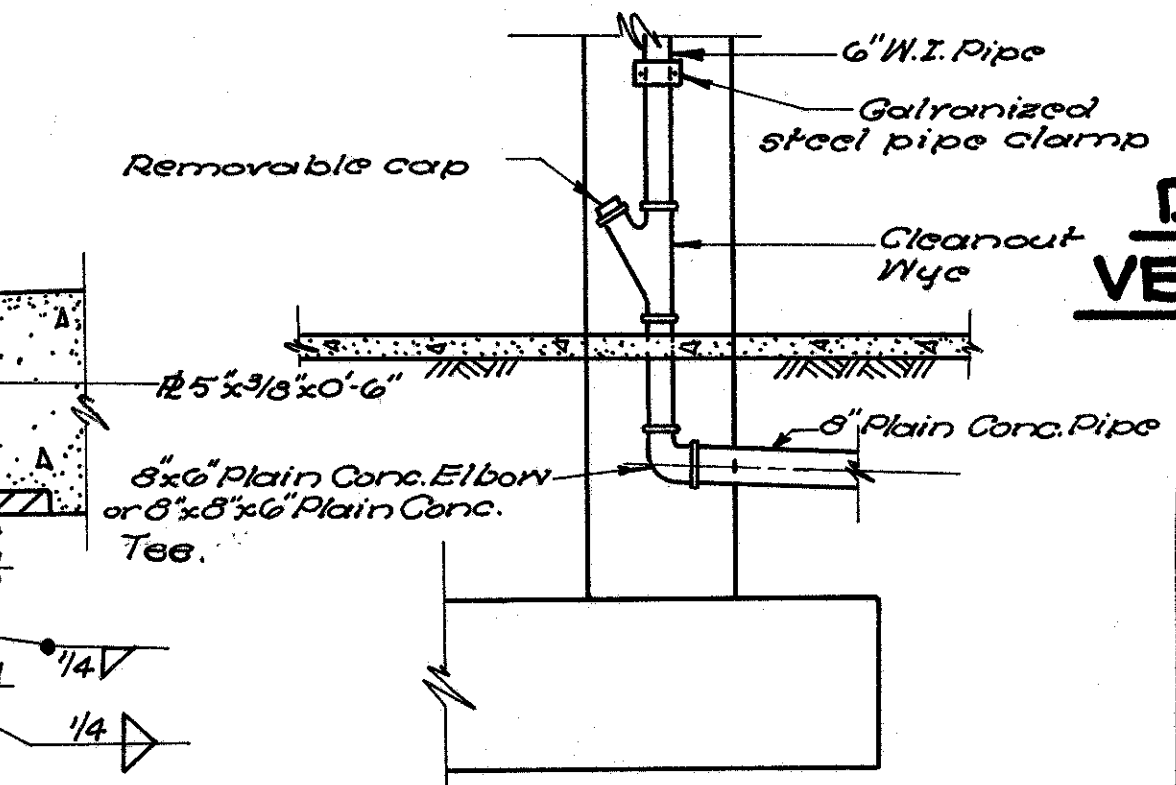

**TYPICAL DRAINAGE PIPE AT BASE OF PIER**

Scale: 1/4" = 1'-0"

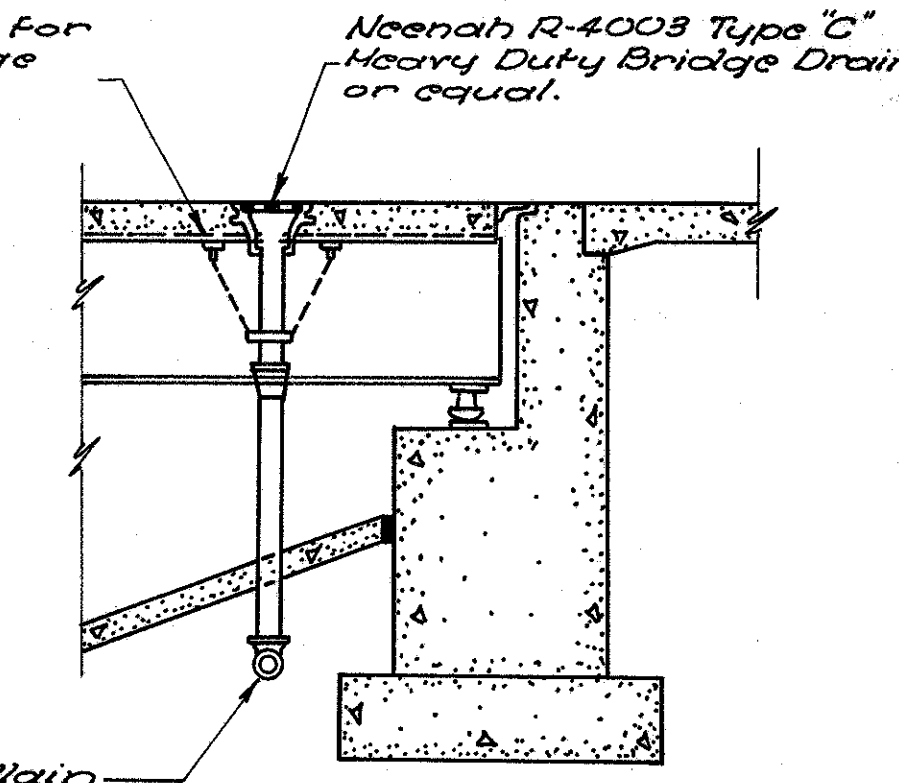



**TYPICAL DRAINAGE PIPE SUPPORTS AT ABUTMENT**

Scale: 1/4" = 1'-0"

**SECTION B-B TYPICAL DRAINAGE PIPE SUPPORTS**


Scale: 1/4" = 1'-0"

For location of Section B-B, see Sheet No. 132

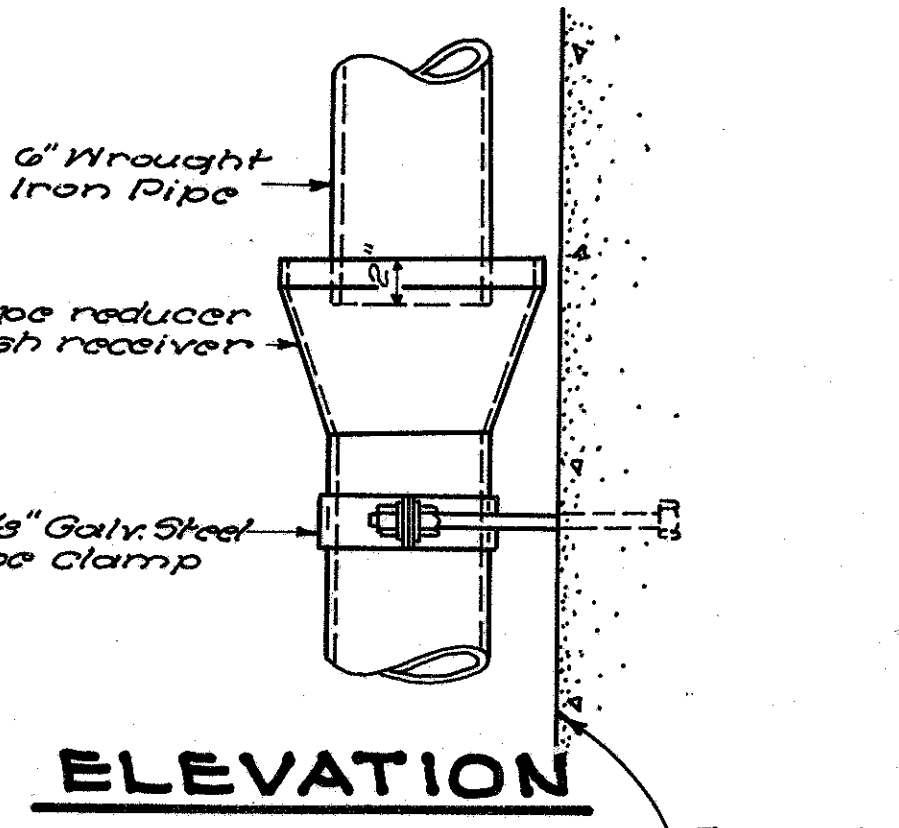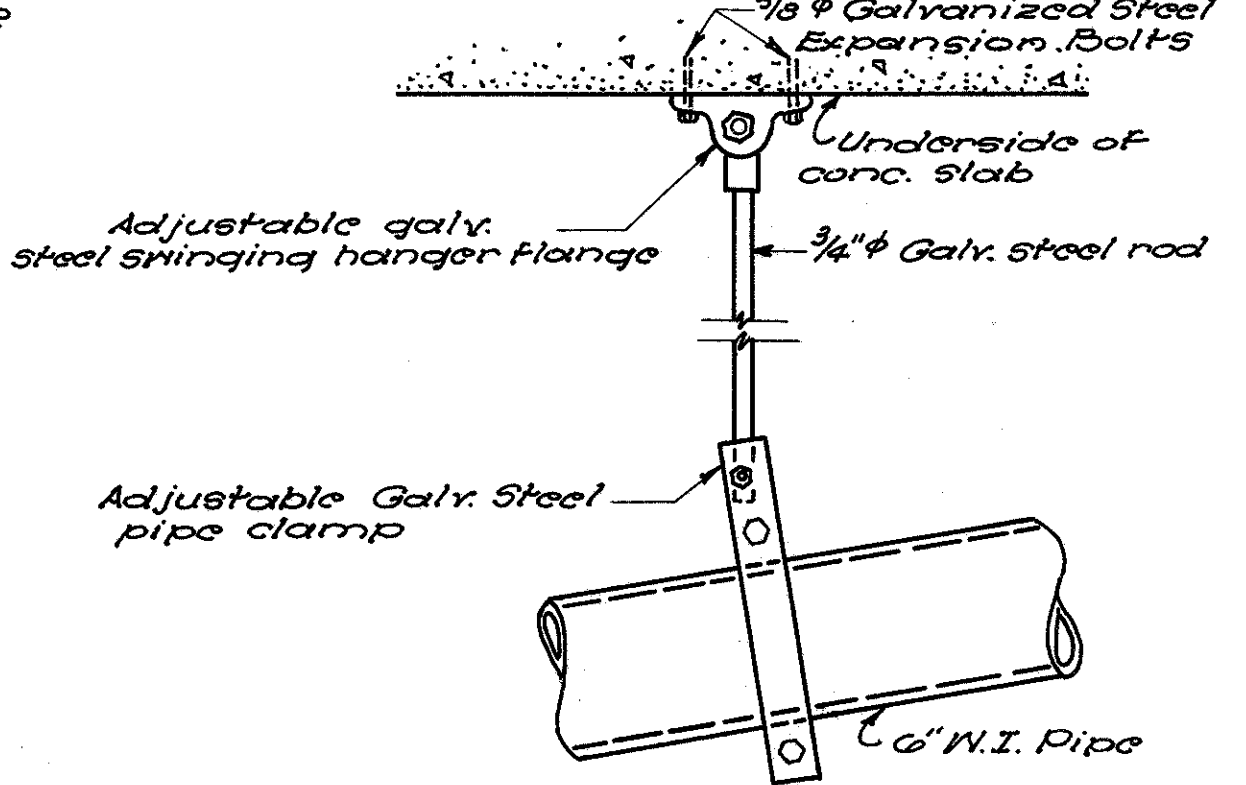

**ELEVATION**

Scale: 1/4" = 1'-0"

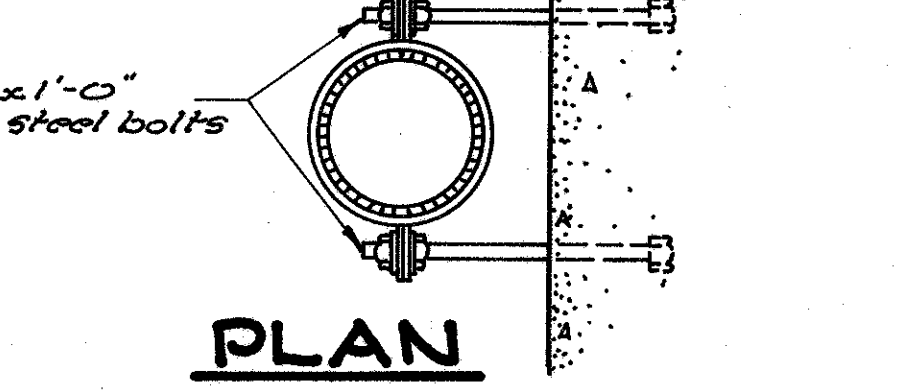

**PLAN**

Scale: 1/2" = 1'-0"

**DETAIL - SUPPORTS FOR VERTICAL DRAINAGE PIPES**

Scale: 1/2" = 1'-0"

VOGT, IVERS, SEAMAN & ASSOCIATES ENGINEERS ARCHITECTS CINCINNATI, OHIO

**SLOPE PROTECTION DRAINAGE DETAILS**  
BRIDGE NO. BU-4-106  
OVER STATE RT. 73 (Relocated)

BUTLER COUNTY  
SEC. BUT.-4  
Scale: As shown

STA. 595 + 32.08  
Sept. 1955

DESIGNED	DRAWN	TRACED	CHECKED	REVIEWED	DATE	REVISED
R.G.H.	R.G.H.	N.B.	R.J.L.	W.J.I.	10-11-55	

### ROADWAY SLAB

MARK	LENGTH	NO.	WEIGHT	SHAPE	BENDING DIAGRAM	
S5a	38'-11"	16	649	Sf.		
S5b	39'-11"	32	1322	Bf.		
S5c	42'-8"	2	89	Bf.		
S5d	43'-2"	107	4817	Bf.		
S5e	30'-6"	2	64	Bf.		
S5f	30'-11"	107	3450	Sf.		
S5g	4'-10"	220	1109	Bf.		
S5h	3'-1"	214	688	Bf.		
S5i	3'-0"	214	670	Bf.		
S5j**	8'-0"	214	1786	Bf.		
S5k**	10'-4"	16	172	Sf.		
S5l**	12'-1"	80	1006	Bf.		
S5m**	5'-10"	8	49	Bf.		
S5n	2'-5"	214	539	Sf.		
S5o	1'-9"	4	7	Bf.		
S6a	39'-2"	16	941	Sf.		
S6b	40'-1"	408	24564	Bf.		
S6c	42'-8"	8	513	Bf.		
S6d	43'-2"	212	13745	Bf.		
S6e	30'-6"	8	366	Bf.		
S6f	30'-11"	212	9845	Bf.		
S6g	25'-0"	108	4055	Sf.		
S7a	42'-8"	2	174	Sf.		
S7b	43'-2"	107	9441	Bf.		
S7c	30'-6"	2	125	Bf.		
S7d	30'-11"	107	6762	Bf.		
S7e	3'-0"	12	74	Bf.		
S7f	3'-6"	12	86	Sf.		
S5o						

### ABUTMENTS

MARK	LENGTH	NO.	WEIGHT	SHAPE	BENDING DIAGRAM
A5a	5'-6"	184	1056	Bf.	
A5b	32'-6"	16	542	Sf.	
A5c	23'-4"	32	779	Sf.	
AGa	5'-6"	182	1504	Sf.	
AGb	31'-8"	28	1332	Sf.	
AGc	10'-0"	70	1051	Bf.	
AGd	5'-1"	76	580	Sf.	
AGe	11'-6"	4	69	Bf.	
AGf	4'-1"	72	442	Bf.	
AGg	5'-0"	22	165	Sf.	
AGh	5'-5"	20	163	Sf.	
AGi	22'-11"	56	1928	Sf.	
AGj	7'-3"	30	327	Sf.	
AGk	6'-11"	22	229	Sf.	
AGl	7'-1"	20	213	Sf.	
AGm	9'-10"	70	1034	Bf.	
AGn	11'-4"	4	68	Bf.	
AGo	3'-7"	32	172	Bf.	
WGa	8'-3"	8	99	Sf.	
WGb	4'-6"	24	162	Bf.	
WGc	14'-2"	16	340	Bf.	
WGd	5'-0"	24	180	Bf.	
WGe	10'-4"	8	124	Bf.	
WGf	11'-9"	7	125	Bf.	
WGg	7'-10"	8	94	Bf.	
WGh	2'-11"	12	53	Bf.	
WGi	6'-10"	12	123	Bf.	
WGj	7'-6"	72	135	Bf.	
WGr	5'-8"	8	68	Bf.	
WGl	14'-8"	12	264	Bf.	
WGa	12'-4"	12	222	Bf.	
WGr	12'-6"	7	131	Bf.	
WGr	12'-0"	7	126	Bf.	
WGr	2'-6"	4	15	Bf.	
WGr	12'-8"	7	133	Sf.	
WGr	3'-9"	12	68	Bf.	
WGr	3'-2"	16	76	Sf.	
WGr					

### PIERS

MARK	LENGTH	NO.	WEIGHT	SHAPE	BENDING DIAGRAM
P4a	11'-7"	102	789	Bf.	
P5a	4'-7"	144	688	Bf.	
P5b	13'-8"	64	912	Bf.	
P5c	12'-3"	4	52	Bf.	
P5d	10'-11"	4	46	Bf.	
P5e	34'-0"	16	568	Sf.	
P6a	10'-0"	188	2824	Bf.	
P8a	12'-10"	56	1919	Bf.	
P9a	22'-5"	32	2439	Sf.	
P9b	28'-6"	16	1550	Bf.	
P11a	7'-5"	144	5674	Bf.	
P11b	19'-10"	72	7587	Sf.	
P11c	38'-5"	32	6532	Sf.	
P11d	18'-1"	72	6918	Sf.	
P4a					

### REPLACEMENT BARS

MARK	LENGTH	NO.	WEIGHT	SHAPE
RE4	5'-3"	1	4	Sf.
RE5	5'-7"	2	12	Bf.
RE6	5'-11"	4	36	Bf.
RE7	6'-3"	1	13	Bf.
RE8	6'-6"	1	17	Bf.
RE9	6'-10"	1	23	Bf.
RE11	7'-7"	2	81	Sf.

Note:  
Reinforcing steel dimensions marked with asterisks\* are out-to-out dimensions requiring exact bending.  
Bars marked with double asterisk\*\* to be included in payment under Item S-14, Railing.


VOGT, IVERS, SEAMAN & ASSOCIATES  
ENGINEERS ARCHITECTS  
CINCINNATI, OHIO

## REINFORCING STEEL LIST

BRIDGE NO. BU-4-186  
OVER STATE ROUTE 73 (RELOCATED)  
BUTLER COUNTY  
SEC. BUT-4 STA. 595+32.88  
Scale: As shown SEPT. 1955

DESIGNED	DRAWN	TRACED	CHECKED	REVIEWED	DATE	REVISOR
G.Y.	R.L.S.	S.J.R.	R.L.S.	W.J.I.	10-11-55	


BUT-4-(16.53-19.15)

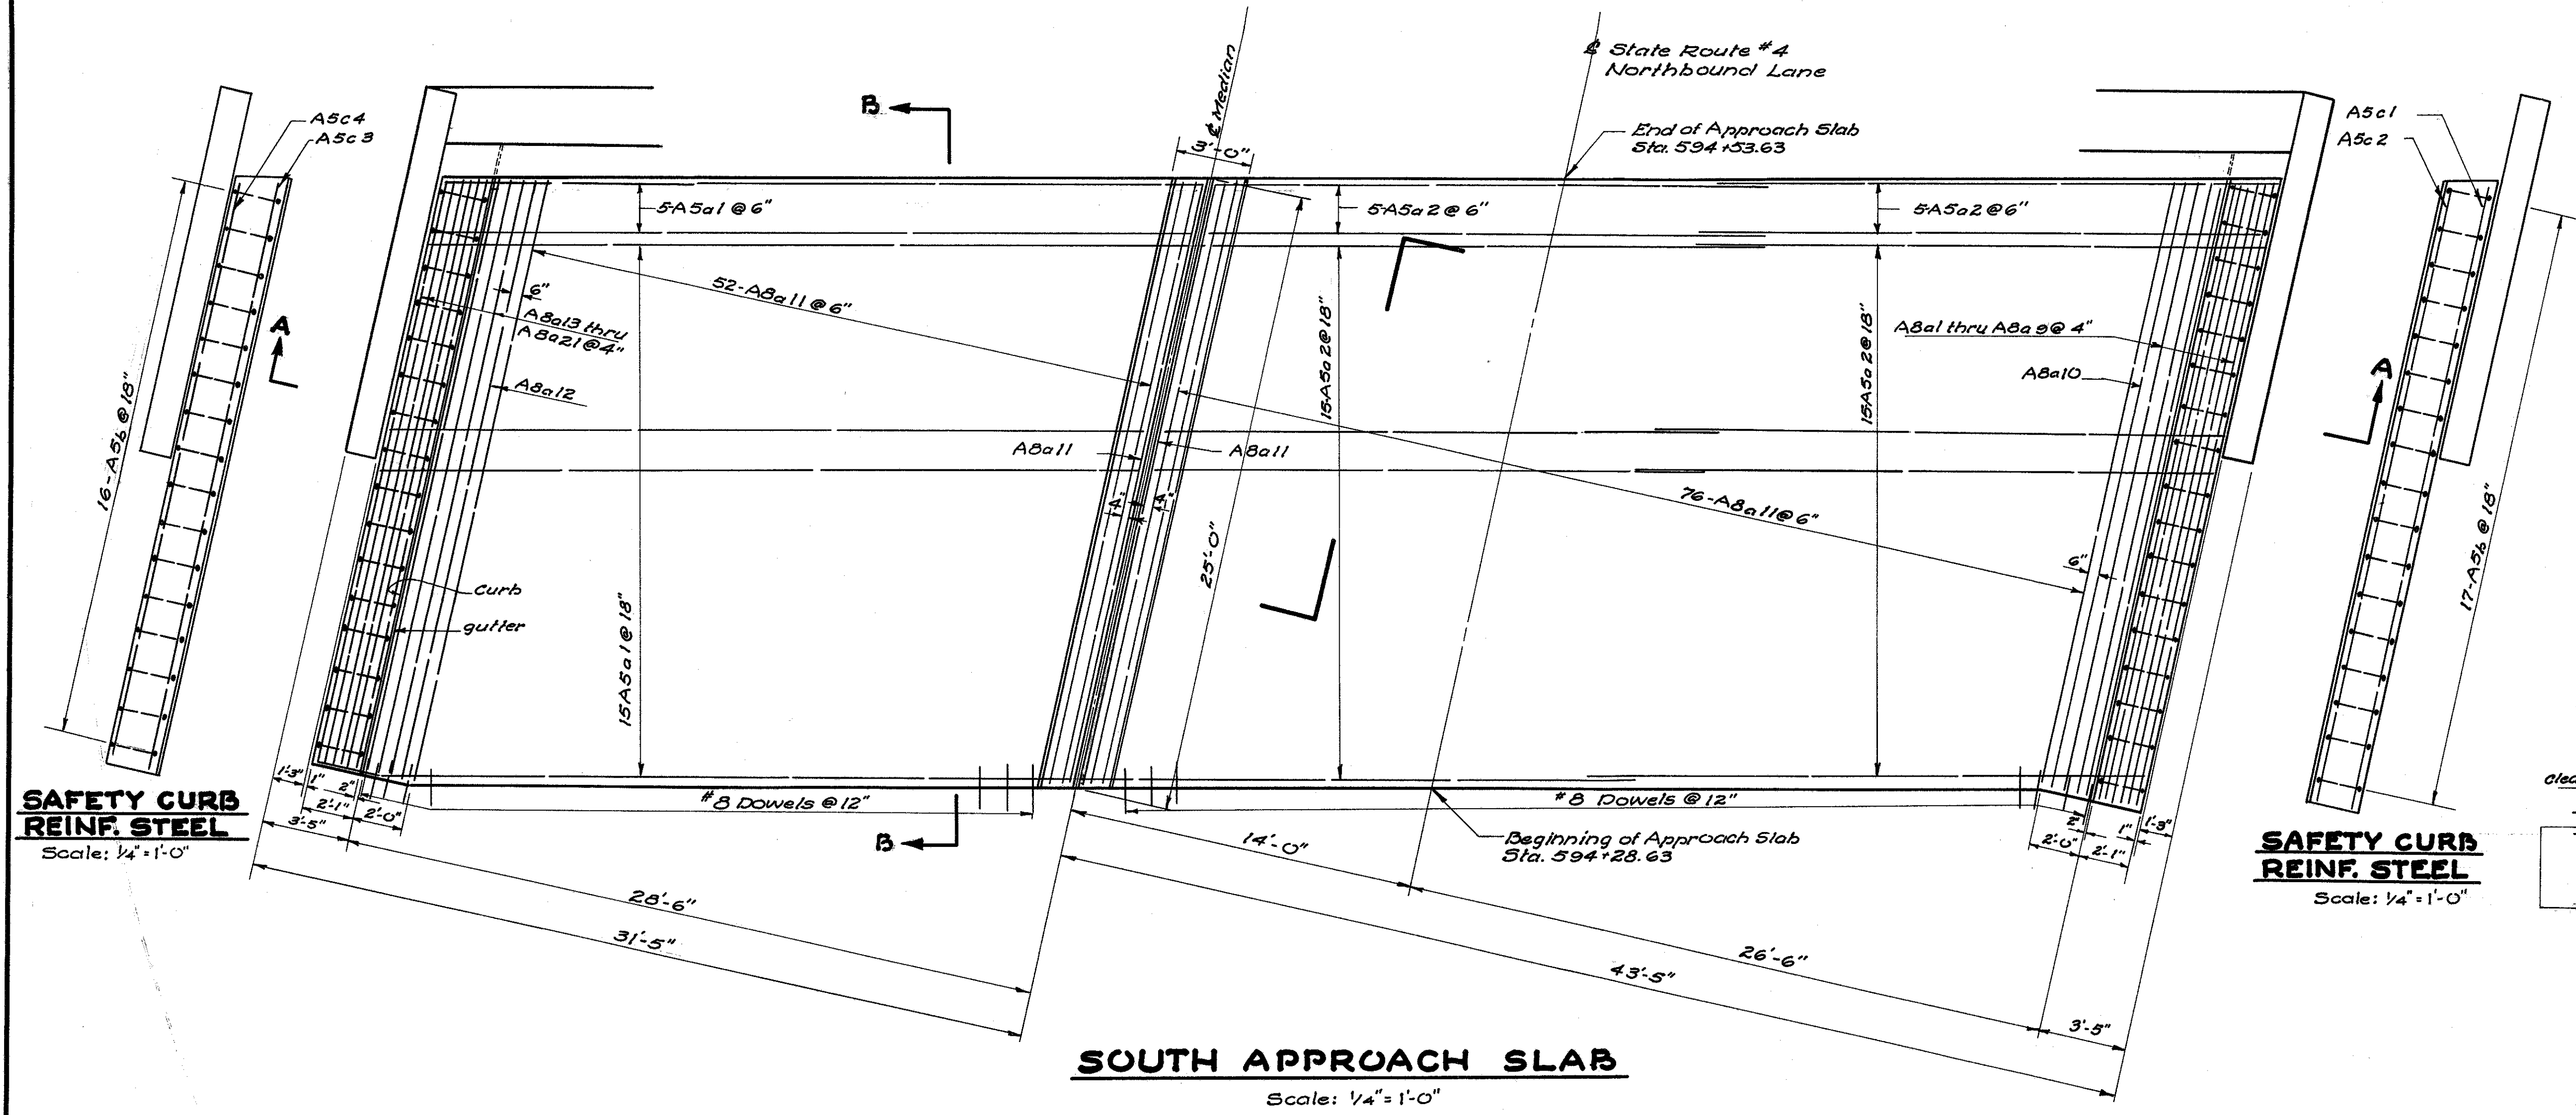

**SAFETY CURB REINF. STEEL**  
Scale: 1/4" = 1'-0"


**SAFETY CURB REINF. STEEL**  
Scale: 1/4" = 1'-0"

**SOUTH APPROACH SLAB**  
Scale: 1/4" = 1'-0"

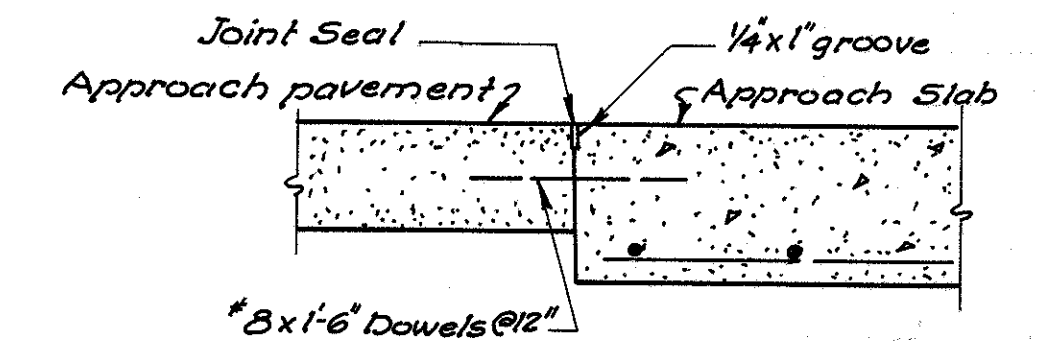


**DETAIL "C"**  
Scale 3/4" = 1'-0"

Payment for the construction joints, including dowel bars, is included in the price per sq. yd. bid for the approach pavement.

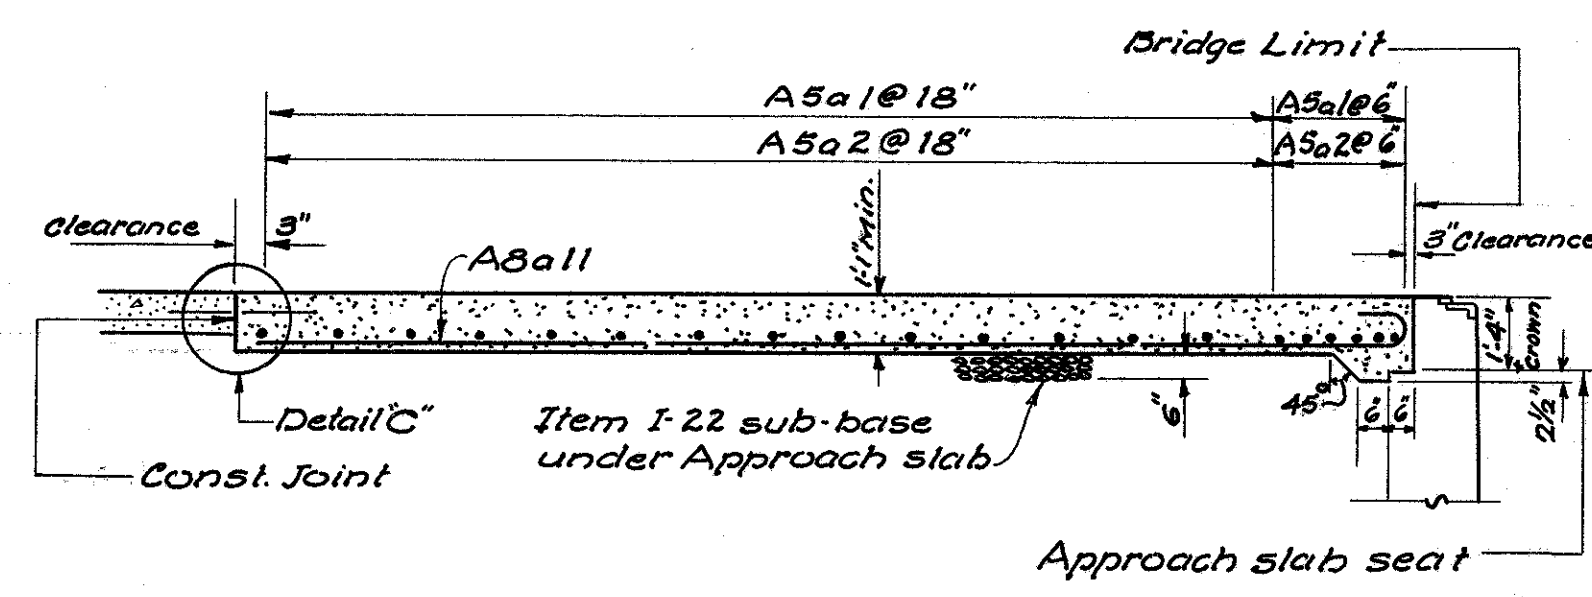

**SECTION B-B**  
Scale: 1/4" = 1'-0"

**NOTE:**  
Approach Slabs to be Class "C" Concrete.  
The price bid for Item I-7 for the approach slab shall include safety curb and 1" preformed expansion joint filler.  
See Sheet 205 for reinforcing steel list.  
For location of expansion joints in the approach pavement adjacent to the bridge see standard drawing T.J. No. 1 dated 3-2-53

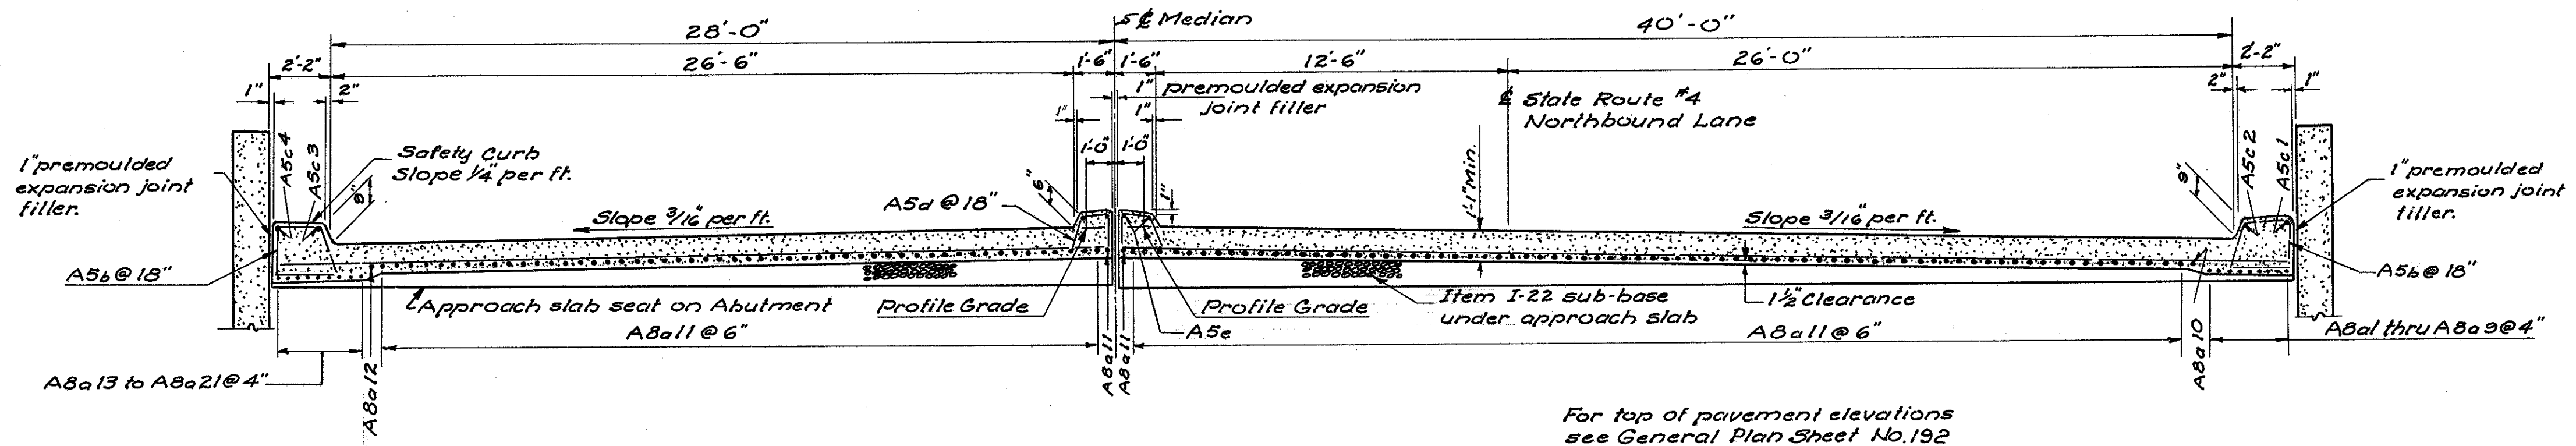

For top of pavement elevations see General Plan Sheet No. 192

**SECTION A-A**  
Scale: 1/4" = 1'-0"



# LOCATION PLAN




## STATE ROUTE 4 BUT-4-(16.53-19.15) BUTLER COUNTY

**R/W PLAN**  
BUTLER COUNTY  
BUT-4-(16.53-19.15)

206  
222

Date	Revision	By

**CURVE DATA**  
 PI 557+08.86  
 $\Delta = 22^\circ-19'-00''$   
 $D = 7''-00'-00''$   
 $R = 2864.79'$   
 $L_s = 200.00'$   
 $L_c = 915.83'$   
 $T_s = 665.19'$

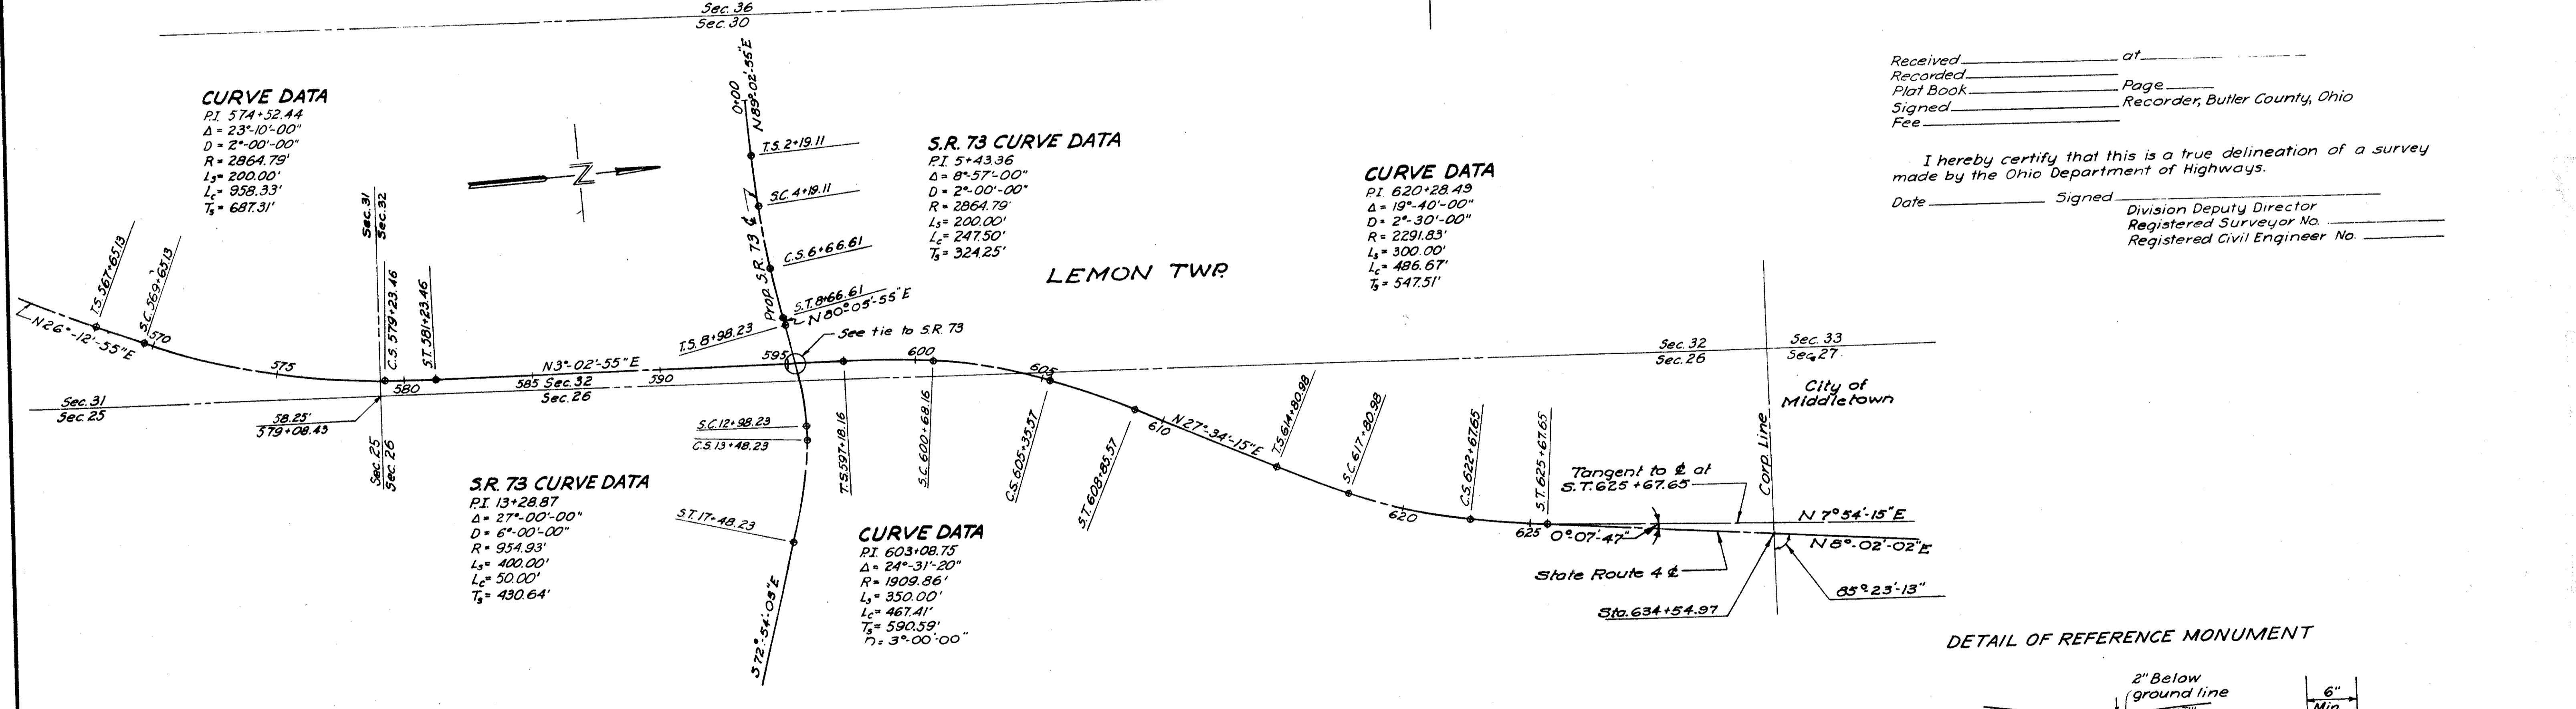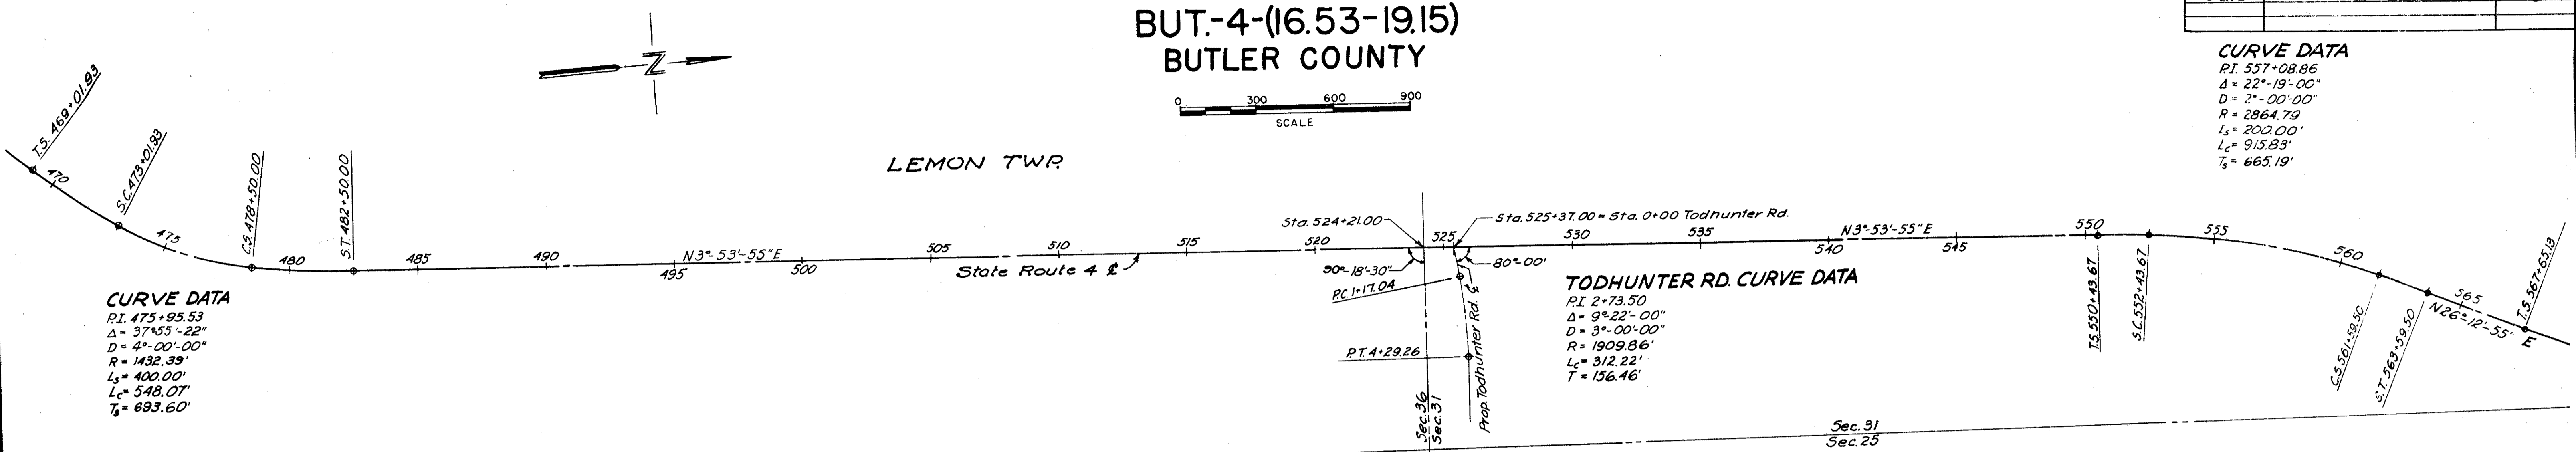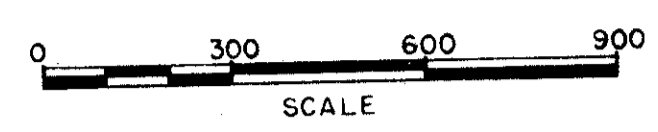


Received \_\_\_\_\_ at \_\_\_\_\_  
 Recorded \_\_\_\_\_ Page \_\_\_\_\_  
 Plat Book \_\_\_\_\_  
 Signed \_\_\_\_\_ Recorder, Butler County, Ohio  
 Fee \_\_\_\_\_

I hereby certify that this is a true delineation of a survey made by the Ohio Department of Highways.


Date \_\_\_\_\_ Signed \_\_\_\_\_  
 Division Deputy Director  
 Registered Surveyor No. \_\_\_\_\_  
 Registered Civil Engineer No. \_\_\_\_\_

**DETAIL OF REFERENCE MONUMENT**

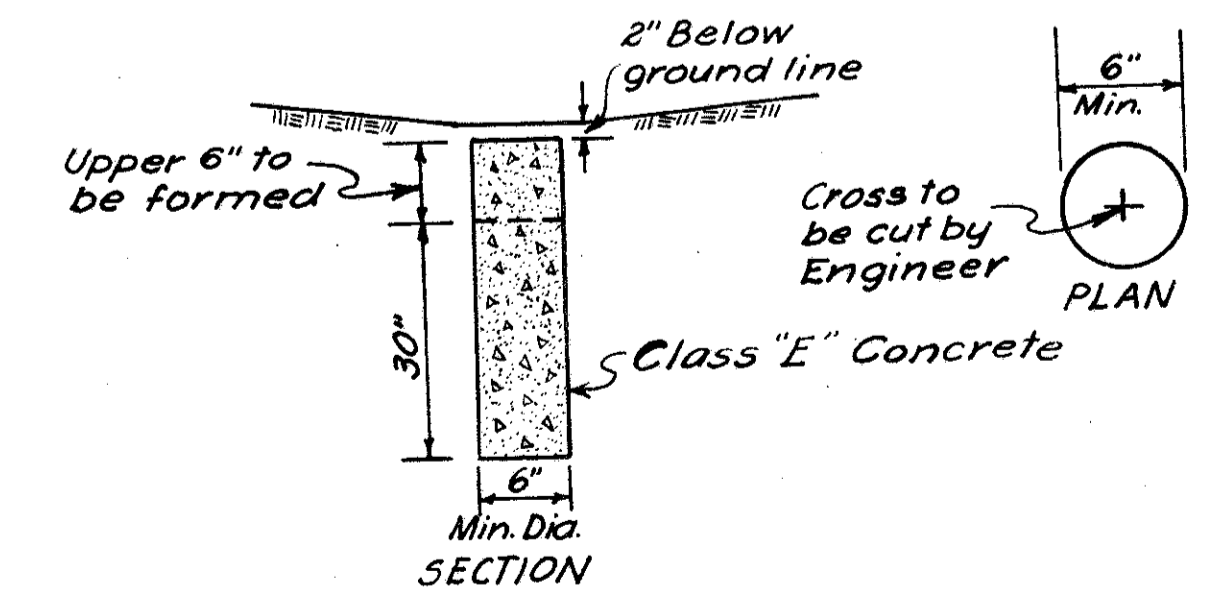

NOTE: Monuments to be placed by Contractor and marked with cross by State Forces.

LOCATION OF CENTER LINE REFERENCE MONUMENTS				TIE TO STATE ROUTE 73			
Station	Dist. R.A.	Dist. L.A.	Location	Station	Dist. R.A.	Dist. L.A.	Location
473+01.93	20'	70'	RADIAL LINE	567+65.13	20'	18'	RIGHT ANGLES
478+50.00	20'	18'	RADIAL LINE	569+65.13	20'	68'	RADIAL LINE
482+50.00	20'	18'	RADIAL LINE	574+44.30	20'	60'	RADIAL LINE
487+00.00	20'	18'	RIGHT ANGLES	579+23.46	20'	52'	RIGHT ANGLES
492+00.00	20'	18'	"	581+23.46	20'	48'	"
495+00.00	20'	18'	"	583+00.00	30'	50'	"
500+00.00	20'	18'	"	590+50.00	31'	46'	"
505+00.00	20'	18'	"	594+00.00	31'	47'	RIGHT ANGLES
510+00.00	20'	18'	"	597+18.16	21'	49'	RADIAL LINE
515+00.00	20'	18'	"	600+68.16	20'	60'	RADIAL LINE
520+50.00	20'	18'	"	605+35.57	20'	50'	RIGHT ANGLES
525+00.00	24'	70'	"	608+85.57	20'	50'	RIGHT ANGLES
530+00.00	20'	18'	"	614+80.98	20'	55'	RIGHT ANGLES
534+00.00	20'	18'	"	617+80.98	20'	48'	RADIAL LINE
539+50.00	20'	18'	"	622+67.65	21'	48'	RADIAL LINE
545+00.00	20'	18'	"	625+67.65	20'	48'	RIGHT ANGLES
550+45.67	20'	88'	RIGHT ANGLES	630+00.00	20'	48'	"
552+45.67	20'	72'	RADIAL LINE	634+50.00	20'	48'	RIGHT ANGLES
557+01.59	20'	80'	"				
561+59.50	20'	75'	RADIAL LINE				
563+59.50	20'	18'	RIGHT ANGLES				

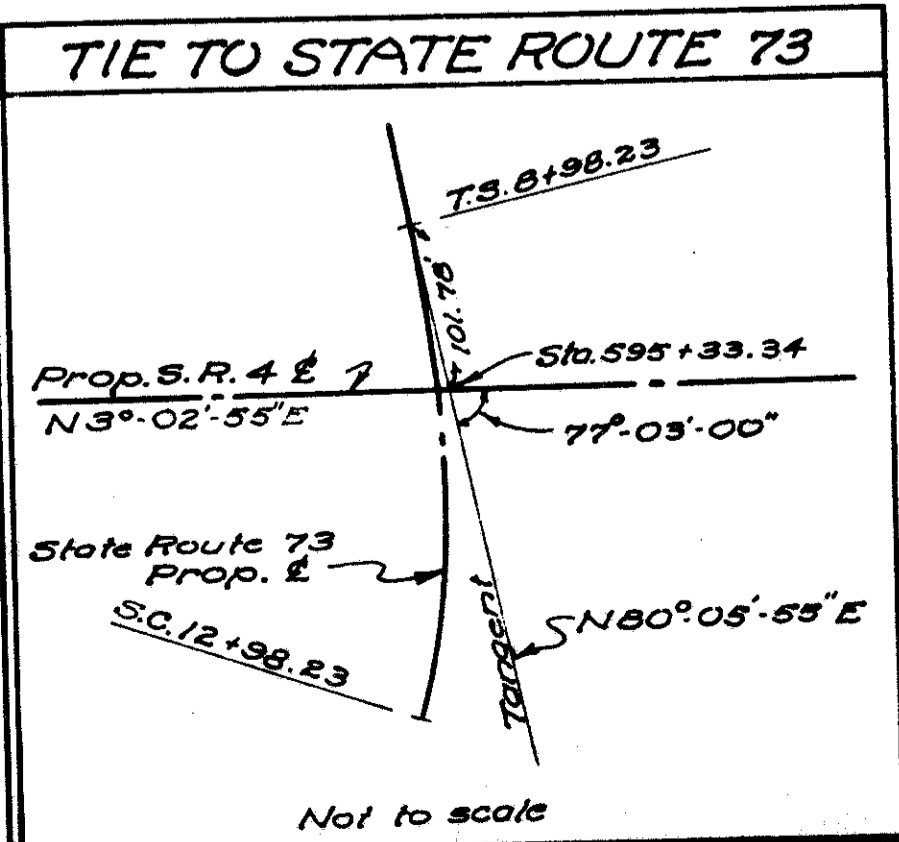



Woodcrest Subdivision

Lemon Twp.  
Sec. 36 T-3 R-3

# R/W PLAN

BUTLER COUNTY  
BUT-4-(16.53-19.15)


207  
222

Date	Revision	By

CURVE DATA  
 PI = 475+95.53  
 A = 37° 55' 22"  
 D = 4° 00' 00"  
 R = 1432.39'  
 Ls = 400.00'  
 Lc = 548.07'  
 Ts = 693.60'  
 Es = 87.15'

Charles E. Matson  
&  
Carrie M. Matson

Channel Agreement

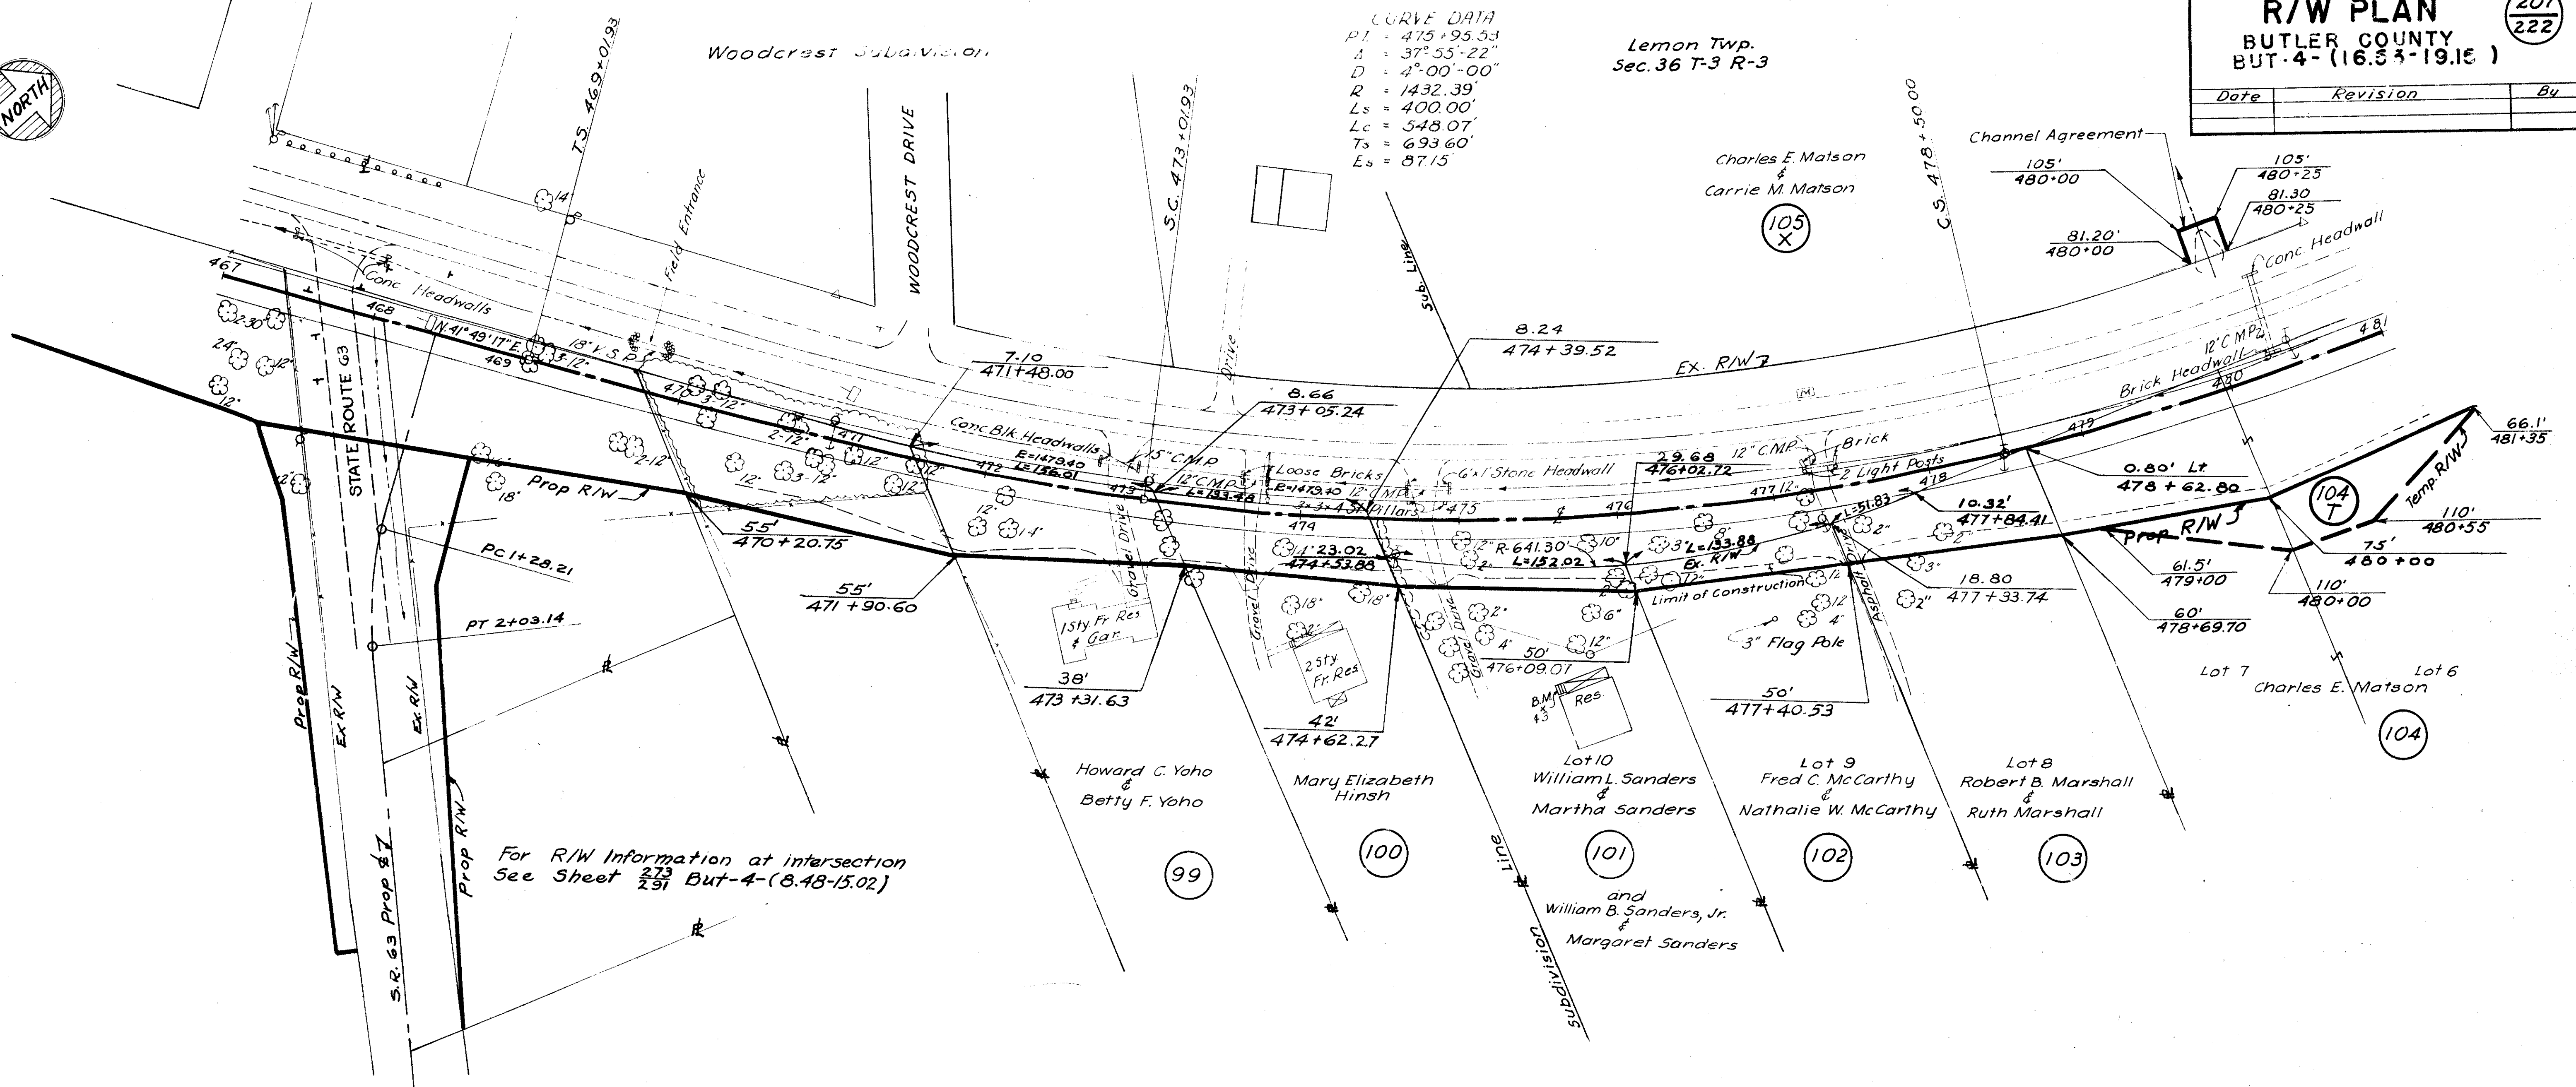

For R/W Information at intersection  
See Sheet 273 But-4-(8.48-15.02)

Hughes Manor Subdivision  
PB.8 P.7

**R/W PLAN**  
**BUTLER COUNTY**  
**BUT-4-(16.53-19.15)**


208  
222

Date	Revision	By



**CURVE DATA**  
 PI = 475+95.53  
 Δ = 37°-55'-22"  
 D = 4°-00'-00"  
 R = 1432.39'  
 L<sub>1</sub> = 400.00'  
 L<sub>2</sub> = 548.01'  
 L<sub>3</sub> = 693.60'  
 L<sub>4</sub> = 87.15'


Lemon Twp.  
 Sec. 36 T-3 R-3

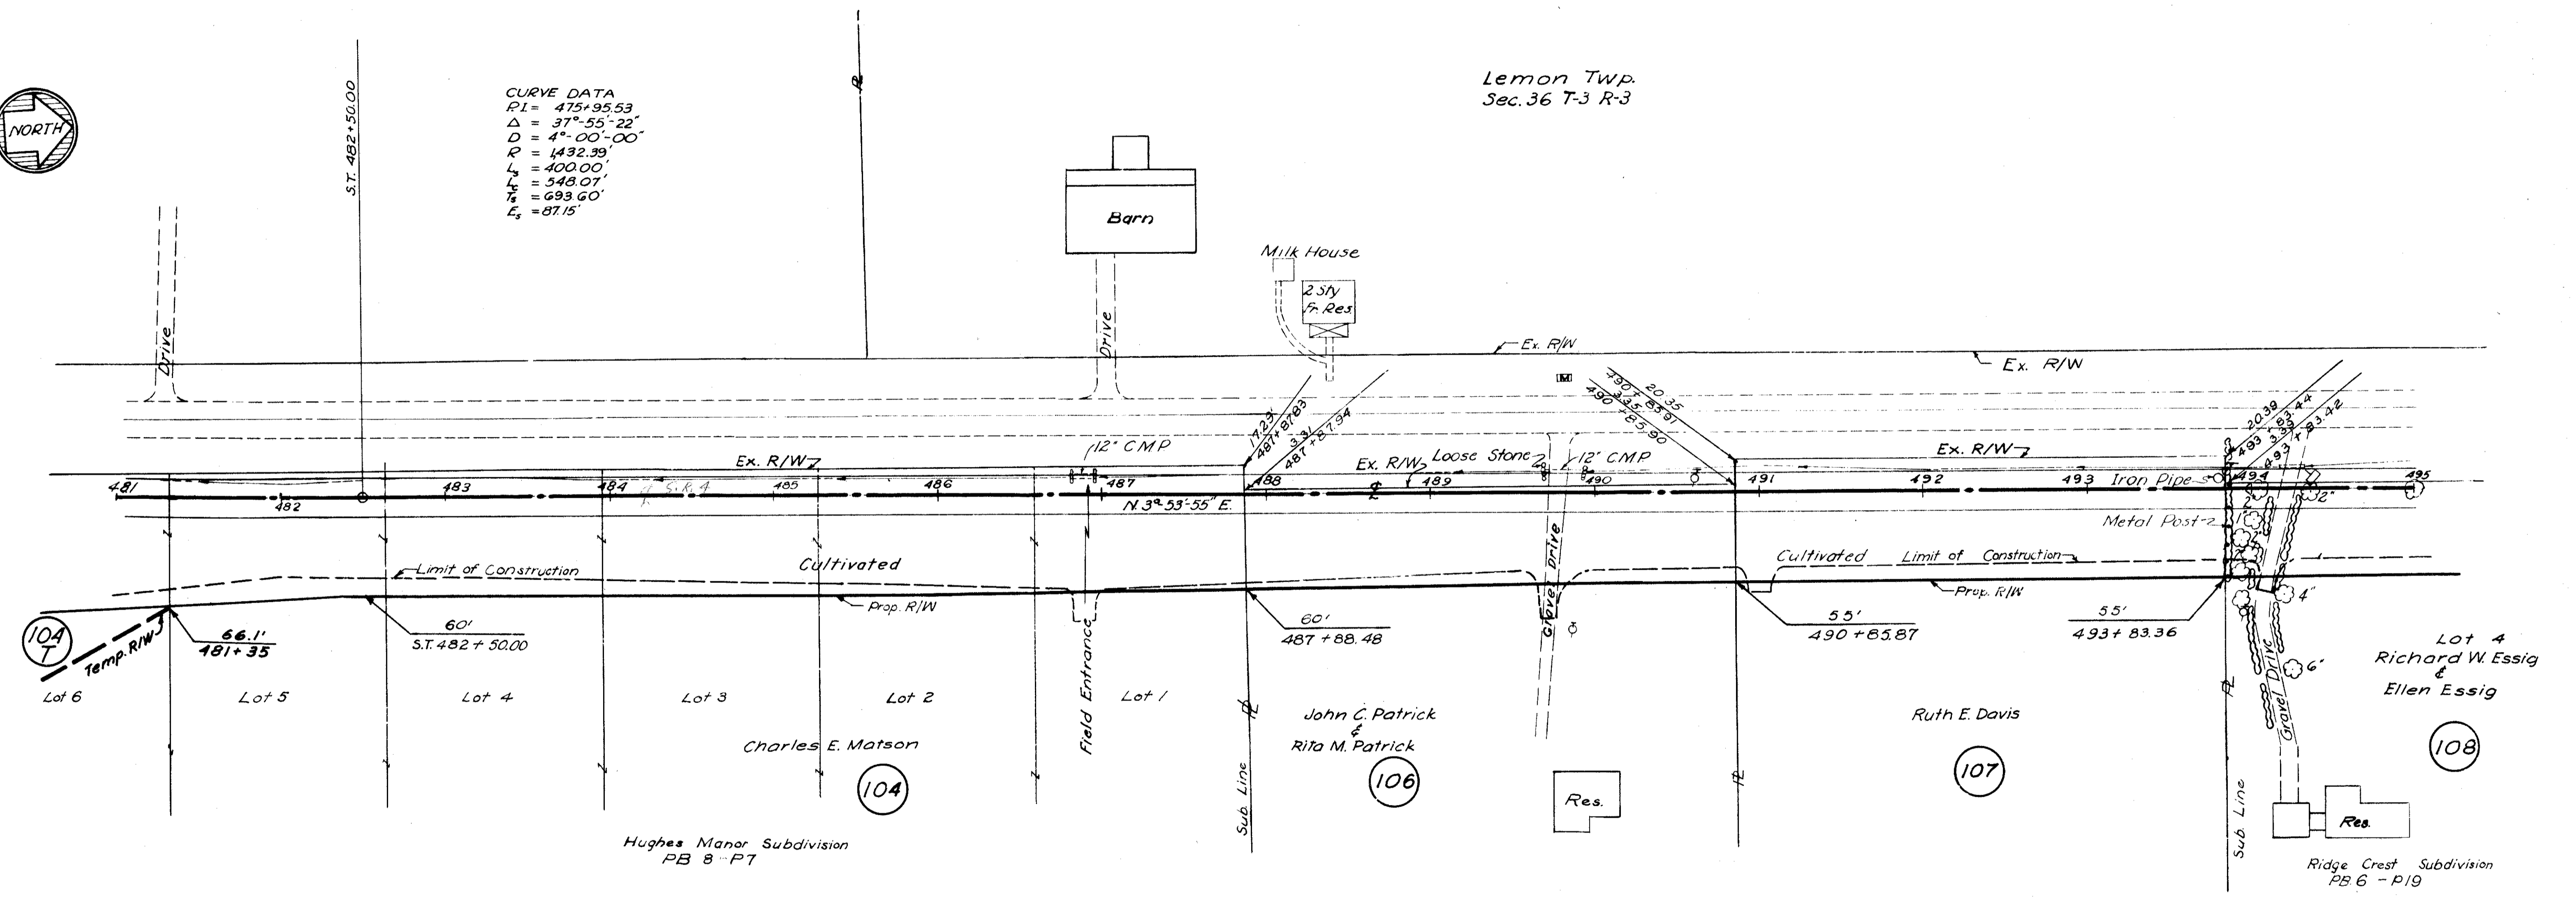



Date	Revision	By

Leimon Twp.  
 Sec. 36 T-3 R-3

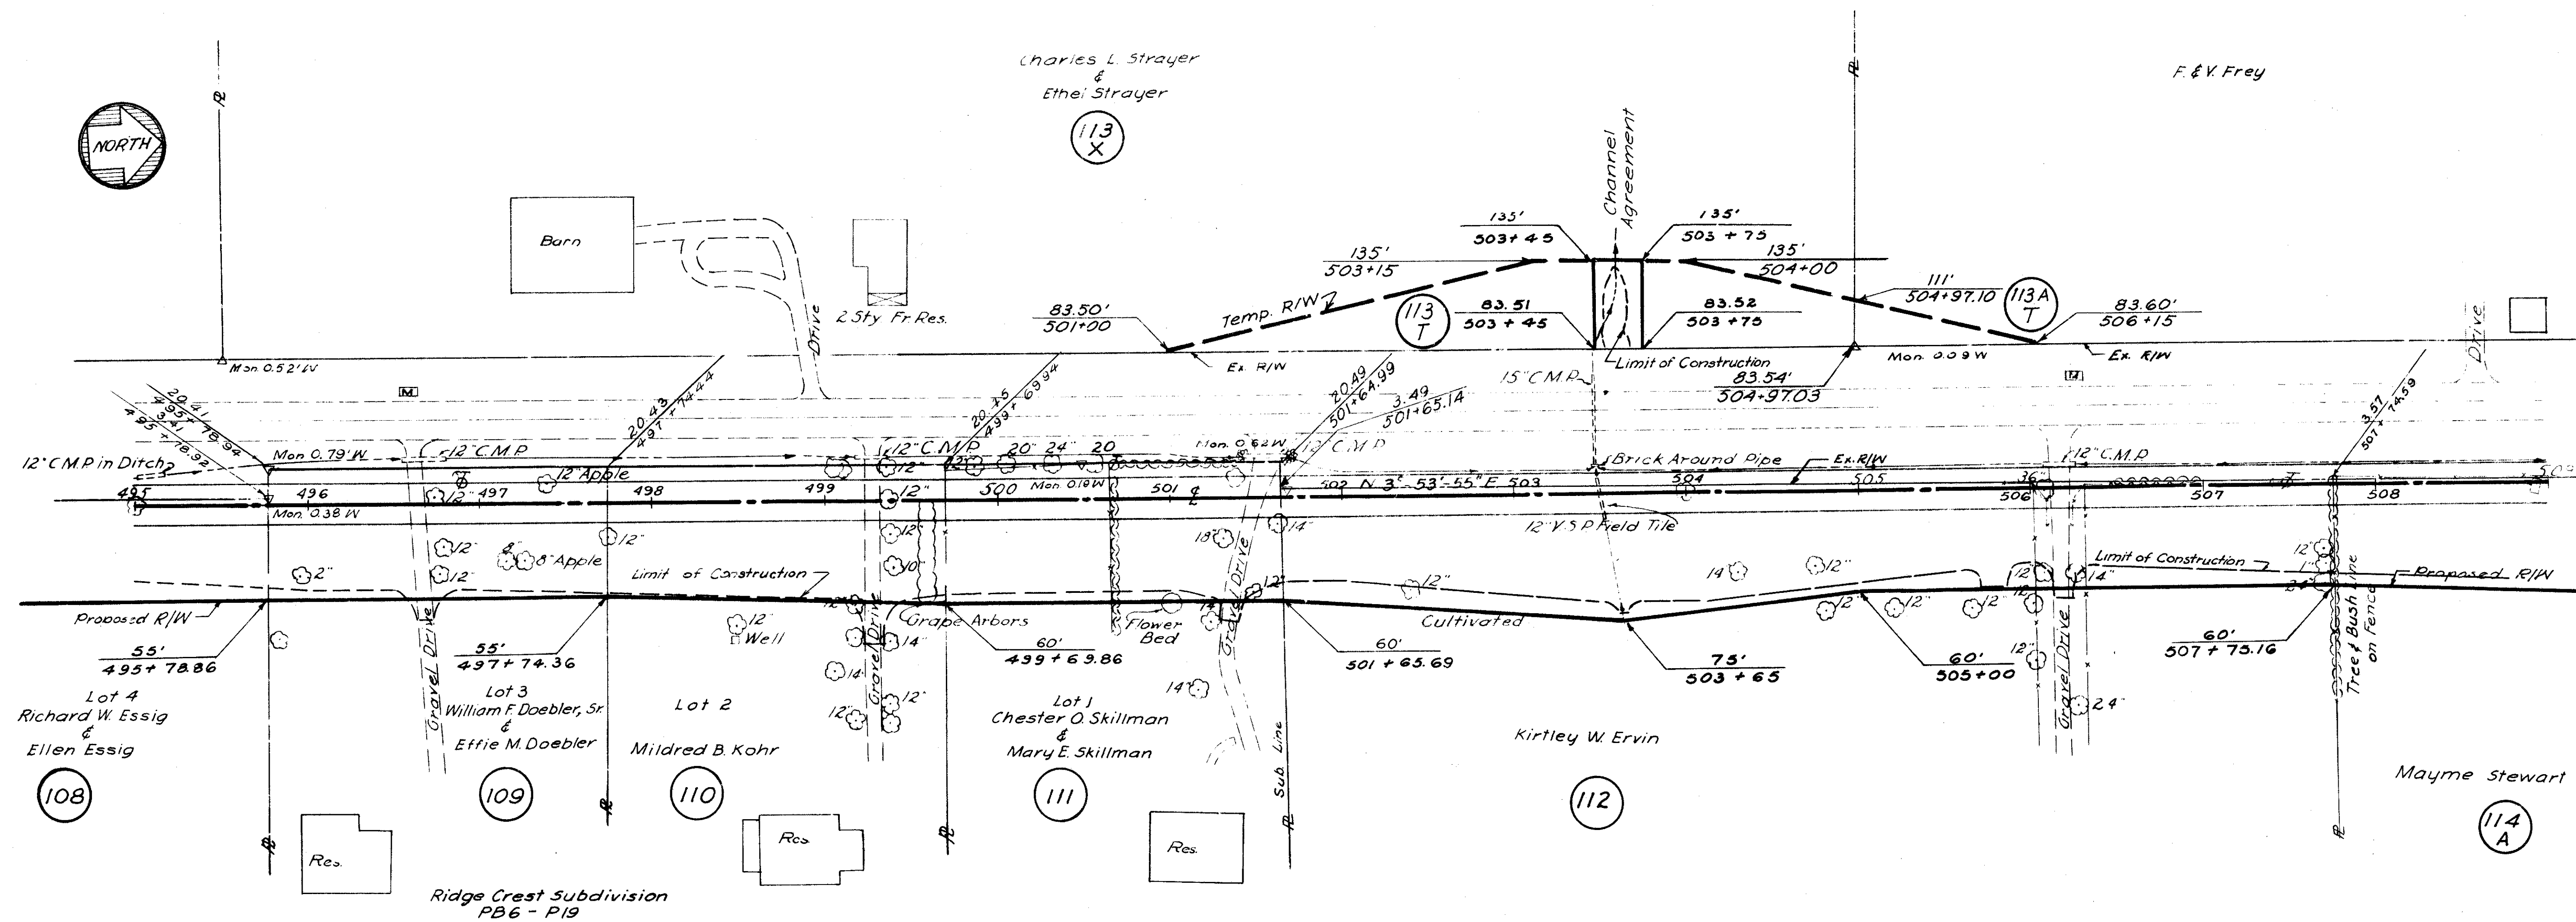


**R/W PLAN**  
**BUTLER COUNTY**  
**BUT-4-(16.53-19.15)**

210  
222

Date	Revision	By

Lemon Twp.  
 Sec. 36 T-3 R-3

Green Ridge Subdivision  
 Section 1

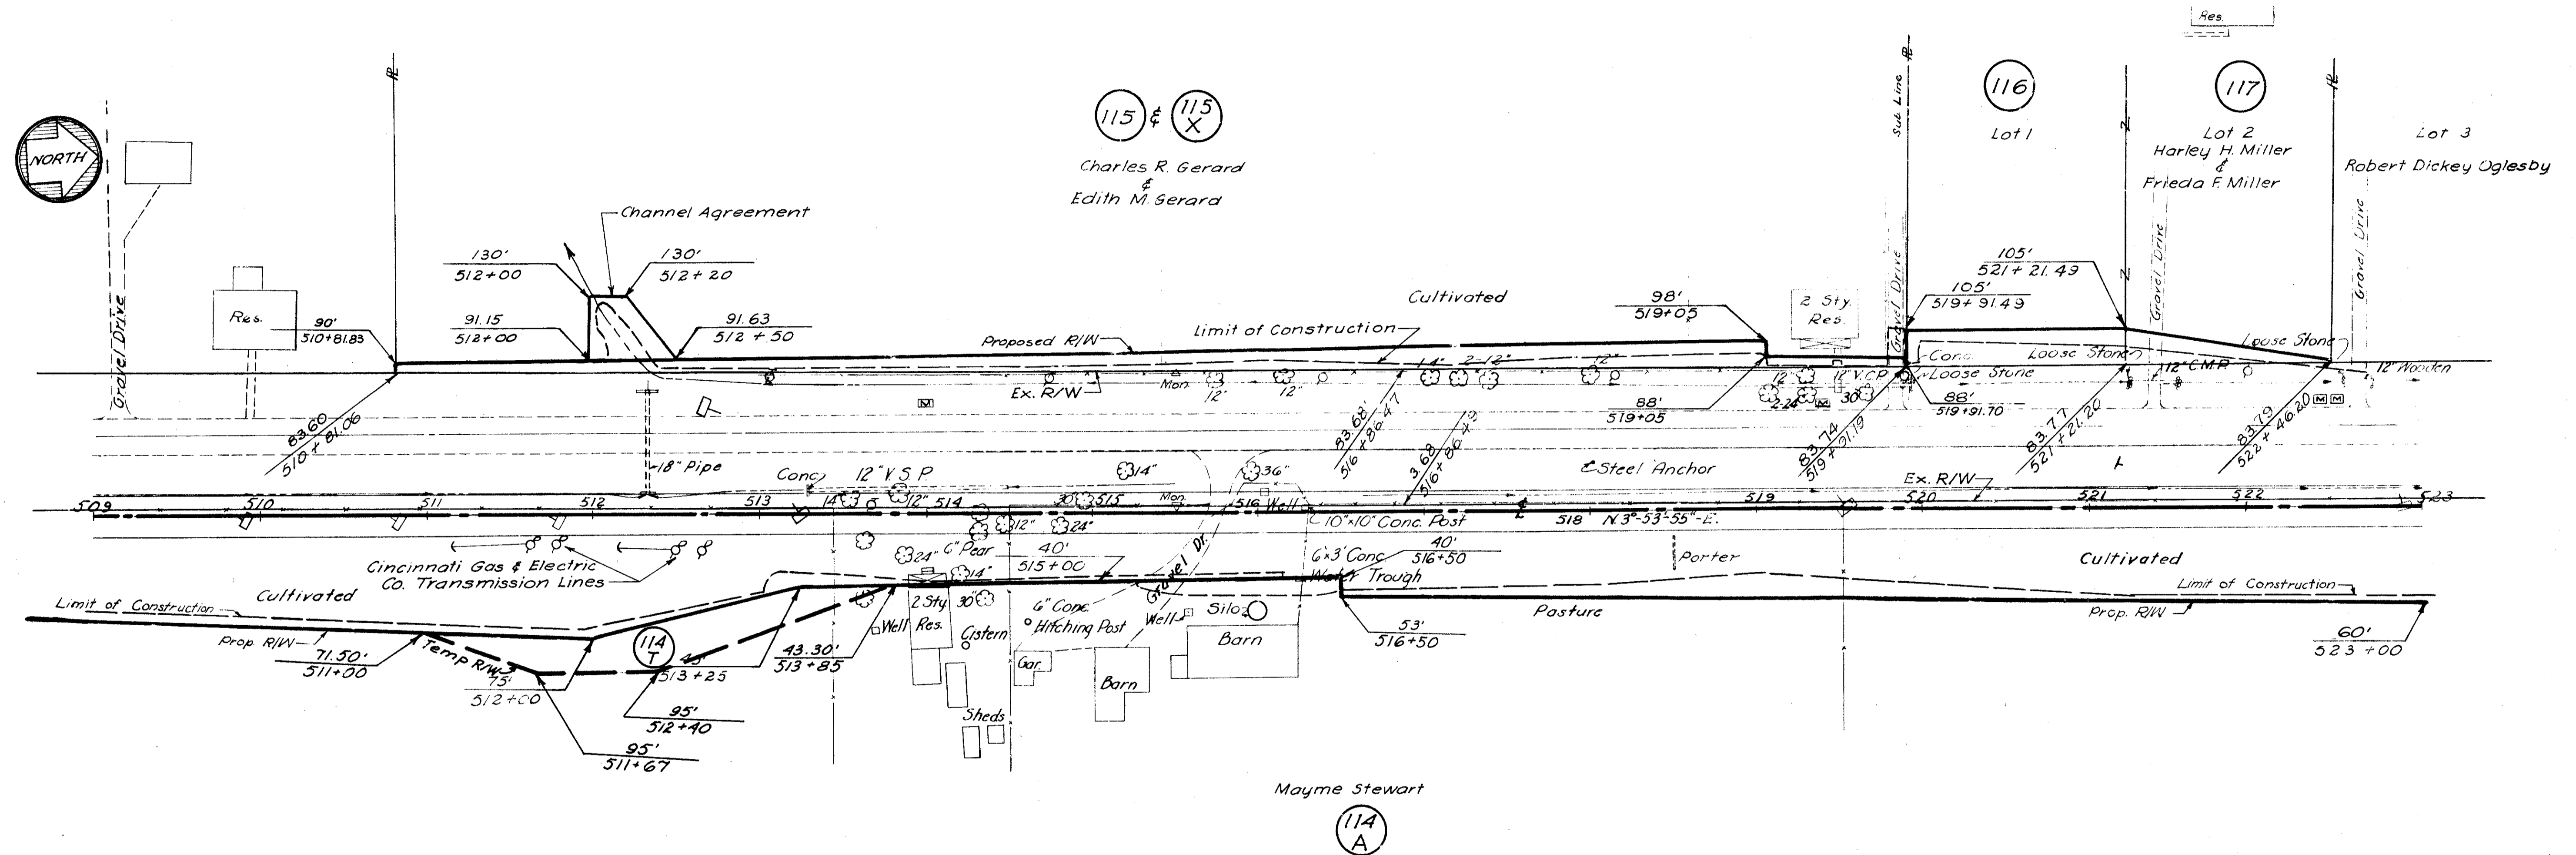


Lemon Twp.  
Sec. 36 T-3 R-3

Lemon Twp.  
Sec. 31 T-2 R-4

**R/W PLAN**  
BUTLER COUNTY  
BUT-4-(16.53-19.15)

211  
222


Date	Revision	By

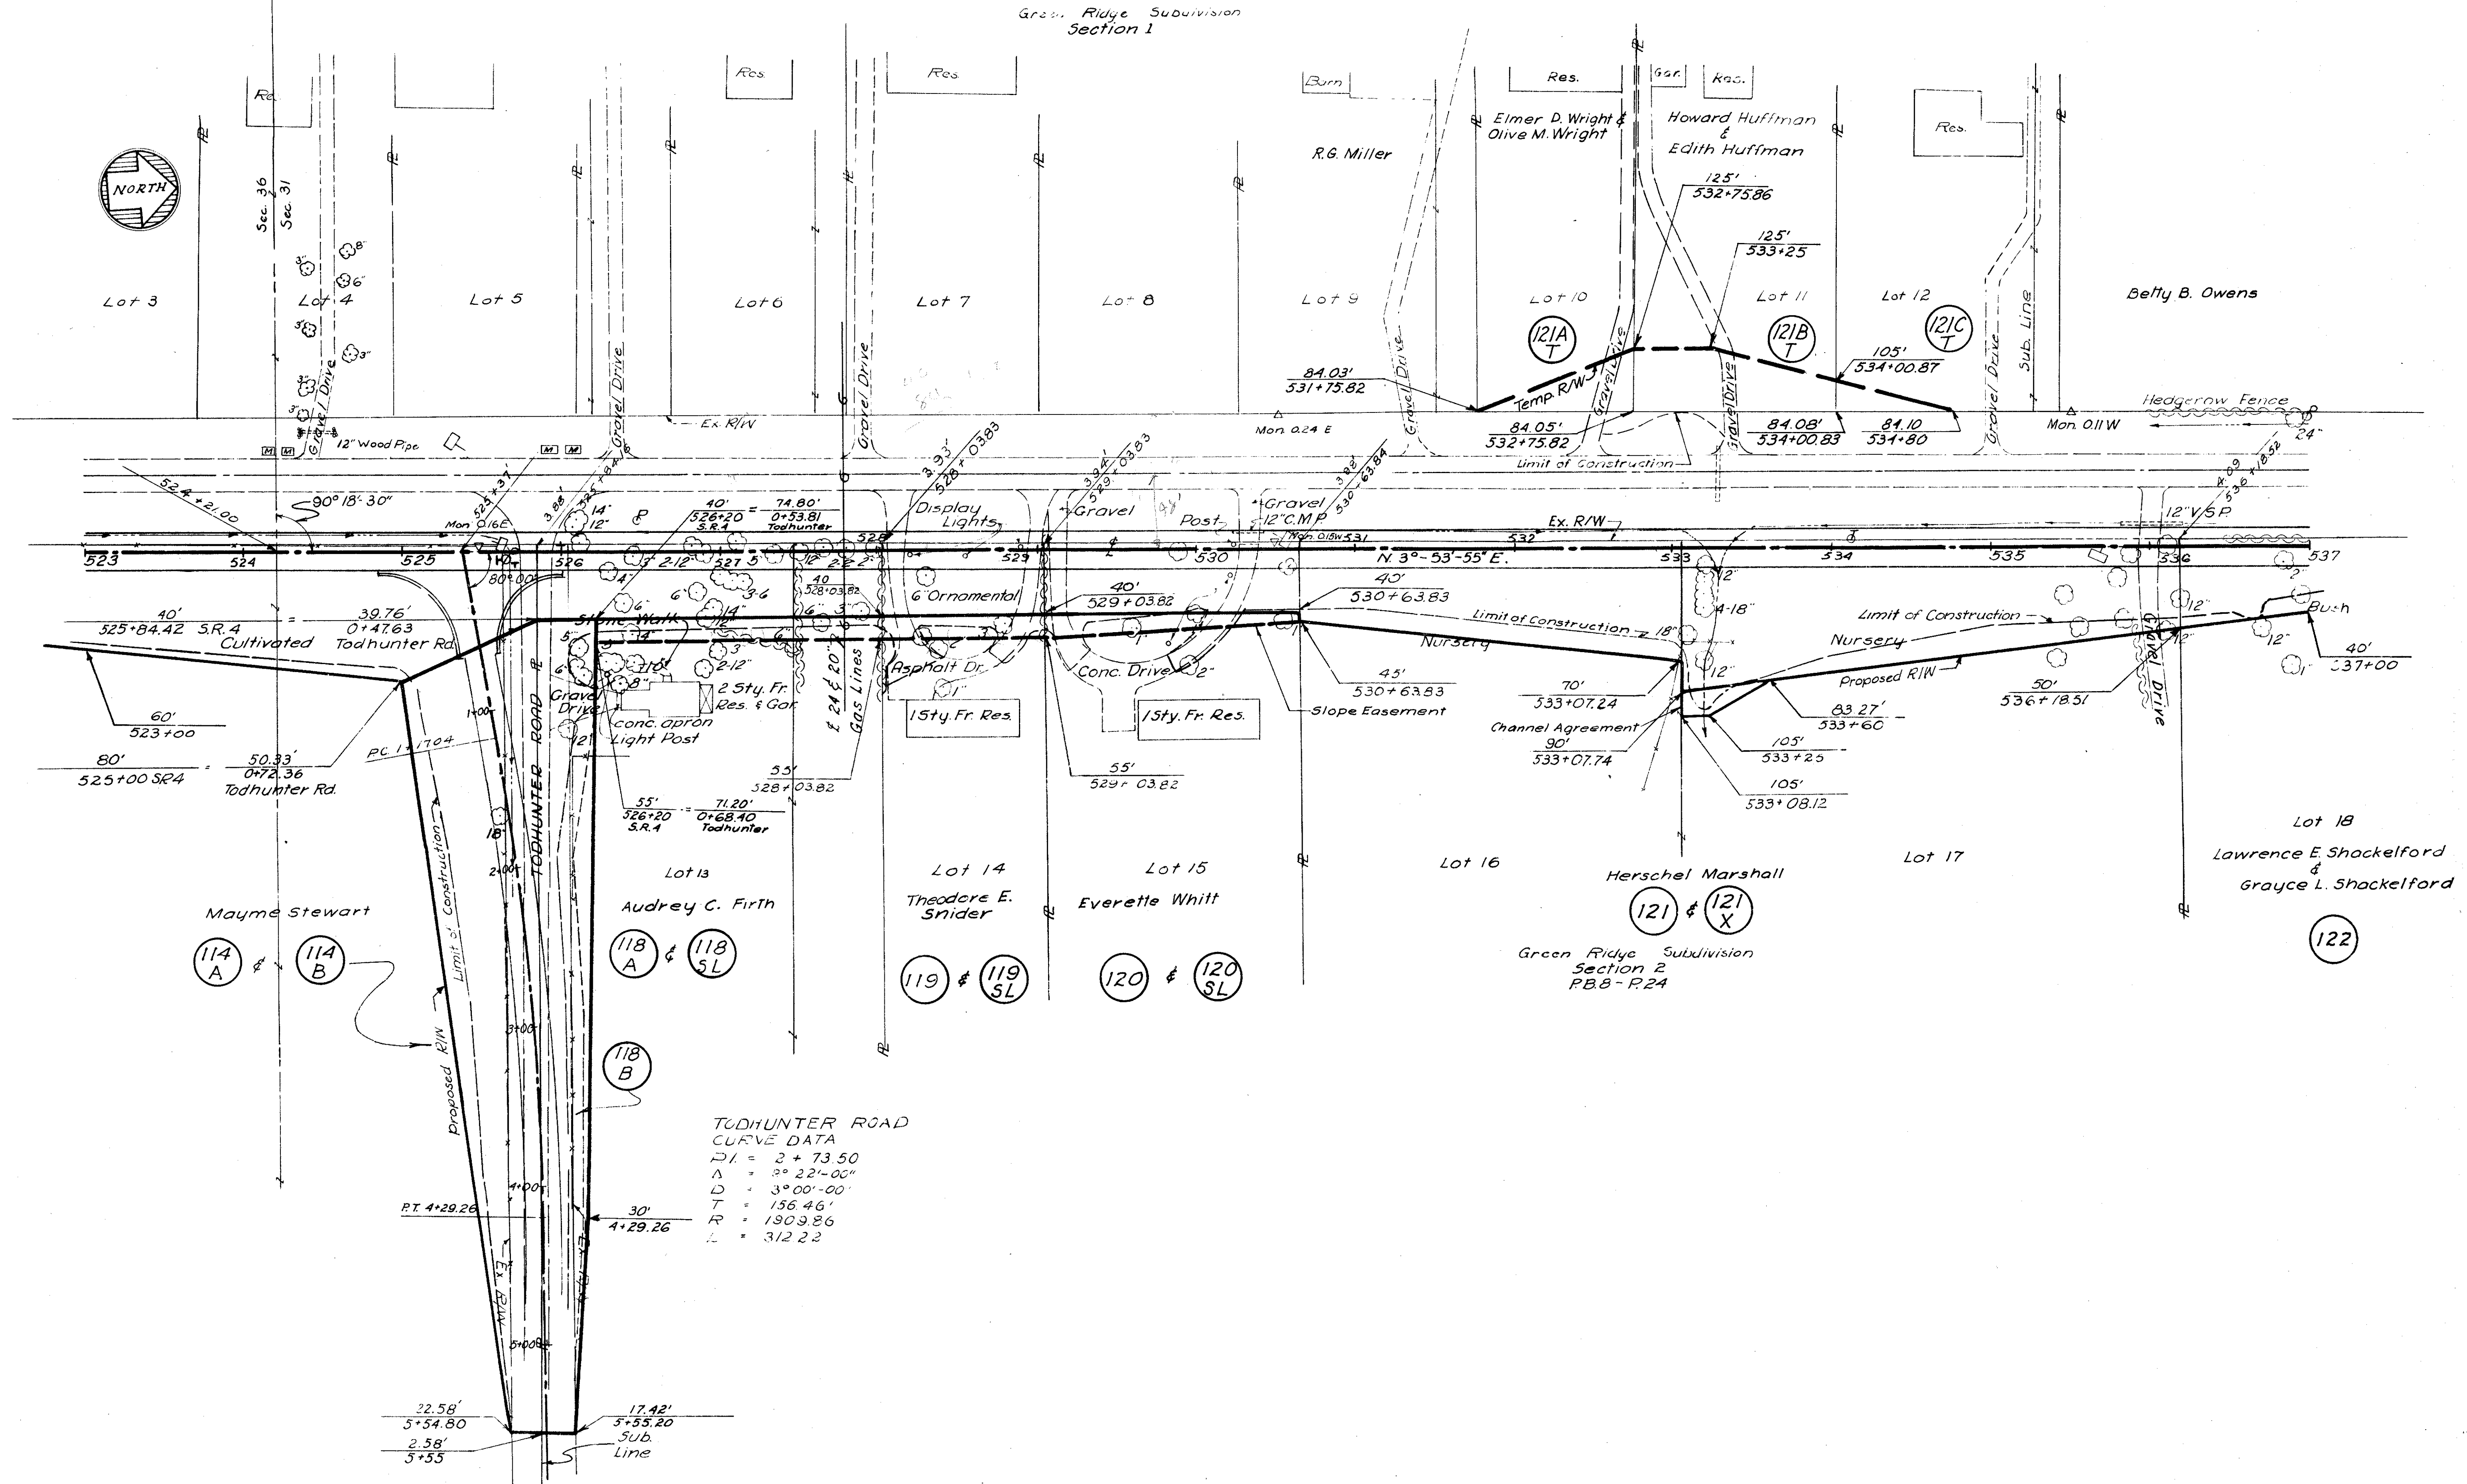

Sta 523+00 to Sta 537+00

Date	Revision	By

Lemon Twp.  
 Sec. 31 T-2 R-4

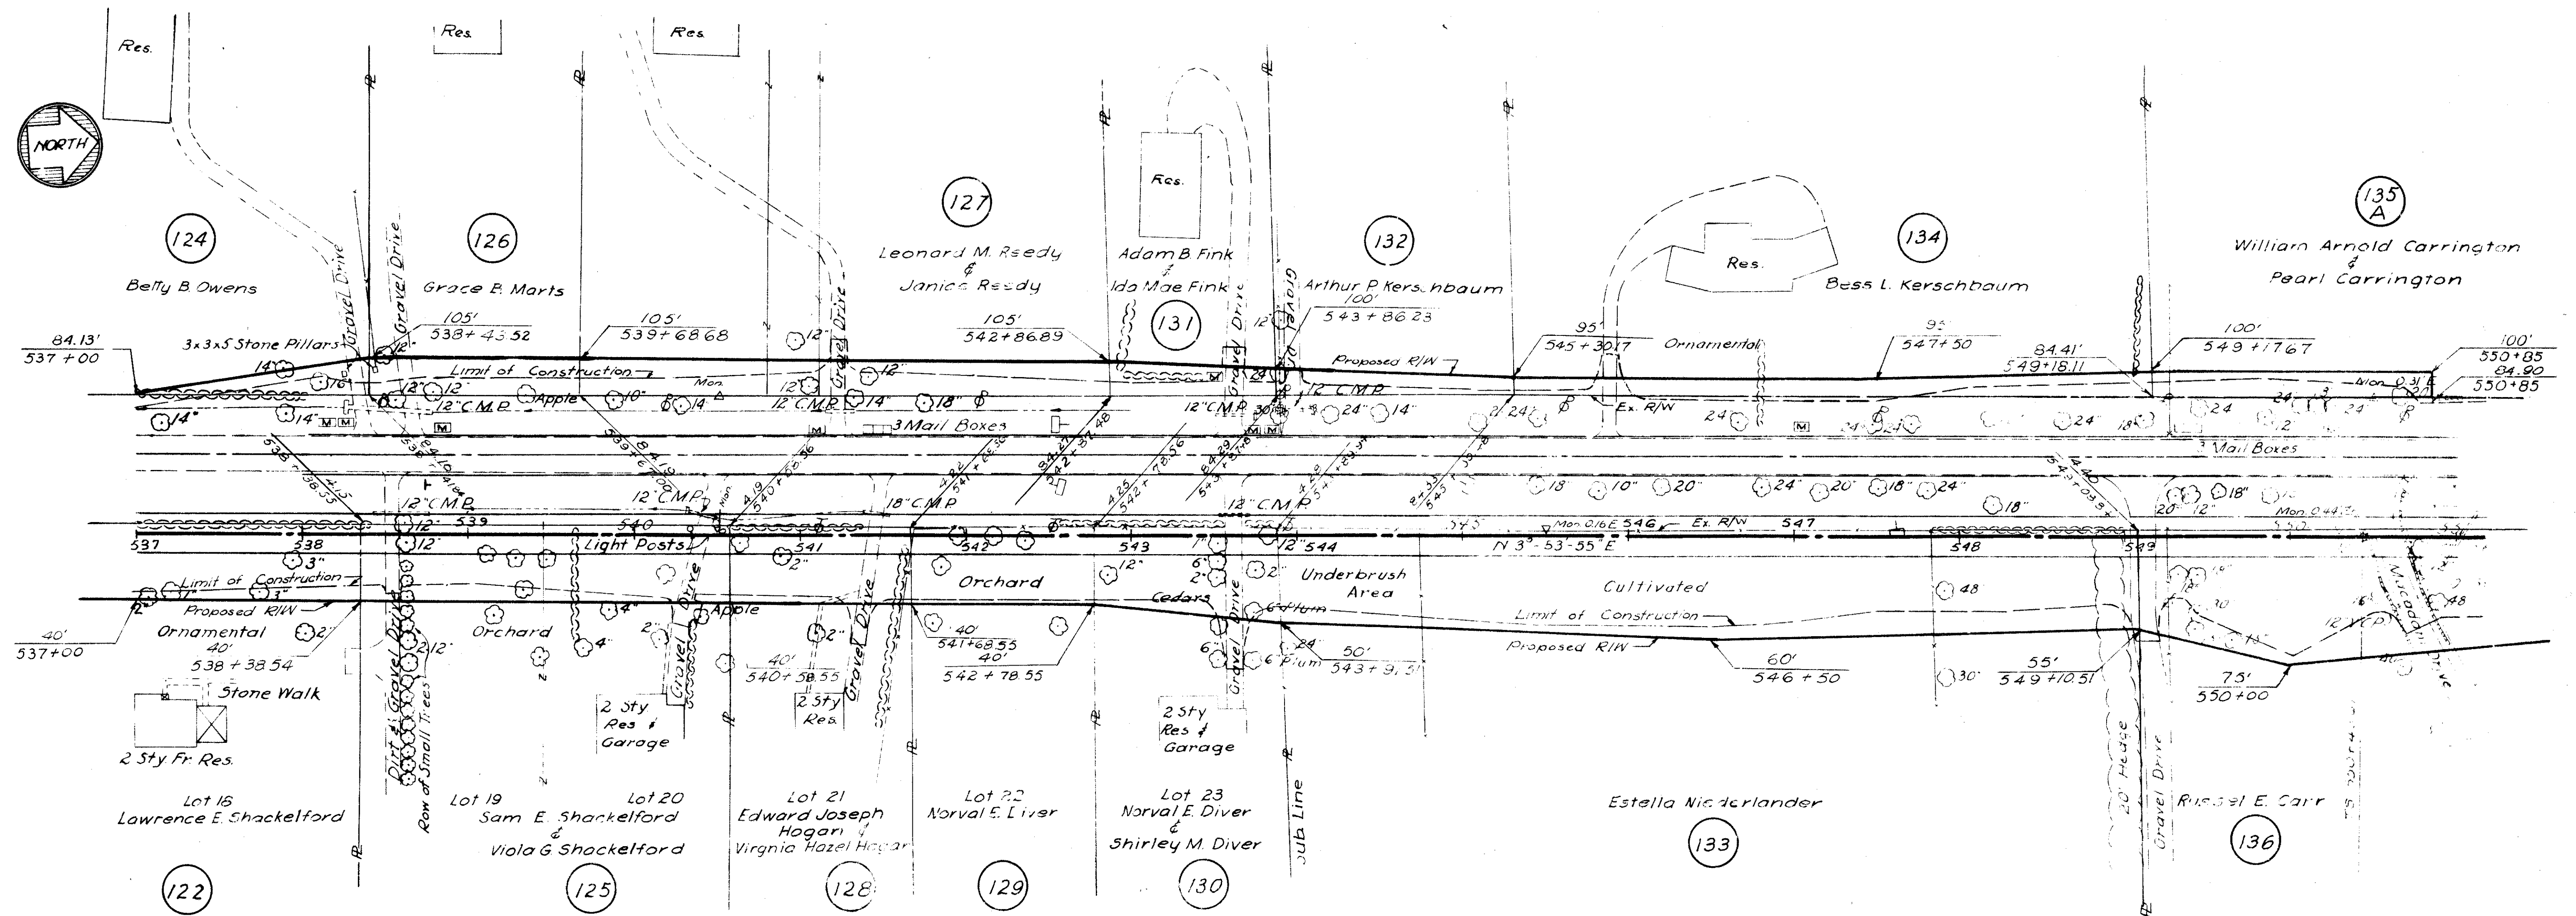

Note: Parcel No. 123 not used

Green Ridge Subdivision  
 Section 2  
 P.B. 8 P. 24


**R/W PLAN**  
**BUTLER COUNTY**  
**BUT-4-(16.53 - 19.15)**

213  
222

Date	Revision	By

**LIMITED ACCESS**

Lemon Twp.  
 Sec. 31 T-2 R-4

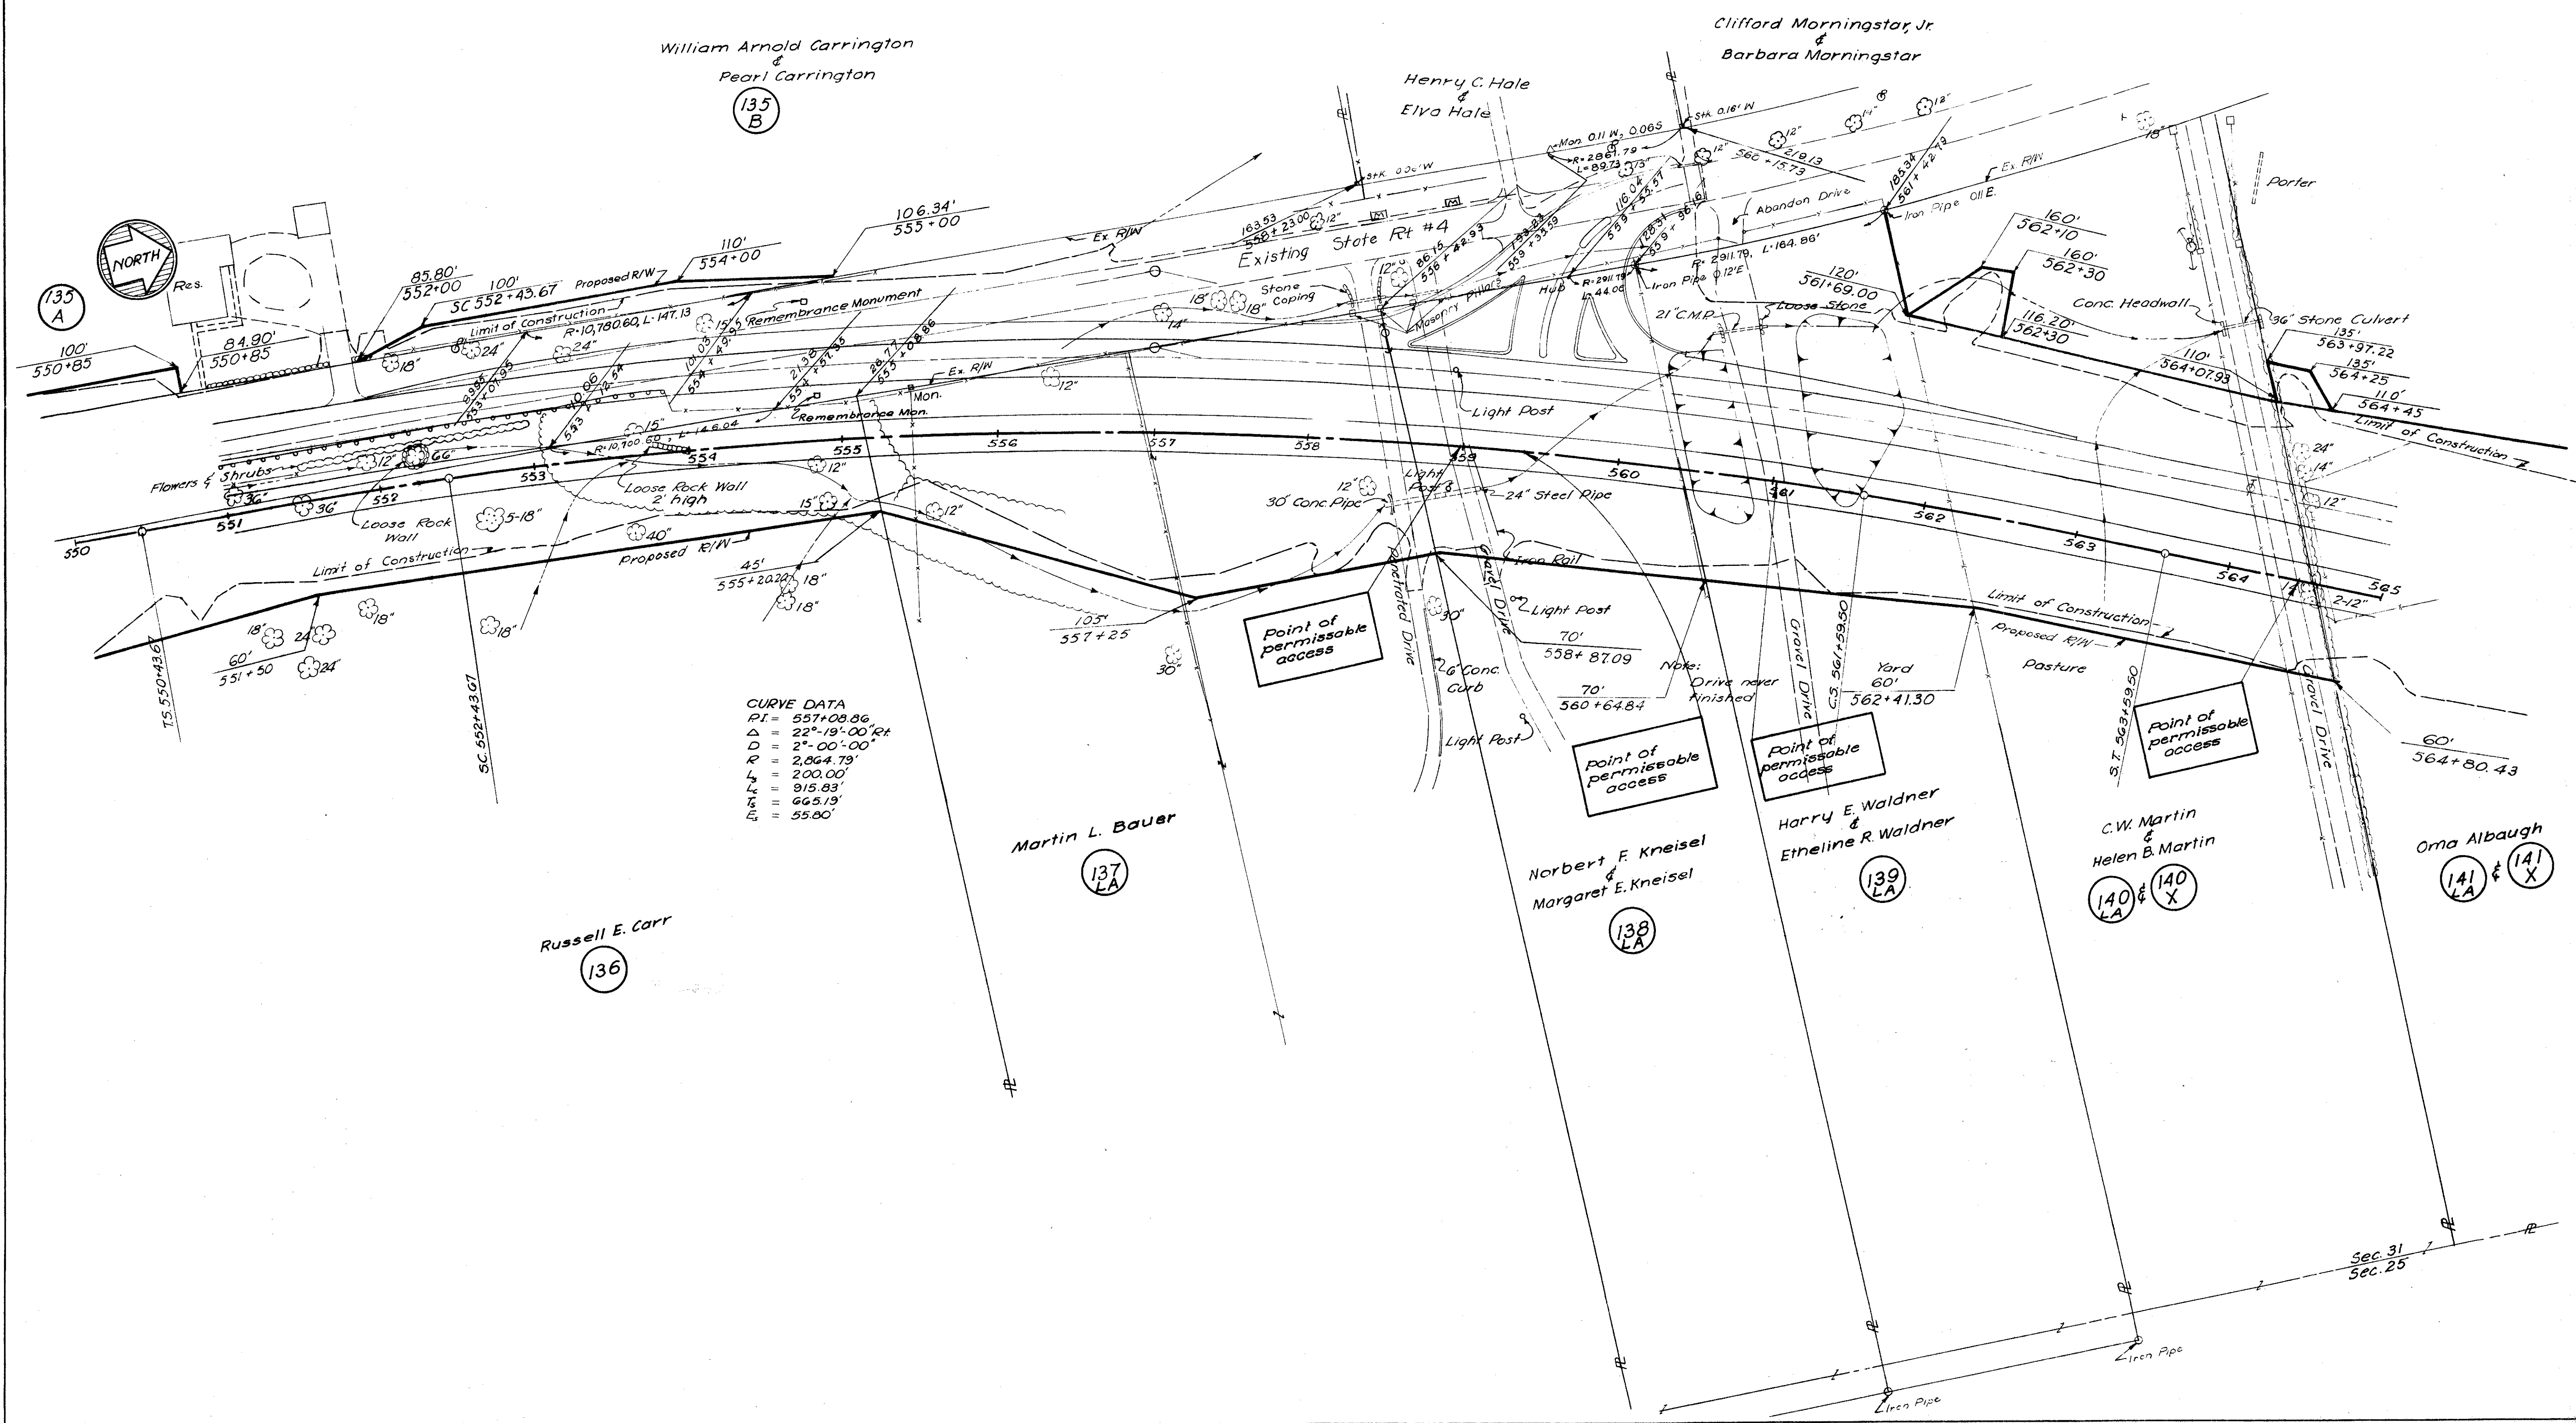

**CURVE DATA**  
 PI = 557+08.86  
 Δ = 22°-19'-00" Rt  
 D = 2"-00'-00"  
 R = 2,864.79'  
 L = 915.83'  
 E = 665.13'  
 E = 55.80'

STA. 551+00 TO STA. 565+00

**R/W PLAN**  
**BUTLER COUNTY**  
**BUT-4-(16.53-19.15)**



214  
222

Date	Revision	By

LIMITED ACCESS

Lemon Twp  
 Sec. 31 T-2 R-4

**CURVE DATA**  
 P.I. = 574 + 52.44 N.B.  
 $\Delta = 23^{\circ} 10' 10''$  L\*  
 D = 2" - 00' - 00"  
 R = 2864.79  
 L<sub>s</sub> = 200.00'  
 L<sub>c</sub> = 558.33'  
 T<sub>s</sub> = 687.31'  
 E<sub>s</sub> = 60.15'

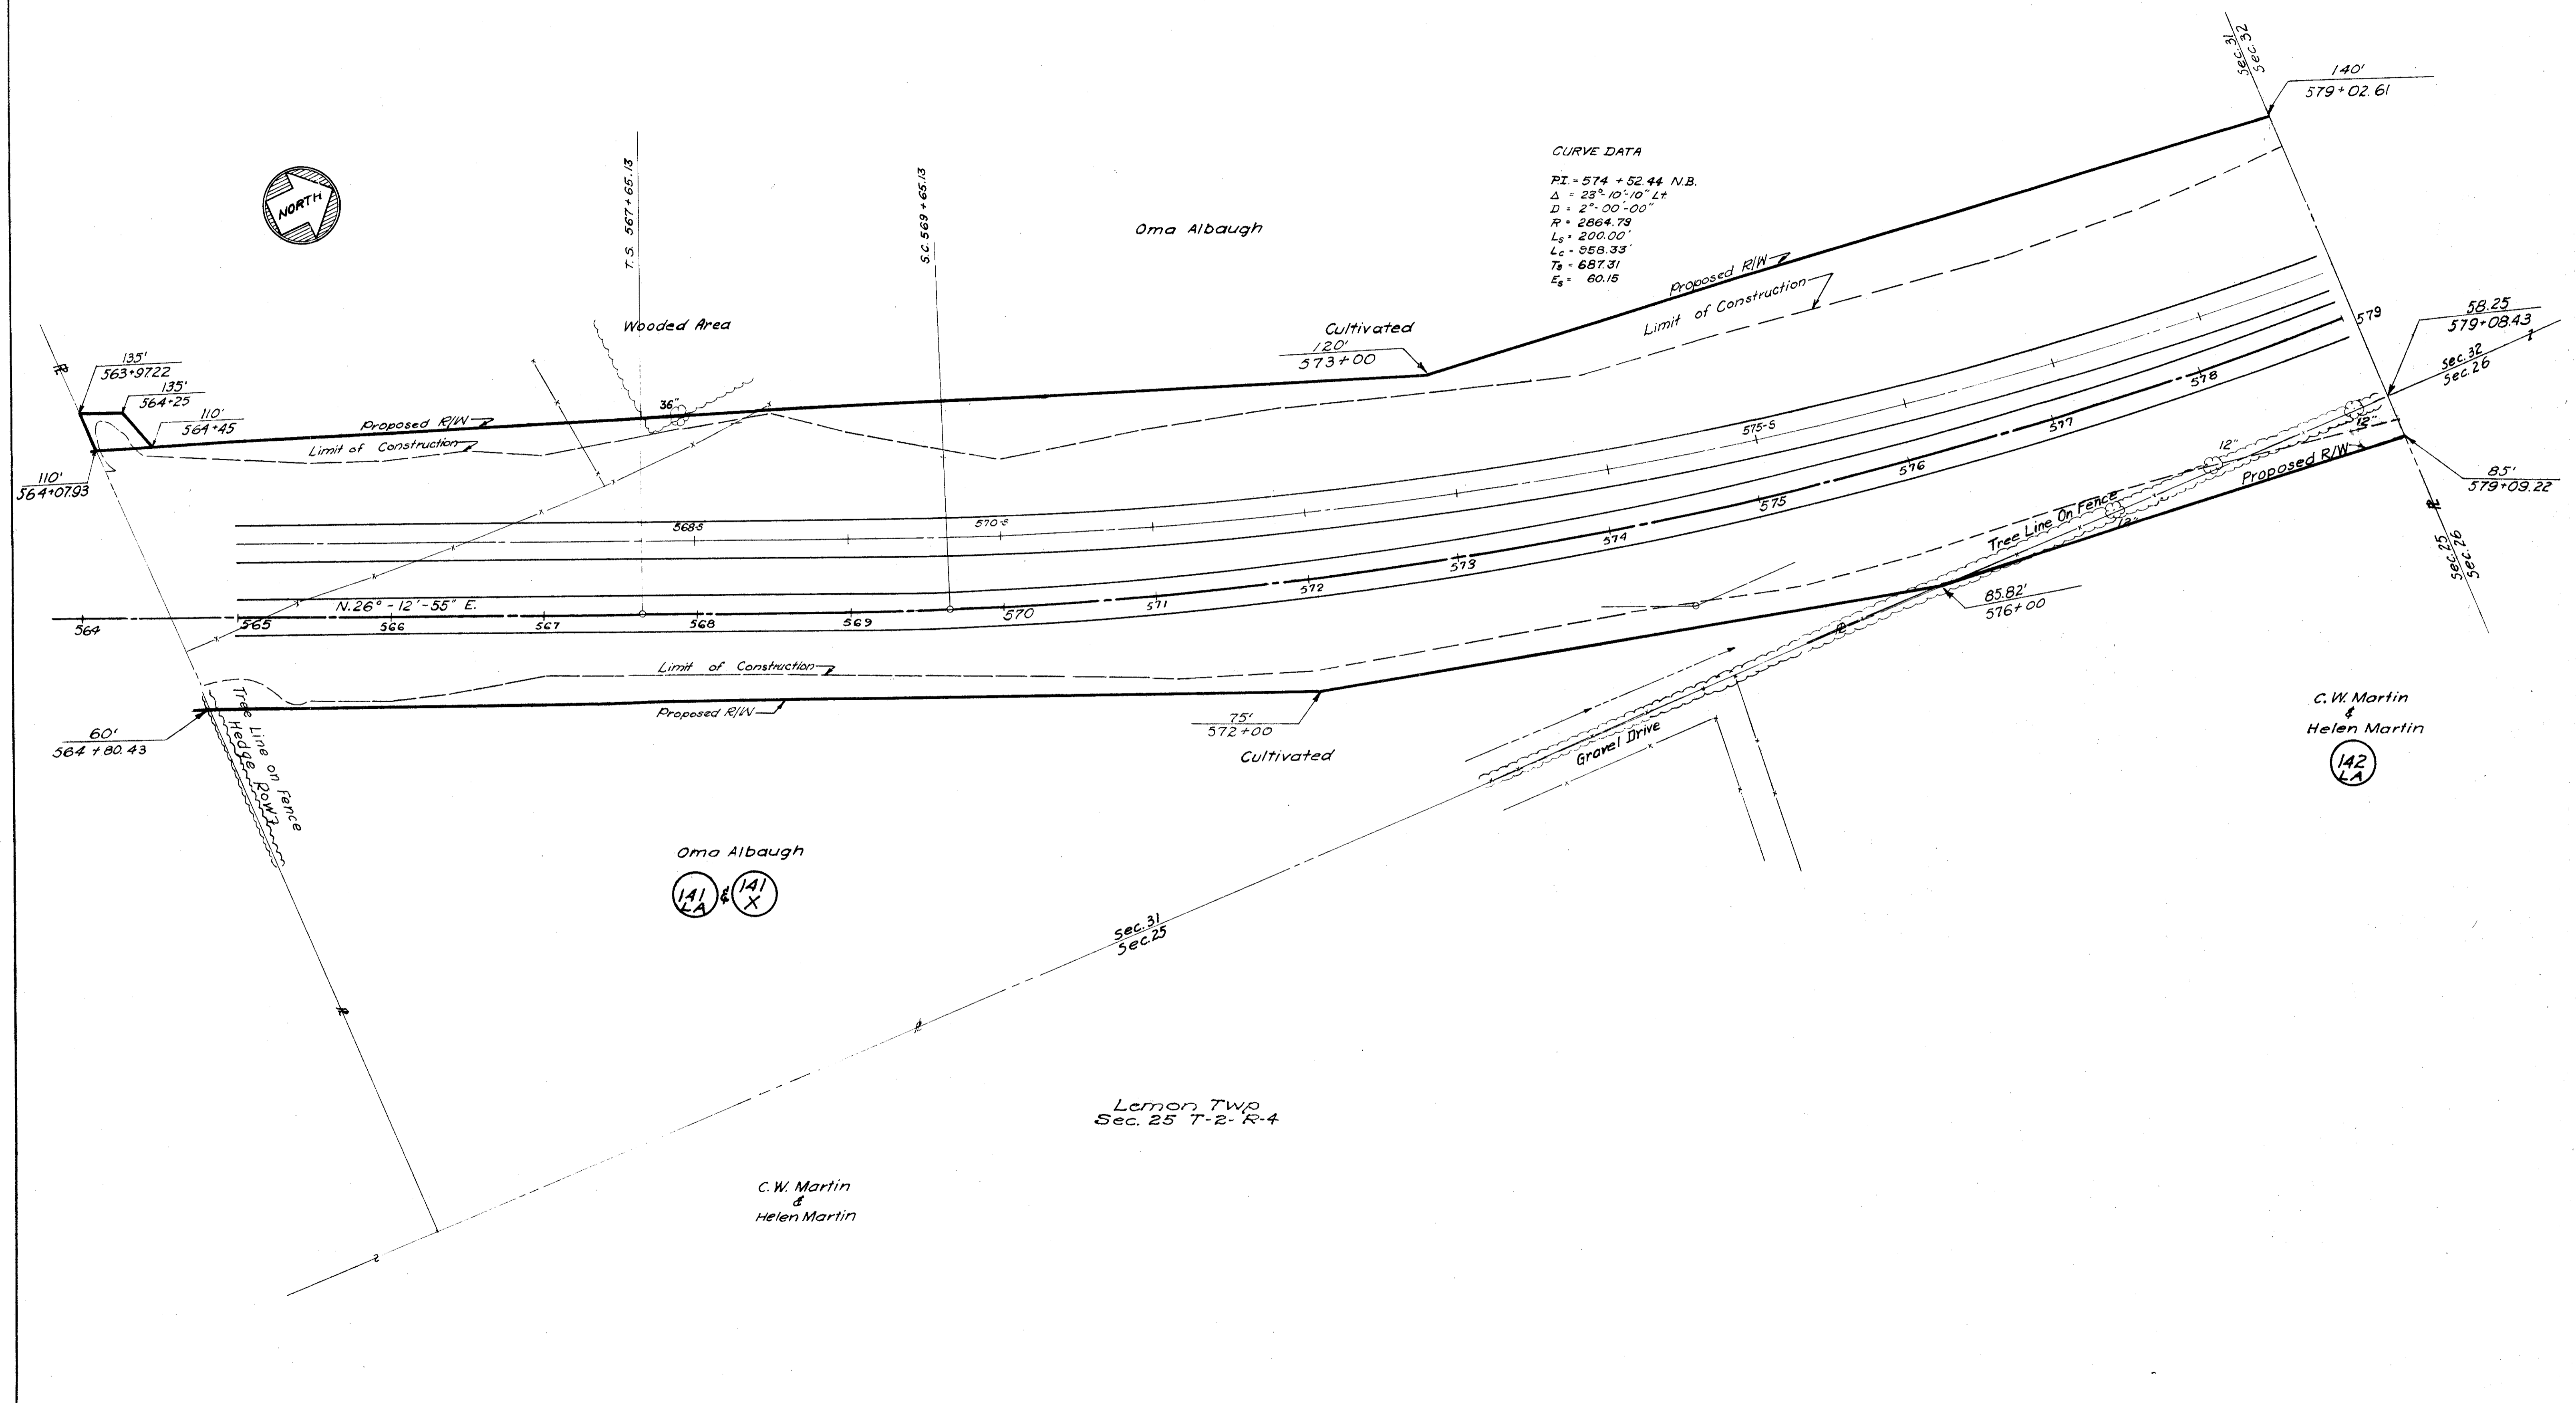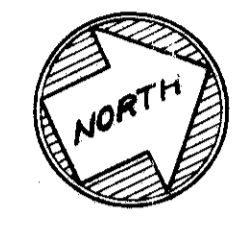

Oma Albaugh

(141) LA (141) X

Lemon Twp  
 Sec. 25 T-2- R-4

C. W. Martin  
 &  
 Helen Martin

C. W. Martin  
 &  
 Helen Martin

(142) LA

Lemon Twp.  
Sec. 32 T-2 R-4

R/W PLAN  
BUTLER COUNTY  
BUT-4-(16.53-19.15)

215  
222

Date	Revision	By

LIMITED ACCESS

Mary Gordon



Engleside Acres Subdivision  
PB 6 P19

The Crystal Tissue Company

The Harding Jones Paper Company

Miami and Erie Canal

The Baltimore & Ohio Railroad Company

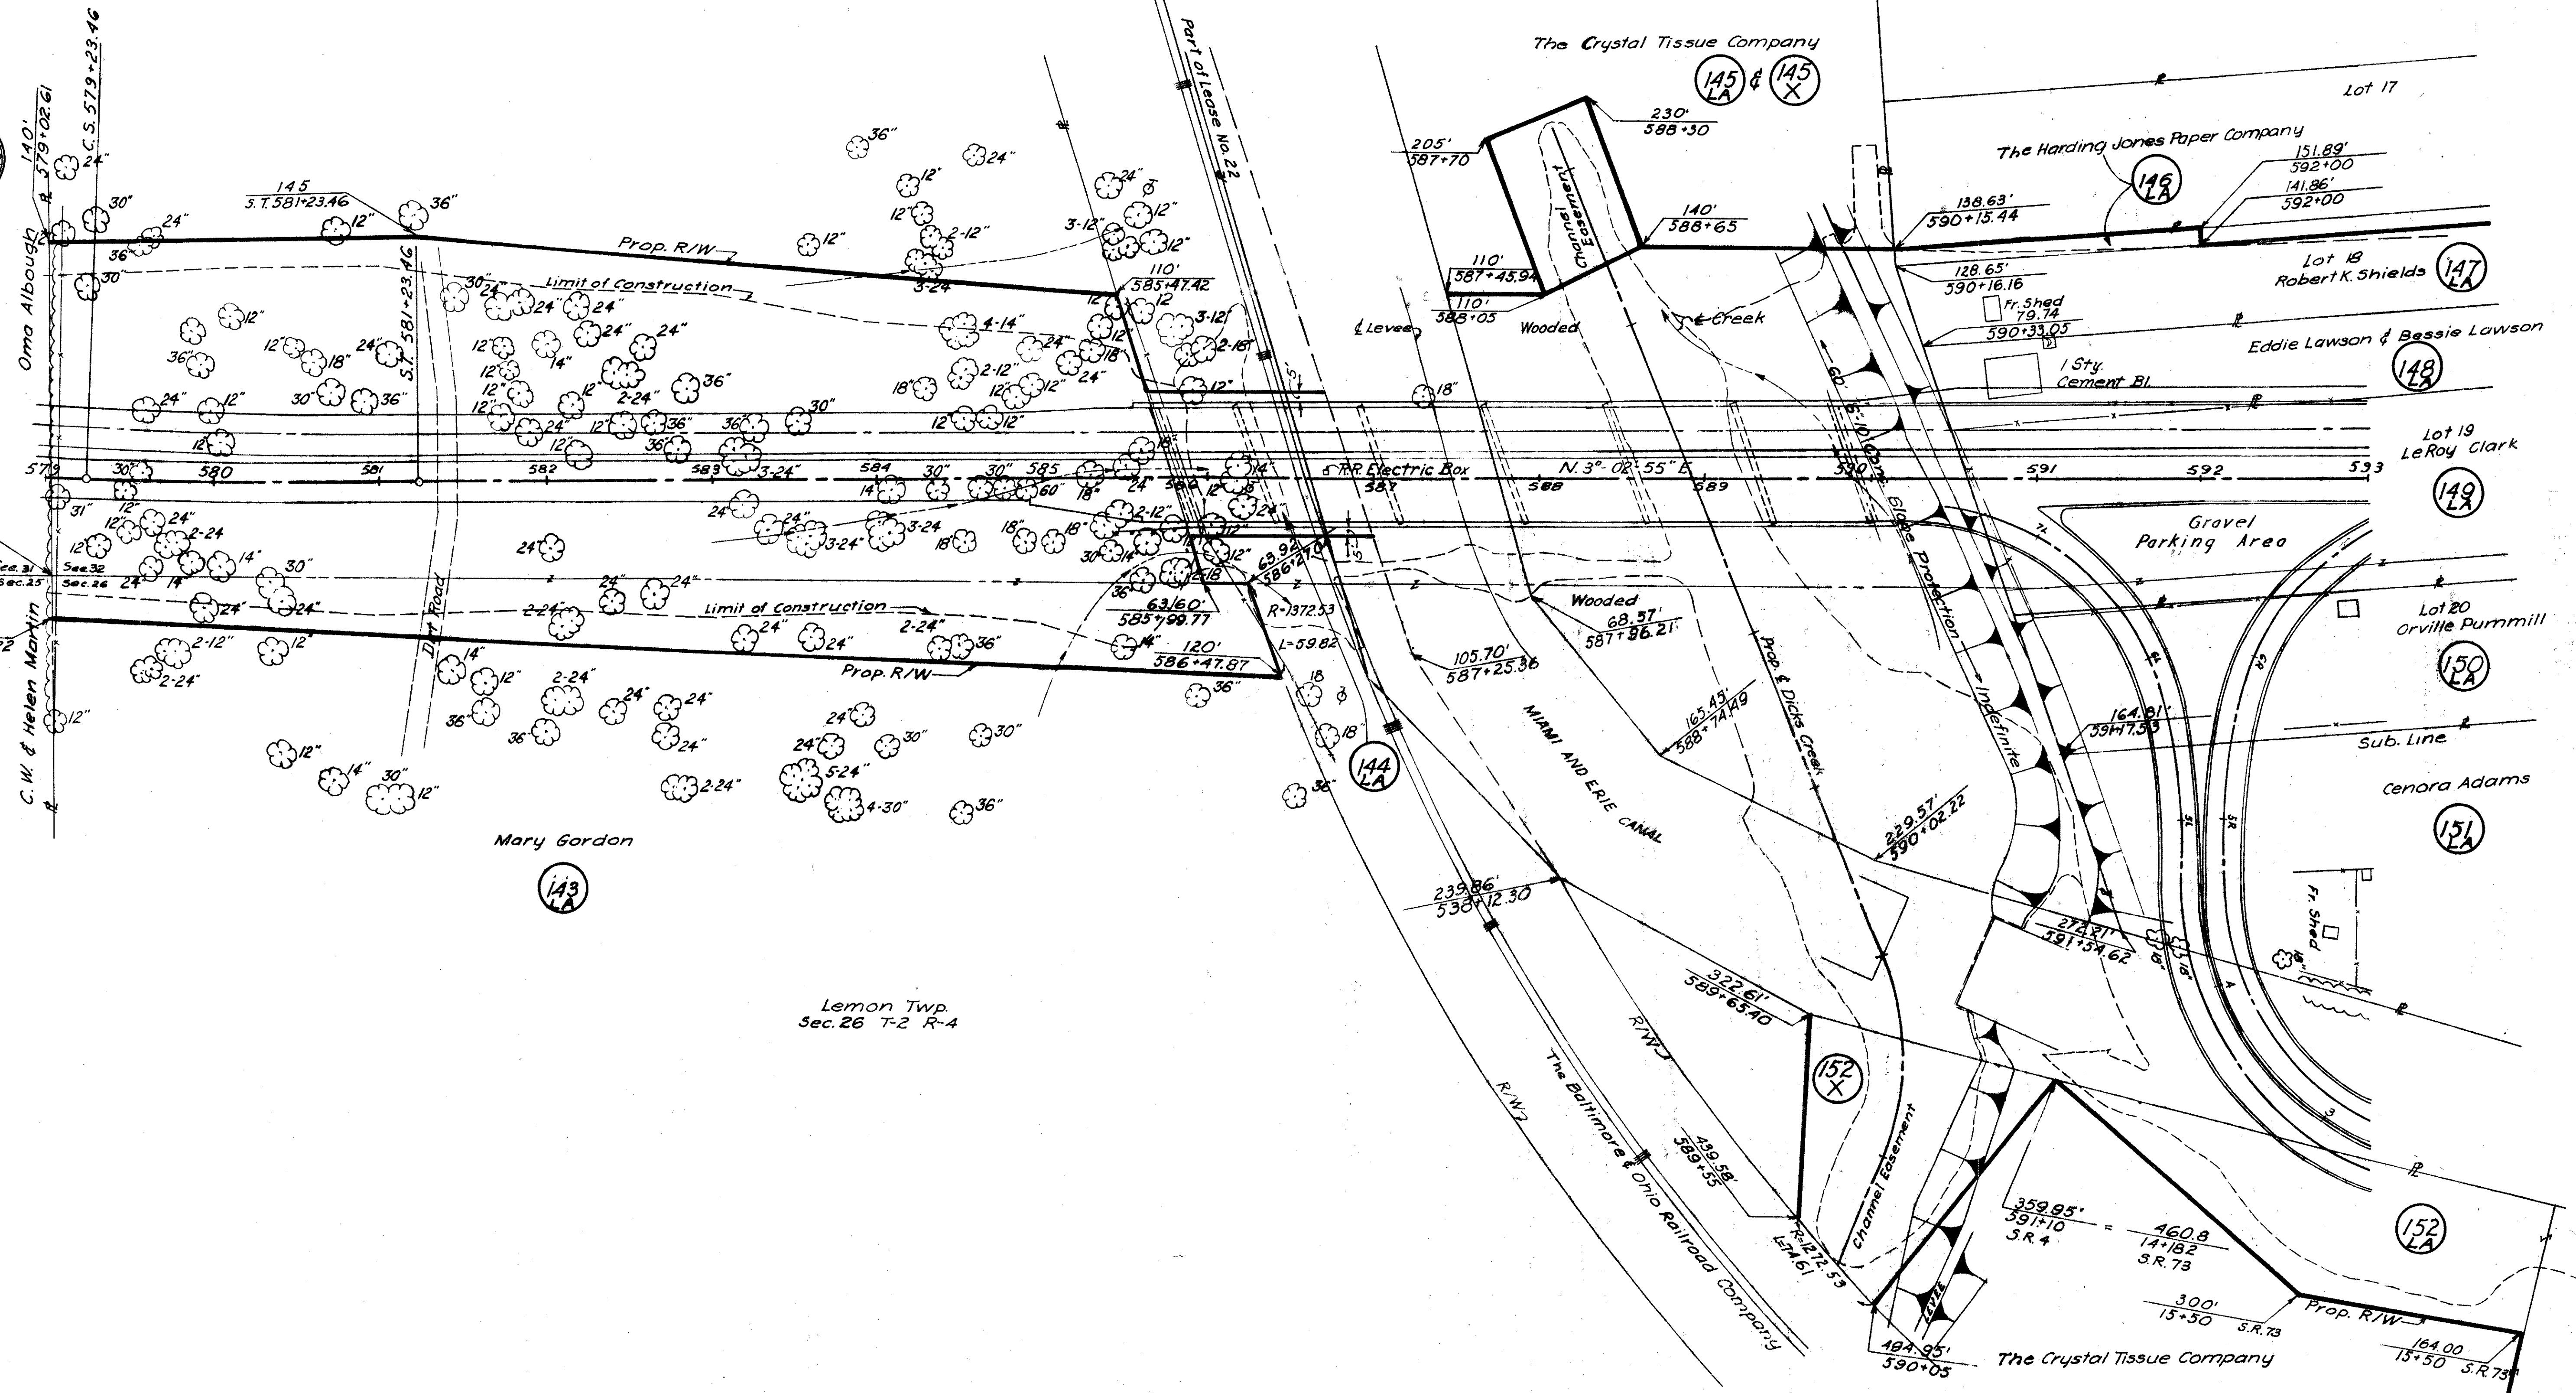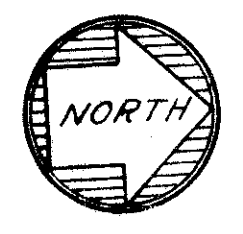

Lemon Twp.  
Sec. 26 T-2 R-4

STA. 579+00 TO STA. 593+00


**R/W PLAN**  
**BUTLER COUNTY**  
**BUT-4-(16.53-19.15)**

Date	Revision	By

216  
222

LIMITED ACCESS

For Proposed R/W in this area, See Sheet # 217  
 Sta. 593+00 to Sta. 607+00 (West)

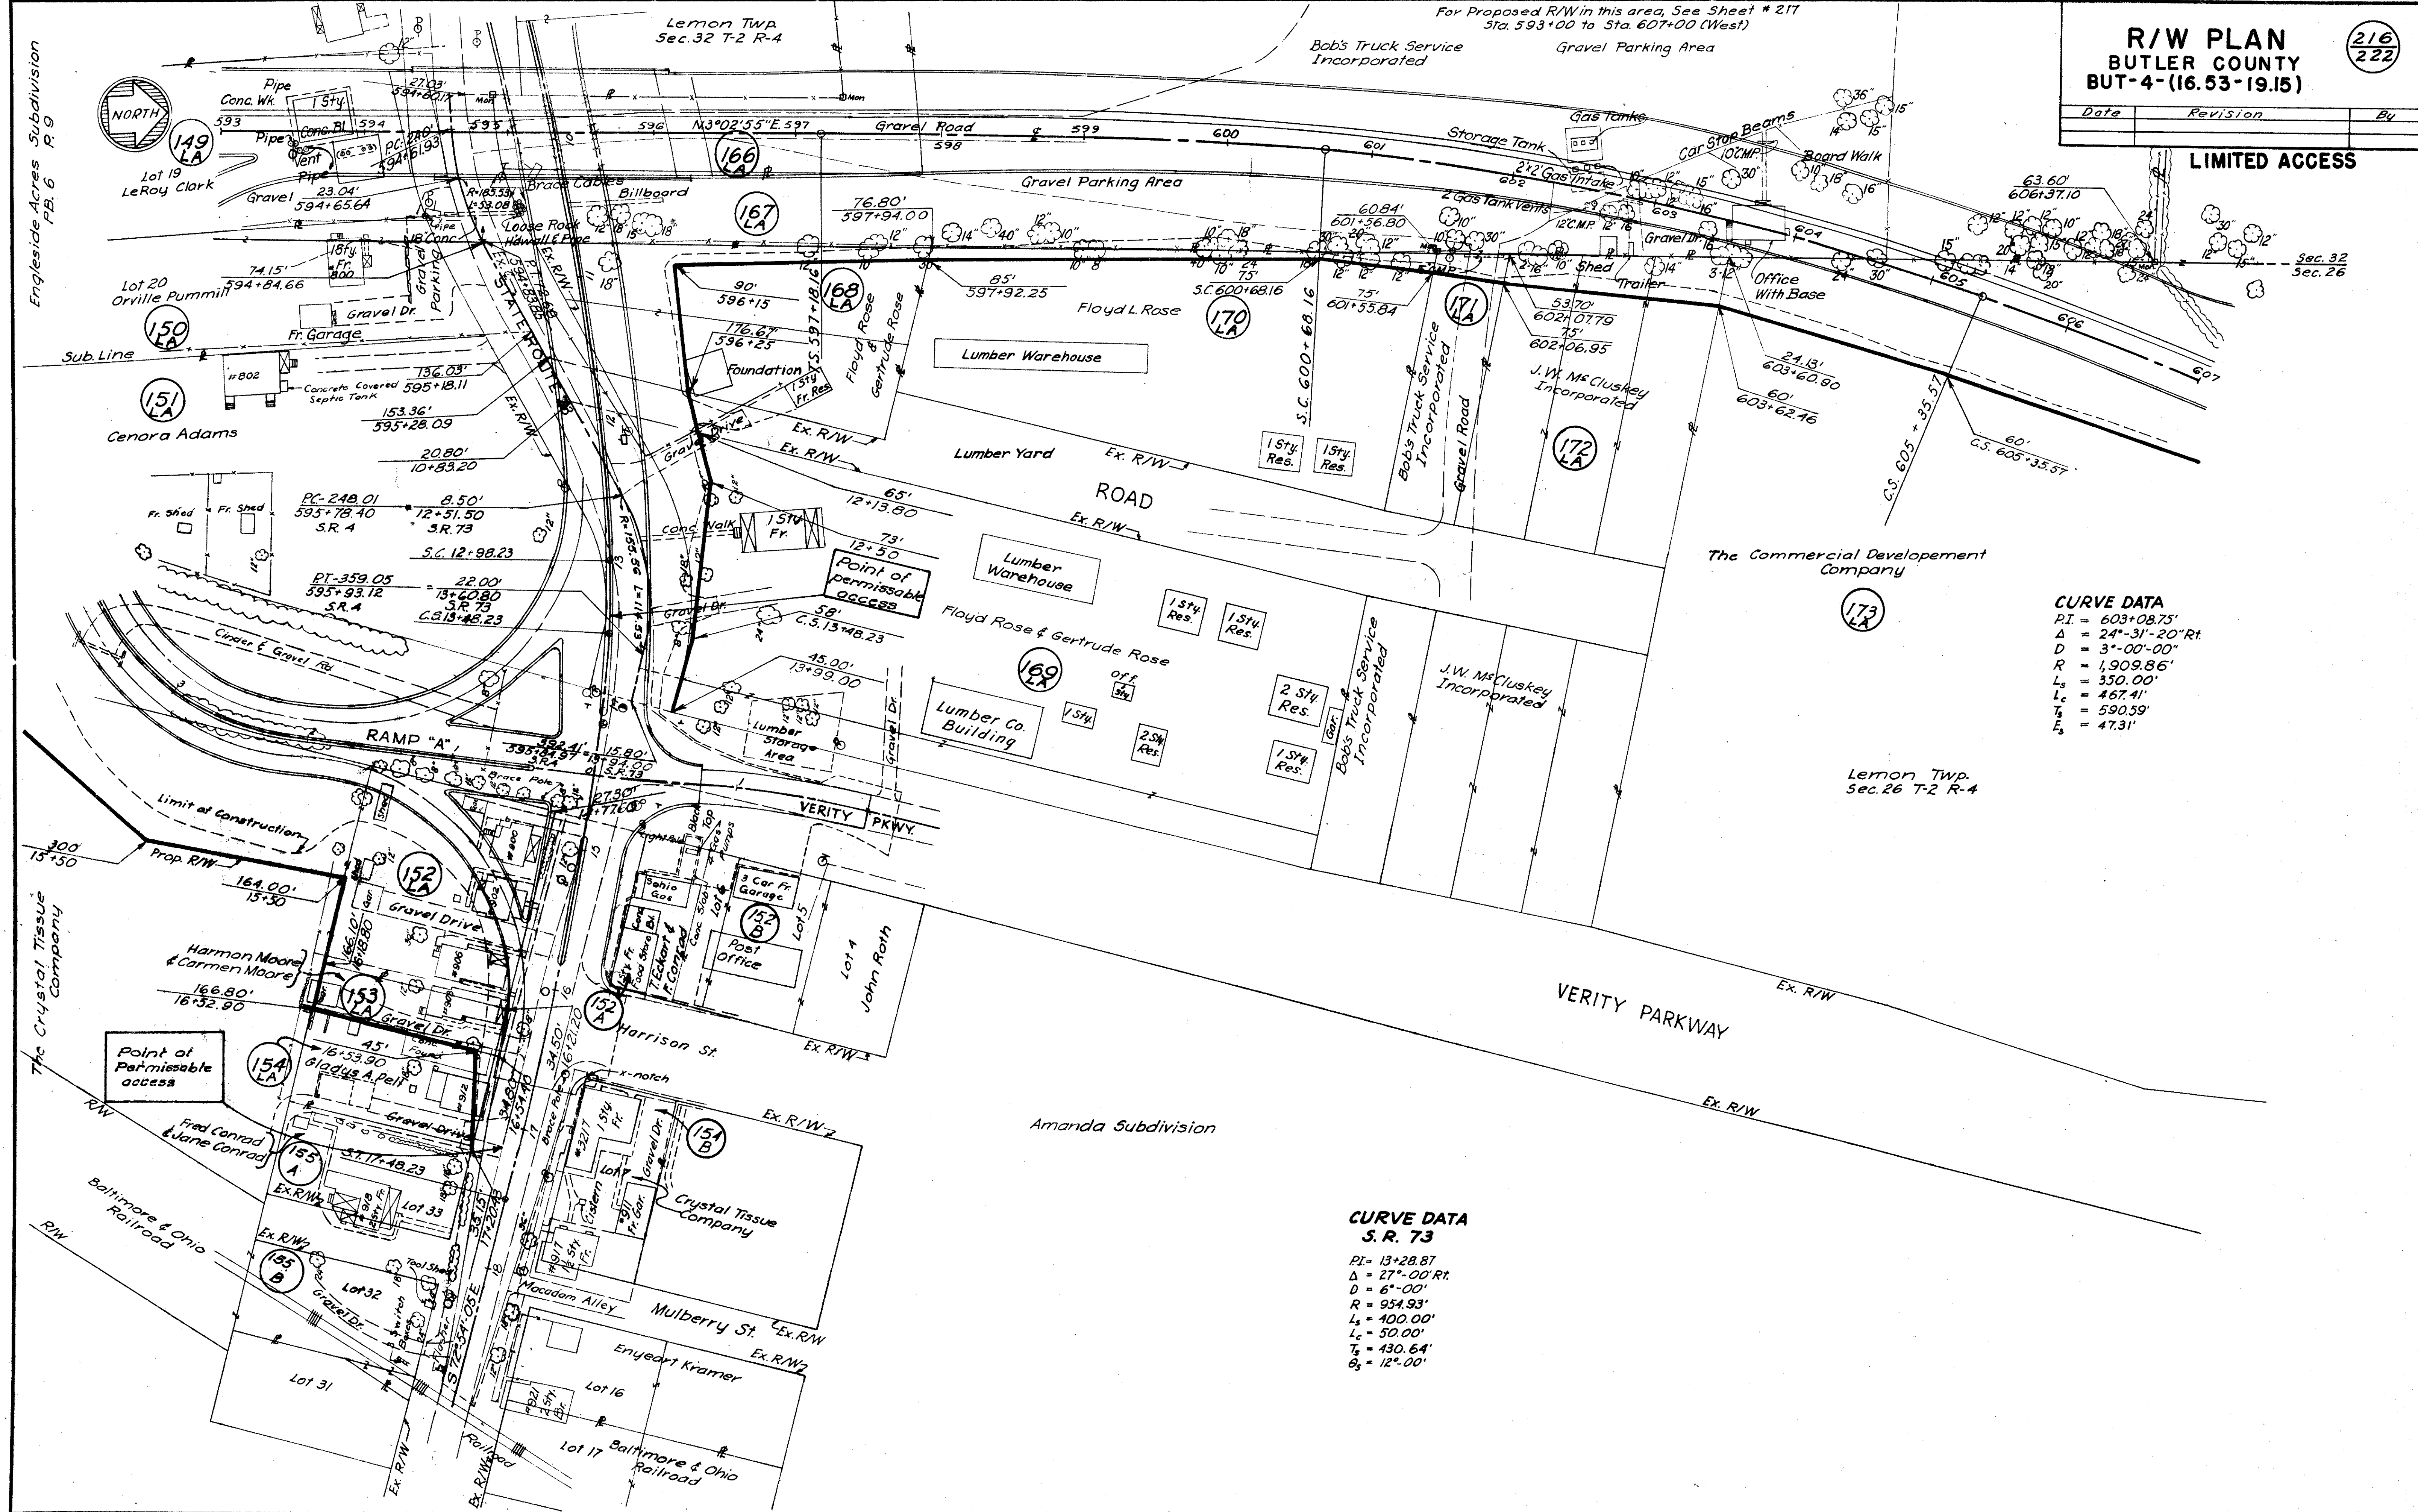

**CURVE DATA**  
 P.I. = 603+08.75'  
 Δ = 24°-31'-20" Rt.  
 D = 3°-00'-00"  
 R = 1,909.86'  
 L<sub>s</sub> = 350.00'  
 L<sub>c</sub> = 467.41'  
 T<sub>s</sub> = 590.59'  
 E<sub>s</sub> = 47.31'

**CURVE DATA**  
**S. R. 73**  
 P.I. = 13+28.87  
 Δ = 27°-00' Rt.  
 D = 6°-00"  
 R = 954.93'  
 L<sub>s</sub> = 100.00'  
 L<sub>c</sub> = 50.00'  
 T<sub>s</sub> = 430.64'  
 E<sub>s</sub> = 12°-00'



**R/W PLAN**  
**BUTLER COUNTY**  
**BUT-4-(16.53-19.15)**

217  
222

Date	Revision	By

LIMITED ACCESS


**CURVE DATA**  
**S.R. 73**

PI = 5+43.36  
 Δ = 8°57' Lt.  
 D = 2°00'  
 R = 2864.79'  
 L<sub>s</sub> = 200.00'  
 L<sub>c</sub> = 247.50'  
 T<sub>s</sub> = 324.25'  
 E<sub>s</sub> = 2°00'

**CURVE DATA**  
**S.R. 4**

PI = 603+08.75'  
 Δ = 24°31'-20" Rt.  
 D = 3°00'-00"  
 R = 1,909.86'  
 L<sub>s</sub> = 350.00'  
 L<sub>c</sub> = 467.41'  
 T<sub>s</sub> = 590.59'  
 E<sub>s</sub> = 47.31'

Engleaside Acres Subdivision PB 6 P 19

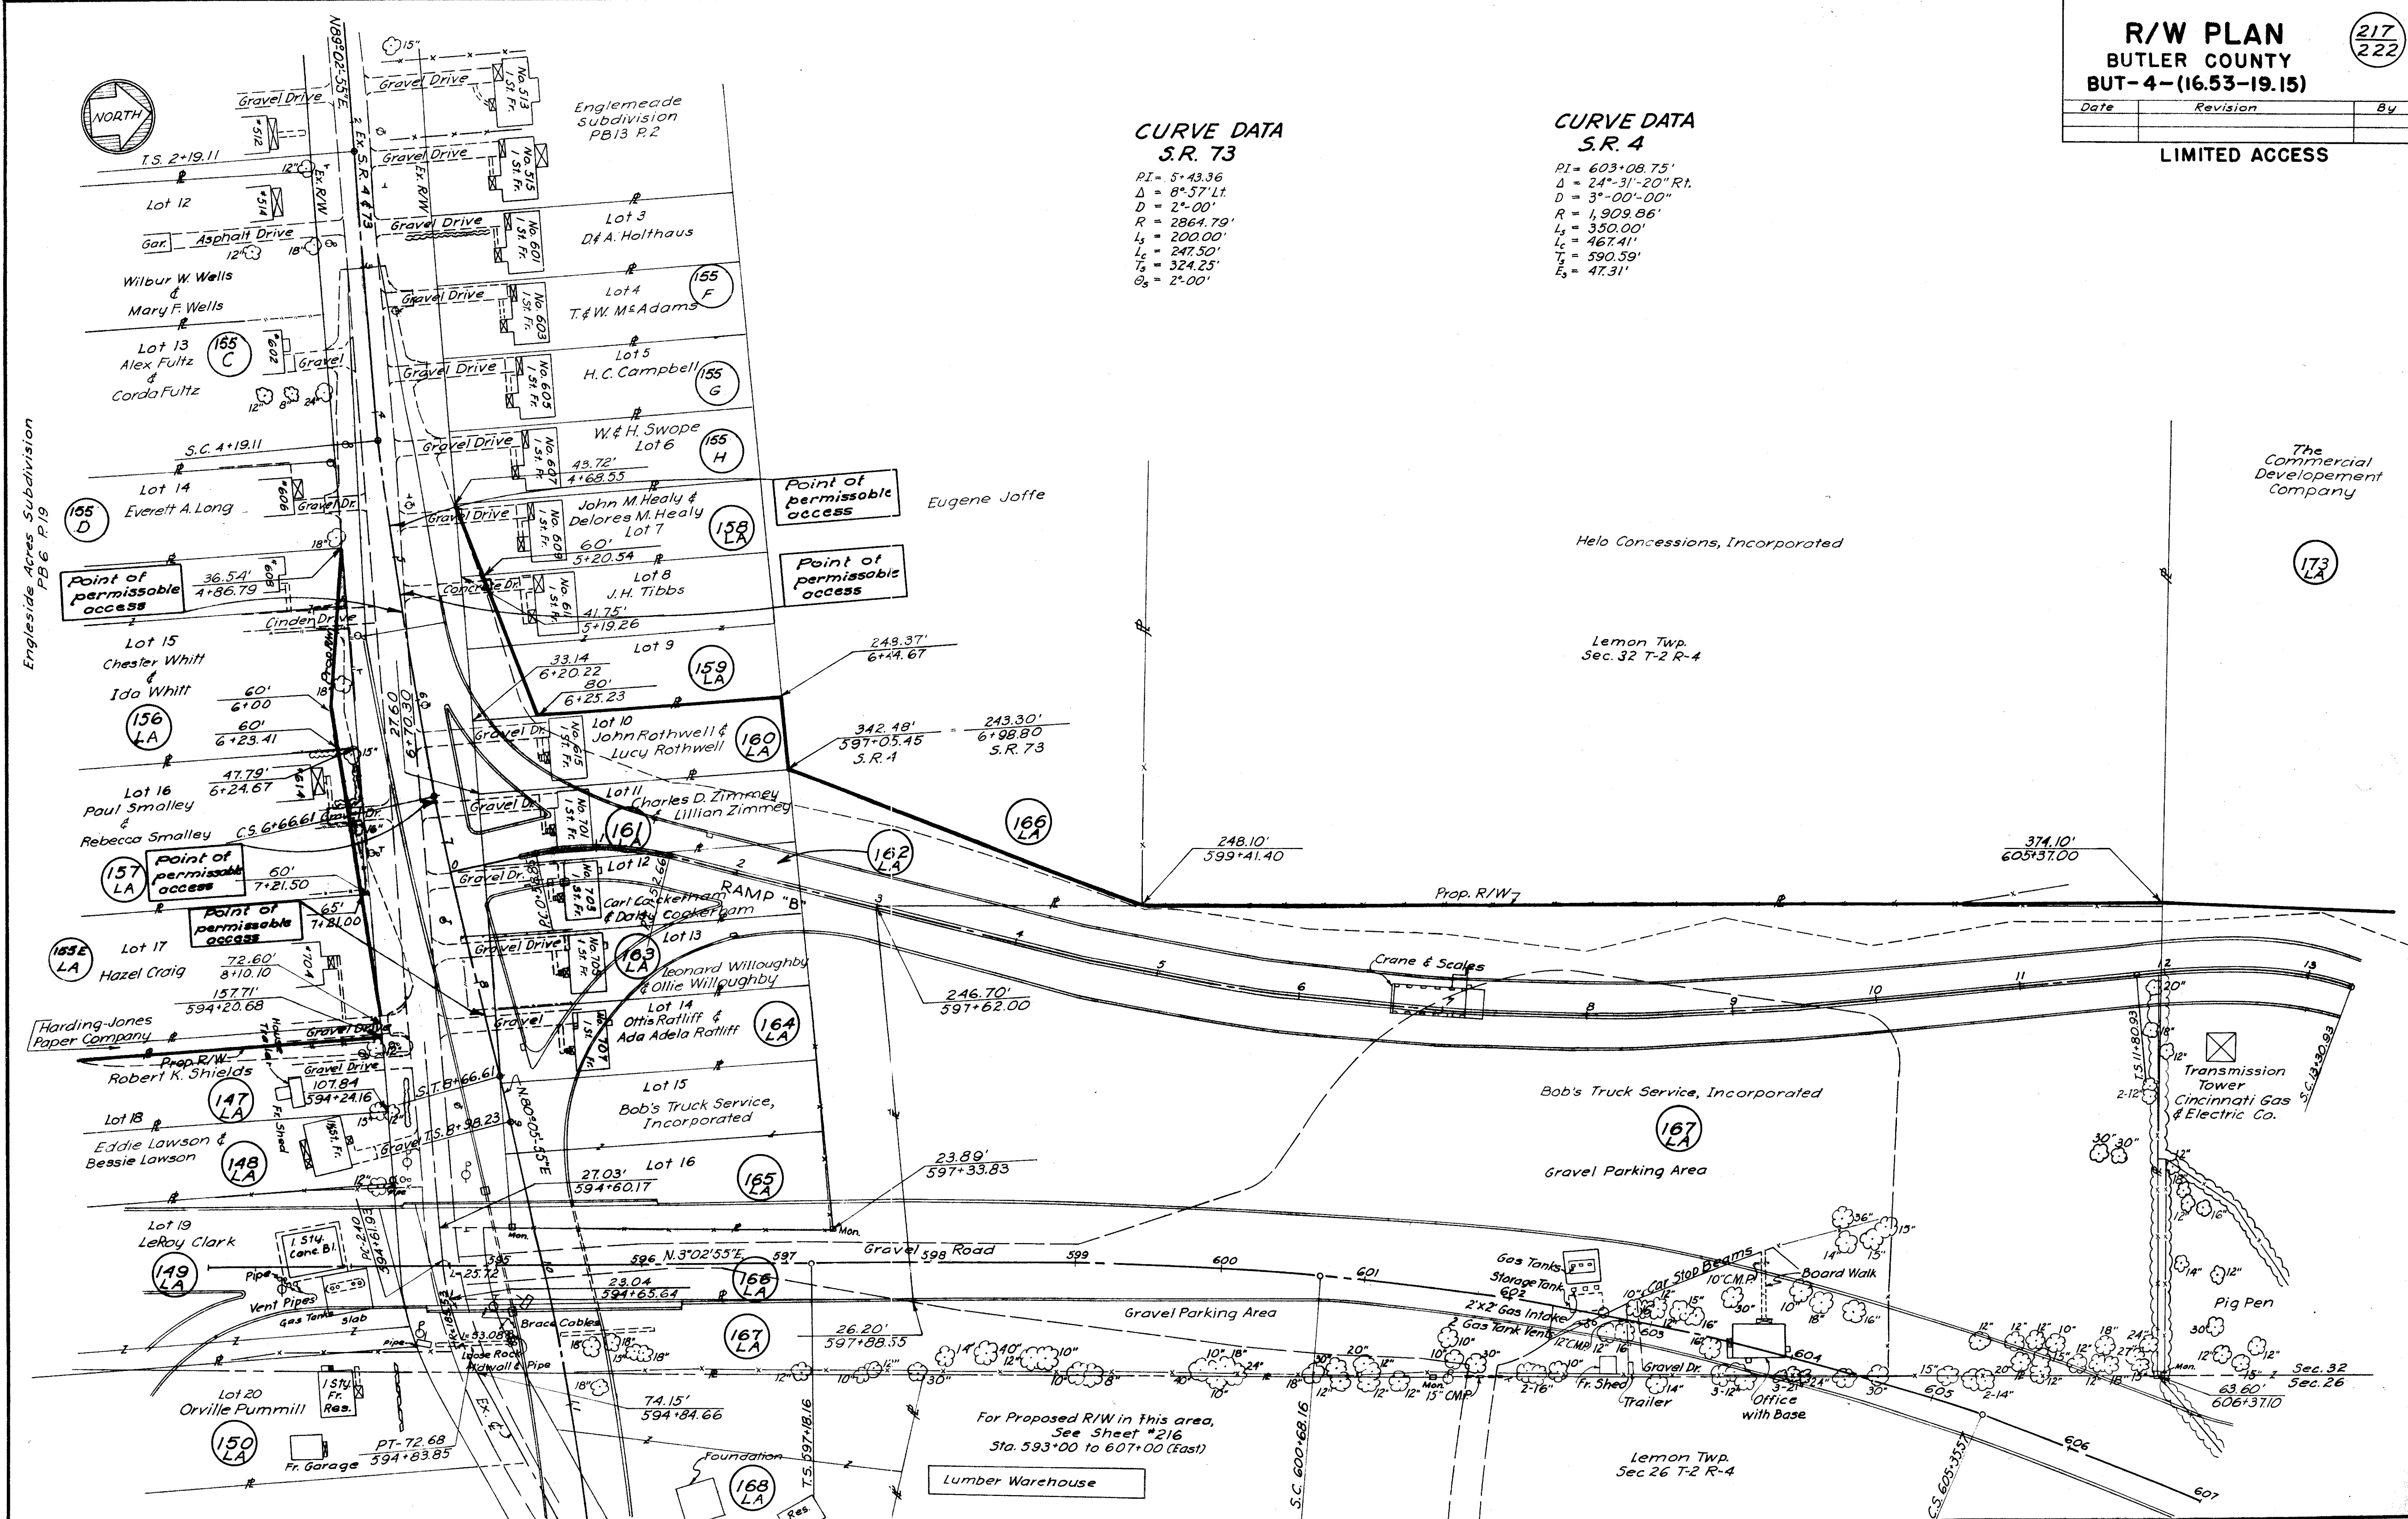

For Proposed R/W in this area,  
 See Sheet #216  
 Sta. 593+00 to 607+00 (East)


STA. 593+00 TO STA. 607+00 (E)

**R/W PLAN**  
**BUTLER COUNTY**  
**BUT-4-(16.53-19.15)**

218  
222

Date	Revision	By


**LIMITED ACCESS**

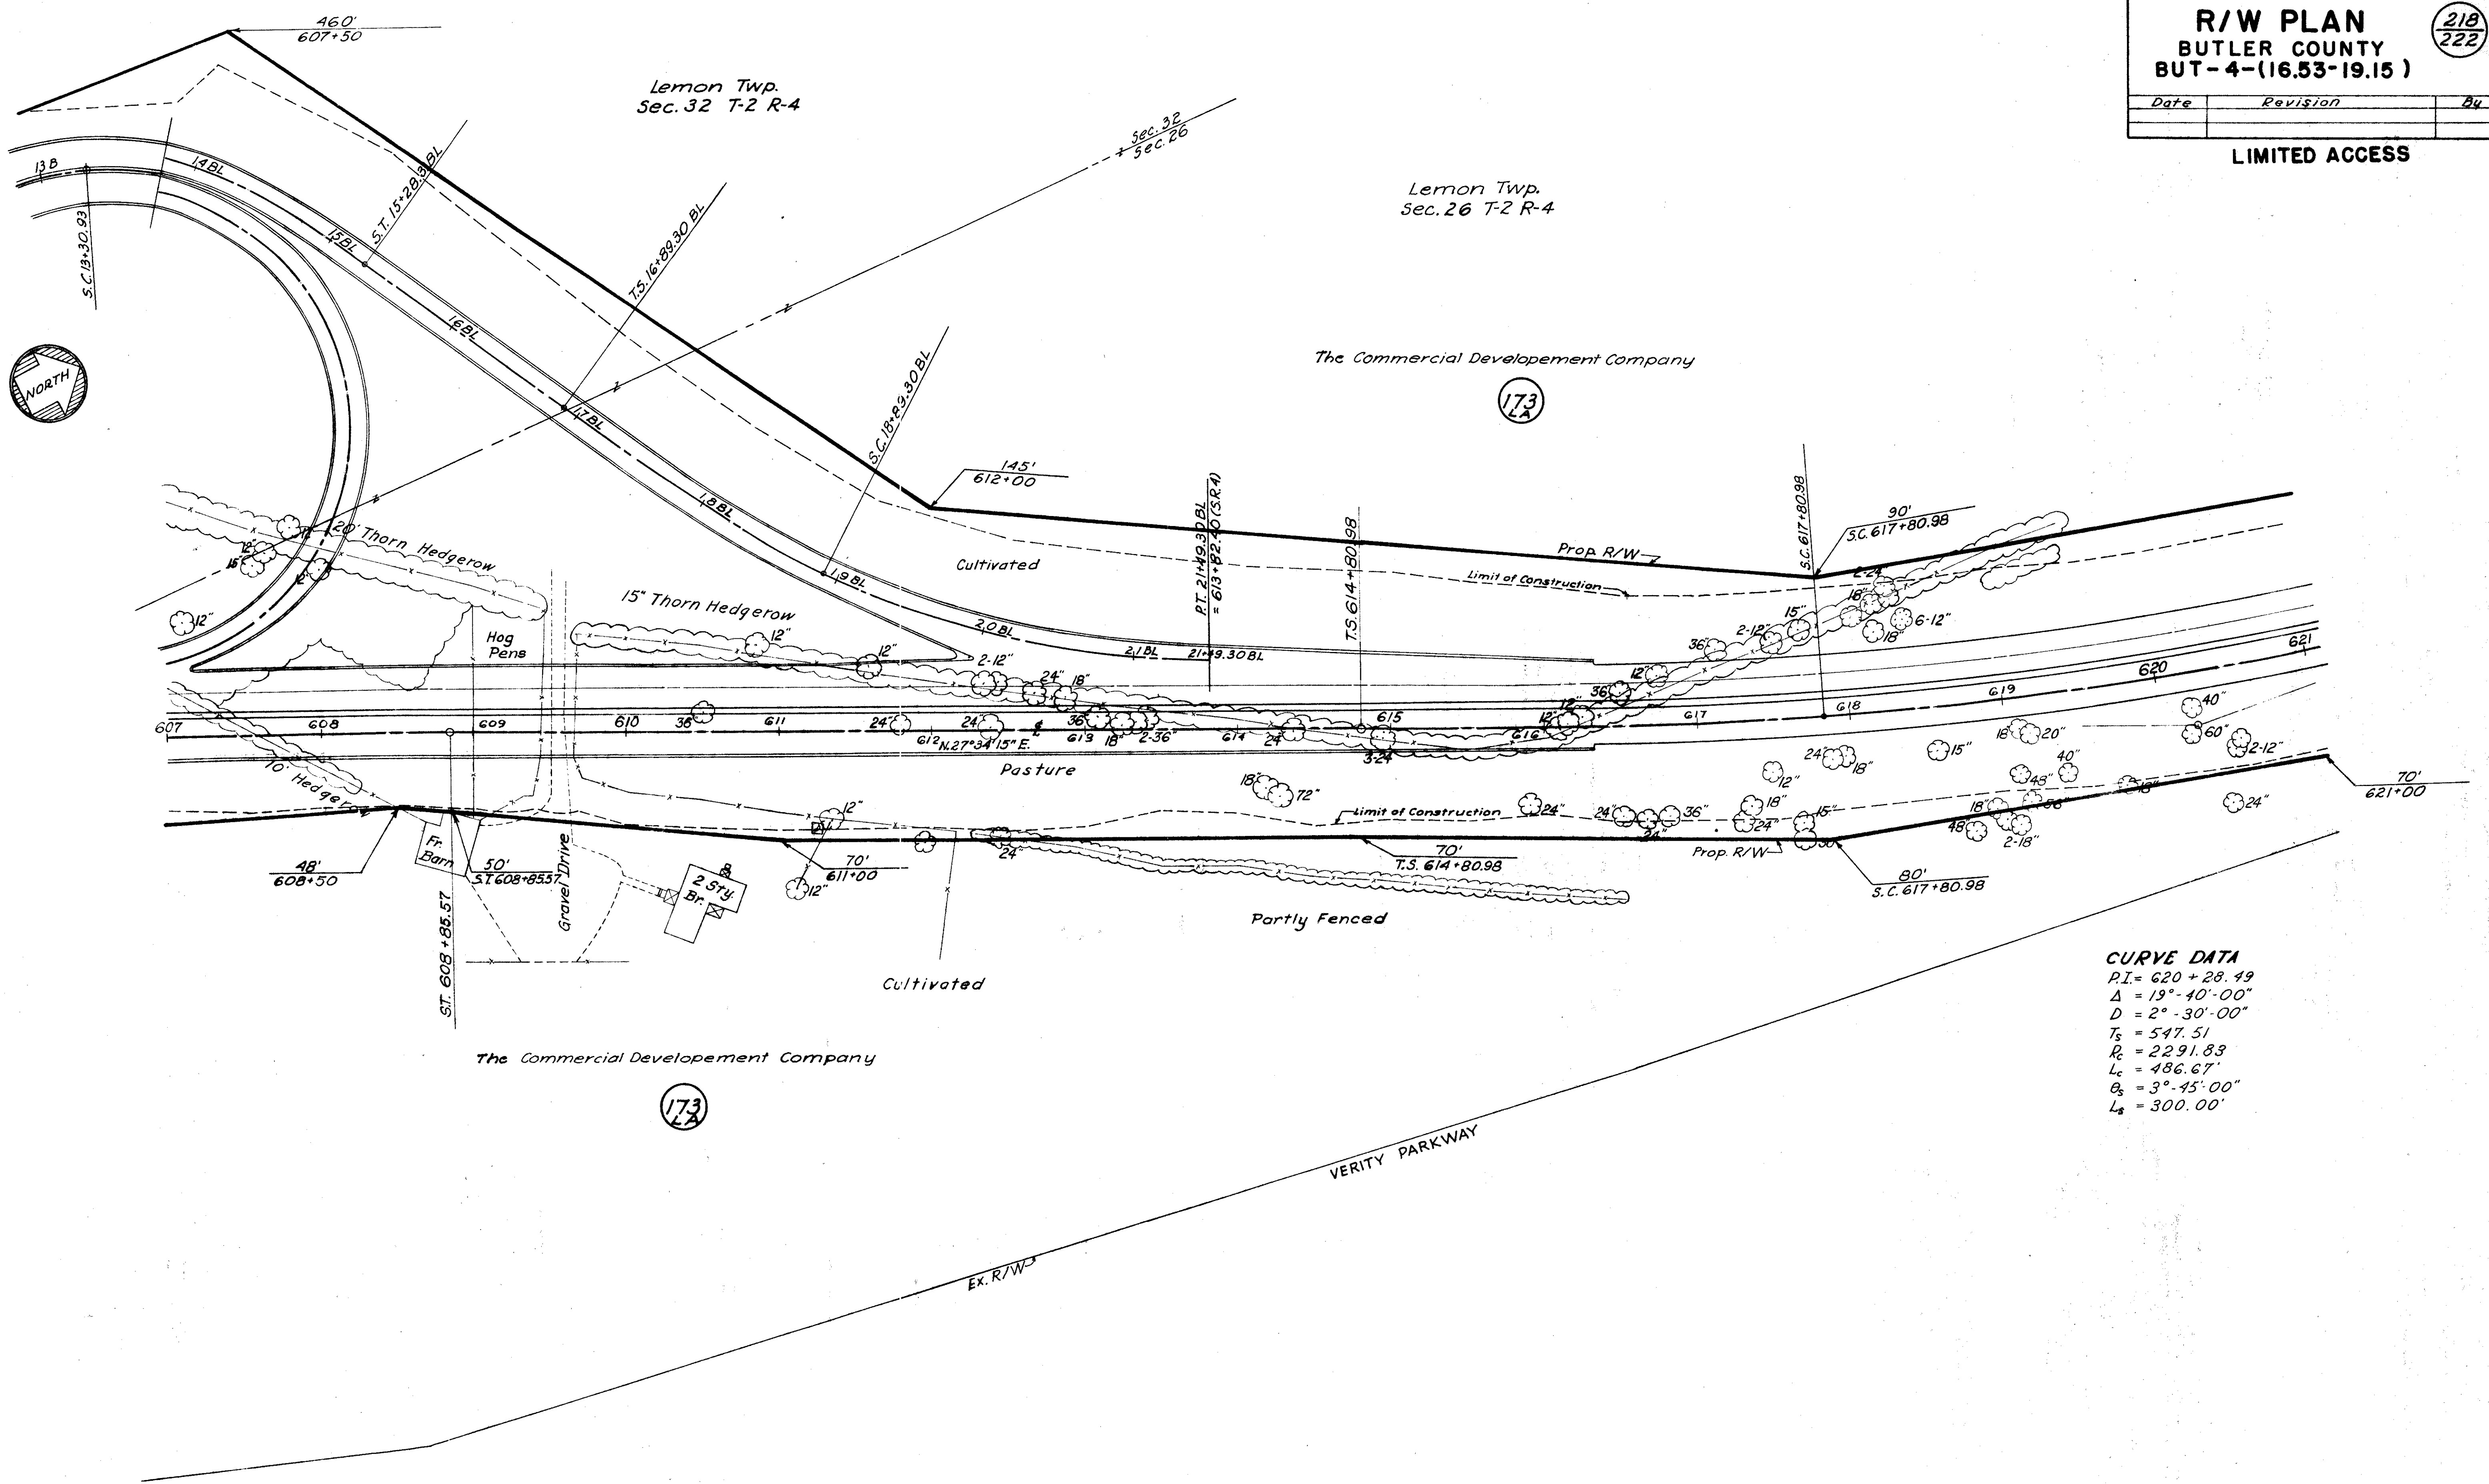

**CURVE DATA**  
 P.I. = 620 + 28.49  
 $\Delta = 19^{\circ} - 40' - 00''$   
 $D = 2^{\circ} - 30' - 00''$   
 $T_s = 547.51$   
 $R_c = 2291.83$   
 $L_c = 486.67'$   
 $\theta_s = 3^{\circ} - 45' - 00''$   
 $L_s = 300.00'$

Lemon Twp.  
 Sec 26 T-2 R-4


Buena Vista Subdivision  
 PB 7 P26  
 PB13 P88

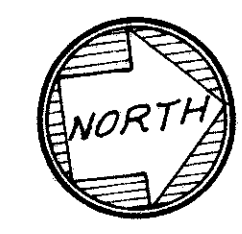

LIMITED ACCESS

City of Middletown

Sec. 26  
 Sec. 27

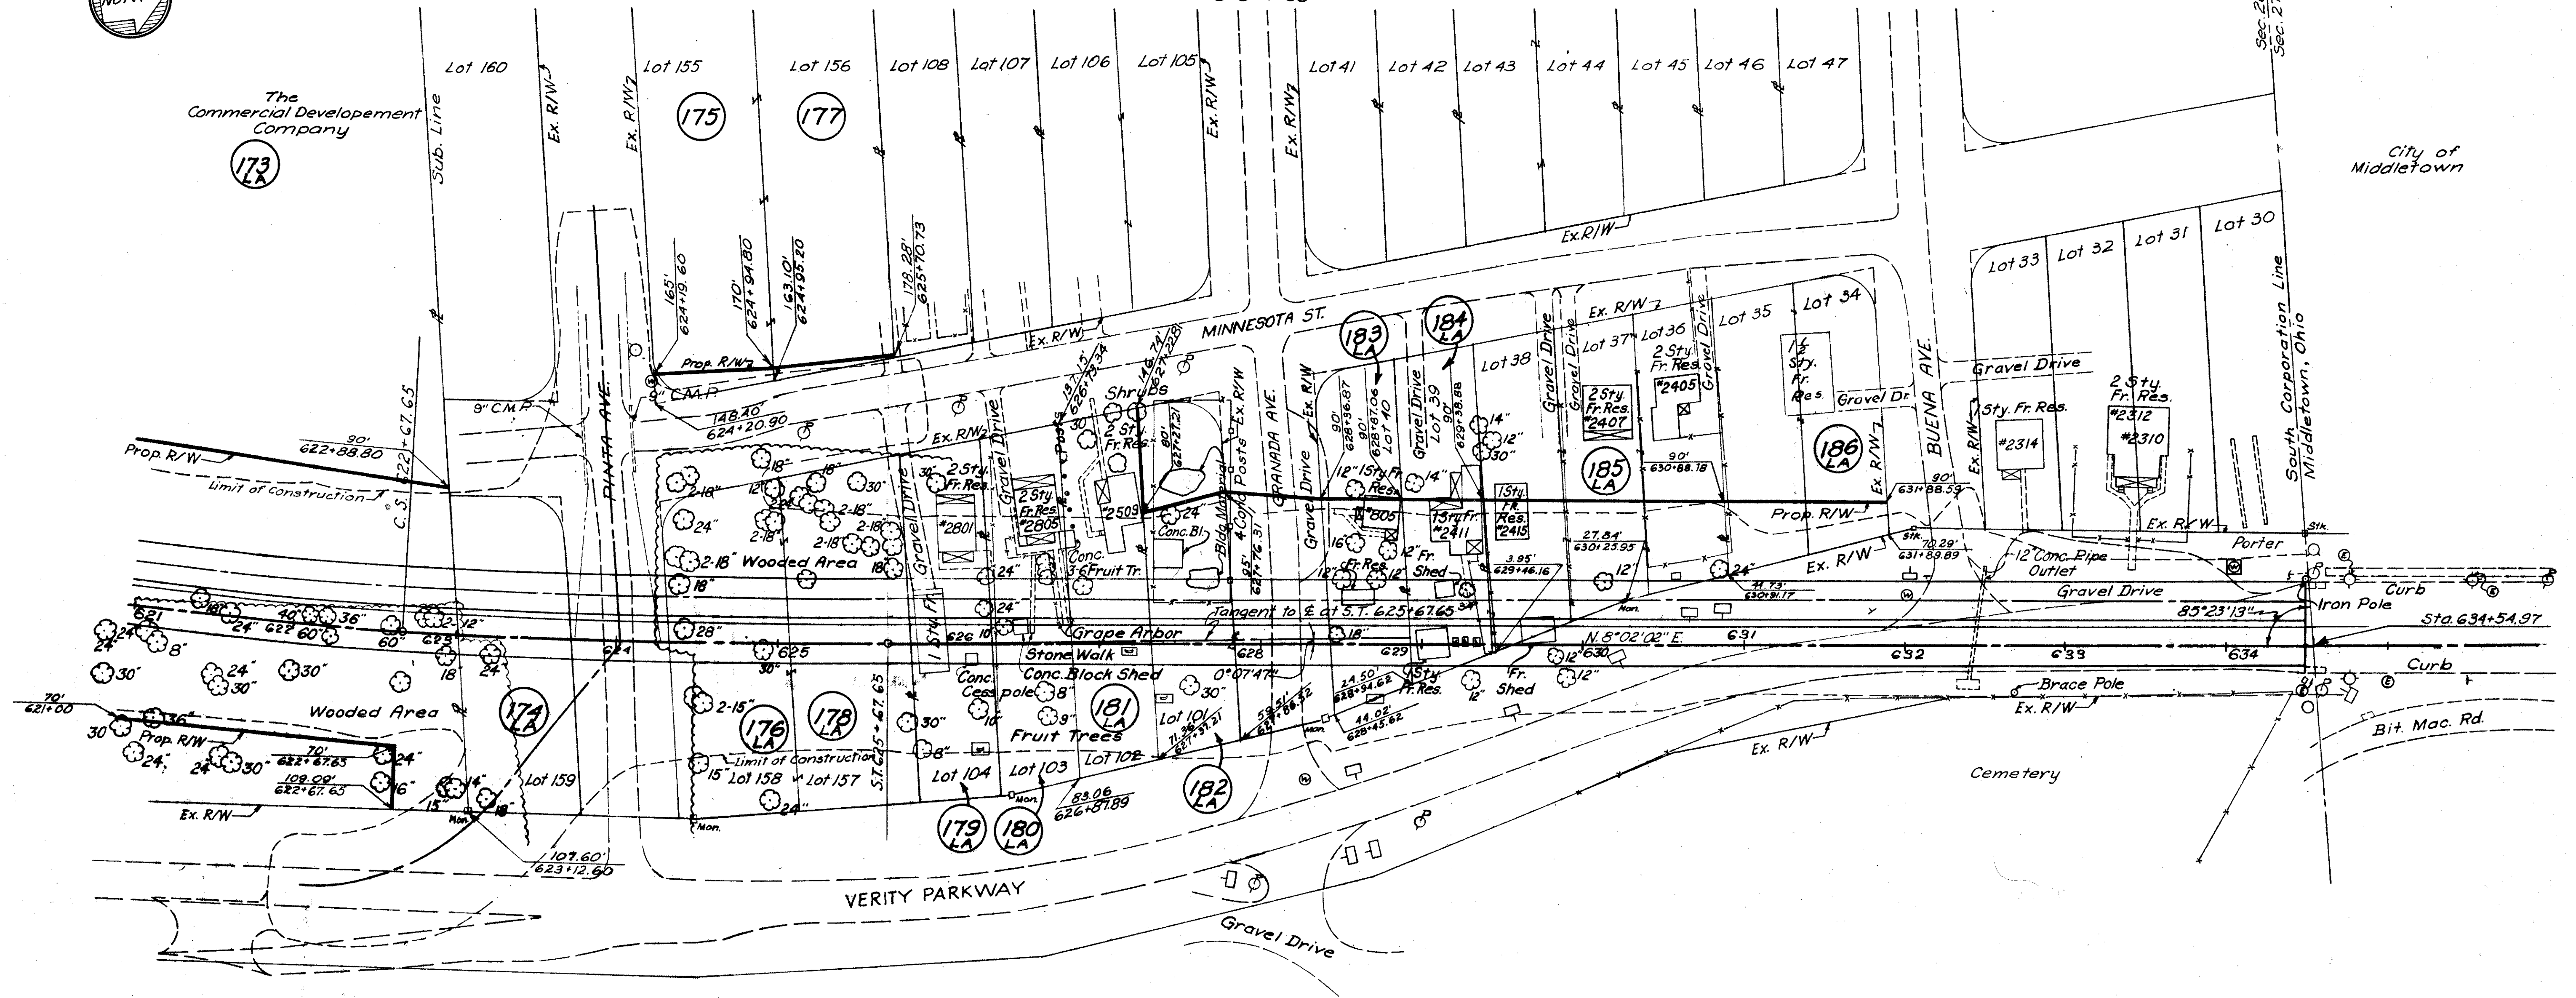

**CURVE DATA**  
 PI = 620+28.49  
 Δ = 19°-40'-00"  
 D = 2°-30'-00"  
 T<sub>s</sub> = 547.51'  
 R<sub>c</sub> = 2291.83  
 L<sub>c</sub> = 486.67  
 θ<sub>s</sub> = 3°-45'-00"  
 L<sub>s</sub> = 300.00'

Buena Vista Subdivision		
Parcel No.	Lot No.	Owner
174 LA	159	Tailored Homes, Incorporated
175	155	" " "
176 LA	158	" " "
177	156	" " "
178 LA	157	Tailored Homes, Incorporated
179 LA	104	Nancy Ann Prater
180 LA	103	Harold E. Smith & Eva Smith
181 LA	102	Carl B. Kash & Nannie Kash
182 LA	101	John Garz
183 LA	40	Zelda R. Hudson
184 LA	39 & pt 38	J.P. Keath & Viola Keath
185 LA	pt 36 & 37 & 36	W.J. Brewer
186 LA	35 & 34	John S. Fisher


**SOIL PROFILE**  
**BUTLER COUNTY**  
**BUT.-4-(16.53-19.15)**  
**STATE HIGHWAY TESTING AND RESEARCH LABORATORY**  
 O. S. U. CAMPUS, COLUMBUS, OHIO

219-A  
222

512

NOTE: THE INFORMATION SHOWN BY THIS SUBGRADE PROFILE WAS SECURED FOR THE USE OF THE STATE OF OHIO AND IS NOT TO BE CONSTRUED AS A PART OF THE PLANS GOVERNING THE CONSTRUCTION OF THE PROJECT.

REVISED - OCTOBER-1954

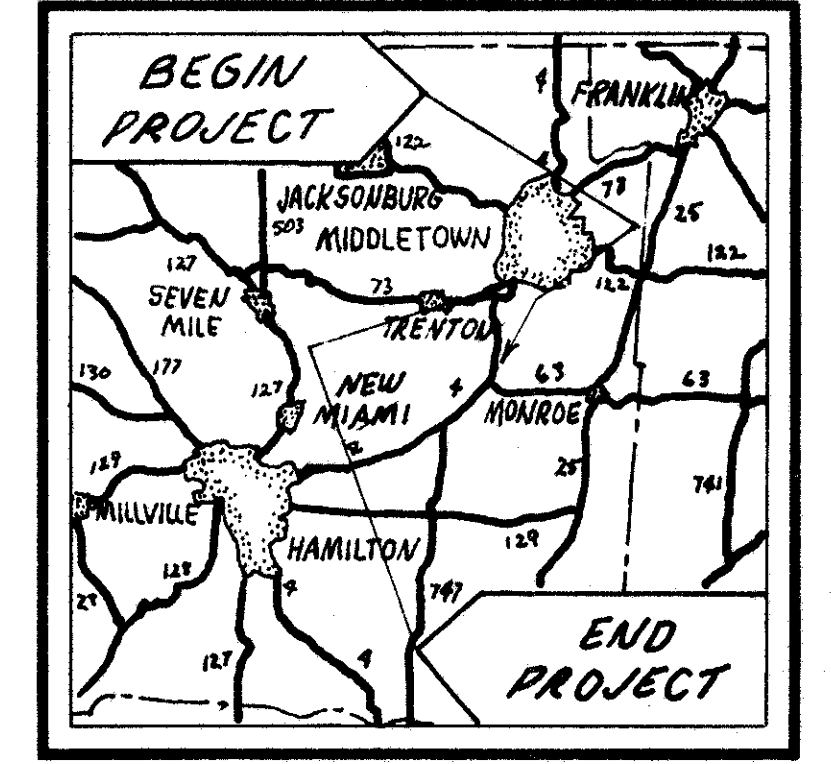

**LEGEND FOR PROJECT-AVERAGE RESULTS OF TESTS- 204 SAMPLES TESTED**

DESCRIPTION	H. R. B. CLASS	OHIO CLASS	% AGG.	% C. SAND	% F. SAND	% SILT	% CLAY	LIQUID LIMIT	PLASTICITY INDEX	WATER CONTENT	SAMPLES TESTED
GRAVEL.	A-1(a)	A-1a	72	12	5	8	3	24	5	-	5
GRAVEL WITH SAND.	A-1-b(a)	A-1b	34	40	12	10	4	23	1	13	3
GRAVEL WITH SAND & SILT.	A-2-4(a)	A-2-4	58	14	4	19	6	25	8	7	2
GRAVEL WITH SAND, SILT, AND CLAY.	A-2-6(a)	A-2-6	48	13	11	15	13	33	16	17	3
COARSE & FINE SAND.	-	A-3a	2	33	42	13	10	N.P.	N.P.	18	5
SANDY SILT.	A-4(a)	A-4a	18	12	18	31	21	23	7	15	49
SILT.	A-4(b)	A-4b	2	3	9	61	25	27	5	19	25
SILT & CLAY.	A-6(a)	A-6a	10	9	13	34	34	29	13	17	51
CLAY.	A-6(a)	A-6b	13	7	11	30	39	36	18	18	30
ELASTIC CLAY WITH SOME ORGANIC MATERIAL.	A-7-5(a)	A-7-5a	4	4	11	50	31	42	13	26	2
CLAY.	A-7-6(a)	A-7-6a	14	3	6	32	45	44	23	21	22
SHALE.											6
LIMESTONE.											
CINDERS.											1


CLASSIFIED BY VISUAL INSPECTION.

CLASSIFIED BY VISUAL INSPECTION.

CLASSIFIED BY VISUAL INSPECTION.

-SAMPLES TESTED -  
 LAB. NOS. 50-1002-1026 INCL.; 1041-1087 INCL.;  
 1192-1219 INCL.; 1448-1477 INCL.; 1496-1515 INCL.;  
 1649-1669 INCL.; 1773-1802 INCL.  
 MOISTURE DENSITY SAMPLE.  
 LAB. NO. 50-1087.  
 NOTE: FIGURES BESIDE BORING INDICATE  
 MOISTURE CONTENT IN PERCENT.

▲ AUGER BORING PLOTTED TO TOP SOIL. TS=X' = MOISTURE CONTENT NEARLY EQUAL TO OR  
 VERTICAL SCALE ONLY. APPROX. DEPTH. GREATER THAN THE LIQUID LIMIT.  
 ⊕ AUGER BORING - PLAN VIEW. ■ BERM MATERIAL. □ CORE BORING PLOTTED TO VERTICAL SCALE ONLY.

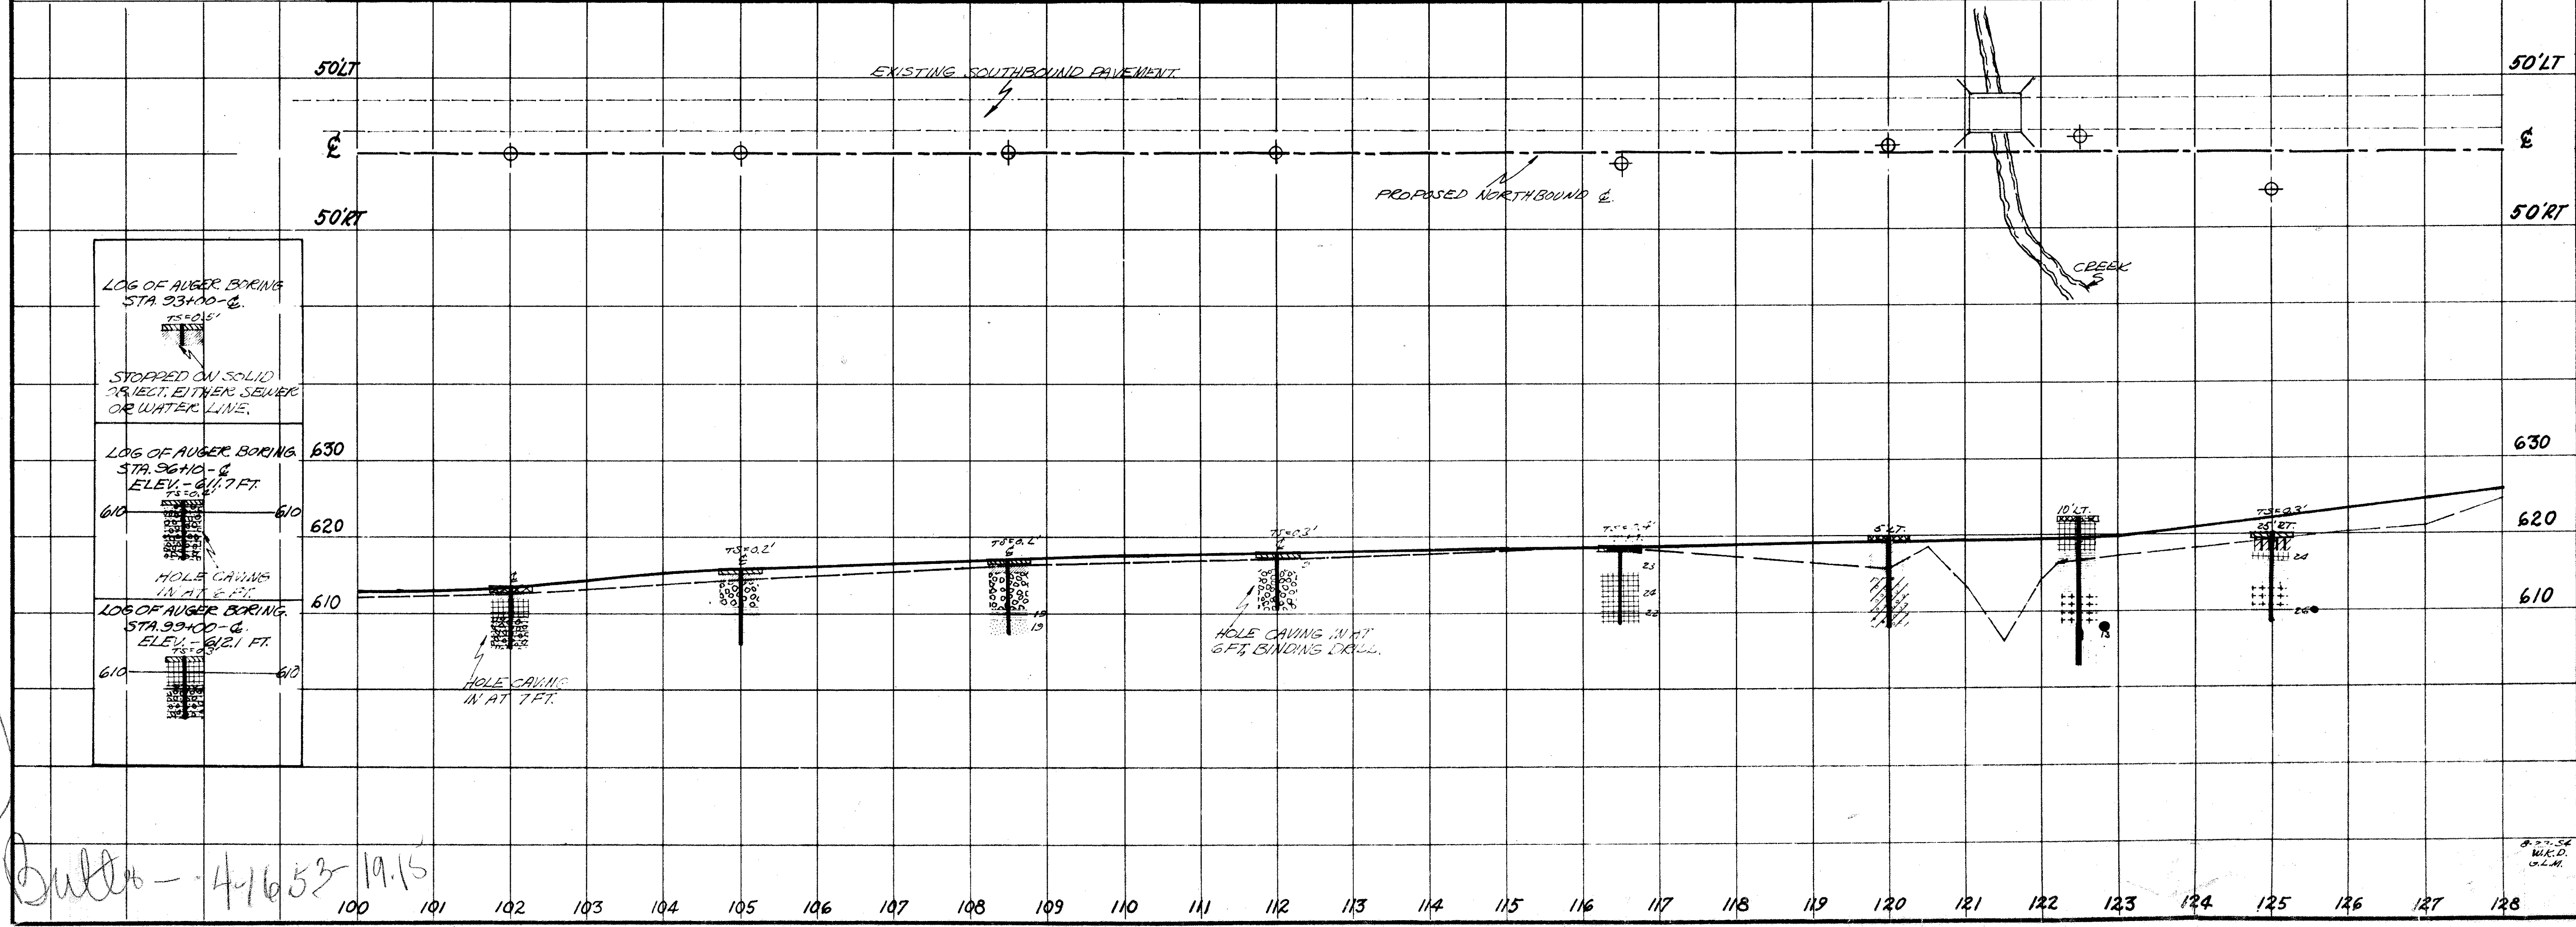


LOG OF AUGER BORING STA. 93+00 - G.  
 STOPPED ON SOLID OBJECT, EITHER SEWER OR WATER LINE.  
 LOG OF AUGER BORING STA. 96+10 - G.  
 ELEV. - 617.7 FT.  
 HOLE CAVING IN AT 6 FT.  
 LOG OF AUGER BORING STA. 99+00 - G.  
 ELEV. - 612.1 FT.  
 HOLE CAVING IN AT 7 FT.

512

Butler - 4-16-53-19.15



**SOIL PROFILE**  
**BUTLER COUNTY**  
**BUT-4 - (16.53-19.15)**  
**STATE HIGHWAY TESTING AND RESEARCH LABORATORY**  
 O. S. U. CAMPUS, COLUMBUS, OHIO

220  
222

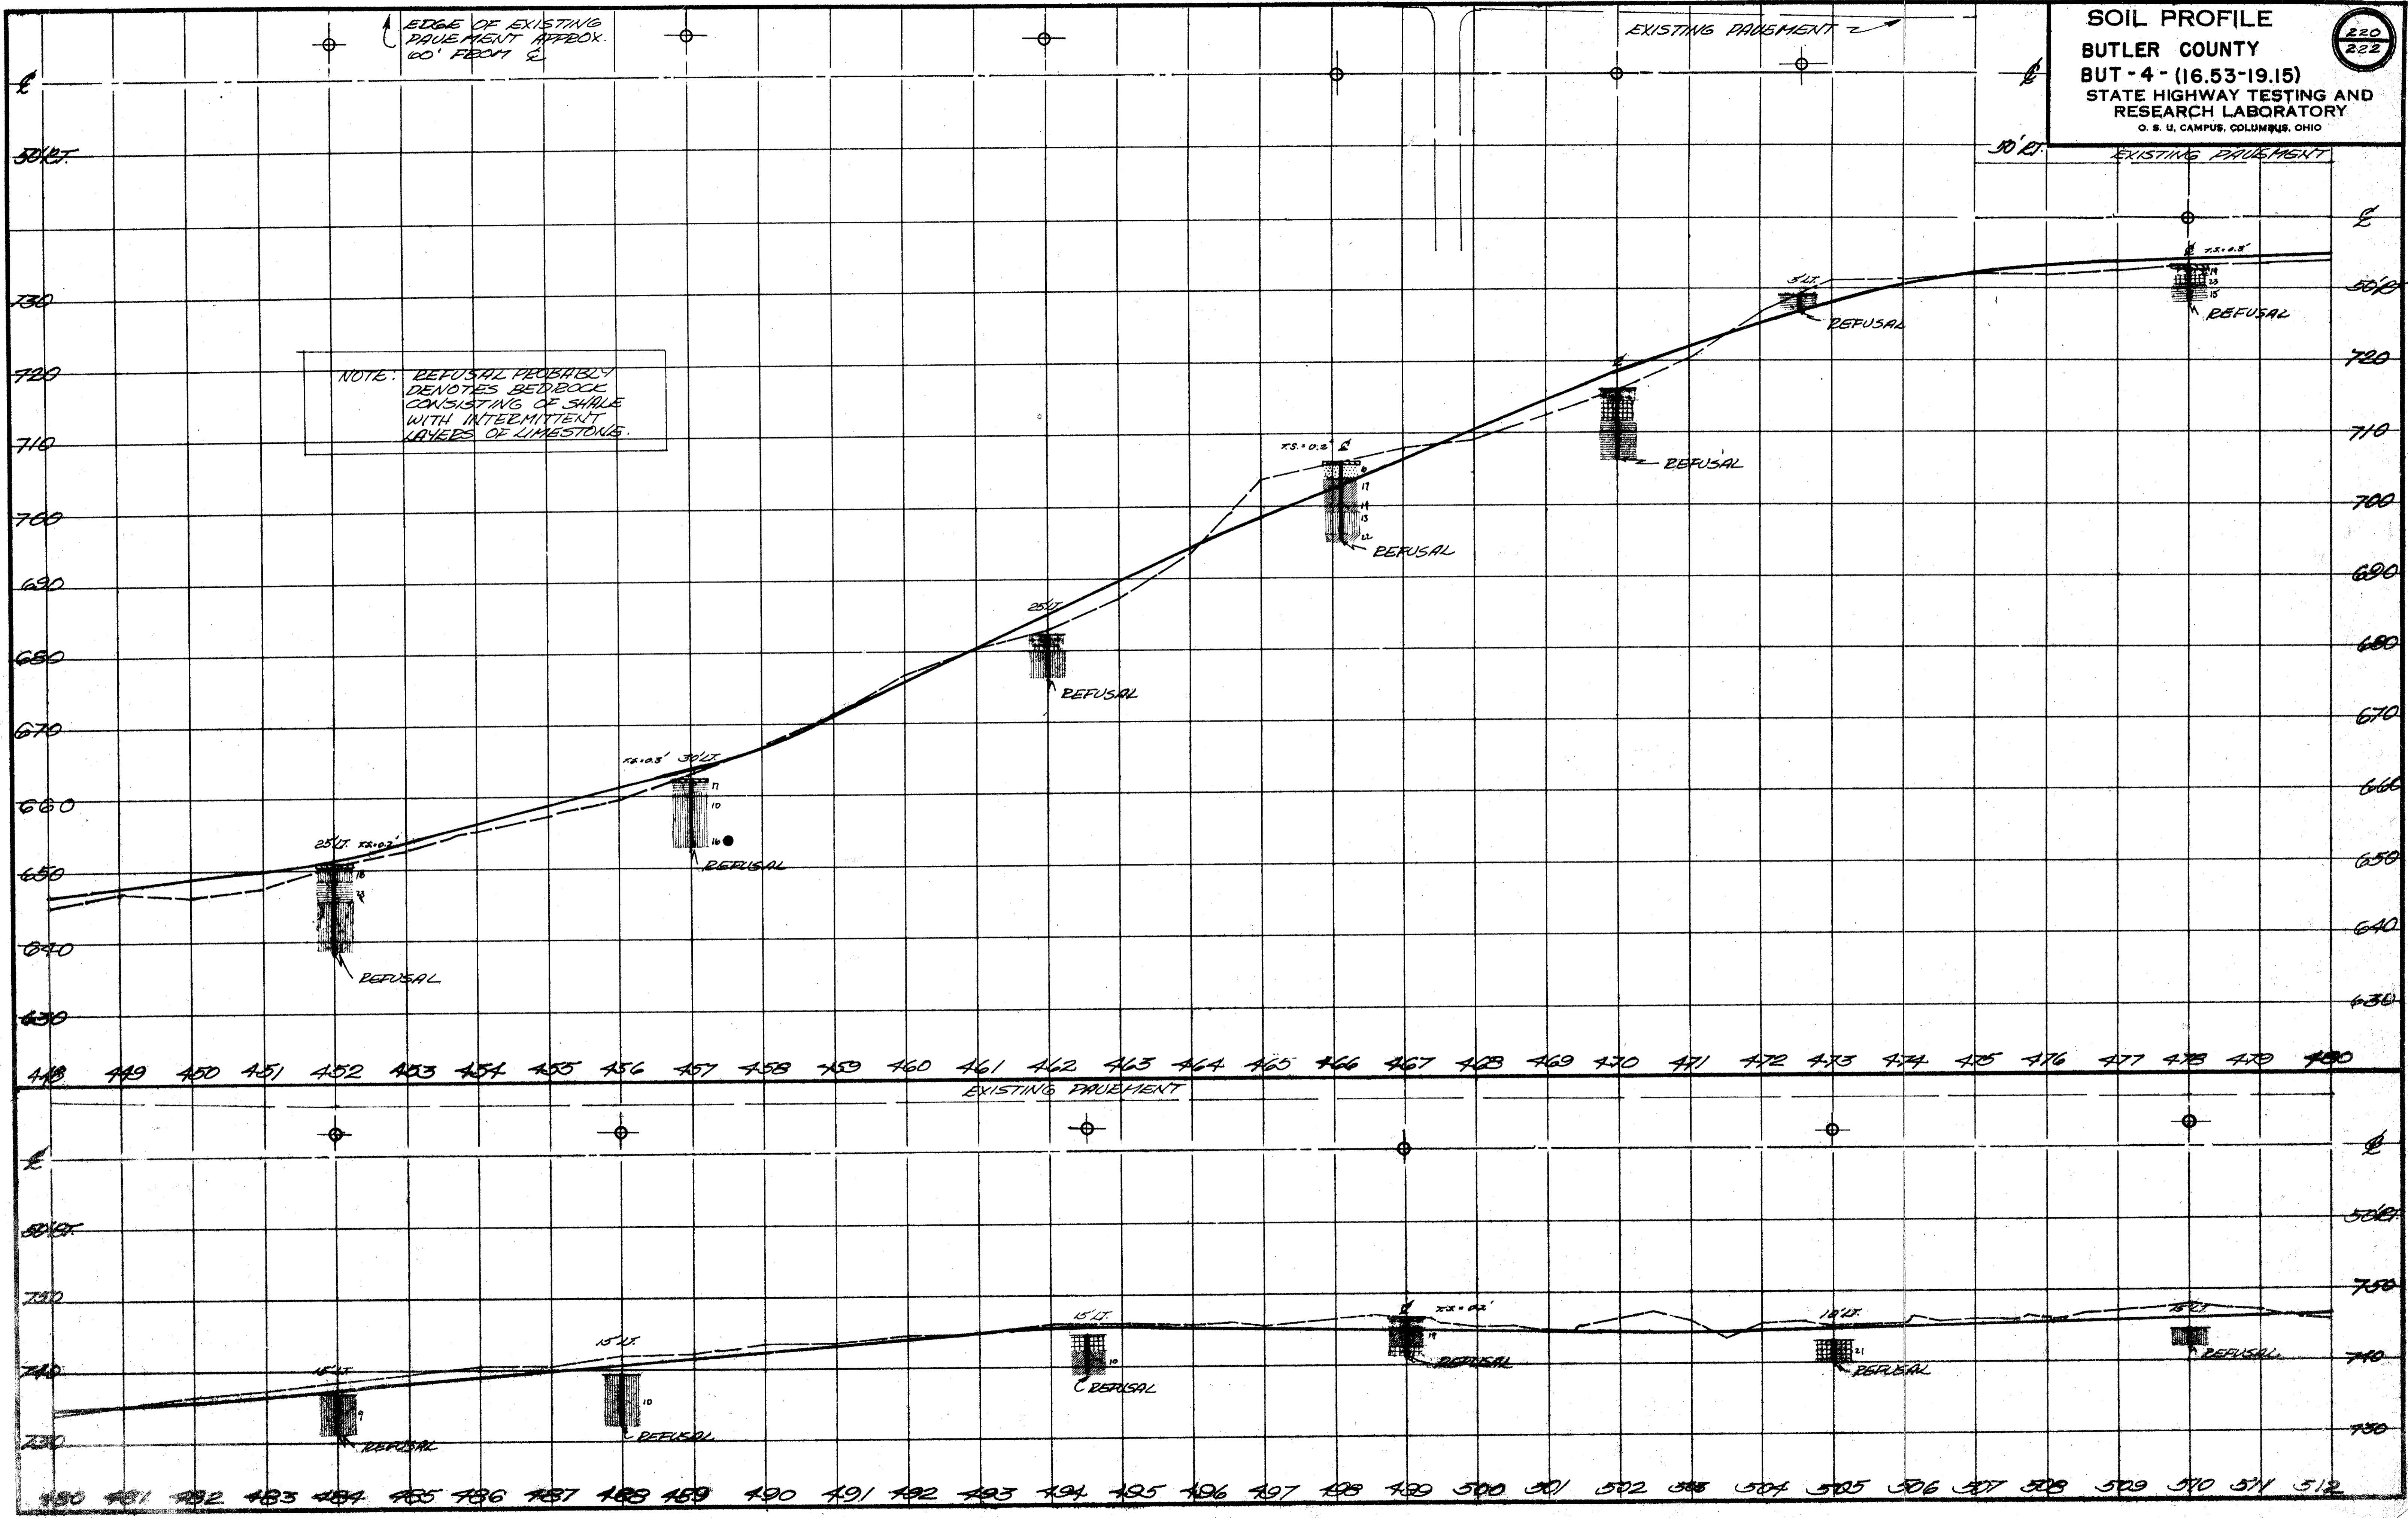

**SOIL PROFILE**  
**BUTLER COUNTY**  
**BUT - 4 - (16.53-19.15)**  
**STATE HIGHWAY TESTING AND**  
**RESEARCH LABORATORY**  
 O. S. U. CAMPUS, COLUMBUS, OHIO

221  
222

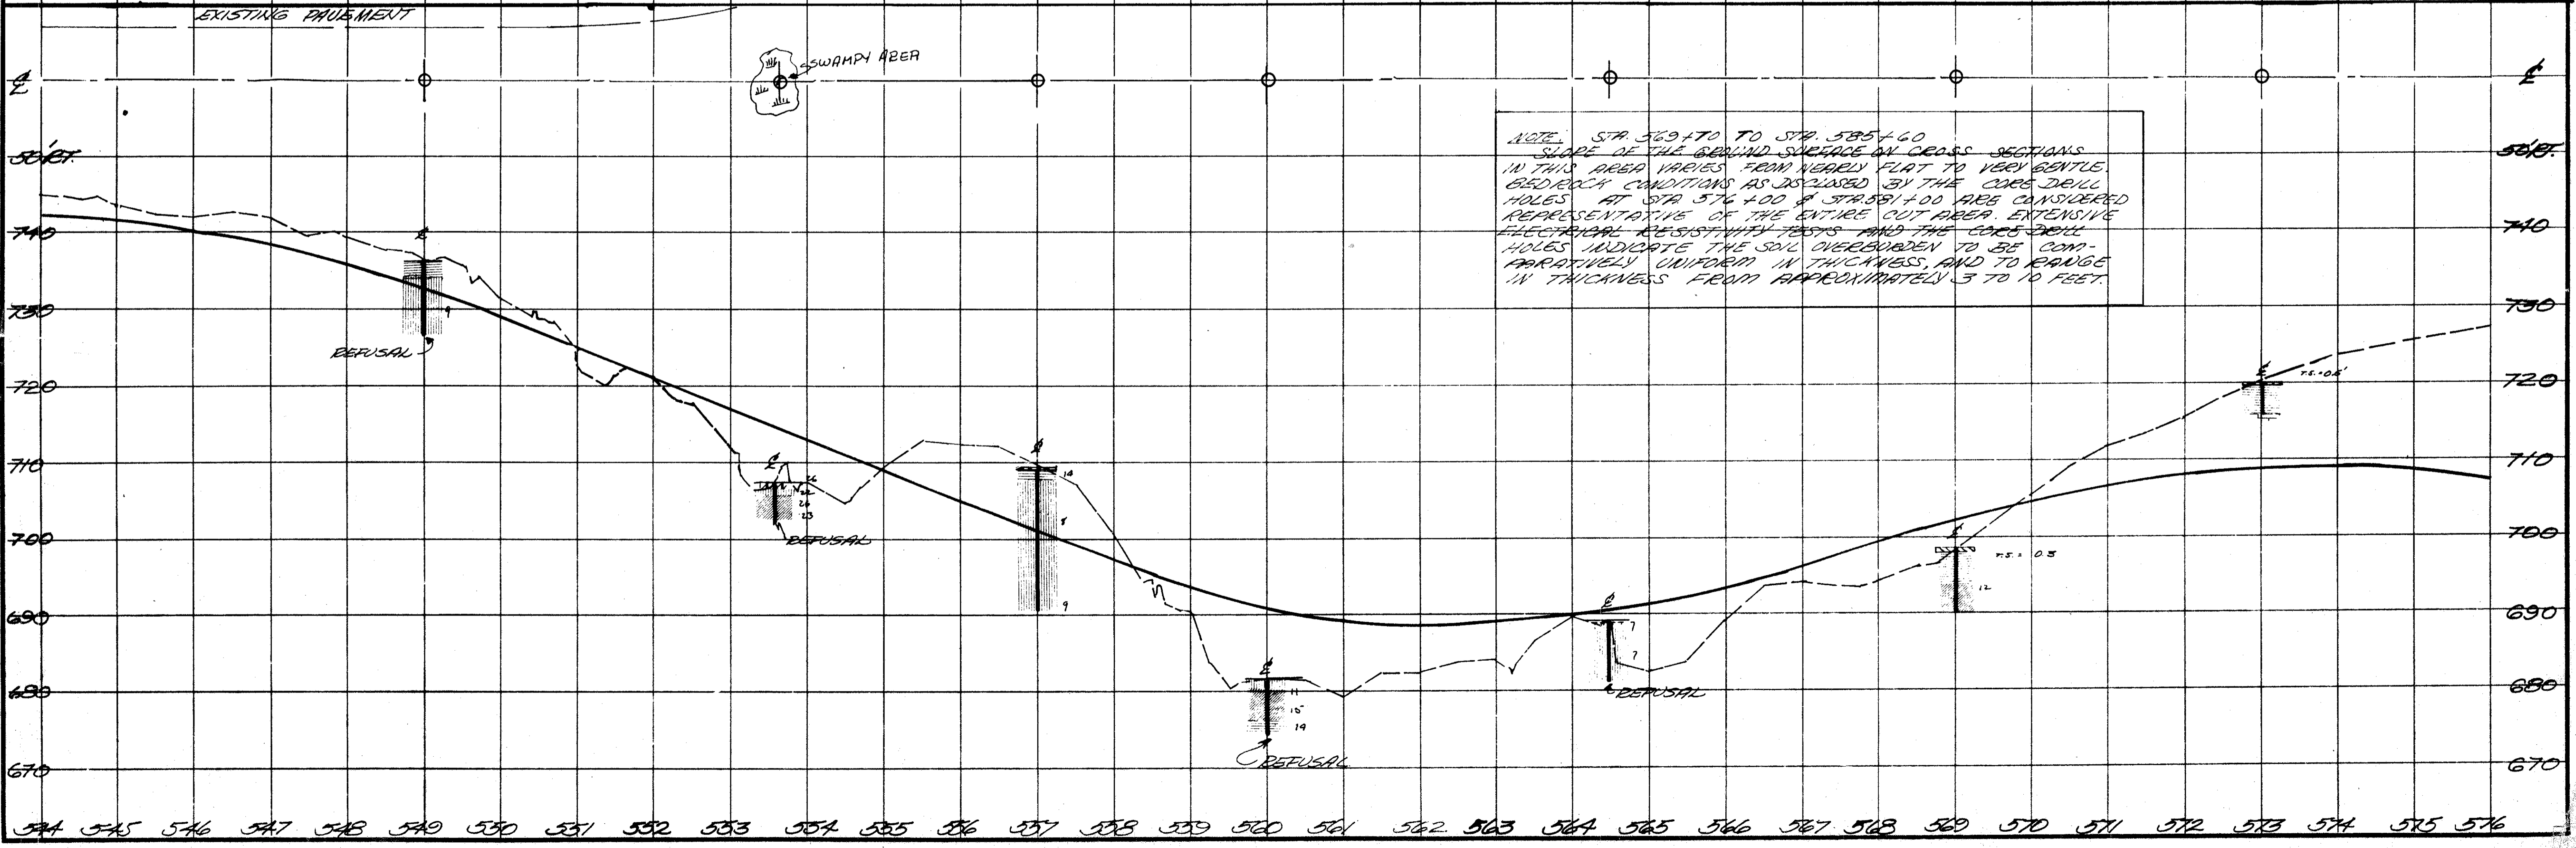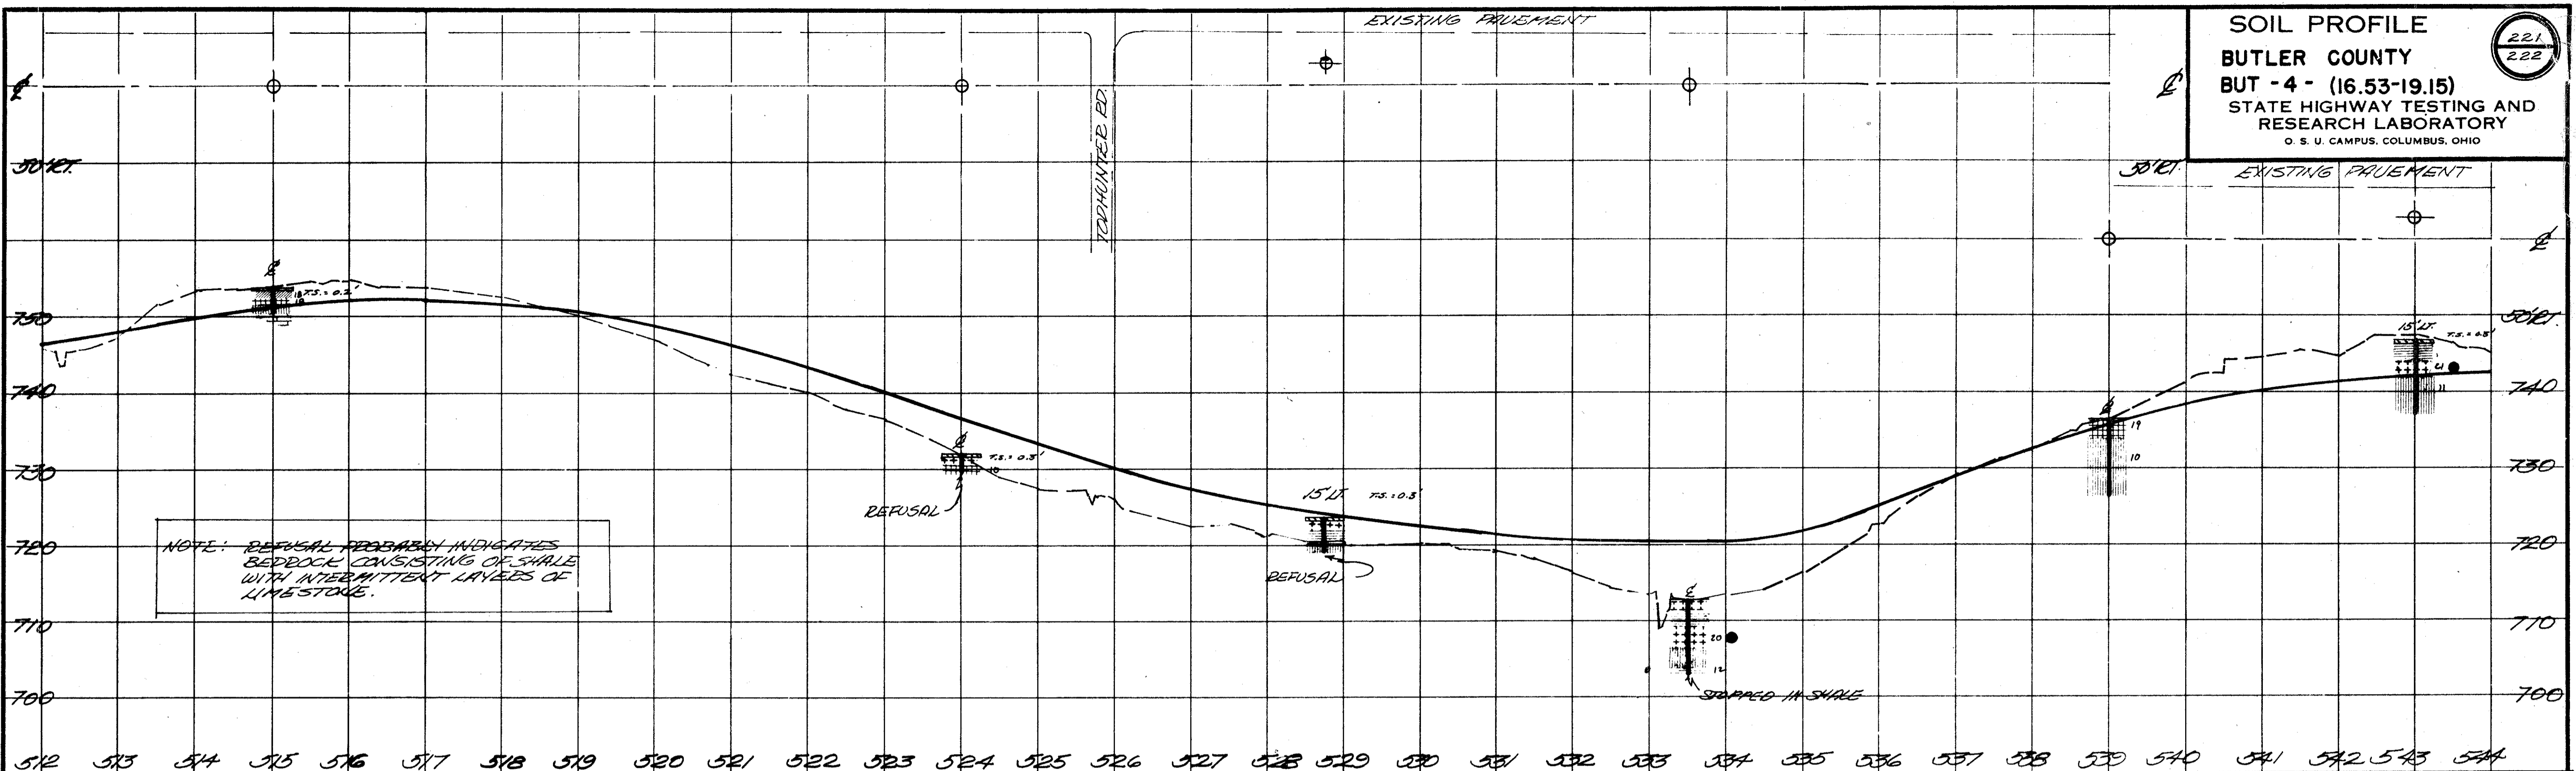

**SOIL PROFILE**  
**BUTLER COUNTY**  
**BUT-4 - (16.53-19.15)**  
**STATE HIGHWAY TESTING AND**  
**RESEARCH LABORATORY**  
O. S. U. CAMPUS, COLUMBUS, OHIO

