


CLI-28/73-17.08/14.91

MODEL: Sheet\_SurvF1 PAPER: 17x11 (in.) DATE: 10/19/2023 TIME: 2:19:49 PM USER: jdv464 p:\vohobol-pw-bentley.com\shahidol-pw-02\Documents\01 Active Projects\Distict 08\Clinton\1051651400-Engineering\Roadway\Sheets\105165\_GS001.dgn

SHEET NUM.							PART.	ITEM	ITEM	GRAND	UNIT	DESCRIPTION	SEE SHEET NO.
2	3	6	7	8	9	01/STR/05		EXT	TOTAL				
					46		46	202	23000	46	SY	ROADWAY	
					1,402		1,402	202	30000	1,402	SF	PAVEMENT REMOVED	
					5		5	202	32000	5	FT	WALK REMOVED	
					647		647	202	38000	647	FT	CURB REMOVED	
					7		7	202	42001	7	EACH	GUARDRAIL REMOVED	7
					1		1	202	42040	1	EACH	ANCHOR ASSEMBLY REMOVED, TYPE A, AS PER PLAN	
					8		8	202	47000	8	EACH	ANCHOR ASSEMBLY REMOVED, TYPE T	
		16					16	209	72050	16	MILE	BRIDGE TERMINAL ASSEMBLY REMOVED	
					375		375	606	15100	375	FT	PREPARING SUBGRADE FOR SHOULDER PAVING	
					7		7	606	26150	7	EACH	GUARDRAIL, TYPE MGS WITH LONG POSTS	
					1		1	606	26550	1	EACH	ANCHOR ASSEMBLY, MGS TYPE E, MASH 2016	
					8		8	606	35141	8	EACH	ANCHOR ASSEMBLY, MGS TYPE T	
					555		555	608	10000	555	SF	BRIDGE TERMINAL ASSEMBLY, TYPE 4, AS PER PLAN	8
					909		909	608	52000	909	SF	4" CONCRETE WALK	
					10		10	608	53020	10	SF	CURB RAMP	
												DETECTABLE WARNING	
												EROSION CONTROL	
		27					27	653	10000	27	CY	TOPSOIL FURNISHED AND PLACED	
		516					516	659	10000	516	SY	SEEDING AND MULCHING	
							1,000	832	30000	1,000	EACH	EROSION CONTROL	
												DRAINAGE	
3							3	611	98630	3	EACH	CATCH BASIN ADJUSTED TO GRADE	
1							1	611	98634	1	EACH	CATCH BASIN RECONSTRUCTED TO GRADE	
10							10	611	99654	10	EACH	MANHOLE ADJUSTED TO GRADE	
												PAVEMENT	
750							750	253	02000	750	CY	PAVEMENT REPAIR, (A)	
					12		12	253	02000	12	CY	PAVEMENT REPAIR, (B)	
		154,197					154,197	254	01000	154,197	SY	PAVEMENT PLANING, ASPHALT CONCRETE, 3.0"	
		1,552					1,552	254	01600	1,552	SY	PATCHING PLANED SURFACE	
		23,148					23,148	407	20000	23,148	GAL	NON-TRACKING TACK COAT	
		5,527					5,527	441	50000	5,527	CY	ASPHALT CONCRETE SURFACE COURSE, TYPE 1, (448), PG64-22	
		7,496					7,496	441	50300	7,496	CY	ASPHALT CONCRETE INTERMEDIATE COURSE, TYPE 2, (448)	
		463					463	617	10100	463	CY	COMPACTED AGGREGATE	
		982					982	617	20000	982	SY	SHOULDER PREPARATION	
		10					10	617	25000	10	MGAL	WATER	
				13.8			13.8	618	41000	13.8	MILE	RUMBLE STRIPES, EDGE LINE (ASPHALT CONCRETE)	
				7.24			7.24	618	43000	7.24	MILE	RUMBLE STRIPES, CENTER LINE (ASPHALT CONCRETE)	
				7.24			7.24	874	21000	7.24	MILE	LONGITUDINAL JOINT PREPARATION	
												WATER WORK	
							27	638	10800	27	EACH	VALVE BOX ADJUSTED TO GRADE	
												TRAFFIC CONTROL	
		470					470	621	00100	470	EACH	RPM	
		470					470	621	54000	470	EACH	RAISED PAVEMENT MARKER REMOVED	
				14			14	626	00110	14	EACH	BARRIER REFLECTOR, TYPE 2, (BI-DIRECTIONAL)	
				17.94			17.94	644	00104	17.94	MILE	EDGE LINE, 6"	
				8.97			8.97	644	00300	8.97	MILE	CENTER LINE	
				283			283	644	00400	283	FT	CHANNELIZING LINE, 8"	
				0.05			0.05	646	10010	0.05	MILE	EDGE LINE, 6"	
				0.02			0.02	646	10200	0.02	MILE	CENTER LINE	
				180			180	644	00500	180	FT	STOP LINE	
				735			735	644	00620	735	FT	CROSSWALK LINE, 12"	
				2			2	644	01000	2	EACH	RAILROAD SYMBOL MARKING	
				2			2	644	01110	2	EACH	SCHOOL SYMBOL MARKING, 96"	
				4			4	644	01300	4	EACH	LANE ARROW	

GENERAL SUMMARY

DESIGN AGENCY



DESIGNER  
JED

REVIEWER  
JDO 4/20/2023


PROJECT ID  
105165

SHEET TOTAL  
P.4 | 20

CLI-SR 28/73-17.08/14.91

MODEL: Sheet\_SurvFI PAPER SIZE: 17x11 (in.) DATE: 10/19/2023 TIME: 12:50:15 PM USER: jfavie4  
 p:\v\hobbs-pw.bentley.com\shahid-pw-02\Documents\01 Active Projects\District 08\Clinton\105165\400-Engineering\Roadway\Sheets\105165\_P\001.dgn

PART	COUNTY-ROUTE	LOG POINT (MILE)		TOTAL	644							646		618		874	REMARKS	
					EDGE LINE 6"	CENTER LINE	8" CHANNELIZING LINE	R/R CROSSING	SCHOOL MARKINGS	LANE ARROWS	CROSSWALK LINE 12"	STOP LINE	EDGE LINE 6"	CENTER LINE	EDGE LINE RUMBLES	CENTER LINE RUMBLES		LONGITUDINAL JOINT PREPERATION
					WHITE													
FROM	TO	MILE	MILE	FEET	EACH	EACH	EACH	FEET	FEET	MILE	MILE	MILE	MILE	MILE				
01/STR/05	CLI-28	17.01	18.16	1.15	2.3	1.15	283		2	4	735	128						
01/STR/05	CLI-73	14.90	22.72	7.82	15.64	7.82		2				52	0.05	0.02				
01/STR/05	CLI-73	14.90	21.81	6.91										13.80	6.91	6.91		
01/STR/05	CLI-28	17.83	18.16	0.33											0.33	0.33		
TOTALS CARRIED TO GENERAL SUMMARY					17.94	8.97	283	2	2	4	735	180	0.05	0.02	13.80	7.24	7.24	

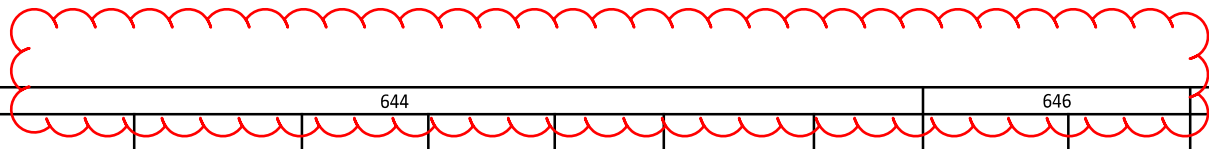

PAVEMENT MARKINGS

DESIGN AGENCY



DESIGNER  
JED

REVIEWER

JDO 04/20/2023

PROJECT ID  
105165

SHEET TOTAL  
P.7 20