

**INDEX OF SHEETS:**

TITLE SHEET	1
PLAN LEGEND AND DESIGN DESIGNATIONS	2
SCHEMATIC PLAN	3-8
GEOMETRIC PLAN	9-13
CURVE DATA	14-16
CONTROL POINT TABLE	17-20
TYPICAL SECTIONS	21-49
GENERAL NOTES	50-59
MAINTENANCE OF TRAFFIC	
NOTES	60-65, 65A
GENERAL SUMMARY	66
SUBSUMMARIES	67-99
TYPICAL SECTIONS	100-123
DETOUR PLANS	124-130, 130A, 131-136
SIGN DETAILS	137-157
SCHEMATIC PLANS	158-175
PLANS	176-262, 262A-262B, 263-286
CROSSOVER ELEVATIONS	287-290
DRAINAGE PLANS	291-315
CROSS SECTIONS	316-450
PLAN INSERT SHEET	451
GENERAL SUMMARY	452-456
SUBSUMMARIES	457-460
ESTIMATED QUANTITIES	461-488
CALCULATIONS	489-493, 493A - 493F
PROJECT SITE PLAN	494-500
PLAN AND PROFILE I-490	501-550
PLAN AND PROFILE - W. 7TH STREET	551-552
PLAN AND PROFILE - RAMP E-S (I-71)	553-558
PLAN AND PROFILE - RAMP S-E (I-71)	559-561
PLAN AND PROFILE - RAMP 7-7C	562-564
PLAN AND PROFILE - RAMP C-7	565
PLAN AND PROFILE - RAMP B-C	566
PLAN AND PROFILE - RAMP C-B	567
PLAN AND PROFILE - RAMP E-N (I-77)	568-571
PLAN AND PROFILE - RAMP E-S (I-77)	572-574
PLAN AND PROFILE - RAMP N-E (I-77)	575-576
PLAN AND PROFILE - RAMP N-W (I-77)	577-579
PLAN AND PROFILE - RAMP S-E (I-77)	580-582
PLAN AND PROFILE - RAMP S-W (I-77)	583-584



PLAN AND PROFILE - RAMP W-N (I-77)	585-587
PLAN AND PROFILE - RAMP W-S (I-77)	588-589
CROSS SECTIONS - I-490	590-659
CROSS SECTIONS - WB I-490	660-667
CROSS SECTIONS - EB I-490	668-681
CROSS SECTIONS - W. 7TH STREET	682-687
CROSS SECTIONS - RAMP E-S (I-71)	688-718
CROSS SECTIONS - RAMP S-E (I-71)	719-729
CROSS SECTIONS - RAMP 7-7C	730-741
CROSS SECTIONS - RAMP C-7	742-747
CROSS SECTIONS - RAMP B-C	748-755
CROSS SECTIONS - RAMP C-B	756-759
CROSS SECTIONS - RAMP E-N (I-77)	760-774
CROSS SECTIONS - RAMP E-S (I-77)	775-783
CROSS SECTIONS - RAMP N-E (I-77)	784-797
CROSS SECTIONS - RAMP N-W (I-77)	798-815
CROSS SECTIONS - RAMP S-E (I-77)	816-828
CROSS SECTIONS - RAMP S-W (I-77)	829-839
CROSS SECTIONS - RAMP W-N (I-77)	840-847
CROSS SECTIONS - RAMP W-S (I-77)	848-858
SUPERELEVATION TABLES	859-887
GORE DETAILS	888-897
PAVEMENT JOINT DETAILS	898-901
INTERSECTION DETAILS	902-905
CURB RAMP DETAILS	906-911
PAVEMENT REMOVAL PLAN	912
ROADWAY DETAILS	913-914
PIPE PROFILES	915-934
UNDERDRAIN DETAILS	935-939
DRAINAGE DETAILS	940-942
WATER WORK NOTES & DETAILS	943-945
TRAFFIC CONTROL	946-991
TRAFFIC SURVEILLANCE	992-1002, 1002A, 1002B
LIGHTING	1003-1031
FENCE PLAN	1032-1038
GEOTECHNICAL PROFILES - ROADWAY	1039-1068

**DESIGN DESIGNATIONS**

	I-490 EB FROM I-71 TO I-77	I-490 EB FROM I-77 TO E. 55TH ST.	I-490 WB FROM I-71 TO E. 55TH ST.
CURRENT YEAR ADT (2023)	38,250	16,450	38,250
DESIGN YEAR ADT (2043)	44,250	9,750	44,250
DESIGN HOURLY VOLUME (2043)	8,050	900	8,050
DIRECTIONAL DISTRIBUTION	70%	52%	70%
TRUCKS (24 HOUR B & C)	8%	8%	8%
TD	4%	6%	4%
DESIGN SPEED	65 MPH	40 MPH	65 MPH
LEGAL SPEED	60 MPH	35 MPH	60 MPH
DESIGN FUNCTIONAL CLASSIFICATION:	01 URBAN INTERSTATES	01 URBAN INTERSTATE	01 URBAN INTERSTATE
NHS PROJECT	YES	YES	YES

	I-71 SOUTH OF I-490	I-77	W. 7TH ST.
CURRENT YEAR ADT (2023)	86,000	52,000	6,000
DESIGN YEAR ADT (2043)	86,000	67,000	6,000
DESIGN HOURLY VOLUME (2043)	8,600	8,000	700
DIRECTIONAL DISTRIBUTION	70%	70%	53%
TRUCKS (24 HOUR B & C)	4%	9%	9%
TD	2%	3%	11%
DESIGN SPEED	65 MPH	55 MPH	30 MPH
LEGAL SPEED	60 MPH	50 MPH	25 MPH
DESIGN FUNCTIONAL CLASSIFICATION:	01 URBAN INTERSTATE	01 URBAN INTERSTATE	05 URBAN MAJOR COLLECTOR
NHS PROJECT	YES	YES	NO

**BALLOON LEGEND**

- AB-# ABANDON
- B-# CONCRETE BARRIER
- BR-# CONCRETE BARRIER REMOVED
- D-# CATCH BASINS, MANHOLES AND INLETS
- DJ-# CATCH BASINS, MANHOLES AND INLETS ADJUSTED/RECONSTRUCTED TO GRADE
- DR-# CATCH BASINS, MANHOLES AND INLETS REMOVED
- DV-# DRIVEWAYS
- E-# EROSION CONTROL
- EX-# EXISTING CATCH BASINS, MANHOLES AND INLETS
- F-# FENCE
- FP-# FILL & PLUG
- FR-# FENCE REMOVED
- G-# GUARDRAIL
- GR-# GUARDRAIL REMOVED
- HR-# HEADWALL REMOVED
- HW-# HEADWALL
- LS-# LANDSCAPING
- P-# DRAINAGE PIPES
- PC-# PIPE CLEANOUT
- PR-# PIPES REMOVED
- R-# MISCELLANEOUS REMOVALS
- SA-# SANITARY MANHOLE
- SJ-# SANITARY STRUCTURE ADJUSTED/RECONSTRUCTED TO GRADE
- SL-# SANITARY LATERAL
- SM-# SEEDING AND MULCHING
- SP-# SANITARY PIPE
- SR-# SANITARY REMOVAL
- U-# UNDERDRAINS
- W-# WATER WORK
- WJ-# WATER WORK ADJUSTED TO GRADE
- WR-# WATER WORK REMOVALS

**EXISTING UTILITY SYMBOL LEGEND**

- Guy Pole
- Flag Pole
- Utility Pole
- Power Pole
- Yard Light
- Parking Meters
- Parking Meter
- Air Condition Unit
- Guy Wire w/Anchor
- Light Pole
- Light Pedestal
- Electric Marker Post
- Electric Meter
- Electric Transformer
- Electric Pedestal
- Electric Tower
- Electric Outlet
- Electric Pull Box
- Electric Manhole
- Gas Valve
- Gas Service
- Gas Marker Post
- Gas Meter/ Regulator
- Tank (Gas, Propane)
- Fire Hydrant
- Water Valve
- Water Manhole
- Water Well
- Water Meter
- Water Spigot / Tap
- Cistern
- Sprinkler
- Sprinkler Control Box
- Monitoring Well
- Cable TV Pole
- Cable TV Marker Post
- Cable TV Pedestal
- Telephone Pole
- Telephone Marker Post
- Telephone Pedestal
- Telephone Booth/or Drive-Up
- Traffic Lighting Control Box
- Traffic Lighting Pull Box
- Sign
- Curb Inlet
- Catch Basin
- Cleanout
- Sanitary Manhole
- Storm Manhole
- Telephone Manhole

**PROPOSED UTILITY SYMBOL LEGEND**

- Proposed Catch Basins
- Proposed Manhole
- Manhole Adjusted To Grade
- Proposed Exfiltration Trench
- Proposed Water Valve
- Proposed Fire Hydrant
- Sanitary Manhole Adjusted To Grade
- Proposed Traffic Pullbox
- Proposed Conventional Luminaire
- Proposed Lighting Pullbox
- Proposed Decorative Luminaire
- Proposed Signal Pole Pedestal
- Proposed Signal Pole
- Test Hole location


**UTILITY LINE LEGEND**

- Water Line
- Gas Line
- Sanitary Line
- Underground Electric
- Propane Line
- Underground Telephone
- Diesel
- Cable TV
- Signal Wiring

REVISIONS			DESIGNER	
NO.	DATE	DESCRIPTION	ATR	REVIEWER
1	01/15/24	ADDED SHEET 65A		PJF 11-21-23
2	02/26/24	ADDED SHEETS 493A-493F		PROJECT ID 107408
4	04/02/24	ADDED SHEETS 262A-262B		SHEET TOTAL 2   1068



DESIGNER	ATR
REVIEWER	PJF 11-21-23
PROJECT ID	107408
SHEET	2
TOTAL	1068

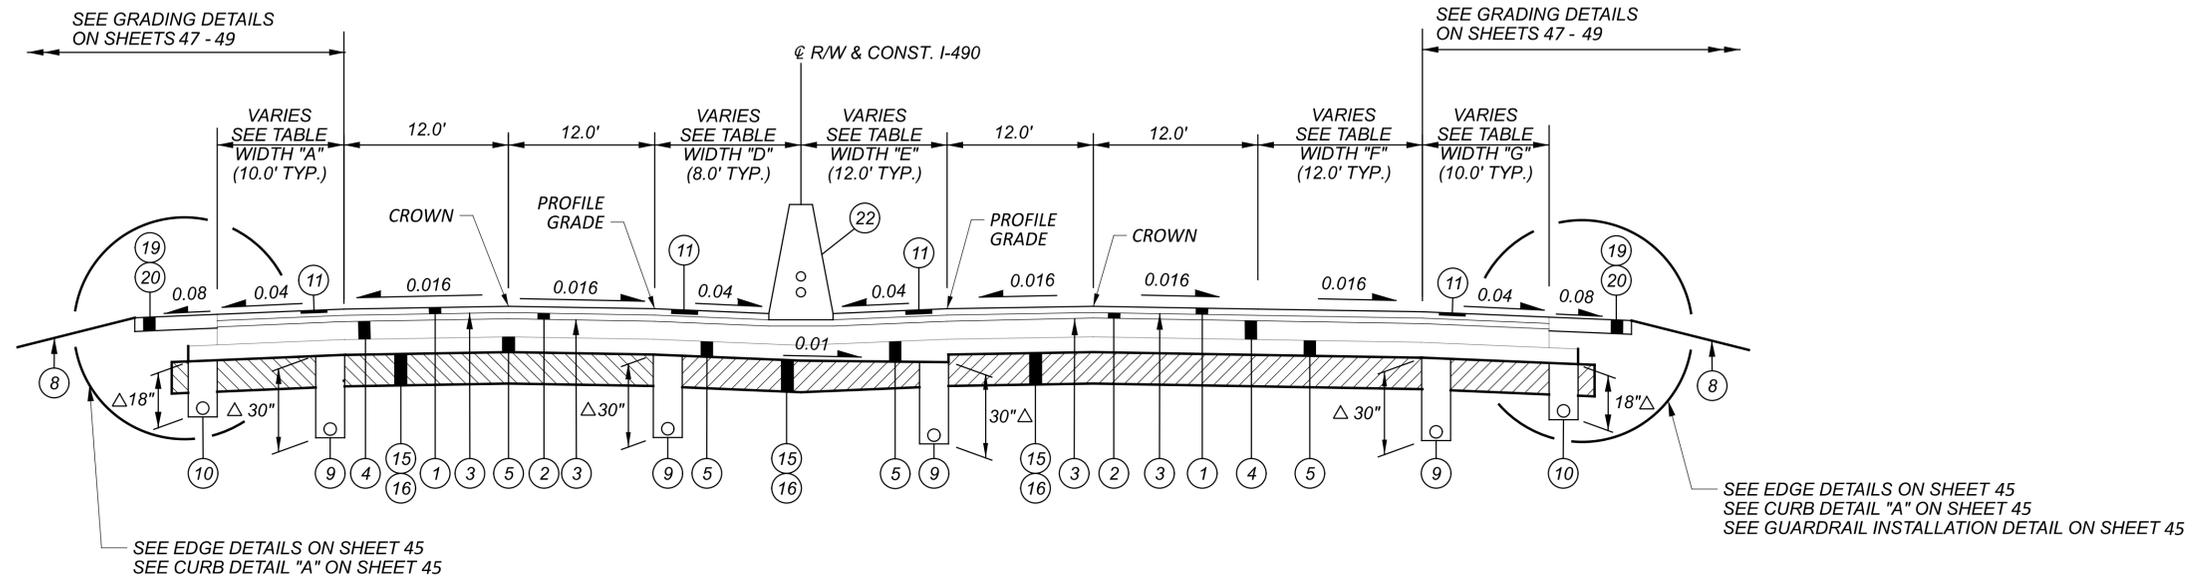

**I-490 NORMAL SECTION**  
 LIMITING STATIONS

WB LANES: STA 933+23.03 TO STA 939+72.56  
 EB LANES: STA 933+23.03 TO STA 938+52.62

FOR WIDTH TABLE, SEE SHEET 29

△ - OR AS SHOWN IN UNDERDRAIN PLANS, SEE SHEET 935


**PROPOSED LEGEND**

- |  |  |  |
|--|--|--|
| <ul style="list-style-type: none"> <li>① ITEM 442 - 1.5" ASPHALT CONCRETE SURFACE COURSE, 12.5 MM, TYPE A (447), AS PER PLAN, PG76-22M</li> <li>② ITEM 442 - 1.75" ASPHALT CONCRETE INTERMEDIATE COURSE, 12.5 MM, TYPE A (446)</li> <li>③ ITEM 407 - NON-TRACKING TACK COAT</li> <li>④ ITEM 302 - 7" ASPHALT CONCRETE BASE, PG 64-22, (449)</li> <li>⑤ ITEM 304 - 6" AGGREGATE BASE</li> <li>⑥ ITEM 452 - 10.5" NON-REINFORCED CONCRETE PAVEMENT, CLASS QC1P WITH QC/QA</li> <li>⑦ ITEM 204 - SUBGRADE COMPACTION</li> <li>⑧ ITEM 659 - SEEDING AND MULCHING</li> <li>⑨ ITEM 605 - 6" SHALLOW PIPE UNDERDRAINS WITH GEOTEXTILE FABRIC (CONSTRUCT AFTER CEMENT STABILIZATION)</li> <li>⑩ ITEM 605 - 6" BASE PIPE UNDERDRAINS WITH GEOTEXTILE FABRIC (CONSTRUCT AFTER CEMENT STABILIZATION)</li> <li>⑪ ITEM 618 - RUMBLE STRIPS, SHOULDER (ASPHALT CONCRETE), AS PER PLAN</li> <li>⑫ ITEM 606 - GUARDRAIL, TYPE MGS</li> <li>⑬ LONGITUDINAL JOINT AS PER BP-2.1</li> </ul> | <ul style="list-style-type: none"> <li>⑭ ITEM 622 - CONCRETE BARRIER, SINGLE SLOPE, TYPE D</li> <li>⑮ ITEM 206 - CEMENT<br/>ITEM 206 - CURING COAT<br/>ITEM 206 - CEMENT STABILIZED SUBGRADE, 14" INCHES DEEP (SEE SHEET 51)</li> <li>⑯ ITEM 204 - PROOF ROLLING</li> <li>⑰ ITEM 441 - 3" ASPHALT CONCRETE INTERMEDIATE COURSE, TYPE 1, (449), (UNDER GUARDRAIL), AS PER PLAN</li> <li>⑱ ITEM 209 - RESHAPING UNDER GUARDRAIL, AS PER PLAN</li> <li>⑲ ITEM 617 - COMPACTED AGGREGATE, AS PER PLAN<br/>ITEM 617 - SHOULDER PREPARATION<br/>ITEM 617 - WATER</li> <li>⑳ ITEM 408 - PRIME COAT, AS PER PLAN</li> <li>㉑ ITEM 609 - CURB, TYPE 4-C</li> <li>㉒ ITEM 622 - CONCRETE BARRIER, SINGLE SLOPE, TYPE C1 (4" LIGHTING CONDUIT AND 2" ITS CONDUIT PER SCD RM-4.3)</li> <li>㉓ ITEM 254 - PAVEMENT PLANING, ASPHALT CONCRETE (1=1.5)</li> <li>㉔ ITEM 622 - CONCRETE BARRIER, SINGLE SLOPE, TYPE D, AS PER PLAN</li> <li>㉕ ITEM 609 - CURB, TYPE 6</li> </ul> | <ul style="list-style-type: none"> <li>㉖ ITEM 601 - PAVED GUTTER, TYPE 1-2, AS PER PLAN</li> <li>㉗ ITEM 601 - CONCRETE SLOPE PROTECTION</li> <li>㉘ ITEM 622 - CONCRETE BARRIER, SINGLE SLOPE, TYPE C1, AS PER PLAN (4" LIGHTING CONDUIT AND 2" ITS CONDUIT PER SCD RM-4.3)</li> <li>㉙ ITEM 622 - CONCRETE BARRIER, SINGLE SLOPE, TYPE B1 (4" LIGHTING CONDUIT AND 2" ITS CONDUIT PER SCD RM-4.3)</li> <li>㉚ ITEM 608 - 4" CONCRETE WALK</li> <li>㉛ ITEM 304 - 3" AGGREGATE BASE</li> <li>㉜ ITEM 609 - 4" CONCRETE TRAFFIC ISLAND</li> <li>㉝ ITEM 304 - 4" AGGREGATE BASE</li> <li>㉞ ITEM 601 - PAVED GUTTER, TYPE 3, AS PER PLAN</li> <li>㉟ ITEM 622 - CONCRETE BARRIER, SINGLE SLOPE, TYPE C</li> <li>㊱ ITEM 203 - GRANULAR MATERIAL, TYPE C</li> </ul> |
|--|--|--|

REVISIONS		
NO.	DATE	DESCRIPTION
4	04/04/24	UPDATED CONDUITS IN MEDIAN BARRIER


DESIGN AGENCY  
  
 DESIGNER  
**NRB**  
 REVIEWER  
**PJF 11-21-23**  
 PROJECT ID  
**107408**  
 SHEET TOTAL  
**24 1068**

REVISIONS		
NO.	DATE	DESCRIPTION
4	04/04/24	UPDATED CONDUITS IN MEDIAN BARRIER

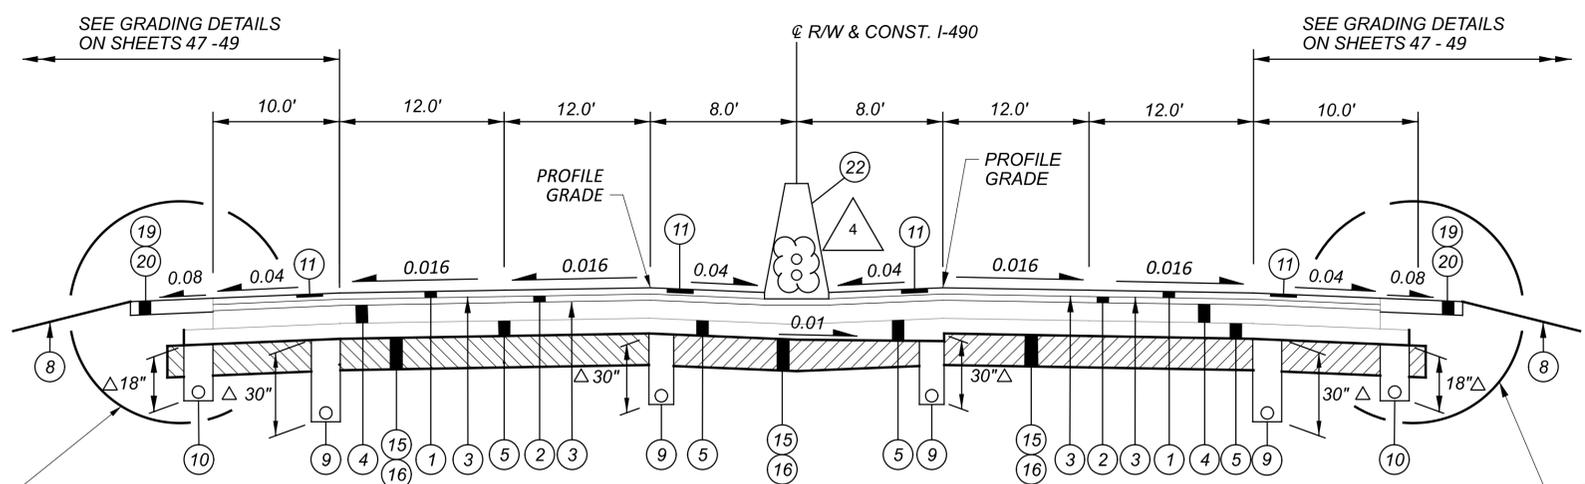

**I-490 NORMAL SECTION**  
LIMITING STATIONS


WB LANES: STA 1032+73.90 TO STA 1035+00.00 EB LANES: STA 1030+94.06 TO STA 1035+00.00

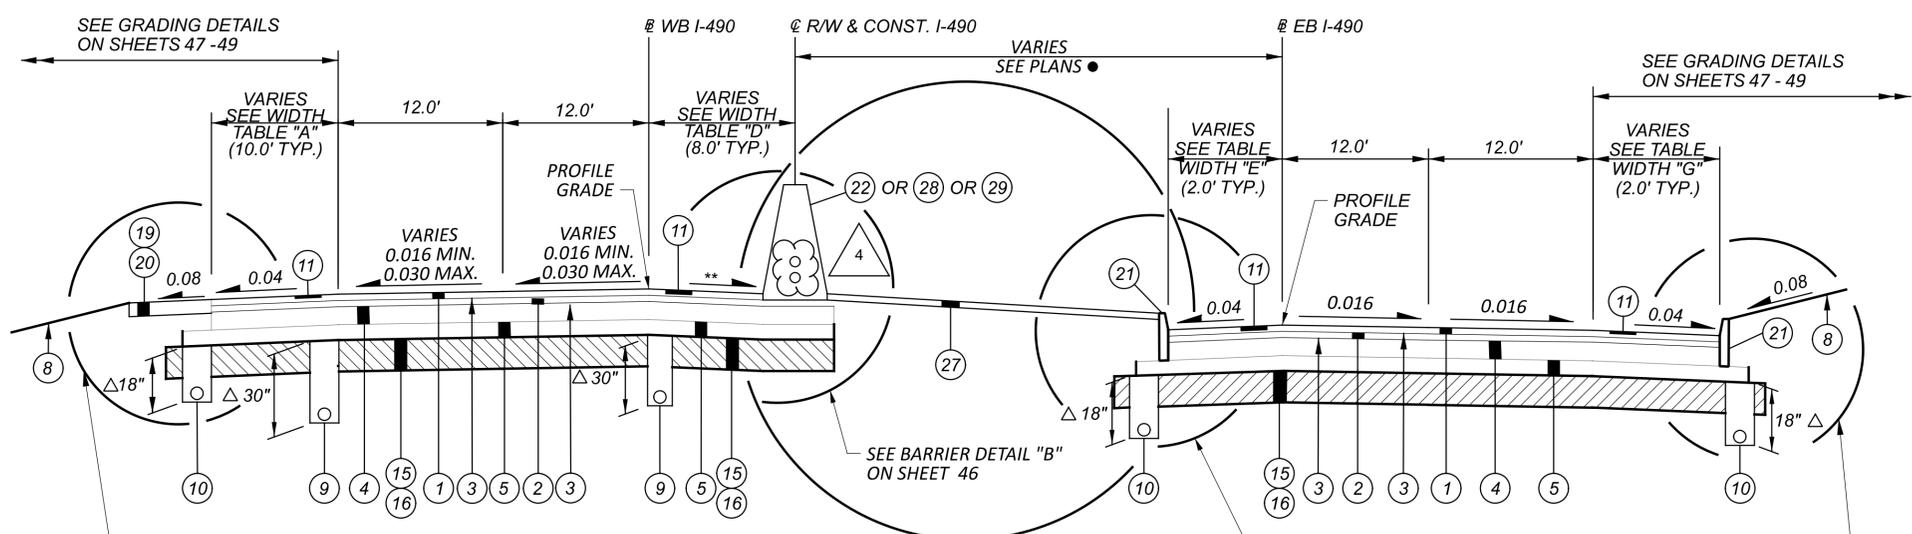

**WB I-490 & EB I-490 NORMAL/ SUPERELEVATED LEFT SECTION**  
LIMITING STATIONS


CONST. WB I-490 STA 3035+00.00 TO STA. 3049+75.86  
CONST. EB I-490 STA. 2035+00.00 TO STA. 2050+87.73

STA. 2035+00.00 TO STA. 2050+07.73  
VARIES - SEE CURVES 6, 7, & 8 DATA IN PLANS

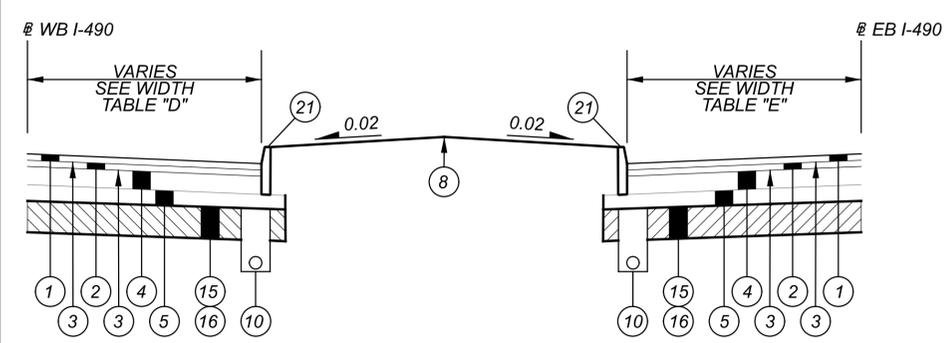

**MEDIAN DETAIL "A"**  
FOR PAVEMENT EDGE EXTENSIONS,  
SEE CURB DETAIL "A" ON SHEET 45  
N.T.S.  
LIMITING STATIONS

CONST. WB I-490 STA 3045+05.00 TO STA. 3049+75.86  
CONST. EB I-490 STA. 2045+05.33 TO STA. 2050+87.73

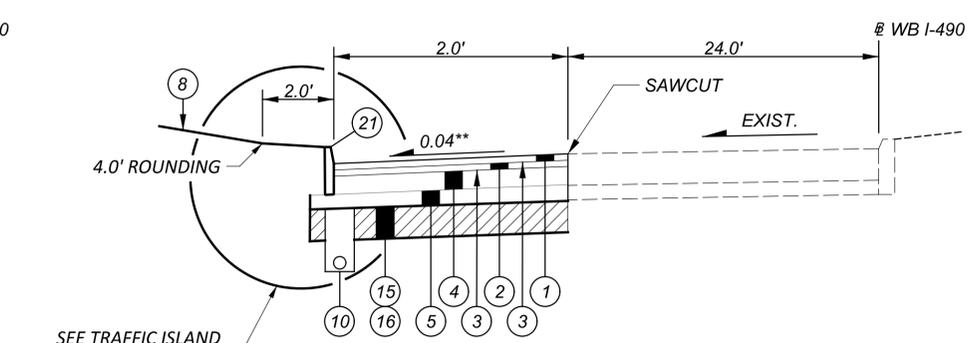

**WB I-490 SHOULDER WIDENING SECTION**  
FOR PAVEMENT EDGE EXTENSIONS,  
SEE CURB DETAIL "A" ON SHEET 45  
N.T.S.  
LIMITING STATIONS

CONST. WB I-490: STA. 3049+75.86 TO STA. 3050+62.68

FOR PROPOSED LEGEND, SEE SHEET 24  
FOR WIDTH TABLE, SEE SHEET 29  
FOR SUPERELEVATION TABLES, SEE SHEETS 866 - 867

\* 0.04 OR RATE OF PAVEMENT SLOPE IF GREATER.  
\*\* FOR HIGH SIDE SHOULDER SLOPES, SEE SHOULDER DETAIL "A" ON SHEET 45.

Δ - OR AS SHOWN IN UNDERDRAIN PLANS, SEE SHEETS 938 - 939

CUY-490-0.00 PART 1  
 MODEL: Sheet PAPER SIZE: 34x22 (in.) DATE: 4/4/2024 TIME: 1:51:27 PM USER: pfly  
 C:\Clients\ORD\2021\2021089\107408\400-Engineering\Roadway\Sheets\107408\_GY005.dgn

TYPICAL SECTIONS

DESIGN AGENCY	NRB
DESIGNER	NRB
REVIEWER	PJF 11-21-23
PROJECT ID	107408
SHEET	28
TOTAL	1068

**GENERAL (CONTINUED)**

**ITEM 619 FIELD OFFICE, TYPE C, AS PER PLAN**

ALL REQUIREMENTS OF C&MS 619 SHALL APPLY EXCEPT AS MODIFIED HEREIN:

THE FIELD OFFICE SHALL BE A SUITE TYPE OFFICE (NO TRAILER OR MODULAR OFFICE) WITH A MINIMUM OF 4,000 SQUARE FEET AND AT GROUND LEVEL WITH A MINIMUM CEILING HEIGHT OF EIGHT (8) FEET. PROVIDE TWO (2) OUTSIDE DOORS, LOCKABLE VANDAL PROOF CYLINDER TYPE DEAD BOLTS AND LOCKABLE WINDOWS. THE FLOOR SPACE WILL BE DIVIDED INTO TWO RESTROOMS, ONE GENERAL OFFICE AREA (MINIMUM 400 SQUARE FEET), NOT LESS THAN SEVEN INDIVIDUAL OFFICES (MINIMUM 300 SQUARE FEET EACH) AS SEPARATE ENCLOSED ROOMS (NO CUBICLE DIVIDERS WILL BE ACCEPTED), ONE KITCHEN SPACE INCLUDING SINK, REFRIGERATOR, AND MICROWAVE, AND ONE CONFERENCE ROOM (MINIMUM 1000 SQUARE FEET).

FURNISH NEAT, SANITARY, ENCLOSED TOILET ACCOMMODATIONS CONNECTED TO AN EXISTING SANITARY SEWER LINE FOR THE USE OF THE OCCUPANTS OF THE FIELD OFFICE, MEETING APPLICABLE STATE AND LOCAL CODES AND ORDINANCES. FURNISH ASSOCIATED LAVATORY AND SANITARY SUPPLIES. POTABLE HOT AND COLD RUNNING WATER WILL BE PROVIDED IN THE RESTROOM FOR SANITARY PURPOSES.

FURNISH TRASH COLLECTION SERVICE/DUMPSTER.

FURNISH PROFESSIONAL, BONDED, AND INSURED JANITORIAL SERVICE WITH A WEEKLY CLEANING OF THE ENTIRE OFFICE TO INCLUDE THE RESTROOM FACILITIES FOR THE DURATION OF THE PROJECT,

FURNISH BOTTLED DRINKING WATER SERVICE WITH A HOT AND COLD DISPENSER AND ASSOCIATED SUPPLIES.

FURNISH A BOX FOR STORING A NUCLEAR DENSITY GAUGE WITH REQUIREMENTS AS SET FORTH IN C&MS 619.02.

FURNISH AND MAINTAIN A BROADBAND INTERNET CONNECTION CAPABLE OF MINIMUM DOWNLOAD SPEEDS OF 1.0 GB/S. PROVIDE A WIRELESS ROUTER THAT SUPPORTS WI-FI STANDARD 802.11AX (WIFI 6) AND A MINIMUM WIRELESS DATA TRANSFER RATE OF 4000 MB/S. PROVIDE PRE-WIRED ETHERNET ACCESS FOR ALL INDIVIDUAL OFFICES AND THE CONFERENCE ROOM.

FURNISH TEN (10) DESK AND CHAIR SETS, THIRTY (30) STACKABLE CHAIRS, TWENTY (20) WORK TABLES (30" x72"), AND TWELVE (12) 24- QUART WASTE BASKETS WITH APPROPRIATE SIZED TRASH BAGS.

FURNISH AND INSTALL TWO (2) WALL-MOUNTED 8' x 4' GLASS, MAGNETIC DRY ERASE BOARDS.

FURNISH ONE NEW TELEVISION WITH THE FOLLOWING SPECIFICATIONS:

- a) DIAGONAL SCREEN SIZE - 70" MINIMUM"
- b) NATIVE RESOLUTION - 4K
- c) HDMI PORTS: 3
- d) ALL ACCESSORIES NECESSARY TO OPERATE
- f) ALL HARDWARE AND INSTALLATION NECESSARY TO HANG THE TELEVISION ON THE WALL IN THE CONFERENCE ROOM

THE FIELD OFFICE WILL BE APPROVED IN ADVANCE BY THE ENGINEER AND FULLY OPERATIONAL WITHIN 30 DAYS AFTER THE SIGNING AND EXECUTION OF THE PROJECT OR PRIOR TO THE START OF ANY CONSTRUCTION WORK, WHICHEVER COMES FIRST.

THE DEPARTMENT WILL MEASURE FIELD OFFICE, TYPE C, AS PER PLAN BY THE NUMBER OF MONTHS THE OFFICE IS MAINTAINED. A PARTIAL MONTH AT THE END OF THE PROJECT WILL BE PAID AS A FULL MONTH.

THE DEPARTMENT WILL PAY FOR ACCEPTED QUANTITIES AT THE CONTRACT PRICE AS FOLLOWS:

ITEM	UNIT	DESCRIPTION
619	MONTH	FIELD OFFICE, TYPE C, AS PER PLAN

REVISIONS		
NO.	DATE	DESCRIPTION
1	01/15/24	PERMITS NOTE ADDED
2	02/15/24	PERMITS NOTE UPDATED
3	03/05/24	EXCAVATION OF SUBGRADE QUANTITY ADDED
4	04/04/24	SUBGRADE NOTE & QUANTITIES UPDATED

QUANTITIES CARRIED TO GENERAL NOTES SUBSUMMARY ON SHEET 59

**ITEM SPECIAL - SURVEY CONTROL VERIFICATION**

THE CONTRACTOR SHALL PERFORM THIS WORK TO VERIFY THE PROVIDED SURVEY CONTROL. THE CONTRACTOR WILL PERFORM THE VERIFICATION USING ONE OF THE TWO METHODS BELOW DEPENDENT UPON THE CONTRACTOR'S CHOSEN MEANS OF SURVEY CONTROL TO BE USED ON THE PROJECT. THE WORK SHALL BE PERFORMED UNDER THE DIRECT SUPERVISION OF AN OHIO LICENSED SURVEYOR.

- 1) IF USING GPS DEVICES TO ESTABLISH AND OR PROVIDE SUPPLEMENTAL HORIZONTAL AND VERTICAL SURVEY CONTROL:
  - a. LOCATE VERTICAL CONTROL POINTS PROVIDED IN THE PLANS AND PERFORM A DIFFERENTIAL LEVEL CIRCUIT.
  - b. PERFORM A SITE CALIBRATION UTILIZING THE AVAILABLE HORIZONTAL AND VERTICAL CONTROL POINTS PROVIDED IN THE PLAN.
  - c. PROVIDE A REPORT, SIGNED BY AN OHIO LICENSED SURVEYOR, TO THE PROJECT ENGINEER COMPARING THE OBSERVED DATA TO THE PLAN DATA ALONG WITH A NARRATIVE DETAILING ANY DISCREPANCIES FOUND.
- 2) IF USING CONVENTIONAL SURVEY INSTRUMENTATION TO ESTABLISH AND OR PROVIDE SUPPLEMENTAL HORIZONTAL AND VERTICAL SURVEY CONTROL:
  - a. LOCATE VERTICAL CONTROL POINTS PROVIDED IN THE PLANS AND PERFORM A DIFFERENTIAL LEVEL CIRCUIT.
  - b. LOCATE AND OBSERVE ANGLE AND DISTANCE TO ALL AVAILABLE HORIZONTAL CONTROL POINTS PROVIDED IN THE PLAN.
  - c. PROVIDE A REPORT, SIGNED BY AN OHIO LICENSED SURVEYOR, TO THE PROJECT ENGINEER COMPARING THE OBSERVED DATA TO THE PLAN DATA ALONG WITH A NARRATIVE DETAILING ANY DISCREPANCIES FOUND.

ALL MATERIALS, LABOR, EQUIPMENT, TOOLS, AND INCIDENTALS NECESSARY TO COMPLETE THIS WORK SHALL BE INCLUDED IN THE LUMP SUM BID ITEM.

**PERMIT**

IN THE CITY OF CLEVELAND, ALL PERMITS MUST BE OBTAINED FROM THE DIVISION OF ASSESSMENTS AND LICENSES PRIOR TO BEGINNING ANY WORK WITHIN THE CITY OF CLEVELAND RIGHT OF WAY. PERMITS INCLUDE BUT ARE NOT LIMITED TO STREET OPENING PERMIT, OVERLOAD PERMIT, OBSTRUCTION PERMIT AND/OR SIDEWALK PERMIT AND MAY BE OBTAINED THROUGH THE FOLLOWING CONTACT:

TRAVIS EVANS  
DEPARTMENT OF FINANCE  
DIVISION OF ASSESSMENTS AND LICENSES  
601 LAKESIDE AVENUE, ROOM 122  
CLEVELAND, OHIO 44114  
PHONE: (216) 664-2174  
EMAIL: DALPERMITS@CITY.CLEVELAND.OH.US

ALL STREET OPENING REPAIRS, CURB REPAIRS, AND/OR SIDEWALK REPAIRS EITHER INCIDENTAL TO THE PROJECT OR PART OF THE PROJECT MUST BE PERFORMED IN ACCORDANCE TO CITY OF CLEVELAND STANDARDS. A COPY OF THE STANDARDS CAN BE OBTAINED ON-LINE UNDER THE "FORMS AND PUBLICATIONS" TAB OF THE CAPITAL PROJECTS WEBSITE OR FROM THE DIVISION OF ENGINEERING AND CONSTRUCTION BY CALLING (216) 664-2381.

ALL PERMITS, FEES AND CHARGES SHALL BE THE RESPONSIBILITY OF THE CONTRACTOR AND THEIR ASSOCIATED COST SHALL BE INCLUDED IN THE CONTRACT UNIT PRICE BID FOR THIS ITEM. THE COST BELOW MAY NOT BE FULLY INCLUSIVE OF ALL PERMIT FEES REQUIRED TO BE PAID. NOTE THAT CLEVELAND WATER DEPARTMENT CHARGES ARE PAID UNDER A SEPARATE ITEM.

FOR BIDDING PURPOSES, THE FOLLOWING FEES AND CHARGES HAVE BEEN ESTIMATED BY THE CITY OF CLEVELAND DIVISION OF ENGINEERING AND CONSTRUCTION ON BEHALF OF THE DIVISION OF ASSESSMENTS AND LICENSES (DAL): \$1,540

DAL HAS ASSIGNED RECORD NUMBER STP24-00196 TO THIS PROJECT. THE AWARDED CONTRACTOR SHALL CONTACT DAL AS DESCRIBED ABOVE, USING THE ASSIGNED STP NUMBER FOR REFERENCE. THE CONTRACTOR SHALL PROVIDE DAL WITH THEIR CERTIFICATE OF INSURANCE (COI) MEETING THE CITY OF CLEVELAND REQUIREMENTS. UPON SUBMITTAL OF THE COI AND RECEIPT OF PAYMENT, DAL WILL ISSUE THE PERMIT.

THE FOLLOWING QUANTITY HAS BEEN CARRIED TO THE GENERAL NOTES SUBSUMMARY:

ITEM SPECIAL - PERMITS LUMP

**ROADWAY**

**ITEM 202 - PAVEMENT REMOVED**

AS SHOWN ON THE PAVEMENT REMOVAL CALCULATIONS (SHEET 489 TO 492), THE CONTRACTOR SHALL REMOVE ALL PAVEMENTS WHETHER ASPHALT, CONCRETE, OR COMPOSITE UNDER THE PRICE BID FOR ITEM 202 - PAVEMENT REMOVAL (SY).

**ITEM 204 - SUBGRADE COMPACTION AND PROOF ROLLING**

CONSTRUCT THE SUBGRADE AS FOLLOWS AND IN THE FOLLOWING SEQUENCE:

1. SHAPE THE SUBGRADE TO WITHIN 0.2 FEET OF THE PLAN SUBGRADE ELEVATION.
2. EXCAVATE AND REPLACE UNSUITABLE SUBGRADE BEFORE PROOF ROLLING. THE EXCAVATION LIMITS ARE SHOWN AND LABELED ON THE CROSS SECTIONS AS UNSUITABLE SUBGRADE. UNSUITABLE SUBGRADE INCLUDES UNSUITABLE SOIL (A-4B, A-2-5, A-5, A-7-5, AND SOIL WITH A LIQUID LIMIT GREATER THAN 65) AND ANY COAL, SHALE, OR ROCK WHICH NEEDS TO BE REMOVED ACCORDING TO SECTION 204.05 OF THE CONSTRUCTION AND MATERIAL SPECIFICATIONS (C&MS).  
  
IF THERE IS UNSUITABLE SUBGRADE IN A SHALLOW FILL LOCATION, EXCAVATE AND REPLACE THE UNSUITABLE SUBGRADE BEFORE CONSTRUCTING THE SHALLOW FILL AND SHAPING THE SUBGRADE.
3. COMPACT THE SUBGRADE ACCORDING TO C&MS 204.03.
4. APPROXIMATE LIMITS FOR EXCAVATION OF UNSTABLE SUBGRADE ARE SHOWN AND LABELED ON THE CROSS SECTIONS AS UNSTABLE SUBGRADE. THE ENGINEER WILL IDENTIFY THE ACTUAL LIMITS OF EXCAVATION FOR UNSTABLE SUBGRADE BASED ON THE PROOF ROLLING RESULTS AND VISUAL OBSERVATIONS.  
  
PROOF ROLL THE COMPACTED SUBGRADE ACCORDING TO C&MS 204.06.
5. EXCAVATE UNSTABLE SUBGRADE AS DIRECTED BY THE ENGINEER AND STABILIZE BY REPLACING WITH THE SPECIFIED MATERIALS ACCORDING TO C&MS 204.07. EXCAVATIONS WILL EXTEND 18 INCHES BEYOND THE EDGE OF THE SURFACE OF THE PAVEMENT, PAVED SHOULDERS, OR PAVED MEDIANS.
6. PROOF ROLL THE STABILIZED AREAS ACCORDING TO C&MS 204.06 TO VERIFY STABILITY.
7. FINE GRADE THE SUBGRADE TO THE SPECIFIED GRADE.

THE QUANTITIES FOR EXCAVATING THE UNSUITABLE SUBGRADE AND UNSTABLE SUBGRADE ARE BOTH PAID UNDER ITEM 204, EXCAVATION OF SUBGRADE.

**ITEM 204 - PROOF ROLLING**

THE FOLLOWING QUANTITY IS PROVIDED IN THE GENERAL SUMMARY TO ADDRESS LOCATIONS REQUIRING PROOF ROLLING. SEE TYPICAL PLAN SHEETS 24 - 46 FOR ADDITIONAL INFORMATION.

ITEM 204 - PROOF ROLLING 80 HOUR

PAVEMENT SUBGRADE IMPROVEMENT SCHEDULE						
ALIGNMENT	BEGIN STATION	END STATION	SUBGRADE METHOD	DEPTH OF TREATMENT	SIDE	TREATMENT REASON
C/L R/W & CONST. I-490	933+23.03	985+67.50	CEMENT	14"	L/R	SILT PRESENT
	1020+69.29	1035+00.00	CEMENT	14"	L/R	SILT PRESENT
B/L CONST. EB I-490	2035+00.00	2050+87.73	CEMENT	14"	L/R	SILT PRESENT
B/L CONST. WB I-490	3035+00.00	3049+75.86	CEMENT	14"	L/R	SILT PRESENT
C/L CONST. W. 7TH ST.	10+24.33	14+47.65	CEMENT	14"	L	SILT PRESENT
	3036+66.35	3042+13.54	CEMENT	14"	L/R	
B/L CONST. RAMP E-S (I-71)	3047+21.36	3058+59.21	CEMENT	14"	L/R	
	3058+59.21	3064+68.90	CEMENT	14"	L/R	SILT PRESENT
B/L CONST. RAMP S-E (I-71)	2049+00.00	2052+23.15	CEMENT	14"	L/R	
	2052+23.15	2058+00.00	CEMENT	14"	L/R	SILT PRESENT
B/L CONST. RAMP 7-7C	68+37.92	80+59.02	CEMENT	14"	L/R	SILT PRESENT
B/L CONST. RAMP C-7	81+96.55	85+63.86	CEMENT	14"	L/R	SILT PRESENT
B/L EX. & CONST. RAMP B-C	14+98.42	18+18.79	CEMENT	14"	L/R	
B/L EX. & CONST. RAMP C-B	14+78.03	17+33.88	CEMENT	14"	L/R	
B/L CONST. RAMP E-N (I-77)	734+00.31	746+47.57	CEMENT	14"	L/R	
B/L CONST. RAMP E-S (I-77)	836+08.78	842+23.67	CEMENT	14"	L/R	
B/L CONST. RAMP N-E (I-77)	437+48.58	445+70.00	CEMENT	14"	L/R	
B/L CONST. RAMP N-W (I-77)	120+15.54	131+37.52	CEMENT	14"	L/R	
B/L CONST. RAMP S-E (I-77)	336+00.00	347+00.00	CEMENT	14"	L/R	
B/L CONST. RAMP S-W (I-77)	224+14.63	227+50.07	CEMENT	14"	L/R	
B/L CONST. RAMP W-N (I-77)	625+00.00	631+44.12	CEMENT	14"	L/R	
B/L CONST. RAMP W-S (I-77)	521+21.52	528+83.00	CEMENT	14"	L/R	

**PAVING IN THE VICINITY OF EXISTING UTILITIES**

CONTRACTOR SHALL SUSPEND THE CEMENT STABILIZED SUBGRADE LAYER WITHIN 10' OF THE EXISTING UTILITIES TO REMAIN, INCLUDING BUT NOT LIMITED TO ODOT I.T.S. FACILITIES.

**PHASED CONSTRUCTION SUBGRADE TREATMENT**

CONTRACTOR SHALL SUSPEND THE CEMENT STABILIZED SUBGRADE LAYER IN THOSE AREAS WHERE PART-WIDTH CONSTRUCTION RESULTS IN LIMITS WHICH ARE LESS THAN THE MINIMUM WIDTH OF 12', INCLUDING UNDER MEDIAN BARRIER, REQUIRED FOR THE CEMENT STABILIZATION EQUIPMENT.

BASED ON THE MAINTENANCE OF TRAFFIC SCHEME INCLUDED IN THESE PLANS, THE FOLLOWING WORK AREAS HAVE BEEN IDENTIFIED, BUT ARE NOT LIMITED TO, AS HAVING WIDTH LESS THAN 12':

MOT PHASE 1 (MEDIAN BARRIER):  
 @ I-490 STA. 961+90.00 TO STA. 985+65.44  
 @ I-490 STA. 1020+67.19 TO STA. 1037+00.00  
 @ WB I-490 STA. 3037+00.00 TO STA. 3045+05.00

MOT PHASE 2A:  
 RAMP E-N (I-77) STA. 740+61.33 TO STA. 742+23.67  
 RAMP E-S (I-77) STA. 840+60.61 TO STA. 842+23.67

MOT PHASE 5A:  
 RAMP W-S (I-77) STA. 525+00.00 TO STA. 526+23.93  
 RAMP W-N (I-77) STA. 625+00.00 TO STA. 626+24.74

WHERE THE CEMENT STABILIZED SUBGRADE LAYER IS SUSPENDED DUE TO WIDTH, THE CONTRACTOR SHALL PROVIDE ITEM 204 - SUBGRADE COMPACTION AND ITEM 204 - GRANULAR EMBANKMENT FOR SUBGRADE TREATMENT IN THESE AREAS. THE DEPTH OF TREATMENT FOR THESE AREAS IS ANTICIPATED TO BE 18" UNLESS DIRECTED OTHERWISE BY THE ENGINEER.


THE FOLLOWING ESTIMATED QUANTITIES HAVE BEEN PROVIDED FOR USE AS DIRECTED BY THE ENGINEER FOR THE WORK NOTED ABOVE:

ITEM 204 - SUBGRADE COMPACTION 2,111 SQ. YD.

ITEM 204 - GRANULAR EMBANKMENT 1,056 CU. YD.

ITEM 204 - EXCAVATION OF SUBGRADE 1,056 CU. YD.

**SUBGRADE STABILIZATION**

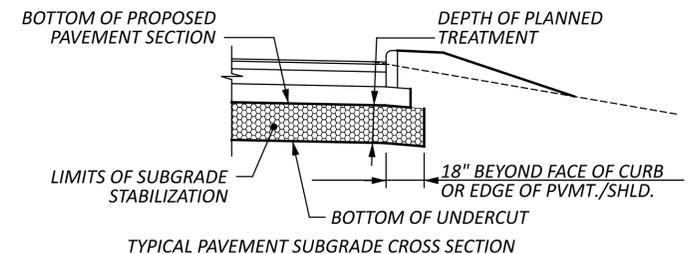

CUY-490-0.00 PART 1

MODEL: Sheet PAPER: 34x22 (in.) DATE: 4/4/2024 TIME: 4:41:37 PM USER: pfr  
 C:\Clients\ORD\2021\2021089\107408-Engineering\Roadway\Sheets\107408\_GN002.dgn

GENERAL NOTES

DESIGN AGENCY



DESIGNER

ATR

REVIEWER

PJF 11-21-23

PROJECT ID

107408

SHEET TOTAL

51 1068

**EROSION CONTROL**

**ITEM 601 - PAVED GUTTER, TYPE 1-2, AS PER PLAN**

THIS ITEM SHALL CONSIST OF CONSTRUCTING CONCRETE PAVED GUTTER AS PER STANDARD CONSTRUCTION DRAWING DM-2.1 AND THE DETAILS AS SHOWN ON SHEET 46 AT THE LOCATIONS SHOWN IN THE PLANS. THE GUTTER SHALL BE CONSTRUCTED TO THE DIMENSIONS SHOWN IN THE DETAIL. PEJF (PERFORMED EXPANSION JOINT FILLER) SHALL BE PER CMS 516 AND IS INCLUDED IN THE COST OF THE PAVED GUTTER.

ALL LABOR, EQUIPMENT AND MATERIALS NECESSARY TO COMPLETE THE ABOVE-DESCRIBED WORK SHALL BE INCLUDED IN THE CONTRACT PRICE BID PER FOOT FOR ITEM 601 - PAVED GUTTER, TYPE 1-2, AS PER PLAN.

**ITEM 601 - PAVED GUTTER, TYPE 3, AS PER PLAN**

THIS ITEM SHALL CONSIST OF CONSTRUCTING CONCRETE PAVED GUTTER AS PER STANDARD CONSTRUCTION DRAWING DM-2.1 AND THE DETAILS AS SHOWN ON SHEET 46 AT THE LOCATIONS SHOWN IN THE PLANS. THE GUTTER SHALL BE CONSTRUCTED TO THE DIMENSIONS SHOWN IN THE DETAIL. PEJF (PERFORMED EXPANSION JOINT FILLER) SHALL BE PER CMS 516 AND IS INCLUDED IN THE COST OF THE PAVED GUTTER. BAFFLES ARE NOT TO BE CONSTRUCTED WITH THIS PAVED GUTTER.

ALL LABOR, EQUIPMENT AND MATERIALS NECESSARY TO COMPLETE THE ABOVE-DESCRIBED WORK SHALL BE INCLUDED IN THE CONTRACT PRICE BID PER FOOT FOR ITEM 601 - PAVED GUTTER, TYPE 3, AS PER PLAN.

**SEEDING AND MULCHING**

THE FOLLOWING QUANTITIES ARE PROVIDED TO PROMOTE GROWTH AND CARE OF PERMANENT SEEDED AREAS:

ITEM 659, SOIL ANALYSIS TEST	2 EACH
ITEM 659, MOWING	150 M. SQ. FT.
ITEM 659, TOPSOIL	7,419 CU. YD.
ITEM 659, SEEDING AND MULCHING, CLASS 3B	3,490 SQ. YD.
ITEM 659, SEEDING AND MULCHING	63,346 SQ. YD.
ITEM 659, REPAIR SEEDING AND MULCHING	3,342 SQ. YD.
ITEM 659, INTER-SEEDING	3,342 SQ. YD.
ITEM 659, COMMERCIAL FERTILIZER	9.33 TON
ITEM 659, LIME	13.81 ACRES
ITEM 659, WATER	370 M. GAL.

APPLY SEEDING AND MULCHING TO ALL AREAS OF EXPOSED SOIL BETWEEN THE RIGHT-OF-WAY LINES AND WITHIN THE CONSTRUCTION LIMITS FOR AREAS OUTSIDE THE RIGHT-OF-WAY LINES COVERED BY WORK AGREEMENT OR SLOPE EASEMENT. QUANTITY CALCULATIONS FOR SEEDING AND MULCHING ARE BASED ON THESE LIMITS.

**EARTHWORK**

THE FOLLOWING IS A SUMMARY OF ALL EARTHWORK QUANTITIES. EARTHWORK END AREA CALCULATIONS HAVE BEEN PROVIDED ON SHEETS 493A-493F FOR REFERENCE ONLY.

I-490 MAINLINE

ITEM 203, EXCAVATION	30,524 CU. YD.
ITEM 203, EMBANKMENT	1,978 CU. YD.
ITEM 659, SEEDING AND MULCHING, CLASS 3B	1,525 SQ. YD.
ITEM 659, SEEDING AND MULCHING	17,190 SQ. YD.

EB I-490 BASELINE

ITEM 203, EXCAVATION	4,243 CU. YD.
ITEM 203, EMBANKMENT	23 CU. YD.
ITEM 659, SEEDING AND MULCHING, CLASS 3B	356 SQ. YD.
ITEM 659, SEEDING AND MULCHING	4,268 SQ. YD.

WB I-490 BASELINE

ITEM 203, EXCAVATION	5,792 CU. YD.
ITEM 203, EMBANKMENT	290 CU. YD.
ITEM 659, SEEDING AND MULCHING, CLASS 3B	208 SQ. YD.
ITEM 659, SEEDING AND MULCHING	7,533 SQ. YD.

RAMP E-S (I-71)

ITEM 203, EXCAVATION	2,323 CU. YD.
ITEM 203, EMBANKMENT	140 CU. YD.
ITEM 659, SEEDING AND MULCHING, CLASS 3B	766 SQ. YD.
ITEM 659, SEEDING AND MULCHING	3,694 SQ. YD.

**EARTHWORK - CONTINUED**

RAMP S-E (I-71)

ITEM 203, EXCAVATION	1,880 CU. YD.
ITEM 203, EMBANKMENT	5 CU. YD.
ITEM 659, SEEDING AND MULCHING, CLASS 3B	116 SQ. YD.
ITEM 659, SEEDING AND MULCHING	903 SQ. YD.

RAMP 7-7C/W. 7TH STREET

ITEM 203, EXCAVATION	8,549 CU. YD.
ITEM 203, EMBANKMENT	408 CU. YD.
ITEM 659, SEEDING AND MULCHING	11,056 SQ. YD.

RAMP C-7

ITEM 203, EXCAVATION	363 CU. YD.
ITEM 203, EMBANKMENT	9 CU. YD.
ITEM 659, SEEDING AND MULCHING	588 SQ. YD.

RAMP B-C

ITEM 203, EXCAVATION	359 CU. YD.
ITEM 203, EMBANKMENT	8 CU. YD.
ITEM 659, SEEDING AND MULCHING, CLASS 3B	29 SQ. YD.
ITEM 659, SEEDING AND MULCHING	260 SQ. YD.

RAMP C-B

ITEM 203, EXCAVATION	386 CU. YD.
ITEM 203, EMBANKMENT	17 CU. YD.
ITEM 659, SEEDING AND MULCHING	325 SQ. YD.

RAMP E-N (I-77)

ITEM 203, EXCAVATION	2,383 CU. YD.
ITEM 203, EMBANKMENT	5 CU. YD.
ITEM 659, SEEDING AND MULCHING	2,693 SQ. YD.

RAMP E-S (I-77)

ITEM 203, EXCAVATION	693 CU. YD.
ITEM 203, EMBANKMENT	10 CU. YD.
ITEM 659, SEEDING AND MULCHING	1,430 SQ. YD.

RAMP N-E (I-77)

ITEM 203, EXCAVATION	2,433 CU. YD.
ITEM 203, EMBANKMENT	4 CU. YD.
ITEM 659, SEEDING AND MULCHING	2,301 SQ. YD.

RAMP N-W (I-77)

ITEM 203, EXCAVATION	2,308 CU. YD.
ITEM 203, EMBANKMENT	20 CU. YD.
ITEM 659, SEEDING AND MULCHING, CLASS 3B	309 SQ. YD.
ITEM 659, SEEDING AND MULCHING	2,357 SQ. YD.

RAMP S-E (I-77)

ITEM 203, EXCAVATION	4,148 CU. YD.
ITEM 203, EMBANKMENT	0 CU. YD.
ITEM 659, SEEDING AND MULCHING, CLASS 3B	181 SQ. YD.
ITEM 659, SEEDING AND MULCHING	4,010 SQ. YD.

RAMP S-W (I-77)

ITEM 203, EXCAVATION	934 CU. YD.
ITEM 203, EMBANKMENT	2 CU. YD.
ITEM 659, SEEDING AND MULCHING	885 SQ. YD.

RAMP W-N (I-77)

ITEM 203, EXCAVATION	716 CU. YD.
ITEM 203, EMBANKMENT	5 CU. YD.
ITEM 659, SEEDING AND MULCHING	2,064 SQ. YD.

RAMP W-S (I-77)

ITEM 203, EXCAVATION	1,106 CU. YD.
ITEM 203, EMBANKMENT	7 CU. YD.
ITEM 659, SEEDING AND MULCHING	1,789 SQ. YD.

THE FOLLOWING GRAND TOTAL HAS BEEN CARRIED TO THE GENERAL NOTES SUBSUMMARY:

ITEM 203, EXCAVATION	69,140 CU. YD.
ADD EXCAVATION FROM VBF	1,476 CU. YD.
	70,616 CU. YD.
ITEM 203, EMBANKMENT	2,931 CU. YD.

REVISIONS		
NO.	DATE	DESCRIPTION
△	02/29/24	UPDATED EARTHWORK QUANTITIES
△	04/04/24	REVISED PAVED GUTTER NOTE AND UPDATED WATER FEES QUANTITY

QUANTITIES CARRIED TO GENERAL NOTES SUBSUMMARY ON SHEET 19

**WATER QUALITY**

**POST CONSTRUCTION STORM WATER TREATMENT**

THIS PLAN UTILIZES STRUCTURAL BEST MANAGEMENT PRACTICES (BMP'S) FOR POST CONSTRUCTION STORM WATER TREATMENT.

**VEGETATED BIOFILTER**

THIS PLAN UTILIZES VEGETATED BIOFILTER(S) FOR POST CONSTRUCTION STORM WATER TREATMENT. PLACE EITHER ITEM 660 SODDING OR ITEM 659 SEEDING AND MULCHING WITH A 4-INCH LIFT OF TOPSOIL AS SHOWN IN THE PLANS TO ANY DISTURBED AREA ON THE SHOULDER AND FORESLOPE DRAINING TO A VEGETATED BIOFILTER. THE DITCH FOR EACH VEGETATED BIOFILTER SHALL BE TRAPEZOIDAL, AS SHOWN IN THE PLAN CROSS SECTIONS. PROVIDE ITEM 670 AS SPECIFIED IN THE PLANS. ALL DITCHES LOCATED WITHIN LIMITS OF VEGETATED BIOFILTER SHALL BE TRAPEZOIDAL AND NOT HAVE ROUNDING.

**ENVIRONMENTAL**

**ENDANGERED BAT HABITAT REMOVAL**

NO TREES SHALL BE REMOVED UNDER THIS PROJECT FROM APRIL 1 THROUGH SEPTEMBER 30. ALL NECESSARY TREE REMOVAL SHALL OCCUR FROM OCTOBER 1 THROUGH MARCH 31. THIS REQUIREMENT IS NECESSARY TO AVOID AND MINIMIZE IMPACTS TO FEDERALLY AND STATE LISTED BAT SPECIES AS REQUIRED BY THE ENDANGERED SPECIES ACT. FOR THE PURPOSE OF THE NOTE, A TREE IS DEFINED AS A LIVE, DYING, OR DEAD WOODY PLANT WITH A TRUNK THREE INCHES OR GREATER IN DIAMETER AT A HEIGHT OF 4.5 FEET ABOVE THE GROUND SURFACE, AND WITH A MINIMUM HEIGHT OF 13 FEET.

**BEST MANAGEMENT PRACTICES/SOIL EROSION AND SEDIMENTATION CONTROL**

ALL SOIL EROSION AND SEDIMENT CONTROL MEASURES AS SPECIFIED IN THE STORM WATER POLLUTION PREVENTION PLAN SHALL BE IN PLACE PRIOR TO ANY EXCAVATION, GRADING OR FILLING OPERATIONS AND INSTALLATION OF PROPOSED STRUCTURES OR UTILITIES. THEY SHALL REMAIN IN PLACE UNTIL CONSTRUCTION IS COMPLETE AND THE AREA IS STABILIZED AS ACCEPTED BY THE ENGINEER.

**WATER WORK**

**CLEVELAND WATER DEPARTMENT FEES AND CHARGES**

THE CONTRACTOR WILL BE RESPONSIBLE FOR ALL CLEVELAND WATER DEPARTMENT FEES AND CHARGES ASSOCIATED WITH THIS PROJECT. A LINE ITEM WITH A FIXED AMOUNT HAS BEEN ADDED TO THE BID FORM. A COPY OF THE CHARGE LETTER WILL BE PROVIDED UPON RECEIPT. PAYMENT WILL BE BASED ON THE CONTRACTOR'S PAID INVOICE TO CLEVELAND WATER DEPARTMENT. FOR BIDDING PURPOSES, THE FOLLOWING FEES AND CHARGES HAVE BEEN ESTIMATED: \$20,000. THE FOLLOWING ESTIMATED QUANTITY HAS BEEN CARRIED TO THE GENERAL SUMMARY.

ITEM 638 - WATER WORK, MISC.: CLEVELAND WATER DEPARTMENT FEES AND CHARGES	20,000 EACH
---	-------------

**CLEVELAND WATER DEPARTMENT AS-BUILTS**

THIS ITEM SHALL INCULDE ALL NECESSARY LABOR AND MATERIAL TO PROVIDE THE CITY OFFICIALS AND THE CITY OF CLEVELAND DIVISION OF WATER WITH ACCURATE AS-BUILT DRAWINGS. THESE DRAWINGS SHALL INCLUDE THE EXACT LOCATION OF ALL NEW VALVES AND HYDRANTS INSTALLED. THE DATE OF VALVE AND HYDRANT INSTALLATION SHALL BE INDICATED ON THE DRAWINGS. THE DRAWINGS SHALL SHOW THE EXACT LIMITS OF THE PIPE THAT WAS INSTALLED. ALL EXCAVATIONS SHALL BE RECORDED WITH LOCATION AND DIMENSIONS, DATE OPENED, DATE BACKFILLED, DATE PAVED AND SHALL BE SHOWN ON THE AS-BUILTS. A REGISTERED PROFESSIONAL ENGINEER SHALL SEAL THE DRAWINGS. AS-BUILTS WILL BE REQUIRED PRIOR TO DISINFECTING THE WATER MAIN. ALL WORK REQUIRED SHALL BE INCLUDED IN THE LUMP SUM BID PRICE FOR "AS-BUILT DRAWINGS." THE FOLLOWING ESTIMATED QUANTITY HAS BEEN CARRIED TO THE GENERAL SUMMARY.

ITEM 638 - WATER WORK, MISC.: CLEVELAND WATER DEPARTMENT AS-BUILT DRAWINGS	LS
--	----

**ITEM SPECIAL - 6" FIRE HYDRANT (CLEVELAND)**

ALL HYDRANTS SHALL BE "MUELLER-CENTURION", "KENNEDY-GUARDIAN", OR AN APPROVED EQUAL (PAINTED YELLOW). THIS ITEM SHALL INCLUDE ALL NECESSARY EXCAVATION, EMBANKMENT, DEWATERING, SHEETING, PREPARATION OF THE TRENCH BOTTOM, ROCK EXCAVATION, VALVE, VALVE BOX, HYDRANT, 12"x6" TEE, JOINT MATERIAL, BLOCKING, ADJUSTMENT, BEDDING, BACKFILL, TESTING, DISPOSAL OF WASTE AND ALL OTHER EXPENSES WHETHER SPECIFICALLY MENTIONED OR NOT, FOR THE INSTALLATION OF A 6" HYDRANT ASSEMBLY IN ACCORDANCE WITH CLEVELAND WATER DEPARTMENT STANDARDS. SEE SHEET 945 FOR CLEVELAND WATER DEPARTMENT STANDARD CONSTRUCTION DRAWING STD-H06.

HYDRANT ASSEMBLIES SHALL BE EQUIPPED WITH A 4" HPHA HARRINGTON PERMANENT HYDRANT STORZ COUPLING AS MANUFACTURED BY HARRINGTON, INC.

THREADS ON HYDRANTS MUST BE CLEVELAND STANDARD THREAD AND MUST BE APPROVED BY THE FIRE CHIEF. THE CONTRACTOR IS REQUIRED TO SCHEDULE AN INSPECTION WITH THE FIRE CHIEF TO REVIEW FUNCTIONALITY OF ALL HYDRANTS PRIOR TO RECEIVING FINAL APPROVAL.

PAYMENT WILL BE MADE AT THE UNIT PRICE BID FOR EACH HYDRANT ASSEMBLY INSTALLED COMPLETE, TESTED, DISINFECTED, AND READY FOR SERVICE INCLUDING PERMANENT ADAPTERS.

**ITEM SPECIAL - FIRE HYDRANT SERVICE LINE EXTENDED AND ADJUSTED TO GRADE (CLEVELAND)**

ALL HYDRANTS SHALL BE "MUELLER-CENTURION", "KENNEDY-GUARDIAN", OR AN APPROVED EQUAL (PAINTED YELLOW). THIS ITEM SHALL INCLUDE ALL NECESSARY EXCAVATION, EMBANKMENT, DEWATERING, SHEETING, PREPARATION OF THE TRENCH BOTTOM, ROCK EXCAVATION, HYDRANT, JOINT MATERIAL, BLOCKING, ADJUSTMENT, BEDDING, BACKFILL, TESTING, DISPOSAL OF WASTE AND ALL OTHER EXPENSES WHETHER SPECIFICALLY MENTIONED OR NOT, FOR THE INSTALLATION OF A 6" HYDRANT ASSEMBLY IN ACCORDANCE WITH CLEVELAND WATER DEPARTMENT STANDARDS. SEE SHEET 945 FOR CLEVELAND WATER DEPARTMENT STANDARD CONSTRUCTION DRAWING STD-H02.

HYDRANT ASSEMBLIES SHALL BE EQUIPPED WITH A 4" HPHA HARRINGTON PERMANENT HYDRANT STORZ COUPLING AS MANUFACTURED BY HARRINGTON, INC.

THREADS ON HYDRANTS MUST BE CLEVELAND STANDARD THREAD AND MUST BE APPROVED BY THE FIRE CHIEF. THE CONTRACTOR IS REQUIRED TO SCHEDULE AN INSPECTION WITH THE FIRE CHIEF TO REVIEW FUNCTIONALITY OF ALL HYDRANTS PRIOR TO RECEIVING FINAL APPROVAL.

PAYMENT WILL BE MADE AT THE UNIT PRICE BID FOR EACH HYDRANT ASSEMBLY EXTENDED, SHORTENED AND ADJUSTED TO GRADE COMPLETE, TESTED, DISINFECTED, AND READY FOR SERVICE INCLUDING PERMANENT ADAPTERS.

DESIGN AGENCY	
DESIGNER	ATR
REVIEWER	PJF 11-21-23
PROJECT ID	107408
SHEET	TOTAL
58	1068

SHEET NO.	201		203	203	204	204	204	503	204	601		605		611	611	611	611	611		SPECIAL		
	CLEARING AND GRUBBING		EXCAVATION	EMBANKMENT	SUBGRADE COMPACTION	GRANULAR EMBANKMENT	PROOF ROLLING	COFFERDAMS AND EXCAVATION BRACING, AS PER PLAN	EXCAVATION OF SUBGRADE	TIED CONCRETE BLOCK MAT WITH TYPE 1 UNDERLAYMENT		6" UNCLASSIFIED PIPE UNDERDRAINS WITH GEOTEXTILE FABRIC		6" CONDUIT, TYPE B	6" CONDUIT, TYPE C	6" CONDUIT, TYPE E	6" CONDUIT, TYPE F	PRECAST REINFORCED CONCRETE OUTLET		MISCELLANEOUS METAL		
	LS		CY	CY	SY	CY	hour	LS	CY	SY		FT		FT	FT	FT	FT	EACH		LB		
50	LS																					
51				4	2111	1056	80		1056	4												
52																						
53																						
54										8		40		200	200	200	240	4		1000		
55																						
56																						
57			70616	2931				LS														
58																						
TOTALS CARRIED TO GENERAL SUMMARY	LS		70616	2931	2111	1056	80	LS	1056	8		40		200	200	200	240	4		1000		
SHEET NO.	618			623		638	638		659	659	659	659	659	659	659	659	659	659		SPECIAL	SPECIAL	
	RUMBLE STRIPS, SHOULDER (ASPHALT CONCRETE), AS PER PLAN			MONUMENT ASSEMBLY, TYPE C		WATER WORK, MISC.: CLEVELAND WATER DEPARTMENT FEES AND CHARGES	WATER WORK, MISC.: CLEVELAND WATER DEPARTMENT AS-BUILT DRAWINGS		SOIL ANALYSIS TEST	TOPSOIL	SEEDING AND MULCHING, CLASS 3B	SEEDING AND MULCHING	REPAIR SEEDING AND MULCHING	INTER-SEEDING	COMMERCIAL FERTILIZER	LIME	WATER	MOWING		SURVEY CONTROL VERIFICATION	PERMITS	
	MILE			EACH	4	EACH	LS		EACH	CY	SY	SY	SY	SY	TON	ACRE	MGAL	MSF		LS	LS	
50				30																		
51																					LS	LS
52																						
53																						
54	5.58																					
55																						
56																						
57																						
58						20000	LS		2	7419	3490	63346	3342	3342	9.33	13.81	370	150				
TOTALS CARRIED TO GENERAL SUMMARY	5.58			30		20000	LS		2	7419	3490	63346	3342	3342	9.33	13.81	370	150		LS	LS	

GENERAL NOTES SUBSUMMARY

REVISIONS		
NO.	DATE	DESCRIPTION
1	01/15/24	PERMITS QUANTITY ADDED
2	02/29/24	UPDATED EARTHWORK QUANTITIES
3	03/05/24	EXCAVATION OF SUBGRADE QUANTITY ADDED
4	04/04/24	UPDATED SUBGRADE QUANTITIES & WATER FEES QUANTITY

DESIGN AGENCY



DESIGNER  
JAN

REVIEWER  
PJF 11-21-23

PROJECT ID  
107408

SHEET 59 TOTAL 1068

**NOTIFICATIONS AND CONTACTS**

THE CONTRACTOR SHALL NOTIFY THE FOLLOWING ENTITIES AT LEAST FOURTEEN (14) DAYS PRIOR TO THE BEGINNING OF CONSTRUCTION ACTIVITIES, INCLUDED IN THE NOTIFICATION SHALL BE THE PROJECTED DATES AND TIME FRAMES OF ANY ROAD CLOSURES OR DETOURS, INCLUDING DETOURS TO THE TOWPATH TRAIL AND IMPACTS TO PARCEL 10-T.

1. ODOT DISTRICT 12  
5500 TRANSPORTATION BLVD.  
GARFIELD HEIGHTS, OHIO 44125  
216-581-2100
2. CITY OF CLEVELAND DEPARTMENT OF PUBLIC WORKS  
500 LAKESIDE AVE.  
CLEVELAND, OHIO 44114  
216-664-2485
3. CITY OF CLEVELAND DIVISION OF FIRE  
1645 SUPERIOR AVE., EAST  
CLEVELAND, OHIO 44114  
216-664-6800
4. CITY OF CLEVELAND DIVISION OF POLICE  
1300 ONTARIO ST.  
CLEVELAND, OHIO 44113  
216-623-5000
5. CITY OF CLEVELAND METROPOLITAN SCHOOLS  
1111 SUPERIOR AVE. E, SUITE 1800  
CLEVELAND, OHIO 44114  
216-838-0000
6. CUYAHOGA COUNTY SHERIFF  
1215 W 3RD ST.  
CLEVELAND, OHIO 44113  
216-443-6000
7. GREATER CLEVELAND REGIONAL TRANSIT AUTHORITY  
1240 WEST 6TH ST.  
CLEVELAND, OHIO 44113-1302  
216-356-3270
8. OHIO STATE HIGHWAY PATROL  
5225 W 140<sup>th</sup> ST.  
BROOKPARK, OHIO 44142  
216-265-1677
9. CUYAHOGA METROPOLITAN HOUSING AUTHORITY  
8120 KINSMAN RD.  
CLEVELAND, OH 44104  
216-348-5000

THE FOLLOWING CONTACTS SHALL BE NOTIFIED 48 HOURS PRIOR TO THE TOWPATH TRAIL CLOSURE.

10. CANALWAY PARTNERS  
ATT: MERA CARDENAS  
PO BOX 609420  
CLEVELAND, OH 44109  
216-520-1825
11. JEREMY SKAGGS SR.  
PARK MANAGER, OHIO & ERIE CANAL RESERVATION  
4101 FULTON PARKWAY  
CLEVELAND, OHIO 44144  
OFFICE: 216-341-1706  
MOBILE: 440-523-1241  
EMAIL: JDS1@CLEVELANDMETROPARKS.COM

SHOULD ANY OF THE PROJECTED DATES AND TIME FRAMES OF THE START AND END OF THE ROAD CLOSURES CHANGE THROUGHOUT THE DURATION OF THE PROJECT, THE AGENCIES LISTED ABOVE MUST BE NOTIFIED IMMEDIATELY.

**SEQUENCE OF CONSTRUCTION**

**PRE-PHASE 1**

PRIOR TO COMMENCING PHASE 1 CONSTRUCTION ACTIVITIES THE CONTRACTOR SHALL CONSTRUCT TEMPORARY PAVEMENT REQUIRED FOR PHASE 1 AND REMOVE ALL EXISTING RUMBLE STRIPS THAT CONFLICT WITH THE TEMPORARY TRAFFIC PATTERNS. TRAFFIC SHALL BE MAINTAINED IN ACCORDANCE WITH MT-95.30. ONLY ONE LANE, ADJACENT TO EITHER THE INSIDE OR OUTSIDE SHOULDER MAY BE CLOSED AT ANY ONE TIME IN ACCORDANCE WITH THE MOST UP TO DATE ODOT PERMITTED LANE CLOSURE CHART (SEE LANE VALUE CONTRACT TABLE ON SHEET 61 ). THIS WORK ZONE SHALL BE REMOVED BY 6 AM DAILY. ALL RAMPS SHALL REMAIN OPEN TO TRAFFIC AT ALL TIMES.



**PHASE 1**

FROM THE BEGINNING OF THE PROJECT TO THE PEDESTRIAN BRIDGE/W. 11TH STREET THE CONTRACTOR SHALL SHIFT TWO EASTBOUND INTERSTATE 490 LANES TO THE OUTSIDE LANES AND SHOULDER AND ONE WESTBOUND INTERSTATE 490 LANE TO THE OUTSIDE LANE AND SHOULDER. THE CONTRACTOR SHALL CONSTRUCT ALL PROPOSED ROADWAY IMPROVEMENTS TO THE MEDIAN DRAINAGE, MEDIAN BARRIER, INSIDE SHOULDERS, AND INSIDE LANES.

**PHASE 1 (CONT.)**

BETWEEN THE PEDESTRIAN BRIDGE/W. 11TH STREET AND THE END OF THE CUYAHOGA RIVER BRIDGE THE CONTRACTOR SHALL SHIFT THREE EASTBOUND AND WESTBOUND LANES TO THE OUTSIDE LANES AND SHOULDER. BETWEEN THE END OF THE CUYAHOGA RIVER BRIDGE AND THE END OF THE PROJECT THE CONTRACTOR SHALL SHIFT TWO EASTBOUND AND WESTBOUND LANES TO THE OUTSIDE LANES AND SHOULDER. THE CONTRACTOR SHALL CONSTRUCT ALL PROPOSED ROADWAY IMPROVEMENTS TO THE MEDIAN DRAINAGE AND MEDIAN BARRIER.

THE CONTRACTOR SHALL SUSPEND CONSTRUCTION OF THE PROPOSED MEDIAN BARRIER JUST EAST OF THE PEDESTRIAN BRIDGE/W. 11TH STREET AND CONSTRUCT THE WEST END Crossover AND ASSOCIATED TEMPORARY PAVEMENT. THE CONTRACTOR SHALL ALSO CONSTRUCT THE EAST END Crossover AND ASSOCIATED TEMPORARY PAVEMENT JUST TO THE EAST OF THE NS RAILROAD BRIDGE. ALL RAMPS SHALL REMAIN OPEN TO TRAFFIC AT ALL TIMES.

IN ORDER TO COMPLETE THE EAST Crossover TEMPORARY PAVEMENT, EAST OF THE N-S RAILROAD BRIDGE. ONE WESTBOUND OPPORTUNITY CORRIDOR LANE SHALL BE CLOSED IN ACCORDANCE WITH THE MOST UP TO DATE ODOT PERMITTED LANE CLOSURE CHART AND PER MT-95.30.

**1ST WINTER OVER PHASE**

AFTER THE COMPLETION OF PHASE 1, THE CONTRACTOR SHALL WINTER OVER IN THE PHASE 1 TRAFFIC PATTERN.

**PRE-PHASE 2**

PRIOR TO COMMENCING PHASE 2 CONSTRUCTION ACTIVITIES THE CONTRACTOR SHALL CONSTRUCT TEMPORARY PAVEMENT REQUIRED FOR PHASE 2. DURING CONSTRUCTION OF THE TEMPORARY PAVEMENT, TRAFFIC SHALL BE MAINTAINED IN ACCORDANCE WITH MT-95.30. ONLY ONE LANE, ADJACENT TO EITHER THE INSIDE OR OUTSIDE SHOULDER MAY BE CLOSED AT ANY ONE TIME BETWEEN 8 PM – 6 AM OR IN ACCORDANCE WITH THE MOST UP TO DATE ODOT PERMITTED LANE CLOSURE CHART. THIS WORK ZONE SHALL BE REMOVED BY 6 AM DAILY. ALL RAMPS SHALL REMAIN OPEN TO TRAFFIC AT ALL TIMES.

**PHASE 2**

FROM THE BEGINNING OF THE PROJECT TO THE PEDESTRIAN BRIDGE/W. 11TH STREET THE CONTRACTOR SHALL KEEP EASTBOUND TRAFFIC IN THE PHASE 1 TRAFFIC PATTERN AND SHIFT TWO WESTBOUND INTERSTATE 490 LANES TO THE INSIDE LANE AND SHOULDER. THE CONTRACTOR SHALL CONSTRUCT ALL PROPOSED ROADWAY IMPROVEMENTS TO THE WESTBOUND OUTSIDE SHOULDER, AND OUTSIDE LANES.

BETWEEN THE PEDESTRIAN BRIDGE/W. 11TH STREET AND THE END OF THE CUYAHOGA RIVER BRIDGE THE CONTRACTOR SHALL SHIFT THREE EASTBOUND LANES TO THE OUTSIDE LANES AND SHOULDER, SHIFT TWO WESTBOUND LANES TO THE OUTSIDE LANES AND SHOULDER, AND Crossover ONE WESTBOUND LANE ONTO EASTBOUND PAVEMENT. THE CONTRACTOR SHALL CONSTRUCT ALL PROPOSED ROADWAY IMPROVEMENTS TO THE WESTBOUND INSIDE SHOULDER AND INSIDE LANES.

BETWEEN THE END OF THE CUYAHOGA RIVER BRIDGE AND THE END OF THE PROJECT THE CONTRACTOR SHALL SHIFT TWO EASTBOUND LANES TO THE OUTSIDE LANES AND SHOULDER AND Crossover ONE WESTBOUND LANE. THE CONTRACTOR SHALL CONSTRUCT ALL PROPOSED ROADWAY IMPROVEMENTS TO THE FULL WIDTH WESTBOUND PAVEMENT.

ALL RAMPS SHALL REMAIN OPEN TO TRAFFIC AT ALL TIMES EXCEPT FOR THE FOLLOWING RAMPS/MOVEMENTS WHICH MAY BE CLOSED AND DETOURED DURING RAMP/PAVEMENT RECONSTRUCTION ONLY:

WESTBOUND OPPORTUNITY CORRIDOR TRAFFIC TRYING TO ACCESS I-71 SOUTHBOUND.

THE CONTRACTOR SHALL CLOSE AND DETOUR THE TOWPATH TRAIL WHEN WORKING ON THE CUYAHOGA RIVER BRIDGE.

**PHASE 2A**

ALL TRAFFIC SHALL REMAIN IN THE PHASE 2 TRAFFIC PATTERN, EXCEPT FOR THE GORE AREAS BETWEEN RAMP N-W (I-77)/RAMP S-W (I-77) AND RAMP E-S (I-77)/RAMP E-S (I-77). THE CONTRACTOR SHALL SHIFT ONE LANE OF TRAFFIC TO THE OUTSIDE OF EACH RAMP AND CONSTRUCT THE CENTER GORE AREAS BETWEEN TRAFFIC. THE CONTRACTOR SHALL CLOSE AND DETOUR RAMP S-W (I-77 NB) DURING RAMP / PAVEMENT RECONSTRUCTION ONLY.

**PRE-PHASE 3**

PRIOR TO COMMENCING PHASE 3 CONSTRUCTION ACTIVITIES THE CONTRACTOR SHALL CONSTRUCT TEMPORARY PAVEMENT REQUIRED FOR PHASE 3. DURING CONSTRUCTION OF THE TEMPORARY PAVEMENT, TRAFFIC SHALL BE MAINTAINED IN ACCORDANCE WITH MT-95.30. ONLY ONE LANE, ADJACENT TO EITHER THE INSIDE OR OUTSIDE SHOULDER MAY BE CLOSED AT ANY ONE TIME BETWEEN 8 PM – 6 AM OR IN ACCORDANCE WITH THE MOST UP TO DATE ODOT PERMITTED LANE CLOSURE CHART. THIS WORK ZONE SHALL BE REMOVED BY 6 AM DAILY. ALL RAMPS SHALL REMAIN OPEN TO TRAFFIC AT ALL TIMES.

**PHASE 3**

FROM THE BEGINNING OF THE PROJECT TO THE PEDESTRIAN BRIDGE/W. 11TH STREET THE CONTRACTOR SHALL KEEP EASTBOUND TRAFFIC IN THE PHASE 1 TRAFFIC PATTERN AND PLACE WESTBOUND TRAFFIC INTO THE PROPOSED TRAFFIC PATTERN. THE CONTRACTOR SHALL NOT CONSTRUCT ANY ROADWAY IMPROVEMENTS IN THIS SECTION OF PAVEMENT.

BETWEEN THE PEDESTRIAN BRIDGE/W. 11TH STREET AND THE END OF THE CUYAHOGA RIVER BRIDGE THE CONTRACTOR SHALL KEEP EASTBOUND TRAFFIC AND THE SINGLE WESTBOUND CROSSED OVER LANE IN THE PHASE 2 TRAFFIC PATTERN AND SHIFT TWO WESTBOUND LANES TO THE INSIDE LANES AND SHOULDER. THE CONTRACTOR SHALL CONSTRUCT ALL PROPOSED ROADWAY IMPROVEMENTS TO THE WESTBOUND OUTSIDE SHOULDER AND OUTSIDE LANES.

BETWEEN THE END OF THE CUYAHOGA RIVER BRIDGE AND THE END OF THE PROJECT THE CONTRACTOR SHALL KEEP BOTH EASTBOUND AND WESTBOUND TRAFFIC IN THE PHASE 2 TRAFFIC PATTERN. THE CONTRACTOR SHALL CONTINUE CONSTRUCTION OF ALL PROPOSED ROADWAY IMPROVEMENTS TO THE FULL WIDTH WESTBOUND PAVEMENT.

ALL RAMPS SHALL REMAIN OPEN TO TRAFFIC AT ALL TIMES EXCEPT FOR THE FOLLOWING RAMPS/MOVEMENTS WHICH MAY BE CLOSED AND DETOURED DURING RAMP/PAVEMENT RECONSTRUCTION ONLY:

WESTBOUND EXIT RAMP C-7 TO W. 7TH STREET  
WESTBOUND ENTRANCE RAMP B-3 FROM BROADWAY AVE./ROCKEFELLER AVE.  
WESTBOUND OPPORTUNITY CORRIDOR TRAFFIC TRYING TO ACCESS I-71 SOUTHBOUND

THE CONTRACTOR SHALL CLOSE AND DETOUR THE TOWPATH TRAIL WHEN WORKING ON THE CUYAHOGA RIVER BRIDGE.

**PHASE 3A**

ALL TRAFFIC SHALL REMAIN IN THE PHASE 3 TRAFFIC PATTERN, EXCEPT FOR THE GORE AREA BETWEEN RAMP E-S (I-71) AND I-490 WB. THE CONTRACTOR SHALL SHIFT ONE LANE OF TRAFFIC TO THE OUTSIDE OF RAMP E-S (I-71) AND ONE LANE OF TRAFFIC TO THE INSIDE OF I-490 WB. THE CONTRACTOR SHALL CONSTRUCT THE CENTER GORE AREA BETWEEN TRAFFIC.

**2ND WINTER OVER PHASE**

AFTER THE COMPLETION OF PHASE 3, THE CONTRACTOR SHALL WINTER OVER IN THE EXISTING/PROPOSED TRAFFIC PATTERN. SEE TRAFFIC CONTROL PLANS FOR PAVEMENT MARKING PLACEMENT.

**PRE-PHASE 4**

PRIOR TO COMMENCING PHASE 4 CONSTRUCTION ACTIVITIES THE CONTRACTOR SHALL CONSTRUCT TEMPORARY PAVEMENT REQUIRED FOR PHASE 4. DURING CONSTRUCTION OF THE TEMPORARY PAVEMENT, TRAFFIC SHALL BE MAINTAINED IN ACCORDANCE WITH MT-95.30. ONLY ONE LANE, ADJACENT TO EITHER THE INSIDE OR OUTSIDE SHOULDER MAY BE CLOSED AT ANY ONE TIME BETWEEN 8 PM – 6 AM OR IN ACCORDANCE WITH THE MOST UP TO DATE ODOT PERMITTED LANE CLOSURE CHART. THIS WORK ZONE SHALL BE REMOVED BY 6 AM DAILY. ALL RAMPS SHALL REMAIN OPEN TO TRAFFIC AT ALL TIMES.

**PHASE 4**

FROM THE BEGINNING OF THE PROJECT TO THE PEDESTRIAN BRIDGE/W. 11TH STREET THE CONTRACTOR SHALL KEEP EASTBOUND TRAFFIC IN THE PHASE 1 TRAFFIC PATTERN AND KEEP WESTBOUND TRAFFIC INTO THE PROPOSED TRAFFIC PATTERN. THE CONTRACTOR SHALL NOT CONSTRUCT ANY ROADWAY IMPROVEMENTS IN THIS SECTION OF PAVEMENT.

BETWEEN THE PEDESTRIAN BRIDGE/W. 11TH STREET AND THE END OF THE CUYAHOGA RIVER BRIDGE THE CONTRACTOR SHALL SHIFT THREE WESTBOUND LANES TO THE OUTSIDE LANES AND SHOULDER, SHIFT TWO EASTBOUND LANES TO THE OUTSIDE LANES AND SHOULDER, AND Crossover ONE EASTBOUND LANE ONTO WESTBOUND PAVEMENT. THE CONTRACTOR SHALL CONSTRUCT ALL PROPOSED ROADWAY IMPROVEMENTS TO THE EASTBOUND INSIDE SHOULDER AND INSIDE LANES.

**PHASE 4 (CONT.)**

BETWEEN THE END OF THE CUYAHOGA RIVER BRIDGE AND THE END OF THE PROJECT THE CONTRACTOR SHALL SHIFT TWO WESTBOUND LANES TO THE OUTSIDE LANES AND SHOULDER, SHIFT ONE EASTBOUND LANE TO THE OUTSIDE LANE AND SHOULDER, AND Crossover ONE EASTBOUND LANE ONTO WESTBOUND PAVEMENT. THE CONTRACTOR SHALL CONSTRUCT ALL PROPOSED ROADWAY IMPROVEMENTS TO THE EASTBOUND INSIDE SHOULDER AND INSIDE LANES.

ALL RAMPS SHALL REMAIN OPEN TO TRAFFIC AT ALL TIMES.

THE CONTRACTOR SHALL CLOSE AND DETOUR THE TOWPATH TRAIL WHEN WORKING ON THE CUYAHOGA RIVER BRIDGE.

**PRE-PHASE 5**

PRIOR TO COMMENCING PHASE 5 CONSTRUCTION ACTIVITIES THE CONTRACTOR SHALL CONSTRUCT TEMPORARY PAVEMENT REQUIRED FOR PHASE 5. DURING CONSTRUCTION OF THE TEMPORARY PAVEMENT, TRAFFIC SHALL BE MAINTAINED IN ACCORDANCE WITH MT-95.30. ONLY ONE LANE, ADJACENT TO EITHER THE INSIDE OR OUTSIDE SHOULDER MAY BE CLOSED AT ANY ONE TIME BETWEEN 8 PM – 6 AM OR IN ACCORDANCE WITH THE MOST UP TO DATE ODOT PERMITTED LANE CLOSURE CHART. THIS WORK ZONE SHALL BE REMOVED BY 6 AM DAILY. ALL RAMPS SHALL REMAIN OPEN TO TRAFFIC AT ALL TIMES.

**PHASE 5**

FROM THE BEGINNING OF THE PROJECT TO THE PEDESTRIAN BRIDGE/W. 11TH STREET THE CONTRACTOR SHALL SHIFT TWO EASTBOUND INTERSTATE 490 LANES TO THE INSIDE LANES AND SHOULDER AND KEEP WESTBOUND TRAFFIC INTO THE PROPOSED TRAFFIC PATTERN. THE CONTRACTOR SHALL CONSTRUCT ALL PROPOSED ROADWAY IMPROVEMENTS TO THE EASTBOUND OUTSIDE SHOULDER AND OUTSIDE LANES.

BETWEEN THE PEDESTRIAN BRIDGE/W. 11TH STREET AND THE END OF THE CUYAHOGA RIVER BRIDGE THE CONTRACTOR SHALL KEEP WESTBOUND TRAFFIC AND THE SINGLE EASTBOUND CROSSED OVER LANE IN THE PHASE 4 TRAFFIC PATTERN AND SHIFT TWO EASTBOUND LANES TO THE OUTSIDE LANES AND SHOULDER. THE CONTRACTOR SHALL CONSTRUCT ALL PROPOSED ROADWAY IMPROVEMENTS TO THE EASTBOUND OUTSIDE SHOULDER AND OUTSIDE LANES.

ALL RAMPS SHALL REMAIN OPEN TO TRAFFIC AT ALL TIMES EXCEPT FOR THE FOLLOWING RAMPS/MOVEMENTS WHICH MAY BE CLOSED AND DETOURED DURING RAMP/PAVEMENT RECONSTRUCTION ONLY:

EASTBOUND ENTRANCE RAMP 7-C FROM W. 7TH STREET  
EASTBOUND EXIT RAMP C-B TO BROADWAY AVE.

THE CONTRACTOR SHALL CLOSE AND DETOUR THE TOWPATH TRAIL WHEN WORKING ON THE CUYAHOGA RIVER BRIDGE.

**PHASE 5A**

ALL TRAFFIC SHALL REMAIN IN THE PHASE 5 TRAFFIC PATTERN, EXCEPT FOR RAMP S-E (I-71) AND BETWEEN THE PEDESTRIAN BRIDGE/W. 11TH STREET AND I-490 EB BEFORE W. 7TH STREET. THE CONTRACTOR SHALL SHIFT ONE LANE OF TRAFFIC TO THE INSIDE OF RAMP S-E (I-71) AND ONE LANE OF TRAFFIC TO THE INSIDE OF I-490 EB. THE CONTRACTOR SHALL CONSTRUCT THE OUTSIDE OF RAMP S-E (I-71) AND THE REMAINING I-490 EB PAVEMENT BETWEEN THE PEDESTRIAN BRIDGE/W. 11TH STREET AND W. 7TH STREET.

**PHASE 6**

THE CONTRACTOR CLOSE THE INSIDE LANE IN BOTH DIRECTIONS AND THE CROSSOVERS SHALL BE REMOVED AND THE PREVIOUSLY SUSPENDED MEDIAN BARRIER SHALL BE CONSTRUCTED. ALL RAMPS SHALL BE OPEN TO TRAFFIC.

ALL TEMPORARY DRAINAGE ITEMS TO THE INSIDE OF I-490 SHALL BE REMOVED AND RESTORED TO THE PERMANENT CONDITION. TRAFFIC SHALL BE MAINTAINED PER MT-95.30 DURING OFF-PEAK HOURS AND IN ACCORDANCE WITH THE LATEST REVISION OF THE PERMITTED LANE CLOSURE SCHEDULE (PLCS).

**PHASE 7**

THE CONTRACTOR SHALL PERFORM PAVEMENT PLANING OPERATIONS, PLACE THE FINAL SURFACE COURSE, AND PLACE THE FINAL PAVEMENT MARKINGS THROUGHOUT THE PROJECT LIMITS. ALL WORK SHALL BE RESTRICTED TO NIGHTTIME HOURS BETWEEN 8 PM AND 6 AM. DURING PAVEMENT PLANING OPERATIONS AND PLACEMENT OF THE FINAL SURFACE COURSE, TRAFFIC SHALL BE MAINTAINED IN ACCORDANCE WITH MT-95.30. DURING PLACEMENT OF THE FINAL PAVEMENT MARKINGS, TRAFFIC SHALL BE MAINTAINED IN ACCORDANCE WITH MT-99.20.

REVISIONS		
NO.	DATE	DESCRIPTION
△	01/15/24	CANALWAY PARTNERS AND CLE. METROPARKS CONTACT INFO ADDED AND TOWPATH TRAIL CLOSURE ADDED TO SEQUENCE OF CONSTRUCTION PHASES
△	03/27/24	ADDED TO PHASE 1 AND 6 SEQUENCE OF CONSTRUCTION

DESIGN AGENCY	KRM
DESIGNER	KRM
REVIEWER	AKF 11-21-23
PROJECT ID	107408
SHEET	60
TOTAL	1068



**SCHEDULE OF THROUGH LANES TO BE MAINTAINED**

ALL LANE CLOSURES MAY ONLY BE IMPLEMENTED AT THE TIMES PERMITTED BY THE "DISTRICT 12 PERMITTED LANE CLOSURE TIMES" LIST, WHICH IS LOCATED ON THE ODOT WEBSITE:

http://www.dot.state.oh.us/districts/D12/HighwayManagement/Pages/PermittedLaneClosures.aspx

THE LATEST REVISION, AT 14 DAYS PRIOR TO THE BID, SHALL BE IN EFFECT FOR THIS PROJECT.

NO LANE OR SHOULDER CLOSURES SHALL BE IN PLACE WHEN NO WORK IS BEING PERFORMED, UNLESS DIRECTED BY THE ENGINEER. SHOULDER CLOSURES SHALL ONLY BE ALLOWED AT THE TIMES SPECIFIED FOR LANE CLOSURES.

ANY ROADWAY NOT LISTED SHALL NOT HAVE ANY CLOSURES ON WEEKDAYS FROM 6:00 AM TO 9:00 AM AND 3:00 PM TO 6:00 PM. CONTACT TROY ONESTI, DISTRICT 12 WORK ZONE TRAFFIC MANAGER, AT (216) 584-2204 IF THERE ARE ANY QUESTIONS.

ALL NOTES ON THE PERMITTED LANE CLOSURE TIMES SHALL BE PART OF THE PROJECT.

**ITEM 614 - MAINTAINING TRAFFIC**

THIS ITEM SHALL CONSIST OF MAINTENANCE OF TRAFFIC ON EXISTING ROADWAYS IN ACCORDANCE WITH THE OHIO MANUAL OF UNIFORM TRAFFIC CONTROL DEVICES FOR STREETS AND HIGHWAYS, CURRENT EDITION, LATEST REVISION, THE SPECIFICATIONS AND THE FOLLOWING:

- 1. A MINIMUM OF THREE (3) ELEVEN FOOT (11') LANES OF TRAFFIC ON I-490 (UNLESS OTHERWISE SPECIFIED IN THE PLANS) IN EACH DIRECTION SHALL BE MAINTAINED AT ALL TIMES BY USE OF THE EXISTING PAVEMENT, THE COMPLETED PAVEMENT OR ITEM 615 PAVEMENT FOR MAINTAINING TRAFFIC, DURING CONSTRUCTION OF THE WORK.
2. THE CONTRACTOR SHALL INFORM THE DISTRICT OFFICE (216) 584-2006 FOURTEEN (14) DAYS PRIOR TO THE BEGINNING OF WORK.
3. LANE RESTRICTIONS OR LANE REDUCTIONS SHALL NOT BE PERMITTED AFTER NORMAL WORKING HOURS. NORMAL WORKING HOURS SHALL BE THOSE HOURS DURING WHICH THE CONTRACTOR HAS A FULL COMPLEMENT OF EMPLOYEES AND EQUIPMENT ACTIVELY REMOVING AND/OR PLACING PAVEMENT MATERIALS.
4. WHEN DETOUR SIGNS ARE IN USE, ALL CONFLICTING SIGNS SHALL BE COVERED.
5. FOR ROUTES NOT ON THE PERMITTED LANE CLOSURE CHART, ONLY DURING ANY PERIOD OTHER THAN 6-9 AM AND 3-6 PM SHALL THE CONTRACTOR INSTALL AND SUBSEQUENTLY RESET ALL TRAFFIC CONTROL NECESSARY FOR THE WORK ZONE FOR EACH CONSTRUCTION PHASE.
6. LENGTH AND DURATION OF LANE CLOSURES AND RESTRICTIONS SHALL BE AT THE APPROVAL OF THE ENGINEER. IT IS THE INTENT TO MINIMIZE THE IMPACT TO THE TRAVELING PUBLIC. LANE CLOSURES OR RESTRICTIONS OVER SEGMENTS OF THE PROJECT IN WHICH NO WORK IS ANTICIPATED WITHIN A REASONABLE TIME FRAME, AS DETERMINED BY THE ENGINEER, SHALL NOT BE PERMITTED. THE LEVEL OF UTILIZATION OF MAINTENANCE OF TRAFFIC DEVICES SHALL BE COMMENSURATE WITH THE WORK IN PROGRESS.
7. A MINIMUM OF ONE LANE OF TRAFFIC ON RAMPS SHALL BE MAINTAINED AT ALL TIMES, EXCEPT FOR A PERIOD NOT TO EXCEED THE CONSECUTIVE CALENDAR DAYS LISTED ON THE LANE VALUE CONTRACT TABLE, WHEN THROUGH TRAFFIC MAY BE DETOURED AS SHOWN ON SHEETS 124 - 136. A DISINCENTIVE SHALL BE ASSESSED IN THE AMOUNT LISTED ON THE LANE VALUE CONTRACT TABLE PER DAY FOR EACH CALENDAR DAY THE ROADWAY REMAINS CLOSED TO TRAFFIC BEYOND THE SPECIFIED LIMIT.
8. IF THE CONTRACTOR FAILS TO COMPLY WITH THE PROVISIONS FOR TRAFFIC CONTROL AS SET FORTH IN THESE PLANS AND PROVISIONS OF THE ODOTCD AND THE FAILURE RESULTS IN A CONDITION AT THE WORK SITE WHICH IS UNSAFE FOR TRAFFIC, THE ENGINEER SHALL SUSPEND WORK UNTIL THE CONTRACTOR COMPLIES WITH THE NECESSARY REQUIREMENTS.
9. THE TEMPORARY TRAFFIC CONTROL SHALL BE MAINTAINED THROUGHOUT THIS PROJECT BY THE CONTRACTOR. PERMANENT TRAFFIC CONTROL MAY BE TEMPORARILY RELOCATED AS APPROVED BY THE ENGINEER. THE CONTRACTOR SHALL ASSUME ALL LIABILITY FOR MISSING, DAMAGED, AND IMPROPERLY PLACED SIGNS. ANY WORK DONE BY THE CITY OF CLEVELAND OR THE OHIO DEPARTMENT OF TRANSPORTATION, INCLUDING INSTALLATION, MODIFICATION, REMOVAL AND/OR REPLACEMENT OF PERMANENT TRAFFIC CONTROL DEVICES, AS A RESULT OF WORK DONE BY THE CONTRACTOR SHALL BE AT THE EXPENSE OF THE CONTRACTOR.

**ITEM 614 - MAINTAINING TRAFFIC (CONT.)**

- 10. NO WORK SHALL BE PERFORMED AND ALL EXISTING MAINLINE I-490 LANES SHALL BE OPEN TO TRAFFIC DURING THE FOLLOWING DESIGNATED HOLIDAYS OR EVENTS:

CHRISTMAS FOURTH OF JULY
NEW YEAR'S LABOR DAY
TOTAL SOLAR ECLIPSE (4/8/24) THANKSGIVING
GENERAL/REGULAR ELECTION DAY (NOV.) MEMORIAL DAY

THE PERIOD OF TIME THAT THE LANES ARE TO BE OPEN DEPENDS ON THE DAY OF THE WEEK ON WHICH THE HOLIDAY OR EVENT FALLS. THE FOLLOWING SCHEDULE SHALL BE USED TO DETERMINE THIS PERIOD:

Table with 2 columns: DAY OF HOLIDAY OR SPECIAL EVENT, TIME ALL MAINLINE I-490 LANES MUST BE OPEN TO TRAFFIC. Rows include SUNDAY, MONDAY, MONDAY (TOTAL SOLAR ECLIPSE), TUESDAY, TUESDAY (GEN./REG. ELECTION), WEDNESDAY, THURSDAY, THURSDAY (THANKSGIVING ONLY), FRIDAY, SATURDAY.

DURING THE SAME PERIOD, MAINTAIN PEDESTRIAN ACCESS IF PEDESTRIAN ACCESS WAS PRESENT PRIOR TO CONSTRUCTION.

SHOULD THE CONTRACTOR FAIL TO MEET ANY OF THESE REQUIREMENTS, THE CONTRACTOR SHALL BE ASSESSED A DISINCENTIVE PER THE LANE VALUE CONTRACT (PN 127).

- 11. IN THE VICINITY OF THE TRAIL THE EXISTING TOWPATH TRAIL SHALL BE OPEN TO TRAFFIC DURING THE FOLLOWING DESIGNATED EVENTS:

- TOWPATH MARATHON - FIRST WEEKEND OF OCTOBER 2024
- TOWPATH TRAIL LANTERN PARADE - FIRST WEEKEND OF MARCH 2025

- 12. PRIOR TO OPENING TRAFFIC EACH LANE SHALL BE IN A SAFE, PASSABLE CONDITION. ALL TRANSVERSE JOINTS SHALL EXTEND ACROSS THE FULL LANE AND SHOULDER WIDTH AND EACH LANE SHALL BE FREE FROM UNEVEN LONGITUDINAL JOINTS. UNEVEN LONGITUDINAL JOINTS SHALL BE TREATED IN ACCORDANCE WITH ODOT SCD MT-101.90. AT UNEVEN TRANSVERSE JOINTS, THE CONTRACTOR SHALL PROVIDE TEMPORARY ASPHALT RAMPING TO ENSURE A SMOOTH TRANSITION FOR THE TRAVELING PUBLIC. THE MINIMUM TAPER RATE FOR TEMPORARY RAMPING AT UNEVEN TRANSVERSE JOINTS IS 120:1. PRIOR TO PLACING THE SURFACE COURSE, ALL TEMPORARY RAMPING AND WEDGE MATERIAL SHALL BE REMOVED. THE FOLLOWING ESTIMATED QUANTITY HAS BEEN CARRIED TO THE MAINTENANCE OF TRAFFIC GENERAL SUMMARY TO BE USED AS DIRECTED BY THE ENGINEER.

ITEM 614 - ASPHALT CONCRETE FOR MAINTAINING TRAFFIC 250 CY

- 13. THE CONTRACTOR SHALL MILL 2 INCHES BY 2 FEET WIDE OF THE EXISTING ASPHALT SHOULDER IN ORDER TO REMOVE THE EXISTING RUMBLE STRIPS IN THE AREA WHERE TRAFFIC IS SHIFTED AS SHOWN IN THE PLANS. THE CONTRACTOR SHALL THEN COAT ALL MILLED SURFACES HORIZONTAL AND VERTICAL WITH APPROVED AC LIQUID. NEXT THE CONTRACTOR SHALL PLACE 2 INCHES OF ITEM 442 ASPHALT CONCRETE SURFACE COURSE, 12.5 MM, TYPE A (447), AS PER PLAN, PG 76-22M. ALL COST ASSOCIATED WITH THE REMOVAL OF THE EXISTING PAVEMENT AND THE PLACEMENT OF THE SURFACE COURSE SHALL BE INCLUDED IN THE PRICE BID PER FOOT OF THE FOLLOWING ITEM:

ITEM 614, MAINTAINING TRAFFIC, MISC.: REMOVE RUMBLE STRIPS, SHOULDER (ASPHALT CONCRETE) 9450 FT

RUMBLE STRIPS LOCATED WITHIN A CONCRETE SHOULDER AREA WHICH IS USED TO MAINTAIN TRAFFIC SHALL BE PAVED OVER WITH ASPHALT FOR A SMOOTH SURFACE. IN AREAS OUTSIDE OF THE SHOULDER RECONSTRUCTION LIMITS, THE ASPHALT SHALL BE SUBSEQUENTLY REMOVED AND THE RUMBLE STRIPS EXPOSED TO ORIGINAL CONDITION.

ITEM 614, MAINTAINING TRAFFIC, MISC.: REMOVE RUMBLE STRIPS, SHOULDER (CONCRETE) 2160 FT

ALL WORK AND TRAFFIC CONTROL DEVICES SHALL BE IN ACCORDANCE WITH C&MS 614 AND OTHER APPLICABLE PORTIONS OF THE SPECIFICATIONS, AS WELL AS THE OHIO MANUAL OF UNIFORM TRAFFIC CONTROL DEVICES, CURRENT EDITION, LATEST REVISION. PAYMENT FOR ALL LABOR, EQUIPMENT AND MATERIALS SHALL BE INCLUDED IN THE LUMP SUM CONTRACT PRICE FOR ITEM 614 - MAINTAINING TRAFFIC, UNLESS SEPARATELY ITEMIZED IN THE PLAN.

**LANE VALUE CONTRACT (PN 127)**

THE CONTRACTOR SHALL BE ASSESSED DISINCENTIVES AS DESIGNATED IN THE LANE VALUE CONTRACT TABLE FOR EACH UNIT OF TIME THE DESCRIBED CRITICAL LANE/RAMP IS RESTRICTED FROM FULL USE BY THE TRAVELING PUBLIC WITHIN THE RESTRICTED TIME PERIOD. THE LANE VALUE CONTRACT TABLE IS LOCATED BELOW. THE DISINCENTIVES WILL BE ASSESSED FOR ALL RESTRICTIONS OF THE CRITICAL WORK.

CRITICAL WORK IS SHOWN IN THE LANE VALUE CONTRACT TABLE.

CRITICAL WORK IS DEFINED AS HAVING THE DESIGNATED SECTIONS OPEN TO UNRESTRICTED TRAFFIC AS SHOWN IN THE TABLE, OR THE ENTIRE PROJECT IF NOT OTHERWISE LISTED.

UNRESTRICTED TRAFFIC IS DEFINED AS ALL TRAFFIC LANES BEING AVAILABLE FOR USE WITH SPECIFIED STRIPING AND SAFETY FEATURES IN PLACE.

LANE VALUE CONTRACT TABLE with columns: DESCRIPTION OF CRITICAL LANE/RAMP TO BE MAINTAINED, RESTRICTED TIME PERIOD, TIME UNIT, DISINCENTIVE \$ PER TIME PERIOD. Rows include I-490 - BEGIN PROJECT TO SR-176 SPLIT (EB), I-490 - SR-176 SPLIT TO BROADWAY (EB), I-490 - BROADWAY TO END PROJECT (EB), I-490 - END PROJECT TO BROADWAY (WB), I-490 - BROADWAY TO I-71 SPLIT (WB), I-490 / I-71 SPLIT TO BEGIN PROJECT (WB).

**DRUM REQUIREMENTS**

IN ADDITION TO THE REQUIREMENTS OF THE PLANS, SPECIFICATION AND PROPOSAL, DRUMS FURNISHED BY THE CONTRACTOR SHALL BE NEW AND UNUSED AT THE TIME OF ARRIVAL ON THE PROJECT. ANY DRUMS BROUGHT ON THE PROJECT, WHICH HAVE PREVIOUSLY BEEN USED ELSEWHERE, WILL NOT BE ACCEPTED. PAYMENT FOR DRUMS SHALL BE INCLUDED IN THE LUMP SUM PRICE BID FOR MAINTAINING TRAFFIC UNLESS SEPARATELY ITEMIZED.

**DUST CONTROL**

THE CONTRACTOR SHALL FURNISH AND APPLY WATER FOR DUST CONTROL AS DIRECTED BY THE ENGINEER. THE FOLLOWING ESTIMATED QUANTITIES HAVE BEEN INCLUDED FOR DUST CONTROL PURPOSES AND CARRIED TO THE MAINTENANCE OF TRAFFIC GENERAL SUMMARY:

ITEM 616, WATER 300 MGAL

**REPLACEMENT SIGN**

FLATSHEET SIGNS FURNISHED BY THE CONTRACTOR IN ACCORDANCE WITH THE REQUIREMENTS OF THE PLANS, SPECIFICATIONS AND PROPOSAL WHICH BECOME DAMAGED BY TRAFFIC FOR REASONS BEYOND THE CONTROL OF THE CONTRACTOR SHALL BE REPLACED IN KIND WHEN ORDERED BY THE ENGINEER. REPLACEMENT SIGNS SHALL BE NEW. OTHER MATERIALS MAY BE IN USED, BUT GOOD, CONDITION SUBJECT TO APPROVAL BY THE ENGINEER.

PAYMENT FOR THE NEW SIGNS SHALL BE MADE AT THE CONTRACT PRICE PER EACH FOR ITEM 614, REPLACEMENT SIGN, AND SHALL INCLUDE THE COST OF REMOVING AND DISPOSING OF DAMAGED SIGNS, HARDWARE AND SUPPORTS, AND PROVIDING THE NECESSARY REPLACEMENT HARDWARE, SUPPORTS, ETC.

AN ESTIMATED QUANTITY OF 50 EACH HAS BEEN PROVIDED IN THE MAINTENANCE OF TRAFFIC GENERAL SUMMARY.

**ITEM 622 - PORTABLE BARRIER, 50", AS PER PLAN**

THIS WORK SHALL CONSIST OF FURNISHING, MAINTAINING, AND SUBSEQUENTLY REMOVING A 50-INCH PORTABLE BARRIER AT THE LOCATIONS SHOWN ON THE PLANS. FOR DETAILS, SEE SCD RM-4.1.

PORTABLE STEEL BARRIER IS AN APPROVED ALTERNATIVE TO PORTABLE CONCRETE BARRIER. FOR INFORMATION ON APPROVED VENDORS, SEE THE APPROVED PRODUCTS LIST MAINTAINED BY THE OFFICE OF ROADWAY ENGINEERING. PORTABLE BARRIER, 32 INCHES HIGH WITH AN 18-INCH MINIMUM HEIGHT GLARE SCREEN MAY BE USED AT THE OPTION OF THE CONTRACTOR. THE GLARE SCREEN SHALL BE CONSTRUCTED USING ONE OF THE SCREENS PROVIDED ON THE APPROVED LIST, AVAILABLE ON THE OFFICE OF ROADWAY ENGINEERING WEBSITE.

PADDLE OR INTERMITTENT TYPE GLARE SCREENS SHALL BE DESIGNED USING A 20 DEGREE CUT-OFF ANGLE BASED ON TANGENT ALIGNMENT. THAT SPACING SHALL BE USED THROUGHOUT THE BARRIER LENGTH WITHOUT REGARD TO BARRIER CURVATURE.

THE GLARE SCREEN SYSTEM SHALL BE SECURELY FASTENED TO THE 32-INCH PORTABLE BARRIER USING THE HARDWARE AND PROCEDURES SPECIFIED BY THE MANUFACTURER. FOR DIRECTIONS ON HOW TO INSTALL THE GLARE SCREEN AND THE BARRIER, SEE THE MANUFACTURER'S INSTRUCTIONS. PAYMENT SHALL INCLUDE ALL LABOR, MATERIAL, AND EQUIPMENT NECESSARY TO PERFORM THE WORK AND SHALL BE PAID FOR AT THE CONTRACT PRICE PER FOOT FOR ITEM 622, PORTABLE BARRIER, 50", AS PER PLAN.

**APPROVED MAINTENANCE OF TRAFFIC (MOT) POLICY EXCEPTION**

PORTIONS OF THE MOT PLANS AS DESCRIBED BELOW HAVE APPROVED MOT EXCEPTION PER TRAFFIC MANAGEMENT IN WORK ZONES POLICY (21-008(P)) AND STANDARD PROCEDURE (123-001(SP)).

APPROVED MOT EXCEPTION(S) INCLUDE:

I-77 SB TO I-490 EB (RAMP N-E)
I-77 NB TO I-490 WB (RAMP S-W)

A MAINTENANCE OF TRAFFIC MEETING SHALL BE HELD A MINIMUM OF 30 CALENDAR DAYS PRIOR TO IMPLEMENTATION OF EACH APPROVED MOT EXCEPTION. THIS MEETING SHALL INCLUDE THE DISTRICT WORK ZONE TRAFFIC MANAGER AND THE CITY OF CLEVELAND AS WELL AS THE CONTRACTOR, WORKSITE TRAFFIC SUPERVISOR (WTS) AND ANY SUBCONTRACTORS INVOLVED WITH TEMPORARY TRAFFIC CONTROL.

IN ADDITION TO ANY NOTIFICATIONS REQUIRED IN OTHER NOTES, THE CONTRACTOR SHALL NOTIFY THE PROJECT ENGINEER AT LEAST 3 BUSINESS DAYS IN ADVANCE OF IMPLEMENTATION OF THE APPROVED MOT EXCEPTION REFERENCED ABOVE SO THAT THE PROJECT ENGINEER CAN SEND EMAIL NOTIFICATION TO THE OFFICE OF ROADWAY ENGINEERING, STATEWIDE TMC, DWZTM AND SPECIAL HAULING PERMITS AT LEAST 2 BUSINESS DAYS IN ADVANCE OF THE IMPLEMENTATION OF THE APPROVED MOT EXCEPTION REFERENCED ABOVE. REFERENCE "EXCEPTION REQUEST APPROVAL DATED 12 / 07 / 2023 FOR PID 107408" IN THE NOTIFICATION AND OTHER CORRESPONDENCE.

ANY CHANGES TO THE MOT THAT IMPACT THE PREVIOUSLY APPROVED MOT EXCEPTION LISTED ABOVE SHALL BE APPROVED IN WRITING BY THE MOT EXCEPTION COMMITTEE (MOTEC). IN THE EVENT THAT SUCH CHANGES ARE PROPOSED, THE REQUEST SHALL BE COORDINATED THROUGH THE DISTRICT WORK ZONE TRAFFIC MANAGER (DWZTM) A MINIMUM OF 30 CALENDAR DAYS PRIOR TO THE DESIRED IMPLEMENTATION DATE. IF THE DISTRICT AGREES WITH THE PROPOSED CHANGES THE DWZTM SHALL SEEK APPROVAL FROM THE MOTEC. IN THE EVENT THE PROPOSED CHANGES ARE APPROVED IN WRITING, THE CLOSURES ARE STILL SUBJECT TO NOTIFICATION REQUIREMENTS WITHIN THIS NOTE PRIOR TO IMPLEMENTATION.

**ITEM 614 - DETOUR SIGNING**

ALL REQUIRED SIGNS AND SUPPORTS SHALL BE FURNISHED, ERECTED, MAINTAINED AND SUBSEQUENTLY REMOVED BY THE CONTRACTOR. PAYMENT FOR ALL WORK ASSOCIATED WITH THE DETOUR SHALL BE INCLUDED UNDER THE LUMP SUM BID FOR ITEM 614 - DETOUR SIGNING.

THE FOLLOWING QUANTITY HAS BEEN CARRIED TO THE MAINTENANCE OF TRAFFIC GENERAL SUMMARY:

ITEM 614 - DETOUR SIGNING LS

Table with columns: NO., DATE, DESCRIPTION, REVISIONS. Rows include 1/15/24, 03/27/24, 04/02/24. Includes a small diagram of a sign with the number 4.

DESIGN AGENCY



DESIGNER

KRM

REVIEWER

AKF 11-21-23

PROJECT ID

107408

SHEET TOTAL

61 1068

**WORK ZONE SPEED ZONES (WZSZS)**

THE FOLLOWING WORK ZONE SPEED ZONE (WZSZ) SPEED LIMIT REVISION(S) HAVE BEEN APPROVED FOR USE ON THIS PROJECT WHEN WORK ZONE CONDITIONS AND FACTORS ARE MET AS DESCRIBED BELOW:

WZSZ REVISION NUMBER(S)	DIRECTION(S)
WZ - 65263-00	CUY-490-0.00-1.00
WZ - 65264-00	CUY-490-1.00
WZ - 65263-01	CUY-490-1.75-2.28

POTENTIAL WZSZ LOCATIONS SHALL HAVE AN ORIGINAL (PRE-CONSTRUCTION) POSTED SPEED LIMIT OF 55 MPH OR GREATER, A QUALIFYING WORK ZONE CONDITION OF AT LEAST 0.5 MILE IN LENGTH, AN EXPECTED WORK DURATION OF AT LEAST THREE HOURS, AND A WORK ZONE CONDITION IN PLACE THAT REDUCES THE EXISTING FUNCTIONALITY OF THE TRAVEL LANES OR SHOULDERS (I.E., LANE CLOSURE, LANE SHIFT, CROSSOVER, CONTRAFLOW AND/OR SHOULDER CLOSURE). THE LENGTH OF THE WORK ZONE CONDITION IS MEASURED FROM THE BEGINNING OF THE TAPER FOR THE SUBJECT WORK ZONE CONDITION IMPACTING THE TRAVEL LANES AND/OR SHOULDER TO THE END OF THE DOWNSTREAM TAPER, WHERE DRIVERS ARE RETURNED TO TYPICAL ALIGNMENT. AN EXPECTED WORK DURATION OF AT LEAST THREE HOURS IS REQUIRED TO BALANCE THE ADDITIONAL EXPOSURE CREATED BY INSTALLING AND REMOVING WZSZ SIGNING WITH THE TIME NEEDED TO COMPLETE THE WORK.

IF THE WORK ZONE MEETS THESE MINIMUM CRITERIA, IT SHALL BE ANALYZED FURTHER USING TABLE 1 BELOW TO DETERMINE IF AND WHEN IT QUALIFIES FOR A SPEED LIMIT REDUCTION. DEPENDING ON THE ORIGINAL POSTED SPEED LIMIT, THE TYPE OF TEMPORARY TRAFFIC CONTROL USED, AND WHETHER OR NOT WORKERS ARE PRESENT, A WARRANTED WZSZ WILL VARY IN THE APPROVED SPEED LIMIT TO BE POSTED OVER TIME.

C&MS ITEM 614, PARAGRAPH 614.02(B), INDICATES THAT TWO DIRECTIONS OF A DIVIDED HIGHWAY ARE CONSIDERED SEPARATE HIGHWAY SECTIONS. THEREFORE, IF THE WORK ON A MULTI-LANE DIVIDED HIGHWAY IS LIMITED TO ONLY ONE DIRECTION, A SPEED LIMIT REDUCTION IN THE DIRECTION OF THE WORK DOES NOT AUTOMATICALLY CONSTITUTE A SPEED LIMIT REDUCTION IN THE OPPOSITE DIRECTION. EACH DIRECTION SHALL BE ANALYZED INDEPENDENTLY FROM EACH OTHER.

ALL WZSZS FLUCTUATE BETWEEN TWO APPROVED REDUCED SPEED LIMITS OR BETWEEN AN APPROVED REDUCED SPEED LIMIT AND THE ORIGINAL POSTED SPEED LIMIT. ONLY ONE OF TWO SIGNING STRATEGIES SHALL BE USED TO IMPLEMENT A WZSZ.

WZSZS USING DSL SIGN ASSEMBLIES SHALL BE IN ACCORDANCE WITH THIS NOTE, APPROVED LIST, SUPPLEMENTAL SPECIFICATIONS (SS) 808 AND 908, AND TRAFFIC SCD MT-104.10.

ONLY ONE WARRANTED SPEED LIMIT APPLIES AT ANY ONE TIME; SPEED LIMIT REDUCTIONS ARE NOT CUMULATIVE. WZSZS SHALL NOT BE USED FOR MOVING/MOBILE ACTIVITIES, AS DEFINED IN OMUTCD PART 6.

WHEN LOOKING UP THE WARRANTED WORK ZONE SPEED LIMITS, ALWAYS USE THE ORIGINAL, PRE-CONSTRUCTION, POSTED SPEED LIMIT. DO NOT USE A PRIOR OR CURRENT WORK ZONE SPEED LIMIT AS A LOOK UP VALUE IN THE TABLE. POSITIVE PROTECTION IS GENERALLY REGARDED AS PORTABLE BARRIER OR OTHER RIGID BARRIER IN USE ALONG THE WORK AREA WITHIN THE SUBJECT WARRANTED WORK ZONE CONDITION. WITHOUT POSITIVE PROTECTION IS GENERALLY REGARDED AS USING DRUMS, CONES, SHADOW VEHICLE, ETC., ALONG THE WORK AREA WITHIN THE SUBJECT WARRANTED WORK ZONE CONDITION. WORKERS ARE CONSIDERED AS BEING PRESENT WHEN ON-SITE, WORKING WITHIN THE SUBJECT WARRANTED WORK ZONE CONDITION. WHEN THE WORK ZONE CONDITION REDUCING THE EXISTING FUNCTIONALITY OF THE TRAVEL LANES OR SHOULDERS IS REMOVED, THE SPEED LIMIT DISPLAYED SHALL RETURN TO THE ORIGINAL POSTED SPEED LIMIT.

**WORK ZONE SPEED ZONES (WZSZS) (CONT.)**

TABLE 1: WARRANTED WORK ZONE SPEED LIMITS (MPH) FOR WORK ZONES ON HIGH-SPEED (55 MPH OR GREATER) MULTI-LANE HIGHWAYS

WITH POSITIVE PROTECTION			
ORIGINAL POSTED SPEED LIMIT	WORKERS PRESENT	WORKERS NOT PRESENT	
70	60	65	
65	55	60	
60	55	60	
55	50	55	
WITHOUT POSITIVE PROTECTION			
ORIGINAL POSTED SPEED LIMIT	WORKERS PRESENT	WORKERS NOT PRESENT	
70	55	65	
65	50	60	
60	50	60	
55	45	55	

THE FOLLOWING ESTIMATED QUANTITY HAS BEEN CARRIED TO THE MAINTENANCE OF TRAFFIC GENERAL SUMMARY.

ITEM 808, DIGITAL SPEED LIMIT (DSL) SIGN ASSEMBLY 42 SNMT

ASSUMING 3 DSL SIGN ASSEMBLIES FOR 12 MONTHS  
ASSUMING 2 DSL SIGN ASSEMBLIES FOR 2 MONTHS  
ASSUMING 2 DSL SIGN ASSEMBLIES FOR 1 MONTHS

**WORK ZONE INCREASED PENALTIES SIGN (R11-H5A)**

R11-H5A-48 SIGNS SHALL BE FURNISHED, ERECTED, AND MAINTAINED IN GOOD CONDITION AND/OR REPLACED AS NECESSARY AND SUBSEQUENTLY REMOVED BY THE CONTRACTOR. SIGNS SHALL BE MOUNTED AT THE APPROPRIATE OFFSETS AND ELEVATIONS AS PRESCRIBED BY THE OHIO MANUAL OF UNIFORM TRAFFIC CONTROL DEVICES. THEY SHALL BE MAINTAINED ON SUPPORTS MEETING CURRENT SAFETY CRITERIA.

THE SIGNS MAY BE ERECTED OR UNCOVERED NO MORE THAN FOUR HOURS BEFORE THE ACTUAL START OF WORK. THE SIGNS SHALL BE REMOVED OR COVERED NO LATER THAN FOUR HOURS FOLLOWING RESTORATION OF ALL LANES TO TRAFFIC WITH NO RESTRICTIONS, OR SOONER AS DIRECTED BY THE ENGINEER. TEMPORARY SIGN COVERING AND UNCOVERING DUE TO TEMPORARY LANE RESTORATIONS SHALL BE GUIDED BY THE FOUR-HOUR LIMITATIONS STATED ABOVE. SUCH LANE RESTORATIONS SHOULD BE EXPECTED TO REMAIN IN EFFECT FOR 30 OR MORE CONSECUTIVE CALENDAR DAYS, SUCH AS DURING WINTER SHUT-DOWNS.

THE SIGNS ON THE MAINLINE SHALL BE DUAL MOUNTED UNLESS NOT PHYSICALLY POSSIBLE. THE FIRST SIGN SHALL BE PLACED BETWEEN THE ROAD WORK AHEAD (W20-1) SIGN AND THE NEXT SIGN IN THE SEQUENCE. SIGNS SHALL BE ERECTED ON EACH ENTRANCE RAMP AND EVERY 2 MILES THROUGH THE CONSTRUCTION WORK LIMITS. SIGNS ON THE MAINLINE SHALL BE R11-H5A-48. SIGNS USED ON THE RAMPS SHALL BE R11-H5A-24. R11-H5A-24 SIGNS MAY BE USED IN THE MEDIAN IN LIEU OF R11-H5A-48 SIGNS IF IT IS NOT PHYSICALLY POSSIBLE TO PROVIDE R11-H5A-48 SIGNS IN THE MEDIAN.

THE R11-H5A-48 SIGNS SHALL BE MOUNTED ON 2 NO. 3 POSTS WHEN LOCATED WITHIN CLEAR ZONES.

THE CONTRACTOR MAY USE SIGNS AND SUPPORTS IN USED, BUT GOOD, CONDITION PROVIDED THE SIGNS MEET CURRENT ODOT SPECIFICATIONS. SIGN FACES SHALL BE RETROREFLECTORIZED WITH TYPE G SHEETING COMPLYING WITH THE REQUIREMENTS OF C&MS 730.19.

WORK ZONE INCREASED PENALTIES SIGNS AND SUPPORTS WILL BE MEASURED AS THE NUMBER OF SIGN INSTALLATIONS, INCLUDING THE SIGN AND NECESSARY SUPPORTS. IF A SIGN AND SUPPORT COMBINATION IS REMOVED AND REERECTED AT ANOTHER LOCATION AS DIRECTED BY THE ENGINEER, IT SHALL BE CONSIDERED ANOTHER UNIT.

PAYMENT FOR ACCEPTED QUANTITIES, COMPLETE, IN PLACE WILL BE MADE AT THE CONTRACT UNIT PRICE. PAYMENT SHALL BE FULL COMPENSATION FOR ALL MATERIALS, LABOR, INCIDENTALS AND EQUIPMENT FOR FURNISHING, ERECTING, MAINTAINING, COVERING DURING SUSPENSION OF WORK, AND REMOVAL OF THE SIGN AND SUPPORT. THE FOLLOWING QUANTITY HAS BEEN CARRIED TO THE MAINTENANCE OF TRAFFIC GENERAL SUMMARY.

ITEM 614, WORK ZONE INCREASED PENALTIES SIGN 14 EACH

**EARTHWORK FOR MAINTAINING TRAFFIC**

THE FOLLOWING QUANTITIES HAVE BEEN INCLUDED IN THE PLAN FOR INFORMATION ONLY.

EXCAVATION FOR MAINTAINING TRAFFIC 1573 CU. YD.

EMBANKMENT FOR MAINTAINING TRAFFIC 563 CU. YD.

WHEN UNDERCUTS ARE NECESSARY FOR MAINLINE PAVEMENT OR EMBANKMENT CONSTRUCTION, EVALUATE THE NEED FOR TEMPORARY ROAD UNDERCUTS IF WITHIN A CLOSE PROXIMITY TO THE MAINLINE UNDERCUTS. A GEOTECHNICAL EVALUATION SHOULD BE CONSIDERED TO DETERMINE IF THE EXISTING SOIL CONDITIONS ARE ADEQUATE TO SUPPORT THE TEMPORARY ROAD. ADDITIONAL SOIL BORINGS ALONG THE TEMPORARY ROAD ARE NOT NORMALLY REQUIRED.

**ITEM 614 - WORK ZONE IMPACT ATTENUATOR FOR 24" WIDE HAZARDS (UNIDIRECTIONAL)**

THIS ITEM SHALL CONSIST OF FURNISHING AND INSTALLING A NON-GATING IMPACT ATTENUATOR. FURNISH AN IMPACT ATTENUATOR FROM THE OFFICE OF ROADWAY ENGINEERING'S APPROVED LIST FOR WORK ZONE IMPACT ATTENUATORS, FROM THE ROADWAY STANDARDS APPROVED PRODUCTS WEB PAGE.

INSTALLATION SHALL BE AT THE LOCATIONS SPECIFIED IN THE PLANS IN ACCORDANCE WITH THE MANUFACTURER'S SPECIFICATIONS.

THE CONTRACTOR SHALL REPAIR OR REPLACE A DAMAGED UNIT WITHIN 24 HOURS OF A DAMAGING IMPACT.

WHEN BIDIRECTIONAL DESIGNS ARE SPECIFIED, THE CONTRACTOR SHALL SUPPLY APPROPRIATE TRANSITIONS.

WHEN GATING IMPACT ATTENUATORS ARE DESIRED, THE CONTRACTOR SHALL SUBMIT DOCUMENTATION TO THE ENGINEER FOR ACCEPTANCE.

THE COST FOR THE ADDITIONAL BARRIER REQUIRED FOR A GATING IMPACT ATTENUATOR SHALL BE INCLUDED IN THE COST OF THE GATING IMPACT ATTENUATOR.

PAYMENT FOR THE ABOVE WORK SHALL BE MADE AT THE UNIT PRICE BID AND SHALL INCLUDE ALL LABOR, TOOLS, EQUIPMENT AND MATERIALS NECESSARY TO CONSTRUCT AND MAINTAIN A COMPLETE AND FUNCTIONAL IMPACT ATTENUATOR SYSTEM, INCLUDING ALL RELATED BACKUPS, TRANSITIONS, LEVELING PADS, HARDWARE AND GRADING, NOT SEPARATELY SPECIFIED, AS REQUIRED BY THE MANUFACTURER.

**ITEM 614 - WORK ZONE CROSSOVER LIGHTING SYSTEM**

THIS WORK SHALL CONSIST OF FURNISHING, ERECTING, OPERATING, MAINTAINING AND REMOVING A WORK ZONE LIGHTING SYSTEM FOR A SINGLE CROSSOVER, OR OVERLAPPING A PAIR OF CROSSOVERS. THE SYSTEM SHALL BE AS SHOWN ON TRAFFIC SCD MT 100.00. THE CONTRACTOR SHALL ARRANGE FOR AND PAY FOR POWER. ALL MATERIALS AND CONSTRUCTION SHALL COMPLY WITH APPLICABLE PORTIONS OF 625 AND 725 EXCEPT: THE PERFORMANCE TEST OF 625.19F, AND CERTIFIED DRAWING REQUIREMENT OF 625.06, ARE WAIVED AND USED MATERIALS IN GOOD CONDITION ARE ACCEPTABLE.

POLES WHICH ARE NOT PROTECTED BY GUARDRAIL OR PORTABLE BARRIER SHALL BE LOCATED OUTSIDE THE CLEAR ZONE, AND SHOULD BE LOCATED AT LEAST 30 FEET (PREFERABLY 40 FEET) FROM THE EDGE OF PAVEMENT WHEN POSSIBLE. ADDITIONAL POLE LINES, CABLES AND APPURTENANCES NECESSARY TO FURNISH POWER TO THE LIGHTING SYSTEM SHALL BE INCLUDED IN THIS ITEM. SERVICE POLES SHALL BE POSITIONED WITH THE SAME CONSTRAINTS AS THE LIGHTING POLES AS A MINIMUM.

PAYMENT WILL BE MADE AT THE UNIT PRICE PER EACH FOR ITEM 614, WORK ZONE CROSSOVER LIGHTING SYSTEM THROUGHOUT ALL PHASES OF WORK WHEN THE CROSSOVER ROADWAYS ARE USED. THE FOLLOWING QUANTITY HAS BEEN CARRIED TO THE MAINTENANCE OF TRAFFIC GENERAL SUMMARY.

ITEM 614 - WORK ZONE CROSSOVER LIGHTING SYSTEM 2 EACH

**FLOODLIGHTING**

FLOODLIGHTING OF THE WORK SITE FOR OPERATIONS CONDUCTED DURING NIGHTTIME PERIODS SHALL BE ACCOMPLISHED SO THAT THE LIGHTS DO NOT CAUSE GLARE TO THE DRIVERS ON THE ROADWAY. TO ENSURE THE ADEQUACY OF THE FLOODLIGHT PLACEMENT, THE CONTRACTOR AND THE ENGINEER SHALL DRIVE THROUGH THE WORK SITE EACH NIGHT WHEN THE LIGHTING IS IN PLACE AND OPERATIVE PRIOR TO COMMENCING ANY WORK. IF GLARE IS DETECTED, THE LIGHT PLACEMENT AND SHIELDING SHALL BE ADJUSTED TO THE SATISFACTION OF THE ENGINEER BEFORE WORK PROCEEDS.

PAYMENT FOR ALL LABOR, EQUIPMENT AND MATERIALS SHALL BE INCLUDED IN THE LUMP SUM CONTRACT PRICE FOR ITEM 614, MAINTAINING TRAFFIC.

**MAINTENANCE OF CANOE TRAFFIC**

CANOE TRAFFIC SHALL BE MAINTAINED THROUGHOUT CONSTRUCTION OF THE PROJECT EITHER THROUGH EXISTING RIVER CHANNEL OR THROUGH PORTAGE TRAIL APPROVED BY THE ENGINEER.

ADEQUATE SIGNING BOTH UPSTREAM AND DOWNSTREAM SHALL BE INSTALLED AND MAINTAINED BY THE CONTRACTOR. THE FOLLOWING TYPE SIGNS ARE CONSIDERED TO BE MINIMUM TREATMENT:

- APPROXIMATELY ONE-QUARTER MILE UPSTREAM, ADVANCED WARNING TYPE SIGNS ON BOTH BANKS;
- APPROXIMATELY 300 FEET UPSTREAM, SIGNS SPECIFYING ACTIONS REQUIRED OF CANOEIST ON BOTH BANKS;
- APPROXIMATELY ONE-QUARTER MILE DOWNSTREAM, ADVANCE WARNING TYPE SIGNS ON BOTH BANKS; AND
- APPROXIMATELY 300 FEET DOWNSTREAM, SIGNS SPECIFYING ACTIONS REQUIRED OF CANOEIST OF BOTH BANKS.

**OVERNIGHT TRENCH CLOSING**

THE BASE WIDENING SHALL BE COMPLETED TO A DEPTH OF NO MORE THAN 3.25" INCHES BELOW THE EXISTING PAVEMENT BY THE END OF EACH WORK DAY. NO TRENCH SHALL BE LEFT OPEN OVERNIGHT EXCEPT FOR A SHORT LENGTH (25 FEET OR LESS) OF A WORK SECTION AT THE END OF THE TRENCH. IN CASE WORK MUST BE SUSPENDED BECAUSE OF INCLEMENT WEATHER OR OTHER REASONS, THE TRENCH FOR THE UNCOMPLETED BASE WIDENING SHALL BE BACKFILLED AT THE DIRECTION OF THE ENGINEER.

**CONCRETE MEDIAN BARRIER REPLACEMENT**

REMOVING, GRADING AND INSTALLING THE REPLACEMENT BARRIER WITHIN THE PROJECT LIMITS IN A CONTINUOUS OPERATION SHALL BE LIMITED TO 471' LINEAR FEET, SEE DETAIL SHEETS 287-288, AND SHALL AT ALL TIMES BE SUBJECT TO THE APPROVAL OF THE ENGINEER. THE ENGINEER SHALL BE SATISFIED THAT ALL INSTALLATIONS WILL AFFORD MAXIMUM PROTECTION FOR TRAFFIC. THE ABOVE QUANTITY HAS BEEN INCLUDED IN ROADWAY OFFICE CALCULATIONS.

**TRENCH FOR WIDENING**

TRENCH EXCAVATION FOR BASE WIDENING SHALL BE ONLY ON ONE SIDE OF THE PAVEMENT AT A TIME. THE OPEN TRENCH SHALL BE ADEQUATELY MAINTAINED AND PROTECTED WITH DRUMS OR BARRICADES AT ALL TIMES. PLACEMENT OF PROPOSED SUBBASE AND BASE MATERIAL SHALL FOLLOW AS CLOSELY AS POSSIBLE BEHIND EXCAVATION OPERATIONS. THE LENGTH OF WIDENING TRENCH WHICH IS OPEN AT ANY ONE TIME SHALL BE HELD TO A MINIMUM AND SHALL AT ALL TIMES BE SUBJECT TO APPROVAL OF THE ENGINEER.

**PLACEMENT OF ASPHALT CONCRETE**

TWO-WAY TRAFFIC SHALL BE MAINTAINED AT ALL TIMES EXCEPT THAT ONE-WAY TRAFFIC WILL BE PERMITTED FOR MINIMUM PERIODS OF TIME CONSISTENT WITH THE REQUIREMENTS OF THE SPECIFICATIONS FOR PROTECTION OF COMPLETED ASPHALT CONCRETE COURSES.

**32" PORTABLE BARRIER (ANCHORED OR UNANCHORED), AS PER PLAN**

ALL 32" PORTABLE BARRIER (ANCHORED OR UNANCHORED), AS PER PLAN CAN BE SUBSTITUTED FOR 50" PORTABLE BARRIER, AS PER PLAN (ANCHORED OR UNANCHORED). ANY ADDITIONAL COST ASSOCIATED WITH THE CHANGE SHALL BE INCLUDED IN ITEM 622 - PORTABLE BARRIER, ANCHORED, AS PER PLAN OR ITEM 622 - PORTABLE BARRIER, UNANCHORED, AS PER PLAN.



MAINTENANCE OF TRAFFIC NOTES

DESIGN AGENCY



DESIGNER

KRM

REVIEWER

AKF 11-21-23

PROJECT ID

107408

SHEET

62

TOTAL

1068

REVISIONS		
NO.	DATE	DESCRIPTION
4	04/02/24	MODIFIED CONCRETE MEDIAN BARRIER REPLACEMENT NOTE

**WINTER OVER PHASE WORK ZONE PAVEMENT MARKINGS AND CROSSOVER CLOSURE**

THE CONTRACTOR SHALL INSTALL THE WINTER OVER WORK ZONE PAVEMENT MARKINGS AND CLOSE THE CROSSOVER WITH PORTABLE BARRIER PER THE TYPICAL SECTIONS FOR THE LAYOUT OF THE WINTER OVER ZONES. TEMPORARY PAVEMENT MARKINGS SHALL BE PER THE REQUIREMENTS OF C&MS 614.04 AND 614.11. THE PORTABLE BARRIER TO CLOSE THE CROSSOVER SHALL BE OVERLAPPED WITH THE MEDIAN BARRIER TO ELIMINATE THE BLUNT END OF THE MEDIAN BARRIER. THE 3RD WINTER OVER PHASE SHALL MATCH THE FINAL PAVEMENT MARKING PLANS.

THE FOLLOWING QUANTITIES HAVE BEEN CARRIED TO THE MAINTENANCE OF TRAFFIC GENERAL SUMMARY:

**1ST WINTER OVER PHASE QUANTITIES:**

ITEM 614 - WORK ZONE LANE LINE, CLASS I, 6"	0.70 MILE
ITEM 614 - WORK ZONE EDGE LINE, CLASS I, 6"	7.79 MILE
ITEM 614 - WORK ZONE CHANNELIZING LINE, CLASS I, 12"	12648 FT
ITEM 614 - WORK ZONE DOTTED LINE, CLASS I	720 FT

**2ND WINTER OVER PHASE QUANTITIES:**

ITEM 614 - WORK ZONE LANE LINE, CLASS I, 6"	6.47 MILE
ITEM 614 - WORK ZONE CENTER LINE, CLASS I	0.05 MILE
ITEM 614 - WORK ZONE EDGE LINE, CLASS I, 4"	0.17 MILE
ITEM 614 - WORK ZONE EDGE LINE, CLASS I, 6"	13.94 MILE
ITEM 614 - WORK ZONE CHANNELIZING LINE, CLASS I, 12"	11247 FT
ITEM 614 - WORK ZONE DOTTED LINE, CLASS I	4100 FT
ITEM 614 - BARRIER REFLECTOR, TYPE 1 (ONE-WAY)	22 EACH
ITEM 614 - OBJECT MARKER, ONE-WAY	11 EACH
ITEM 622 - PORTABLE BARRIER, 50", AS PER PLAN	510 FT

**3RD WINTER OVER PHASE QUANTITIES:**

ITEM 614 - WORK ZONE LANE LINE, CLASS I, 6"	10.79 MILE
ITEM 614 - WORK ZONE CENTER LINE, CLASS I	0.11 MILE
ITEM 614 - WORK ZONE EDGE LINE, CLASS I, 6"	14.57 MILE
ITEM 614 - WORK ZONE CHANNELIZING LINE, CLASS I, 12"	15868 FT
ITEM 614 - WORK ZONE DOTTED LINE, CLASS I	8869 FT
ITEM 614 - WORK ZONE STOP LINE	70 FT
ITEM 614 - WORK ZONE LANE ARROW	24 EACH
ITEM 614 - MAINTAINING TRAFFIC, MISC.: LANE REDUCTION ARROW	1 EACH

ITEM 614 - MAINTAINING TRAFFIC, MISC.: LANE REDUCTION ARROW SHALL BE PER THE PERMANENT DESIGN EXCEPT THE MATERIAL SHALL BE WORK ZONE PAVEMENT MARKING CLASS I, 642 PAINT.

**WORK ZONE SIGNING**

THE FOLLOWING ESTIMATED QUANTITIES HAVE BEEN INCLUDED IN THE MAINTENANCE OF TRAFFIC GENERAL SUMMARY FOR THE WORK ZONE SIGNING AS SHOWN ON THE MAINTENANCE OF TRAFFIC ELEVATION DETAILS.

ITEM 630 - SIGN ATTACHMENT ASSEMBLY	14 EACH
ITEM 630 - SIGN, OVERHEAD EXTRUSHEET	824.3 SF

ALL MATERIAL, LABOR AND EQUIPMENT REQUIRED TO INSTALL AND SUBSEQUENTLY REMOVE SOLID WOOD POST SUPPORTS (OR APPROVED EQUAL) FOR WORK ZONE SIGNING SHALL BE INCLUDED IN THE LUMP SUM BID FOR ITEM 614 - MAINTAINING TRAFFIC.

ALL MATERIAL, LABOR AND EQUIPMENT TO REMOVE, ADJUST AND/OR RELOCATE EXISTING OVERHEAD MOUNTED SIGNS SHALL BE INCLUDED IN THE LUMP SUM BID FOR ITEM 614 - MAINTAINING TRAFFIC.

ALL REMAINING WORK ZONE SIGNING AND TEMPORARY SUPPORTS NOT SPECIFICALLY ITEMIZED SHALL BE INCLUDED IN THE LUMP SUM BID FOR ITEM 614 - MAINTAINING TRAFFIC.

**NOTIFICATION OF TRAFFIC RESTRICTIONS**

THROUGHOUT THE DURATION OF THE PROJECT, THE CONTRACTOR SHALL NOTIFY THE PROJECT ENGINEER IN WRITING OF ALL TRAFFIC RESTRICTIONS AND UPCOMING MAINTENANCE OF TRAFFIC CHANGES. THE CONTRACTOR SHALL ENSURE THE WRITTEN NOTIFICATION IS SUBMITTED IN A TIMELY MANNER TO ALLOW THE PROJECT ENGINEER TO MEET THE REQUIRED TIME FRAMES SET FORTH IN THE TABLE BELOW TO INFORM THE SPECIAL HAULING PERMITS SECTION (HAULING.PERMITS@DOT.OHIO.GOV) AND THE DISTRICT PUBLIC INFORMATION OFFICE (PIO). THIS NOTIFICATION SHALL BE RECEIVED BY THE PROJECT ENGINEER PRIOR TO THE PHYSICAL SETUP OF ANY APPLICABLE SIGNS OR MESSAGE BOARDS.

INFORMATION SHOULD INCLUDE, BUT IS NOT LIMITED TO, ALL CONSTRUCTION ACTIVITIES THAT IMPACT OR INTERFERE WITH TRAFFIC AND SHALL LIST THE SPECIFIC LOCATION, TYPE OF WORK, ROAD STATUS, DATE AND TIME OF RESTRICTION, DURATION OF RESTRICTION, NUMBER OF LANES MAINTAINED, NUMBER OF LANES CLOSED, MINIMUM VERTICAL CLEARANCE, MINIMUM WIDTH OF DRIVABLE PAVEMENT, DETOUR ROUTES, IF APPLICABLE, AND ANY OTHER INFORMATION REQUESTED BY THE PROJECT ENGINEER.

NOTIFICATION OF TRAFFIC RESTRICTION		
ITEM	DURATION OF CLOSURE	NOTICE DUE TO PERMITS & PIO
ROAD CLOSURES	>= 2 WEEKS	21 CALENDAR DAYS PRIOR TO CLOSURE
	> 12 HOURS & < 2 WEEKS	14 CALENDAR DAYS PRIOR TO CLOSURE
	<= 12 HOURS	4 BUSINESS DAYS PRIOR TO CLOSURE
LANE CLOSURES & RESTRICTIONS	>= 2 WEEKS	14 CALENDAR DAYS PRIOR TO CLOSURE
	< 2 WEEKS	5 BUSINESS DAYS PRIOR TO CLOSURE
START OF CONSTRUCTION & TRAFFIC PATTERN CHANGES	N/A	14 CALENDAR DAYS PRIOR TO IMPLEMENTATION

ANY UNFORESEEN CONDITIONS NOT SPECIFIED IN THE PLANS REQUIRING TRAFFIC RESTRICTIONS SHALL ALSO BE REPORTED TO THE PROJECT ENGINEER USING THE NOTIFICATION TIME TABLE.

**NOTICE OF CLOSURE SIGN**

NOTICE OF CLOSURE SIGNS (W20-H13) SHALL BE ERECTED BY THE CONTRACTOR PRIOR TO THE SCHEDULED ROAD OR RAMP CLOSURE IN ACCORDANCE WITH THE NOTICE OF CLOSURE TIMETABLE BELOW. AT THE APPROVAL OF THE ENGINEER, PORTABLE CHANGEABLE MESSAGE SIGNS MAY BE USED IN LIEU OF THE STANDARD FLATSHEET SIGN FOR CLOSURE DURATIONS OF LESS THAN 1 WEEK.

THE SIGNS SHALL BE ERECTED ON THE RIGHT-HAND SIDE OF THE ROAD/RAMP FACING TRAFFIC. THEY SHALL BE PLACED SO AS NOT TO INTERFERE WITH THE VISIBILITY OF ANY OTHER TRAFFIC CONTROL SIGNS. ON ROADWAYS, THEY SHOULD BE ERECTED AT OR NEAR THE POINT OF CLOSURE. THE SIGNS MAY BE ERECTED ANYWHERE ON RAMPS AS LONG AS THEY ARE VISIBLE TO THE MOTORISTS USING THE RAMP. ON ENTRANCE RAMPS, THE SIGNS SHALL BE ERECTED WELL IN ADVANCE OF THE MERGE AREA TO AVOID DISTRACTING MOTORISTS.

NOTICE OF CLOSURE TIME TABLE		
ITEM	DURATION OF CLOSURE	SIGN DISPLAYED TO PUBLIC
RAMP & ROAD CLOSURES	>= 2 WEEKS	14 CALENDAR DAYS PRIOR TO CLOSURE
	> 12 HOURS & < 2 WEEKS	7 CALENDAR DAYS PRIOR TO CLOSURE
	<= 12 HOURS	2 BUSINESS DAYS PRIOR TO CLOSURE

THE SIGN SHALL DISPLAY THE DATE OF THE CLOSURE IN MMM-DD FORMAT AND THE NUMBER OF DAYS OF THE CLOSURE. THE LAST LINE OF THE W20-H13 SIGN LISTS A PHONE NUMBER WHICH A MOTORIST MAY CALL FOR ADDITIONAL INFORMATION. THIS IS TO BE A SPECIFIC OFFICE WITHIN THE DISTRICT RATHER THAN GENERAL SWITCHBOARD NUMBER.

**CROSSOVER #1/3/4/6 - #2/5 CONSTRUCTION AND REMOVAL**

CROSSOVER CONSTRUCTION SHALL INCLUDE THE PLACEMENT OF A VARIABLE DEPTH ASPHALT PAVEMENT IN THE SHOULDER AREA. SLOTTED DRAINS AND TEMPORARY OUTLETS ARE INCLUDED IN ORDER TO PROMOTE DRAINAGE. THE REQUIREMENTS OF ITEM 611.04BCD SHALL BE WAVED FOR THE FOLLOWING AS PER PLAN TEMPORARY DRAINAGE ITEMS. THE FOLLOWING ITEMS ARE INCLUDED IN THE MAINTENANCE OF TRAFFIC GENERAL SUMMARY FOR THE CROSSOVER CONSTRUCTION:

ITEM 611 - 12" CONDUIT, TYPE B, AS PER PLAN	452 FT
ITEM 611 - 12" SLOTTED DRAIN, TYPE 1, 12", AS PER PLAN	1150 FT

CROSSOVER REMOVAL SHALL INCLUDE REMOVING THE SLOTTED DRAINS, ALL ASSOCIATED PAVEMENT REPAIR, FILL AND PLUG SLOTTED DRAIN OUTLETS AND PAVEMENT PLANING TO RESTORE THE SURROUNDING PAVED SURFACES TO THEIR ORIGINAL CONDITION AND GRADE. THE FOLLOWING ITEMS ARE INCLUDED IN THE MAINTENANCE OF TRAFFIC GENERAL SUMMARY FOR THE CROSSOVER CONSTRUCTION:

ITEM 202 - PIPE REMOVED	452 FT
ITEM 253 - PAVEMENT REPAIR	1965 SY
ITEM 254 - PAVEMENT PLANING	1170 SY

PAVEMENT REPAIR SHALL INCLUDE THE REMOVAL OF THE TEMPORARY SLOTTED DRAINS IN THE CROSSOVER AREAS. THE CONTRACTOR SHALL SAW CUT A NEAT EDGE ONE (1) FOOT FROM THE EDGE OF THE TEMPORARY SLOTTED DRAINS, REMOVE THE SLOTTED DRAINS, AND REMOVE EXCESS EXISTING PAVEMENT PER C&MS 253.02. THIS TRENCHED AREA SHALL BE REPLACED WITH ASPHALT PAVEMENT TO MATCH THE EXISTING ASPHALT PAVEMENT COMPOSITION, AS DIRECTED BY THE ENGINEER. AFTER BACKFILLING OF THE CAVITY PER C&MS 202.02, THE CONTRACTOR SHALL PROVIDE AN ASPHALT CONCRETE PAVED SURFACE IN THIS AREA BY MATCHING THE EXISTING ASPHALT PAVEMENT COMPOSITION, AS DIRECTED BY THE ENGINEER.

ANY ADDITIONAL ITEMS OF WORK NOT SPECIFICALLY LISTED WHICH ARE REQUIRED TO CONSTRUCT OR REMOVE THE CROSSOVERS SHALL BE CONSIDERED INCIDENTAL TO AND INCLUDED IN THE LUMP SUM BID FOR ITEM 615 - ROADS FOR MAINTAINING TRAFFIC.

**TEMPORARY TROUGHS**

TEMPORARY TROUGHS WILL BE ADDED THROUGHOUT THE CORRIDOR TO CONTROL THE SPREAD FOR THE TWO-YEAR STORM DURING CONSTRUCTION. THE LOCATION AND SIZE OF THESE TROUGHS ARE SHOWN IN THE MOT PLANS. WHERE THE TROUGHS ARE PLACED WITHIN EXISTING/PROPOSED PAVEMENT LIMITS, THE PLAN SPECIFIED DEPTH WILL BE MILLED FROM THE TROUGH AREA SHOWN IN THE PLANS. IN LOCATIONS WHERE THE TROUGHS ARE TO BE PLACED WITHIN THE PROPOSED PAVEMENT LIMITS, THE INTERMEDIATE COURSE WILL NOT BE PLACED WITHIN THE TROUGH AREAS UNTIL THE MOT PHASES FOR WHICH THEY ARE REQUIRED ARE COMPLETED.

TEMPORARY TROUGHS LABELED ON THE MAINTENANCE OF TRAFFIC PLAN ARE ITEMIZED ON THE MOT PLANS AND CARRIED TO THE GENERAL SUMMARY.

ITEM 254 - PAVEMENT PLANING, ASPHALT CONCRETE (DEPTH 1.5")	111 SY
--	--------

**ITEM 301 - STABILIZED CRUSHED AGGREGATE**

ITEM 301 - STABILIZED CRUSHED AGGREGATE SHALL BE 2' WIDE AND 6" DEEP AND PLACED ADJACENT TO THE OUTSIDE OF ALL ITEM 615 - PAVEMENT FOR MAINTAINING TRAFFIC, CLASS A PAVEMENT, EXCEPT WHEN THE PAVEMENT FOR MAINTAINING TRAFFIC HAS A TEMPORARY CURB. THE MAINTENANCE OF TRAFFIC SUB SUMMARIES QUANTITY ITEM 301 - STABILIZED CRUSHED AGGREGATE AND ACCURATELY DISPLAYS THE STATION RANGES WHERE THE ITEM IS REQUIRED.

**ITEM 615 - ROADS FOR MAINTAINING TRAFFIC**

ROADS FOR MAINTAINING TRAFFIC WILL BE REQUIRED AT VARIOUS LOCATIONS AS SHOWN IN THE PLANS, AND SHALL BE CONSTRUCTED ACCORDING TO C&MS 615 AND AS DETAILED IN THE PLANS.

FOLLOWING CONSTRUCTION OF PAVEMENTS AND ROADS FOR MAINTAINING TRAFFIC, TEMPORARY FACILITIES SHALL BE REMOVED AS PER C&MS 615.08, AND THE EXISTING TOPOGRAPHY SHALL BE RESTORED, UNLESS OTHERWISE SPECIFIED IN THE PLANS.

PAYMENT FOR ALL LABOR, EQUIPMENT, MATERIALS AND OTHER INCIDENTALS FOR ROADS AND PAVEMENTS FOR MAINTAINING TRAFFIC SHALL BE INCLUDED IN THE LUMP SUM CONTRACT PRICE FOR ITEM 615 - ROADS FOR MAINTAINING TRAFFIC UNLESS SEPARATELY ITEMIZED IN THE PLANS.

THE FOLLOWING QUANTITY HAS BEEN CARRIED TO THE MAINTENANCE OF TRAFFIC GENERAL SUMMARY:

ITEM 615 - ROADS FOR MAINTAINING TRAFFIC	LS
--	----

**TEMPORARY DRAINAGE ITEMS**

THE REQUIREMENTS OF ITEM 611.04BCD SHALL BE WAVED FOR THE FOLLOWING AS PER PLAN, AS PER PLAN "C" AND AS PER PLAN "D" TEMPORARY DRAINAGE ITEMS. TEMPORARY DRAINAGE ITEMS LABELED ON THE MAINTENANCE OF TRAFFIC PLAN ARE ITEMIZED ON THE MOT PLANS AND CARRIED TO THE MAINTENANCE OF TRAFFIC GENERAL SUMMARY.

ITEM 611 - CATCH BASIN, NO. 3A, AS PER PLAN "D"	11 EACH
ITEM 611 - CATCH BASIN, NO. 2-2B, AS PER PLAN "C"	7 EACH
ITEM 611 - 12" CONDUIT, TYPE B, AS PER PLAN	3489 FT
ITEM 611 - 12" CONDUIT, TYPE C, AS PER PLAN	416 FT
ITEM 611 - CATCH BASIN RECONSTRUCTED TO GRADE, AS PER PLAN	1 EACH
ITEM 611 - SLOTTED DRAIN, TYPE 1, 12", AS PER PLAN	5462 FT

TEMPORARY DRAINAGE REMOVAL SHALL INCLUDE REMOVING THE TEMPORARY SLOTTED DRAINS, TEMPORARY CATCH BASINS, ALL ASSOCIATED PAVEMENT REPAIR, FILL AND PLUG SLOTTED DRAIN OUTLETS AND ANYTHING ELSE NECESSARY TO RESTORE THE SURROUNDING AREA TO THE ORIGINAL OR FINAL CONDITION.

PAVEMENT REPAIR SHALL INCLUDE THE REMOVAL OF THE TEMPORARY SLOTTED DRAINS OUTSIDE THE CROSSOVER AREAS WHERE TEMPORARY DRAINAGE HAD BEEN INSTALLED. THE CONTRACTOR SHALL SAW CUT A NEAT EDGE ONE (1) FOOT FROM THE EDGE OF THE TEMPORARY SLOTTED DRAINS, REMOVE THE SLOTTED DRAINS, AND REMOVE EXCESS EXISTING PAVEMENT PER C&MS 253.02. THIS TRENCHED AREA SHALL BE REPLACED WITH ASPHALT PAVEMENT TO MATCH THE EXISTING OR PROPOSED ASPHALT PAVEMENT COMPOSITION, AS DIRECTED BY THE ENGINEER. AFTER BACKFILLING OF THE CAVITY PER C&MS 202.02, THE CONTRACTOR SHALL PROVIDE AN ASPHALT CONCRETE PAVED SURFACE IN THIS AREA BY MATCHING THE EXISTING OR PROPOSED ASPHALT PAVEMENT COMPOSITION, AS DIRECTED BY THE ENGINEER. THE FOLLOWING QUANTITY HAS BEEN PROVIDED AND CARRIED TO THE MAINTENANCE OF TRAFFIC GENERAL SUMMARY TO RESTORE AREAS WHERE TEMPORARY DRAINAGE ITEMS WILL BE REMOVED.

ITEM 253 - PAVEMENT REPAIR	115 SY
----------------------------	--------

ANY ADDITIONAL ITEMS OF WORK NOT SPECIFICALLY LISTED WHICH ARE REQUIRED TO CONSTRUCT OR REMOVE ANY TEMPORARY PAVEMENT SHALL BE CONSIDERED INCIDENTAL TO AND INCLUDED IN THE LUMP SUM BID FOR ITEM 615 - ROADS FOR MAINTAINING TRAFFIC.

REVISIONS		
NO.	DATE	DESCRIPTION
3	03/14/24	MODIFIED 615 NOTE AND ADDED NOTES
3	03/20/24	MODIFIED WINTER OVER PHASE NOTE
4	03/27/24	ADDED TO TEMPORARY DRAINAGE ITEMS NOTE
4	04/02/24	ADDED 3RD WINTER OVER PHASE TO WINTER OVER NOTE
4	04/02/24	CARRIED CROSSOVER QUANTITIES TO GENERAL SUMMARY
4	04/02/24	MADE ALL TEMP. DRAINAGE ITEMS "AS PER PLAN" AND ADDED TO TEMP. DRAINAGE NOTE
4	04/02/24	MOVED SIGNAL/FLASHER NOTE TO SHEET 65A

MAINTENANCE OF TRAFFIC NOTES

DESIGN AGENCY	
DESIGNER	KRM
REVIEWER	AKF
PROJECT ID	11-21-23
SHEET	107408
TOTAL	65
	1068

**INCENTIVE/DISINCENTIVE CONTRACT (PN 121)**

THE CONTRACTOR SHALL COMPLETE ALL CRITICAL WORK AND SAFETY ITEMS ACCORDING TO THE INCENTIVE/DISINCENTIVE CONTRACT TABLE BELOW. IN THE EVENT THE CONTRACTOR IMPEDES THE FLOW OF TRAFFIC SUBSEQUENT TO THE OPENING TO UNRESTRICTED TRAFFIC, THE CONTRACTOR SHALL BE ASSESSED A DISINCENTIVE ACCORDING TO THE INCENTIVE/DISINCENTIVE CONTRACT TABLE.

CRITICAL WORK IS SHOWN BELOW IN THE INCENTIVE/DISINCENTIVE CONTRACT TABLE.

CRITICAL WORK IS DEFINED AS HAVING THE DESIGNATED SECTION OF WORK OPEN TO UNRESTRICTED TRAFFIC AS SHOWN IN THE TABLE, OR THE ENTIRE PROJECT IF NOT OTHERWISE LISTED.

UNRESTRICTED TRAFFIC IS DEFINED AS ALL TRAFFIC LANES BEING AVAILABLE FOR USE AT THEIR FINAL DESIGN WIDTH WITH ALL MARKINGS, AND SAFETY FEATURES INSTALLED, ALONG WITH NO RESTRICTIONS WITHIN 2 FEET OF THE EDGE LINE ON THE SHOULDER, EXCEPT AS REQUIRED BY THE WINTER OVER #2 TRAFFIC PATTERN.

INCENTIVE/DISINCENTIVE AMOUNT: THE CONTRACTOR WILL BE PAID AN INCENTIVE OR WILL BE ASSESSED A DISINCENTIVE ACCORDING TO THE INCENTIVE/DISINCENTIVE CONTRACT TABLE BELOW.

EXTENSIONS OF TIME WILL BE FOR CALENDAR DAYS AND CALCULATED IN ACCORDANCE WITH C&MS 108.06 EXCEPT AS FOLLOWS: NO EXTENSIONS OF TIME WILL BE GRANTED FOR DELAYS IN MATERIAL DELIVERIES (UNLESS SUCH DELAYS ARE INDUSTRY WIDE), AND LABOR STRIKES (UNLESS SUCH STRIKES ARE AREA WIDE).

INCENTIVE/DISINCENTIVE TABLE			
DESCRIPTION OF CRITICAL WORK	COMPLETION DATE	DISINCENTIVE \$ PER DAY	INCENTIVE \$ PER DAY
COMPLETION OF PHASE 1 (ASPHALT ITEMS ONLY) PRIOR TO WINTER SHUTDOWN	10-15-2024	ASSESSED PER CMS 108.07	\$ 0
COMPLETION OF PHASE 3A PRIOR TO WINTER SHUTDOWN	10-15-2025	ASSESSED PER CMS 108.07	\$ 0
COMPLETION OF PHASE 5 PRIOR TO WINTER SHUTDOWN	10-15-2026	ASSESSED PER CMS 108.07	\$ 0

**FLEXIBLE START WINDOW CONTRACT (PN 129)**

THE CONTRACTOR HAS THE NUMBER OF CALENDAR DAYS DESIGNATED IN THE WINDOW CONTRACT TABLE IN WHICH TO COMPLETE ALL ITEMS OF CRITICAL WORK. THE WINDOW CONTRACT TABLE IS LOCATED BELOW. THE CONTRACTOR MAY BEGIN ANY TIME AS IDENTIFIED IN THE WINDOW CONTRACT TABLE AND MUST COMPLETE THE CRITICAL WORK WITHIN THE CALENDAR DAYS DESIGNATED IN THE WINDOW CONTRACT TABLE OR BY THE COMPLETION DATE LISTED IN THE PROPOSAL, WHICHEVER COMES FIRST.

CRITICAL WORK IS SHOWN IN THE WINDOW CONTRACT TABLE.

COMPLETION OF CRITICAL WORK IS DEFINED AS HAVING THE DESIGNATED SECTION OF WORK OPEN TO UNRESTRICTED TRAFFIC AS SHOWN IN THE TABLE, OR THE ENTIRE PROJECT IF NOT OTHERWISE LISTED.

UNRESTRICTED TRAFFIC IS DEFINED AS ALL TRAFFIC LANES BEING AVAILABLE FOR USE AT THEIR FINAL DESIGN WIDTH WITH ALL MARKINGS, RPM'S, AND SAFETY FEATURES INSTALLED, ALONG WITH NO RESTRICTIONS WITHIN 2 FEET OF THE EDGE LINE ON THE SHOULDERS.

THE CONTRACTOR MUST SCHEDULE THE LATEST START DATE OF THE CRITICAL WORK PRIOR TO THE FOLLOWING CALCULATED DATE:

LATE CRITICAL WORK START DATE = [WORK WINDOW END DATE] - [(CALENDAR DAYS TO COMPLETE) X 1.25]

IF THE CRITICAL WORK IS NOT STARTED BY THE LATE CRITICAL WORK START DATE, THE CONTRACTOR WILL BE ASSESSED A DISINCENTIVE AS DEFINED IN THE WINDOW CONTRACT TABLE FOR EVERYDAY THE CONTRACTOR DOES NOT START THE CRITICAL WORK.

**FLEXIBLE START WINDOW CONTRACT (PN 129) (CONTINUED)**

IF THE WORK IS NOT COMPLETED WITHIN THE CALENDAR DAYS DESIGNATED IN THE WINDOW CONTRACT TABLE, THE CONTRACTOR WILL BE SUBJECT TO DISINCENTIVES AS IDENTIFIED IN THE CONTRACT CRITICAL WORK TABLE. IF THE WINDOW CONTRACT CRITICAL WORK TABLE DOES NOT DESIGNATE A DISINCENTIVE VALUE, THE CONTRACTOR WILL BE SUBJECT TO THE LIQUIDATED DAMAGES IN ACCORDANCE WITH THE SCHEDULE SET FORTH IN C&MS 108.07.

108.06 C SHALL BE MODIFIED TO THE FOLLOWING AND SHALL BE APPLICABLE ONLY TO THE CRITICAL WORK (AS DEFINED IN THE WINDOW CONTRACT TABLE):

108.06 C EXTENSION TO THE COMPLETION DATE FOR WEATHER OR SEASONAL CONDITIONS. A WEATHER DAY FOR CRITICAL WORK IS DEFINED AS A WORKDAY THAT WEATHER REDUCED PRODUCTION BY MORE THAN 50 PERCENT ON ITEMS OF WORK ON THE CRITICAL PATH FOR CRITICAL WORK. SUBMIT A REQUESTED FOR AN EXTENSION OF TIME FOR A LOST WORKDAY DUE TO WEATHER WITH 2 DAYS OF OCCURRENCE. THE ENGINEER WILL EXTEND THE CALENDAR DAYS TO COMPLETE BY CALENDAR DAYS. THE ENGINEER WILL CONVERT WORKDAYS TO CALENDAR DAYS FOR EACH LOST WORKDAY DUE TO WEATHER BY MULTIPLYING THE NUMBER OF LOST WORKDAYS BY 1.4 FOR A 5-DAY WORK WEEK OR LESS; 1.2 FOR A 6-DAY WORK WEEK; AND 1 FOR A 7-DAY WORK WEEK; AND EXTEND THE CALENDAR DAYS TO COMPLETE BY THE RESULTING NUMBER OF CALENDAR DAYS PLUS ANY HOLIDAYS THE CONTRACTOR DOES NOT NORMALLY WORK THAT OCCUR IN THE EXTENSION PERIOD. WHEN THE CONVERSION OF WORKDAYS TO CALENDAR DAYS RESULTS IN A DECIMAL OF 0.5 OR GREATER, THE ENGINEER WILL ROUND THE NUMBER OF CALENDAR DAYS TO THE NEXT HIGHEST WHOLE NUMBER. WHEN THE CONVERSION RESULTS IN A DECIMAL LESS THAN 0.5, THE ENGINEER WILL DELETE THE DECIMAL PORTION OF THE CALENDAR DAYS.

FLEXIBLE START WINDOW TABLE					
DESCRIPTION OF CRITICAL WORK	CALENDAR DAYS TO COMPLETE	DISINCENTIVE \$ PER DAY	WORK WINDOW		
			START	END	
1-490 - SR-10 WB TO I-71 SB (PHASE 2 & 3)	210 DAYS (PHASES 2 & 3)	\$ 3,000	BEGIN PHASE 2	END PHASE 3	WORK NEEDED TO REPLACE THE PAVEMENT FOR ALL RAMPS LISTED EXCEPT #490/SR-10 WB TO I-71 SB
RAMP N-E (I-77 SB)	60 DAYS (PHASE 5)	\$ 1,500	BEGIN PHASE 5	END PHASE 5	
RAMP S-W (I-77 NB)	45 DAYS (PHASE 2A)	\$ 8,000	BEGIN PHASE 2A	END PHASE 2A	

**MAINTENANCE OF TRAFFIC SIGNAL/FLASHER INSTALLATION**

THE CONTRACTOR SHALL BE RESPONSIBLE FOR MAINTAINING TRAFFIC SIGNAL/FLASHER INSTALLATIONS WITHIN THE PROJECT UNDER THE FOLLOWING CONDITIONS:

- EXISTING SIGNAL/FLASHER INSTALLATIONS WHICH THE PLANS REQUIRE THE CONTRACTOR TO ADJUST, MODIFY, ADD ONTO OR REMOVE, OR WHICH THE CONTRACTOR ACTUALLY ADJUSTS, MODIFIES OR OTHERWISE DISTURBS. THE CONTRACTOR SHALL BE RESPONSIBLE FOR THE ENTIRE INSTALLATION (AT AN INTERSECTION) FROM THE TIME HIS OPERATIONS FIRST DISTURB THE INSTALLATION UNTIL THE INSTALLATION HAS BEEN SUBSEQUENTLY REMOVED OR MODIFIED AND THE WORK IS ACCEPTED.
- NEW OR REUSED SIGNAL/FLASHER INSTALLATIONS OR DEVICES, INSTALLED BY THE CONTRACTOR. THE CONTRACTOR SHALL BE RESPONSIBLE FOR MAINTENANCE OF THESE FROM THE TIME OF INSTALLATION UNTIL THE WORK IS ACCEPTED.

THE CONTRACTOR SHALL CORRECT AS QUICKLY AS POSSIBLE ALL OUTAGES OR MALFUNCTIONS. HE SHALL PROVIDE THE MAINTAINING AGENCY AND THE ENGINEER SUCH ADDRESSES AND PHONE NUMBERS WHERE HIS MAINTENANCE FORCES CAN BE CONTACTED. THE CONTRACTOR SHALL PROVIDE ONE OR MORE PERSONS TO RECEIVE ALL CALLS AND DISPATCH THE NECESSARY MAINTENANCE FORCES TO CORRECT OUTAGES. SUCH A PERSON OR PERSONS MAY BE USED TO PERFORM OTHER DUTIES AS LONG AS PROMPT ATTENTION IS GIVEN TO THESE CALLS AND A PERSON IS READILY AVAILABLE CONTINUOUSLY 24 HOURS A DAY, 7 DAYS A WEEK. ALL LAMP OUTAGES, CABLE OUTAGES, ELECTRICAL FAILURES, EQUIPMENT MALFUNCTIONS AND MISALIGNED SIGNAL HEADS SHALL BE CORRECTED TO THE SATISFACTION OF THE ENGINEER WITH THE SIGNAL BACK TO SERVICE WITHIN FOUR HOURS AFTER THE CONTRACTOR HAS BEEN NOTIFIED OF THE OUTAGE.

**MAINTENANCE OF TRAFFIC SIGNAL/FLASHER INSTALLATION (CONTINUED)**

THE CONTRACTOR SHALL CORRECT AS QUICKLY AS POSSIBLE ALL OUTAGES OR MALFUNCTIONS. HE SHALL PROVIDE THE MAINTAINING AGENCY AND THE ENGINEER SUCH ADDRESSES AND PHONE NUMBERS WHERE HIS MAINTENANCE FORCES CAN BE CONTACTED. THE CONTRACTOR SHALL PROVIDE ONE OR MORE PERSONS TO RECEIVE ALL CALLS AND DISPATCH THE NECESSARY MAINTENANCE FORCES TO CORRECT OUTAGES. SUCH A PERSON OR PERSONS MAY BE USED TO PERFORM OTHER DUTIES AS LONG AS PROMPT ATTENTION IS GIVEN TO THESE CALLS AND A PERSON IS READILY AVAILABLE CONTINUOUSLY 24 HOURS A DAY, 7 DAYS A WEEK. ALL LAMP OUTAGES, CABLE OUTAGES, ELECTRICAL FAILURES, EQUIPMENT MALFUNCTIONS AND MISALIGNED SIGNAL HEADS SHALL BE CORRECTED TO THE SATISFACTION OF THE ENGINEER WITH THE SIGNAL BACK TO SERVICE WITHIN FOUR HOURS AFTER THE CONTRACTOR HAS BEEN NOTIFIED OF THE OUTAGE.

IN THE EVENT NEW SIGNALS ARE DAMAGED PRIOR TO ACCEPTANCE, ALL DAMAGED EQUIPMENT EXCEPT POLES AND CONTROL EQUIPMENT SHALL BE REPLACED BY THE CONTRACTOR TO THE SATISFACTION OF THE ENGINEER WITH THE SIGNAL BACK IN SERVICE WITHIN 8 HOURS AFTER THE CONTRACTOR'S NOTIFICATION OF THE OUTAGE. THE CONTRACTOR SHALL ARRANGE FOR FULL TRAFFIC CONTROL UNTIL THE SIGNAL IS BACK IN OPERATION.

IF POLES AND/OR CONTROL EQUIPMENT ARE DAMAGED AND MUST BE REPLACED, THE CONTRACTOR SHALL MAKE TEMPORARY REPAIRS AS NECESSARY TO BRING THE SIGNAL BACK INTO FULL OPERATION WITHIN THE ALLOWED 8-HOUR PERIOD, AND SHALL MAKE PERMANENT REPAIRS OR REPLACEMENT AS SOON THEREAFTER AS POSSIBLE.

NONE OF THE ABOVE SHALL BE CONSTRUED AS COLLECTIVE OR CONSECUTIVE OUTAGE TIME PERIODS AT ANY ONE LOCATION. THAT IS, WHERE MORE THAN ONE OUTAGE OCCURS AT ANY ONE LOCATION THEN THE ALLOTTED TIME LIMIT SHALL BE FOR THE WORST SINGLE OUTAGE.

WHERE OUTAGES ARE THE DIRECT RESULT OF A VEHICLE CRASH THE RESPONSE OF THE CONTRACTOR SHALL BE AS OUTLINED ABOVE. THE CONTRACTOR SHALL BE RESPONSIBLE FOR COLLECTION OF ANY COMPENSATION FOR THIS WORK FROM THOSE PARTIES RESPONSIBLE FOR THE DAMAGE.

WHERE THE CONTRACTOR HAS FAILED TO, OR CANNOT RESPOND TO, AN OUTAGE OR SIGNAL EQUIPMENT MALFUNCTION, AT THESE LOCATIONS WITHIN HIS RESPONSIBILITY, WITHIN PERIODS AS SPECIFIED ABOVE, THE ENGINEER MAY INVOKE THE PROVISIONS OF SECTION 105.15 AND ANY SUBSEQUENT BILLINGS TO THE STATE OR THE CITY OF CLEVELAND FOR POLICE SERVICES AND MAINTENANCE SERVICES BY CITY FORCES SHALL BE DEDUCTED FROM MONIES DUE OR TO BECOME DUE THE CONTRACTOR IN ACCORDANCE WITH PROVISIONS OF SECTION 105.15.

THE CONTRACTOR SHALL PROVIDE THE MAINTENANCE SERVICE ENTIRELY WITH HIS FORCES OR HE MAY CHOOSE TO ENTER INTO A COOPERATIVE UNDERSTANDING WITH THE LOCAL MAINTAINING AGENCY TO PROVIDE THE MAINTENANCE. THE CONTRACTOR SHALL INFORM THE ENGINEER, IN WRITING, OF THE MAINTENANCE METHOD SELECTED.

THE CONTRACTOR SHALL BE RESPONSIBLE FOR ANY DAMAGE TO ANY TRAFFIC SIGNAL COMPONENTS REQUIRED TO BE HANDLED DURING THE RELOCATION OF POLES AND REVISIONS TO THE SIGNAL SYSTEM. WHEN A TRAFFIC SIGNAL MUST BE TAKEN OUT OF SERVICE BY THE CONTRACTOR, DUE TO CONSTRUCTION PROCEDURES, THIS OUTAGE SHALL NOT EXCEED 4 HOURS AND SHALL NOT INCLUDE THE HOURS OF 6-8 AM TO 4-6 PM. ANY SIGNALIZED INTERSECTION, WHERE THE SIGNAL IS OUT OF SERVICE DUE TO CONSTRUCTION PROCEDURES, OR DUE TO AN OUTAGE OR MALFUNCTION OF EQUIPMENT AS DESCRIBED ABOVE, SHALL BE PROTECTED, BY THE CONTRACTOR, BY THE INSTALLATION OF TEMPORARY "STOP" SIGNS.

ANY VEHICULAR TRAFFIC SIGNAL HEAD, EITHER NEW OR EXISTING WHICH WILL BE OUT OF OPERATION SHALL BE COVERED IN THE MANNER DESCRIBED IN 632.25.

THE CONTRACTOR SHALL MAINTAIN COMPLETE RECORDS OF MALFUNCTIONS INCLUDING:

- TIME OF NOTIFICATION OF MALFUNCTION;
- TIME OF WORK CREWS ARRIVAL TO CORRECT THE MALFUNCTION;
- ACTIONS TAKEN TO CORRECT THE MALFUNCTION, INCLUDING A LIST OF PARTS REPAIRED OR REPLACED;
- A DIAGNOSIS OF REASON FOR THE MALFUNCTION AND PROBABILITY OF REOCCURRENCE;
- TIME OF COMPLETION OF THE REPAIR AND SYSTEM RESTORED TO FULL SERVICE.

A COPY OF THESE RECORDS SHALL BE PROVIDED TO THE ENGINEER WITHIN THREE (3) WORKING DAYS FOLLOWING COMPLETION OF EACH REPAIR.

ALL COSTS RESULTING FROM THE ABOVE REQUIREMENTS SHALL BE CONSIDERED TO BE INCLUDED IN THE LUMP SUM PRICE BID FOR ITEM 614, MAINTAINING TRAFFIC.

REVISIONS		
NO.	DATE	DESCRIPTION
1	01/15/24	CREATED SHEET, ADDED PN 121, ADDED PN 129, UPDATED DISINCENTIVE \$ AMOUNTS AND ADDED WORK WIDOWS BASED ON ODOT COMMENTS
3	03/15/24	MODIFIED CALENDAR DAYS TO COMPLETE RAMP WORK
4	04/02/24	MOVED SIGNAL FLASHER NOTE FROM SHEET 65
4	04/02/24	MODIFIED FLEXIBLE START WINDOW TABLE
4	04/02/24	MODIFIED INCENTIVE/DISINCENTIVE NOTE ADDED

DESIGN AGENCY	
DESIGNER	KRM
REVIEWER	AKF 11-21-23
PROJECT ID	107408
SHEET	65A
TOTAL	1068



										PARTICIPATION		ITEM	ITEM EXT.	GRAND TOTAL	UNIT	DESCRIPTION	SEE SHEET NO.
61	62	63	64	65	94	95	01/IMS/04										
				4			4										
				452			452		202	34900	452	FT	PIPE REMOVED				
			4	2080			2080		253	01000	2080	SY	PAVEMENT REPAIR				
				1281			1281		254	01000	1,281	SY	PAVEMENT PLANING, ASPHALT CONCRETE (DEPTH 1.5")				
						281	281		411	10000	281	CY	STABILIZED CRUSHED AGGREGATE				
						2823	2823		606	15050	2823	FT	GUARDRAIL, TYPE MGS				
						3	3		606	26150	3	EACH	ANCHOR ASSEMBLY, MSG TYPE E (MASH 2016)				
						3	3		606	26550	3	EACH	ANCHOR ASSEMBLY, MSG TYPE T				
						3369	3369		609	24510	3369	FT	CURB, TYPE 4-C				
				3941			3941		611	04401	3941	FT	12" CONDUIT, TYPE B, AS PER PLAN			65	
				416			416		611	04601	416	FT	12" CONDUIT, TYPE C, AS PER PLAN			65	
				6612			6612		611	97011	6612	FT	SLOTTED DRAIN, TYPE 1, 12", AS PER PLAN			65	
				11			11		611	98181	11	EACH	CATCH BASIN, NO. 3A, AS PER PLAN "D"			65	
				7			7		611	98471	7	EACH	CATCH BASIN, NO. 2-2B, AS PER PLAN "C"			65	
				1			1		611	98635	1	EACH	CATCH BASIN RECONSTRUCTED TO GRADE, AS PER PLAN			65	
			600				600		614	11110	600	hour	LAW ENFORCEMENT OFFICER WITH PATROL CAR FOR ASSISTANCE				
						4	1453		614	11630	1453	FT	INCREASED BARRIER DELINEATION				
						53	53		614	12380	53	EACH	WORK ZONE IMPACT ATTENUATOR, 24" WIDE HAZARDS, (UNIDIRECTIONAL)				
LS							LS		614	12420	LS	LS	DETOUR SIGNING				
	14						14		614	12484	14	EACH	WORK ZONE INCREASED PENALTIES SIGN				
							50		614	12500	50	EACH	REPLACEMENT SIGN				
		2					2		614	12756	2	EACH	WORK ZONE CROSSOVER LIGHTING SYSTEM				
						3372	3372		614	12800	3372	EACH	WORK ZONE RAISED PAVEMENT MARKER				
						2970	2970		614	12801	2970	EACH	WORK ZONE RAISED PAVEMENT MARKER, AS PER PLAN			63	
							446		614	13000	446	CY	ASPHALT CONCRETE FOR MAINTAINING TRAFFIC				
				22			3548		614	13310	3548	EACH	BARRIER REFLECTOR, TYPE 1 (ONE-WAY)				
				11			161		614	13312	161	EACH	BARRIER REFLECTOR, TYPE 2 (ONE-WAY)				
							3698		614	13350	3698	EACH	OBJECT MARKER, ONE WAY				
				1			1		614	18000	1	EACH	MAINTAINING TRAFFIC, MISC.: LANE REDUCTION ARROW			65	
				9450			9450		614	18030	9450	FT	MAINTAINING TRAFFIC, MISC.: REMOVE RUMBLE STRIPS, SHOULDER (ASPHALT CONCRETE)			61	
				2160			2160		614	18030	2160	FT	MAINTAINING TRAFFIC, MISC.: REMOVE RUMBLE STRIPS, SHOULDER (CONCRETE)			61	
			40				40		614	18601	40	SNMT	PORTABLE CHANGEABLE MESSAGE SIGN, AS PER PLAN			63	
				17.96			17.96		614	20010	17.96	MILE	WORK ZONE LANE LINE, CLASS I, 6"				
				0.16			0.34		614	21000	0.34	MILE	WORK ZONE CENTER LINE, CLASS I				
				0.17			0.50		614	22000	0.50	MILE	WORK ZONE EDGE LINE, CLASS I, 4"				
				36.30			36.30		614	22010	36.30	MILE	WORK ZONE EDGE LINE, CLASS I, 6"				
						4	64.64		614	22056	64.64	MILE	WORK ZONE EDGE LINE, CLASS I, 6", 807 PAINT				
				39763			39763		614	23010	39763	FT	WORK ZONE CHANNELIZING LINE, CLASS I, 12"				
							60755		614	23110	60755	FT	WORK ZONE CHANNELIZING LINE, CLASS I, 12", 807 PAINT				
				13689			13689		614	24000	13689	FT	WORK ZONE DOTTED LINE, CLASS I				
							21389		614	24102	21389	FT	WORK ZONE DOTTED LINE, CLASS I, 6", 807 PAINT				
				70			139		614	26000	139	FT	WORK ZONE STOP LINE, CLASS I				
							318		614	27010	318	FT	WORK ZONE CROSSWALK LINE, CLASS I, 12"				
							3255		614	28000	3255	FT	WORK ZONE GORE MARKING, CLASS II				
				24			44		614	30000	44	EACH	WORK ZONE ARROW, CLASS I				
				LS			LS		615	10000	LS	LS	ROADS FOR MAINTAINING TRAFFIC				
							13468		615	20000	13468	SY	PAVEMENT FOR MAINTAINING TRAFFIC, CLASS A				
				300			300		616	10000	300	MGAL	WATER				
				510			18300		622	41011	18300	FT	PORTABLE BARRIER, 50", AS PER PLAN			61	
							16		622	41060	16	EACH	DUAL PORTABLE BARRIER TRANSITION/TERMINATION				
							96130		622	41101	96130	FT	PORTABLE BARRIER, UNANCHORED, AS PER PLAN			62	
							11100		622	41111	11100	FT	PORTABLE BARRIER, ANCHORED, AS PER PLAN			62	
							14		630	75000	14	EACH	SIGN ATTACHMENT ASSEMBLY				
				824.3			824.3		630	80224	824.3	SF	SIGN, OVERHEAD EXTRUSHEET				
							42		808	18700	42	SNMT	DIGITAL SPEED LIMIT (DSL) SIGN ASSEMBLY				

REVISIONS		
NO.	DATE	DESCRIPTION
3	03/05/24	MODIFIED QUANTITY ADDED TEMP. DRAINAGE ITEMS PREV. IN ITEM 615
3	03/14/24	
3	03/20/24	MODIFIED PB ITEMS ADDED PAVEMENT REPAIR AND RUMBLE STRIPS
4	03/27/24	REVISED AND ADDED QUANTITIES FROM SHEET 65
4	04/02/24	ADDED QUANTITY FOR NEW SHEETS 262A - 262B

MAINTENANCE OF TRAFFIC - GENERAL SUMMARY

DESIGN AGENCY  
  
 DESIGNER: KRM  
 REVIEWER: AKF 11-21-23  
 PROJECT ID: 107408  
 SHEET: 66 TOTAL: 1068



SHEET NO.	REF. NO.	LOCATION	STATION		SIDE	411 STABILIZED CRUSHED AGGREGATE CY	606 ANCHOR ASSEMBLY, MGS TYPE E (MASH 2016) EACH	606 ANCHOR ASSEMBLY, MGS TYPE T EACH	606 GUARDRAIL, TYPE MGS FT	609 CURB, TYPE 4-C FT	614 INCREASED BARRIER DELINEATION FT	614 WORK ZONE IMPACT ATTENUATOR, 24" WIDE HAZARDS, (UNIDIRECTIONAL) EACH	614 BARRIER REFLECTOR, TYPE 1 (ONE-WAY) EACH	614 BARRIER REFLECTOR, TYPE 2 (ONE-WAY) EACH	614 OBJECT MARKER, ONE WAY EACH	615 PAVEMENT FOR MAINTAINING TRAFFIC, CLASS A SY	614 ASPHALT CONCRETE FOR MAINTAINING TRAFFIC CY	622 PORTABLE BARRIER, 50", AS PER PLAN FT	622 DUAL PORTABLE BARRIER TRANSITION/TERMINATION EACH	622 PORTABLE BARRIER, UNANCHORED, AS PER PLAN FT	622 PORTABLE BARRIER, ANCHORED, AS PER PLAN FT		
			FROM	TO																			
PHASE 5																							
247	PB-133	B/L EX. RAMP W-S	31+60	33+30	LT								4	4									
247	PB-134	C/L R/W & CONST. I-490	931+60	935+50	RT						1	8	8						1	390			
247		C/L R/W & CONST. I-490	931+80	935+50	RT							9	9										
248	PB-135	C/L R/W & CONST. I-490	935+50	948+00	RT								25	25						1250			
248		C/L R/W & CONST. I-490	935+50	948+00	RT								25	25									
249	PB-136	C/L R/W & CONST. I-490	948+00	960+50	RT								25	25						1250			
249	PB-137	RAMP S-E / I-490	2050+50	960+50	LT/RT								20	20						200	800		
249	PB-138	C/L R/W & CONST. I-490	955+70	960+50	LT						1	20	20					480					
249		C/L R/W & CONST. I-490	960+45	960+50	CL						1												
249		C/L R/W & CONST. I-490	948+00	955+70	RT							16	16										
250	PB-139	C/L R/W & CONST. I-490	960+50	961+00	LT							2	2										
250	PB-140	C/L R/W & CONST. I-490	960+50	961+00	RT							1	1							50			
250	PB-141	C/L R/W & CONST. I-490	960+50	961+00	RT							1	1							50			
250	PB-142	C/L R/W & CONST. I-490	961+00	973+00	RT						1	24	24							1200			
250		C/L R/W & CONST. I-490	960+50	973+00	RT							25	25										
251	PB-143	C/L R/W & CONST. I-490	973+00	985+50	RT								25	25						1250			
251		C/L R/W & CONST. I-490	973+00	985+50	RT								25	25									
252	PB-144	C/L R/W & CONST. I-490	985+50	987+00	RT								3	3						150			
252	PB-144A	C/L R/W & CONST. I-490	986+90	993+50	RT								15	15						660			
252	PB-144B	C/L R/W & CONST. I-490	994+70	998+00	RT						1	8	8							330			
252		C/L R/W & CONST. I-490	985+50	998+00	RT							25	25										
253	PB-145	C/L R/W & CONST. I-490	998+00	1010+50	RT								25	25						1250			
253		C/L R/W & CONST. I-490	998+00	1010+50	RT								25	25									
254	PB-146	C/L R/W & CONST. I-490	1010+50	1022+00	RT								23	23						1150			
254		C/L R/W & CONST. I-490	1010+50	1022+00	RT								23	23									
255	PB-147	B/L CONST. RAMP W-S	522+00	529+00	LT								14	14						700			
255	PB-148	B/L CONST. RAMP W-S	522+70	525+30	LT								6	6						260			
255	PB-149	B/L CONST. RAMP W-S	527+50	528+80	LT							1	3	3				1		130			
255	PB-150	C/L R/W & CONST. I-490	1023+70	1033+00	RT						1	20	20							930			
255	PB-151	B/L CONST. RAMP W-N	627+70	632+00	RT								9	9						430			
255		B/L CONST. RAMP W-S	522+58	527+28	LT	18																	
255		B/L CONST. RAMP W-S	523+58	529+00	RT	21																	
255		C/L R/W & CONST. I-490	1022+00	1033+00	RT								22	22				852					
255		B/L CONST. RAMP W-N	628+20	632+00	LT								5	3	8			264					
255				630+50																			
256	PB-152	I-490 / OPPOR. CORRIDOR	1033+00	111+50	RT								29	29						1420			
256	PB-153	B/L CONST. RAMP S-E	339+50	347+00	LT								15	15						750			
256		C/L R/W & CONST. I-490	1033+00	1045+00	RT								24	24									
256		C/L R/W & CONST. I-490	340+80	345+00	RT								6	4	10								
257	PB-154	OPPORTUNITY CORRIDOR	111+50	115+20	RT								8	8						370			
258	PB-155	B/L CONST. RAMP S-E	2046+40	2050+50	LT								9	9						410			
259	PB-156	B/L EX. W. 7TH ST.	10+14	15+14	LT								2	11	11					430	70		
260	PB-157	B/L CONST. RAMP W-S	529+00	532+10	RT								1	7	7					310			
260		B/L CONST. RAMP W-S	529+00	532+20	RT	12																	
261	PB-158	B/L EX. BROADWAY AVE.	15+50	19+00	RT								1	8	8					350			
262	PB-159	B/L EX. RAMP S-W	3+40	4+60	RT								4	4						120	4		
262	PB-160	B/L CONST. RAMP S-E	335+20	339+50	LT								1	10	10					430	4		
262A	PB-160A	B/L CONST. RAMP N-E	437+70	447+00	RT								1	20	20					930	4		
TOTALS CARRIED TO MAINTENANCE OF TRAFFIC SUBSUMMARY - TOTALS 2						51						4	13	632	7	639	4	1148		530	4	17320	870

NO.	DATE	DESCRIPTION	ADDED QUANTITY FOR NEW SHEETS 262A - 262B
4	04/03/24		

MAINTENANCE OF TRAFFIC SUBSUMMARY 2 - PHASE 5

DESIGN AGENCY  
  
 GPD GROUP  
 6000 Old York Road, Suite 200, York, PA 17403

DESIGNER  
KRM

REVIEWER  
AKF 11-21-23

PROJECT ID  
107408

SHEET TOTAL  
88 1068



SHEET NO.	REF. NO.	LOCATION	SIDE		411 STABILIZED CRUSHED AGGREGATE CY	606 ANCHOR ASSEMBLY, MGS TYPE E (MASH 2016) EACH	606 ANCHOR ASSEMBLY, MGS TYPE T EACH	606 GUARDRAIL, TYPE MGS FT	609 CURB, TYPE 4-C FT	614 INCREASED BARRIER DELINEATION FT	614 WORK ZONE IMPACT ATTENUATOR, 24" WIDE HAZARDS, (UNIDIRECTIONAL) EACH	614 BARRIER REFLECTOR, TYPE 1 (ONE-WAY) EACH	614 BARRIER REFLECTOR, TYPE 2 (ONE-WAY) EACH	614 OBJECT MARKER, ONE WAY EACH	615 PAVEMENT FOR MAINTAINING TRAFFIC, CLASS A SY	614 ASPHALT CONCRETE FOR MAINTAINING TRAFFIC CY	622 PORTABLE BARRIER, 50", AS PER PLAN FT	622 DUAL PORTABLE BARRIER TRANSITION/TERMINATION EACH	622 PORTABLE BARRIER, UNANCHORED, AS PER PLAN FT	622 PORTABLE BARRIER, ANCHORED, AS PER PLAN FT
			SHEET	TOTAL																
PHASE 1 TOTALS CARRIED FROM SHEET			69	OF 1068		2	2	2277	2670	583	5	521	48	569	4836	178		1	20380	4850
PHASE 2 TOTALS CARRIED FROM SHEET			74	OF 1068	61		1	510	510		7	749	31	780	3086	18	7150	1	16710	350
PHASE 2 & 2A TOTALS CARRIED FROM SHEET			75	OF 1068	128	1		36	189	50	7	257	7	264	3532		880	4	6840	2010
PHASE 3 & 3A TOTALS CARRIED FROM SHEET			78	OF 1068	8						9	441	25	466	68			2	13570	1590
PHASE 4 TOTALS CARRIED FROM SHEET			83	OF 1068	33					820	5	680	38	718	798		9230	2	10570	830
PHASE 5 TOTALS CARRIED FROM SHEET			88	OF 1068	51					4	13	632	7	639	1148		530	4	17320	870
PHASE 5A TOTALS CARRIED FROM SHEET			89	OF 1068							3	132	5	137				2	5360	600
PHASE 6 TOTALS CARRIED FROM SHEET			93	OF 1068							4	114		114				4	5380	
TOTALS CARRIED TO MAINTENANCE OF TRAFFIC GENERAL SUMMARY					281	3	3	2823	3369	1453	53	3526	161	3687	13468	196	17790	16	96130	11100

MAINTENANCE OF TRAFFIC SUBSUMMARY - TOTALS 2

REVISIONS		
NO.	DATE	DESCRIPTION
3	03/05/24	MODIFIED QUANTITY
3	03/20/24	MODIFIED PB ITEMS
4	04/02/24	ADDED QUANTITY FOR NEW SHEETS 262A - 262B

DESIGN AGENCY  
  
**GPD GROUP**  
 10000 Old York Road, Suite 200, York, PA 17403  
 (717) 765-8800  
 DESIGNER: KRM  
 REVIEWER: AKF 11-21-23  
 PROJECT ID: 107408  
 SHEET: 95 TOTAL: 1068











MODEL: CLK\_490\_RW-2 - Plan 13 PAPER SIZE: 34x22 (in.) DATE: 4/3/2024 TIME: 4:34:58 PM USER: kmonas  
O:\Clients\ORD\2021\107408\400-Engineering\WOT\Sheets\107408\_MP510A.dgn

**MAINTENANCE OF TRAFFIC NOTES:**

1. THE CONTRACTOR SHALL COVER OR REMOVE EXISTING CONFLICTING SIGNING AND COVER OR REMOVE EXISTING CONFLICTING PAVEMENT MARKINGS PRIOR TO CONSTRUCTION.
2. FOR MAINTENANCE OF TRAFFIC PLAN LEGEND, SEE SHEET 176

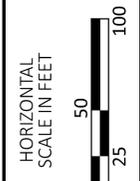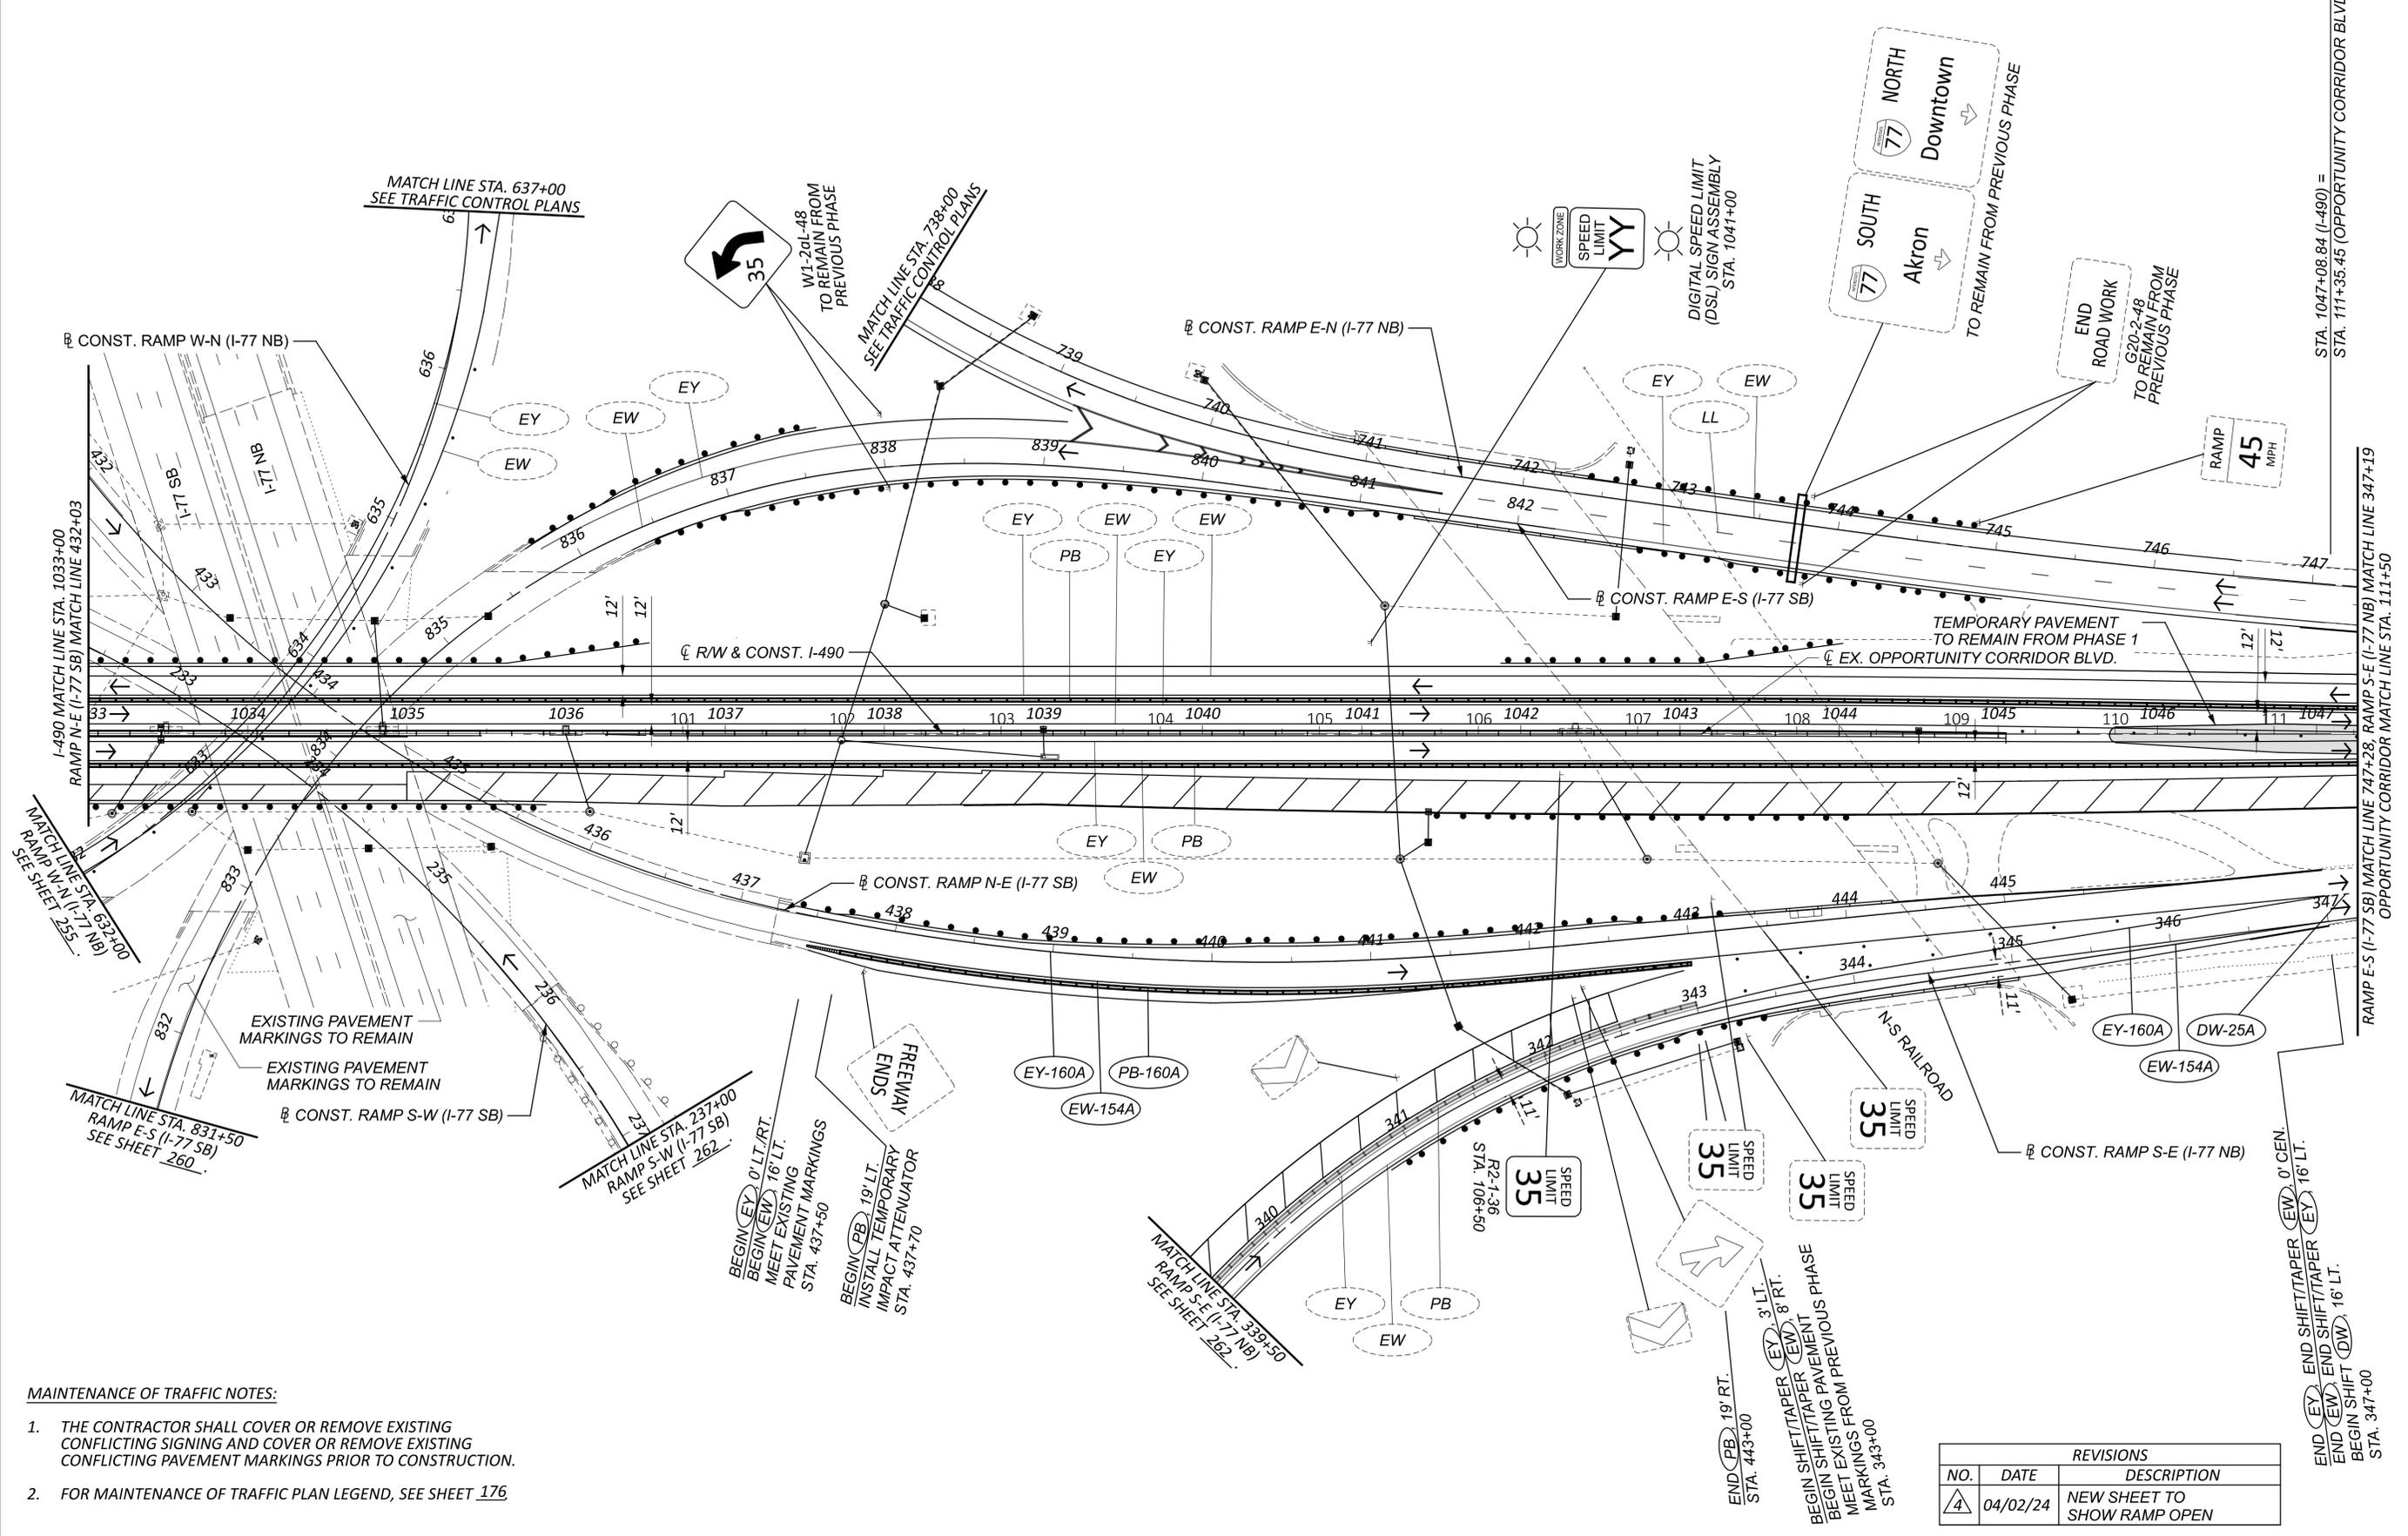

**MAINTENANCE OF TRAFFIC - PHASE 5 (RAMP OPEN)**  
**I-490 - STA. 1033+00 TO STA. 111+50**

REVISIONS		
NO.	DATE	DESCRIPTION
4	04/02/24	NEW SHEET TO SHOW RAMP OPEN

DESIGN AGENCY  
  
 DESIGNER  
 KRM  
 REVIEWER  
 AKF 11-21-23  
 PROJECT ID  
 107408  
 SHEET TOTAL  
 262A 1068

END (EY) END SHIFT/TAPER (EW) 0' LT. / 16' LT.  
 END (EY) END SHIFT/TAPER (EW) 16' LT.  
 BEGIN SHIFT (DW) 16' LT.  
 STA. 347+00

END (PB) 19' RT. STA. 443+00  
 BEGIN SHIFT/TAPER (EY) 3' LT. / 8' RT.  
 BEGIN SHIFT/TAPER (EW) 8' RT.  
 BEGIN SHIFT/TAPER (EW) 8' RT.  
 MEET EXISTING PAVEMENT MARKINGS FROM PREVIOUS PHASE  
 STA. 343+00

BEGIN (EY) 0' LT. / RT. / MEET EXISTING PAVEMENT MARKINGS STA. 437+50  
 BEGIN (PB) 19' LT. / RT. / INSTALL TEMPORARY IMPACT ATTENUATOR STA. 437+70

EXISTING PAVEMENT MARKINGS TO REMAIN  
 EXISTING PAVEMENT MARKINGS TO REMAIN  
 CONST. RAMP S-W (I-77 SB)

MATCH LINE STA. 831+50 RAMP E-S (I-77 SB) SEE SHEET 260



MATCH LINE STA. 237+00 RAMP S-W (I-77 SB) SEE SHEET 262

MATCH LINE STA. 339+50 RAMP S-E (I-77 NB) SEE SHEET 262

RAMP E-S (I-77 SB) MATCH LINE STA. 747+28, RAMP S-E (I-77 NB) MATCH LINE STA. 347+19 OPPORTUNITY CORRIDOR MATCH LINE STA. 111+50

STA. 1047+08.84 (I-490) = STA. 111+35.45 (OPPORTUNITY CORRIDOR BLVD.)

MODEL: CLK\_OC3 - Plan 14 PAPER SIZE: 34x22 (in.) DATE: 4/3/2024 TIME: 4:39:22 PM USER: kmonas  
O:\Clients\ORD\2021\20210891\107408\400-Engineering\WOT\Sheets\107408\_MP511A.dgn

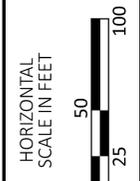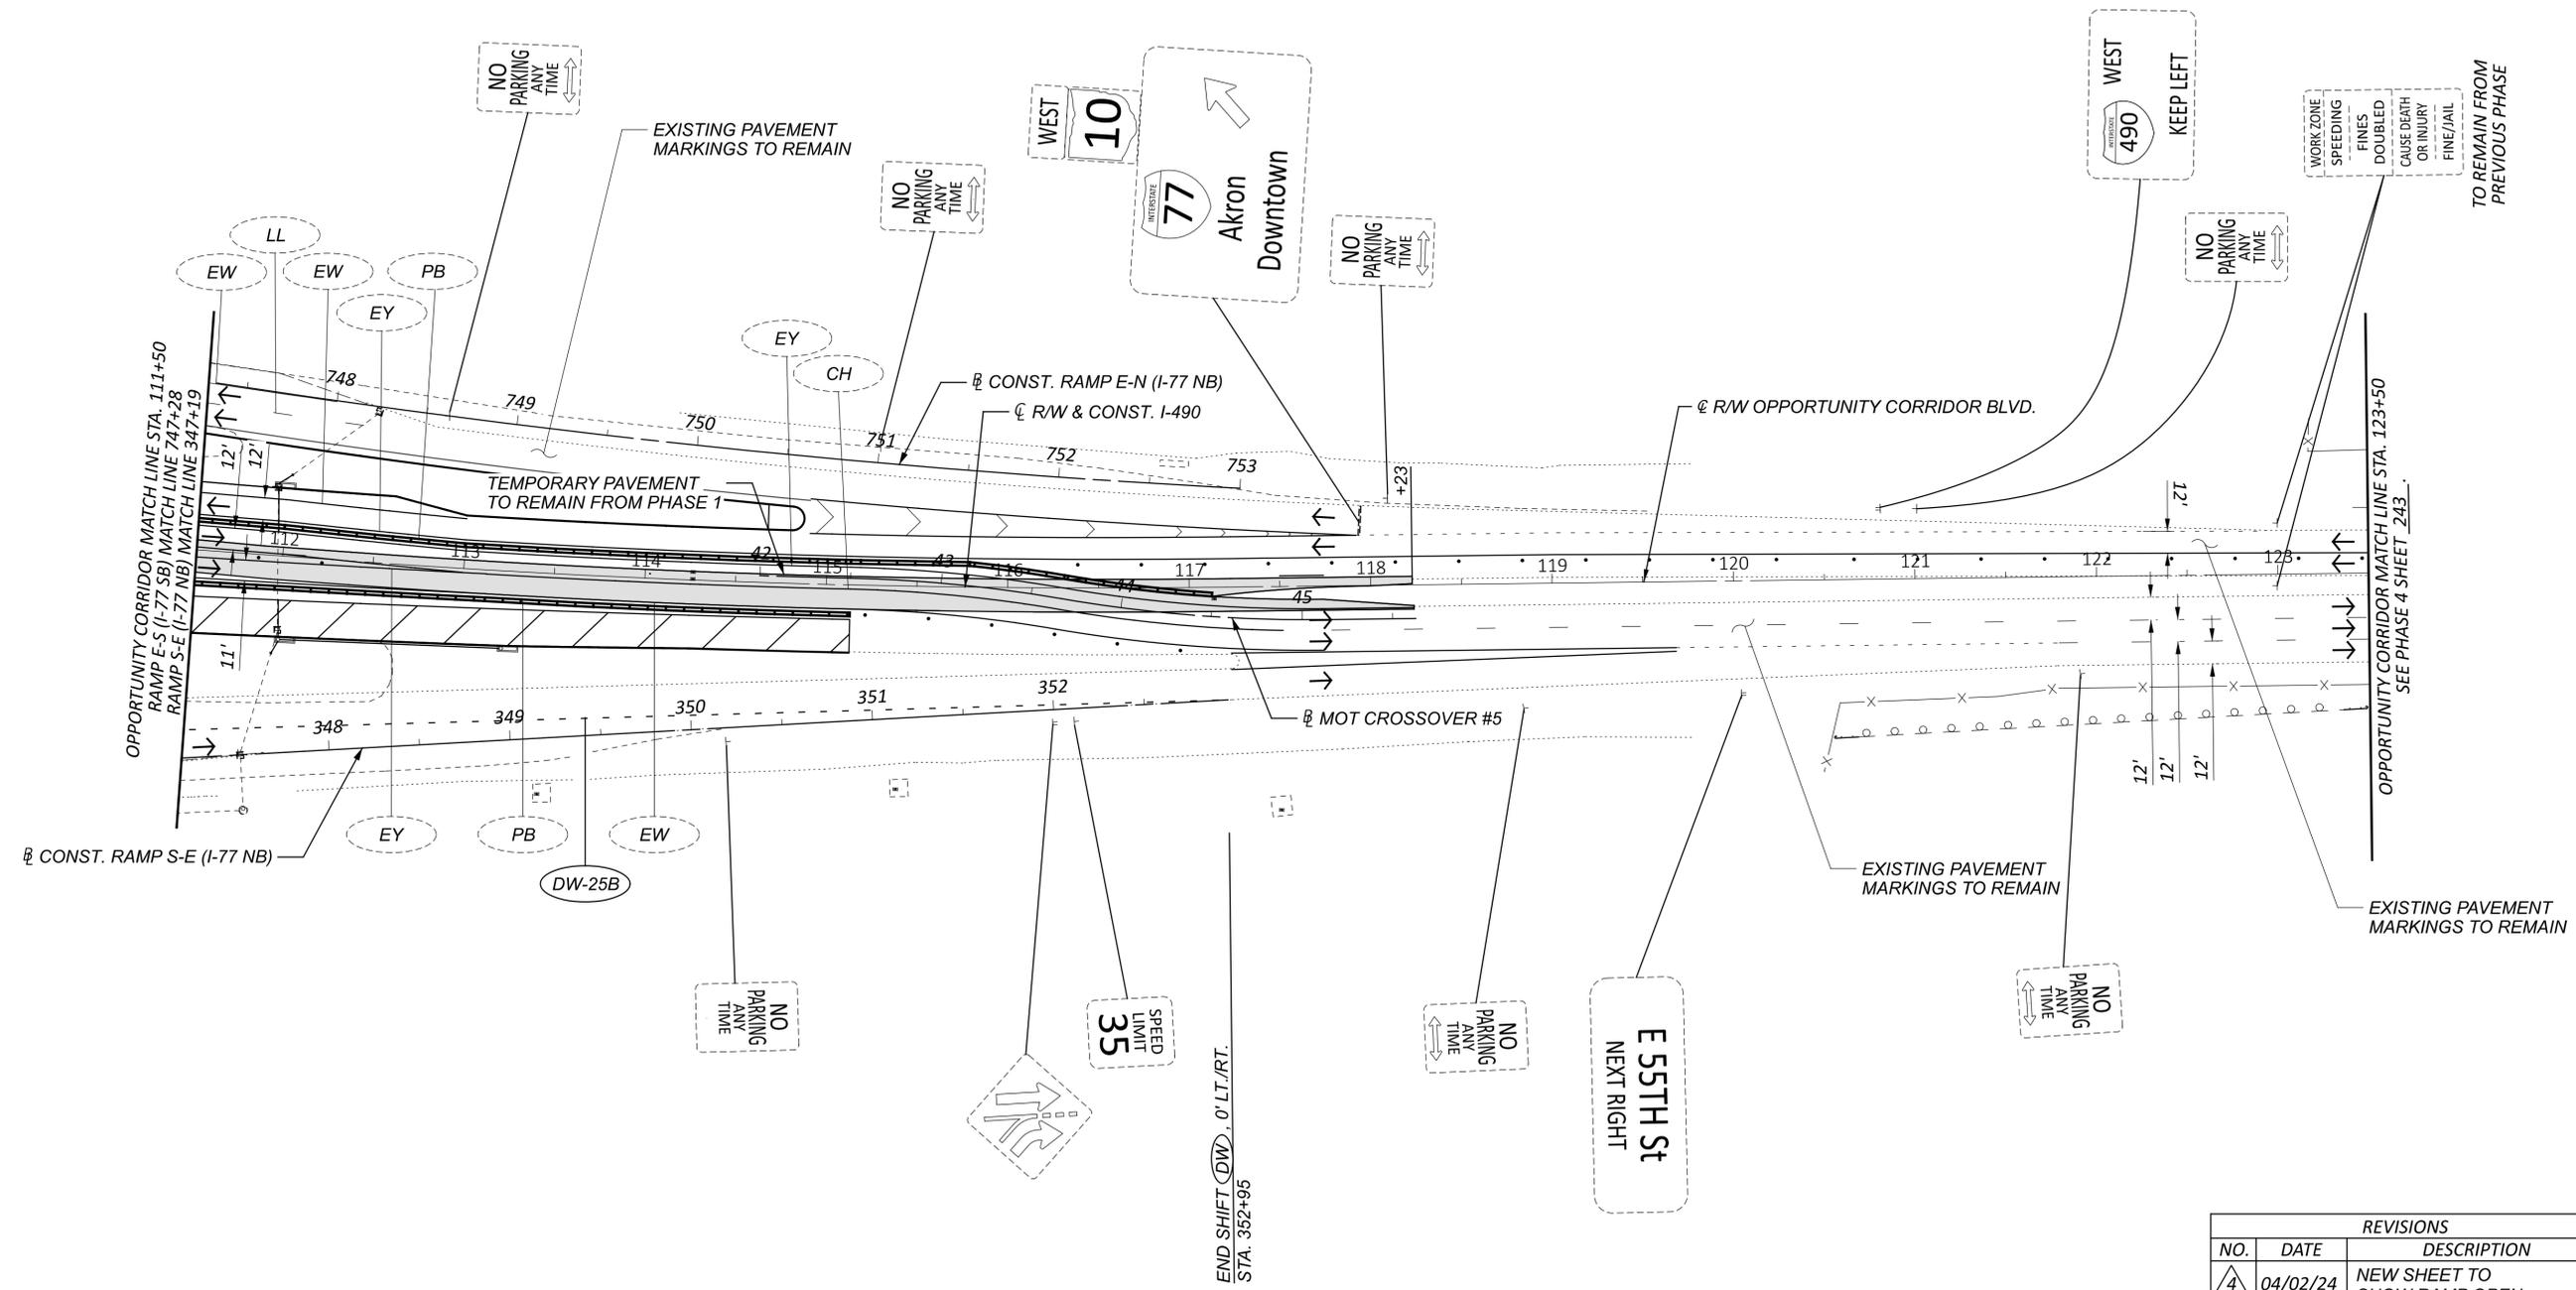

**MAINTENANCE OF TRAFFIC - PHASE 5 (RAMP OPEN)**  
**OPPORTUNITY CORRIDOR - STA. 111+50 TO 123+50**

REVISIONS		
NO.	DATE	DESCRIPTION
4	04/02/24	NEW SHEET TO SHOW RAMP OPEN

- MAINTENANCE OF TRAFFIC NOTES:**
- THE CONTRACTOR SHALL COVER OR REMOVE EXISTING CONFLICTING SIGNING AND COVER OR REMOVE EXISTING CONFLICTING PAVEMENT MARKINGS PRIOR TO CONSTRUCTION.
  - FOR MAINTENANCE OF TRAFFIC PLAN LEGEND, SEE SHEET 176

DESIGN AGENCY



DESIGNER  
KRM


REVIEWER  
AKF 11-21-23

PROJECT ID  
107408



SHEET	TOTAL
262B	1068

- ① TEMPORARY 66' - 12" CONDUIT TYPE B, AS PER PLAN @ 3.03%
- ② TEMPORARY CB-3A STA. 934+86, 48' LT (⊥ R/W & CONST. I-490)
- ③ TEMPORARY 10' - 12" CONDUIT TYPE B, AS PER PLAN @ 7.20%
- ④ EXISTING INLET (DR-58) (TO BE PLATED IN PRE-PHASE 1)
- ⑤ EXISTING MANHOLE (EX-1) (TO BE TEMPORARILY RECONSTRUCTED TO GRADE)
- ⑥ TEMPORARY 98' - 12" CONDUIT TYPE C, AS PER PLAN @ 0.50%
- ⑦ TEMPORARY CB-2-2B STA. 935+25, 67' RT. (⊥ R/W & CONST. I-490)

- ⑧ TEMPORARY 85' - 12" CONDUIT TYPE B, AS PER PLAN
- ⑨ TEMPORARY 70' - 12" CONDUIT TYPE B, AS PER PLAN
- ⑩ TEMPORARY 70' - 12" CONDUIT TYPE B, AS PER PLAN @ 3.56%
- ⑪ PROPOSED INLET (D-1) (CONSTRUCT IN PHASE 1) STA. 934+85, (⊥ R/W & CONST. I-490)

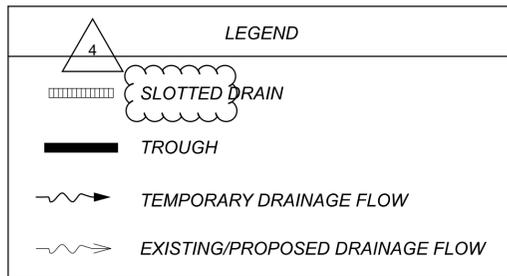

**MAINTENANCE OF TRAFFIC DRAINAGE NOTE:**  
 1. PROPOSED DRAINAGE TO BE CONSTRUCTED IN PHASE 1.

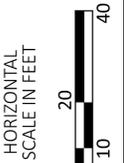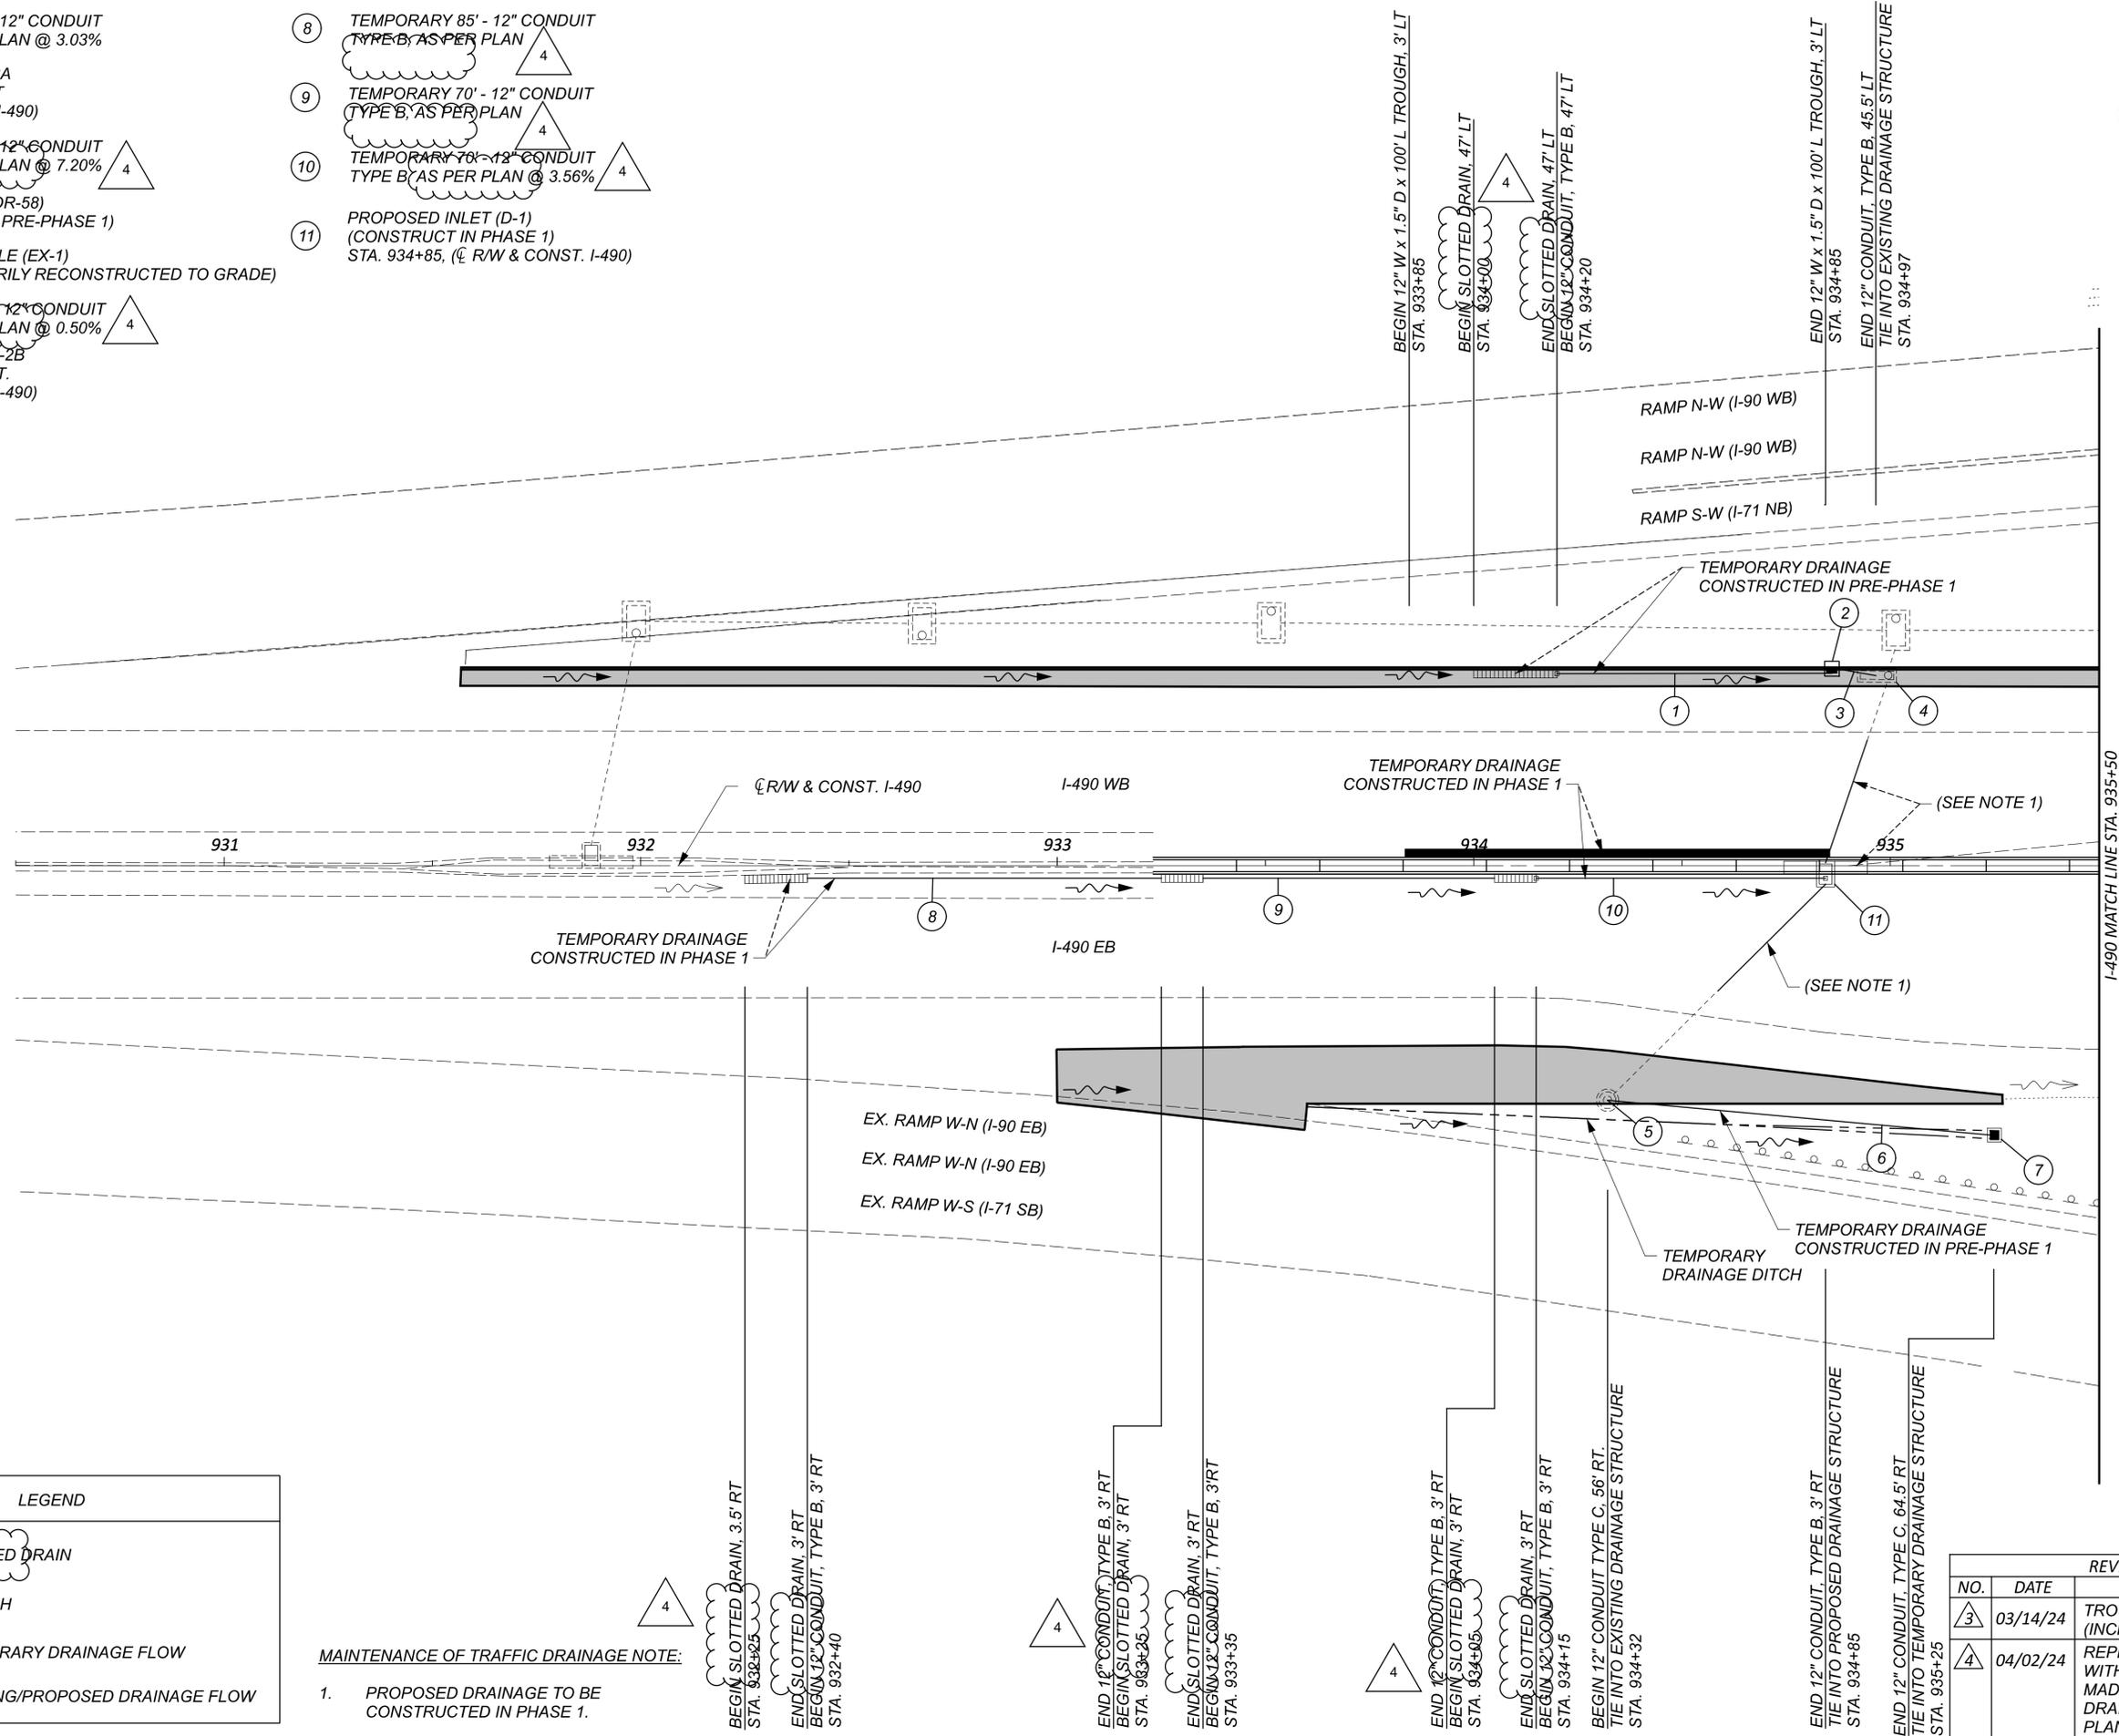

**MAINTENANCE OF TRAFFIC - TEMPORARY DRAINAGE - PRE-PHASE 1 & PHASE 1**  
 I-490 STA. 930+50 TO STA. 935+50

DESIGN AGENCY





DESIGNER	KRM
REVIEWER	AKF 11-21-23
PROJECT ID	107408
SHEET	291
TOTAL	1068

REVISIONS		
NO.	DATE	DESCRIPTION
③	03/14/24	TROUGH DEPTH UNITS (INCHES) ADDED
④	04/02/24	REPLACED TRENCH DRAIN WITH SLOTTED DRAIN AND MADE ALL TEMPORARY DRAINAGE ITEMS "AS PER PLAN"

- ① TEMPORARY 90' - 12" CONDUIT TYPE B, AS PER PLAN
- ② TEMPORARY 90' - 12" CONDUIT TYPE B, AS PER PLAN
- ③ TEMPORARY 90' - 12" CONDUIT TYPE B, AS PER PLAN
- ④ TEMPORARY 70' - 12" CONDUIT TYPE B, AS PER PLAN @ 4.09%
- ⑤ TEMPORARY CB-3A STA. 939+80, 48' LT (℄ R/W & CONST. I-490)
- ⑥ TEMPORARY 10' - 12" CONDUIT TYPE B, AS PER PLAN @ 7.28%
- ⑦ EXISTING INLET (DR-59) (TO BE PLATED IN PRE-PHASE 1)
- ⑧ EXISTING MANHOLE (DJ-2) (TO BE TEMPORARILY PLATED IN PRE-PHASE 1)
- ⑨ TEMPORARY 20' - 12" CONDUIT TYPE B, AS PER PLAN @ 5.15 %
- ⑩ EXISTING INLET (DR-50) (TO REMAIN OPERATIONAL)
- ⑪ EXISTING MANHOLE (DR-130) (TO BE TEMPORARILY PLATED IN PRE-PHASE 1)
- ⑫ TEMPORARY 20' - 12" CONDUIT TYPE B, AS PER PLAN @ 4.40%
- ⑬ EXISTING INLET (DR-51) (TO REMAIN OPERATIONAL)

**MAINTENANCE OF TRAFFIC DRAINAGE NOTES:**

- 1. PROPOSED DRAINAGE TO BE CONSTRUCTED IN PHASE 1.
- 2. FOR MAINTENANCE OF TRAFFIC DRAINAGE LEGEND, SEE SHEET 291.

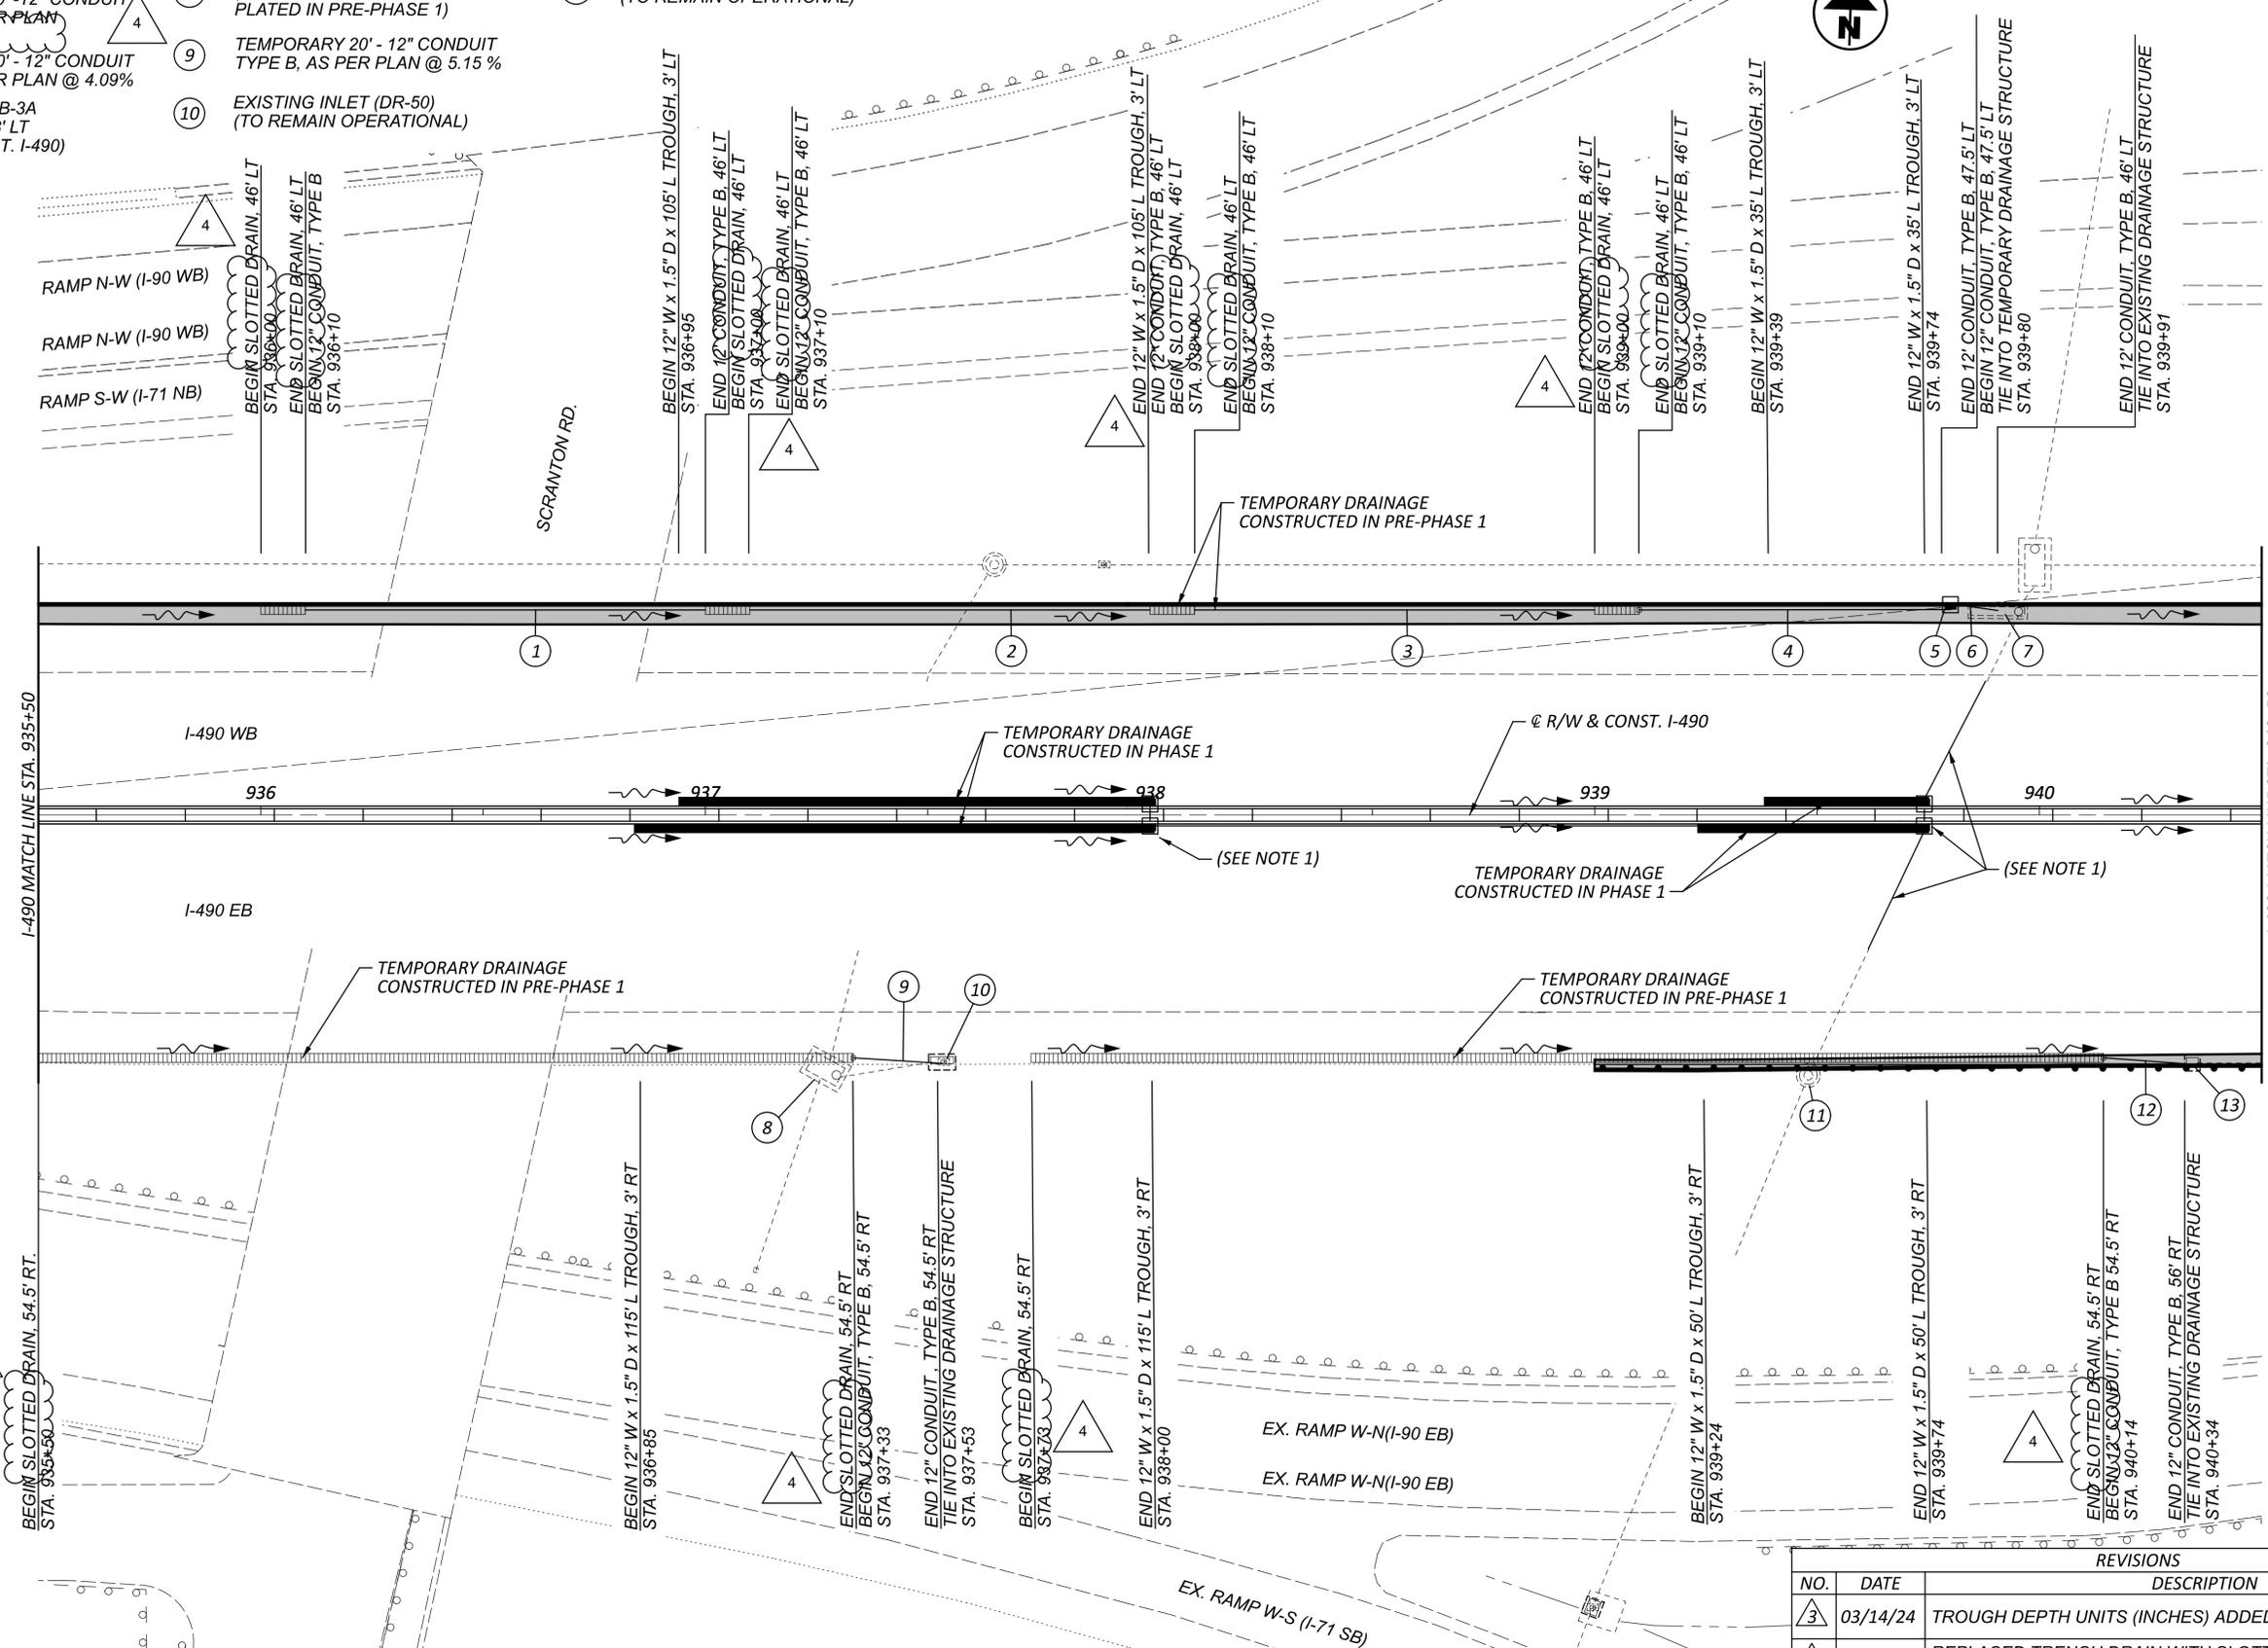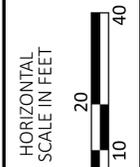

REVISIONS		
NO.	DATE	DESCRIPTION
③	03/14/24	TROUGH DEPTH UNITS (INCHES) ADDED
④	04/02/24	REPLACED TRENCH DRAIN WITH SLOTTED DRAIN AND MADE ALL TEMPORARY DRAINAGE ITEMS "AS PER PLAN"

**MAINTENANCE OF TRAFFIC - TEMPORARY DRAINAGE - PRE-PHASE 1 & PHASE 1**  
 I-490 - STA. 935+50 TO STA. 940+50

DESIGN AGENCY  
  
 DESIGNER  
 KRM  
 REVIEWER  
 AKF 11-21-23  
 PROJECT ID  
 107408  
 SHEET  
 292  
 TOTAL  
 1068



- ① TEMPORARY 40' - 12" CONDUIT TYPE B, AS PER PLAN
- ② TEMPORARY 20' - 12" CONDUIT TYPE B, AS PER PLAN @ 4.00%
- ③ TEMPORARY CB-3A STA. 941+30, 47.5' LT (℄ R/W & CONST. I-490)
- ④ TEMPORARY 7' - 12" CONDUIT TYPE B, AS PER PLAN @ 7.14%
- ⑤ EXISTING INLET (DR-60 SEE BELOW) (TO BE PLATED IN PRE-PHASE 1)
- ⑥ EXISTING INLET (DR-61) (TO BE PLATED IN PRE-PHASE 1)
- ⑦ TEMPORARY 8' - 12" CONDUIT TYPE B, AS PER PLAN @ 6.59%
- ⑧ TEMPORARY CB-3A STA. 942+15, 47.5' LT (℄ R/W & CONST I-490)
- ⑨ EXISTING INLET (DR-62) (TO BE PLATED IN PRE-PHASE 1)
- ⑩ TEMPORARY 20' - 12" CONDUIT TYPE B, AS PER PLAN @ 10.00%
- ⑪ TEMPORARY 20' - 12" CONDUIT TYPE B, AS PER PLAN @ 2.90%
- ⑫ TEMPORARY CB-3A STA. 941+00, 56' RT (℄ R/W & CONST I-490)
- ⑬ TEMPORARY 7' - 12" CONDUIT TYPE B, AS PER PLAN @ 3.00%
- ⑭ EXISTING INLET (DR-52) (TO BE TEMPORARILY PLATED IN PRE-PHASE 1)
- ⑮ TEMPORARY 13' - 12" CONDUIT TYPE B, AS PER PLAN @ 13.87%
- ⑯ EXISTING INLET (DR-53) (TO BE TEMPORARILY PLATED IN PRE-PHASE 1)
- ⑰ TEMPORARY 9' - 12" CONDUIT TYPE B, AS PER PLAN @ 6.07%
- ⑱ TEMPORARY CB-3A STA. 941+97, 57.5' RT (℄ R/W & CONST I-490)
- ⑲ TEMPORARY 20' - 12" CONDUIT TYPE B, AS PER PLAN @ 8.62%
- ⑳ TEMPORARY CB-3A STA. 944+90, 57.5' RT (℄ R/W & CONST I-490)
- ㉑ TEMPORARY 10' - 12" CONDUIT TYPE B, AS PER PLAN @ 10.70%
- ㉒ EXISTING INLET (DR-54) (TO BE TEMPORARILY PLATED IN PRE-PHASE 1)
- ㉓ TEMPORARY 19' - 12" CONDUIT TYPE B, AS PER PLAN @ 10.16%
- ㉔ PROPOSED INLET (D-8) (CONSTRUCTED IN PHASE 1)
- ㉕ TEMPORARY 20' - 12" CONDUIT TYPE B, AS PER PLAN @ 8.40%
- ㉖ PROPOSED INLET (D-10) (CONSTRUCTED IN PHASE 1)
- ㉗ TEMPORARY 30' - 12" CONDUIT TYPE B, AS PER PLAN @ 9.57%

MAINTENANCE OF TRAFFIC DRAINAGE NOTES:

1. PROPOSED DRAINAGE TO BE CONSTRUCTED IN PHASE 1.
2. FOR MAINTENANCE OF TRAFFIC DRAINAGE LEGEND, SEE SHEET 291.



DR-60  
 STA. 941+38.01, 43.46' LT.  
 EX. I-2-A6  
 EX. GRATE ELEV. 630.33  
 EX. 15" RCP N 625.13  
 TEMP. 12" (W) 626.50

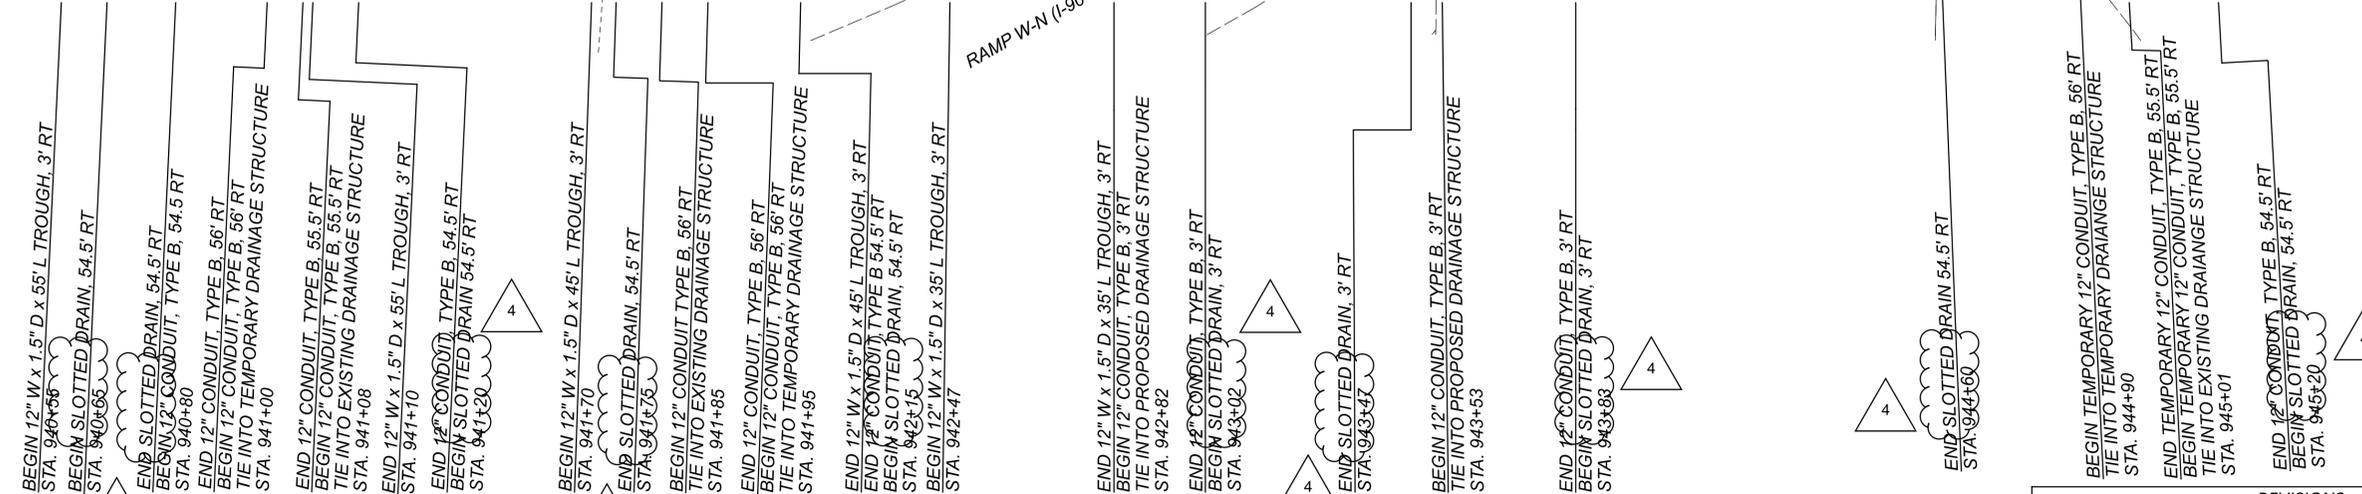
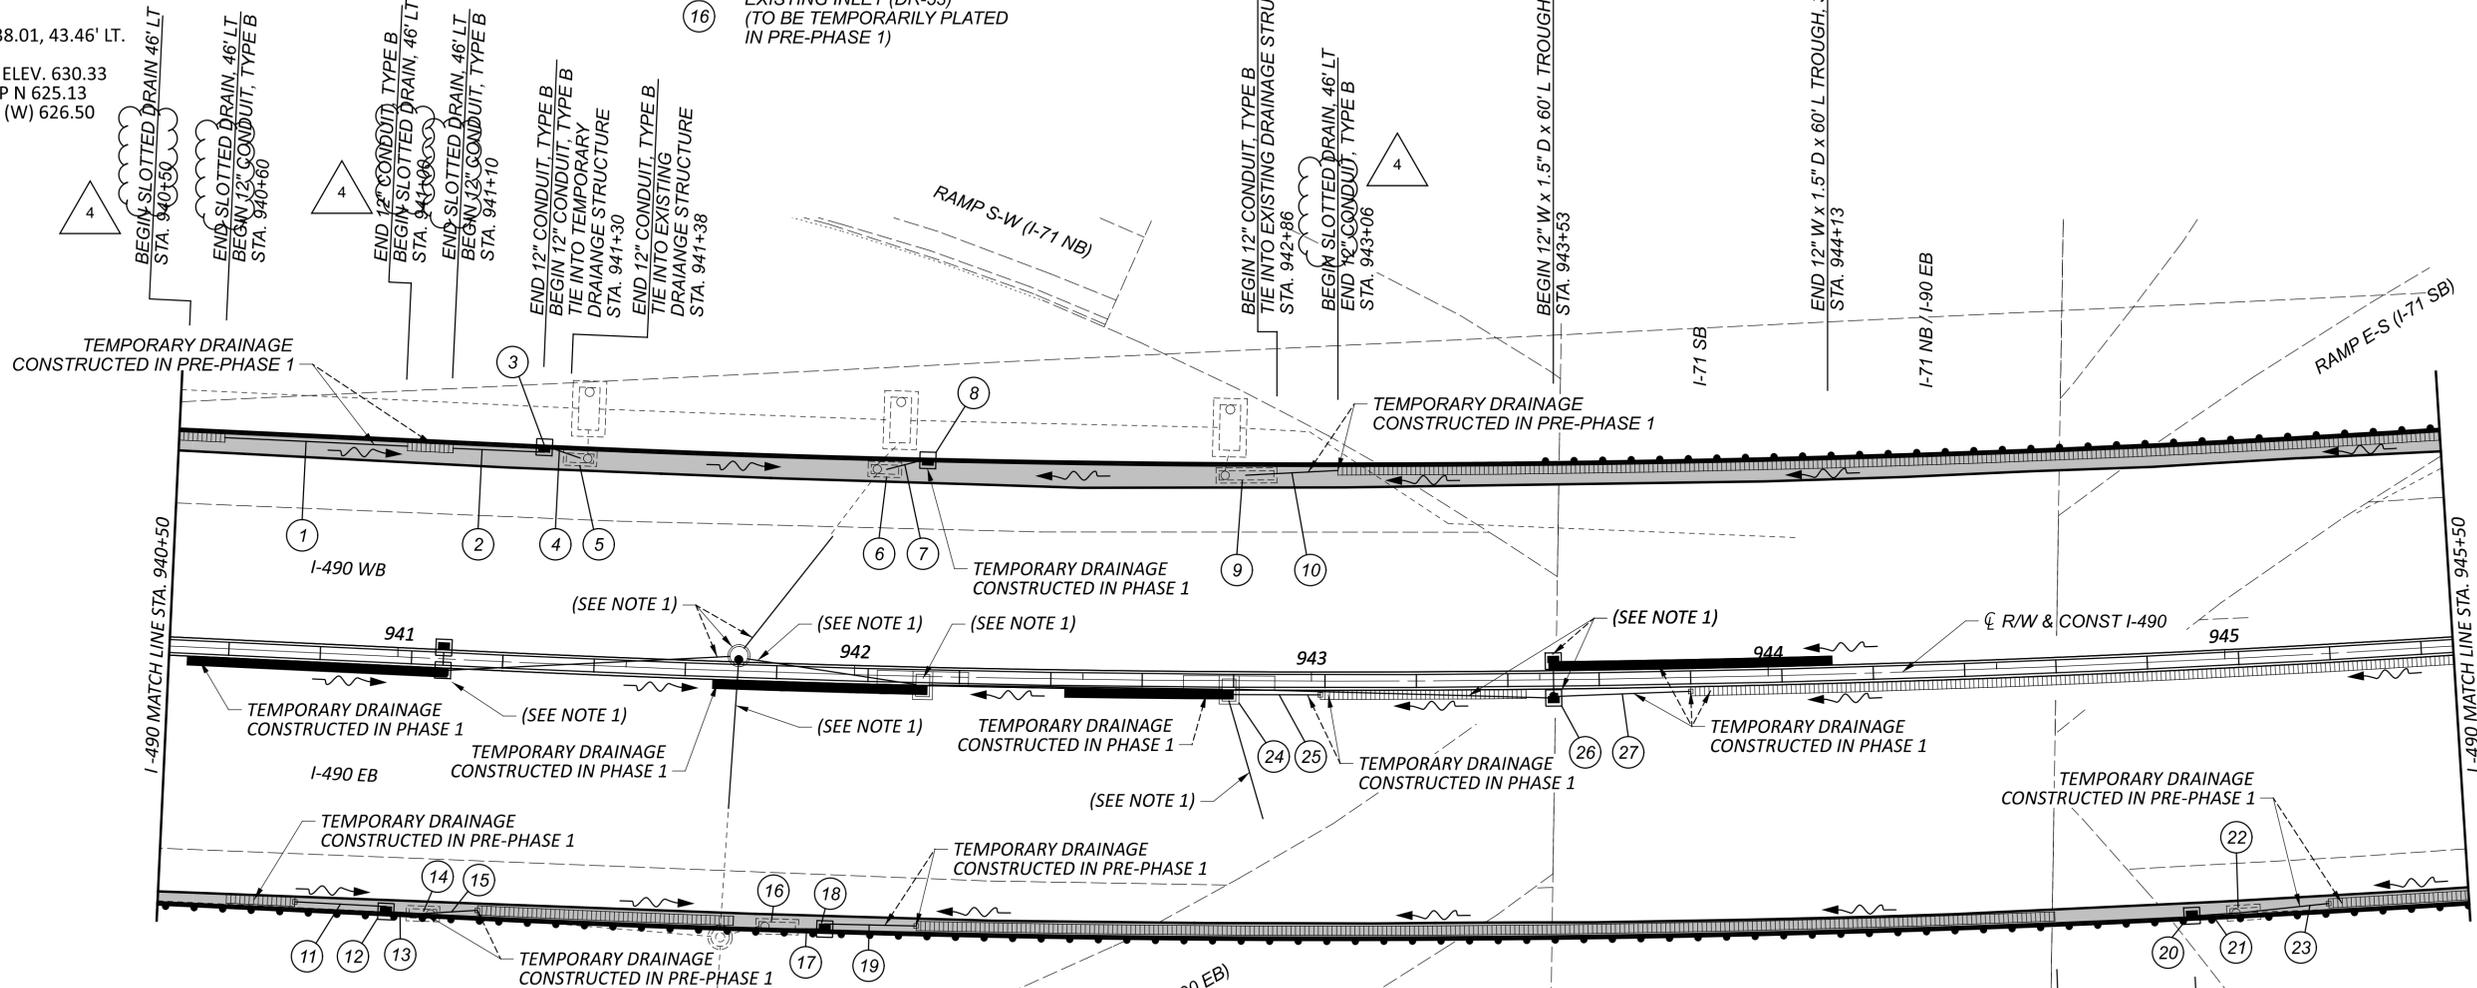


REVISIONS		
NO.	DATE	DESCRIPTION
④	04/02/24	REPLACED SLOTTED DRAIN WITH SLOTTED DRAIN AND MADE ALL TEMPORARY DRAINAGE ITEMS "AS PER PLAN"

MAINTENANCE OF TRAFFIC - TEMPORARY DRAINAGE - PRE-PHASE 1 & PHASE 1  
 I-490 STA. 940+50 TO STA. 945+50

DESIGN AGENCY  
  
 DESIGNER  
 KRM  
 REVIEWER  
 AKF 11-21-23  
 PROJECT ID  
 107408  
 SHEET TOTAL  
 293 1068

- ① EXISTING INLET (DR-63)  
(TO BE PLATED IN PRE-PHASE 1)
- ② TEMPORARY 20'-12 CONDUIT TYPE B,  
AS PER PLAN @ 9.70%
- ③ TEMPORARY CB-3A  
STA. 949+85, 47'RT  
(C R/W & CONST I-490)
- ④ TEMPORARY 8'-12" CONDUIT  
TYPE B, AS PER PLAN @ 4.21%
- ⑤ EXISTING INLET (DR-64)  
(TO BE PLATED IN PRE-PHASE 1)
- ⑥ TEMPORARY 53'-12" CONDUIT TYPE B,  
AS PER PLAN @ 4.37%
- ⑦ EXISTING MANHOLE (DR-133)  
(TO BE PLATED IN PRE-PHASE 1)
- ⑧ TEMPORARY CB-3A  
STA. 946+90, 57'RT  
(C R/W & CONST I-490)
- ⑨ TEMPORARY 10'-12" CONDUIT  
TYPE B, AS PER PLAN @ 7.55%
- ⑩ EXISTING INLET (DR-55)  
(TO BE TEMPORARILY PLATED  
IN PRE-PHASE 1)
- ⑪ TEMPORARY 19'-12" CONDUIT TYPE B,  
AS PER PLAN @ 10.84%
- ⑫ EXISTING MANHOLE (DR-136)  
(TO BE PLATED IN PRE-PHASE 1)
- ⑬ PROPOSED INLET (DR-12)  
(TO BE CONSTRUCTED IN PHASE 1)
- ⑭ TEMPORARY 30'-12" CONDUIT  
TYPE B, AS PER PLAN @ 6.33%

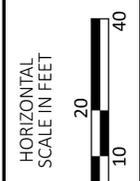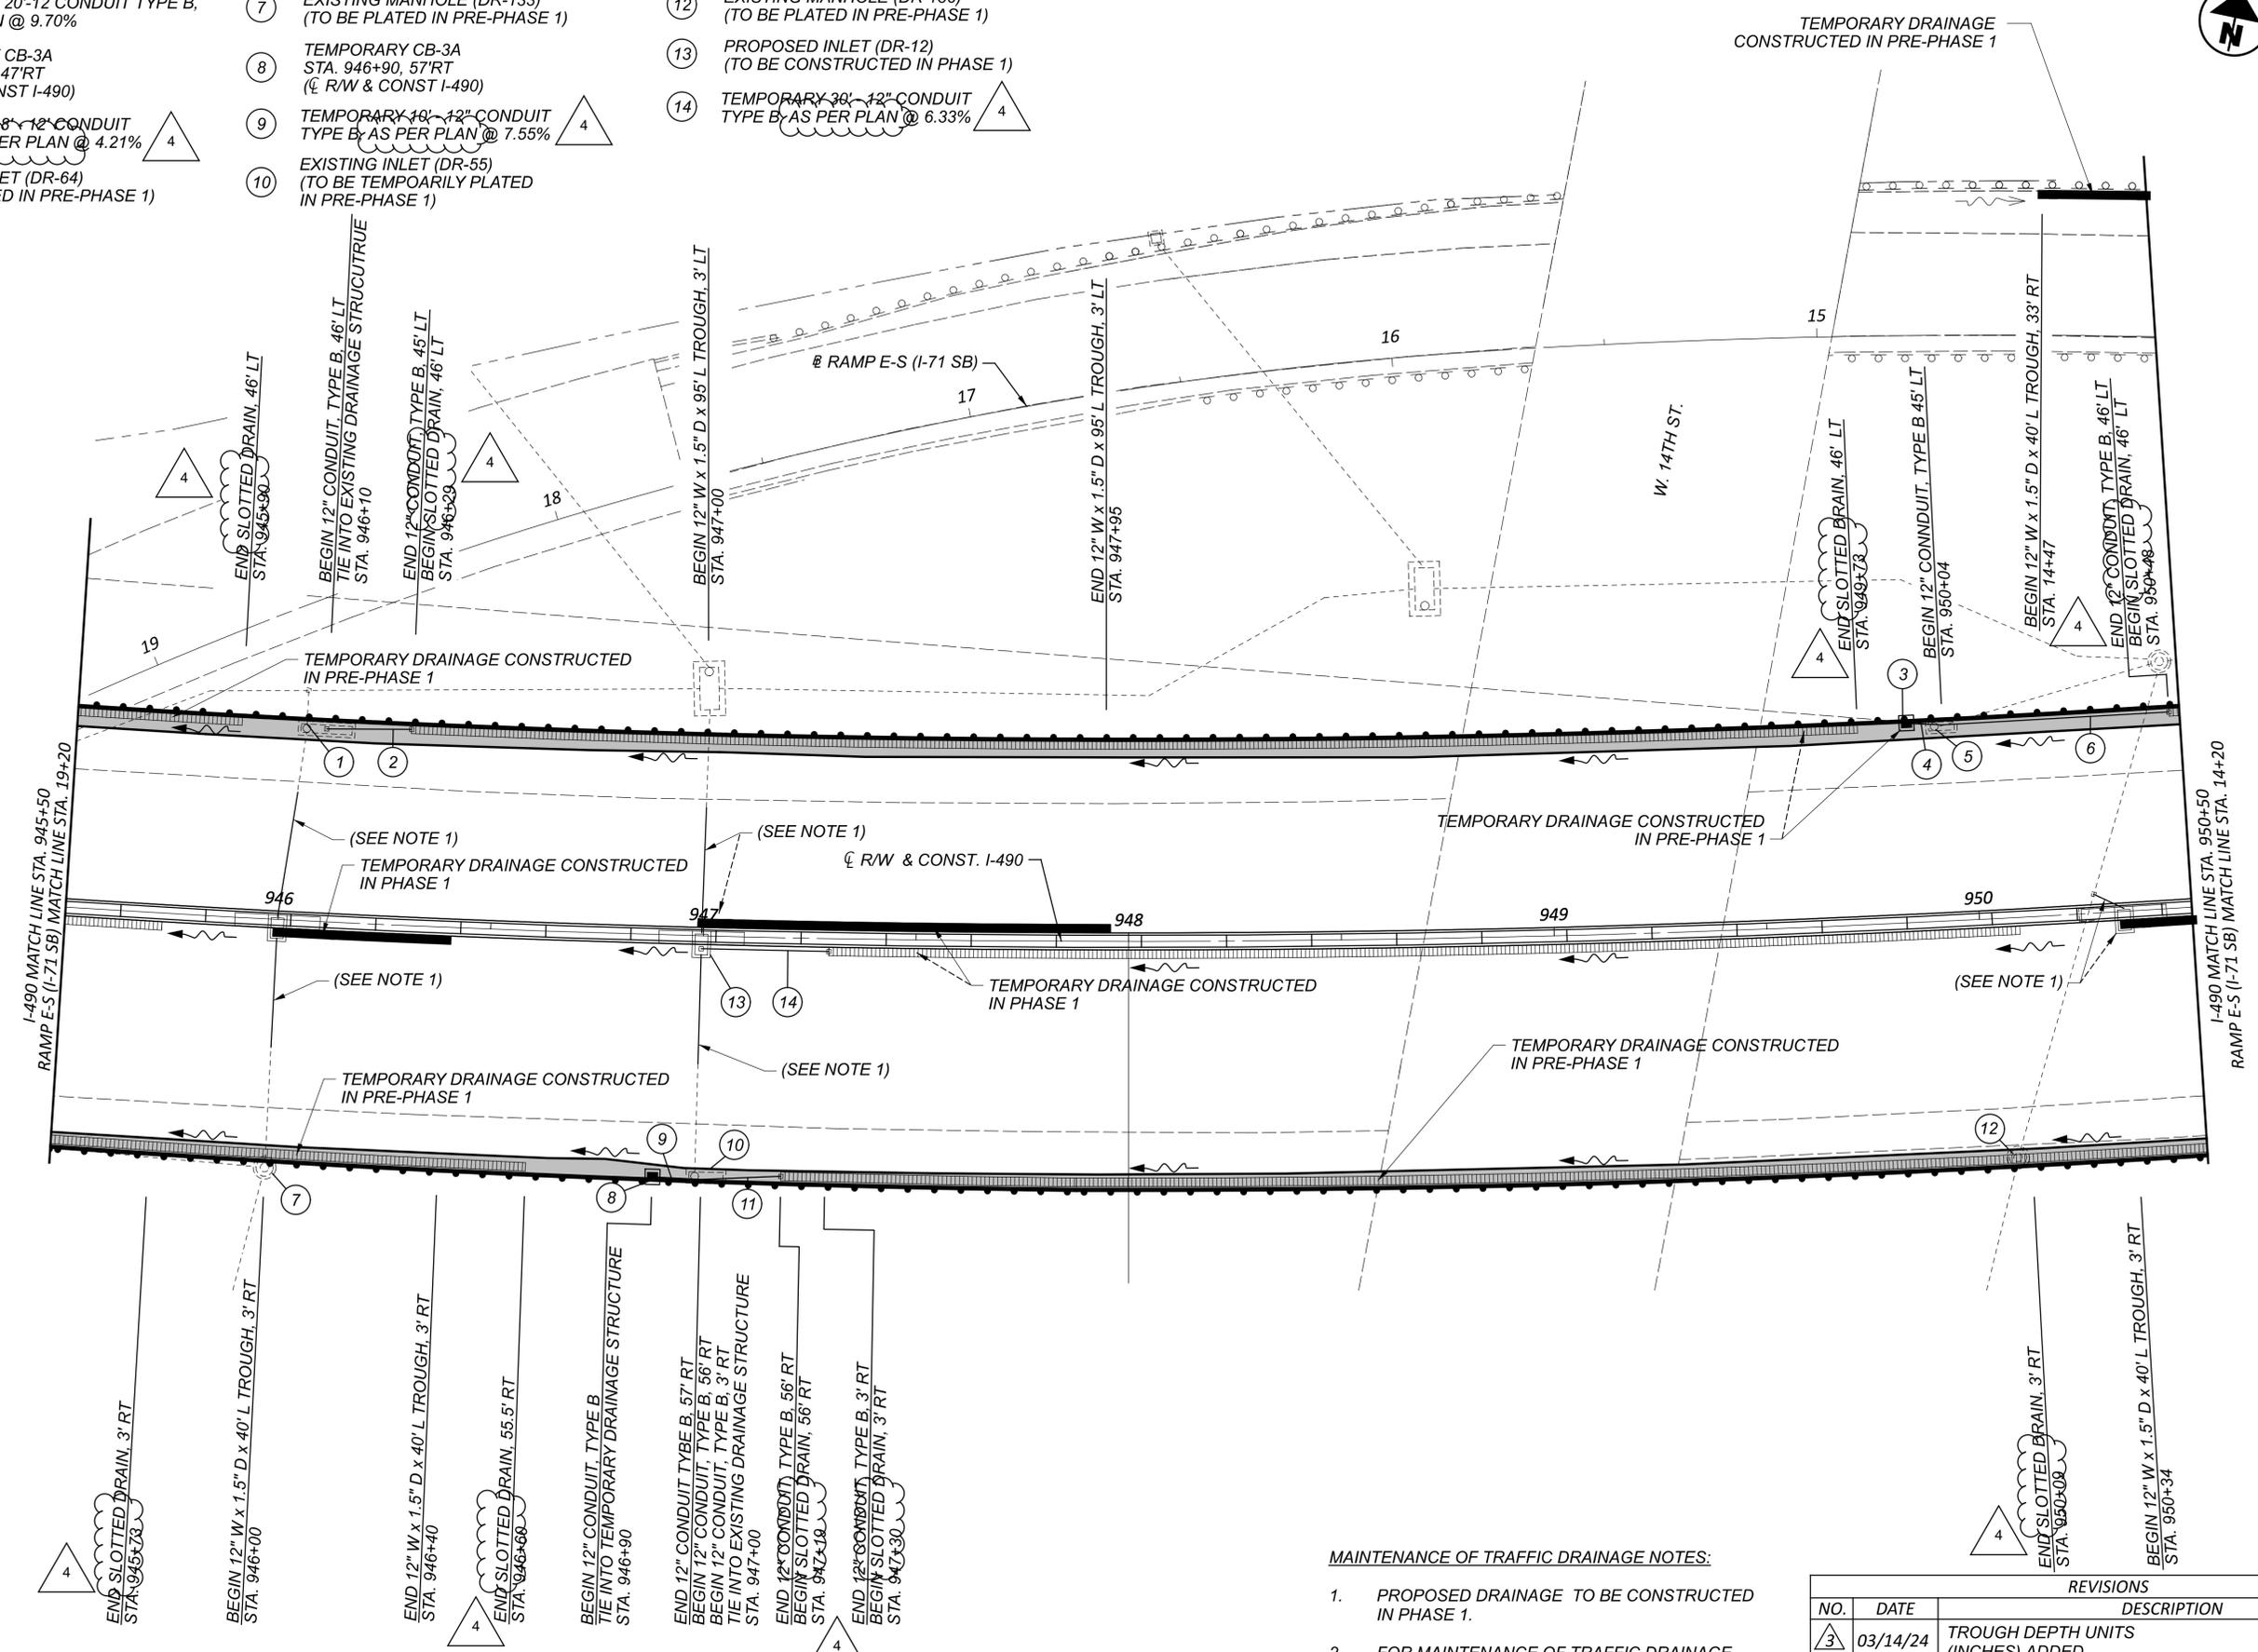

**MAINTENANCE OF TRAFFIC - TEMPORARY DRAINAGE - PRE-PHASE 1 & PHASE 1**  
 I-490 - STA. 945+50 TO STA. 950+50

**MAINTENANCE OF TRAFFIC DRAINAGE NOTES:**


1. PROPOSED DRAINAGE TO BE CONSTRUCTED IN PHASE 1.
2. FOR MAINTENANCE OF TRAFFIC DRAINAGE LEGEND, SEE SHEET 291.

REVISIONS		DESCRIPTION
③	03/14/24	TROUGH DEPTH UNITS (INCHES) ADDED
④	04/02/24	REPLACE SLOTTED DRAIN WITH SLOTTED DRAIN AND MADE ALL TEMP. DRAINAGE ITEMS "AS PER PLAN"

DESIGN AGENCY		
DESIGNER		
DESIGNER		KRM
REVIEWER		AKF
PROJECT ID		107408
SHEET	TOTAL	
294	1068	

**CUY-490-0.00 PART 1**


MODEL: 107408\_MPD04D-3 PAPER SIZE: 34x22 (in.) DATE: 4/2/2024 TIME: 1:34:41 PM USER: kmonas  
 O:\Clients\ORD\2021\107408\107408-400-Engineering\WOT\Sheets\107408\_MM106.dgn

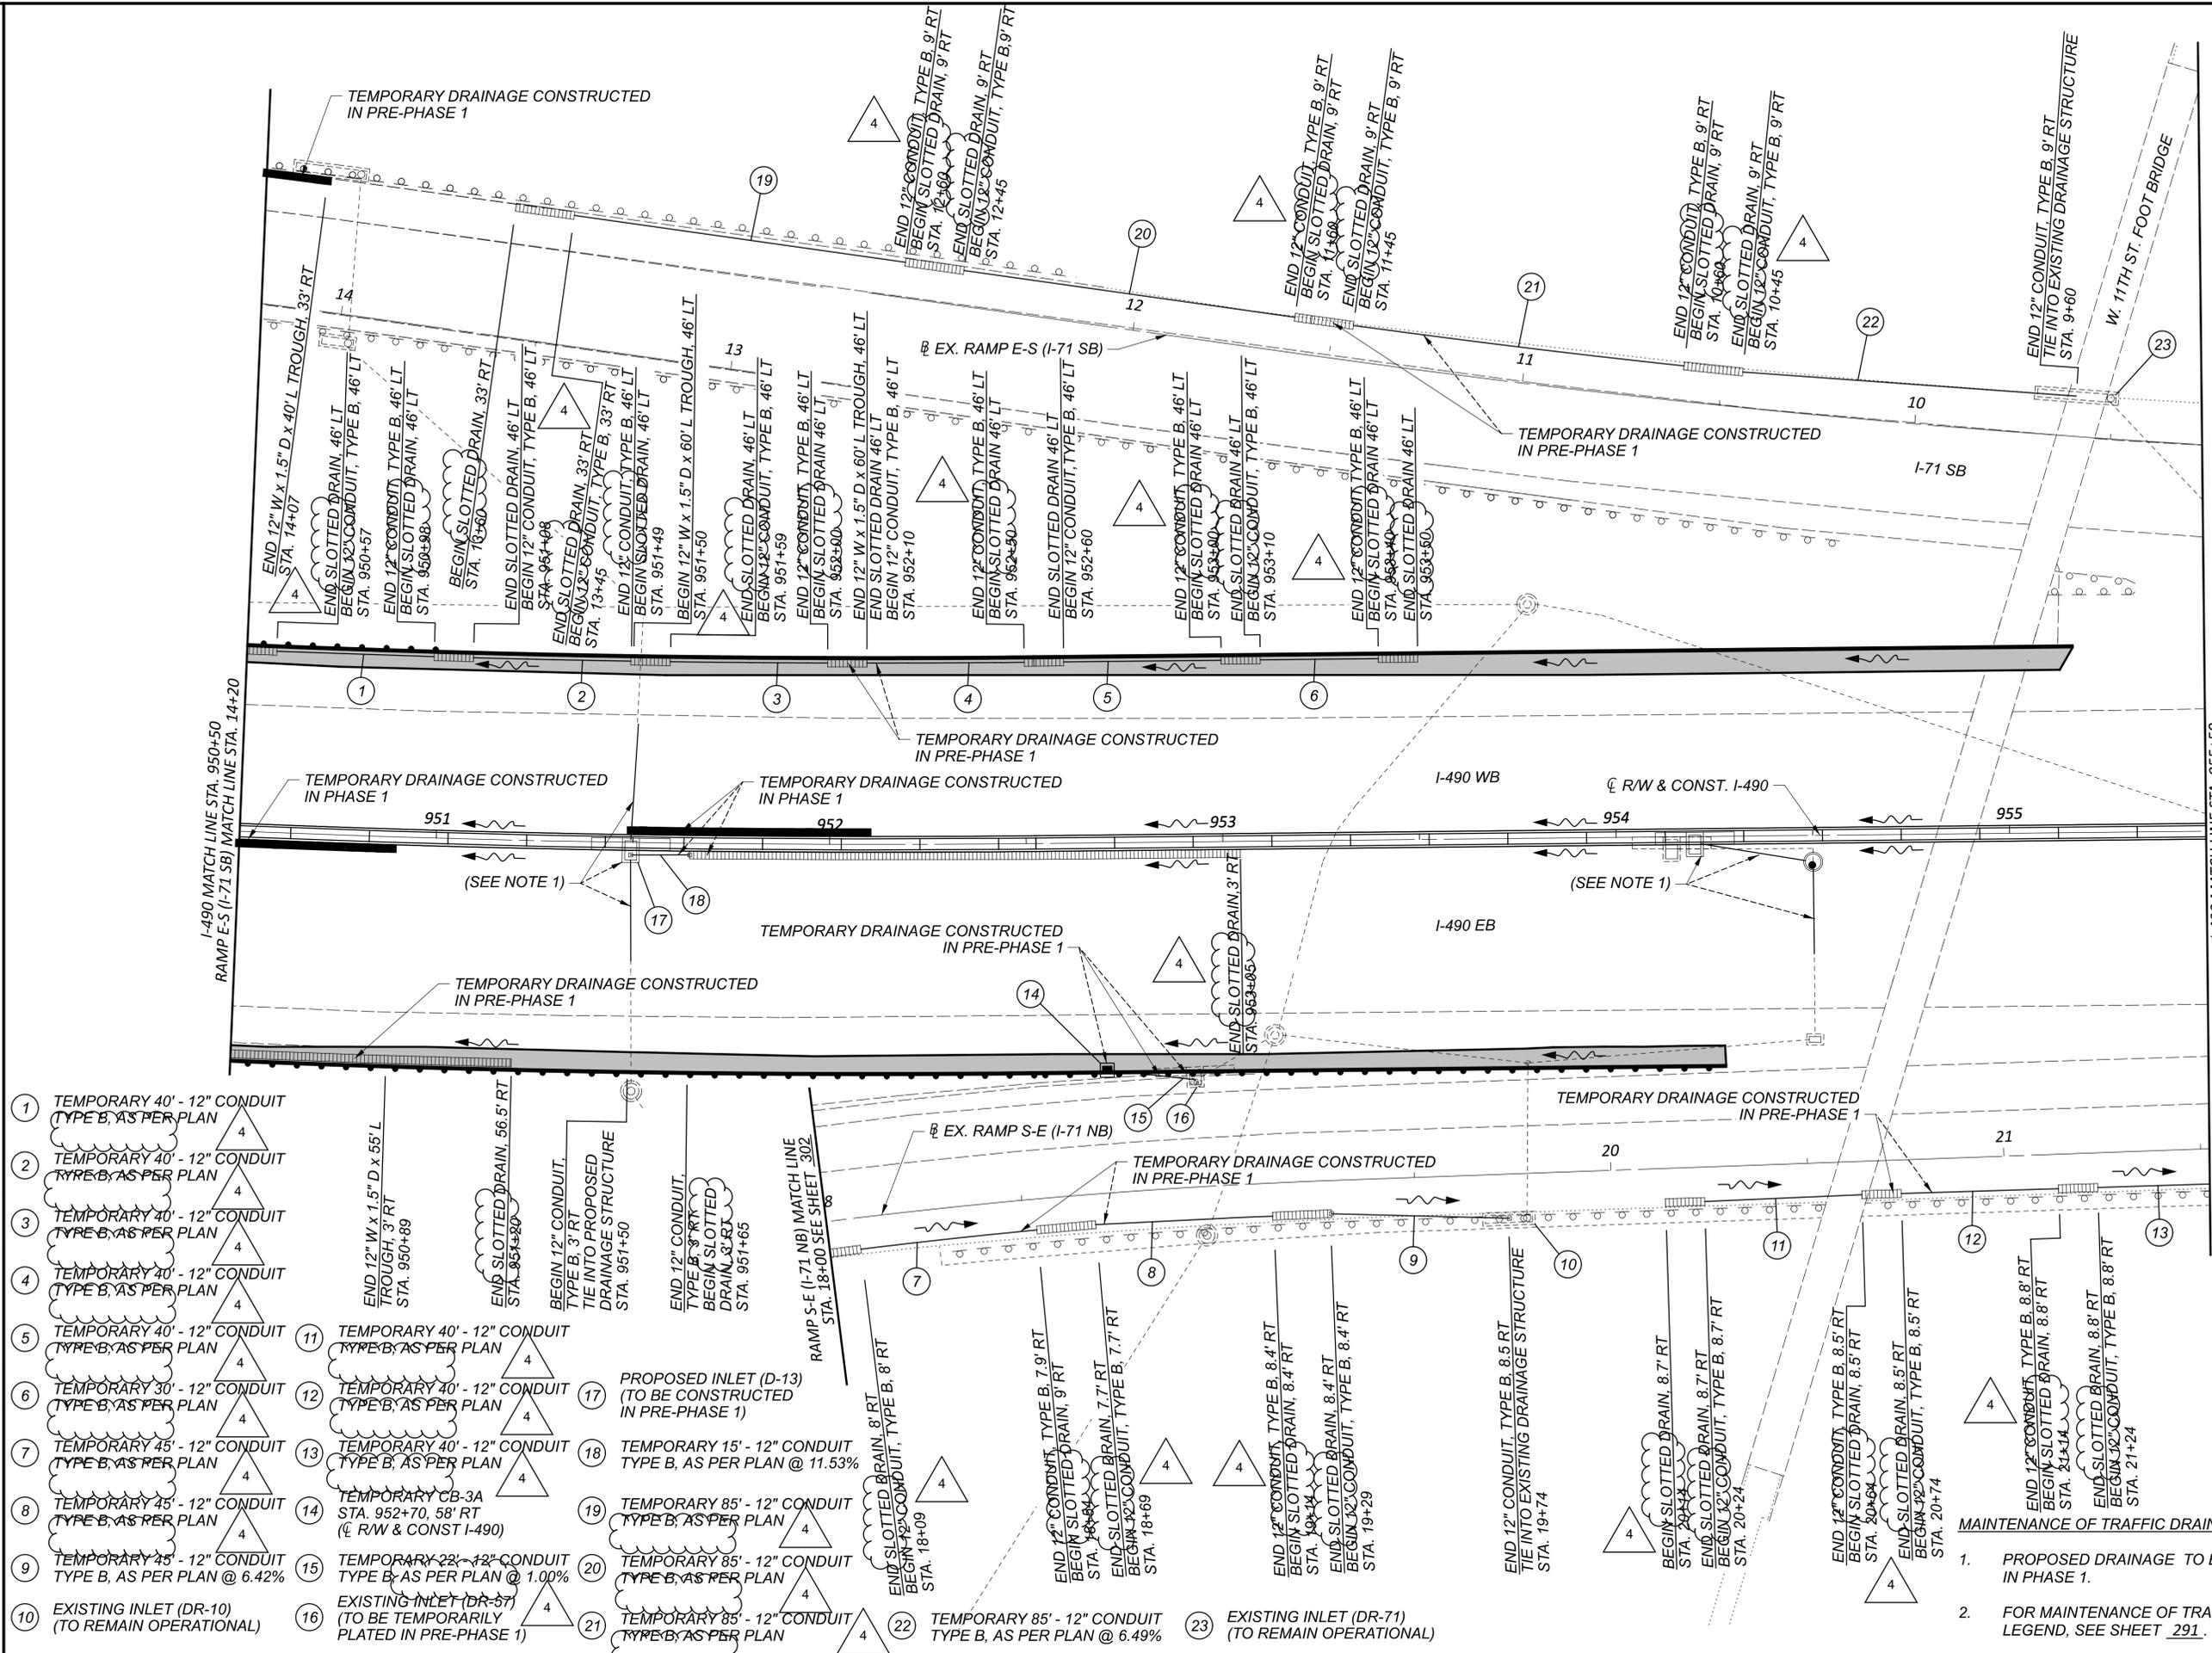

- 1 TEMPORARY 40' - 12" CONDUIT TYPE B, AS PER PLAN
- 2 TEMPORARY 40' - 12" CONDUIT TYPE B, AS PER PLAN
- 3 TEMPORARY 40' - 12" CONDUIT TYPE B, AS PER PLAN
- 4 TEMPORARY 40' - 12" CONDUIT TYPE B, AS PER PLAN
- 5 TEMPORARY 40' - 12" CONDUIT TYPE B, AS PER PLAN
- 6 TEMPORARY 30' - 12" CONDUIT TYPE B, AS PER PLAN
- 7 TEMPORARY 45' - 12" CONDUIT TYPE B, AS PER PLAN
- 8 TEMPORARY 45' - 12" CONDUIT TYPE B, AS PER PLAN
- 9 TEMPORARY 45' - 12" CONDUIT TYPE B, AS PER PLAN @ 6.42%
- 10 EXISTING INLET (DR-10) (TO REMAIN OPERATIONAL)
- 11 TEMPORARY 40' - 12" CONDUIT TYPE B, AS PER PLAN
- 12 TEMPORARY 40' - 12" CONDUIT TYPE B, AS PER PLAN
- 13 TEMPORARY 40' - 12" CONDUIT TYPE B, AS PER PLAN
- 14 TEMPORARY CB-3A STA. 952+70, 58' RT (CL R/W & CONST I-490)
- 15 TEMPORARY 22' - 12" CONDUIT TYPE B, AS PER PLAN @ 1.00%
- 16 EXISTING INLET (DR-57) (TO BE TEMPORARILY PLATED IN PRE-PHASE 1)
- 17 PROPOSED INLET (D-13) (TO BE CONSTRUCTED IN PRE-PHASE 1)
- 18 TEMPORARY 15' - 12" CONDUIT TYPE B, AS PER PLAN @ 11.53%
- 19 TEMPORARY 85' - 12" CONDUIT TYPE B, AS PER PLAN
- 20 TEMPORARY 85' - 12" CONDUIT TYPE B, AS PER PLAN
- 21 TEMPORARY 85' - 12" CONDUIT TYPE B, AS PER PLAN
- 22 TEMPORARY 85' - 12" CONDUIT TYPE B, AS PER PLAN @ 6.49%
- 23 EXISTING INLET (DR-71) (TO REMAIN OPERATIONAL)


- MAINTENANCE OF TRAFFIC DRAINAGE NOTES:**
- PROPOSED DRAINAGE TO BE CONSTRUCTED IN PHASE 1.
  - FOR MAINTENANCE OF TRAFFIC DRAINAGE LEGEND, SEE SHEET 291.

NO.	DATE	DESCRIPTION
1	04/02/24	REPLACE SLOTTED DRAIN WITH SLOTTED DRAIN AND MADE ALL TEMP. DRAINAGE ITEMS "AS PER PLAN"

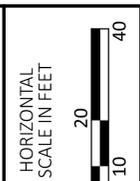


**MAINTENANCE OF TRAFFIC - TEMPORARY DRAINAGE - PRE-PHASE 1 & PHASE 1**  
 I-490 - STA. 950+50 TO STA. 955+50

DESIGN AGENCY	
DESIGNER	KRM
REVIEWER	AKF 11-21-23
PROJECT ID	107408
SHEET	295
TOTAL	1068

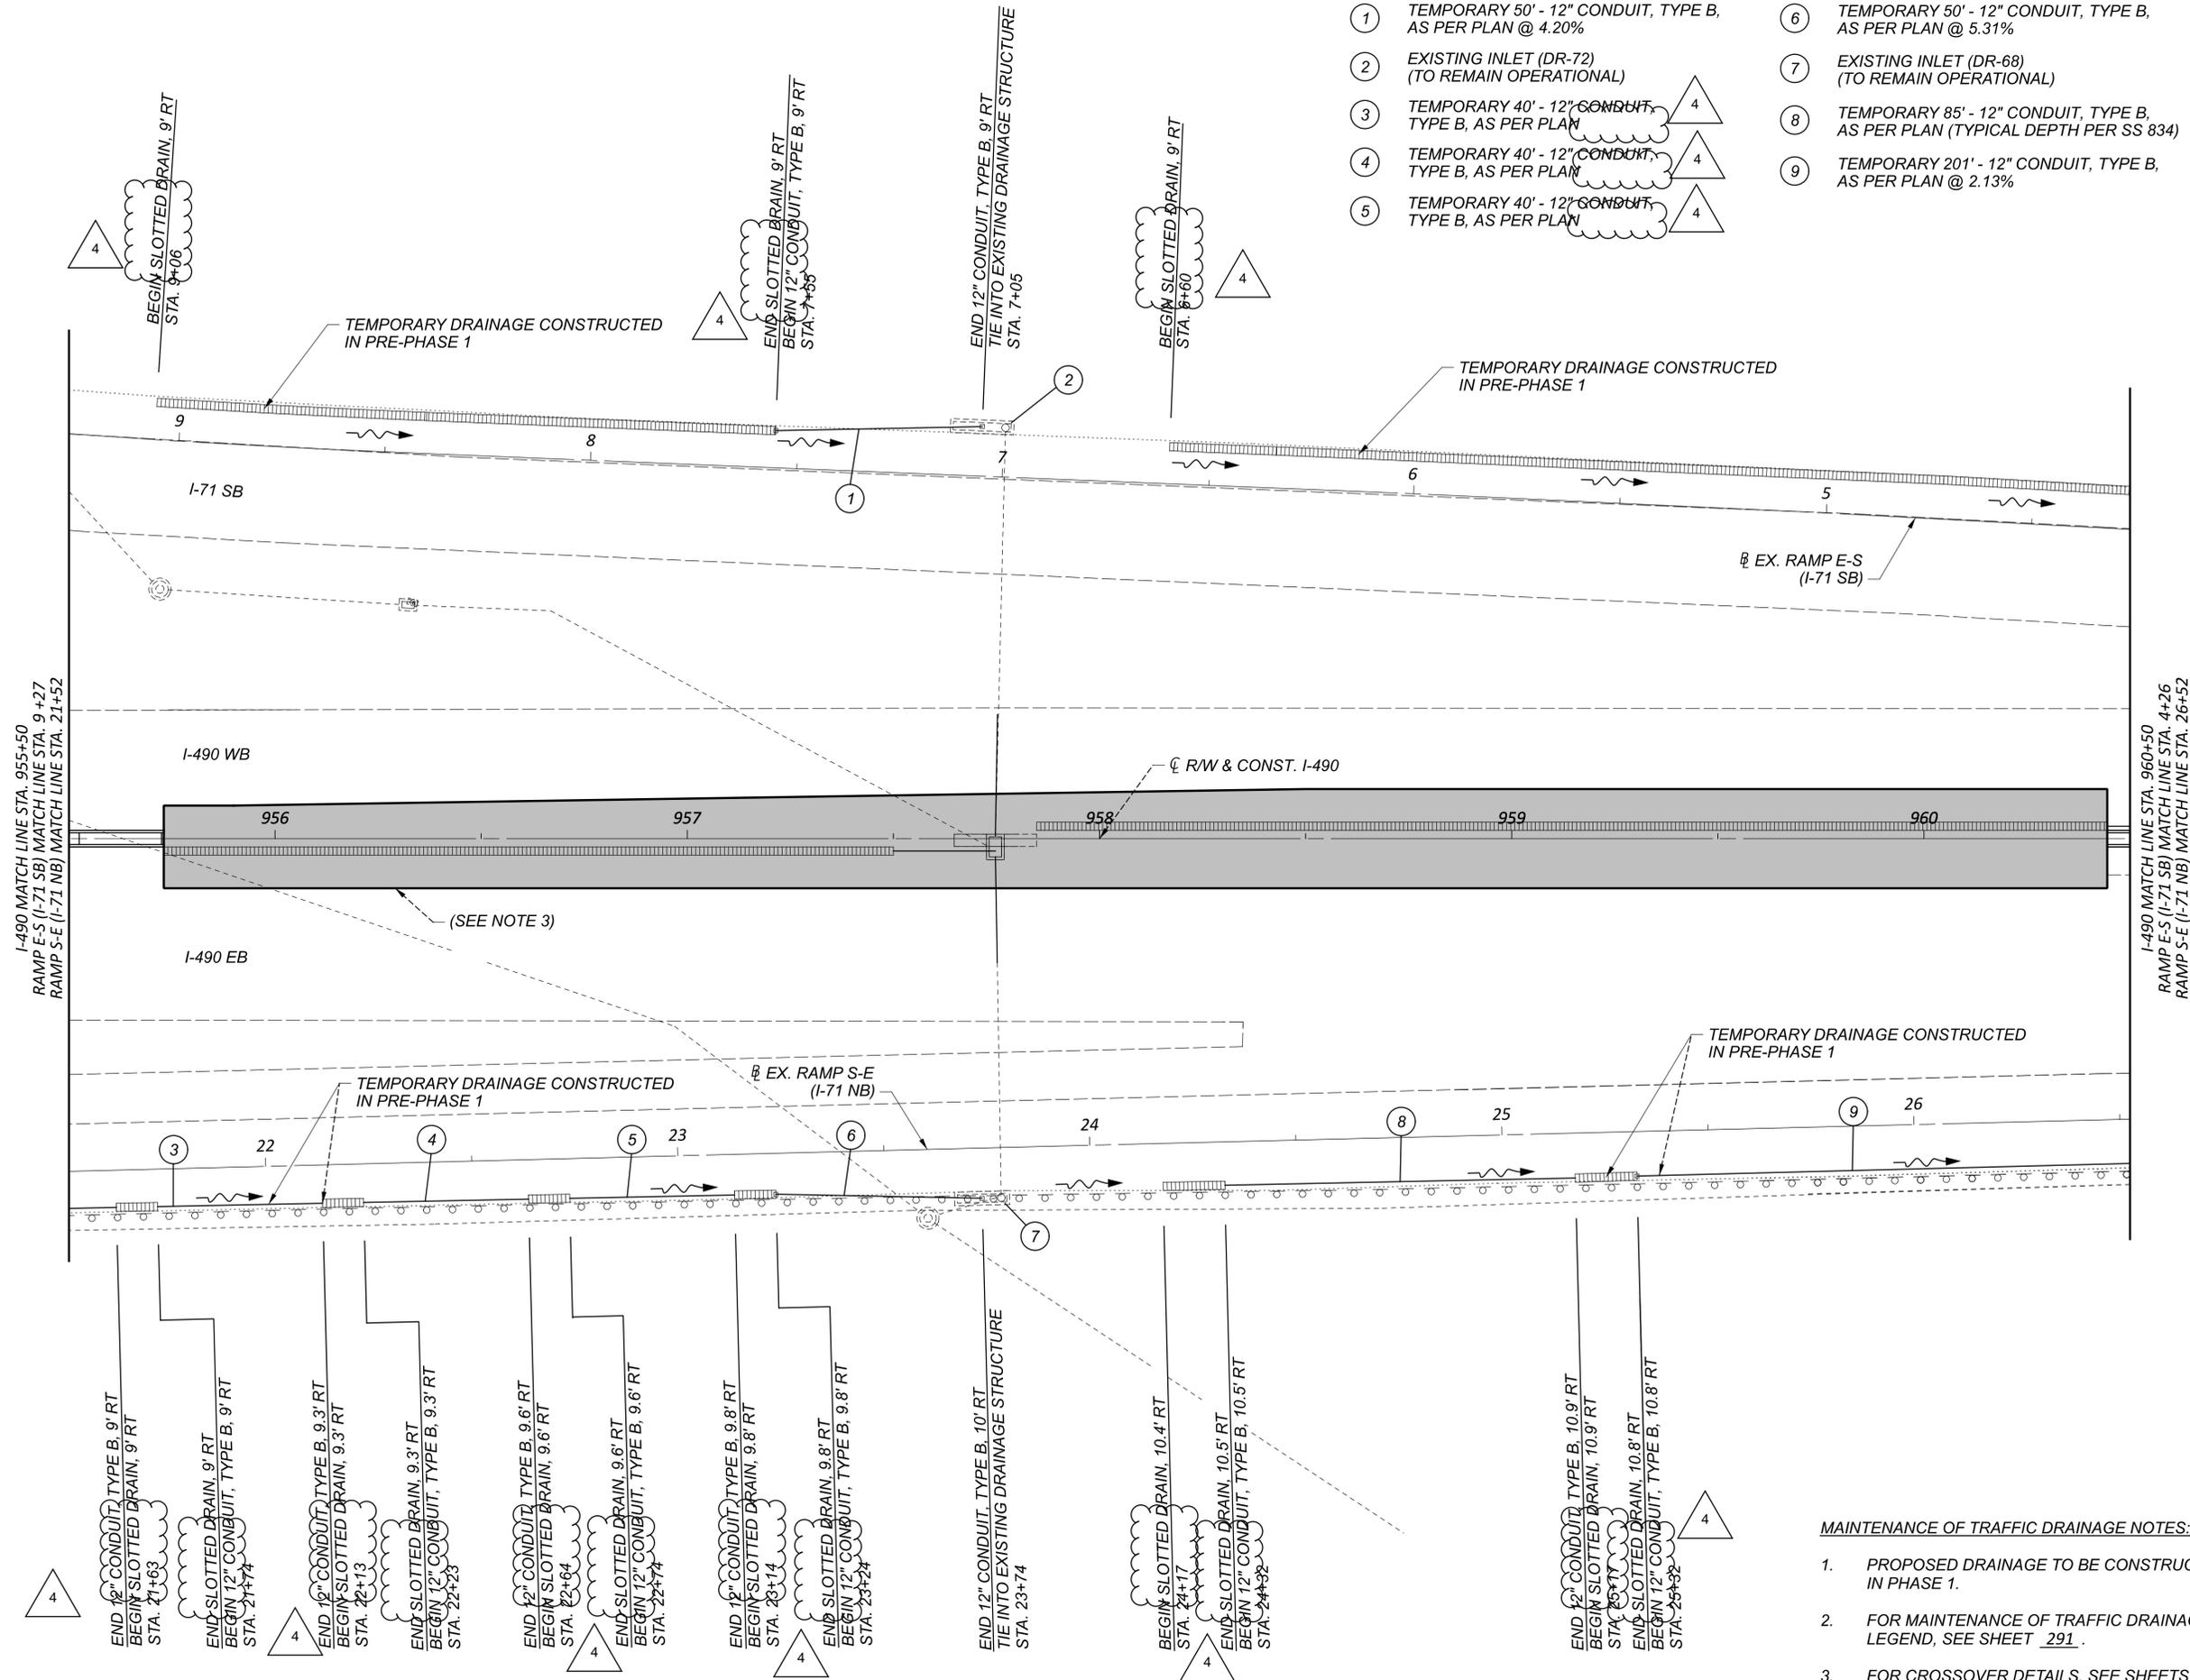

- ① TEMPORARY 50' - 12" CONDUIT, TYPE B, AS PER PLAN @ 4.20%
- ② EXISTING INLET (DR-72) (TO REMAIN OPERATIONAL)
- ③ TEMPORARY 40' - 12" CONDUIT, TYPE B, AS PER PLAN
- ④ TEMPORARY 40' - 12" CONDUIT, TYPE B, AS PER PLAN
- ⑤ TEMPORARY 40' - 12" CONDUIT, TYPE B, AS PER PLAN
- ⑥ TEMPORARY 50' - 12" CONDUIT, TYPE B, AS PER PLAN @ 5.31%
- ⑦ EXISTING INLET (DR-68) (TO REMAIN OPERATIONAL)
- ⑧ TEMPORARY 85' - 12" CONDUIT, TYPE B, AS PER PLAN (TYPICAL DEPTH PER SS 834)
- ⑨ TEMPORARY 201' - 12" CONDUIT, TYPE B, AS PER PLAN @ 2.13%

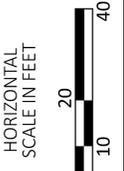

**MAINTENANCE OF TRAFFIC - TEMPORARY DRAINAGE - PRE-PHASE 1 & PHASE 1**  
**I-490 - STA. 955+50 TO STA. 960+50**

REVISIONS	
NO.	DATE
4	04/02/24

REPLACE SLOTTED DRAIN WITH SLOTTED DRAIN AND MADE ALL TEMP. DRAINAGE ITEMS "AS PER PLAN"

**MAINTENANCE OF TRAFFIC DRAINAGE NOTES:**

1. PROPOSED DRAINAGE TO BE CONSTRUCTED IN PHASE 1.
2. FOR MAINTENANCE OF TRAFFIC DRAINAGE LEGEND, SEE SHEET 291.
3. FOR CROSSOVER DETAILS, SEE SHEETS 287 - 288.

DESIGN AGENCY



DESIGNER

KRM

REVIEWER

AKF 11-21-23


PROJECT ID

107408

SHEET TOTAL


296 1068

- ① TEMPORARY 40' - 12" CONDUIT, TYPE B, AS PER PLAN @ 5.85%
- ② EXISTING INLET (DR-73) (TO REMAIN OPERATIONAL)
- ③ TEMPORARY 40' - 12" CONDUIT, TYPE B, AS PER PLAN
- ④ TEMPORARY 55' - 12" CONDUIT, TYPE B, AS PER PLAN
- ⑤ TEMPORARY 70' - 12" CONDUIT, TYPE B, AS PER PLAN @ 4.39%
- ⑥ EXISTING INLET (DR-74) (TO REMAIN OPERATIONAL)
- ⑦ TEMPORARY 50' - 12" CONDUIT, TYPE B, AS PER PLAN
- ⑧ TEMPORARY 50' - 12" CONDUIT, TYPE B, AS PER PLAN
- ⑨ TEMPORARY 201' - 12" CONDUIT, TYPE B, AS PER PLAN @ 2.13%
- ⑩ EXISTING MANHOLE (DR-140) (TO REMAIN OPERATIONAL)

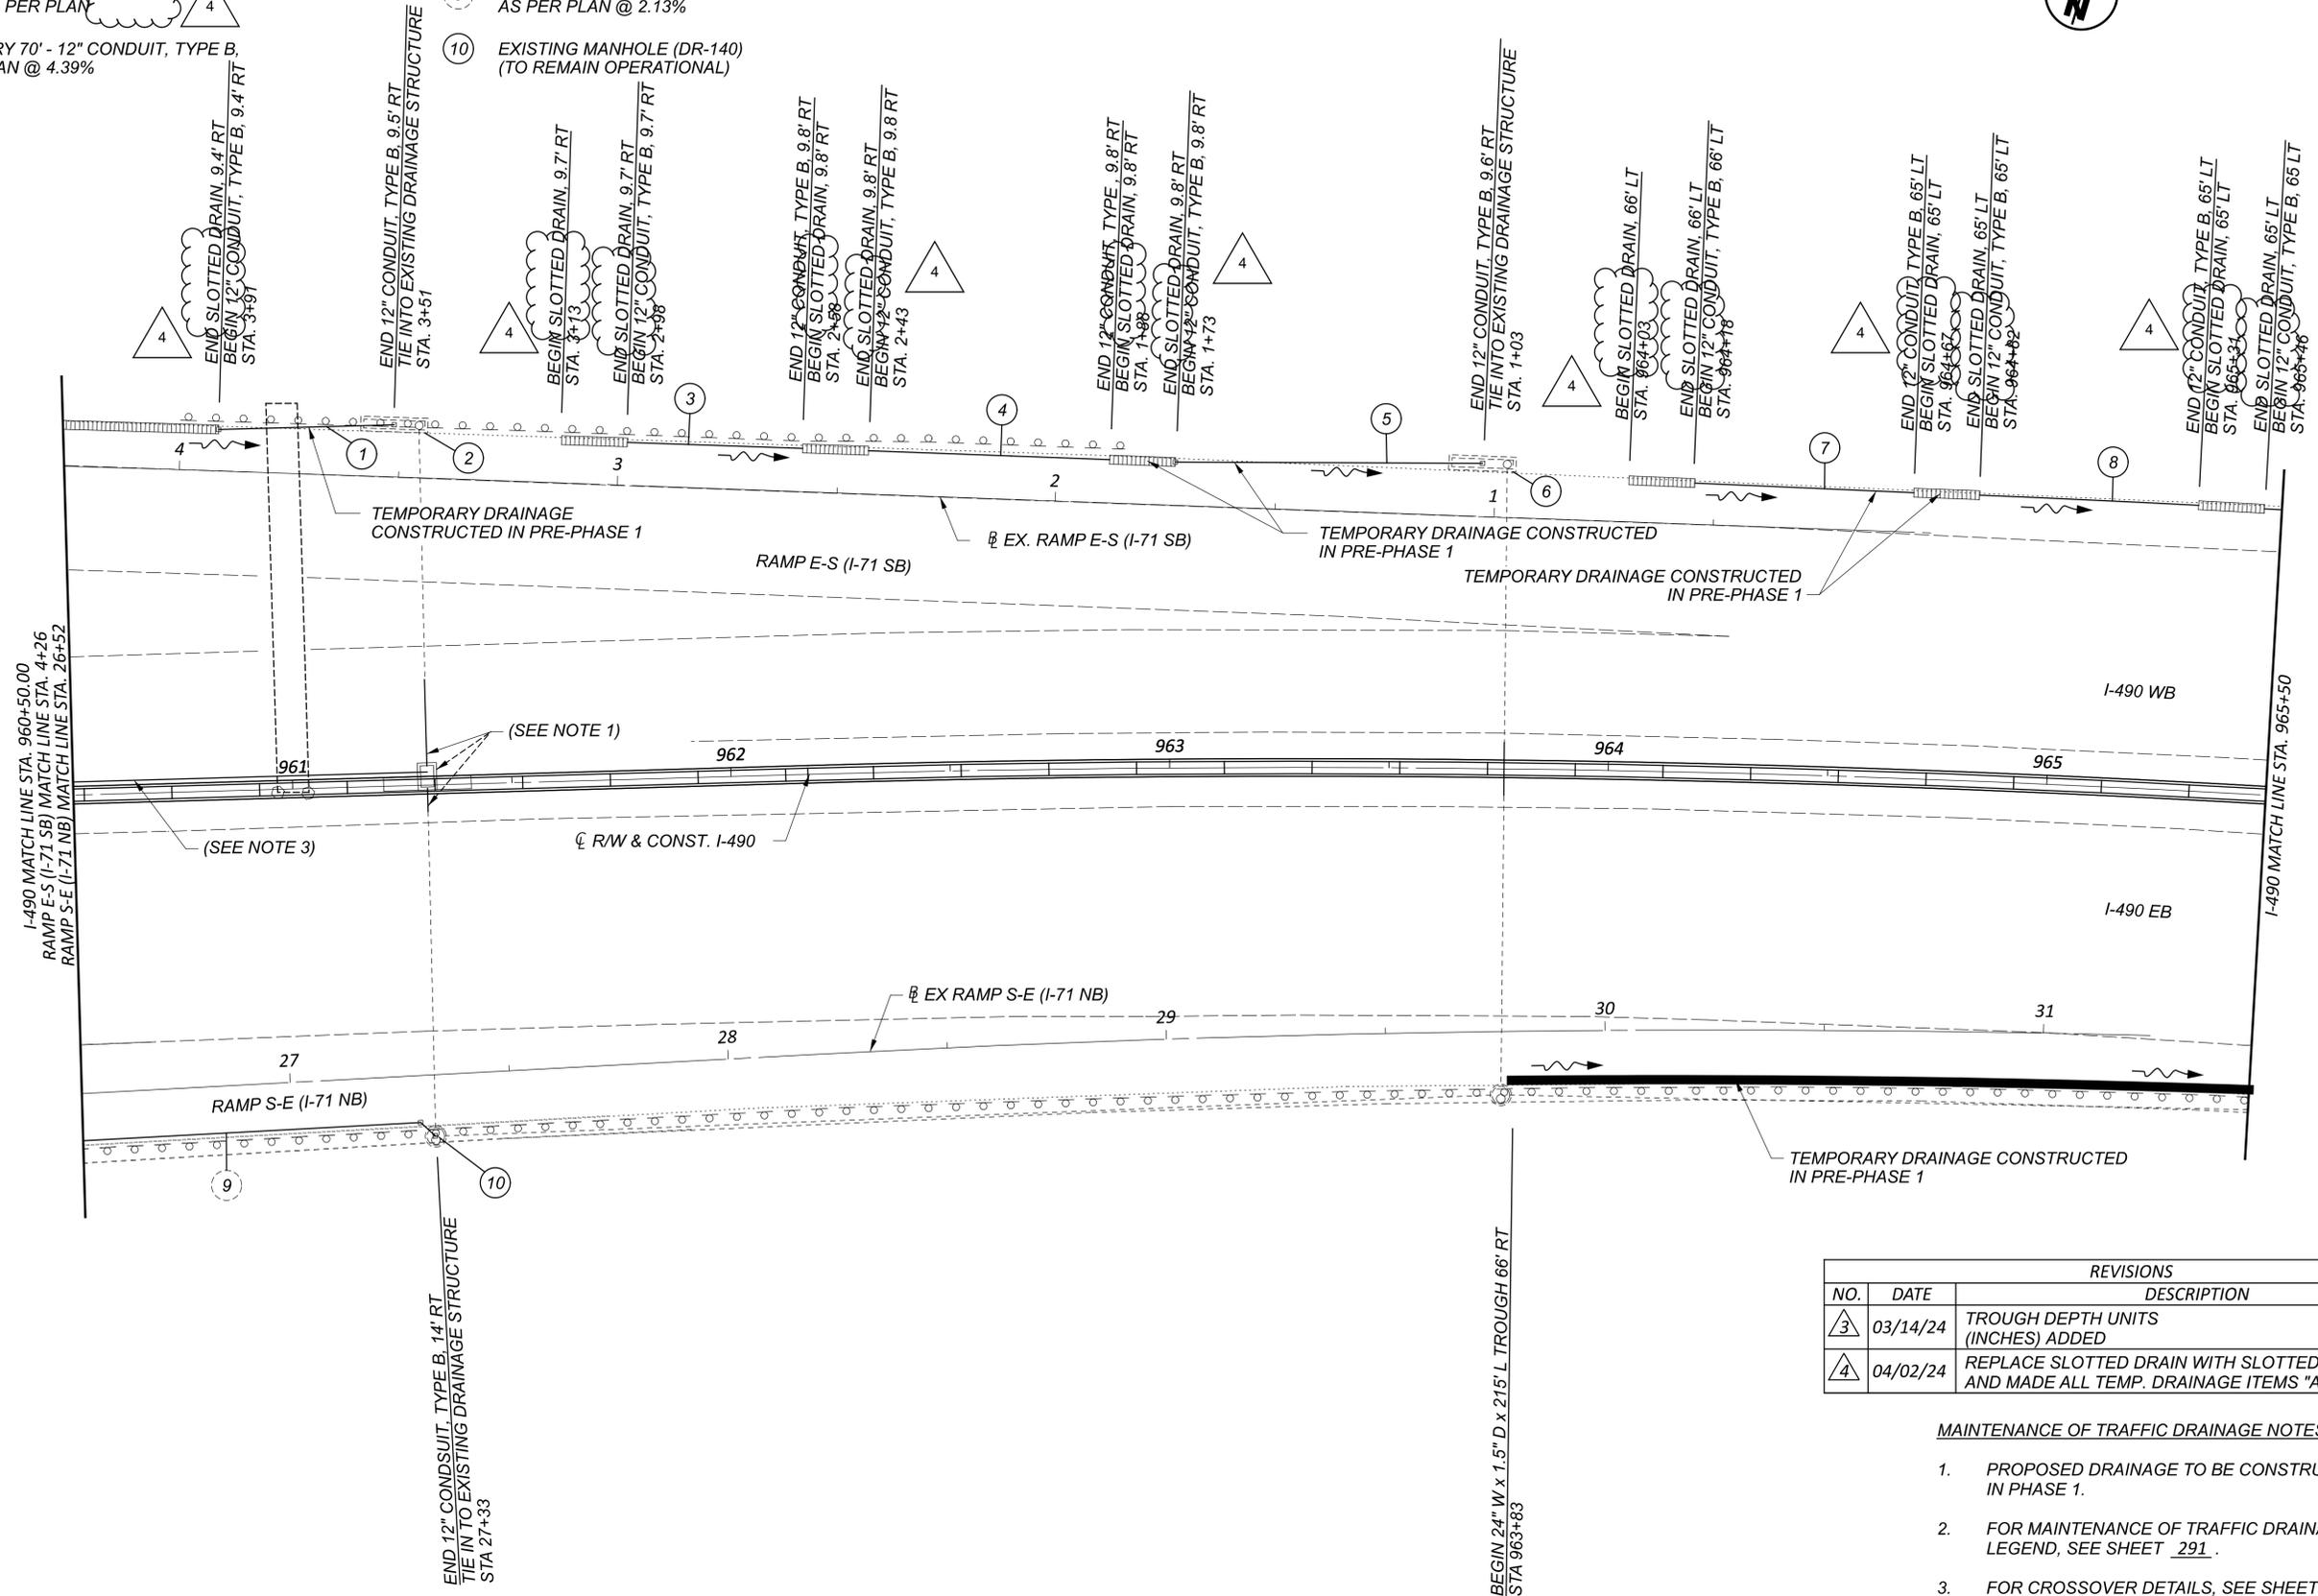

REVISIONS		
NO.	DATE	DESCRIPTION
③	03/14/24	TROUGH DEPTH UNITS (INCHES) ADDED
④	04/02/24	REPLACE SLOTTED DRAIN WITH SLOTTED DRAIN AND MADE ALL TEMP. DRAINAGE ITEMS "AS PER PLAN"

- MAINTENANCE OF TRAFFIC DRAINAGE NOTES:**
- PROPOSED DRAINAGE TO BE CONSTRUCTED IN PHASE 1.
  - FOR MAINTENANCE OF TRAFFIC DRAINAGE LEGEND, SEE SHEET 291.
  - FOR CROSSOVER DETAILS, SEE SHEETS 287 - 288.

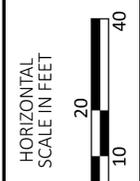

**MAINTENANCE OF TRAFFIC - TEMPORARY DRAINAGE - PRE-PHASE 1 & PHASE 1**  
 I-490 - STA. 960+50 TO STA. 965+50

DESIGN AGENCY	
DESIGNER	KRM
REVIEWER	AKF 11-21-23
PROJECT ID	107408
SHEET	297
TOTAL	1068



- ① TEMPORARY 50' - 12" CONDUIT, TYPE B, AS PER PLAN
- ② TEMPORARY 50' - 12" CONDUIT, TYPE B, AS PER PLAN
- ③ TEMPORARY 50' - 12" CONDUIT, TYPE B, AS PER PLAN
- ④ TEMPORARY 55' - 12" CONDUIT, TYPE B, AS PER PLAN @ 6.43%
- ⑤ EXISTING INLET (DR-200) (TO REMAIN OPERATIONAL)



END 24" W x 1.5" D x 215' L TROUGH 66' RT  
 STA 965+98

- ⑥ TEMPORARY 40' - 12" CONDUIT, TYPE B, AS PER PLAN @ 5.48%
- ⑦ EXISTING INLET (DR-83) (TO REMAIN OPERATIONAL)
- ⑧ TEMPORARY 20' - 12" CONDUIT, TYPE B, AS PER PLAN @ 12.08%
- ⑨ EXISTING INLET (DR-143) (TO REMAIN OPERATIONAL)
- ⑩ TEMPORARY 20' - 12" CONDUIT, TYPE B, AS PER PLAN @ 12.22%

BEGIN 24" W x 1.5" D x 40' L TROUGH 66' RT  
 STA 967+57

END 24" W x 1.5" D x 40' L TROUGH 66' RT  
 STA 967+97



BEGIN 24" W x 1.5" D x 30' L TROUGH 66' RT  
 STA 969+19

END 24" W x 1.5" D x 30' L TROUGH 66' RT  
 STA 969+49

REVISIONS		
NO.	DATE	DESCRIPTION
③	03/14/24	TROUGH DEPTH UNITS (INCHES) ADDED
④	04/02/24	REPLACE SLOTTED DRAIN WITH SLOTTED DRAIN AND MADE ALL TEMP. DRAINAGE ITEMS "AS PER PLAN"

**MAINTENANCE OF TRAFFIC DRAINAGE NOTES:**


1. PROPOSED DRAINAGE TO BE CONSTRUCTED IN PHASE 1.
2. FOR MAINTENANCE OF TRAFFIC DRAINAGE LEGEND, SEE SHEET 291.

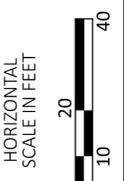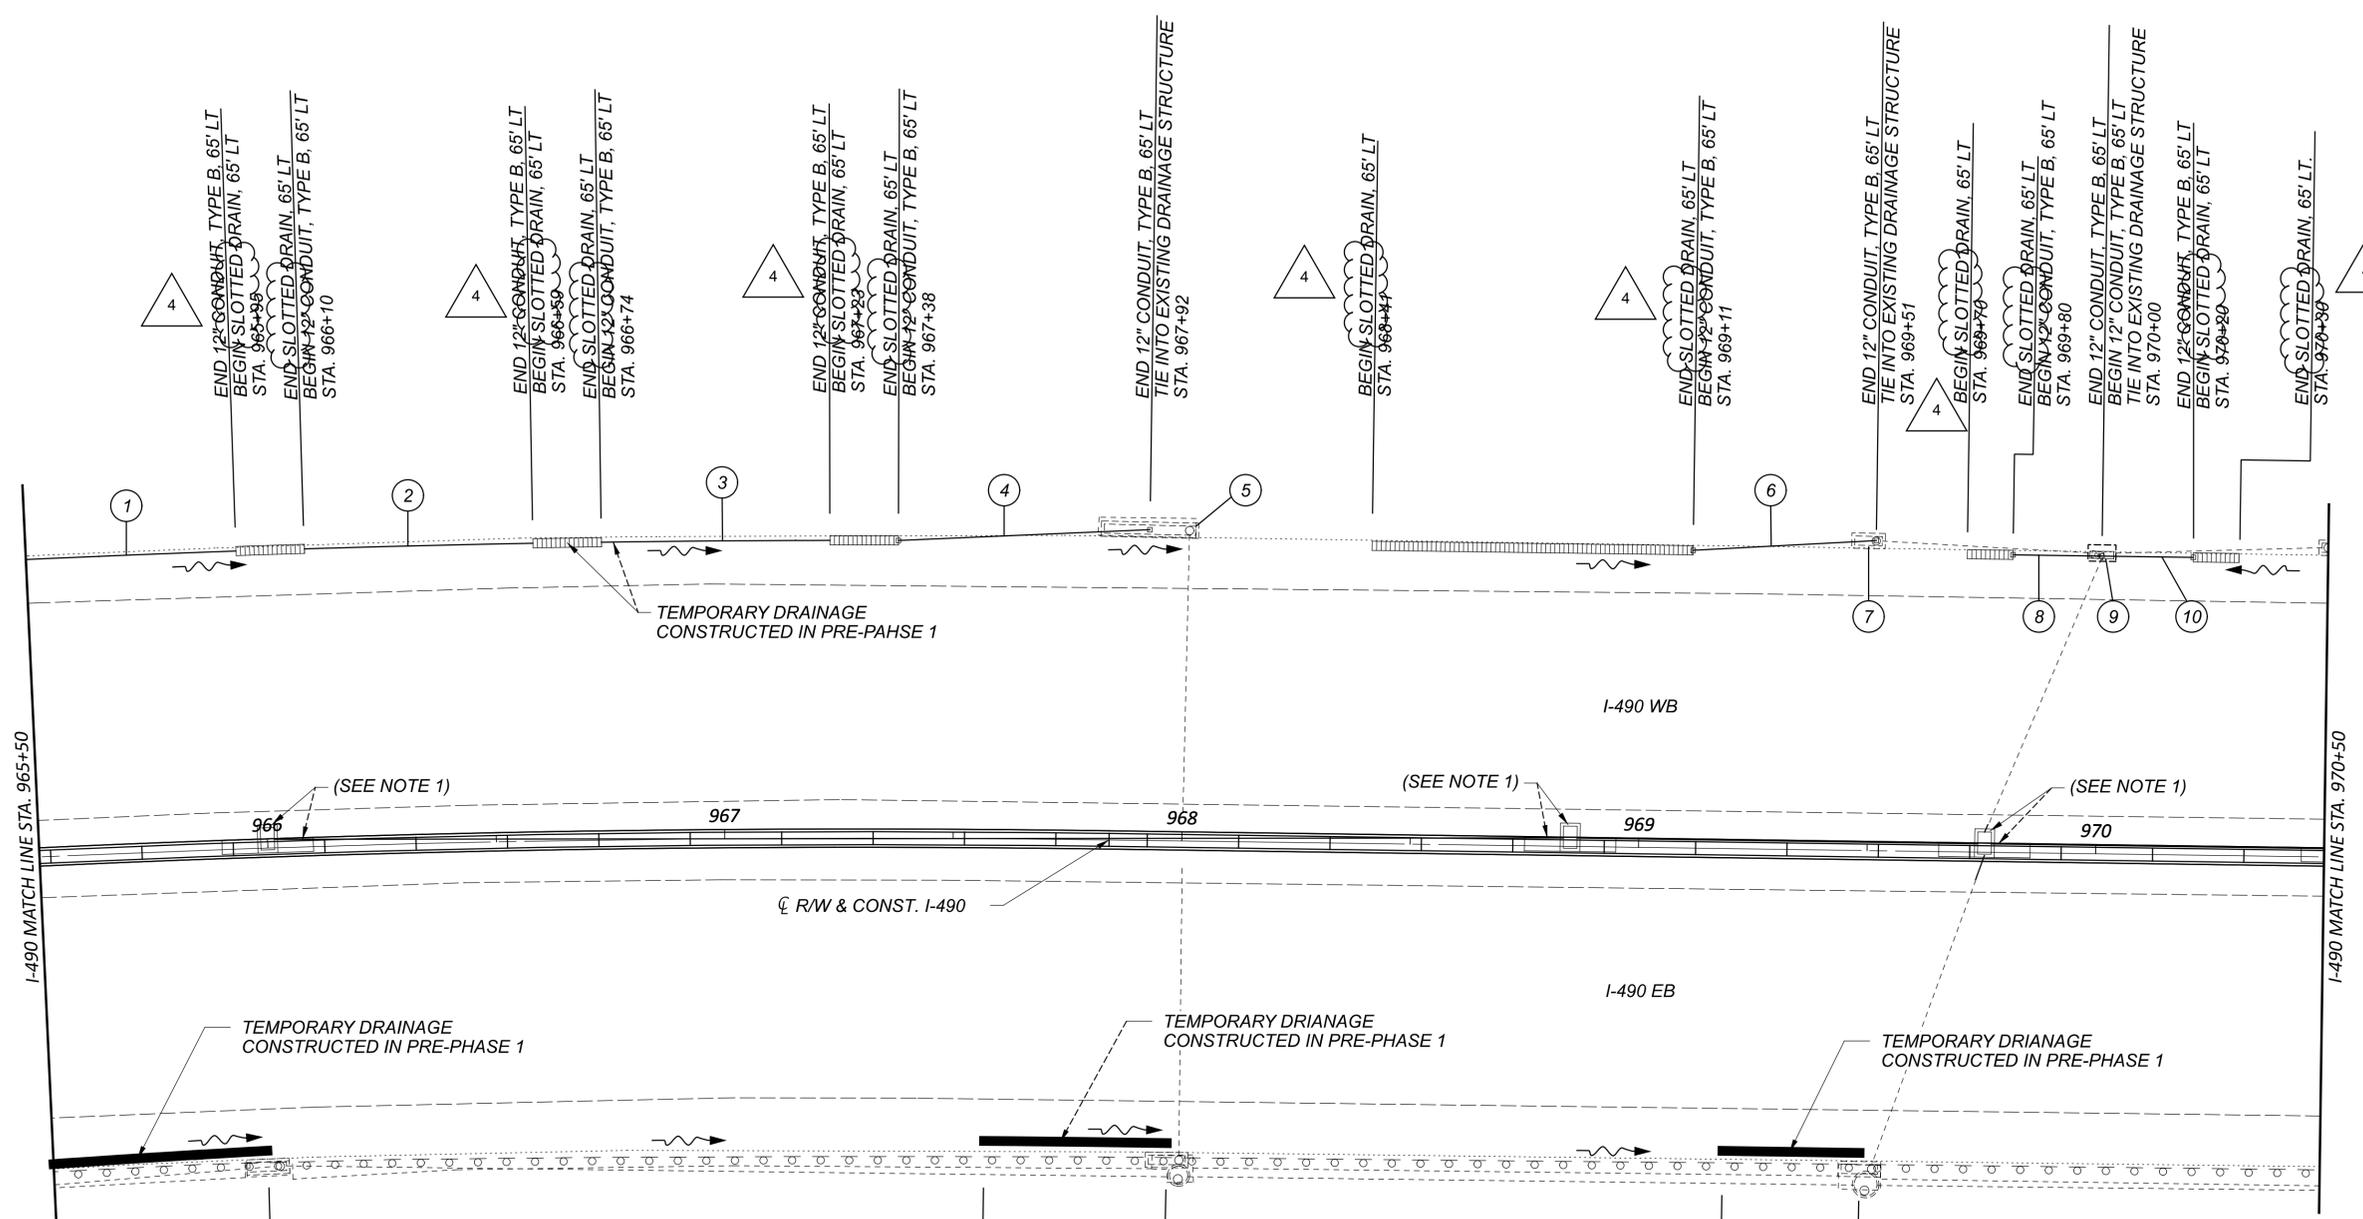

**MAINTENANCE OF TRAFFIC - TEMPORARY DRAINAGE - PRE-PHASE 1 & PHASE 1**  
 I-490 - STA. 965+50 TO STA. 970+50

DESIGN AGENCY	
DESIGNER	KRM
REVIEWER	AKF 11-21-23
PROJECT ID	107408
SHEET	298
TOTAL	1068


- ① EXISTING INLET (DR-84)  
(TO REMAIN OPERATIONAL)
- ② TEMPORARY 40' - 12" CONDUIT, TYPE B,  
AS PER PLAN @ 5.50%
- ③ EXISTING INLET (DR- 86)  
(TO REMAIN OPERATIONAL)
- ④ TEMPORARY 50' 12" CONDUIT TYPE B,  
AS PER PLAN @ 5.77%

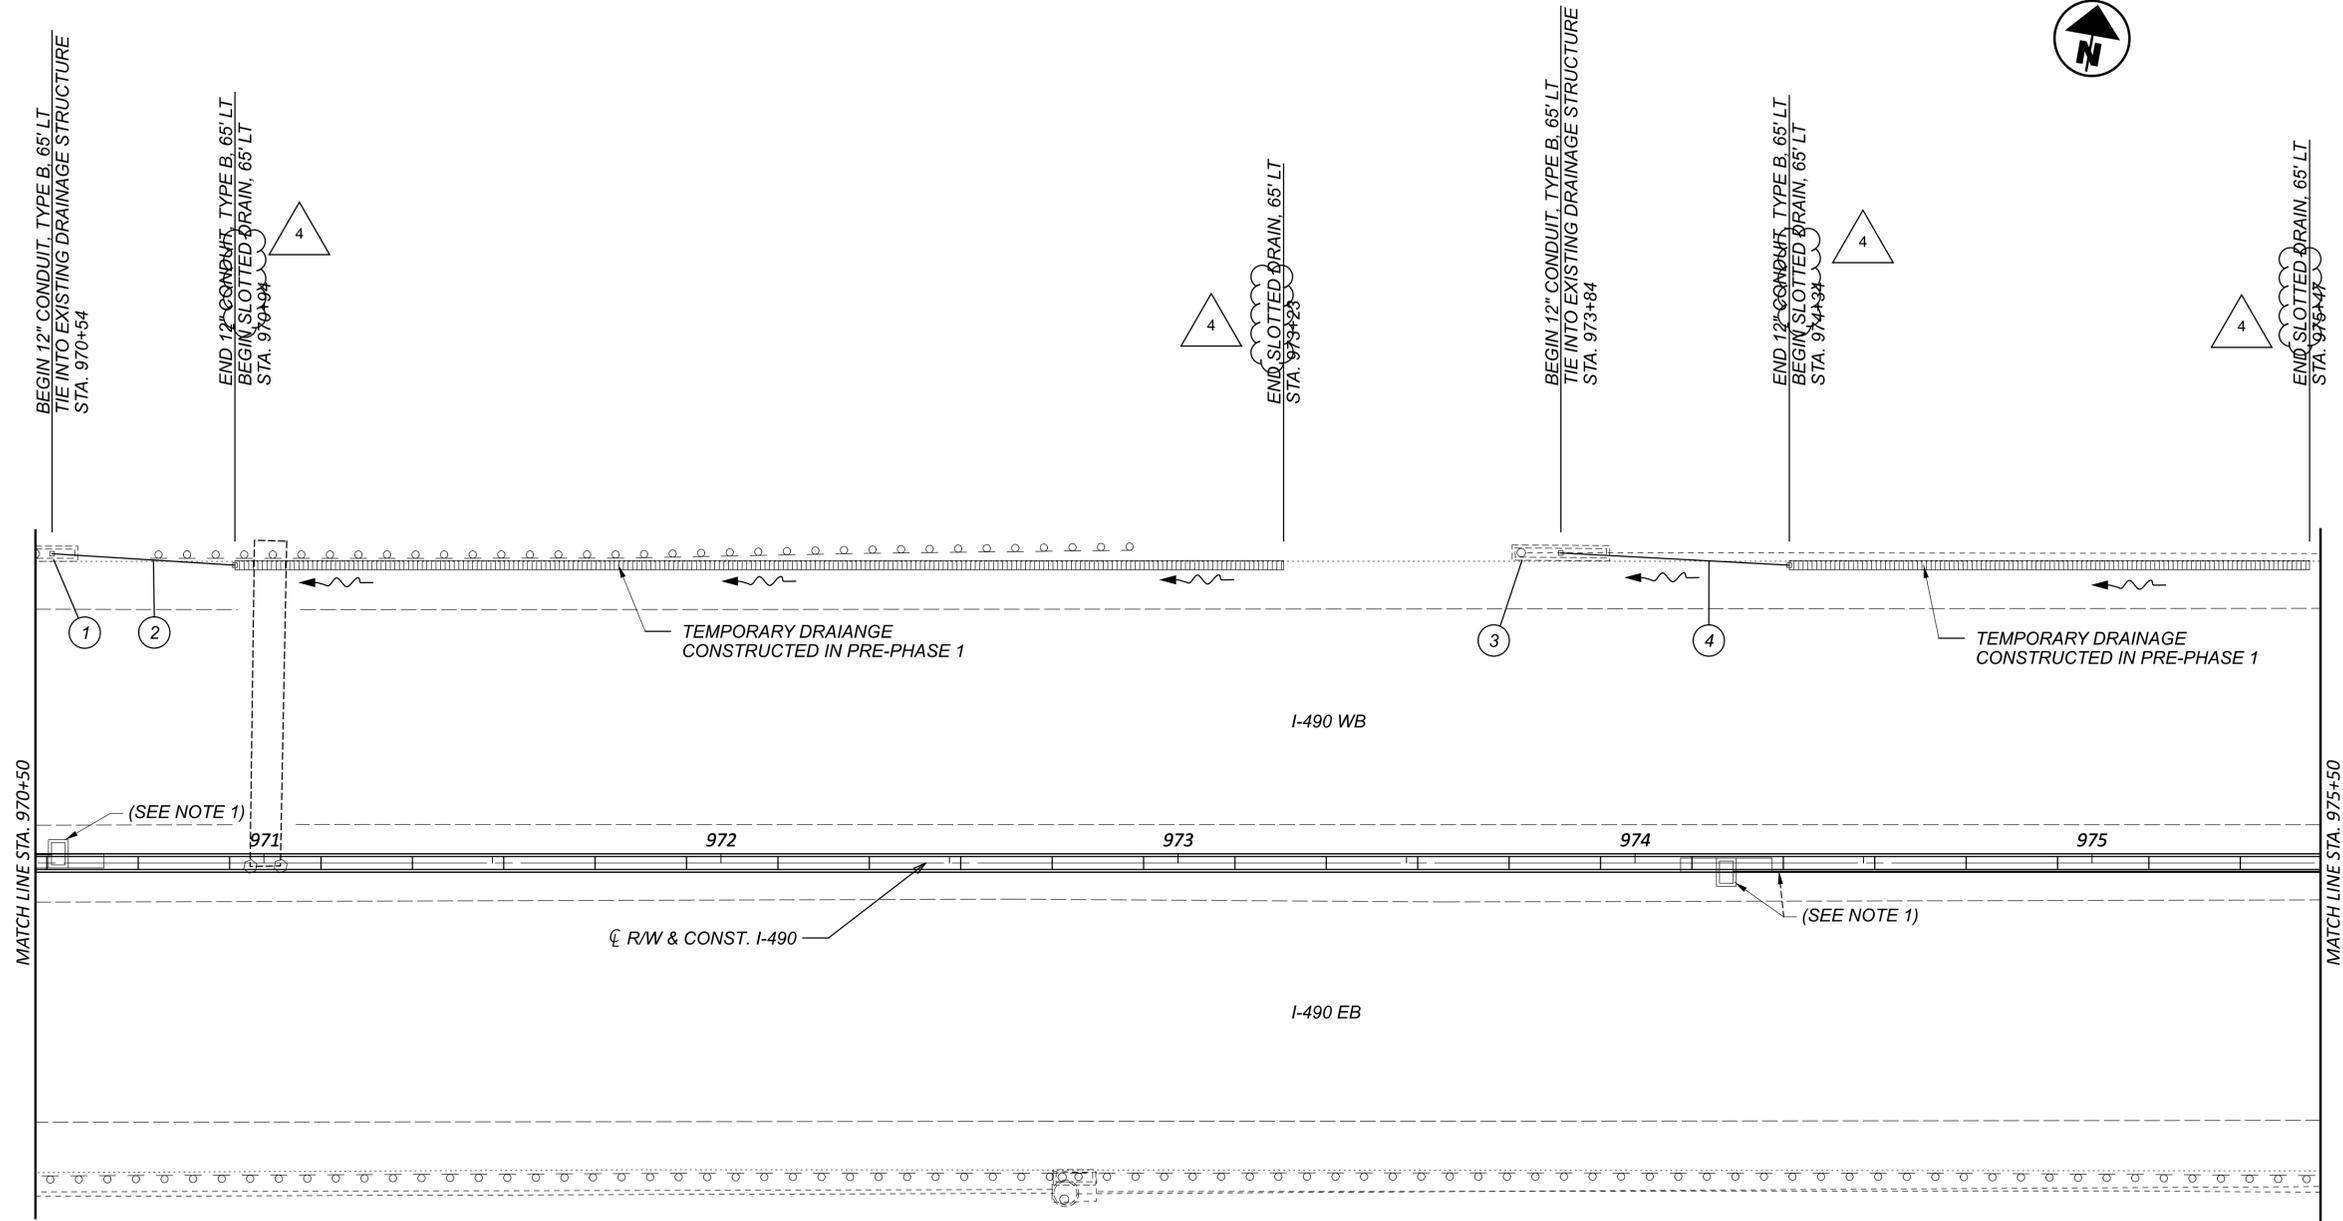

REVISIONS		
NO.	DATE	DESCRIPTION
④	04/02/24	REPLACE SLOTTED DRAIN WITH SLOTTED DRAIN AND MADE ALL TEMP. DRAINAGE ITEMS "AS PER PLAN"

**MAINTENANCE OF TRAFFIC DRAINAGE NOTES:**

1. PROPOSED DRAINAGE TO BE CONSTRUCTED IN PHASE 1.
2. FOR MAINTENANCE OF TRAFFIC DRAINAGE LEGEND, SEE SHEET 291.

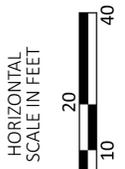

**MAINTENANCE OF TRAFFIC - TEMPORARY DRAINAGE - PRE-PHASE 1 & PHASE 1**  
**I-490 - STA. 970+50 TO STA. 975+50**

DESIGN AGENCY




DESIGNER  
KRM

REVIEWER  
AKF 11-21-23

PROJECT ID  
107408

SHEET	TOTAL
299	1068


- ① EXISTING INLET (DR-87)  
(TO REMAIN OPERATIONAL)
- ② TEMPORARY 45' - 12" CONDUIT, TYPE B,  
AS PER PLAN @ 5.78%
- ③ EXISTING INLET (DR- 88)  
(TO REMAIN OPERATIONAL)
- ④ TEMPORARY 26' - 12" CONDUIT TYPE B,  
AS PER PLAN @ 9.58%

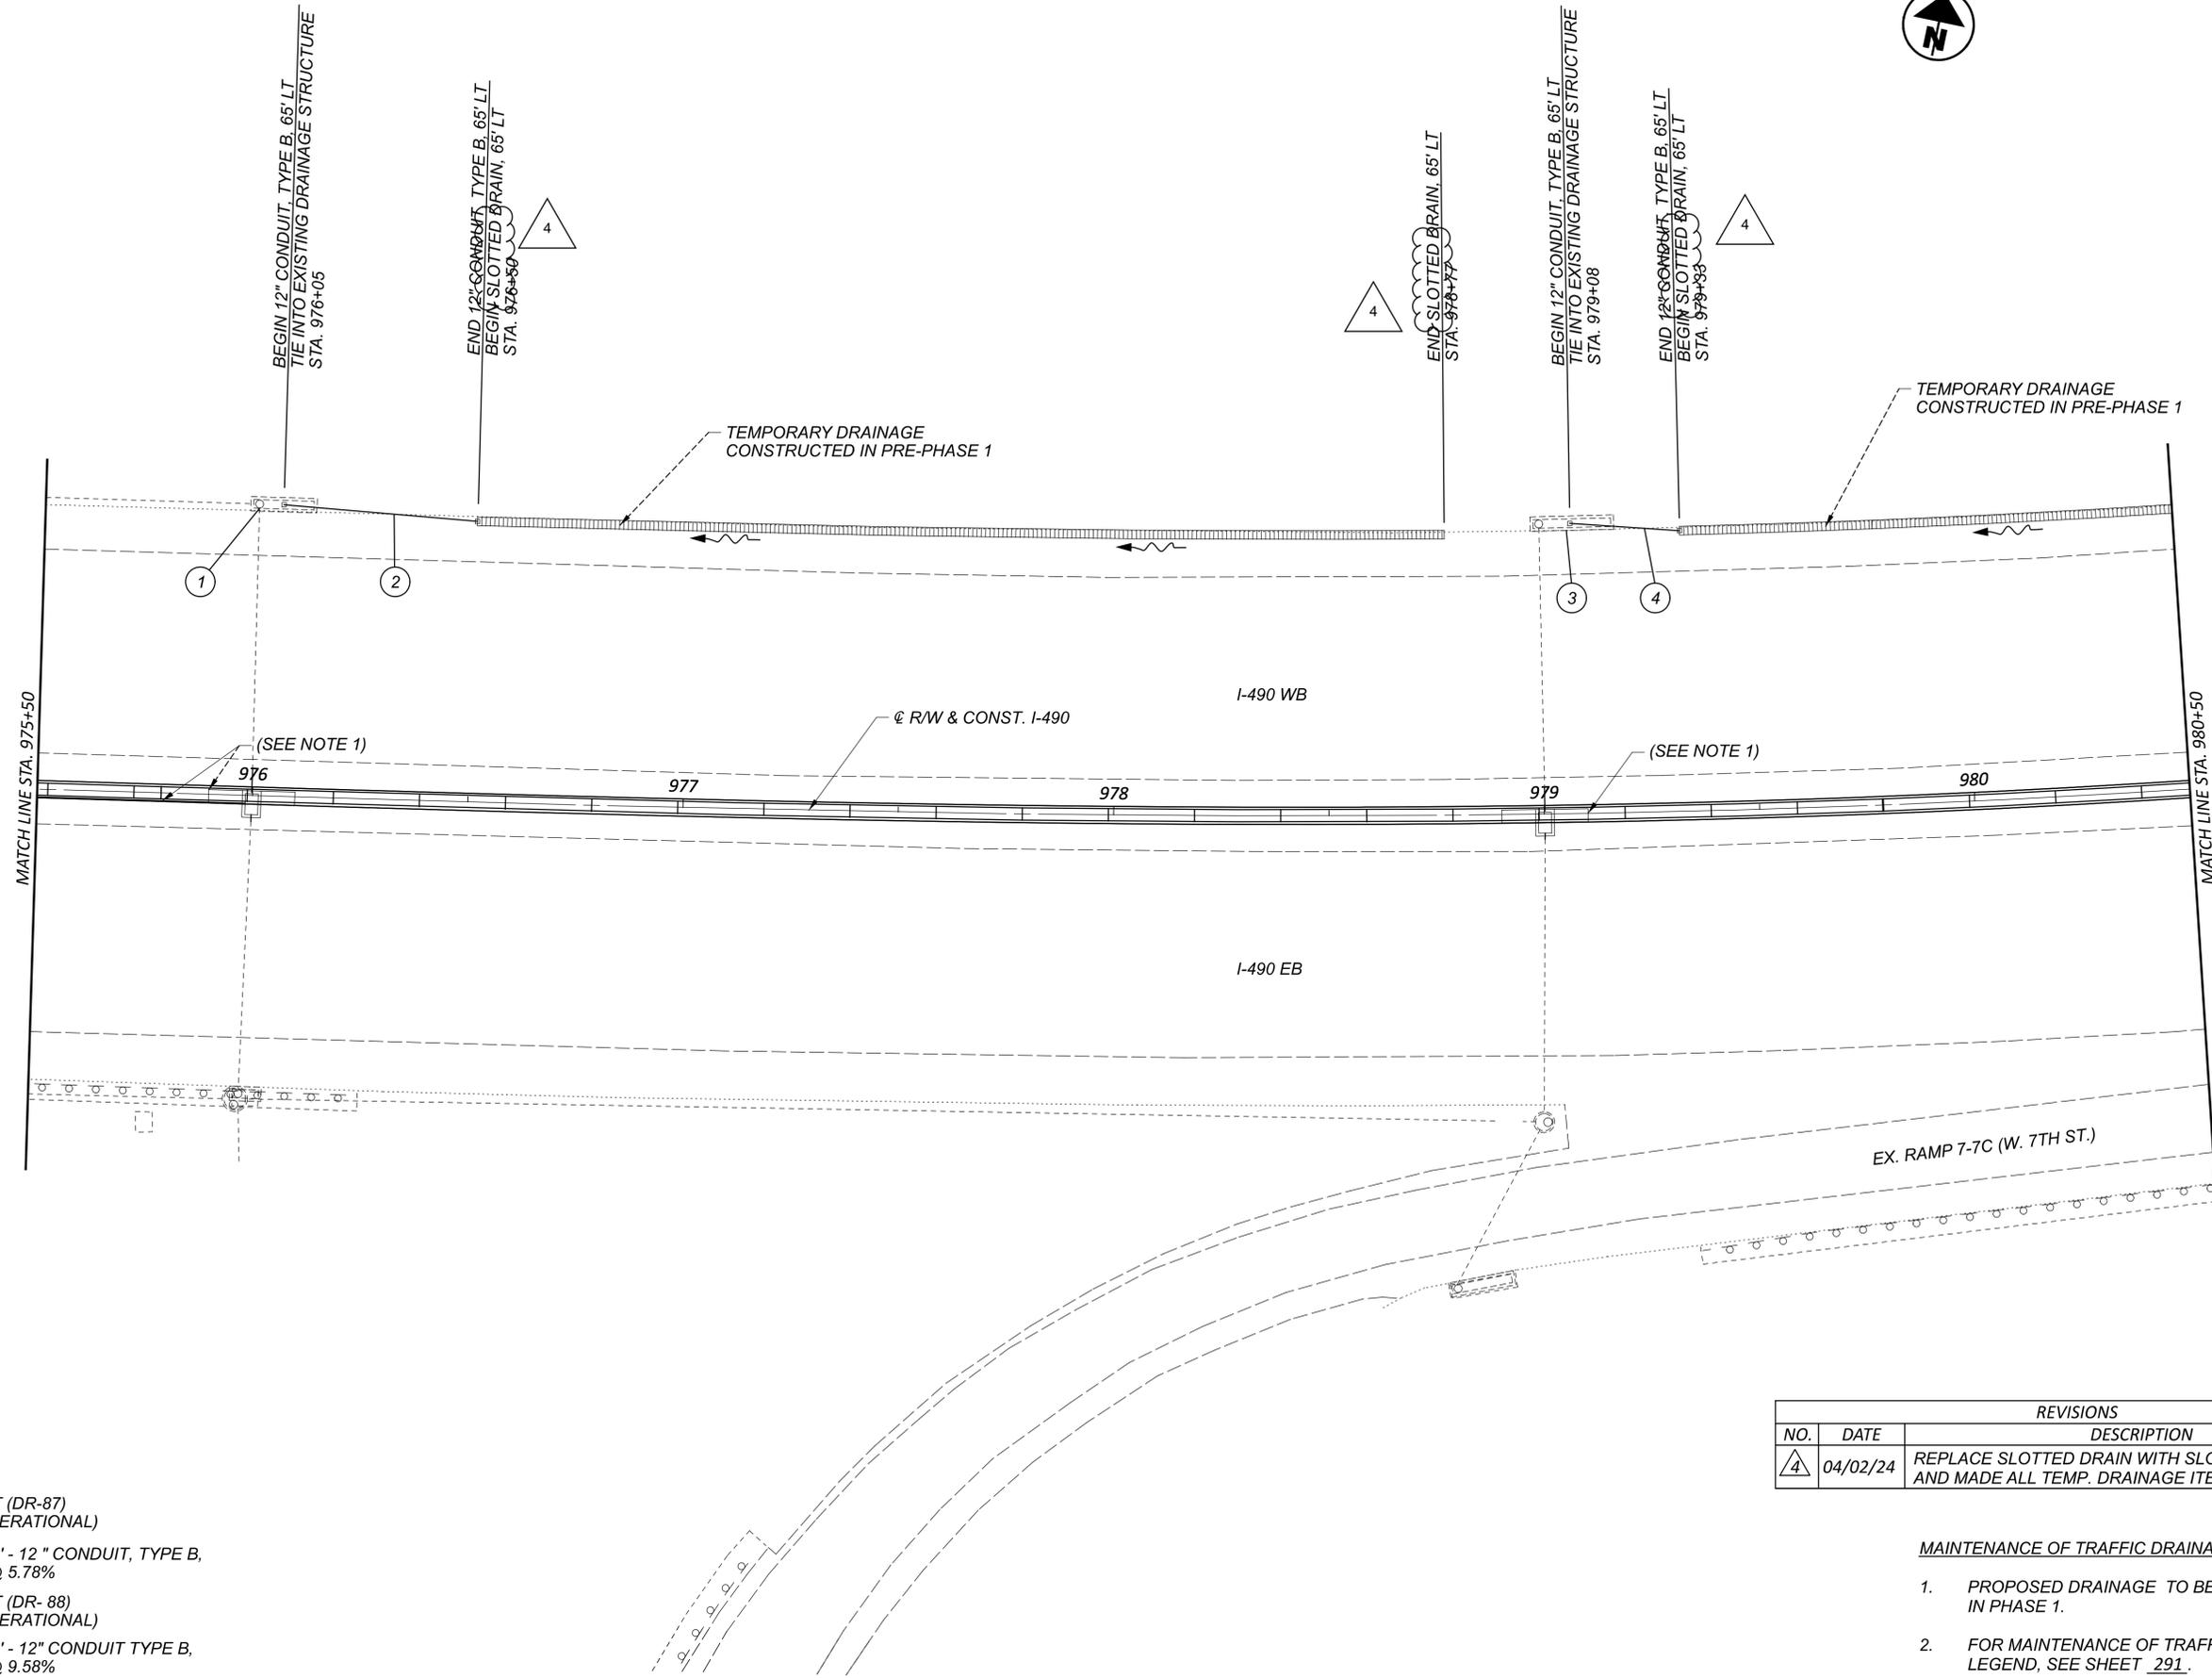

REVISIONS		
NO.	DATE	DESCRIPTION
④	04/02/24	REPLACE SLOTTED DRAIN WITH SLOTTED DRAIN AND MADE ALL TEMP. DRAINAGE ITEMS "AS PER PLAN"

**MAINTENANCE OF TRAFFIC DRAINAGE NOTES:**

1. PROPOSED DRAINAGE TO BE CONSTRUCTED IN PHASE 1.
2. FOR MAINTENANCE OF TRAFFIC DRAINAGE LEGEND, SEE SHEET 291.

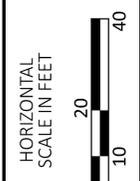


**MAINTENANCE OF TRAFFIC - TEMPORARY DRAINAGE - PRE-PHASE 1 & PHASE 1**  
 I-490 - STA. 975+50 TO STA. 980+50

DESIGN AGENCY




DESIGNER	KRM
REVIEWER	AKF 11-21-23
PROJECT ID	107408
SHEET	300
TOTAL	1068

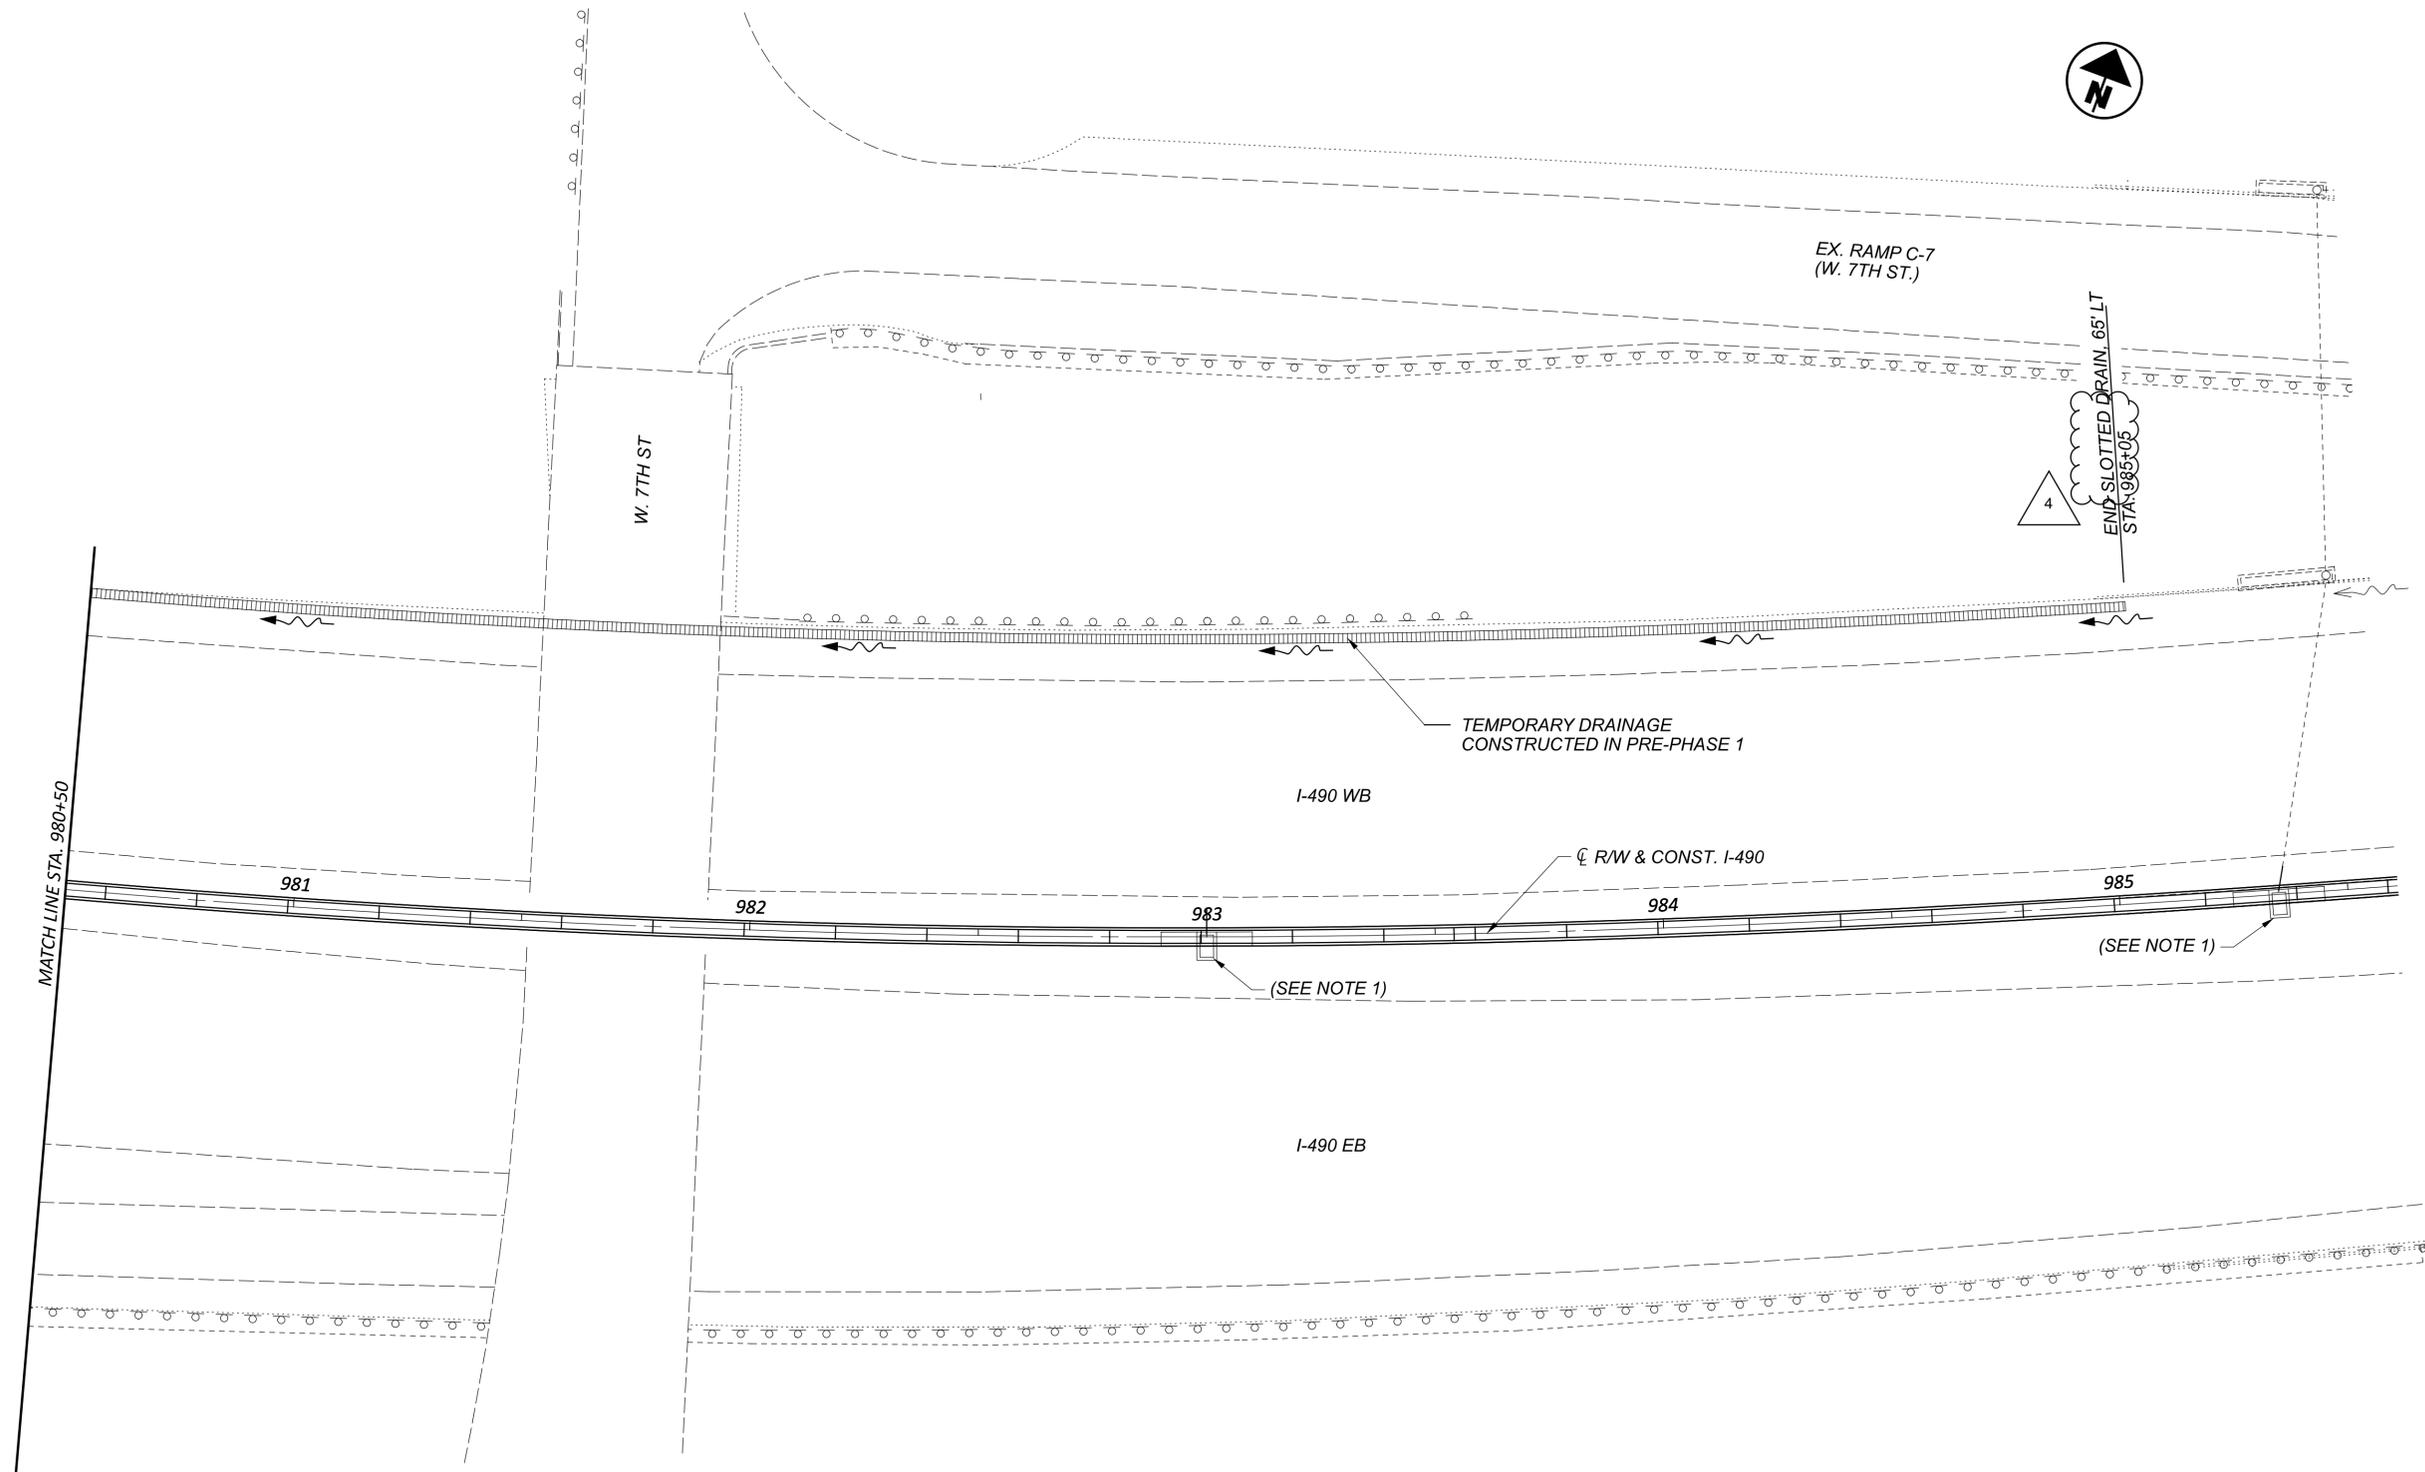

REVISIONS		
NO.	DATE	DESCRIPTION
4	04/02/24	REPLACE SLOTTED DRAIN WITH SLOTTED DRAIN AND MADE ALL TEMP. DRAINAGE ITEMS "AS PER PLAN"

**MAINTENANCE OF TRAFFIC DRAINAGE NOTES:**

1. PROPOSED DRAINAGE TO BE CONSTRUCTED IN PHASE 1.
2. FOR MAINTENANCE OF TRAFFIC DRAINAGE LEGEND, SEE SHEET 291.

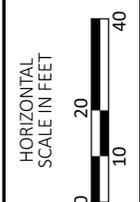

**MAINTENANCE OF TRAFFIC - TEMPORARY DRAINAGE - PRE-PHASE 1 & PHASE 1**  
 I-490 - STA. 980+50 TO STA. 985+50

DESIGN AGENCY




DESIGNER  
KRM

REVIEWER  
AKF 11-21-23

PROJECT ID  
107408

SHEET	TOTAL
301	1068

- ① TEMPORARY 65' -12" CONDUIT, TYPE B, AS PER PLAN
- ② TEMPORARY 65' -12" CONDUIT, TYPE B, AS PER PLAN
- ③ TEMPORARY 65' -12" CONDUIT, TYPE B, AS PER PLAN
- ④ TEMPORARY 80' -12" CONDUIT, TYPE B AS PER PLAN @ 5.43%
- ⑤ EXISTING INLET (DR-66) (TO REMAIN OPERATIONAL)

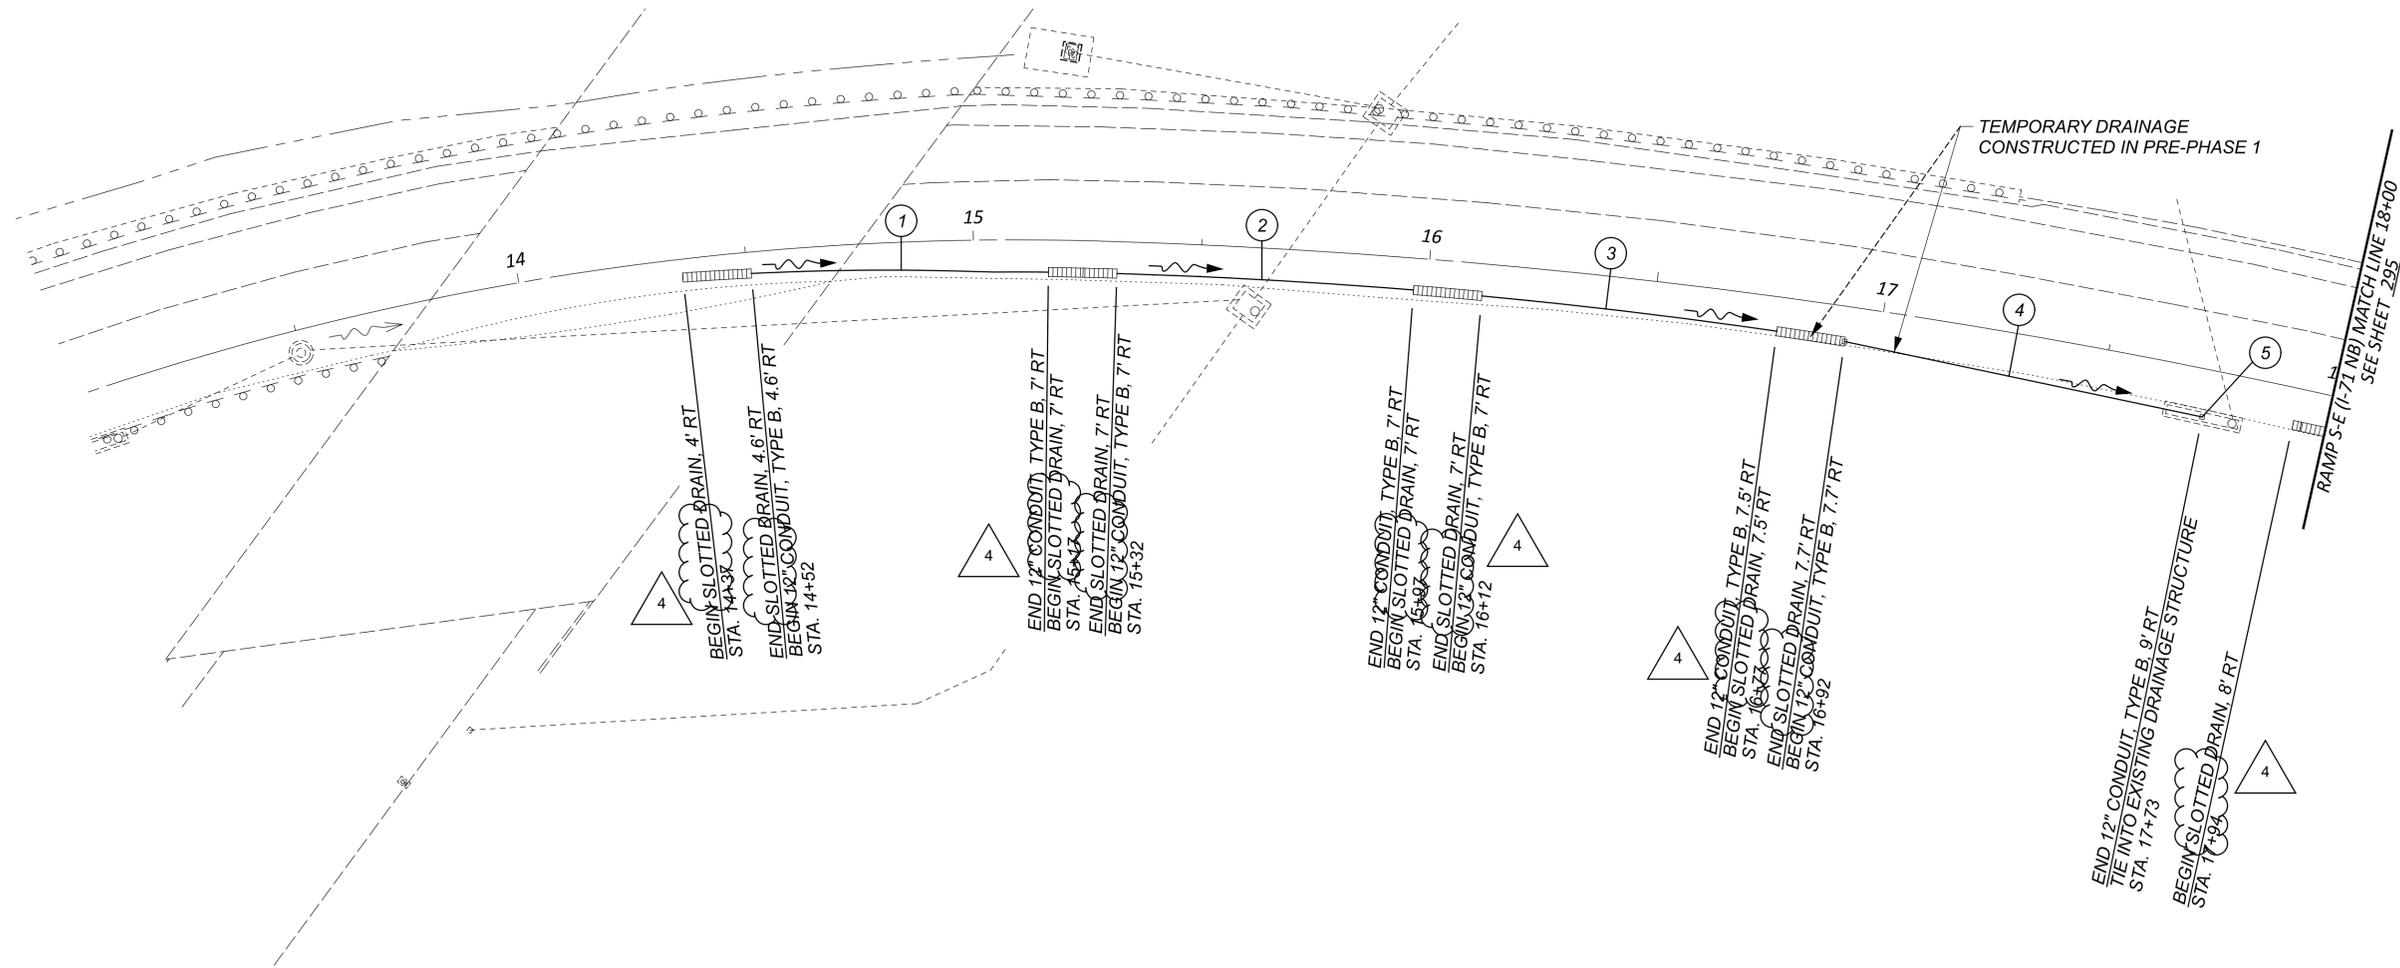

REVISIONS		
NO.	DATE	DESCRIPTION
④	04/02/24	REPLACE SLOTTED DRAIN WITH SLOTTED DRAIN AND MADE ALL TEMP. DRAINAGE ITEMS "AS PER PLAN"

**MAINTENANCE OF TRAFFIC DRAINAGE NOTES:**



1. PROPOSED DRAINAGE TO BE CONSTRUCTED IN PHASE 1.
2. FOR MAINTENANCE OF TRAFFIC DRAINAGE LEGEND, SEE SHEET 291.

**MAINTENANCE OF TRAFFIC - TEMPORARY DRAINAGE - PRE-PHASE 1 & PHASE 1  
 RAMP S-E (I-71 NB) - BEGIN TO STA. 18+00**

DESIGN AGENCY



DESIGNER  
**KRM**  
 REVIEWER  
**AKF 11-21-23**  
 PROJECT ID  
**107408**  
 SHEET TOTAL  
**302 1068**

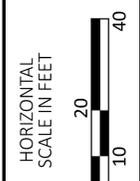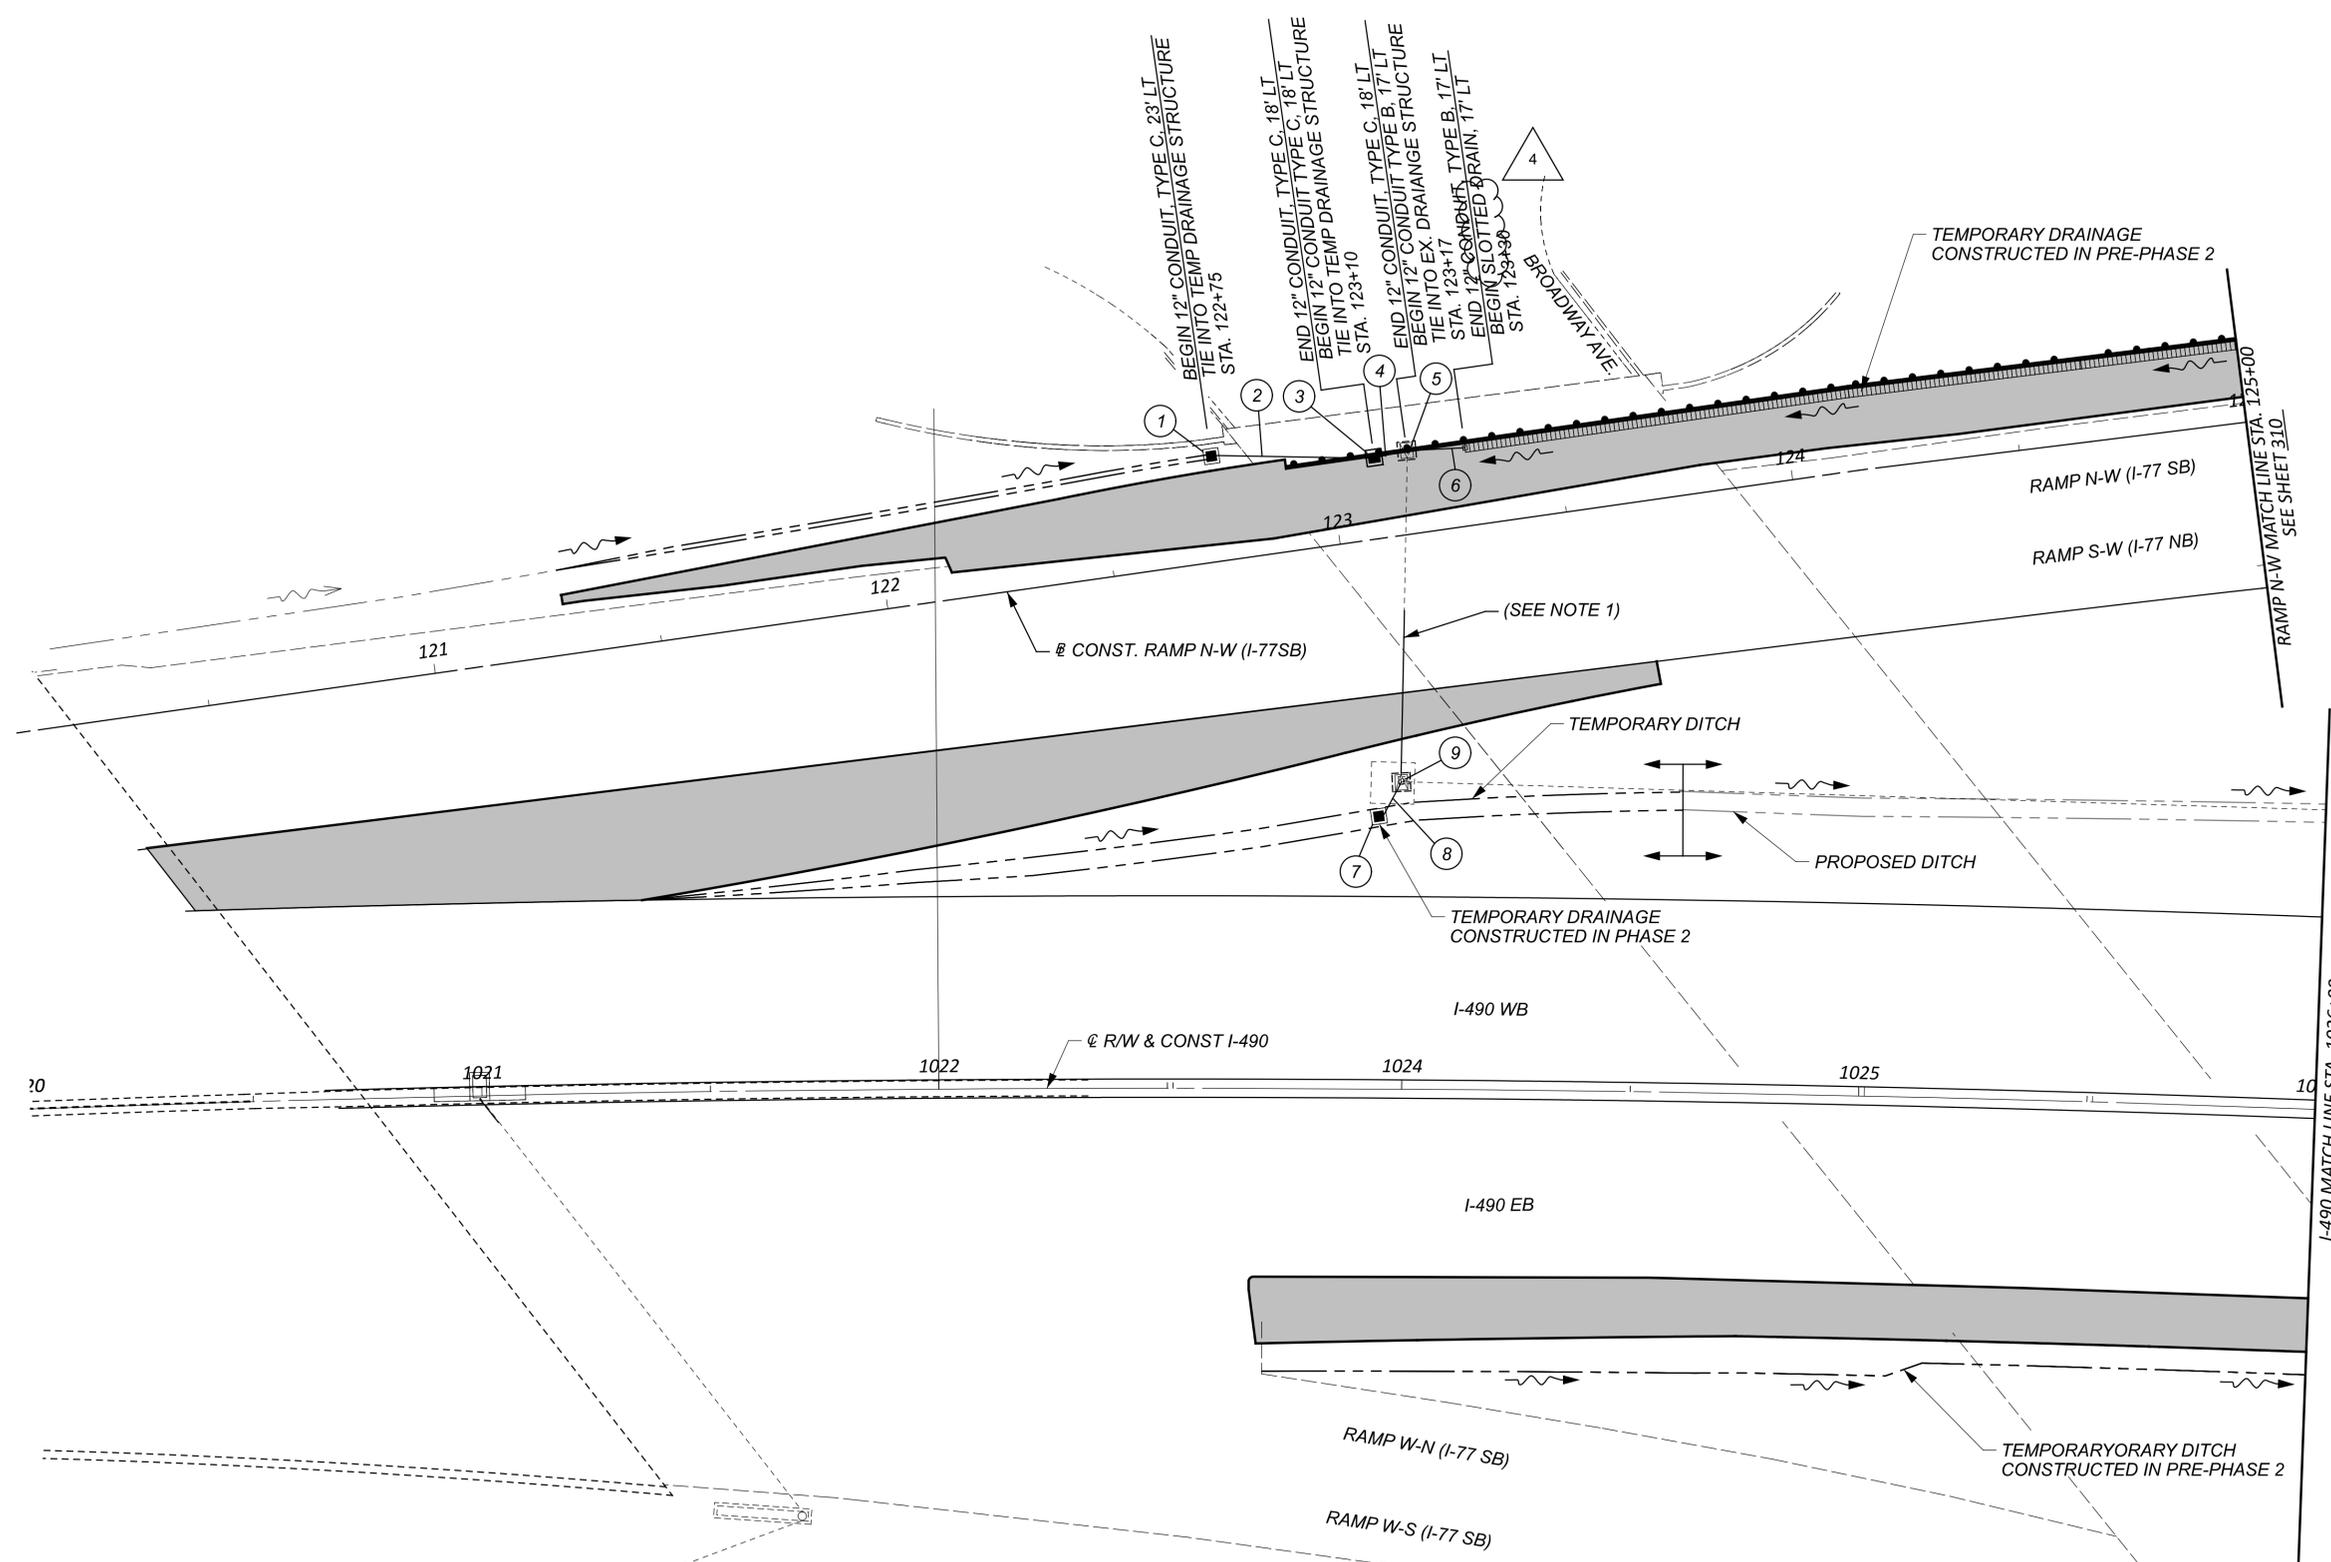

- ① TEMPORARY CB-2-2B STA. 122+75, 23' LT (@ CONST. RAMP N-W (I-77 SB))
- ② TEMPORARY 24" - 12" CONDUIT TYPE C AS PER PLAN @ 4.11%
- ③ TEMPORARY CB-3A STA. 123+10, 18' LT (@ CONST. RAMP N-W (I-77 SB))
- ④ TEMPORARY 6" - 12" CONDUIT TYPE C AS PER PLAN @ 2.00%
- ⑤ EXISTING INLET (DR-115) (TO BE PLATED IN PRE-PHASE 2)
- ⑥ TEMPORARY 13" - 12" CONDUIT, TYPE B AS PER PLAN @ 18.44%
- ⑦ TEMPORARY CB-2-2B STA. 123+00, 60' RT (@ CONST RAMP N-W (I-77 SB))
- ⑧ TEMPORARY 8" - 12" CONDUIT TYPE C AS PER PLAN @ 6.16%
- ⑨ EXISTING INLET (DJ-106) (TO BE PLATED IN PHASE 2)

REVISIONS		
NO.	DATE	DESCRIPTION
④	04/02/24	REPLACE SLOTTED DRAIN WITH SLOTTED DRAIN AND MADE ALL TEMP. DRAINAGE ITEMS "AS PER PLAN"

- MAINTENANCE OF TRAFFIC DRAINAGE NOTES:**
- PROPOSED DRAINAGE TO BE CONSTRUCTED PRIOR TO PHASE 2 AND PRE-PHASE 2.
  - FOR MAINTENANCE OF TRAFFIC DRAINAGE LEGEND, SEE SHEET 291.

MAINTENANCE OF TRAFFIC - TEMPORARY DRAINAGE - PRE-PHASE 2 & PHASE 2  
 I-490 BEGIN TO 1026+00

DESIGN AGENCY  
  
 DESIGNER  
 KRM  
 REVIEWER  
 AKF 11-21-23  
 PROJECT ID  
 107408  
 SHEET TOTAL  
 303 1068


- ① TEMPORARY CB-2-2B  
STA. 128+50, 26' LT  
(@ CONST. RAMP N-W (I-77SB))
- ② TEMPORARY 8" x 12" CONDUIT  
TYPE C AS PER PLAN @ 6.35%
- ③ EXISTING INLET (DR-116)  
(TO BE PLATED IN PRE-PHASE 2)
- ④ EXISTING INLET (EX-11)  
(TO REMAIN OPERATIONAL)



REVISIONS		
NO.	DATE	DESCRIPTION
④	04/02/24	REPLACE SLOTTED DRAIN WITH SLOTTED DRAIN AND MADE ALL TEMP. DRAINAGE ITEMS "AS PER PLAN"

**MAINTENANCE OF TRAFFIC DRAINAGE NOTES:**

1. PROPOSED DRAINAGE TO BE CONSTRUCTED PRIOR TO PHASE 2 AND PRE-PHASE 2.
2. FOR MAINTENANCE OF TRAFFIC DRAINAGE LEGEND, SEE SHEET 291.

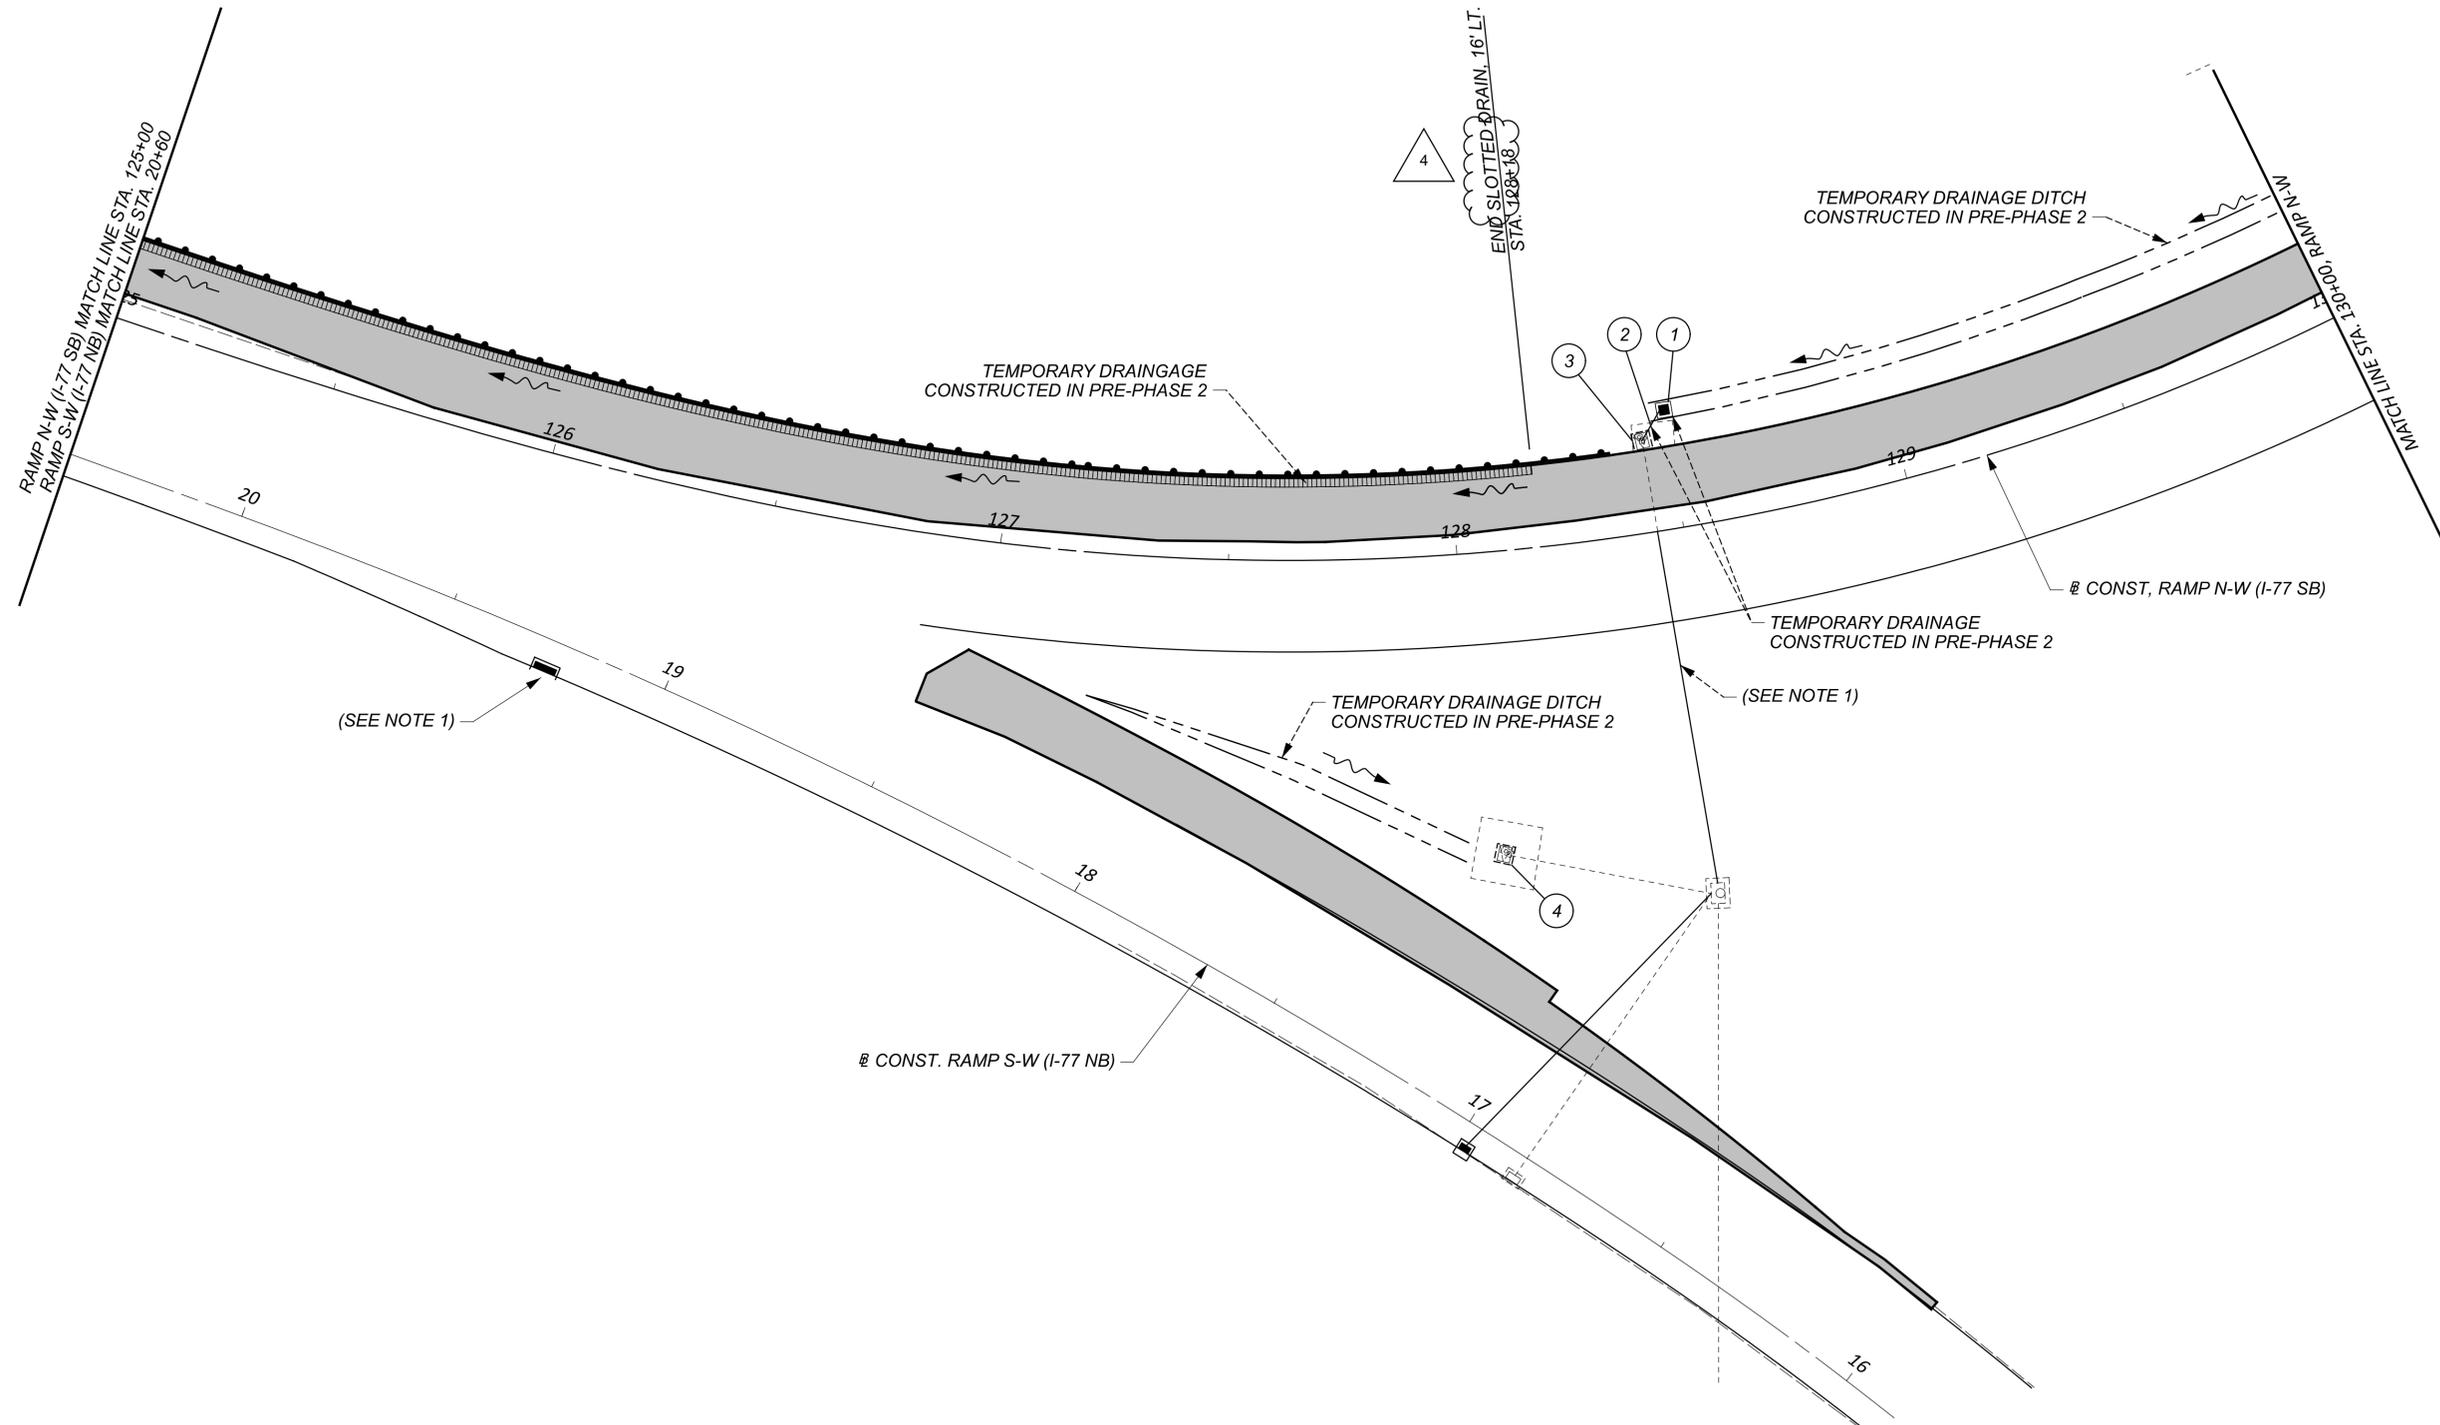

**MAINTENANCE OF TRAFFIC - TEMPORARY DRAINAGE - PRE-PHASE 2  
 RAMP N-W (I-77) STA. 125+00 TO STA. 130+00**



DESIGN AGENCY



DESIGNER

KRM

REVIEWER


AKF 11-21-23

PROJECT ID


107408

SHEET TOTAL

310 1068

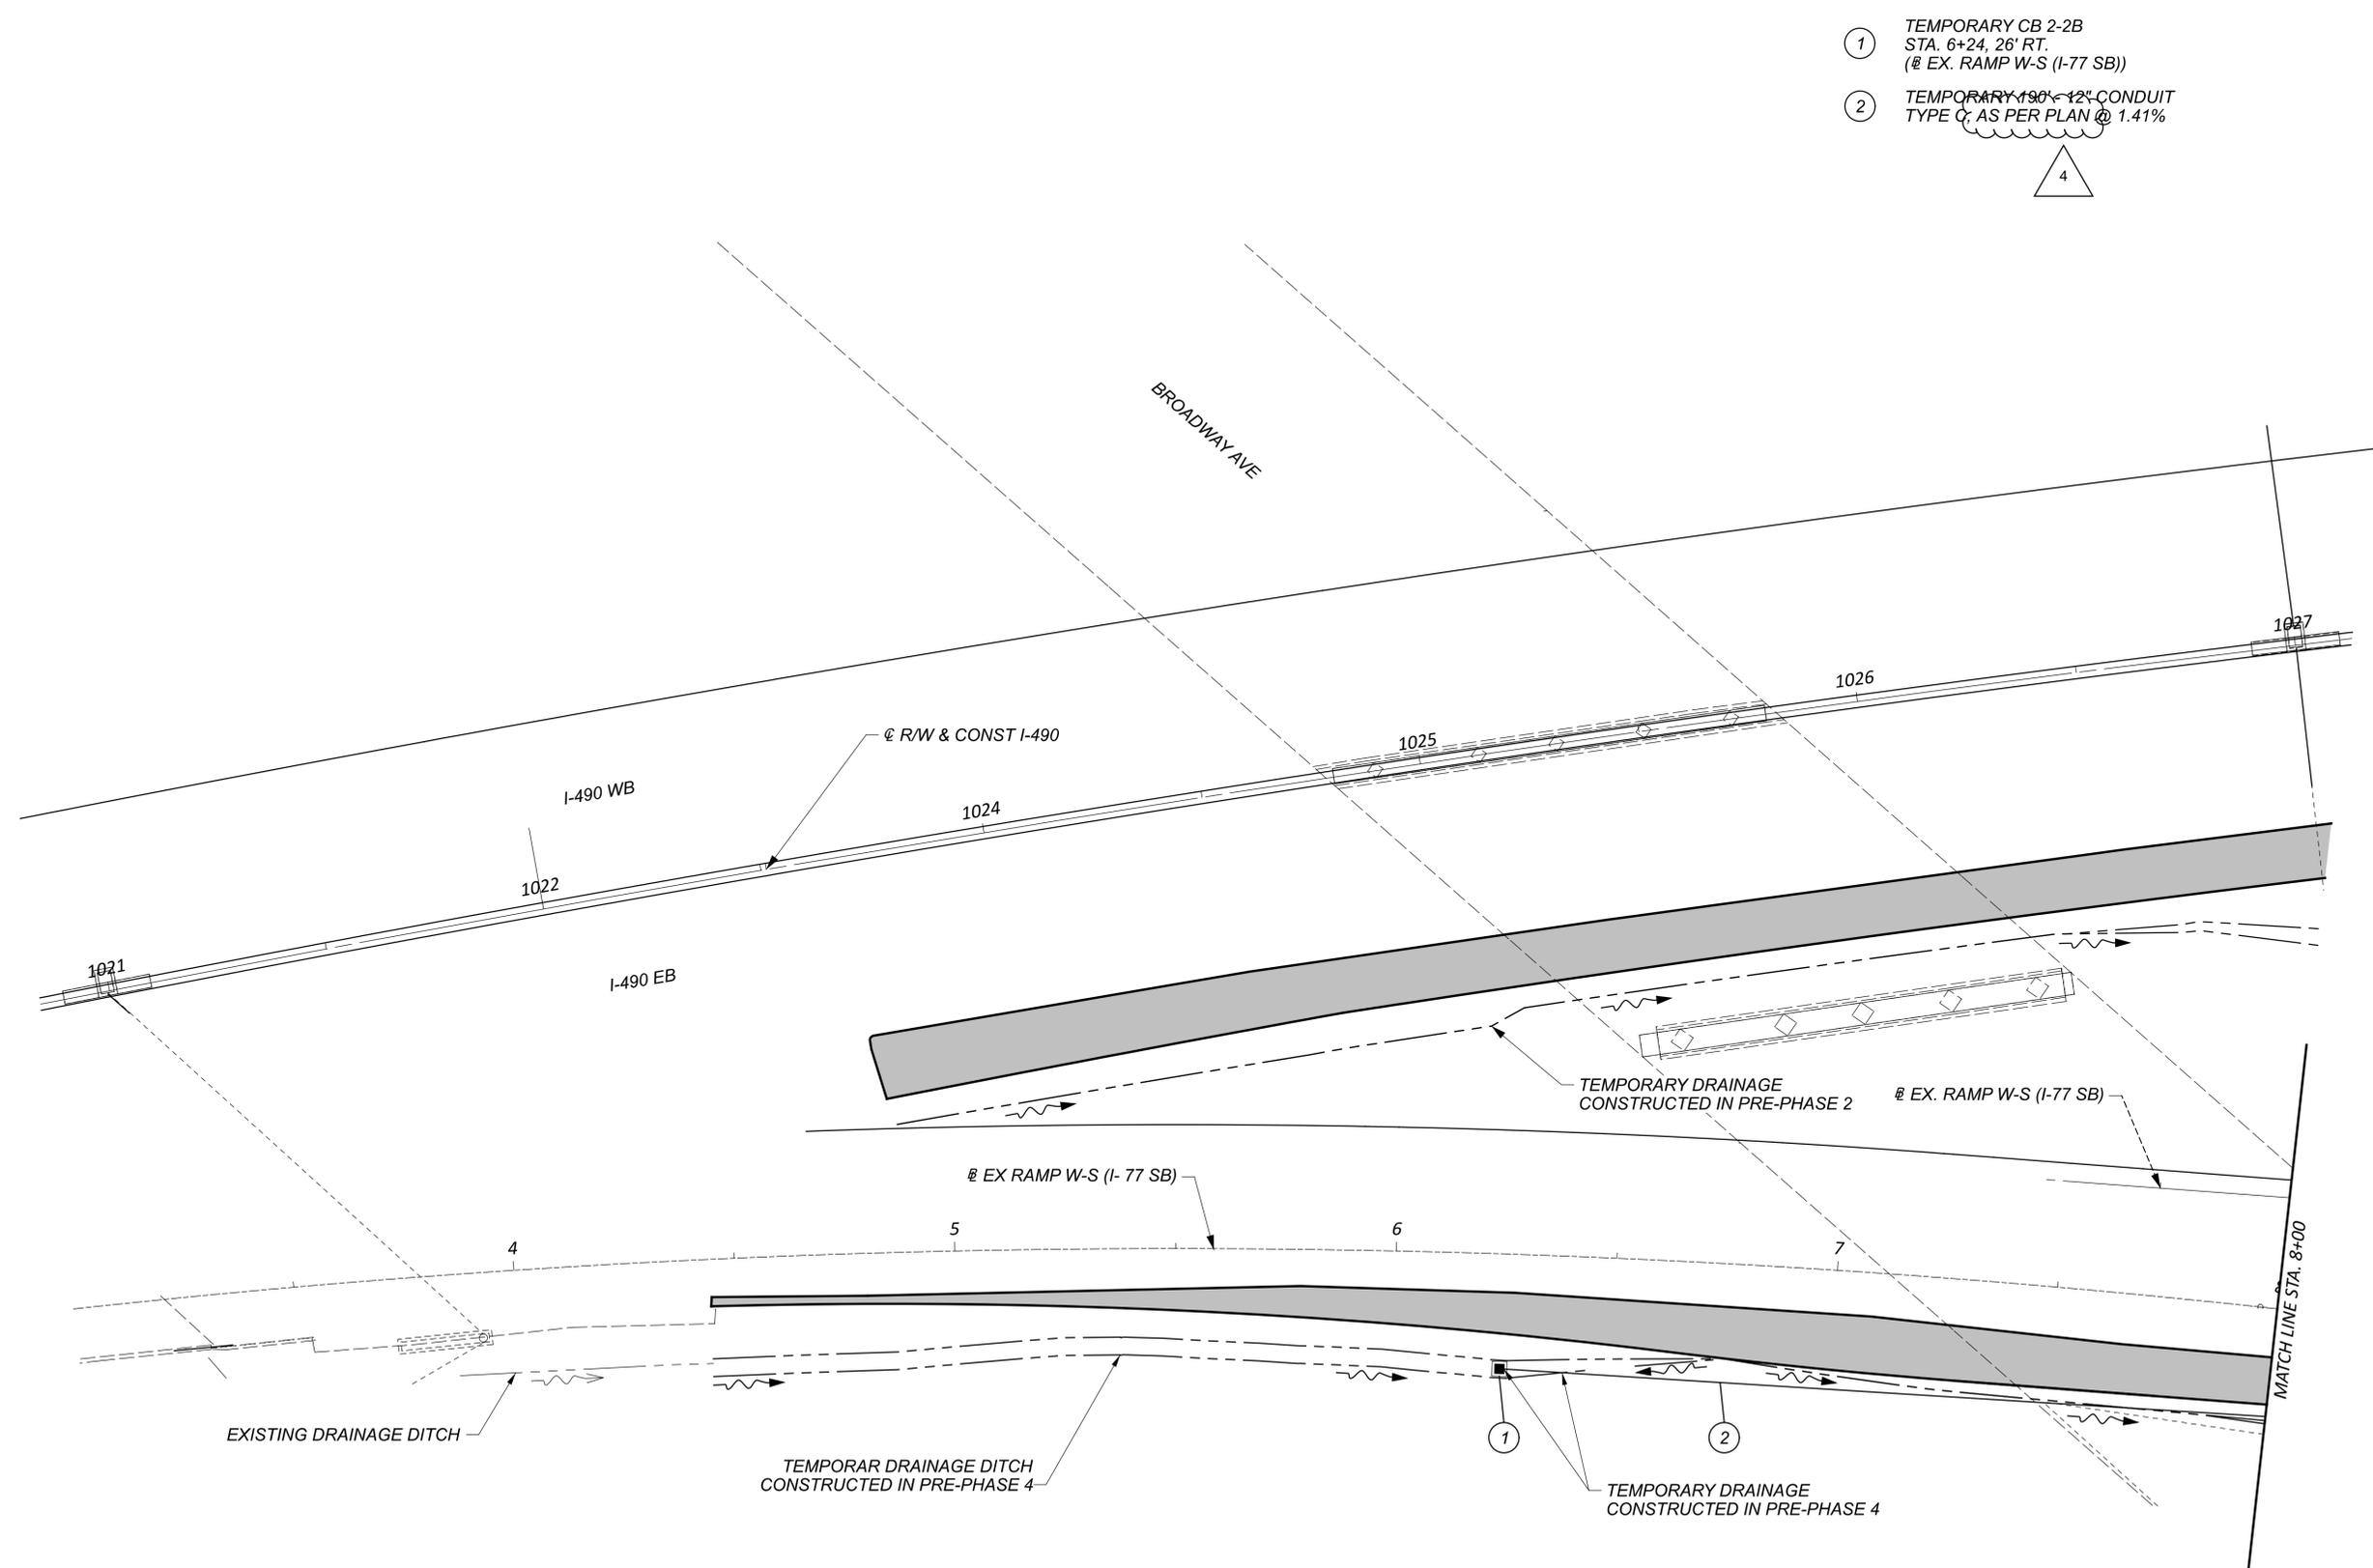

- ① TEMPORARY CB 2-2B  
STA. 6+24, 26' RT.  
(@ EX. RAMP W-S (I-77 SB))
- ② TEMPORARY 180" x 12" CONDUIT  
TYPE C, AS PER PLAN @ 1.41%

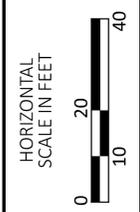

MAINTENANCE OF TRAFFIC - TEMPORARY DRAINAGE - PRE-PHASE 4  
 RAMP W-S (I-77 SB) BEGIN TO STA. 8+00

REVISIONS		
NO.	DATE	DESCRIPTION
④	04/02/24	MADE ALL TEMP. DRAINAGE ITEMS "AS PER PLAN"

MAINTENANCE OF TRAFFIC DRAINAGE NOTES:

1. FOR MAINTENANCE OF TRAFFIC DRAINAGE LEGEND, SEE SHEET 291.

DESIGN AGENCY




DESIGNER  
KRM


REVIEWER  
AKF 11-21-23

PROJECT ID  
107408

SHEET	TOTAL
312	1068

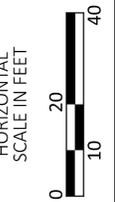

MAINTENANCE OF TRAFFIC - TEMPORARY DRAINAGE - PRE-PHASE 4  
 RAMP W-S (I-77 SB) STA. 8+00 TO END

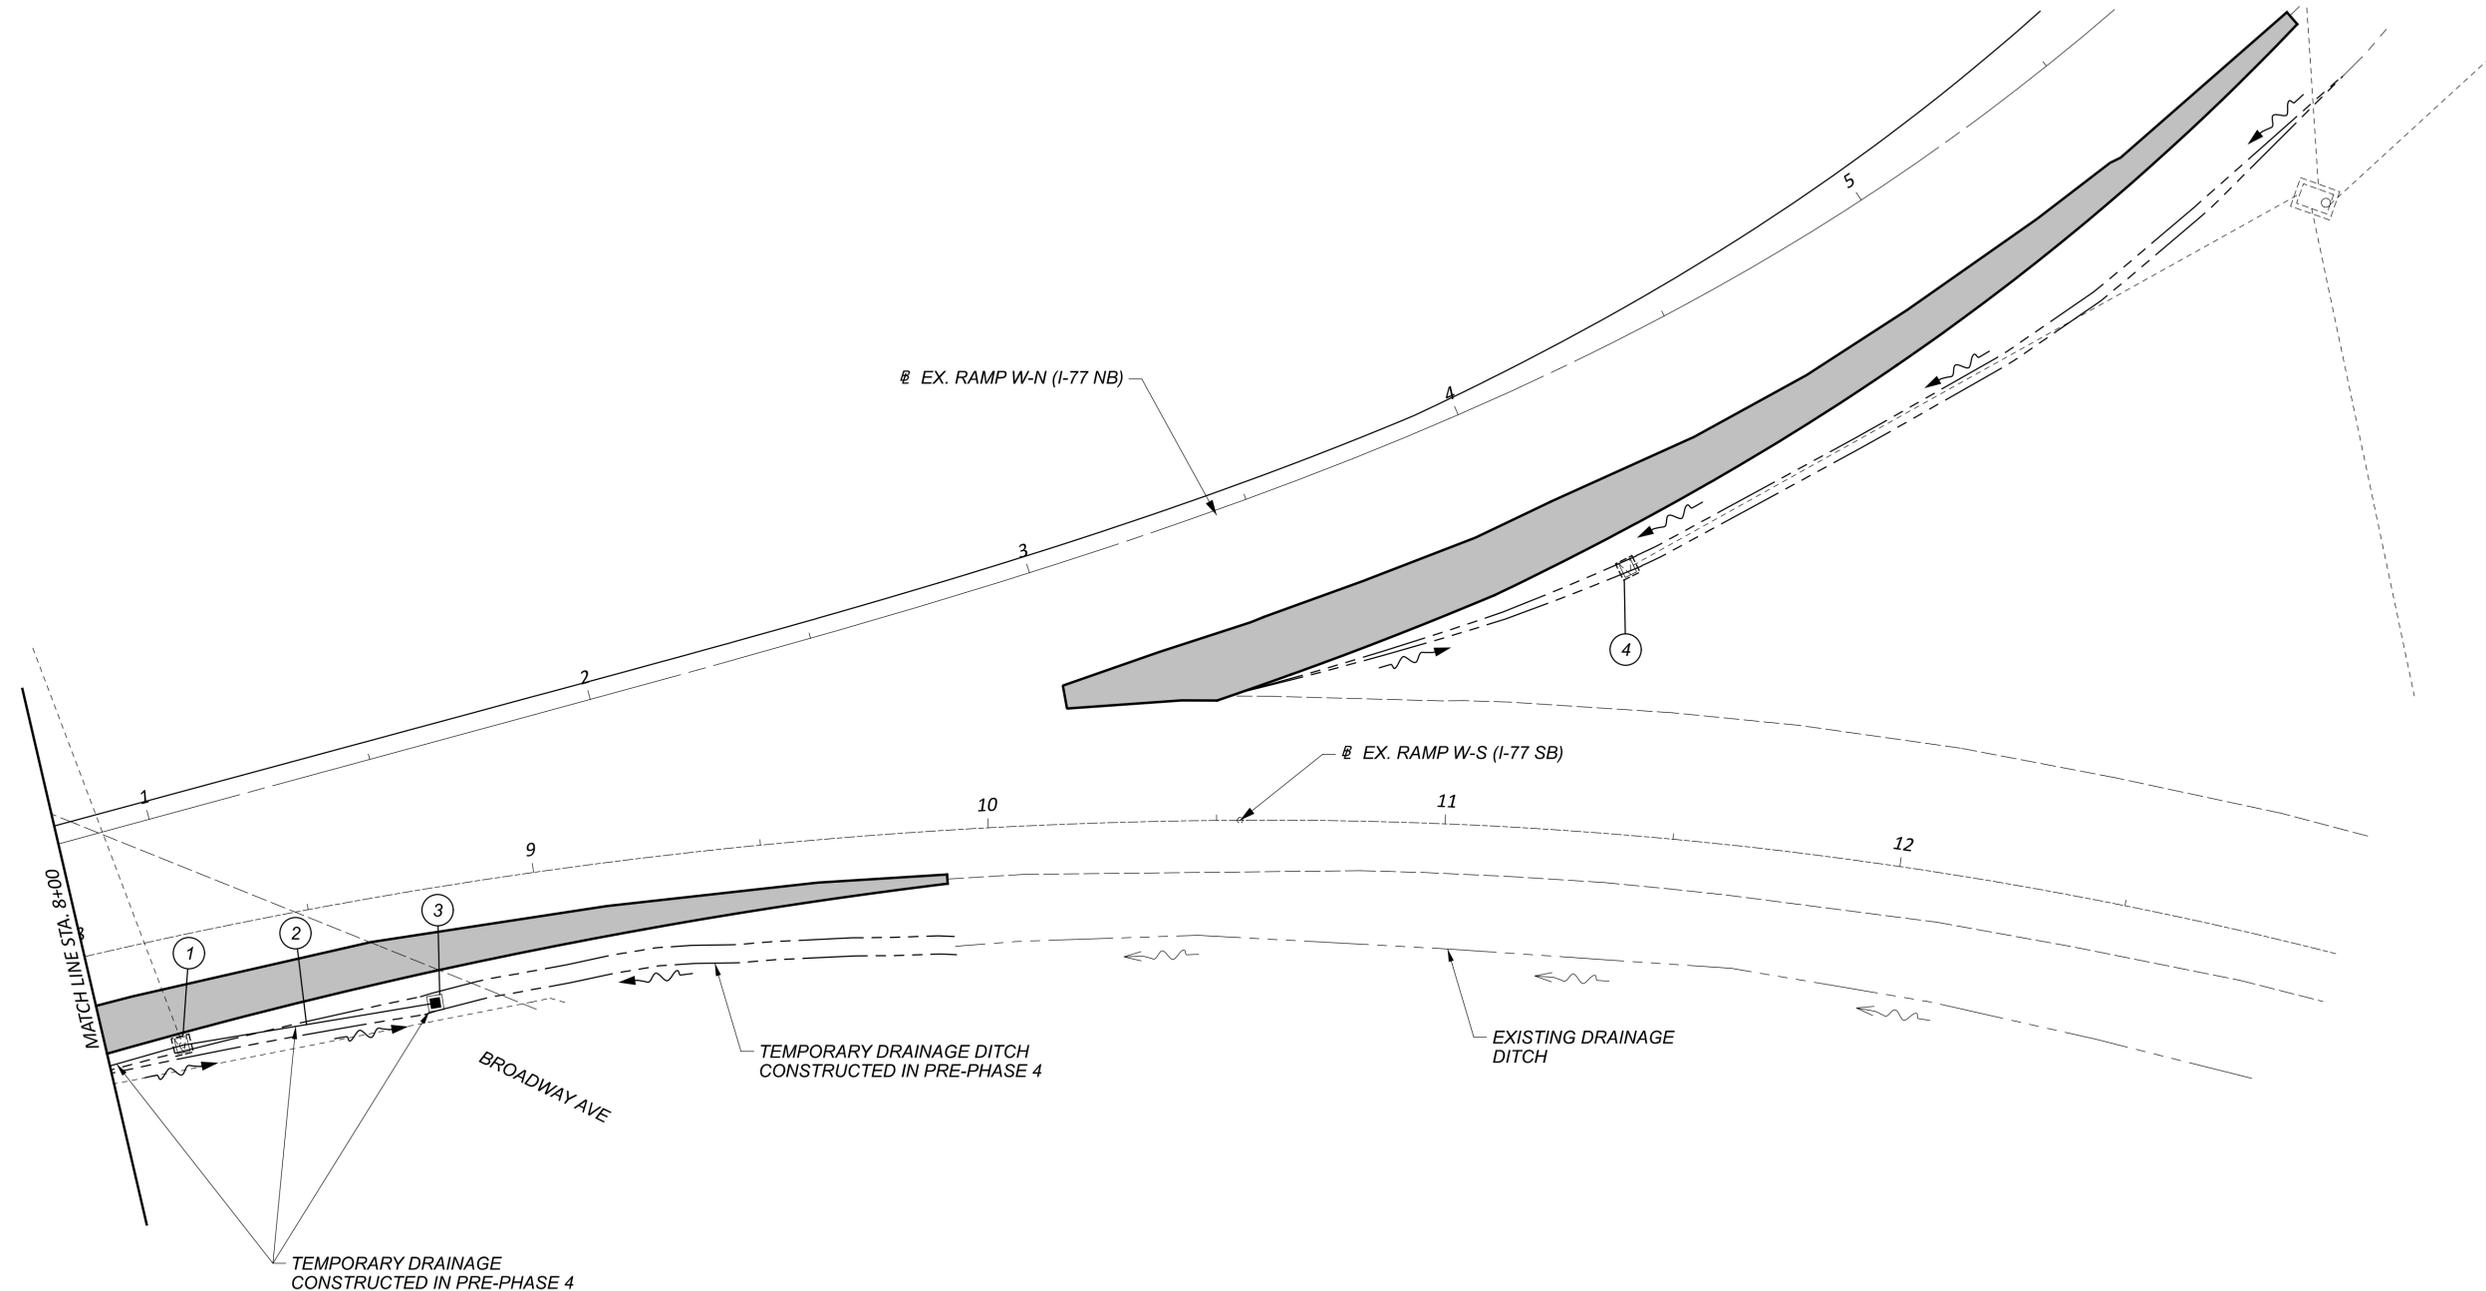

TEMPORARY DRAINAGE CONSTRUCTED IN PRE-PHASE 4

TEMPORARY DRAINAGE DITCH CONSTRUCTED IN PRE-PHASE 4

EXISTING DRAINAGE DITCH

REVISIONS		
NO.	DATE	DESCRIPTION
4	04/02/24	MADE ALL TEMP. DRAINAGE ITEMS "AS PER PLAN"

- ① EXISTING INLET (DR-119) (TO BE TEMPORARILY PLATED IN PRE-PHASE 4)
- ② TEMPORARY 65'-12" CONDUIT TYPE C AS PER PLAN @ 1.75%
- ③ TEMPORARY CB 2-2B STA. 8+74, 25' RT. (@ EX. RAMP W-S (I-77 SB))
- ④ EXISTING INLET (DJ-120) (TO BE TEMPORARILY RECONSTRUCTED TO GRADE IN PRE-PHASE 4)

MAINTENANCE OF TRAFFIC DRAINAGE NOTES:

1. FOR MAINTENANCE OF TRAFFIC DRAINAGE LEGEND, SEE SHEET 291.

DESIGN AGENCY



DESIGNER  
KRM

REVIEWER  
AKF 11-21-23

PROJECT ID  
107408

SHEET TOTAL  
313 1068

SHEET NUM.										PART.	ITEM	ITEM	GRAND	UNIT	DESCRIPTION	SEE SHEET NO.
OFFICE CALCS		59		457		459				01/IMS/04	EXT	TOTAL				
		LS								LS	201	11000	LS		CLEARING AND GRUBBING	50
				146,031						146,031	202	23000	146,031	SY	PAVEMENT REMOVED	51
				1,225						1,225	202	30000	1,225	SF	WALK REMOVED	
				9						9	202	30600	9	SY	CONCRETE MEDIAN REMOVED	
				8,796						8,796	202	30700	8,796	FT	CONCRETE BARRIER REMOVED	
				140						140	202	30800	140	SY	TRAFFIC ISLAND REMOVED	
				17,483						17,483	202	32000	17,483	FT	CURB REMOVED	
				7,908						7,908	202	35100	7,908	FT	PIPE REMOVED, 24" AND UNDER	
				257						257	202	35200	257	FT	PIPE REMOVED, OVER 24"	
				13,152						13,152	202	38000	13,152	FT	GUARDRAIL REMOVED	
				2						2	202	47800	2	EACH	IMPACT ATTENUATOR REMOVED	
				13						13	202	58000	13	EACH	MANHOLE REMOVED	
				28						28	202	58100	28	EACH	CATCH BASIN REMOVED	
				61						61	202	58200	61	EACH	INLET REMOVED	
						163				163	SPECIAL	20270110	163	FT	PIPE CLEANOUT, 24" AND UNDER	55
						798				798	SPECIAL	20270120	798	FT	PIPE CLEANOUT, 27" TO 48"	55
				10,034						10,034	202	75000	10,034	FT	FENCE REMOVED	
		70,616								70,616	203	10000	70,616	CY	EXCAVATION	
		2,931								2,931	203	20000	2,931	CY	EMBANKMENT	
				750						750	203	35120	750	CY	GRANULAR MATERIAL, TYPE C	
		2,111		205						2,316	204	10000	2,316	SY	SUBGRADE COMPACTION	51
		1,056								1,056	204	21000	1,056	CY	GRANULAR EMBANKMENT	51
		80								80	204	45000	80	HOUR	PROOF ROLLING	51
		1,056								1,056	204	13000	1,056	CY	EXCAVATION OF SUBGRADE	51
4,356										4,356	206	10500	4,356	TON	CEMENT	
144,043										144,043	206	11000	144,043	SY	CURING COAT	
144,043										144,043	206	15020	144,043	SY	CEMENT STABILIZED SUBGRADE, 14 INCHES DEEP	
										145	209	15001	145	STA	RESHAPING UNDER GUARDRAIL, AS PER PLAN	52
				12,078						12,078	606	15050	12,078	FT	GUARDRAIL, TYPE MGS	
				125						125	606	15150	125	FT	GUARDRAIL, TYPE MGS HALF POST SPACING	
				2						2	606	26050	2	EACH	ANCHOR ASSEMBLY, MGS TYPE B	52
				23						23	606	26150	23	EACH	ANCHOR ASSEMBLY, MGS TYPE E (MASH 2016)	52
				16						16	606	26550	16	EACH	ANCHOR ASSEMBLY, MGS TYPE T	
				26						26	606	35002	26	EACH	MGS BRIDGE TERMINAL ASSEMBLY, TYPE 1	
				11						11	606	35102	11	EACH	MGS BRIDGE TERMINAL ASSEMBLY, TYPE 2	
				1						1	606	60050	1	EACH	IMPACT ATTENUATOR, TYPE 3 (BIDIRECTIONAL) (72" WIDTH)	52
				11,119						11,119	607	23000	11,119	FT	FENCE, TYPE CLT	
				11,119						11,119	607	70000	11,119	FT	FENCELINE SEEDING AND MULCHING	
				1,152						1,152	608	10000	1,152	SF	4" CONCRETE WALK	
				687						687	608	52000	687	SF	CURB RAMP	
				720						720	622	10100	720	FT	CONCRETE BARRIER, SINGLE SLOPE, TYPE B1	
				640						640	622	10120	640	FT	CONCRETE BARRIER, SINGLE SLOPE, TYPE C	
				31						31	622	10121	31	FT	CONCRETE BARRIER, SINGLE SLOPE, TYPE C, AS PER PLAN	52
4,930										4,930	622	10140	4,930	FT	CONCRETE BARRIER, SINGLE SLOPE, TYPE C1	
30										30	622	10141	30	FT	CONCRETE BARRIER, SINGLE SLOPE, TYPE C1, AS PER PLAN	52
				712						712	622	10160	712	FT	CONCRETE BARRIER, SINGLE SLOPE, TYPE D	
				78						78	622	10161	78	FT	CONCRETE BARRIER, SINGLE SLOPE, TYPE D, AS PER PLAN	52
34										34	622	10200	34	EACH	BARRIER TRANSITION	
				3						3	622	24840	3	EACH	CONCRETE BARRIER END SECTION, TYPE B	
1										1	622	24850	1	EACH	CONCRETE BARRIER END SECTION, TYPE B1	
				14						14	622	25000	14	EACH	CONCRETE BARRIER END SECTION, TYPE D	
				2						2	622	25001	2	EACH	CONCRETE BARRIER END SECTION, TYPE D, AS PER PLAN	52
6										6	622	25006	6	EACH	CONCRETE BARRIER, END ANCHORAGE, REINFORCED, TYPE B1	
				1						1	622	25009	1	EACH	CONCRETE BARRIER, END ANCHORAGE, REINFORCED, TYPE C, AS PER PLAN	53

REVISIONS		
NO.	DATE	DESCRIPTION
2	02/29/24	UPDATED EARTHWORK QUANTITIES
3	03/18/24	EXCAVATION OF SUBGRADE QUANTITY ADDED. UPDATED QUANTITIES FOR PAVEMENT REMOVED; BARRIER REMOVED; CURB REMOVED; CONCRETE BARRIER, SINGLE SLOPE, TYPE C1; BARRIER TRANSITION; AND CONCRETE BARRIER, END ANCHORAGE, REINFORCED, TYPE B1.
4	04/04/24	UPDATED SUBGRADE TREATMENT QUANTITIES

GENERAL SUMMARY

DESIGN AGENCY  
  
 GPD GROUP  
 DESIGNER  
 JAN  
 REVIEWER  
 PJF 11-21-23  
 PROJECT ID  
 107408  
 SHEET TOTAL  
 452 1068



X:\Projects\2022\00100\_0001\_D12-CUY-490-0-25622-00-Engineer\Structures\CUY490\_01000\Sheets\025622\_SF081991\_S0001.dgn 3/29/2024 5:47:08 PM zguo

**REFER TO THE FOLLOWING STANDARD BRIDGE DRAWINGS:**

AS-1-15	REVISED	01-20-23
AS-2-15	REVISED	01-20-23
BR-1-13	REVISED	01-17-14
EXJ-4-87	REVISED	01-20-23
GSD-1-19	DATED	01-15-21
PCB-91	REVISED	07-17-20
RB-1-55	DATED	07-19-13
VPF-1-90	REVISED	01-20-23

**AND TO THE FOLLOWING SUPPLEMENTAL SPECIFICATIONS:**

800	DATED	04-21-23
844	DATED	04-20-18
848	DATED	01-15-21

**DESIGN SPECIFICATIONS:**

THE EXISTING STRUCTURE WAS DESIGNED IN CONFORMANCE WITH THE "STANDARD SPECIFICATIONS FOR HIGHWAY BRIDGES" ADOPTED BY THE AMERICAN ASSOCIATION OF STATE HIGHWAY AND TRANSPORTATION OFFICIALS, DATED 1969, INCLUDING THE 1970 INTERIM SPECIFICATIONS AND THE OHIO "SUPPLEMENT" TO THESE SPECIFICATIONS.

**DESIGN LOADING:**

HS20-44 CASE I AND THE ALTERNATE MILITARY LOADING FUTURE WEARING SURFACE (FWS) OF 0.030 KIPS PER SQUARE FOOT

**DESIGN DATA:**

CONCRETE CLASS QC2 - COMPRESSIVE STRENGTH 4500 PSI (SUPERSTRUCTURE)  
CONCRETE CLASS QC1 - COMPRESSIVE STRENGTH 4000 PSI (SUBSTRUCTURE)

CONCRETE REINFORCEMENT - ASTM A615 OR A996, GRADE 60, MINIMUM YIELD STRENGTH 60,000 PSI

STRUCTURAL STEEL - ASTM A572 GRADE 50, YIELD STRENGTH 50 KSI (EXISTING)  
STRUCTURAL STEEL - ASTM A709 GRADE 50, YIELD STRENGTH 50 KSI (PROPOSED)

**MONOLITHIC WEARING SURFACE:**

MONOLITHIC WEARING SURFACE IS ASSUMED, FOR DESIGN PURPOSES, TO BE 1 INCH THICK.

**EXISTING STRUCTURE VERIFICATION:**

DETAILS AND DIMENSIONS SHOWN ON THESE PLANS PERTAINING TO THE EXISTING STRUCTURE HAVE BEEN OBTAINED FROM PLANS OF THE EXISTING STRUCTURE AND FROM FIELD OBSERVATIONS AND MEASUREMENTS. CONSEQUENTLY, THEY ARE INDICATIVE OF THE EXISTING STRUCTURE AND THE PROPOSED WORK, BUT THEY SHALL BE CONSIDERED TENTATIVE AND APPROXIMATE. THE CONTRACTOR IS REFERRED TO CMS SECTIONS 102.05, 105.02 AND 513.04.

BASE CONTRACT BID PRICES UPON A RECOGNITION OF THE UNCERTAINTIES DESCRIBED ABOVE AND UPON A PREBID EXAMINATION OF THE EXISTING STRUCTURE. HOWEVER, THE OWNER WILL PAY FOR ALL PROJECT WORK BASED UPON ACTUAL DETAILS AND DIMENSIONS THAT HAVE BEEN VERIFIED IN THE FIELD.

**EXISTING STRUCTURE PLANS:**

PLANS MAY BE EXAMINED BY PROSPECTIVE BIDDERS AT THE OHIO DEPARTMENT OF TRANSPORTATION, DISTRICT 12, 5500 TRANSPORTATION BLVD., GARFIELD HEIGHTS, OH 44125-5396, TEL 216-581-2100. EXISTING PLANS MAY ALSO BE DOWNLOADED AT THE FOLLOWING LINK: <ftp://ftp.dot.state.oh.us/pub/Contracts/Attach>

**USCG ENVIRONMENTAL COMMITMENTS:**

1. SCAFFOLDING UNDER THE BRIDGE IS AUTHORIZED BUT MUST NOT EXTEND MORE THAN 4-FEET BELOW LOW STEEL.
2. LIGHTING OF THE BOTTOM AND FOUR-CORNERS OF THE SCAFFOLDING WITH STEADY BURNING YELLOW LIGHTS IS REQUIRED SO THAT APPROACHING VESSELS ARE WARNED OF THE TEMPORARY REDUCTION IN CLEARANCE.
3. SNOOPER VEHICLES OR OTHER MANLIFTS ARE AUTHORIZED AND WILL REQUIRE SPOTTERS TO WARN WORKERS OF APPROACHING VESSELS AND TO MOVE MANLIFTS TO ALLOW VESSELS TO PASS IS REQUIRED.
4. USE OF BARGES OR FALSEWORK MUST BE AUTHORIZED BY THE USCG WITH A MINIMUM OF 30 DAYS ADVANCED NOTICE OF DEPLOYMENT.

**ITEM 202 - PORTIONS OF STRUCTURE REMOVED, OVER 20 FOOT SPAN, AS PER PLAN:**

DESCRIPTION: WORK TO BE PAID FOR UNDER THIS ITEM SHALL INCLUDE THE REMOVAL OF EXISTING STRUCTURE COMPONENTS AS DETAILED IN THE PLANS AND AS DIRECTED BY THE ENGINEER. THE REMOVALS SHALL INCLUDE BUT NOT NECESSARILY BE LIMITED TO THE FOLLOWING:

1. PORTIONS OF EXISTING BRIDGE DECK SLAB AND CONCRETE PARAPETS AS SHOWN IN THE PLANS, INCLUDING SAW CUTTING.
2. PORTIONS OF EXISTING ABUTMENT BACKWALLS AND WINGWALLS AS SHOWN IN THE PLANS, INCLUDING SAW CUTTING.
3. EXISTING STEEL END CROSSFRAMES, STEEL END DAMS, AND SLIDING PLATE OR STRIP SEAL EXPANSION JOINTS AT ALL ABUTMENTS AND JOINT 6 AS SHOWN IN THE PLANS.
4. EXISTING NEOPRENE DRAINAGE TROUGHS AND STEEL ANGLES BELOW JOINTS 1 THRU 6, INCLUDING ALL DIRT AND DEBRIS CONTAINED WITHIN.
5. EXISTING STEEL PIPE COLLECTORS AND DOWNSPOUTS AS SHOWN IN THE PLANS, INCLUDING ALL DIRT AND DEBRIS CONTAINED WITHIN.
6. EXISTING PIER ACCESS LADDERS AND MANHOLES IN BRIDGE DECK AS SHOWN IN THE PLANS.
7. EXISTING ITEMS NOTED TO BE REMOVED FOR REPAIRS TO EXISTING FINGER JOINTS, EXISTING INSPECTION SAFETY CABLE SYSTEM, AND EXISTING SCUPPER GRATES AS SHOWN IN THE PLANS.
8. MISCELLANEOUS ITEMS THAT ARE NOT SHOWN TO BE INCORPORATED INTO THE FINAL CONSTRUCTION AND ARE DIRECTED TO BE REMOVED BY THE ENGINEER.

THE PROVISIONS OF ITEM 202 APPLY EXCEPT AS SPECIFIED BY THE FOLLOWING NOTES. PERFORM WORK CAREFULLY DURING DECK REMOVALS TO PROTECT PORTIONS OF SUCH SYSTEMS THAT ARE TO BE SALVAGED AND INCORPORATED INTO THE PROPOSED STRUCTURE. THE USE OF EXPLOSIVES, HEADACHE BALLS AND/OR HOE RAM TYPE OF EQUIPMENT IS PROHIBITED. SUBMIT CONSTRUCTION PLANS ACCORDING TO C&MS 501.05.

PROTECTION OF STEEL SUPPORT SYSTEMS: BEFORE DECK SLAB CUTTING IS PERMITTED, DRAW THE OUTLINE OF PRIMARY STEEL MEMBERS IN CONTACT WITH THE BOTTOM OF THE DECK ON THE SURFACE OF DECK. DRILL SMALL DIAMETER PILOT HOLES 2 INCHES OUTSIDE THESE LINES TO CONFIRM THE LOCATION OF FLANGE EDGES. DECK CUTS OVER OR WITHIN 2 INCHES OF FLANGE EDGES SHALL NOT EXTEND LOWER THAN THE BOTTOM LAYER OF DECK SLAB REINFORCING STEEL. CUTS MADE OUTSIDE 2 INCHES OF FLANGE EDGES MAY EXTEND THE FULL DEPTH OF THE DECK. PERFORM WORK CAREFULLY DURING CUTTING OF THE DECK SLAB TO AVOID DAMAGING STEEL MEMBERS THAT ARE TO BE INCORPORATED INTO THE PROPOSED STRUCTURE. REPLACE OR REPAIR STEEL MEMBERS DAMAGED BY THE DECK SLAB CUTTING OPERATIONS AT NO COST TO THE PROJECT. AT LEAST 7 DAYS BEFORE PERFORMING REPAIR WORK, SUBMIT A PROPOSED REPAIR PLAN, DEVELOPED BY AN OHIO REGISTERED PROFESSIONAL ENGINEER TO THE ENGINEER. OBTAIN THE ENGINEER'S APPROVAL BEFORE PERFORMING REPAIR.

**4** PROTECTION OF RAILWAY TRACK: A TEMPORARY SHIELD SHALL BE PROVIDED OVER THE RAILWAY TRACK AREA DURING DEMOLITION. SEE SECTION "D" OF CSX TRANSPORTATION COORDINATION NOTE ON SHEET 8A OF 120 FOR DETAILS.

REMOVAL METHODS: THE CONTRACTOR MAY REMOVE CONCRETE BY CUTTING AND BY MEANS OF HAND OPERATED PNEUMATIC HAMMERS EMPLOYING POINTED OR BLUNTED CHISEL TYPE TOOLS. FOR REMOVALS OVER STRUCTURAL MEMBERS (STEEL GIRDER, STEEL STRINGER, ETC.), THE CONTRACTOR MAY USE A HAMMER HEAVIER THAN 35 POUNDS BUT NOT TO EXCEED 90 POUNDS UNLESS APPROVED BY THE ENGINEER. REMOVAL METHODS OVER STRUCTURAL MEMBERS SHALL ENSURE ADEQUATE DEPTH CONTROL AND PREVENT NICKING OR GOUGING THE PRIMARY STRUCTURAL MEMBERS. DUE TO THE POSSIBLE PRESENCE OF ATTACHMENTS (E.G., FINISHING MACHINE, SCUPPER AND FORM SUPPORTS, ETC.) TO EXISTING STRUCTURAL MEMBERS, PERFORM WORK CAREFULLY DURING DECK REMOVAL TO AVOID DAMAGING STRUCTURAL MEMBERS THAT ARE TO REMAIN. REPLACE OR REPAIR STRUCTURAL MEMBERS DAMAGED BY THE REMOVAL OPERATIONS AT NO COST TO THE PROJECT. AT LEAST 7 DAYS BEFORE PERFORMING REPAIR WORK, SUBMIT A PROPOSED REPAIR PLAN, DEVELOPED BY AN OHIO REGISTERED PROFESSIONAL ENGINEER TO THE ENGINEER. OBTAIN THE ENGINEER'S APPROVAL BEFORE PERFORMING REPAIR.

**ITEM 202 - PORTIONS OF STRUCTURE REMOVED, OVER 20 FOOT SPAN, AS PER PLAN (CON'T):**

CUT LINE CONSTRUCTION JOINT PREPARATION: SAW CUT BOUNDARIES OF PROPOSED CONCRETE REMOVALS 1 INCH DEEP. REMOVE CONCRETE TO A ROUGH SURFACE. LEAVE THE EXISTING REINFORCING STEEL, IF REQUIRED IN THE PLANS, IN PLACE. INSTALL DOWEL BARS IF SPECIFIED. PRIOR TO CONCRETE PLACEMENT ABRASIVELY CLEAN JOINT SURFACES AND EXISTING EXPOSED REINFORCEMENT TO REMOVE LOOSE AND DISINTEGRATED CONCRETE AND LOOSE RUST. THOROUGHLY CLEAN THE JOINT SURFACE AND EXPOSED REINFORCEMENT OF ALL DIRT, DUST, RUST OR OTHER FOREIGN MATERIAL BY THE USE OF WATER, AIR UNDER PRESSURE, OR OTHER METHODS THAT PRODUCE SATISFACTORY RESULTS. EXISTING REINFORCING STEEL DOES NOT HAVE TO HAVE A BRIGHT STEEL FINISH BUT REMOVE ALL PACK AND LOOSE RUST. THOROUGHLY DRENCH EXISTING CONCRETE SURFACES WITH CLEAN WATER AND ALLOW TO DRY TO A DAMP CONDITION BEFORE PLACING CONCRETE.

SUBSTRUCTURE CONCRETE REMOVAL: REMOVE CONCRETE BY MEANS OF APPROVED PNEUMATIC HAMMERS EMPLOYING POINTED AND BLUNT CHISEL TOOLS. HYDRAULIC HOE-RAM TYPE HAMMERS WILL NOT BE PERMITTED. THE WEIGHT OF THE HAMMER SHALL NOT BE MORE THAN 35 POUNDS FOR REMOVAL WITHIN 18 INCHES OF PORTIONS TO BE PRESERVED. OUTSIDE THE 18-INCH LIMIT, THE CONTRACTOR MAY USE HAMMERS NOT EXCEEDING 90 POUNDS UPON THE APPROVAL OF THE ENGINEER. DO NOT PLACE PNEUMATIC HAMMERS IN DIRECT CONTACT WITH REINFORCING STEEL THAT IS TO BE RETAINED IN THE REBUILT STRUCTURE.

MEASUREMENT & PAYMENT: THE DEPARTMENT WILL MEASURE THE QUANTITY OF REMOVALS ON A LUMP SUM BASIS. THE DEPARTMENT WILL PAY FOR THE ACCEPTED QUANTITIES OF REMOVALS AT THE CONTRACT PRICE FOR ITEM 202 - PORTIONS OF STRUCTURE REMOVED, OVER 20 FOOT SPAN, AS PER PLAN.

**ITEM 509 - CONCRETE REINFORCEMENT, REPLACEMENT OF EXISTING REINFORCEMENT, AS PER PLAN:**

REPLACE ALL EXISTING REINFORCING STEEL BARS DEEMED BY THE ENGINEER TO BE UNUSABLE BECAUSE OF CORROSION. THE DEPARTMENT WILL MEASURE THE REPLACEMENT REINFORCING STEEL BY THE NUMBER OF POUNDS ACCEPTED IN PLACE. REPLACE ALL EXISTING REINFORCING STEEL BARS WHICH ARE TO BE INCORPORATED INTO THE NEW WORK AND ARE DEEMED BY THE ENGINEER TO BE MADE UNUSABLE BY CONCRETE REMOVAL OPERATIONS WITH NEW EPOXY COATED REINFORCING STEEL OF THE SAME SIZE AT NO COST TO THE DEPARTMENT.

**ITEM 512 - SEALING OF CONCRETE SURFACES (EPOXY-URETHANE):**

APPLY AN EPOXY-URETHANE SEALER TO THE EXPOSED CONCRETE SURFACES OF THE FOLLOWING BRIDGE ELEMENTS:

1. ABUTMENTS: ALL FACES OF BACKWALLS, BRIDGE SEAT, BREASTWALLS, WINGWALLS, AND PARAPETS (REMOVE EXISTING SEALER).
2. PIERS 4L, 4R, 9L, 9R, 12L, 12R, 15L, 15R, 20L AND 20R: ALL FACES OF CAPS AND COLUMNS, INCLUDING TOP OF CAP (DO NOT REMOVE EXISTING SEALER).
3. PIERS 7L, 7R AND 8R: ALL FACES OF COLUMNS, GROUND LINE TO THE BOTTOM OF CAP (DO NOT REMOVE EXISTING SEALER).
4. PIERS 13L, 13R, 14L AND 14R: ALL FACES OF CAPS AND COLUMNS, EXCLUDING TOP OF CAP (NO EXISTING SEALER).
5. PIERS 6L, 6R, 10L, 10R, AND CAPS OF PIERS 7L AND 7R: AREAS OF CONCRETE PATCHING REPAIR ONLY (OVERLAP EXISTING SEALER SIX INCHES ON ALL SIDES OF REPAIR AREA PERIMETER).
6. SUPERSTRUCTURE: PARAPETS AND DECK EDGES, SEE SHEETS 11/120 AND 12/120 FOR LIMITS (REMOVE EXISTING SEALER).
7. APPROACH SLABS: PARAPETS (NEW WORK, NO EXISTING SEALER).

COMPLETE ALL CRACK REPAIR AND CONCRETE PATCHING ON A GIVEN STRUCTURE ELEMENT BEFORE SEALING. THE COLOR OF THE FINISH COAT FOR ALL SURFACES SHALL BE FEDERAL COLOR NUMBER 595B-27778 (LIGHT NEUTRAL, SEMIGLOSS).



DATE 08/05/20  
REVIEWED MJL  
STRUCTURE FILE NUMBER 1811991

DRAWN PAT/VS  
REVISOR REVISED

DESIGNED PAT/VS  
CHECKED JAM/JCS

STRUCTURE GENERAL NOTES - 1  
BRIDGE NO. CUY-490-0100  
I-490 OVER CUYAHOGA RIVER

CUY-490-01.00  
PID No. 107408

5/120  
16/131

X:\Projects\2022\00100\_0DOT\_D12-CUY-490-0\25622\400-Engineer\ng\Structures\CUY490\_0100C\Sheets\025622\_SFN81991\_S0003.dgn 3/29/2024 3:37:14 PM zguo

**ITEM 518 - STRUCTURE DRAINAGE, MISC.: SCUPPER GRATE REPLACEMENT (CONTINUED):**

MATERIALS: STRUCTURAL STEEL FOR SCUPPER GRATES SHALL BE ASTM A709 GRADE 36 OR 50, GALVANIZED IN ACCORDANCE WITH C&MS 711.02. FURNISH MATERIALS IN CONFORMANCE WITH C&MS 513 AND C&MS 518.

MEASUREMENT AND PAYMENT: THE DEPARTMENT WILL MEASURE THIS WORK BY THE NUMBER OF EACH ACCEPTED IN PLACE. THE BID PRICE SHALL INCLUDE ALL LABOR, MATERIALS, EQUIPMENT, AND INCIDENTALS NECESSARY TO COMPLETE THE SCUPPER GRATE REPLACEMENT. THE DEPARTMENT WILL PAY FOR THE ACCEPTED QUANTITIES AT THE CONTRACT UNIT PRICE BID FOR ITEM 518 - STRUCTURE DRAINAGE, MISC.: SCUPPER GRATE REPLACEMENT.

**ITEM 518 - STRUCTURE DRAINAGE, MISC.: BRIDGE DRAINAGE SYSTEM CLEANING:**

DESCRIPTION: THIS WORK CONSISTS OF REMOVING SEDIMENT AND DEBRIS FROM THE BRIDGE DECK, THE BRIDGE SEATS AT ALL SUBSTRUCTURES, AND ALL PORTIONS OF THE EXISTING BRIDGE DRAINAGE SYSTEM TO BE REUSED, INCLUDING THE INLETS, CATCH BASINS, AND PIPES OF THE UNDERGROUND STORM SEWER SYSTEM AS SHOWN IN THE PLANS. ALL MATERIAL REMOVED SHALL BE DISPOSED OF AS PER C&MS 105.16 AND 105.17. ALL DOWNSPOUTS AND SEWERS SHALL BE CLEANED OUT TO THE SATISFACTION OF THE ENGINEER.

EXECUTION: AFTER THE SEDIMENT AND DEBRIS ARE REMOVED, THE EXISTING BRIDGE DRAINAGE SYSTEM SHALL BE FLUSHED WITH CLEAN WATER MAKING CERTAIN THE WATER FLOWS SMOOTHLY. THE CONTRACTOR SHALL PROVIDE ALL NECESSARY EQUIPMENT PRIOR TO BEGINNING WORK FOR THE PURPOSE OF EXAMINING THE PORTIONS OF THE EXISTING BRIDGE DRAINAGE SYSTEM TO REMAIN AFTER CLEANING TO VERIFY THE CONDITION OF ALL DOWNSPOUTS AND SEWERS. THE CONTRACTOR'S SUPERINTENDENT SHALL ACCOMPANY THE ENGINEER IN MAKING THE DETAILED EXAMINATION OF THE DRAINAGE SYSTEM.

MEASUREMENT AND PAYMENT: THE DEPARTMENT WILL MEASURE THIS WORK ON A LUMP SUM BASIS. THE BID PRICE SHALL INCLUDE ALL LABOR, MATERIALS, EQUIPMENT, AND INCIDENTALS NECESSARY TO COMPLETE THE BRIDGE DRAINAGE SYSTEM CLEANING. THE DEPARTMENT WILL PAY FOR THE ACCEPTED QUANTITIES AT THE CONTRACT UNIT PRICE BID FOR ITEM 518 - STRUCTURE DRAINAGE, MISC.: BRIDGE DRAINAGE SYSTEM CLEANING.

**ITEM 526 - REINFORCED CONCRETE APPROACH SLABS (T=13"), AS PER PLAN:**

THIS ITEM CONSISTS OF CONSTRUCTING REINFORCED CONCRETE APPROACH SLABS WITH INTEGRAL CURBS AND/OR MEDIAN BARRIER IN ACCORDANCE WITH THE DETAILS SHOWN IN THE PLANS, STANDARD DRAWINGS AS-1-15 AND AS-2-15, AND CMS 526.

MEASUREMENT AND PAYMENT: THE DEPARTMENT WILL MEASURE THIS WORK BY THE NUMBER OF SQUARE YARDS ACCEPTED IN PLACE. THE BID PRICE SHALL INCLUDE ALL CONCRETE FOR THE APPROACH SLABS, INTEGRAL CURBS AND/OR MEDIAN BARRIER, JUNCTION BOX, CONDUIT, EPOXY COATED REINFORCING STEEL, PREFORMED EXPANSION JOINT FILLER, JOINT SEALER, AND ALL OTHER INCIDENTAL MATERIALS, LABOR AND EQUIPMENT REQUIRED TO COMPLETE THE WORK. THE DEPARTMENT WILL PAY FOR THE ACCEPTED QUANTITIES AT THE CONTRACT UNIT PRICE BID FOR ITEM 526 - REINFORCED CONCRETE APPROACH SLABS (T=13"), AS PER PLAN.

**ITEM 625 - SPECIAL - MAINTAIN EXISTING LIGHTING**

DESCRIPTION: THIS ITEM CONSISTS OF RESTORING THE LIGHTING THAT IS DISTURBED IN THE COURSE OF WORK.

MEASUREMENT AND PAYMENT: THE DEPARTMENT WILL MEASURE THIS WORK ON A LUMP SUM BASIS. THE BID PRICE SHALL INCLUDE ALL LABOR, MATERIALS, EQUIPMENT, AND INCIDENTALS NECESSARY TO COMPLETE THE RESTORATION OF DISTURBED LIGHTING. THE DEPARTMENT WILL PAY FOR THE ACCEPTED QUANTITIES AT THE CONTRACT UNIT PRICE BID FOR ITEM 625 - SPECIAL - MAINTAIN EXISTING LIGHTING.

**ITEM 844 - CONCRETE PATCHING WITH GALVANIC ANODE PROTECTION, AS PER PLAN:**

THIS WORK CONSISTS OF PATCHING EXISTING REINFORCED CONCRETE IN ACCORDANCE WITH SUPPLEMENTAL SPECIFICATION 844, MODIFIED AS FOLLOWS:

WHERE THE AREA OF AN INDIVIDUAL REPAIR, AS DETERMINED IN THE FIELD AT THE TIME OF CONSTRUCTION, TOTALS LESS THAN FIVE (5) SQUARE FEET, THE INSTALLATION OF GALVANIC ANODES IS NOT REQUIRED, AND THE WORK SHALL BE PERFORMED IN ACCORDANCE WITH C&MS 519.

ANODE SPACING SHALL BE 30" FOR REPAIRS ON EXISTING ABUTMENTS, 28" FOR REPAIRS ON EXISTING PIERS, AND 24" FOR REPAIRS ON EXISTING SUPERSTRUCTURE PARAPETS.

**ASBESTOS NOTIFICATION:**

A CERTIFIED ASBESTOS HAZARD EVALUATION SPECIALIST SURVEYED THE BRIDGE STRUCTURE SCHEDULED FOR DEMOLITION AND/OR REHABILITATION THE SURVEY DETERMINED THAT NO ASBESTOS IS PRESENT ON THE BRIDGE STRUCTURE.

ODOT SHALL PROVIDE A COPY OF THE OHIO ENVIRONMENTAL PROTECTION AGENCY (OEPA) NOTIFICATION OF DEMOLITION AND RENOVATION FORM, PARTIALLY COMPLETED AND SIGNED BY THE BRIDGE OWNER, TO THE SUCCESSFUL BIDDER. THE CONTRACTOR SHALL COMPLETE THE FORM AND SUBMIT IT TO ONE OF THE ADDRESSES BELOW AT LEAST TEN (10) WORKING DAYS PRIOR TO THE START OF ANY DEMOLITION AND/OR RENOVATION.

ASBESTOS PROGRAM OHIO EPA, DAPC P.O. BOX 1049 COLUMBUS, OH 43216-1049 OR ASBESTOS PROGRAM OHIO EPA, DAPC 50 W. TOWN ST., SUITE 700 COLUMBUS, OH 43215

THE CONTRACTOR SHALL PROVIDE A COPY OF THE COMPLETED FORM TO THE ENGINEER AT LEAST TEN (10) WORKING DAYS PRIOR TO THE START OF ANY DEMOLITION AND/OR RENOVATION. THE FORM SHALL INCLUDE: 1) THE CONTRACTORS NAME AND ADDRESS, 2) THE SCHEDULED DATES FOR THE START AND COMPLETION OF THE BRIDGE REMOVAL AND 3) A DESCRIPTION OF THE PLANNED DEMOLITION WORK AND THE METHOD(S) TO BE USED. COPIES OF THE OEPA FORM AND BRIDGE INSPECTION REPORT ARE AVAILABLE FOR REVIEW AT THE ODOT DISTRICT 12 OFFICE, 5500 TRANSPORTATION BOULEVARD, GARFIELD HEIGHTS, OHIO 44125.

BASIS FOR PAYMENT: THE CONTRACTOR SHALL FURNISH ALL FEES, LABOR, AND MATERIAL NECESSARY TO COMPLETE AND SUBMIT THE OEPA NOTIFICATION FORM. PAYMENT FOR THIS WORK SHALL BE INCLUDED IN ITEM 202 - PORTIONS OF STRUCTURE REMOVED, OVER 20 FOOT SPAN, AS PER PLAN.

**SUMMARY OF PROPOSED REHABILITATION WORK:**

THE FOLLOWING LIST CONTAINS THE MAJOR ITEMS OF WORK INCLUDED IN THESE PLANS FOR THE REHABILITATION OF THIS STRUCTURE:

- 1. REPLACEMENT OF THE EXISTING APPROACH SLABS.
- 2. REPLACEMENT OF PARAPET TRANSITIONS TO ACCEPT MGS BRIDGE TERMINAL ASSEMBLY, TYPE 1 OR TYPE 2, AND REPLACEMENT OF APPROACH GUARDRAIL.
- 3. REPLACEMENT OF THE EXISTING STRIP SEAL OR SLIDING PLATE EXPANSION JOINTS AT THE WEST ABUTMENT, EAST ABUTMENT, ABUTMENT B-C, AND ABUTMENT C-B, AND INTERMEDIATE JOINT 6 ON RAMP C-B WITH NEW STRIP SEAL EXPANSION JOINTS, INCLUDING REPLACEMENT OF THE EXISTING END CROSSFRAMES AND RECONSTRUCTION OF THE TOPS OF THE ABUTMENT BACKWALLS AND PORTIONS OF THE EXISTING DECK SLAB AND PARAPETS AT ALL LOCATIONS.
- 4. REPAIR OF THE EXISTING INTERMEDIATE FINGER EXPANSION JOINTS, JOINTS 1 THRU 5, INCLUDING REPLACEMENT OF MISSING/DAMAGED FINGERS AT JOINTS 2 AND 3.
- 5. REPLACEMENT OF THE EXISTING NEOPRENE DRAINAGE TROUGHS BELOW JOINTS 1 THRU 5 WITH NEW GALVANIZED STEEL DRAINAGE TROUGHS, INCLUDING THE INSTALLATION OF A NEW COLLECTOR PIPE SYSTEM SEPARATE FROM THAT OF THE DECK SCUPPERS, AND REMOVAL OF THE EXISTING NEOPRENE DRAINAGE TROUGH BELOW JOINT 6.
- 6. CLEANOUT OF THE EXISTING DECK SCUPPERS, REPLACEMENT OF ONE EXISTING DECK SCUPPER GRATE, REPLACEMENT OF THE EXISTING DOWNSPOUT PIPE SYSTEM, AND CLEANING OF EXISTING STORM SEWERS.
- 7. MISCELLANEOUS REPAIRS TO THE SUPERSTRUCTURE STEEL, INCLUDING REPLACEMENT OF LOOSE AND MISSING BOLTS, REPAIR OF THE EXISTING INSPECTION SAFETY CABLE SYSTEM, SHIMMING OF THE FLOATING BEARINGS OF THREE (3) BEAMS AT THE WEST ABUTMENT, AND REMOVAL OF EXISTING PIER ACCESS MANHOLES AND LADDERS.
- 8. PAINTING OF THE BEAM/GIRDER ENDS AT THE ABUTMENTS AND INTERMEDIATE EXPANSION JOINTS.
- 9. REPLACEMENT OF THE EXISTING BRIDGE DECK OVERLAY, INCLUDING FULL-DEPTH DECK SLAB REPAIRS.
- 10. SUBSTRUCTURE CONCRETE PATCHING AND CRACK REPAIR.
- 11. SUPERSTRUCTURE AND SUBSTRUCTURE CONCRETE SEALING.
- 12. REPLACEMENT OF THE EXISTING CONCRETE SLOPE PROTECTION AT THE SOUTH COLUMN OF PIER 14R.

**SUGGESTED CONSTRUCTION PROCEDURE:**

PRE-PHASE WORK, USING INSIDE SHOULDER CLOSURE:

- 1. PERFORM CLEAN-OUT OF ALL SCUPPERS ALONG THE MEDIAN PARAPETS.
- 2. CLEAN ALL DEBRIS FROM INSIDE SHOULDERS IN BOTH DIRECTIONS.

PHASE 1 CONSTRUCTION:

- 1. IMPLEMENT PHASE 1 MAINTENANCE OF TRAFFIC. MAINTAIN THREE LANES OF I-490 TRAFFIC IN EACH DIRECTION ON THE EXISTING OUTER PORTIONS OF THE EASTBOUND AND WESTBOUND DIRECTIONS ON THE DECK AND APPROACH SLABS.
- 2. PERFORM WORK AT THE WEST ABUTMENT AND EAST ABUTMENT:
  - A. REMOVE EXISTING MEDIAN BARRIER ON EXISTING ABUTMENT APPROACH SLABS AND ON ABUTMENT BACKWALLS.
  - B. REMOVE EXISTING APPROACH SLAB AND SLEEPER SLAB TO LIMITS OF PROPOSED MEDIAN BARRIER ON APPROACH SLAB AND REMOVE TOPS OF EXISTING ABUTMENT BACKWALL TO LIMITS OF PROPOSED MEDIAN BARRIER ON ABUTMENT BACKWALL. ADDITIONAL APPROACH SLAB AND TOPS OF ABUTMENT BACKWALL MAY BE REMOVED TO WITHIN 10'-0" OF CENTERLINE I-490 ON THE WESTBOUND SIDE.
  - C. CONSTRUCT PROPOSED ABUTMENT BACKWALL UNDER PROPOSED ABUTMENT MEDIAN BARRIER, SLEEPER SLAB AND APPROACH SLAB UNDER PROPOSED APPROACH SLAB MEDIAN TRANSITION BARRIER.
  - D. CONSTRUCT MEDIAN BARRIERS ATOP NEW ABUTMENT BACKWALL AND APPROACH SLAB SEGMENTS.

PHASE 2 CONSTRUCTION:

- 1. IMPLEMENT PHASE 2 MAINTENANCE OF TRAFFIC. SHIFT TRAFFIC AND MAINTAIN THREE LANES OF I-490 TRAFFIC IN EACH DIRECTION ON THE EXISTING EASTBOUND BRIDGE DECK AND APPROACH SLABS AND THE OUTER PORTION OF THE EXISTING WESTBOUND BRIDGE DECK AND APPROACH SLABS.
- 2. SAW CUT THE EXISTING BRIDGE DECK OVERLAY AND THE EXISTING EAST AND WEST ABUTMENT APPROACH SLABS AND TOP OF BACKWALL AT OFFSET OF 36'-7" LEFT OF  $\varnothing$  I-490.
- 3. PERFORM WORK AT THE WEST ABUTMENT AND EAST ABUTMENT:
  - A. REMOVE REMAINING INNER PORTIONS OF EXISTING APPROACH SLABS.
  - B. REMOVE REMAINING INNER PORTIONS OF EXISTING TOPS OF BACKWALL, EXPANSION JOINTS, AND ENDS OF BRIDGE DECK.
  - C. REMOVE AND REPLACE EXISTING END CROSSFRAMES WITHIN THE SAME LIMITS. RESET BEARINGS OF BEAMS M AND N AFTER EXISTING CROSSFRAME REMOVAL AND BEFORE PROPOSED CROSSFRAME INSTALLATION.
  - D. INSTALL INNER PORTION OF PROPOSED STRIP SEAL EXPANSION JOINTS.
  - E. CONSTRUCT INNER PORTIONS OF PROPOSED ENDS OF DECK, TOPS OF BACKWALL, AND APPROACH SLABS. BUILD TO LONG-ITUDINAL CONSTRUCTION JOINT AT OFFSET OF 35'-7" LEFT OF  $\varnothing$  I-490.
- 4. PERFORM REPAIRS TO INNER PORTIONS OF EXISTING MAINLINE BRIDGE DECK, FINGER JOINTS, AND MEDIAN PARAPETS.

PHASE 3 CONSTRUCTION:

- 1. IMPLEMENT PHASE 3 MAINTENANCE OF TRAFFIC. SHIFT TRAFFIC AND MAINTAIN THREE LANES OF I-490 TRAFFIC IN EACH DIRECTION ON THE EXISTING EASTBOUND BRIDGE DECK AND APPROACH SLABS AND THE INNER PORTION OF THE EXISTING WESTBOUND BRIDGE DECK AND APPROACH SLABS.
- 2. REFER TO PART 1 PLANS FOR CLOSURE DURATION AT RAMP C-7 TO W. 7TH ST. TO PERFORM WORK AT THE EXIT RAMP PORTION OF THE WEST ABUTMENT:
  - A. REMOVE OUTER PORTION OF EXISTING APPROACH SLAB AND EXISTING PARAPET ON ABUTMENT WINGWALL.
  - B. REMOVE OUTER PORTIONS OF EXISTING TOP OF BACKWALL, EXPANSION JOINT, AND END OF BRIDGE DECK.



DATE 08/05/20  
REVIEWED MJL  
STRUCTURE FILE NUMBER 1811991

DRAWN PAT/VJS  
CHECKED JAM/CJS  
REVISIONS

STRUCTURE GENERAL NOTES - 3  
BRIDGE NO. CUY-490-0100  
I-490 OVER CUYAHOGA RIVER

CUY-490-01.00  
PID No. 107408

7/120

18/131

x:\Projects\2020\2022\00100\_0001\_D12-CUY-490-0-25622-Engineer\g\Structures\CUY490-0100C\Sheets\025622\_SFNI81991\_SN004.dgn 3/29/2024 4:45:41 PM zguo

PHASE 3 CONSTRUCTION (CONTINUED):

- C. REMOVE AND REPLACE EXISTING END CROSSFRAMES WITHIN THE SAME LIMITS. RESET BEARING OF BEAM D AFTER EXISTING CROSSFRAME REMOVAL AND BEFORE PROPOSED CROSSFRAME INSTALLATION.
  - D. INSTALL OUTER PORTION OF PROPOSED STRIP SEAL EXPANSION JOINT.
  - E. CONSTRUCT OUTER PORTION OF PROPOSED END OF DECK, TOP OF BACKWALL, AND APPROACH SLAB. BUILD TO LONGITUDINAL CONSTRUCTION JOINT AT EDGE OF GORE AREA.
3. REFER TO PART 1 PLANS FOR CLOSURE DURATION AT RAMP B-C FROM ROCKEFELLER AVENUE TO PERFORM WORK AT ABUTMENT B-C:
    - A. REMOVE EXISTING APPROACH SLAB AND EXISTING NORTH PARAPET ON ABUTMENT WINGWALL.
    - B. REMOVE EXISTING TOP OF BACKWALL, EXPANSION JOINT, AND END OF BRIDGE DECK.
    - C. REMOVE AND REPLACE ALL EXISTING END CROSSFRAMES.
    - D. INSTALL PROPOSED STRIP SEAL EXPANSION JOINT.
    - E. CONSTRUCT PROPOSED END OF DECK, TOP OF BACKWALL, APPROACH SLAB, AND NORTH PARAPET ON ABUTMENT WINGWALL.
  4. PERFORM REPAIRS TO OUTER PORTIONS EXISTING MAINLINE BRIDGE DECK, FINGER JOINTS, AND EXTERIOR PARAPETS AS REQUIRED TO RE-OPEN THE ENTRANCE AND EXIT RAMPS TO TRAFFIC.
  5. PERFORM WORK AT THE REMAINING PORTION OF THE WEST ABUTMENT AND AT THE EAST ABUTMENT:
    - A. REMOVE OUTER PORTIONS OF EXISTING APPROACH SLABS AND EXISTING PARAPETS ON ABUTMENT WINGWALLS.
    - B. REMOVE OUTER PORTIONS OF EXISTING TOPS OF BACKWALL, EXPANSION JOINTS, AND ENDS OF BRIDGE DECK.
    - C. REMOVE AND REPLACE EXISTING END CROSSFRAMES WITHIN THE SAME LIMITS.
    - D. INSTALL OUTER PORTIONS OF PROPOSED STRIP SEAL EXPANSION JOINT.
    - E. CONSTRUCT OUTER PORTIONS OF PROPOSED ENDS OF DECK, TOPS OF BACKWALL, APPROACH SLABS, AND PARAPETS ON ABUTMENT WINGWALLS. BUILD TO LONGITUDINAL CONSTRUCTION JOINT AT OFFSET OF 35'-7" LEFT OF  $\text{C}$  I-490.
  6. PERFORM REPAIRS TO REMAINING OUTER PORTIONS OF EXISTING EASTBOUND BRIDGE DECK, FINGER JOINTS, AND EXTERIOR PARAPETS.
  7. PERFORM CLEAN-OUT OF ALL SCUPPERS ALONG THE EXTERIOR PARAPET.

PHASE 4 CONSTRUCTION:

1. IMPLEMENT PHASE 4 MAINTENANCE OF TRAFFIC. SHIFT TRAFFIC AND MAINTAIN THREE LANES OF I-490 TRAFFIC IN EACH DIRECTION ON THE EXISTING WESTBOUND BRIDGE DECK AND APPROACH SLABS AND THE OUTER PORTION OF THE EXISTING EASTBOUND BRIDGE DECK AND APPROACH SLABS.
2. SAW CUT THE EXISTING BRIDGE DECK OVERLAY AND THE EXISTING EAST AND WEST ABUTMENT APPROACH SLABS AND TOP OF BACKWALL AT OFFSET OF 37'-7" RIGHT OF  $\text{C}$  I-490.
3. PERFORM WORK AT THE WEST ABUTMENT AND EAST ABUTMENT:
  - A. REMOVE REMAINING INNER PORTIONS OF EXISTING APPROACH SLABS.
  - B. REMOVE REMAINING INNER PORTIONS OF EXISTING TOPS OF BACKWALL, EXPANSION JOINTS, AND ENDS OF BRIDGE DECK.
  - C. REMOVE AND REPLACE EXISTING END CROSSFRAMES WITHIN THE SAME LIMITS.
  - D. INSTALL INNER PORTIONS OF PROPOSED STRIP SEAL EXPANSION JOINTS.
  - E. CONSTRUCT INNER PORTIONS OF PROPOSED ENDS OF DECK, TOPS OF BACKWALL, AND APPROACH SLABS. BUILD TO LONGITUDINAL CONSTRUCTION JOINT AT OFFSET OF 36'-7" RIGHT OF  $\text{C}$  I-490.



PHASE 4 CONSTRUCTION (CONTINUED):

4. PERFORM REPAIRS TO INNER PORTIONS OF EXISTING MAINLINE BRIDGE DECK, FINGER JOINTS, AND MEDIAN PARAPETS.
- PHASE 5 CONSTRUCTION:
1. IMPLEMENT PHASE 5 MAINTENANCE OF TRAFFIC. SHIFT TRAFFIC AND MAINTAIN THREE LANES OF I-490 TRAFFIC IN EACH DIRECTION ON THE EXISTING WESTBOUND BRIDGE DECK AND APPROACH SLABS AND THE INNER PORTION OF THE EXISTING EASTBOUND BRIDGE DECK AND APPROACH SLABS.
  2. REFER TO PART 1 PLANS FOR CLOSURE DURATION AT RAMP C-B TO BROADWAY AVENUE TO PERFORM WORK AT ABUTMENT C-B AND JOINT 6:
    - A. REMOVE EXISTING APPROACH SLAB AND EXISTING PARAPETS ON ABUTMENT WINGWALLS.
    - B. REMOVE EXISTING TOP OF BACKWALL, EXPANSION JOINTS, AND ENDS OF BRIDGE DECK.
    - C. REMOVE AND REPLACE ALL EXISTING END CROSSFRAMES.
    - D. INSTALL PROPOSED STRIP SEAL EXPANSION JOINTS.
    - E. CONSTRUCT PROPOSED ENDS OF DECK, TOP OF BACKWALL, APPROACH SLAB, AND PARAPETS ON ABUTMENT WINGWALLS.
  3. PERFORM REPAIRS TO RAMP C-B BRIDGE DECK AND EXTERIOR PARAPETS AS REQUIRED TO RE-OPEN THE EXIT RAMP TO TRAFFIC.
  4. PERFORM WORK AT THE WEST ABUTMENT AND AT THE EAST ABUTMENT:
    - A. REMOVE OUTER PORTIONS OF EXISTING APPROACH SLABS AND EXISTING PARAPETS ON ABUTMENT WINGWALLS.
    - B. REMOVE OUTER PORTIONS OF EXISTING TOPS OF BACKWALL, EXPANSION JOINTS, AND ENDS OF BRIDGE DECK.
    - C. REMOVE AND REPLACE EXISTING END CROSSFRAMES WITHIN THE SAME LIMITS.
    - D. INSTALL OUTER PORTIONS OF PROPOSED STRIP SEAL EXPANSION JOINT.
    - E. CONSTRUCT OUTER PORTIONS OF PROPOSED ENDS OF DECK, TOPS OF BACKWALL, APPROACH SLABS, AND PARAPETS ON ABUTMENT WINGWALLS. BUILD TO LONGITUDINAL CONSTRUCTION JOINT AT OFFSET OF 36'-7" RIGHT OF  $\text{C}$  I-490.
  5. PERFORM REPAIRS TO OUTER PORTIONS OF EXISTING EASTBOUND BRIDGE DECK, FINGER JOINTS, AND EXTERIOR PARAPETS.
  6. PERFORM CLEAN-OUT OF ALL SCUPPERS ALONG THE EXTERIOR PARAPET.

WORK BELOW THE BRIDGE DECK:

WORK BELOW THE BRIDGE DECK IS NOT RESTRICTED TO A SPECIFIC CONSTRUCTION PHASE BUT MAY BE SUBJECT TO COMPLETION OF OTHER WORK AT A GIVEN LOCATION. THIS WORK INCLUDES:

1. MODIFY THE BRIDGE DRAINAGE SYSTEM (AFTER SCUPPER CLEANING IS COMPLETE):
  - A. REMOVE EXISTING NEOPRENE DRAINAGE TROUGHS, STEEL ANGLES, AND STEEL COLLECTOR PIPES BELOW JOINTS 1 THRU 5 ON I-490 MAINLINE AND JOINT 6 ON RAMP C-B. INSTALL RETROFIT CLEANOUTS WHERE EXISTING COLLECTOR PIPE WAS CONNECTED TO EXISTING SCUPPER PIPE.
  - B. REMOVE EXISTING STEEL DOWNSPOUT PIPES FROM PIERS.
  - C. PERFORM CLEANOUT OF EXISTING SCUPPER PIPES, INLETS, CATCH BASINS, AND STORM SEWERS TO REMAIN.
  - D. INSTALL PROPOSED GALVANIZED STEEL DOWNSPOUT PIPES ON PIER.
  - E. INSTALL PROPOSED GALVANIZED STEEL DRAINAGE TROUGHS BELOW JOINTS 1 THRU 5 ON I-490 MAINLINE.
  - F. INSTALL PROPOSED GALVANIZED STEEL COLLECTOR PIPES.
2. REPLACE LOOSE AND MISSING BOLTS IN SUPERSTRUCTURE FRAMING.

PHASE 5 CONSTRUCTION (CONTINUED):

3. REPLACE MISSING SAFETY CABLE AND REMOVE SAFETY CABLE ATTACHED TO HANDRAIL AND REATTACH TO SUPPORT.
4. PAINT THE BEAM/GIRDER ENDS AT THE ABUTMENTS AND INTERMEDIATE EXPANSION JOINTS (AFTER PROPOSED END CROSSFRAMES, EXPANSION JOINTS, AND/OR PROPOSED DRAINAGE TROUGHS ARE INSTALLED).
5. PERFORM SUBSTRUCTURE CONCRETE PATCHING AND CRACK REPAIR.
6. PERFORM SUBSTRUCTURE CONCRETE SEALING (AFTER CONCRETE PATCHING AND CRACK REPAIR IS COMPLETE).
7. REPLACE CONCRETE SLOPE PROTECTION AT THE SOUTH COLUMN OF PIER 14R.

THE ABOVE IS A SUGGESTED CONSTRUCTION PROCEDURE. THE CONTRACTOR SHALL SUBMIT HIS OR HER PROPOSED CONSTRUCTION PROCEDURE AND SCHEDULE TO THE ENGINEER FOR APPROVAL BEFORE BEGINNING CONSTRUCTION. NO CONSTRUCTION OPERATIONS WILL BE PERMITTED WITHOUT PRIOR APPROVAL.

CSX TRANSPORTATION COORDINATION NOTES:

REFER TO THE CSX TRANSPORTATION PUBLIC PROJECT INFORMATION MANUAL FOR ADDITIONAL REQUIREMENTS NEEDED FOR WORKING ON/ABOVE/ADJACENT TO CSXT. SPECIFIC SECTIONS THAT PERTAIN TO THIS PROJECT ARE SPECIAL PROVISIONS FOR CONSTRUCTION NEAR CSXT PROPERTY, OVERHEAD BRIDGE CRITERIA, CONSTRUCTION SUBMISSION CRITERIA, AND INSURANCE REQUIREMENTS FOR PUBLIC PROJECTS.

CONTRACTOR ACCESS WILL BE LIMITED TO THE IMMEDIATE PROJECT AREA ONLY. THE CSXT RIGHT-OF-WAY OUTSIDE THE PROJECT AREA MAY NOT BE USED FOR CONTRACTOR ACCESS TO THE PROJECT SITE AND NO TEMPORARY AT-GRADE CROSSINGS WILL BE ALLOWED.

THE CONTRACTOR WILL BE REQUIRED TO ABIDE BY THE PROVISIONS OF THE AGENCY/CSXT CONSTRUCTION AGREEMENT. PERIODICALLY, THROUGHOUT THE PROJECT DURATION, THE CONTRACTOR MAY BE REQUIRED TO MEET, DISCUSS AND, IF NECESSARY, TAKE IMMEDIATE ACTION AT THE DISCRETION OF CSXT PERSONNEL AND/OR THEIR AUTHORIZED REPRESENTATIVE, TO COMPLY WITH PROVISIONS OF THAT AGREEMENT AND THESE SPECIFICATIONS.

IT IS THE RESPONSIBILITY OF THE INDIVIDUAL OWNERS OF WIRELINES, PIPELINES, UTILITIES, ETC TO COORDINATE DIRECTLY WITH CSXT REAL ESTATE AND FACILITIES MANAGEMENT (REFM) GROUP. THIS INCLUDES ALL NEW INSTALLATIONS AND THE ADJUSTMENT, MODIFICATION, REMOVAL OR RETIREMENT IN PLACE OF ALL EXISTING FACILITIES.

THE CONTRACTOR MAY NOT USE CSXT RIGHT-OF-WAY FOR STORAGE OF MATERIALS OR EQUIPMENT DURING CONSTRUCTION WITHOUT PRIOR CSXT APPROVAL. THE CSXT RIGHT-OF-WAY MUST ALWAYS REMAIN CLEAR FOR RAILROAD USE. EQUIPMENT MAY NOT BE POSITIONED TO BLOCK THE RAILROAD ACCESS ROAD, TRACK AREA OR ANY PART OF THE CSXT RIGHT-OF-WAY WITHOUT PRIOR CSXT APPROVAL. ALL MOVEMENTS OF EQUIPMENT WITHIN RAILROAD RIGHT-OF-WAY MUST BE COORDINATED WITH THE RAILROAD FLAGGER.

THE ROADWAY AUTHORITY, OR DESIGNATED CONTRACTOR, SHALL COORDINATE WITH THE RAILROAD WHENEVER THE CONTRACTOR'S WORK ACTIVITIES ARE LOCATED OVER, UNDER OR WITHIN THE RAILROAD'S RIGHT-OF-WAY.

ANY DAMAGE CAUSED BY THE PROJECT WORK TO THE TRACK OR RAILROAD PROPERTY WILL REQUIRE REPAIR IMMEDIATELY UPON NOTIFICATION FROM THE RAILROAD OR THEIR DESIGNATED REPRESENTATIVE. IF THE DAMAGE AFFECTS THE TRACK, TRACK STRUCTURE, RAILROAD FACILITIES, OR TRAIN OPERATIONS AS DETERMINED BY THE RAILROAD, THE REPAIRS WILL BE PERFORMED BY THE RAILROAD AT THE CONTRACTOR'S EXPENSE INCLUDING ALL ASSOCIATED COSTS OF DELAYS TO THE RAILROAD.

DURING TRAIN MOVEMENTS THROUGH THE PROJECT LOCATION, VEHICLES, EQUIPMENT, AND PERSONNEL WILL NOT BE ALLOWED TO OPERATE WITHIN TWENTY-FIVE (25) FEET OF THE TRACK.

CSXT SHALL BE NOTIFIED AT LEAST FIVE (5) DAYS IN ADVANCE OF THE PRE-CONSTRUCTION MEETING.

THE CONTRACTOR SHALL COORDINATE ALL WORK ON, OVER OR ADJACENT TO THE RAILROADS WITHIN THE PROJECT'S LIMITS. THE CONTRACTOR SHALL CONTACT CSX RAILROAD, AT LEAST THIRTY (30) DAYS IN ADVANCE, IN ORDER TO COORDINATE THE NECESSARY WORK. UNDER NO CIRCUMSTANCES SHALL THERE BE ANY WORK WITHIN THE RAILROAD RIGHT-OF-WAY WITHOUT THE PROPER AUTHORIZATION AND/OR FLAG PROTECTION FROM THE RAILROAD.



DESIGNED	DRAWN	REVIEWED	DATE
PAT/VS	PAT/VS	MJL	08/05/20
CHECKED	REVISED	STRUCTURE FILE NUMBER	181991
JAM/CJS			

STRUCTURE GENERAL NOTES - 4  
BRIDGE NO. CUY-490-0100  
I-490 OVER CUYAHOGA RIVER

CUY-490-01.00  
PID No. 107408

8/120  
19/131

X:\Projects\2020\2022\00100 DOT D12-CUY-490-0-25622\400-Engineering\Structures\CUY490\_0100C\Sheets\025622\_SF\N181991\_S\_001.dgn 3/29/2024 3:37:16 PM zguo

FUNDING		ESTIMATED QUANTITIES										CALC. BY: PAT/VS DATE: 08/04/20		CHKD. BY: JAM/JDA DATE: 08/05/20	
02/IMS/13	ITEM	ITEM EXTENSION	TOTAL	UNIT	DESCRIPTION	WEST ABUTMENT	EAST ABUTMENT	ABUTMENT B-C	ABUTMENT C-B	PIERS	SUPER-STRUCTURE	GENERAL	REF. SHEET NUMBER		
LS	201	11000	LS		CLEARING AND GRUBBING							LS			
LS	202	11203	LS		PORTIONS OF STRUCTURE REMOVED, OVER 20 FOOT SPAN, AS PER PLAN							LS	5/120		
1,341	202	22900	1,341	SY	APPROACH SLAB REMOVED							1,341			
50	202	32800	50	SY	CONCRETE SLOPE PROTECTION REMOVED							50			
90	202	75266	90	FT	VANDAL PROTECTION FENCE REMOVED AND RESET						90				
LS	503	11100	LS		COFFERDAMS AND EXCAVATION BRACING							LS			
8	503	21100	8	CY	UNCLASSIFIED EXCAVATION	2	2	4	2						
4	15,296	509	15,296	4	LB	EPOXY COATED REINFORCING STEEL	3,052	3,749	769		6,011				
2,000	509	20001	2,000	LB	CONCRETE REINFORCEMENT, REPLACEMENT OF EXISTING REINFORCEMENT, AS PER PLAN	250	250	125	125	250	1,000		120/120		
4	1,062	510	1,062	4	EACH	DOWEL HOLES WITH NONSHRINK, NONMETALLIC GROUT	462	448	52	100					
33	511	34444	33	CY	CLASS QC2 CONCRETE, BRIDGE DECK						33				
5	511	34448	5	CY	CLASS QC2 CONCRETE, BRIDGE DECK (PARAPET)						5				
55	511	45710	55	CY	CLASS QC1 CONCRETE, ABUTMENT	17	21	5	12			4			
4	21,531	512	21,531	4	SY	SEALING OF CONCRETE SURFACES (EPOXY-URETHANE)	231	288	85	112	8,426	12,344	45		
2,723	512	10600	2,723	FT	CONCRETE REPAIR BY EPOXY INJECTION	2	70		36	2,615					
12,908	512	74000	12,908	SY	REMOVAL OF EXISTING COATINGS FROM CONCRETE SURFACES	212	247	67	67		12,315				
15,800	513	10201	15,800	LB	STRUCTURAL STEEL MEMBERS, LEVEL UF, AS PER PLAN						15,800		6/120		
LS	513	95020	LS		STRUCTURAL STEEL, MISC.: INSPECTION SAFETY CABLE SYSTEM REPAIR							LS	6/120		
1	513	95030	1	EACH	STRUCTURAL STEEL, MISC.: FINGER JOINT EXPANSION PLATE REPAIR						1		6/120		
3	513	95030	3	EACH	STRUCTURAL STEEL, MISC.: FINGER JOINT SINGLE FINGER REPAIR						3		6/120		
125	513	95030	125	EACH	STRUCTURAL STEEL, MISC.: REPLACE LOOSE OR MISSING BOLT						125		6/120		
41,800	514	00050	41,800	SF	SURFACE PREPARATION OF EXISTING STRUCTURAL STEEL						41,800				
41,800	514	00056	41,800	SF	FIELD PAINTING OF EXISTING STRUCTURAL STEEL, PRIME COAT						41,800		6/120		
43,800	514	00060	43,800	SF	FIELD PAINTING STRUCTURAL STEEL, INTERMEDIATE COAT						43,800		6/120		
43,800	514	00066	43,800	SF	FIELD PAINTING STRUCTURAL STEEL, FINISH COAT						43,800		6/120		
40	514	00504	40	MNHR	GRINDING FINS, TEARS, SLIVERS ON EXISTING STRUCTURAL STEEL						40				
27	514	10000	27	EACH	FINAL INSPECTION REPAIR						27				
508	516	11210	508	FT	STRUCTURAL EXPANSION JOINT INCLUDING ELASTOMERIC STRIP SEAL						508				
34	516	11211	34	FT	STRUCTURAL EXPANSION JOINT INCLUDING ELASTOMERIC STRIP SEAL, AS PER PLAN						34		81/120		
3	516	46701	3	EACH	RESET BEARING, AS PER PLAN						3		6/120		
LS	516	47001	LS		JACKING AND TEMPORARY SUPPORT OF SUPERSTRUCTURE, AS PER PLAN							LS	6/120		
173	518	62100	173	FT	STRUCTURE DRAINAGE, MISC.: DRAINAGE TROUGH SYSTEM, EXPANSION JOINT 1						173		6/120		
135	518	62100	135	FT	STRUCTURE DRAINAGE, MISC.: DRAINAGE TROUGH SYSTEM, EXPANSION JOINT 2						135		6/120		
135	518	62100	135	FT	STRUCTURE DRAINAGE, MISC.: DRAINAGE TROUGH SYSTEM, EXPANSION JOINT 3						135		6/120		
143	518	62100	143	FT	STRUCTURE DRAINAGE, MISC.: DRAINAGE TROUGH SYSTEM, EXPANSION JOINT 4						143		6/120		
144	518	62100	144	FT	STRUCTURE DRAINAGE, MISC.: DRAINAGE TROUGH SYSTEM, EXPANSION JOINT 5						144		6/120		
2,970	518	62100	2,970	FT	STRUCTURE DRAINAGE, MISC.: 10" GALVANIZED STEEL PIPE, INCLUDING SPECIALS						2,970		6/120		
35	518	62200	35	EACH	STRUCTURE DRAINAGE, MISC.: SCUPPER CLEANOUT						35		6/120		
1	518	62200	1	EACH	STRUCTURE DRAINAGE, MISC.: SCUPPER GRATE REPLACEMENT						1		7/120		
LS	518	63300	LS		STRUCTURE DRAINAGE, MISC.: BRIDGE DRAINAGE SYSTEM CLEANING							LS	7/120		
1,032	526	15001	1,032	SY	REINFORCED CONCRETE APPROACH SLABS (T=13"), AS PER PLAN							1,032	7/120		
481	526	90010	481	FT	TYPE A INSTALLATION							481			

ESTIMATED QUANTITIES CONTINUE ON SHEET 10/120



REVIEWED DATE 08/05/20  
 DRAWN PAT/VS  
 DESIGNED PAT/VS  
 CHECKED JAM/JDA

ESTIMATED QUANTITIES - 1  
 BRIDGE NO. CUY-490-0100  
 I-490 OVER CUYAHOGA RIVER

CUY-490-01.00  
 PID No. 107408

X:\Projects\2020\2022\00100\_0001\_D12-CUY-490-0\25622\400-Engineer\Structures\CUY490\_0100C\Sheets\025622\_SF\N181991\_0002.dgn 3/29/2024 5:09:30 PM zguo

FUNDING		ESTIMATED QUANTITIES										CALC. BY: PAT/VS DATE: 08/04/20		CHKD. BY: JAM/JDA DATE: 08/05/20	
02/IMS/13	ITEM	ITEM EXTENSION	TOTAL	UNIT	DESCRIPTION	WEST ABUTMENT	EAST ABUTMENT	ABUTMENT B-C	ABUTMENT C-B	PIERS	SUPER-STRUCTURE	GENERAL	REF. SHEET NUMBER		
50	601	21000	50	SY	CONCRETE SLOPE PROTECTION							50			
LS	SPECIAL	62540000	LS		MAINTAIN EXISTING LIGHTING							LS	7/120		
724	844	10001	724	SF	CONCRETE PATCHING WITH GALVANIC ANODE PROTECTION, AS PER PLAN		15		54	655					
58,030	848	10000	58,030	SY	MICRO SILICA MODIFIED CONCRETE OVERLAY USING HYDRODEMOLITION (2.50" THICK)						58,030				
58,030	848	20000	58,030	SY	SURFACE PREPARATION USING HYDRODEMOLITION						58,030				
403	848	30000	403	CY	MICRO SILICA MODIFIED CONCRETE OVERLAY (VARIABLE THICKNESS), MATERIAL ONLY						403				
2,902	848	50000	2,902	SY	HAND CHIPPING						2,902				
LS	848	50100	LS		TEST SLAB							LS			
65	848	50200	65	CY	FULL DEPTH REPAIR						65				
10	848	50201	10	CY	FULL DEPTH REPAIR, AS PER PLAN						10		63/120		
58,030	848	50321	58,030	SY	EXISTING CONCRETE OVERLAY REMOVED, AS PER PLAN						58,030		11 TO 13/120		



**INDEX OF STRUCTURE PLANS**

SITE PLAN	1 - 4
STRUCTURE GENERAL NOTES	5 - 8, 8A
ESTIMATED QUANTITIES	9 - 10
PHASE CONSTRUCTION DETAILS	11 - 28
WEST ABUTMENT REPAIR DETAILS	29 - 31
PIER REPAIR DETAILS	32 - 53
EAST ABUTMENT REPAIR DETAILS	54 - 57
ABUTMENT B-C REPAIR DETAILS	58
ABUTMENT C-B REPAIR DETAILS	59 - 60
ABUTMENT PARAPET REPLACEMENT DETAILS	61
WEARING SURFACE REPAIR DETAILS	62 - 66
SUPERSTRUCTURE PARAPET DETAILS	67
PIER ACCESS MANHOLE REMOVAL DETAILS	68 - 69
MISCELLANEOUS STEEL REPAIR DETAILS	70 - 81
CLIMBING SYSTEM REPAIR DETAILS	82
STRIP SEAL EXPANSION JOINT DETAILS	83 - 87
FINGER JOINT REPAIR DETAILS	88
DRAINAGE TROUGH REPLACEMENT DETAILS	89 - 97
DRAINAGE REPAIRS AND CLEANING DETAILS	98 - 102
TROUGH DRAINAGE SYSTEM DETAILS	103 - 108
STORM SEWER CLEANING DETAILS	109 - 112
APPROACH SLAB DETAILS	113 - 119
REINFORCING STEEL LIST	120



DESIGNED: PAT/VS  
 CHECKED: JAM  
 DRAWN: PAT/VS  
 REVISED:  
 REVIEWED: MJL  
 DATE: 08/05/20  
 STRUCTURE FILE NUMBER: 181991

ESTIMATED QUANTITIES - 2  
 BRIDGE NO. CUY-490-0100  
 I-490 OVER CUYAHOGA RIVER

CUY-490-01.00  
 PID No. 107408


10 / 120

21 / 131




03/29/2024

X:\Projects\2020\2022\00100 DOT D12-CUY-490-0\25622\400-Engineering\Structures\CUY490-0100C\Sheets\025622\_SFN181991\_SC001.dgn 3/29/2024 3:37:18 PM zguo

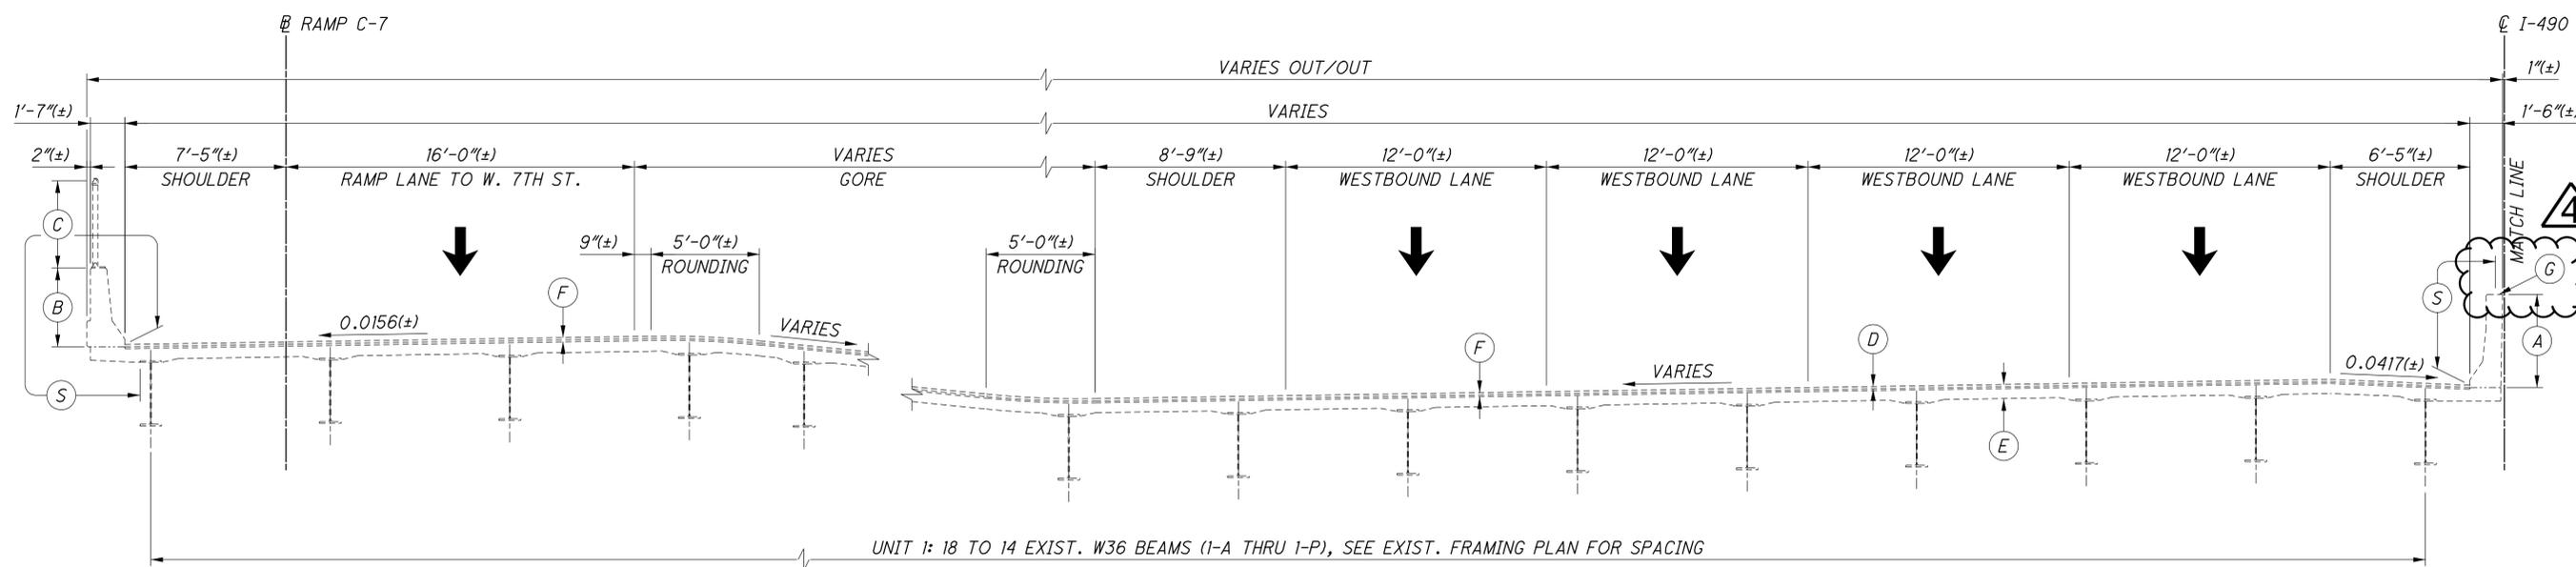

**LEFT SIDE**

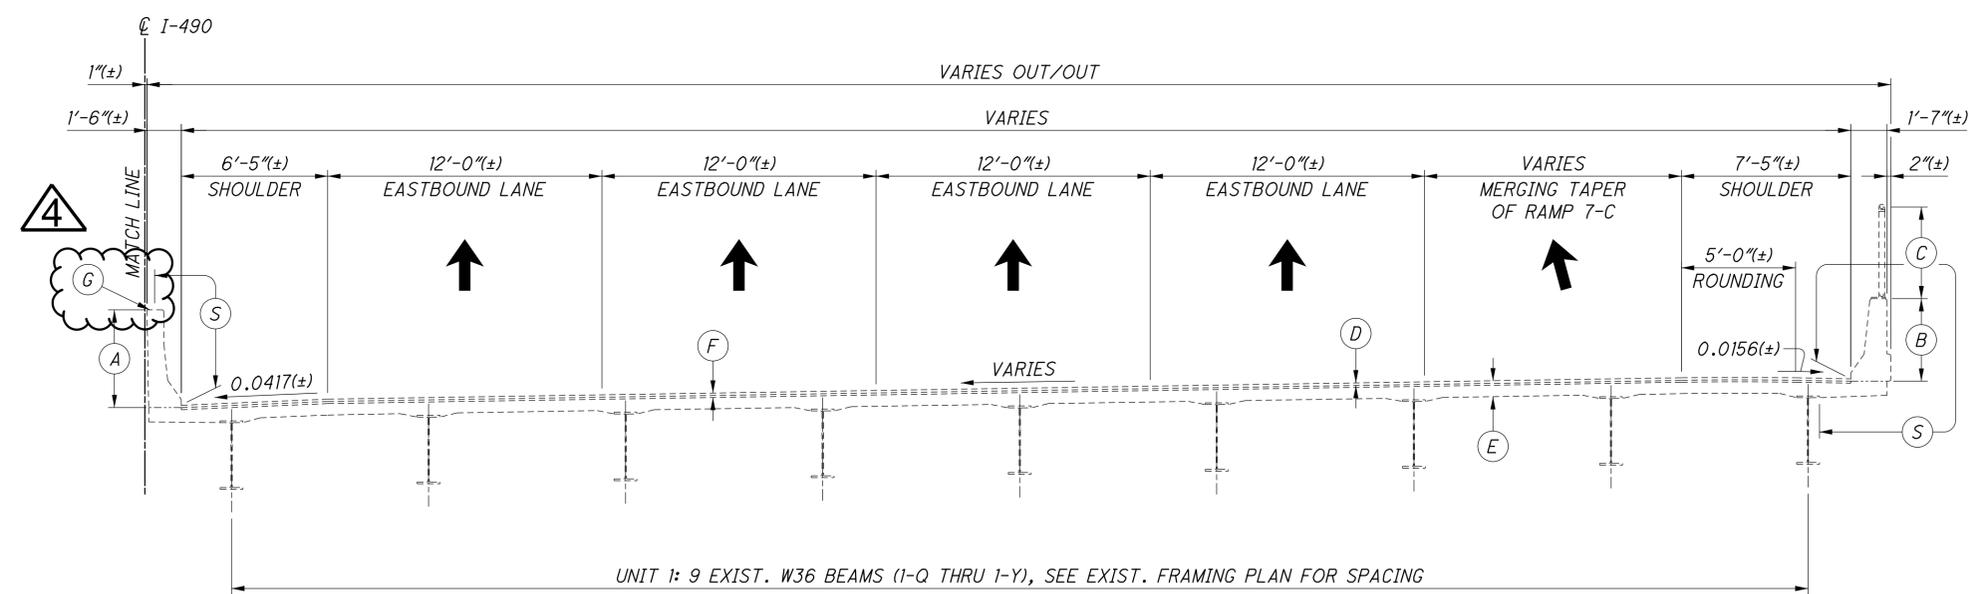

**RIGHT SIDE**

**EXISTING TRANSVERSE SECTION - UNIT 1**  
SHOWN AT STA. 986+80(±) IN SPAN 2

**LEGEND**

- (A) EXIST. 4'-3 1/4" (±) MEDIAN PARAPET
- (B) EXIST. 3'-7 1/4" (±) EXTERIOR PARAPET
- (C) EXIST. 4'-0" (±) VANDAL PROTECTION FENCE
- (D) EXIST. 1/4" (±) LATEX MODIFIED CONCRETE WEARING SURFACE (1986 ORIGINAL CONSTRUCTION) OR EXIST. 1/2" (±) MICRO-SILICA MODIFIED CONCRETE OVERLAY (1998 AND 2021 WEARING SURFACE REPAIRS)
- (E) EXIST. REINFORCED CONCRETE DECK SLAB, 7 3/4" (±) MIN. TO 8 1/4" (±) MAX. TOTAL THICKNESS INCLUDING WEARING SURFACE, SEE EXIST. BRIDGE PLANS FOR MORE INFORMATION
- (F) 2 1/2" (±) TOTAL THICKNESS OF EXIST. OVERLAY AND CONCRETE LAYER BELOW THE OVERLAY TO BE REMOVED PER ITEM 848 - EXISTING CONCRETE OVERLAY REMOVED, AS PER PLAN.
- (G) EXIST. MEDIAN BARRIER NEOPRENE COVER
- (S) REMOVAL OF EXISTING COATINGS FROM CONCRETE SURFACES AND SEALING OF CONCRETE SURFACES (EPOXY-URETHANE)



DESIGNED	PAT	CHECKED	JAM
DRAWN	PAT	REVISED	
REVIEWED	MJL	STRUCTURE FILE NUMBER	181991
DATE	08/05/20		


**PHASE CONSTRUCTION DETAILS - 1**  
BRIDGE NO. CUY-490-0100  
I-490 OVER CUYAHOGA RIVER

**CUY-490-01.00**  
PID No. 107408


11 / 120

22 / 131

X:\Projects\2020\2022\00100 ODOT D12-CUY-490-0\25622\400-Engineering\Structures\CUY490\_0100C\Sheets\025622\_SF\N181991\_SC002.dgn 3/29/2024 3:37:18 PM zguo

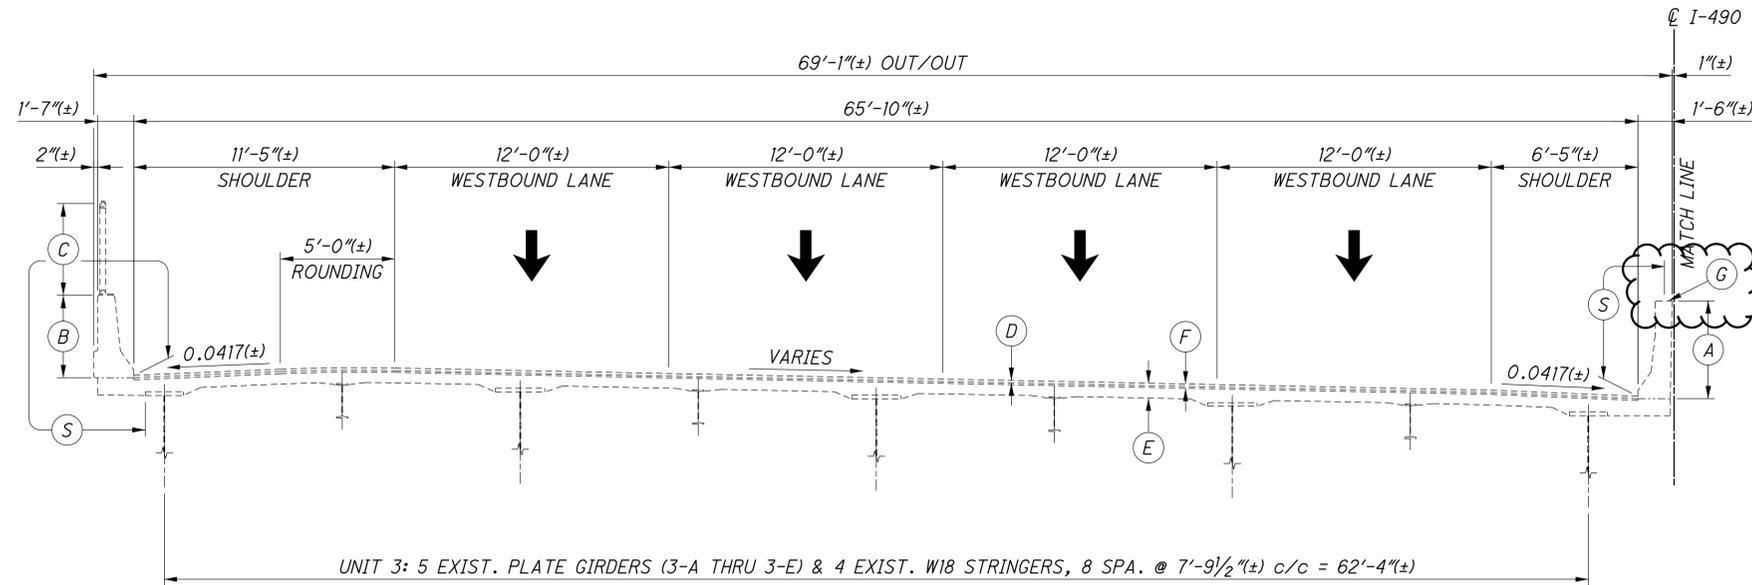

**LEFT SIDE**

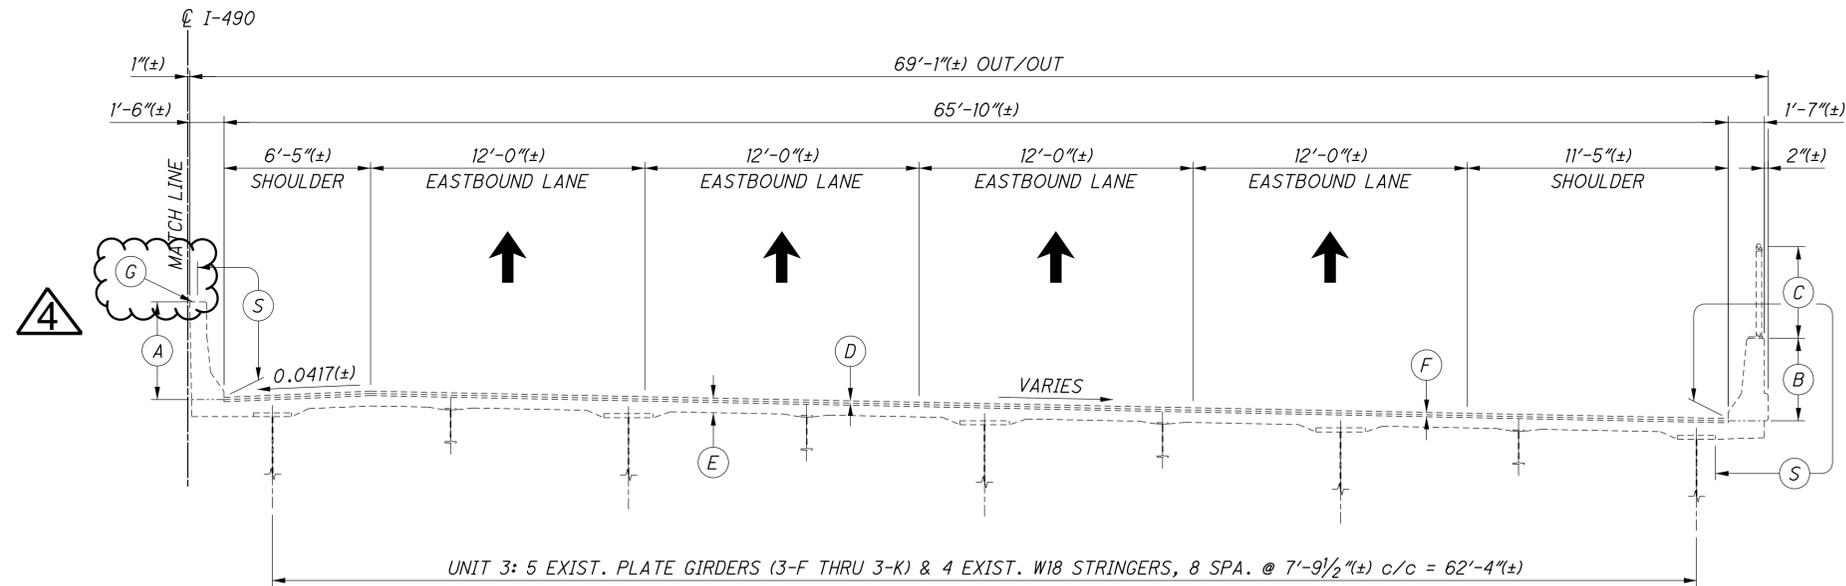

**RIGHT SIDE**

**EXISTING TRANSVERSE SECTION - UNIT 3**

SHOWN AT STA. 999+50 (±) IN SPAN 11

**LEGEND**

- (A) EXIST. 4'-3 1/4" (±) MEDIAN PARAPET
- (B) EXIST. 3'-7 1/4" (±) EXTERIOR PARAPET
- (C) EXIST. 4'-0" (±) VANDAL PROTECTION FENCE
- (D) EXIST. 1/4" (±) LATEX MODIFIED CONCRETE WEARING SURFACE (1986 ORIGINAL CONSTRUCTION) OR EXIST. 1/2" (±) MICRO-SILICA MODIFIED CONCRETE OVERLAY (1998 AND 2021 WEARING SURFACE REPAIRS)
- (E) EXIST. REINFORCED CONCRETE DECK SLAB, 7 3/4" (±) MIN. TO 8 1/4" (±) MAX. TOTAL THICKNESS INCLUDING WEARING SURFACE, SEE EXIST. BRIDGE PLANS FOR MORE INFORMATION
- (F) 2 1/2" (±) TOTAL THICKNESS OF EXIST. OVERLAY AND CONCRETE LAYER BELOW THE OVERLAY TO BE REMOVED PER ITEM 848 - EXISTING CONCRETE OVERLAY REMOVED, AS PER PLAN.
- (G) EXIST. MEDIAN BARRIER NEOPRENE COVER
- (S) REMOVAL OF EXISTING COATINGS FROM CONCRETE SURFACES AND SEALING OF CONCRETE SURFACES (EPOXY-URETHANE)




DESIGNED	PAT	CHECKED	JAM
DRAWN	PAT	REVISED	
REVIEWED	MJL	STRUCTURE FILE NUMBER	181991
DATE	08/05/20		


PHASE CONSTRUCTION DETAILS - 2  
BRIDGE NO. CUY-490-0100  
I-490 OVER CUYAHOGA RIVER

CUY-490-01.00  
PID No. 107408


X:\Projects\2022\100100 DOT D12-CUY-490-0\25622\400-Engineering\Structures\CUY490\_0100C\Sheets\025622\_SF\N181991\_SC003.dgn 3/29/2024 3:37:19 PM zguo

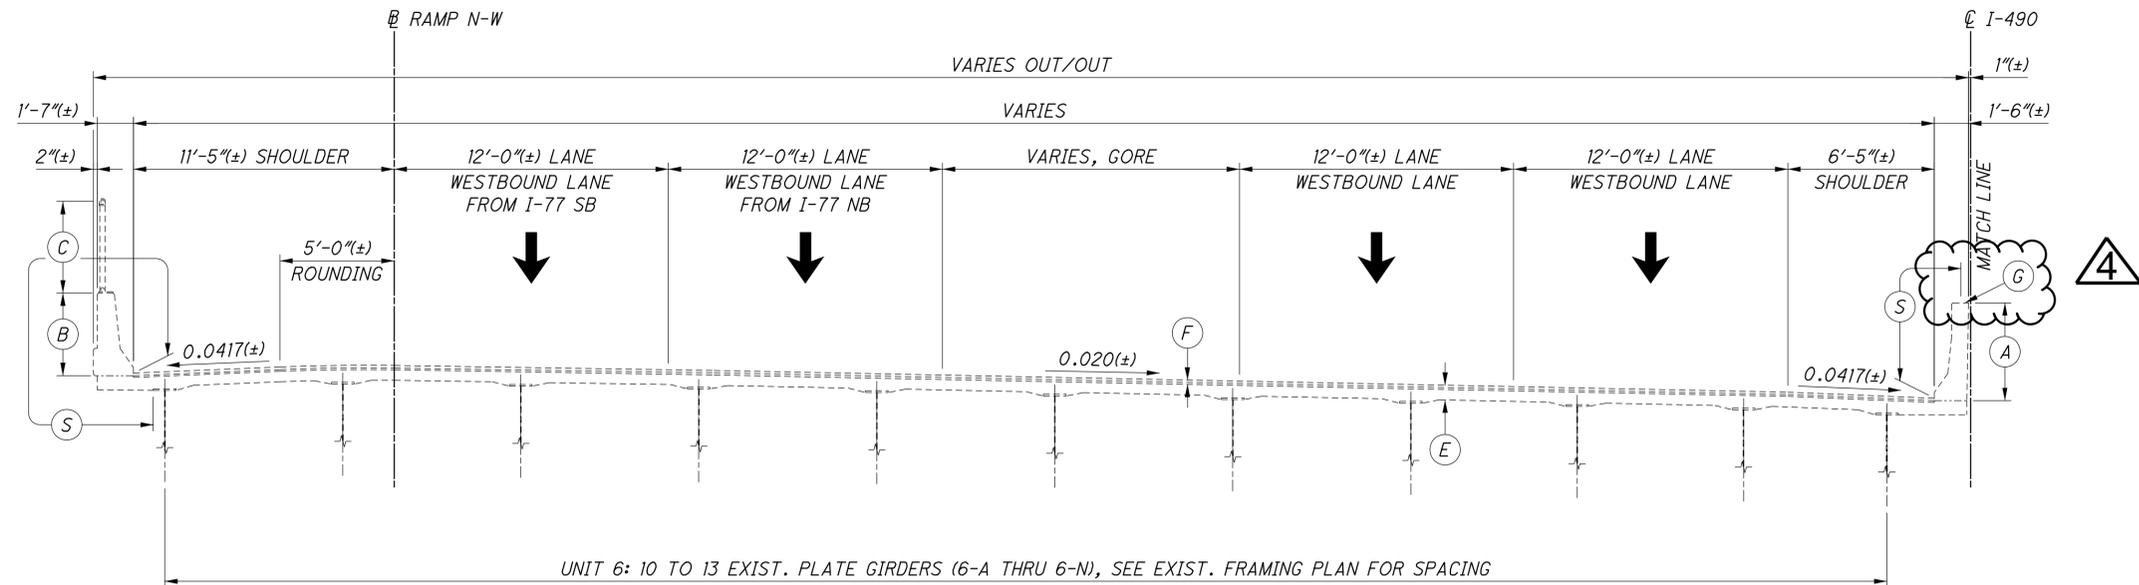

**LEFT SIDE**

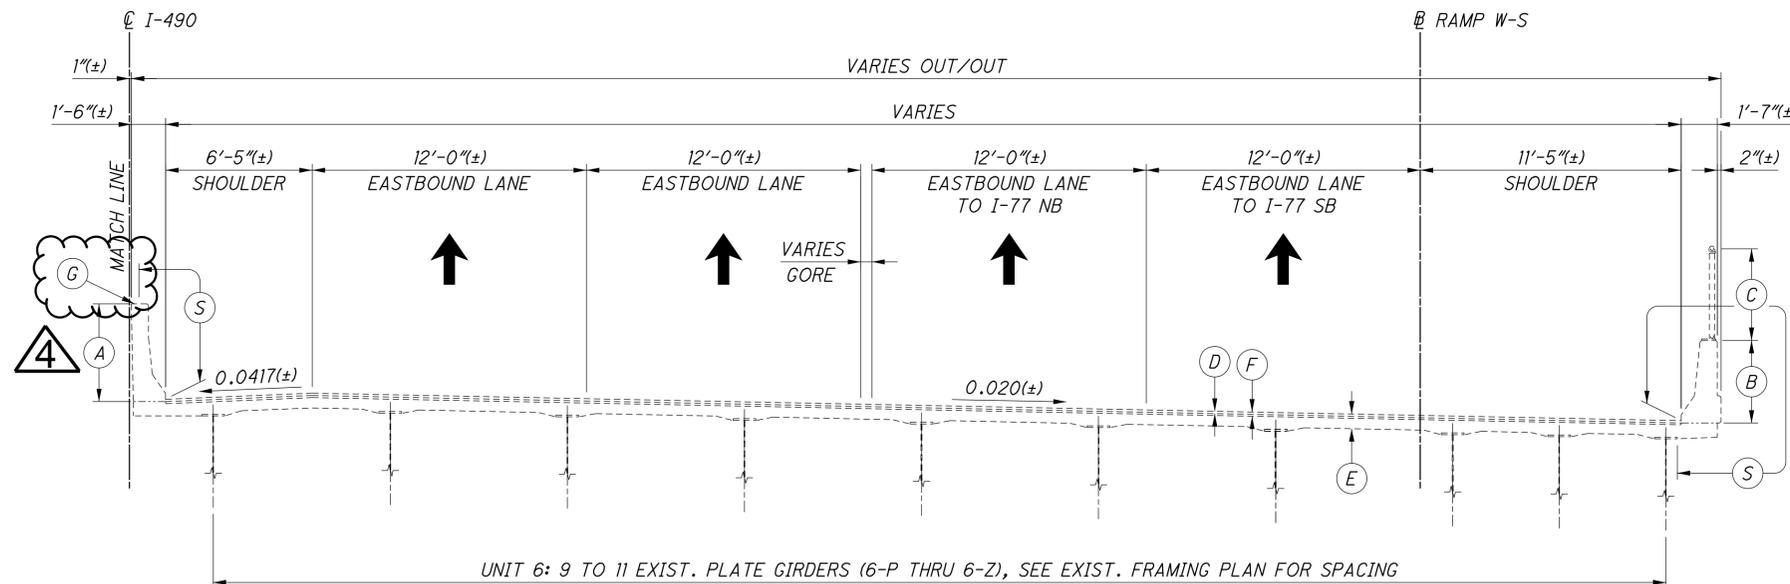

**RIGHT SIDE**

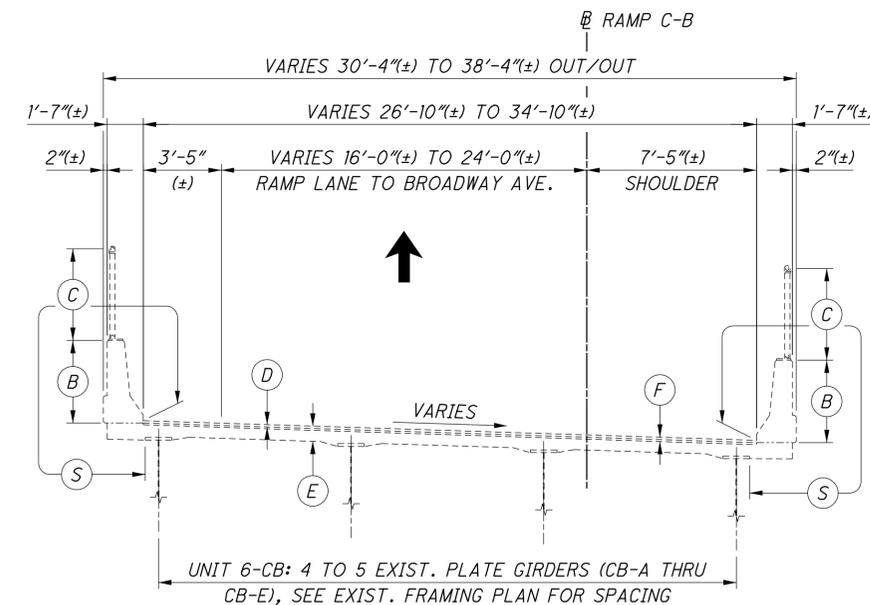

**EXISTING TRANSVERSE SECTION - UNIT 6**  
SHOWN AT STA. 1018+30(±) IN SPANS 23 & 24

**LEGEND**

- (A) EXIST. 4'-3/4" (±) MEDIAN PARAPET
- (B) EXIST. 3'-7/4" (±) EXTERIOR PARAPET
- (C) EXIST. 4'-0" (±) VANDAL PROTECTION FENCE
- (D) EXIST. 1/4" (±) LATEX MODIFIED CONCRETE WEARING SURFACE (1986 ORIGINAL CONSTRUCTION) OR EXIST. 1/2" (±) MICRO-SILICA MODIFIED CONCRETE OVERLAY (1998 AND 2021 WEARING SURFACE REPAIRS)
- (E) EXIST. REINFORCED CONCRETE DECK SLAB, 7 3/4" (±) MIN. TO 8 1/4" (±) MAX. TOTAL THICKNESS INCLUDING WEARING SURFACE, SEE EXIST. BRIDGE PLANS FOR MORE INFORMATION
- (F) 2 1/2" (±) TOTAL THICKNESS OF EXIST. OVERLAY AND CONCRETE LAYER BELOW THE OVERLAY TO BE REMOVED PER ITEM 848 - EXISTING CONCRETE OVERLAY REMOVED AS PER PLAN.
- (G) EXIST. MEDIAN BARRIER NEOPRENE COVER
- (S) REMOVAL OF EXISTING COATINGS FROM CONCRETE SURFACES AND SEALING OF CONCRETE SURFACES (EPOXY-URETHANE)




REVIEWED DATE 08/05/20  
MUL 08/05/20  
STRUCTURE FILE NUMBER 181991

PHASE CONSTRUCTION DETAILS - 3  
BRIDGE NO. CUY-490-0100  
I-490 OVER CUYAHOGA RIVER


CUY-490-01.00  
PID No. 107408

13 / 120  
24 / 131

X:\Projects\2022\00100\_ODOT\_DI2-CUY-490-0\25622\400-Engineering\Structures\CUY490\_0100C\Sheets\025622\_SF\N181991\_SC007.dgn 3/29/2024 3:37:21 PM zguo

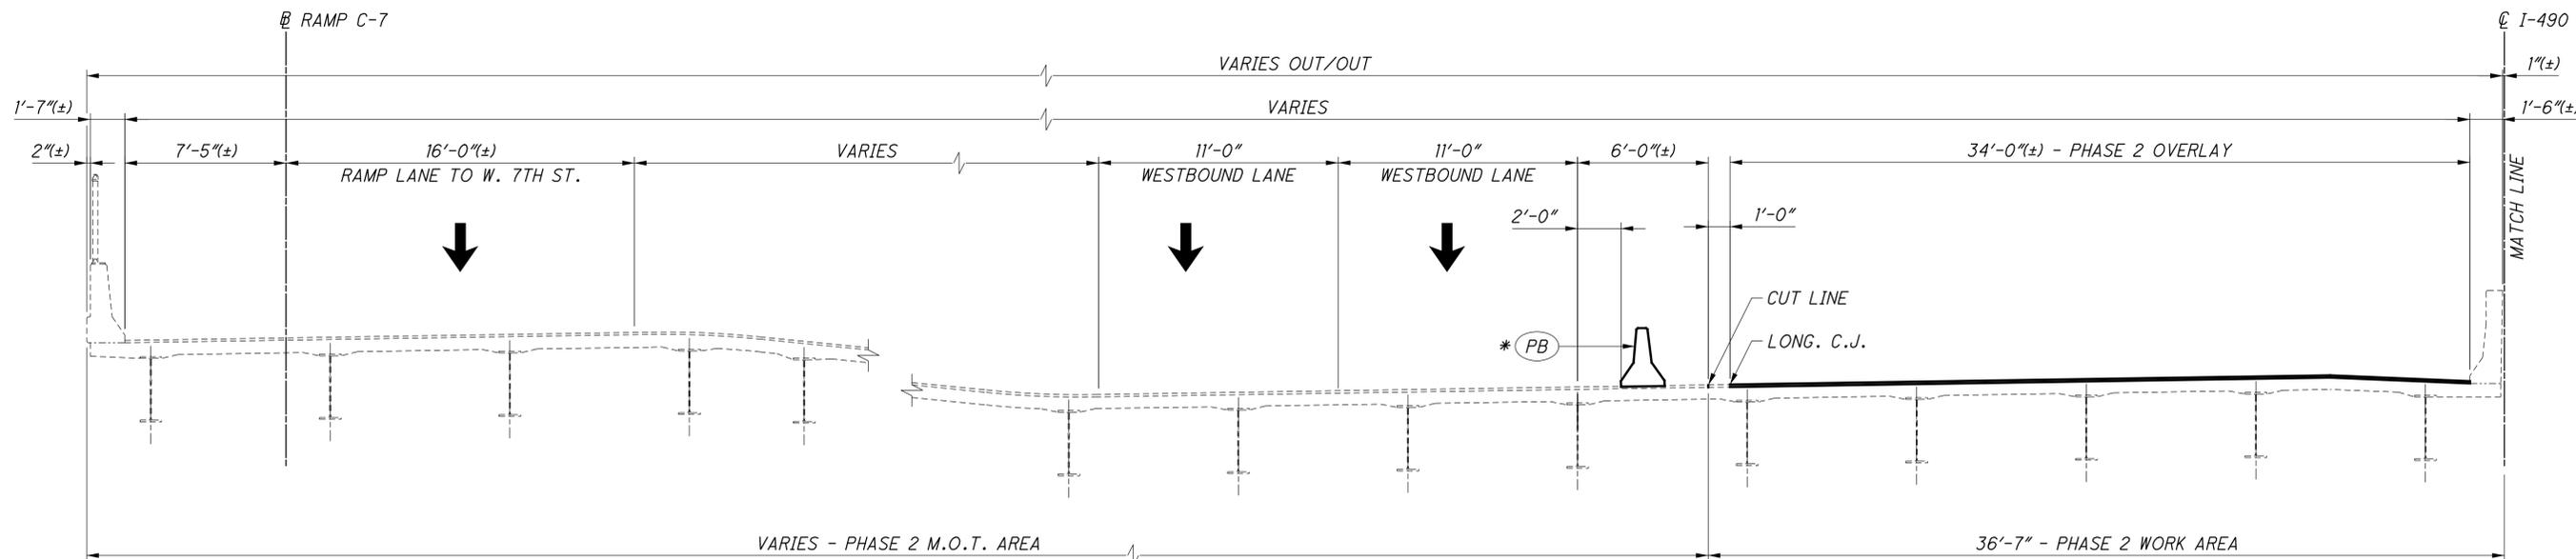

**LEFT SIDE**

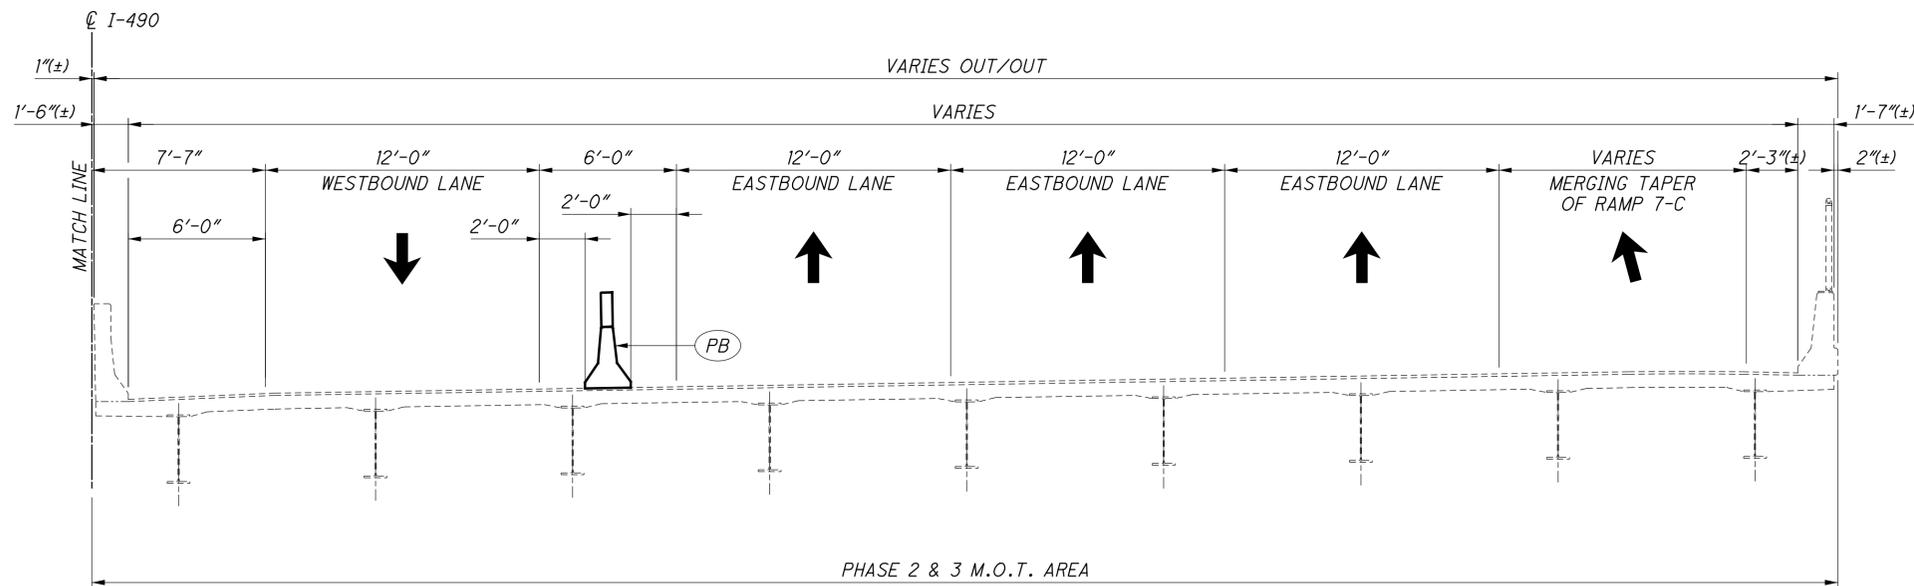

**RIGHT SIDE**

**PHASE 2 CONSTRUCTION TRANSVERSE SECTION - UNIT 1**

SHOWN AT STA. 986+80(±) IN SPAN 2

**NOTE:** CONSTRUCT PROPOSED MEDIAN BARRIER ON APPROACH SLAB, APPROACH SLAB AND SLEEPER SLAB BELOW MEDIAN BARRIER, ABUTMENT BACKWALL, AND MEDIAN BARRIER ON ABUTMENT BACKWALL IN PHASE 1.

FOR PHASE 1 CONSTRUCTION OF ABUTMENT BACKWALL AND MEDIAN BARRIER ON ABUTMENT BACKWALL, SEE SHEETS 29 & 55/120.

FOR PHASE 1 CONSTRUCTION OF APPROACH SLAB MEDIAN BARRIER AND PHASE 2 CONSTRUCTION OF APPROACH SLAB, SEE SHEETS 114 & 117/120.



**LEGEND**

- (PB) PORTABLE BARRIER, UNANCHORED, 50" HEIGHT OR 32" HEIGHT WITH 18" GLARE SCREEN
- (PB)\* PORTABLE BARRIER, UNANCHORED, 32" HEIGHT ON EXISTING BRIDGE DECK AND ANCHORED ON EXISTING OR PROPOSED APPROACH SLABS

**PHASE 2 CONSTRUCTION**

1. MAINTAIN I-490 TRAFFIC AS SHOWN ON EXISTING EASTBOUND BRIDGE DECK AND APPROACH SLABS AND OUTER PORTION OF EXISTING WESTBOUND BRIDGE DECK AND APPROACH SLABS.
2. PERFORM WORK ON INNER PORTION OF EXISTING WESTBOUND BRIDGE DECK AND APPROACH SLABS.
3. DURING PHASE 2, ALL ENTRANCE AND EXIT RAMPS ARE TO REMAIN OPEN TO TRAFFIC AT ALL TIMES.
4. FOR DETAILS OF WORK IN THIS PHASE, SEE SUGGESTED CONSTRUCTION PROCEDURE ON SHEET 7/120.




DESIGNED	PAT/JG	CHECKED	MHK/JDA
DRAWN	PAT/JG	REVISED	
REVIEWED	MJL	STRUCTURE FILE NUMBER	181991
DATE	08/05/20		


**PHASE CONSTRUCTION DETAILS - 4**  
 BRIDGE NO. CUY-490-0100  
 I-490 OVER CUYAHOGA RIVER

**CUY-490-01.00**  
 PID No. 107408

X:\Projects\2022\100100\_ODOT\_DI2-CUY-490-0\25622\_400-Engineering\Structures\CUY490\_0100C\Sheets\025622\_SF\N181991\_SC009.dgn 3/29/2024 3:37:23 PM zguo

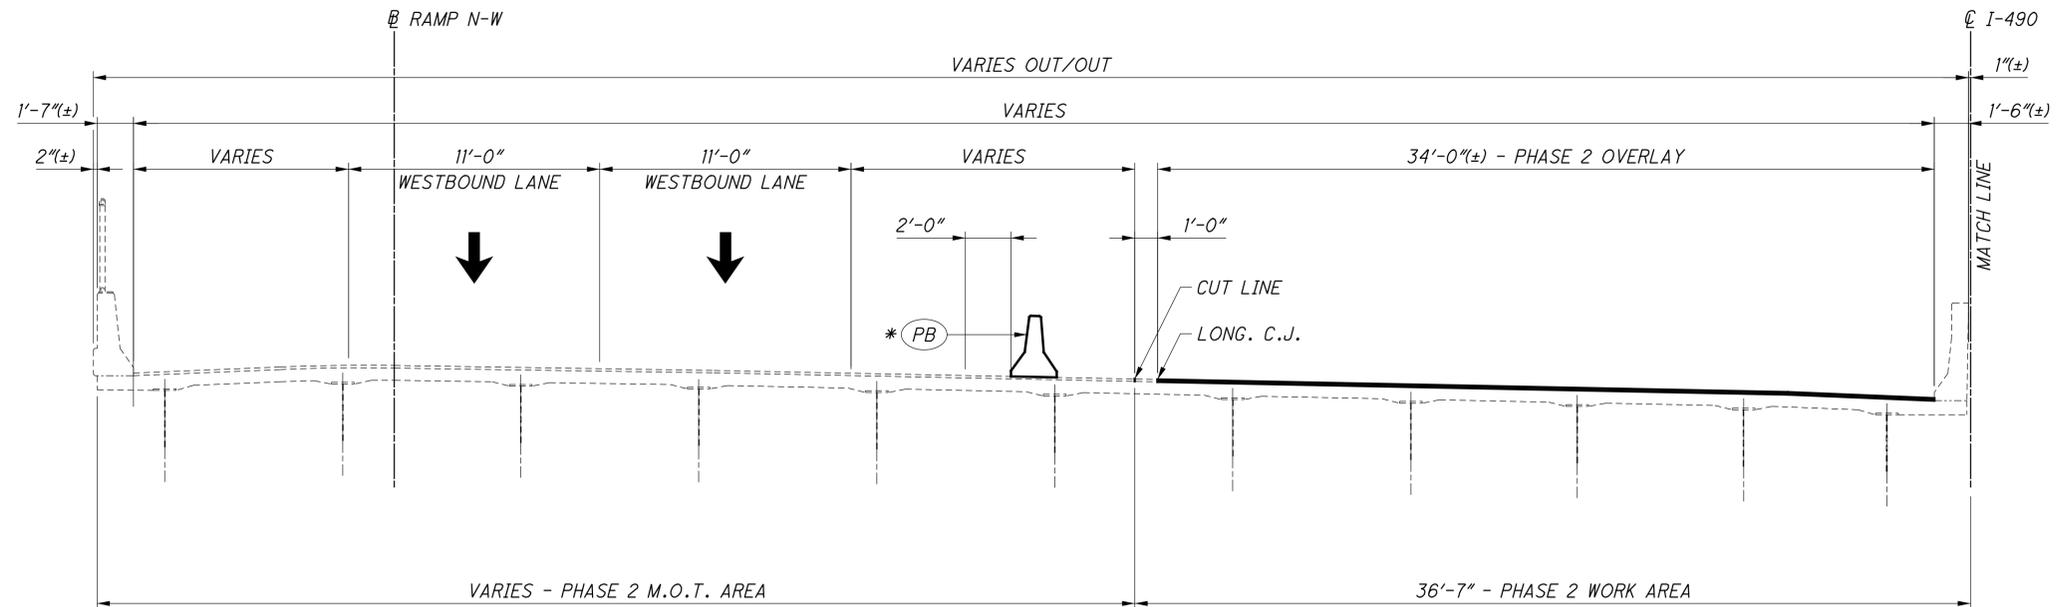

LEFT SIDE

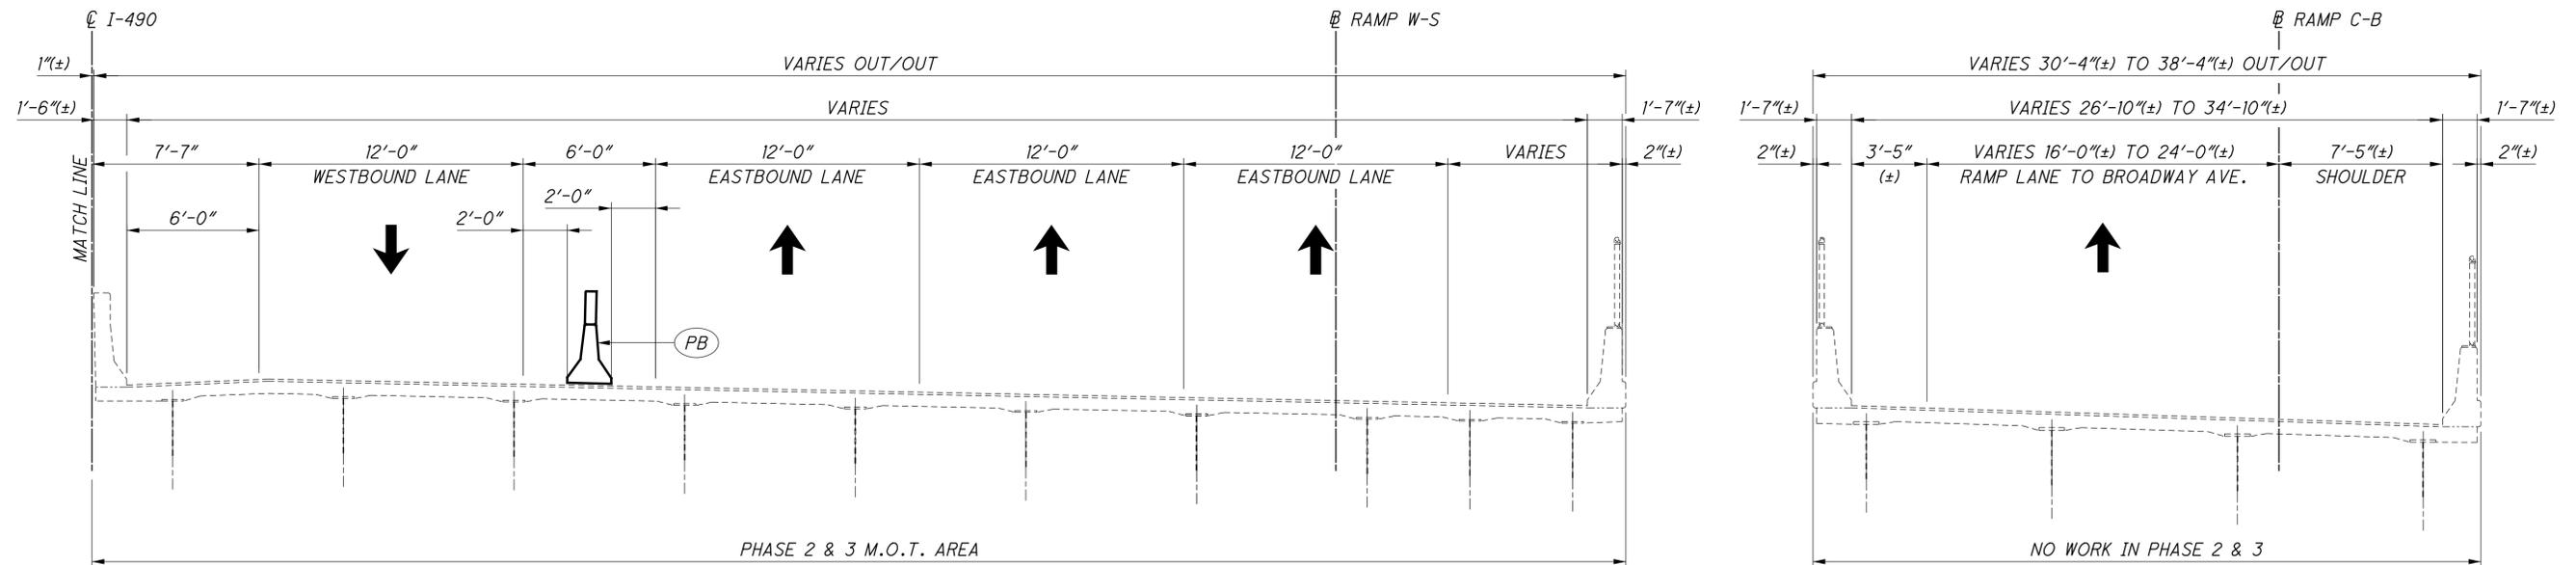

RIGHT SIDE

**PHASE 2 CONSTRUCTION TRANSVERSE SECTION - UNIT 6**

SHOWN AT STA. 1018+30(±) IN SPANS 23 & 24

**NOTE:** CONSTRUCT PROPOSED MEDIAN BARRIER ON APPROACH SLAB, APPROACH SLAB AND SLEEPER SLAB BELOW MEDIAN BARRIER, ABUTMENT BACKWALL, AND MEDIAN BARRIER ON ABUTMENT BACKWALL IN PHASE 1.

FOR PHASE 1 CONSTRUCTION OF ABUTMENT BACKWALL AND MEDIAN BARRIER ON ABUTMENT BACKWALL, SEE SHEETS 29 & 55/120.

FOR PHASE 1 CONSTRUCTION OF APPROACH SLAB MEDIAN BARRIER AND PHASE 2 CONSTRUCTION OF APPROACH SLAB, SEE SHEETS 114 & 117/120.



**LEGEND**

- (PB) PORTABLE BARRIER, UNANCHORED, 50" HEIGHT OR 32" HEIGHT WITH 18" GLARE SCREEN
- (PB)\* PORTABLE BARRIER, UNANCHORED, 32" HEIGHT ON EXISTING BRIDGE DECK AND ANCHORED ON EXISTING OR PROPOSED APPROACH SLABS

**PHASE 2 CONSTRUCTION**

1. MAINTAIN I-490 TRAFFIC AS SHOWN ON EXISTING EASTBOUND BRIDGE DECK AND APPROACH SLABS AND OUTER PORTION OF EXISTING WESTBOUND BRIDGE DECK AND APPROACH SLABS.
2. PERFORM WORK ON INNER PORTION OF EXISTING WESTBOUND BRIDGE DECK AND APPROACH SLABS.
3. DURING PHASE 2, ALL ENTRANCE AND EXIT RAMPS ARE TO REMAIN OPEN TO TRAFFIC AT ALL TIMES.
4. FOR DETAILS OF WORK IN THIS PHASE, SEE SUGGESTED CONSTRUCTION PROCEDURE ON SHEET 7/120.



DESIGNED	PAT/JG	CHECKED	MHK/JDA
DRAWN	PAT/JG	REVISED	
REVIEWED	MJL	STRUCTURE FILE NUMBER	181991
DATE	08/05/20		

PHASE CONSTRUCTION DETAILS - 6  
 BRIDGE NO. CUY-490-0100  
 I-490 OVER CUYAHOGA RIVER

CUY-490-01.00  
 PID No. 107408

16 / 120

27 / 131

X:\Projects\2022\100100\_ODOT\_DI2-CUY-490-0\25622\400-Engineering\Structures\CUY490\_0100C\Sheets\025622\_SF\N181991\_SC013.dgn 3/29/2024 3:31:26 PM zguo





REVIEWED DATE 08/05/20  
 M.J.L.  
 STRUCTURE FILE NUMBER 181991

PHASE CONSTRUCTION DETAILS - 10  
 BRIDGE NO. CUY-490-0100  
 I-490 OVER CUYAHOGA RIVER

CUY-490-01.00  
 PID No. 107408

20/120  
 31/131

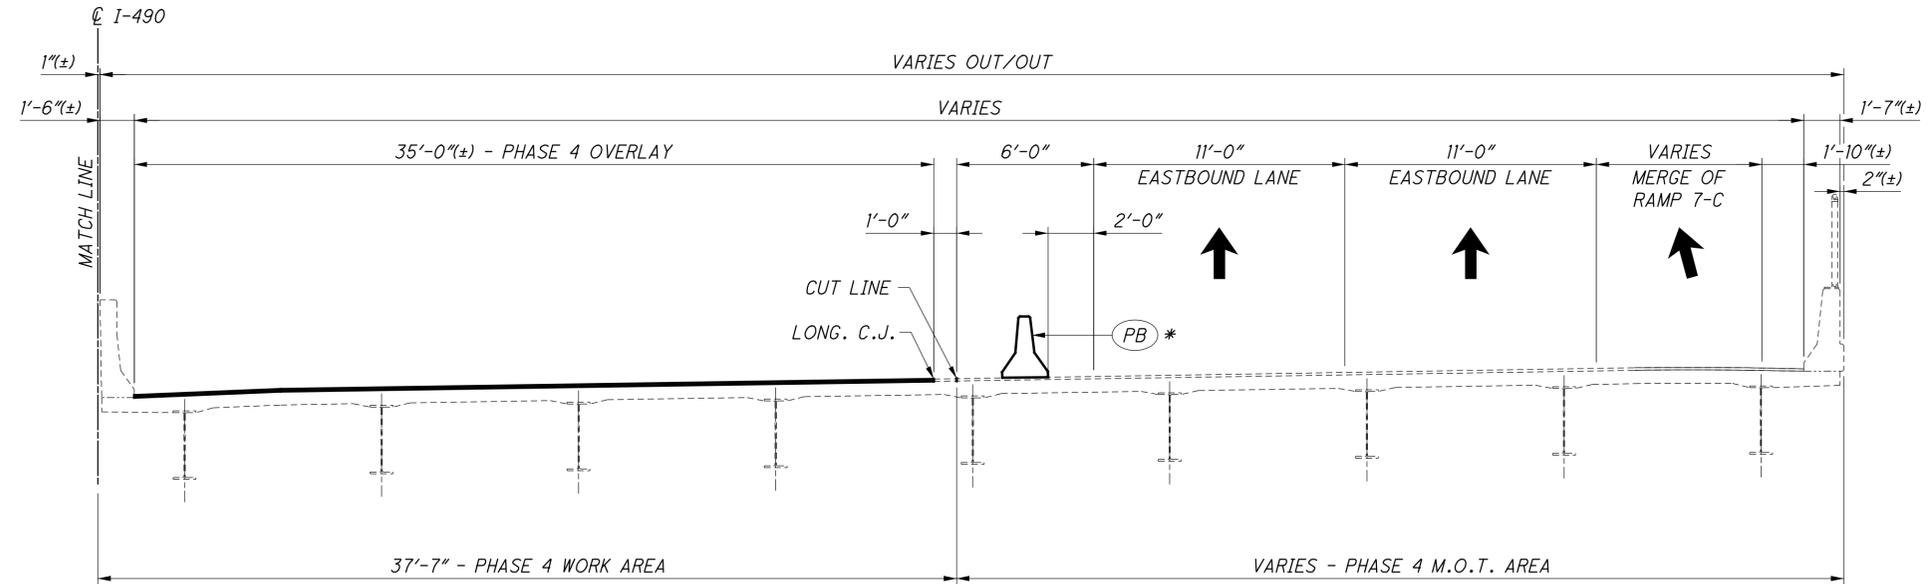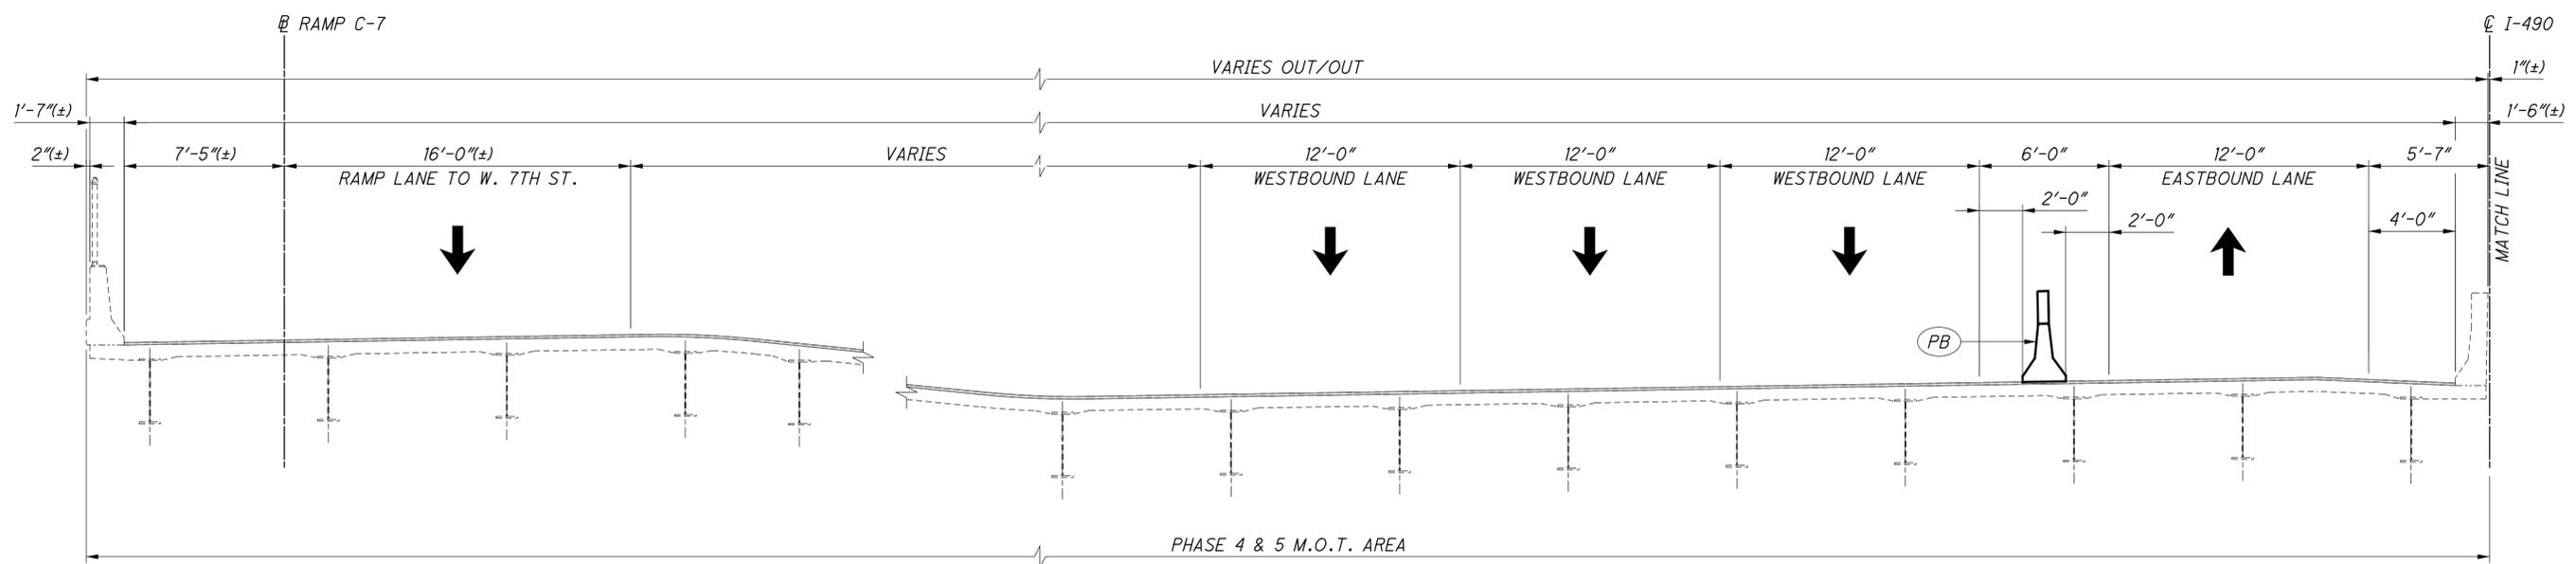

**PHASE 4 CONSTRUCTION TRANSVERSE SECTION - UNIT 1**  
 SHOWN AT STA. 986+80(±) IN SPAN 2



**NOTE:** CONSTRUCT PROPOSED MEDIAN BARRIER ON APPROACH SLAB, APPROACH SLAB AND SLEEPER SLAB BELOW MEDIAN BARRIER, ABUTMENT BACKWALL, AND MEDIAN BARRIER ON ABUTMENT BACKWALL IN PHASE 1.

FOR PHASE 1 CONSTRUCTION OF ABUTMENT BACKWALL AND MEDIAN BARRIER ON ABUTMENT BACKWALL, SEE SHEETS 29 & 55/120.

FOR PHASE 1 CONSTRUCTION OF APPROACH SLAB MEDIAN BARRIER AND PHASE 4 CONSTRUCTION OF APPROACH SLAB, SEE SHEETS 113 & 116/120.


**LEGEND**

- (PB) PORTABLE BARRIER, UNANCHORED, 50" HEIGHT OR 32" HEIGHT WITH 18" GLARE SCREEN
- (PB) \* PORTABLE BARRIER, UNANCHORED, 32" HEIGHT ON EXISTING BRIDGE DECK AND ANCHORED ON EXISTING OR PROPOSED APPROACH SLABS


**PHASE 4 CONSTRUCTION**

1. MAINTAIN I-490 TRAFFIC AS SHOWN ON EXISTING WESTBOUND BRIDGE DECK AND APPROACH SLABS AND OUTER PORTION OF EXISTING EASTBOUND BRIDGE DECK AND APPROACH SLABS.
2. PERFORM WORK ON INNER PORTION OF EXISTING EASTBOUND BRIDGE DECK AND APPROACH SLABS.
3. DURING PHASE 4, ALL ENTRANCE AND EXIT RAMP ARE TO REMAIN OPEN TO TRAFFIC AT ALL TIMES.
4. FOR DETAILS OF WORK IN THIS PHASE, SEE SUGGESTED CONSTRUCTION PROCEDURE ON SHEET 8/120.

X:\Projects\2022\100100\_ODOT\_DI2-CUY-490-0\25622\400-Engineering\Structures\CUY490\_0100C\Sheets\025622\_SF\N181991\_SC015.dgn 3/29/2024 3:31:28 PM zguo

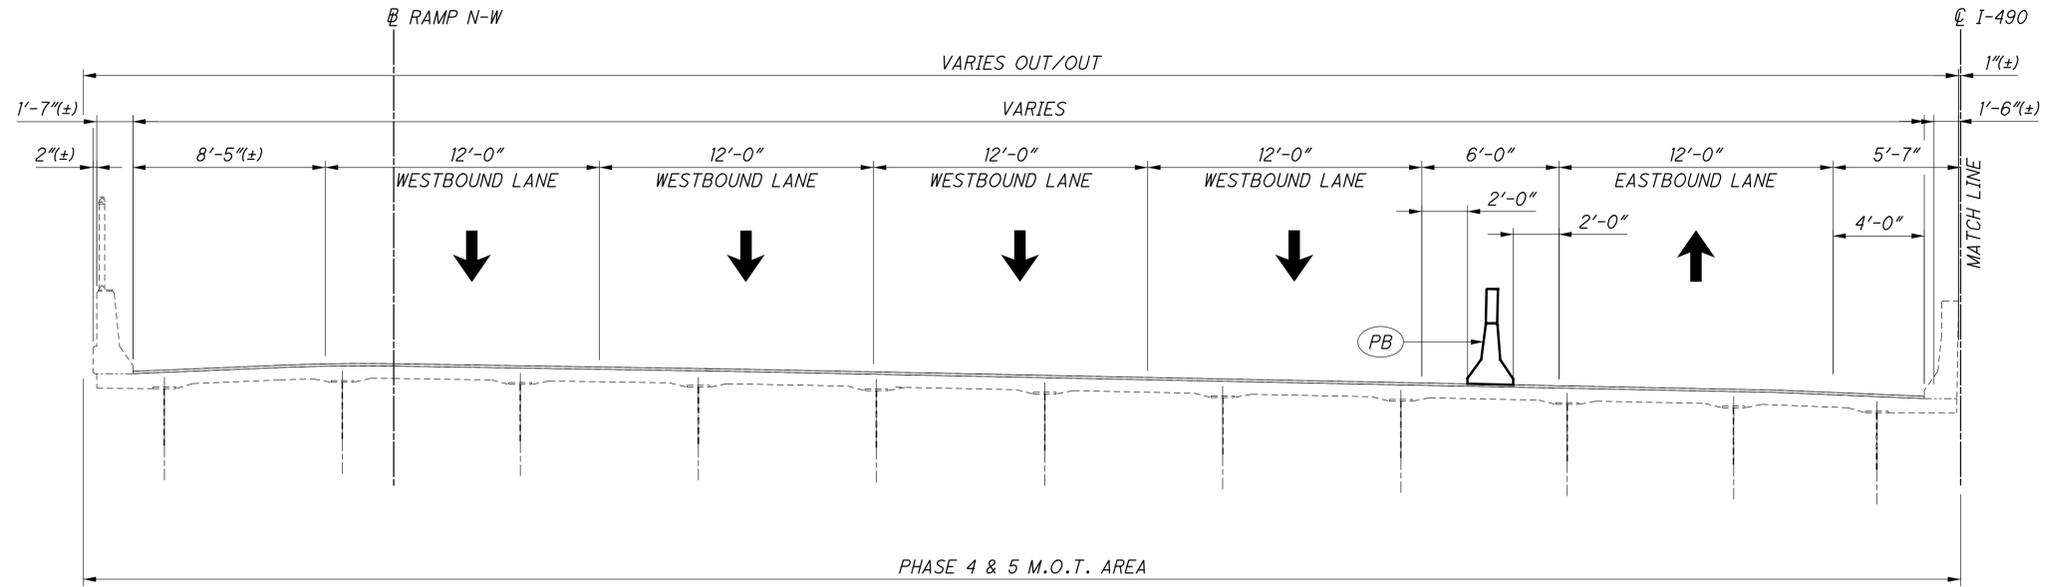

**LEFT SIDE**

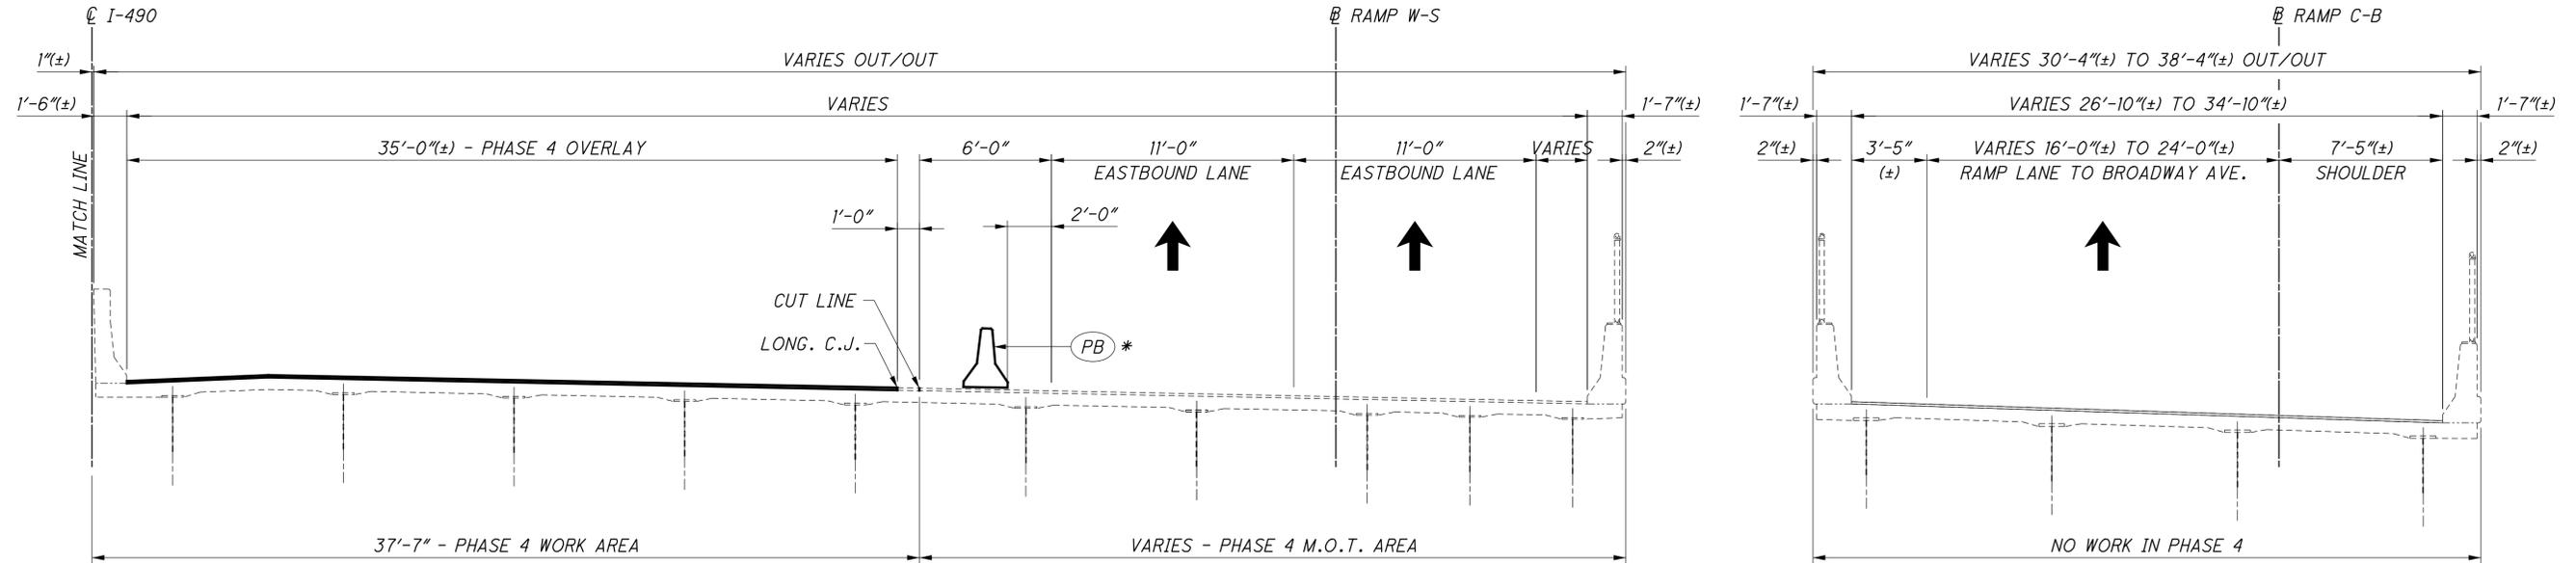

**RIGHT SIDE**

**PHASE 4 CONSTRUCTION TRANSVERSE SECTION - UNIT 6**

SHOWN AT STA. 1018+30(±) IN SPANS 23 & 24

**NOTE:** CONSTRUCT PROPOSED MEDIAN BARRIER ON APPROACH SLAB, APPROACH SLAB AND SLEEPER SLAB BELOW MEDIAN BARRIER, ABUTMENT BACKWALL, AND MEDIAN BARRIER ON ABUTMENT BACKWALL IN PHASE 1.

FOR PHASE 1 CONSTRUCTION OF ABUTMENT BACKWALL AND MEDIAN BARRIER ON ABUTMENT BACKWALL, SEE SHEETS 29 & 55/120.

FOR PHASE 1 CONSTRUCTION OF APPROACH SLAB MEDIAN BARRIER AND PHASE 4 CONSTRUCTION OF APPROACH SLAB, SEE SHEETS 113 & 116/120.



**LEGEND**

- (PB) PORTABLE BARRIER, UNANCHORED, 50" HEIGHT OR 32" HEIGHT WITH 18" GLARE SCREEN
- (PB) \* PORTABLE BARRIER, UNANCHORED, 32" HEIGHT ON EXISTING BRIDGE DECK AND ANCHORED ON EXISTING OR PROPOSED APPROACH SLABS

**PHASE 4 CONSTRUCTION**

1. MAINTAIN I-490 TRAFFIC AS SHOWN ON EXISTING WESTBOUND BRIDGE DECK AND APPROACH SLABS AND OUTER PORTION OF EXISTING EASTBOUND BRIDGE DECK AND APPROACH SLABS.
2. PERFORM WORK ON INNER PORTION OF EXISTING EASTBOUND BRIDGE DECK AND APPROACH SLABS.
3. DURING PHASE 4, ALL ENTRANCE AND EXIT RAMPS ARE TO REMAIN OPEN TO TRAFFIC AT ALL TIMES.
4. FOR DETAILS OF WORK IN THIS PHASE, SEE SUGGESTED CONSTRUCTION PROCEDURE ON SHEET 8/120.



DESIGNED	PAT/JG	CHECKED	MHK/JDA
DRAWN	PAT/JG	REVISED	
REVIEWED	MJL	STRUCTURE FILE NUMBER	1811991
DATE	08/05/20		


**PHASE CONSTRUCTION DETAILS - 12**  
 BRIDGE NO. CUY-490-0100  
 I-490 OVER CUYAHOGA RIVER

**CUY-490-01.00**  
 PID No. 107408


22/120

33/131

X:\Projects\2020\2022\001000\_ODOT\_DI2-CUY-490-0\25622\400-Engineering\Structures\CUY490\_0100C\Sheets\025622\_SF\N181991\_SC016.dgn 3/29/2024 3:37:31 PM zguo

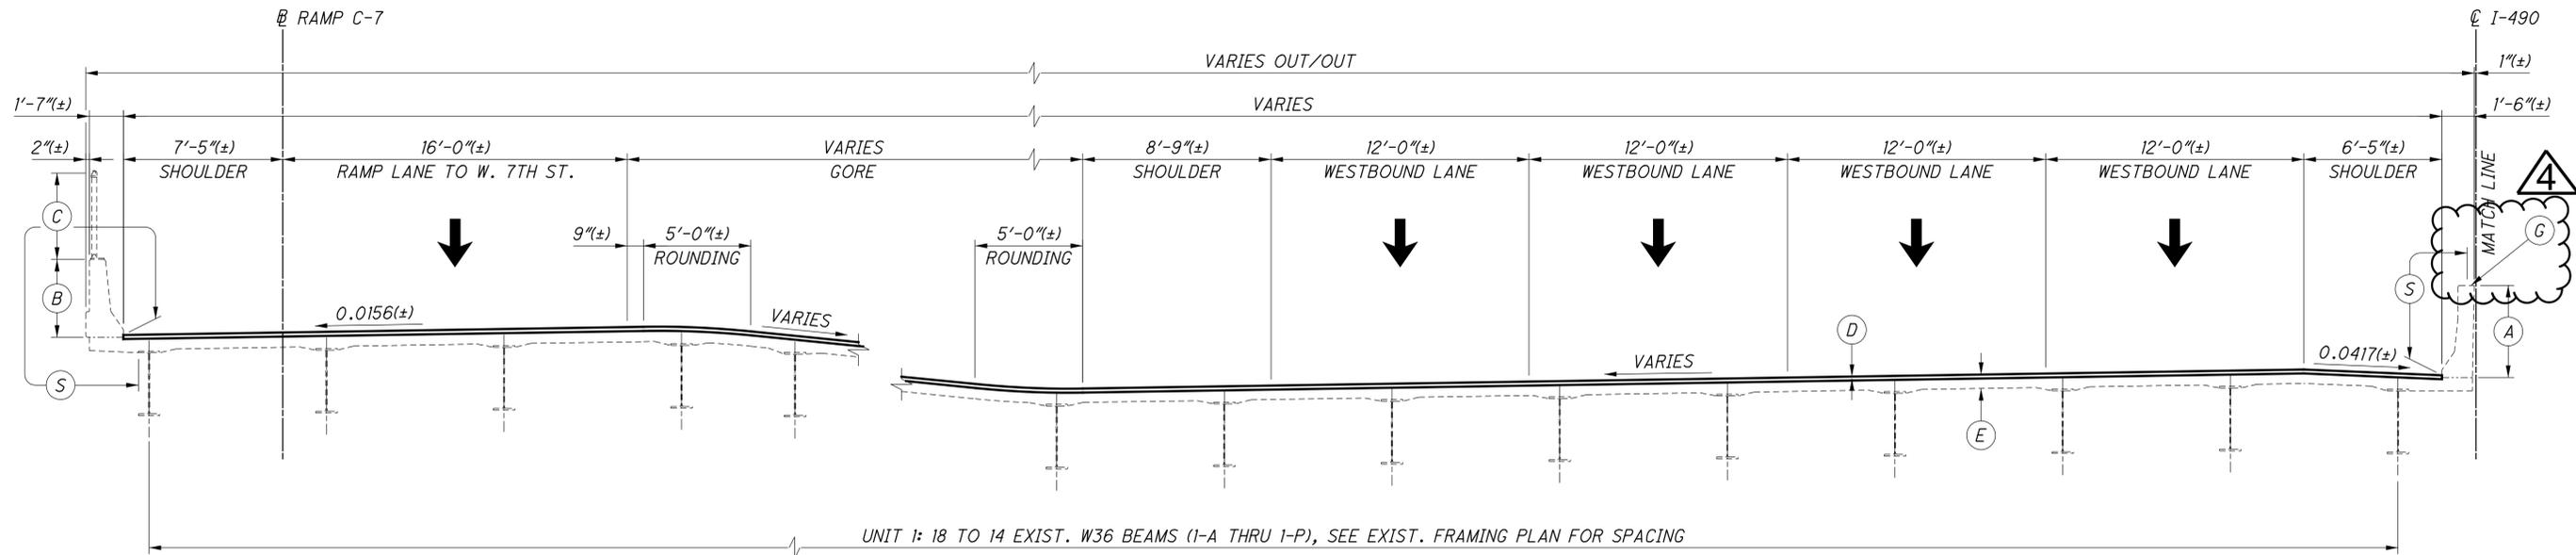

**LEFT SIDE**

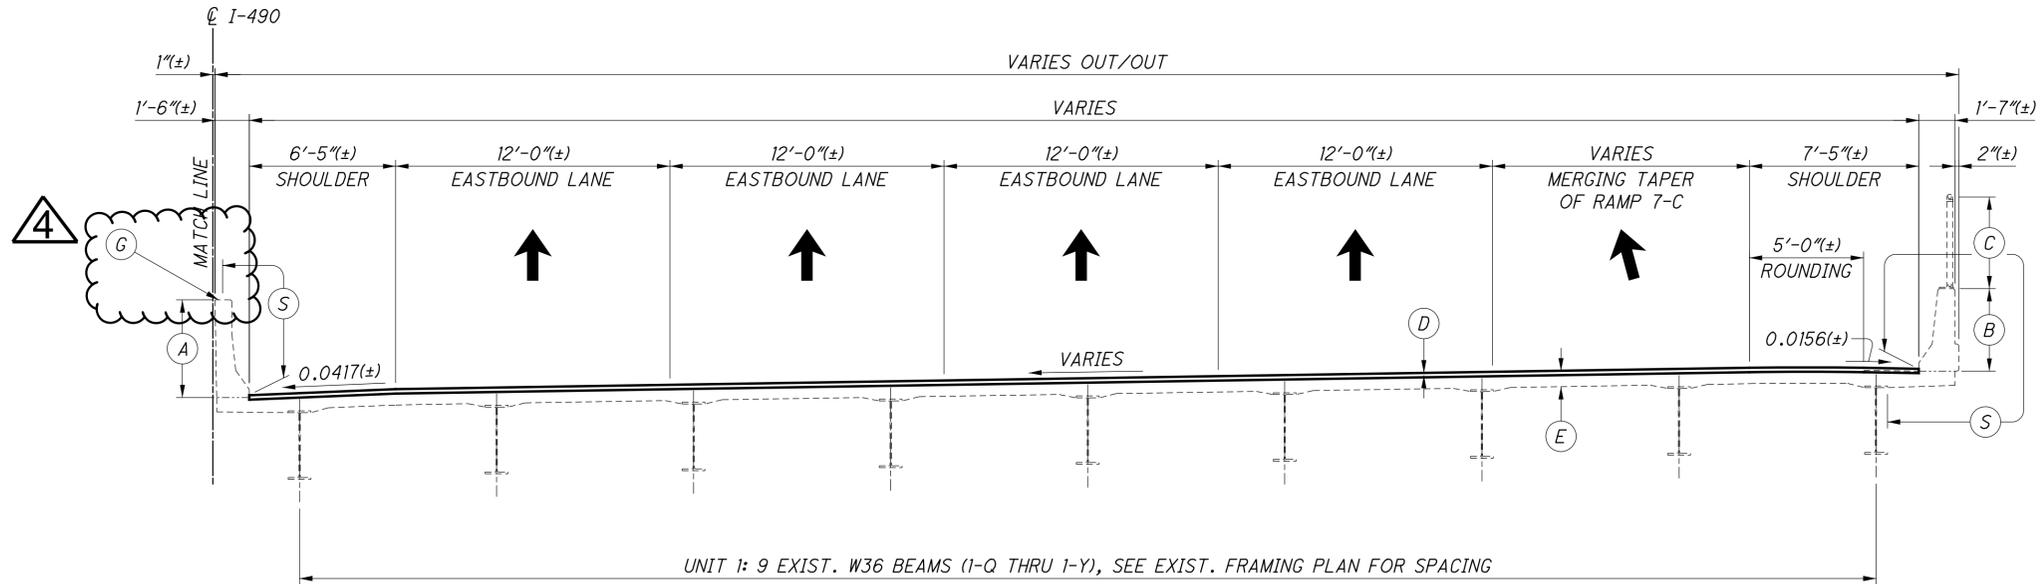

**RIGHT SIDE**

**PROPOSED TRANSVERSE SECTION - UNIT 1**  
SHOWN AT STA. 986+80(±) IN SPAN 2

**LEGEND**

- (A) EXIST. 4'-3/4" (±) MEDIAN PARAPET
- (B) EXIST. 3'-7/4" (±) EXTERIOR PARAPET
- (C) EXIST. 4'-0" (±) VANDAL PROTECTION FENCE
- (D) PROP. 2 1/2" MICRO-SILICA MODIFIED CONCRETE OVERLAY
- (E) EXIST. REINFORCED CONCRETE DECK SLAB, 7 3/4" (±) MIN. TO 8 1/4" (±) MAX. TOTAL THICKNESS INCLUDING WEARING SURFACE, SEE EXIST. BRIDGE PLANS FOR MORE INFORMATION
- (G) MEDIAN BARRIER NEOPRENE COVER TO REMAIN
- (S) REMOVAL OF EXISTING COATINGS FROM CONCRETE SURFACES AND SEALING OF CONCRETE SURFACES (EPOXY-URETHANE)



DESIGNED	PAT	CHECKED	JAM
DRAWN	PAT	REVISED	
REVIEWED	MUL	STRUCTURE FILE NUMBER	181991
DATE	08/05/20		


**PHASE CONSTRUCTION DETAILS - 16**  
BRIDGE NO. CUY-490-0100  
I-490 OVER CUYAHOGA RIVER

**CUY-490-01.00**  
PID No. 107408


26 / 120

37 / 131

X:\Projects\2020\2022\001000\_ODOT\_DI2-CUY-490-0\25622\400-Engineering\Structures\CUY490\_0100C\Sheets\025622\_SF\N181991\_SC017.dgn 3/29/2024 3:37:31PM zguo

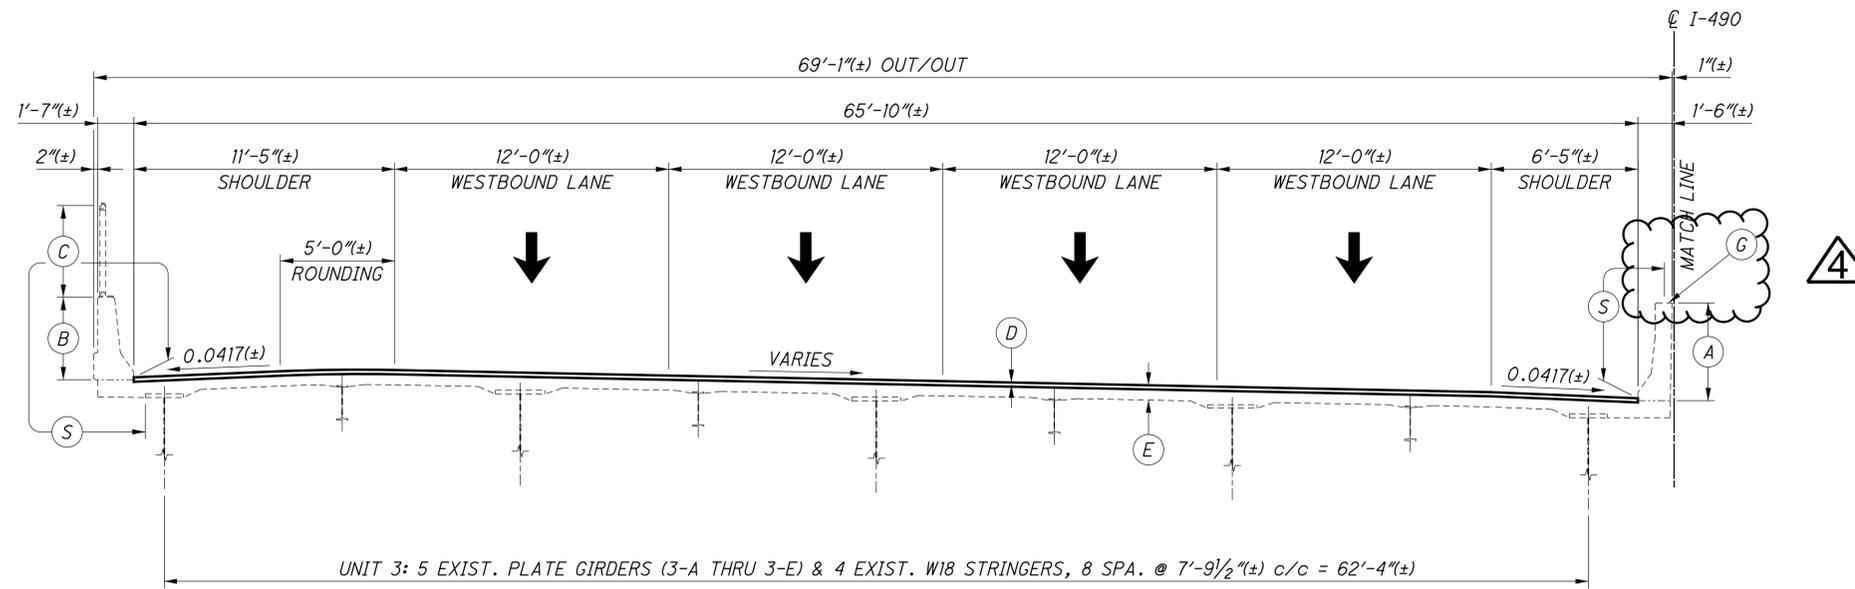

**LEFT SIDE**

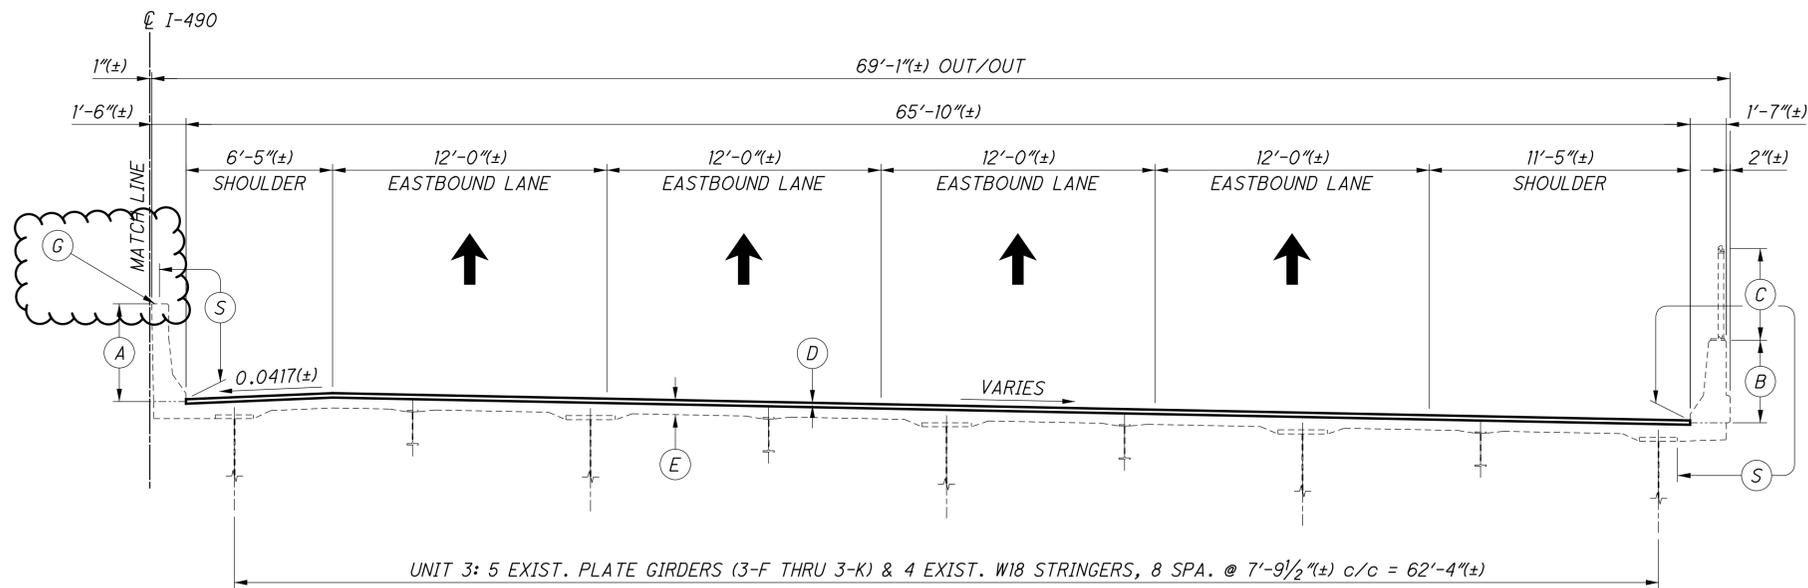

**RIGHT SIDE**

**PROPOSED TRANSVERSE SECTION - UNIT 3**

SHOWN AT STA. 999+50 (±) IN SPAN 11

**LEGEND**

- (A) EXIST. 4'-3 1/4" (±) MEDIAN PARAPET
- (B) EXIST. 3'-7 1/4" (±) EXTERIOR PARAPET
- (C) EXIST. 4'-0" (±) VANDAL PROTECTION FENCE
- (D) PROP. 2 1/2" MICRO-SILICA MODIFIED CONCRETE OVERLAY
- (E) EXIST. REINFORCED CONCRETE DECK SLAB, 7 3/4" (±) MIN. TO 8 1/4" (±) MAX. TOTAL THICKNESS INCLUDING WEARING SURFACE, SEE EXIST. BRIDGE PLANS FOR MORE INFORMATION
- (G) MEDIAN BARRIER NEOPRENE COVER TO REMAIN
- (S) REMOVAL OF EXISTING COATINGS FROM CONCRETE SURFACES AND SEALING OF CONCRETE SURFACES (EPOXY-URETHANE)



DESIGNED	PAT	CHECKED	JAM
DRAWN	PAT	REVISED	
REVIEWED	MJL	STRUCTURE FILE NUMBER	181991
DATE	08/05/20		




**PHASE CONSTRUCTION DETAILS - 17**  
BRIDGE NO. CUY-490-0100  
I-490 OVER CUYAHOGA RIVER

**CUY-490-01.00**  
PID No. 107408

27/120

38/131

X:\Projects\2020\2022\100100\_ODOT\_DI2-CUY-490-0\25622\400-Engineering\Structures\CUY490\_0100C\Sheets\025622\_SF\N181991\_SC018.dgn 3/29/2024 3:37:32 PM zguo

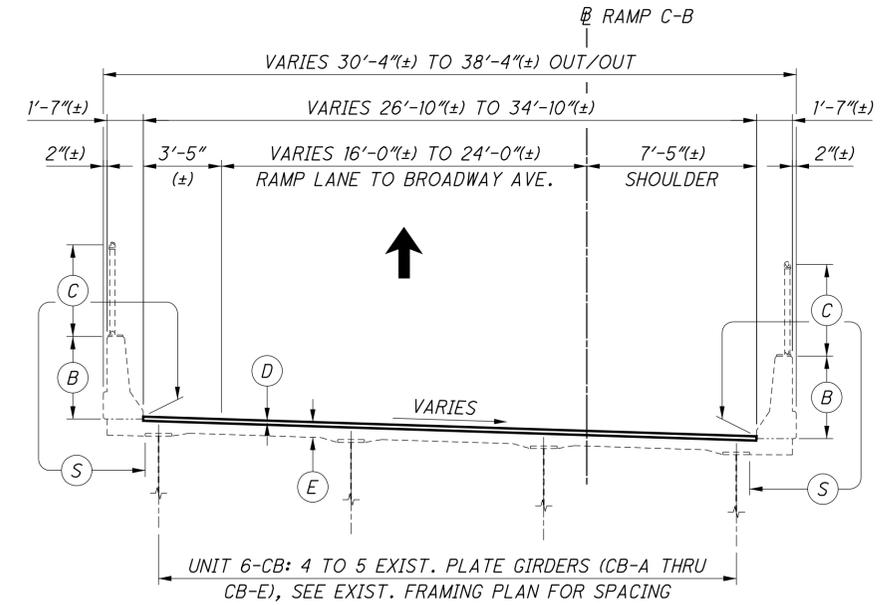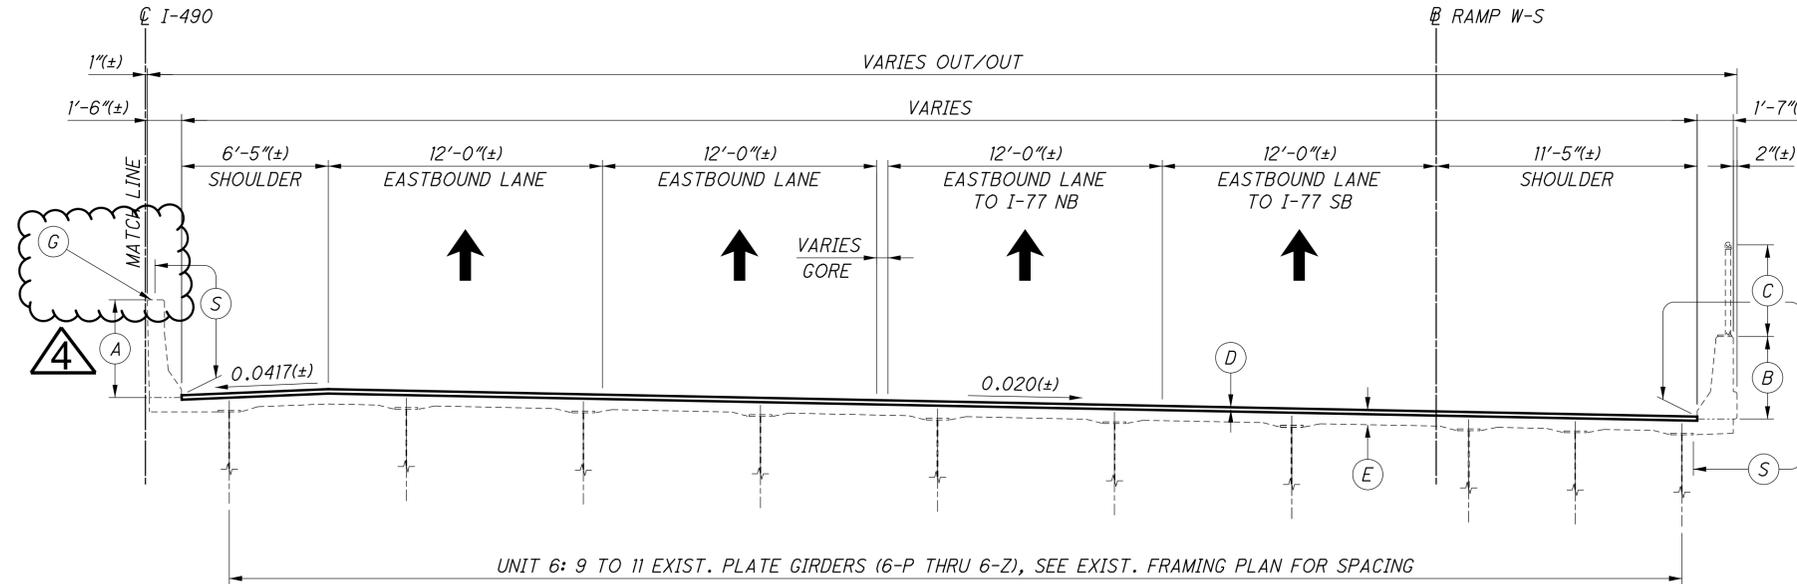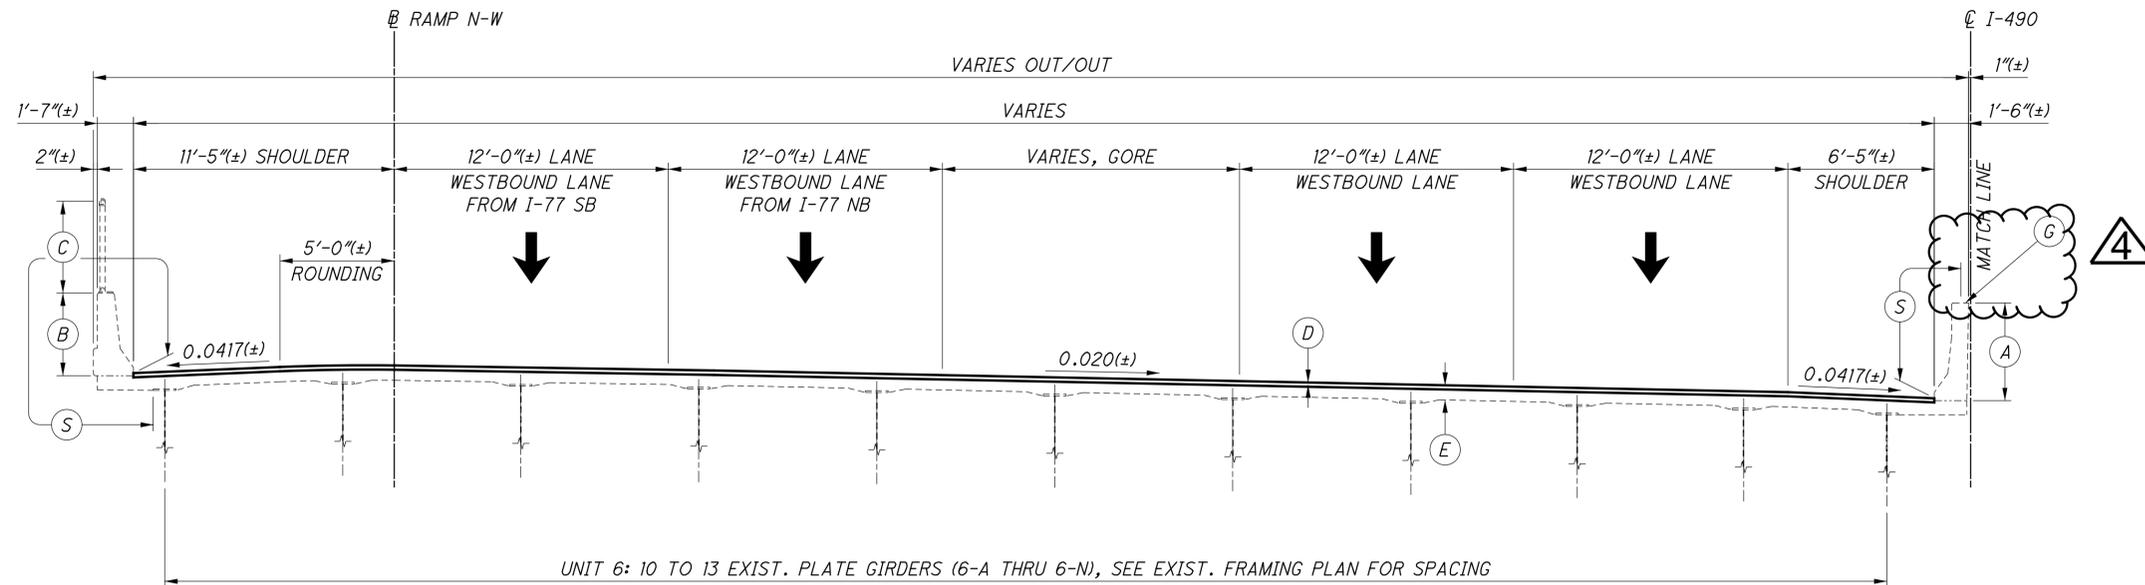

**PROPOSED TRANSVERSE SECTION - UNIT 6**  
SHOWN AT STA. 1018+30(±) IN SPANS 23 & 24

**LEGEND**

- (A) EXIST. 4'-3/4" (±) MEDIAN PARAPET
- (B) EXIST. 3'-7/4" (±) EXTERIOR PARAPET
- (C) EXIST. 4'-0" (±) VANDAL PROTECTION FENCE
- (D) PROP. 2 1/2" MICRO-SILICA MODIFIED CONCRETE OVERLAY
- (E) EXIST. REINFORCED CONCRETE DECK SLAB, 7 3/4" (±) MIN. TO 8 1/4" (±) MAX. TOTAL THICKNESS INCLUDING WEARING SURFACE, SEE EXIST. BRIDGE PLANS FOR MORE INFORMATION
- (G) MEDIAN BARRIER NEOPRENE COVER TO REMAIN
- (S) REMOVAL OF EXISTING COATINGS FROM CONCRETE SURFACES AND SEALING OF CONCRETE SURFACES (EPOXY-URETHANE)



REVIEWED DATE 08/05/20  
MUL 08/05/20  
STRUCTURE FILE NUMBER 181991

DRAWN PAT  
PAT REVISED

DESIGNED PAT  
PAT CHECKED JAM


PHASE CONSTRUCTION DETAILS - 18  
BRIDGE NO. CUY-490-0100  
I-490 OVER CUYAHOGA RIVER

CUY-490-01.00  
PID No. 107408


28/120

39/131


X:\Projects\2022\00100 DOT D12-CUY-490-0-25622-400-Engineering\Structures\CUY490\_0100C\Sheets\025622\_SF\N81991\_S\_001.dgn 3/29/2024 3:37:34 PM zguo

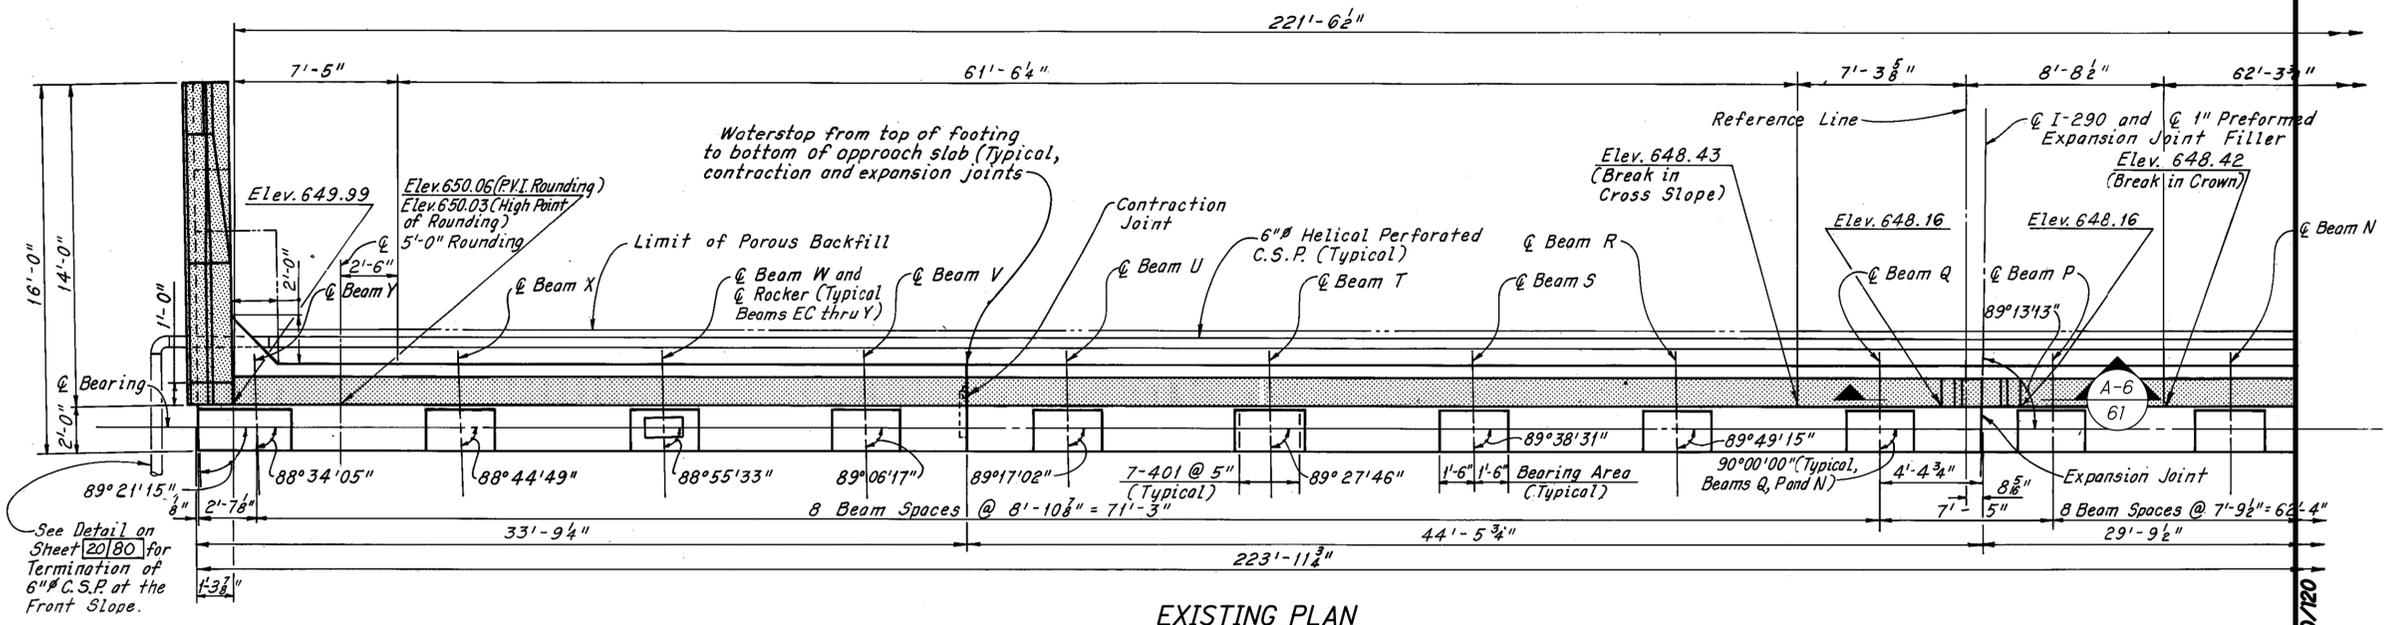

**EXISTING PLAN**

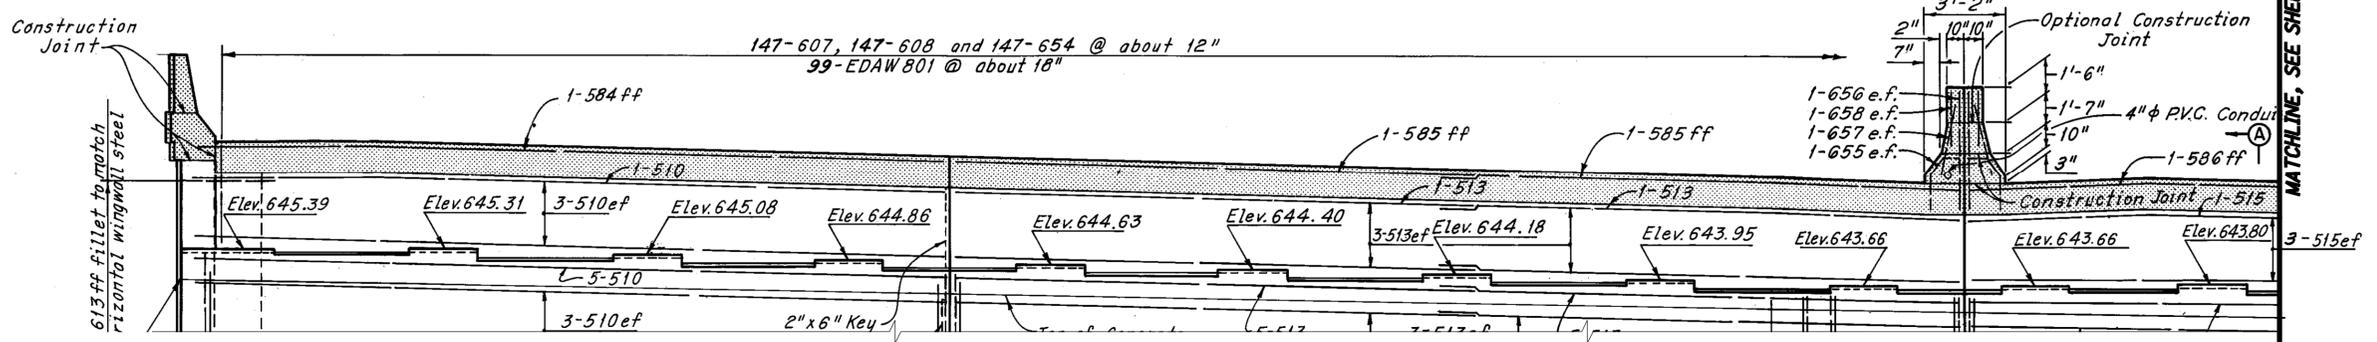

**EXISTING PARTIAL ELEVATION**

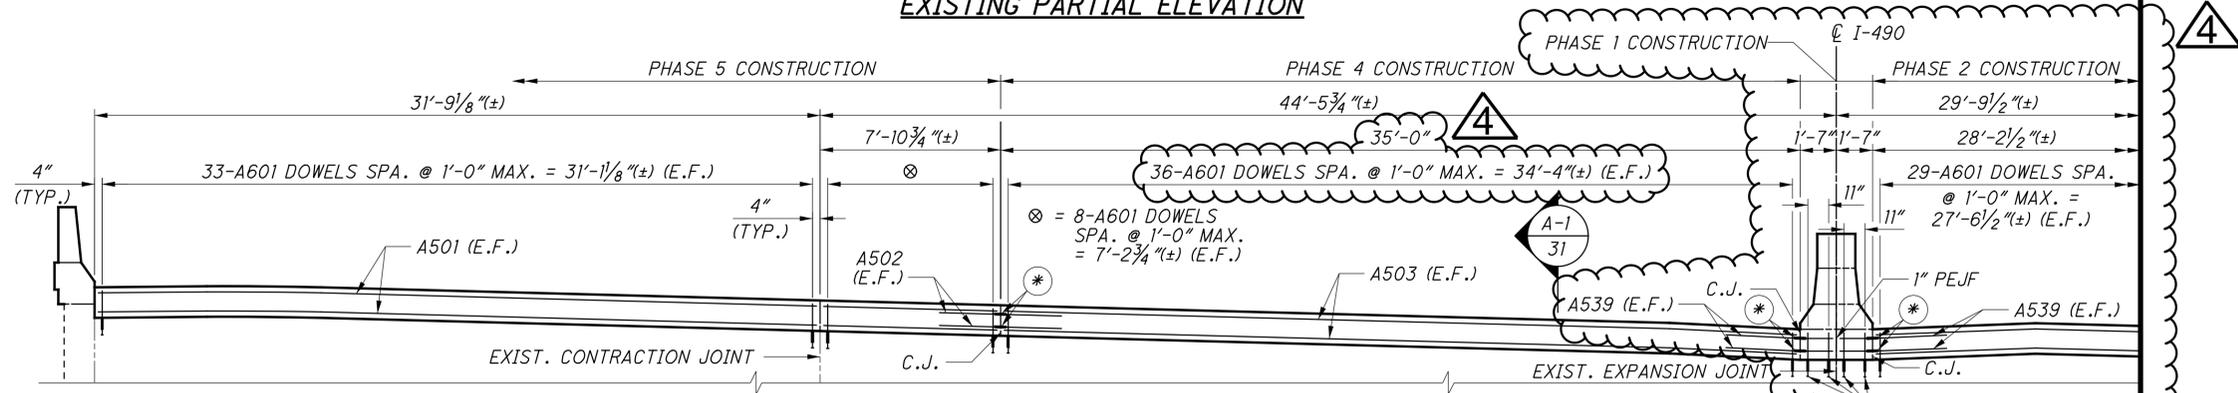

**PROPOSED PARTIAL ELEVATION**

**LEGEND**

- ITEM 202 - PORTIONS OF STRUCTURE REMOVED, OVER 20' SPAN, AS PER PLAN
- AREA OF DELAMINATION TO BE REPAIRED PER ITEM 844 - CONCRETE PATCHING WITH GALVANIC ANODE PROTECTION, AS PER PLAN
- AREA OF CONCRETE DELAMINATION LOCATION NUMBER
- EXISTING CRACK TO BE REPAIRED LOCATION NUMBER
- THREADED MECHANICAL CONNECTOR, PROVIDING 3'-1" MIN. LAP, SHALL BE RICHMOND SCREW ANCHOR THREADED DOWEL BAR ASSEMBLY, LENTON REBAR SPLICING MECHANISM, OR APPROVED EQUAL AND THE COST SHALL BE INCLUDED WITH ITEM 509 - EPOXY COATED REINFORCING STEEL FOR PAYMENT

ESTIMATED PATCHING QUANTITIES		
LOCATION	WIDTH X HEIGHT	AREA (SF)
	NO DETERIORATION NOTED	
TOTAL AREA MEASURED		-
TOTAL AREA ESTIMATED *		-

\* SEE NOTE 3

ESTIMATED CRACK REPAIR QUANTITIES		
LOCATION	DESCRIPTION	LENGTH
	NO DETERIORATION NOTED	
TOTAL LENGTH MEASURED		-
TOTAL LENGTH ESTIMATED *		-

\* SEE NOTE 3

**NOTES**

1. EXISTING PLAN AND ELEVATION VIEW LINE WORK ON THIS SHEET COMES FROM SCANS OF THE 1986 RECORD PLANS. REFERENCES TO I-290 SHOULD BE REPLACED WITH I-490.
2. PHYSICAL INVENTORY OF MEASURED QUANTITIES OF DETERIORATION WAS PERFORMED IN AUGUST 2018. THE EXACT DIMENSIONS AND LOCATIONS OF PATCHES AND CRACK REPAIRS SHALL BE DETERMINED BY THE ENGINEER IN THE FIELD FOR FINAL PAY QUANTITY.
3. ESTIMATED PATCHING AND CRACK REPAIR QUANTITIES HAVE BEEN INCREASED BY 50% OVER MEASURED QUANTITIES TO ALLOW FOR ADDITIONAL DETERIORATION.
4. FOR PARAPET REPLACEMENT DETAILS, SEE SHEET 61/120.
5. THE MINIMUM LAP LENGTH FOR ABUTMENT REINFORCING STEEL SHALL BE 2'-5" FOR #5 BARS.



DATE: 08/05/20  
 REVIEWED: JAM/JG  
 STRUCTURE FILE NUMBER: 181991  
 DRAWN: JAM/JG  
 DESIGNED: JAM/JG  
 CHECKED: CJS/PAT


WEST ABUTMENT REPAIR DETAILS - 1  
 BRIDGE NO. CUY-490-0100  
 I-490 OVER CUYAHOGA RIVER

CUY-490-01.00  
 PID No. 107408


29/120

40/131


X:\Projects\2022\00100 DOT D12-CUY-490-0\25622\400-Engineering\Structures\CUY490\_0100C\Sheets\025622\_SF\N181991\_S\_002.dgn 3/29/2024 3:38:09 PM zguo

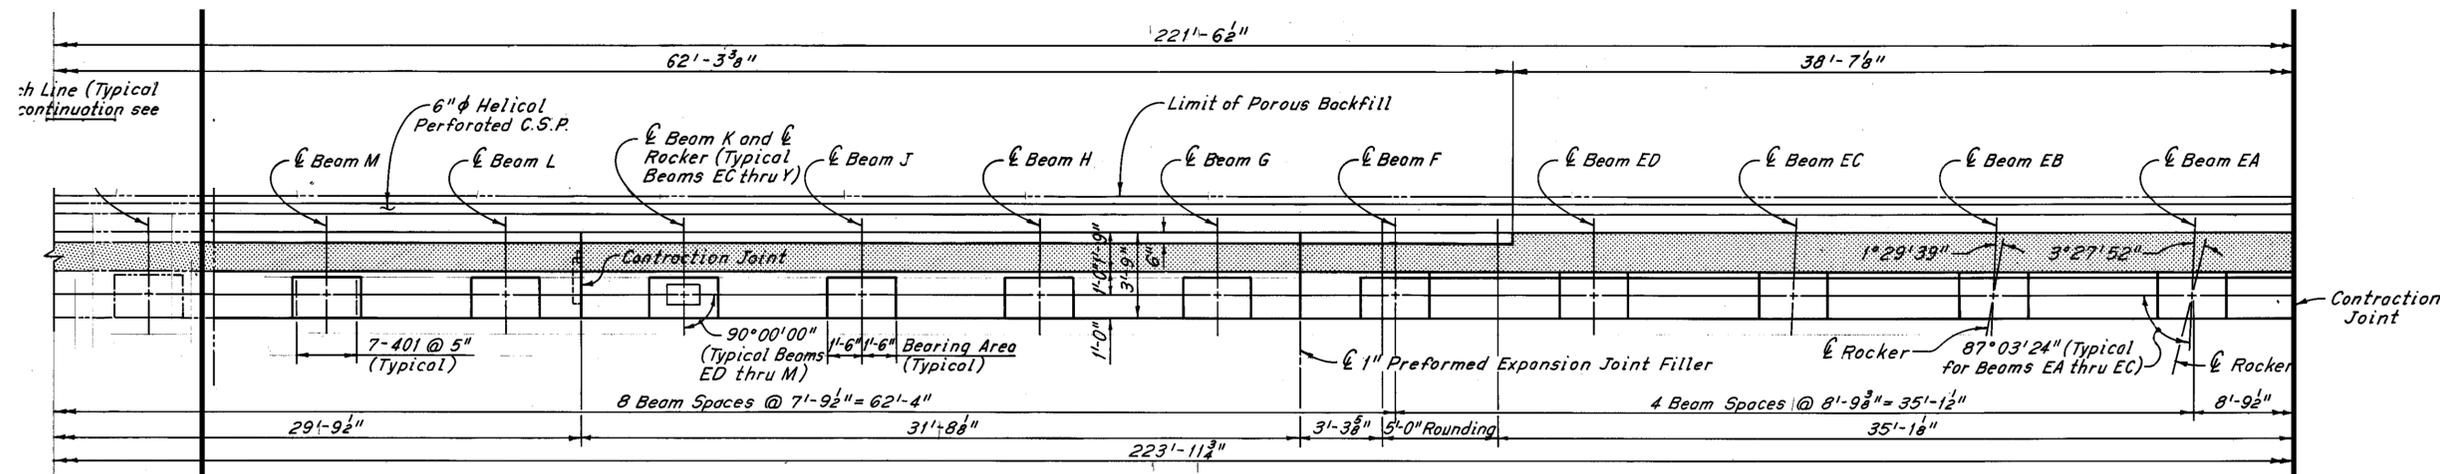

EXISTING PLAN

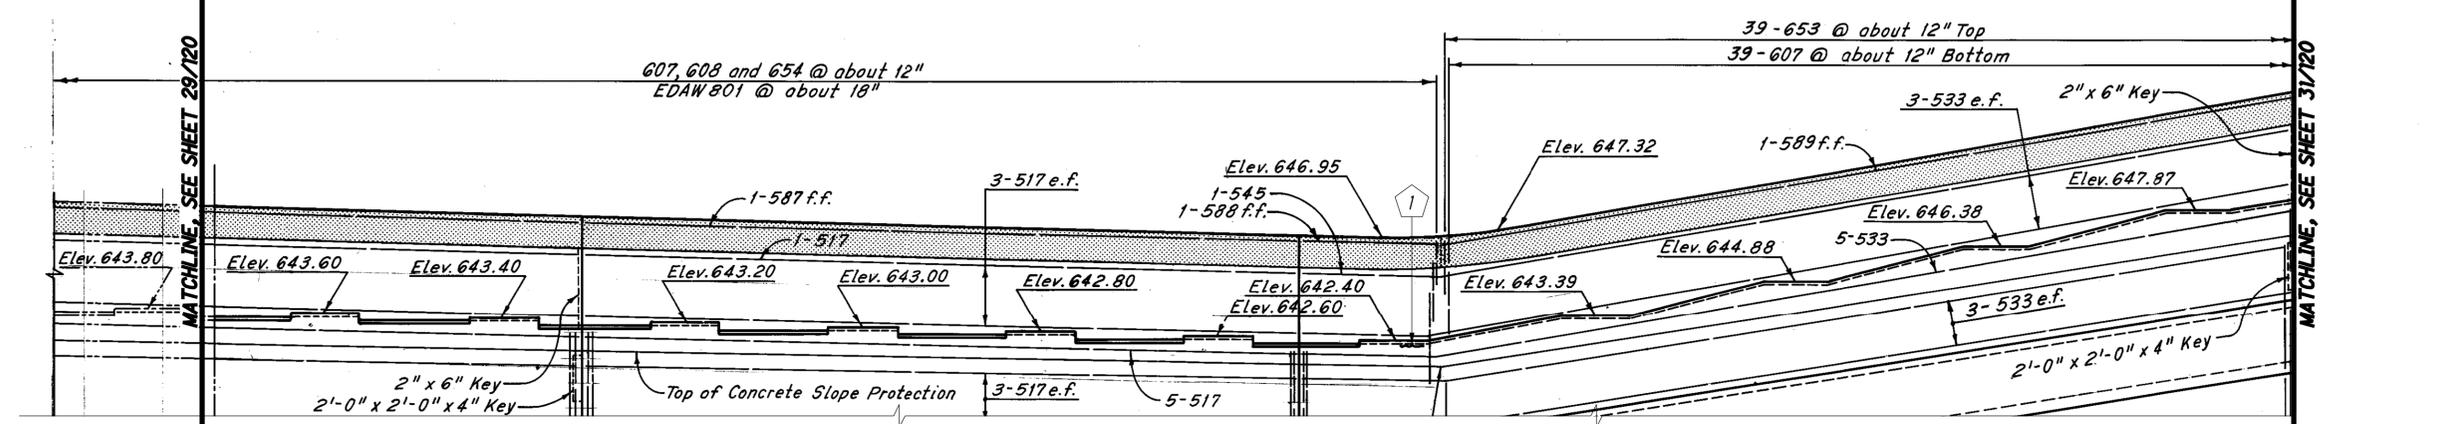

EXISTING PARTIAL ELEVATION

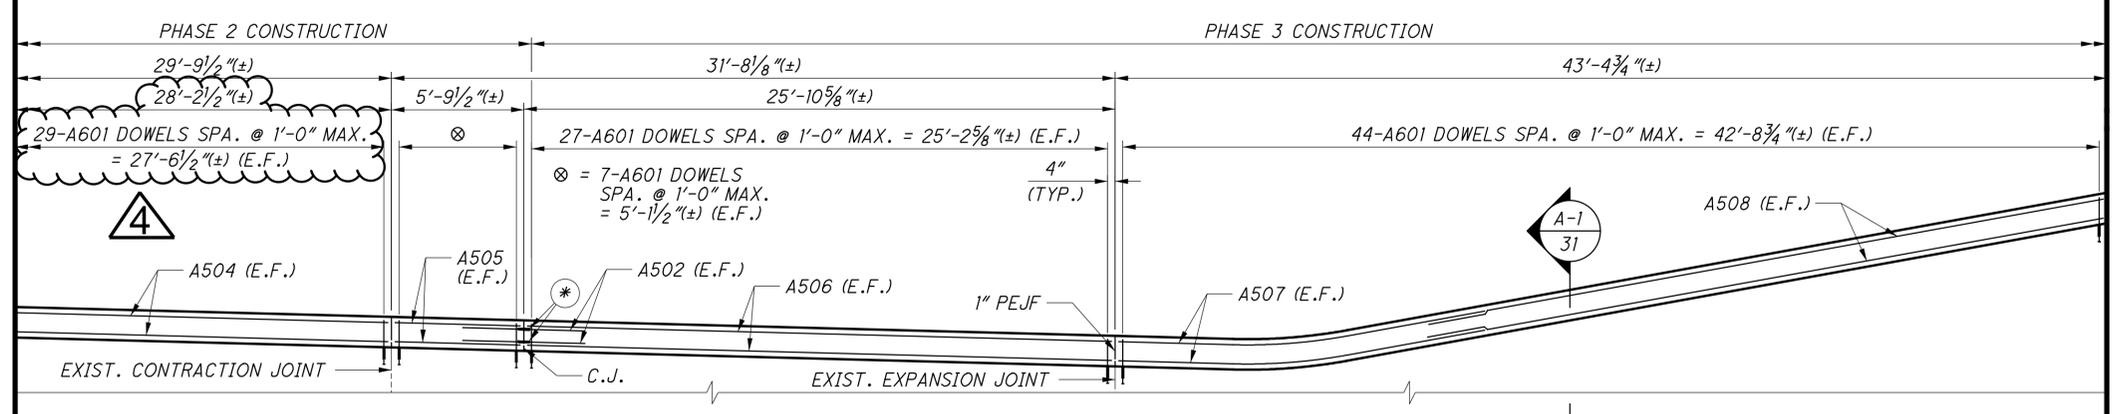

PROPOSED PARTIAL ELEVATION

**LEGEND**

- ITEM 202 - PORTIONS OF STRUCTURE REMOVED, OVER 20' SPAN, AS PER PLAN
- AREA OF DELAMINATION TO BE REPAIRED PER ITEM 844 - CONCRETE PATCHING WITH GALVANIC ANODE PROTECTION, AS PER PLAN
- AREA OF CONCRETE DELAMINATION LOCATION NUMBER
- EXISTING CRACK TO BE REPAIRED LOCATION NUMBER
- THREADED MECHANICAL CONNECTOR, PROVIDING 3'-1" MIN. LAP, SHALL BE RICHMOND SCREW ANCHOR THREADED DOWEL BAR ASSEMBLY, LENTON REBAR SPLICING MECHANISM, OR APPROVED EQUAL AND THE COST SHALL BE INCLUDED WITH ITEM 509 - EPOXY COATED REINFORCING STEEL FOR PAYMENT

ESTIMATED PATCHING QUANTITIES		
LOCATION	WIDTH X HEIGHT	AREA (SF)
	NO	
	DETERIORATION NOTED	
TOTAL AREA MEASURED		-
TOTAL AREA ESTIMATED *		-

\* SEE NOTE 3

ESTIMATED CRACK REPAIR QUANTITIES		
LOCATION	DESCRIPTION	LENGTH
1	STEM	1.00'
TOTAL LENGTH MEASURED		1.00'
TOTAL LENGTH ESTIMATED *		1.50'

\* SEE NOTE 3

**NOTES**

1. EXISTING PLAN AND ELEVATION VIEW LINE WORK ON THIS SHEET COMES FROM SCANS OF THE 1986 RECORD PLANS. REFERENCES TO I-290 SHOULD BE REPLACED WITH I-490.
2. PHYSICAL INVENTORY OF MEASURED QUANTITIES OF DETERIORATION WAS PERFORMED IN AUGUST 2018. THE EXACT DIMENSIONS AND LOCATIONS OF PATCHES AND CRACK REPAIRS SHALL BE DETERMINED BY THE ENGINEER IN THE FIELD FOR FINAL PAY QUANTITY.
3. ESTIMATED PATCHING AND CRACK REPAIR QUANTITIES HAVE BEEN INCREASED BY 50% OVER MEASURED QUANTITIES TO ALLOW FOR ADDITIONAL DETERIORATION.
4. FOR PARAPET REPLACEMENT DETAILS, SEE SHEET 61/120.
5. THE MINIMUM LAP LENGTH FOR ABUTMENT REINFORCING STEEL SHALL BE 2'-5" FOR #5 BARS.



DATE: 08/05/20  
 REVIEWED: MJL  
 DRAWN: JAM/JG  
 DESIGNED: JAM/JG  
 CHECKED: JAM/JG  
 STRUCTURE FILE NUMBER: 181991  
 REVISED: JCS/JDA


WEST ABUTMENT REPAIR DETAILS - 2  
 BRIDGE NO. CUY-490-0100  
 I-490 OVER CUYAHOGA RIVER

CUY-490-01.00  
 PID No. 107408


30/120

41/131


X:\Projects\2022\100100 DOT D12-CUY-490-0\25622-400-Engineering\Structures\CUY490\_01000\Sheets\025622\_SF002.dgn 3/29/2024 3:40:31PM zguo

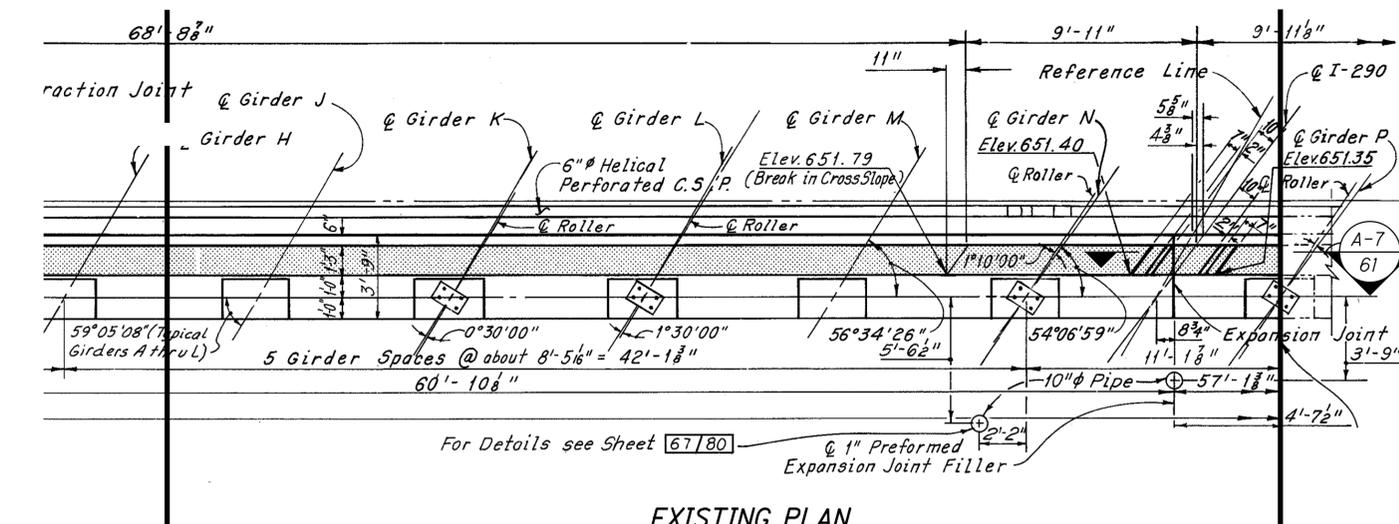


**EXISTING PLAN**

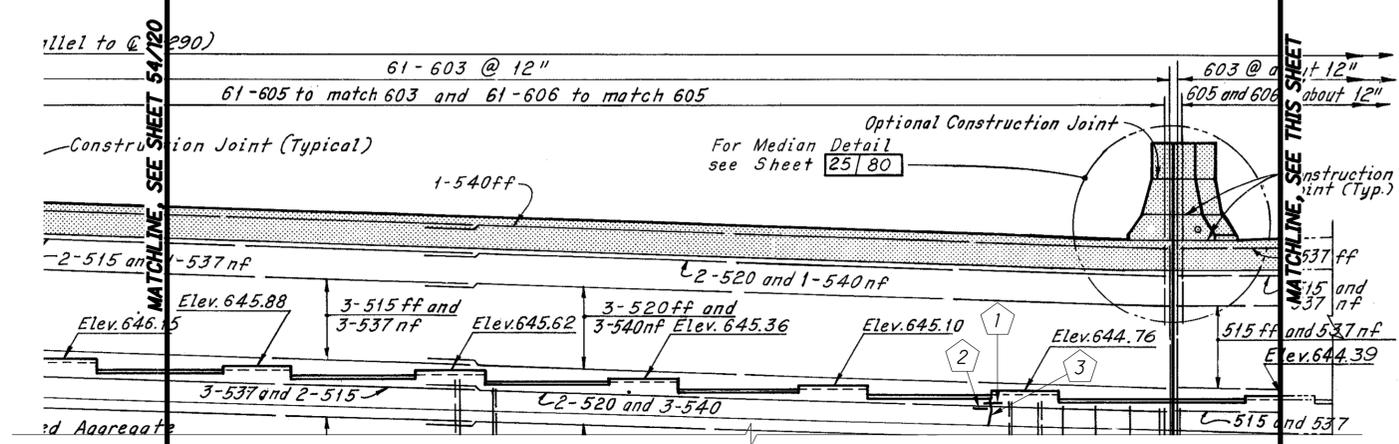


**EXISTING PARTIAL ELEVATION**

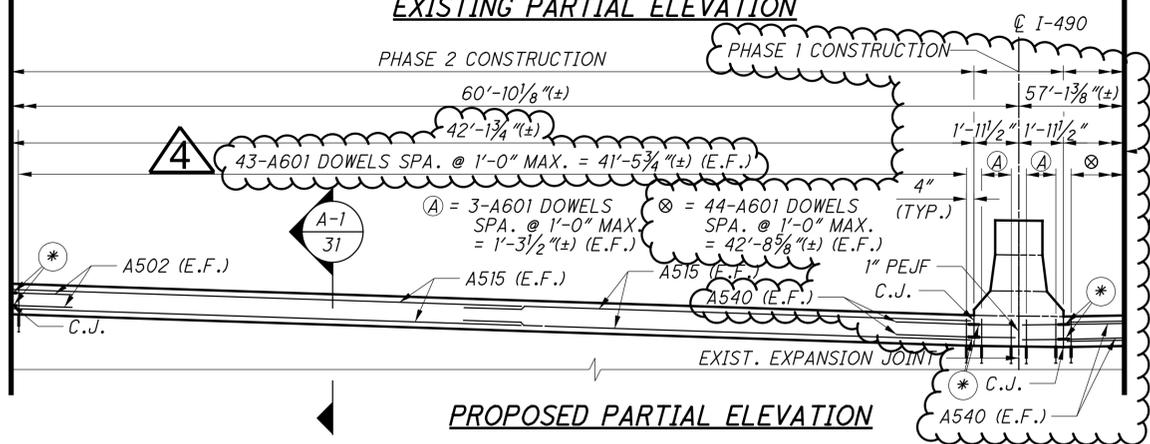


**PROPOSED PARTIAL ELEVATION**

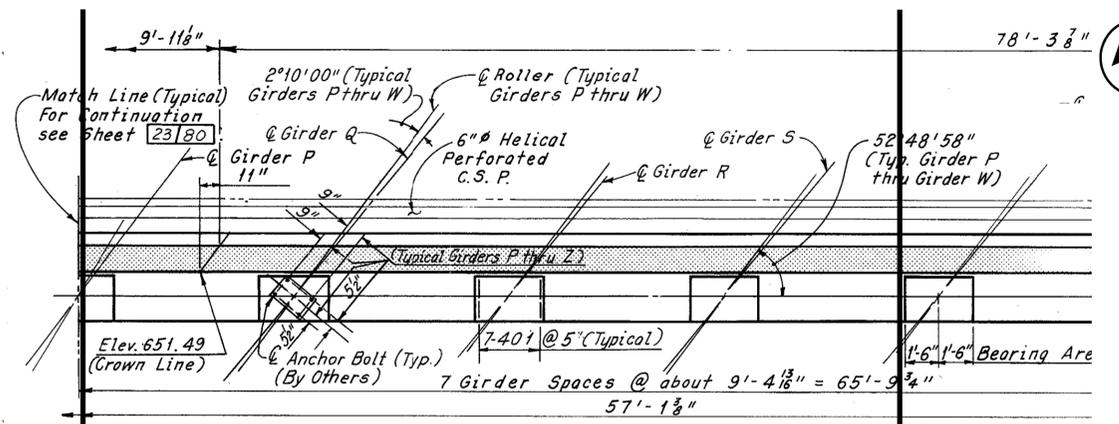

**EXISTING PLAN**

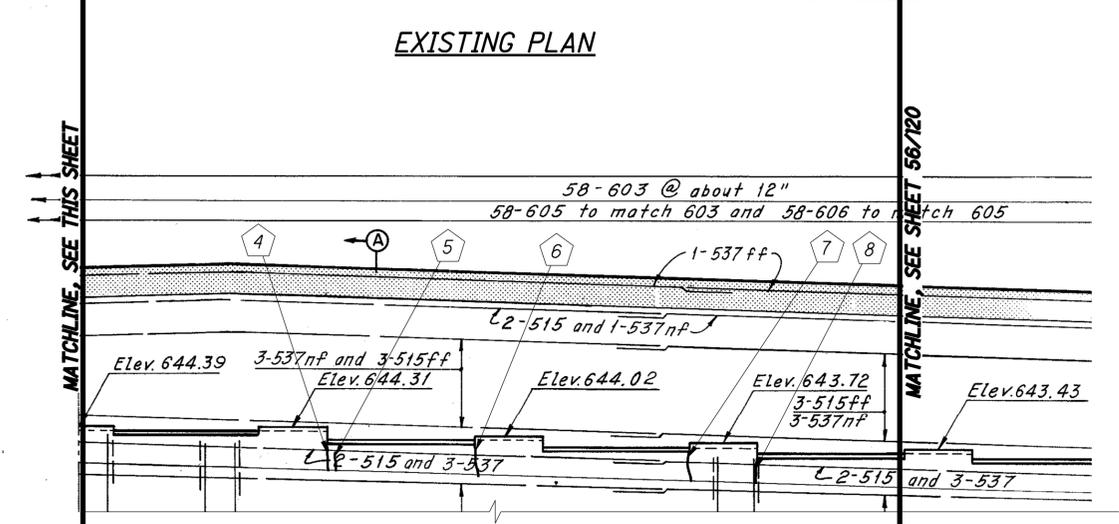

**EXISTING PARTIAL ELEVATION**

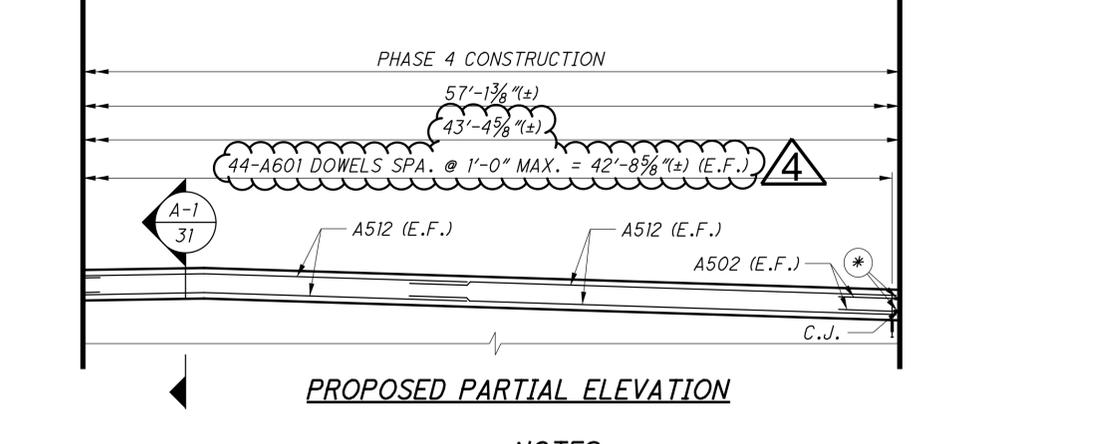

**PROPOSED PARTIAL ELEVATION**

**LEGEND**

- ITEM 202 - PORTIONS OF STRUCTURE REMOVED, OVER 20' SPAN, AS PER PLAN
- AREA OF DELAMINATION TO BE REPAIRED PER ITEM 844 - CONCRETE PATCHING WITH GALVANIC ANODE PROTECTION, AS PER PLAN
- AREA OF CONCRETE DELAMINATION LOCATION NUMBER
- EXISTING CRACK TO BE REPAIRED LOCATION NUMBER
- THREADED MECHANICAL CONNECTOR, PROVIDING 3'-1" MIN. LAP, SHALL BE RICHMOND SCREW ANCHOR THREADED DOWEL BAR ASSEMBLY, LENTON REBAR SPLICING MECHANISM, OR APPROVED EQUAL AND THE COST SHALL BE INCLUDED WITH ITEM 509 - EPOXY COATED REINFORCING STEEL FOR PAYMENT

ESTIMATED PATCHING QUANTITIES		
LOCATION	WIDTH X HEIGHT	AREA (SF)
	NO DETERIORATION NOTED	
TOTAL AREA MEASURED		-
TOTAL AREA ESTIMATED *		-

\* SEE NOTE 3

ESTIMATED CRACK REPAIR QUANTITIES		
LOCATION	DESCRIPTION	LENGTH
1	STEM	1.50'
2	STEM	1.00'
3	STEM	2.50'
4	STEM	3.50'
5	STEM	2.50'
6	STEM	3.50'
7	STEM	3.00'
8	STEM	3.00'
TOTAL LENGTH MEASURED		20.50'
TOTAL LENGTH ESTIMATED *		30.75'

\* SEE NOTE 3

**NOTES**


1. EXISTING PLAN AND ELEVATION VIEW LINE WORK ON THIS SHEET COMES FROM SCANS OF THE 1986 RECORD PLANS. REFERENCES TO I-290 SHOULD BE REPLACED WITH I-490.
2. PHYSICAL INVENTORY OF MEASURED QUANTITIES OF DETERIORATION WAS PERFORMED IN AUGUST 2018. THE EXACT DIMENSIONS AND LOCATIONS OF PATCHES AND CRACK REPAIRS SHALL BE DETERMINED BY THE ENGINEER IN THE FIELD FOR FINAL PAY QUANTITY.
3. ESTIMATED PATCHING AND CRACK REPAIR QUANTITIES HAVE BEEN INCREASED BY 50% OVER MEASURED QUANTITIES TO ALLOW FOR ADDITIONAL DETERIORATION.
4. FOR PARAPET REPLACEMENT DETAILS, SEE SHEET 61/120.
5. THE MINIMUM LAP LENGTH FOR ABUTMENT REINFORCING STEEL SHALL BE 2'-5" FOR #5 BARS.

DATE: 08/05/20  
 REVIEWED: MJL  
 DRAWN: JAM/JG  
 DESIGNED: JAM/JG  
 CHECKED: CJS/PAT  
 STRUCTURE FILE NUMBER: 181991  
 EAST ABUTMENT REPAIR DETAILS - 2  
 BRIDGE NO. CUY-490-0100  
 I-490 OVER CUYAHOGA RIVER

CUY-490-01.00  
 PID No. 107408

55 / 120  
 66  
 131

X:\Projects\2020\2022\00100\_0001\DOT\12-CUY-490-0\25622\400-Engineering\Structures\CUY490\_01000\Sheets\025622\_SF\81991\_SD001.dgn 3/29/2024 5:47:10 PM zguo

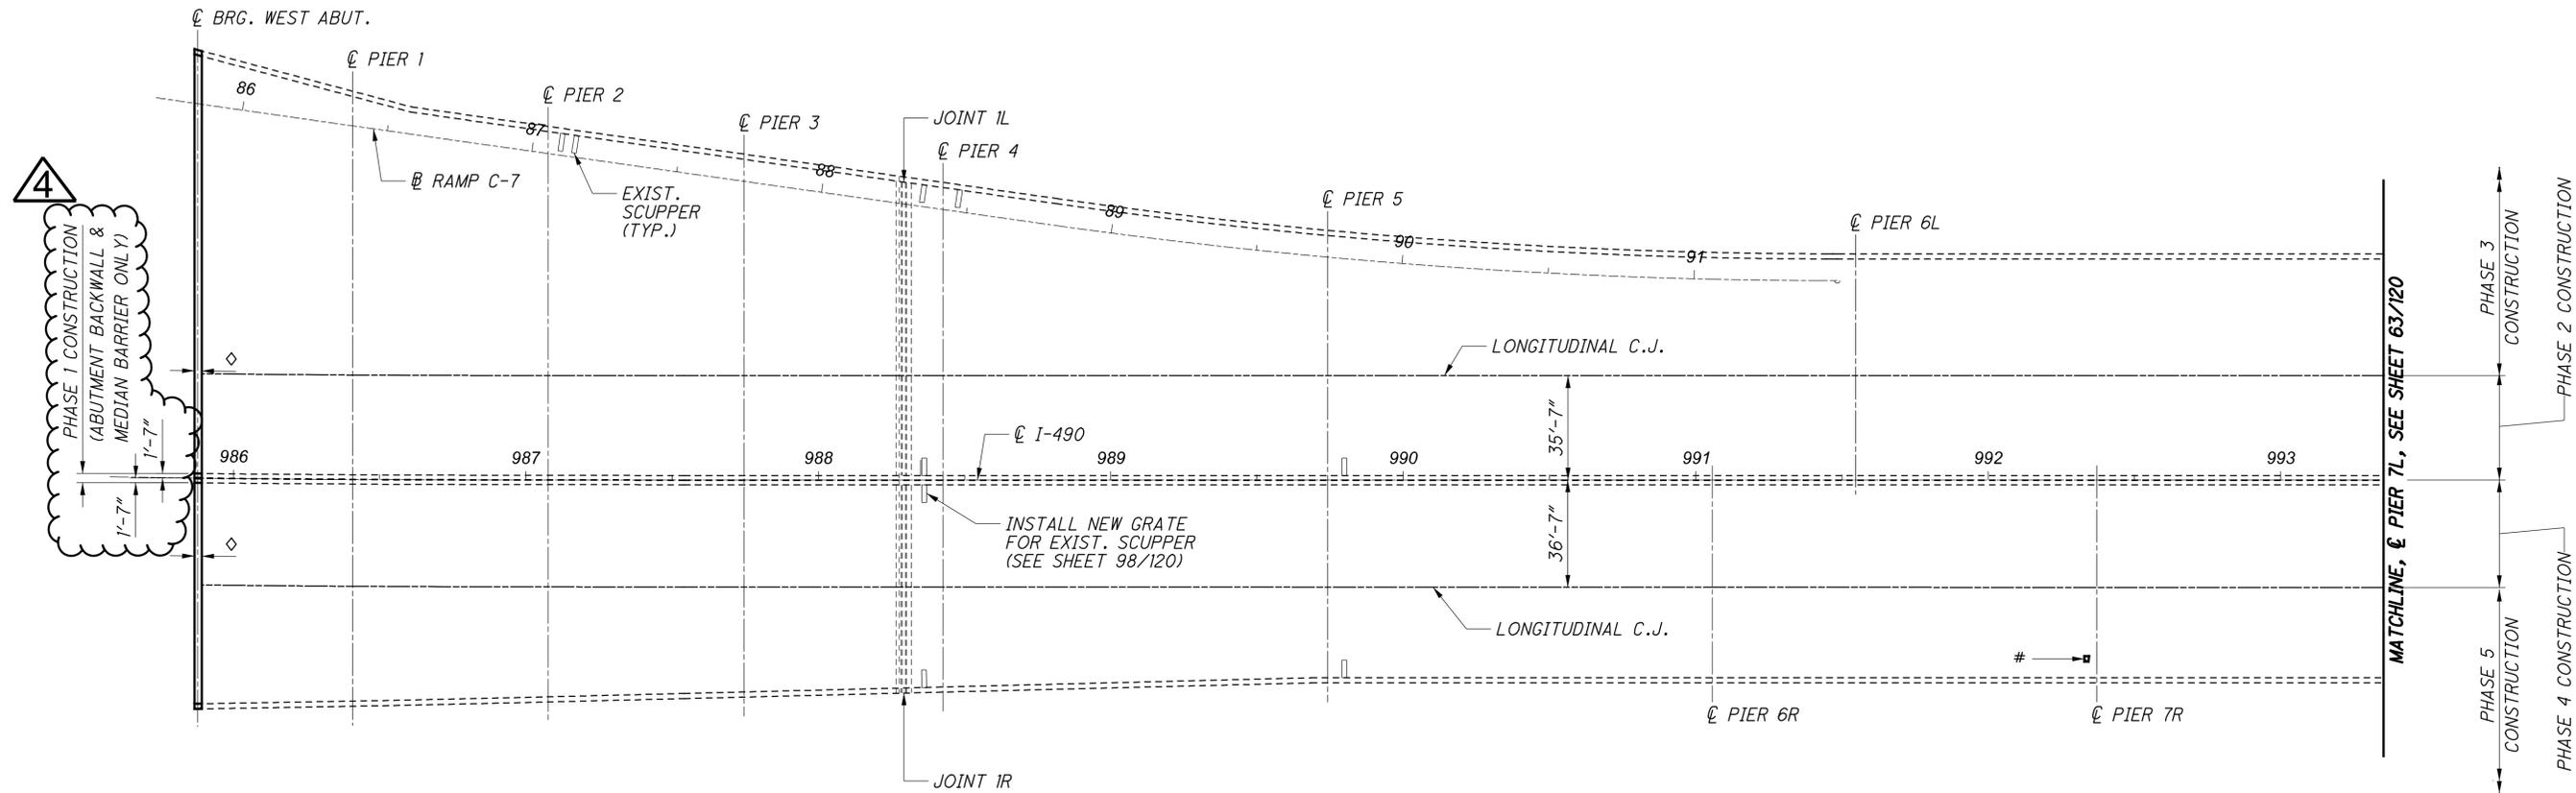

**DECK PLAN**

**LEGEND**

- # FULL DEPTH REPAIR OF PIER ACCESS MANHOLE LOCATION, SEE SHEET 69/120.
- ◇ PORTION OF EXISTING DECK SLAB TO BE REMOVED AND RECONSTRUCTED FOR EXPANSION JOINT REPLACEMENT

**NOTES**

1. REMOVE THE EXISTING CONCRETE OVERLAY BY HYDRODEMOLITION IN ACCORDANCE WITH ITEM 848 - EXISTING CONCRETE OVERLAY REMOVED, AS PER PLAN.
2. PLACE MICRO SILICA CONCRETE OVERLAY IN ACCORDANCE WITH ITEM 848 - MICRO SILICA MODIFIED CONCRETE OVERLAY USING HYDRODEMOLITION.



DESIGNED	JAM/JG	CHECKED	PAT/JDA
DRAWN	JAM/JG	REVISSED	
REVIEWED	MJL	STRUCTURE FILE NUMBER	181991
DATE	08/05/20		

**WEARING SURFACE REPAIR DETAILS - 1**  
 BRIDGE NO. CUY-490-0100  
 I-490 OVER CUYAHOGA RIVER

**CUY-490-01.00**  
 PID No. 107408

62/120

73/131

X:\Projects\2022\00100\_0DOT D12-CUY-490-0\25622\400-Engineering\Structures\CUY490\_01000\Sheets\025622\_SFN\81991\_SD002.dgn 3/29/2024 4:53:07 PM zguo




DESIGNED	JAM/JG	CHECKED	PAT/JDA
DRAWN	JAM/JG	REVISED	
REVIEWED	MJL	STRUCTURE FILE NUMBER	181991
DATE	08/05/20		

**WEARING SURFACE REPAIR DETAILS - 2**  
 BRIDGE NO. CUY-490-0100  
 I-490 OVER CUYAHOGA RIVER

**CUY-490-01.00**  
 PID No. 107408

63	120
74	131

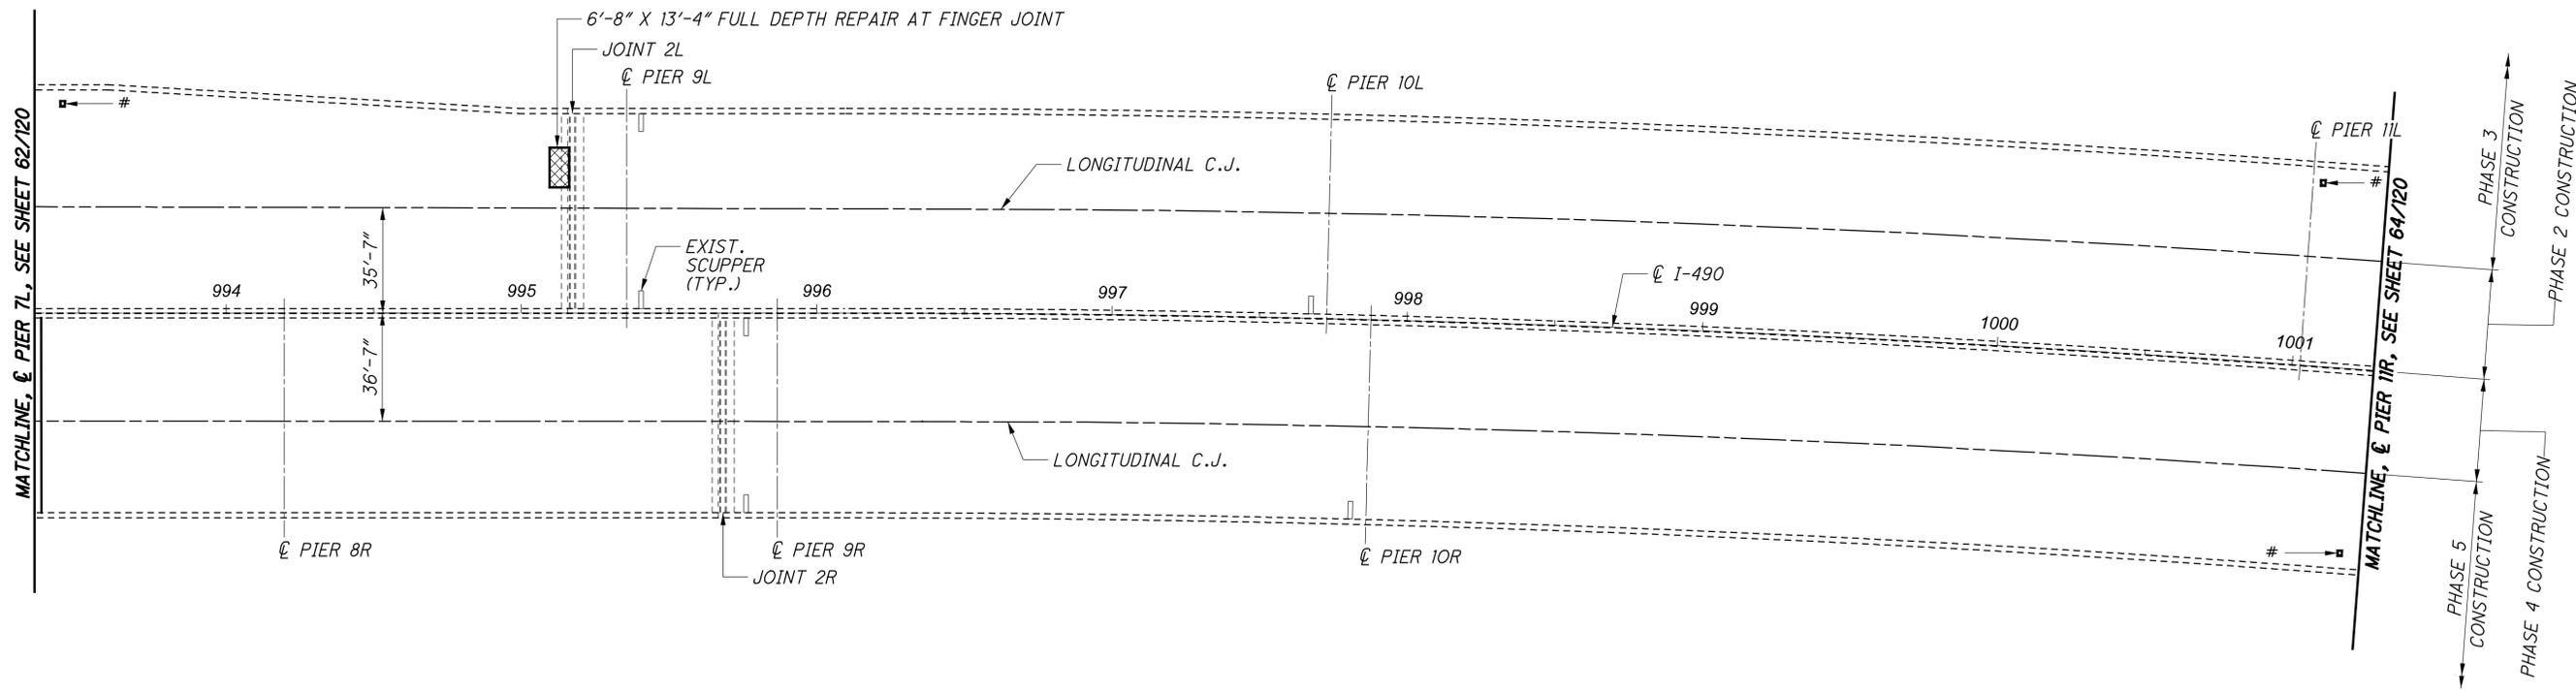

**DECK PLAN**

**LEGEND**

- # FULL DEPTH REPAIR OF PIER ACCESS MANHOLE LOCATION, SEE SHEET 69/120.
- ◇ PORTION OF EXISTING DECK SLAB TO BE REMOVED AND RECONSTRUCTED FOR EXPANSION JOINT REPLACEMENT

**NOTES**

1. REMOVE THE EXISTING CONCRETE OVERLAY BY HYDRODEMOLITION IN ACCORDANCE WITH ITEM 848 - EXISTING CONCRETE OVERLAY REMOVED, AS PER PLAN.
2. PLACE MICRO SILICA CONCRETE OVERLAY IN ACCORDANCE WITH ITEM 848 - MICRO SILICA MODIFIED CONCRETE OVERLAY USING HYDRODEMOLITION.
3. 10 CY OF FULL DEPTH REPAIR OVER WATER TO BE USED AS DIRECTED BY THE ENGINEER PER ITEM 848 - FULL DEPTH REPAIR, AS PER PLAN.



X:\Projects\2020\2022\00100 DOT D12-CUY-490-0\25622\400-Engineering\Structures\CUY490\_0100C\Sheets\025622\_SFN\81991\_SD005.dgn 3/29/2024 5:47:43 PM zguo




DESIGNED	JAM/JG	CHECKED	PAT/JDA
DRAWN	JAM/JG	REVISED	
REVIEWED	MJL	STRUCTURE FILE NUMBER	181991
DATE	08/05/20		

**WEARING SURFACE REPAIR DETAILS - 5**  
 BRIDGE NO. CUY-490-0100  
 I-490 OVER CUYAHOGA RIVER

**CUY-490-01.00**  
 PID No. 107408

66/120  
 77/131

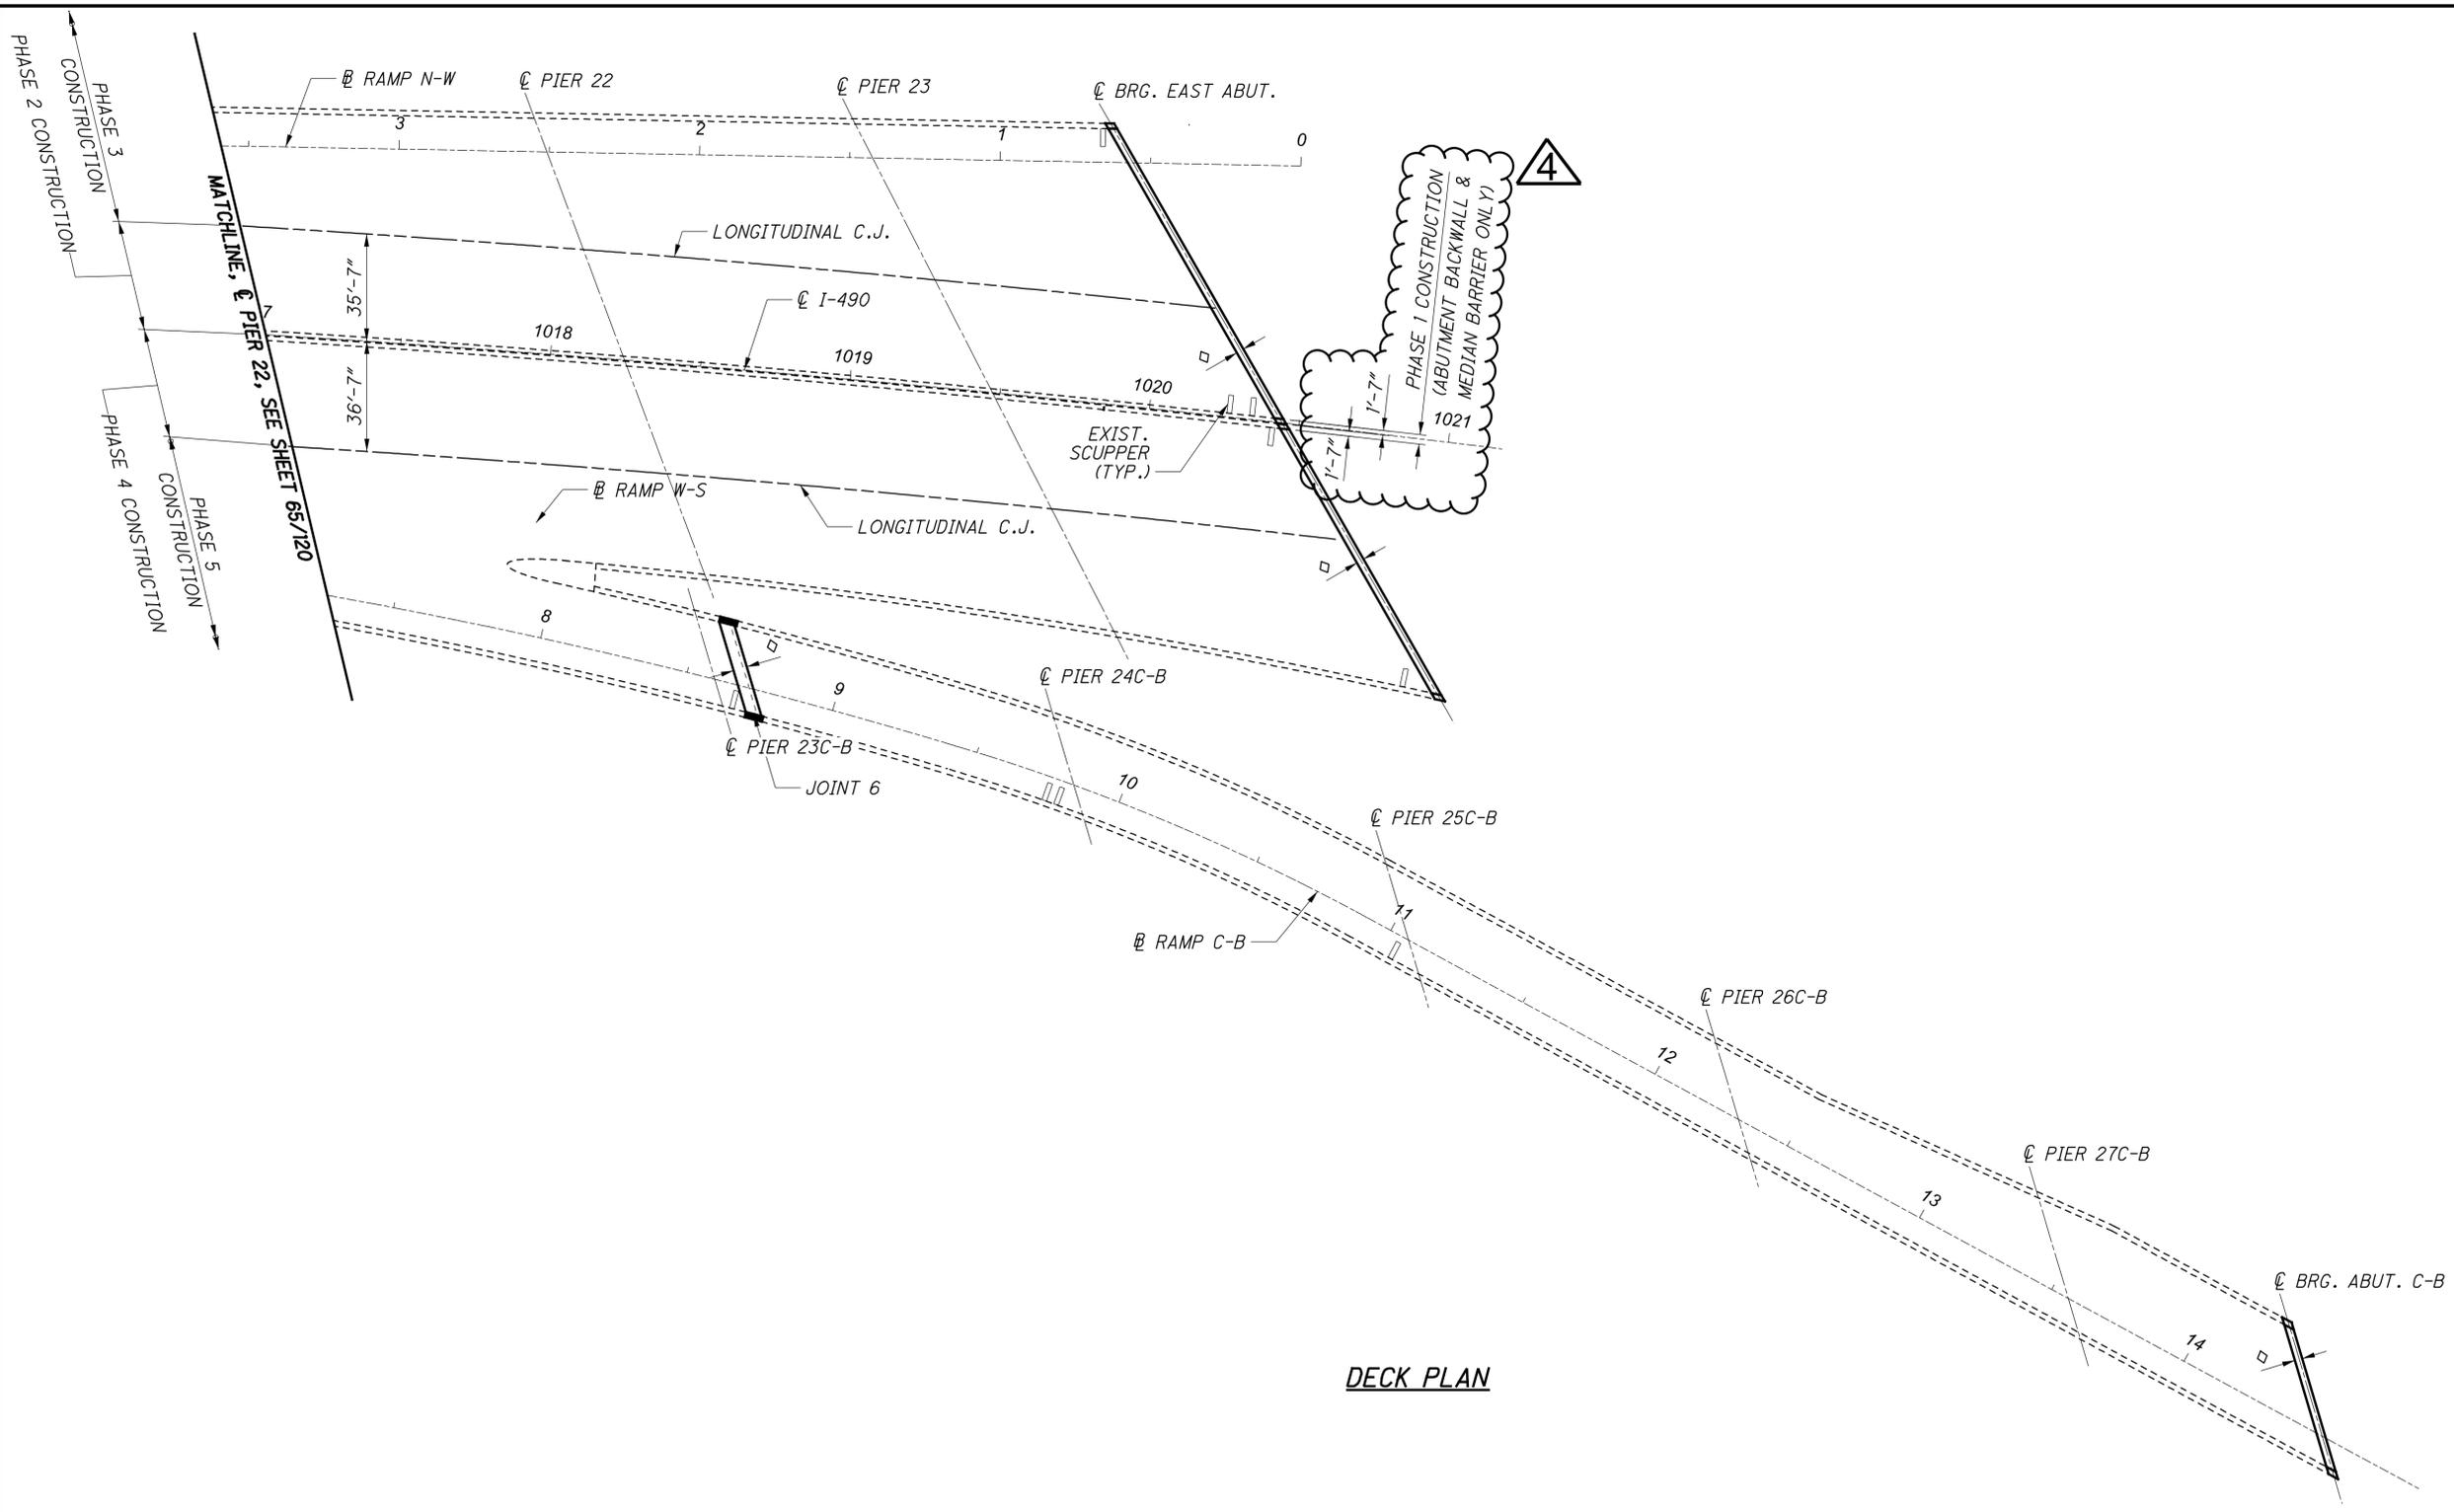

**DECK PLAN**


**LEGEND**

- # FULL DEPTH REPAIR OF PIER ACCESS MANHOLE LOCATION, SEE SHEET 69/120.
- ◇ PORTION OF EXISTING DECK SLAB TO BE REMOVED AND RECONSTRUCTED FOR EXPANSION JOINT REPLACEMENT

**NOTES**


1. REMOVE THE EXISTING CONCRETE OVERLAY BY HYDRODEMOLITION IN ACCORDANCE WITH ITEM 848 - EXISTING CONCRETE OVERLAY REMOVED, AS PER PLAN.
2. PLACE MICRO SILICA CONCRETE OVERLAY IN ACCORDANCE WITH ITEM 848 - MICRO SILICA MODIFIED CONCRETE OVERLAY USING HYDRODEMOLITION.

X:\Projects\2020\2022\100100\_0DOT\_D12-CUY-490-0\25622-400-Engineering\Structures\CUY490\_0100C\Sheets\025622\_SF\N181991\_S\02020.dgn 3/29/2024 3:58:50 PM zguo

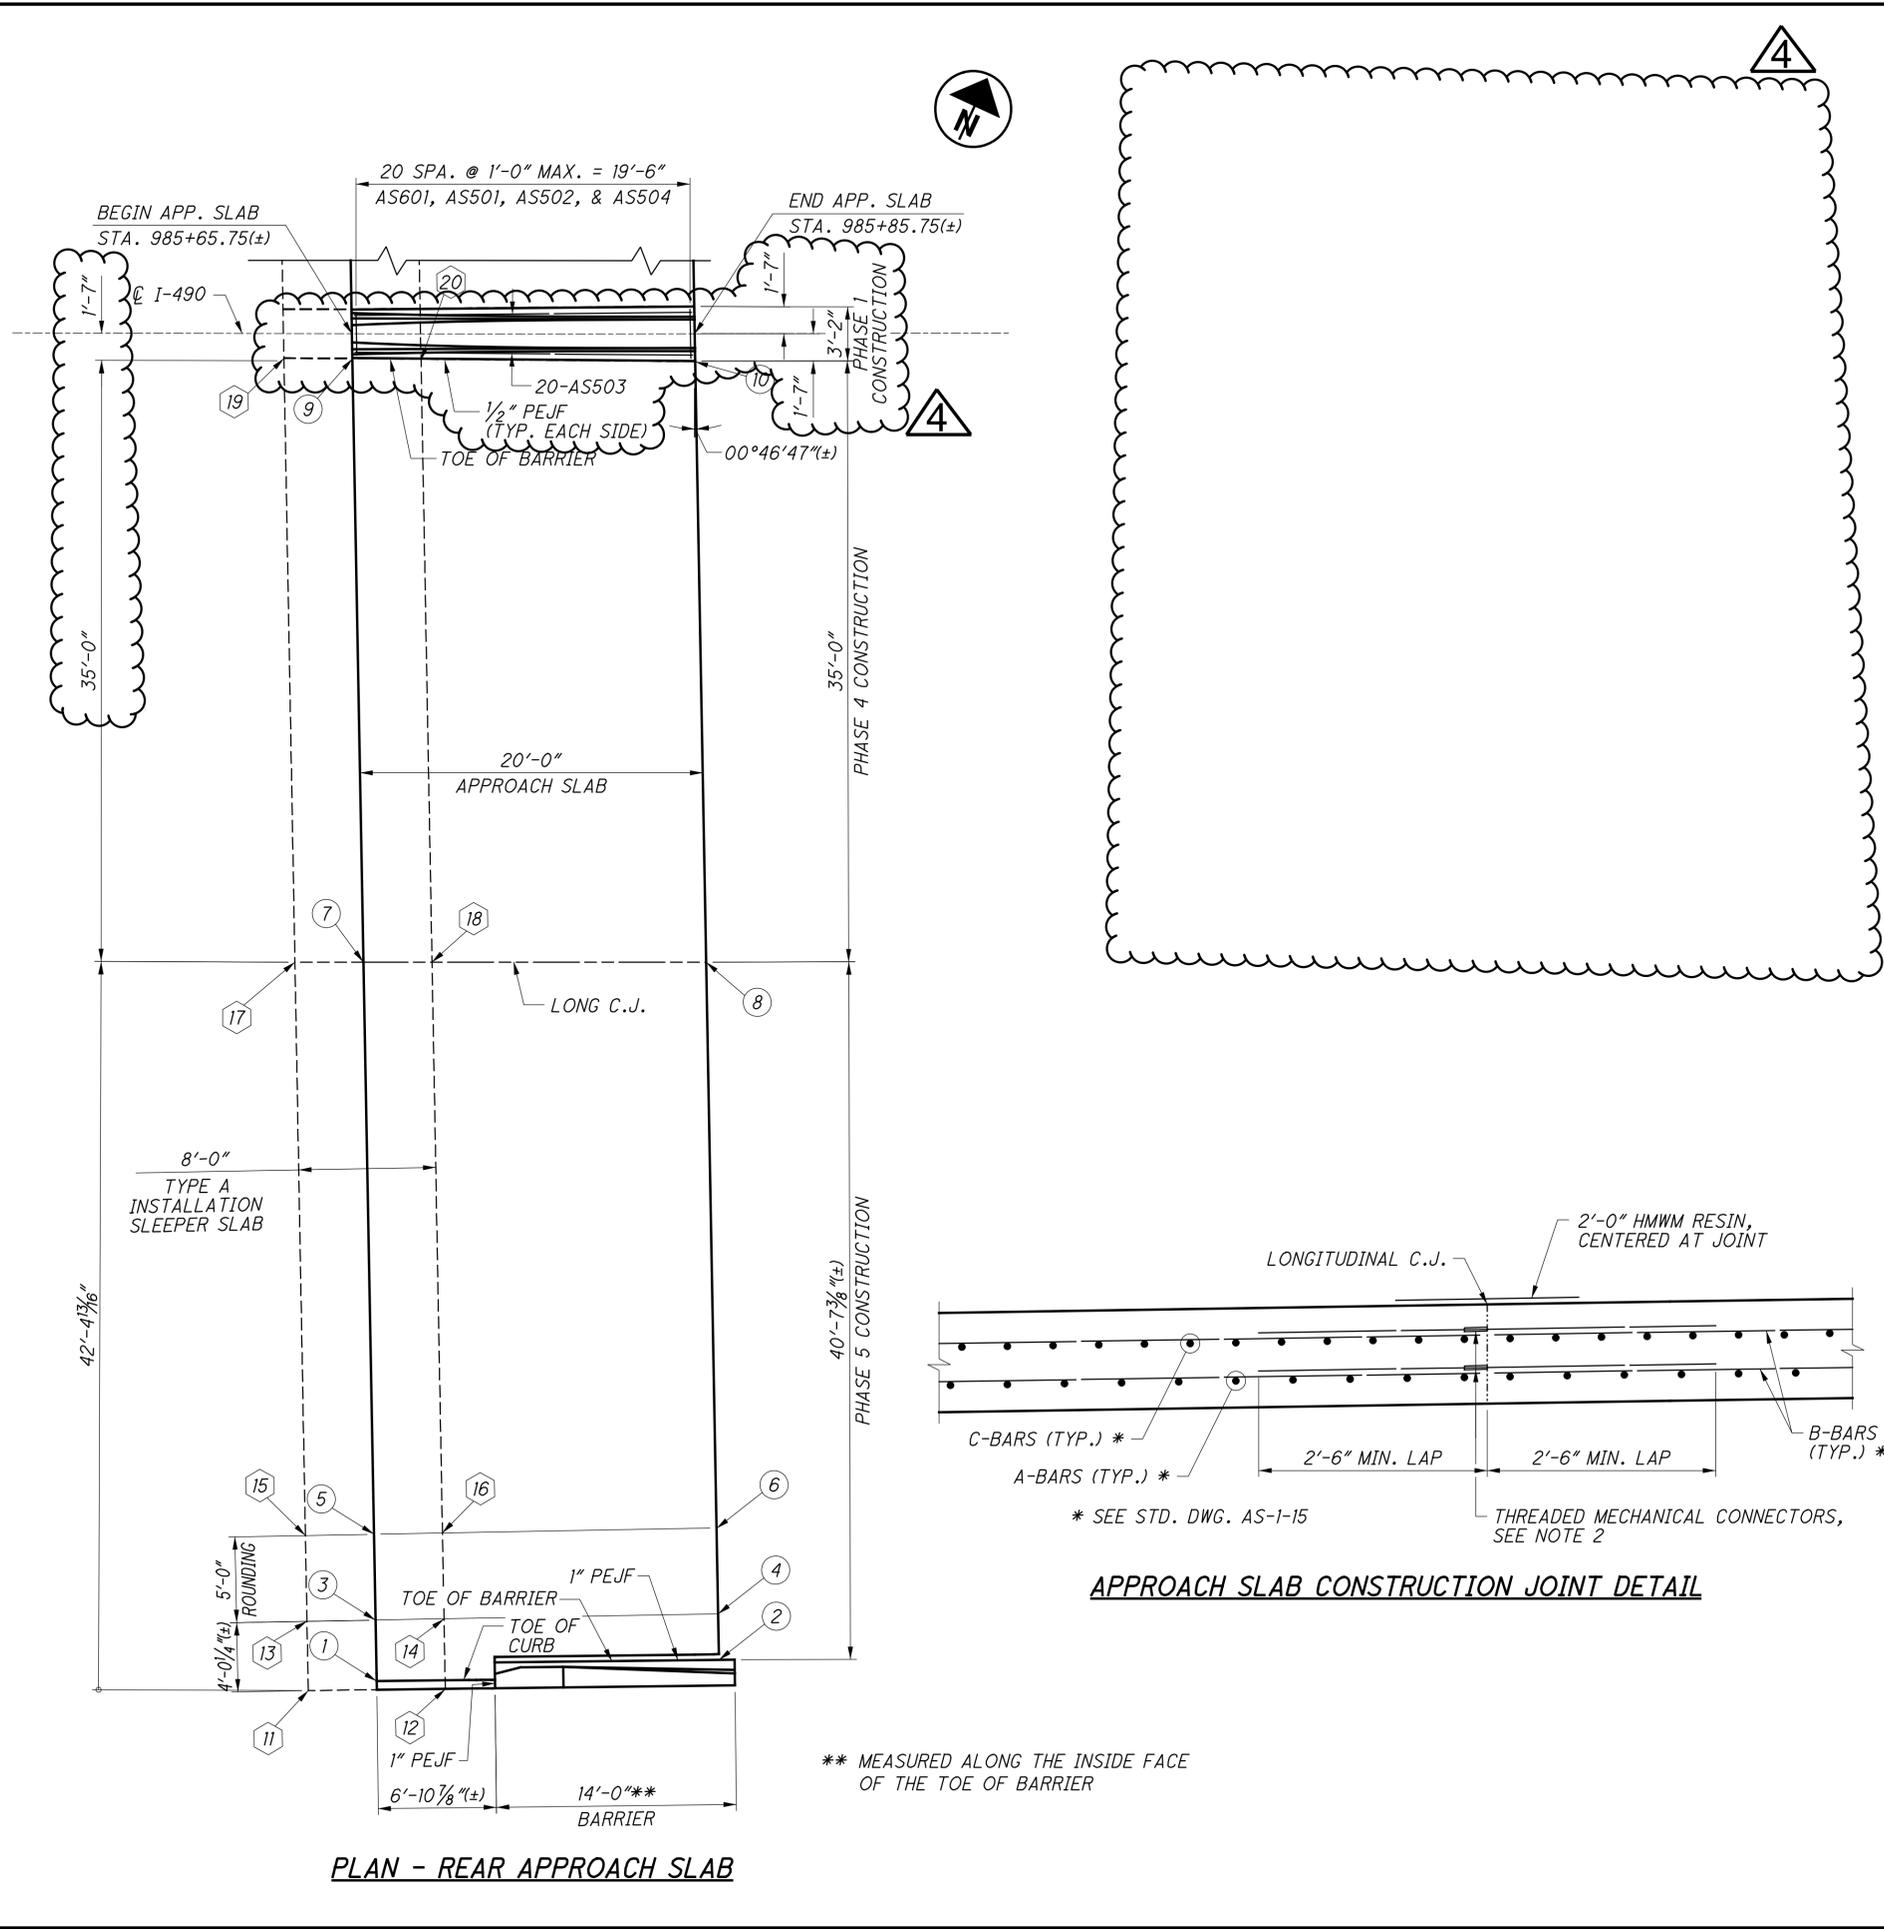

PLAN - REAR APPROACH SLAB

\*\* MEASURED ALONG THE INSIDE FACE OF THE TOE OF BARRIER

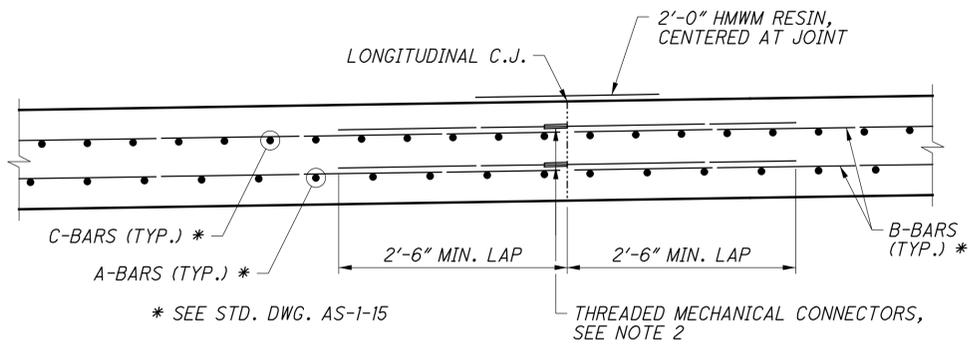

APPROACH SLAB CONSTRUCTION JOINT DETAIL

APPROACH SLAB ELEVATIONS

LOCATION	REAR
①	STATION 985+66.84
	OFFSET 78.44
	ELEVATION 648.97
②	STATION 985+86.58
	OFFSET 77.21
	ELEVATION 649.17
③	STATION 985+66.84
	OFFSET 74.88
	ELEVATION 648.93
④	STATION 985+86.54
	OFFSET 74.52
	ELEVATION 649.13
⑤	STATION 985+66.71
	OFFSET 69.89
	ELEVATION 648.90
⑥	STATION 985+86.46
	OFFSET 69.55
	ELEVATION 649.10
⑦	STATION 985+66.04
	OFFSET 36.58
	ELEVATION 648.08
⑧	STATION 985+85.91
	OFFSET 36.58
	ELEVATION 648.39
⑨	STATION 985+65.33
	OFFSET 1.45
	ELEVATION 647.20
⑩	STATION 985+85.33
	OFFSET 1.63
	ELEVATION 647.61

SLEEPER SLAB ELEVATIONS

LOCATION	REAR
⑪	STATION 985+62.90
	OFFSET 78.99
	ELEVATION 647.95
⑫	STATION 985+70.80
	OFFSET 78.89
	ELEVATION 648.00
⑬	STATION 985+62.82
	OFFSET 74.96
	ELEVATION 647.92
⑭	STATION 985+70.72
	OFFSET 74.81
	ELEVATION 647.95
⑮	STATION 985+62.72
	OFFSET 69.97
	ELEVATION 647.75
⑯	STATION 985+70.63
	OFFSET 69.81
	ELEVATION 647.88
⑰	STATION 985+62.03
	OFFSET 36.58
	ELEVATION 646.91
⑱	STATION 985+69.98
	OFFSET 36.58
	ELEVATION 647.06
⑲	STATION 985+61.30
	OFFSET 1.45
	ELEVATION 646.02
⑳	STATION 985+69.30
	OFFSET 1.48
	ELEVATION 646.20

ALL ELEVATIONS ARE ±

NOTES

- ELEVATIONS SHOWN ON THIS SHEET ARE TO BE FIELD VERIFIED AND ADJUSTED TO MATCH THE EXISTING STRUCTURE.
- THREADED MECHANICAL CONNECTORS SHALL BE RICHMOND SCREW ANCHOR THREADED DOWEL BAR ASSEMBLY, LENTON REBAR SPLICING MECHANISM, OR APPROVED EQUAL. COST SHALL BE INCLUDED FOR PAYMENT WITH ITEM 526, REINFORCED CONCRETE APPROACH SLABS (T-13"), AS PER PLAN.
- SEAL THE LONGITUDINAL CONSTRUCTION JOINT WITH HIGH MOLECULAR WEIGHT METHACRYLATE (HMWM). THE WIDTH OF THE SEALING SHALL BE TWO FEET (2'), CENTERED OVER THE JOINT. PAYMENT SHALL BE MADE UNDER ITEM 526, REINFORCED CONCRETE APPROACH SLABS (T-13"), AS PER PLAN.
- FOR REINFORCING STEEL LIST, SEE SHEET 120/120.
- FOR MEDIAN BARRIER ELEVATION, SEE SHEET 118/120.

**DLZ**  
68 W. SUPERIOR AVE., SUITE 100 • CLEVELAND, OHIO 44113

DATE: 08/05/20  
REVIEWED: MJL  
DRAWN: DAF/JG  
DESIGNED: KJS/JG  
CHECKED: CLH/JDA

STRUCTURE FILE NUMBER: 1811991


WEST ABUTMENT APPROACH SLAB DETAILS - 1  
BRIDGE NO. CUY-490-0100  
I-490 OVER CUYAHOGA RIVER

PID No. 107408

113/120


124/131

X:\Projects\2022\100100\_ODOT\_D12-CUY-490-0\25622\_400-Engineering\Structures\CUY490\_0100C\Sheets\025622\_SFNI81991\_SMO2L.dgn 3/29/2024 3:58:51 PM zguo

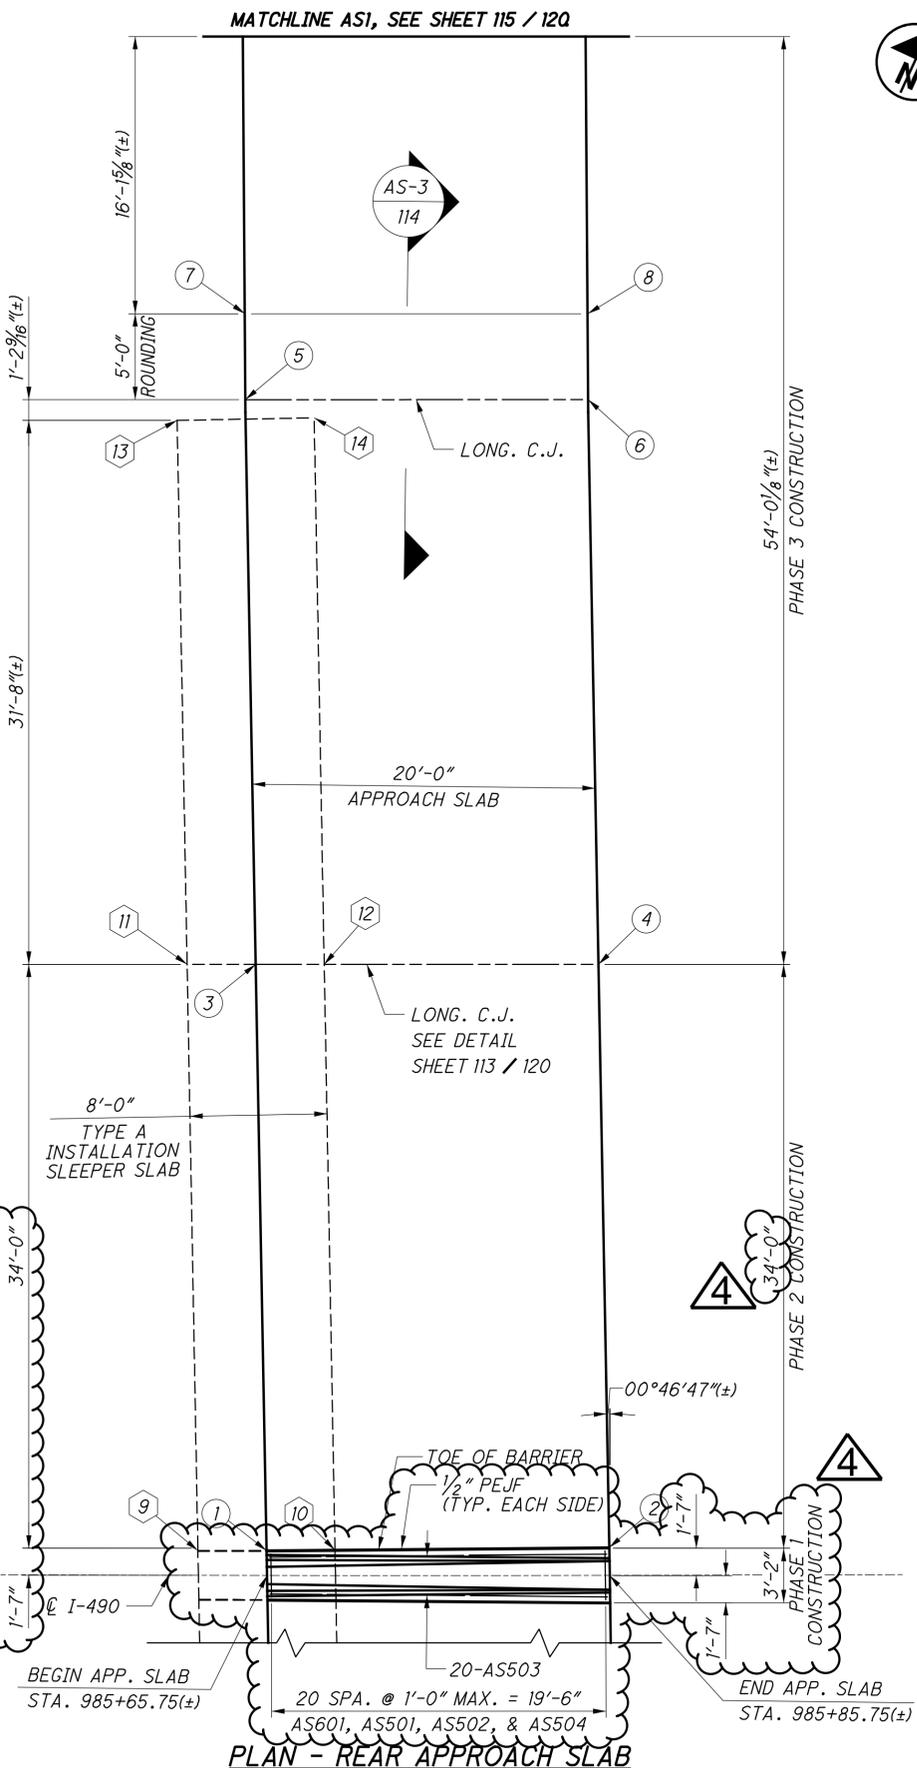

APPROACH SLAB ELEVATIONS		
LOCATION	REAR	
①	STATION	985+65.40
	OFFSET	-1.45
	ELEVATION	647.13
②	STATION	985+85.45
	OFFSET	-1.63
	ELEVATION	647.54
③	STATION	985+64.72
	OFFSET	-35.58
	ELEVATION	646.52
④	STATION	985+84.86
	OFFSET	-35.58
	ELEVATION	647.09
⑤	STATION	985+64.07
	OFFSET	-68.46
	ELEVATION	645.92
⑥	STATION	985+84.29
	OFFSET	-68.46
	ELEVATION	646.55
⑦	STATION	985+64.02
	OFFSET	-73.46
	ELEVATION	646.30
⑧	STATION	985+84.26
	OFFSET	-73.46
	ELEVATION	646.88

SLEEPER SLAB ELEVATIONS		
LOCATION	REAR	
⑨	STATION	985+61.43
	OFFSET	-1.45
	ELEVATION	645.95
⑩	STATION	985+69.44
	OFFSET	-1.49
	ELEVATION	646.14
⑪	STATION	985+60.71
	OFFSET	-35.58
	ELEVATION	645.26
⑫	STATION	985+68.76
	OFFSET	-35.58
	ELEVATION	645.50
⑬	STATION	985+60.04
	OFFSET	-67.24
	ELEVATION	644.62
⑭	STATION	985+68.13
	OFFSET	-67.40
	ELEVATION	644.90

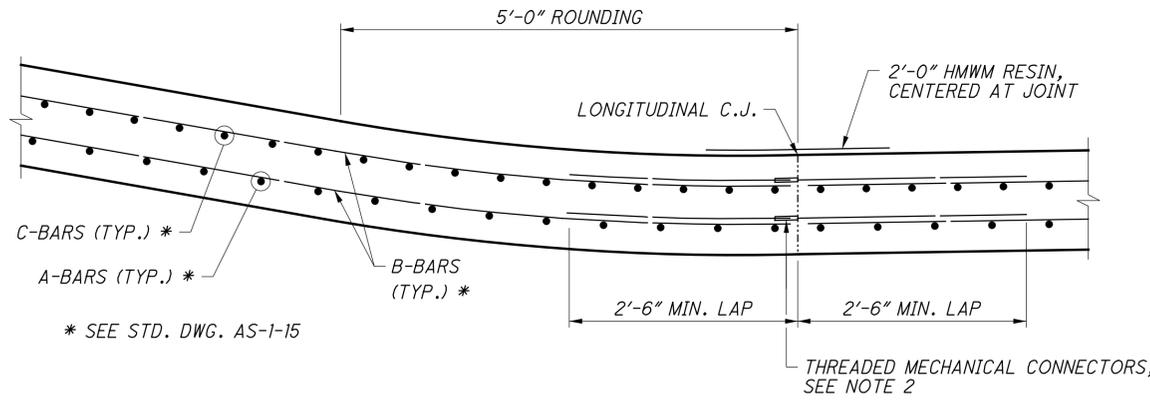

SECTION AS-3  
114

ALL ELEVATIONS ARE ±

NOTES

- ELEVATIONS SHOWN ON THIS SHEET ARE TO BE FIELD VERIFIED AND ADJUSTED TO MATCH THE EXISTING STRUCTURE.
- THREADED MECHANICAL CONNECTORS SHALL BE RICHMOND SCREW ANCHOR THREADED DOWEL BAR ASSEMBLY, LENTON REBAR SPLICING MECHANISM, OR APPROVED EQUAL. COST SHALL BE INCLUDED FOR PAYMENT WITH ITEM 526, REINFORCED CONCRETE APPROACH SLABS (T=13"), AS PER PLAN.
- SEAL THE LONGITUDINAL CONSTRUCTION JOINT WITH HIGH MOLECULAR WEIGHT METHACRYLATE (HMWM). THE WIDTH OF THE SEALING SHALL BE TWO FEET (2'), CENTERED OVER THE JOINT. PAYMENT SHALL BE MADE UNDER ITEM 526, REINFORCED CONCRETE APPROACH SLABS (T=13"), AS PER PLAN.

- FOR REINFORCING STEEL LIST, SEE SHEET 120/120.
- FOR MEDIAN BARRIER ELEVATION, SEE SHEET 118/120.



DATE 08/05/20  
REVIEWED MJL  
STRUCTURE FILE NUMBER 1811991  
DRAWN DAF/JG  
CHECKED CLH/JDA


WEST ABUTMENT APPROACH SLAB DETAILS - 2  
BRIDGE NO. CUY-490-0100  
I-490 OVER CUYAHOGA RIVER

CUY-490-01.00  
PID No. 107408


114/120

125  
131


X:\Projects\2022\00100\_0DOT D12-CUY-490-0\25622-400-Engineering\Structures\CUY490\_0100C\Sheets\025622\_SFNI8191\_SMO22.dgn 3/29/2024 3:58:53 PM zguo

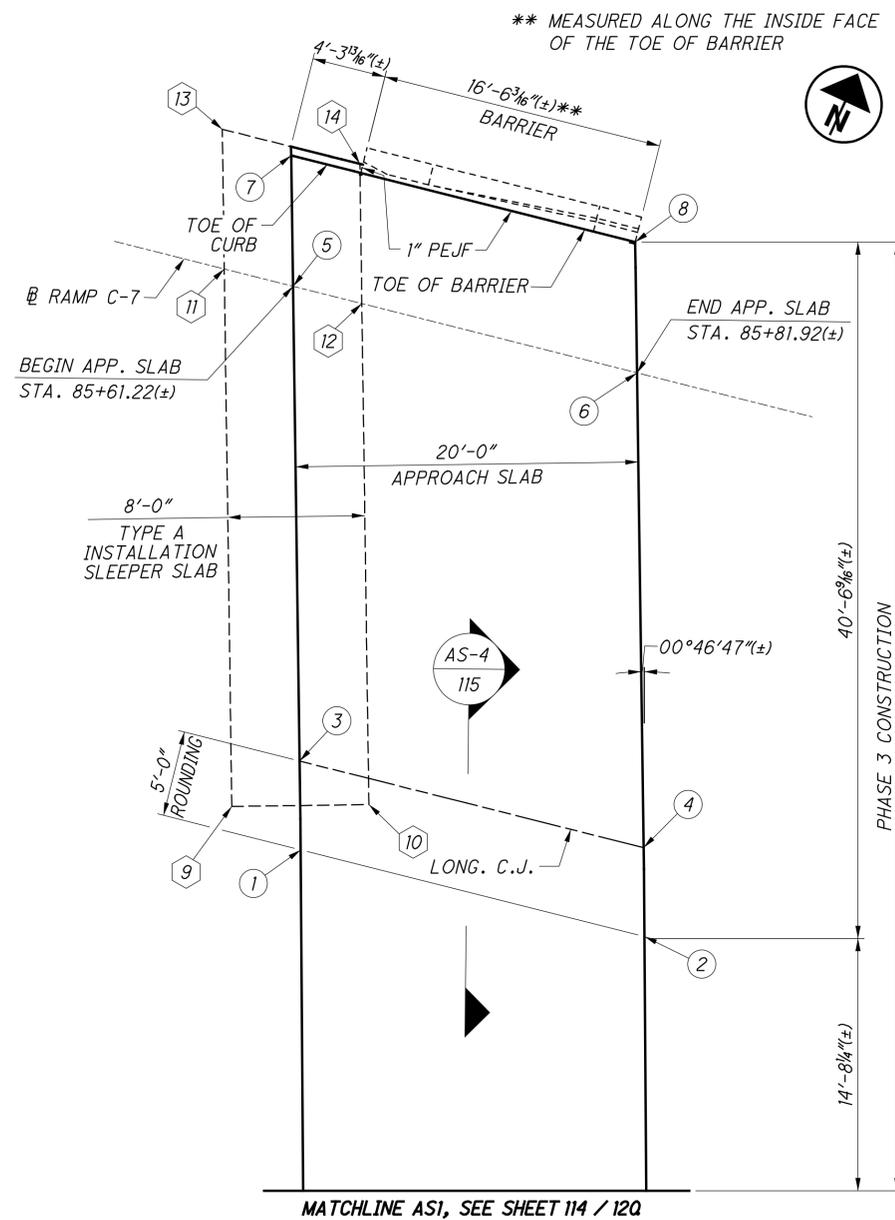

PLAN - REAR APPROACH SLAB

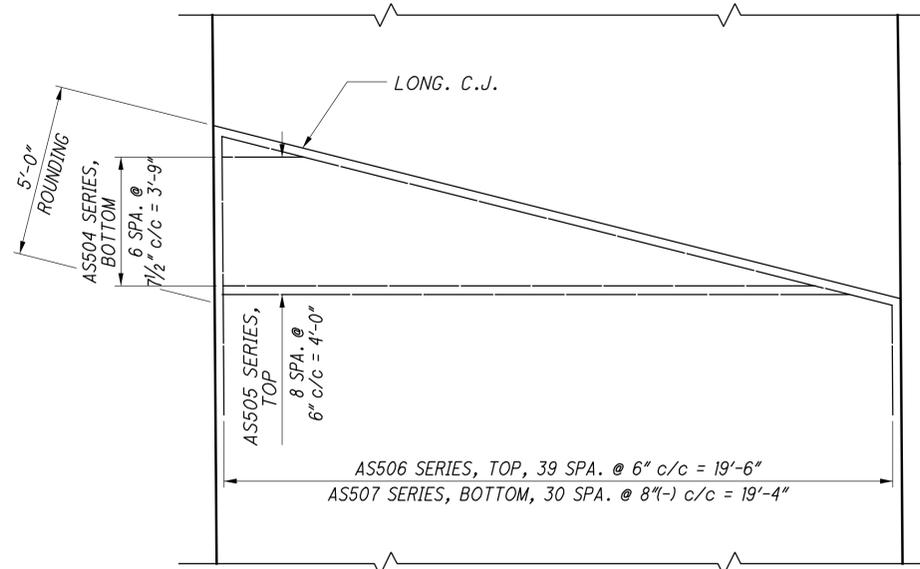

PART PLAN - REAR APPROACH SLAB REINFORCING

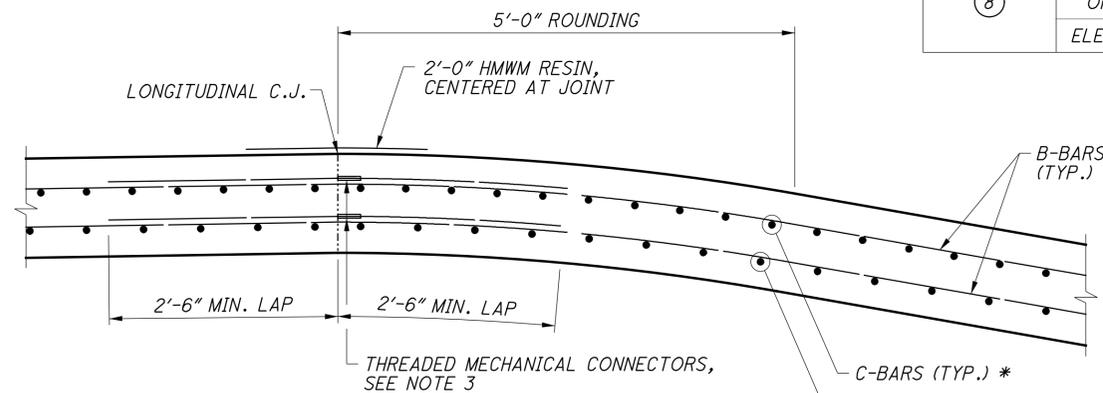

SECTION AS-4 115

APPROACH SLAB ELEVATIONS

LOCATION	REAR
①	STATION 985+63.69
	OFFSET -109.44
	ELEVATION 649.26
②	STATION 985+84.09
	OFFSET -104.41
	ELEVATION 649.43
③	STATION 985+84.09
	OFFSET -114.61
	ELEVATION 649.68
④	STATION 985+84.06
	OFFSET -109.57
	ELEVATION 649.85
⑤	STATION 985+63.18
	OFFSET -142.25
	ELEVATION 652.34
⑥	STATION 985+83.70
	OFFSET -137.21
	ELEVATION 652.17
⑦	STATION 985+63.05
	OFFSET -149.87
	ELEVATION 653.02
⑧	STATION 985+83.60
	OFFSET -144.83
	ELEVATION 652.80

SLEEPER SLAB ELEVATIONS

LOCATION	REAR
⑨	STATION 985+59.59
	OFFSET -111.96
	ELEVATION 648.53
⑩	STATION 985+67.74
	OFFSET -112.09
	ELEVATION 648.36
⑪	STATION 985+59.06
	OFFSET -143.25
	ELEVATION 651.29
⑫	STATION 985+67.29
	OFFSET -141.25
	ELEVATION 651.23
⑬	STATION 985+58.92
	OFFSET -151.39
	ELEVATION 651.99
⑭	STATION 985+67.16
	OFFSET -149.39
	ELEVATION 651.90

ALL ELEVATIONS ARE ±

NOTES

- ELEVATIONS SHOWN ON THIS SHEET ARE TO BE FIELD VERIFIED AND ADJUSTED TO MATCH THE EXISTING STRUCTURE.
- THIS DRAWING PROVIDES DETAILS TO SUPPLEMENT THE STANDARD DRAWING. FOR APPROACH SLAB REINFORCING STEEL AND DETAILS NOT SHOWN, REFER TO STANDARD DRAWING AS-1-15.
- THREADED MECHANICAL CONNECTORS SHALL BE RICHMOND SCREW ANCHOR THREADED DOWEL BAR ASSEMBLY, LENTON REBAR SPLICING MECHANISM, OR APPROVED EQUAL. COST SHALL BE INCLUDED FOR PAYMENT WITH ITEM 526, REINFORCED CONCRETE APPROACH SLABS (T=13"), AS PER PLAN.
- SEAL THE LONGITUDINAL CONSTRUCTION JOINT WITH HIGH MOLECULAR WEIGHT METHACRYLATE (HMWM). THE WIDTH OF THE SEALING SHALL BE TWO FEET (2'), CENTERED OVER THE JOINT. PAYMENT SHALL BE MADE UNDER ITEM 526, REINFORCED CONCRETE APPROACH SLABS (T=13"), AS PER PLAN.
- FOR REINFORCING STEEL LIST, SEE SHEET 120/120.

**DLZ**  
614 W. SUPERIOR AVE., SUITE 1000 • CLEVELAND, OHIO 44113

DESIGNED KJS/MHK	DRAWN DAF/MHK	REVIEWED MJL	DATE 08/05/20
CHECKED CLH/PAT	REVISED	STRUCTURE FILE NUMBER 1811991	


**WEST ABUTMENT APPROACH SLAB DETAILS - 3**  
BRIDGE NO. CUY-490-0100  
I-490 OVER CUYAHOGA RIVER

**CUY-490-01.00**  
PID No. 107408

115 / 120

126  
131

X:\Projects\2022\00100\_ODOT\_DI2-CUY-490-0\25622-400-Engineering\Structures\CUY490\_0100C\Sheets\025622\_SFN181991\_SM023.dgn 3/29/2024 3:58:54 PM zguo

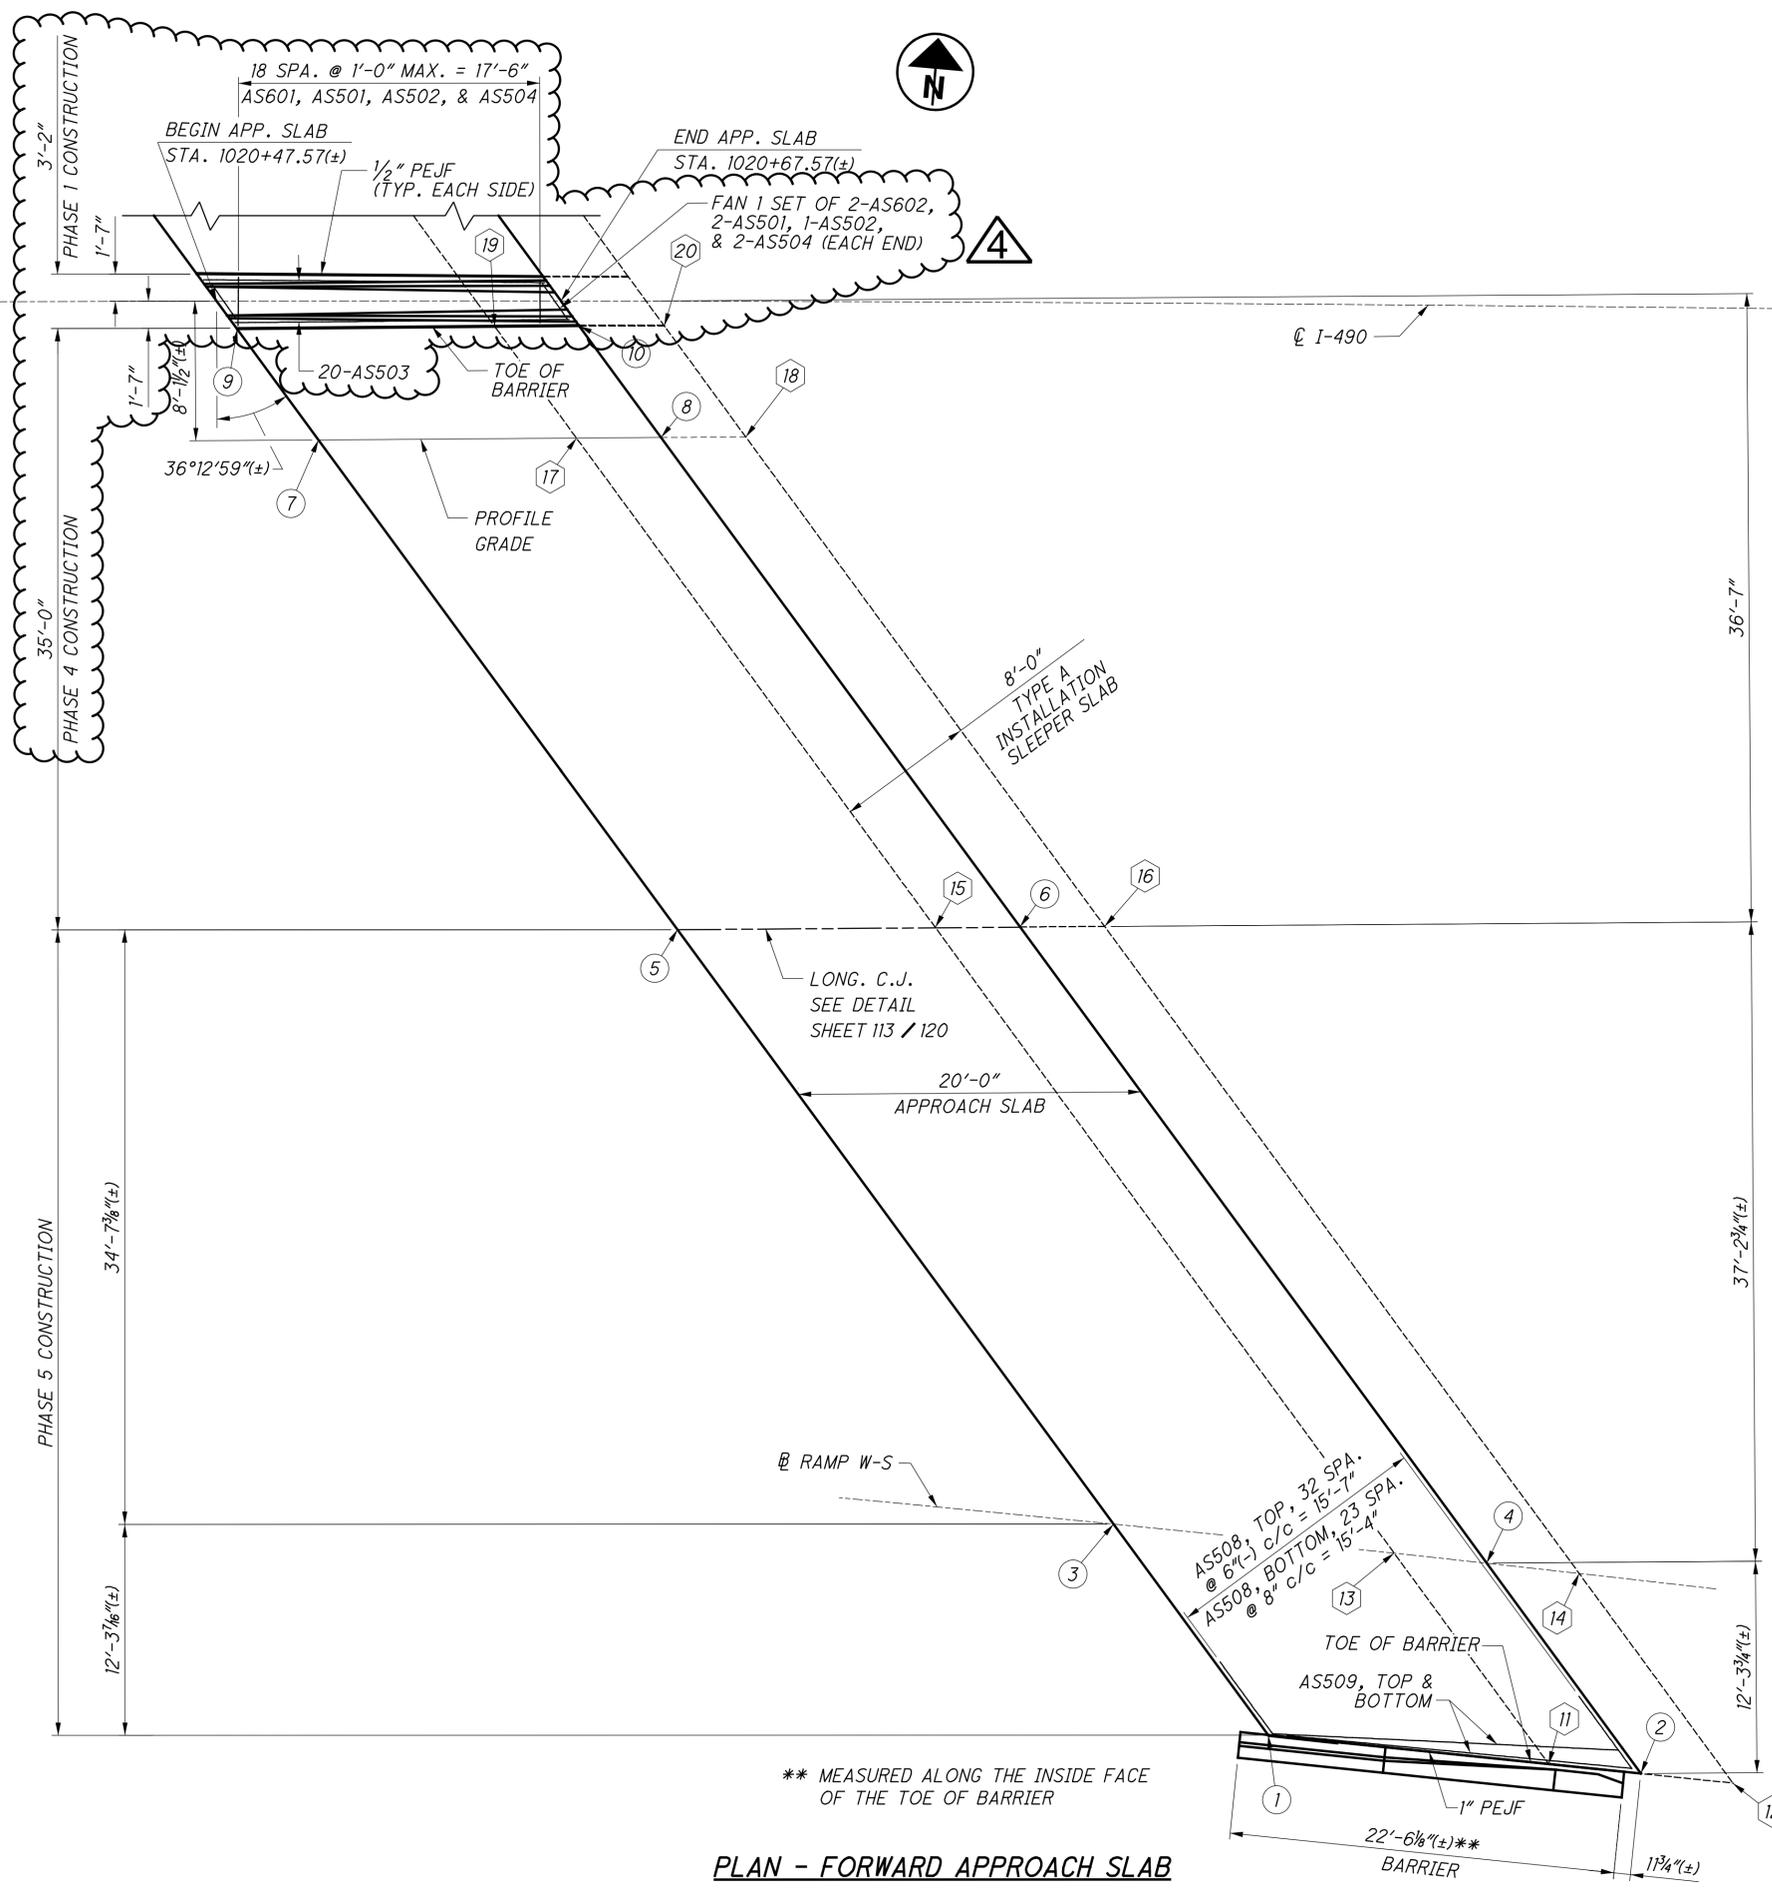

PLAN - FORWARD APPROACH SLAB

\*\* MEASURED ALONG THE INSIDE FACE OF THE TOE OF BARRIER

APPROACH SLAB ELEVATIONS		
LOCATION	STATION	FORWARD
①	STATION	1021+09.30
	OFFSET	83.31
	ELEVATION	648.43
②	STATION	1021+31.34
	OFFSET	85.37
	ELEVATION	646.91
③	STATION	1021+00.08
	OFFSET	71.09
	ELEVATION	648.11
④	STATION	1021+22.11
	OFFSET	73.21
	ELEVATION	647.32
⑤	STATION	1020+74.44
	OFFSET	36.58
	ELEVATION	649.41
⑥	STATION	1020+94.69
	OFFSET	36.58
	ELEVATION	648.89
⑦	STATION	1020+53.26
	OFFSET	8.09
	ELEVATION	650.49
⑧	STATION	1020+73.25
	OFFSET	7.94
	ELEVATION	650.10
⑨	STATION	1020+48.52
	OFFSET	1.45
	ELEVATION	650.67
⑩	STATION	1020+68.53
	OFFSET	1.63
	ELEVATION	650.19

SLEEPER SLAB ELEVATIONS		
LOCATION	STATION	FORWARD
⑪	STATION	1021+25.89
	OFFSET	84.87
	ELEVATION	645.92
⑫	STATION	1021+36.78
	OFFSET	85.86
	ELEVATION	645.71
⑬	STATION	1021+16.65
	OFFSET	72.67
	ELEVATION	646.23
⑭	STATION	1021+27.55
	OFFSET	73.75
	ELEVATION	646.14
⑮	STATION	1020+89.66
	OFFSET	36.58
	ELEVATION	647.86
⑯	STATION	1020+99.72
	OFFSET	36.58
	ELEVATION	647.69
⑰	STATION	1020+68.26
	OFFSET	7.98
	ELEVATION	649.13
⑱	STATION	1020+78.23
	OFFSET	7.89
	ELEVATION	648.86
⑳	STATION	1020+63.56
	OFFSET	1.50
	ELEVATION	649.24
㉑	STATION	1020+73.46
	OFFSET	1.45
	ELEVATION	648.93

ALL ELEVATIONS ARE ±

NOTES

- ELEVATIONS SHOWN ON THIS SHEET ARE TO BE FIELD VERIFIED AND ADJUSTED TO MATCH THE EXISTING STRUCTURE.
- THIS DRAWING PROVIDES DETAILS TO SUPPLEMENT THE STANDARD DRAWING. FOR APPROACH SLAB REINFORCING STEEL AND DETAILS NOT SHOWN, REFER TO STANDARD DRAWING AS-1-15.
- THREADED MECHANICAL CONNECTORS SHALL BE RICHMOND SCREW ANCHOR THREADED DOWEL BAR ASSEMBLY, LENTON REBAR SPLICING MECHANISM, OR APPROVED EQUAL. COST SHALL BE INCLUDED FOR PAYMENT WITH ITEM 526, REINFORCED CONCRETE APPROACH SLABS (T=13"), AS PER PLAN.
- SEAL THE LONGITUDINAL CONSTRUCTION JOINT WITH HIGH MOLECULAR WEIGHT METHACRYLATE (HMWM). THE WIDTH OF THE SEALING SHALL BE TWO FEET (2'), CENTERED OVER THE JOINT. PAYMENT SHALL BE MADE UNDER ITEM 526, REINFORCED CONCRETE APPROACH SLABS (T=13"), AS PER PLAN.
- FOR REINFORCING STEEL LIST, SEE SHEET 120/120.

6. FOR MEDIAN BARRIER ELEVATION, SEE SHEET 118/120.

**DLZ**  
84 W. SUPERIOR AVE., SUITE 1000 • CLEVELAND, OHIO 44113

DATE: 08/05/20  
REVIEWED: MJL  
DRAWN: DAF/AMHK  
DESIGNED: KJS/AMHK  
CHECKED: CLH/PAT

STRUCTURE FILE NUMBER: 1811991


**EAST ABUTMENT APPROACH SLAB DETAILS - 1**  
BRIDGE NO. CUY-490-0100  
I-490 OVER CUYAHOGA RIVER

PID No. 107408

116/120

127/131

X:\Projects\2020\00100 DOT D12-CUY-490-0\25622\400-Engineering\Structures\CUY490\_0100C\Sheets\025622\_SF\N181991\_S\02024.dgn 3/29/2024 3:58:54 PM zguo

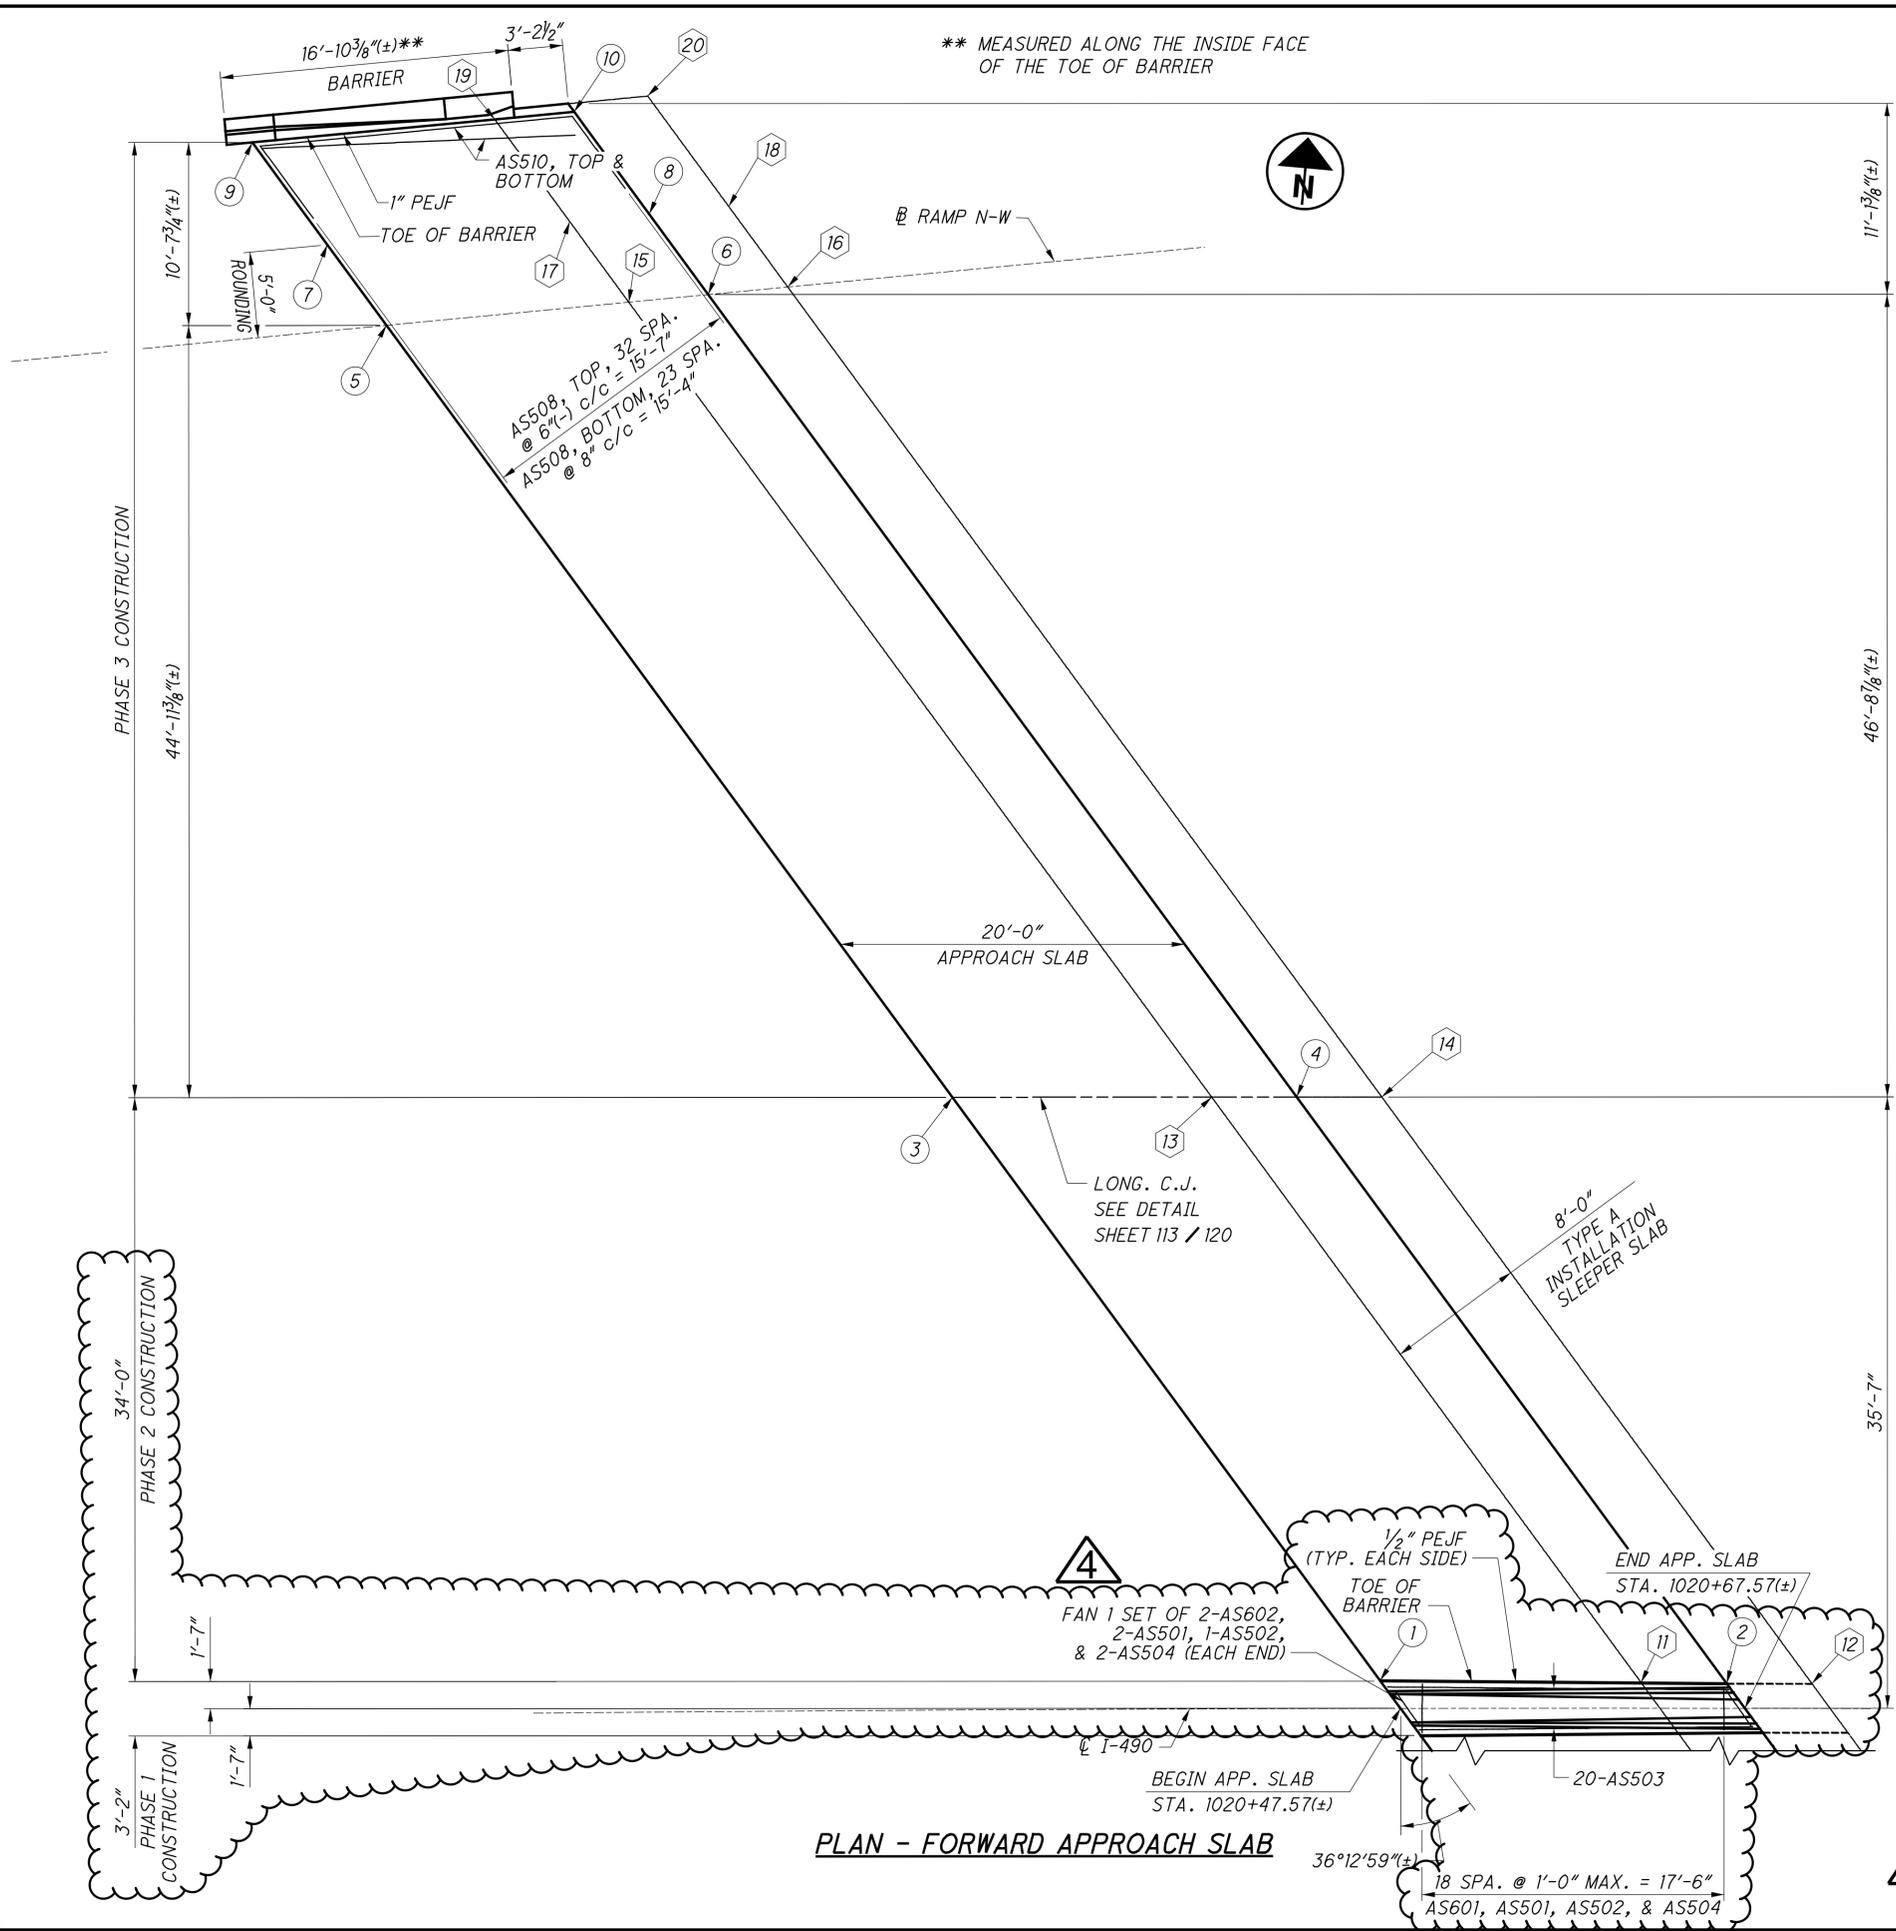

APPROACH SLAB ELEVATIONS		
LOCATION	FORWARD	
①	STATION	1020+46.14
	OFFSET	-1.63
	ELEVATION	650.75
②	STATION	1020+66.36
	OFFSET	-1.45
	ELEVATION	650.24
③	STATION	1020+21.64
	OFFSET	-35.58
	ELEVATION	651.71
④	STATION	1020+41.59
	OFFSET	-35.58
	ELEVATION	651.30
⑤	STATION	1019+88.97
	OFFSET	-80.87
	ELEVATION	652.99
⑥	STATION	1020+07.55
	OFFSET	-82.50
	ELEVATION	652.76
⑦	STATION	1019+85.61
	OFFSET	-85.60
	ELEVATION	653.28
⑧	STATION	1020+04.18
	OFFSET	-87.22
	ELEVATION	652.94
⑨	STATION	1019+81.35
	OFFSET	-91.60
	ELEVATION	653.58
⑩	STATION	1019+99.91
	OFFSET	-93.20
	ELEVATION	653.28

SLEEPER SLAB ELEVATIONS		
LOCATION	FORWARD	
⑪	STATION	1020+61.37
	OFFSET	-1.48
	ELEVATION	649.32
⑫	STATION	1020+71.33
	OFFSET	-1.45
	ELEVATION	649.02
⑬	STATION	1020+36.66
	OFFSET	-35.58
	ELEVATION	650.35
⑭	STATION	1020+46.53
	OFFSET	-35.58
	ELEVATION	650.13
⑮	STATION	1020+02.96
	OFFSET	-82.09
	ELEVATION	651.74
⑯	STATION	1020+12.14
	OFFSET	-82.91
	ELEVATION	651.66
⑰	STATION	1019+99.59
	OFFSET	-86.81
	ELEVATION	651.92
⑱	STATION	1019+08.76
	OFFSET	-87.62
	ELEVATION	651.81
⑲	STATION	1019+95.33
	OFFSET	-92.80
	ELEVATION	652.27
⑳	STATION	1020+04.15
	OFFSET	-94.08
	ELEVATION	652.16

ALL ELEVATIONS ARE ±

**NOTES**

- ELEVATIONS SHOWN ON THIS SHEET ARE TO BE FIELD VERIFIED AND ADJUSTED TO MATCH THE EXISTING STRUCTURE.
- THIS DRAWING PROVIDES DETAILS TO SUPPLEMENT THE STANDARD DRAWING. FOR APPROACH SLAB REINFORCING STEEL AND DETAILS NOT SHOWN, REFER TO STANDARD DRAWING AS-1-15.
- THREADED MECHANICAL CONNECTORS SHALL BE RICHMOND SCREW ANCHOR THREADED DOWEL BAR ASSEMBLY, LENTON REBAR SPLICING MECHANISM, OR APPROVED EQUAL. COST SHALL BE INCLUDED FOR PAYMENT WITH ITEM 526, REINFORCED CONCRETE APPROACH SLABS (T=13"), AS PER PLAN.
- SEAL THE LONGITUDINAL CONSTRUCTION JOINT WITH HIGH MOLECULAR WEIGHT METHACRYLATE (HMWM). THE WIDTH OF THE SEALING SHALL BE TWO FEET (2'), CENTERED OVER THE JOINT. PAYMENT SHALL BE MADE UNDER ITEM 526, REINFORCED CONCRETE APPROACH SLABS (T=13"), AS PER PLAN.
- FOR REINFORCING STEEL LIST, SEE SHEET 120/120.

④ FOR MEDIAN BARRIER ELEVATION, SEE SHEET 118/120.

**DLZ**  
84 W. SUPERIOR AVE., SUITE 1000 • CLEVELAND, OHIO 44113

DATE: 08/05/20  
REVIEWED: MJL  
DRAWN: DAF/AMHK  
DESIGNED: KJS/AMHK  
CHECKED: CLH/PAT

STRUCTURE FILE NUMBER: 1811991

**EAST ABUTMENT APPROACH SLAB DETAILS - 2**  
BRIDGE NO. CUY-490-0100  
I-490 OVER CUYAHOGA RIVER


CUY-490-01.00  
PID No. 107408

117/120  
128  
131


④ 03/29/2024

X:\Projects\2022\100100 DOT D12-CUY-490-0\25622-400-Engineering\Structures\CUY490\_0100C\Sheets\025622\_SFN\18191\_SMO25.dgn 3/29/2024 3:58:55 PM zguo

\*\* MEASURED ALONG THE INSIDE FACE OF THE TOE OF BARRIER

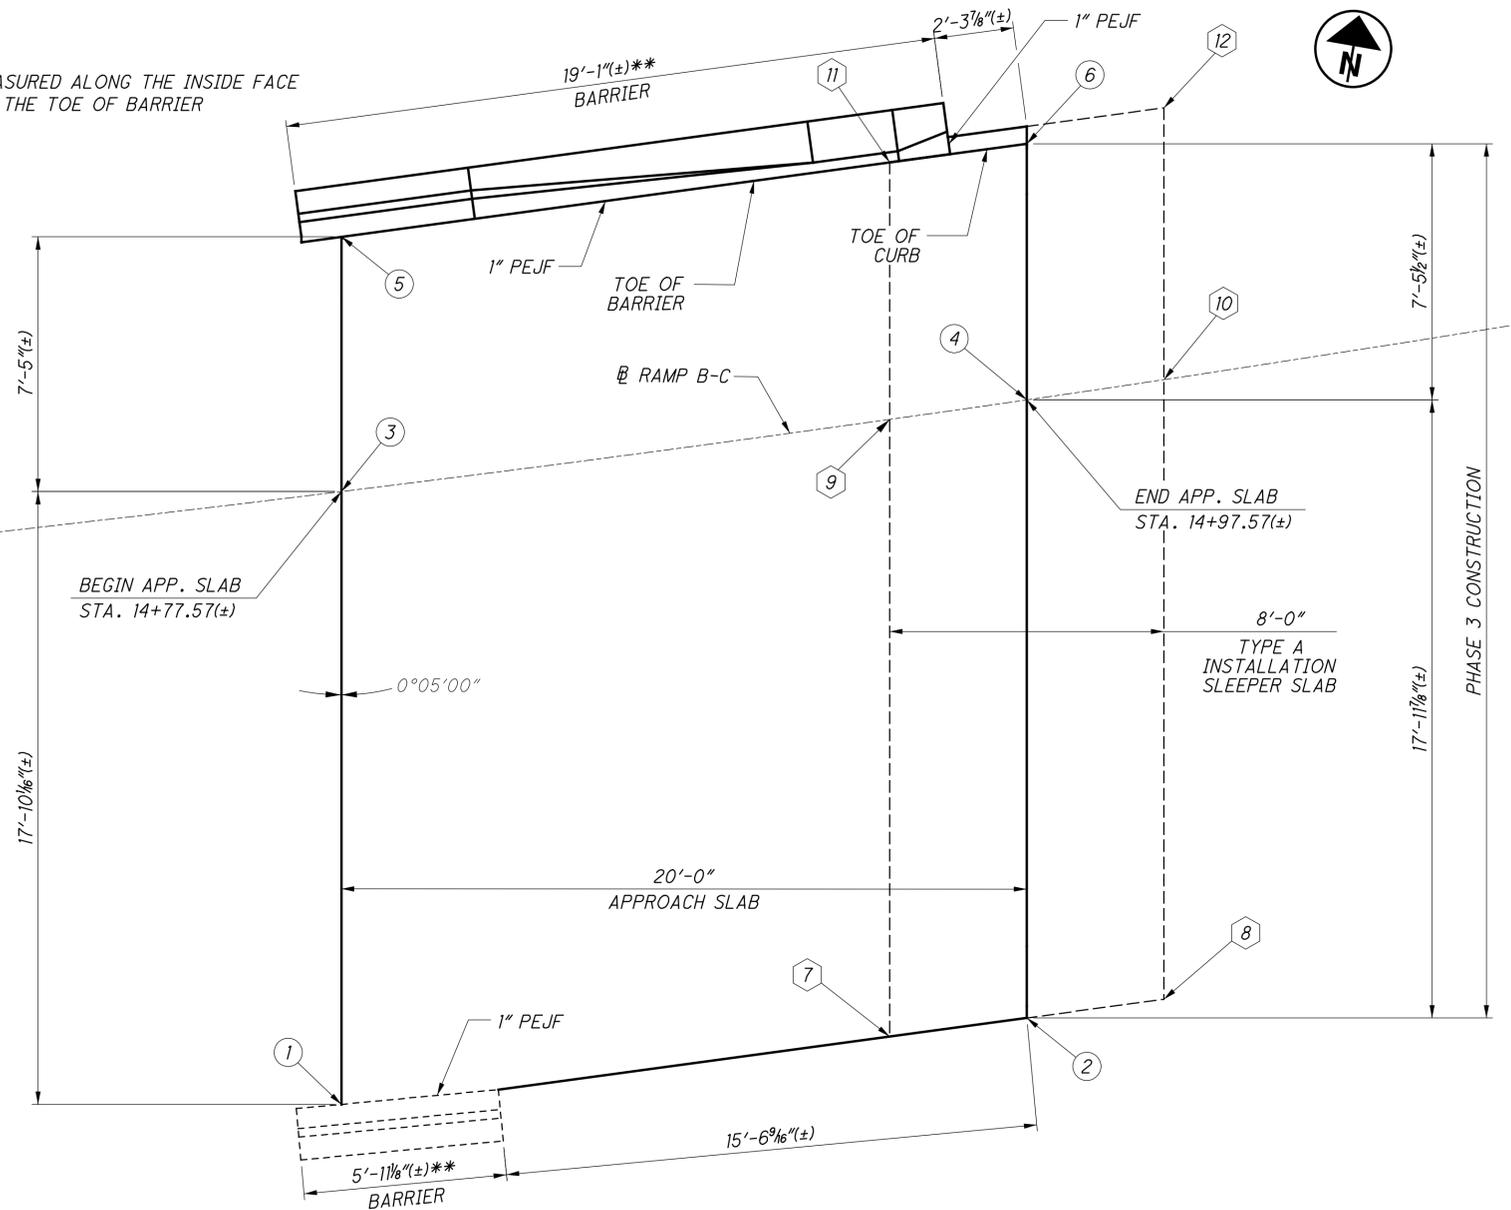

PLAN - FORWARD APPROACH SLAB

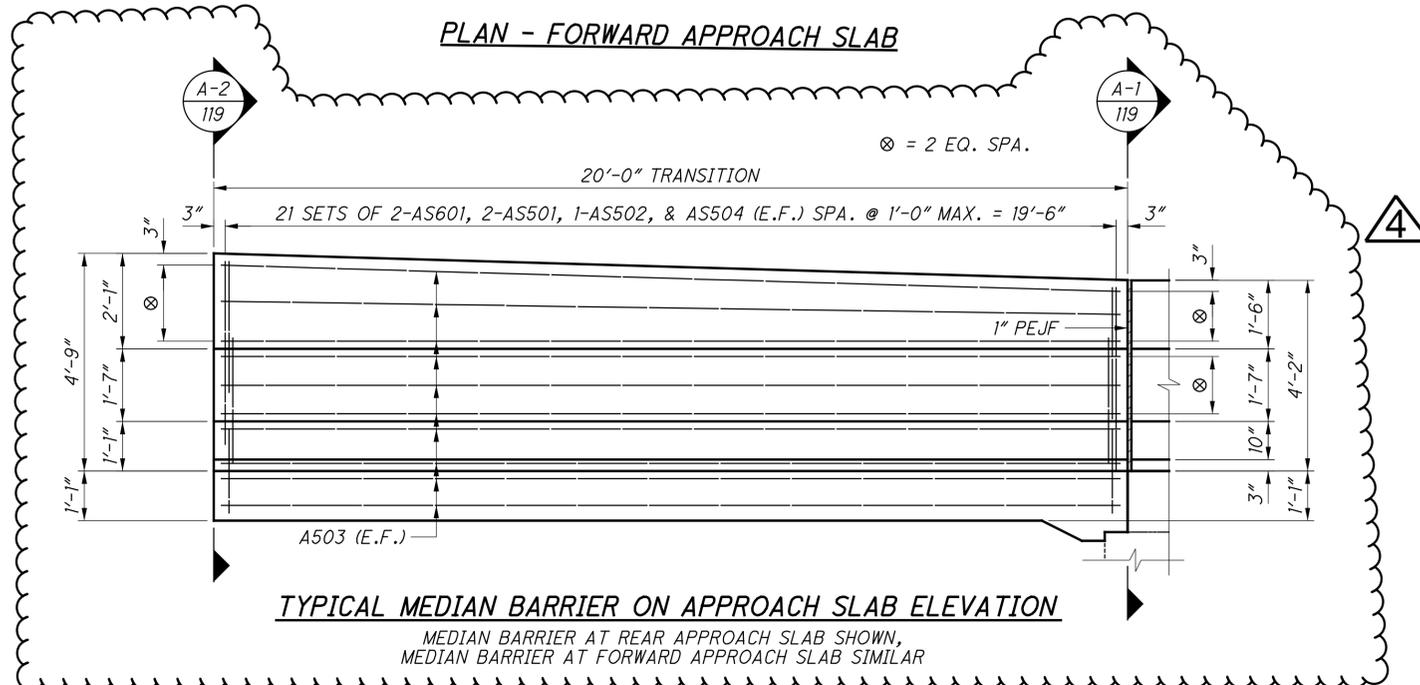

TYPICAL MEDIAN BARRIER ON APPROACH SLAB ELEVATION

MEDIAN BARRIER AT REAR APPROACH SLAB SHOWN,  
MEDIAN BARRIER AT FORWARD APPROACH SLAB SIMILAR

APPROACH SLAB ELEVATIONS

LOCATION	STATION	FORWARD
①	STATION	14+75.44
	OFFSET	17.71
	ELEVATION	666.47
②	STATION	14+95.24
	OFFSET	17.81
	ELEVATION	666.23
③	STATION	14+77.61
	OFFSET	0.00
	ELEVATION	666.00
④	STATION	14+97.75
	OFFSET	0.00
	ELEVATION	666.08
⑤	STATION	14+78.48
	OFFSET	-7.36
	ELEVATION	665.75
⑥	STATION	14+98.83
	OFFSET	-7.38
	ELEVATION	666.00

SLEEPER SLAB ELEVATIONS

LOCATION	STATION	FORWARD
⑦	STATION	14+91.20
	OFFSET	17.79
	ELEVATION	665.20
⑧	STATION	14+99.17
	OFFSET	17.84
	ELEVATION	665.11
⑨	STATION	14+93.71
	OFFSET	0.00
	ELEVATION	664.99
⑩	STATION	15+01.79
	OFFSET	0.00
	ELEVATION	665.02
⑪	STATION	14+94.75
	OFFSET	-7.41
	ELEVATION	664.87
⑫	STATION	15+05.41
	OFFSET	-7.82
	ELEVATION	664.91

ALL ELEVATIONS ARE ±

NOTES

- ELEVATIONS SHOWN ON THIS SHEET ARE TO BE FIELD VERIFIED AND ADJUSTED TO MATCH THE EXISTING STRUCTURE.



DATE: 08/05/20  
REVIEWED: MJL  
DRAWN: DAF/VJS  
CHECKED: CLH/JDA  
STRUCTURE FILE NUMBER: 1811991


ABUTMENT B-C APPROACH SLAB DETAILS  
BRIDGE NO. CUY-490-0100  
I-490 OVER CUYAHOGA RIVER

CUY-490-01.00  
PID No. 107408

118/120

129/131

X:\Projects\2020\100100 DOT D12-CUY-490-0\25622-400-Engineering\Structures\CUY490\_0100C\Sheets\025622\_SF\N181991\_SM026.dgn 3/29/2024 3:58:56 PM zguo

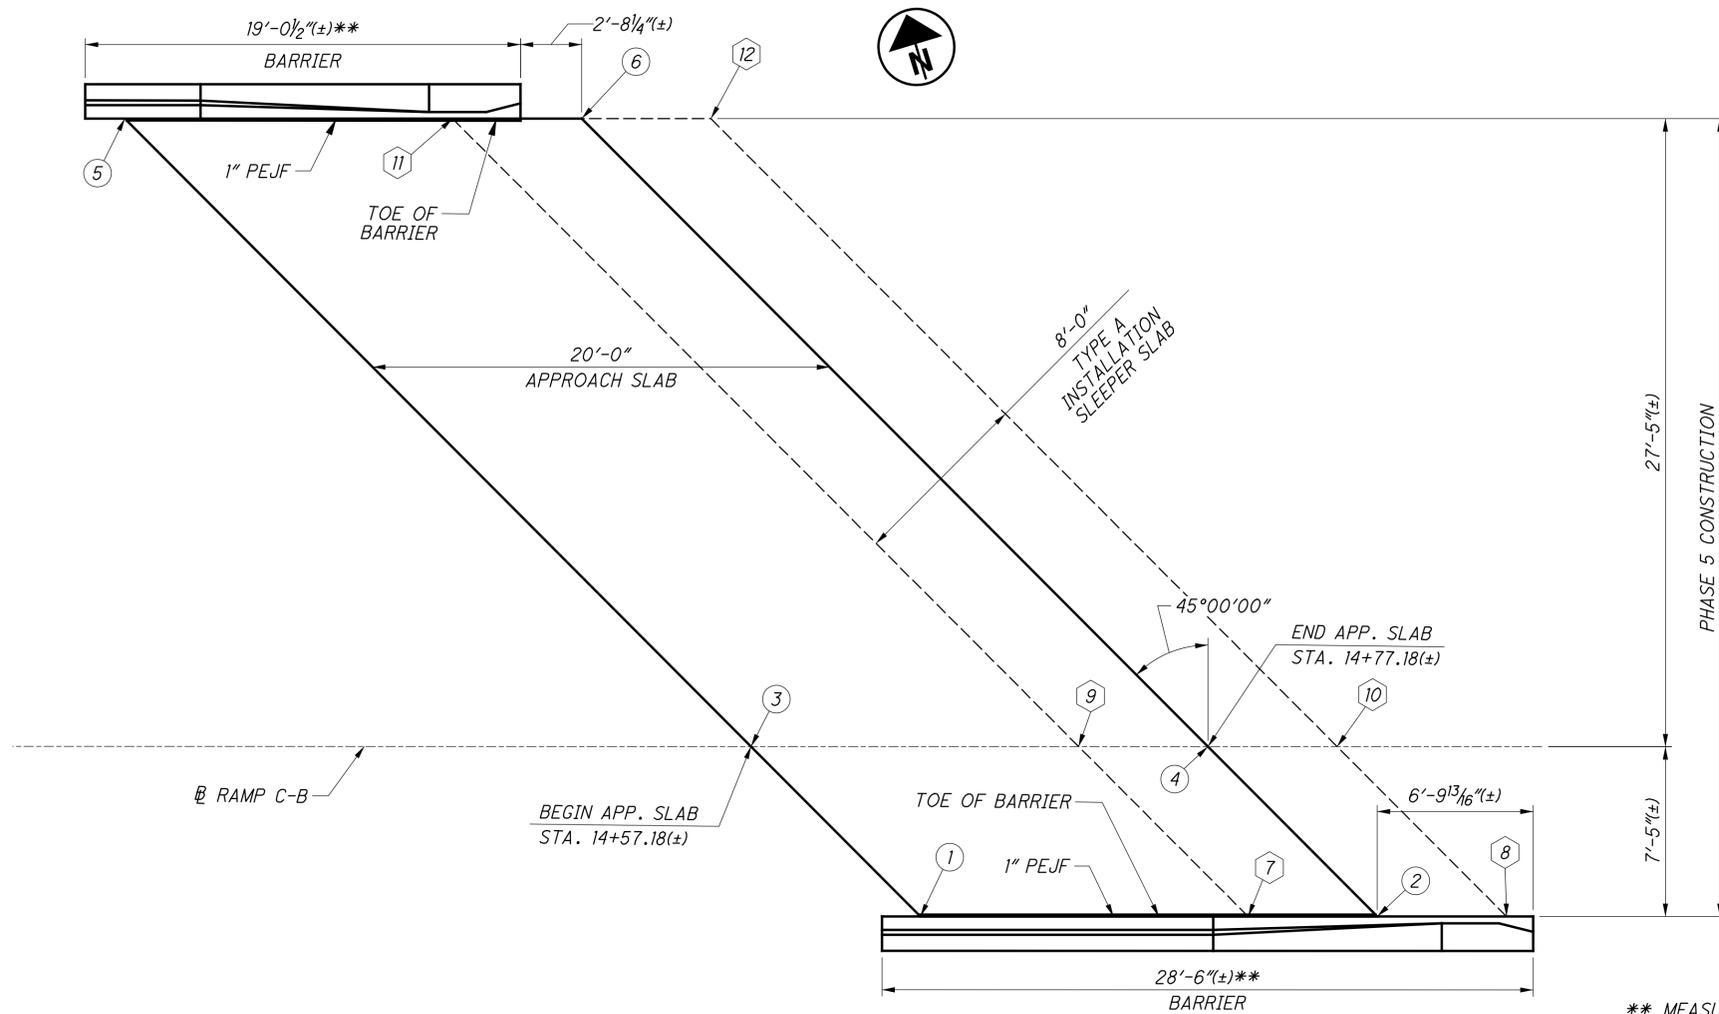

PLAN - FORWARD APPROACH SLAB

**APPROACH SLAB ELEVATIONS**


LOCATION	REAR
①	STATION 14+64.60
	OFFSET 7.42
	ELEVATION 667.82
②	STATION 14+84.60
	OFFSET 7.42
	ELEVATION 668.65
③	STATION 14+57.18
	OFFSET 0.00
	ELEVATION 667.61
④	STATION 14+77.18
	OFFSET 0.00
	ELEVATION 668.39
⑤	STATION 14+29.76
	OFFSET -27.41
	ELEVATION 666.97
⑥	STATION 14+49.76
	OFFSET -27.41
	ELEVATION 667.57

**SLEEPER SLAB ELEVATIONS**

LOCATION	REAR
⑦	STATION 14+78.96
	OFFSET 7.42
	ELEVATION 667.34
⑧	STATION 14+90.21
	OFFSET 7.42
	ELEVATION 667.81
⑨	STATION 14+71.52
	OFFSET 0.00
	ELEVATION 667.09
⑩	STATION 14+82.84
	OFFSET 0.00
	ELEVATION 667.53
⑪	STATION 14+44.11
	OFFSET -27.41
	ELEVATION 666.32
⑫	STATION 14+55.40
	OFFSET -27.41
	ELEVATION 666.66

ALL ELEVATIONS ARE (±)

\*\* MEASURED ALONG THE INSIDE FACE OF THE TOE OF BARRIER

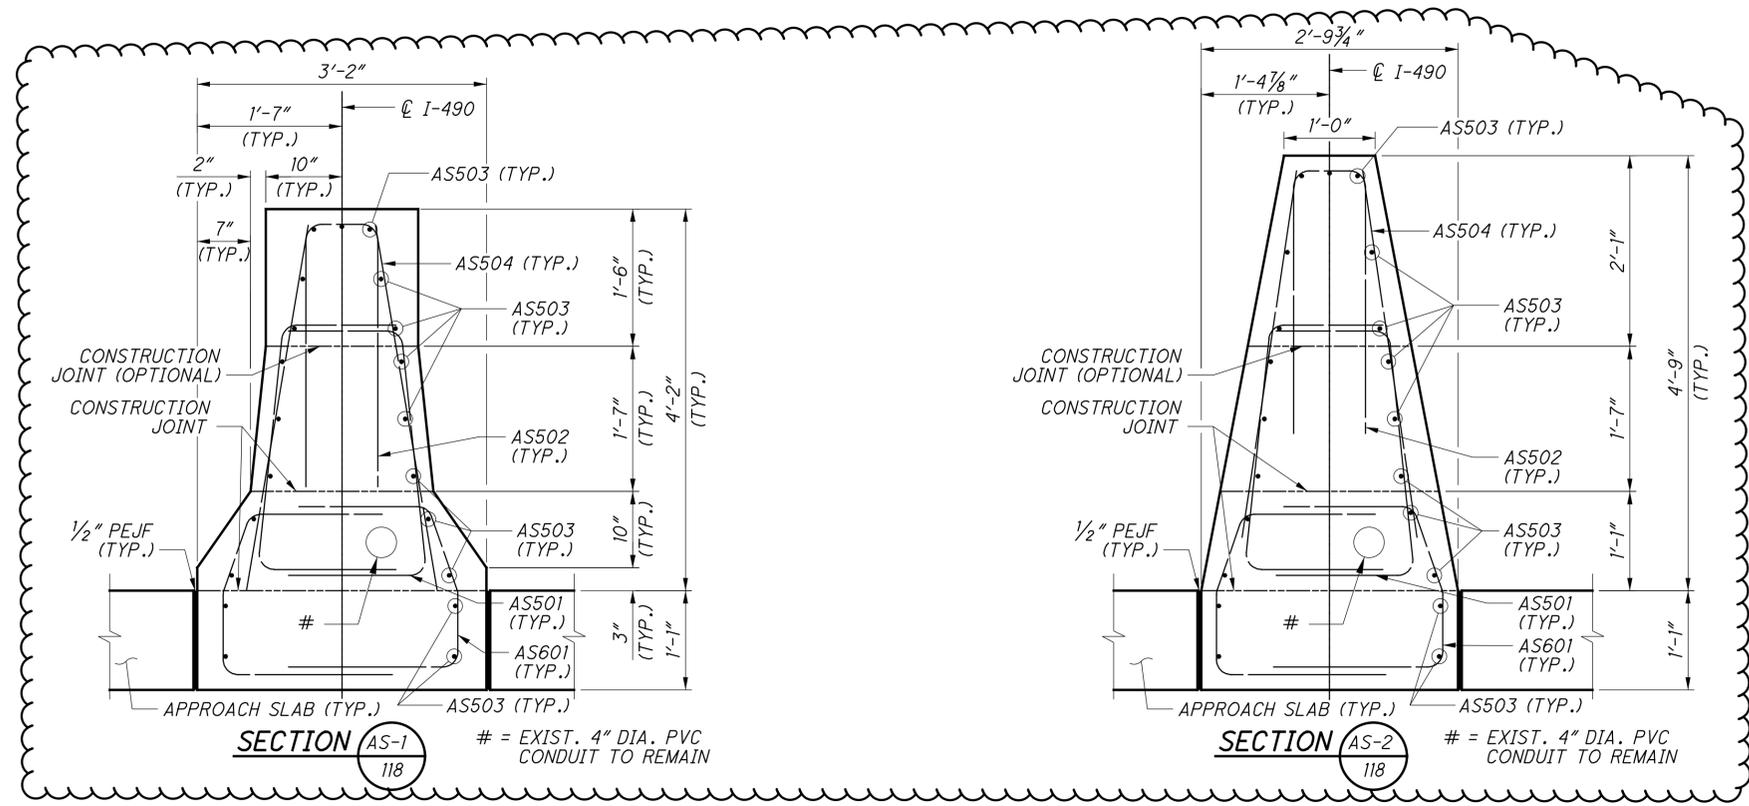

**NOTES**

- ELEVATIONS SHOWN ON THIS SHEET ARE TO BE FIELD VERIFIED AND ADJUSTED TO MATCH THE EXISTING STRUCTURE.



DATE 08/05/20  
 REVIEWED MJL  
 DRAWN DAF/JG  
 CHECKED CLH/JDA  
 STRUCTURE FILE NUMBER 181991

ABUTMENT C-B APPROACH SLAB DETAILS  
 BRIDGE NO. CUY-490-0100  
 I-490 OVER CUYAHOGA RIVER

CUY-490-01.00  
 PID No. 107408

119/120

130/131

X:\Projects\2022\00100\_0DOT D12-CUY-490-0\25622-400-Engineering\Structures\CUY490\_0100C\Sheets\025622\_SF\N181991\_SL001.dgn 3/29/2024 4:45:42 PM zguo

**REINFORCING STEEL LIST**


MARK	NO.	LENGTH	WEIGHT	TYPE	DIMENSIONS					SERIES INC.
					A	B	C	D	E	
<b>ABUTMENTS</b>										
A501	4	31'-5"	131	STR						
A502	16	7'-6"	125	STR						
A503	4	18'-7"	78	STR						
A504	4	15'-2"	63	STR						
A505	4	5'-5"	23	STR						
A506	4	25'-6"	106	STR						
A507	4	16'-5"	68	STR						
A508	4	30'-4"	127	STR						
A509	4	38'-5"	160	STR						
A510	8	27'-1"	226	STR						
A511	4	16'-4"	68	STR						
A512	8	22'-9"	190	STR						
A513	4	11'-5"	48	STR						
A514	8	24'-3"	202	STR						
A515	8	22'-2"	185	STR						
A516	NOT USED									
A517	NOT USED									
A518	4	25'-2"	105	STR						
A519	8	26'-2"	218	STR						
A520	6	3'-0"			2'-5"					
	SER OF	TO	321	16						0.75"
	15	3'-10"			3'-3"					
A521	24	13'-10"	346	STR						
A522	12	5'-7"	70	25	1'-10"	2'-5"	1'-4"	0'-2"	0'-5"	
A523	12	5'-8"	71	STR						
A524	36	10'-0"	375	STR						
A525	39	7'-0"	285	23	0'-8"	3'-3"	3'-0"			
A526	2	13'-8"	29	STR						
A527	6	2'-6"	16	STR						
A528	4	4'-9"	20	STR						
A529	2	16'-6"	34	STR						
A530	6	6'-8"	42	STR						
A531	4	8'-11"	37	STR						
A532	2	20'-8"	43	STR						
A533	12	4'-8"	58	STR						
A534	8	6'-11"	58	STR						
A535	4	18'-9"	78	STR						
A536	6	14'-2"	89	STR						
A537	4	16'-5"	68	STR						
A538	2	28'-2"	59	STR						
A539	8	4'-8"	39	STR						
A540	8	5'-1"	42	STR						
A601	1,060	2'-6"	3,980	1	0'-9"	1'-11"				
	8	3'-10"				3'-0"				
A602	SER OF	TO	575	1	1'-0"					0.75"
	15	4'-8"				3'-10"				
A603	36	3'-10"	207	1	1'-0"	3'-0"				
A604	4	4'-11"	30	24	0'-5"	2'-2"				
A605	4	5'-4"	32	23	0'-8"	2'-5"	2'-2"			
A606	4	3'-5"	21	14	1'-0"	1'-3"	0'-8"	0'-6"	0'-7"	
A607	8	4'-4"	52	1	1'-0"	3'-6"				
A608	4	5'-2"	31	24	0'-7"	2'-2"				
A609	4	5'-4"	32	23	0'-8"	2'-5"	2'-2"			
A610	4	3'-7"	22	14	1'-0"	1'-3"	0'-8"	0'-7"	0'-9"	
		TOTAL	9,285	LBS						

**REINFORCING STEEL LIST**

MARK	NO.	LENGTH	WEIGHT	TYPE	DIMENSIONS					SERIES INC.
					A	B	C	D	E	
<b>SUPERSTRUCTURE</b>										
S501	36	7'-0"	263	23	0'-8"	3'-3"	3'-0"			
S502	48	3'-0"	150	14	1'-0"	0'-10"	0'-8"	0'-6"	0'-7"	
S503	48	2'-4"	117	1	1'-0"	1'-6"				
S504	12	4'-10"	60	24	0'-4"	2'-2"				
S505	12	5'-4"	67	23	0'-8"	2'-5"	2'-2"			
S601	156	5'-8"	1,328	17	4'-4"					
S602	76	30'-0"	3,425	STR						
S603	20	20'-0"	601	STR						
		TOTAL	6,011	LBS						
<b>APPROACH SLABS</b>										
AS501	84	5'-1"	445	28	2'-9"	1'-3"				
AS502	42	6'-3"	274	2	2'-11"	0'-8"	2'-11"			
AS503	40	19'-8"	820	STR						
AS504	84	5'-3"	460	STR						
AS601	84	4'-9"	599	14	1'-10"	0'-10"	0'-11"	0'-4"	1'-5"	
		TOTAL	2,598	LBS						

CONCRETE REINFORCEMENT WEIGHTS AND TOTALS FOR THE APPROACH SLABS ARE PROVIDED FOR INFORMATION ONLY. THE CONCRETE REINFORCEMENT LISTED ABOVE IS REQUIRED IN ADDITION TO THE CONCRETE REINFORCEMENT SHOWN IN ODOT STANDARD DRAWING AS-1-15. INCLUDE ALL CONCRETE REINFORCEMENT FOR APPROACH SLABS FOR PAYMENT WITH ITEM 526 - REINFORCED CONCRETE APPROACH SLABS (T=13'), AS PER PLAN.

**BENDING DIAGRAMS**

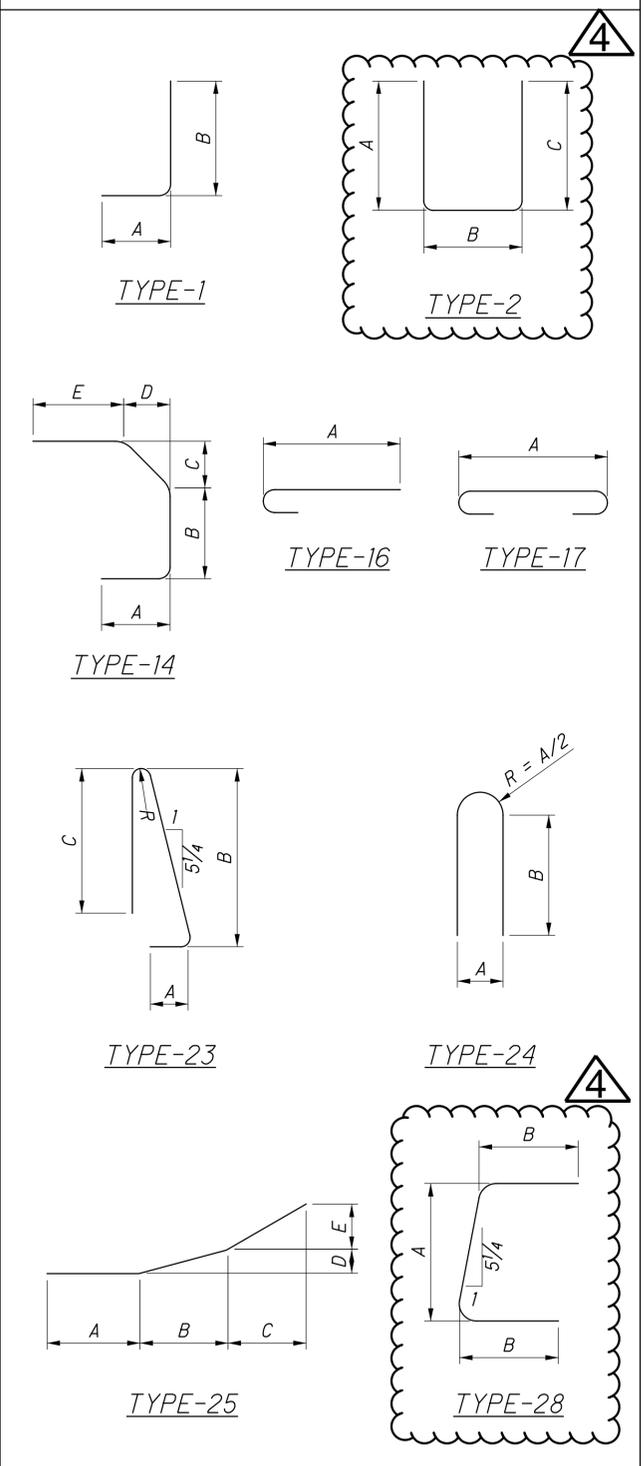

**CONCRETE REINFORCEMENT NOTES**

- SERIES BARS - EACH BAR VARIES BY TABULATED AMOUNT.
- ALL DIMENSIONS ARE OUT TO OUT.
- TYPE 'STR' INDICATES A STRAIGHT BAR.
- THE BAR SIZE NUMBER IS INDICATED IN THE 'MARK' COLUMN. THE FIRST ONE OR TWO DIGITS OF EACH MARK INDICATES THE BAR SIZE NUMBER. FOR EXAMPLE, A501 IS A #5 BAR SIZE AND P1001 IS A #10 BAR SIZE.
- ALL CONCRETE REINFORCEMENT SHALL BE EPOXY COATED.



DATE: 08/05/20  
 REVIEWED: MJL  
 DRAWN: JAM/VS  
 DESIGNED: JAM/VS  
 CHECKED: PAT/JDA

CONCRETE REINFORCEMENT LIST  
 BRIDGE NO. CUY-490-0100  
 I-490 OVER CUYAHOGA RIVER

CUY-490-01.00  
 PID No. 107408

120/120

131/131