



FOR LOCATION MAPS, LATTITUDE AND LONGITUDE
SEE SHEET 2

LOCATION MAP

STATE OF OHIO DEPARTMENT OF TRANSPORTATION

D01-BP-FY26

BATH, MILFORD, AND MONROE TOWNSHIPS

ALLEN AND DEFIANCE COUNTIES

FEDERAL PROJECT NUMBER

E250(153)

RAILROAD INVOLVEMENT

NORFOLK SOUTHERN RAILWAY GREAT LAKES DIVISION,
MILEPOST SP-81.25/SP-82.37

PROJECT DESCRIPTION

IMPROVEMENT OF VARIOUS STRUCTURES IN DISTRICT 1 BY PAINTING THE
STRUCTURAL STEEL.

EARTH DISTURBED AREAS

PROJECT EARTH DISTURBED AREA: 0.0 ACRES
 ESTIMATED CONTRACTOR EARTH DISTURBED AREA: 0.0 ACRES
 NOTICE OF INTENT EARTH DISTURBED AREA: N/A (NOI NOT REQUIRED)*
 *ROUTINE MAINTENANCE PROJECT

LIMITED ACCESS

THIS IMPROVEMENT IS ESPECIALLY DESIGNED FOR THROUGH TRAFFIC AND
HAS BEEN DECLARED A LIMITED ACCESS HIGHWAY OR FREEWAY BY ACTION
OF THE DIRECTOR IN ACCORDANCE WITH THE PROVISIONS OF SECTION
5511.02 OF THE OHIO REVISED CODE.

2023 SPECIFICATIONS

THE STANDARD SPECIFICATIONS OF THE STATE OF OHIO, DEPARTMENT OF
TRANSPORTATION, INCLUDING SUPPLEMENTAL SPECIFICATIONS LISTED IN
THE PLANS, CHANGES LISTED IN THE PROPOSAL, AND THE SUPPLEMENTAL
SPECIFICATION 800 VERSION INDICATED ON THE PROPOSAL SHALL GOVERN
THIS IMPROVEMENT.

I HEREBY APPROVE THESE PLANS AND DECLARE THAT THE MAKING OF THIS
IMPROVEMENT WILL REQUIRE THE CLOSING TO TRAFFIC OF THE HIGHWAY
AND THAT DETOURS WILL BE PROVIDED AS INDICATED ON SHEET 7 & 8.

Christopher A. Hughes
 Christopher A. Hughes, P.E.
 District 01 Deputy Director

Pamela Boratyn
 Pamela Boratyn
 Director, Department of Transportation

INDEX OF SHEETS:

TITLE SHEET	1
LOCATION MAPS	2
GENERAL NOTES	3
MAINTENANCE OF TRAFFIC	4-8
GENERAL SUMMARY	9
STRUCTURE- ALL-75-13.87	10-12
STRUCTURE - ALL-75-15.05	13-15
STRUCTURE - DEF-249-0.10	16-18

DESIGN EXCEPTIONS

NONE REQUIRED

ADA DESIGN WAIVERS


NONE REQUIRED

UNDERGROUND UTILITIES
 Contact Two Working Days
 Before You Dig

OHIO811. 8-1-1. or 1-800-362-2764
 (Non members must be called directly)

PLAN PREPARED BY:
 OHIO DEPT. OF TRANSPORTATION, DISTRICT 1
 1885 N. MCCULLOUGH ST.
 LIMA, OHIO 45801

STANDARD CONSTRUCTION DRAWINGS					SUPPLEMENTAL SPECIFICATIONS	SPECIAL PROVISIONS
MT-95.30	7/19/19				800	1/17/25
MT-95.50	7/21/17				821	4/20/12
MT-97.10	4/19/19				832	7/19/24
MT-101.60	1/17/25				921	7/19/24
MT-102.20	4/19/19					
MT-105.10	1/17/20					
TC-41.20	10/18/13					
TC-42.20	10/18/13					
TC-52.10	10/18/13					
TC-52.20	1/15/21					

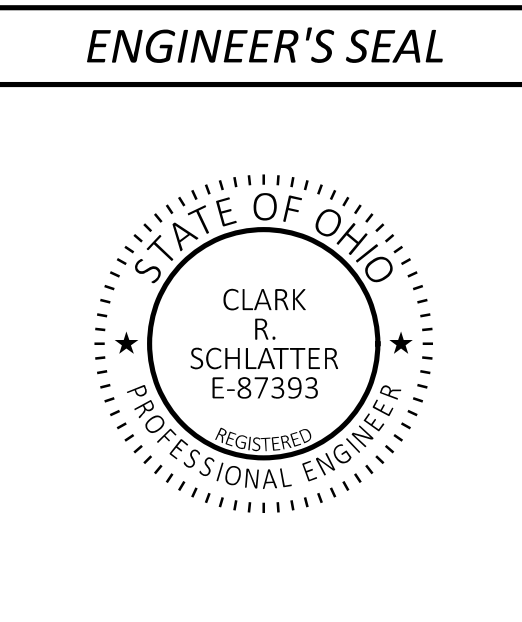

DESIGN AGENCY	
DESIGNER	KRH
REVIEWER	---
PROJECT ID	119050
SHEET	P.1
TOTAL	18