


GENERAL PLAN



EXISTING TRANSVERSE VIEW

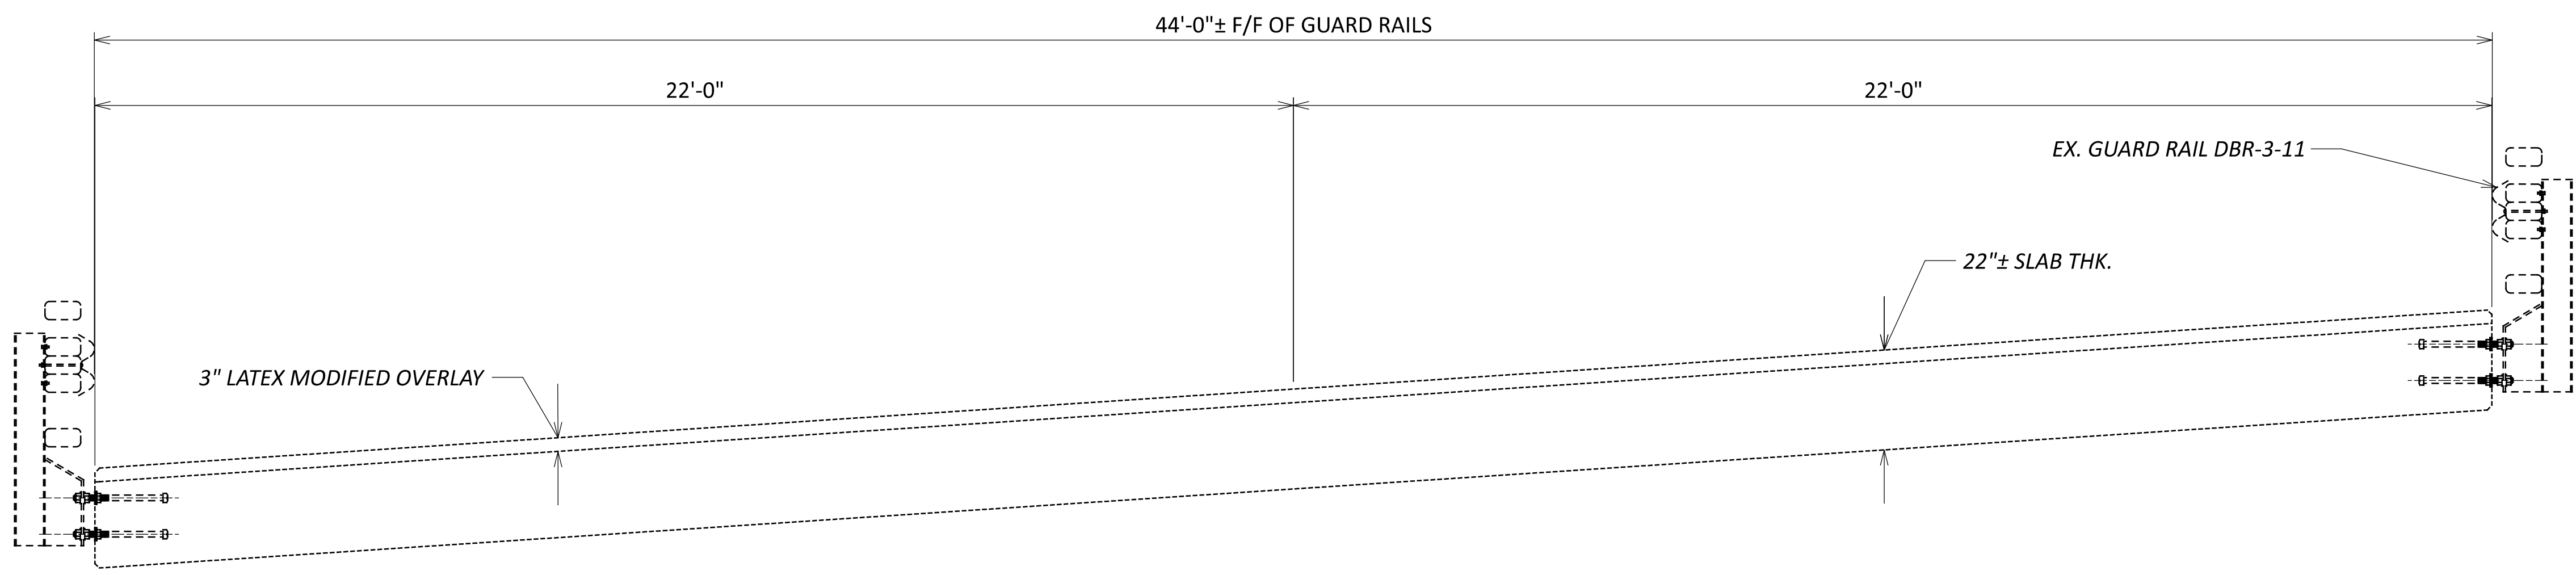

PROPOSED TRANSVERSE VIEW

NOTES
 DETAILS SHOWN ARE TAKEN FROM EXISTING PLANS AND ARE FOR REFERENCE ONLY.
 ALL DIMENSIONS CONSIDERED APPROXIMATE.

PROPOSED WORK
1.) REMOVE EX. OVERLAY 2"± MICRO-SIL. CONC. HYDRODEM. 1"
2.) PLACE 3" OF LATEX MODIFIED CONCRETE (NO OVERLAY ON APPROACH SLABS)
3.) PATCH DECK EDGES, WINGWALLS, AND LEFT SIDE OF PEIR 1 CAP

EXISTING STRUCTURE
TYPE: 3 SPAN CONTINUOUS REINFORCED CONCRETE SLAB WITH REINFORCED CONCRETE SUBSTRUCTURE.
SPANS: 40'-0", 50'-0", 40'-0"
ROADWAY: 44' F/F GUARD RAIL.
SKEW: 17°00'00" R.F.
WEARING SURFACE: 2" MICRO-SILICA OVERLAY
APPROACH SLABS: AS-1-54 (20' LONG)
ALIGNMENT: 2°01'21.3" CURVE (LEFT)
SUPERELEVATION: .064 FT/FT
STRUCTURAL FILE NUMBER: 3202135
DATE BUILT: 1958
DISPOSITION: TO BE REHABILITATED

SFN	3202135
DESIGN AGENCY	
DESIGNER	CRS
CHECKER	XXX
REVIEWER	XXX
PROJECT ID	119052
SUBSET	TOTAL
2	2
SHEET	TOTAL
P.26	31