
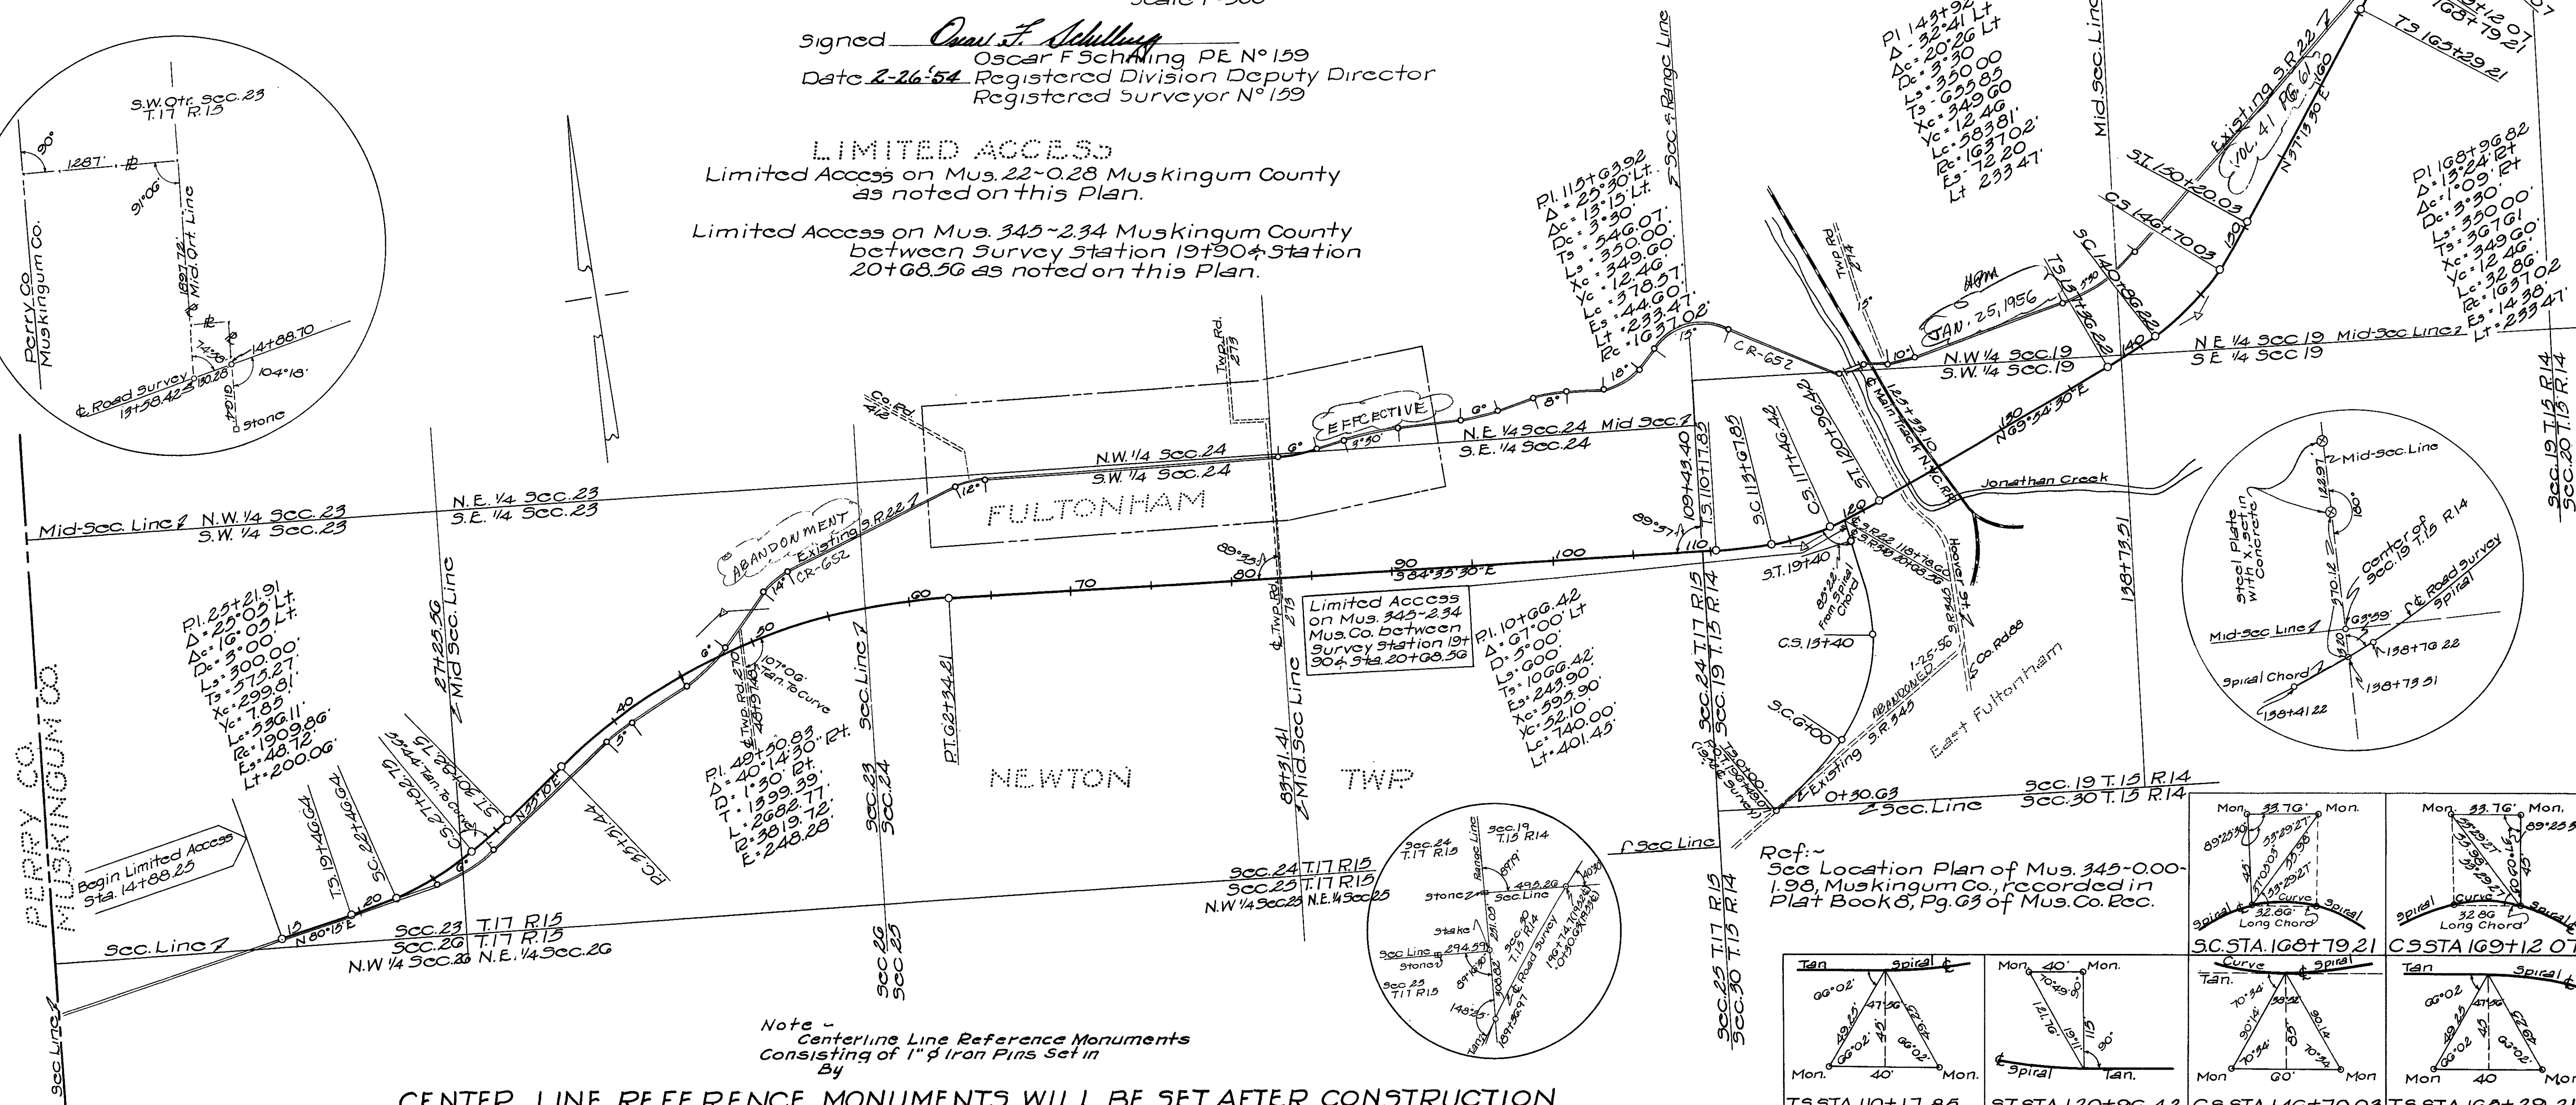


LA

End Limited Access
Sta. 177+00

0 500 1000 1500 2000
scale 1" = 500

LIMITED ACCESS
Limited Access on Mus. 22-0.28 Muskingum County
as noted on this Plan.
Limited Access on Mus. 345 ~2.34 Muskingum County
between Survey Station 19+90 & Station
20+68.56 as noted on this Plan.

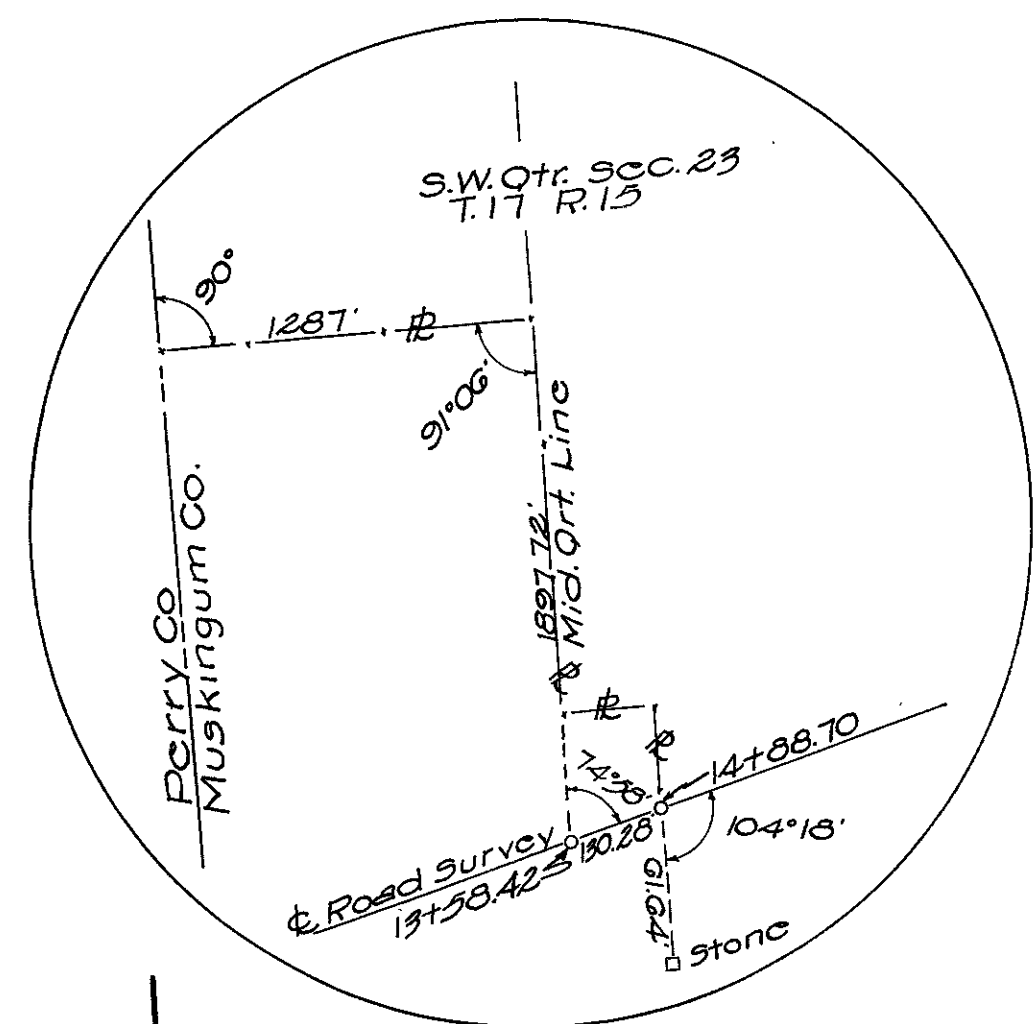


CENTER LINE REFERENCE MONUMENTS WILL BE SET AFTER CONSTRUCTION

<p>Tan Spiral</p> <p>Mon. 40' Mon.</p> <p>$60^{\circ}02'$</p> <p>$47'50''$ $62'08''$</p> <p>$60^{\circ}02'$ $40'$ $60^{\circ}02'$</p> <p>T.S. STA. 110+17.85</p>	<p>Mon. 40' Mon.</p> <p>Spiral Tan.</p> <p>$121'16''$ $115'11''$ $90'$</p> <p>St. STA. 120+96.42</p>	<p>Curve & Spiral</p> <p>Tan.</p> <p>Mon. 60' Mon.</p> <p>$70'34''$ $39'34''$ $60'34''$</p> <p>$70'34''$ $60'$ $70'34''$</p> <p>C.S. STA. 146+70.03</p>	<p>Tan</p> <p>Spiral</p> <p>Mon. 40' Mon.</p> <p>$60^{\circ}02'$</p> <p>$47'50''$ $62'08''$</p> <p>$60^{\circ}02'$ $40'$ $60^{\circ}02'$</p> <p>T.S. STA. 165+29.21</p>
<p>Mon. 40' Mon.</p> <p>Spiral Tan</p> <p>$63'23''$ $30'23''$ $71'34''$</p> <p>$63'23''$ $40'$ $63'23''$</p> <p>SC STA. 113+67.85</p>	<p>Mon. 40' Mon.</p> <p>Tan Spiral</p> <p>$63'00''$ $30'00''$ $71'34''$</p> <p>$63'00''$ $40'$ $63'00''$</p> <p>T.S. STA. 137+36.22</p>	<p>Spiral Tan</p> <p>Mon. 60' Mon.</p> <p>$60^{\circ}02'20''$ $30'02''$ $60'02''$</p> <p>$60^{\circ}02'20''$ $60'$ $60^{\circ}02'20''$</p> <p>ST STA. 150+20.03</p>	<p>Mon. 20' Mon.</p> <p>Spiral Tan</p> <p>$29'13''$ $10'13''$ $41'45'30''$</p> <p>$29'13''$ $20'$ $29'13''$</p> <p>ST STA. 172+62.07</p>
<p>Mon. 20' Mon.</p> <p>Curve Spiral</p> <p>$63'23''$ $30'23''$ $71'34''$</p> <p>$63'23''$ $20'$ $63'23''$</p> <p>C.S. STA. 117+46.42</p>	<p>Spiral Curve</p> <p>Mon. 40' Mon.</p> <p>$70'01''$ $30'01''$ $70'01''$</p> <p>$70'01''$ $60'$ $70'01''$</p> <p>SC STA. 140+86.22</p>	<p>Mon. 60' Mon.</p> <p>Tan Tan</p> <p>$68'21'45''$ $30'21'45''$ $68'21'45''$</p> <p>$68'21'45''$ $60'$ $68'21'45''$</p> <p>POT STA. 160+00</p>	<p>Mon. 40' Mon.</p> <p>Tan Tan</p> <p>$41'45'30''$ $10'45'30''$ $41'45'30''$</p> <p>$41'45'30''$ $40'$ $41'45'30''$</p> <p>POT STA. 177+00</p>

FED. RD. DIVISION	STATE	PROJECT	TYPE FUNDS
2	OHIO		

Newton Twp. Muskingum Co.
Sec. 23 T.17 R.15


MUS-22-0.28
RIW PLAN
LIMITED ACCESS

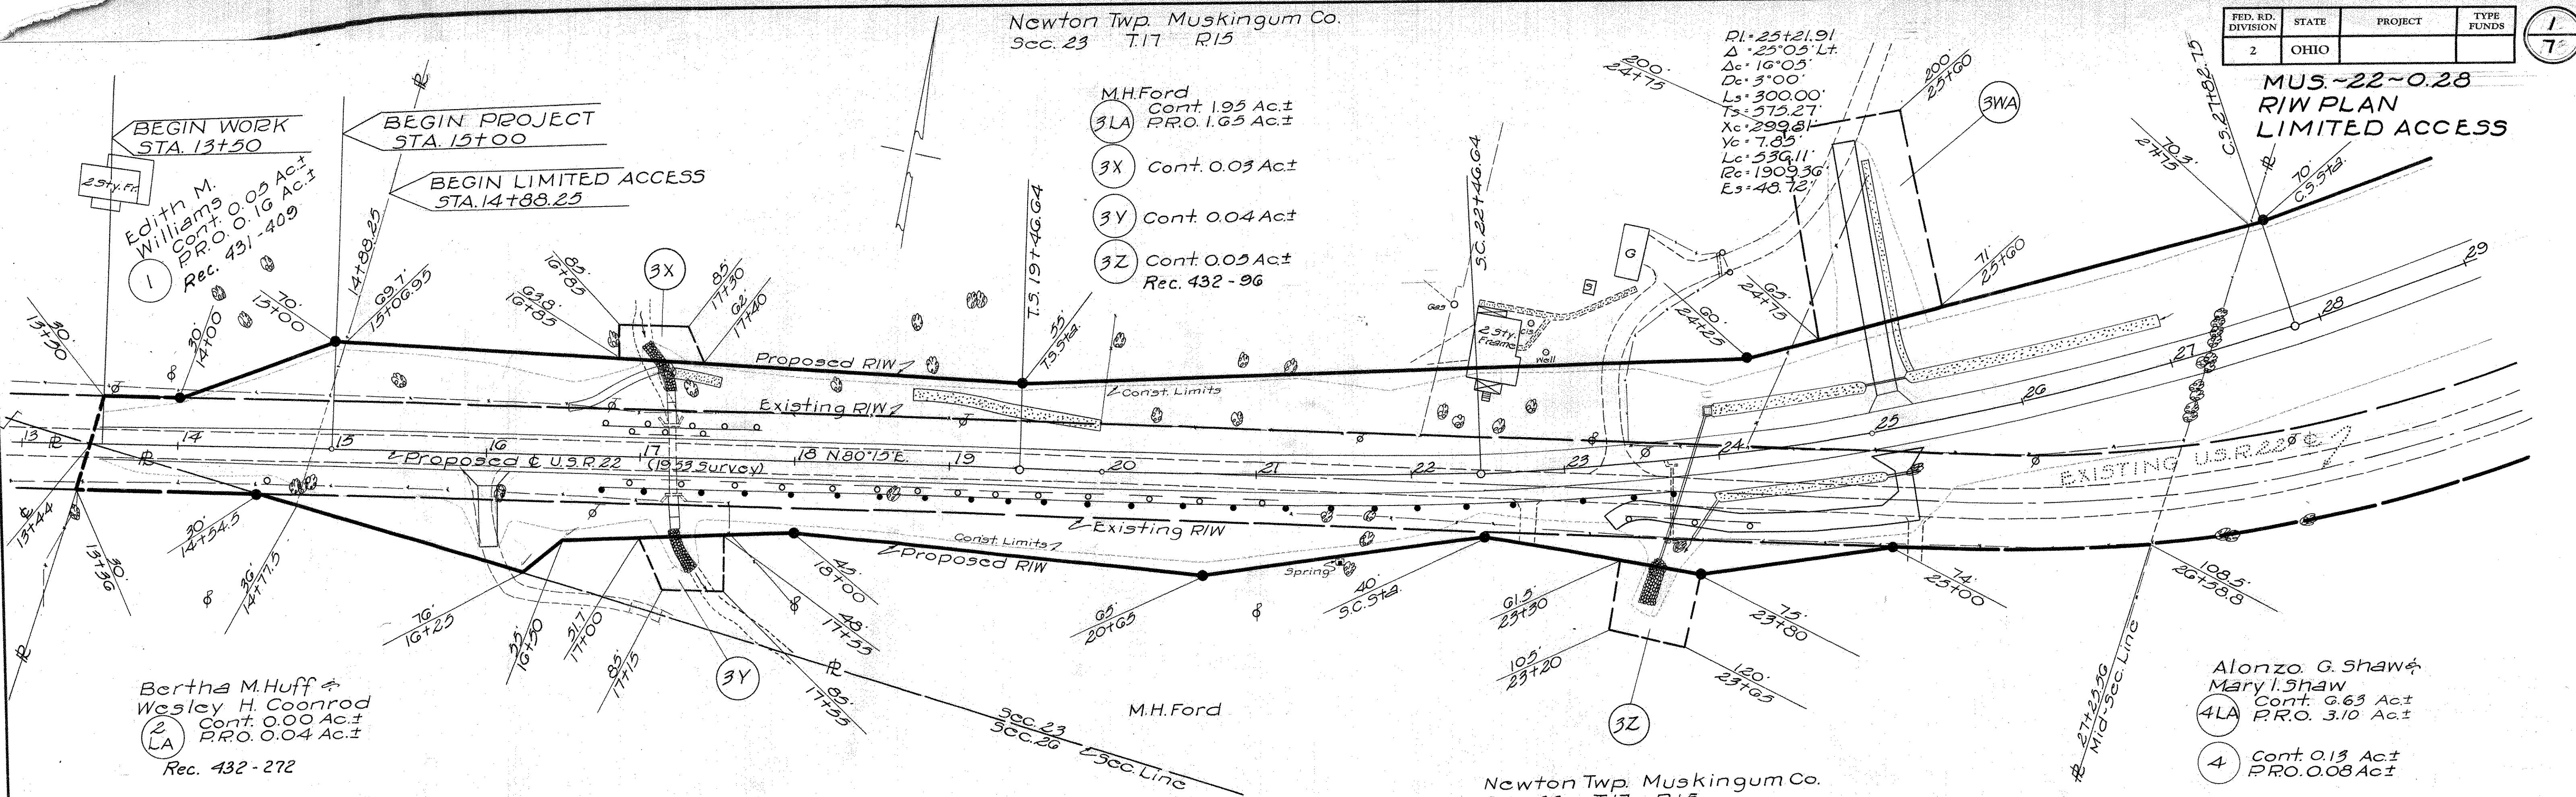

Newton Twp. Muskingum Co.
Sec. 26 T.17 R.15



Newton Twp. Muskingum Co.
Sec. 23 T.17 R.15

Note:-
Location Plan recorded in
Plat Book 8, Page 81 of Mus.
Co. Plat Records.

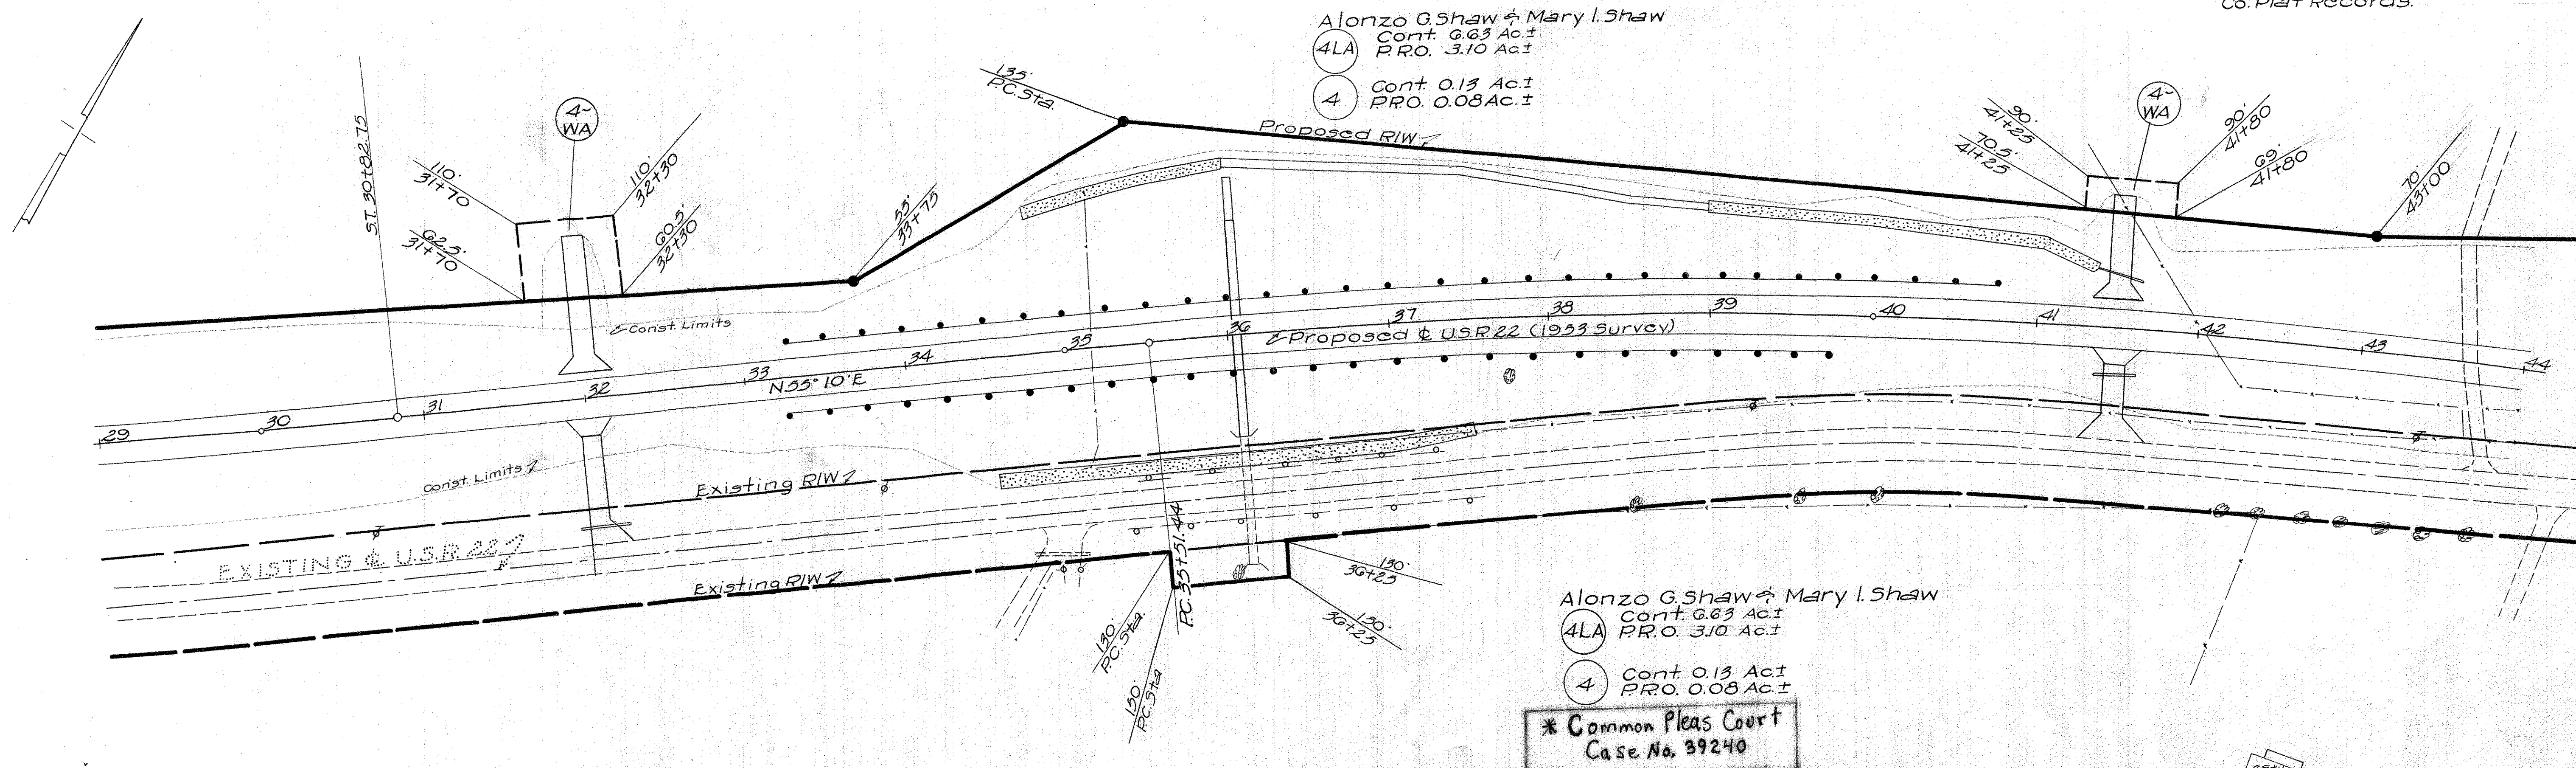

Newton Twp. Muskingum Co.
Sec. 23 T.17 R.15

**MUS.-22-0.28
RIW PLAN
LIMITED ACCESS**

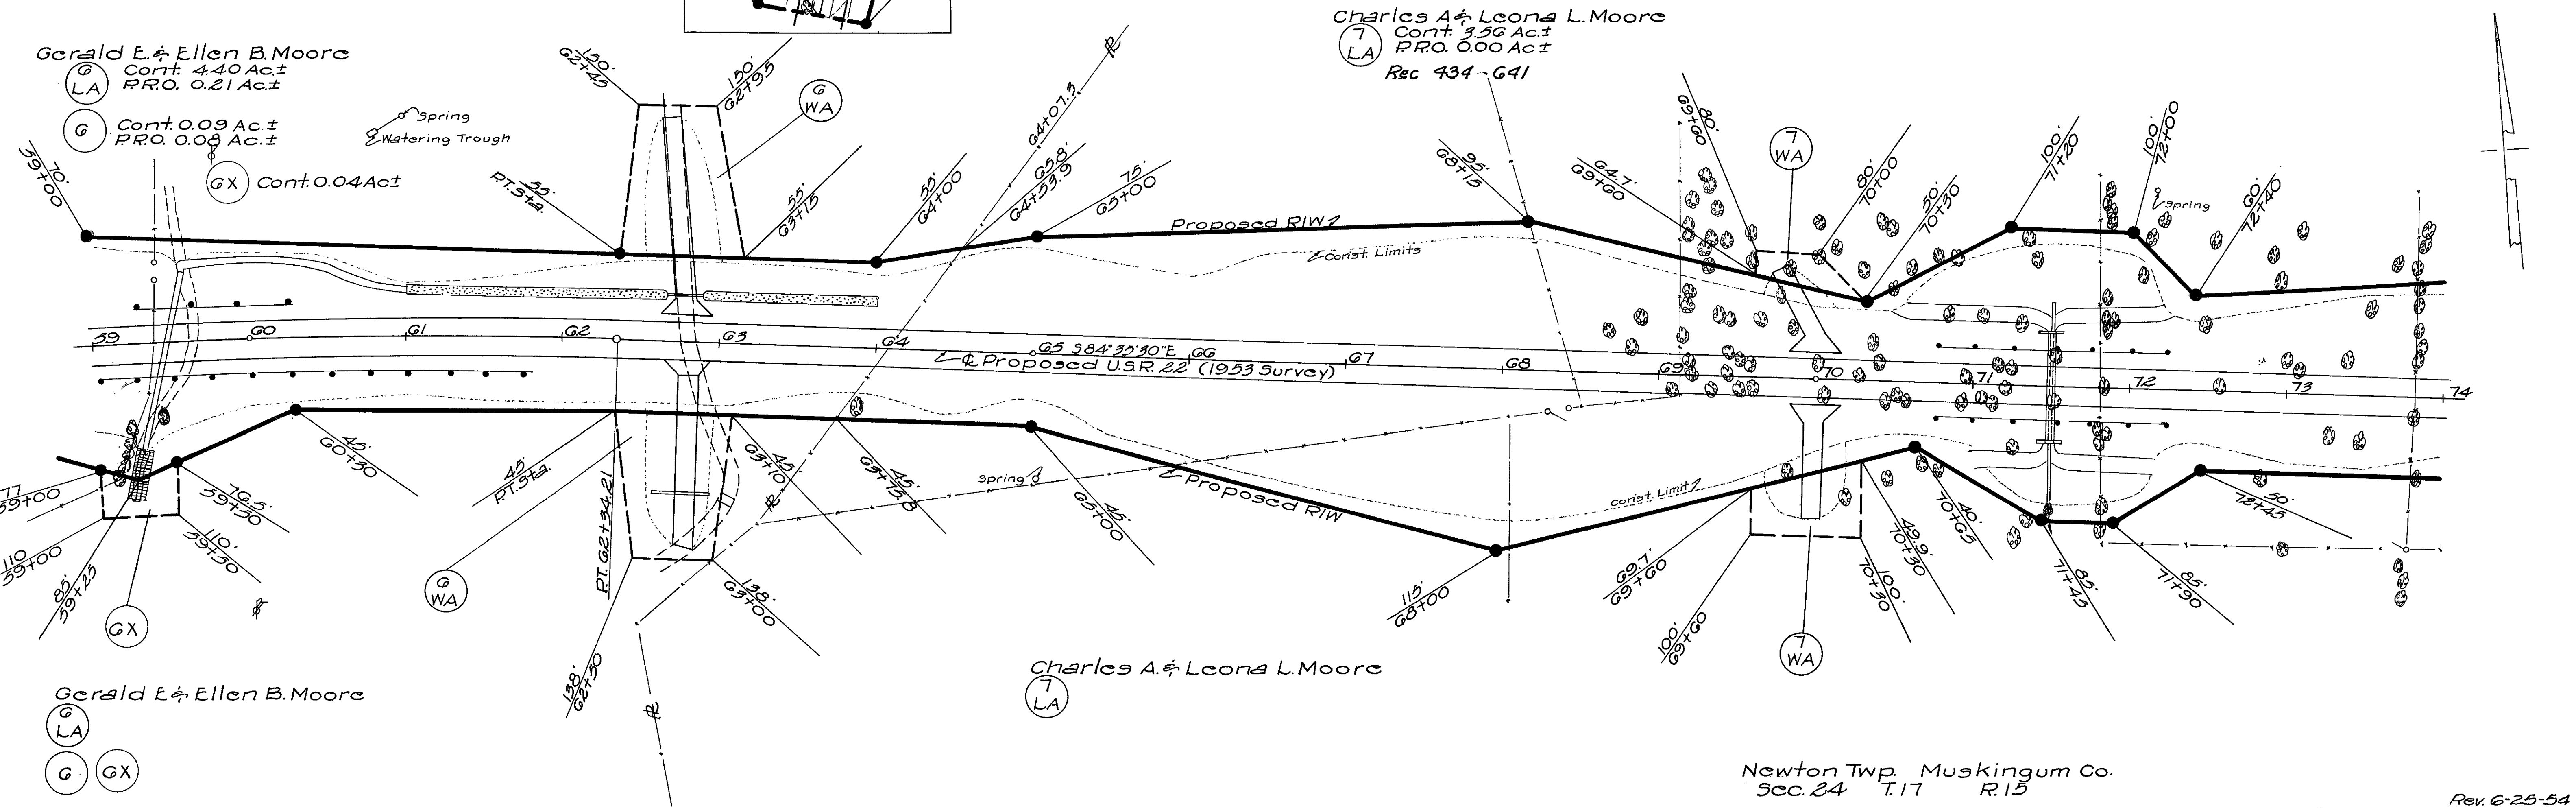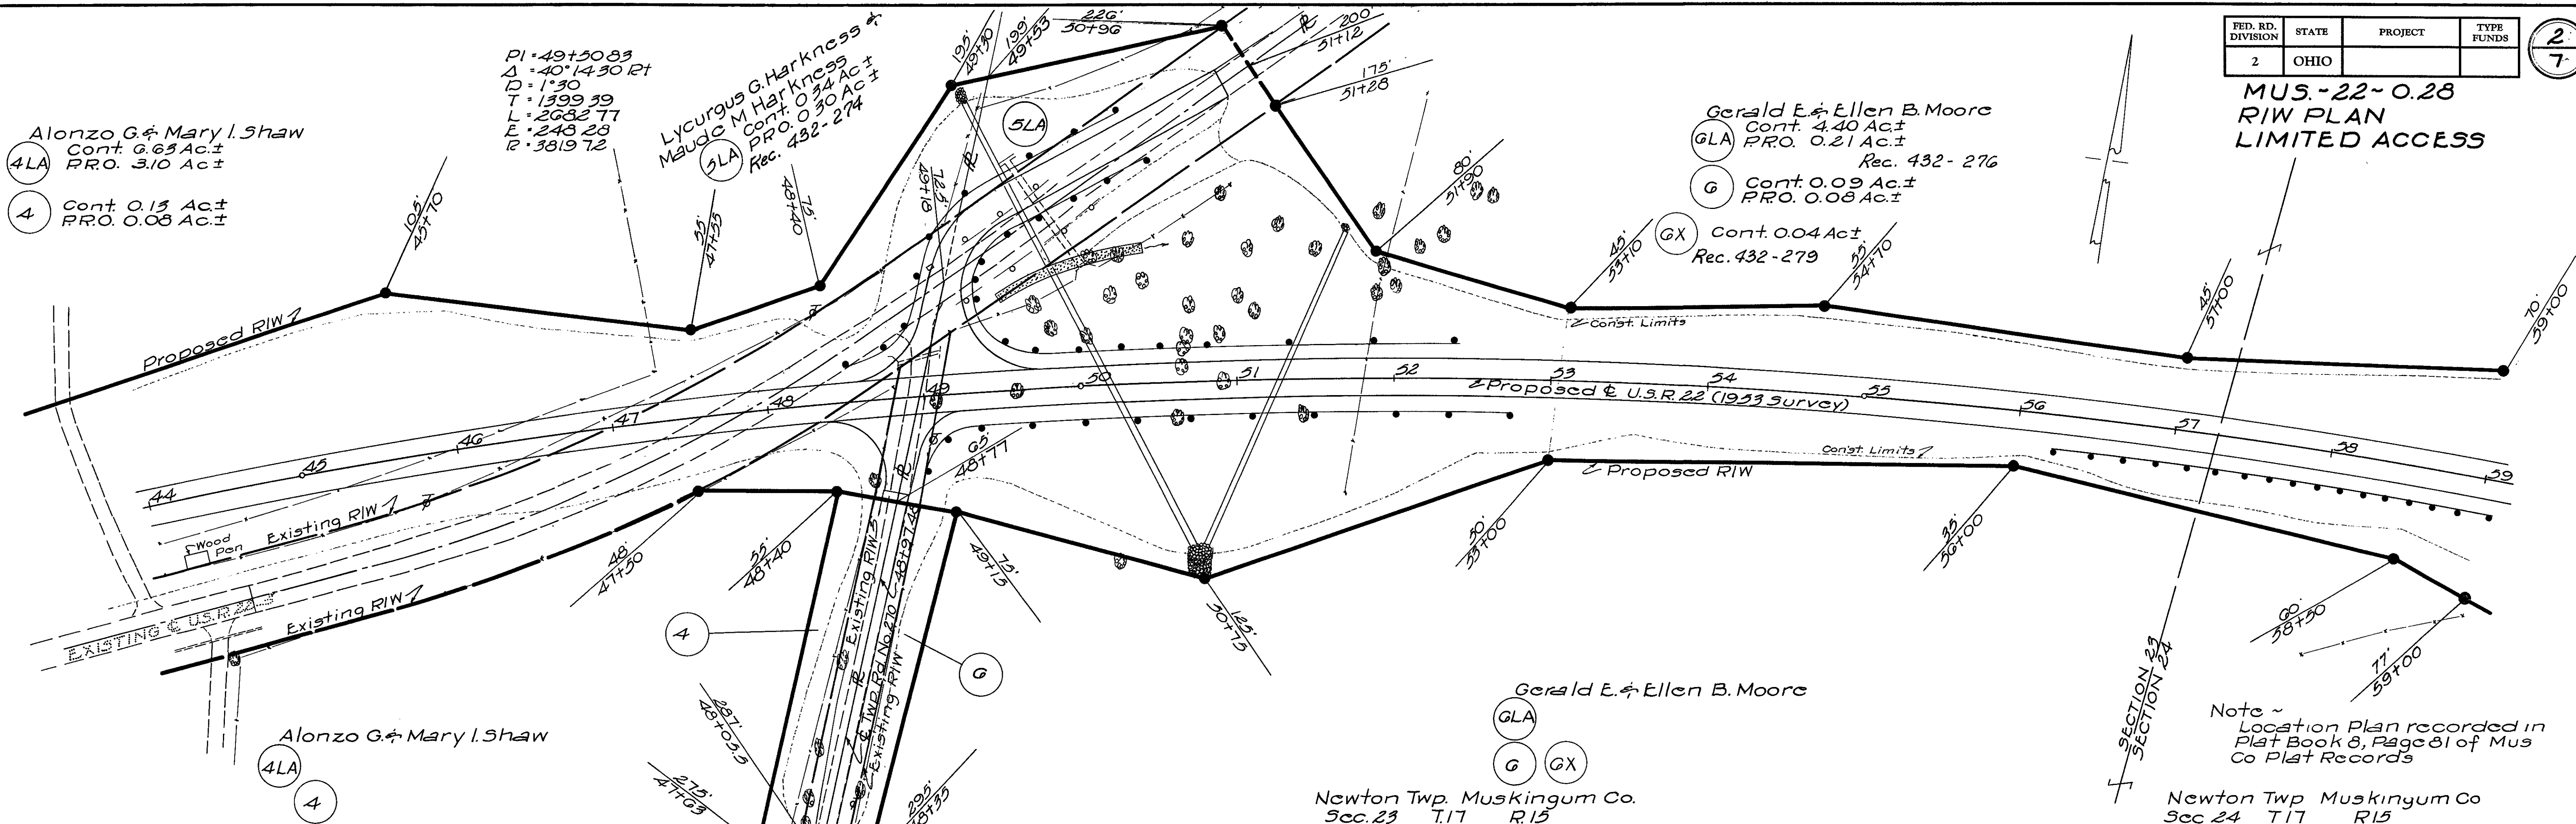



REV 3/13/34
REV 3-24-34

FED. RD. DIVISION	STATE	PROJECT	TYPE FUNDS
2	OHIO		

3
7

MUS.-22-0.28
RIW PLAN
LIMITED ACCESS

Charles A. & Leona L. Moore

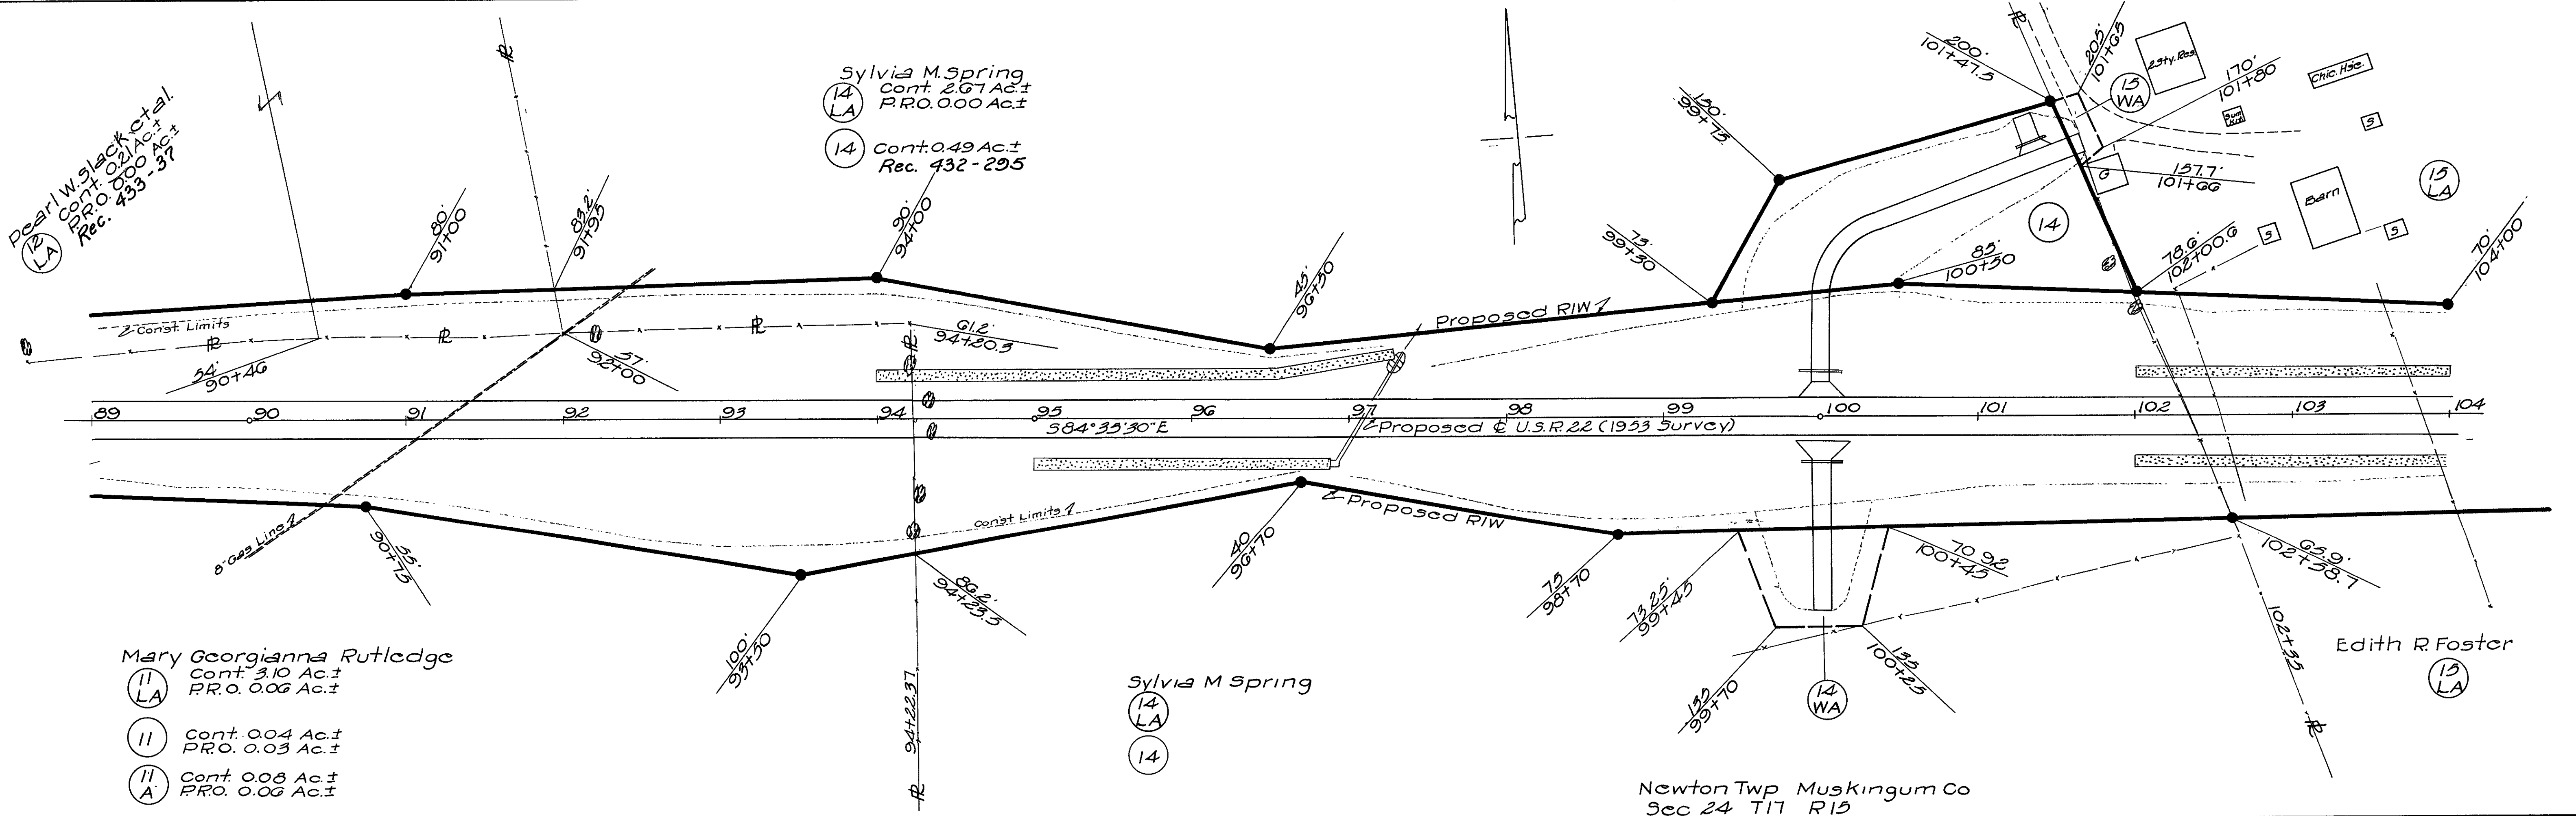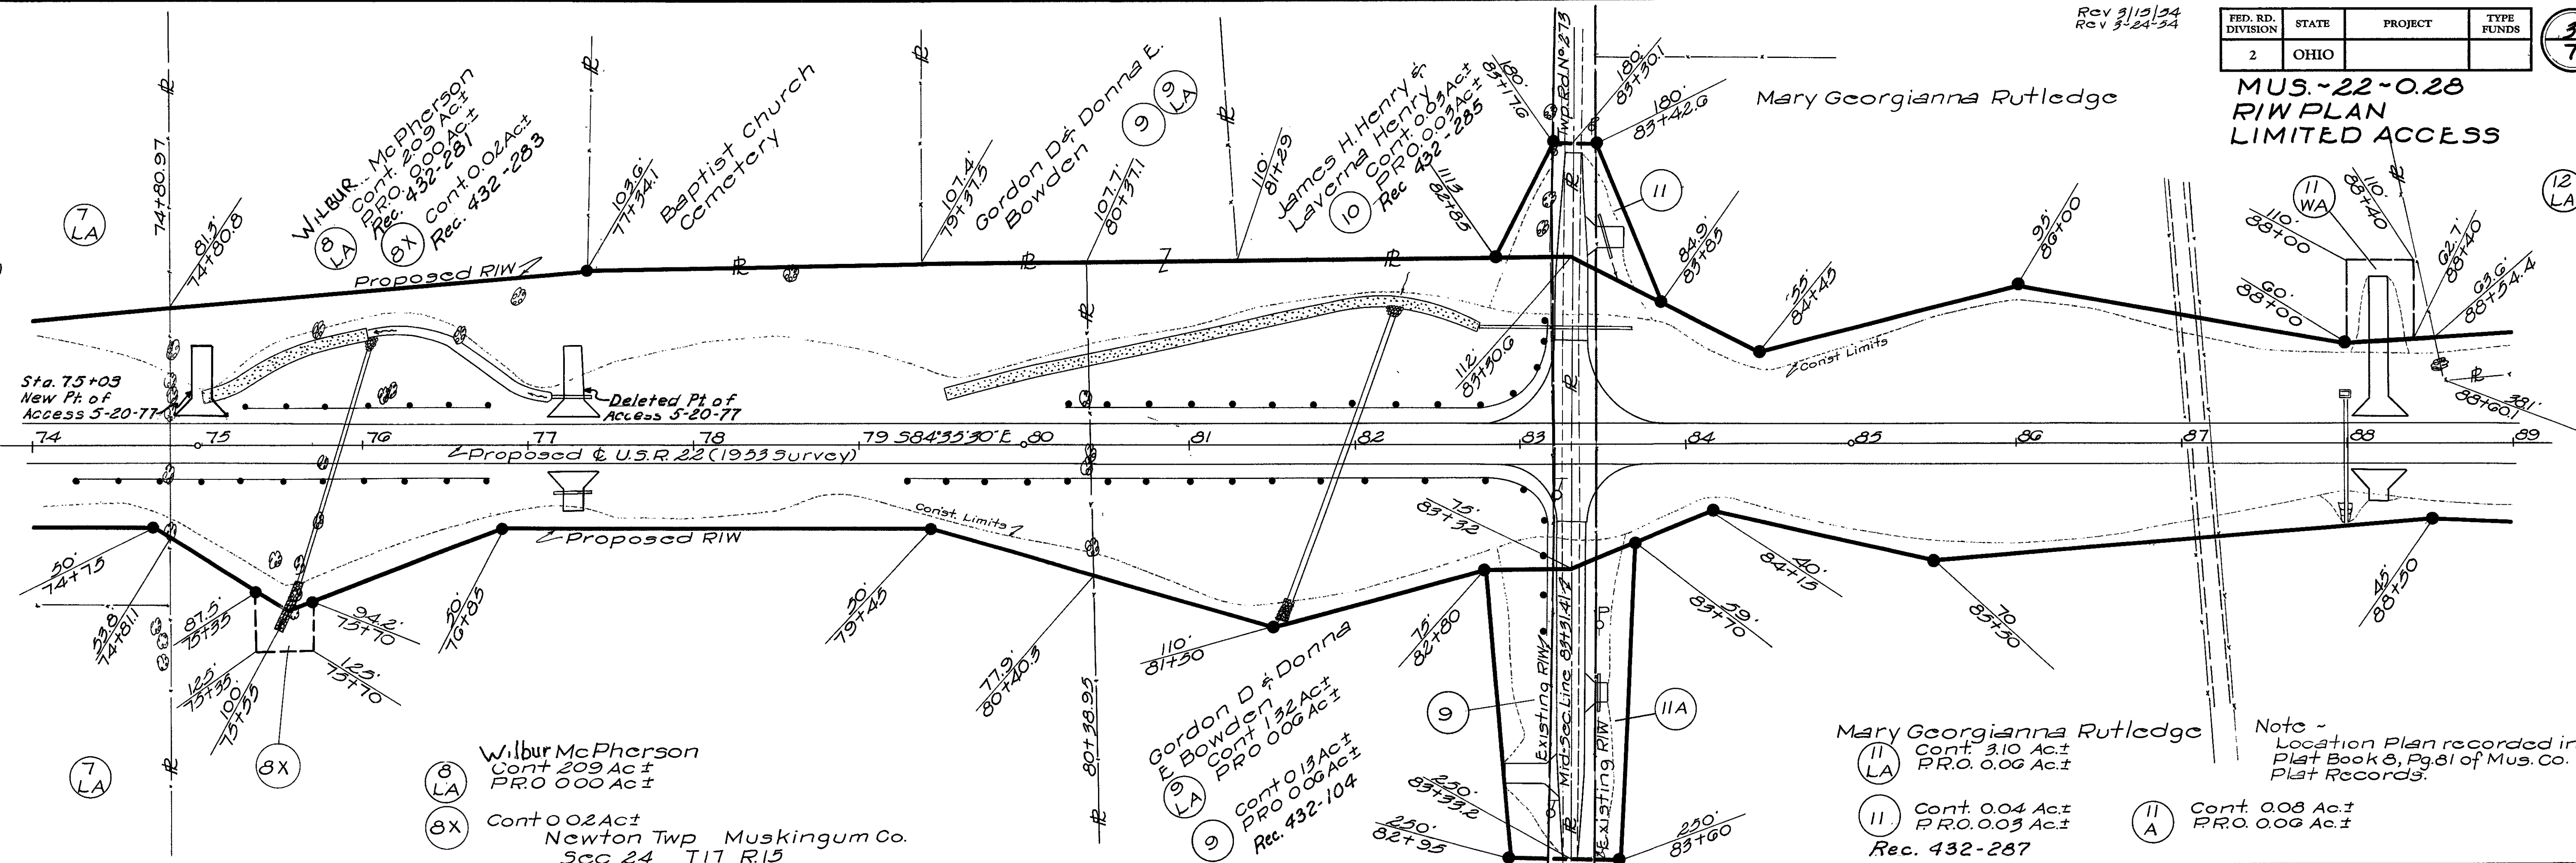

FED. RD. DIVISION	STATE	PROJECT	TYPE FUNDS
2	OHIO		

4
7


MUS.-22-0.28
RIW PLAN
LIMITED ACCESS

Edith R. Foster
Cont. 2.17 Ac.±
P.R.O. 0.00 Ac.±
Rec. 432-291
15X Cont. 0.05 Ac.±
Rec. 432-293

Pittsburgh Plate Glass Co.
16 Cont. 2.59 Ac.±
P.R.O. 0.00 Ac.±
Rec. 432-298
16X Cont. 0.07 Ac.±
Rec. 432-302

RI = 115+63.92
Δ = 25°30' Lt.
Ac = 13°15'
D = 3°30'
Ts = 546.07'
Ls = 350.00'
Xc = 349.60'
Yc = 12.46'
Lc = 378.57'
Ec = 1637.02'
Es = 44.60'
Lt = 233.47'


REV. 3/3/54
REV. 3-10-54
REV. 3-13-54
REV. 3-17-54

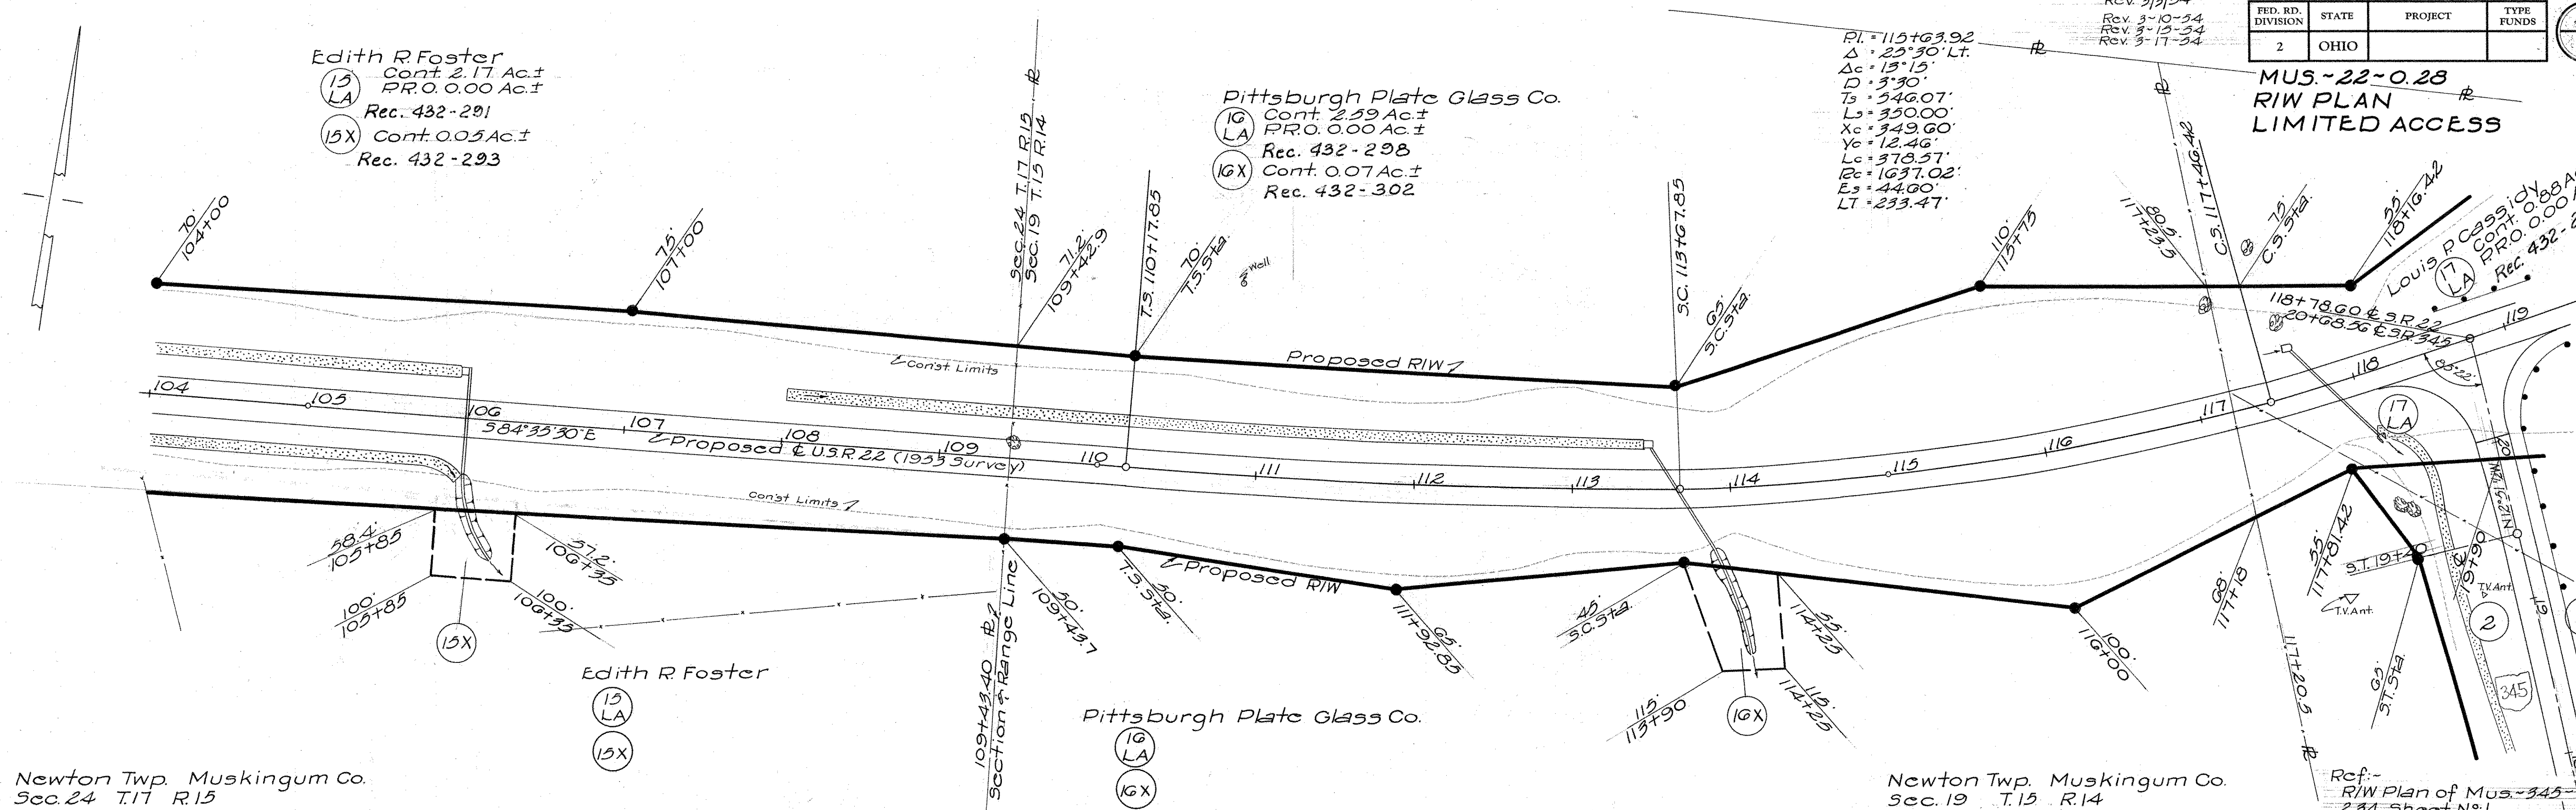

Newton Twp. Muskingum Co.
Sec. 24 T.17 R.15

Newton Twp. Muskingum Co.
Sec. 19 T.15 R.14

Ref. -
RIW Plan of Mus.-345-
2.34 Sheet N°1

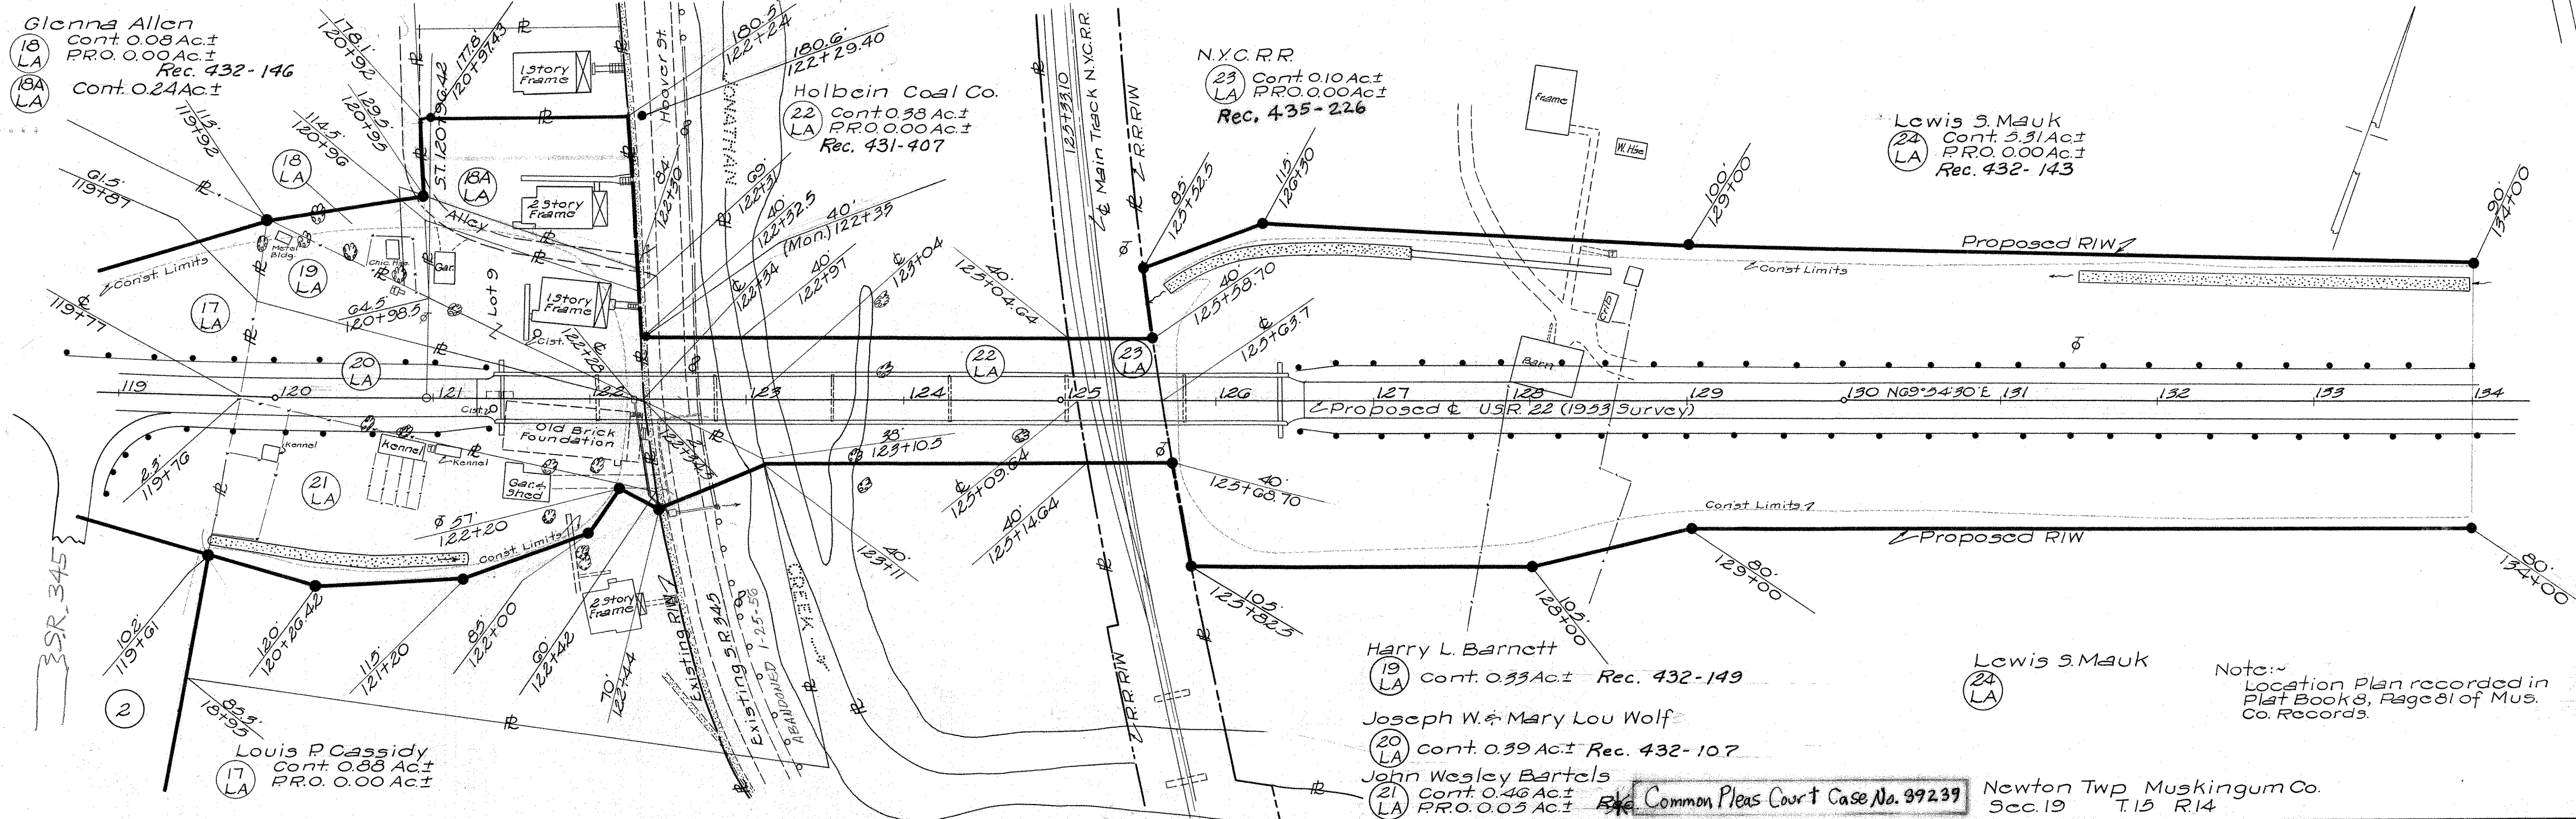

Glenna Allen
18 Cont. 0.08 Ac.±
P.R.O. 0.00 Ac.±
Rec. 432-146
18A Cont. 0.24 Ac.±

Holbein Coal Co.
22 Cont. 0.38 Ac.±
P.R.O. 0.00 Ac.±
Rec. 431-407

NYCRR
23 Cont. 0.10 Ac.±
P.R.O. 0.00 Ac.±
Rec. 435-226

Lewis S. Mauk
24 Cont. 3.31 Ac.±
P.R.O. 0.00 Ac.±
Rec. 432-143

Harry L. Barnett
19 Cont. 0.33 Ac.±
Rec. 432-149

Joseph W. & Mary Lou Wolf
20 Cont. 0.39 Ac.±
Rec. 432-107

John Wesley Bartels
21 Cont. 0.46 Ac.±
P.R.O. 0.03 Ac.±

Lewis S. Mauk
24 Cont. 3.31 Ac.±
P.R.O. 0.00 Ac.±
Rec. 432-143

Note: -
Location Plan recorded in
Plat Book 8, Page 81 of Mus.
Co. Records.

Common Pleas Court Case No. 39239

Newton Twp. Muskingum Co.
Sec. 19 T.15 R.14

FED. RD. DIVISION	STATE	PROJECT	TYPE FUNDS
2	OHIO		

7
7

MUS. 345-2.34
RIW PLAN

