D07-MEDIAN REPAIRS

STATE OF OHIO **DEPARTMENT OF TRANSPORTATION**

D07-MEDIAN REPAIRS

CLARK COUNTY MIAMI COUNTY

INDEX OF SHEETS:

TITLE SHEET	1
LOCATION AND DESIGN DESIGNATION	2
SCHEMATIC SHEET (CLA-70)	3,4
SCHEMATIC SHEET (MIA-75)	5-7
TYPICAL SECTIONS	8,9
GENERAL NOTES	10,11
MAINTENANCE OF TRAFFIC NOTES	12-15
GENERAL SUMMARY	16
PLAN SHEETS	17-20

FEDERAL PROJECT NUMBER

NON-FEDERAL

RAILROAD INVOLVEMENT

NONE

PROJECT DESCRIPTION

REPAIR OF VARIOUS MEDIAN AND RIGHT SIDE PROTECTIVE CONCRETE WALLS. INCLUDES QUANTITIES FOR ON-CALL MAINTENANCE FOR TWO YEARS.

EARTH DISTURBED AREAS

PROJECT EARTH DISTURBED AREA: N/A ACRES ESTIMATED CONTRACTOR EARTH DISTURBED AREA: N/A ACRES NOTICE OF INTENT EARTH DISTURBED AREA: N/A ACRES

LIMITED ACCESS

THIS IMPROVEMENT IS ESPECIALLY DESIGNED FOR THROUGH TRAFFIC AND HAS BEEN DECLARED A LIMITED ACCESS HIGHWAY OR FREEWAY BY ACTION OF THE DIRECTOR IN ACCORDANCE WITH THE PROVISIONS OF SECTION 5511.02 OF THE OHIO REVISED CODE.

2023 SPECIFICATIONS

THE STANDARD SPECIFICATIONS OF THE STATE OF OHIO, DEPARTMENT OF TRANSPORTATION, INCLUDING SUPPLEMENTAL SPECIFICATIONS LISTED IN THE PLANS, CHANGES LISTED IN THE PROPOSAL, AND THE SUPPLEMENTAL SPECIFICATION 800 VERSION INDICATED ON THE PROPOSAL SHALL GOVERN THIS IMPROVEMENT.

I HEREBY APPROVE THESE PLANS AND DECLARE THAT THE MAKING OF THESE IMPROVEMENTS WILL NOT REQUIRE THE CLOSING TO TRAFFIC OF THE HIGHWAY FOR CLA-70 OR MIA-75, AND THAT PROVISIONS FOR THE MAINTENANCE AND SAFETY OF TRAFFIC WILL BE AS SET FORTH ON THE PLANS AND ESTIMATES.

(W. Offin hn W. O'Brien District 07 Deputy Director

Pamela Boratyn

Director, Department of Transportation

DESIGN EXCEPTIONS

ADA DESIGN WAIVERS

UNDERGROUND UTILITIES Contact Two Working Days

FOR LOCATION MAPS AND DESIGN


DESIGNATION SEE SHEET 2.

Before You Dig

☆ 0HI0811,org Before You Dig

OHIO811, 8-1-1, or 1-800-362-2764 (Non members must be called directly)

> PLAN PREPARED BY: DISTRICT 7 ENGINEERING 1001 ST MARYS AVE. SIDNEY, OHIO 45365

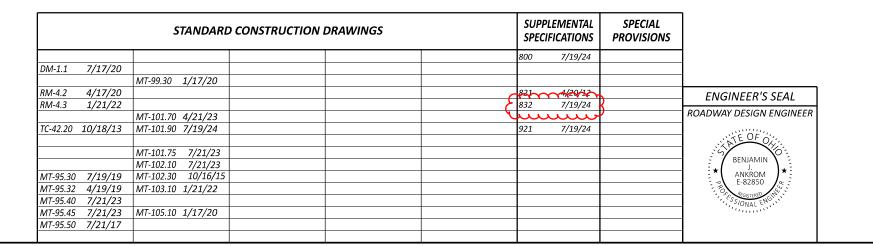



BJA 08-22-24 120846

P.01 20