PAVEMENT

Alignment And Profile

Place the proposed pavement to follow the alignment and profile of the existing pavement. Place the proposed asphalt concrete overlay as shown on the typical sections. The intent of the plans is to maintain the existing profile while smoothing out ruts and bumps.


Asphalt Concrete Surface Course Sealing Requirements

In addition to the gutter sealing requirements specified in SCD BP-3.1 and C&MS 401.15, after completion of the surface course, the Contractor shall use a certified 702.01 PG binder to seal the following locations:


- All castings including but not limited to monuments, manholes, water valves, catch basins, curb inlets.
- Butt joints and feather joints including bridge approaches.
- Forward joint for driveway asphalt and trailing joint when butting to existing asphalt drive.
- Perimeter of all pavement repairs or other asphalt inlays when pavement repairs/inlays are not overlaid with an asphalt concrete surface course.
- All cold longitudinal joints between paved shoulders and guardrail asphalt.

The material used shall be a certified 702.01 PG binder. The width of the sealer shall be 2-3 inches.

Any additional costs associated with the work identified in this note shall be included in the appropriate asphalt concrete surface course item of work.

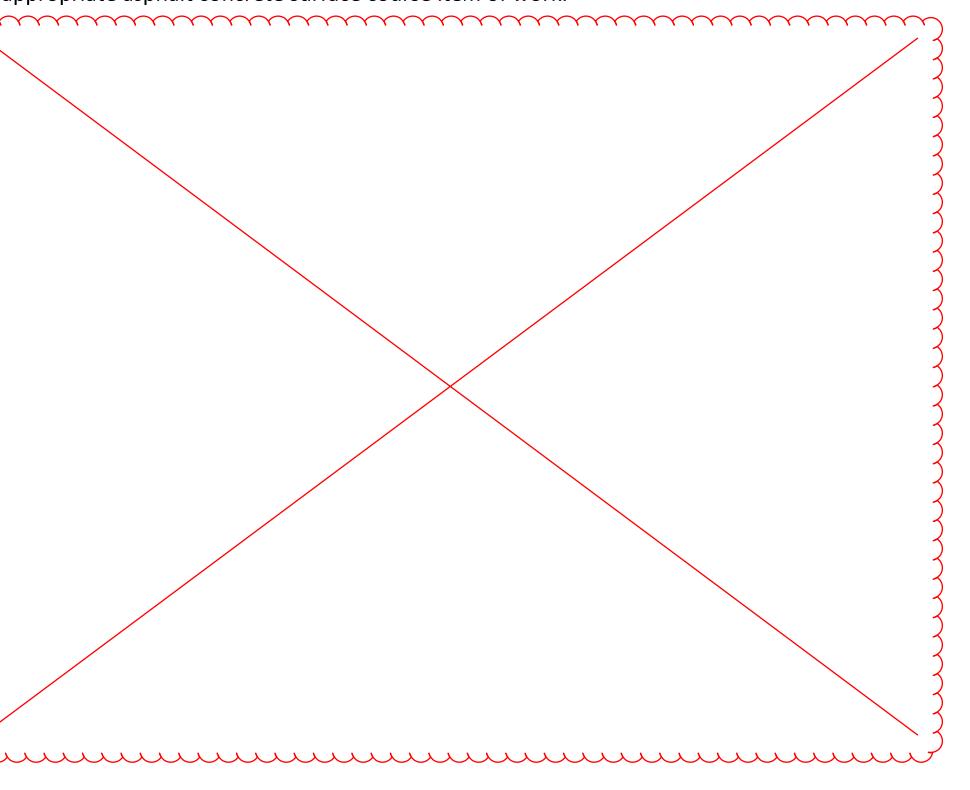

GENERAL NOTES D12-PPM-FY2025

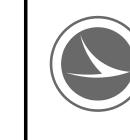

DESIGNER