- ERI-SHELDON MARSH SNP-FY2026 **LOCATION MAP** LATITUDE: 41°24'31" LONGITUDE: -82°36'09"

	X
PORTION TO BE IMPROVED	
INTERSTATE HIGHWAY	
FEDERAL ROUTES	
STATE ROUTES	
COUNTY & TOWNSHIP ROADS	
OTHER ROADS	

DESIGN DESIGNATION

N/A - NO DESIGN DESIGNATION INFORMATION FOR OFF-SYSTEM STATE PARK ROUTES. NHS PROJECT.....

STATE OF OHIO DEPARTMENT OF TRANSPORTATION

ERI-SHELDON MARSH SNP-FY2026

HURON TOWNSHIP ERIE COUNTY

INDEX OF SHEETS:

ITLE SHEET	1
CHEMATIC	2
YPICAL SECTIONS	3
ENERAL NOTES	4
1AINTENANCE OF TRAFFIC NOTES	5
ENERAL SUMMARY	6
OADWAY SUBSUMMARY	7
ARKING LOT DETAILS	8


DESIGN EXCEPTIONS

ADA DESIGN WAIVERS



PLANS PREPARED BY:



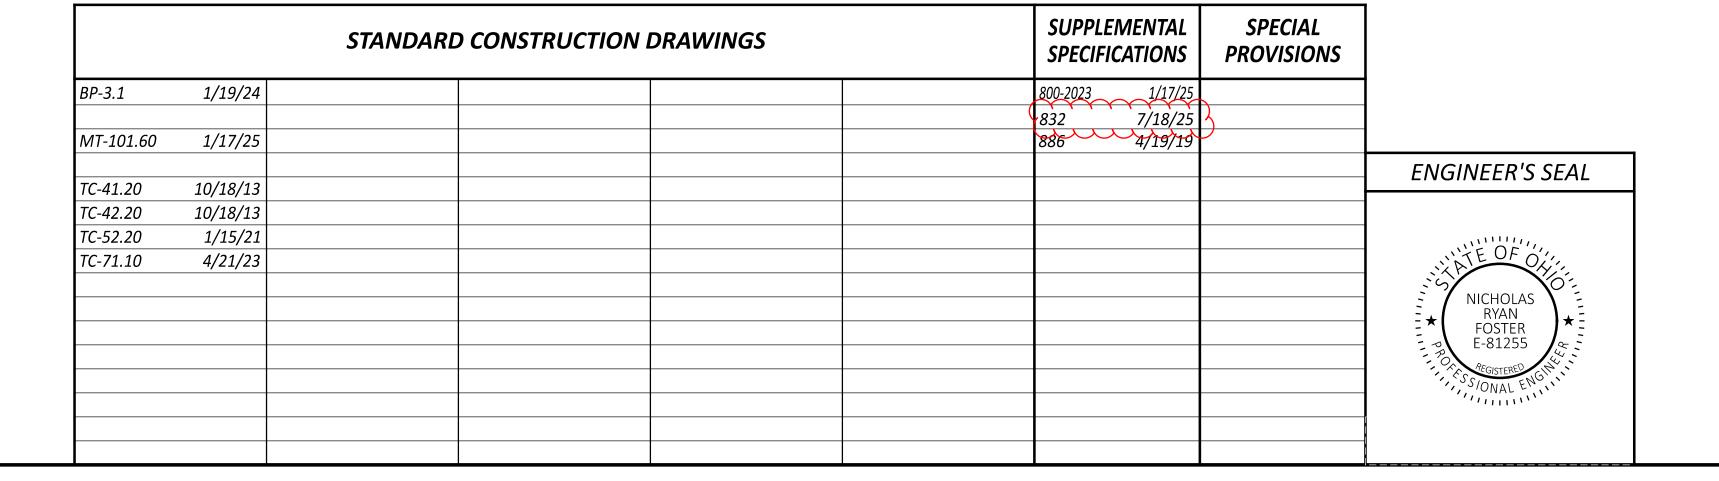

FEDERAL PROJECT NUMBER

NONE

RAILROAD INVOLVEMENT

PROJECT DESCRIPTION

THIS PROJECT IS AN ASPHALT CONCRETE RESURFACING AND FOG SEAL OF THE ROADS AND PARKING LOT THROUGH SHELDON MARSH.
THIS PROJECT ALSO INCLUDES CURB REPLACEMENT.

EARTH DISTURBED AREAS

PROJECT EARTH DISTURBED AREA: N/A** ESTIMATED CONTRACTOR EARTH DISTURBED AREA: N/A** NOTICE OF INTENT EARTH DISTURBED AREA: N/A**

**MAINTENANCE PROJECT

2023 SPECIFICATIONS

THE STANDARD SPECIFICATIONS OF THE STATE OF OHIO, DEPARTMENT OF TRANSPORTATION, INCLUDING SUPPLEMENTAL SPECIFICATIONS LISTED IN THE PLANS, CHANGES LISTED IN THE PROPOSAL, AND THE SUPPLEMENTAL SPECIFICATION 800 VERSION INDICATED ON THE PROPOSAL SHALL GOVERN THIS IMPROVEMENT.

MAINTENANCE OF TRAFFIC ENDORSEMENT

I HEREBY APPROVE THESE PLANS AND DECLARE THAT THE MAKING OF THIS IMPROVEMENT WILL REQUIRE THE CLOSING TO TRAFFIC OF THE STATE NATURE PRESERVE.

DIRECTOR, DEPARTMENT OF TRANSPORTATION

ESIGN AGENCY DISTRICT 3 ENGINEERING TEAM FOUR

SHEET

TITLE

NRF 04-01-25 ROJECT ID 120106