

FRA-270-32.92

FRA I-270 : Easton Way  
at Stelger Road

year 2006

2 plan sheets

Type - Lighting

**PROJECT: 528-04**


**FILE #: HL-17**

**TO:**


**OFFICE FILE**

**DATE: SEP 12, 2006**

**REPAIR LIGHT POLE  
FOUNDATION AT FRA  
I-270 & EASTON WAY**

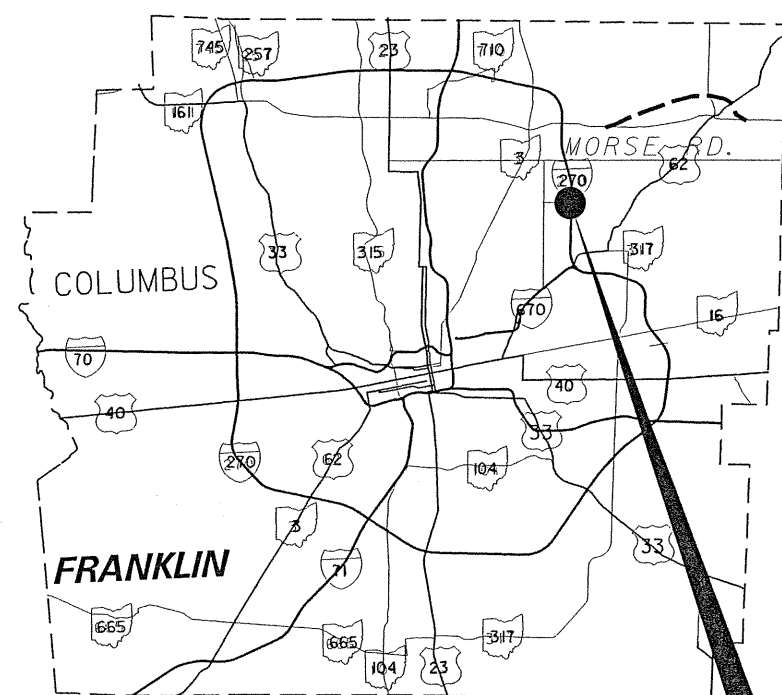

STATE OF OHIO  
DEPARTMENT OF TRANSPORTATION  
DISTRICT SIX  
ELECTRICAL MAINTENANCE  
2004  
HIGHWAY LIGHTING FOUNDATION  
REPAIR AT FRA I-270 & EASTON WAY  
WORK ORDER # HL-17

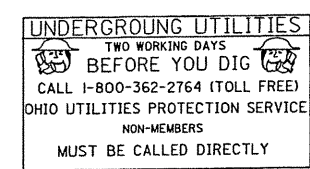

LOCATION  
FRA I-270 & EASTON WAY  
FRA I-270 (32.92)

LIGHT POLE FOUNDATION  
REPAIR  
ELECTRICAL INSTALLATION & MAINTENANCE  
CONTRACT FOR SIGNAL INSTALLATION /  
REPLACEMENT / MAJOR & MINOR UPGRADE /  
MAINTENANCE: LIGHTING MAINTENANCE:  
AUXILIARY PAVEMENT MARKING: SIGN WORK

SEPTEMBER 12, 2006  
PROJECT ENGINEER:  
JOE WARINO, P.E.  
PROJECT INSPECTORS:  
DWIGHT BARRON  
BOB MEDLEY

TRAFFIC MANAGER:  
TOM JACOBY, TM-2

INDEX OF SHEETS

|             |   |
|-------------|---|
| TITLE SHEET | 1 |
| PLAN SHEET  | 2 |

PLAN PREPARED BY:  
JAMES A. BERGANDINE, TT-3  
ROADWAY SERVICES DEPARTMENT

2  
2



0 50 100  
HORIZONTAL  
SCALE IN FEET


LIGHTING PLAN  
STA. 57+00 TO STA. 70+00 CONNECTOR ROAD

FRA-270-32.46

376  
593

# WORK TO DO

LIGHT POLE FOUNDATION REPAIR FOR SA-4  
POLE WILL BE REPLACED BY ODOT DIST. 6

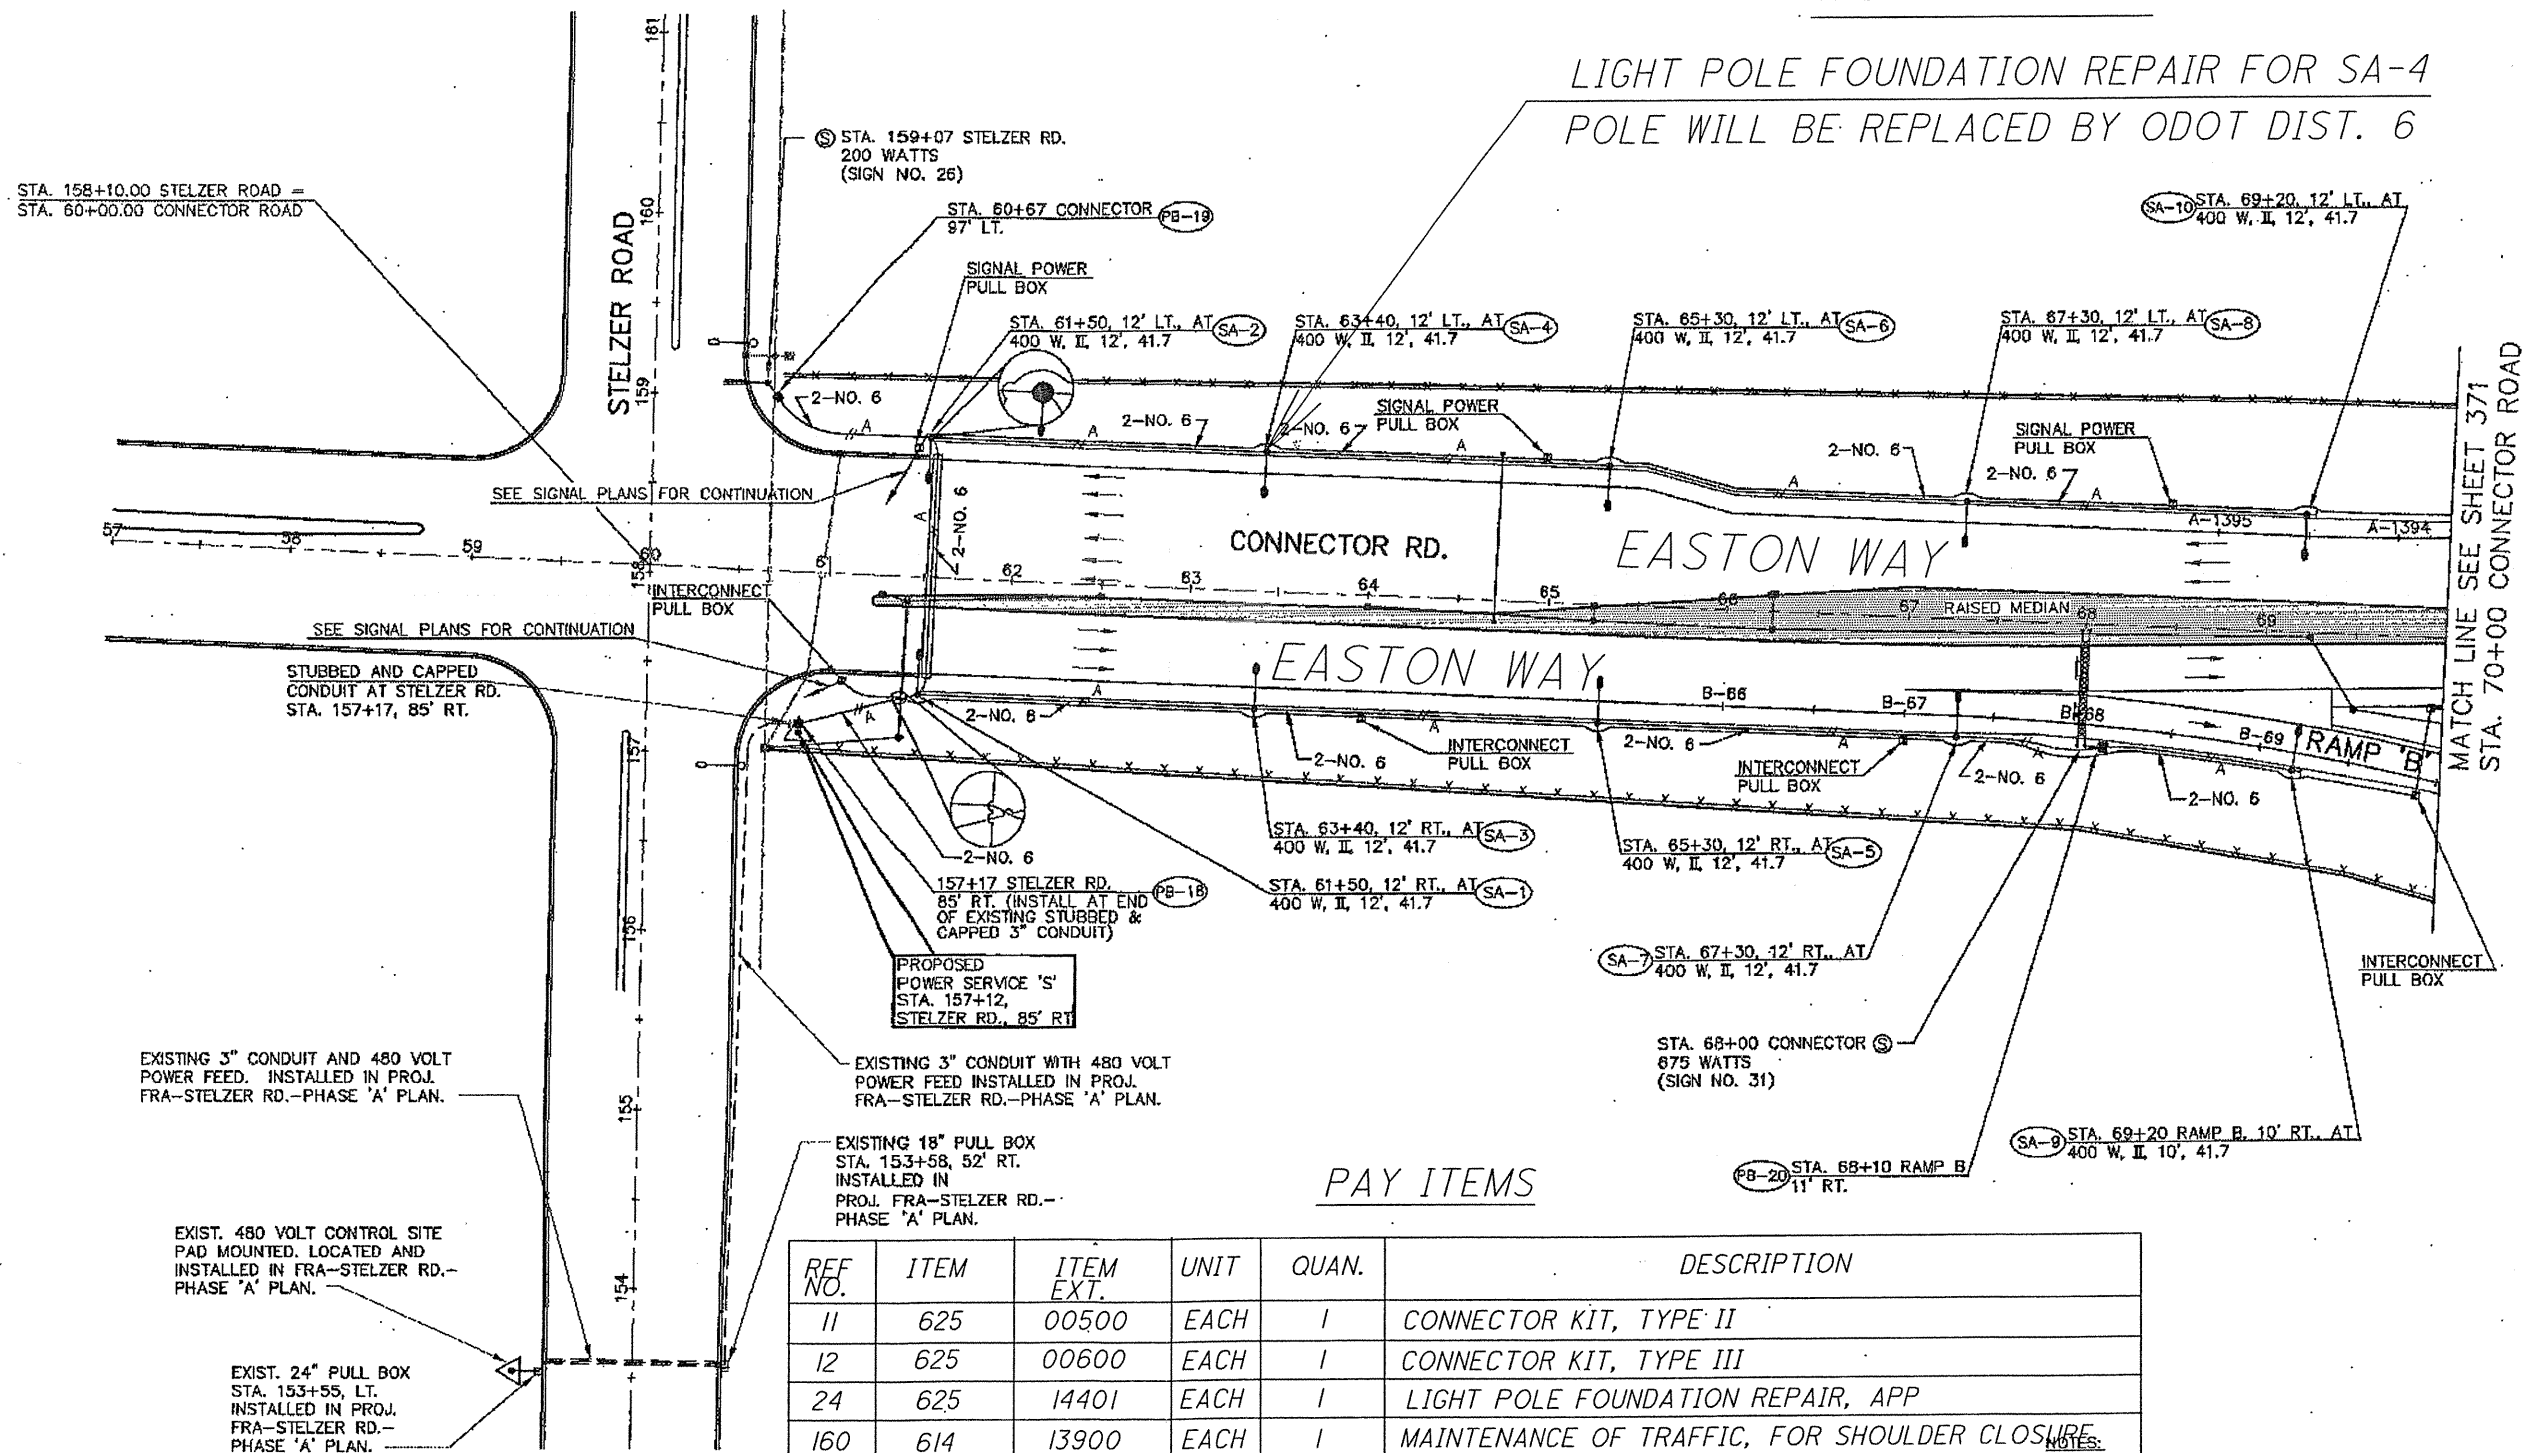

## PAY ITEMS

| REF NO. | ITEM | ITEM EXT. | UNIT | QUAN. | DESCRIPTION                                  |
|---------|------|-----------|------|-------|----------------------------------------------|
| 11      | 625  | 00500     | EACH | 1     | CONNECTOR KIT, TYPE II                       |
| 12      | 625  | 00600     | EACH | 1     | CONNECTOR KIT, TYPE III                      |
| 24      | 625  | 14401     | EACH | 1     | LIGHT POLE FOUNDATION REPAIR, APP            |
| 160     | 614  | 13900     | EACH | 1     | MAINTENANCE OF TRAFFIC, FOR SHOULDER CLOSURE |
|         |      |           |      |       |                                              |
|         |      |           |      |       |                                              |
|         |      |           |      |       |                                              |
|         |      |           |      |       |                                              |

NOTES:  
ALL WIRE TO BE 2-#2, UNLESS OTHERWISE NOTED.  
FOR LIGHTING LEGEND SEE SHEET 369  
FOR QUANTITIES SEE SHEETS 365-367  
FOR SIGNAL QUANTITIES SEE SHEET 357  
FOR INTERCONNECT QUANTITIES SEE SHEETS 340 & 357

PLT SCALE  
C:\DRAWING\06082310\HL\06082310.DWG  
FEBRUARY-13-1995