

D.O.W. Work Order No.:

Water Service Report

Date of Installation:

12-5-19

Project/Permit Number: <u>AGR-2725</u>	Approval (circle one): <u>Yes</u> No Partial
Property Address: <u>1302 E. London BLD #2</u>	Contractor: <u>TRUCCO</u>
Premise Number: <u>Groveport</u>	Inspector: <u>WILLIAM FIELDS</u>
Lot Number/Subdivision:	Supervisor: <u>DAN GRAY</u>

WORK PERFORMED:

Circle One:

NewTransfer
(Replace)

Repair

Put-In-Shape
(PIS)Corporation Stop
Repair/Replacement

TAP/SERVICE INFORMATION

Curb Box Location: 235 Feet North of c/L of LONDON GROVEPORT Rd
27 Feet EAST of c/L of COLLINGS

Depth of Tap (at curb box):

7 FT

Depth of Tap (at main):

5 FT

Water Main Size:

8"

Tap Size (at main):

2"

New Water Service Length
(W.M. to curb box):

33 FT

New Water Service
Manufacturer:

Cerro

New Water Service Material
(W.M. to curb box):

Copper

Owner's Side Water Service
Material (Curb box to meter):

Poly

Northing:

667689.99

Easting:

1837713.08

ABANDONED TAP/SERVICE INFORMATION


Premise Number:

Previous
Tap Size:

Previous Water Service
Material (W.M. to curb box):

Remarks:

Tap Drawing

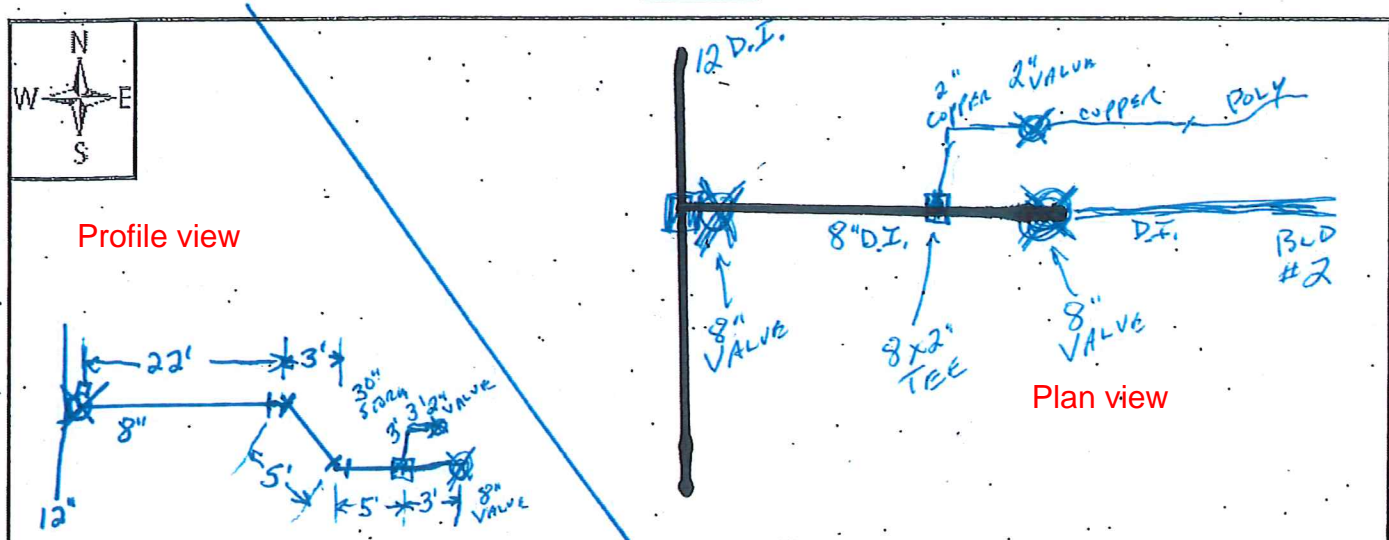

Date of Installation: 12-5-19

WORK PERFORMED: Circle One: New Transfer (Replace) Repair Put-In-Shape (PIS) Corporation Stop Repair/Replacement

Curb Box Location: 232 Feet North of C/L of GROVEPORT London Rd
27 Feet EAST of C/L of Collings

Depth of Tap (at main): 5 ft

Tap Size (at main):

New Water Service
Manufacturer: AMERICAN

Owner's Side Water Service
Material (Curb box to meter):

Easting: 183 7712.78

Premise Number: _____

Previous
Tap Size: _____

Previous Water Service
Material (W.M. to curb box): _____

Remarks: _____

The image contains two hand-drawn engineering sketches of a piping system, labeled 'Profile view' and 'Plan view'.

Profile view: This sketch shows a vertical line on the left labeled '12"'. A horizontal line extends to the right, labeled '8"'. A diagonal line branches off from the horizontal line, labeled '30"'. Dimensions along the horizontal line are '22'' and '3''. Dimensions along the diagonal line are '5'' and '1.5''. A valve is indicated on the horizontal line near the diagonal branch.

Plan view: This sketch shows a horizontal line labeled '8" DI.'. A vertical line intersects it from the left, labeled '12" DI.'. There are two valves on the horizontal line, one on each side of the vertical intersection. A '2" elbow' and a '2" valve' are shown on a branch connected to the horizontal line. A '2" tee' and another '2" valve' are also shown on the horizontal line.

D.O.W. Work Order No.:

Water Service Report

Date of Installation:

11-25-19

Project/Permit Number: <u>Collings Dr. AGR-2725</u>	Approval (circle one): <u>Yes</u> No Partial
Property Address: <u>BLD# 3 1322 E London</u>	Contractor: <u>TRUCCO</u>
Premise Number: <u>Groveport</u>	Inspector: <u>WILLIAM FIELDS</u>
Lot Number/Subdivision:	Supervisor: <u>DAN GRAY</u>

WORK PERFORMED:

Circle One:

NewTransfer
(Replace)

Repair

Put-In-Shape
(PIS)Corporation Stop
Repair/Replacement

TAP/SERVICE INFORMATION

Curb Box

Location:

657

Feet

North

of

C/L

of

LONDON-GROVEPORT Rd21

Feet

EAST

of

C/L

of

Collings Dr.

Depth of Tap (at curb box):

5 FT

Depth of Tap (at main):

5 FT

Water Main Size:

8"

Tap Size (at main):

2"New Water Service Length
(W.M. to curb box):42 FTNew Water Service
Manufacturer:Cerro vNew Water Service Material
(W.M. to curb box):CopperOwner's Side Water Service
Material (Curb box to meter):PVC

Northing:

668095.6

Easting:

1837738.39

ABANDONED TAP/SERVICE INFORMATION

Premise Number:

Previous


Tap Size:

Previous Water Service

Material (W.M. to curb box):

Remarks:

Tap Drawing

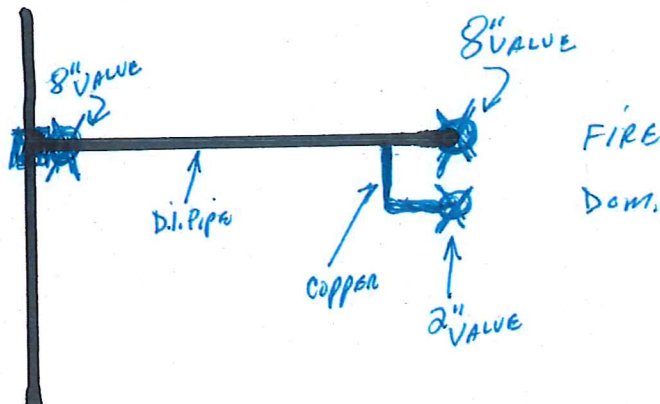

D.O.W. Work Order No.:

Water Service Report

Date of Installation:

11-25-19

Project/Permit Number: <u>Collings Dr. AGR-2725</u>	Approval (circle one): <u>Yes</u> No Partial
Property Address: <u>BLD #3 1322 E. London</u>	Contractor: <u>TRUCCO</u>
Premise Number: <u>Groveport</u>	Inspector: <u>WILLIAM FIELDS</u>
Lot Number/Subdivision:	Supervisor: <u>DAN GRAY</u>

WORK PERFORMED:

Circle One:

NewTransfer
(Replace)

Repair

Put-In-Shape
(PIS)Corporation Stop
Repair/Replacement

TAP/SERVICE INFORMATION

Curb Box

Location:

660

Feet

North

of

C/L

of

LONDON-GROVEPORT Rd21

Feet

EAST

of

C/L

of

Collings Dr.

Depth of Tap (at curb box):

5 FT

Depth of Tap (at main):

5 FT

Water Main Size:

12"

Tap Size (at main):

8"New Water Service Length
(W.M. to curb box):42 FTNew Water Service
Manufacturer:AMERICANNew Water Service Material
(W.M. to curb box):DUCTILE IRONOwner's Side Water Service
Material (Curb box to meter):C900

Northing:

668098.24

Easting:

18377 37.66

ABANDONED TAP/SERVICE INFORMATION

Premise Number:


Previous
Tap Size:

Previous Water Service

Material (W.M. to curb box):

Remarks:

Tap Drawing

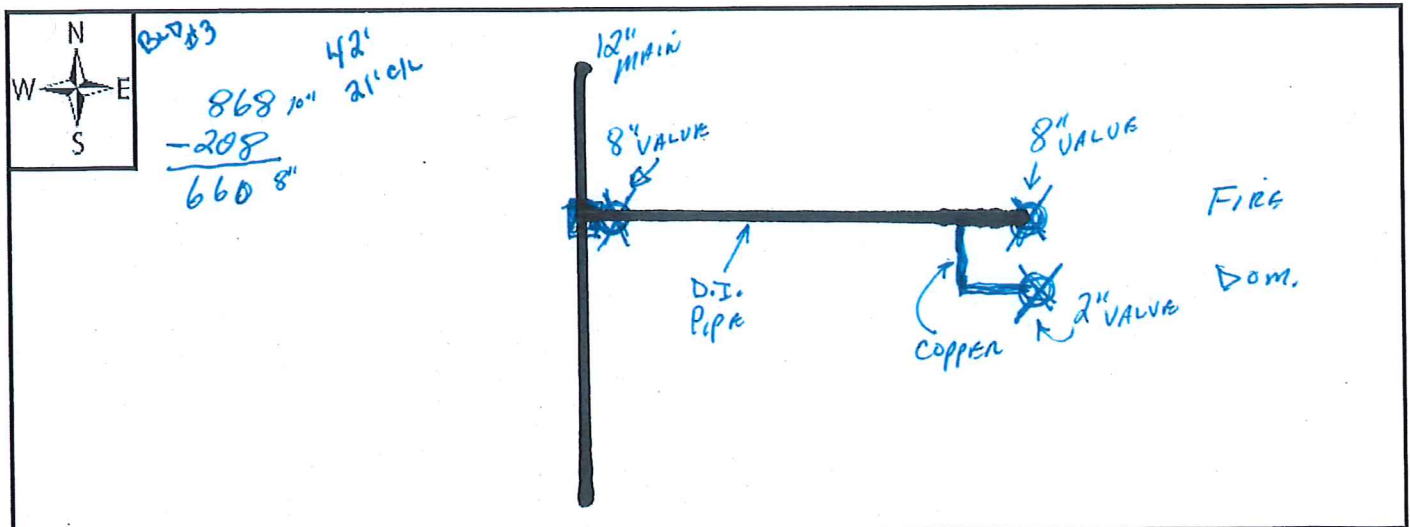

D.O.W. Work Order No.:

Water Service Report

Date of Installation: 11-26-19

Project/Permit Number: Collings Dr. AGR-2725	Approval (circle one): <input checked="" type="radio"/> Yes <input type="radio"/> No <input type="radio"/> Partial
Property Address: BLD #1 1260 E. London	Contractor: TRUCCO
Premise Number: Groveport Rd	Inspector: William Fields
Lot Number/Subdivision:	Supervisor: DAN GRAY

WORK PERFORMED:

 Circle One: ☒ New ☐ Transfer (Replace) ☐ Repair ☐ Put-In-Shape (PIS) ☐ Corporation Stop Repair/Replacement

TAP/SERVICE INFORMATION

 Curb Box Location: 243 Feet North of C/L of London-Groveport Rd
 24FT Feet WEST of C/L of Collings Rd

Depth of Tap (at curb box): 5FT Depth of Tap (at main): 5FT

Water Main Size: 12" Tap Size (at main): 8"

New Water Service Length (W.M. to curb box): 13FT New Water Service Manufacturer: AMERICAN

New Water Service Material (W.M. to curb box): DUCTILE IRON Owner's Side Water Service Material (Curb box to meter): D.I.

Northing: 667697.28 Easting: 1837664.73


ABANDONED TAP/SERVICE INFORMATION

Premise Number: Previous Tap Size:

Previous Water Service Material (W.M. to curb box):

Remarks:

Tap Drawing

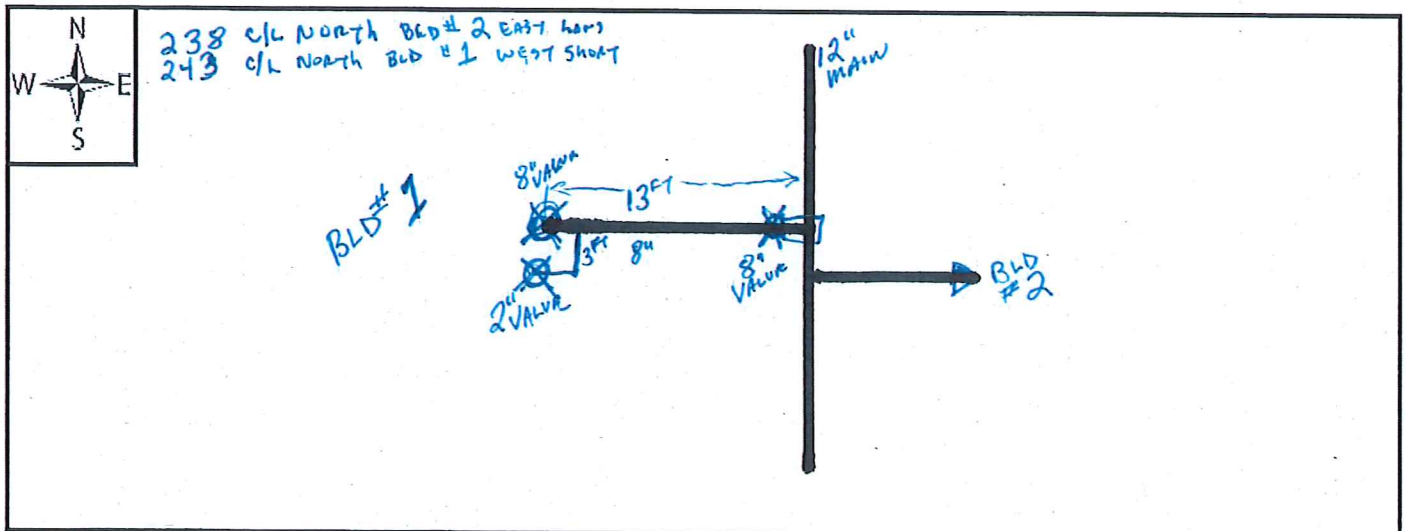

D.O.W. Work Order No.:

Water Service Report

Date of Installation:

11-26-19

Project/Permit Number: <u>Collings Dr AGR-2725</u>	Approval (circle one): <u>Yes</u> No Partial
Property Address: <u>BLD #1 1260 E. London Groveport</u>	Contractor:
Premise Number: <u>Rd.</u>	Inspector: <u>William Fields</u>
Lot Number/Subdivision:	Supervisor: <u>DAN GRAY</u>

WORK PERFORMED:

Circle One:

NewTransfer
(Replace)

Repair

Put-In-Shape
(PIS)Corporation Stop
Repair/Replacement

TAP/SERVICE INFORMATION

Curb Box

Location:

240

Feet

North

of

C/L

of

LONDON-GROVEPORT Rd13

Feet

WEST

of

C/L

of

Collings Dr.

Depth of Tap (at curb box):

5 FT

Depth of Tap (at main):

5 FT

Water Main Size:

8"

Tap Size (at main):

2"New Water Service Length
(W.M. to curb box):13 FTNew Water Service
Manufacturer:CerroNew Water Service Material
(W.M. to curb box):CopperOwner's Side Water Service
Material (Curb box to meter):PVC

Northing:

667694.72

Easting:

183 7664.55

ABANDONED TAP/SERVICE INFORMATION

Premise Number:

Previous


Tap Size:

Previous Water Service

Material (W.M. to curb box):

Remarks:

Tap Drawing

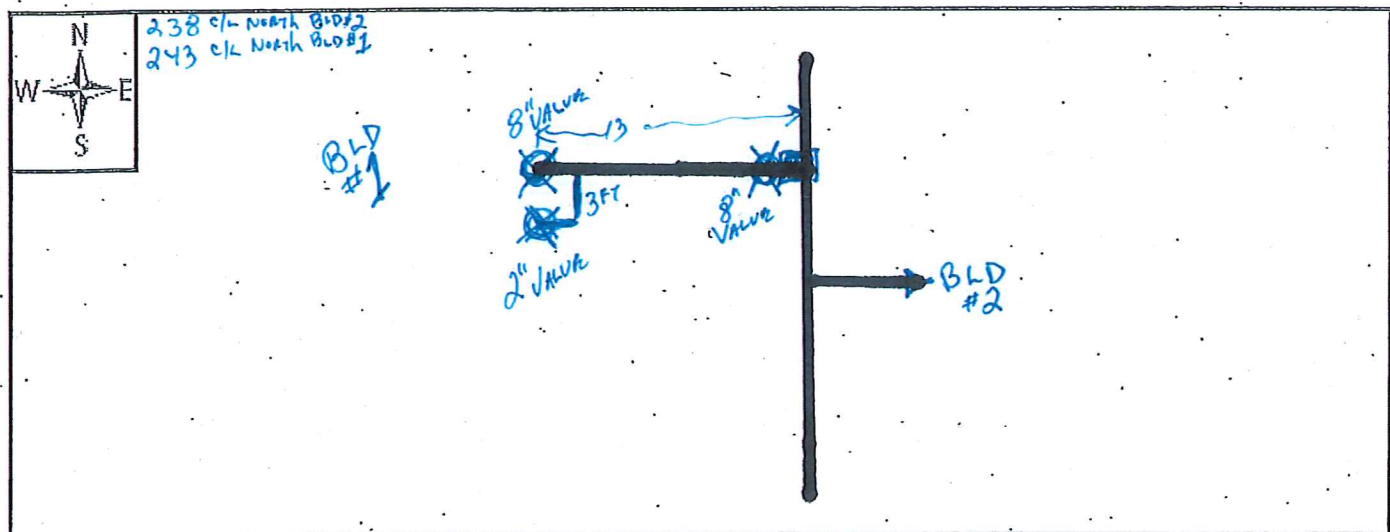

D.O.W. Work Order No.:

Water Service Report

Date of Installation:

NOV-21-19

Project/Permit Number: <u>COLLINGS DR AGR-2725</u>	Approval (circle one): <u>Yes</u> No Partial
Property Address: <u>1280 London Building #6</u>	Contractor: <u>TRUCCO</u>
Premise Number: <u>Groveport</u>	Inspector: <u>William Field</u>
Lot Number/Subdivision:	Supervisor: <u>DAN GRAY</u>

WORK PERFORMED:

Circle One:

NewTransfer
(Replace)

Repair

Put-In-Shape
(PIS)Corporation Stop
Repair/Replacement

TAP/SERVICE INFORMATION

Curb Box

Location:

865

Feet

North

of

C/L

of

LONDON GROVEPORT Rd247

Feet

WEST

of

C/L

of

COLLINGS DR

Depth of Tap (at curb box):

5 FT

Depth of Tap (at main):

5 FT

Water Main Size:

10"

Tap Size (at main):

2" DOMESTICNew Water Service Length
(W.M. to curb box):6 FTNew Water Service
Manufacturer:CerroNew Water Service Material
(W.M. to curb box):COPPEROwner's Side Water Service
Material (Curb box to meter):PVC

Northing:

668304.45

Easting:

1837698.7

ABANDONED TAP/SERVICE INFORMATION

Premise Number:

Previous


Tap Size:

Previous Water Service

Material (W.M. to curb box):

Remarks:

Tap Drawing

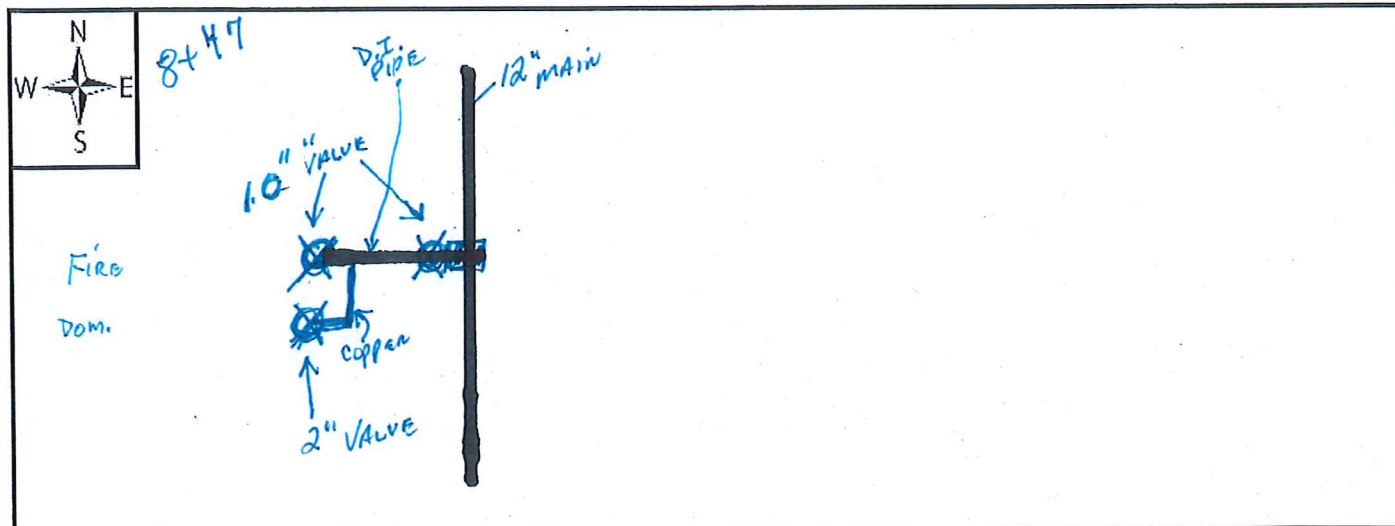

D.O.W. Work Order No.:

Water Service Report

Date of Installation:

NOV 21/2019

Project/Permit Number: <u>Collings Drv. AGR-2725</u>	Approval (circle one): <u>Yes</u> No Partial
Property Address: <u>Building #6 1280 London</u>	Contractor: <u>TRUCCO</u>
Premise Number: <u>Groveport</u>	Inspector: <u>WILLIAM FIELDS</u>
Lot Number/Subdivision:	Supervisor: <u>DAN GRAY</u>

WORK PERFORMED:

Circle One:

NewTransfer
(Replace)

Repair

Put-In-Shape
(PIS)Corporation Stop
Repair/Replacement

TAP/SERVICE INFORMATION

Curb Box

Location:

868

Feet

North

of

C/L

of

LONDON-GROVEPORT Rd24 FT

Feet

WEST

of

C/L

of

Collings Drv.

Depth of Tap (at curb box):

5 FT

Depth of Tap (at main):

5 FT

Water Main Size:

12"

Tap Size (at main):

10"<FIRE>New Water Service Length
(W.M. to curb box):6 FTNew Water Service
Manufacturer:AMERICANNew Water Service Material
(W.M. to curb box):DUCTILE IRONOwner's Side Water Service
Material (Curb box to meter):C900 PVC

Northing:

668306.78

Easting:

1837699.12

ABANDONED TAP/SERVICE INFORMATION

Premise Number:

Previous

Tap Size:

Previous Water Service

Material (W.M. to curb box):

Remarks:

Tap Drawing

