



Tacked Nubs  
 423.311 ft  
 Stone  
 Sta 176+84.60  
 $\Delta = 0^{\circ}15'24''$

FED. RD. DIST. NO.	STATE	PROJECT	FISCAL YEAR
10	OHIO		1942

FRANKLIN COUNTY  
 S.H. 924 SEC. F (pt)  
 R/W PLANS  
 REV. 6-30-42

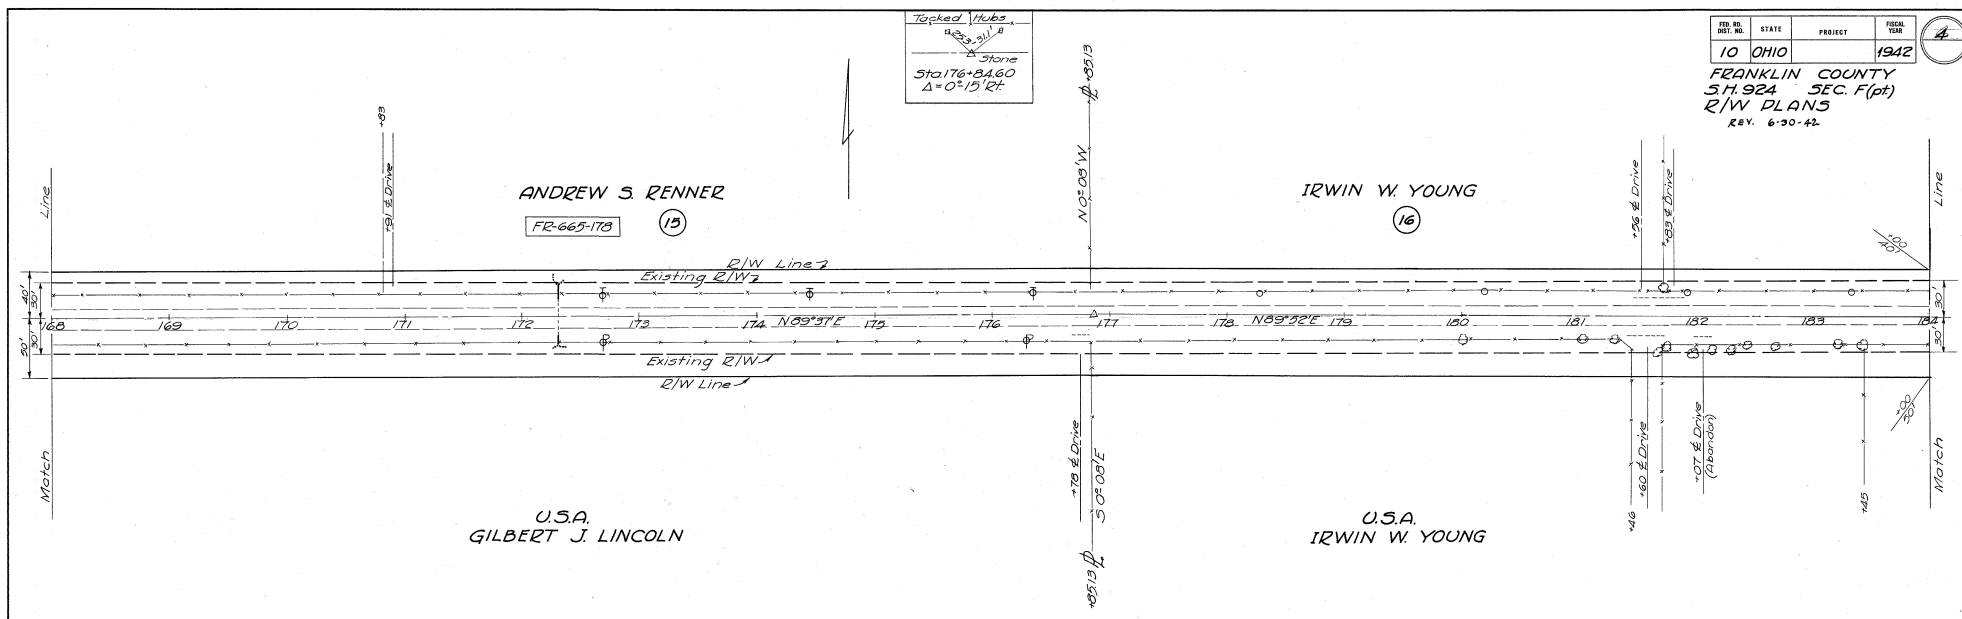

Nail in post  
 84" Ash  
 Nail in post  
 Franklin Co Manu  
 6" Dia. Concrete  
 with Orange Plate  
 6" Dia. Gr. Manu  
 44-575.15  
 Sta 190+33.98  $\Delta = 0^{\circ}28'14''$

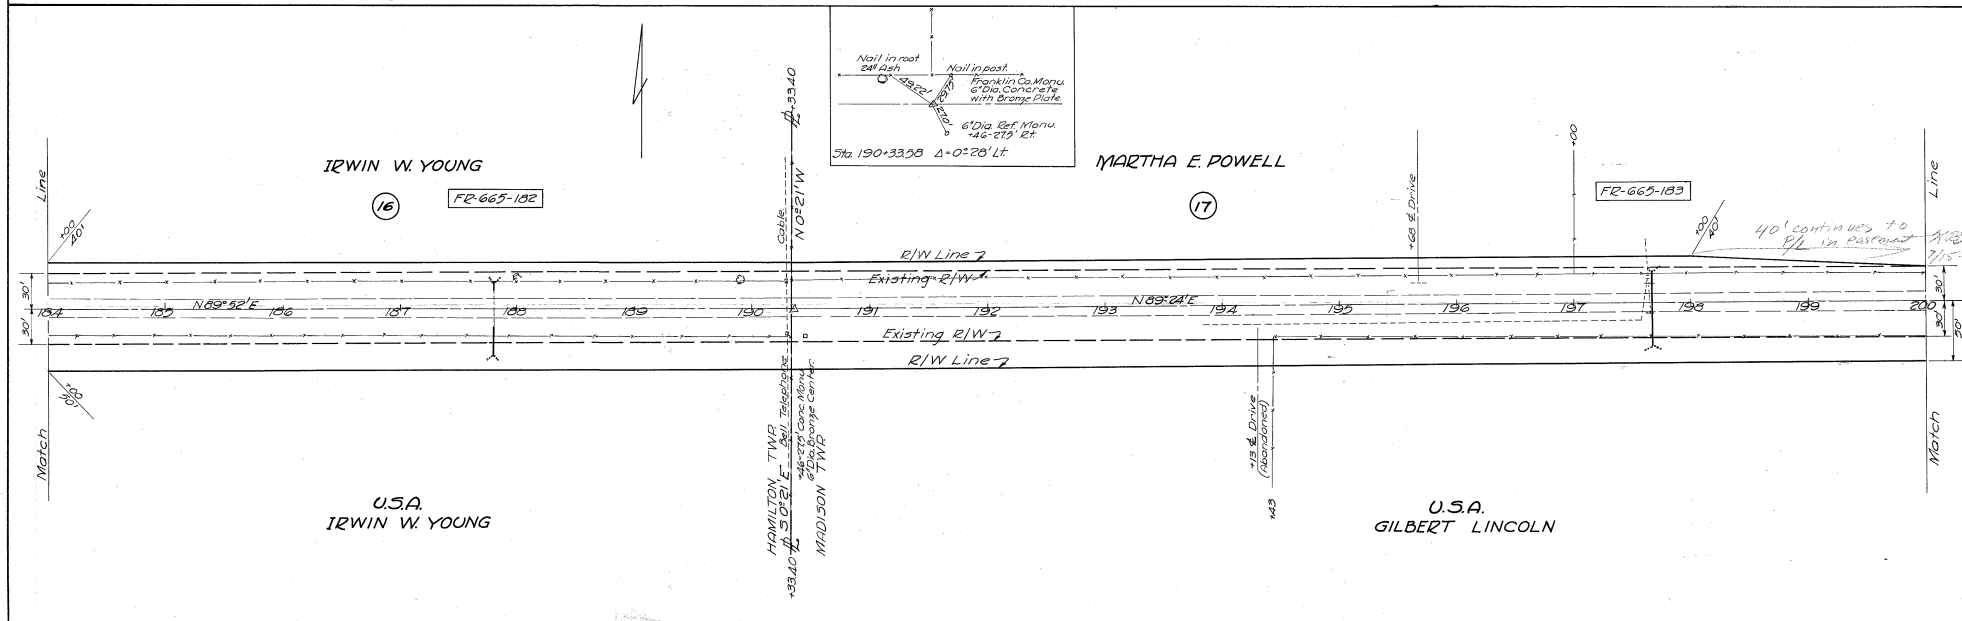



REV.	DATE	BY	REASON
10	10/10		

FRANKLIN COUNTY  
S.H. 924 SEC F (pt)  
R/W PLANS

1942

1942

Lock in Post  
Nail in  
Post  
Stone  
Sta 163+36.05 Δ=0°12'LT

Locked  
Nail  
Stone  
Sta 173+24.60  
Δ=0°15'LT

Nail in Post  
Nail in Post  
Sta 193+33.58 Δ=0°20'LT

ANDREW S. RENNER

IRWIN W. YOUNG

MARTHA E. POWELL

U.S.A.

Hamilton Twp.  
Sec. 1, T-3, R-22

Nail in Pole  
Nail in Pole  
Sta 206+00  
Δ=0°15'LT

Nail in Pole  
Nail in Pole  
Sta 223+03.30

MARTHA E. POWELL

CARL E AND GERTRUDE SCHMIDT

ARTHUR KNAPP

ALBERT GRAMLICH

Total 7.15 Ac  
Ex. 4.29 -  
Net 2.86 Ac

U.S.A.

Madison Twp.  
Sec. 6, T-10, R-21