


RETAINING WALL
Sta 802+07 to 804+32
Price per cu yd of wall
include the following:
Quarry-faced stone 66.4 Cu Yds
Gravel Backfill 159 Cu Yds
4" Drain Tile 178 Lin Ft
6" Drain Tile 166 Lin Ft
Excav (Found) 70 Cu Yds

MONUMENT BOXES				
ITEM	STA.	LOC'N	NO.	REMARKS
1-M	884+00.50		1	DOT
2-M	884+48.48		1	DOT
3-M	884+58.83	Angle	1	DOT
4-M	884+58.15		1	DOT
5-M	886+58.34		1	Angle Point
TOTAL			5	

6" CONC. SIDEWALK
Item I-13
Sta 805+57 to 806+27
300 Sq. Ft. Sidewalk
as directed by the
Engineer to replace
Existing walk on Lt.

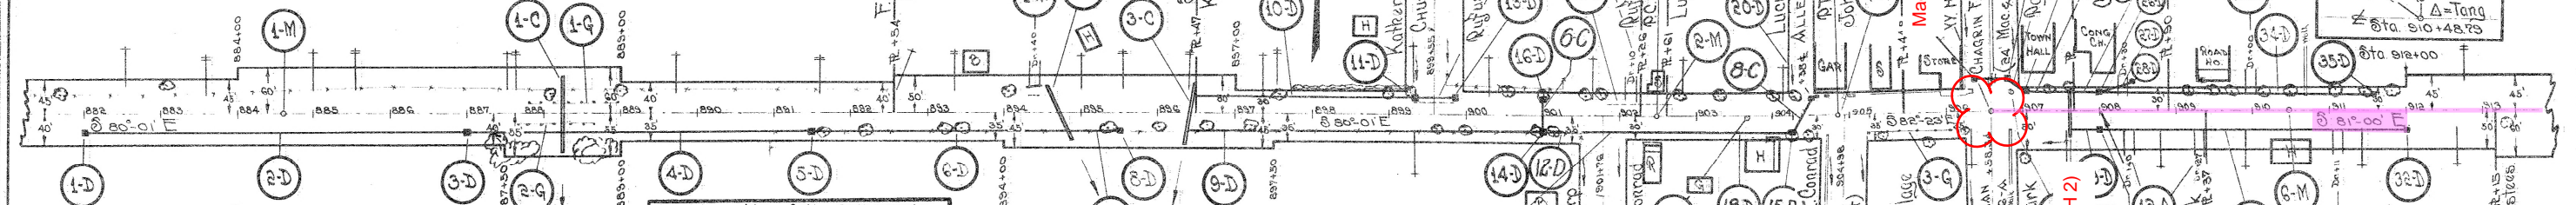

STORM SEWER												
ITEM	STATION		SIDE	LINEAL		FEET		12" PIPE BLDG BT	CURB		STD. I-2 C-2.	
				PIPE			PIPE No. 1 M.H. No.		PIPE REMOVED	14" FT.		INLETS
	FROM	TO		12"	15"	18"						NB2
1-D	882+01		RT							1		
2-D	882+02	882+08	RT	456								
3-D	882+09		RT							1		
4-D	882+09	891+48	RT		448							
5-D	891+49		RT							1		
6-D	891+50	894+80	RT			330						
7-D	894+81	895+49	RT	62								
8-D	895+50		RT						1			
9-D	895+54	901+00	RT		466							
10-D	896+01	899+28	LT					278				
11-D	899+29		LT							1		
12-D	901+02	901+51	RL	49								
13-D	892+81		LT								1	
14-D	901+01		LT							1		
15-D	904+22		RL							1		
16-D	901+01		LT							1		
17-D	901+84	902+71	LT				87					
18-D	902+01	904+24	RT	223								
19-D	906+80	906+98	LT	26								
20-D	904+50		LT									
SUB TOTALS				356	814	330	0	87	278	1	7	2