

SHEET NUMBER												PART.		ITEM	ITEM EXT	GRAND TOTAL	UNIT	DESCRIPTION	SEE SHEET NO.
2	3	4	6	7	8	9						01/S>2	02/STR						
					25							25		202	38000	25	FT	ROADWAY	
					7							6	1	202	42010	7	EACH	ANCHOR ASSEMBLY REMOVED, TYPE E	
					1							1		202	42040	1	EACH	ANCHOR ASSEMBLY REMOVED, TYPE T	
						5						5		204	10000	5	SY	SUBGRADE COMPACTION	
					425							425		606	15050	425	FT	GUARDRAIL, TYPE MGS	
					8							7	1	606	26150	8	EACH	ANCHOR ASSEMBLY, MGS TYPE E	
						48						48		608	10000	48	SF	4" CONCRETE WALK	
						86						86		608	52000	86	SF	CURB RAMP	
						28						28		608	53020	28	SF	DETECTABLE WARNING	
																		EROSION CONTROL	
222												178	44	659	00300	222	CY	TOPSOIL	
2,000												1,600	400	659	10000	2,000	SY	SEEDING AND MULCHING	
0.27												0.22	0.05	659	20000	0.27	TON	COMMERCIAL FERTILIZER	
0.41												0.33	0.08	659	31000	0.41	ACRE	LIME	
11.1												8.9	2.2	659	35000	11.1	MGAL	WATER	
												800	200	832	30000	1,000	EACH	EROSION CONTROL	
																		DRAINAGE	
8												8		611	98630	8	EACH	CATCH BASIN ADJUSTED TO GRADE	
3												3		611	99654	3	EACH	MANHOLE ADJUSTED TO GRADE	
																		PAVEMENT	
						5						5		253	01000	5	SY	PAVEMENT REPAIR	
1,000												800	200	253	02000	1,000	CY	PAVEMENT REPAIR, (A)	
365												292	73	253	02000	365	CY	PAVEMENT REPAIR, (B)	
			109,016									80,731	28,285	254	01000	109,016	SY	PAVEMENT PLANING, ASPHALT CONCRETE, 1.5" DEPTH	
			1,092									809	283	254	01600	1,092	SY	PATCHING PLANED SURFACE	
												7,266	2,546	407	20000	9,812	GAL	NON-TRACKING TACK COAT	
			9,812									3,364	1,179	442	10001	4,543	CY	ASPHALT CONCRETE SURFACE COURSE, 12.5 MM, TYPE A (446), AS PER PLAN, PG76-22M	
			4,543									261	105	617	10100	366	CY	COMPACTED AGGREGATE	
			366									4,705	1,889	617	20000	6,594	SY	SHOULDER PREPARATION	
			6,594									4.9	2.1	617	25000	7	MGAL	WATER	
			7																
													1.61	618	43000	1.61	MILE	RUMBLE STRIPES, CENTER LINE (ASPHALT CONCRETE)	
			1.61																
																		TRAFFIC CONTROL	
430												344	86	621	00100	430	EACH	RPM	
430												344	86	621	54000	430	EACH	RAISED PAVEMENT MARKER REMOVED	
					8							8		626	00110	8	EACH	BARRIER REFLECTOR, TYPE 2 (BIDIRECTIONAL)	
				11.13								7.96	3.17	644	00104	11.13	MILE	EDGE LINE, 6"	
				5.81								4.22	1.59	644	00300	5.81	MILE	CENTER LINE	
				1,712								1,612	100	644	00400	1,712	FT	CHANNELIZING LINE, 8"	
				262								236	26	644	00500	262	FT	STOP LINE	
				247								247		644	00620	247	FT	CROSSWALK LINE, 12"	
												672		644	00700	672	FT	TRANSVERSE/DIAGONAL LINE, 24"	
				672								2		644	01100	2	EACH	SCHOOL SYMBOL MARKING, 72"	
				2															
												27	2	644	01300	29	EACH	LANE ARROW	
				29															
	200											180	20	614	11110	200	HOURL	MAINTENANCE OF TRAFFIC	
		8										7	1	614	18600	8	SNMT	LAW ENFORCEMENT OFFICER WITH PATROL CAR FOR ASSISTANCE	
		5.81										4.22	1.59	614	21550	5.81	MILE	PORTABLE CHANGEABLE MESSAGE SIGN	
		11.13										7.96	3.17	614	22360	11.13	MILE	WORK ZONE CENTER LINE, CLASS III, 642 PAINT	
		1,712										1,612	100	614	23690	1,712	FT	WORK ZONE EDGE LINE, CLASS III, 6", 642 PAINT	
																		WORK ZONE CHANNELIZING LINE, CLASS III, 12", 642 PAINT	
												672		614	25620	672	FT	WORK ZONE TRANSVERSE/DIAGONAL LINE, CLASS III, 642 PAINT	
		672										236	26	614	26610	262	FT	WORK ZONE STOP LINE, CLASS III, 642 PAINT	
		262										247		614	27260	247	FT	WORK ZONE CROSSWALK LINE, CLASS III, 24", 642 PAINT	
		247										27	2	614	30650	29	EACH	WORK ZONE ARROW, CLASS III, 642 PAINT	
		29										2		614	31740	2	EACH	WORK ZONE SCHOOL SYMBOL MARKING, 72", CLASS III, 642 PAINT	
		2																	
																		INCIDENTALS	
												LS		614	11000	LS		MAINTAINING TRAFFIC	
												LS		623	10001	LS		CONSTRUCTION LAYOUT STAKES AND SURVEYING, AS PER PLAN	2
												LS		624	10000	LS		MOBILIZATION	

GENERAL SUMMARY

DESIGN AGENCY



DESIGNER

TCS

REVIEWER

KSD 09-05-25

PROJECT ID




116333

SHEET

5

TOTAL

9

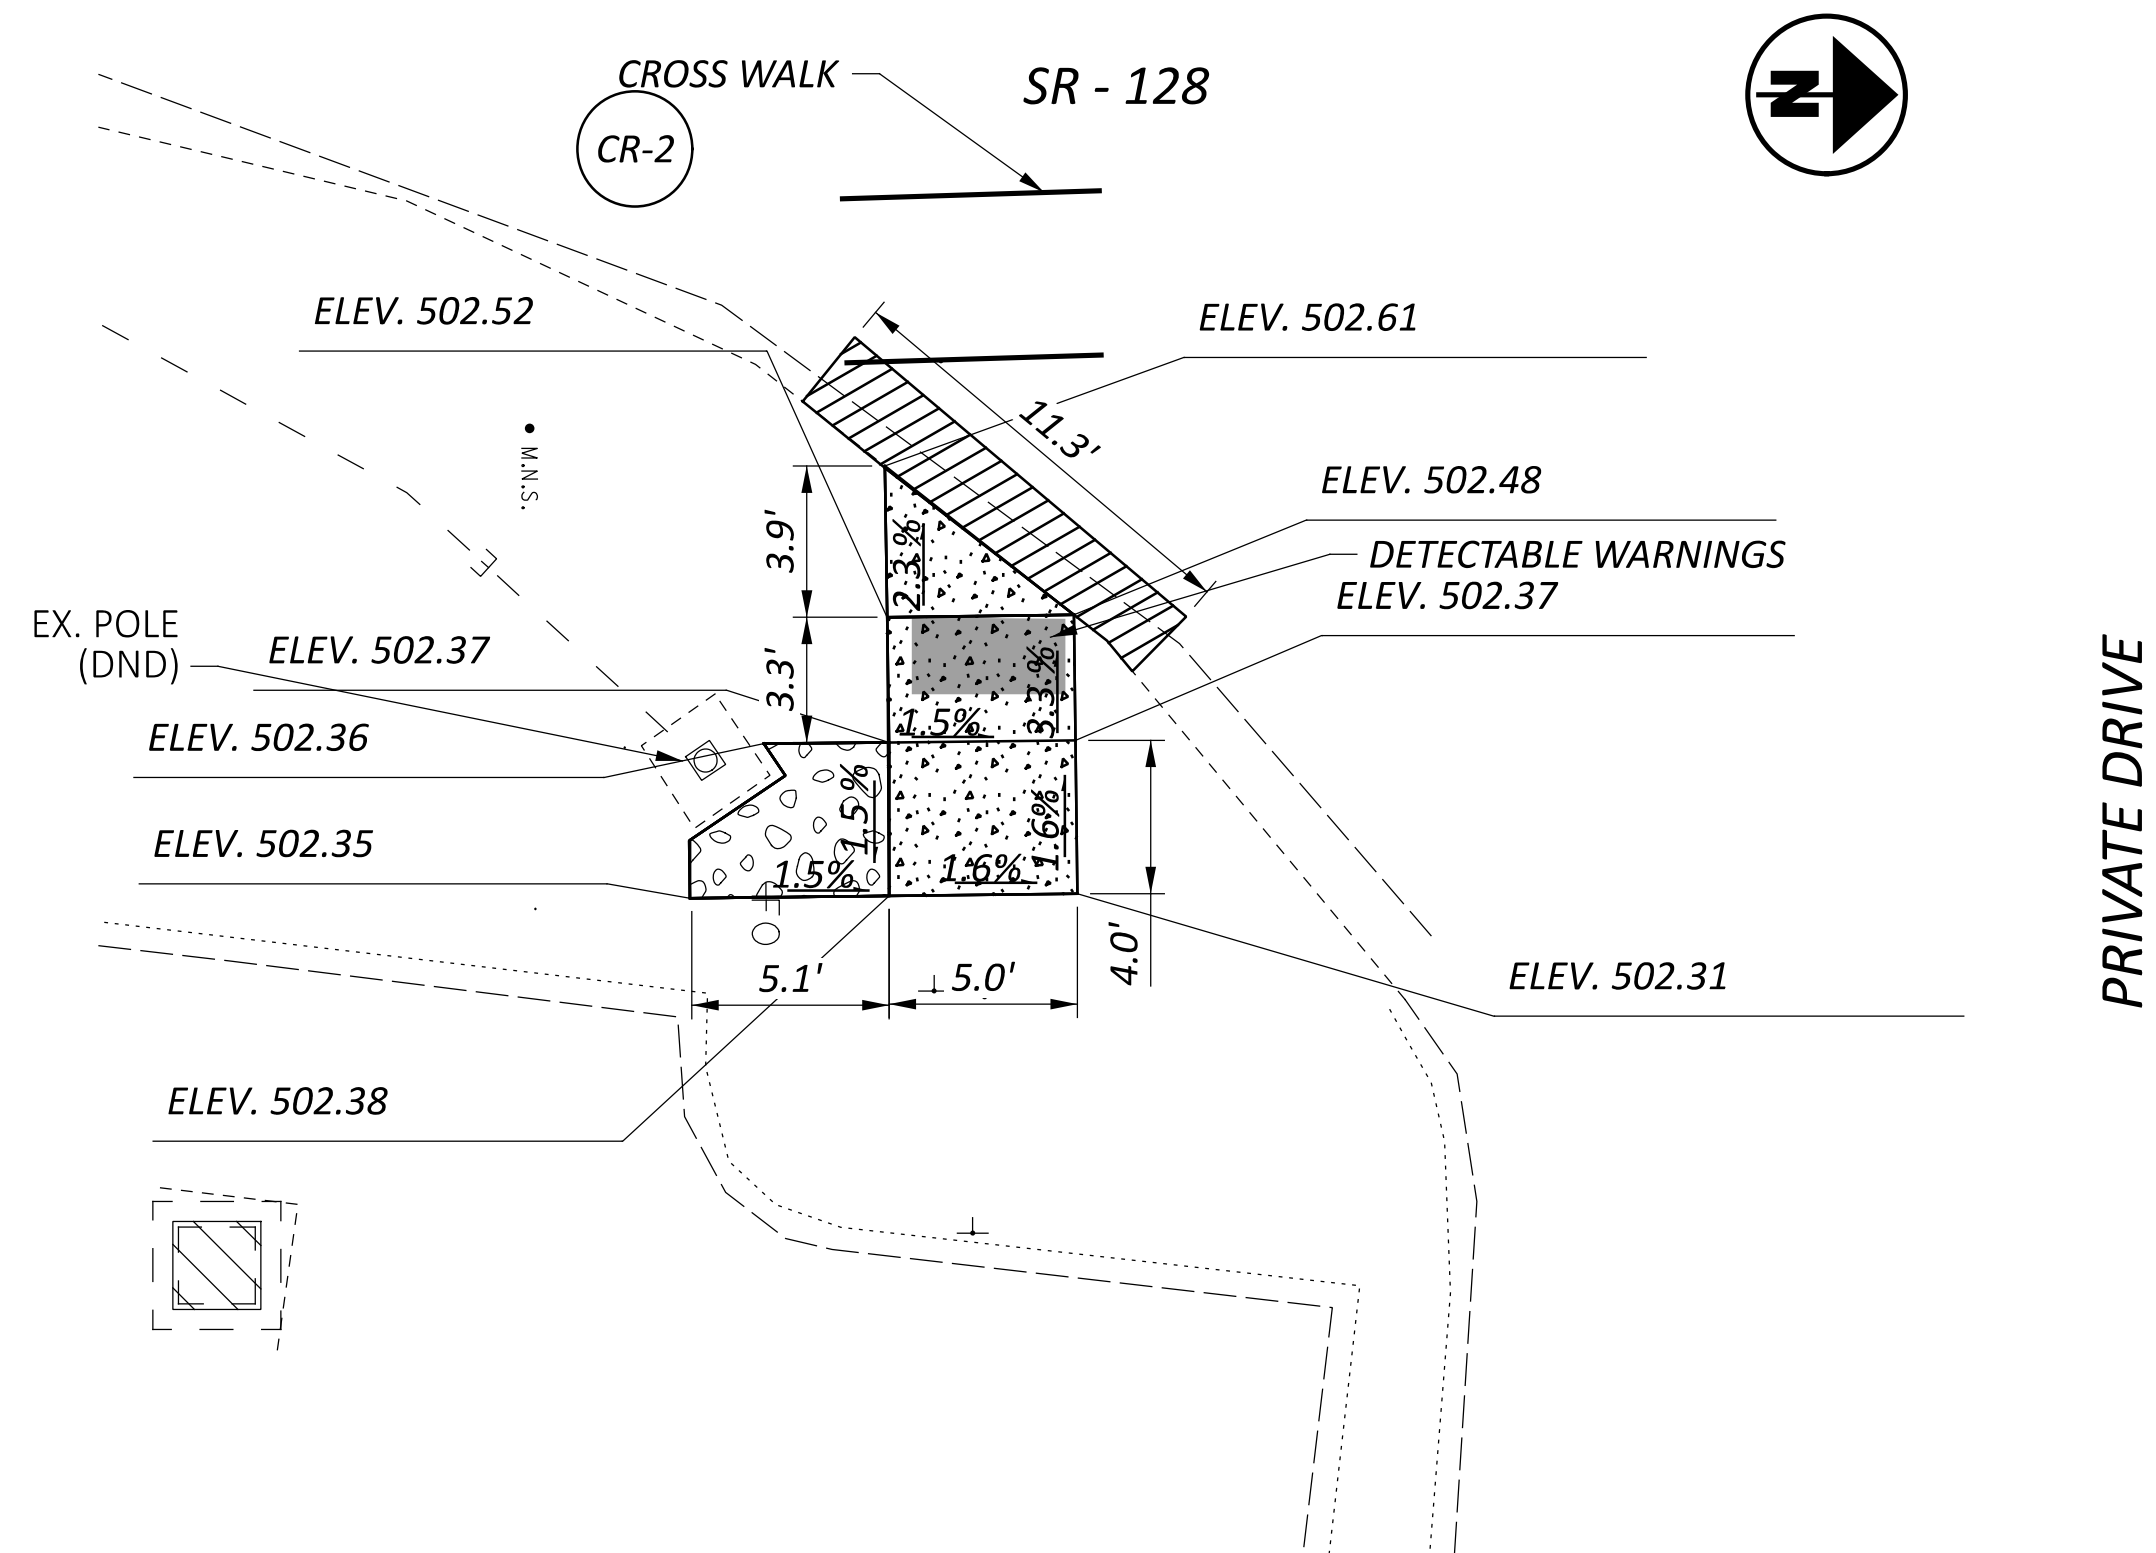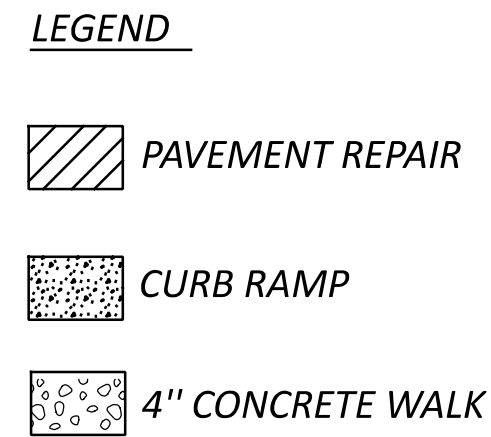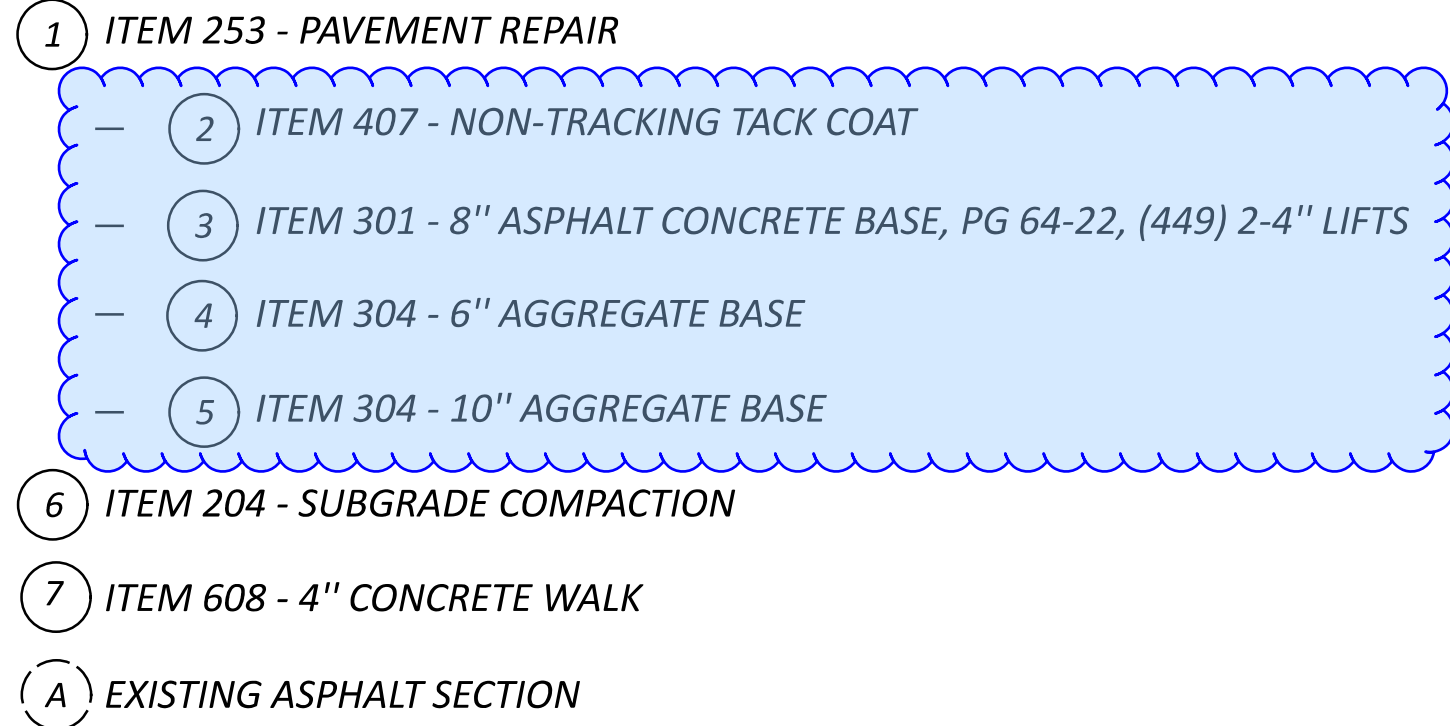

COUNTY	ROUTE	LOGPOINT OR INTERSECTING STREETNAME	FOR INFORMATION ONLY								204	253	FOR INFORMATION ONLY				608			ADDITIONAL NOTES
			CURB RAMP TYPE PER BP-7.1								SUBGRADE COMPACTION	PAVEMENT REPAIR	301	304	407	4" CONCRETE WALK	CURB RAMP	DETECTABLE WARNING		
			TYPE A1	TYPE A2	TYPE B2	TYPE B3	TYPE C1	TYPE C2	BLENDED TRANSITION	DETECTABLE WARNING			ASPHALT CONCRETE BASE, PG64-22	6" AGGREGATE BASE	10" AGGREGATE BASE				NON TRACKING TACK COAT	
HAM	SR-128	SW KROGER INTERSECTION (CR-1)						1		1	2.1	2.1	0.5	0.4	1.1	0.1	31	42	14	
HAM	SR-128	SE KROGER INTERSECTION (CR-2)							1	1	2.5	2.5	0.6	0.4	1.3	0.2	17	44	14	
TOTALS CARRIED TO GENERAL SUMMARY											5	5					48	86	28	