

J:\20240445\0DOT\HAM\117525\Design\Roadway\Sheets\77889GY401.dgn 3/10/2025 1:33:30 PM hbrendlinger




LEGEND

- 1 ITEM 442 - 1 1/2" ASPHALT CONCRETE SURFACE COURSE, 12.5MM, TYPE A (447), AS PER PLAN
- 2 ITEM 407 - NON-TRACKING TACK COAT (@0.055 GAL/SY)
- 3 ITEM 442 - 1 3/4" ASPHALT CONCRETE INTERMEDIATE COURSE, 12.5MM, TYPE A (446)
- 4 ITEM 302 - 13" ASPHALT CONCRETE BASE (2-6.5" LIFTS)
- 5 ITEM 304 - 6" AGREGGATE BASE
- 6 ITEM 452 - 6" NON-REINFORCED CONCRETE PAVEMENT
- 7 ITEM 605 - 6" BASE PIPE UNDERDRAINS
- 8 ITEM 204 - PROOF ROLLING
- 9 ITEM 659 - SEEDING AND MULCHING
- 10 ITEM 606 - GUARDRAIL, TYPE MGS
- 11 ITEM 452 - 15" NON-REINFORCED CONCRETE PAVEMENT
- 12 ITEM 206 - CEMENT STABILIZED SUBGRADE, 14" DEEP
- 13 ITEM 605 - 6" SHALLOW PIPE UNDERDRAINS
- 14 ITEM 605 - 6" UNCLASSIFIED PIPE UNDERDRAINS
- 15 ITEM 526 - REINFORCED CONCRETE APPROACH SLAB (T=17")
- 16 ITEM 302 - 9" ASPHALT CONCRETE BASE (2-4.5" LIFTS)
- 17 ITEM 609 - CURB, TYPE 6
- 18 ITEM 608 - 4" CONCRETE WALK
- 19 ITEM 254 - 1 1/2" PAVEMENT PLANING, ASPHALT CONCRETE
- 20 ITEM 411 - 8" STABILIZED CRUSHED AGGREGATE
- 21 ITEM 622 - CONCRETE BARRIER, SINGLE SLOPE, TYPE B1
- 22 ITEM 622 - CONCRETE BARRIER, SINGLE SLOPE, TYPE C1
- 23 ITEM 622 - CONCRETE BARRIER, SINGLE SLOPE, TYPE D
- 24 ITEM 618 - RUMBLE STRIPS, SHOULDER (ASPHALT CONCRETE)
- 25 ITEM 407 - NON-TRACKING TACK COAT (@0.085 GAL/SY)
- 26 ITEM 609 - CURB, TYPE 4-C, AS PER PLAN
- 27 ITEM 204 - SUBGRADE COMPACTION
- 28 ITEM 302 - 4 3/4" ASPHALT CONCRETE BASE
- 29 ITEM 659 - TOPSOIL
- 30 ITEM 441 - 1 1/2" ASPHALT CONCRETE SURFACE COURSE, TYPE 1 (448), PG 64-22
- 31 ITEM 408 - PRIME COAT
- 32 ITEM 441 - 1 3/4" ASPHALT CONCRETE INTERMEDIATE COURSE, TYPE 1 (448)

- 1 VARIES 10.0' TO 8.1'
STA 466+22.08 TO STA 467+25.00
- 2 VARIES 0.0' TO 1.9'
STA 466+22.08 TO STA 467+25.00
- 3 VARIES 0.0' TO 12'
STA 466+22.08 TO STA 466+65.00
12'
STA 466+65.00 TO STA 467+25.00
- 4 VARIES 16.9'± TO 8.0'
STA 466+22.08 TO STA 466+65.00
8.0'
STA 466+65.00 TO STA 467+25.00
- 5 VARIES 8.1' TO 8.0'
STA 467+25.00 TO STA 467+29.10
8.0'
STA 467+29.10 TO STA 472+00.00
- 6 VARIES 1.9' TO 11.7'
STA 467+25.00 TO STA 472+00.00
- 7 12'
STA 467+25.00 TO STA 469+74.52
VARIES 12' TO 21.6'
STA 469+74.52 TO STA 472+00.00

- A 0.04 OR RATE OF SUPER IF GREATER
B 0.07 MAX BREAK
C VARIES 0.04 TO 0.01
S SEE SHEET 19 FOR GRADING DETAILS.
SEE SHEET 21 FOR ROADSIDE BARRIER DETAILS

FOR EXISTING LEGEND, SEE SHEET 10

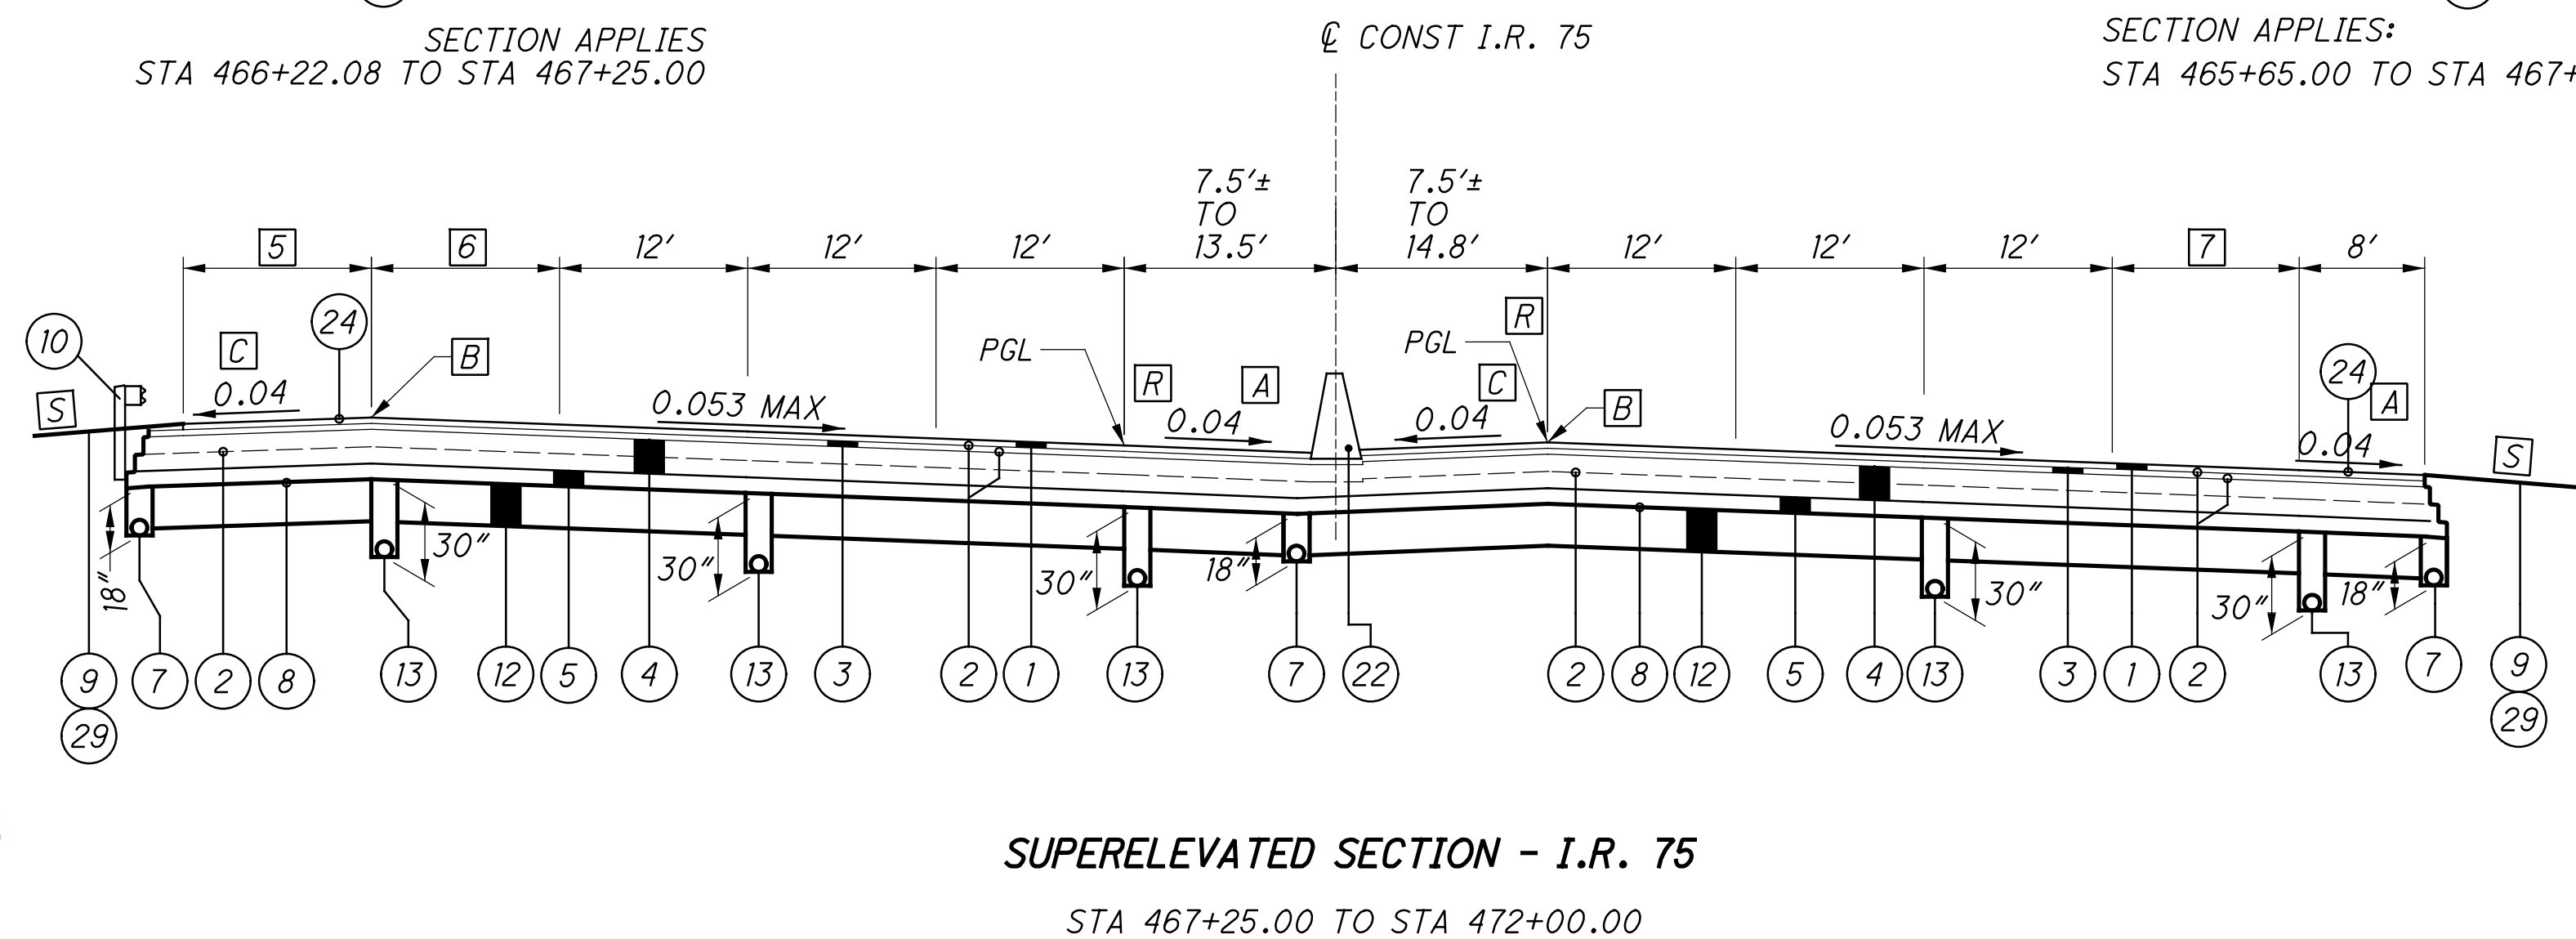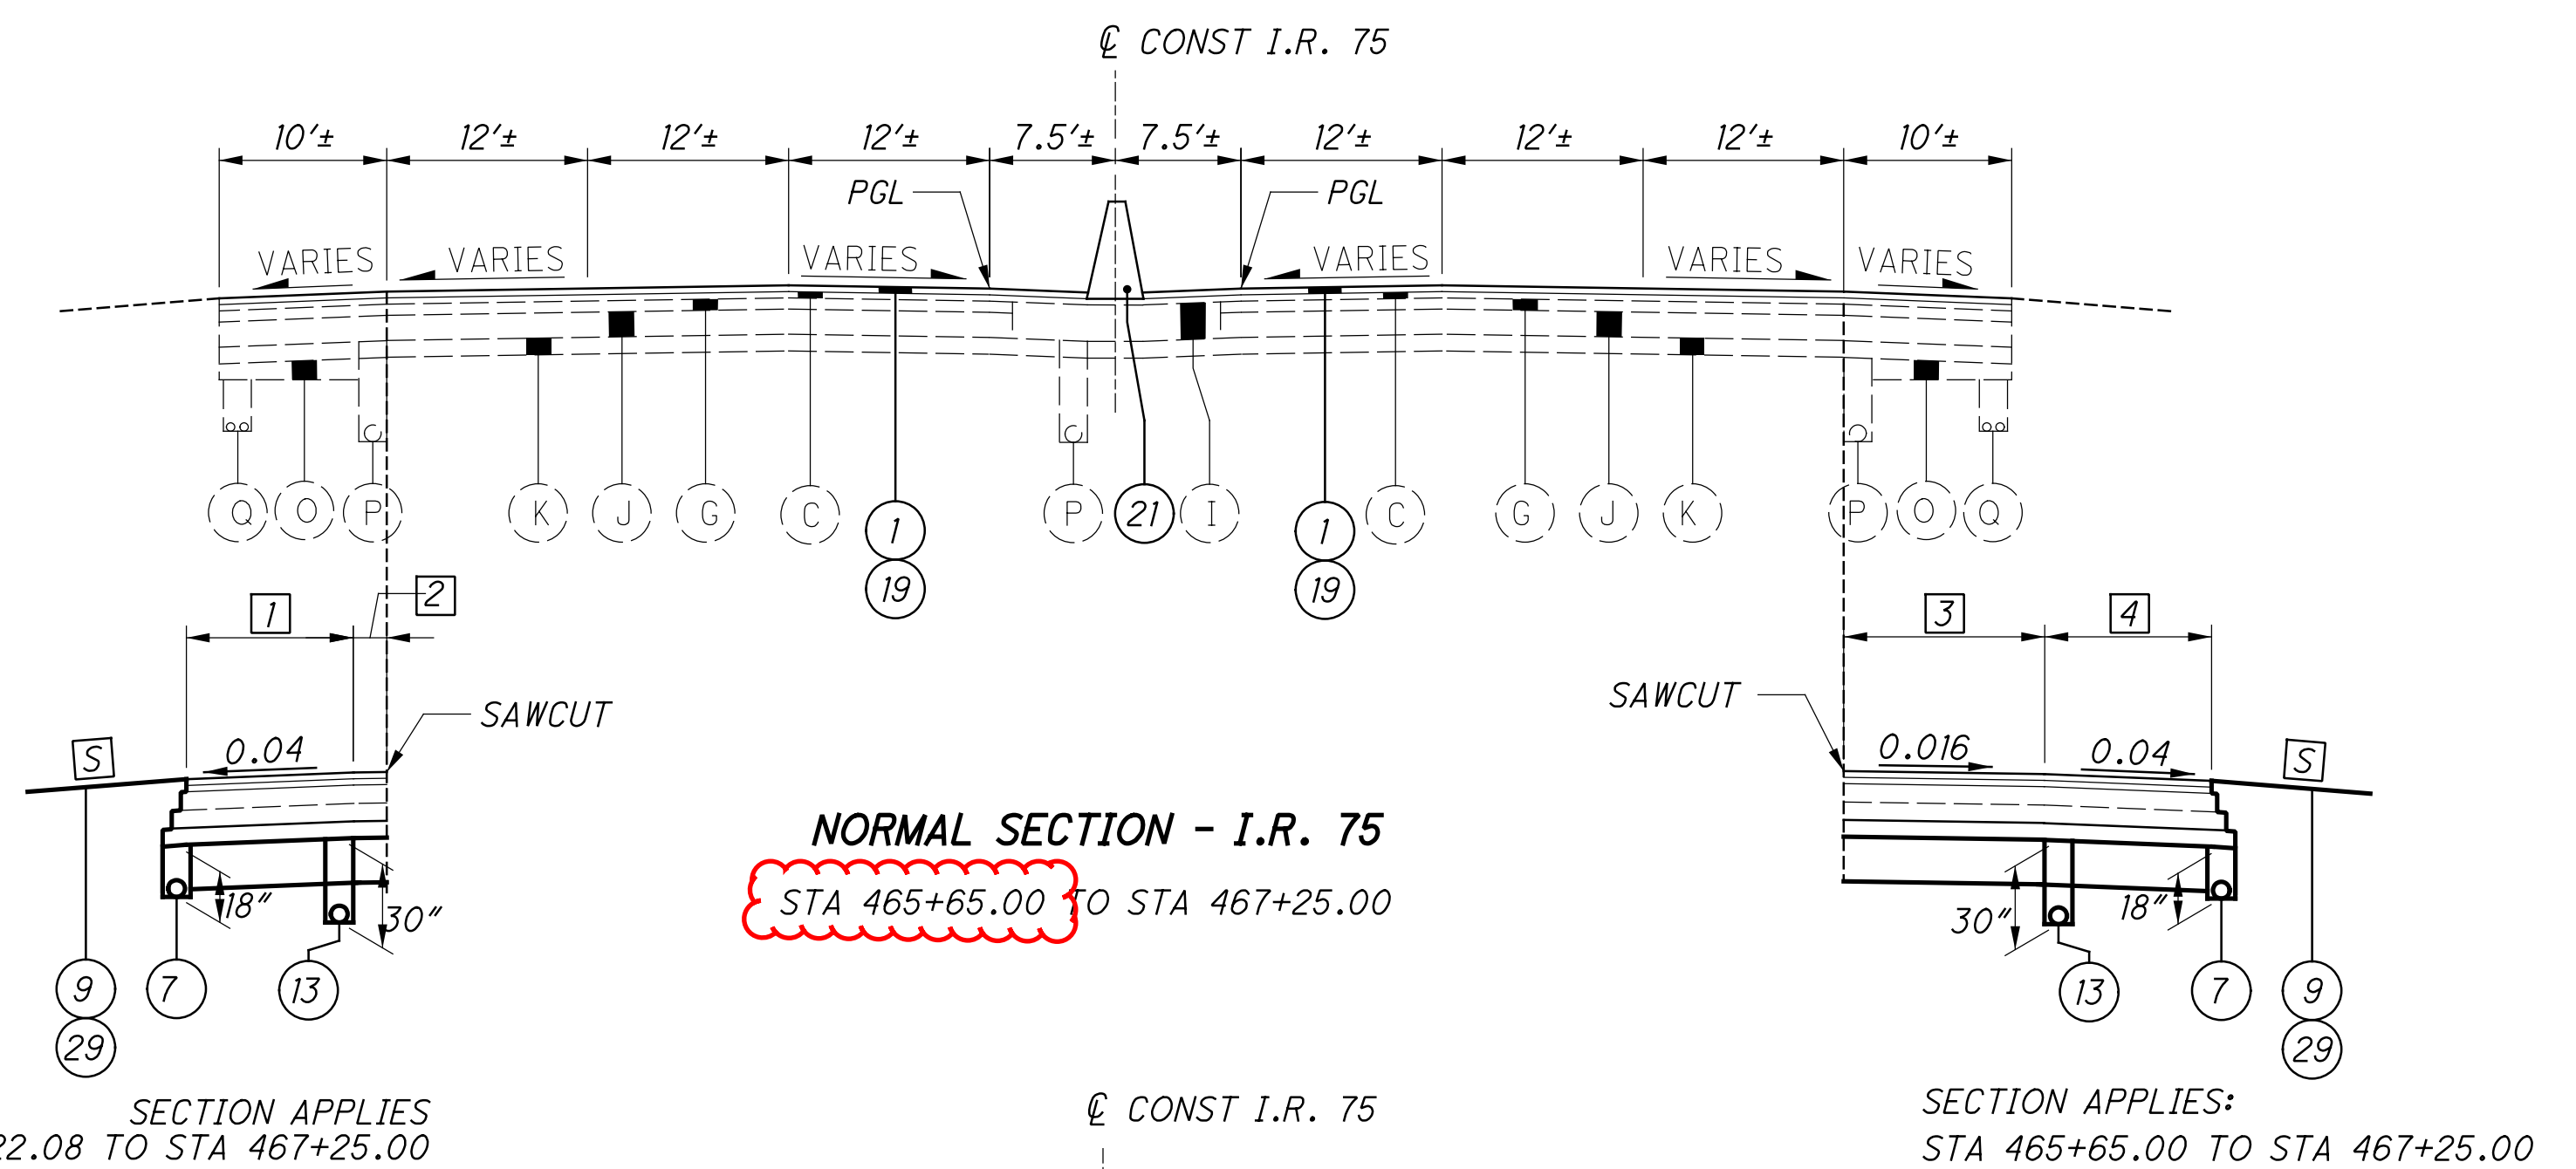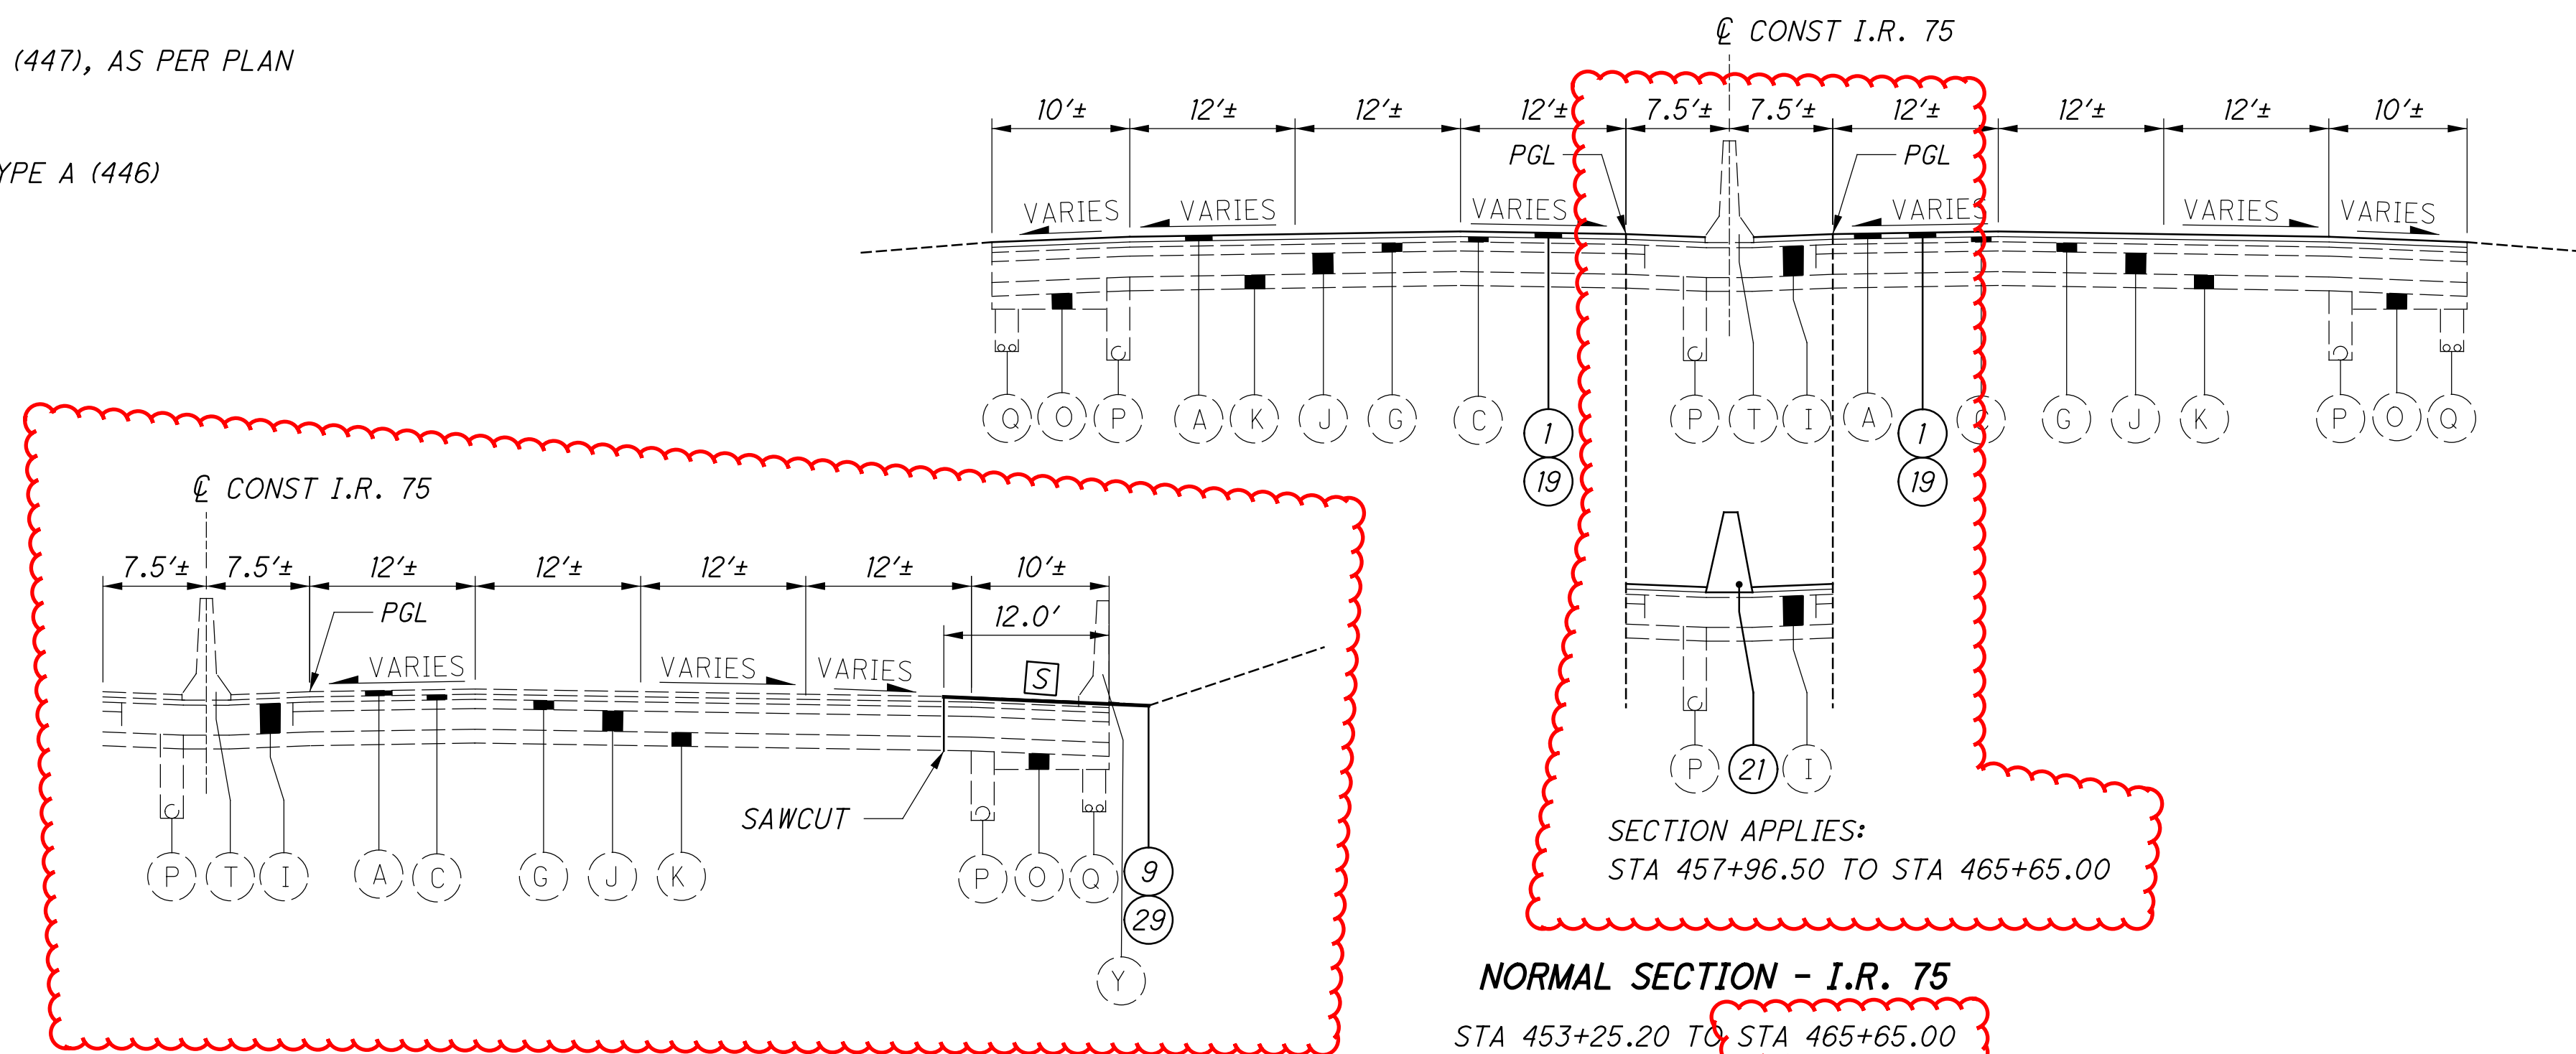

J:\20240445\0DOT\HAM\117525\Design\Roadway\Sheets\77889GN001.dgn 3/7/2025 10:22:05 AM hbrendlinger

SEEDING AND MULCHING

THE FOLLOWING QUANTITIES ARE PROVIDED TO PROMOTE GROWTH AND CARE OF PERMANENT SEEDED AREAS:

659, SOIL ANALYSIS TEST	2 EACH
659, TOPSOIL	6,479 CU. YD.
659, SEEDING AND MULCHING	58,372 SQ. YD.
659, REPAIR SEEDING AND MULCHING	2,919 SQ. YD
659, INTER-SEEDING	2,919 SQ. YD.
659, COMMERCIAL FERTILIZER	13.13 TON
659, LIME	12.06 ACRES
659, WATER	331 M. GAL.
659, MOWING	525 M. SQ. FT.

ITEM 606 – IMPACT ATTENUATOR, TYPE 3 (UNIDIRECTIONAL OR BIDIRECTIONAL)

THIS ITEM SHALL CONSIST OF FURNISHING AND INSTALLING ANY OF THE TYPE 3 IMPACT ATTENUATORS AS LISTED ON THE OFFICE OF ROADWAY ENGINEERING’S WEB PAGE (REFER TO THE POSTED SHOP DRAWINGS FOR THE MOST CURRENT APPROVED PRODUCT MODELS). WHEN BI-DIRECTIONAL DESIGNS ARE SPECIFIED, THE CONTRACTOR SHALL SUPPLY APPROPRIATE TRANSITIONS.

PAYMENT FOR THE ABOVE WORK SHALL BE MADE AT THE UNIT PRICE BID FOR ITEM 606, IMPACT ATTENUATOR, TYPE 3 [(SPEED (IN MPH), HAZARD WIDTH (IN INCHES)), (UNIDIRECTIONAL OR BIDIRECTIONAL)], EACH, AND SHALL INCLUDE ALL LABOR, TOOLS, EQUIPMENT AND MATERIALS NECESSARY TO CONSTRUCT A COMPLETE AND FUNCTIONAL IMPACT ATTENUATOR SYSTEM, INCLUDING ALL RELATED BACKUPS/BACKSTOPS, TRANSITIONS, HARDWARE AND GRADING, NOT SEPARATELY SPECIFIED, AS REQUIRED BY THE MANUFACTURER. INSTALLATION SHALL BE AT THE LOCATIONS SPECIFIED IN THE PLANS, IN ACCORDANCE WITH THE MANUFACTURER’S SPECIFICATIONS.

ITEM 606 – ANCHOR ASSEMBLY, MGS TYPE E

THIS ITEM SHALL CONSIST OF FURNISHING AND INSTALLING ANY OF THE GUARDRAIL END TERMINALS FOR TYPE MGS GUARDRAIL AS LISTED ON ROADWAY ENGINEERING’S WEB PAGE UNDER ROADSIDE SAFETY DEVICES FOR APPROVED GUARDRAIL END TREATMENTS. INSTALLATION SHALL BE AT THE LOCATIONS SPECIFIED IN THE PLANS, IN ACCORDANCE WITH THE MANUFACTURER’S SPECIFICATIONS.

THE FACE OF THE TYPE E IMPACT HEAD SHALL BE COVERED WITH A SHEET OF TYPE G REFLECTIVE SHEETING, PER CMS 730.19.

REFER TO THE MANUFACTURER’S INSTRUCTIONS REGARDING THE INSTALLATION OF, AND THE GRADING AROUND THE FOUNDATION TUBES AND GROUND STRUT. THE TOP OF ANY FOUNDATION TUBE SHOULD BE LESS THAN 4 INCHES ABOVE THE GROUND. THE PLACEMENT OF THE FOUNDATION TUBES SHOULD BE AN APPROPRIATE DEPTH BELOW THE LEVEL LINE IN ORDER TO MAINTAIN THE FINISHED GUARDRAIL HEIGHT OF 31 INCHES FROM THE EDGE OF THE SHOULDER.

ON-SITE GRADING IS REQUIRED IF THE TOP OF THE FOUNDATION TUBES OR TOP OF THE GROUND STRUT DOES PROJECT MORE THAN 4 INCHES ABOVE THE GROUND LINE.

PAYMENT FOR THE ABOVE WORK SHALL BE MADE AT THE UNIT PRICE BID FOR ITEM 606, ANCHOR ASSEMBLY, MGS TYPE E, EACH, AND SHALL INCLUDE ALL LABOR, TOOLS, EQUIPMENT AND MATERIALS NECESSARY TO CONSTRUCT A COMPLETE AND FUNCTIONAL ANCHOR ASSEMBLY SYSTEM, INCLUDING ALL RELATED TRANSITIONS, REFLECTIVE SHEETING, HARDWARE, GRADING, EMBANKMENT AND EXCAVATION NOT SEPARATELY SPECIFIED, AS REQUIRED BY THE MANUFACTURER.

CONNECTION BETWEEN EXISTING AND PROPOSED GUARDRAIL

WHEN IT IS NECESSARY TO SPLICE PROPOSED GUARDRAIL TO EXISTING GUARDRAIL, ONLY THE EXISTING GUARDRAIL SHALL BE CUT, DRILLED, OR PUNCHED. THE CONNECTION SHALL BE MADE USING A W-BEAM, BEAM SPLICE AS SHOWN IN AASHTO M 180-12, EXCEPT THE BEAM WASHERS ARE NOT TO BE USED. PAYMENT SHALL BE INCLUDED IN THE CONTRACT PRICE FOR THE RESPECTIVE GUARDRAIL ITEMS.

ITEM 611 – INLET, NO. 3 FOR SINGLE SLOPE BARRIER, TYPE B1, AS PER PLAN

THE CONTRACTOR SHALL RE-CONSTRUCT THE MEDIAN INLET PER SCD I-3B, 3B1. ALL LABOR, EQUIPMENT, AND MATERIALS ASSOCIATED WITH THIS WORK SHALL BE INCLUDED IN PAYMENT FOR ITEM 611 – INLET, NO. 3 FOR SINGLE SLOPE BARRIER, TYPE B1, AS PER PLAN

ITEM 611 – INLET, NO. 3 FOR SINGLE SLOPE BARRIER, TYPE D, AS PER PLAN C

THE INLET BOX AND GRATE PROTION OF STRUCTURES 708, 709 AND 710 WERE CONSTRUCTED WITH A PREVIOUS PROJECT. THE CONTRACTOR SHALL CONSTRUCT THE REMAINING PORTIONS OF THE INLET IN ACCORDANCE WITH THE STANDARD CONSTRUCTION DRAWINGS.

ALL MATERIAL, EQUIPMENT AND LABOR NECESSARY TO PERFORM THIS WORK IS INCIDENTAL TO ITEM 611 – INLET, NO. 3 FOR SINGLE SLOPE BARRIER, TYPE D, AS PER PLAN C

ITEM 611 – MANHOLE NO.3, AS PER PLAN

THE CONTRACTOR SHALL CONSTRUCT A MANHOLE NO. 3 PER SCD MH-1 AND MH-3, EXCEPT THAT IT SHALL HAVE A CB-6 FRAME AND GRATE. ALL LABOR, EQUIPMENT, AND MATERIALS ASSOCIATED WITH THIS WORK SHALL BE INCLUDED IN PAYMENT FOR ITEM 611 – MANHOLE NO.3, AS PER PLAN

ITEM 611 – CATCH BASIN, NO. 3, AS PER PLAN

THE CONTRACTOR SHALL RE-CONSTRUCT THE CURB INLET PER SCD CB-3. ALL LABOR, EQUIPMENT, AND MATERIALS ASSOCIATED WITH THIS WORK SHALL BE INCLUDED IN PAYMENT FOR ITEM 611 – CATCH BASIN, NO. 3, AS PER PLAN

ITEM 607 – FENCE, TYPE CLT, AS PER PLAN

THE PROPOSED FENCE ALONG LONGVIEW AVENUE (A PRIVATE ACCESS ROAD), ADJACENT TO THE GIVAUDAN FLAVORS FACILITY SHALL INCLUDE ALL NECESSARY TOOLS, LABOR, MATERIALS, AND INCIDENTALS NECESSARY TO INSTALL THE CHAIN LINK FENCE WITH BARBED WIRE AS INDICATED ON THE FENCING PLAN. THE MATERIALS AND SPECIFICATIONS INCLUDED IN THE FOLLOWING NOTE ARE NECESSARY TO ENSURE THE PROPOSED FENCE MEETS FDA REQUIREMENTS FOR SAFETY AND SECURITY FOR FOOD PROCESSING FACILITIES.

THE EXISTING FACILITY MUST REMAIN SECURED AT ALL TIMES PER FDA REGULATIONS. THE CONTRACTOR SHALL COORDINATE WITH GIVAUDAN FLAVORS TO DISCUSS THE TEMPORARY FENCE THAT WILL BE REQUIRED DURING CONSTRUCTION, WHICH WILL REMAIN IN PLACE UNTIL THE PROPOSED FENCE IS INSTALLED. A SUGGESTED LOCATION OF THE TEMPORARY FENCE IS SHOWN IN THE FENCING PLAN, BUT SHALL BE CONFIRMED WITH GIVAUDAN PRIOR TO INSTALLATION. ALL COSTS ASSOCIATED WITH COORDINATING, PLACING AND REMOVING OF THE TEMPORARY FENCE SHALL BE INCLUDED WITHIN THIS PAY ITEM. THE CONTRACTOR WILL COORDINATE WITH GIVAUDAN REGARDING ACCESS FOR TEMPORARY FENCE INSTALLATION AS WELL AS REPLACEMENT OF THE EXISTING SIDEWALK AND CONCRETE TRUCK TURNING AREA FOLLOWING THE REMOVAL OF THE TEMPORARY FENCE. THE REMOVAL AND REPLACEMENT OF THE SIDEWALK AND TRUCK TURNING AREA ARE PAID FOR UNDER SEPERATE PAY ITEMS.

ITEM 607 – FENCE, TYPE CLT, AS PER PLAN

THE PROPOSED FENCE ALONG LONGVIEW AVENUE (A PRIVATE ACCESS ROAD), ADJACENT TO THE GIVAUDAN FLAVORS FACILITY SHALL INCLUDE ALL NECESSARY TOOLS, LABOR, MATERIALS, AND INCIDENTALS NECESSARY TO INSTALL THE CHAIN LINK FENCE WITH BARBED WIRE AS INDICATED ON THE FENCING PLAN. THE MATERIALS AND SPECIFICATIONS INCLUDED IN THE FOLLOWING NOTE ARE NECESSARY TO ENSURE THE PROPOSED FENCE MEETS FDA REQUIREMENTS FOR SAFETY AND SECURITY FOR FOOD PROCESSING FACILITIES.

THE EXISTING FACILITY MUST REMAIN SECURED AT ALL TIMES PER FDA REGULATIONS. THE CONTRACTOR SHALL COORDINATE WITH GIVAUDAN FLAVORS TO DISCUSS THE TEMPORARY FENCE THAT WILL BE REQUIRED DURING CONSTRUCTION, WHICH WILL REMAIN IN PLACE UNTIL THE PROPOSED FENCE IS INSTALLED. A SUGGESTED LOCATION OF THE TEMPORARY FENCE IS SHOWN IN THE FENCING PLAN, BUT SHALL BE CONFIRMED WITH GIVAUDAN PRIOR TO INSTALLATION. ALL COSTS ASSOCIATED WITH COORDINATING, PLACING AND REMOVING OF THE TEMPORARY FENCE SHALL BE INCLUDED WITHIN THIS PAY ITEM. THE CONTRACTOR WILL COORDINATE WITH GIVAUDAN REGARDING ACCESS FOR TEMPORARY FENCE INSTALLATION AS WELL AS REPLACEMENT OF THE EXISTING SIDEWALK AND CONCRETE TRUCK TURNING AREA FOLLOWING THE REMOVAL OF THE TEMPORARY FENCE. THE REMOVAL AND REPLACEMENT OF THE SIDEWALK AND TRUCK TURNING AREA ARE PAID FOR UNDER SEPERATE PAY ITEMS.

PRIOR TO REMOVING THE EXISTING FENCE AND INSTALLING THE NEW SYSTEM, THE CONTRACTOR SHALL NOTIFY GIVAUDAN FLAVORS IN WRITING A MINIMUM OF 30 DAYS IN ADVANCE PER THE CONTACT INFORMATION PROVIDED IN THE UTILITY SECTION OF THE PLAN NOTES:

SUMMARY

1.01 QUALITY ASSURANCE

A. INSTALLER QUALIFICATIONS: INSTALLER SHALL BE FENCE MANUFACTURER OR AUTHORIZED DEALER/DISTRIBUTOR OR INSTALLER CERTIFIED BY MANUFACTURER, WITH NO LESS THAN FIVE (5) YEARS’ EXPERIENCE IN INSTALLATION SIMILAR TO THAT REQUIRED.

1.02 DELIVERY, HANDLING AND STORAGE

A. PACKAGE MATERIALS IN MANUFACTURER’S SUITABLE CONTAINERS TO PREVENT DAMAGE DURING TRANSIT, HANDLING AND STORAGE.

1. UNWRAPPED MATERIAL SHALL BE ROLLED, BUNDLED, BOUND OR OTHERWISE FASHIONED TO AVOID DISPLACEMENT AND DAMAGE.

B. STORE MATERIAL IN ACCORDANCE WITH MANUFACTURER’S INSTRUCTION, OFF THE GROUND, IN A DRY LOCATION UNTIL READY FOR INSTALLATION.

1. STORE IN A MANNER THAT DOES NOT DISTORT, BEND, CRUSH OR OTHERWISE DEFORM FRAMING MEMBERS OR FABRIC.

PRODUCTS

2.01 STEEL FABRIC

A. FABRIC: NO. 9 GAGE (0.148” ± 0.005”) SIZE STEEL WIRES, 2” MESH, BY 8’-0” WIDE WITH TOP AND BOTTOM SALVAGES TWISTED AND BARBED.

1. FABRIC FINISH: GALVANIZED, ASTM A-392, CLASS I, WITH NOT LESS THAN 1.2 OUNCE ZINC PER SQUARE FOOT OF SURFACE.

ITEM 607 – FENCE, TYPE CLT, AS PER PLAN (CONT)

2.02 FRAMING AND ACCESSORIES

A. STEEL FRAMEWORK, GENERAL: GALVANIZED STEEL, ASTM A-120 OR A-123, WITH NOT LESS THAN 1.8 OUNCE ZINC PER SQUARE FOOT OF SURFACE.

1. FITTINGS AND ACCESSORIES: GALVANIZED, ASTM A-153, WITH ZINC WEIGHTS PER TABLE I.

B. END, CORNER AND PULL POSTS: MINIMUM SIZES AND WEIGHTS AS FOLLOWS:

1. UP TO 6’ FABRIC HEIGHT, 2.375” OD STEEL PIPE, 3.65 POUNDS PER LIN. FOOT OR 3.5” BY 3.5” ROLL-FORMED SECTIONS, 4.85 POUNDS PER LIN. FOOT.

2. OVER 6’ FABRIC HEIGHT, 2.875” OD STEEL PIPE, 5.79 POUNDS PER LIN. FOOT OR 3.5” BY 3.5” ROLL-FORMED SECTIONS, 4.85 POUNDS PER LIN. FOOT.

C. LINE POSTS: SPACE 10’ O.C. MAXIMUM, UNLESS OTHERWISE INDICATED, OF FOLLOWING MINIMUM SIZES AND WEIGHTS.

1. UP TO 6’ FABRIC HEIGHT, 1.90” OD STEEL PIPE, 2.70 POUNDS PER LIN. FOOT OR 1.875” BY 1.625” C-SECTIONS, 2.28 POUNDS PER LIN. FOOT.

2. OVER 6’ FABRIC HEIGHT, 2.875” OD STEEL PIPE, 5.79 POUNDS PER LIN. FOOT OR 3.5” BY 3.5” ROLL-FORMED SECTIONS, 4.85 POUNDS PER LIN. FOOT.

D. GATE POSTS: FURNISH POSTS FOR SUPPORTING SINGLE GATE LEAF, OR ONE LEAF OF A DOUBLE GATE INSTALLATION, FOR NOMINAL GATE WIDTHS AS FOLLOWS:

LEAF WIDTH	GATE POST	LBS/LN FEET
UP TO 6’	¾”x¾” ROLL-FORMED SECTION OR 2.875” OD PIPE	4.85
OVER 6’ TO 13’	4.00” OD PIPE	5.79
OVER 13’ TO 18’	6.625” OD PIPE	9.11
OVER 18’	8.625” OD PIPE	18.97
		28.55

E. TENSION WIRE: 7 GAGE, COATED COIL SPRING WIRE, METAL AND FINISH TO MATCH FABRIC.

1. LOCATE AT BOTTOM OF FABRIC.

F. WIRE TIES: 11 GAGE GALVANIZED STEEL OR 11 GAGE ALUMINUM WIRE, TO MATCH FABRIC CORE MATERIAL.


G. POST BRACE ASSEMBLY: MANUFACTURER’S STANDARD ADJUSTABLE BRACE AT END AND GATEPOSTS AND AT BOTH SIDES OF CORNER AND PULL POSTS, WITH HORIZONTAL BRACE LOCATED AT MID-HEIGHT OF FABRIC. USE SAME MATERIAL AS TOP RAIL FOR BRACE, AND TRUSS TO LINE POSTS WITH 0.375” DIAMETER ROD AND ADJUSTABLE TIGHTENER.

H. METALLIC COATED STEEL BARBED WIRE: COMPLY WITH ASTM A121, DESIGN NUMBER 12-4-5-14R, DOUBLE 12-1/2 GAUGE TWISTED STRAND WIRE, WITH 4 POINT 14 GAUGE ROUND BARBS SPACED 5 INCHES ON CENTER. MATCH COATING TYPE TO THAT OF THE CHAIN LINK FABRIC.


1. PROVIDE 3 BARBED WIRE STRANDS

I. BARBED WIRE ARMS: IN COMPLIANCE WITH ASTM F626, PRESSED STEEL GALVANIZED AFTER FABRICATION, MINIMUM ZINC COATING OF 1.20 OZ. / SQ FT, CAPABLE OF SUPPORTING A VERTICAL 250 LB LOAD. TYPE I – THREE STRAND 45 DEGREE ARM.

PLOTTED BY hbrendlinger 3/7/2025 4:15:56 PM J:\20240445\000T\HAM\17525\Design\Roadway\Sheets\77880G1002.dgn

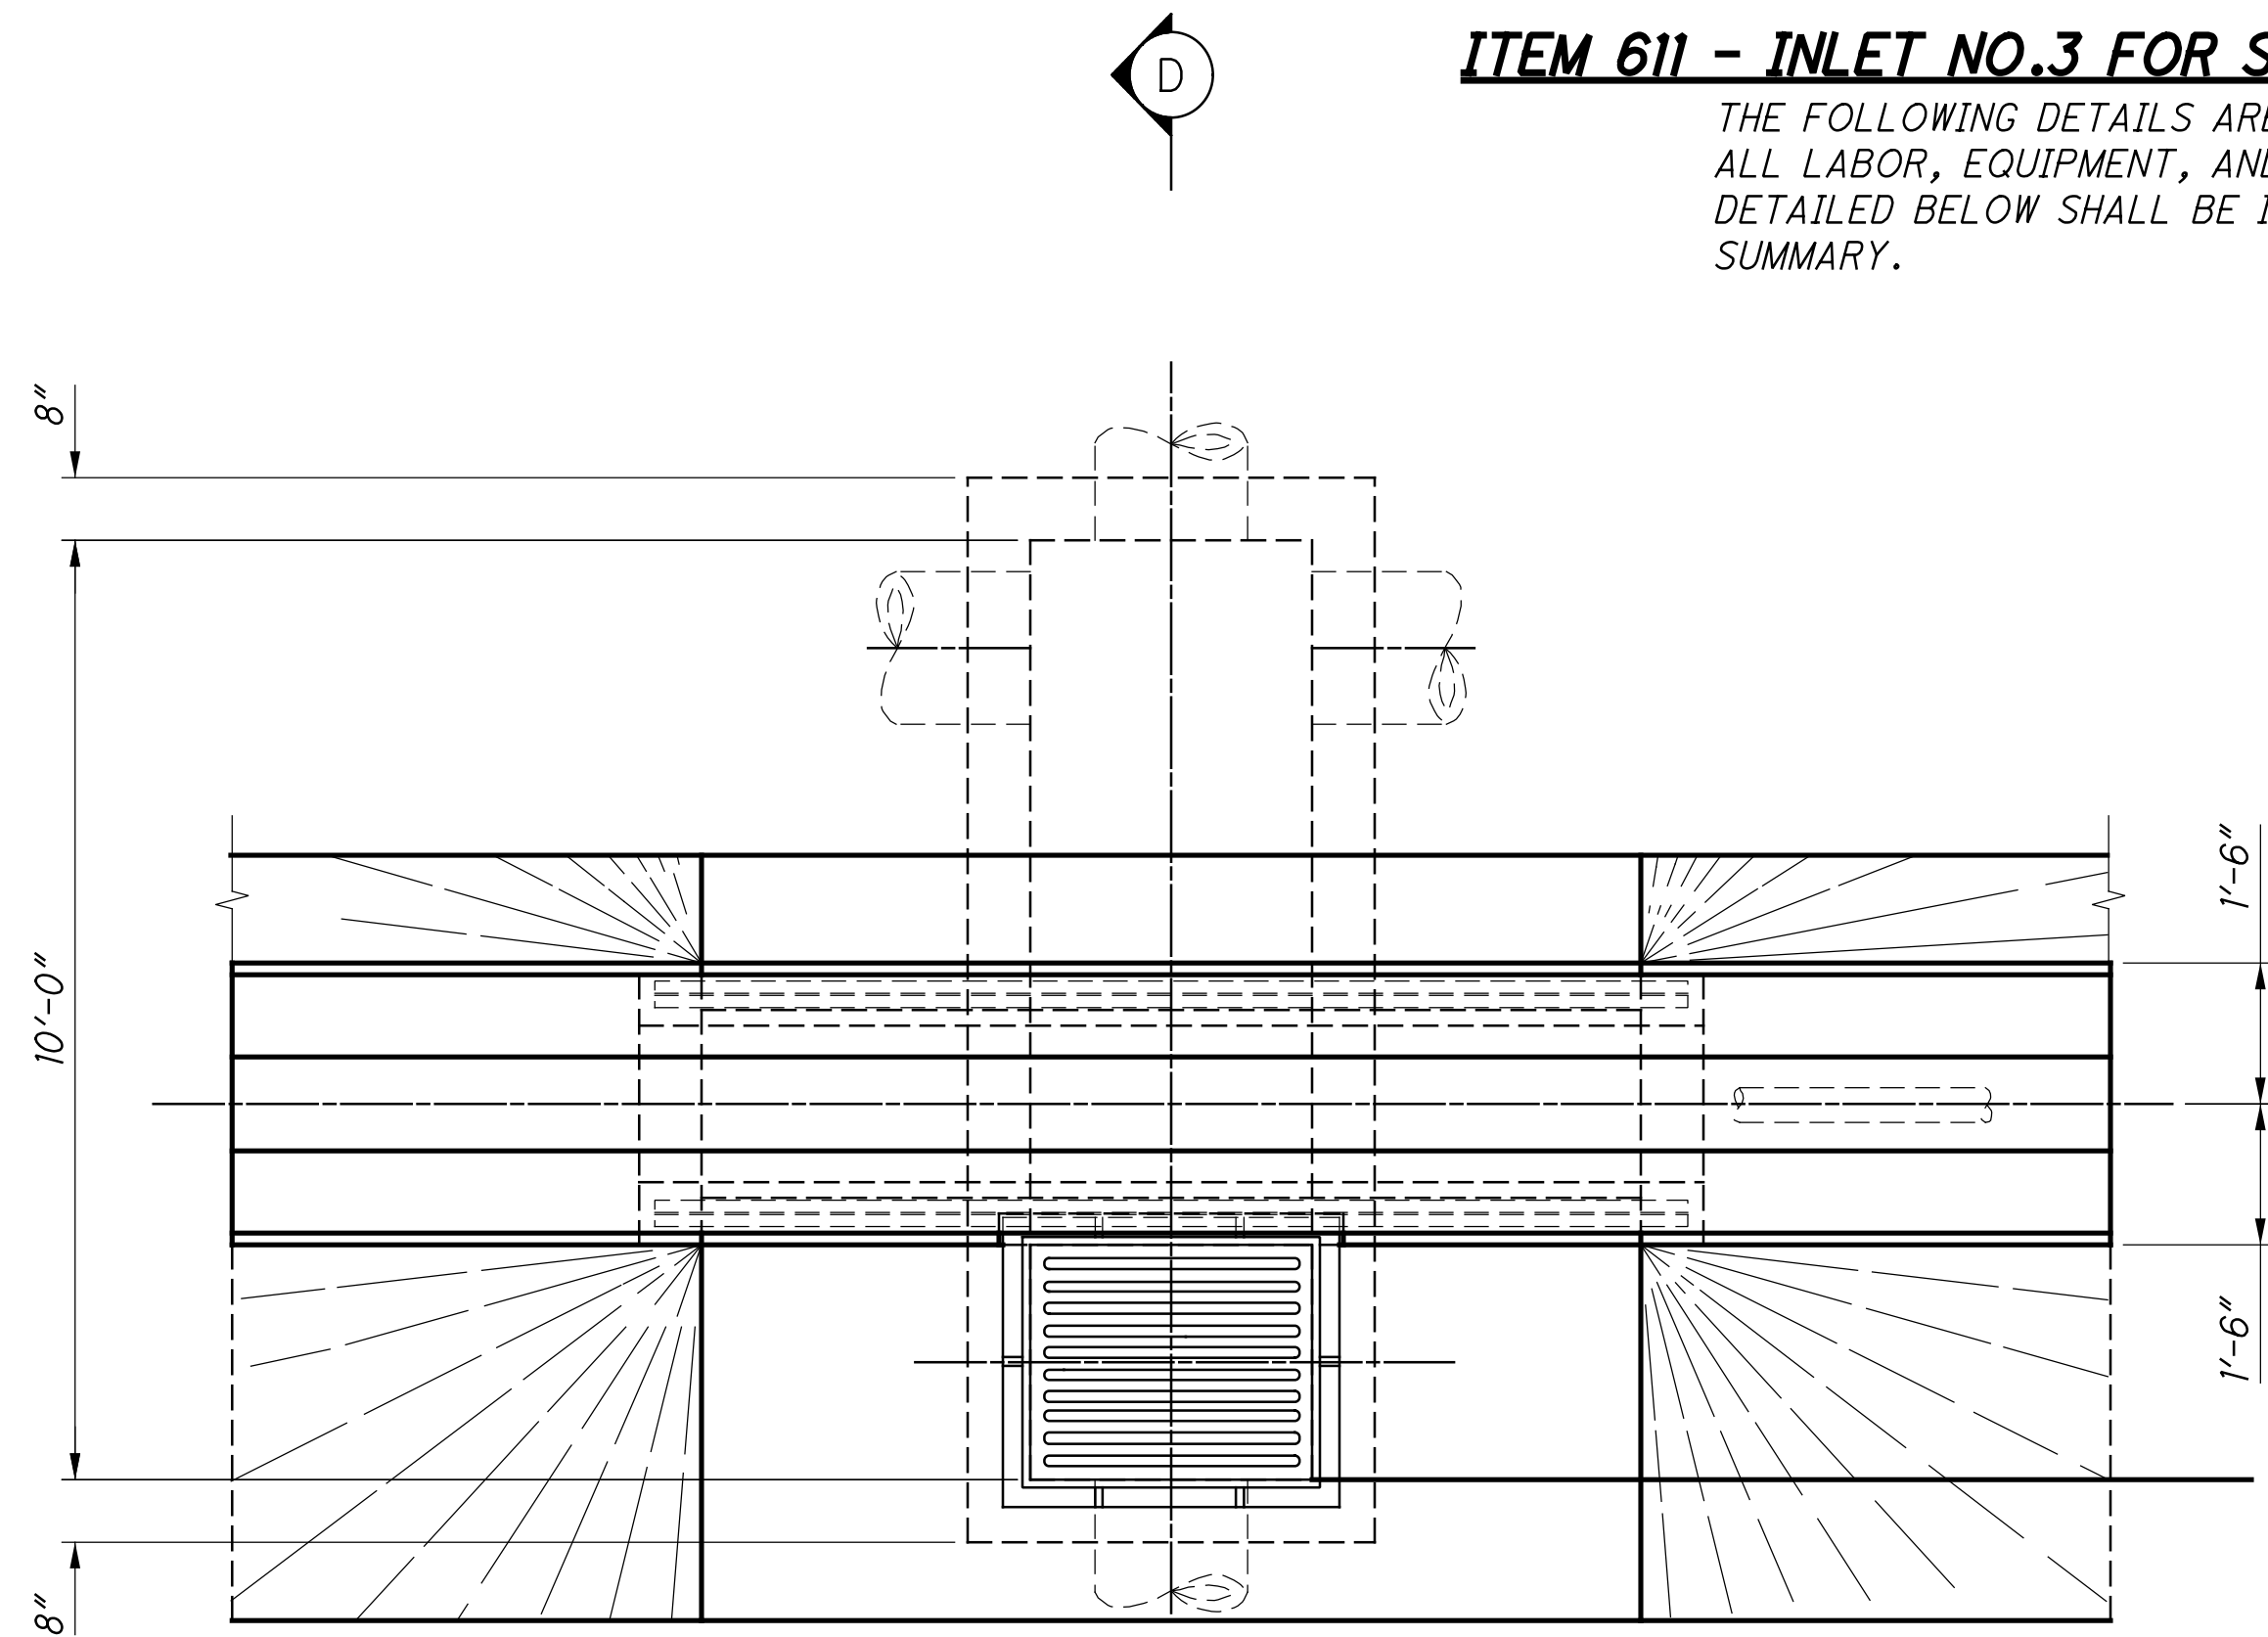

PLAN

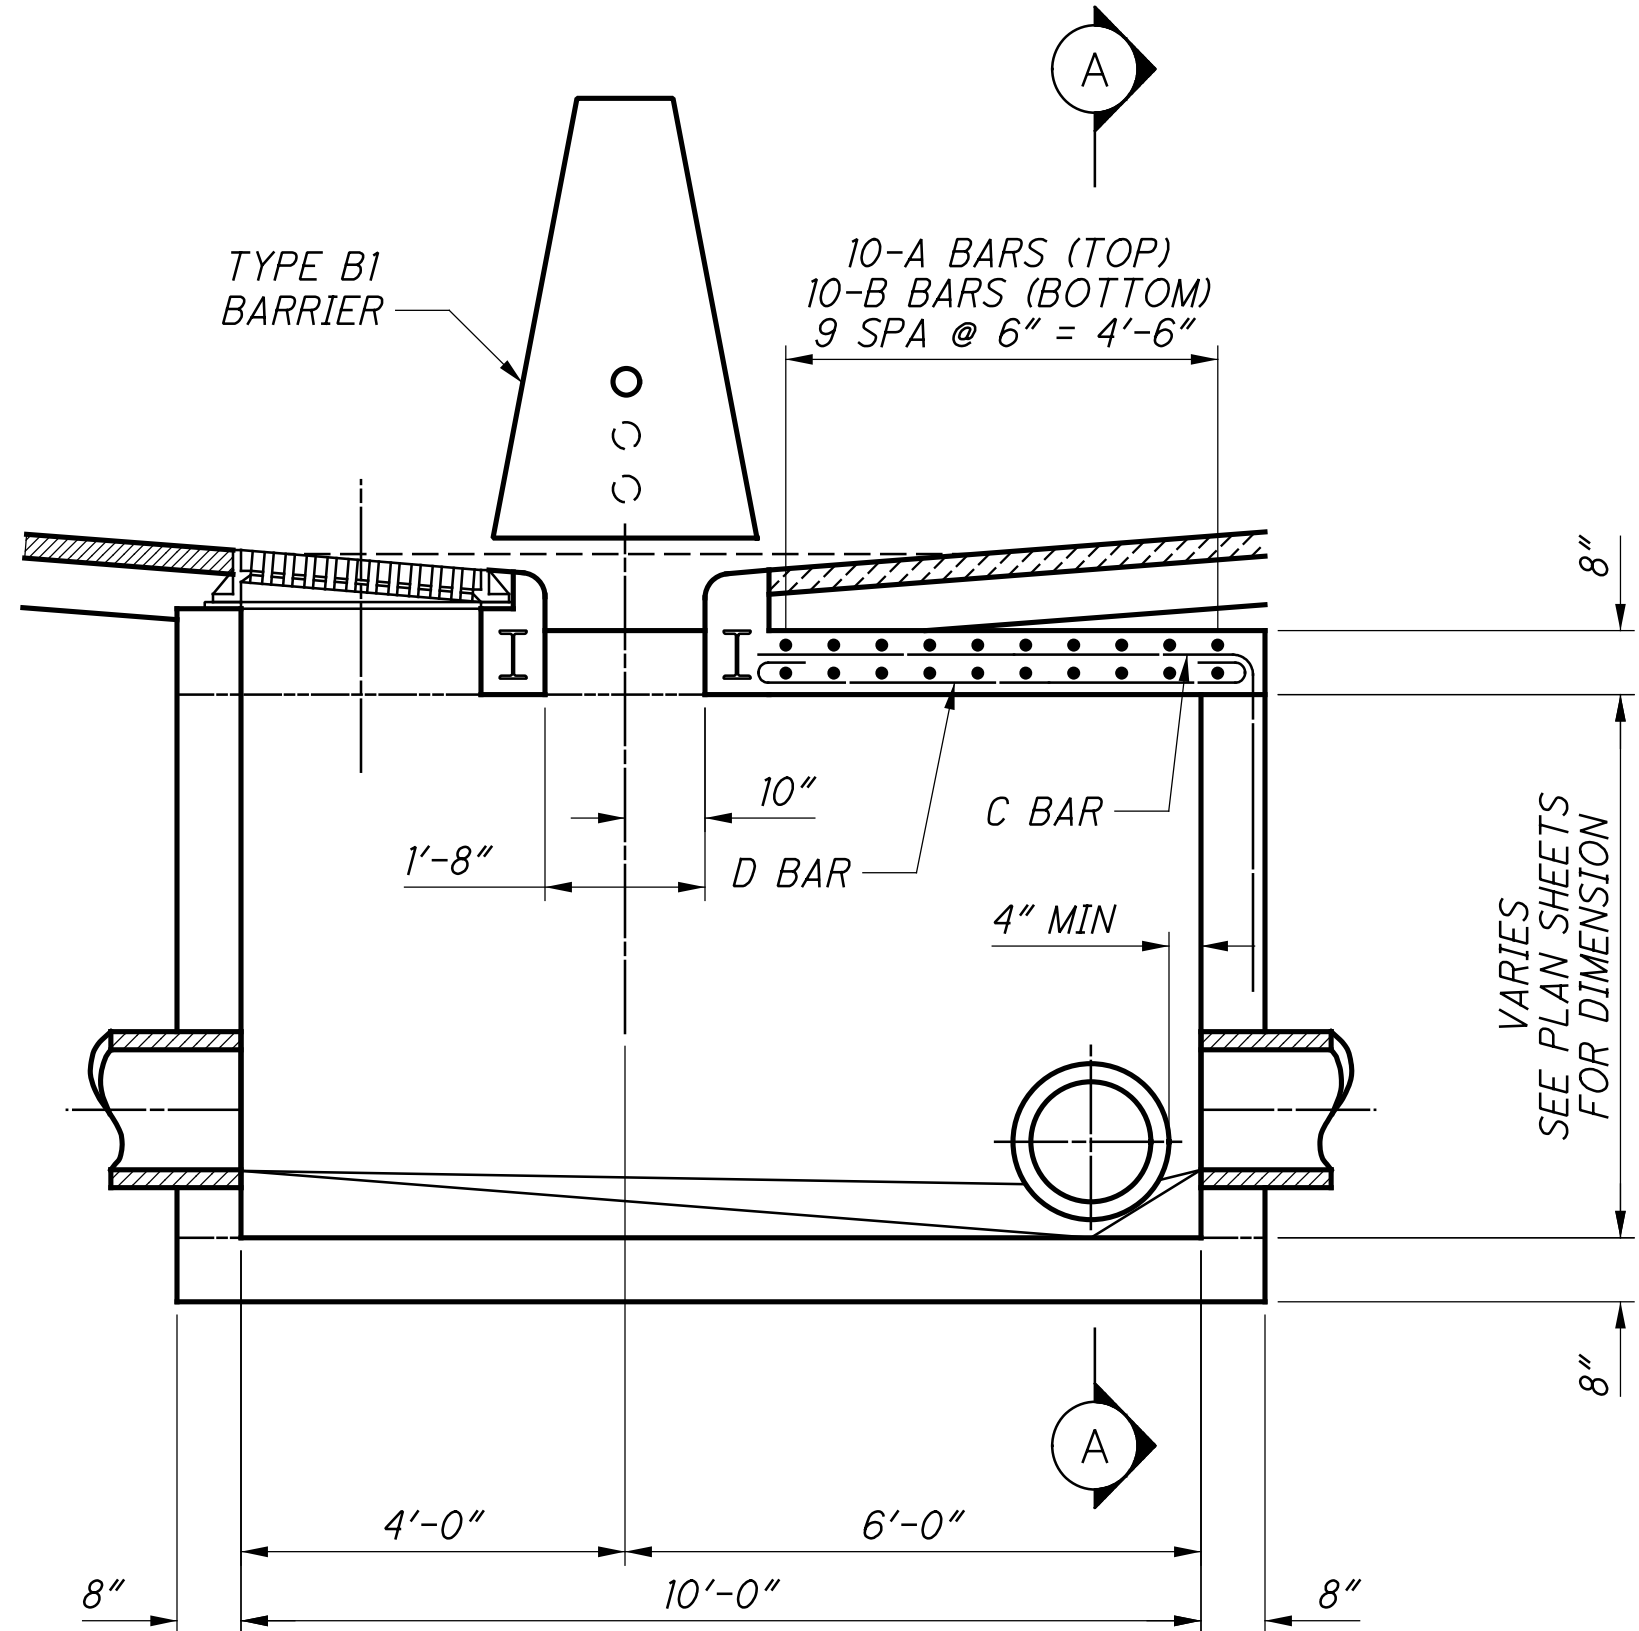

SECTION D-D


ITEM 611 - INLET NO.3 FOR SINGLE SLOPE BARRIER, TYPE B1, AS PER PLAN, A

THE FOLLOWING DETAILS ARE PROVIDED FOR THE STRUCTURES LISTED BELOW.
ALL LABOR, EQUIPMENT, AND MATERIALS NECESSARY TO PERFORM THE WORK
DETAILED BELOW SHALL BE INCLUDED IN THE THIS PAY ITEM PER THE GENERAL
SUMMARY.


STR. NO.	STATION	SIDE
302	480+69	LT
607	502+00	LT
622	505+00	LT
725	527+00	RT

THIS DETAIL APPLIES TO INLETS AT THE FOLLOWING LOCATIONS: SEE TABLE ABOVE


INLET REINFORCING LIST											
BAR A			BAR B			BAR C			BAR D		
NUMBER	SIZE	LENGTH	NUMBER	SIZE	LENGTH	NUMBER	SIZE	LENGTH	NUMBER	SIZE	LENGTH
10	#6	10'-10"	10	#6	5'-4"	8	#6	8'-1"	8	#6	6'-0"

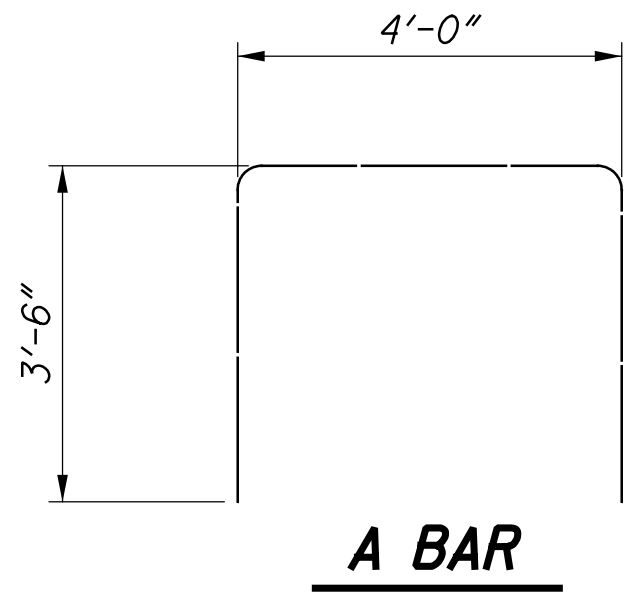


A BAR

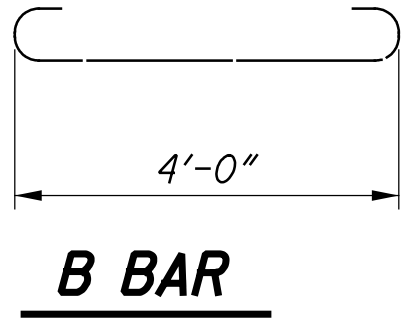


B BAR

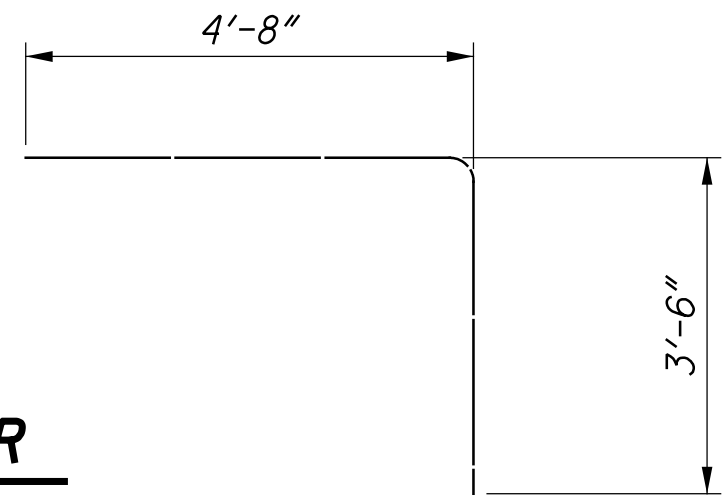

C BAR

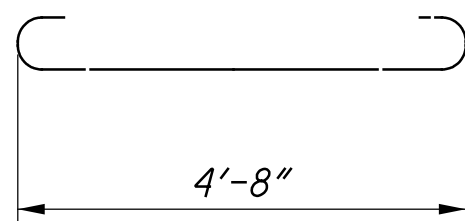

D BAR

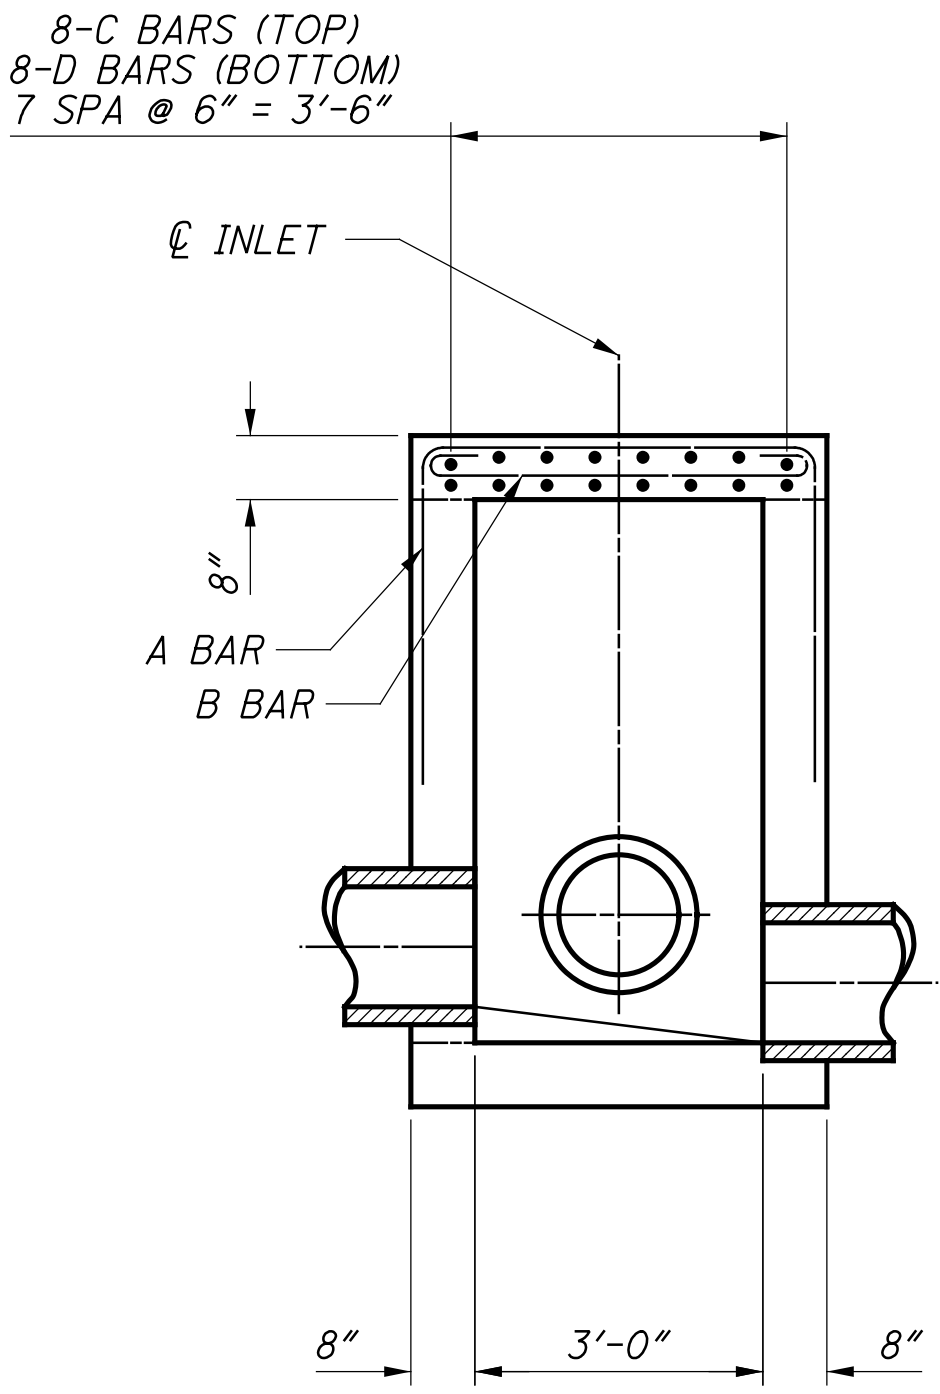

SECTION A-A

NOTES




- FOR ADDITIONAL DETAILS, DIMENSIONS AND REINFORCING, SEE STANDARD CONSTRUCTION DRAWING I-2.1.
- ROTATE BARS AS NECESSARY TO MAINTAIN REQUIRED MINIMUM CONCRETE COVER.

GENERAL NOTES

HAM-75-7.85

31A
826

PLOTTED BY hbrendlinger 3/7/2025 10:41:27 AM U:\20240445\ODOT\HAM\117525\Design\Roadway\Sheets\77889GN011.dgn

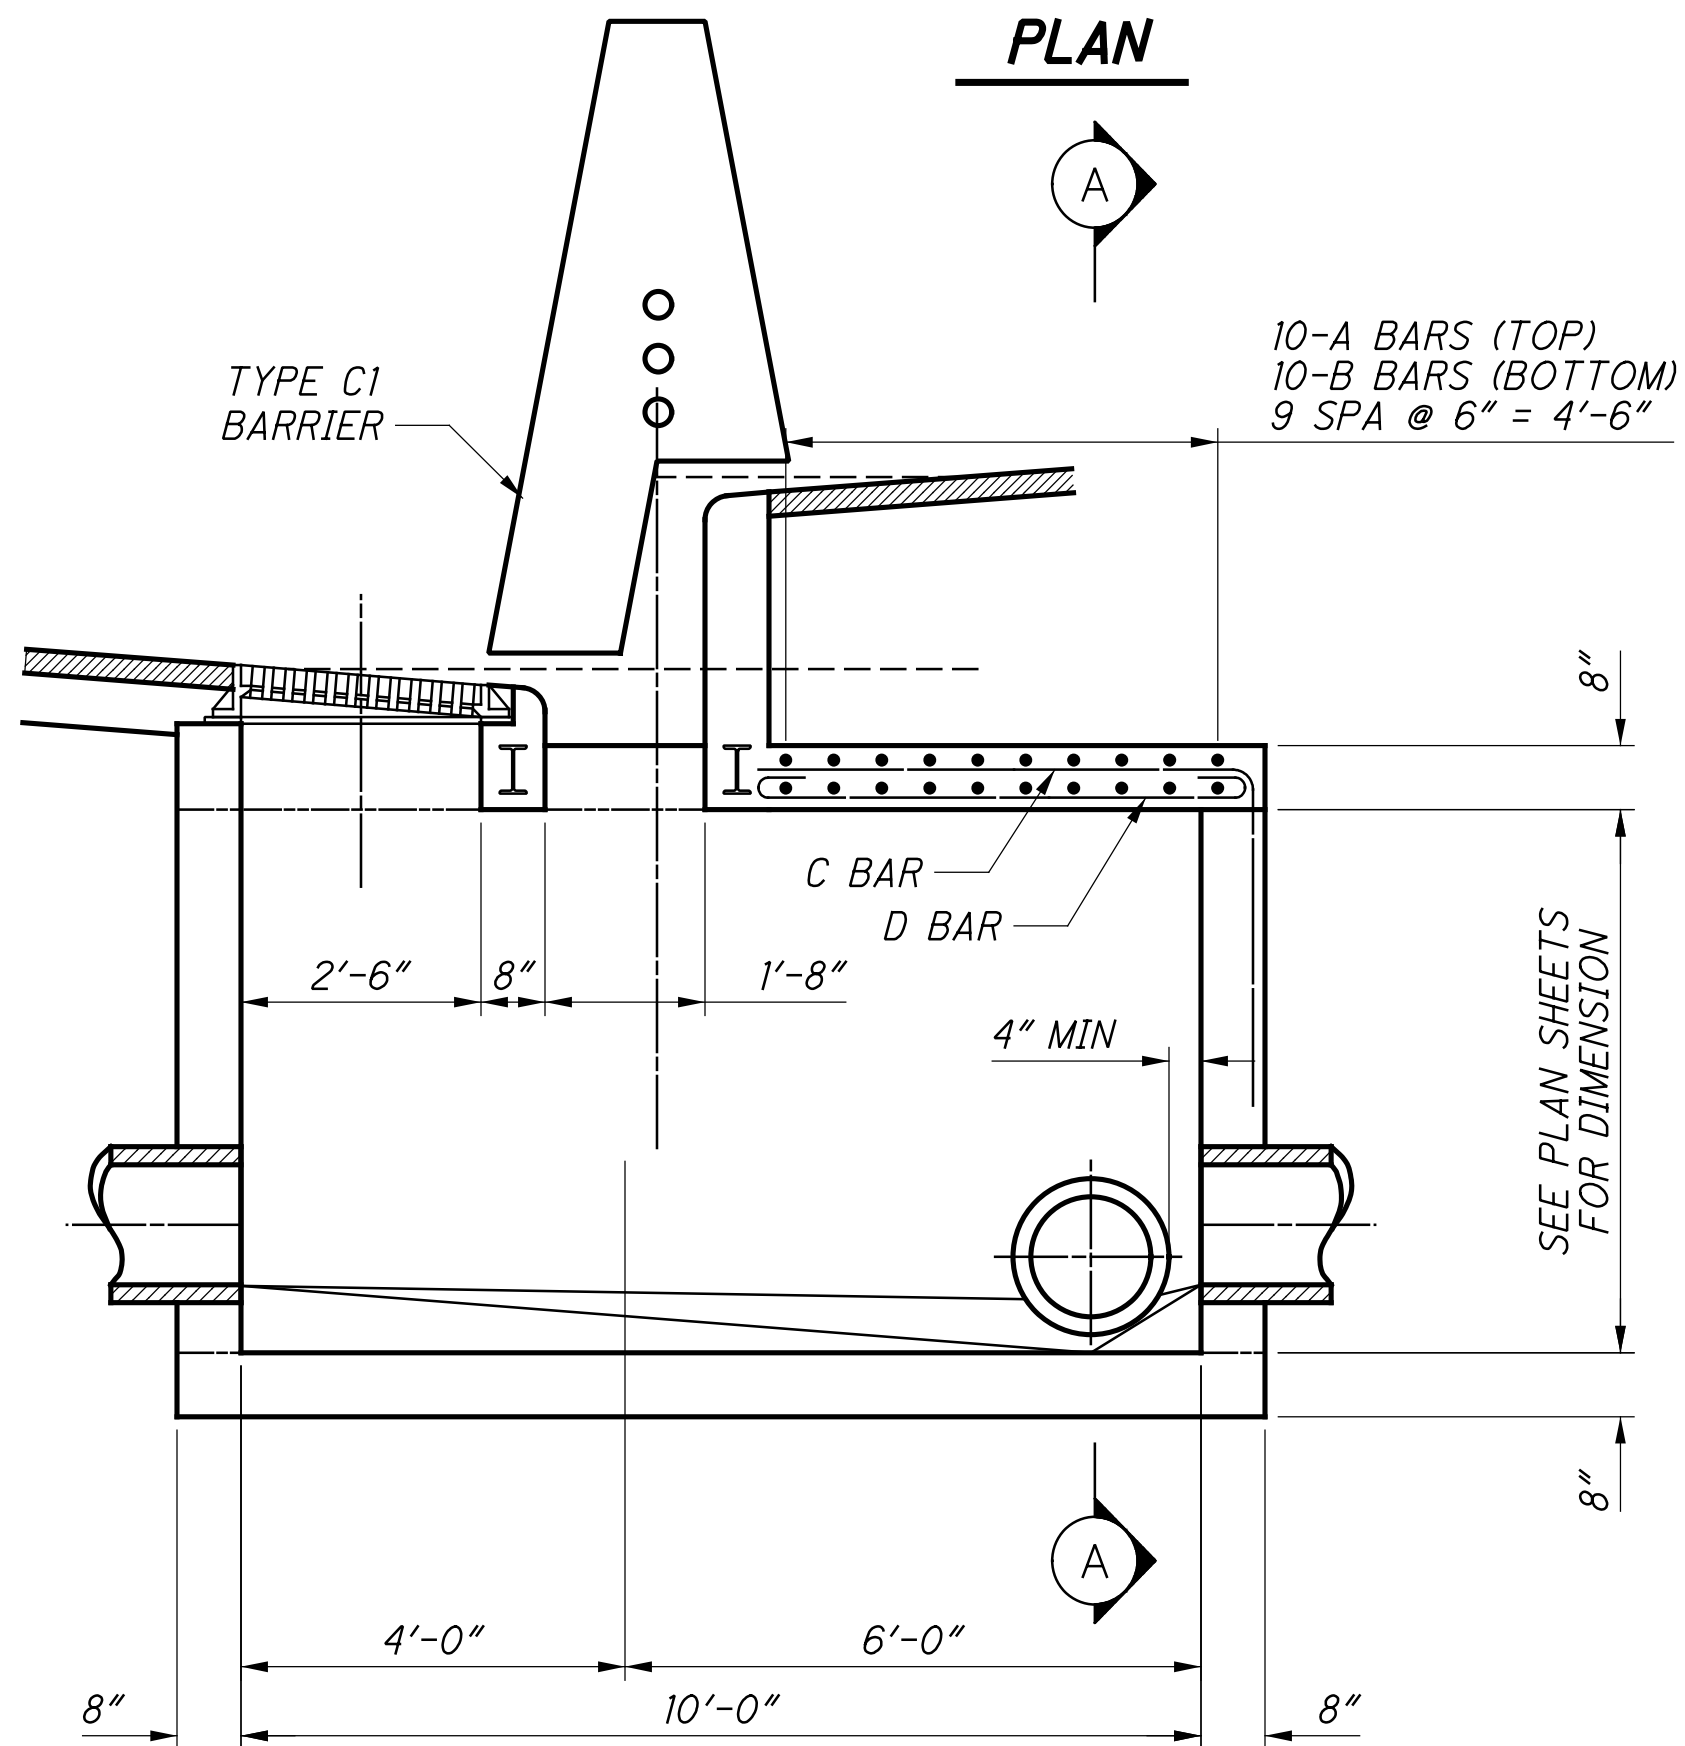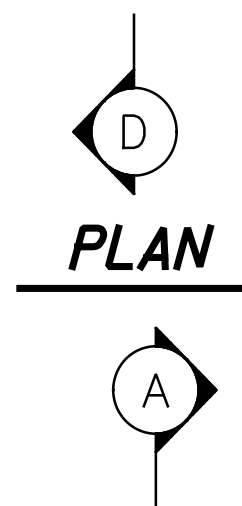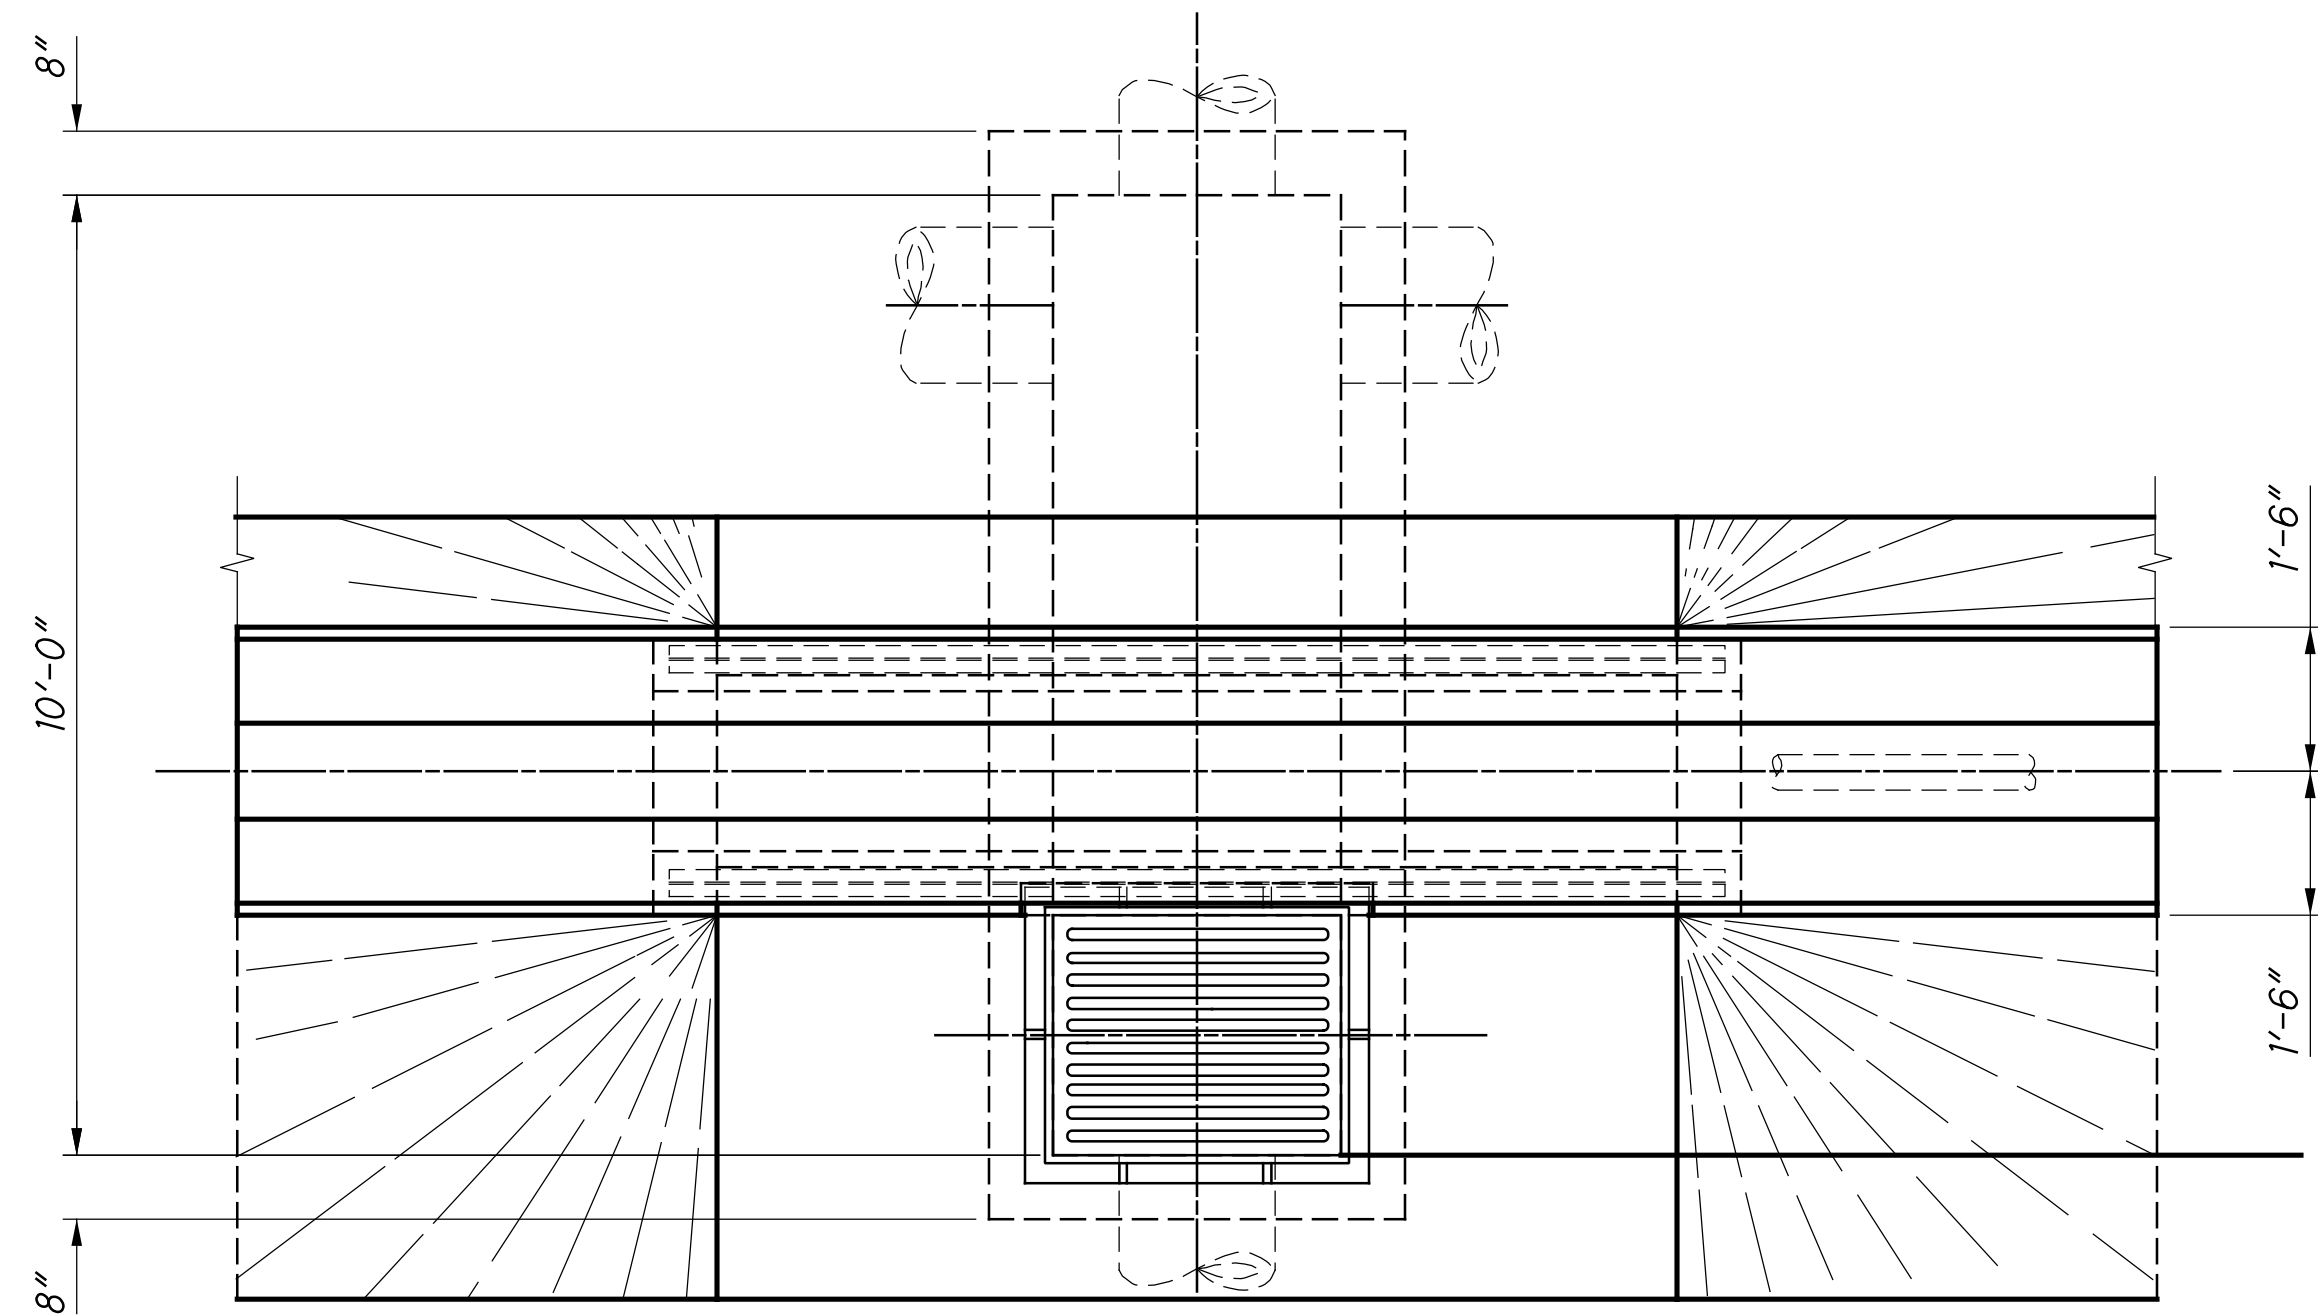

SECTION D-D






ITEM 611 - INLET NO.3 FOR SINGLE SLOPE BARRIER, TYPE C1, AS PER PLAN

THE FOLLOWING DETAILS ARE PROVIDED FOR THE STRUCTURES LISTED BELOW.
ALL LABOR, EQUIPMENT, AND MATERIALS NECESSARY TO PERFORM THE WORK
DETAILED BELOW SHALL BE INCLUDED IN THE THIS PAY ITEM PER THE GENERAL
SUMMARY.

STR. NO.	STATION	SIDE
303	478+50	LT

THIS DETAIL APPLIES TO INLETS AT THE FOLLOWING LOCATIONS: SEE TABLE ABOVE

INLET REINFORCING LIST											
BAR A			BAR B			BAR C			BAR D		
NUMBER	SIZE	LENGTH	NUMBER	SIZE	LENGTH	NUMBER	SIZE	LENGTH	NUMBER	SIZE	LENGTH
10	#6	10'-8"	10	#6	5'-4"	8	#6	8'-0"	8	#6	6'-0"

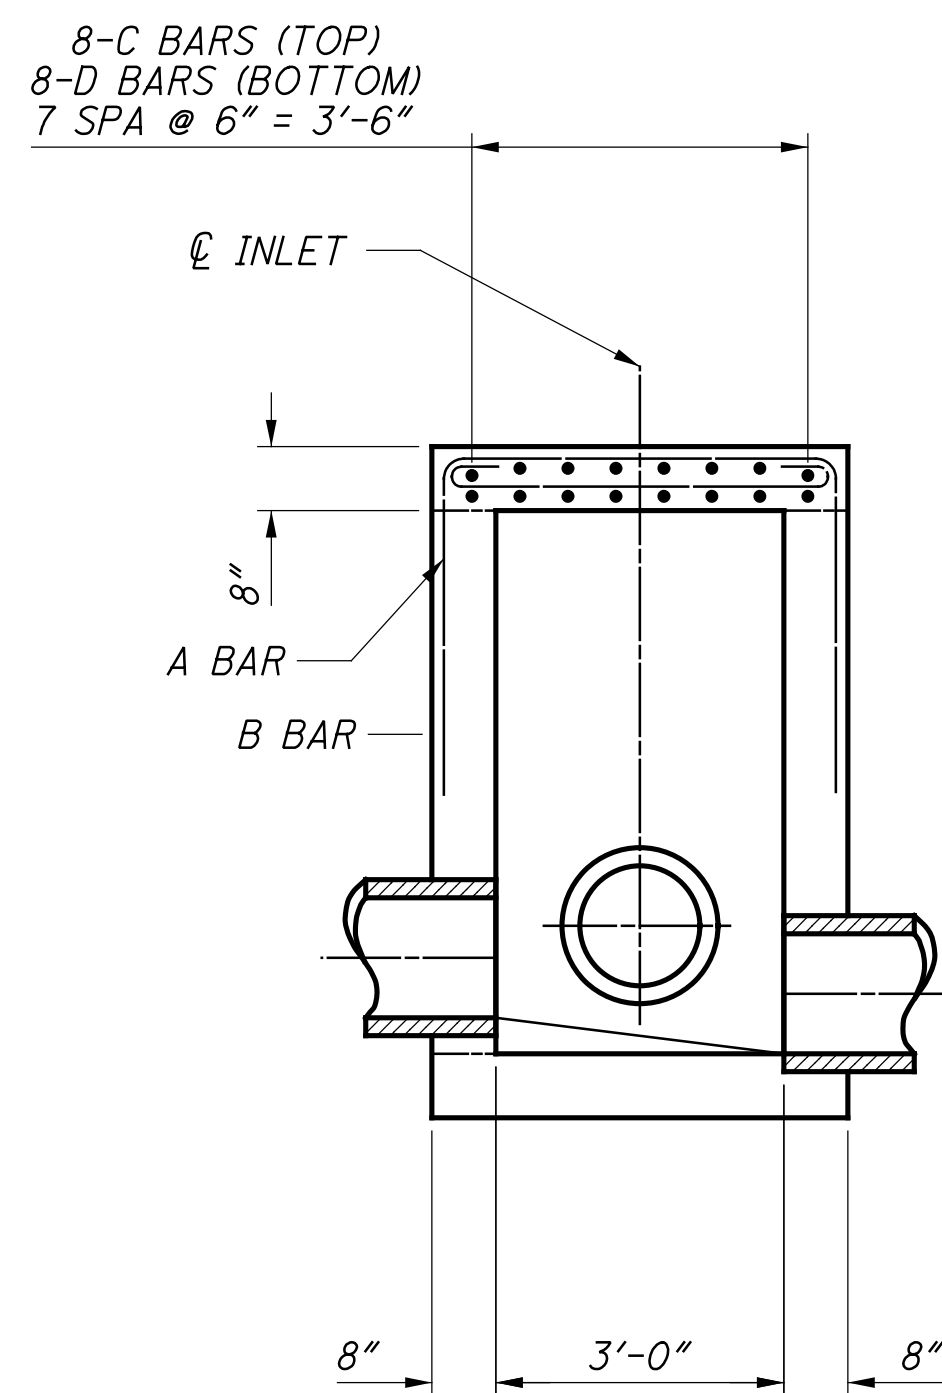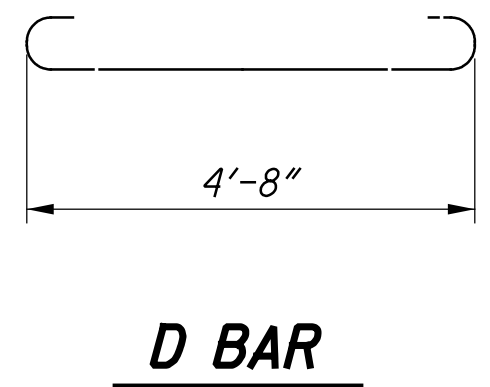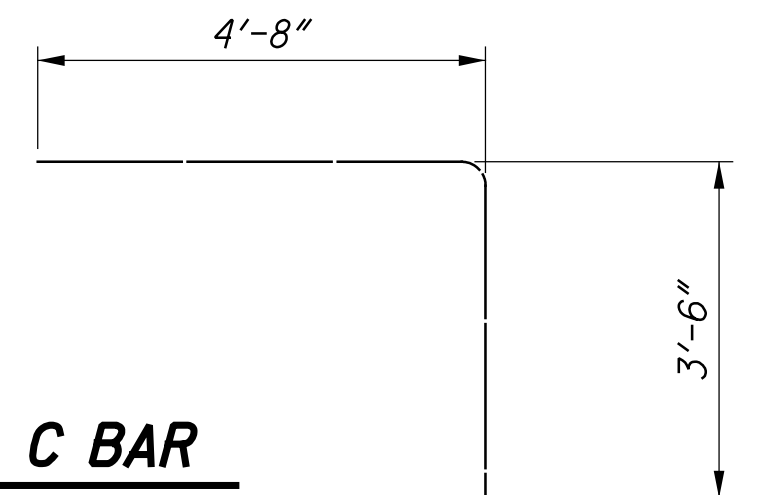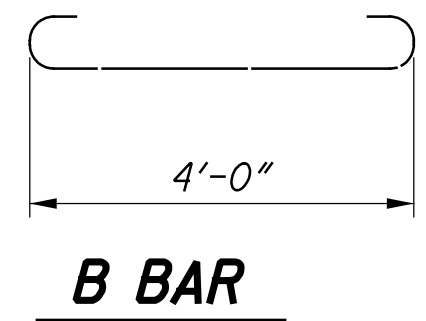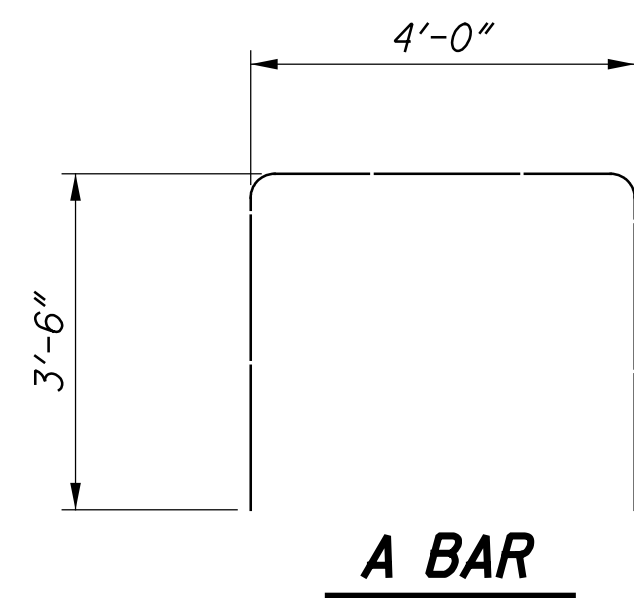

SECTION A-A

NOTES

- FOR ADDITIONAL DETAILS, DIMENSIONS AND REINFORCING, SEE STANDARD CONSTRUCTION DRAWING I-3C.
- ROTATE BARS AS NECESSARY TO MAINTAIN REQUIRED MINIMUM CONCRETE COVER.

J:\20240445\ODOT\HAM\117525\Design\Roadway\Sheets\778896G001.dgn 3/10/2025 3:16:18 PM hbrendlinger

SHEET NUM.											PART.			ITEM	ITEM EXT	GRAND TOTAL	UNIT	DESCRIPTION	SEE SHEET NO.	CALCULATED DLR CHECKED EDK
24	27	164	165	166	167	168	169	179	171		01/IMS/04	02/IMS/03	03/IMS/10							
	LUMP										LUMP	LUMP		202	11201	LS		ROADWAY		GENERAL SUMMARY
				3							2	1		202	20010	3	EACH	PORTIONS OF STRUCTURE REMOVED, AS PER PLAN		
		56,389	28,044	7,484							67,099	24,818		202	23001	91,917	SY	HEADWALL REMOVED	27	
		56,389	27,966	7,484							67,042	24,797		202	23500	91,839	SY	PAVEMENT REMOVED, AS PER PLAN		
		2,248	638	768							2,667	987		202	30000	3,654	SF	WEARING COURSE REMOVED		
		789				5,370	3,765				7,245	2,679		202	30700	9,924	FT	WALK REMOVED		
																		CONCRETE BARRIER REMOVED		
			1,827	2,115							2,878	1,064		202	32000	3,942	FT			
		815	500								960	355		202	32600	1,315	FT	CURB REMOVED		
		3,639	1,976	3,406							6,585	2,436		202	35100	9,021	FT	GUTTER REMOVED		
		1,087	2,025	41							2,302	851		202	35200	3,153	FT	PIPE REMOVED, 24" DIAMETER AND UNDER		
																		PIPE REMOVED, OVER 24" DIAMETER		
						2,546	4,326				5,016	1,856		202	38000	6,872	FT			
		7	13	22							31	11		202	58000	42	EACH	GUARDRAIL REMOVED		
		17	32	11							44	16		202	58100	60	EACH	MANHOLE REMOVED		
		21	8								21	8		202	58200	29	EACH	CATCH BASIN REMOVED		
																		INLET REMOVED		
			2								1	1		202	58700	2	EACH			
			1,348	36							1,010	374		SPECIAL	20270000	1,384	FT	MANHOLE ABANDONED		
100											73	27		SPECIAL	20270110	100	FT	FILL AND PLUG EXISTING CONDUITVARIES	23	
100											73	27		SPECIAL	20270120	100	FT	PIPE CLEANOUT, 24" AND UNDER	24	
100											73	27		SPECIAL	20270130	100	FT	PIPE CLEANOUT, 27" TO 48"	24	
																		PIPE CLEANOUT OVER 48"	24	
								9,367			6,838	2,529		202	75000	9,367	FT			
								1			1			202	75250	1	EACH	FENCE REMOVED		
											LUMP	LUMP		202	98000	LS		GATE REMOVED		
	56										41	15		202	98100	56	EACH	REMOVAL MISC.: ACCESS HATCH REMOVAL	26	
	1,824										1,332	492		202	98200	1,824	FT	REMOVAL MISC.: DRAINAGE STRUCTURE ABANDONED, AS PER PLAN	27	
																		REMOVAL MISC.: DRAINAGE PIPE ABANDONED, 24" AND UNDER, AS PER PLAN	27	
197											118,591	43,862		203	10000	162,453	CY			
197											18,963	7,014		203	20000	25,977	CY	EXCAVATION		
50											37	13		204	45000	50	hour	EMBANKMENT		
4,174											3,047	1,127		206	10500	4,174	TON	PROOF ROLLING		
135,130											98,645	36,485		206	11000	135,130	SY	CEMENT		
																		CURING COAT		
135,130											98,645	36,485		206	15020	135,130	SY			
LUMP											LUMP	LUMP		206	30000	LS		CEMENT STABILIZED SUBGRADE, 14 INCHES DEEP		
						4,900	3,333				6,010	2,223		606	15050	8,233	FT	MIXTURE DESIGN FOR CHEMICALLY STABILIZED SOILS		
						25					18	7		606	15150	25	FT	GUARDRAIL, TYPE MGS		
						6	2				6	2		606	26150	8	EACH	GUARDRAIL, TYPE MGS HALF POST SPACING		
						6	1				5	2		606	26550	7	EACH	ANCHOR ASSEMBLY, MGS TYPE E (MASH 2016)		
																		ANCHOR ASSEMBLY, MGS TYPE T		
						6	4				7	3		606	35002	10	EACH			
						5					4	1		606	35102	5	EACH	MGS BRIDGE TERMINAL ASSEMBLY, TYPE 1		
						2	1				2	1		606	60040	3	EACH	MGS BRIDGE TERMINAL ASSEMBLY, TYPE 2		
								8,736			6,377	2,359		607	25000	8,736	FT	IMPACT ATTENUATOR, TYPE 3 UNIDIRECTIONALSEE PLANS FOR WIDTH AND SPEED INFORMATION		
								508			371	137		607	23001	508	FT	FENCE, TYPE CLT		
																		FENCE, TYPE CLT, AS PER PLAN	25	
								8,736			6,377	2,359		607	70000	8,736	FT			
				250				250			365	135		607	98000	500	FT	FENCELINE SEEDING AND MULCHING		
				1,251							913	338		608	10000	1,251	SF	FENCE, MISC.: WOOD FENCE		
				236							172	64		608	52000	236	SF	4" CONCRETE WALK		
						2,157	2,767				3,595	1,329		622	10100	4,924	FT	CURB RAMP		
																		CONCRETE BARRIER, SINGLE SLOPE, TYPE B1		
						2,151					1,570	581		622	10140	2,151	FT			
						267	3,288				2,595	960		622	10160	3,555	FT	CONCRETE BARRIER, SINGLE SLOPE, TYPE C1		
						1					1			622	10200	1	EACH	CONCRETE BARRIER, SINGLE SLOPE, TYPE D		
						2					1	1		622	24850	2	EACH	BARRIER TRANSITION		
						1					1			622	24860	1	EACH	CONCRETE BARRIER END SECTION, TYPE B1		
																		CONCRETE BARRIER END SECTION, TYPE C1		
						4	6				7	3		622	25000	10	EACH			
						23	31				39	15		622	25006	54	EACH	CONCRETE BARRIER END SECTION, TYPE D		
						3	7				7	3		622	25007	10	EACH	CONCRETE BARRIER, END ANCHORAGE, REINFORCED, TYPE B1		
						18					13	5		622	25014	18	EACH	CONCRETE BARRIER, END ANCHORAGE, REINFORCED, TYPE B1, AS PER PLAN	29	
						2					1	1		622	25015	2	EACH	CONCRETE BARRIER, END ANCHORAGE, REINFORCED, TYPE C1		
																		CONCRETE BARRIER, END ANCHORAGE, REINFORCED, TYPE C1, AS PER PLAN	29	
						6	26				23	9		622	25050	32	EACH			
							1				1			622	25051	1	EACH	CONCRETE BARRIER, END ANCHORAGE, REINFORCED, TYPE D		
																		CONCRETE BARRIER, END ANCHORAGE, REINFORCED, TYPE D, AS PER PLAN	29	

$$\begin{array}{r} 151 \\ \hline 826 \end{array}$$

J:\20240445\ODOT\HAM\117525\Design\Roadway\Sheets\778890G001.dgn 3/10/2025 3:52:43 PM hbrendinger

SHEET NUM.											PART.			ITEM	ITEM	GRAND	UNIT	DESCRIPTION	SEE SHEET NO.	CALCULATED DLR CHECKED EDK
23	24	180									01/IMS/04	02/IMS/03	03/IMS/10		EXT	TOTAL				
																		DRAINAGE		GENERAL SUMMARY
		14									10	4		611	98150	14	EACH	CATCH BASIN, NO. 3		
		9									7	2		611	98180	9	EACH	CATCH BASIN, NO. 3A		
		11									8	3		611	98300	11	EACH	CATCH BASIN, NO. 5		
		12									9	3		611	98370	12	EACH	CATCH BASIN, NO. 6		
		9									7	2		611	98410	9	EACH	CATCH BASIN, NO. 8		
		4									3	1		611	98434	4	EACH	CATCH BASIN, NO. 8A		
		1									1			611	98470	1	EACH	CATCH BASIN, NO. 2-2B		
		11									8	3		611	98510	11	EACH	CATCH BASIN, NO. 2-3		
		2									1	1		611	99100	2	EACH	INLET, NO. 3 FOR SINGLE SLOPE BARRIER, TYPE B1		
		5									4	1		611	99101	5	EACH	INLET, NO. 3 FOR SINGLE SLOPE BARRIER, TYPE B1, AS PER PLAN		
		6									4	2		611	99101	6	EACH	INLET, NO. 3 FOR SINGLE SLOPE BARRIER, TYPE B1, AS PER PLAN, A	25	
		7									5	2		611	99101	7	EACH	INLET, NO. 3 FOR SINGLE SLOPE BARRIER, TYPE B1, AS PER PLAN, B	32	
		2									1	1		611	99101	2	EACH	INLET, NO. 3 FOR SINGLE SLOPE BARRIER, TYPE B1, AS PER PLAN, C	33	
		8									6	2		611	99110	8	EACH	INLET, NO. 3 FOR SINGLE SLOPE BARRIER, TYPE C1		
		1									1			611	99111	1	EACH	INLET, NO. 3 FOR SINGLE SLOPE BARRIER, TYPE C1, AS PER PLAN	34	
		9									7	2		611	99114	9	EACH	INLET, NO. 3 FOR SINGLE SLOPE BARRIER, TYPE D		
		1									1			611	99115	1	EACH	INLET, NO. 3 FOR SINGLE SLOPE BARRIER, TYPE D, AS PER PLAN, A	35	
		1									1			611	99115	1	EACH	INLET, NO. 3 FOR SINGLE SLOPE BARRIER, TYPE D, AS PER PLAN, B	36	
		22									16	6		611	99574	22	EACH	MANHOLE, NO. 3		
		1									1			611	99900	1	EACH	DRAINAGE STRUCTURE, MISC.: CHECK VALVE FOR 54" CONDUIT	24	
		4									3	1		SPECIAL	69098000	4	EACH	MANHOLE MISC.: SANITARY MANHOLE PER MSD ACC NO. 49037		
		2									1	1		SPECIAL	69098000	2	EACH	MANHOLE MISC.: SANITARY MANHOLE PER MSD ACC NO. 49040		
		876									639	237		839	30000	876	FT	TRENCH DRAIN, TYPE B WITH STANDARD GRATE		
5											4	1		611	99710	5	EACH	PRECAST REINFORCED CONCRETE OUTLET		
	12										9	3		SPECIAL	69099550	12	MNTH	TEMPORARY DRAINAGE PUMP	24	
																		DRAINAGE ALTERNATES - 69TH STREET - STA 481		
												34		611	06100	34	FT	15" CONDUIT, TYPE C, WITH CLASS II BEDDING (ALTERNATE 1)		
												126		611	13400	126	FT	30" CONDUIT, TYPE B, WITH CLASS II BEDDING (ALTERNATE 1)		
												2		SPECIAL	69098000	2	EACH	MANHOLE MISC.: SANITARY MANHOLE PER MSD ACC NO. 49037 (ALTERNATE 1)		
		34										34		611	06100	34	FT	15" CONDUIT, TYPE C, WITH CLASS II BEDDING (ALTERNATE 2)		
		126										126		611	13400	126	FT	30" CONDUIT, TYPE B, WITH CLASS II BEDDING (ALTERNATE 2)		
		2										2		SPECIAL	69098000	2	EACH	MANHOLE MISC.: SANITARY MANHOLE PER MSD ACC NO. 49037 (ALTERNATE 2)		
		18										18		611	16600	18	FT	36" CONDUIT, TYPE C, WITH CLASS II BEDDING (ALTERNATE 2)		
		252										252		611	96600	252	FT	CONDUIT, BORED OR JACKED 36", TYPE B, WITH JOINTS PER 706.11 (ALTERNATE 2)		
		3										3		611	99574	3	EACH	MANHOLE, NO. 3 (ALTERNATE 2)		
																		DRAINAGE ALTERNATES - SEYMORE AVE - STA 492		
												93		611	06100	93	FT	15" CONDUIT, TYPE C, WITH CLASS II BEDDING (ALTERNATE 1)		
												256		611	96600	256	FT	CONDUIT, BORED OR JACKED 36", TYPE B, WITH JOINTS PER 706.11 (ALTERNATE 1)		
												23		611	16600	23	FT	36" CONDUIT, TYPE C, WITH CLASS II BEDDING (ALTERNATE 1)		
												3		SPECIAL	69098000	3	EACH	MANHOLE MISC.: SANITARY MANHOLE PER MSD ACC NO. 49037 (ALTERNATE 1)		
		256										256		611	96600	256	FT	CONDUIT, BORED OR JACKED 36", TYPE B, WITH JOINTS PER 706.11 (ALTERNATE 2)		
		23										23		611	16600	23	FT	36" CONDUIT, TYPE C, WITH CLASS II BEDDING (ALTERNATE 2)		
		2										2		SPECIAL	69098000	2	EACH	MANHOLE MISC.: SANITARY MANHOLE PER MSD ACC NO. 49037 (ALTERNATE 2)		
		235										235		611	22400	235	FT	54" CONDUIT, TYPE B, WITH CLASS II BEDDING (ALTERNATE 2)		
		112										112		611	22600	112	FT	54" CONDUIT, TYPE C, WITH CLASS II BEDDING (ALTERNATE 2)		
		2										2		SPECIAL	69098000	2	EACH	MANHOLE MISC.: SANITARY MANHOLE PER MSD ACC NO. 49040 (ALTERNATE 2)		
																		DRAINAGE ALTERNATES - WOODLAND/SUMMIT - STA 525		
		32										32		611	05900	32	FT	15" CONDUIT, TYPE B (ALTERNATE 1)		
		79										79		611	07400	79	FT	18" CONDUIT, TYPE B (ALTERNATE 1)		
		147										147		611	08900	147	FT	21" CONDUIT, TYPE B (ALTERNATE 1)		
		312										312		611	10400	312	FT	24" CONDUIT, TYPE B (ALTERNATE 1)		
		244										244		611	10600	244	FT	24" CONDUIT, TYPE C (ALTERNATE 1)		
												223		611	10400	223	FT	24" CONDUIT, TYPE B (ALTERNATE 2)		
												32		611	13400	32	FT	30" CONDUIT, TYPE B (ALTERNATE 2)		
												135		611	16400	135	FT	36" CONDUIT, TYPE B (ALTERNATE 2)		
												244		611	16600	244	FT	36" CONDUIT, TYPE C (ALTERNATE 2)		
												180		611	19400	180	FT	42" CONDUIT, TYPE B (ALTERNATE 2)		

160
826

J:\20240445\ODOT\HAM\117525\Design\Roadway\Sheets\778890S003_Roadside Barrier.dgn 3/7/2025 2:40:42 PM hbrendlinger


REF NO.	SHEET NO.	STATION TO STATION			SIDE	CENTERLINE ROADWAY REFERENCE	202	202	606	606	606	606	606	606	606	622	622	622	622	622	622	622	622	622	622				
							CONCRETE BARRIER REMOVED	GUARDRAIL REMOVED	GUARDRAIL, TYPE MGS	GUARDRAIL, TYPE MGS HALF POST SPACING	ANCHOR ASSEMBLY, MGS TYPE E (MASH 2016)	ANCHOR ASSEMBLY, MGS TYPE T	MGS BRIDGE TERMINAL ASSEMBLY, TYPE 1	MGS BRIDGE TERMINAL ASSEMBLY, TYPE 2	IMPACT ATTENUATOR, TYPE 3 UNIDIRECTIONAL	CONCRETE BARRIER, SINGLE SLOPE, TYPE B1	CONCRETE BARRIER, SINGLE SLOPE, TYPE C1	CONCRETE BARRIER, SINGLE SLOPE, TYPE D	BARRIER TRANSITION	CONCRETE BARRIER END SECTION, TYPE B1	CONCRETE BARRIER END SECTION, TYPE C1	CONCRETE BARRIER END SECTION, TYPE D	CONCRETE BARRIER, END ANCHORAGE, REINFORCED, TYPE B1	CONCRETE BARRIER, END ANCHORAGE, REINFORCED, TYPE B1, AS PER PLAN	CONCRETE BARRIER, END ANCHORAGE, REINFORCED, TYPE C1	CONCRETE BARRIER, END ANCHORAGE, REINFORCED, TYPE C1, AS PER PLAN	CONCRETE BARRIER, END ANCHORAGE, REINFORCED, TYPE D		
			TO				FT	FT	FT	FT	EACH	EACH	EACH	EACH	EACH	FT	FT	FT	EACH	EACH	EACH	EACH	EACH	EACH	EACH				
R1	506	457+96		469+50	CL	IR 75	1154																						
R2	506	467+53		469+50	LT	IR 75		197																					
B1	506	457+96		469+50	CL	IR 75										848.5			1				11						
R1	507	469+50		469+68	LT	IR 75		17																					
R2	507	472+37		482+00	LT	IR 75		982																					
R3	507	469+50		482+00	CL	IR 75	1250																						
R4	507	476+20		477+65	RT	IR 75	34	106																					
G1	507	472+00		479+46	LT	IR 75			765			1		1															
G2	507	481+77		484+17	RT	RAMP E			337		1	1																	
B1	507	469+50		482+00	CL	IR 75										241	774						2		4	2			
B2	507	475+21		482+00	RT	IR 75									1	515			1	1					4				
B3	507	479+46		480+63	LT	IR 75												88				1				1			
R1	508	482+00		482+20	LT	IR 75		20																					
R2	508	482+00		494+50	CL	IR 75	1250																						
R3	508	487+25		488+77	RT	IR 75		153																					
R4	508	10+37		11+38	LT	SEYMOUR		101																					
G1	508	485+75		490+48	LT	RAMP E			481	25				1															
G2	508	485+58		491+42	RT	RAMP D			552			1			1														
G3	508	487+88		490+26	RT	RAMP E			175		1	1																	
G4	508	491+38		493+66	LT	RAMP D			233			1		1															
G5	508	486+00		489+50	LT	RAMP C			322				1	1															
G6	508	493+87		494+50	RT	IR 75			63					1															
B1	508	493+23		493+87	RT	IR 75												35				1				1			
B2	508	482+00		490+65	RT	IR 75											700								7				
B3	508	482+00		494+50	CL	IR 75										978							10	3					
B4	508	489+50		491+73	LT	RAMP C												144				1				3			
B5	508	491+00		494+41	RT	RAMP C										89	162			1					3				
B6	508	491+11		491+38	LT	RAMP D																1				1			
R1	509	498+15		502+55	LT	IR 75	234	206																					
R2	509	505+27		507+02	RT	RAMP B	4	173																					
R3	509	495+43		499+31	RT	IR 75	194	193																					
R4	509	494+50		507+00	CL	IR 75	1250																						
R5	509	17+65		21+60	LT	SUMMIT		398																					
G1	509	494+41		496+82	RT	RAMP C			213		1		1																
G2	509	500+50		507+00	LT	IR 75			625				1																
G3	509	502+29		507+01	RT	RAMP B			464.5			1																	
G4	509	494+50		496+96	RT	IR 75			221.5				1																
G5	509	503+01		504+63	RT	RAMP A			100		1		1																
G6	509	497+25		498+13	LT	RAMP C			12.5		1		1																
G7	509	17+65		21+60	LT	SUMMIT			335		1																		
TOTALS CARRIED TO GENERAL SUMMARY							5370	2546	4900	25	6	6	6	5	2	2157	2151	267	1	2	1	4	23	3	18	2	6		

DRAINAGE ESTIMATED QUANTITIES

[illegible]


182 826 HAM-75-8.91	DRAINAGE ESTIMATED QUANTITIES		
	CALCULATED		
	RSH		
	CHECKED		
	DLR		

CROSS REFERENCES	
SHEET NO	DESCRIPTION
397-407	DRAINAGE PLANS
408-428	STORM SEWER PROFILES
429	SANITARY SEWER PROFILES
164-191	ESTIMATED QUANTITIES
375-384	SUPERELEVATION TABLES
506-511	ROADSIDE BARRIER PLANS
385-393	INTERCHANGE DETAILS
595-614	LIGHTING PLANS
633-637	FENCING PLANS

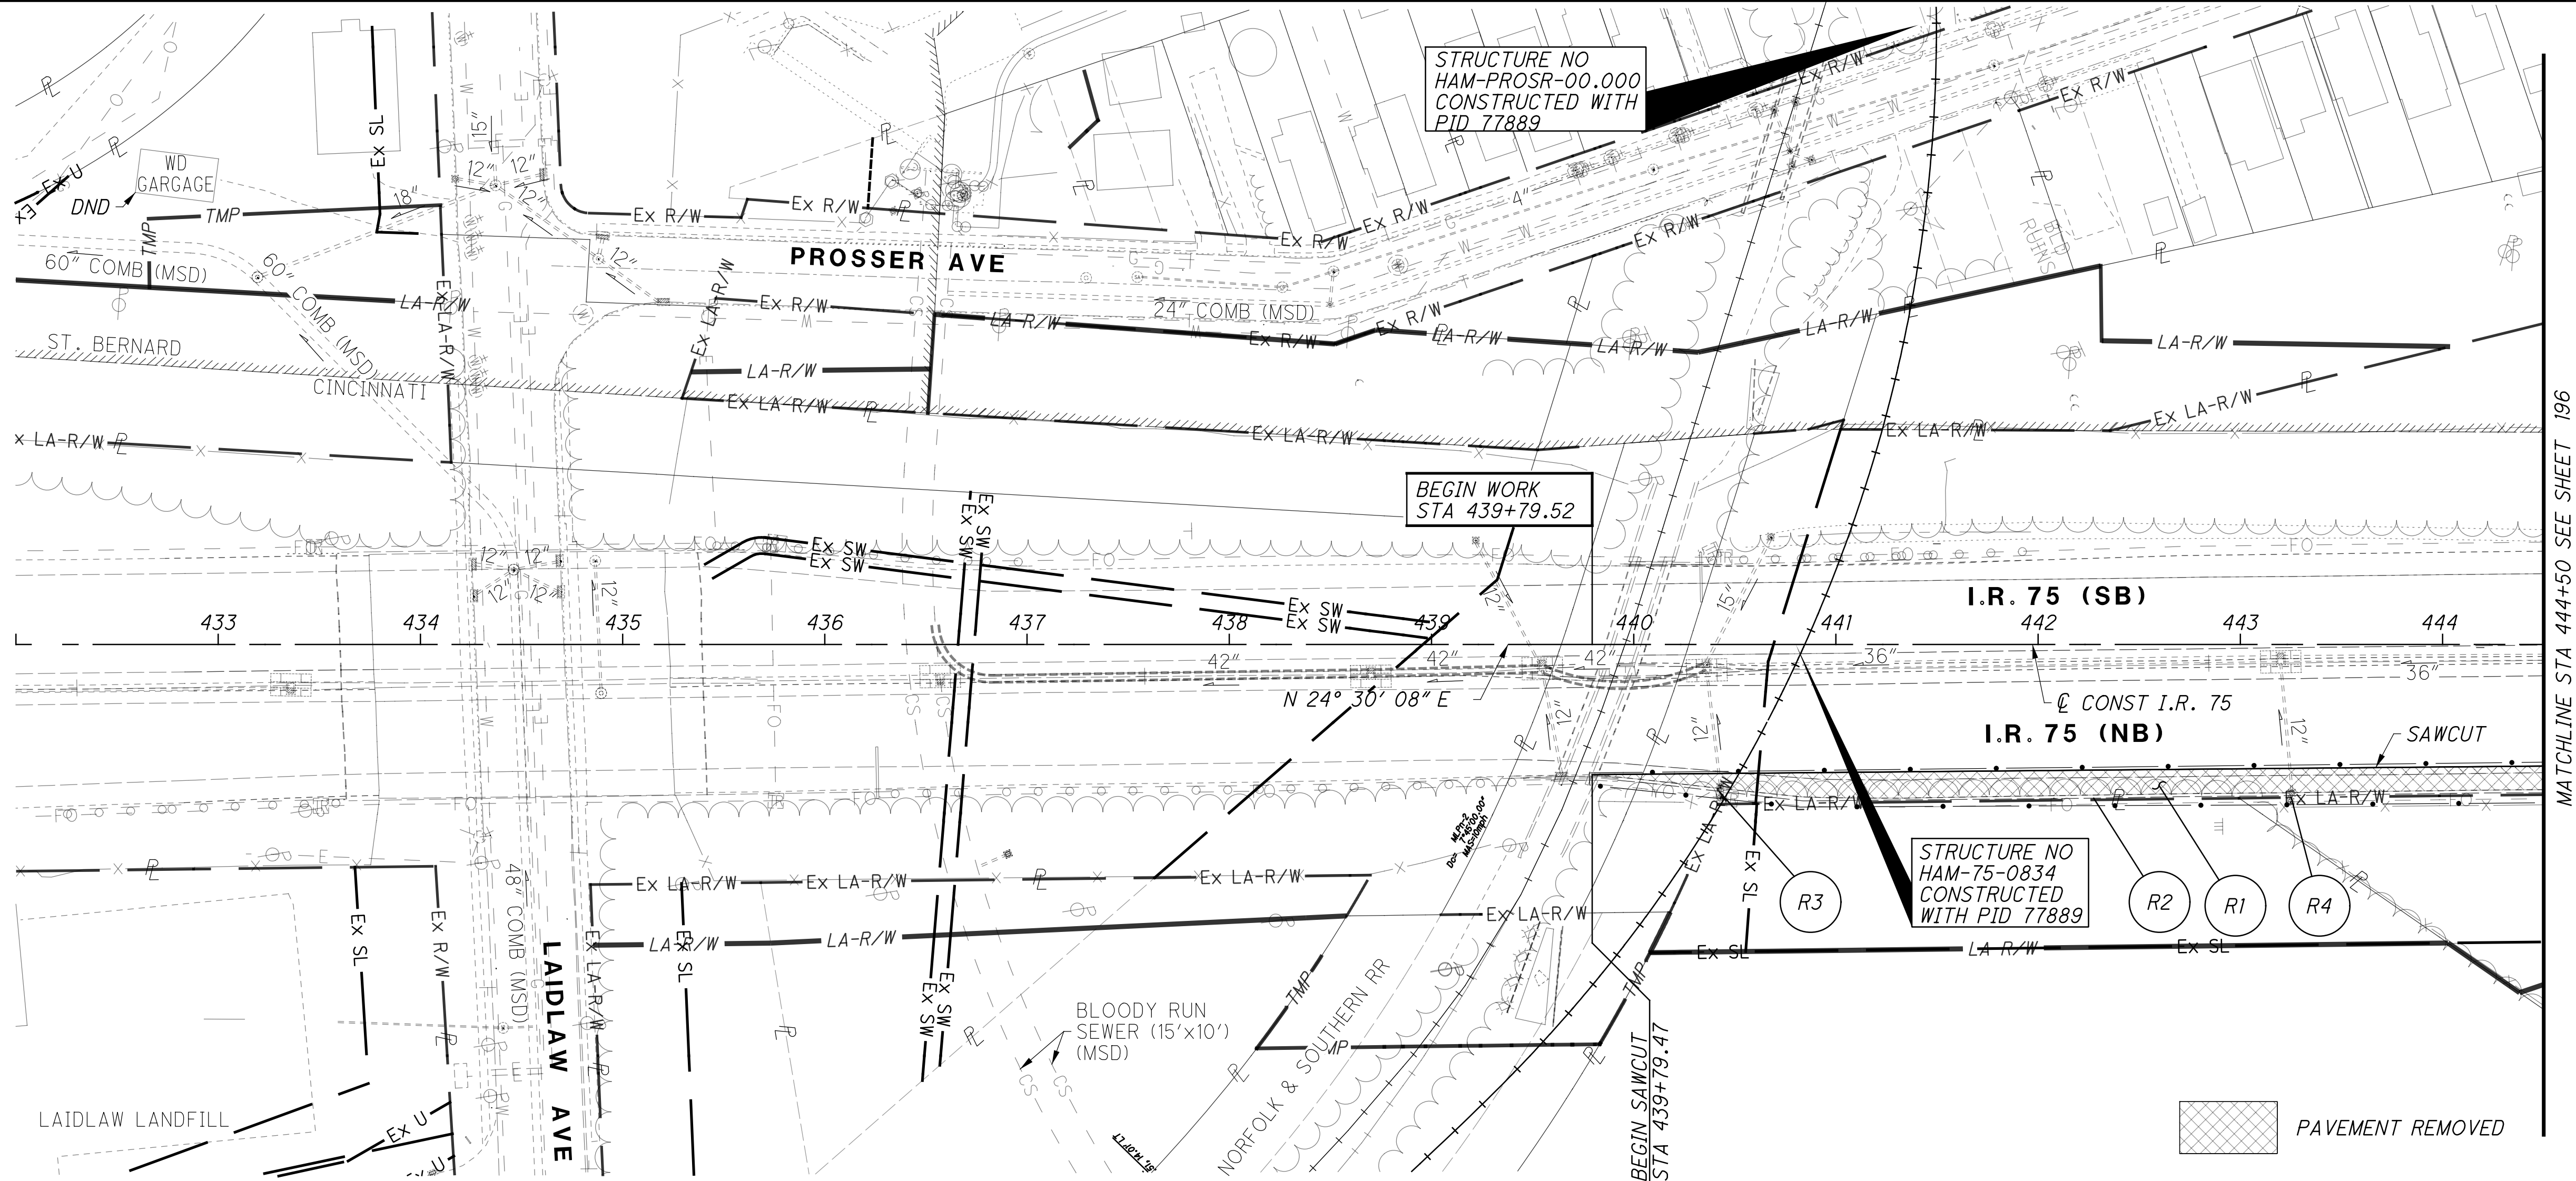


CFN	LENGTH (FT)	SIZE	TYPE	SLOPE	START STRUCTURE	START INVERT ELEV	STOP STRUCTURE	STOP INVERT ELEV
1997466	169.00	15"	TYPE B	3.37%	306	563.17	323	557.49
1997491	83.00	15"	TYPE B	3.11%	304	553.70	322	551.12
1997479	187.00	15"	TYPE B	1.04%	317	538.96	307	536.75
1997465	44.00	15"	TYPE B	1.07%	321	539.50	307	538.75
1997489	251.00	36"	TYPE B	4.48%	319	532.00	307	520.73
1997490	126.00	30"	TYPE B	5.40%	312	526.39	311	519.59
1997486	191.00	30"	TYPE B	0.26%	402	526.25	407	525.75
1997667	41.00	15"	TYPE B	1.22%	402	528.50	402	528.00
1997668	42.00	15"	TYPE B	0.48%	506	529.50	501	528.00
1997469	83.00	30"	TYPE B	0.78%	501	525.65	500	525.00
1997463	256.00	36"	TYPE B	0.49%	906	528.00	905	526.75
1997476	235.00	54"	TYPE B	0.66%	904	526.81	902	525.25
1997480	68.00	36"	TYPE B	0.47%	EX INLET	526.48	T102	526.19
1997464	42.00	15"	TYPE B	0.60%	924	526.50	922	526.25
1997670	59.00	36"	TYPE B	0.91%	T101	525.98	T100	525.44
1997470	84.00	18"	TYPE B	0.28%	619	529.25	606	529.01
1997470	80.00	18"	TYPE B	0.30%	620	529.25	606	529.01
1997483	94.00	15"	TYPE B	0.26%	608	530.63	607	530.39
1997482	98.00	42"	TYPE B	0.17%	739	528.5	738	528.33
1997472	93.00	15"	TYPE B	0.47%	737	535.62	736	535.18
1997477	88.00	15"	TYPE B	1.00%	733	537.09	732	536.21
1997485	83.00	15"	TYPE B	1.01%	730	540.04	729	539.2
1997487	84.00	48"	TYPE B	0.15%	728	526.25	707	526.12
1997488	180.00	42"	TYPE B	1.30%	771	536.35	770	534
1997478	105.00	21"	TYPE B	1.05%	725	528.5	704	527.4
1997669	93.00	15"	TYPE B	3.20%	726	539.59	725	536.61

J:\20240445\ODOT\HAM\117525\Design\Roadway\Sheets\77889XS542.dgn 3/10/2025 4:52:20 PM hbrendinger

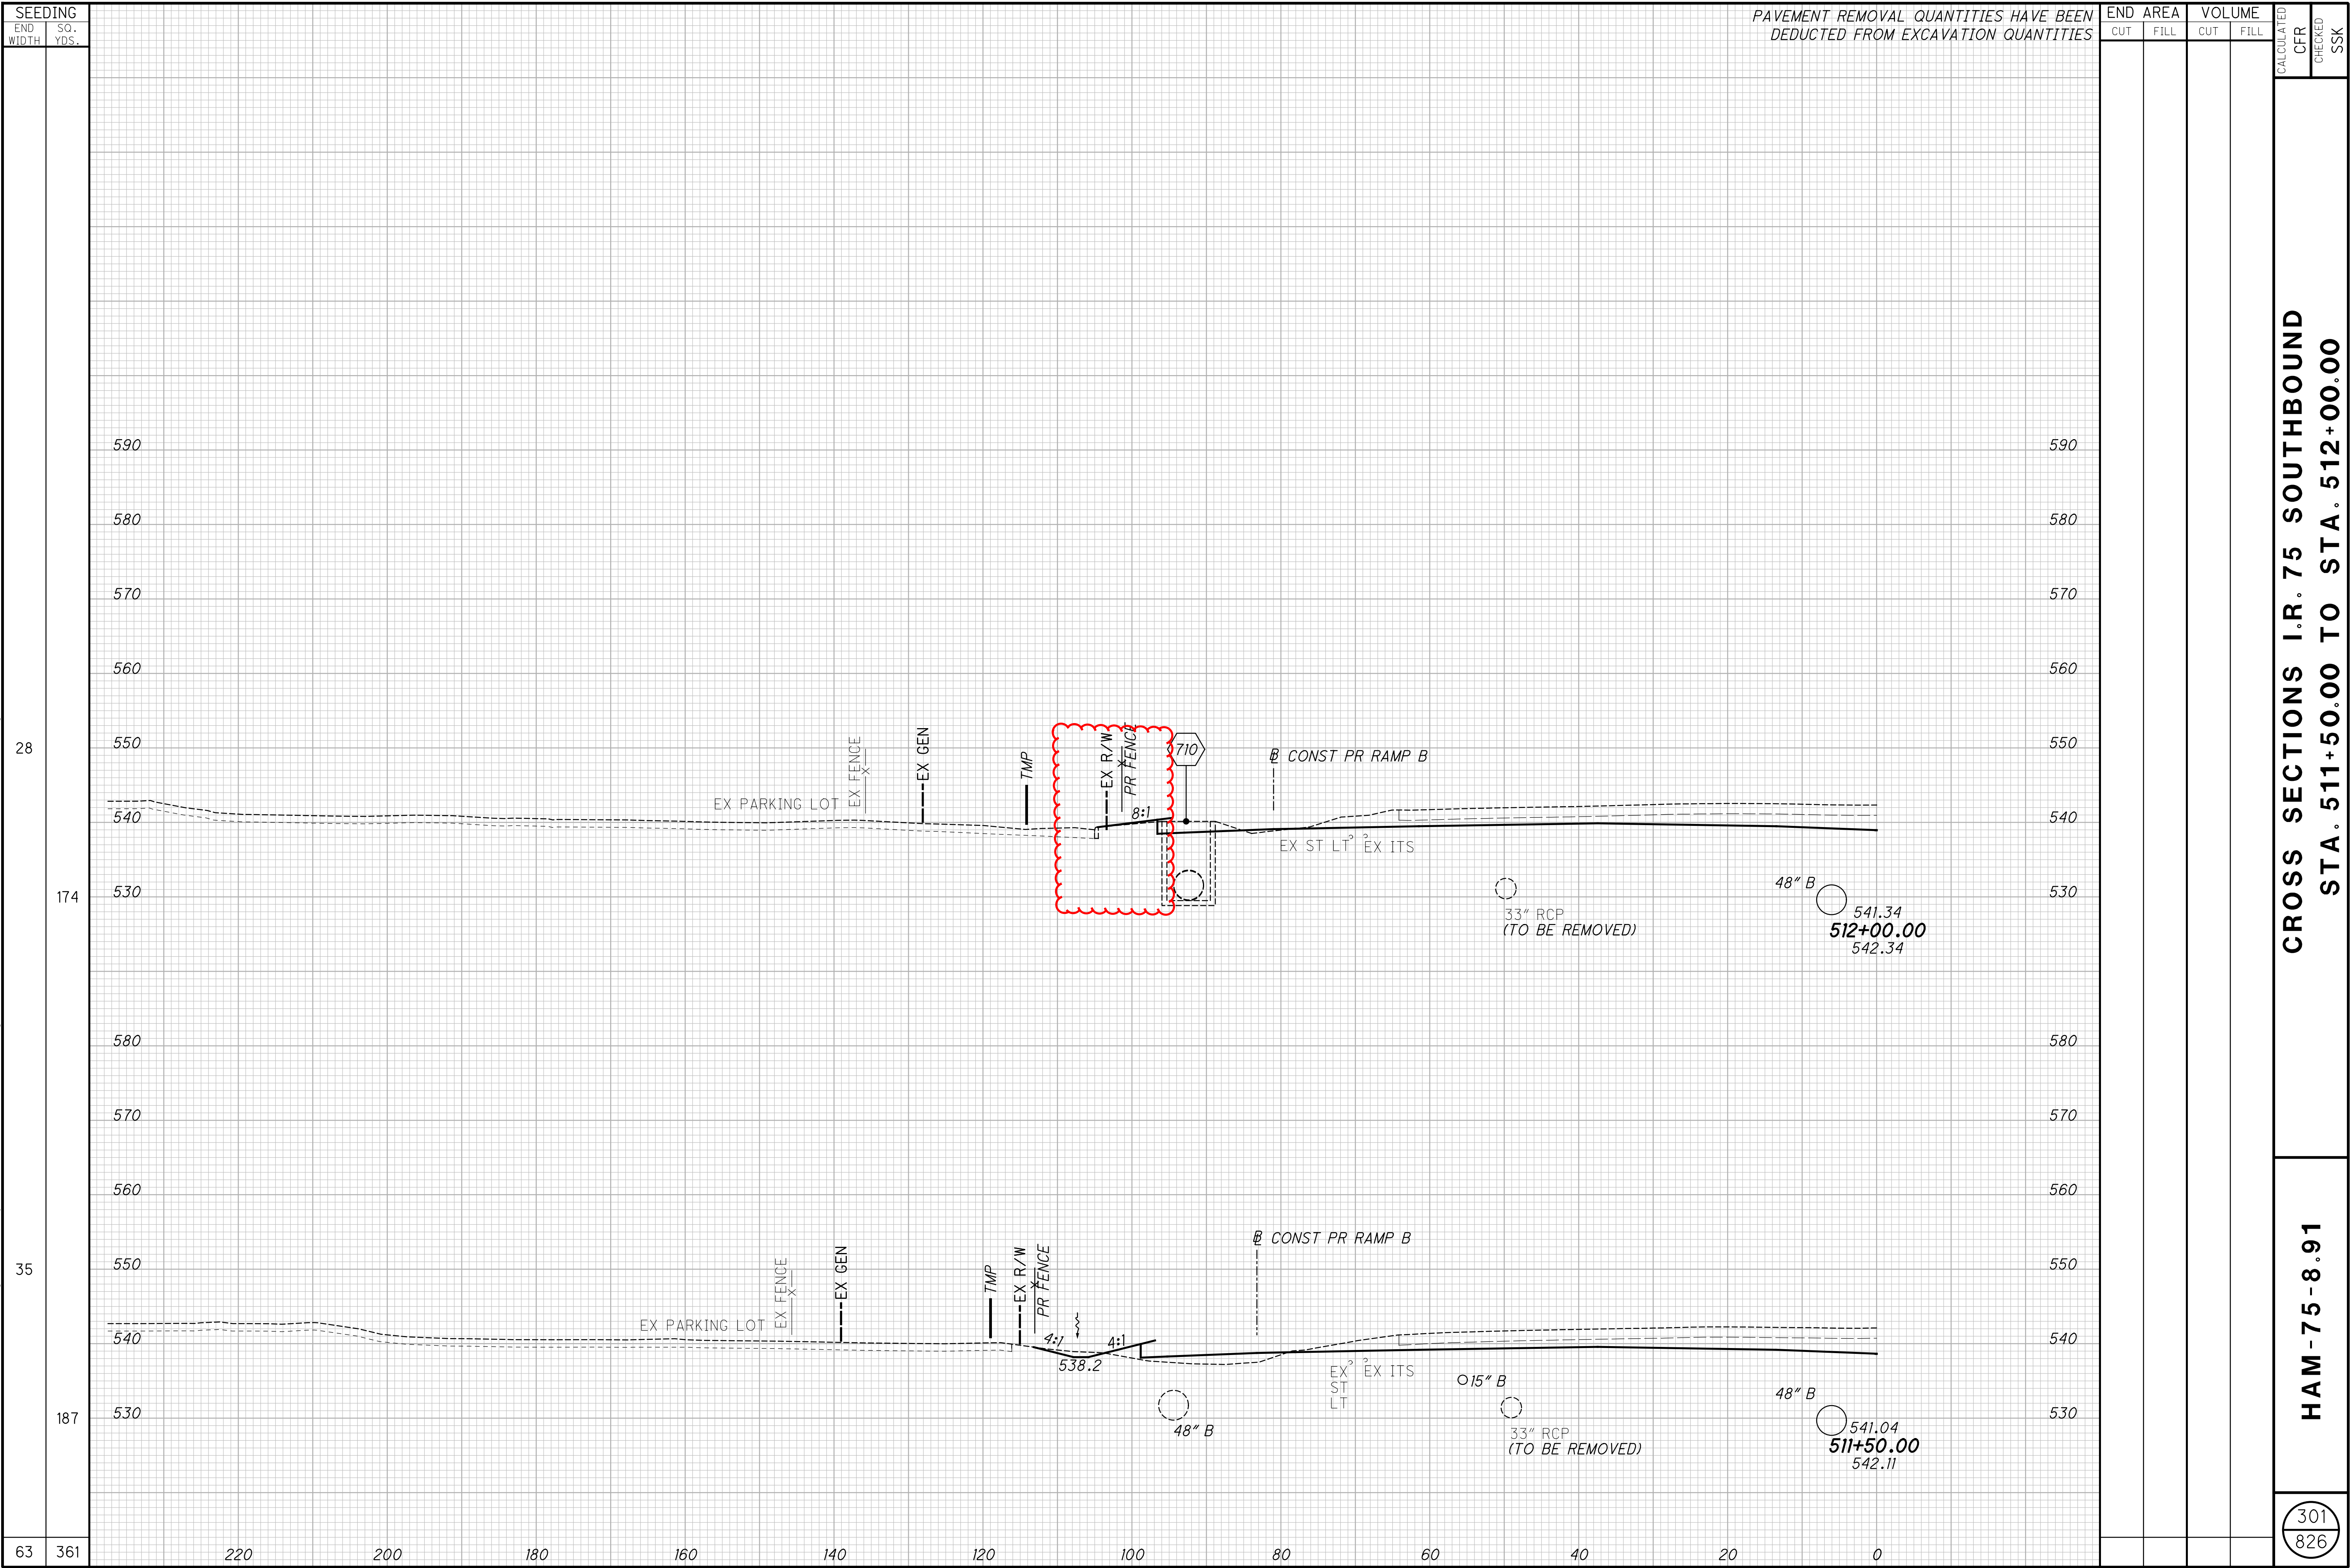


J:\20240445\ODOT\HAM\117525\Design\Roadway\Sheets\77889XS544.dgn 3/10/2025 4:59:06 PM hbrendinger

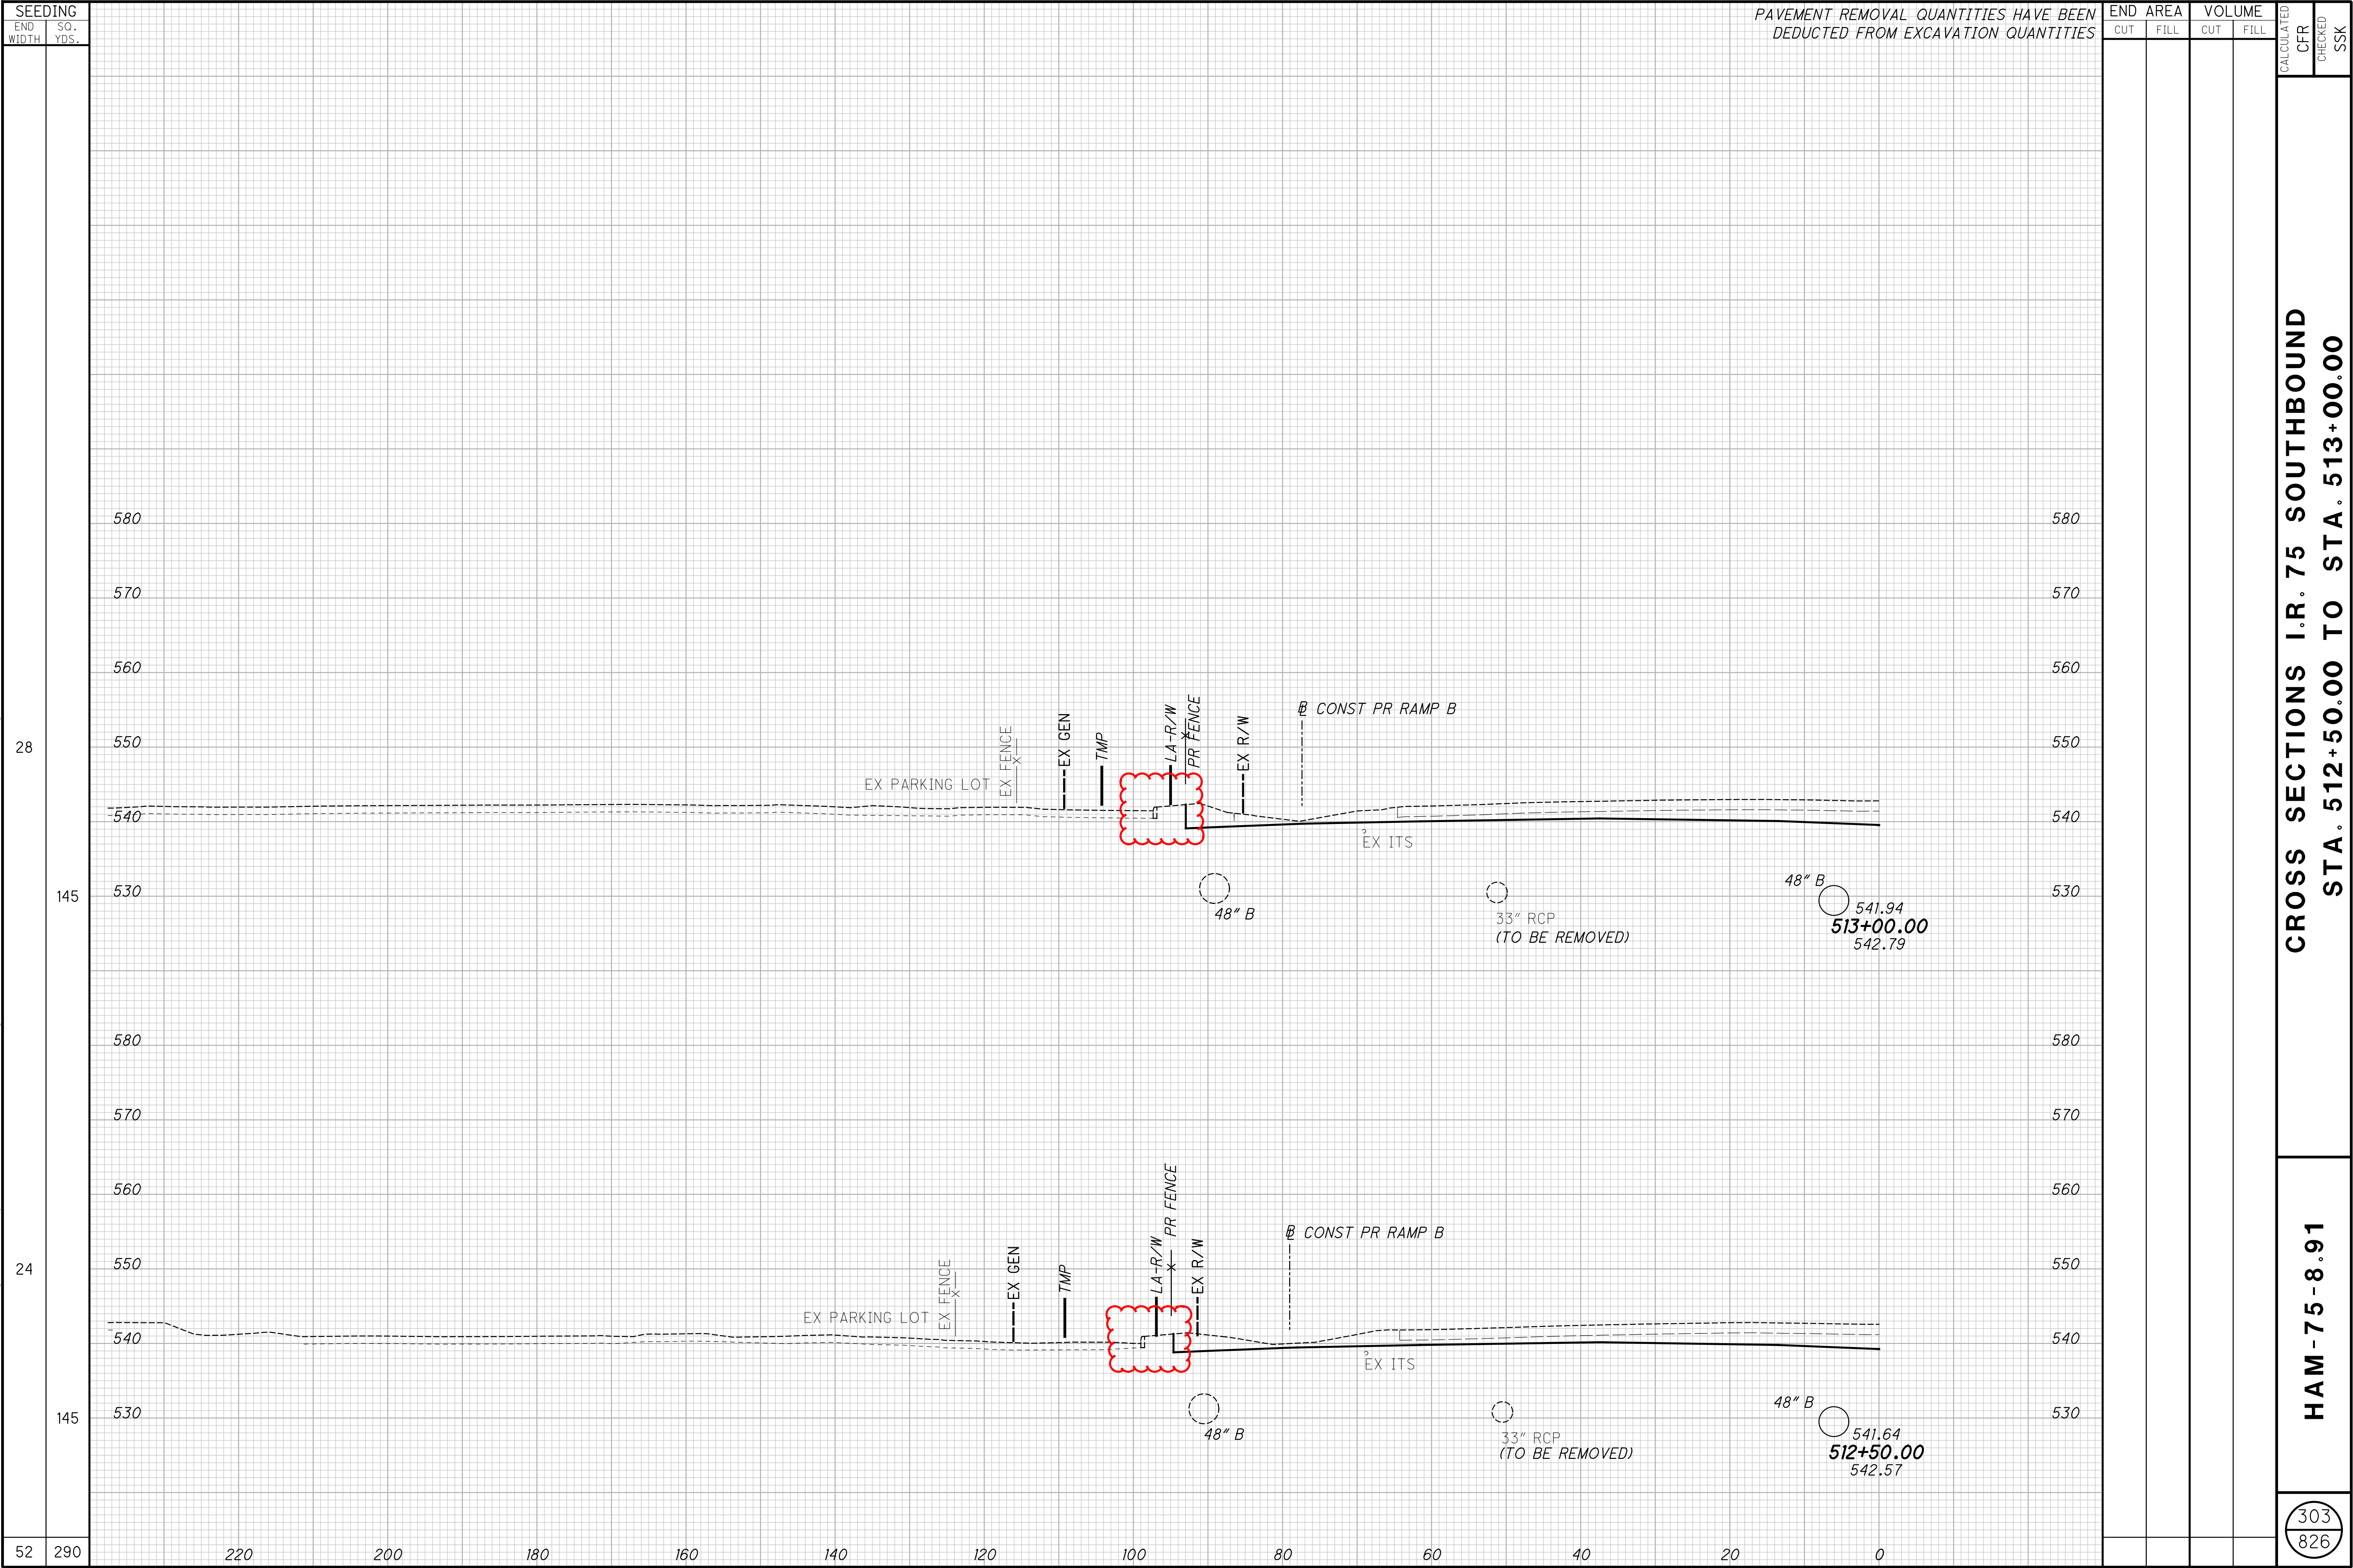

PAVEMENT REMOVAL QUANTITIES HAVE BEEN DEDUCTED FROM EXCAVATION QUANTITIES

J:\20240445\ODOT\HAM\117525\Design\Roadway\Sheets\77889XS546.dgn 3/10/2025 5:00:08 PM hbrendinger

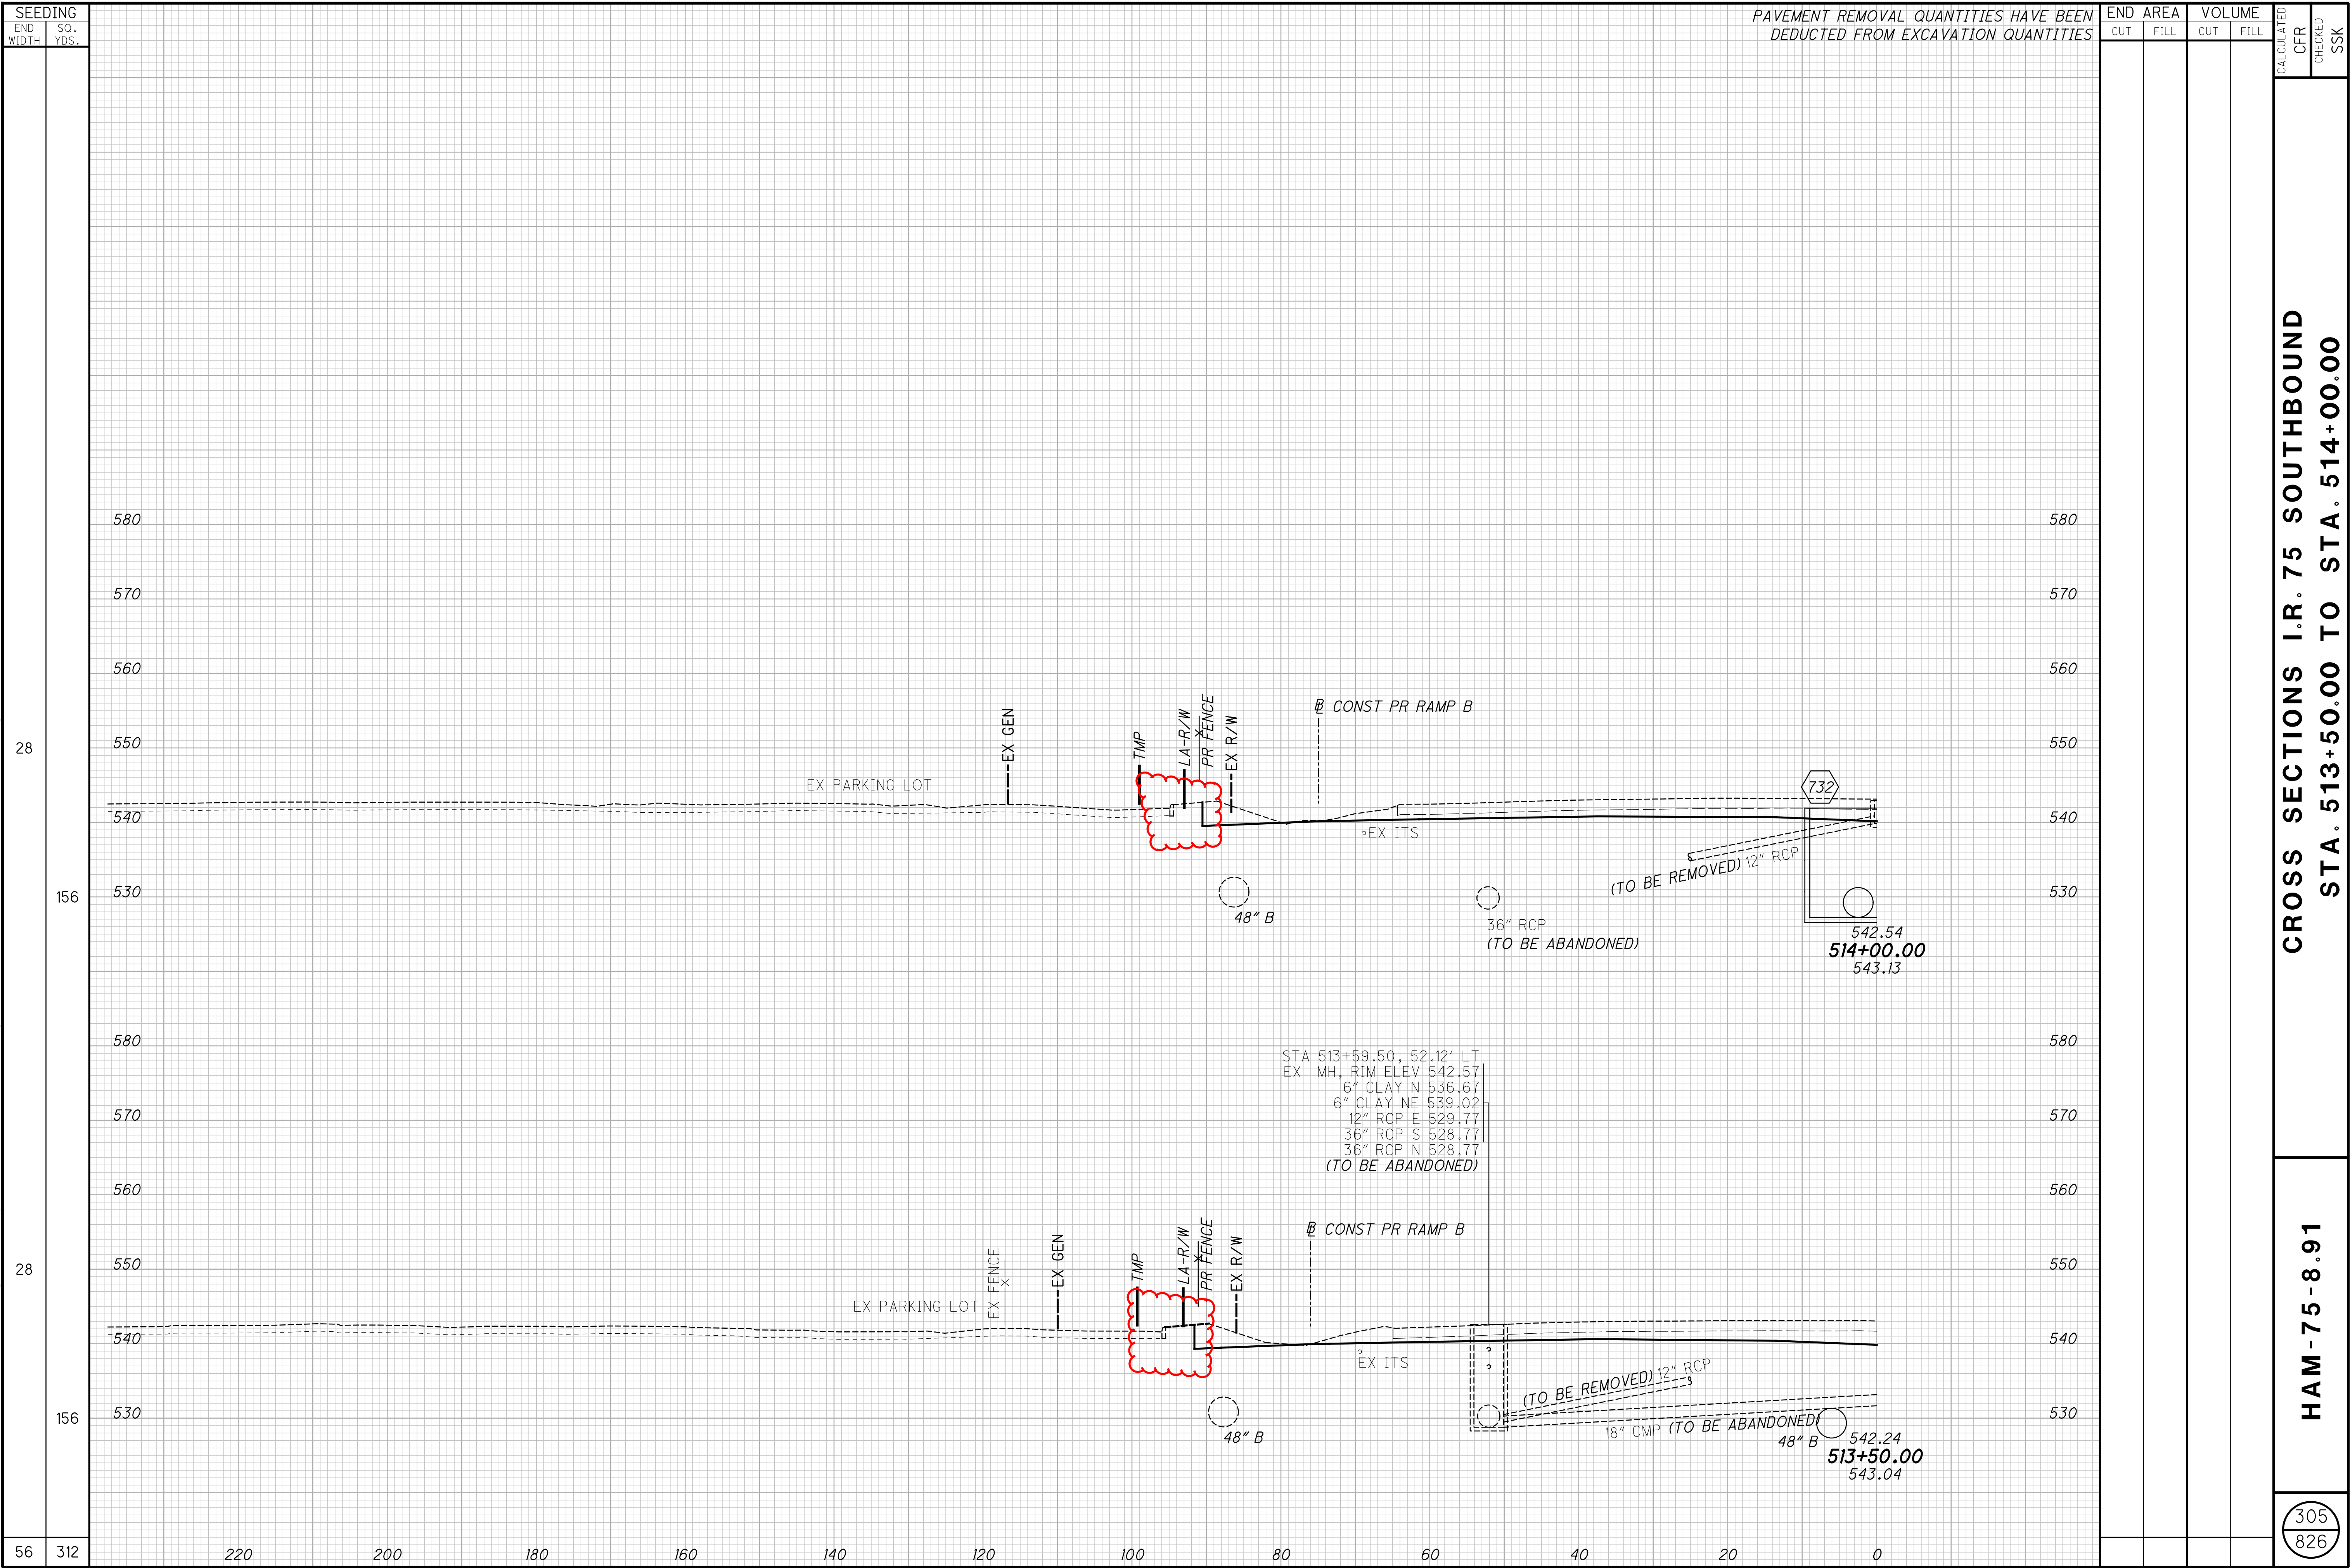

CROSS SECTIONS I.R. 75 SOUTHBOUND


STA. 513+50.00 TO STA. 514+00.00

HAM - 75 - 8.91


305

826

J:\20240445\ODOT\HAM\117525\Design\Roadway\Sheets\77889XS548.dgn 3/10/2025 5:01:02 PM hbrendlinger

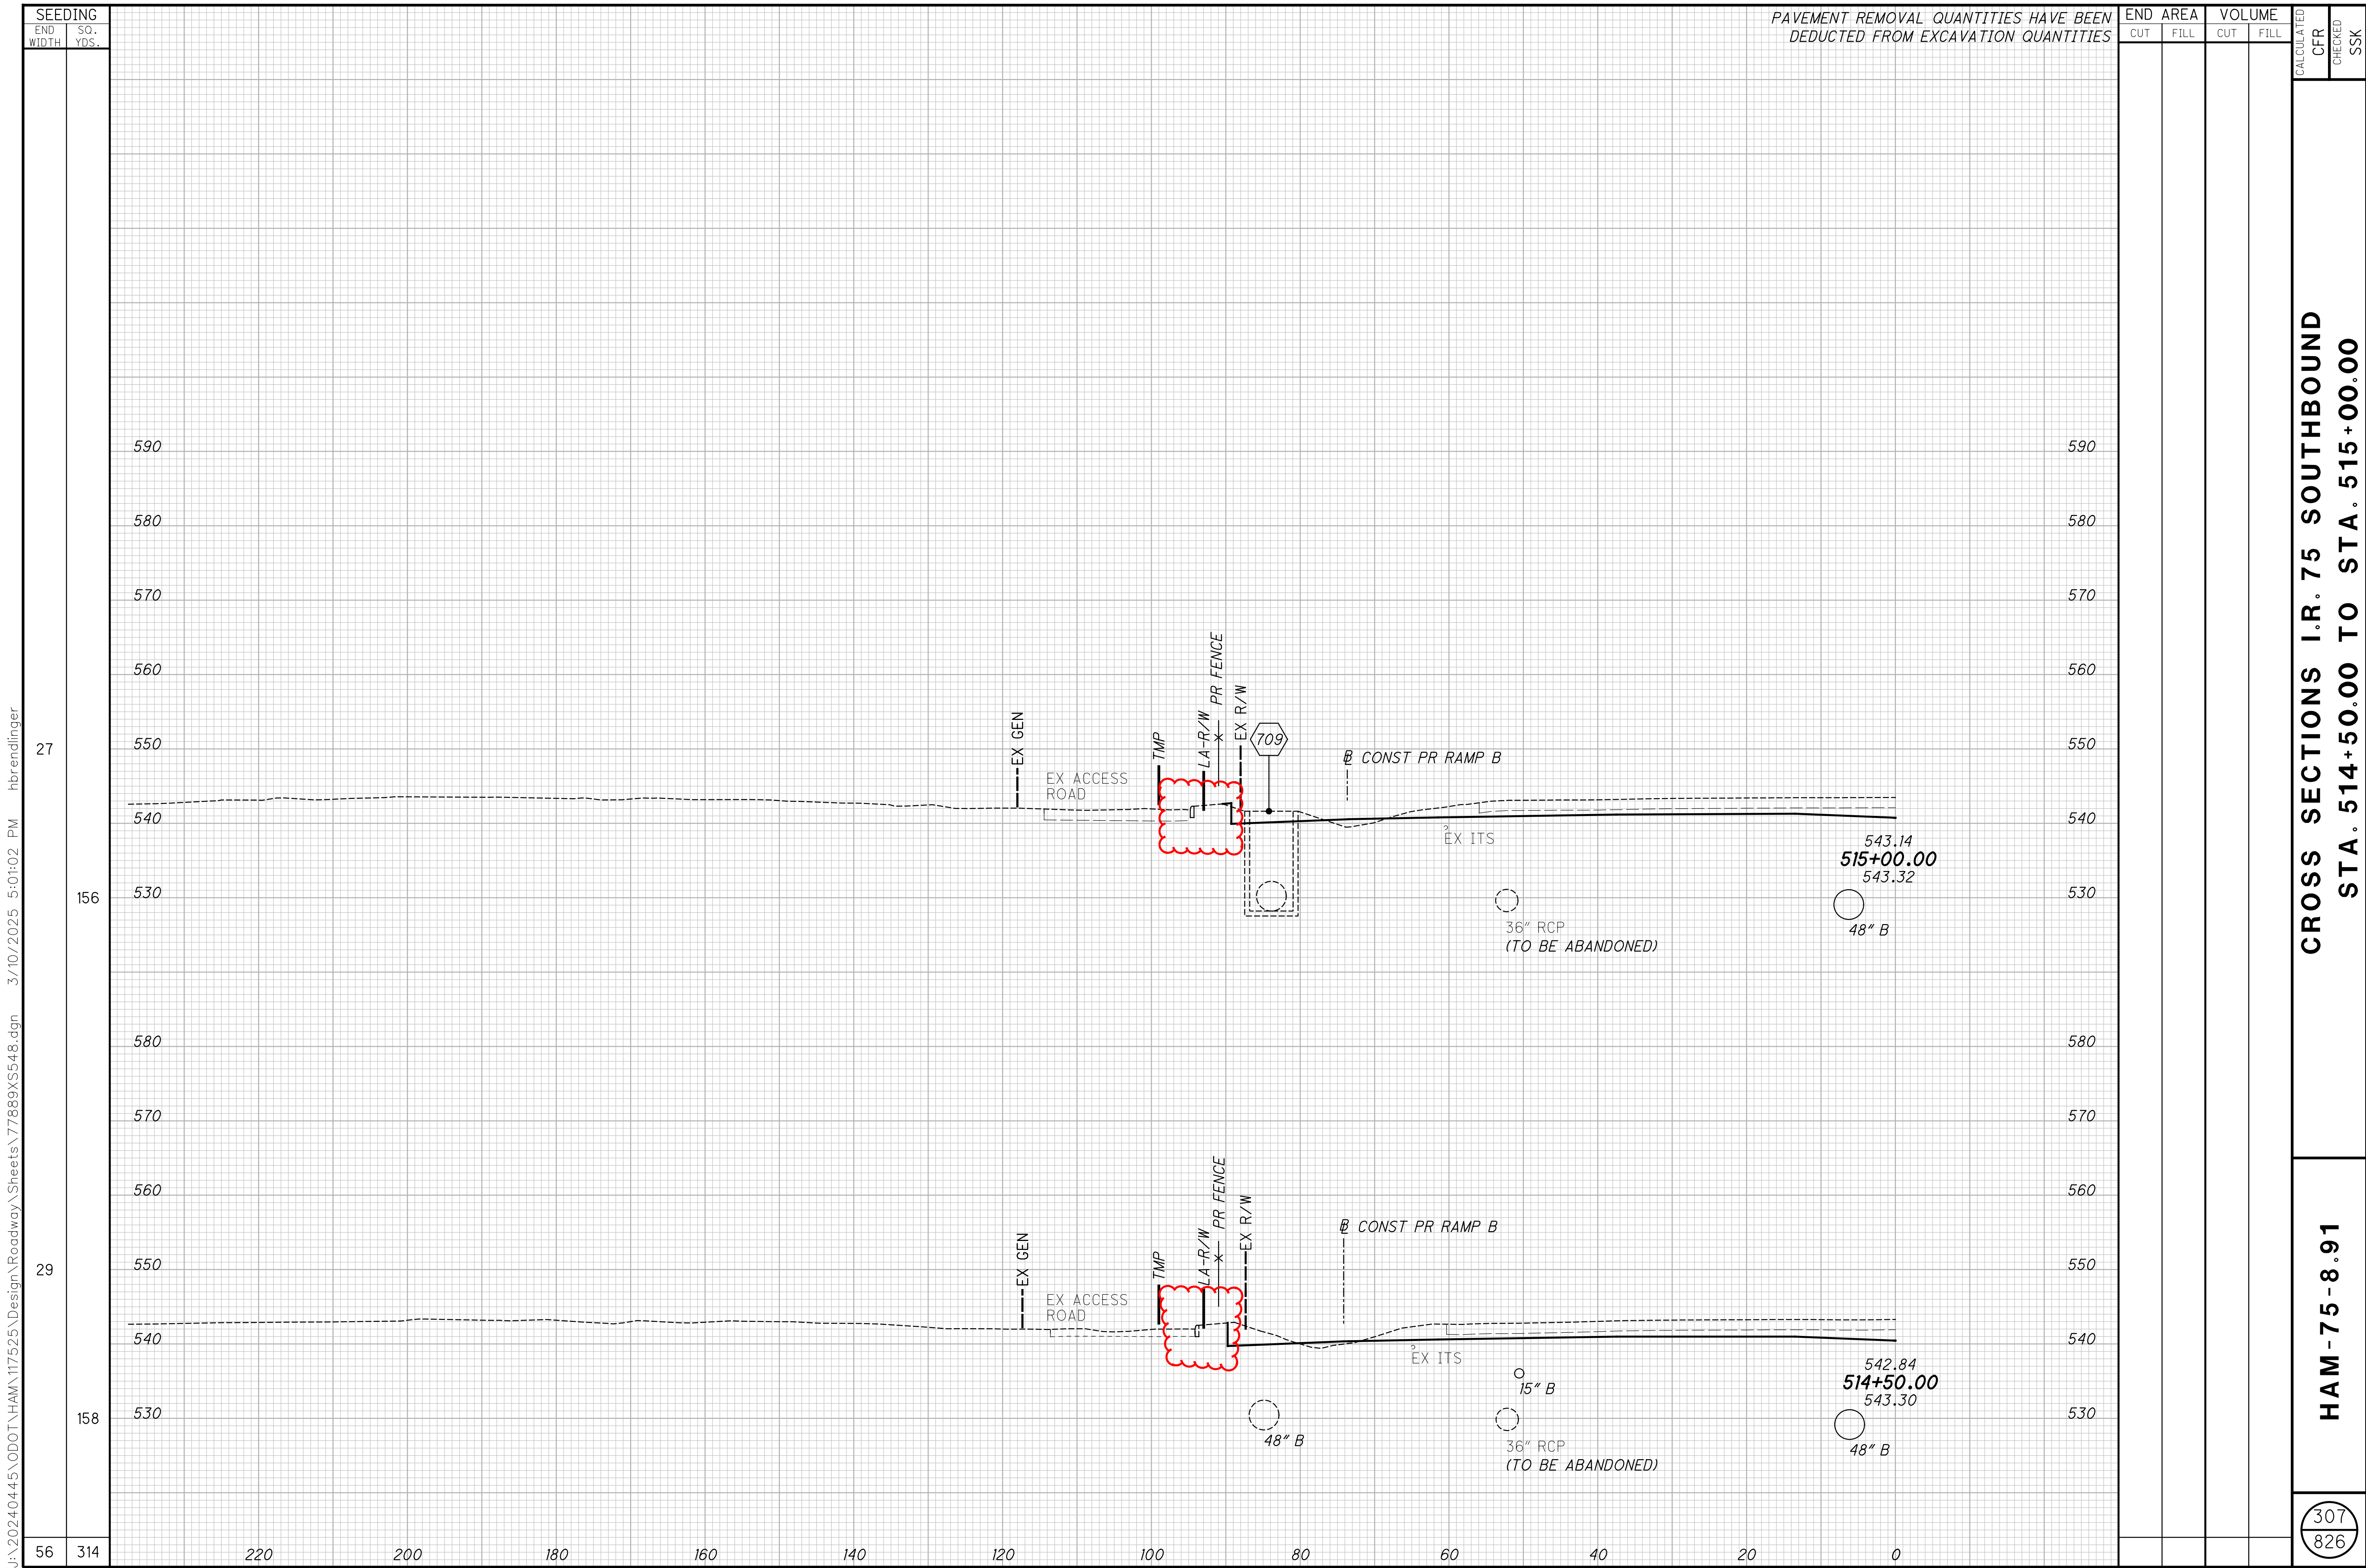

J:\20240445\ODOT\HAM\117525\Design\Roadway\Sheets\77889XS550.dgn 3/10/2025 5:02:01 PM hbrendlinger

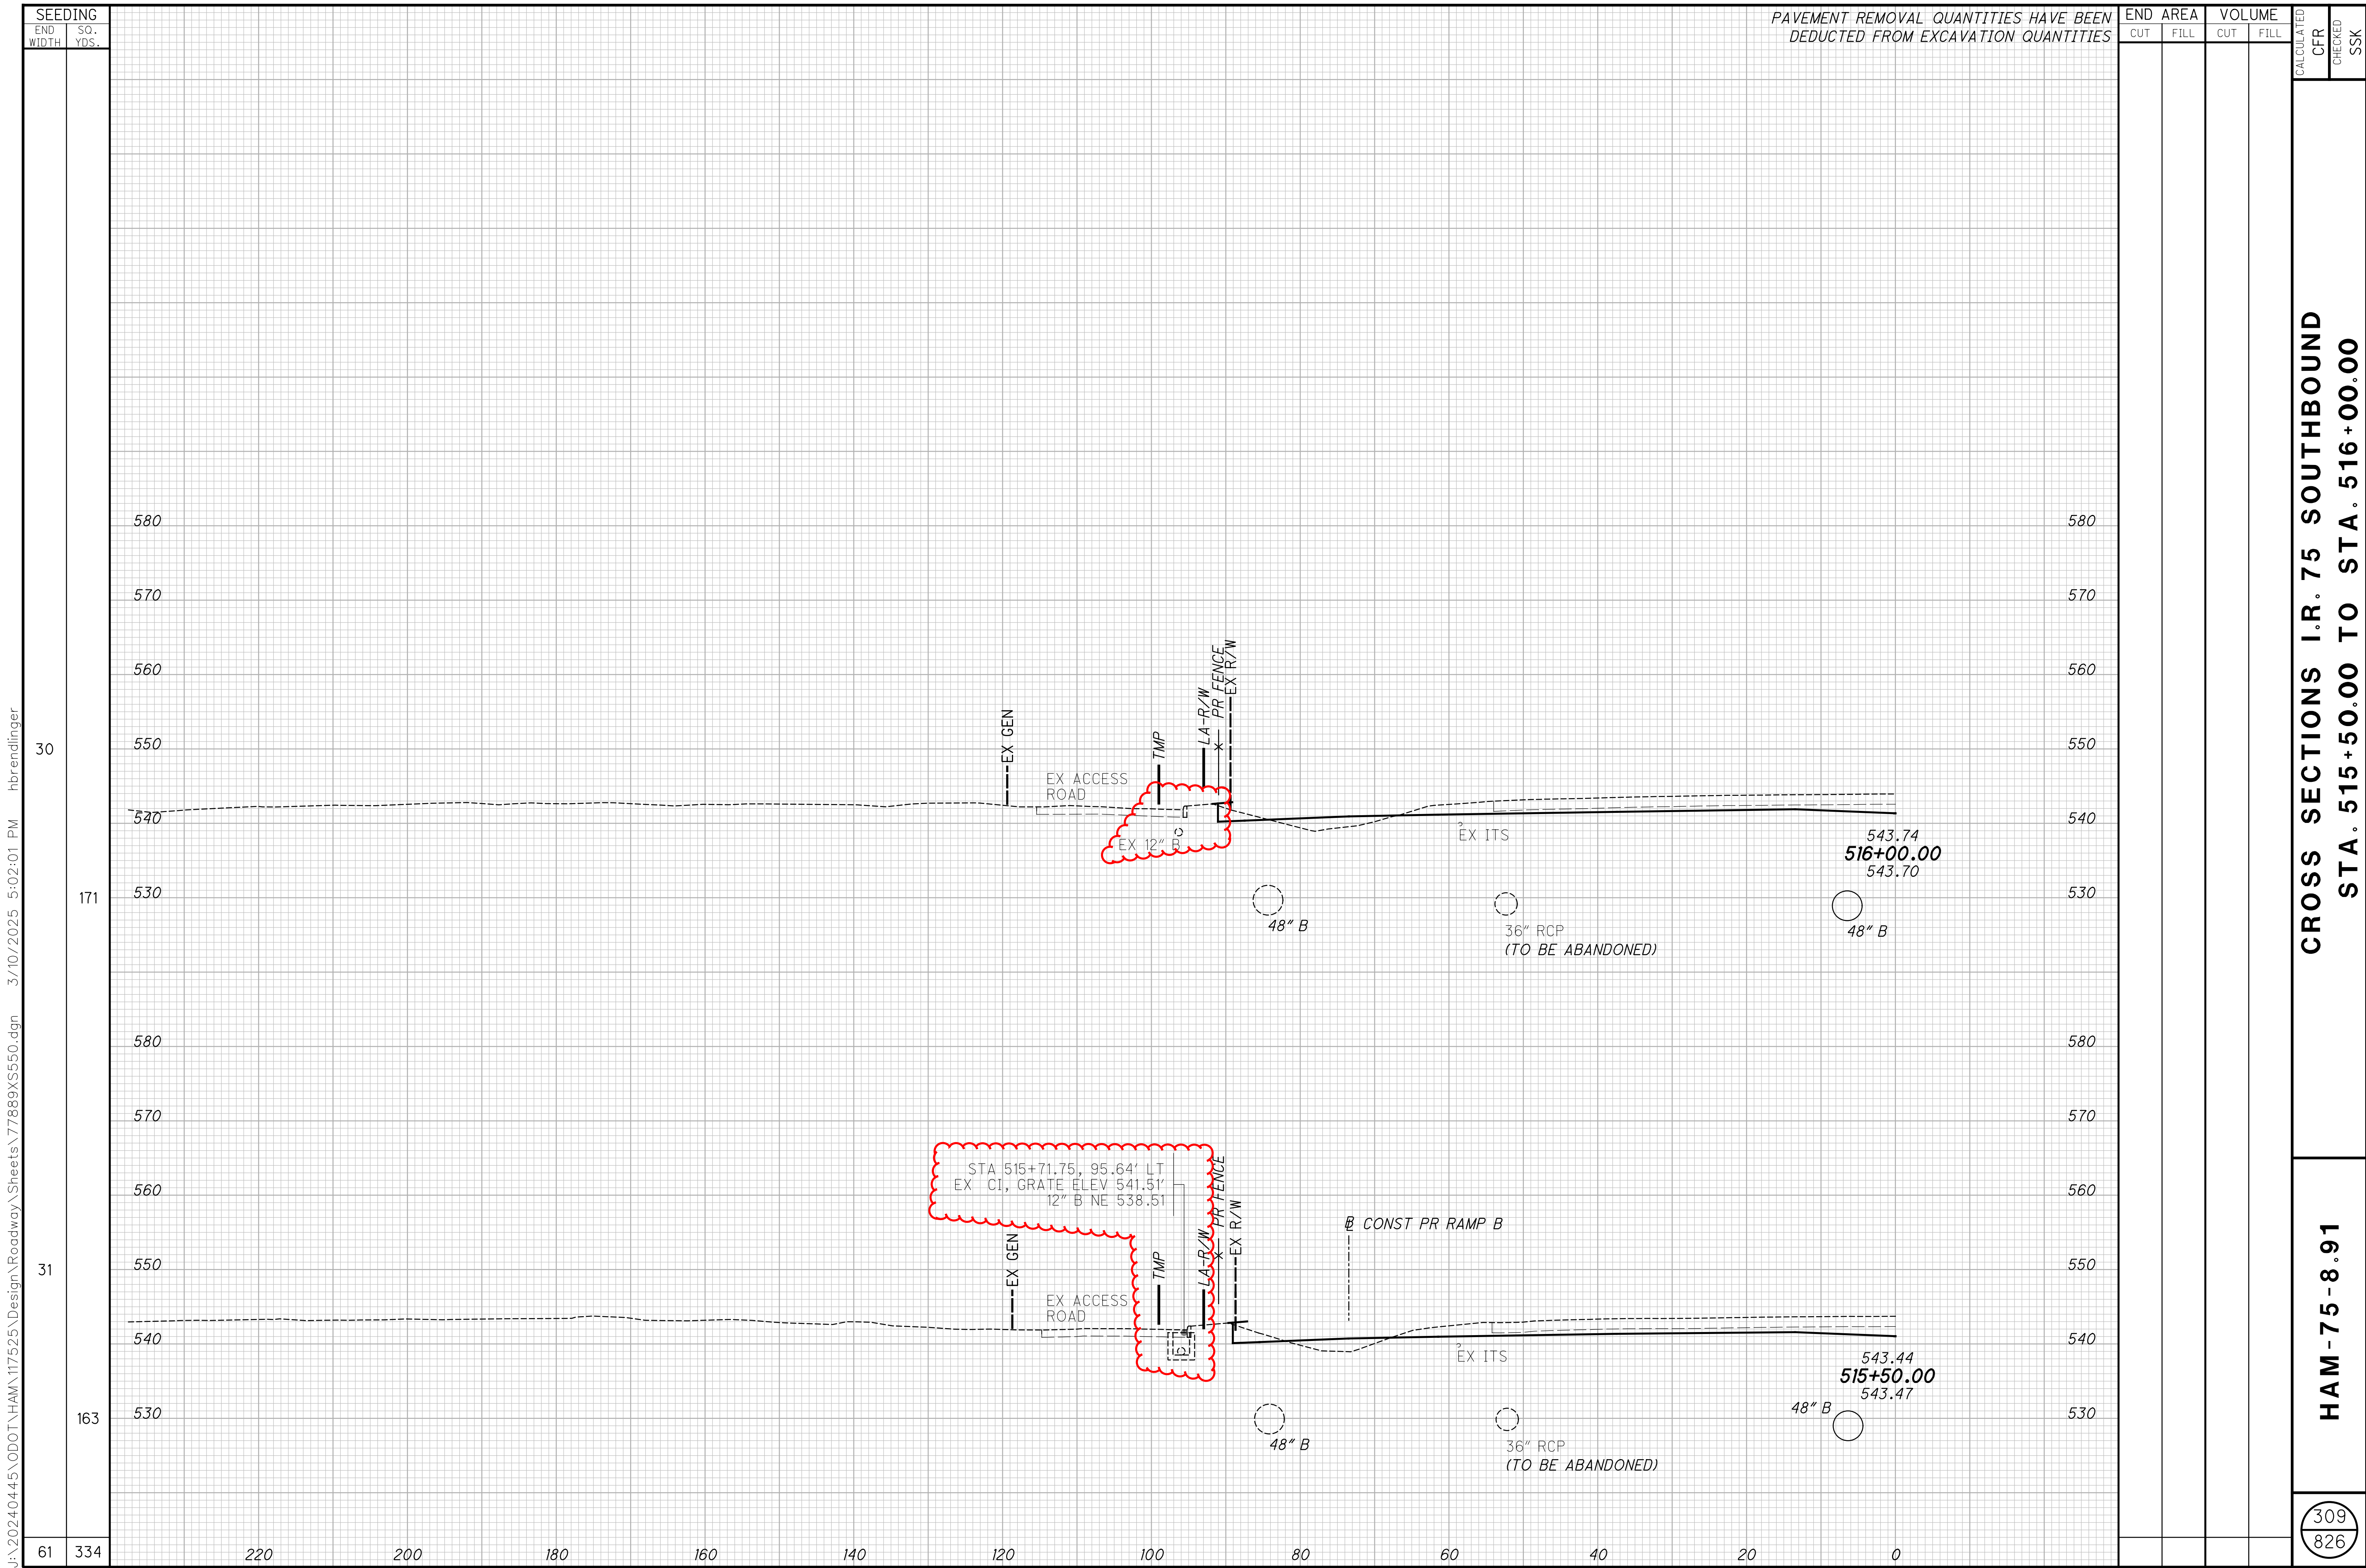


CROSS SECTIONS I.R. 75 SOUTHBOUND
STA. 515+50.00 TO STA. 516+00.00

HAM-75-8.91


309
826


311
826


J:\20240445\ODOT\HAM\117525\Design\Roadway\Sheets\77889XS554.dgn 3/10/2025 5:04:17 PM hbrendlinger

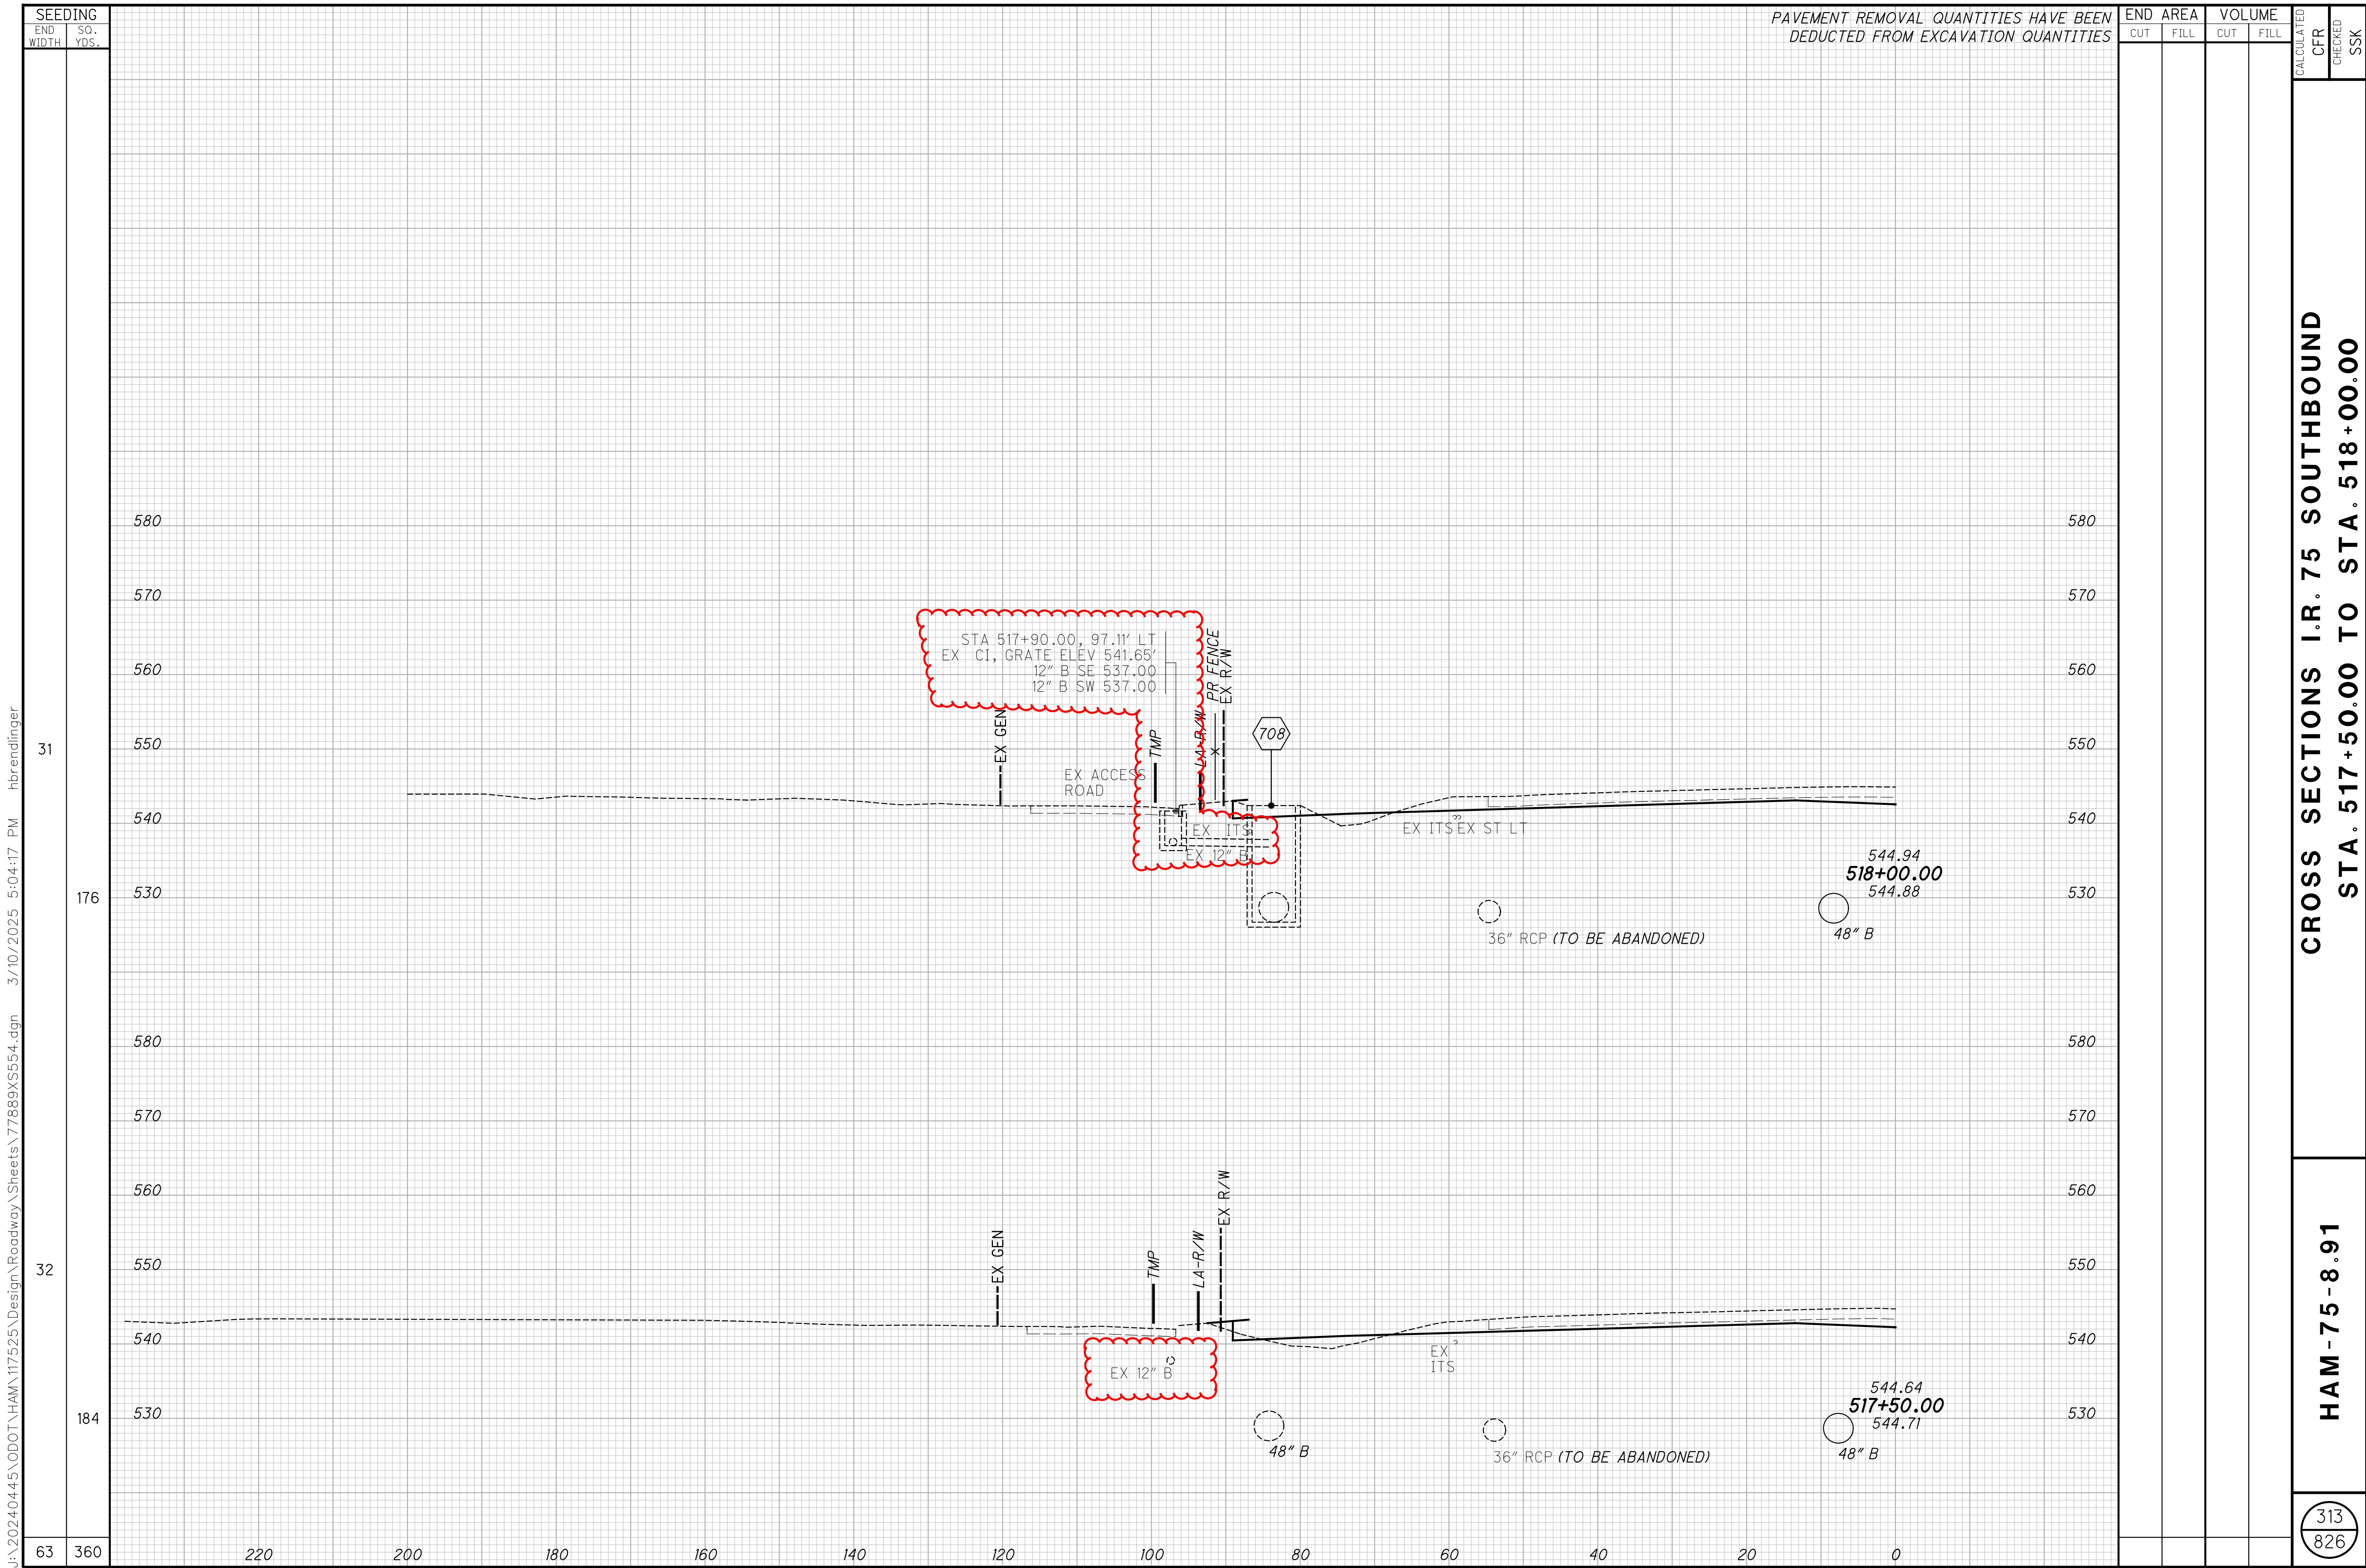


J:\20240445\ODOT\HAM\117525\Design\Roadway\Sheets\77889XS919A.dgn 3/10/2025 5:05:41 PM hbrendinger

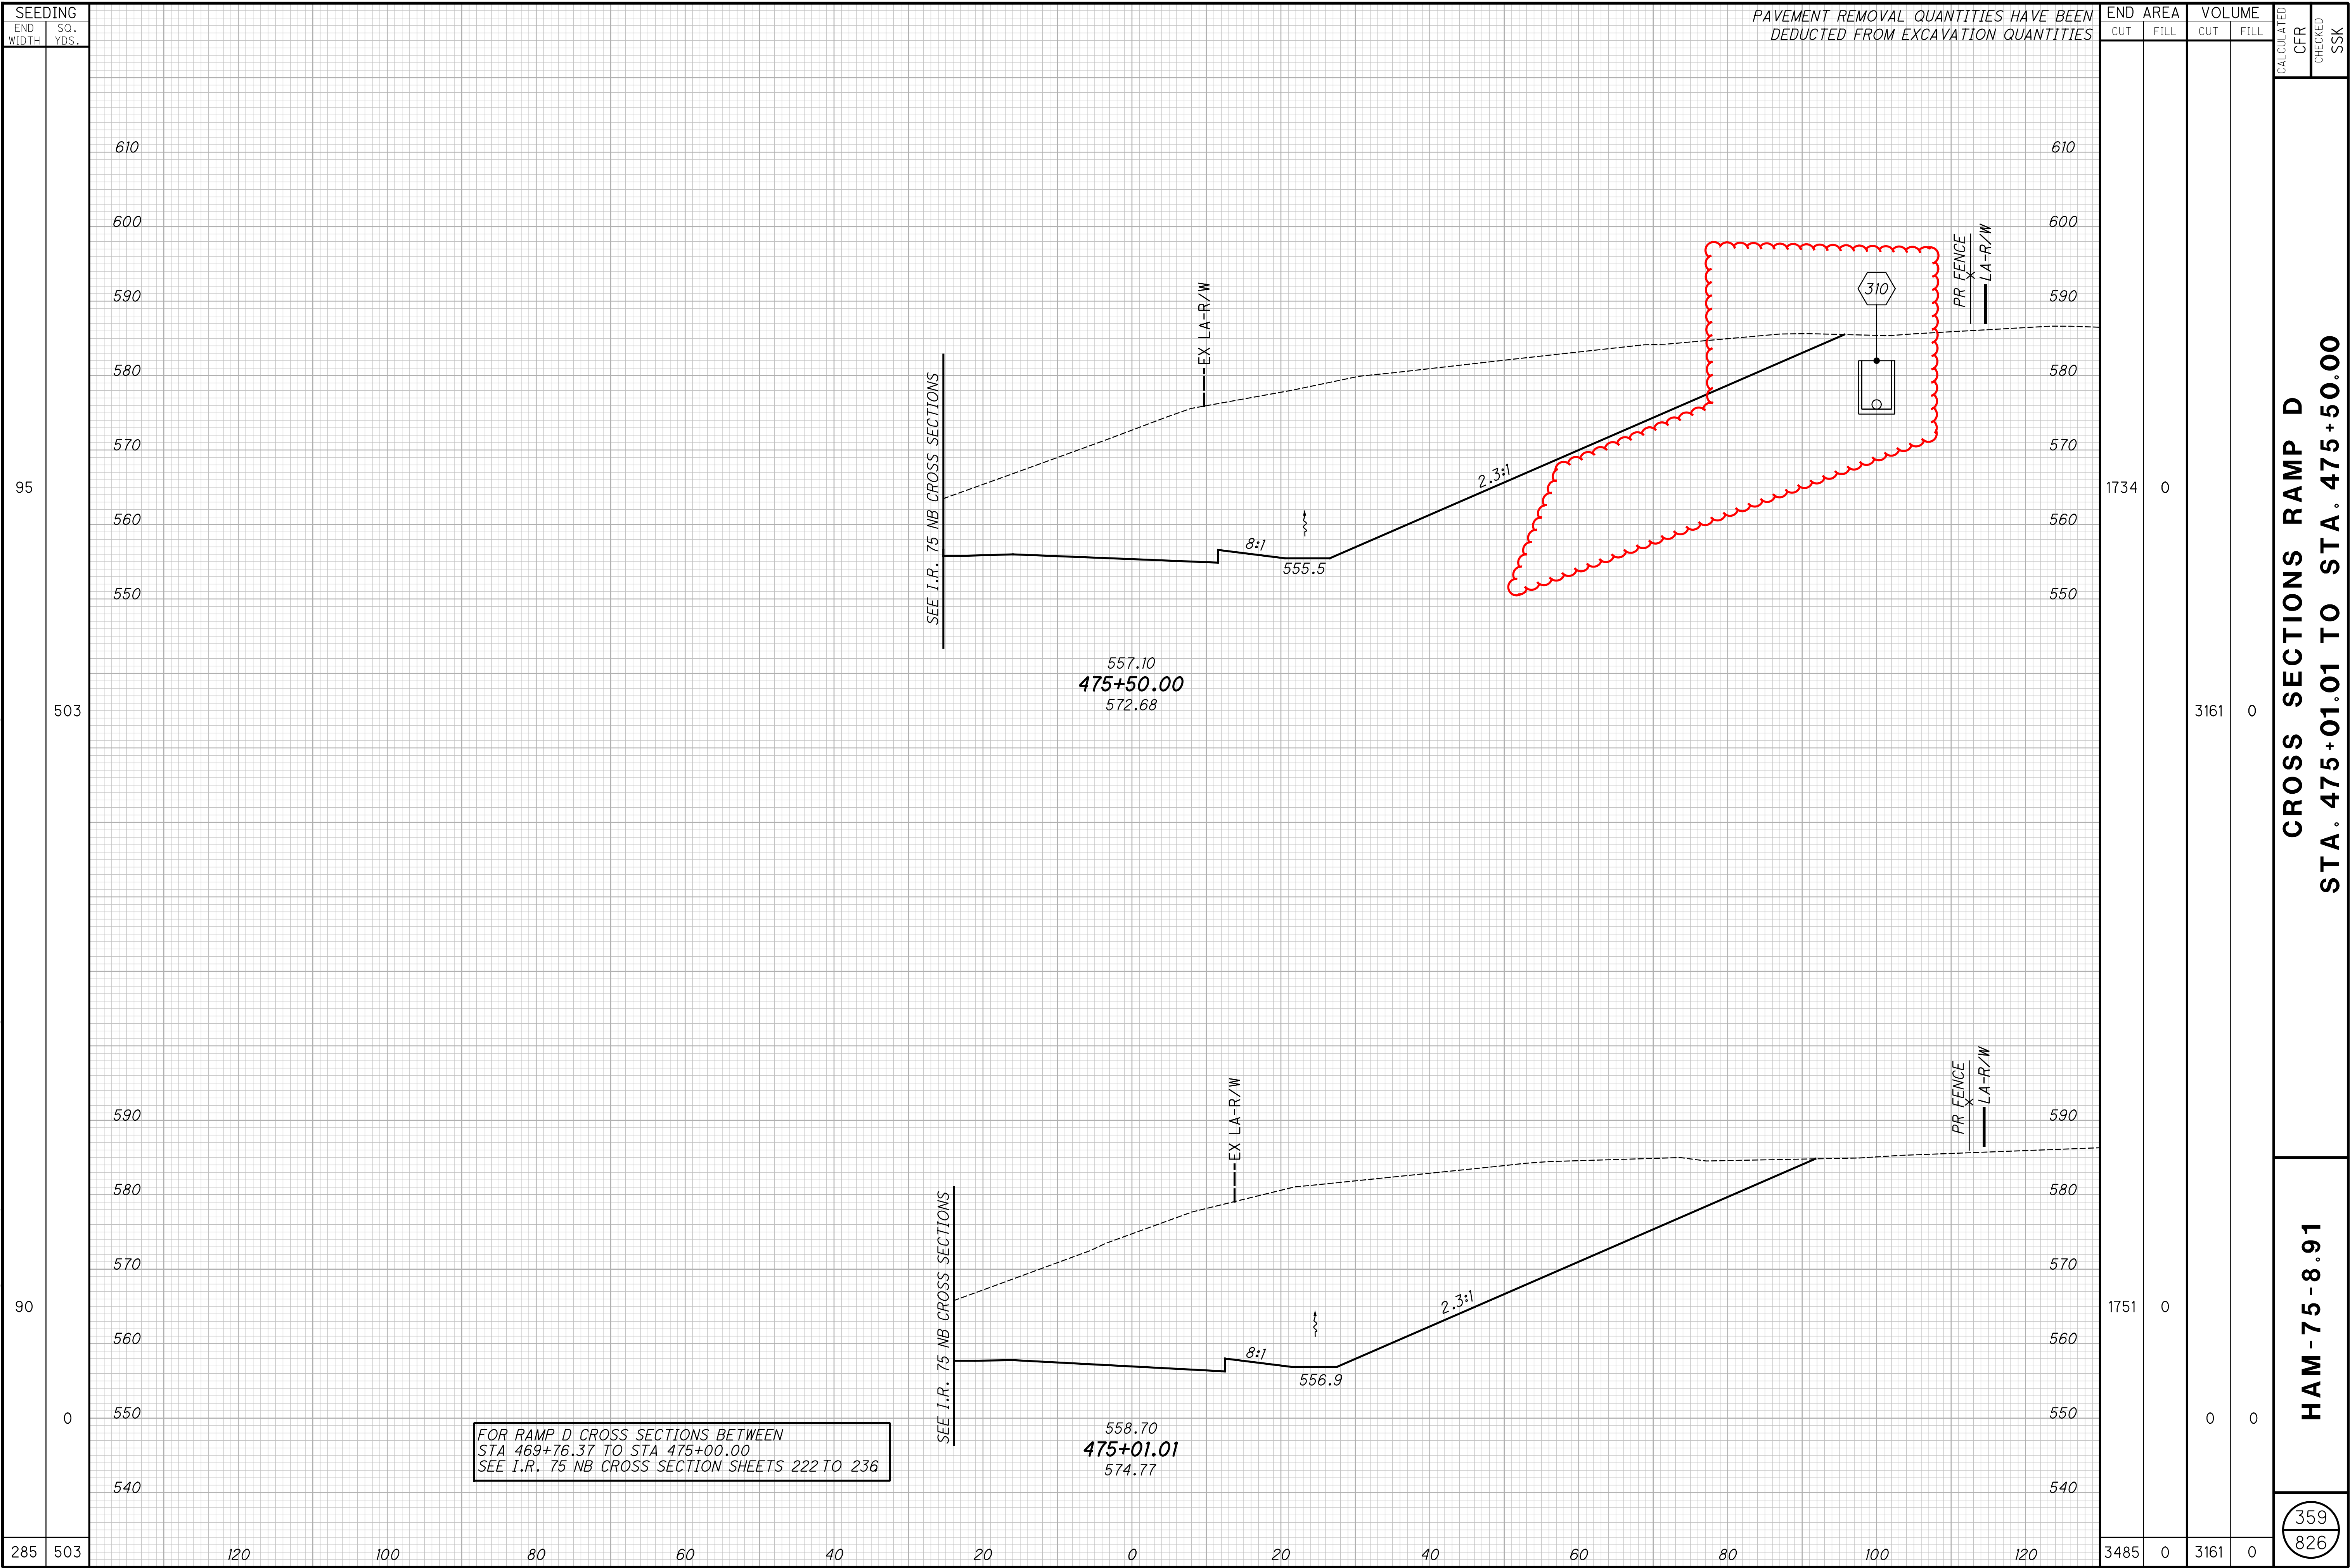


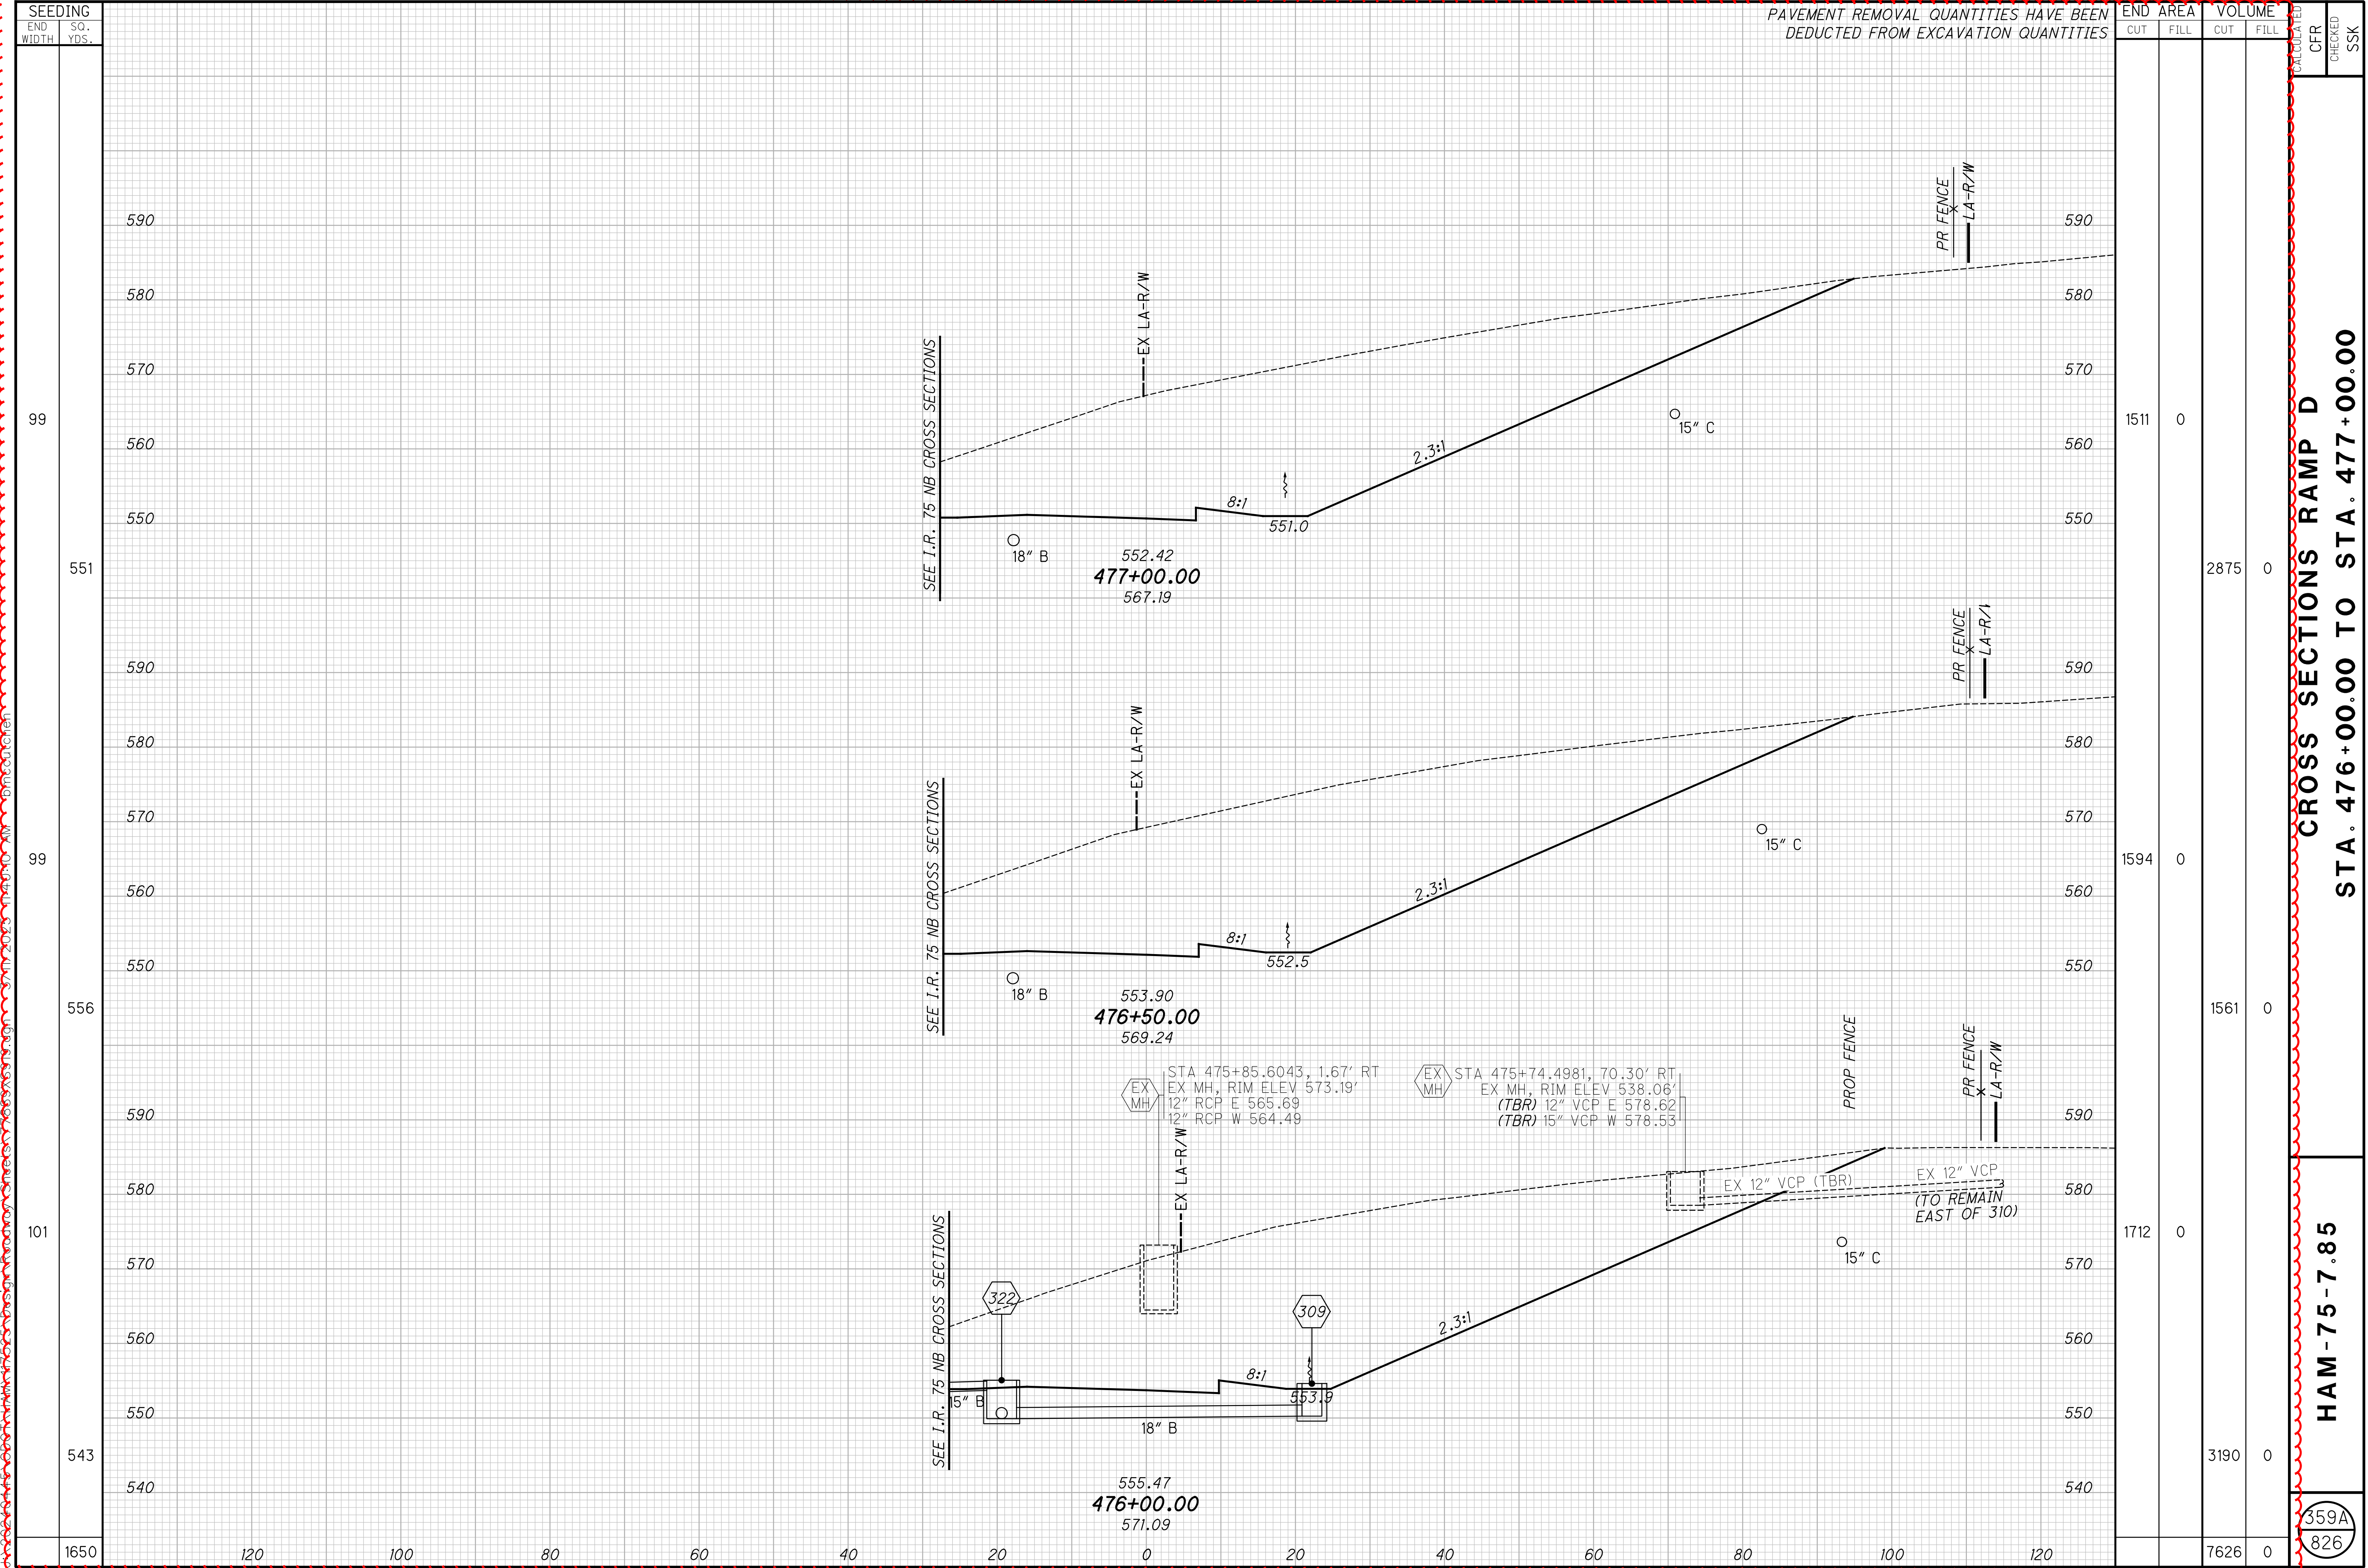


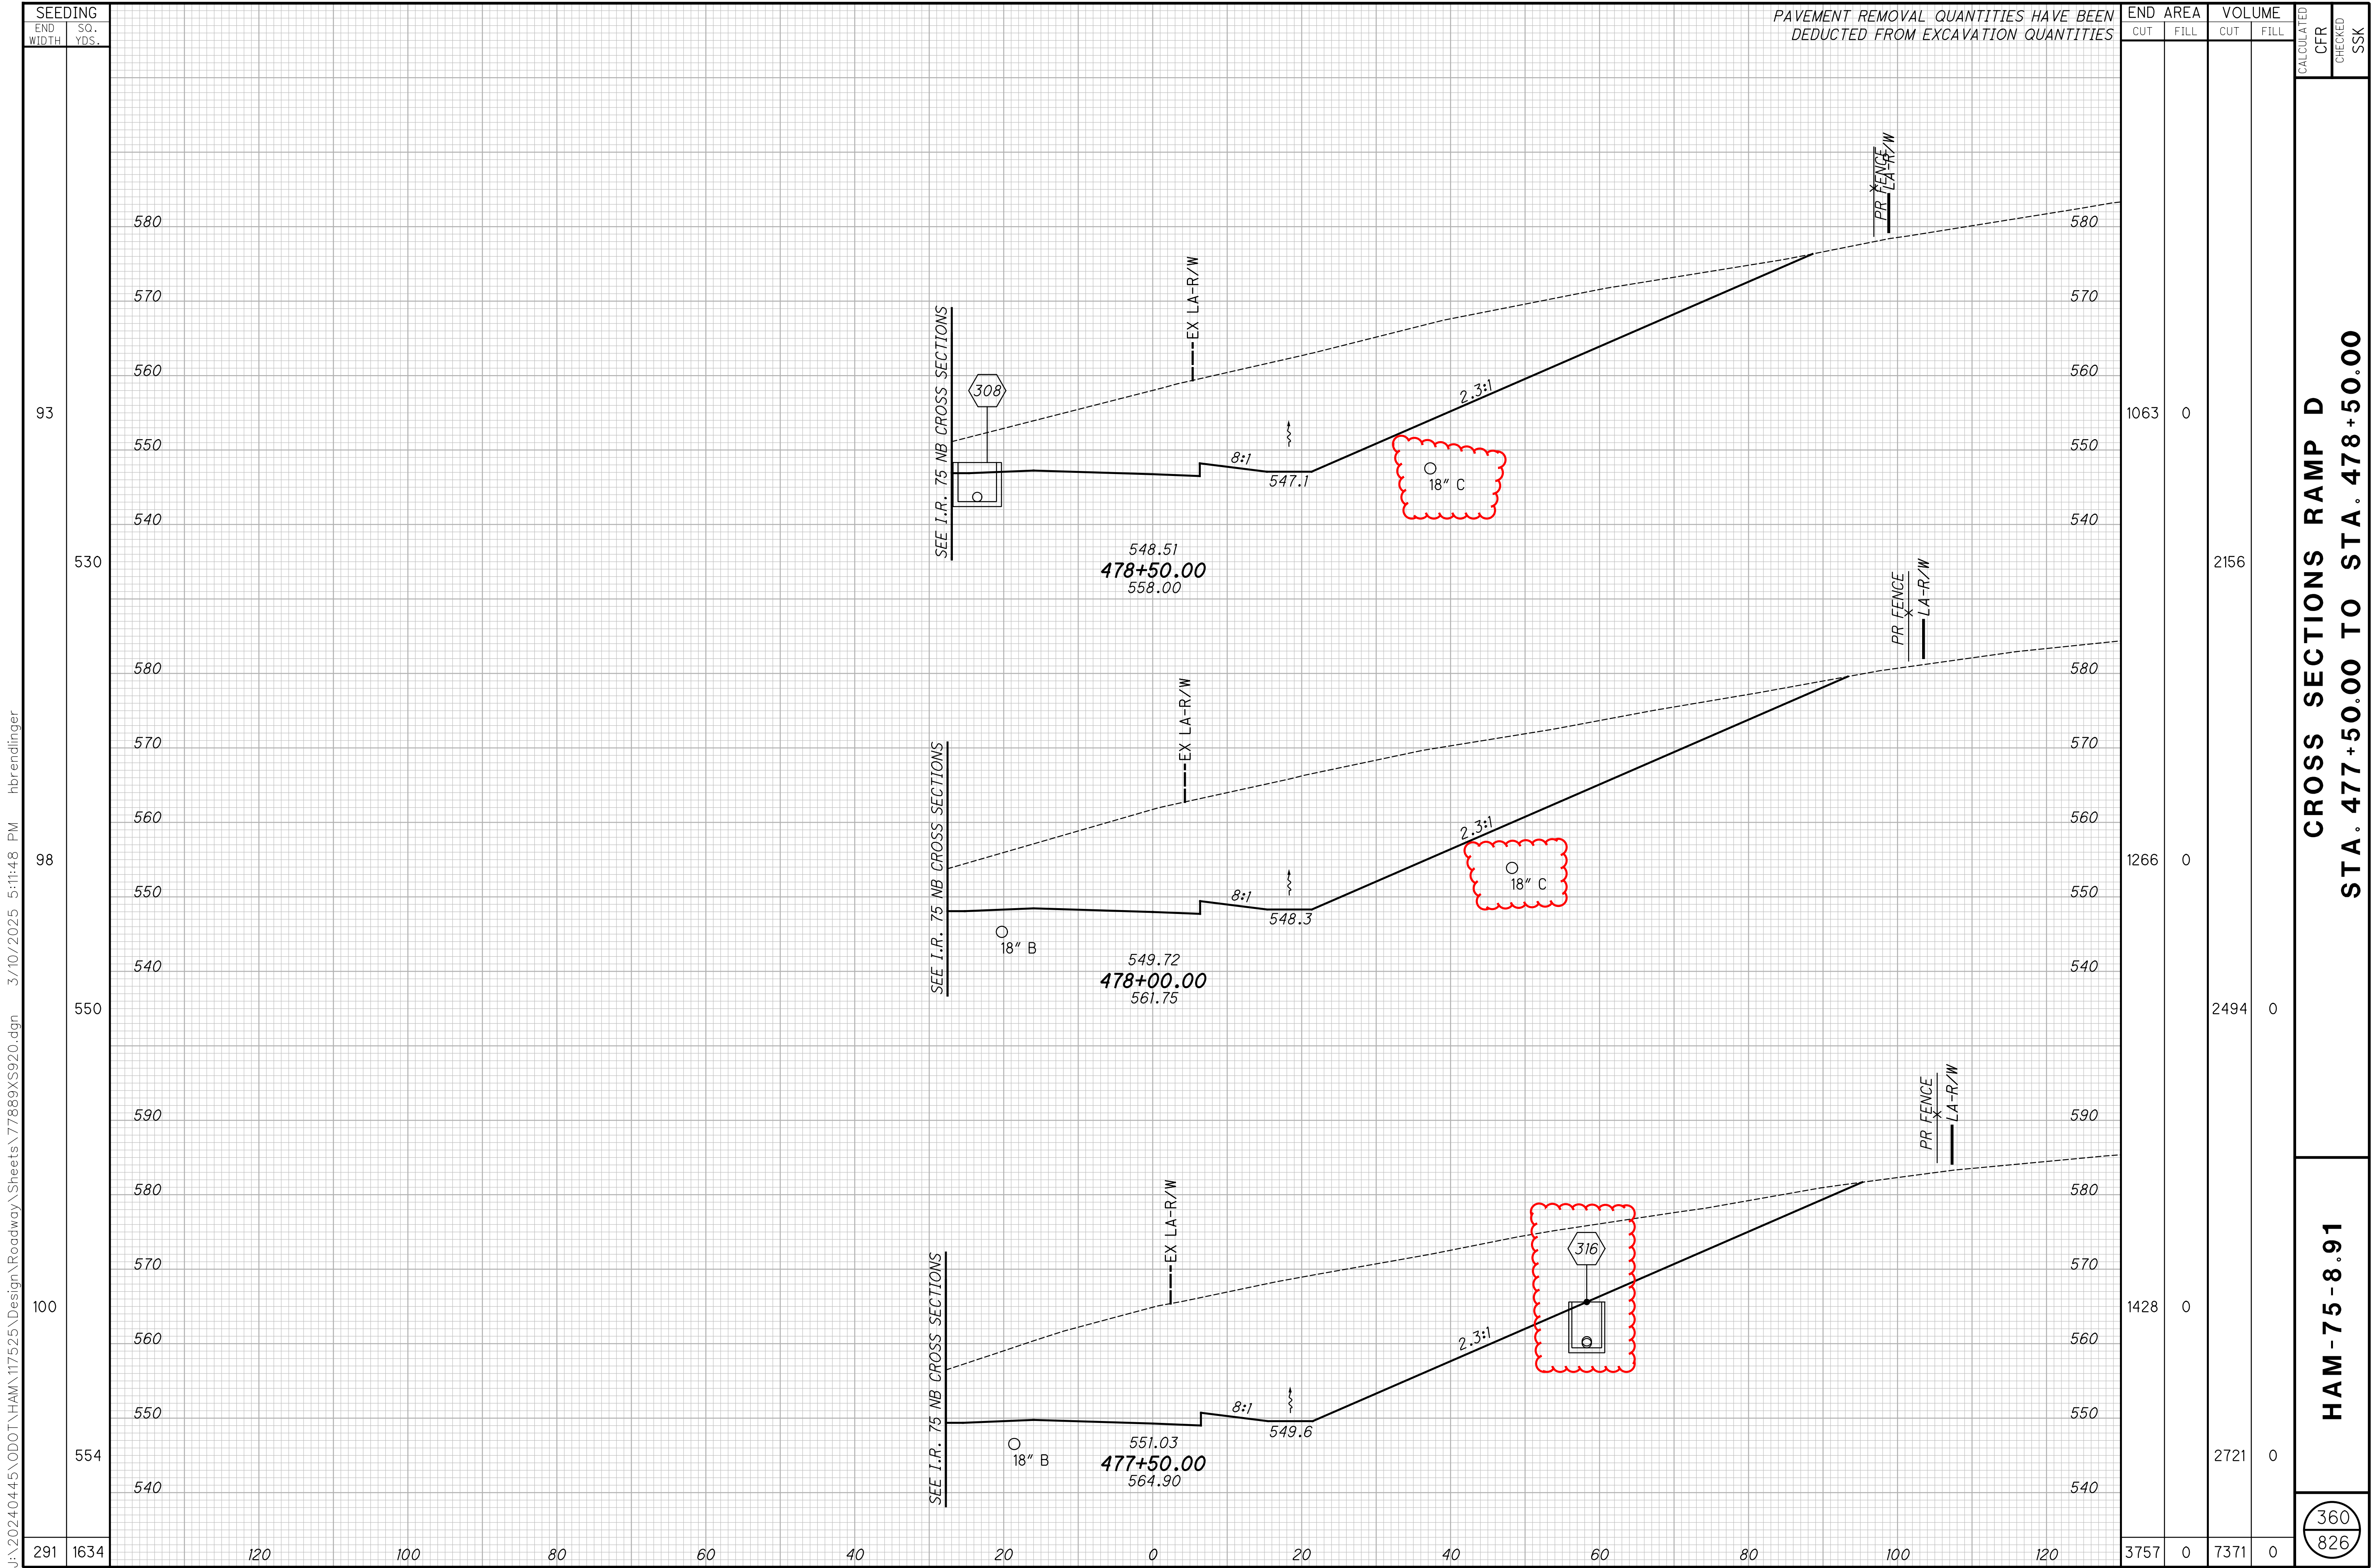


J:\20240445\ODOT\HAM\117525\Design\Roadway\Sheets\77889XS921.dgn 3/10/2025 5:07:00 PM hbrendinger

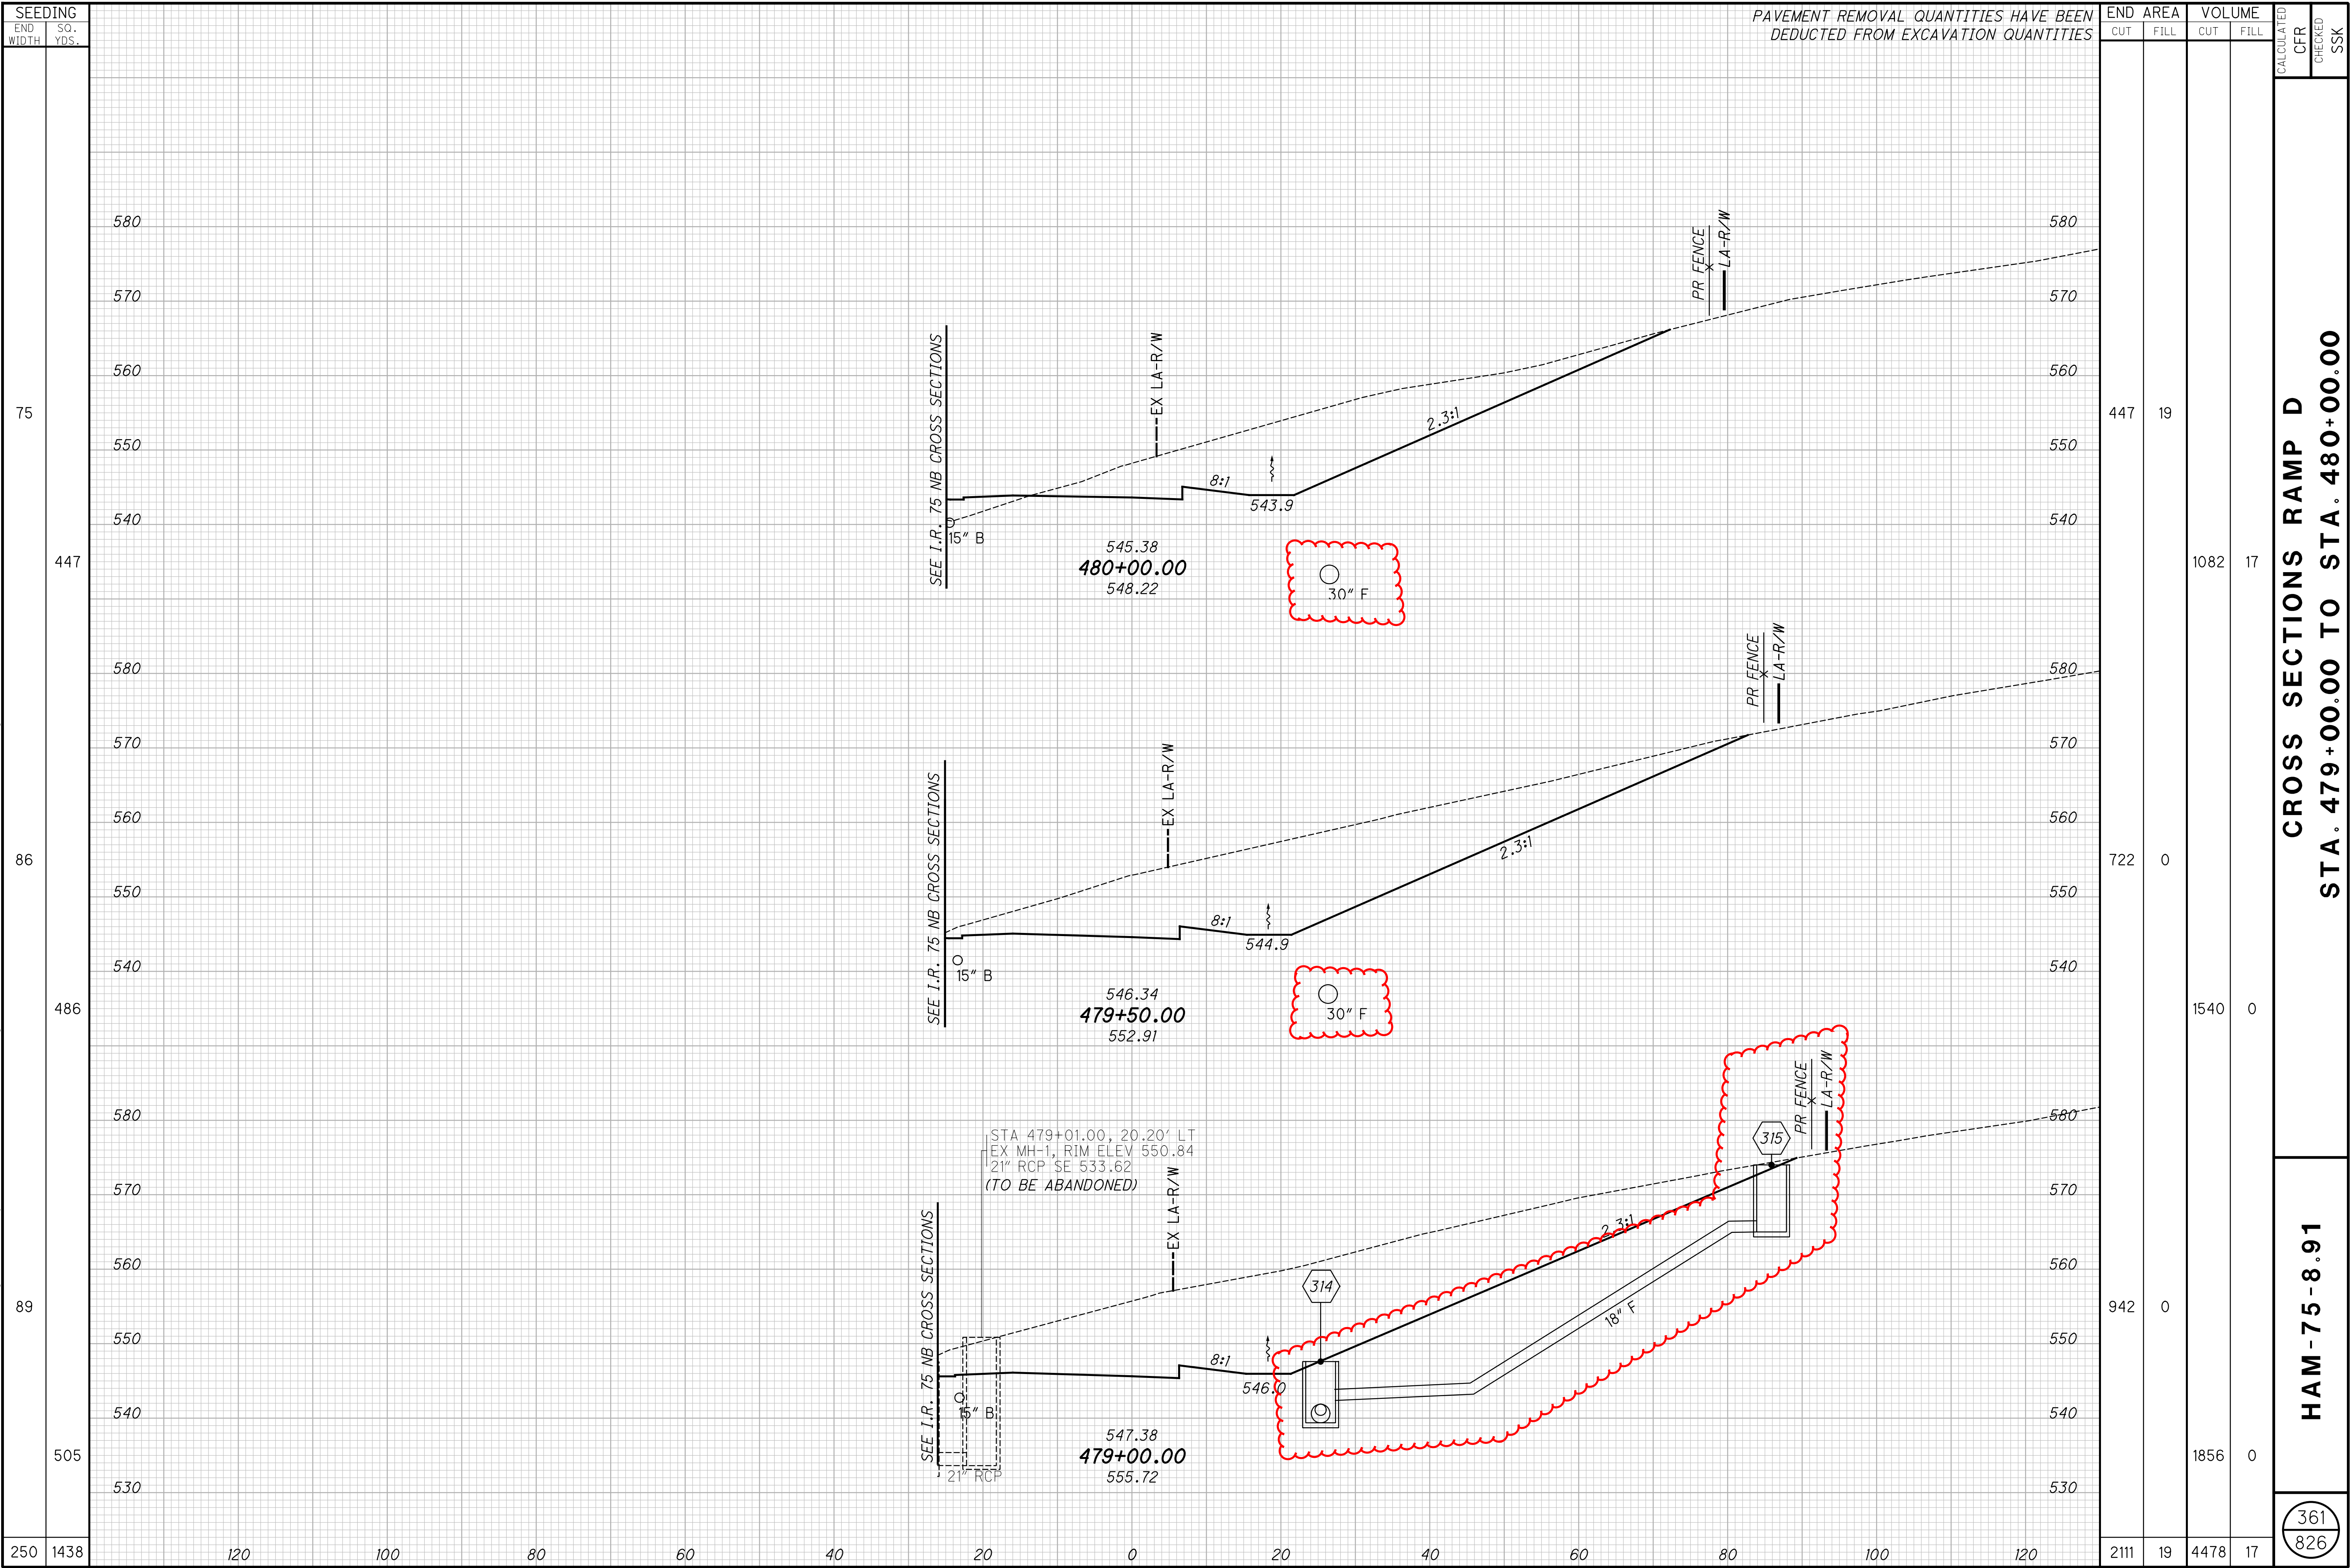

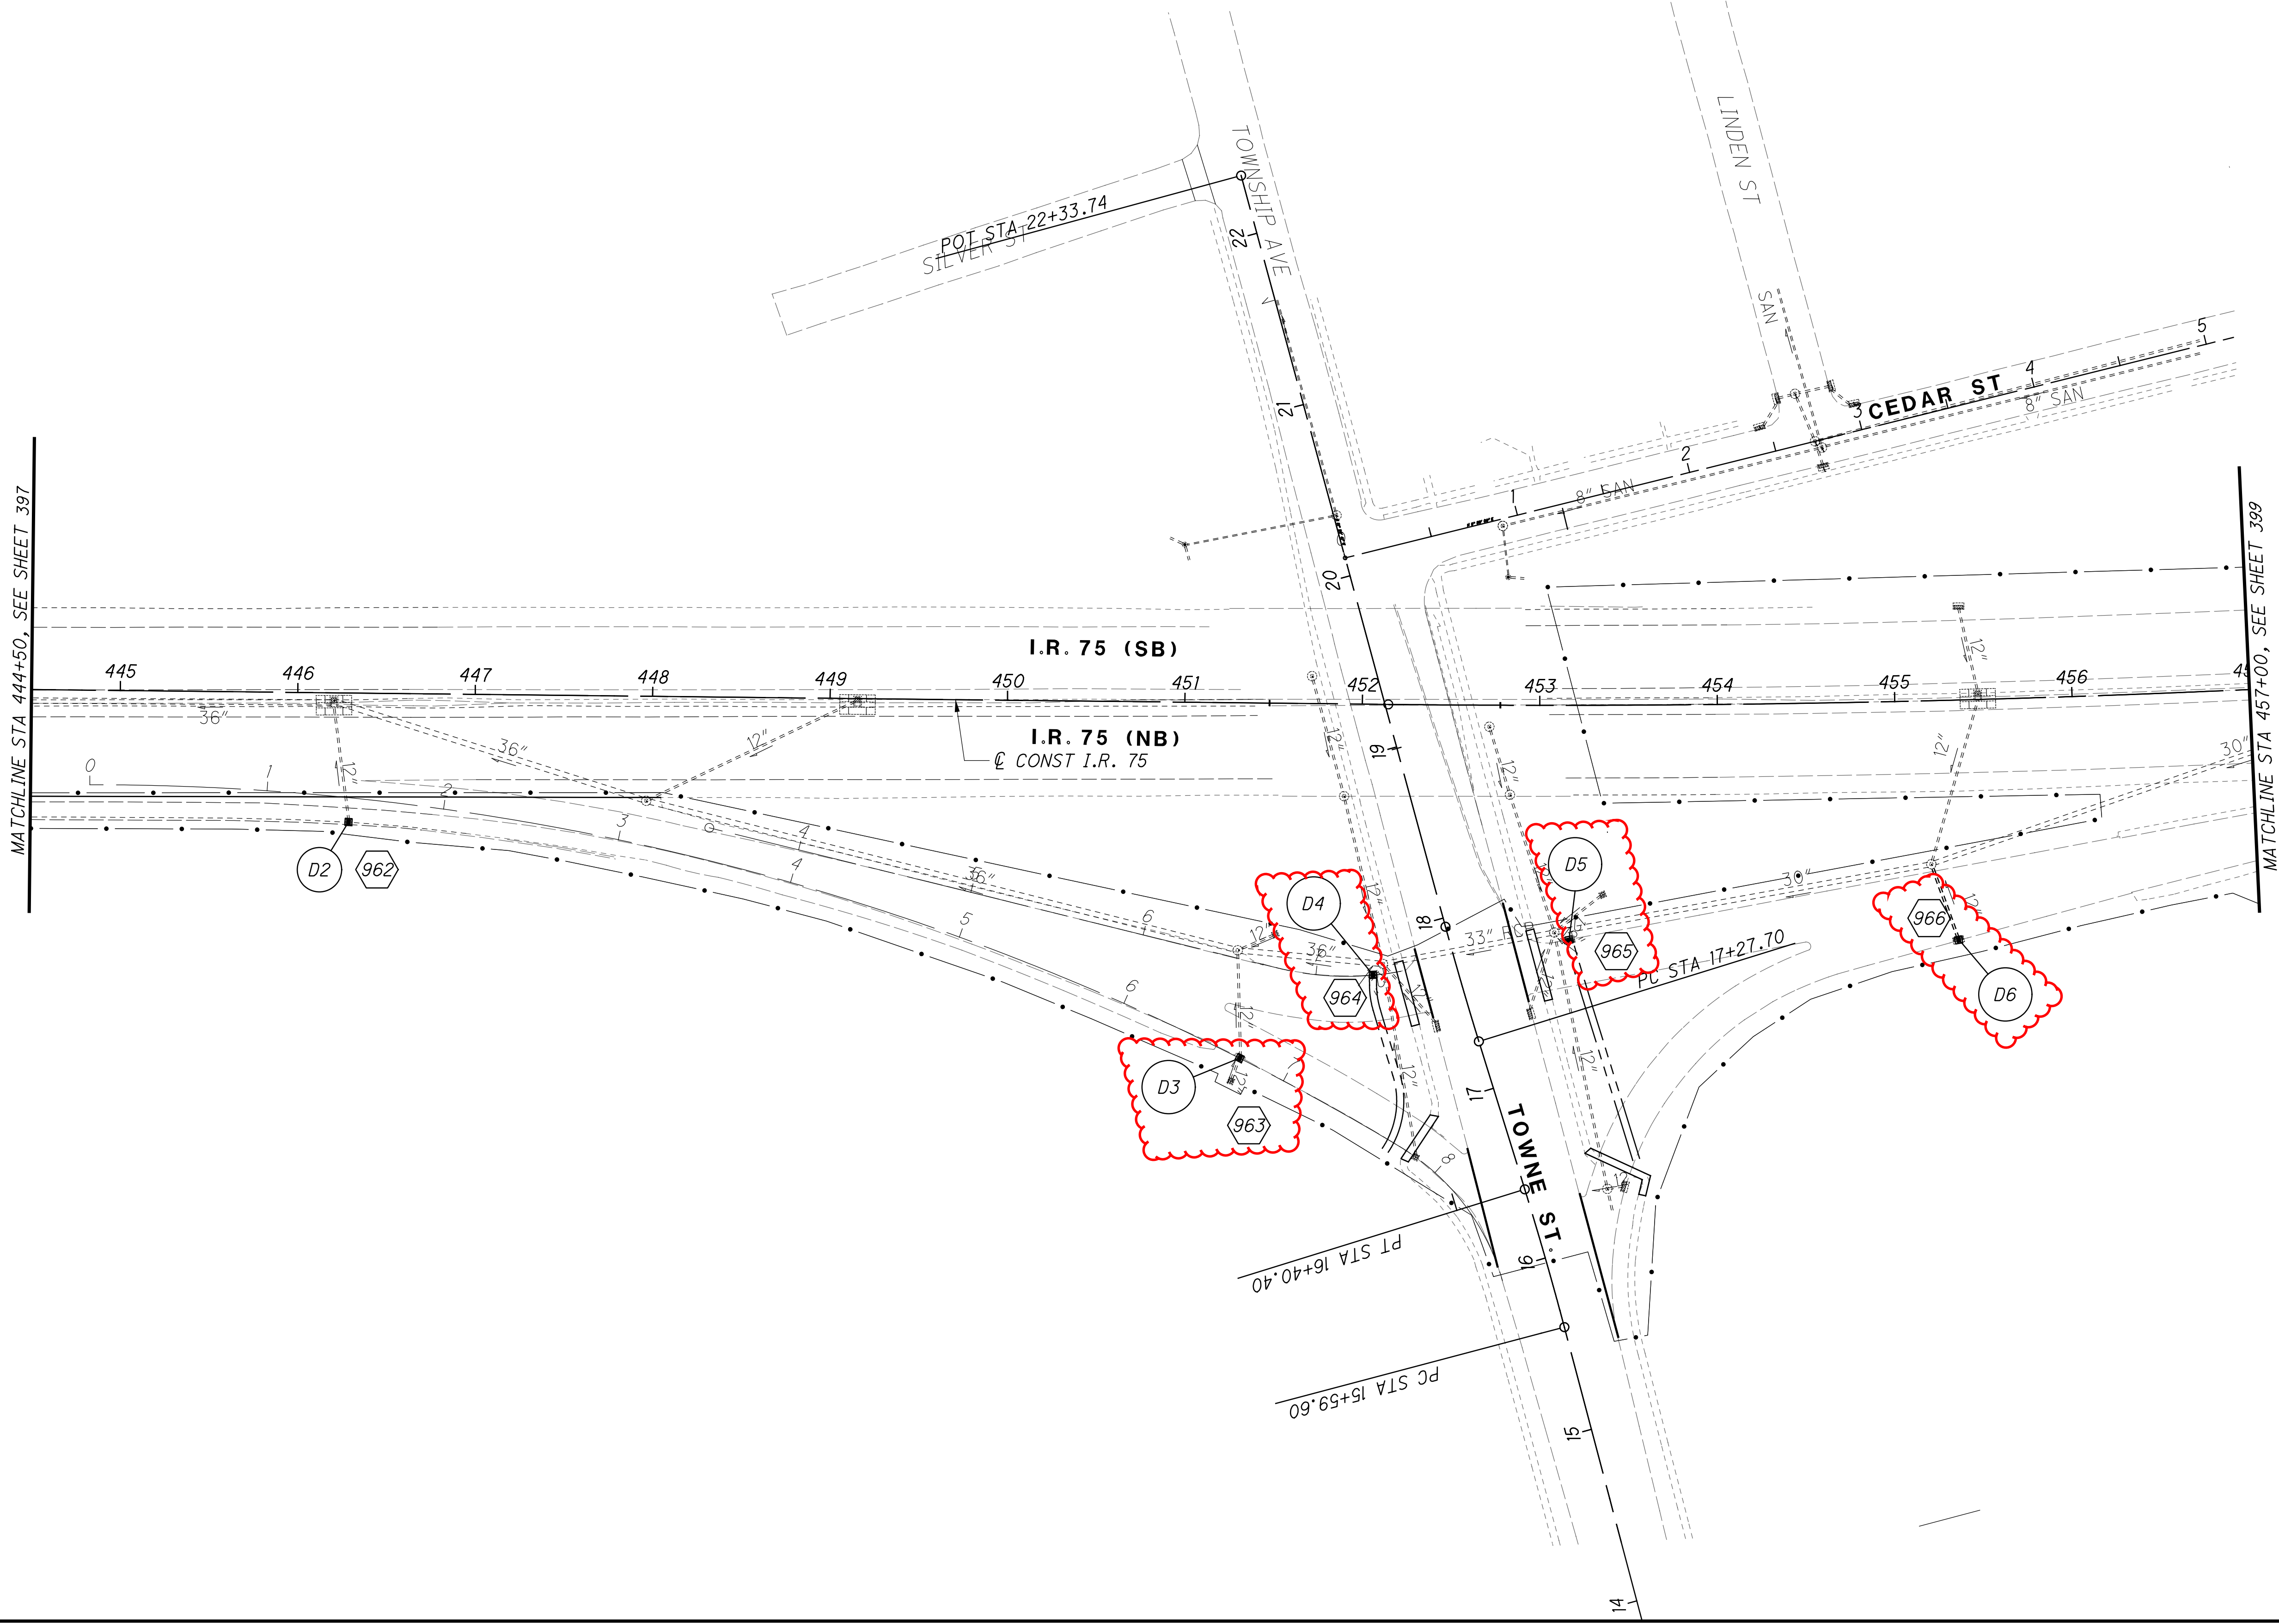

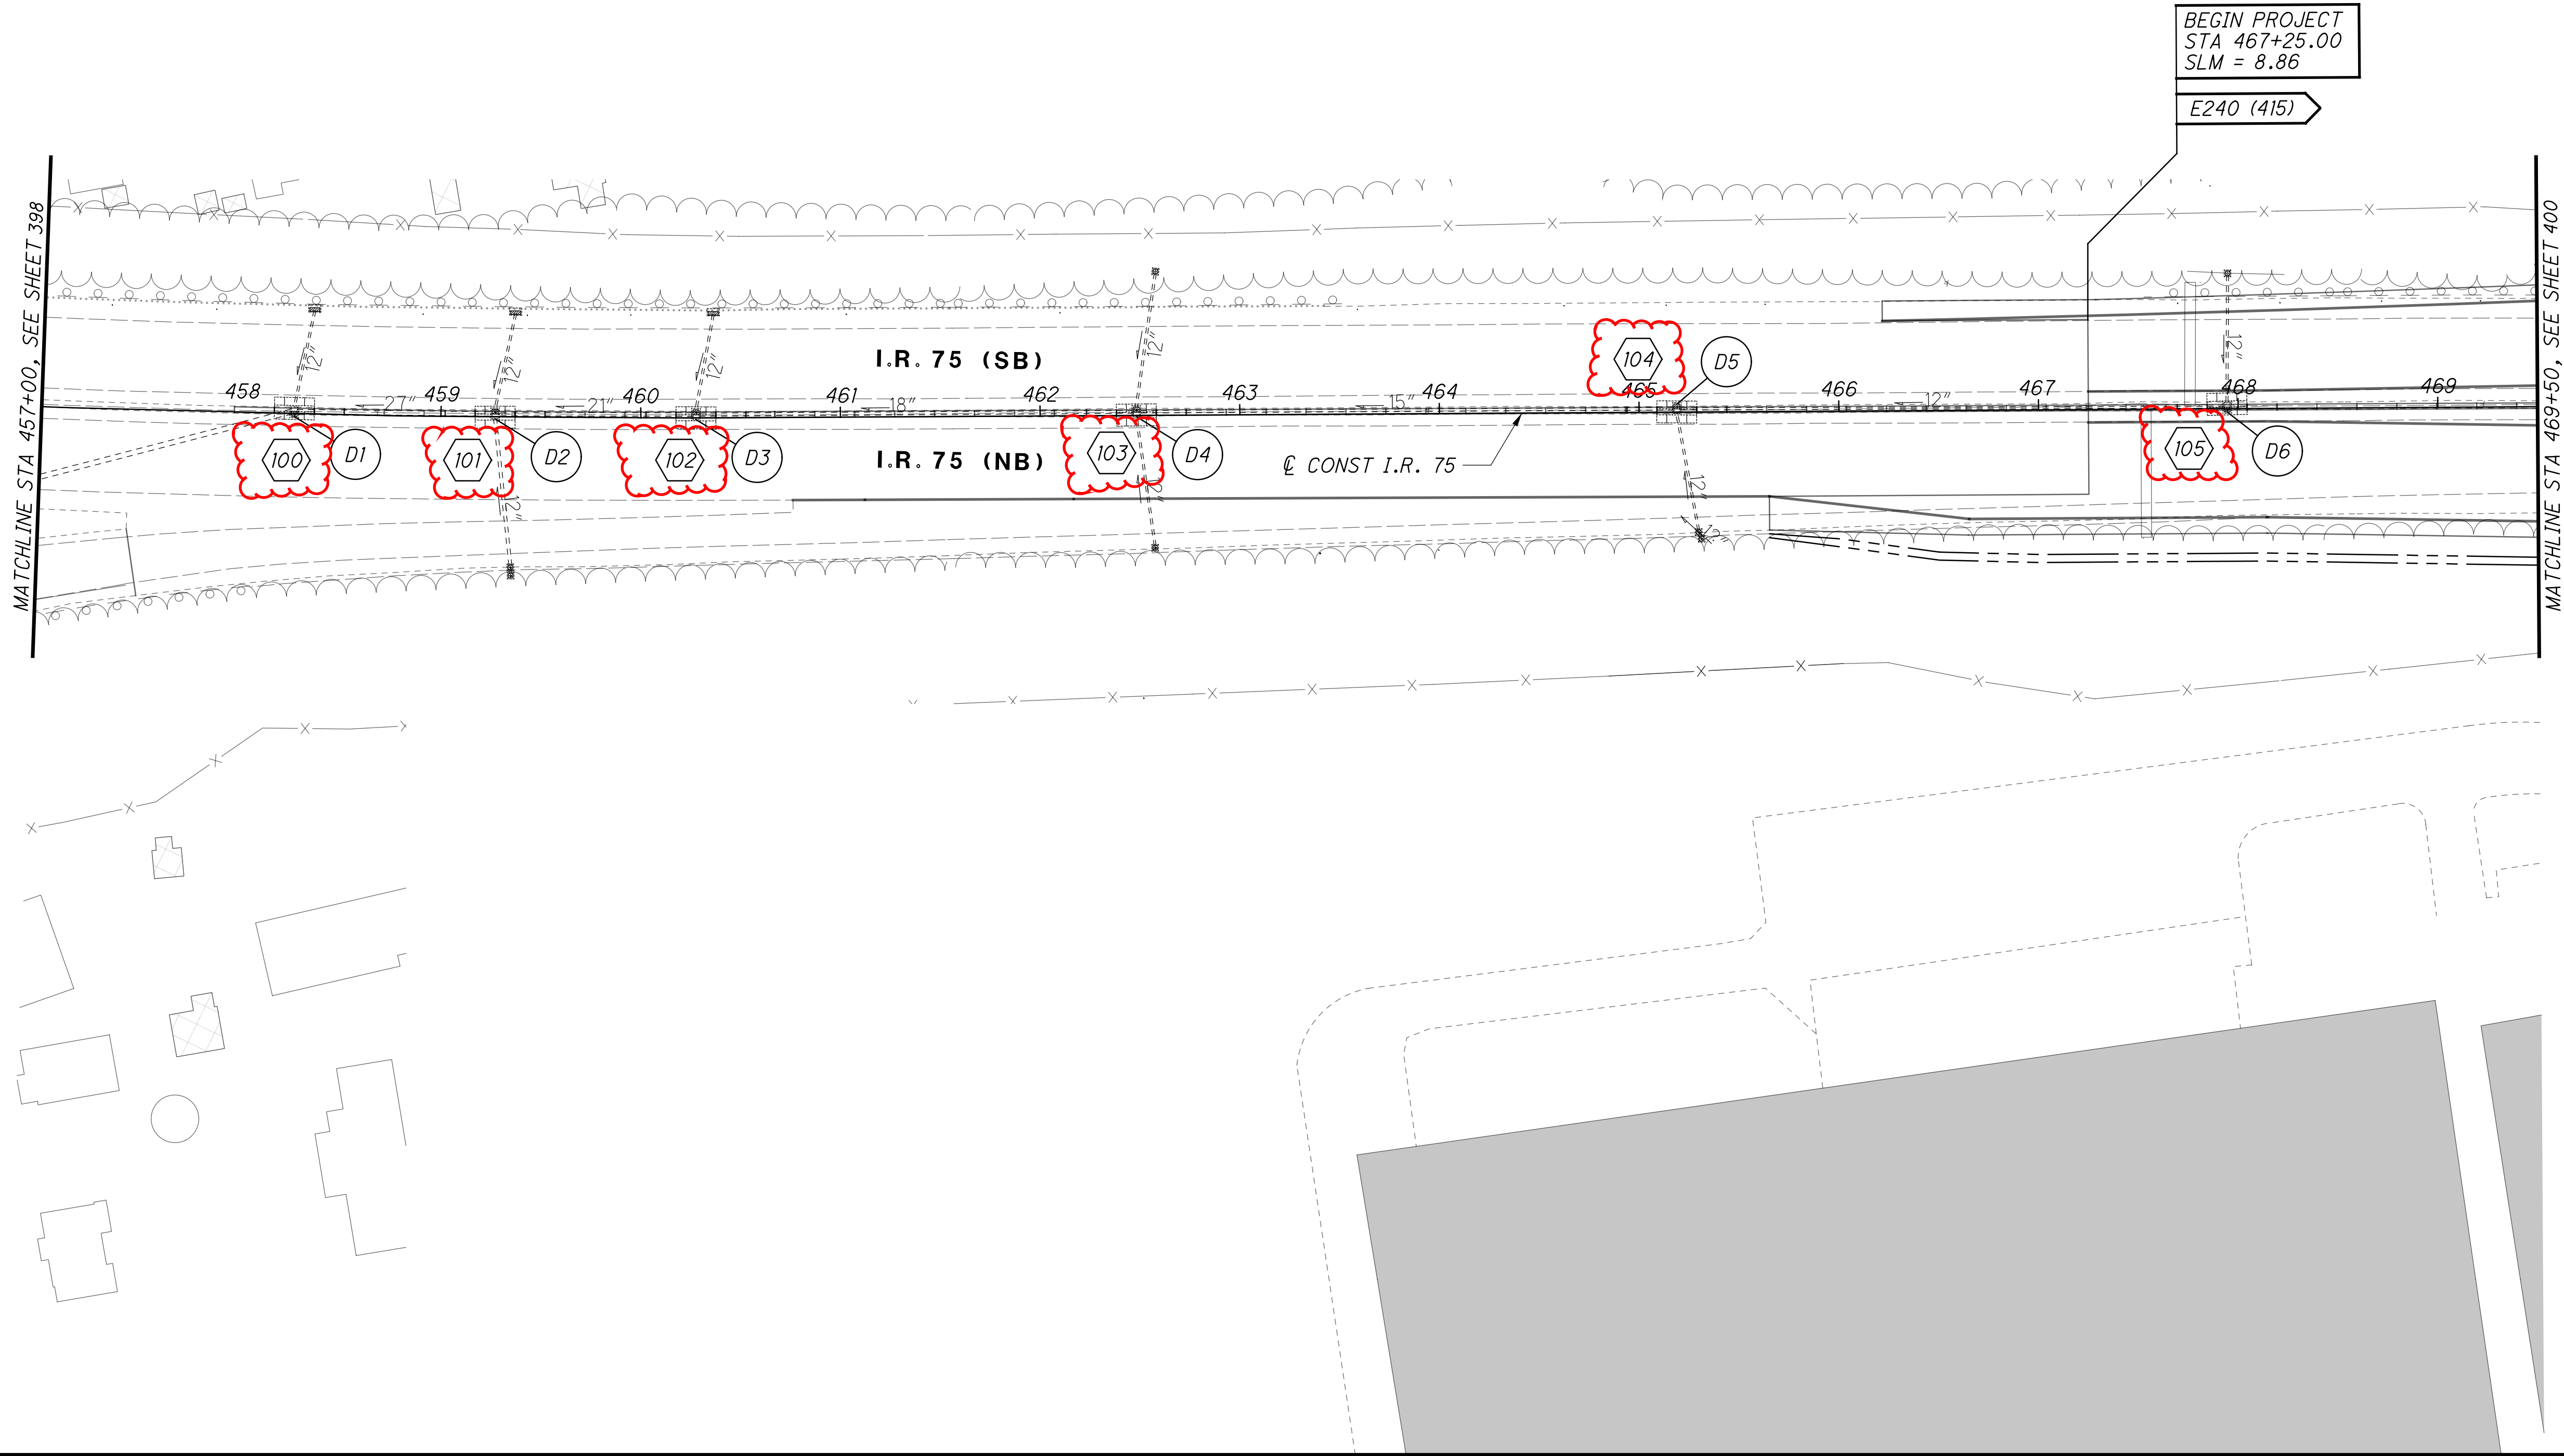

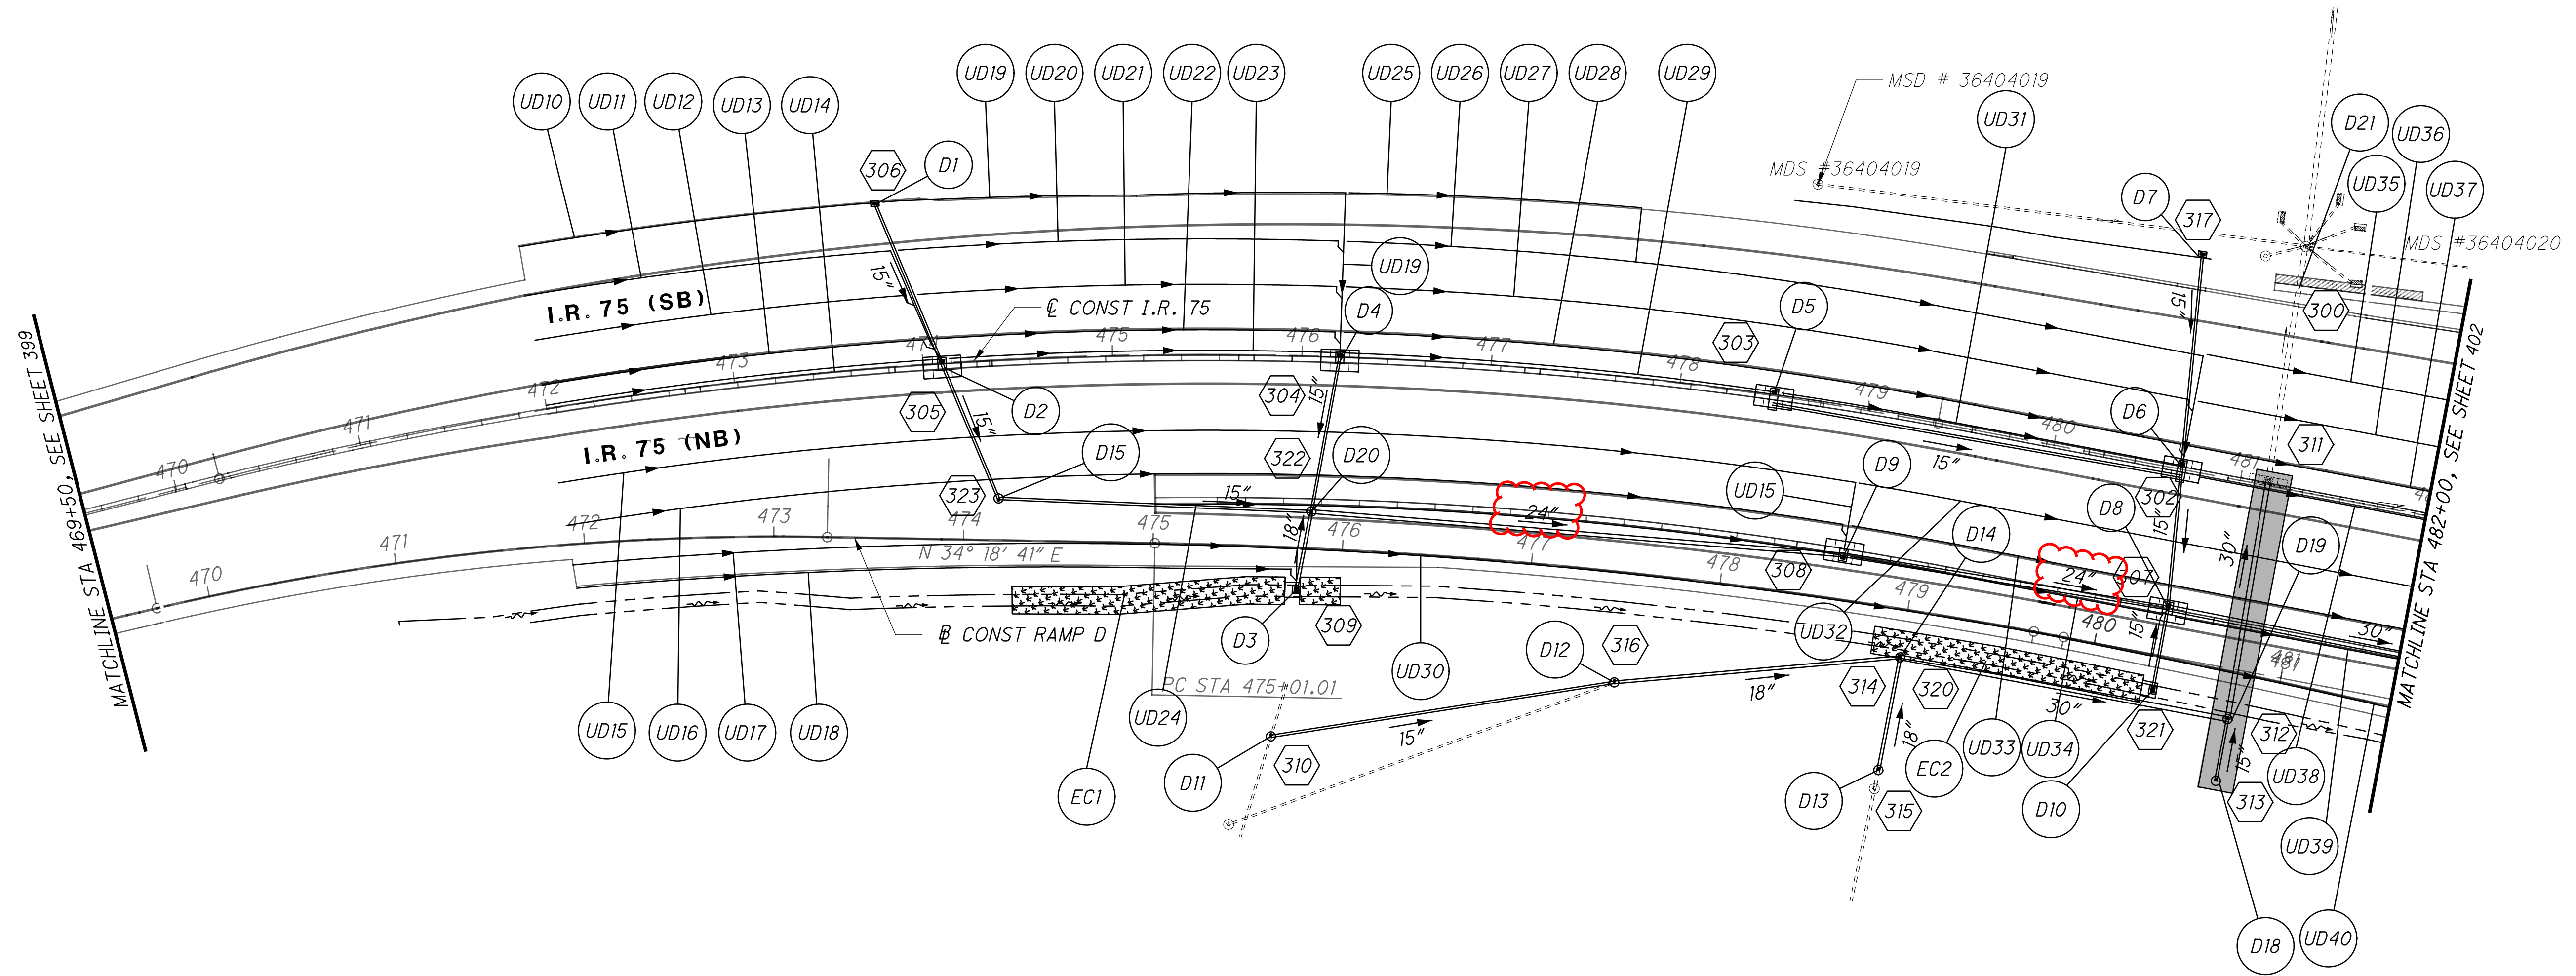


LEGEND



DRAINAGE ALTERNATE 1

NOTE: SHEETS 400 AND 401 ARE IDENTICAL WITH THE EXCEPTION OF THE SHADED DRAINAGE ALTERNATE

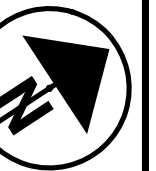

0 50 100
HORIZONTAL
SCALE IN FEET


CALCULATED
CT
CHECKED
SSK

DRAINAGE PLANS - I.R. 75
STA 469+50 TO STA 482+00

HAM-75-8.91

400
826

J:\20240445\ODOT\HAM\117525\Design\Drainage\Sheets\77889DM403A.dgn 3/18/2025 11:37:59 AM bmcutchen

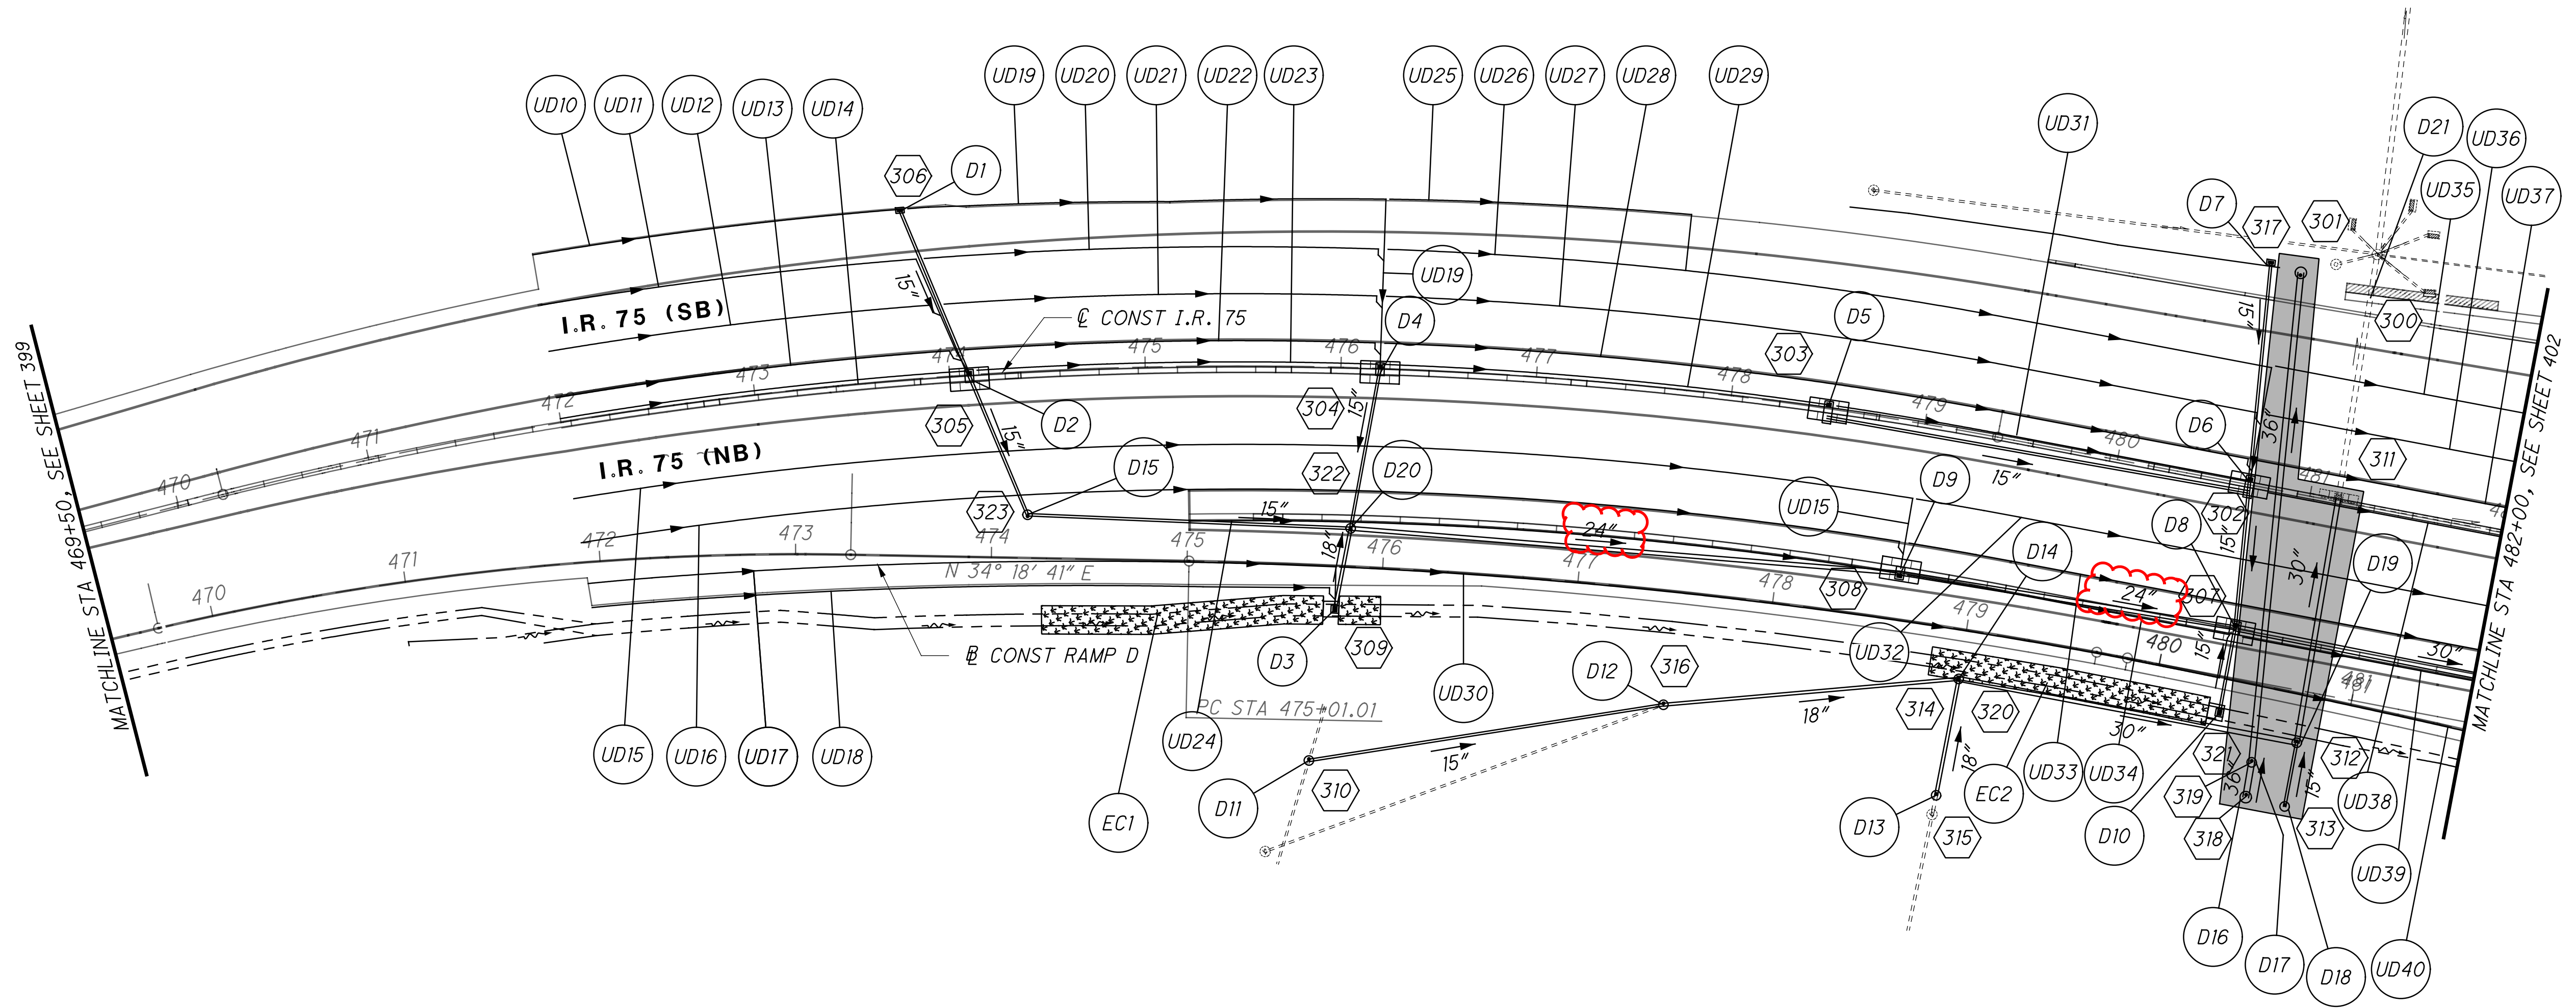


LEGEND




DRAINAGE ALTERNATE 2

NOTE: SHEETS 400 AND 401 ARE IDENTICAL WITH THE EXCEPTION OF THE SHADED DRAINAGE ALTERNATE

J:\20240445\ODOT\HAM\117525\Design\Drainage\Sheets\77889DM404.dgn 3/7/2025 10:50:35 AM hbreindinger

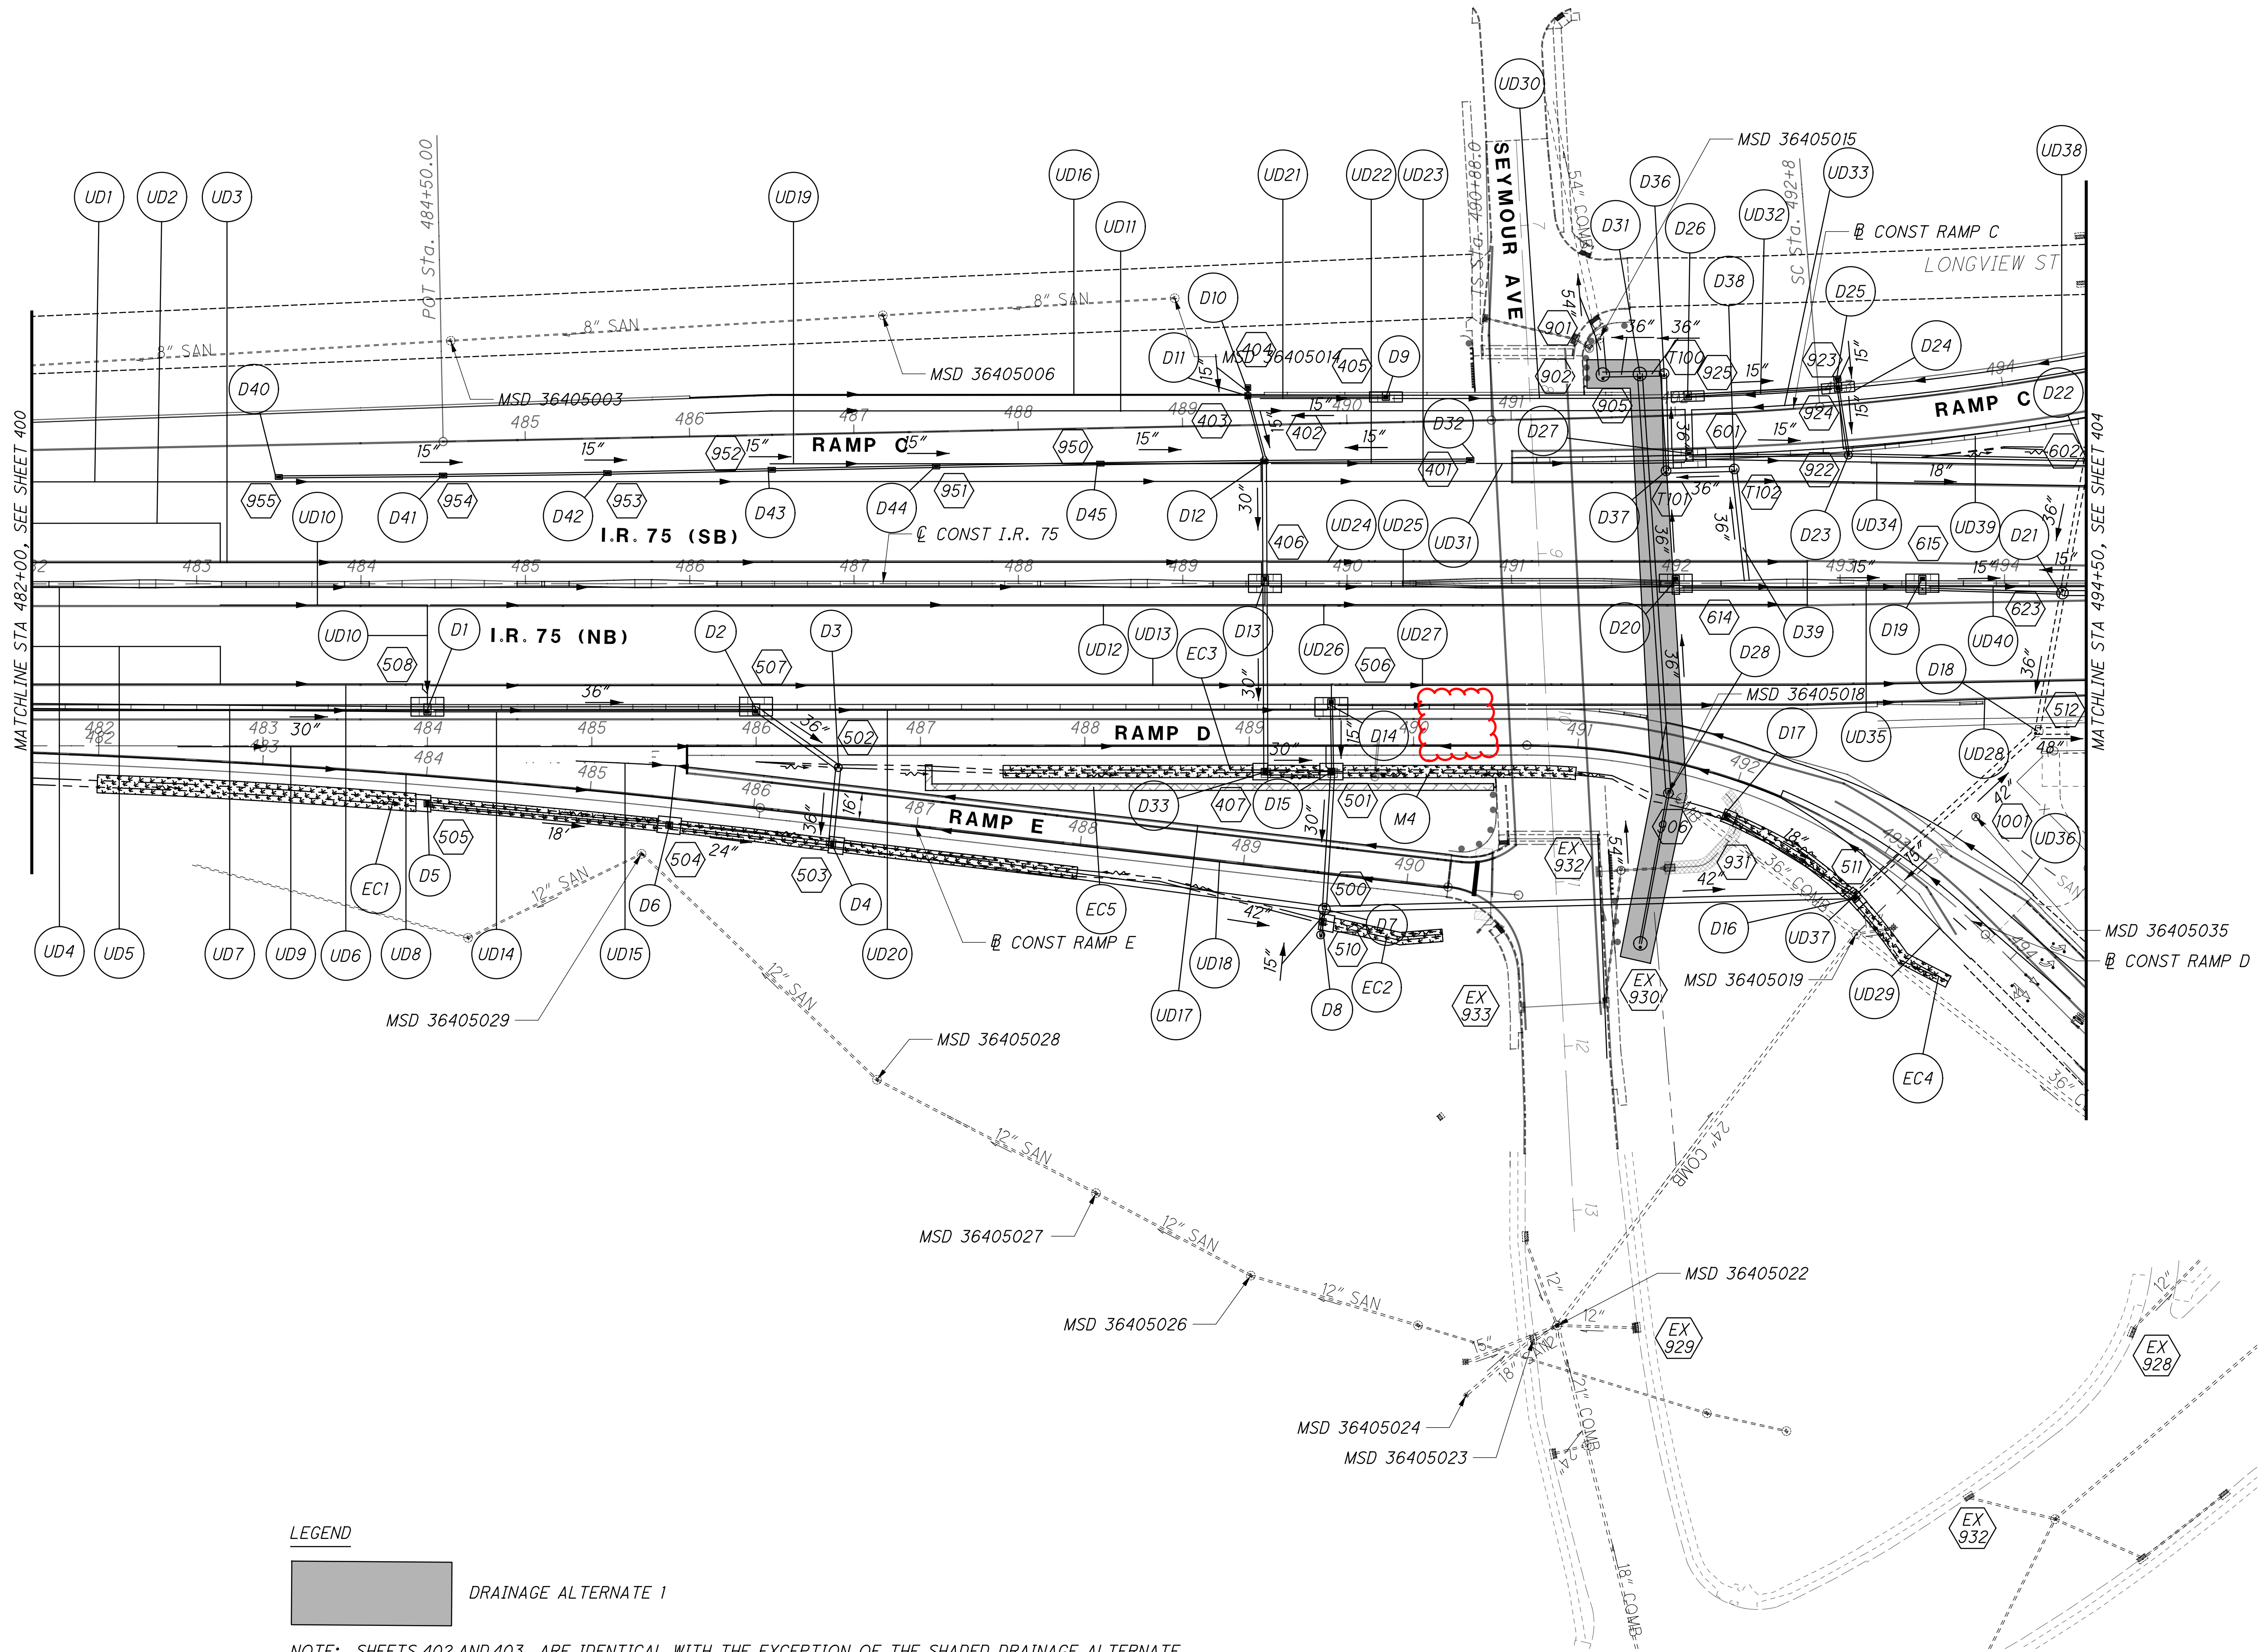


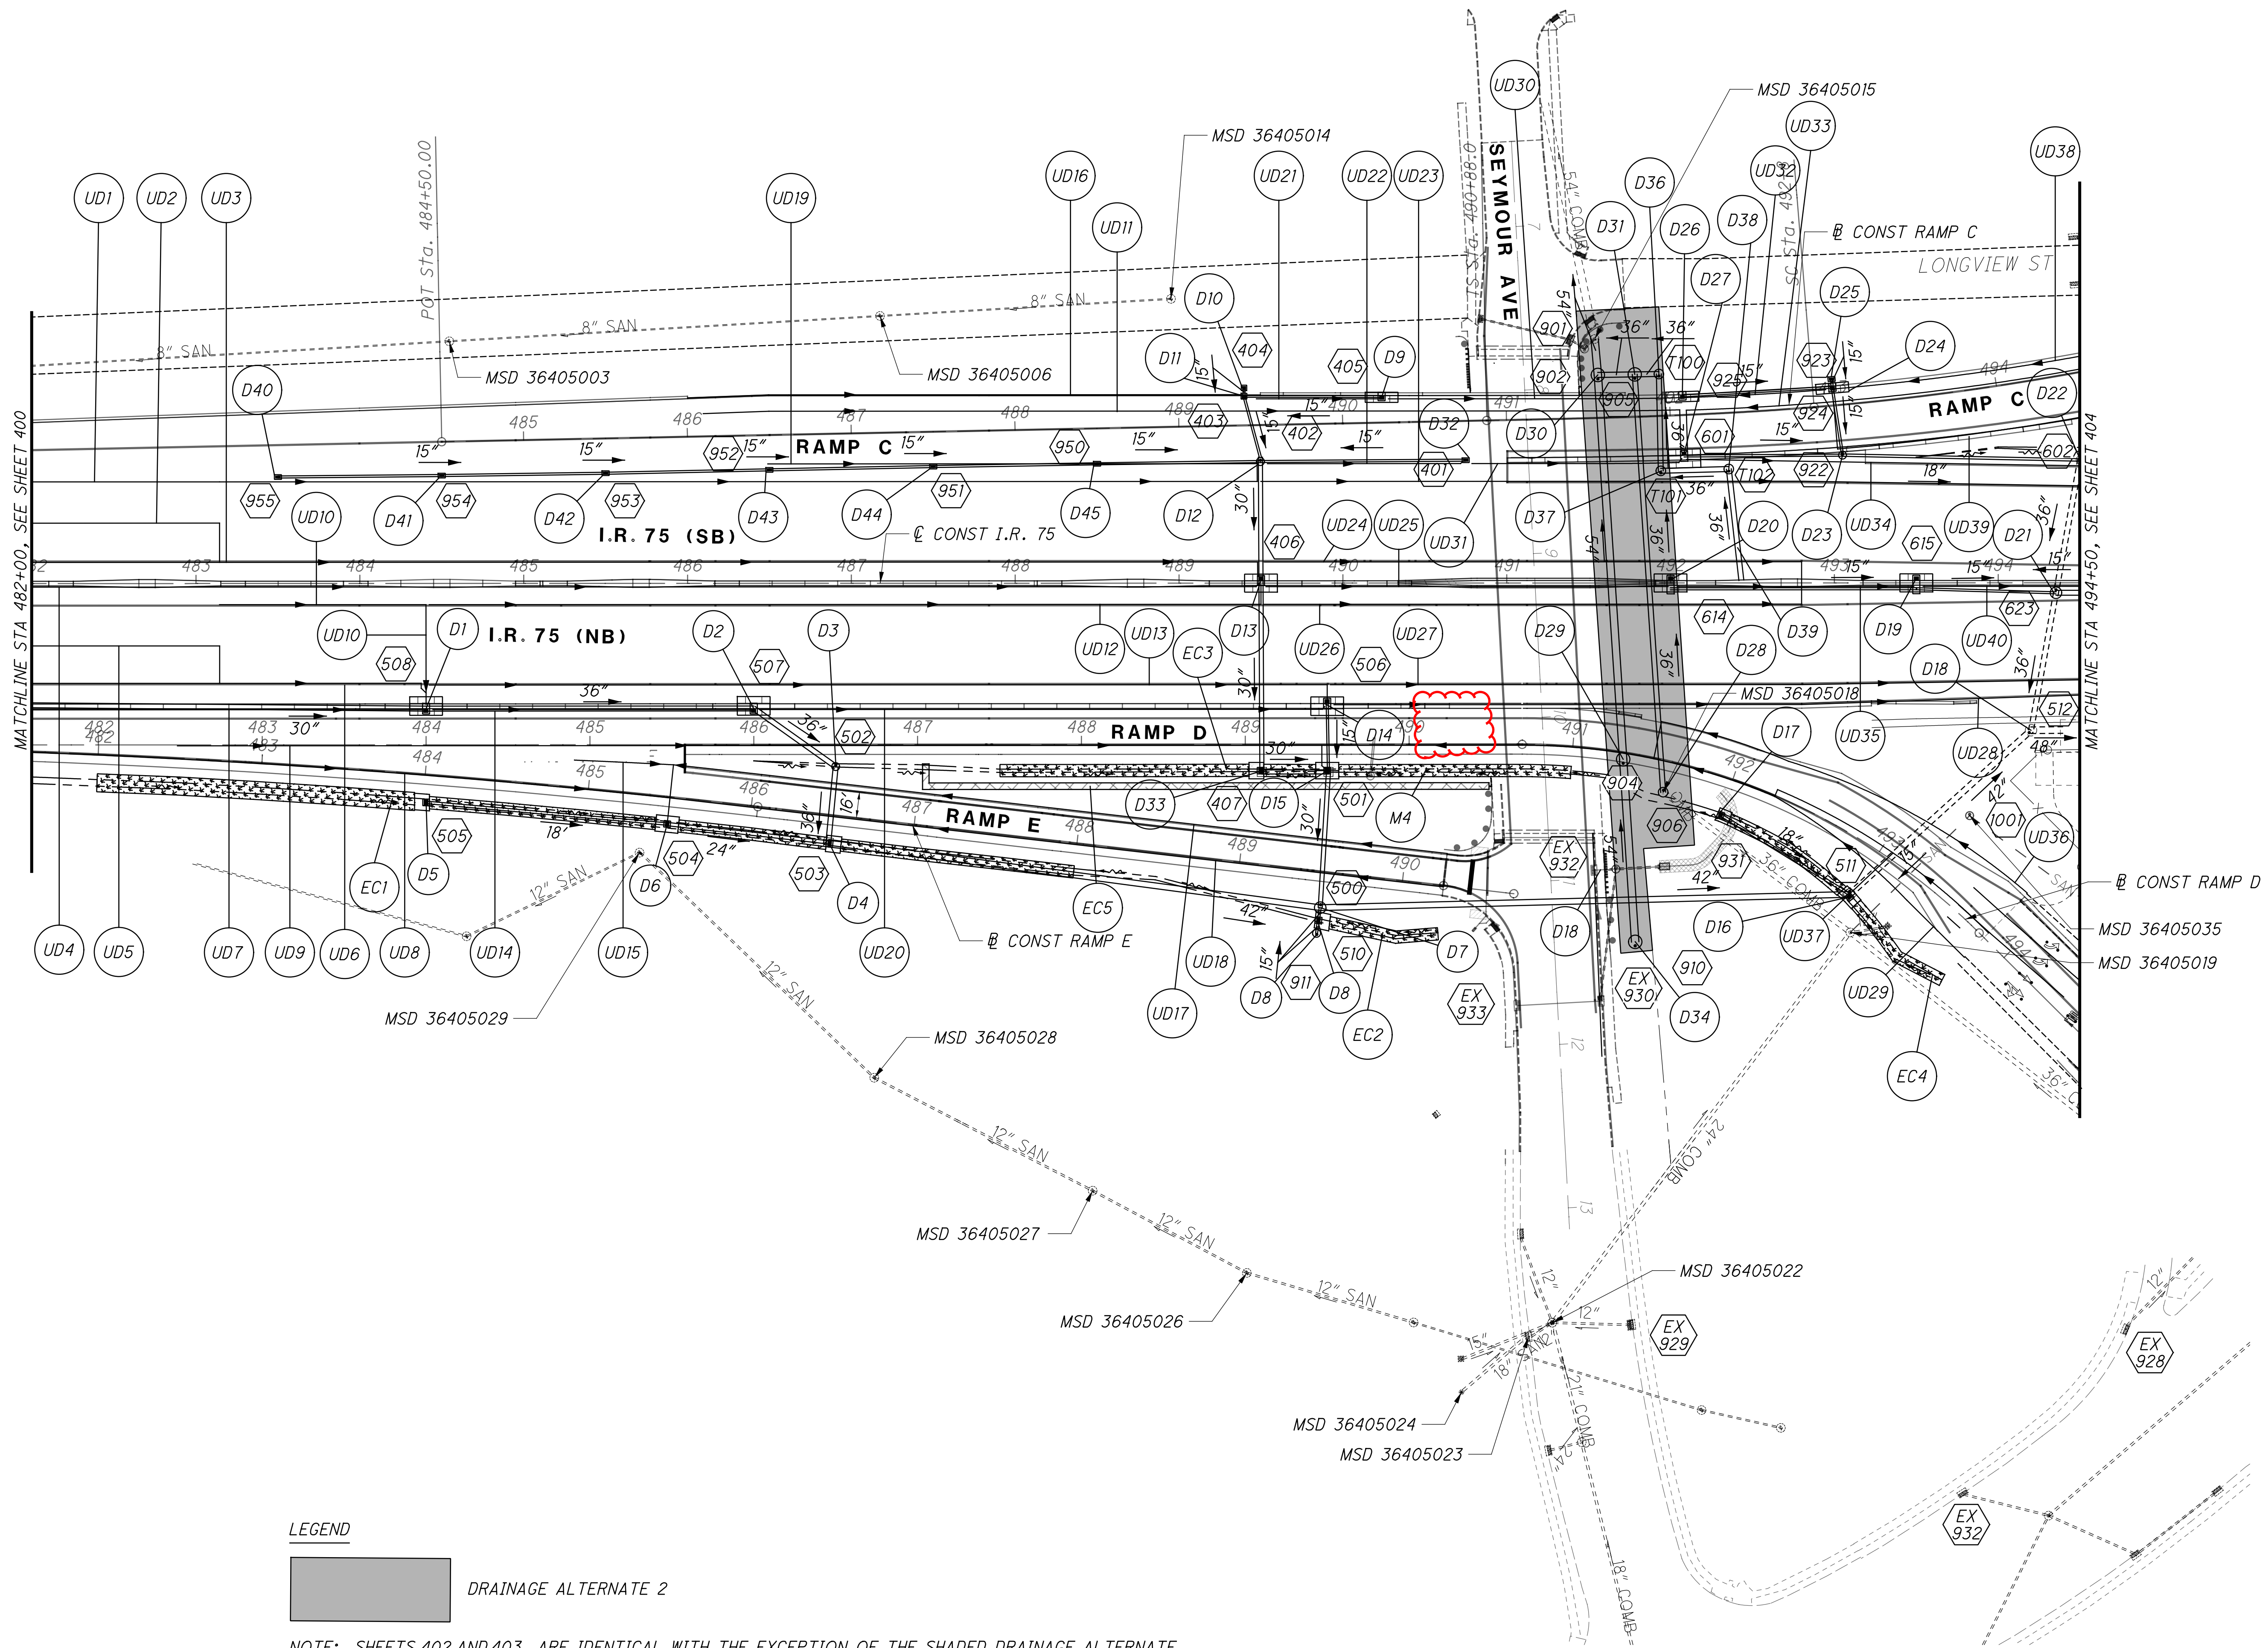



LEGEND

 DRAINAGE ALTERNATE 2



NOTE: SHEETS 402 AND 403 ARE IDENTICAL WITH THE EXCEPTION OF THE SHADED DRAINAGE ALTERNATE

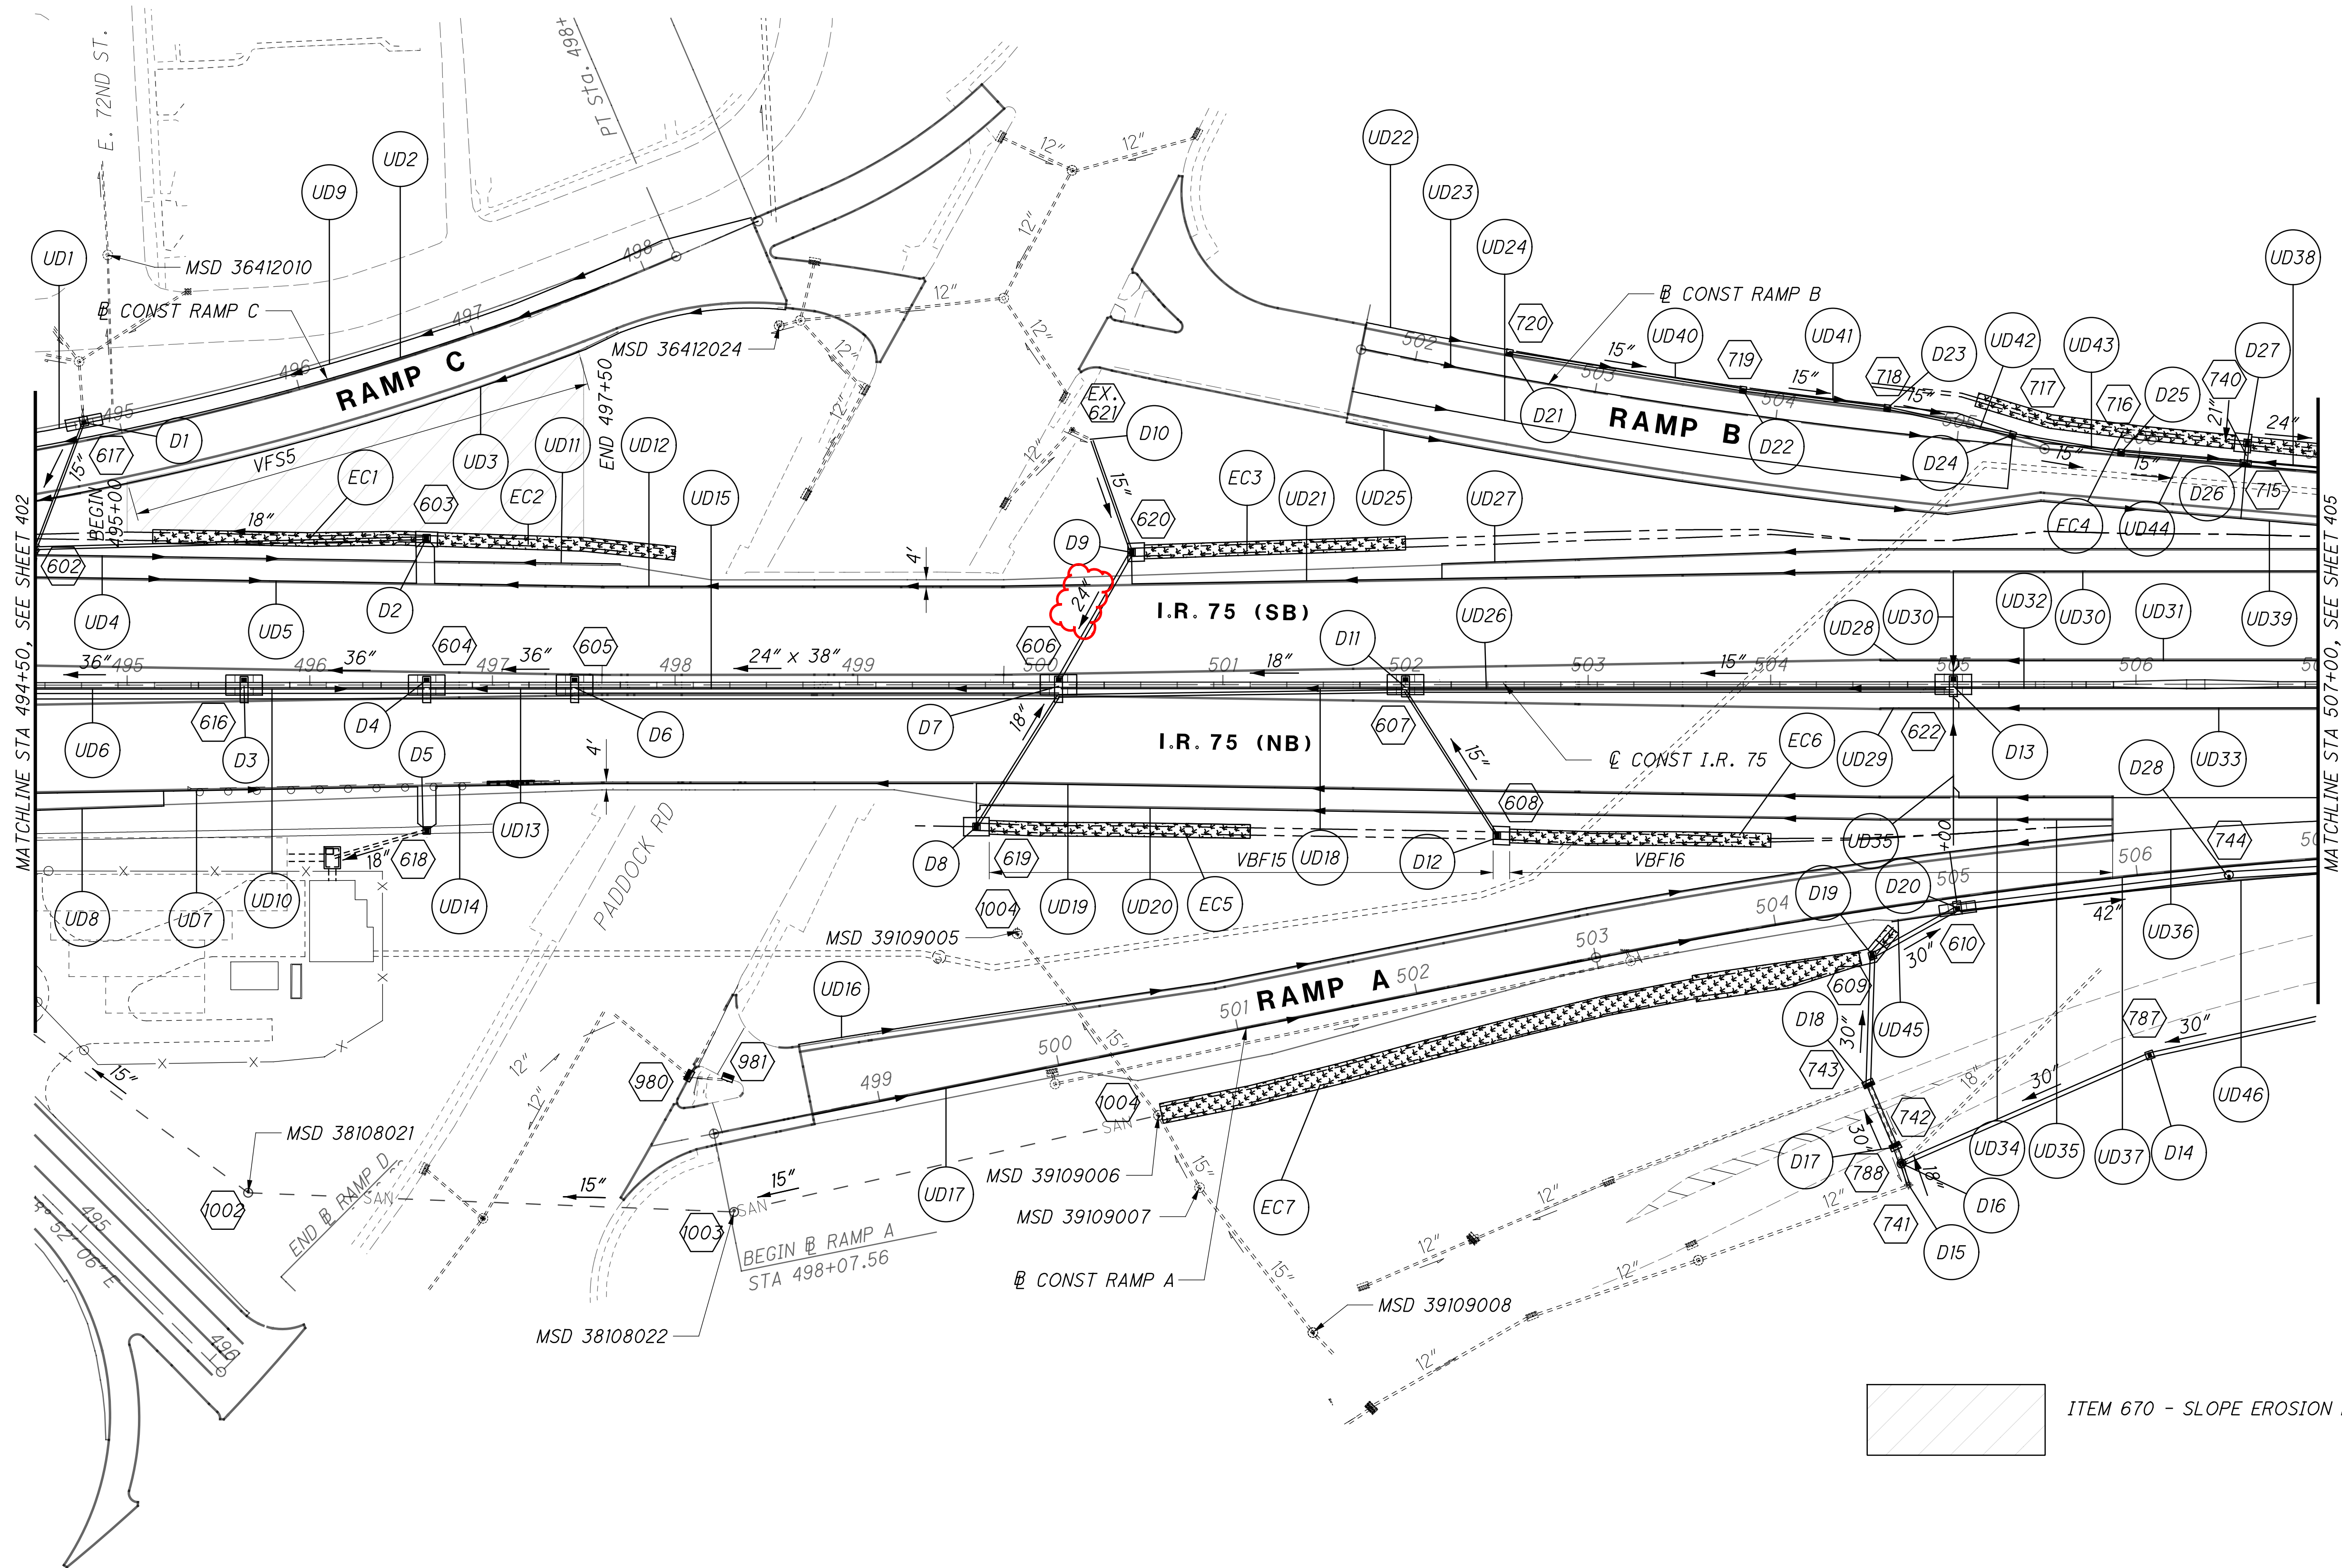



J:\202404445\ODOT\HAM\117525\Design\Drainage\Sheets\77889DF 406.dgn 3/18/2025 11:44:26 AM bmcclutchen

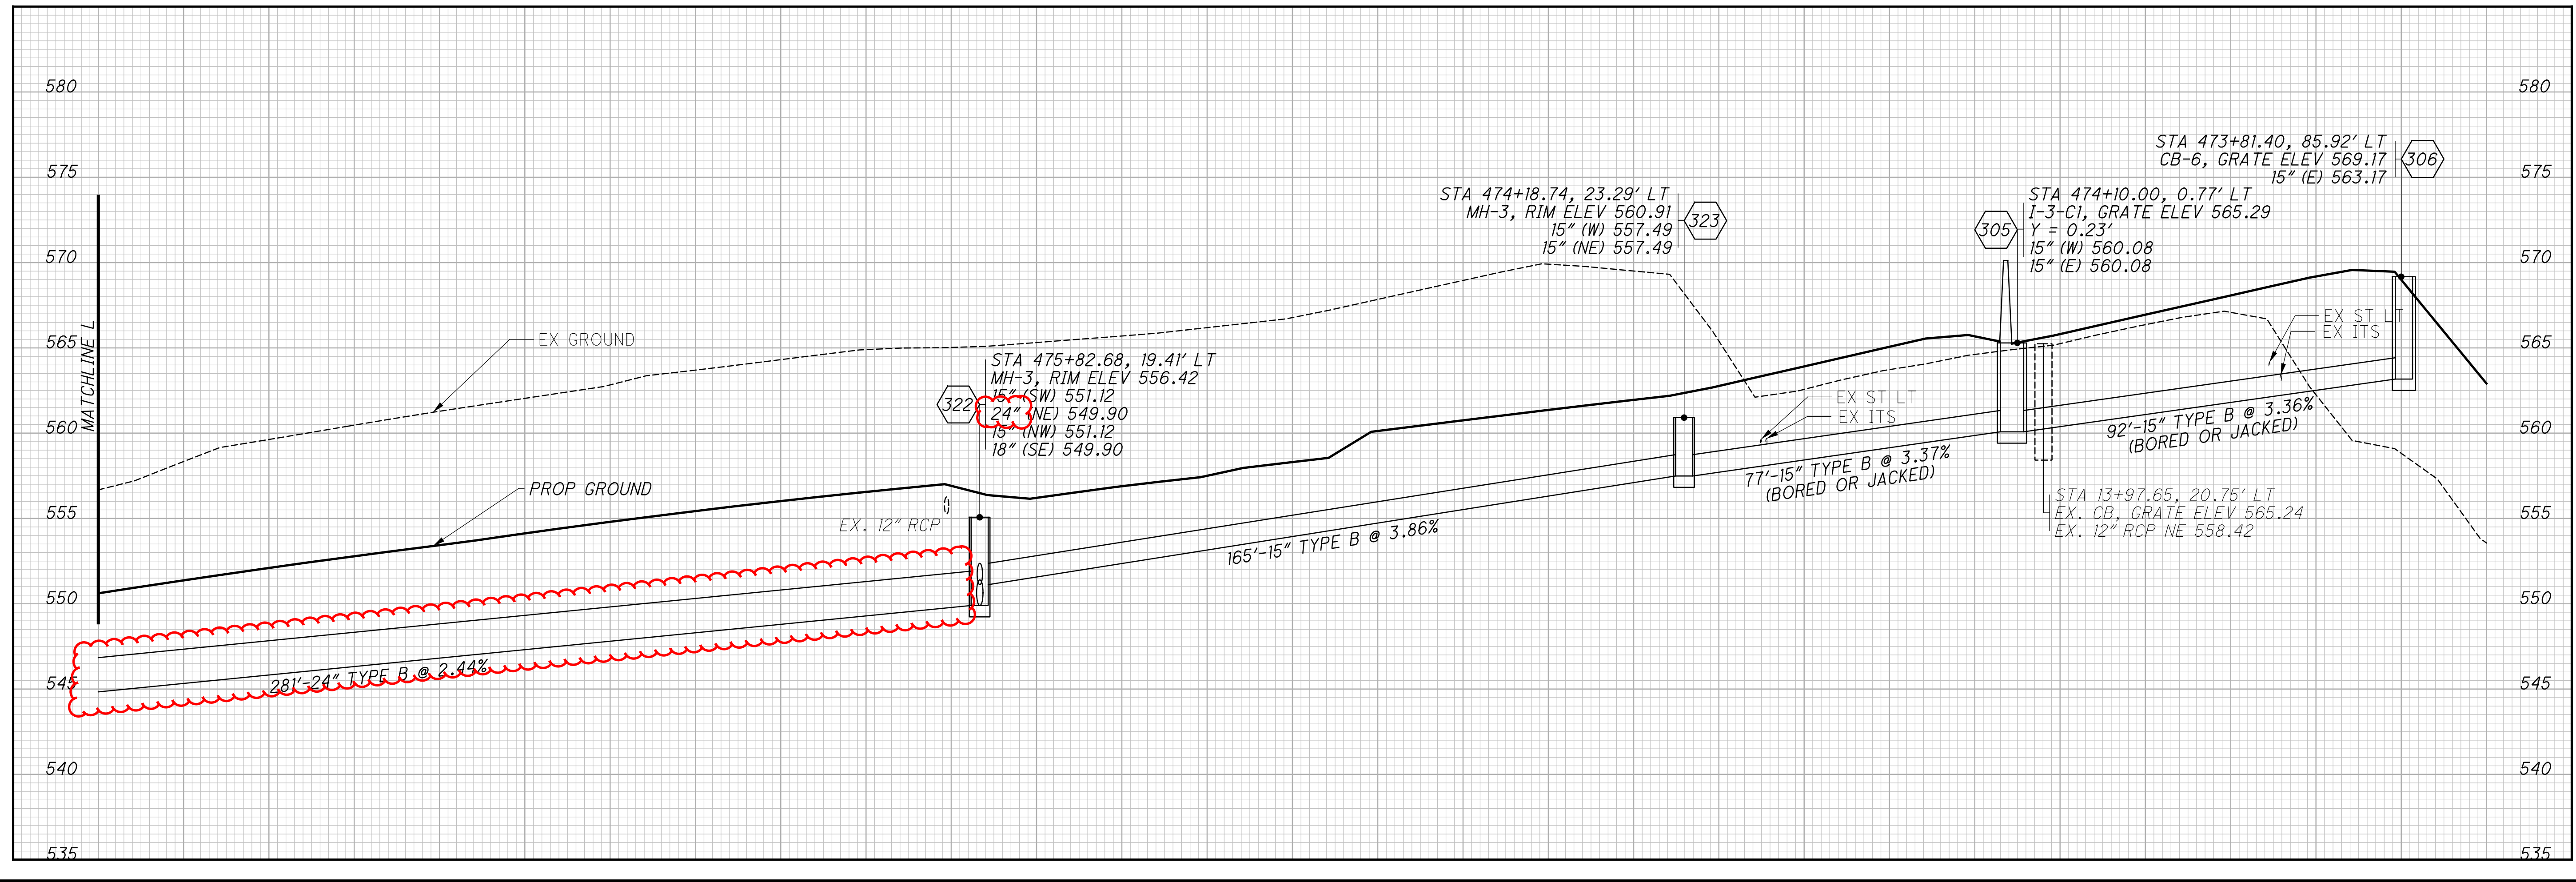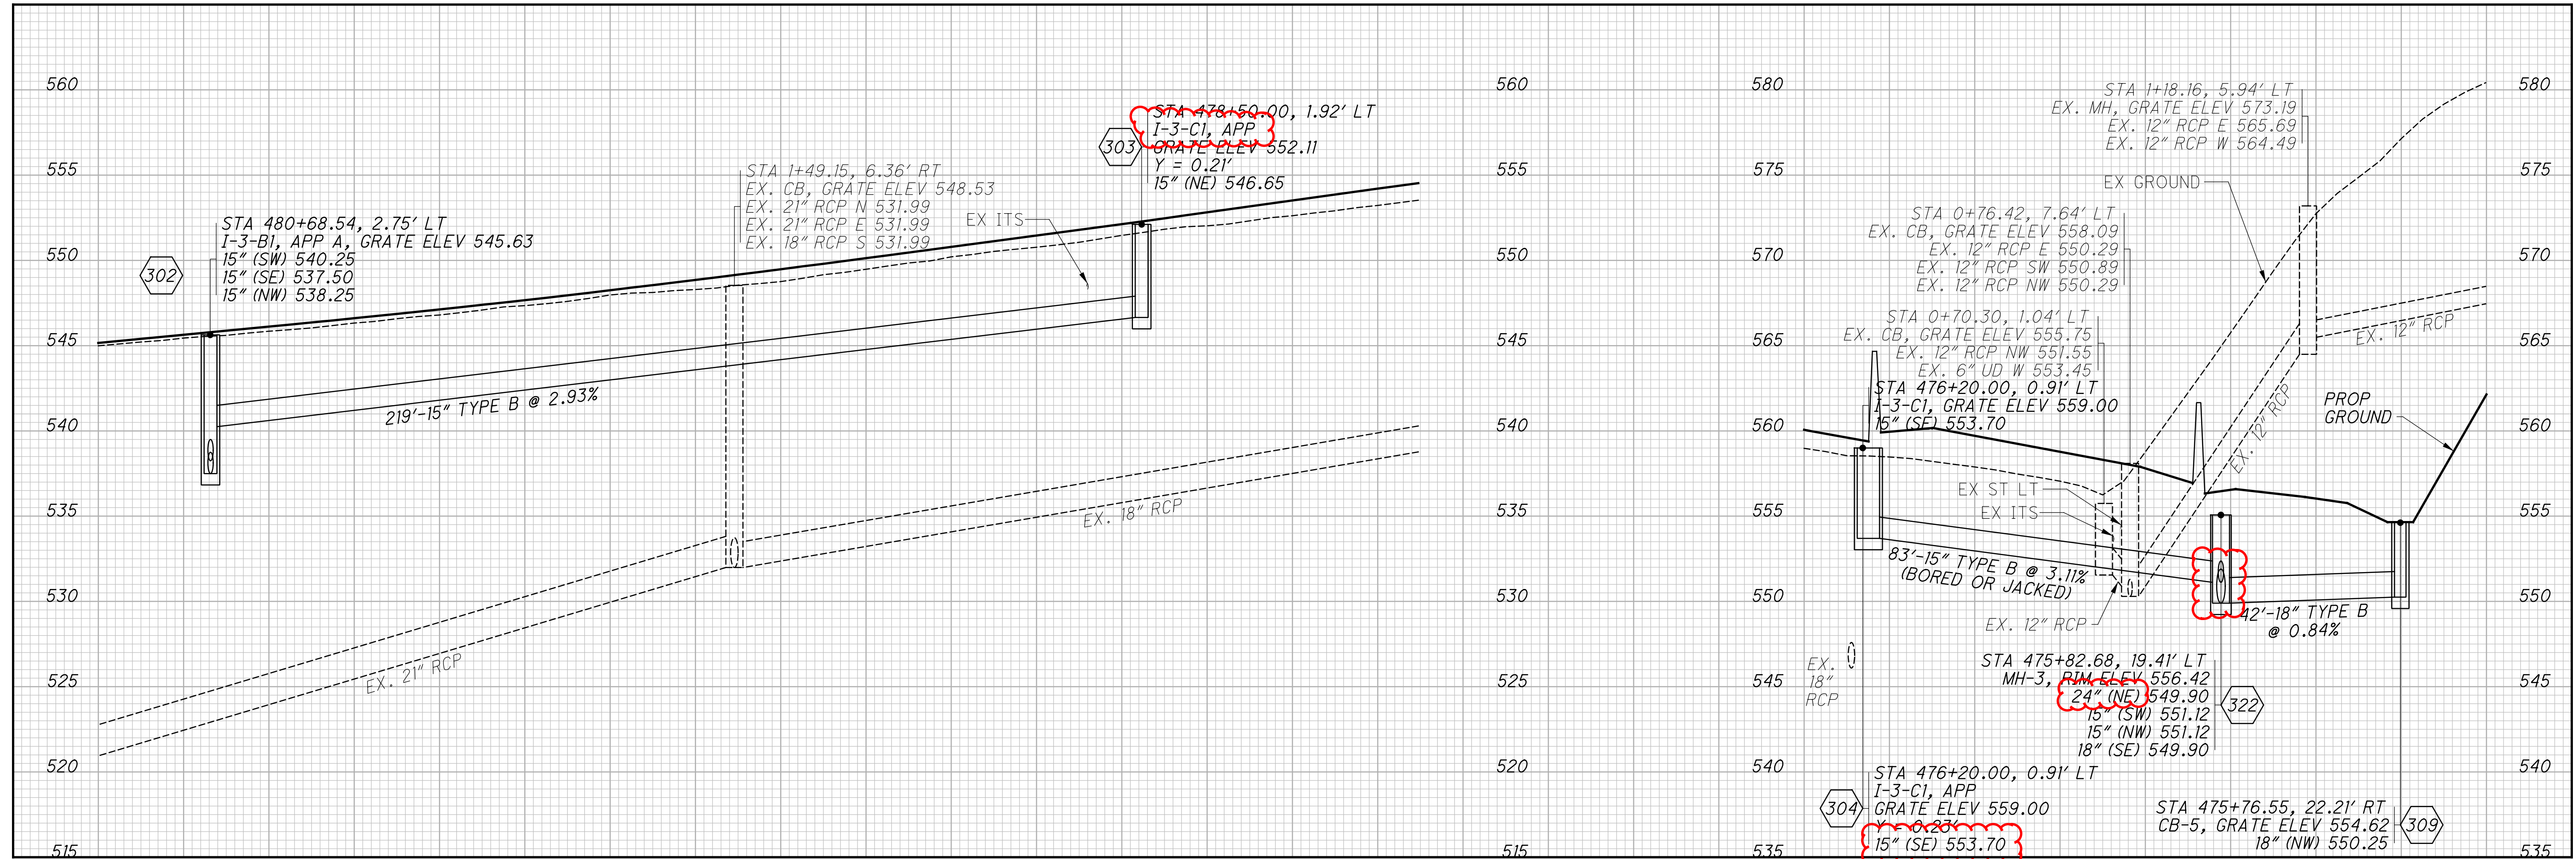

J:\20240445\ODOT\HAM\117525\Design\Drainage\Sheets\77889DF 407.dgn 3/18/2025 1:10:46 PM bmcutchen

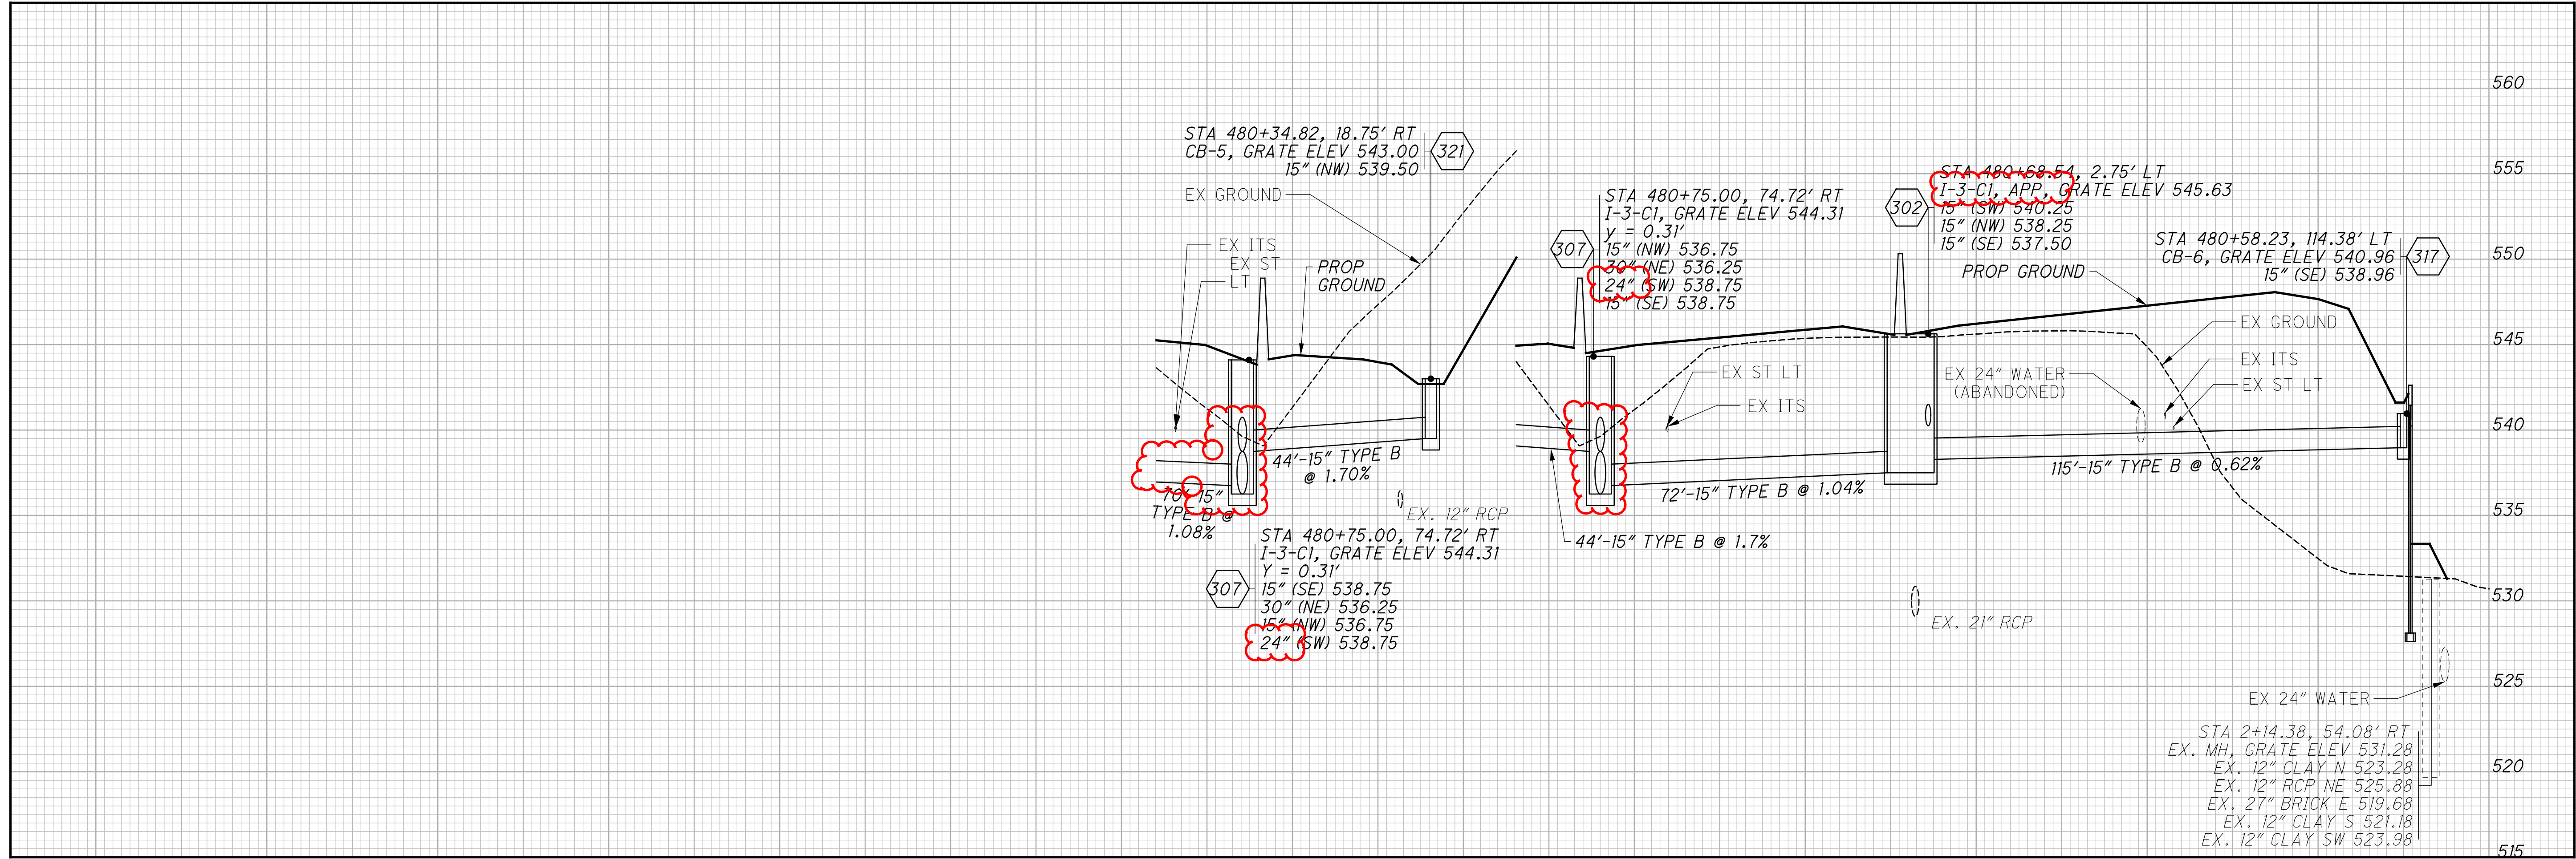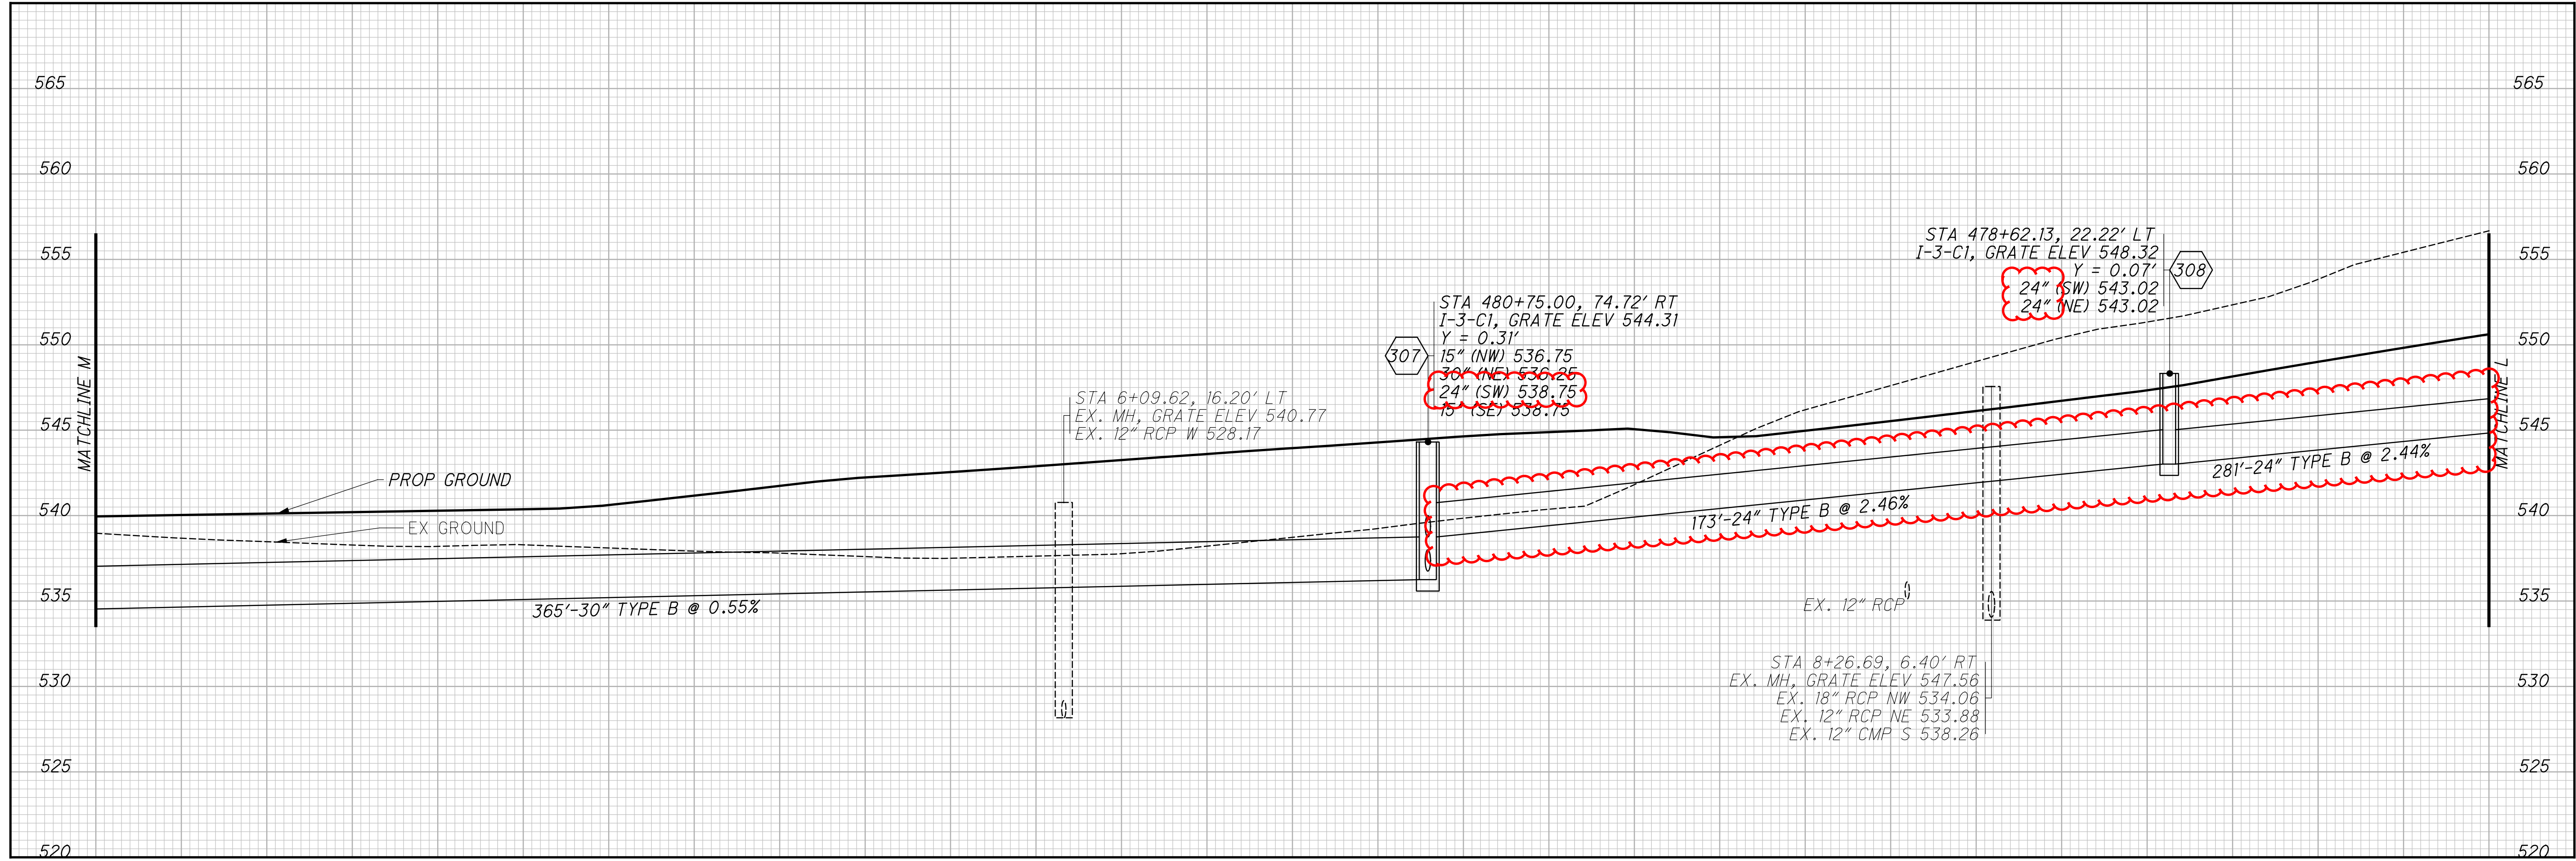

J:\20240445\ODOT\HAM\117525\Design\Drainage\Sheets\77889DF 407A.dgn 3/3/2025 10:32:30 AM rhoops

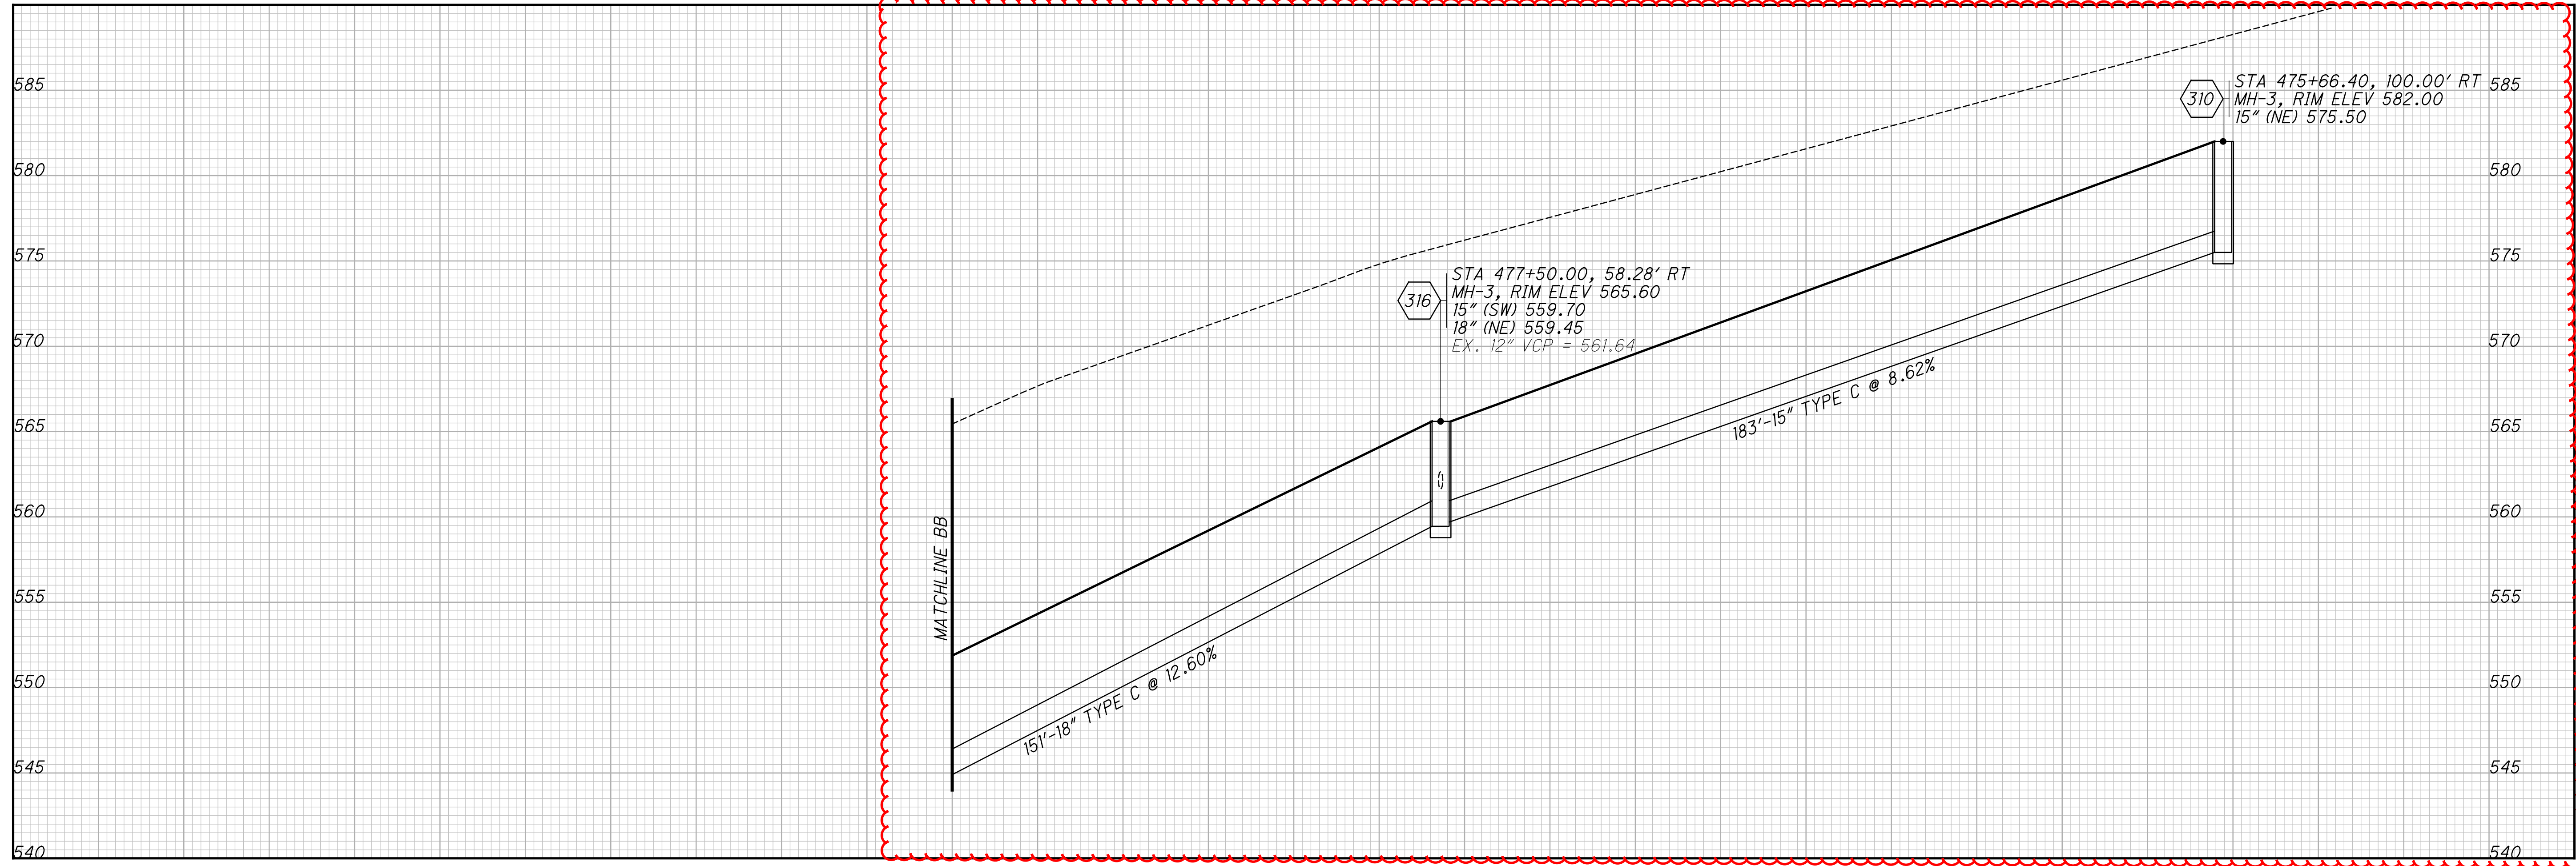
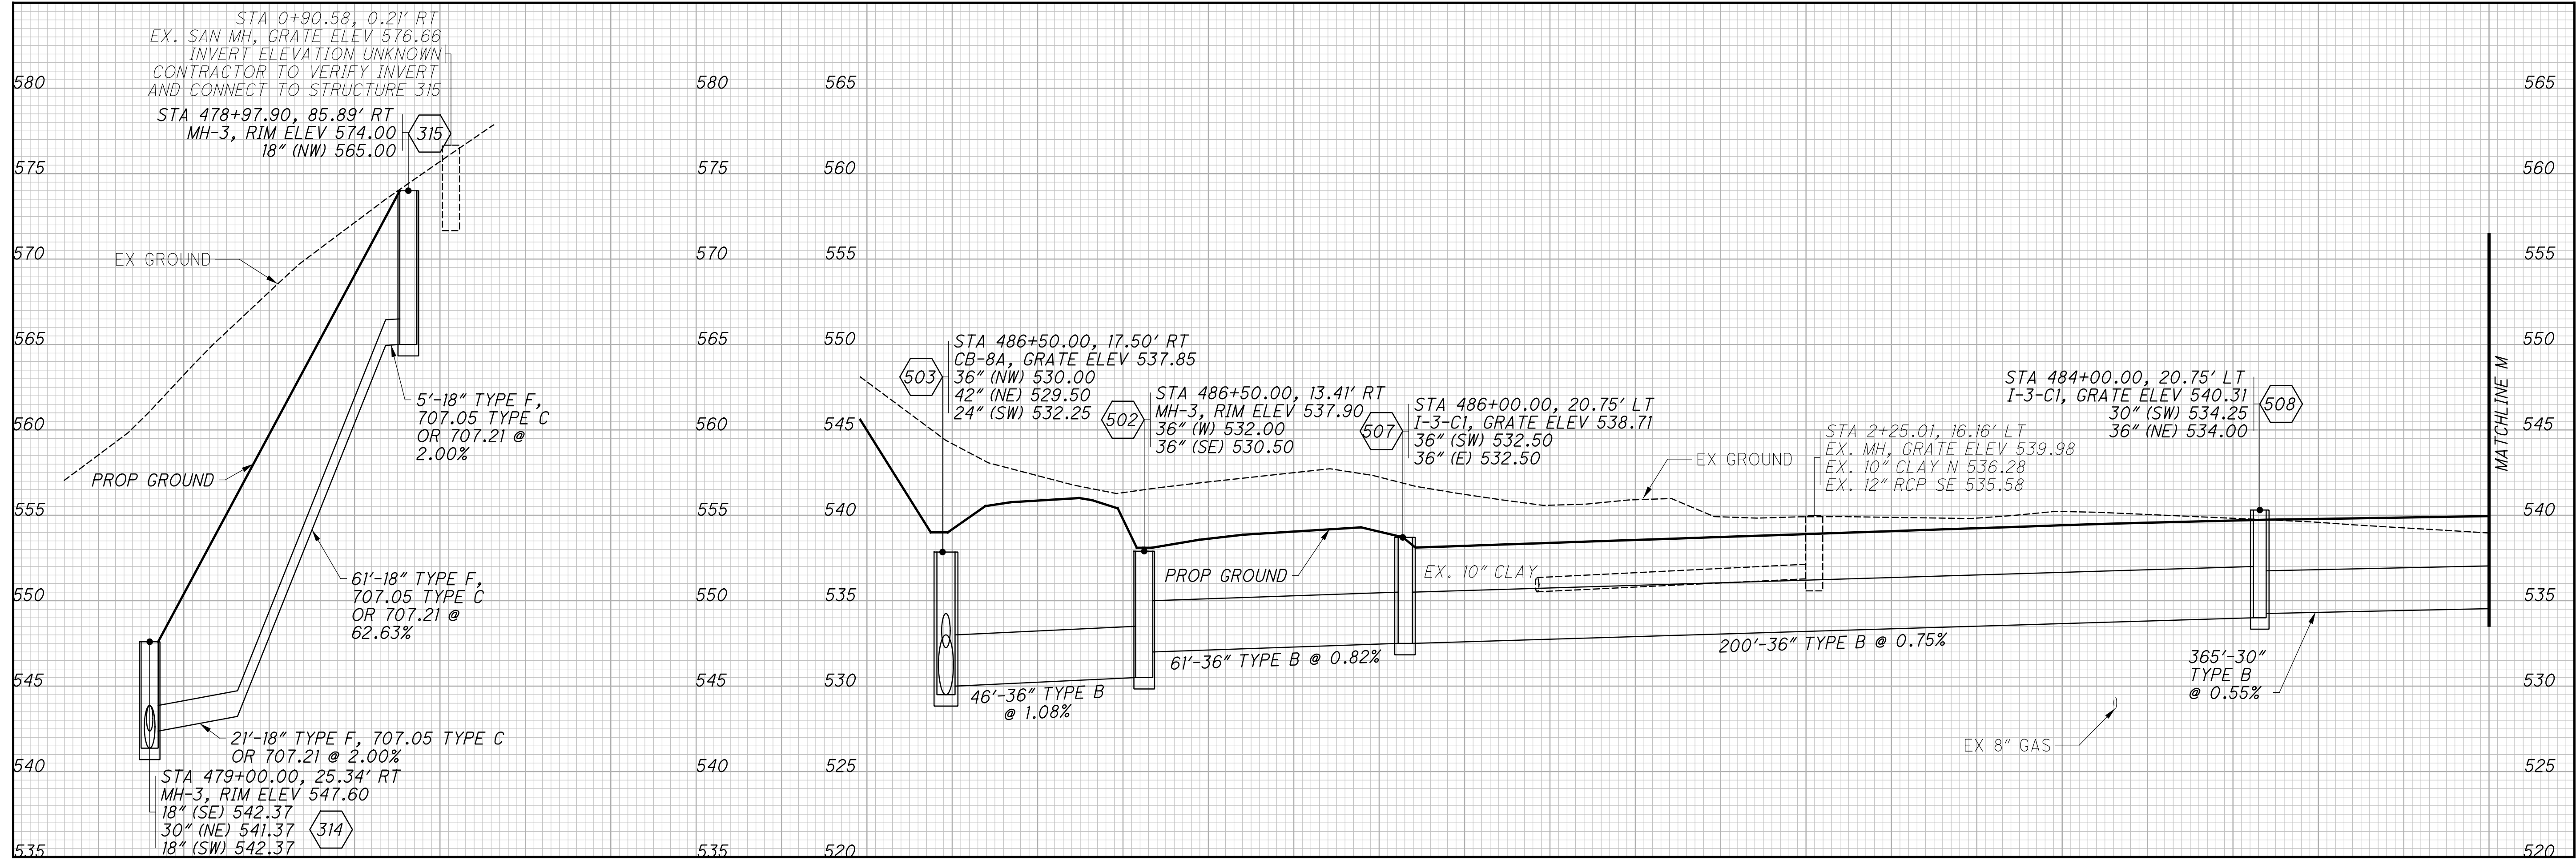


CALCULATED
ECH
CHECKED
SSK



STORM SEWER PROFILES

HAM-75-8.91

411
826

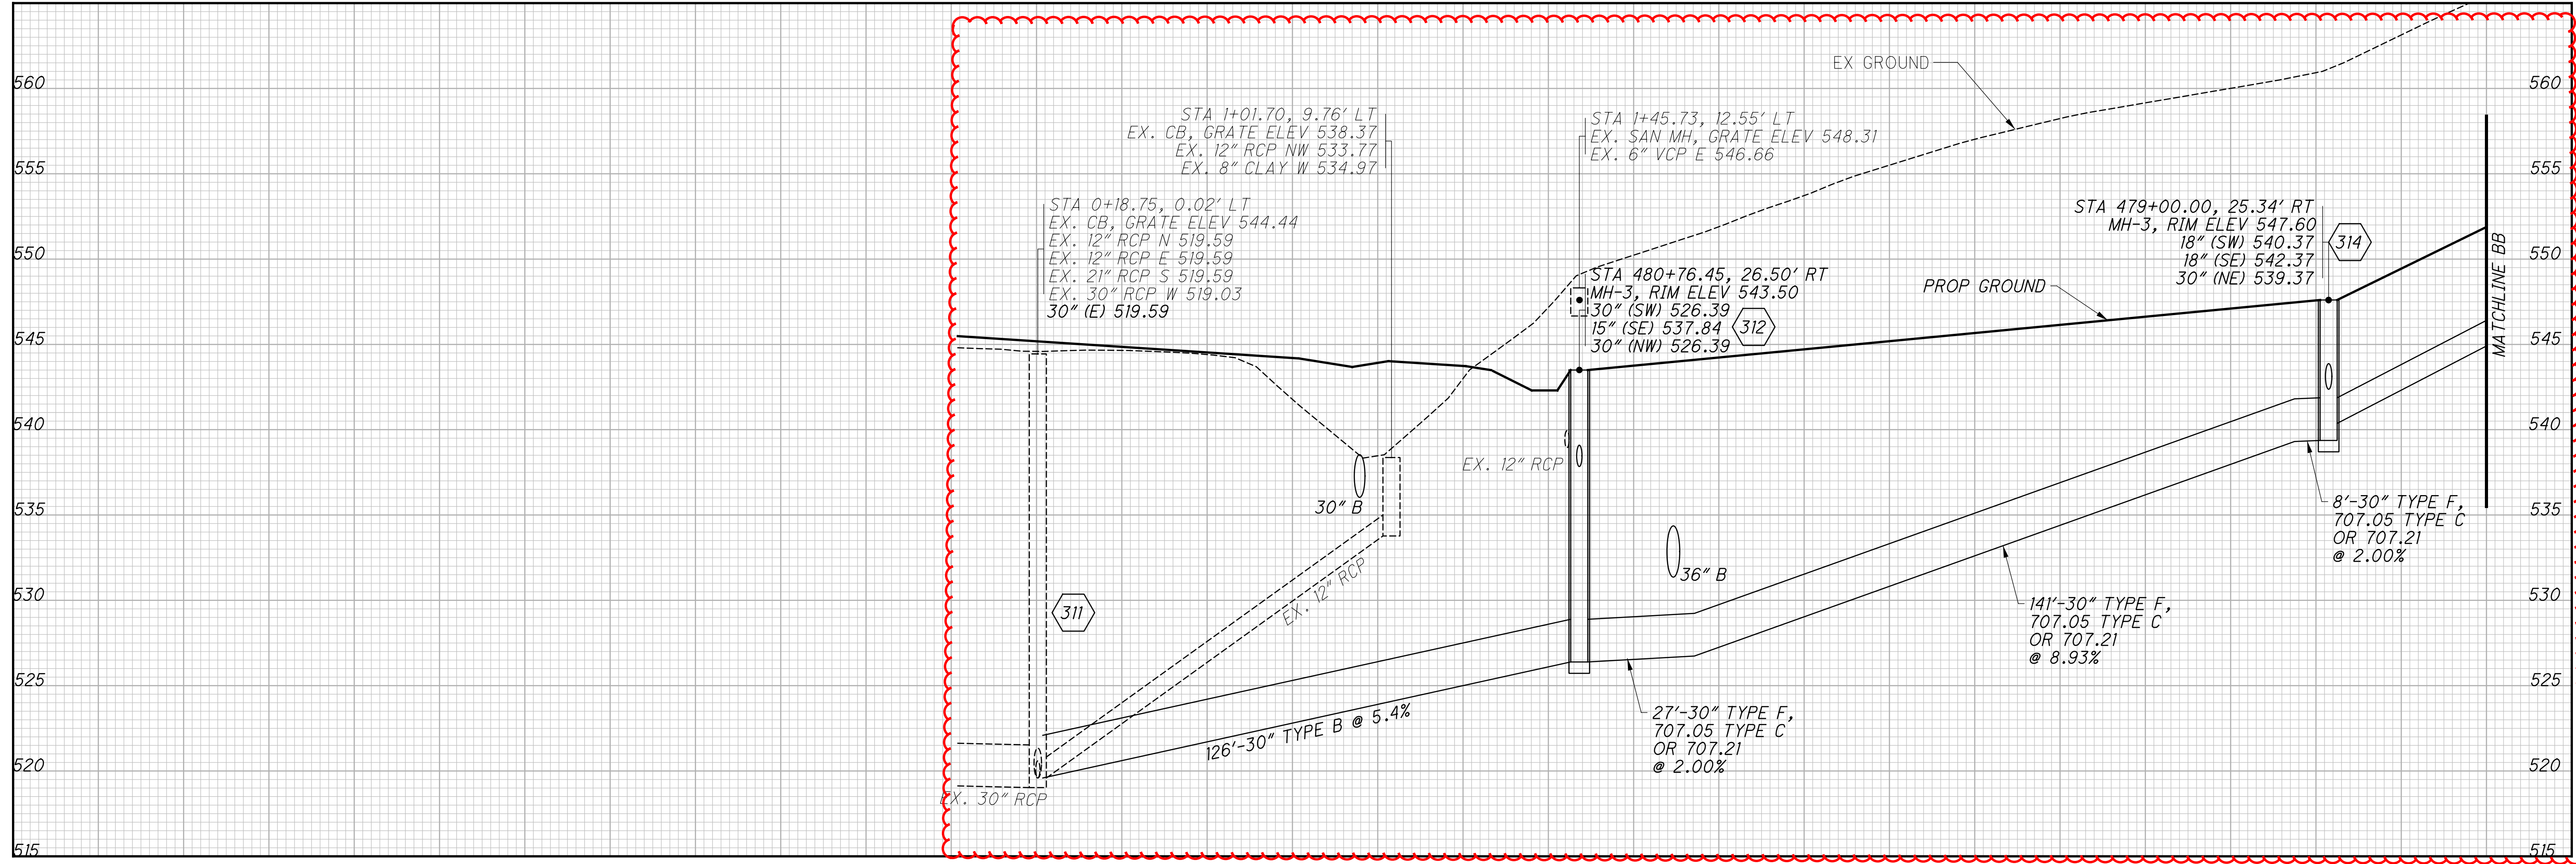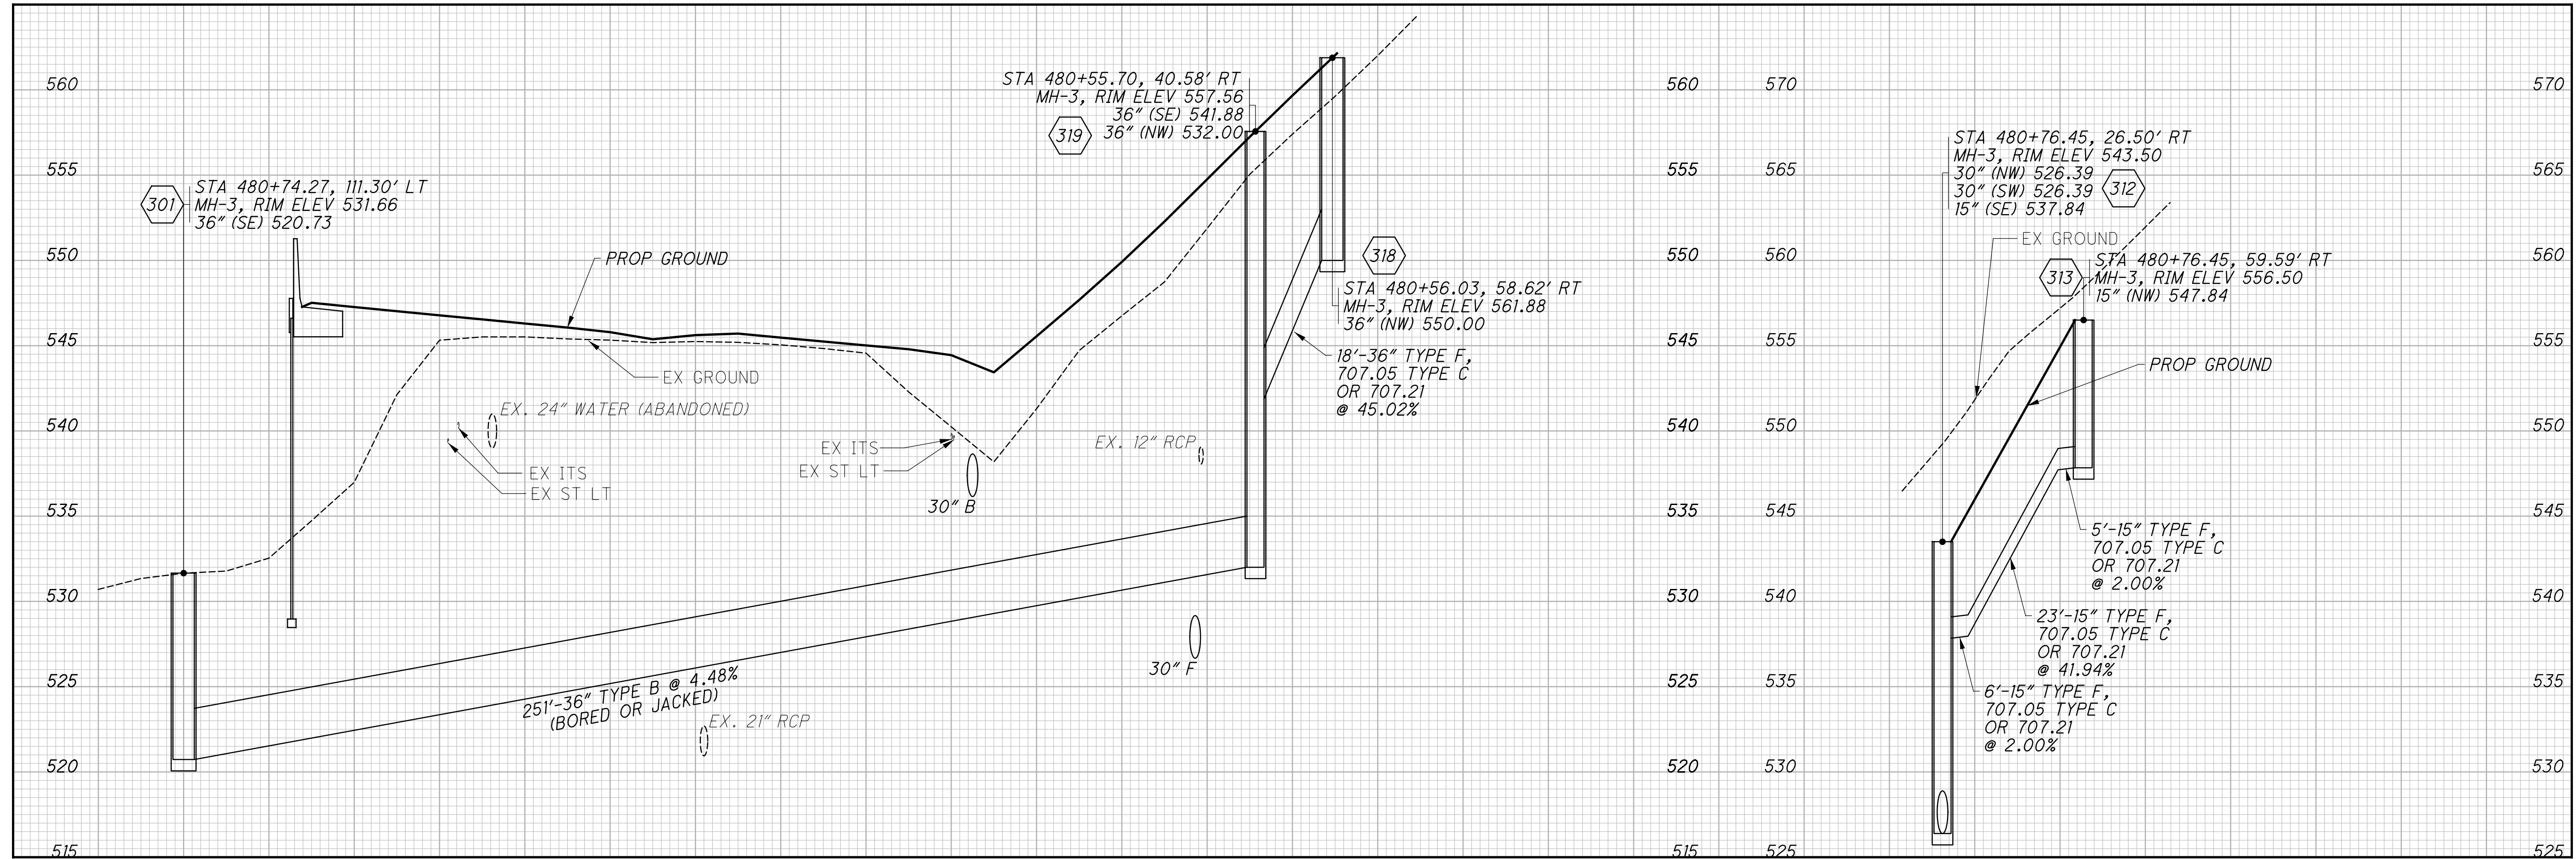

J:\20240445\ODOT\HAM\117525\Design\Drainage\Sheets\77889DF 408.dgn 3/7/2025 10:58:31 AM hblendinger

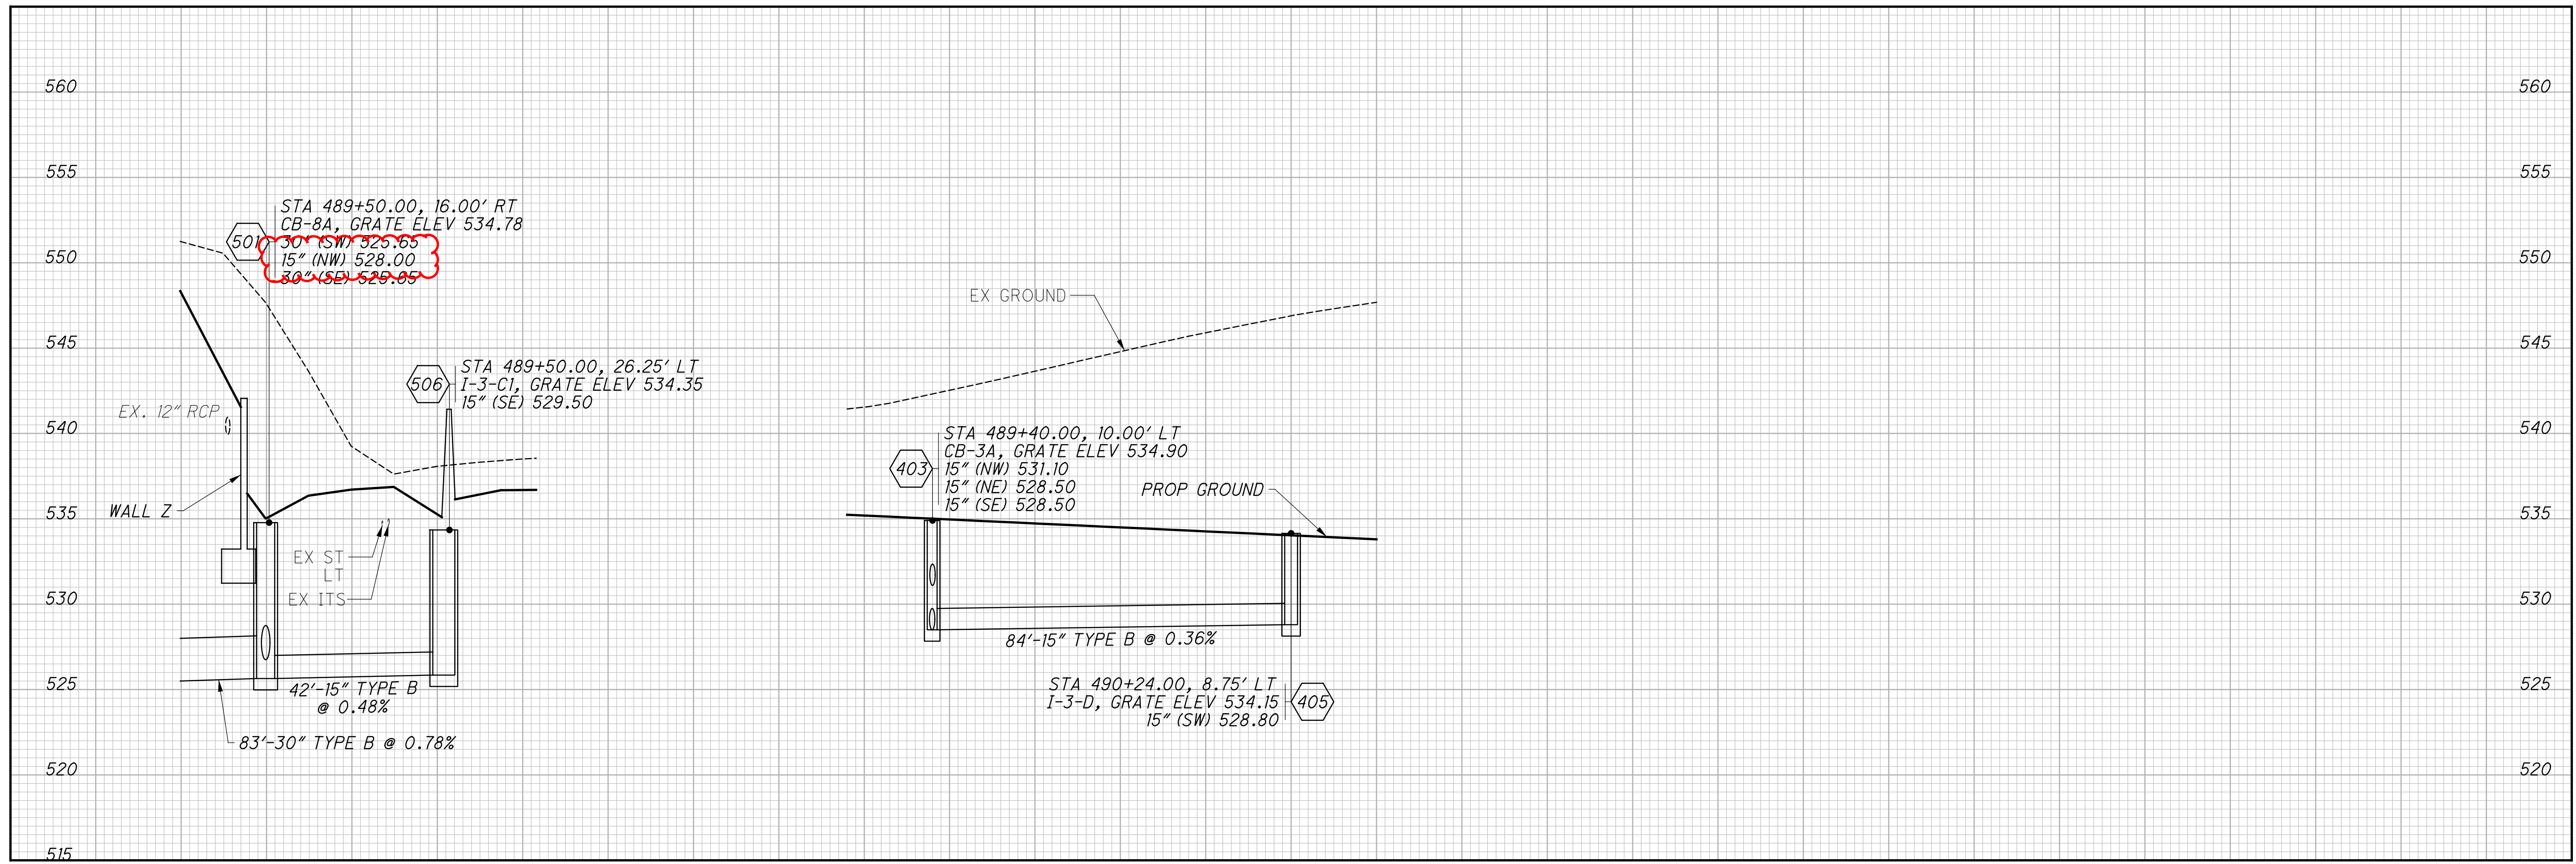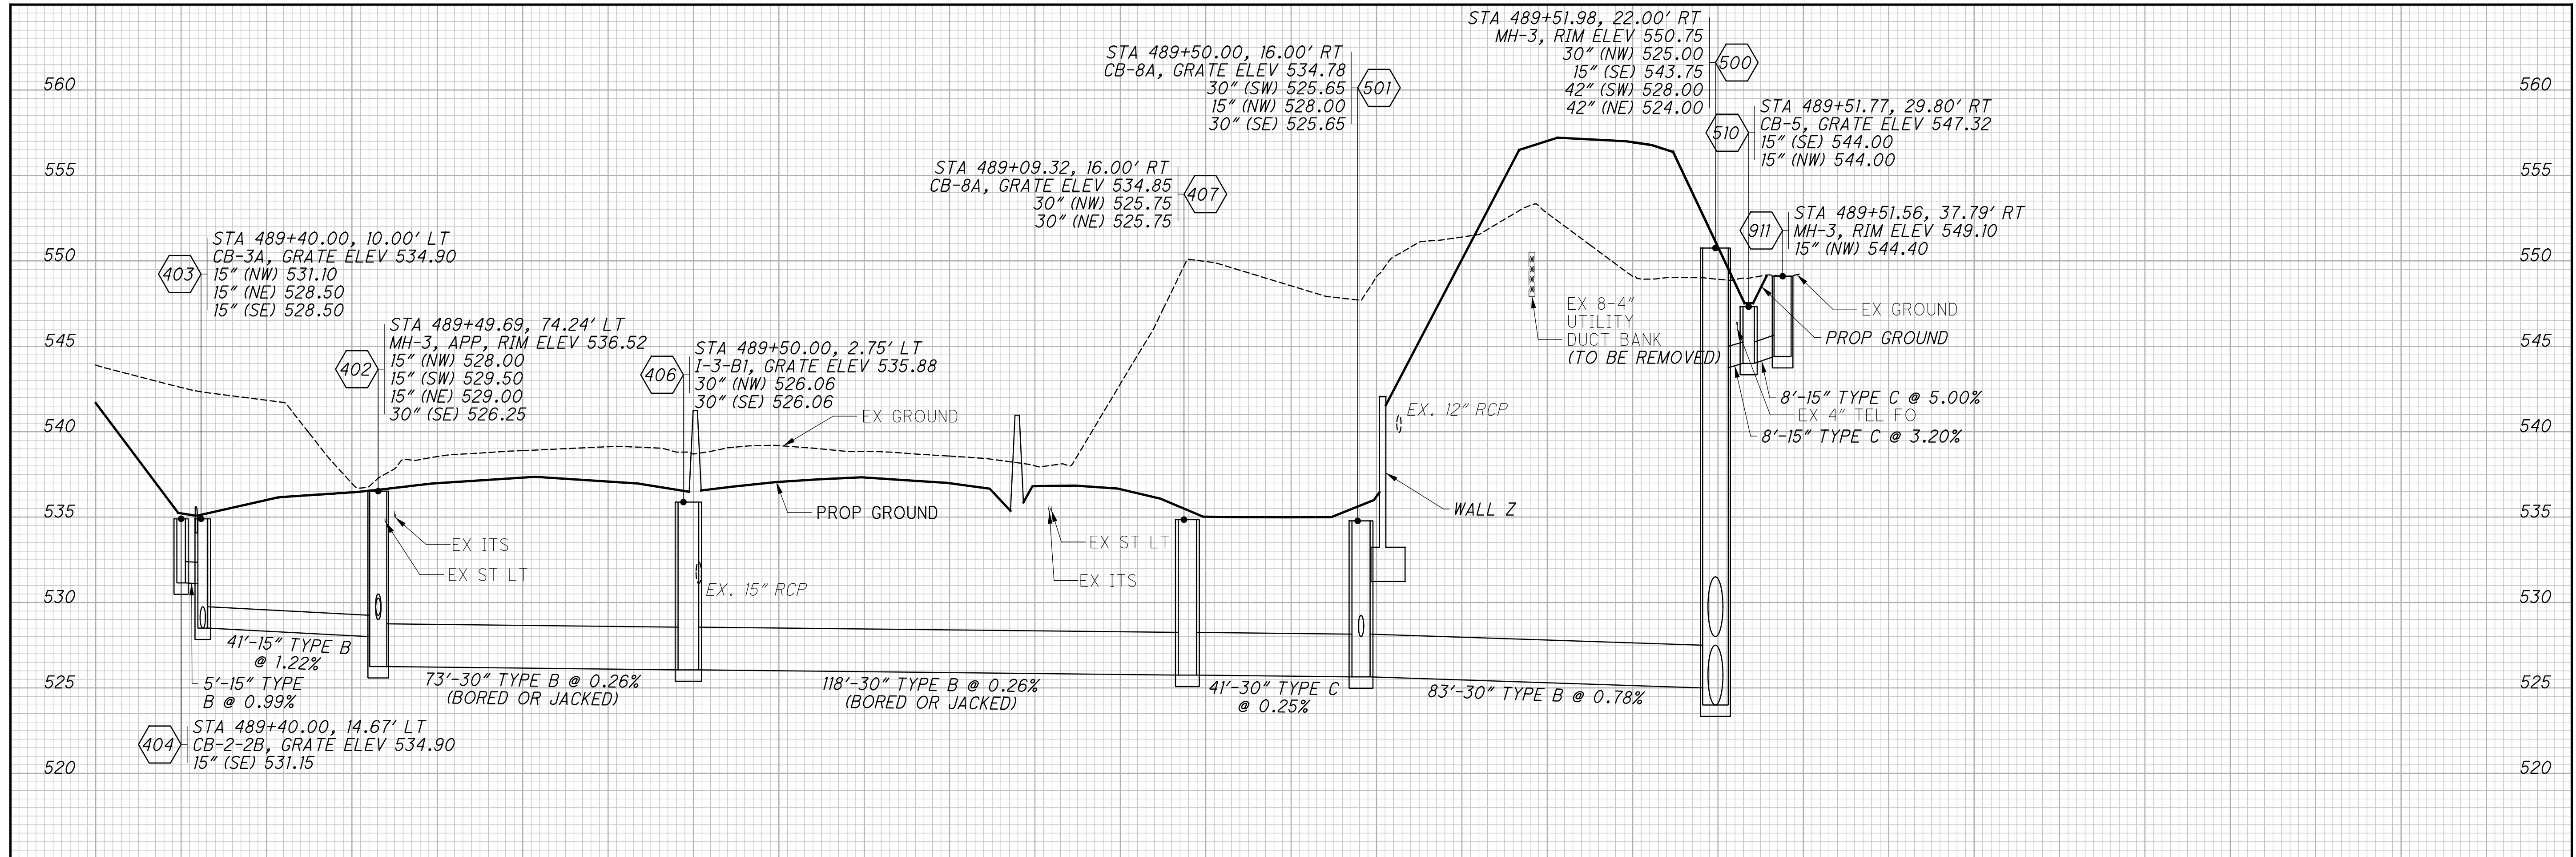



CALCULATED
ECH
CHECKED
SSK

STORM SEWER PROFILES



HAM-75-8.91

413
826

J:\20240445\ODOT\HAM\117525\Design\Drainage\Sheets\77889DF 412.dgn 3/18/2025 1:12:06 PM bmcutchen

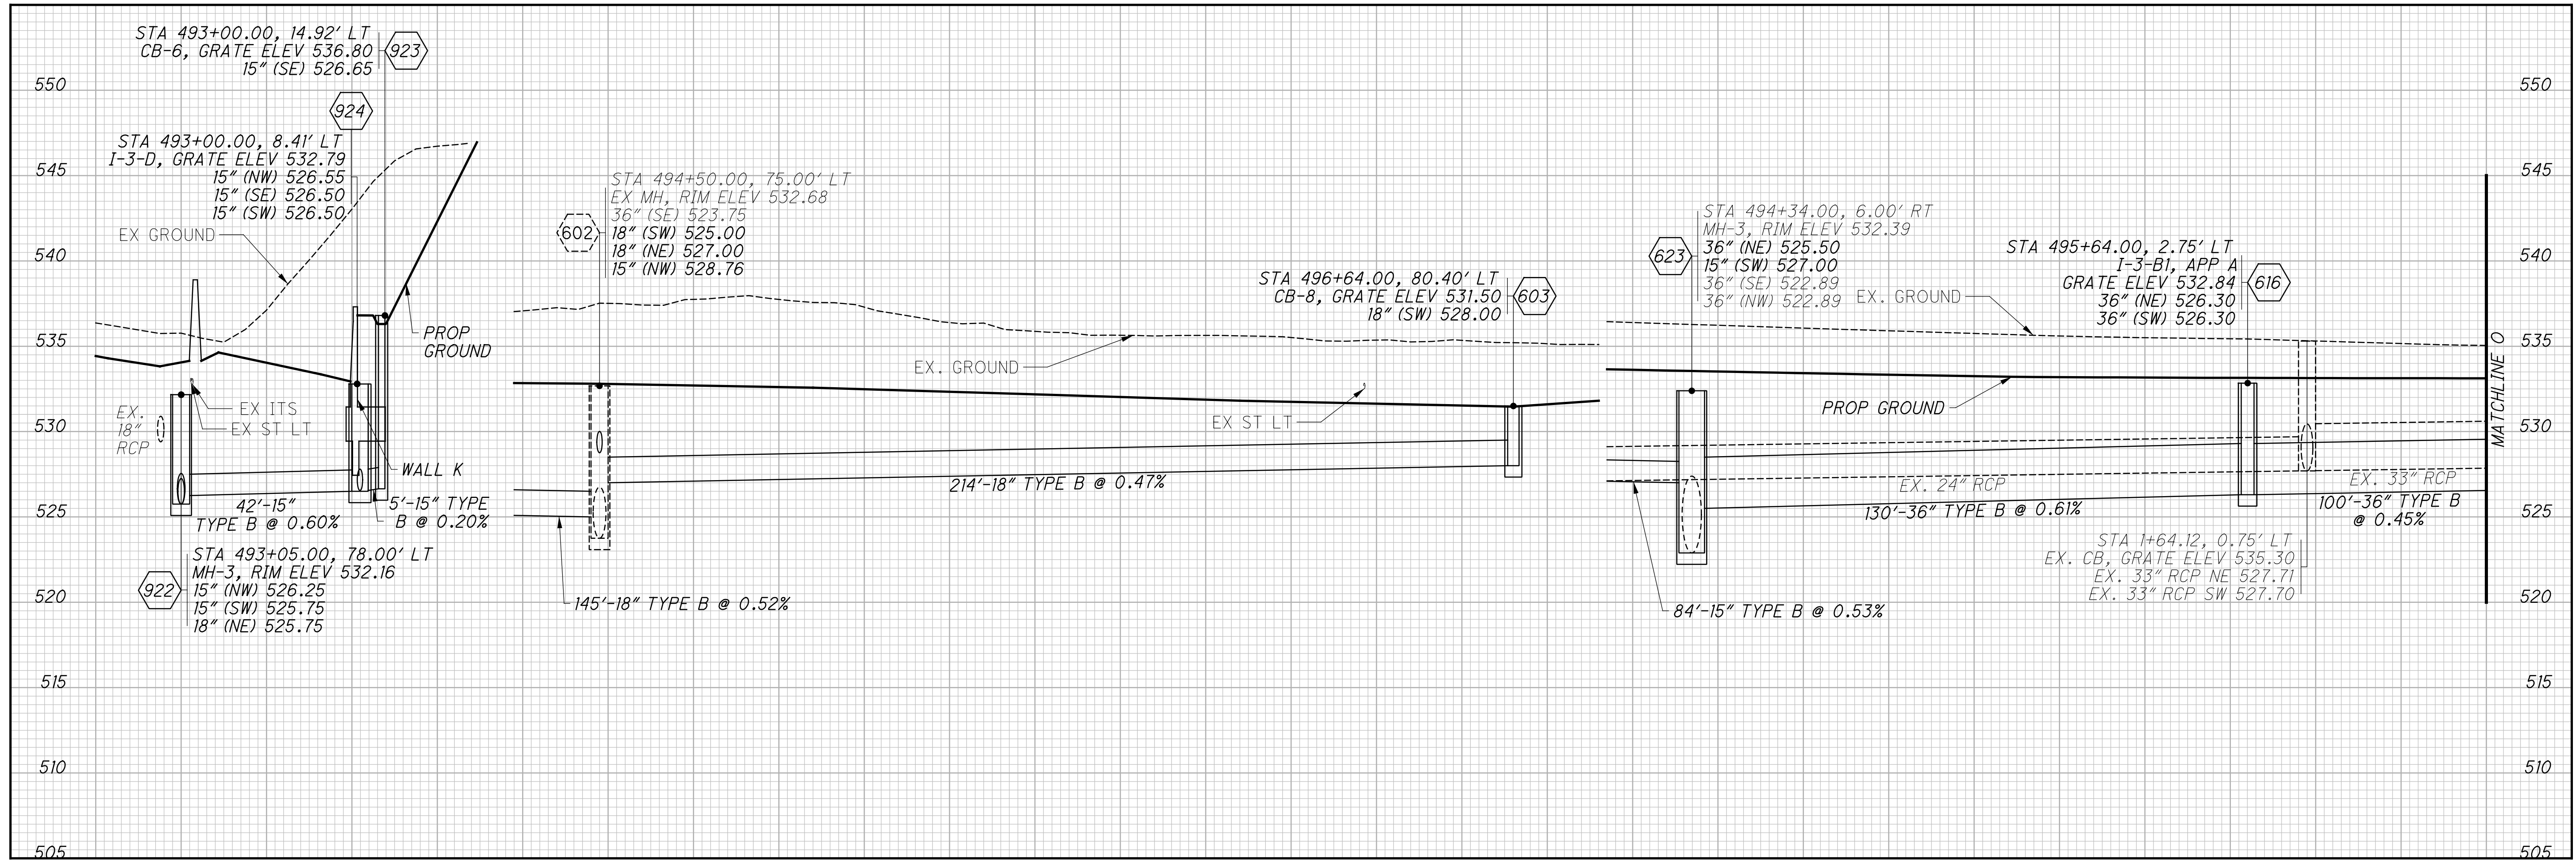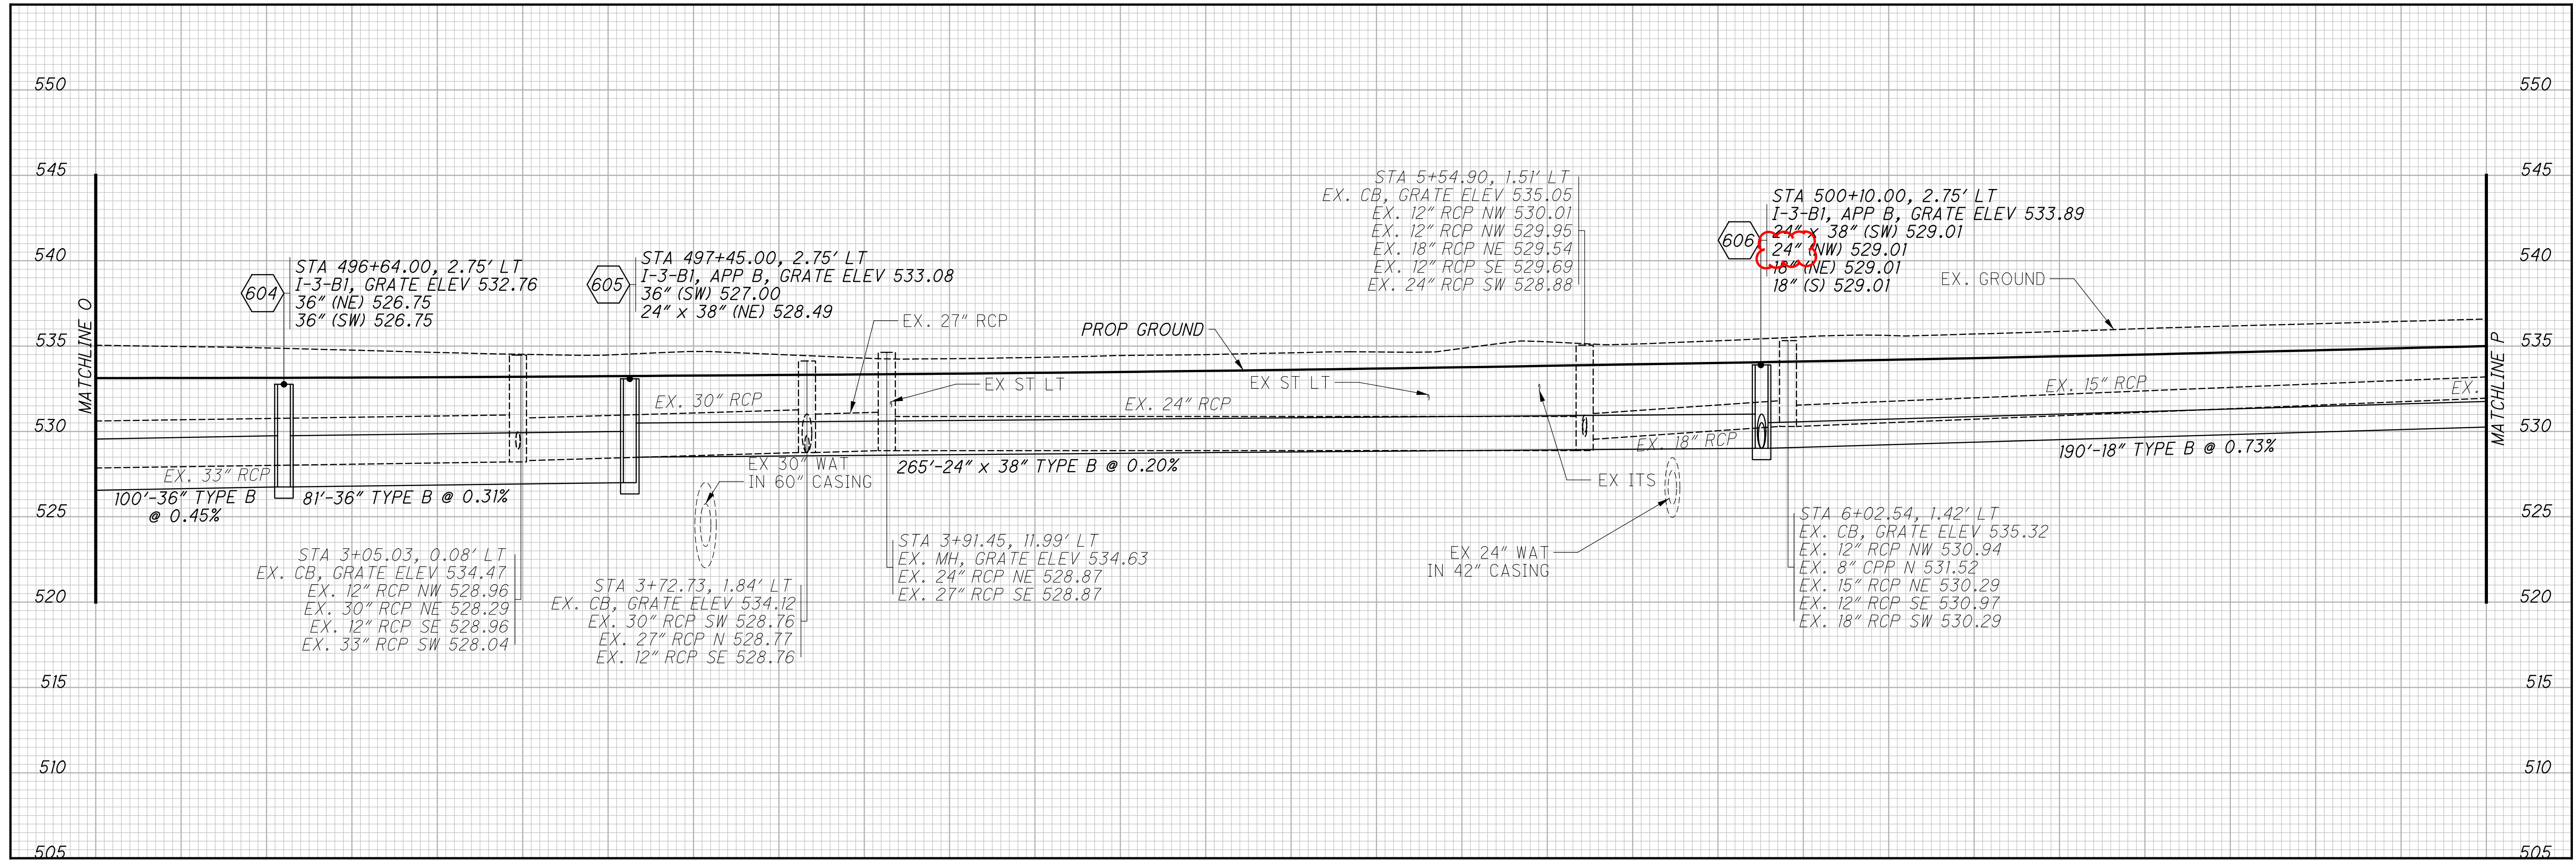

J:\20240445\ODOT\HAM\117525\Design\Drainage\Sheets\77889DF 413.dgn 3/18/2025 1:13:04 PM bmcclutchen

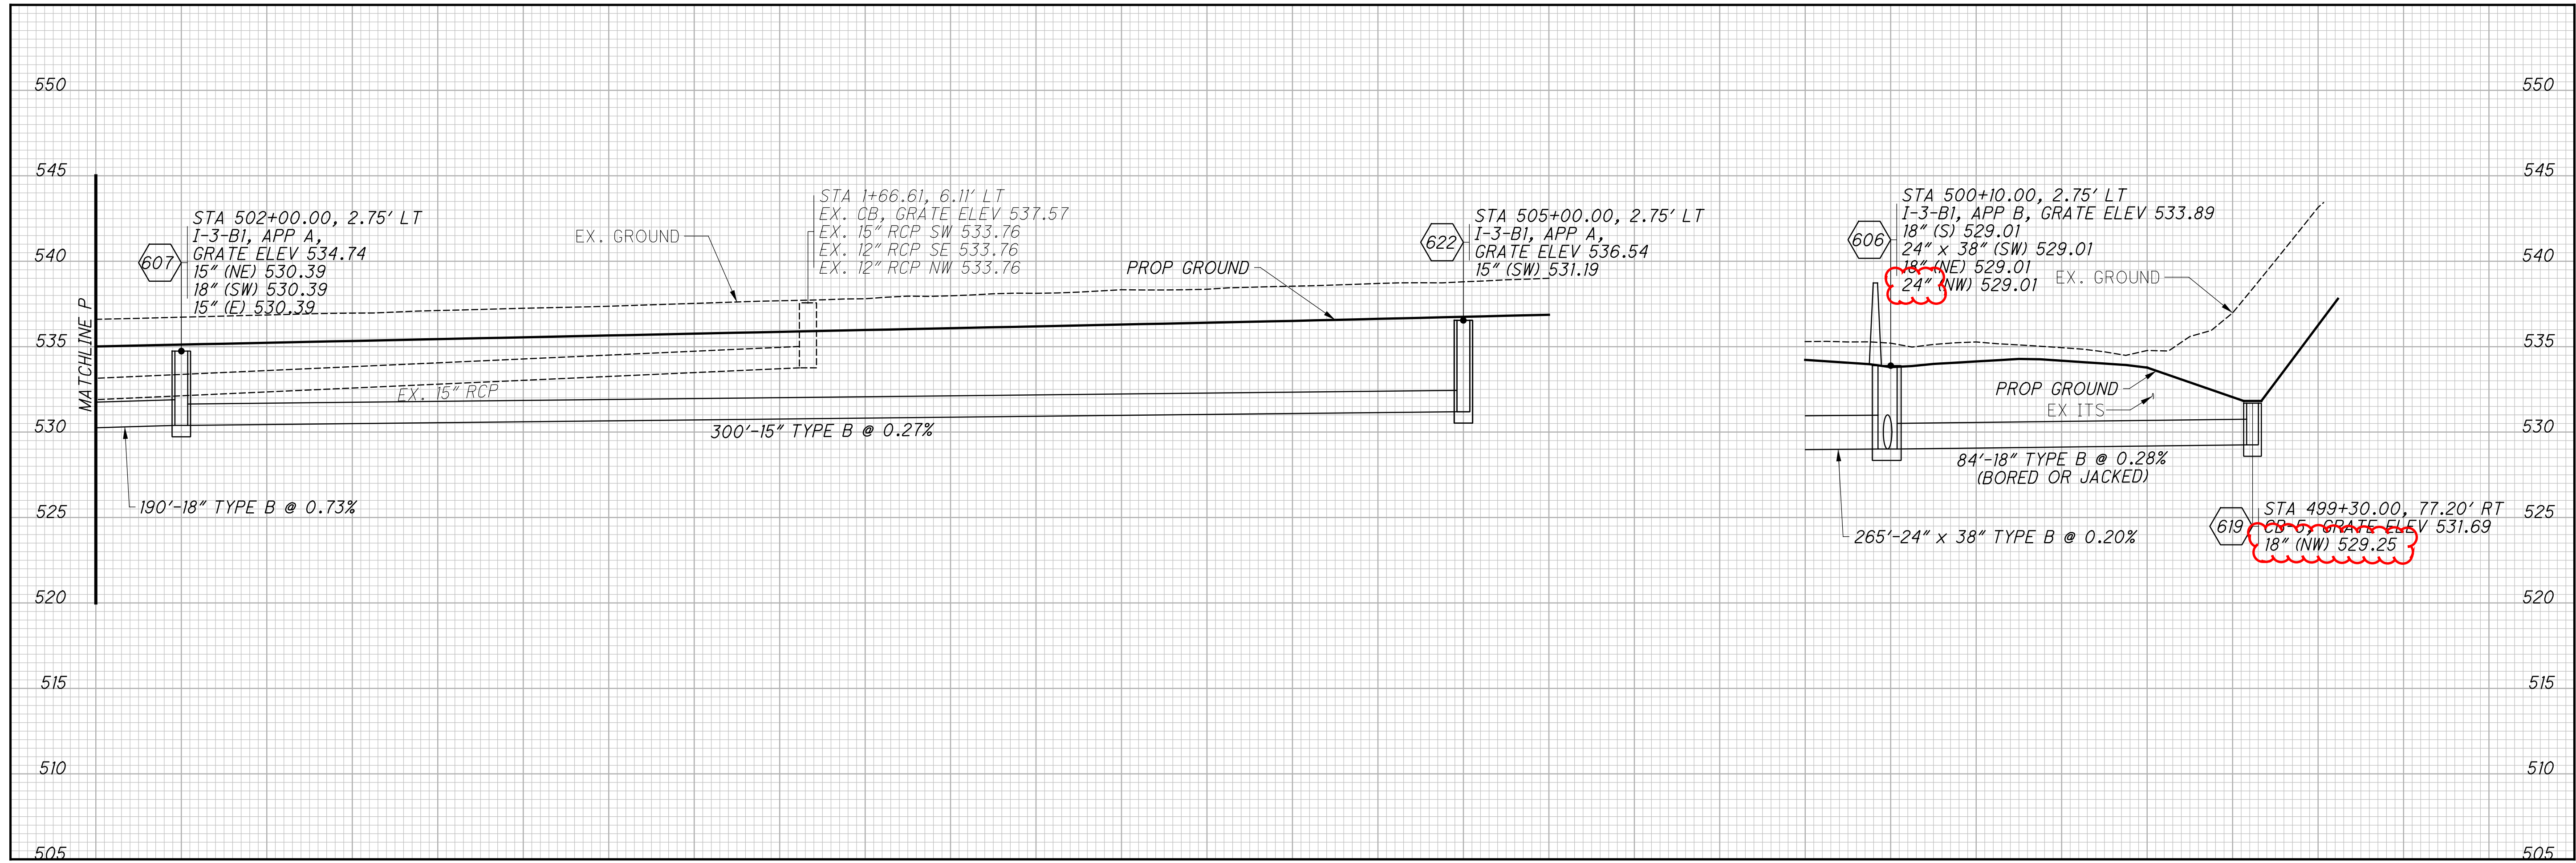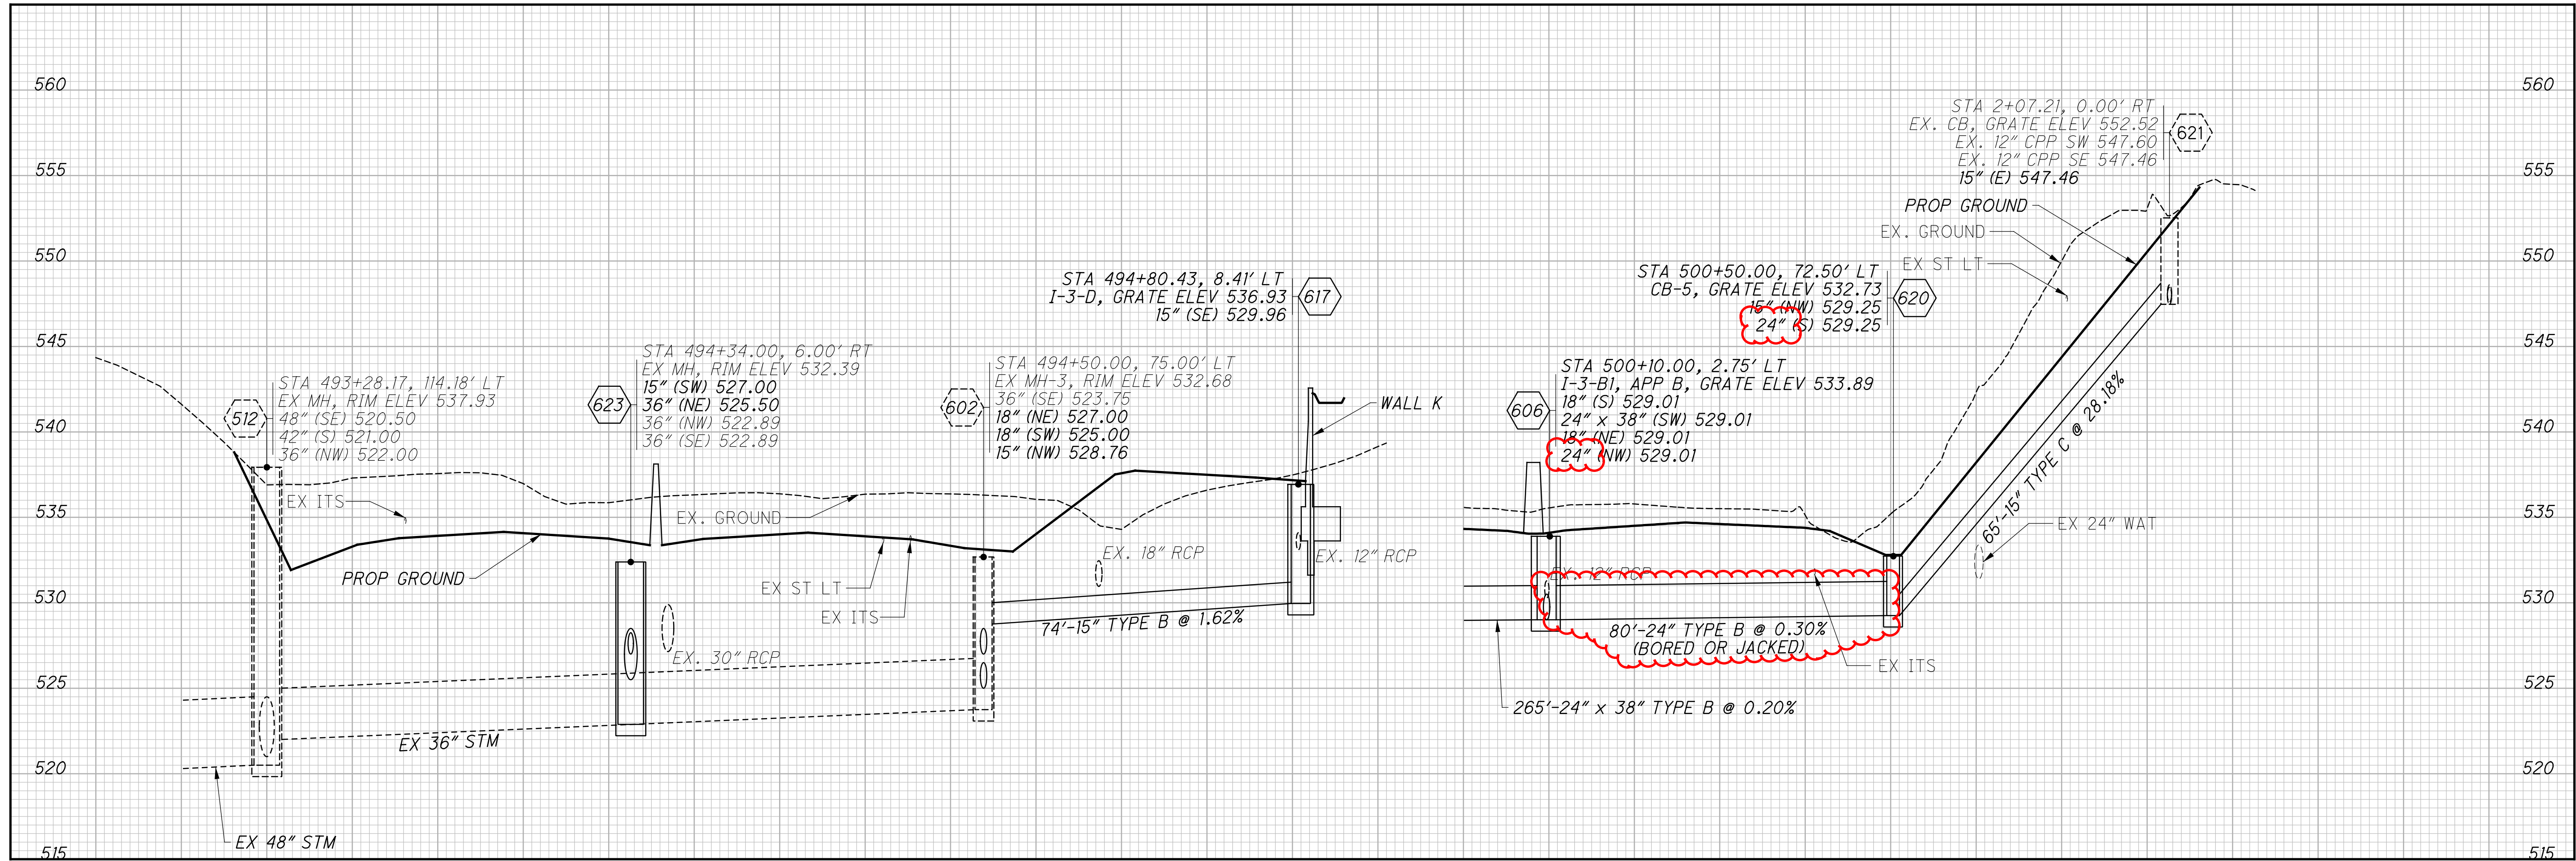



STORM SEWER PROFILES

HAM-75-8.91

419
826

CALCULATED
ECH
CHECKED
SSK


J:\20240445\ODOT\HAM\117525\Design\Drainage\Sheets\77889DF 418.dgn 3/7/2025 11:00:39 AM hbrendinger

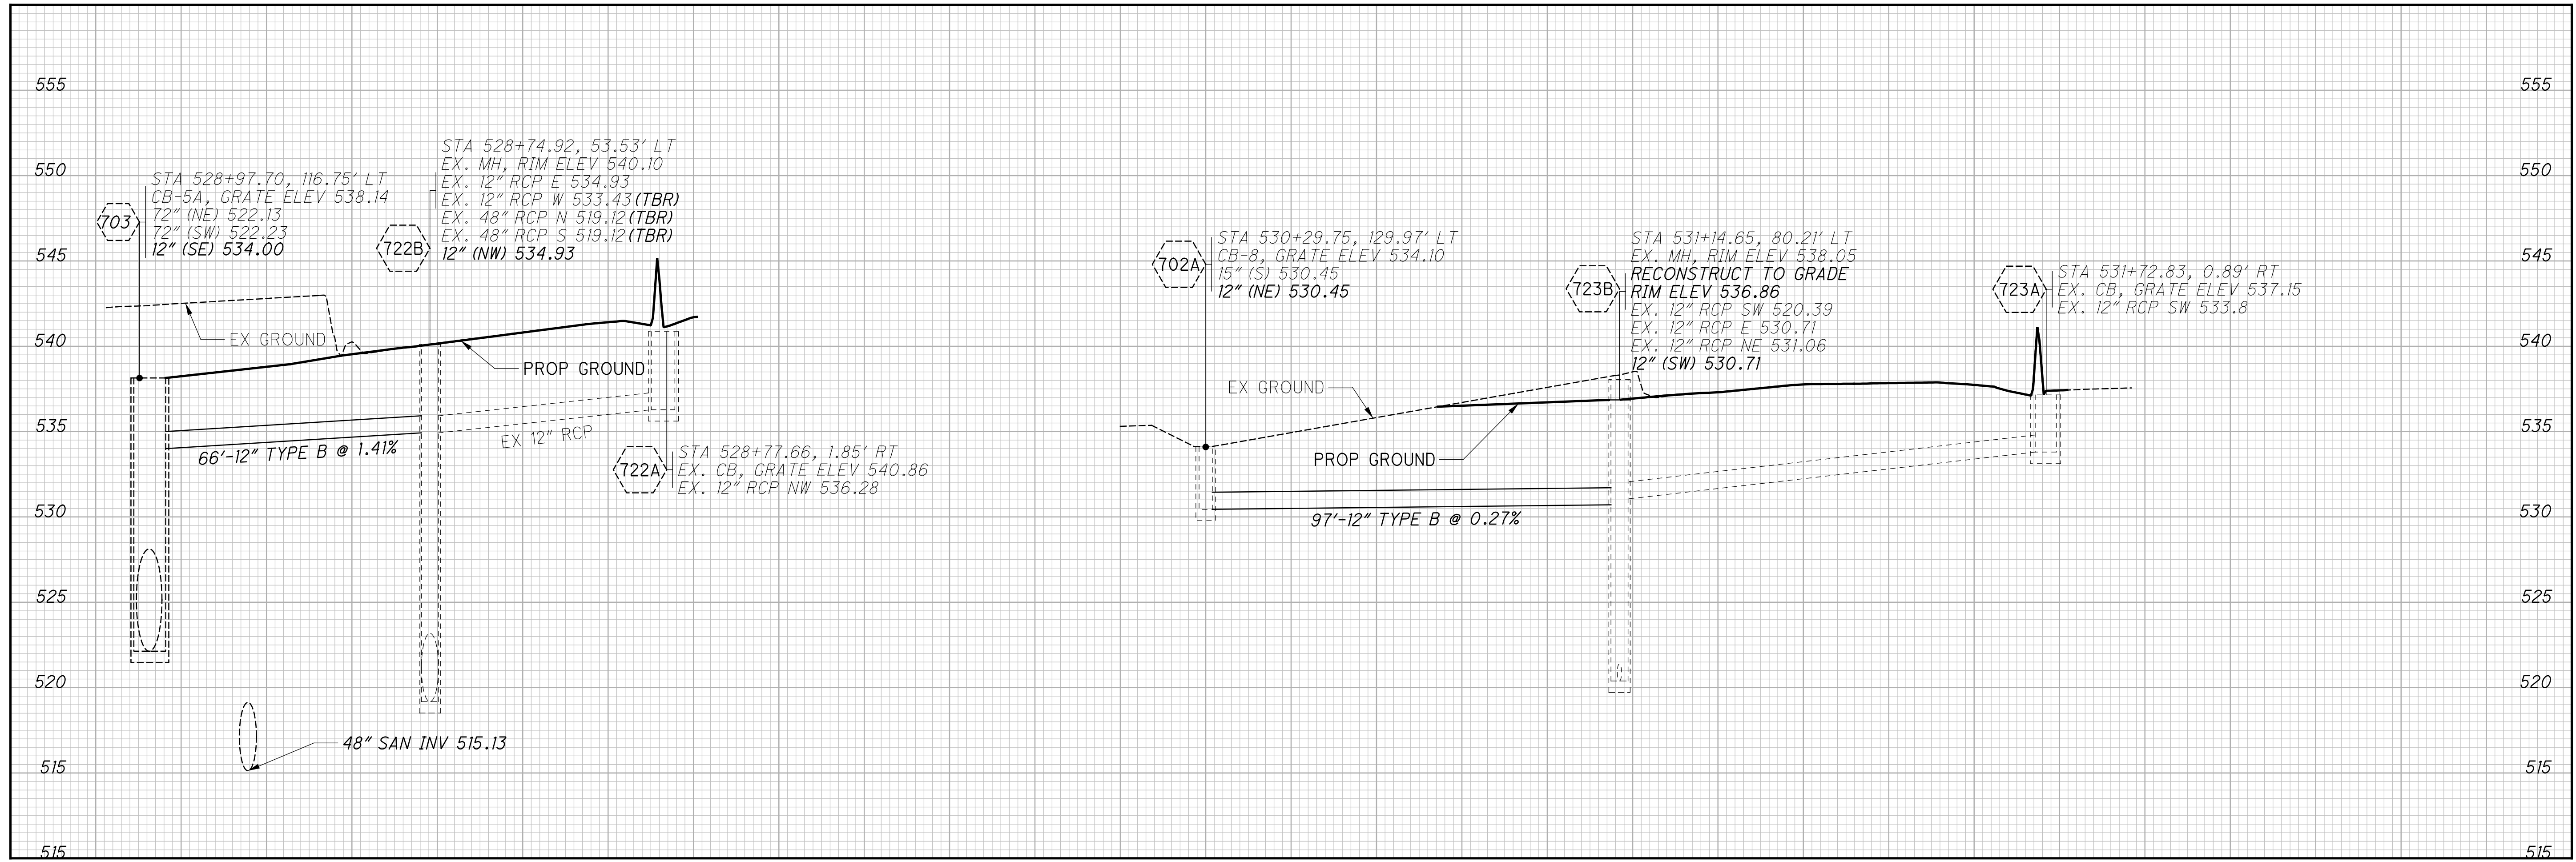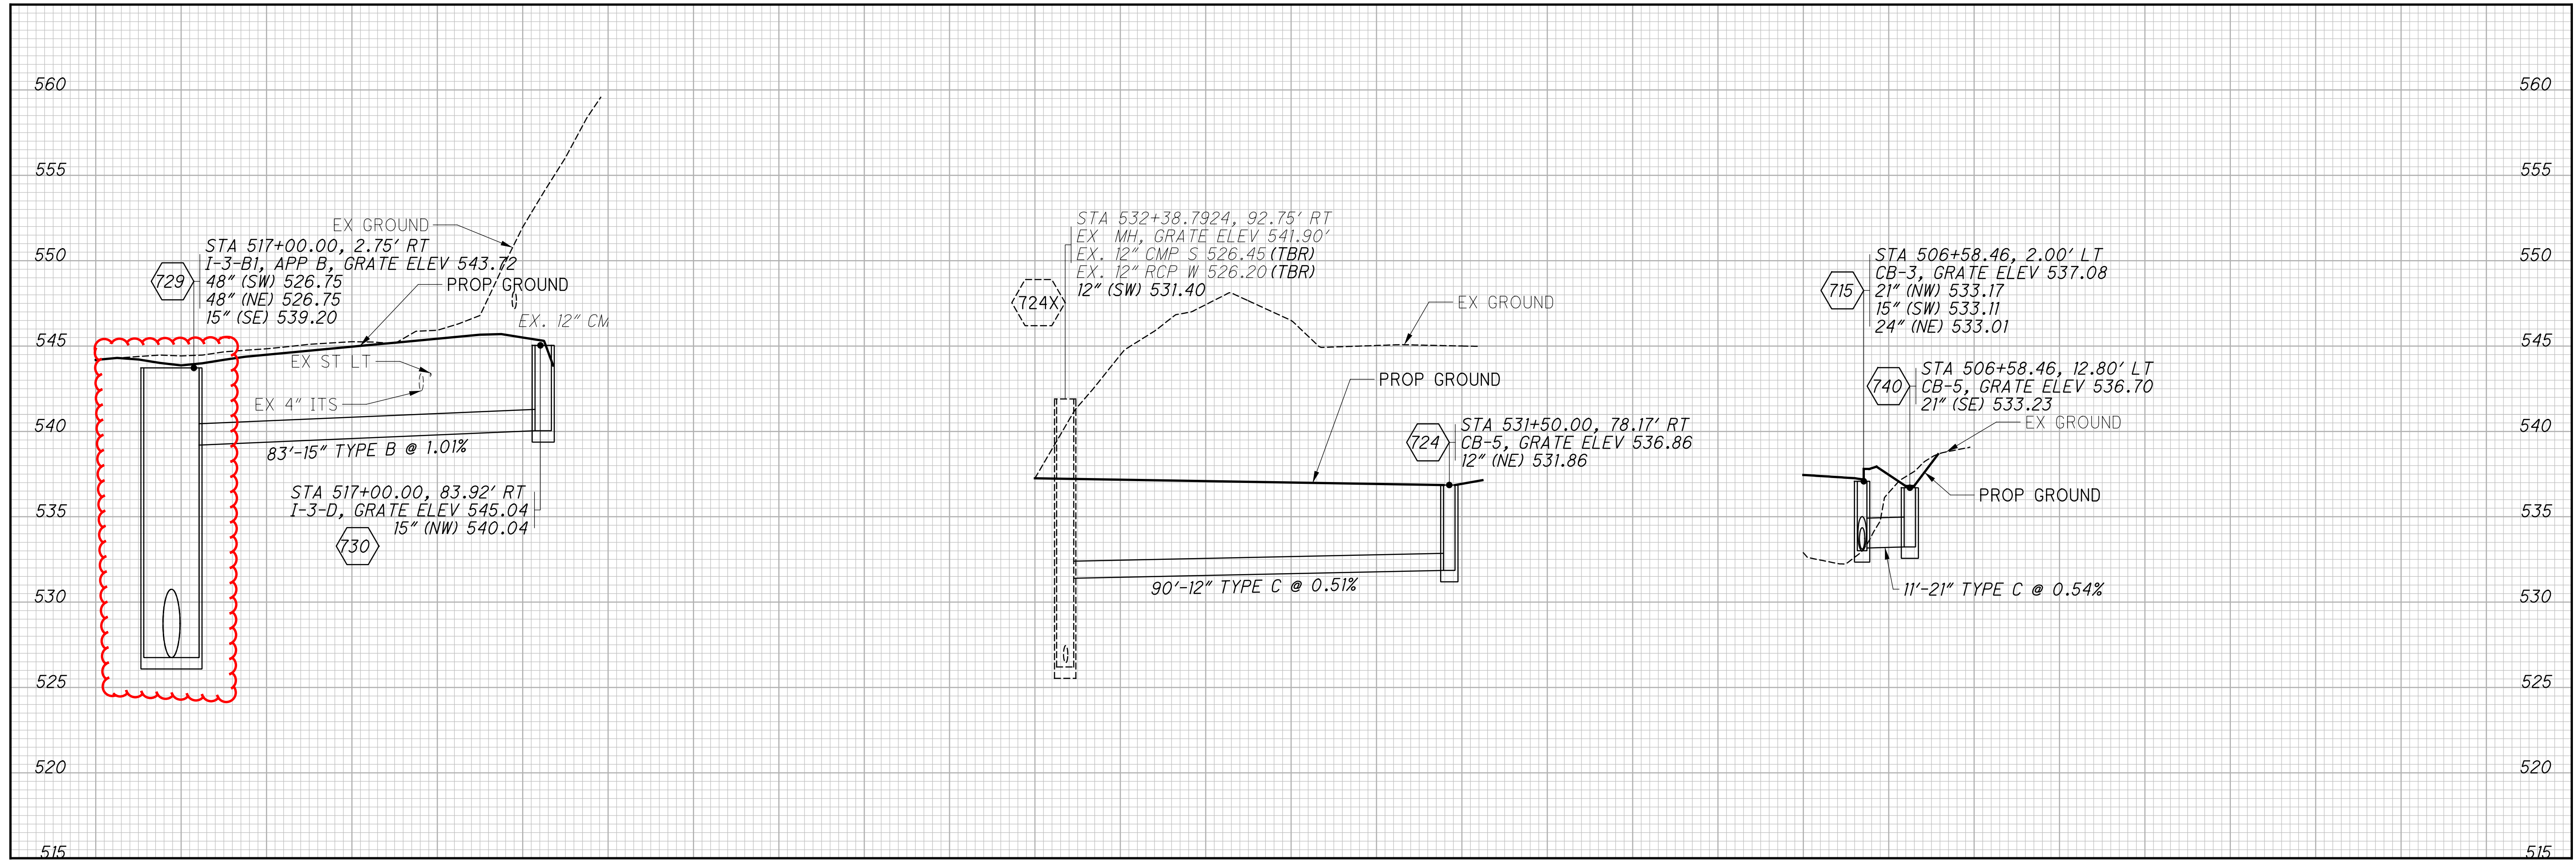


J:\20240445\ODOT\HAM\117525\Design\Roadway\Sheets\778896R403.dgn 3/7/2025 11:11:27 AM hbreindinger

FOR ESTIMATED QUANTITIES SEE SHEET 168 - 169


ALL GUARDRAIL ASSUMED TO BE TYPE MGS, UNLESS OTHERWISE NOTED

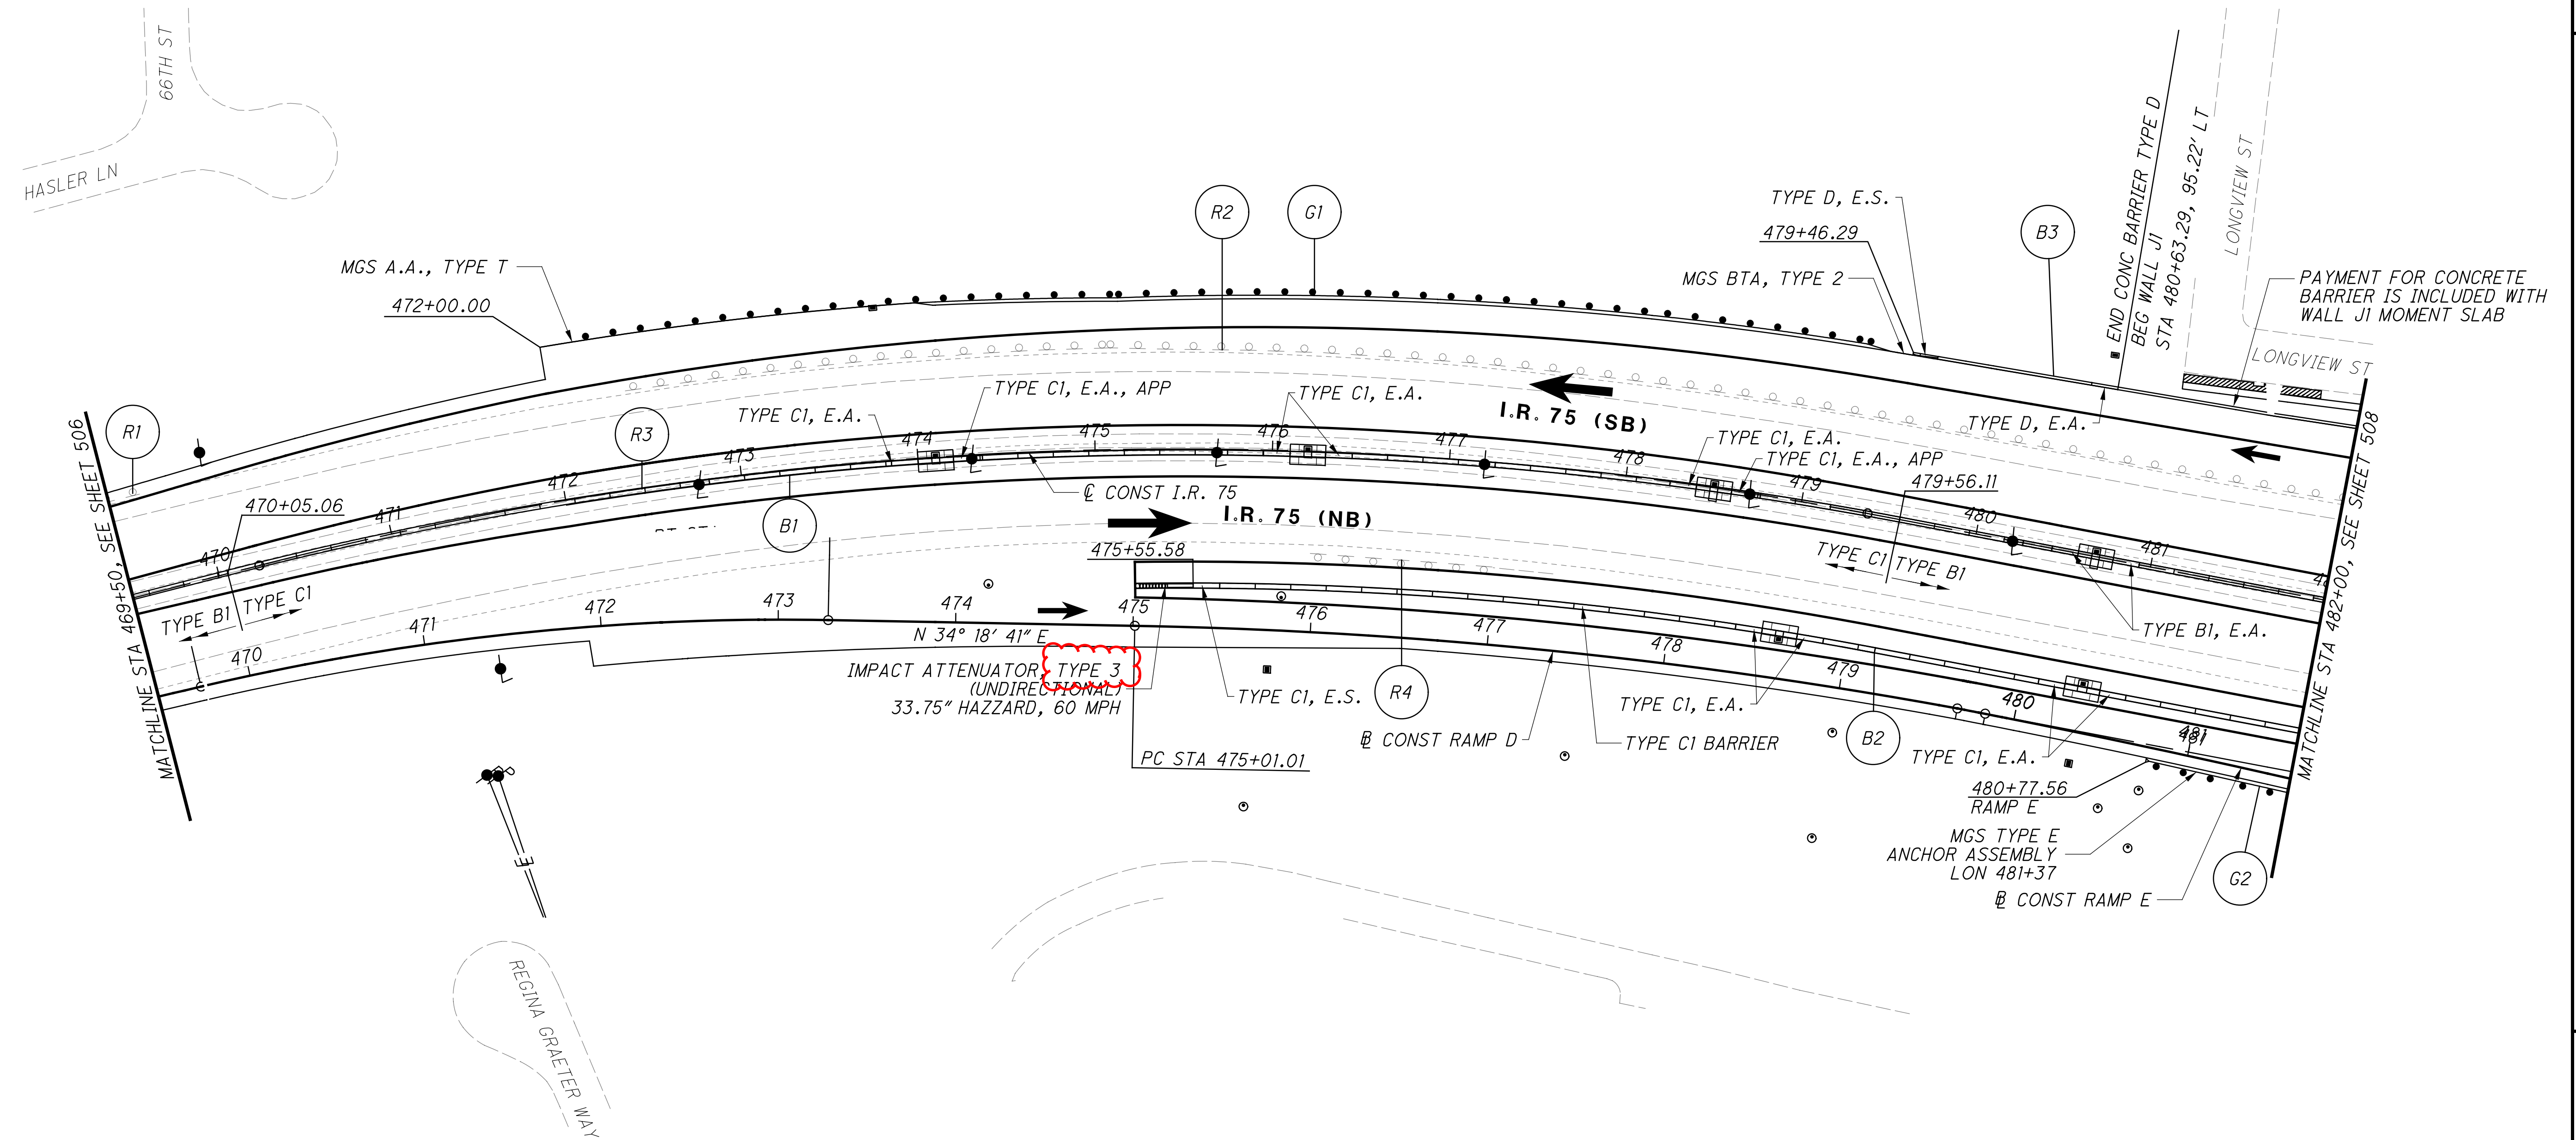

J:\20240445\ODOT\HAM\117525\Design\Roadway\Sheets\778896R404.dgn 3/7/2025 11:13:11 AM hbrendlinger

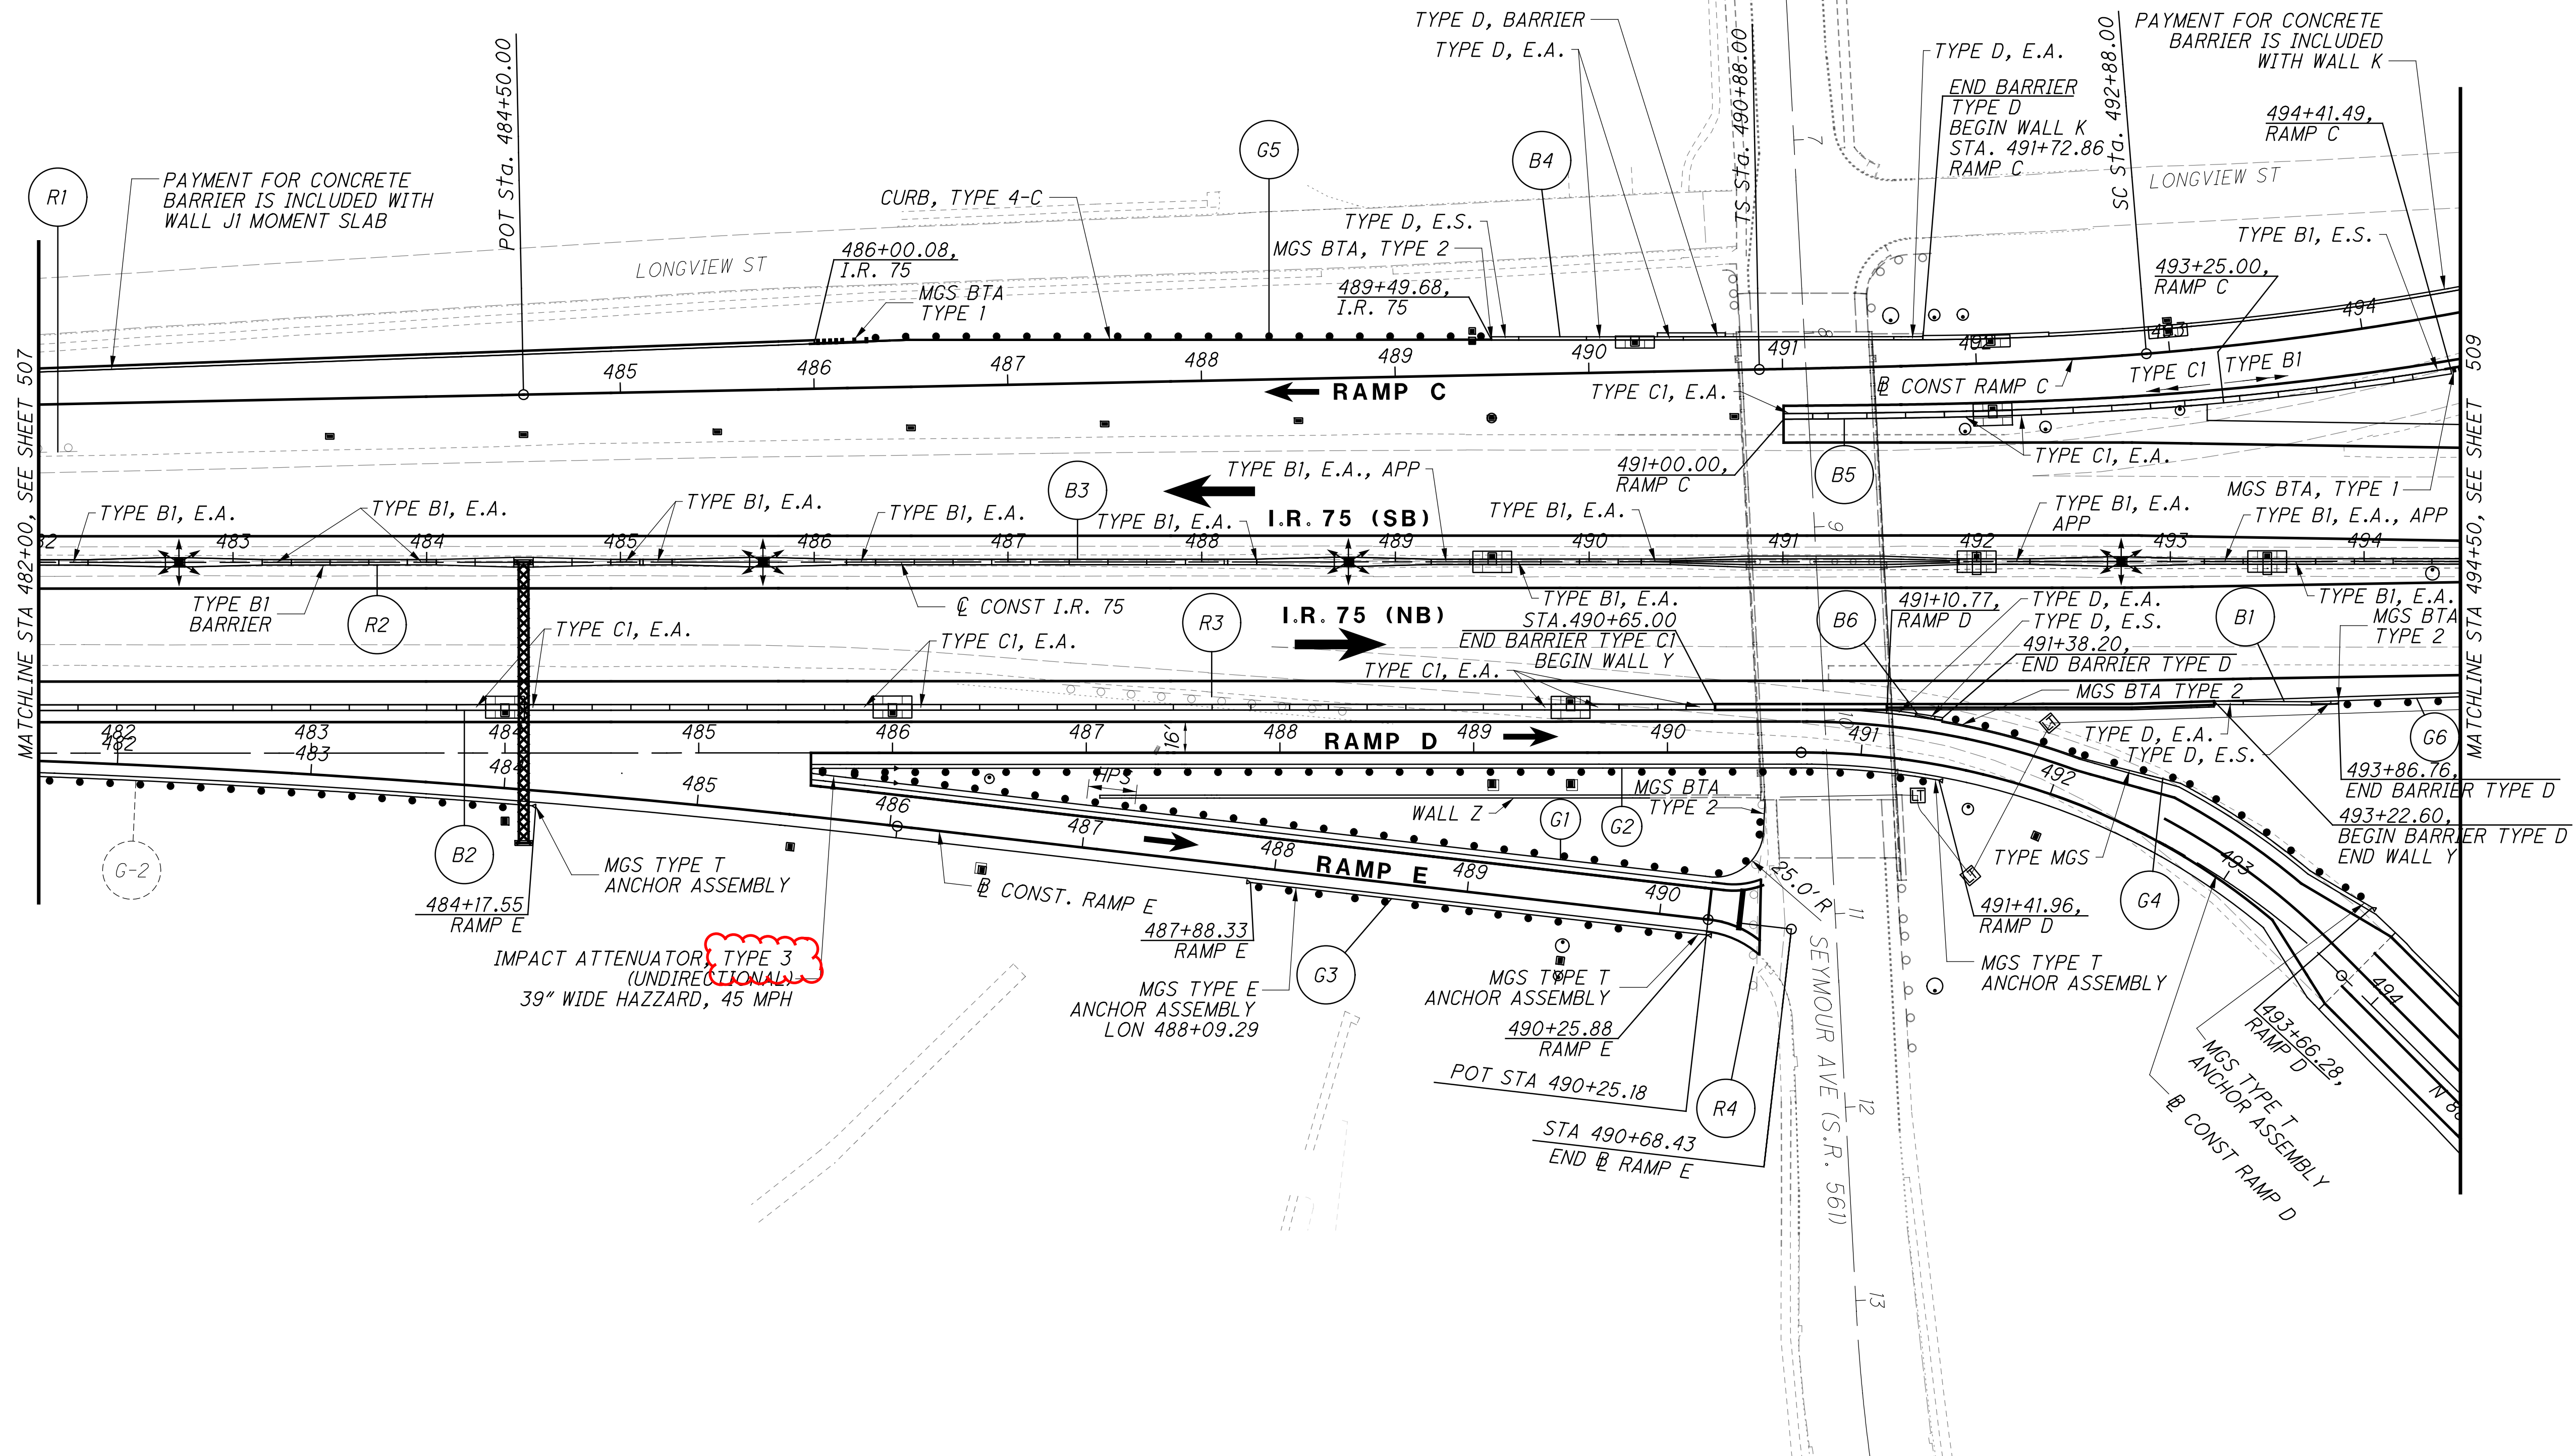

- LEGEND**
- E.A. = END ANCHORAGE
 - E.S. = END SECTION
 - A.A. = ANCHOR ASSEMBLY
 - BTA = BRIDGE TERMINAL ASSEMBLY
 - APP = AS PER PLAN

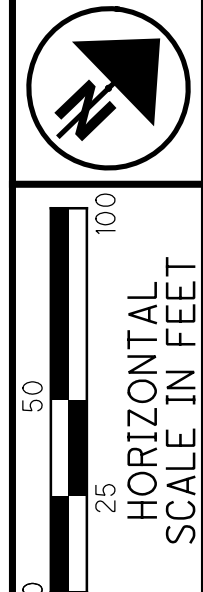

CALCULATED	BLM	CHECKED	SSK
------------	-----	---------	-----

ROADSIDE BARRIER PLAN
STA 482+00 TO STA 494+50

HAM-75-8.91


FOR ESTIMATED QUANTITIES SEE SHEET 168 - 169

ALL GUARDRAIL ASSUMED TO BE TYPE MGS, UNLESS OTHERWISE NOTED
HPS = HALF POST SPACING MGS GUARDRAIL 487+00 TO 487+25 RAMP E

J:\20240445\000T\HAM\117525\Design\Roadway\Sheets\778896R406.dgn 3/7/2025 11:15:04 AM hbreindinger

FOR ESTIMATED QUANTITIES SEE SHEET 168 - 169

ALL GUARDRAIL ASSUMED TO BE TYPE MGS, UNLESS OTHERWISE NOTED

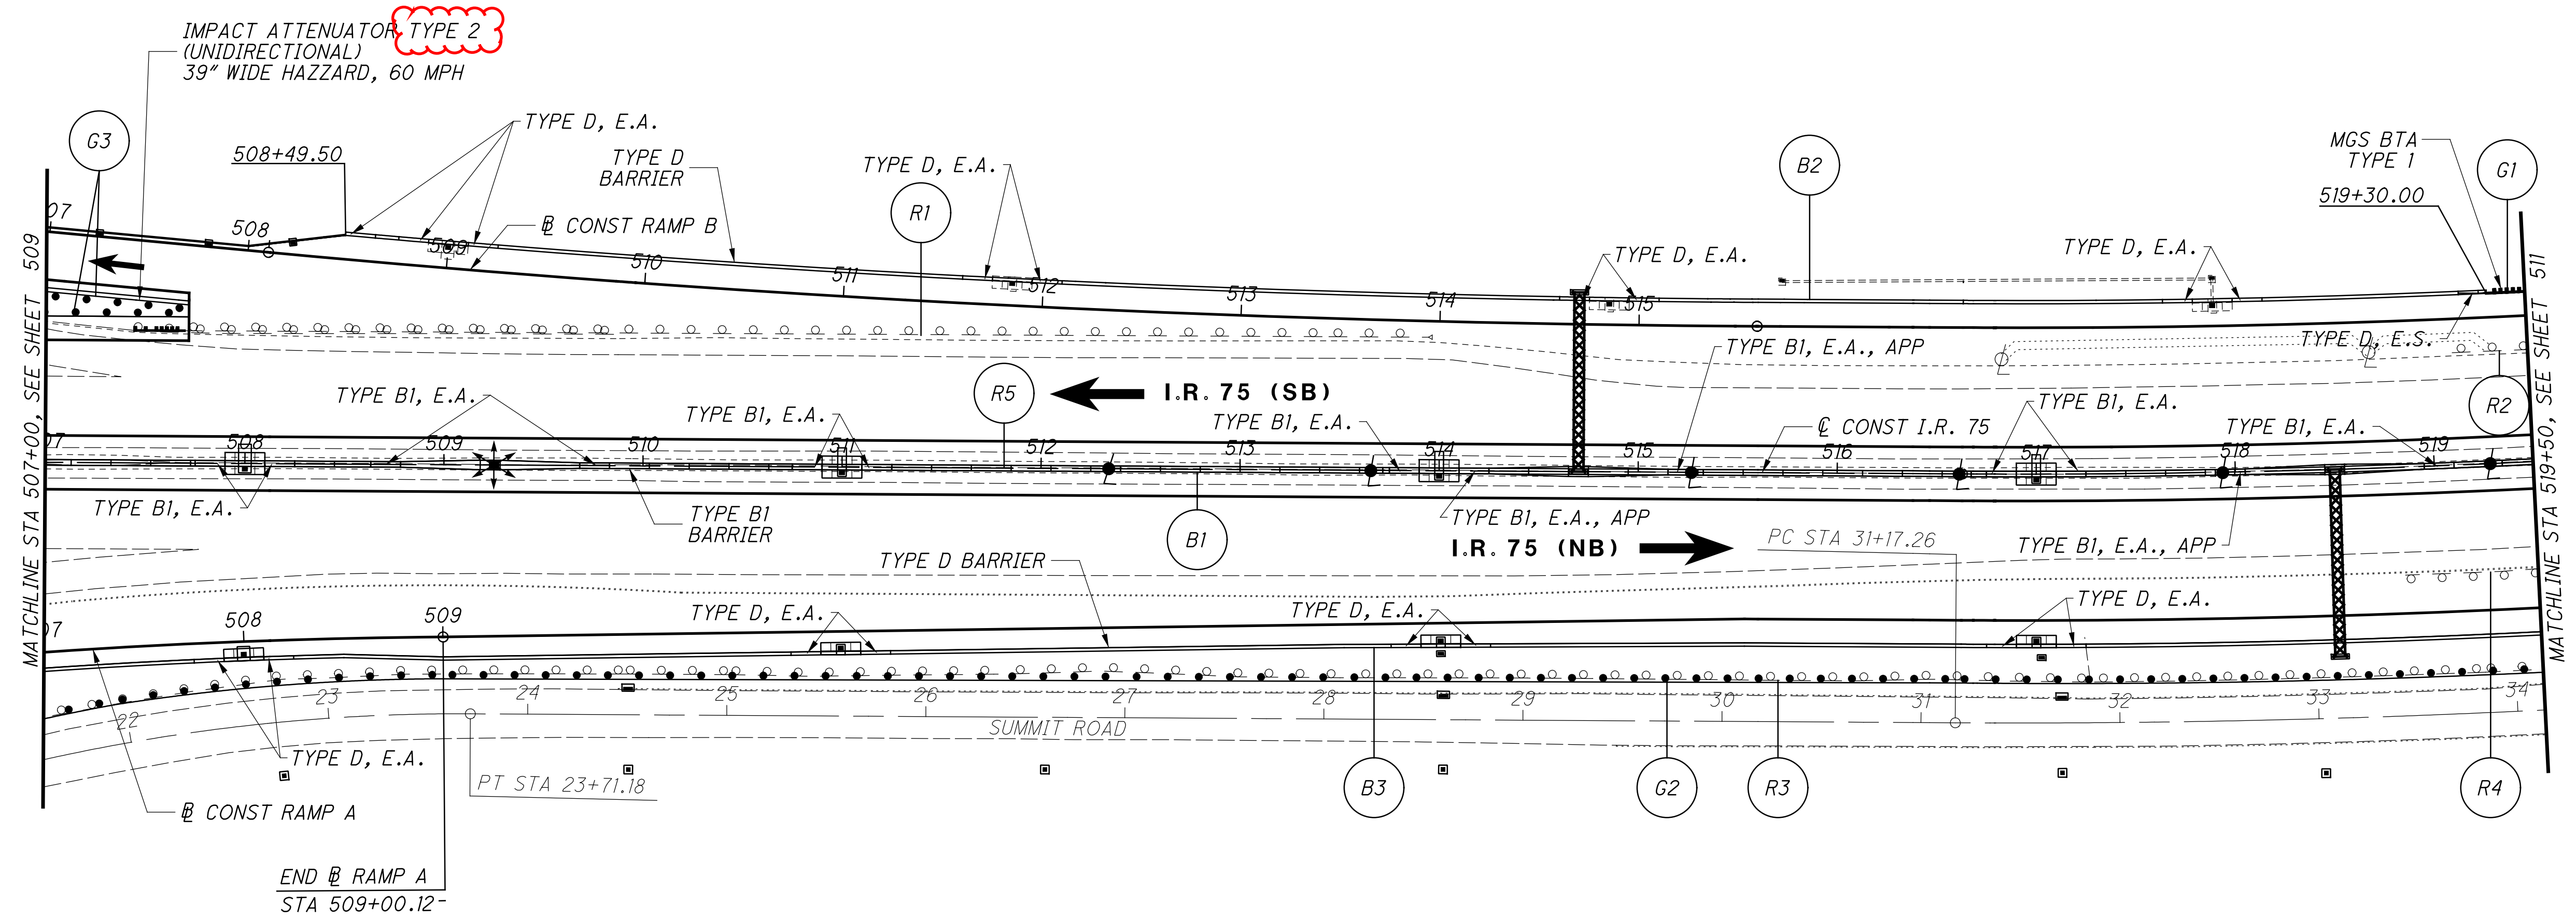

LEGEND
E.A. = END ANCHORAGE
E.S. = END SECTION
A.A. = ANCHOR ASSEMBLY
BTA = BRIDGE TERMINAL ASSEMBLY
APP = AS PER PLAN

CALCULATED
BLM

CHECKED
SSK

ROADSIDE BARRIER PLAN
STA 507+00 TO STA 519+50

HAM-75-8.91

510
826

0 50 100
HORIZONTAL
SCALE IN FEET