

General

It is the responsibility of the Contractor to provide through vehicular access in both directions at all times throughout the project area. The project shall be constructed in phases in order to minimize traffic disruption and inconvenience to the general public. The Contractor shall be responsible for providing all equipment, materials and manpower needed to adequately maintain traffic as provided for in the plans and specifications.

The Contractor is reminded that, in the conduct of this project, the sequence of operations shall be planned in a fashion which minimizes the number of lane reductions and/or lane width reductions required to maintain traffic through the project.

Permitted lane closures shall be followed as shown on the "Schedule of Through Lanes to be Maintained" table and the Published Permitted Lane Closure Schedule (PLCS). The time limits shown in this table and PLCS shall be adhered to or road user costs will be assessed.

Construction Sequence

No permanent maintenance of traffic zones are detailed in these plans. Traffic shall be maintained in accordance to the "Schedule of Through Lanes to be Maintained" and "Permitted Lane Closure Schedule" notes. All work zone closures shall comply with the appropriate Standard Construction Drawings.

Prior to opening all lanes to normal traffic, the Contractor shall ensure that the pavement is in a drivable condition with no potholes or dust and that all longitudinal drop-offs greater than 1-1/2" and transverse drop-offs are ramped as per the "Maintaining Traffic and Sequence of Operations" note.

Maintenance of Traffic Control Zones

The contractor shall be subject to liquidated damages equal to 1% of the original bid amount for Item 614 Maintaining Traffic for any day that a traffic control issue is identified in the field and is not corrected within 24 hours of notification by the Engineer.

Suspension of Work

If the Contractor fails to comply with the provisions for traffic control as set forth in these plans or with provisions of the OMUTCD, the Engineer shall suspend work until the Contractor complies with the necessary requirements.

Lane Closure/Reduction Required

Length and duration of lane closures and restrictions shall be at the approval of the Engineer. It is the intent to minimize the impact to the traveling public. Lane closures or restrictions over segments of the project in which no work is anticipated within a reasonable time frame, as determined by the Engineer, shall not be permitted. The level of utilization of maintenance of traffic devices shall be commensurate with the work in progress.

Payment

All work and traffic control devices shall be in accordance with CMS 614 and other applicable portions of the specifications, as well as the Ohio Manual of Uniform Traffic Control Devices. Payment for all labor, equipment, and materials shall be included in the lump sum contract price for Item 614 – Maintaining Traffic unless separately itemized in the plans.

Construction Traffic

All construction traffic shall use acceptable truck routes to access the construction area. Use of local residential streets is strictly prohibited unless allowed in writing by the local enforcement authorities.

Permitted Lane Closure Schedule (PLCS)

Permitted lane closure schedule (PLCS)

Lane closure(s) shall conform to the PLCS. Published PLCS information can be found on the ODOT website at: <https://www.transportation.ohio.gov/wps/portal/gov/odot/working/data-tools/resources/permitted-lane-closure>

The monthly published schedules required to be used, for each PLCS segment within the project area, are those that comprise the consecutive 12-month period beginning 15 months prior to the month and year of Sale and ending 4 months prior to the month and year of sale. These same 12 months apply for the life of the project and shall be applied to each respective month of construction (month of lane closure(s) shall match month of PLCS used). Lane closure(s) in place for multiple months shall always comply with the current respective month.

More restrictive changes to the allowable lane closure hours are at the discretion of the engineer in order to comply with the traffic management in work zones policy (21-008(p)) and standard procedure (123-001(SP)).

Less restrictive changes to the allowable lane closure hours are subject to the traffic management in work zones policy (21-008(p)) and standard procedure (123-001(sp)) and shall not be implemented until, and unless, approved by the proper ODOT authority.

Allowable lane closure hours for facilities not covered by the PLCS can be found in the "Schedule of Through Lanes to Be Maintained". Contact Troy Onesti, District 12 Work Zone Traffic Manager, at (216) 379-5337 if there are any questions.

Schedule of Through Lanes to be Maintained

| SR-2 Ramps | | |
|---------------|--|--|
| Location | Permitted Ramp Closures, Lane Reductions | |
| | Short Term Closure | Partial Width Closure (maintain one 11' lane) |
| US 20 EB Exit | Not Permitted; Not Detour Route Readily Nearby | <u>Weekday</u> 8:00 PM to 6:00AM <u>Weekend</u> 8:00 PM to 8:00AM |
| SR 283, 535 | <u>Weekday</u> 8:00 PM to 5:00AM <u>Weekend</u> 8:00 PM Fri to 9:00AM Sat 8:00 PM Sat to 10 AM Sun 8:00 PM Sun to 6:00 AM Mon | <u>Weekday</u> 7:00 PM to 6:00AM <u>Weekend</u> 8:00 PM Fri to 9:00AM Sat 8:00 PM Sat to 11 AM Sun 4:00 PM Sun to 6:00 AM Mon |

Each ramp shall be closed for a maximum of two (2) separate times using an approved detour. Any closure shall be as directed by the Engineer.

Ramp Closures for Resurfacing

The Contractor may close one ramp at a time at each location for milling, partial depth pavement repairs, or resurfacing. Closures for ramps scheduled for repairs and resurfacing shall be limited according to the days of the week and hours shown in the "Schedule of Through Lanes to be Maintained" table.

The motoring public shall be given advance warning of closures at least 72 hours in advance through the use of either a ground mounted flat sheet sign or a portable changeable message sign. A LEO with patrol car (paid for separately) shall be used for each ramp closure and be present for the entire closure time.

Freeway entrance ramps shall be closed with a PCMS suggesting a recommended detour.

Freeway exit ramps shall be closed with a PCMS routing traffic to the next exit

and a second PCMS indicating a U-turn at the exit, unless directed differently by the Project Engineer.

For ramp closures, one or two additional PCMS units will be needed as described above. These will be in addition to the PCMS units specified in the plans and shall be included for payment in Item 614 – Maintaining Traffic.

Notice of Closure Sign

Notice of Closure signs (W20-H13) shall be erected by the Contractor prior to the scheduled road or ramp closure in accordance with the Notice of Closure Time Table below. [At the approval of the Engineer, portable changeable message signs may be used in lieu of the standard flatsheet sign for closure durations of less than 1 week.]

The signs shall be erected on the right-hand side of the road/ramp facing traffic. They shall be placed so as not to interfere with the visibility of any other traffic control signs. On roadways, they should be erected at or near the point of closure. The signs may be erected anywhere on ramps as long as they are visible to the motorists using the ramp. On entrance ramps, the sign shall be erected well in advance of the merge area to avoid distracting motorists.

| Notice of Closure Sign Table | | |
|------------------------------|-----------------------|-----------------------------------|
| Item | Duration of Closure | Sign Displayed to Public |
| Ramp & Road Closures | ≥ 2 weeks | 14 calendar days prior to closure |
| | >12 hours & < 2 weeks | 7 calendar days prior to closure |
| | ≤ 12 hours | 2 business days prior to closure |

The sign shall display the date of the closure in MMM-DD format and the number of days of the closure. The last line of the W20-H13 sign lists a phone number which a motorist may call for additional information. This is to be a specific office within the District rather than the general switchboard number.

Alternate Methods

If the Contractor so elects, he may submit alternate methods for the maintenance of traffic, provided the intent of the provisions is followed and no additional inconvenience to the traveling public results there from. No alternate plan shall be placed into effect until approval has been granted, in writing, by the Director.


All items proposed for use under these provisions must comply with current Department standards for their use when the plan detail, Standard Construction Drawing or other bid document governing their use is not provided as part of the bid package.

Lane Value Contract Table

| Description of Critical Lane/Ramp to be Maintained | Direction | Lanes | Restricted Time Period | Time Unit | Disincentive (per time unit per lane) |
|--|-----------|-------|--|-------------|---------------------------------------|
| SR-2 Local: | | | | | |
| SR-2 | EB | 2 | As Per the Permitted Lane Closure Schedule | Each Minute | \$195 |
| SR-2 | WB | 2 | As Per the Permitted Lane Closure Schedule | Each Minute | \$195 |


The Contractor shall be assessed a disincentive in the amount of the largest disincentive within all sections impacted by the physical lane restriction, including the Transition Area, Activity Area, and Termination Area as defined by the OMUTCD.





| | |
|---|----------|
| General Summary | |
| DESIGN AGENCY | |
|  | |
| DESIGNER | |
| JDA | |
| REVIEWER | |
| DAB | 11/29/24 |
| PROJECT ID | |
| 99583 | |
| SHEET | TOTAL |
| 16 | 34 |

| STATION TO STATION | | LENGTH | BEGIN WIDTH | ENDING WIDTH | AVERAGE WIDTH | AREA | 254 PAVEMENT PLANING, ASPHALT CONCRETE, AS PER PLAN, 1-1/2" | 442 ASPHALT CONCRETE SURFACE COURSE, 12.5 MM, TYPE A (447), AS PER PLAN, PG76-22M 1-1/2" | 442 ANTI-SEGREGATION EQUIPMENT | 407 NON-TRACKING TACK COAT | 872 VOID REDUCING ASPHALT MEMBRANE (VRAM) | 442 ASPHALT CONCRETE SURFACE COURSE, 12.5 MM, TYPE A (446), AS PER PLAN, PG76-22M 1-1/2" |
|---------------------|-----------|-----------|-------------|--------------|---------------|------|--|--|--------------------------------------|-------------------------------|---|--|
| | | FT. | FT. | FT. | FT. | SY | SY | CY | CY | GAL | FT | CY |
| Ramp C-C | | | | | | | | | | | | |
| 9+80.68 | 12+69.49 | 288.81 | 27.0 | 26.0 | 26.5 | 850 | 850 | | 36 | 72 | 289 | 36 |
| 10+37.25 | 12+69.49 | 232.24 | 21.0 | 23.0 | 22.0 | 568 | 568 | | 24 | 48 | 233 | 24 |
| 12+69.49 | 14+28.21 | 158.72 | 26.0 | 50.0 | 38.0 | 670 | 670 | | 28 | 57 | 159 | 28 |
| 14+28.21 | 15+77.69 | 149.48 | 26.0 | 26.0 | 26.0 | 432 | 432 | | 18 | 37 | 150 | 18 |
| 15+77.69 | 19+15.75 | 338.06 | 31.0 | 31.0 | 31.0 | 1164 | 1164 | | 49 | 99 | 339 | 49 |
| | | | | | | | | | | | | |
| | | | | | | | | | | | | |
| Ramp D-D | | | | | | | | | | | | |
| 10+37.25 | 12+50.08 | 212.83 | 31.0 | 30.0 | 30.5 | 721 | 721 | | 31 | 61 | 213 | 31 |
| 12+50.08 | 13+43.41 | 93.33 | 30.0 | 25.0 | 27.5 | 285 | 285 | | 12 | 24 | 94 | 12 |
| 13+43.41 | 20+96.00 | 752.59 | 25.0 | 25.0 | 25.0 | 2091 | 2091 | | 88 | 178 | 753 | 88 |
| 20+96.00 | 22+50.98 | 154.98 | 25.0 | 29.0 | 27.0 | 465 | 465 | | 20 | 40 | 155 | 20 |
| | | | | | | | | | | | | |
| Ramp E-E | | | | | | | | | | | | |
| 9+86.54 | 11+69.88 | 183.34 | 28.0 | 28.0 | 28.0 | 570 | 570 | | 24 | 48 | 184 | 24 |
| 10+35.01 | 11+69.88 | 134.87 | 22.0 | 25.0 | 23.5 | 352 | 352 | | 15 | 30 | 135 | 15 |
| 11+69.88 | 12+89.69 | 119.81 | 57.0 | 13.0 | 35.0 | 466 | 466 | | 20 | 40 | 120 | 20 |
| 12+89.69 | 15+03.51 | 213.82 | 31.0 | 30.0 | 30.5 | 725 | 725 | | 31 | 62 | 214 | 31 |
| 15+03.51 | 18+60.56 | 357.05 | 30.0 | 30.0 | 30.0 | 1190 | 1190 | | 50 | 101 | 358 | 50 |
| | | | | | | | | | | | | |
| Ramp F-F | | | | | | | | | | | | |
| 10+35.01 | 12+03.25 | 168.24 | 25.0 | 24.0 | 24.5 | 458 | 458 | | 20 | 39 | 169 | 20 |
| 9+78.23 | 12+16.41 | 238.18 | 22.5 | 22.5 | 22.5 | 595 | 595 | | 25 | 51 | 239 | 25 |
| 12+16.41 | 13+50.61 | 134.20 | 49.0 | 23.0 | 36.0 | 537 | 537 | | 23 | 46 | 135 | 23 |
| 13+50.61 | 13+91.59 | 40.98 | 23.0 | 24.0 | 23.5 | 107 | 107 | | 5 | 9 | 41 | 5 |
| 13+91.59 | 15+16.32 | 124.73 | 22.0 | 24.0 | 23.0 | 319 | 319 | | 14 | 27 | 125 | 14 |
| 15+16.32 | 20+75.02 | 558.70 | 24.0 | 24.0 | 24.0 | 1490 | 1490 | | 63 | 127 | 559 | 63 |
| | | | | | | | | | | | | |
| Ramp G-G | | | | | | | | | | | | |
| 11+91.83 | 18+56.96 | 665.13 | 28.0 | 28.0 | 28.0 | 2069 | 2069 | | 87 | 176 | 666 | 87 |
| 18+56.96 | 19+37.66 | 80.70 | 28.0 | 51.0 | 39.5 | 354 | 354 | | 15 | 30 | 81 | 15 |
| 19+37.66 | 20+42.05 | 104.39 | 27.0 | 30.5 | 28.8 | 333 | 333 | | 14 | 28 | 105 | 14 |
| 19+44.43 | 20+34.69 | 90.26 | 22.0 | 51.0 | 36.5 | 366 | 366 | | 16 | 31 | 91 | 16 |
| | | | | | | | | | | | | |
| Ramp H-H | | | | | | | | | | | | |
| 16+51.93 | 21+44.82 | 492.89 | 28.0 | 27.0 | 27.5 | 1506 | 1506 | | 63 | 128 | 493 | 63 |
| 21+44.82 | 22+93.45 | 148.63 | 27.0 | 33.0 | 30.0 | 495 | 495 | | 21 | 42 | 149 | 21 |
| 22+93.45 | 24+43.80 | 150.35 | 33.0 | 34.0 | 33.5 | 560 | 560 | | 24 | 48 | 151 | 24 |
| 24+43.80 | 25+10.95 | 67.15 | 34.0 | 92.0 | 63.0 | 470 | 470 | | 20 | 40 | 68 | 20 |
| Crossover | | | | | | | | | | | | |
| 661+59.00 | 666+31.00 | CADD AREA | | | | | 728 | | | 62 | | 31 |
| 728+97.00 | 733+15.00 | CADD AREA | | | | | 671 | | | 57 | | 28 |
| 757+00.00 | 761+60.00 | CADD AREA | | | | | 355 | | | 30 | | 15 |
| 793+23.00 | 796+64.00 | CADD AREA | | | | | 292 | | | 25 | | 13 |
| 858+24.00 | 861+94.00 | CADD AREA | | | | | 339 | | | 29 | | 15 |
| TOTALS, LEFT COLUMN | | | | | | | 22,593 | | 856 | 1,922 | 6,468 | 958 |

| STATION TO STATION | | LENGTH | BEGIN WIDTH | ENDING WIDTH | AVERAGE WIDTH | AREA | 254 PAVEMENT PLANING, ASPHALT CONCRETE, AS PER PLAN, 1-1/2" | 442 ASPHALT CONCRETE SURFACE COURSE, 12.5 MM, TYPE A (447), AS PER PLAN, PG76-22M 1-1/2" | 442 ANTI-SEGREGATION EQUIPMENT | 407 NON-TRACKING TACK COAT | 872 VOID REDUCING ASPHALT MEMBRANE (VRAM) | 442 ASPHALT CONCRETE SURFACE COURSE, 12.5 MM, TYPE A (446), AS PER PLAN, PG76-22M 1-1/2" |
|-----------------------------------|--|--------|-------------|--------------|---------------|---------|--|--|--------------------------------------|-------------------------------|---|--|
| | | FT. | FT. | FT. | FT. | SQ. YD. | SY | CY | CY | GAL | FT | CY |
| TOTALS, RIGHT COLUMN | | | | | | | 32,315 | | 1,288 | 2,747 | 6,468 | 1,362 |
| TOTALS, LEFT COLUMN | | | | | | | 32,315 | | 1,288 | 2,747 | 6,468 | 1,362 |
| TOTALS CARRIED TO GENERAL SUMMARY | | | | | | | 32,315 | | 1,288 | 2,747 | 6,468 | 1,362 |

| | | |
|---------------------|--|---|
| Pavement Subsummary | | DESIGN AGENCY |
| | |  |
| | | DESIGNER JDA |
| | | REVIEWER DAB 11/29/24 |
| | | PROJECT ID 99583 |
| SHEET | | TOTAL |
| 19 | | 34 |

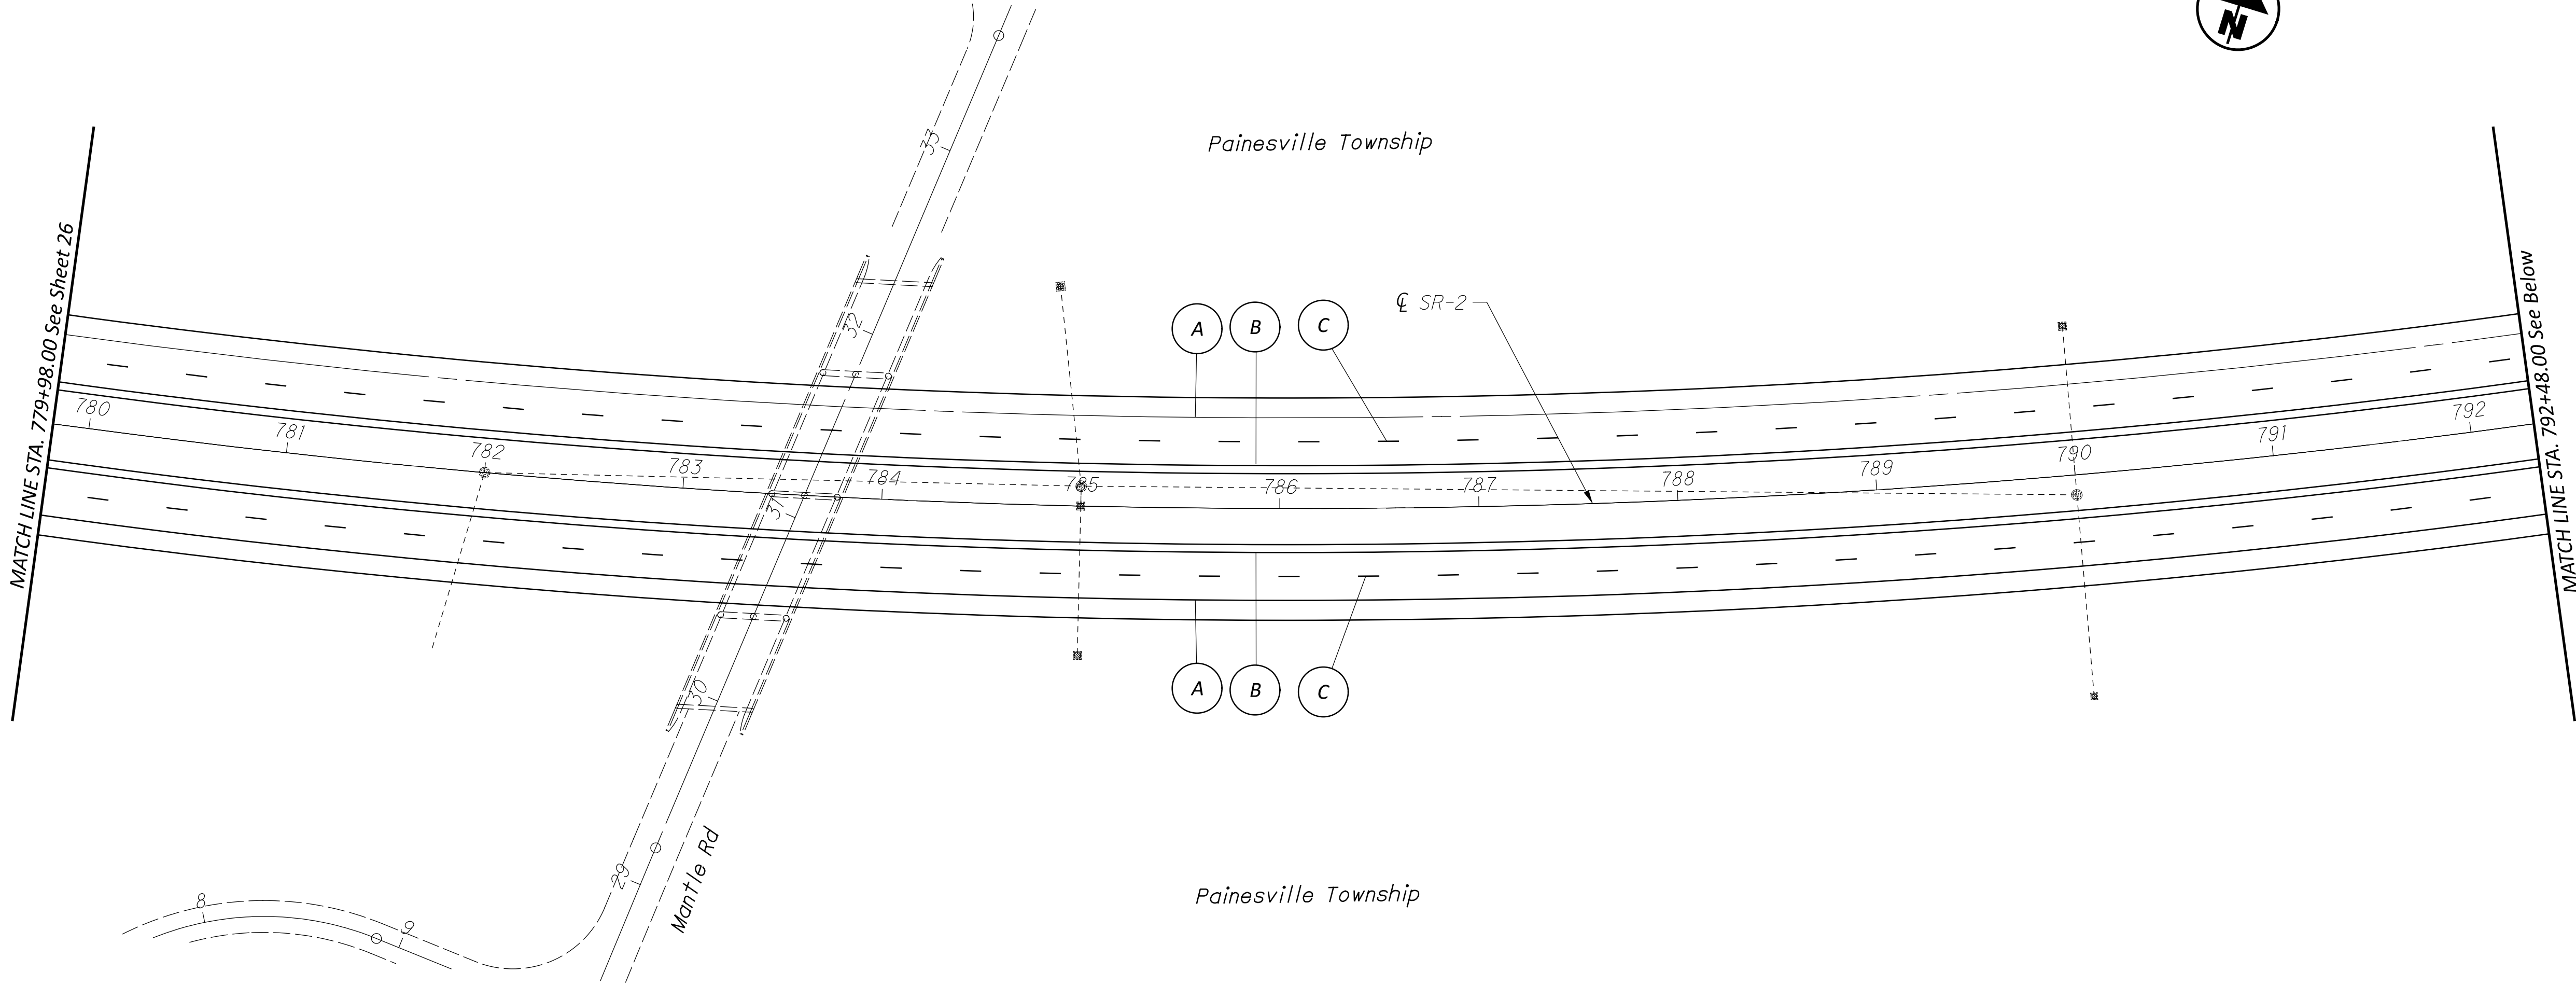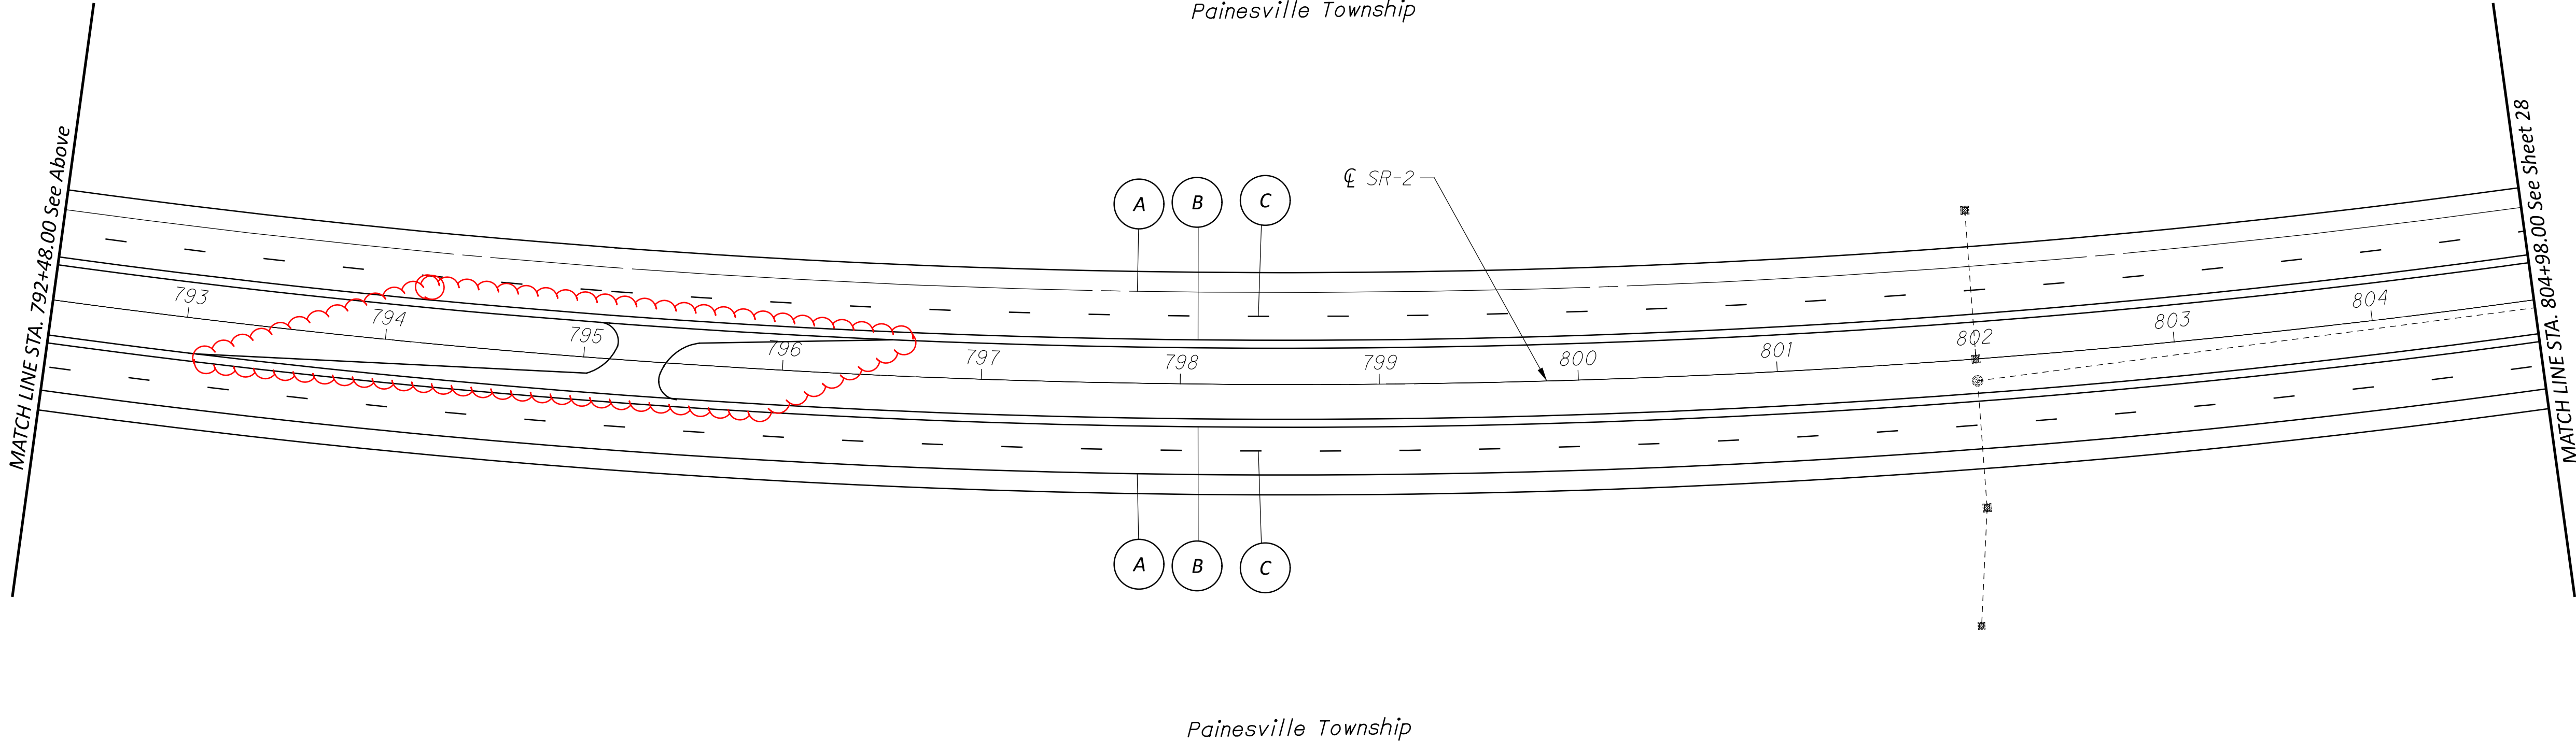

DESIGN AGENCY

DESIGNER

JDA

REVIEWER

DAB 11/29/24

PROJECT ID

99583

SHEET

27



TOTAL

34

Plan Sheet
Sta. 779+98.00 to Sta. 804+98.00

HORIZONTAL
SCALE IN FEET



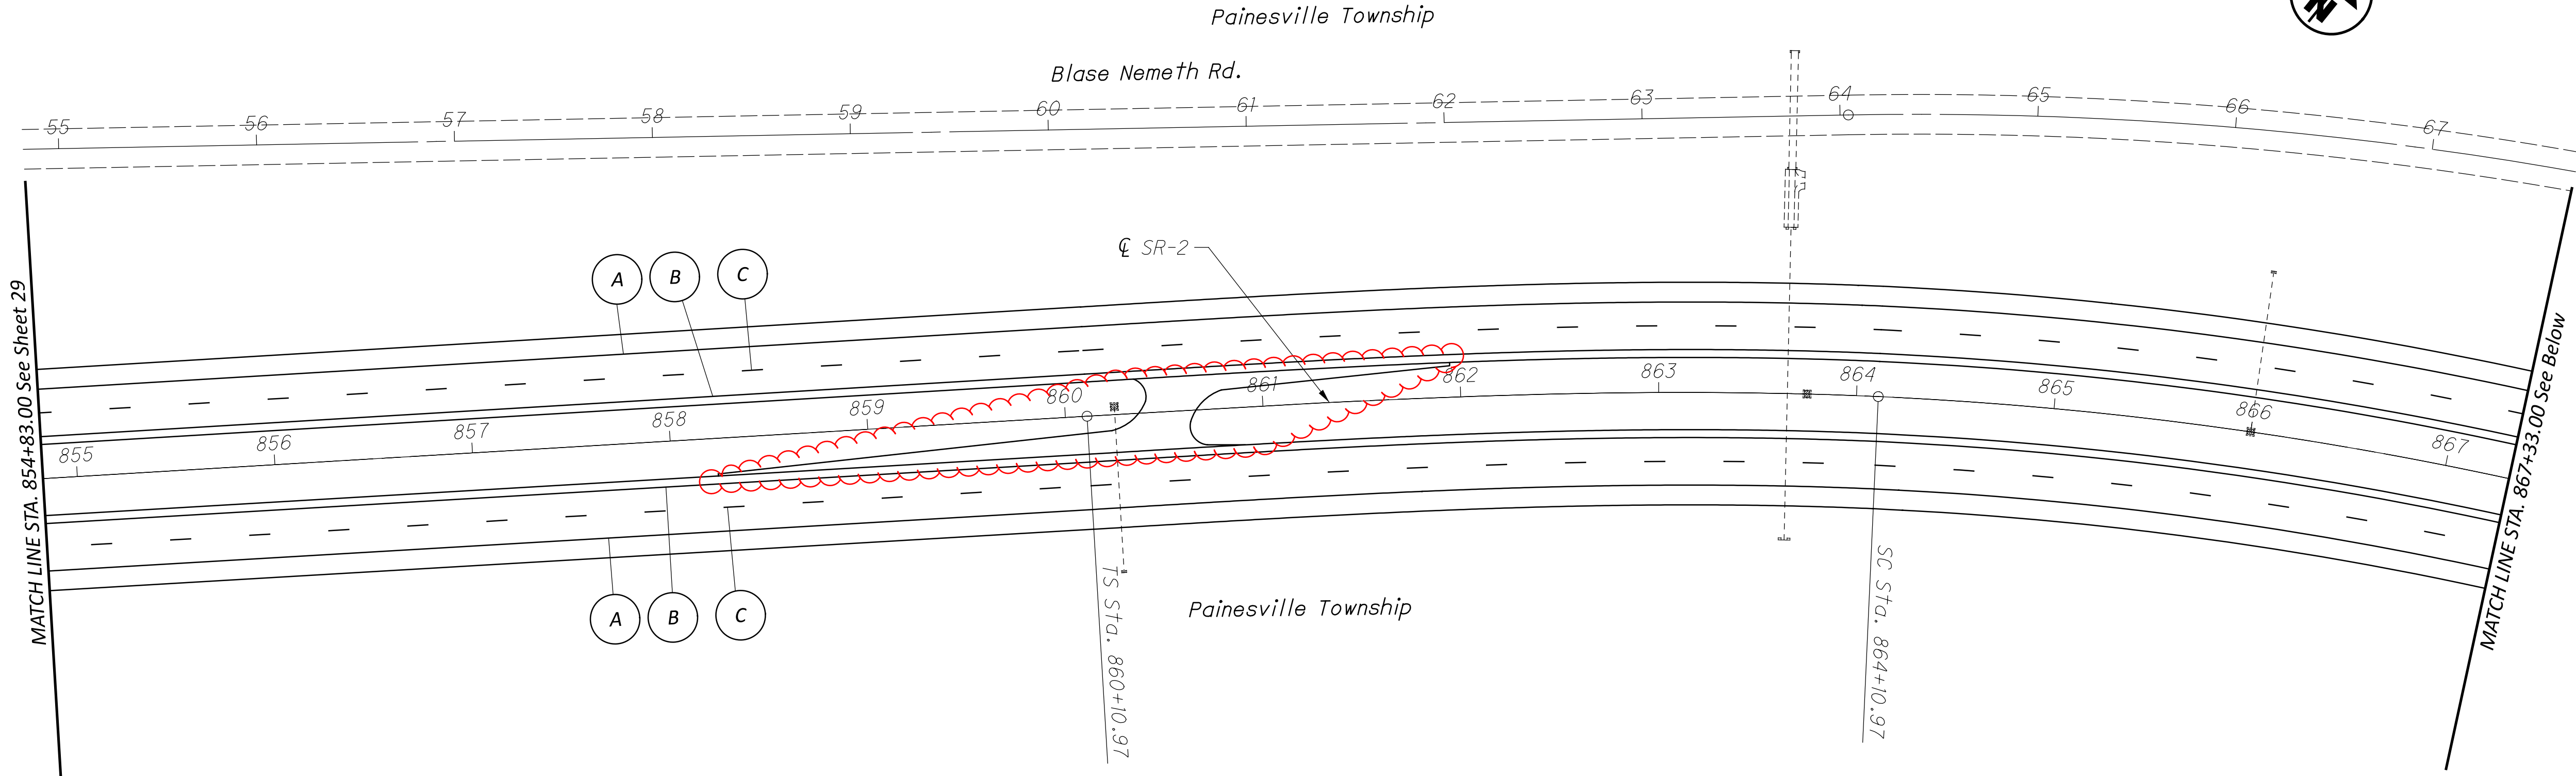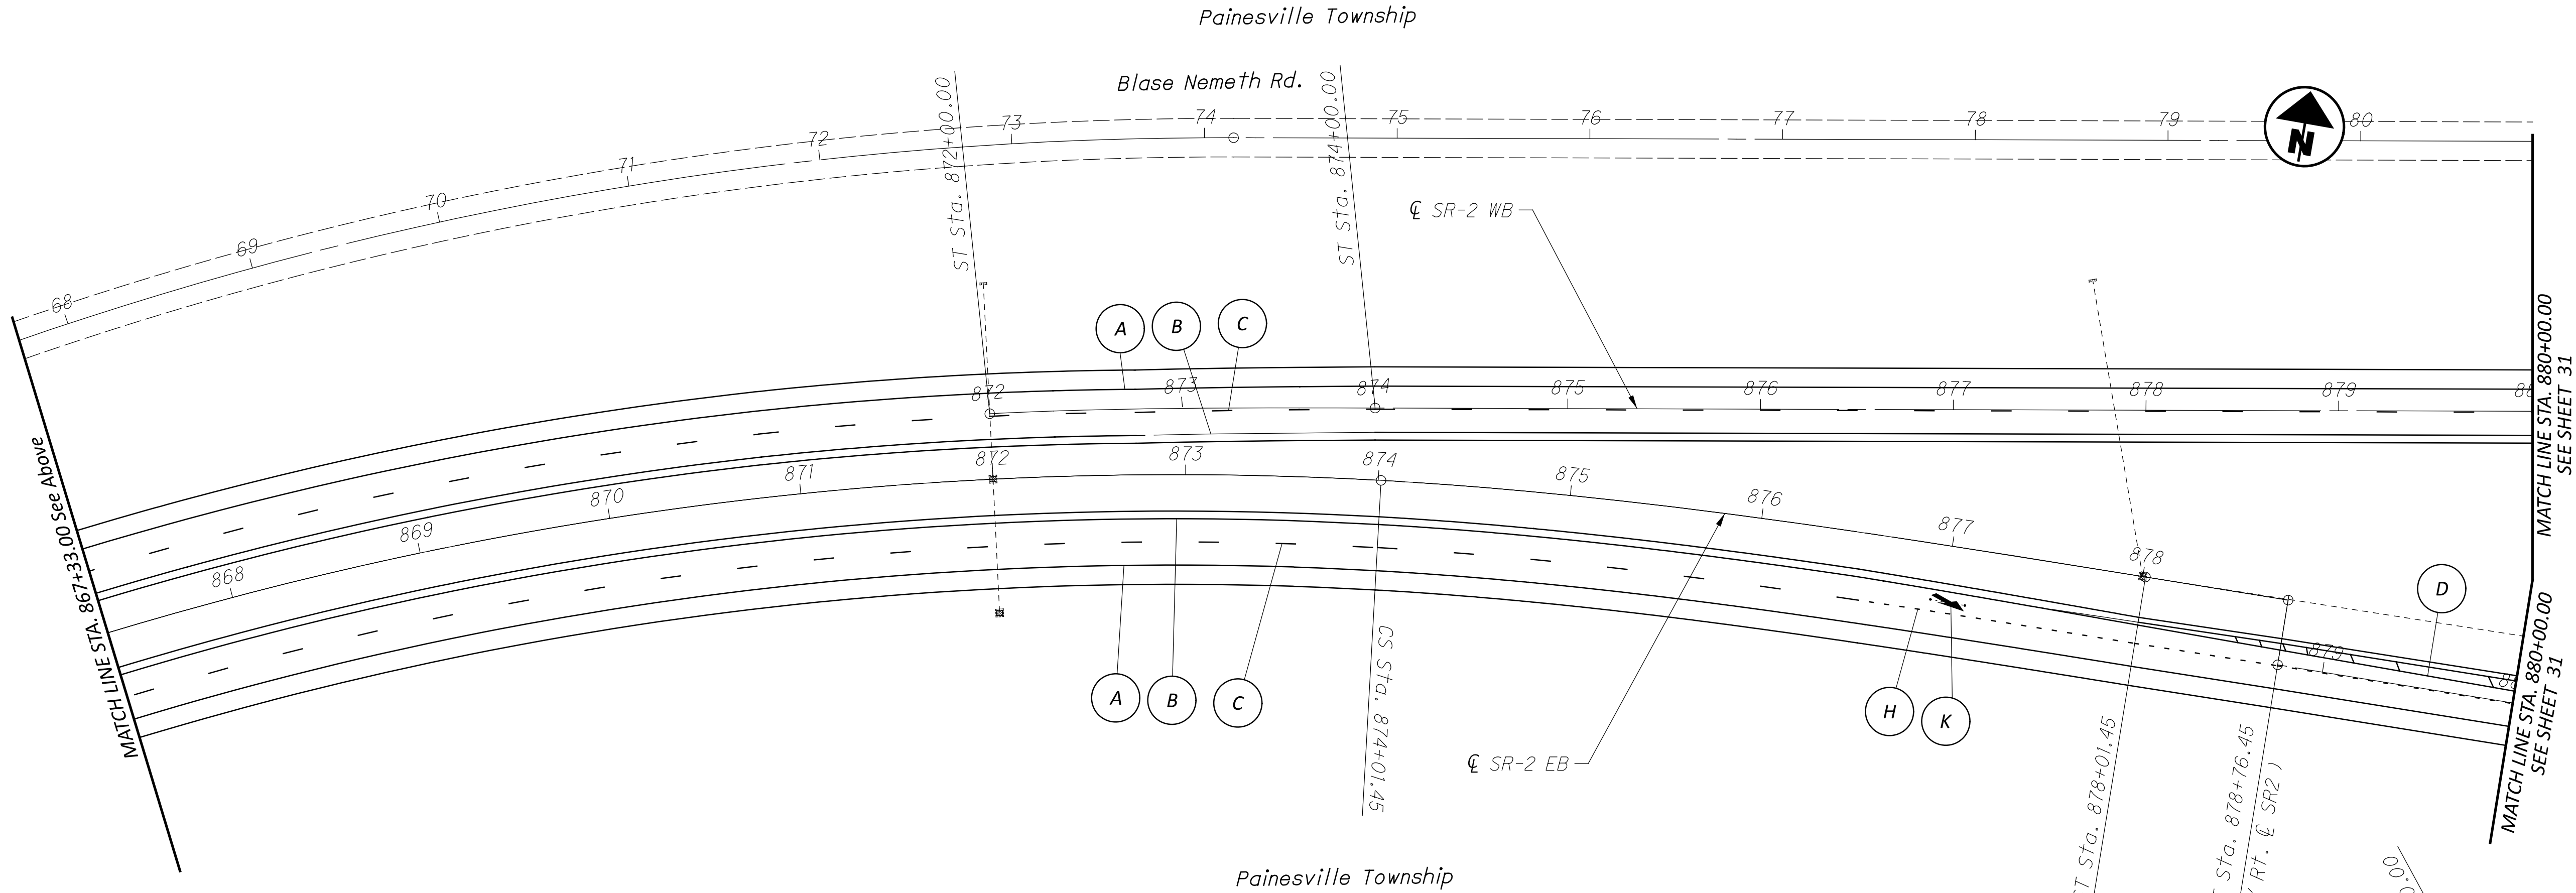

DESIGN AGENCY

DESIGNER
JDA

REVIEWER
DAB 11/29/24

PROJECT ID
99583

SHEET
30

TOTAL
34

Plan Sheet
Sta. 854+83.00 to End Project

HORIZONTAL
SCALE IN FEET
0 25 50 100