

**UTILITIES**

THERE ARE NO EXISTING UNDERGROUND UTILITY FACILITIES SHOWN ON THIS PLAN, NOR WILL ANY EXISTING UTILITY FACILITIES BE RELOCATED AHEAD OF THIS PROJECT. HOWEVER, THE NATURE OF THE WORK REQUIRED BY THIS PROJECT MAY HAVE THE POTENTIAL TO AFFECT UTILITIES THAT MAY EXIST WITHIN OR ADJACENT THE WORK AREA. IT IS THE RESPONSIBILITY OF THE PROJECT CONTRACTOR TO IDENTIFY POTENTIAL UTILITY CONFLICTS, BY VISUAL INSPECTION AND BY CONTACTING THE OHIO UTILITIES PROTECTION SERVICE (OHIO 811) FOR FIELD MARKINGS OF THE UNDERGROUND UTILITIES. THE CONTRACTOR SHALL CONTACT AND COORDINATE WITH THE UTILITY OWNERS TO RESOLVE ALL UTILITY CONFLICTS PRIOR TO CONSTRUCTION OR, WITH THE APPROVAL OF THE PROJECT ENGINEER, THE CONTRACTOR SHALL ADJUST THE PROJECT CONSTRUCTION ACCORDINGLY, SO AS TO AVOID DAMAGE TO THE EXISTING UTILITY FACILITIES.

THE UTILITY CONTACT INFORMATION FOR THE PROJECT CAN BE OBTAINED THROUGH THE ODOT DISTRICT 9 UTILITY COORDINATOR AT 740-774-9055.

**WINDOW CONTRACT TABLE**

DESCRIPTION OF CRITICAL WORK	CALENDAR DAYS TO COMPLETE	DISINCENTIVE (\$ PER DAY)
ALL WORK ON PROJECT	90	\$1,500

**PROFILE AND ALIGNMENT**

PLACE THE PROPOSED PAVEMENT TO FOLLOW THE ALIGNMENT AND PROFILE OF THE EXISTING PAVEMENT. PLACE THE PROPOSED ITEM 424, FINE GRADED POLYMER ASPHALT CONCRETE, TYPE B AS SHOWN ON THE TYPICAL SECTIONS.

**DISPOSAL OF ASPHALT GRINDINGS**

ASPHALT GRINDINGS FROM THIS PROJECT ARE TO BECOME THE PROPERTY OF THE CONTRACTOR.

**RPM**

IN ADDITION TO CMS 621.03, RPMs SHALL NOT BE INSTALLED ON BRIDGES OR APPROACH SLABS THAT HAVE A CONCRETE SURFACE. INSTALL RPMs IN ASPHALT CONCRETE BEFORE AND AFTER THE SUPERSTRUCTURE. RPM'S LOCATED IN EXISTING CONCRETE BRIDGE DECKS OR APPROACH SLABS SHALL BE LEFT IN PLACE.

INSTALL NEW RPMs IN ACCORDANCE WITH ODOT STANDARD DRAWINGS TC-65.10 AND TC-65.11.

**PLACEMENT OF PAVEMENT**

THE AMOUNT OF TIME THAT THE MILLED SURFACE IS OPEN TO TRAFFIC SHOULD BE MINIMIZED AND THE PROPOSED ASPHALT CONCRETE SHALL BE PLACED NO MORE THAN 14 DAYS FOLLOWING THE MILLING OPERATION.

**SHOULDER WORK**

THE PURPOSE OF THIS WORK IS TO CREATE PROPER ROADWAY DRAINAGE BY REMOVING HIGH BERM AND TO ELIMINATE DROP-OFFS BY PLACING COMPACTED AGGREGATE IN LOW AREAS.

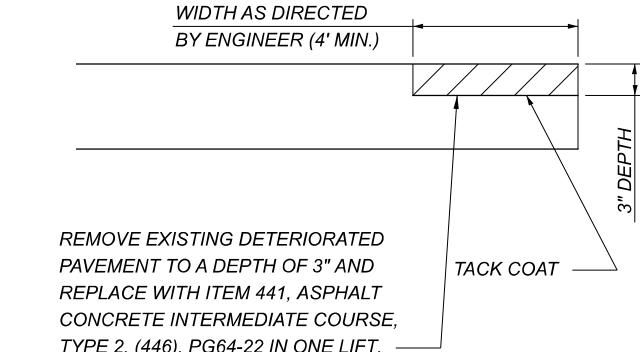
THE FOLLOWING ESTIMATED QUANTITIES HAVE BEEN INCLUDED FOR WORK ALONG S.R. 125 & S.R. 247 AND HAS BEEN CARRIED TO THE GENERAL SUMMARY FOR AREAS TO BE DESIGNATED BY THE ENGINEER.

ITEM 209 - LINEAR GRADING  
01/NFA 4.54 MILE

4.54 MILE

ITEM 617 - COMPACTED AGGREGATE  
01/NFA 111 CY

111 CY

**ITEM 251 - PARTIAL DEPTH PAVEMENT REPAIR (441)**

THE FOLLOWING ESTIMATED QUANTITIES HAVE BEEN INCLUDED AND CARRIED TO THE GENERAL SUMMARY FOR USE AS DIRECTED BY THE ENGINEER:

**ITEM 251 - PARTIAL DEPTH PAVEMENT REPAIR (441), AS PER PLAN**

01/NFA LAW-775 4000 SY  
01/NFA LAW-790 300 SY

TOTALS: 4300 SY

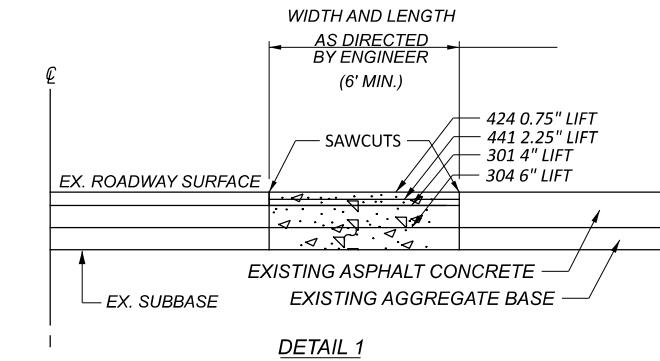
**ITEM 254- PATCHING PLANED SURFACE**

THIS ITEM SHALL BE IN ACCORDANCE WITH SECTION 254 OF THE CONSTRUCTION AND MATERIALS SPECIFICATIONS.

THE FOLLOWING ESTIMATED QUANTITIES HAVE BEEN CARRIED TO THE GENERAL SUMMARY TO BE USED AS DIRECTED BY THE ENGINEER.

**ITEM 254 PATCHING PLANED SURFACE**

14,663 SQ. YD.

**ITEM 253 - PAVEMENT REPAIR, AS PER PLAN**

FOR PAVEMENT REPAIRS ON SR 775, REMOVE EXISTING DETERIORATED MATERIAL TO A DEPTH OF 13" OR TO BOTTOM OF ASPHALT AND REPLACE WITH ITEM 304 AGGREGATE BASE IN 1, 6" LIFT, ITEM 301 ASPHALT CONCRETE BASE IN 1, 4" LIFT, ITEM 441 ASPHALT CONCRETE INTERMEDIATE COURSE, TYPE 2 (446), IN 1, 2.25" LIFT, AND ITEM 424 FINE GRADED POLYMER ASPHALT CONCRETE, TYPE B (448) IN 1, 0.75" LIFT.

IF THE DEPTH OF THE REPAIR EXCEEDS 13", INCREASE THE THICKNESS OF ITEM 304 AND INSTALL IN TWO LIFTS.

ALL OF THE CONSTRUCTION REQUIREMENTS OF THE CMS FOR ITEM 253 SHALL APPLY AND BE IN ACCORDANCE WITH STANDARD CONSTRUCTION DRAWINGS BP-2.1, BP-2.2, AND BP-2.5.

THE FOLLOWING ESTIMATED QUANTITIES HAVE BEEN INCLUDED AND CARRIED TO THE GENERAL SUMMARY FOR USE AS DIRECTED BY THE ENGINEER.

**ITEM 253, PAVEMENT REPAIR, (AS PER PLAN)**

LAW-775 01/NFA 1000 SQ. YD.

**GENERAL NOTES**

DESIGNER  
ZDR

REVIEWER

EMB 8-15-25

PROJECT ID

113817

SHEET TOTAL

P.4 12

**ITEM 614, MAINTAINING TRAFFIC**

A MINIMUM OF 1 LANE OF TRAFFIC IN EACH DIRECTION SHALL BE MAINTAINED AT ALL TIMES BY USE OF THE EXISTING PAVEMENT AND THE COMPLETED PAVEMENT. FOLLOWING A PERIOD OF 90 CONSECUTIVE CALENDAR DAYS COMMENCING WITH THE FIRST LANE CLOSURE, NO TRAFFIC RESTRICTIONS OR LANE CLOSURES SHALL BE IN PLACE. A DISINCENTIVE SHALL BE ASSESSED IN THE AMOUNT OF \$1,500 PER DAY FOR EACH CALENDAR DAY TRAFFIC IS BEING MAINTAINED BEYOND THE SPECIFIED LIMIT.

BEFORE THE WORK BEGINS, THE CONTRACTOR SHALL SUBMIT TO THE ENGINEER THE NAME(S) AND TELEPHONE NUMBER(S) OF A PERSON OR PERSONS WHO CAN BE CONTACTED TWENTY-FOUR (24) HOURS PER DAY BY THE OHIO DEPARTMENT OF TRANSPORTATION AND ALL INTERESTED POLICE AGENCIES.

THIS PERSON OR PERSONS SHALL BE RESPONSIBLE FOR PLACING OR REPLACING NECESSARY TRAFFIC CONTROL DEVICES IN ACCORDANCE WITH THE OHIO MANUAL OF UNIFORM TRAFFIC CONTROL DEVICES.

THE CONTRACTOR WILL ADVISE THE DISTRICT PUBLIC INFORMATION OFFICER AT (740) 774-8834, OR EMAIL D09.PIO@DOT.OHIO.GOV FOURTEEN (14) DAYS PRIOR TO THE START OF CONSTRUCTION ACTIVITIES. THE PROJECT ENGINEER WILL PROVIDE ASSISTANCE/CLARIFICATION FOR ANY QUESTIONS.

THE CONTRACTOR SHALL ARRANGE FOR ALL MAINTENANCE OF TRAFFIC OPERATIONS SUCH THAT THERE WILL BE NO OBSTRUCTIONS TO THE CONTINUOUS FLOW OF TRAFFIC. ALL INTERSECTIONS AND DRIVEWAYS SHALL BE OPEN TO TRAFFIC AT ALL TIMES UNLESS OTHERWISE SHOWN IN THE PLAN.

NO WORK SHALL BE PERFORMED AND ALL EXISTING LANES SHALL BE OPEN TO TRAFFIC DURING THE FOLLOWING DESIGNATED HOLIDAYS OR SPECIAL EVENTS:

NEW YEAR'S (OBSERVED)	THANKSGIVING
MEMORIAL DAY	CHRISTMAS (OBSERVED)
FOURTH OF JULY (OBSERVED)	
LABOR DAY	

THE PERIOD OF TIME THAT THE LANES ARE TO BE OPEN DEPENDS ON THE DAY OF THE WEEK ON WHICH THE HOLIDAY OR SPECIAL EVENT FALLS. THE FOLLOWING SCHEDULE SHALL BE USED TO DETERMINE THIS PERIOD:

DAY OF HOLIDAY OR SPECIAL EVENT	TIME ALL LANES MUST BE OPEN TO TRAFFIC
SUNDAY	12:00N FRIDAY THROUGH 6:00 AM MONDAY
MONDAY	12:00N FRIDAY THROUGH 6:00 AM TUESDAY
TUESDAY	12:00N MONDAY THROUGH 6:00 AM WEDNESDAY
TUESDAY (GEN./REG. ELECTION)	5:00 AM TUESDAY THROUGH 12:00 AM WEDNESDAY
WEDNESDAY	12:00N TUESDAY THROUGH 6:00 AM THURSDAY
THURSDAY	12:00N WEDNESDAY THROUGH 6:00 AM FRIDAY
THURSDAY (THANKSGIVING ONLY)	6:00 AM WEDNESDAY THROUGH 6:00 AM MONDAY
FRIDAY	12:00N THURSDAY THROUGH 6:00 AM MONDAY
SATURDAY	12:00N THURSDAY THROUGH 6:00 AM MONDAY

**ITEM 614, MAINTAINING TRAFFIC, CONT'D**

DURING THE SAME PERIODS, MAINTAIN PEDESTRIAN ACCESS IF PEDESTRIAN ACCESS WAS PRESENT PRIOR TO CONSTRUCTION. SHOULD THE CONTRACTOR FAIL TO MEET ANY OF THESE REQUIREMENTS, THE CONTRACTOR SHALL BE ASSESSED A DISINCENTIVE PER THE LANE VALUE CONTRACT (PN 127).

**LANE VALUE CONTRACT TABLE**

DESCRIPTION OF CRITICAL LANE	TIME UNIT	DISINCENTIVE \$ PER TIME UNIT
ALL LANES OF LAW-775 FROM SLM 18.51-23.96, & LAW-790 FROM SLM 0.00-0.55.	EACH MINUTE	\$5.00

LENGTH AND DURATION OF LANE CLOSURES AND RESTRICTIONS SHALL BE AT THE APPROVAL OF THE ENGINEER. IT IS THE INTENT TO MINIMIZE THE IMPACT TO THE TRAVELING PUBLIC. LANE CLOSURES OR RESTRICTIONS OVER SEGMENTS OF THE PROJECT IN WHICH NO WORK IS ANTICIPATED WITHIN A REASONABLE TIME FRAME, AS DETERMINED BY THE ENGINEER, SHALL NOT BE PERMITTED. THE LEVEL OF UTILIZATION OF MAINTENANCE OF TRAFFIC DEVICES SHALL BE COMMENSURATE WITH THE WORK IN PROGRESS.

ALL WORK AND TRAFFIC CONTROL DEVICES SHALL BE IN ACCORDANCE WITH C&MS 614 AND OTHER APPLICABLE PORTIONS OF THE SPECIFICATIONS, AS WELL AS THE OHIO MANUAL OF UNIFORM TRAFFIC CONTROL DEVICES. PAYMENT FOR ALL LABOR, EQUIPMENT AND MATERIALS SHALL BE INCLUDED IN THE LUMP SUM CONTRACT PRICE FOR ITEM 614, MAINTAINING TRAFFIC, UNLESS SEPARATELY ITEMIZED IN THE PLAN.

ITEM	DURATION OF CLOSURE	NOTICE DUE TO PERMITS & PIO
RAMP & ROAD CLOSURES	>= 2 WEEKS	21 CALENDAR DAYS PRIOR TO CLOSURE
	> 12 HOURS & < 2 WEEKS	14 CALENDAR DAYS PRIOR TO CLOSURE
	<= 12 HOURS	4 CALENDAR DAYS PRIOR TO CLOSURE
LANE CLOSURES & RESTRICTIONS	>2 WEEKS	14 CALENDAR DAYS PRIOR TO CLOSURE
	< 2 WEEKS	5 CALENDAR DAYS PRIOR TO CLOSURE
START OF CONST. & TRAFFIC PATTERN CHANGES	N/A	14 CALENDAR DAYS PRIOR TO CLOSURE

ANY UNFORESEEN CONDITIONS NOT SPECIFIED IN THE PLANS REQUIRING TRAFFIC RESTRICTIONS SHALL ALSO BE REPORTED TO THE PROJECT ENGINEER USING THE NOTIFICATION TIME TABLE.

**WORK ZONE MARKINGS AND SIGNS**

THE FOLLOWING ESTIMATED QUANTITIES HAVE BEEN CARRIED TO THE GENERAL SUMMARY FOR USE AT LOCATIONS IDENTIFIED BY THE ENGINEER FOR WORK ZONE PAVEMENT MARKINGS AND SIGNS PER THE REQUIREMENTS OF C&MS 614.04 AND 614.11.

ITEM 614, WORK ZONE MARKING SIGN 23 EACH  
 ITEM 614, WORK ZONE CENTER LINE, CLASS III, 642 PAINT 11.86 MILE  
 ITEM 614, WORK ZONE EDGE LINE, CLASS III, 642 PAINT 23.72 MILE  
 ITEM 614, WORK ZONE STOP LINE, CLASS III, 642 PAINT 24 FT

**NOTIFICATION OF TRAFFIC RESTRICTIONS**

THROUGHOUT THE DURATION OF THE PROJECT, THE CONTRACTOR SHALL NOTIFY THE PROJECT ENGINEER IN WRITING OF ALL TRAFFIC RESTRICTIONS AND UPCOMING MAINTENANCE OF TRAFFIC CHANGES. THE CONTRACTOR SHALL ENSURE THE WRITTEN NOTIFICATION IS SUBMITTED IN A TIMELY MANNER TO ALLOW THE PROJECT ENGINEER TO MEET THE REQUIRED TIME FRAMES SET FORTH IN THE TABLE BELOW TO INFORM THE SPECIAL HAULING PERMITS SECTION (HAULING.PERMITS@DOT.OHIO.GOV) AND THE DISTRICT PUBLIC INFORMATION OFFICE (PIO). THIS NOTIFICATION SHALL BE RECEIVED BY THE PROJECT ENGINEER PRIOR TO THE PHYSICAL SETUP OF ANY APPLICABLE SIGNS OR MESSAGE BOARDS.

INFORMATION SHOULD INCLUDE, BUT IS NOT LIMITED TO, ALL CONSTRUCTION ACTIVITIES THAT IMPACT OR INTERFERE WITH TRAFFIC AND SHALL LIST THE SPECIFIC LOCATION, TYPE OF WORK, ROAD STATUS, DATE AND TIME OF RESTRICTION, DURATION OF RESTRICTION, NUMBER OF LANES MAINTAINED, NUMBER OF LANES CLOSED, MINIMUM VERTICAL CLEARANCE, MINIMUM WIDTH OF DRIVABLE PAVEMENT, DETOUR ROUTES, IF APPLICABLE, AND ANY OTHER INFORMATION REQUESTED BY THE PROJECT ENGINEER.

**MAINTENANCE OF TRAFFIC GENERAL NOTES**

DESIGNER

ZDR

REVIEWER

EMB 8-15-25

PROJECT ID

113817

SHEET

TOTAL

P.5

12