BEGIN PROJECT S.R. 522 S.L.M. 0.000 END PROJECT S.K. 522 S.L.M. 8.290 ELIZABETH Pine Grove Acceptable Reversalle

LATITUDE: 38°40'28" LONGITUDE: -82°41'33"



DESIGN DESIGNATION

CURRENT ADT (2025)	550
DESIGN YEAR ADT (2037)	600
DESIGN HOURLY VOLUME (2037)	90
DIRECTIONAL DISTRIBUTION	68.9%
TRUCKS (24 HOUR B&C)	5%
DESIGN SPEED	55 MPH
LEGAL SPEED	55 MPH
DESIGN FUNCTIONAL CLASSIFICATION:	
05 MAJOR COLLECTOR	
NHS PROJECT	NO

DESIGN EXCEPTIONS

NONE

ADA DESIGN WAIVERS

NONE REQUIRED

UNDERGROUND UTILITIES		
Contact Two Working Days		
Before You Dig		
OHIO 811.org		

OHIO811, 8-1-1, or 1-800-362-2764 (Non members must be called directly)

PLAN PREPARED BY:
DISTRICT 9 PLANNING & ENGINEERING
650 EASTERN AVENUE
CHILLICOTHE, OHIO 45601

STATE OF OHIO DEPARTMENT OF TRANSPORTATION

LAW-522-0.00

ELIZABETH & DECATUR TOWNSHIPS LAWERENCE COUNTY

INDEX OF SHEETS:

TITLE SHEET	P.1
TYPICAL SECTIONS	P.2
GENERAL NOTES	P.3
MAINTENANCE OF TRAFFIC	P.4
GENERAL SUMMARY	P.5
PAVEMENT CALCULATIONS	P.6
PAVEMENT MARKINGS	P.7
STRUCTURE QUANTITIES	P.8

FEDERAL PROJECT NUMBER

E250317

RAILROAD INVOLVEMENT

NONE

PROJECT DESCRIPTION

THIS PROJECT CONSISTS OF A SINGLE CHIP SEAL, TYPE A SURFACE TREATMENTS TO 8.29 MILES OF S.R. 522 FROM S.L.M. 0.000 to S.L.M. 8.290.

EARTH DISTURBED AREAS

PROJECT EARTH DISTURBED AREA: 0.0 ACRES

ESTIMATED CONTRACTOR EARTH DISTURBED AREA: 0.0 ACRES

NOTICE OF INTENT EARTH DISTURBED AREA: N/A (NOI NOT REQUIRED)

2023 SPECIFICATIONS


THE STANDARD SPECIFICATIONS OF THE STATE OF OHIO, DEPARTMENT OF TRANSPORTATION, INCLUDING SUPPLEMENTAL SPECIFICATIONS LISTED IN THE PLANS AND CHANGES LISTED IN THE PROPOSAL SHALL GOVERN THIS IMPROVEMENT.

I HEREBY APPROVE THESE PLANS AND DECLARE THAT THE MAKING OF THIS IMPROVEMENT WILL NOT REQUIRE THE CLOSING TO TRAFFIC OF THE HIGHWAY AND THAT PROVISIONS FOR THE MAINTENANCE AND SAFETY OF TRAFFIC WILL BE AS SET FORTH ON THE PLANS AND ESTIMATES.

Michael G. Dombrowski

Pamela Boratyn

Director, Department of Transportation

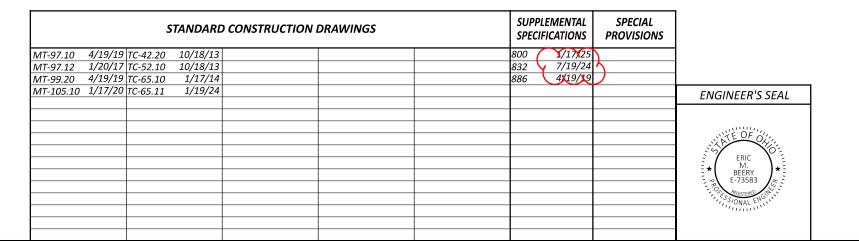

DESIGN AGENCY



JRH
REVIEWER
EMB 03/10/25
PROJECT ID
121324