

CONCRETE CAP (TYP.)
 (SMOOTH FINISH)
 ITEM 512 SEALING OF CONCRETE
 SURFACES (NON-EPOXY)


"THOMAS J. EVANS TRAIL" TEXT RECESSED
 3/4" INTO HEADWALL; 6 INCH HIGH LETTERS;
 CORBEL TEXT FONT
 ITEM 512 SEALING OF CONCRETE SURFACES
 (EPOXY-URETHANE) (BLACK)

CONCRETE (SMOOTH FINISH)
 ITEM 512 SEALING OF CONCRETE SURFACES
 (EPOXY-URETHANE) (WHITE)


PRECAST CONCRETE MOCK KEYSTONE CENTERED OVER ARCH,
 RECESSED 3/4" INTO ARCH UNIT AND HEADWALL, SEPARATE
 PRECAST CONCRETE KEYSTONE PROPERLY INSTALLED INTO
 RECESSED AREA ON PRECAST ARCH

CONCRETE CAP (TYP.)
 (SMOOTH FINISH)
 ITEM 512 SEALING OF CONCRETE
 SURFACES (NON-EPOXY)


PRECAST CONCRETE MOCK KEYSTONE NOTES:
 THE PRECAST KEYSTONE SHALL BE INSTALLED WITH 4 - 1/4" DIAMETER BOLTS
 THAT ARE TO BE DOWELED 3" IN DEPTH INTO THE PRECAST ARCH. THE BOLTS
 SHALL BE COUNTER SUNK INTO THE FACE OF THE PRECAST KEYSTONE 1/2"
 IN DEPTH. THE 1/2" HOLES SHALL AND GROUTED/STAINED TO MATCH. ANY
 ALTERNATIVE METHOD OF INSTALLATION WILL NEED APPROVAL FROM THE
 ENGINEER.

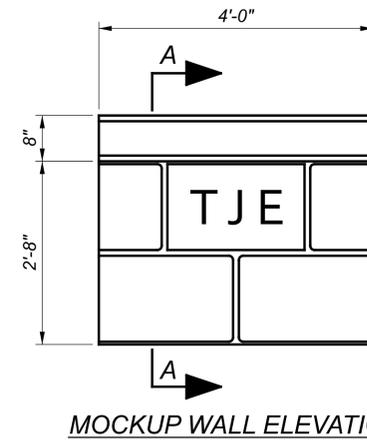


MOCKUP WALL ELEVATION

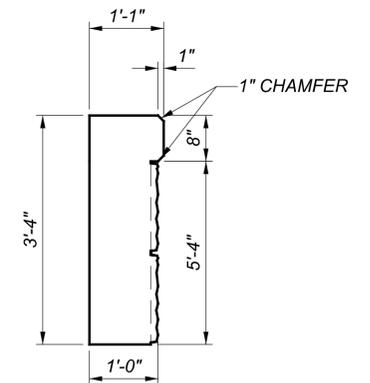

SECTION A-A

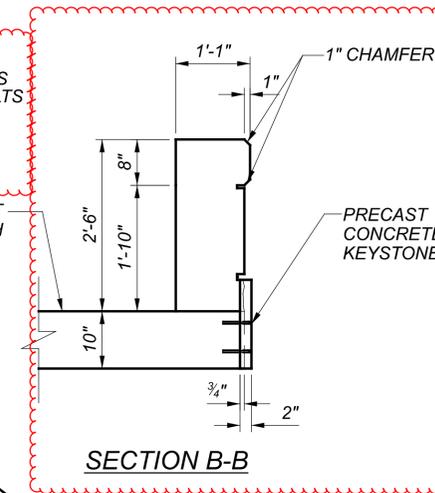


SECTION B-B

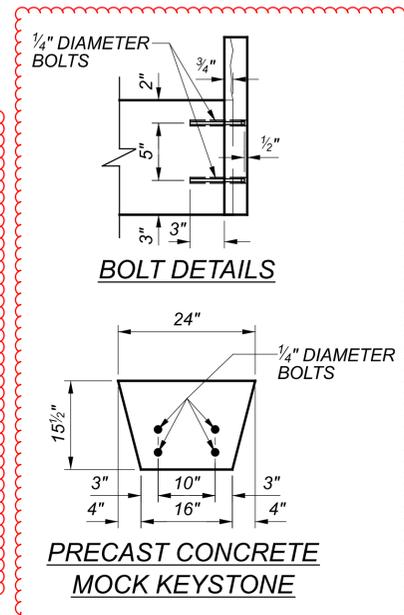

BOLT DETAILS

PRECAST CONCRETE
 MOCK KEYSTONE

NOTES:
 FORMLINER: RANDOM CUT STONE PATTERN WITH A MAXIMUM RELIEF
 OF 1 3/8" AND A COURSE HEIGHT OF 16" (SEE NOTE LABELED
 ITEM 530 SPECIAL FORM LINER (MOLDED RANDOM CUT
 STONE SURFACE))
 CONCRETE STAIN: CONCRETE STAIN TO BE APPLIED TO ALL FORMLINER
 CONCRETE SURFACES. CONCRETE STAIN SHALL NOT
 BE APPLIED TO CAPS, PRECAST CONCRETE ARCH, AND
 KEYSTONE. (SEE NOTE LABELED ITEM 530 SPECIAL
 STRUCTURES (STAINING CONCRETE SURFACES))

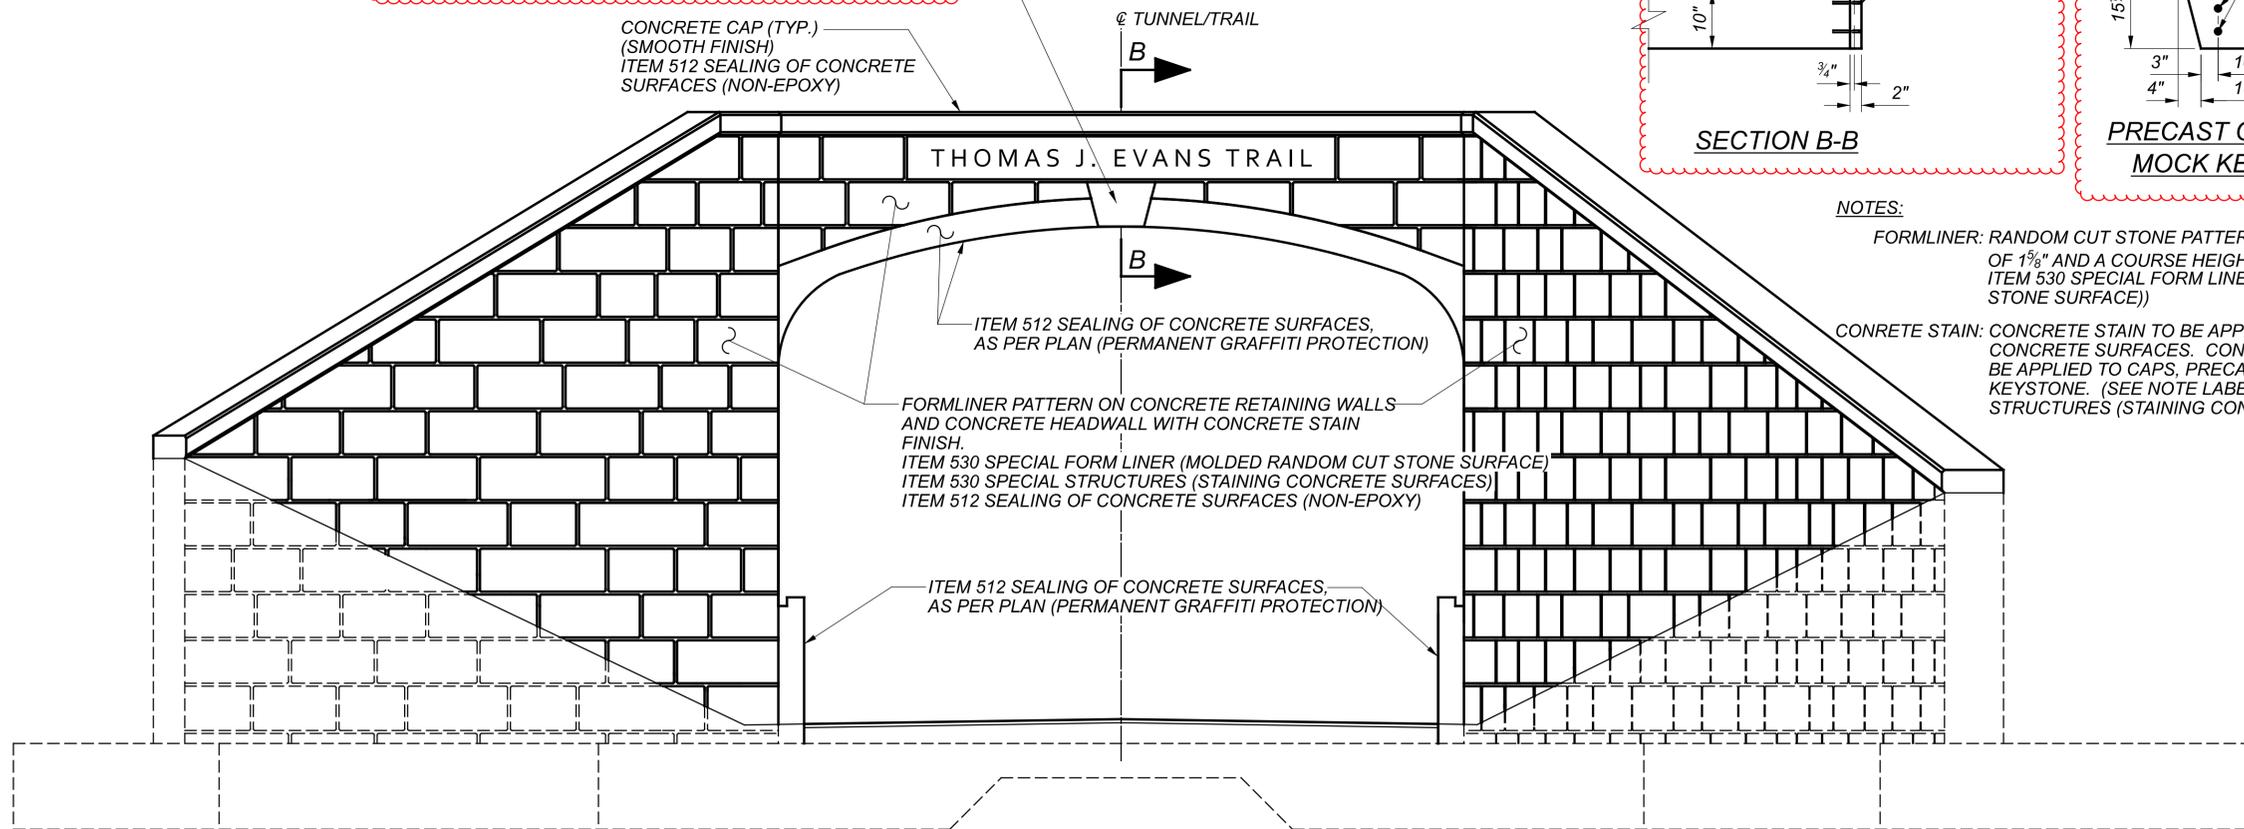

AESTHETIC DETAILS
 (TYPICAL AT BOTH ENDS OF TUNNEL)

STRUCTURE NOTES
 BRIDGE NO. LIC-16-1594 (TUNNEL)
 UNDER S.R. 16

SFN	4500785
DESIGN AGENCY	
DESIGNER	CPS
CHECKER	TDF
REVIEWER	
PROJECT ID	97990
SUBSET	6
TOTAL	30
SHEET	P.283
TOTAL	320