
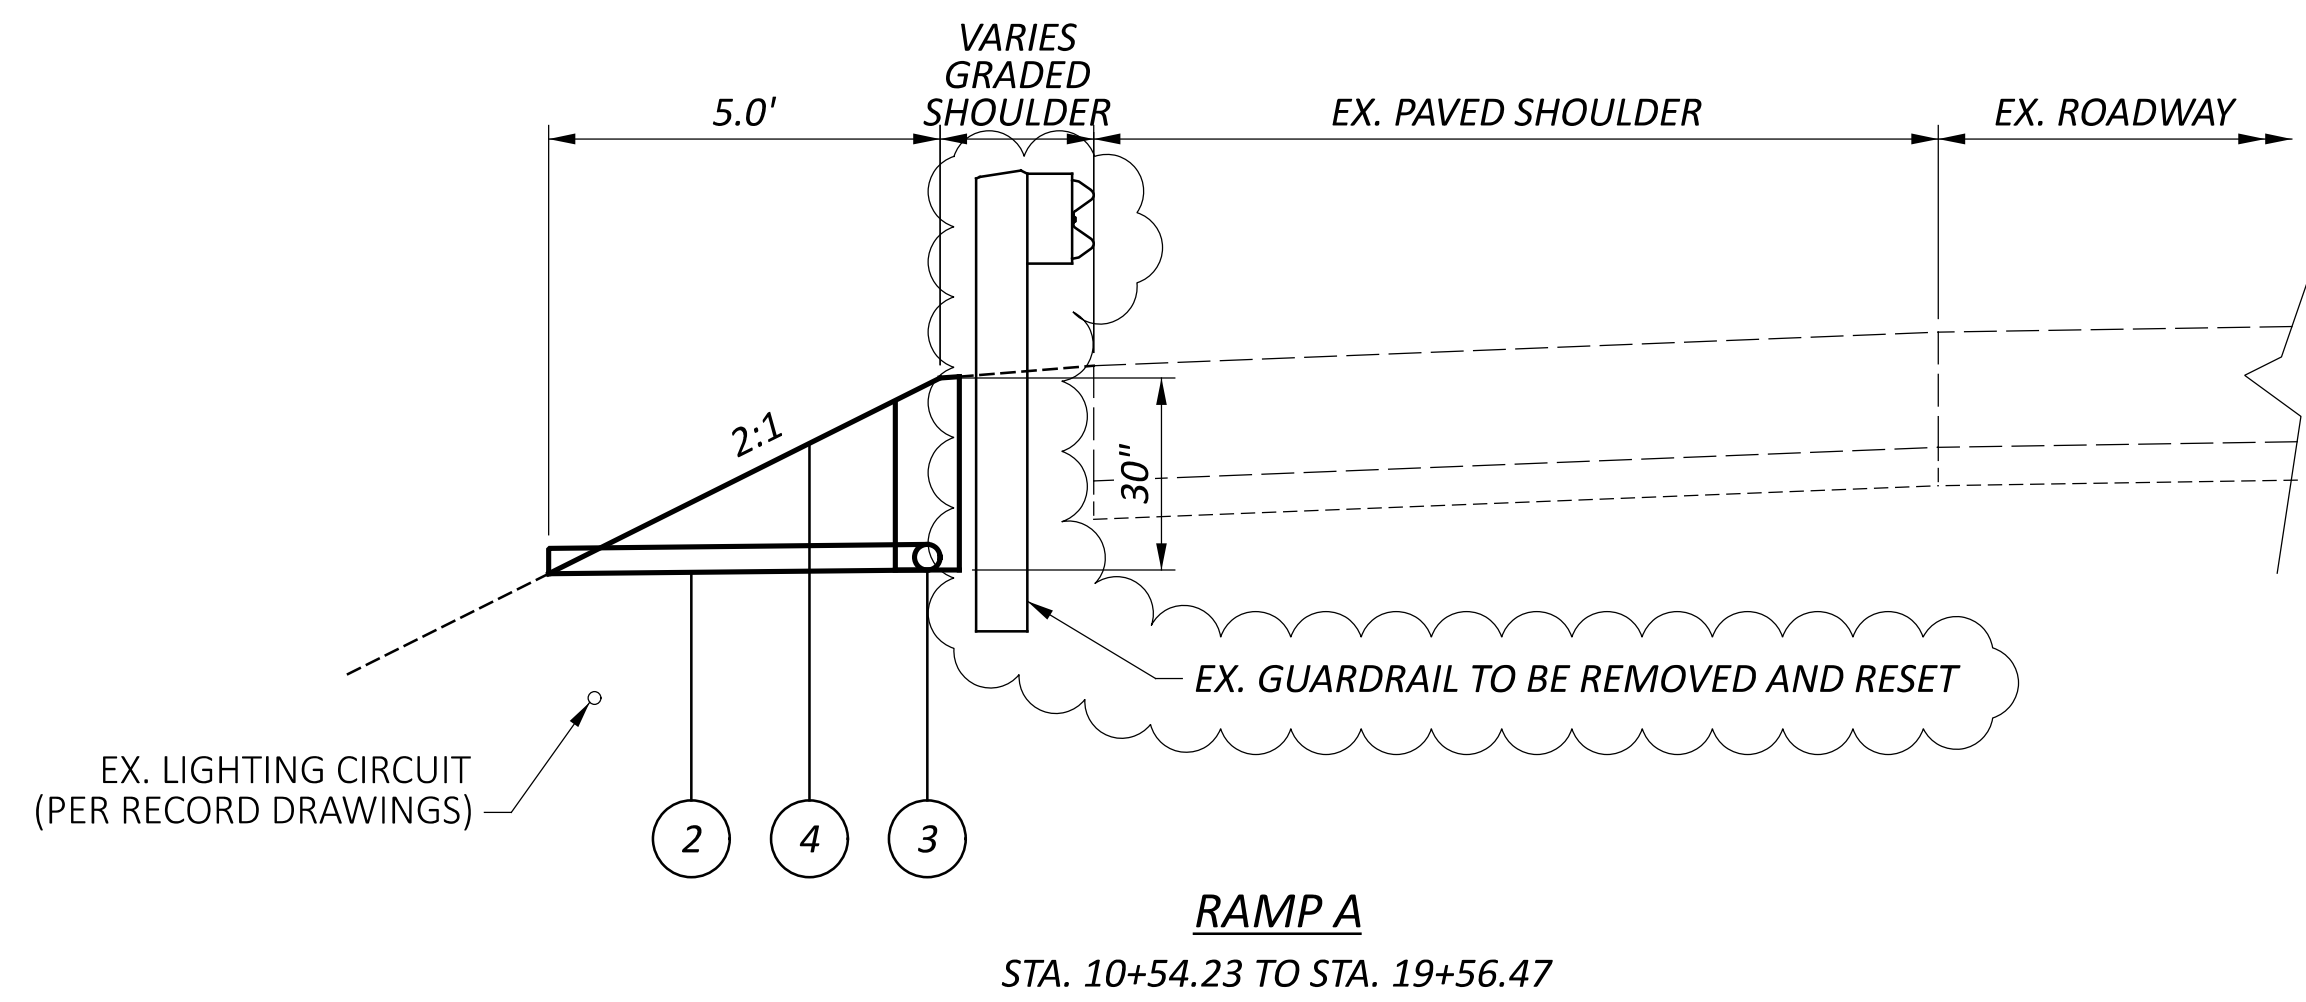


- 1 ITEM 601 - DUMPED ROCK FILL, TYPE B
- 2 ITEM 611 - 4" CONDUIT, TYPE F FOR UNDERDRAIN OUTLET
- 3 ITEM 605 - 4" SHALLOW PIPE UNDERDRAINS WITH GEOTEXTILE FABRIC
- 4 ITEM 659 - SEEDING AND MULCHING, CLASS 3B

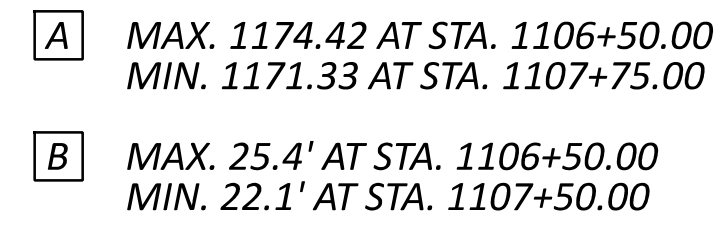

SHEET NUM.													PART.	ITEM	ITEM EXT	GRAND TOTAL	UNIT	DESCRIPTION	SEE SHEET NO.
3	4	5	8	9	15	OFFICE							01/STR/06						
LS													LS	201	11000	LS		ROADWAY	
			125	913									1,038	202	38000	1,038	FT	CLEARING AND GRUBBING	
						1,387							1,387	203	10001	1,387	CY	GUARDRAIL REMOVED	
			125	913									1,038	606	15050	1,038	FT	EXCAVATION, AS PER PLAN	3
																		GUARDRAIL, TYPE MGS	
																		EROSION CONTROL	
				153									153	601	21050	153	SY	TIED CONCRETE BLOCK MAT WITH TYPE 1 UNDERLAYMENT	
						2,217							2,217	601	26000	2,217	CY	DUMPED ROCK FILL, TYPE B	
2													2	659	00100	2	EACH	SOIL ANALYSIS TEST	
863													863	659	00300	863	CY	TOPSOIL	
7,777													7,777	659	00530	7,777	SY	SEEDING AND MULCHING, CLASS 3B	
389													389	659	14000	389	SY	REPAIR SEEDING AND MULCHING	
389													389	659	15000	389	SY	INTER-SEEDING	
1.08													1.08	659	20000	1.08	TON	COMMERCIAL FERTILIZER	
1.61													1.61	659	31000	1.61	ACRE	LIME	
43													43	659	35000	43	MGAL	WATER	
													28,200	832	30000	28,200	EACH	EROSION CONTROL	
																		DRAINAGE	
				900									900	605	05110	900	FT	4" SHALLOW PIPE UNDERDRAINS WITH GEOTEXTILE FABRIC	
				20									20	611	00410	20	FT	4" CONDUIT, TYPE F FOR UNDERDRAIN OUTLET	
				4									4	611	99710	4	EACH	PRECAST REINFORCED CONCRETE OUTLET	
																		TRAFFIC CONTROL	
						0.46							0.46	642	00204	0.46	MILE	LANE LINE, 6", TYPE 1	
						0.07							0.07	646	10110	0.07	MILE	LANE LINE, 6"	
																		MAINTENANCE OF TRAFFIC	
	300												300	614	11110	300	HOURL	LAW ENFORCEMENT OFFICER WITH PATROL CAR FOR ASSISTANCE	
		1											1	614	12380	1	EACH	WORK ZONE IMPACT ATTENUATOR, 24" WIDE HAZARDS, (UNIDIRECTIONAL)	
	20												20	614	13310	20	EACH	BARRIER REFLECTOR, TYPE 1, (ONE-WAY)	
	19												19	614	13350	19	EACH	OBJECT MARKER, ONE WAY	
		0.46											0.46	614	22010	0.46	MILE	WORK ZONE EDGE LINE, CLASS I, 6", (WHITE)	
		0.07											0.07	614	22360	0.07	MILE	WORK ZONE EDGE LINE, CLASS III, 6", 642 PAINT, (WHITE)	
		840											840	614	24000	840	FT	WORK ZONE DOTTED LINE, CLASS I	
		1,140											1,140	622	41100	1,140	FT	PORTABLE BARRIER, UNANCHORED	
																		INCIDENTALS	
	LS												LS	614	11000	LS		MAINTAINING TRAFFIC	
													LS	623	10000	LS		CONSTRUCTION LAYOUT STAKES AND SURVEYING	
													LS	624	10000	LS		MOBILIZATION	

GENERAL SUMMARY

DESIGN AGENCY



DESIGNER

JDK

REVIEWER

MWZ 01/07/25

PROJECT ID

118780


SHEET

P.7

TOTAL


P.28

LEGEND

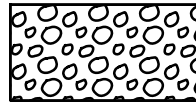


TIED CONCRETE BLOCK MAT, TYPE 1

HORIZONTAL
SCALE IN FEET

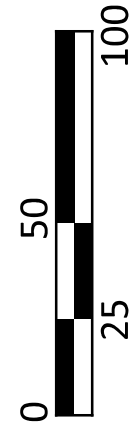

PLAN
RAMP A EROSION REPAIR

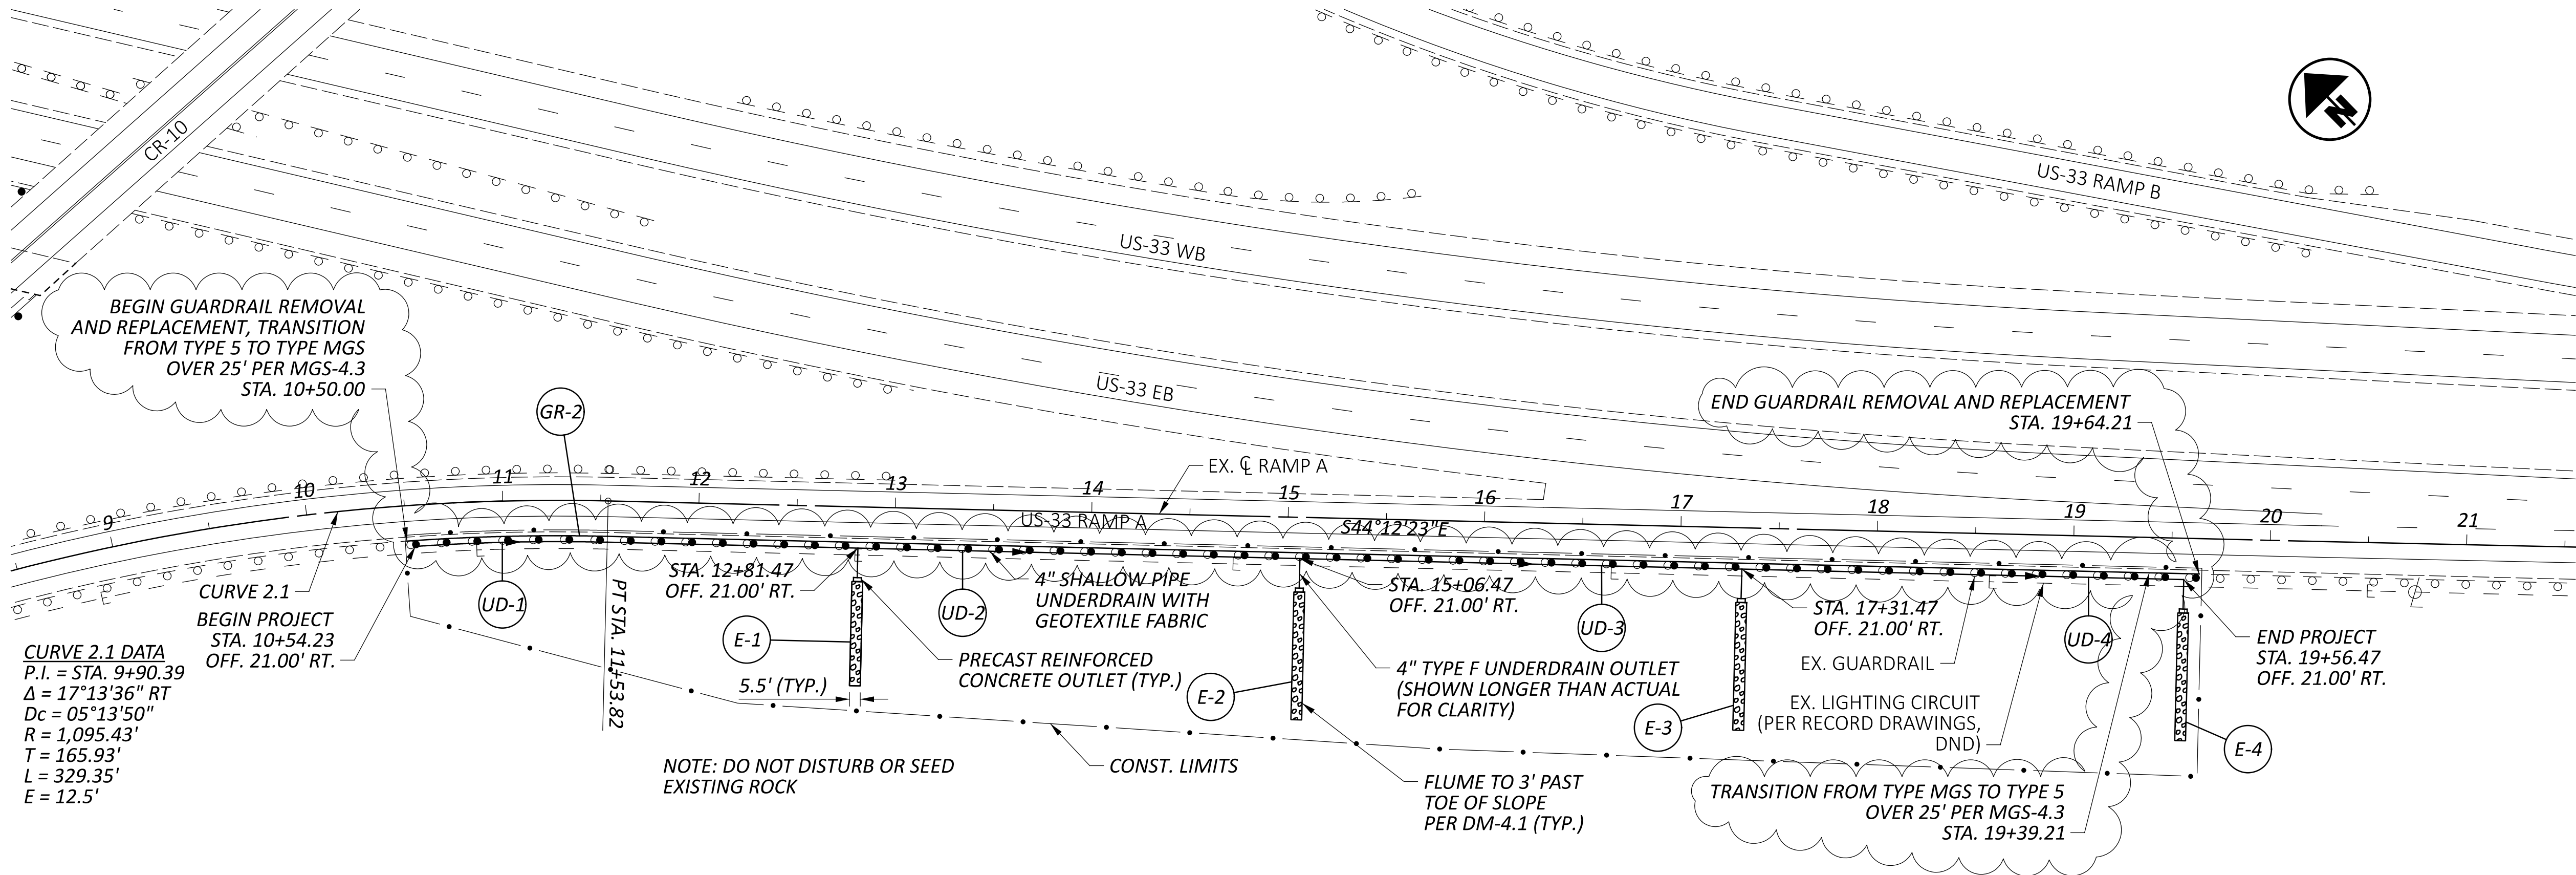

REF NO.	SHEET NO.	STATION TO STATION				202		601		605		606		611	611
						GUARDRAIL REMOVED		TIED CONCRETE BLOCK MAT WITH TYPE 1 UNDERLAYMENT		4" SHALLOW PIPE UNDERDRAINS WITH GEOTEXTILE FABRIC		GUARDRAIL, TYPE MGS		4" CONDUIT, TYPE F FOR UNDERDRAIN OUTLET	PRECAST REINFORCED CONCRETE OUTLET
						FT		SY		FT		FT		FT	EACH
UD-1	9	10+54.23	TO	12+81.47	RT					225				5	1
UD-2	9	12+81.47	TO	15+06.47	RT					225				5	1
UD-3	9	15+06.47	TO	17+31.47	RT					225				5	1
UD-4	9	17+31.47	TO	19+56.47	RT					225				5	1
E-1	9			12+81.47	RT			33							
E-2	9			15+06.47	RT			40							
E-3	9			17+31.47	RT			40							
E-4	9			19+56.47	RT			40							
GR-2	9	10+50.00	TO	19+64.21	RT	913						913			
TOTALS CARRIED TO GENERAL SUMMARY						913		153		900		913		20	4

DESIGN AGENCY

WOOLPERT

DESIGNER

JDK

REVIEWER

MWZ 01/07/25

PROJECT ID

118780

SHEET

P.9

TOTAL

P.28