

LEGEND

- 1 ITEM 442 - ASPHALT CONCRETE SURFACE COURSE, 9.5MM, TYPE A (446), AS PER PLAN (1.5")
- 2 ITEM 407 - TACK COAT (0.09 GAL/SQ YD)
- 3 ITEM 442 - ASPHALT CONCRETE INTERMEDIATE COURSE, 12.5MM, TYPE A (446), AS PER PLAN (2")
- 4 ITEM 301 - 4" ASPHALT CONCRETE BASE, PG64-22 (449)
- 5 ITEM 304 - 6" AGGREGATE BASE
- 6 ITEM 204 - SUBGRADE COMPACTION
- 7 ITEM 609 - TYPE 2 CURB AND GUTTER
- 8 ITEM 605 - 6" BASE PIPE UNDERDRAIN, WITH GEOTEXTILE FABRIC
- 9 ITEM 609 - CURB TYPE 6
- 10 ITEM 452 - 6" NON-REINFORCED CONCRETE PAVEMENT, CLASS QC MS, AS PER PLAN
- 11 NOT USED
- 12 ITEM 609 - COMBINATION CURB AND GUTTER, TYPE 9
- 13 ITEM 452 - 8" NON-REINFORCED CONCRETE PAVEMENT, CLASS QC MS, AS PER PLAN
- 14 ITEM 659 - SEEDING AND MULCHING
- 15 NOT USED
- 16 NOT USED
- 17 ITEM 206 - CEMENT STABILIZED SUBGRADE (14")
- 18 ITEM 690 SPECIAL - STONE MULCH (12" DEPTH)
- A EXISTING ASPHALT PAVEMENT

- A VARIES 1.9' TO 4.0'
STA. 381+98.19 TO STA. 385+30.24

VARIES 4.0' TO 2.7'
STA. 389+72.29 TO STA. 392+93.19
- B VARIES 11.1' TO 17.0'
STA. 381+98.19 TO STA. 385+30.24

VARIES 17.0' TO 12.1'
STA. 389+72.29 TO STA. 392+93.19
- C VARIES 11.1' TO 17.0'
STA. 381+98.19 TO STA. 385+30.24


VARIES 17.0' TO 9.82'
STA. 389+72.29 TO STA. 392+93.19
- D VARIES 1.5' TO 4.0'
STA. 381+98.19 TO STA. 385+30.24

VARIES 4.0' TO 2.7'
STA. 389+72.29 TO STA. 392+93.19


- E VARIES 17.0' TO 43.0'
STA. 385+30.24 TO STA. 386+81.27

VARIES 30.4' TO 17.0'
STA. 388+09.26 TO STA. 389+60.23
- F VARIES 17.0' TO 27.9'
STA. 385+30.24 TO STA. 386+81.27


VARIES 43.0' TO 17.0'
STA. 388+09.26 TO STA. 389+60.23
- G 0'
STA. 383+50.00 TO STA. 385+30.23

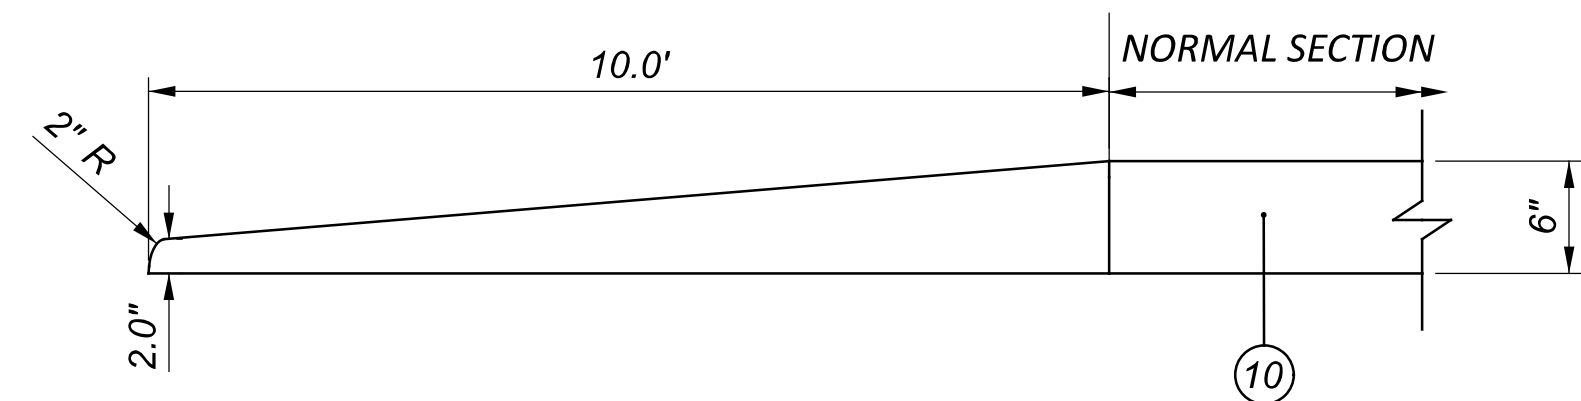


MEDIAN NOSE APPROACH DETAIL

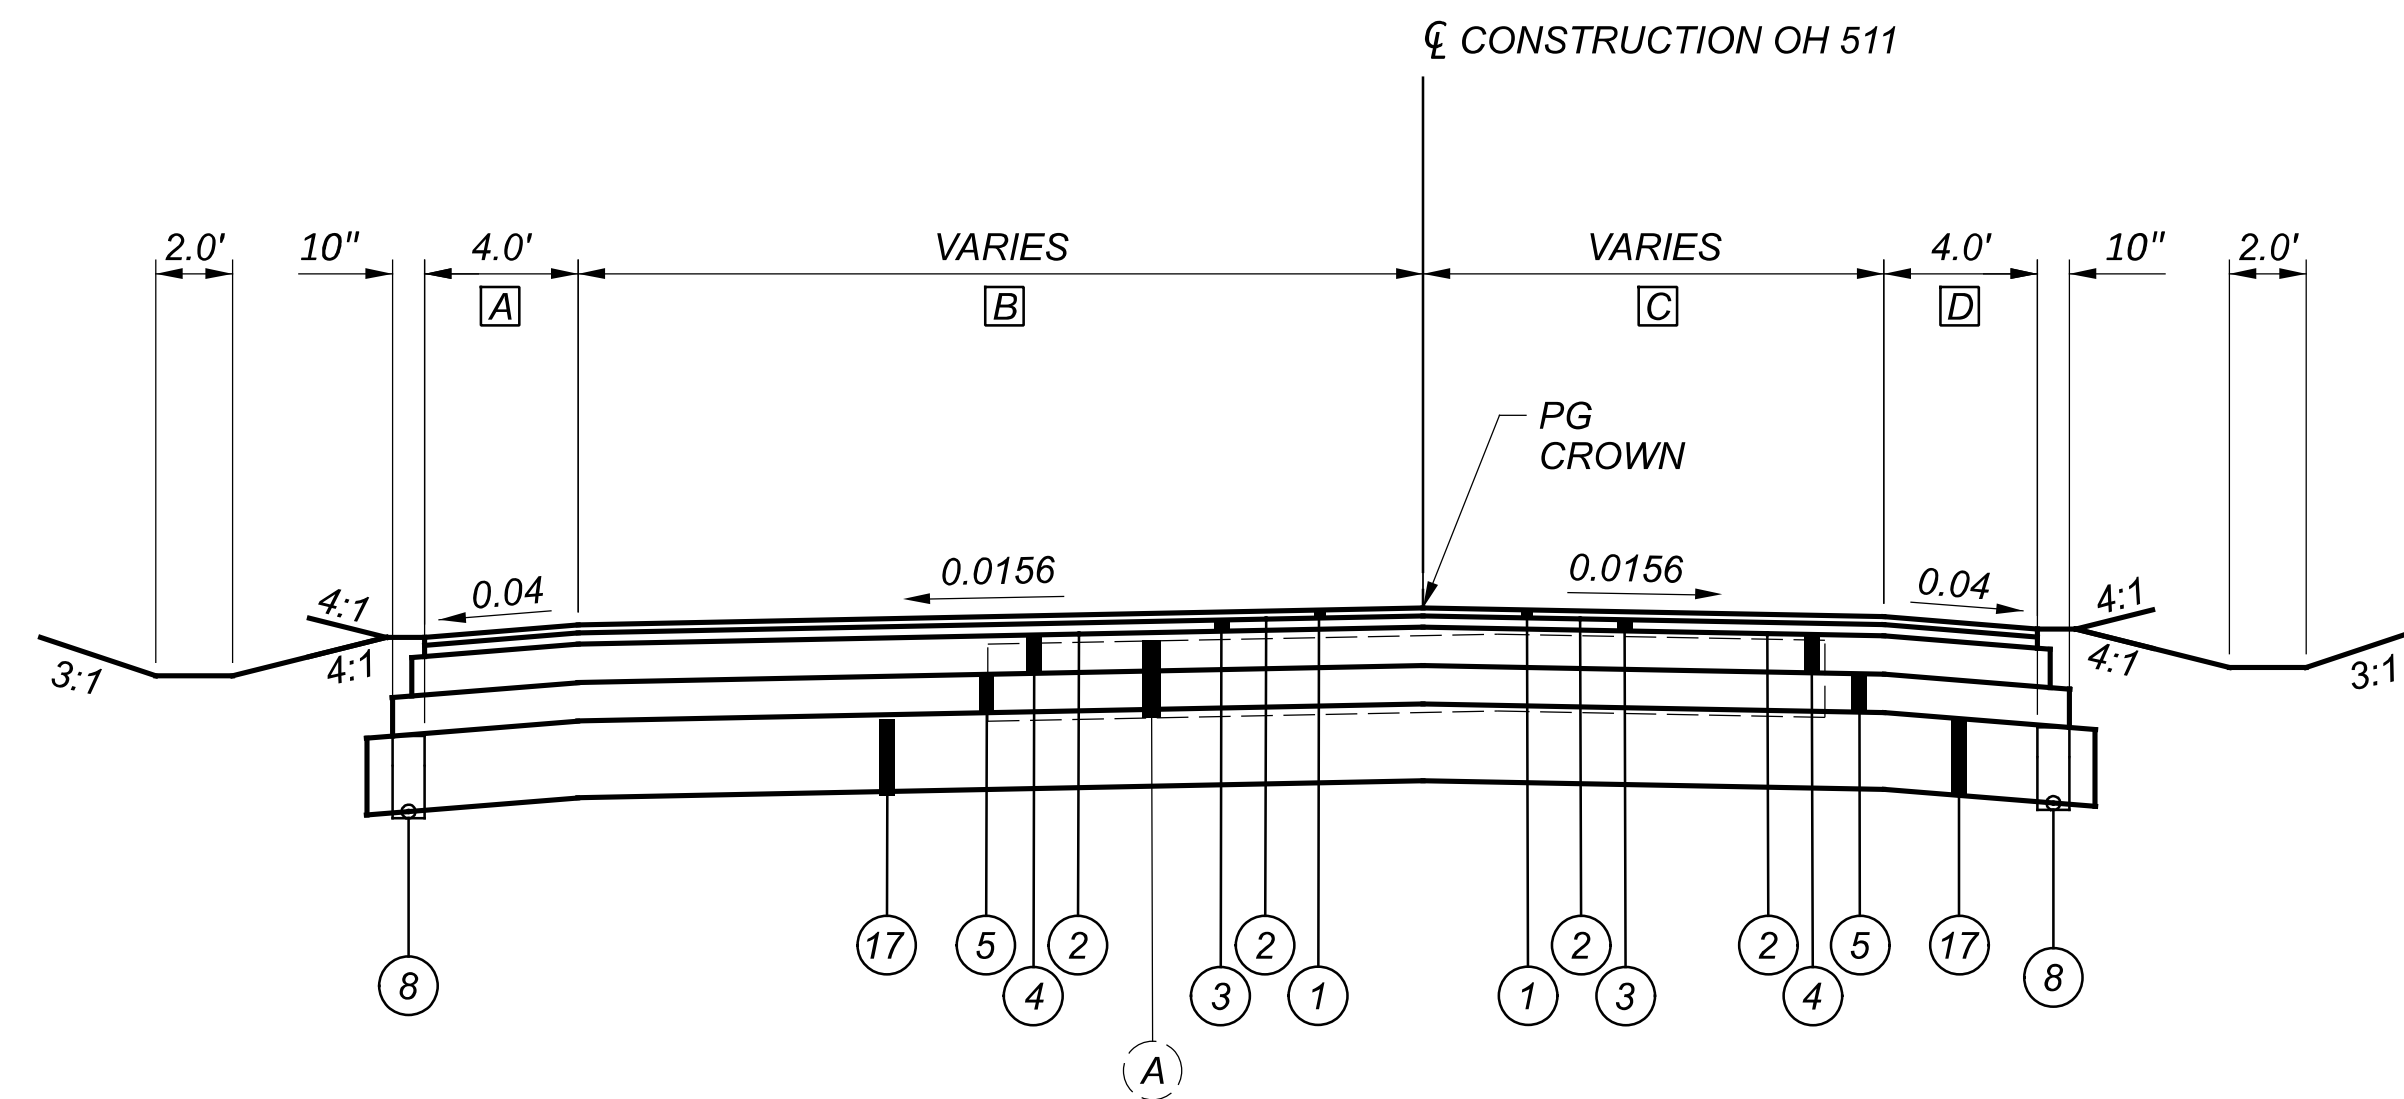


OH 511 (B-B)
STA. 381+98.19 TO STA. 383+50.00
STA. 389+60.23 TO STA. 392+93.19

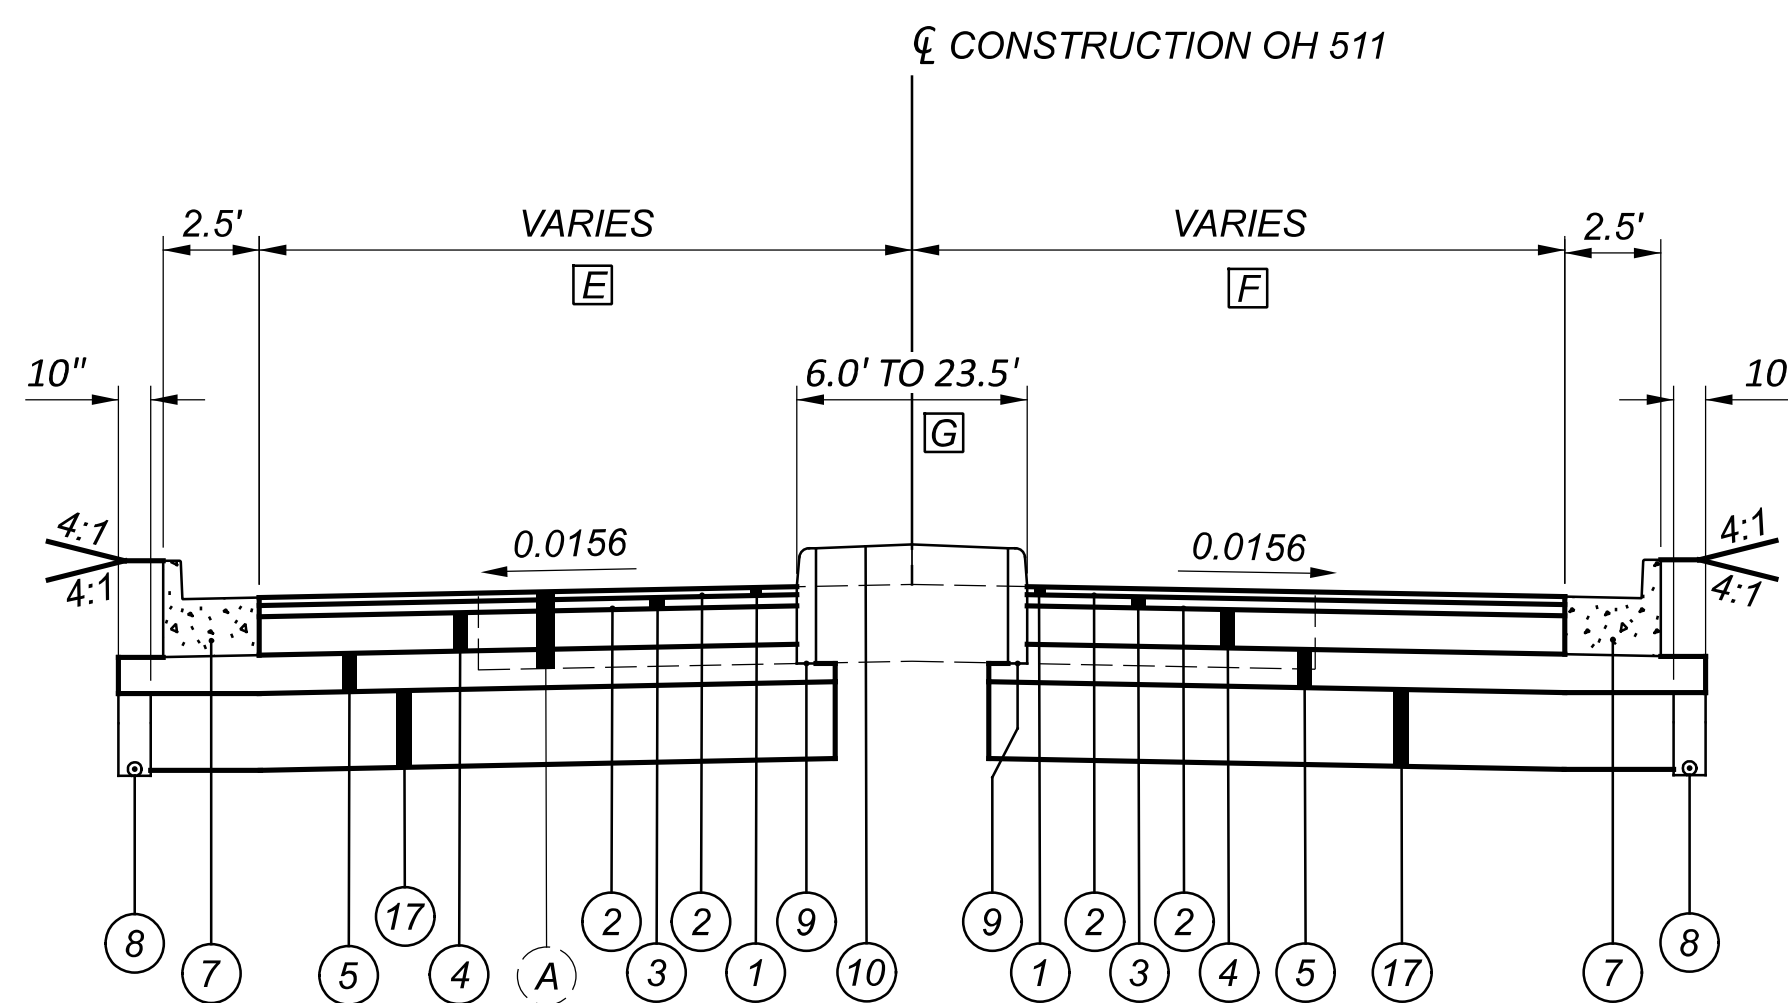

OH 511 (A-A)
STA. 383+50.00 TO STA. 386+81.27
STA. 388+09.26 TO STA. 389+60.23

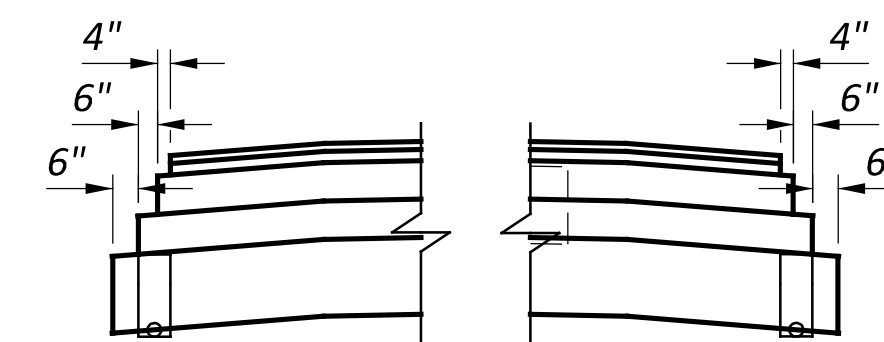


PAVEMENT STEP DETAIL

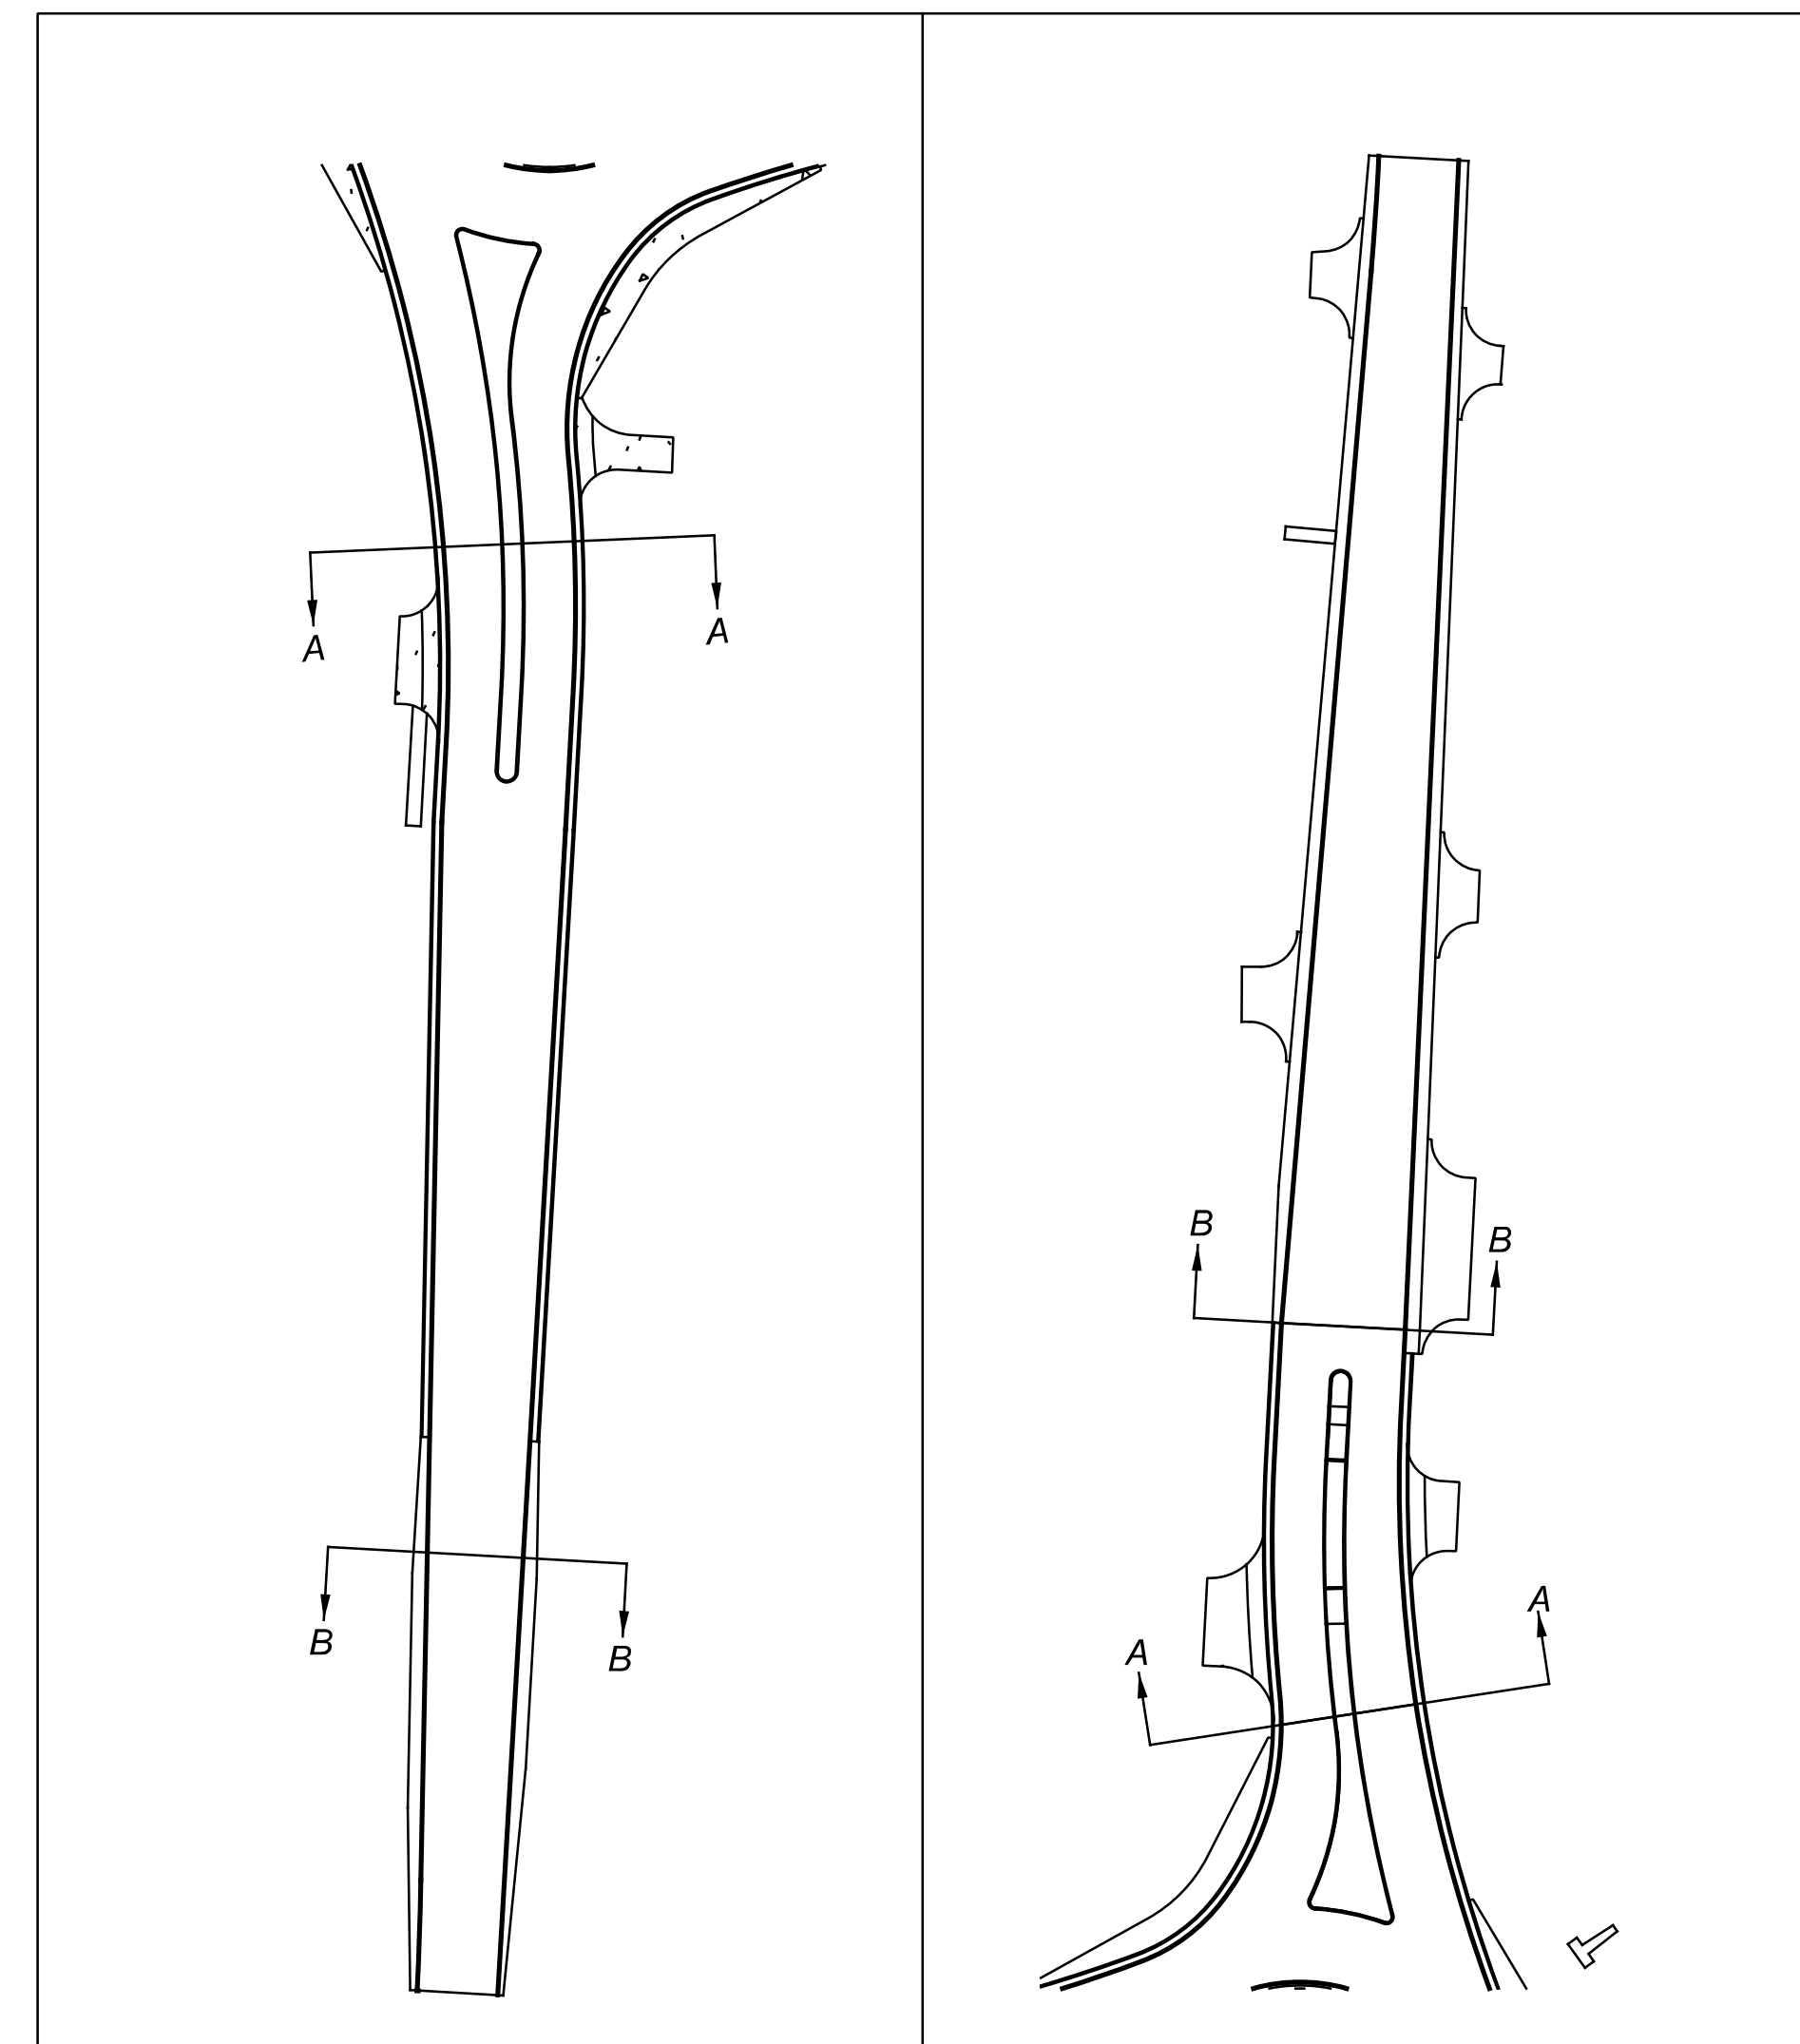

SECTION LOCATION MAP

NO SCALE

DESIGN AGENCY

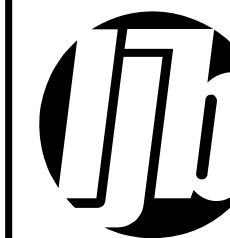

DESIGNER

ARW

REVIEWER

JRE 09/29/25

PROJECT ID

116214

SHEET TOTAL

P.5 P.73

UTILITY CONTACTS:
RURAL LORAIN COUNTY
WATER AUTHORITY
 42401 SR 303, BOX 567
 LAGRANGE, OHIO 44050
 440-355-5121
 JOE DEMCZYK
JDEMCZYK@RLCWA.COM

EVERSTREAM
 JOSEPH GIRDLESTONE
 1228 EUCLID AVE SUITE 250
 CLEVELAND, OH 44115
 234-521-2999
JGIRDLESTONE@EVERSTREAM.NET

FRONTIER COMMUNICATIONS
 RANDY HOWARD
 6223 NORWALK ROAD
 MEDINA, OHIO 44256
 330-722-9586
J.HOWARD@FTR.COM

ARMSTRONG UTILITIES
 RON WHITED
 1215 CLAREMONT AVENUE
 ASHLAND, OHIO 44805
 419-289-0161
RWHITED@AGOC.COM

LORAIN MEDINA RURAL ELECTRIC
 JIM BRASEE
 P.O. BOX 158
 WELLINGTON, OHIO 44090
 800-222-5673 EXT. 222
JBRASEE@FESCO-OH.ORG

INDIANA BAT
 THE PROJECT IS LOCATED WITHIN THE KNOWN HABITAT RANGES OF THE FEDERALLY ENDANGERED NORTHERN LONG-EARED BAT, INDIANA BAT, TRICOLORED BAT AND THE STATE ENDANGERED LITTLE BROWN. NO TREES SHALL BE REMOVED UNDER THIS PROJECT FROM APRIL 1 THROUGH SEPTEMBER 30. ALL NECESSARY TREE REMOVAL SHALL OCCUR FROM OCTOBER 1 THROUGH MARCH 31. THIS REQUIREMENT IS NECESSARY TO AVOID AND MINIMIZE IMPACTS TO THESE SPECIES AS REQUIRED BY THE ENDANGERED SPECIES ACT AND ORC 1531.25. FOR THE PURPOSES OF THIS NOTE, A TREE IS DEFINED AS A LIVE, DYING, OR DEAD WOODY PLANT, WITH A TRUNK THREE INCHES OR GREATER IN DIAMETER AT A HEIGHT OF 4.5 FEET ABOVE THE GROUND SURFACE, AND WITH A MINIMUM HEIGHT OF 13 FEET.

ROUNDING
 THE ROUNDING AT SLOPE BREAKPOINTS SHOWN ON THE TYPICAL SECTIONS APPLIES TO ALL CROSS-SECTIONS, EVEN THOUGH OTHERWISE SHOWN.

WORK LIMITS
 THE WORK LIMITS SHOWN ON THESE PLANS ARE FOR PHYSICAL CONSTRUCTION ONLY. PROVIDE THE INSTALLATION AND OPERATION OF ALL WORK ZONE TRAFFIC CONTROL AND WORK ZONE TRAFFIC CONTROL DEVICES REQUIRED BY THESE PLANS WHETHER INSIDE OR OUTSIDE THESE WORK LIMITS.

ITEM 611 - RESIDENTIAL AND COMMERCIAL DRAINAGE CONNECTIONS

EXISTING ROOF DRAINS, FOOTER DRAINS, OR YARD DRAINS, DISTURBED BY THE WORK, SHALL BE PROVIDED WITH UNOBSTRUCTED OUTLETS BY CONNECTING A CONDUIT THROUGH THE CURB OR INTO A DRAINAGE STRUCTURE. THE LOCATION, TYPE, SIZE AND GRADE OF THE NEW CONDUIT REQUIRED TO REPLACE OR EXTEND THE EXISTING DRAIN WILL BE DETERMINED BY THE ENGINEER.

THE FOLLOWING CONDUIT TYPES MAY BE USED: 707.33, 707.41 NON-PERFORATED, 707.42, 707.43, 707.45, 707.46, 707.47, 707.51, 707.52 SDR35.

PAYMENT FOR ALL LABOR AND MATERIALS WILL BE PERFORMED BY CHANGE ORDER.

ITEM 202, REMOVAL MISC.: RELOCATE CANNON
 THIS WORK SHALL CONSIST OF THE TEMPORARY MOVING OF THE EXISTING HISTORIC CANNON AND RELOCATING TO A FINAL LOCATION AS ILLUSTRATED WITHIN THESE PLANS. THIS ITEM WILL INCLUDE ALL LABOR, MATERIALS, EQUIPMENT, ETC. REQUIRED TO RELOCATE THE ITEM. ANY DAMAGE CAUSED BY THE CONTRACTOR SHALL PAID TO THE DEPARTMENT AS DETERMINED BY THE ENGINEER.

SURVEYING PARAMETERS
 PRIMARY PROJECT CONTROL MONUMENTS GOVERN ALL POSITIONING ON ODOT PROJECTS. SEE SHEET 2 OF THE PLANS FOR A TABLE CONTAINING PROJECT CONTROL INFORMATION.
 USE THE FOLLOWING PROJECT CONTROL, VERTICAL POSITIONING, AND HORIZONTAL POSITIONING PARAMETERS FOR ALL SURVEYING:

PROJECT CONTROL
 POSITIONING METHOD: PER 502.2.D OF SURVEY MANUAL, STATIC GNSS SURVEY.
 MONUMENT TYPE: PROJECT CONTROL MONUMENT TYPE A(2) AND TYPE B(4)
 VERTICAL POSITIONING
 ORTHOMETRIC HEIGHT DATUM: NAVD88
 GEIOD: GEIOD 18

HORIZONTAL POSITIONING
 REFERENCE FRAME: NAD83(2011)
 ELLIPSOID: GRS80
 COORDINATE SYSTEM: OHIO STATE PLANE, NORTH ZONE (3401)
 ORIGIN OF SCALE(X,Y): EASTING(X) 0, NORTHING(Y) 0
 COMBINED SCALE FACTOR: 1.000097049

USE THE POSITIONING METHODS AND MONUMENT TYPE USED IN THE ORIGINAL SURVEY TO RESTORE ALL MONUMENTS RELATED TO PRIMARY PROJECT CONTROL THAT ARE DAMAGED OR DESTROYED BY CONSTRUCTION ACTIVITIES. RESTORE THE DAMAGED OR DESTROYED MONUMENTS IN ACCORDANCE WITH CMS 623.

UNITS ARE IN U.S. SURVEY FEET.

ODOT CONSTRUCTION AND MATERIAL SPECIFICATIONS ITEM 623 WILL GOVERN CONSTRUCTION SURVEYING ACTIVITY.

THE FOLLOWING MONUMENT VERIFICATION REPORT(S) WILL BE REQUIRED:
 623.04a - PRECONSTRUCTION MONUMENT VERIFICATION AND REPORT - [LUMP SUM CARRIED TO GEN SUM]

623.04b - POST CONSTRUCTION MONUMENT VERIFICATION AND REPORT - [LUMP SUM CARRIED TO GEN SUM]

ITEM 201 - CLEARING AND GRUBBING

REMOVE ALL TREES AND STUMPS SPECIFICALLY MARKED FOR REMOVAL WITHIN THE CONSTRUCTION LIMITS UNDER THE LUMP SUM BID FOR ITEM 201, CLEARING AND GRUBBING. THE FOLLOWING IS AN APPROXIMATE ESTIMATE OF THE NUMBER OF TREES TO BE REMOVED UNDER A SEPARATE TREE PRUNING CONTRACT BY APRIL 1, 2026.

SIZES	NO. TREES	NO. STUMPS	TOTAL
4"-12"	8	-	8
14"	2	-	2
15"	1	-	1
18"	2	-	2
20"	1	-	1
24"	4	-	4
28"	1	-	1
36"	1	-	1

A LUMP SUM QUANTITY IS INCLUDED IN THE GENERAL SUMMARY FOR ITEM 201 - CLEARING AND GRUBBING FOR AREAS NOT INCLUDED IN THE ABOVE LIST AND FOR STUMPS TO BE REMOVED FROM TREES CLEARED UNDER THE SEPARATE PRUNING CONTRACT. ALL PROVISIONS AS SET FORTH IN THE SPECIFICATIONS UNDER THIS ITEM ARE INCLUDED IN THE LUMP SUM BID PRICE FOR ITEM 201 - CLEARING AND GRUBBING

SEEDING AND MULCHING
 THE FOLLOWING QUANTITIES ARE PROVIDED TO PROMOTE GROWTH AND CARE OF PERMANENT SEEDED AREAS:

659, TOPSOIL	350 CU. YD.
659, SEEDING AND MULCHING	3149 SQ. YD.
659, REPAIR SEEDING AND MULCHING	158 SQ. YD.
659, INTER-SEEDING	158 SQ. YD.
659, COMMERCIAL FERTILIZER	0.44 TON
659, LIME	0.66 ACRES
659, WATER	18 M. GAL.

SEEDING AND MULCHING SHALL BE APPLIED TO ALL AREAS OF EXPOSED SOIL BETWEEN THE RIGHT-OF-WAY LINES, AND WITHIN THE CONSTRUCTION LIMITS FOR AREAS OUTSIDE THE RIGHT-OF-WAY LINES COVERED BY WORK AGREEMENT OR SLOPE EASEMENT. QUANTITY CALCULATIONS FOR SEEDING AND MULCHING ARE BASED ON THESE LIMITS.

MONUMENT ASSEMBLIES

CONSTRUCT MONUMENT ASSEMBLIES IN ACCORDANCE WITH THE DETAILS SHOWN ON THE STANDARD CONSTRUCTION DRAWINGS AND AT THE LOCATIONS SHOWN ON SHEET NO. P.2.

REVIEW OF DRAINAGE FACILITIES

PRIOR TO THE START OF WORK AND AGAIN BEFORE FINAL ACCEPTANCE, PERFORM AN INSPECTION WITH REPRESENTATIVES OF THE DEPARTMENT, CONTRACTOR AND LOCALS OF ALL EXISTING DRAINAGE FACILITIES THAT ARE TO REMAIN IN SERVICE WHICH MAY BE AFFECTED BY THE WORK. THE CONDITION OF THE EXISTING CONDUITS AND THEIR APPURTENANCES IS DETERMINED FROM FIELD OBSERVATIONS. RECORDS OF THE INSPECTION ARE MAINTAINED BY THE DEPARTMENT.

CONFIRM ALL EXISTING SEWERS INSPECTED INITIALLY BY THE ABOVE-MENTIONED PARTIES ARE MAINTAINED AND LEFT IN A CONDITION COMPARABLE TO THAT DETERMINED BY THE ORIGINAL INSPECTION. THE CONTRACTOR IS RESPONSIBLE TO CORRECT ANY CHANGE IN THE CONDITION RESULTING FROM THEIR OPERATIONS AS DIRECTED AND APPROVED BY THE ENGINEER.

IN ADDITION TO DOCUMENTING THE EXISTING CONDITION, THE CONTRACTOR SHALL FIELD VERIFY THE EXISTING LOCATIONS, SIZES, AND ELEVATIONS OF THE EXISTING STORM SEWER PRIOR TO ORDERING ANY STORM CONDUIT OR STRUCTURES.

PAYMENT FOR ALL OPERATIONS DESCRIBED ABOVE IS INCLUDED IN THE CONTRACT PRICE FOR THE PERTINENT 611 CONDUIT ITEMS.

POST CONSTRUCTION STORM WATER TREATMENT

THIS PLAN UTILIZES STRUCTURAL BEST MANAGEMENT PRACTICES (BMP'S) FOR POST CONSTRUCTION STORM WATER TREATMENT.

VEGETATED BIOFILTER

THIS PLAN UTILIZES VEGETATED BIOFILTER(S) FOR POST CONSTRUCTION STORM WATER TREATMENT. PLACE EITHER ITEM 660 SODDING OR ITEM 659 SEEDING AND MULCHING WITH A 4-INCH LIFT OF TOPSOIL AS SHOWN IN THE PLANS TO ANY DISTURBED AREA ON THE SHOULDER AND FORESLOPE DRAINING TO A VEGETATED BIOFILTER. THE DITCH FOR EACH VEGETATED BIOFILTER SHALL BE TRAPEZOIDAL, AS SHOWN IN THE PLAN CROSS SECTIONS. PROVIDE ITEM 670 AS SPECIFIED IN THE PLANS.

ITEM 202, REMOVAL MISC.: STONE PATH

THIS WORK SHALL CONSIST OF THE REMOVAL AND DISPOSAL OF THE NOTED ITEM. THIS ITEM WILL INCLUDE ALL LABOR, MATERIALS, EQUIPMENT, ETC. REQUIRED TO DISPOSE OF THE ITEM.

CROSSINGS AND CONNECTIONS TO EXISTING PIPES AND UTILITIES

WHERE PLANS PROVIDE FOR A PROPOSED CONDUIT TO BE CONNECTED TO, OR CROSS OVER OR UNDER AN EXISTING SEWER OR UNDERGROUND UTILITY, LOCATE THE EXISTING PIPES OR UTILITIES BOTH AS TO LINE AND GRADE BEFORE STARTING TO LAY THE PROPOSED CONDUIT.

IF IT IS DETERMINED THAT THE ELEVATION OF THE EXISTING CONDUIT, OR EXISTING APPURTENANCE TO BE CONNECTED, DIFFERS FROM THE PLAN ELEVATION OR RESULTS IN A CHANGE IN THE PLAN CONDUIT SLOPE, NOTIFY THE ENGINEER BEFORE STARTING CONSTRUCTION OF ANY PORTION OF THE PROPOSED CONDUIT WHICH WILL BE AFFECTED BY THE VARIANCE IN THE EXISTING ELEVATIONS.

IF IT IS DETERMINED THAT THE PROPOSED CONDUIT WILL INTERSECT AN EXISTING SEWER OR UNDERGROUND UTILITY IF CONSTRUCTED AS SHOWN ON THE PLAN, NOTIFY THE ENGINEER BEFORE STARTING CONSTRUCTION OF ANY PORTION OF THE PROPOSED CONDUIT WHICH WOULD BE AFFECTED BY THE INTERFERENCE WITH AN EXISTING FACILITY.

PAYMENT FOR ALL THE OPERATIONS DESCRIBED ABOVE IS INCLUDED IN THE CONTRACT PRICE FOR THE PERTINENT 611 CONDUIT ITEM.

ITEM SPECIAL - MAILBOX SUPPORT

THIS WORK SHALL CONSIST OF FURNISHING AND ERECTING MAILBOX SUPPORTS AND ANY ASSOCIATED MOUNTING HARDWARE IN ACCORDANCE WITH PLAN DETAILS, AND ATTACHING AN OWNER-SUPPLIED MAILBOX AT LOCATIONS SPECIFIED IN THE PLAN, OR OTHERWISE ESTABLISHED BY THE ENGINEER.

WOOD POSTS SHALL BE NOMINAL 4 INCHES BY 4 INCHES SQUARE OR 4.5 INCHES DIAMETER ROUND, AND CONFORM TO 710.14.

STEEL POSTS SHALL BE NOMINAL PIPE SIZE 2 INCHES I.D., AND CONFORM TO AASHTO M 181.

ALL HARDWARE INCLUDING BUT NOT LIMITED TO PLATES, SCREWS, BOLTS, AND ETC. SHALL BE COMMERCIAL-GRADE GALVANIZED STEEL.

POSTS SHALL BE SET PER THE FIRST PARAGRAPH OF 606.03, AND SHALL IN NO INSTANCE BE ENCASED IN CONCRETE.

SUPPORT HARDWARE SHALL ACCOMMODATE EITHER A SINGLE OR A DOUBLE MAILBOX INSTALLATION, AND NO MORE THAN TWO BOXES MAY BE MOUNTED ON A SINGLE POST.

THE MAILBOX SHALL BE SECURELY AND NEATLY ATTACHED BY THE CONTRACTOR TO THE NEW SUPPORT. THE CONTRACTOR SHALL FURNISH ALL NECESSARY ATTACHMENT HARDWARE (NUTS, BOLTS, PLATES, SPACERS, AND WASHERS) AS NECESSARY TO ACCOMMODATE THE COMPLETE INSTALLATION.

IN THE ABSENCE OF A NEW BOX SUPPLIED BY THE OWNER, THE CONTRACTOR SHALL SALVAGE THE EXISTING BOX AND PLACE IT ON THE NEW SUPPORT. DUE CARE SHALL BE EXERCISED IN SUCH AN OPERATION, AND THE CONTRACTOR SHALL BE RESPONSIBLE FOR REPAIRING OR REPLACING ANY BOX DAMAGED BY IMPROPER HANDLING ON HIS PART, AS JUDGED AND DIRECTED BY THE ENGINEER.

THE CONTRACTOR SHALL BE RESPONSIBLE FOR COORDINATING WITH THE LOCAL POST MASTER REGARDING THE TIMING OF THE MOVEMENT OF ANY MAILBOX TO A NEW LOCATION.

PAYMENT UNDER THIS ITEM SHALL BE LIMITED TO FINAL PERMANENT INSTALLATIONS. TEMPORARY INSTALLATIONS SHALL BE IN ACCORDANCE WITH 107.10. HOWEVER, THE SAME MATERIAL AND SIZE LIMITATIONS AS FOR PERMANENT INSTALLATIONS SHALL APPLY.


MAILBOX SUPPORTS, COMPLETE IN PLACE, WILL BE PAID FOR AT THE CONTRACT UNIT PRICE PER EACH, FOR ITEM SPECIAL MAILBOX SUPPORT SYSTEM, (SINGLE) (DOUBLE).

ITEM 452, 6"/8" NON-REINFORCED CONCRETE PAVEMENT, CLASS QC MS, AS PER PLAN

THE ITEM SHALL MEET THE ODOT CMS WITH THE FOLLOWING EXCEPTION. THE BRICK RED COLOR SHALL BE MIXED IN. THE SURFACE SHALL BE BROOM FINISHED.

ITEM 202, REMOVAL MISC.: ROCK/BRICK PILLAR/CONCRETE SLAB/FLAG POLE/POST/PRIVATE SIGN

THIS WORK SHALL CONSIST OF THE REMOVAL AND DISPOSAL OF THE NOTED ITEM. THIS ITEM WILL INCLUDE ALL LABOR, MATERIALS, EQUIPMENT, ETC. REQUIRED TO DISPOSE OF THE ITEM.

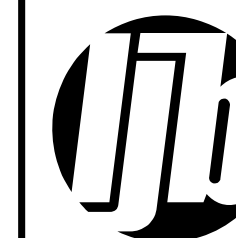

ENDANGERED BAT HABITAT REMOVAL

THE PROJECT IS LOCATED WITHIN THE KNOWN HABITAT RANGES OF THE FEDERALLY ENDANGERED NORTHERN LONG-EARED BAT, INDIANA BAT, TRICOLORED BAT AND THE STATE ENDANGERED LITTLE BROWN. NO TREES SHALL BE REMOVED UNDER THIS PROJECT FROM APRIL 1 THROUGH SEPTEMBER 30. ALL NECESSARY TREE REMOVAL SHALL OCCUR FROM OCTOBER 1 THROUGH MARCH 31. THIS REQUIREMENT IS NECESSARY TO AVOID AND MINIMIZE IMPACTS TO THESE SPECIES AS REQUIRED BY THE ENDANGERED SPECIES ACT AND ORC 1531.25. FOR THE PURPOSES OF THIS NOTE, A TREE IS DEFINED AS A LIVE, DYING, OR DEAD WOODY PLANT, WITH A TRUNK THREE INCHES OR GREATER IN DIAMETER AT A HEIGHT OF 4.5 FEET ABOVE THE GROUND SURFACE, AND WITH A MINIMUM HEIGHT OF 13 FEET.

UNDERGROUND STORAGE TANK AND PETROLEUM CONTAMINATED SOILS

ENVIRONMENTAL STUDIES INDICATED THAT AN UNDERGROUND STORAGE TANK (UST) WILL BE AND PETROLEUM CONTAMINATED SOIL (PCS) MAY BE ENCOUNTERED DURING EXCAVATIONS WITHIN THE PROJECT LIMITS. THESE LIMITS ARE ESTIMATED TO BE STATE ROUTE 18, FROM APPROXIMATELY STATION 80+20 TO APPROXIMATELY STATION 82+00, LEFT; IN THE AREA OF 51110 ST RT 18 WELLINGTON, OH 44090. THE CONTRACTOR MUST DETERMINE APPROPRIATE PERSONAL PROTECTIVE EQUIPMENT FOR THOSE WHO CONDUCT WORK WITHIN THE LIMITS OF THE PCS. ALL EXCAVATED PCS THAT CANNOT BE REUSED AS PROJECT FILL PER CMS 203.03(j), SHALL BE MANAGED AND DISPOSED OF AT A LICENSED LANDFILL. THE ENGINEER MAY PERMIT THE CONTRACTOR TO DIRECT LOAD THE EXCAVATED PCS INTO TRUCKS FOR TRANSPORT AND DISPOSAL. AS AN ALTERNATE, THE ENGINEER MAY PERMIT THE CONTRACTOR TO TEMPORARILY STOCKPILE THE EXCAVATED PCS ON AN IMPERMEABLE MEMBRANE, IN AN AREA PROVIDED BY THE CONTRACTOR AND APPROVED BY THE ENGINEER. THE STOCKPILE SHOULD BE SURROUNDED BY STRAW BALES TO REDUCE RUNOFF. THE CONTRACTOR WILL PROVIDE COMPLETED LOG FORMS AND MANIFESTS FOR TRANSPORT AND DISPOSAL TO THE ENGINEER FOR SIGNATURE. THE CONTRACTOR IS RESPONSIBLE FOR ANY ADDITIONAL TESTING THAT THE LANDFILL MAY REQUIRE FOR DISPOSAL. ONE (1) UNDERGROUND STORAGE TANK (UST) WAS IDENTIFIED DURING PROJECT DEVELOPMENT SHALL FOLLOW CMS 202.08 FOR PROPER PERMITTING, REMOVAL, AND DISPOSAL OF THE TANK. THE CONTRACTOR IS RESPONSIBLE FOR ALL PERMITTING, SOIL AND GROUNDWATER DISPOSAL, TANK PREPARATION, REMOVAL AND DISPOSAL, INSPECTIONS, SAMPLING, AND REPORTING. ALL TANK REMOVAL ACTIVITIES MUST BE CONDUCTED BY A CERTIFIED TANK INSTALLER. IF EXCAVATIONS WITHIN THE PCS REQUIRE DEWATERING FOR CONSTRUCTION PURPOSES, THE CONTRACTOR SHALL DEWATER, CONTAINERIZE, AND DISPOSE OF WATERS BY METHOD APPROVED BY THE ENGINEER. THE CONTRACTOR SHALL OBTAIN ALL THE NECESSARY PERMITS NEEDED TO STORE, TRANSPORT, AND DISPOSE OF WATER IN ACCORDANCE WITH APPLICABLE LOCAL, STATE, AND FEDERAL REGULATIONS. THE CONTRACTOR IS RESPONSIBLE FOR ANY ADDITIONAL TESTING REQUIRED FOR DISPOSAL. ALL EXCAVATED AREAS SHALL BE BACKFILLED WITH SUITABLE MATERIAL IN ACCORDANCE WITH PROJECT PLANS, APPLICABLE ODOT SPECIFICATIONS OR AS DIRECTED BY THE ENGINEER. THE CONTRACTOR SHALL FURNISH ALL THE LABOR, EQUIPMENT, AND MATERIALS NECESSARY TO PROPERLY MANAGE, STORE (IF NECESSARY), TEST FOR DISPOSAL, TRANSPORT AND DISPOSE OF REGULATED MATERIALS, INCLUDING ANY REQUIRED PERMITS OR FEES WITHIN THE IDENTIFIED LIMITS. PAYMENT FOR THIS WORK SHALL BE MADE AT THE CONTRACT PRICE BID. THE FOLLOWING ESTIMATED QUANTITY HAS BEEN INCLUDED IN THE GENERAL SUMMARY.

690E65000 - WORK INVOLVING NON-REGULATED MATERIAL	550 TON
690E65016 - WORK INVOLVING PCS	550 TON
690E67000 - REGULATED UNDERGROUND STORAGE TANK REMOVED	1 EACH
690E65022 - NON-REGULATED WATER	500 GALLON
690E65024 - REGULATED WATER	500 GALLON

HAZARDOUS MATERIALS

ACCORDING TO THE PLANS, A 10-INCH ASBESTOS CONCRETE WATER MAIN IS LOCATED WITHIN THE PROJECT AREA. SHOULD THE CONTRACTOR DISTURB THE WATER MAIN DURING CONSTRUCTION, THEY ARE REQUIRED TO ADHERE TO CMS 202.04 REGARDING THE REMOVAL OF PIPES CONTAINING ASBESTOS MATERIALS.

611 TYPE A OR B CONDUIT, AS PER PLAN

USE 703.11 STRUCTURAL BACKFILL TYPE 1 OR 613 LOW STRENGTH MORTAR, TYPE 2 AS STRUCTURAL BACKFILL FOR ALL TYPE A AND B FLEXIBLE CONDUITS 12-INCH DIAMETER AND LARGER. DETAIL THE SELECTED CONDUIT MATERIAL AND STRUCTURAL BACKFILL IN THE 611 INSTALLATION PLAN PER 611.04 B. NOTIFY THE ENGINEER IMMEDIATELY WHEN GROUNDWATER IS ENCOUNTERED DURING EXCAVATION. USE 703.11 STRUCTURAL BACKFILL IN AREAS WHERE GROUNDWATER IS PRESENT. INSTALL 703.11 STRUCTURAL BACKFILL TYPE 3 AND GEOTEXTILE FABRIC ACCORDING TO 611.06. VERIFY THE CONDUIT MATERIAL AND REVISED BACKFILL MEET THE STRUCTURAL DESIGN REQUIREMENTS WITH THE CONDUIT MANUFACTURER PRIOR TO INSTALLATION.

ITEM 442 - ASPHALT CONCRETE SURFACE COURSE, 9.5 MM, TYPE A (446), AS PER PLAN

ALL OPEN TRANSVERSE JOINTS SHALL BE TAPERED TO MEET EXISTING PAVEMENT BEFORE INTRODUCING TRAFFIC. A "BUMP" SIGN (W8-1-36) SHALL BE ERECTED ON EACH SIDE OF TRANSVERSE JOINTS LEFT OPEN OVER NIGHT, INCLUDING A SPEED ADVISORY SIGN. THESE SIGNS SHALL BE REMOVED IMMEDIATELY AFTER JOINT HAS BEEN CLOSED. PLACEMENT OF SIGNS SHALL BE INCLUDED IN THE UNIT PRICE BID FOR ITEM 614 MAINTAINING TRAFFIC.

CARE SHALL BE TAKEN TO MATCH EXISTING PAVEMENT ELEVATIONS AT EXISTING PAVED BERMS, DRIVES, INTERSECTIONS, ETC.

REQUIREMENTS OF 442 APPLY EXCEPT AS FOLLOWS:
 MIX DESIGN: FOR Ndes USE 50 GYRATIONS, FOR Nmax USE 75 GYRATIONS. CHOOSE OPTIMUM BINDER CONTENT AT DESIGN AIR VOIDS OF 3.5%. MINIMUM TOTAL PG BINDER CONTENT IS 6.3 PERCENT. MINIMUM VIRGIN PG BINDER CONTENT IS 5.2 PERCENT. USE A PG 64-22 BINDER. WHEN AN AGGREGATE SOURCE IS SPECIALLY DESIGNATED WITH AN SR ON THE AGGREGATE GRAVITY LIST DO NOT USE THE AGGREGATE EXCEPT AS ALLOWED FOR MEDIUM TRAFFIC IN THE GUIDELINES FOR MAINTAINING ADEQUATE PAVEMENT FRICTION IN SURFACE PAVEMENT.

ITEM 442 - ASPHALT CONCRETE INTERMEDIATE COURSE, 12.5MM, TYPE A (446), AS PER PLAN


ALL OPEN TRANSVERSE JOINTS SHALL BE TAPERED TO MEET EXISTING PAVEMENT BEFORE INTRODUCING TRAFFIC. A "BUMP" SIGN (W8-1-36) SHALL BE ERECTED ON EACH SIDE OF TRANSVERSE JOINTS LEFT OPEN OVER NIGHT, INCLUDING A SPEED ADVISORY SIGN. THESE SIGNS SHALL BE REMOVED IMMEDIATELY AFTER JOINT HAS BEEN CLOSED. PLACEMENT OF SIGNS SHALL BE INCLUDED IN THE UNIT PRICE BID FOR ITEM 614 MAINTAINING TRAFFIC.

REQUIREMENTS OF 442 APPLY EXCEPT AS FOLLOWS:
 MIX DESIGN: FOR Ndes USE 50 GYRATIONS, FOR Nmax USE 75 GYRATIONS. CHOOSE OPTIMUM BINDER CONTENT AT DESIGN AIR VOIDS OF 3.5%. MINIMUM TOTAL PG BINDER CONTENT IS 5.6 PERCENT. MINIMUM VIRGIN PG BINDER CONTENT IS 3.8 PERCENT. PER SPECIFICATIONS, USE A PG 64-22 BINDER WHEN 25% AND LESS RAP IS USED. USE A PG 64-28 BINDER WHEN MORE THAN 25% RAP IS USED. MAX RAP PERCENTAGE IS 30%.

APPLY 703.05 FOR COARSE AND FINE AGGREGATE EXCEPT GRADATION FOR FINE AGGREGATE DOES NOT APPLY.

GENERAL NOTES

DESIGN AGENCY

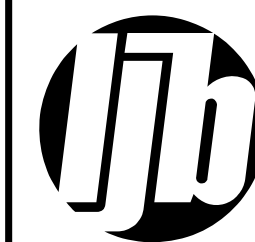

DESIGNER
ARW

REVIEWER
JRE 01/06/26


PROJECT ID
116214

SHEET TOTAL
P.7A | P.73

SHEET NUMBER													PART.	ITEM	ITEM	GRAND	UNIT	DESCRIPTION	SEE SHEET NO.	
RW.3	RW.4	P.7	P.7A	P.14	P.15	P.16	P.17	P.30	P.38	P.41	P.42	Office Calc	01/SAF	EXT	TOTAL					
		LS											LS	201	11000	LS		CLEARING AND GRUBBING		
				7,096									7,096	202	23000	7,096	SY	PAVEMENT REMOVED		
				616									616	202	30000	616	SF	WALK REMOVED		
				258									258	202	35100	258	FT	PIPE REMOVED, 24" DIAMETER AND UNDER		
				8									8	202	58100	8	EACH	CATCH BASIN REMOVED		
				40									40	202	75000	40	FT	FENCE REMOVED		
				1									1	202	75250	1	EACH	GATE REMOVED		
				2									2	202	98100	2	EACH	REMOVAL MISC.: ROCK	P.7	
				1									1	202	98100	1	EACH	REMOVAL MISC.:BRICK PILLAR	P.7	
				2									2	202	98100	2	EACH	REMOVAL MISC.:CONCRETE SLAB	P.7	
				2									2	202	98100	2	EACH	REMOVAL MISC.:FLAG POLE	P.7	
				4									4	202	98100	4	EACH	REMOVAL MISC.:POST	P.7	
				1									1	202	98100	1	EACH	REMOVAL MISC.:PRIVATE SIGN	P.7	
				1									1	202	98100	1	EACH	REMOVAL MISC.:RELOCATE CANNON	P.7	
				146									146	202	98400	146	SF	REMOVAL MISC.:STONE PATH	P.7	
								1,512	1,310	251			3,073	203	10000	3,073	CY	EXCAVATION		
								248	365	2,859			3,472	203	20000	3,472	CY	EMBANKMENT		
					437								8,416	8,853	204	10000	8,853	SY	SUBGRADE COMPACTION	
													5	204	45000	5	HOUR	PROOF ROLLING		
													277	206	10500	277	TON	CEMENT		
													9,176	206	11000	9,176	SY	CURING COAT		
													9,176	206	15020	9,176	SY	CEMENT STABILIZED SUBGRADE, 14 INCHES DEEP		
					572								572	608	10000	572	SF	4" CONCRETE WALK		
4													4	623	38500	4	EACH	MONUMENT ASSEMBLY, TYPE C	RW.3	
1													1	623	40500	1	EACH	REFERENCE MONUMENT, TYPE A	RW.3	
7	25												32	623	40520	32	EACH	RIGHT-OF-WAY MONUMENT, TYPE B		
		LS											LS	623	50000	LS		PRECONSTRUCTION SURVEY MONUMENT VERIFICATION AND REPORT		
		LS											LS	623	51000	LS		POST CONSTRUCTION SURVEY MONUMENT VERIFICATION AND REPORT		
					10								10	SPECIAL	69050350	10	EACH	MAILBOX REMOVED AND RESET	P.7	
											269		269	SPECIAL	69098300	269	SY	STONE MULCH	P.42	
																		EROSION CONTROL		
		350				79							429	659	00300	429	CY	TOPSOIL		
		3,149											3,149	659	10000	3,149	SY	SEEDING AND MULCHING		
		158											158	659	14000	158	SY	REPAIR SEEDING AND MULCHING		
		158											158	659	15000	158	SY	INTER-SEEDING		
		0.44											0.44	659	20000	0.44	TON	COMMERCIAL FERTILIZER		
		0.66											0.66	659	31000	0.66	ACRE	LIME		
		18											18	659	35000	18	MGAL	WATER		
						242							242	670	00700	242	SY	DITCH EROSION PROTECTION		
							LS						LS	832	15000	LS		STORM WATER POLLUTION PREVENTION PLAN		
							LS						LS	832	15002	LS		STORM WATER POLLUTION PREVENTION INSPECTIONS		
							LS						LS	832	15010	LS		STORM WATER POLLUTION PREVENTION INSPECTION SOFTWARE		
							50,000						50,000	832	30000	50,000	EACH	EROSION CONTROL		
																		ENVIRONMENTAL / REMEDIATION		
			1										1	202	67000	1	EACH	REGULATED UNDERGROUND STORAGE TANK REMOVED		
		550											550	SPECIAL	69065000	550	TON	WORK INVOLVING NON-REGULATED MATERIALS	P.7A	
		550											550	SPECIAL	69065016	550	TON	WORK INVOLVING PETROLEUM CONTAMINATED SOIL	P.7A	
		500											500	SPECIAL	69065022	500	GAL	WORK INVOLVING NON-REGULATED WATER	P.7A	
		500											500	SPECIAL	69065024	500	GAL	WORK INVOLVING REGULATED WATER	P.7A	
																		DRAINAGE		
						0.84							0.84	602	20000	0.84	CY	CONCRETE MASONRY		
						2,867							2,867	605	14000	2,867	FT	6" BASE PIPE UNDERDRAINS		
						186							186	611	00510	186	FT	6" CONDUIT, TYPE F FOR UNDERDRAIN OUTLETS		
						42							42	611	00900	42	FT	6" CONDUIT, TYPE B		
						19							19	611	01800	19	FT	8" CONDUIT, TYPE B		
						55							55	611	02000	55	FT	8" CONDUIT, TYPE C		
													588	611	04401	588	FT	12" CONDUIT, TYPE B, AS PER PLAN	P.7A	
													43	611	04600	43	FT	12" CONDUIT, TYPE C		
													87	611	05901	87	FT	15" CONDUIT, TYPE B, AS PER PLAN	P.7A	
													30	611	06100	30	FT	15" CONDUIT, TYPE C		
													2	611	98150	2	EACH	CATCH BASIN, NO. 3		
													10	611	98180	10	EACH	CATCH BASIN, NO. 3A		
													10	611	98470	10	EACH	CATCH BASIN, NO. 2-2B		
													8	611	99574	8	EACH	MANHOLE, NO. 3		

GENERAL SUMMARY

DESIGN AGENCY



DESIGNER
ARW


REVIEWER
JRE 09/29/25





PROJECT ID
116214

SHEET TOTAL
P.12 | P.73

REF NO.	SHEET NO.	STATION TO STATION	605	611	602	611	611	611	611	611	611	611	611	611	611	611	611	611	670	659
			6" BASE PIPE UNDERDRAINS	6" CONDUIT, TYPE F FOR UNDERDRAIN OUTLETS	CONCRETE MASONRY	6" CONDUIT, TYPE B	8" CONDUIT, TYPE B	8" CONDUIT, TYPE C	12" CONDUIT, TYPE B, AS PER PLAN	12" CONDUIT, TYPE C	15" CONDUIT, TYPE B, AS PER PLAN	15" CONDUIT, TYPE C	CATCH BASIN, NO. 3	CATCH BASIN, NO. 3A	CATCH BASIN, NO. 2-2B	MANHOLE, NO. 3	DITCH EROSION PROTECTION	TOPSOIL		
			FT	FT	CY	FT	FT	FT	FT	FT	FT	FT	FT	EACH	EACH	EACH	EACH	SY	CY	
D-1	P.18	79+59.58 LT TO 79+75.03 LT					7	7					9				2			
D-2	P.18	80+73.81 LT TO 81+35.05 RT			0.42					64										
D-3	P.18	81+17.40 LT TO 81+30.39 LT					12													
D-4	P.19	82+11.59 LT TO 82+37.00 RT								42			9			2	1			
D-5	P.19	NOT USED																		
D-6	P.19	82+67.60 LT/RT TO 82+80.60 LT/RT								46					2	1				
D-7	P.19	83+69.22 LT TO 83+82.22 LT							12											
D-8	P.19	387+91.20 LT TO 388+04.20 LT								12										
D-9	P.19	388+18.62 LT TO 388+31.61 LT								30							1	1		
D-10		NOT USED																		
D-11	P.19	86+12.30 LT TO 86+45.32 RT							12								2	1	1	
D-12	P.21	382+05.60 LT/RT TO 382+19.10 LT/RT											50	18			2			
D-13	P.21	383+46.29 LT/RT TO 383+59.78 LT/RT											31	12			2			
D-14	P.21	384+34.68 LT TO 384+47.67 LT								6									1	
D-15	P.21	385+17.28 LT/RT TO 385+28.94 LT/RT								50							2		1	
D-16		NOT USED																		
D-17	P.21	386+37.02 LT TO 386+50.02 LT					6			12									1	
D-18	P.22	389+55.31 LT/RT TO 389+72.00 LT/RT								57				2			1		1	
D-19	P.22	389+61.81 LT TO 390+29.63 LT								68										
D-20		NOT USED																		
D-21	P.22	390+23.14 LT TO 390+63.14 LT/RT								124							2		1	
D-22	P.22	390+50.60 LT TO 390+73.17 LT			0.42					22										
D-23	P.22	391+78.50 LT TO 391+97.50 LT											19							
E-1	P.19	86+85.26 RT TO 89+71.94 RT																126	46	
E-2	P.20	87+11.50 LT TO 89+71.94 LT																116	33	
UD-1	P.18	79+68.53 LT TO 82+11.80 LT	234	10																
UD-2	P.18	79+68.83 LT/RT TO 82+34.44 RT	266			36														
UD-3	P.19	82+20.75 LT TO 82+71.22 LT	41	10																
UD-4	P.19	82+38.75 RT TO 82+77.66 RT	30	10																
UD-5	P.19	82+75.69 LT TO 83+62.53 LT	80	10																
UD-6	P.19	82+82.20 RT TO 83+31.04 RT	40	10																
UD-7	P.19	383+54.73 LT TO 386+68.30 LT	306	10																
UD-8	P.19	388+17.09 RT TO 389+58.77 RT	135	10																
UD-9	P.19	85+16.58 RT TO 86+43.34 RT	119	10																
UD-10	P.19	85+47.24 LT TO 86+17.04 LT	60	10																
UD-11	P.19	86+21.54 LT TO 89+71.94 LT	350	14																
UD-12	P.19	86+49.50 RT TO 89+71.94 RT	323	19																
UD-13	P.21	382+11.88 RT TO 383+50.01 RT	122	23																
UD-14	P.21	382+12.60 LT TO 383+50.02 LT	129	10																
UD-15	P.21	383+54.78 RT TO 386+36.47 RT	272	10																
UD-16	P.22	388+58.58 LT TO 389+58.77 LT	90	10																
UD-17	P.22	389+72.23 LT TO 392+41.28 LT	270	10																
TOTALS CARRIED TO GENERAL SUMMARY			2867	186	0.84	42	19	55		588	43		87	30	2	10	10	8	242	79

DRAINAGE SUBSUMMARY

DESIGN AGENCY

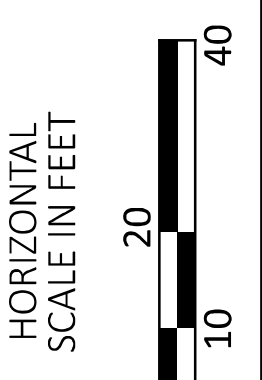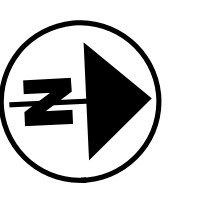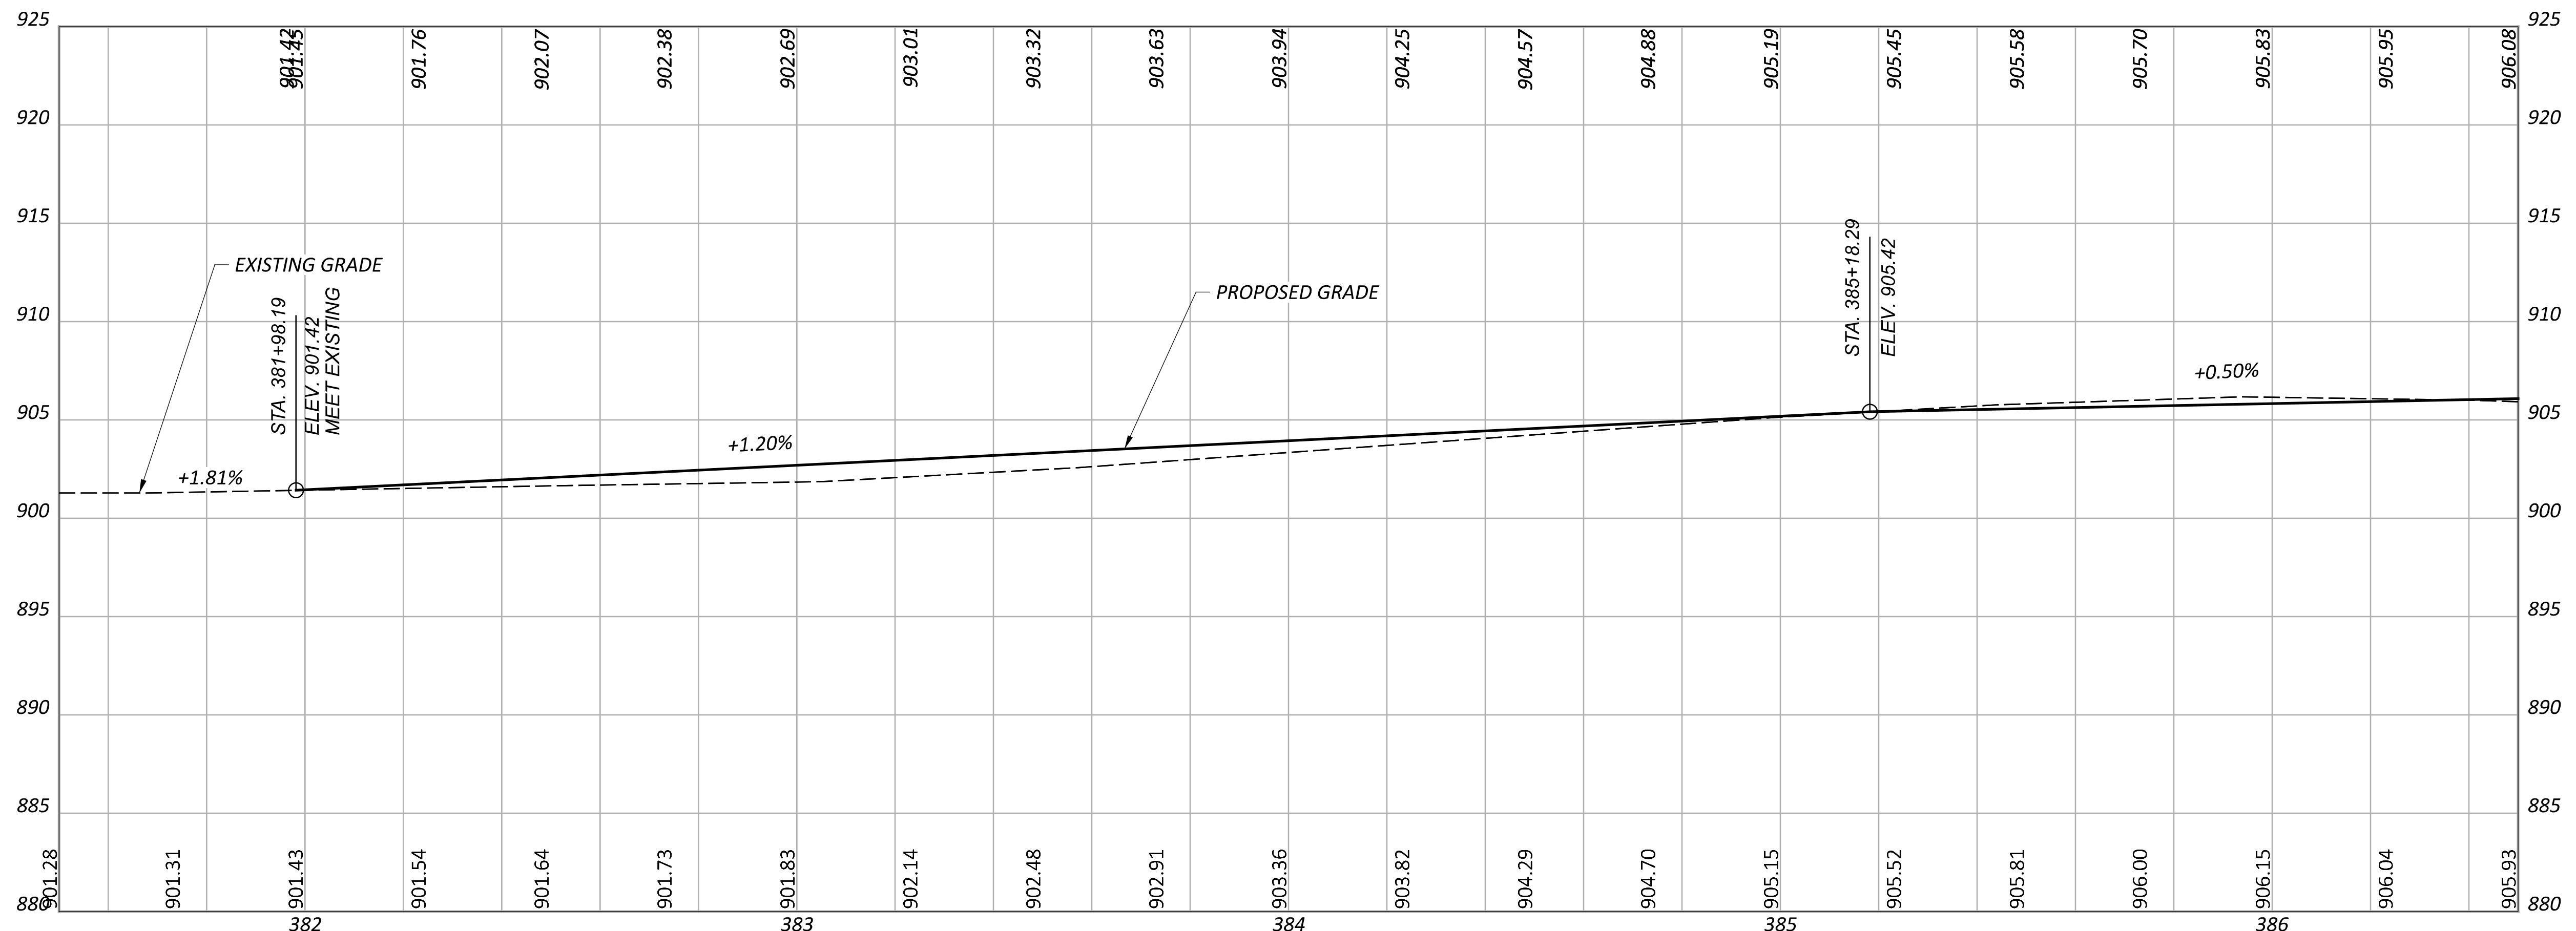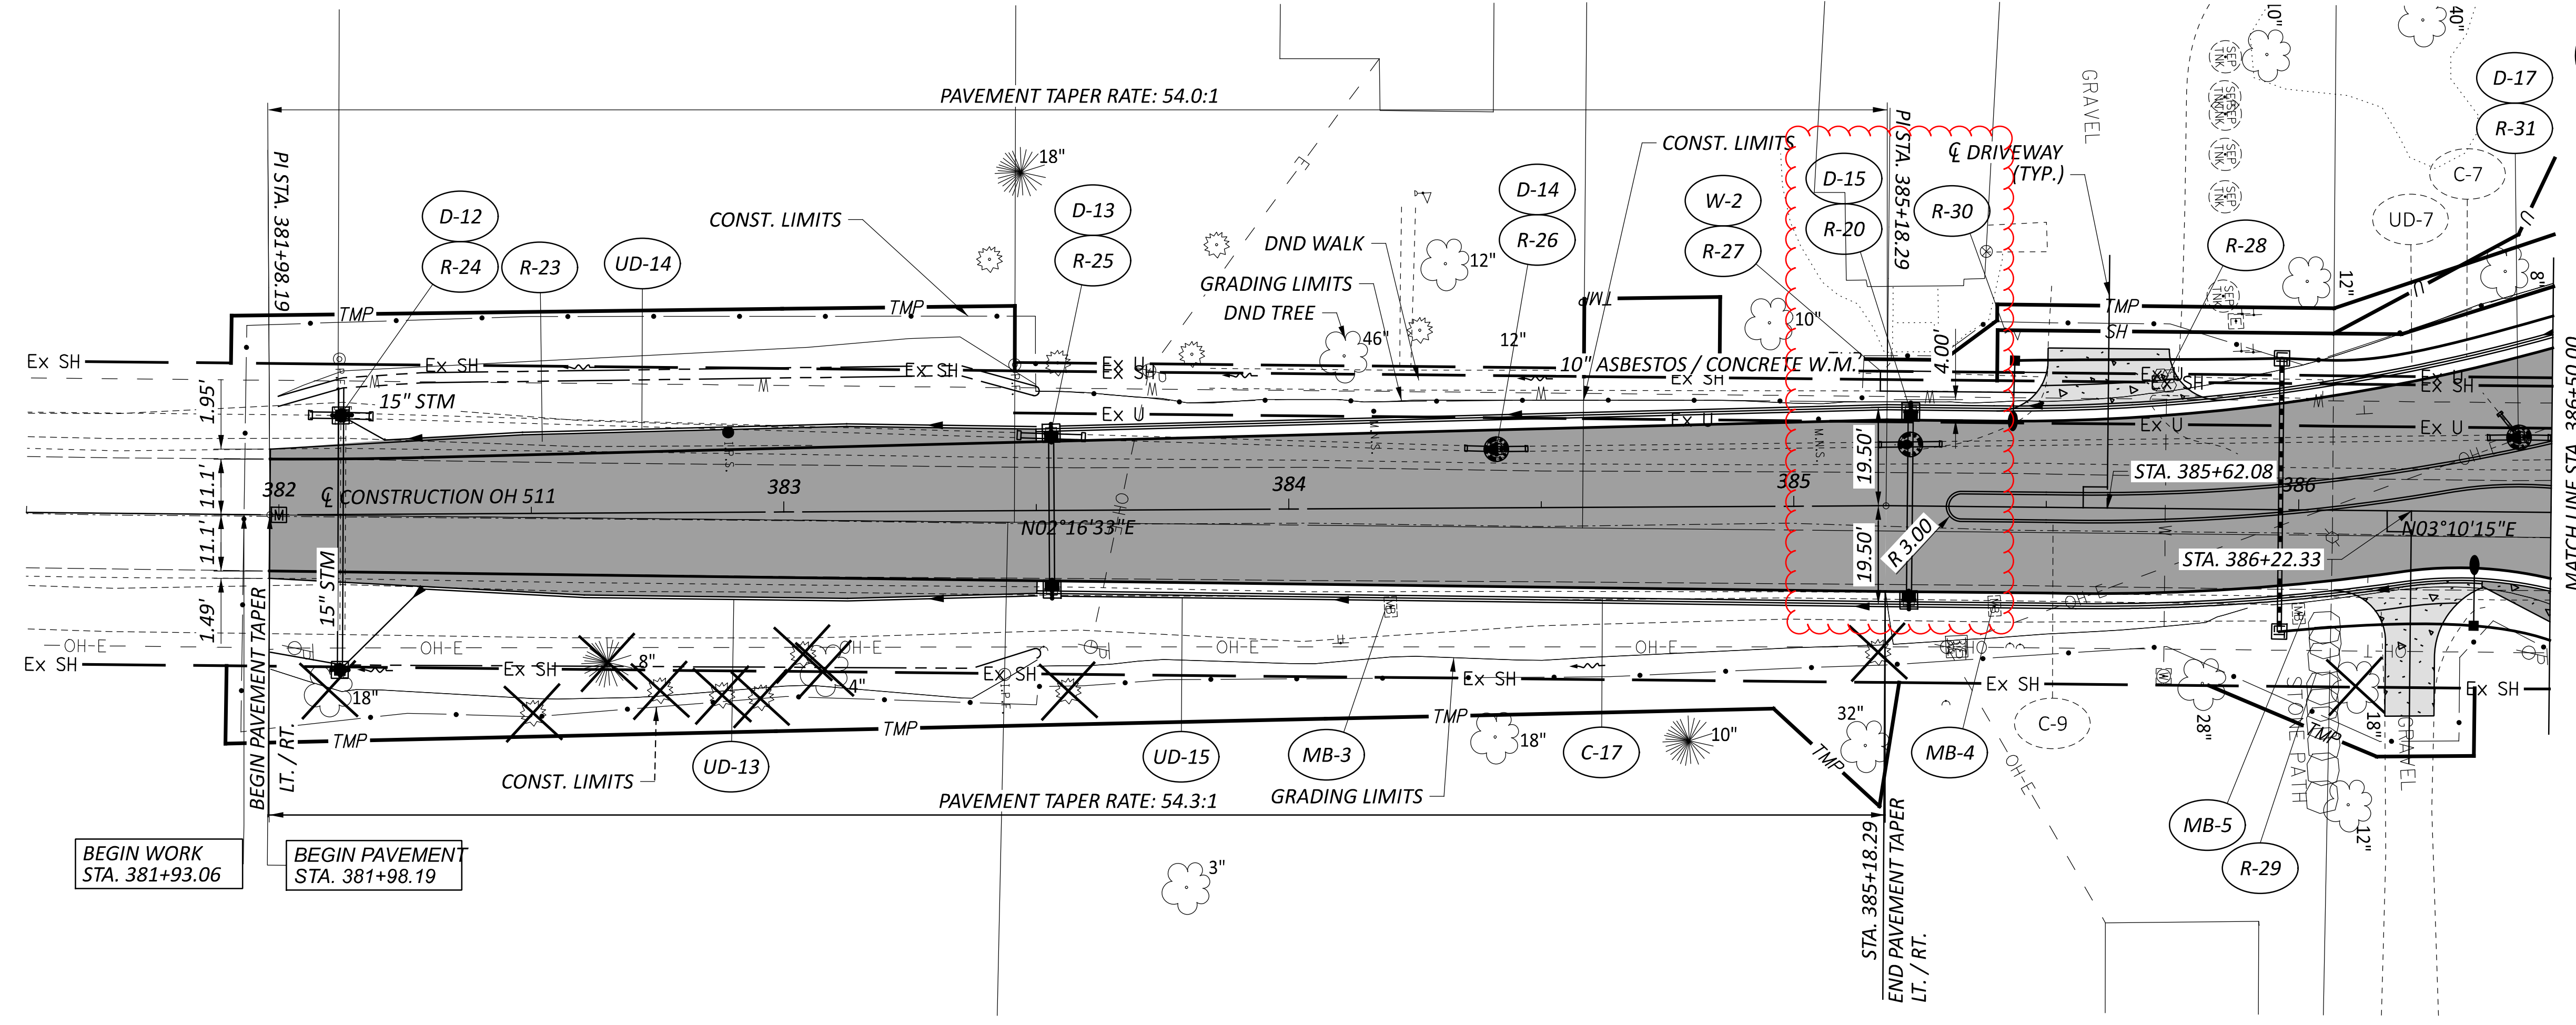 DESIGNER
 ARW
 REVIEWER
 JRE 09/29/25
 PROJECT ID
 116214
 SHEET TOTAL
 P.16 P.73



PLAN AND PROFILE - OH 511
 STA. 380+00.00 TO STA. 386+00.00

DESIGN AGENCY





DESIGNER
JML

REVIEWER
JRE 09/29/25

PROJECT ID
116214

SHEET TOTAL
 P.21 | P.73

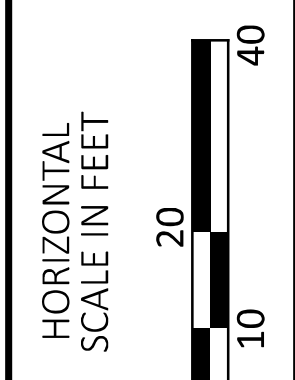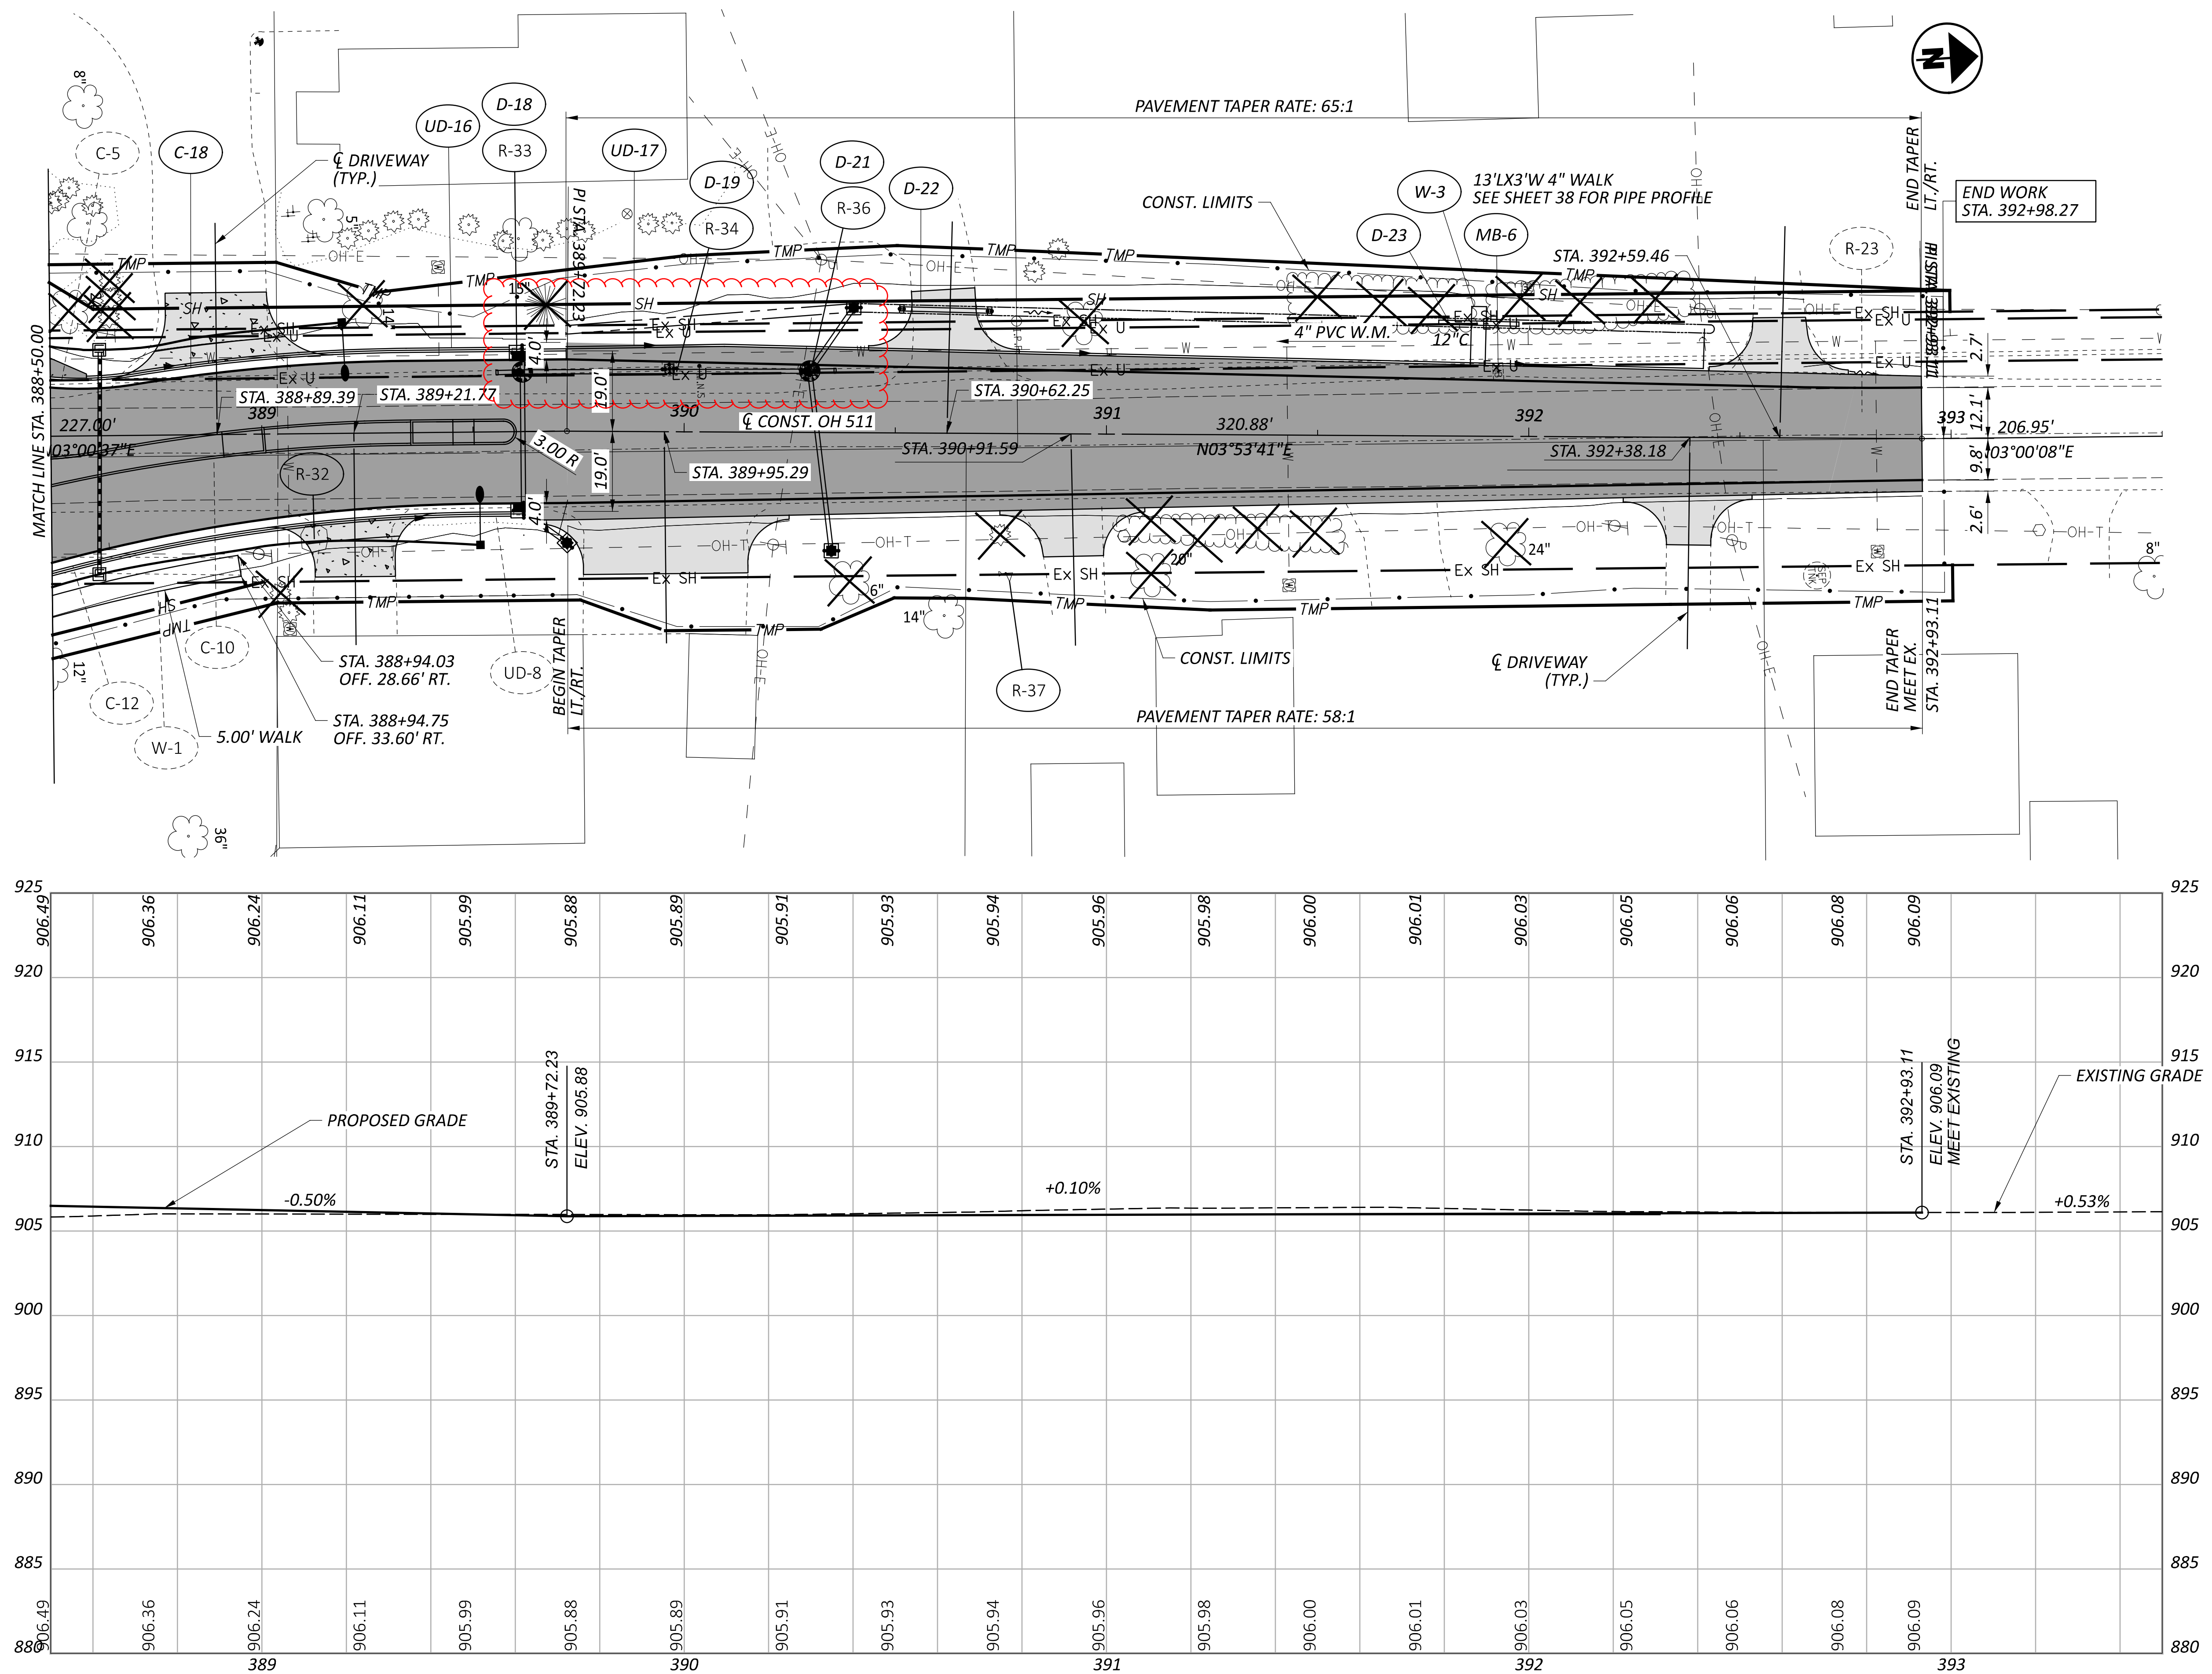

PLAN AND PROFILE - OH 511
 STA. 388+50.00 TO STA. 393+50.00

DESIGN AGENCY





DESIGNER
 JML


REVIEWER
 JRE 09/29/25

PROJECT ID
 116214


SHEET TOTAL
 P.22 P.73

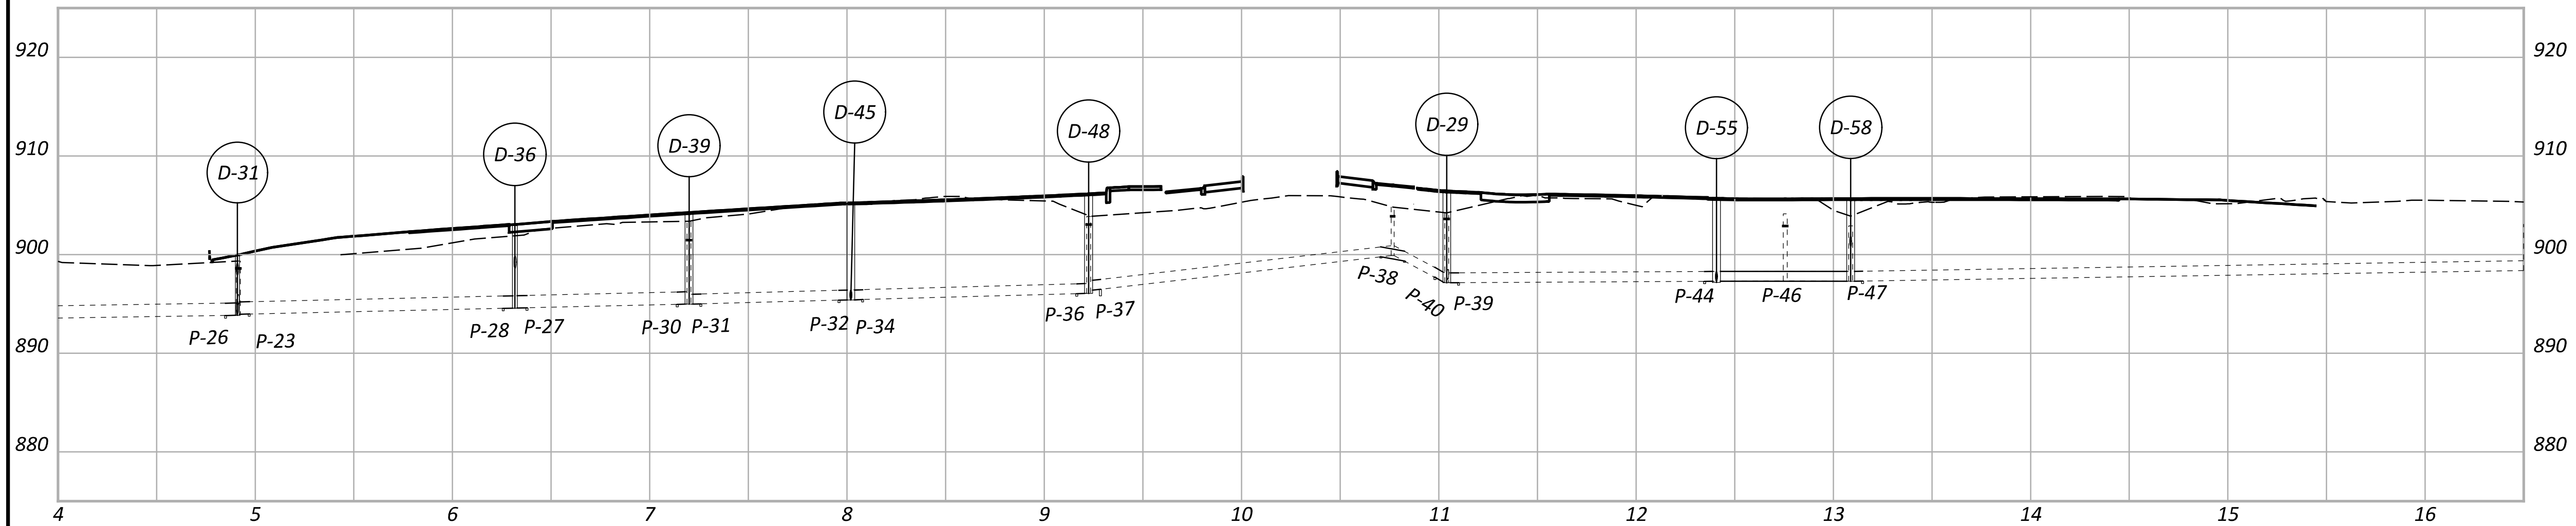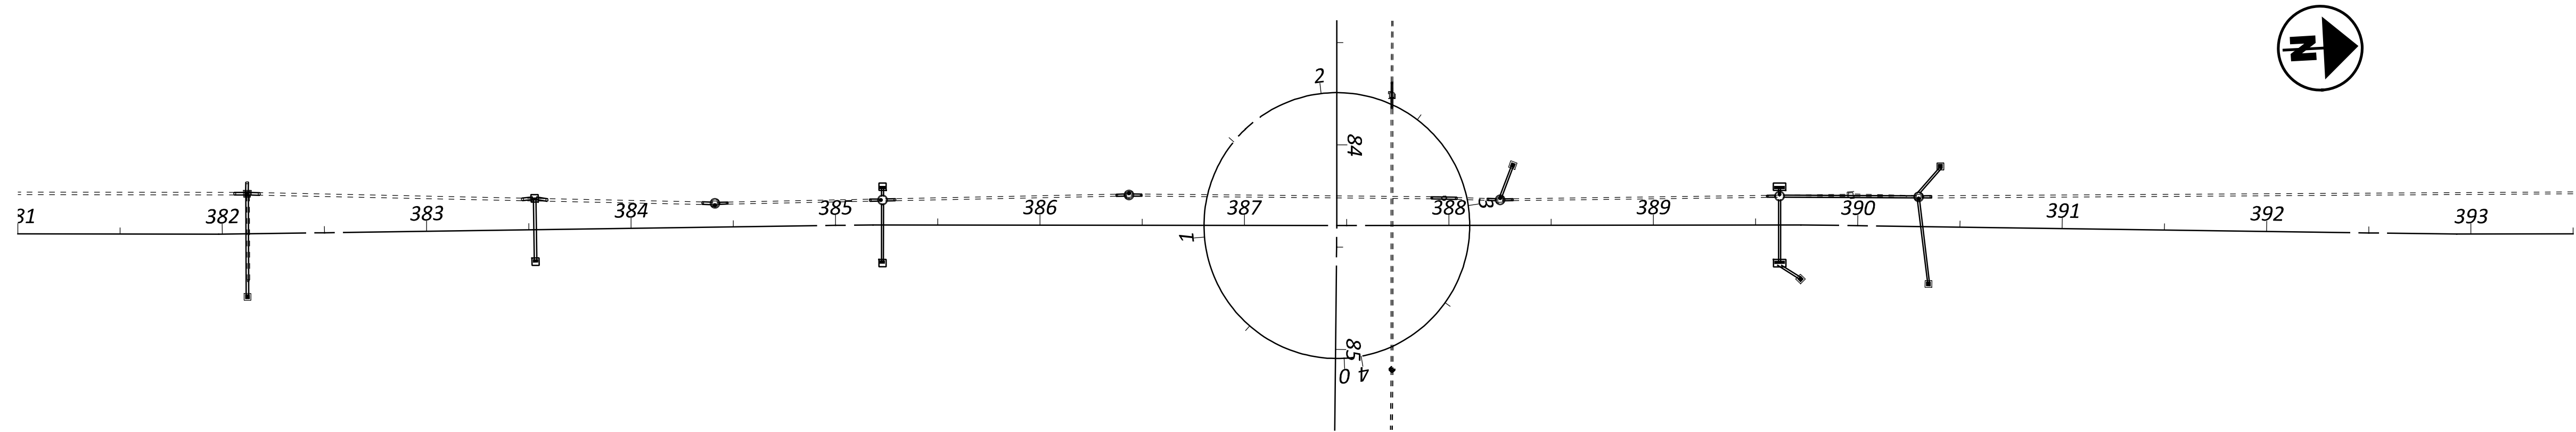

DRAINAGE PIPES DETAILS									
REF NO.	CFN	LENGTH	SIZE	TYPE	SLOPE	START STRUCT. REF NO.	START INVERT ELEV.	STOP STRUCT. REF NO.	STOP INVERT ELEV.
P-9	NA	42.84 ft	12"	TYPE B	1.00 %	D-22	901.29 ft	D-58	900.86 ft
P-22		18.07 ft	12"	TYPE B	1.00 %	D-13	897.68 ft	D-29	897.50 ft
P-23	NA	6.00 ft	15"	TYPE C	0.33 %	D-33	893.97 ft	D-31	893.95 ft
P-24		5.34 ft	15"	TYPE C	5.15 %	D-32	898.18 ft	D-31	897.90 ft
P-25		50.43 ft	15"	TYPE B	0.52 %	D-30	894.26 ft	D-31	894.00 ft
P-26	NA	6.00 ft	15"	TYPE C	0.50 %	D-31	893.85 ft	D-34	893.82 ft
P-27	NA	6.10 ft	15"	TYPE C	0.33 %	D-37	894.61 ft	D-36	894.59 ft
P-28	NA	5.98 ft	15"	TYPE C	0.45 %	D-36	894.57 ft	D-38	894.55 ft
P-29		31.05 ft	15"	TYPE B	1.00 %	D-35	898.93 ft	D-36	898.62 ft
P-30		6.00 ft	15"	TYPE B	0.33 %	D-39	894.97 ft	D-40	894.95 ft
P-31		6.00 ft	12"	TYPE B	0.50 %	D-41	895.00 ft	D-39	894.97 ft
P-32		6.00 ft	12"	TYPE B	0.50 %	D-45	895.41 ft	D-44	895.38 ft
P-33	1995802	30.91 ft	12"	TYPE B	1.00 %	D-43	895.72 ft	D-45	895.41 ft
P-34		6.00 ft	12"	TYPE B	0.50 %	D-46	895.44 ft	D-45	895.41 ft
P-35		6.51 ft	12"	TYPE B	1.08 %	D-42	895.48 ft	D-45	895.41 ft
P-36		6.00 ft	12"	TYPE B	0.50 %	D-48	896.06 ft	D-47	896.03 ft
P-37		6.00 ft	12"	TYPE B	1.33 %	D-49	896.48 ft	D-48	896.40 ft
P-38		12.00 ft	12"	TYPE B	3.58 %	D-50	899.78 ft	D-51	899.35 ft
P-39		6.00 ft	12"	TYPE B	0.00 %	D-29	897.14 ft	D-53	897.14 ft
P-40		6.00 ft	12"	TYPE B	8.17 %	D-52	897.71 ft	D-29	897.22 ft
P-42		12.80 ft	12"	TYPE B	0.23 %	D-7	897.65 ft	D-56	897.62 ft
P-43	1995803	32.83 ft	12"	TYPE B	1.01 %	D-56	897.62 ft	D-55	897.29 ft
P-44		6.00 ft	12"	TYPE B	0.17 %	D-55	897.29 ft	D-57	897.28 ft
P-45		4.58 ft	12"	TYPE B	1.09 %	D-54	897.34 ft	D-55	897.29 ft
P-46		68.05 ft	12"	TYPE B	0.01 %	D-58	897.30 ft	D-55	897.29 ft
P-47		6.00 ft	12"	TYPE B	0.33 %	D-59	897.32 ft	D-58	897.30 ft
P-50	NA	18.28 ft	12"	TYPE C	1.09 %	D-61	901.06 ft	D-58	900.86 ft

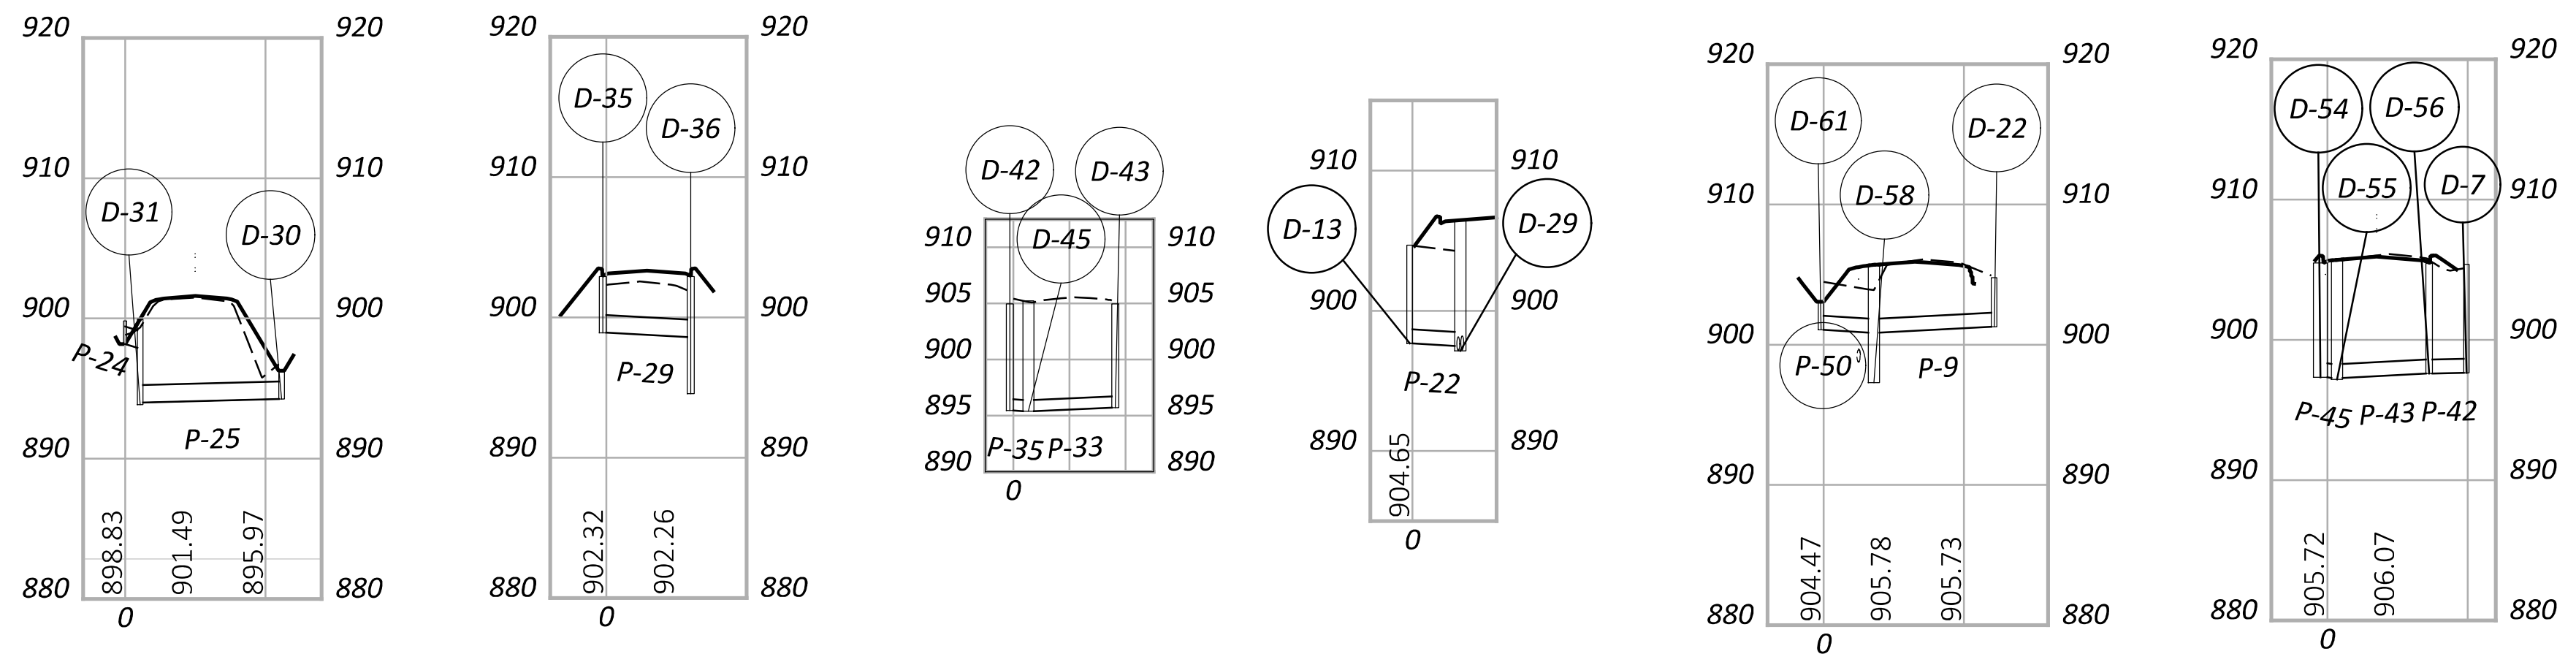

DRAINAGE STRUCTURES DETAILS								
REF NO.	BASELINE NAME	STATION	OFFSET	SIDE	TYPE	GRATE/RIM ELEV.	INVERT ELEV.	CONNECTED PIPES
D-7	CLP_CONST. OH511	389+72.00	26.45 ft	RT	CB-2-2B	905.39 ft	897.65 ft	(OUT) P-42 NE 897.65
D-13	CLP_CONST. OH511	388+31.34	29.43 ft	LT	CB-2-2B	904.67 ft	897.68 ft	(OUT) P-22 NW 897.68
D-22	CLP_CONST. OH511	390+35.00	27.98 ft	RT	CB-2-2B	904.79 ft	901.29 ft	(OUT) P-9 E 901.29
D-29	CLP_CONST. OH511	388+25.11	12.47 ft	LT	MH-3	906.46 ft	897.14 ft	(IN) P-40 S 897.22, (IN) P-22 NW 897.5, (OUT) P-39 S 897.14
D-30	CLP_CONST. OH511	382+11.88	30.81 ft	RT	CB-2-2B	896.26 ft	894.26 ft	(OUT) P-25 E 894.26
D-31	CLP_CONST. OH511	382+12.35	19.61 ft	LT	CB-2-2A	899.95 ft	893.85 ft	(IN) P-25 E 894, (IN) P-24 W 897.9, (IN) P-23 N 893.95, (OUT) P-26 N 893.85
D-35	CLP_CONST. OH511	383+53.03	15.96 ft	RT	CB-3A	902.93 ft	898.90 ft	(OUT) P-29 E 898.93
D-36	CLP_CONST. OH511	383+53.00	15.67 ft	LT	CB-3A	902.93 ft	894.57 ft	(IN) P-29 E 898.62, (IN) P-27 N 894.59, (OUT) P-28 N 894.57
D-39	CLP_CONST. OH511	384+41.17	11.64 ft	LT	MH-3	904.28 ft	894.97 ft	(IN) P-31 N 894.97, (OUT) P-30 N 894.97
D-42	CLP_CONST. OH511	385+23.00	19.00 ft	RT	CB-3A	904.97 ft	895.48 ft	(OUT) P-35 W 895.48
D-43	CLP_CONST. OH511	385+23.00	19.00 ft	RT	CB-3A	904.97 ft	895.72 ft	(OUT) P-33 E 895.72
D-45	CLP_CONST. OH511	385+23.00	12.20 ft	LT	MH-3	905.25 ft	895.41 ft	(IN) P-35 W 895.41, (IN) P-33 E 895.41, (IN) P-34 N 895.41, (OUT) P-32 N 895.41
D-48	CLP_CONST. OH511	386+43.52	14.80 ft	LT	MH-3	906.17 ft	896.06 ft	(IN) P-37 N 896.4, (OUT) P-36 N 896.06
D-54	CLP_CONST. OH511	389+61.81	19.00 ft	LT	CB-3	905.50 ft	897.34 ft	(OUT) P-45 W 897.34
D-55	CLP_CONST. OH511	389+61.81	14.13 ft	LT	MH-3	905.71 ft	897.19 ft	(IN) P-43 E 897.29, (IN) P-45 W 897.29, (IN) P-46 N 897.29, (OUT) P-44 N 897.29
D-56	CLP_CONST. OH511	389+61.81	19.00 ft	RT	CB-3	905.47 ft	897.62 ft	(IN) P-42 NE 897.62, (OUT) P-43 E 897.62
D-58	CLP_CONST. OH511	390+29.64	14.53 ft	LT	MH-3	905.69 ft	897.30 ft	(IN) P-47 N 897.3, (IN) P-9 E 900.86, (IN) P-50 NW 900.86, (OUT) P-46 N 897.3
D-61	CLP_CONST. OH511	390+40.00	29.59 ft	LT	CB-2-2B	903.06 ft	901.06 ft	(OUT) P-50 NW 901.06

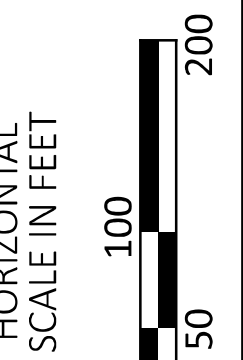

DRAINAGE DETAILS
S.R. 511

DESIGN AGENCY



DESIGNER
ARW
REVIEWER
JRE 09/29/25
PROJECT ID
116214
SHEET TOTAL
P.58 P.73