

**UTILITIES**

LISTED BELOW ARE ALL UTILITIES LOCATED WITHIN THE PROJECT CONSTRUCTION LIMITS TOGETHER WITH THEIR RESPECTIVE OWNERS:

AES (DAYTON POWER AND LIGHT) MIAMI VALLEY LIGHTING  
ATTN: WILLIAM WARD ATTN: STEVEN GAYLORD  
william.ward@aes.com steven.gaylo@aes.com

CENTERPOINT ENERGY (VECTREN)  
ATTN: PUBLIC PROJECT  
publicproject@centerpointenergy.com

LEVEL 3 COMMUNICATIONS (LUMEN) AT&T  
ATTN: DANIEL GOETTE ATTN: HOWARD LAUDERMILK  
relocations@lumen.com HL1596@att.com

CITY OF MIAMISBURG CHARTER COMMUNICATIONS  
ATTN: VALERIE GRIFFIN ATTN: MARY EVANS  
600 N. MAIN STREET MARY.EVANS@CHARTER.COM  
MIAMISBURG, OH  
valerie.griffin@cityofmiamisburg.com

CITY OF WEST CARROLTON ODOT CENTRAL OFFICE  
300 E. CENTRAL AVENUE TRAFFIC/ITS  
WEST CARROLTON, OH 45449 1606 W. BROAD STREET  
service@westcarrolton.org COLUMBUS, OH 43223  
(614) 387-4113

MONTGOMERY COUNTY ENVIRONMENTAL SERVICES  
ATTN: KIRBY M. KING  
19850 SPAULDING ROAD  
KETTERING, OH 45332  
P (937) 781-2543  
kingki@mcOhio.org cen.its.lab@dot.ohio.gov

THE LOCATION OF THE UNDERGROUND UTILITIES SHOWN ON THE PLANS ARE AS OBTAINED FROM THE OWNERS AS REQUIRED BY SECTION 153.64 O.R.C.

**CLEARING AND GRUBBING**

ALTHOUGH THERE ARE NO TREES OR STUMPS SPECIFICALLY MARKED FOR REMOVAL WITHIN THE LIMITS OF THE PROJECT, A LUMP SUM QUANTITY IS INCLUDED IN THE GENERAL SUMMARY FOR ITEM 201, CLEARING AND GRUBBING. ALL PROVISIONS AS SET FORTH IN THE SPECIFICATIONS UNDER THIS ITEM ARE INCLUDED IN THE LUMP SUM PRICE BID FOR ITEM 201, CLEARING AND GRUBBING.

**ENDANGERED BAT HABITAT REMOVAL**

THIS PROJECT IS LOCATED WITHIN THE KNOWN HABITAT RANGES OF THE FEDERALLY LISTED AND PROTECTED INDIANA BAT, AND NORTHERN LONG-EARED BAT. NO TREES SHALL BE REMOVED UNDER THIS PROJECT FROM APRIL 1 THROUGH SEPTEMBER 30. ALL NECESSARY TREE REMOVAL SHALL OCCUR FROM OCTOBER 1 THROUGH MARCH 31. THIS REQUIREMENT IS NECESSARY TO AVOID AND MINIMIZE IMPACTS TO THESE SPECIES AS REQUIRED BY THE ENDANGERED SPECIES ACT (ESA). FOR THE PURPOSES OF THIS NOTE, A TREE IS DEFINED AS: A LIVE, DYING, OR DEAD WOODY PLANT, WITH A TRUNK 3 INCHES OR GREATER IN DIAMETER AT A HEIGHT OF 4.5 FEET ABOVE THE GROUND SURFACE, AND WITH A MINIMUM HEIGHT OF 13 FEET.

**SURVEYING PARAMETERS**

PRIMARY PROJECT CONTROL MONUMENTS GOVERN ALL POSITIONING ON ODOT PROJECTS. SEE SHEET 2 OF THE PLANS FOR A TABLE CONTAINING PROJECT CONTROL INFORMATION.

USE THE FOLLOWING PROJECT CONTROL, VERTICAL POSITIONING, AND HORIZONTAL POSITIONING PARAMETERS FOR ALL SURVEYING:

**PROJECT CONTROL**

POSITIONING METHOD: ODOT VRS  
MONUMENT TYPE: IRON PIN

**VERTICAL POSITIONING**

ORTHOMETRIC HEIGHT DATUM: NAVD 88  
GEOID: GEOID12B

**HORIZONTAL POSITIONING**

REFERENCE FRAME: NAD\_83(2011)EPOCH:2010.0000  
ELLIPSOID: GRS80  
MAP PROJECTION: LAMBERT CONFORMAL CONIC  
COORDINATE SYSTEM: STATE PLANE COORDINATES  
COMBINED SCALE FACTOR: 1.000094479  
ORIGIN OF COORDINATE SYSTEM: NORTHING 0.000 EASTING 0.000

USE THE POSITIONING METHODS AND MONUMENT TYPE USED IN THE ORIGINAL SURVEY TO RESTORE ALL MONUMENTS RELATED TO PRIMARY PROJECT CONTROL THAT ARE DAMAGED OR DESTROYED BY CONSTRUCTION ACTIVITIES. RESTORE THE DAMAGED OR DESTROYED MONUMENTS IN ACCORDANCE WITH CMS 623.

UNITS ARE IN U.S. SURVEY FEET.

**AIRWAY/HIGHWAY CLEARANCE FOR AIRPORTS AND HELIPORTS**

THIS PROJECT HAS BEEN IDENTIFIED AS BEING WITHIN THE INFLUENCE AREA OF A PUBLIC USE AIRPORT OR HELIPORT. NO TEMPORARY STRUCTURES OR CONSTRUCTION EQUIPMENT AT MAXIMUM OPERATING HEIGHT SHALL EXCEED A HEIGHT OF 100 FT. IF ANY TEMPORARY STRUCTURES OR CONSTRUCTION EQUIPMENT WILL EXCEED THIS HEIGHT, FURTHER COORDINATION WITH THE FEDERAL AVIATION ADMINISTRATION (FAA), AND ODOT OFFICE OF AVIATION, WILL BE NECESSARY PRIOR TO ERECTING SUCH TEMPORARY STRUCTURES OR OPERATING SUCH EQUIPMENT ON THE PROJECT. THE CONTRACTOR WILL BE REQUIRED TO SUBMIT FORM 7460-1 TO THE FAA. NOTIFY THE ODOT OFFICE OF AVIATION WHEN SUBMITTING AN FAA FORM 7460-1.

NO TEMPORARY STRUCTURES OR CONSTRUCTION EQUIPMENT SHALL EXCEED THE PERMISSIBLE HEIGHT, UNTIL A COPY OF THE FAA APPROVAL AND ODOT OFFICE OF AVIATION PERMIT HAS BEEN FURNISHED TO THE PROJECT ENGINEER.

EXPRESS PROCESSING CENTER  
THE FEDERAL AVIATION ADMINISTRATION  
SOUTHWEST REGIONAL OFFICE  
AIR TRAFFIC AIRSPACE BRANCH ASW-520  
2601 MEACHAN BLVD.  
FORT WORTH, TX 76137-4298

OHIO DEPARTMENT OF TRANSPORTATION  
OFFICE OF AVIATION  
2829 WEST DUBLIN-GRANVILLE ROAD  
COLUMBUS, OHIO 43235  
614-387-2346

**WORK LIMITS**

THE WORK LIMITS SHOWN ON THESE PLANS ARE FOR PHYSICAL CONSTRUCTION ONLY. PROVIDE THE INSTALLATION AND OPERATION OF ALL WORK ZONE TRAFFIC CONTROL AND WORK ZONE TRAFFIC CONTROL DEVICES REQUIRED BY THESE PLANS WHETHER INSIDE OR OUTSIDE THESE WORK LIMITS.

**ITEM 606 - ANCHOR ASSEMBLY, MGS TYPE E**

THIS ITEM SHALL CONSIST OF FURNISHING AND INSTALLING ANY OF THE GUARDRAIL END TERMINALS FOR TYPE MGS GUARDRAIL AS LISTED ON ROADWAY ENGINEERING'S WEB PAGE UNDER ROADSIDE SAFETY DEVICES FOR APPROVED GUARDRAIL END TREATMENTS. INSTALLATION SHALL BE AT THE LOCATIONS SPECIFIED IN THE PLANS, IN ACCORDANCE WITH THE MANUFACTURER'S SPECIFICATIONS.

THE FACE OF THE TYPE E IMPACT HEAD SHALL BE COVERED WITH A SHEET OF TYPE G REFLECTIVE SHEETING, PER CMS 730.19.

REFER TO THE MANUFACTURER'S INSTRUCTIONS REGARDING THE INSTALLATION OF, AND THE GRADING AROUND THE FOUNDATION TUBES AND GROUND STRUT. THE TOP OF ANY FOUNDATION TUBE SHOULD BE LESS THAN 4 INCHES ABOVE THE GROUND. THE PLACEMENT OF THE FOUNDATION TUBES SHOULD BE AN APPROPRIATE DEPTH BELOW THE LEVEL LINE IN ORDER TO MAINTAIN THE FINISHED GUARDRAIL HEIGHT OF 31 INCHES FROM THE EDGE OF THE SHOULDER.

ON-SITE GRADING IS REQUIRED IF THE TOP OF THE FOUNDATION TUBES OR TOP OF THE GROUND STRUT DOES PROJECT MORE THAN 4 INCHES ABOVE THE GROUND LINE.

PAYMENT FOR THE ABOVE WORK SHALL BE MADE AT THE UNIT PRICE BID FOR ITEM 606, ANCHOR ASSEMBLY, MGS TYPE E, EACH, AND SHALL INCLUDE ALL LABOR, TOOLS, EQUIPMENT AND MATERIALS NECESSARY TO CONSTRUCT A COMPLETE AND FUNCTIONAL ANCHOR ASSEMBLY SYSTEM, INCLUDING ALL RELATED TRANSITIONS, REFLECTIVE SHEETING, HARDWARE, GRADING, EMBANKMENT AND EXCAVATION NOT SEPARATELY SPECIFIED, AS REQUIRED BY THE MANUFACTURER.

**ITEM 202 REMOVAL MISC.: RIPRAP REMOVED**

THIS ITEM SHALL INCLUDE THE COMPLETE REMOVAL AND DISPOSAL OF THE RIPRAP AS CALLED OUT ON THE PLANS AND AS DIRECTED BY THE ENGINEER.

PAYMENT FOR ITEM 202 REMOVAL MISC.: RIPRAP REMOVED SHALL BE AT THE UNIT BID PRICE PER SQUARE YARD AND SHALL INCLUDE ALL MATERIALS, EQUIPMENT AND LABOR NECESSARY TO REMOVE AND DISPOSE OF THE RIPRAP.

**ITEM 654 RENOVATING EXISTING SOIL, AS PER PLAN.**

THIS ITEM SHALL INCLUDE THE COMPLETE RENOVATION OF EXISTING SOIL AS CALLED OUT ON PLAN SHEETS 45 - 46 AND AS DIRECTED BY THE ENGINEER.

PAYMENT FOR ITEM 654 RENOVATING EXISTING SOIL, AS PER PLAN SHALL BE AT THE UNIT BID PRICE PER THOUSAND SQUARE FEET AND SHALL INCLUDE ALL MATERIALS, EQUIPMENT AND LABOR NECESSARY TO RENOVATE THE EXISTING SOIL.

**ITEM SPECIAL - FILL AND PLUG EXISTING CONDUIT**

THIS ITEM CONSISTS OF THE CONSTRUCTION OF BULKHEADS IN AN EXISTING 15 INCH DIAMETER CONDUIT AND FILLING THE AREA SEALED OFF WITH ITEM 613, SAND OR OTHER MATERIAL APPROVED BY THE ENGINEER.

LOCATE THE BULKHEADS AT THE LIMITS OF THE AREA TO BE FILLED, AS INDICATED ON THE PLANS. THE BULKHEADS CONSIST OF BRICK OR CONCRETE MASONRY WITH A MINIMUM THICKNESS OF 12 INCHES.

PUMP THE FILL MATERIAL INTO PLACE OR BY OTHER MEANS APPROVED BY THE ENGINEER, SO THAT AFTER SETTLEMENT, AT LEAST 90 PERCENT OF THE CROSS-SECTIONAL AREA OF THE CONDUIT, FOR ITS ENTIRE LENGTH IS FILLED. THE LENGTH OF THE FILLED AND PLUGGED CONDUIT TO BE PAID FOR IS THE ACTUAL NUMBER OF FEET (MEASURED ALONG THE CENTERLINE OF EACH CONDUIT FROM OUTER FACE TO OUTER FACE OF BULKHEADS FILLED AND PLUGGED AS DESCRIBED ABOVE.

IN LIEU OF FILLING AND PLUGGING THE EXISTING CONDUIT, THE PIPE MAY BE CRUSHED AND BACKFILLED PER ITEM 203, OR IT MAY BE REMOVED. THE LENGTH, MEASURED AS PROVIDED ABOVE, WILL BE PAID FOR AT THE CONTRACT PRICE PER FOOT FOR, ITEM SPECIAL, FILL AND PLUG EXISTING CONDUIT.

**ITEM 608 WALKWAY, MISC.: 4" STAMPED WALK.**

THIS ITEM SHALL INCLUDE THE CONSTRUCTION OF A 4" STAMPED WALK AS CALLED OUT ON PLAN SHEET 166 AND AS DIRECTED BY THE ENGINEER.

PAYMENT FOR ITEM 608 WALKWAY, MISC.: 4" STAMPED WALK SHALL BE AT THE UNIT BID PRICE PER SQUARE FOOT AND SHALL INCLUDE ALL MATERIALS, EQUIPMENT AND LABOR NECESSARY TO CONSTRUCT THE WALKWAY.

**ITEM 202 GUARDRAIL REMOVED, AS PER PLAN**

MANY OF THE EXISTING GUARDRAIL POSTS ARE SET IN A CONCRETE FOUNDATION. THIS ITEM INCLUDES REMOVAL OF THE POST AND CONCRETE FOUNDATION AND BACKFILL OF THE RESULTING CAVITY IN ACCORDANCE WITH SECTION 203.

PAYMENT FOR ITEM 202 GUARDRAIL REMOVED SHALL BE AT THE UNIT BID PRICE PER FOOT AND SHALL INCLUDE ALL MATERIALS, EQUIPMENT AND LABOR NECESSARY TO REMOVE AND DISPOSE OF THE GUARDRAIL INCLUDING POSTS AND CONCRETE FOUNDATIONS.

O:\2018\1802295\_001\_MOT\_725-14\roadway\sheets\08619GN001.dgn 4/29/2024 10:08:30 AM agrdff

CALCULATED  
VLC  
CHECKED  
RJM

**GENERAL NOTES**

**MOT - 725 - 14.41**

O:\2018\1802295\_001\_MOT\_725\_14\roadway\sheets\08619CG001.dgn 4/29/2024 10:08:33 AM agrdff

SHEET NUM.										PART.				ITEM	ITEM EXT	GRAND TOTAL	UNIT	DESCRIPTION	SEE SHEET NO.	CALCULATED VLC	CHECKED RJM
10	39	40	41	42	43	83	171	OFFICE CALCS		01/SAF/21	02/S>2/21	03/MPO/28	04/ENH/31								
								LUMP				LUMP		201	11000	LS		ROADWAY			
		1										1		202	20010	1	EACH	CLEARING AND GRUBBING			
		1,593										1,593		202	23000	1,593	SY	HEADWALL REMOVED			
		830										830		202	30000	830	SF	PAVEMENT REMOVED			
		4										4		202	30600	4	SY	WALK REMOVED			
																		CONCRETE MEDIAN REMOVED			
												936		202	32000	936	FT	CURB REMOVED			
												78		202	32500	78	FT	CURB AND GUTTER REMOVED			
												44		202	32600	44	FT	GUTTER REMOVED			
												64		202	35100	64	FT	PIPE REMOVED, 24" AND UNDER			
												43		202	35200	43	FT	PIPE REMOVED, OVER 24"			
		1,074										1,074		202	38000	1,074	FT	GUARDRAIL REMOVED			
		318										318		202	38001	318	FT	GUARDRAIL REMOVED, AS PER PLAN	9		
		8										8		202	58300	8	EACH	CATCH BASIN OR INLET REMOVED			
		1										1		202	58500	1	EACH	CATCH BASIN ABANDONED			
		8										8		SPECIAL	20270000	8	FT	FILL AND PLUG EXISTING CONDUIT 15"	9		
		1,255										1,255		202	98400	1,255	SF	REMOVAL MISC.: RIPRAP REMOVED	9		
				2,023								2,023		203	10000	2,023	CY	EXCAVATION			
				1,432								1,432		203	20000	1,432	CY	EMBANKMENT			
							86		1,201			1,287		204	10000	1,287	SY	SUBGRADE COMPACTION			
		762.5										762.5		606	15050	762.5	FT	GUARDRAIL, TYPE MGS			
		12.5										12.5		606	17360	12.5	FT	GUARDRAIL, TYPE MGS, LONG-SPAN			
												5		606	26150	5	EACH	ANCHOR ASSEMBLY, MGS TYPE E MASH 2016	10		
												4		606	26550	4	EACH	ANCHOR ASSEMBLY, MGS TYPE T			
												1		606	35002	1	EACH	MGS BRIDGE TERMINAL ASSEMBLY, TYPE 1			
		23,225										23,225		608	10000	23,225	SF	4" CONCRETE WALK			
		9										9		608	10001	9	SF	4" CONCRETE WALK, AS PER PLAN	10		
		1,939										1,939		608	52000	1,939	SF	CURB RAMP			
		154									2,431	2,585		608	98000	2,585	SF	WALKWAY, MISC.: TYPE A	9		
		246										246		622	10160	246	FT	CONCRETE BARRIER, SINGLE SLOPE, TYPE D			
		1										1		622	25000	1	EACH	CONCRETE BARRIER END SECTION, TYPE D			
		3										3		622	25050	3	EACH	CONCRETE BARRIER, END ANCHORAGE, REINFORCED, TYPE D			
												10.43		654	10001	10.43	MSF	RENOVATING EXISTING SOIL, AS PER PLAN	9		
																		EROSION CONTROL			
												3.94		601	11000	3.94	SY	RIPRAP, TYPE D			
		5										7		601	21050	7	SY	TIED CONCRETE BLOCK MAT WITH TYPE 1 UNDERLAYMENT			
												455		601	37500	455	FT	PAVED GUTTER, TYPE 1-2			
		416										416		659	00300	416	CY	TOPSOIL			
		3,752										3,752		659	00500	3,752	SY	SEEDING AND MULCHING, CLASS 1			
		188										188		659	14000	188	SY	REPAIR SEEDING AND MULCHING			
		188										188		659	15000	188	SY	INTER-SEEDING			
		0.85										0.85		659	20000	0.85	TON	COMMERCIAL FERTILIZER			
		0.78										0.78		659	31000	0.78	ACRE	LIME			
		21										21		659	35000	21	MGAL	WATER			
												1,158.69		671	14000	1,158.69	SY	EROSION CONTROL MAT			
												LUMP		832	15000	LS		STORM WATER POLLUTION PREVENTION PLAN			
												LUMP		832	15002	LS		STORM WATER POLLUTION PREVENTION INSPECTIONS			
												LUMP		832	15010	LS		STORM WATER POLLUTION PREVENTION INSPECTION SOFTWARE			
												5,000		832	30000	5,000	EACH	EROSION CONTROL			
																		DRAINAGE			
												0.69		602	20000	0.69	CY	CONCRETE MASONRY			
												1,350		605	11110	1,350	FT	6" SHALLOW PIPE UNDERDRAINS WITH GEOTEXTILE FABRIC			
		100										100		605	13300	100	FT	6" UNCLASSIFIED PIPE UNDERDRAINS			
		200										279		611	00510	279	FT	6" CONDUIT, TYPE F FOR UNDERDRAIN OUTLETS			
												59		611	04400	59	FT	12" CONDUIT, TYPE B			
												8		611	05900	8	FT	15" CONDUIT, TYPE B			
												5		611	07600	5	FT	18" CONDUIT, TYPE C			
												21		611	10400	21	FT	24" CONDUIT, TYPE B			
												5		611	10600	5	FT	24" CONDUIT, TYPE C			
												15		611	16400	15	FT	36" CONDUIT, TYPE B			
												65		611	16600	65	FT	36" CONDUIT, TYPE C			
												2		611	98150	2	EACH	CATCH BASIN, NO. 3			
												1		611	98540	1	EACH	CATCH BASIN, NO. 2-4			
												1		611	98630	1	EACH	CATCH BASIN ADJUSTED TO GRADE			
												3		611	98710	3	EACH	INLET, NO. 2-6			

**GENERAL SUMMARY**

**MOT - 725 - 14.41**



O:\2018\1802295\_001\_MOT\_725\_14\roadway\sheets\086\9GG004.dgn 4/29/2024 10:08:35 AM agr.off

SHEET NUM.					PART.				ALT	ITEM	ITEM	GRAND	UNIT	DESCRIPTION	SEE SHEET NO.	CALCULATED VLC	CHECKED RJM
116	117	148	173		01/SAF/21	02/SAF/21	03/MPO/28	04/ENH/31	(X)	EXT	TOTAL						
TRAFFIC SIGNALS (CONT.)																	
95.75					92		3.75			630	80100	95.75	SF	SIGN, FLAT SHEET			
126					126					630	80224	126	SF	SIGN, OVERHEAD EXTRUSHEET			
	1				1					630	89812	1	EACH	REMOVAL OF WOOD POLE AND DISPOSAL			
19					19					632	05006	19	EACH	VEHICULAR SIGNAL HEAD, (LED), 3-SECTION, 12" LENS, 1-WAY, POLYCARBONATE			
4							4			632	20740	4	EACH	PEDESTRIAN SIGNAL HEAD (LED), TYPE D2, COUNTDOWN, AUDIBLE			
4							4			632	20751	4	EACH	ACCESSIBLE PEDESTRIAN PUSHBUTTON, AS PER PLAN	114		
19					19					632	25000	19	EACH	COVERING OF VEHICULAR SIGNAL HEAD			
4							4			632	25010	4	EACH	COVERING OF PEDESTRIAN SIGNAL HEAD			
408							408			632	40200	408	FT	SIGNAL CABLE, 2 CONDUCTOR, NO. 14 AWG			
4,789					4,362		427			632	40700	4,789	FT	SIGNAL CABLE, 7 CONDUCTOR, NO. 14 AWG			
6					6					632	64011	6	EACH	SIGNAL SUPPORT FOUNDATION, AS PER PLAN	114		
		8				8				632	64020	8	EACH	PEDESTAL FOUNDATION			
3							3			632	64021	3	EACH	PEDESTAL FOUNDATION, AS PER PLAN	114		
		3,247				3,247				632	67300	3,247	FT	POWER CABLE, 3 CONDUCTOR, NO. 8 AWG			
		1,595				1,595				632	68300	1,595	FT	POWER CABLE, 3 CONDUCTOR, NO. 6 AWG			
310	113				423					632	69320	423	FT	POWER CABLE, 3 CONDUCTOR, NO. 2 AWG			
2					2					632	70000	2	EACH	POWER SERVICE			
		2				2				632	70001	2	EACH	POWER SERVICE, AS PER PLAN	147		
	3	3			3	3				632	70400	6	EACH	CONDUIT RISER, 2" DIAMETER			
1					1					632	72131	1	EACH	SIGNAL SUPPORT, TYPE TC-81.22, DESIGN 12, AS PER PLAN	114		
2					2					632	72141	2	EACH	SIGNAL SUPPORT, TYPE TC-81.22, DESIGN 13, AS PER PLAN	114		
2					2					632	72151	2	EACH	SIGNAL SUPPORT, TYPE TC-81.22, DESIGN 14, AS PER PLAN	114		
1					1					632	78101	1	EACH	COMBINATION SIGNAL SUPPORT, TYPE TC-12.31, DESIGN 6, AS PER PLAN	114		
	1				1					632	89300	1	EACH	WOOD POLE			
3							3			632	90008	3	EACH	PEDESTAL, 15', TRANSFORMER BASE	114		
		8				8				632	90010	8	EACH	PEDESTAL, MISC.: PEDESTAL, 15' TRANSFORMER BASE	147		
2					2					632	90100	2	EACH	REMOVAL OF TRAFFIC SIGNAL INSTALLATION			
2					2					633	65511	2	EACH	CABINET, TYPE TS-2, AS PER PLAN	115		
2					2					633	67100	2	EACH	CABINET FOUNDATION			
2					2					633	67200	2	EACH	CONTROLLER WORK PAD			
2					2					633	74000	2	EACH	UNINTERRUPTIBLE POWER SUPPLY (UPS)			
	3,101				3,101					804	15010	3,101	FT	FIBER OPTIC CABLE, 24 FIBER			
	1,389				1,389					809	24500	1,389	FT	CONDUIT, 4", MULTICELL, HDPE WITH 4 * 1" INNERDUCTS			
2					2					809	60040	2	EACH	CCTV IP-CAMERA SYSTEM, QUAD MULTI-VIEW FIXED WITH PTZ			
		807			807					809	64550	807	FT	ETHERNET CABLE, OUTDOOR-RATED			
		2				2				809	65990	2	EACH	ITS DEVICE, MISC.:RELOCATE CCTV IP-CAMERA SYSTEM, WRONG WAY	147		
6					6					809	69001	6	EACH	ADVANCE RADAR DETECTION, AS PER PLAN	115		
3					3					809	69101	3	EACH	STOP LINE RADAR DETECTION, AS PER PLAN	115		
2					2					809	69123	2	EACH	ATC CONTROLLER, AS PER PLAN	114		
		2				2				809	69130	2	EACH	WRONG WAY DETECTION SYSTEM			
	LUMP				LUMP					809	70050	LS		AS-BUILT CONSTRUCTION PLANS			
RETAINING WALLS (002)																	
			LUMP				LUMP			503	21300	LS		UNCLASSIFIED EXCAVATION			
			2,918				2,918			509	10000	2,918	LB	EPOXY COATED STEEL REINFORCEMENT			
			32				32			511	46210	32	CY	CLASS QCI CONCRETE, RETAINING/WINGWALL INCLUDING FOOTING			
			32				32			512	10100	32	SY	SEALING OF CONCRETE SURFACES (EPOXY-URETHANE)			
			7				7			512	33000	7	SY	TYPE 2 WATERPROOFING			
			46				46			516	13600	46	SF	1" PREFORMED EXPANSION JOINT FILLER			
			23				23			518	21200	23	CY	POROUS BACKFILL WITH GEOTEXTILE FABRIC			
			76				76			518	39800	76	FT	4" PERFORATED CORRUGATED PLASTIC PIPE			
			70				70			518	39900	70	FT	4" NON-PERFORATED CORRUGATED PLASTIC PIPE, INCLUDING SPECIALS			

**GENERAL SUMMARY**

**MOT - 725 - 14.41**



O:\2018\1802295\_001\_MOT\_725\_14\drainage\sheets\08619DS001.dgn 4/29/2024 10:08:36 AM agr01ff

REF. NO.	SHEET NO.	STATION		SIDE	601	601	602	611	611	611	611	611	611	611	611	611	611	611	611	611	611	654	671	
		FROM	TO		RIPPRAP, TYPE D SY	PAVED GUTTER, TYPE 1-2 FT	CONCRETE MASONRY CY	12" CONDUIT, TYPE B FT	15" CONDUIT, TYPE B FT	18" CONDUIT, TYPE C FT	24" CONDUIT, TYPE B FT	24" CONDUIT, TYPE C FT	36" CONDUIT, TYPE B FT	36" CONDUIT, TYPE C FT	CATCH BASIN, NO. 3 EACH	CATCH BASIN, NO. 2-4 EACH	CATCH BASIN ADJUSTED TO GRADE EACH	INLET, NO. 2-6 EACH	INLET NO. 3 FOR SINGLE SLOPE BARRIER, TYPE D EACH	MANHOLE, NO. 3 EACH	MANHOLE ADJUSTED TO GRADE EACH	MANHOLE RECONSTRUCTED TO GRADE EACH	RENOVATING EXISTING SOIL, AS PER PLAN MSF	EROSION CONTROL MAT SY
D-1	47	753+07.48		RT																				
AVFS-1	47-49	3+13.71	6+74.10	LT																		1.82	202.3	
D-2	49	756+28.50		RT																				
D-3	49	757+11.06		RT																				
D-4	49	758+12.81	758+27.83	RT																				
AVFS-2	49-51	7+56.38	10+53.24	LT																		2.39	265.02	
D-5	51	760+36.91	760+54.65	RT	3.94		0.69																	
D-6	51	760+97.98		RT				5																
D-7	51	762+70.01		RT					8															
D-8	51	762+62.51	762+77.51	RT																				
D-9	51	764+98.94	765+00.88	RT				9																
D-9A	51	764+99.91		RT																				
PG-1	51	761+25.00	765+50.00	RT		425																		
AVFS-3	51-53	14+61.75	16+89.67	LT																		1.81	201.6	
D-10	53	766+42.90	766+52.88	RT																				
D-11	53	767+05.15	767+18.10	RT		5																		
D-12	53	769+76.04		RT				7		15	5													
D-13	53	769+73.88		RT						6														
PG-2	53	765+50.00	765+75.00	RT		25																		
AVFS-4	53-55	17+99.75	22+77.47	LT																		2.46	273.14	
D-14	55	773+11.42	773+21.27	RT				14																
D-15	55	773+10.01		RT																				
D-16	55	773+63.34		RT																				
D-17	55	774+88.52	775+00.00	LT				24																
D-18	55	774+83.52	774+88.52	LT					5															
AVFS-5	55-57	25+00.00	28+89.93	RT																		1.95	216.63	
NOTE: THE STATIONING ASSOCIATED WITH THE PROPOSED DRAINAGE QUANTITIES ARE BASED UPON THE EXISTING CENTERLINE STATIONING OF SR 725. THE AMENDED VEGETATED FILTER STRIP QUANTITIES ARE BASED UPON THE BASELINE OF CONSTRUCTION OF THE WALK.																								
<b>TOTALS CARRIED TO GENERAL SUMMARY</b>					3.94	455	0.69	59	8	5	21	5	15	65	2	1	1	3	1	4	3	2	10.43	1158.69


**DRAINAGE SUB-SUMMARY**

**MOT - 725 - 14.41**




CALCULATED  
JDC  
CHECKED  
RJM



O:\2018\1802295\_001\_M01\_725\_14\structures\sheets\wall\_2\08619\_002WD001.dgn 4/25/2024 1:42:36 PM agroff

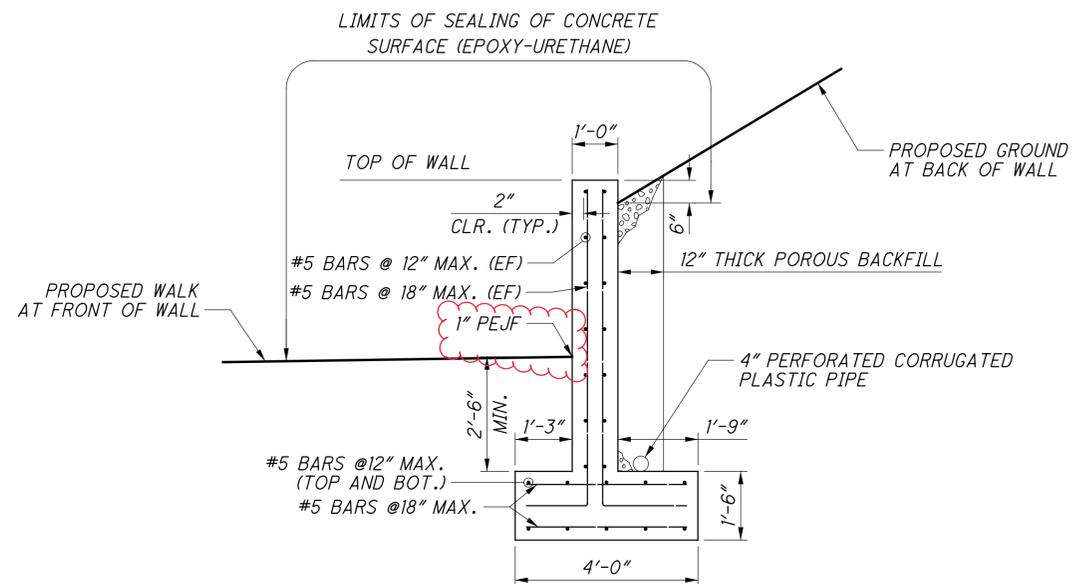

**SECTION**

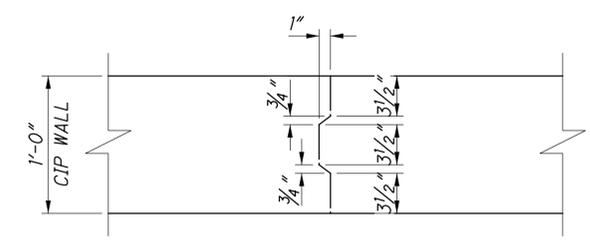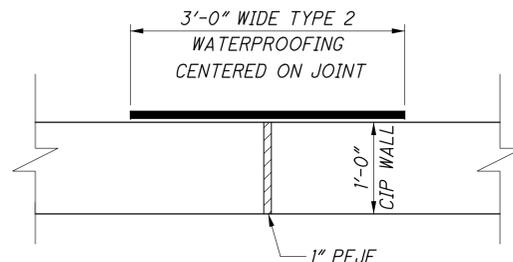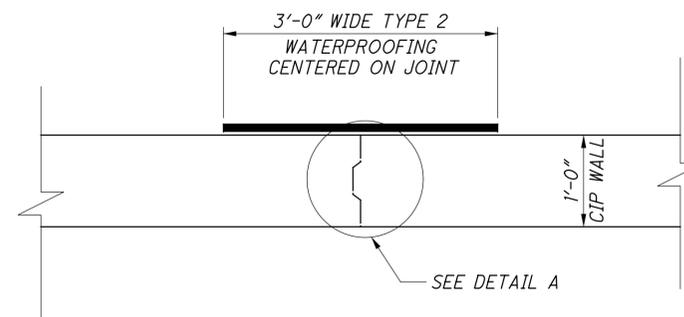


**DETAIL A**


- NOTES:**
- SEE SHEET 172 FOR WALL 2 PLAN AND PROFILE.
  - SEE SHEET 173 FOR REINFORCING SCHEDULE.

DESIGNED		PPA	CHECKED	SOL
DRAWN		PPA	REVISED	
REVIEWED	RJM	STRUCTURE	FILE NUMBER	
DATE	1/11/2024			
 <small>2020 Computer Exchange, Inc. All Rights Reserved. © 2020</small>				
<b>RETAINING WALL DETAILS</b>				
RETAINING WALL 2				
<b>MOT-725-14.41</b>				
PID No. 108619				
3 / 4				
174 220				

O:\2018\1802295\_001\_MOT\_725\_14\_structures\sheets\wall\_2\08619\_002WD002.dgn 4/25/2024 1:42:39 PM agriff

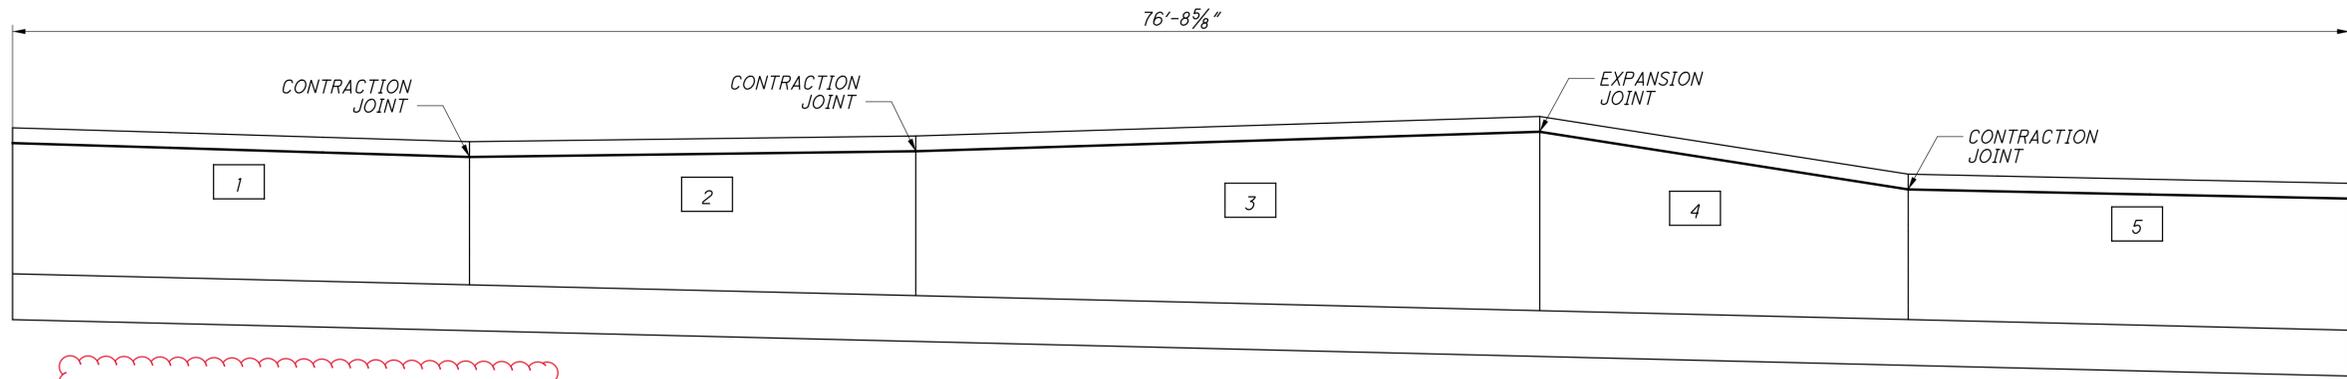


**WALL ELEVATION**

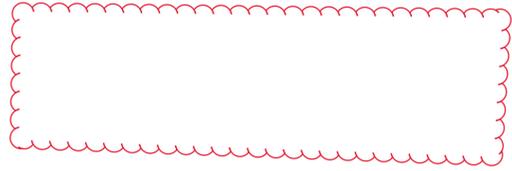

**LEGEND:**

- X PANEL NUMBER
- TYPE 2 WATERPROOFING

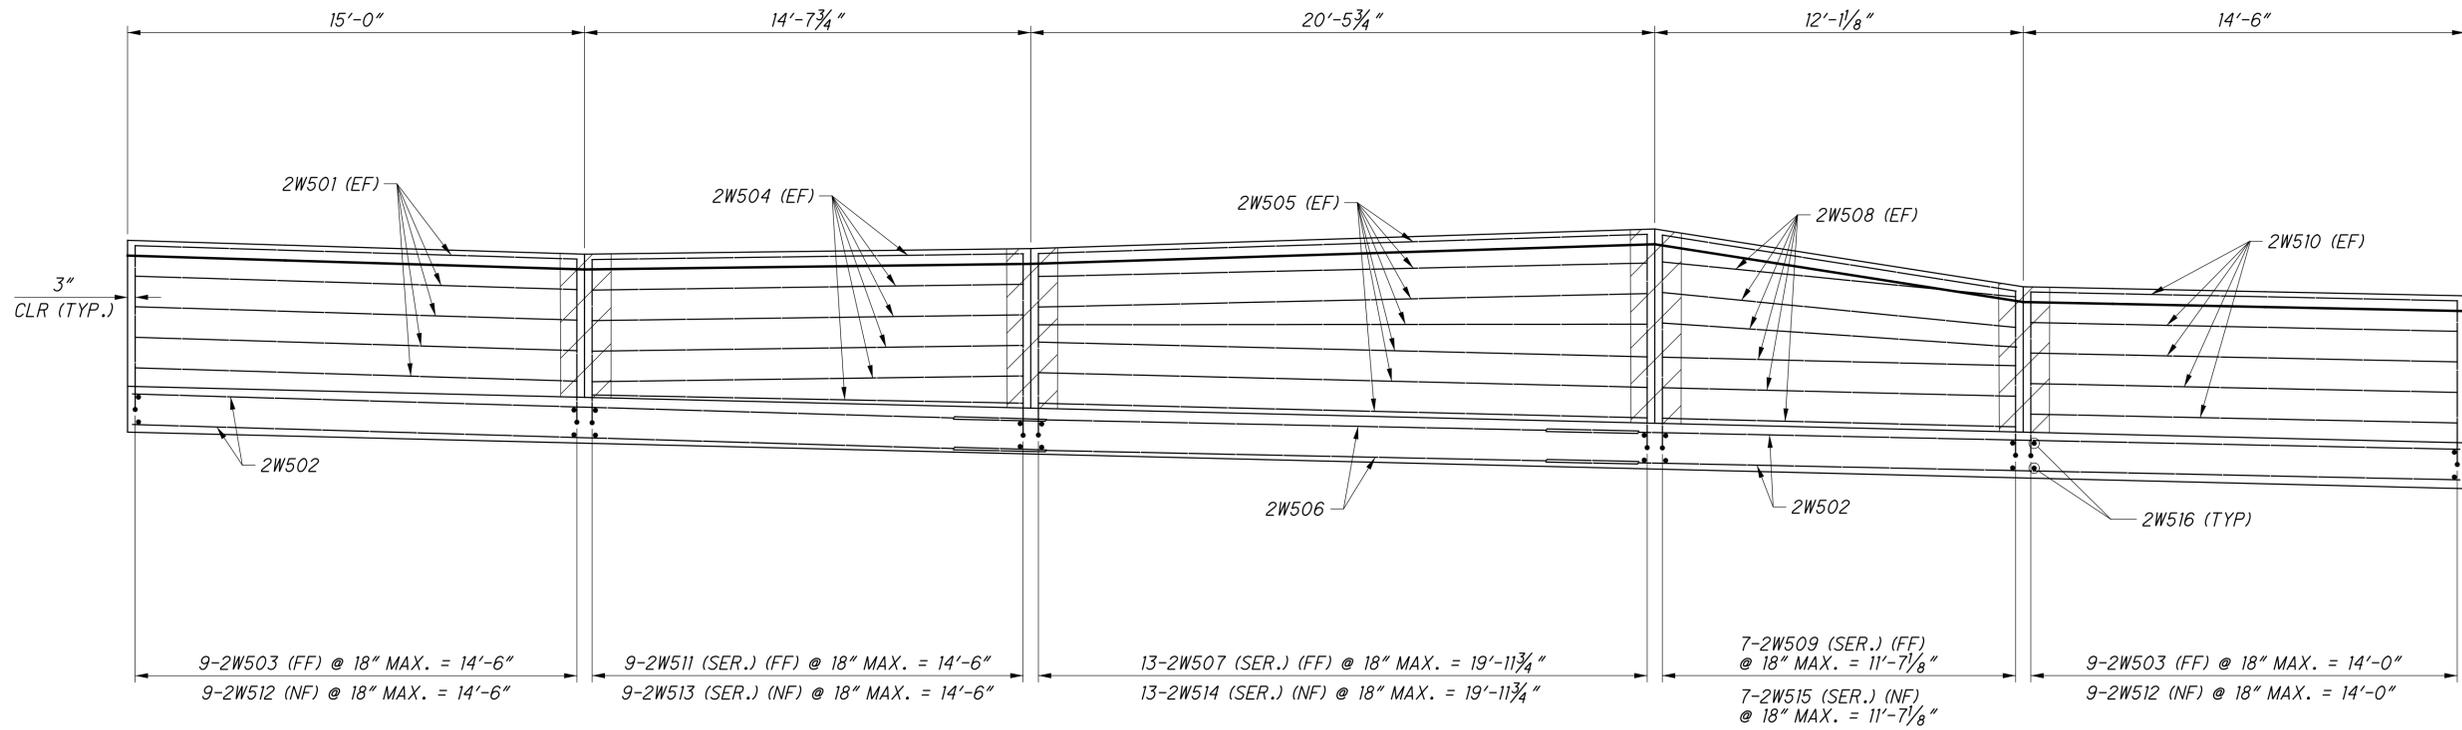

**REINFORCING LAYOUT**

**NOTES:**

1. SEE SHEET 174 FOR ADDITIONAL WALL DETAILS.
2. FIELD BEND BARS WHERE REQUIRED.
3. ALL LONGITUDINAL BARS SPACED AT 12" UNLESS OTHERWISE NOTED.

RETAINING WALL DETAILS  
RETAINING WALL 2

MOT-725-14.41  
PID No. 108619

4 / 4

175  
220



DESIGNED	PPA	CHECKED	SOL
DRAWN	PPA	REVISED	
REVIEWED	RJM	STRUCTURE	FILE NUMBER
DATE	1/11/2024		

**ITEM 520 - PNEUMATICALLY PLACED CONCRETE SHOTCRETE,**

**AS PER PLAN**

**ITEM 518 - PREFABRICATED GEOCOMPOSITE DRAIN**

**ITEM 518 - 4" PERFORATED CORRUGATED PLASTIC PIPE**

**ITEM 518 - 4" CORRUGATED PLASTIC PIPE**

**ITEM 518 - POROUS BACKFILL WITH GEOTEXTILE FABRIC**

**1.0 DESCRIPTION.**

SHOTCRETE FACING AND WALL DRAINAGE WORK CONSISTS OF FURNISHING ALL MATERIALS AND LABOR REQUIRED FOR PLACING AND SECURING GEOCOMPOSITE DRAINAGE MATERIAL, CONNECTION PIPES, WEEPHOLES, REINFORCING STEEL AND SHOTCRETE FOR THE TEMPORARY SHOTCRETE CONSTRUCTION FACING FOR THE SOIL NAIL WALL SHOWN ON THE PLANS. THE WORK SHALL INCLUDE ANY PREPARATORY TRIMMING AND CLEANING OF SOIL/ROCK SURFACES AND SHOTCRETE COLD JOINTS TO RECEIVE NEW SHOTCRETE.

SHOTCRETE SHALL COMPLY WITH THE REQUIREMENTS OF ACI 506.2, "SPECIFICATIONS FOR MATERIALS, PROPORTIONING AND APPLICATION OF SHOTCRETE," EXCEPT AS OTHERWISE SPECIFIED. SHOTCRETE SHALL CONSIST OF AN APPLICATION OF ONE OR MORE LAYERS OF CONCRETE CONVEYED THROUGH A HOSE AND PNEUMATICALLY PROJECTED AT A HIGH VELOCITY AGAINST A PREPARED SURFACE.

SHOTCRETE MAY BE PRODUCED BY EITHER A WET-MIX OR DRY-MIX PROCESS. THE WET-MIX PROCESS CONSISTS OF THOROUGHLY MIXING ALL THE INGREDIENTS EXCEPT ACCELERATING ADMIXTURES, BUT INCLUDING THE MIXING WATER, INTRODUCING THE MIXTURE INTO THE DELIVERY EQUIPMENT AND DELIVERING IT, BY POSITIVE DISPLACEMENT, TO THE NOZZLE. THE WET-MIX SHOTCRETE SHALL THEN BE AIR JETTED FROM THE NOZZLE AT HIGH VELOCITY ONTO THE SURFACE. THE DRY-MIX PROCESS CONSISTS OF SHOTCRETE WITHOUT MIXING WATER WHICH IS CONVEYED THROUGH THE HOSE PNEUMATICALLY WITH THE MIXING WATER INTRODUCED AT THE NOZZLE. FOR ADDITIONAL DESCRIPTIVE INFORMATION, THE CONTRACTOR'S ATTENTION IS DIRECTED TO THE AMERICAN CONCRETE INSTITUTE ACI 506R "GUIDE TO SHOTCRETE."

CAST IN PLACE CONCRETE FACING CONSTRUCTION IS COVERED BY THE STANDARD SPECIFICATIONS.

**1.1 CONTRACTOR'S EXPERIENCE REQUIREMENTS.**

WORKERS, INCLUDING FOREMEN, NOZZLEMEN, AND DELIVERY EQUIPMENT OPERATORS, SHALL BE FULLY EXPERIENCED TO PERFORM THE WORK. ALL SHOTCRETE NOZZLEMEN ON THIS PROJECT SHALL HAVE EXPERIENCE ON AT LEAST 3 PROJECTS IN THE PAST 3 YEARS IN SIMILAR SHOTCRETE APPLICATION WORK AND SHALL DEMONSTRATE ABILITY TO SATISFACTORILY PLACE THE SHOTCRETE.

INITIAL QUALIFICATION OF NOZZLEMEN WILL BE BASED EITHER ON PREVIOUS ACI CERTIFICATION OR SATISFACTORY COMPLETION OF PRECONSTRUCTION TEST PANELS. THE REQUIREMENT FOR NOZZLEMEN TO SHOOT PRECONSTRUCTION QUALIFICATION TEST PANELS WILL BE WAIVED FOR NOZZLEMEN WHO CAN SUBMIT DOCUMENTED PROOF THEY HAVE BEEN CERTIFIED IN ACCORDANCE WITH THE ACI 506.3R GUIDE TO CERTIFICATION OF SHOTCRETE NOZZLEMEN. THE CERTIFICATION SHALL HAVE BEEN DONE BY AN ACI RECOGNIZED SHOTCRETE TESTING LAB AND/OR RECOGNIZED SHOTCRETING CONSULTANT AND HAVE COVERED THE TYPE OF SHOTCRETE TO BE USED. ALL NOZZLEMEN WILL BE REQUIRED TO PERIODICALLY SHOOT PRODUCTION TEST PANELS DURING THE COURSE OF THE WORK AT THE FREQUENCY SPECIFIED HEREIN.

NOTIFY THE ENGINEER NO LESS THAN 2 DAYS PRIOR TO THE SHOOTING OF PRECONSTRUCTION TEST PANELS TO BE USED TO QUALIFY NOZZLEMEN WITHOUT PREVIOUS ACI CERTIFICATION. USE THE SAME SHOTCRETE MIX AND EQUIPMENT TO MAKE THE QUALIFICATION TEST PANELS AS THOSE TO BE USED FOR THE SOIL NAIL WALL SHOTCRETE FACING. INITIAL QUALIFICATION OF THE NOZZLEMEN WILL BE BASED ON A VISUAL INSPECTION OF THE SHOTCRETE DENSITY AND VOID STRUCTURE AND ON ACHIEVING THE SPECIFIED 3-DAY AND 28-DAY COMPRESSIVE STRENGTH REQUIREMENTS DETERMINED FROM TEST SPECIMENS EXTRACTED FROM THE PRECONSTRUCTION TEST PANELS. PRECONSTRUCTION AND PRODUCTION TEST PANELS, CORE EXTRACTION AND COMPRESSIVE STRENGTH TESTING SHALL BE CONDUCTED IN ACCORDANCE WITH ACI 506.2 AND AASHTO T24/ASTM C42, UNLESS OTHERWISE SPECIFIED HEREIN. NOZZLEMEN WITHOUT ACI CERTIFICATION WILL BE ALLOWED TO BEGIN PRODUCTION SHOOTING BASED ON SATISFACTORY COMPLETION OF THE PRECONSTRUCTION TEST PANELS AND PASSING 3-DAY STRENGTH TEST REQUIREMENTS. CONTINUED QUALIFICATION WILL BE SUBJECT TO PASSING THE 28-DAY STRENGTH TESTS AND SHOOTING SATISFACTORY PRODUCTION TEST PANELS.

**1.2 CONSTRUCTION SUBMITTALS.**

AT LEAST 15 CALENDAR DAYS BEFORE THE PLANNED START OF SHOTCRETE PLACEMENT, SUBMIT 5 COPIES OF THE FOLLOWING INFORMATION, IN WRITING, TO THE ENGINEER FOR REVIEW:

- A. WRITTEN DOCUMENTATION OF THE NOZZLEMEN'S QUALIFICATIONS INCLUDING PROOF OF ACI CERTIFICATION (IF APPLICABLE).
- B. PROPOSED METHODS OF SHOTCRETE PLACEMENT AND OF CONTROLLING AND MAINTAINING FACING ALIGNMENT AND LOCATION AND SHOTCRETE THICKNESS.
- C. SHOTCRETE MIX DESIGN INCLUDING: TYPE OF PORTLAND CEMENT, AGGREGATE SOURCE AND GRADATION, PROPORTIONS OF MIX BY WEIGHT AND WATER-CEMENT RATIO, PROPOSED ADMIXTURES, MANUFACTURER, DOSAGE, TECHNICAL LITERATURE. PREVIOUS STRENGTH TEST RESULTS FOR THE PROPOSED SHOTCRETE MIX COMPLETED WITHIN ONE YEAR OF THE START OF SHOTCRETING MAY BE SUBMITTED FOR INITIAL VERIFICATION OF THE REQUIRED COMPRESSIVE STRENGTHS AT START OF PRODUCTION WORK.
- D. CERTIFICATIONS OF COMPLIANCE, MANUFACTURER'S ENGINEERING DATA AND INSTALLATION INSTRUCTIONS FOR THE GEOCOMPOSITE DRAIN STRIP, DRAIN GRATE AND ACCESSORIES.
- E. CERTIFICATE OF COMPLIANCE FOR PVC DRAIN PIPING.
- F. FORMWORK DIMENSIONS AND DETAILS FOR CASTING THE CAST IN PLACE CONCRETE FACING OVER THE SHOTCRETE CONSTRUCTION FACING, INCLUDE DETAILS FOR FORMWORK CONNECTIONS TO THE SHOTCRETE FACING AND/OR NAILS (IF APPLICABLE), PROPOSED CONCRETE PLACEMENT METHOD AND PLACEMENT RATES, AND ACCOMPANYING STRUCTURAL CALCULATIONS VERIFYING THE STRUCTURAL ADEQUACY OF THE FORMWORK, CONNECTIONS, AND SHOTCRETE FACING AND/OR NAILS TO SUPPORT THE LOADING INDUCED BY THE FLUID CAST IN PLACE CONCRETE. WHEN ANCHORS EMBEDDED INTO THE SHOTCRETE FACING WILL BE USED TO SUPPORT THE I-SIDED CAST IN PLACE CONCRETE FACE FORM, INCLUDE CALCULATIONS ILLUSTRATING THE ANCHOR DESIGN LOAD (CALCULATED AS THE DESIGN CONCRETE FLUID PRESSURE TIMES THE ANCHOR TRIBUTARY AREA). THE STRUCTURAL CALCULATIONS SHALL BE PREPARED AND SEALED BY A REGISTERED PROFESSIONAL ENGINEER LICENSED IN THE STATE OF OHIO.

THE ENGINEER WILL APPROVE OR REJECT THE CONTRACTOR'S SUBMITTALS WITHIN 10 CALENDAR DAYS AFTER RECEIPT OF A COMPLETE SUBMISSION. THE CONTRACTOR WILL NOT BE ALLOWED TO BEGIN WALL CONSTRUCTION OR INCORPORATE MATERIALS INTO THE WORK UNTIL THE SUBMITTAL REQUIREMENTS ARE SATISFIED AND FOUND ACCEPTABLE TO THE ENGINEER. CHANGES OR DEVIATIONS FROM THE APPROVED SUBMITTALS MUST BE RESUBMITTED FOR APPROVAL. NO ADJUSTMENTS IN CONTRACT TIME WILL BE ALLOWED DUE TO INCOMPLETE SUBMITTALS.

UPON DELIVERY TO THE PROJECT SITE, PROVIDE CERTIFIED MILL TEST RESULTS FOR ALL REINFORCING STEEL SPECIFYING THE MINIMUM ULTIMATE STRENGTH, YIELD STRENGTH, ELONGATION AND CHEMICAL COMPOSITION.

**1.3 PRE-CONSTRUCTION MEETING.**

A PRE-CONSTRUCTION MEETING SCHEDULED BY THE ENGINEER WILL BE HELD PRIOR TO THE START OF WALL CONSTRUCTION. ATTENDANCE IS MANDATORY. THE SHOTCRETE CONTRACTOR, IF DIFFERENT FROM THE SOIL NAIL SPECIALTY CONTRACTOR, SHALL ATTEND.

**2.0 MATERIALS.**

ALL MATERIALS FOR SHOTCRETE SHALL CONFORM TO THE FOLLOWING REQUIREMENTS:

CEMENT	AASHTO M85/ASTM C150, TYPE I, II, III, OR V.
FINE AGGREGATE	AASHTO M6/ASTM C33 CLEAN, NATURAL.
COARSE AGGREGATE	AASHTO M80, CLASS B FOR QUALITY.
WATER	CLEAN AND POTABLE, AASHTO M157/ASTM C94.
CHEMICAL ADMIXTURES:	
ACCELERATOR	FLUID TYPE, APPLIED AT NOZZLE, MEETING REQUIREMENTS OF AASHTO M194/ASTM C494/ASTM C1141.
WATER-REDUCER AND SUPERPLASTISIZER	AASHTO M194 / ASTM C494 TYPE A, C, D, E, F, OR G.
RETARDERS	AASHTO M194 / ASTM C494 TYPE B OR D.
MINERAL ADMIXTURES:	
FLY ASH	AASHTO M295 / ASTM C618 TYPE F OR G, CEMENT REPLACEMENT UP TO 35 PERCENT BY WEIGHT OF CEMENT.
SILICA FUME	ASTM C1240, 90 PERCENT, MINIMUM SILICON DIOXIDE SOLIDS CONTENT, NOT TO EXCEED 12 PERCENT BY WEIGHT OF CEMENT.
WELDED WIRE FABRIC	AASHTO M55 / ASTM A185 OR A497.
REINFORCING BARS FOR SHOTCRETE FACING	AASHTO M31 / ASTM A615, GRADE 60, DEFORMED.
PREPACKAGED SHOTCRETE	ASTM C928.
DRAINAGE GEOTEXTILE:	
FOR DRAIN STRIP	AASHTO M288 CLASS 3, PERMITTIVITY MIN. 0.2 PER SECOND; AOS 0.01 INCH MAX.
GEOCOMPOSITE DRAIN STRIP	MIRADRAIN 6000, AMERDRAIN 500 OR APPROVED EQUAL.
FILM PROTECTION	POLYETHYLENE FILMS PER AASHTO M-171

MATERIALS SHALL BE DELIVERED, STORED AND HANDLED TO PREVENT CONTAMINATION, SEGREGATION, CORROSION OR DAMAGE. STORE LIQUID ADMIXTURES TO PREVENT EVAPORATION AND FREEZING.

GEOCOMPOSITE DRAIN STRIPS SHALL BE PROVIDED IN ROLLS WRAPPED WITH A PROTECTIVE COVERING AND STORED IN A MANNER WHICH PROTECTS THE MATERIAL FROM MUD, DIRT, DUST, DEBRIS, AND SHOTCRETE REBOUND. PROTECTIVE WRAPPING SHALL NOT BE REMOVED UNTIL IMMEDIATELY BEFORE THE DRAIN STRIP IS INSTALLED. EXTENDED EXPOSURE TO ULTRA-VIOLET LIGHT SHALL BE AVOIDED. EACH ROLL OF DRAIN STRIP IN THE SHIPMENT SHALL BE LABELED TO IDENTIFY THE PRODUCTION RUN.

O:\2018\1802295\_001\_MOT\_725\_14\structures\sheets\wall\_3 (soil\_nail)\08619\_003\WN006.dgn 4/25/2024 1:43:06 PM agr.off



DESIGNED	PPA	CHECKED	RPM
DRAWN	TBC	REVISOR	
REVIEWED	RJM	DATE	1/11/2024
FILE NUMBER	STRUCTURE FILE NUMBER		

**GENERAL NOTES**  
RETAINING WALL 3

**MOT-725-14.41**  
PID No. 108619

## 2.1 SHOTCRETE MIX DESIGN.

THE CONTRACTOR MUST RECEIVE NOTIFICATION FROM THE ENGINEER THAT THE PROPOSED MIX DESIGN AND METHOD OF PLACEMENT ARE ACCEPTABLE BEFORE SHOTCRETE PLACEMENT CAN BEGIN.

### 2.1.1 AGGREGATE.

AGGREGATE FOR SHOTCRETE SHALL MEET THE STRENGTH AND DURABILITY REQUIREMENTS OF AASHTO M6 / M80 AND THE FOLLOWING GRADATION REQUIREMENTS:

SIEVE SIZE	PERCENT PASSING BY WEIGHT
1/2 INCH	100
3/8 INCH	90-100
NO. 4	70-85
NO. 8	50-70
NO. 16	35-55
NO. 30	20-35
NO. 50	8-20
NO. 100	2-10

### 2.1.2 PROPORTIONING AND USE OF ADMIXTURES.

PROPORTION THE SHOTCRETE TO BE PUMPABLE WITH THE CONCRETE PUMP FURNISHED FOR THE WORK, WITH A CEMENTING MATERIALS CONTENT OF AT LEAST 720 POUNDS PER CUBIC YARD AND WATER/CEMENT RATIO NOT GREATER THAN 0.50. DO NOT USE ADMIXTURES UNLESS APPROVED BY THE ENGINEER. THOROUGHLY MIX ADMIXTURES INTO THE SHOTCRETE AT THE RATE SPECIFIED BY THE MANUFACTURER. ACCELERATORS (IF USED) SHALL BE COMPATIBLE WITH THE CEMENT USED, BE NON-CORROSIVE TO STEEL AND NOT PROMOTE OTHER DETRIMENTAL EFFECTS SUCH AS CRACKING OR EXCESSIVE SHRINKAGE. THE MAXIMUM ALLOWABLE CHLORIDE ION CONTENT OF ALL INGREDIENTS SHALL NOT EXCEED 0.10% WHEN TESTED ACCORDING TO AASHTO T260.

### 2.1.3 AIR ENTRAINMENT.

AIR ENTRAINMENT IS NOT REQUIRED FOR TEMPORARY SHOTCRETE CONSTRUCTION FACINGS.

### 2.1.4 STRENGTH REQUIREMENTS.

PROVIDE A SHOTCRETE MIX CAPABLE OF ATTAINING 2,000 PSI COMPRESSIVE STRENGTH IN 3 DAYS AND 4,000 PSI IN 28 DAYS. THE AVERAGE COMPRESSIVE STRENGTH OF EACH SET OF THREE TEST CORES EXTRACTED FROM TEST PANELS OR WALL FACE MUST EQUAL OR EXCEED 85 PERCENT OF THE SPECIFIED COMPRESSIVE STRENGTH, WITH NO INDIVIDUAL CORE LESS THAN 75 PERCENT OF THE SPECIFIED COMPRESSIVE STRENGTH, IN ACCORDANCE WITH ACI 506.2.

### 2.1.5 MIXING AND BATCHING.

AGGREGATE AND CEMENT MAY BE BATCHED BY WEIGHT OR BY VOLUME IN ACCORDANCE WITH THE REQUIREMENTS OF ASTM C94 OR AASHTO M241 / ASTM C685. MIXING EQUIPMENT SHALL THOROUGHLY BLEND THE MATERIALS IN SUFFICIENT QUANTITY TO MAINTAIN PLACING CONTINUITY. READY MIX SHOTCRETE SHALL COMPLY WITH AASHTO M157. SHOTCRETE SHALL BE BATCHED, DELIVERED, AND PLACED WITHIN 90 MINUTES OF MIXING. THE USE OF RETARDING ADMIXTURES MAY EXTEND APPLICATION TIME BEYOND 90 MINUTES IF APPROVED BY THE ENGINEER.

PREMIXED AND PACKAGED SHOTCRETE MIX MAY BE PROVIDED FOR ON-SITE MIXING. THE PACKAGES SHALL CONTAIN MATERIALS CONFORMING TO THE MATERIALS SECTION OF THIS SPECIFICATION. PLACING TIME LIMIT AFTER MIXING SHALL BE PER THE MANUFACTURER'S RECOMMENDATIONS.

## 2.2 FIELD QUALITY CONTROL.

BOTH PRECONSTRUCTION TEST PANELS (FOR NOZZLEMEN WITHOUT PREVIOUS ACI CERTIFICATION) AND PRODUCTION TEST PANELS OR TEST CORES FROM THE WALL FACING ARE REQUIRED. SHOTCRETING AND CORING OF TEST PANELS SHALL BE PERFORMED BY QUALIFIED PERSONNEL IN THE PRESENCE OF THE ENGINEER. THE CONTRACTOR SHALL PROVIDE EQUIPMENT, MATERIALS, AND PERSONNEL AS NECESSARY TO OBTAIN SHOTCRETE CORES FOR TESTING INCLUDING CONSTRUCTION OF TEST PANEL BOXES, FIELD CURING REQUIREMENTS AND CORING. COMPRESSIVE STRENGTH TESTING WILL BE PERFORMED BY THE ENGINEER. SHOTCRETE FINAL ACCEPTANCE WILL BE BASED ON THE 28-DAY STRENGTH.

SHOTCRETE PRODUCTION WORK MAY COMMENCE UPON INITIAL APPROVAL OF THE DESIGN MIX AND NOZZLEMEN AND CONTINUE IF THE SPECIFIED STRENGTHS ARE OBTAINED. THE SHOTCRETE WORK BY A CREW WILL BE SUSPENDED IF THE TEST RESULTS FOR THEIR WORK DOES NOT SATISFY THE STRENGTH REQUIREMENTS. THE CONTRACTOR SHALL CHANGE ALL OR SOME OF THE FOLLOWING: THE MIX, THE CREW, THE EQUIPMENT, OR THE PROCEDURES. BEFORE RESUMING WORK, THE CREW MUST SHOOT ADDITIONAL TEST PANELS AND DEMONSTRATE THAT THE SHOTCRETE IN THE PANELS SATISFIES THE SPECIFIED STRENGTH REQUIREMENTS. THE COST OF ALL WORK REQUIRED TO OBTAIN SATISFACTORY STRENGTH TESTS WILL BE BORNE BY THE CONTRACTOR.

### 2.2.1 PRECONSTRUCTION TEST PANELS.

EACH NOZZLEMAN WITHOUT PREVIOUS ACI CERTIFICATION SHALL FURNISH AT LEAST ONE PRECONSTRUCTION TEST PANEL FOR EACH PROPOSED MIXTURE BEING CONSIDERED AND FOR EACH SHOOTING POSITION TO BE ENCOUNTERED ON THE JOB. PRECONSTRUCTION TEST PANELS SHALL BE MADE PRIOR TO THE COMMENCEMENT OF PRODUCTION WORK USING THE SAME EQUIPMENT, MATERIALS, MIXTURE PROPORTIONS AND PROCEDURES PROPOSED FOR THE JOB.

MAKE PRECONSTRUCTION TEST PANELS WITH MINIMUM DIMENSIONS OF 30 X 30 INCHES SQUARE AND AT LEAST 4 INCHES THICK. SLOPE THE SIDES OF PRECONSTRUCTION AND PRODUCTION TEST PANELS AT 45 DEGREES OVER THE FULL PANEL THICKNESS TO RELEASE REBOUND.

### 2.2.2 PRODUCTION TEST PANELS.

FURNISH AT LEAST ONE PRODUCTION TEST PANEL OR, IN LIEU OF PRODUCTION TEST PANELS, SIX 3 INCH DIAMETER CORES TAKEN FROM THE SHOTCRETE FACING, DURING THE FIRST PRODUCTION APPLICATION OF SHOTCRETE AND HENCEFORTH FOR EVERY 2,500 SQUARE FEET OF SHOTCRETE PLACED. CONSTRUCT THE PRODUCTION TEST PANELS SIMULTANEOUSLY WITH THE SHOTCRETE FACING INSTALLATION AT TIMES DESIGNATED BY THE ENGINEER. MAKE PRODUCTION TEST PANELS WITH MINIMUM DIMENSIONS OF 18 X 18 INCHES SQUARE AND AT LEAST 4 INCHES THICK.

## 2.2.3 TEST PANEL CURING, TEST SPECIMEN EXTRACTION AND TESTING.

IMMEDIATELY AFTER SHOOTING, FIELD MOIST CURE THE TEST PANELS BY COVERING AND TIGHTLY WRAPPING WITH A SHEET OF MATERIAL MEETING THE REQUIREMENTS OF ASTM C171 UNTIL THEY ARE DELIVERED TO THE TESTING LAB OR TEST SPECIMENS ARE EXTRACTED. DO NOT IMMEDIATELY TEST PANELS IN WATER. DO NOT FURTHER DISTURB TEST PANELS FOR THE FIRST 24 HOURS AFTER SHOOTING. PROVIDE AT LEAST SIX 3 INCH DIAMETER CORE SAMPLES CUT FROM EACH PRECONSTRUCTION TEST PANEL AND PRODUCTION TEST PANEL. CONTRACTOR HAS THE OPTION OF EXTRACTING TEST SPECIMENS FROM TEST PANELS IN THE FIELD OR TRANSPORTING TO ANOTHER LOCATION FOR EXTRACTION. KEEP PANELS IN THEIR FORMS WHEN TRANSPORTED. DO NOT TAKE CORES FROM THE OUTER 6 INCHES OF TEST PANELS MEASURED IN FROM THE TOP AND OUTSIDE EDGES OF THE PANEL FORM. TRIM THE ENDS OF THE CORES TO PROVIDE TEST CYLINDERS AT LEAST 3 INCHES LONG. IF THE CONTRACTOR CHOOSES TO TAKE CORES FROM THE WALL FACE IN LIEU OF MAKING PRODUCTION TEST PANELS, LOCATIONS WILL BE DESIGNATED BY THE ENGINEER. CLEARLY MARK THE CORES AND CONTAINER TO IDENTIFY THE CORE LOCATIONS AND WHETHER THEY ARE FOR PRECONSTRUCTION OR PRODUCTION TESTING. IF FOR PRODUCTION TESTING, MARK THE SECTION OF THE WALL REPRESENTED BY THE CORES ON THE CORES AND CONTAINER. IMMEDIATELY WRAP CORES IN WET BURLAP OR MATERIAL MEETING REQUIREMENTS OF ASTM C171 AND SEAL IN A PLASTIC BAG. DELIVER CORES TO THE ENGINEER OR TESTING LAB, AS DIRECTED BY THE ENGINEER, WITHIN 48 HOURS OF SHOOTING THE PANELS. THE REMAINDER OF THE PANELS WILL BECOME THE PROPERTY OF THE CONTRACTOR. COMPRESSIVE STRENGTH TESTING WILL BE PERFORMED BY THE ENGINEER. UPON DELIVERY TO THE TESTING LAB, SAMPLES WILL BE PLACED IN THE MOIST ROOM UNTIL THE TIME OF TEST. WHEN THE TEST LENGTH OF A CORE IS LESS THAN TWICE THE DIAMETER, THE CORRECTION FACTORS GIVEN IN AASHTO T24/ASTM C42 WILL BE APPLIED TO OBTAIN THE COMPRESSIVE STRENGTH OF INDIVIDUAL CORES. THREE CORES WILL BE TESTED AT 3 DAYS AND THREE CORES WILL BE TESTED AT 28 DAYS IN ACCORDANCE WITH AASHTO T24/ASTM C42.

FILL CORE HOLES IN THE WALL BY DRY-PACKING WITH NON-SHRINK PATCHING MORTAR AFTER THE HOLES ARE CLEANED AND DAMPENED. DO NOT FILL CORE HOLES WITH SHOTCRETE.

## 3.0 CONSTRUCTION REQUIREMENTS.

### 3.1 WALL DRAINAGE NETWORK.

INSTALL AND SECURE ALL ELEMENTS OF THE WALL DRAINAGE NETWORK AS SHOWN ON THE PLANS, SPECIFIED HEREIN, OR AS REQUIRED BY THE ENGINEER TO SUIT THE SITE CONDITIONS. THE DRAINAGE NETWORK SHALL CONSIST OF INSTALLING GEOCOMPOSITE DRAIN STRIPS, POROUS BACKFILL, 4" PERFORATED CORRUGATED PLASTIC PIPE AND 4" CORRUGATED PLASTIC PIPE AS SHOWN ON THE PLANS OR AS DIRECTED BY THE ENGINEER. ALL ELEMENTS OF THE DRAINAGE NETWORK SHALL BE INSTALLED PRIOR TO SHOTCRETING.

UNANTICIPATED SUBSURFACE DRAINAGE FEATURES EXPOSED IN THE EXCAVATION CUT FACE SHALL BE CAPTURED INDEPENDENTLY OF THE WALL DRAINAGE NETWORK AND SHALL BE MITIGATED PRIOR TO SHOTCRETE APPLICATION.

### 3.1.1 GEOCOMPOSITE DRAIN STRIPS AND CONNECTION PIPES.

INSTALL GEOCOMPOSITE DRAIN STRIPS CENTERED BETWEEN THE COLUMNS OF NAILS AS SHOWN ON THE PLANS. INSTALL HORIZONTAL GEOCOMPOSITE DRAIN STRIPS BEHIND HORIZONTAL SHOTCRETE CONSTRUCTION JOINTS AND WHERE ZONES OF LOCALIZED GROUNDWATER SEEPAGE ARE ENCOUNTERED DURING CONSTRUCTION. THE DRAIN STRIPS SHALL BE AT LEAST 30 INCHES WIDE AND PLACED WITH THE GEOTEXTILE SIDE AGAINST THE GROUND. SECURE THE STRIPS TO THE EXCAVATION FACE AND PREVENT SHOTCRETE FROM CONTAMINATING THE GROUND SIDE OF THE GEOTEXTILE. DRAIN STRIPS WILL BE CONTINUOUS. SPLICES SHALL BE MADE WITH A 12 INCH MINIMUM OVERLAP SUCH THAT THE FLOW OF WATER IS NOT IMPEDED. REPAIR DAMAGE TO THE GEOCOMPOSITE DRAIN STRIP, WHICH MAY INTERRUPT THE FLOW OF WATER.

IN ACCORDANCE WITH C&MS 518.06.D AND AS SHOWN IN THE PLANS, FOR THE PREFABRICATED GEOCOMPOSITE DRAIN, PROVIDE PREFABRICATED WEEP HOLE FITTINGS PROVIDED BY THE MANUFACTURER AND INSTALLED TO THE MANUFACTURER'S INSTRUCTIONS EVERY 15 FEET ALONG THE LENGTH OF THE WALL, PASSING THROUGH THE SHOTCRETE AND CIP WALL FACE TO THE POROUS BACKFILL RUNNING IN FRONT OF THE FACE OF THE WALL. TEMPORARILY BLOCK THE OUTLETS OF THE PREFABRICATED WEEP HOLE FITTINGS DURING PLACEMENT OF SHOTCRETE AND THE CIP WALL FACE, TO AVOID INTRUSION OF CONCRETE INTO THE OUTLETS. PROVIDE A 1-FOOT WIDE BY 1-FOOT TALL BLOCK OF POROUS BACKFILL WITH GEOTEXTILE FABRIC AT THE BOTTOM OF THE FRONT FACE OF THE WALL, CONTAINING A 4" PERFORATED CORRUGATED PLASTIC PIPE, SLOPED TO DRAIN. AT THE WEST END OF THE WALL, CONNECT THE PERFORATED CORRUGATED PLASTIC COLLECTION PIPE TO THE 4" NON-PERFORATED CORRUGATED PLASTIC PIPE, INCLUDING SPECIALS, RUNNING TO THE DRAINAGE OUTLET AS SHOWN IN THE PLANS.

## 3.2 TEMPORARY SHOTCRETE CONSTRUCTION FACING.

### 3.2.1 SHOTCRETE ALIGNMENT AND THICKNESS CONTROL.

ENSURE THAT THE THICKNESS OF SHOTCRETE SATISFIES THE MINIMUM REQUIREMENTS SHOWN ON THE PLANS USING SHOOTING WIRES, THICKNESS CONTROL PINS, OR OTHER DEVICES ACCEPTABLE TO THE ENGINEER. INSTALL THICKNESS CONTROL DEVICES NORMAL TO THE SURFACE SUCH THAT THEY PROTRUDE THE REQUIRED SHOTCRETE THICKNESS OUTSIDE THE SURFACE. ENSURE THAT THE FRONT FACE OF THE SHOTCRETE DOES NOT EXTEND BEYOND THE LIMITS SHOWN ON THE PLANS.

### 3.2.2 SURFACE PREPARATION.

CLEAN THE FACE OF THE EXCAVATION AND OTHER SURFACES TO BE SHOTCRETED OF LOOSE MATERIALS, MUD, REBOUND, OVERSPRAY OR OTHER FOREIGN MATTER THAT COULD PREVENT OR REDUCE SHOTCRETE BOND. PROTECT ADJACENT SURFACES FROM OVERSPRAY DURING SHOOTING. AVOID LOOSENING, CRACKING, OR SHATTERING THE GROUND DURING EXCAVATION AND CLEANING. REMOVE ANY SURFACE MATERIAL WHICH IS SO LOOSENED OR DAMAGED TO A SUFFICIENT DEPTH TO PROVIDE A BASE THAT IS SUITABLE TO RECEIVE THE SHOTCRETE. REMOVE MATERIAL THAT LOOSENS AS THE SHOTCRETE IS APPLIED. COST OF ADDITIONAL SHOTCRETE IS INCIDENTAL TO THE WORK. DIVERT WATER FLOW AND REMOVE STANDING WATER SO THAT SHOTCRETE PLACEMENT WILL NOT BE DETRIMENTALLY AFFECTED BY STANDING WATER. DO NOT PLACE SHOTCRETE ON FROZEN SURFACES.

**3.2.3 DELIVERY AND APPLICATION.**

MAINTAIN A CLEAN, DRY, OIL-FREE SUPPLY OF COMPRESSED AIR SUFFICIENT FOR MAINTAINING ADEQUATE NOZZLE VELOCITY AT ALL TIMES. THE EQUIPMENT SHALL BE CAPABLE OF DELIVERING THE PREMIXED MATERIAL ACCURATELY, UNIFORMLY, AND CONTINUOUSLY THROUGH THE DELIVERY HOSE. CONTROL SHOTCRETE APPLICATION THICKNESS, NOZZLE TECHNIQUE, AIR PRESSURE, AND RATE OF SHOTCRETE PLACEMENT TO PREVENT SAGGING OR SLOUGHING OF FRESHLY-APPLIED SHOTCRETE.

APPLY THE SHOTCRETE FROM THE LOWER PART OF THE AREA UPWARDS TO PREVENT ACCUMULATION OF REBOUND. ORIENT NOZZLE AT A DISTANCE AND APPROXIMATELY PERPENDICULAR TO THE WORKING FACE SO THAT REBOUND WILL BE MINIMAL AND COMPACTION WILL BE MAXIMIZED. PAY SPECIAL ATTENTION TO ENCAPSULATING REINFORCEMENT. DO NOT WORK REBOUND BACK INTO THE CONSTRUCTION. WHERE SHOTCRETE IS USED TO COMPLETE THE TOP UNGROUTED ZONE OF THE NAIL DRILL HOLE NEAR THE FACE, POSITION THE NOZZLE INTO MOUTH OF THE DRILLHOLE TO COMPLETELY FILL THE VOID.

A CLEARLY DEFINED PATTERN OF CONTINUOUS HORIZONTAL AND VERTICAL RIDGES OR DEPRESSIONS AT THE REINFORCING ELEMENTS AFTER THEY ARE COVERED WITH SHOTCRETE WILL BE CONSIDERED AN INDICATION OF INSUFFICIENT REINFORCEMENT COVER OR POOR NOZZLE TECHNIQUES. IN THIS CASE THE APPLICATION OF SHOTCRETE SHALL BE IMMEDIATELY SUSPENDED AND THE CONTRACTOR SHALL IMPLEMENT CORRECTIVE MEASURES BEFORE RESUMING THE SHOTCRETE OPERATIONS. THE SHOTCRETING PROCEDURE MAY BE CORRECTED BY ADJUSTING THE NOZZLE DISTANCE AND ORIENTATION, BY INSURING ADEQUATE COVER OVER THE REINFORCEMENT, BY ADJUSTING THE WATER CONTENT OF THE SHOTCRETE MIX OR OTHER MEANS. ADJUSTMENT IN WATER CONTENT OF WET-MIX WILL REQUIRE REQUALIFYING THE SHOTCRETE MIX.

**3.2.4 DEFECTIVE SHOTCRETE.**

REPAIR SHOTCRETE SURFACE DEFECTS AS SOON AS POSSIBLE AFTER PLACEMENT. REMOVE AND REPLACE SHOTCRETE WHICH EXHIBITS SEGREGATION, HONEYCOMBING, LAMINATION, VOIDS, OR SAND POCKETS. IN-PLACE SHOTCRETE DETERMINED NOT TO MEET THE SPECIFIED STRENGTH REQUIREMENT WILL BE SUBJECT TO REMEDIATION AS DETERMINED BY THE ENGINEER. POSSIBLE REMEDIATION OPTIONS INCLUDE PLACEMENT OF ADDITIONAL SHOTCRETE THICKNESS OR REMOVAL AND REPLACEMENT, AT THE CONTRACTOR'S COST.

**3.2.5 CONSTRUCTION JOINTS.**

TAPER CONSTRUCTION JOINTS UNIFORMLY TOWARD THE EXCAVATION FACE OVER A MINIMUM DISTANCE EQUAL TO THE THICKNESS OF THE SHOTCRETE LAYER. PROVIDE A MINIMUM REINFORCEMENT OVERLAP AT REINFORCEMENT SPLICE JOINTS AS SHOWN ON THE PLANS. CLEAN AND WET THE SURFACE OF A JOINT BEFORE ADJACENT SHOTCRETE IS APPLIED. WHERE SHOTCRETE IS USED TO COMPLETE THE TOP UNGROUTED ZONE OF THE NAIL DRILL HOLE NEAR THE FACE, TO THE MAXIMUM EXTENT PRACTICAL, CLEAN AND DAMPEN THE UPPER GROUT SURFACE TO RECEIVE SHOTCRETE, SIMILAR TO A CONSTRUCTION JOINT.

**3.2.6 FINISH.**

SHOTCRETE FINISH SHALL BE EITHER AN UNDISTURBED GUN FINISH AS APPLIED FROM THE NOZZLE OR A ROUGH SCREEDED FINISH. REMOVE SHOTCRETE EXTENDING INTO THE CAST IN PLACE CONCRETE FINISH FACE SECTION BEYOND THE TOLERANCES SHOWN ON THE PLANS OR SPECIFIED HEREIN.

**3.2.7 ATTACHMENT OF NAIL HEAD BEARING PLATE AND NUT.**

ATTACH A BEARING PLATE AND NUT TO EACH NAIL HEAD AS SHOWN ON THE PLANS. WHILE THE SHOTCRETE IS STILL PLASTIC AND BEFORE ITS INITIAL SET, UNIFORMLY SEAT THE PLATE ON THE SHOTCRETE BY HAND WRENCH TIGHTENING THE NUT. WHERE UNIFORM CONTACT BETWEEN THE PLATE AND THE SHOTCRETE CANNOT BE PROVIDED, SET THE PLATE IN A BED OF GROUT. AFTER GROUT HAS SET FOR 24 HOURS, HAND WRENCH TIGHTEN THE NUT. ENSURE BEARING PLATES WITH HEADED STUDS ARE IN INTIMATE CONTACT WITH THE CONSTRUCTION FACING AND THE STUDS ARE LOCATED WITHIN THE TOLERANCES SHOWN ON THE PLANS OR SPECIFIED HEREIN.

**3.2.8 WEATHER LIMITATIONS.**

PROTECT THE SHOTCRETE IF IT MUST BE PLACED WHEN THE AMBIENT TEMPERATURE IS BELOW 32°F AND FALLING OR WHEN IT IS LIKELY TO BE SUBJECTED TO FREEZING TEMPERATURES BEFORE GAINING SUFFICIENT STRENGTH. MAINTAIN COLD WEATHER PROTECTION UNTIL THE IN PLACE COMPRESSIVE STRENGTH OF THE SHOTCRETE IS GREATER THAN 700 PSI. COLD WEATHER PROTECTION INCLUDES BLANKETS, HEATING UNDER TENTS, OR OTHER MEANS ACCEPTABLE TO THE ENGINEER. THE TEMPERATURE OF THE SHOTCRETE MIX, WHEN DEPOSITED, SHALL BE NOT LESS THAN 50° F OR MORE THAN 95° F.

SUSPEND SHOTCRETE APPLICATION DURING HIGH WINDS AND HEAVY RAINS UNLESS SUITABLE PROTECTIVE COVERS, ENCLOSURES OR WIND BREAKS ARE INSTALLED. REMOVE AND REPLACE NEWLY PLACED SHOTCRETE EXPOSED TO RAIN THAT WASHES OUT CEMENT OR OTHERWISE MAKES THE SHOTCRETE UNACCEPTABLE. PROVIDE A POLYETHYLENE FILM OR EQUIVALENT TO PROTECT THE WORK FROM EXPOSURE TO ADVERSE WEATHER.

**3.2.9 CURING.**

CURING IS NOT REQUIRED FOR TEMPORARY CONSTRUCTION FACINGS TO BE COVERED BY A CAST IN PLACE CONCRETE FACING OR WHOSE SERVICE LIFE IS LESS THAN 36 MONTHS.

**3.2.10 CONSTRUCTION FACING TOLERANCES.**

CONSTRUCTION TOLERANCES FOR THE TEMPORARY SHOTCRETE CONSTRUCTION FACING ARE AS FOLLOWS:

HORIZONTAL LOCATION OF WIRE MESH; REBAR; HEADED STUDS ON BEARING PLATES, FROM PLAN LOCATION: + OR - 1/2 INCH.

HEADED STUDS LOCATION ON BEARING PLATE, FROM PLAN LOCATION: 1/4 INCH.

SPACING BETWEEN REINFORCING BARS, FROM PLAN DIMENSION: 1 INCH.

REINFORCING LAP, FROM SPECIFIED DIMENSION: - 1 INCH.

THICKNESS OF SHOTCRETE: - 3/8 INCH.

NAIL HEAD BEARING PLATE, DEVIATION FROM PARALLEL TO WALL FACE: 10 DEGREES.

**3.3 BACKFILLING BEHIND WALL FACING UPPER CANTILEVER.**

COMPACT ANY BACKFILL WITHIN 3 FEET BEHIND THE WALL FACING UPPER CANTILEVER USING LIGHT MECHANICAL TAMPERS.

**3.4 SAFETY REQUIREMENTS.**

NOZZLEMEN AND HELPERS SHALL BE EQUIPPED WITH GLOVES, EYE PROTECTION, AND ADEQUATE PROTECTIVE CLOTHING DURING THE APPLICATION OF SHOTCRETE. THE CONTRACTOR IS RESPONSIBLE FOR MEETING ALL FEDERAL, STATE, AND LOCAL SAFETY CODE REQUIREMENTS.

**3.5 CAST IN PLACE CONCRETE FORM CONNECTION TO SHOTCRETE FACING.**

WHEN MECHANICAL, GROUTED, OR EPOXIED ANCHORS EMBEDDED INTO THE SHOTCRETE FACING ARE USED TO SUPPORT A ONE-SIDED CAST IN PLACE CONCRETE FACE FORM, PERFORM PULLOUT TESTING OF THE EMBEDDED ANCHORS IN ACCORDANCE WITH ASTM C900 AND AS MODIFIED HEREIN. PERFORM PULLOUT TESTING OF INSTALLED ANCHORS PRIOR TO ATTACHMENT OF THE FACE FORM. SELECT TEST ANCHOR LOCATIONS TO BE REPRESENTATIVE OF THE FULL WALL SURFACE AREA TO BE COVERED.

FOR FACING AREAS UP TO 5,000 SQUARE FEET, PERFORM A MINIMUM OF THREE FLEXURE/SHEAR PULLOUT TESTS WITH THE ANCHORS LOCATED APPROXIMATELY MID-SPAN BETWEEN TWO ADJACENT NAIL HEADS AND WITH THE NAIL HEADS OR OTHER REACTION POINTS LOCATED APPROXIMATELY ONE-HALF THE NAIL SPACING FROM THE ANCHOR. FOR FACING AREAS IN EXCESS OF 5,000 SQUARE FEET, PERFORM ONE ADDITIONAL FLEXURE/SHEAR PULLOUT TEST FOR EACH ADDITIONAL 2,500 SQUARE FEET OF FACE AREA. TEST THESE ANCHORS TO 1.5 TIMES THEIR REQUIRED DESIGN LOAD (CALCULATED AS THE DESIGN CONCRETE FLUID PRESSURE TIMES THE ANCHOR TRIBUTARY AREA).

PERFORM LOCAL PUNCHING SHEAR PULLOUT TESTING ON 2 PERCENT OF THE INSTALLED ANCHORS. PLACE THE LOAD REACTION SUPPORT NO CLOSER TO THE EDGE OF THE ANCHOR THAN THE EMBEDMENT DEPTH OF THE ANCHOR INTO THE CONSTRUCTION FACING. TEST THESE ANCHORS TO 2.0 TIMES THEIR REQUIRED DESIGN LOAD.

MODIFY THE ANCHOR AND/OR FACE FORM SUPPORT SYSTEM IF THE TESTED ANCHORS DO NOT MEET THE ABOVE TEST ACCEPTANCE CRITERIA. MODIFIED ANCHOR INSTALLATION WILL REQUIRE RE-TESTING IN ACCORDANCE WITH THE ABOVE TESTING CRITERIA. COST OF ANCHOR PULLOUT TESTING IS INCIDENTAL TO THE WORK.

**4.0 METHOD OF MEASUREMENT.**

THE SHOTCRETE FACING WILL BE MEASURED IN SQUARE FEET OF THE SHOTCRETE AREA COMPLETED AND ACCEPTED IN THE FINAL WORK. THE NET AREA LYING IN A PLANE OF THE OUTSIDE FRONT FACE OF THE STRUCTURE AS SHOWN ON THE PLANS WILL BE MEASURED. NO MEASUREMENT OR PAYMENT WILL BE MADE FOR ADDITIONAL SHOTCRETE OR CAST IN PLACE CONCRETE NEEDED TO FILL VOIDS CREATED BY IRREGULARITIES IN THE CUT FACE, EXCAVATION OVERBREAK OR INADVERTENT EXCAVATION BEYOND THE PLAN FINAL WALL FACE EXCAVATION LINE, OR FAILURE TO CONSTRUCT THE FACING TO THE SPECIFIED LINE AND GRADE AND TOLERANCES. THE FINAL PAY QUANTITY SHALL INCLUDE ALL STRUCTURAL SHOTCRETE, ADMIXTURES, WELDED WIRE MESH, WIRE HOLDING DEVICES, EMBEDDED CAST IN PLACE CONCRETE FACE FORM SUPPORT ANCHORS, TEST PANELS AND ALL SAMPLING, TESTING AND REPORTING REQUIRED BY THE PLANS AND THIS SPECIFICATION.

**5.0 BASIS OF PAYMENT.**

THE ACCEPTED QUANTITY MEASURED AS PROVIDED ABOVE WILL BE PAID FOR AT THE CONTRACT UNIT PRICE PER SQUARE FEET. PAYMENT WILL BE FULL COMPENSATION FOR FURNISHING ALL EQUIPMENT, MATERIALS, LABOR, TOOLS AND INCIDENTALS NECESSARY TO COMPLETE THE WORK AS SPECIFIED AND AS DETAILED ON THE PLANS, INCLUDING THE WORK REQUIRED TO PROVIDE THE PROPER SHOTCRETE FACING ALIGNMENT AND THICKNESS CONTROL. THE FOLLOWING WALL DRAINAGE MATERIALS WILL BE PAID SEPARATELY FROM THE SHOTCRETE FACING: THE PAVED GUTTER, GEOCOMPOSITE DRAIN STRIPS, POROUS BACKFILL, AND 4" CORRUGATED PLASTIC PIPE. THE FOLLOWING MATERIALS ARE CONSIDERED INCIDENTAL TO THE CONSTRUCTION OF THE GEOCOMPOSITE DRAIN STRIPS AND WILL NOT BE PAID SEPARATELY: THE DRAIN GEOTEXTILE, PREFABRICATED WEEPHOLE FITTINGS, 3" WEEPHOLE PIPE, AND ANY FITTINGS OR ACCESSORIES.

PAYMENT WILL BE MADE FOR THE FOLLOWING BID ITEMS INCLUDED IN THE BID FORM:

ITEM	DESCRIPTION	UNIT
509	EPOXY COATED STEEL REINFORCING	LB
511	CLASS QC1 CONCRETE, RETAINING; WINGWALL NOT INCLUDING FOOTING, AS PER PLAN	CY
512	SEALING OF CONCRETE SURFACES (EPOXY-URETHANE), AS PER PLAN	SY
518	PREFABRICATED GEOCOMPOSITE DRAIN	SY
518	POROUS BACKFILL	CY
520	PNEUMATICALLY PLACED CONCRETE SHOTCRETE, AS PER PLAN	SF

*(Handwritten note in red circles: DRAINAGE MATERIALS WILL BE PAID SEPARATELY FROM THE SHOTCRETE FACING...)*

*(Handwritten note in red circles: PNEUMATICALLY PLACED CONCRETE SHOTCRETE...)*

O:\2018\1802295\_001\_MOT\_725\_14\_structures\sheets\wall\_3 (soil nail)\08619\_003\WNO08.dgn 4/25/2024 1:43:10 PM agroff



DESIGNED	PPA	CHECKED	RPM
DRAWN	TBC	REVISED	
REVIEWED	RJM	DATE	1/11/2024
FILE NUMBER	STRUCTURE	FILE NUMBER	


**GENERAL NOTES**  
RETAINING WALL 3

**MOT - 725 - 14.41**  
PID No. 108619

ESTIMATED QUANTITIES					
ITEM	EXT.	QUANTITY	UNIT	DESCRIPTION	REF.
203	20000	50	CY	EMBANKMENT	178
503	21101	LUMP		UNCLASSIFIED EXCAVATION, AS PER PLAN	178
509	10000	34,963	LB	EPOXY COATED STEEL REINFORCEMENT	
511	46011	150	CY	CLASS QC1 CONCRETE, RETAINING/WINGWALL INCLUDING FOOTING, AS PER PLAN	178
511	71200	4,050	SF	CONCRETE, MISC.: FORMLINER	168
511	81300	2	EACH	CONCRETE, MISC.: AESTHETIC TEST PANEL	168
512	10100	530	SY	SEALING OF CONCRETE SURFACES (EPOXY-URETHANE)	
516	13600	202	SF	1" PREFORMED EXPANSION JOINT FILLER	
518	20000	400	SY	PREFABRICATED GEOCOMPOSITE DRAIN	
518	21050	17	CY	POROUS BACKFILL WITH GEOTEXTILE FABRIC	
518	39800	450	FT	4" PERFORATED CORRUGATED PLASTIC PIPE	179
518	39900	45	FT	4" NON-PERFORATED CORRUGATED PLASTIC PIPE, INCLUDING SPECIALS	179
520	10001	5,190	SF	PNEUMATICALLY PLACED CONCRETE SHOTCRETE, AS PER PLAN	179
530	51100	363	EACH	RETAINING WALL, SOIL NAIL 20' LONG, MINIMUM	178
530	51110	11	EACH	RETAINING WALL, SOIL NAIL VERIFICATION TEST	178
530	51120	19	EACH	RETAINING WALL, SOIL NAIL PROOF TEST	178

**NOTES:**


1. SEE SHEET 176 AND 177 FOR WALL 3 PLAN AND PROFILE.
2. ARCHITECTURAL FORMLINER NOT SHOWN IN THIS DETAIL. SEE SHEETS 194 AND 167 - 169 FOR ARCHITECTURAL FORMLINER DETAILS.
3. THIS DETAIL CORRESPONDS TO THE NAIL COLUMN CONSISTING OF NAILS 28, 131, 228, and 288. THE TOP NAIL OF THIS COLUMN IS THE CLOSEST IN ELEVATION TO THE BOTTOM OF THE PIER CAP. THEREFORE THIS NAIL, ALONG WITH NAILS 279 THROUGH 288, HAS BEEN DESIGNED WITH A 12 DEGREE INCLINATION ANGLE IN ORDER TO NOT CONFLICT WITH THE PIER CAP DURING INSTALLATION.
4. SOIL NAIL ADJUSTMENT: EACH SOIL NAIL WAS LOCATED SO AS TO MISS THE ABUTMENT PILES IN FRONT AND THE PIER COLUMNS BEHIND. IN SOME CASES, LATERAL ANGLES, WHICH WILL REQUIRE EXTRA BEVELED WASHERS, WERE PRESCRIBED IN ORDER TO MISS THE EXISTING COLUMNS AND PILES. EXERCISE CARE WHILE DRILLING AND INSTALLING THE NAILS AS SOME OF THE PILES MAY HAVE BEEN DRIVEN AT DIFFERENT LOCATIONS THAN SHOWN ON THE PLANS. IF CONTACT IS MADE WITH AN EXISTING PILE, THEN FOLLOW THE INSTRUCTIONS ON SHEET 194.

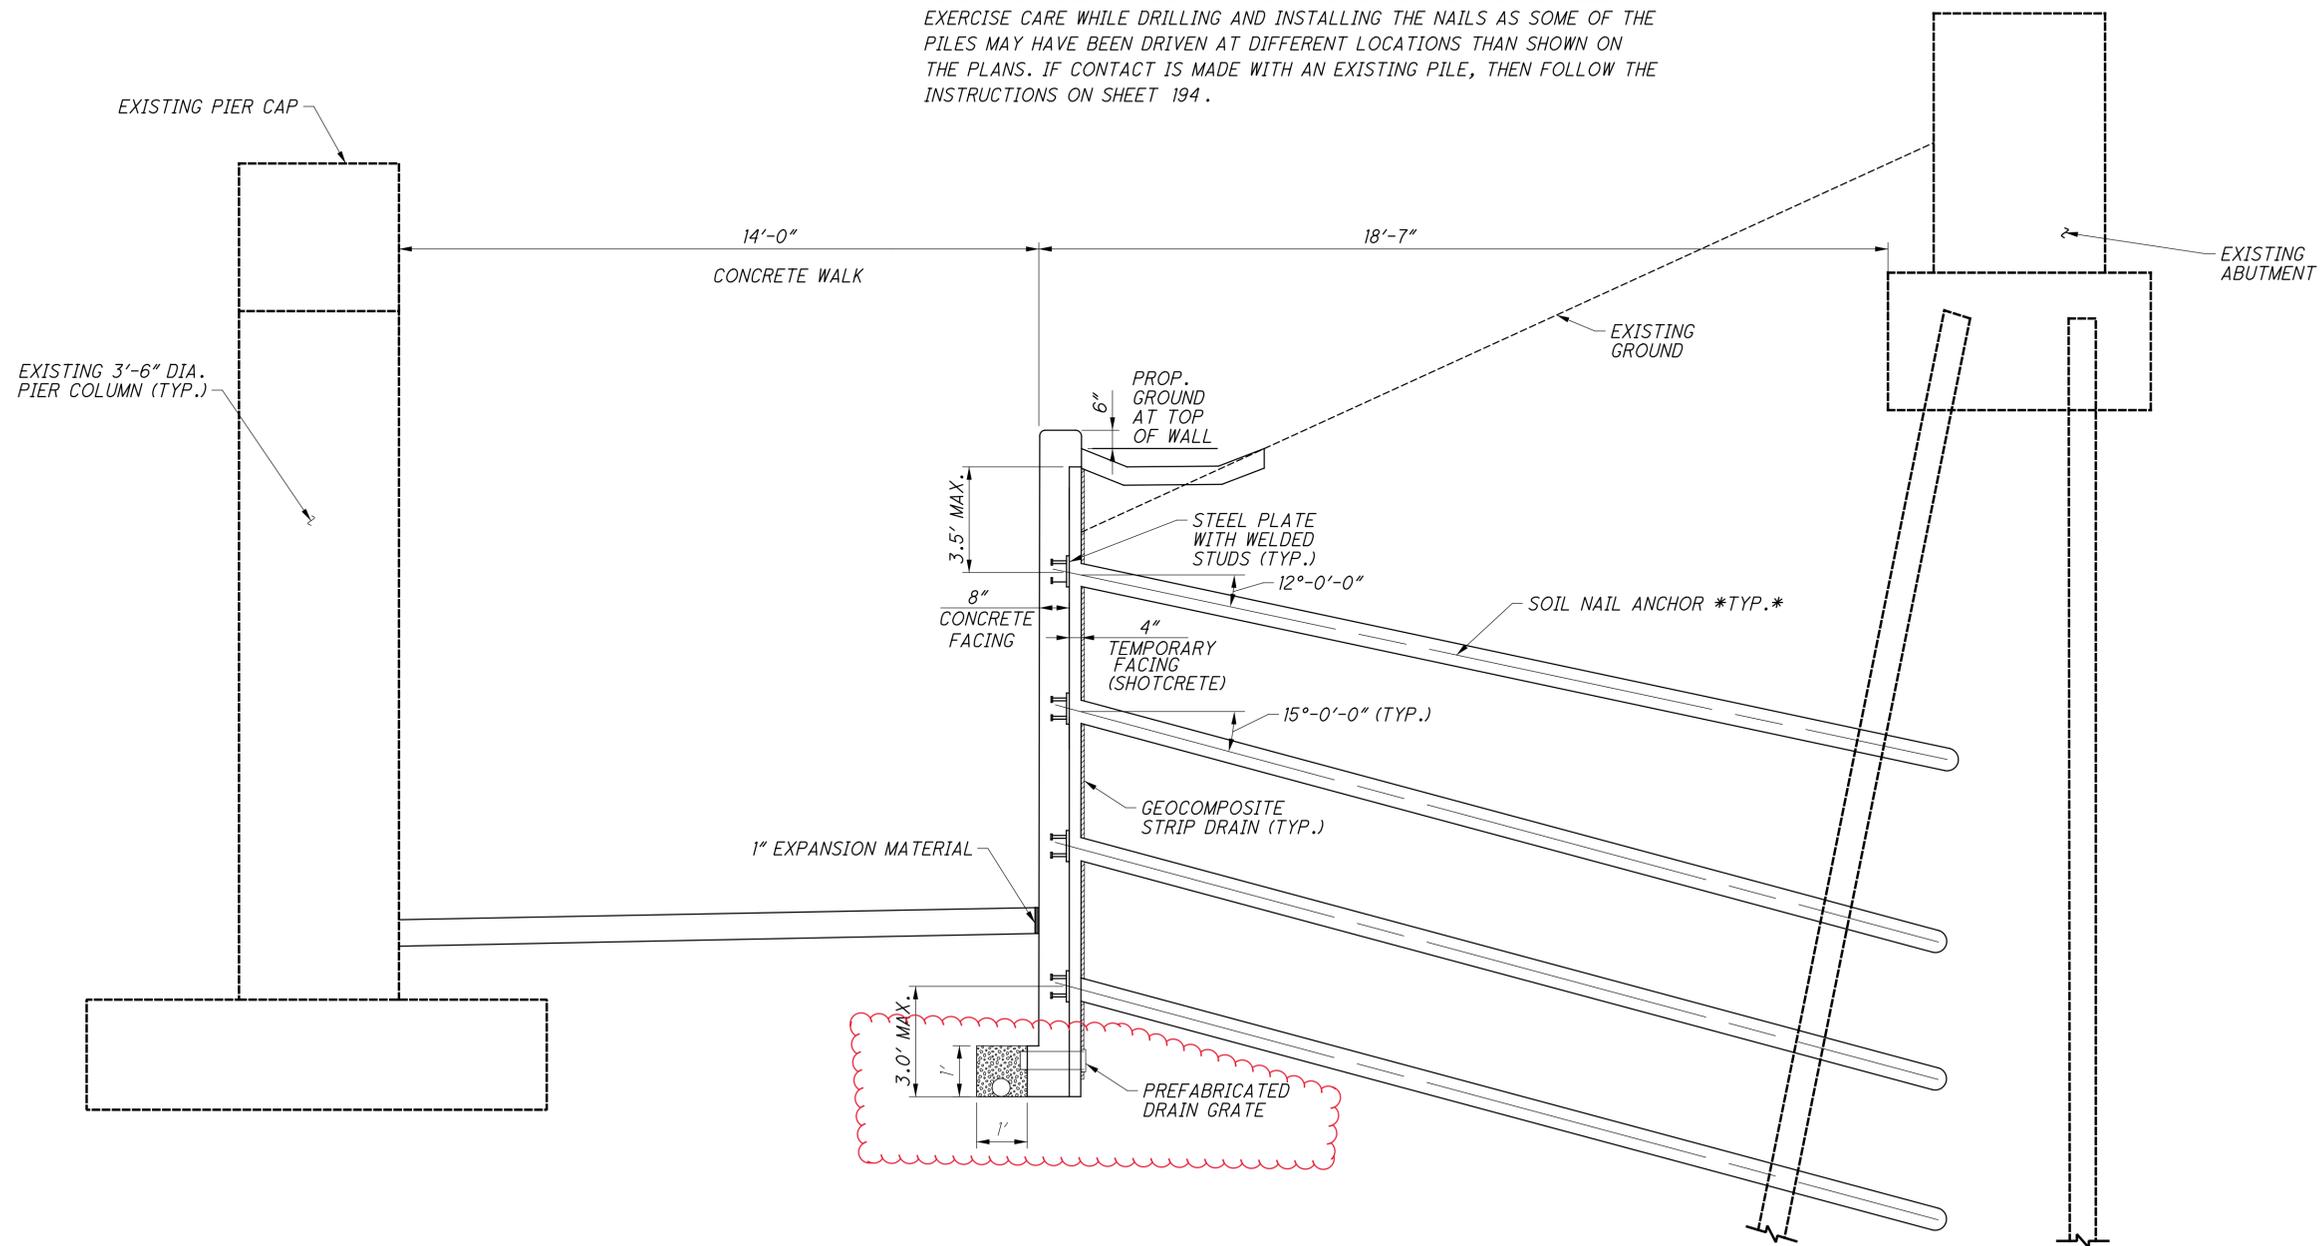

**TYPICAL SECTION**

O:\2018\1802295\_001\_MOT\_725\_14\structures\sheets\wall\_3 (soil nail)\08619\_003WD002.DGN 4/25/2024 1:43:39 PM agroff

O:\2018\1802295\_001\_MOT\_725\_14\_structures\sheets\wall\_3 (soil nail)\08619\_003\WD004.dgn 4/25/2024 1:43:41 PM agroff

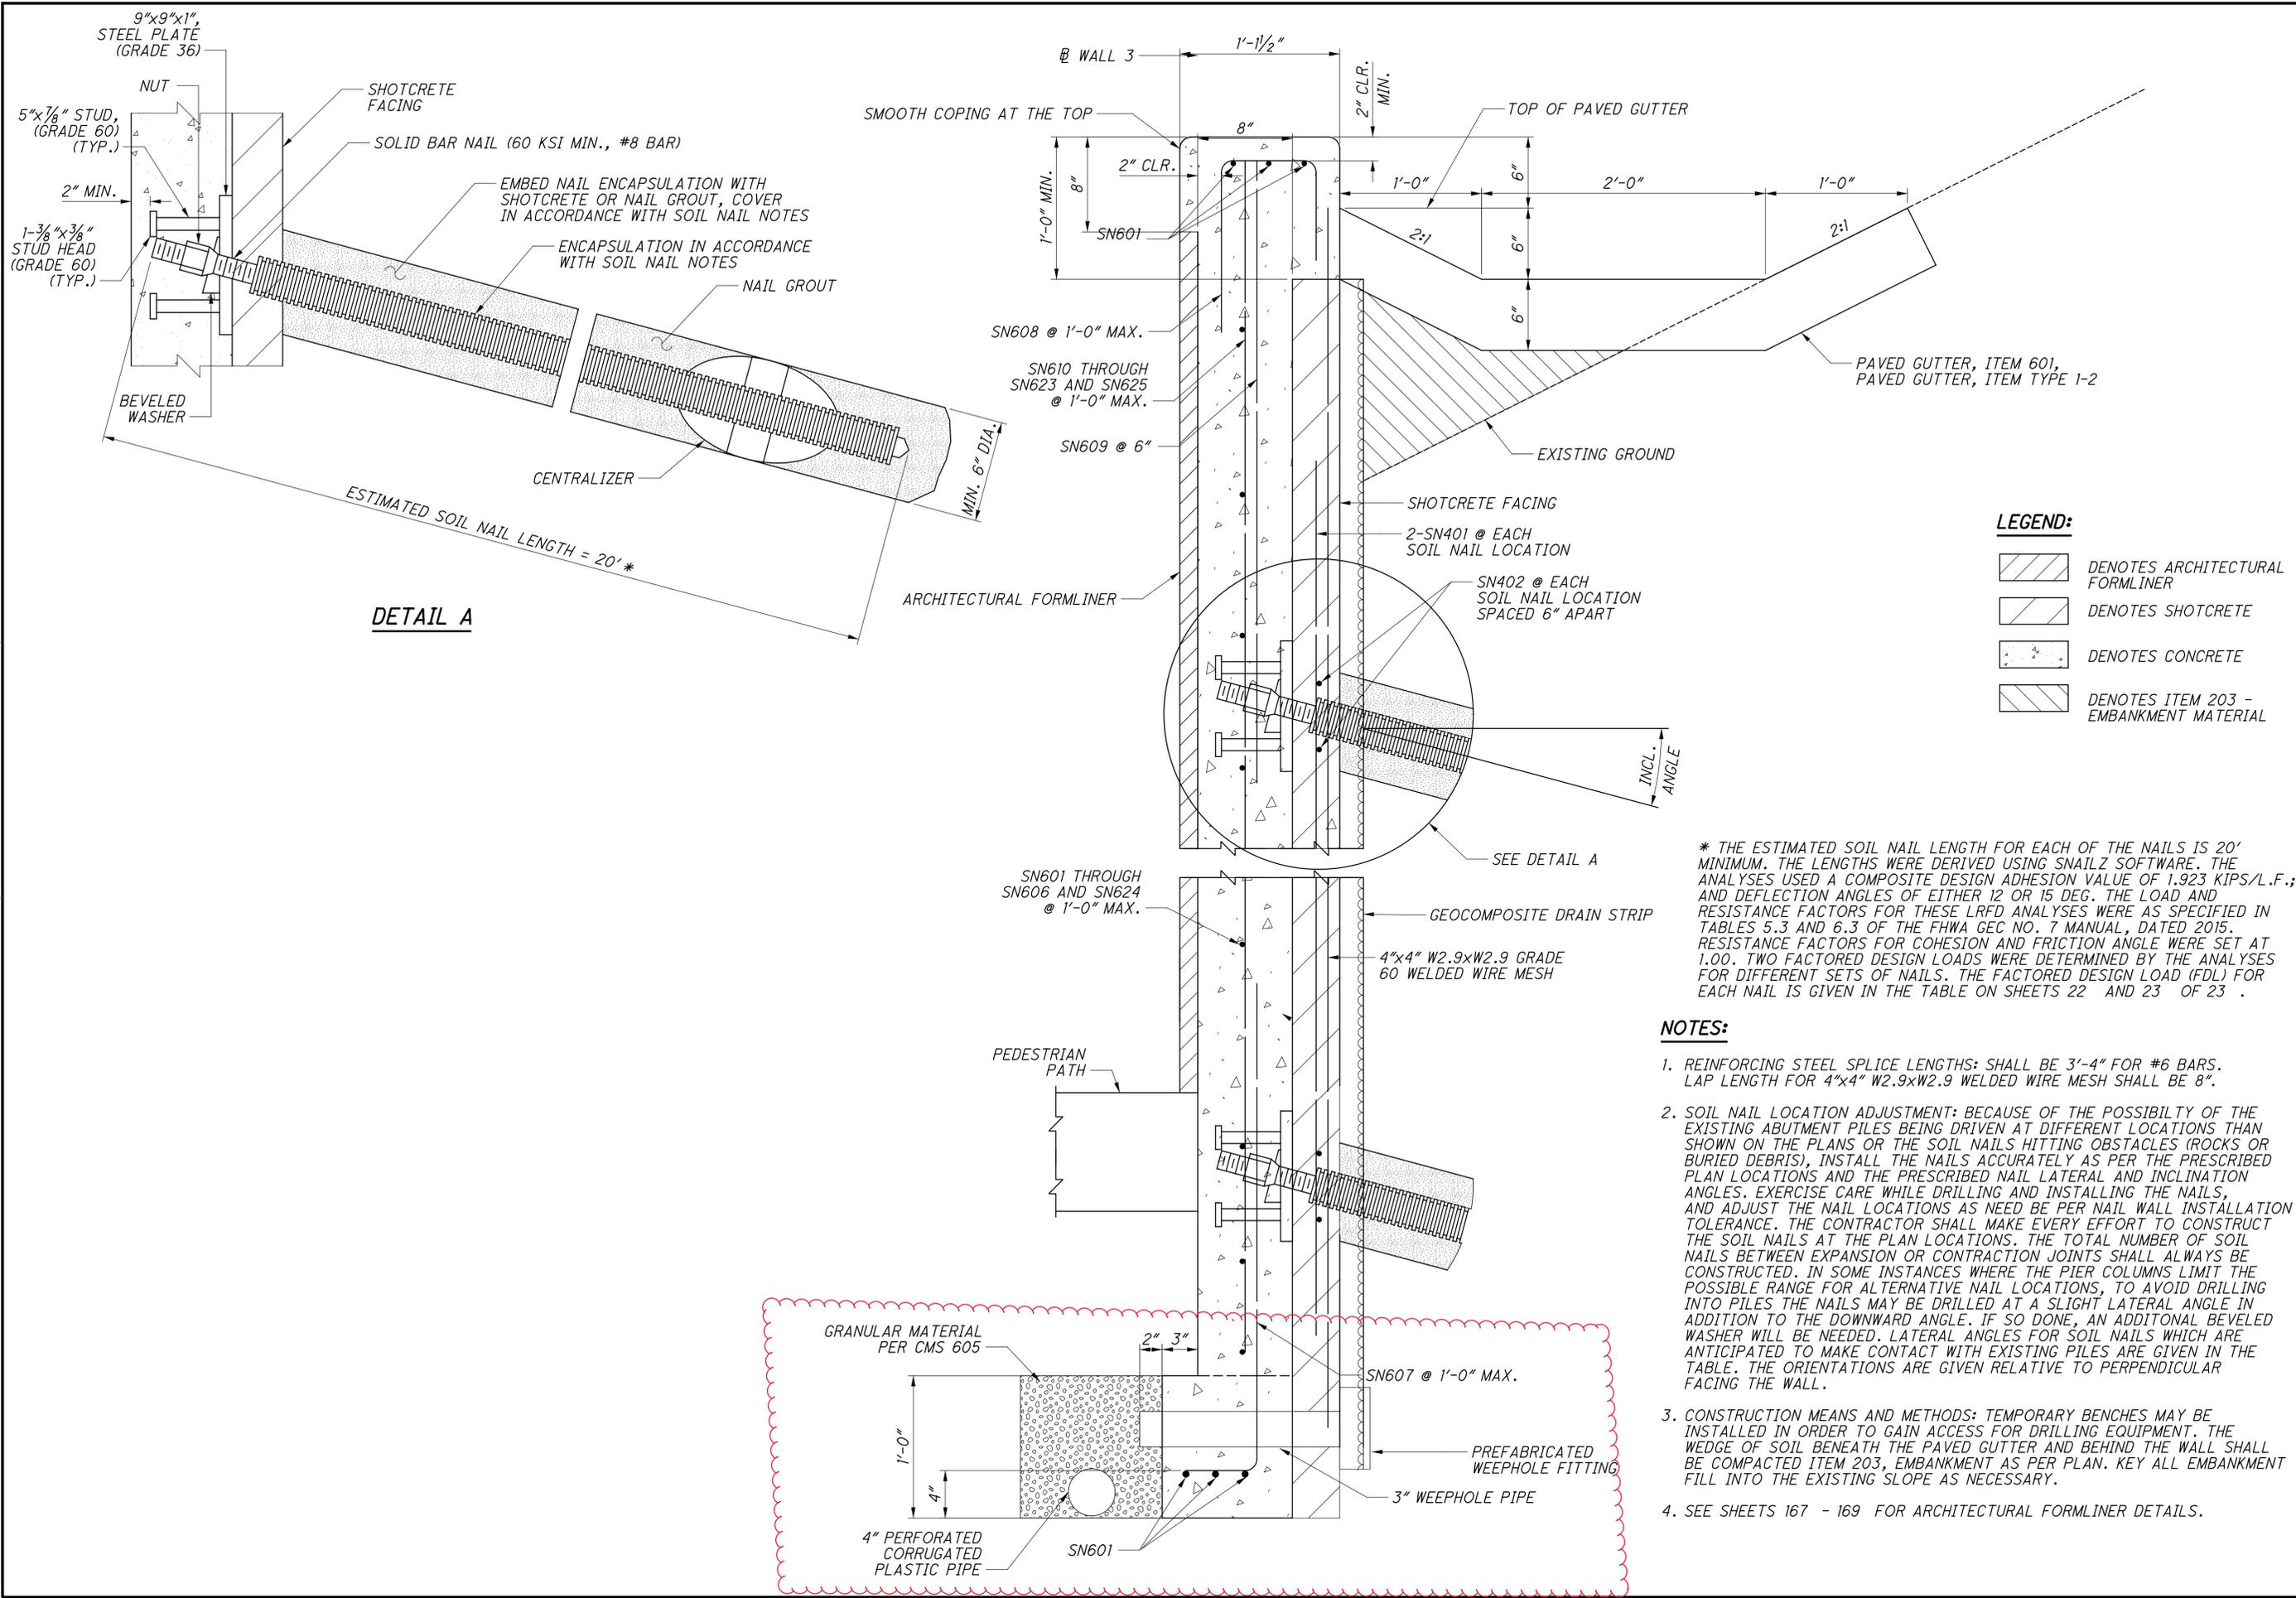


**LEGEND:**

	DENOTES ARCHITECTURAL FORMLINER
	DENOTES SHOTCRETE
	DENOTES CONCRETE
	DENOTES ITEM 203 - EMBANKMENT MATERIAL


\* THE ESTIMATED SOIL NAIL LENGTH FOR EACH OF THE NAILS IS 20' MINIMUM. THE LENGTHS WERE DERIVED USING SNAILZ SOFTWARE. THE ANALYSES USED A COMPOSITE DESIGN ADHESION VALUE OF 1.923 KIPS/L.F.; AND DEFLECTION ANGLES OF EITHER 12 OR 15 DEG. THE LOAD AND RESISTANCE FACTORS FOR THESE LRFD ANALYSES WERE AS SPECIFIED IN TABLES 5.3 AND 6.3 OF THE FHWA GEC NO. 7 MANUAL, DATED 2015. RESISTANCE FACTORS FOR COHESION AND FRICTION ANGLE WERE SET AT 1.00. TWO FACTORED DESIGN LOADS WERE DETERMINED BY THE ANALYSES FOR DIFFERENT SETS OF NAILS. THE FACTORED DESIGN LOAD (FDL) FOR EACH NAIL IS GIVEN IN THE TABLE ON SHEETS 22 AND 23 OF 23.

- NOTES:**
1. REINFORCING STEEL SPLICE LENGTHS: SHALL BE 3'-4" FOR #6 BARS. LAP LENGTH FOR 4"x4" W2.9xW2.9 WELDED WIRE MESH SHALL BE 8".
  2. SOIL NAIL LOCATION ADJUSTMENT: BECAUSE OF THE POSSIBILITY OF THE EXISTING ABUTMENT PILES BEING DRIVEN AT DIFFERENT LOCATIONS THAN SHOWN ON THE PLANS OR THE SOIL NAILS HITTING OBSTACLES (ROCKS OR BURIED DEBRIS), INSTALL THE NAILS ACCURATELY AS PER THE PRESCRIBED PLAN LOCATIONS AND THE PRESCRIBED NAIL LATERAL AND INCLINATION ANGLES. EXERCISE CARE WHILE DRILLING AND INSTALLING THE NAILS, AND ADJUST THE NAIL LOCATIONS AS NEED BE PER NAIL WALL INSTALLATION TOLERANCE. THE CONTRACTOR SHALL MAKE EVERY EFFORT TO CONSTRUCT THE SOIL NAILS AT THE PLAN LOCATIONS. THE TOTAL NUMBER OF SOIL NAILS BETWEEN EXPANSION OR CONTRACTION JOINTS SHALL ALWAYS BE CONSTRUCTED. IN SOME INSTANCES WHERE THE PIER COLUMNS LIMIT THE POSSIBLE RANGE FOR ALTERNATIVE NAIL LOCATIONS, TO AVOID DRILLING INTO PILES THE NAILS MAY BE DRILLED AT A SLIGHT LATERAL ANGLE IN ADDITION TO THE DOWNWARD ANGLE. IF SO DONE, AN ADDITIONAL BEVELED WASHER WILL BE NEEDED. LATERAL ANGLES FOR SOIL NAILS WHICH ARE ANTICIPATED TO MAKE CONTACT WITH EXISTING PILES ARE GIVEN IN THE TABLE. THE ORIENTATIONS ARE GIVEN RELATIVE TO PERPENDICULAR FACING THE WALL.
  3. CONSTRUCTION MEANS AND METHODS: TEMPORARY BENCHES MAY BE INSTALLED IN ORDER TO GAIN ACCESS FOR DRILLING EQUIPMENT. THE WEDGE OF SOIL BENEATH THE PAVED GUTTER AND BEHIND THE WALL SHALL BE COMPACTED ITEM 203, EMBANKMENT AS PER PLAN. KEY ALL EMBANKMENT FILL INTO THE EXISTING SLOPE AS NECESSARY.
  4. SEE SHEETS 167 - 169 FOR ARCHITECTURAL FORMLINER DETAILS.


DESIGN AGENCY 200 Corporate Center Blvd., Suite 200, Columbus, GA 31907
DATE: 1/11/2024 REVIEWED: RJM DRAWN: TBC DESIGNED: PPA CHECKED: RPM
STRUCTURE FILE NUMBER
<b>RETAINING WALL DETAILS</b> RETAINING WALL 3
<b>MOT-725-14.41</b> PID No. 108619
19 / 23
194 220

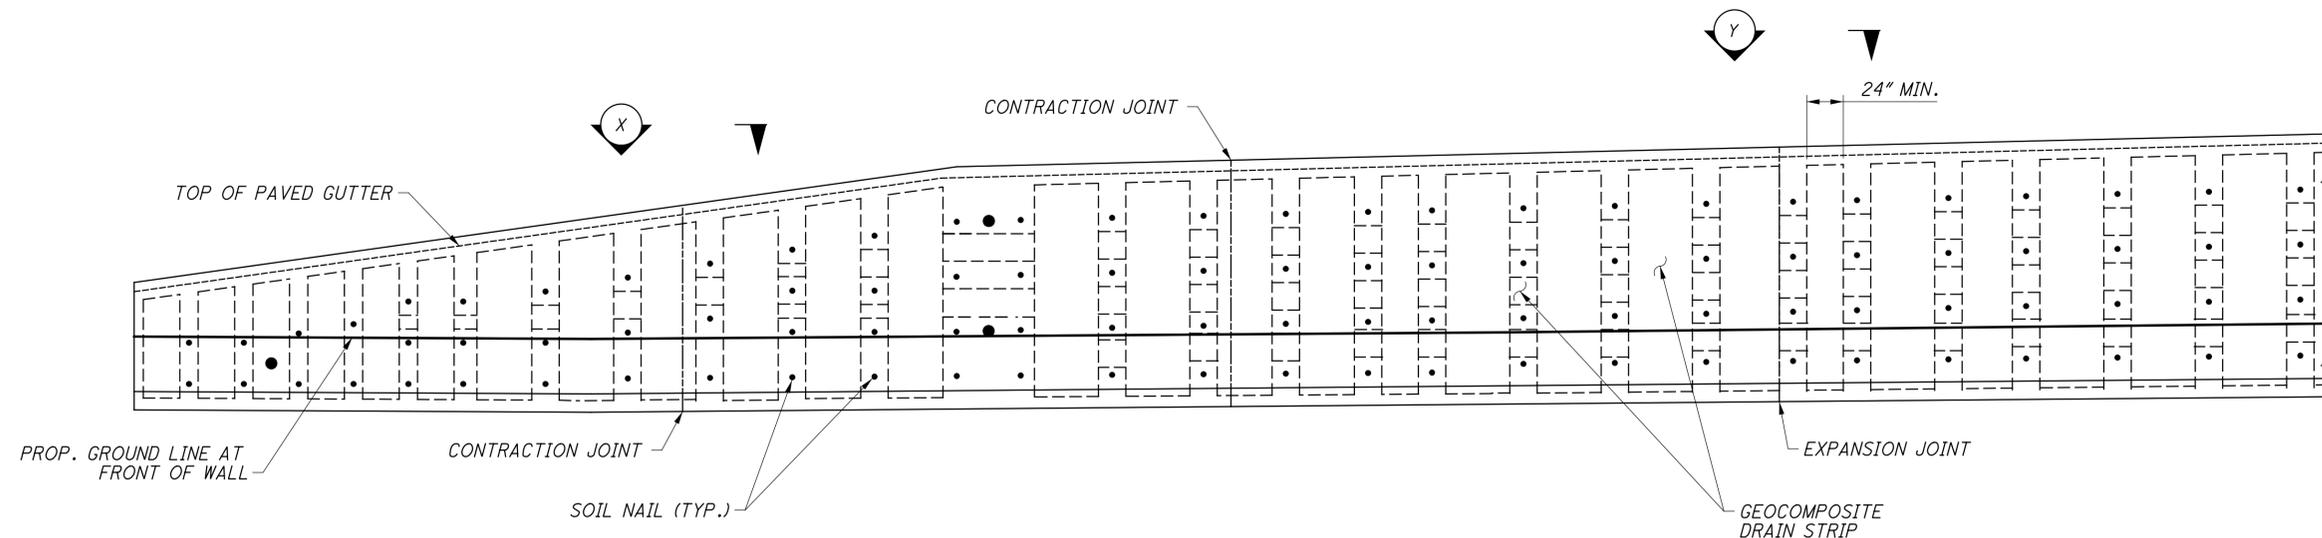


**WALL DRAINAGE DETAIL**

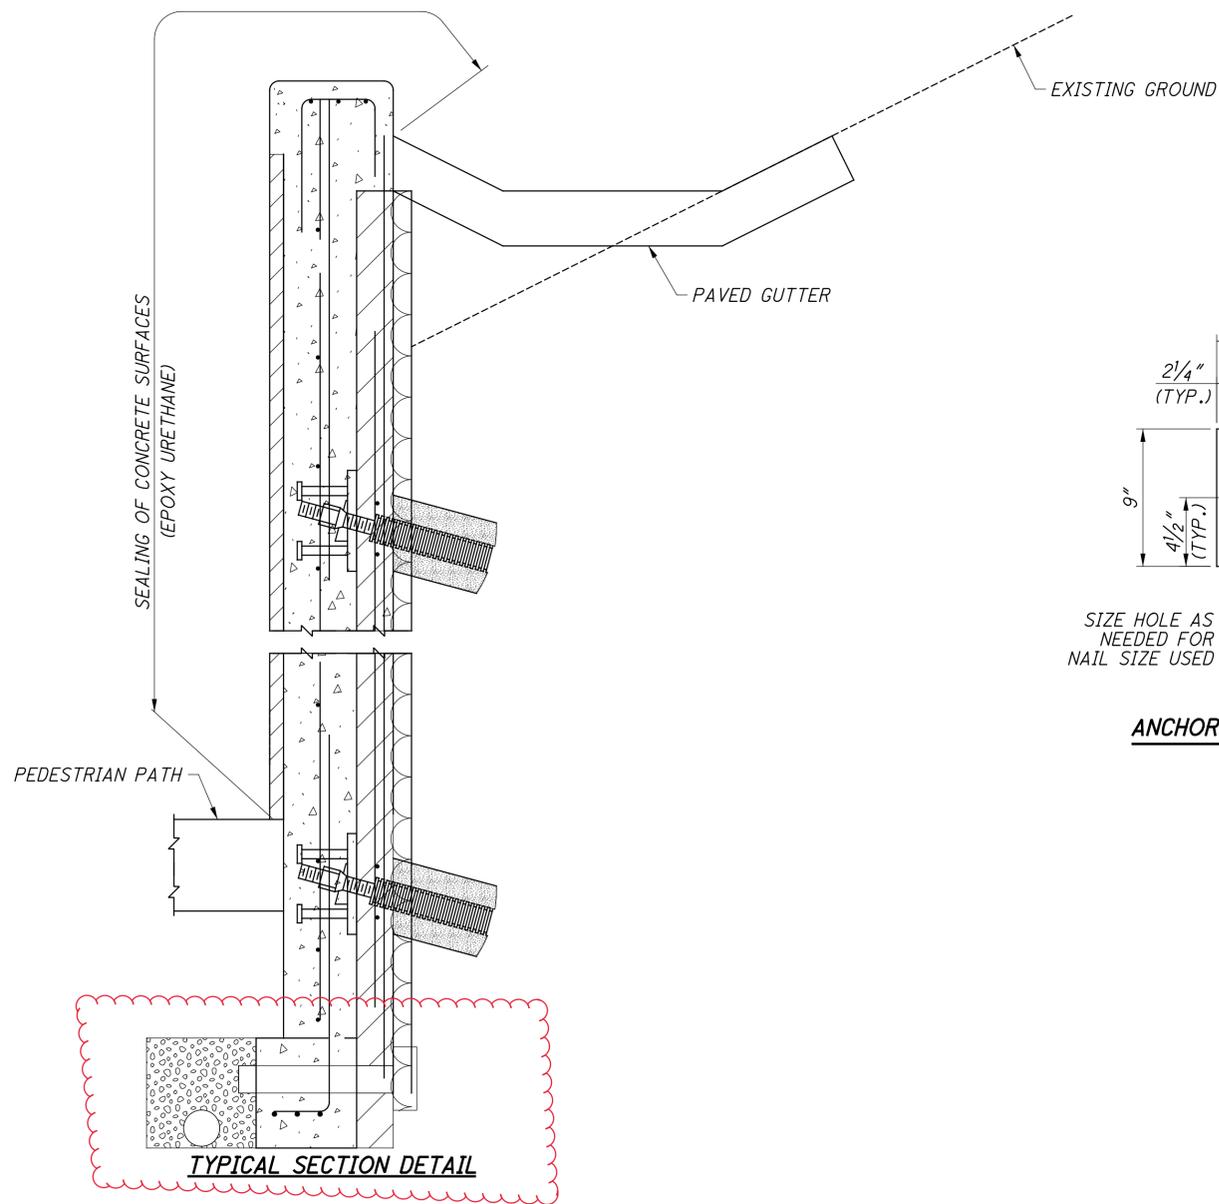


**TYPICAL SECTION DETAIL**

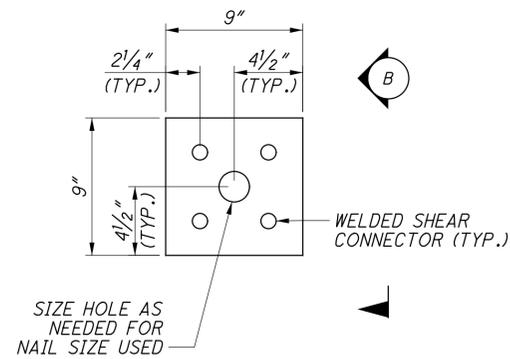


**ANCHOR PLATE DETAILS**

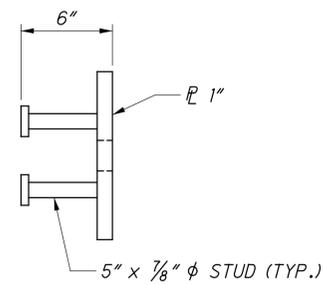


**VIEW B**

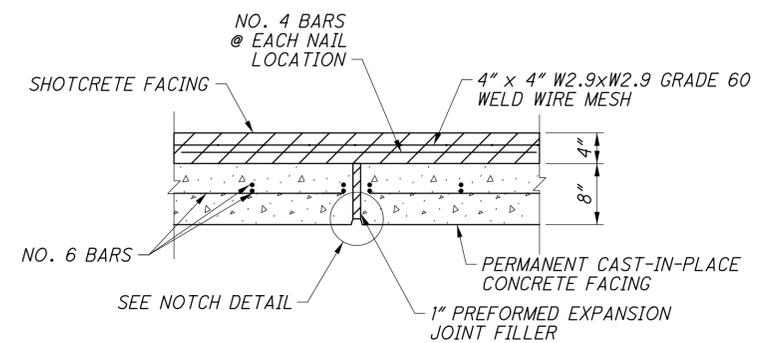

**VIEW Y-Y  
(TYPICAL EXPANSION JOINT)**

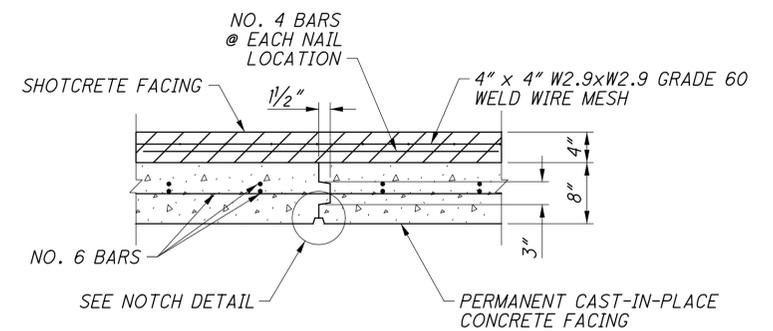

**VIEW X-X  
(TYPICAL CONTRACTION JOINT)**

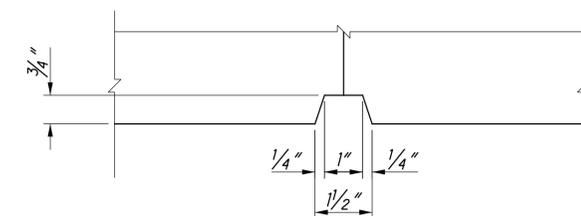

**NOTCH DETAIL**

O:\2018\1802295\_001\_MOT\_725\_14\structures\sheets\wall\_3 (soil nail)\08619\_003\WD009.dgn 4/25/2024 1:43:45 PM agrdff