

Application for permit to install and operate a
SEWAGE DISPOSAL SYSTEM

The applicant must submit the following information as requested by the Zanesville-Muskingum County General Health District in order for the department to properly assess the suitability of on-lot sewage disposal for proposed lot (s):

Ronald Lester 9145 18 1/2 Innis Ave 443-5576
Property Owner's Name Address Phone #

ON RT 555 in Philo next to 9125 Center Rd. Brushcreek
Location of Lot Township

Name of Installer Roy Taylor Certification # _____

THIS APPLICATION IS FOR:

New Construction _____ Number of Bedrooms _____
One Family Residence _____ Apartment Building _____
Mobile Home ☒ Commercial/Industrial Building _____

I agree to comply with the rules and regulations of the Board of Health of Zanesville-Muskingum County Health Department governing the installation and operation of sewage disposal systems.

I further agree that I will call for final inspection and approval of the Health Department of this installation prior to its being covered with earth.

Ronald Lester 1-7-93
Applicant's Signature Date

TO BE COMPLETED BY ENVIRONMENTALIST

Staff Analysis of Soil Conditions
Excavated test hole: Yes ☒ No _____
Soil Properties and Limitations _____

Severe
% Slope 5-20%
(Seasonal) water table none
Staff Comments: _____

Septic tank: Yes ☒ No _____
Size: 1,500 gallon
Make: Hepp

Leach Field: _____
Feet Utilized 100' x 12" x 12" gravel leaching

Aeration Unit: Yes _____ No ☒
Size: _____
Make: _____
Model: _____

Other means of sewage disposal _____
2 (9' x 40' x 42") subsurface filter beds



OFFICE USE ONLY:

Permit Issued: 6927 1-7-93 75.00
No. Date Fee Paid - Amount

Approval Mark Khis S.E.T. Disapproval _____

2/10/93

9145 Center Road

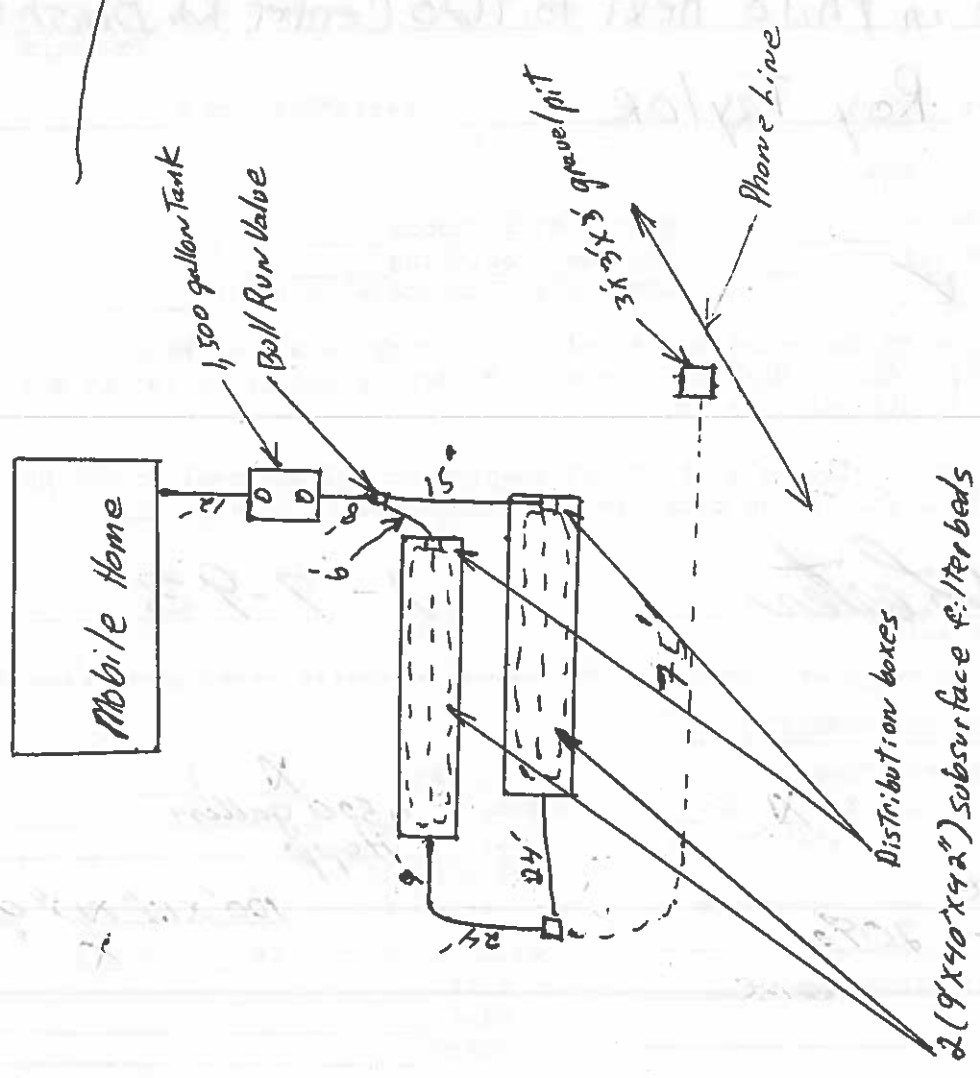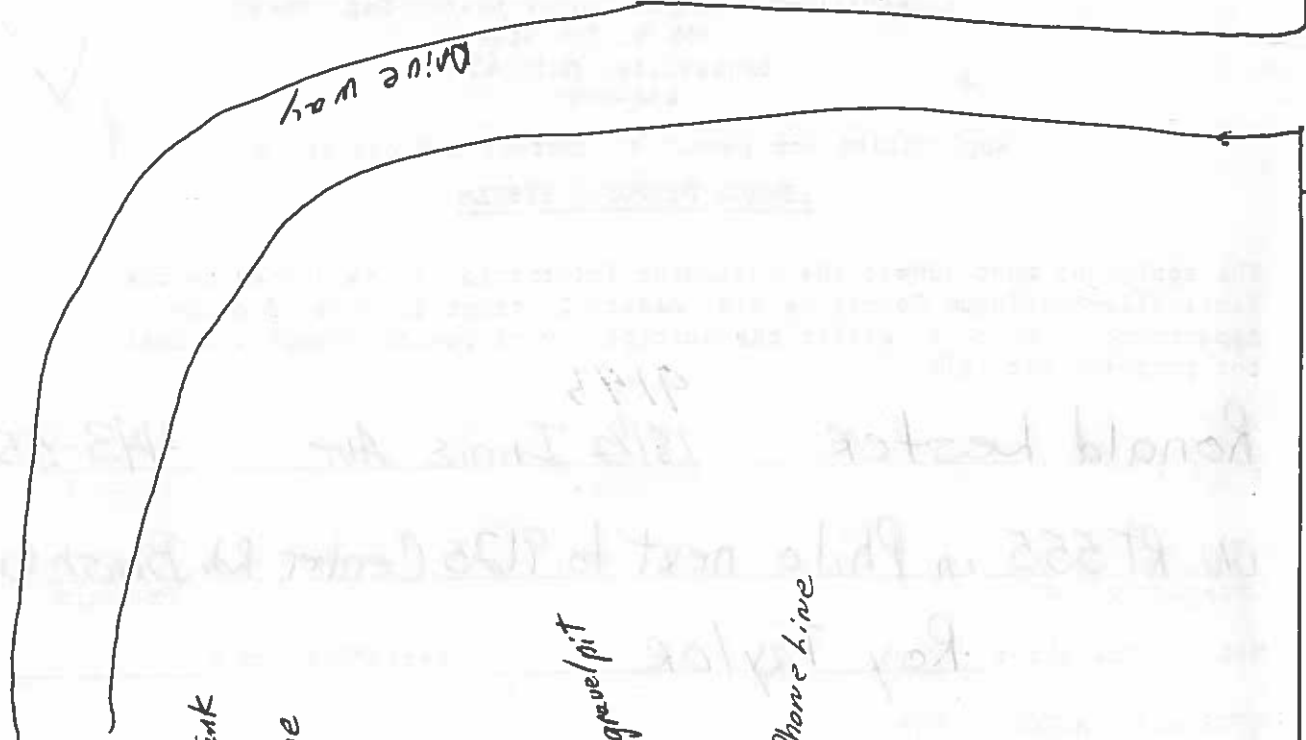

Center Road