




Zanesville-Muskingum County Health Department
205 N. 7th Street, Zanesville, Ohio 43701
Phone: (740) 454-9741

X

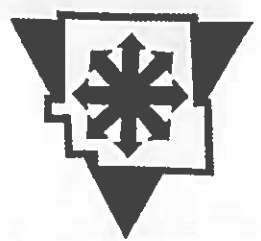

Application for permit to install and operate a

SEWAGE DISPOSAL SYSTEM

The applicant must submit the following information as requested by the Zanesville-Muskingum County General Health District in order for the department to properly assess the suitability of on-lot sewage disposal for proposed lot(s):

Ronald L Rhoades Jr. and Mandy E Denman 6285 Windsong Way
Property Owner's Name CURRENT Mailing Address

Nashport, Ohio 43830
City State Zip

9147 Center Rd. Blue Rock, Ohio 43220
ADDRESS of Installation Site Township Phone (740) 454-8948

Name of Installer Chuck Hina Certification # _____

THIS APPLICATION IS FOR: New Installation ☒ Alteration _____

New Construction _____ Number of Bedrooms 3
Existing Home _____ Apartment Building _____
Mobile Home ☒ Commercial/Industrial Building _____

I agree to comply with the rules and regulations of the Board of Health of Zanesville-Muskingum County Health Department governing the installation and operation of sewage disposal systems.

I further agree that I will call for final inspection and approval of the Health Department of this installation prior to its being covered with earth.

This permit is valid for one year from the date of issue.

I believe all information submitted above to be accurate as recorded.

Mandy E Denman Ronald Rhoades Jr. 11-2-99
Applicant's Signature Date

OFFICE USE ONLY:

Permit Issued 10283 11/5/99 \$ 120.00 + _____ = 120.00
No. Date Permit Fee Penalty Fee Total

Soil Properties and Limitations

% Slope _____
(Seasonal) water table _____
Staff Comments: _____

Tank: Septic/Aeration
Size: 1500 gallon
Make: Hypp
Model #: _____
Secondary Treatment:
Leaching [] Filterbed ☒ Other []


Approval [Signature]

Disapproval _____

Inspection Date 11/15/99

SEE REVERSE SIDE FOR LAYOUT

9147 CENTER ROAD

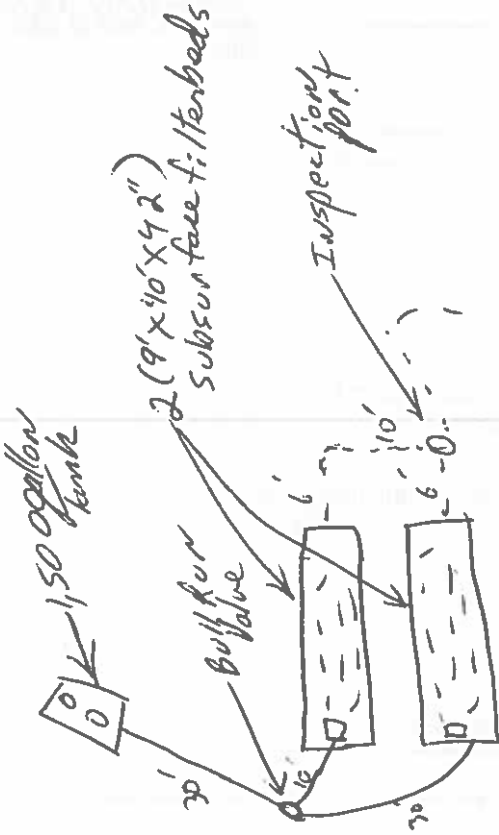

ZANESVILLE-MUSKINGUM COUNTY
GENERAL HEALTH DISTRICT

NOV 05 1999
RECEIVED