

Permit#

Zanesville-Muskingum County
Health Department
205 N. 7th Street
Zanesville, Ohio 43701

File#

Phone: (614) 454-9741

Application for permit to install and operate a

SEWAGE DISPOSAL SYSTEM

The applicant must submit the following information as requested by the Zanesville-Muskingum County General Health District in order for the department to properly assess the suitability of on-lot sewage disposal for proposed lot (s):

Ronald B. Miracle 9395 CENTER Rd. 697-7225
Property Owner's Name Address Phone #

SAME BRUSH CREEK
Location of Lot Township

Name of Installer SELF Certification # _____

Shape and total area of proposed lot, location of streams, bodies of water, ditches and all easements. This information must be supplied by sketch on a separate sheet of paper. House and lot lines must be properly identified and marked (staked).

THIS APPLICATION IS FOR:

New Construction ☒One Family Residence ☒Mobile Home ☐Number of Bedrooms 3Apartment Building ☐Commercial/Industrial Building ☐

Ronald B. Miracle
Applicant's Signature

2/1/89
Date

TO BE COMPLETED BY ENVIRONMENTALIST

Staff Analysis of Soil Conditions

Excavated test hole: Yes ☒ No ☐

Soil Properties and Limitations _____

shale with coarse loam

% Slope _____

(Seasonal) water table _____

Staff Comments: long narrow lot -
filter beds should work well.

Septic tank: Yes ☒ No ☐Size: 1,500 GALLONMake: HUPP

Leach Field: _____

Feet Utilized 2-9'x42'x42" FILTER BEDSAeration Unit: Yes ☐ No ☐

Size: _____

Make: _____

Model# _____

Other means of sewage disposal

Mike Krosch 6-19-89 & 12/5/89

OFFICE USE ONLY:

Permit Issued: 33481 3/17/89
No. Date


\$50.00
Fee Paid - Amount

Approval yes, March '88 by M.K.

Disapproval _____

7395 Center Road

Spring
~300' from
TANK

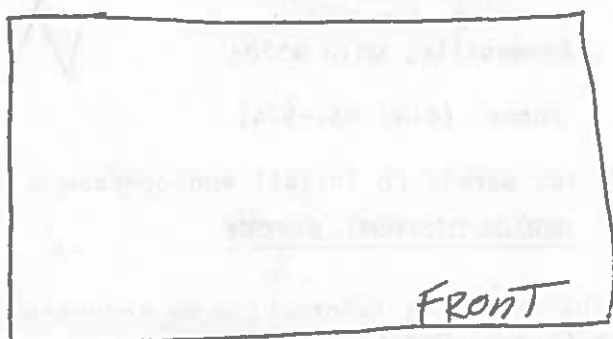

←20'→



~15'



←1,500
Gallon TANK

Flow
DIVERTOR

10'

←18'→

5'


1'-2'

W L D
9'x42'x42"

Subsurface FILTER
beds with
____' leaching
outlet



9'

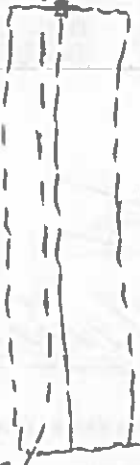

~15'



Inspection Port
to grade

W L D
1'x130'x12"

1'x40'x12"

creek

ST. RT. 555