



MODEL: Sheet PAPER: 34x22 (in.) DATE: 4/16/2025 TIME: 2:25:47 PM USER: DSUPINSKI
 L:\City of Port Clinton\OH\20225628\001A-PORT CLINTON INFRASTRUCTURE\Final Deliverables\115148\400-Engineering\Roadway\Sheets\115148_GTO01.dgn

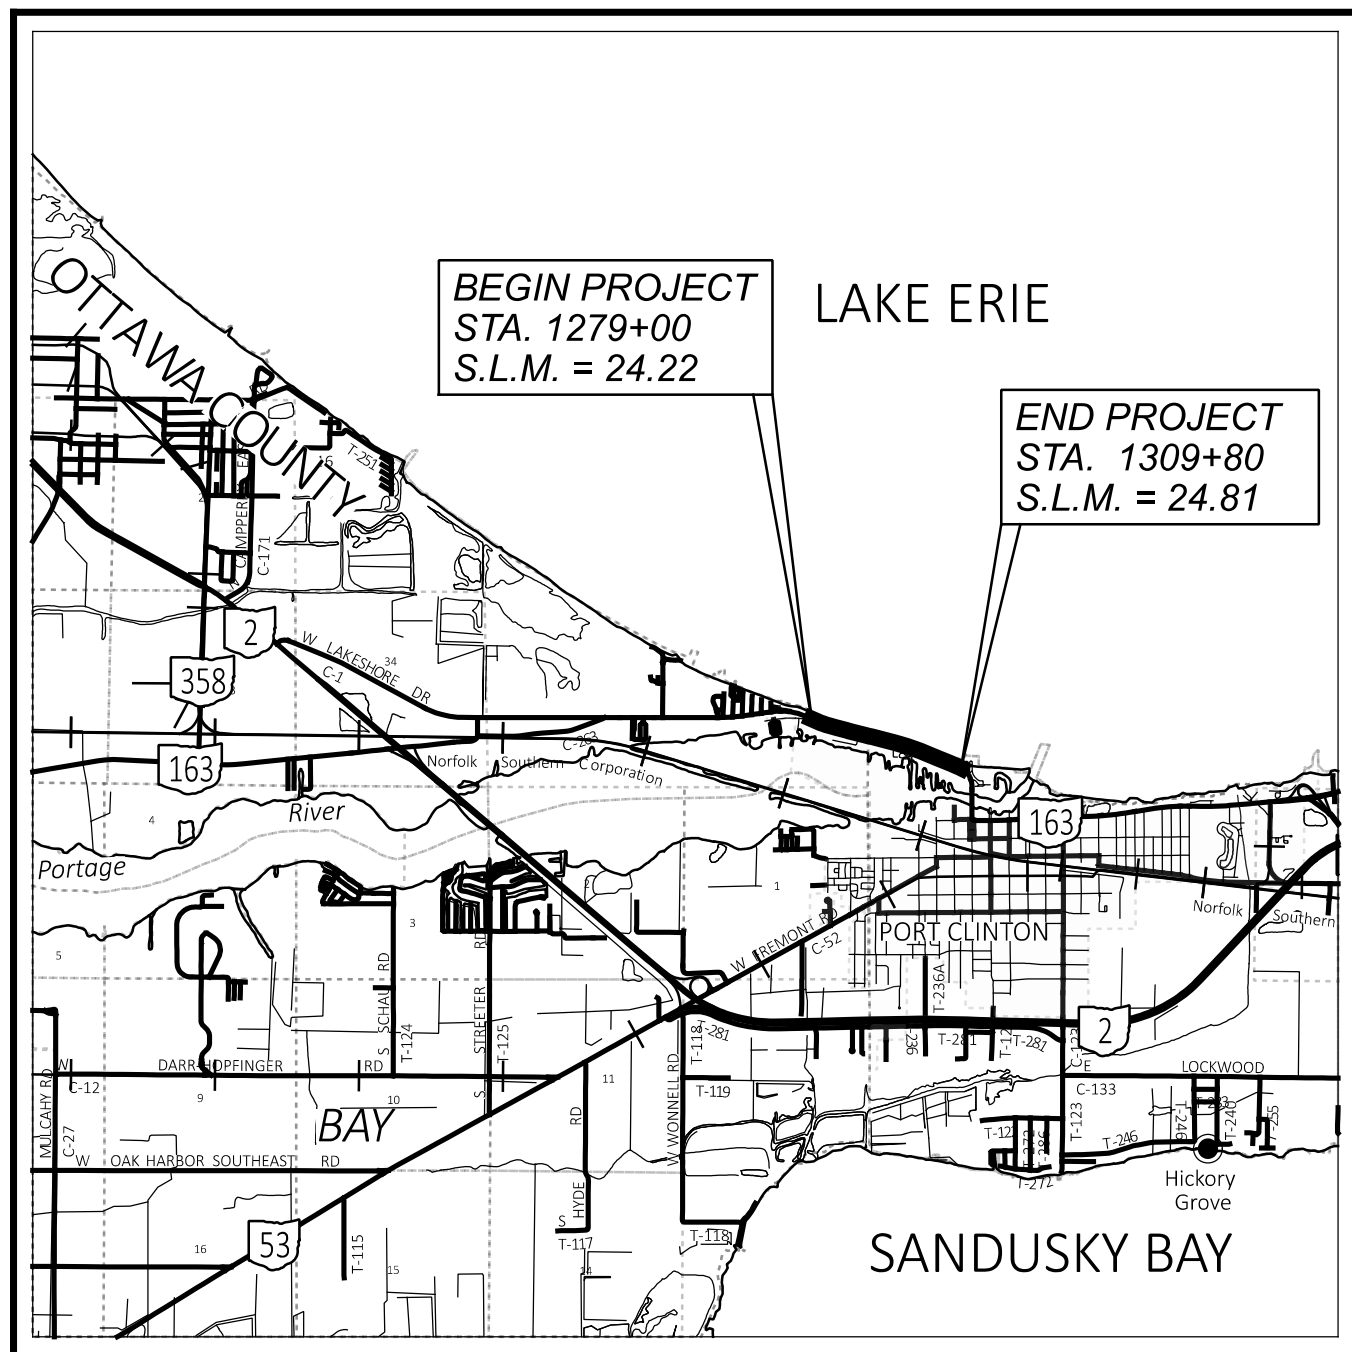

LOCATION MAP

LATITUDE: N41°31'10" LONGITUDE: W82°57'07"

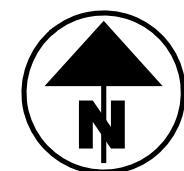

- PORTION TO BE IMPROVED
- INTERSTATE HIGHWAY
- FEDERAL ROUTES
- STATE ROUTES
- COUNTY & TOWNSHIP ROADS
- OTHER ROADS

DESIGN DESIGNATION

- CURRENT ADT (2021) 3,330
- DESIGN YEAR ADT (2023) 4,100
- DESIGN HOURLY VOLUME (2021) 357
- DIRECTIONAL DISTRIBUTION 0.56
- TRUCKS (24 HOUR B&C) 3%
- DESIGN SPEED 35 MPH
- LEGAL SPEED 35 MPH
- DESIGN FUNCTIONAL CLASSIFICATION:
 04-MINOR ARTERIAL (URBAN)
- NHS PROJECT NO

DESIGN EXCEPTIONS

NONE REQUIRED

ADA DESIGN WAIVERS

NONE REQUIRED

UNDERGROUND UTILITIES
 Contact Two Working Days
 Before You Dig

OHIO811.org
Before You Dig

OHIO 811. 8-1-1, or 1-800-362-2764
 (Non members must be called directly)

PLAN PREPARED BY:

KLEINFELDER
 Bright People. Right Solutions.
 1168 N. MAIN STREET
 BOWLING GREEN, OH
 419.352.7537

ENGINEER'S SEAL:

STRUCTURAL:

SIGNED: _____
 DATE: _____

ENGINEER'S SEAL:

ROADWAY:

SIGNED: _____
 DATE: _____

STATE OF OHIO

DEPARTMENT OF TRANSPORTATION

OTT-163-24.22

SHORE REVETMENT

CITY OF PORT CLINTON OTTAWA COUNTY, OHIO

INDEX OF SHEETS:

TITLE SHEET	1
SCHEMATIC PLAN	2 - 3
TYPICAL SECTIONS	4 - 5
GENERAL NOTES	6 - 7
MAINTENANCE OF TRAFFIC	8 - 9
GENERAL SUMMARY	10
PROJECT SITE PLAN	11
PLAN AND PROFILE - SR-163	12 - 18
CROSS SECTIONS - SR-163	19 - 35
RIGHT OF WAY CENTERLINE PLAT	RW1 - RW2
RIGHT OF WAY DETAIL SHEETS	RW3 - RW5

STANDARD CONSTRUCTION DRAWINGS						SUPPLEMENTAL SPECIFICATIONS	SPECIAL PROVISIONS
						800-2023	7/19/2024
						832	7/19/2024
						961	4/17/2020
						821	4/20/19
						921	7/19/24

FEDERAL PROJECT NUMBER

E230028

RAILROAD INVOLVEMENT

NONE

PROJECT DESCRIPTION

REPAIR OF APPROXIMATELY 3,100 FT OF REVETMENT ALONG THE NORTH SIDE SHORELINE OF SR-163 (WEST LAKESHORE DR) IN THE CITY OF PORT CLINTON.

EARTH DISTURBED AREAS

- PROJECT EARTH DISTURBED AREA: 3.0 ACRES
- ESTIMATED CONTRACTOR EARTH DISTURBED AREA: 0.3 ACRES
- NOTICE OF INTENT EARTH DISTURBED AREA: 3.3 ACRES

2023 SPECIFICATIONS

THE STANDARD SPECIFICATIONS OF THE STATE OF OHIO, DEPARTMENT OF TRANSPORTATION, INCLUDING SUPPLEMENTAL SPECIFICATIONS LISTED IN THE PLANS AND CHANGES LISTED IN THE PROPOSAL SHALL GOVERN THIS IMPROVEMENT.

I HEREBY APPROVE THESE PLANS AND DECLARE THAT THE MAKING OF THIS IMPROVEMENT WILL NOT REQUIRE THE CLOSING TO TRAFFIC OF THE HIGHWAY AND THAT PROVISIONS FOR THE MAINTENANCE AND SAFETY OF TRAFFIC WILL BE AS SET FORTH ON THE PLANS AND ESTIMATES.

CITY OF PORT CLINTON

 Pat McColley, P.E., S.I.
 District 02 Deputy Director

Pamela Boratyn
 Director, Department of Transportation

TITLE SHEET

DESIGN AGENCY

KLEINFELDER
Bright People. Right Solutions.

DESIGNER DPF

REVIEWER RPD

PROJECT ID 115148

SHEET TOTAL
1 | 35

