

Middle

Images mid CBS 1, 2, 3

By: FM/BM  
 Date: 03/26/24  
 Job #: ROSS 772  
**Manhole and Catch Basin Report**

**PT 30157**

Station and Offset: \_\_\_\_\_  
 Address / Street: \_\_\_\_\_  
 Survey Data Point No.: \_\_\_\_\_  
 Manhole No.: \_\_\_\_\_ Type: Sanitary \_\_\_\_\_ Storm \_\_\_\_\_ Combined \_\_\_\_\_

Surface Data

Location	Pavement Condition/Type	Casting/Cover Condition
<input type="checkbox"/> Gutter	<input type="checkbox"/> Cracked	<input checked="" type="checkbox"/> Good
<input type="checkbox"/> Crown	<input type="checkbox"/> Sunken	<input type="checkbox"/> Fair
<input type="checkbox"/> Drive	<input checked="" type="checkbox"/> Good	<input type="checkbox"/> Poor
<input type="checkbox"/> Parking Lot	<input type="checkbox"/> Broken	<input type="checkbox"/> Cracked
<input type="checkbox"/> Treelawn	<input type="checkbox"/> Heaved	<input type="checkbox"/> Broken
<input type="checkbox"/> Ditch		
<input type="checkbox"/> Street	<input type="checkbox"/> Asphalt	Above/Below Grade <u>0</u> in.
<input checked="" type="checkbox"/> Yard	<input type="checkbox"/> Concrete	Ponding <input type="checkbox"/> Y <input checked="" type="checkbox"/> N <u>0</u> sf
<input type="checkbox"/> Field	<input type="checkbox"/> Gravel	Holes in cover <input type="checkbox"/> Y <input type="checkbox"/> N
<input type="checkbox"/> Swale		Total # _____ size _____ in


Drainage Structure

Cover	Type	Construction	Overflow*	Condition	Steps
<input checked="" type="checkbox"/> Vented	<input checked="" type="checkbox"/> Single	<input checked="" type="checkbox"/> Precast	<input type="checkbox"/> Sidechannel Spillway	<input checked="" type="checkbox"/> Good	<input type="checkbox"/> Good
<input type="checkbox"/> No Vent	<input type="checkbox"/> Dual	<input type="checkbox"/> Brick	<input type="checkbox"/> Weir	<input type="checkbox"/> Poor	<input type="checkbox"/> Poor
	<input type="checkbox"/> Round	<input type="checkbox"/> Other	<input type="checkbox"/> Pipe Overflow*	<input type="checkbox"/> Fair	
	<input checked="" type="checkbox"/> Square		<input type="checkbox"/> Other		
Grate	<input type="checkbox"/> Rectangle				
<input type="checkbox"/> Bike Safe	<input type="checkbox"/> Force Main Outlet				
<input type="checkbox"/> Directional	<input checked="" type="checkbox"/> Drop				
	<input type="checkbox"/> Other		* Provide sketch		

Piping Configuration

Rim Elevation: \_\_\_\_\_

Size (inches)	Direction	Material Type	Invert Depth (feet)	Other Comments or Observations
42	N	CMP	3.74	
42	S	CMP	3.76	

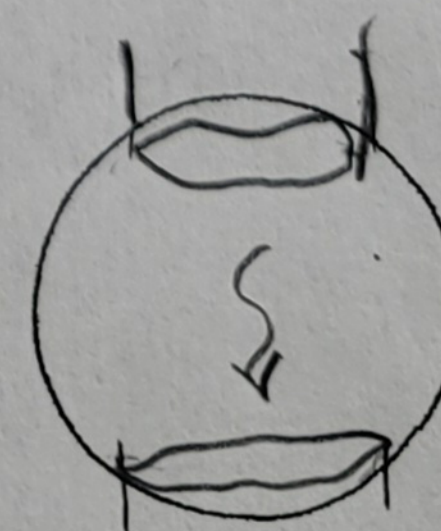

Sketch -- Indicate pipes and direction of flow



NORTH

IMAGES

NORTH CBS 1, 2, 3, 4

By:

FM/BM

Date:

03/26/24

Job #:

ROSS 772

## Manhole and Catch Basin Report

PT 30207

Station and Offset:

Address / Street:

Survey Data Point No.: \_\_\_\_\_

Manhole No.:

Type:

Sanitary \_\_\_\_\_

Storm ☒

Combined \_\_\_\_\_

## Surface Data

Location	Pavement Condition/Type	Casting/Cover Condition
<input type="checkbox"/> Gutter	<input type="checkbox"/> Cracked	<input checked="" type="checkbox"/> Good
<input type="checkbox"/> Crown	<input type="checkbox"/> Sunken	<input type="checkbox"/> Fair
<input type="checkbox"/> Drive	<input checked="" type="checkbox"/> Good	<input type="checkbox"/> Poor
<input type="checkbox"/> Parking Lot	<input type="checkbox"/> Broken	<input type="checkbox"/> Cracked
<input type="checkbox"/> Tree lawn	<input type="checkbox"/> Heaved	<input type="checkbox"/> Broken
<input type="checkbox"/> Ditch		
<input type="checkbox"/> Street	<input type="checkbox"/> Asphalt	Above/Below Grade _____ in.
<input checked="" type="checkbox"/> Yard	<input type="checkbox"/> Concrete	Ponding <input type="checkbox"/> Y <input checked="" type="checkbox"/> N _____ sf
<input type="checkbox"/> Field	<input type="checkbox"/> Gravel	Holes in cover <input checked="" type="checkbox"/> Y <input type="checkbox"/> N
<input type="checkbox"/> Swale		Total # _____ size _____ in

## Drainage Structure


Cover	Type	Construction	Overflow*	Condition	Steps
<input checked="" type="checkbox"/> Vented	<input type="checkbox"/> Single	<input checked="" type="checkbox"/> Precast	<input type="checkbox"/> Sidechannel Spillway	<input checked="" type="checkbox"/> Good	<input type="checkbox"/> Good
<input type="checkbox"/> No Vent	<input type="checkbox"/> Dual	<input type="checkbox"/> Brick	<input type="checkbox"/> Weir	<input type="checkbox"/> Poor	<input type="checkbox"/> Poor
	<input type="checkbox"/> Round	<input type="checkbox"/> Other	<input type="checkbox"/> Pipe Overflow*	<input type="checkbox"/> Fair	
	<input type="checkbox"/> Square		<input type="checkbox"/> Other		
Grate	<input type="checkbox"/> Rectangle				
<input type="checkbox"/> Bike Safe	<input type="checkbox"/> Force Main Outlet				
<input type="checkbox"/> Directional	<input checked="" type="checkbox"/> Drop				
	<input type="checkbox"/> Other				
* Provide sketch					

## Piping Configuration

Rim Elevation: \_\_\_\_\_

Size (inches)	Direction	Material Type	Invert Depth (feet)	Other Comments or Observations
30	NNE	CPP	4.56	
32	ESE	CPP	4.29	
42	S	CMF	4.62	

North

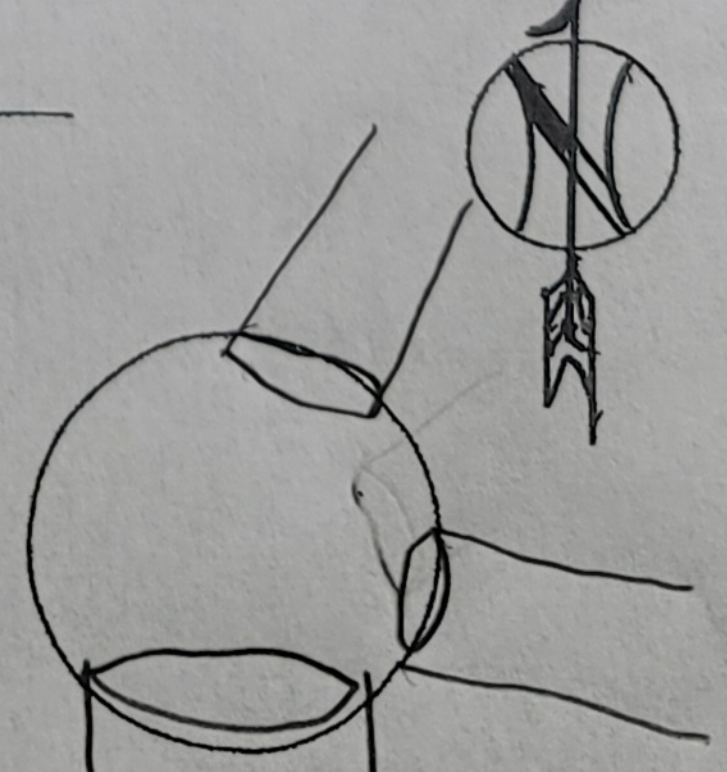

Sketch – Indicate pipes and direction of flow



South CB IMAGES

SCBS 1+2

By: FM/BM  
Date: 03/26/24  
Job #: ROSS 772

# Manhole and Catch Basin Report

PT 30988

Station and Offset: \_\_\_\_\_  
Address / Street: \_\_\_\_\_

Survey Data Point No.: \_\_\_\_\_

Manhole No.: \_\_\_\_\_ Type: Sanitary \_\_\_\_\_ Storm ☒ Combined \_\_\_\_\_

## Surface Data

Location	Pavement Condition/Type	Casting/Cover Condition
<input type="checkbox"/> Gutter	<input type="checkbox"/> Cracked	<input checked="" type="checkbox"/> Good
<input type="checkbox"/> Crown	<input type="checkbox"/> Sunken	<input type="checkbox"/> Fair
<input type="checkbox"/> Drive	<input checked="" type="checkbox"/> Good	<input type="checkbox"/> Poor
<input type="checkbox"/> Parking Lot	<input type="checkbox"/> Broken	<input type="checkbox"/> Cracked
<input type="checkbox"/> Treelawn	<input type="checkbox"/> Heaved	<input type="checkbox"/> Broken
<input type="checkbox"/> Ditch		
<input type="checkbox"/> Street	<input type="checkbox"/> Asphalt	Above/Below Grade <input checked="" type="checkbox"/> in.
<input checked="" type="checkbox"/> Yard	<input type="checkbox"/> Concrete	Ponding <input type="checkbox"/> Y <input type="checkbox"/> N sf
<input type="checkbox"/> Field	<input type="checkbox"/> Gravel	Holes in cover <input checked="" type="checkbox"/> Y <input type="checkbox"/> N
<input type="checkbox"/> Swale		Total # _____ size _____ in



## Drainage Structure

Cover	Type	Construction	Overflow*	Condition	Steps
<input checked="" type="checkbox"/> Vented	<input checked="" type="checkbox"/> Single	<input type="checkbox"/> Precast	<input type="checkbox"/> Sidechannel Spillway	<input checked="" type="checkbox"/> Good	<input type="checkbox"/> Good
<input type="checkbox"/> No Vent	<input type="checkbox"/> Dual	<input checked="" type="checkbox"/> Brick	<input type="checkbox"/> Weir	<input type="checkbox"/> Poor	<input type="checkbox"/> Poor
	<input type="checkbox"/> Round	<input type="checkbox"/> Other	<input type="checkbox"/> Pipe Overflow*	<input type="checkbox"/> Fair	<input checked="" type="checkbox"/> N/A
	<input checked="" type="checkbox"/> Square		<input type="checkbox"/> Other		
Grate	<input type="checkbox"/> Rectangle				
<input type="checkbox"/> Bike Safe	<input type="checkbox"/> Force Main Outlet				
<input checked="" type="checkbox"/> Directional	<input type="checkbox"/> Drop				
	<input type="checkbox"/> Other		* Provide sketch		

## Piping Configuration

Rim Elevation: \_\_\_\_\_

Size (inches)	Direction	Material Type	Invert Depth (feet)	Other Comments or Observations
15	E	RCP	1.96	

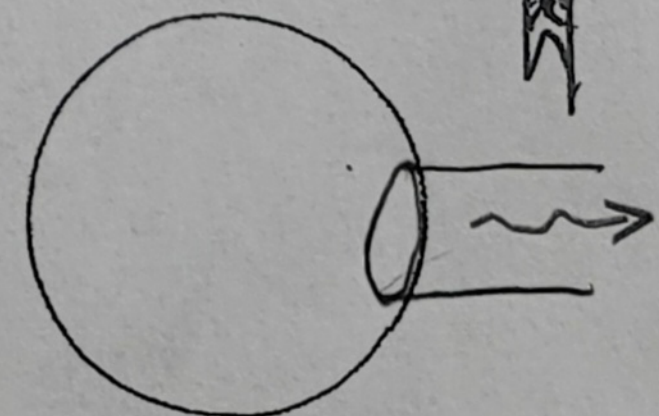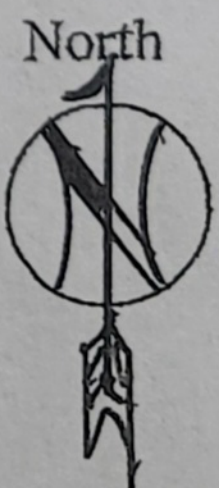

Sketch – Indicate pipes and direction of flow