

STATE OF OHIO
DEPARTMENT OF TRANSPORTATION

SUM-76 / 77-7.58 / 9.59

CITY OF AKRON
SUMMIT COUNTY

PROJECT DESCRIPTION


THIS PROJECT CONSISTS OF THE REPLACEMENT OF THE BRIDGE DECK FOR SUM-76-0758. IT ALSO CONSISTS OF THE REPLACEMENT OF THE BRIDGE DECK AND WIDENING OF SUM 77-0959. RAMP B2 AND B AT THE IR 277- IR 77 INTERCHANGE ARE BEING WIDENED AND RESURFACED AS PART OF THE PROJECT.

EARTH DISTURBED AREA

PROJECT EARTH DISTURBED AREA: 2.41 ACRES
ESTIMATED CONTRACTOR EARTH DISTURBED AREA: 1.20 ACRES
NOTICE OF INTENT EARTH DISTURBED AREA: 4.90 ACRES


2013 SPECIFICATIONS

THE STANDARD SPECIFICATIONS OF THE STATE OF OHIO, DEPARTMENT OF TRANSPORTATION, INCLUDING CHANGES AND SUPPLEMENTAL SPECIFICATIONS LISTED IN THE PROPOSAL SHALL GOVERN THIS IMPROVEMENT.

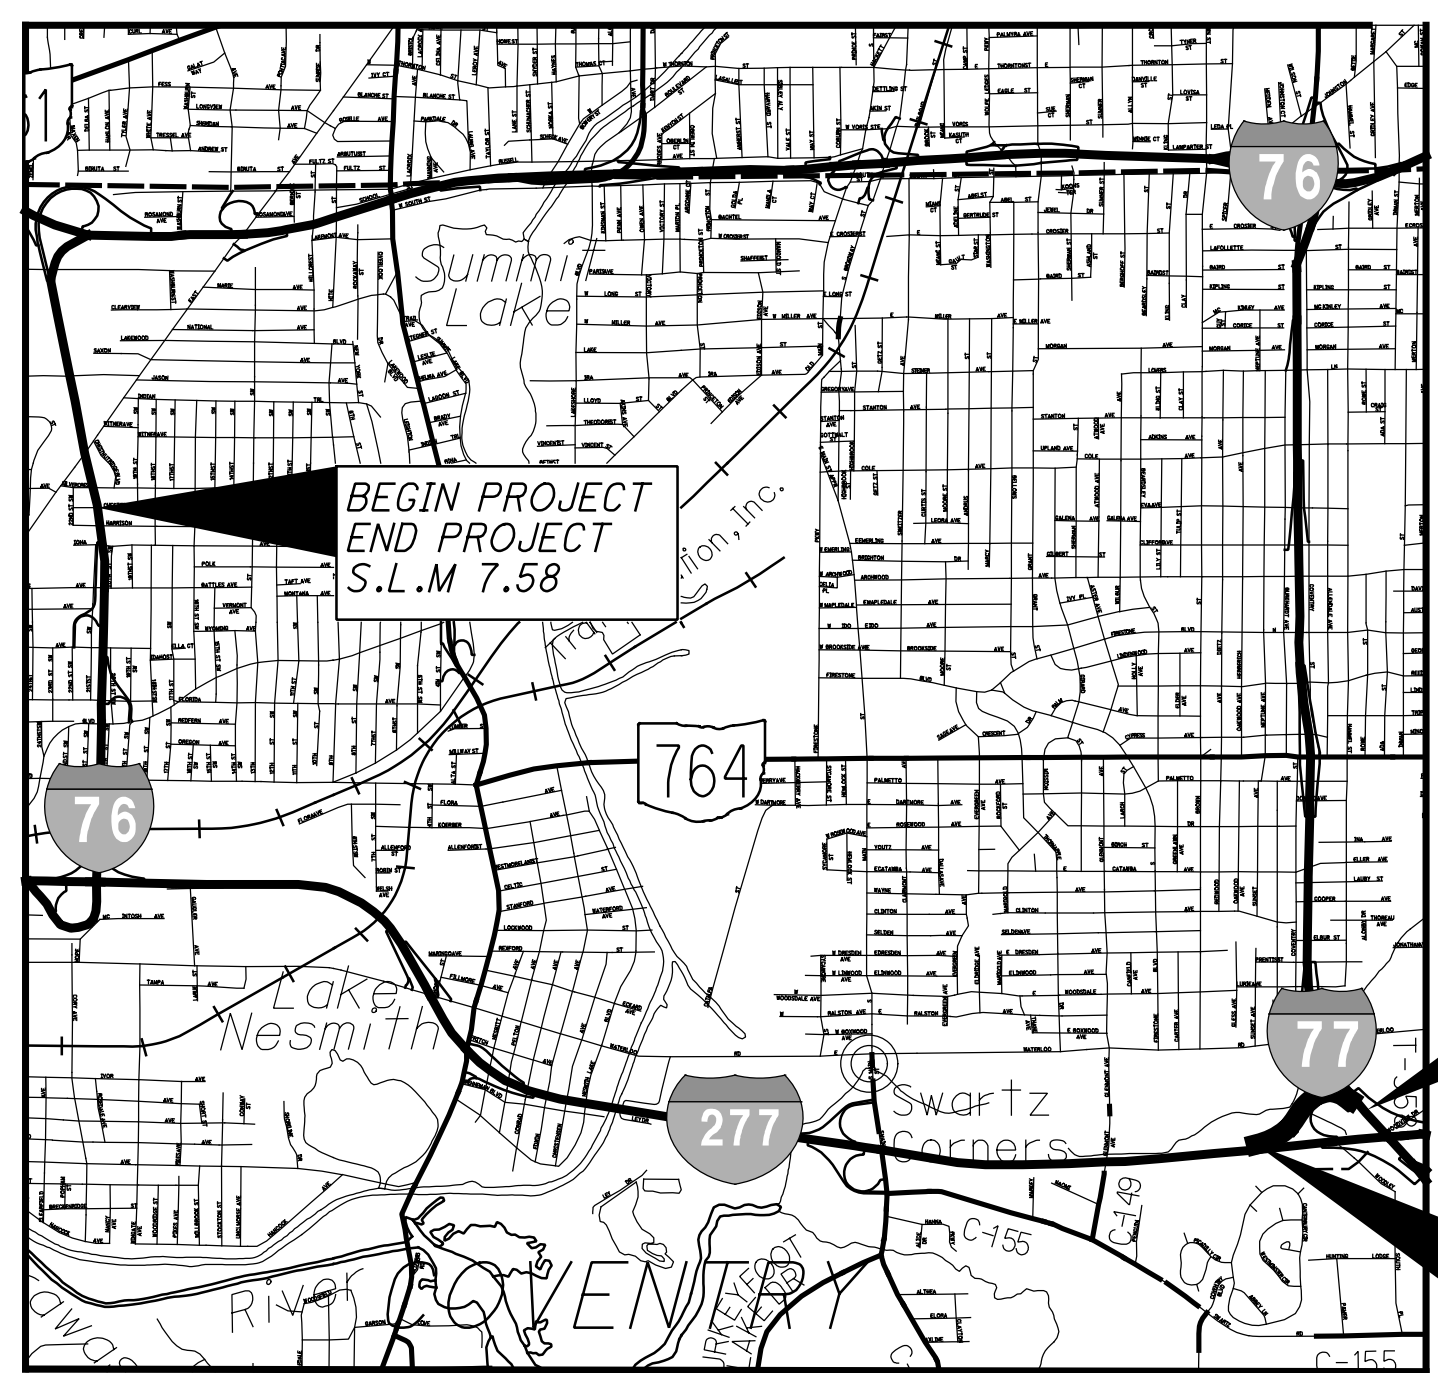

LOCATION MAP

LATITUDE: 41°01'32.00" LONGITUDE: 81°30'04.30"

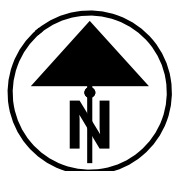

PORTION TO BE IMPROVED	—————
INTERSTATE HIGHWAY	—————
FEDERAL ROUTES	—————
STATE ROUTES	—————
COUNTY & TOWNSHIP ROADS	—————
OTHER ROADS	—————

DESIGN DESIGNATION

	IR-76	RAMP B-2 (IR-77/IR-277 INTRCHG)
CURRENT ADT (2015)	59,000	12,800
DESIGN YEAR ADT (2035)	60,000	15,500
DESIGN HOURLY VOLUME (2035)	5,400	1,485
DIRECTIONAL DISTRIBUTION	57%	1.0%
TRUCKS (24 HOUR B&C)	14%	9%
DESIGN SPEED	65 M.P.H.	VARIABLES, MIN 35 M.P.H.
LEGAL SPEED	55 M.P.H.	-
DESIGN FUNCTIONAL CLASSIFICATION:	FREEWAY	FREEWAY
NHS PROJECT	YES	YES

DESIGN EXCEPTIONS NONE REQUIRED

INDEX OF SHEETS:

TITLE SHEET	1
STRUCTURE PLANS	2 -14

AS BUILT SHEETS
2

**BU5 - APPROVED FOR CONSTRUCTION
SUM-77-0959 SUBSTRUCTURE
JULY 27, 2015**

UNDERGROUND UTILITIES

CONTACT BOTH SERVICES
CALL TWO WORKING DAYS
BEFORE YOU DIG

CALL
1-800-362-2764
(TOLL FREE)

OHIO UTILITIES PROTECTION SERVICE
NON-MEMBERS
MUST BE CALLED DIRECTLY

OIL & GAS PRODUCERS UNDERGROUND
PROTECTION SERVICE CALL: **1-800-925-0988**

ENGINEERS SEAL:

SIGNED: *Joe Mellman*
DATE: 07/27/2015

STANDARD CONSTRUCTION DRAWINGS				SUPPLEMENTAL SPECIFICATIONS		SPECIAL PROVISIONS	
A-1-69	07/19/02			800	10/17/14		
AS-1-15	07/17/15			821	4/20/12		
EXJ-4-87	07/19/02			832	01/17/14		
GSD-1-96	01/19/02						
RB-1-55	07/19/13						
SBR-1-13	01/17/14						

I HEREBY APPROVE THESE PLANS AND DECLARE THAT THE MAKING OF THIS IMPROVEMENT WILL REQUIRE THE CLOSING TO TRAFFIC OF THE HIGHWAY AND THAT DETOURS WILL BE PROVIDED AS INDICATED IN BUILDABLE UNIT 2.

APPROVED _____
DATE _____ DISTRICT DEPUTY DIRECTOR


APPROVED _____
DATE _____ DIRECTOR, DEPARTMENT OF TRANSPORTATION

g:\projects\2015\w-15-001 SUM77-76_DB_with_S&S\98061\structures\SUM077_0959C\sheets\98061ST001.dgn 9/12/2016 3:07:37 PM juans

BU5 - AS-BUILT DRAWINGS - 09/12/2016

RAILROAD INVOLVEMENT	NONE
CONSTRUCTION PROJECT NO.	15-3000
PID NO.	98061
FEDERAL PROJECT NO.	E140 (478)
SUM 76 / 77-7.58 / 9.59	1 14


G:\projects\2015\W-15-001 SUM77-76 DB with S&S\98061\structures\SUM077_0959C\SP001.dgn 9/12/2016 3:07:42 PM juans

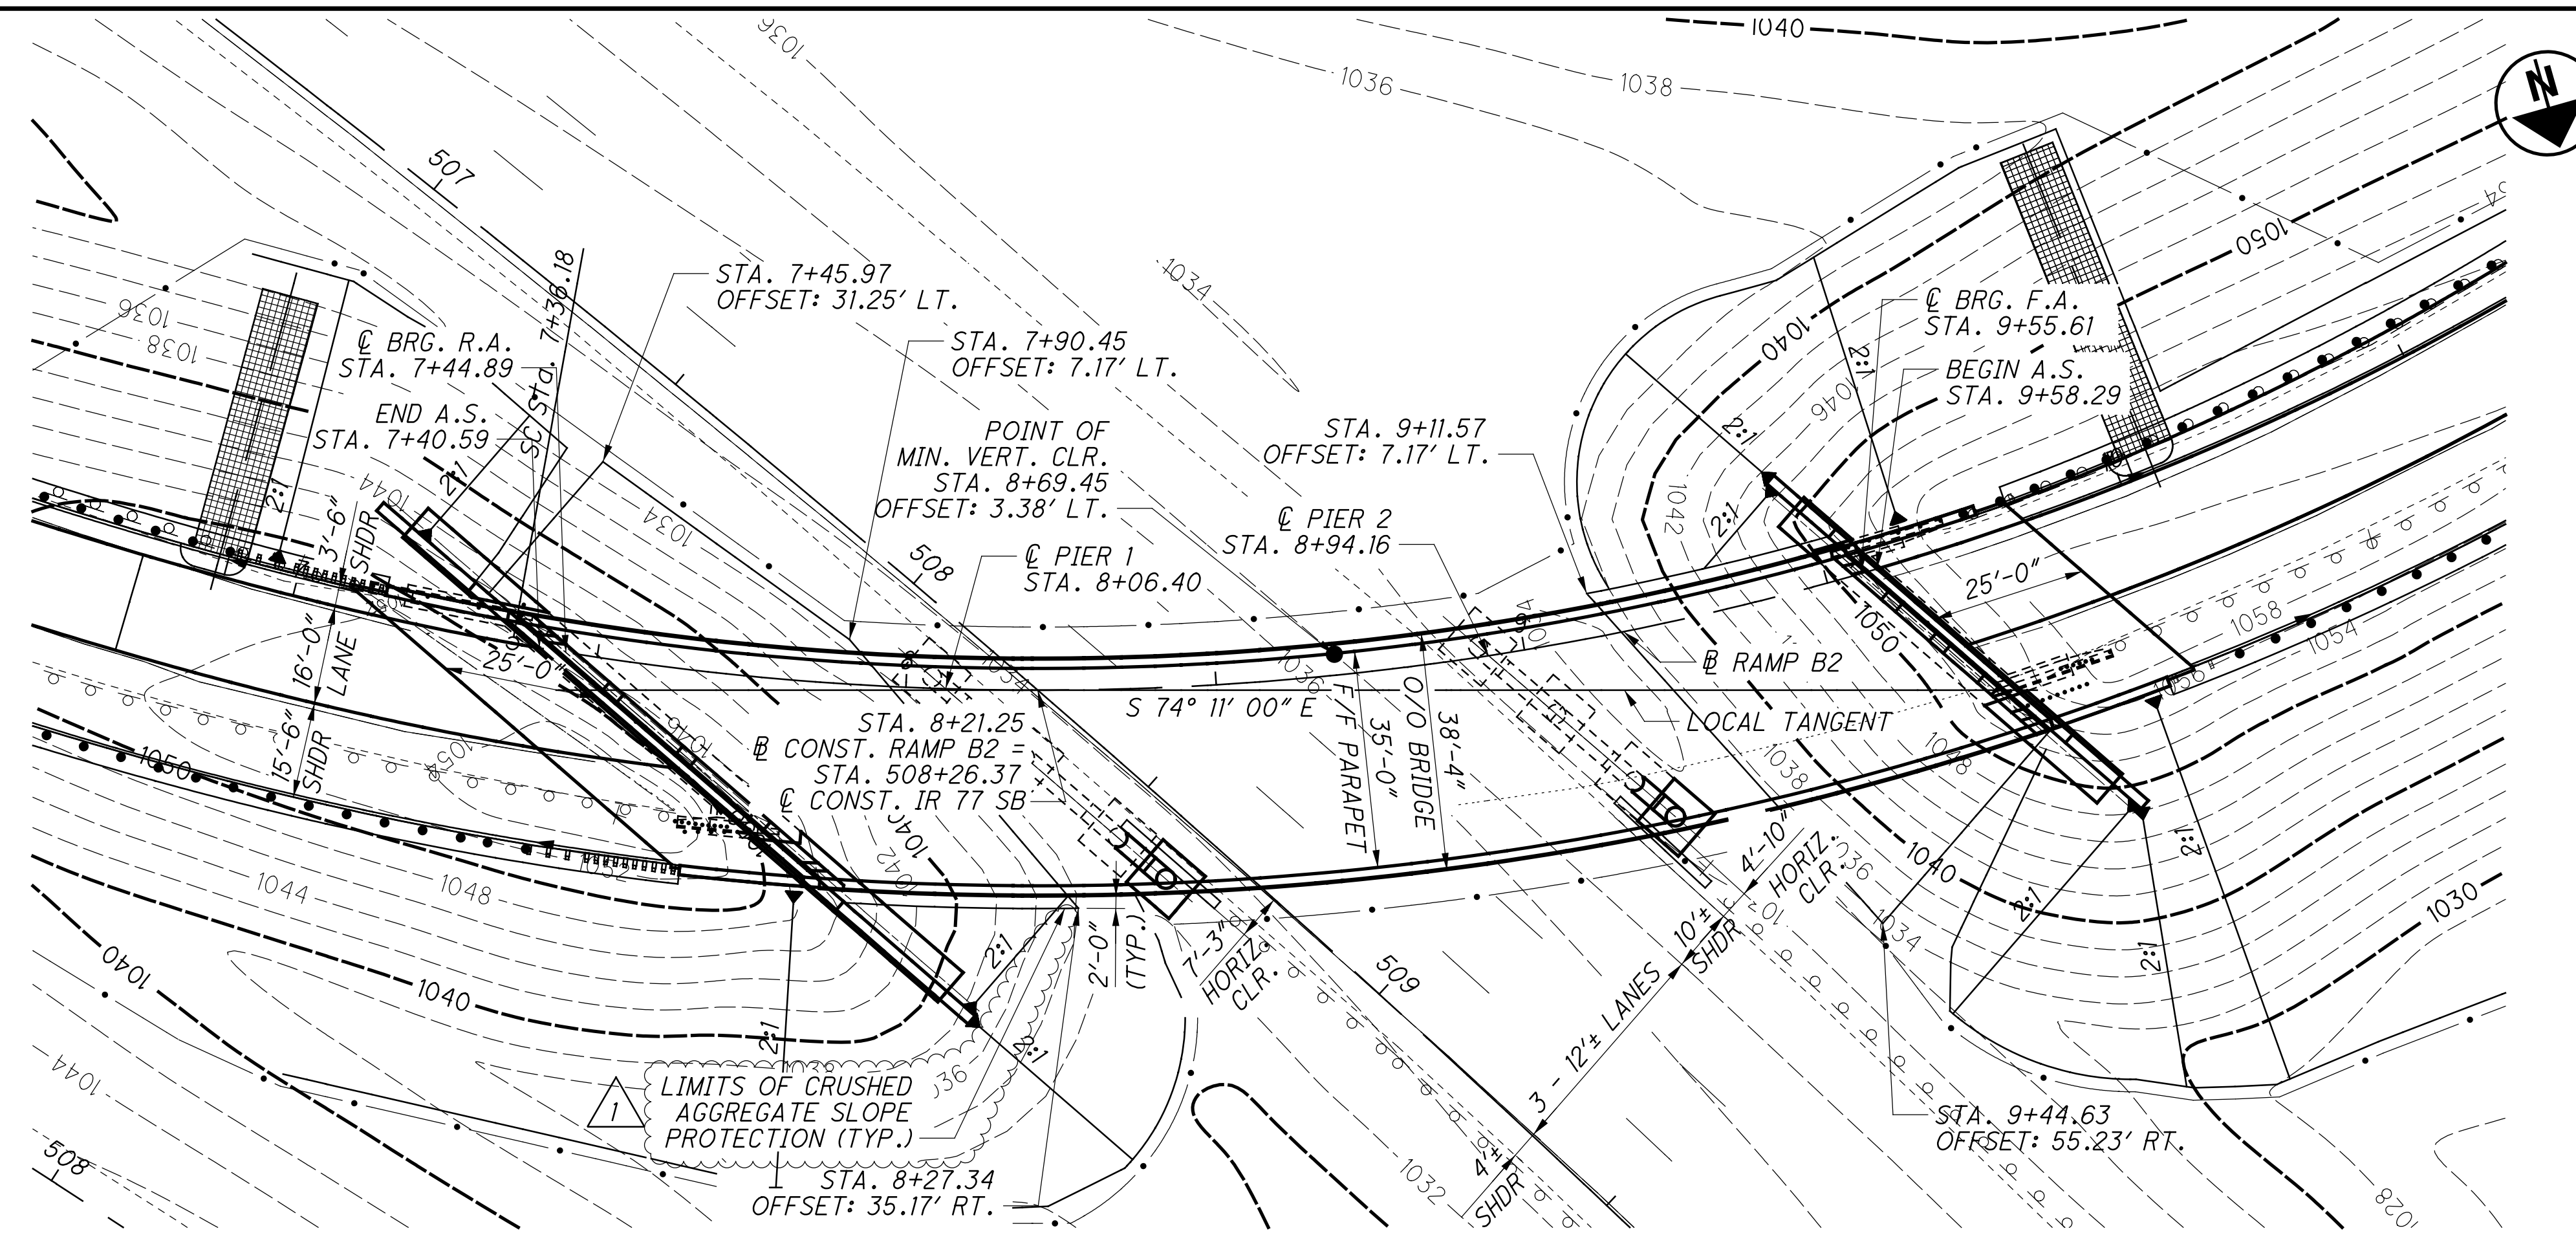

PLAN

CURVE C8
 P.I. STA. 10+65.43
 $\Delta = 69^\circ 10' 46.21''$ (LT)
 $Dc = 12^\circ 00' 00.44''$
 $R = 477.46'$
 $T = 329.25'$
 $L = 576.49'$
 $E = 102.52'$
 $PC = 7+36.18$
 $PT = 13+12.67$

DATE	DESCRIPTION
9/12/16	AS BUILT

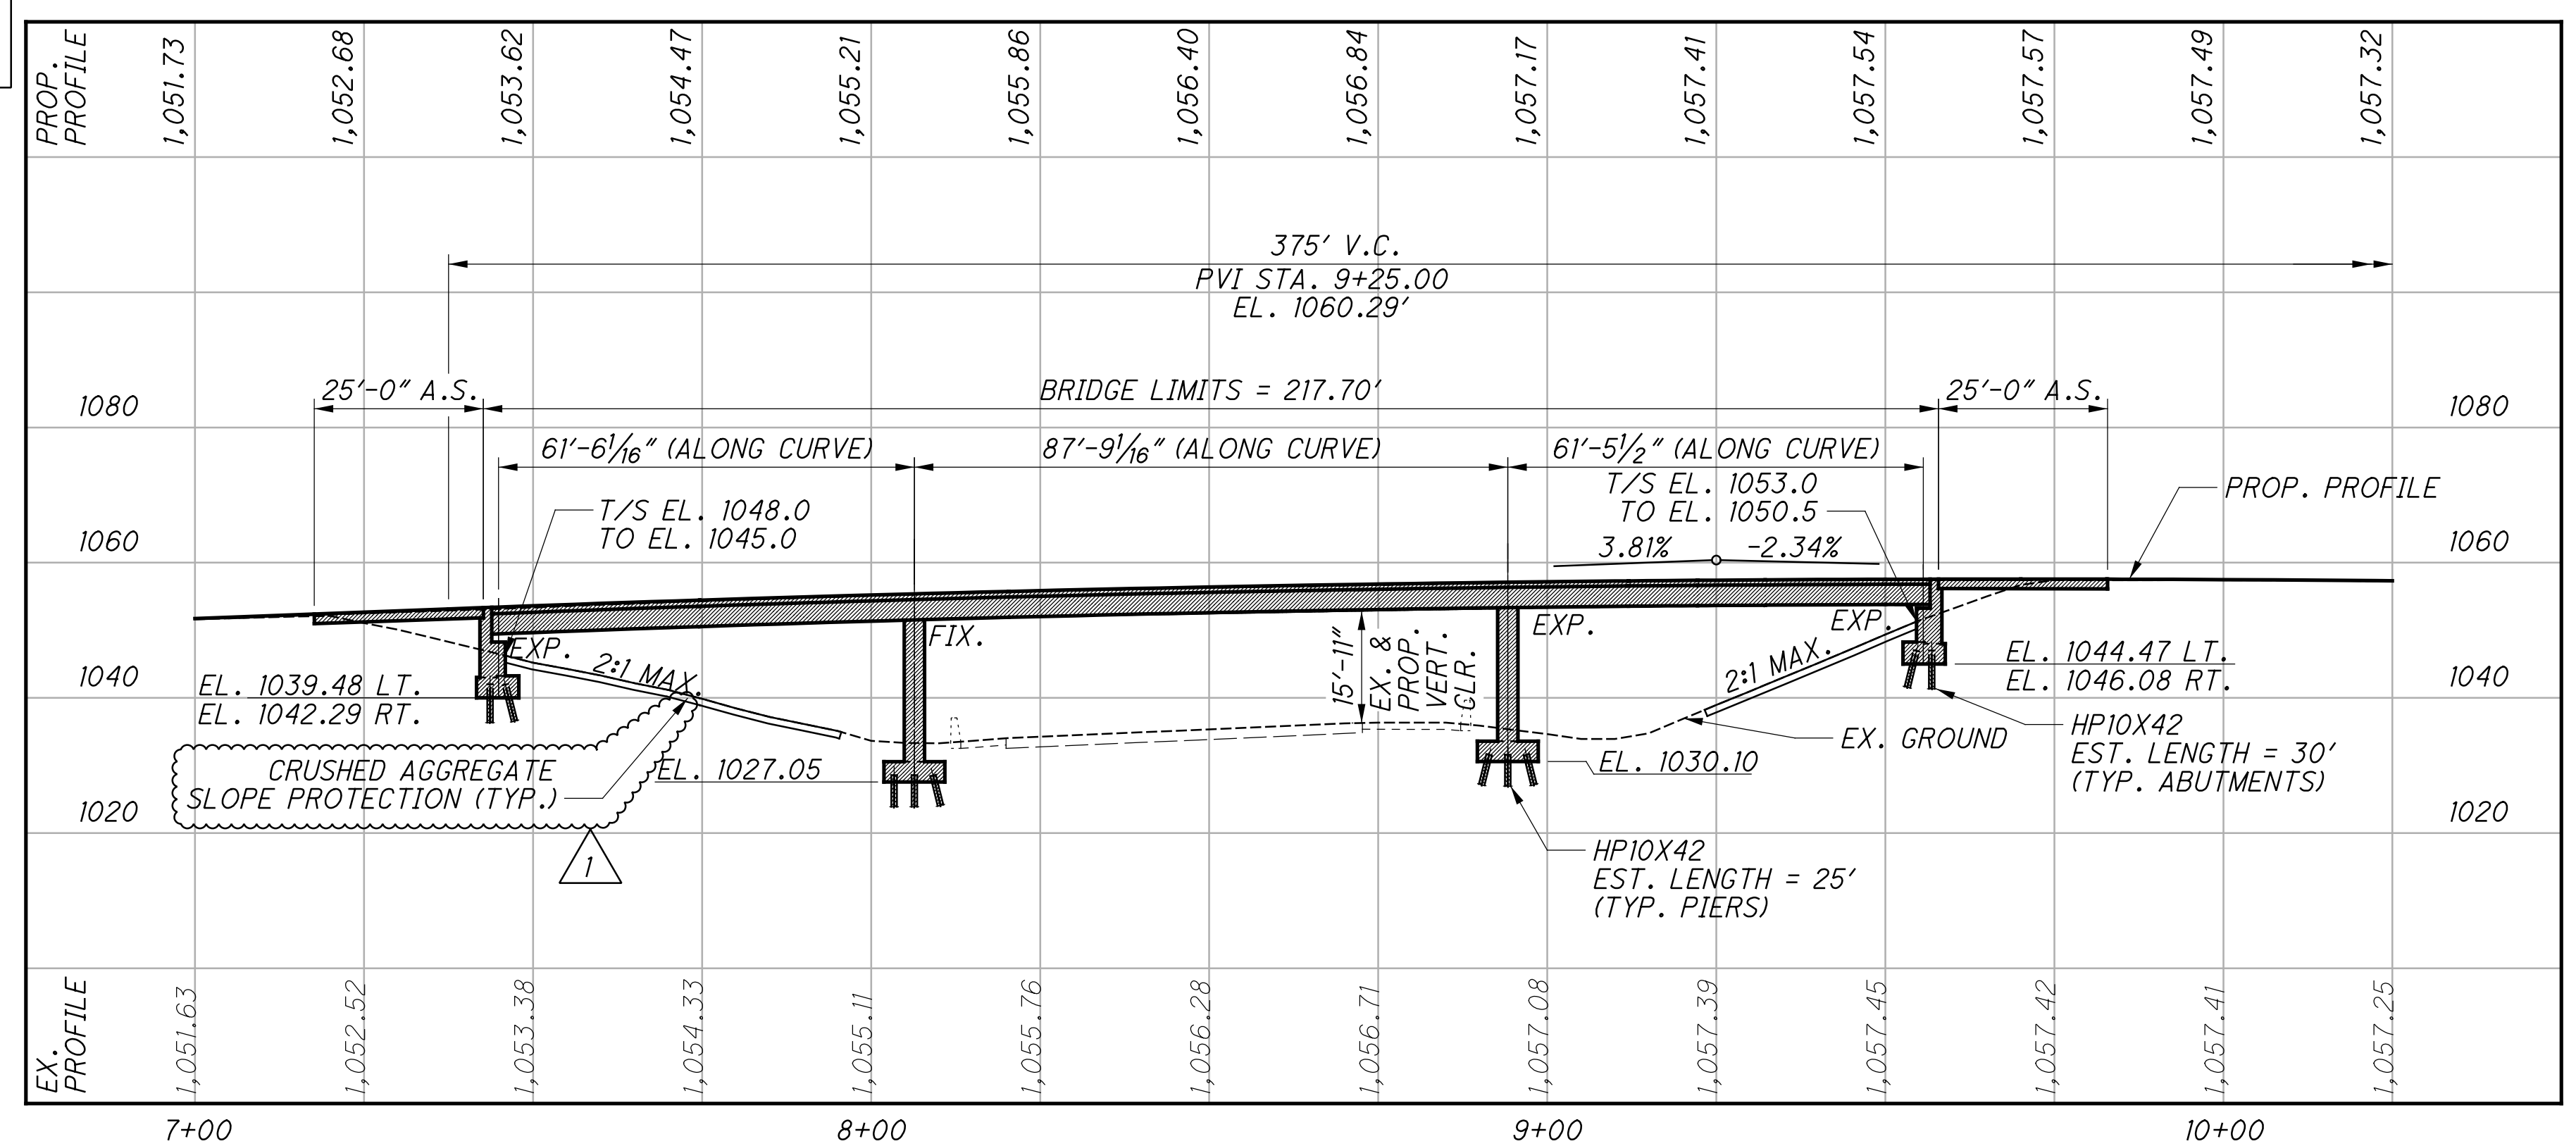

PROFILE

BENCHMARK DATA

BM 5000 STA. 16+94.71, ELEV. 1037.38, OFFSET 92.94', LT.
 BM 2000 STA. 4+72.10, ELEV. 1037.38, OFFSET 31.55', RT.

FOR ADDITIONAL BENCHMARK INFORMATION. SEE ROADWAY PLANS IN BUILDABLE UNIT 4.

NOTES

EARTHWORK LIMITS SHOWN ARE APPROXIMATE. ACTUAL SLOPES SHALL CONFORM TO PLAN CROSS SECTIONS.
 DESIGN TRAFFIC:
 2015 ADT = 12,800 2015 ADTT = 1,152
 2035 ADT = 16,500 2035 ADTT = 1,485
 DIRECTIONAL DISTRIBUTION = 1.0

LEGEND

- ⊕ BORING LOCATION
- 15'-11" ACTUAL MINIMUM VERTICAL CLEARANCE

PROPOSED WORK

1. REMOVE EXISTING DECK.
2. WIDEN EXISTING ABUTMENT AND PIERS.
3. PATCH SUBSTRUCTURE.
4. CONSTRUCT NEW STEEL BEAM ON NEW ROCKER/ BOLSTER BEARINGS.
5. REPLACE CORRODED CROSSFRAMES AND FATIGUE RETROFIT EXISTING MOMENT PLATES.
6. CONSTRUCT COMPOSITE DECK AND APPROACH SLABS.
7. SEAL CONCRETE SURFACES WITH EPOXY-URETHANE SEALER.
8. INSTALL A POLYMER MODIFIED EXPANSION JOINT BETWEEN THE APPROACH SLABS AND THE APPROACH PAVEMENT.
9. REGRADE THE SLOPES AND PLACE NEW SLOPE PROTECTION.
10. INSTALL STRUCTURE IDENTIFICATION SIGN.

EXISTING STRUCTURE

TYPE: CONTINUOUS STEEL BEAM WITH REINFORCED CONCRETE DECK AND SUBSTRUCTURE.
 SPANS: 61'-6"_±, 88'-0"_±, 61'-6"_± C/C BEARINGS
 ROADWAY: 28'-0"_± F/F PARAPET
 LOADING: CF 2000 ADEQUATE FOR AASHTO ALTERNATE LOADING
 SKEW: 49° 10' 19" R.F. TO LOCAL TANGENT
 APPROACH SLABS: 25' LONG (AS-1-54)
 WEARING SURFACE: 1" CONCRETE OVERLAY
 ALIGNMENT: 12° 00' 00.44" CURVE LEFT
 SUPERELEVATION: 0.0833
 STRUCTURAL FILE NUMBER: 7702671
 DATE BUILT: 1966
 DISPOSITION: TO BE REHABILITATED

PROPOSED STRUCTURE

TYPE: CONTINUOUS STEEL BEAM WITH COMPOSITE REINFORCED CONCRETE DECK AND SUBSTRUCTURE.
 SPANS: 61'-6", 88'-0", 61'-6" C/C BEARINGS
 ROADWAY: 35'-0" TOE/TOE PARAPET
 LOADING: HS-25 CASE II AND ALTERNATE MILITARY EX. SUBSTRUCTURE: CF 2000 ADEQUATE FOR AASHTO ALTERNATE LOADING AND HS-25-44
 FUTURE WEARING SURFACE: 60 PSF
 SKEW: 49° 10' 19" TO LOCAL TANGENT
 WEARING SURFACE: 1" MONOLITHIC CONCRETE
 APPROACH SLABS: 25'-0" LONG (AS-1-81)
 ALIGNMENT: 12° 00' 00.44" CURVE LEFT
 SUPERELEVATION: 0.0833
 COORDINATES: LATITUDE 41° 01' 38"
 LONGITUDE 81° 30' 14"

BU5 - AS-BUILT DRAWINGS - 09/12/2016

RESOURCE INTERNATIONAL INC.
 6350 PRESIDENTIAL GATEWAY
 COLUMBUS, OHIO 43231
 (614) 823-4949



DATE: 7/2015
 SSK: 7702671
 STRUCTURE FILE NUMBER: 7702671

DRAWN: JGM
 CHECKED: NCK
 DESIGNED: JGM
 COUNTY: SUMMIT
 STA.: 7+40.59
 STA.: 9+58.29

SITE PLAN
 BRIDGE NO.: SUM-077-0959
 RAMP B2 OVER IR-77 S.B.

SUM 76 / 77-7.58 / 9.59
 PID No. 98061

1 / 13

2 / 14

REFER TO THE FOLLOWING STANDARD BRIDGE DRAWING(S):

A-1-69 REVISED 07-19-02
AS-1-81 REVISED 01-18-13
EXJ-4-87 REVISED 07-19-02
GSD-1-96 REVISED 07-19-02
RB-1-55 REVISED 07-19-13
SBR-1-13 REVISED 01-17-14

DESIGN SPECIFICATIONS:

THIS STRUCTURE CONFORMS TO "STANDARD SPECIFICATIONS FOR HIGHWAY BRIDGES" ADOPTED BY THE AMERICAN ASSOCIATION OF STATE HIGHWAY AND TRANSPORTATION OFFICIALS, 2002, AND THE ODOT BRIDGE DESIGN MANUAL.

DESIGN LOADING:

HS-25-44 CASE II AND ALTERNATE MILITARY LOADING
FUTURE WEARING SURFACE (FWS) OF 60 PSF

EX. SUBSTRUCTURE: CF 2000 ADEQUATE FOR AASHTO
ALTERNATE LOADING AND HS-25-44

DESIGN DATA:

CONCRETE CLASS QC2 - COMPRESSIVE STRENGTH 4500 PSI
(SUPERSTRUCTURE)

CONCRETE CLASS QC1 - COMPRESSIVE STRENGTH 4000 PSI
(SUBSTRUCTURE)

REINFORCING STEEL - ASTM A615 OR A996 GRADE 60 MINIMUM
YIELD STRENGTH 60,000 PSI

STRUCTURAL STEEL - ASTM A709 GRADE 50W -
YIELD STRENGTH 50 KSI

DECK PROTECTION METHOD:

EPOXY COATED REINFORCING STEEL
2 1/2" CONCRETE COVER

MONOLITHIC WEARING SURFACE:

MONOLITHIC WEARING SURFACE IS ASSUMED, FOR DESIGN
PURPOSES, TO BE 1 INCH THICK.

EXISTING STRUCTURE REMOVAL NOTES:

SUBSTRUCTURE CONCRETE REMOVAL:

REMOVE CONCRETE BY MEANS OF APPROVED PNEUMATIC HAMMERS
EMPLOYING POINTED AND BLUNT CHISEL TOOLS. HYDRAULIC
HOE-RAM TYPE HAMMERS WILL NOT BE PERMITTED. THE WEIGHT OF
THE HAMMER SHALL NOT BE MORE THAN 35 POUNDS FOR REMOVAL
WITHIN 18 INCHES OF PORTIONS TO BE PRESERVED. OUTSIDE THE
18 INCH LIMIT, THE CONTRACTOR MAY USE HAMMERS NOT EXCEEDING
90 POUNDS UPON THE APPROVAL OF THE ENGINEER. DO NOT PLACE
PNEUMATIC HAMMERS IN DIRECT CONTACT WITH REINFORCING STEEL
THAT IS TO BE RETAINED IN REBUILT STRUCTURE.

CONCRETE DECK REMOVAL PROJECTS:

THIS WORK CONSISTS OF THE REMOVAL OF CONCRETE DECKS
INCLUDING, PARAPETS, DECK JOINTS AND OTHER
APPURTENANCES FROM STEEL SUPPORTING SYSTEMS (GIRDERS,
CROSS FRAMES, ETC.). THE PROVISIONS OF ITEM 202 APPLY
EXCEPT AS SPECIFIED BY THE FOLLOWING NOTES. PERFORM
WORK CAREFULLY DURING DECK REMOVALS TO PROTECT
PORTIONS OF SUCH SYSTEMS THAT ARE TO BE SALVAGED AND
INCORPORATED INTO THE PROPOSED STRUCTURE. THE USE OF
EXPLOSIVES, HEADACHE BALLS AND/OR HOE RAM TYPE OF
EQUIPMENT IS PROHIBITED. SUBMIT CONSTRUCTION PLANS
ACCORDING TO CMS 501.05.

PROTECTION OF STEEL SUPPORT SYSTEMS:

BEFORE DECK SLAB CUTTING IS PERMITTED, DRAW THE
OUTLINE OF PRIMARY STEEL MEMBERS IN CONTACT WITH THE
BOTTOM OF THE DECK ON THE SURFACE OF DECK. DRILL
SMALL DIAMETER PILOT HOLES 2 INCHES OUTSIDE THESE
LINES TO CONFIRM THE LOCATION OF FLANGE EDGES. DECK
CUTS OVER OR WITHIN 2 INCHES OF FLANGE EDGES SHALL
NOT EXTEND LOWER THAN BOTTOM LAYER DECK SLAB
REINFORCING STEEL. CUTS MADE OUTSIDE 2 INCHES OF
FLANGE EDGES MAY EXTEND THE FULL DEPTH OF THE DECK.
PERFORM WORK CAREFULLY DURING CUTTING OF THE DECK
SLAB TO AVOID DAMAGING STEEL MEMBERS THAT ARE TO BE
INCORPORATED INTO THE PROPOSED STRUCTURE. REPLACE
OR REPAIR STEEL MEMBERS DAMAGED BY THE DECK SLAB
CUTTING OPERATIONS AT NO COST TO THE PROJECT. AT
LEAST 7 DAYS BEFORE PERFORMING REPAIR WORK, SUBMIT A
PROPOSED REPAIR PLAN, DEVELOPED BY AN OHIO
REGISTERED PROFESSIONAL ENGINEER TO THE DIRECTOR.
OBTAIN THE DIRECTOR'S APPROVAL BEFORE PERFORMING
REPAIR.

REMOVAL METHODS:

THE CONTRACTOR MAY REMOVE CONCRETE BY CUTTING AND
BY MEANS OF HAND OPERATED PNEUMATIC HAMMERS POINTED
OR BLUNTED CHISEL TOOLS. FOR REMOVALS OVER
STRUCTURAL MEMBERS (STEEL GIRDER), THE CONTRACTOR
MAY USE A HAMMER HEAVIER THAN 35 POUNDS BUT NOT TO
EXCEED 90 POUNDS UNLESS APPROVED BY THE ENGINEER.
REMOVAL METHODS OVER STRUCTURAL MEMBERS SHALL
ENSURE ADEQUATE DEPTH CONTROL AND PREVENT NICKING OR
GOUGING THE PRIMARY STRUCTURAL MEMBERS.
DUE TO THE POSSIBLE PRESENCE OF ATTACHMENTS (EG.,
FINISHING MACHINE, SCUPPER AND FORM SUPPORTS, ETC.) TO
EXISTING STRUCTURAL MEMBERS, PERFORM WORK CAREFULLY
DURING DECK REMOVAL TO AVOID DAMAGING STRUCTURAL
MEMBERS THAT ARE REMAIN. REPLACE OR REPAIR STRUCTURAL
MEMBERS DAMAGED BY THE REMOVAL OPERATIONS AT NO
COST TO THE PROJECT. AT LEAST 7 DAYS BEFORE
PERFORMING REPAIR WORK, SUBMIT A PROPOSED REPAIR
PLAN, DEVELOPED BY AN OHIO REGISTERED PROFESSIONAL
ENGINEER TO THE DIRECTOR. OBTAIN THE DIRECTOR'S
APPROVAL BEFORE PERFORMING REPAIR.

EXISTING WELDED ATTACHMENTS:

REMOVE EXISTING WELDED ATTACHMENTS (E.G., FINISHING
MACHINE AND FORM SUPPORTS; AND SUPPORTS FOR SCUPPERS
AND BULB ANGLES WHICH ARE TO BE REMOVED) LOCATED IN
THE DESIGNATED TENSION PORTIONS OF THE TOP FLANGES OF
EXISTING STEEL MEMBERS AND GRIND THE FLANGE SURFACES
SMOOTH. CAREFULLY GRIND PARALLEL TO THE FLANGES.

CUT LINE CONSTRUCTION JOINT PREPARATION:

SAW CUT BOUNDARIES OF PROPOSED CONCRETE REMOVALS
1 INCH DEEP. REMOVE CONCRETE TO A ROUGH SURFACE.
LEAVE THE EXISTING REINFORCING STEEL, IF REQUIRED IN
THE PLANS, IN PLACE. INSTALL DOWEL BARS IF SPECIFIED.
PRIOR TO CONCRETE PLACEMENT ABRASIVELY CLEAN JOINT
SURFACES AND EXISTING EXPOSED REINFORCEMENT TO REMOVE
LOOSE AND DISINTEGRATED CONCRETE AND LOOSE RUST.
THOROUGHLY CLEAN THE JOINT SURFACE AND EXPOSED
REINFORCEMENT OF ALL DIRT, DUST, RUST OR OTHER FOREIGN
MATERIAL BY THE USE OF WATER, AIR UNDER PRESSURE, OR
OTHER METHODS THAT PRODUCE SATISFACTORY RESULTS.
EXISTING REINFORCING STEEL DOES NOT HAVE TO HAVE A
BRIGHT STEEL FINISH, BUT REMOVE ALL PACK AND LOOSE RUST.
THOROUGHLY DRENCH EXISTING CONCRETE SURFACES WITH CLEAN
WATER AND ALLOW TO DRY TO A DAMP CONDITION BEFORE
PLACING CONCRETE.

REHABILITATION OF EXISTING STRUCTURES:

EXISTING STRUCTURE VERIFICATION:

DETAILS AND DIMENSIONS SHOWN ON THESE PLANS PERTAINING
TO THE EXISTING STRUCTURE HAVE BEEN OBTAINED FROM PLANS
OF THE EXISTING STRUCTURE AND FROM FIELD OBSERVATIONS
AND MEASUREMENTS. CONSEQUENTLY, THEY ARE INDICATIVE
OF THE EXISTING STRUCTURE AND THE PROPOSED WORK BUT
THEY SHALL BE CONSIDERED TENTATIVE AND APPROXIMATE.
THE CONTRACTOR IS REFERRED TO CMS SECTIONS 102.05,105.02
AND 513.04.

REINFORCING STEEL REPLACEMENT:

**ITEM 509 REINFORCING STEEL, REPLACEMENT OF EXISTING
REINFORCING STEEL, AS PER PLAN:**

REPLACE ALL EXISTING REINFORCING BARS DEEMED BY THE
ENGINEER TO BE UNUSABLE BECAUSE OF CORROSION. THE
DEPARTMENT WILL MEASURE THE REPLACEMENT REINFORCING
STEEL BY THE NUMBER OF POUNDS ACCEPTED IN PLACE.

REPLACE ALL EXISTING REINFORCING STEEL BARS WHICH ARE
TO BE INCORPORATED INTO THE NEW WORK AND ARE DEEMED
BY THE ENGINEER TO BE MADE UNUSABLE BY CONCRETE
REMOVAL OPERATIONS WITH NEW EPOXY COATED REINFORCING
STEEL OF THE SAME SIZE AT NO COST TO THE DEPARTMENT.

ITEM 514 - FIELD PAINTING STRUCTURAL STEEL, FINISH COAT:

THE FINISH COAT OF PAINT ON THE STRUCTURAL STEEL IS
TO BE FEDERAL COLOR - BUFF (#13522).

**ITEM 512 - SEALING OF CONCRETE SURFACES (EPOXY-URETHANE),
AS PER PLAN:**

THE COLOR OF SEALER SHALL CONFORM TO FEDERAL COLOR
NUMBER 17778 (LIGHT NEUTRAL).

ITEM 513 - CROSSFRAMES

REMOVE AND REPLACE CROSSFRAMES AS DIRECTED BY THE
PROJECT ENGINEER. THE DBT WILL INCLUDE IN THE BID AN
ESTIMATED QUANTITY OF 10 CROSSFRAMES (DEFINED AS
THE ENTIRE CROSSFRAME INCLUDING ALL THREE ANGLES) TO
BE REMOVED AND REPLACED.

DECK PLACEMENT DESIGN ASSUMPTIONS:

THE FOLLOWING ASSUMPTIONS OF CONSTRUCTION MEANS AND
METHODS WERE MADE FOR THE ANALYSIS AND DESIGN OF THE
SUPERSTRUCTURE. THE CONTRACTOR IS RESPONSIBLE FOR THE
DESIGN OF THE FALSEWORK SUPPORT SYSTEM WITHIN THESE
PARAMETERS AND WILL ASSUME RESPONSIBILITY FOR
SUPERSTRUCTURE ANALYSIS FOR DEVIATION FROM THESE
DESIGN ASSUMPTIONS.

AN EIGHT WHEEL FINISHING MACHINE WITH A MAXIMUM LOAD OF
2.6 KIPS FOR A TOTAL MACHINE LOAD OF 21 KIPS.

A MINIMUM OUT-TO-OUT WHEEL SPACING AT EACH END OF THE
MACHINE OF 103".

A MAXIMUM SPACING OF OVERHANG FALSEWORK BRACKETS OF
48 IN.

A MAXIMUM DISTANCE FROM THE CENTERLINE OF THE FASCIA
GIRDER TO THE FACE OF THE SAFETY HANDRAIL OF 65".

PILE DESIGN LOADS (ULTIMATE BEARING VALUE):

DRIVE PILES TO REFUSAL ON BEDROCK. THE DEPARTMENT
WILL CONSIDER REFUSAL TO BE OBTAINED WHEN THE PILE
PENETRATION IS AN INCH OR LESS AFTER RECEIVING AT
LEAST 20 BLOWS FROM THE PILE HAMMER. SELECT THE
HAMMER SIZE TO ACHEIVE THE REQUIRED DEPTH TO BEDROCK
AND REFUSAL.

THE TOTAL FACTORED LOAD IS 40 KIPS PER PILE FOR THE
ABUTMENT PILES. THE TOTAL FACTORED LOAD IS 72 KIPS
PER PILE FOR THE PIER PILES.

PILE SPLICES:

IN LIEU OF USING THE FULL PENETRATION BUTT WELDS
SPECIFIED IN CMS 507.09 TO SPLICE STEEL H-PILES,
THE CONTRACTOR MAY USE A MANUFACTURED H-PILE
SPLICER. FURNISH SPLICERS FROM THE FOLLOWING
MANUFACTURER:

ASSOCIATED PILE AND FITTING CORPORATION
8 WOOD HOLLOW RD. PLAZA 1
PARSIPPANY, NEW JERSEY 07054

INSTALL AND WELD THE SPLICER TO THE PILE SECTIONS
IN ACCORDANCE WITH THE MANUFACTURER'S WRITTEN
ASSEMBLY PROCEDURE SUPPLIED TO THE ENGINEER
BEFORE THE WELDING IS PERFORMED.

ITEM 516 - REFURBISHING BEARING DEVICES, AS PER PLAN

ITEM 516 - REFURBISHING BEARING DEVICES, AS PER PLAN:
THIS ITEM SHALL INCLUDE ALL WORK NECESSARY TO PROPERLY
ALIGN EXISTING PIER BEARINGS AS WELL AS THEIR CLEANING
AND PAINTING. INCLUDED SHALL BE THE DISASSEMBLY OF THE
BEARINGS, HAND TOOL CLEANING (GRINDING IF NECESSARY),
PAINTING ACCORDING TO ITEM 514, REPLACEMENT OF ANY
DAMAGED SHEET LEAD WITH PREFORMED BEARING PADS (711.21),
INSTALLATION OF ANY NECESSARY STEEL SHIMS OF THE SAME
SIZE AS THE BEARINGS TO PROVIDE A SNUG FIT, REALIGNMENT
OF THE UPPER BEARING PLATE BY REMOVING EXISTING WELDS
AND REWELDING SO THAT THE BEARINGS ARE VERTICALLY
ALIGNED AT 60 DEGREES F, LUBRICATING SLIDING SURFACES,
AND REASSEMBLY OF THE BEARINGS. ASSURE ALL BEARINGS
ARE SHIMMED ADEQUATELY AND THAT NO BEAMS AND/OR BEAR-
ING DEVICES ARE "FLOATING". AT NO ADDITIONAL COST TO
THE STATE, THE CONTRACTOR MAY INSTALL NEW BEARINGS OF
THE SAME TYPE AS THE EXISTING IN PLACE OF REFURBISHING
THE BEARINGS. ALL WORK SHALL BE TO THE SATISFACTION
OF THE ENGINEER.

**ITEM 516, JACKING AND TEMPORARY SUPPORT OF SUPER-
STRUCTURE, AS PER PLAN**

THIS WORK CONSISTS OF RAISING OR RE-POSITIONING EXISTING
STRUCTURES TO THE DIMENSIONS AND REQUIREMENTS DEFINED
IN THE PROJECT PLANS.

SUBMIT CONSTRUCTION PLANS IN ACCORDANCE WITH CMS 501.05.

**ITEM 516, JACKING AND TEMPORARY SUPPORT OF SUPER-
STRUCTURE, AS PER PLAN CONTINUED:**

IF, DURING THE JACKING OPERATIONS, CRACKING OF THE CON-
CRETE SUPERSTRUCTURE, SEPARATION OF THE CONCRETE DECK
FROM THE STEEL STRINGERS, OR OTHER DAMAGE TO THE
STRUCTURE IS VISUALLY OBSERVED, IMMEDIATELY CEASE THE
JACKING OPERATION AND INSTALL SUPPORTS TO THE SATIS-
FACTION OF THE ENGINEER. ANALYZE THE DAMAGE AND SUB-
MIT A METHOD OF CORRECTION TO THE ENGINEER FOR APPROVAL.
EPOXY INJECT ALL BEAMS THAT SEPARATE FROM THE DECK
FOR THE DISTANCE OF THE SEPARATION IN ACCORDANCE WITH
CMS 512.07. THE DEPARTMENT WILL NOT PAY FOR THE COST
OF THIS EPOXY INJECTION OR OTHER REQUIRED REPAIRS.
THE BRIDGE BEARINGS SHALL BE FULLY SEATED AT ALL CON-
TACT AREAS. IF FULL SEATING IS NOT ATTAINED, SUBMIT A
REPAIR PLAN TO THE ENGINEER. THE DEPARTMENT WILL NOT
PAY FOR THE REPAIR COSTS TO ENSURE FULL SEATING ON
BEARINGS.

THE DEPARTMENT WILL MEASURE THIS WORK ON A LUMP SUM
BASIS.

INSPECTION OF EXISTING STRUCTURAL STEEL

INSPECTION OF EXISTING STRUCTURAL STEEL: THE ENGINEER
WILL VISUALLY INSPECT ALL EXISTING BUTT-WELDED SPLICES
AND/OR TOP FLANGE COVER PLATE FILLET WELDS TO ENSURE
THE WELDS, PLATES AND BEAMS OR GIRDERS ARE FREE OF
DEFECTS AND CRACKS. IF NECESSARY, REMOVE ALL DECK
SLAB HAUNCH FORMS IMMEDIATELY ADJACENT TO SUCH WELDS
THAT MAY INTERFERE WITH THE ENGINEER'S INSPECTION. THE
INSPECTION WILL NOT TAKE PLACE UNTIL THE TOP FLANGES
ARE CLEANED ACCORDING TO 511.10, BUT IT WILL BE DONE
BEFORE THE DECK SLAB REINFORCEMENT IS INSTALLED. THE
ENGINEER WILL REPORT ALL CRACKS FOUND TO THE OFFICE OF
CONSTRUCTION ADMINISTRATION, BRIDGE CONSTRUCTION SPE-
CIALIST, ALONG WITH SPECIFIC INFORMATION ON LOCATION
OF THE CRACKS, LENGTH, AND DEPTH SO AN EVALUATION AND
REPAIR OR REPLACEMENT RECOMMENDATION CAN BE MADE.
WORK ALSO INCLUDES REMOVING AND REPLACING CORRODED
CROSSFRAMES AS DIRECTED BY THE PROJECT ENGINEER.
AN ESTIMATED QUANTITY OF TEN (10) CROSSFRAMES IS
PROVIDED.

ASBESTOS NOTIFICATION:

AN ASBESTOS SURVEY OF THE SUM-077-0959 BRIDGE WAS
CONDUCTED BY A CERTIFIED ASBESTOS HAZARD EVALUATION
SPECIALIST. THE SURVEY DETERMINED THAT NO ASBESTOS
IS PRESENT ON THE BRIDGE STRUCTURE.

A COPY OF THE OHIO ENVIRONMENTAL PROTECTION AGENCY
(OEPA) NOTIFICATION OF DEMOLITION AND RENOVATION FORMS,
PARTIALLY COMPLETED AND SIGNED BY THE BRIDGE OWNER, WILL
BE PROVIDED TO THE SUCCESSFUL BIDDER. THE CONTRACTOR
SHALL COMPLETE THE FORM AND SUBMIT IT TO:

AKRON REGIONAL AIR QUALITY MANAGEMENT DISTRICT
146 S. HIGH ST. SUITE 904
AKRON, OHIO 44308
BOB HASENYAGER, ACTING ADMIN.
(330) 375-2480
FAX: (330) 375-2402

AT LEAST TEN (10) WORKING DAYS PRIOR TO THE START OF ANY
DEMOLITION AND/OR REHABILITATION, THE CONTRACTOR SHALL
PROVIDE A COPY OF THE COMPLETED FORM TO THE ENGINEER.

INFORMATION REQUIRED ON THE FORM WILL INCLUDE: 1) THE
CONTRACTORS NAME AND ADDRESS, 2) THE SCHEDULED DATES
FOR THE START AND COMPLETION OF THE BRIDGE REMOVAL
AND 3) A DESCRIPTION OF THE PLANNED DEMOLITION WORK
AND THE METHOD(S) TO BE USED. A COPY OF THE OEPA FORMS
IS AVAILABLE FOR INSPECTION AT THE ODOT DISTRICT 4
OFFICE, 2088 SOUTH ARLINGTON, AKRON, OHIO 44306.


THE CONTRACTOR SHALL FURNISH ALL FEES, LABOR, AND
MATERIAL NECESSARY TO COMPLETE AND SUBMIT THE OEPA
NOTIFICATION FORM.

BU5 - AS-BUILT DRAWINGS - 09/12/2016


RESOURCE INTERNATIONAL INC. 6350 PRESIDENTIAL GATEWAY COLUMBUS, OHIO 43231 (614) 823-1849	
DATE	7/2015
REVIEWED	NCK
STRUCTURE FILE NUMBER	7702671
DRAWN	FTB
REVISION	
DESIGNED	FTB
CHECKED	JGM
GENERAL NOTES	
BRIDGE NO. SUM-077-0959 RAMP B2 OVER IR-77 S.B.	
SUM	76 / 77 - 7.58 / 9.59
PID	No. 98061
2 / 13	
3	
14	

g:\projects\2015\w-15-001 SUM77-76 DB with S&S\98061\structures\SUM077_0959C\sheets\077_0959C\001.dgn 9/12/2016 3:07:43 PM juans


G:\projects\2015\W-15-001 SUM77-76 DB with S&S\9806\structures\SUM077_0959C\sheets\077_0959CRE001.dgn 9/12/2016 3:07:44 PM juans

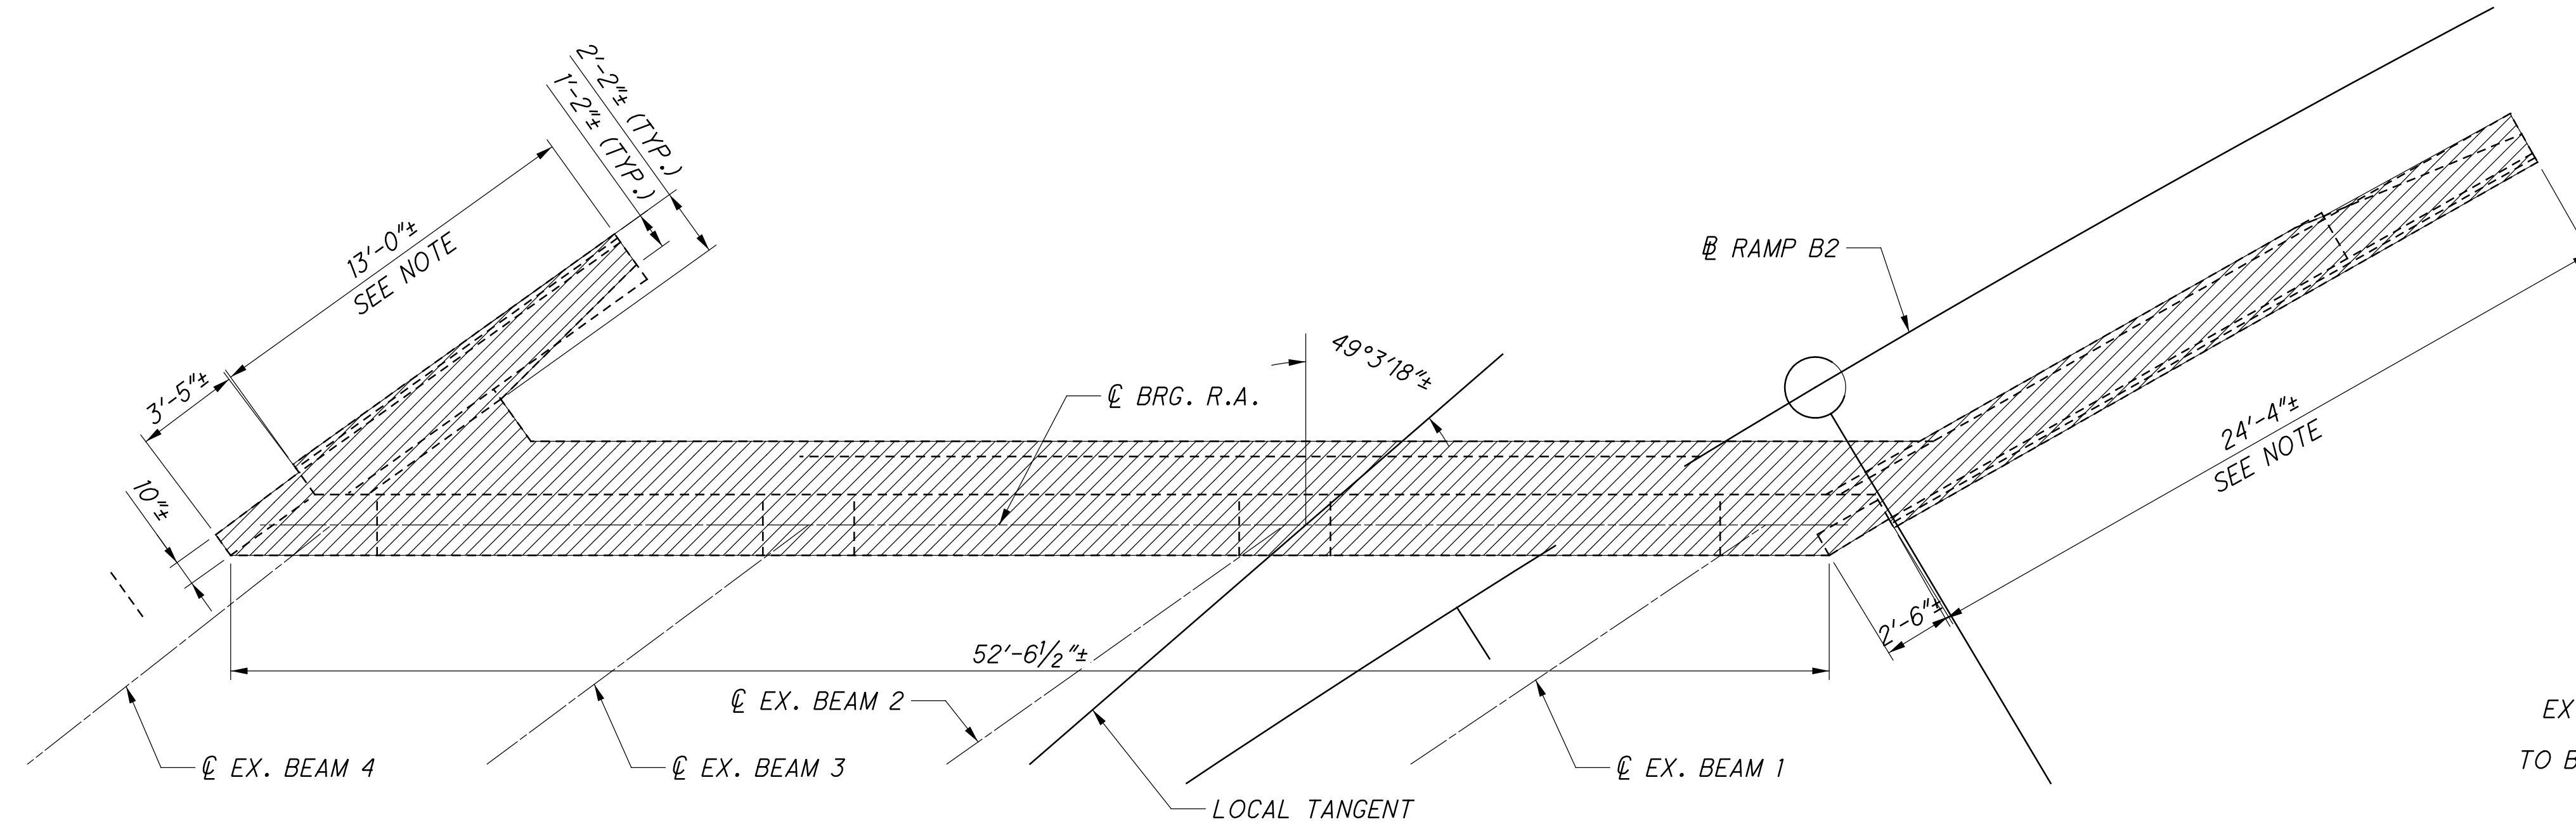

REAR ABUTMENT - PLAN

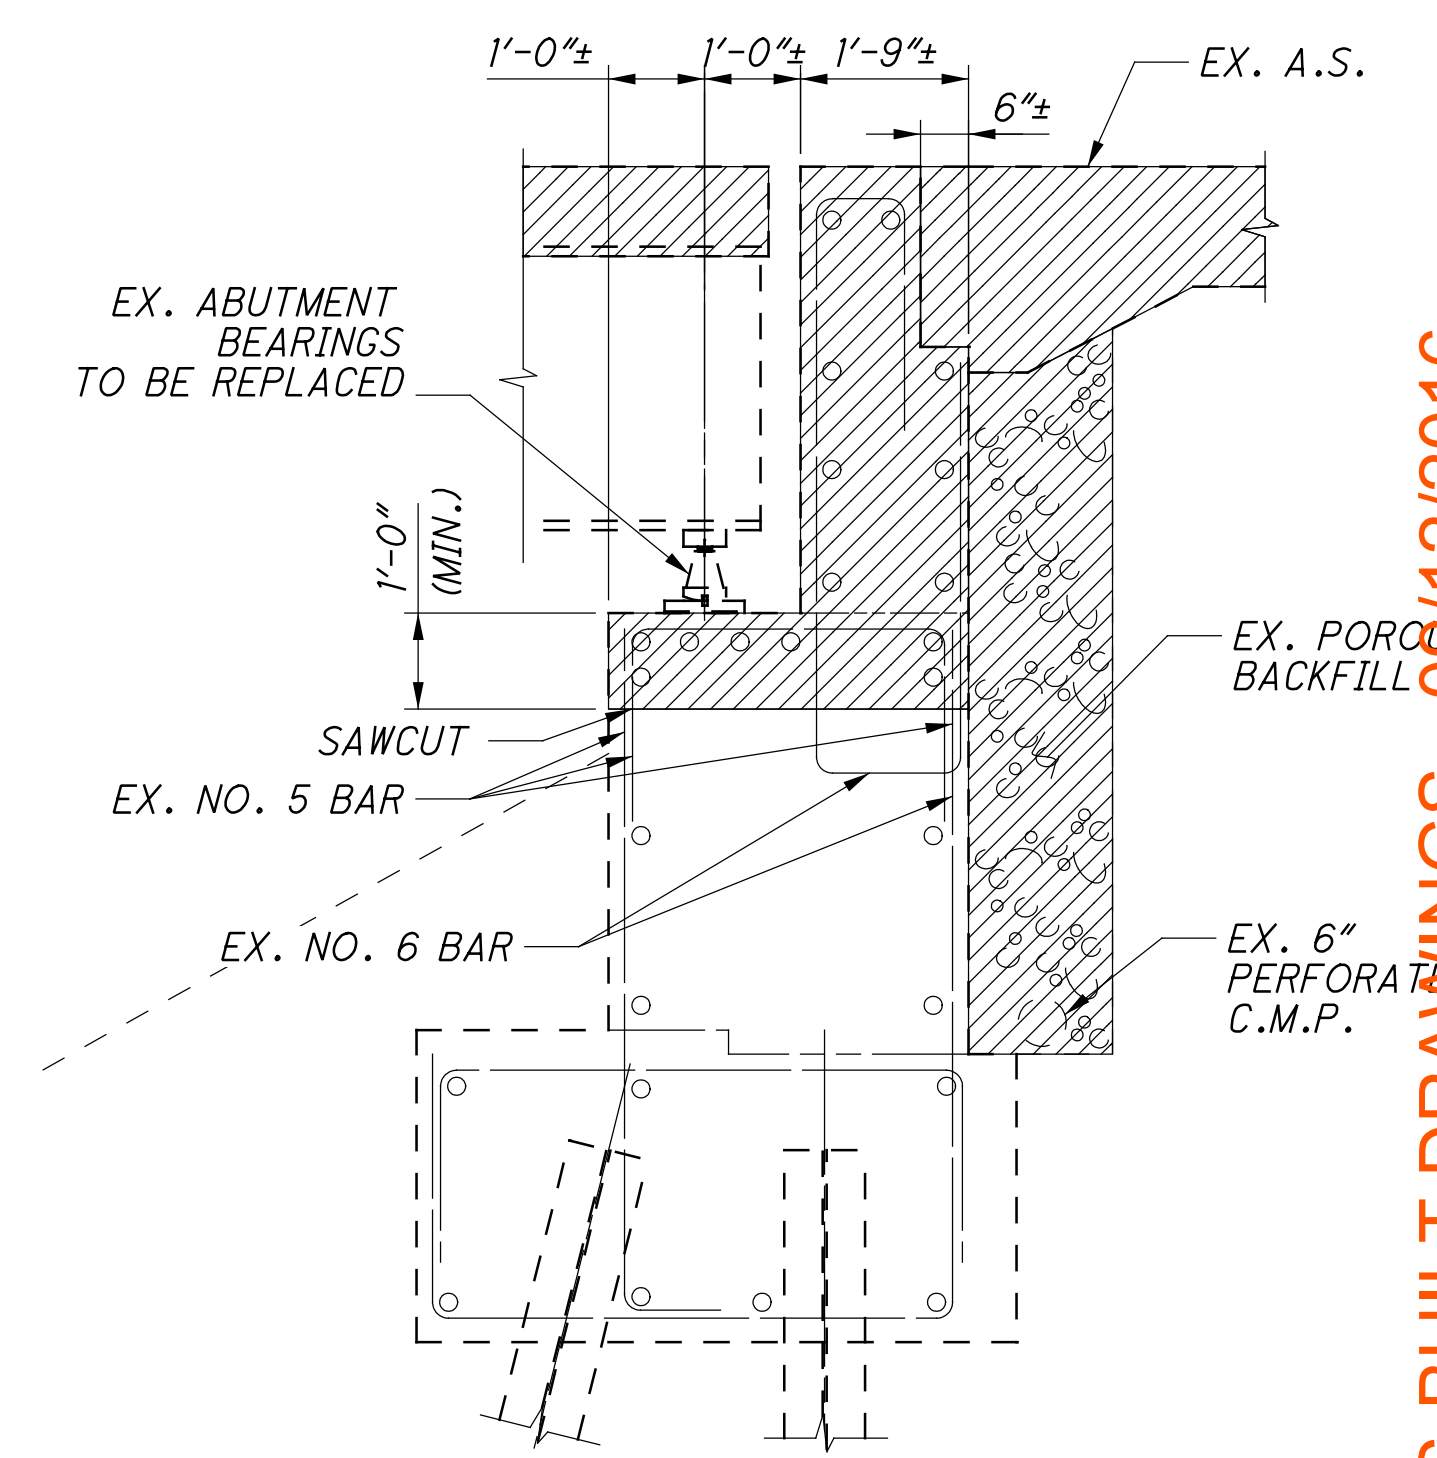

SECTION A-A

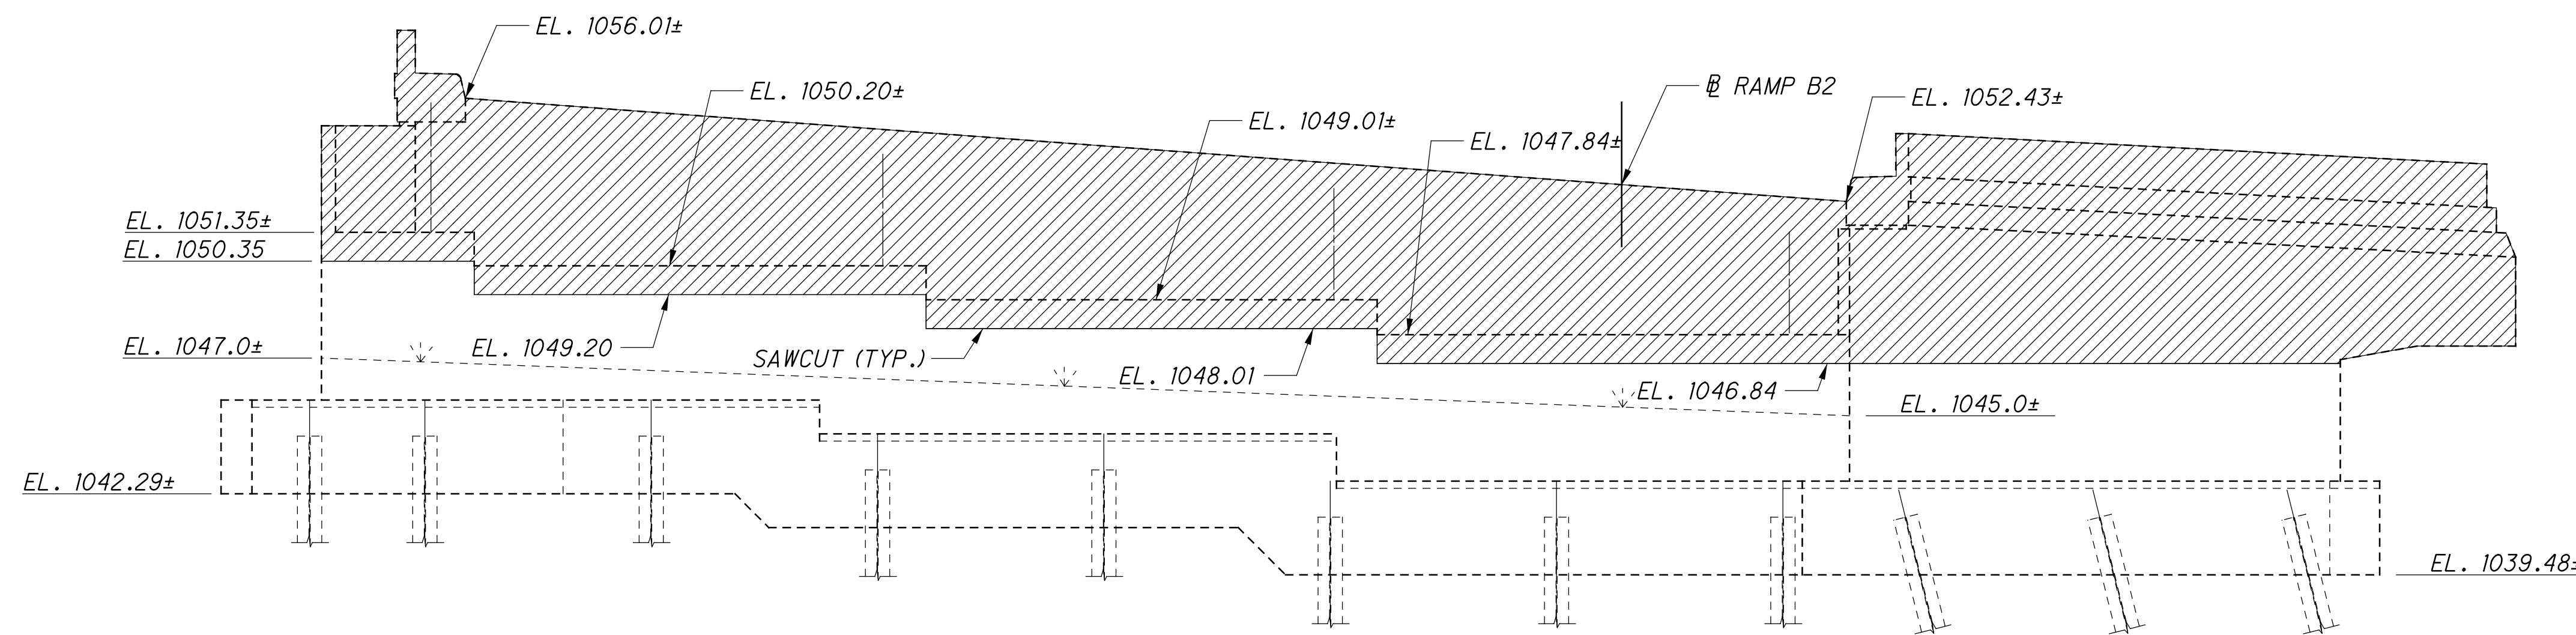


REAR ABUTMENT - ELEVATION

LEGEND:

- ITEM 202 PORTIONS OF STRUCTURE REMOVED

NOTE:

CONTRACTOR TO DETERMINE ACTUAL REMOVAL LIMITS IN THE FIELD AS APPROVED BY THE ENGINEER.

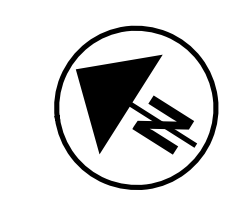

BU5 - AS-BUILT DRAWINGS - 08/12/2016

REAR ABUTMENT REMOVAL DETAILS

BRIDGE NO. SUM-077-0959
RAMP B2 OVER IR-77 S.B.

SUM 76 / 77-7.58 / 9.59
PID No. 98061

3 / 13


4
14

RESOURCE INTERNATIONAL INC.
6350 PRESIDENTIAL GATEWAY
COLUMBUS, OHIO 43231
(614) 823-4949




DESIGNED	JGM	CHECKED	NCK
DRAWN	JGM	REVISED	
REVIEWED	SSK	DATE	7/2015
STRUCTURE FILE NUMBER			7702671



G:\projects\2015\W-15-001 SUM77-76 DB with S&S\98061\structures\SUM077_0959C\sheets\077_0959CRE002.dgn 9/12/2016 3:07:45 PM juans

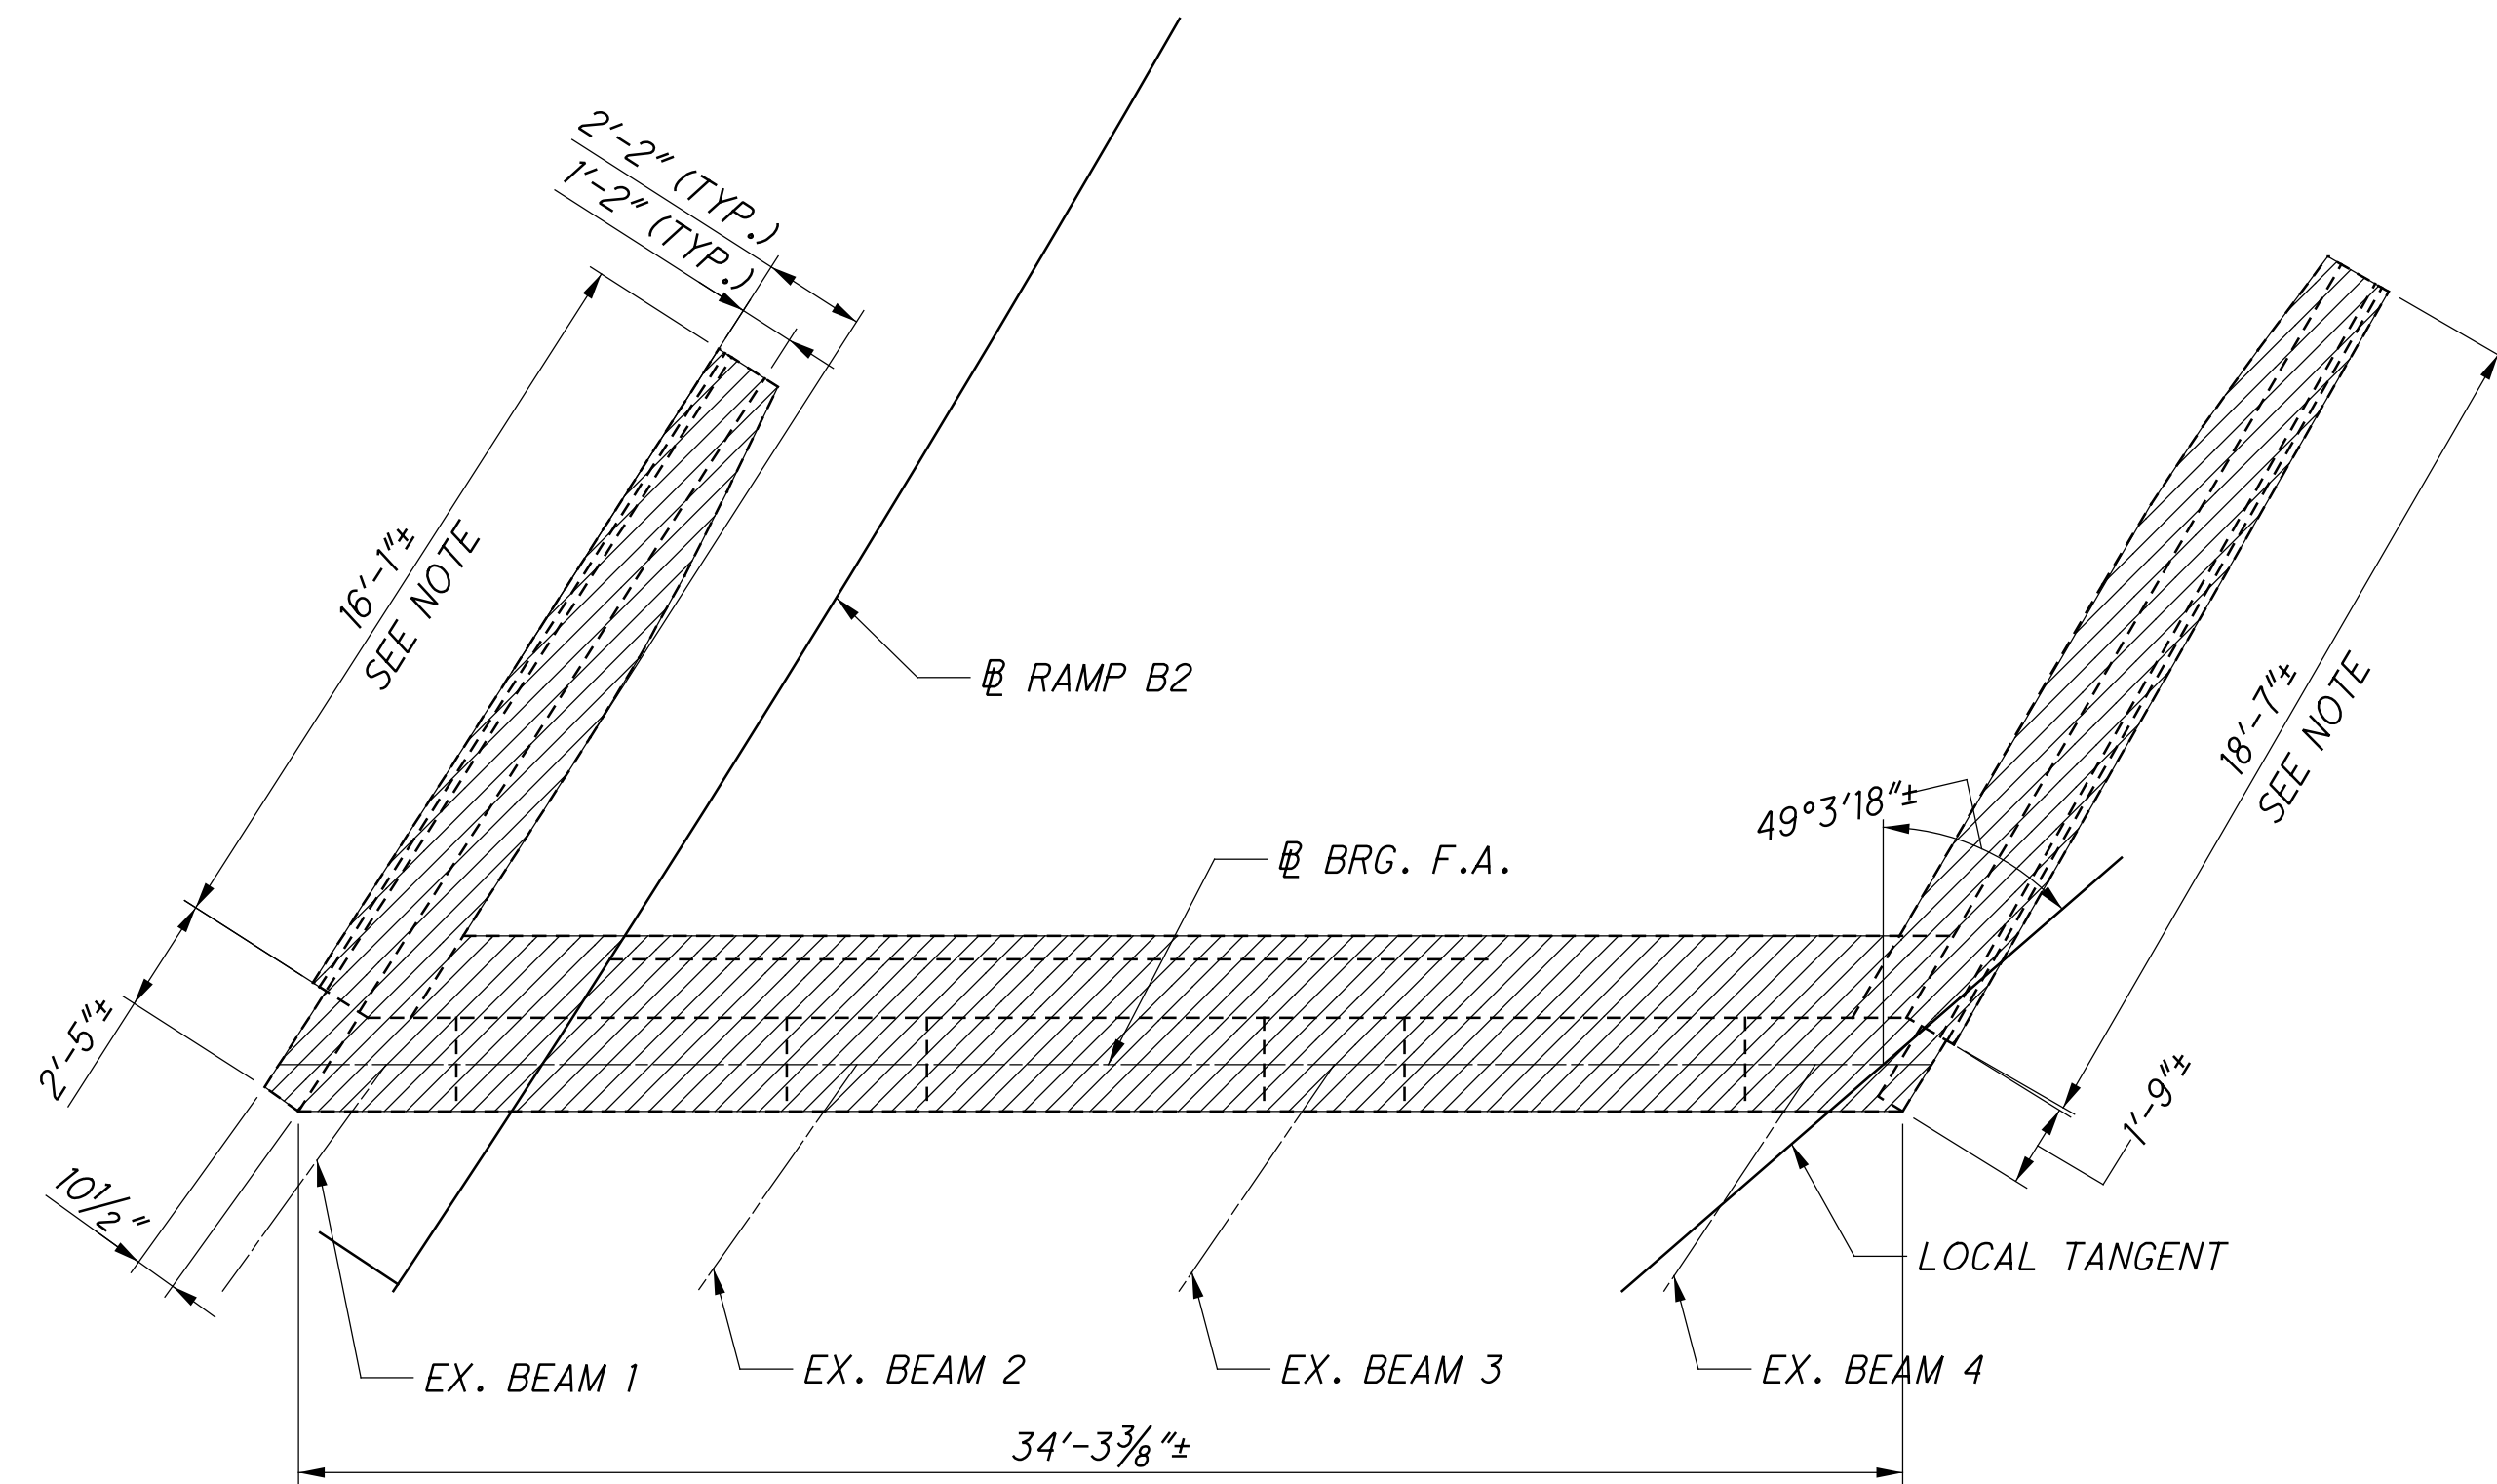

FORWARD ABUTMENT - PLAN

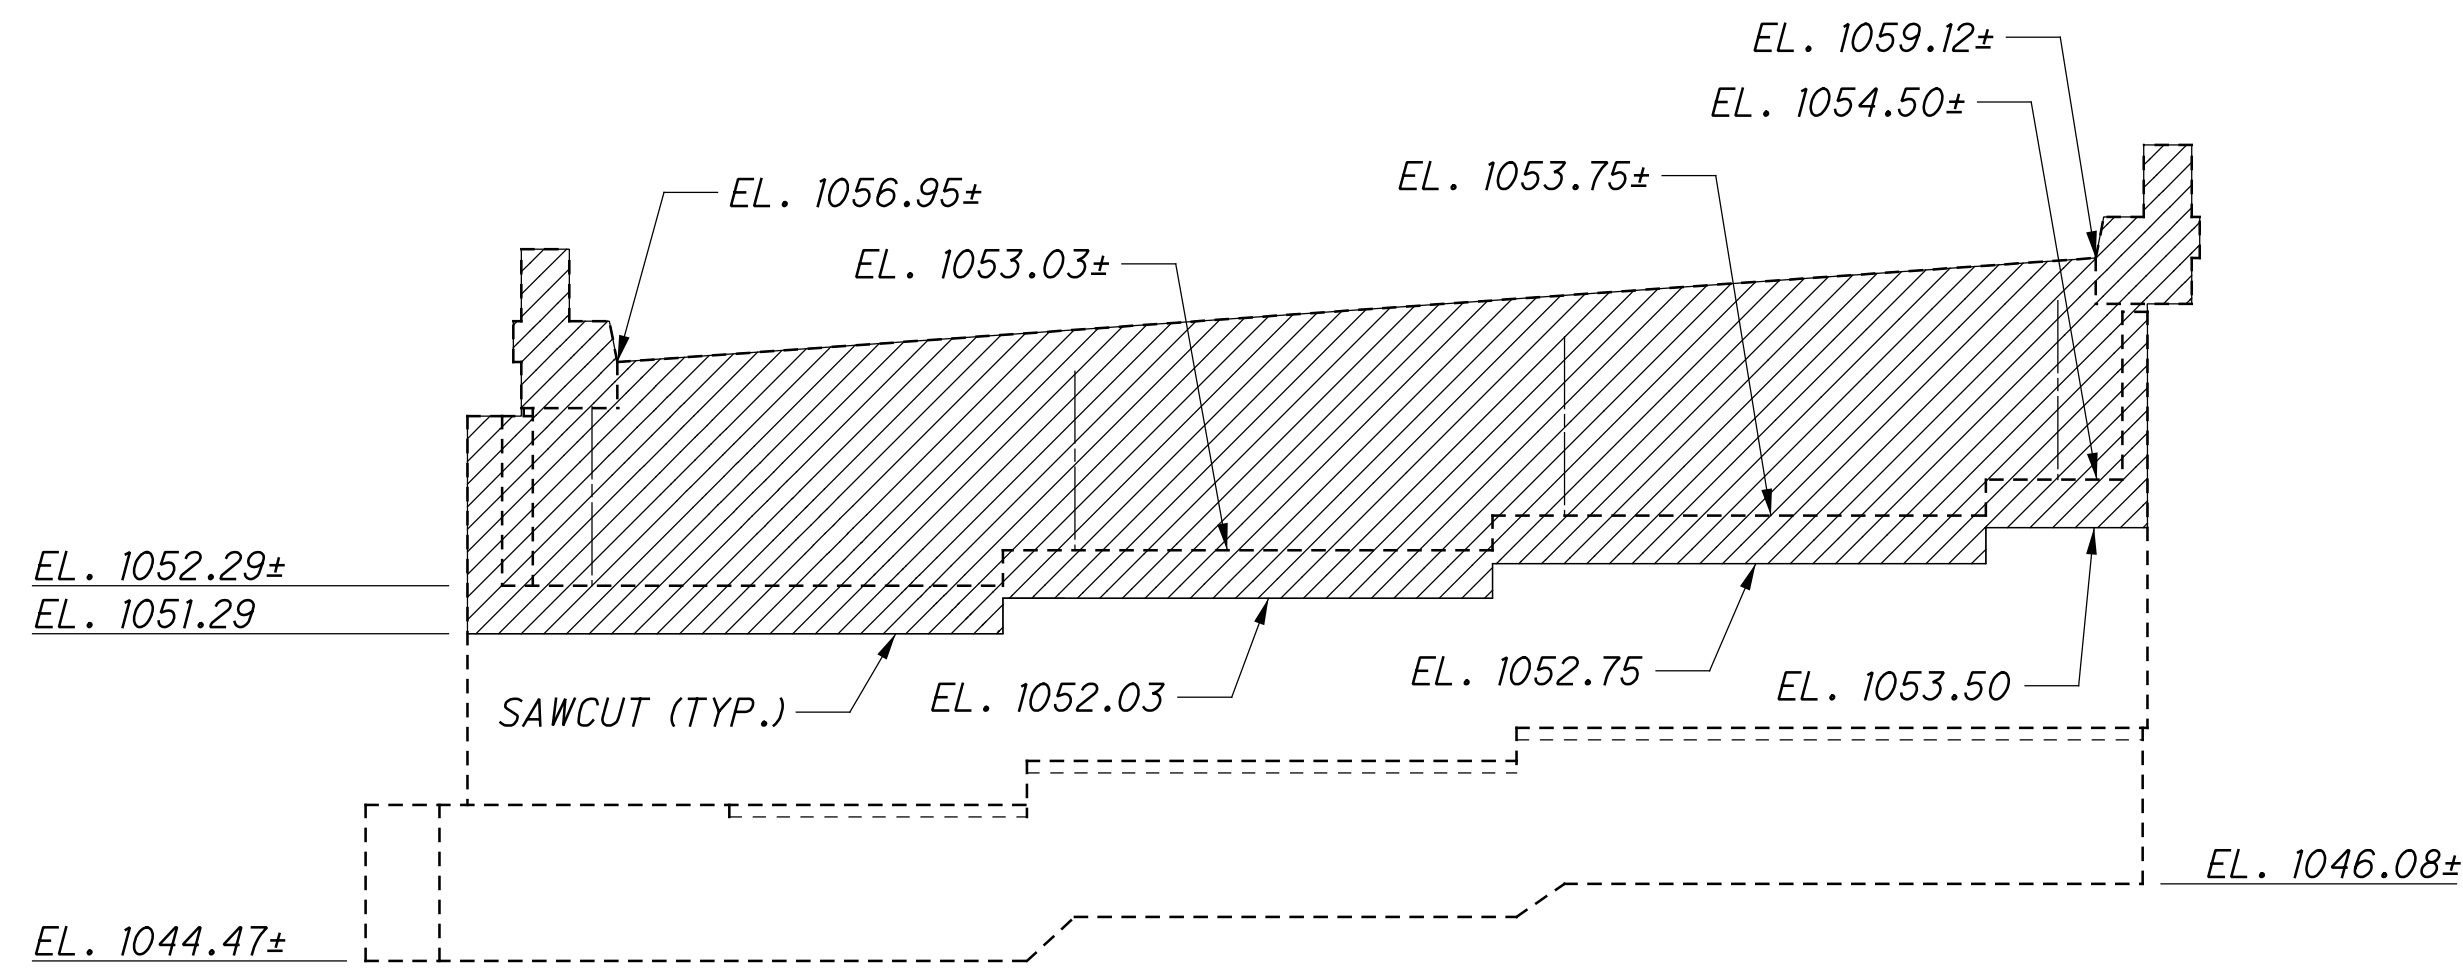

FORWARD ABUTMENT - ELEVATION

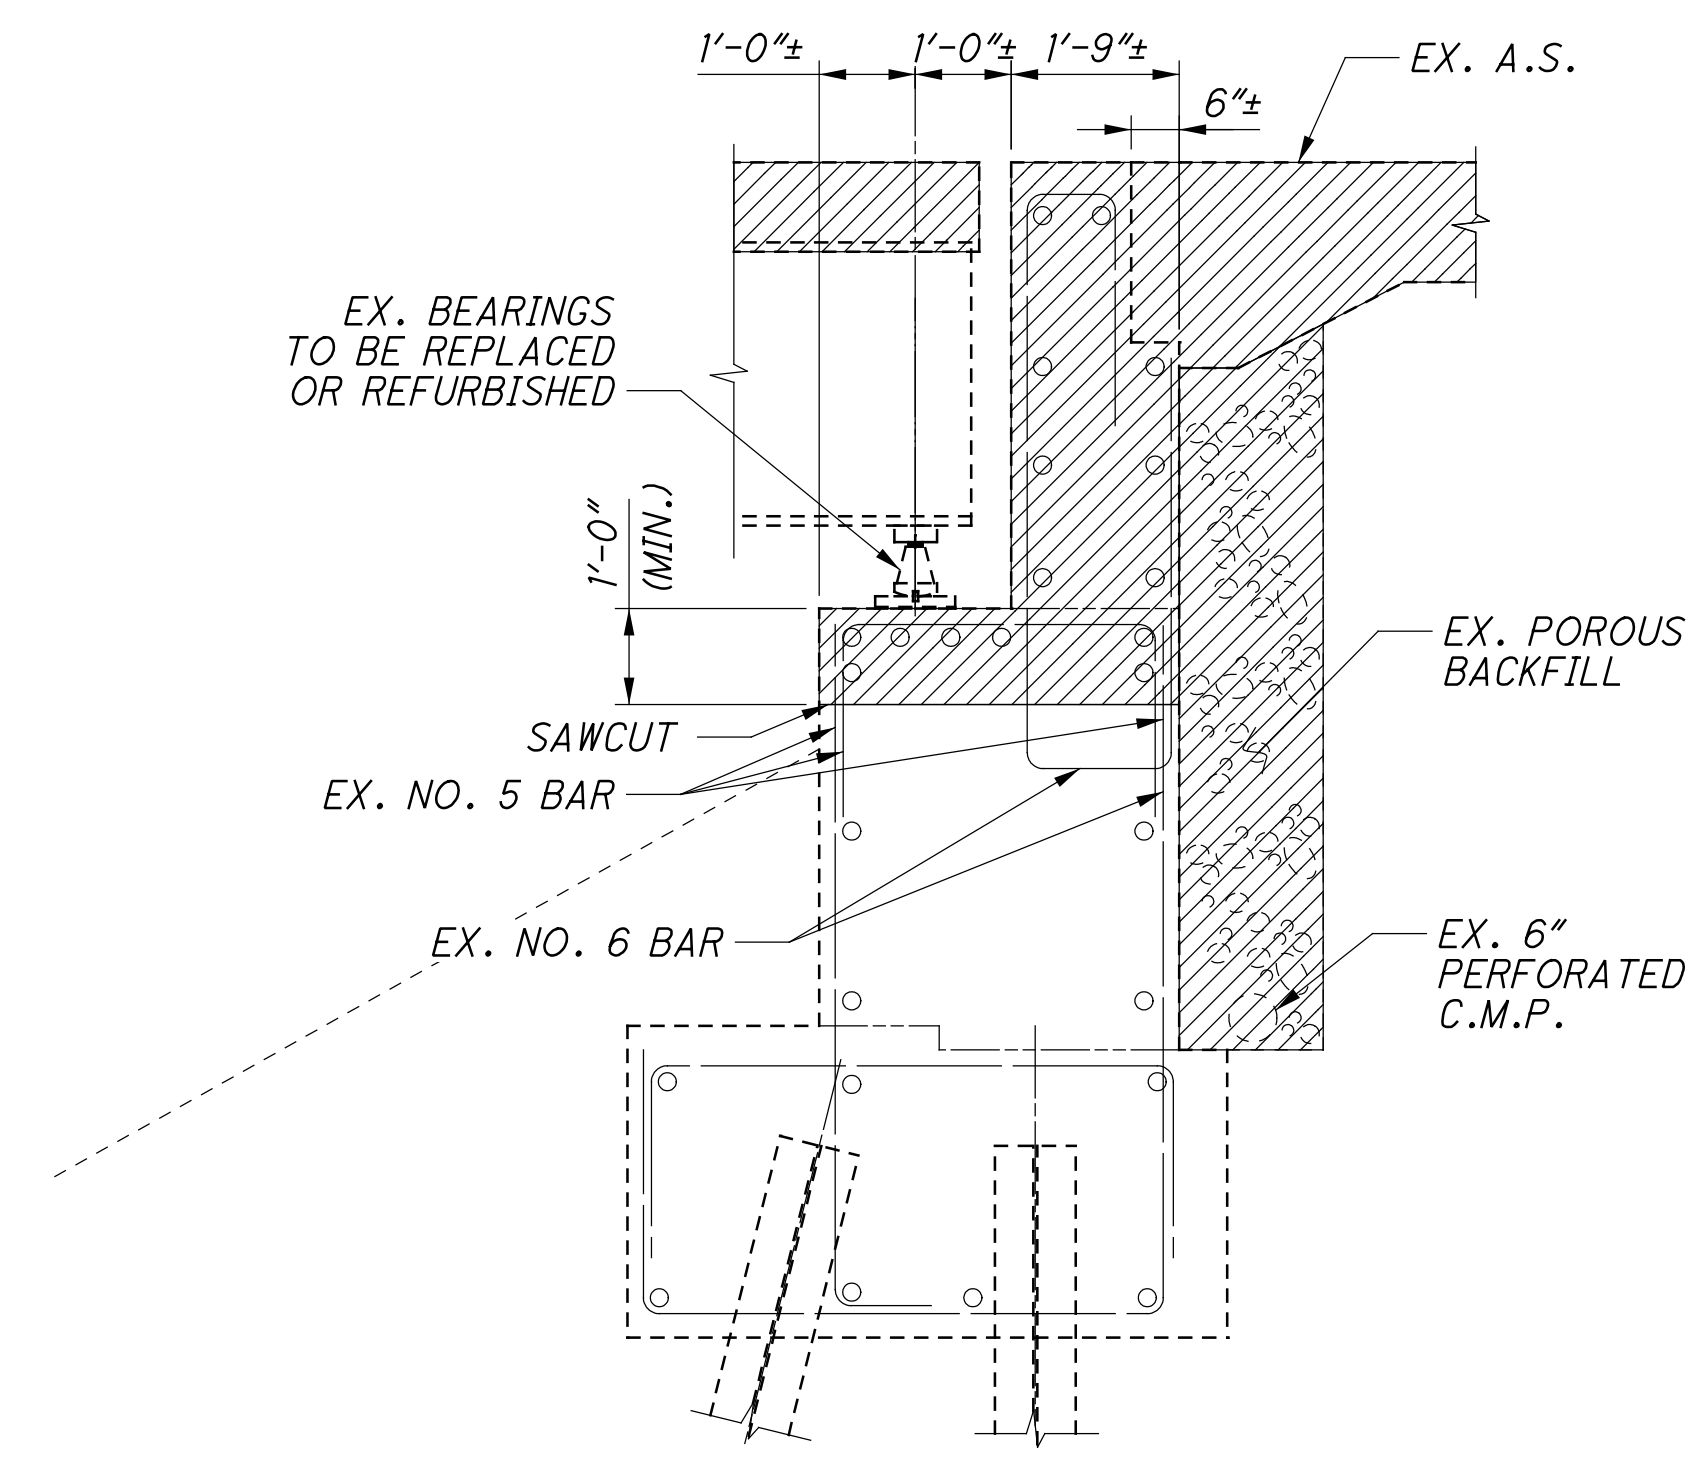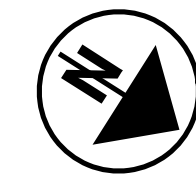

SECTION A-A

LEGEND:

- ITEM 202 PORTIONS OF STRUCTURE REMOVED

NOTE:

CONTRACTOR TO DETERMINE ACTUAL REMOVAL LIMITS IN THE FIELD AS APPROVED BY THE ENGINEER.

BU5 - AS-BUILT DRAWINGS - 09/12/2016

FORWARD ABUTMENT REMOVAL DETAILS

BRIDGE NO. SUM-077-0959
RAMP B2 OVER IR-77 S.B.

SUM 76 / 77-7.58 / 9.59
PID No. 98061

4 / 13


5 / 14

DESIGNED	JGM	CHECKED	NCK
DRAWN	JGM	REVISED	
REVIEWED	SSK	STRUCTURE FILE NUMBER	7702671
DATE	7/2015		




RESOURCE INTERNATIONAL INC.
6350 PRESIDENTIAL GATEWAY
COLUMBUS, OHIO 43231
(614) 823-4949

G:\projects\2015\W-15-001 SUM77-76 DB with S&S\9806\structures\SUM077_0959C\sheets\077_0959CFP001.dgn 9/12/2016 3:07:47 PM juans

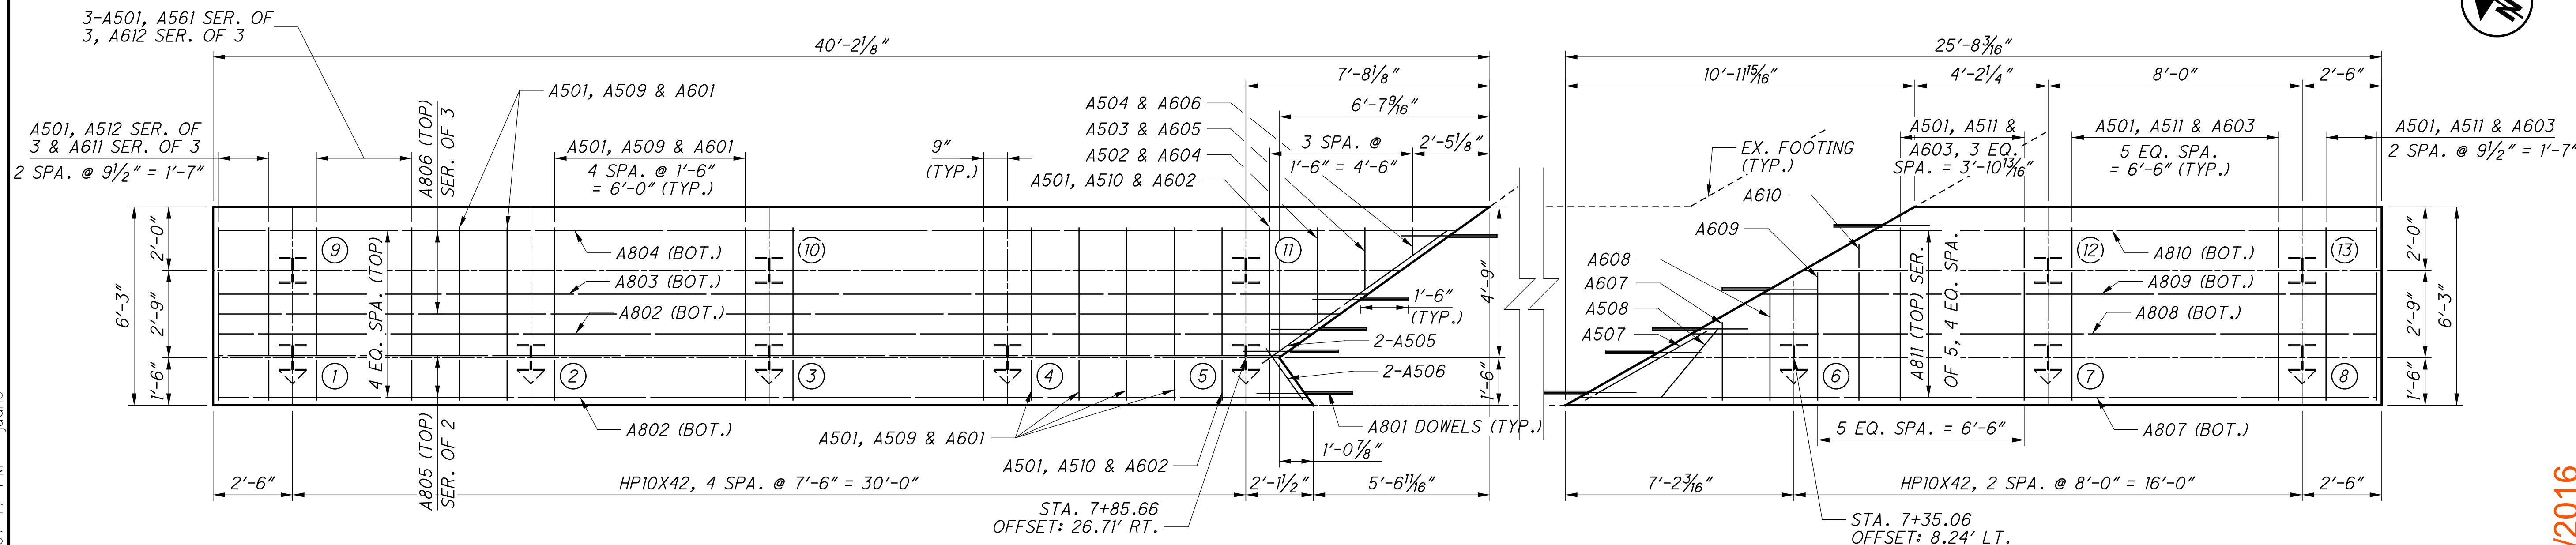


REAR ABUTMENT - PLAN

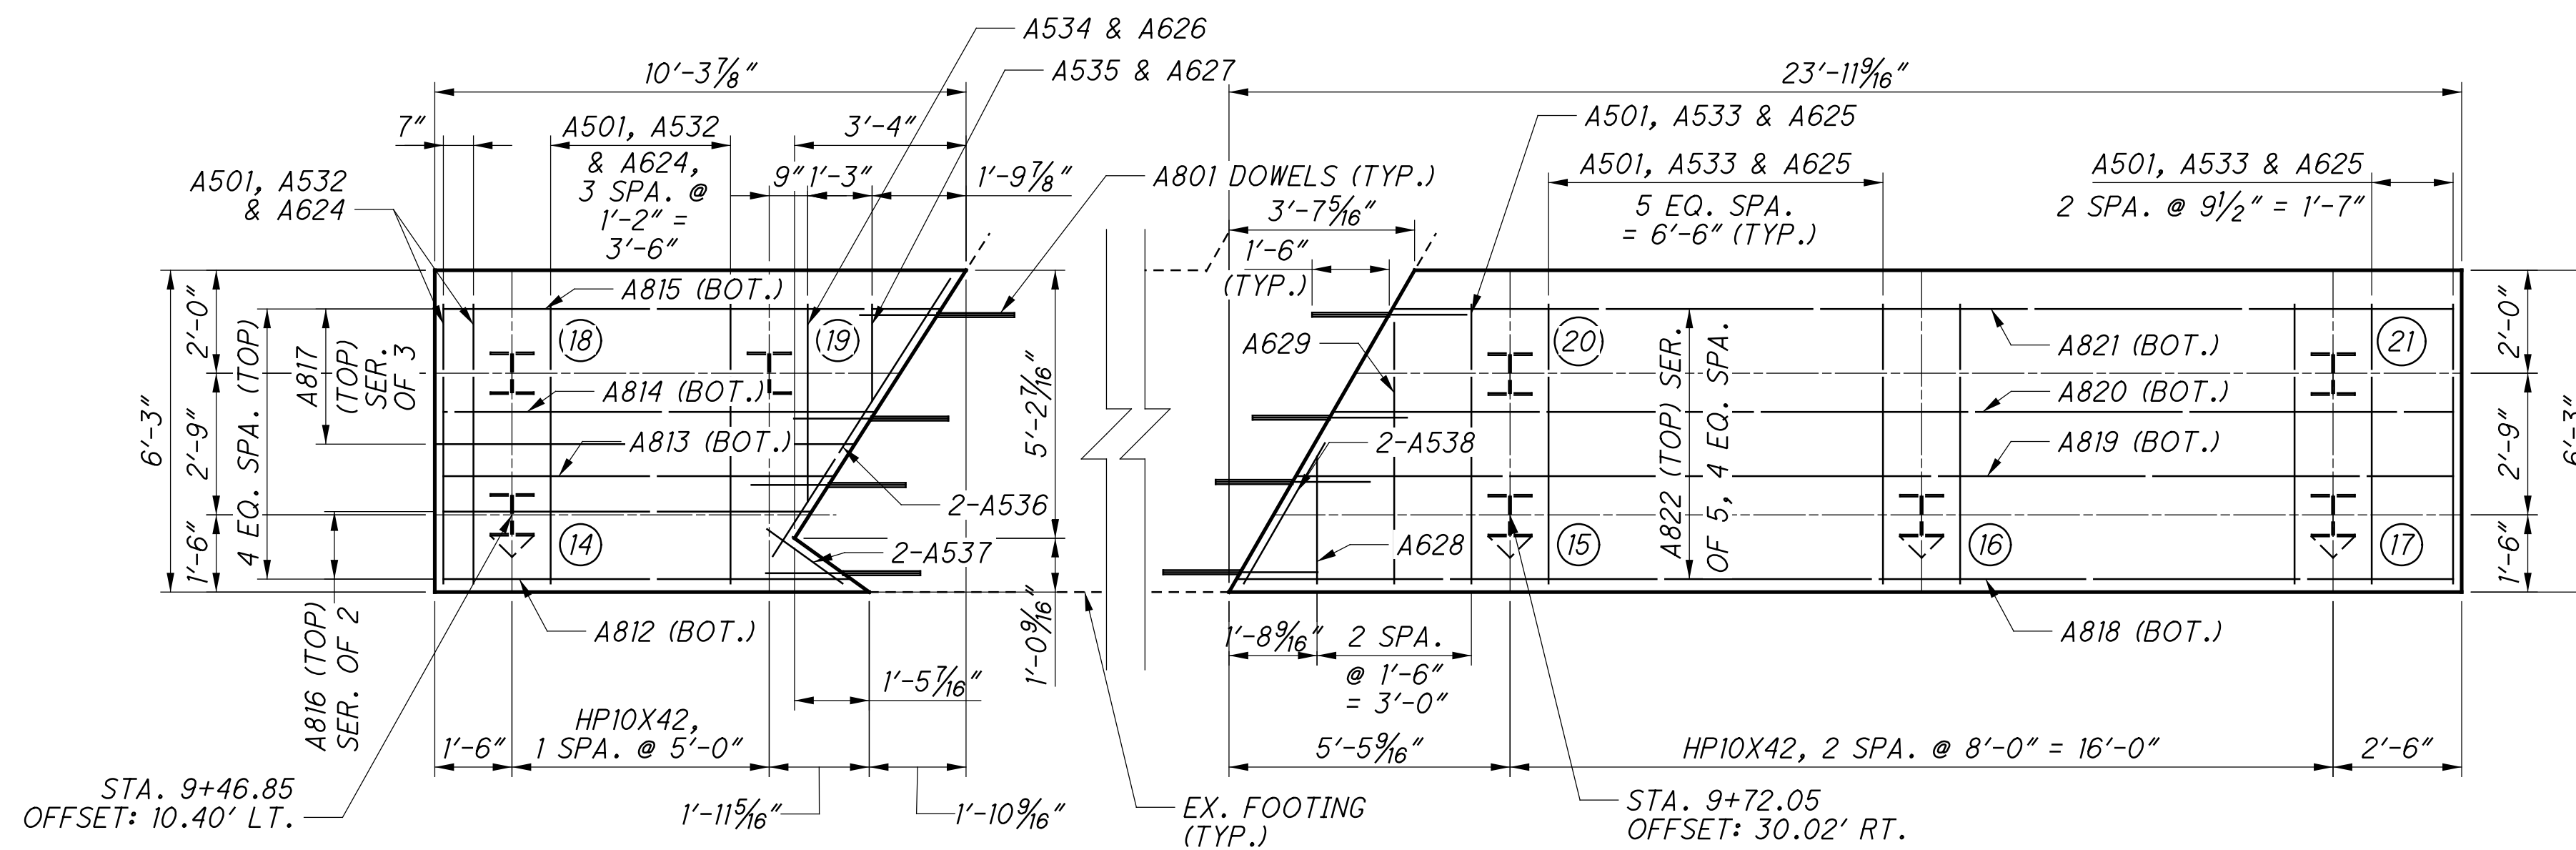

FORWARD ABUTMENT - PLAN

LEGEND:


- (X) - PILE MARK
- |— - PROPOSED PILES, HP10X42
- |— - PROPOSED BATTERED PILES (1:4), HP10X42

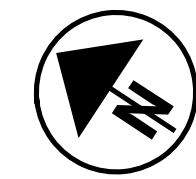


BU5 - AS-BUILT DRAWINGS - 09/12/2016

		RESOURCE INTERNATIONAL INC. 6350 PRESIDENTIAL GATEWAY COLUMBUS, OHIO 43231 (614) 823-4849	
DESIGNED	JGM	CHECKED	NCK
DRAWN	JGM	REVISED	
REVIEWED	SSK	STRUCTURE FILE NUMBER	7702671
DATE	7/2015		
FOOTING DETAILS			
BRIDGE NO. SUM-077-0959			
RAMP B2 OVER IR-77 S.B.			
SUM 76 / 77-7.58 / 9.59			
PID No. 98061			
5 / 13			
<div style="border: 1px solid black; border-radius: 50%; width: 30px; height: 30px; display: flex; align-items: center; justify-content: center; margin: 0 auto;"> 6 14 </div>			


C:\projects\2015\W-15-001 SUM77-76 DB with S&S\9806\structures\SUM077_0959C\sheets\077_0959CAF001.dgn 9/12/2016 3:07:49 PM juans

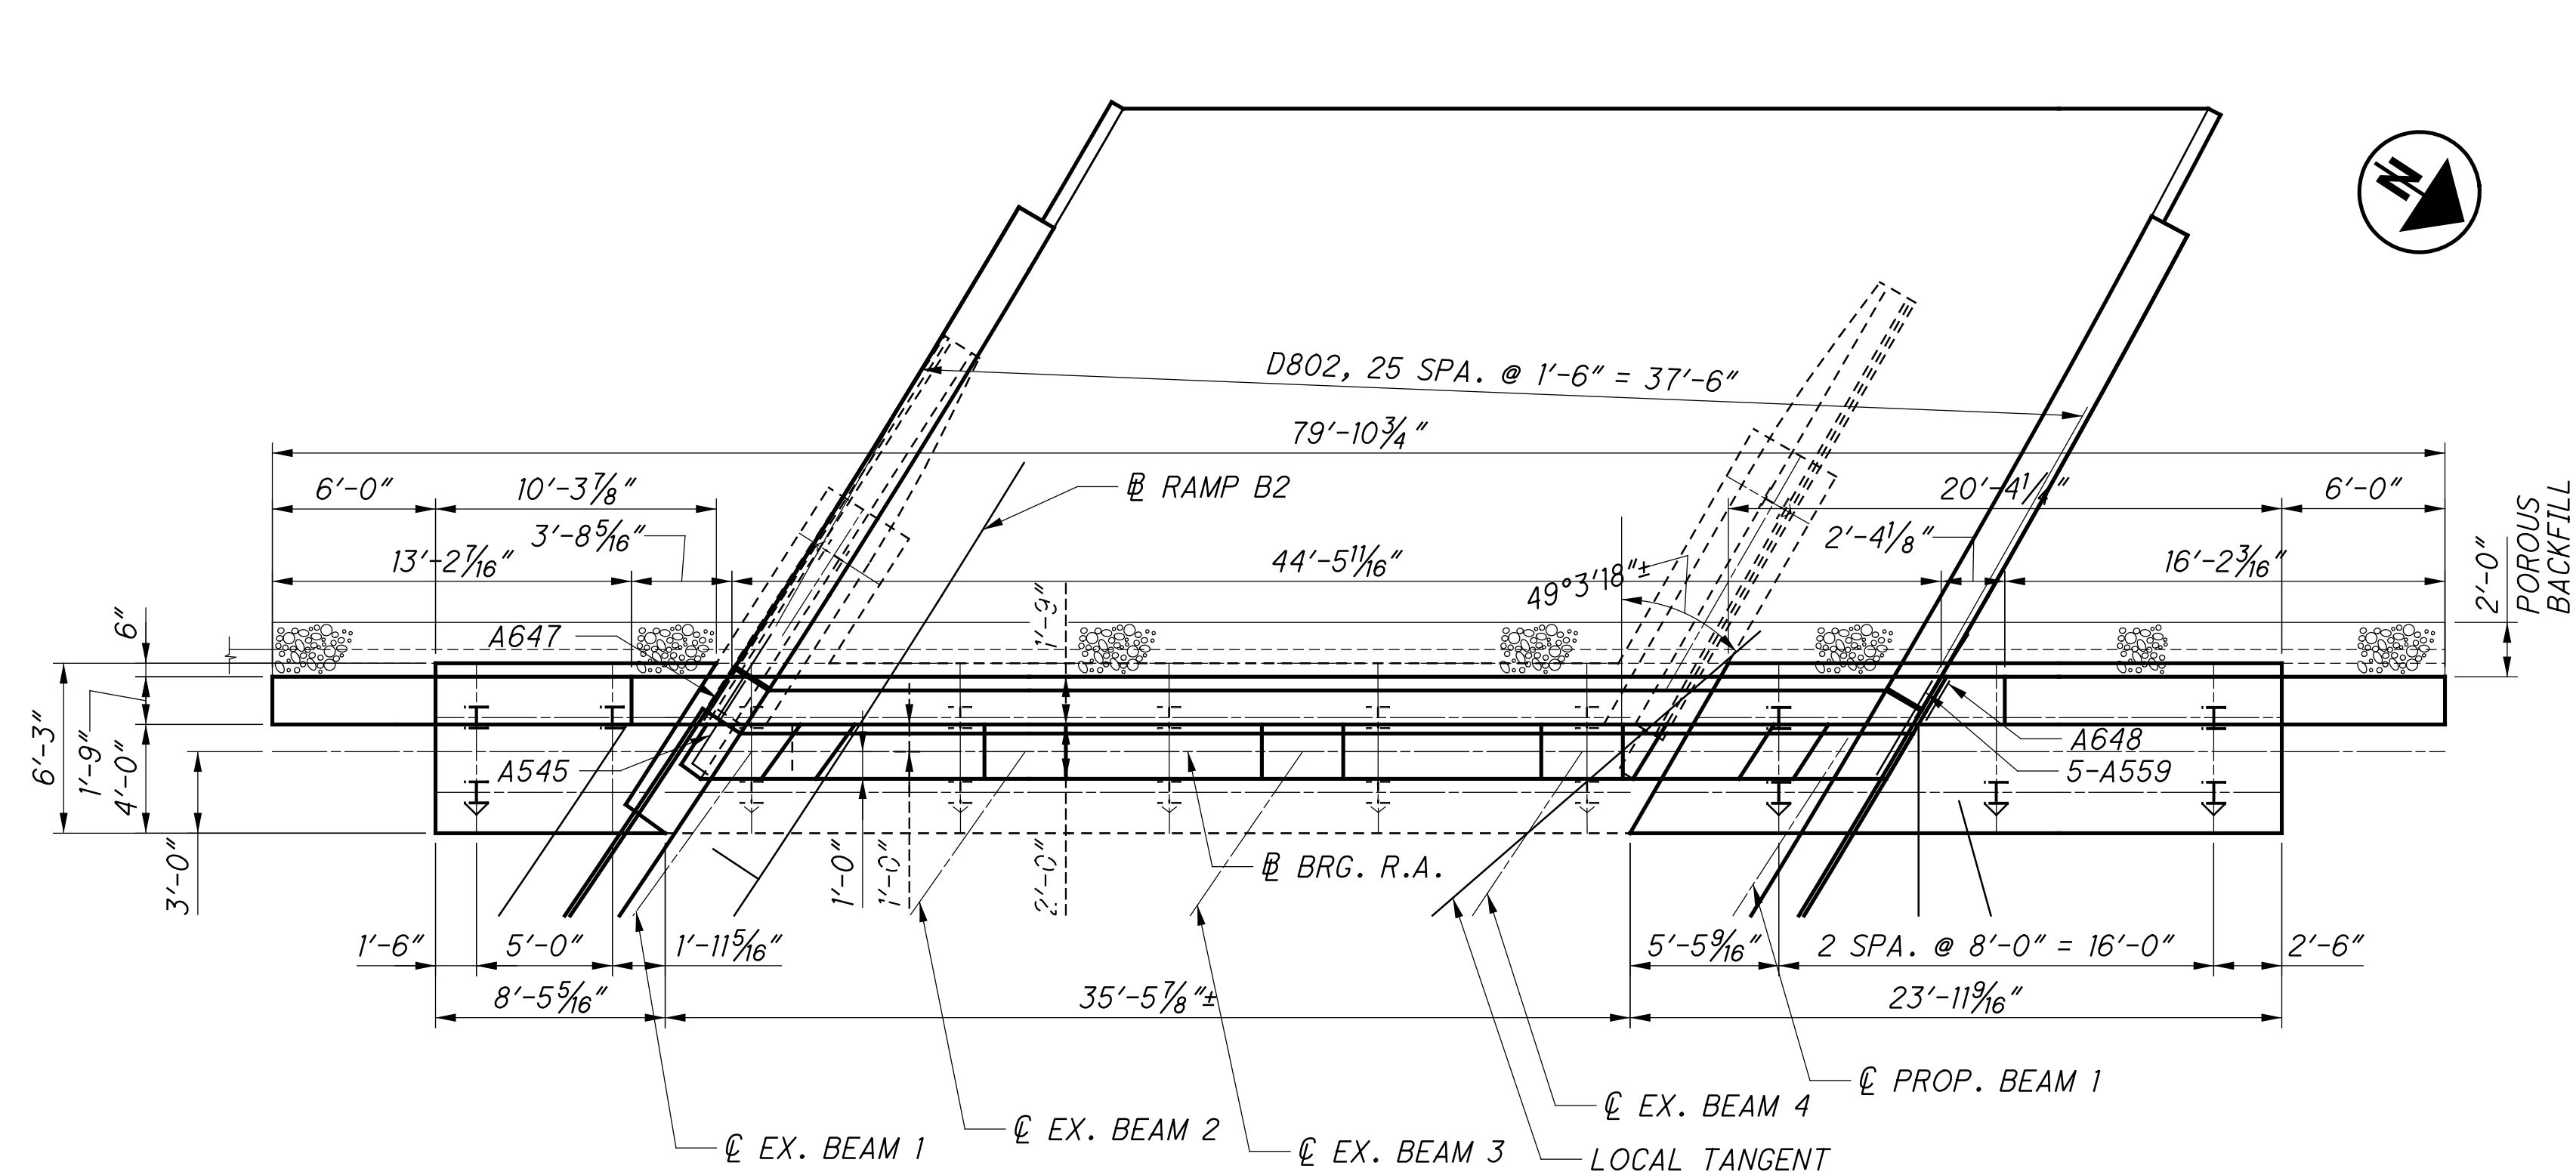


FORWARD ABUTMENT - PLAN

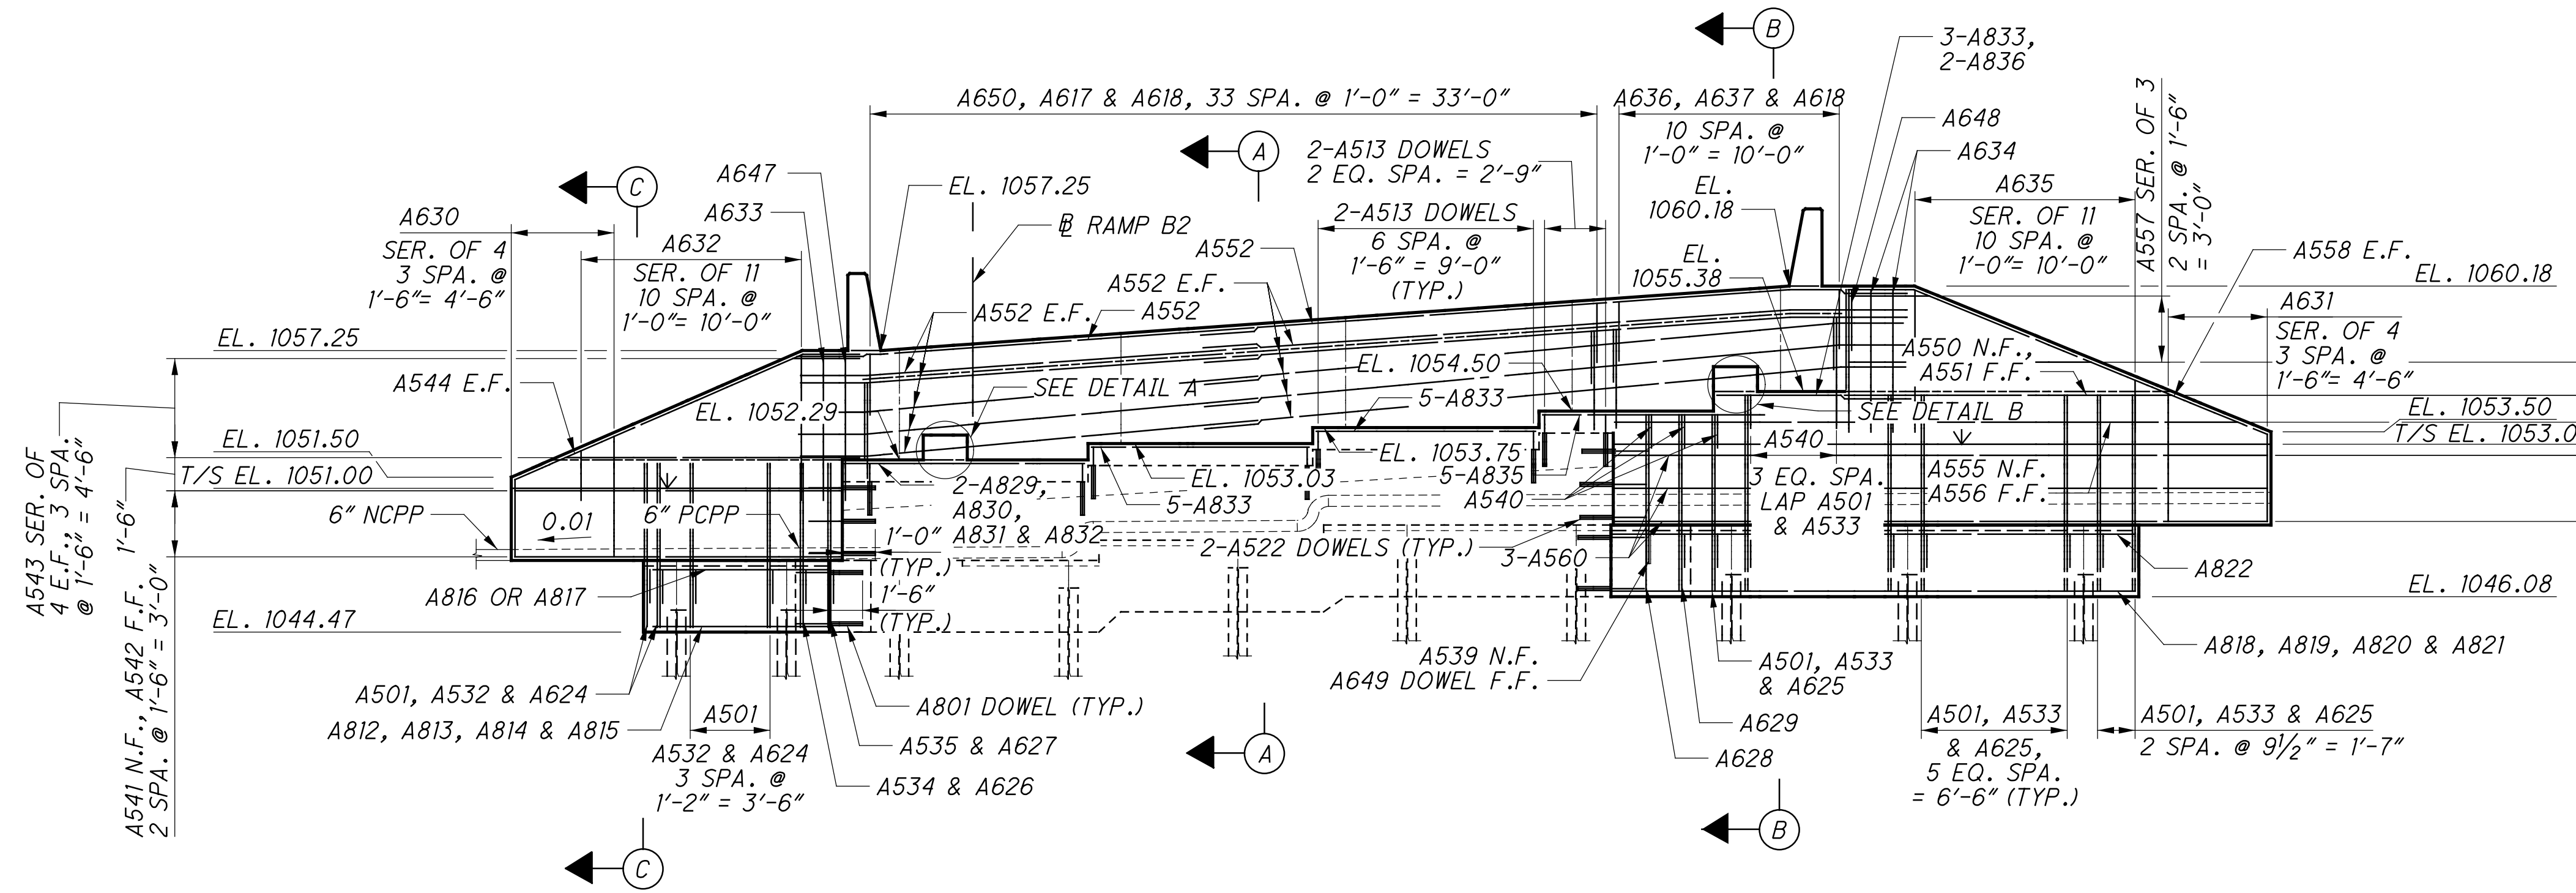


FORWARD ABUTMENT - ELEVATION

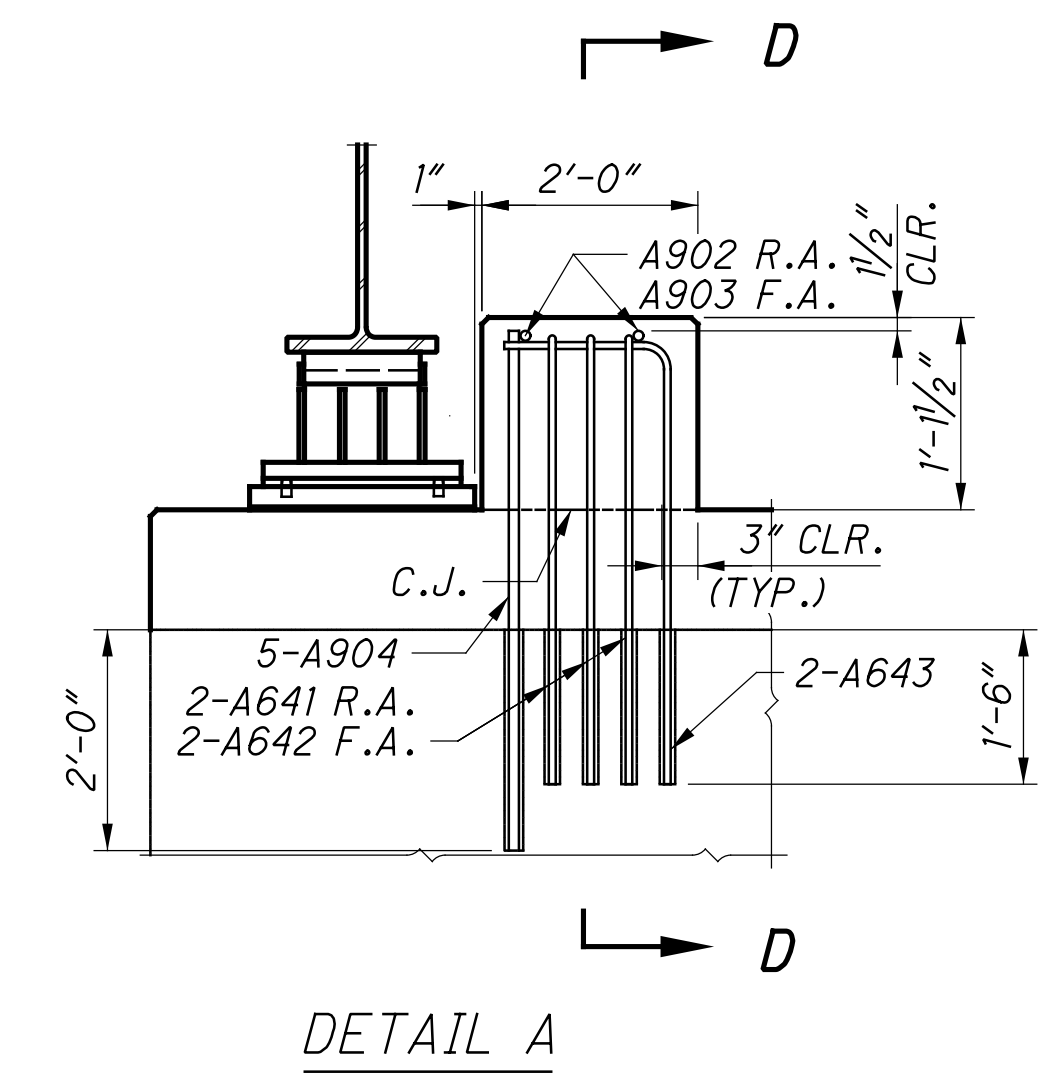

DETAIL A

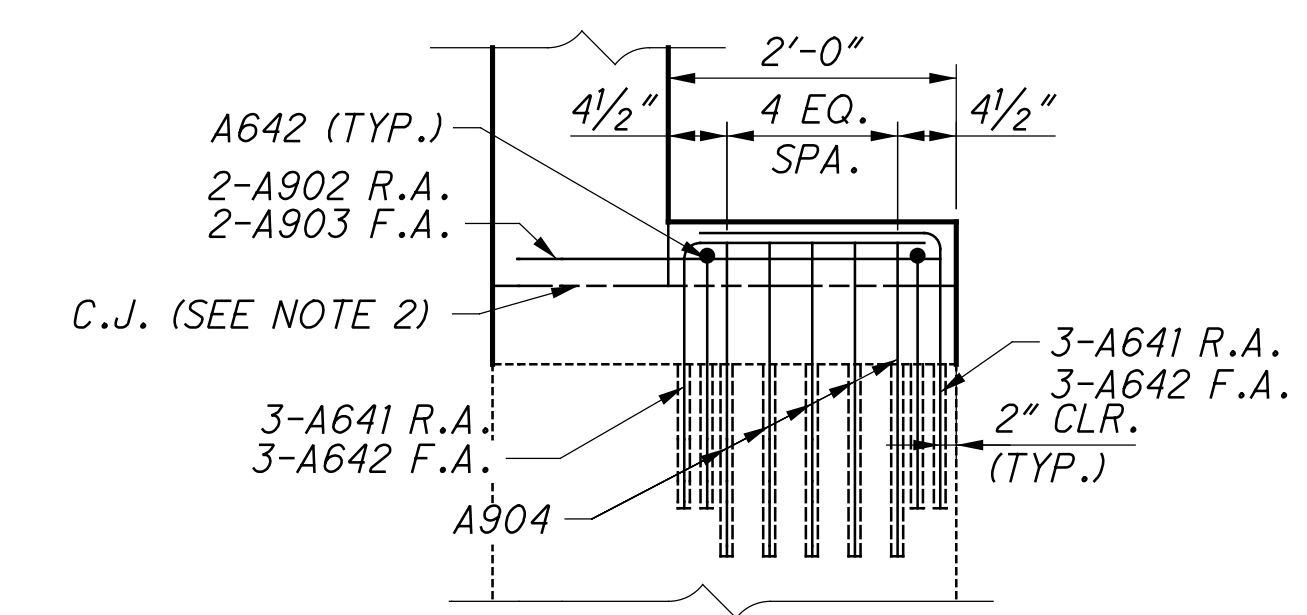

SECTION D-D

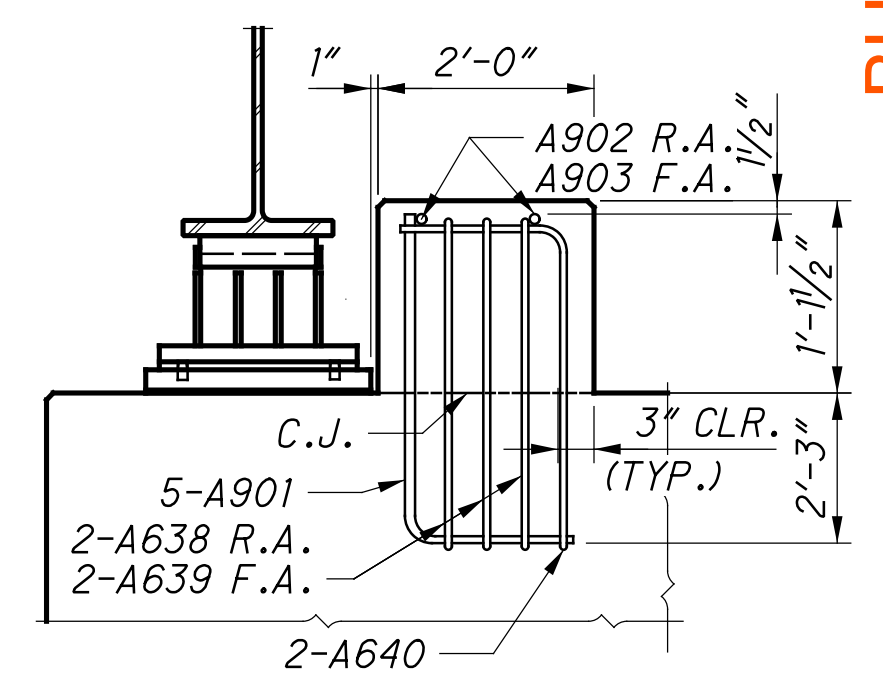

DETAIL B

- NOTES:
1. THE A638 BARS SHALL BE PLACED PARALLEL TO THE BEAM. THE A639 & A902 BARS SHALL BE PLACED PARALLEL TO THE CENTERLINE OF BEARING.
 2. THE SURFACE OF THE BEAM SEAT IN THIS AREA SHALL BE FINISHED WITH A SERRATED TROWEL. THE SERRATIONS SHALL BE 1/4" DEEP MINIMUM.
 3. SEE SHEET [8/13] FOR SECTION A-A, B-B & C-C.
 4. LAP NO. 5 BAR: 2'-5" MIN.

BU5 - AS-BUILT DRAWINGS - 09/12/2016

FORWARD ABUTMENT DETAILS

BRIDGE NO. SUM-077-0959
RAMP B2 OVER IR-77 S.B.

SUM 76 / 77-7.58 / 9.59
PID No. 98061

7 / 13


8
14

RESOURCE INTERNATIONAL INC.
6350 PRESIDENTIAL GATEWAY
COLUMBUS, OHIO 43231
(614) 823-4949




DATE	8/2015
REVIEWED	SSK
STRUCTURE FILE NUMBER	7702671
DRAWN	JGM
CHECKED	NCK
DESIGNED	JGM


C:\projects\2015\W-15-001 SUM77-76 DB with S&S\98061\structures\SUM077_0959C\sheets\077_0959C\AR002.dgn 9/12/2016 3:07:50 PM juans

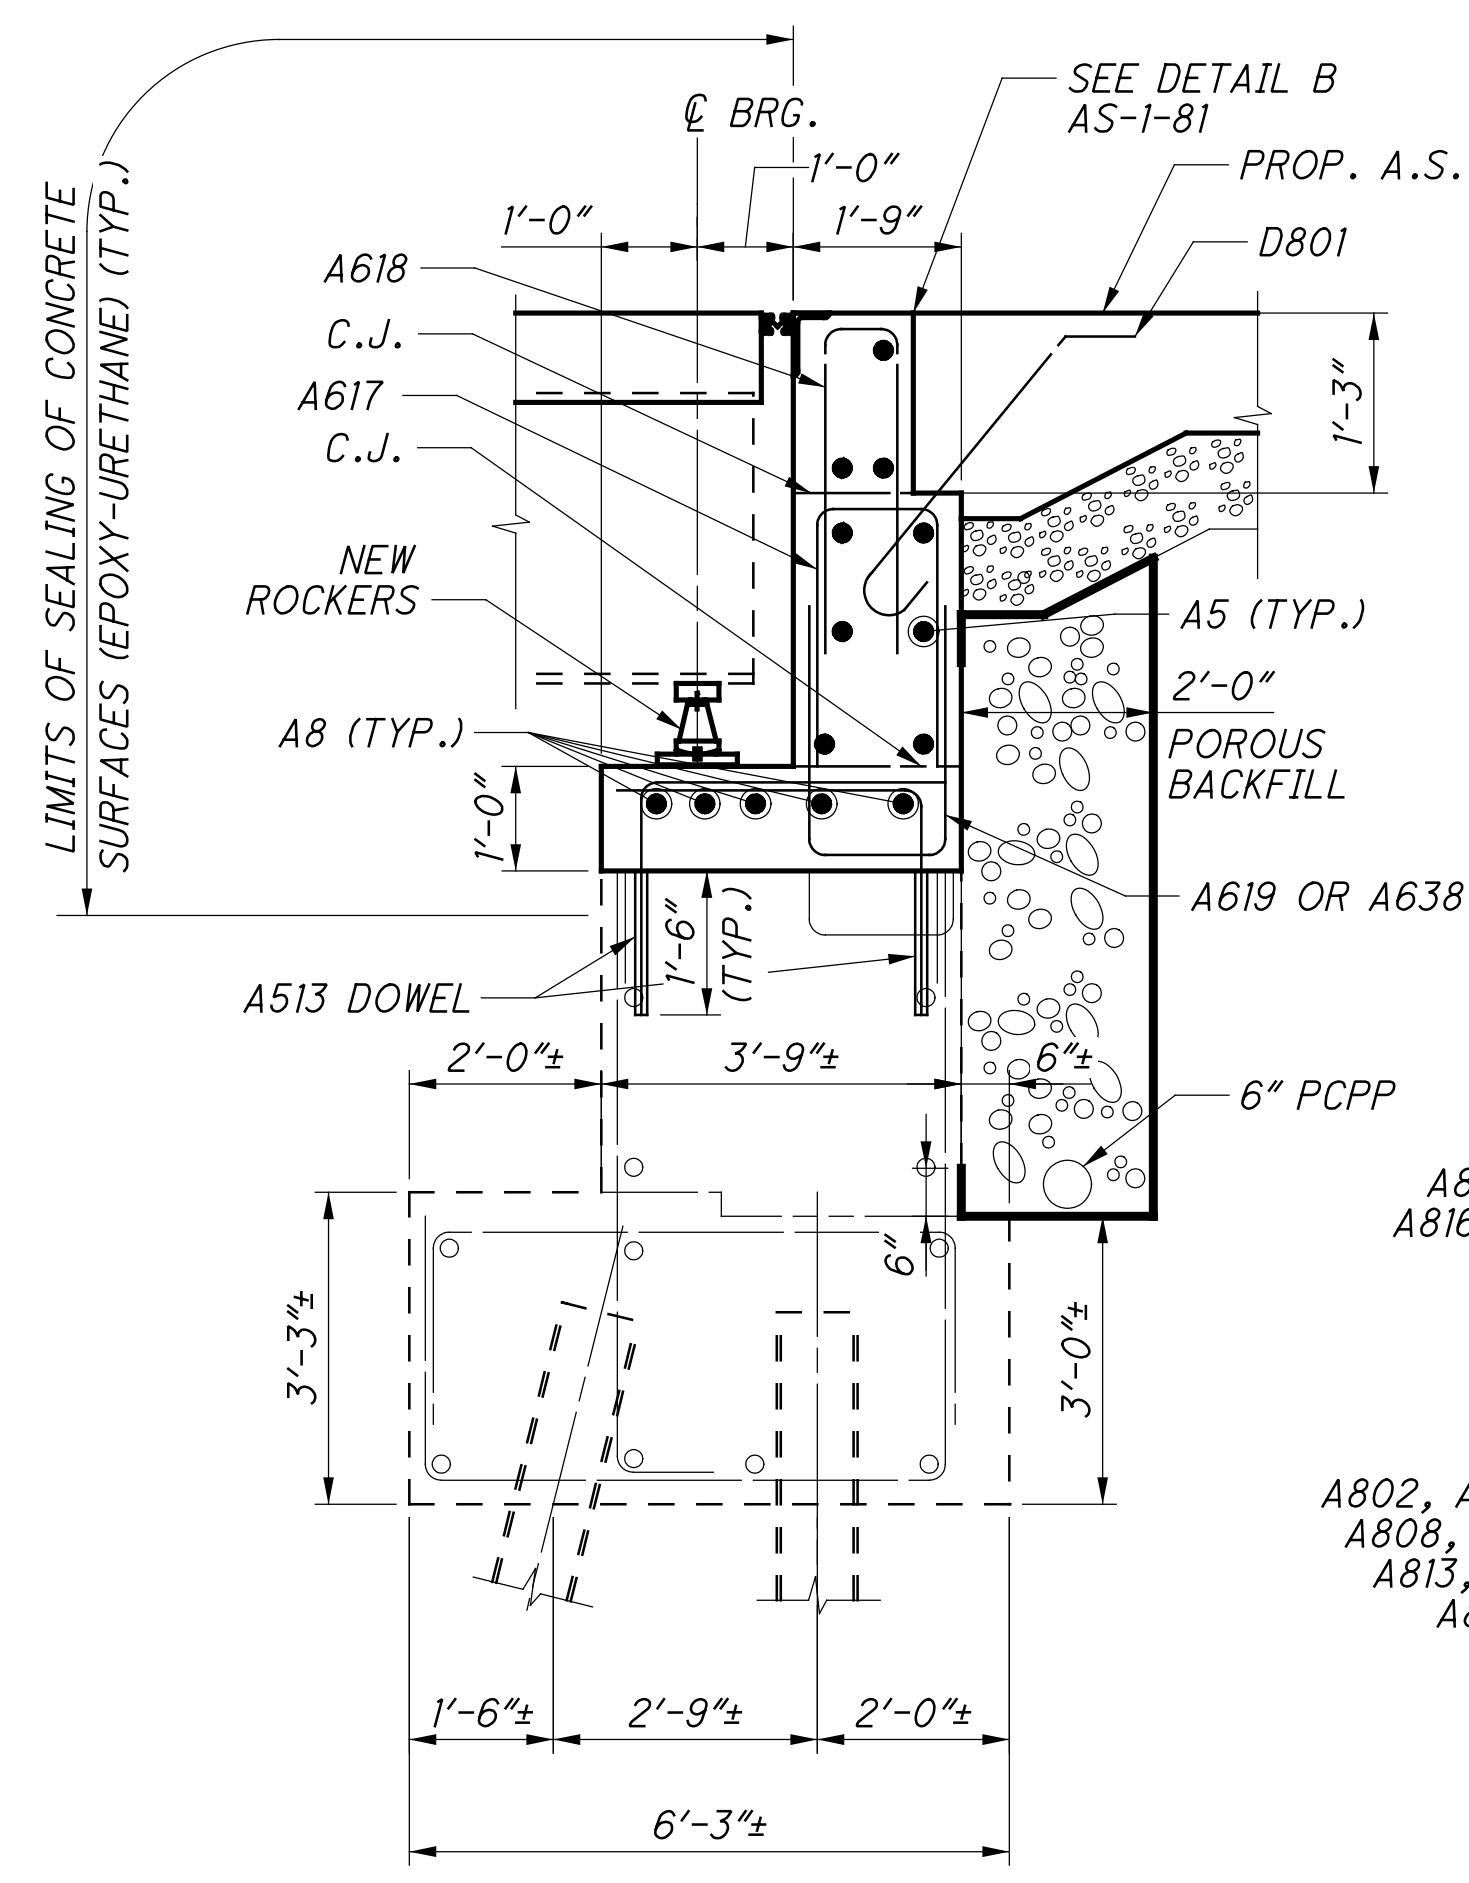

SECTION A-A

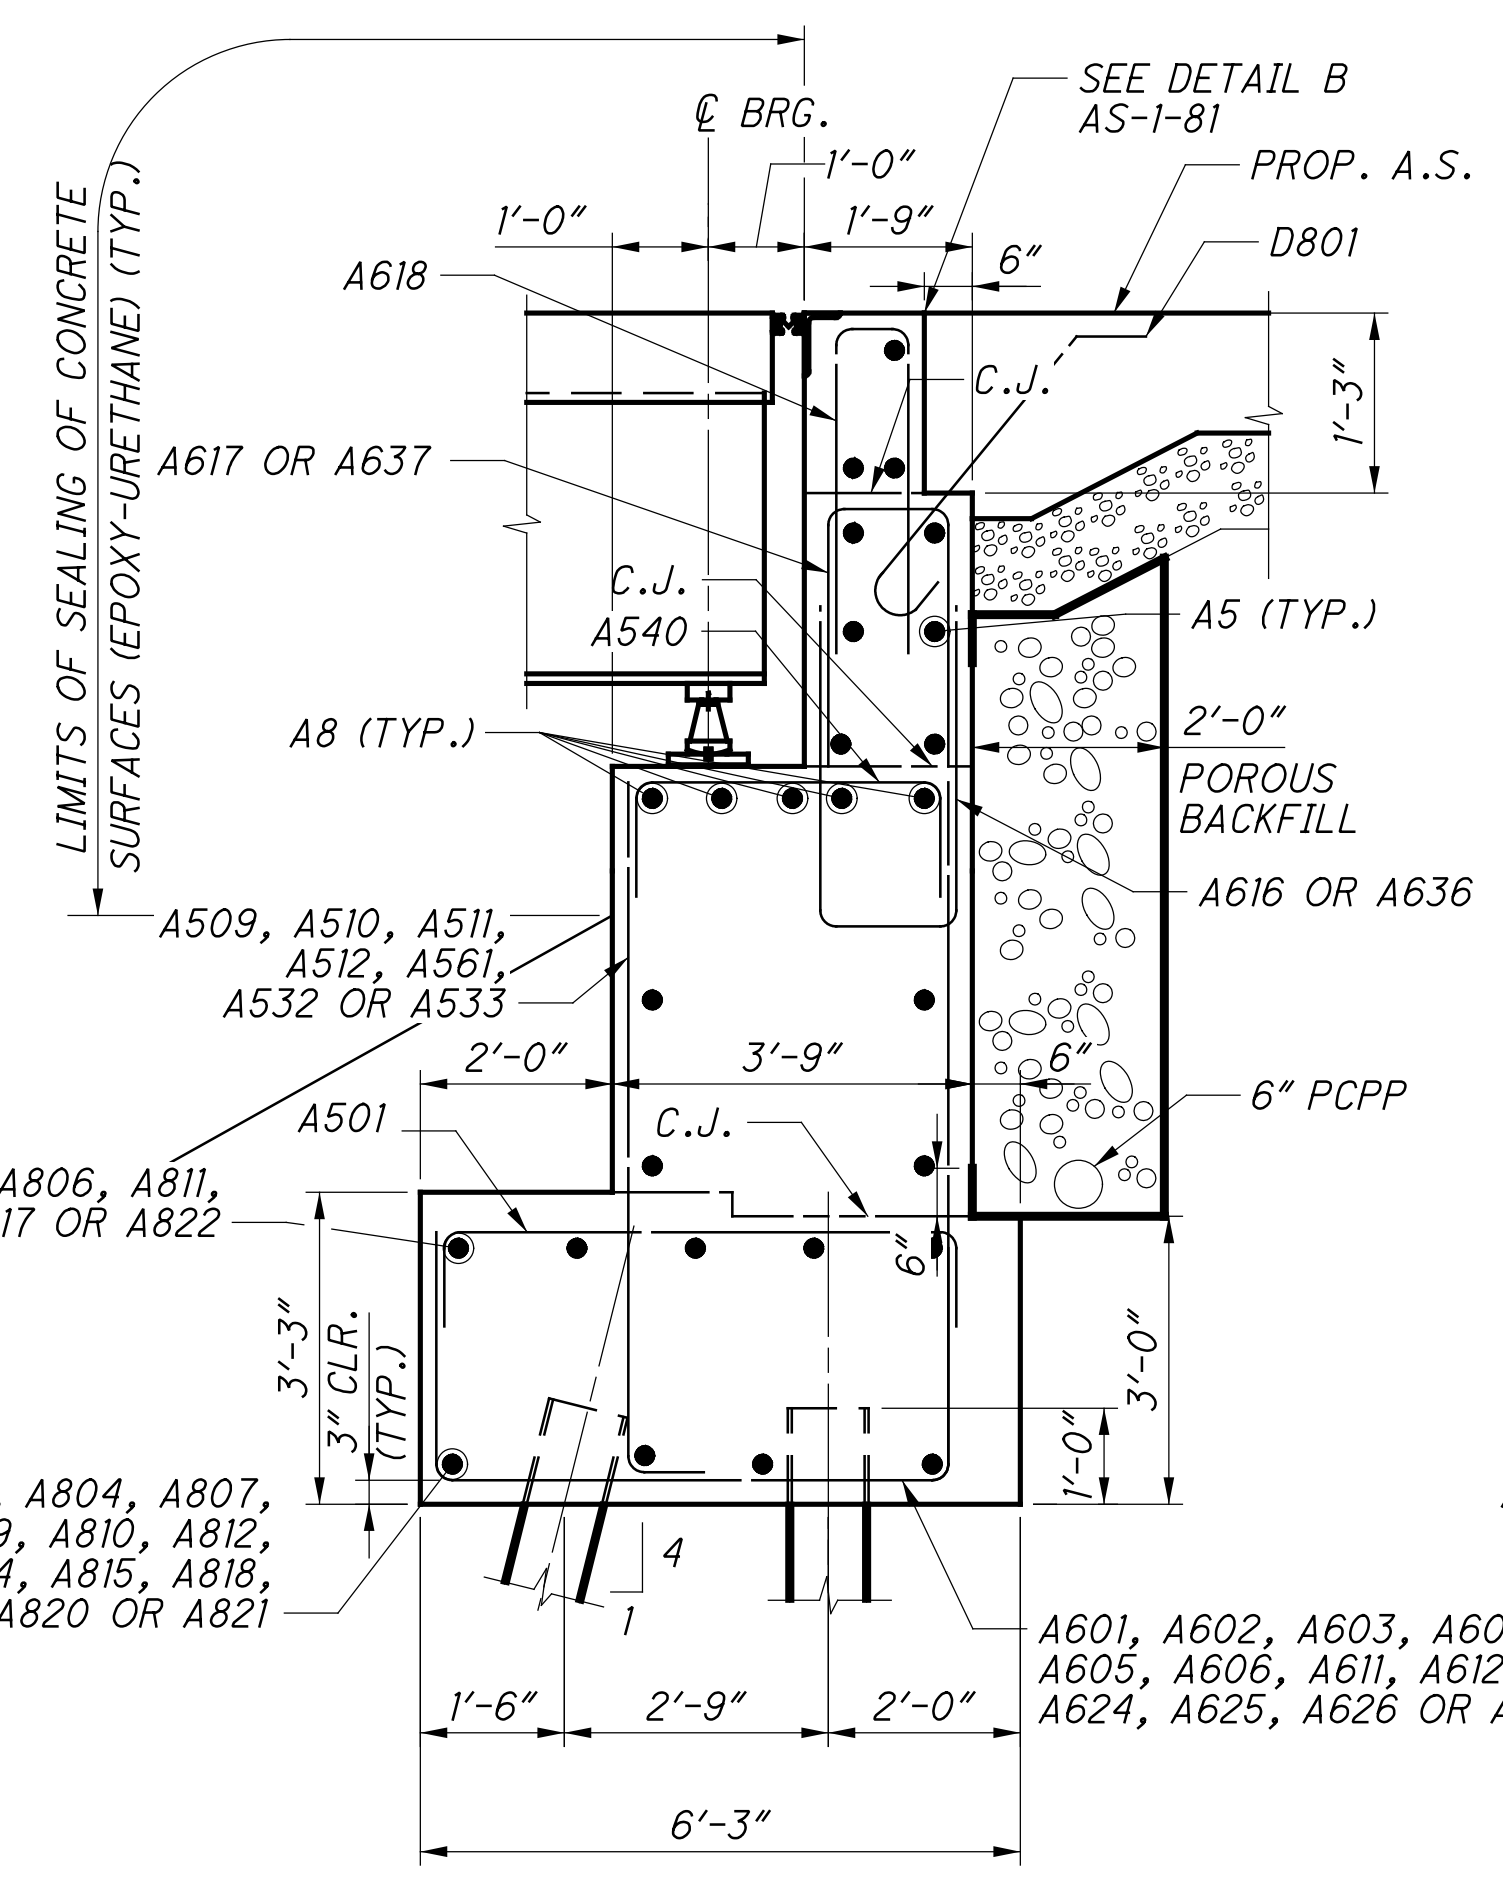

SECTION B-B

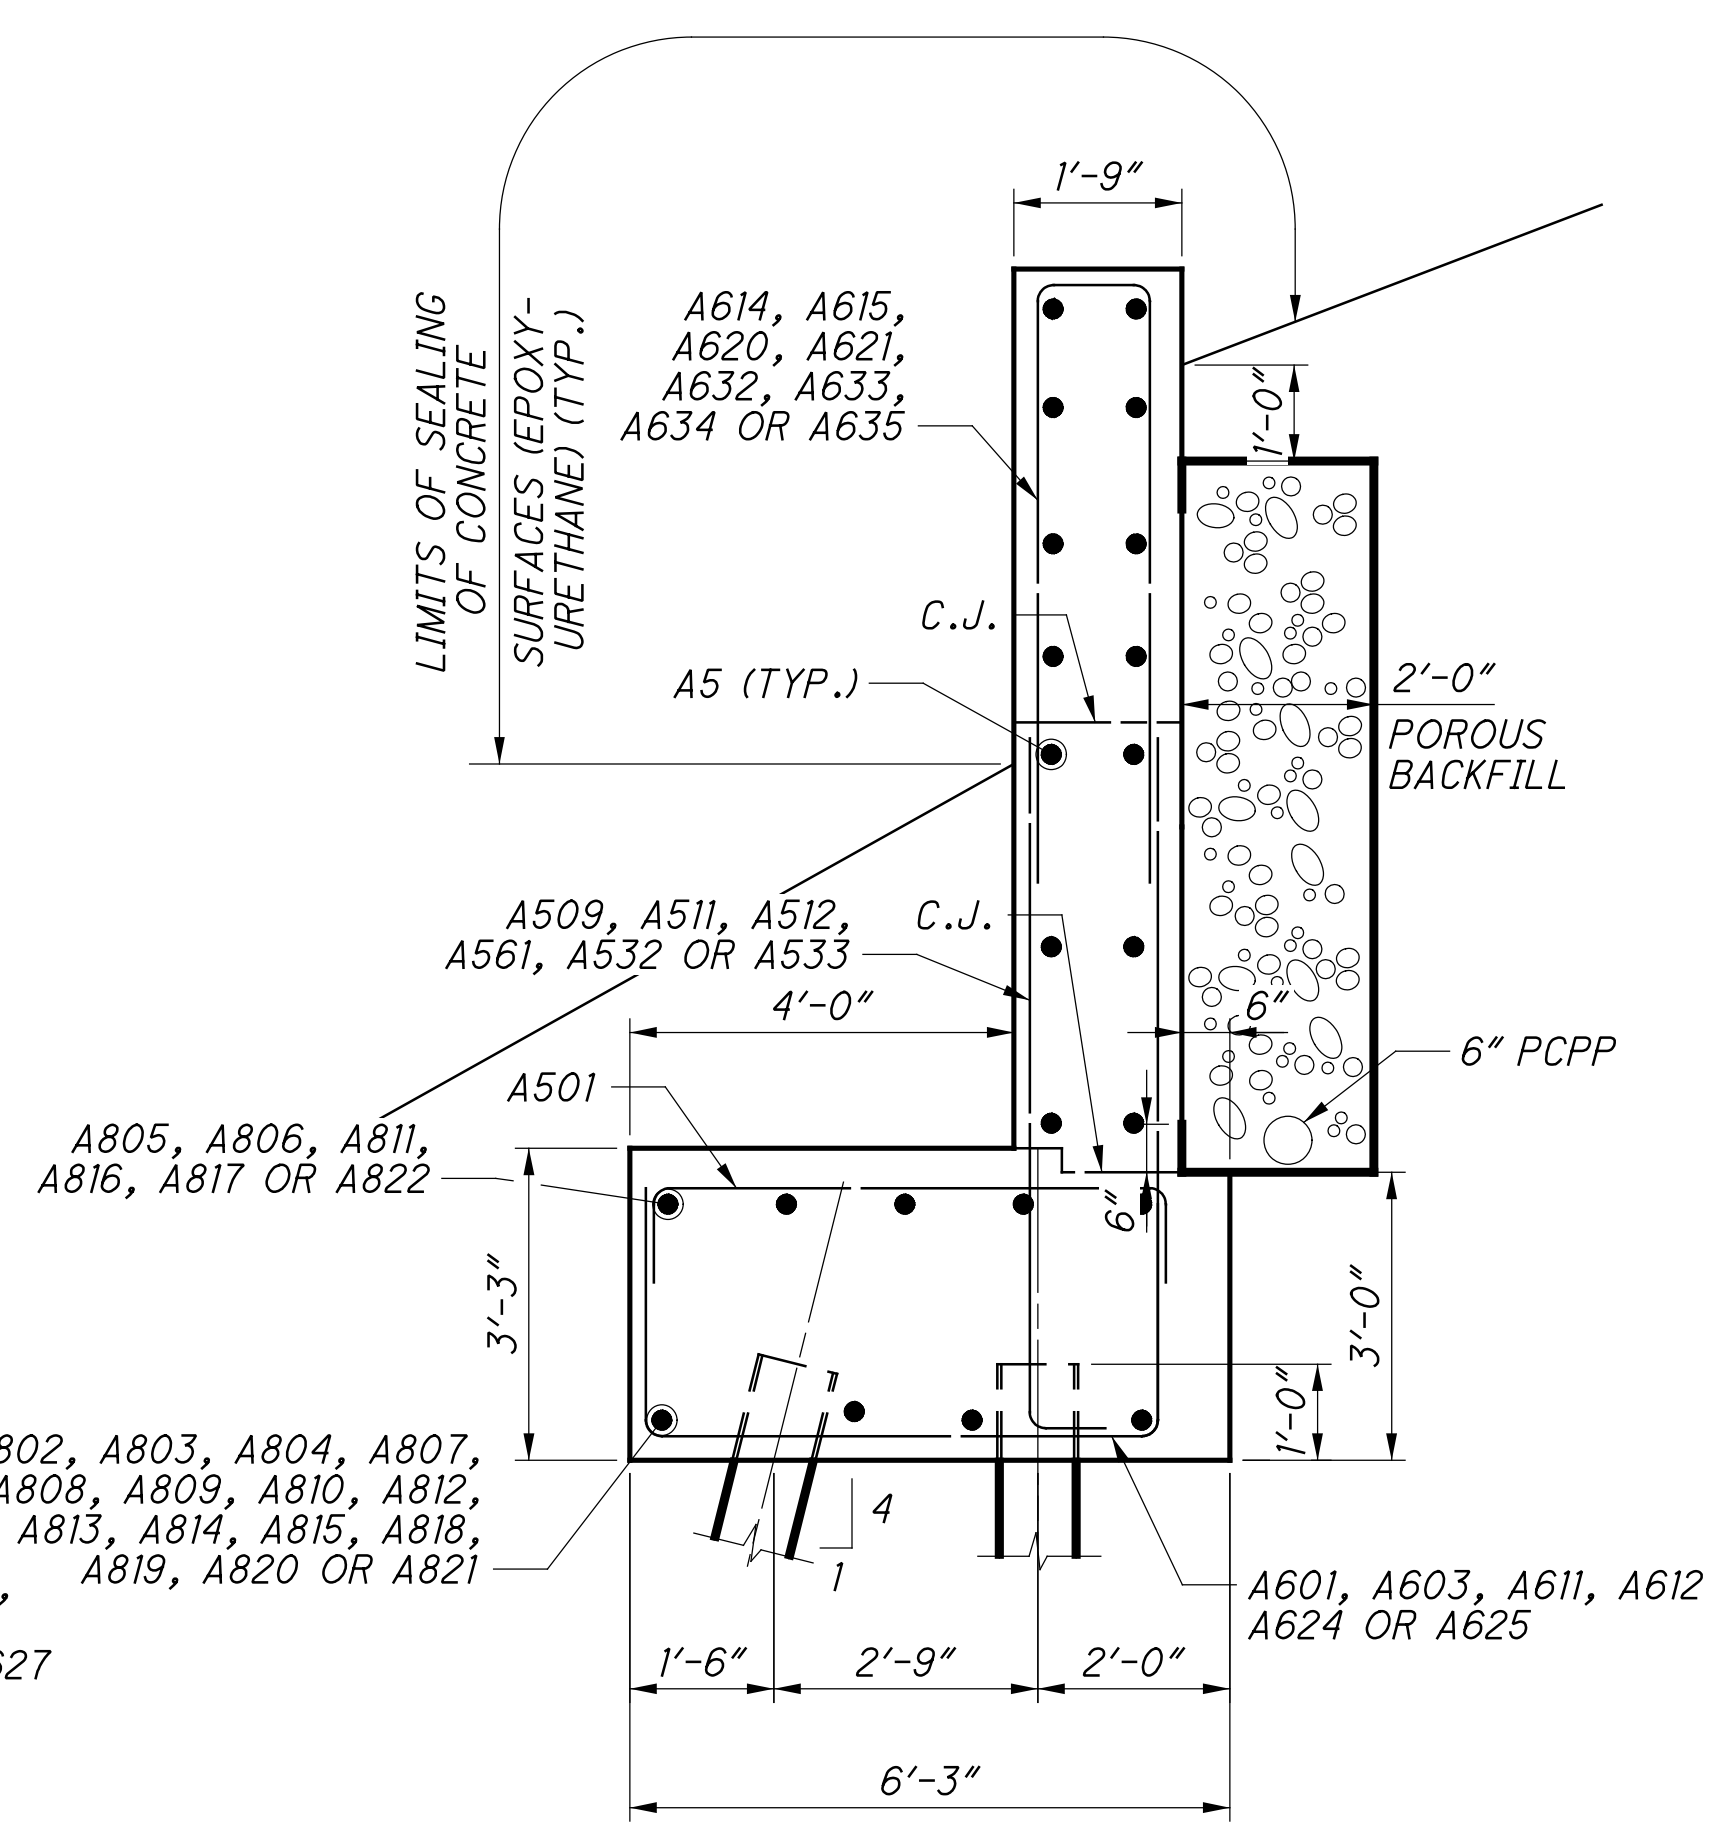

SECTION C-C

- NOTES:
- FOR ADDITIONAL DETAILS, SEE STD. DWG. A-1-69.
 - SEE SHEETS 6/13 & 7/13 FOR LOCATION OF SECTIONS A-A, B-B & C-C.

BU5 - AS-BUILT DRAWINGS - 09/12/2016

ABUTMENT DETAILS
 BRIDGE NO. SUM-077-0959
 RAMP B2 OVER IR-77 S.B.


SUM 76 / 77-7.58 / 9.59
PID No. 98061




DESIGNED	JGM	CHECKED	NCK
DRAWN	JGM	REVISED	
REVIEWED	SSK	STRUCTURE FILE NUMBER	7702671
DATE	7/2015		

RESOURCE INTERNATIONAL INC.
 6350 PRESIDENTIAL GATEWAY
 COLUMBUS, OHIO 43231
 (614) 823-4949


G:\projects\2015\W-15-001 SUM77-76 DB with S&S\9806\structures\SUM077_0959C\sheets\077_0959CP\001.dgn 9/12/2016 3:07:51 PM juans

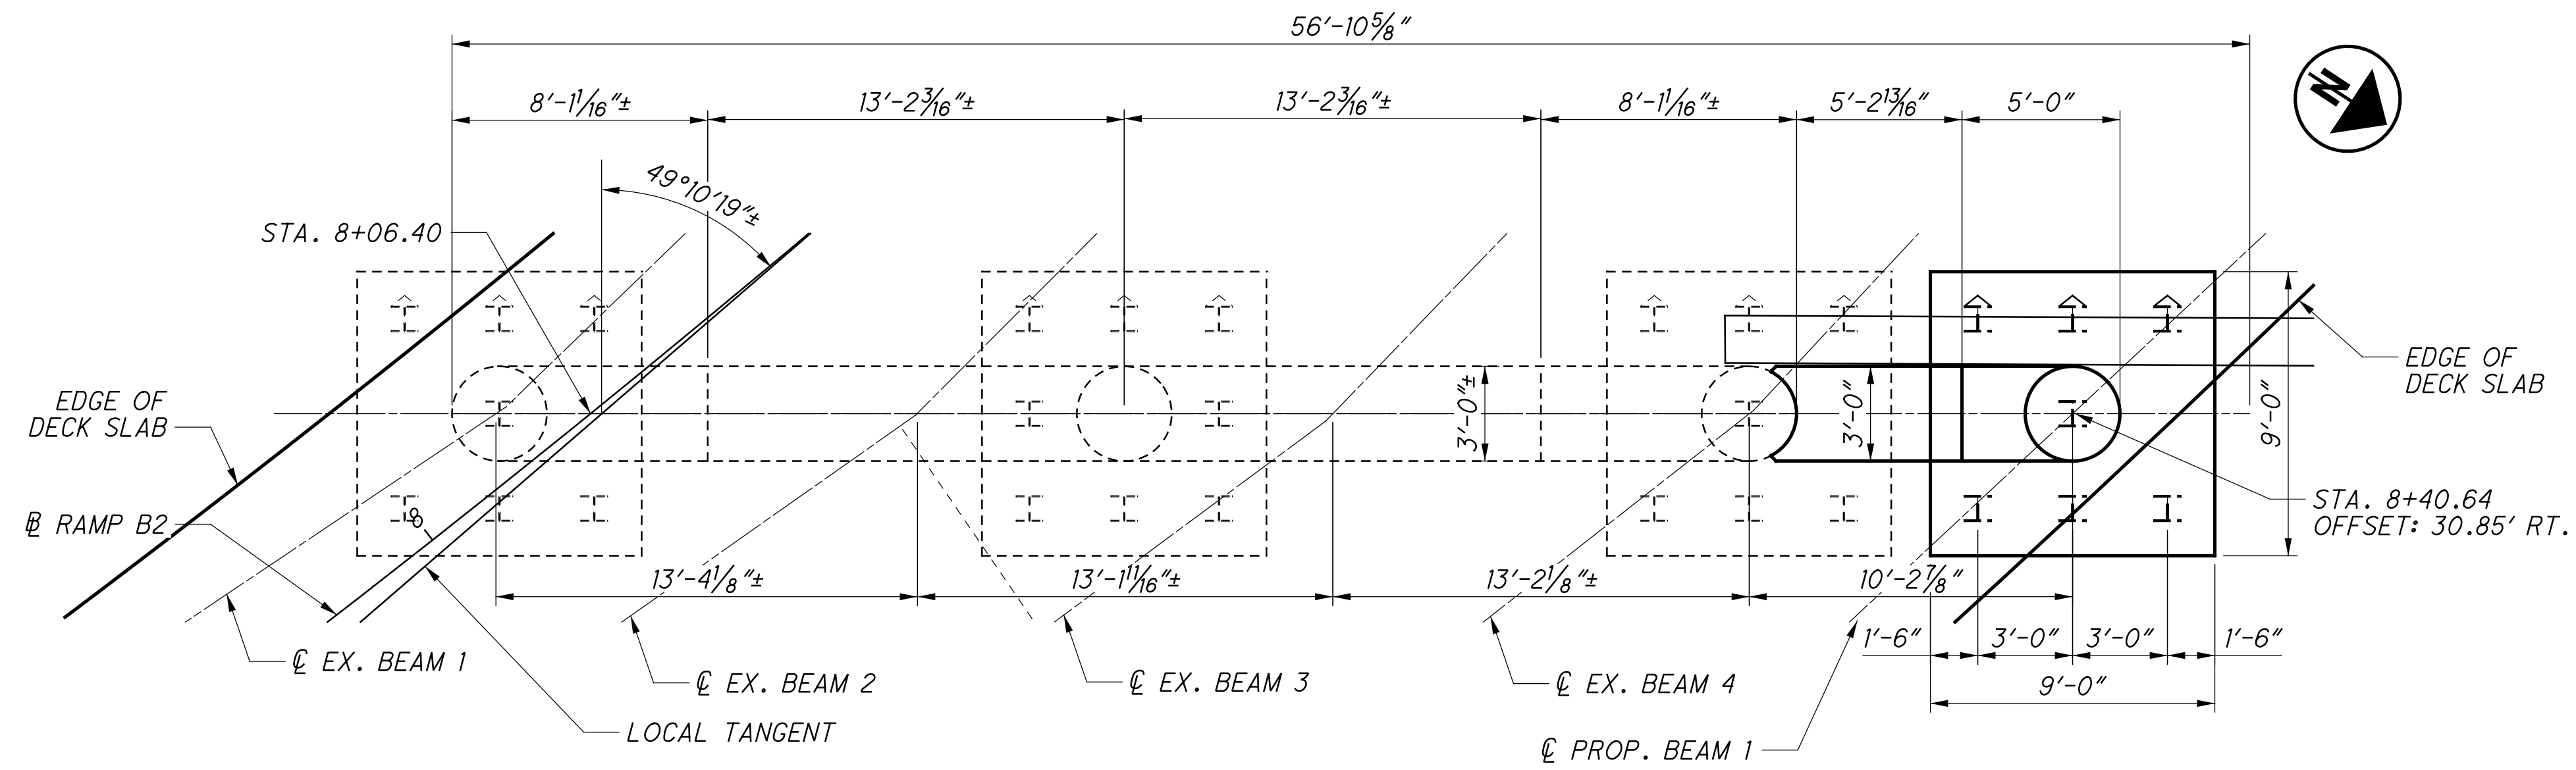

PIER 1 - PLAN

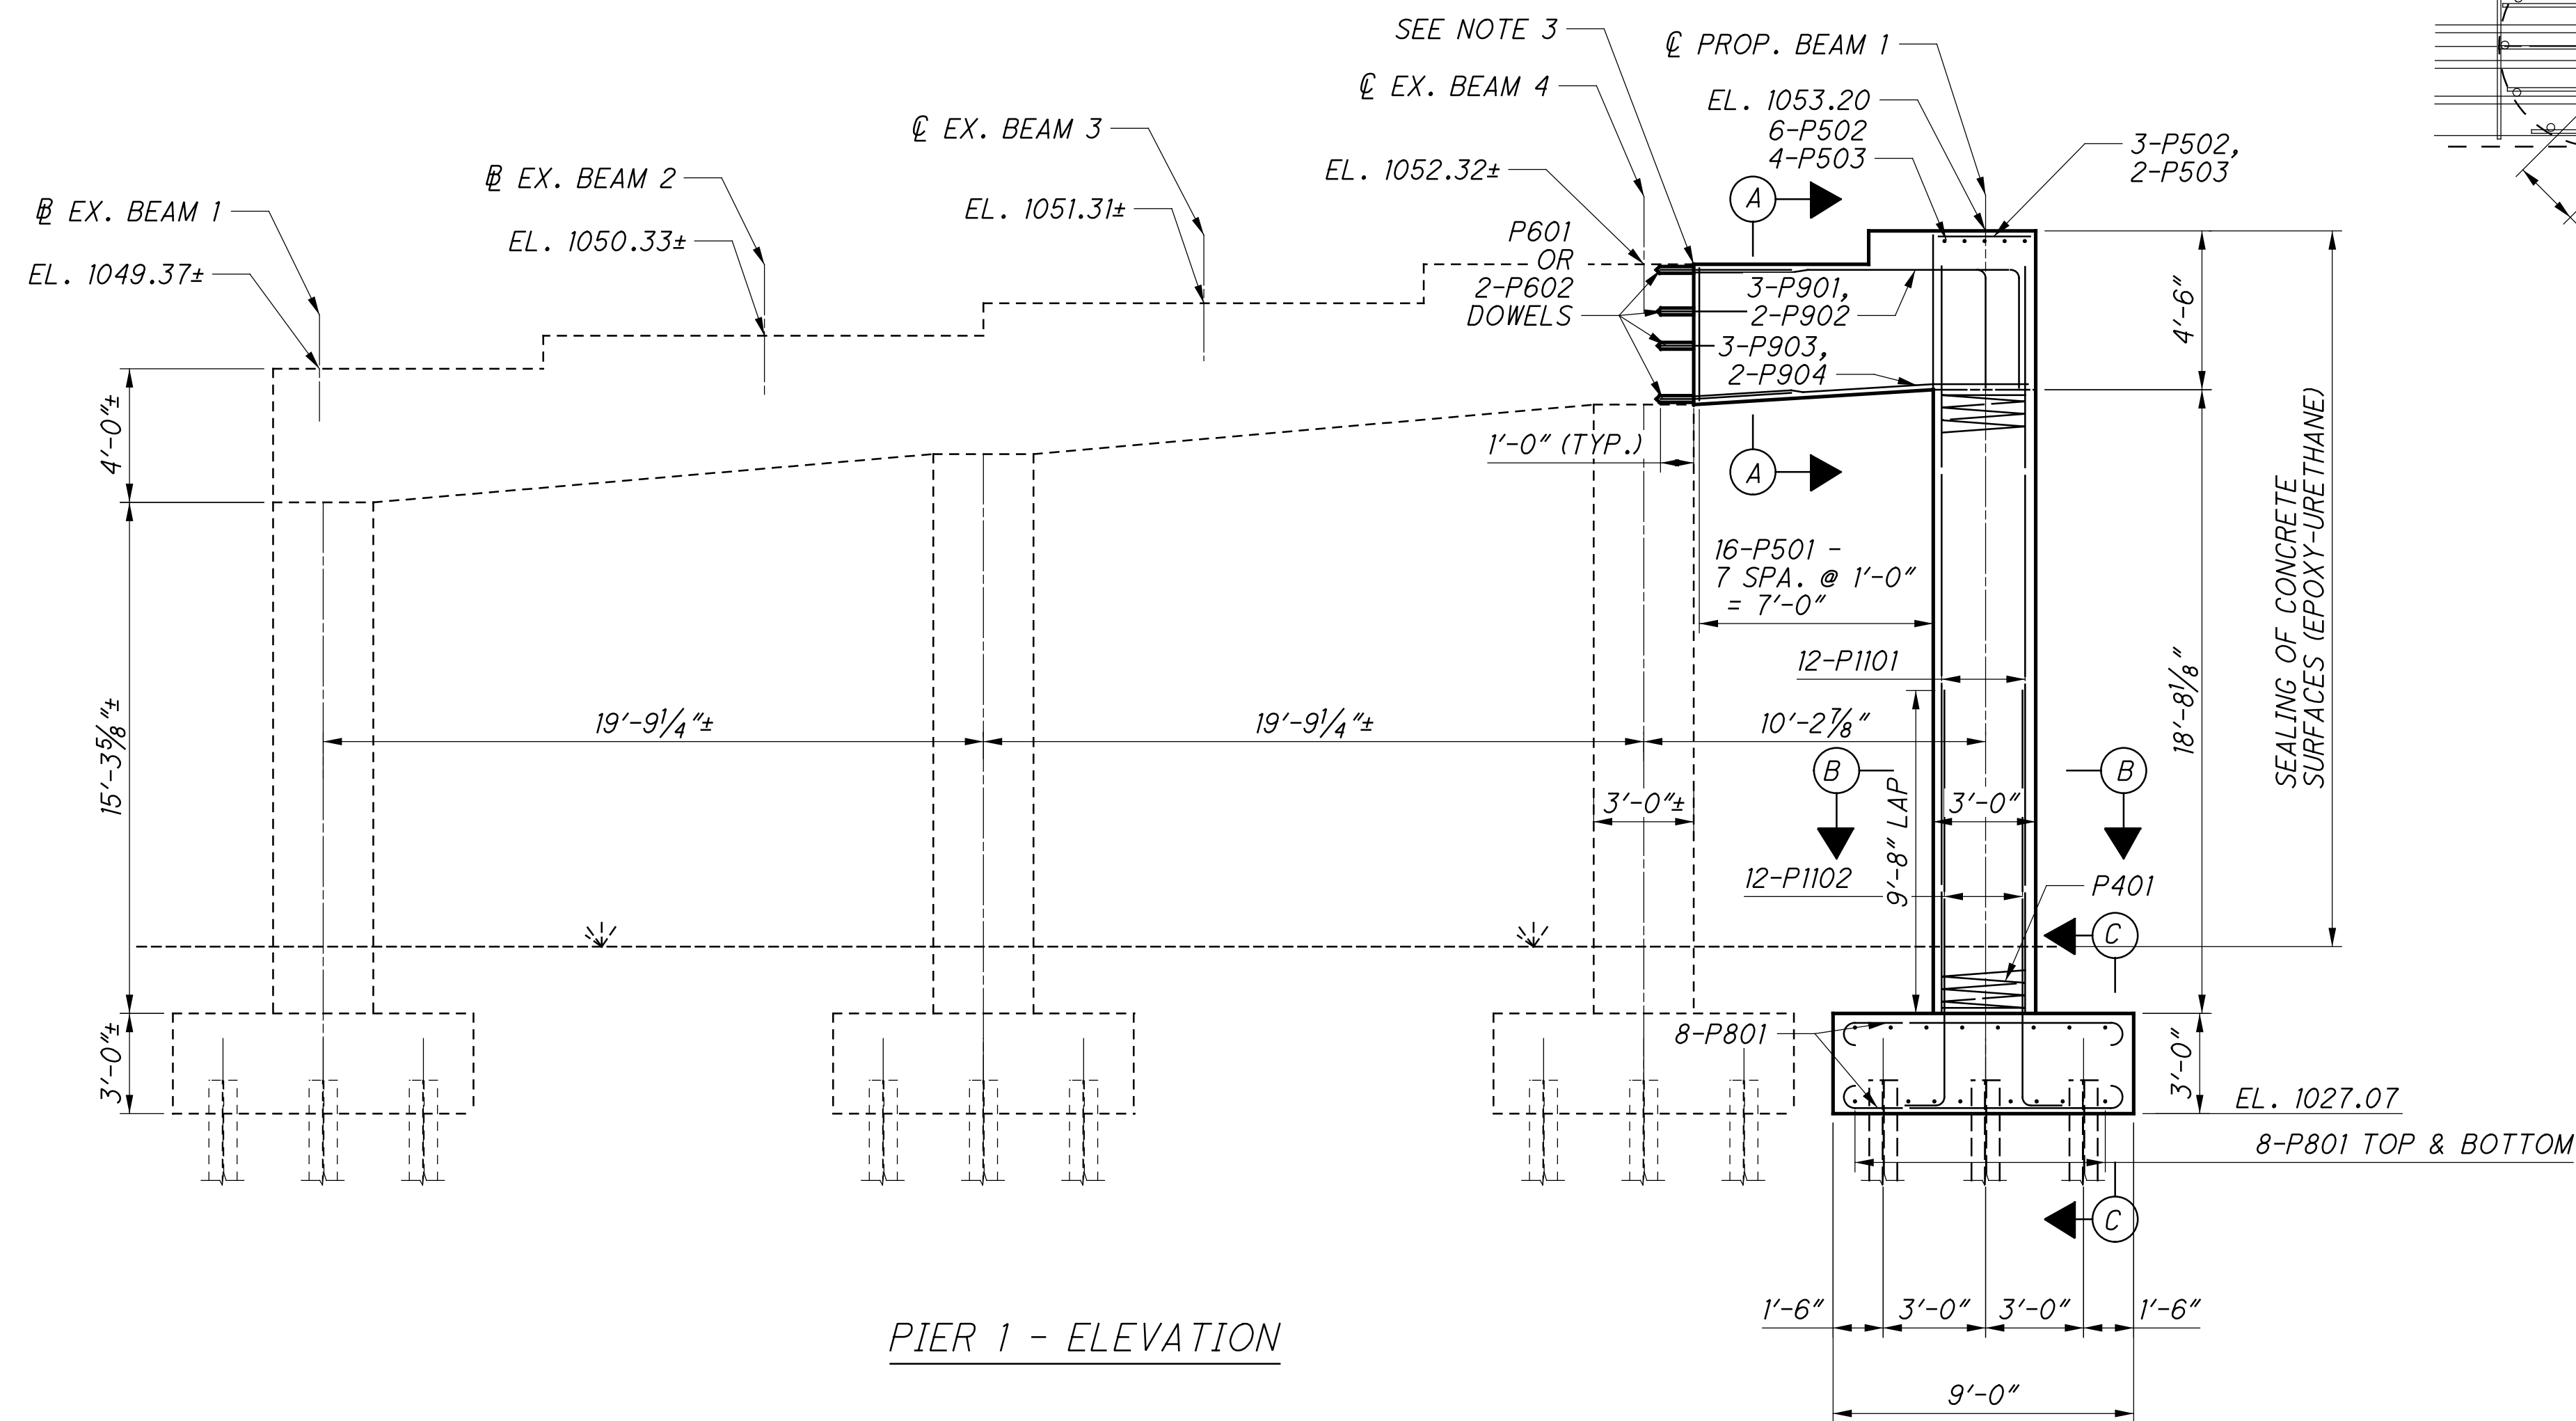

PIER 1 - ELEVATION

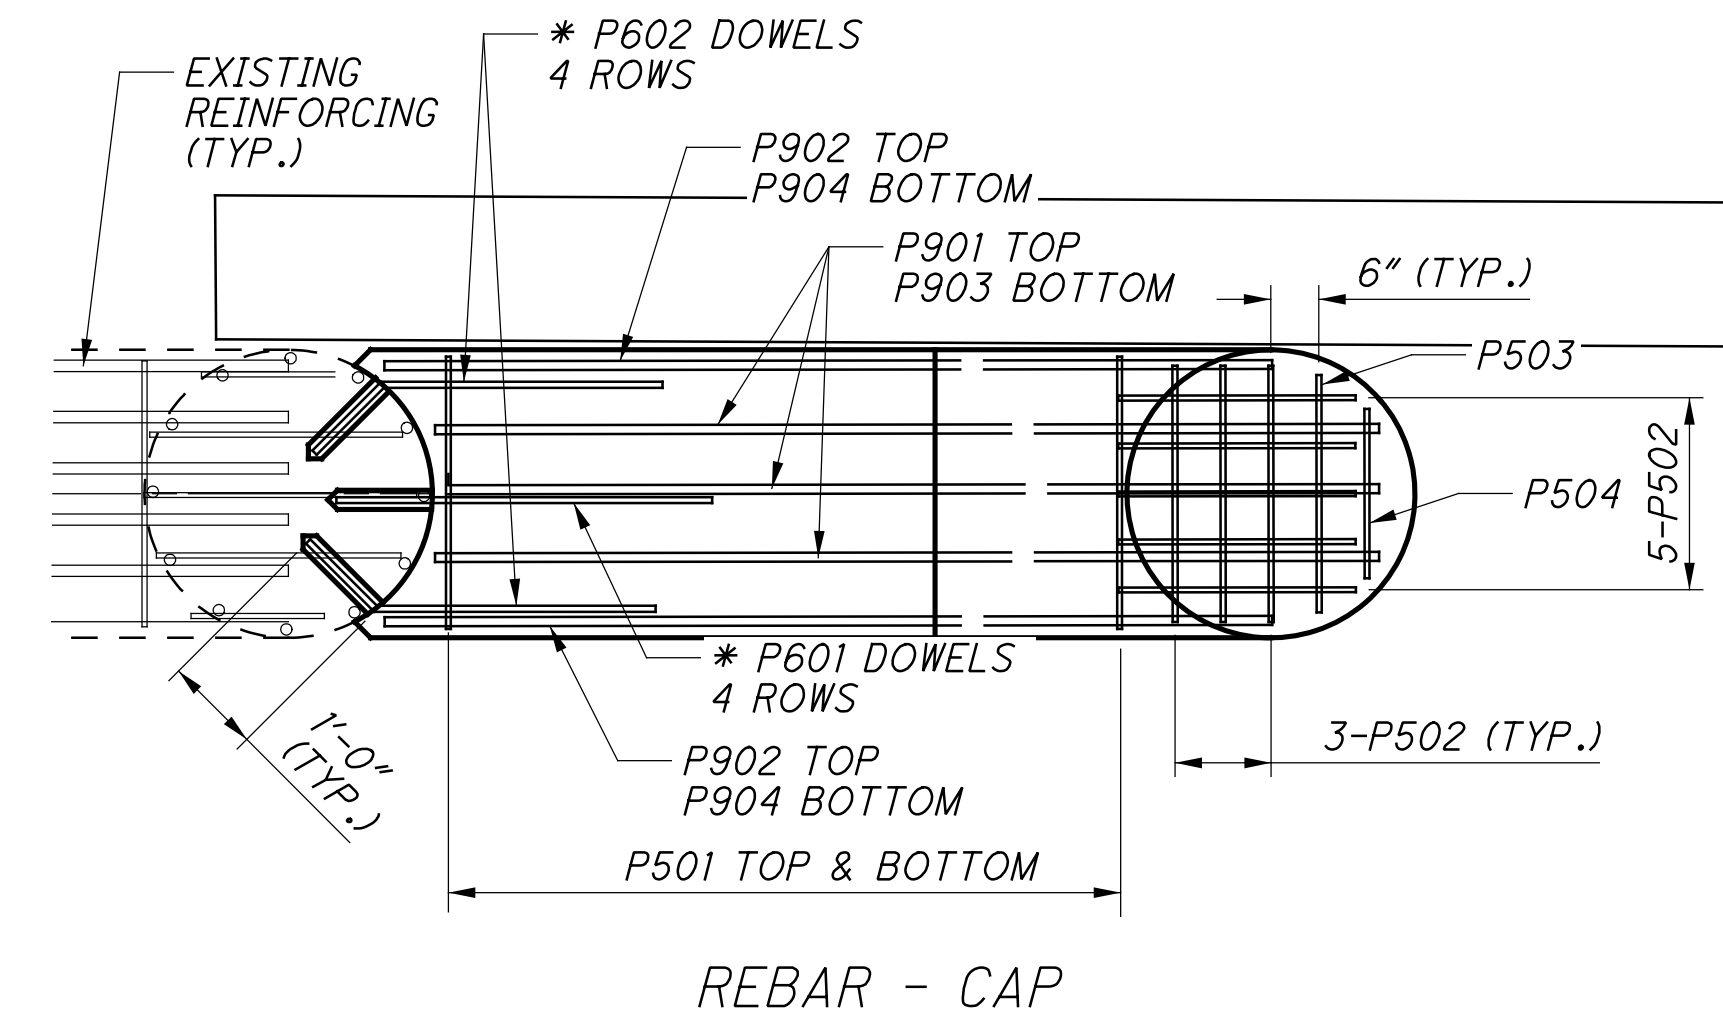

REBAR - CAP

MINIMUM LAP LENGTHS:
 #5 BAR = 2'-5"
 #6 BAR = 2'-11"
 #8 BAR = 4'-11"
 #9 BAR = 6'-2"
 #11 BAR = 9'-8"

- NOTES:
- 1.) ACCURATELY PLACE REINFORCING STEEL IN THE VICINITY OF THE BRIDGE SEAT TO AVOID INTERFERENCE WITH THE DRILLING OF BEARING ANCHOR HOLES OR THE PRE-SETTING OF BEARING ANCHORS.
 - 2.) SEE FOOTING PLAN ON SHEET 11/13.
 - 3.) ROUGHEN THE SURFACE OF THE NEW INTERFACE BETWEEN THE EXTENDED PIER CAP AND THE EXISTING PIER CAP.

* ADJUST LOCATIONS OF DOWELS AS NECESSARY TO PROVIDE REQUIRED CLEARANCE AND AVOID EXISTING REINFORCING

BU5 - AS-BUILT DRAWINGS - 09/12/2016

PIER WIDENING DETAILS

BRIDGE NO. SUM-77-0959
 RAMP B2 OVER IR-77 S.B.

SUM 76 / 77-7.58 / 9.59
 PID No. 98061

9 / 13


10
14

RESOURCE INTERNATIONAL INC.
 6350 PRESIDENTIAL GATEWAY
 COLUMBUS, OHIO 43231
 (614) 823-4949




DESIGNED	JLM	CHECKED	JGM
DRAWN	JLM	REVISED	
REVIEWED	NCK	DATE	7/2015
STRUCTURE FILE NUMBER	7702671		


c:\projects\2015\w-15-001 SUM77-76 DB with S&S\98061\structures\SUM077_0959C\sheets\077_0959CPI002.dgn 9/12/2016 3:07:53 PM juans

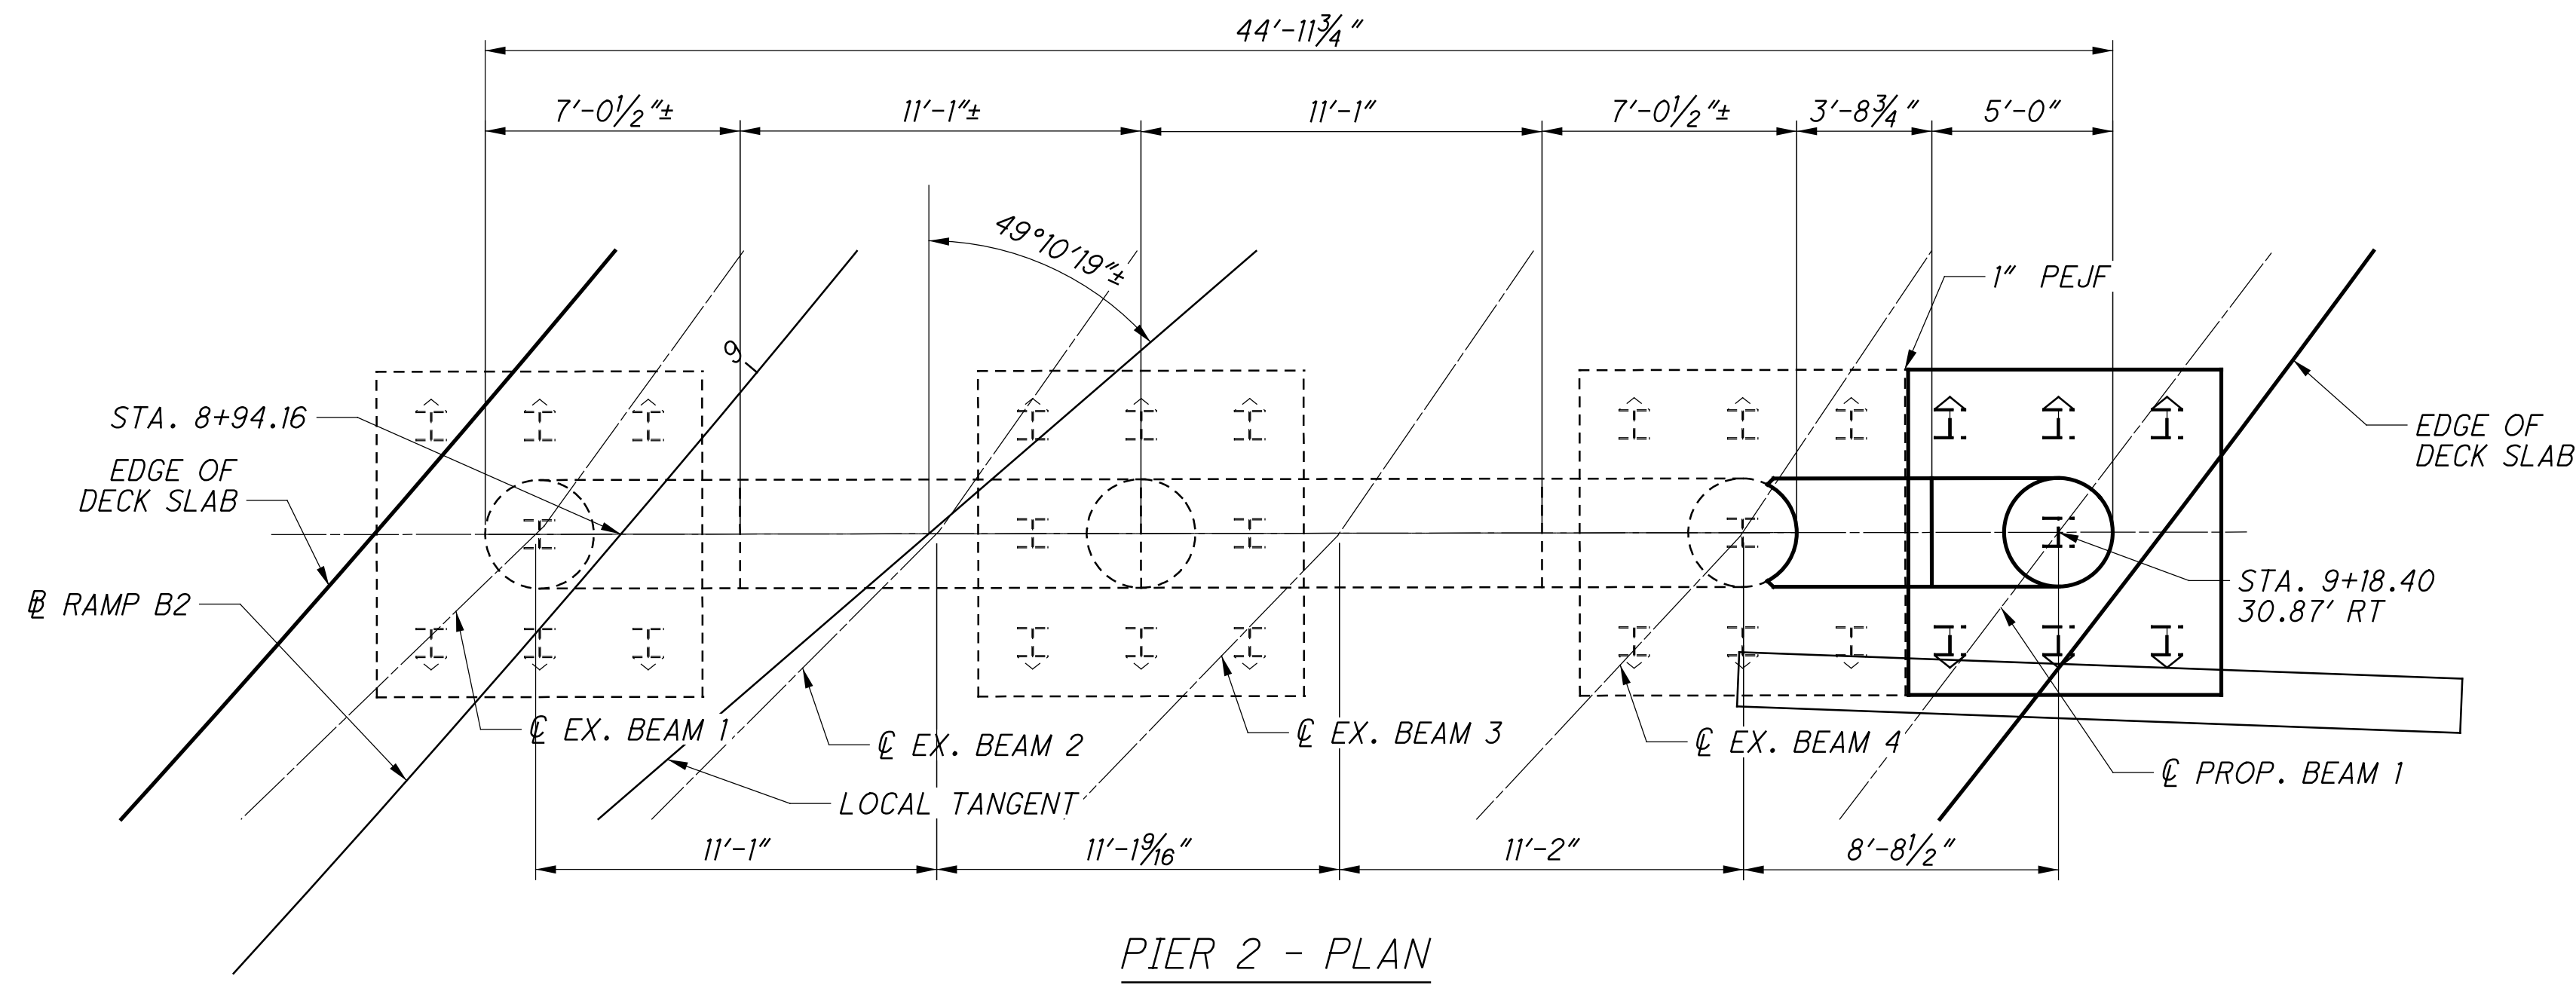

PIER 2 - PLAN

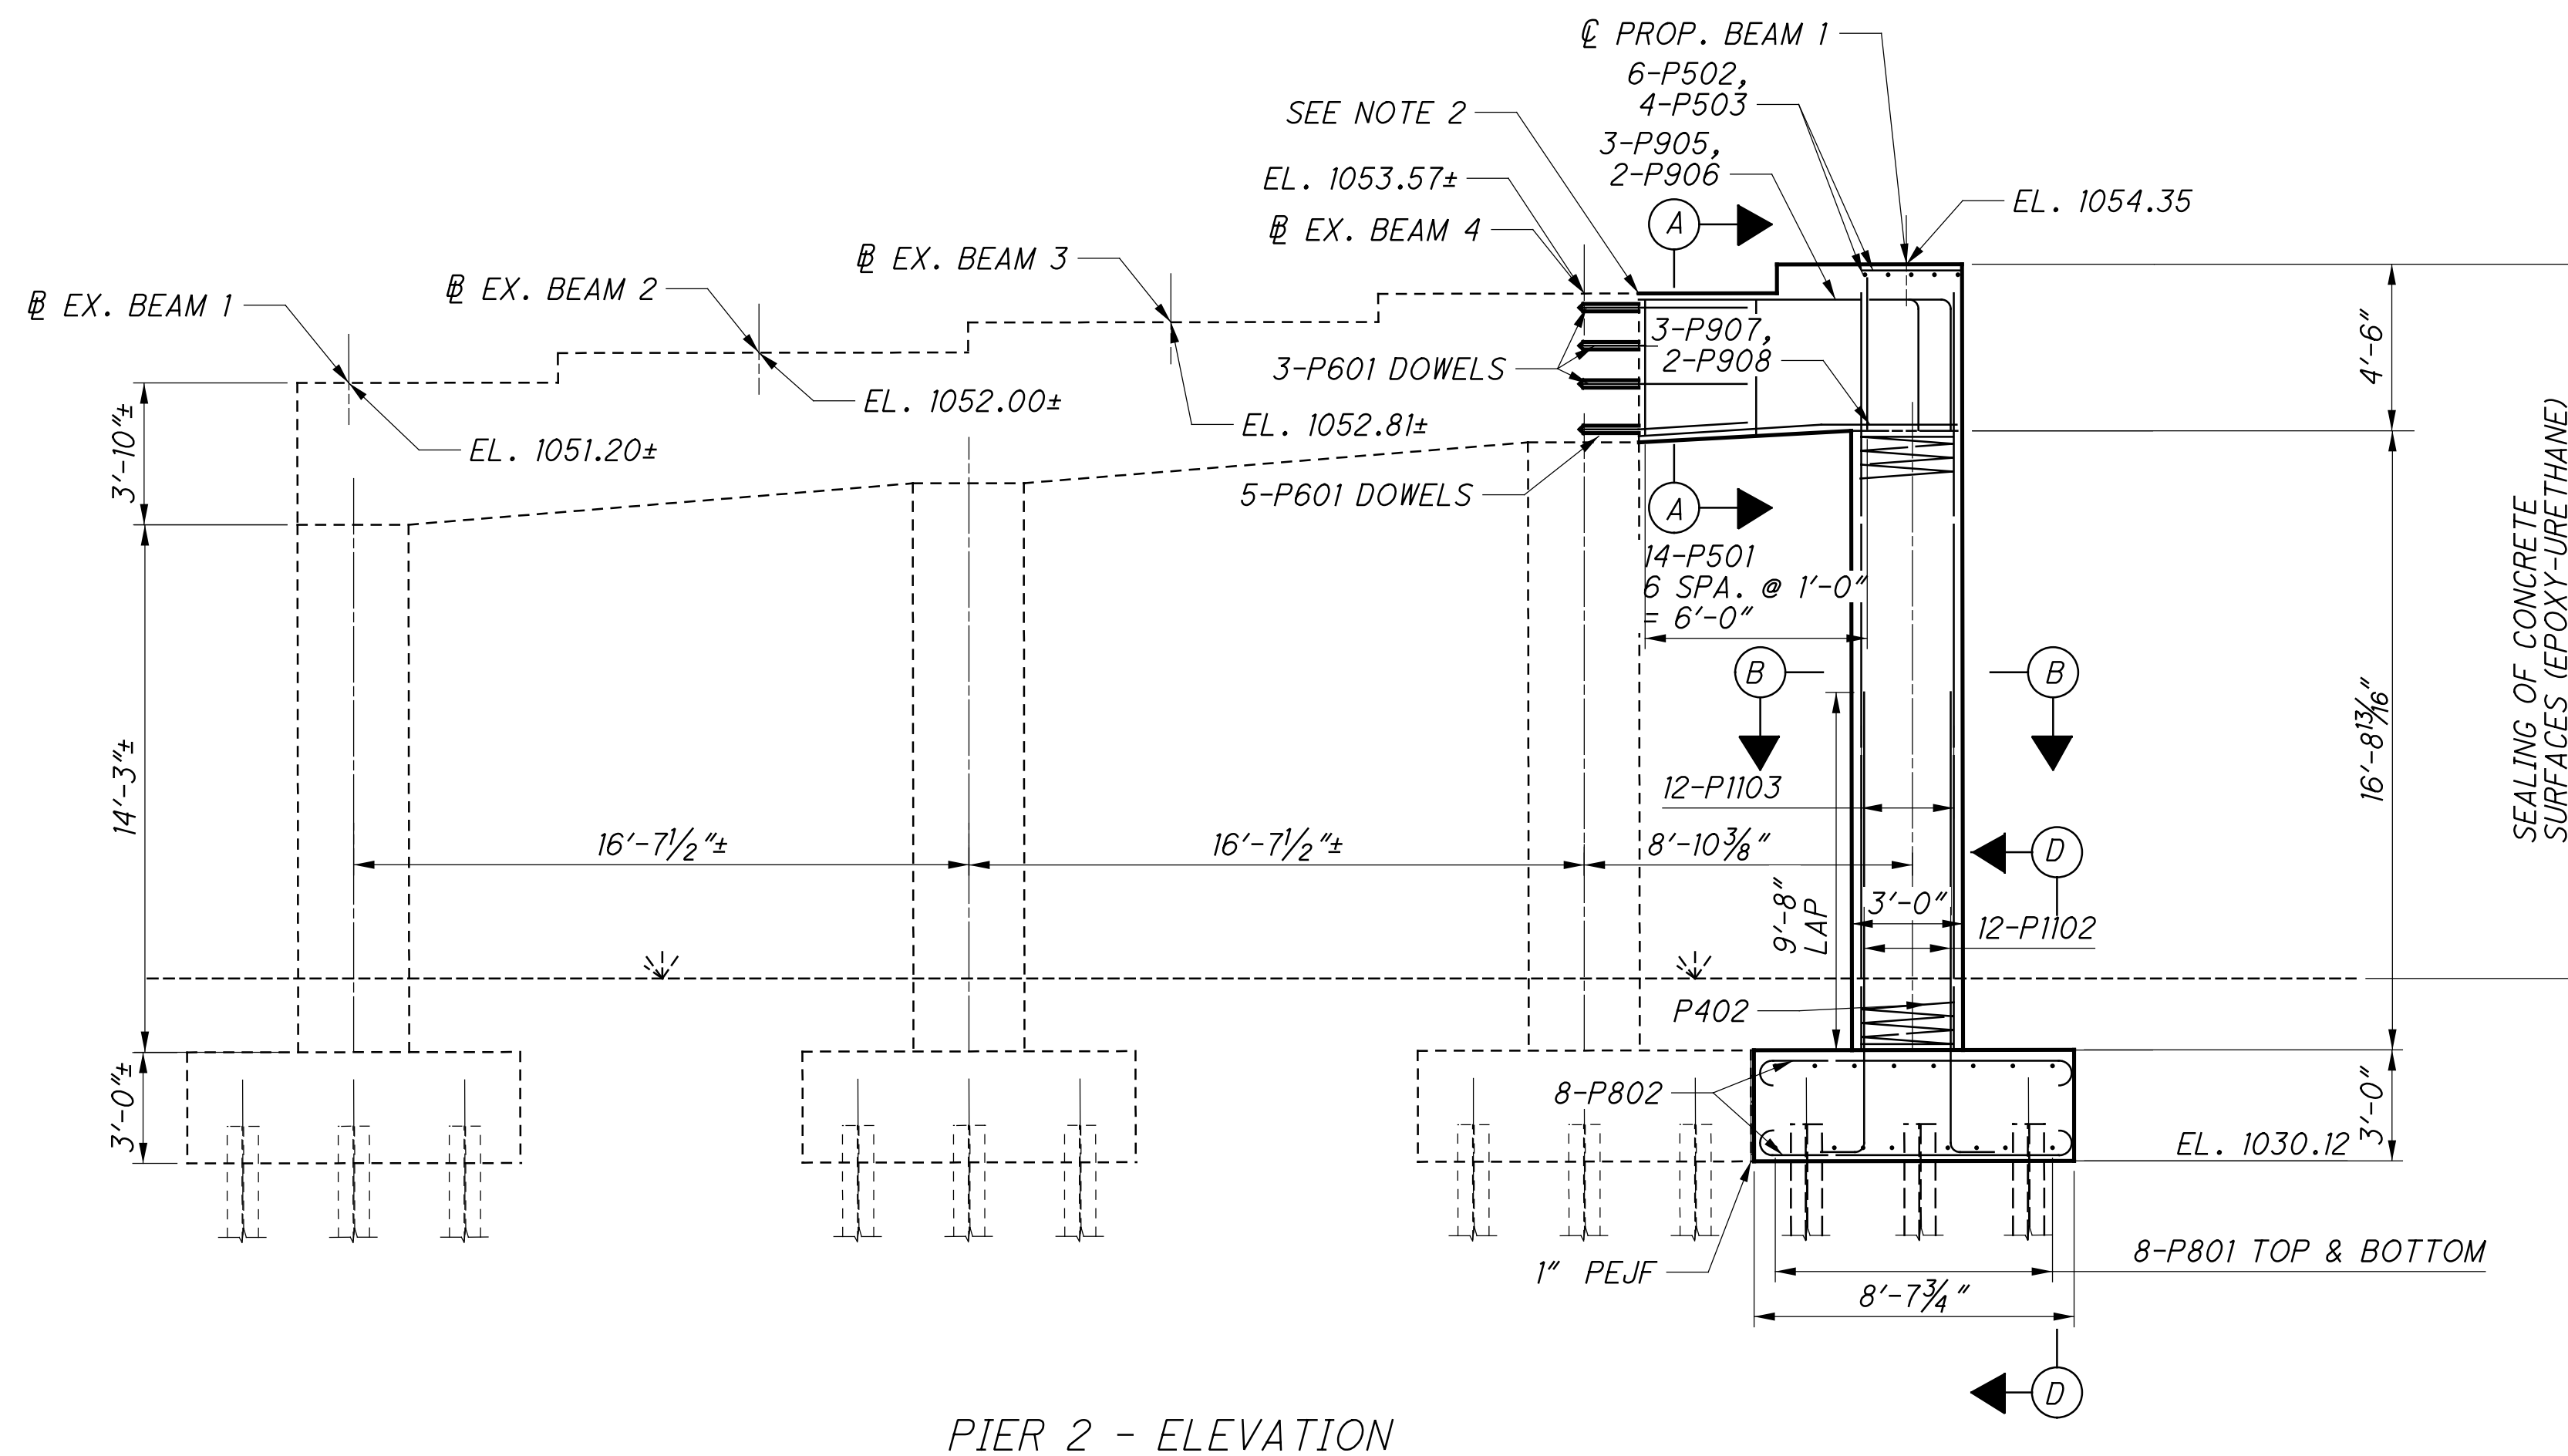


PIER 2 - ELEVATION

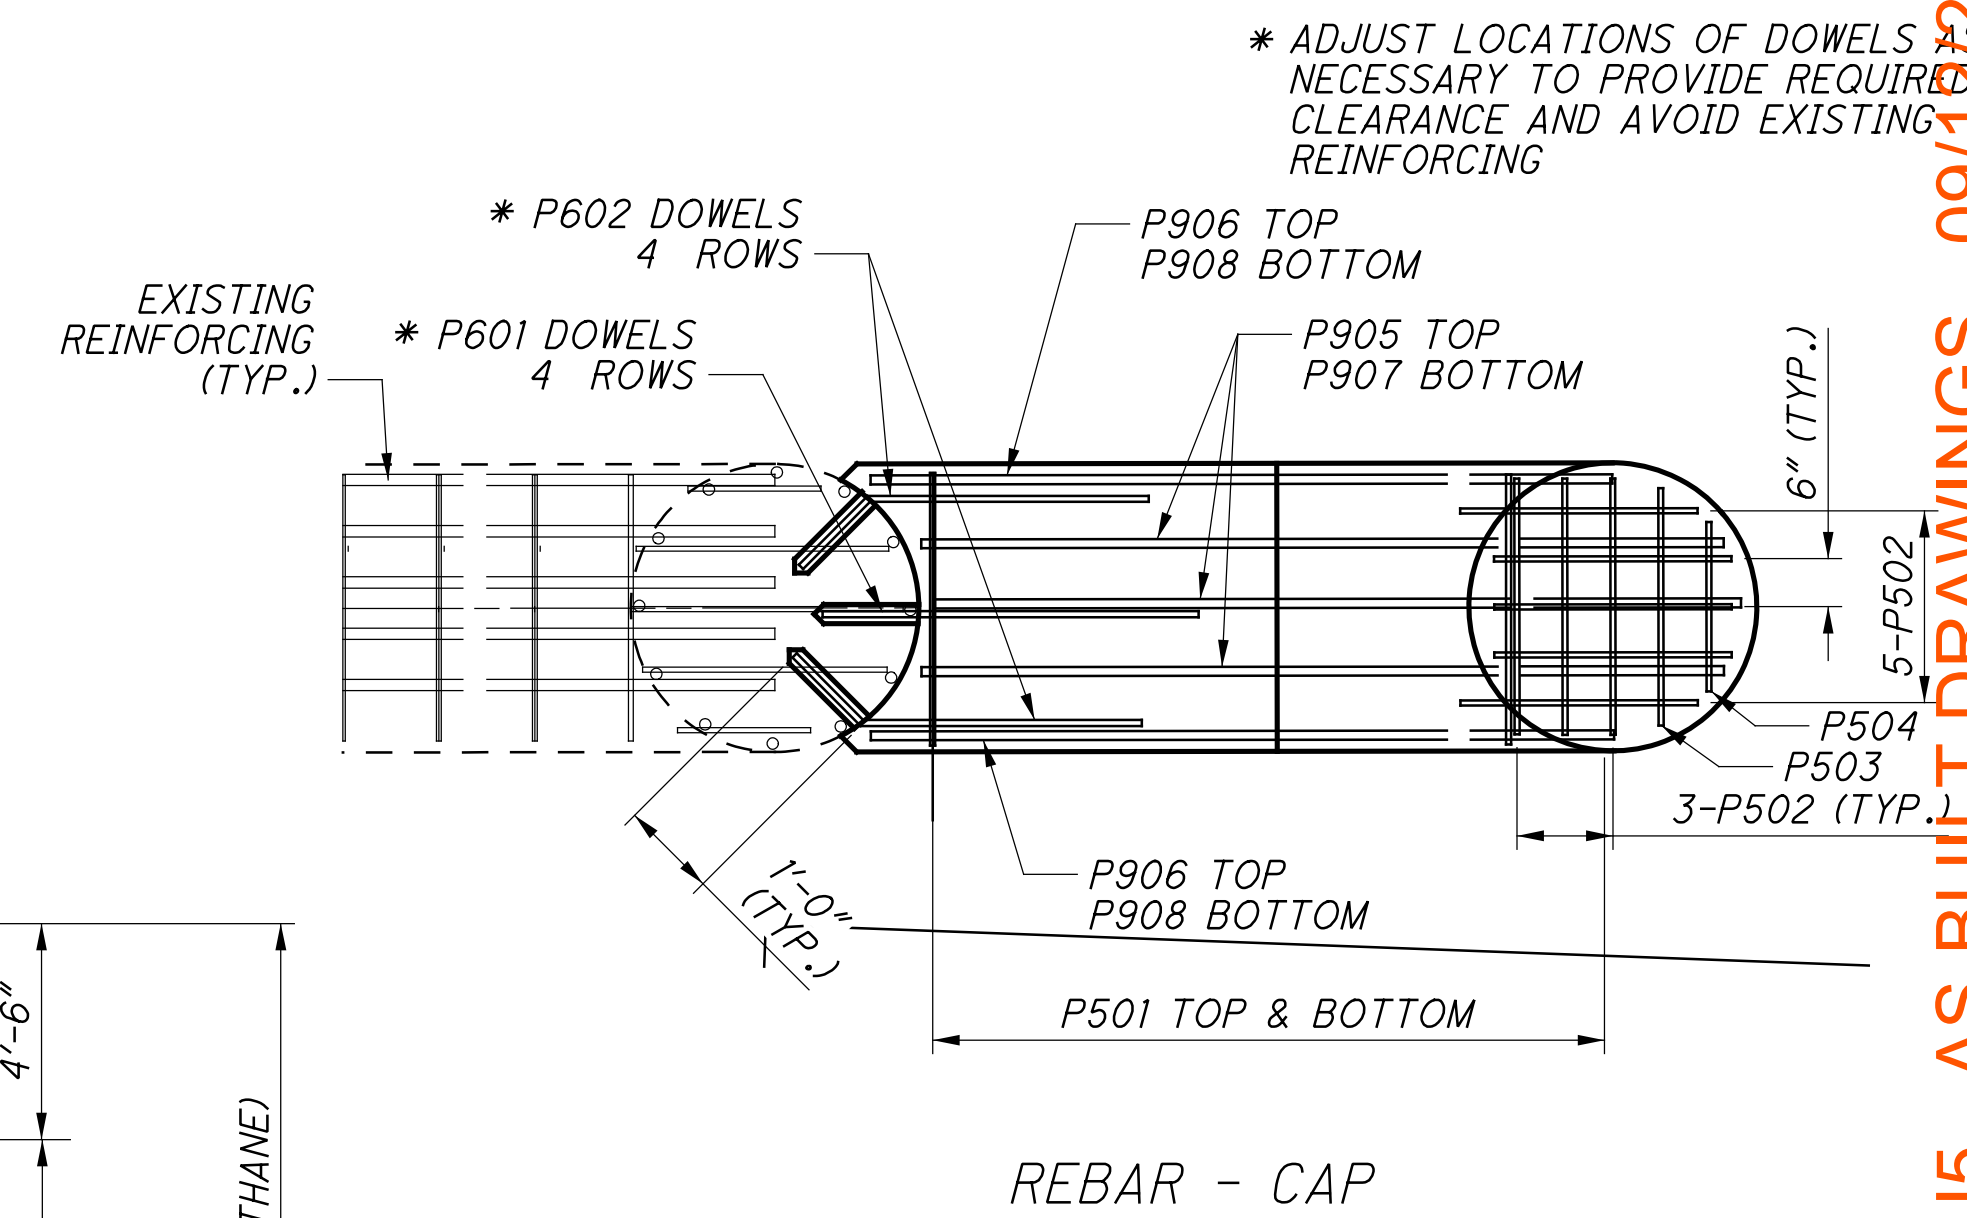

REBAR - CAP

- MINIMUM LAP LENGTHS:
- #5 BAR = 2'-5"
 - #6 BAR = 2'-11"
 - #8 BAR = 4'-11"
 - #9 BAR = 6'-2"
 - #11 BAR = 9'-8"

- NOTES:
- 1.) SEE FOOTING PLAN ON SHEET 11/13.
 - 2.) ROUGHEN THE SURFACE OF THE NEW INTERFACE BETWEEN THE EXTENDED PIER CAP AND THE EXISTING PIER CAP.

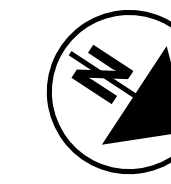

BU5 - AS-BUILT DRAWINGS - 09/12/2016

RESOURCE INTERNATIONAL INC.
6350 PRESIDENTIAL GATEWAY
COLUMBUS, OHIO 43231
(614) 823-4848



DESIGNED	JLM	CHECKED	JGM
DRAWN	JLM	REVISED	
REVIEWED	NCK	STRUCTURE FILE NUMBER	7702671
DATE	7/2015		


PIER WIDENING DETAILS
BRIDGE NO. SUM-77-0959
RAMP B2 OVER IR-77 S.B.

SUM 76 / 77-7.58 / 9.59
PID No. 98061


10 / 13

11
14


G:\projects\2015\w-15-001 SUM77-76 DB with S&S\9806\structures\SUM077_0959C\sheets\077_0959CPI003.dgn 9/12/2016 3:07:54 PM juans

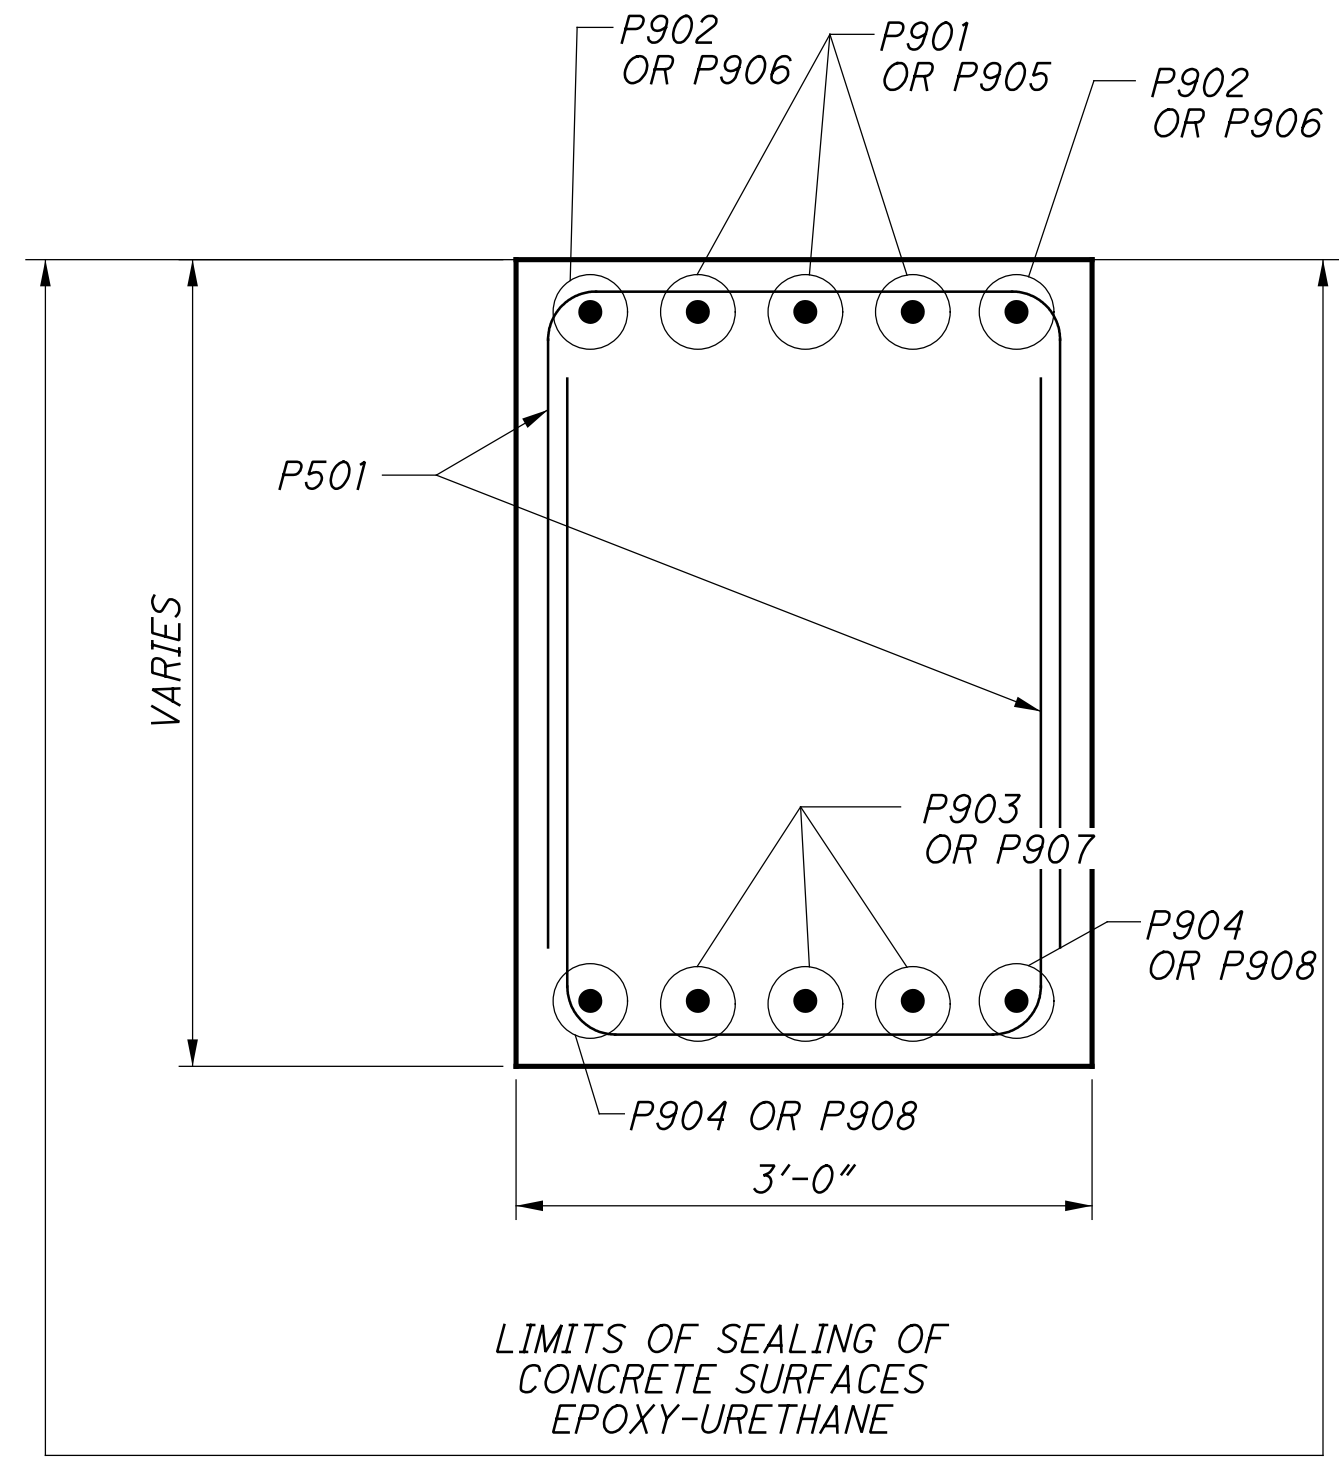


SECTION A-A

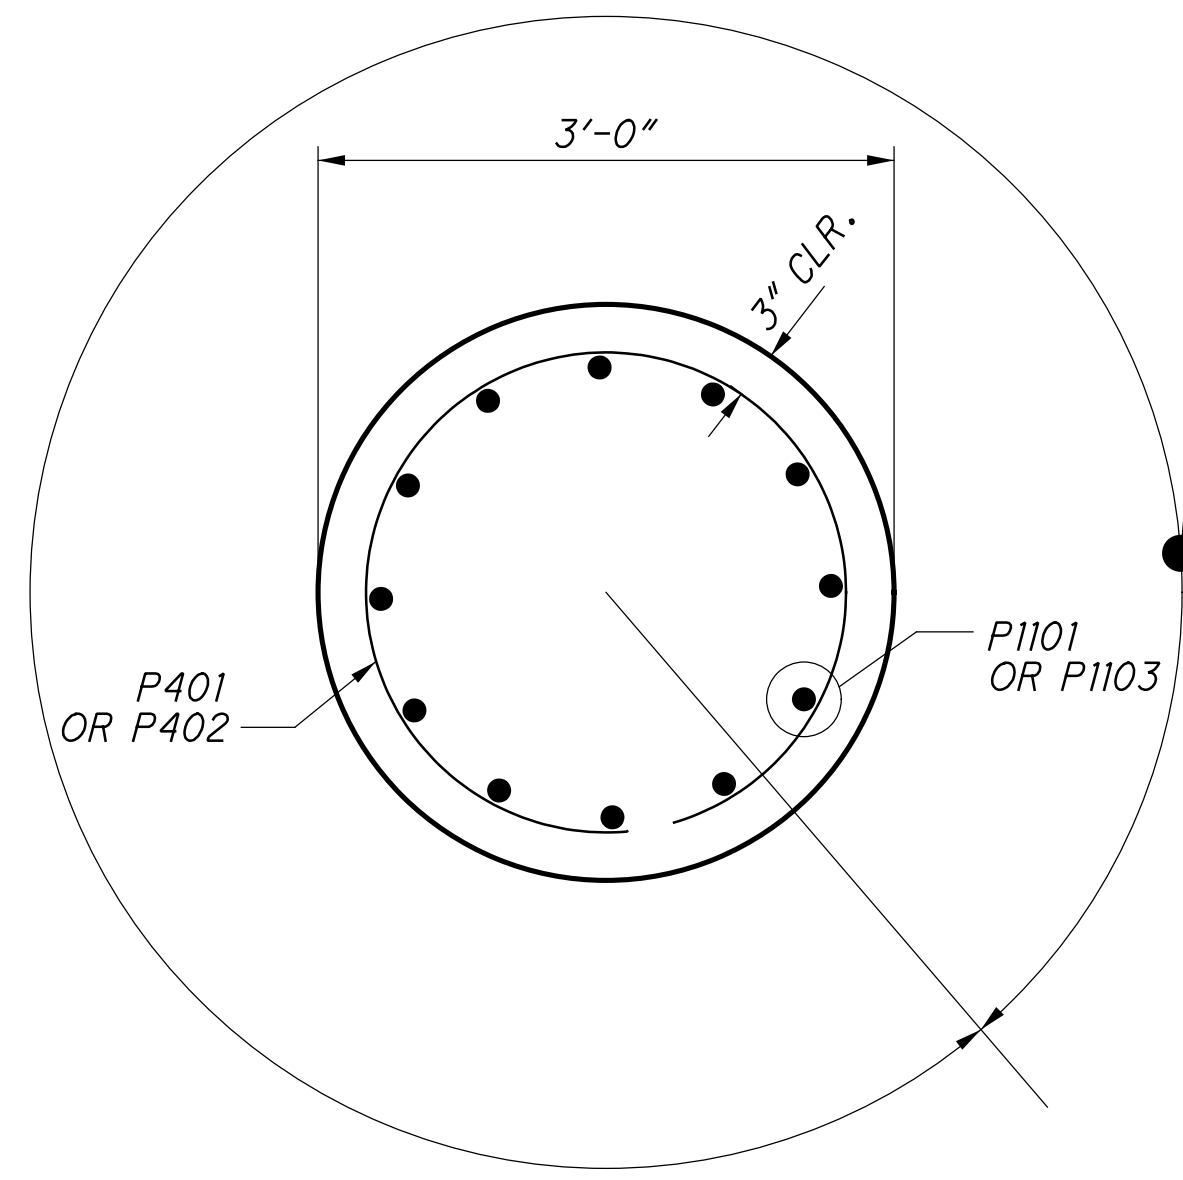


SECTION B-B

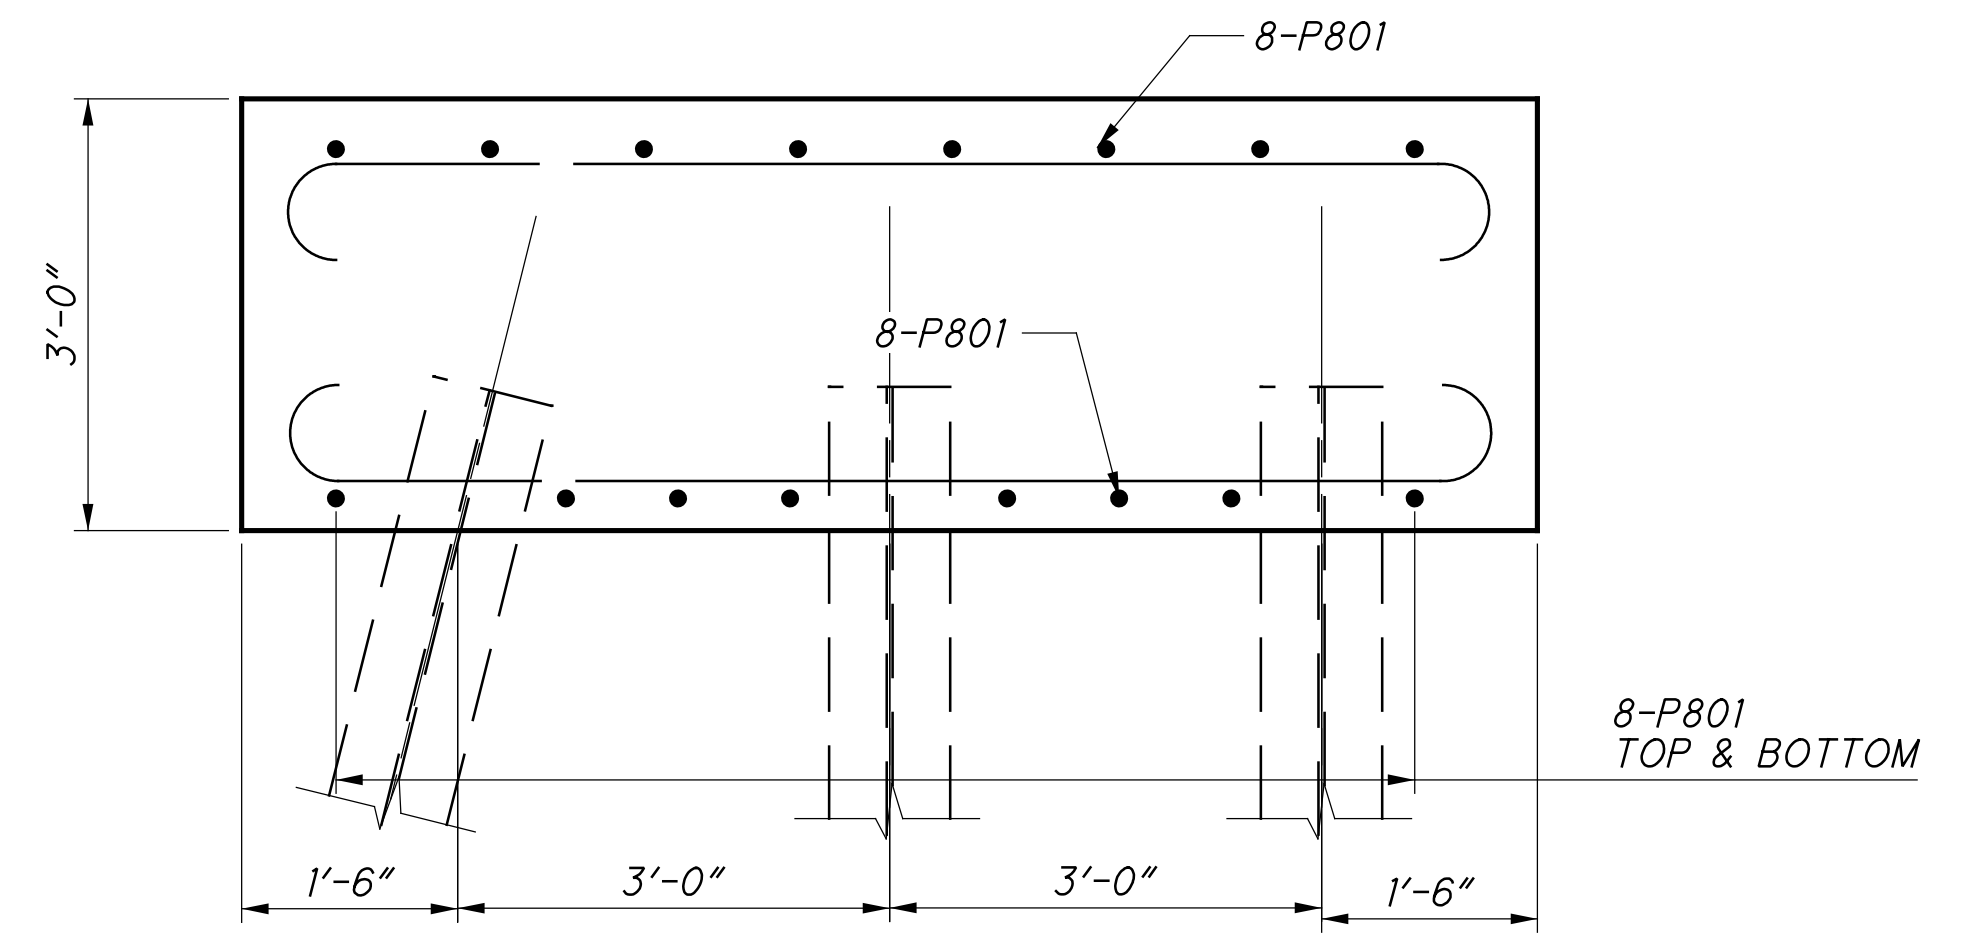

SECTION C-C

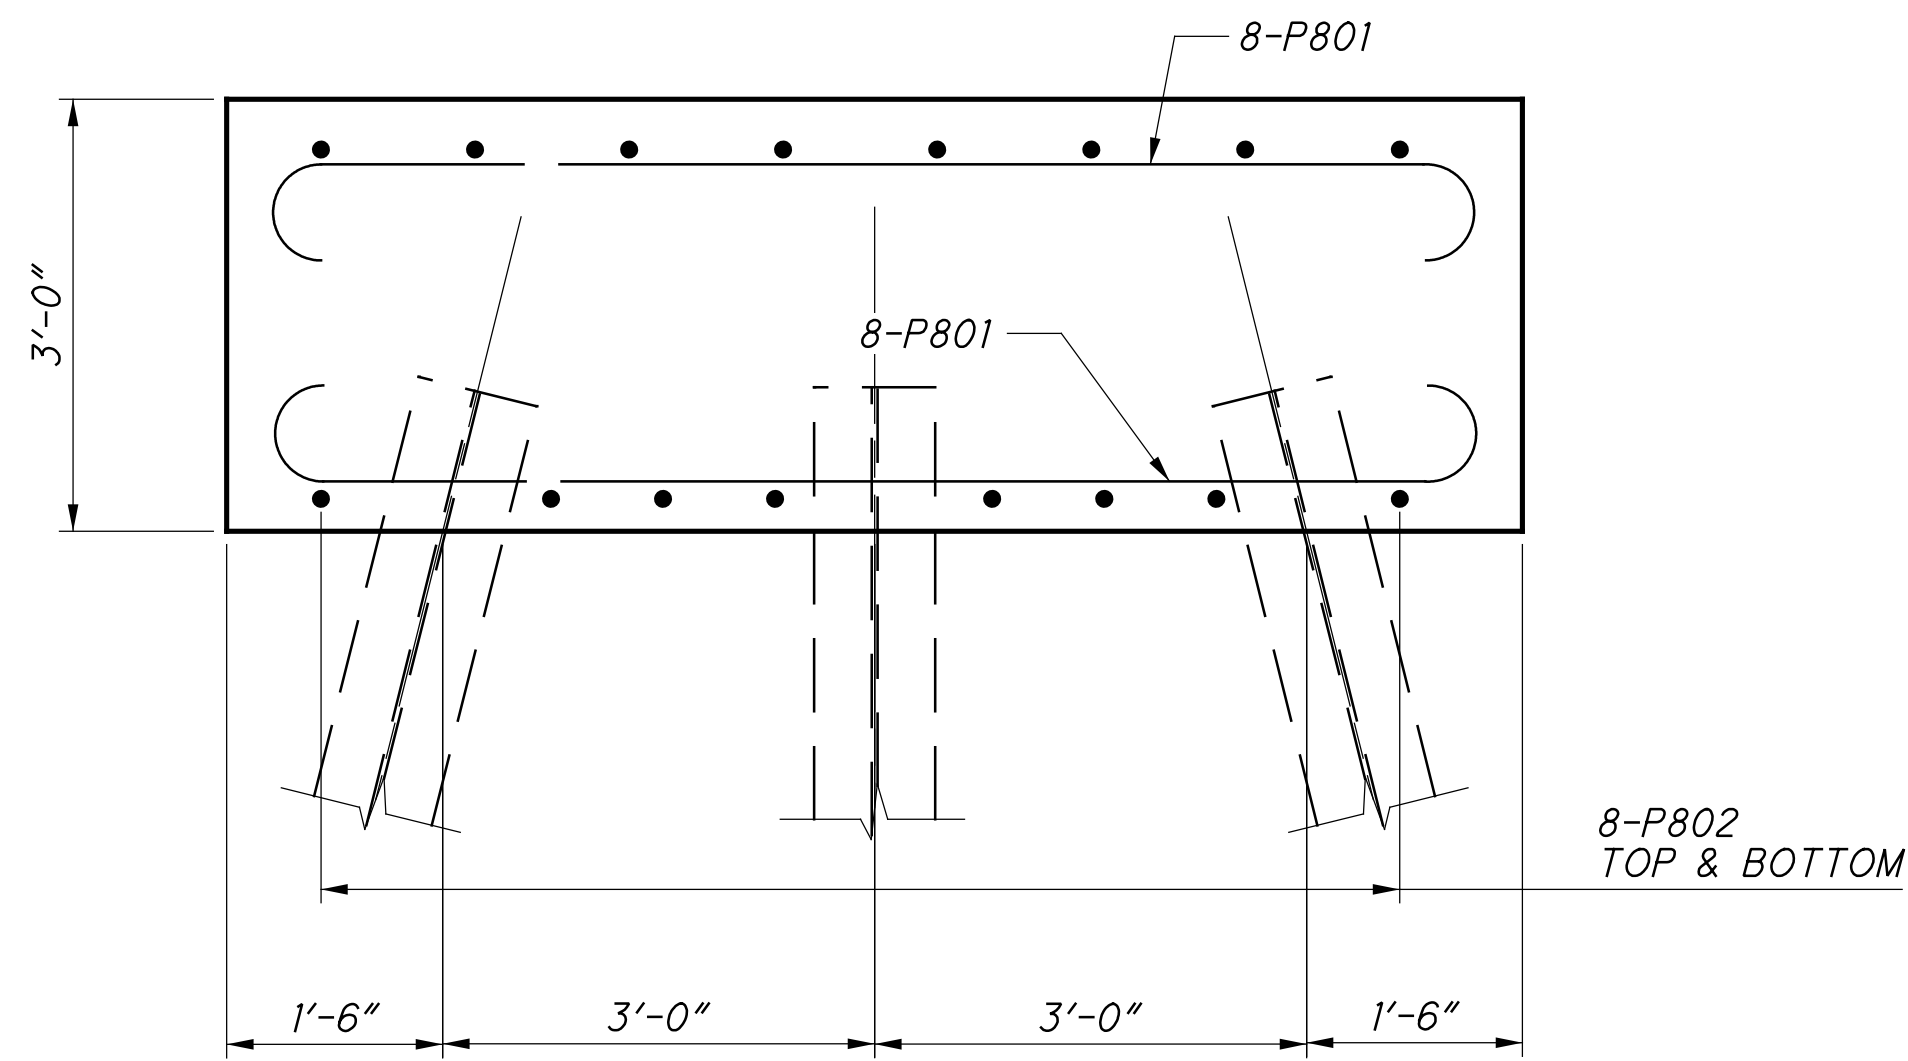

SECTION D-D

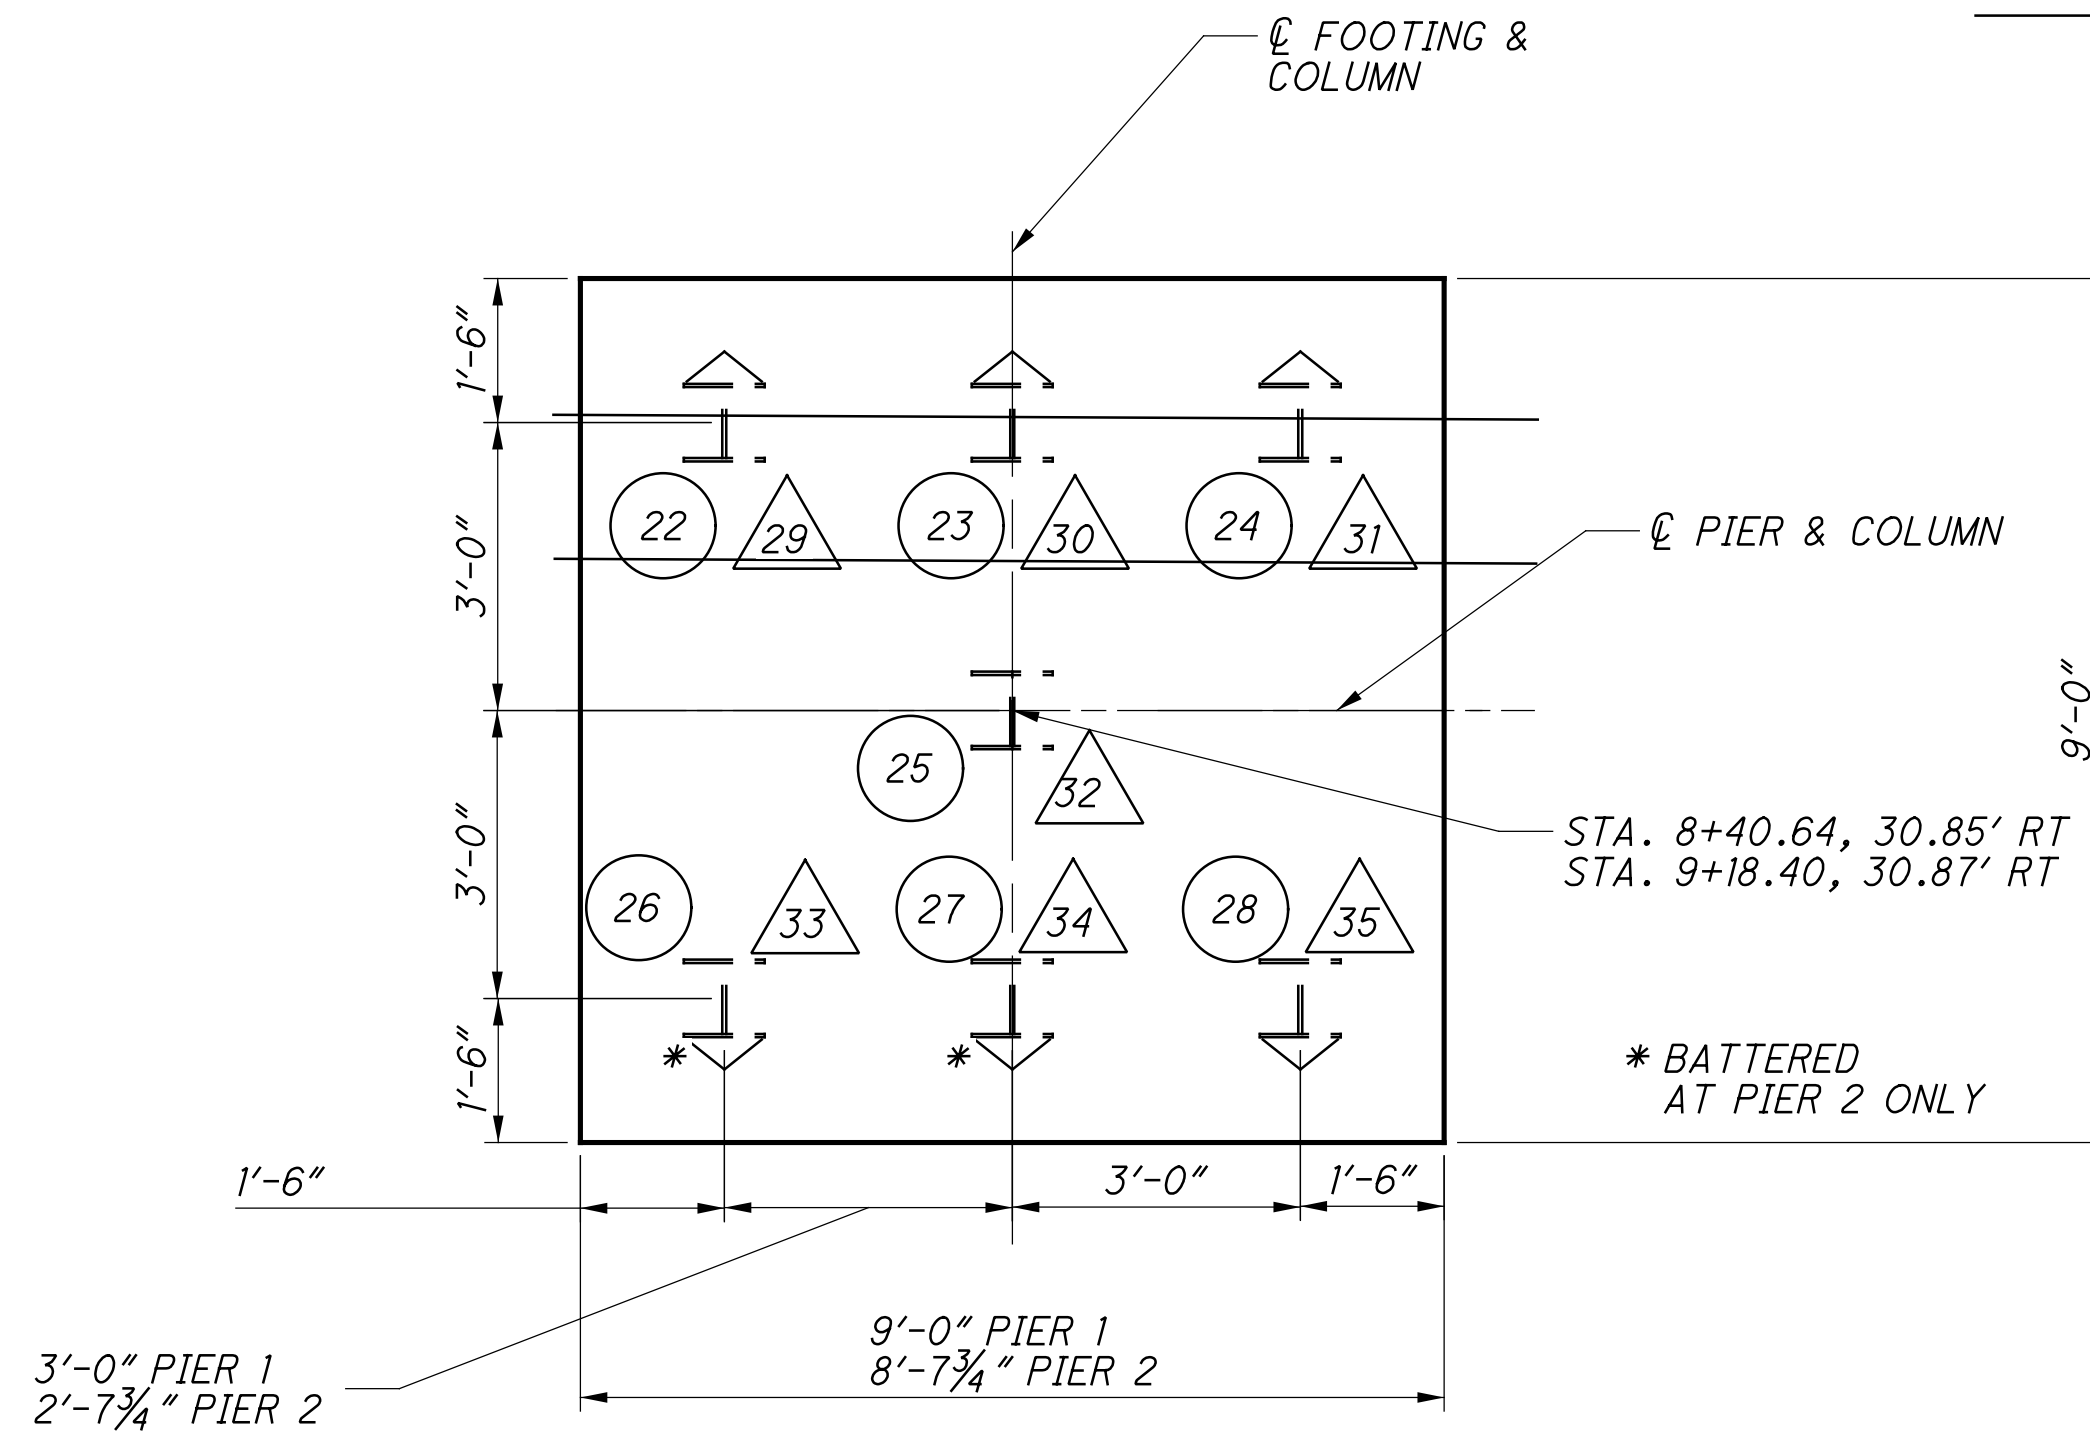

FOOTING PLAN

LEGEND

- PILE MARK - PIER 1
- PILE MARK - PIER 2
- PROPOSED PILE, HP 10X42
- PROPOSED BATTERED PILES (1:4), HP 10X42

BU5 - AS-BUILT DRAWINGS - 09/12/2016

PIER WIDENING DETAILS

BRIDGE NO. SUM-77-0959
RAMP B2 OVER IR-77 S.B.

SUM 76 / 77-7.58 / 9.59

PID No. 98061

11 / 13

12 / 14

RESOURCE INTERNATIONAL INC.
6350 PRESIDENTIAL GATEWAY
COLUMBUS, OHIO 43231
(614) 823-4949



DESIGNED	JLM	CHECKED	JGM
DRAWN	JLM	REVISED	
REVIEWED	NCK	STRUCTURE FILE NUMBER	7702671
DATE	7/2015		

G:\projects\2015\W-15-001 SUM77-76 DB with S&S\98061\structures\SUM077_0959C\sheets\077_0959RL001.dgn 9/12/2016 3:07:54 PM juans

MARK	NUMBER			LENGTH	WEIGHT (LBS.)	TYPE	DIMENSIONS					
	R.A	F.A	TOTAL				A	B	C	D	E	R
ABUTMENTS												
A501	37	22	59	9'-2"	564	2	2'-0"	5'-5"	2'-0"			
A502	1		1	6'-9"	7	2	2'-0"	3'-0"	2'-0"			
A503	1		1	5'-8"	6	2	2'-0"	1'-11"	2'-0"			
A504	1		1	4'-7"	5	2	2'-0"	10"	2'-0"			
A505	2		2	7'-6"	16	ST						
A506	2		2	2'-0"	4	ST						
A507	1		1	14'-9"	15	3	4'-4"	2'-7"				
A508	1		1	11'-7"	12	3	2'-9"	2'-7"				
A509	16		16	10'-10"	181	1	1'-0"	10'-0"				
A510	2		2	9'-5"	20	1	1'-0"	8'-7"				
A511	13		13	8'-9"	119	1	1'-0"	7'-11"				
A512	1 SER OF 3		1 SER OF 3	8'-7" TO 9'-1"	28	1	1'-0"	7'-9" TO 8'-3"				3"
*A513	72	48	120	5'-6"	688	1	3'-4"	2'-4"				
A514	4		4	33'-6"	140	ST						
A515	2 SER OF 6		2 SER OF 6	8'-10" TO 32'-3"	257	ST						4'-8 1/4"
A516	2		2	35'-0"	73	19	29'-4"	5'-5"	1'-9"			
A517	2		2	27'-5"	57	19	20'-6"	6'-7"	2'-2"			
A518	5		5	5'-3"	27	1	6"	4'-11"	0			
A519	NOT	USED										
A520	NOT	USED										
A521	NOT	USED										
*A522	14	12	26	3'-0"	81	ST						
A523	4		4	13'-4"	56	ST						
A524	16		16	13'-2"	220	ST						
A525	NOT	USED										
A526	NOT	USED										
A527	NOT	USED										
A528	6		6	29'-10"	187	ST						
A529	2 SER OF 3		2 SER OF 3	9'-4" TO 18'-7"	87	ST						4'-7 1/2"
A530	18		18	39'-0"	732	ST						
A531	1		1	1'-3"	1	ST						
A532		6	6	8'-2"	51	1	1'-0"	7'-4"				
A533		16	16	9'-8"	161	1	1'-0"	8'-10"				
A534		1	1	7'-7"	8	2	2'-0"	3'-10"	2'-0"			
A535	NOT	USED										
A536	2		2	6'-4"	13	ST						
A537	2		2	1'-10"	4	ST						
A538	2		2	3'-2"	7	ST						
A539	1		1	8'-10"	9	1	1'-0"	8'-0"				
A540	10	7	17	6'-6"	115	2	1'-8"	3'-5"	1'-8"			
A541	3		3	15'-11"	50	ST						
A542	3		3	16'-10"	53	ST						
A543		2 SER OF 4	2 SER OF 4	5'-10" TO 16'-10"	95	ST						3'-8"
A544		2	2	18'-5"	38	19	14'-3"	3'-10"	1'-8"			
A545		1	1	4'-1"	4	1	8"	3'-7"				
A546	NOT	USED										
A547	NOT	USED										
A548	NOT	USED										
A549	NOT	USED										
A550	1		1	14'-6"	15	ST						
A551	1		1	13'-8"	14	ST						
A552	18		18	26'-6"	498	ST						
A553	3		3	28'-4"	89	ST						
A554	3		3	27'-6"	86	ST						
A555	1		1	16'-8"	17	ST						
A556	1		1	17'-6"	18	ST						

MARK	NUMBER			LENGTH	WEIGHT (LBS.)	TYPE	DIMENSIONS					
	R.A	F.A	TOTAL				A	B	C	D	E	R
ABUTMENTS												
A557		1 SER OF 3	1 SER OF 3	5'-3" TO 12'-7"	28	ST						3'-8"
A558		2	2	21'-10"	46	19	17'-4"	4'-2"	1'-8"			
A559		5	5	3'-11"	20	ST						
A560		9	9	9'-1"	85	ST						
A561	1 SER OF 3		1 SER OF 3	9'-7" TO 10'-6"	31	1	1'-0"	8'-9" TO 9'-8"				5 1/2"
A601	16		16	17'-11"	431	2	2'-10"	5'-5"	10'-0"			
A602	2		2	16'-6"	50	2	2'-10"	5'-5"	8'-7"			
A603	13		13	15'-10"	309	2	2'-10"	5'-5"	7'-11"			
A604	1		1	14'-1"	21	2	2'-10"	3'-0"	8'-7"			
A605	1		1	13'-1"	20	2	2'-10"	2'-0"	8'-7"			
A606	1		1	11'-11"	18	2	2'-10"	10"	8'-7"			
A607	1		1	11'-1"	17	3	2'-5"	2'-7"				
A608	1		1	12'-9"	19	3	3'-3"	2'-7"				
A609	1		1	14'-5"	22	3	4'-1"	2'-7"				
A610	1		1	15'-11"	24	3	4'-10"	2'-7"				
A611	1 SER OF 3		1 SER OF 3	15'-8" TO 16'-2"	72	2	2'-10"	5'-5"	7'-9" TO 8'-3"			3"
A612	1 SER OF 3		1 SER OF 3	16'-8" TO 17'-7"	77	2	2'-10"	5'-5"	8'-9" TO 9'-8"			5 1/2"
A613	1 SER OF 4		1 SER OF 4	10'-8" TO 13'-8"	73	3	1'-5"	3'-6" TO 5'-0"				6"
A614	1 SER OF 14		1 SER OF 14	5'-1" TO 13'-6"	195	2	2'-0" TO 6'-2 3/8"	1'-5" TO 6'-2 3/8"	2'-0" TO 6'-2 3/8"			3 7/8"
A615	4		4	13'-9"	83	2	6'-4"	1'-5"	6'-4"			
A616	15		15	10'-9"	242	2	4'-8"	1'-5"	4'-8"			
A617	68	34	102	7'-1"	1085	2	3'-0"	1'-5"	3'-0"			
A618	68	45	113	6'-1"	1032	2	2'-9"	11"	2'-9"			
A619	53		53	10'-3"	856	2	4'-10"	1'-5"	4'-10"			
A620	5		5	14'-7"	109	2	6'-9"	1'-5"	6'-9"			
A621	1 SER OF 15		1 SER OF 15	5'-3" TO 14'-7"	223	2	TO	1'-5" TO 6'-9"	2'-1" TO 6'-9"			4"
*A622	4		4	6'-5"	39	ST						
*A623	2		2	7'-11"	24	1	1'-0"	7'-1"				
A624		6	6	15'-3"	137	2	2'-10"	5'-5"	7'-4"			
A625		16	16	16'-9"	403	2	2'-10"	5'-5"	8'-10"			
A626		1	1	13'-8"	21	2	2'-10"	3'-10"	7'-4"			
A627		1	1	11'-8"	18	2	2'-10"	1'-10"	7'-4"			
A628		1	1	10'-10"	16	3	2'-5"	2'-7"				
A629		1	1	16'-0"	24	3	5'-0"	2'-7"				
A630		1 SER OF 4	1 SER OF 4	10'-8" TO 14'-7"	76	3	1'-5"	3'-6" TO 5'-5"				7 11/16"
A631		1 SER OF 4	1 SER OF 4	5'-9" TO 11'-7"	80	3	1'-5"	3'-11" TO 5'-9"				7 5/16"
A632		1 SER OF 11	1 SER OF 11	5'-7" TO 14'-3"	164	2	2'-3" TO 6'-7"	1'-5" TO 6'-7"	2'-3" TO 6'-7"			5 3/16"
A633		1	1	14'-3"	21	2	6'-7"	1'-5"	6'-7"			
A634		2	2	13'-11"	42	2	6'-5"	1'-5"	6'-5"			
A635		1 SER OF 11	1 SER OF 11	5'-9" TO 13'-11"	162	2	TO	1'-5" TO 6'-4 3/4"	2'-4" TO 6'-4 3/4"			4 7/8"
A636		11	11	5'-1"	84	2	2'-0"	1'-5"	2'-0"			
A637		11	11	6'-1"	100	2	2'-6"	1'-5"	2'-6"			
A638	6		6	13'-2"	119	33	2'-9"	3'-3"				
A639		6	6	11'-8"	105	33	2'-0"	3'-3"				

BU5 - AS-BUILT DRAWINGS - 09/12/2016

REINFORCING STEEL LIST

BRIDGE NO. SUM-77-0959
RAMP B2 OVER IR-77 S.B.

SUM 76 / 77 7.58 / 9.59

PID No. 98061

RESOURCE INTERNATIONAL INC.
6350 PRESIDENTIAL GATEWAY
COLUMBUS, OHIO 43231
(614) 823-4949




DATE: 7/2015
REVIEWED: NCK
DRAWN: JLM
DESIGNED: JLM
CHECKED: JGM
STRUCTURE FILE NUMBER: 7702671

G:\projects\2015\W-15-001 SUM77-76 DB with S&S\98061\structures\SUM077_0959C\sheets\077_0959R\002.dgn 9/12/2016 3:07:55 PM juans

MARK	NUMBER			LENGTH	WEIGHT (LBS.)	TYPE	DIMENSIONS					
	R.A	F.A	TOTAL				A	B	C	D	E	R
ABUTMENTS												
A640	2	2	4	4'-8"	28	1	1'-7"	3'-3"				
*A641	6		6	6'-1"	55	1	2'-9"	3'-6"				
*A642		6	6	5'-4"	48	1	2'-0"	3'-6"				
A643	2	2	4	4'-11"	30	1	1'-7"	3'-6"				
A644	1 SER OF 4		1 SER OF 4	8'-8" TO 11'-8"	61	3	1'-5"	TO 4'-0"				6"
A645	1		1	14'-8"	22	2	6'-4"	2'-4"	6'-4"			
A646	1		1	16'-0"	24	2	6'-9"	2'-10"	6'-9"			
A647		1	1	14'-6"	22	2	6'-7"	1'-8"	6'-7"			
A648		1	1	14'-1"	21	2	6'-5"	1'-7"	6'-5"			
*A649		1	1	6'-9"	10	ST						
A650		34	34	8'-1"	413	2	3'-6"	1'-5"	3'-6"			
*A801	20	16	36	3'-6"	336	ST						
A802	2		2	34'-3"	183	ST						
A803	1		1	36'-0"	96	ST						
A804	1		1	38'-10"	104	ST						
A805	1 SER. OF 2		1 SER. OF 2	33'-4" TO 34'-3"	180	ST						11"
A806	1 SER. OF 3		1 SER. OF 3	35'-2" TO 38'-10"	296	ST						1'-10"
A807	1		1	25'-1"	67	ST						
A808	1		1	21'-6"	57	ST						
A809	1		1	19'-4"	52	ST						
A810	1		1	15'-10"	42	ST						
A811	1 SER. OF 5		1 SER. OF 5	15'-10" TO 25'-1"	273	ST						2'-3 3/4"
A812		1	1	7'-11"	21	ST						
A813		1	1	7'-7"	20	ST						
A814		1	1	8'-4"	22	ST						
A815		1	1	9'-8"	26	ST						
A816		1 SER. OF 2	1 SER. OF 2	7'-2" TO 7'-11"	40	ST						9"
A817		1 SER. OF 3	1 SER. OF 3	8'-2" TO 9'-8"	71	ST						9"
A818		1	1	23'-7"	63	ST						
A819		1	1	22'-6"	60	ST						
A820		1	1	21'-9"	58	ST						
A821		1	1	20'-7"	55	ST						
A822		1 SER. OF 5	1 SER. OF 5	20'-7" TO 23'-7"	295	ST						9"
A823		1	1	5'-3"	14	ST						
A824		4	4	6'-1"	65	ST						
A825		5	5	14'-0"	187	ST						
A826		10	10	15'-4"	409	ST						
A827	1 SER OF 3		1 SER OF 3	16'-3" TO 18'-5"	139	ST						1'-1"
A828		4	4	24'-4"	260	ST						
A829		2	2	10'-2"	54	ST						
A830		1	1	10'-7"	28	ST						
A831		1	1	9'-9"	26	ST						
A832		1	1	8'-10"	24	ST						
A833		8	8	5'-0"	107	ST						
A834		5	5	7'-0"	93	ST						
A835		5	5	11'-3"	150	ST						
A836		2	2	8'-0"	43	ST						
A901	5	5	10	4'-7"	156	1	1'-7"	3'-3"				
A902	4		4	6'-1"	83	ST						
A903		4	4	4'-0"	54	ST						
*A904	5	5	10	4'-0"	136	ST						
D801	26		26	6'-6"	451	18	4'-4"	1'-0"	1'-0"			
D802		26	26	5'-4"	370	18	3'-2"	1'-0"	1'-0"			
SUB-TOTAL 17753												

MARK	PIER 1	PIER 2	TOTAL	LENGTH	WEIGHT (LBS.)	TYPE	DIMENSIONS					
							A	B	C	D	E	R
PIERS												
P401	1			18'-7"	271	27	4 1/2'	2'-6"	18'-7"			
P402	1			16'-8"	245	27	4 1/2'	2'-6"	16'-8"			
P501	18	16	34	9'-3"	328	2	3'-5"	2'-8"	3'-5"			
P502	8	8	16	6'-5"	107	2	2'-0"	2'-8"	2'-0"			
P503	1	1	2	6'-2"	13	2	2'-0"	2'-5"	2'-0"			
P504	1	1	2	5'-6"	11	2	2'-0"	1'-9"	2'-0"			
*P601	4	4	8	3'-11"	47	ST.						
*P602	8	8	8	3'-11"	47	19	2'-11"	8 1/2"	8 1/2"			
P801	32	16	48	10'-4"	1324	17	8'-8"					
P802		16	16	9'-1"	388	17	8'-3"					
P901	3		3	13'-0"	133	1	9'-10"	3'-5"				
P902	2		2	12'-4"	84	1	9'-2"	3'-5"				
P903	3		3	9'-10"	100	ST.						
P904	2		2	9'-2"	62	ST.						
P905		3	3	11'-5"	116	1	8'-4"	3'-4"				
P906		2	2	10'-9"	73	1	7'-8"	3'-4"				
P907		3	3	8'-4"	85	ST.						
P908		2	2	7'-8"	52	ST.						
P1101	12		12	21'-8"	1381	ST.						
P1102	12	12	24	14'-2"	1806	1	12'-4"	2'-0"				
P1103		12	12	19'-9"	1259	ST.						
				SubTotal	7935							

BENDING DIAGRAMS

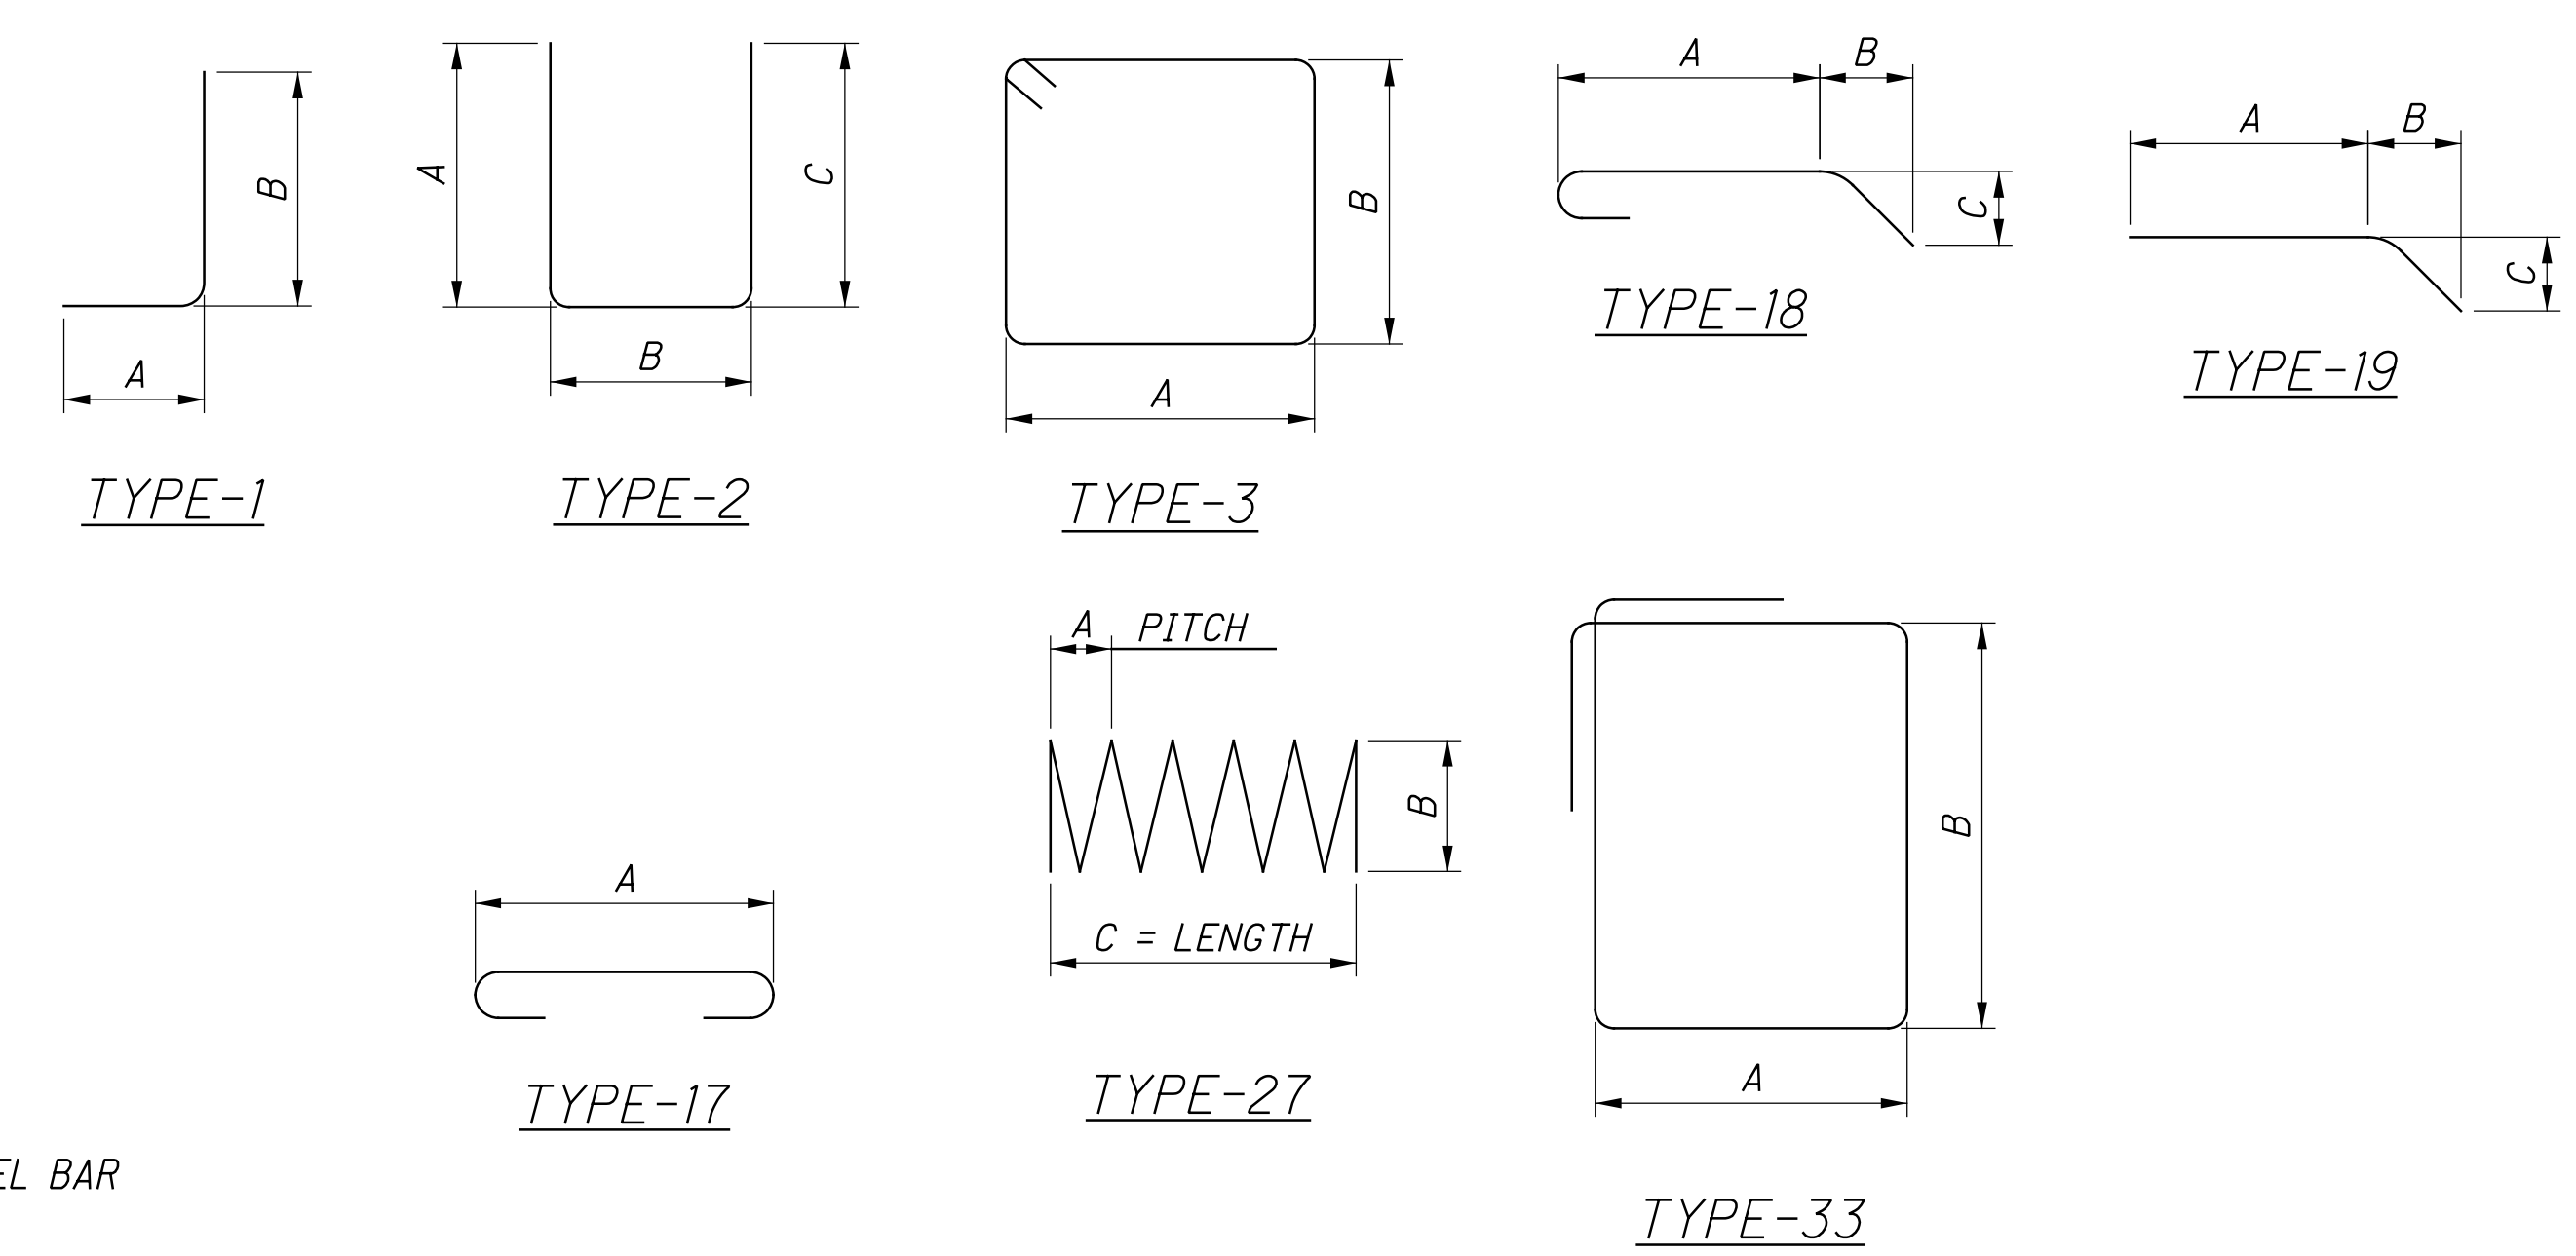

LEGEND:
* - DOWEL BAR
NOTES:

- THE BAR SIZE NUMBER IS SPECIFIED ON THE PLANS IN THE BAR MARK COLUMN. THE FIRST DIGIT WHERE 3 DIGITS ARE USED, AND THE FIRST 2 DIGITS WHERE FOUR DIGITS ARE USED, INDICATES THE BAR SIZE NUMBER. FOR EXAMPLE, P601 IS A NO. 6 BAR. BAR DIMENSIONS SHOWN ARE OUT TO OUT UNLESS OTHERWISE INDICATED. "R" INDICATES INSIDE RADIUS, UNLESS OTHERWISE NOTED. "STD." WRITTEN IN PLACE OF A DIMENSION INDICATES A STANDARD BEND AT THE END OF THE BAR.
- ALL REINFORCING STEEL TO BE EPOXY COATED, UNLESS NOTED OTHERWISE.

BU5 - AS-BUILT DRAWINGS - 09/12/2016

RESOURCE INTERNATIONAL INC. 6350 PRESIDENTIAL GATEWAY COLUMBUS, OHIO 43231 (614) 823-4949	DATE: 7/2015 REVISION: NCK DRAWN: JLM CHECKED: JGM STRUCTURE FILE NUMBER: 7702671
REINFORCING STEEL LIST BRIDGE NO. SUM-77-0959 RAMP B2 OVER IR-77 S.B.	
SUM 76 / 77 7.58 / 9.59	PID No. 98061
13 / 13	14 / 14