




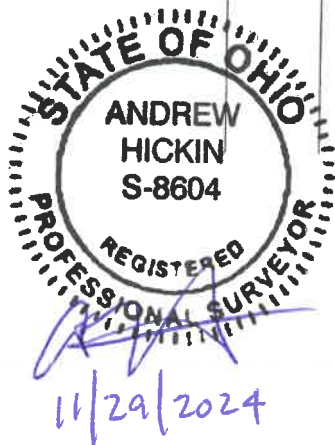

Ohio Department of Transportation
Vertical Clearance Survey Form

County: SUM Route: 77 Date: _____
Structure No. 07.44 (William Rd) By: _____

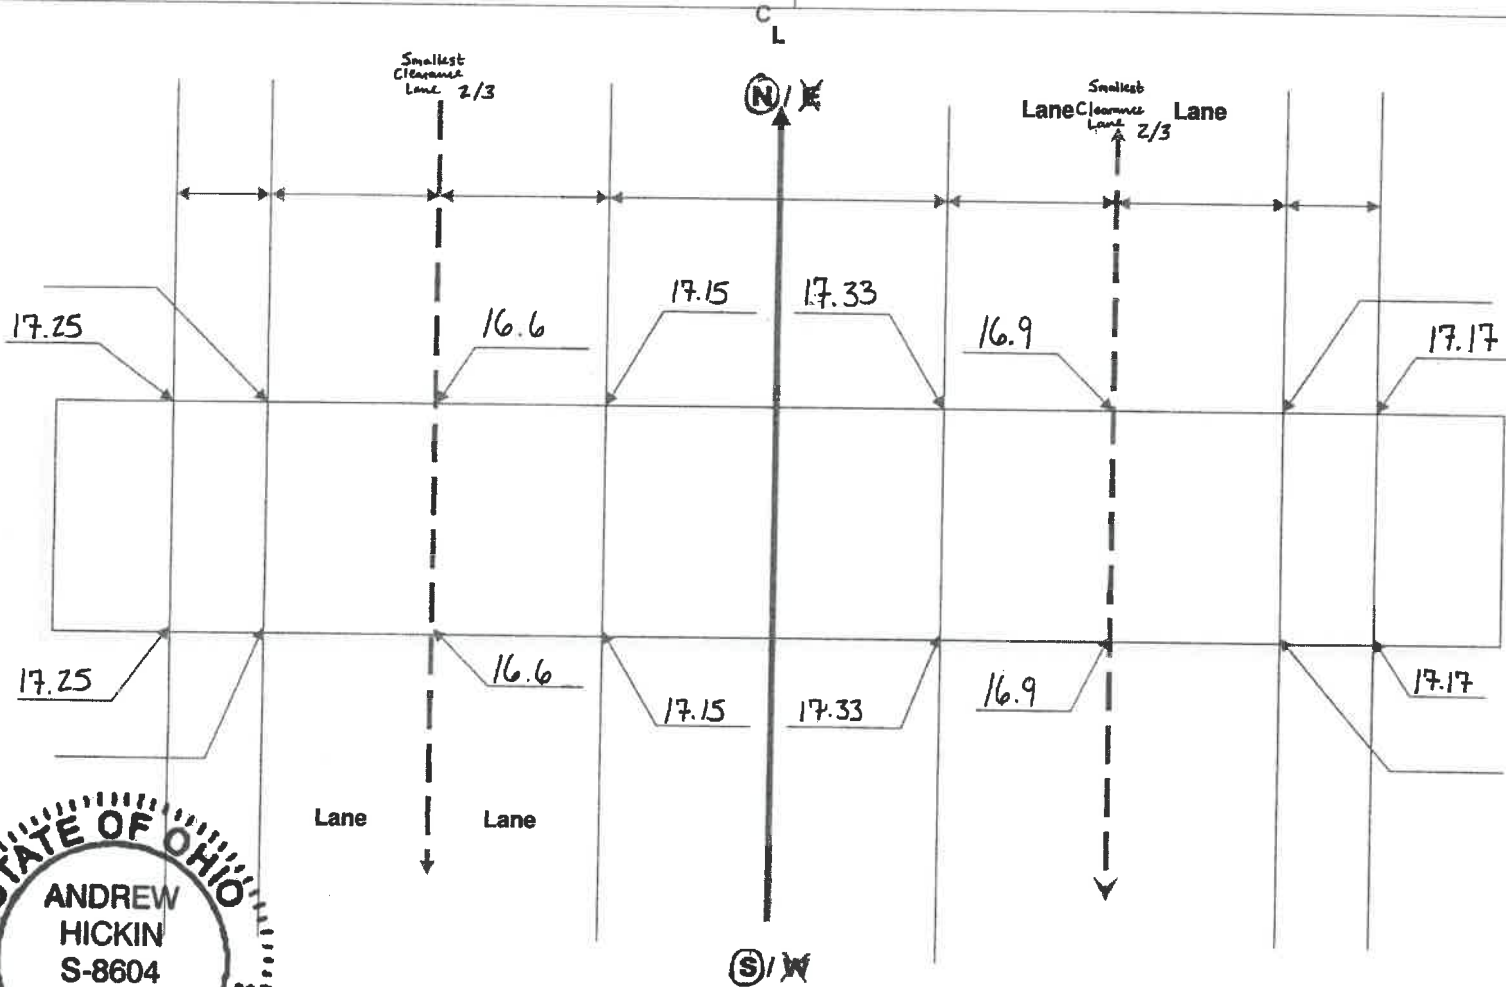

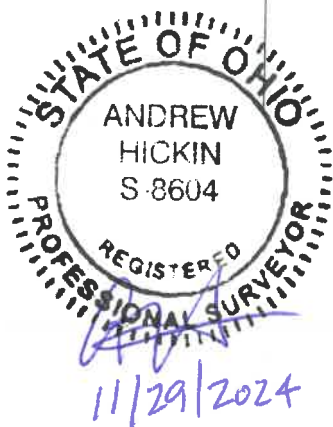

REV 09/10/07





Ohio Department of Transportation
Vertical Clearance Survey Form

County: SUM Route: 77

Date: _____

Structure No. 0886 (Swartz Rd)

By: _____

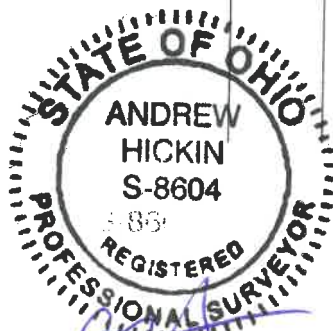
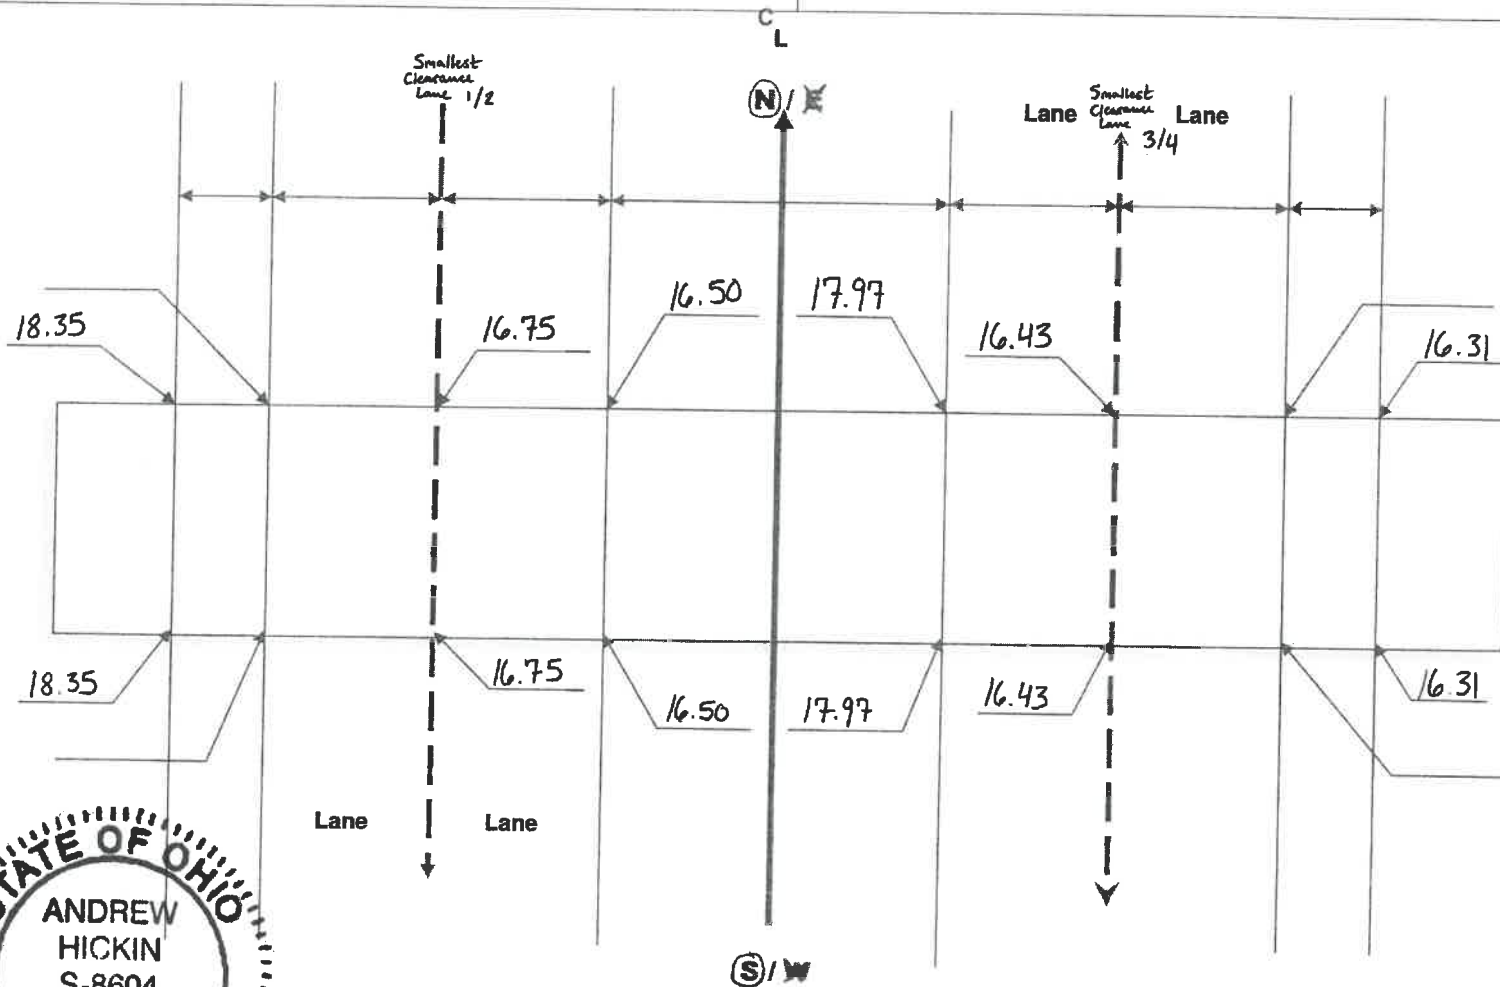


11/29/2024



Ohio Department of Transportation
Vertical Clearance Survey Form

County: SUM Route: 77 Date: _____
Structure No. 0927 (S97 to E 297/224) By: _____

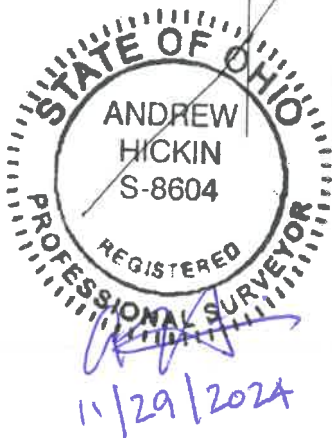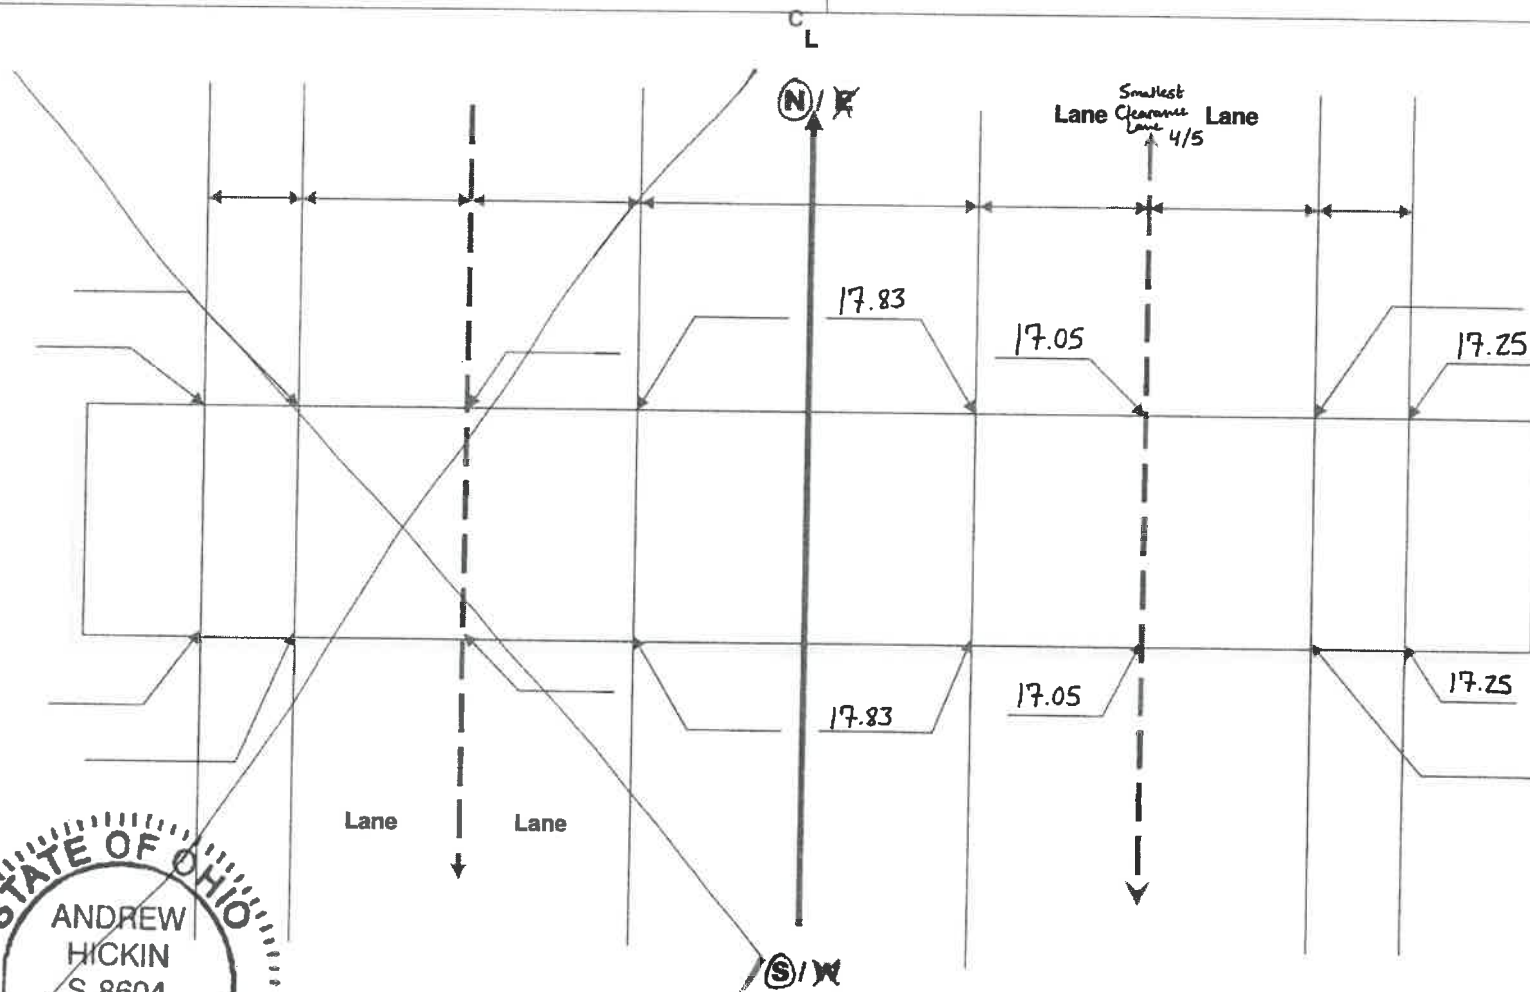





Ohio Department of Transportation
Vertical Clearance Survey Form

County: SUM Route: 77

Date: _____

Structure No. 0958 L (N77 to W 277/224)

By: _____

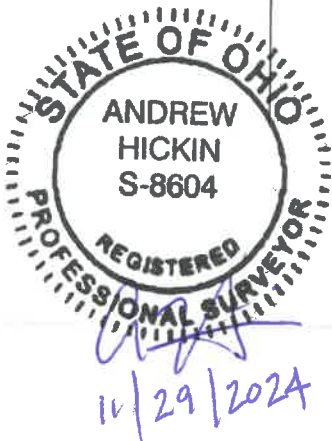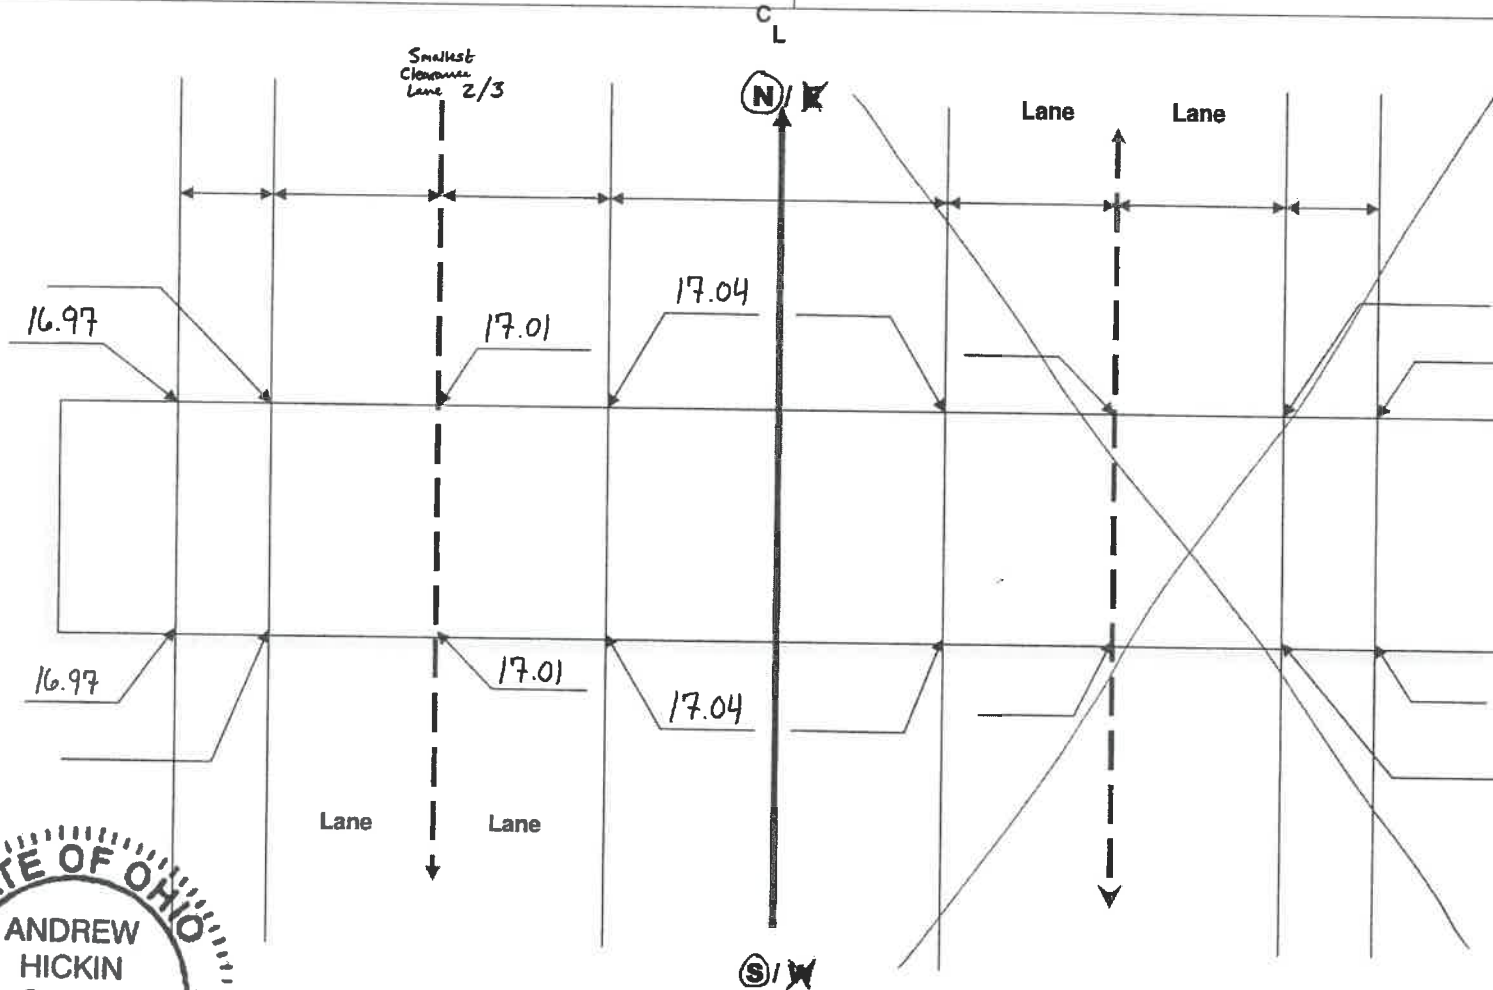




Ohio Department of Transportation
Vertical Clearance Survey Form

County: SUM Route: 277 (77)

Date: _____

Structure No. 0369 (E:W 277 over 77)

By: _____

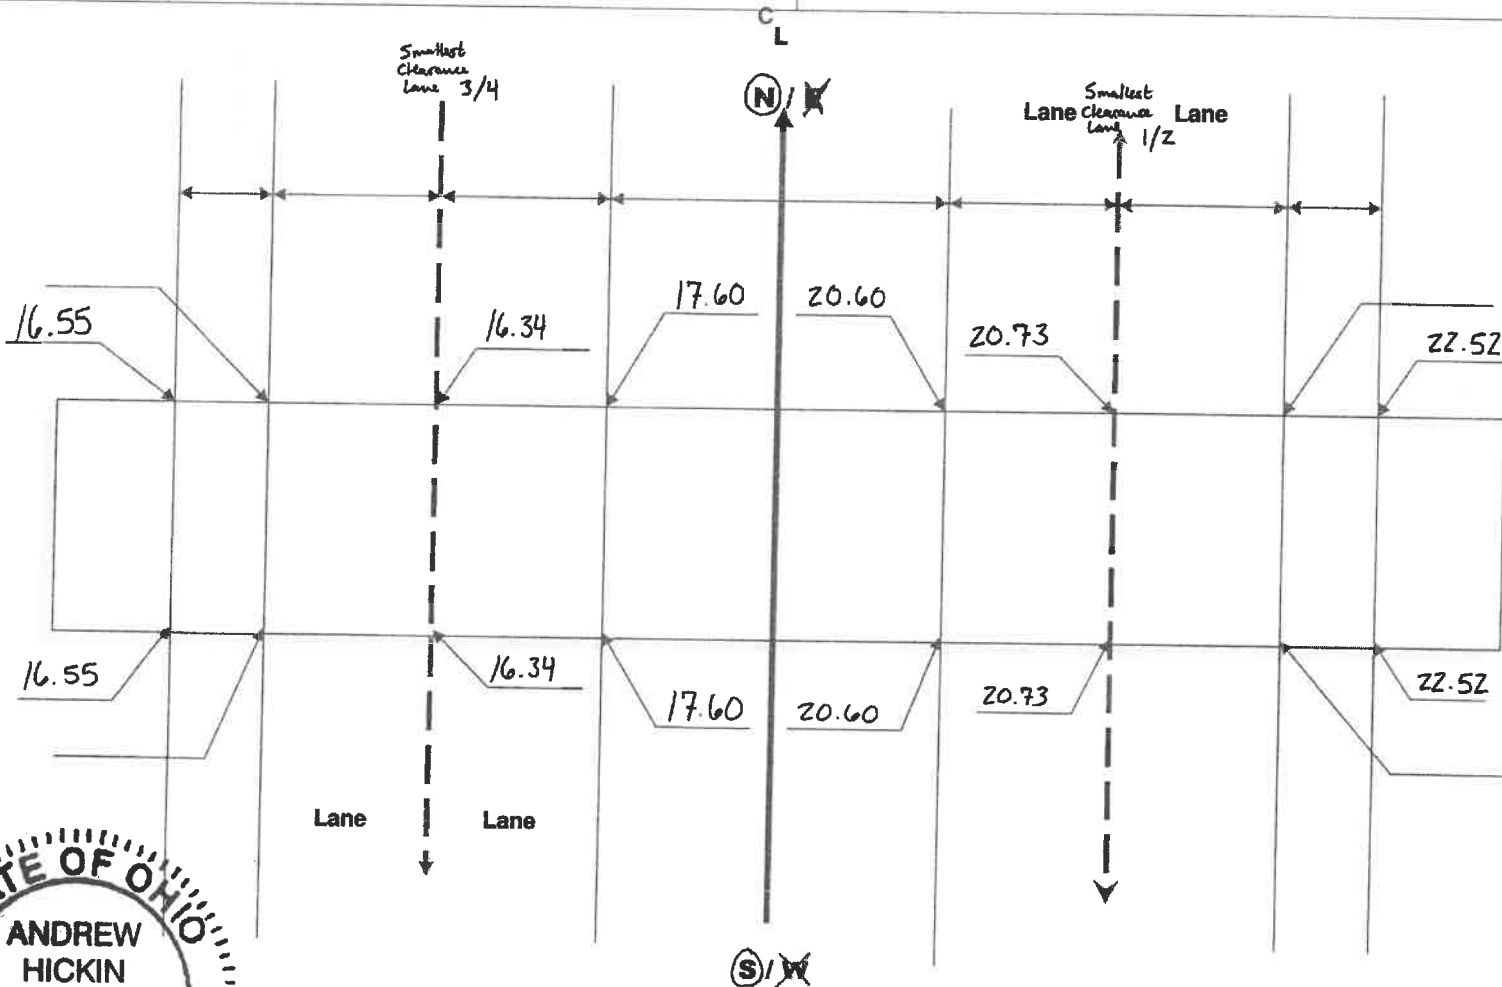




Ohio Department of Transportation
Vertical Clearance Survey Form

County: SUM Route: 277 (77)

Date: _____

Structure No. 0369 (E 1/4 W 277 and 77
N 77 to W 277 / 224)

By: _____

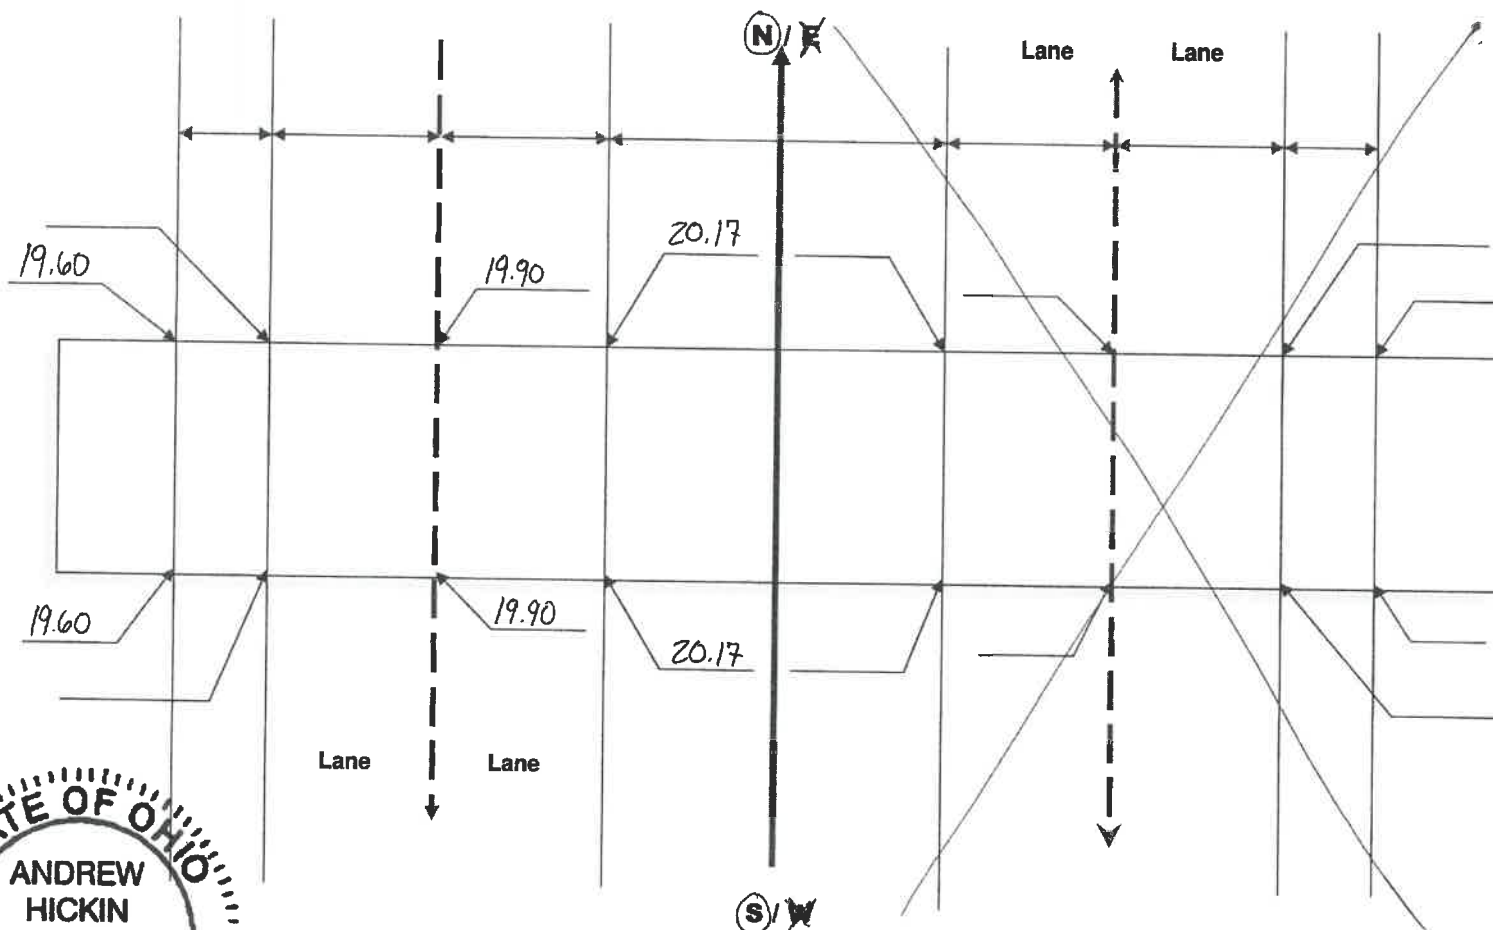

11/29/2024