


All hanger assembly components shall be new. (excluding Web plate)

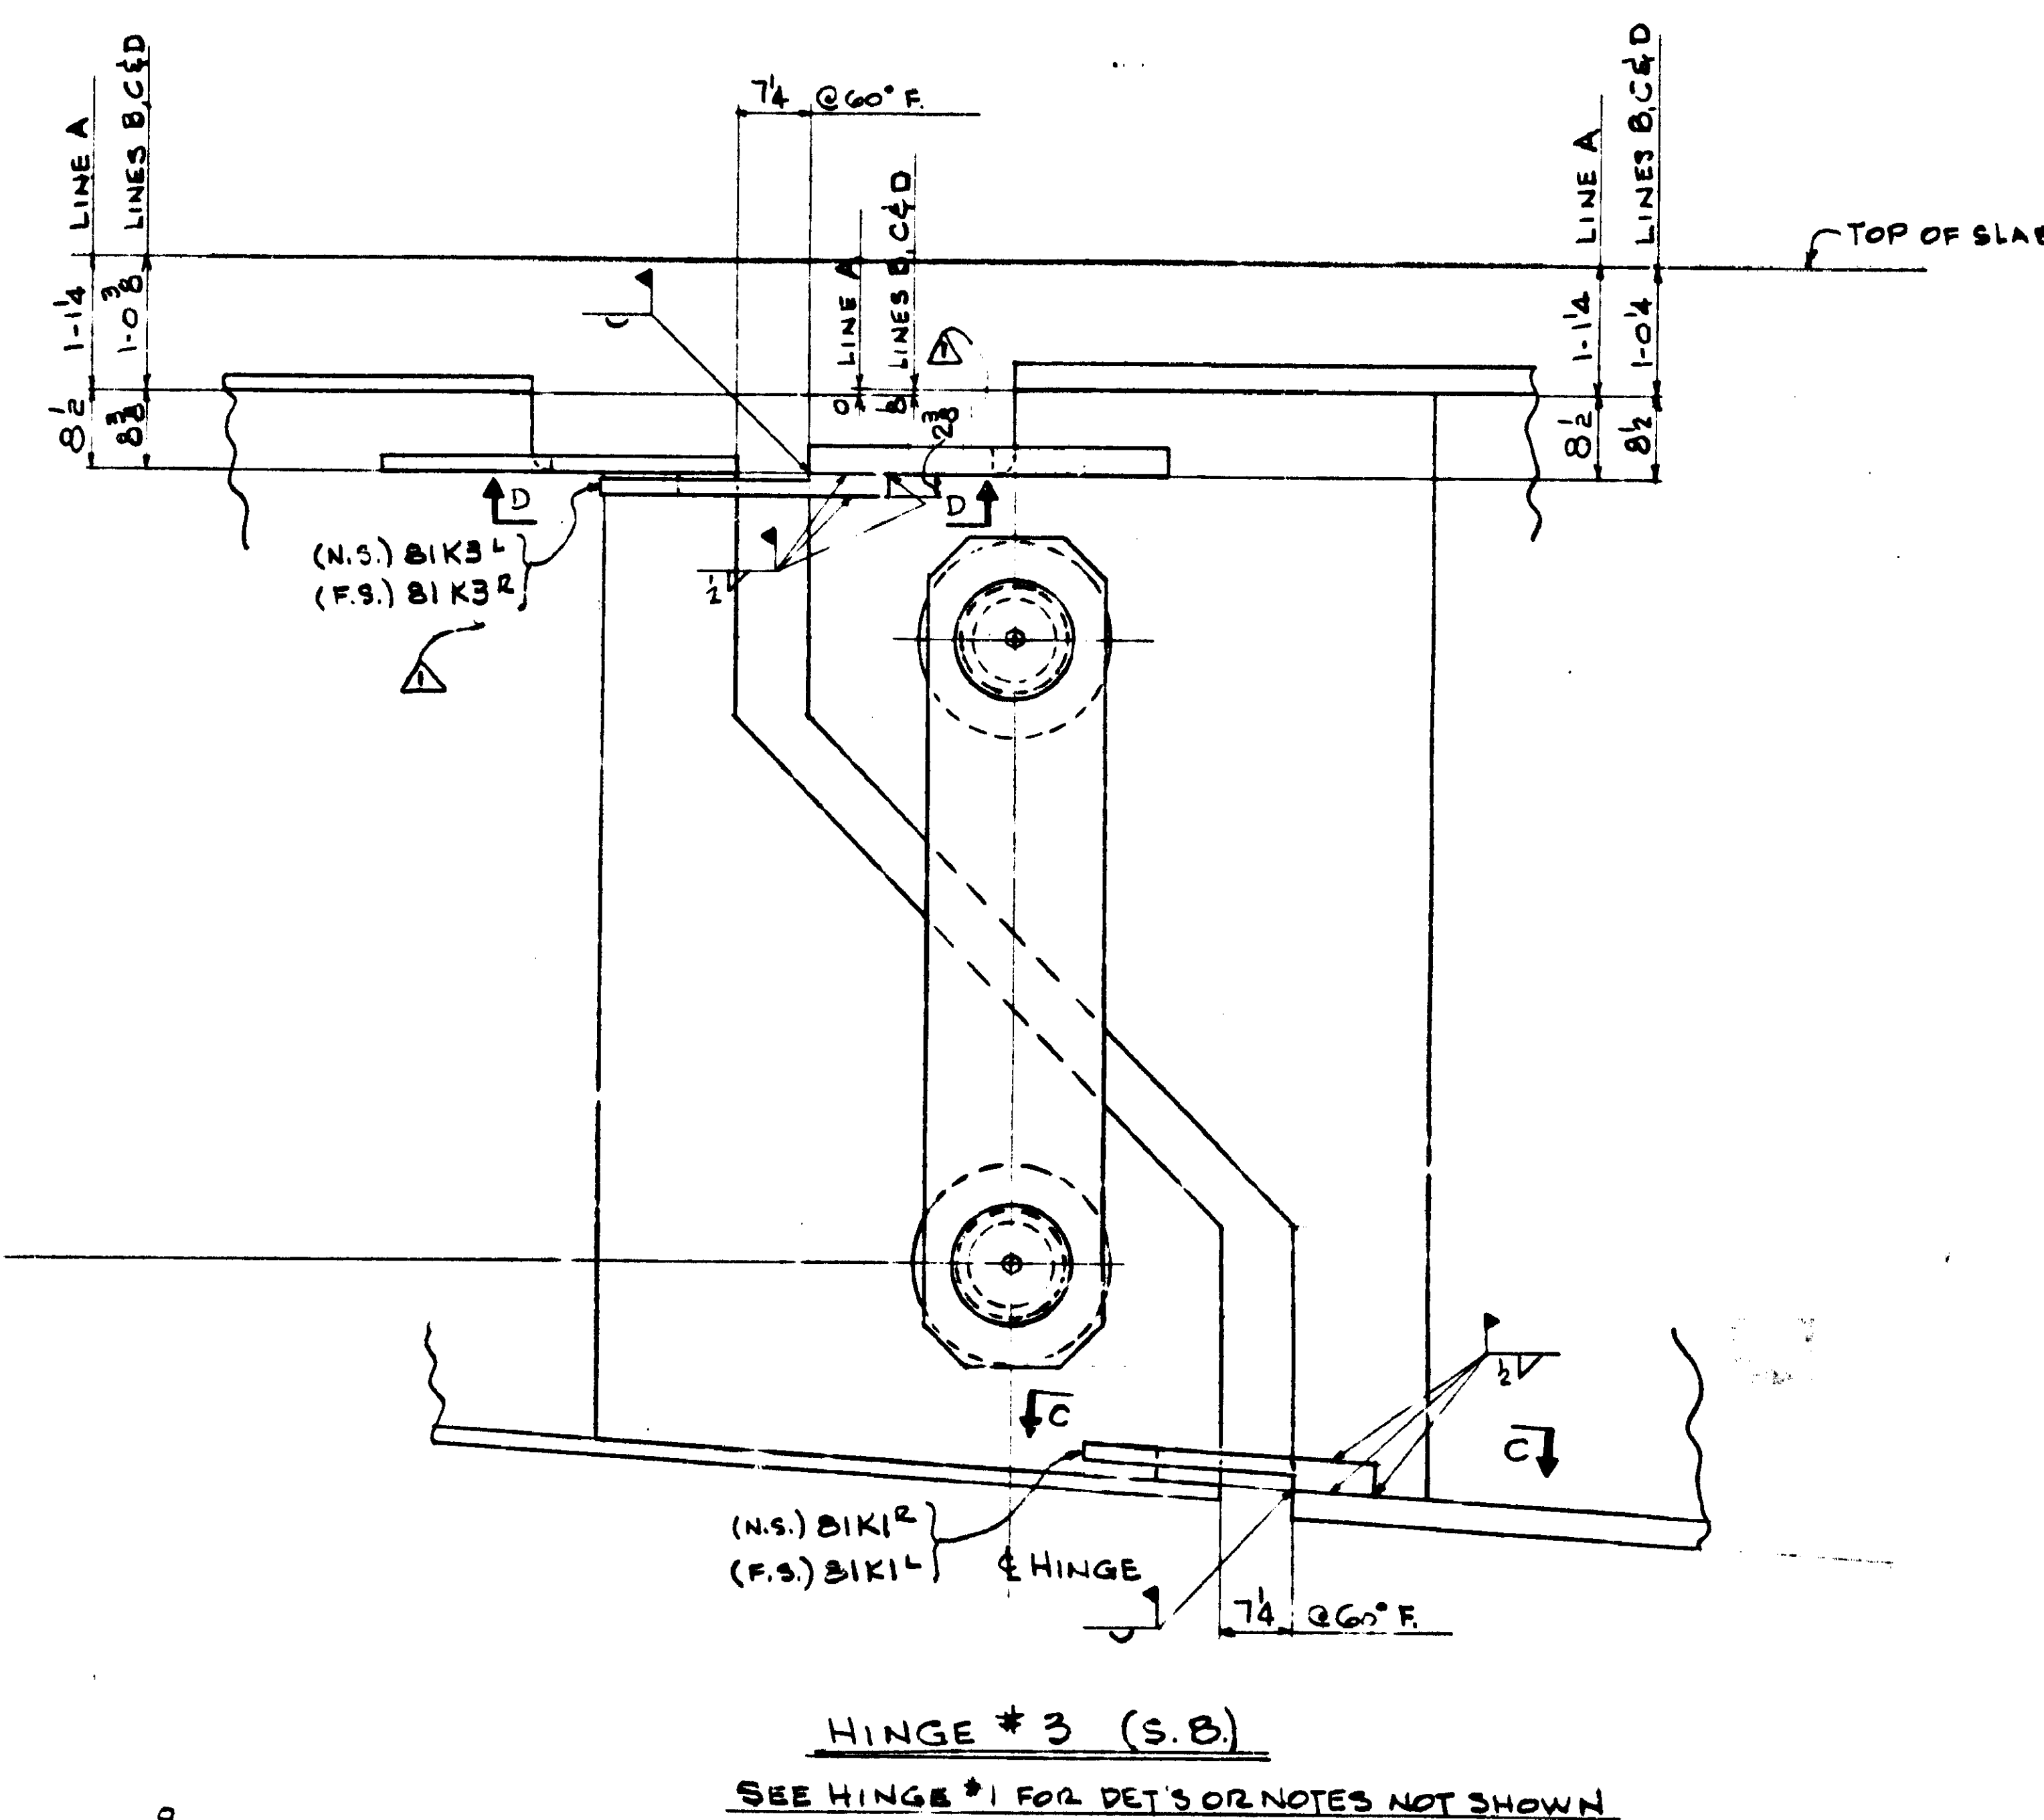

Approved By the  
State of Ohio.  
4-17-80  
6-30-80

PUT IN SHOP <u>MAY 10 1980</u>		PROD. CONTROL	
NO. <u>1</u>		REVISIONS	
SPECIFICATIONS		CUSTOMER <u>INDUSTRIAL FIRST</u>	
MATERIAL		ENGR. OR ARCHT. <u>DALTON LITTLE NEWPORT</u>	
SHOP PAINT		DESCRIPTION <u>N. MAIN ST. VIADUCT (S.S.)</u>	
REAMING		<u>SR. N° SUM. 261-1003</u>	
HOLES GALV. _____ WELD. _____ MACH. _____		<u>SUMMIT CO., OHIO</u>	
LAST ASSEMBLY MK. _____ ERECT. DWG. _____		<u>HINGERS #1 &amp; 2</u>	
MADE <u>JJM</u> DATE <u>1-8-80</u> CHECKED <u>EDJ</u> DATE <u>2-28-80</u>		IN CHARGE <u>J.N.G., INC.</u>	
CONTRACT NO. <u>C-1808</u>		DWG. NO. <u>E9</u>	