

STATE OF OHIO DEPARTMENT OF TRANSPORTATION

TRU-11-9.97

VIENNA TOWNSHIP TRUMBULL COUNTY

FEDERAL PROJECT NUMBER

E240(004)

RAILROAD INVOLVEMENT

NONE

PROJECT DESCRIPTION

RESURFACING SR 11 IN TRUMBULL COUNTY
WITH MINOR BRIDGE WORK ON THREE STRUCTURES.

EARTH DISTURBED AREAS

PROJECT EARTH DISTURBED AREA: 3.22 ACRES
ESTIMATED CONTRACTOR EARTH DISTURBED AREA: 0.25 ACRES
NOTICE OF INTENT EARTH DISTURBED AREA: N/A (MAINTENANCE PROJECT)

LIMITED ACCESS

THIS IMPROVEMENT IS ESPECIALLY DESIGNED FOR THROUGH TRAFFIC AND HAS BEEN DECLARED A LIMITED ACCESS HIGHWAY OR FREEWAY BY ACTION OF THE DIRECTOR IN ACCORDANCE WITH THE PROVISIONS OF SECTION 5511.02 OF THE OHIO REVISED CODE.


2023 SPECIFICATIONS

THE STANDARD SPECIFICATIONS OF THE STATE OF OHIO, DEPARTMENT OF TRANSPORTATION, INCLUDING SUPPLEMENTAL SPECIFICATIONS LISTED IN THE PLANS, CHANGES LISTED IN THE PROPOSAL, AND THE SUPPLEMENTAL SPECIFICATION 800 VERSION INDICATED ON THE PROPOSAL SHALL GOVERN THIS IMPROVEMENT.

I HEREBY APPROVE THESE PLANS AND DECLARE THAT THE MAKING OF THIS IMPROVEMENT WILL NOT REQUIRE THE CLOSING TO TRAFFIC OF THE HIGHWAY EXCEPT FOR THE RAMPS AS DESCRIBED ON SHEET P.7 AND THAT PROVISIONS FOR THE MAINTENANCE AND SAFETY OF TRAFFIC WILL BE AS SET FORTH ON THE PLANS AND ESTIMATES.

Arthur G. Noiro Jr.
Arthur G. Noiro Jr., P.E.
District 04 Deputy Director

Jack Marchbanks
Jack Marchbanks, PhD
Director, Department of Transportation

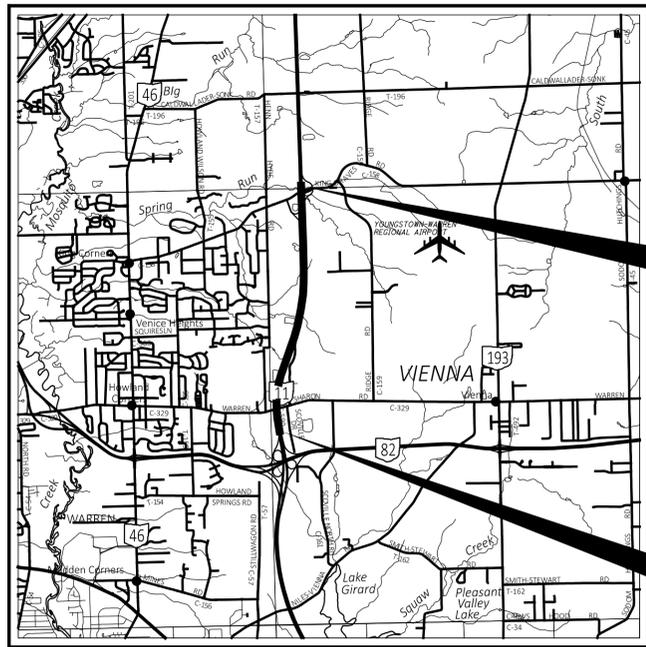

LOCATION MAP

LATITUDE: 41°15'10" LONGITUDE: 80°42'25"



PORTION TO BE IMPROVED	—————
INTERSTATE HIGHWAY	=====
FEDERAL ROUTES	=====
STATE ROUTES	=====
COUNTY & TOWNSHIP ROADS	=====
OTHER ROADS	—————

DESIGN DESIGNATION FOR REFERENCE PURPOSES ONLY, BASED ON ODOT TDMS

CURRENT ADT (2023)	39,896
DESIGN HOURLY VOLUME (2023)	3,643
DIRECTIONAL DISTRIBUTION	51%
TRUCKS (24 HOUR B&C)	9%
DESIGN SPEED	70 MPH
LEGAL SPEED	70 MPH
DESIGN FUNCTIONAL CLASSIFICATION:	
02 OTHER FREEWAYS OR EXPRESSWAYS (URBAN)	
NHS PROJECT	YES

DESIGN EXCEPTIONS

NONE

ADA DESIGN WAIVERS

NONE

UNDERGROUND UTILITIES
Contact Two Working Days
Before You Dig

OHIO811.org
Before You Dig

OHIO811, 8-1-1, or 1-800-362-2764
(Non members must be called directly)


PLAN PREPARED BY:
ODOT --- DISTRICT 4, CAPITAL PLANNING
2088 S. ARLINGTON ROAD
AKRON, OHIO 44306

INDEX OF SHEETS:

TITLE SHEET	P.1
TYPICAL SECTIONS	P.2
GENERAL NOTES	P.3-P.4
MAINTENANCE OF TRAFFIC	P.5-P.7
GENERAL SUMMARY	P.8-P.9
SUBSUMMARY & CALCULATIONS	P.10-P.12
STRUCTURES	P.13-P.15

Revised Date

STANDARD CONSTRUCTION DRAWINGS						SUPPLEMENTAL SPECIFICATIONS	SPECIAL PROVISIONS
BP-3.1	1/19/24	MT-98.29	1/17/20	TC-71.10	4/21/23	800-2023	1/19/24
BP-9.1	1/18/19	MT-98.30	7/16/21	TC-72.20	7/21/23	807	4/21/22
		MT-99.20	4/19/19	TC-73.20	7/21/23	808	1/18/19
DM-4.3	1/15/16	MT-101.60	4/21/23			832	7/21/23
DM-4.4	1/15/16	MT-101.90	7/17/20			843	1/19/24
		MT-104.10	1/19/24			850	7/21/23
MT-95.30	7/19/19	MT-105.10	1/17/20			905	4/17/20
MT-95.40	7/21/23					908	10/20/17
MT-95.50	7/21/17	TC-41.20	10/18/13				
MT-97.10	4/19/19	TC-42.10	10/18/13				
MT-97.12	1/20/17	TC-42.20	10/18/13				
MT-98.10	1/17/20	TC-52.10	10/18/13				
MT-98.11	1/17/20	TC-52.20	1/15/21				
MT-98.20	4/19/19	TC-61.30	7/19/19				
MT-98.22	1/17/20	TC-65.10	1/17/14				
MT-98.28	1/17/20	TC-65.11	1/19/24				

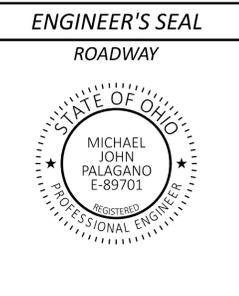

TITLE SHEET

DESIGN AGENCY	
DESIGNER	SJD
REVIEWER	MJP
PROJECT ID	118948
SHEET	P.1
TOTAL	15

TRU-11-9.97

MODEL: Sheet_SurvFI PAPER SIZE: 34x22 (in.) DATE: 6/21/2024 TIME: 7:57:50 AM USER: sdudek
pvc:\ohiodot-pw-bentley.com\ohiodot-pw-02\Documents\01 Active Projects\District 04\Trumbull\118948\400-Engineering\Roadway\Sheets\118948_GT001.dgn