

SHEET NUMBER											PART.			ITEM	ITEM EXT	GRAND TOTAL	UNIT	DESCRIPTION	SEE SHEET NO.
9	11	14	17	18	29	39	48	RW.3 SR 585	RW.3 US 250		01/NHS	02/STR	03/S5K						
																		TRAFFIC CONTROL	
			4									2	2	621	54000	4	EACH	RAISED PAVEMENT MARKER REMOVED	
				14							5	9		626	00110	14	EACH	BARRIER REFLECTOR, TYPE 2 (BIDIRECTIONAL)	
		0.1	0.21								0.1	0.12	0.09	642	00104	0.31	MILE	EDGE LINE, 6", TYPE 1	
		0.3	0.1								0.3	0.06	0.04	642	00300	0.4	MILE	CENTER LINE, TYPE 1	
		0.05									0.05			642	30030	0.05	MILE	REMOVAL OF PAVEMENT MARKING (EDGE LINE)	
		0.1									0.1			642	30030	0.1	MILE	REMOVAL OF PAVEMENT MARKING (CENTER LINE)	
					LS 2.37							LS 2.37		503	11100	LS		STRUCTURE 20 FOOT SPAN AND UNDER (WAY-301-4.64)	
														602	20000	2.37	CY	COFFERDAMS AND EXCAVATION BRACING	
																		CONCRETE MASONRY	
						LS							LS	503	11100	LS		STRUCTURE 20 FOOT SPAN AND UNDER (WAY-585-6.20)	
						LS							LS	503	21300	LS		COFFERDAMS AND EXCAVATION BRACING	
						3,176							3,176	509	10000	3,176	LB	UNCLASSIFIED EXCAVATION	
						10							10	511	46010	10	CY	EPOXY COATED STEEL REINFORCEMENT	
						21							21	511	46510	21	CY	CLASS QC1 CONCRETE, RETAINING/WINGWALL NOT INCLUDING FOOTING	
																		CLASS QC1 CONCRETE, FOOTING	
						1							1	511	46610	1	CY	CLASS QC1 CONCRETE, HEADWALL	
						29							29	512	10100	29	SY	SEALING OF CONCRETE SURFACES (EPOXY-URETHANE)	
						112							112	512	33000	112	SY	TYPE 2 WATERPROOFING	
						97							97	512	33010	97	SY	TYPE 3 WATERPROOFING	
						39							39	516	13600	39	SF	1" PREFORMED EXPANSION JOINT FILLER	
						LS							LS	518	21230	LS			
																		POROUS BACKFILL WITH GEOTEXTILE FABRIC	
							LS				LS			503	11100	LS		STRUCTURE 20 FOOT SPAN AND UNDER (WAY-250-25.67)	
							LS				LS			503	21300	LS		COFFERDAMS AND EXCAVATION BRACING	
							1,821				1,821			509	10000	1,821	LB	UNCLASSIFIED EXCAVATION	
							8				8			511	46010	8	CY	EPOXY COATED STEEL REINFORCEMENT	
							12				12			511	46510	12	CY	CLASS QC1 CONCRETE, RETAINING/WINGWALL NOT INCLUDING FOOTING	
																		CLASS QC1 CONCRETE, FOOTING	
							1				1			511	46610	1	CY		
							15				15			512	10100	15	SY	CLASS QC1 CONCRETE, HEADWALL	
							11				11			512	33000	11	SY	SEALING OF CONCRETE SURFACES (EPOXY-URETHANE)	
							23				23			516	13600	23	SF	TYPE 2 WATERPROOFING	
							LS				LS			518	21230	LS		1" PREFORMED EXPANSION JOINT FILLER	
																		POROUS BACKFILL WITH GEOTEXTILE FABRIC	
																		MAINTENANCE OF TRAFFIC	
	LS	2									2			614	12384	2	EACH	WORK ZONE IMPACT ATTENUATOR, 24" WIDE HAZARDS, (BIDIRECTIONAL)	
		6										LS	LS	614	12420	LS		DETOUR SIGNING	
		5									6			614	13310	6	EACH	BARRIER REFLECTOR, TYPE 1 (BIDIRECTIONAL)	
		6									5			614	13312	5	EACH	BARRIER REFLECTOR, TYPE 2 (BIDIRECTIONAL)	
											6			614	13360	6	EACH	OBJECT MARKER, TWO WAY	
	4											2	2	614	18601	4	SNMT	PORTABLE CHANGEABLE MESSAGE SIGN, AS PER PLAN	11
		0.2									0.2			614	21200	0.2	MILE	WORK ZONE CENTER LINE, CLASS I, 740.06, TYPE I	
		0.12									0.12			614	22210	0.12	MILE	WORK ZONE EDGE LINE, CLASS I, 6", 740.06, TYPE I	
		24									24			614	26400	24	FT	WORK ZONE STOP LINE, CLASS I, 740.06, TYPE I	
		320									320			622	41100	320	FT	WORK ZONE STOP LINE, CLASS I, 740.06, TYPE I	
																		PORTABLE BARRIER, UNANCHORED	
											LS	LS	LS	614	11000	LS		INCIDENTALS	
											1	2	1	619	16010	4	MNTH	MAINTAINING TRAFFIC	
											LS	LS	LS	623	10000	LS		FIELD OFFICE, TYPE B	
											LS	LS	LS	624	10000	LS		CONSTRUCTION LAYOUT STAKES AND SURVEYING	
																		MOBILIZATION	

GENERAL SUMMARY

DESIGN AGENCY
DISTRICT 3



ENGINEERING
TEAM ONE


DESIGNER
ACM

REVIEWER
KCK 11-12-25

PROJECT ID
112742

SHEET
P.16

TOTAL
58

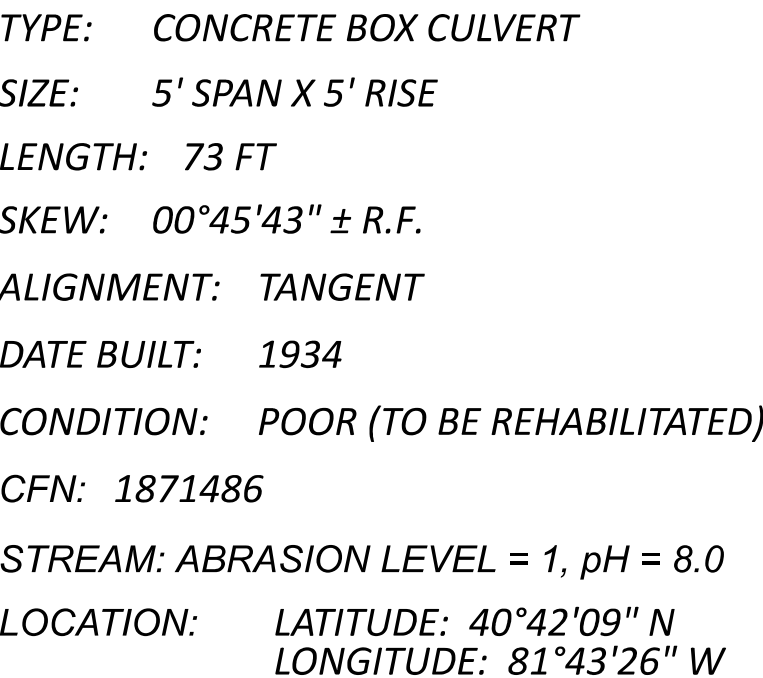

ALL QUANTITIES CARRIED TO GENERAL SUMMARY (01/NHS)