



**CUY-90-14.90**

**PID 77332/85531**

---

**APPENDIX ST-07**

---

**CCG1 Bridge Location Plan  
(Basic Configuration)**


State of Ohio  
Department of Transportation  
Jolene M. Molitoris, Director

**Innerbelt Bridge  
Construction Contract Group 1 (CCG1)**

# BRIDGE LOCATION PLAN

## CLEVELAND INNERBELT CCG1

### PID 77332

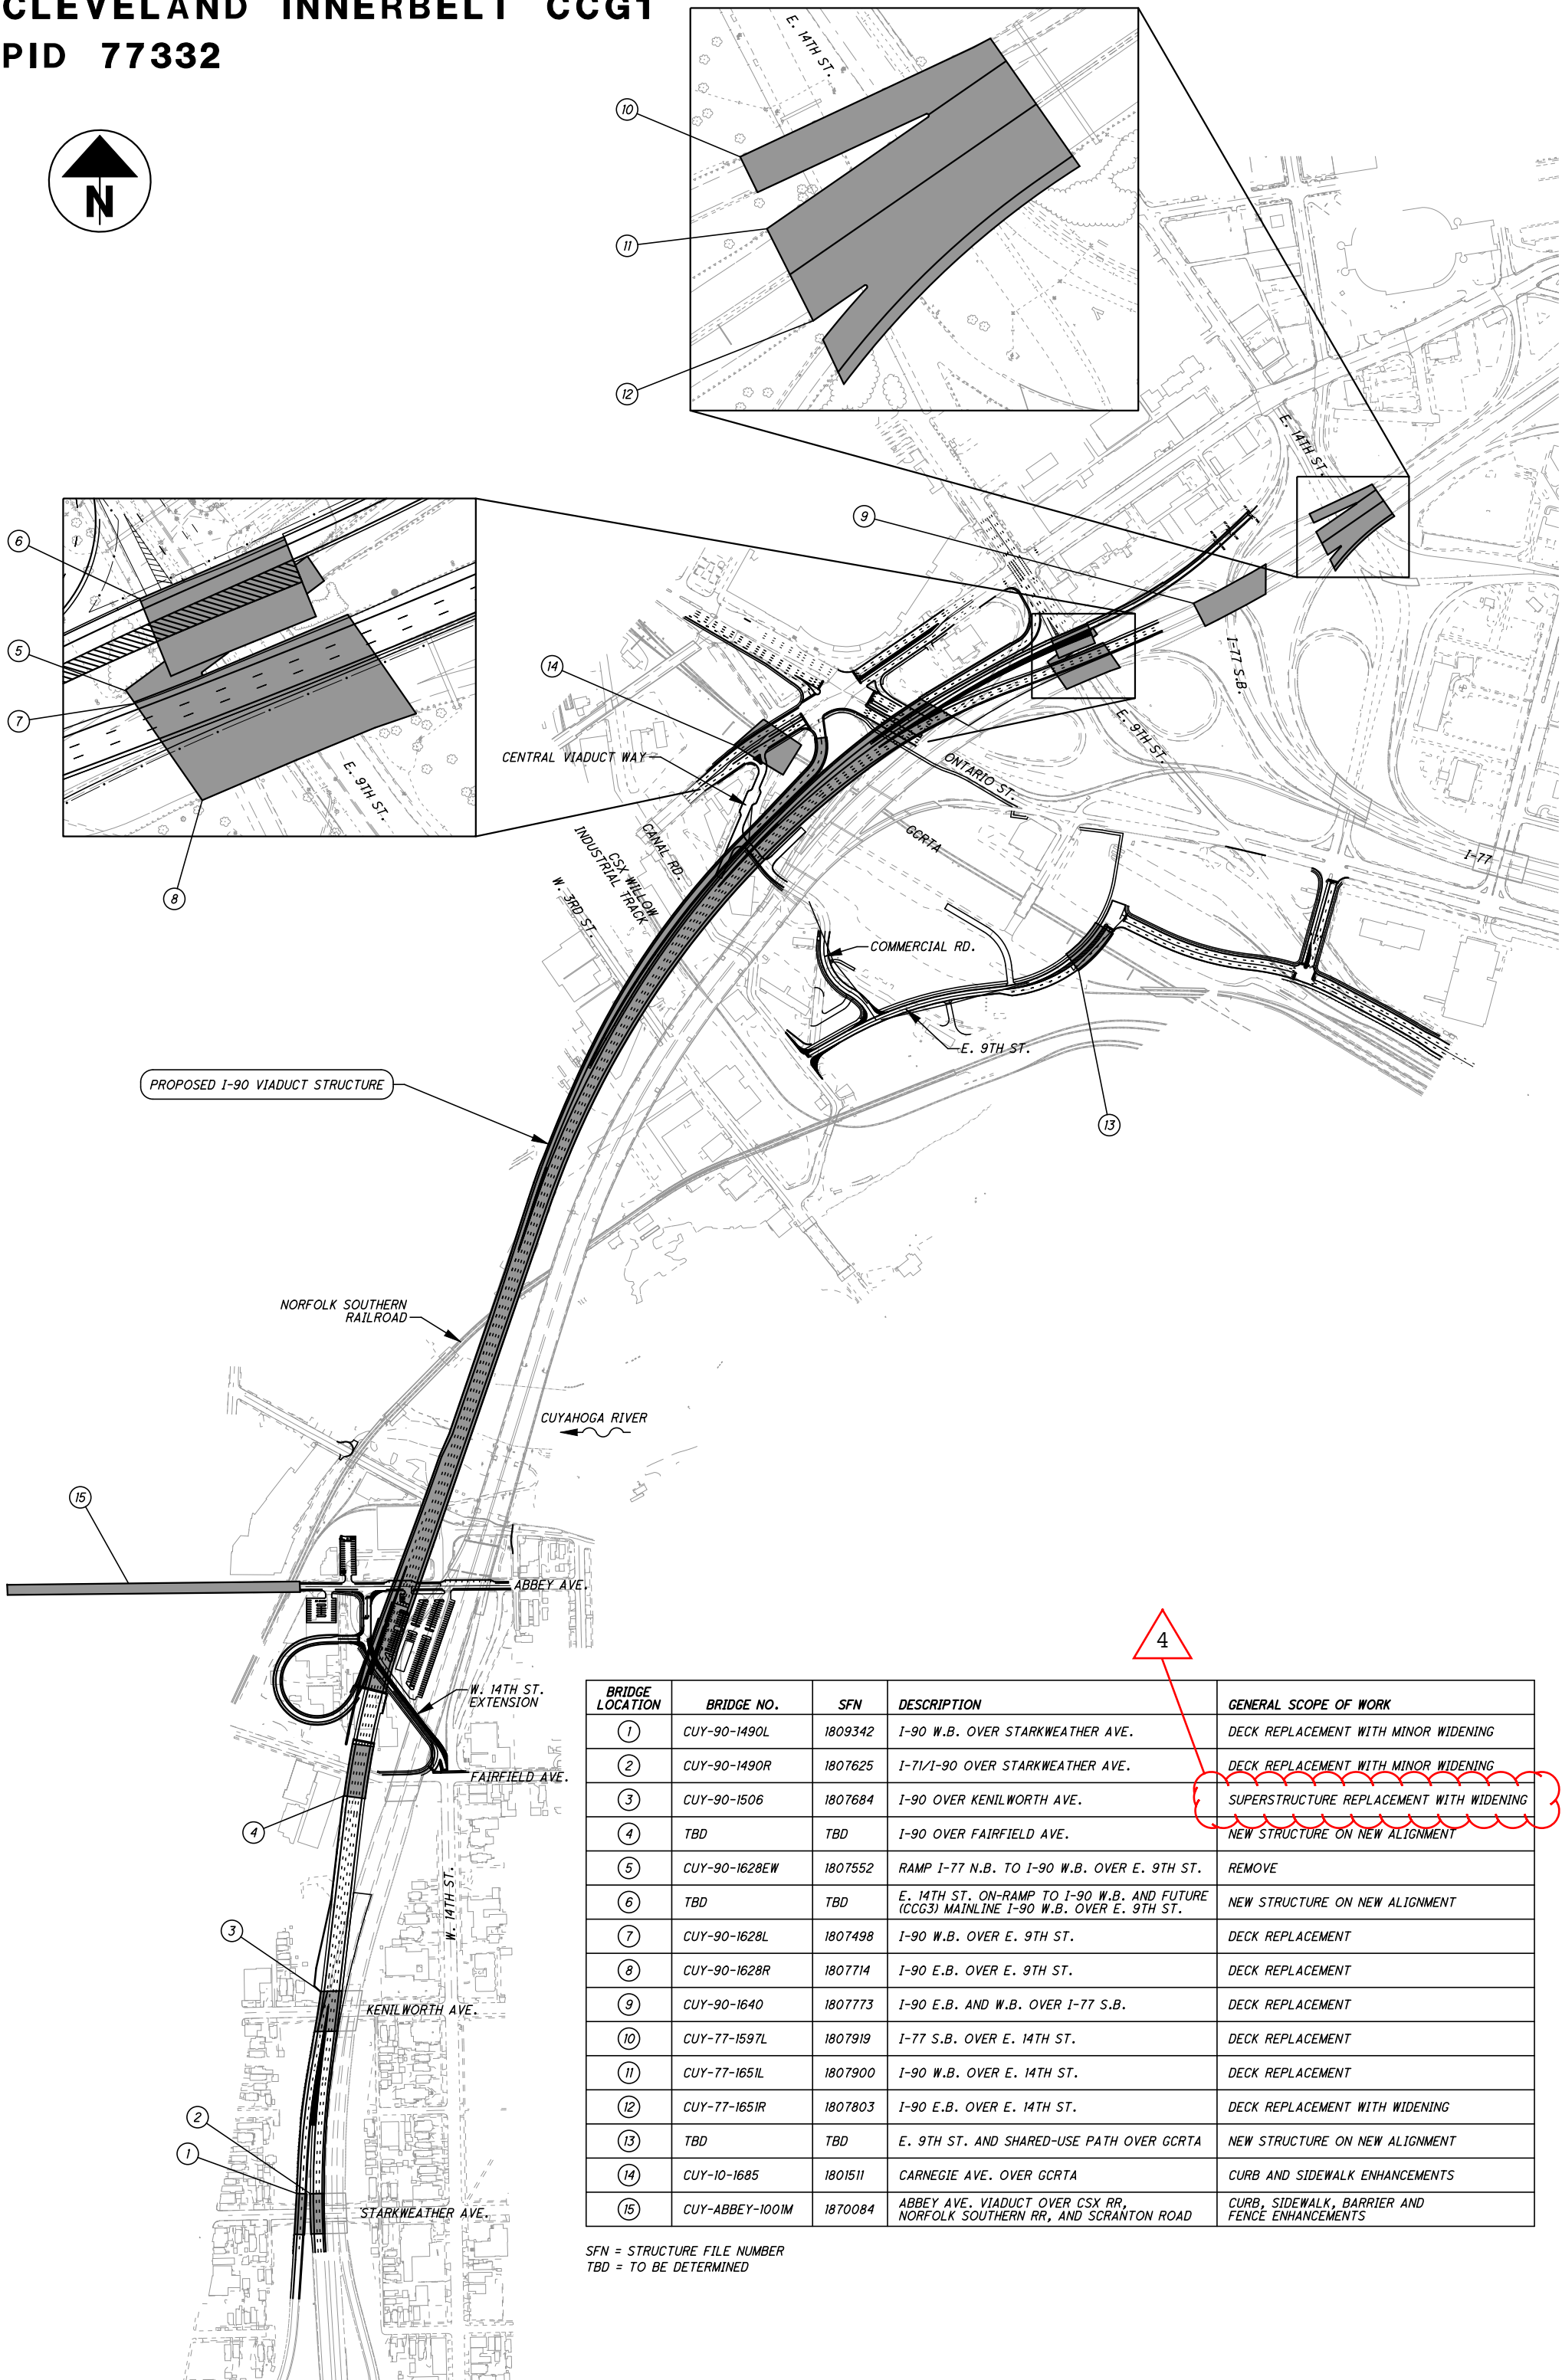

BRIDGE LOCATION	BRIDGE NO.	SFN	DESCRIPTION	GENERAL SCOPE OF WORK
①	CUY-90-1490L	1809342	I-90 W.B. OVER STARKWEATHER AVE.	DECK REPLACEMENT WITH MINOR WIDENING
②	CUY-90-1490R	1807625	I-71/I-90 OVER STARKWEATHER AVE.	DECK REPLACEMENT WITH MINOR WIDENING
③	CUY-90-1506	1807684	I-90 OVER KENILWORTH AVE.	SUPERSTRUCTURE REPLACEMENT WITH WIDENING
④	TBD	TBD	I-90 OVER FAIRFIELD AVE.	NEW STRUCTURE ON NEW ALIGNMENT
⑤	CUY-90-1628EW	1807552	RAMP I-77 N.B. TO I-90 W.B. OVER E. 9TH ST.	REMOVE
⑥	TBD	TBD	E. 14TH ST. ON-RAMP TO I-90 W.B. AND FUTURE (CCG3) MAINLINE I-90 W.B. OVER E. 9TH ST.	NEW STRUCTURE ON NEW ALIGNMENT
⑦	CUY-90-1628L	1807498	I-90 W.B. OVER E. 9TH ST.	DECK REPLACEMENT
⑧	CUY-90-1628R	1807714	I-90 E.B. OVER E. 9TH ST.	DECK REPLACEMENT
⑨	CUY-90-1640	1807773	I-90 E.B. AND W.B. OVER I-77 S.B.	DECK REPLACEMENT
⑩	CUY-77-1597L	1807919	I-77 S.B. OVER E. 14TH ST.	DECK REPLACEMENT
⑪	CUY-77-1651L	1807900	I-90 W.B. OVER E. 14TH ST.	DECK REPLACEMENT
⑫	CUY-77-1651R	1807803	I-90 E.B. OVER E. 14TH ST.	DECK REPLACEMENT WITH WIDENING
⑬	TBD	TBD	E. 9TH ST. AND SHARED-USE PATH OVER GCRTA	NEW STRUCTURE ON NEW ALIGNMENT
⑭	CUY-10-1685	1801511	CARNEGIE AVE. OVER GCRTA	CURB AND SIDEWALK ENHANCEMENTS
⑮	CUY-ABBEY-1001M	1870084	ABBEY AVE. VIADUCT OVER CSX RR, NORFOLK SOUTHERN RR, AND SCRANTON ROAD	CURB, SIDEWALK, BARRIER AND FENCE ENHANCEMENTS

SFN = STRUCTURE FILE NUMBER  
TBD = TO BE DETERMINED