



CUY-90-14.90

PID 77332/85531

APPENDIX EX-11

**Willow Innerbelt Freeway Part 7-A (CUY-21-15.32 and CUY-42-18.42)
(Reference Document)**

State of Ohio
Department of Transportation
Jolene M. Molitoris, Director

**Innerbelt Bridge
Construction Contract Group 1 (CCG1)**

210
S

THIS IMPROVEMENT IS ESPECIALLY DESIGNED FOR THROUGH TRAFFIC AND HAS BEEN DECLARED A LIMITED ACCESS HIGHWAY OR FREEWAY BY ACTION OF THE DIRECTOR OF HIGHWAYS IN ACCORDANCE WITH THE PROVISIONS OF SECTION 5511.02 REVISED CODE OF OHIO.

COMBINED LINE DATA

LENGTH OF PROJECT PART 6 [I-71-5(6)247]	= 668.53'	= 0.126 MILE
LENGTH OF PROJECT PART 7-A [I-77-5(1)162]	= 1203.24'	= 0.227 MILE
LENGTH OF PROJECT PARTS 7-A&B [I-71-5(8)248]	= 4643.73'	= 0.879 MILE
TOTAL LENGTH OF PROJECTS	= 6,515.55'	= 1.234 MILES
LENGTH OF WORK PART 6 [I-71-5(6)247]	= 3885.53'	= 0.735 MILE
LENGTH OF WORK PART 7-A [I-77-5(1)162]	= 1895.12'	= 0.353 MILE
LENGTH OF WORK PARTS 7-A&B [I-71-5(8)248]	= 10,577.65'	= 2.003 MILES
TOTAL LENGTH OF WORK	= 16,358.30'	= 3.098 MILES

INDEX OF SHEETS

SHEET NO.	TITLE SHEET	36-39	DRAINAGE PROFILES	137-144	RAMP E-10 OVER RAMP E-8
2	SCHEMATIC PLAN	40	DRAINAGE DETAILS	145-155	BR. NO. CUY - 21-1573
3-4	TYPICAL SECTIONS	41-47	LIGHTING PLANS	145-155	BR. NO. CUY - 21-1573
5-6	GEOMETRICS	48	LIGHTING NOTES	156-163	BR. NO. CUY - 21-1559
7	GENERAL NOTES	49-52	LIGHTING DETAILS	164-170	BR. NO. CUY - 21-1544
8-11	QUANTITY CALCULATIONS	53-59	EXISTING UTILITIES	171-172	PIER CAP PLANS
12,13	GENERAL SUMMARY OF QUANTITIES	60	CROSS-SECTION KEY SHEET	173	END DAM DETAILS
14,14A,14-B,14-C	QUANTITIES	61-90	CROSS-SECTIONS	174	DRAINAGE DETAILS
15-20	PAVEMENT DETAILS	91-97	RIGHT OF WAY	175	RAILING AND GUARD RAIL DETAILS
21	OMITTED	98-98A	GENERAL NOTES FOR STRUCTURES	176-177	LIGHTING DETAILS
22-26	ROADWAY PROFILES	99-99A	ESTIMATED QUANTITIES	177A-177B	SIGN BRIDGE DETAILS
27-31	MISCELLANEOUS DETAILS	100-113	BR. NO. CUY - 42-1843	178-181	OMITTED
32-35	DRAINAGE PLANS	114-136	BR. NO. CUY - 42-1854		

LINE DATA

LENGTH OF PROJECT	CUY-21-15.32 (WILLOW) I-77-5(1)162	STA 30+41.98 TO STA 42+45.12	= 1,203.24' = 0.227 MILE
	CUY-42-18.42 (INNER BELT) Part 7-A	STA 64+68.53 TO STA 83+09.31	= 1,840.78'
	CUY-42-18.77 (INNER BELT) Part 7-B	STA 0+200 TO STA 26+03	= 2,803.00'
	TOTAL I-71-5(8)248		= 4,643.73' = 0.879 MILE
LENGTH OF WORK	CUY-21-15.32 (WILLOW) I-77-5(1)162	STA 23+50 TO STA 42+45.12	= 1,895.12' = 0.353 MILE
	CUY-42-18.42 (INNER BELT) Part 7-A	STA 64+68.53 TO STA 83+09.31	= 1,840.78'
	(E-18) STA 10+38 TO STA 19+88.32		= 291.03'
	(WILLOW) STA 12+52.21 TO STA 17+88.32		= 483.01'
	(WILLOW) STA 42+73.11 TO STA 42+45.12		= 67.59'
	CUY-42-18.77 (INNER BELT) Part 7-B	STA 0+200 TO STA 70+86	= 7,286.00'
	Add for Elevation	STA 27+09.87 to STA 26+61.13 RA	= 48.74'
	TOTAL I-71-5(8)248		= 10,577.65' = 2.003 MILES

PREPARED AND RECOMMENDED BY
HOWARD, NEEDLES, TAMMEN & BERGENDOFF
CONSULTING ENGINEERS
KANSAS CITY CLEVELAND NEW YORK

H.G. SOURS
ASSOCIATE
COLUMBUS

SUPPLEMENTAL SPECIFICATIONS			
NUMBER	DATE	NUMBER	DATE
S-101	12-2-59	S-207	4-28-59
M-106 (6d) Rev.	4-1-58	B-219 Rev.	3-12-59
M-206.14	7-15-49	18 Rev.	6-15-59

FILE NO. CUYAHOGA COUNTY
SEC. CUY-21-15.32 & CUY-42-18.42
DATE OF LETTING
CONTRACT NO. 196

STATE OF OHIO
DEPARTMENT OF HIGHWAYS
C U Y - 21 - 15.32
C U Y - 42 - 18.42
CUYAHOGA COUNTY
CITY OF CLEVELAND
WILLOW INNERBELT FREEWAY
PART 7-A

NOTE
Since the Construction Plans for PART N26, PART N27-A and PART N27-B are now Combined into ONE CONTRACT and PROJECT, the General Notes and Traffic Maintenance Notes of each of the aforesaid PARTS, shall apply in the general execution and completion of this COMBINED PROJECT.

FED. ROAD DIV. NO.	STATE	FEDERAL AID PROJECT NO.	TYPE FUNDS
2	OHIO	I-71-5(8)248 I-77-5(1)162	1 181

CUY-21-15.32
CUY-42-18.42


MAR 22 1965
GROUND PHOTOGRAPH

MICROFILMED
JUL 9 1985

I - 71 - 5 (8) 248
I - 77 - 5 (1) 162
LIMITED ACCESS

PART 7-A


For Part 6, see plans for CUY-42-18.29
For Part 7-B, see plans for CUY-42-18.77

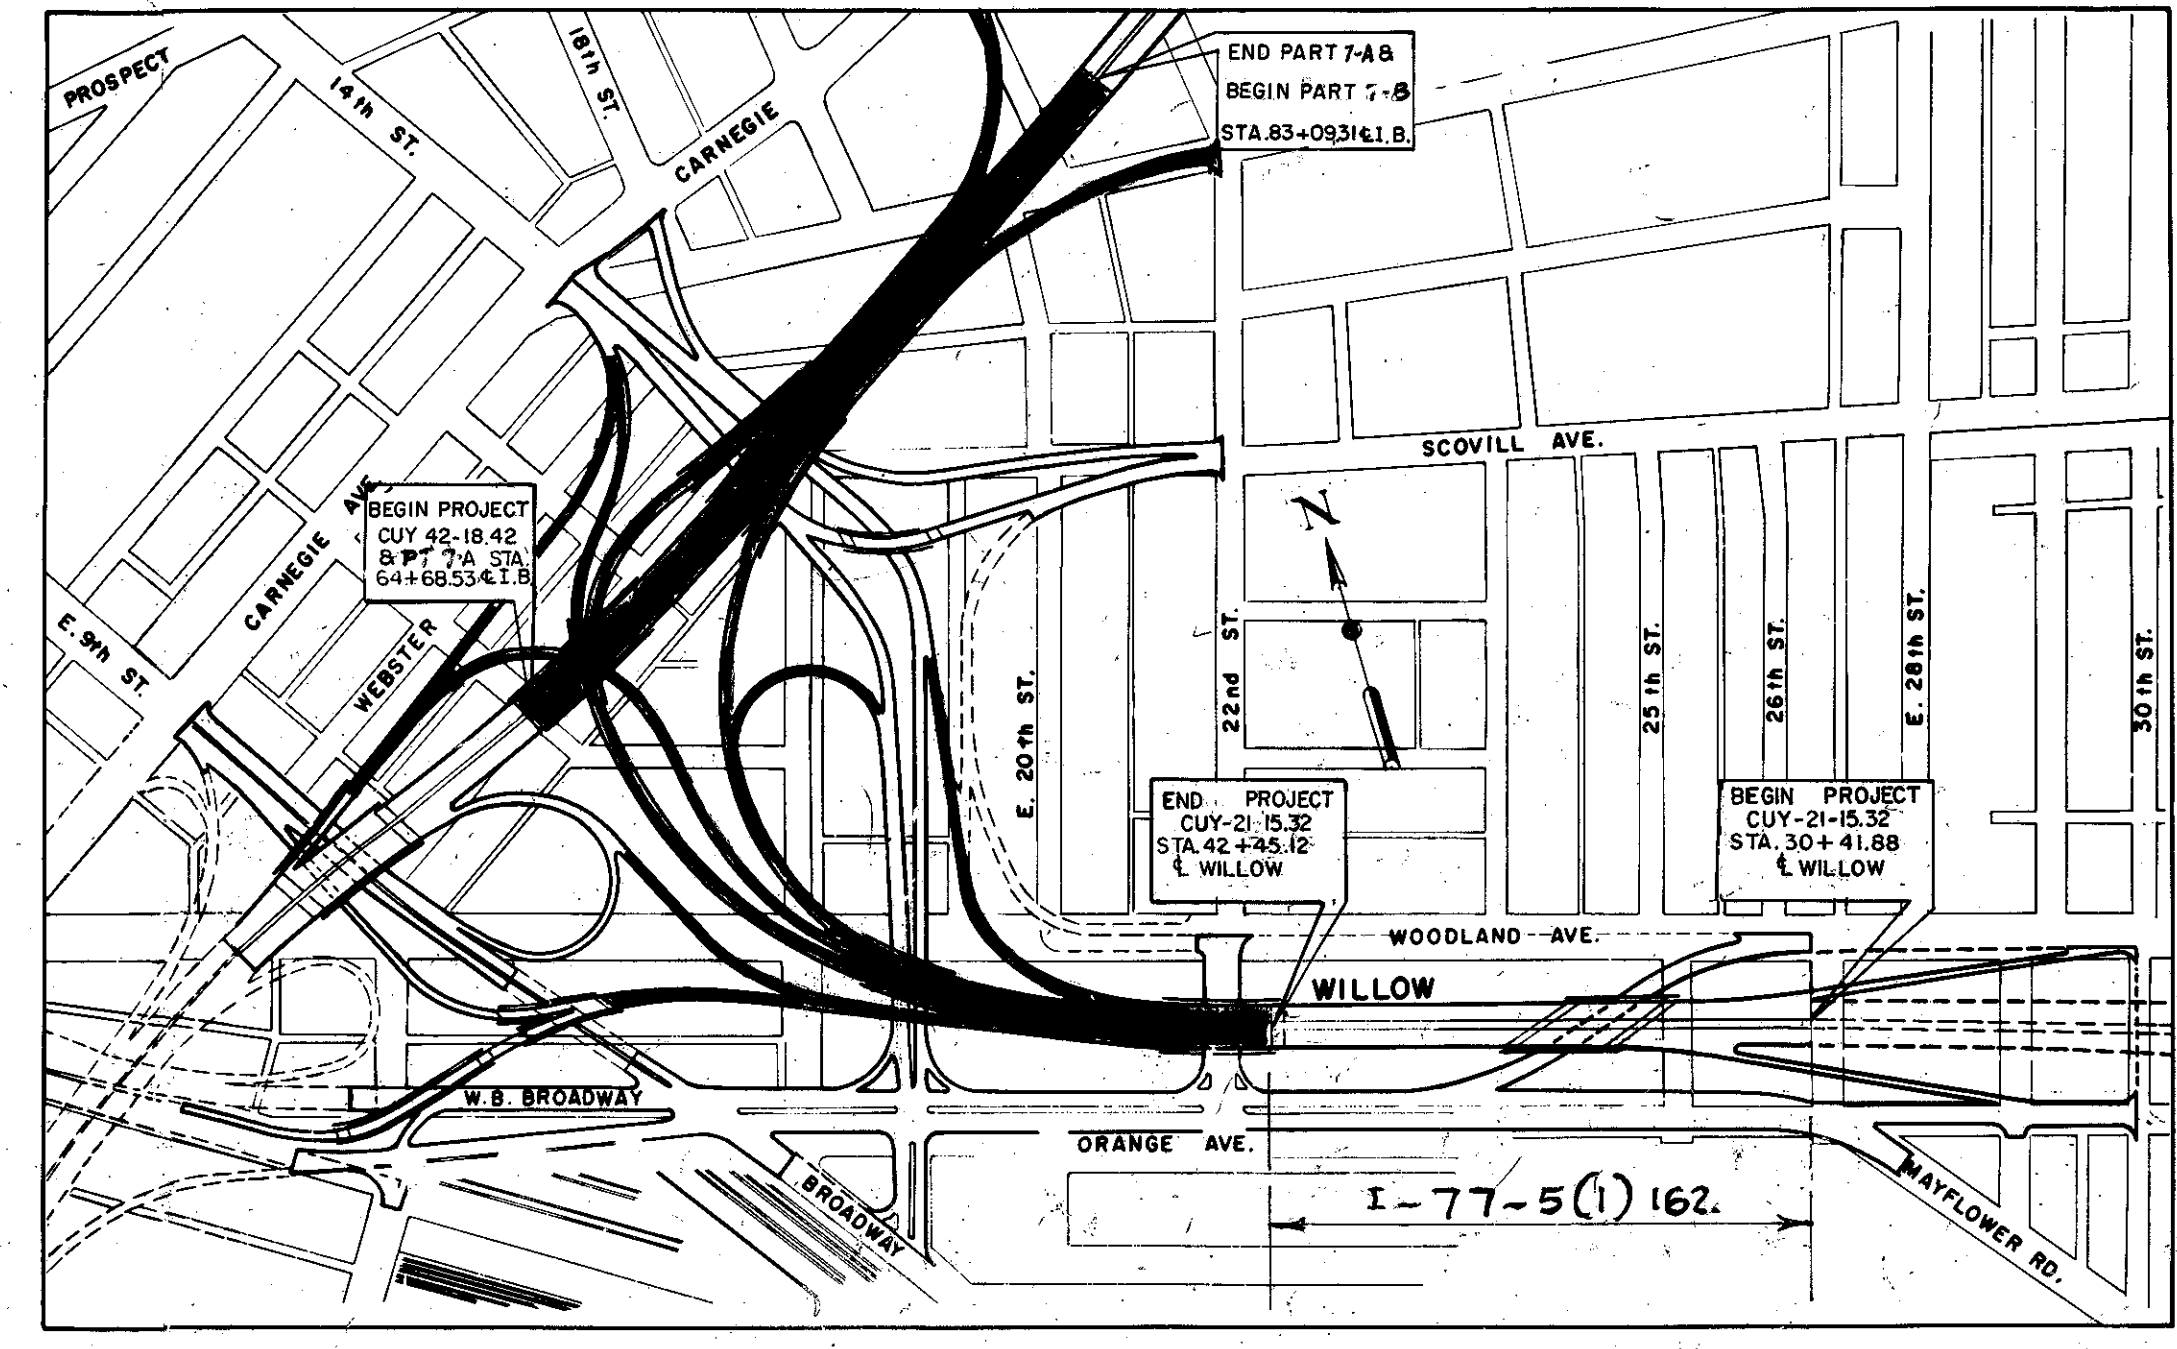

DELIVERY POINT - N.Y.C. ST.L. R.R. BROADWAY TEAM TRACKS AVERAGE HAUL 1/2 MILE

LOCATION PLAN

CONVENTIONAL SIGNS	
PAVEMENT PLANS	SHEET 15
DRAINAGE PLANS	SHEET 31
LIGHTING PLANS	SHEET 43
EXISTING UTILITIES	SHEET 53

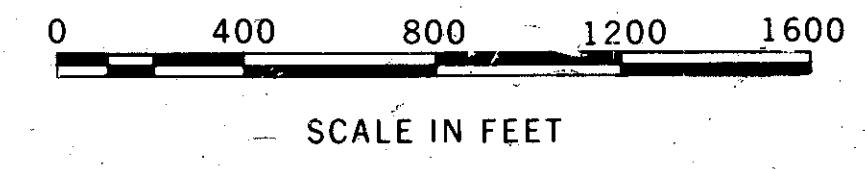

PORTION TO BE IMPROVED ■
OTHER HIGHWAYS & STREETS □

THE STANDARD SPECIFICATIONS OF THE STATE OF OHIO DEPARTMENT OF HIGHWAYS, INCLUDING CHANGES AND SUPPLEMENTAL SPECIFICATIONS LISTED IN THE PROPOSAL SHALL GOVERN THIS IMPROVEMENT. I HEREBY APPROVE THESE PLANS AND DECLARE THAT THE MAKING OF THIS IMPROVEMENT WILL NOT REQUIRE THE CLOSING TO TRAFFIC OF THE HIGHWAY AND THAT PROVISIONS FOR THE MAINTENANCE AND SAFETY OF TRAFFIC WILL BE AS SET FORTH IN THE PLANS AND ESTIMATES. THE RIGHT OF WAY FOR THIS IMPROVEMENT WILL BE PROVIDED BY THE STATE OF OHIO.

APPROVED DATE 2/12/59
APPROVED DATE 2/12/59
APPROVED DATE 3-11-60
APPROVED DATE 3-4-60
APPROVED DATE 8-9-60
APPROVED DATE 3-9-60
APPROVED DATE 3-9-60
APPROVED DATE 3-9-60

Louis R. Drauder
DIRECTOR OF PUBLIC SERVICE, CITY OF CLEVELAND
W. B. Perry
DIVISION DEPUTY DIRECTOR
Ray E. Neenan
DEPUTY DIRECTOR OF PLANNING AND PROGRAMMING
W. J. Corman
ENGINEER OF BRIDGES
W. J. Corman
ENGINEER OF LOCATION AND DESIGN
C. W. M. Raughy
DEPUTY DIRECTOR OF DESIGN AND CONSTRUCTION
Ed. J. Berry
FIRST ASSISTANT DIRECTOR
Ed. J. Berry
DIRECTOR OF HIGHWAYS

SCALES

PLAN 1" = 50'
PROFILE HORIZONTAL 1" = 100'
" VERTICAL 1" = 10'
CROSS SECTIONS 1" = 10'

STANDARD DRAWINGS			
NUMBER	DATE	NUMBER	DATE
DR-1	1-3-55	I-HS No. 1	11-3-58
AR-1-57	2-2-59	I-75 No. 6	7-1-59
		I-75 No. 1	8-21-59
L-3	4-1-50	F-3	9-1-59
L-3-A	4-1-50	I-15 NO. 2A	5-21-59
R1-1	7-15-58	BT-50-70-71 ENO	10-1-47
B-T-71 R	3-2-53	AS-1-54	12-1-54
LJ NO. 1	7-1-55	G-7.07	6-1-56
I-1, 2, 3, 4, 5	4-24-58	F-1	9-1-59
I-8CB 2-2-A&B	3-2-59	I-12	7-1-54
I-8CB NO. 9-A	1-26-59	L-1	4-1-50
I-8CB NO. 6	1-26-59	TJ	5-1-56
I-8 MH NO. 1	1-26-59	T-35	1-2-56
I-8 MH NO. 2	1-26-59	I-14G	1-22-52
I-15 NO. 1	5-21-59	I-21-23	8-1-56
I-8CB NO. 3	1-26-59	I-8CB NO. 7	3-2-59
I-8CB NO. 3-A	1-26-59	I-8 I NO. 2-A	4-23-59
I-RMH NO. 1-A	1-26-59	I-8 I NO. 2	4-23-59
I-8 2-3 6-2-4	7-26-59		
RG-1-55	2-2-59	RN-45	8-18-47

Sheets 116, 131, 132, 133 & 175 revised 6-17-60.
Sheets 109, 110, 111, 125, 126, 127 & 128 revised 6-20-60.
Sheets 147, 153 & 171 revised 7-22-60.
Sheet 12 revised 8-22-60 REC.
Sheets 146, 147, 150, 153, 155 & 171 revised 9-21-60.
Sheet 162 revised 12-6-60.
Sheet 1AA revised 1-12-61.

MAR 22 1965
Revised As Built
GROUND PHOTOGRAPH

DEPARTMENT OF COMMERCE
BUREAU OF PUBLIC ROADS
APPROVED:
DIVISION ENGINEER
DATE

Note: Federal Aid Markers will be furnished and erected by State Forces on the Right at Beginning of each Project and on the Left at End of each Project prior to acceptance of this improvement.

CUYAHOGA COUNTY
CITY OF CLEVELAND
CUY-42-18.42
CUY-21-15.32
SCHEMATIC PLAN

Note: Typical Section of adjoining pavement is the same as the proposed construction.

MICROFILMED
JUL 3 1985

- LEGEND**
- Previous Contract - Part 5
 - Part 6
 - Part 7 - I-77-5(8)248
 - Part 7-I-77-5(1)162
 - Fence

CUY-42-1843
BRIDGE NUMBER 3

TYPE: Continuous welded steel girder with reinforced concrete deck and substructure.

SPANS: 90'-0", 123'-8 1/2" & 89'-9" (along E.I.B.F.)

ROADWAY: 102'-0" f./f. parapets

LOADING: CF 2000 - Adequate for A.A.S.H.O. alternate loading.

SKEW: Varies

SURFACE COURSE: 1" Monolithic Concrete

ALIGNMENT: 1°30' Curve left

APPROACH SLABS: AS-1-54 (25' Long)

SUPERELEVATION: .03' per ft.

CUY-21-1573
BRIDGE NUMBER 9

TYPE: Continuous steel beam with reinforced concrete deck and substructure.

SPANS: 37'-4 1/16", 42'-1 9/16", 53'-1 11/16", & 32'-0 7/8" along E-15.

ROADWAY: Varies

LOADING: CF 2000 - Adequate for A.A.S.H.O. alternate loading.

SKEW: 6°43'20"

SURFACE: 1" Monolithic Concrete

ALIGNMENT: Tangent

APPROACH SLABS: AS-1-54 (25' Long)

SUPERELEVATION: Varies

CUY-21-1544
BRIDGE NUMBER 11

TYPE: Continuous steel beam with reinforced concrete deck and substructure.

SPANS: 56'-0", 93'-0" & 56'-0"

ROADWAY: 112'-0" (Normal) f/f parapets

LOADING: CF 2000 - Adequate for A.A.S.H.O. alternate loading.

SURFACE COURSE: 1" Monolithic concrete

ALIGNMENT: Tangent

APPROACH SLABS: AS-1-54 (25' long)

SUPERELEVATION: None

SKEW: 56°00'

CUY-42-1854
BRIDGE NUMBER 4

TYPE: Continuous welded steel girder with reinforced concrete deck and substructure.

SPANS: 55'-0", 88'-6", 99'-0", & 60'-0" along E.I.B.

ROADWAY: Varies

LOADING: CF 2000 - Adequate for A.A.S.H.O. alternate loading.

SKEW: Varies

SURFACE: 1" Monolithic Concrete

ALIGNMENT: 1°-30' Left Tangent

APPROACH SLABS: AS-1-54 (25' Long)

SUPERELEVATION: Varies

CUY-21-1559
BRIDGE NUMBER 10

TYPE: Continuous steel beam with reinforced concrete deck and substructure.

SPANS: 56'-0", 93'-3", & 56'-0" along Willow Freeway

ROADWAY: 112'-0" (nominal) f./f. parapets.

LOADING: CF 2000 - Adequate for A.A.S.H.O. alternate loading.

SURFACE COURSE: 1" Monolithic Concrete

ALIGNMENT: Tangent to 3°00' Rt.

APPROACH SLABS: AS-1-54 (25' Long)

SUPERELEVATION: Varies

SKEW: 0°-00'

BRIDGE NUMBER 5

TYPE: Continuous steel beam with reinforced concrete deck and substructure.

SPANS: 31'-0 3/8", 48'-2 1/2", 34'-1" along E-10

ROADWAY: Varies

LOADING: CF 2000 - Adequate for A.A.S.H.O. alternate loading.

SKEW: Varies

SURFACE COURSE: 1" Monolithic Concrete

ALIGNMENT: 14°30' Curve left.

APPROACH SLABS: AS-1-54 (25' Long)

SUPERELEVATION: .08' ft. per ft.

CUY-21-1573
BRIDGE NUMBER 8

TYPE: Continuous steel beam with reinforced concrete deck and substructure.

SPANS: 38'-7 5/16", 43'-10 1/16", 55'-9 1/2", & 33'-11 3/8" along E Willow Freeway.

ROADWAY: 84'-0" (nominal) face to face parapets.

LOADING: CF 2000 - Adequate for A.A.S.H.O. alternate loading.


SKEW: Varies

SURFACE: 1" Monolithic Concrete

ALIGNMENT: 3°00'00" Rt.

APPROACH SLABS: AS-1-54 (25' Long)

SUPERELEVATION: .05' ft./ft.

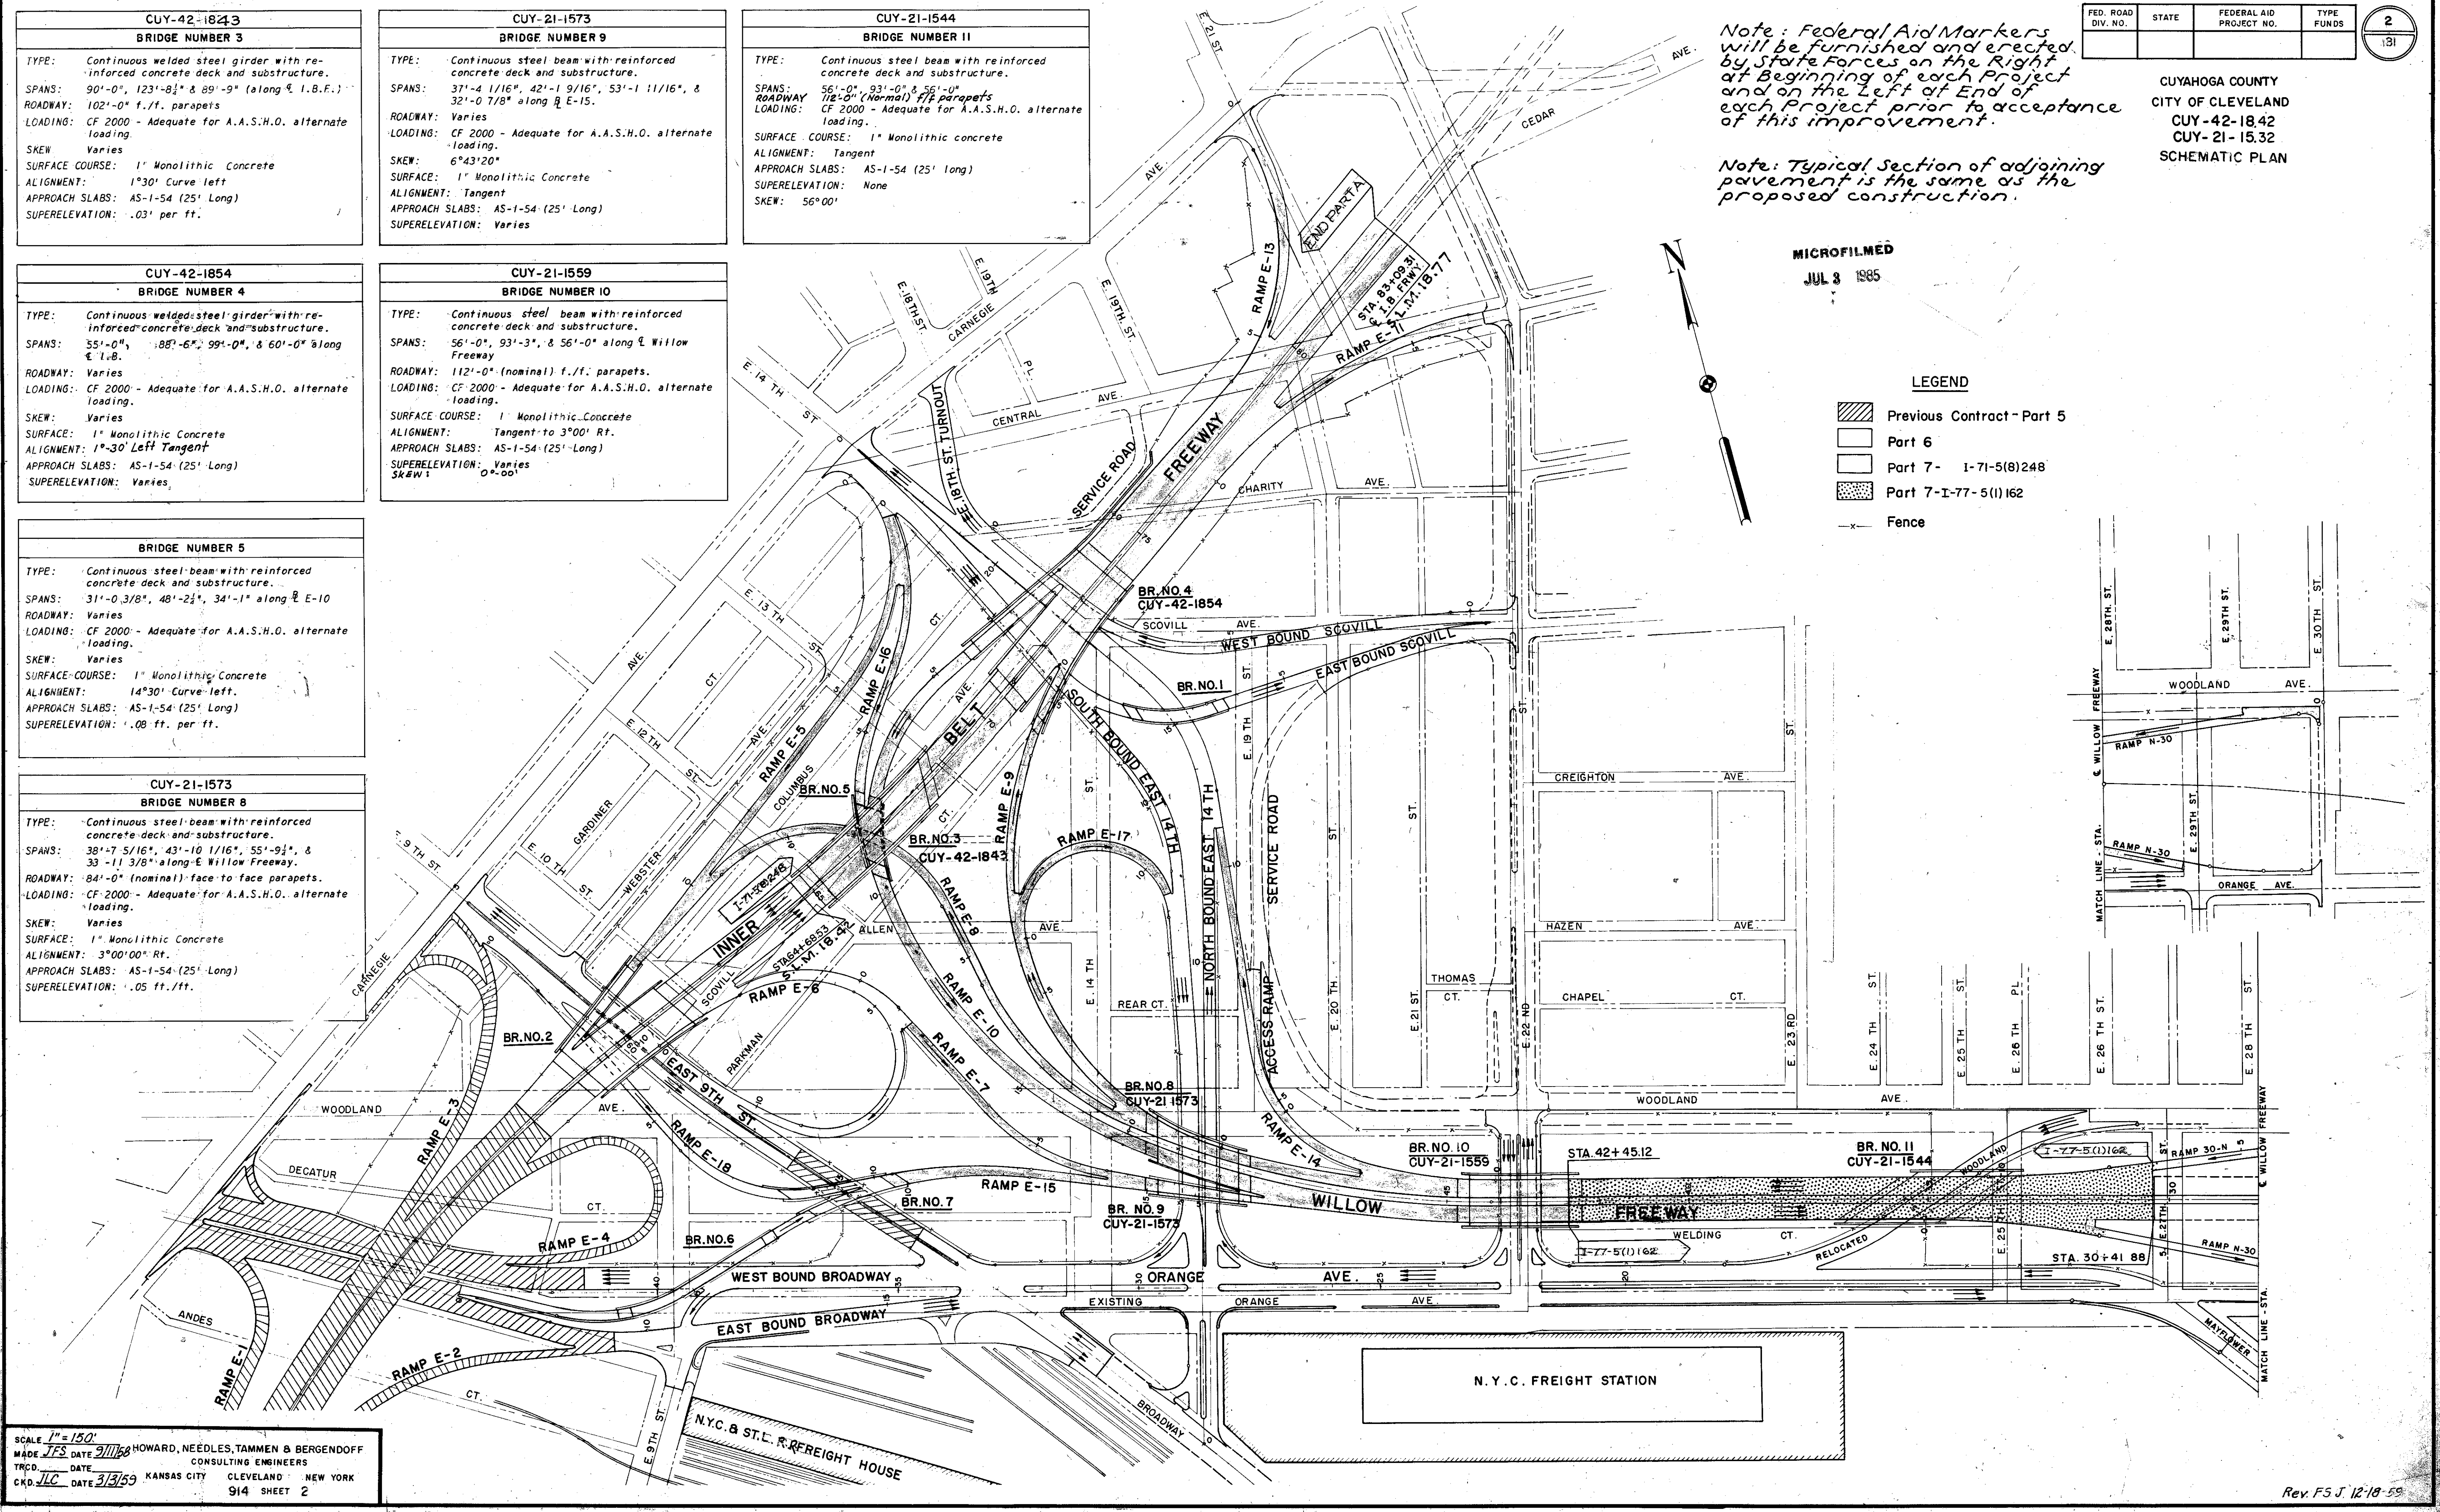


SCALE 1" = 150'
MADE JFS DATE 9/11/58 HOWARD, NEEDLES, TAMMEN & BERGENDOFF CONSULTING ENGINEERS
TRCD. DATE KANSAS CITY CLEVELAND NEW YORK
CND. JLC DATE 3/3/59 914 SHEET 2

TYPICAL SECTIONS TYPE T-71


FED. ROAD DIV. NO.	STATE	FEDERAL AID PROJECT NO.	TYPE FUNDS
2	OHIO		

3
181

CUYAHOGA COUNTY
CITY OF CLEVELAND
CUY-42-18.42
CUY-21-15.32
TYPICAL SECTIONS

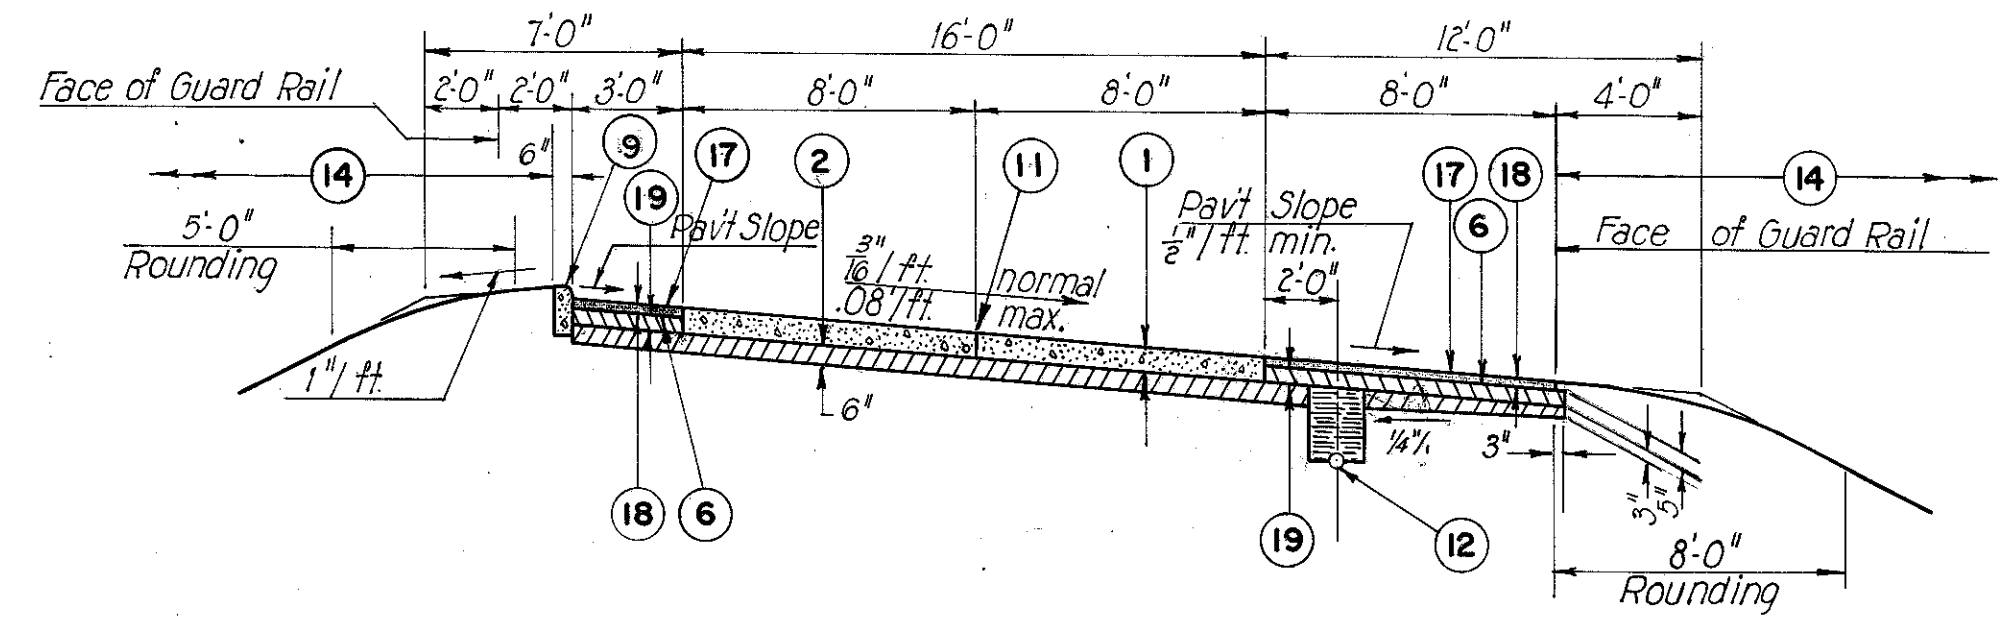


ONE LANE
NORMAL AND CURVE RIGHT

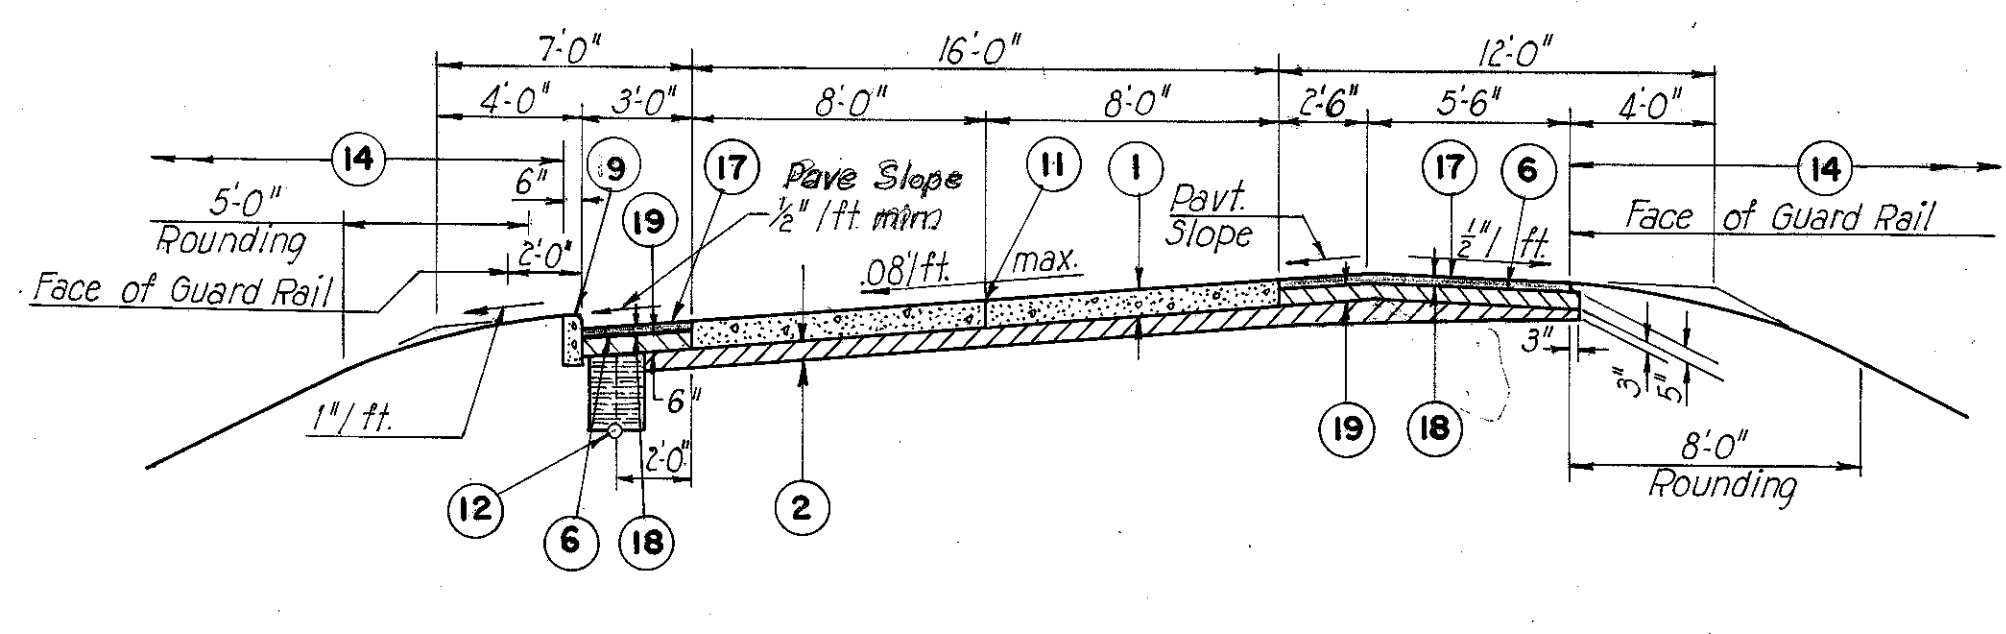


ONE LANE
CURVE LEFT

Note: Depth of I-4 = 18" from top of Pipe to bottom of I-22 unless otherwise shown.

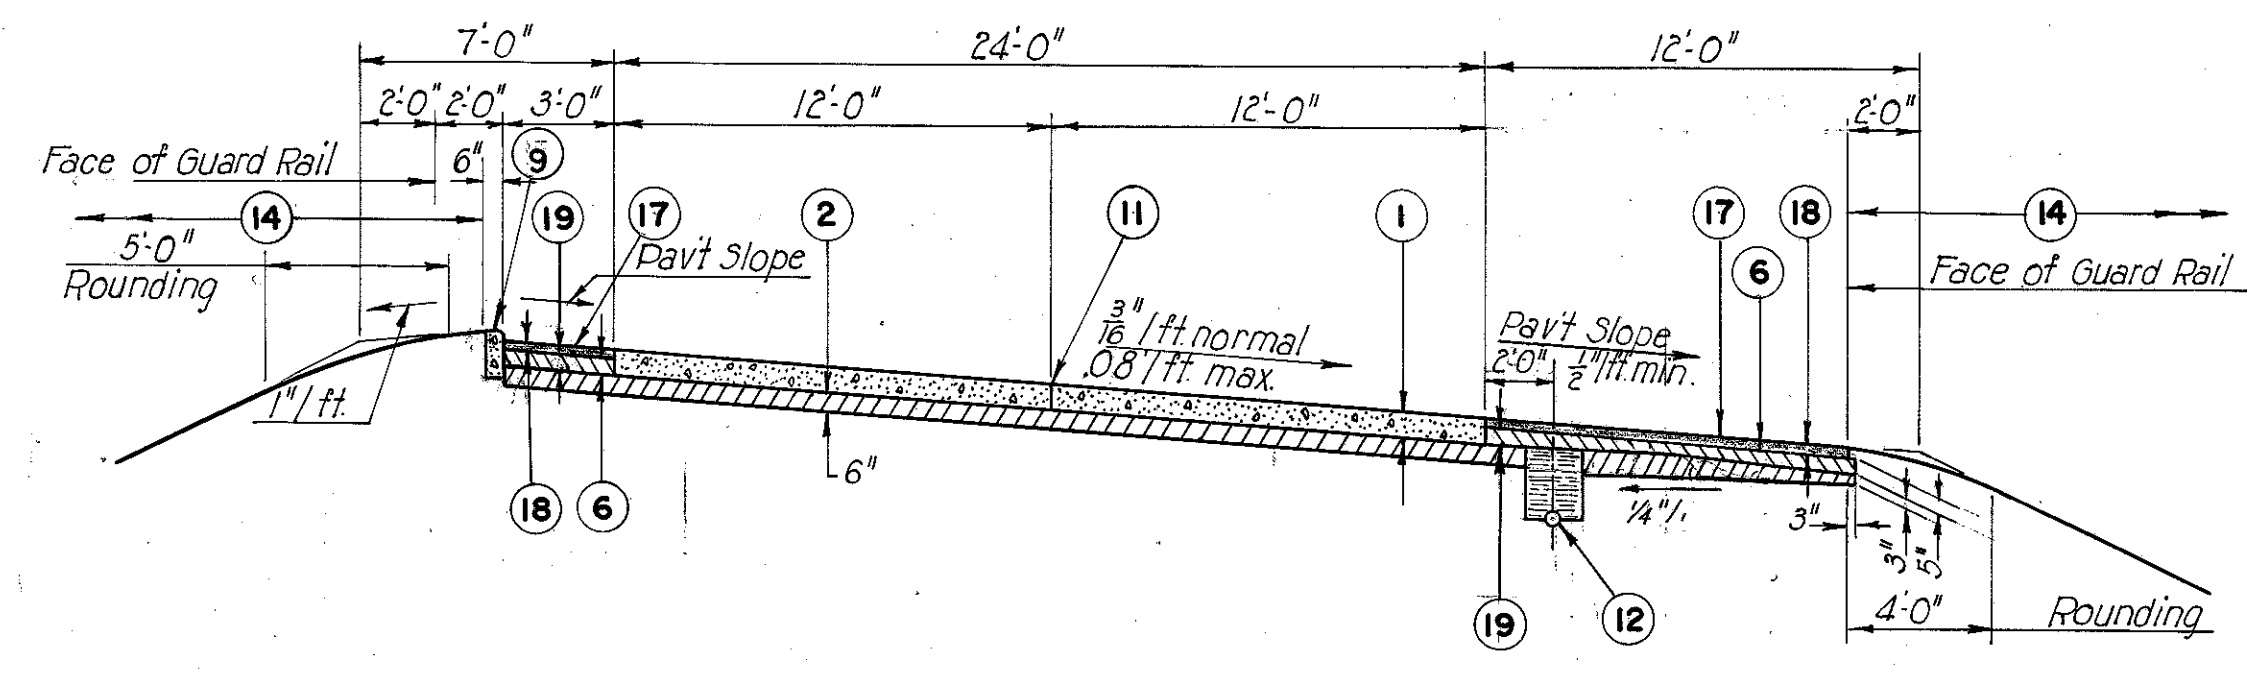

TWO LANE
NORMAL AND CURVE RIGHT

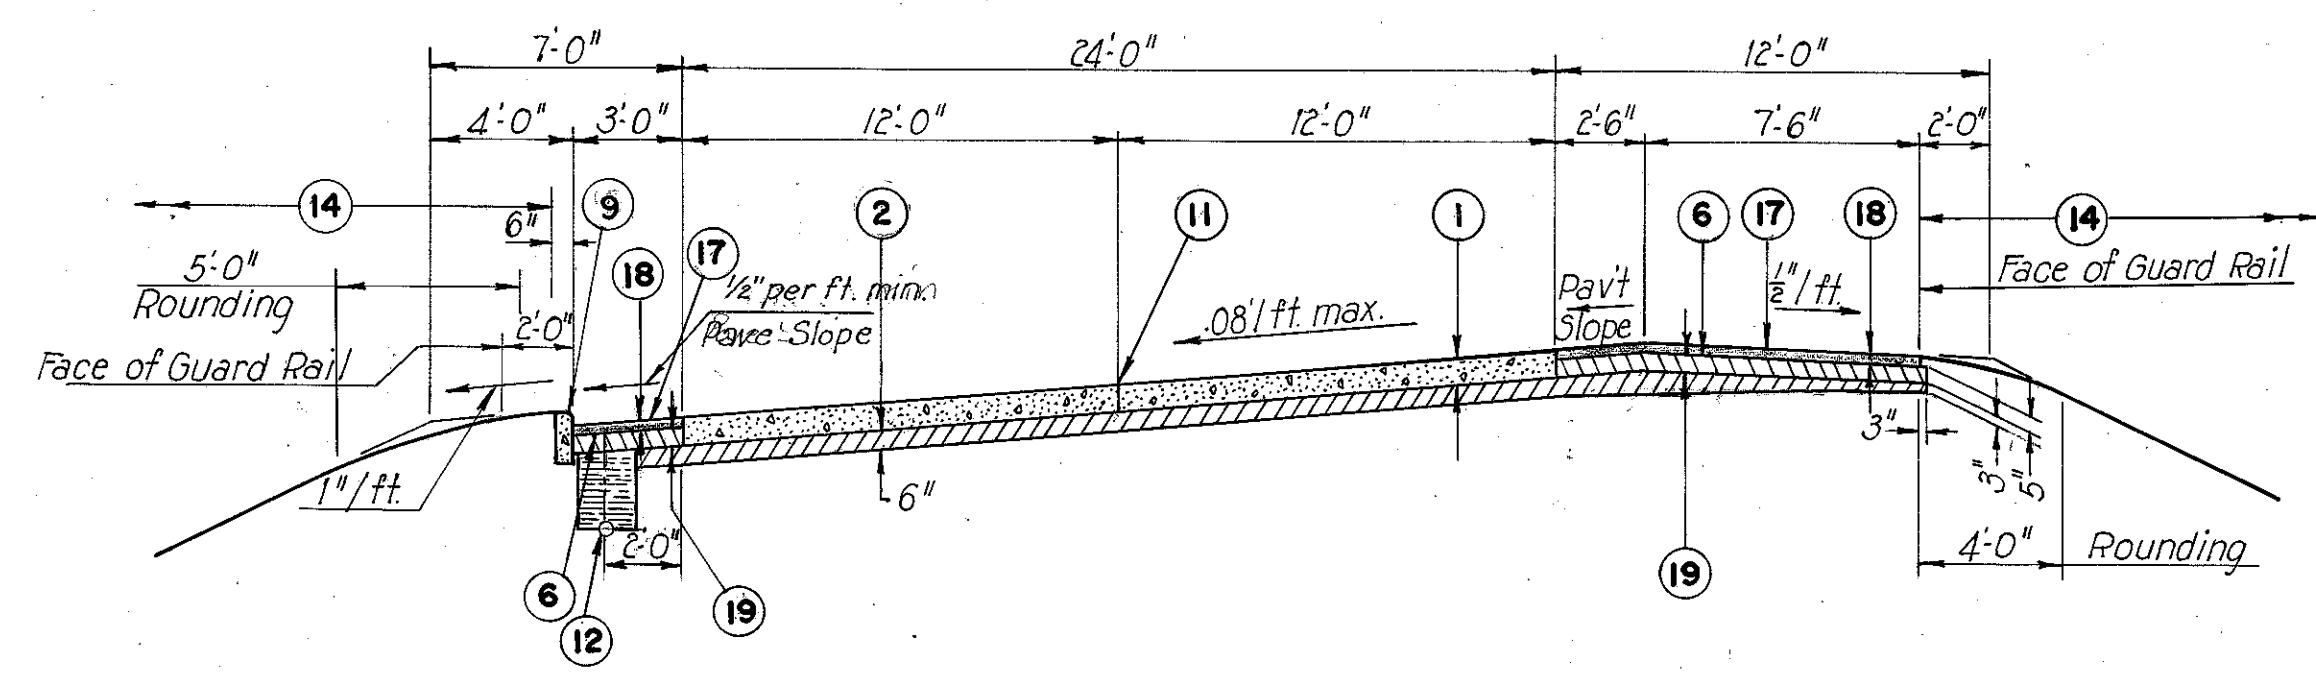

TWO LANE
CURVE LEFT

Ramp No.	One or Two Lane Ramp	Tangent		Curve Right		Curve Left		Diverging Trans.		Merging Trans.		Bridges	
		Sta.	Sta.	Sta.	Sta.	Sta.	Sta.	Sta.	Sta.	Sta.	Sta.	Sta.	Sta.
E-5	One	4+68.32	9+60.56	2+50.32	4+68.32			1+13.65	2+50.32	9+60.56	11+95±		
E-6*	Two			1+98.47	4+48.29			1+09±	1+98.47				
	One			5+68.20	10+38.11			4+48.29	5+68.20				
E-7	One	1+36.63	3+73.22			3+73.22	6+50.40			6+50.40	7+43±	7+43±	8+97.35
E-8	One	4+33.14	6+17.14	0+47.96	4+33.14	6+17.14	11+60.35	0+00.00	0+47.96	11+74.52	14+10±	14+10±	14+17.67
		11+60.35	11+74.52										
E-9	One			0+93.60	4+31±			0+00.00	0+93.60			4+31±	7+50.38
E-10	Two	4+18±	5+06.54			5+06.54	7+93±	0+00.00	0+79±	9+79±	9+90.07	0+79±	4+18±
						9+90.07	17+41.98					7+93±	9+66±
E-11	Variable	6+26.30	6+55.84	1+98.46	6+26.30			0+00.00	1+98.46				
E-13	Variable	1+04.35	1+41.06	1+41.06	4+96.25			0+00.00	1+04.35	4+96.25	6+12.32		
E-14	One			2+76.73	4+72.70			0+82±	2+76.73			0+00.00	0+82±
		7+76.96	10+79.56					4+72.70	7+76.96				
E-15	One	12+57.21	14+05.74							10+06±	12+57.21		
		17+22±	17+40.32							14+05.74	15+02±	15+02±	17+22±
										17+40.32	19+80.49		
E-16	One	3+44.96	4+98.38	1+82.29	3+44.96	4+98.38	6+24±	0+38.25	1+82.29	8+09±	8+32.85	6+24±	8+09±
E-17	Two			2+31.62	6+21.14			1+63±	2+31.62			0+00.00	1+63±
								6+21.14	7+06.65				
	One			7+06.65	10+70.65								
Access	One							0+00.00	3+02.49				
N-30	One	3+66.67	9+04.20	3+53.61	3+66.67			0+75±	3+53.61	9+04.20	10+51.81	0+00	0+75±
30-N	One	1+73.65	7+16.40					0+00	1+73.65	7+16.40	9+81±	9+81±	10+52.42

LEGEND

- ① 9" Reinforced Portland Cement Concrete Pavement, Item T-71.
- ② Subbase, Item I-22.
- ⑥ Bituminous Prime Coat, Item T-30, Sec. M57 (RT-2 or RT-3). Applied at rate of 0.4 Gal. per Sq. Yd.
- ⑨ 6" x 18" Sandstone Curb, Item I-11.
- ⑩ Standard Type I Median Pavement, Item I-21.
- ⑪ Standard Longitudinal Joint.
- ⑫ 6" Underdrain, Item I-4.
- ⑭ Seeding and Protecting, Item L-9.
- ⑰ Bituminous Surface Treatment using 0.008 Cu. Yd. No. 6 Aggregate and 0.25 Gal. Bituminous Material per sqyd. (See Note in Proposal), Item T-31.
- ⑱ 3" Waterproofed Aggregate Base Course Item B-219.
- ⑲ Stabilized Crushed Aggregate Shoulder, Item I-18.
- ⑳ Guard Rail, Steel Beam, Barrier Type (Deep), Item I-15.


RAMP NO.	Sta.	Sta.	INCREASE IN WIDTH
E-6*	2+18.42	4+48.29	2'
E-6*	4+48.29	9+03.24*	3'
E-7	3+73.22	6+57.92	1'
E-8	6+17.14	11+60.35	2'
E-10	5+06.54	9+90.07	2'
Access	0+00.00	1+61.73	2'
E-14	2+97.97	4+72.70	2'
E-16	4+98.38	6+24±	1'
E-17	6+21.14	11+14.37*	3'

FED. ROAD DIV. NO.	STATE	FEDERAL AID PROJECT NO.	TYPE FUNDS
2	OHIO		

4
181

CUYAHOGA COUNTY
CITY OF CLEVELAND
INNER BELT
CUY-42-18.42
CUY-21-15.32

TYPICAL SECTIONS TYPE T-71

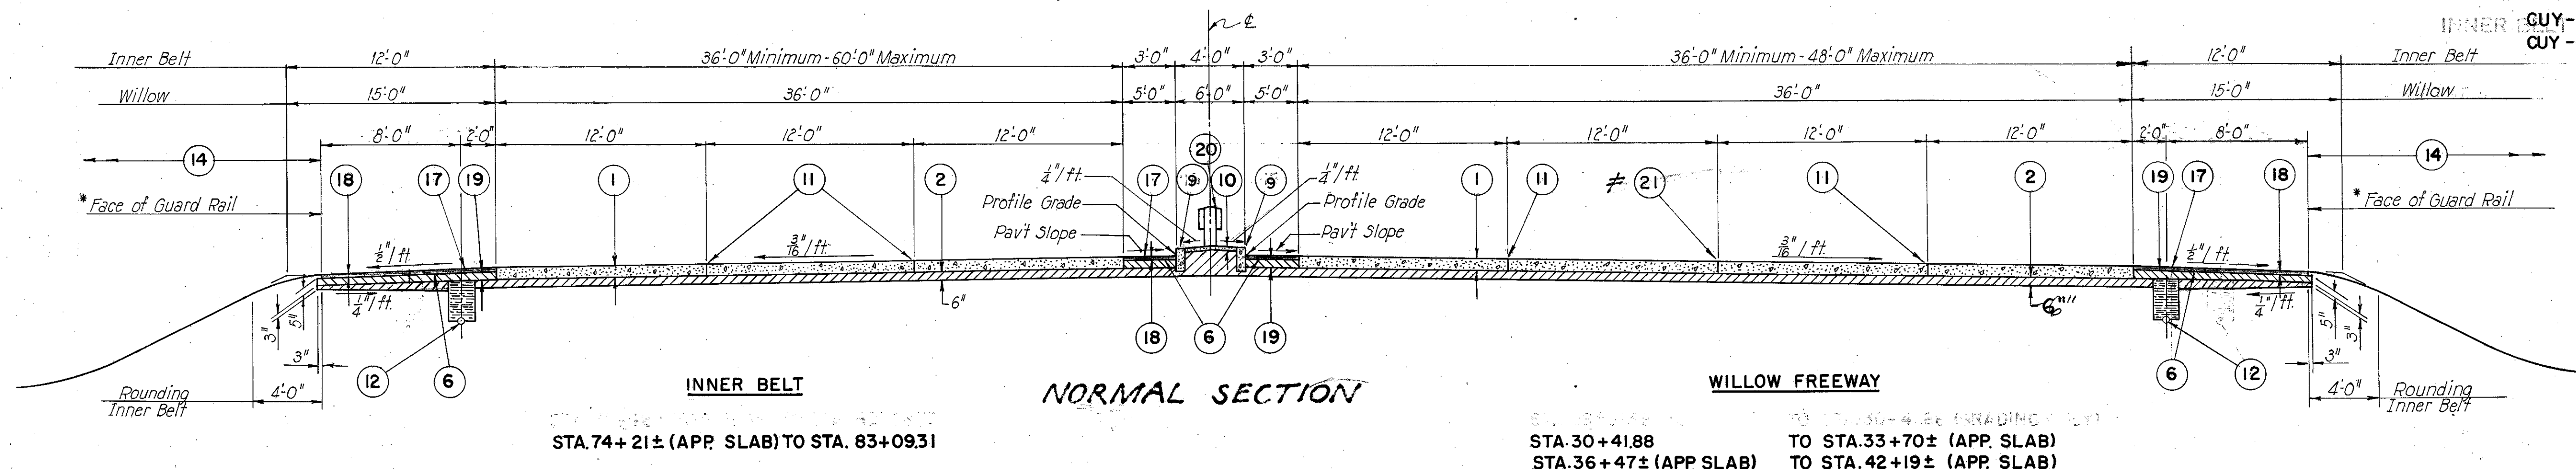


Note: Depth of I-4 = 18" from top of pipe to bottom of I-22 unless otherwise shown.

LEGEND


- ① 9" Reinforced Portland Cement Concrete Pavement, Item T-71
- ② Subbase, Item I-22.
- ⑥ Bituminous Prime Coat, Item T-30, Sec. M5.7 (RT-2 or RT-3) Applied at rate of 0.4 Gal. per Sq. Yd.
- ⑨ 6" x 18" Sandstone Curb, Item I-11.
- ⑩ Standard Type 1 Median Pavement, Item I-21.
- ⑪ Standard Longitudinal Joint.
- ⑫ 6" Underdrain, Item I-4
- ⑭ Seeding and Protecting, Item L-9.
- ⑰ Bituminous Surface Treatment Using 0.008 Cu. Yd. No. 6 Aggregate and 0.25 Gal. Bituminous Material per Sq. yd. (See Note in Proposal), Item T-31.
- ⑱ 3" Waterproofed Aggregate Base Course Item B-219.
- ⑳ Guard Rail, Steel Beam, Barrier Type (Deep), Item I-15.
- ≠ ㉑ Standard Longitudinal Key Joint without tie bars.

* Center joint shall be a standard Longitudinal Key Joint without Tie Bars when Pavement Width exceeds 36'-0" unless otherwise shown.

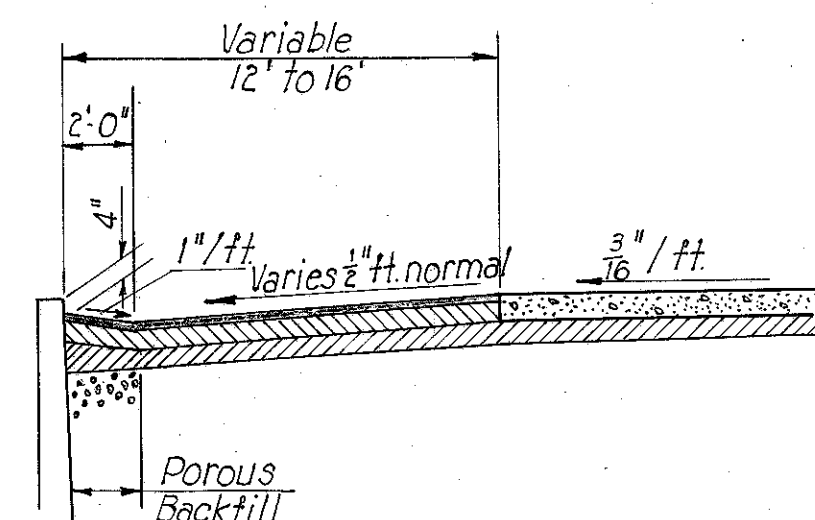

PARTIAL SECTION
STA. 74+09 TO STA. 76+25

* Note:
Face of guard rail on Willow Freeway, is 12' from edge of pavement.

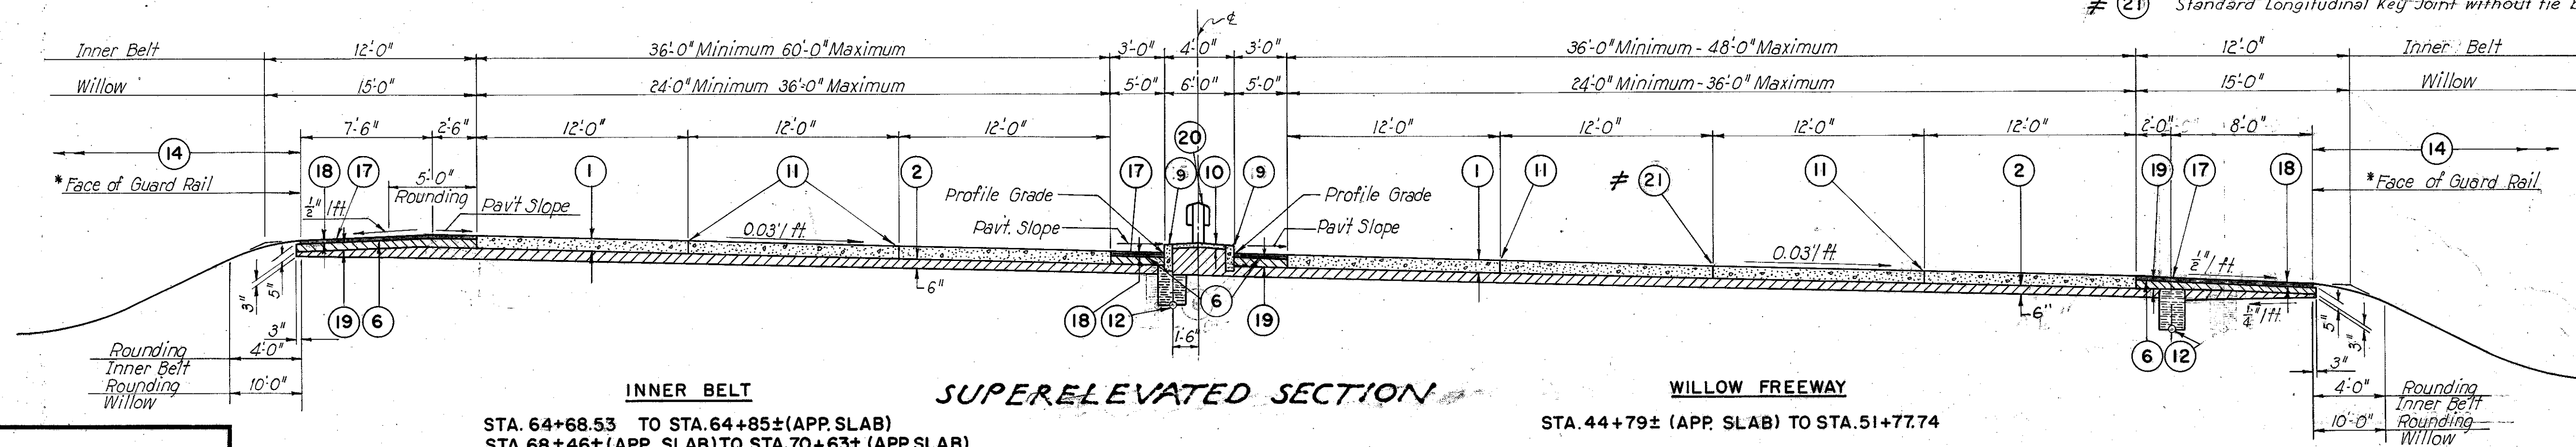


SCALE: 1" = 1'-0"
 MADE: M.C. DATE: 8-4-58
 TRCD: R.R. DATE: 2-10-58
 CKD: J.L.C. DATE: 12-11-58

HOWARD, NEEDLES, TAMMEN & BERGENDOFF
CONSULTING ENGINEERS
KANSAS CITY CLEVELAND NEW YORK
914 SHEET 4

FED. ROAD DIV. NO.	STATE	FEDERAL AID PROJECT NO.	TYPE FUNDS
2	OHIO		

CUYAHOGA COUNTY
CITY OF CLEVELAND
CUY - 42-18.42
CUY - 21-15.32

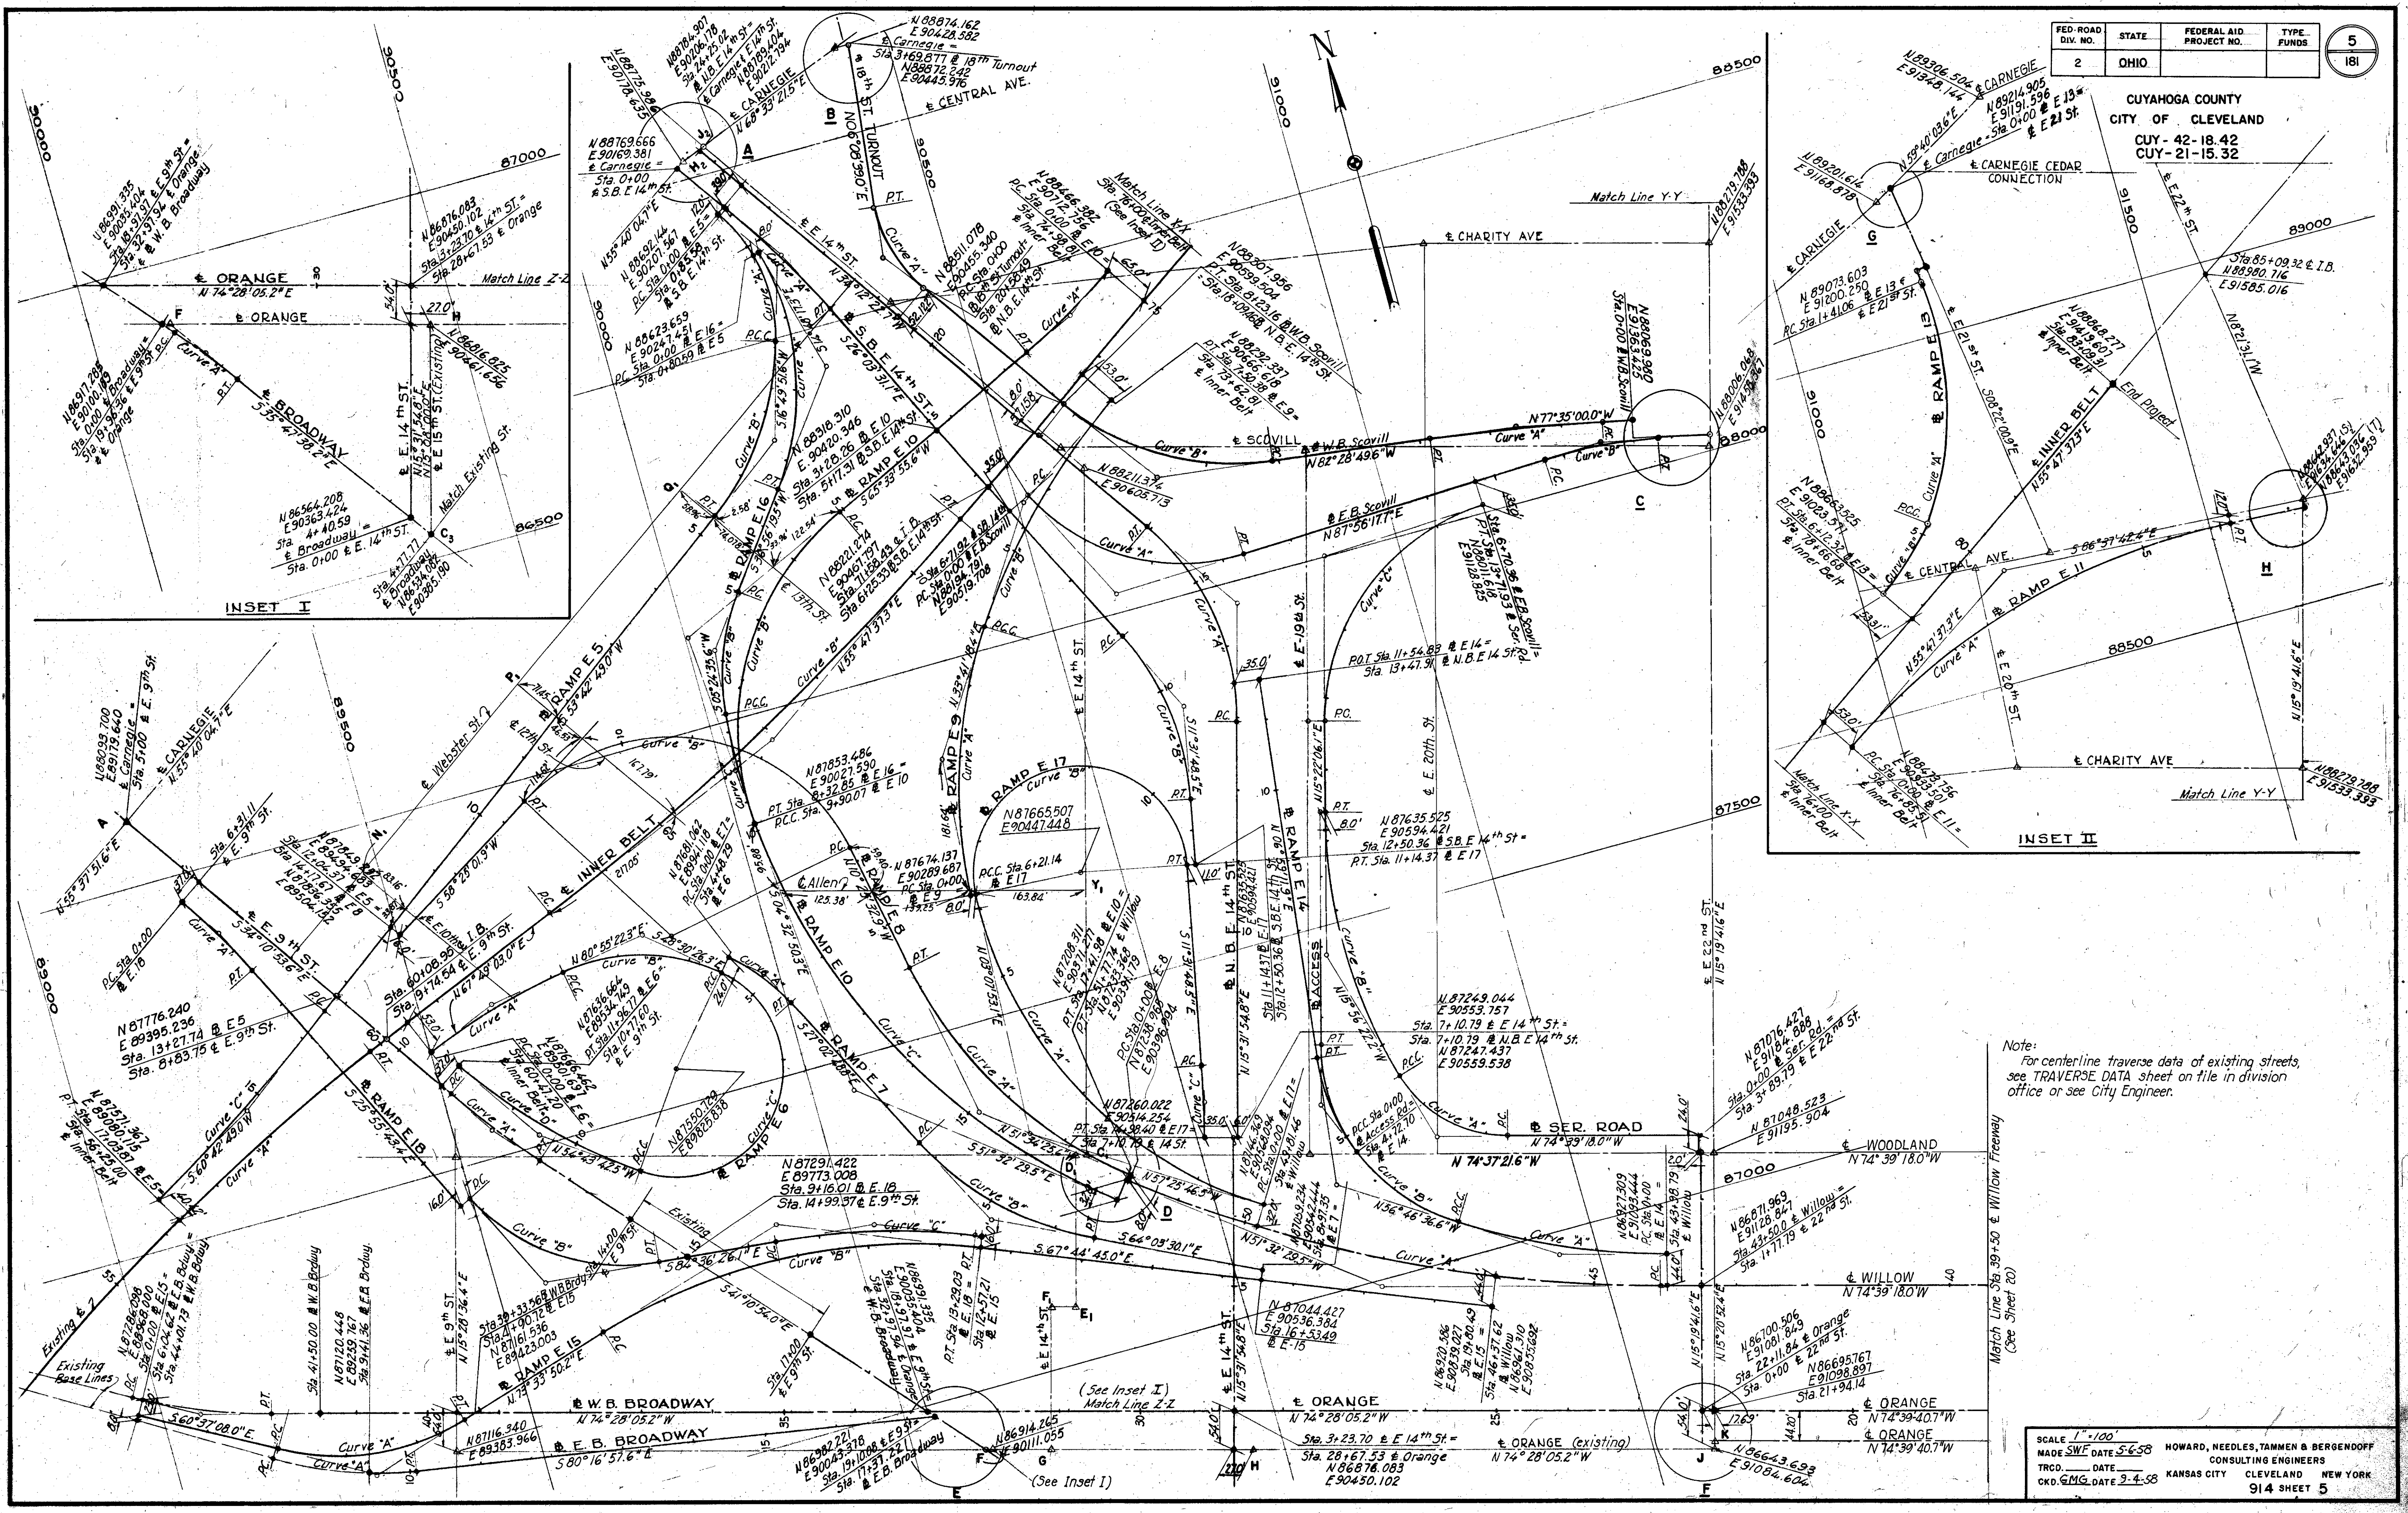

INSET I

INSET II

Note:
For centerline traverse data of existing streets,
see TRAVERSE DATA sheet on file in division
office or see City Engineer.

Match Line Sta 39+50 & Willow Freeway
(See Sheet 20)

SCALE 1"=100'
MADE S.W.E. DATE 5-6-58
TRCD. DATE
CKD. M.G. DATE 2-4-58

HOWARD, NEEDLES, TAMMEN & BERGENDOFF
CONSULTING ENGINEERS
KANSAS CITY
CLEVELAND NEW YORK

914 SHEET 5

FED. ROAD DIV. NO.	STATE	FEDERAL AID PROJECT NO.	TYPE FUNDS	7 181
--------------------	-------	-------------------------	------------	----------

CUYAHOGA COUNTY
CITY OF CLEVELAND
CUY-42-18.42
CUY-21-15.32

GRADING TOLERANCES (COMBINED PROJECT)

FOR AREAS IN FRONT OF RESIDENCES, FOR AREAS BETWEEN CURB AND SIDEWALK AND FOR OTHER AREAS SPECIFICALLY INDICATED ON THE PLANS, THE SEED BED SHALL BE PREPARED TO PROVIDE A SMOOTH SURFACE. ALL STONES LARGER THAN ONE INCH IN DIAMETER SHALL BE REMOVED FROM THE SURFACE OF THE SEED BED. HAND RAKING WILL BE REQUIRED IN AREAS INACCESSIBLE TO MACHINES AND HAND RAKING MAY BE REQUIRED, IF DIRECTED BY THE ENGINEER, IN ALL THE AFOREMENTIONED AREAS IF MACHINES USED DO NOT PROVIDE RESULTS EQUIVALENT TO RESULTS OBTAINED BY HAND RAKING. COST OF THIS ADDITIONAL WORK SHALL BE INCLUDED IN THE UNIT PRICE BID FOR ROADWAY EXCAVATION, ITEM E-1.

DESIGN STANDARDS

THE DESIGN SPEED FOR THIS PROJECT IS 50 M.P.H.

FIELD OFFICE

THE CONTRACTOR SHALL PROVIDE A SUITABLE FIELD OFFICE IN ACCORDANCE WITH SEC. S-0.01(b) HAVING A MINIMUM OF 500 SQ. FT. OF FLOOR SPACE. THE CONTRACTOR SHALL HAVE A TELEPHONE INSTALLED AND MAINTAINED IN THE FIELD OFFICE DURING CONSTRUCTION OF THIS PROJECT.

PERMITS, LAWS AND REGULATIONS

THE CONTRACTOR SHALL SECURE, AT HIS OWN EXPENSE, ALL NECESSARY PERMITS FROM THE MUNICIPAL OR OTHER PUBLIC AUTHORITIES, SHALL GIVE ALL NOTICES REQUIRED BY LAW OR MUNICIPAL ORDINANCES, AND SHALL PAY ALL FEES AND CHARGES INCIDENT TO THE DUE AND LAWFUL PROSECUTION OF THE WORK COVERED BY THIS CONTRACT.

UTILITIES

FOLLOWING IS A LIST OF THE UTILITIES WITHIN THE LIMITS OF CONSTRUCTION.

EAST OHIO GAS COMPANY
CITY OF CLEVELAND WATER DEPARTMENT
CLEVELAND ELECTRIC ILLUMINATING COMPANY
MUNICIPAL ELECTRIC LIGHT AND POWER COMPANY
OHIO BELL TELEPHONE COMPANY
WESTERN UNION
AMERICAN TELEPHONE & TELEGRAPH COMPANY

UNDERGROUND UTILITIES

THE LOCATIONS OF THE UNDERGROUND UTILITIES SHOWN ON THE PLANS HAVE BEEN OBTAINED BY DILIGENT FIELD CHECKS AND SEARCHES OF AVAILABLE RECORDS. IT IS BELIEVED THEY ARE ESSENTIALLY CORRECT, BUT THE STATE OF OHIO MAKES NO GUARANTEES AS TO THEIR ACCURACY OR COMPLETENESS.

UTILITY NOTE

ANY AND ALL WORK REQUIRED FOR REMOVING, RELOCATING AND CONSTRUCTION OF NEW FACILITIES FOR PRIVATE OR PUBLIC UTILITIES WILL BE DONE BY AND AT THE EXPENSE OF THE RESPECTIVE OWNERS UNLESS OTHERWISE NOTED ON THE PLANS.

WATER METER BOXES

THE CITY WATER DEPARTMENT WILL RELOCATE ALL PRIVATELY OWNED WATER METER BOXES AND THIS ITEM WILL NOT BE INCLUDED AS A PART OF THE WORK TO BE PERFORMED BY THE CONTRACTOR.

CONNECTIONS TO EXISTING SEWERS

AT PLACES WHERE THE PLANS PROVIDE FOR PROPOSED DRAINAGE PIPE TO BE CONNECTED TO EXISTING PIPES, IT SHALL BE THE RESPONSIBILITY OF THE CONTRACTOR TO LOCATE THE EXISTING PIPE BOTH AS TO LINE AND GRADE, BEFORE HE STARTS TO LAY THE PROPOSED SEWER. THE COST OF THIS OPERATION SHALL BE INCLUDED IN THE COST BID FOR ITEM I-2 STORM SEWERS.

THE CONTRACTOR SHALL SO CONDUCT HIS OPERATIONS THAT THE FLOW OF ALL EXISTING SEWERS WILL BE MAINTAINED AT ALL TIMES. ANY ADDITIONAL LABOR OR COST INVOLVED IN MAINTAINING THIS FLOW BY PUMPING OR BY ANY OTHER APPROVED METHOD WHICH IS NECESSARY FOR THE COMPLETION OF THIS PROJECT SHALL BE INCLUDED IN THE PRICE BID PER LINEAR FOOT OF STORM SEWERS, ITEM I-2. SEE DRAINAGE NOTE 2, SHEET 40.

GENERAL NOTES

WORK BY THE CITY OF CLEVELAND

THE CITY WILL PROVIDE FOR THE REMOVAL OR DISPOSAL OF ALL EXISTING BUILDINGS WITHIN THE LIMITS OF THE RIGHT OF WAY LINES AS FOLLOWS:
BUILDINGS WITH BASEMENTS - TO THE LEVEL OF EXISTING GROUND
BUILDINGS WITHOUT BASEMENTS - TO THE GROUND FLOOR
BUILDING FLOOR SLABS TO BE REMOVED BY CONTRACTOR AND PAID FOR AS ITEM E-1, ROADWAY EXCAVATION.

TRAFFIC

THE CONTRACTOR, AT ALL TIMES, MUST COOPERATE WITH THE CITY OF CLEVELAND TRAFFIC ENGINEERING AND PARKING DIVISIONS IN THE PERFORMANCE OF HIS WORK, AND SHALL PRESENT ONE WEEK IN ADVANCE A PROPOSED WORK SCHEDULE, INCLUDING TIME ESTIMATES TO THE PROJECT ENGINEER, AND SECURE WRITTEN APPROVAL OF SAME BEFORE ANY WORK IS UNDERTAKEN THAT WOULD DISRUPT NORMAL FLOW OF TRAFFIC.

WHERE ANY OF THE WORK CALLED FOR UNDER THIS CONTRACT INVOLVES THE CLOSING OF EXISTING STREETS AND/OR THE RE-ROUTING OF TRAFFIC, THE CONTRACTOR FOR THIS PROJECT SHALL PROSECUTE TO THE FULLEST EXTENT THE WORK INVOLVED SO AS TO REDUCE TO A MINIMUM THE LENGTH OF TIME THAT THE STREETS CONCERNED WILL BE CLOSED TO TRAFFIC.

IN ADDITION TO THE ABOVE, SECTION G-4.05 "MAINTENANCE OF LOCAL TRAFFIC" WILL BE IN FORCE DURING THE ENTIRE LIFE OF THE CONTRACT.

ATTENTION IS DIRECTED PARTICULARLY TO THE NEED FOR PROVIDING ADEQUATE FACILITIES TO ACCOMMODATE SCHOOL CHILDREN AND OTHER PEDESTRIAN TRAFFIC, IN THE VICINITY OF THE PROJECT. THE CONTRACTOR SHALL PROVIDE AND MAINTAIN SUCH TEMPORARY BOARD WALKS, CINDER WALKS, HANDRAILS, ADJACENT TO EXCAVATIONS, ETC. AS MAY BE NECESSARY TO ACCOMMODATE IN A REASONABLE AND SAFE MANNER PEDESTRIAN TRAFFIC IN THE VICINITY OF THE PROJECT.

ALL OF THE ABOVE ARE INCLUDED IN THE LUMP SUM BID FOR "MAINTAINING TRAFFIC." AGGREGATE AND CALCIUM CHLORIDE ARE CARRIED IN THE GENERAL SUMMARY TO BE USED AS DIRECTED BY THE ENGINEER, FOR THE MAINTENANCE OF LOCAL TRAFFIC.

OVERHEAD CONSTRUCTION SHALL NOT BE CONSIDERED SUFFICIENT REASON TO CLOSE A STREET TO TRAFFIC, IF IN THE OPINION OF THE PROJECT ENGINEER THE CONSTRUCTION MAY BE ADEQUATELY ISOLATED AND TRAFFIC PROTECTED FROM FALLING OBJECTS OF WHATEVER NATURE. IN ORDER TO INSURE THAT TRAFFIC BE FULLY PROTECTED, BELOW THE STRUCTURES, FROM FALLING OBJECTS, THE CONTRACTOR SHALL PROVIDE NECESSARY PROTECTIVE NETTING OR PLATFORMS.

SURVEY DATA

FOR CENTERLINE DATA OF EXISTING STREETS, SEE SHEET SD-1 (ADJUSTED SURVEY DATA) ON FILE IN DIVISION OFFICE.

REMOVAL OF TREES AND STUMPS

THE NUMBER OF TREES INDICATED FOR REMOVAL IS APPROXIMATE AND THE STATE OF OHIO RESERVES THE RIGHT TO ORDER REMOVAL OF ADDITIONAL TREES OR STUMPS. PAYMENT FOR THE REMOVAL OF THESE ADDITIONAL TREES AND STUMPS IS INCLUDED IN THE LUMP SUM BID FOR REMOVAL OF TREES AND STUMPS, ITEM E-9.

REMOVAL OF REFUSE AND DEBRIS

ANY EXISTING REFUSE, DEBRIS OR ANY OTHER UNSUITABLE MATERIAL SHALL BE REMOVED AND DISPOSED OF BY THE CONTRACTOR IN ACCORDANCE WITH ITEM E-1. THE QUANTITY OF REFUSE OR DEBRIS, OR OTHER UNSUITABLE MATERIAL REMOVED AND DISPOSED OF WILL BE DETERMINED BY FINAL CROSS SECTIONS, AND THE YARDAGE SO DETERMINED WILL BE PAID FOR AT THE CONTRACT UNIT PRICE BID FOR ROADWAY EXCAVATION, ITEM E-1.

REMOVAL AND DISPOSAL OF EXISTING PAVEMENT


THE EXTENT OF RIGID PAVEMENT REMOVAL, SHOWN ON EXISTING UTILITIES SHEETS 54 THROUGH 60, MAY BE MODIFIED AS NECESSARY BY THE ENGINEER. RIGID PAVEMENT LOCATED WITHIN THE LIMITS OF PROPOSED CONSTRUCTION AND NOT INDICATED FOR REMOVAL, IS TO BE BROKEN UP INTO PORTIONS NOT TO EXCEED 1 SQUARE FOOT IN AREA BUT NEED NOT BE REMOVED; PAYMENT FOR THIS WORK TO BE CONSIDERED INCLUDED IN THE PRICE BID FOR ITEM E-1, ROADWAY EXCAVATION.

PAVEMENT REMOVAL

REMOVAL AND DISPOSAL OF ALL EXISTING PAVEMENT WHERE REQUIRED, EXCEPT THAT SET UP FOR REMOVAL ON THE PLANS AS ITEM E-8 SHALL BE REMOVED AND PAID FOR AS ITEM E-1, ROADWAY EXCAVATION.

CLEARING, GRUBBING AND SCALPING (COMBINED PROJECT)

ALL PROPERTIES OR PORTIONS OF PROPERTIES WITHIN THE RIGHT-OF-WAY FOR THIS PROJECT SHALL BE CLEARED, GRUBBED AND SCALPED IN ACCORDANCE WITH PROVISIONS OF SEC. E-1.03 OF THE CONSTRUCTION AND MATERIAL SPECIFICATIONS.

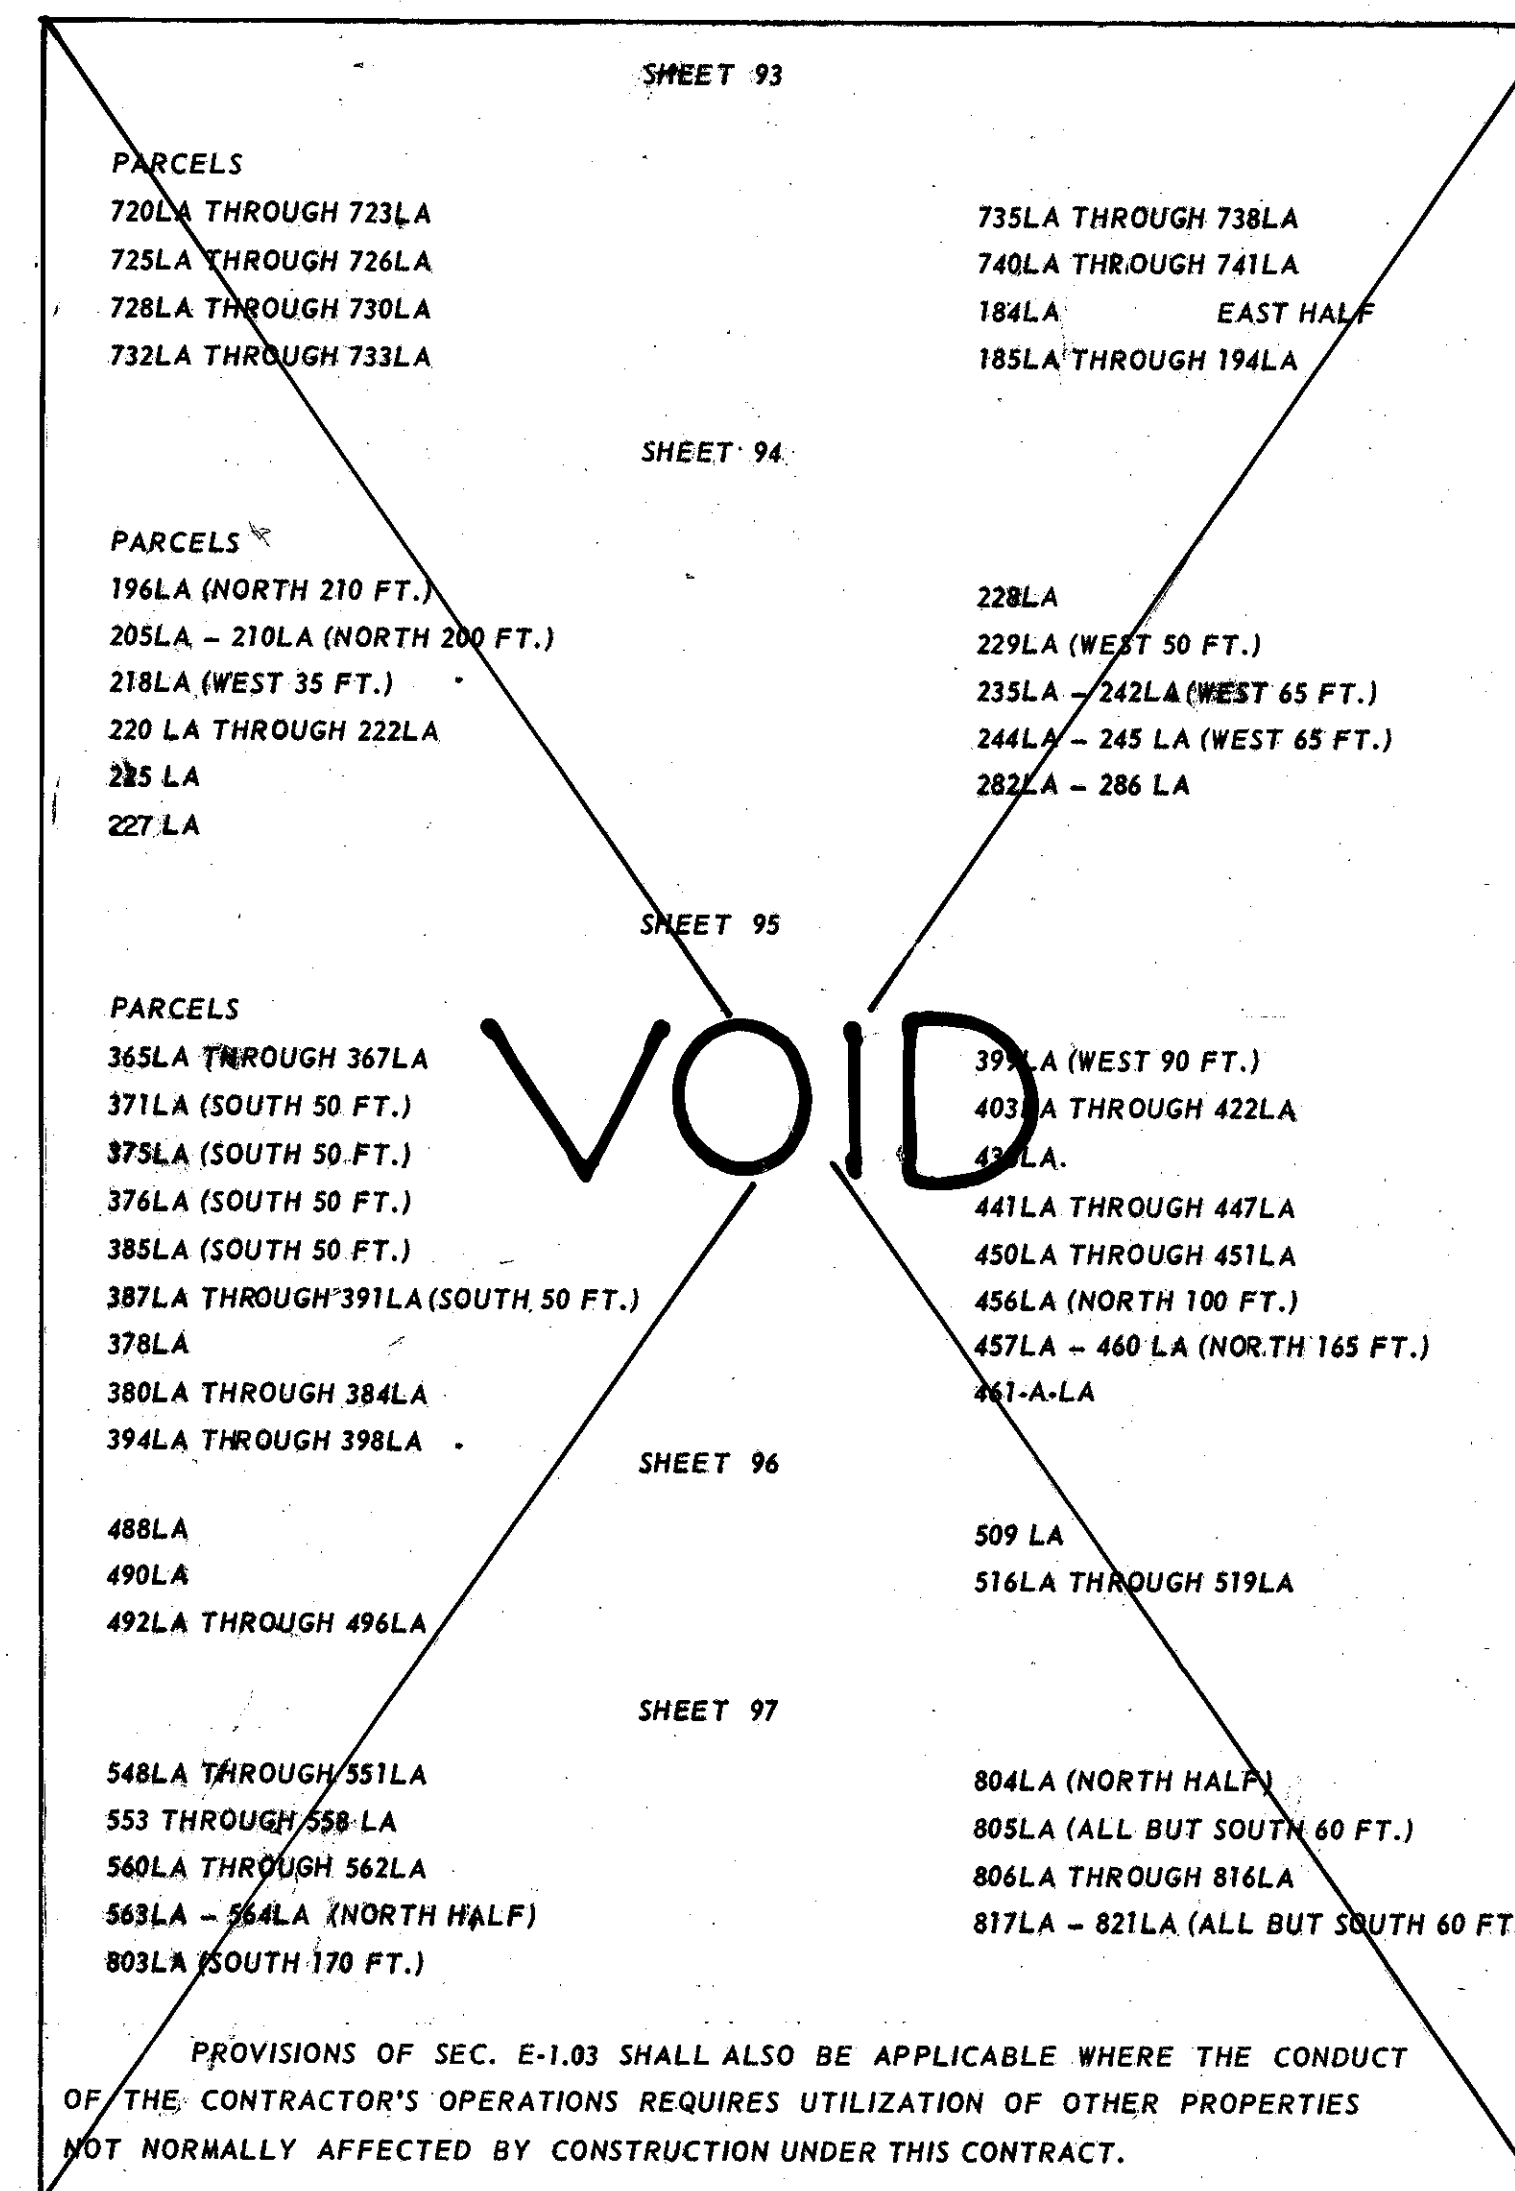

SS-18 FENCING

FOR LOCATION OF FENCING, SEE RIGHT OF WAY SHEETS 92 THROUGH 97, AND SHEETS 55 TO 64 OF PART 7-B

FOR ADDITIONAL NOTES SEE SHEET 10 OF PART 6 AND SHEET 7 OF PART 7-B

ESTIMATED QUANTITIES (COMBINED PROJECT)

SPECIFIC LOCATIONS AND USAGE OF ESTIMATED QUANTITIES SET UP ON THIS PLAN TO BE USED "AS DIRECTED BY THE ENGINEER" SHALL BE MADE A MATTER OF RECORD BY INCORPORATION INTO THE FINAL CHANGE ORDER GOVERNING COMPLETION OF THIS PROJECT.

EARTHWORK

THE TOP 2 FEET OF ALL EMBANKMENT SHALL BE CONSTRUCTED OF SOIL MATERIAL FREE FROM ROCKS, BOULDERS AND OTHER SIMILAR MATERIALS WHICH ARE RESTRICTIVE TO VEGETATIVE GROWTH OR HANDICAP MAINTENANCE OPERATION. DURING THE EXCAVATION AND EMBANKMENT CONSTRUCTION OPERATIONS, THE ROADWAY SECTION SHALL BE MAINTAINED AT ALL TIMES IN SUCH A SHAPE THAT NO CONCENTRATION OF WATER WILL DISCHARGE IN A CONCENTRATED FLOW OVER THE SLOPES.

L-9 SEEDING AND PROTECTING

QUANTITIES FOR SEEDING FOR PART 7-A ARE CALCULATED FOR THE SOIL AREAS BETWEEN THE RIGHT-OF-WAY FENCE LINES, BETWEEN THE RIGHT-OF-WAY LINES IN UNFENCED AREAS, AND WITHIN THE WORK LIMITS FOR AREAS OUTSIDE THE RIGHT-OF-WAY LINES COVERED BY WORK AGREEMENT OR SLOPE EASEMENTS, EXCEPT THOSE AREAS INCLUDED IN PART 6.

THE QUANTITY AND LIMITS FOR SEEDING MAY BE REVISED WHERE CONSIDERED NECESSARY BY THE ENGINEER.

THE SEED MIX FOR ALL AREAS IS AS FOLLOWS:

- 30 PER CENT KENTUCKY BLUE GRASS
- 30 PER CENT KENTUCKY, 31 FESCUE
- 20 PER CENT CREEPING RED FESCUE
- 15 PER CENT RED TOP
- 5 PER CENT WHITE DUTCH CLOVER

SEED TO BE APPLIED AT THE RATE OF 3 LBS. PER 1,000 SQ. FT.

L-9 AGRICULTURAL LIMING MATERIALS

AGRICULTURAL LIMING MATERIALS SHALL BE USED IN CONNECTION WITH SEEDING AND SODDING AT THE RATE OF 100 POUNDS PER 1,000 SQ. FT.

ADDITIONAL NOTES

- STRUCTURES SHEETS 98 AND 98A
- DRAINAGE SHEET 40
- LIGHTING SHEET 48

SUGGESTED CONSTRUCTION PROCEDURE FOR COMBINED PROJECT

THE FIRST ORDER OF CONSTRUCTION SHALL COMPRISE "THE SEQUENCE OF CONSTRUCTION" AS OUTLINED ON SHEET NO. 3 IN PART 6 OF THE PLANS AND CONSTRUCTION OF RAMP NO. 8 AS OUTLINED ON SHEET NO. 7 IN PART 7B OF THE PLANS.

THE SCHEDULING OF ALL OTHER WORK, INCLUDING THE CONSTRUCTION OF THE REMAINING PORTIONS OF THE INNER BELT FREEWAY, RAMPS AND THE WILLOW FREEWAY, SHALL BE AT THE OPTION OF THE CONTRACTOR, SUBJECT TO APPROVAL BY THE ENGINEER. THIS WORK SHALL BE PERFORMED IN SUCH A MANNER SO AS NOT TO INTERFERE WITH THE CONSTRUCTION OUTLINED IN THE PRECEDING PARAGRAPH.

ALTERNATE CONSTRUCTION PROCEDURE

IN LIEU OF THE SUGGESTED CONSTRUCTION PROCEDURE, THE CONTRACTOR MAY SUBMIT AN ALTERNATE PLAN TO THE DIRECTOR FOR APPROVAL. NO ALTERNATE PLAN SHALL BE PLACED INTO EFFECT UNTIL APPROVAL HAS BEEN GRANTED, IN WRITING, BY THE DIRECTOR.

COMPACTION USING HEAVY PNEUMATIC TIRED ROLLER -

SEE NOTE ON SHEET NO. 10 OF PART 6.

HEAVY EQUIPMENT (COMBINED PROJECT)

THE CONTRACTOR SHALL EXERCISE CARE IN THE USE OF HEAVY EQUIPMENT OVER FINISHED WORK AND WILL BE REQUIRED TO REMOVE AND REPLACE ANY COMPLETED WORK DESTROYED THEREBY. CULVERTS SHALL BE BACKFILLED TO A HEIGHT OF FOUR FEET BEFORE LOADED. EARTH-MOVING EQUIPMENT IS PERMITTED TO CROSS THE TRENCH, ANY ADDITIONAL FILL AND SUBSEQUENT EXCAVATION REQUIRED TO PROVIDE THIS MINIMUM COVER SHALL BE MADE AT NO ADDITIONAL COST TO THE STATE. HEAVY EQUIPMENT SHALL NOT BE OPERATED OVER ANY COMPLETED LAYER OF EMBANKMENT, COMPACTED SUBGRADE, OR SUBBASE IF SUCH OPERATION TENDS TO DESTROY THE SOIL STRUCTURE OR PIPE UNDERDRAINS; HOWEVER, IF SUCH OPERATION CANNOT BE AVOIDED, THE CONTRACTOR WILL BE REQUIRED TO REDUCE THE SIZE OF LOADS TO AN EXTENT THAT DAMAGE DOES NOT OCCUR.

CUYAHOGA COUNTY
CITY OF CLEVELAND
CUY-42-18.42
CUY-21-15.32
QUANTITY CALCULATIONS

T-71 9" REINFORCED P.C.C. PAVEMENT					
ROADWAY	STATION TO STATION		LENGTH	CALCULATION width ft. - 9 sq. yds.	AREA sq. yds.
E-5	2+50.52 8+60.56 9+60.56	8+60.56 9+60.56 11+96.00	610.24 100.00 236.44	16 1/2(19+16) 1/2(16+36) Sub Total	1085 194 683 1962
E-7	1+36.63 2+36.63 3+60.72 3+85.72 4+50.40 4+50.40 6+50.40	2+36.63 3+60.72 3+85.72 4+50.40 6+50.40 7+44.00	100.00 124.09 23.00 64.68 200.00 93.60	24 16 1/2(16+17) 17 1/2(25+15) 1/2(17+10) Sub Total	267 221 46 122 444 140 1240
E-8	0+00 1+47.96 6+17.14 9+94.52	1+47.96 6+17.14 9+94.52 11+74.52	147.96 469.18 377.38 180.00	24 16 18 1/2(27+14) Sub Total	395 834 755 410 2394
E-9	0+00 1+93.60	1+93.60 4+35	193.60 241.40	24 16 Sub Total	516 429 945
E-10	0+00 4+18 4+81.54 5+31.54 7+09.78 9+77 10+33	0+78 4+81.54 5+31.54 7+09.78 10+33 17+96	78.00 63.54 50.00 178.24 85.22 56.00 763.00	1/2(0+4) 24 1/2(24+26) 26 1/2(36+32) 1/2(24+26) 24 Sub Total	17 169 139 515 322 156 2055 3333
E-11	0+00 1+98.46 3+90.04 5+43	1+98.46 3+90.04 5+43 6+55.84	198.46 191.56 152.96 112.84	1/2(0+21) 16 1/2(16+92) 24 Sub Total	232 341 323 301 1197
E-13	0+33 1+03 3+96.25 4+96.25	1+03 3+96.25 4+96.25 6+12.32	70.00 299.25 100.00 116.07	Var. 1/2(24+195) 1/2(22.5+14) Var. Sub Total	356 723 203 69 1351
E-14	0+82 2+72.97 3+22.97 4+72.70 6+16.79 8+76.96 9+79.56	2+72.97 3+22.97 4+72.70 6+16.79 8+76.96 10+79.56	190.97 50.00 149.73 144.09 260.17 102.60 100.00	Var. 1/2(16+18) 18 Var. 24 16 Var. Sub Total	231 94 299 328 694 182 208 2036
Access Road	1+40	3+02.49	162.49	1/2(0+22) Sub Total	199 199
E-15	9+95 12+25.74 14+05.74 17+23	12+25.74 14+05.74 15+01 17+40.32	230.74 180.00 95.26 17.32	Var. 1/2(19+14) 16 1/2(15+14) Sub Total	536 330 169 28 1063
E-16	0+38.25 1+82.29 2+82.29 4+98.38 5+50.46	1+82.29 2+82.29 4+98.38 5+50.46 6+26	144.04 100.00 216.09 52.08 75.54	1/2(28.12+47) 24 16 17 1/2(20+16.5) Sub Total	601 267 384 98 153 1503
E-17	1+60 1+90 2+31.62 6+21.14 7+06.65 8+90.65 9+70.65	1+90 2+31.62 6+21.14 7+06.65 8+90.65 10+70.65	30.00 41.62 389.52 85.51 184.00 80.00 100.00	1/2(38+46) 1/2(20+31) 24 Var. 19 1/2(27+21.5) 1/2(24.5+14) Sub Total	140 118 1039 120 388 216 222 2243
* N-30	* 0+72 * 3+53.61 * 8+50	* 3+53.61 * 8+50 * 9+04.20	281.61 496.39 54.20	Var. 16 1/2(18+14) Sub Total	* 435 * 882 * 96 * 1413
* 30-N	* 0+12 * 1+73.65 * 2+73.65 * 6+16.40 * 7+16.40	* 1+73.65 * 2+73.65 * 6+16.40 * 7+16.40 * 9+87	161.65 100.00 342.75 100.00 270.60	Var. 24 16 1/2(18+14) Var. Sub Total	* 394 * 267 * 609 * 178 * 381 * 1829

T-71 9" REINFORCED P.C.C. PAVEMENT (CONT)					
ROADWAY	STATION TO STATION		LENGTH	CALCULATION width ft. - 9 sq. yds.	AREA sq. yds.
Willow	* 30+41.88 * 30+53.44 * 31+54 * 36+43 44+79 46+37.62	* 30+53.44 * 31+54 * 33+74 * 42+19 46+37.62 49+00	11.56 100.56 220.00 376.00 158.62 262.38	72 82 72 72 72 Var. Sub Total	* 92 * 916 * 1760 * 3008 1269 2038 **9083
Inner Belt	64+68.53 68+46 74+21 74+98.21 70+66.68 78+86.88 79+85.88	64+83 70+64 74+98.21 78+66.68 78+86.88 79+85.88 83+09.31	14.47 218.00 77.21 368.47 20.20 99.00 323.43	72 72 108 1/2(108+96.31) 96.31 1/2(94.31+92) 72 Sub Total	116 1744 926 4183 216 1025 2587 10,797
				CUY 42-18.42	33,590
				CUY 21-15.32	9,018
TOTAL					42,608

* - Project CUY 21-15.32
** - Total includes 5776 sq. yds. under CUY 21-15.32

I-22 SUBBASE								
ROADWAY	LOCATION	STATION TO STATION		LENGTH ft.	WIDTH ft.	AREA sq. yds.	DEPTH in.	VOLUME Cu. Yds.
E-5	Under Pavement " Rt. Shoulder " Lt. "	1+84 2+50.32	12+20 8+60.56	1036.0 610.2	7.00 3.00	1922 806 203	6.00 4.79 6.00	321 107 34 Sub Total 462
E-7	Under Pavement " Rt. Shoulder " Lt. "	2+36.63 1+36.63	4+50.40 7+43	213.8 606.4	8.25 1.75	1240 196 118	6.00 4.95 6.00	207 27 20 Sub Total 254
E-8	Under Pavement " Rt. Shoulder " Lt. " " Lt. "	1+47.96 0-70 0+00 4+50	9+94.52 0+00 4+50 14+10	846.5 70.0 450.0 960.0	7.80 5.00 3.00 1.75	2394 734 39 150 187	6.00 4.79 6.00 6.00	400 97 7 25 31 Sub Total 560
E-9	Under Pavement " Rt. Shoulder " Lt. "	1+93.60 0+00	4+58 4+38	264.4 438.0	7.00 3.00	945 206 146	6.00 4.79 6.00	158 27 24 Sub Total 209
E-10	Under Pavement " Rt. Shoulder " Lt. " " Lt. " " Lt. "	3+92 9+40 4+18 9+84 17+01.98	7+09.78 18+25 7+98 17+01.98 18+16	317.8 885.0 380.0 718.0 114.0	10.25 10.25 1.75 1.75 3.75	3353 362 1008 74 140 47	6.00 4.87 4.87 6.00 6.00 6.00	560 49 136 12 23 8 Sub Total 788
E-11	Under Pavement " Rt. Shoulder " Rt. " " Lt. "	0+00 4+46.40 4+46.40 1+98.46	4+46.40 5+43 5+65	446.4 96.6 366.5	7.00 1/2(7+138) 3.00	1197 347 45 122	6.00 4.79 6.00 6.00	200 46 8 20 Sub Total 274
E-13	Under Pavement " Rt. Shoulder " Lt. "	1+02 0+50	4+96.25 3+96.25	394.2 346.2	7.00 3.00	1351 307 115	6.00 4.79 6.00	226 41 19 Sub Total 286
E-14	Under Pavement " Rt. Shoulder " Rt. " " Lt. "	2+76.73 8+76.96 2+76.73	4+72.70 10+54.83 9+79.56	196.0 177.9 702.8	7.00 7.00 3.00	2036 152 138 234	6.00 4.79 4.79 6.00	340 20 18 39 Sub Total 417
Access Road	Under Pavement " Rt. Shoulder	0+00	2+02.50	202.5	7.00	199 158	6.00 4.79	33 21 Sub Total 54
E-15	Under Pavement " Rt. Shoulder " Lt. "	10+50 9+54	15+26 12+25.74	476.0 271.7	7.00 3.00	1063 370 91	6.00 4.79 6.00	178 49 15 Sub Total 242
E-16	Under Pavement " Rt. Shoulder " Lt. "	2+82.29 0+38.25	6+50 5+50.46	367.7 512.2	8.25 1.75	1503 337 90	6.00 4.95 6.00	251 46 15 Sub Total 312

CUYAHOGA COUNTY
CITY OF CLEVELAND
CUY-42-18.42
CUY-21-15.32
QUANTITY CALCULATIONS

I-11 SANDSTONE CURB				
ROADWAY	SIDE	STATION TO STATION		LENGTH ft.
E-5	Rt.	1+13.65	2+00	86
	Lt.	1+13.65	9+60.56	847
			Sub Total	933
E-7	Rt.	1+36.63	2+36.63	100
	Rt.	5+50.40	6+50.40	100
	Lt.	1+36.63	7+54	617
			Sub Total	817
E-8	Rt.	0+47.96	1+47.96	100
	Rt.	9+94.52	11+74.52	180
	Lt.	0-70	14+10	1480
			Sub Total	1760
E-9	Rt.	0+93.60	1+93.60	100
	Lt.	0+00	4+54	454
			Sub Total	554
E-10	Rt.	7+09.78	7+95	85
	Lt.	4+05	7+95	390
	Lt.	9+83	18+14	831
			Sub Total	1306
E-11	Lt.	1+98.46	6+55.84	456
			Sub Total	456
E-13	Rt.	0+30	1+20	106
	Lt.	0+30	4+96.25	478
			Sub Total	584
E-14	Rt.	7+76.96	8+76.96	100
	Rt.	10+54	10+79.56	26
	Lt.	2+76.73	10+79.56	803
			Sub Total	929
E-15	Lt.	9+86	14+05.74	420
			Sub Total	420
E-16	Rt.	1+82.29	2+82.29	100
	Lt.	0+38.25	6+30	592
			Sub Total	692
E-17	Rt.	8+90.65	10+70.65	180
	Lt.	2+31.62	6+21.14	389
	Lt.	7+06.65	10+70.65	364
			Sub Total	933
* 30-N	* Rt.	* 1+73.65	* 2+73.65	* 100
	* Lt.	* 0+10	* 7+16.40	* 706
			Sub Total	* 806
* N-30	* Rt.	* 7+04.20	* 9+04.20	* 200
	* Lt.	* 3+53.61	* 9+04.20	* 551
			Sub Total	* 751
Willow	* Median	* 30+41.88	* 34+00	* 716
	"	* 36+24	* 42+45	* 1242
	"	* 44+54	* 49+31	* 954
	Rt.	* 46+88.02	* 47+85.02	* 100
	Lt.	* 30+53.44	* 31+53.44	* 100
			Sub Total	**3112
Inner Belt	Median	64+68.53	64+85	33
	"	68+45	70+65	440
	"	74+22	83+09.31	1775
	Rt.	78+86.88	79+86.88	100
	Lt.	79+85.88	80+85.88	100
			Sub Total	2448
			CUY 42-18.42	12,901
			CUY 21-15.32	3,615
			TOTAL	16,516

* - Project CUY 21-15.32
** - Total includes 2058 lin. ft. under CUY 21-15.32

I-21 P.C.C. MEDIAN PAVEMENT (4")					
ROADWAY	STATION TO STATION		LENGTH ft.	WIDTH ft.	AREA sq. yds.
Willow	* 30+41.88	* 34+00	358	5	* 199
	* 36+24	* 42+45	621	5	* 345
	* 44+54	* 49+31	477	5	* 265
	* 51+07	* 51+86	79	5	* 44
	* 31+53.44	* Nose	42	1/2(2+10)	* 28
	* 46+85.02	* Nose	46	1/2(2+10)	* 31
			Sub Total	** 912	
Inner Belt	64+68	65+10	42	3	14
	68+20	70+90	270	3	90
	73+97	80+09.31	612	3	204
	80+09.31	83+09.31	300	1/2(3+9)	200
	78+86.88	Nose	38	1/2(2+10)	25
	79+85.88	Nose	33	1/2(2+10)	22
			Sub Total	555	
E-5	9+60.56	Nose	80	1/2(2+10)	53
	2+50.32	Nose	55	"	37
			Sub Total	90	
E-7	1+36.63	Nose	18	1/2(2+10)	12
			Sub Total	12	
E-10	8+09.78	Nose	85	1/2(4+10)	66
			Sub Total	66	
E-14	10+79.56	Nose	79	1/2(2+10)	53
			Sub Total	53	
E-15	14+05.74	Nose	100	1/2(2+10)	67
	17+40.32	Nose	45	1/2(2+6)	20
			Sub Total	87	
E-16	0+38.25	Nose	15	1/2(2+10)	10
			Sub Total	10	
E-17	2+31.62	Nose	48	1/2(2+10)	32
	7+06.65	Nose	18	"	12
	10+70.65	Nose	28	"	19
			Sub Total	63	
* N-30	* 9+04.20	* Nose	78	1/2(2+10)	* 52
			Sub Total	* 52	
* 30-N	* 1+73.65	* Nose	60	1/2(2+10)	* 40
			Sub Total	* 40	
			CUY 42-18.42	1276	
			CUY 21-15.32	664	
			TOTAL	1940	

* - Project CUY 21-15.32
** - Total includes 572 sq. yds. under CUY 21-15.32

I-12 2A MODIFIED (10") CONCRETE CURB				
ROADWAY	SIDE	STATION TO STATION		LENGTH ft.
E-15	Lt.	16+95	17+40.32	45
			Sub Total	45
Willow	Lt.	48+73.11	49+20	47
			Sub Total	47
			TOTAL	92

L-10 SODDING	
ITEM	AREA Sq. yds.
Sodding	268
Sodding, Including 2" Galvanized Wire Mesh	625

I-7 APPROACH SLABS			
ROADWAY	BRIDGE	LOCATION	AREA sq. yds.
Inner Belt	3	East Approach	216
		West "	217
Inner Belt	4	East Approach	329
		West "	345
E-10	5	South Approach	87
		North "	130
E-15	7	East Approach	85
Willow	8	East Approach	160
		West "	183
E-15	9	East Approach	44
		West "	76
Willow	10	* East Approach	* 200
		West "	204
Willow	11	* East Approach	* 206
		* West "	* 200
		CUY 42-18.42	2076
		CUY 21-15.32	606
		TOTAL	2682

* - Project CUY 21-15.32

CUYAHOGA COUNTY
CITY OF CLEVELAND
CUY-42-18.42
CUY-21-15.32
QUANTITY CALCULATIONS

E-8 REMOVAL & DISPOSAL EXISTING SIDEWALK						
ROADWAY	SIDE	LIMITS	LENGTH	WIDTH	AREA	
Central	N	19 th St. - 21 st St.	325	12	3900	
	S	" - 20 th St.	230	12	2760	
	S	20 th St. - 21 st St.	170	12	2040	
	N	21 st St. - 22 nd St.	325	13	4225	
	S	" - "	294	12	3528	
Sub Total					16,453	
E. 21 st St.	E	Carnegie - Central	500	5	2500	
	W	" - "	475	6	2850	
Sub Total					5,350	
Charity	N	14 th St. - 20 th St.	320	5	1600	
	S	" - "	320	5	1600	
Sub Total					3,200	
E. 29 th St.	E	Orange - Woodland	250	6	* 1500	
	W	" - "	250	6	* 1500	
Sub Total					* 3,000	
Woodland	N	19 th St. - 20 th St.	152	17	2584	
	S	" - "	258	18.5	4773	
	S	27 th St. - 29 th St.	360	18	* 6480	
	S	29 th St. - 30 th St.	225	18	* 4050	
Sub Total					** 17,887	
E. 19 th St.	E	Woodland - Scovill	752	6	4512	
	W	" - "	740	6	4400	
Sub Total					8,952	
E. 20 th St.	E	Charity - Central	105	5	525	
	W	" - "	105	5	525	
Sub Total					1,050	
			CUY 42-18.42		42,362	
			CUY 21-15.32		13,530	
TOTAL					55,892	

* - Project CUY 21-15.32
** - Total includes 10,530 sq. ft. under CUY 21-15.32

E-8 REMOVAL & DISPOSAL EXISTING SANDSTONE CURB				
ROADWAY	SIDE	LIMITS	LENGTH	
E. 19 th St.	E	Woodland - Scovill	782	
	W	" - "	185	
Sub Total			1567	
E. 20 th St.	E	Charity - Central	125	
	W	" - "	125	
Sub Total			250	
E. 21 st St.	E	Charity - Central	70	
	W	" - "	70	
	E	Central - Carnegie	520	
	W	" - "	500	
Sub Total			1160	
* E. 29 th St.	E	* Orange - Woodland	* 280	
	W	* " - "	* 280	
Sub Total			* 560	
Central	N	19 th St. - 22 nd St.	780	
	S	" - "	795	
	Sub Total			1575
Woodland	N	19 th St. - 20 th St.	135	
	S	" - "	265	
	S	* 29 th St. - 30 th St.	* 180	
	Sub Total			** 580
			CUY 42-18.42	4952
			CUY 21-15.32	740
TOTAL				5692

* - Project CUY 21-15.32
** - Total includes 180 lin. ft. under CUY 21-15.32

E-8 REMOVAL & DISPOSAL EXISTING RIGID PAVEMENT				
ROADWAY	LIMITS	LENGTH	WIDTH	AREA
Central	E. 19 th St. - E. 22 nd St.	695	40	3089
Woodland	E. 19 th St. - E. 20 th St.	217	62	1495
Parcel 184	Market Place			2167
TOTAL				6751

SS-18 FENCING		
PROJECT	SHEET	LENGTH
CUY 42-18.42	Sheet # 92	2255
	" # 93	1587
	" # 94	3218
	" # 95	2380
	" # 96	920
Sub Total		10,360
CUY 21-15.32	Sheet # 97	3900
Sub Total		3900
TOTAL		14,260

I-15 GUARD RAIL		
PROJECT	SHEET	LENGTH
CUY 42-18.42	Sheet # 15	457
	" # 16	660
	" # 18	3583
	" # 19	1167
	" # 20	2175
Sub Total		8,042
CUY 21-15.32	Sheet # 16	560
	" # 17	1870
Sub Total		2430
TOTAL		10,472

I-15 BARRIER RAIL		
PROJECT	SHEET	LENGTH
CUY 42-18.42	Sheet # 16	339
	" # 18	208
	" # 19	48
	" # 20	1162.5
Sub Total		1757.5
CUY 21-15.32	Sheet # 16	286
	" # 17	686.5
Sub Total		972.5
TOTAL		2730

L-9 QUANTITIES			
PROJECT	ITEM	CALCULATION	QUANTITY
CUY 42-18.42 CUY 21-15.32	SEEDING & PROTECTION	Planimeter	108,543 Sq. Yds. #
	" " "	"	44,500 " "
		Total	153,043 " "
CUY 42-18.42 CUY 21-15.32	AGRICULTURAL LIMING MATERIALS	100#/1000 Sq. Ft.	48.84 Tons
	" " "	"	20.03 Tons
		Total	68.87 Tons
CUY 42-18.42 CUY 21-15.32	COMMERCIAL FERTILIZER	20#/1000 Sq. Ft.	9.77 Tons
	" " "	"	4.01 " "
		Total	13.78 Tons

Includes 893 Sq. Yd. Sodding

E-11 WATER		
PROJECT	CALCULATION	M. GAL.
CUY 42-18.42	6.5 gal./cu. yd. embankment x 1.15 = 6.5 x 282,342	1835
CUY 42-18.42	5.0 gal./cu. yd. subbase (See I-22) = 5.0 x 8,085	40
CUY 42-18.42	5.0 gal./cu. yd. Agg. Base (See I-18) = 5.0 x 2,106	11
Sub Total		1886
CUY 21-15.32	6.5 gal./cu. yd. embankment x 1.15 = 6.5 x 124,768	811
CUY 21-15.32	5.0 gal./cu. yd. subbase (See I-22) = 5.0 x 2,589	13
CUY 21-15.32	5.0 gal./cu. yd. Agg. Base (See I-18) = 5.0 x 652	3
Sub Total		827
TOTAL		2713

E-1 COMPACTED SUBGRADE		
PROJECT	ITEM	AREA
CUY 42-18.42	Area of T-71+B-219+I-11+I-7	49,559
CUY 21-15.32	Area of T-71+B-219+I-11+I-7	13,833
TOTAL		63,392

E-9 TREE REMOVAL			
SHEET	SIZE		TOTAL
	12"	18"	
# 92			
# 93	10	3	13
# 94	6	4	10
# 95	38	5	43
# 96			
# 97	4		4
TOTAL	58	12	70

GENERAL SUMMARY ESTIMATED QUANTITIES

TYPE CODE 7221

FED. ROAD DIV. NO.	STATE	FEDERAL AID PROJECT NO.	TYPE FUNDS
2	OHIO		

13
181

There are no 100% City Participating Items in Part 7-A or Part 7-B on this sheet.

CUYAHOGA COUNTY
CITY OF CLEVELAND
CUY-42-18.42
CUY-21-18.32

PART 6				PART 7							GRAND TOTAL	UNIT	ITEM NO.	DESCRIPTION	COMBINED TOTALS		TOTALS I-71-5(8)248 FED. PARTICIPATION		
SHEET NUMBERS	I-71-5(8)247			SHEET NUMBERS	I-71-5(8)248			PART 7-A TOTAL	SHEET NUMBER	I-71-5(8)248					PART 7-B TOTAL	100% CITY		FED. PART.	
	CUY-42-18.29	100% CITY	TOTAL		CUY-42-18.42	FED. PARTICIPATION	TOTAL			CUY-42-18.77	TOTAL								
PAVEMENT																			
13	57		57										57	Cu.Yds	B-19	Aggregate Base Course		57	
11	105	13	118										118	Cu.Yds	B-35	Asphaltic Concrete Leveling Course (60-70)	13	105	
12	2462	249	2411										2411	Sq.Yds	B-70	9" Portland Cement Concrete Base Course	249	2,162	
12	262		262	9	1,098	9	339	339	1,437	10	899	899	2,598	Cu.Yds.	B-219	Water Proofed Aggregate Base Course,		2,598	1997
11	928		928	10	2,076	10	606	606	2,682				3,610	Sq.Yds.	I-7	Reinforced Concrete Approach Slabs (T-13')		3,610	2076
12	7117	1480	8597										8597	Lin.Ft.	I-11	Sandstone Curb reset, as per plan	1480	7117	
12	2644	602	2646	10	12,901	10	3,615	3615	16,516	10	10,121	10,121	53,283	Lin.Ft.	I-11	6'x18" Sandstone Curb, as per plan	602	52,681	23022
13	151		151	10	92			92					243	Lin.Ft.	I-12	Standard Type 2-A Concrete Curb, Modifications "A" & "B" as per plan		243	92
12	405		405	9	2,106	9	652	652	2,758	10	1,721	1,721	4,884	Cu.Yds.	I-18	Stabilized Crushed Aggregate Shoulders and Approaches		4,884	3827
12	1,380		1,380	10	1,276	10	664	664	1,940	10	2,803	2,803	6,123	Sq.Yds.	I-21	Portland Cement Concrete Median Pavement, 4" Std. Type I	6,123		4079
12	135		135										135	Sq.Yds.	I-21	Standard Type 2 Portland Cement Concrete Median Pavement, as per plan		135	
11	13,329	257	13,586	9	8,085	9	2,589	2589	10,674	10	8,559	8,559	32,810	Cu.Yds.	I-22	Subbase	257	32,562	16644
12	247		247										247	Gals.	T-30	Bituminous Tack Coat, Sec.M-5.5, MS-2 or RS-1 or Sec.M.5.2, RC-1, RC-2, or RC-3, as per Sec.T-30.02		247	
12	1,280		1,280	9	4,618	9	1,426	1426	6,044	10	4,315	4,315	11,639	Gals.	T-30	Bituminous Prime Coat, See M-5.7 RT. 2 or 3		11,639	8933
12	23		23	9	106	9	33	33	139	10	86	86	248	Cu.Yds.	T-31	Bituminous Surface Treatment, No. 6 Aggregate		248	192
12	714		714	9	3,303	9	1,018	1018	4,321	10	2,697	2,697	7,732	Gals.	T-31	Bituminous Surface Treatment, Bituminous Material, as per plan		7,732	6090
11	75	9	84										84	Cu.Yds.	T-35	Asphaltic Concrete Surface Course Type "C" (60-70)	11	90	
13	341		341										341	Sq.Yds.	T-70	8" Portland Cement Concrete Pavement, as per plan		341	
11	72,100	1,537	73,637	8	33,590	8	9,018	9018	42,608	10	34,467	34,467	150,712	Sq.Yds.	T-71	9" Reinforced Portland Cement Concrete Pavement, as per plan	1,537	149,175	68057
RETAINING WALLS																			
For Estimated Quantities, see Sheet No. 11, Part 7-B																			
BUILDING REMOVAL																			
For Estimated Quantities, See Sheet No 14-A, 14-B & 14-C of Part No 7-A																			
STRUCTURES OVER 20 FT. SPAN																			
See Sheet No 92-92A (Part 6) For Structure Quantities																			
See Sheet No 99-99A (Part 7-A) For Structure Quantities																			
LIGHTING (CONTINUED FROM SHEET NO. 12)																			
	150	55	205										205	Lin.Ft.	S-25	3 Way Duct, 4 inch, as per plan		55	150
		1	1										1	Each	S-25	Removing Wood Pole, as per plan		1	1
		65	65										65	Each	S-25	Remove and Reinstall Lighting Unit, as per plan		65	
		2	2										2	Each	S-25	Trolley Pole, 10 foot duplex bracket, as per plan		2	

GENERAL SUMMARY ESTIMATED QUANTITIES

FED. ROAD DIV. NO. 2 STATE OHIO FEDERAL AID PROJECT NO. TYPE FUNDS 14 (181)

TYPE CODE 7221

There are no 100% City Participating. Items in Part 7-A or Part 7-B on this sheet.

CUYAHOGA COUNTY CITY OF CLEVELAND CUY-42-18.42 CUY-21-15.32

Table with columns: SHEET NUMBERS, I-71-5(6)247, SHEET NUMBERS, I-71-5(6)248, SHEET NUMBERS, I-77-5(1)162, PART 7-A, SHEET NUMBERS, I-71-5(6)248, PART 7-B, I-71-5(6)248, GRAND TOTAL, UNIT, ITEM NO., DESCRIPTION, COMBINED TOTALS. Includes sub-sections PART 6, PART A, PART B, and DRAINAGE (CONTINUED).

DRAINAGE (CONTINUED) table with columns: ITEM #, UNIT, GRAND TOTAL, PART 6 SHEET NUMBERS, DESCRIPTION.

SCALE None MADE G.M.G. DATE 11-10-59 HOWARD, NEEDLES, TAMMEN & BERGENDOFF TRCD. DATE 11-10-59 CONSULTING ENGINEERS KANSAS CITY CLEVELAND NEW YORK CKD. J.F.S. DATE 11-11-59 914 SHEET 14






GENERAL SUMMARY

FED. RD. DIVISION	STATE	PROJECT	14-A 181
2	OHIO		

CUYAHOGA COUNTY
CUY-42-18.42; CUY-21-15.32

ITEM N ^o	QUANTITY		UNIT	DESCRIPTION
		CUY 42-18.29 I-71-5(6)247		
				BUILDING REMOVAL
S-24		Lump Sum	Lump	REMOVAL OF 1-STORY BRICK BUILDING, PARCEL N ^o 116 LA
S-24		Lump Sum	Lump	REMOVAL OF 2-STORY BRICK BUILDING AND 1-STORY BRICK BUILDING, PARCEL N ^o 182 LA
S-24		Lump Sum	Lump	REMOVAL OF 3-STORY BRICK, 2-STORY FRAME BUILDING AND 1-STORY BRICK DWELLING, PARCEL N ^o 187 LA
S-24		Lump Sum	Lump	REMOVAL OF 2-STORY BRICK, 1-STORY BRICK BUILDING AND 1-STORY FRAME SHED, PARCEL N ^o 202 LA
S-24		Lump Sum	Lump	REMOVAL OF 2-STORY BRICK BUILDING, 2-STORY BRICK, 1-STORY BRICK BUILDING, AND 2-STORY BRICK, 2-STORY FRAME BUILDING, PARCEL N ^o 205 LA
S-24		Lump Sum	Lump	REMOVAL OF 2-STORY BRICK, 1-STORY BRICK BUILDING, PARCEL N ^o 208 LA
S-24		Lump Sum	Lump	REMOVAL OF 2-STORY FRAME BUILDING, PARCEL N ^o 213 LA
S-24		Lump Sum	Lump	REMOVAL OF 2-STORY BRICK, 1-STORY BRICK BUILDING, PARCEL N ^o 219 LA
S-24		Lump Sum	Lump	REMOVAL OF 2-STORY BRICK BUILDING AND 1-STORY SHEET METAL GARAGE, PARCEL N ^o 227 LA
S-24		Lump Sum	Lump	REMOVAL OF TWO 1-STORY BRICK BUILDINGS AND 1-STORY FRAME, 1-STORY FRAME DWELLING AND 2-STORY FRAME DWELLING, PARCEL N ^o 229 LA
S-24		Lump Sum	Lump	REMOVAL OF 2-STORY BRICK, 1 1/2 STORY FRAME, 1-STORY FRAME DWELLING AND 1-STORY FRAME DWELLING, PARCEL N ^o 232 LA
S-24		Lump Sum	Lump	REMOVAL OF 2-STORY BRICK, 2-STORY FRAME DWELLING AND 2-STORY BRICK AND BLOCK GARAGE, PARCEL N ^o 236 LA
S-24		Lump Sum	Lump	REMOVAL OF 2-STORY FRAME DWELLING AND 1-STORY BRICK AND BLOCK GARAGE, PARCEL N ^o 237 LA
S-24		Lump Sum	Lump	REMOVAL OF 2-STORY FRAME AND BRICK, 1-STORY FRAME DWELLING, PARCEL N ^o 239 LA
S-24		Lump Sum	Lump	REMOVAL OF 2-STORY FRAME DWELLING AND 2-STORY BRICK DWELLING, PARCEL N ^o 240 LA
S-24		Lump Sum	Lump	REMOVAL OF 2-STORY FRAME, 1-STORY FRAME DWELLING AND 2-STORY FRAME DWELLING, PARCEL N ^o 241 LA
S-24		Lump Sum	Lump	REMOVAL OF TWO 2-STORY FRAME DWELLINGS, PARCEL N ^o 242 LA
S-24		Lump Sum	Lump	REMOVAL OF 1-STORY FRAME DWELLING, PARCEL N ^o 248 LA
S-24		Lump Sum	Lump	REMOVAL OF 1-STORY BRICK BUILDING, PARCEL N ^o 257 LA
S-24		Lump Sum	Lump	REMOVAL OF 2-STORY BRICK, 1-STORY FRAME BUILDING, PARCEL N ^o 258 LA
S-24		Lump Sum	Lump	REMOVAL OF THREE 2-STORY FRAME DWELLINGS AND 1-STORY FRAME BUILDING, PARCEL N ^o 260 LA
S-24		Lump Sum	Lump	REMOVAL OF 2-STORY FRAME, 1-STORY FRAME DWELLING, PARCEL N ^o 263 LA
S-24		Lump Sum	Lump	REMOVAL OF 2-STORY BRICK DWELLING AND 1-STORY GARAGE, PARCEL N ^o 265 LA
S-24		Lump Sum	Lump	REMOVAL OF 2-STORY FRAME DWELLING, PARCEL N ^o 268 LA
S-24		Lump Sum	Lump	REMOVAL OF 1 1/2-STORY FRAME DWELLING, 2 1/2-STORY FRAME DWELLING, 2-STORY FRAME DWELLING AND 1-STORY BRICK GARAGE, PARCEL N ^o 269 LA
S-24		Lump Sum	Lump	REMOVAL OF 1-STORY FRAME GARAGE, PARCEL N ^o 272 LA
S-24		Lump Sum	Lump	REMOVAL OF FOUR 1 1/2 STORY FRAME BUILDINGS, PARCEL N ^o 726 LA
S-24		Lump Sum	Lump	REMOVAL OF 2-STORY BRICK, 1-STORY BRICK BUILDING, PARCEL N ^o 728 LA
S-24		Lump Sum	Lump	REMOVAL OF 1-STORY FRAME, 1-STORY FRAME, 2-STORY FRAME BUILDING, AND 1-STORY FRAME BUILDING AND 2-STORY FRAME BUILDING, PARCEL N ^o 733 LA
S-24		Lump Sum	Lump	REMOVAL OF TWO 2-STORY FRAME BUILDINGS AND TWO 1-STORY BRICK BUILDINGS, PARCEL N ^o 736 LA
S-24		Lump Sum	Lump	REMOVAL OF 3-STORY BRICK BUILDING AND 1-STORY BRICK BUILDING, PARCEL N ^o 801 LA
S-24		Lump Sum	Lump	REMOVAL OF 2-STORY BRICK BUILDING, 1-STORY BRICK BUILDING, 1-STORY BRICK GARAGE, PARCEL N ^o 802 LA
S-24		Lump Sum	Lump	REMOVAL OF 3-STORY BRICK BUILDING, 2-STORY FRAME, 2-STORY FRAME AND BRICK BUILDING, AND TWO 2-STORY FRAME BUILDINGS, PARCEL N ^o 803 LA
S-24		Lump Sum	Lump	REMOVAL OF 1-STORY BRICK GARAGE AND 1-STORY SHEET METAL BUILDING, PARCEL N ^o 804 LA
S-24		Lump Sum	Lump	REMOVAL OF 1-STORY SHEET METAL AND FRAME GARAGE WITH HEAVY CONCRETE FLOOR SLAB, 1-STORY CONCRETE BLOCK GARAGE, 3-STORY BRICK BUILDING, 1-STORY FRAME AND BRICK BUILDING WITH HEAVY CONCRETE FLOOR SLAB, PARCEL N ^o 805 LA
S-24		Lump Sum	Lump	REMOVAL OF 1 1/2-STORY FRAME AND BRICK BUILDING AND 2-STORY FRAME DWELLING, PARCEL N ^o 818 LA
S-24		Lump Sum	Lump	REMOVAL OF 1-STORY FRAME GARAGE, PARCEL N ^o 819 LA
(CONTINUED ON SHEET N ^o 14-B)				

CUYAHOGA COUNTY
CITY OF CLEVELAND
CUY-42-18-42
CUY-21-15-32

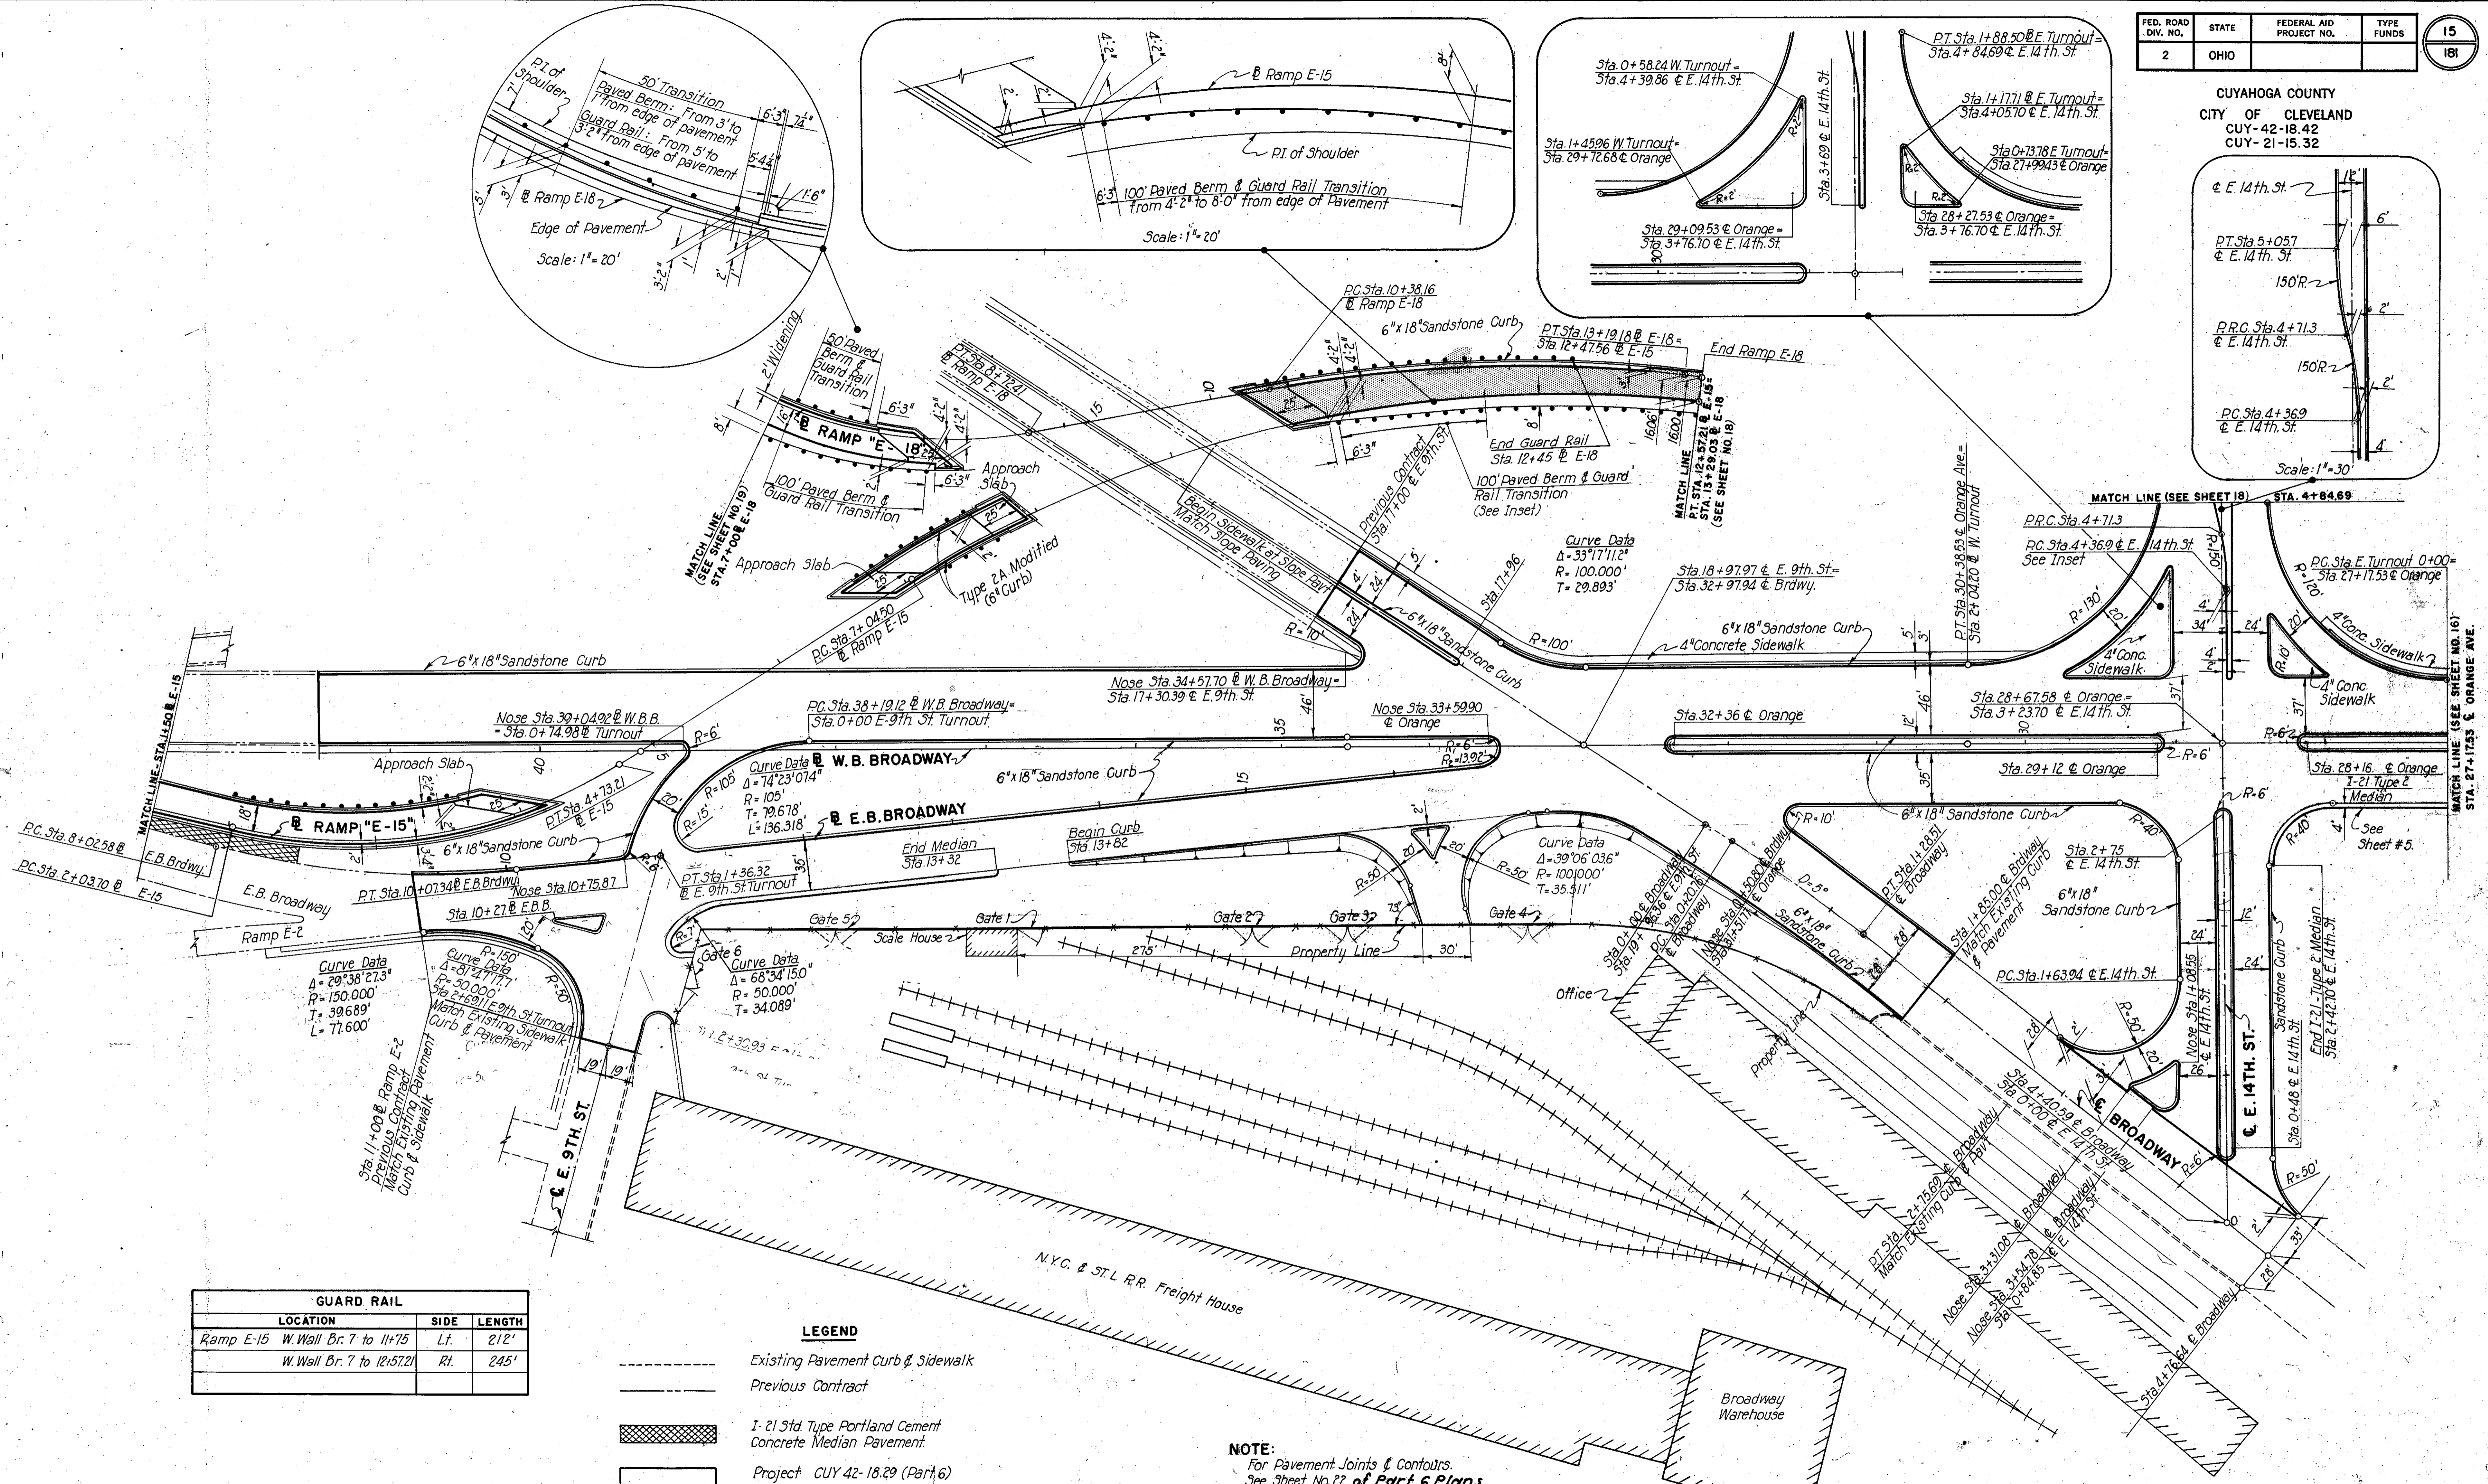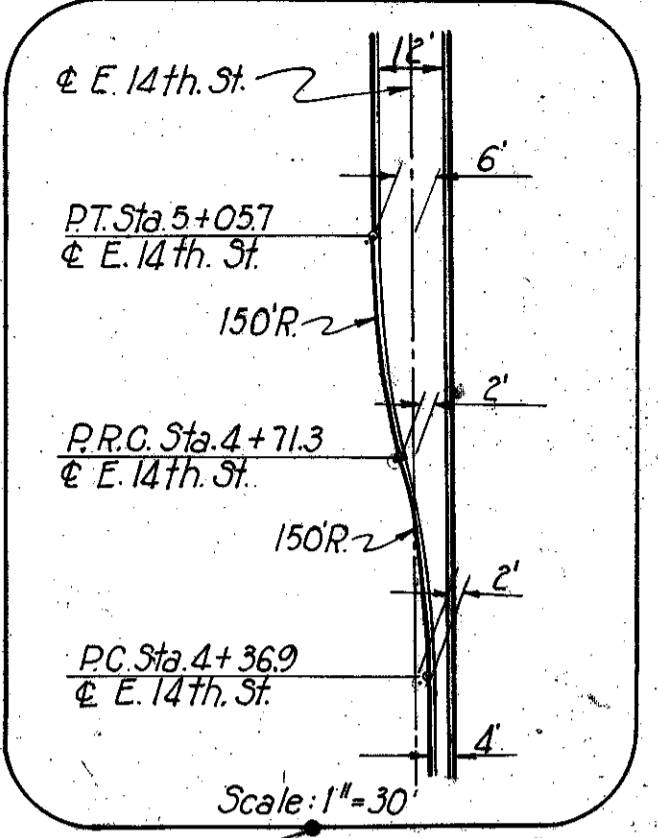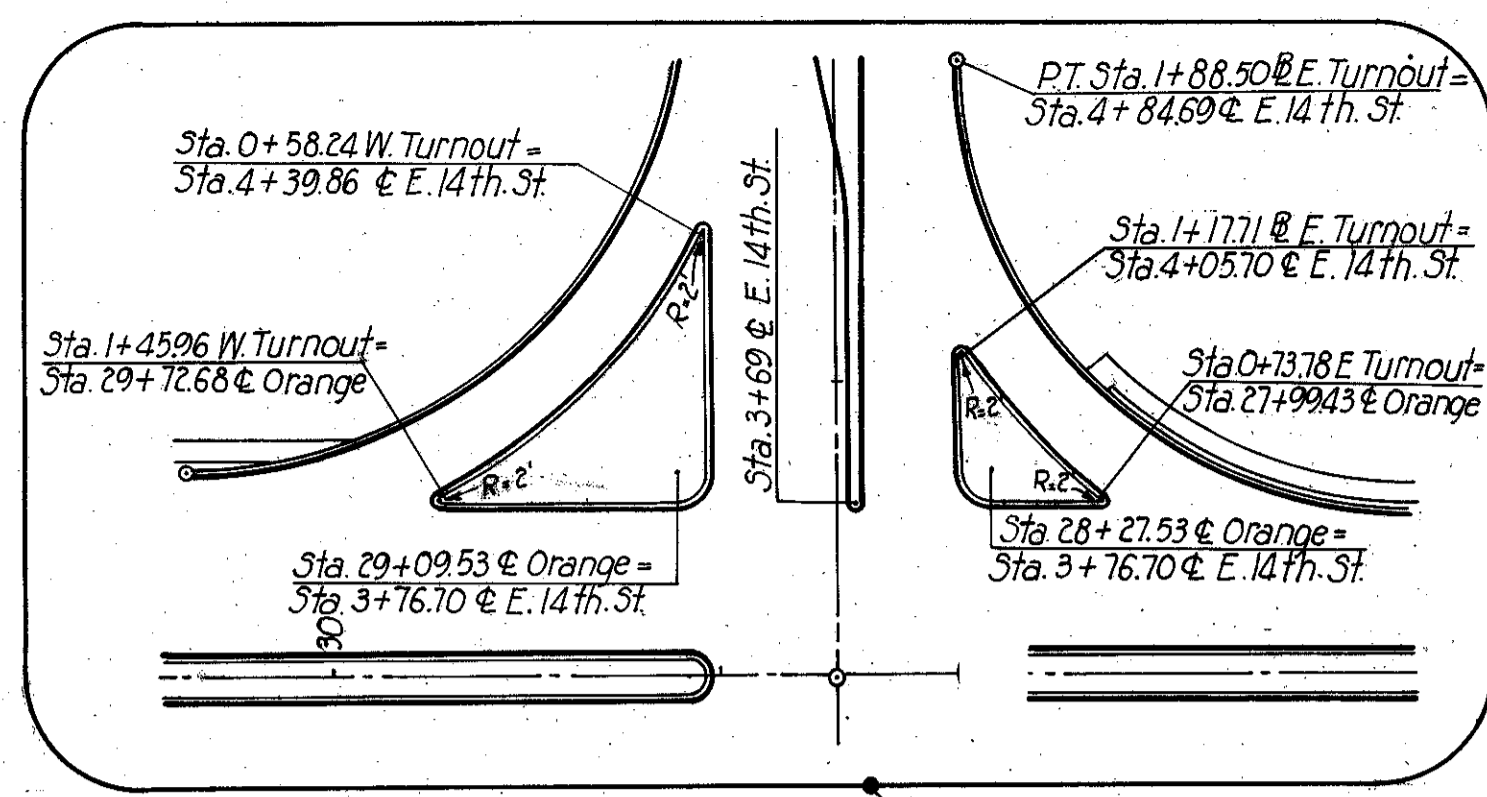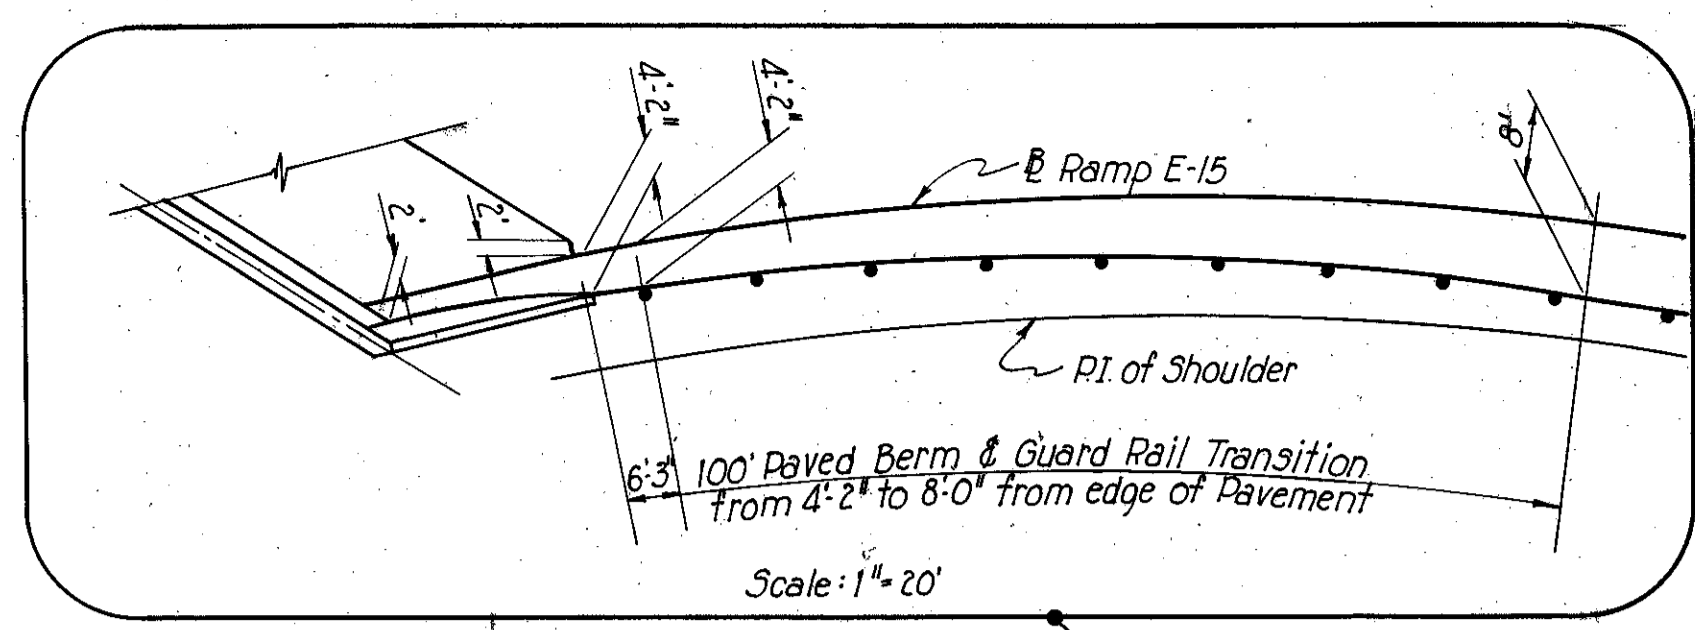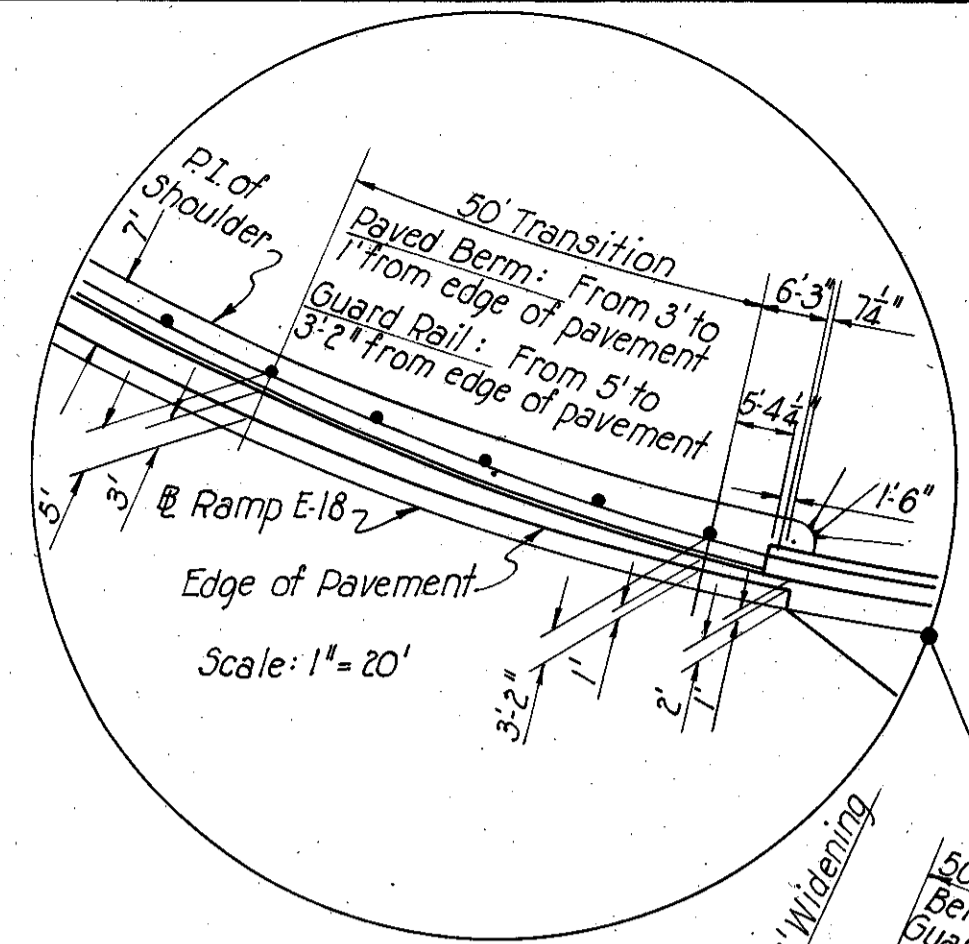



GUARD RAIL		
LOCATION	SIDE	LENGTH
Ramp E-15 W. Wall Br. 7 to 11+75	Lt.	212'
W. Wall Br. 7 to 12+57.21	Rt.	245'

- LEGEND**
- Existing Pavement Curb & Sidewalk
 - Previous Contract
 - ▨ I-21 Std. Type Portland Cement Concrete Median Pavement
 - ▭ Project CUY 42-18.29 (Part 6)
 - ▭ Project CUY 42-18.42 (Part 7) CUY 21-15.32

NOTE:
For Pavement Joints & Contours. See Sheet No. 22 of Part 6 Plans.
For detail of Typical Joint Layout see: Exit Ramps, Sheet 20 of Part 7B; Entrance Ramps, Sheet 21 of Part 7B.


PAVEMENT DETAILS

CUYAHOGA COUNTY
CITY OF CLEVELAND
CUY 42-18.42
CUY 21-15.32

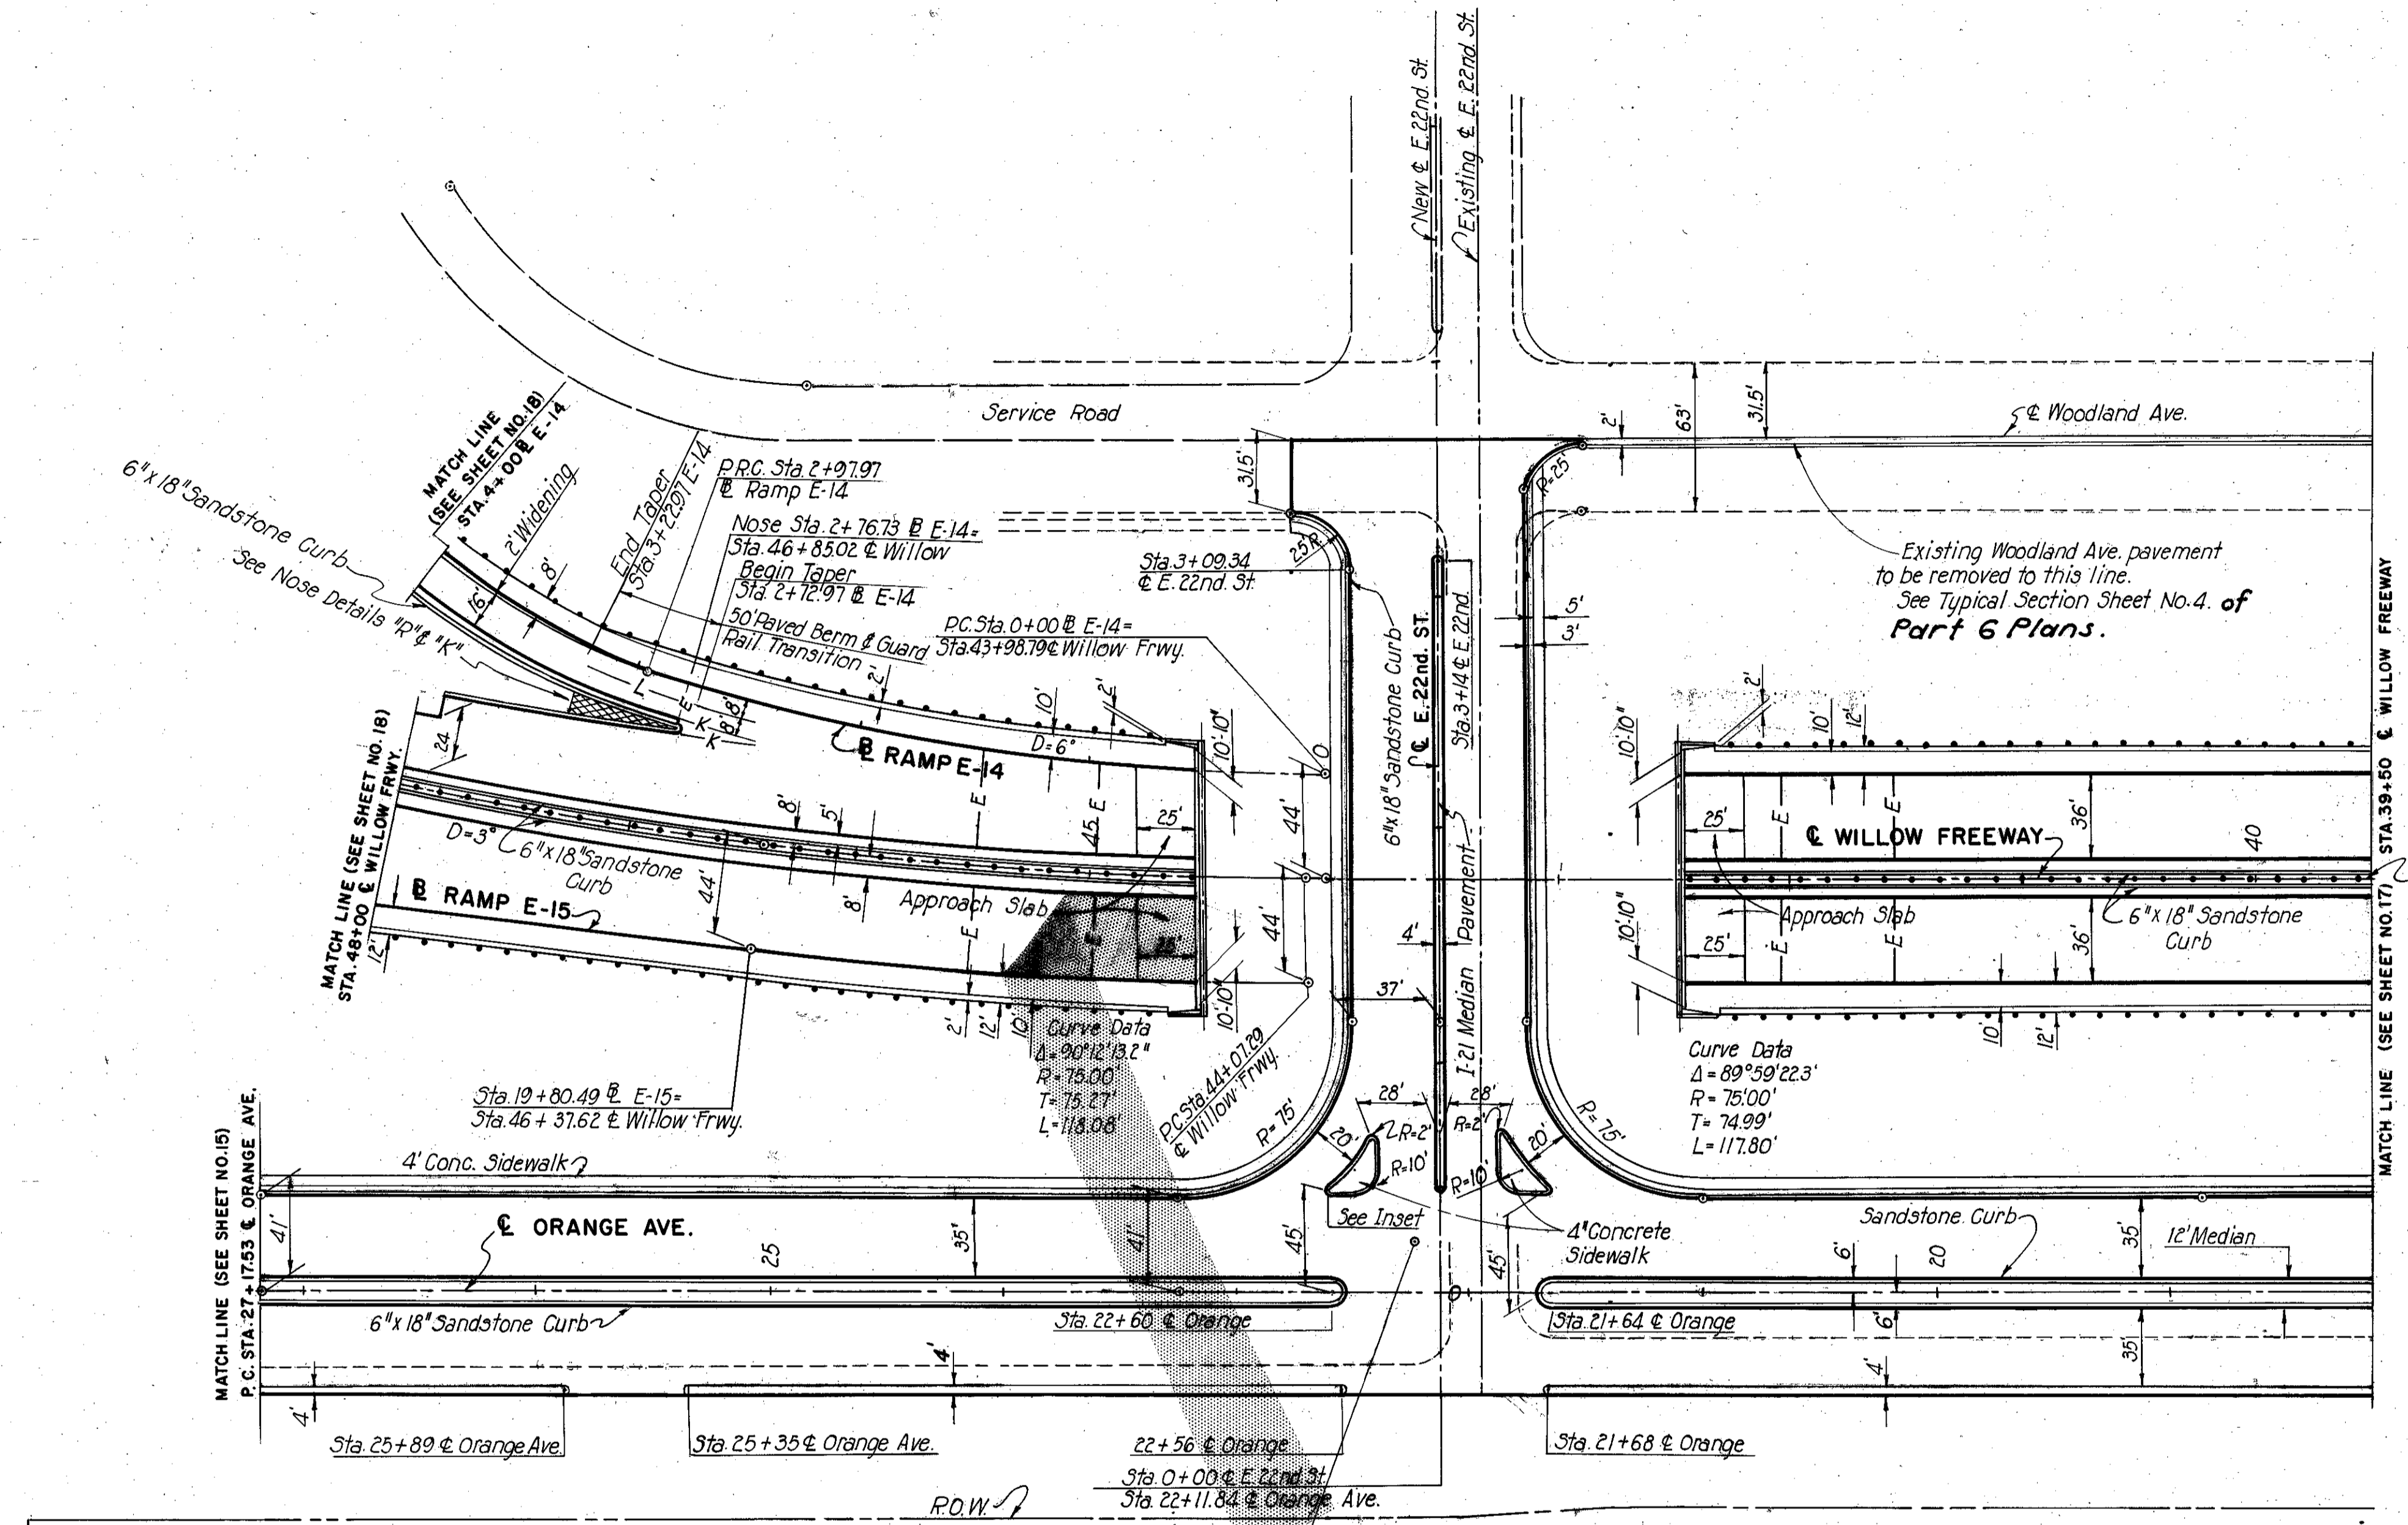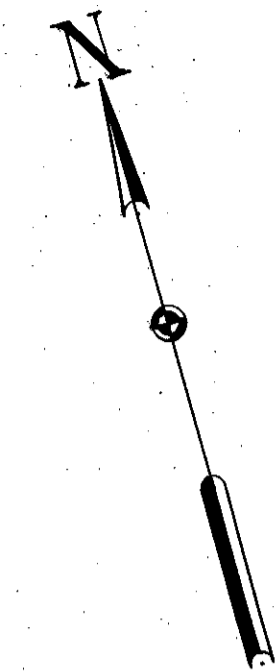

I-15 Guard Rail, Steel Beam Barrier Type (Deep).

GUARD RAIL			
LOCATION	SIDE	LENGTH	
Ramp E-14 W. Wall Br. 10 to 4+00	Rt.	318'	
Ramp E-15 18+17 to 19+80.49	Rt.	162'	
Willow Frwy. W. Wall Br. 10 to 46+37.62	Lt.	180'	
39+50 to W. Wall Br. 10	Lt.	280'	
39+50 to W. Wall Br. 10	Rt.	280'	
BARRIER RAIL			
Willow Frwy. 39+50 to 42+36	Ctr.	286'	
44+61 to 48+00	Ctr.	339'	

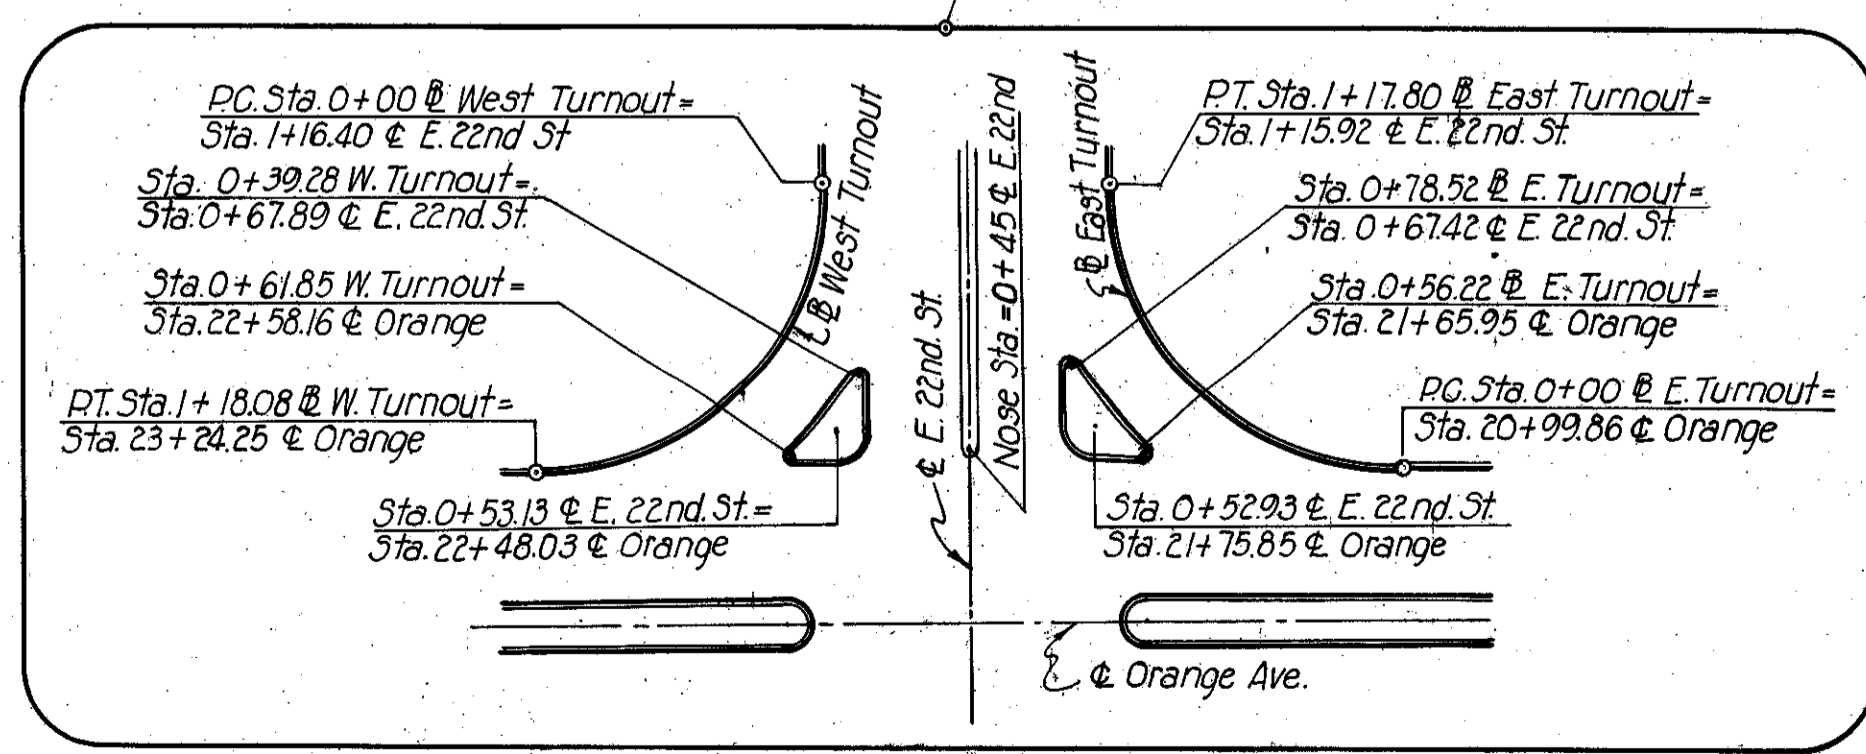

- LEGEND**
- Existing Pavement, Curb & Sidewalk
 - Future Construction
 - I-21 Std. Type 1 Portland Cement Concrete Median Pavement.
 - Project: CUY 42-18.29 (Part 6).
 - Project: CUY 42-18.42 (Part 7).
 - CUY 21-15.32


Note: For Orange Ave. Joint Layout and contours, see Sheet 22 of Part 6 Plans

PAVEMENT DETAILS

CUYAHOGA COUNTY
CITY OF CLEVELAND
CUY 42-18.42
CUY 21-15.32

GUARD RAIL		
LOCATION	SIDE	LENGTH
Ramp 30-N 3+75 to W.Wall Br. II	Rt.	587'
Ramp N-30 W.Wall Br. II to 6+97	Rt.	657'
Willow Frwy. W.Wall Br. II to 39+50	Rt.	399'
W.Wall Br. II to 39+50	Lt.	227'

BARRIER RAIL		
LOCATION	SIDE	LENGTH
Willow Frwy. 30+48.5 to 33+98.5	Ctr.	350'
36+23.5 to 39+50	Ctr.	336.5'

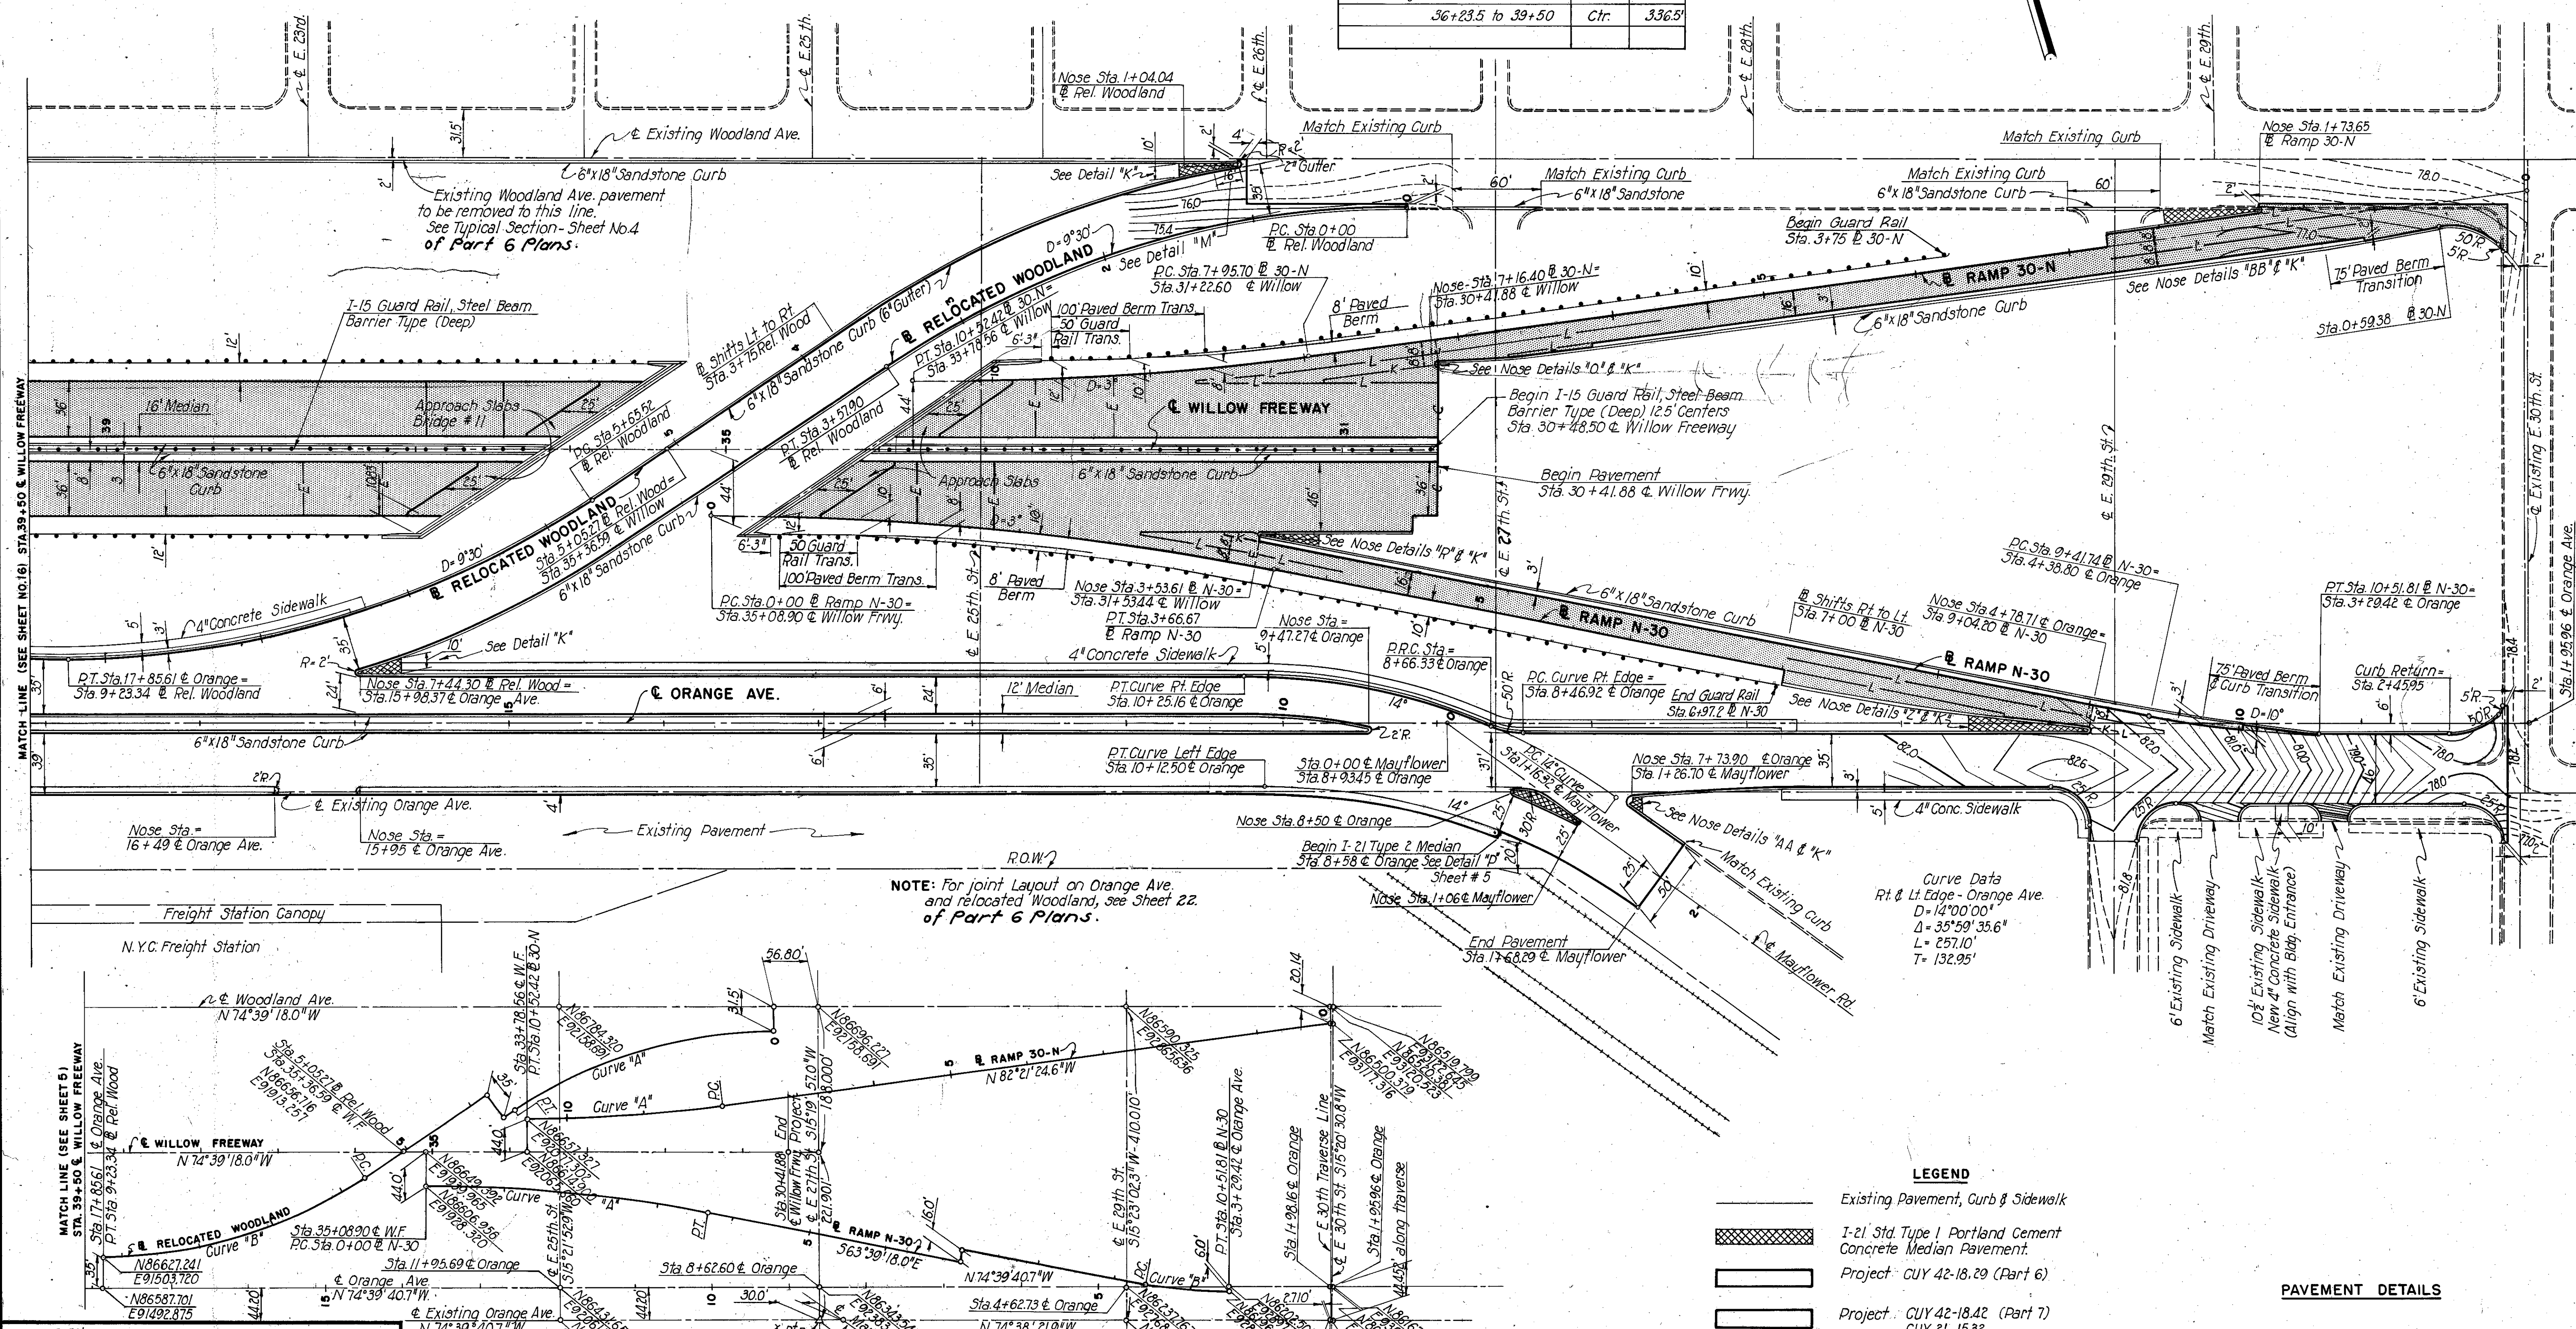

NOTE: For joint layout on Orange Ave. and relocated Woodland, see Sheet 22 of Part 6 Plans.

Curve Data
Rt & Lt Edge - Orange Ave.
D = 14°00'00"
Δ = 35°59'35.6"
L = 257.10'
T = 132.95'

LEGEND

- Existing Pavement, Curb & Sidewalk
- 1-21 Std. Type 1 Portland Cement Concrete Median Pavement
- Project: CUY 42-18.29 (Part 6)
- Project: CUY 42-18.42 (Part 7)
- CUY 21-15.32

PAVEMENT DETAILS

Note: For Orange Ave. Pavement Joints and Contours, see Sheet # 22 of Part 6 Plans.


SCALE: 1"=50'
MADE I.F.S. DATE _____
TRCD. R.R. DATE _____
CKD. L.L.C. DATE _____

HOWARD, NEEDLES, TAMMEN & BERGENDOFF
CONSULTING ENGINEERS
KANSAS CITY CLEVELAND NEW YORK
914 SHEET 17

GEOMETRIC LAYOUT
Scale: 1"=100'

CUYAHOGA COUNTY
CITY OF CLEVELAND
CUY 42-18.42
CUY 21-15.32

GUARD RAIL				
LOCATION	SIDE	LENGTH		
Ramp E-7	2+00 to W. Wall Br. 9	Lt.	552'	
	2+00 to 4+49	Rt.	251'	
Ramp E-10	13+00 to 14+54	Rt.	147'	
	14+00 to W. Wall Br. 8	Lt.	415'	
Ramp E-15	12+57.21 to W. Wall Br. 8	Rt.	258'	
	W. Wall Br. 8 to 18+17	Rt.	104'	
Ramp E-17	W. Wall Br. 8 to 8+32	Rt.	645'	
	4+27 to 6+21.14	Lt.	204'	
	7+7.3 to 8+94	Lt.	141'	
Ramp E-9	0+00 to 2+00	Lt.	204'	
	1+67 to 2+00	Rt.	33'	
Ramp E-14	4+00 to 6+00	Rt.	188'	
	4+20 to 7+70	Lt.	361'	
Willow Frwy.	48+45 to W. Wall Br. 8	Rt.	80'	
BARRIER RAIL				
Willow Frwy.	48+00 to Bridge 8	Ctr.	129'	
	Bridge 8 to 51+86	Ctr.	79'	

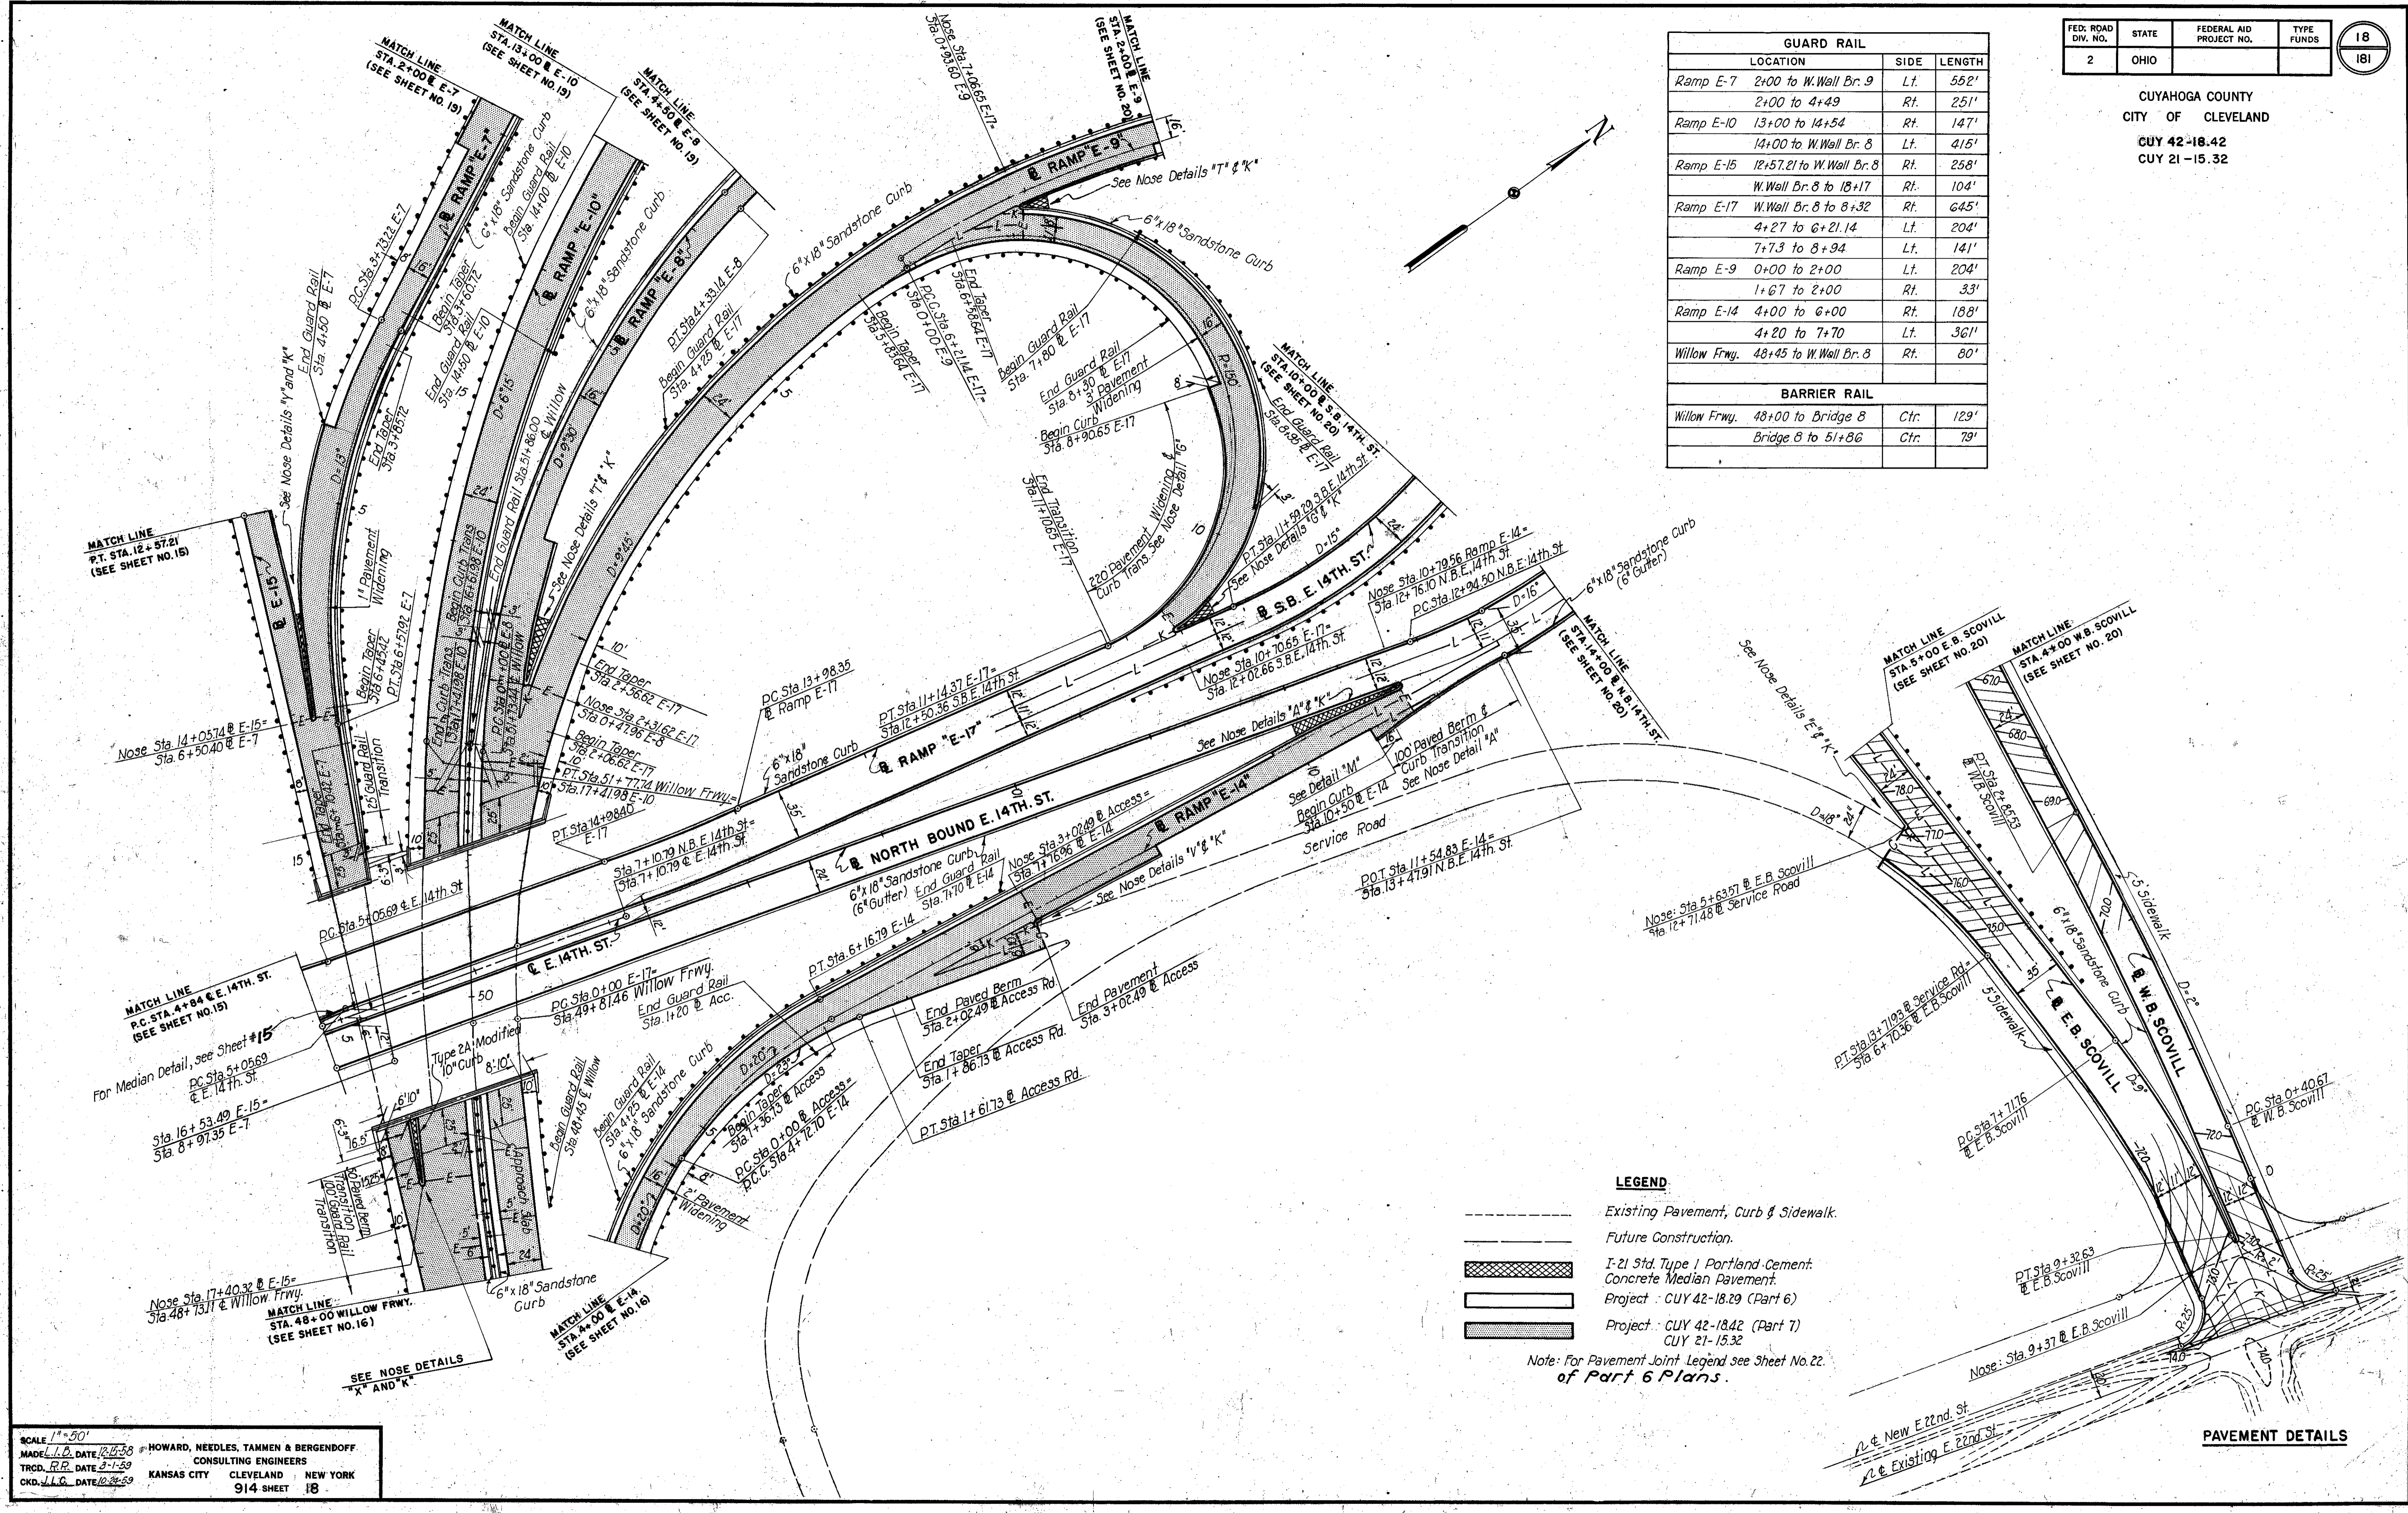

LEGEND


- Existing Pavement, Curb & Sidewalk.
- Future Construction.
- ▨ I-21 Std. Type 1 Portland-Cement Concrete Median Pavement.
- ▨ Project: CUY 42-18.29 (Part 6)
- ▨ Project: CUY 42-18.42 (Part 7)
- ▨ CUY 21-15.32

Note: For Pavement Joint Legend see Sheet No. 22 of Part 6 Plans.

SCALE 1"=50'
MADE L.D. DATE 12-15-58 HOWARD, NEEDLES, TAMMEN & BERGENDOFF CONSULTING ENGINEERS
TRCD. R.R. DATE 2-1-59 KANSAS CITY CLEVELAND NEW YORK
CKD. L.L.C. DATE 12-22-59 914 SHEET 18

PAVEMENT DETAILS

CUYAHOGA COUNTY
CITY OF CLEVELAND
CUY 42-18-42
CUY 21-15-32

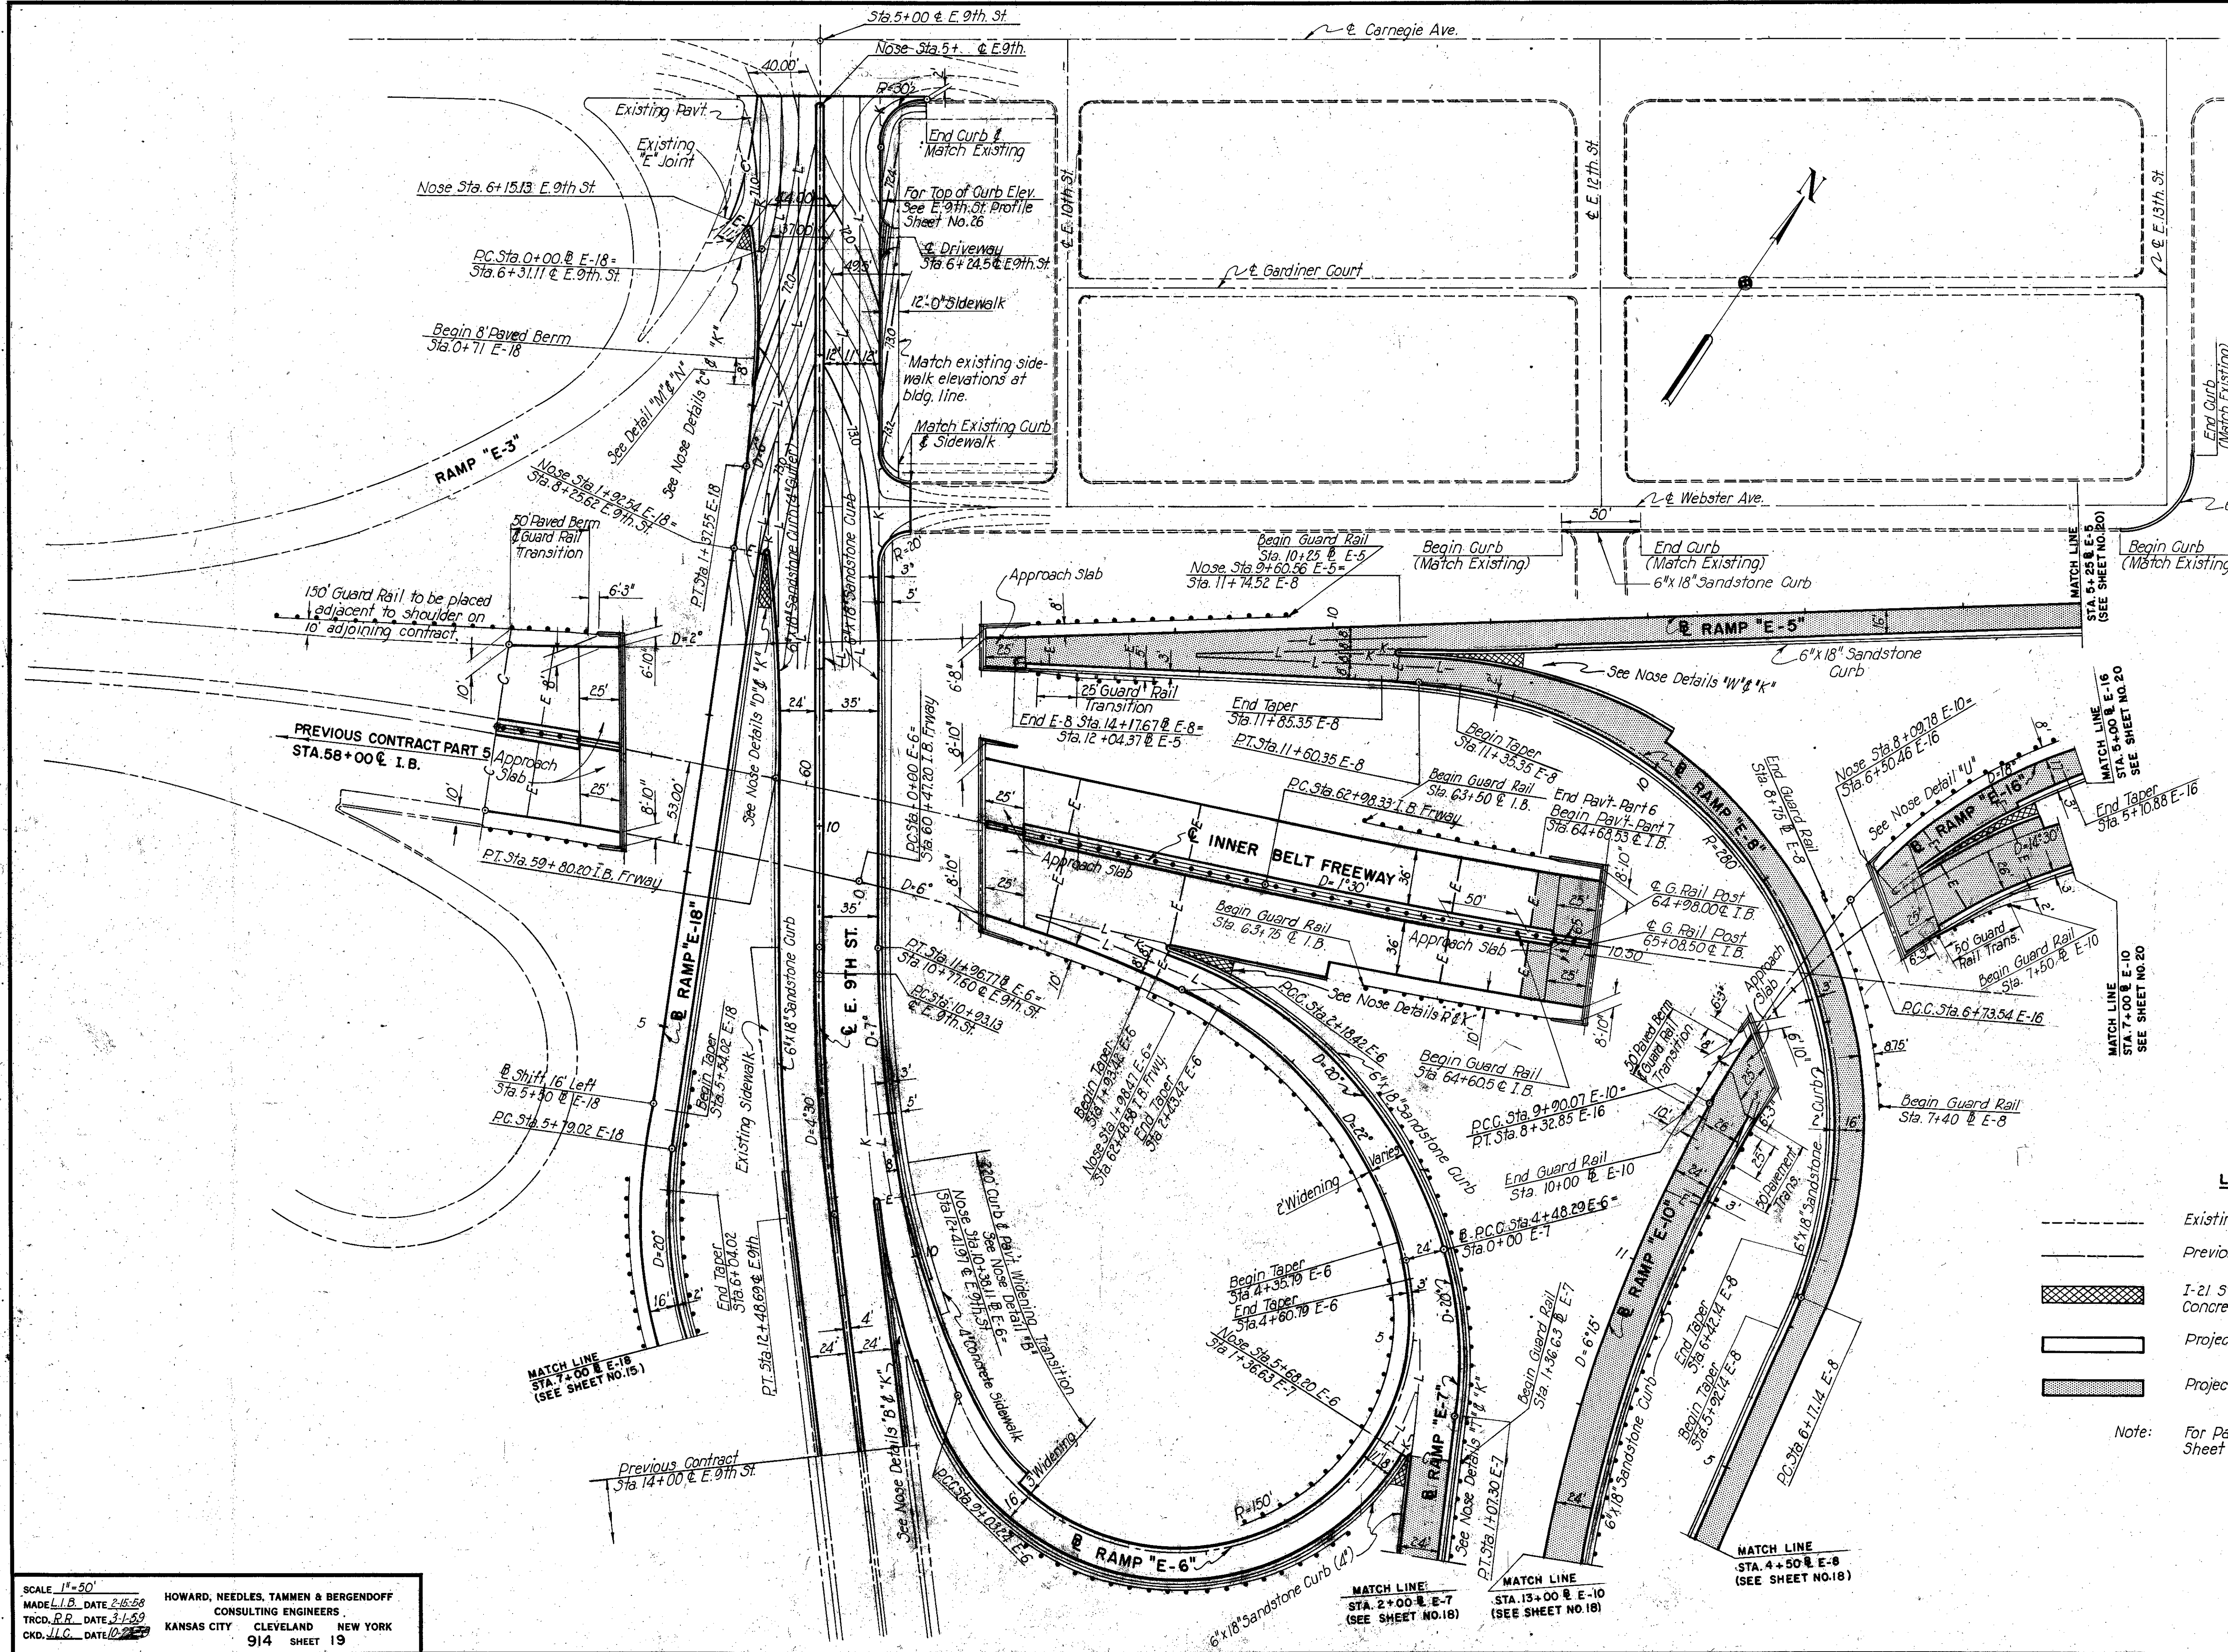

GUARD RAIL			
Location	Side	Length	
Ramp E-5 10+26 to W.Wall Br. 2	Rt.	185'	
Ramp E-8 7+40 to 8+75	Rt.	142'	
Ramp E-10 W.Wall Br. 5 to 13+00	Rt.	303'	
7+48 to W.Wall Br. 5	Lt.	57'	
Ramp E-7 1+36.63 to 2+00	Lt.	63'	
Ramp E-16 5+00 to W.Wall Br. 5	Rt.	137'	
W.Wall Br. 5 to 8+45	Rt.	58'	
Inner Belt 63+50 to W.Wall Br. 3	Lt.	120'	
63+75 to W.Wall Br. 3	Rt.	122'	
BARRIER RAIL			
Inner Belt 64+60.5 to Bridge 3	Ctr.	48'	


LEGEND

- Existing Pavement, Curb & Sidewalk
- Previous Contract
- I-21 Std. Type 1 Portland Cement Concrete Median Pavement
- Project: CUY 42-18-29 (Part 6)
- Project: CUY 42-18-42 (Part 7) CUY 21-15-32

Note: For Pavement Joint Legend, see Sheet No. 22 of Part 6 Plans.

PAVEMENT DETAILS

GUARD RAIL		
LOCATION	SIDE	LENGTH
Ramp E-9 2+00 to W. Wall Br. 4	Rt.	233'
2+00 to W. Wall Br. 4	Lt.	257'
Ramp E-10 W. Wall Br. 4 to 6+25	Rt.	220'
W. Wall Br. 4 to 5+25	Lt.	120'
Ramp E-16 3+50 to 5+00	Rt.	150'
Inner Belt W. Wall Br. 3 to W. Wall Br. 4	Lt.	201'
W. Wall Br. 3 to W. Wall Br. 4	Rt.	260'
W. Wall Br. 4 to 77+75	Lt.	368'
W. Wall Br. 4 to 77+75	Rt.	366'
BARRIER RAIL		
Inner Belt 68+21 to 70+83.5	Ctr.	262.5'
74+05.25 to 83+05.25	Ctr.	900'

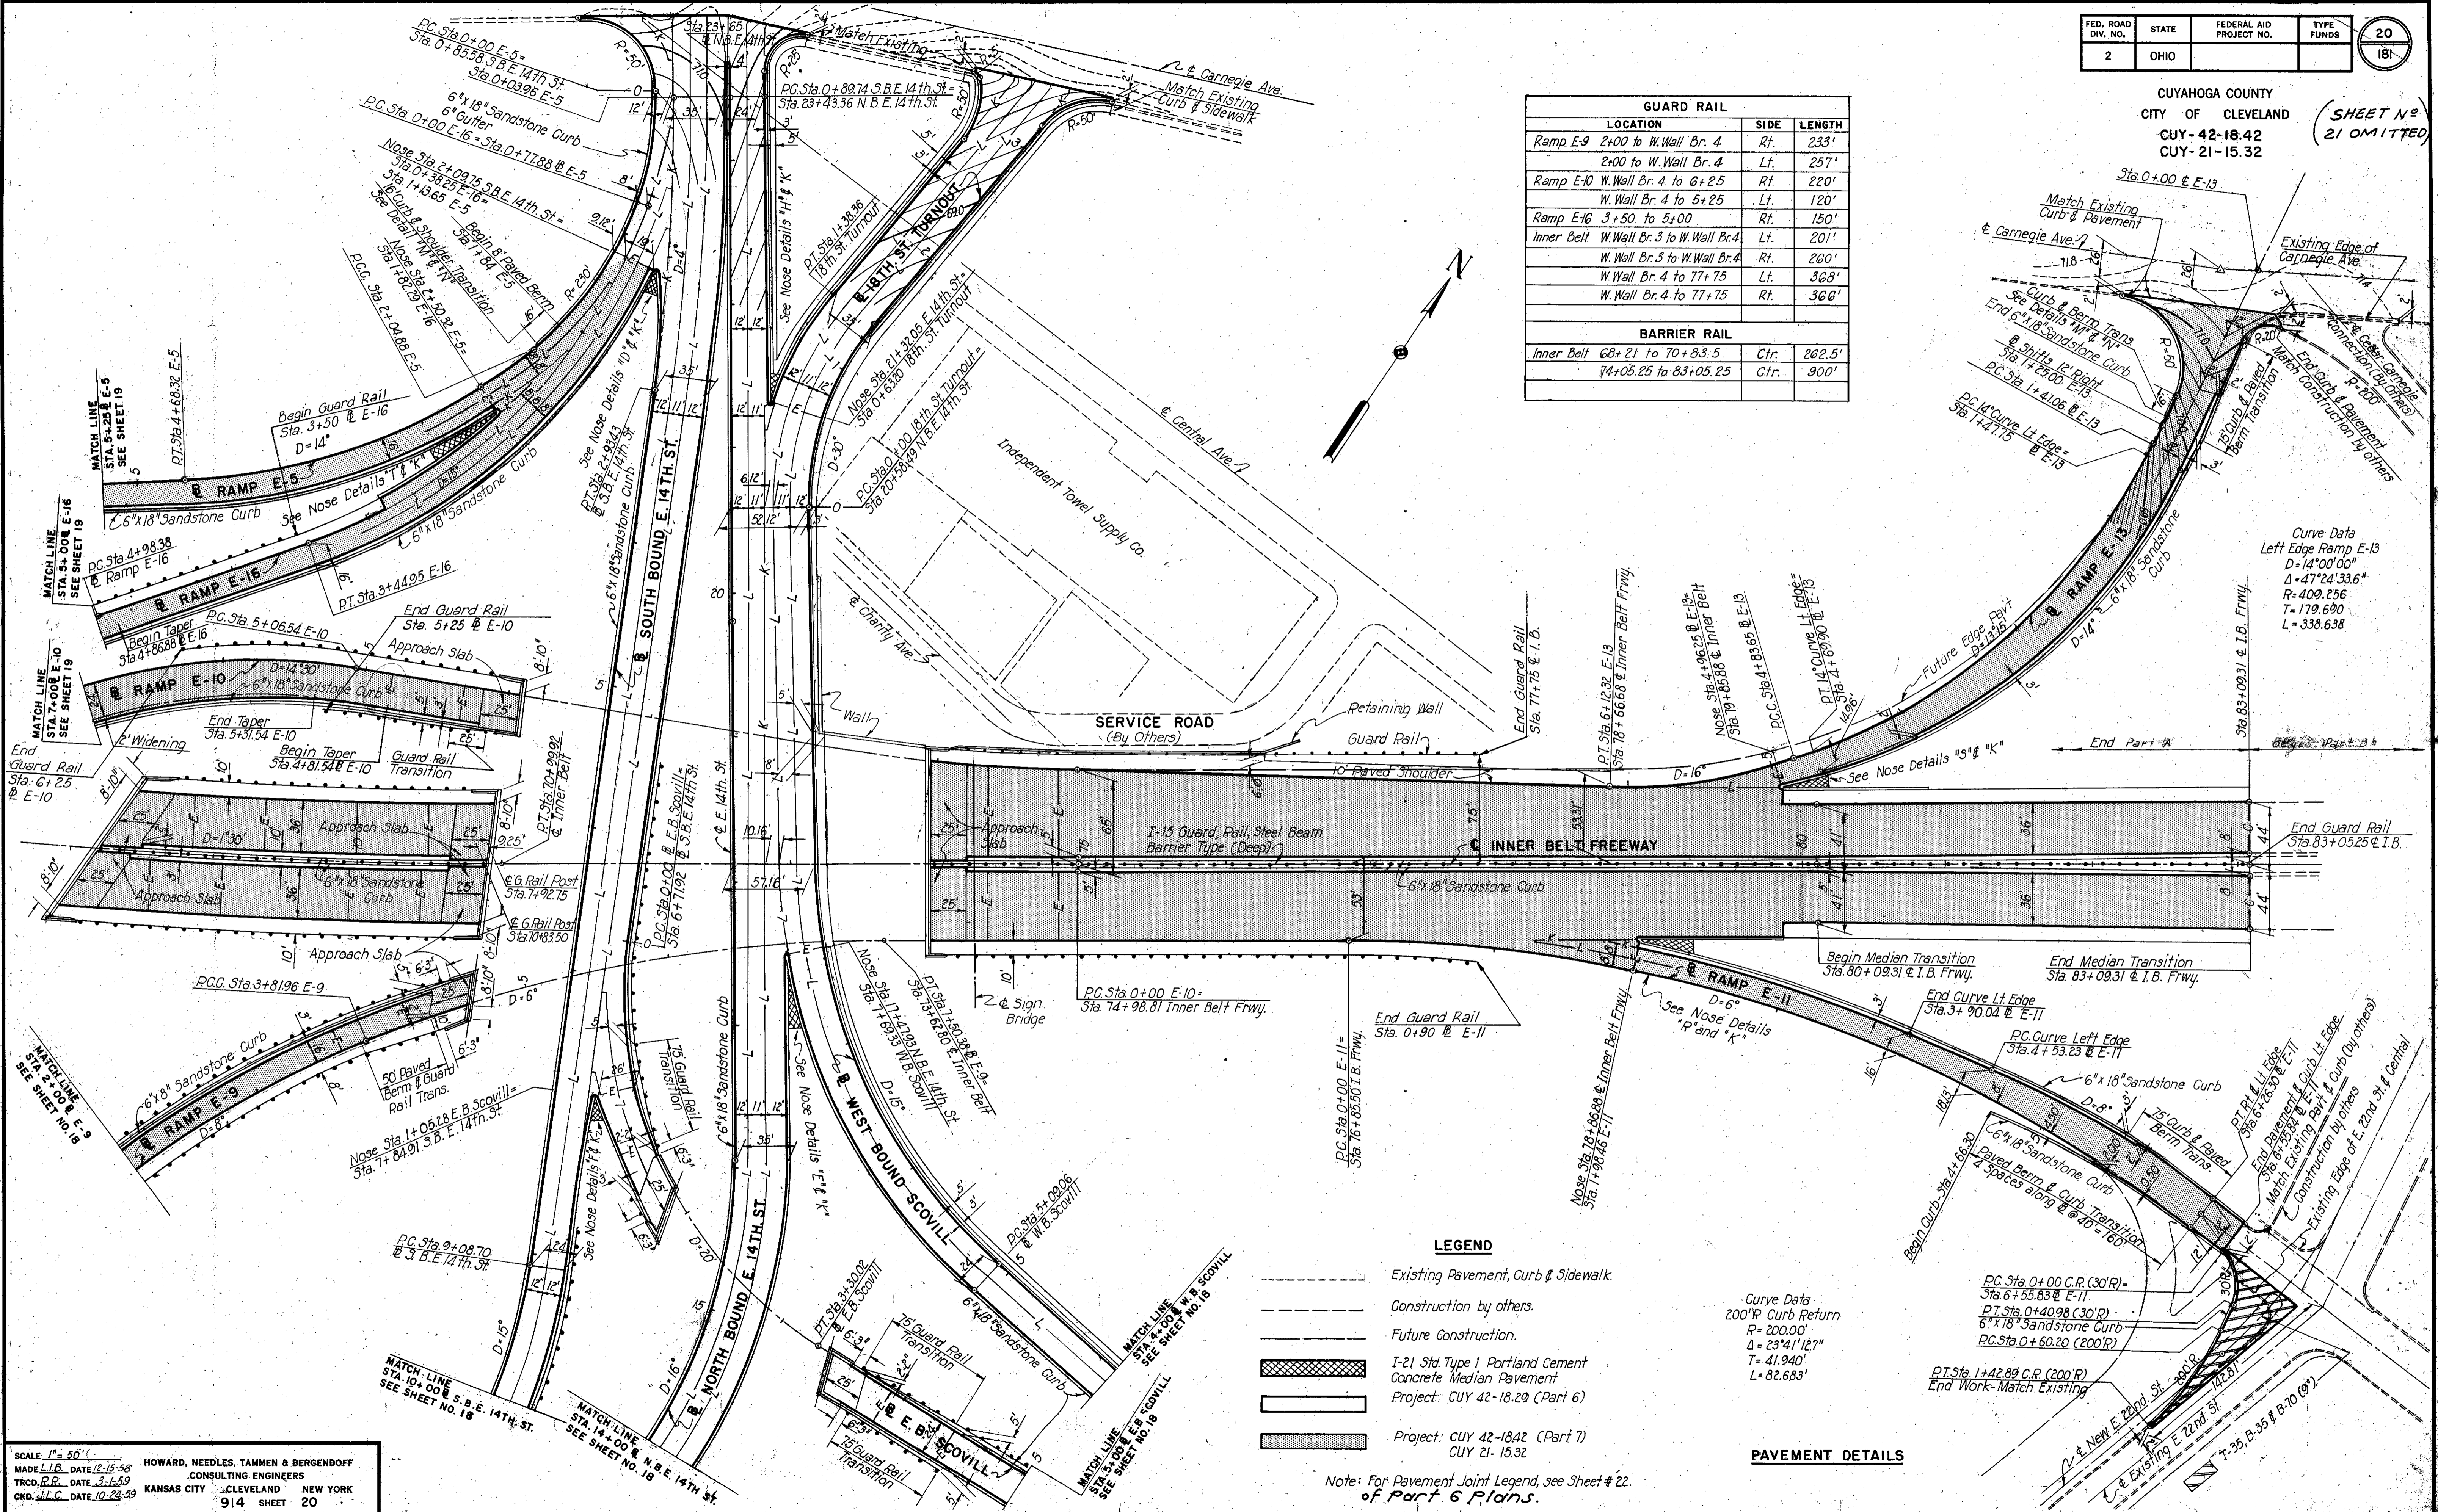

Curve Data
Left Edge Ramp E-13
D=14°00'00"
Δ=47°24'33.6"
R=409.256
T=179.690
L=338.638



Curve Data
200' R Curb Return
R=200.00'
Δ=23°41'12.7"
T=41.940'
L=82.683'

PAVEMENT DETAILS

- LEGEND**
- - - Existing Pavement, Curb & Sidewalk.
 - - - Construction by others.
 - - - Future Construction.
 - ▨ I-21 Std. Type 1 Portland Cement Concrete Median Pavement Project: CUY 42-18.29 (Part 6)
 - ▨ Project: CUY 42-18.42 (Part 7) CUY 21-15.32

Note: For Pavement Joint Legend, see Sheet # 22 of Part 6 Plans.





CUYAHOGA COUNTY
 CITY OF CLEVELAND
 CUY-42-18.42 (SHEET N^o 21 OMITTED)
 CUY-21-15.32
 PROFILES

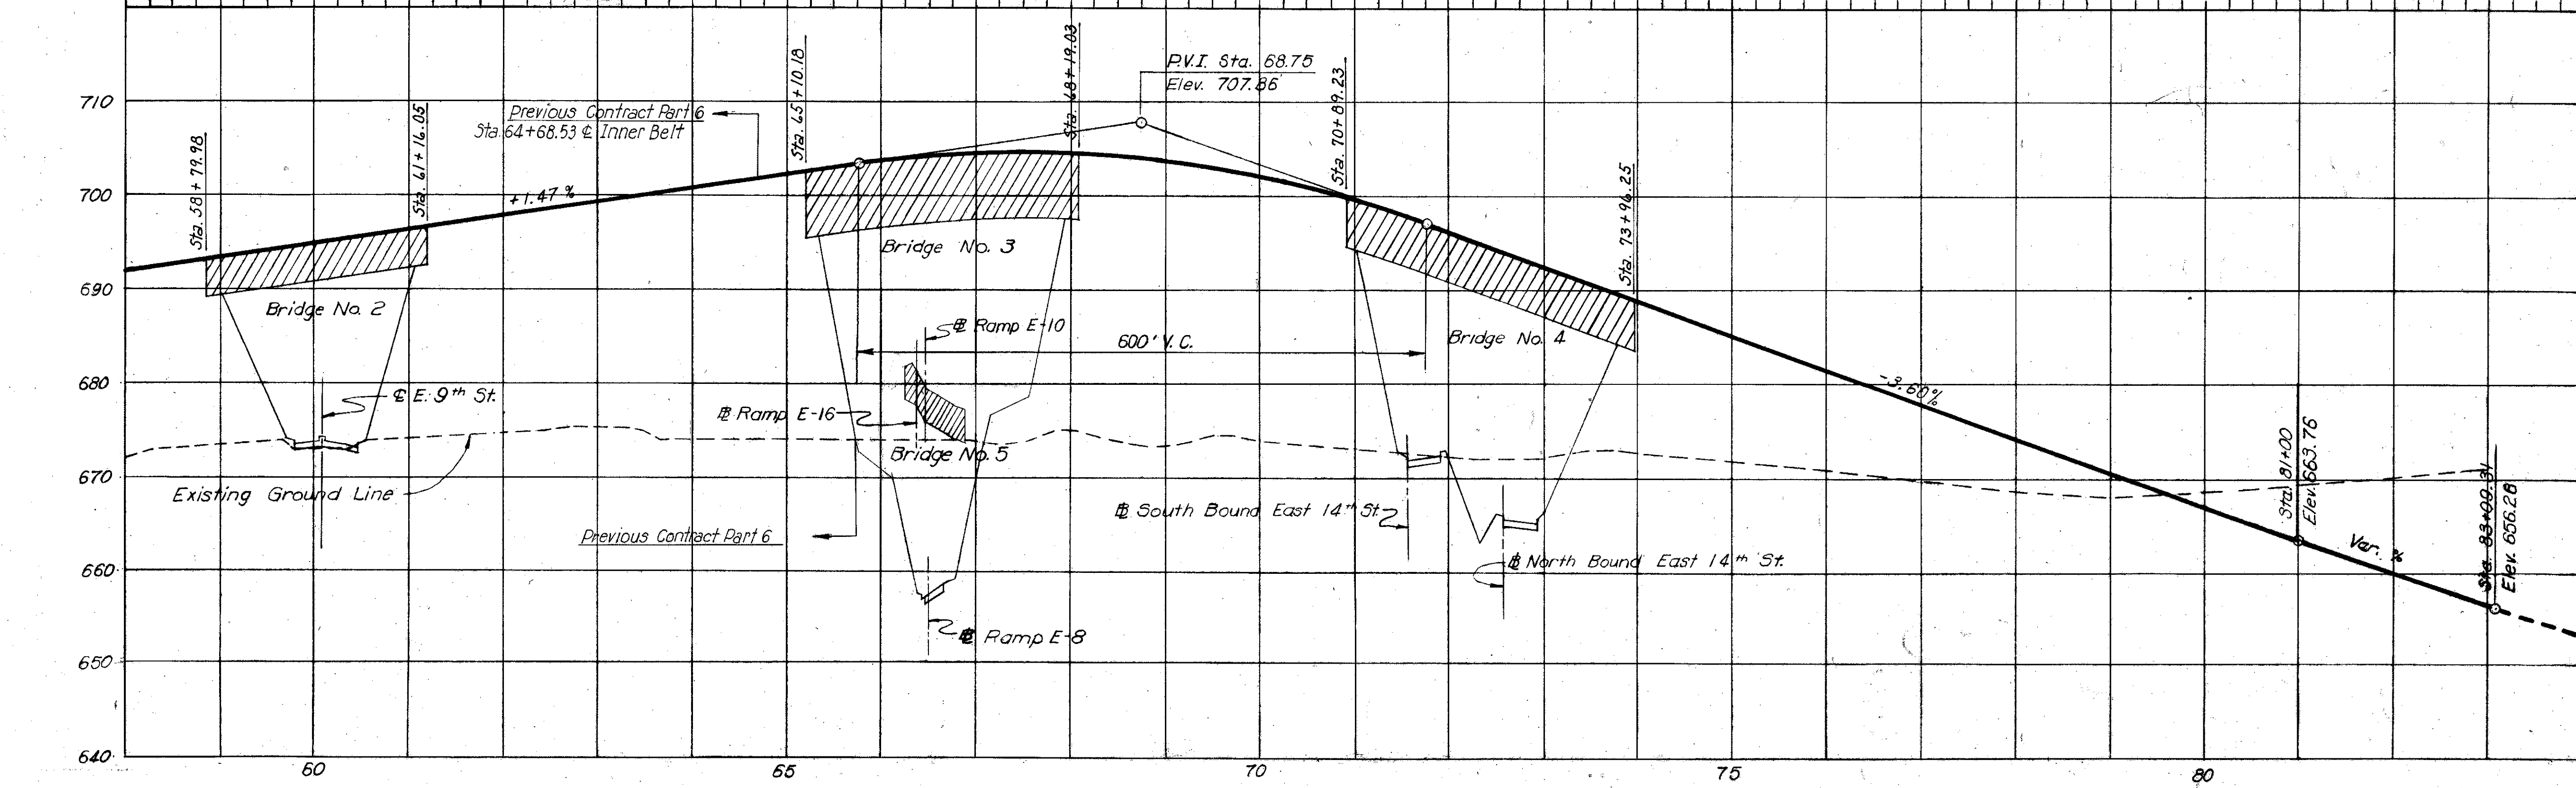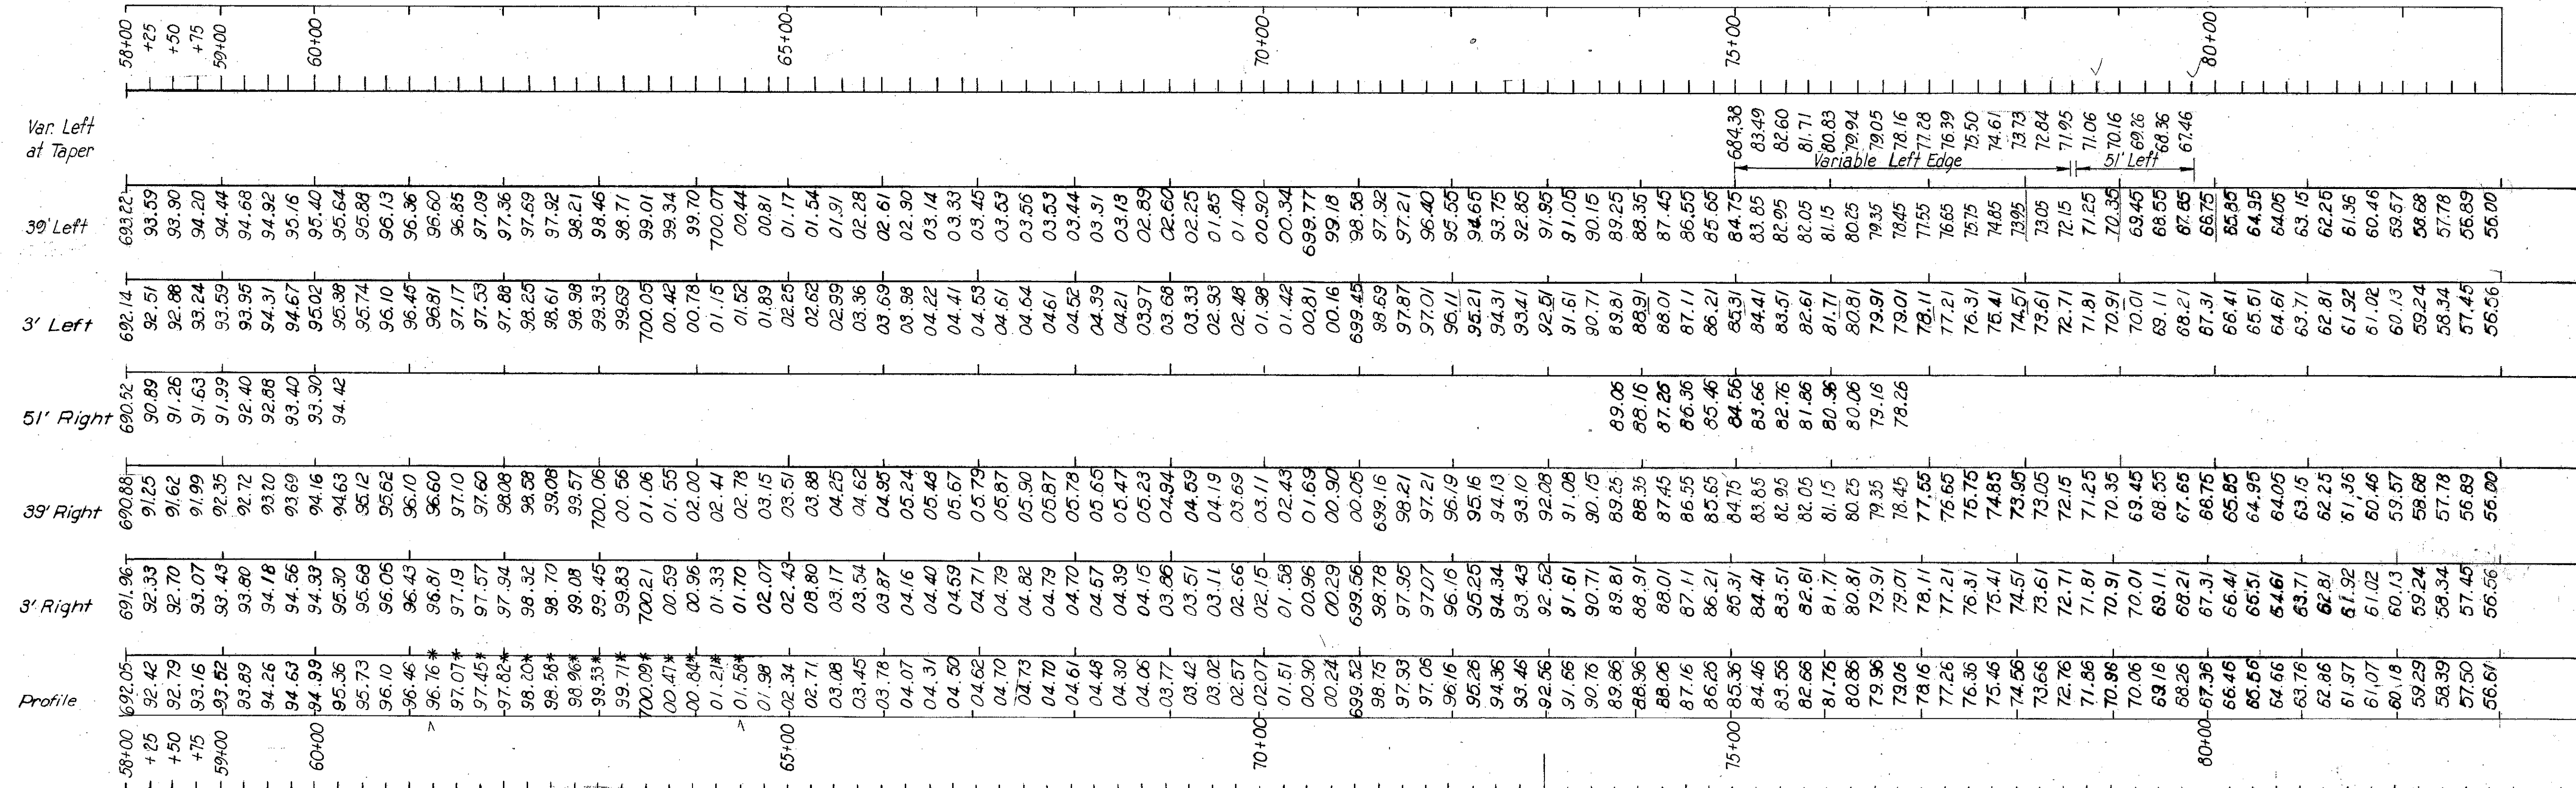

INNER BELT

* Note:
 Profile grade elevations were lowered to produce a .04% super elevation in the 3' right area for drainage purposes.


CUYAHOGA COUNTY
CITY OF CLEVELAND
CUY-42-18-42
INNER BELT FREEWAY - PART
CUY-21-1532
PROFILES

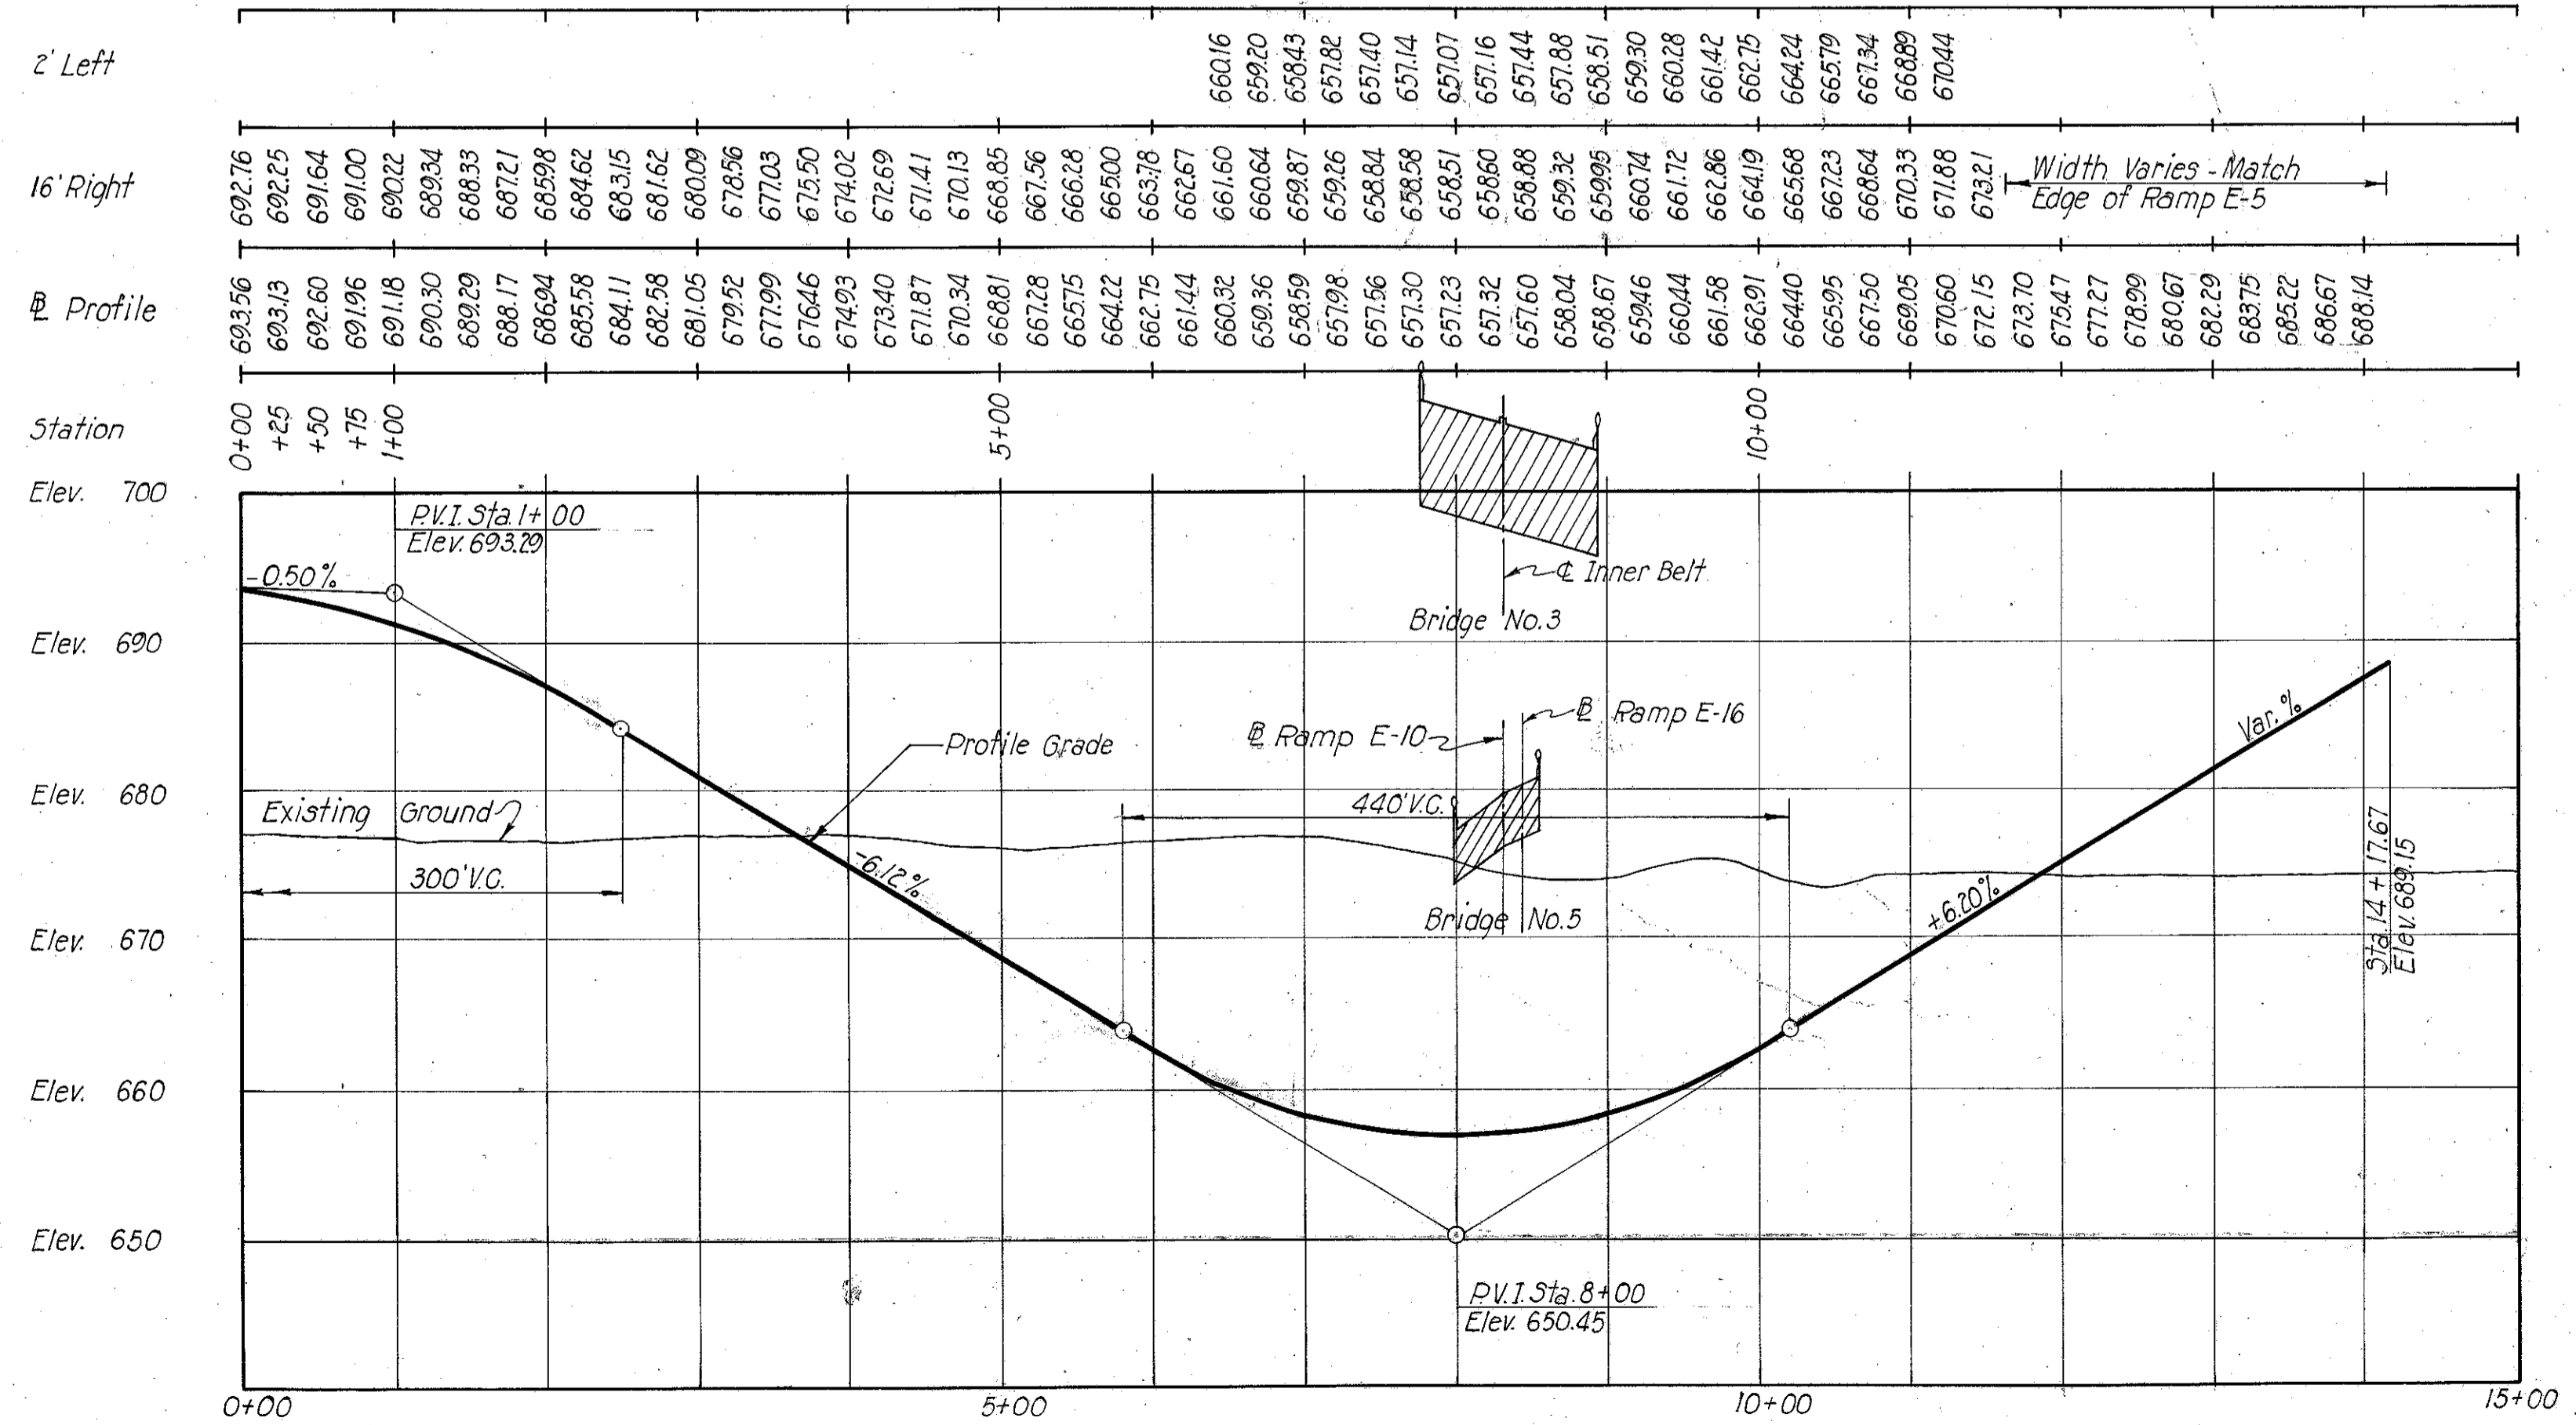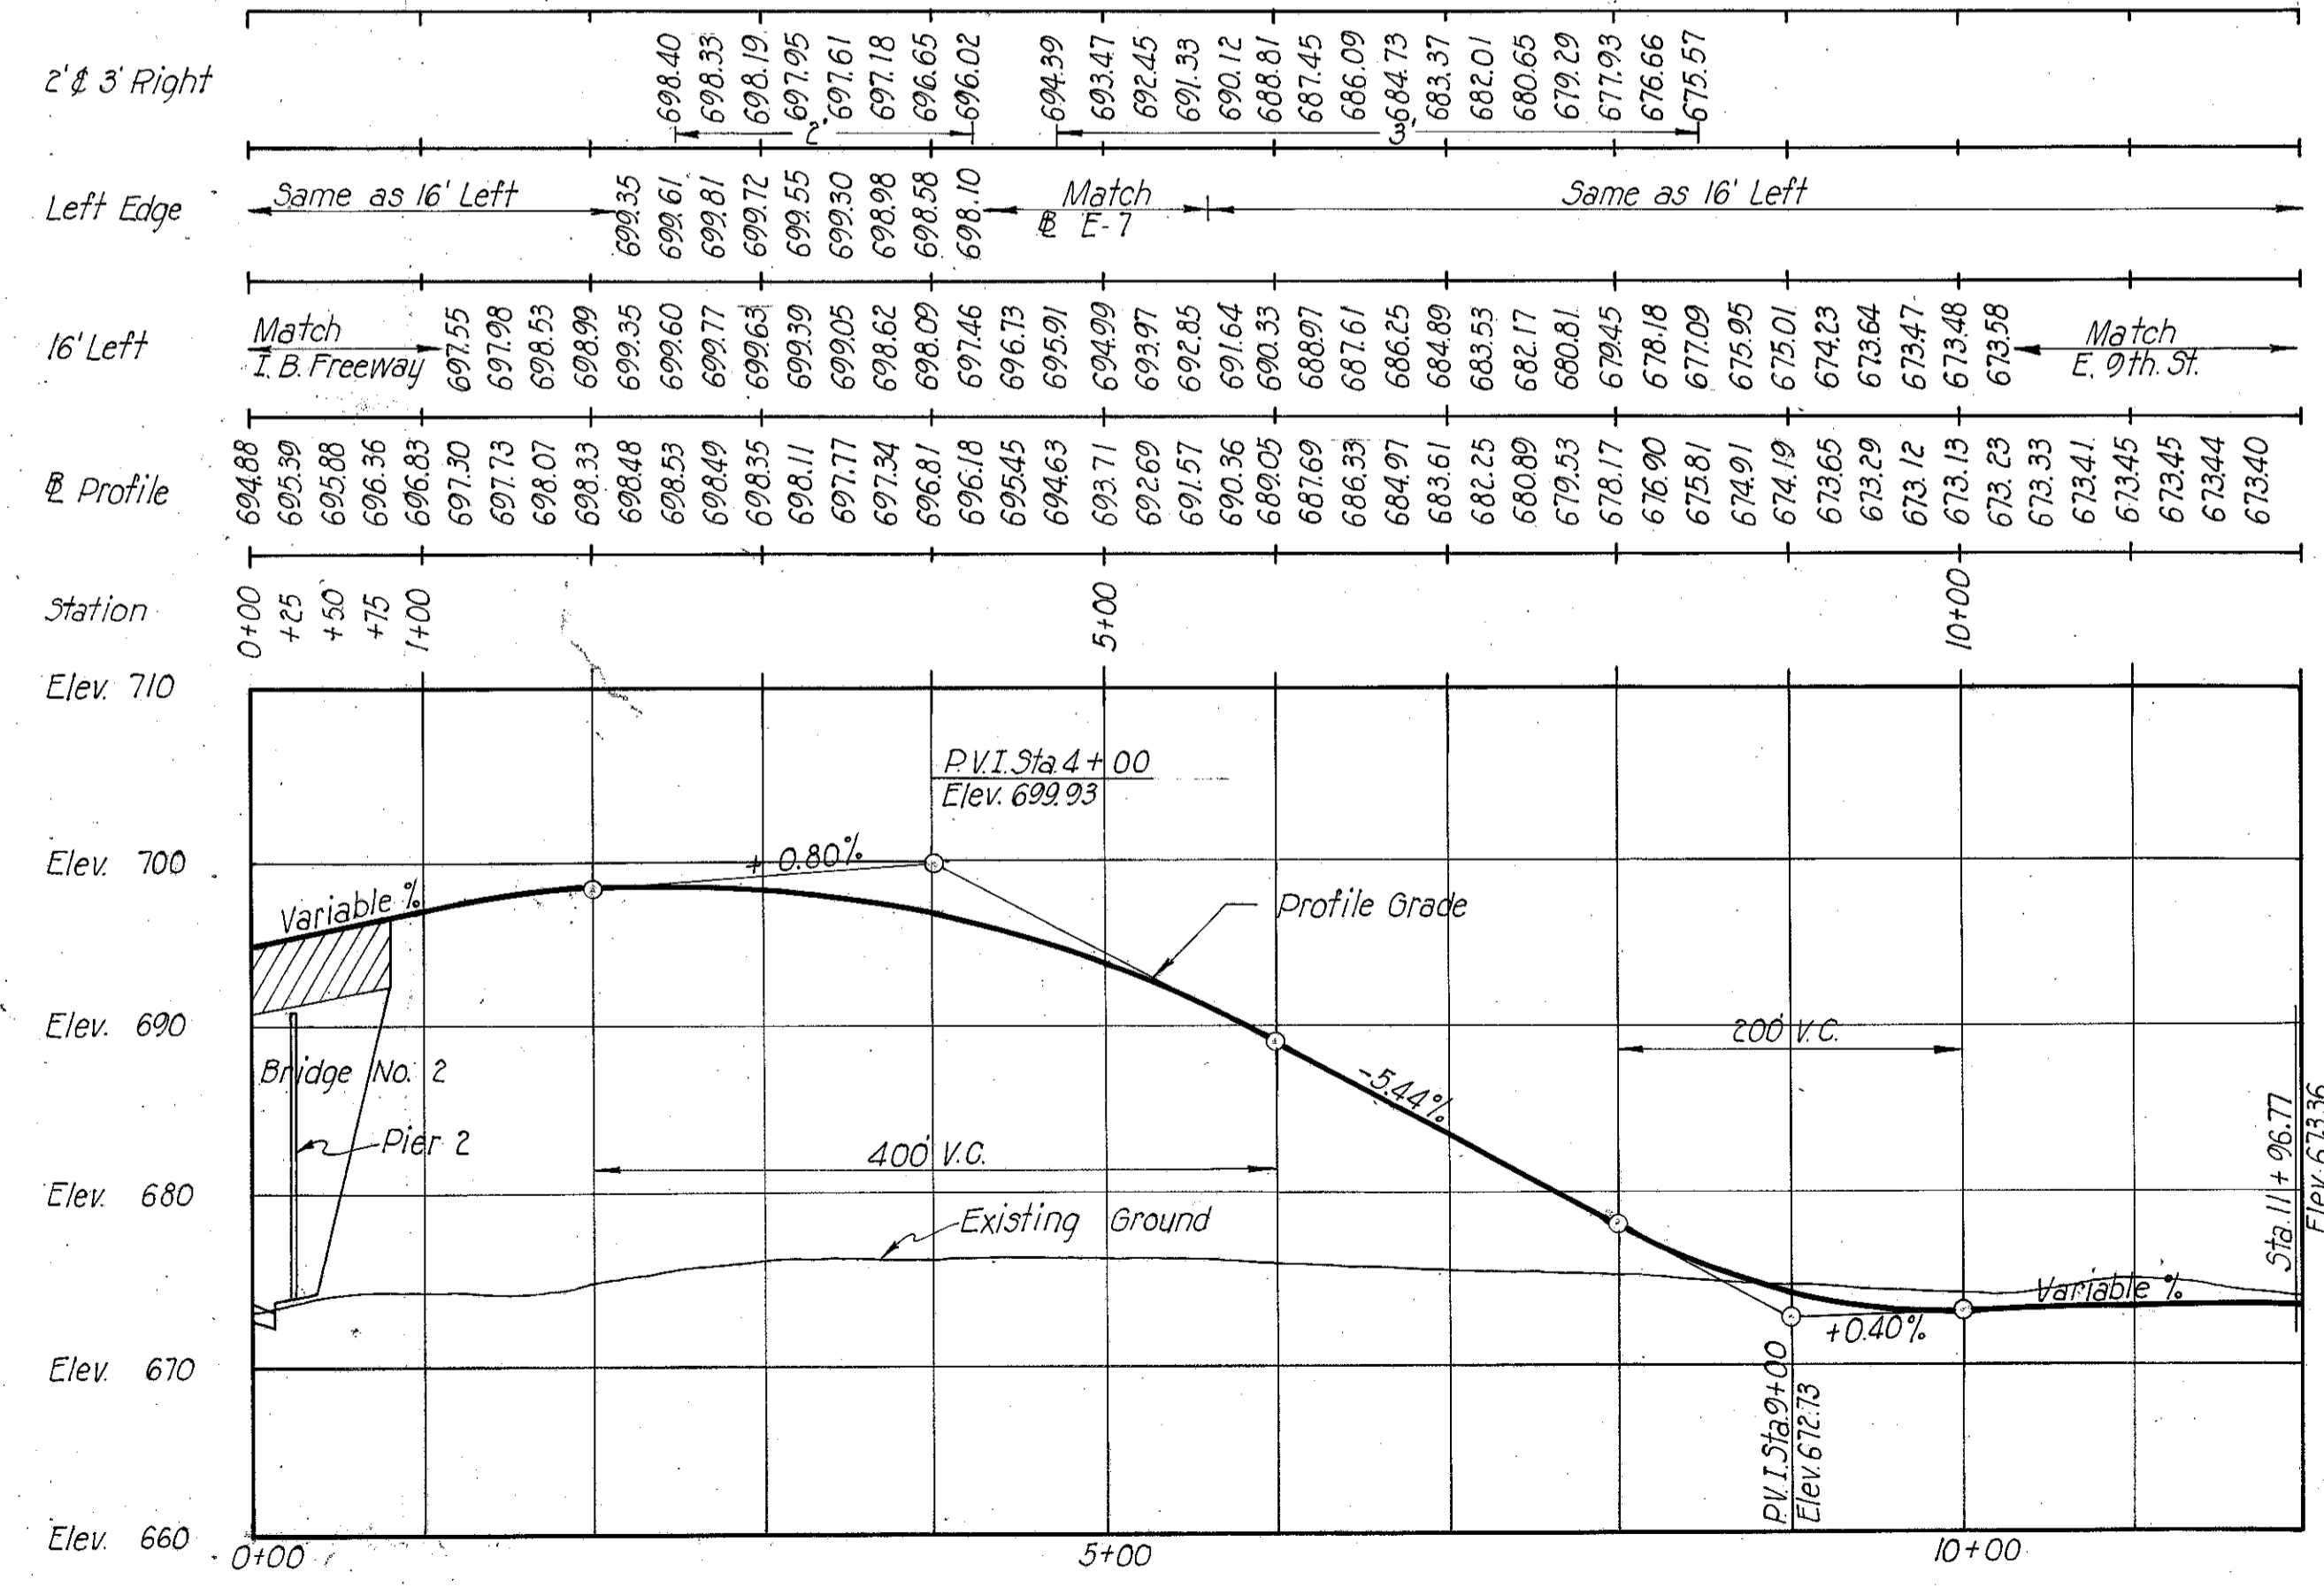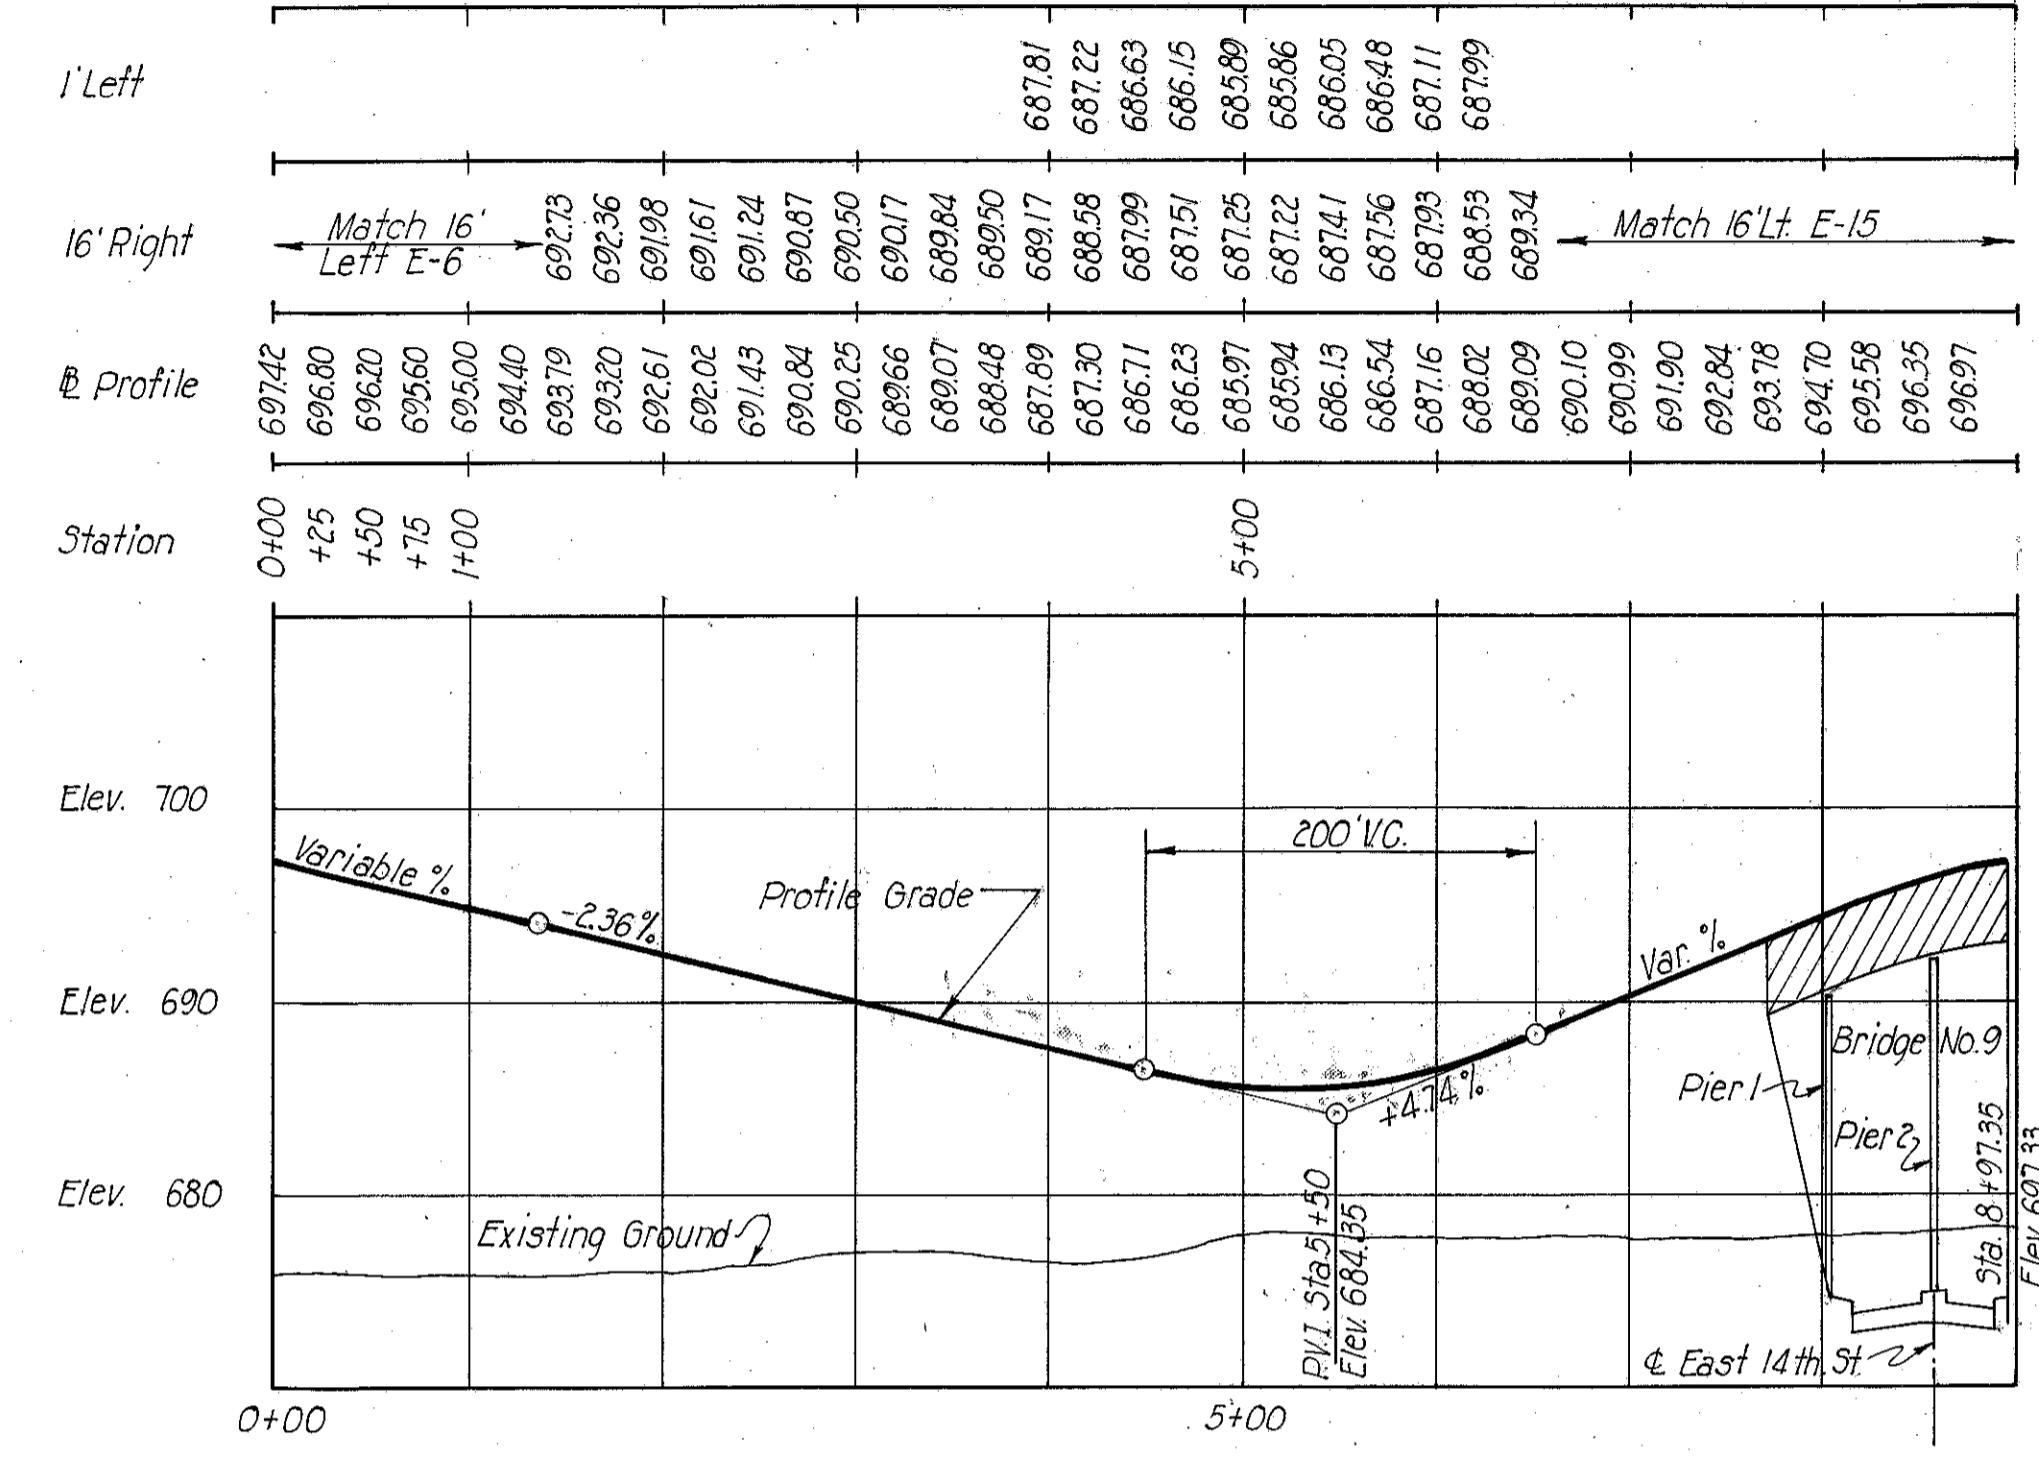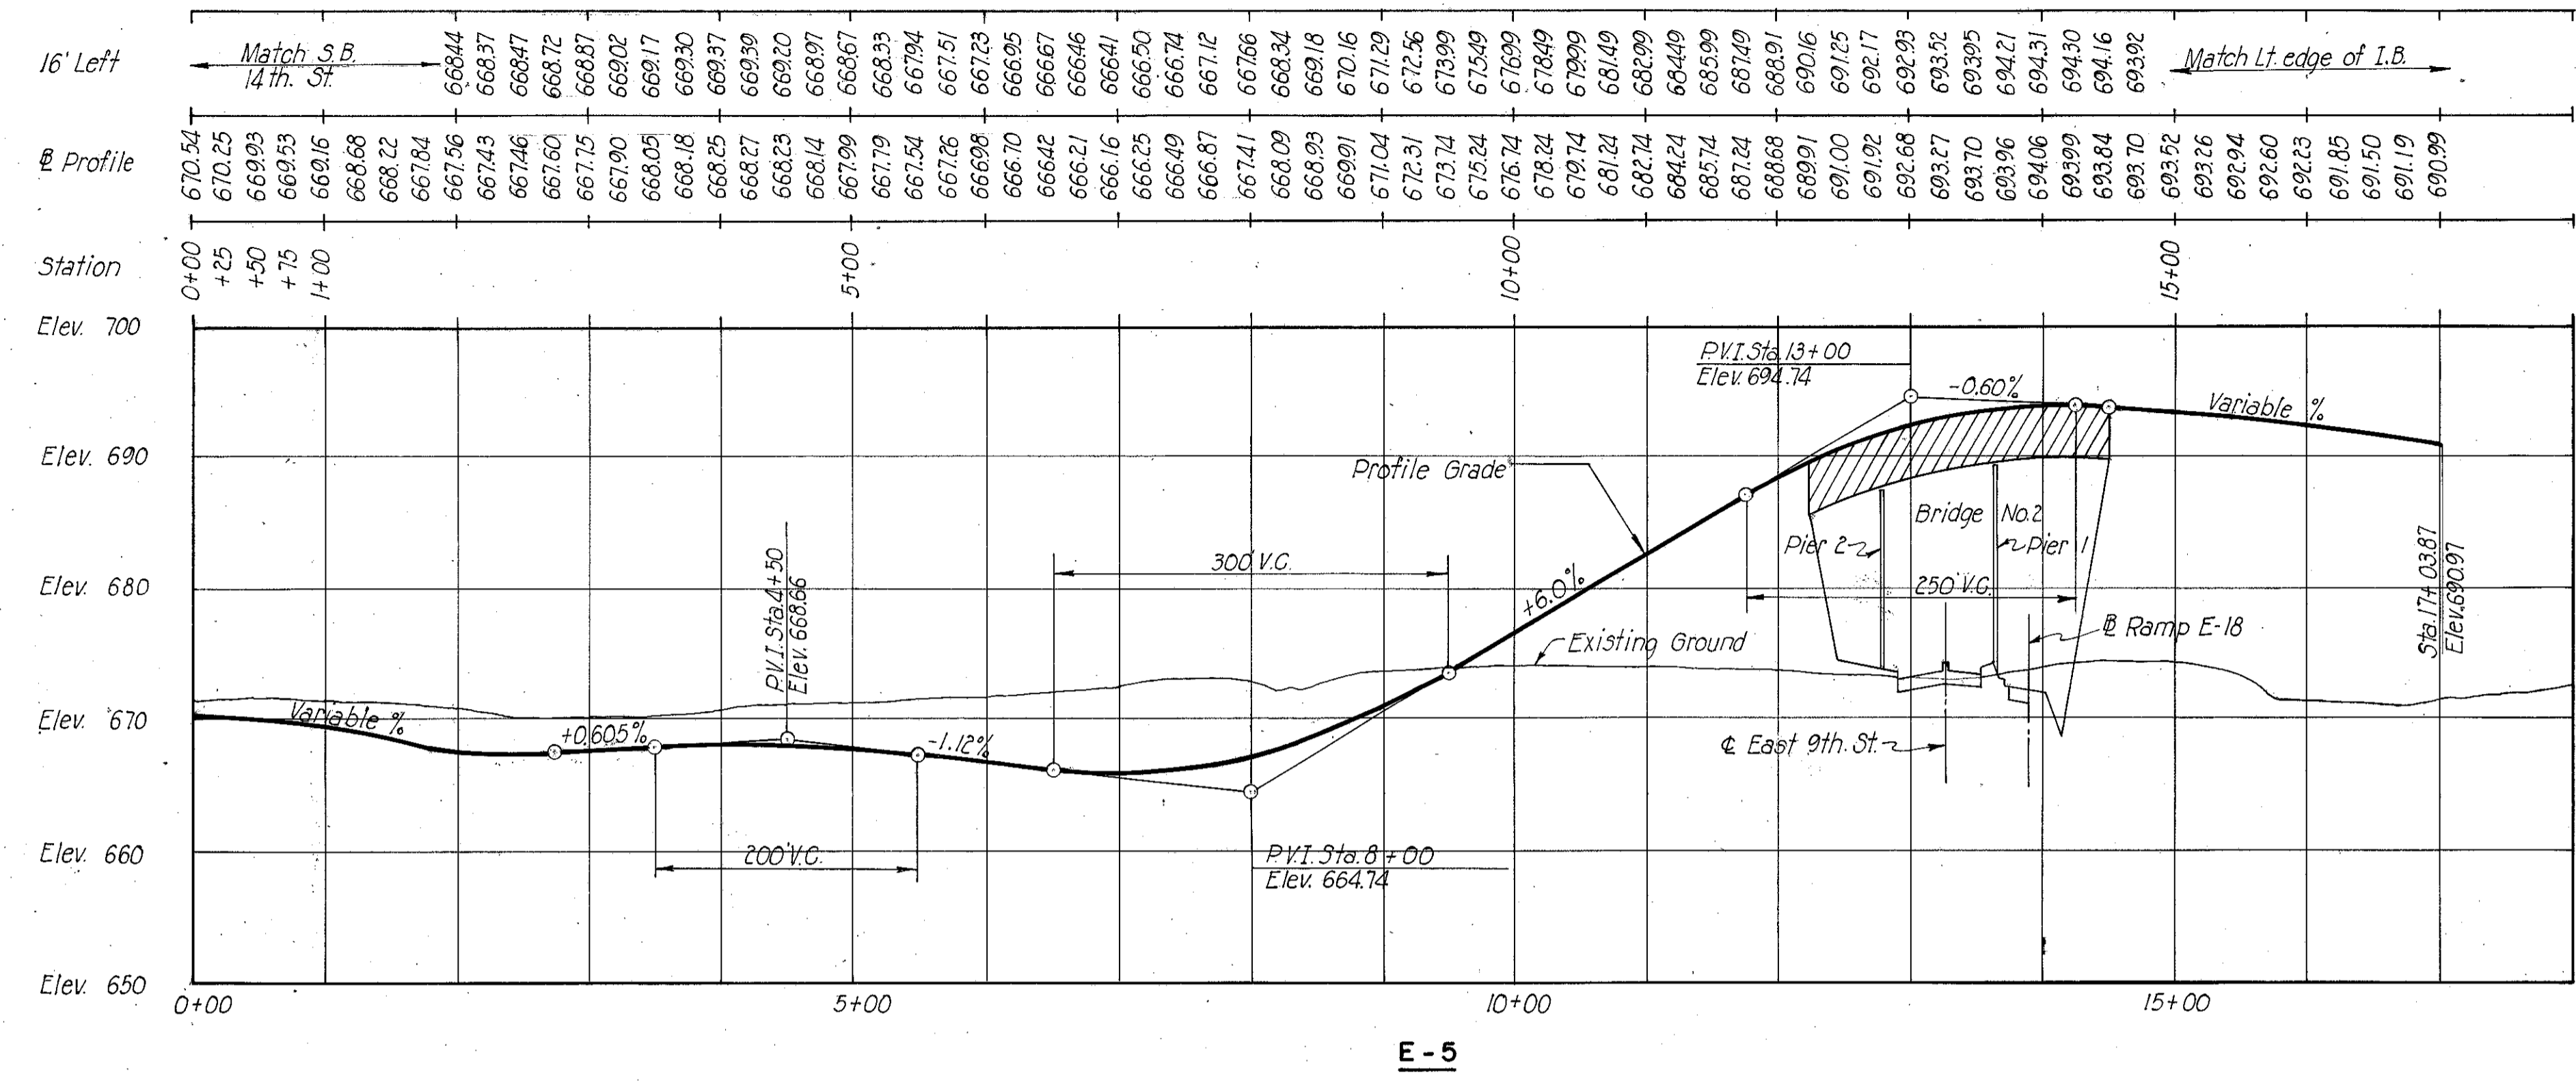


SCALE 1"=10' Ver.: 1"=100' Hor.
MADE BY DDH DATE 8-14-58 HOWARD, NEEDLES, TAMMEN & BERGENDOFF
TRCD. RE DATE 12/16/58 CONSULTING ENGINEERS
CKD. G.M.G. DATE 2-16-59 KANSAS CITY CLEVELAND NEW YORK
914 SHEET 23

* Not applicable to this contract


CUYAHOGA COUNTY
CITY OF CLEVELAND
INNER CUY-42-18.42
CUY-21-15.32
PROFILES

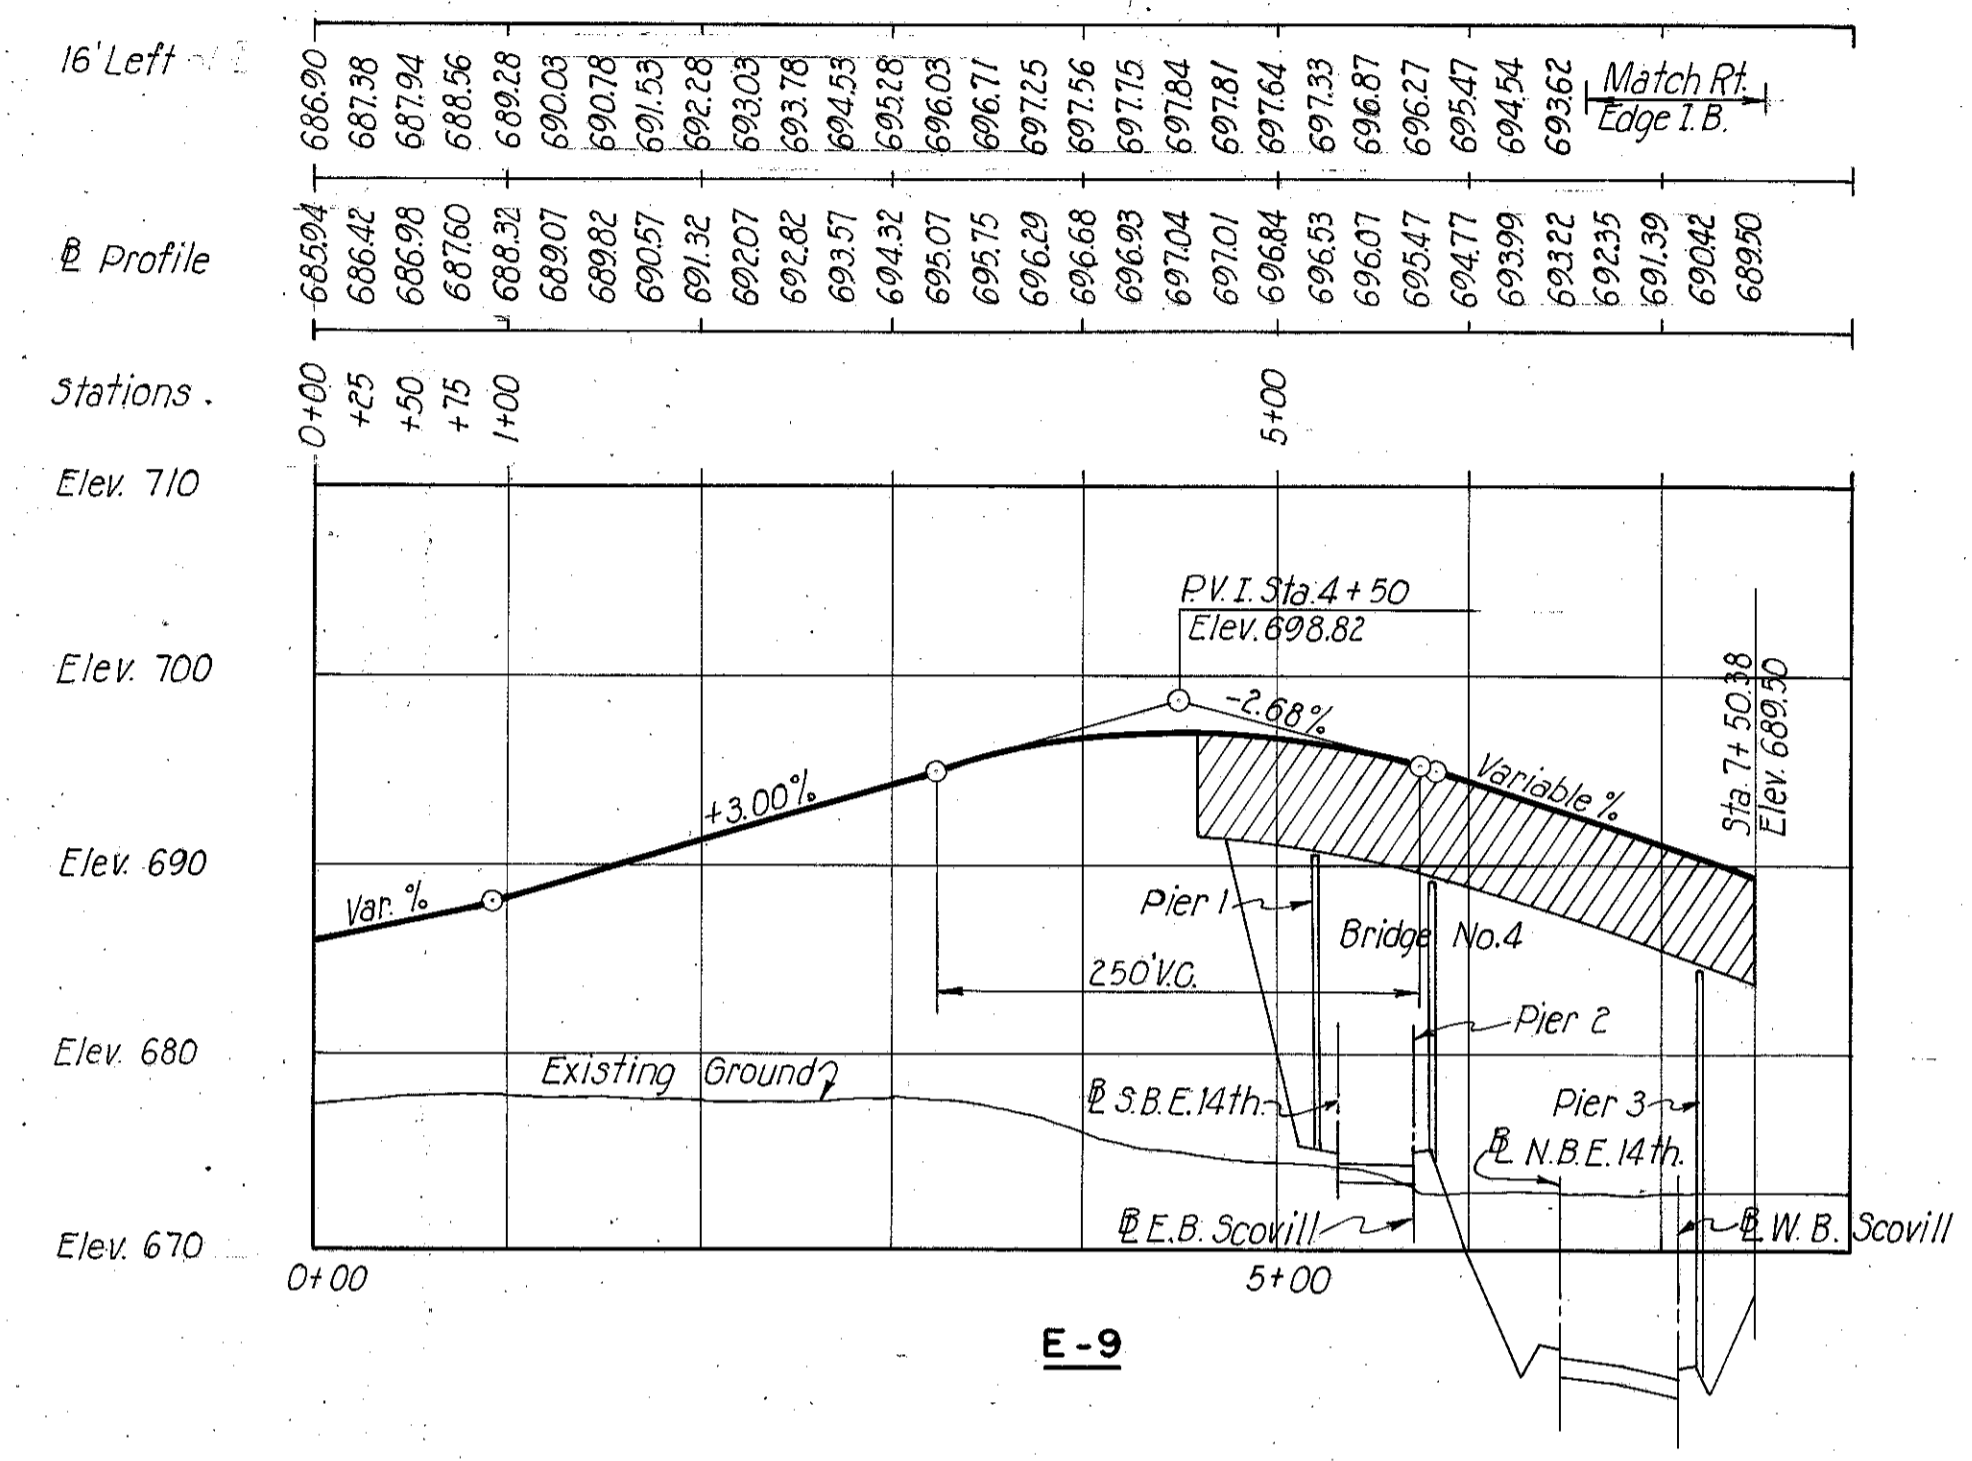


E-9

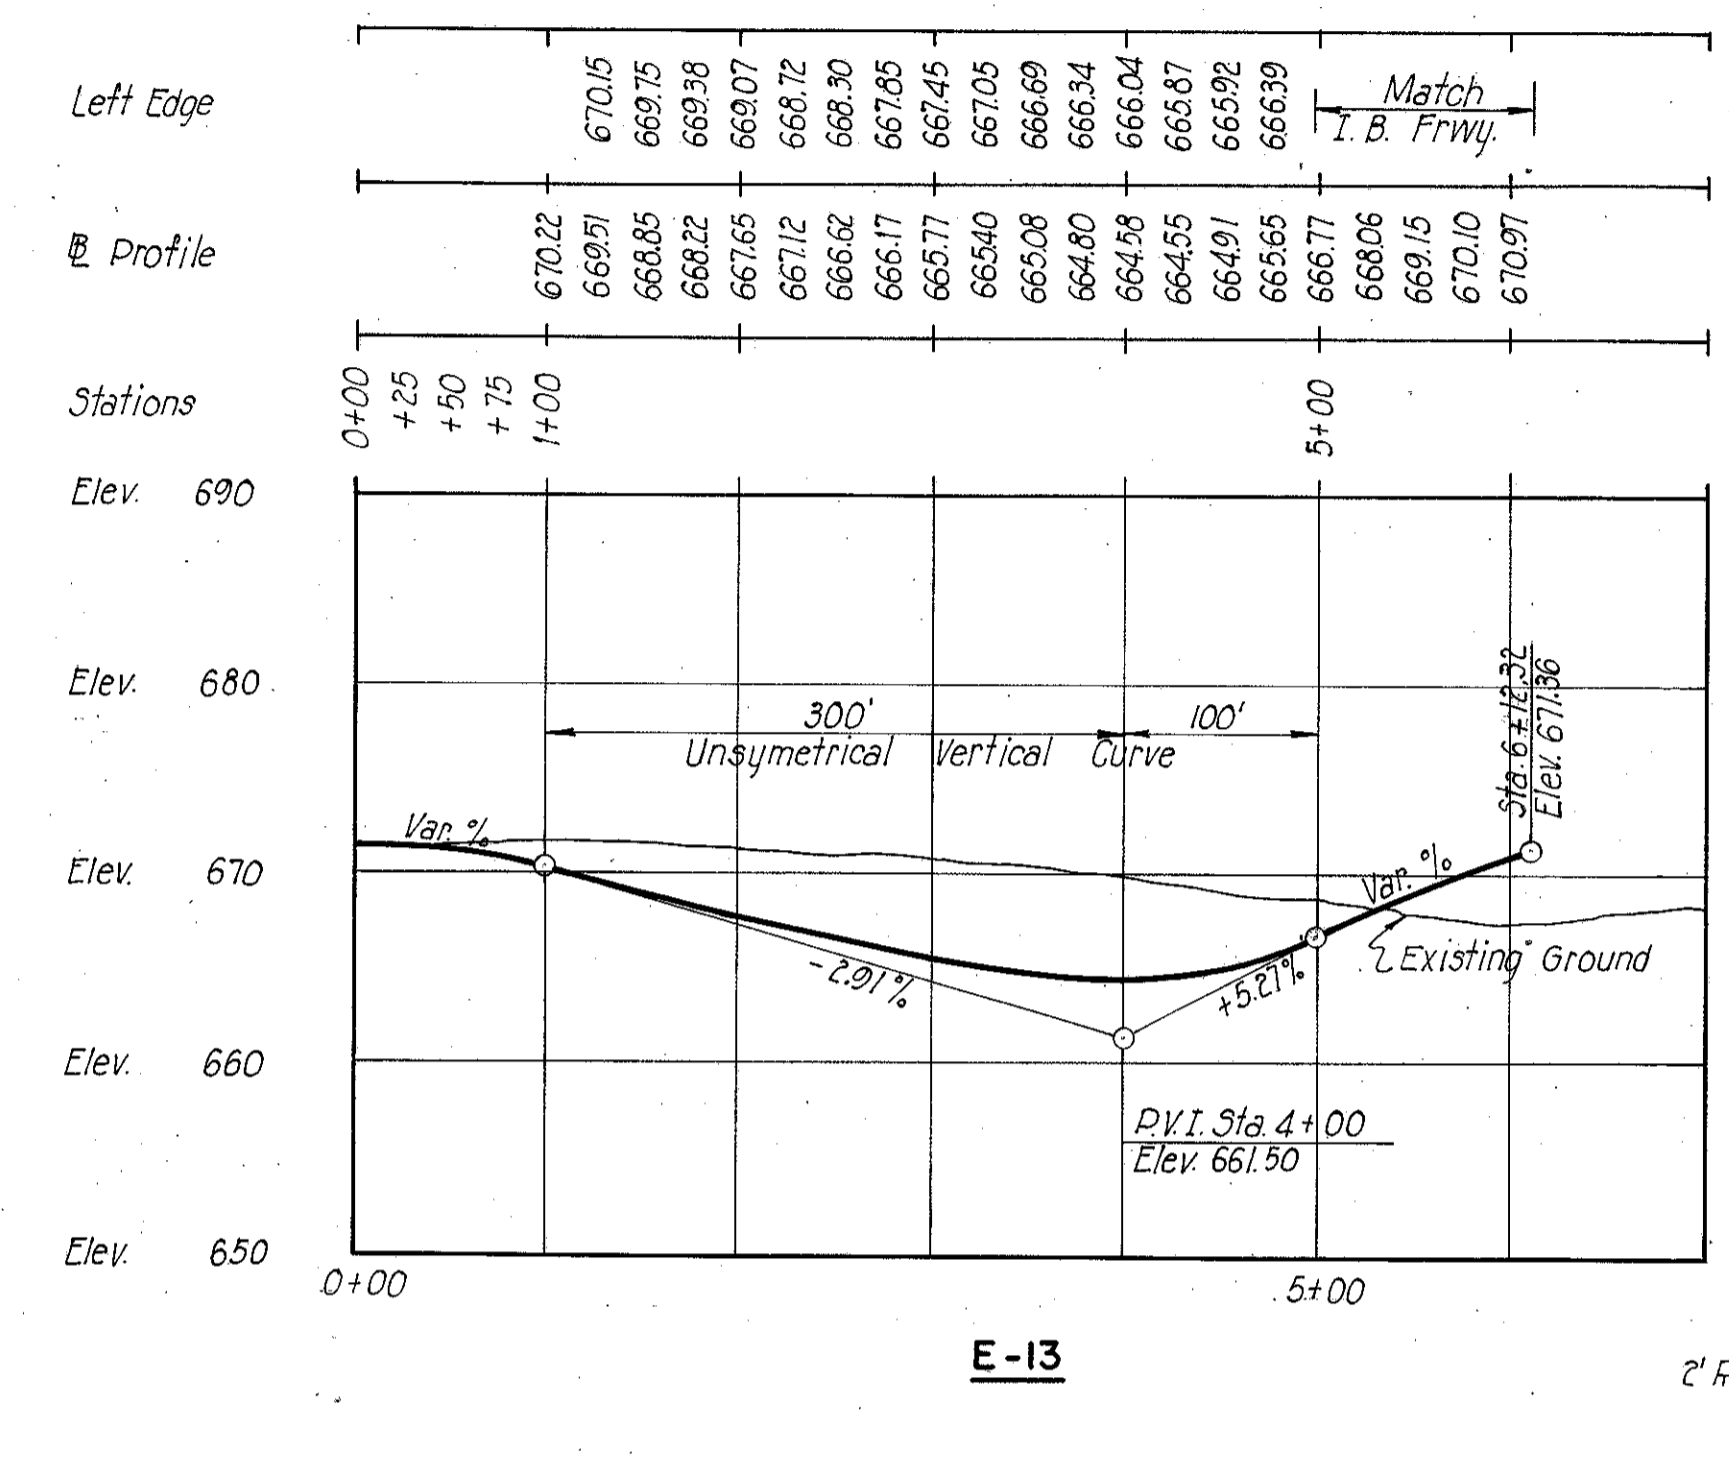


E-13

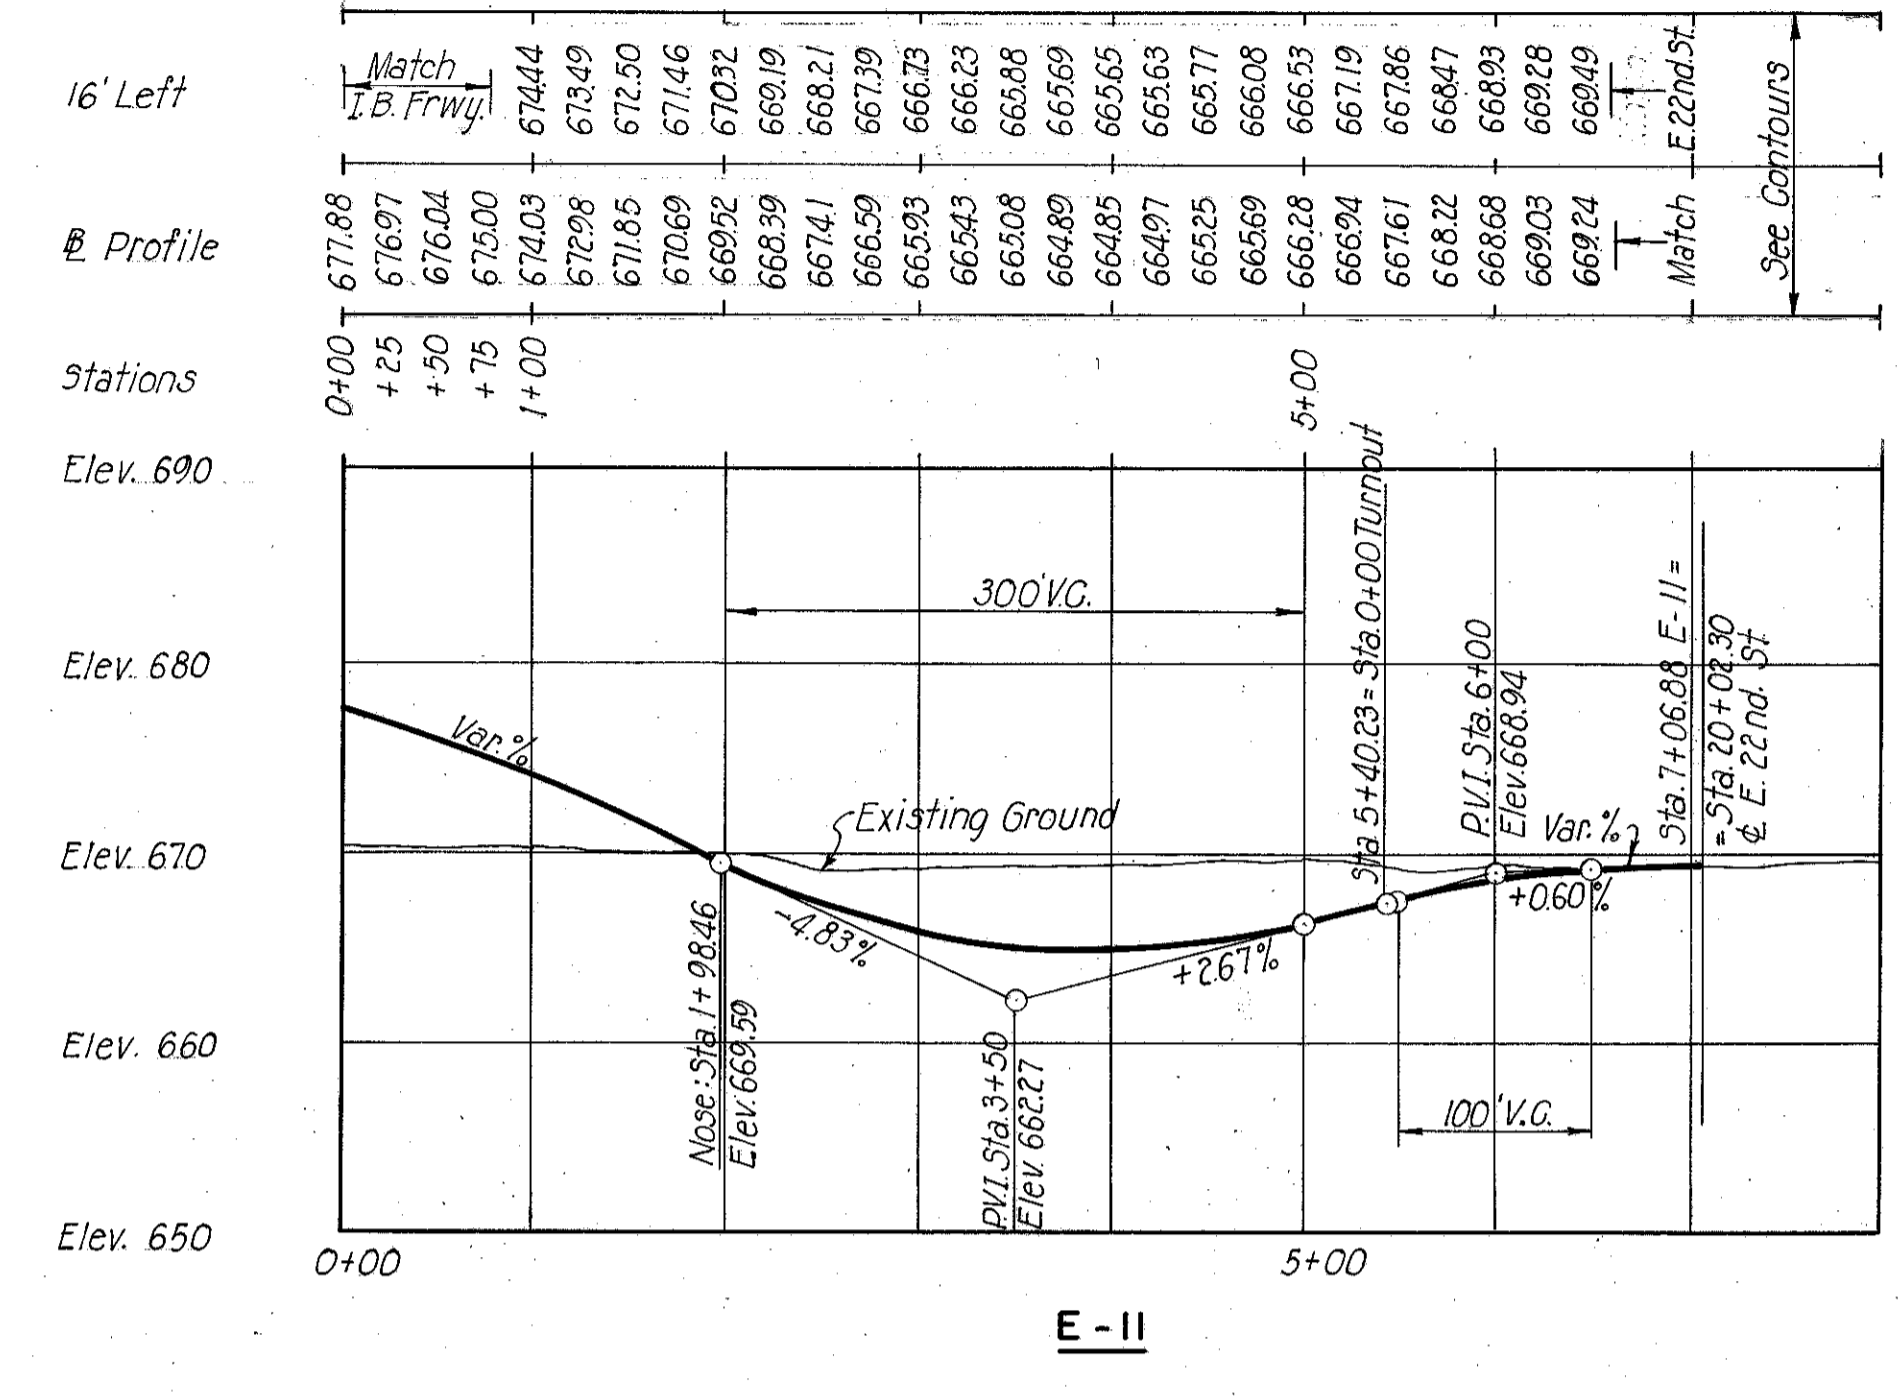

E-11

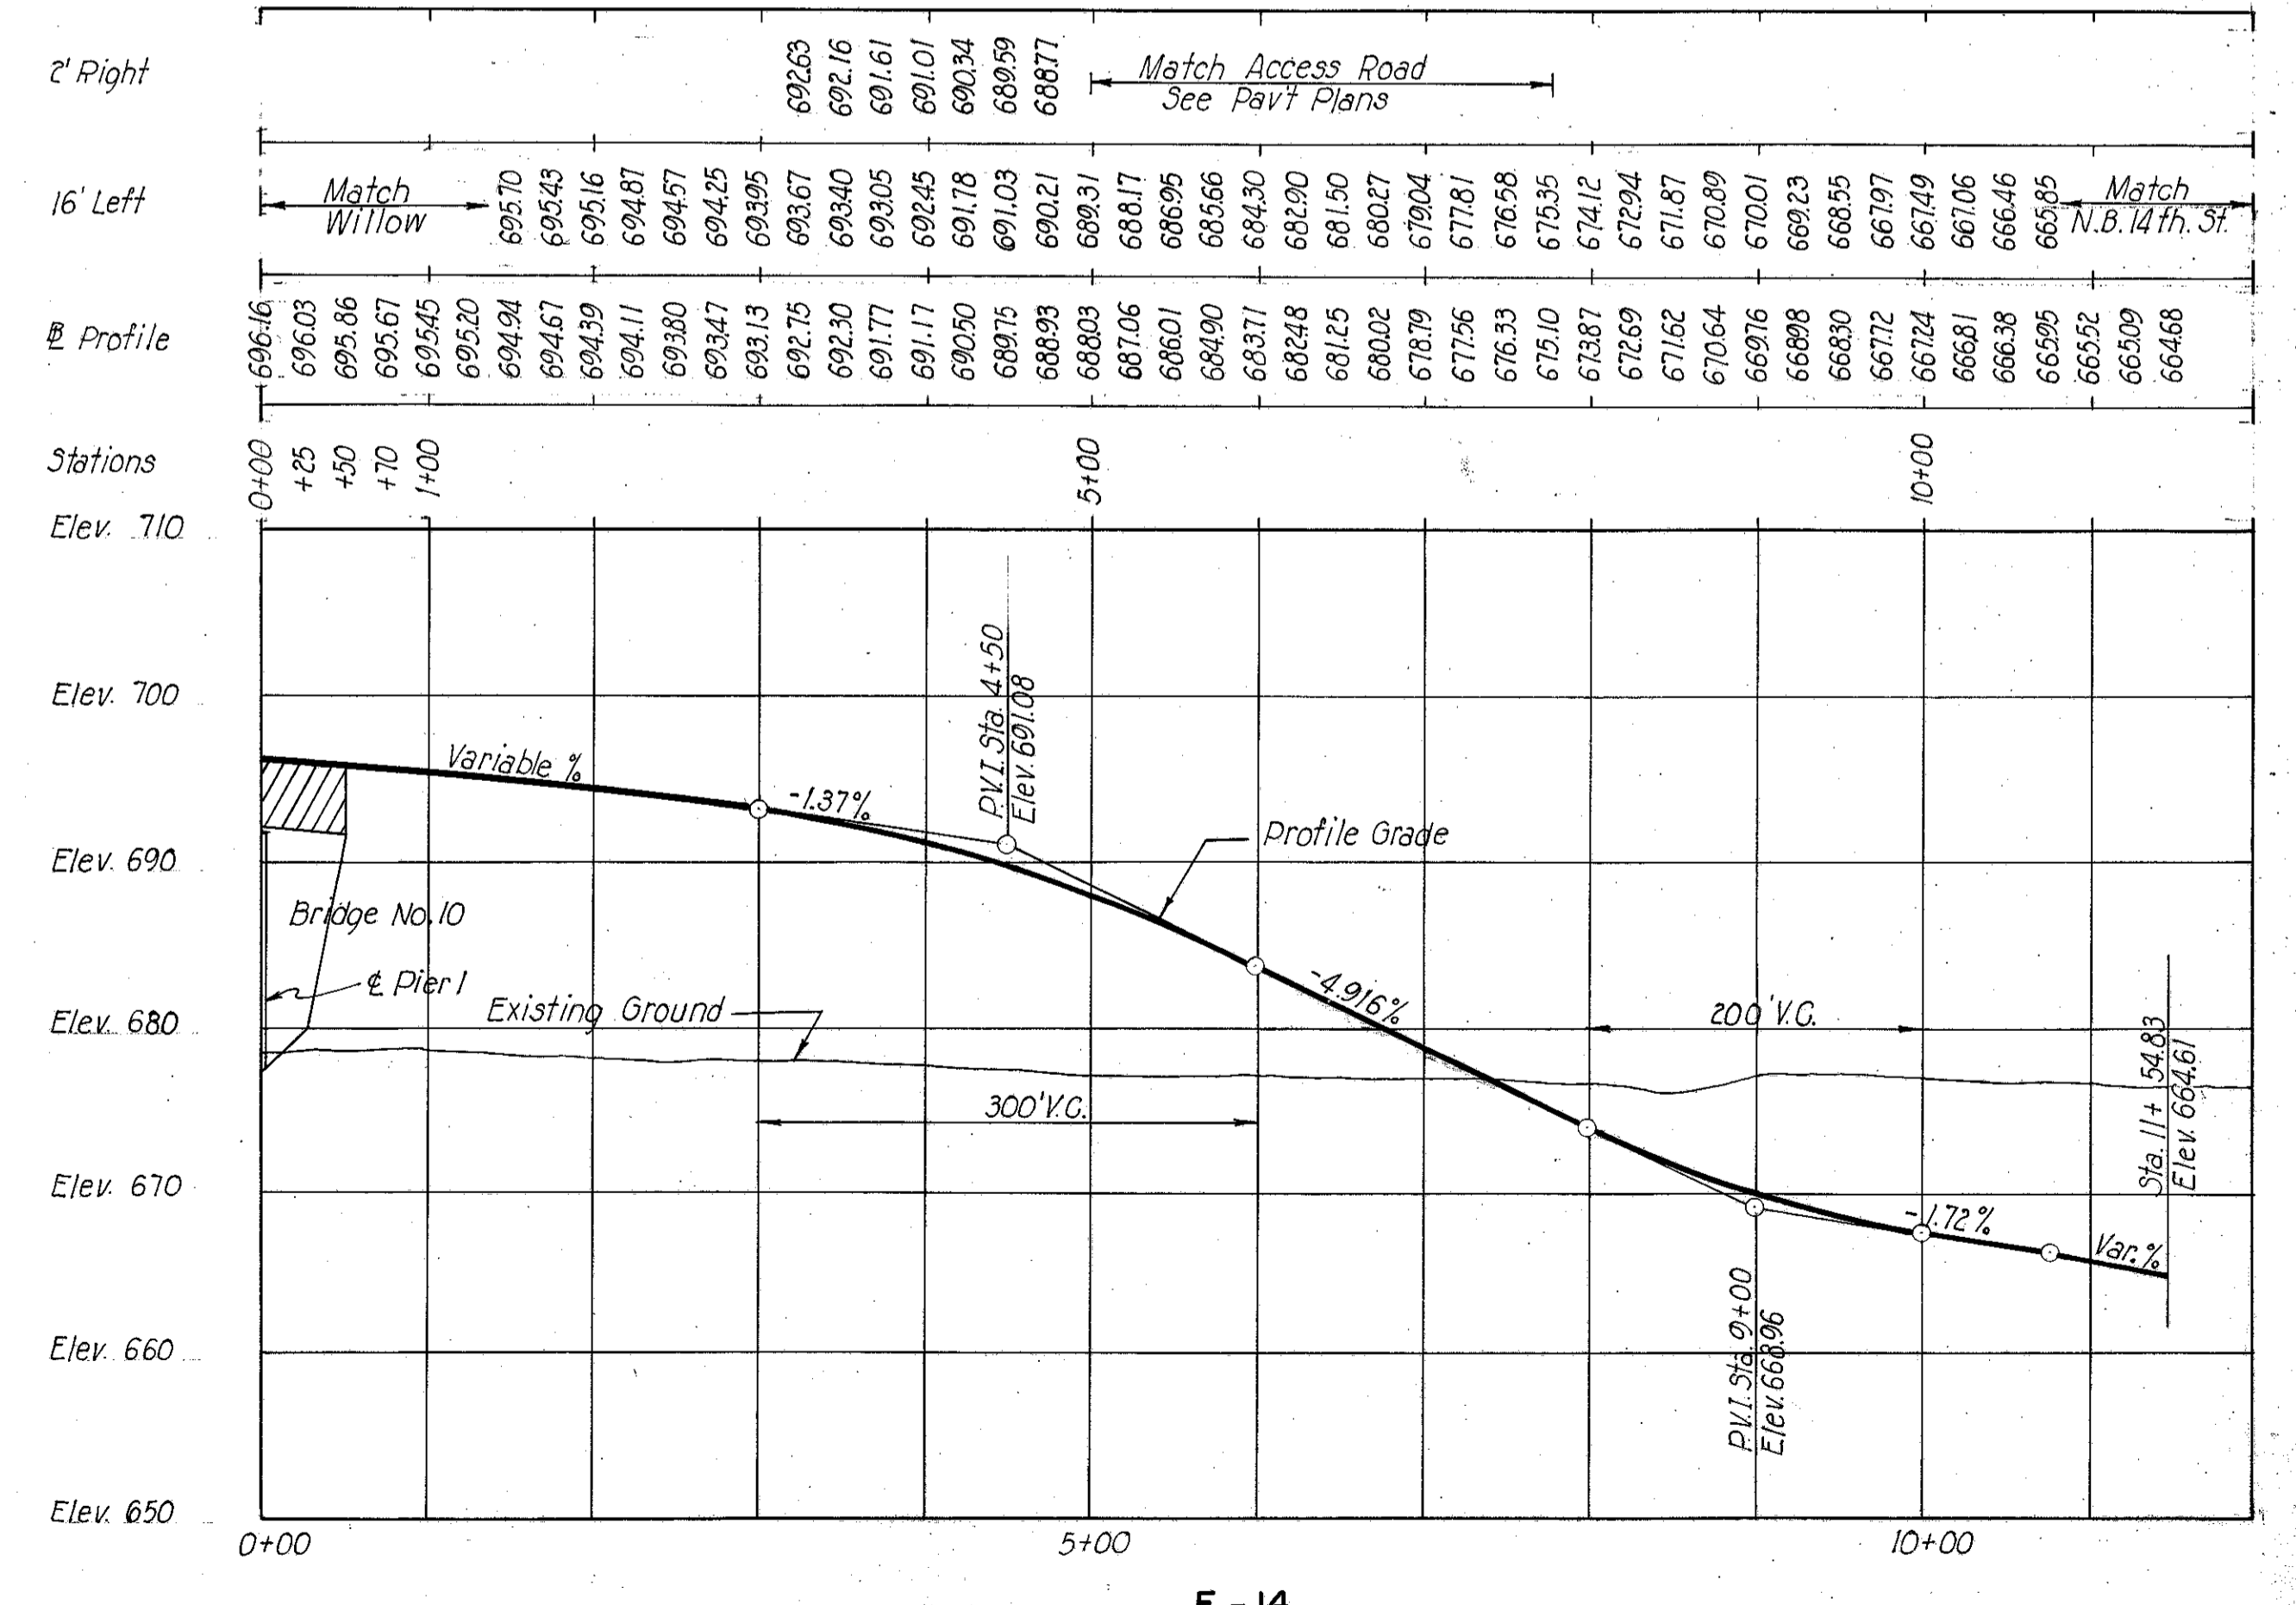


E-14

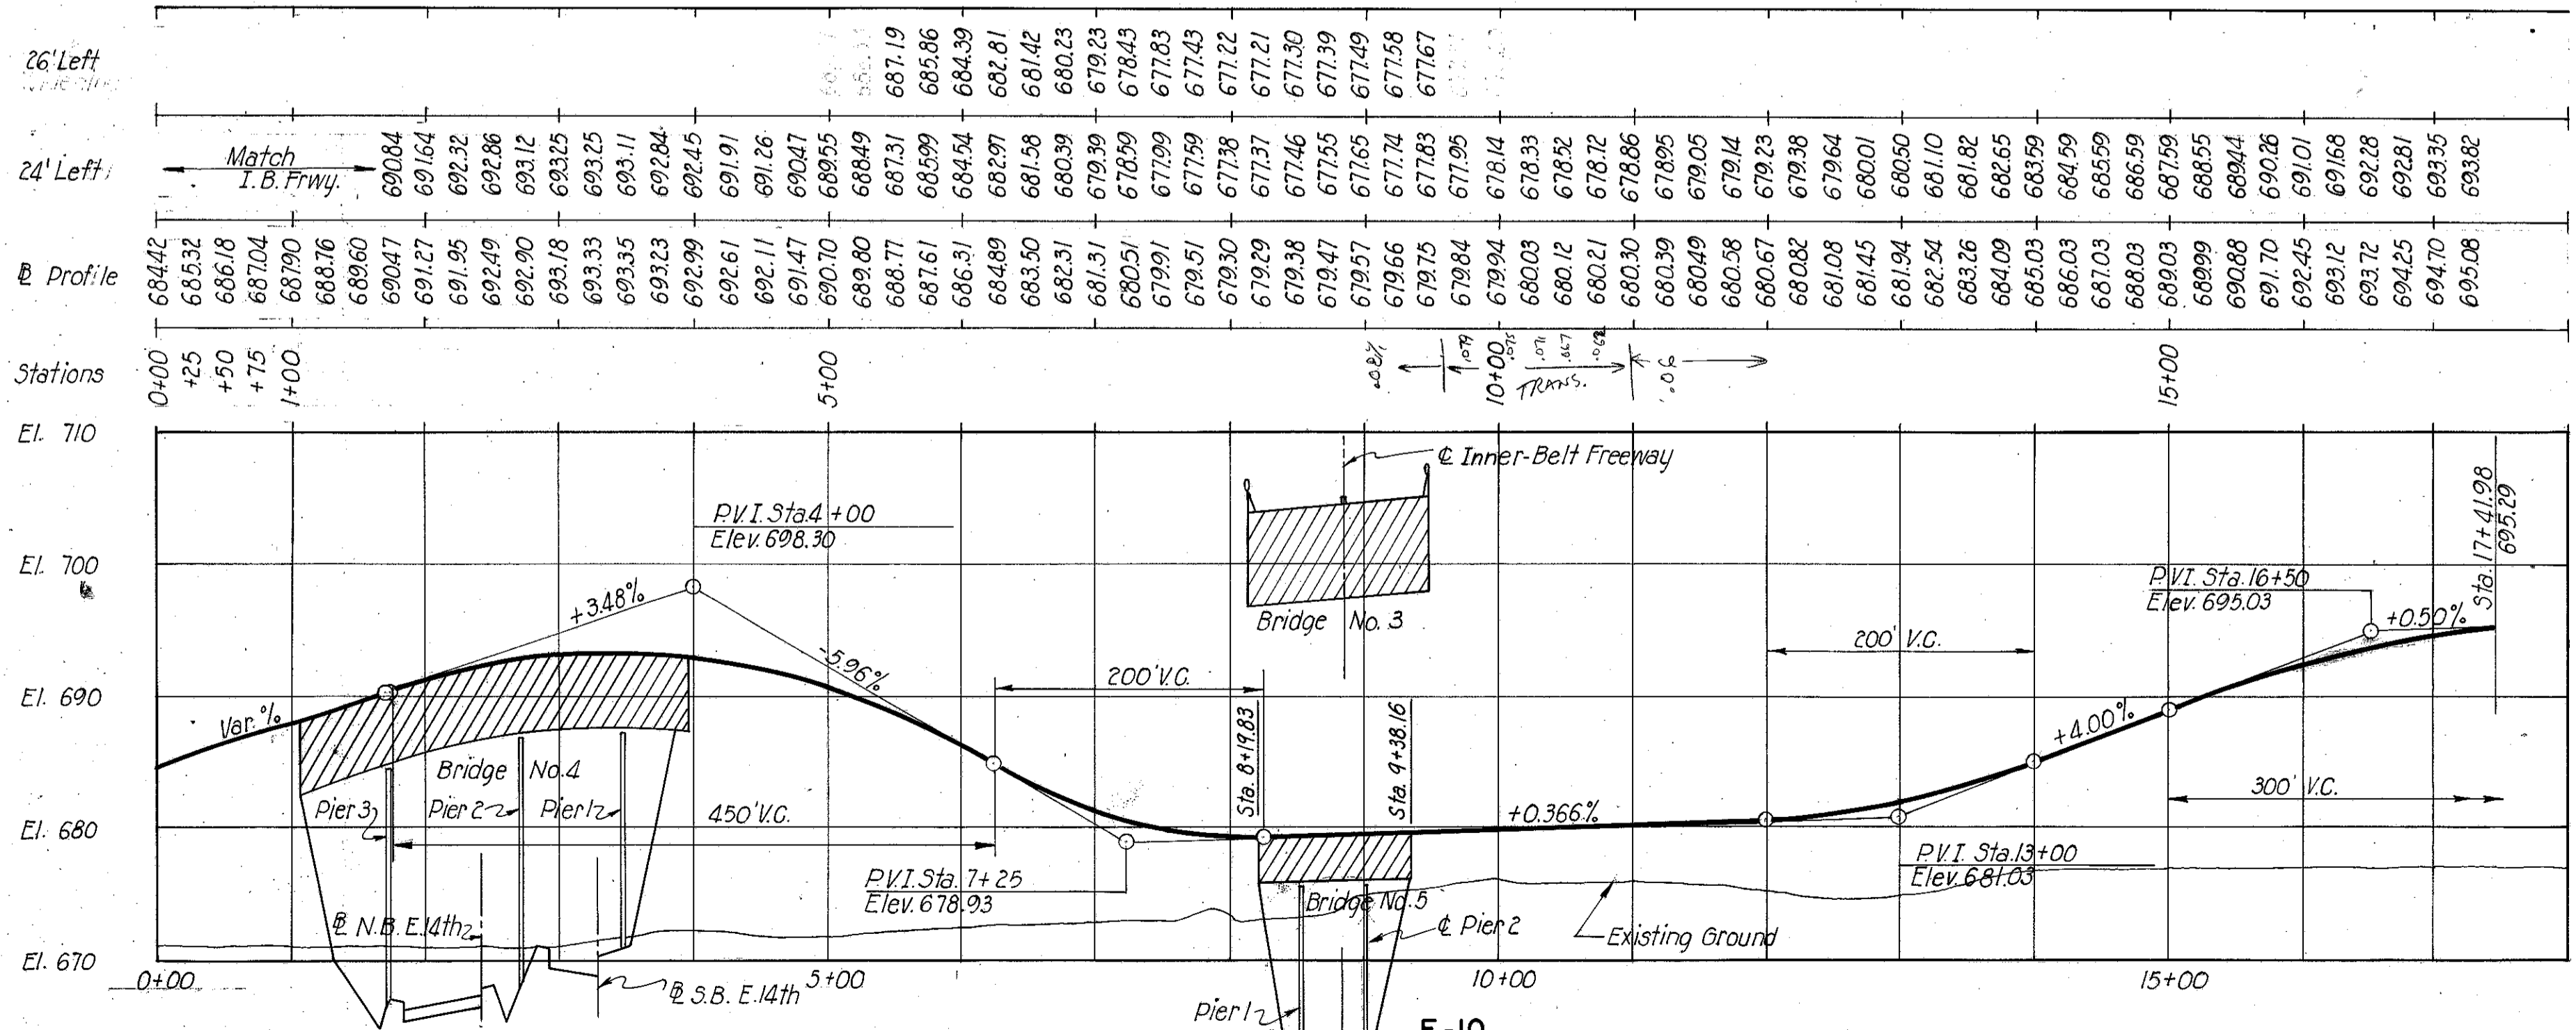


E-10

SCALE 1"=10' Ver.: 1"=100' Hor.
MADE DPH DATE 5-11-58 HOWARD, NEEDLES, TAMMEN & BERGENDOFF
TRCD. RR. DATE 10-7-58 CONSULTING ENGINEERS
CKD. G.M.G. DATE 3/13/59 KANSAS CITY CLEVELAND NEW YORK
SHEET


CUYAHOGA COUNTY
CITY OF CLEVELAND
INNER CUY-42-18.42AY PART
CUY-21-15.32
PROFILES

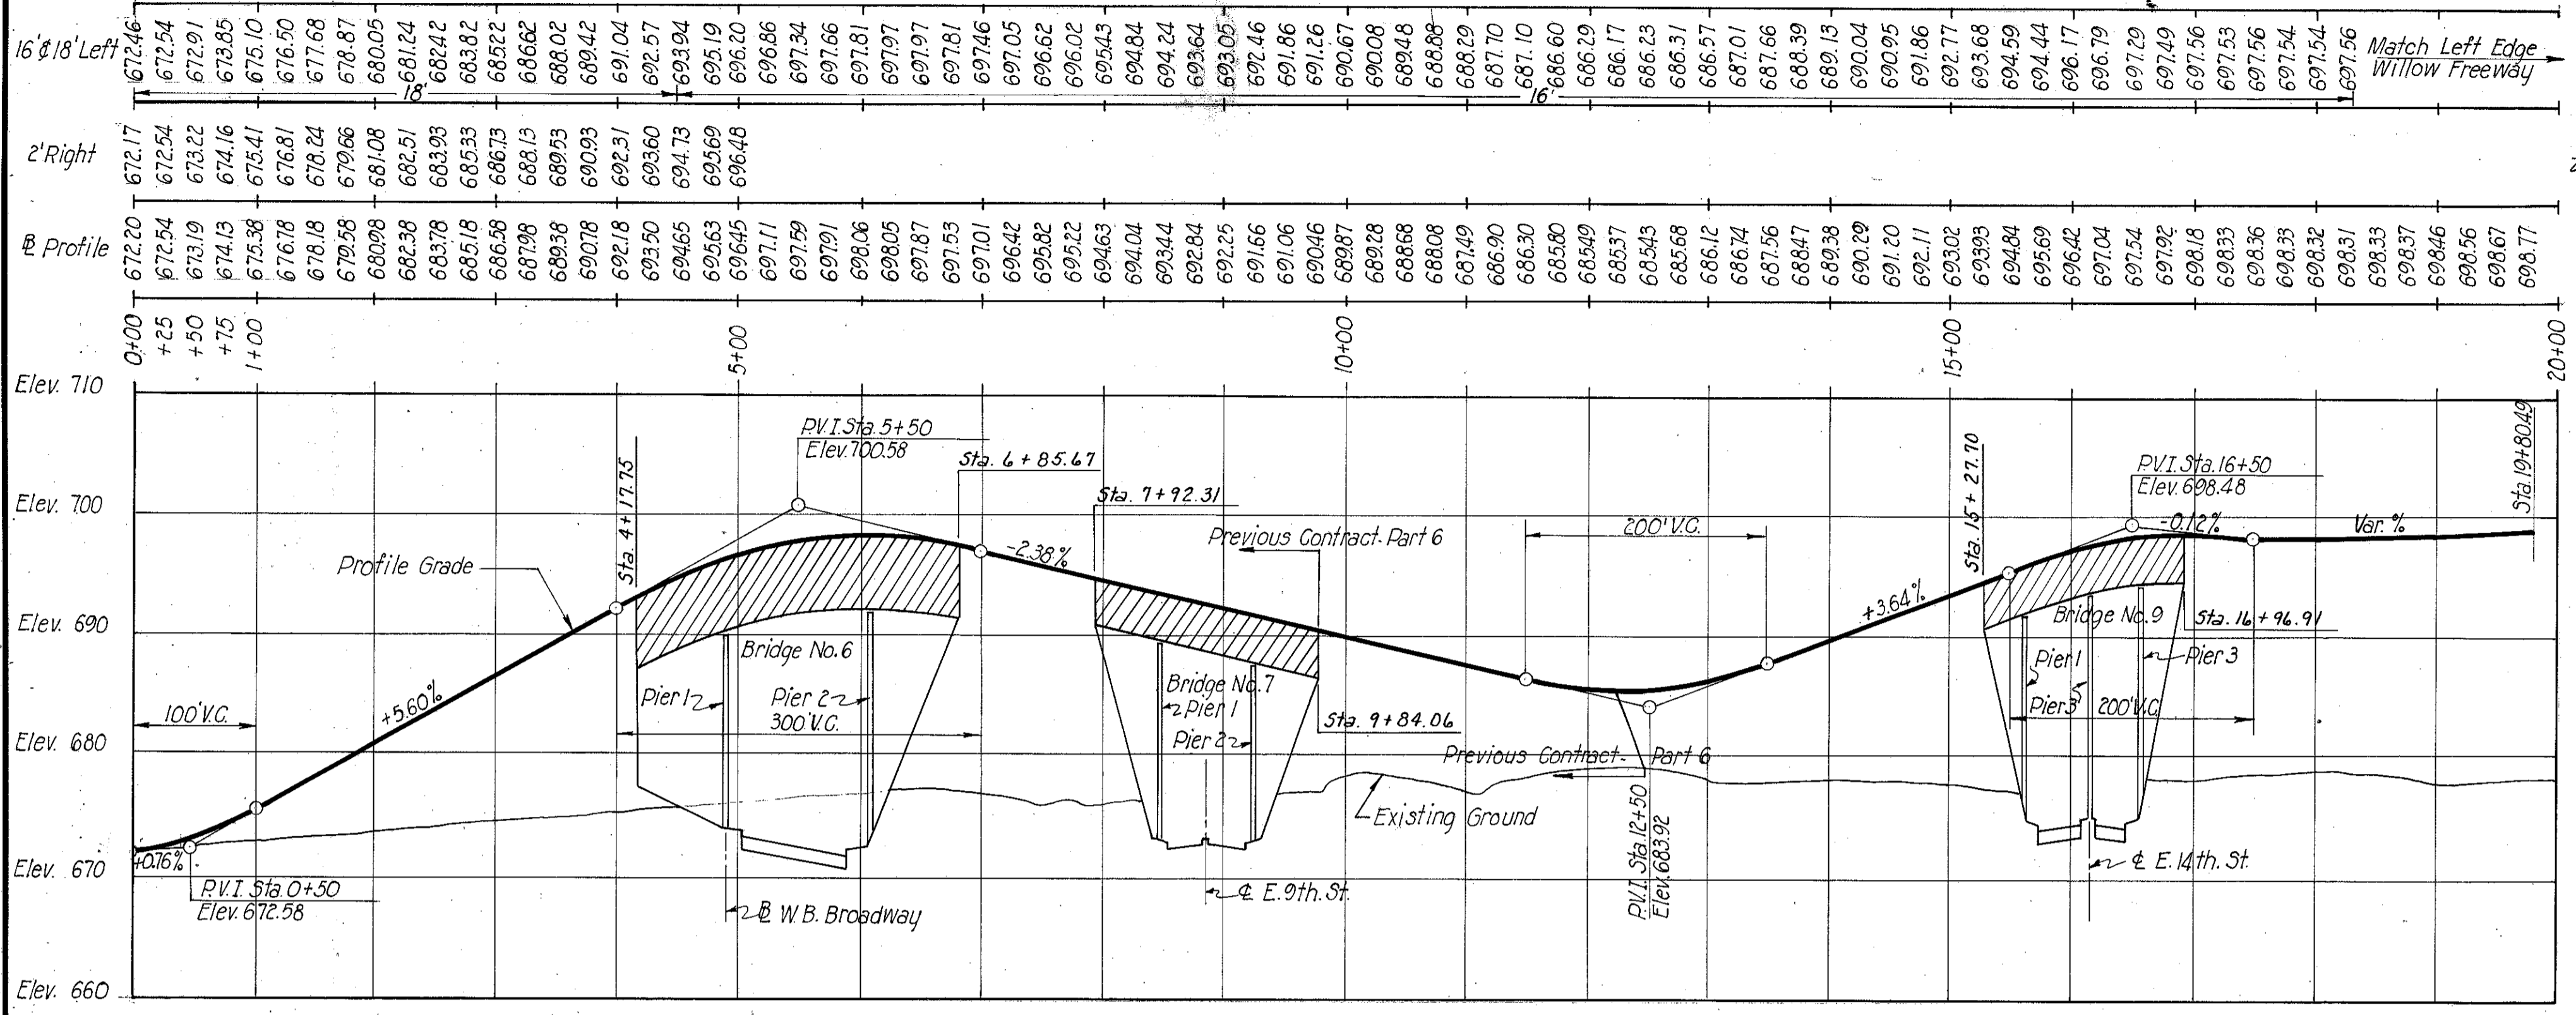


E-15

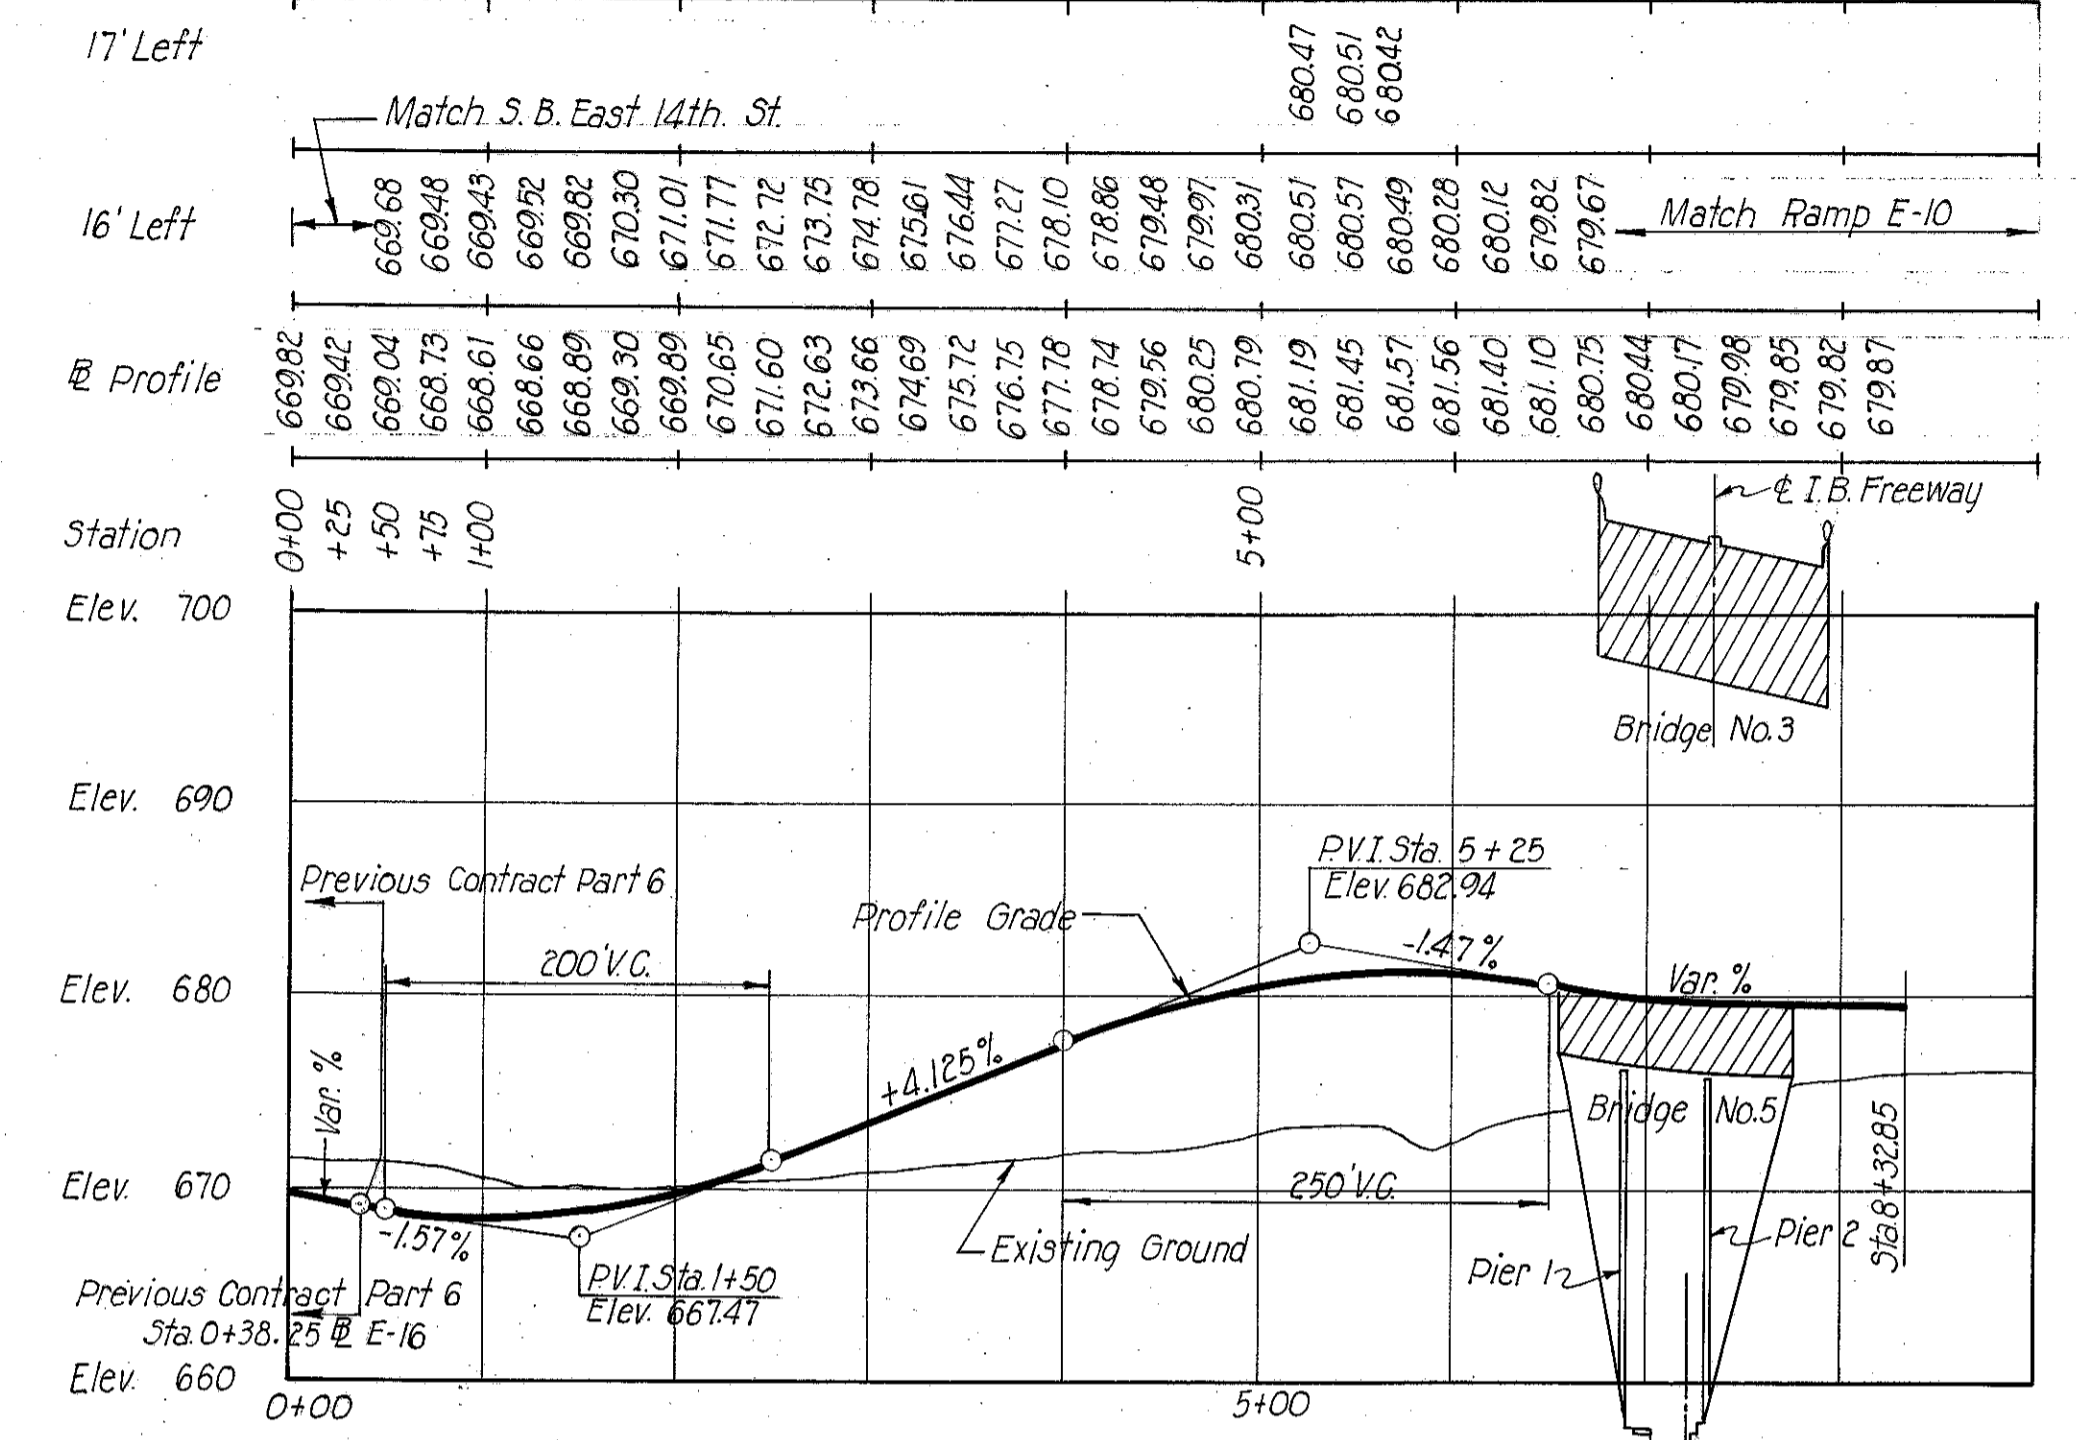

E-16

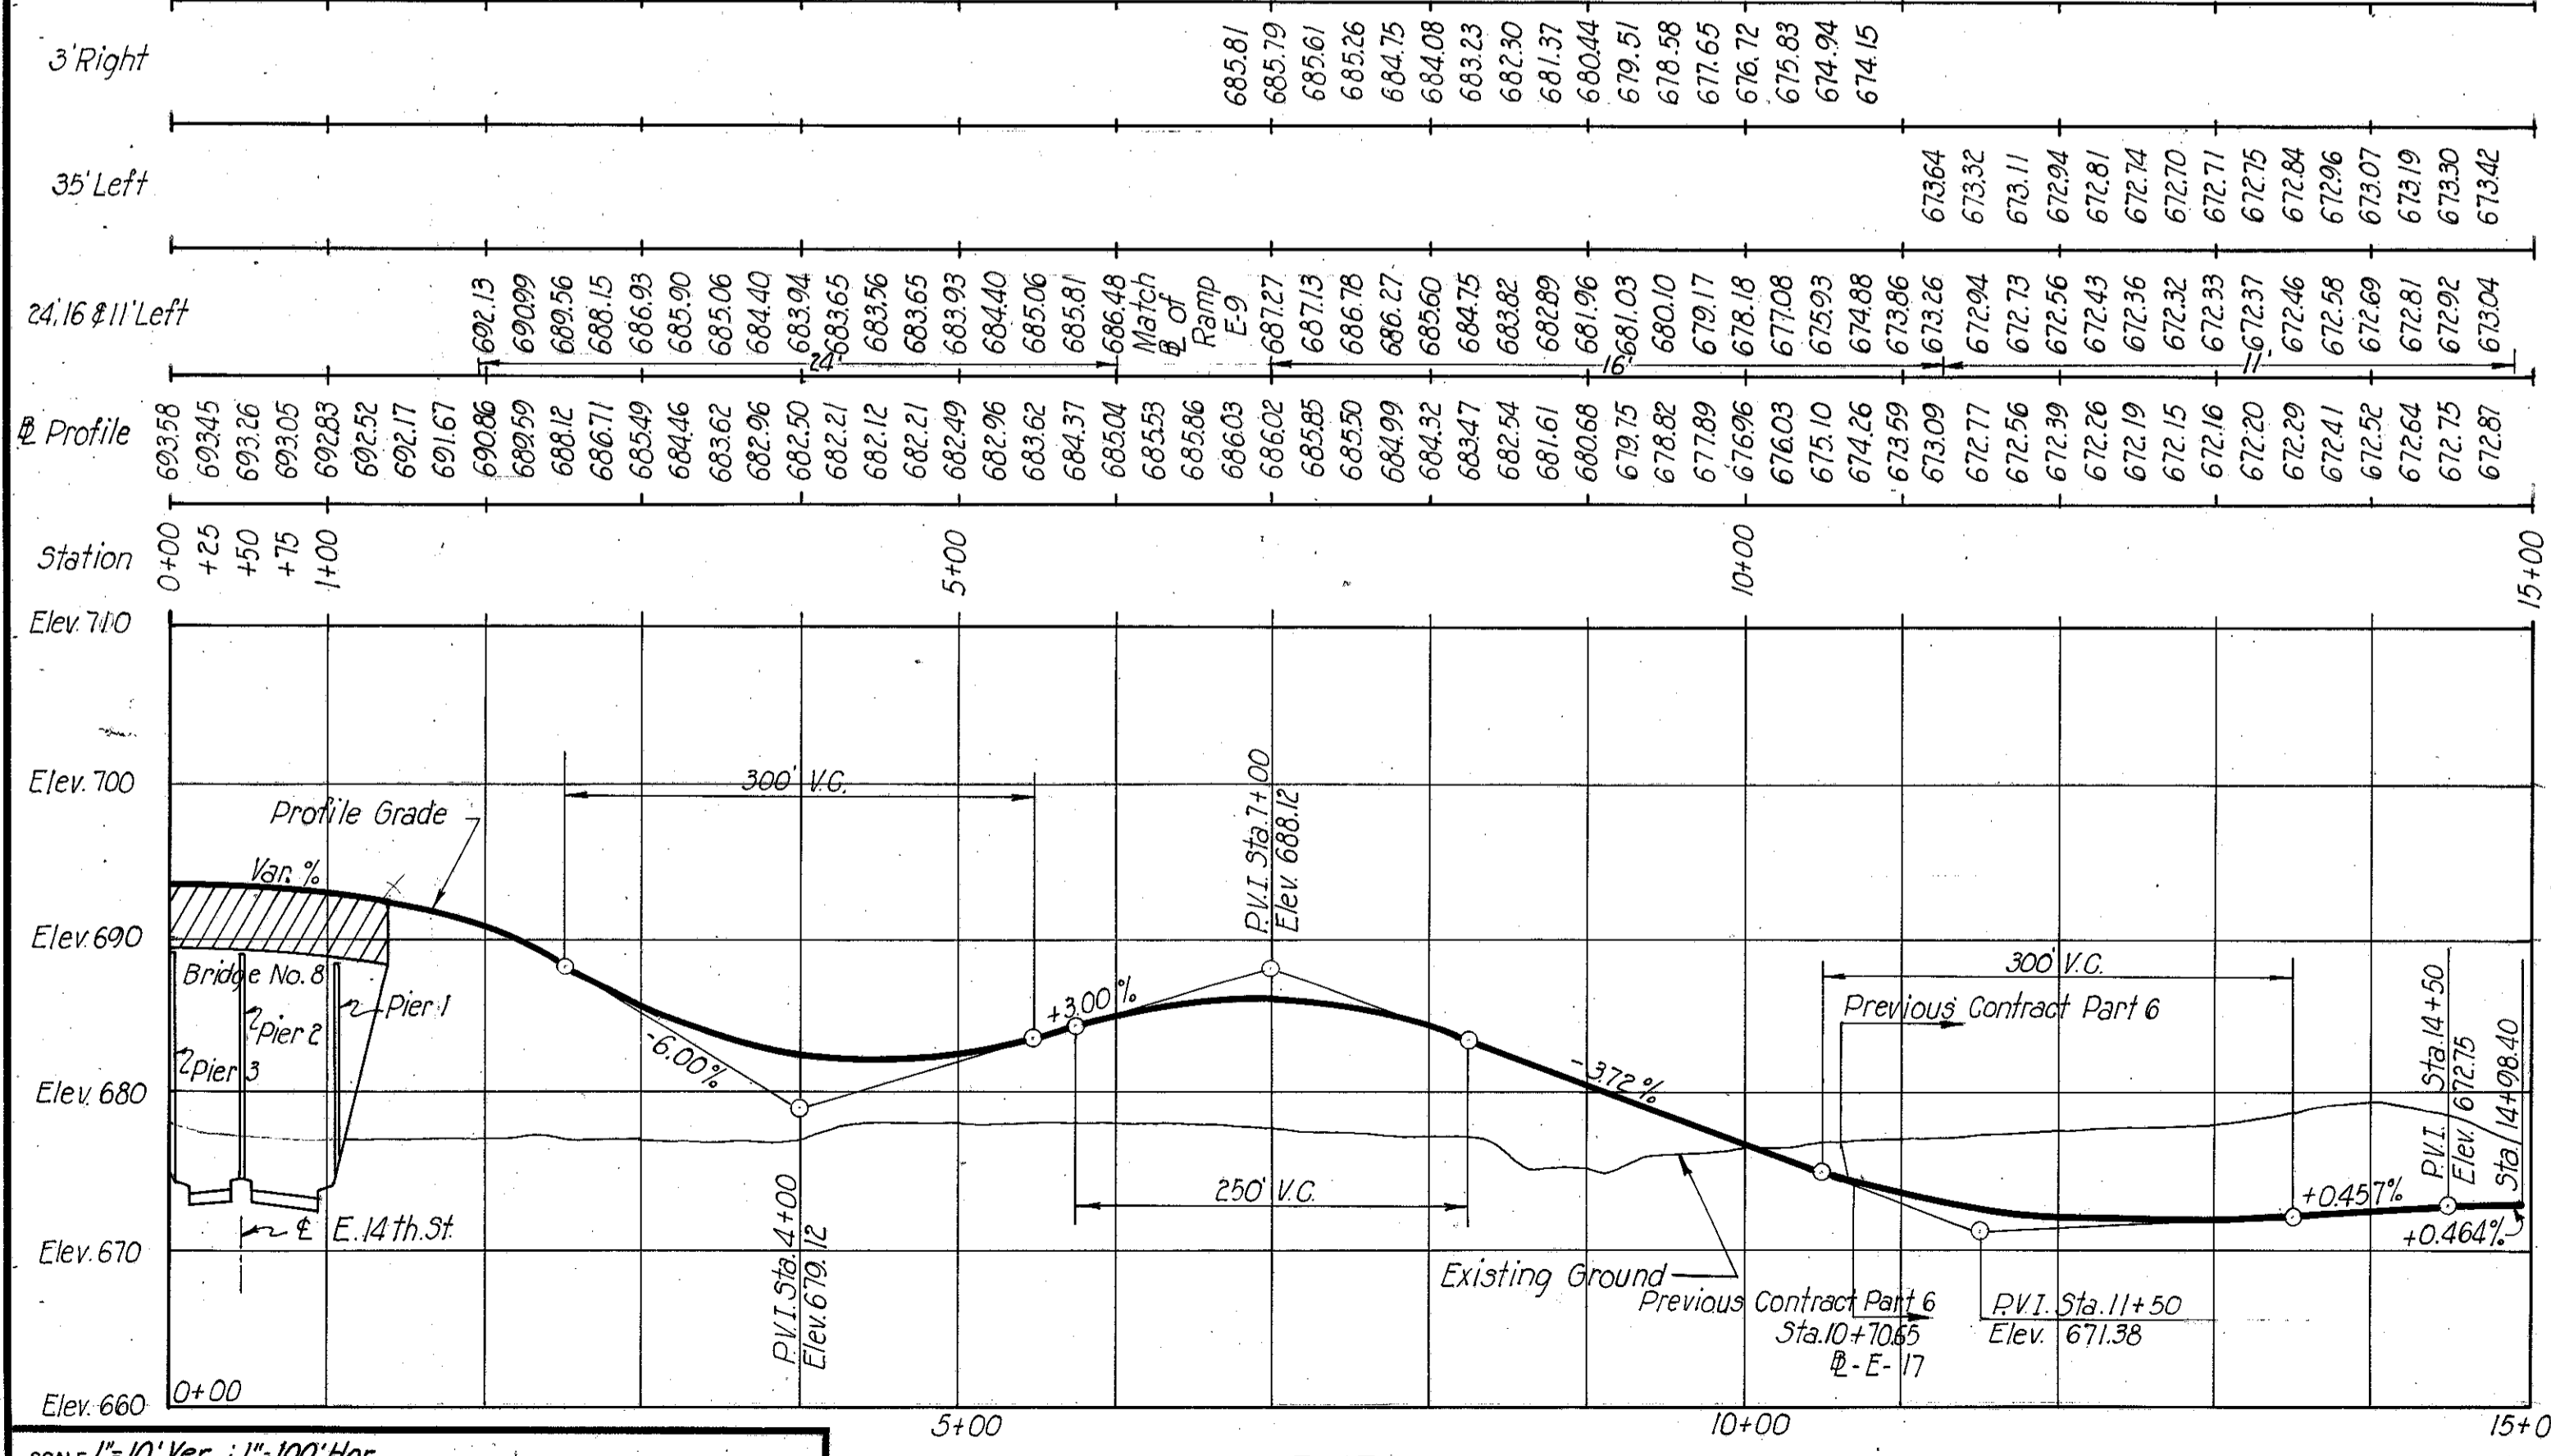




E-17

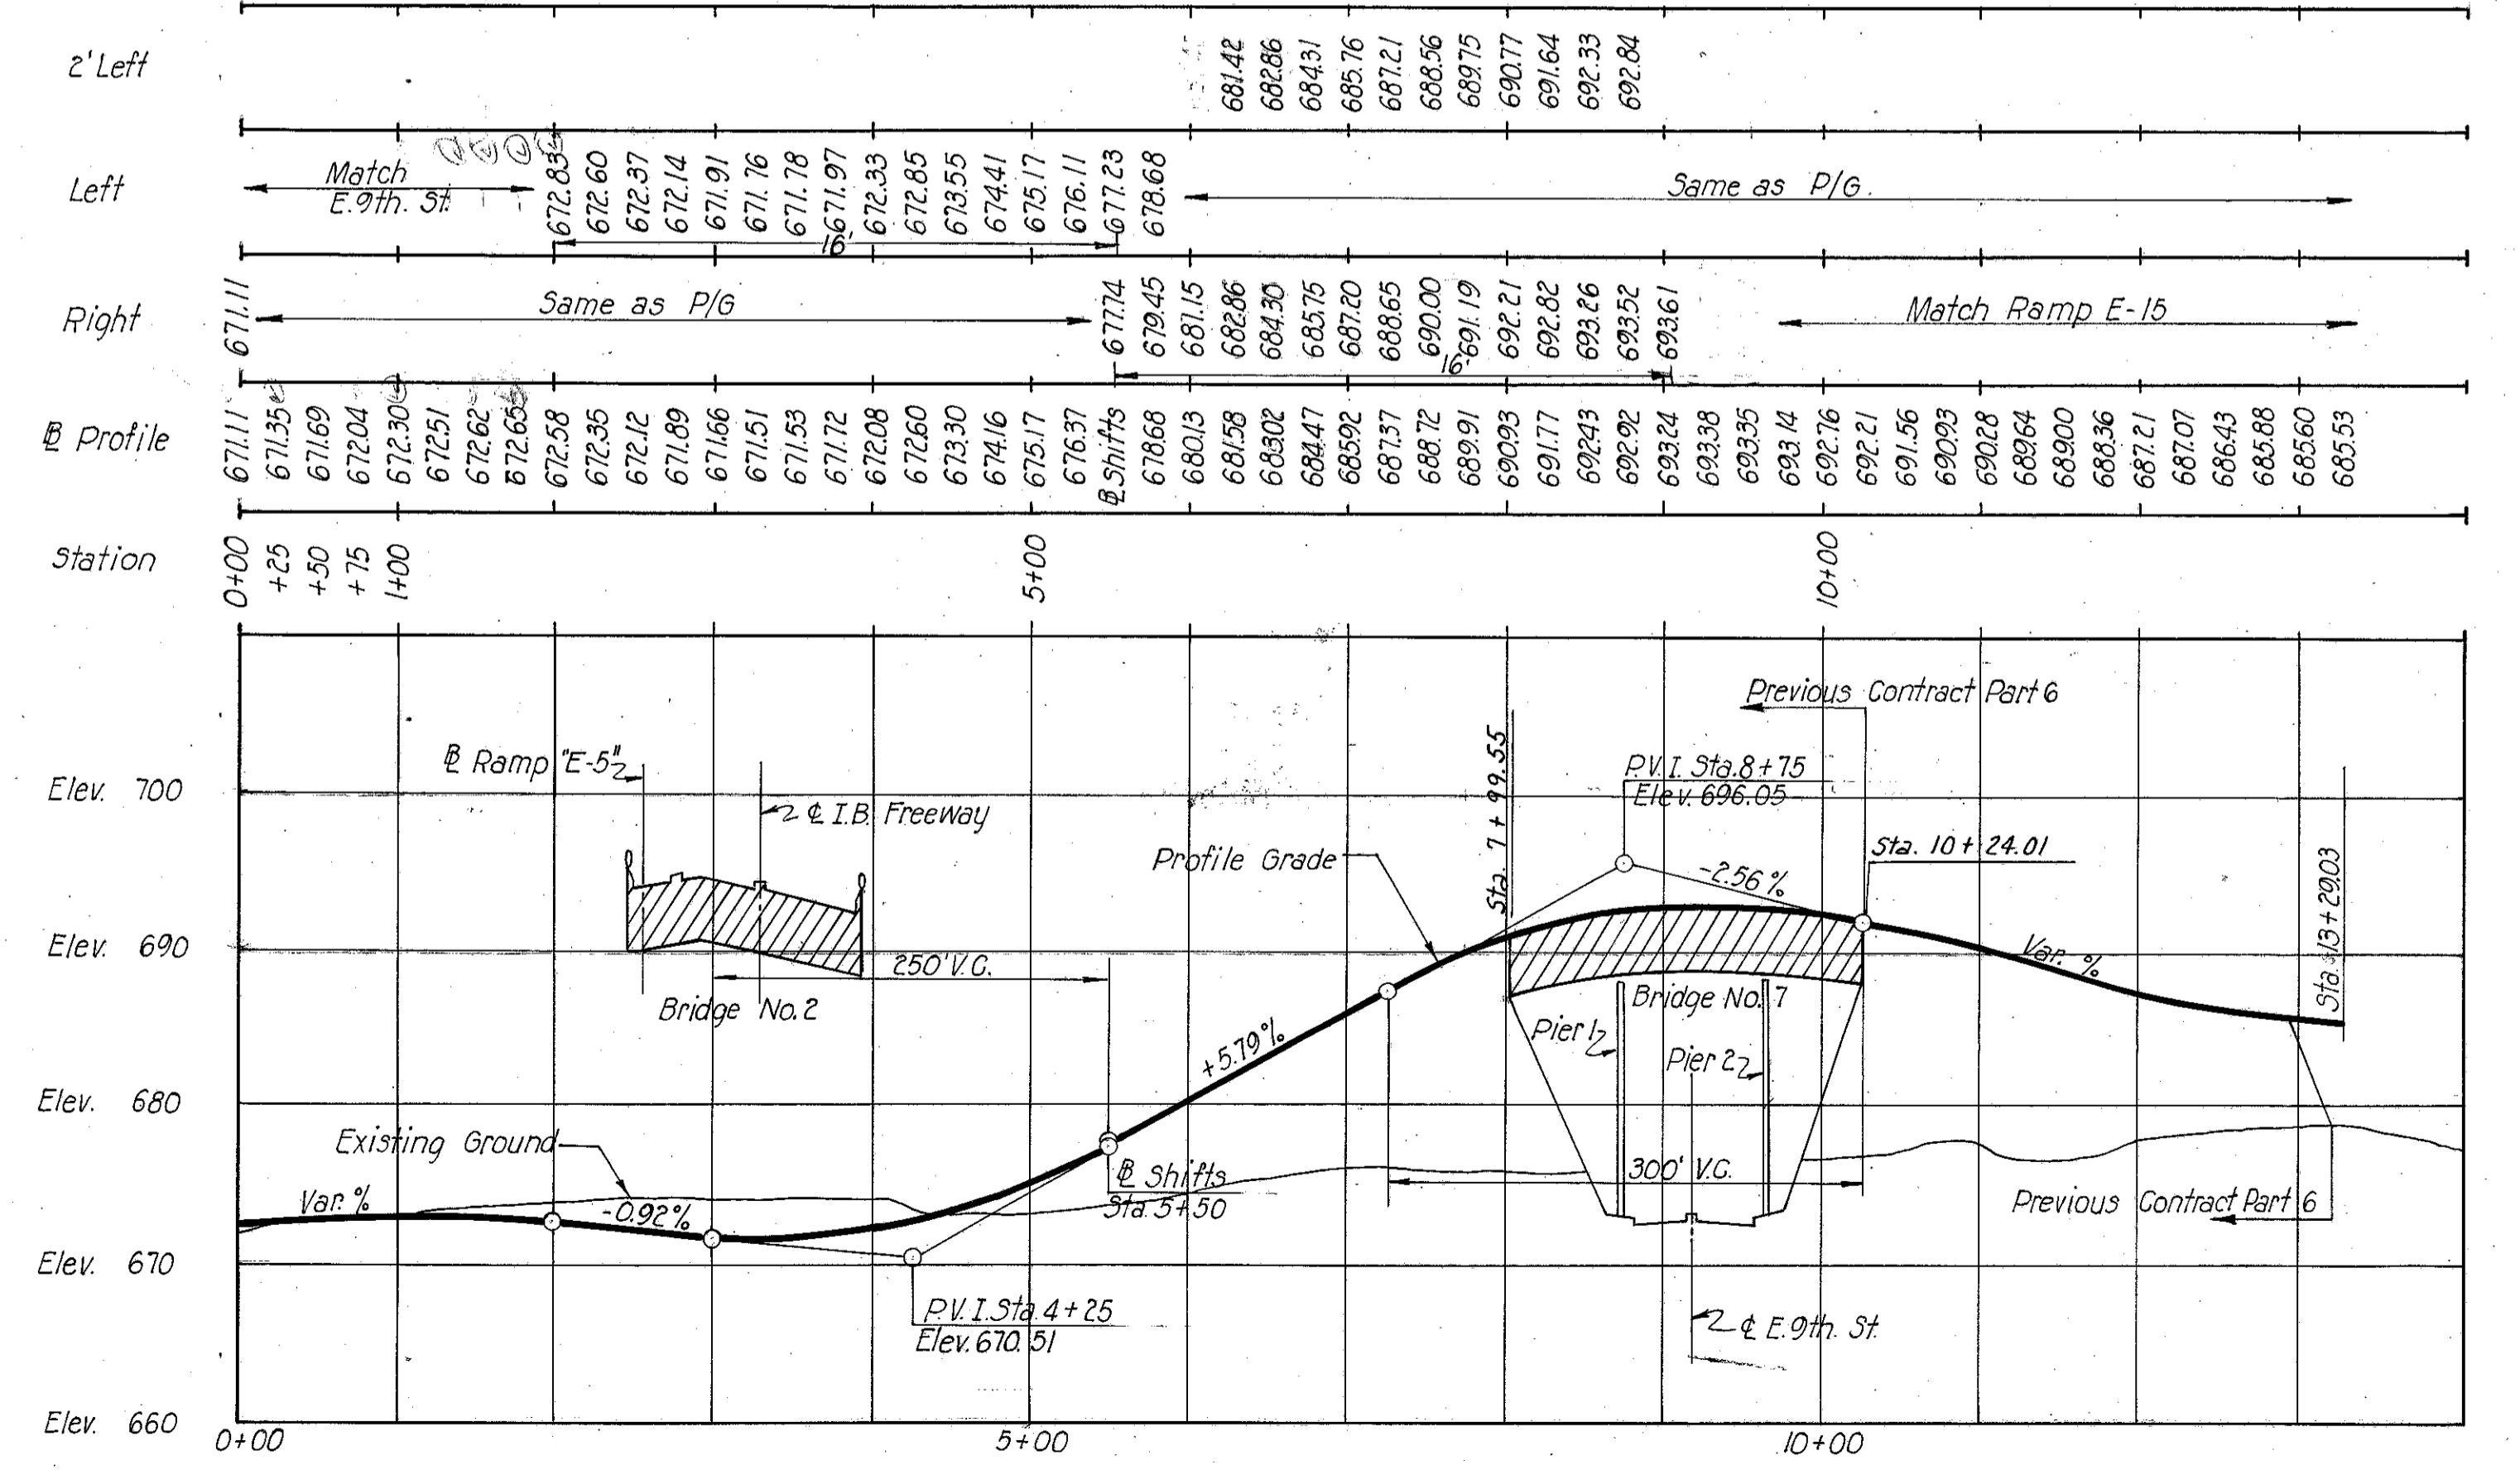

E-18


SCALE 1"=10' Ver. : 1"=100' Hor.
 MADE DPH DATE 7/21/58 HOWARD, NEEDLES, TAMMEN & BERGENDOFF
 TRCD. DATE 9-8-58 CONSULTING ENGINEERS
 CKD. G.M.G. DATE 10/18/58 KANSAS CITY CLEVELAND NEW YORK
 914 SHEET 25

CUYAHOGA COUNTY
CITY OF CLEVELAND
INNER BELTWAY
CUY-42-18-42
CUY-21-15-32
PROFILES

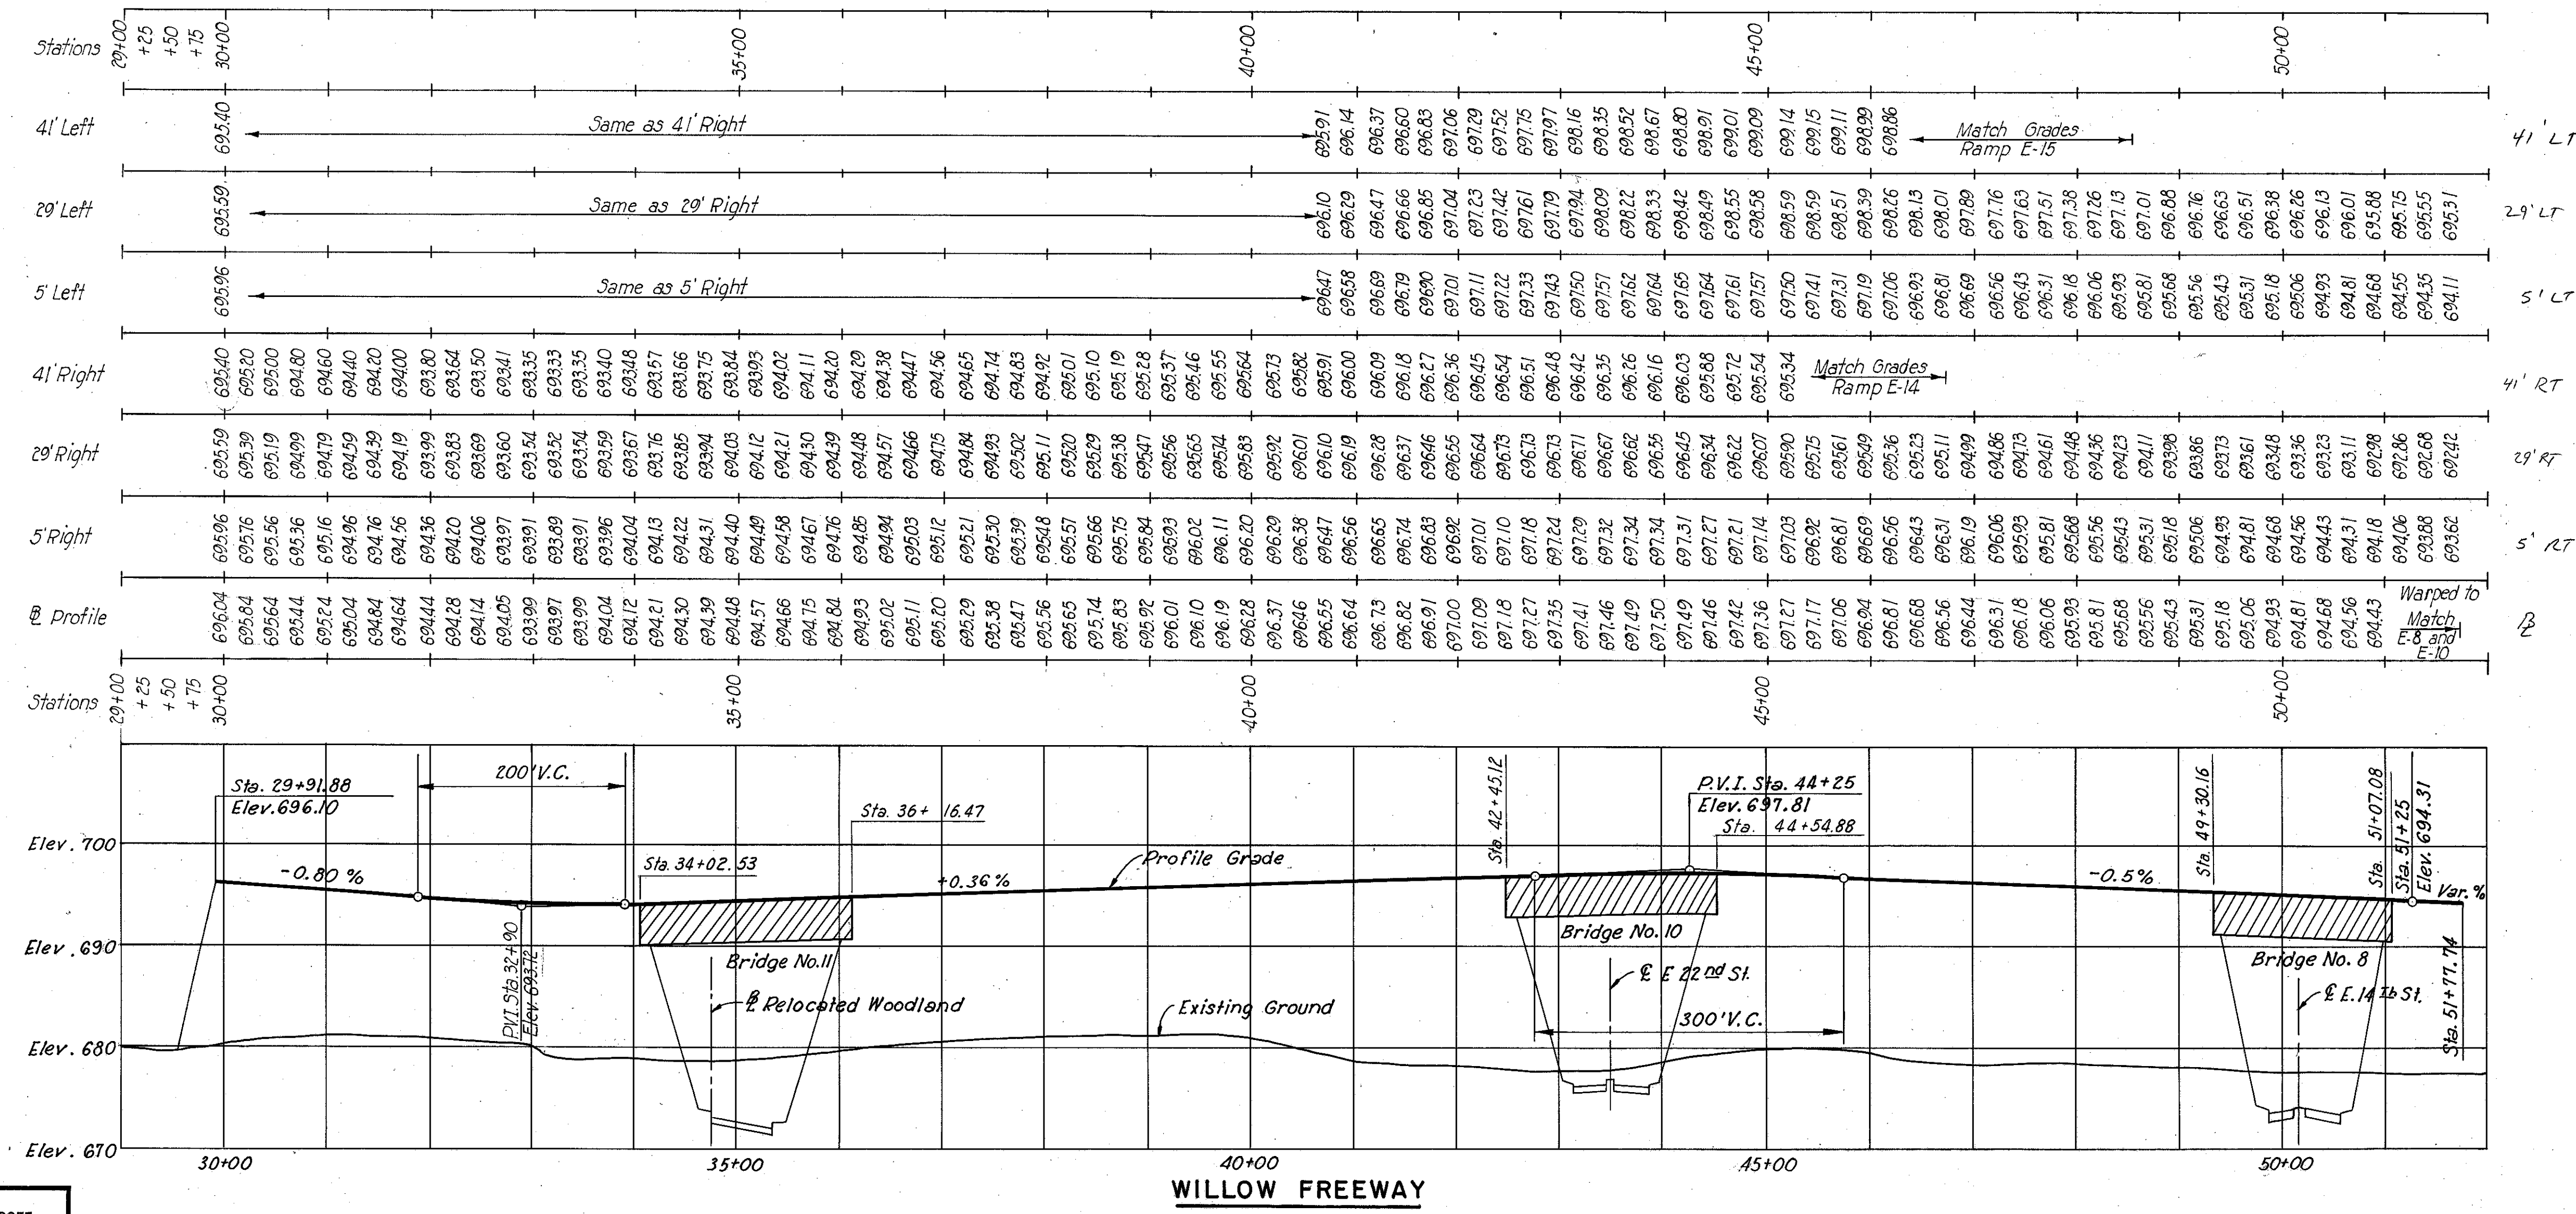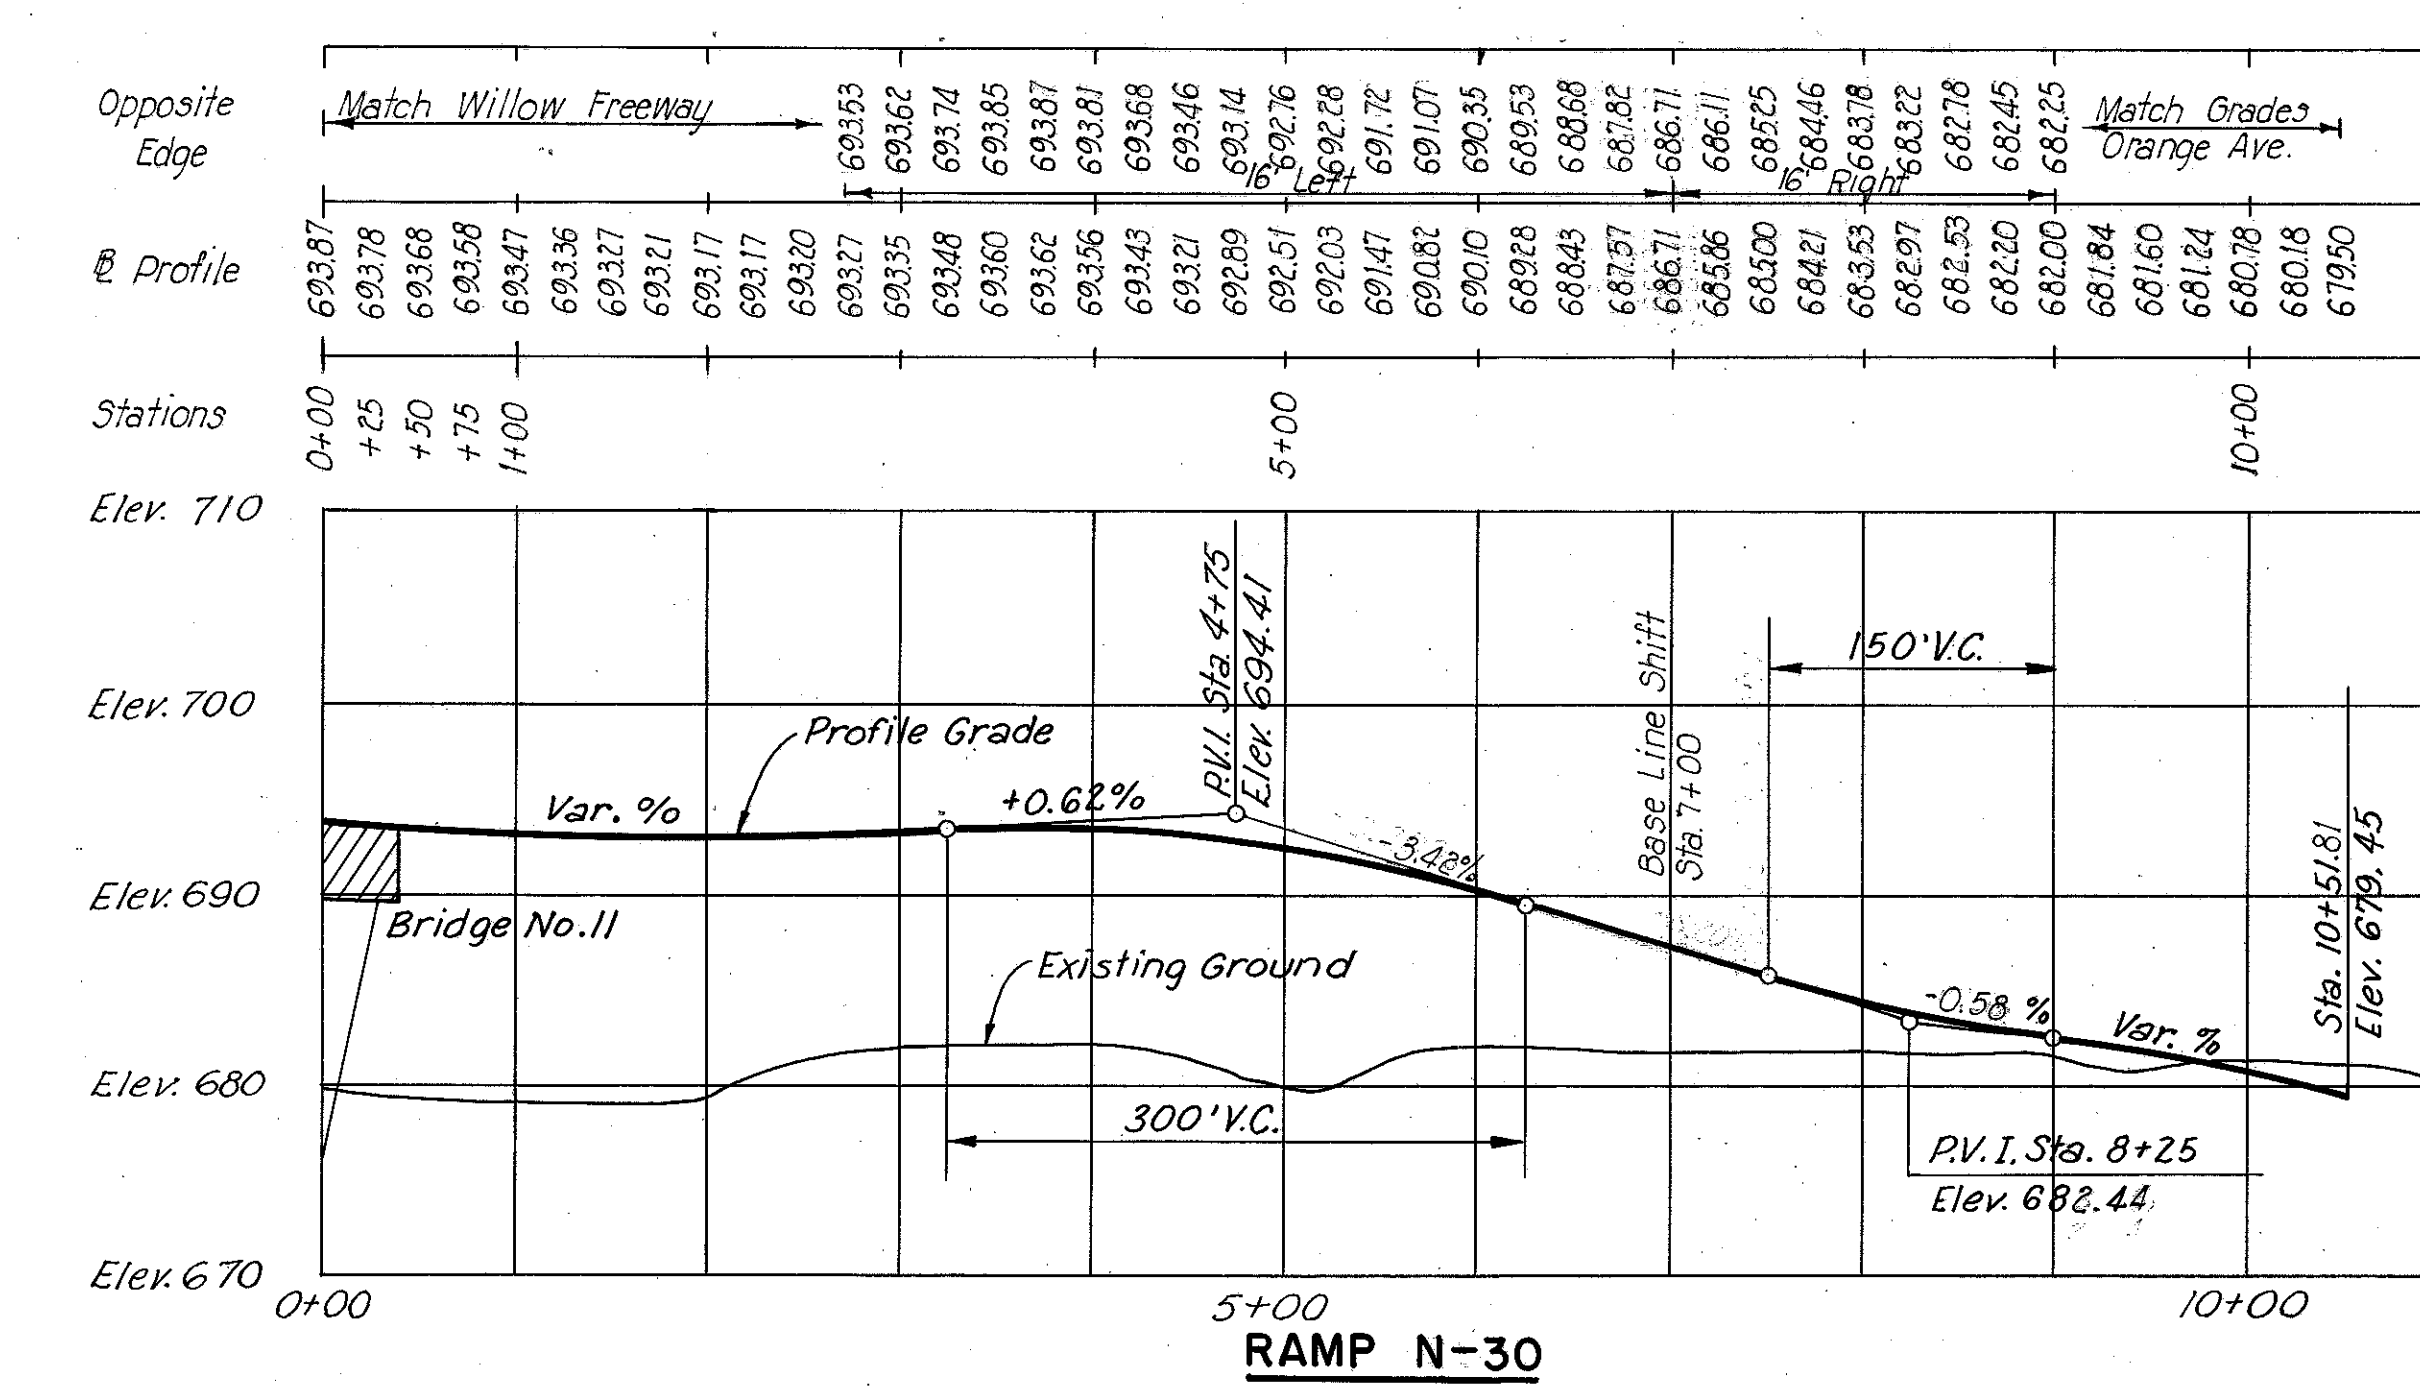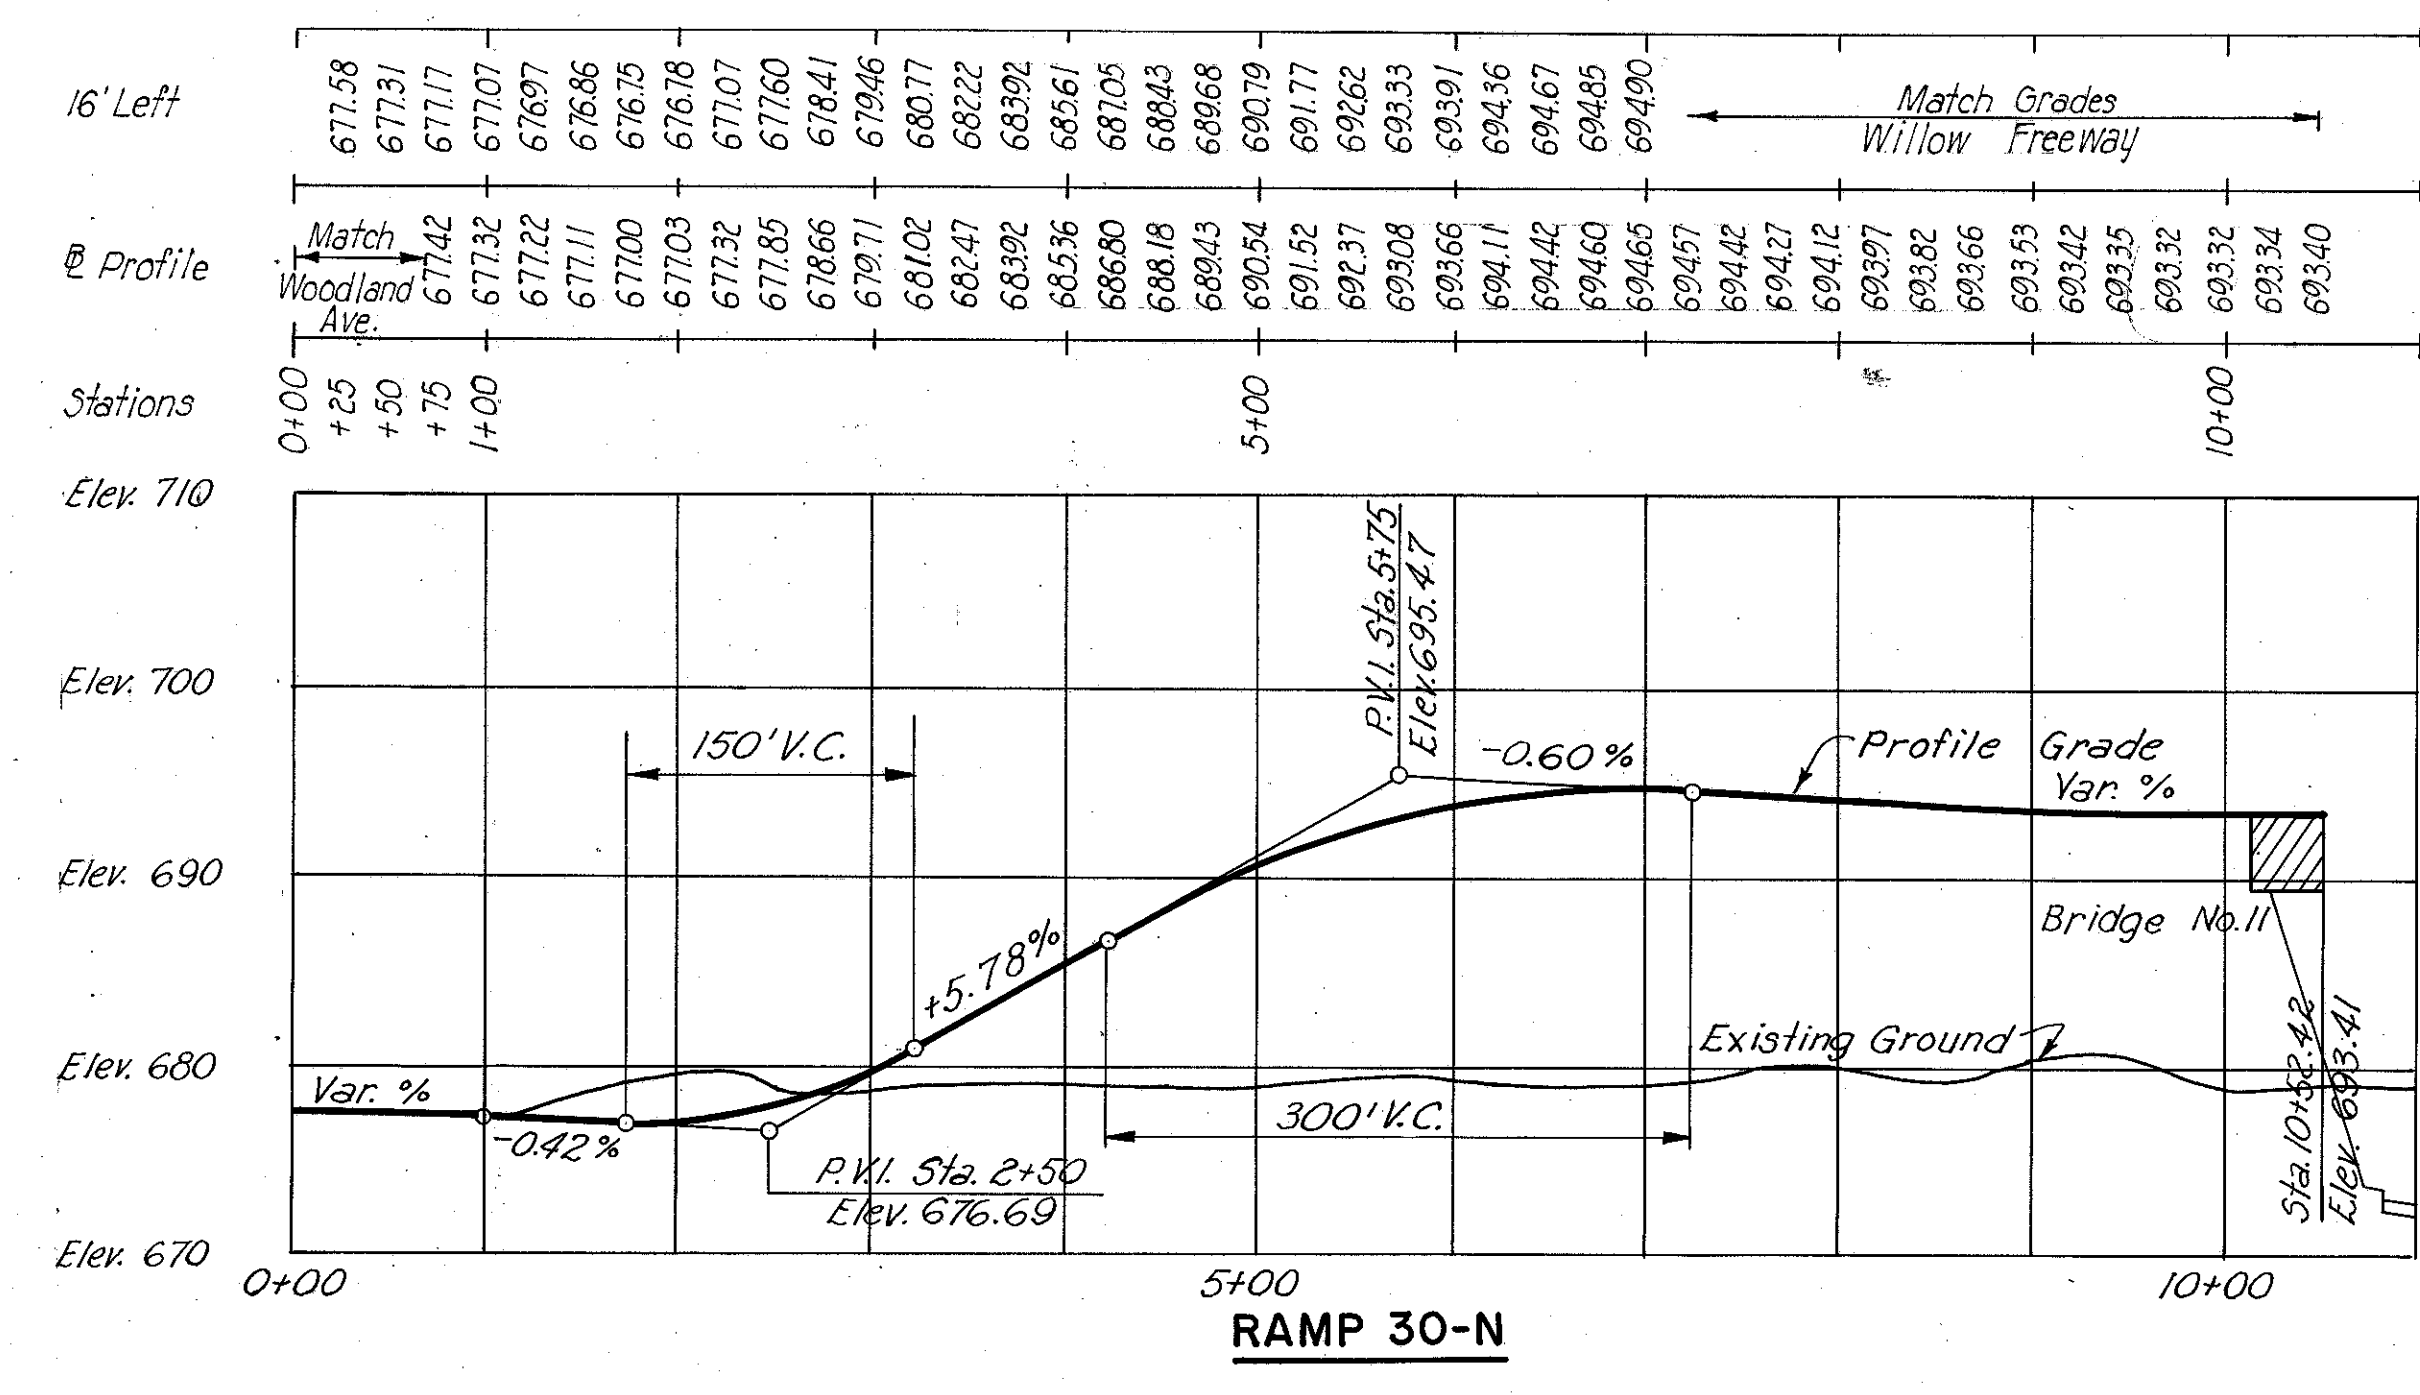


SCALE 1"=10' Ver. : 1"=100' Hor.
MADE DPH DATE 9-11-58 HOWARD, NEEDLES, TAMMEN & BERGENOFF
TRCD. RR DATE 10-7-58 CONSULTING ENGINEERS
CKD. GME DATE 3/3/59 KANSAS CITY CLEVELAND NEW YORK
914 SHEET 26


CUYAHOGA COUNTY
CITY OF CLEVELAND
CUY - 42 - 18.42
CUY - 21 - 15.32

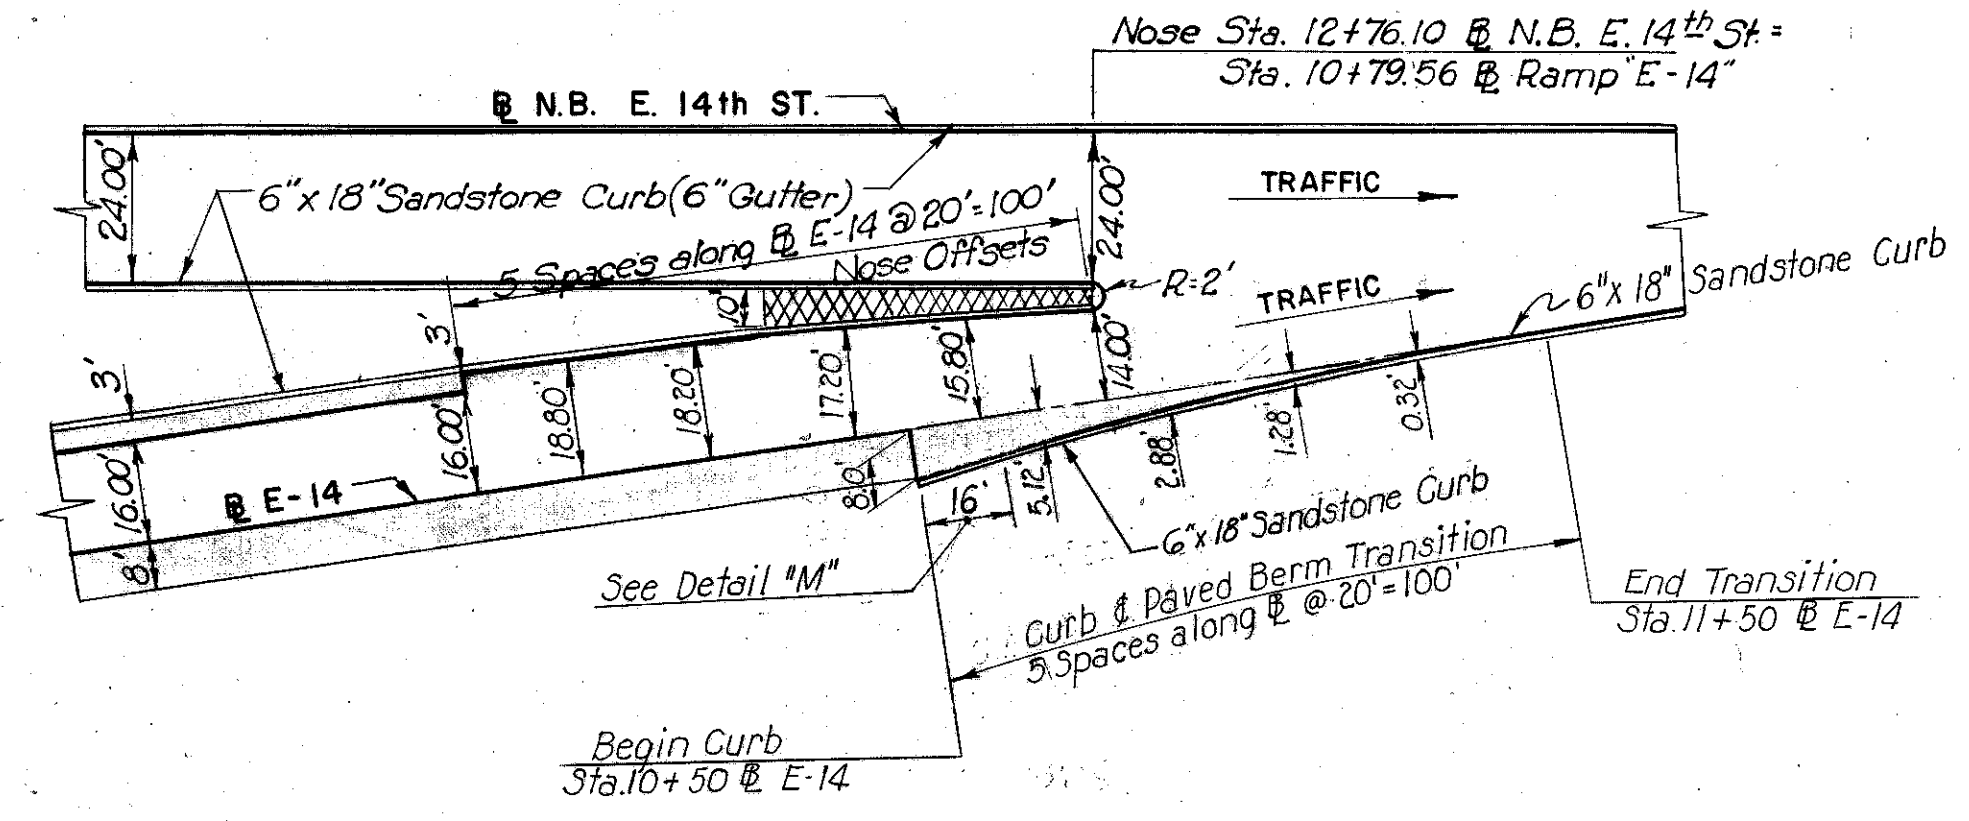


DETAIL "A"

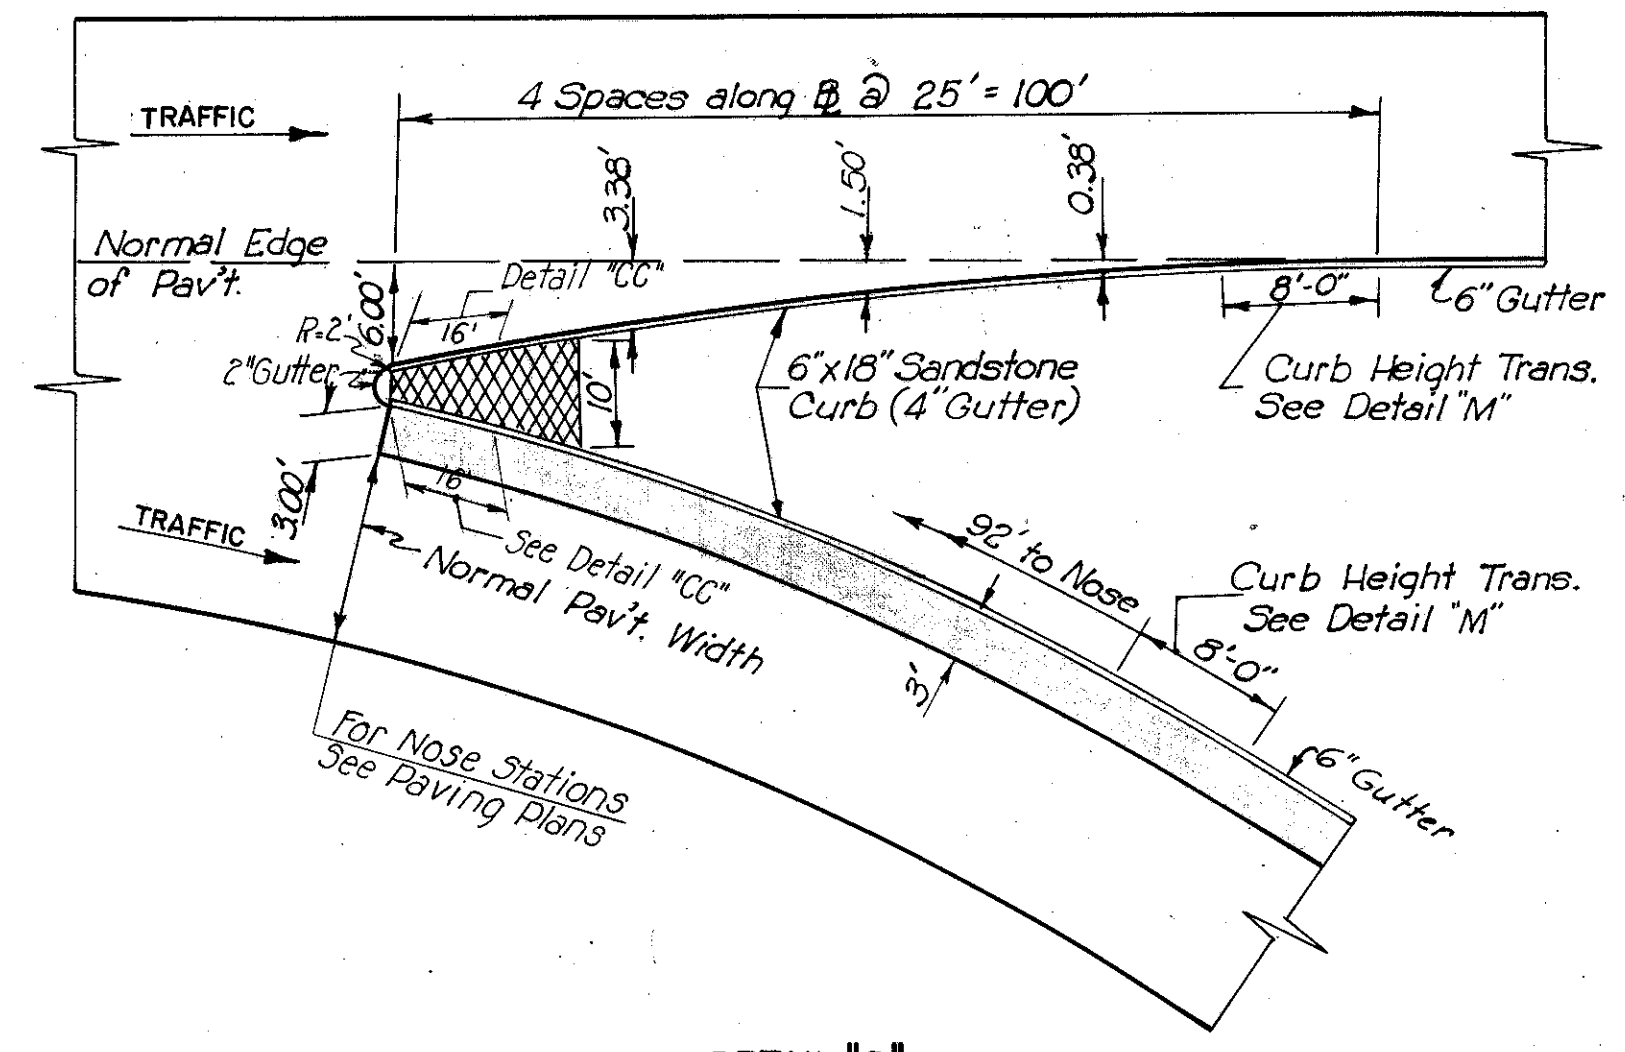


DETAIL "D"

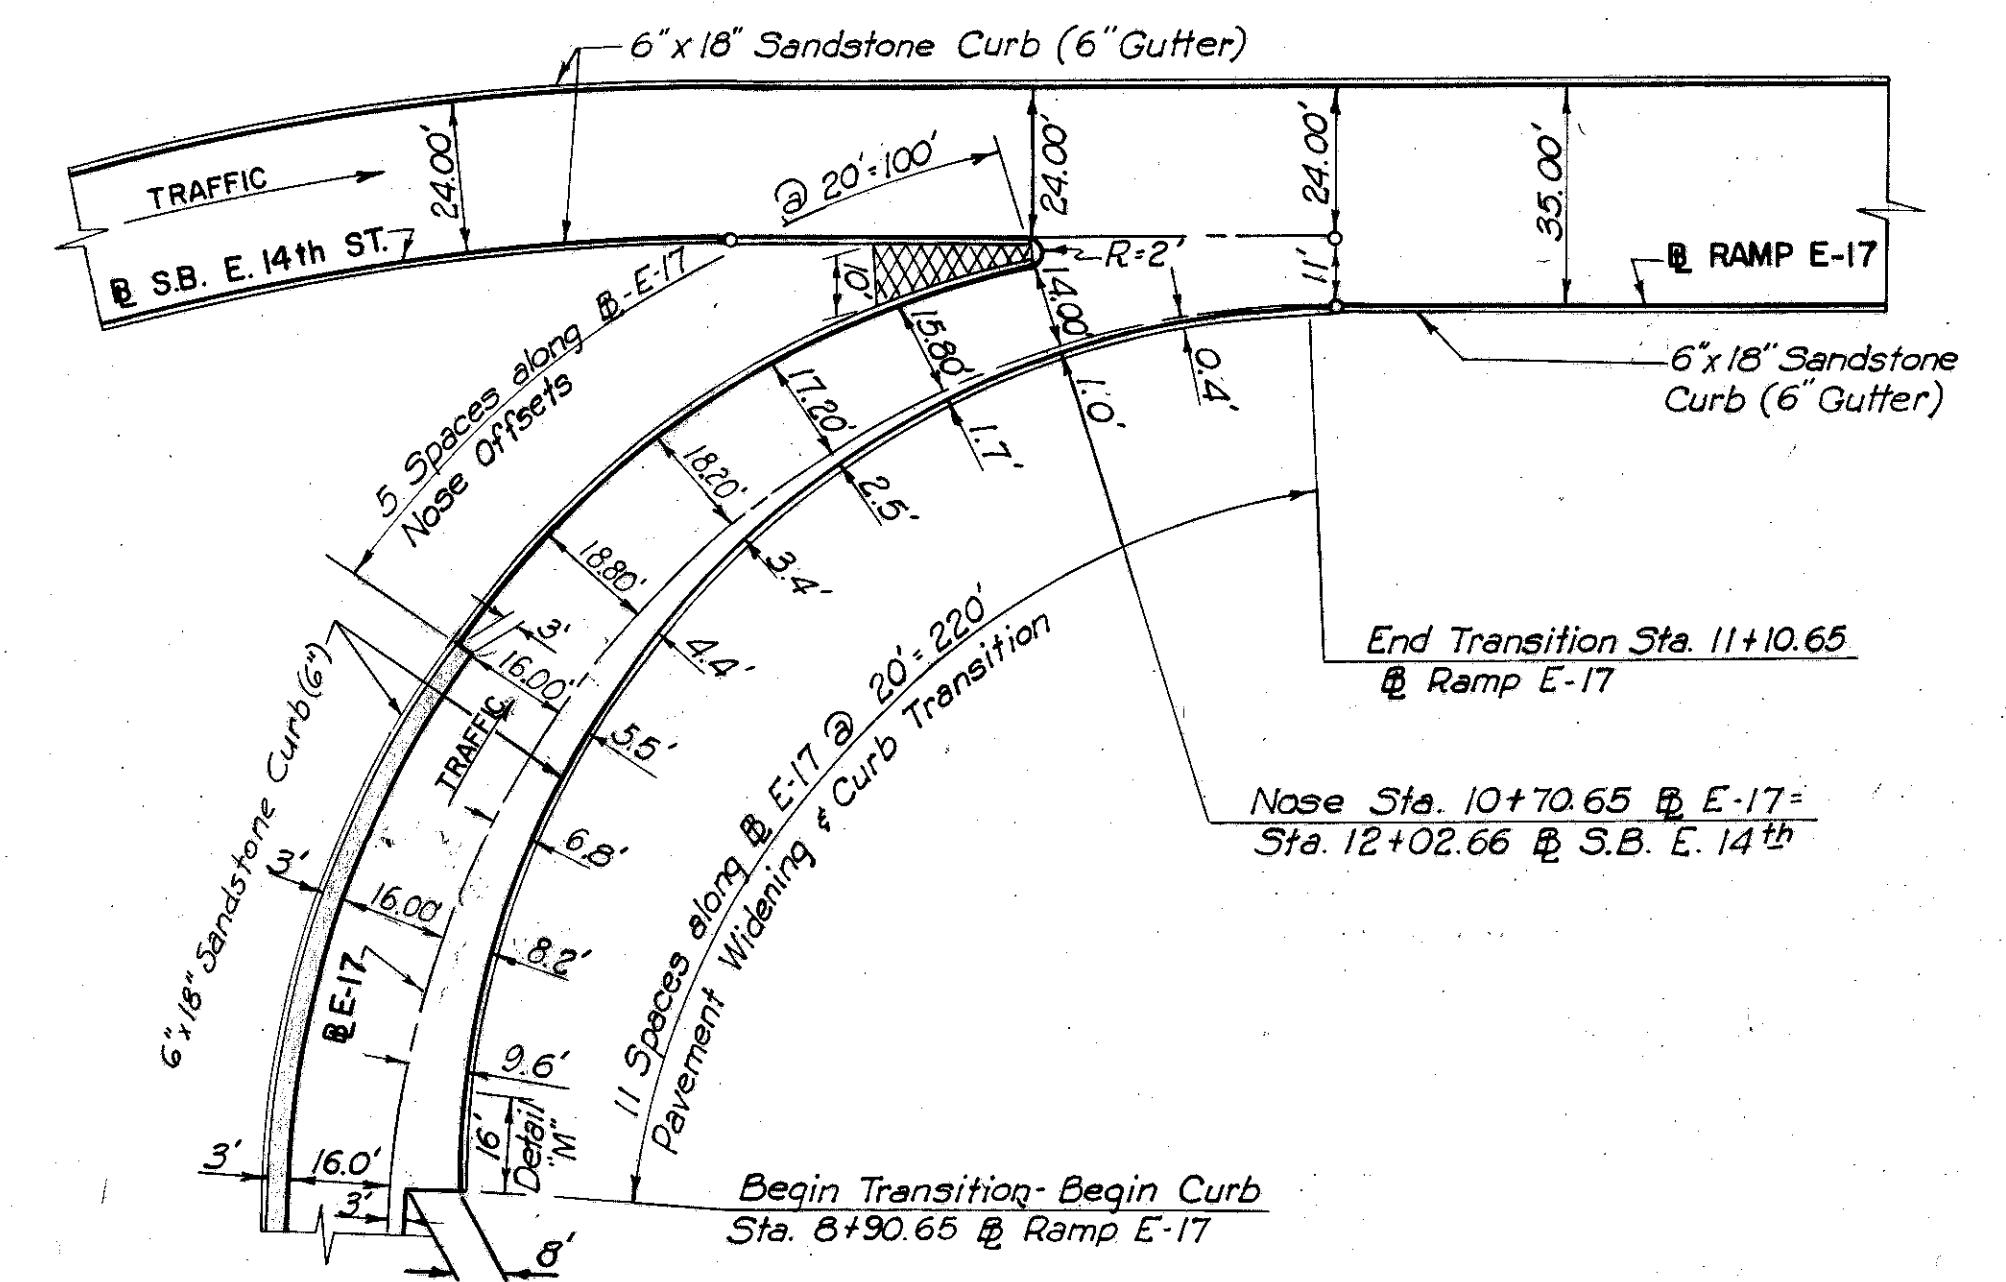


DETAIL "G"

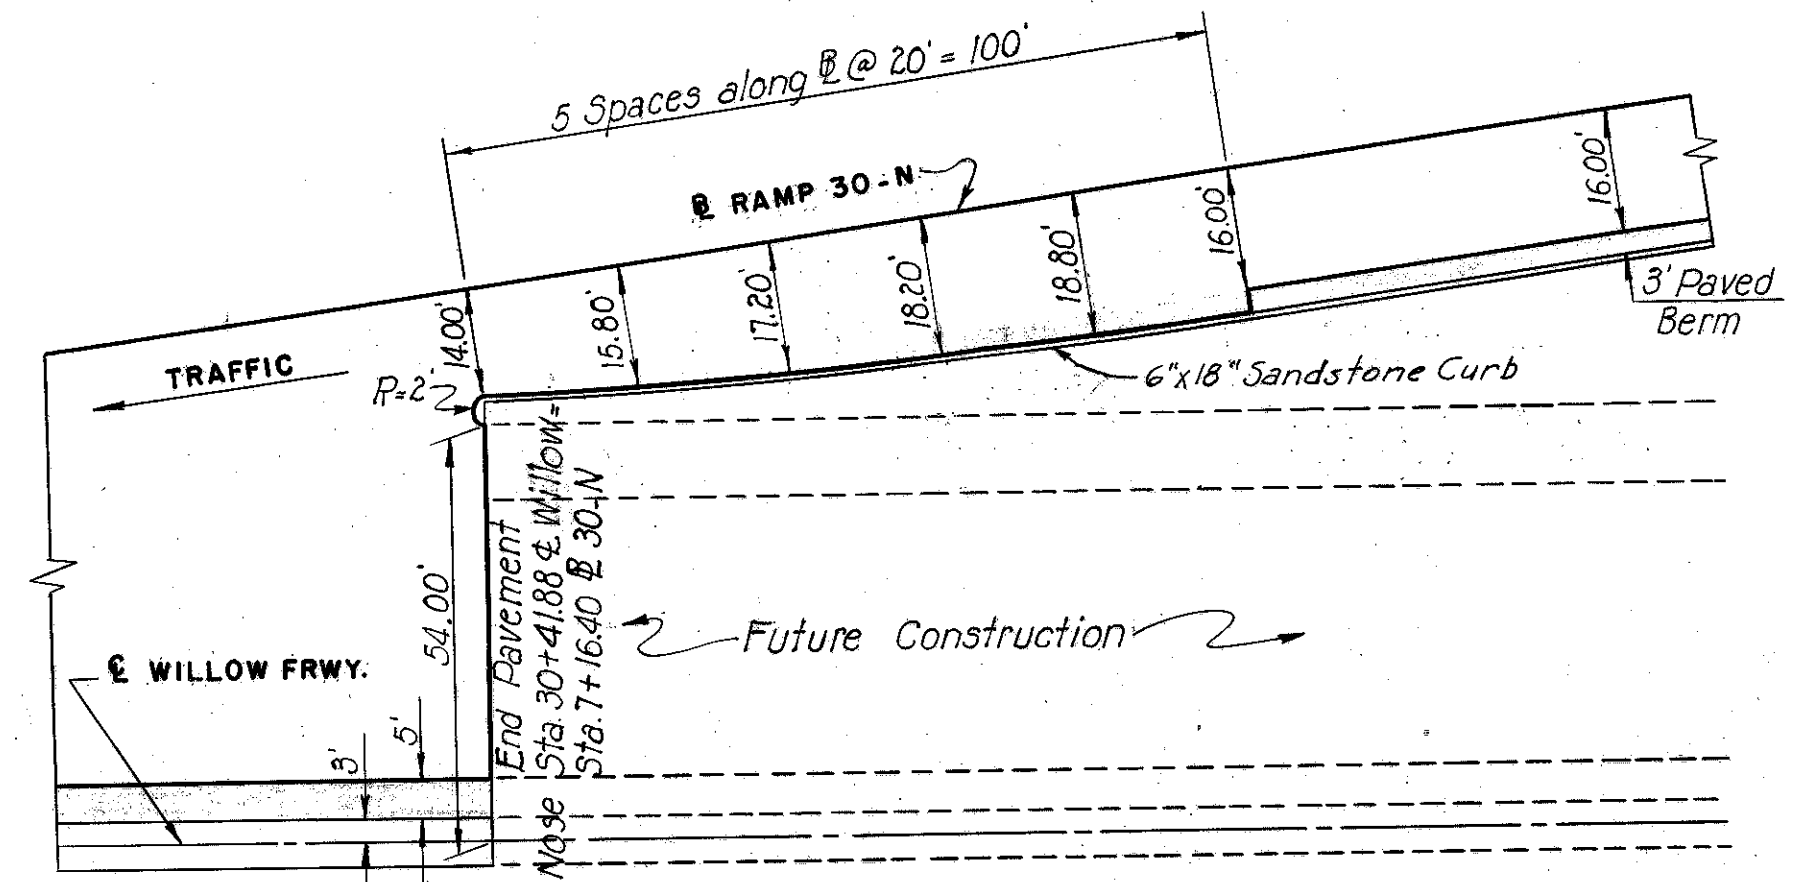


DETAIL "O"

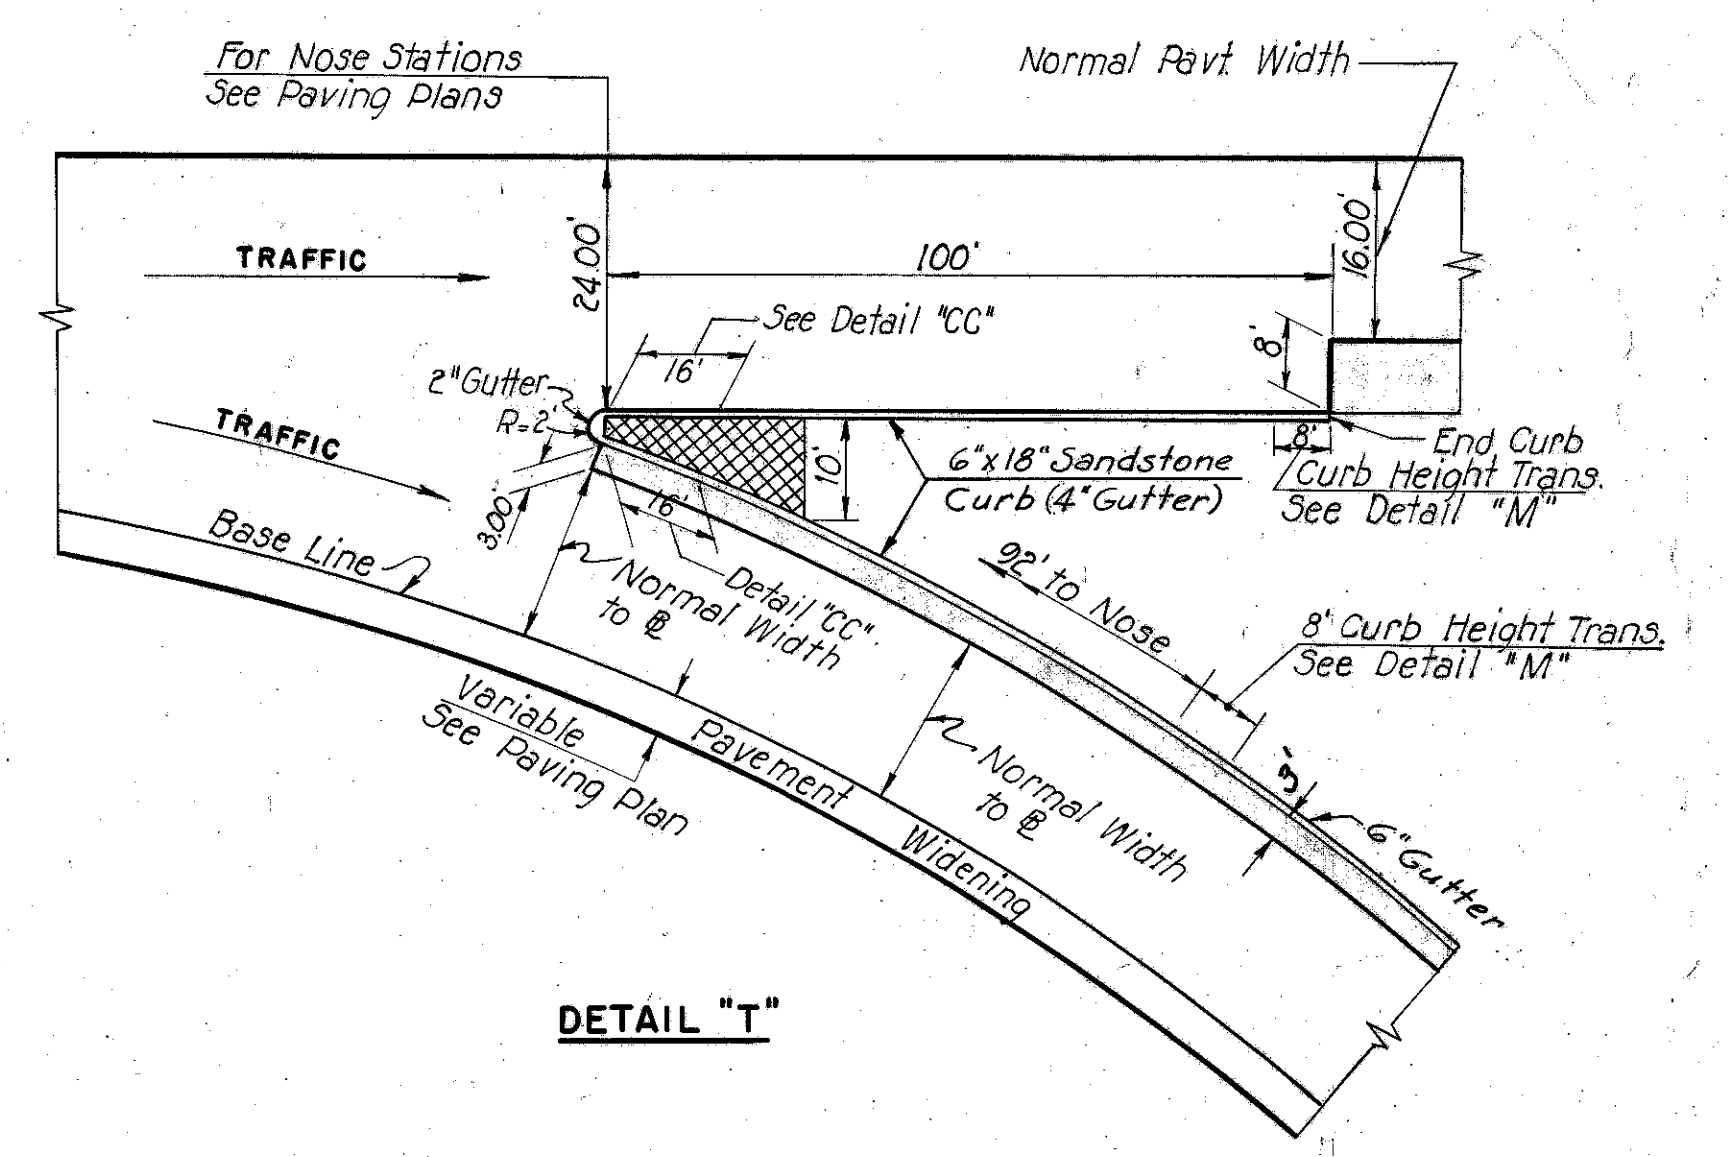

DETAIL "T"

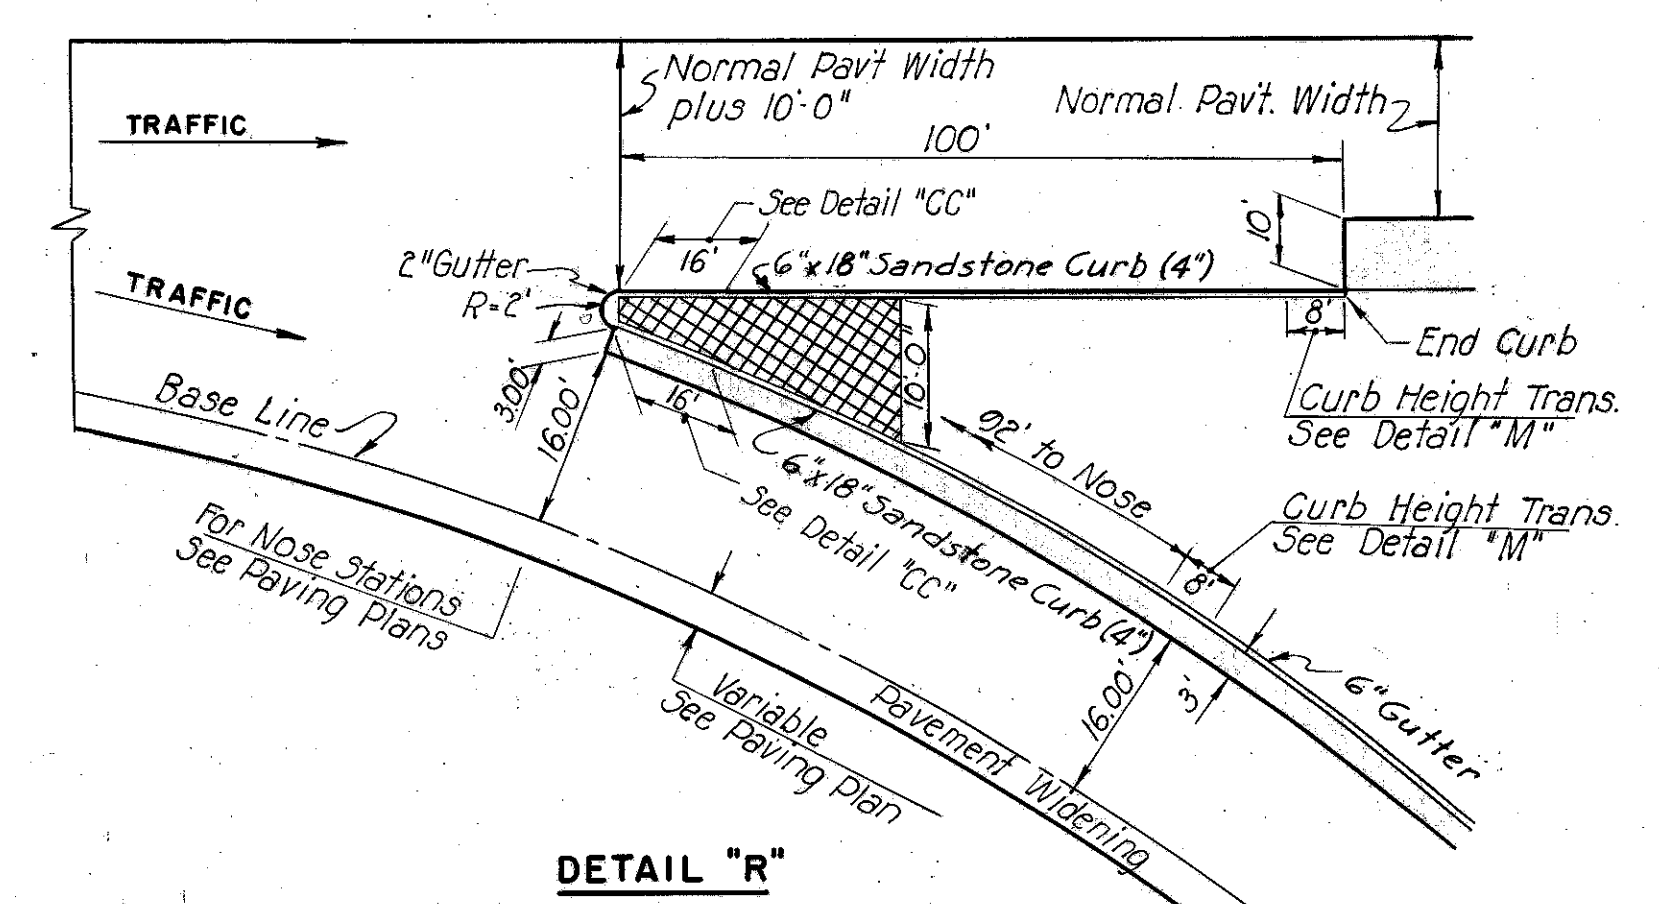

DETAIL "R"

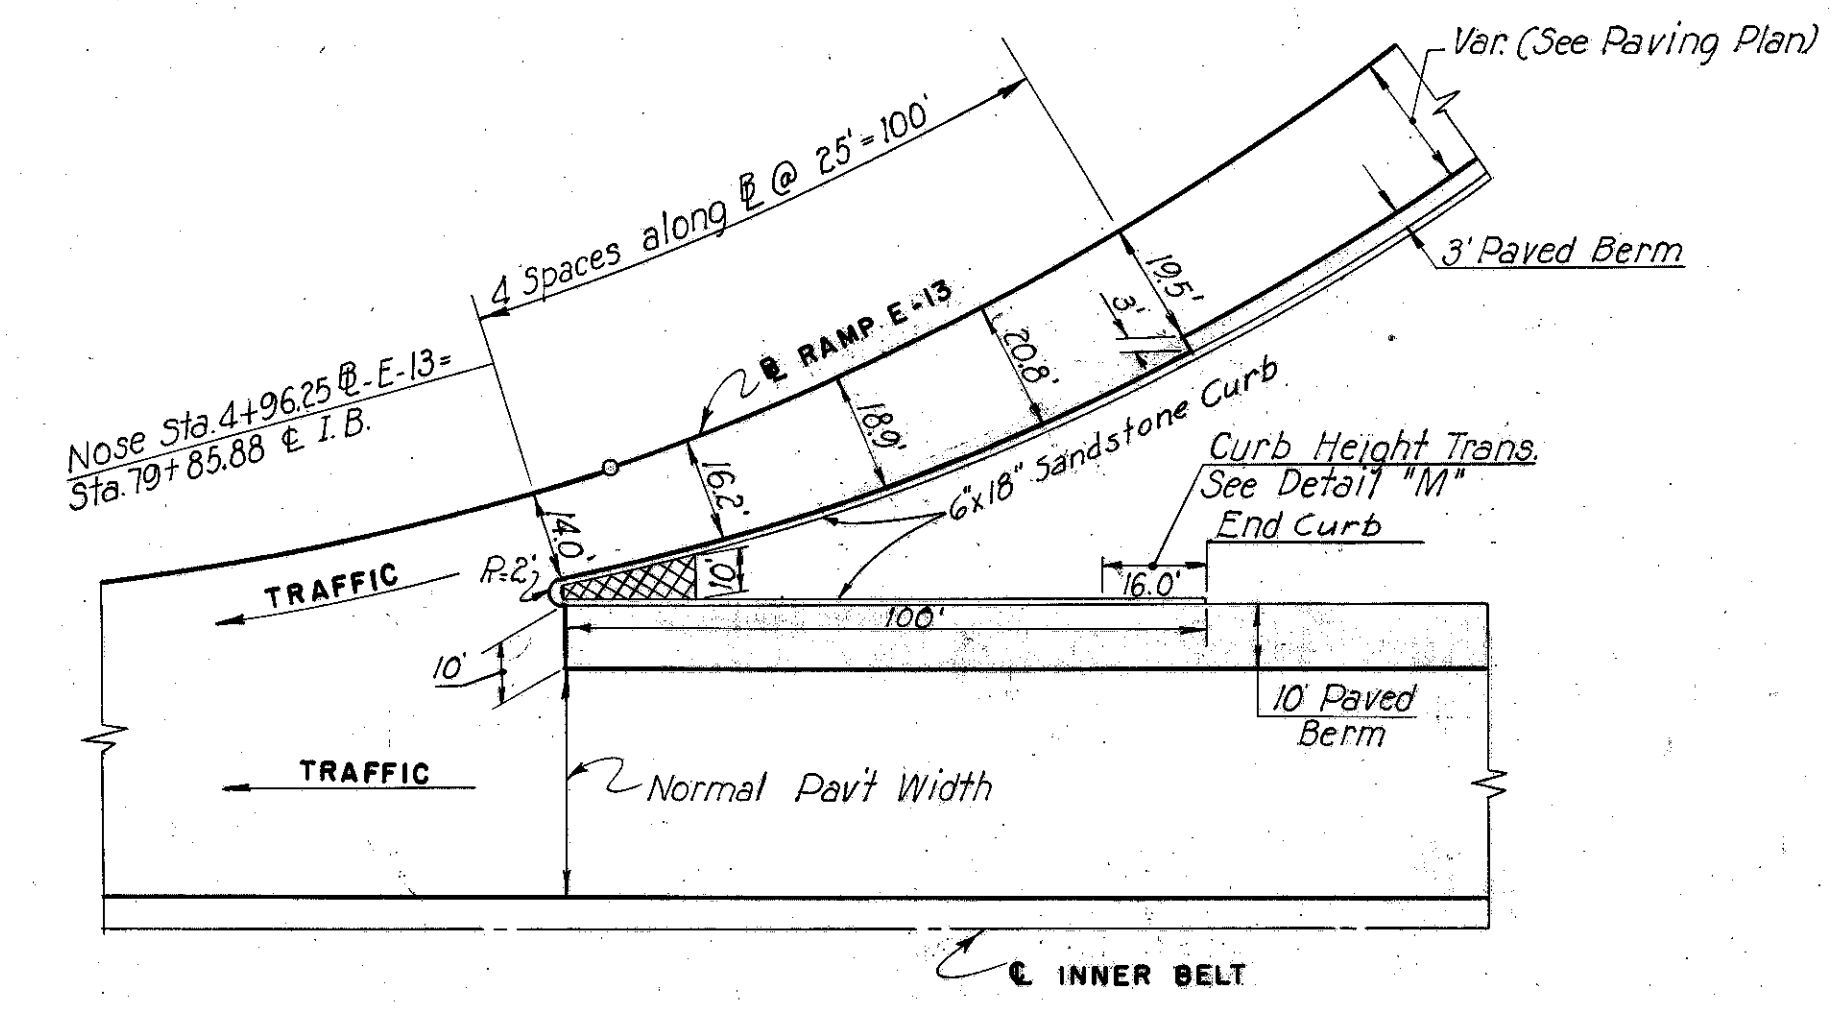

DETAIL "S"


LEGEND

I-21 Standard Type 1 Portland Cement Concrete Median Pavement.

Paved Berm.


NOSE DETAILS
A, D, G, O, R, S & T

CUYAHOGA COUNTY
CITY OF CLEVELAND
INNER CUYAHOGA FREEWAY - PART
CUY-42-18.42
CUY-21-15.32

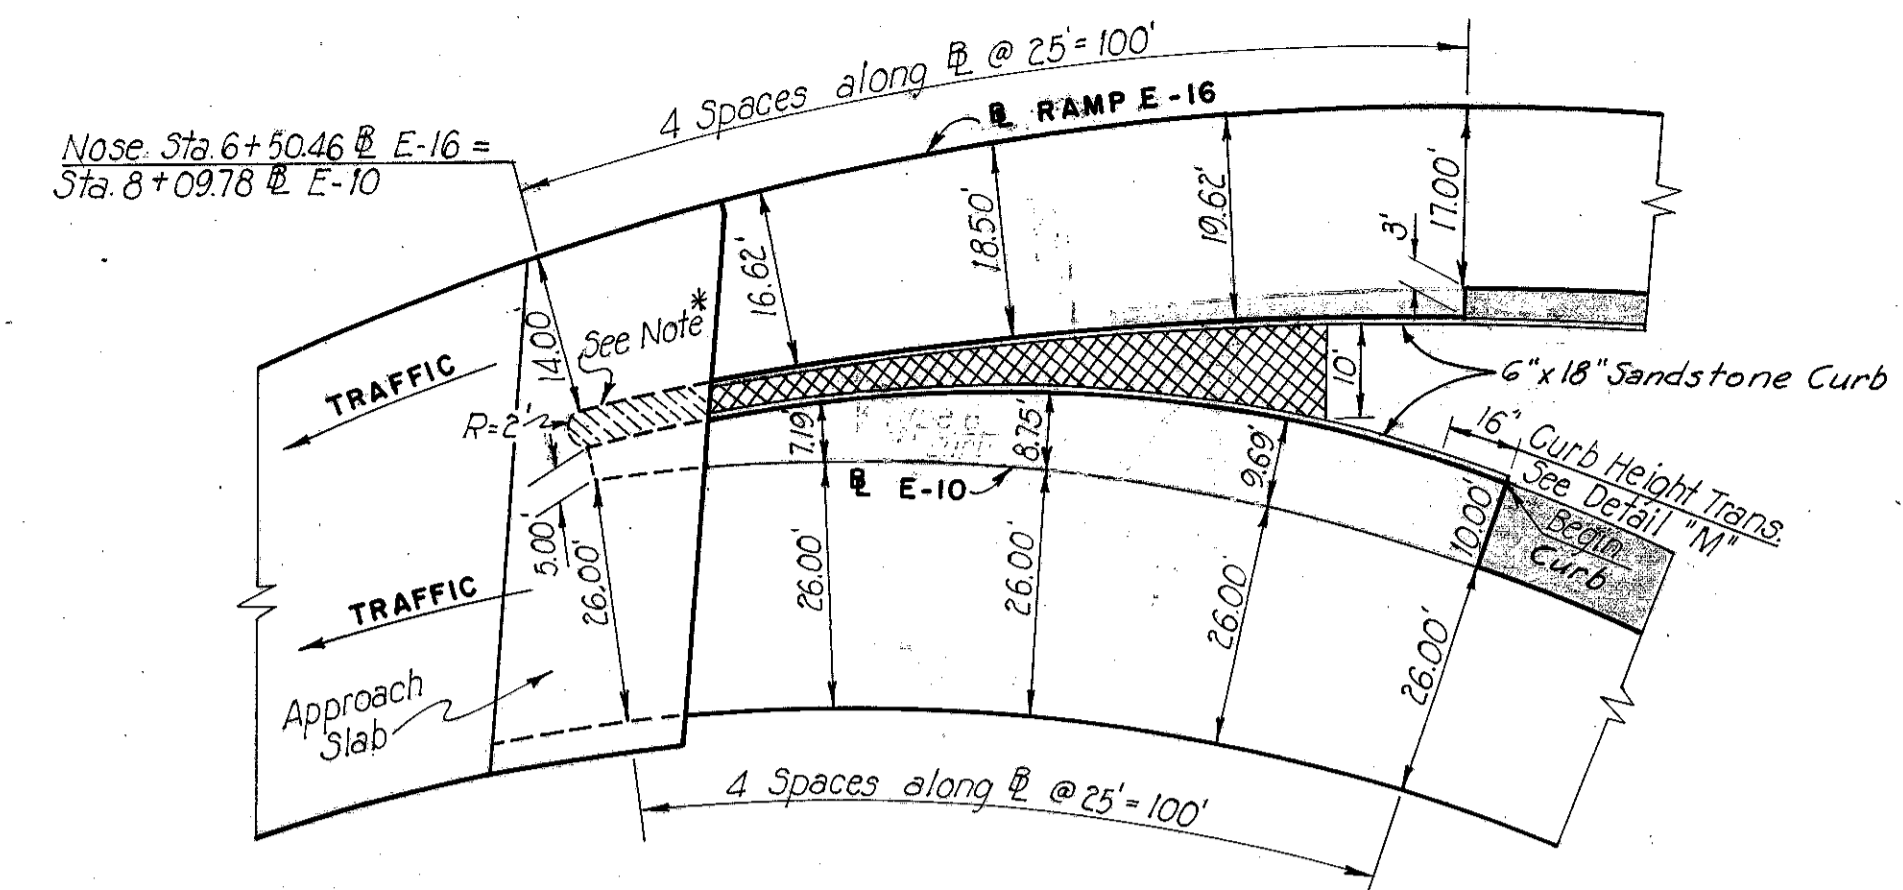


* Note:
6" Concrete median and nose to be placed on top of Approach Slab and anchored with eight (8), #5 round, straight bars, nine (9) inches long, imbedded in Approach Slab to a depth of six (6) inches. Bars to be uniformly spaced throughout median. All the above to be included for payment in the price bid for Item I-7, Approach Slabs.


DETAIL "U"
Not to Scale

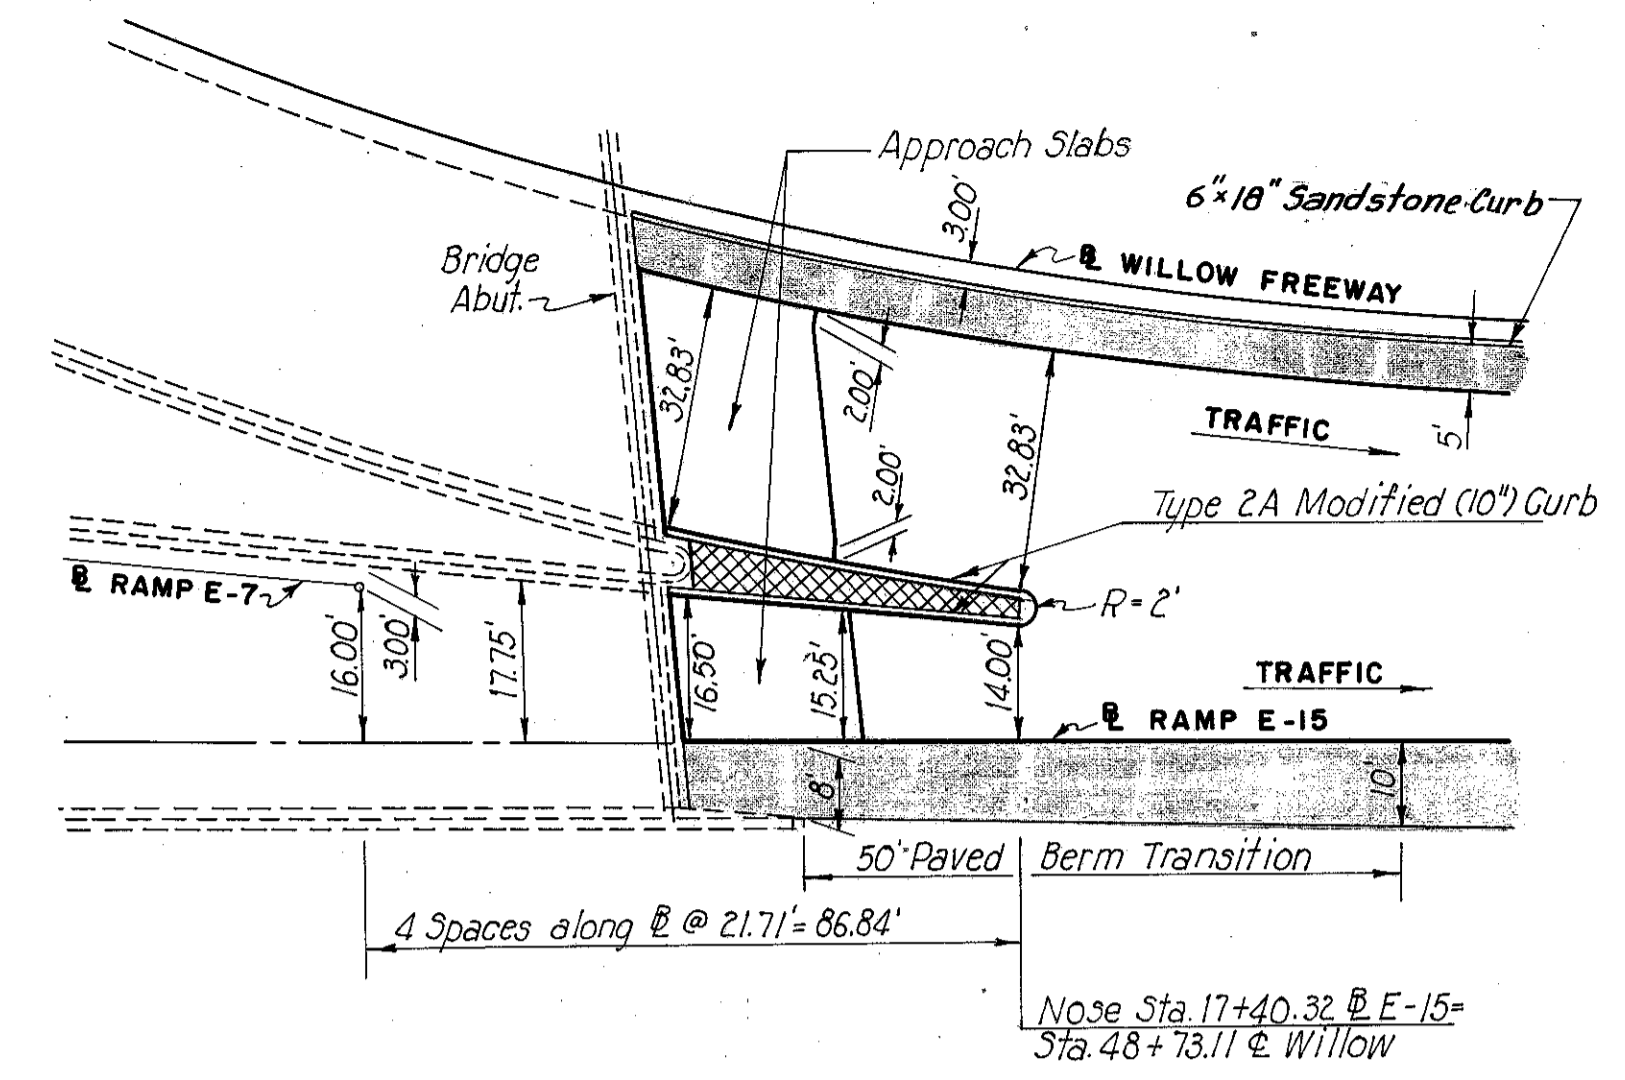


DETAIL "X"
Not to Scale

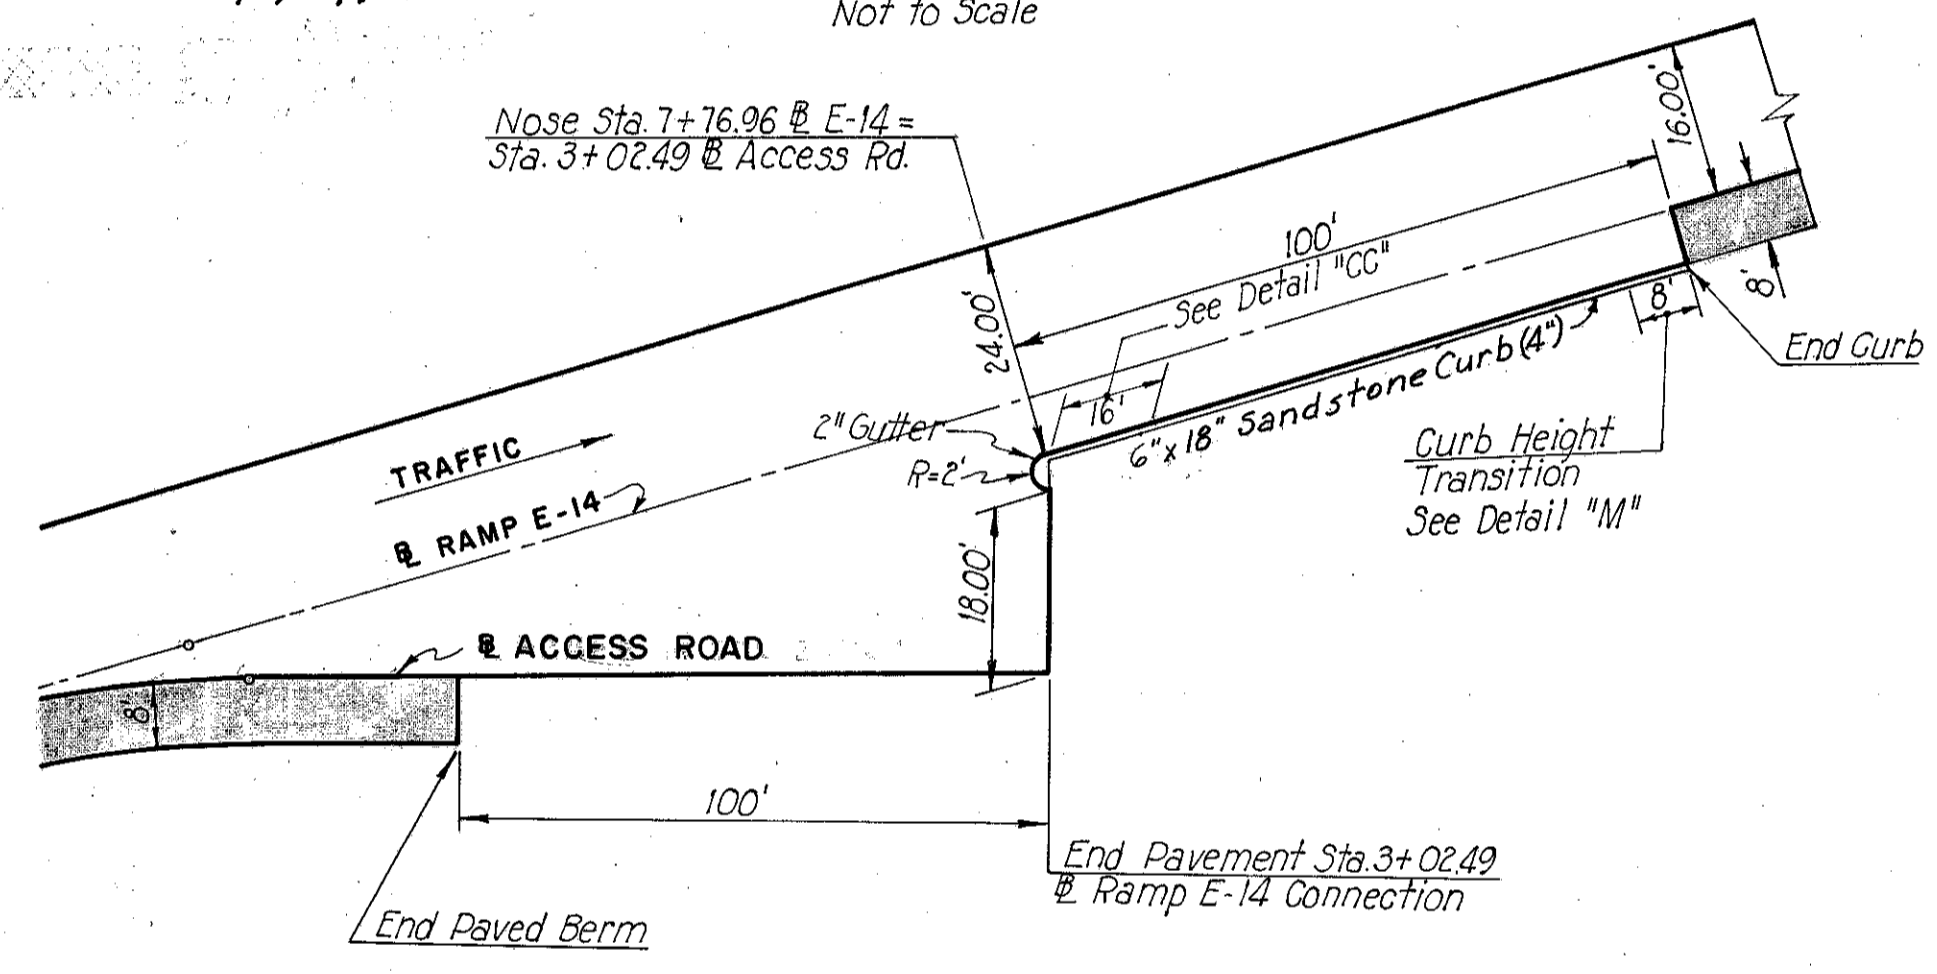


DETAIL "V"
Not to Scale

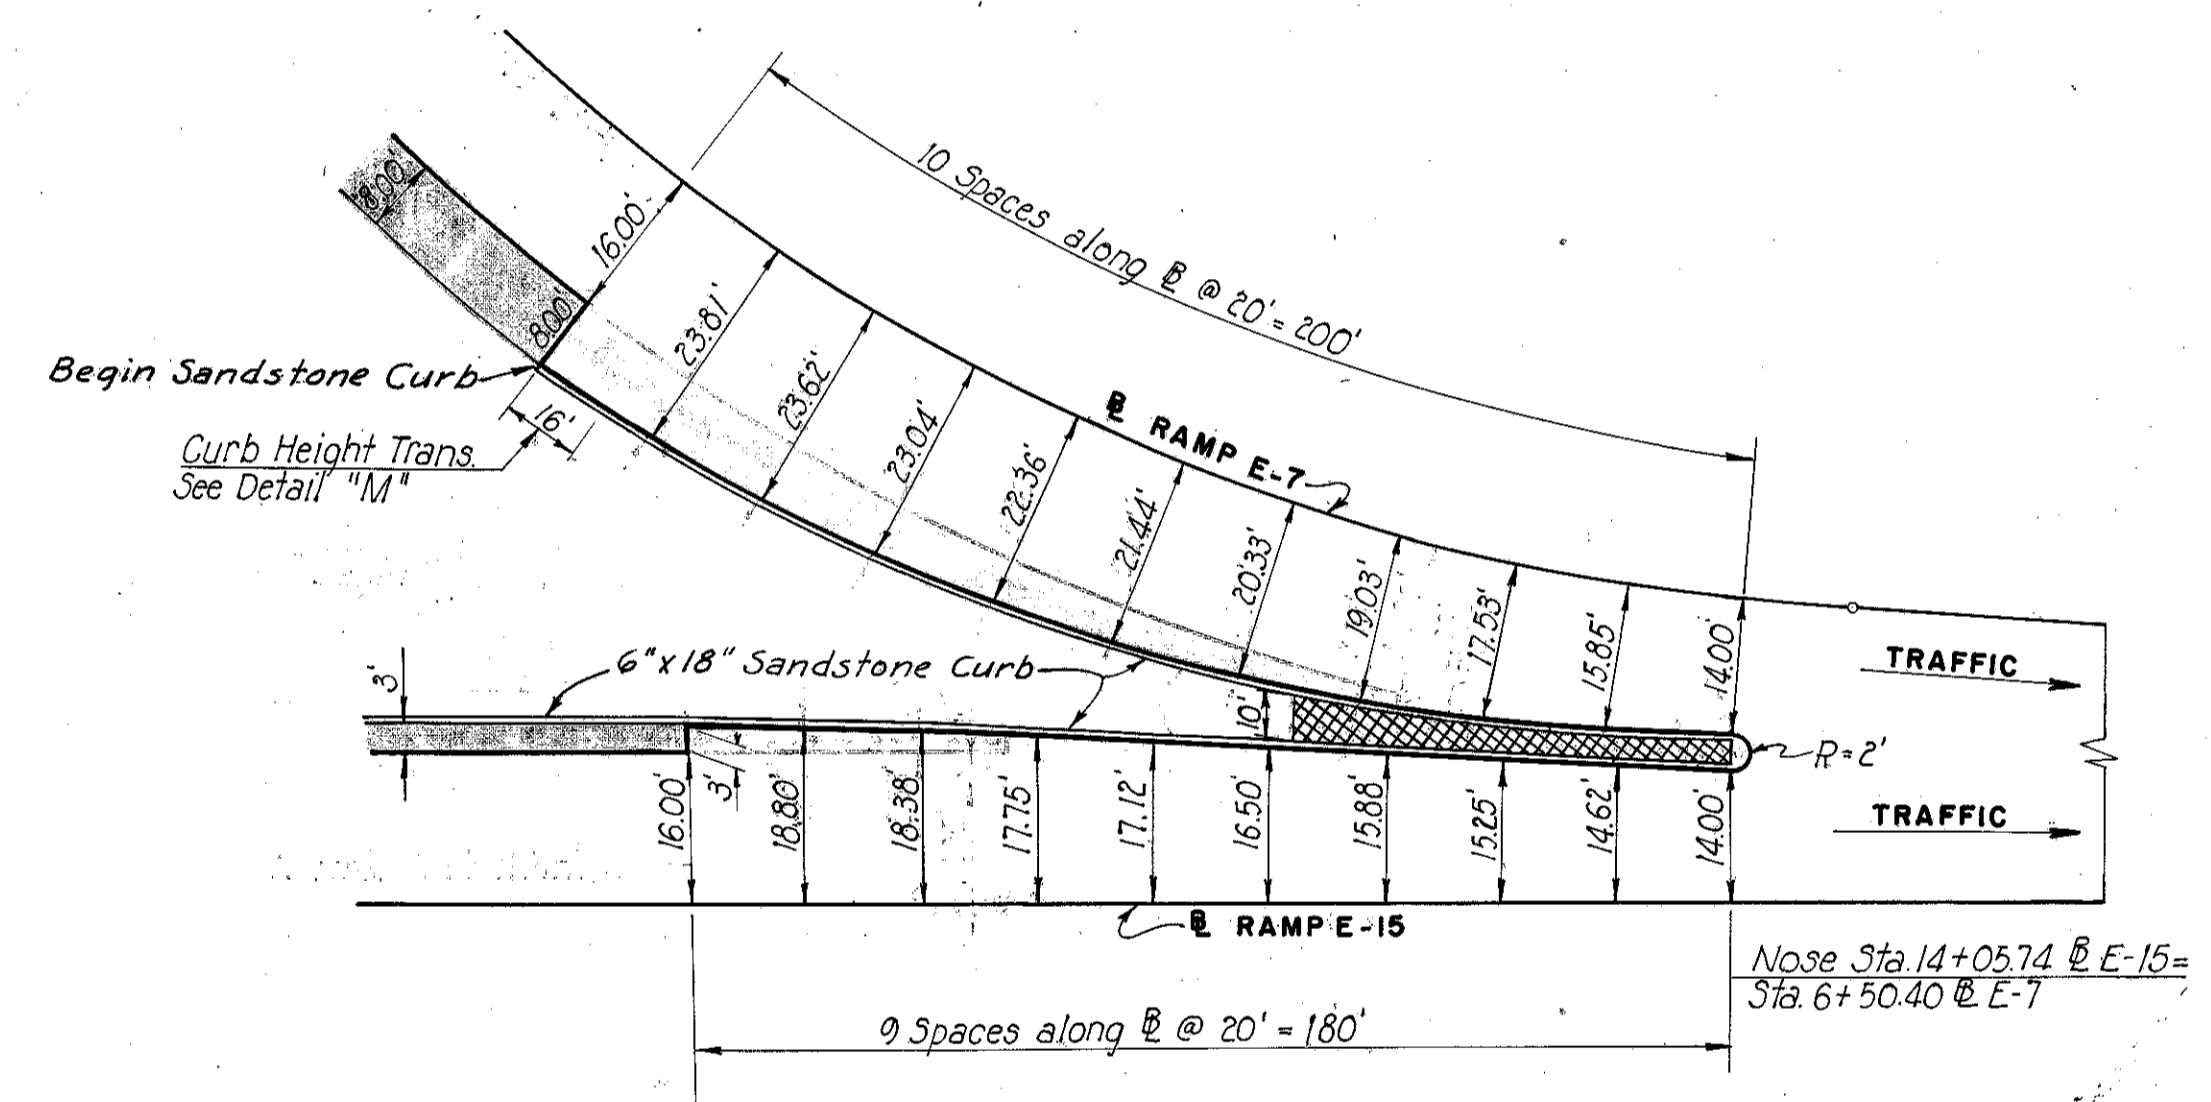


DETAIL "Y"
Not to Scale

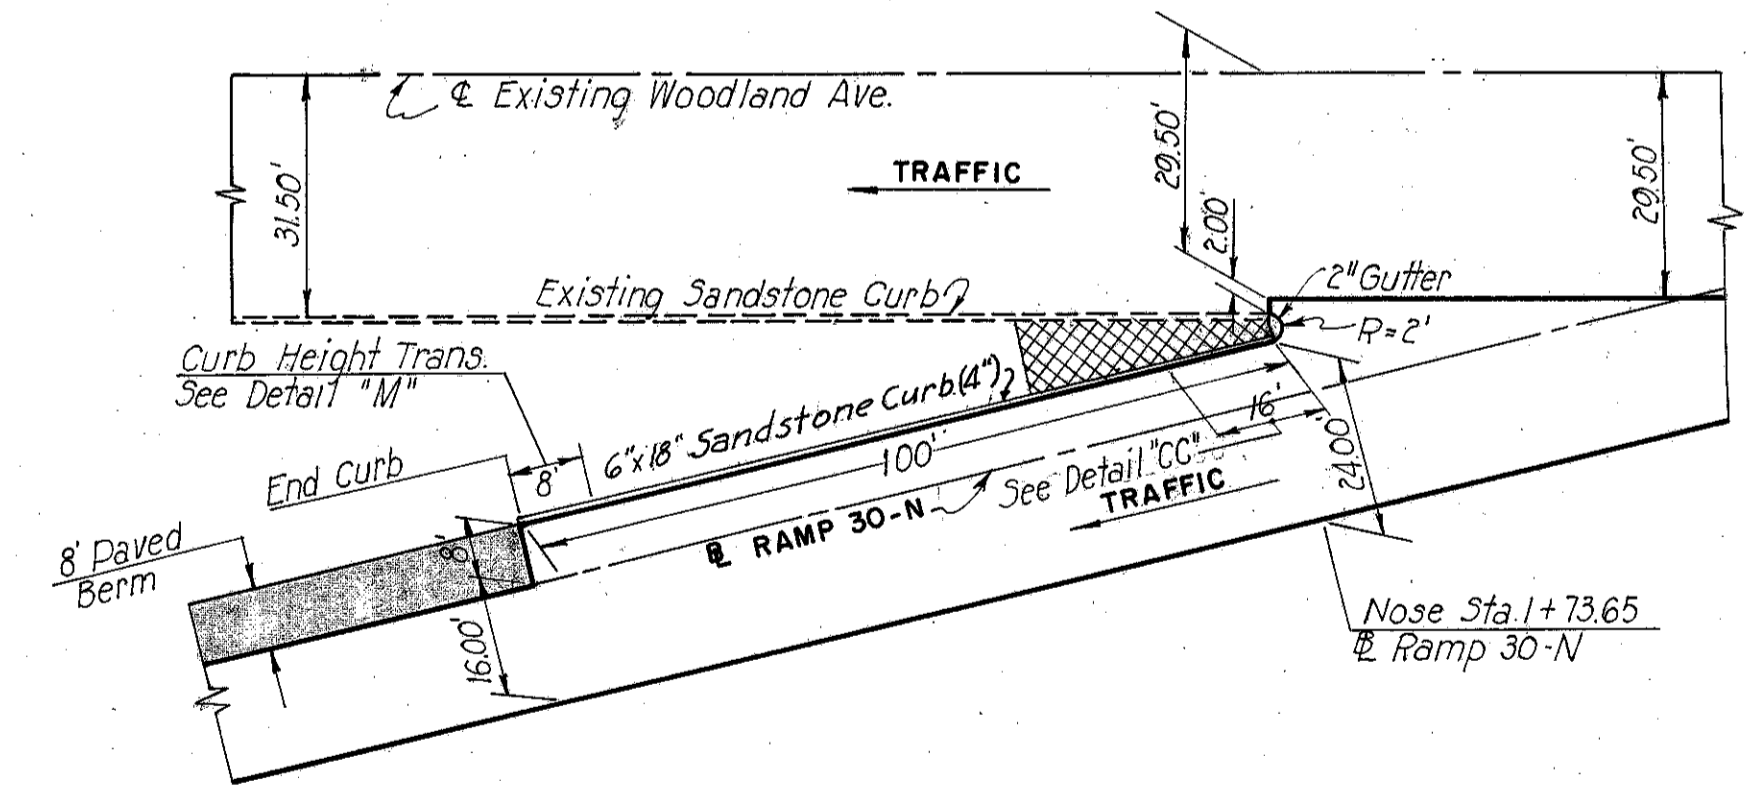

DETAIL "BB"
Not to Scale

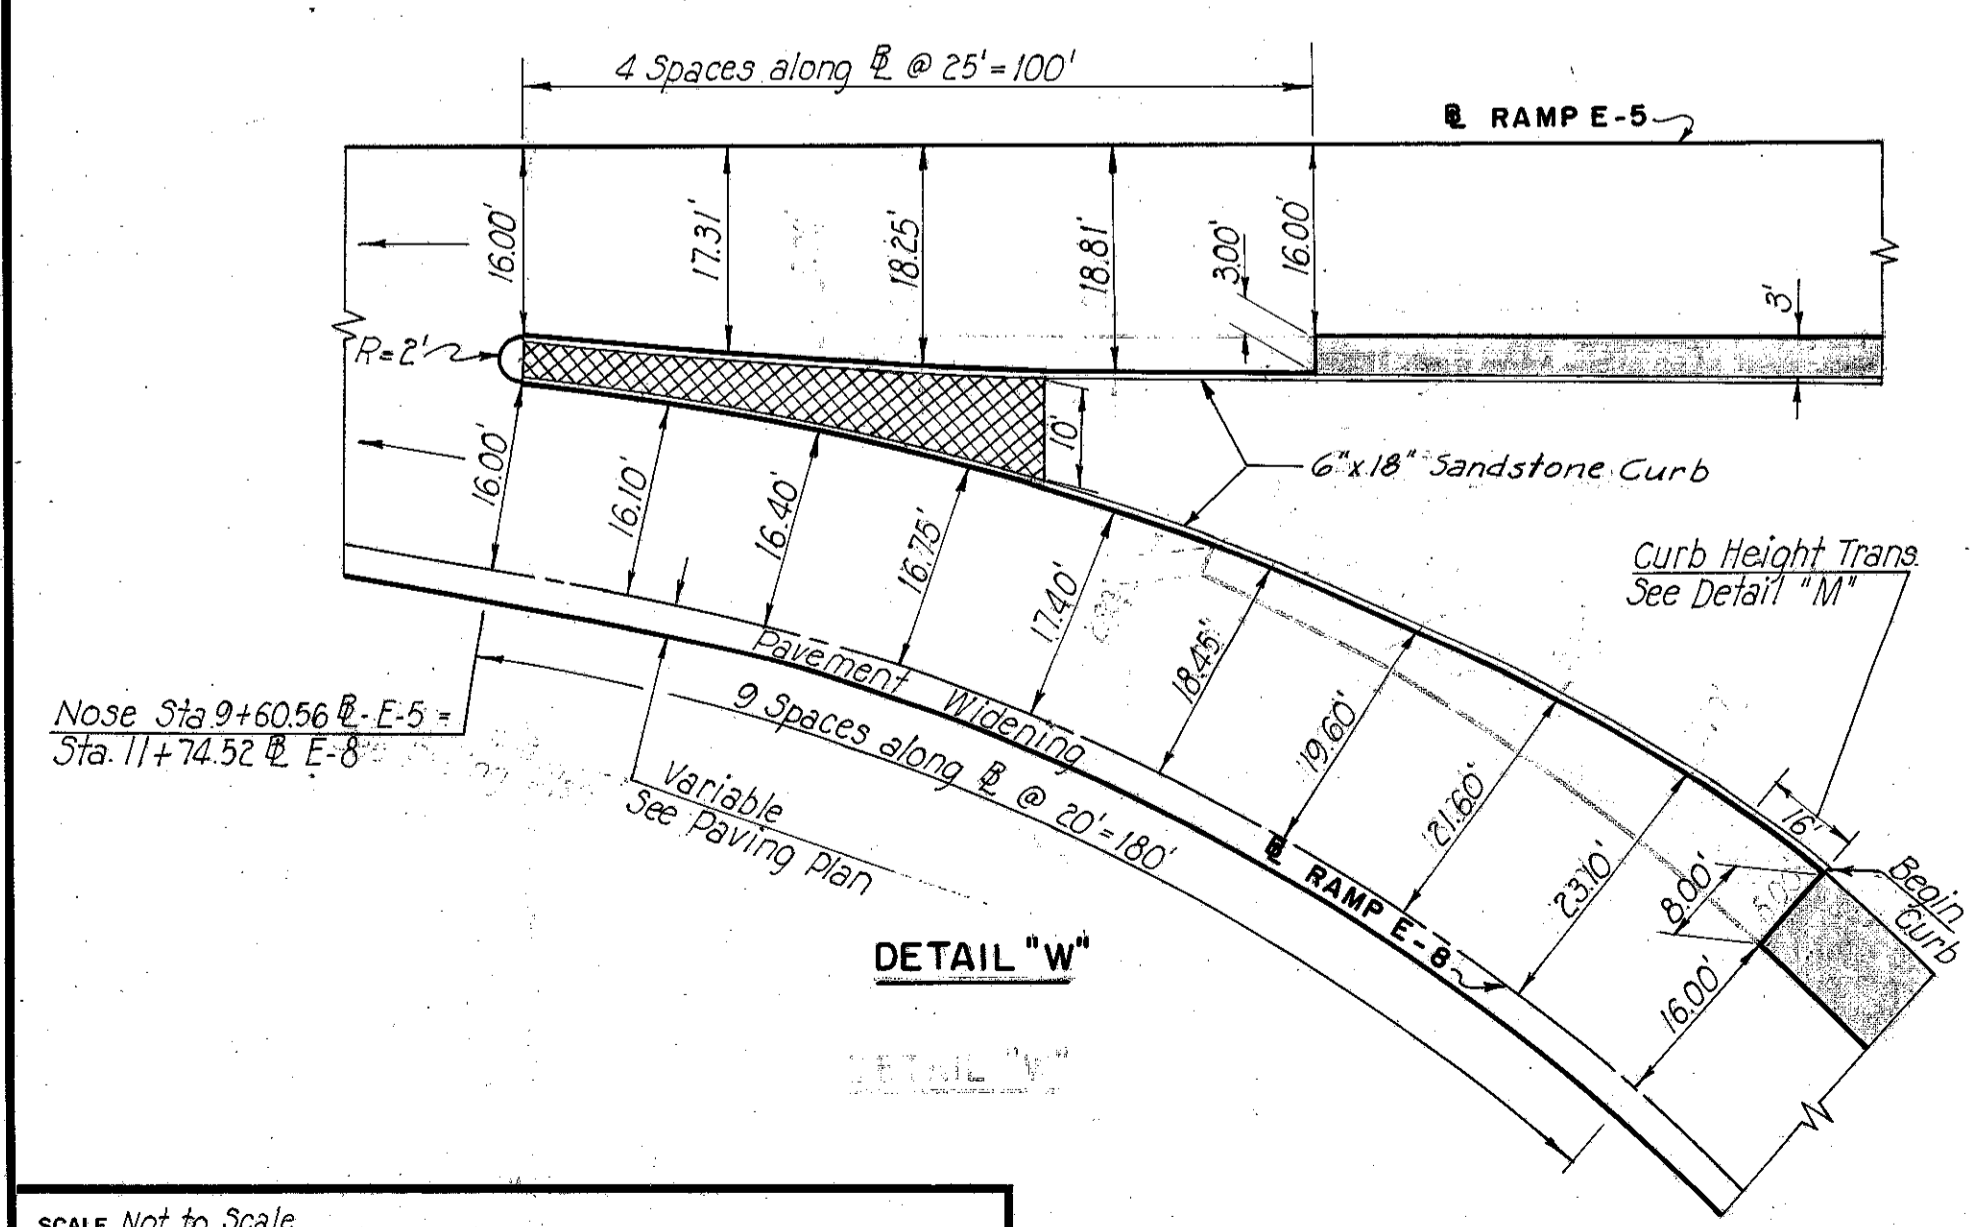

DETAIL "W"
Not to Scale

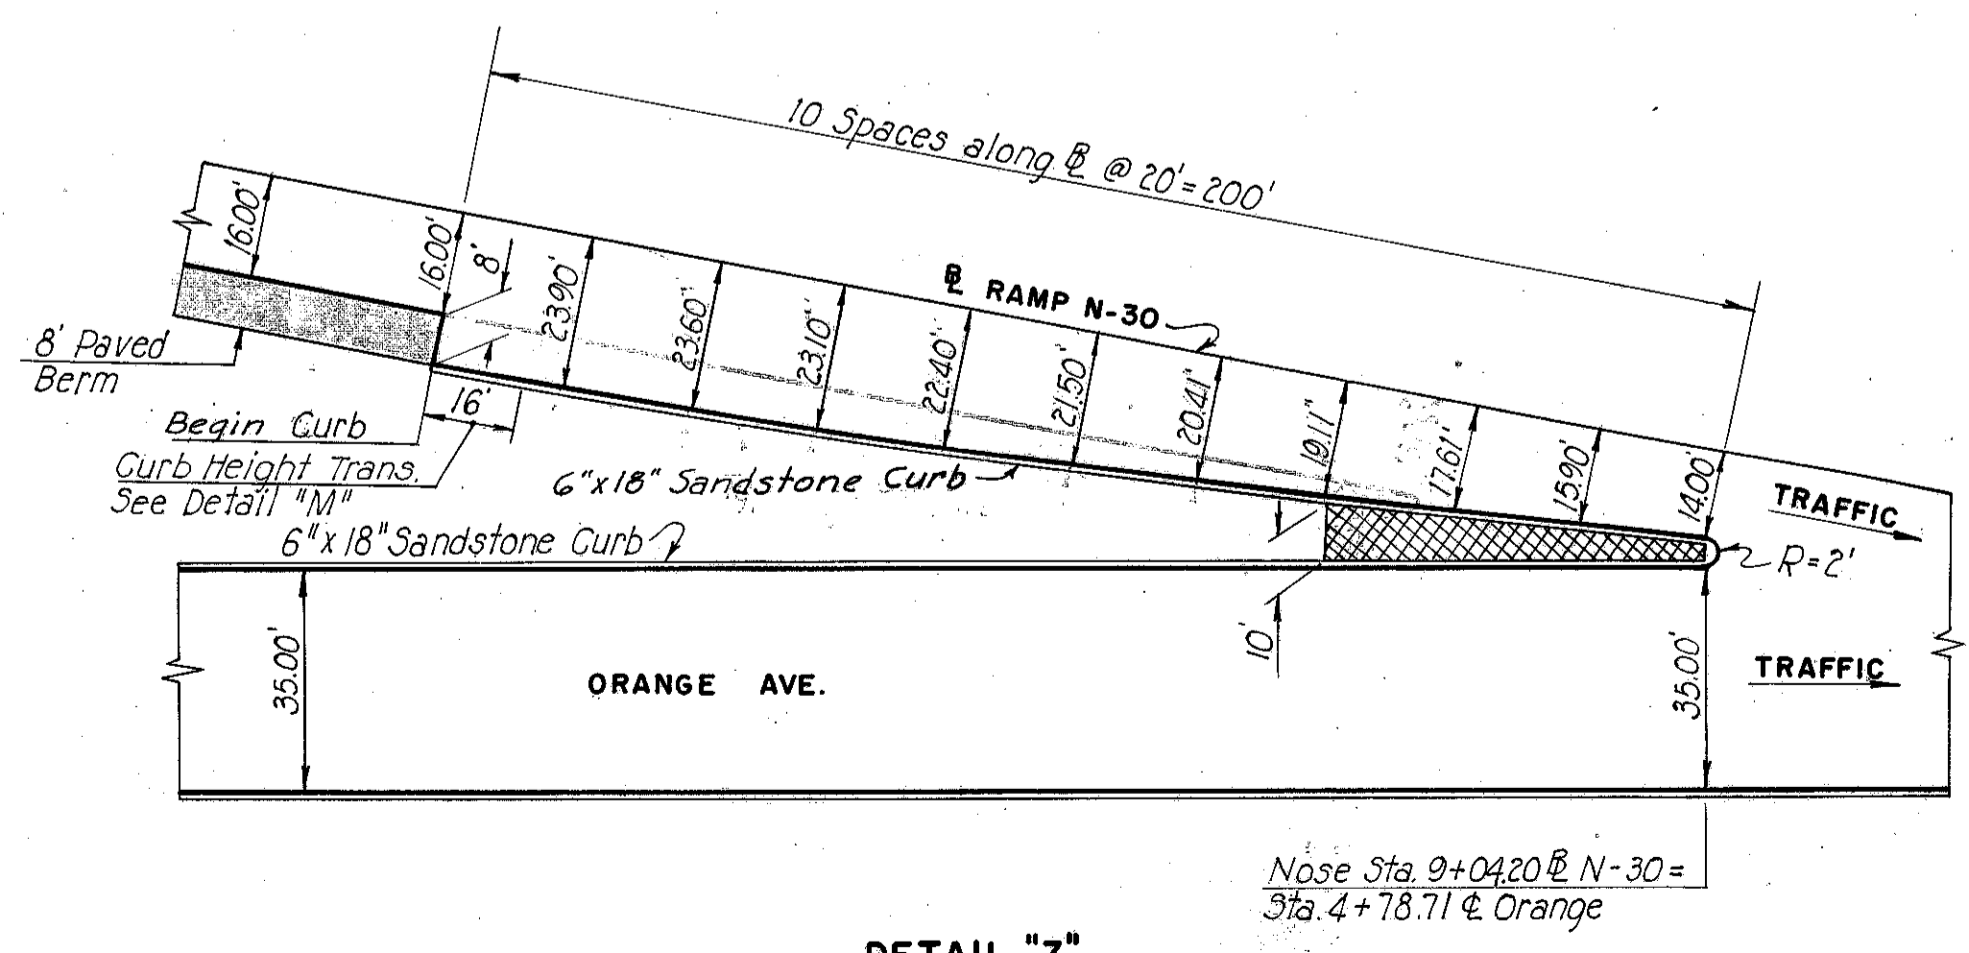

DETAIL "Z"
Not to Scale


LEGEND

I-21 Standard Type I Portland Cement Concrete Median Pavement.

Paved Berm.

NOSE DETAILS
U, V, W, X, Y, Z & BB

CUYAHOGA COUNTY
CITY OF CLEVELAND
CUY - 42-18.42
CUY - 21-15.32

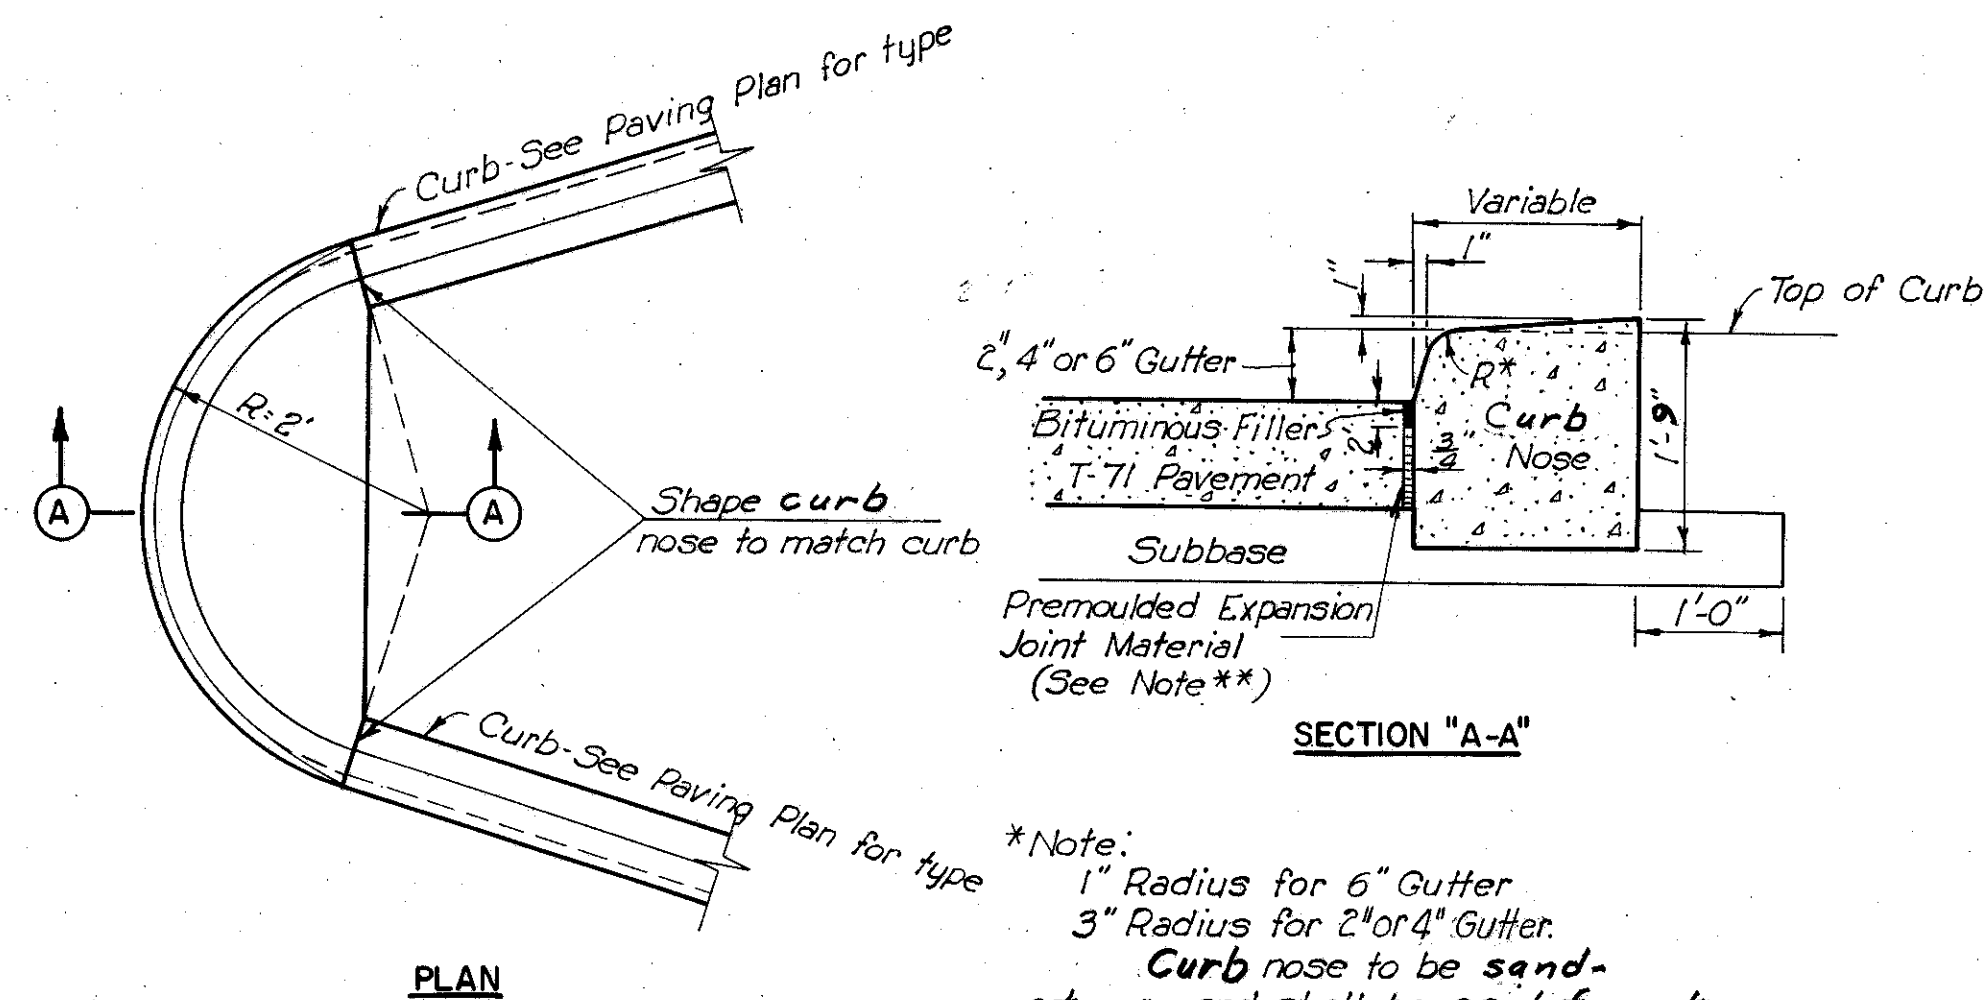


SECTION "A-A"

***Note:**
1" Radius for 6" Gutter
3" Radius for 2" or 4" Gutter.
Curb nose to be sandstone and shall be paid for at price bid per lineal foot of sandstone curb.


**** Note:**
The three quarter (¾) inch Premoulded Joint Material shall meet the requirements of Section M-10.02 of the Standard Specifications. It shall be placed in front of the Bumper Block to within two (2) inches of the surface. The remaining space shall be filled with Bituminous Filler meeting the requirements of Section M-5.6 F2 of the Standard Specifications.
The cost of the joint shall be included in price bid per lineal foot of curb.

PLAN


DETAIL "K"
CURB TERMINATION AT NOSE AND BUMPER BLOCK
Scale: ¾" = 1'-0"

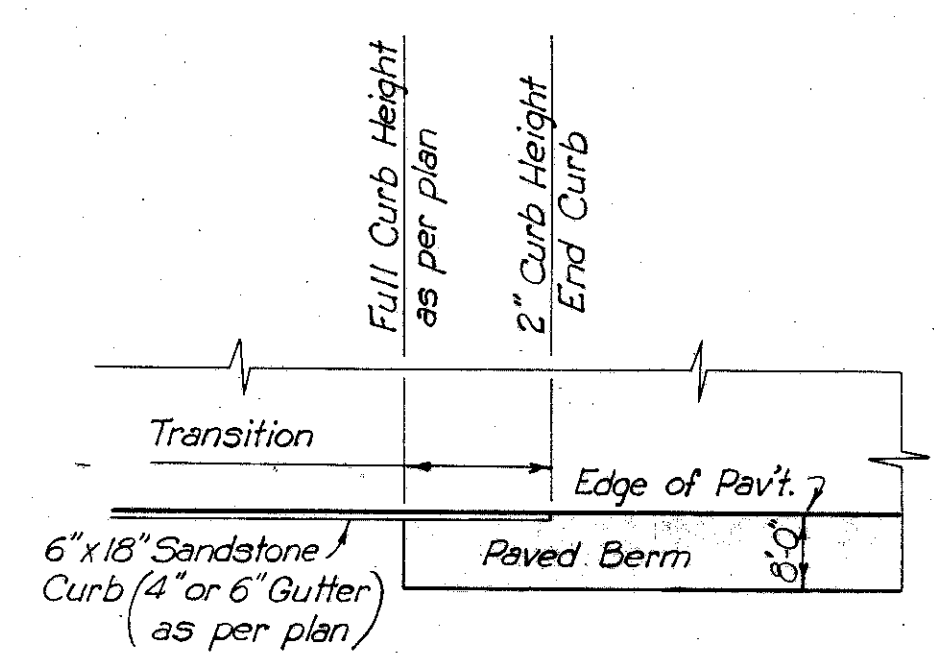


DETAIL "N"
CURB AND SHOULDER TRANSITION
Not to Scale:

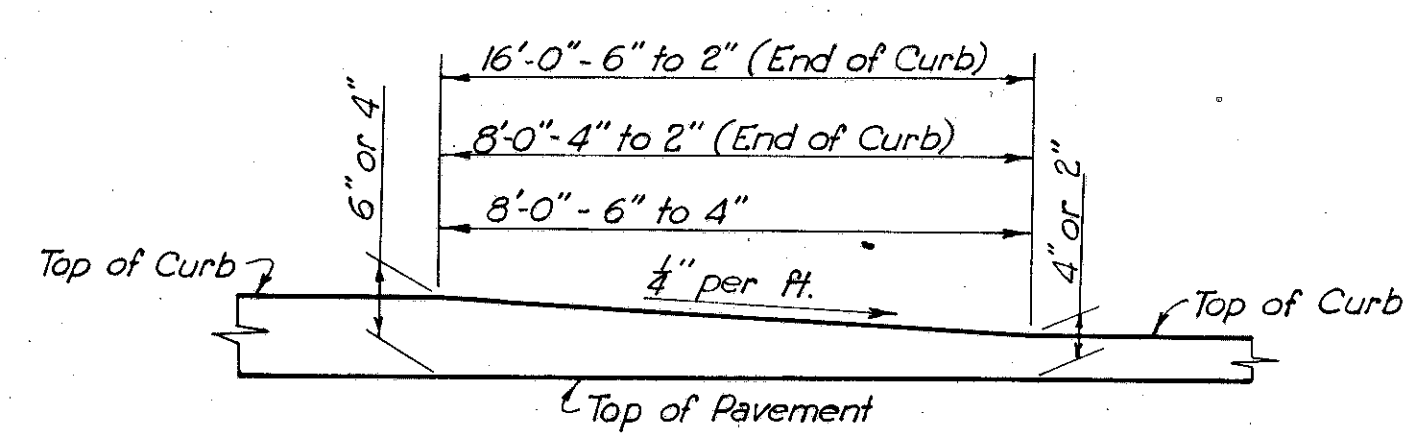

DETAIL "M"
CURB HEIGHT TRANSITION
Not to Scale:

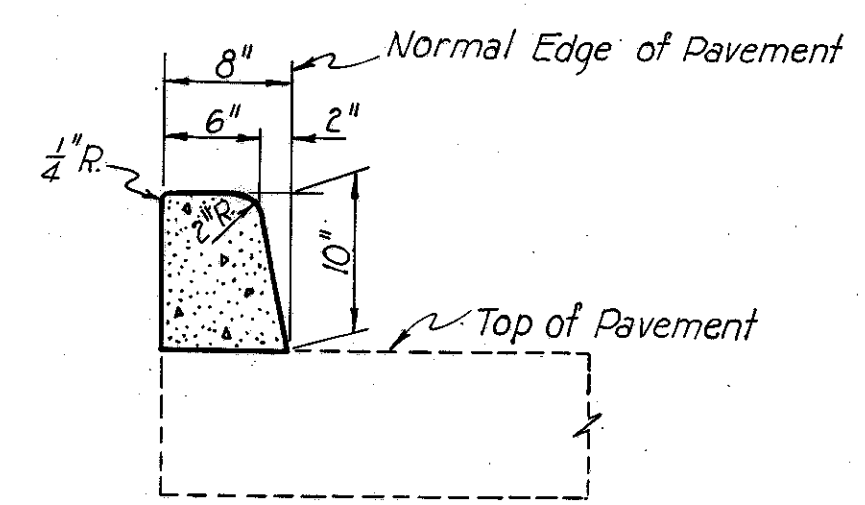


TYPE 2A MODIFIED (10') CURB (MODIFICATION B)
Scale: 1" = 1'-0"

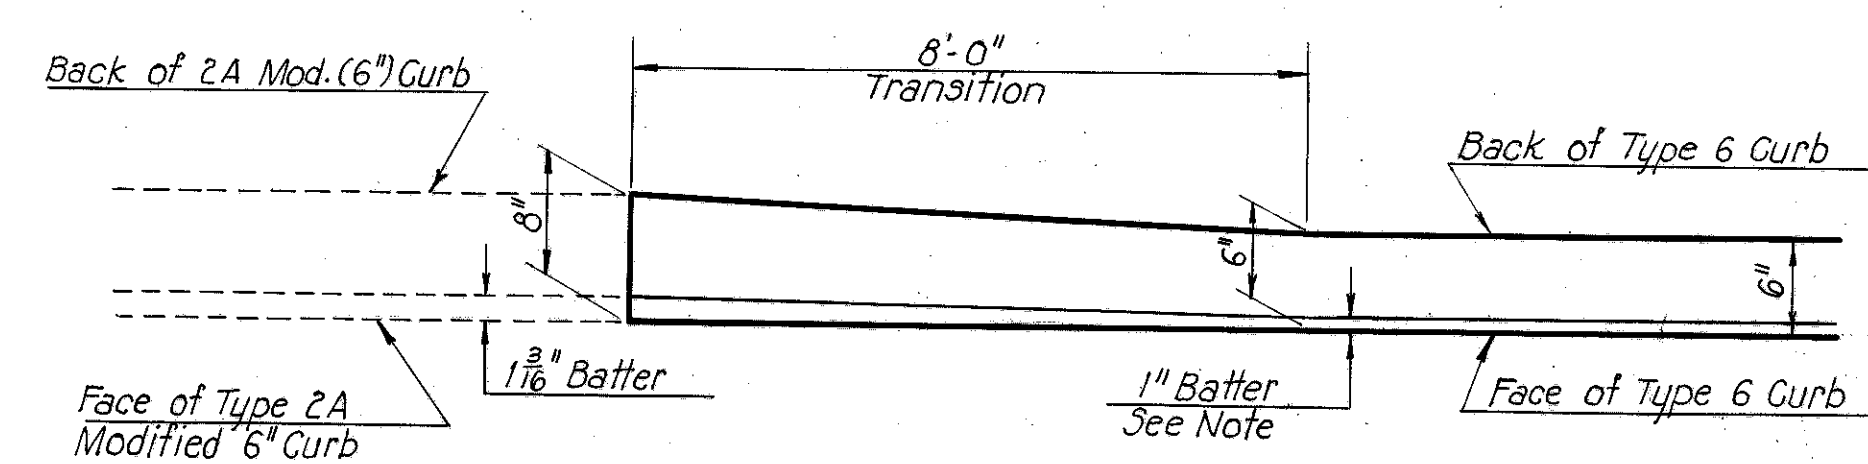


Note:
Type 6 Curb face to be transitioned to match 2A Modified (6") Curb face in the same 8'-0" transition.

DETAIL "Q"
BACK OF CURB TRANSITION
Not to Scale

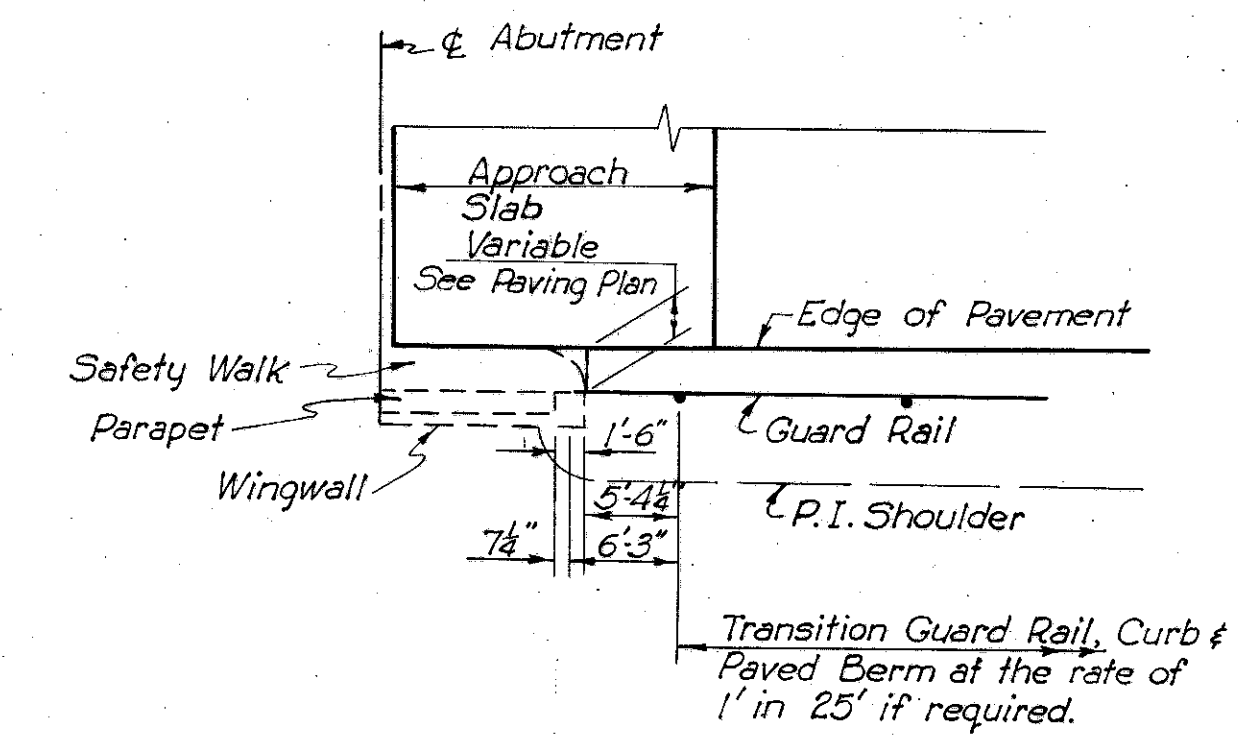


GUARD RAIL TREATMENT AT TERMINAL POST
Not to Scale:

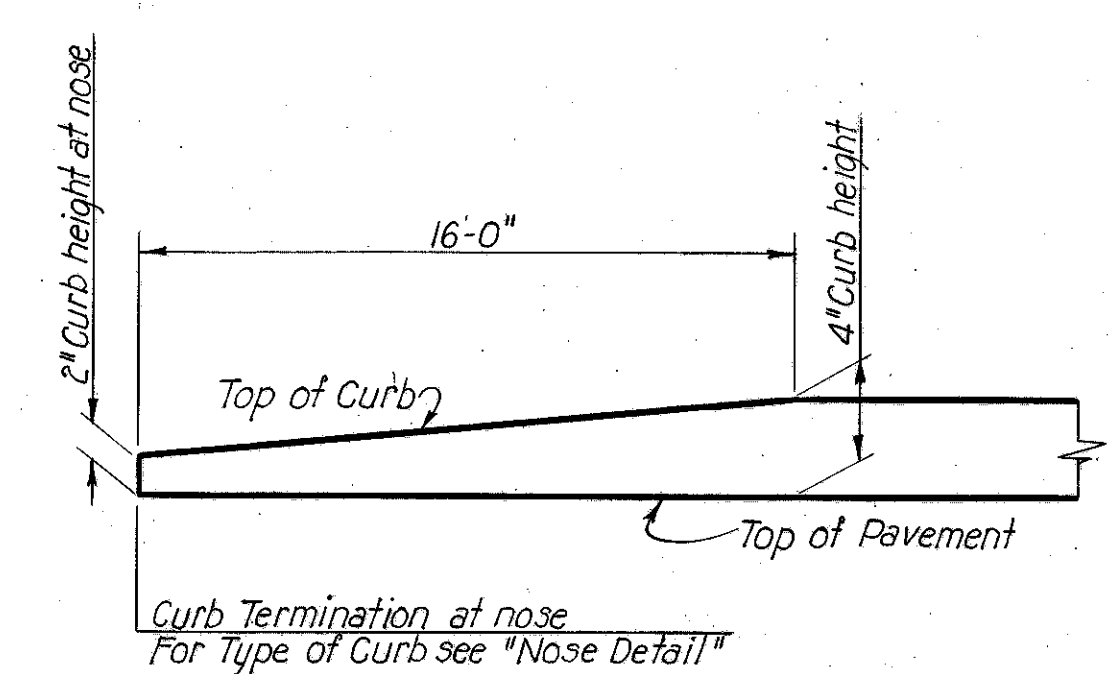


DETAIL "CC"
CURB HEIGHT TRANSITION AT NOSE
FOR
DIVERGING RAMPS & LANES
Not to Scale

MISCELLANEOUS DETAILS


CUYAHOGA COUNTY
CITY OF CLEVELAND
CUY-42-18.42
CUY-21-15.32
APPROACH SLABS

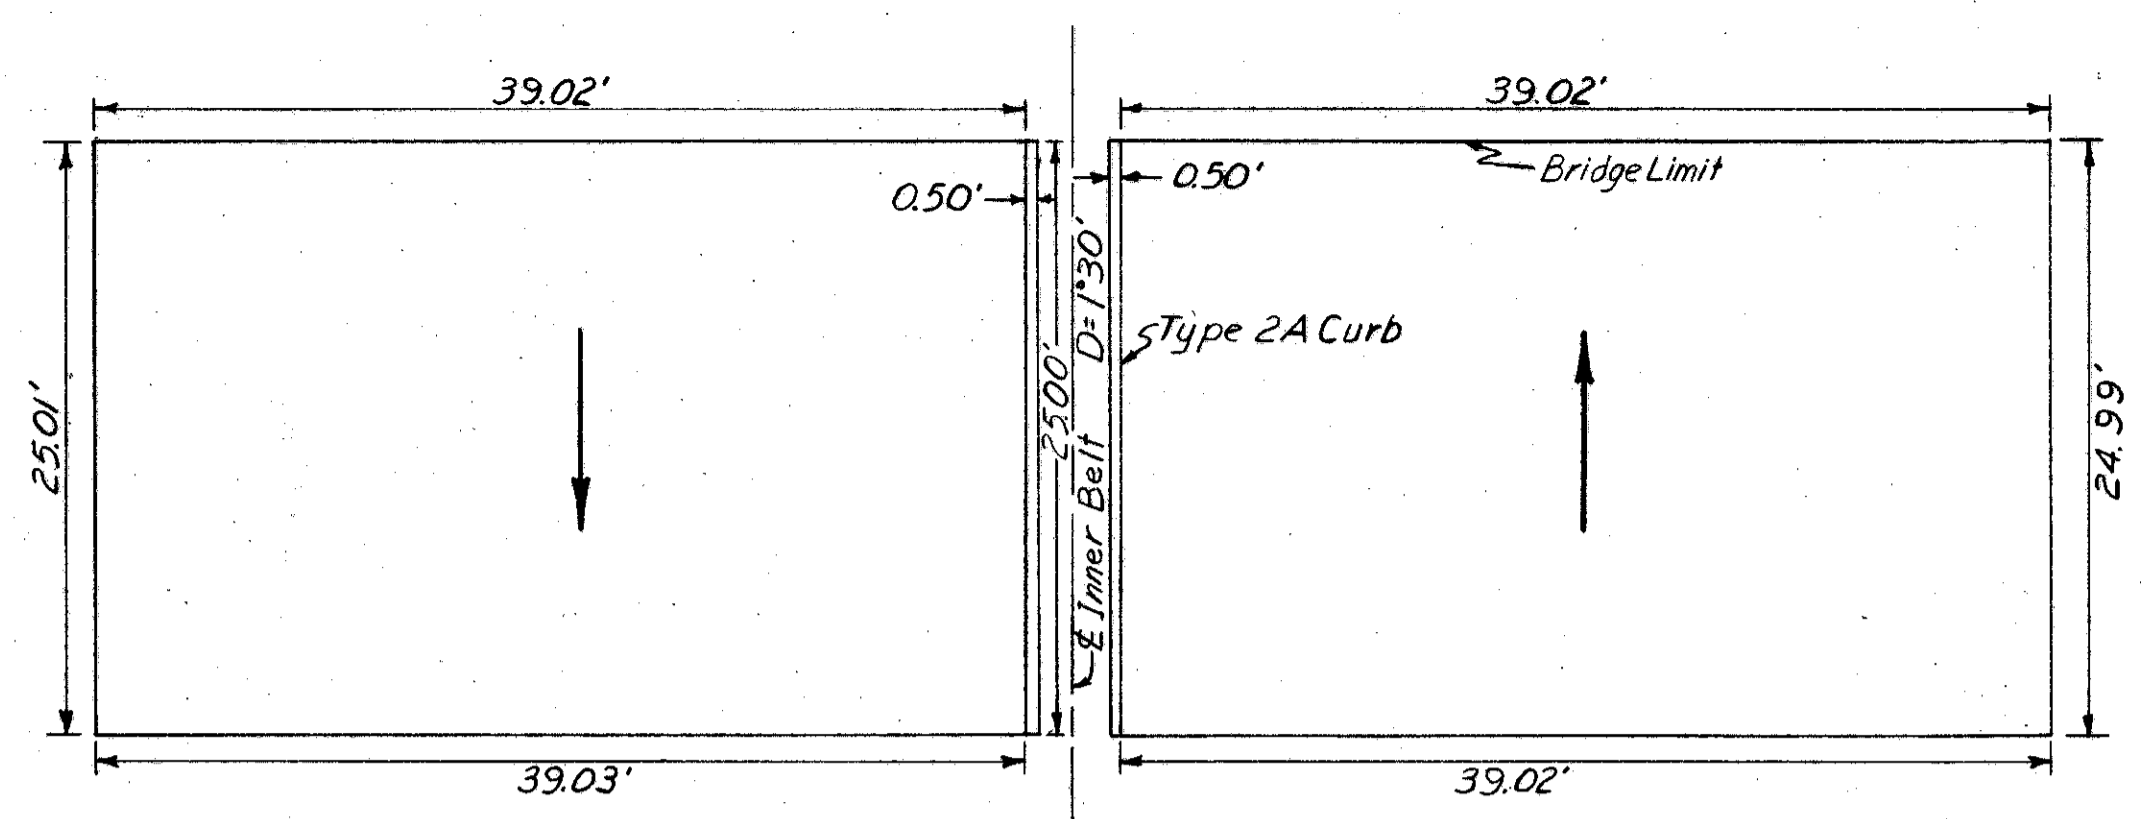


BRIDGE NO. 3
WEST APPROACH SLABS

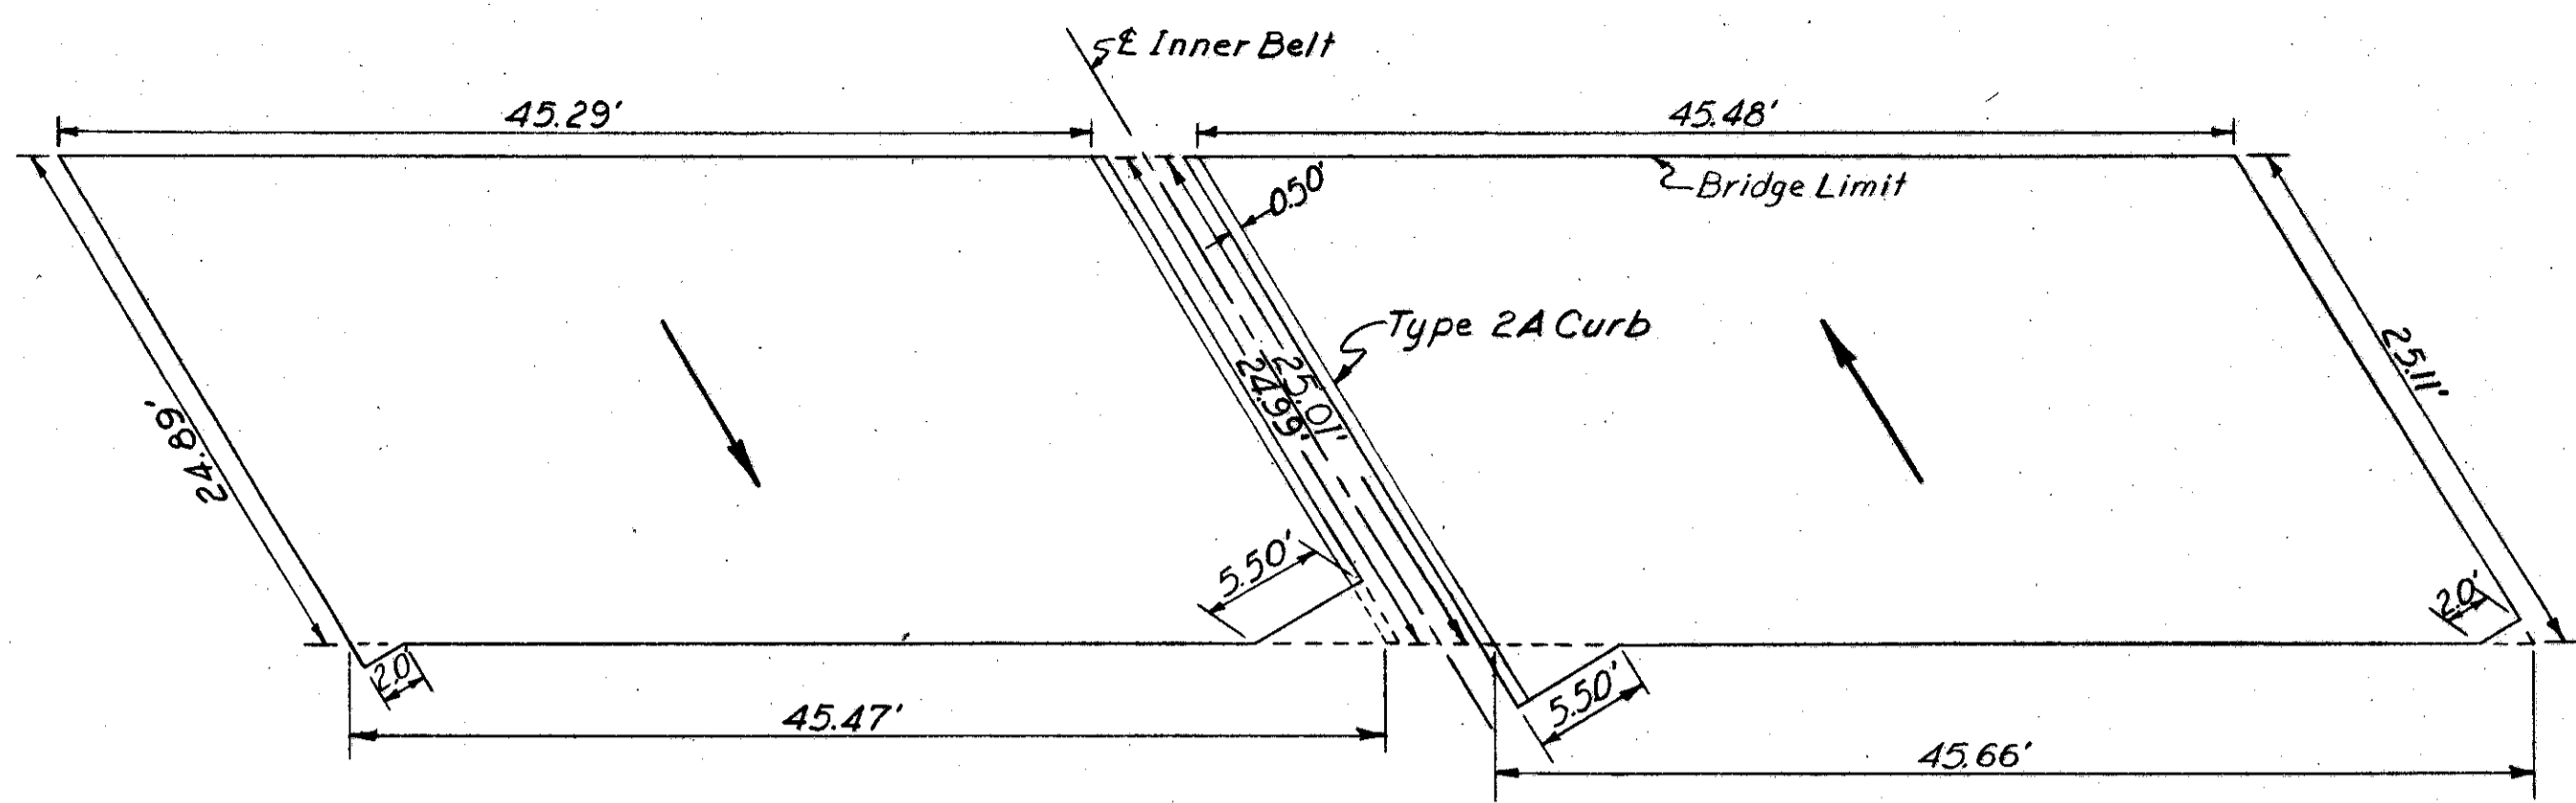


BRIDGE NO. 3
EAST APPROACH SLABS

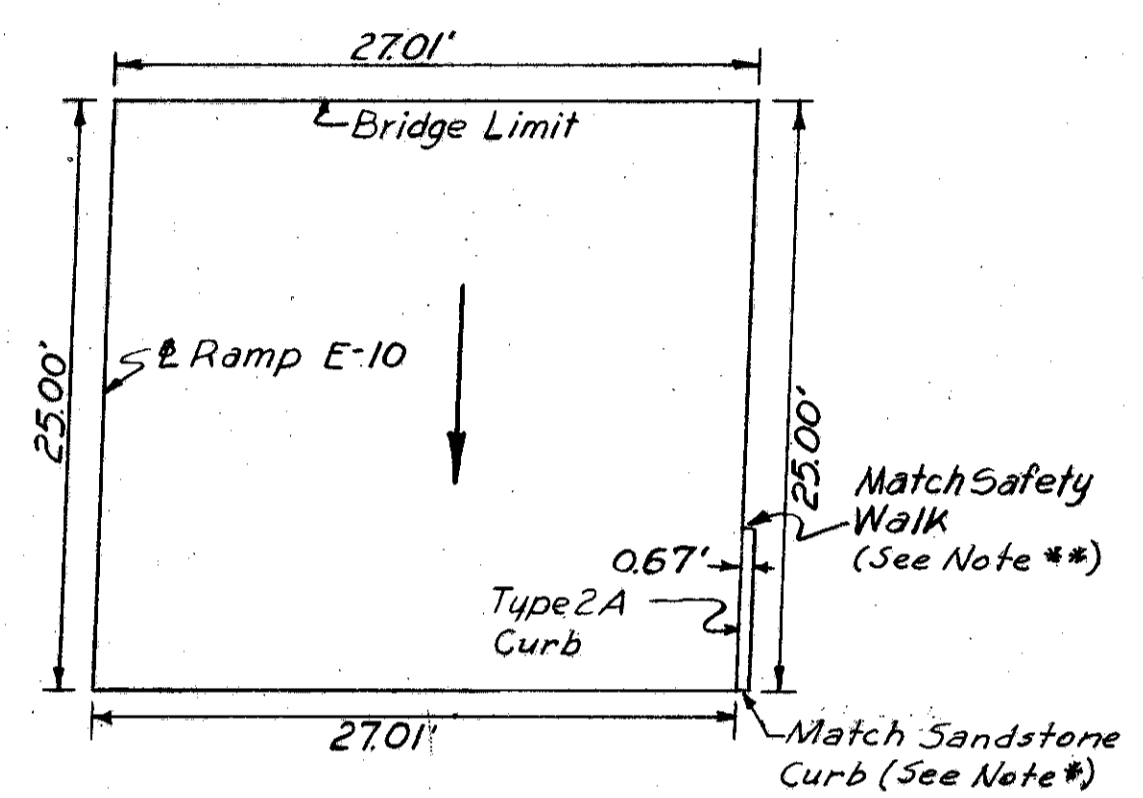


BRIDGE NO. 4
WEST APPROACH SLAB
RAMP E-10

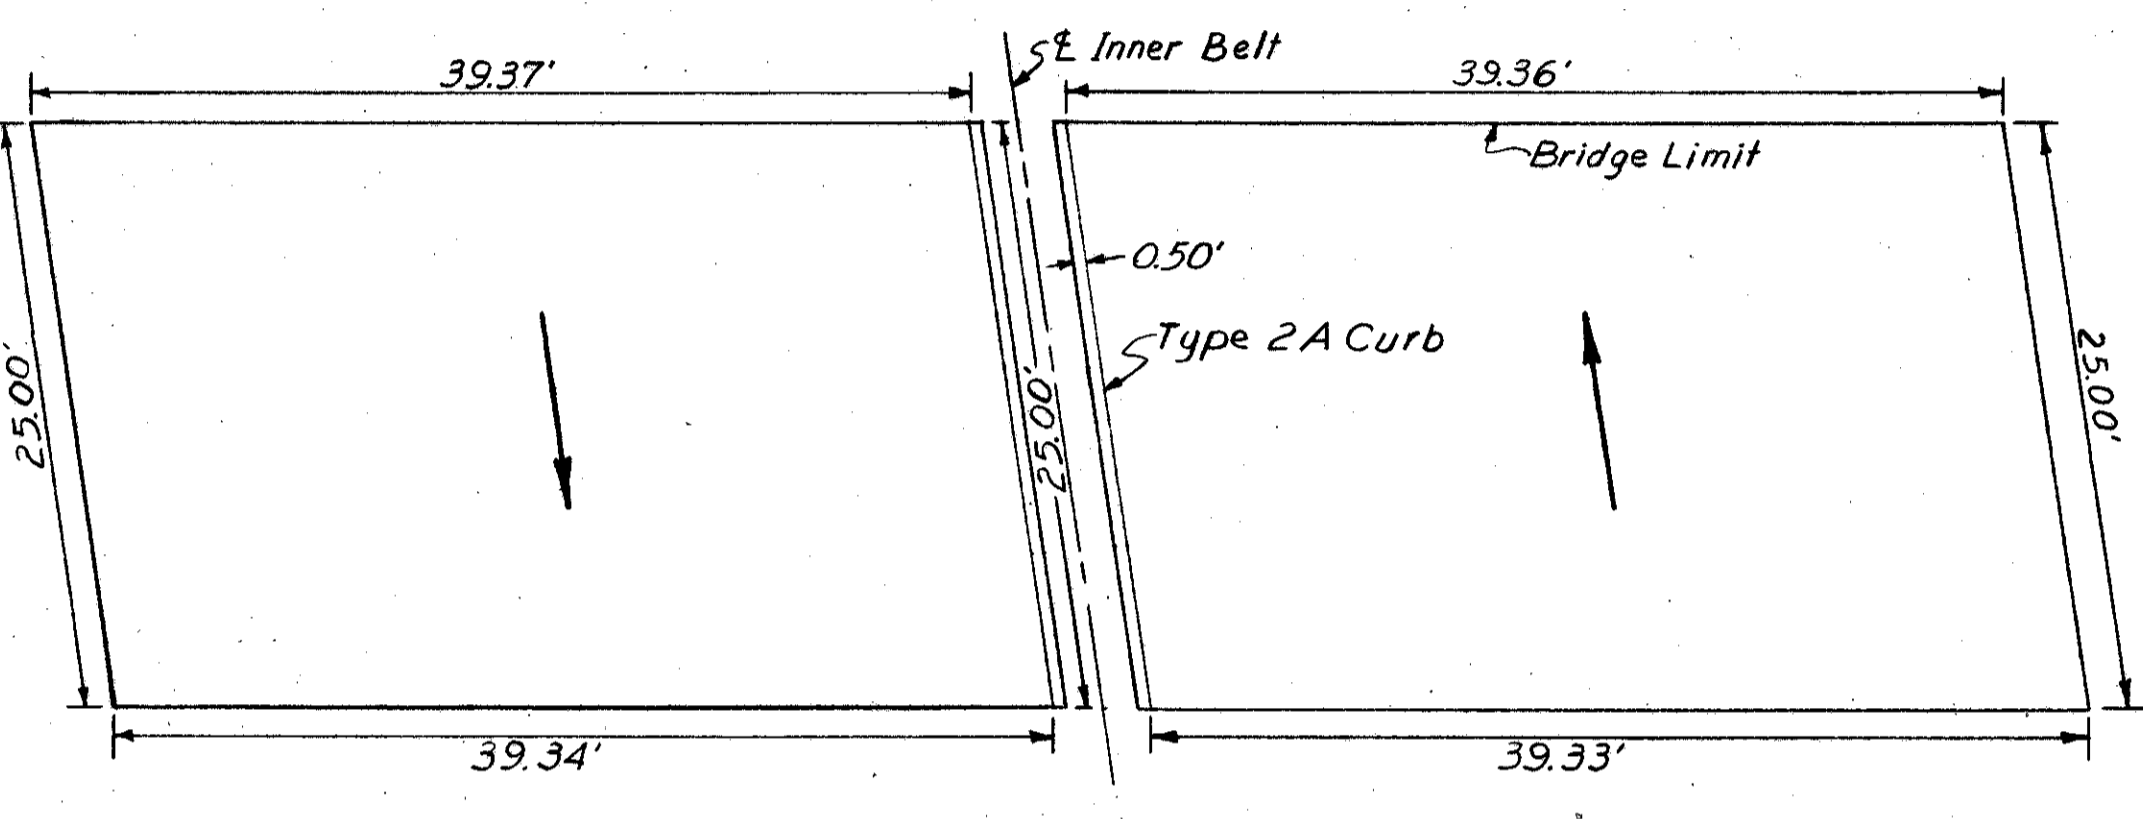


BRIDGE NO. 4
WEST APPROACH SLABS

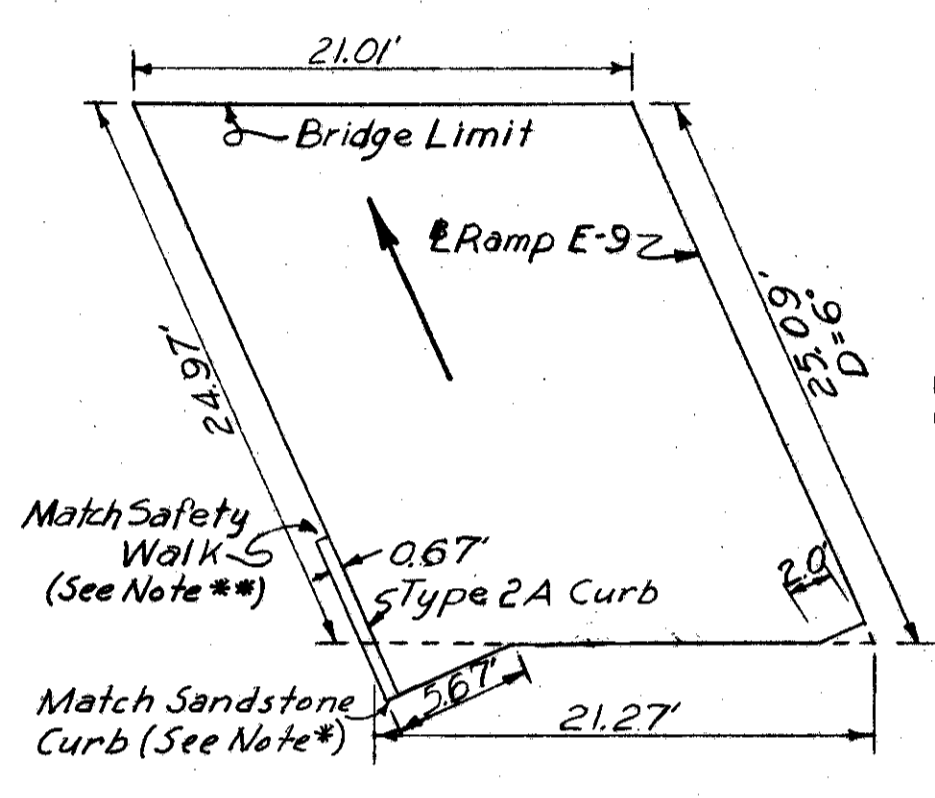


BRIDGE NO. 4
WEST APPROACH SLAB
RAMP E-9

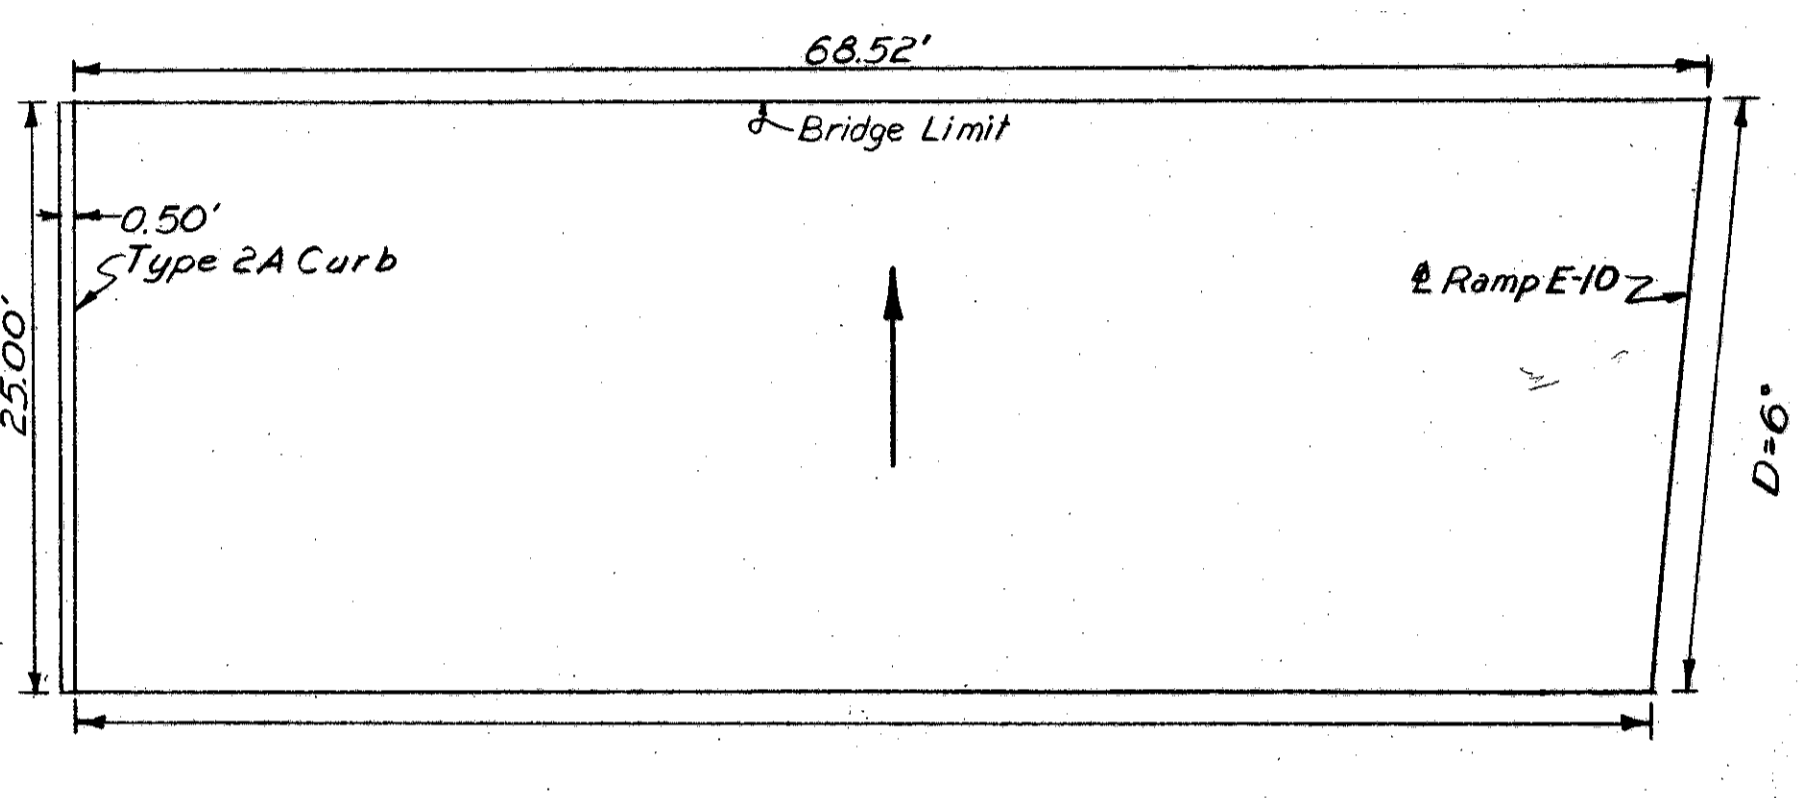


BRIDGE NO. 4
EAST APPROACH SLAB
LEFT LANE

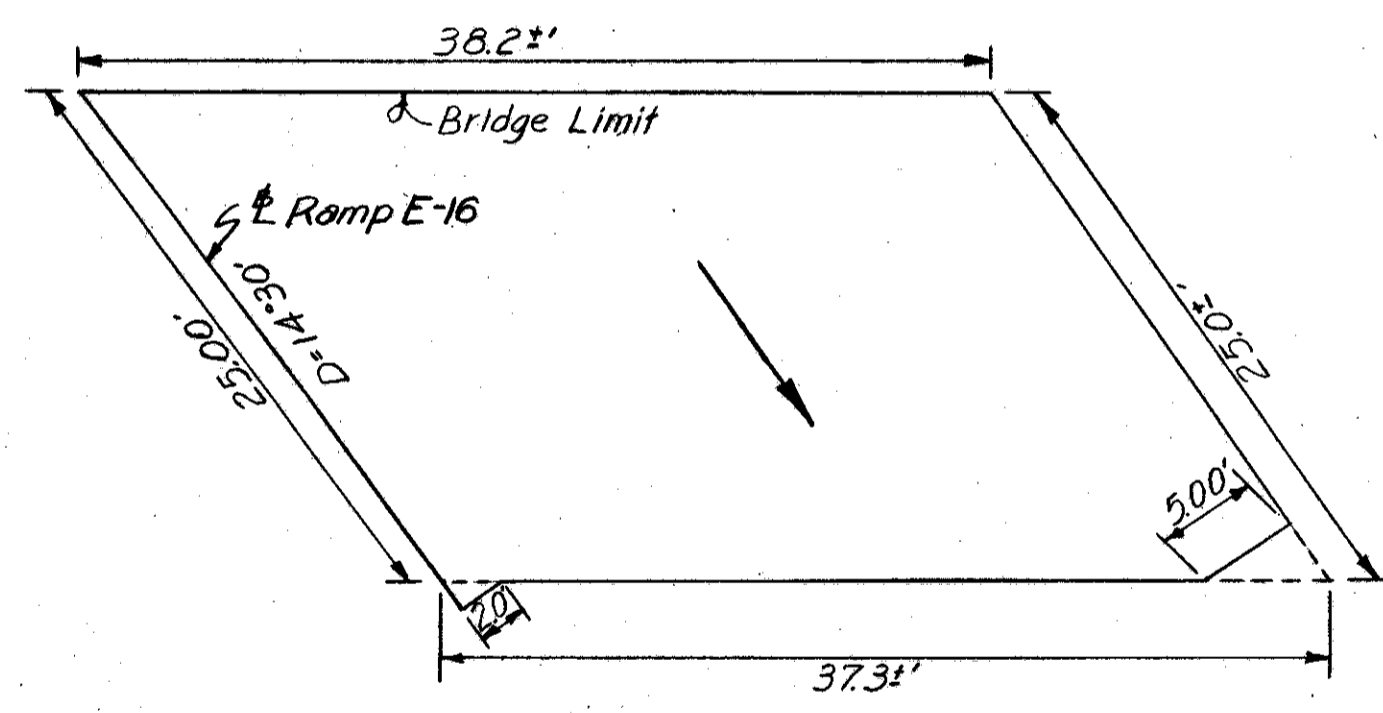


BRIDGE NO. 5
SOUTH APPROACH SLAB

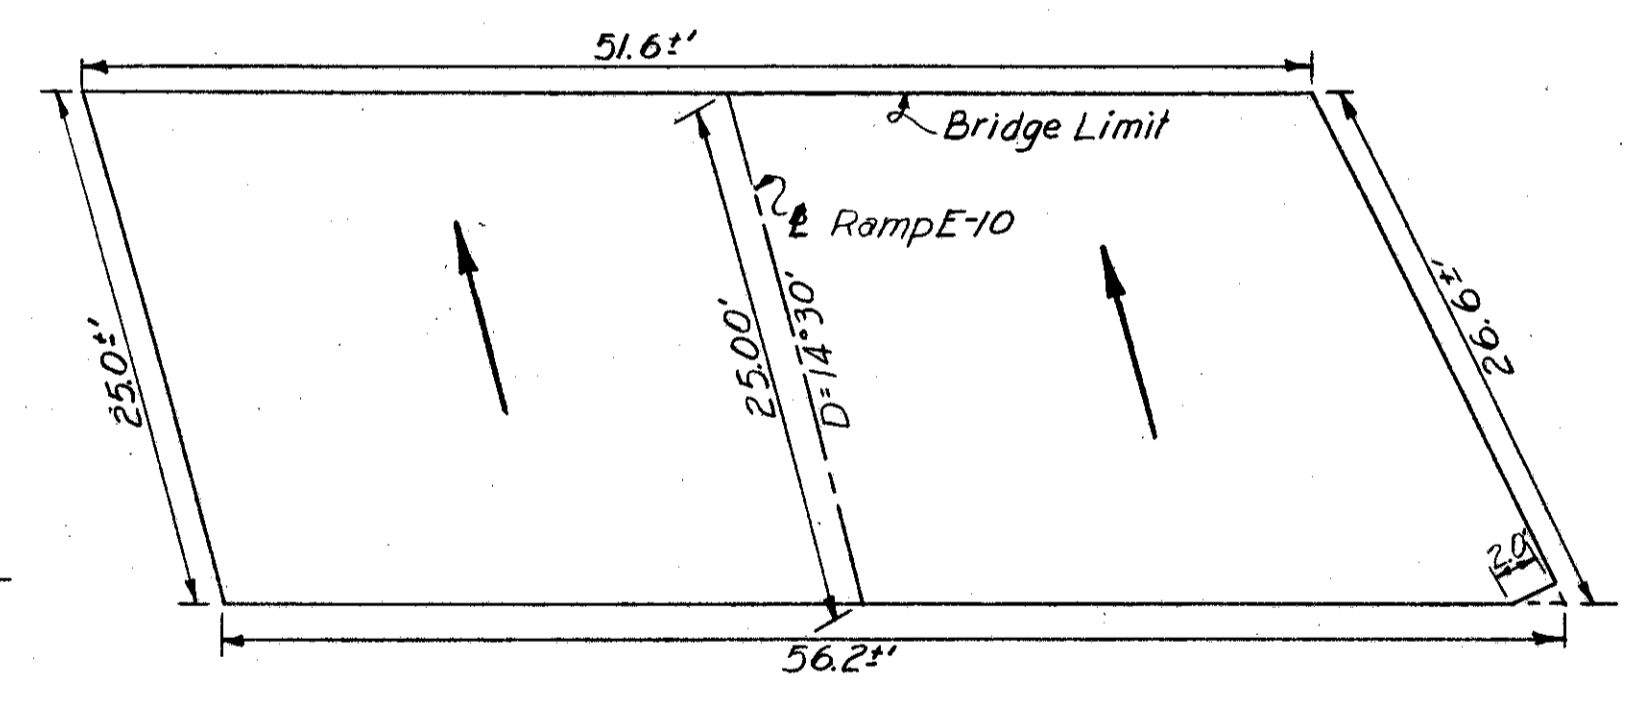


BRIDGE NO. 5
NORTH APPROACH SLAB

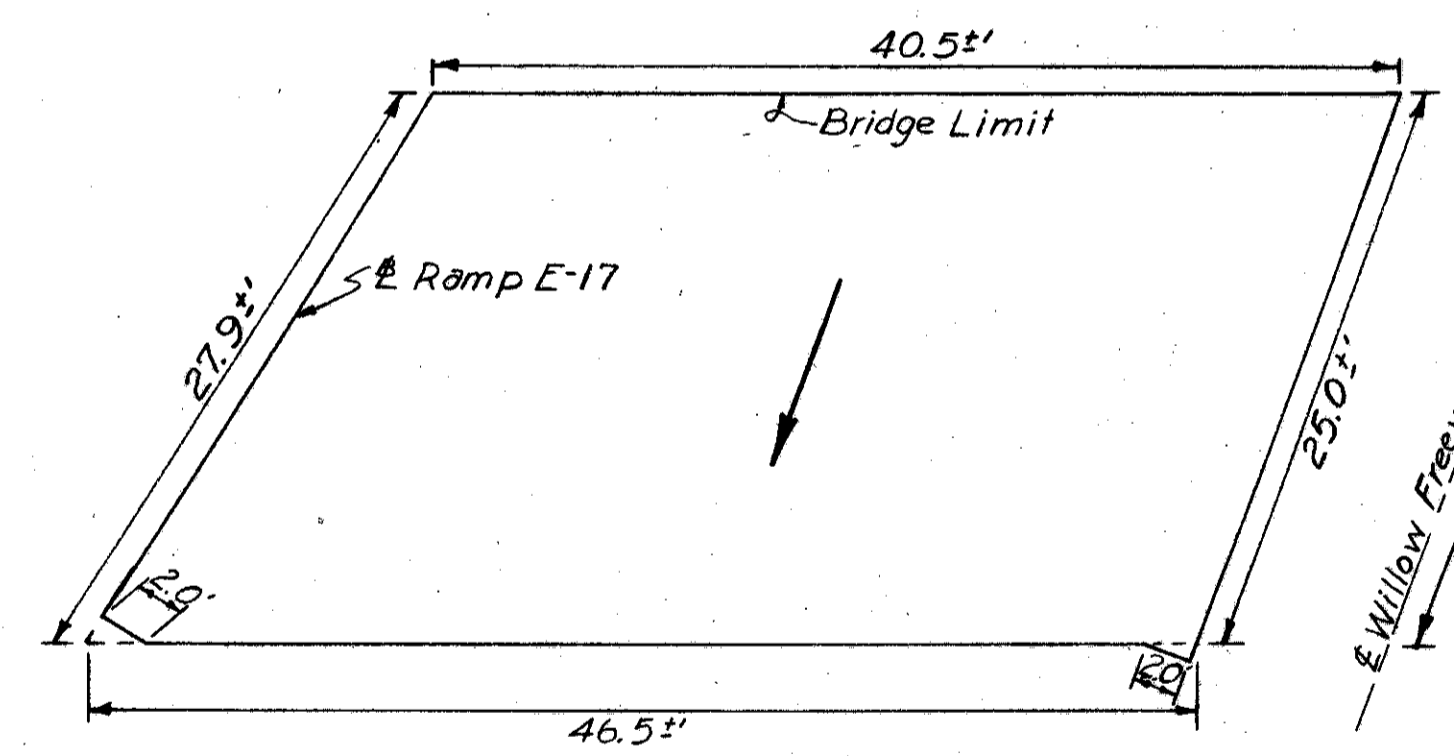


BRIDGE NO. 8
WEST APPROACH SLABS

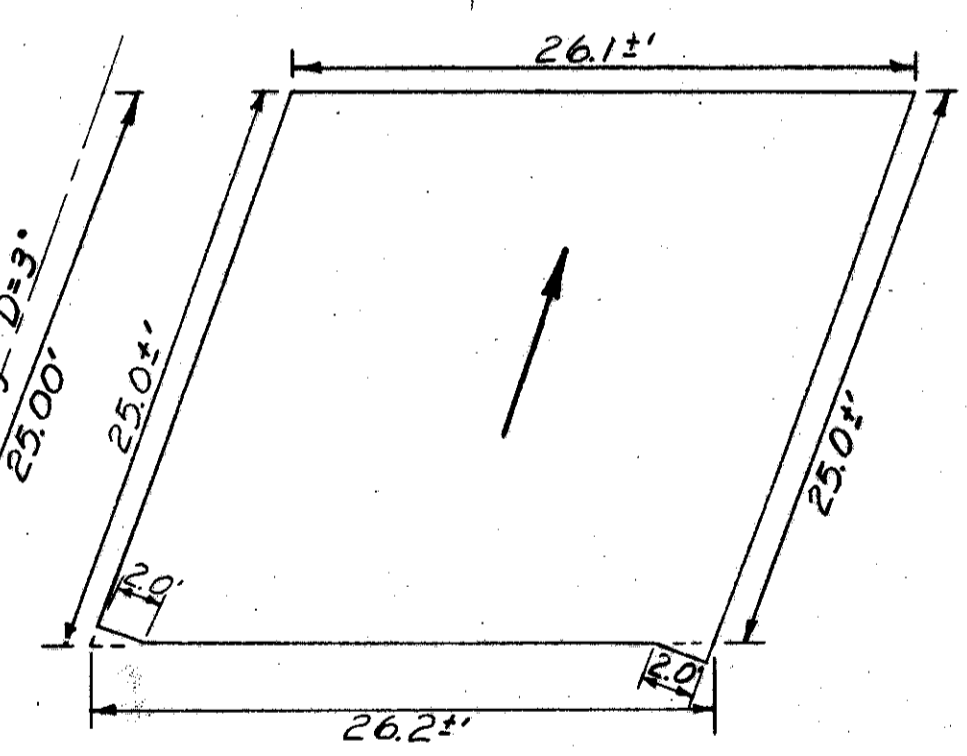


BRIDGE NO. 8
EAST APPROACH SLAB
RIGHT LANE

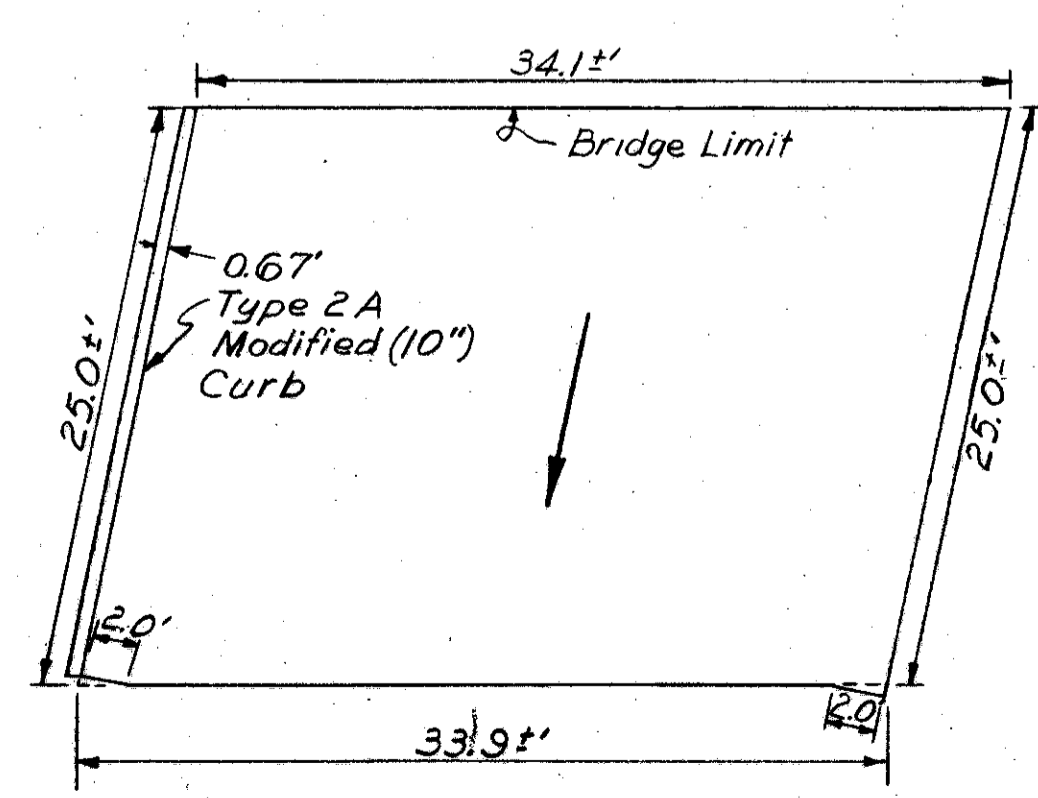

BRIDGE NO. 8
EAST APPROACH SLAB

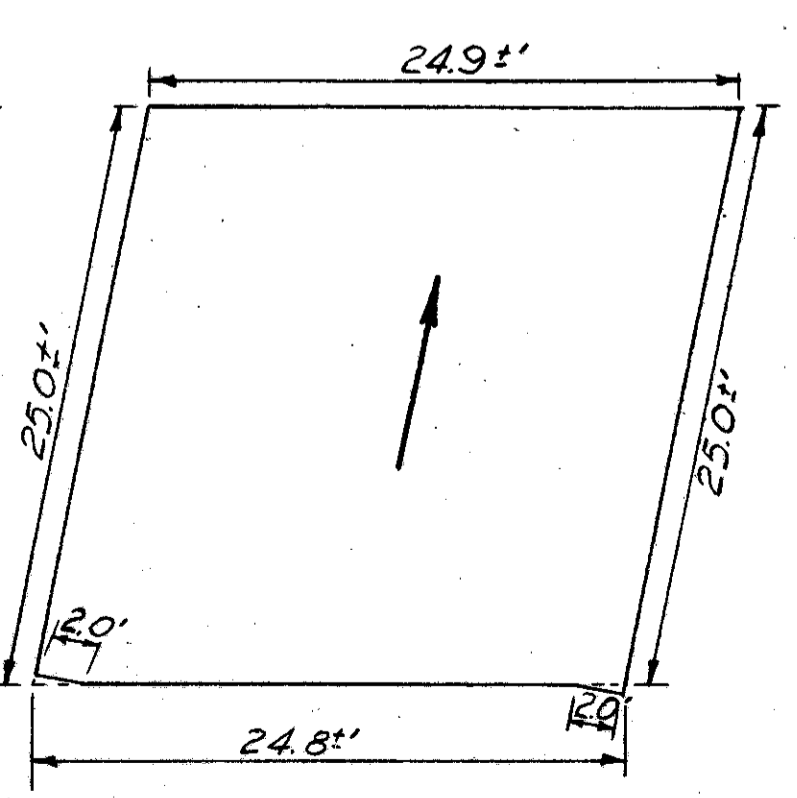

BRIDGE NO. 4
EAST APPROACH SLAB
RIGHT LANE

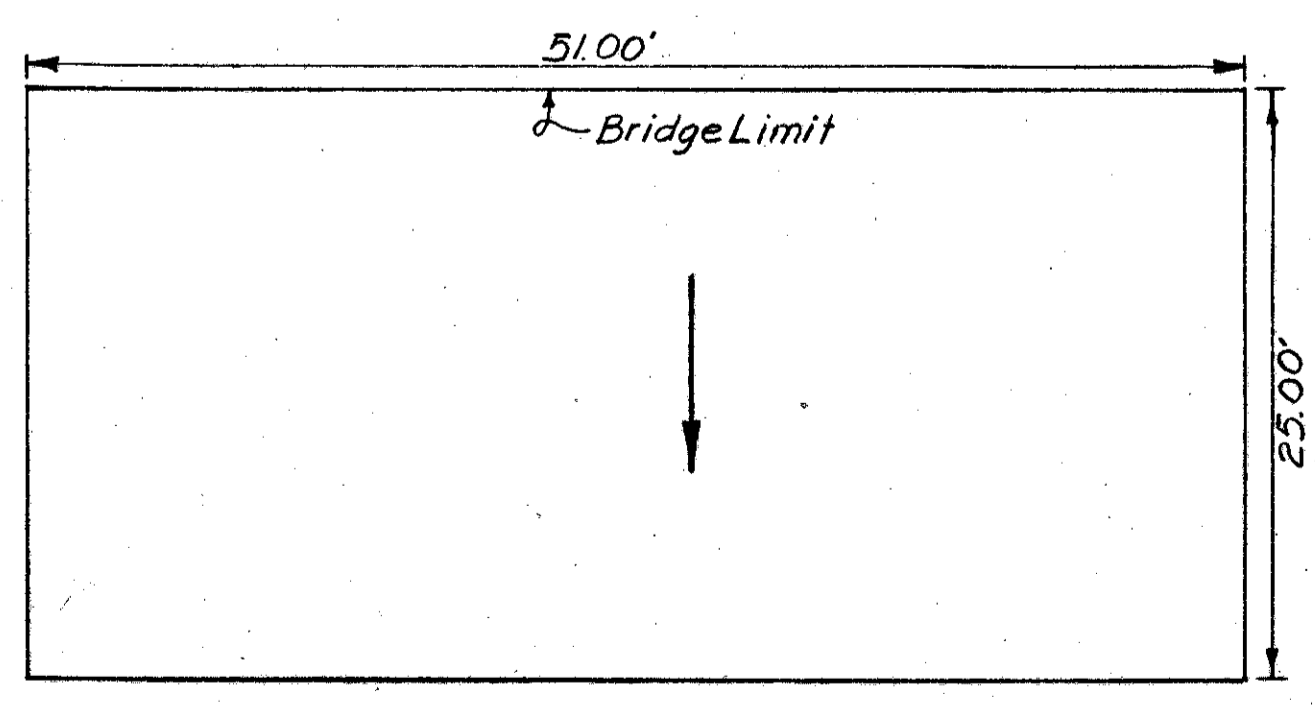

BRIDGE NO. 4
EAST APPROACH SLAB
RIGHT LANE

→ Direction of Traffic

* Note:
Type 2A Curb to be transitioned uniformly in eight (8) feet to match 6"x18" Sandstone Curb.


** Note:
The batter on Type 2A Curb to be transitioned uniformly in two (2) feet to match batter on Safety Walk.

Note:
Approach Slabs shall meet construction requirements as shown on State of Ohio Standard Drawing AS-1-54.


Payment for curb sections on approach slabs shall be included in the unit price bid for Item I-7, Approach Slabs.

FED. ROAD DIV. NO.	STATE	FEDERAL AID PROJECT NO.	TYPE FUNDS
2	OHIO		


CUYAHOGA COUNTY
CITY OF CLEVELAND
CUY-42-18-42
CUY-21-15.32
APPROACH SLABS

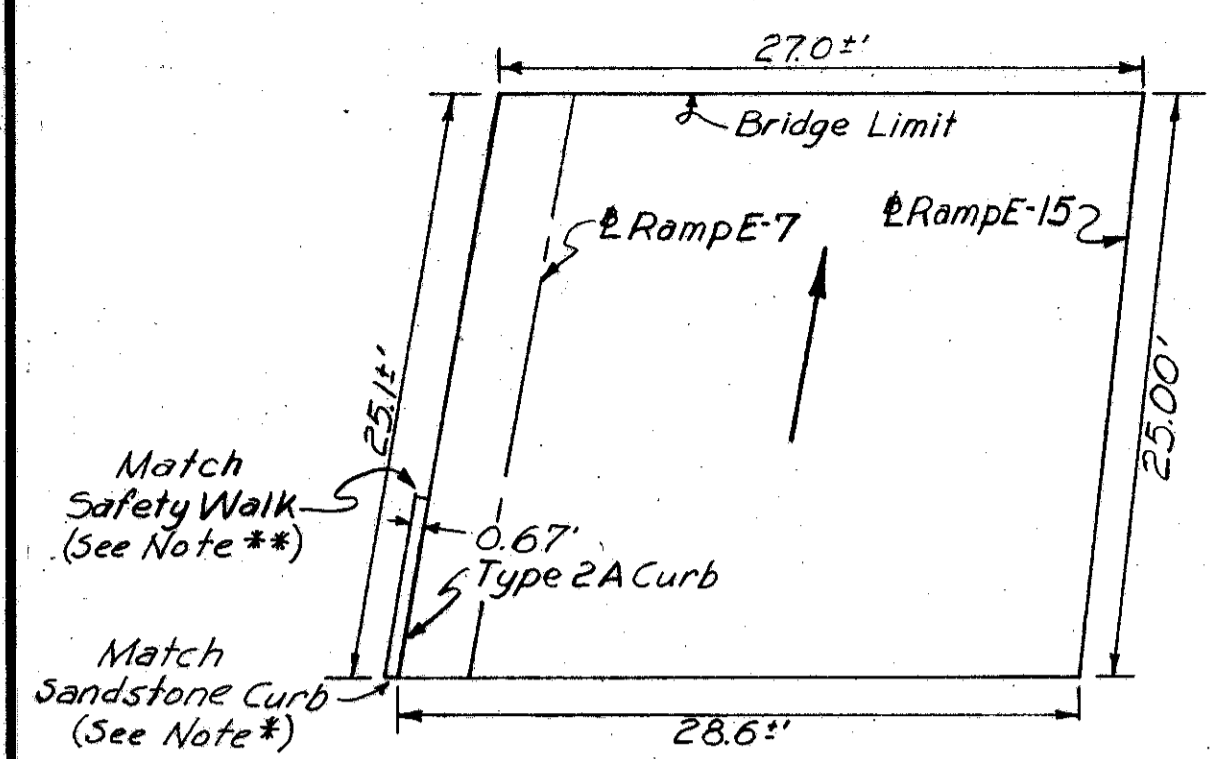


BRIDGE NO. 9
WEST APPROACH SLAB

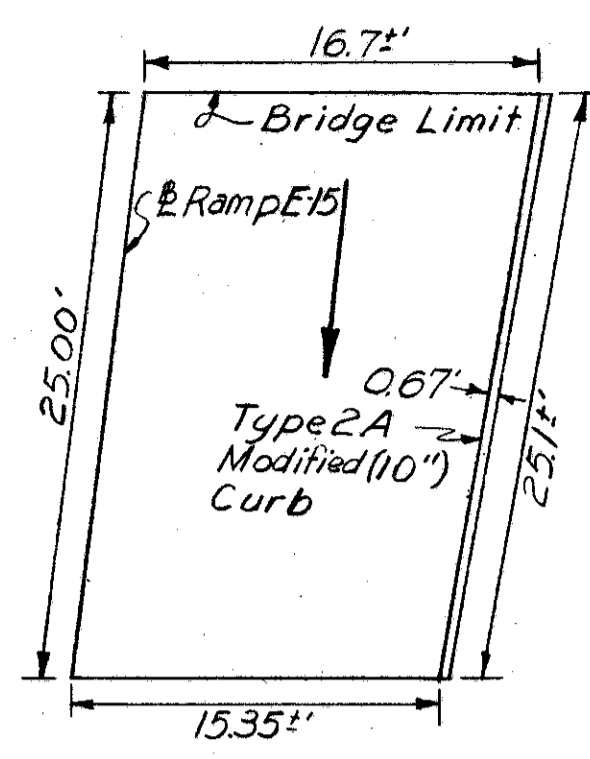



BRIDGE NO. 9
EAST APPROACH SLAB

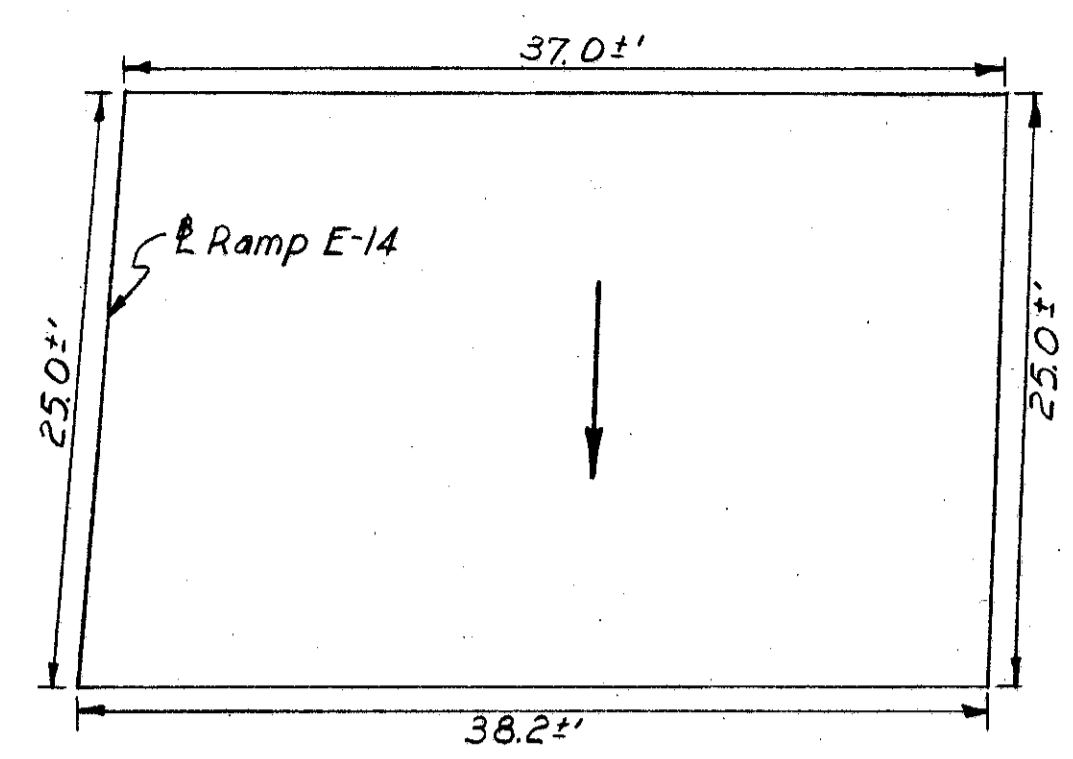


BRIDGE NO. 10
WEST APPROACH SLABS

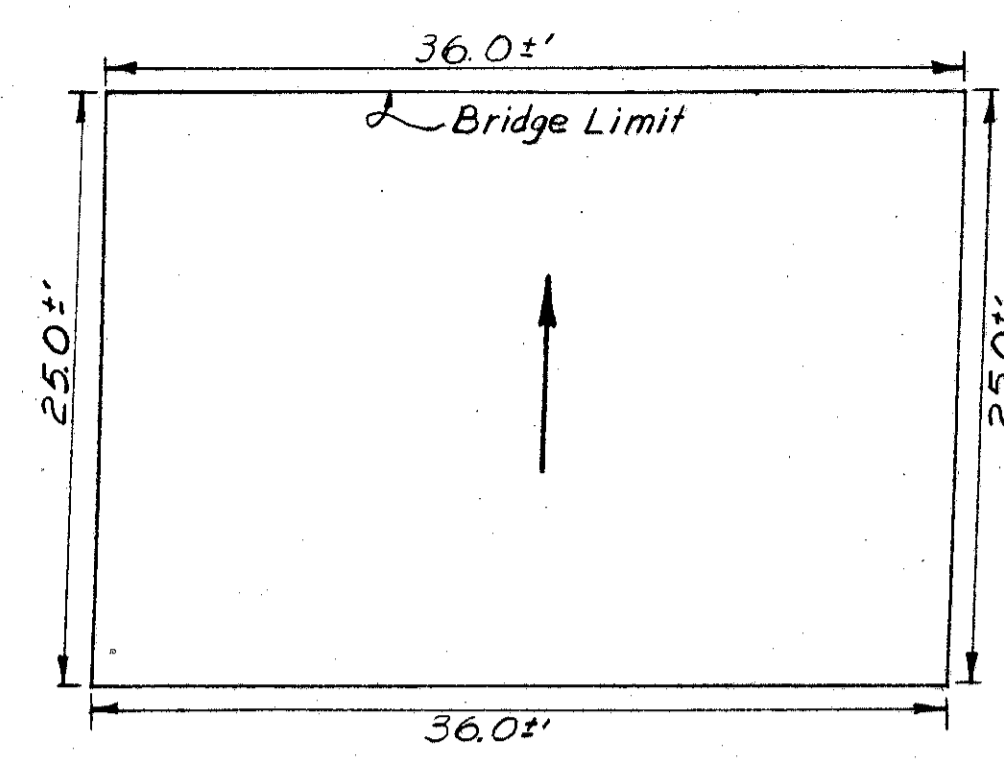


BRIDGE NO. 10
EAST APPROACH SLABS

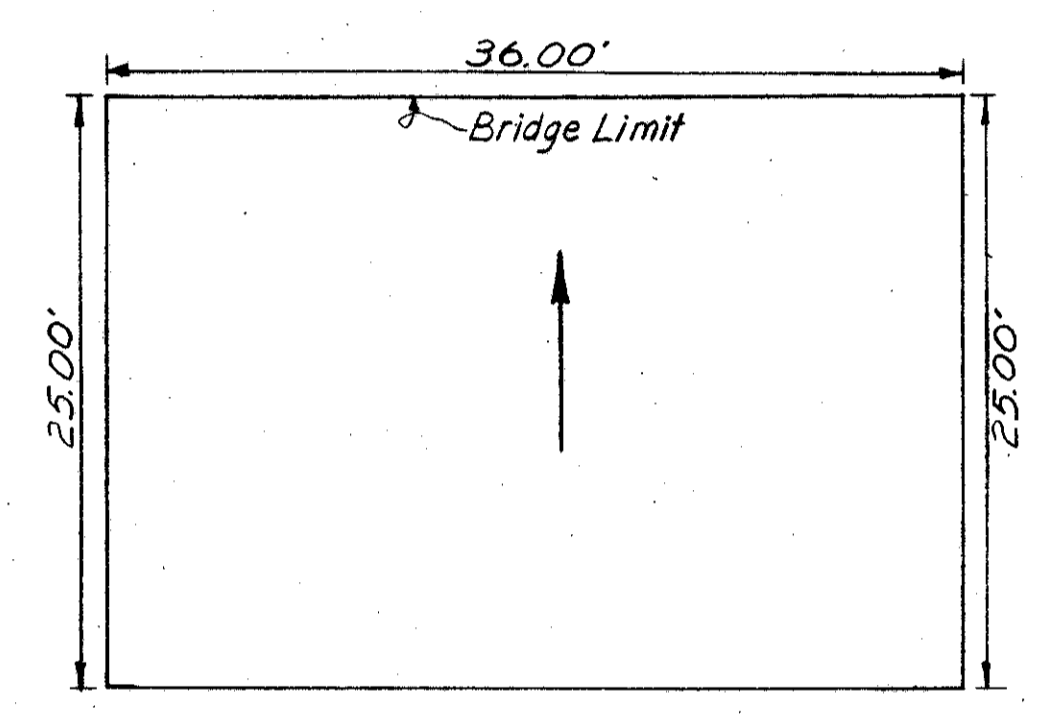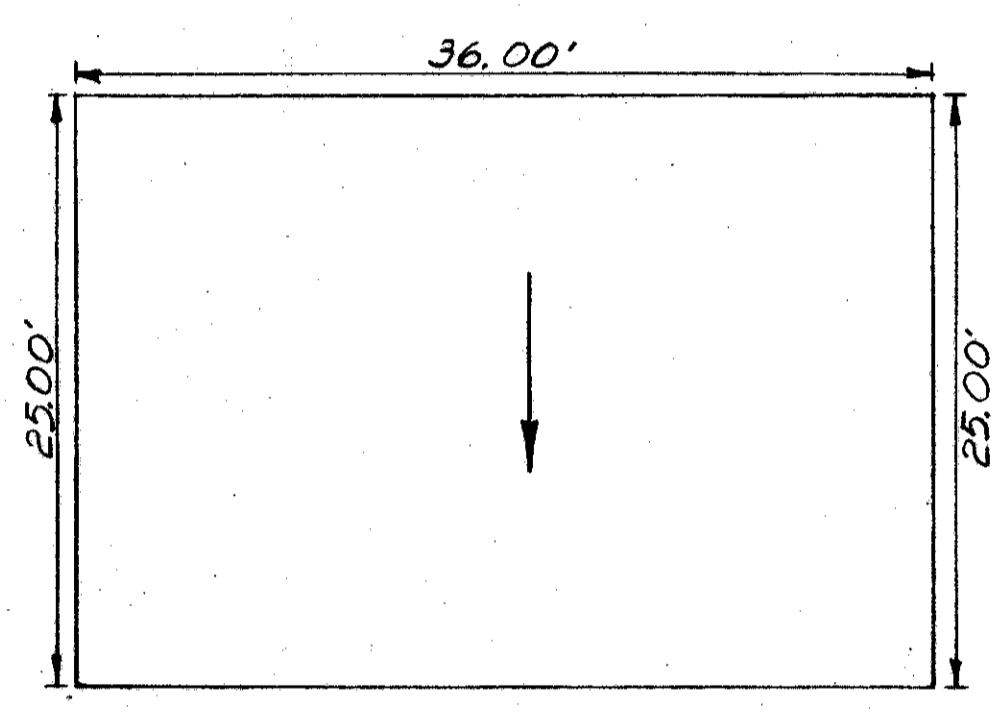


BRIDGE NO. 10
EAST APPROACH SLABS

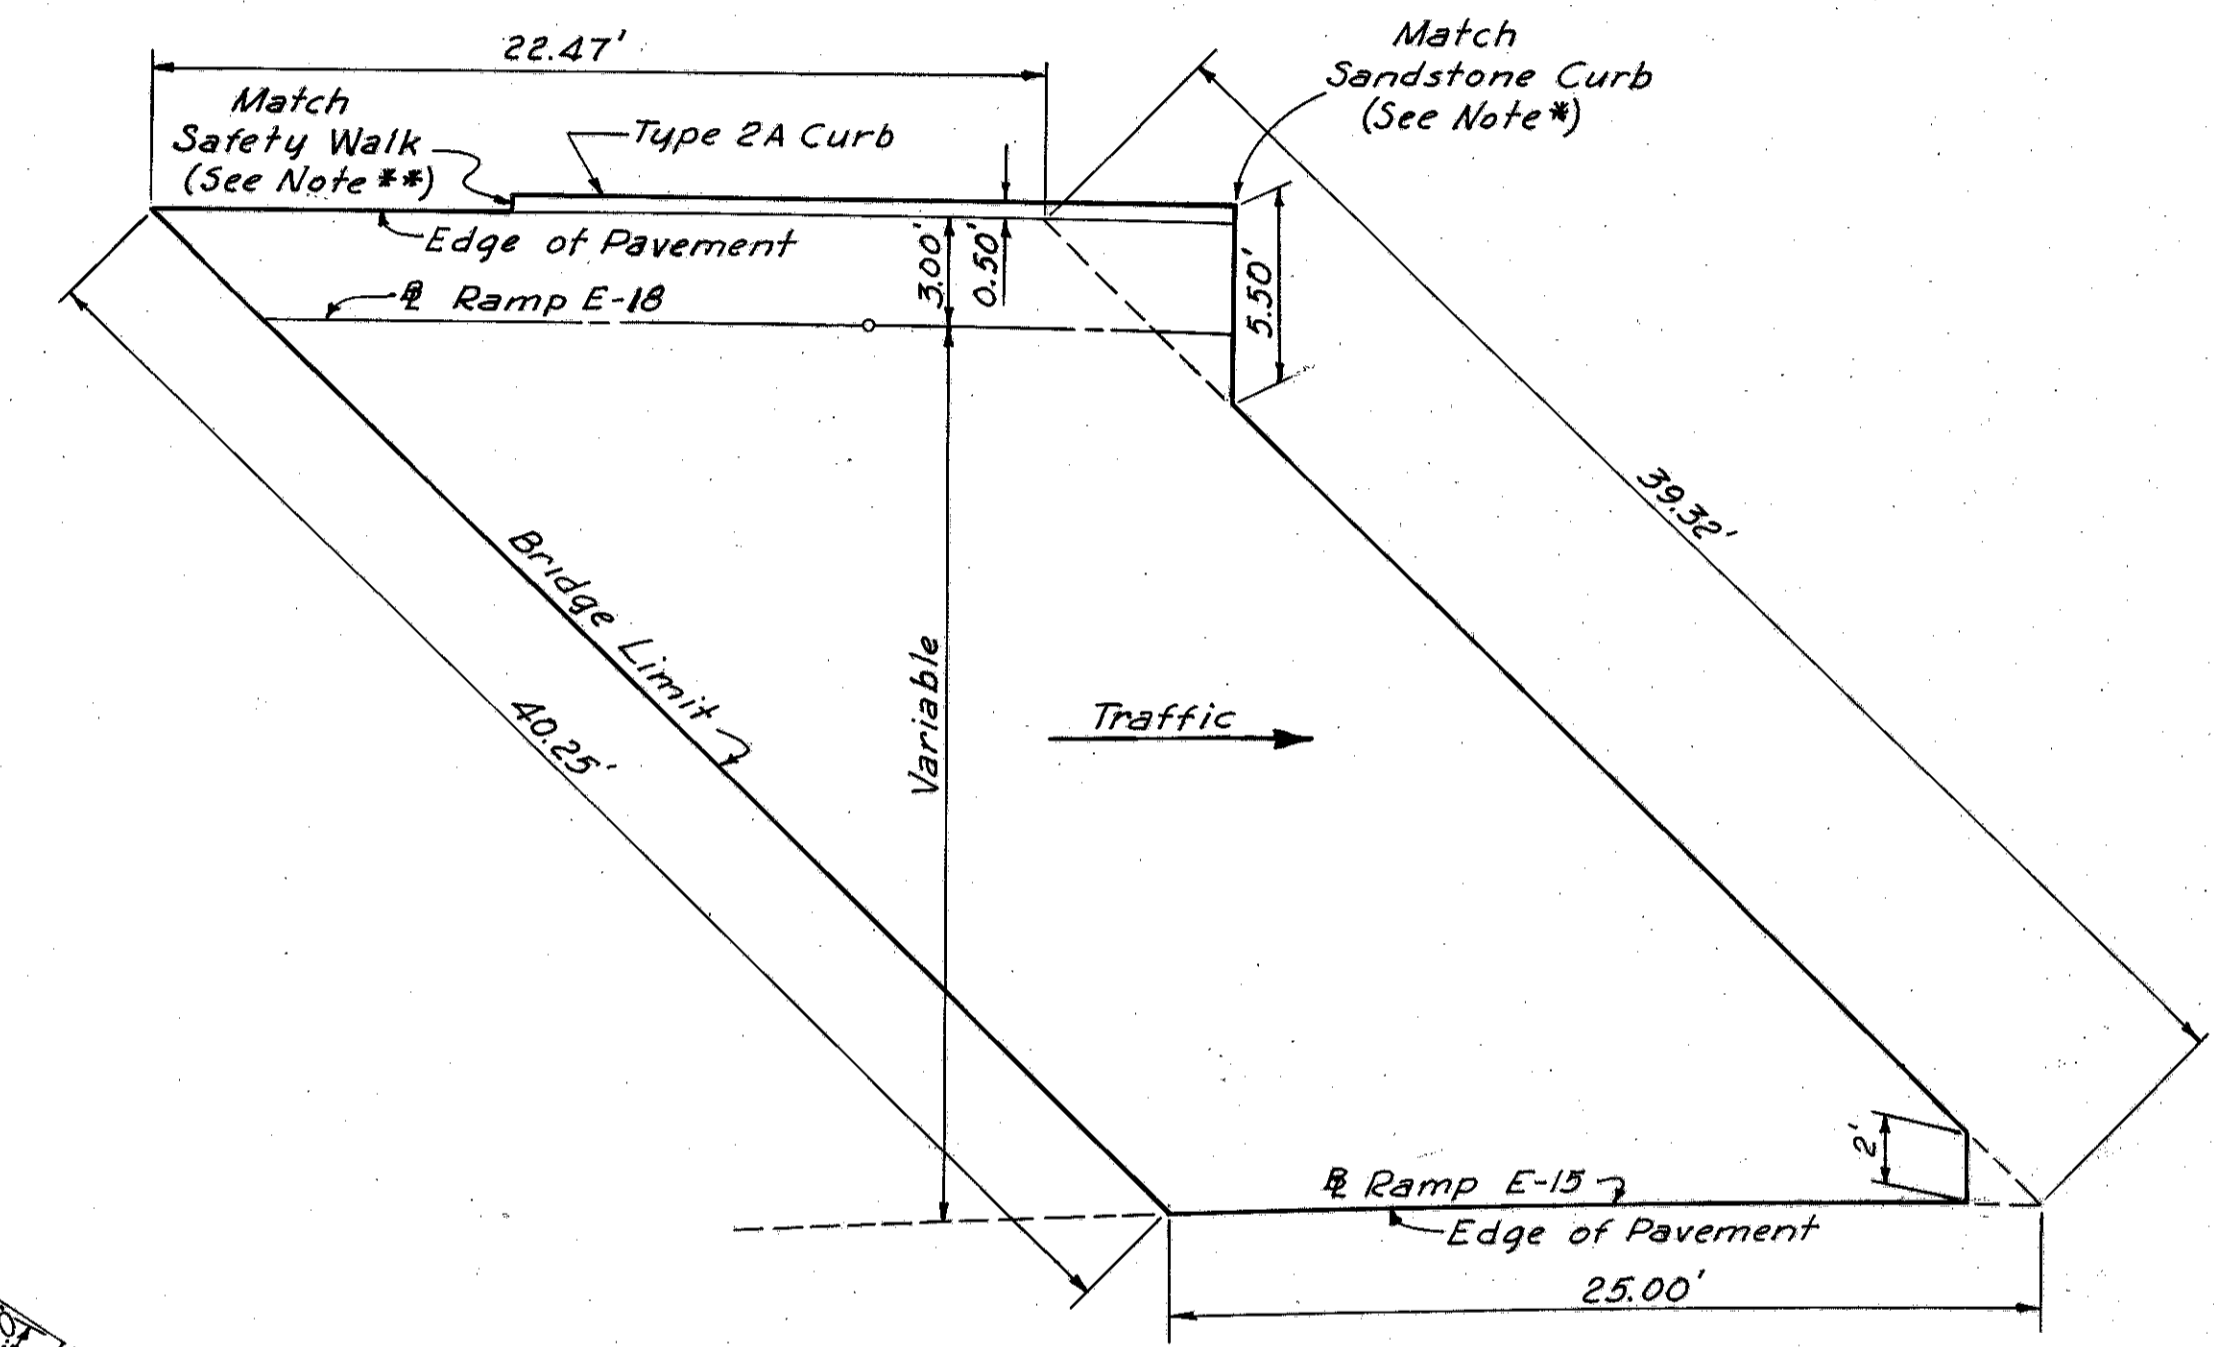



BRIDGE NO. 7
EAST APPROACH SLAB

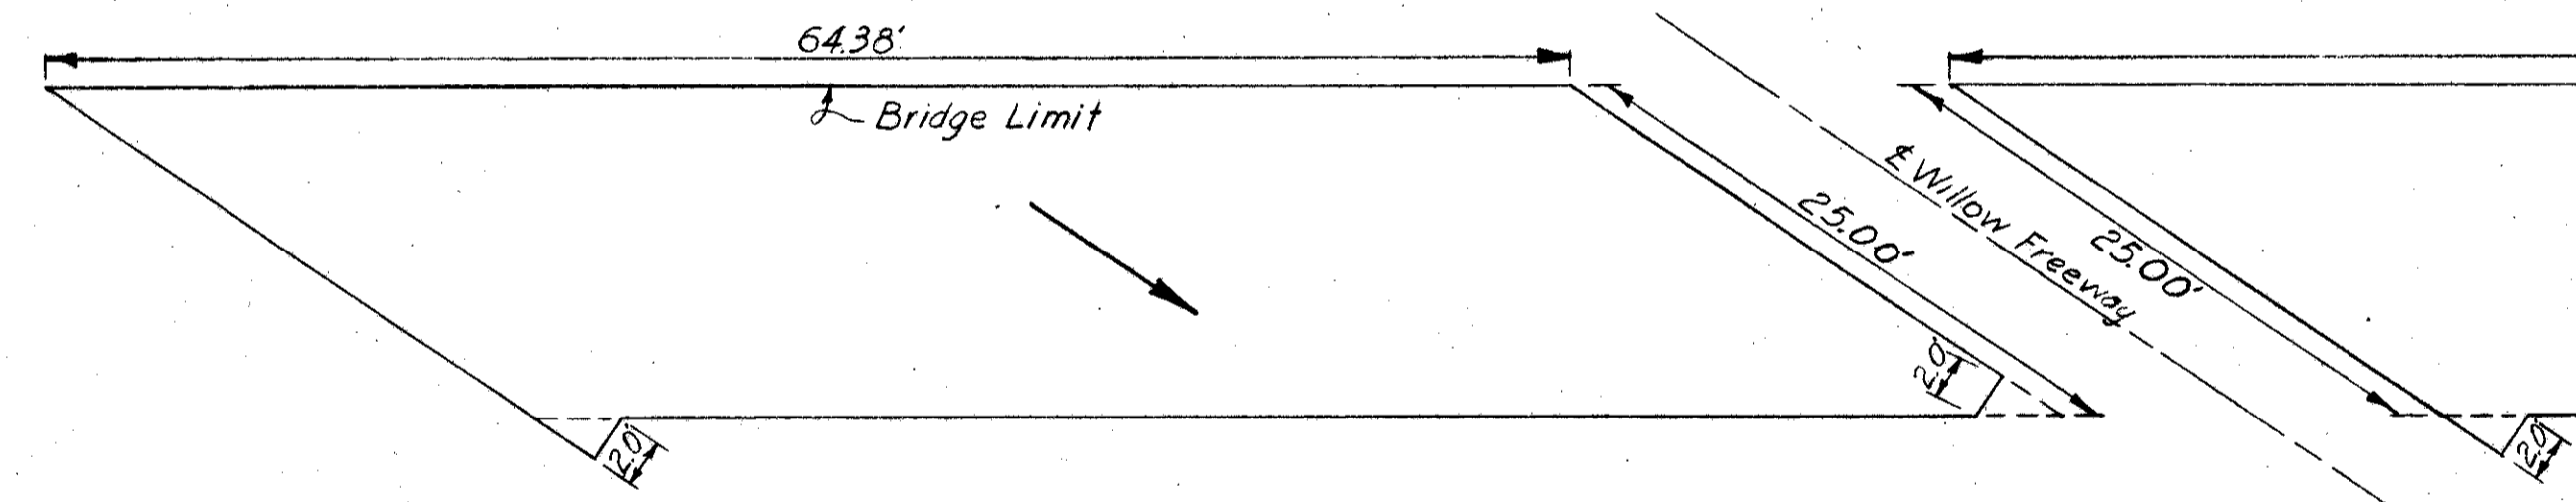

BRIDGE NO. 11
WEST APPROACH SLABS

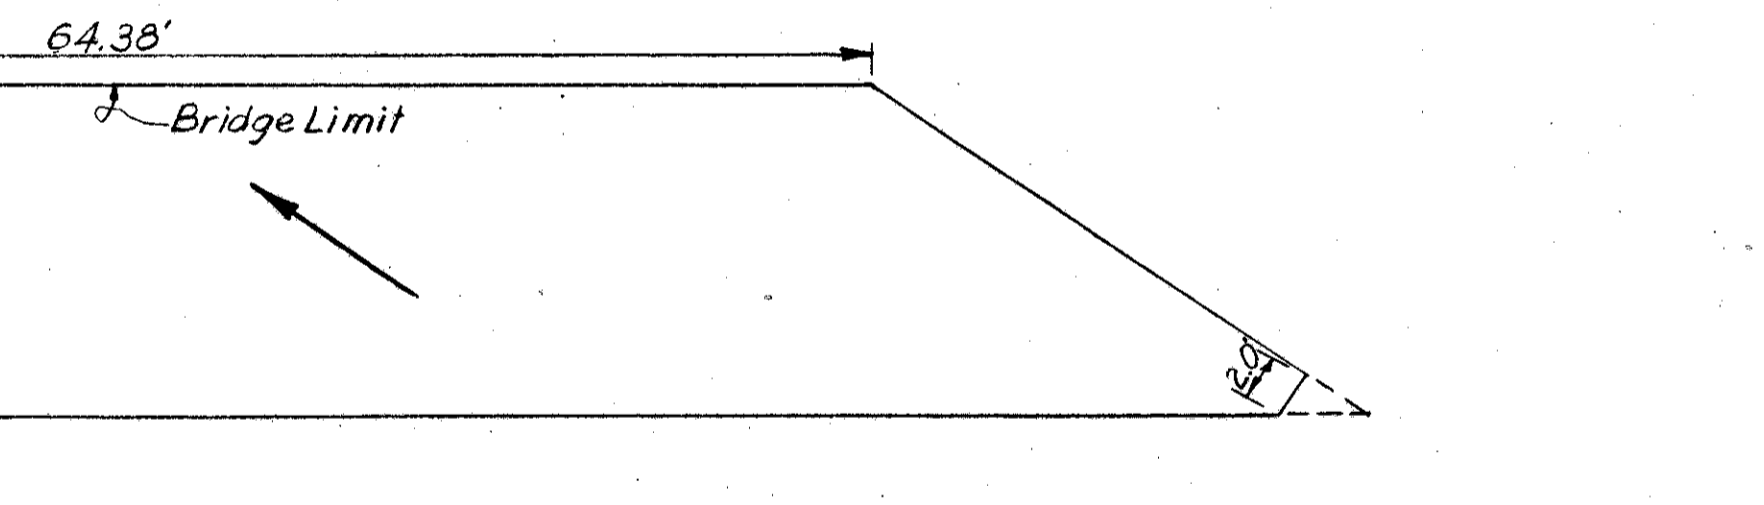

BRIDGE NO. 11
EAST APPROACH SLABS

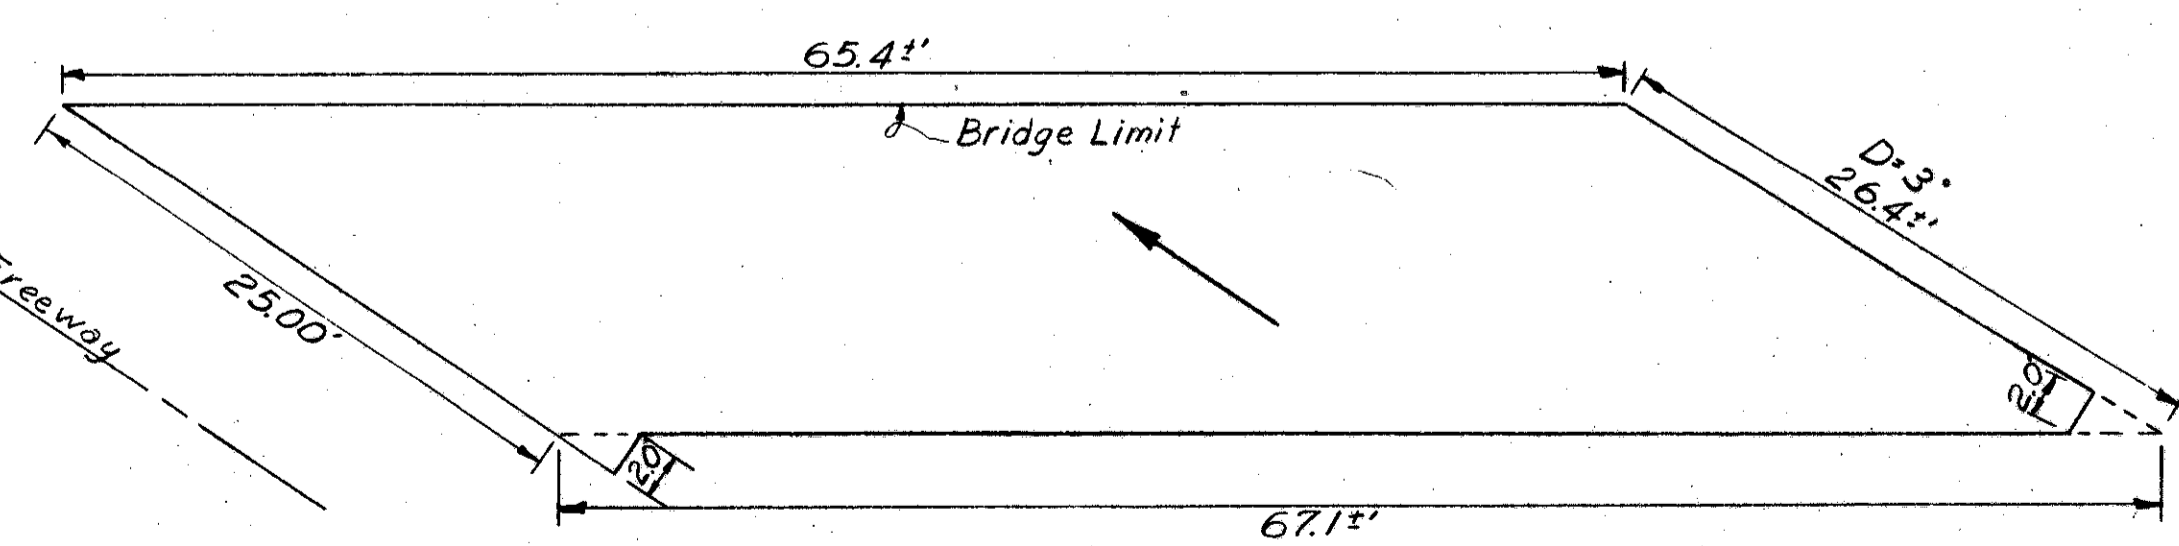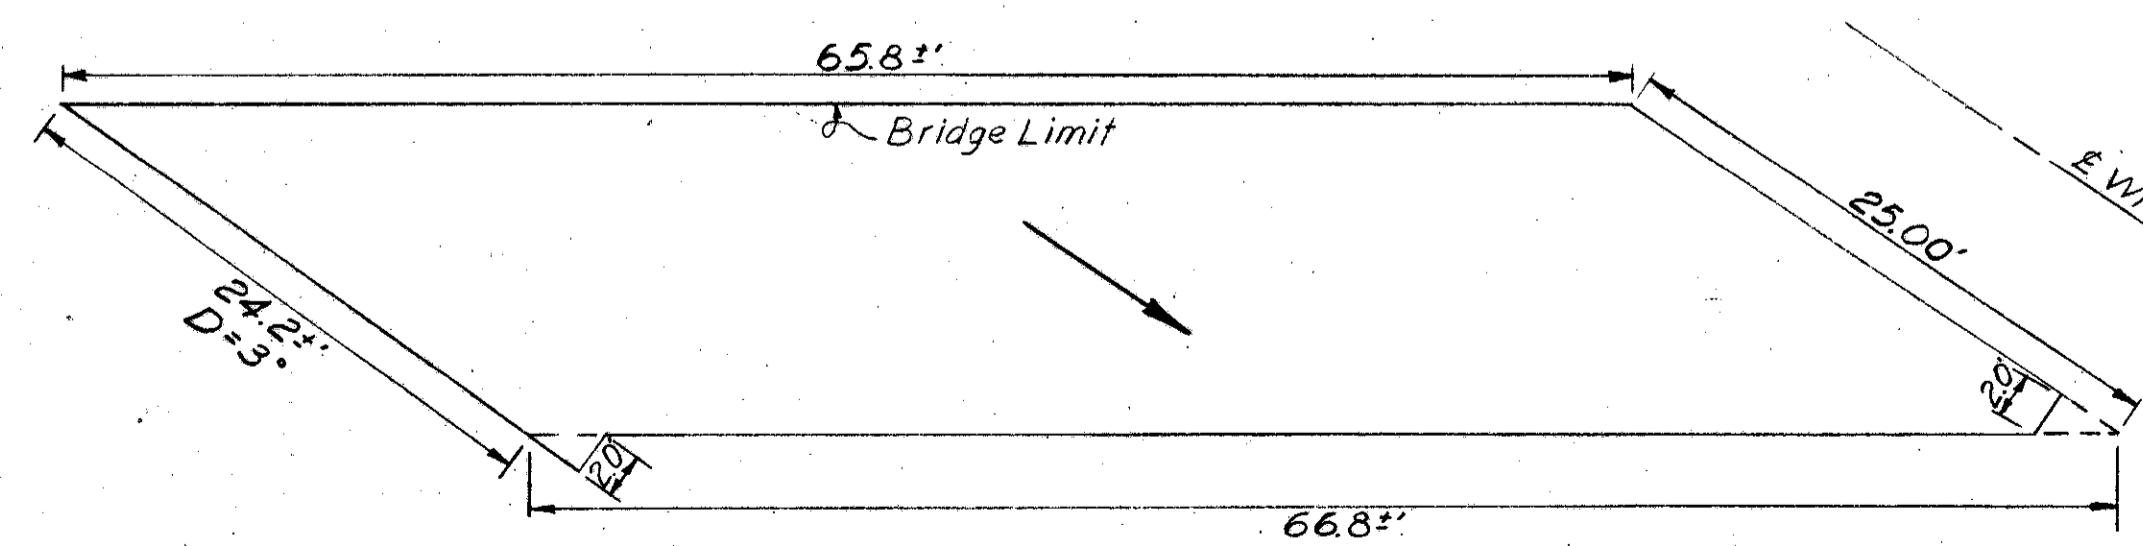


→ Direction of Traffic

*Note:
Type 2A Curb to be transitioned uniformly in eight (8) feet to match 6"x18" Sandstone Curb.

**Note:
The batter on Type 2A Curb to be transitioned uniformly in two (2) feet to match batter on Safety Walk.

Note:
Approach Slabs shall meet construction requirements as shown on State of Ohio Standard Drawing AS-1-54.
Payment for curb sections on approach slabs shall be included in the unit price bid for Item I-7, Approach slabs.

CUYAHOGA COUNTY
CITY OF CLEVELAND
CUY-42-18.42
CUY-21-15.32
DRAINAGE PLAN

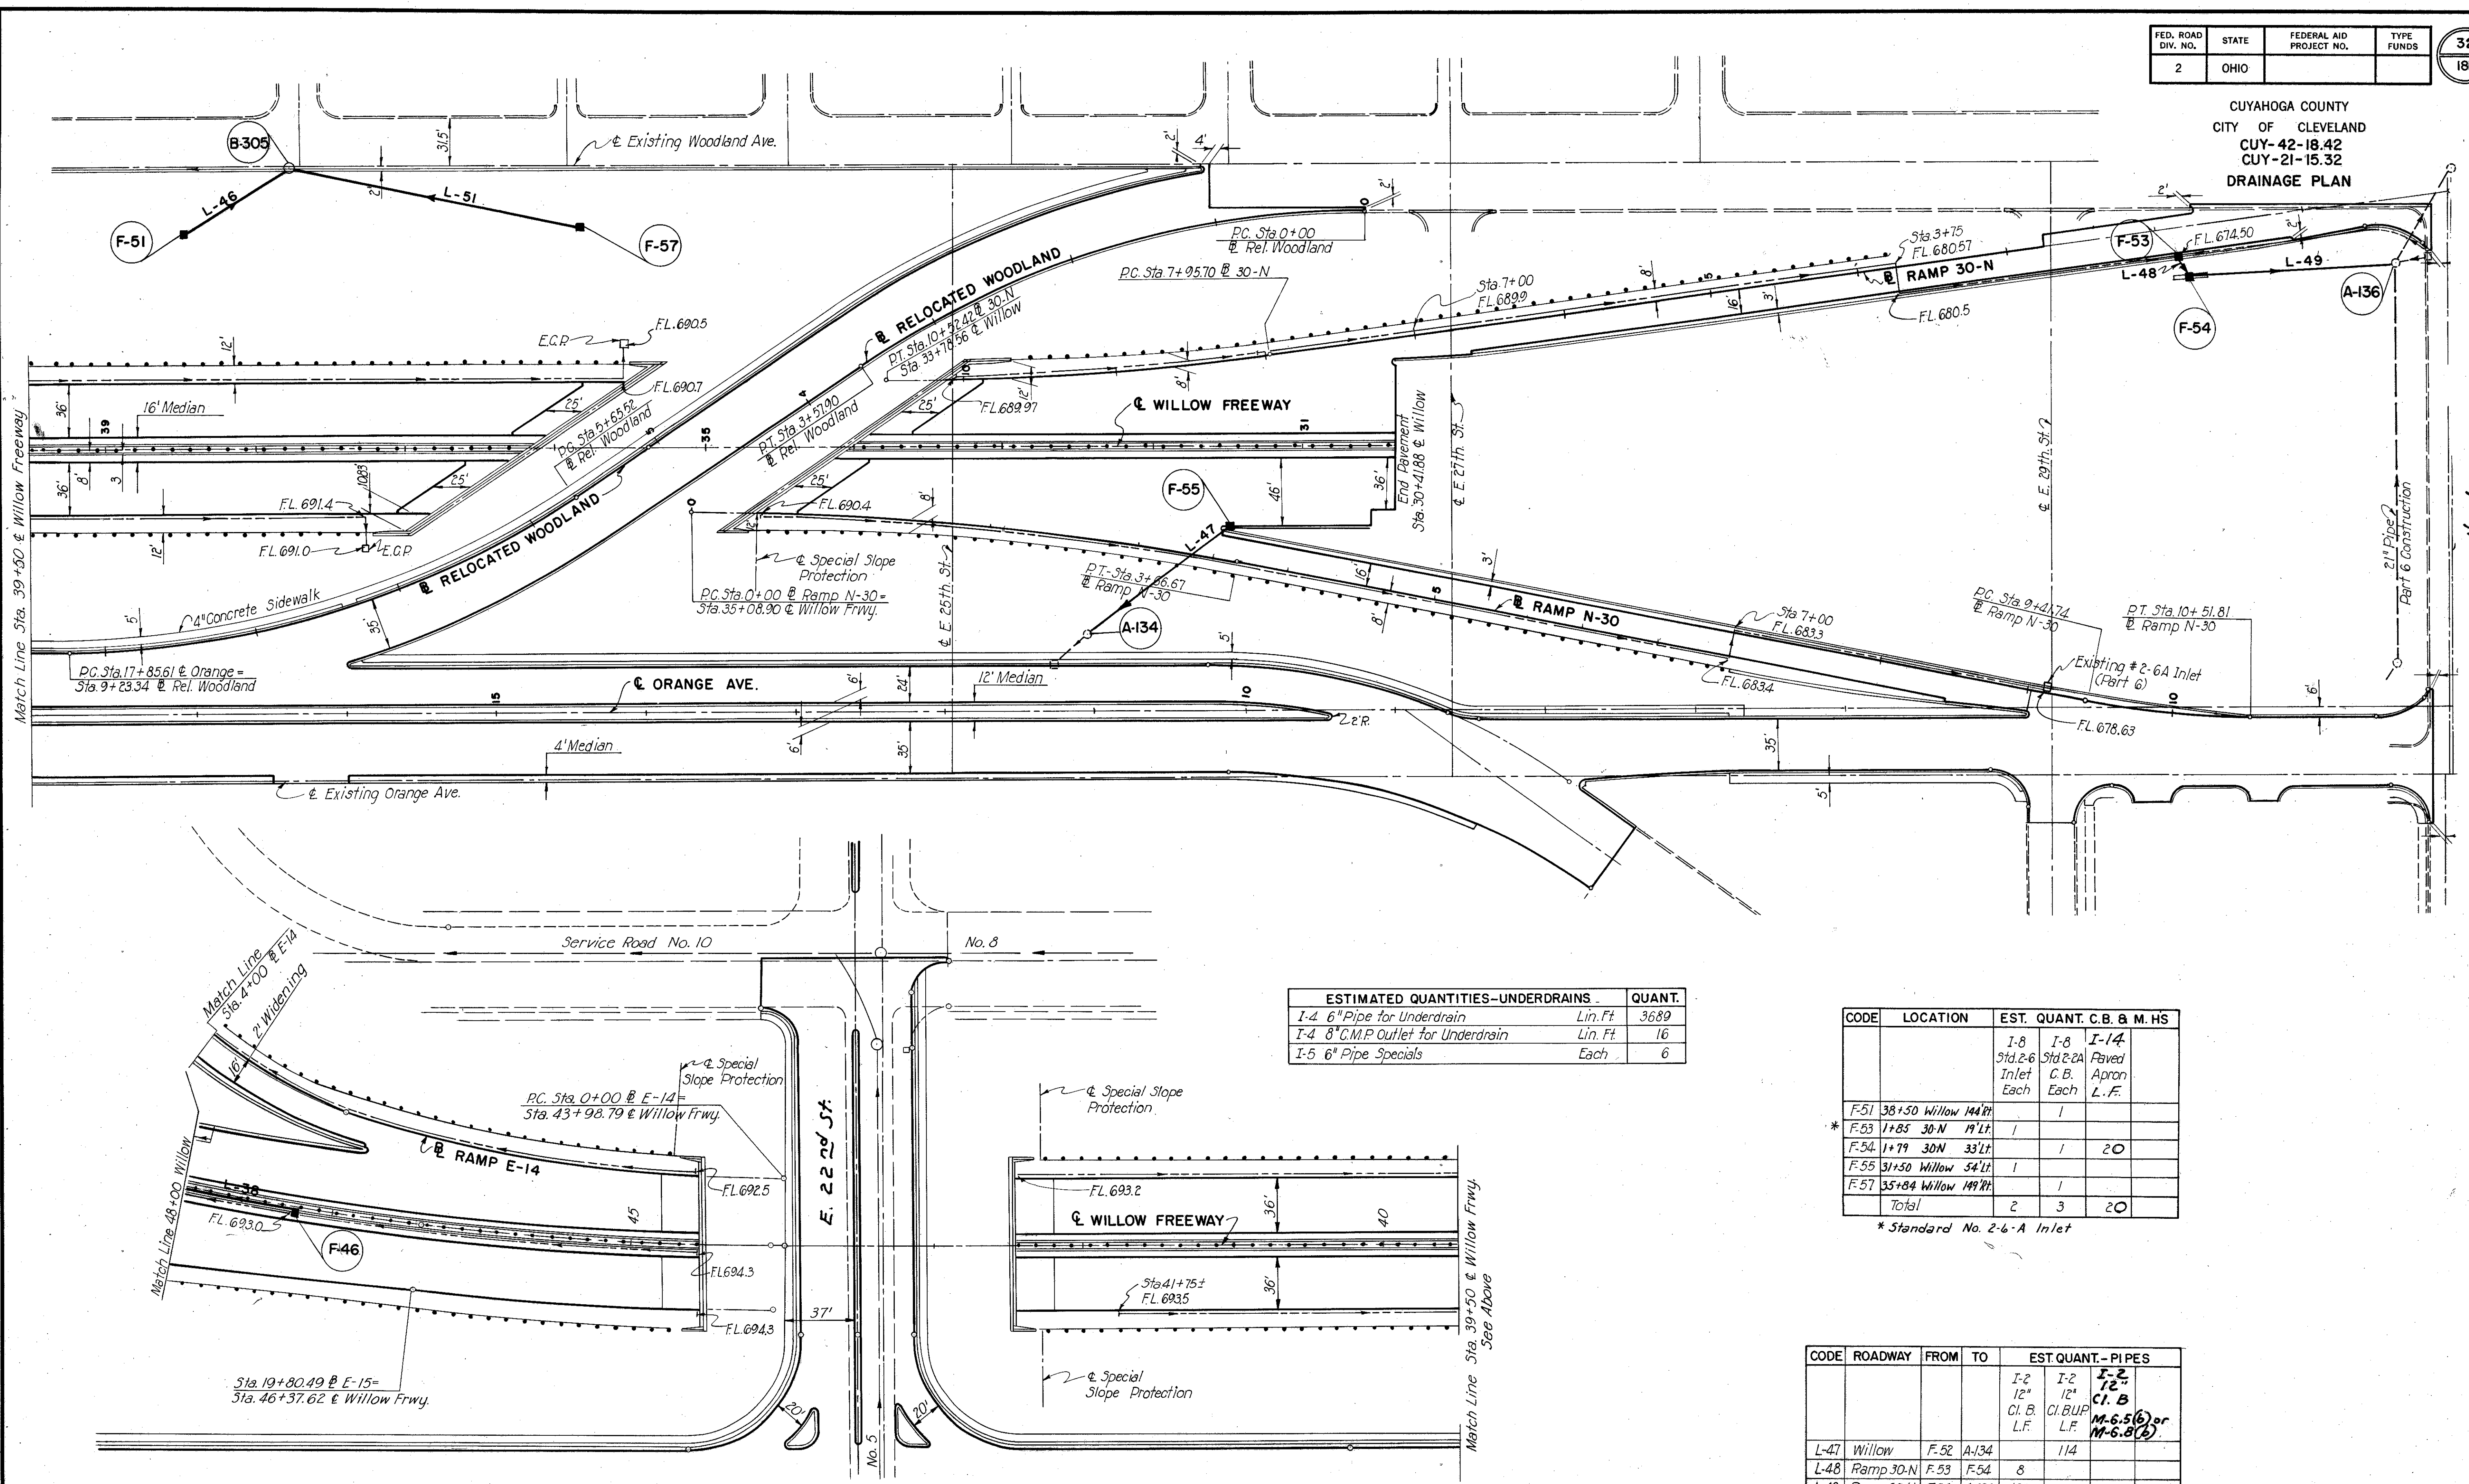

ESTIMATED QUANTITIES-UNDERDRAINS			QUANT.
I-4	6" Pipe for Underdrain	Lin. Ft.	3689
I-4	8" C.M.P. Outlet for Underdrain	Lin. Ft.	16
I-5	6" Pipe Specials	Each	6

CODE	LOCATION	EST. QUANT. C.B. & M.H.S.		
		I-8 Std. 2-6 Inlet Each	I-8 Std. 2-2A C.B. Each	I-14 Paved Apron L.F.
F-51	38+50 Willow 144'lt		1	
* F-53	1+85 30-N 19'lt	1		
F-54	1+79 30N 33'lt		1	20
F-55	31+50 Willow 54'lt	1		
F-57	35+84 Willow 149'lt		1	
Total		2	3	20

* Standard No. 2-6-A Inlet


CODE	ROADWAY	FROM	TO	EST. QUANT.-PIPES		
				I-2 12" C.I. B. L.F.	I-2 12" C.I. B.U.P. L.F.	I-2 12" C.I. B. M-6.5(6) or M-6.8(6) L.F.
L-47	Willow	F-52	A-134		114	
L-48	Ramp 30-N	F-53	F-54	8		
L-49	Ramp 30-N	F-54	A-136		132	
L-46	Woodland	F-51	B-305			78
L-51	Woodland	F-51	B-305			198
Total				140	114	276

SCALE 1"=50'
MADE M.K.M. DATE 3-2-59
TRCD. R.R. DATE 3-5-59
CKD. J.L.C. DATE 3-22-59

HOWARD, NEEDLES, TAMMEN & BERGENOFF
CONSULTING ENGINEERS
KANSAS CITY CLEVELAND NEW YORK

914 SHEET 32

CUYAHOGA COUNTY
CITY OF CLEVELAND
CUY-42-18.42
CUY-21-15.32
DRAINAGE PLAN

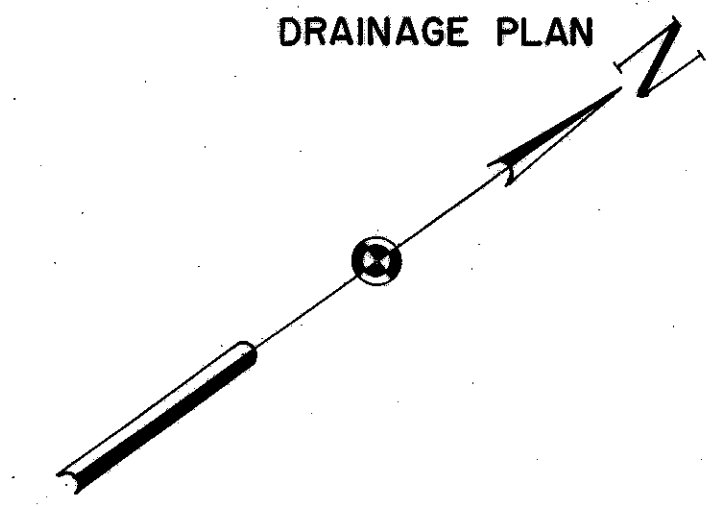

CODE	LOCATION	EST. QUANTITIES C.B. & M.H.'S	EST. QUANTITIES C.B. & M.H.'S		
			I-8 M.H. Adj To Grade Each	I-16 M.H. Abandoned Each	I-16 Inlet Abandoned Each
E-200	2+82 E-7	126 Rt	1		
E-203	3+90 E-14	60 Rt	1		
E-213	2+35 E-7	125 Rt			1
E-220	6+29 E-17	3 Rt		1	
E-222	9+08 E-17	43 Lt			1
E-223	8+64 E-17	28 Lt			1
E-224	2+02 E-9	16 Rt		1	
E-218	13+77 N.B.E. 14th	125 Rt			1
Totals			2	2	4

ESTIMATED QUANTITIES-UNDERDRAINS		
1.4	6" Underdrain Pipe	L.F. 3625
1.4	8" CMP Outlet for Underdrains	L.F. 50
1.5	Pipe Special	Each 13

CODE	LOCATION	EST. QUANTITIES-INLETS AND MANHOLES	EST. QUANTITIES-INLETS AND MANHOLES				
			I-8 Std. 2-6 Inlet Each	I-8 Std #7 C.B. Each	I-8 Std 2-2A C.B. Each	I-8 Std #1 M.H. Each	I-14 Paved Apron L.F.
F-33	5+16.5 Ramp E-7	4 Lt	1				
F-34	4+50 Ramp E-7	34 Lt			1		20
F-35	3+05 Ramp E-7	140 Rt			1		
F-46	47+20 Willow	3 Lt	1				
F-47	49+20 Willow	3 Lt	1				
F-48	49+10 Willow	75 Rt				1	
F-49	4+25 Ramp E-14	60 Rt		1			
TOTAL CUY-42-18.42			3*	1	2	1	20

CODE	ROADWAY	FROM	TO	ESTIMATED QUANTITIES-PIPES			
				I-2 12" Class 'B' L.F.	I-2 12" B-UP L.F.	I-2 12" C.I. B M-6.5(B) M-6.8(B) L.F.	
L-31	Ramp E-7	F-35	E-200	26			
L-32	Ramp E-7	F-33	F-34	68			
L-33	Ramp E-7	F-34	E-200		226		
L-38	Willow	F-46	F-47		198		
L-39	Willow	F-47	F-48		76		
L-40	Willow	F-48	A-32			92	
L-41	Ramp E-14	F-49	E-203	26			
TOTAL CUY-42-18.42				120	500	92	

- LEGEND**
- No. 3 Existing Sewer
 - Existing Catch Basins & Manholes
 - Proposed Sewer
 - Proposed Manhole
 - Proposed Inlet
 - Proposed Underdrains
 - Existing Sewer to be Abandoned
 - Proposed Drainage Structure
 - Proposed Sewer
 - Proposed Drainage Structure, Part 6
 - Existing Drainage Structure, Part 6

CUYAHOGA COUNTY
CITY OF CLEVELAND
CUY-42-18.42
CUY-21-15.32
DRAINAGE PLAN

LEGEND

No. 3 Existing Sewers
 Existing Catch Basins & Manholes
 Proposed Sewers
 Proposed Manhole
 Proposed Inlet
 Proposed Underdrains
 Existing Sewer to be Abandoned

FL 680.00
 Gardiner Court
 Webster Ave.
 E. 10th St.
 E. 12th St.
 E. 13th St.

ESTIMATED QUANTITIES-UNDERDRAINS

1-4 6" Underdrain Pipe	L.F.	205
1-4 8" C.M.P. Outlet for Underdrains	L.F.	20
1-5 Pipe Special	Each	2

ESTIMATED QUANTITIES, PIPES

CODE	ROADWAY	FROM	TO	ESTIMATED QUANTITIES, PIPES							
				I-2 12" Class 'B' L.F.	I-2 12" B-UP L.F.	I-2 15" Class B L.F.	I-2 15" B-UP L.F.	I-2 15" BUP M-6.6(6) L.F.	I-2 12" C.I. B M-6.5(6) L.F.	I-2 18" B-UP M-6.6(6) L.F.	
L-1	Ramp E-10	F.6	A-142	100							
L-3	Ramp E-8	F.2	F.17	34							
L-4	Ramp E-8	F.17	A-101						204		
L-5	Ramp E-8	F.10	A-101	110							
L-13	Ramp E-10	F.7	F.8	56							
L-14	I-B. Freeway	F.8	F.14			222					
L-15	Ramp E-10	F.24	F.8	116							
L-16	Ramp E-5	F.11	F.12	46							
L-17	Ramp E-5	F.12	A-102						30		
L-18	Ramp E-8	F.16	F.15	58							
L-19	Ramp E-8	F.15	F.1				100				
L-20	Ramp E-8	F.1	A-102						296		
L-22	Ramp E-5	F.19	B-79	46							
L-23	Ramp E-8	F.14	F.30			200					
L-27	Ramp E-8	F.30	F.31				47				
L-28	Ramp E-10	F.31	A-143							124	
L-29	Ramp E-10	F.32	A-143	54							
L-52	Ramp E-16	F.52	F.7	36							
TOTAL CUY-42-18.42				116	540	422	147	500	30	124	

EST. QUANTITIES, CATCH BASINS, INLETS & MHS

CODE	LOCATION	EST. QUANTITIES, CATCH BASINS, INLETS & MHS				
		I-8 Std 2-6 Inlet Each	I-8 Std 2-8 C.B. Each	I-8 Std 2-24 C.B. Each	I-8 Std #3 C.B. Each	I-14 Paved Apron L.F.
* F-1	7+98 Ramp E-8	5	1			
* F-2	9+25 Ramp E-8	5	1			
* F-6	9+85 Ramp E-10	29	1			
F-7	8+10 Ramp E-10	20	1			
* F-8	7+50 Ramp E-10	20	1			
F-10	10+65 Ramp E-8	18		1		10
F-11	6+97 Ramp E-5	30		1		20
F-12	6+97 Ramp E-5	18		1		20
F-14	6+78 Ramp E-8	100		1		
F-15	7+10 Ramp E-8	32		1		10
F-16	6+75 Ramp E-8	18		1		10
F-17	9+30 Ramp E-8	30		1		10
F-19	4+95 Ramp E-5	41			1	
F-30	5+00 Ramp E-8	37		1		10
F-31	5+00 Ramp E-8	15		1		10
F-32	13+00 Ramp E-10	27	1			
F-52	6+40 Ramp E-16	18	1			
TOTAL CUY-42-18.42		6	1	9	1	100

Note: Asterisked inlets are to be Std. 2-4 inlets as per Standard drawing I-8 I & A 4-23-59.


CUYAHOGA COUNTY
CITY OF CLEVELAND
CUY-42-18.42
CUY-21-15.32
DRAINAGE PLAN

CODE	ROADWAY	FROM	TO	EST. QUANTITIES-PIPES						
				I-2 12" C.I.B. L.F.	I-2 12" B.U.P. L.F.	I-2 12" M-6.5(6) L.F.	I-2 15" C.I.B. L.F.	I-2 18" M-6.5(6) L.F.	I-2 24" B.U.P. L.F.	
L-10	I.B. Freeway	F-22	F-23		108					
L-11	I.B. Freeway	F-23	F-24		116					
L-12	Ramp E-10	F-25	F-24		70					
L-24	Ramp E-5	F-26	F-27		52					
L-25	Ramp E-5	F-27	F-28					34		
L-26	Ramp E-5	F-29	F-28		34					
L-34	Ramp E-11	F-37	F-38		268					
L-35	Ramp E-11	F-38	F-56					96		
L-36	Ramp E-11	F-39	F-56		16					
L-37	Ramp E-11	F-40	E-202					54		
L-42	I.B. Freeway	F-41	F-42		204					
L-43	Ramp E-13	F-44	F-43		90					
L-44	Ramp E-13	F-43	F-42					176		
L-45	E-22nd St.	F-45	# 5		12					
L-50	Ramp E-11	F-56	E-202						92	
Total CUY-42-1842					540	430	54	130	176	92

ESTIMATED QUANTITIES-UNDERDRAINS		
I-4, 6" Underdrain Pipe	L.F.	3650
I-4, 8" CMP Outlet for Underdrain	L.F.	50
I-5, 6" Pipe Special	Each	7

CODE	LOCATION	EST. QUANTITIES C. B. & M.H.'S		
		I-8 M.H. Adj. to Grade Each	I-16 M.H. Abandon Each	I-16 Inlet Each
E-202	80+52 Inner Belt 60Rt	1		
E-225	4+45 E-5	1		
E-226	79+50 Inner Belt 37Rt			1
E-227	79+59 Inner Belt 62Rt	1		
E-228	79+69 Inner Belt 61Rt			1
E-229	79+66 Inner Belt 1Rt		1	
E-230	6+95 E-11	1		
E-231	7+04 E-11	25Rt		
E-232	7+26 E-11	5Rt		
E-233	7+36 E-11	25Rt		
E-234	80+80 Inner Belt 37Rt			1
E-235	8+93 Inner Belt 45Rt		1	
E-236	81+00 Inner Belt 51Rt			1
E-237	2+66 E-13		1	
E-238	0+49 E-13		52Rt	
B-152	75+11 Inner Belt 45Lt		1	
B-153	77+33 Inner Belt 166Rt		1	
E-242	68+41 Inner Belt 66Lt			1
E-243	68+60 Inner Belt 33Lt			1
E-244	75+53 Inner Belt 8Rt			1
E-245	75+68 Inner Belt 6			1
Total		5	5	11






CODE	LOCATION	ESTIMATED QUANTITIES-INLETS & MANHOLES								
		I-8 Std. 2-6 C.B. Each	I-8 Std. 2-10 C.B. Each	I-8 Std. 2-24 C.B. Each	I-8 Std. 3 C.B. Each	I-8 Std. #1 M.H. Each	I-8 Std. #2 M.H. Each	I-14 Paved Apron L.F.	I-8 Std. #A C.B. Each	
* F-22	70+56 I.B. Frwy. 2'Rt	1								
F-23	69+53 I.B. Frwy. 2'Rt	1								
F-24	6+25 Ramp E-10 37'Lt			1						
* F-25	4+75 Ramp E-16 19'Lt	1						10		
F-26	1+75 Ramp E-5 6		1							
F-27	2+31 Ramp E-5 18'Rt			1				20		
F-28	2+73 Ramp E-5 10'Rt					1				
F-29	1+85 Ramp E-16 8'Rt	1								
F-37	76+85 I.B. Frwy. 87'Rt							10		
F-38	2+75 Ramp E-11 18'Rt			1				10		
F-39	3+93 Ramp E-11 18'Rt			1				20		
F-40	3+93 Ramp E-11 31'Lt			1				20		
F-41	77+30 I.B. Frwy. 74'Lt							1		
F-42	78+50 I.B. Frwy. 86'Lt							1		
E-43	3+14 Ramp E-13 16'Rt			1				20		
F-44	3+38 Ramp E-13 32'Lt			1				20		
F-45	18+65 E-22nd 2'Rt			1						
F-56	3+75 Ramp E-11 32'Rt					1				
Total	CUY-42-1842	4	1	8	1	2	1	130	1	

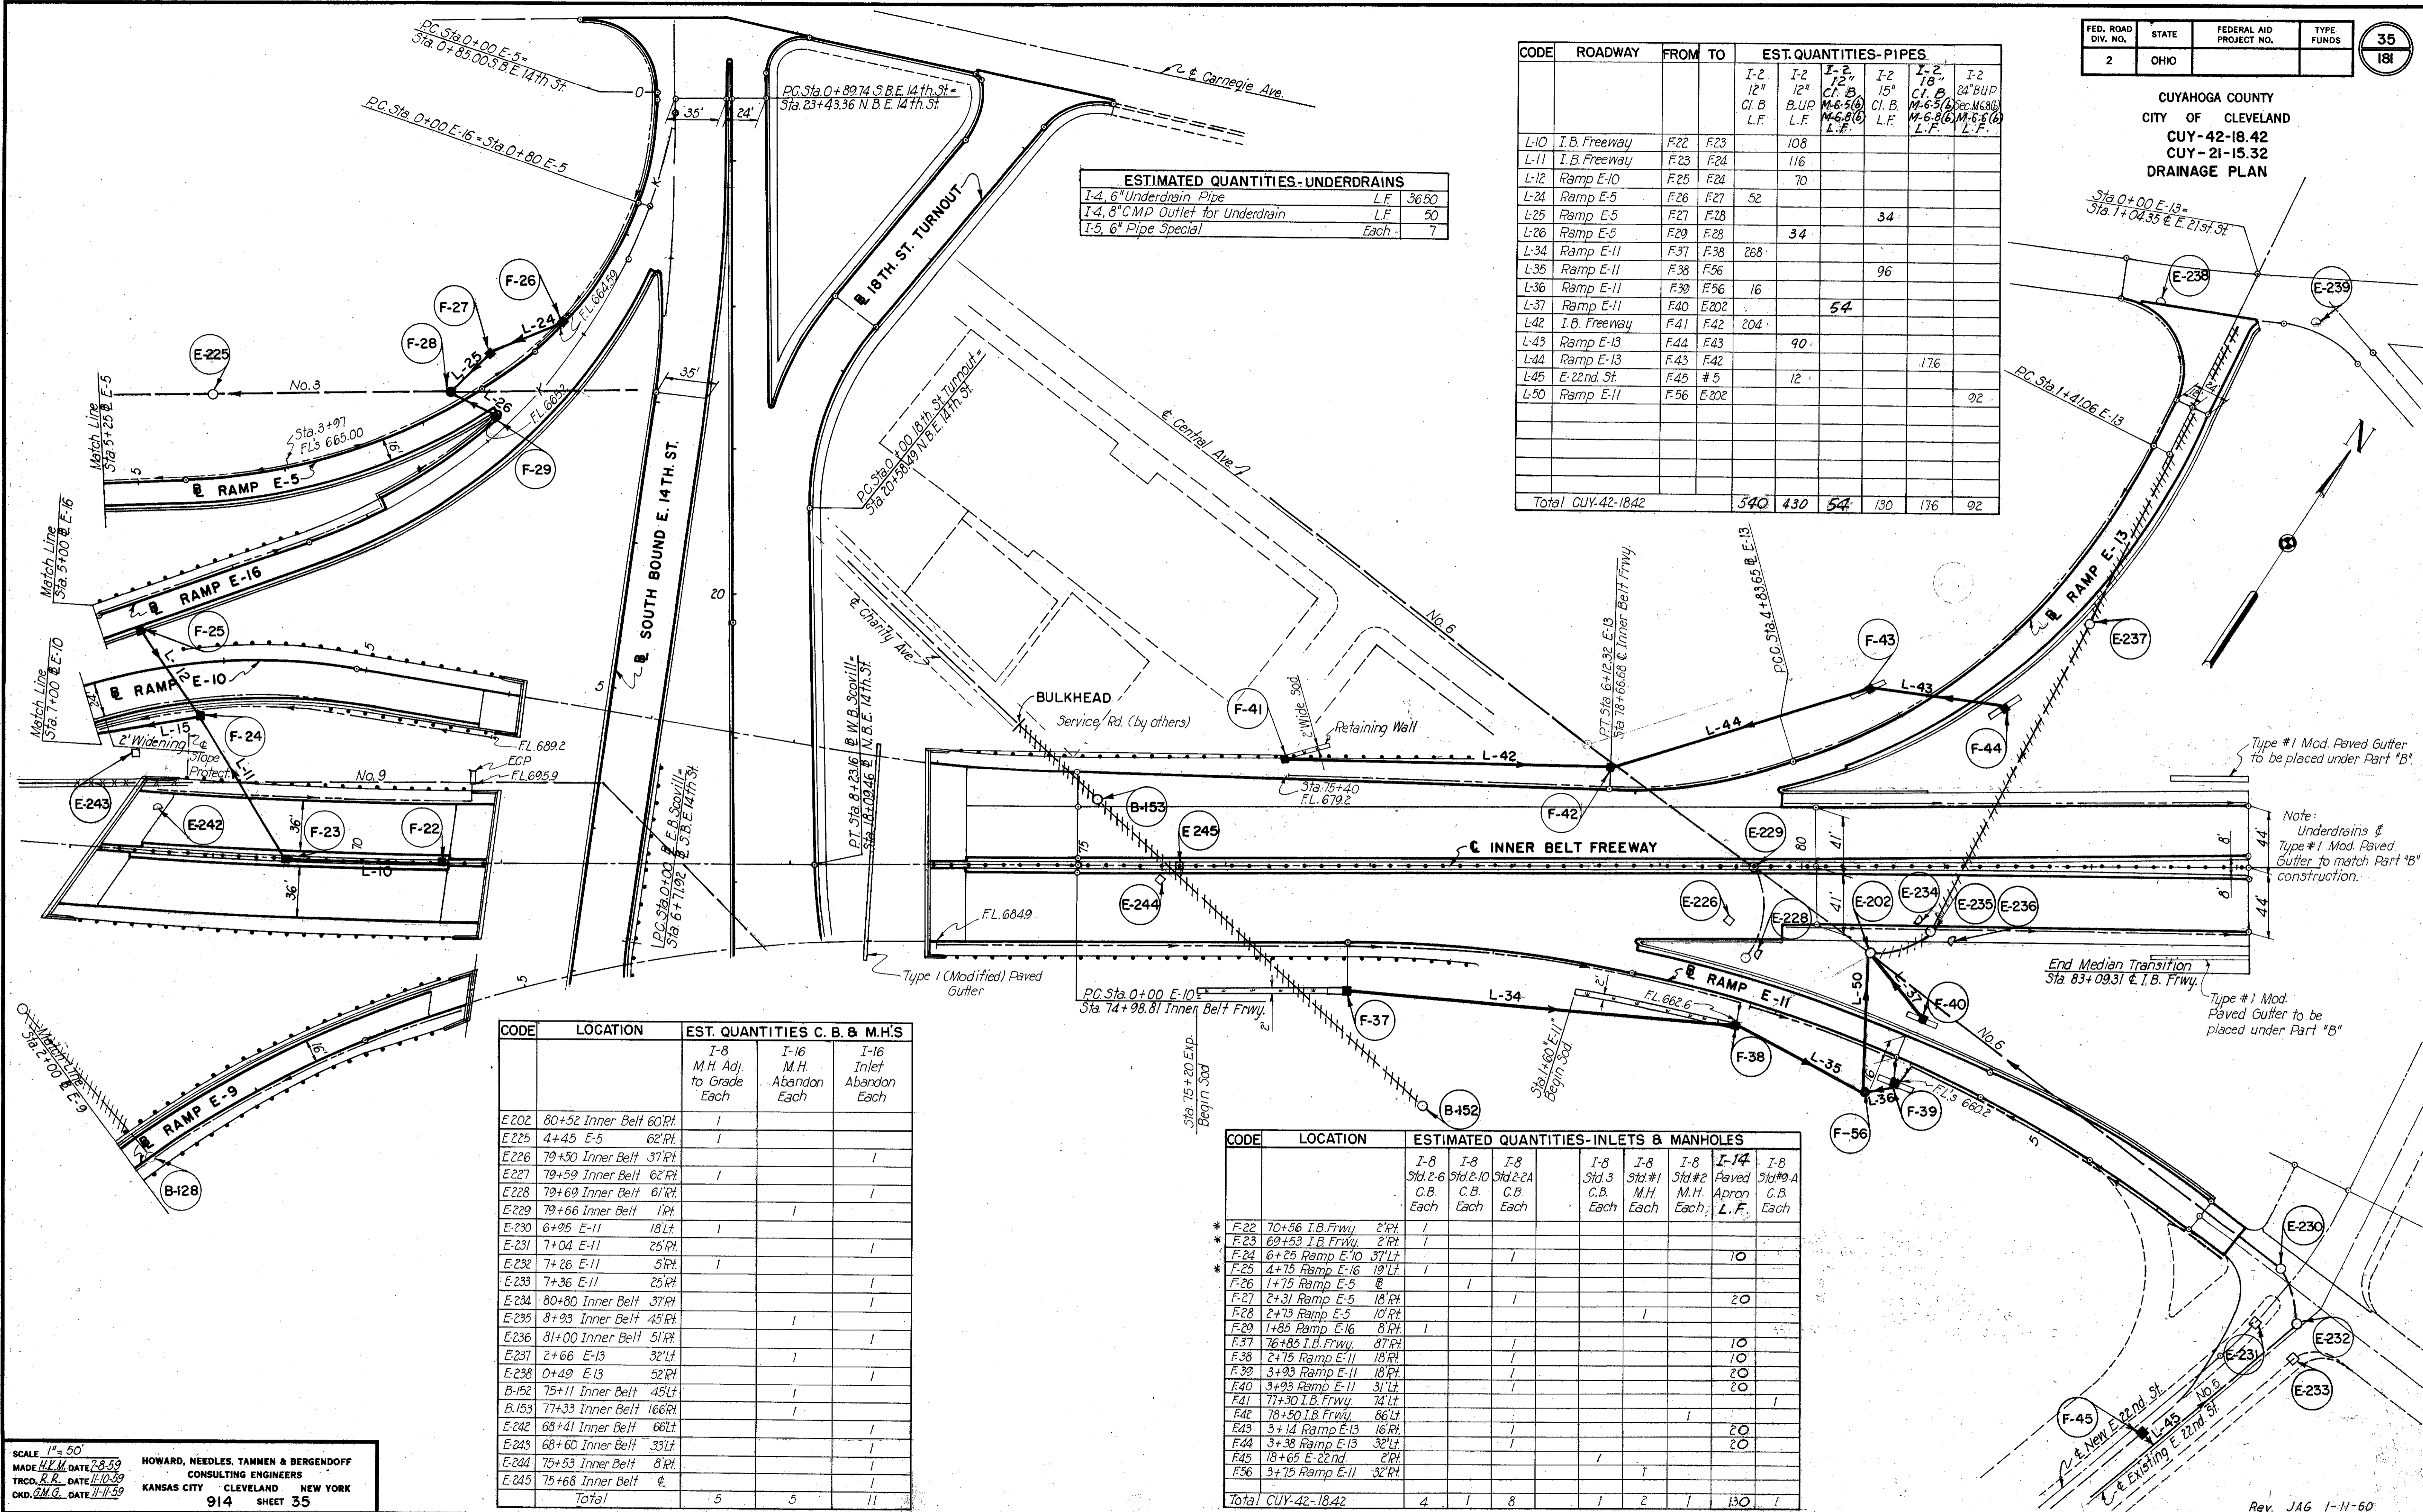

FED. ROAD DIV. NO.	STATE	FEDERAL AID PROJECT NO.	TYPE FUNDS
2	OHIO		

36
181

CUYAHOGA COUNTY
CITY OF CLEVELAND
CUY-42-18.42
CUY-21-15.32
DRAINAGE PROFILES

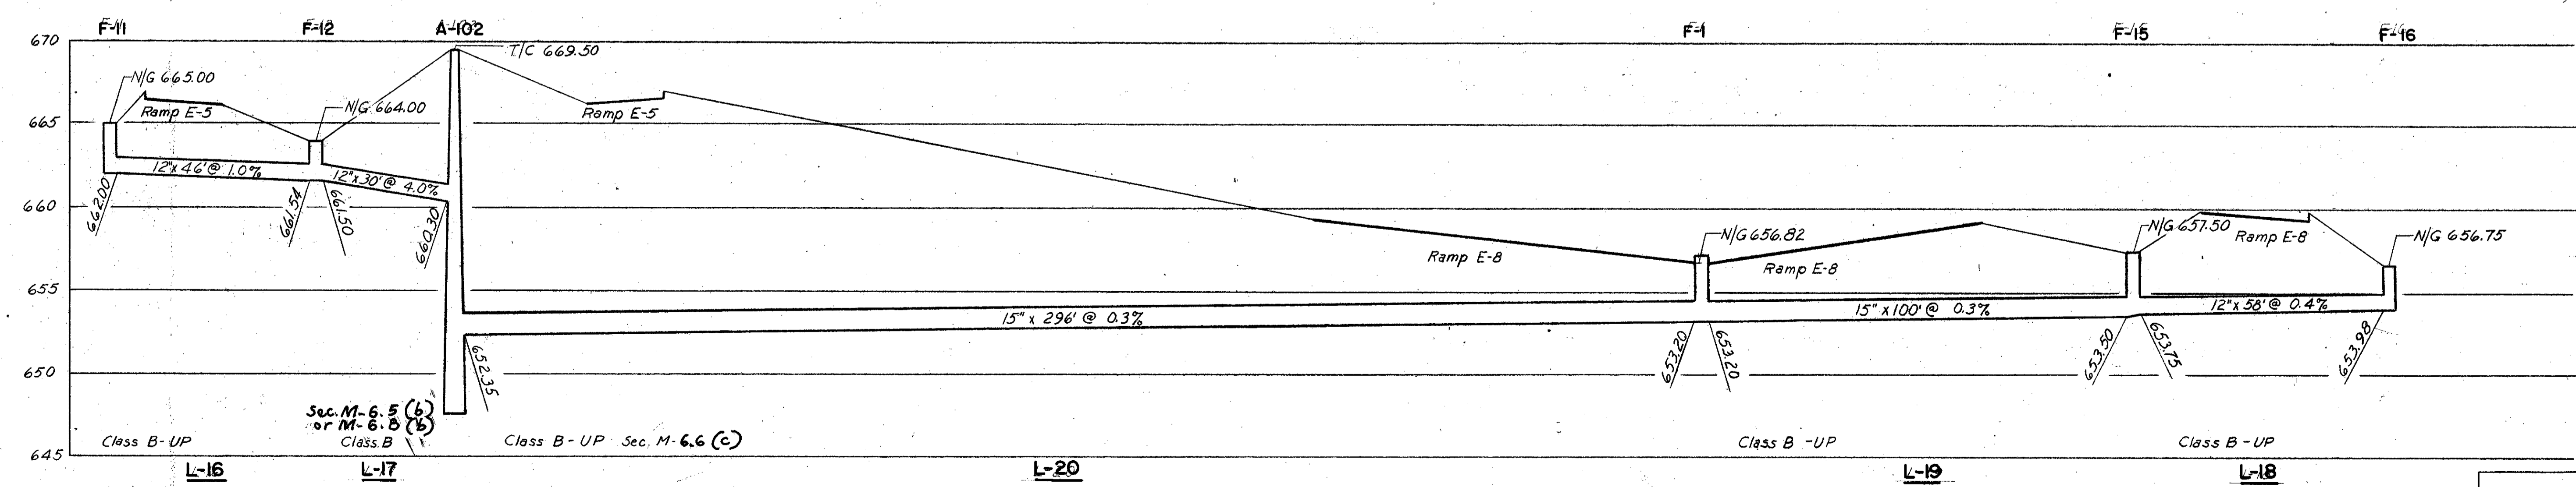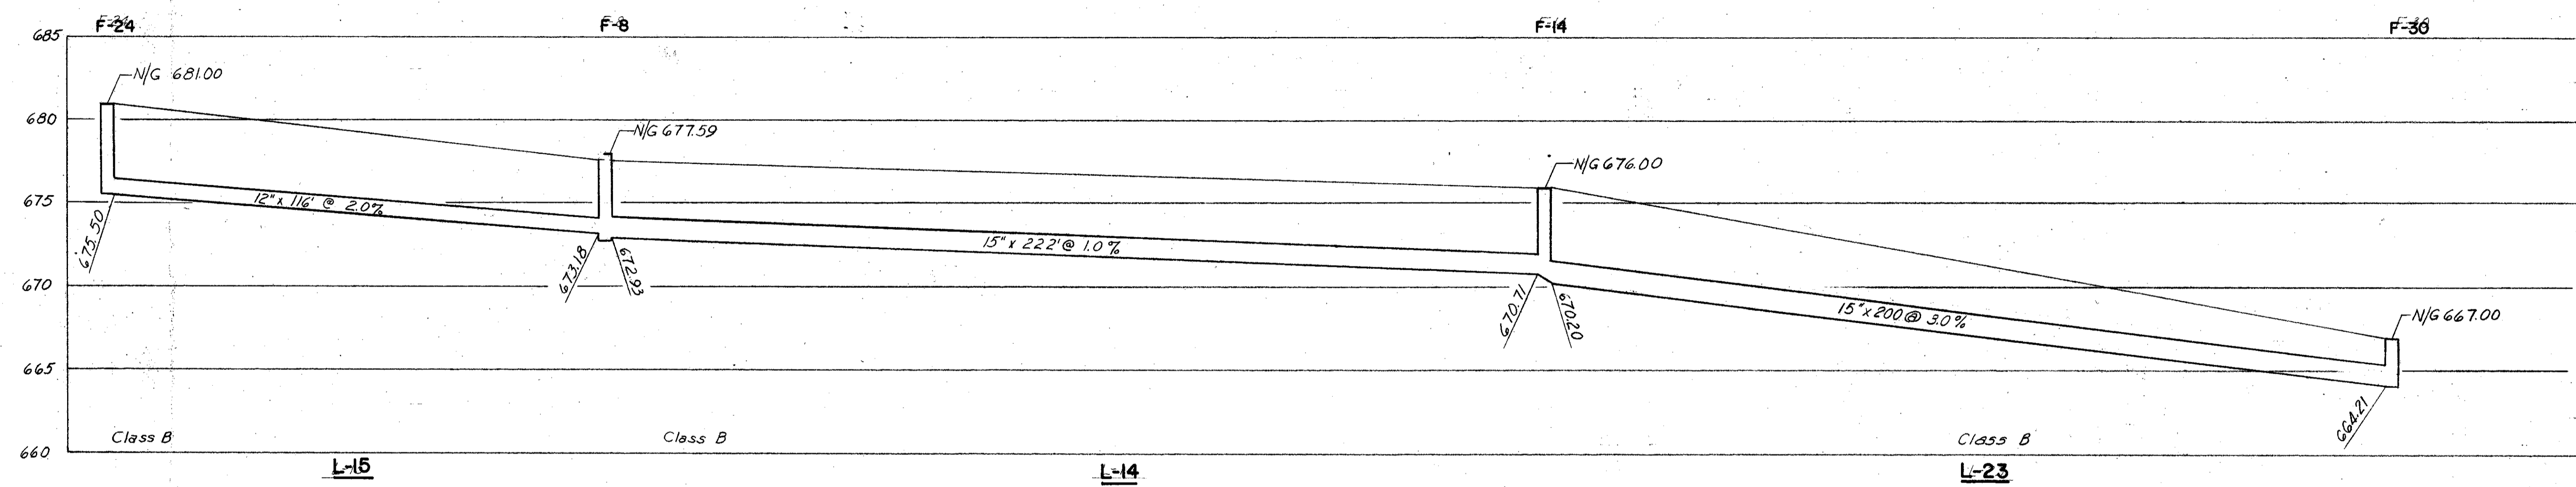
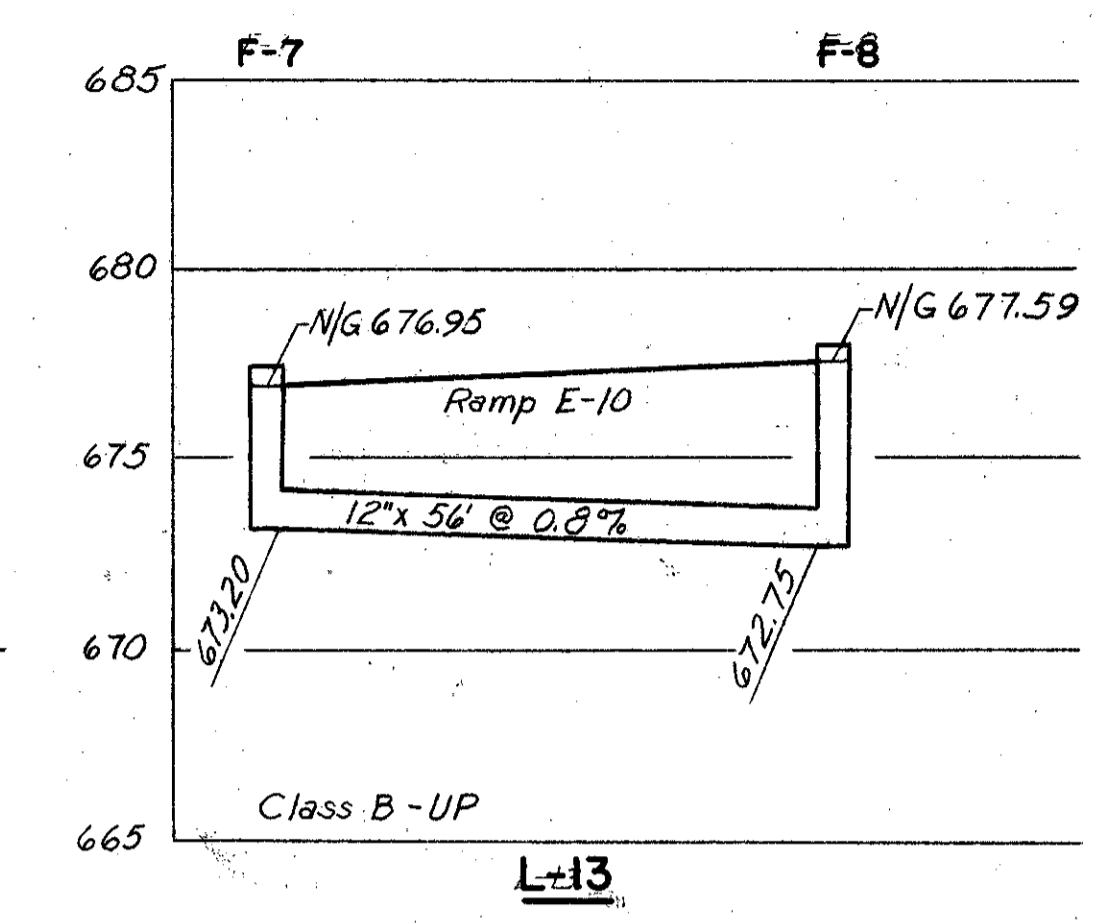
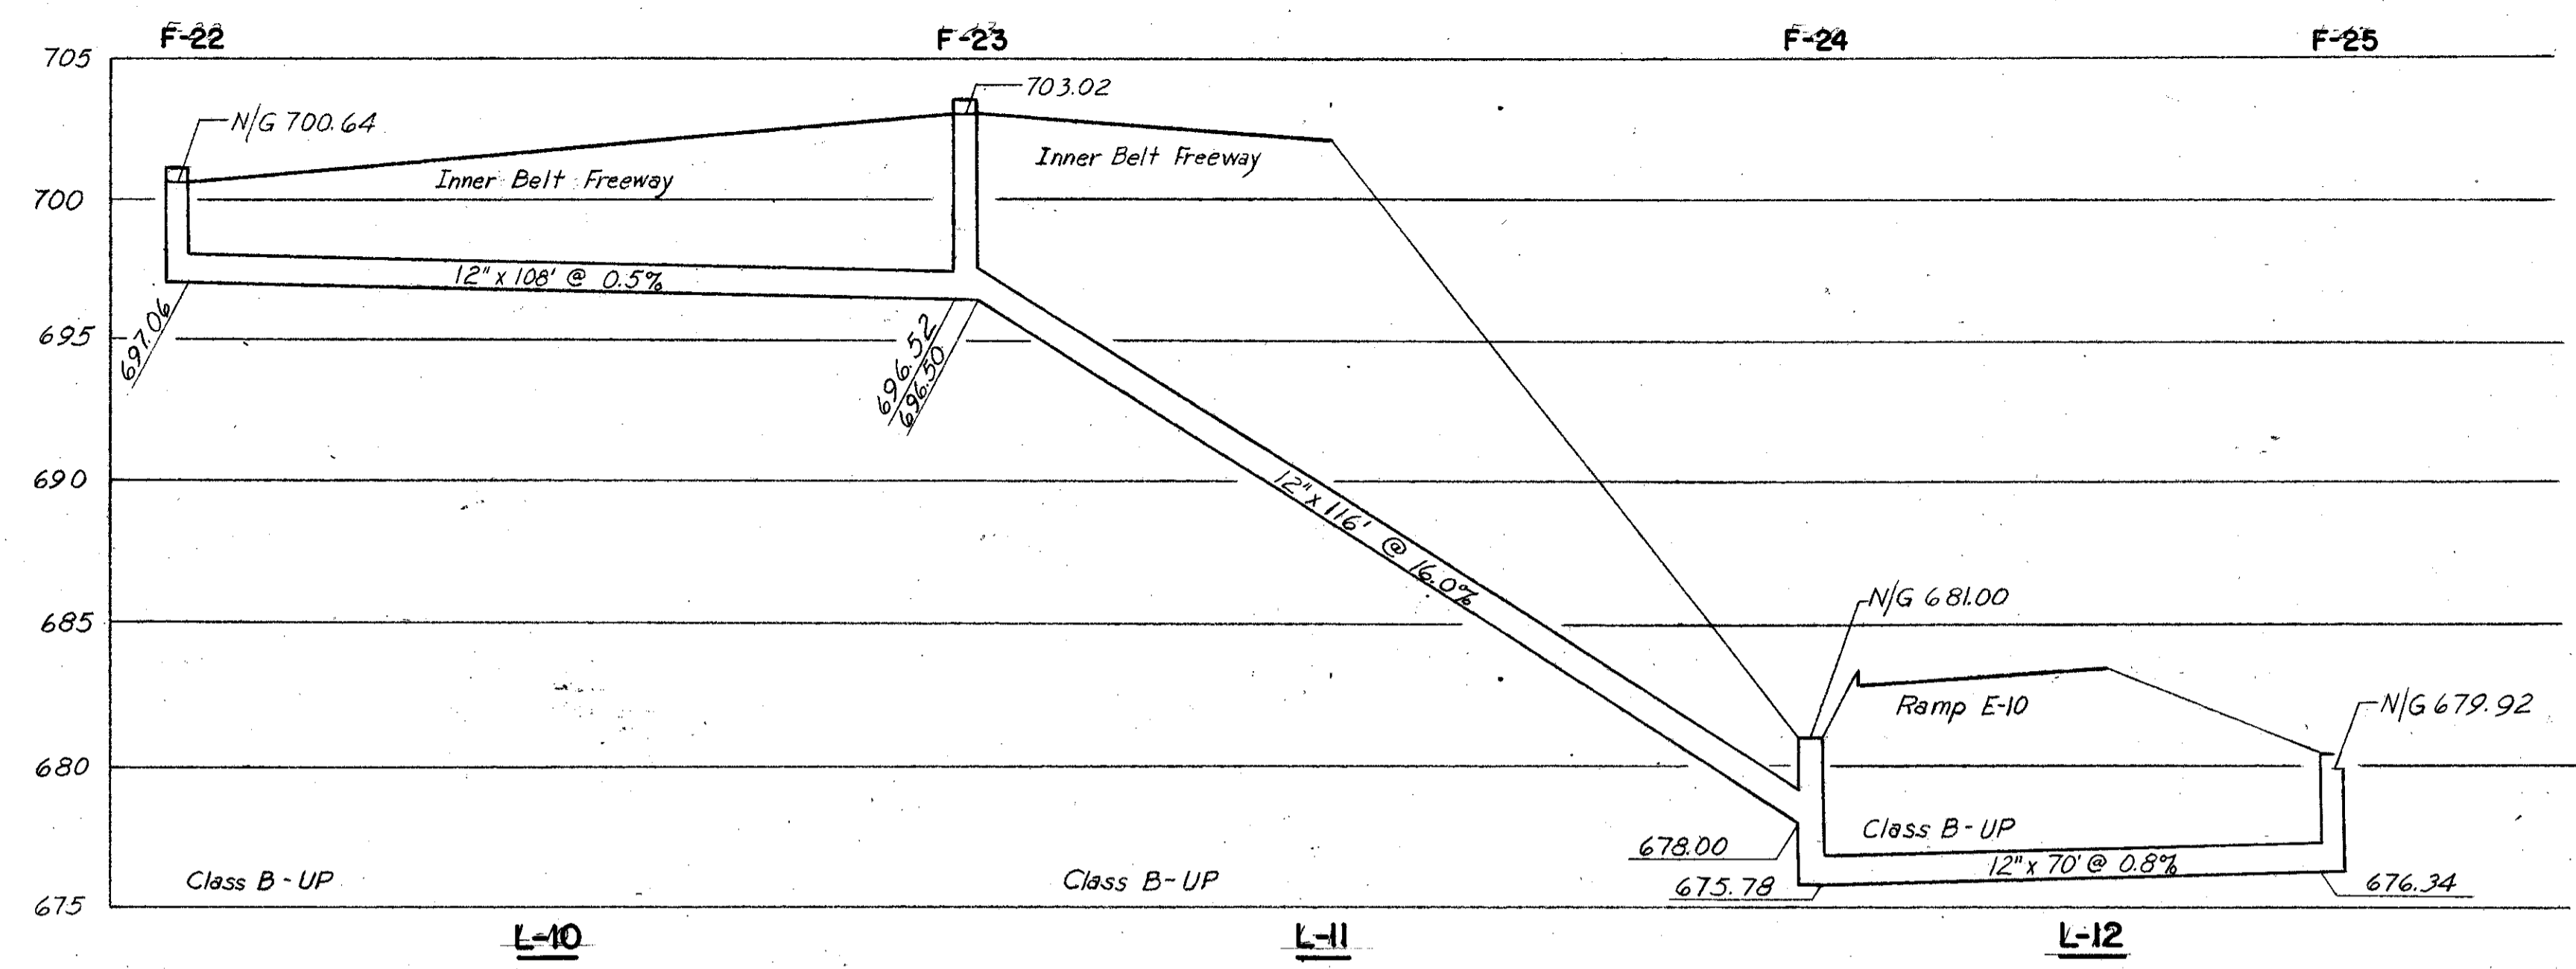
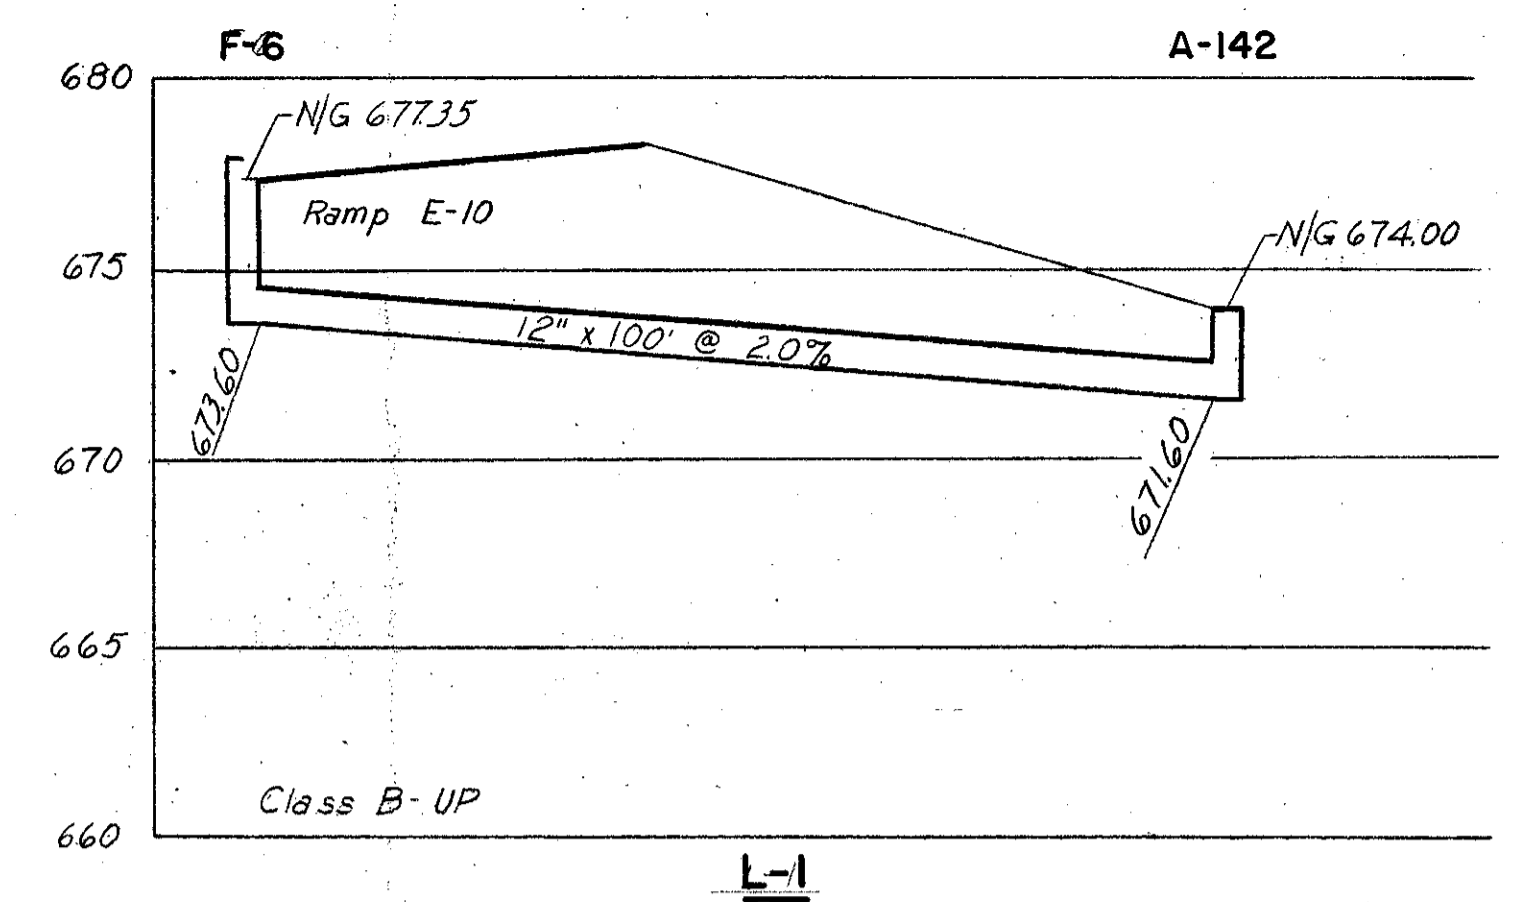


PROFILES
L-1, L-10 TO L-20,
& L-23

FED. ROAD DIV. NO.	STATE	FEDERAL AID PROJECT NO.	TYPE FUNDS
2	OHIO		

37
181

CUYAHOGA COUNTY
CITY OF CLEVELAND
CUY-42-18.42
CUY-21-15.32
DRAINAGE PROFILES

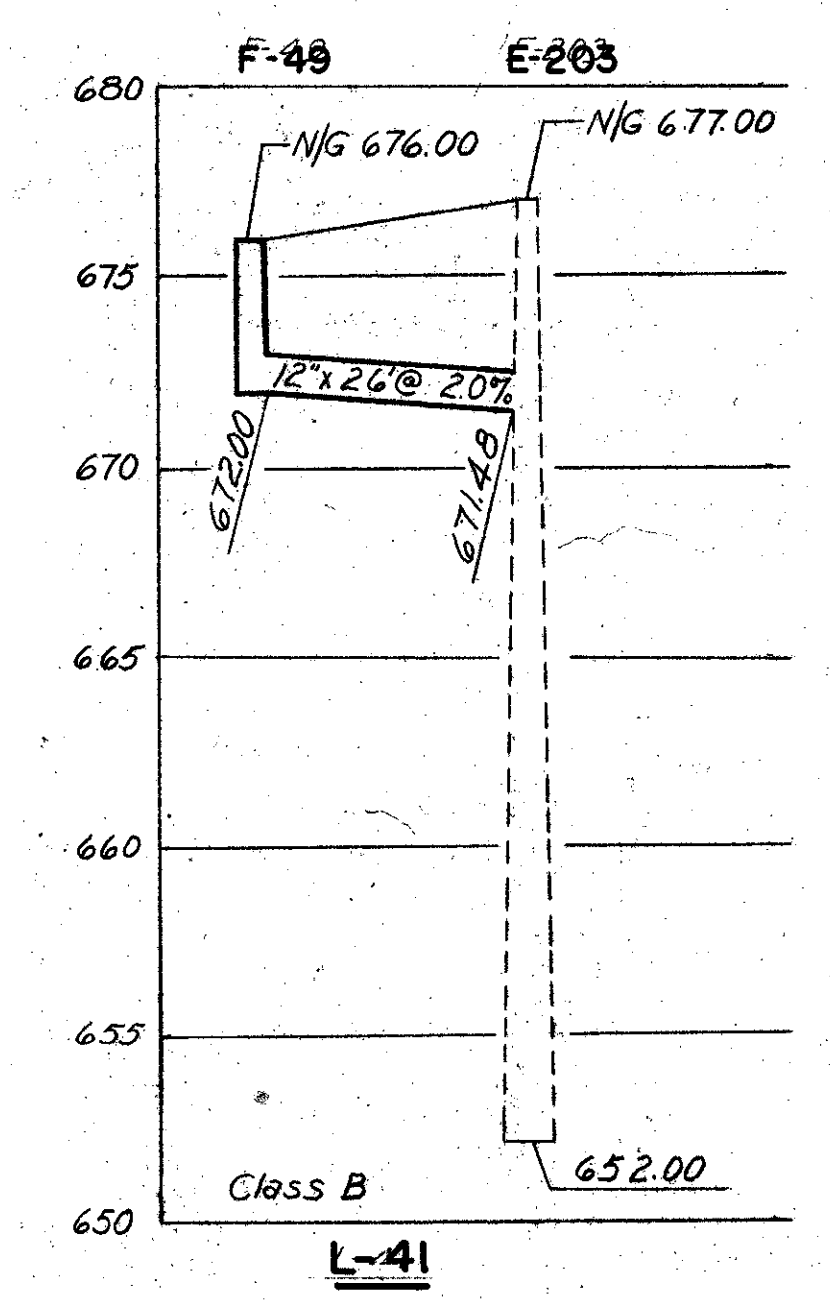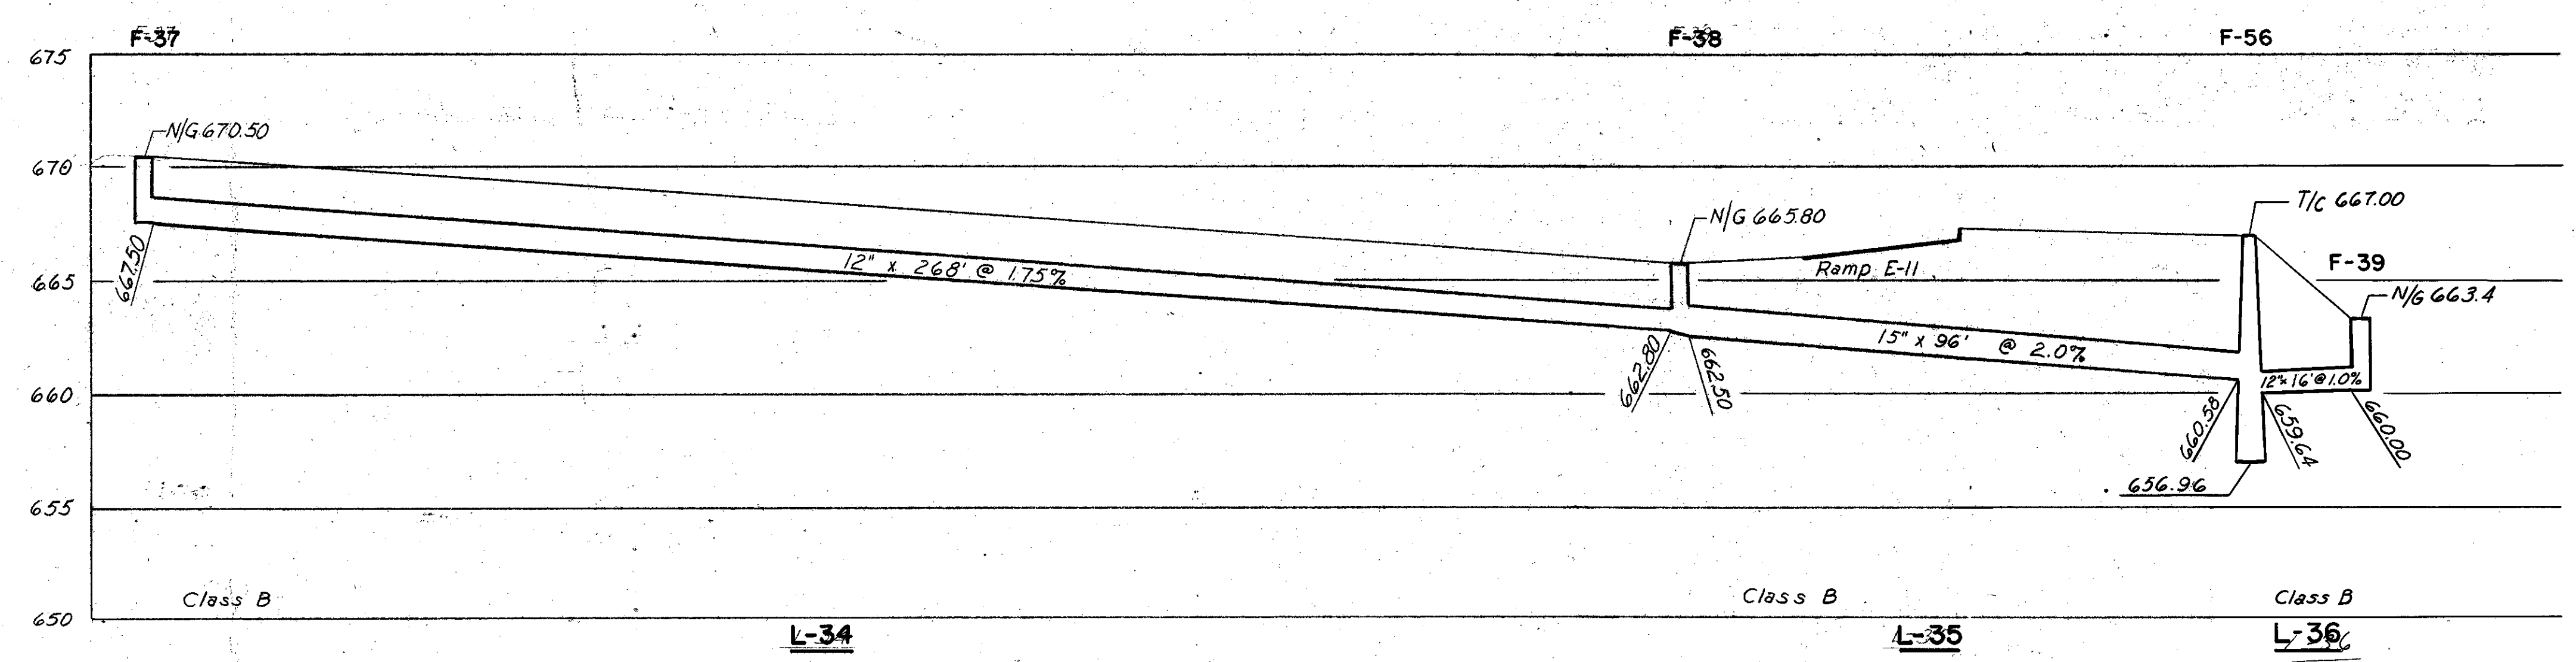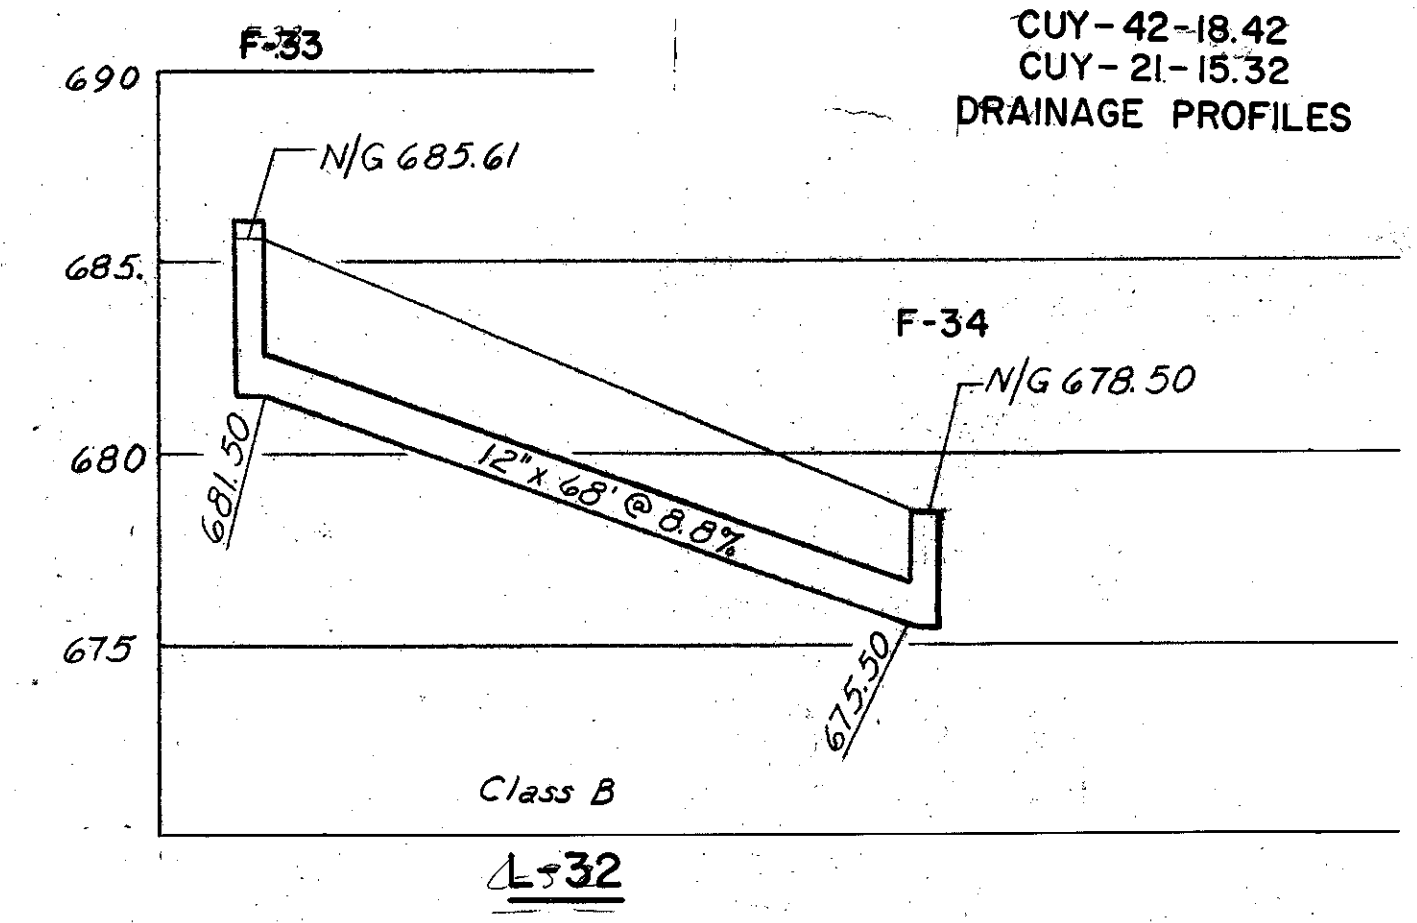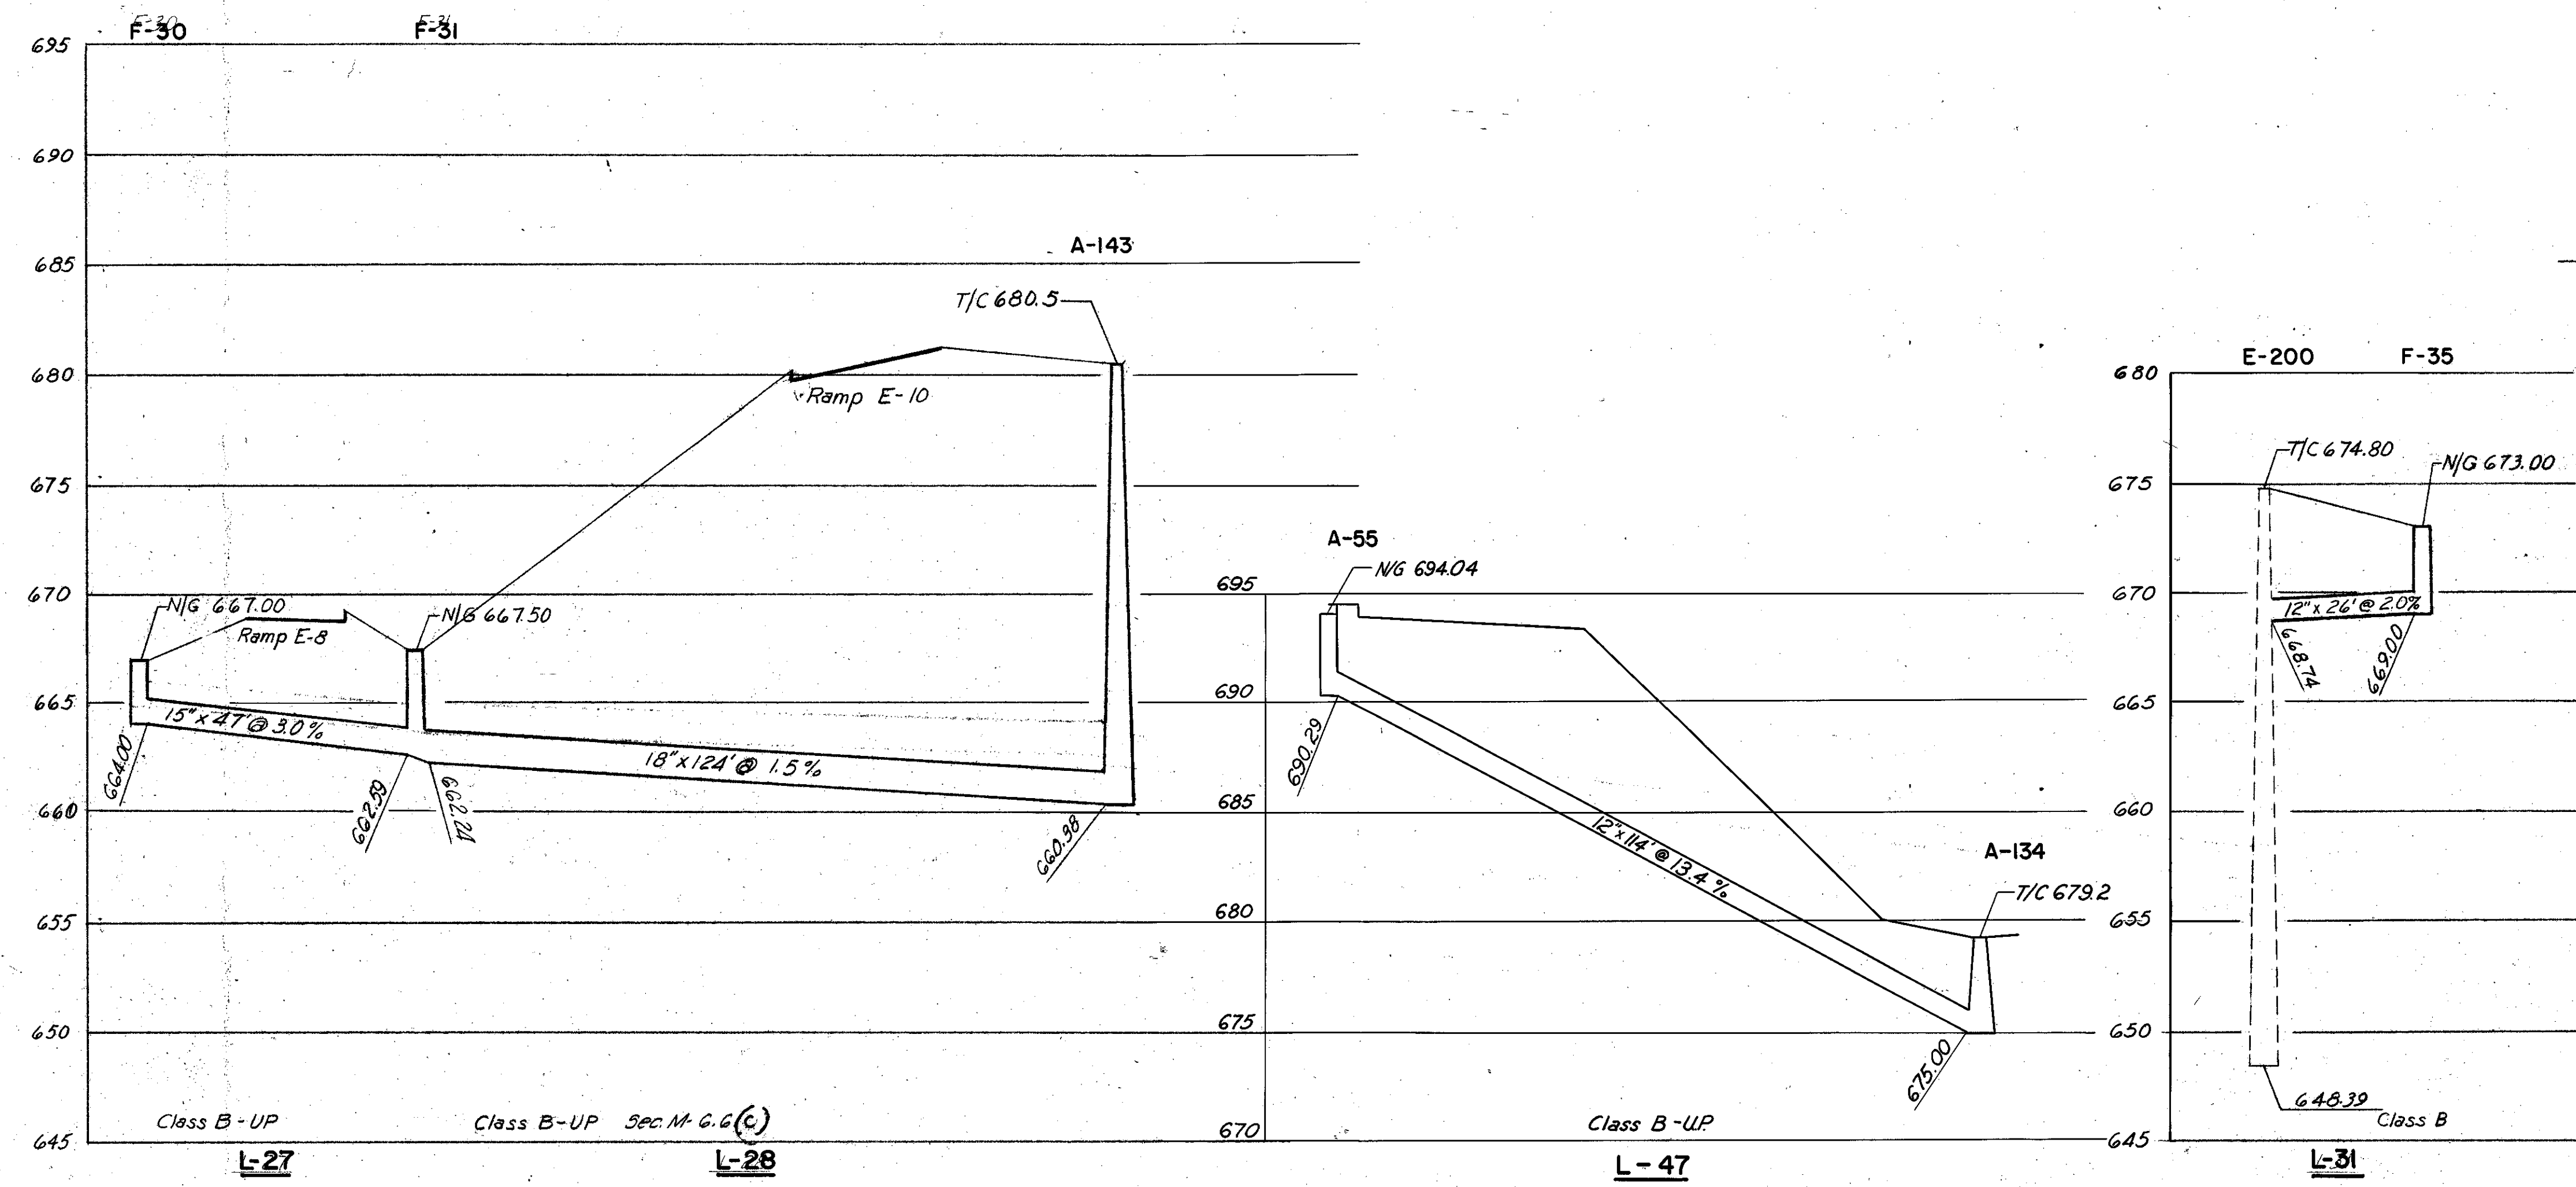

SCALE: 1" = 20'
DATE: 7/10/59
HOWARD, NEEDLES, TAMMEN & BERGENDOFF
CONSULTING ENGINEERS
KANSAS CITY CLEVELAND NEW YORK
914 SHEET 37 37







PROFILES
L-27, L-28, L-31, L-32
L-34, L-35, & L-41
L-36
L-47

Rev. RJK 1-11-60

FED. ROAD DIV. NO.	STATE	FEDERAL AID PROJECT NO.	TYPE FUNDS
2	OHIO		

38
181

CUYAHOGA COUNTY
CITY OF CLEVELAND
CUY - 42-18.42
CUY - 21-15.32
DRAINAGE PROFILES

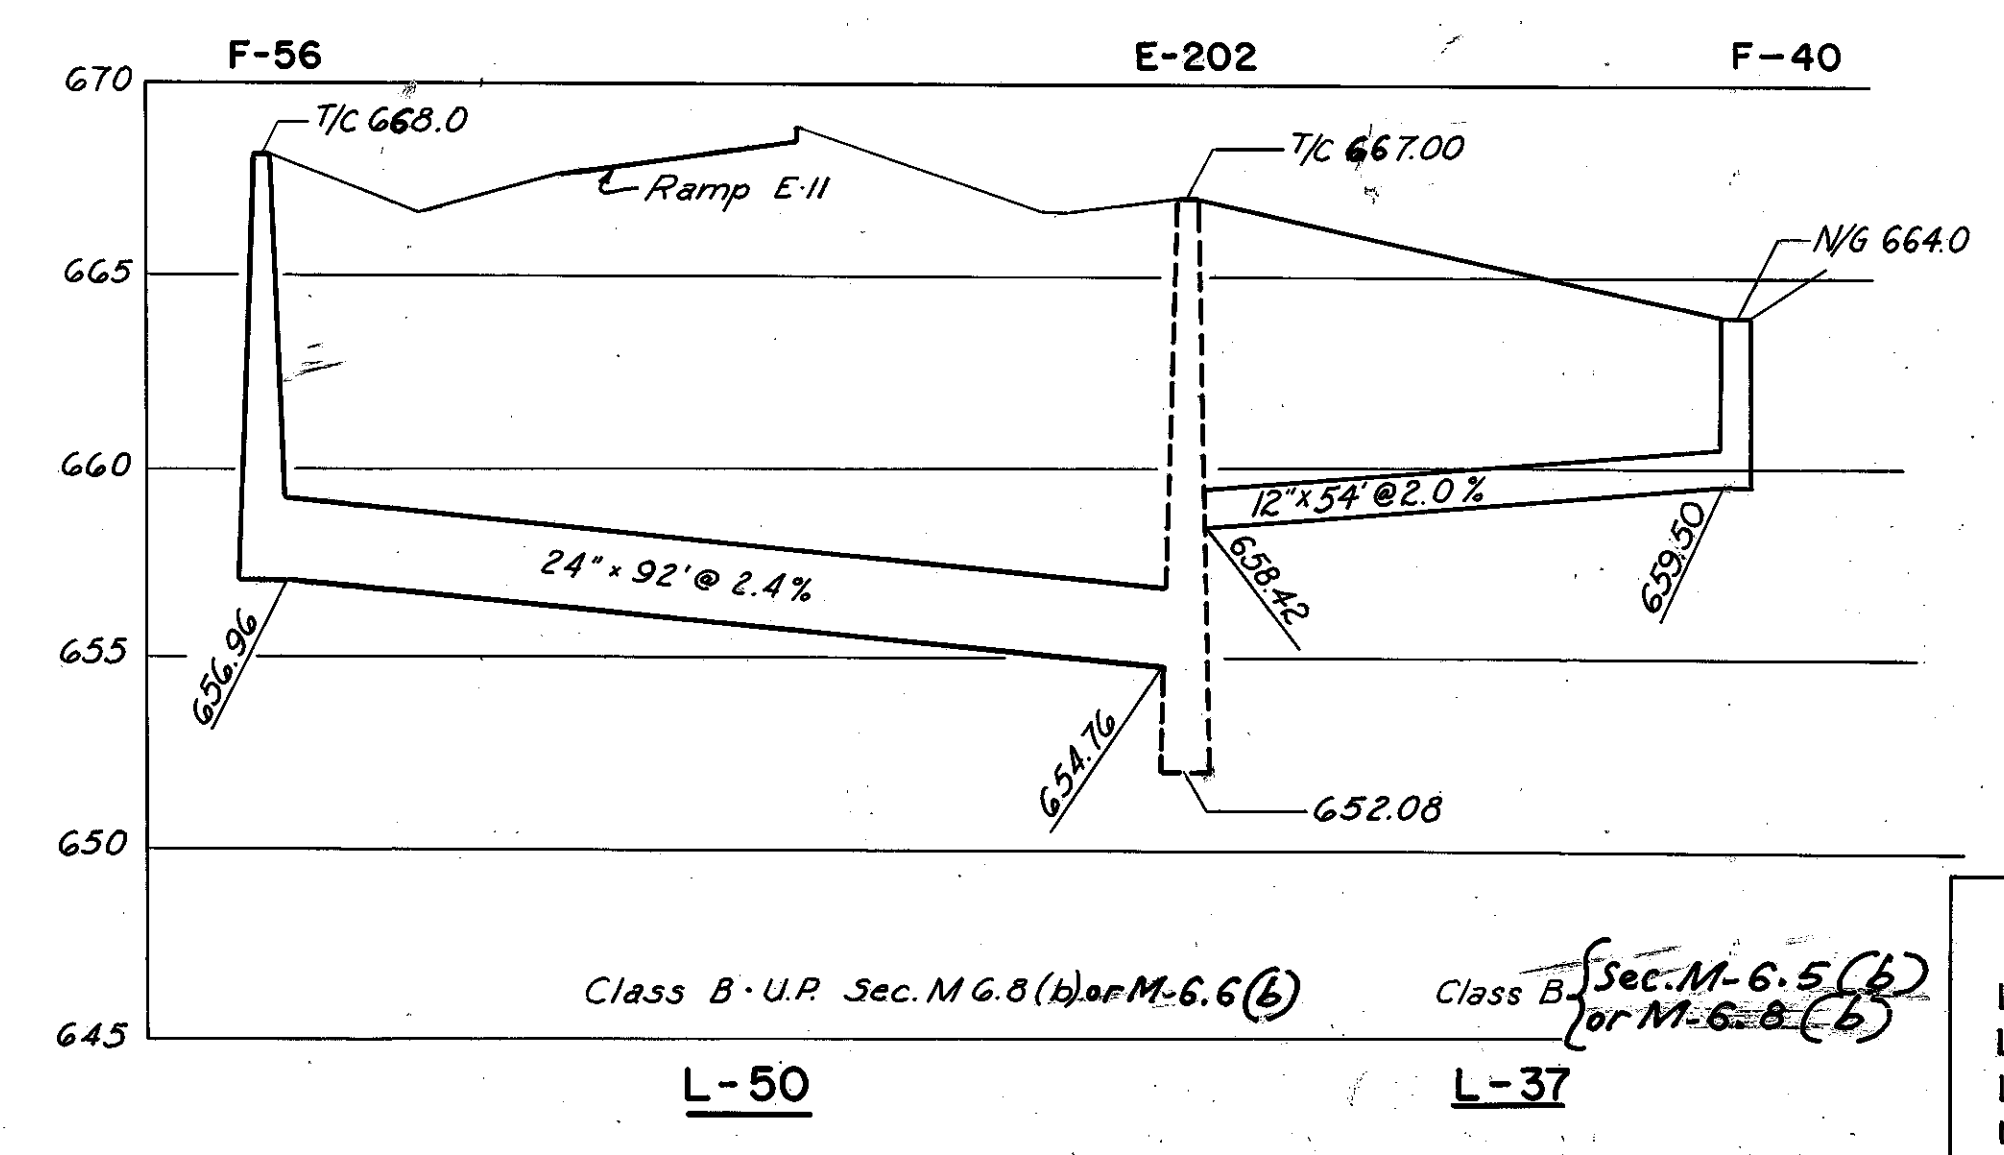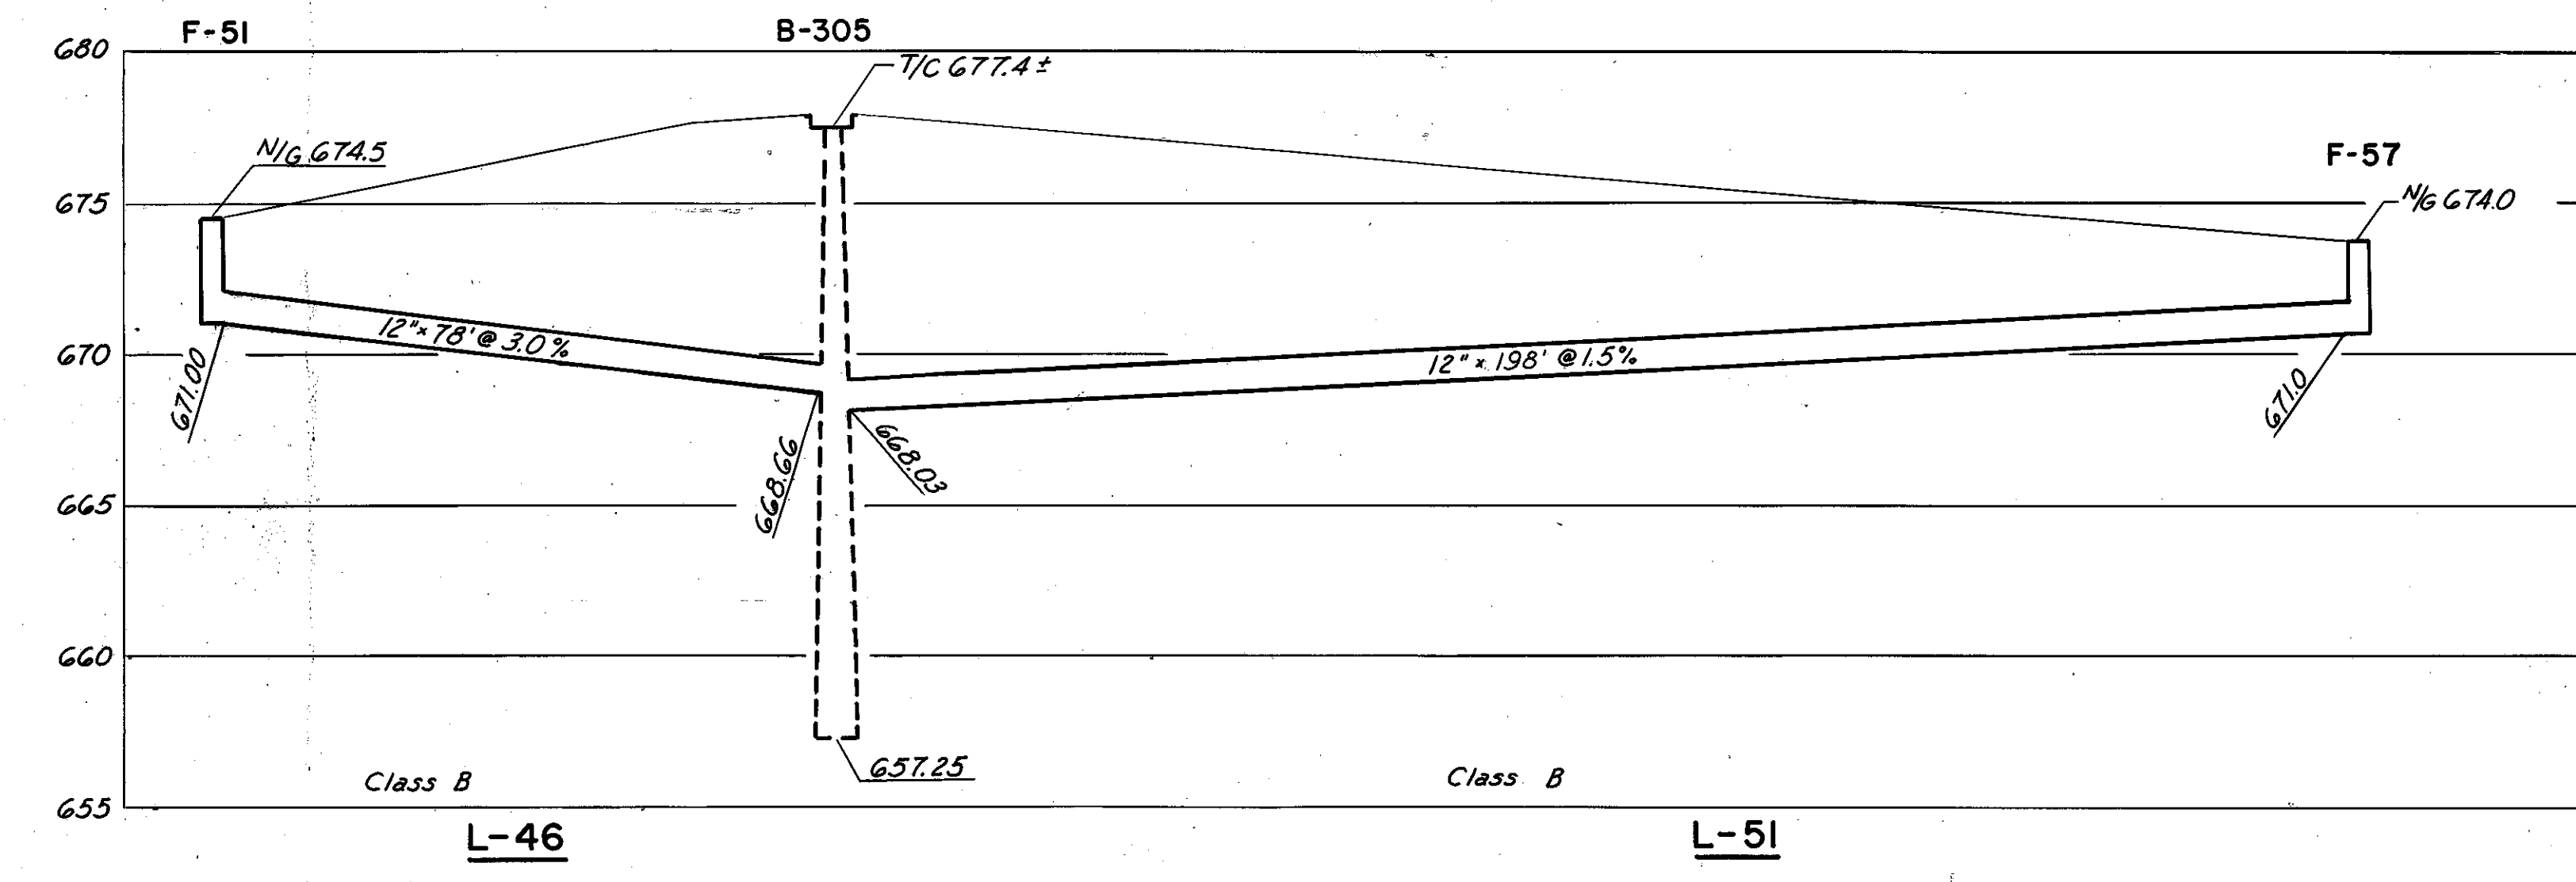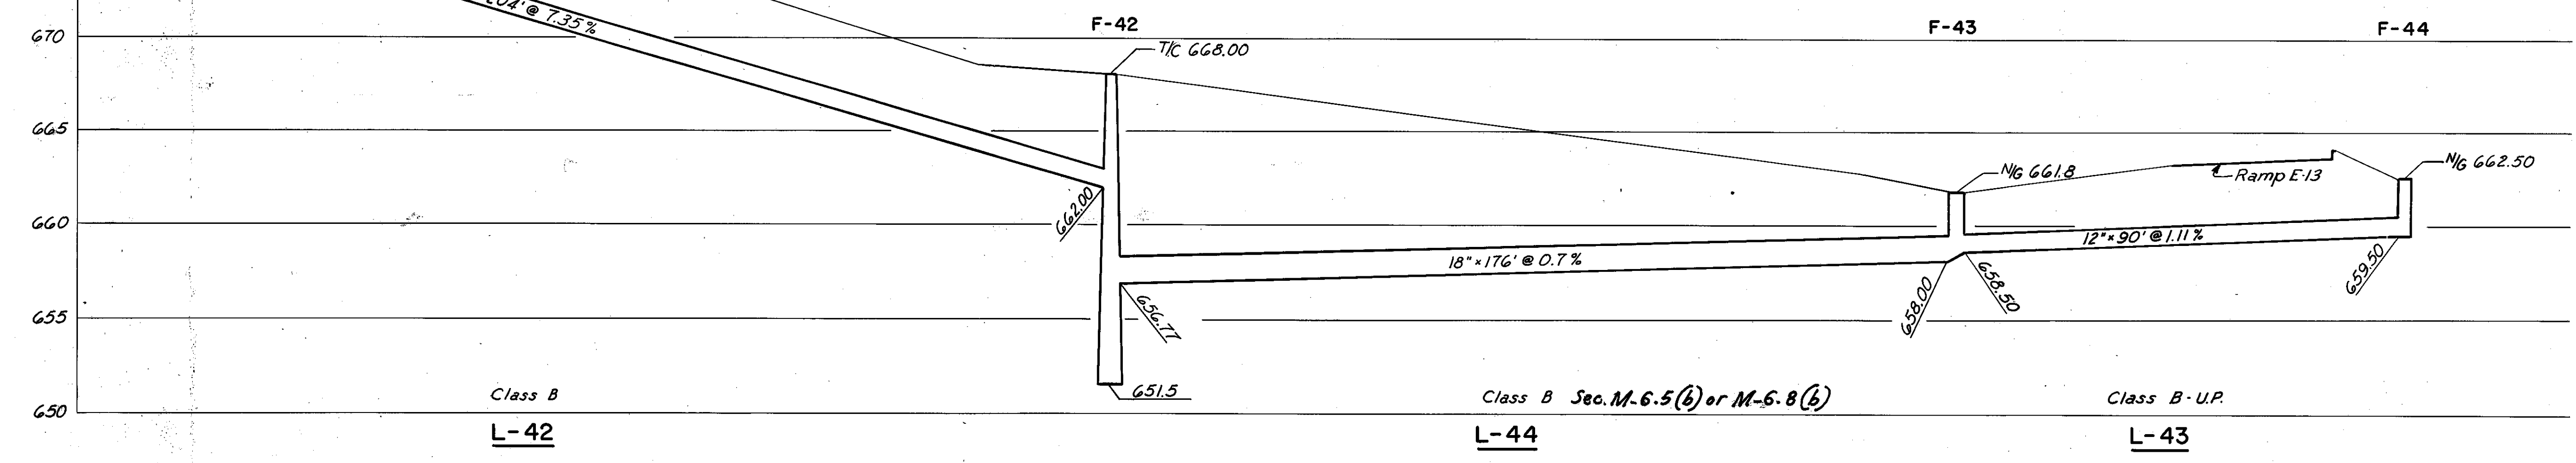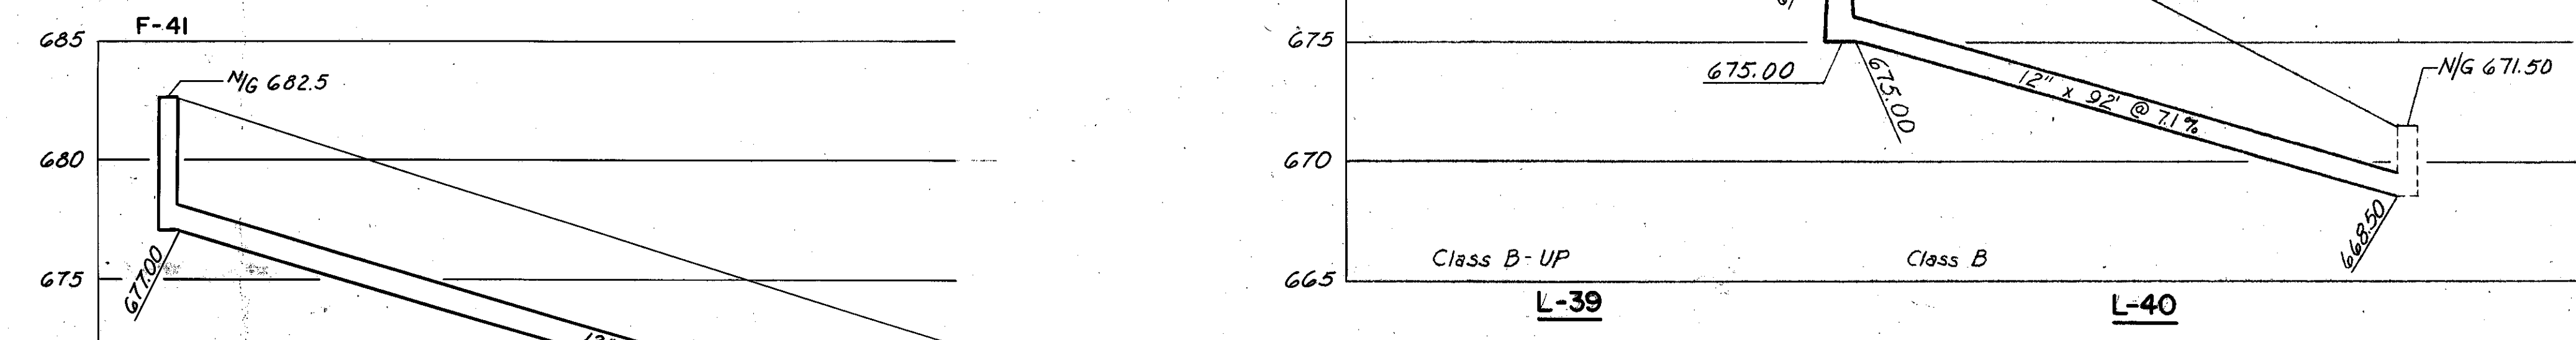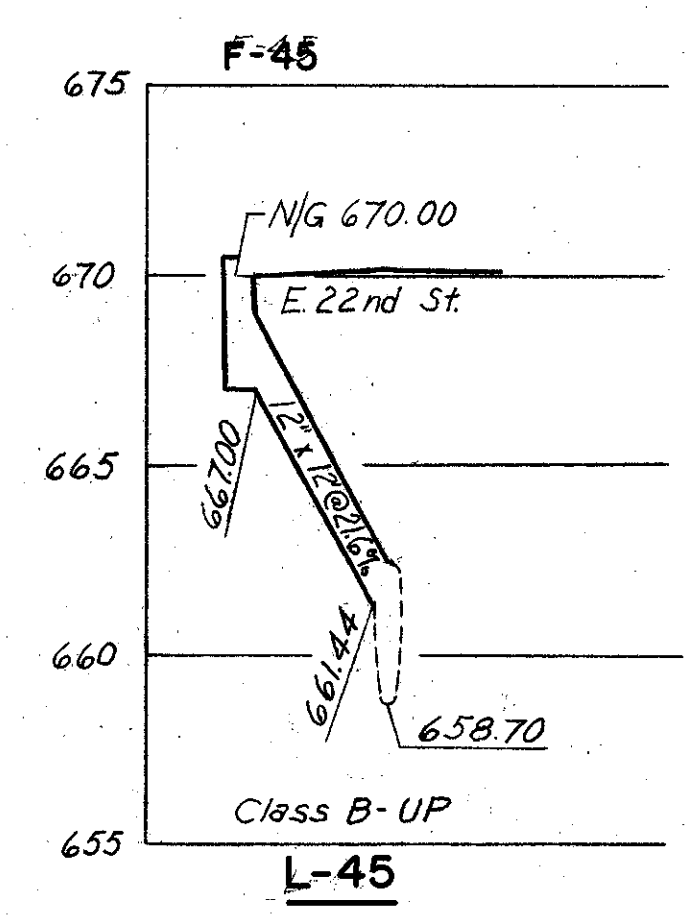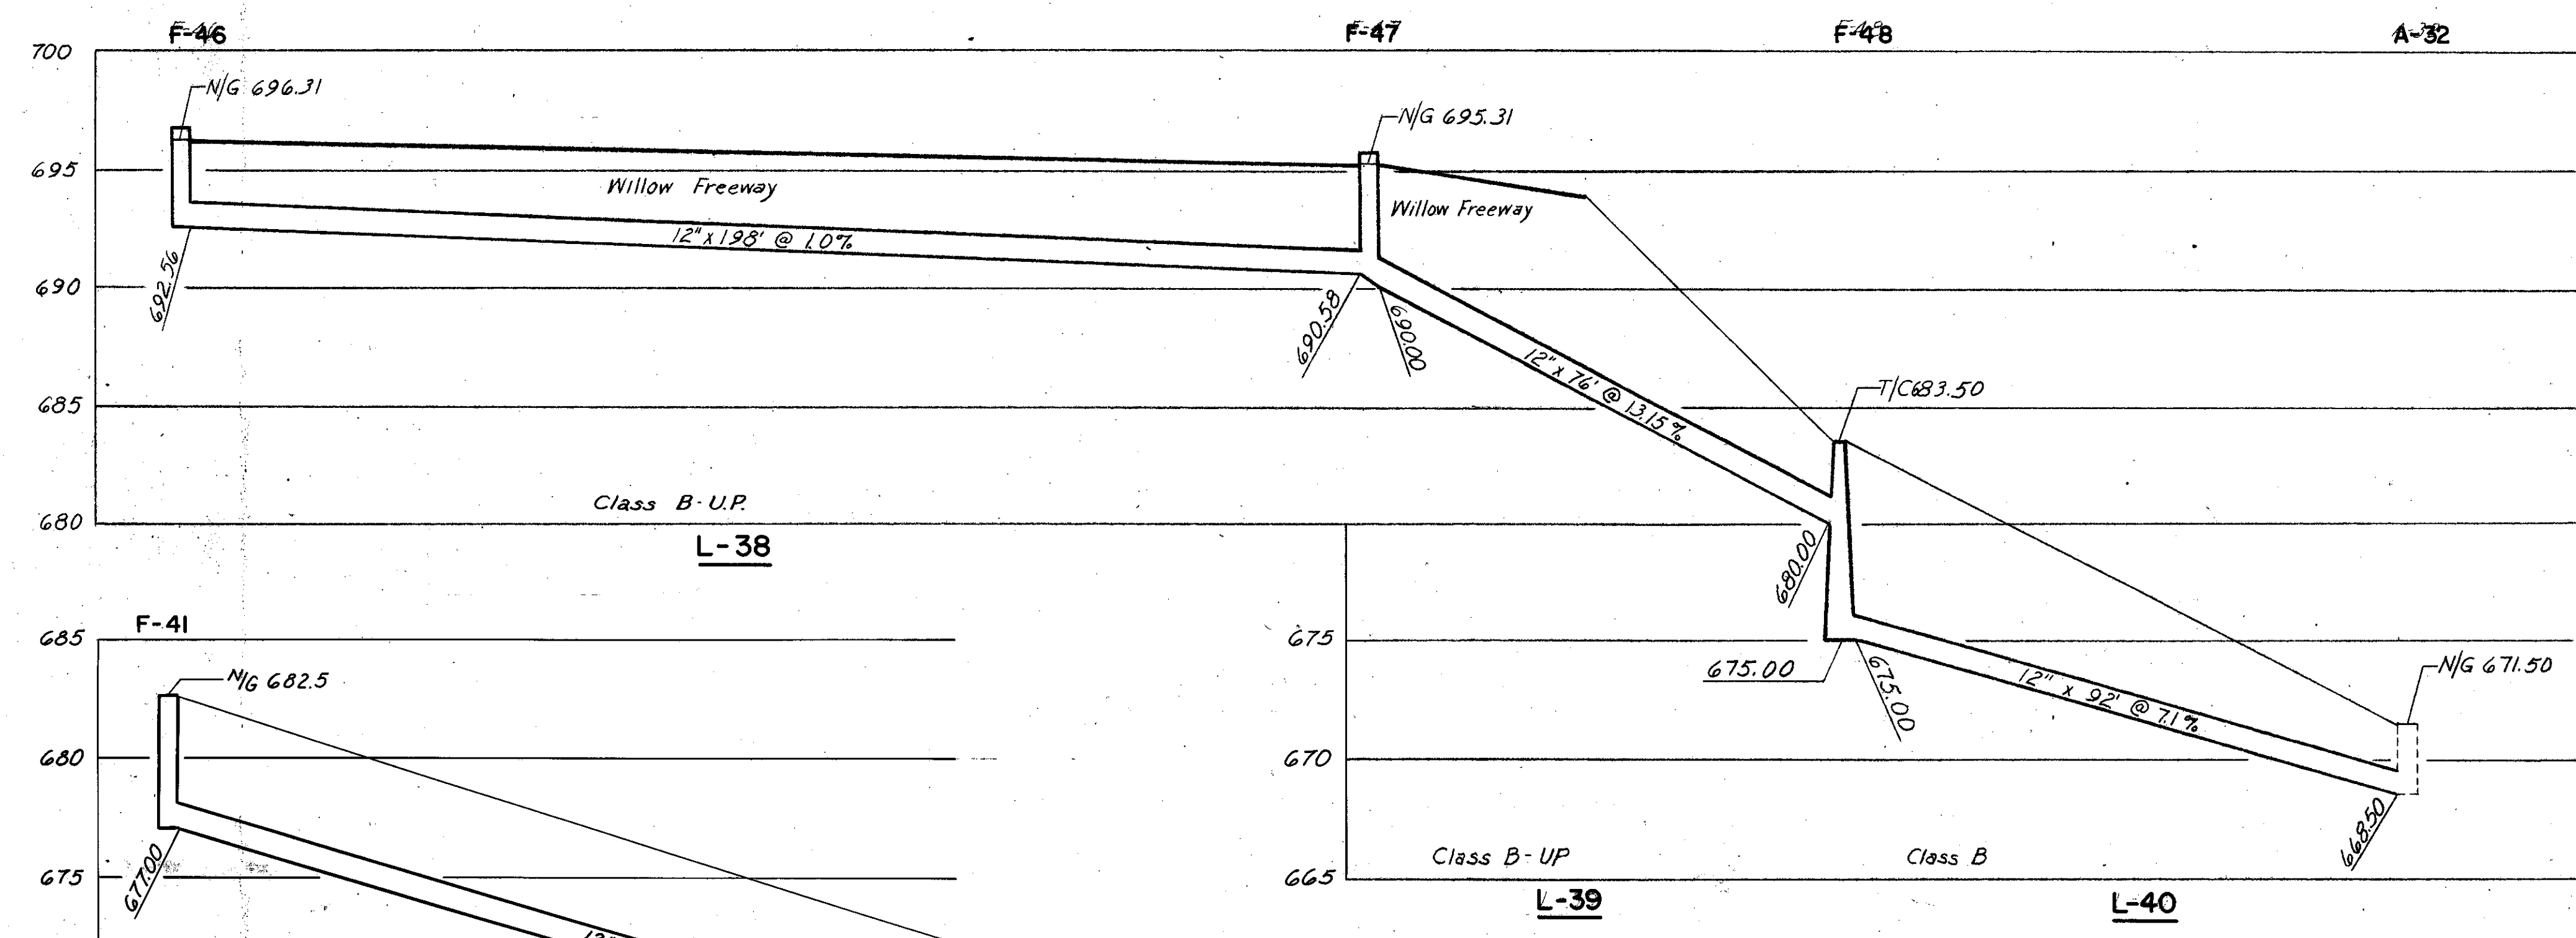

SCALE: HORIZ. 1" = 20'
VERT. 1" = 5'
DATE: 7-8-59
HOWARD, NEEDLES, TAMMEN & BERGENDOFF
CONSULTING ENGINEERS
KANSAS CITY CLEVELAND NEW YORK
914 SHEET 38








PROFILES
L-38 TO L-40
L-42 TO L-46
L-50 TO L-51
L-37

Rev. R.J.K. 1-11-60

FED. ROAD DIV. NO.	STATE	FEDERAL AID PROJECT NO.	TYPE FUNDS
2	OHIO		

39
181

CUYAHOGA COUNTY
CITY OF CLEVELAND
CUY-42-18.42
CUY-21-15.32
DRAINAGE PROFILES

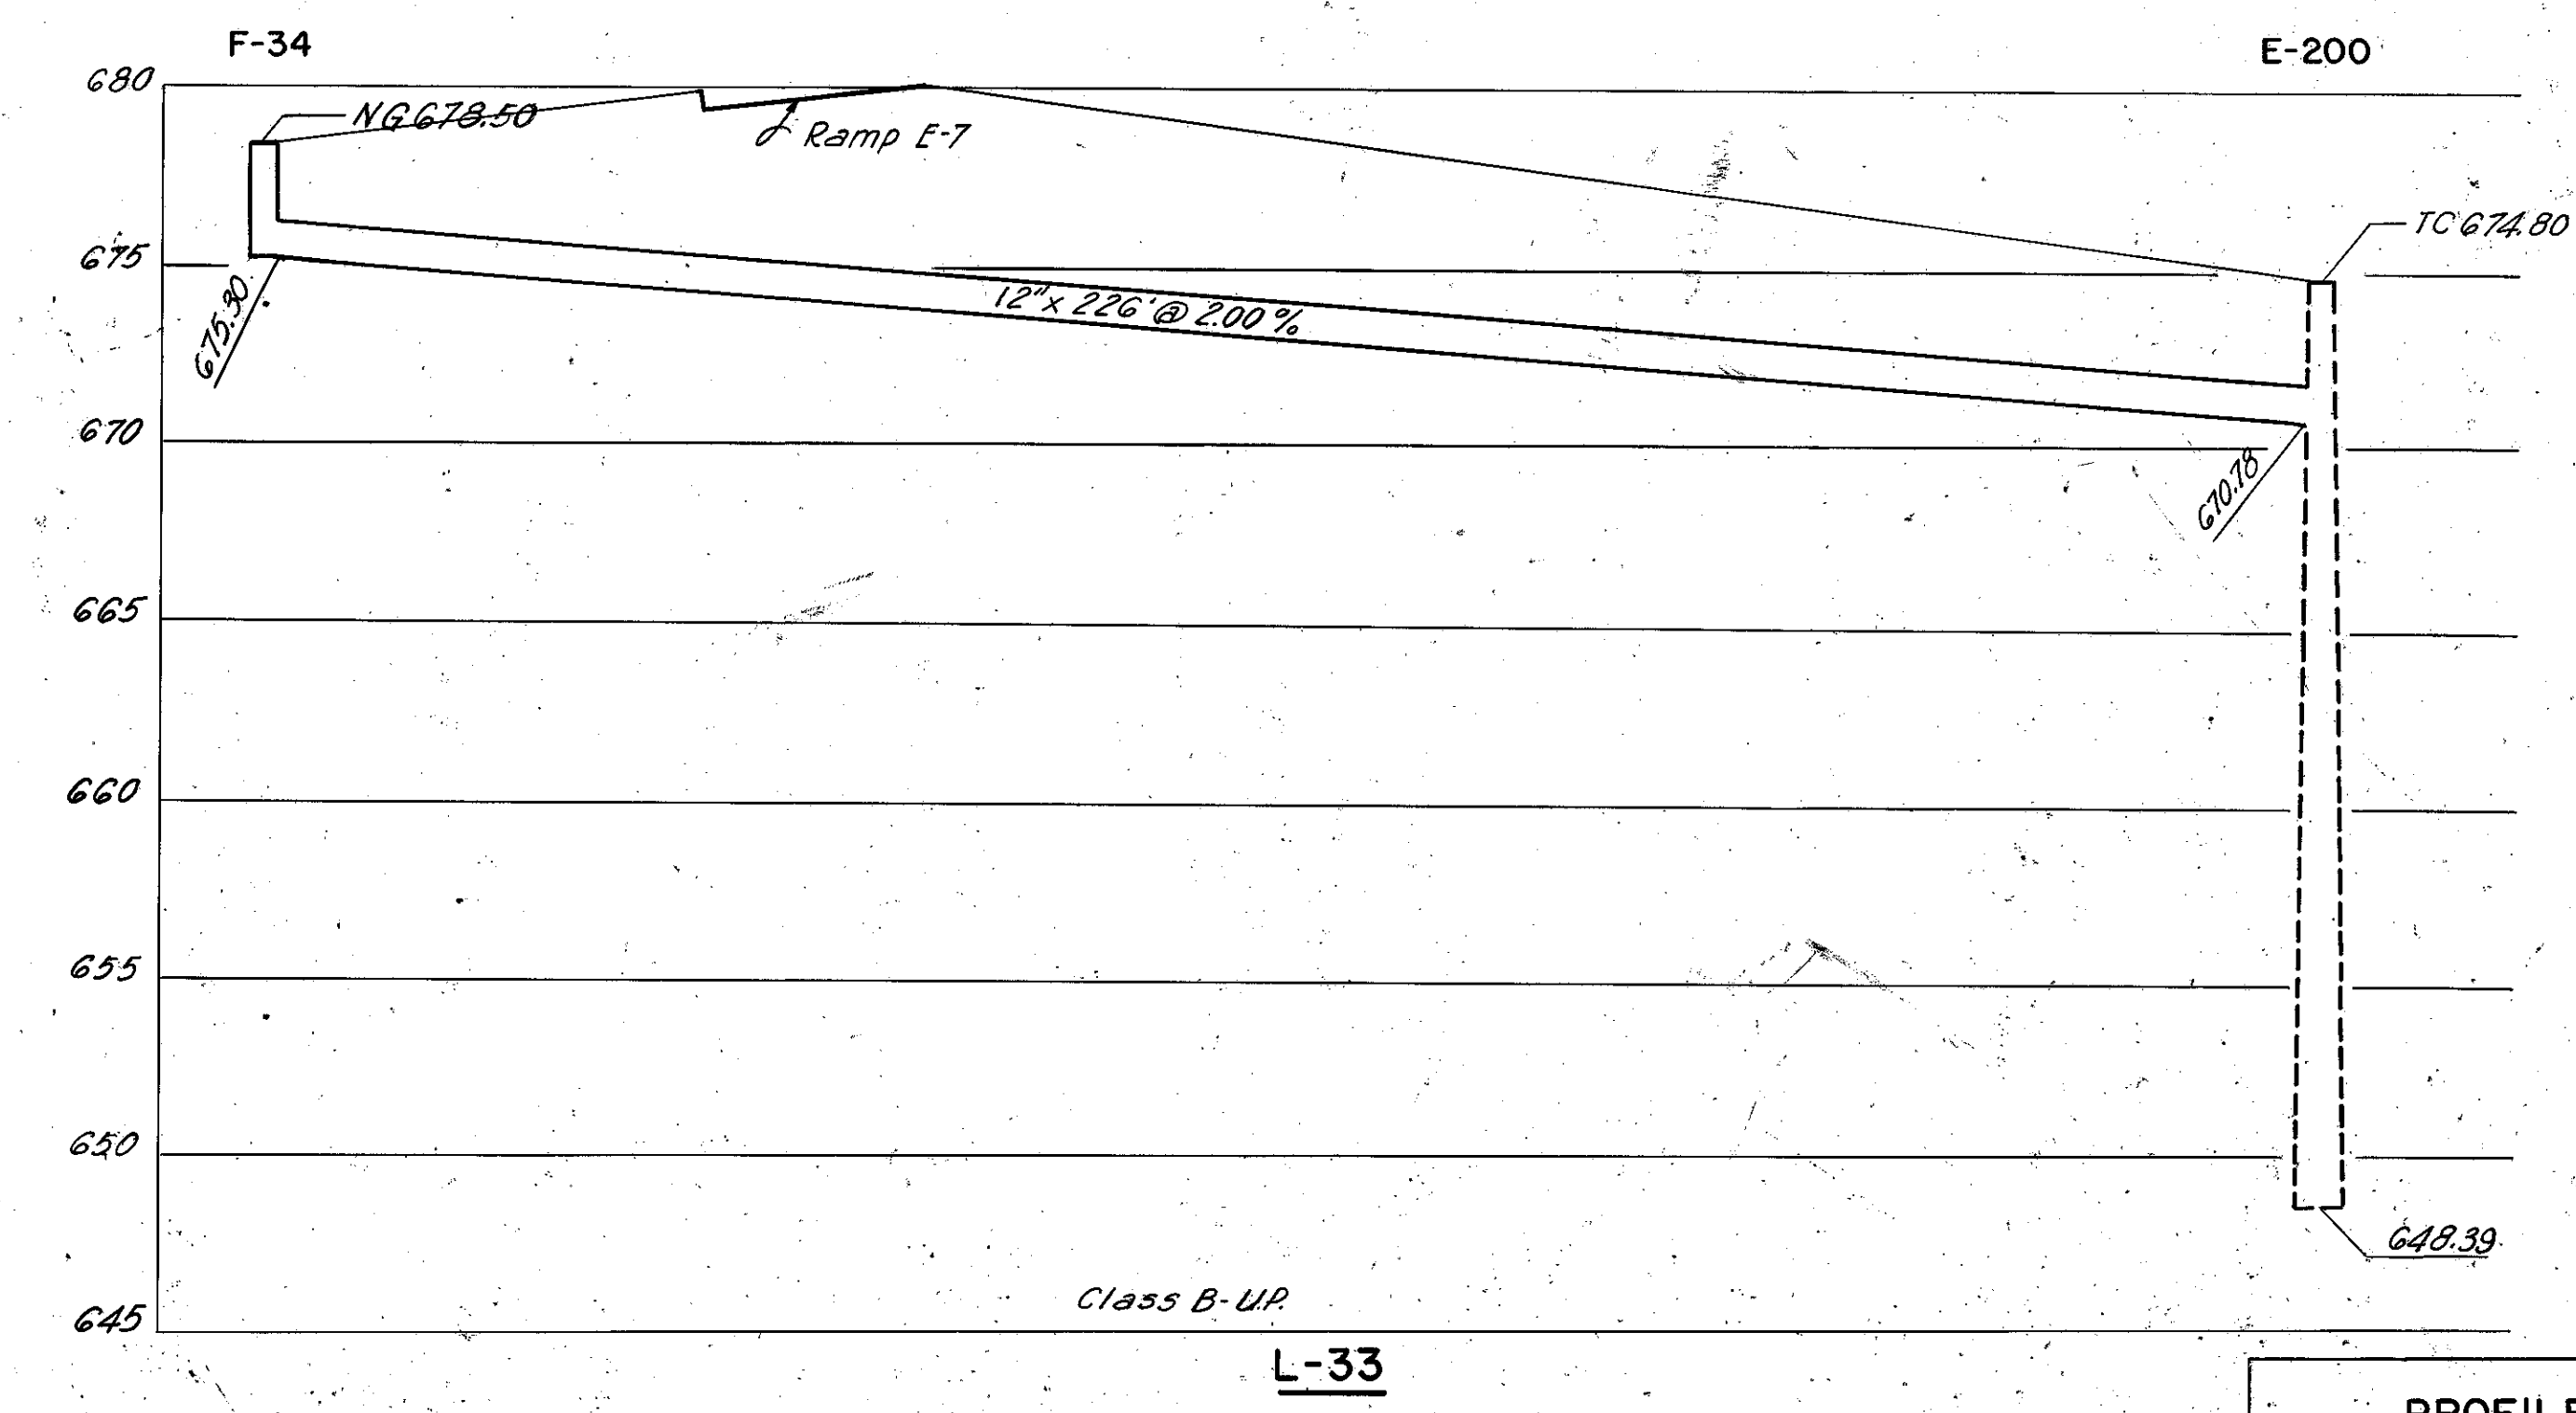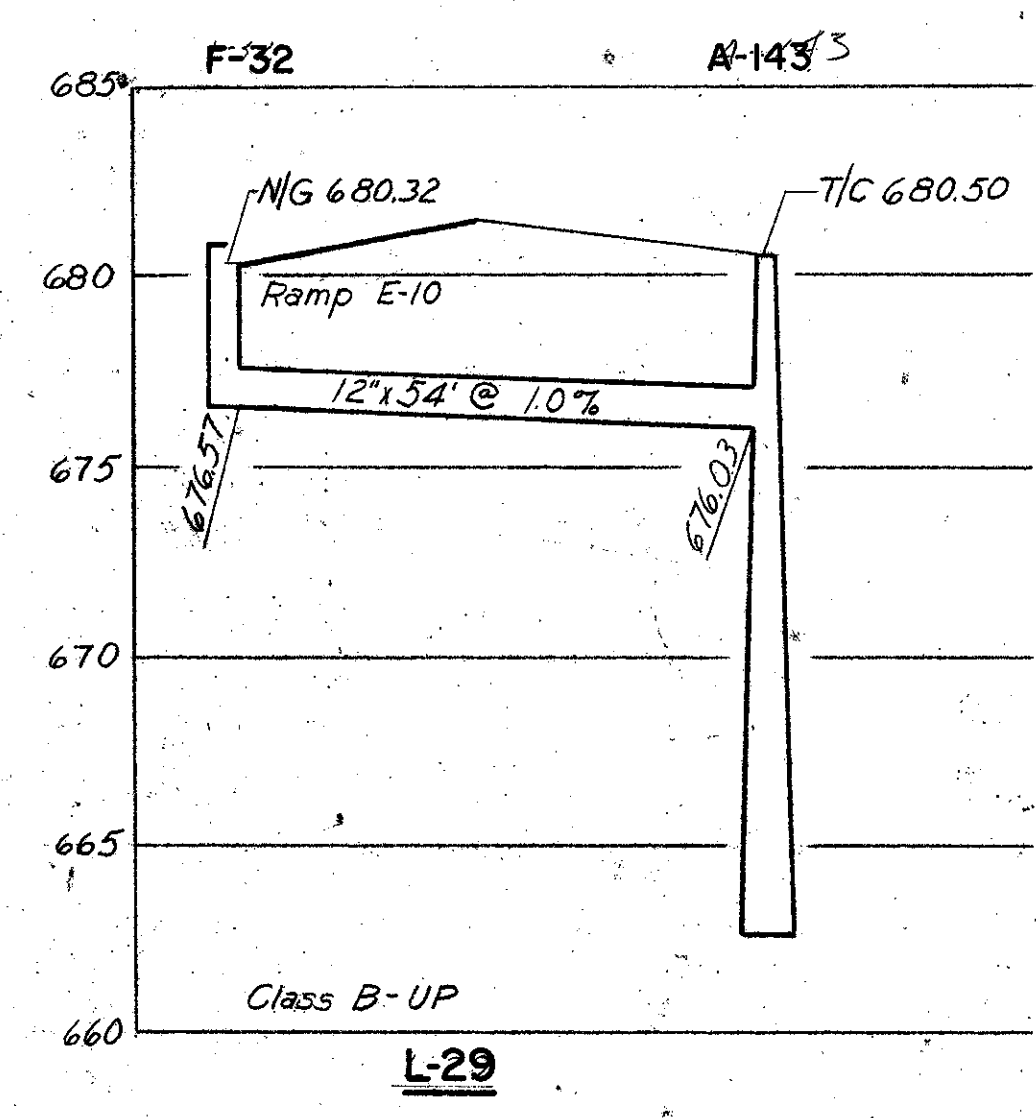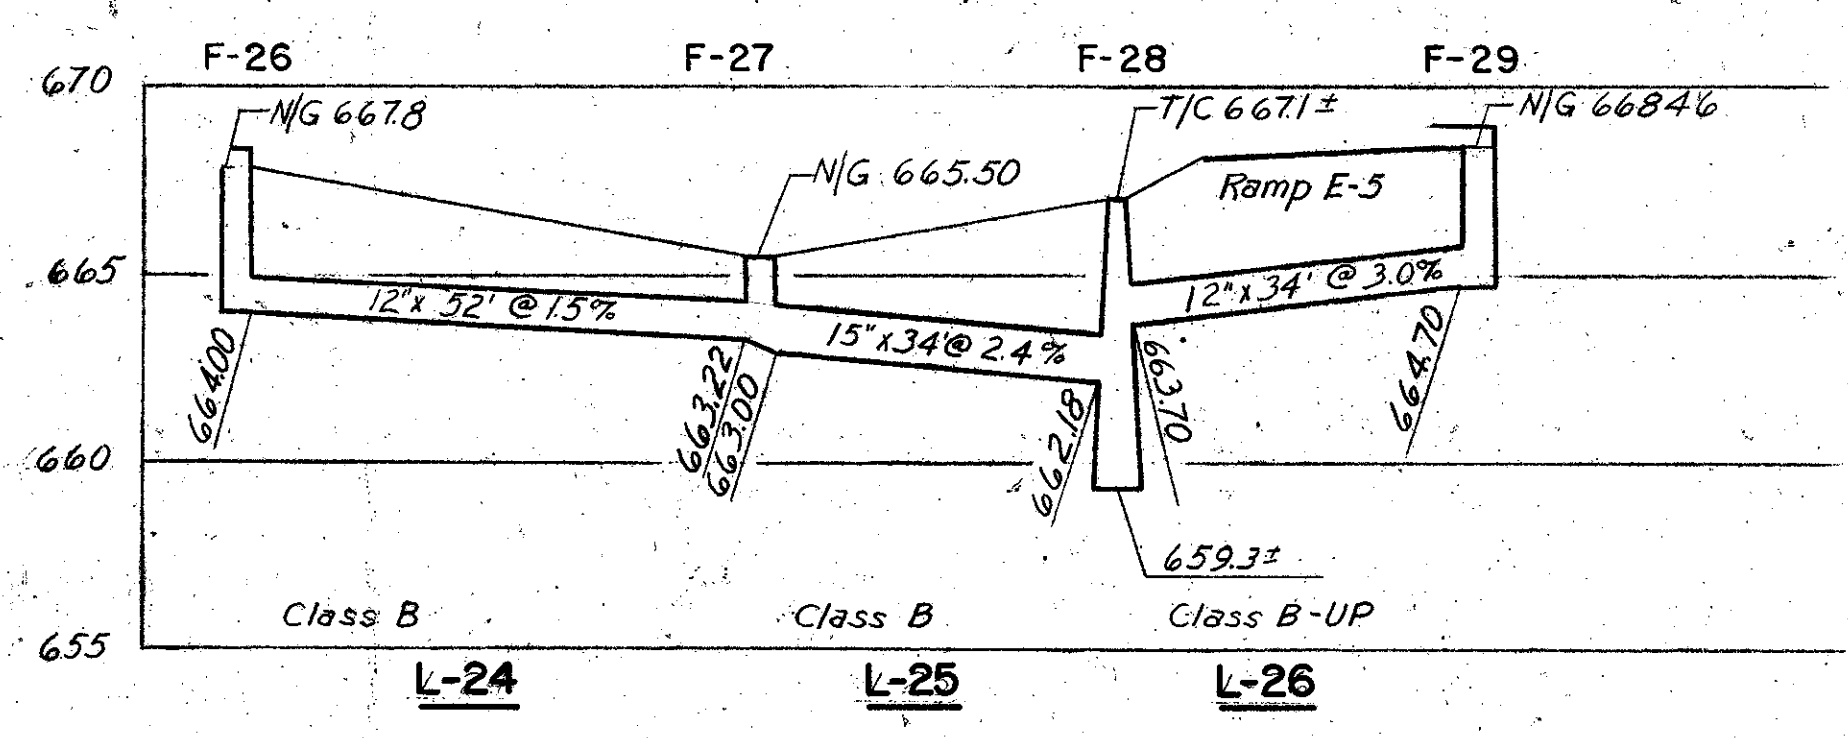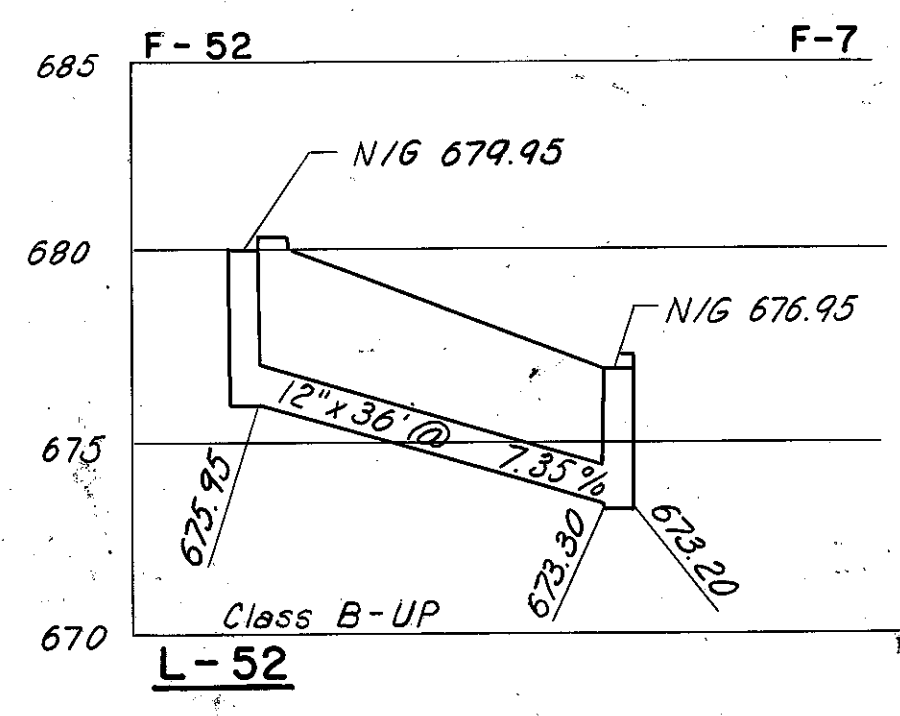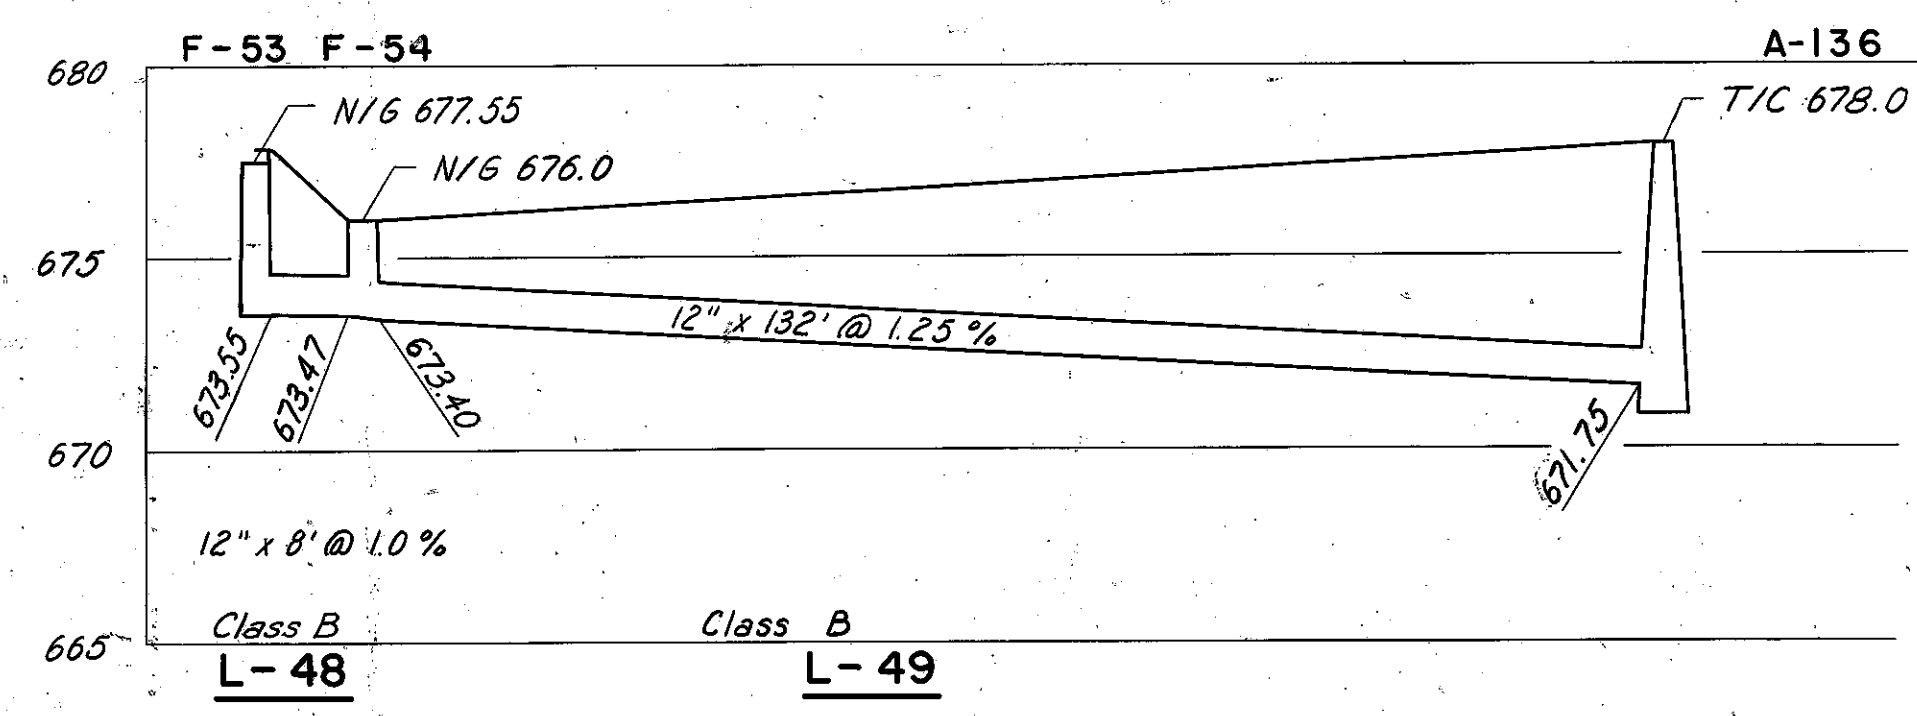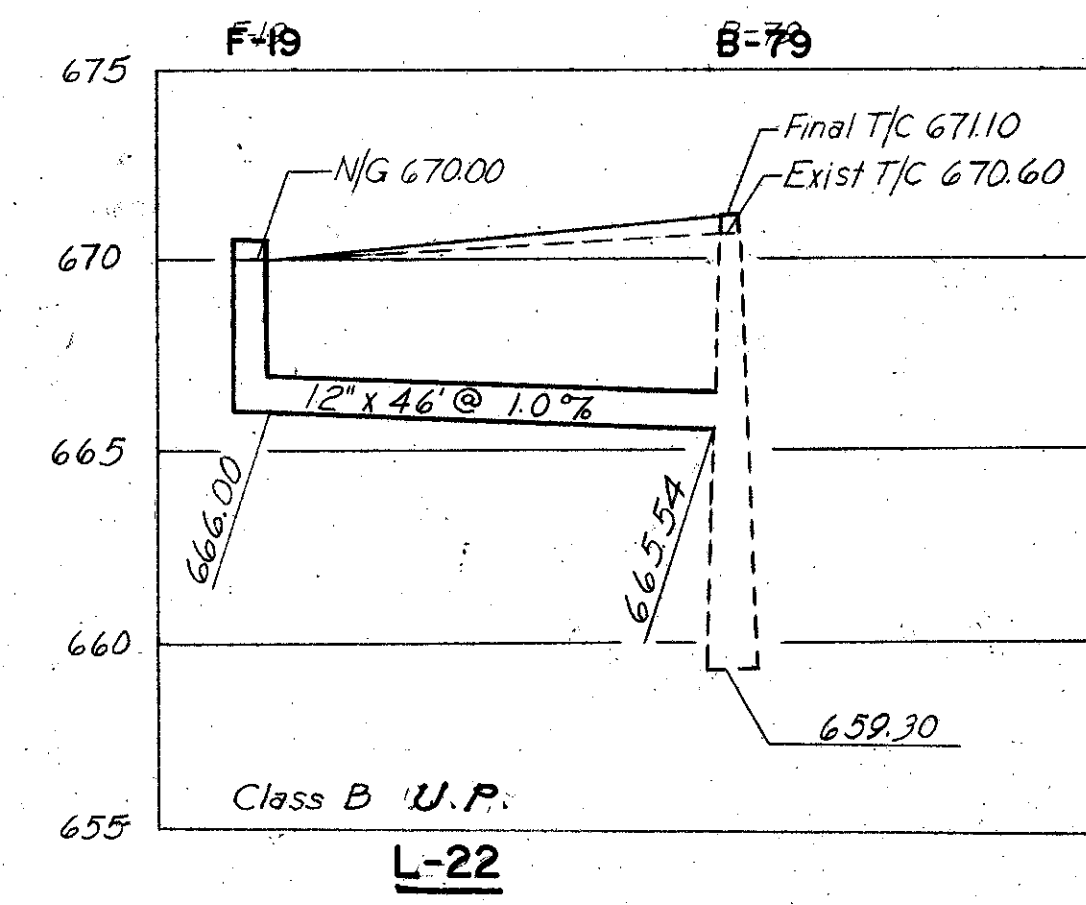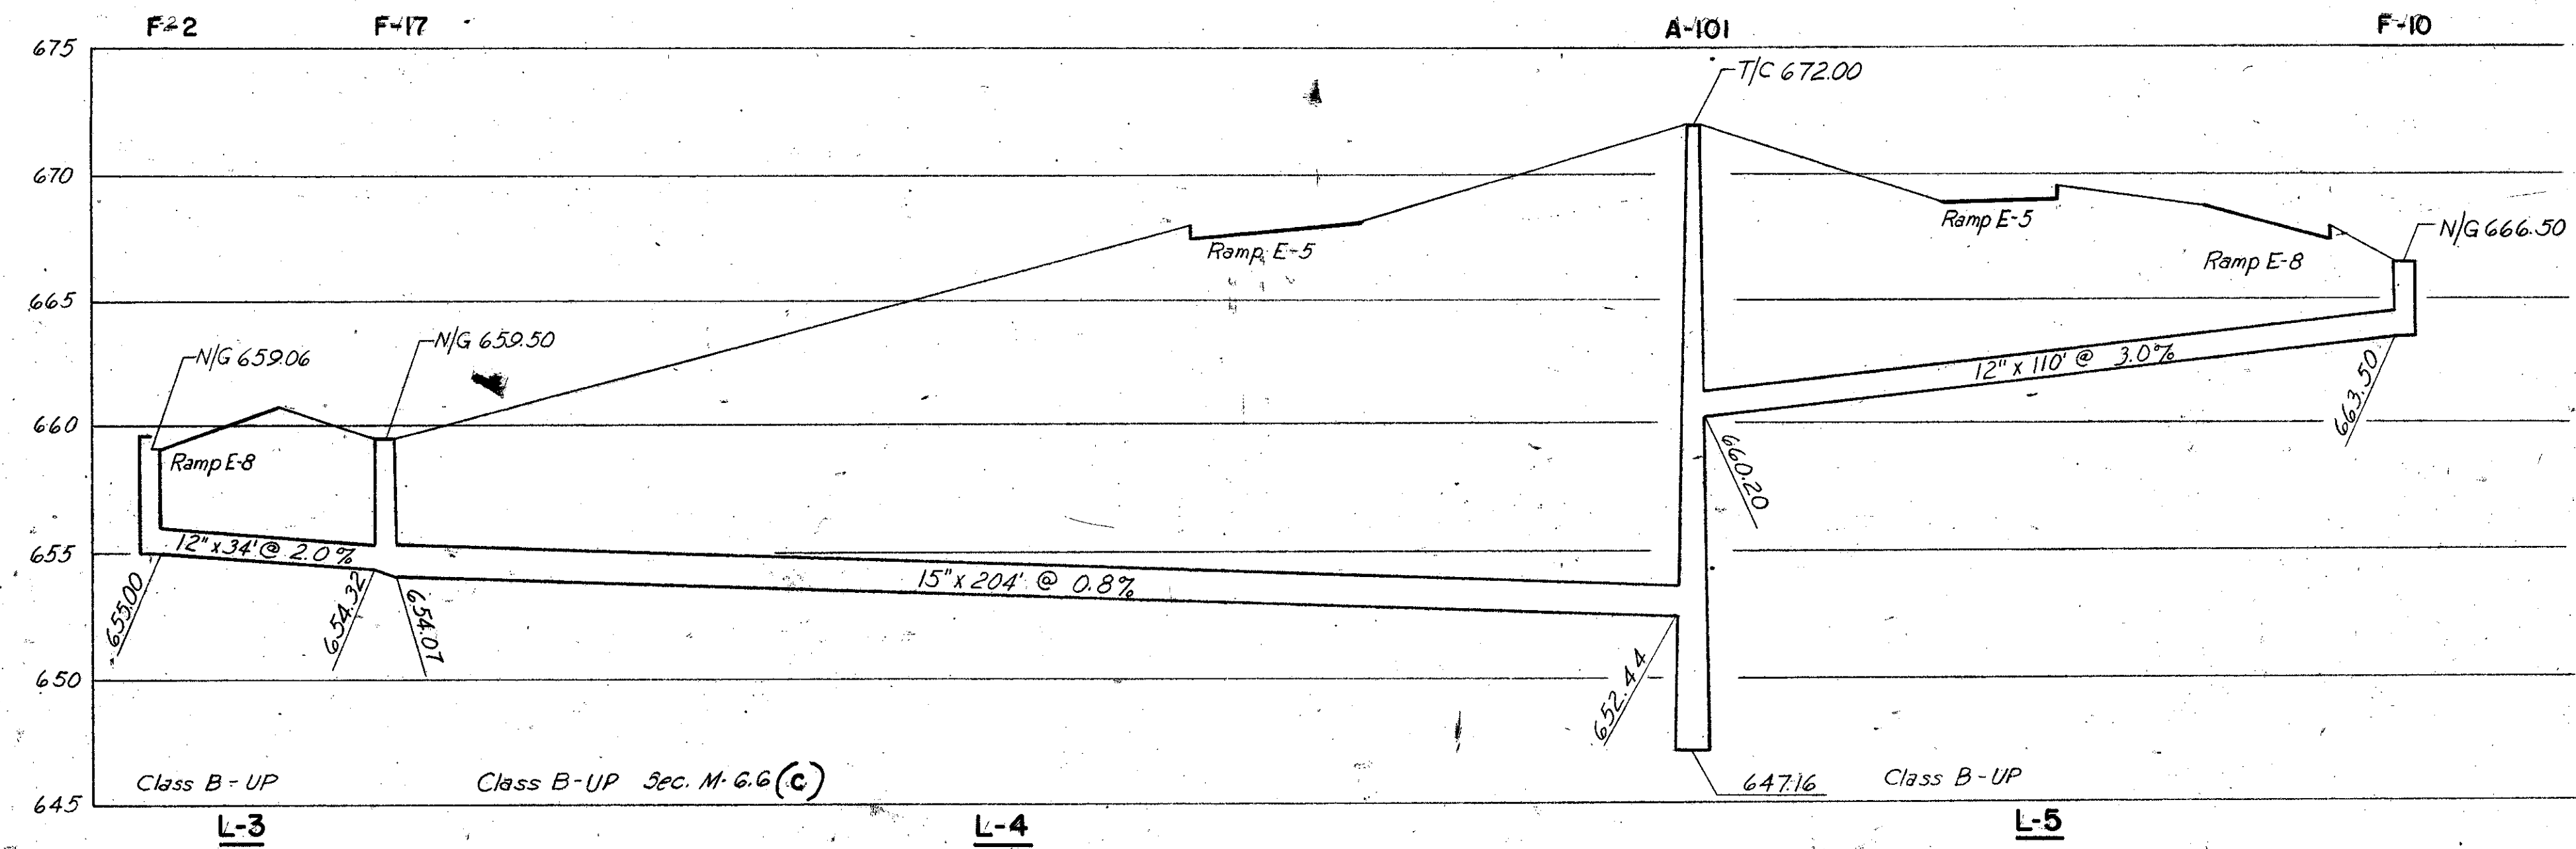

SCALE: HORIZ. 1" = 80'
VERT. 1" = 5'
HOWARD, NEEDLES, TAMMEN & BERGENDOFF
CONSULTING ENGINEERS
KANSAS CITY CLEVELAND NEW YORK
914 SHEET 39

Rev. JAG 1-11-60

PROFILES
L-3 TO L-5
L-22
L-24 TO L-26
L-29 & L-33
L-48 TO L-49 & L-52




21-0

FED. ROAD DIV. NO.	STATE	FEDERAL AID PROJECT NO.	TYPE FUNDS
2	OHIO		

40
181

CUYAHOGA COUNTY
CITY OF CLEVELAND
CUY-42-18.42
CUY-21-15.32


DRAINAGE DETAILS

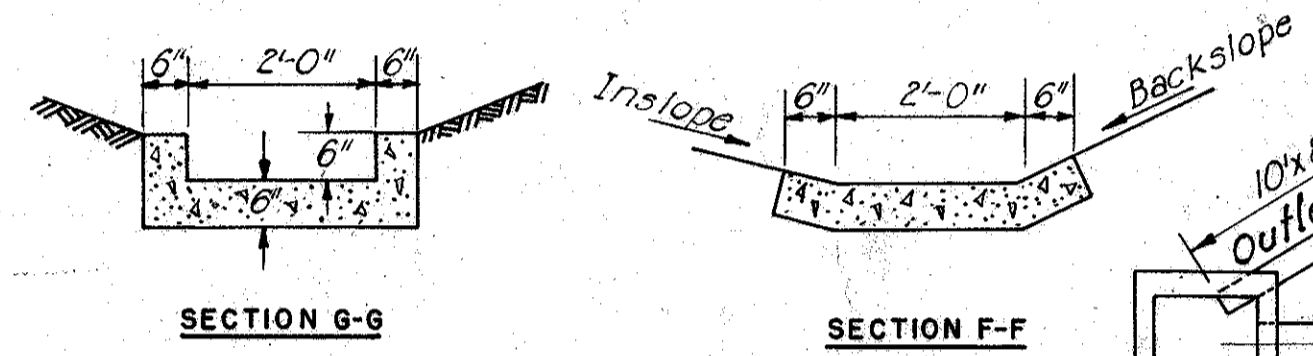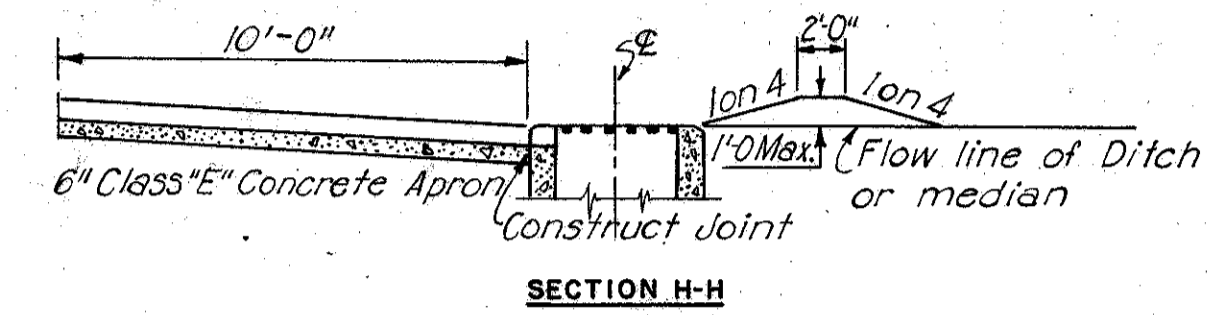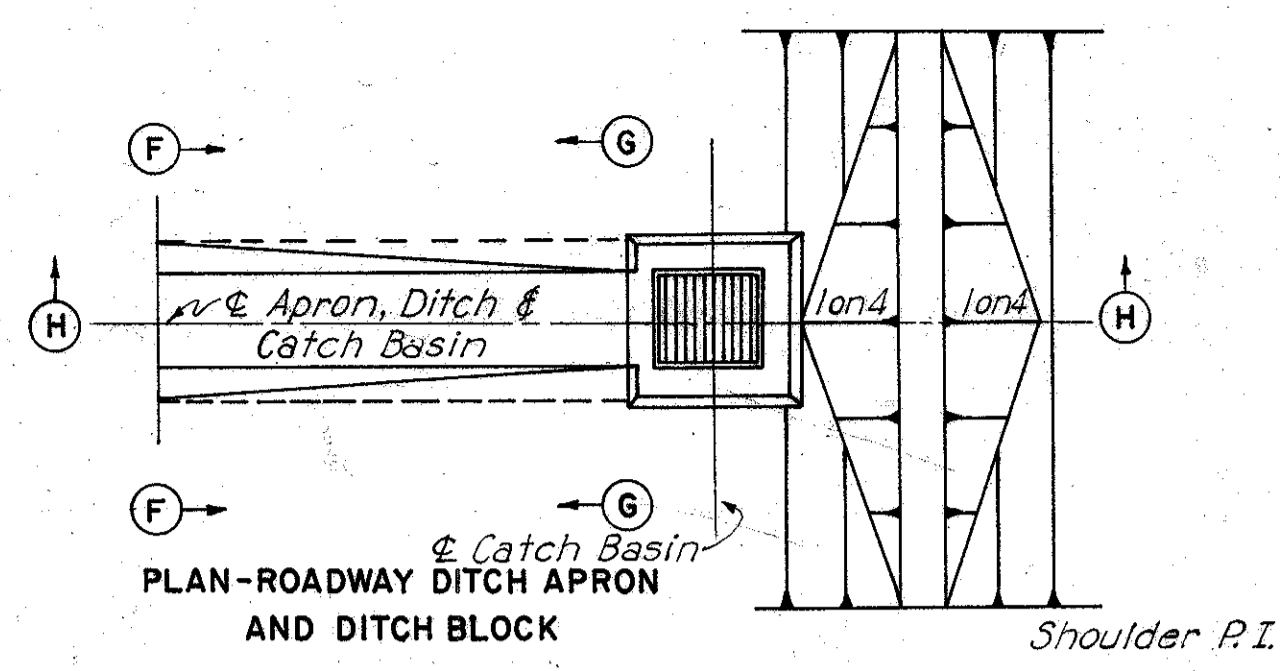


Note:
Ditch blocks shall be placed downstream from all catch basins on a continuous grade. Payment shall be included in the unit price bid for Item E-1 Excavation.
The paved apron and catch basin are separate pay items. See Summary Sheet.
The appropriate paved apron shall be installed upstream from all catch basins located in defined ditch or median. Minimum thickness of concrete is 6" concrete shall be Class "E"

SPECIAL PAVED APRON DETAILS (PAVED GUTTER)

Unless otherwise shown.

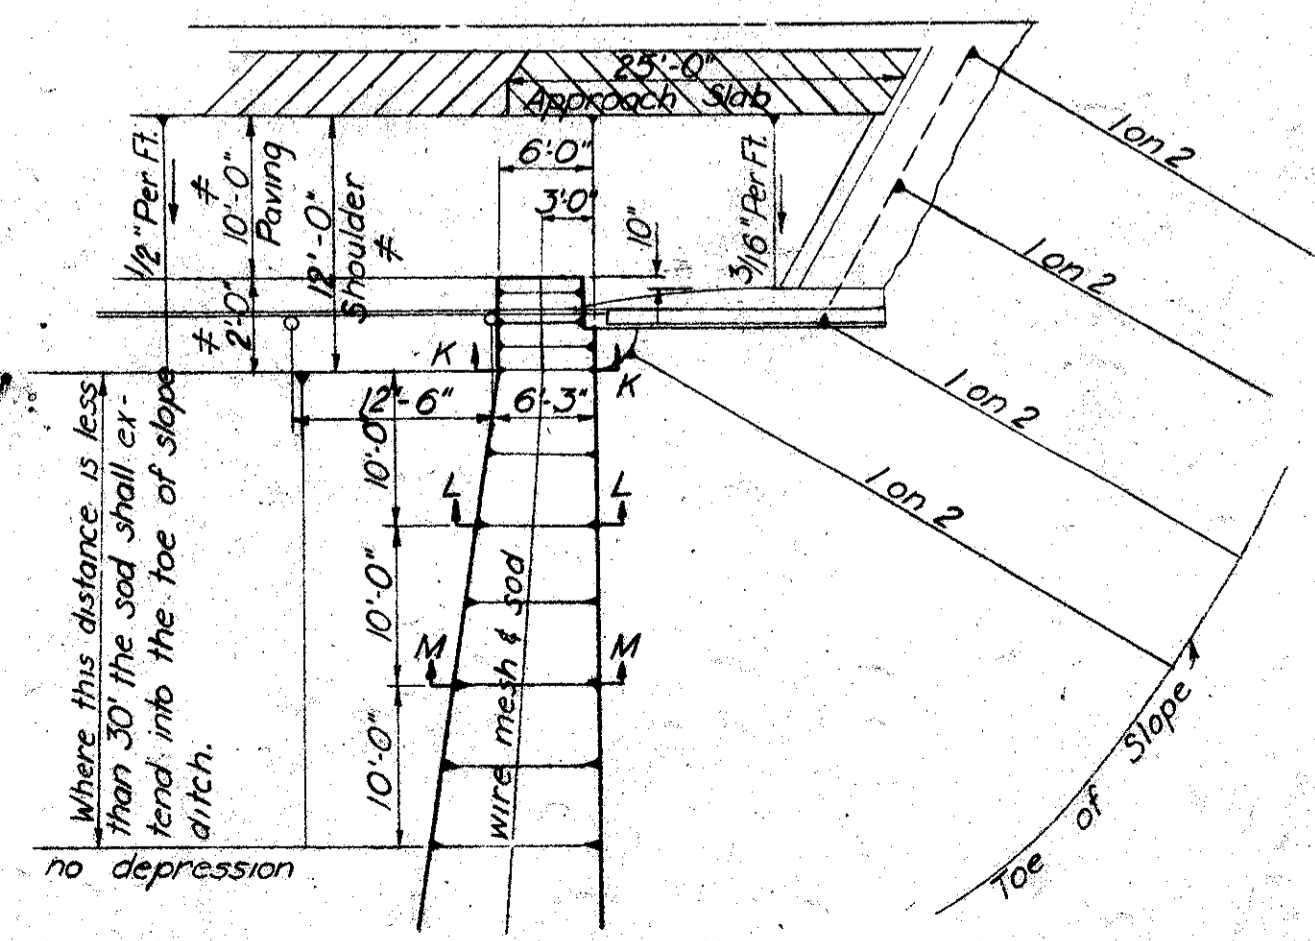

SPECIAL BERM & SLOPE PROTECTION
No Scale

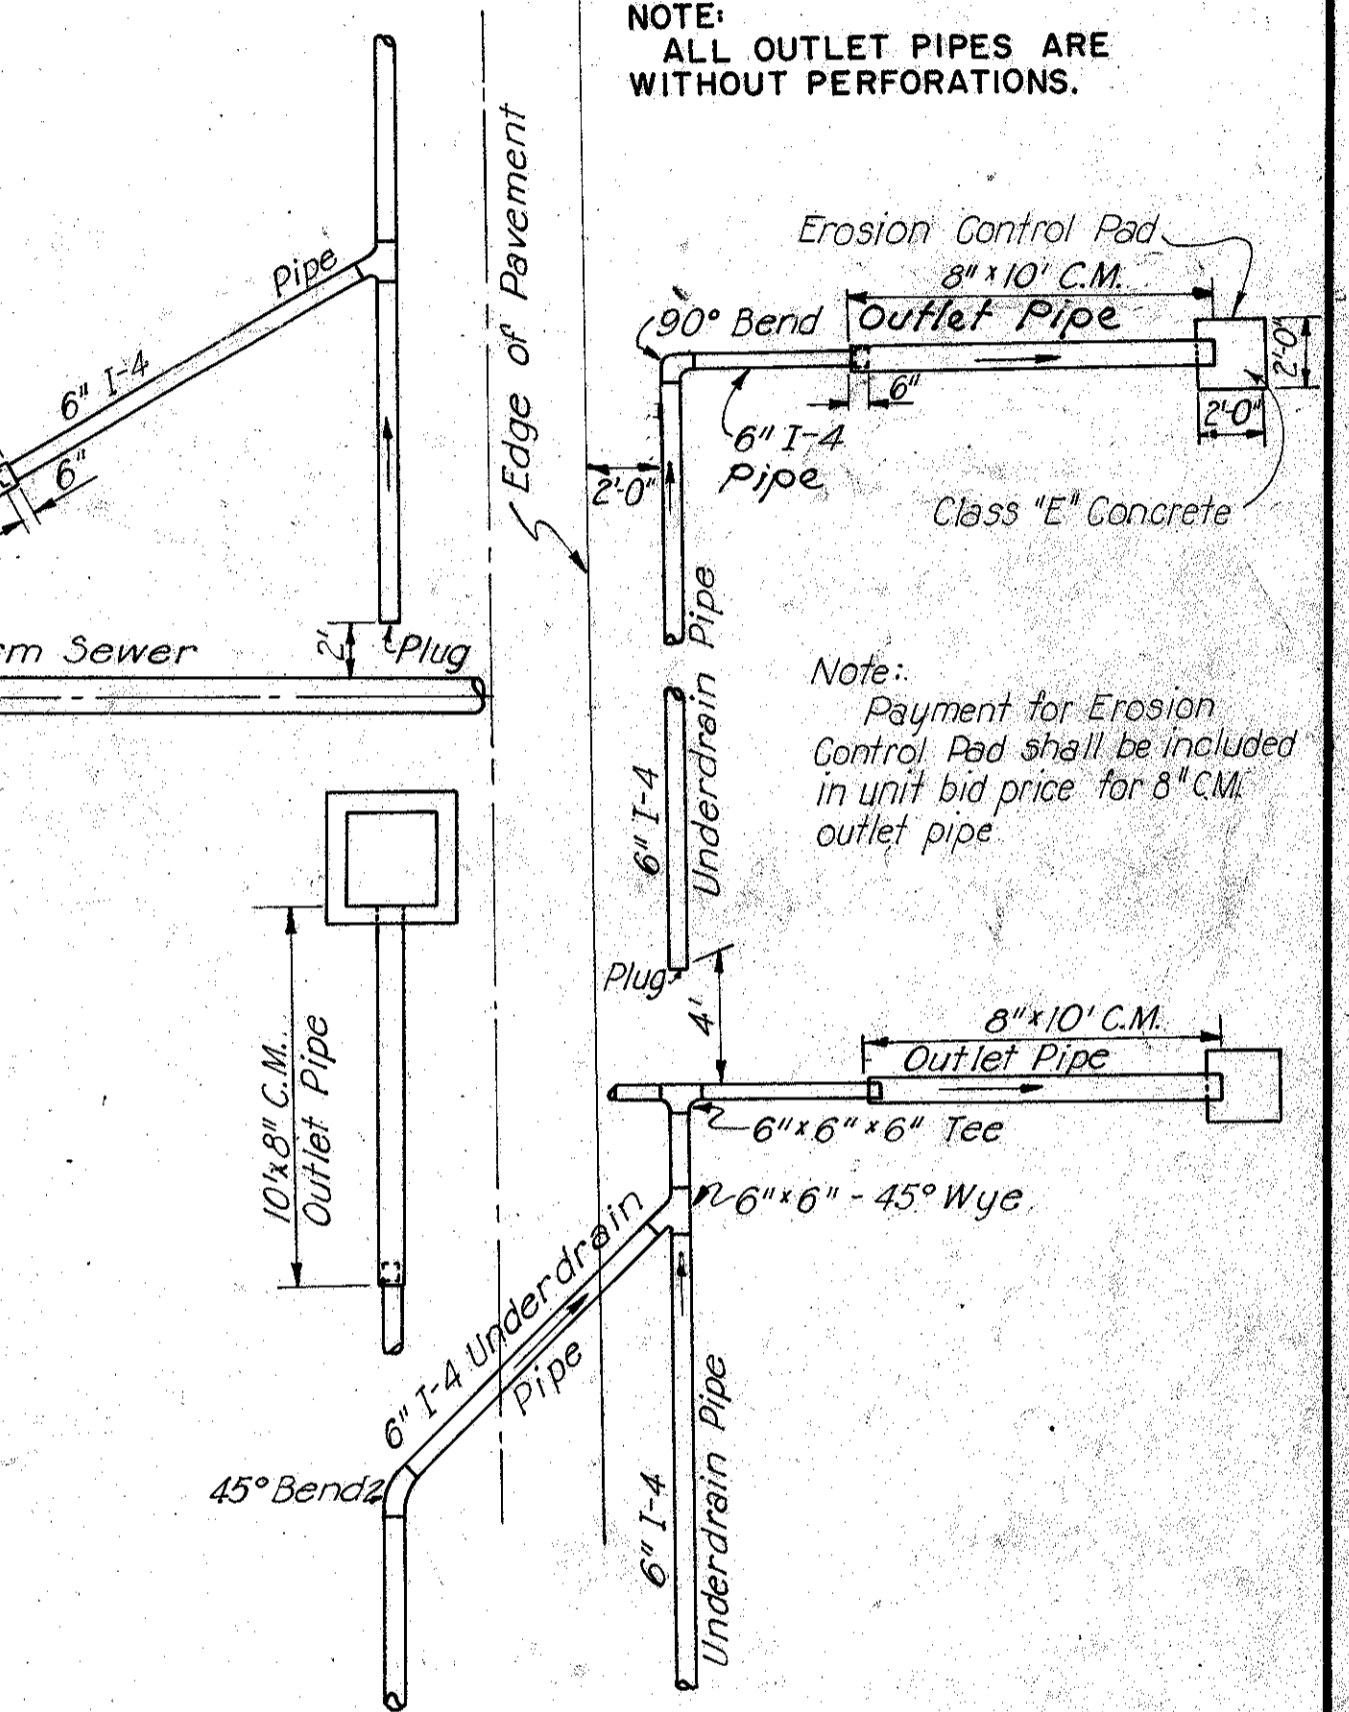

TYPICAL UNDERDRAIN AND OUTLET PIPE DETAIL

NOTES


Prior to placement of sod in the berm and slope, galvanized poultry fence shall be placed on the finished grade in strands which shall be at right angles to the direction of flow. Each strand shall be staked securely on top and bottom with stakes spaced at four foot intervals and alternated in rows four (4) feet apart.
Stakes shall be 1"x1"x8" wood stakes and shall be perpendicular to the ground and flush with the finished grade.
The fence shall be Straight Line Poultry Fence or equivalent with strand width of four feet, having a two inch mesh and all wires No. 20 Gauge.
Each strand of fencing shall be fastened together at twelve inch intervals by means of hog rings.
The fence shall be secured to the wood stakes by metal staples.
Sod shall be laid in accordance with Construction and Materials Specifications Section L-10.07.

GENERAL NOTES

- The abandoning of existing manholes shall be in accordance with Section I-16.03 of the Construction and Material Specifications with the following exceptions: (1) The existing inlet and outlet pipes shall be sealed with brick. (2) After sealing of the existing pipes is complete and the walls removed to the required depth, the manhole shall be filled with granular material and compacted in accordance with Sec. I-16.03.
- Where proposed sewer pipes are to be connected into existing sewers, the hole in the existing sewer shall be cut by the City of Cleveland forces.
- Not all sewer pipes connected to existing catch basins are shown on the plans. Where sewer pipes not shown are encountered during construction, the pipes shall be cut at the limits of construction and sealed to the satisfaction of the Engineer. Payment for cutting and sealing in accordance with paragraph 4 of Item I-16.03 shall be included in the unit price bid for Item E-1 Roadway Excavation.
- 3.A. Standard City Sewer Manhole Frames and Covers as shown on sheet No 52 shall be used on all new Manholes.
4. For the location of underdrains, see typical sections. For details of underdrain outlets, see this sheet.
5. The Contractor's attention is directed to the removal of the existing No. 9 Brick Sewer in the areas of bridge construction. All work necessary for removal of this egg-shaped sewer, including footing, if any, in the areas indicated on the plans, shall be paid for as Item E-12, Pipe Removed.

FED. ROAD DIV. NO.	STATE	FEDERAL AID PROJECT NO.	TYPE FUNDS	41
				181

CUYAHOGA COUNTY
 CITY OF CLEVELAND
 CUY-42-1842
 CUY-21-1532
 LIGHTING KEY

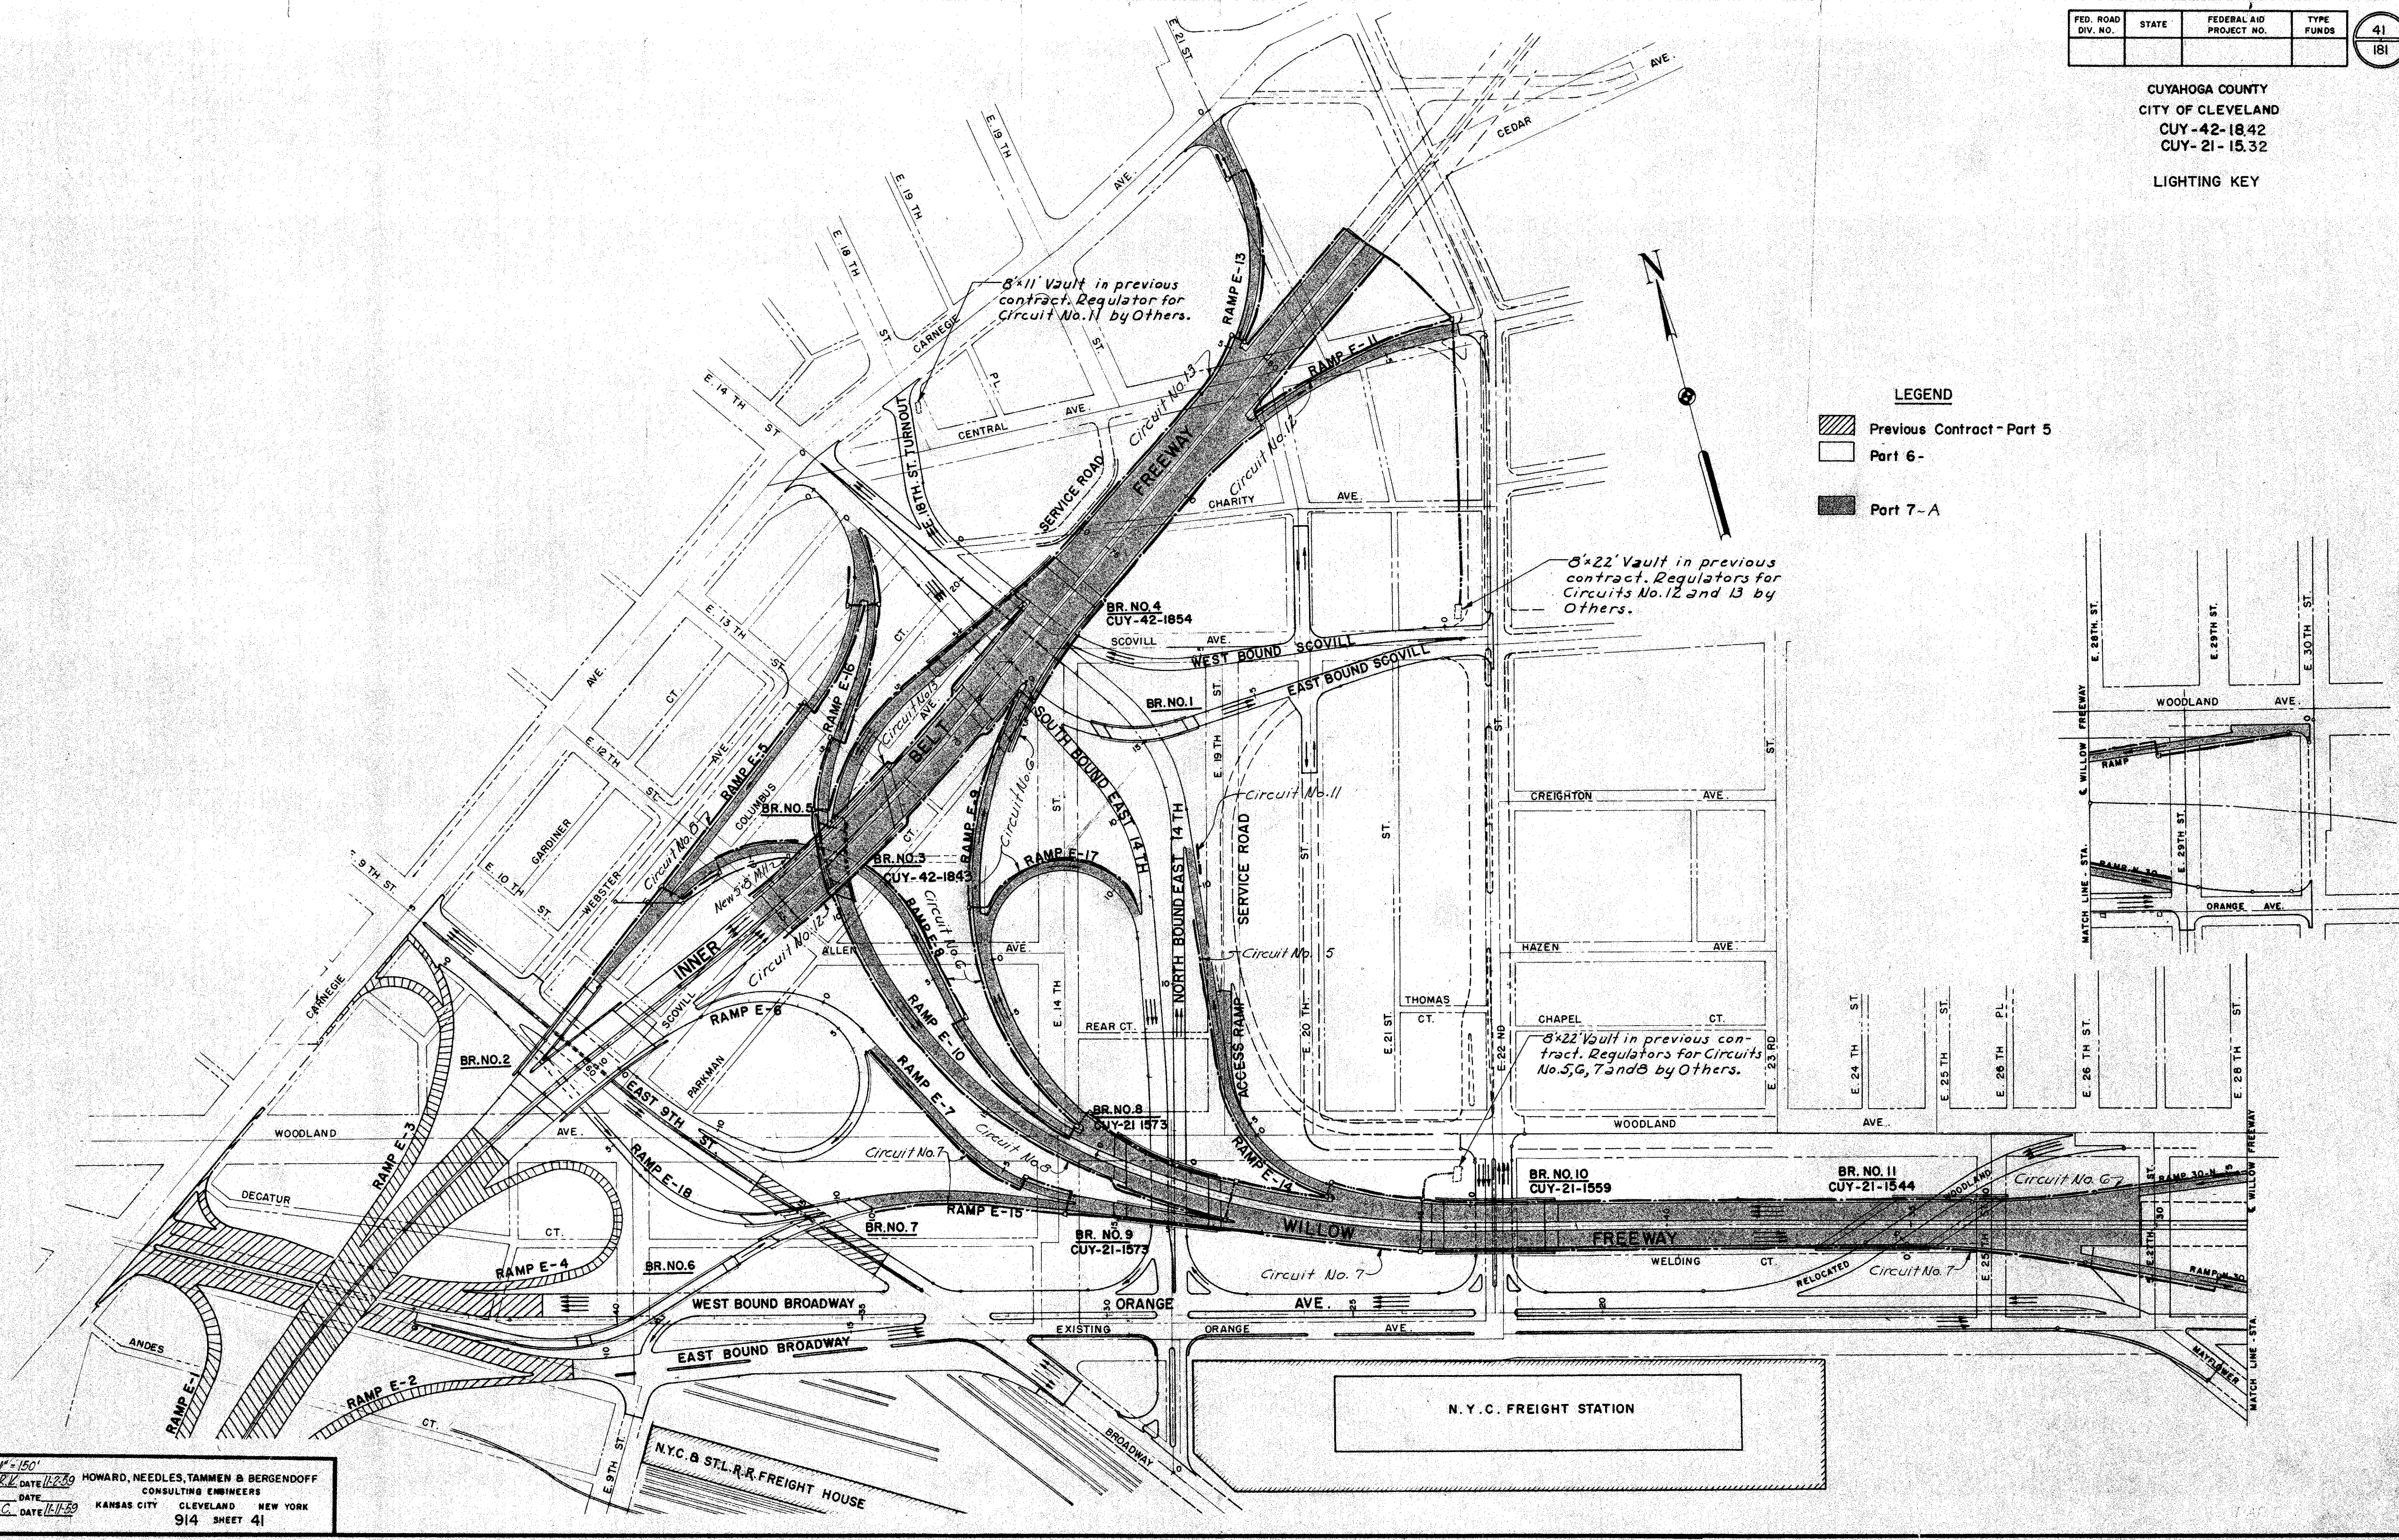


LEGEND

▨ Previous Contract - Part 5

□ Part 6 -


■ Part 7-A

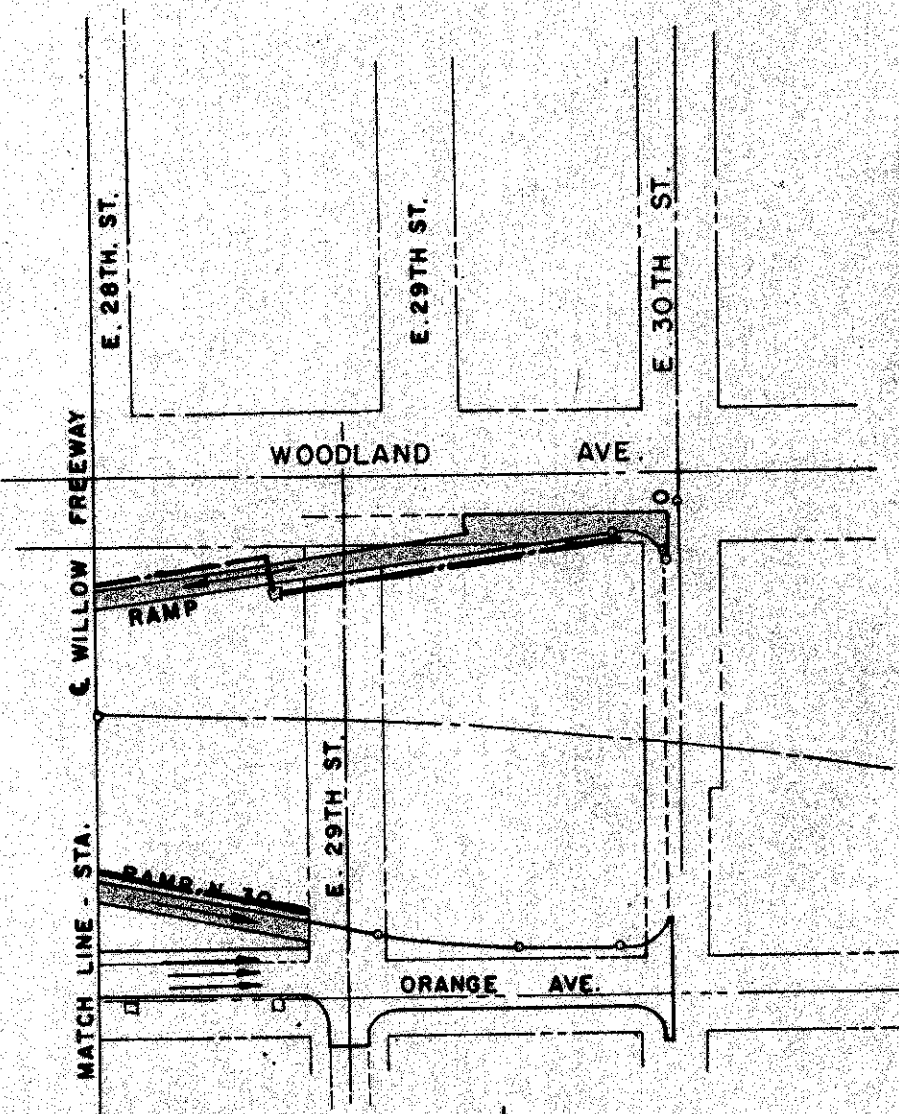

SCALE 1" = 150'
 MADE J.R.L. DATE 11-2-59 HOWARD, NEEDLES, TAMMEN & BERGENOFF
 TRCD. DATE 11-11-59 CONSULTING ENGINEERS
 CKD. G.L.C. DATE 11-11-59 KANSAS CITY CLEVELAND NEW YORK
 914 SHEET 41

FED. ROAD DIV. NO.	STATE	FEDERAL AID PROJECT NO.	TYPE FUNDS	42 181
2	OHIO			

CUYAHOGA COUNTY
 CITY OF CLEVELAND
 CUY-42-18.42
 CUY-21-15.32
 LIGHTING PLAN

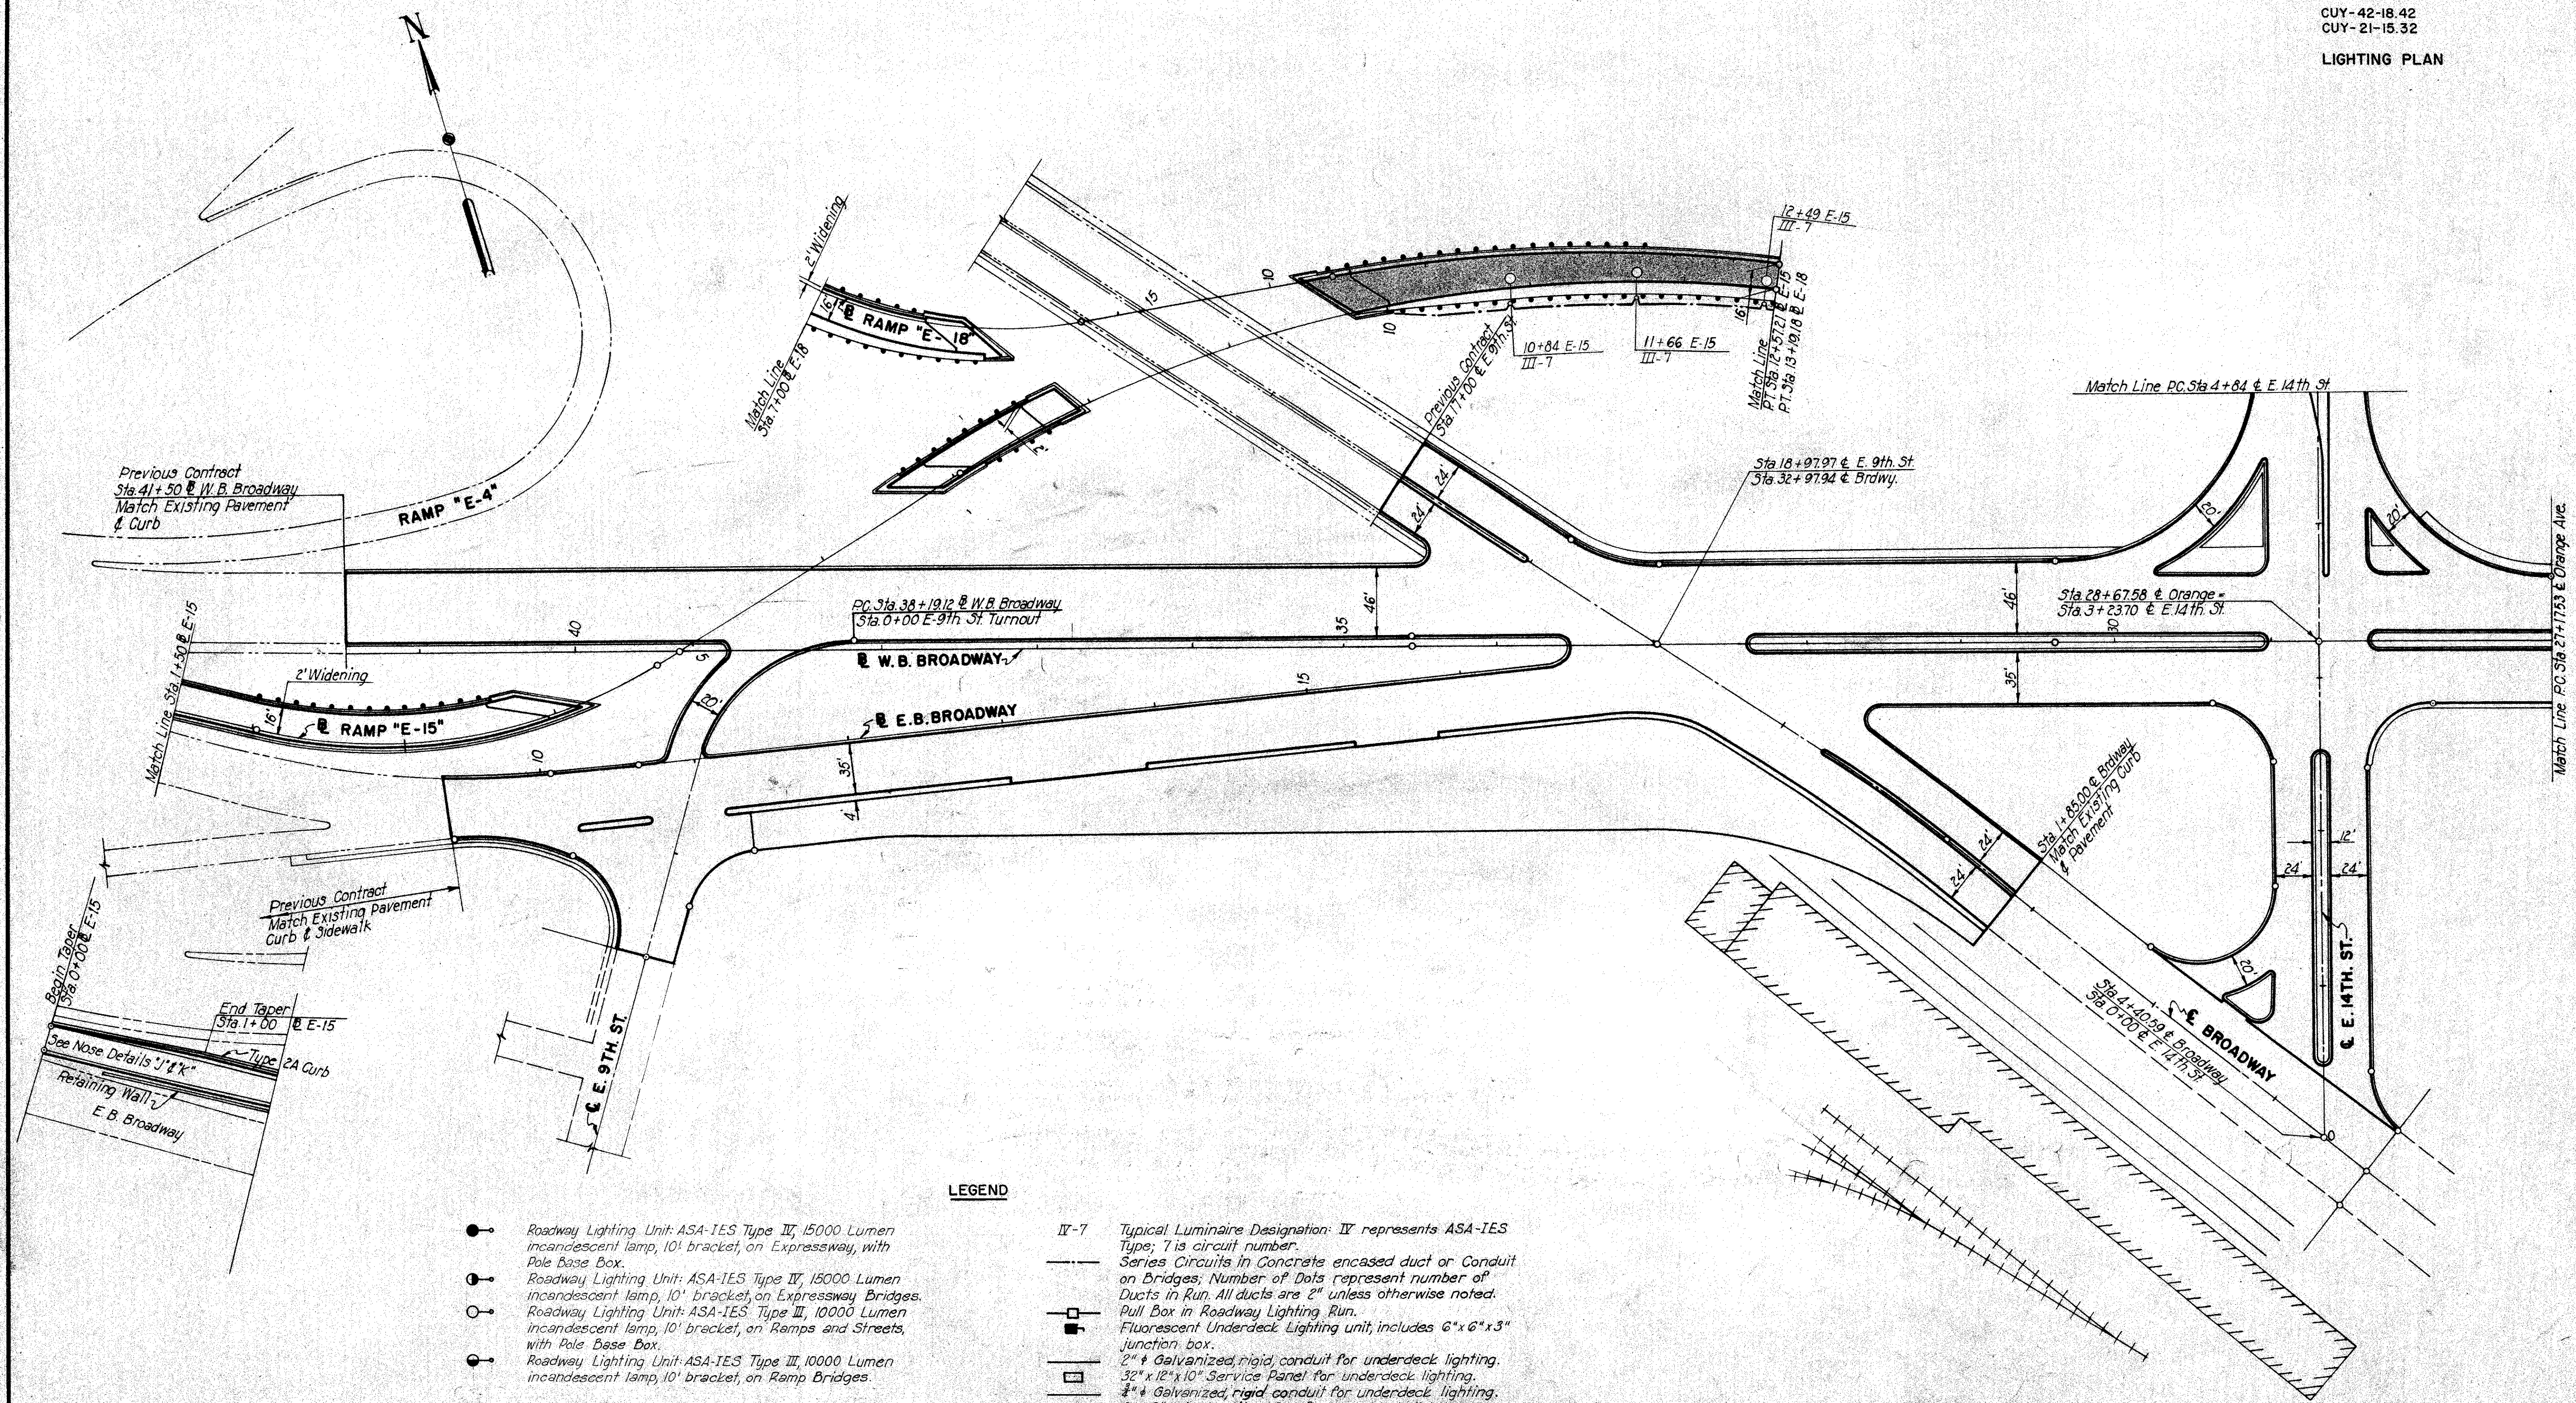

LEGEND

- Roadway Lighting Unit: ASA-IES Type IV, 15000 Lumen incandescent lamp, 10' bracket, on Expressway, with Pole Base Box.
 - Roadway Lighting Unit: ASA-IES Type IV, 15000 Lumen incandescent lamp, 10' bracket, on Expressway Bridges.
 - Roadway Lighting Unit: ASA-IES Type III, 10000 Lumen incandescent lamp, 10' bracket, on Ramps and Streets, with Pole Base Box.
 - Roadway Lighting Unit: ASA-IES Type III, 10000 Lumen incandescent lamp, 10' bracket, on Ramp Bridges.
 - IV-7 Typical Luminaire Designation: IV represents ASA-IES Type; 7 is circuit number.
 - Series Circuits in Concrete encased duct or Conduit on Bridges; Number of Dots represent number of Ducts in Run. All ducts are 2" unless otherwise noted.
 - Pull Box in Roadway Lighting Run.
 - Fluorescent Underdeck Lighting unit, includes 6"x6"x3" junction box.
 - ▭ 2" Galvanized, rigid, conduit for underdeck lighting.
 - ▭ 32"x12"x10" Service Panel for underdeck lighting.
 - ▭ 2" Galvanized, rigid, conduit for underdeck lighting.
 - ▭ 8"x8"x4" Junction Box for underdeck lighting.
 - ▭ Regulator Vault, size called out on sheets.
 - 5'x8' Manhole.
- Note: All ducts under pavement shall be 2-Way Duct, 2-inch, except as otherwise noted.



SCALE 1" = 50'
 MADE 1/24/59 DATE 2-16-59 HOWARD, NEEDLES, TAMMEN & BERGENOFF
 TRCD. DATE CONSULTING ENGINEERS
 CND. 6-16 DATE 11-12-59 KANSAS CITY CLEVELAND NEW YORK
 9/4 SHEET 42

FED. ROAD DIV. NO.	STATE	FEDERAL AID PROJECT NO.	TYPE FUNDS
2	OHIO		

43
181

CUYAHOGA COUNTY
CITY OF CLEVELAND
CUY-42-18.42
CUY-21-15.32

LIGHTING PLAN

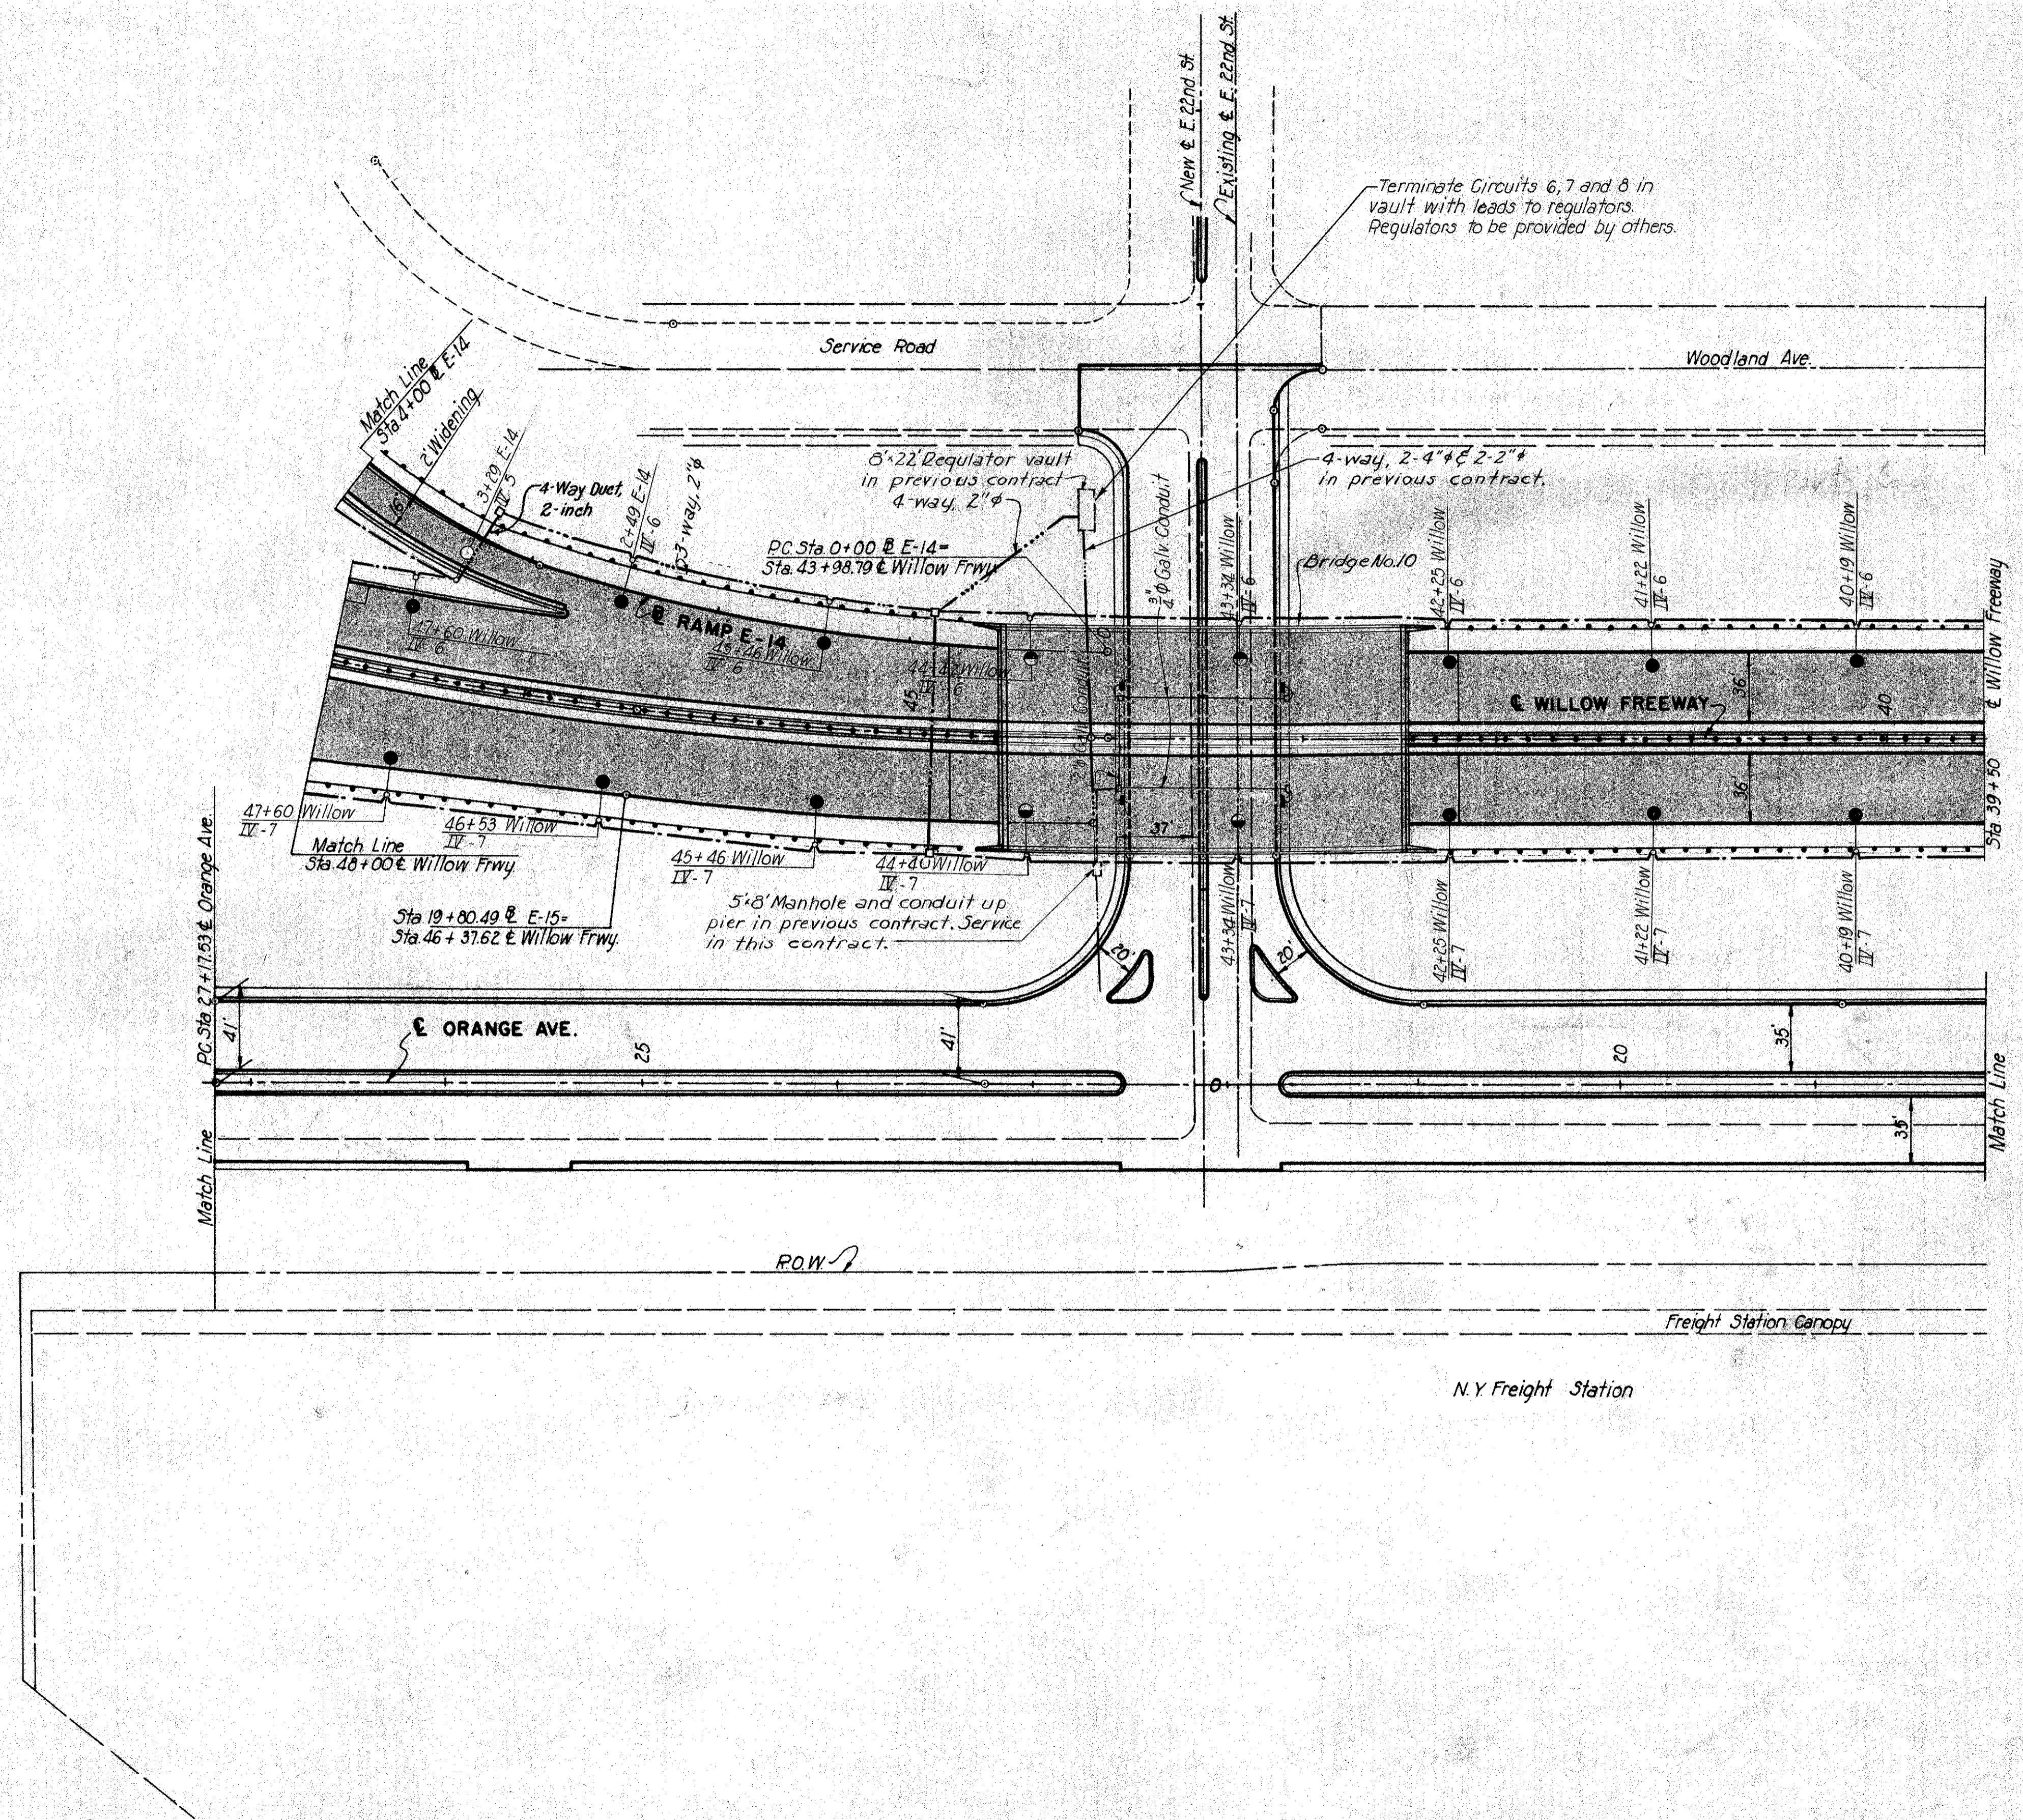
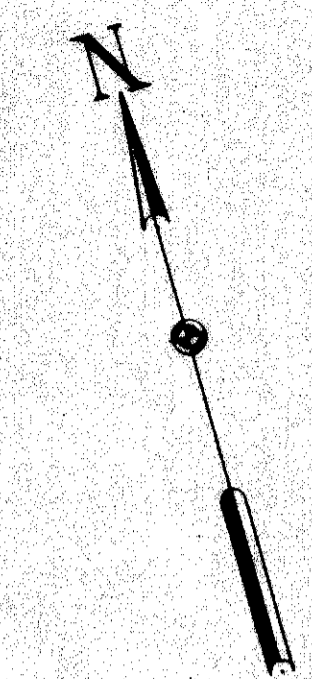


SCALE 1" = 50'
MADE I.P.C. DATE 3-17-59
TRCD. DATE
CKD. DATE 11-12-59
HOWARD, NEEDLES, TAMMEN & BERGENDOFF
CONSULTING ENGINEERS
KANSAS CITY CLEVELAND NEW YORK
914 SHEET 43

FED. ROAD DIV. NO.	STATE	FEDERAL AID PROJECT NO.	TYPE FUNDS
2	OHIO		

44
181

CUYAHOGA COUNTY
CITY OF CLEVELAND
CUY-42-18.42
CUY-21-15.32
LIGHTING PLAN

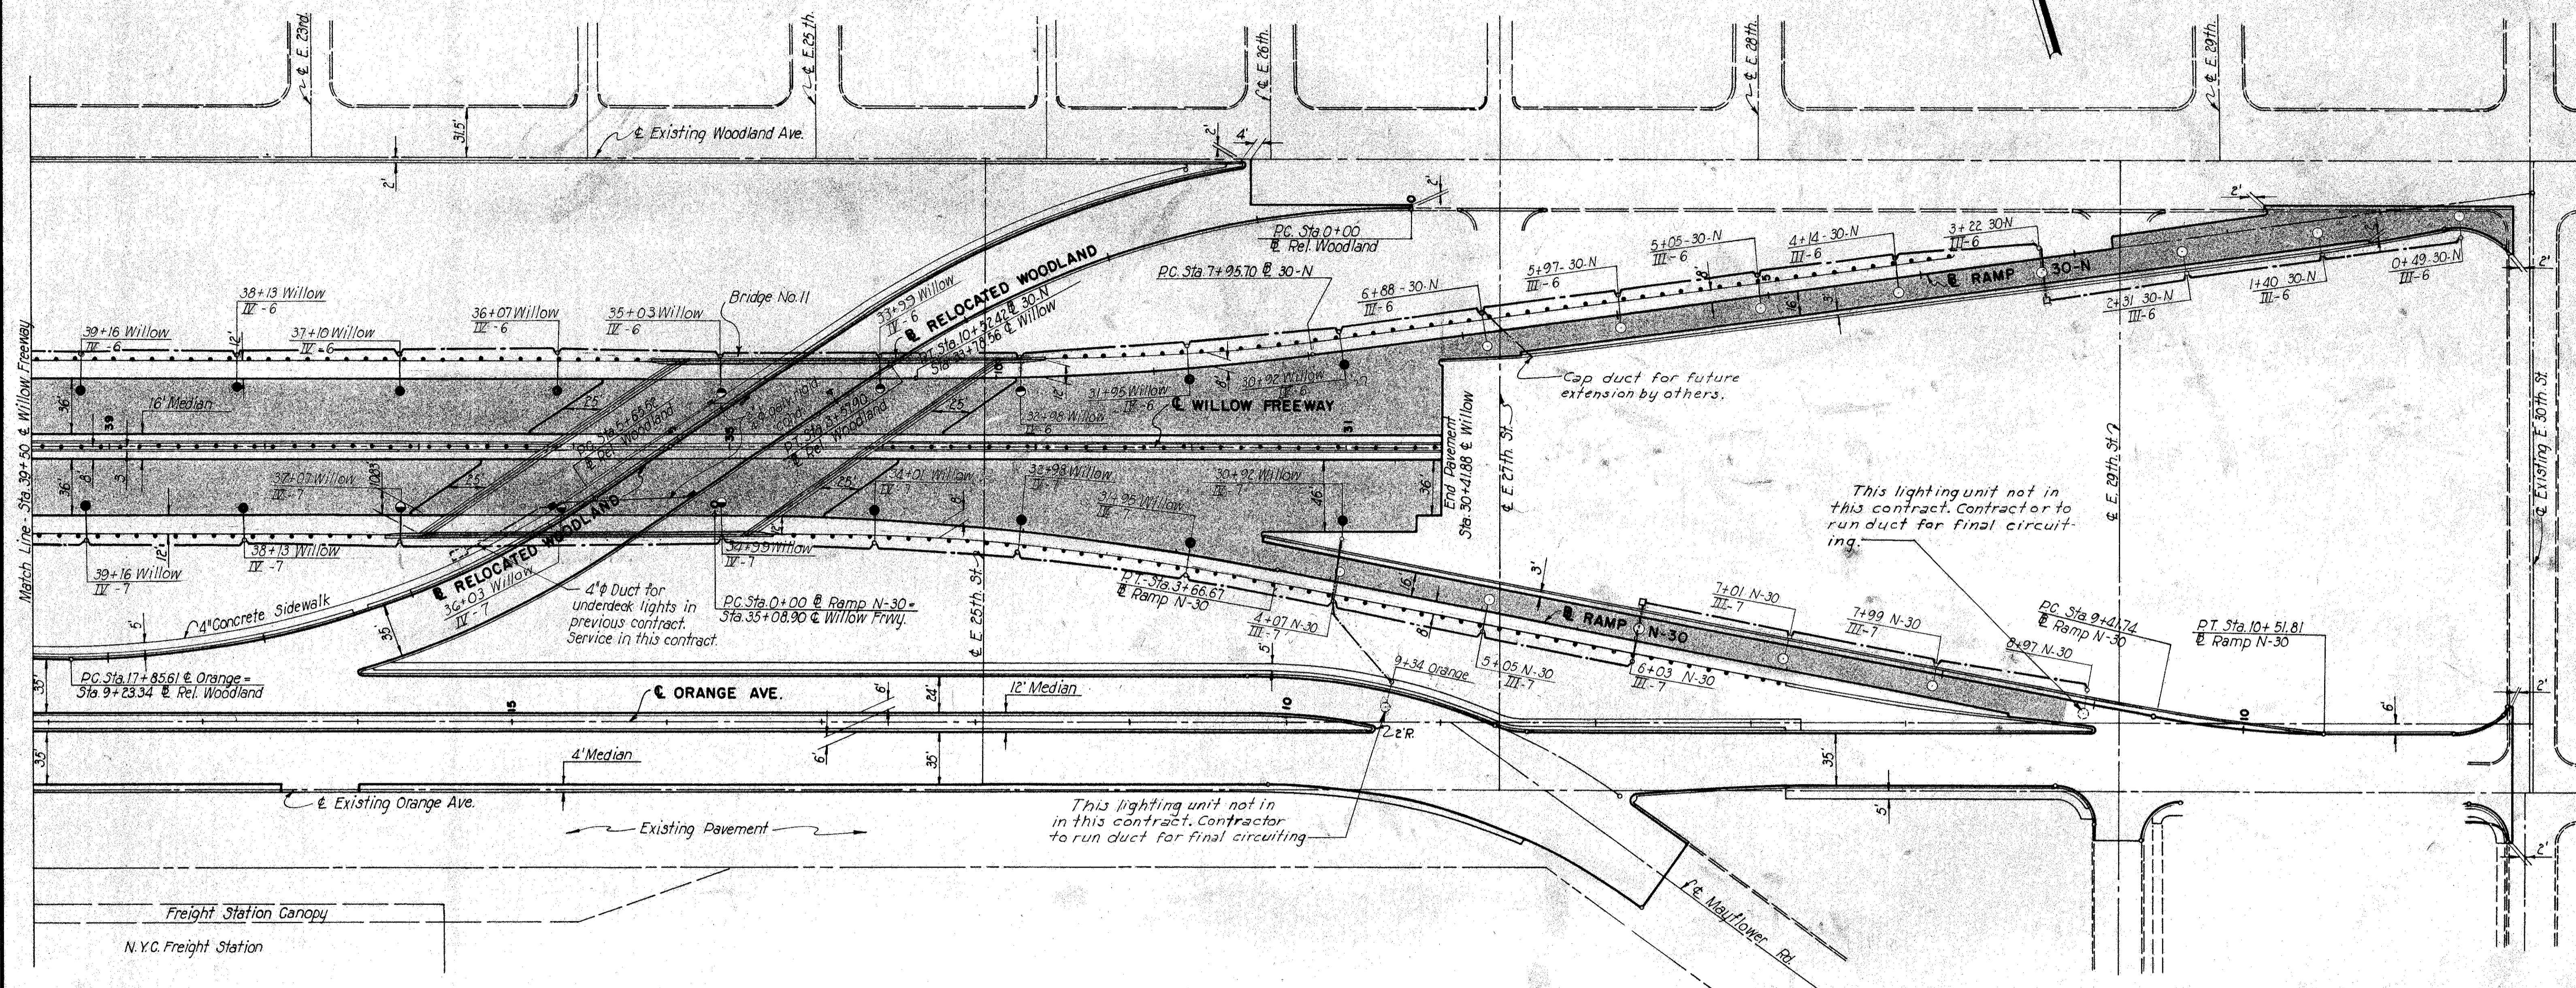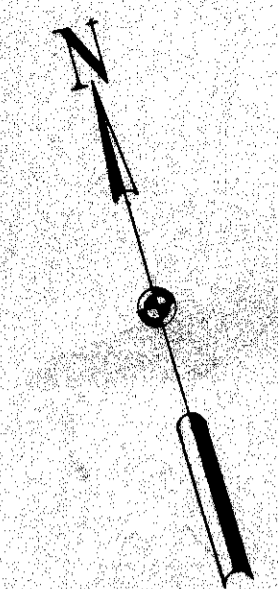


SCALE 1"=50'
MADE BY DATE 2/12/59
TRCD. DATE
CKD. G.J.C. DATE 11-12-59

HOWARD, NEEDLES, TAMMEN & BERGENOFF
CONSULTING ENGINEERS
KANSAS CITY CLEVELAND NEW YORK
914 SHEET 44

FED. ROAD DIV. NO.	STATE	FEDERAL AID PROJECT NO.	TYPE FUNDS
2	OHIO		

CUYAHOGA COUNTY
CITY OF CLEVELAND
CUY-42-18.42
CUY-21-15.32
LIGHTING PLAN

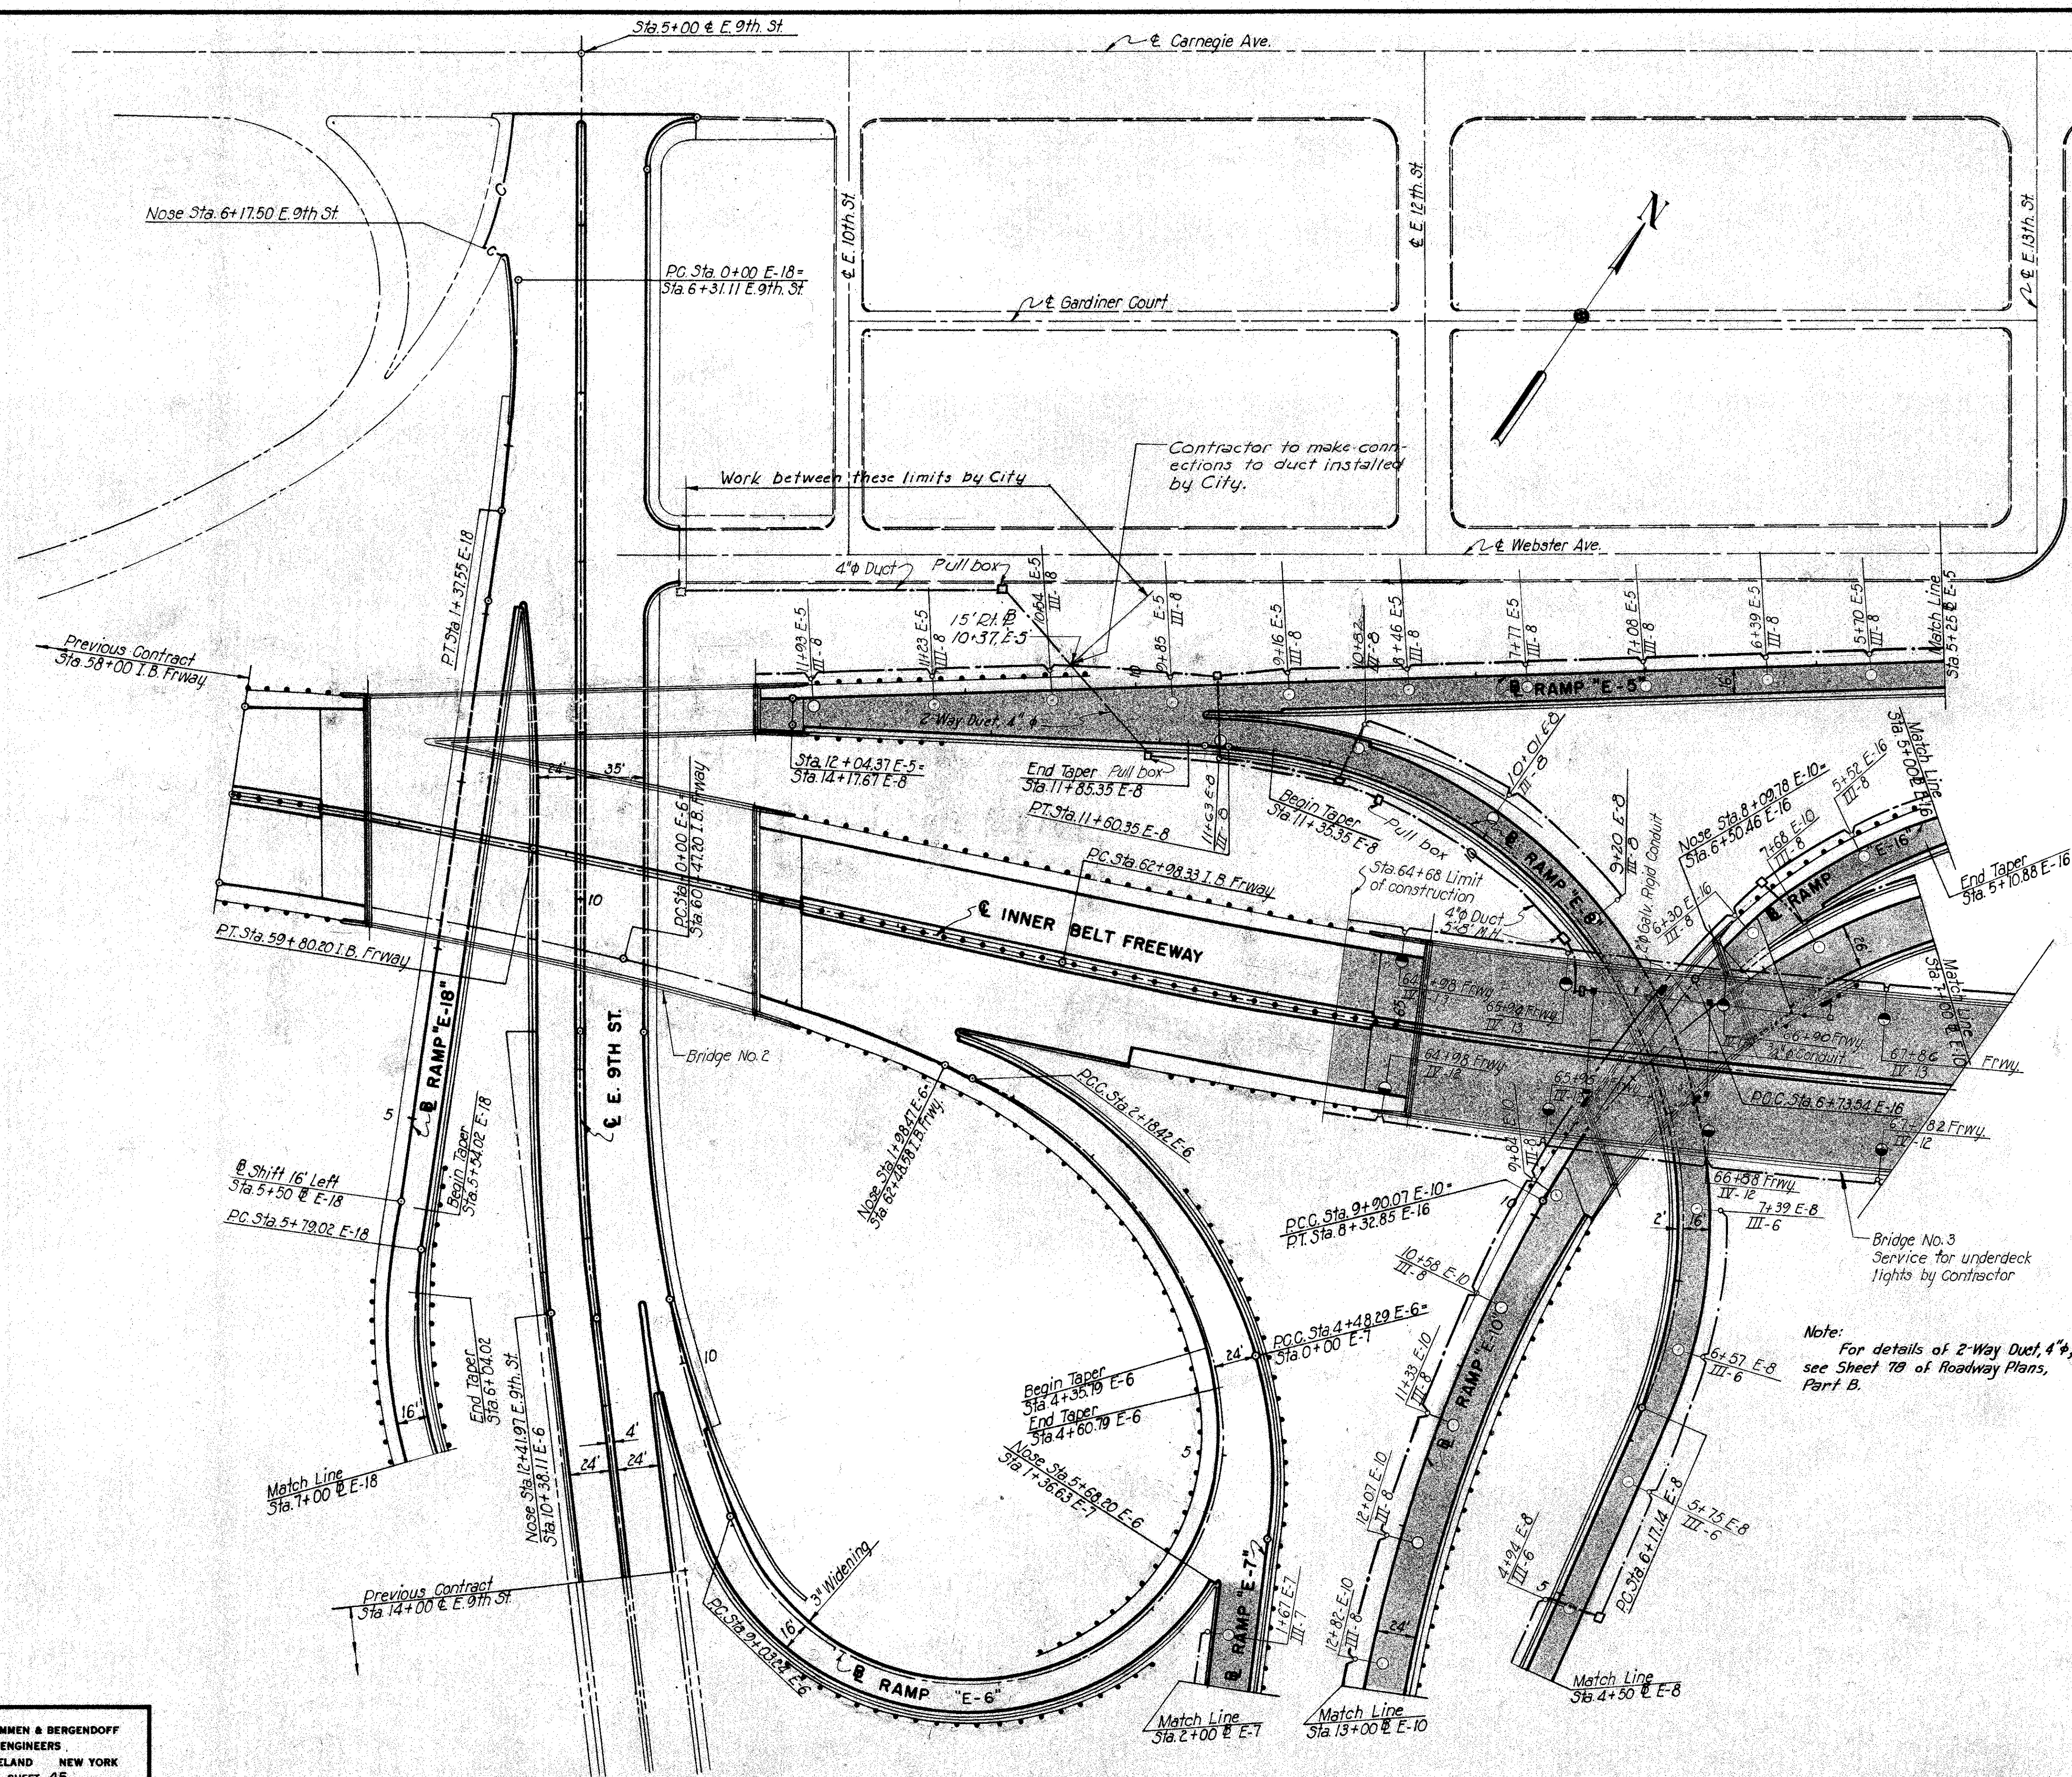

Work between these limits by City

Contractor to make connections to duct installed by City.

Note:
For details of 2-Way Duct, 4",
see Sheet 78 of Roadway Plans,
Part B.


SCALE 1" = 50'
MADE & DATE 9-22-59 HOWARD, NEEDLES, TAMMEN & BERGENDOFF CONSULTING ENGINEERS
TRCD. DATE 6-10-59 KANSAS CITY CLEVELAND NEW YORK
CKD. DATE 1-12-59 914 SHEET 45

FOR LEGEND SEE SHEET 42 Rev. F.S.J. 12-8-59

FED. ROAD DIV. NO.	STATE	FEDERAL AID PROJECT NO.	TYPE FUNDS
2	OHIO		

46
181

CUYAHOGA COUNTY
CITY OF CLEVELAND
CUY-42-18.42
CUY-21-15.32
LIGHTING PLAN

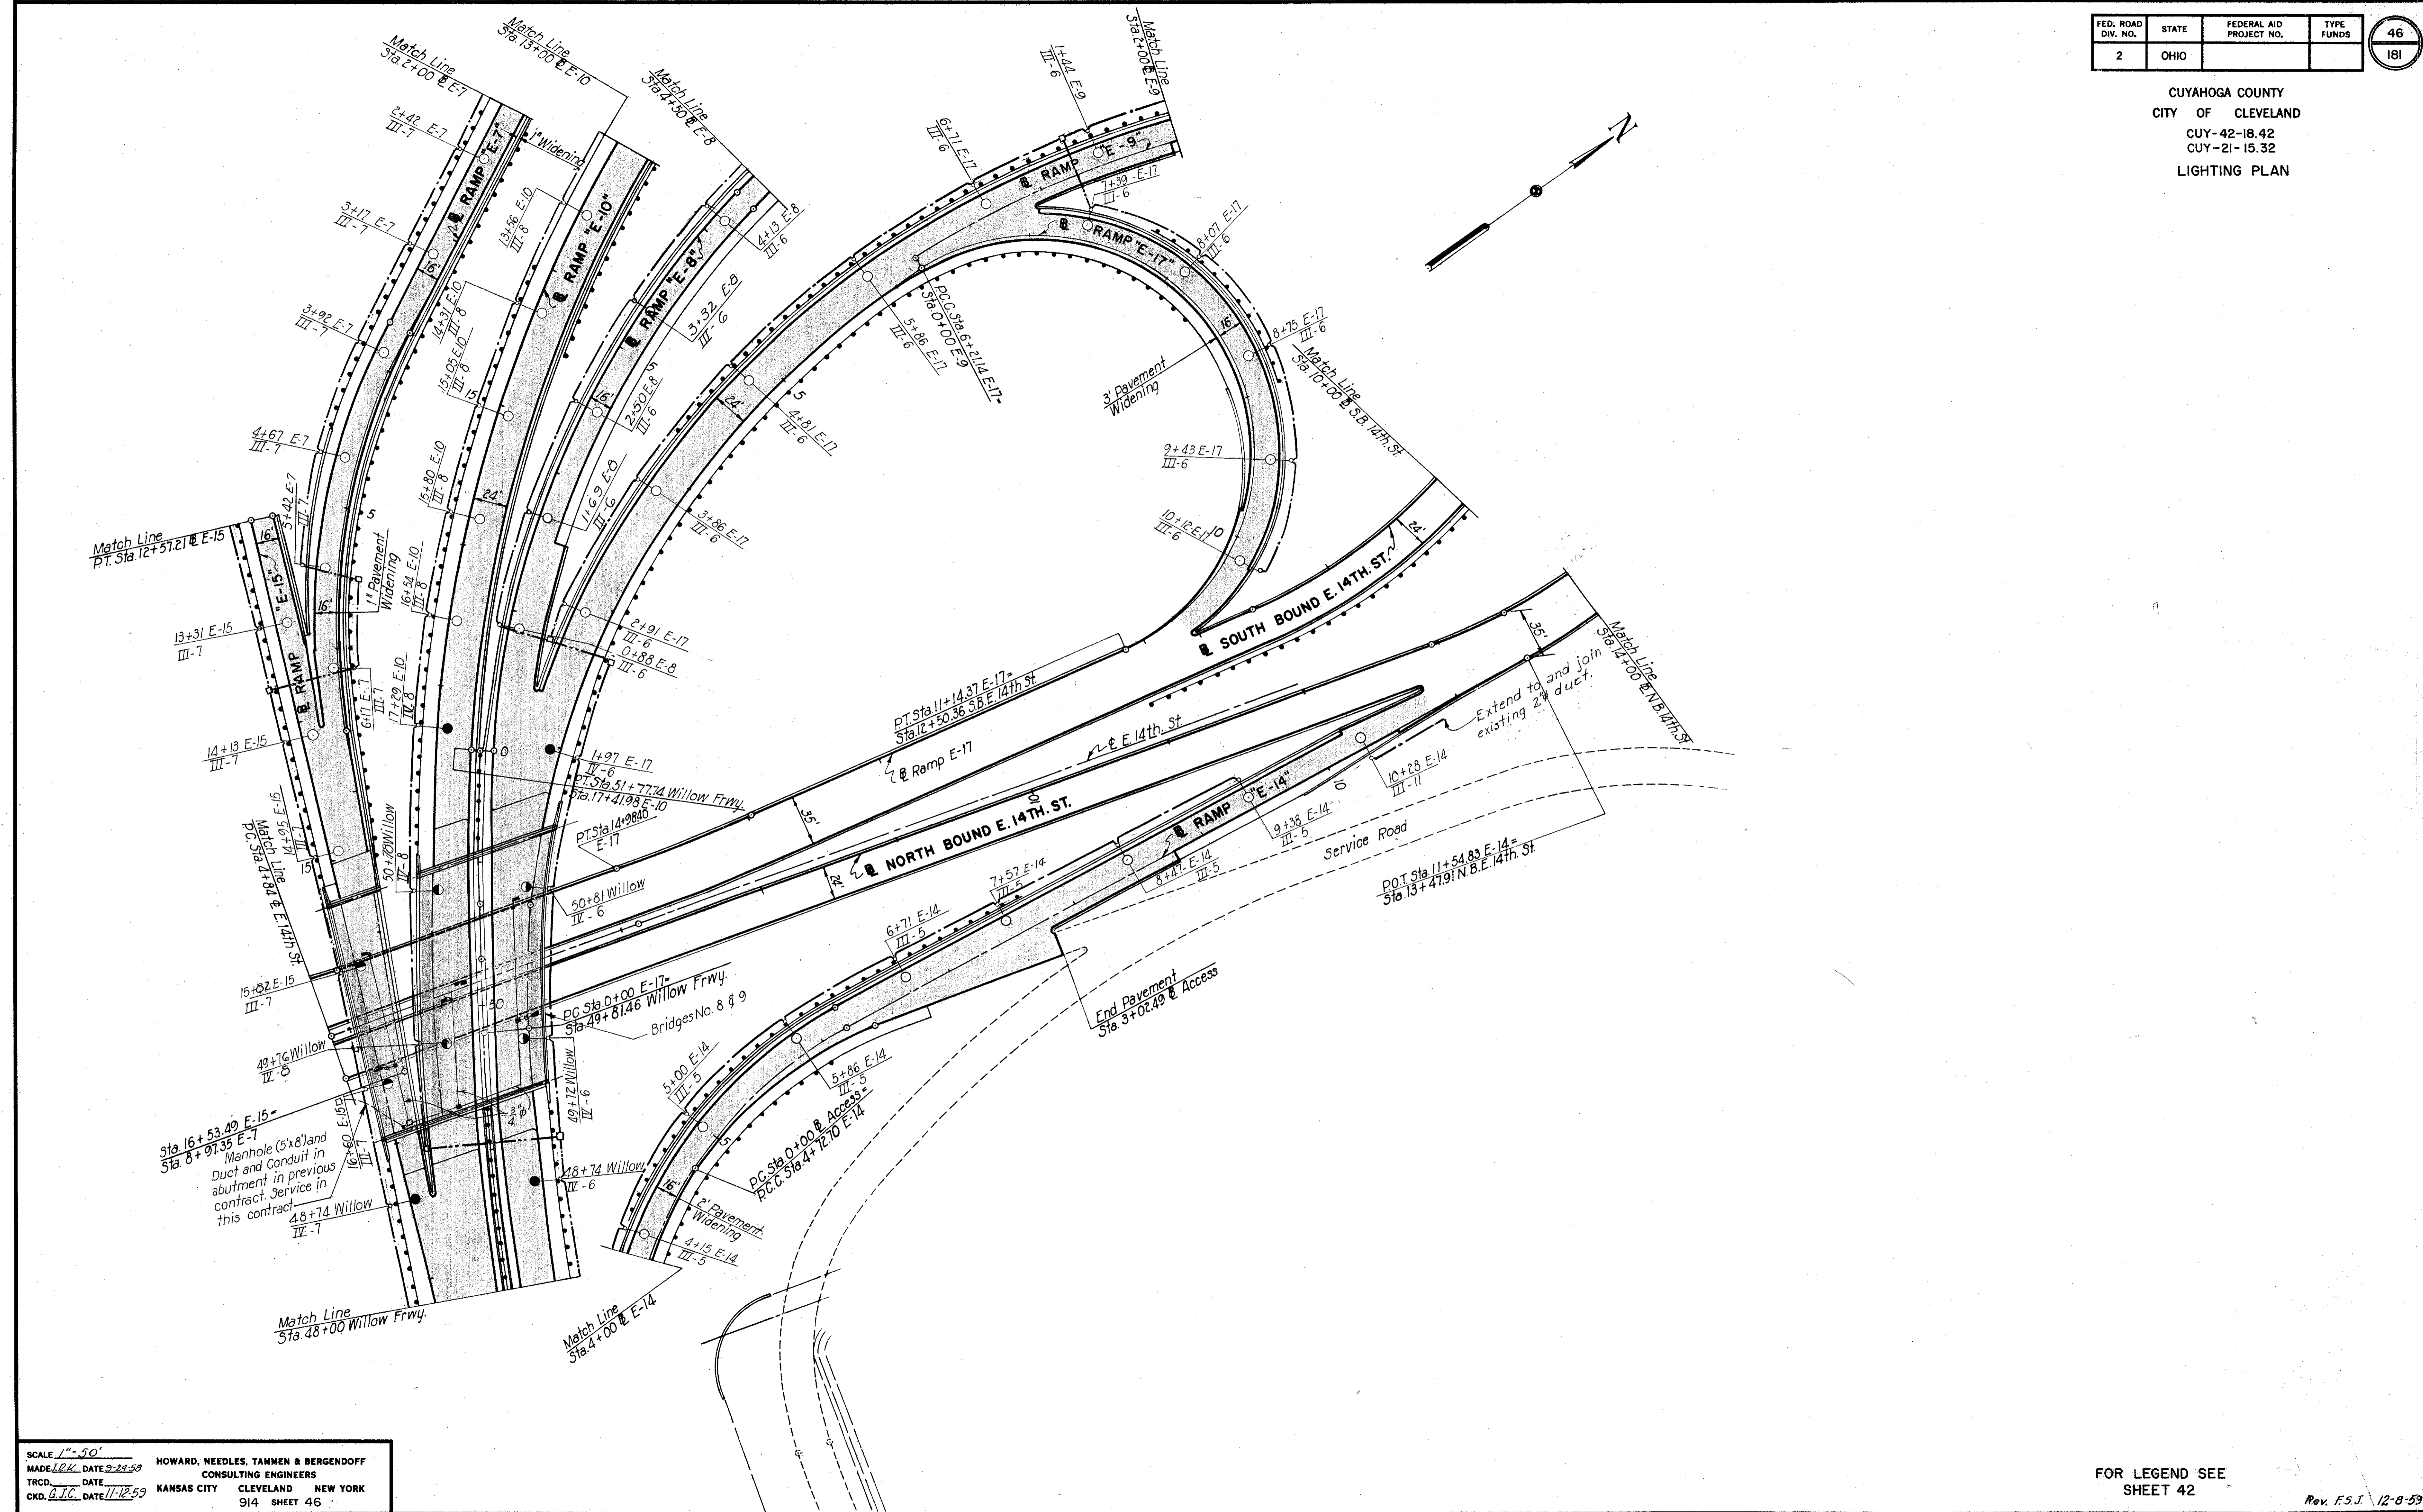

SCALE 1" = 50'
MADE L.P.K. DATE 9-24-58
TRCD. DATE
CKD. G.J.C. DATE 11-12-59
HOWARD, NEEDLES, TAMMEN & BERGENDOFF
CONSULTING ENGINEERS
KANSAS CITY CLEVELAND NEW YORK
914 SHEET 46


FOR LEGEND SEE
SHEET 42

Rev. F.5.J. 12-8-59

FED. ROAD DIV. NO.	STATE	FEDERAL AID PROJECT NO.	TYPE FUNDS
2	OHIO		

47
181

CUYAHOGA COUNTY
CITY OF CLEVELAND
CUY-42-18.42
CUY-21-15.32
LIGHTING PLAN

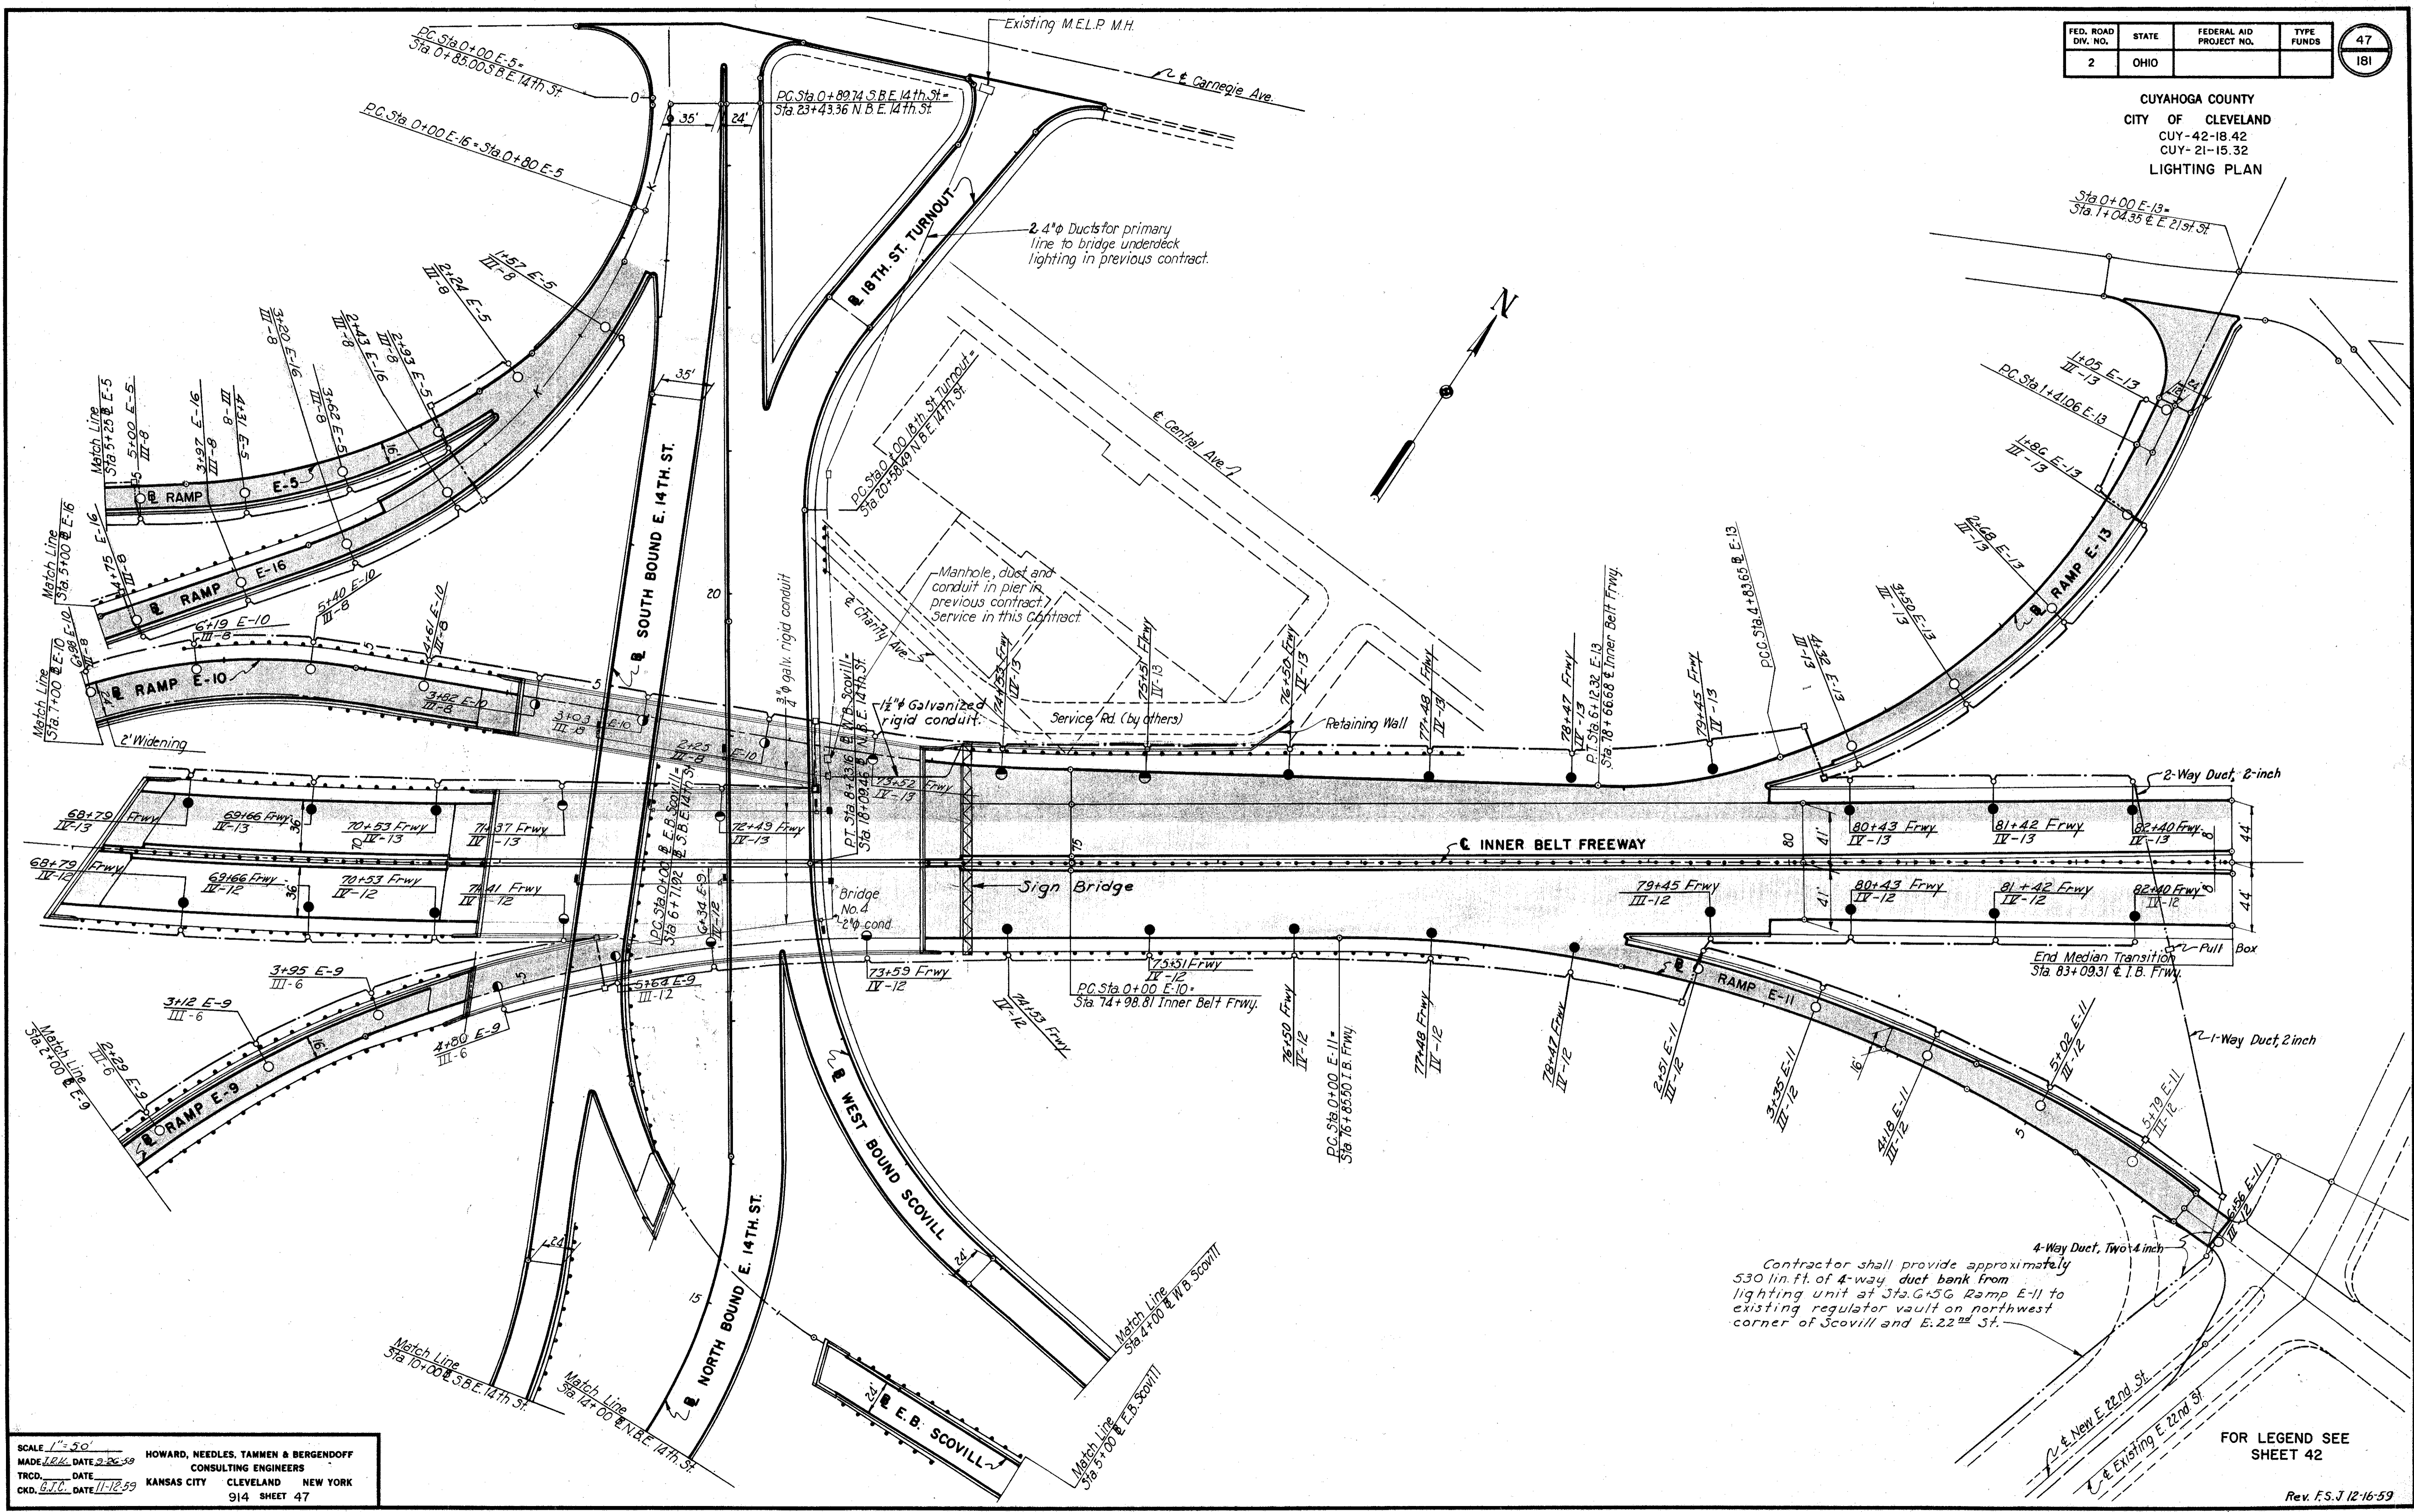

Contractor shall provide approximately 530 lin. ft. of 4-way duct bank from lighting unit at Sta. 6+56 Ramp E-11 to existing regulator vault on northwest corner of Scovill and E. 22nd St.


SCALE 1" = 50'
MADE 12-14-59 DATE 2-26-59
TRCD. DATE
CKD. B.T.C. DATE 11-12-59
HOWARD, NEEDLES, TAMMEN & BERGENDOFF
CONSULTING ENGINEERS
KANSAS CITY CLEVELAND NEW YORK
914 SHEET 47

FOR LEGEND SEE SHEET 42

Rev. F.S. J 12-16-59

CUYAHOGA COUNTY
CITY OF CLEVELAND
CUY 42-18.42
CUY 21-15.32
LIGHTING DETAILS


For manhole frames and covers, see Standard Drawing No. 2371, of The City of Cleveland, Sheet No. 52.

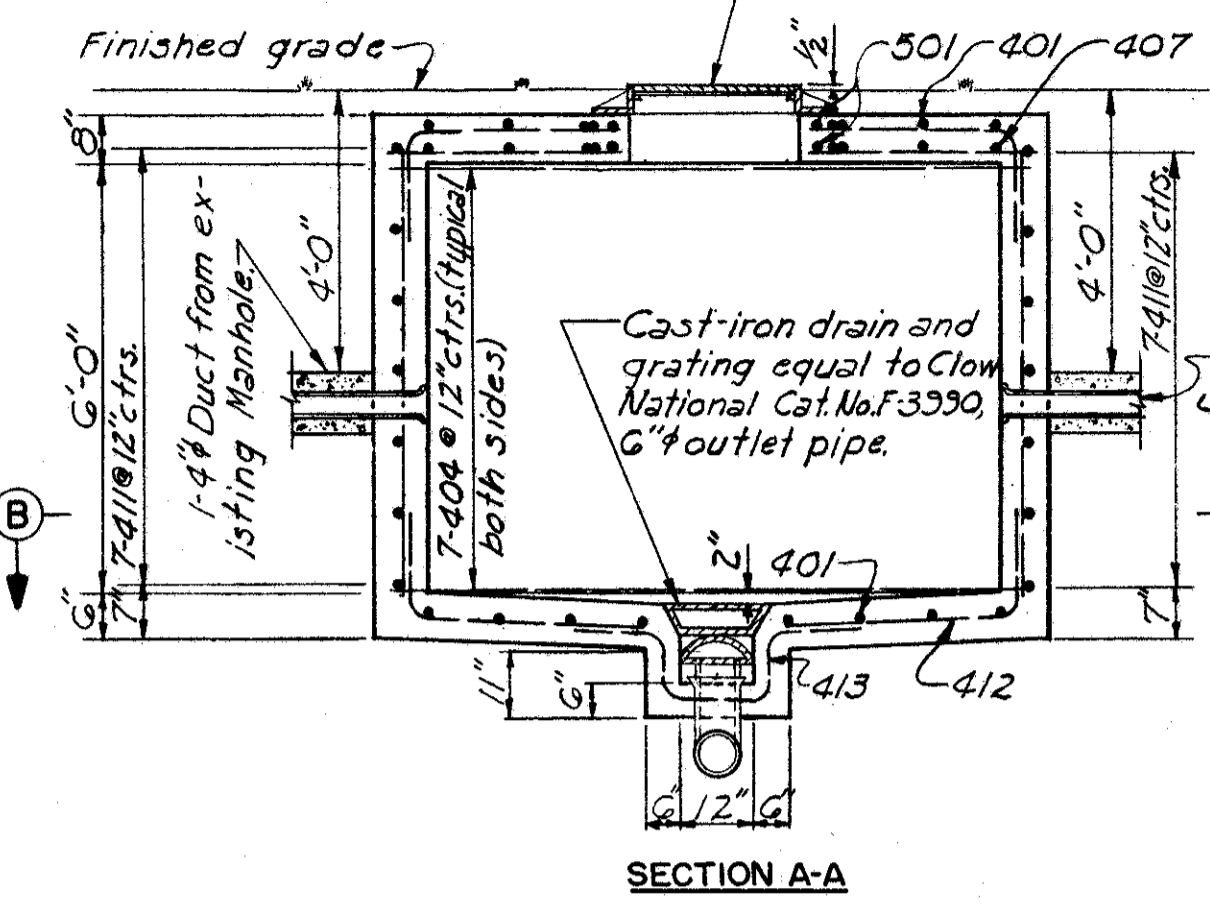

SECTION A-A


Notes:
The top and sides of the manhole shall be provided with "Type B" waterproofing according to Ohio Standard Construction and Materials Specifications. For the floor vapor barrier Plumbizer a 0.004" polyethylene film shall be applied over the sub-grade. The film shall be lapped not less than 6".
A 1" x 10'-0" ground rod shall be placed in one corner of the manhole, with 6" of the rod extending above the floor, for a minimum of 5 ohms to ground.
Install one pulling iron opposite each duct entrance.

For location of drainage manholes and lengths of 6" Vitreous Clay Pipe, see Roadway Lighting Plans.
For number and placement of ducts in and out of Transformer Manhole, see Roadway Lighting Plans.
6" outlet pipe shall be constructed in accordance with Item I-2 using Sec. M-6.8 (b) pipe.

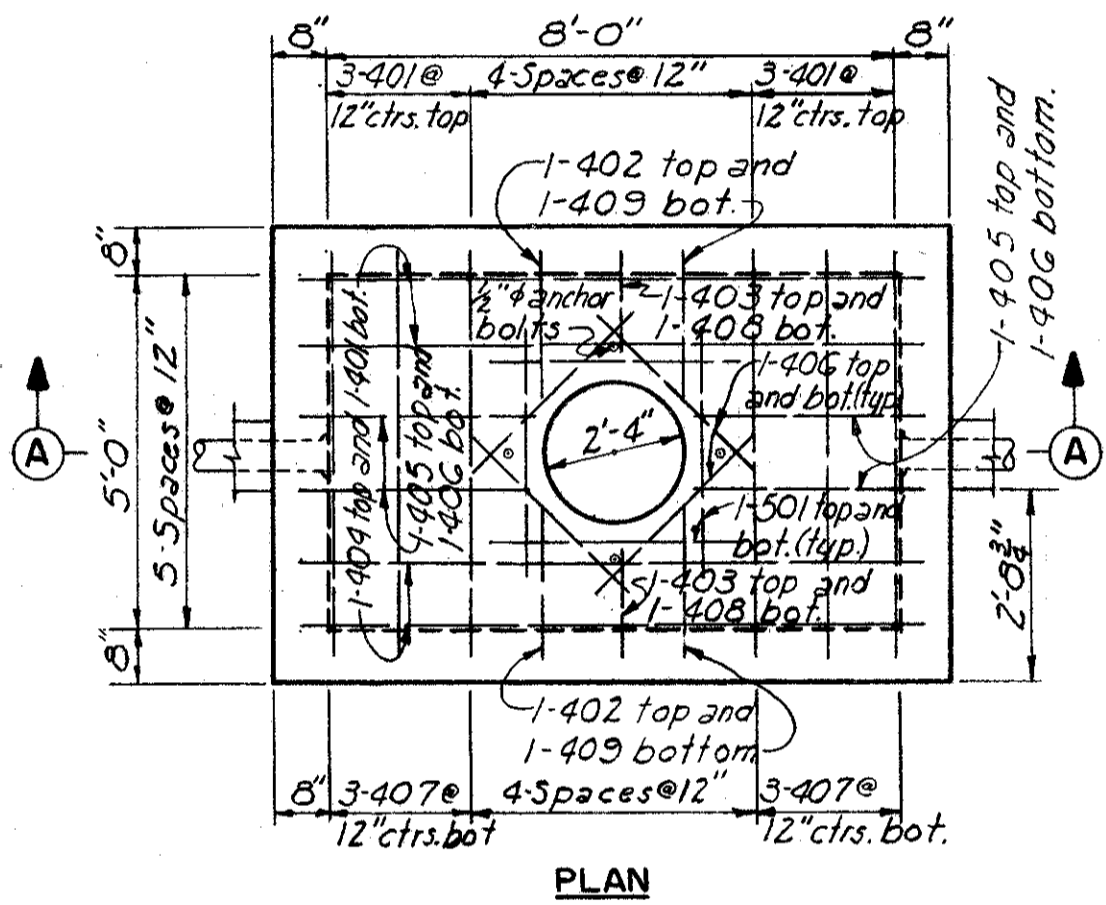


PLAN

TRANSFORMER MANHOLE
Scale: 3/8" = 1'-0"

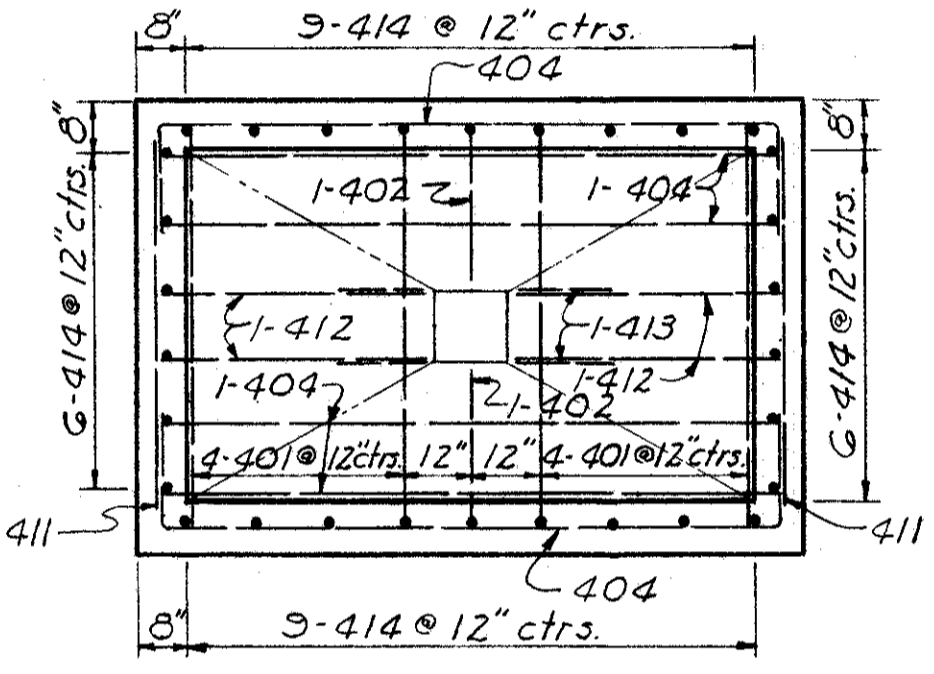


SECTION B-B

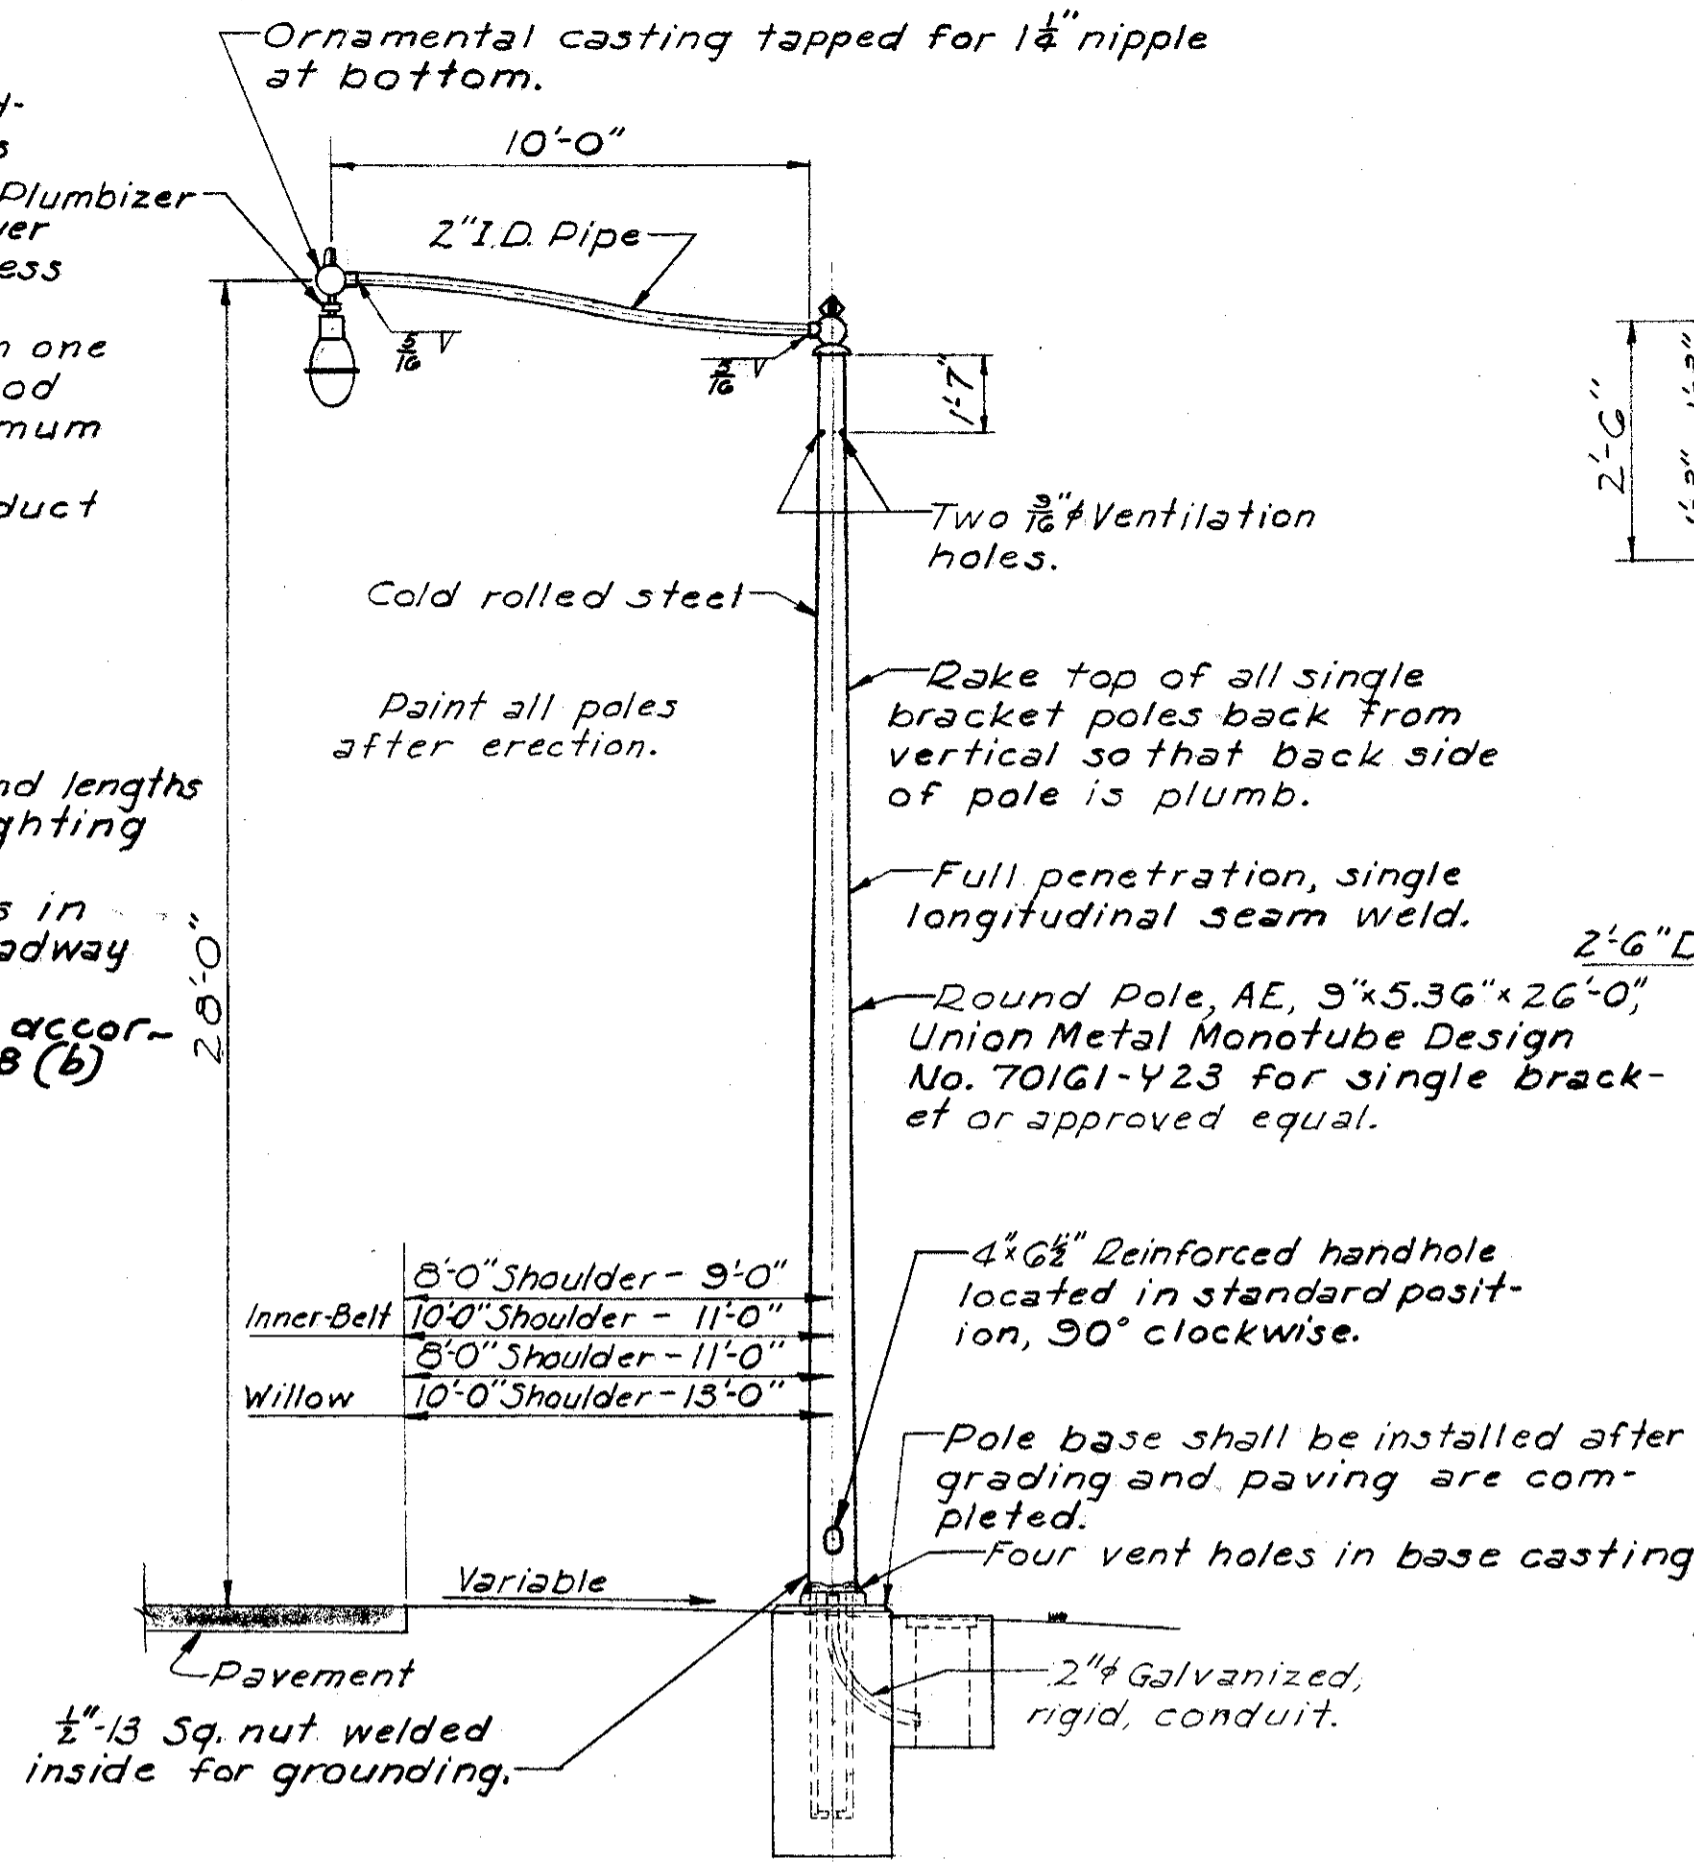


TYPICAL ROADWAY LIGHTING UNIT
No Scale

Note: Allow at least 4 days after pouring before allowing compaction by rollers over duct bank.

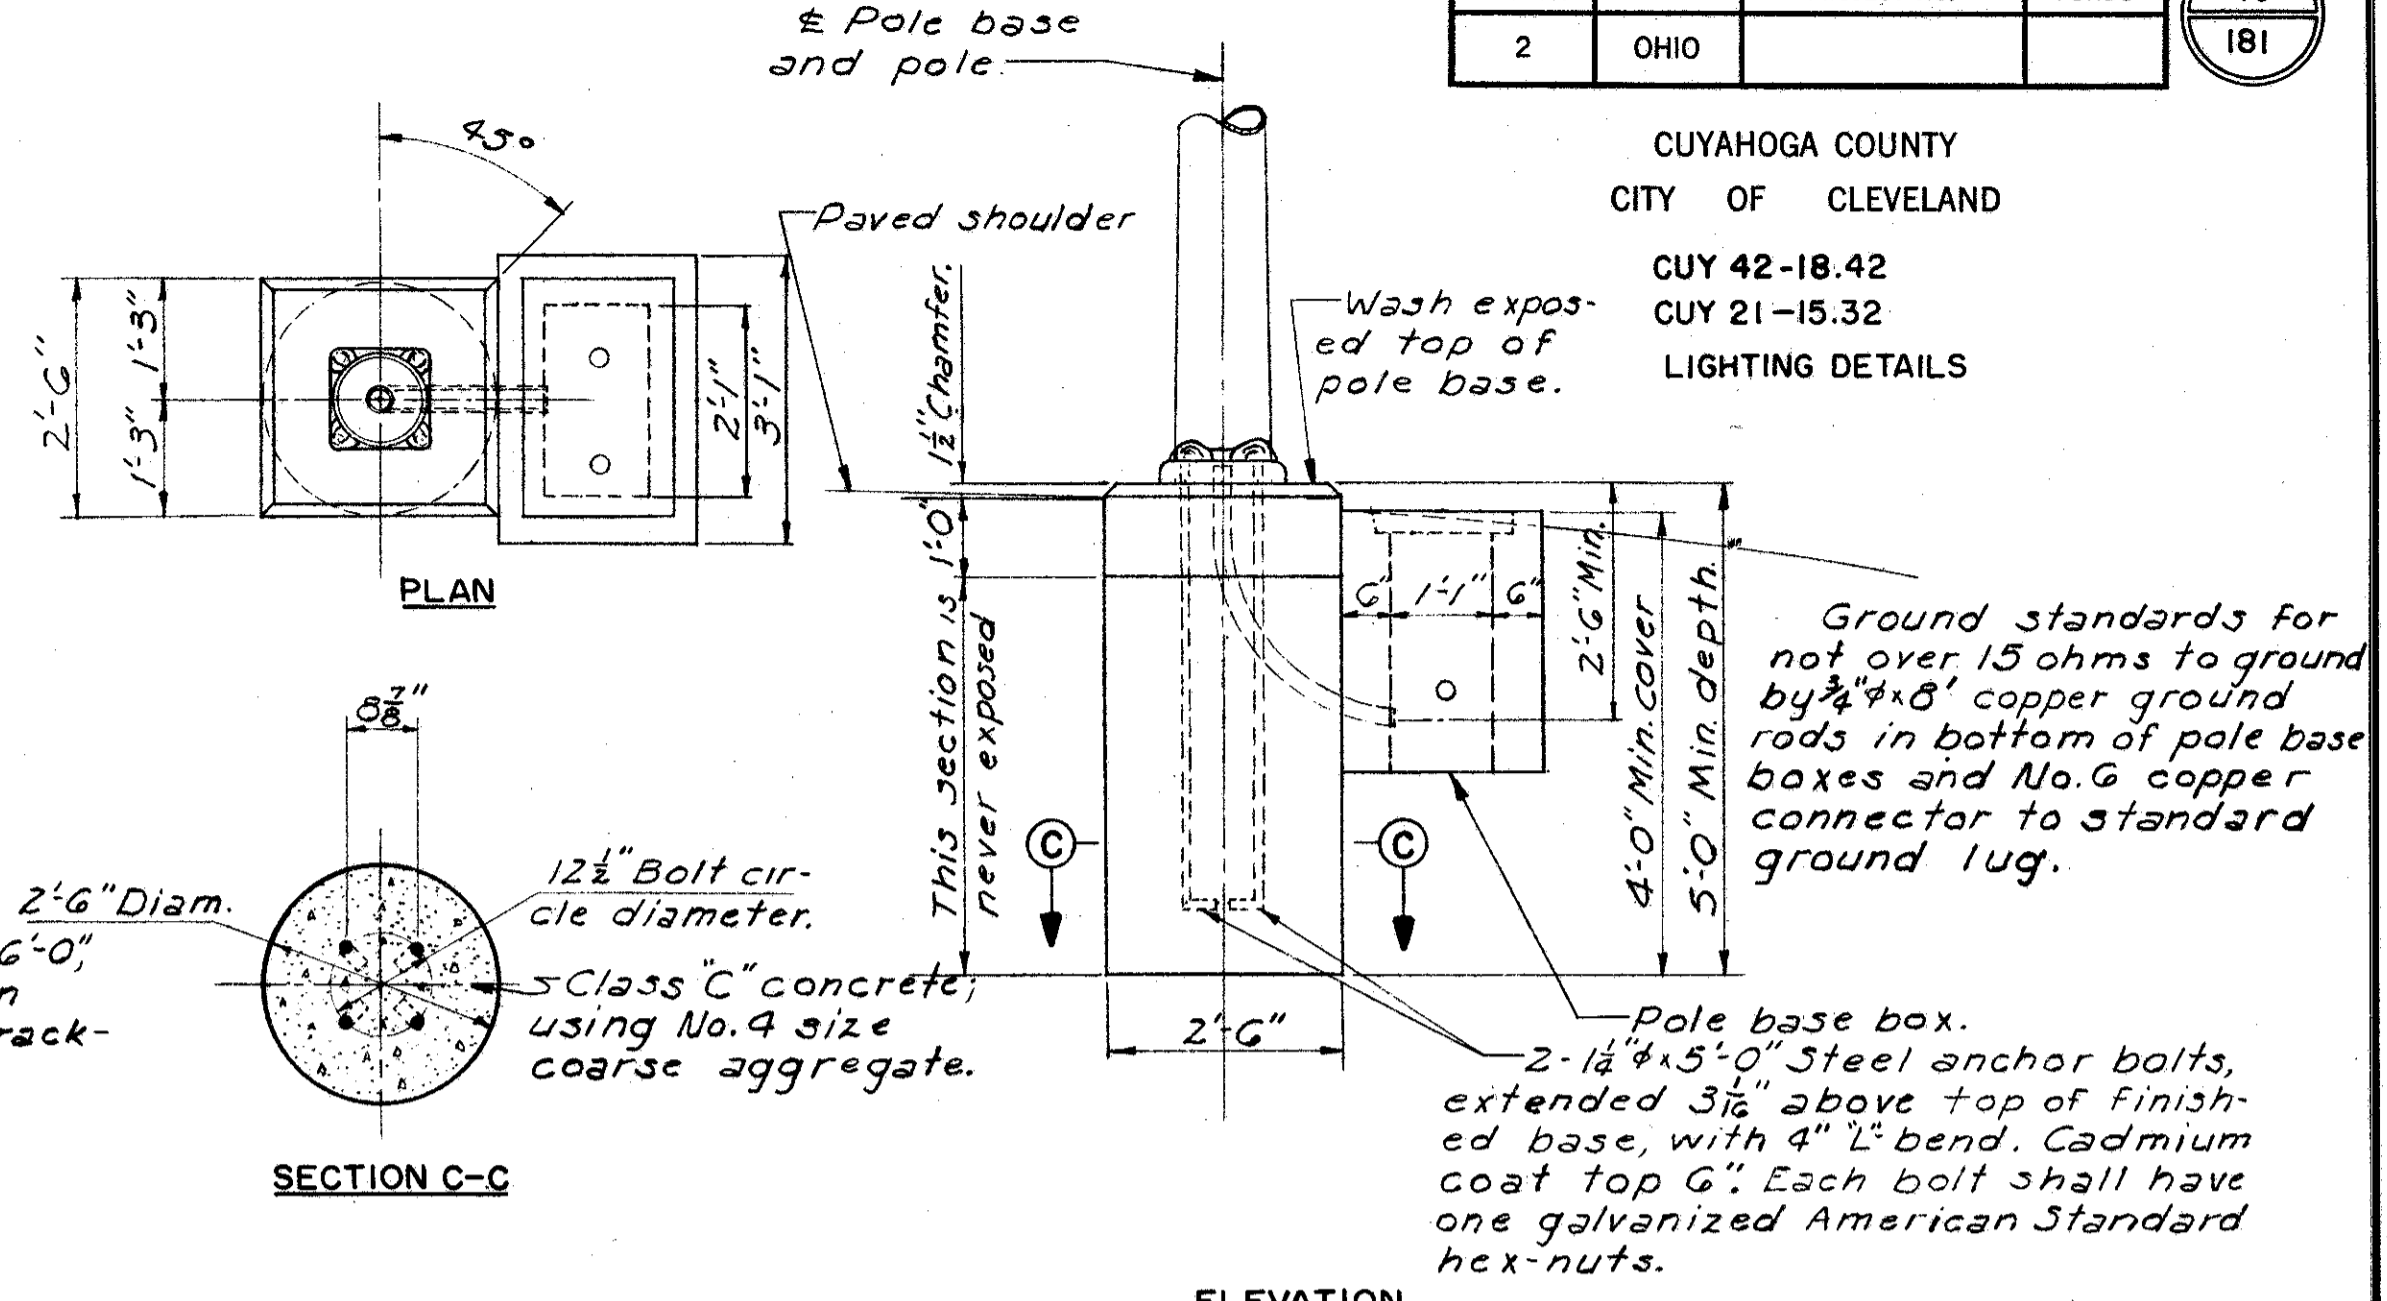


SECTION C-C


TYPICAL POLE BASE
Scale: 1/2" = 1'-0"

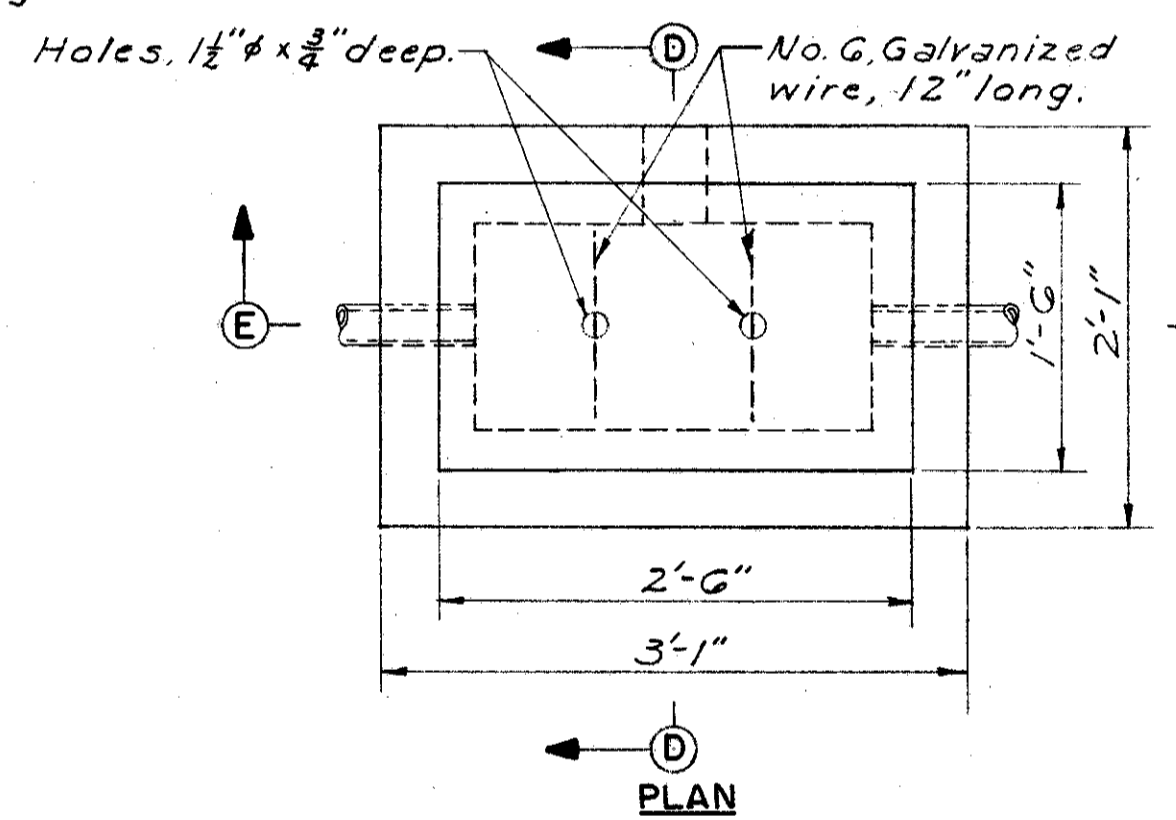

PLAN

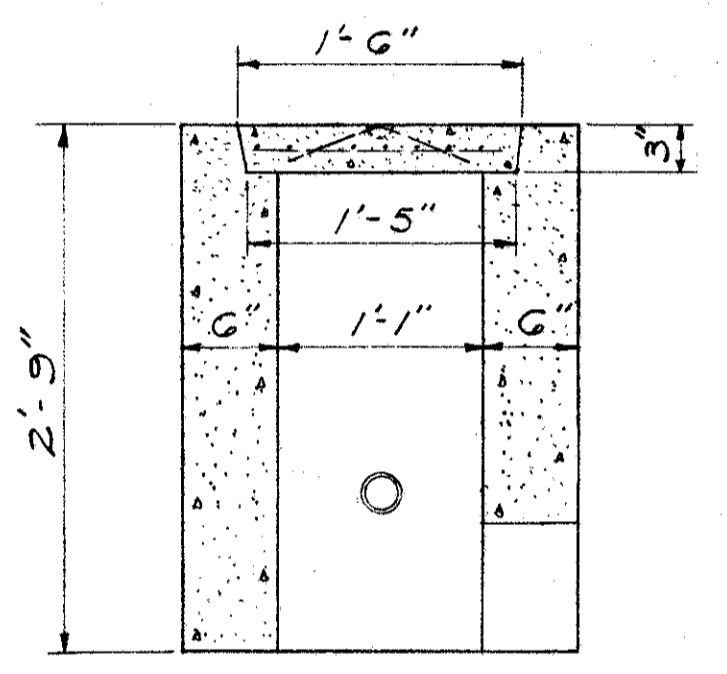

SECTION D-D

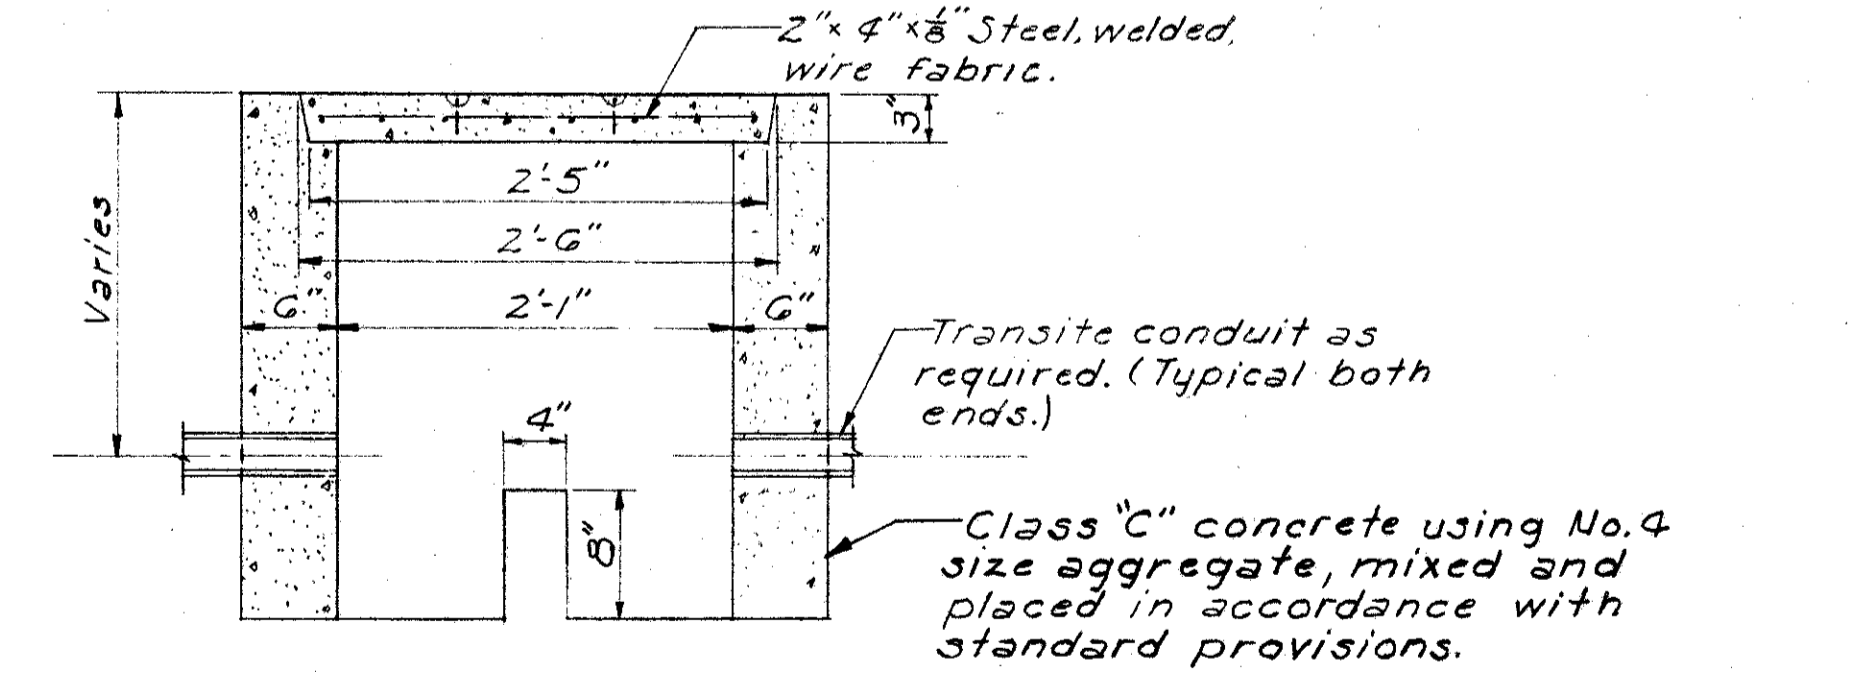


SECTION E-E


CONCRETE PULL BOX
Scale: 1" = 1'-0"

Note:
Pitch ducts to drain toward boxes, manholes and vaults a minimum of 1ft. in 100 ft.
Forms for ducts may be omitted if Engineer considers soil sufficiently firm.


REINFORCING BAR SCHEDULE					
MARK	NO.	LENGTH	TYPE	DIMENSIONS	
				A	B
401	14	8'-8"	105	5'-8"	1'-6"
402	6	3'-8"	104	2'-2"	1'-6"
403	2	3'-2"	104	1'-8"	1'-6"
404	22	11'-8"	105	8'-8"	1'-6"
405	4	4'-9"	104	3'-3"	1'-6"
406	12	3'-3"	Str.		
407	6	6'-0"	Str.		
408	2	1'-9"	Str.		
409	4	2'-3"	Str.		
410	4	9'-0"	Str.		
411	14	5'-6"	Str.		
412	4	4'-11"	104	3'-5"	1'-6"
413	2	5'-10"	121	11"	1'-6"
414	30	6'-3"	Str.		
501	8	3'-6"	Str.		

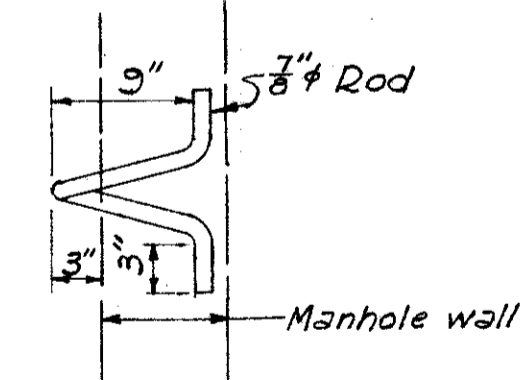


PULLING IRON
No Scale

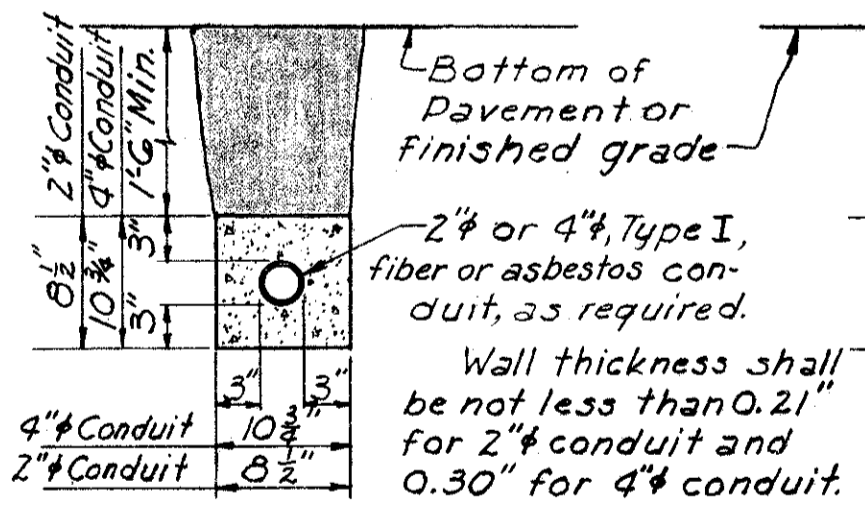


ONE-WAY DUCT BANK
Scale: 1" = 1'-0"

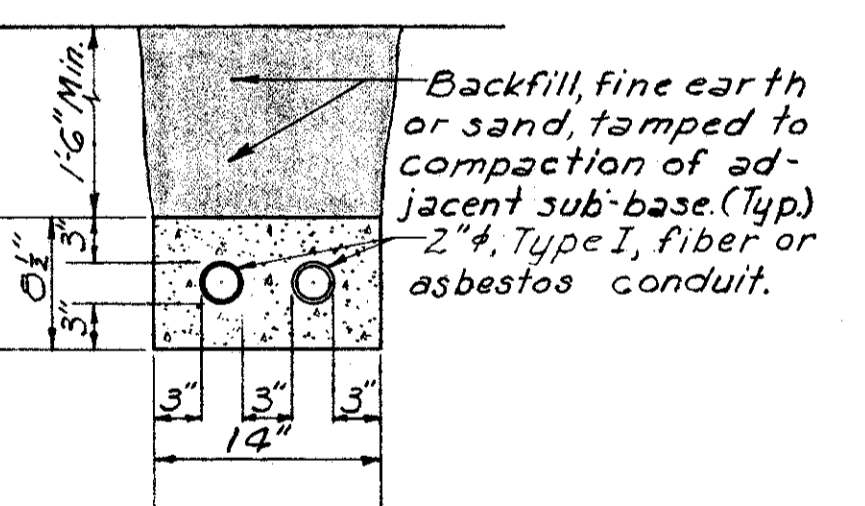

TWO-WAY DUCT BANK
Scale: 1" = 1'-0"

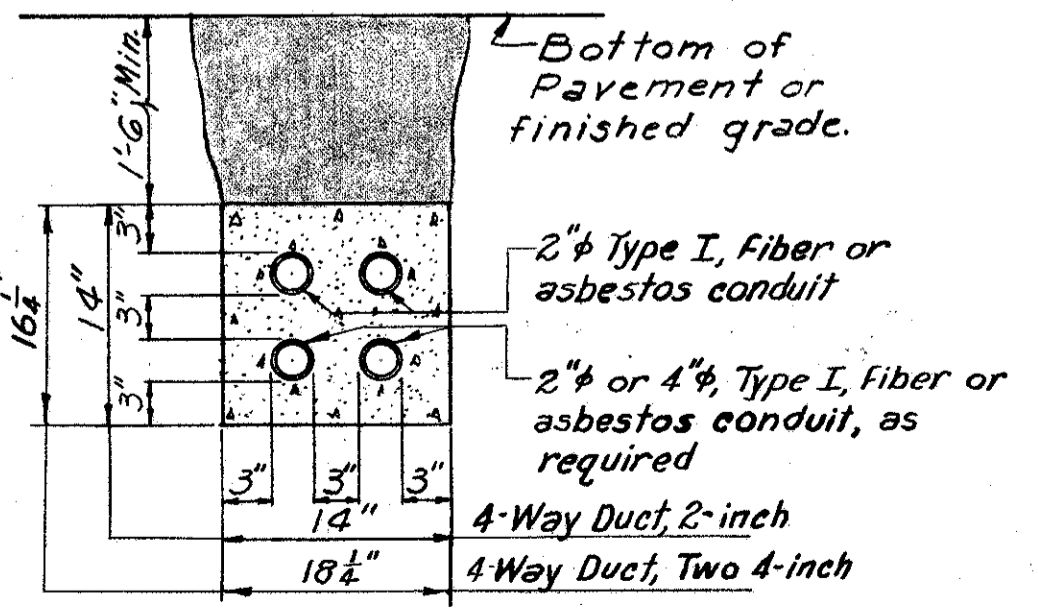

FOUR-WAY DUCT BANK
Scale: 1" = 1'-0"

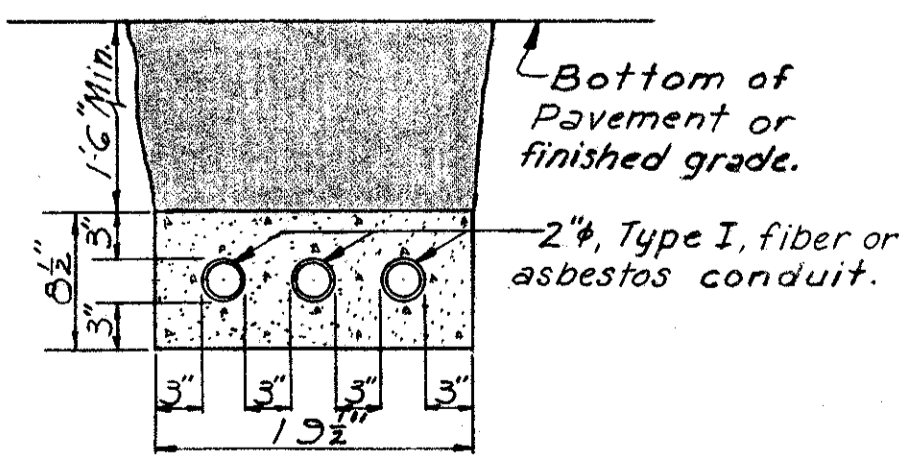


THREE-WAY DUCT BANK
Scale: 1" = 1'-0"

FED. ROAD DIV. NO.	STATE	FEDERAL AID PROJECT NO.	TYPE FUNDS
2	OHIO		

50
181


CUYAHOGA COUNTY
CITY OF CLEVELAND
CUY 42-18.42
CUY 21-15.32

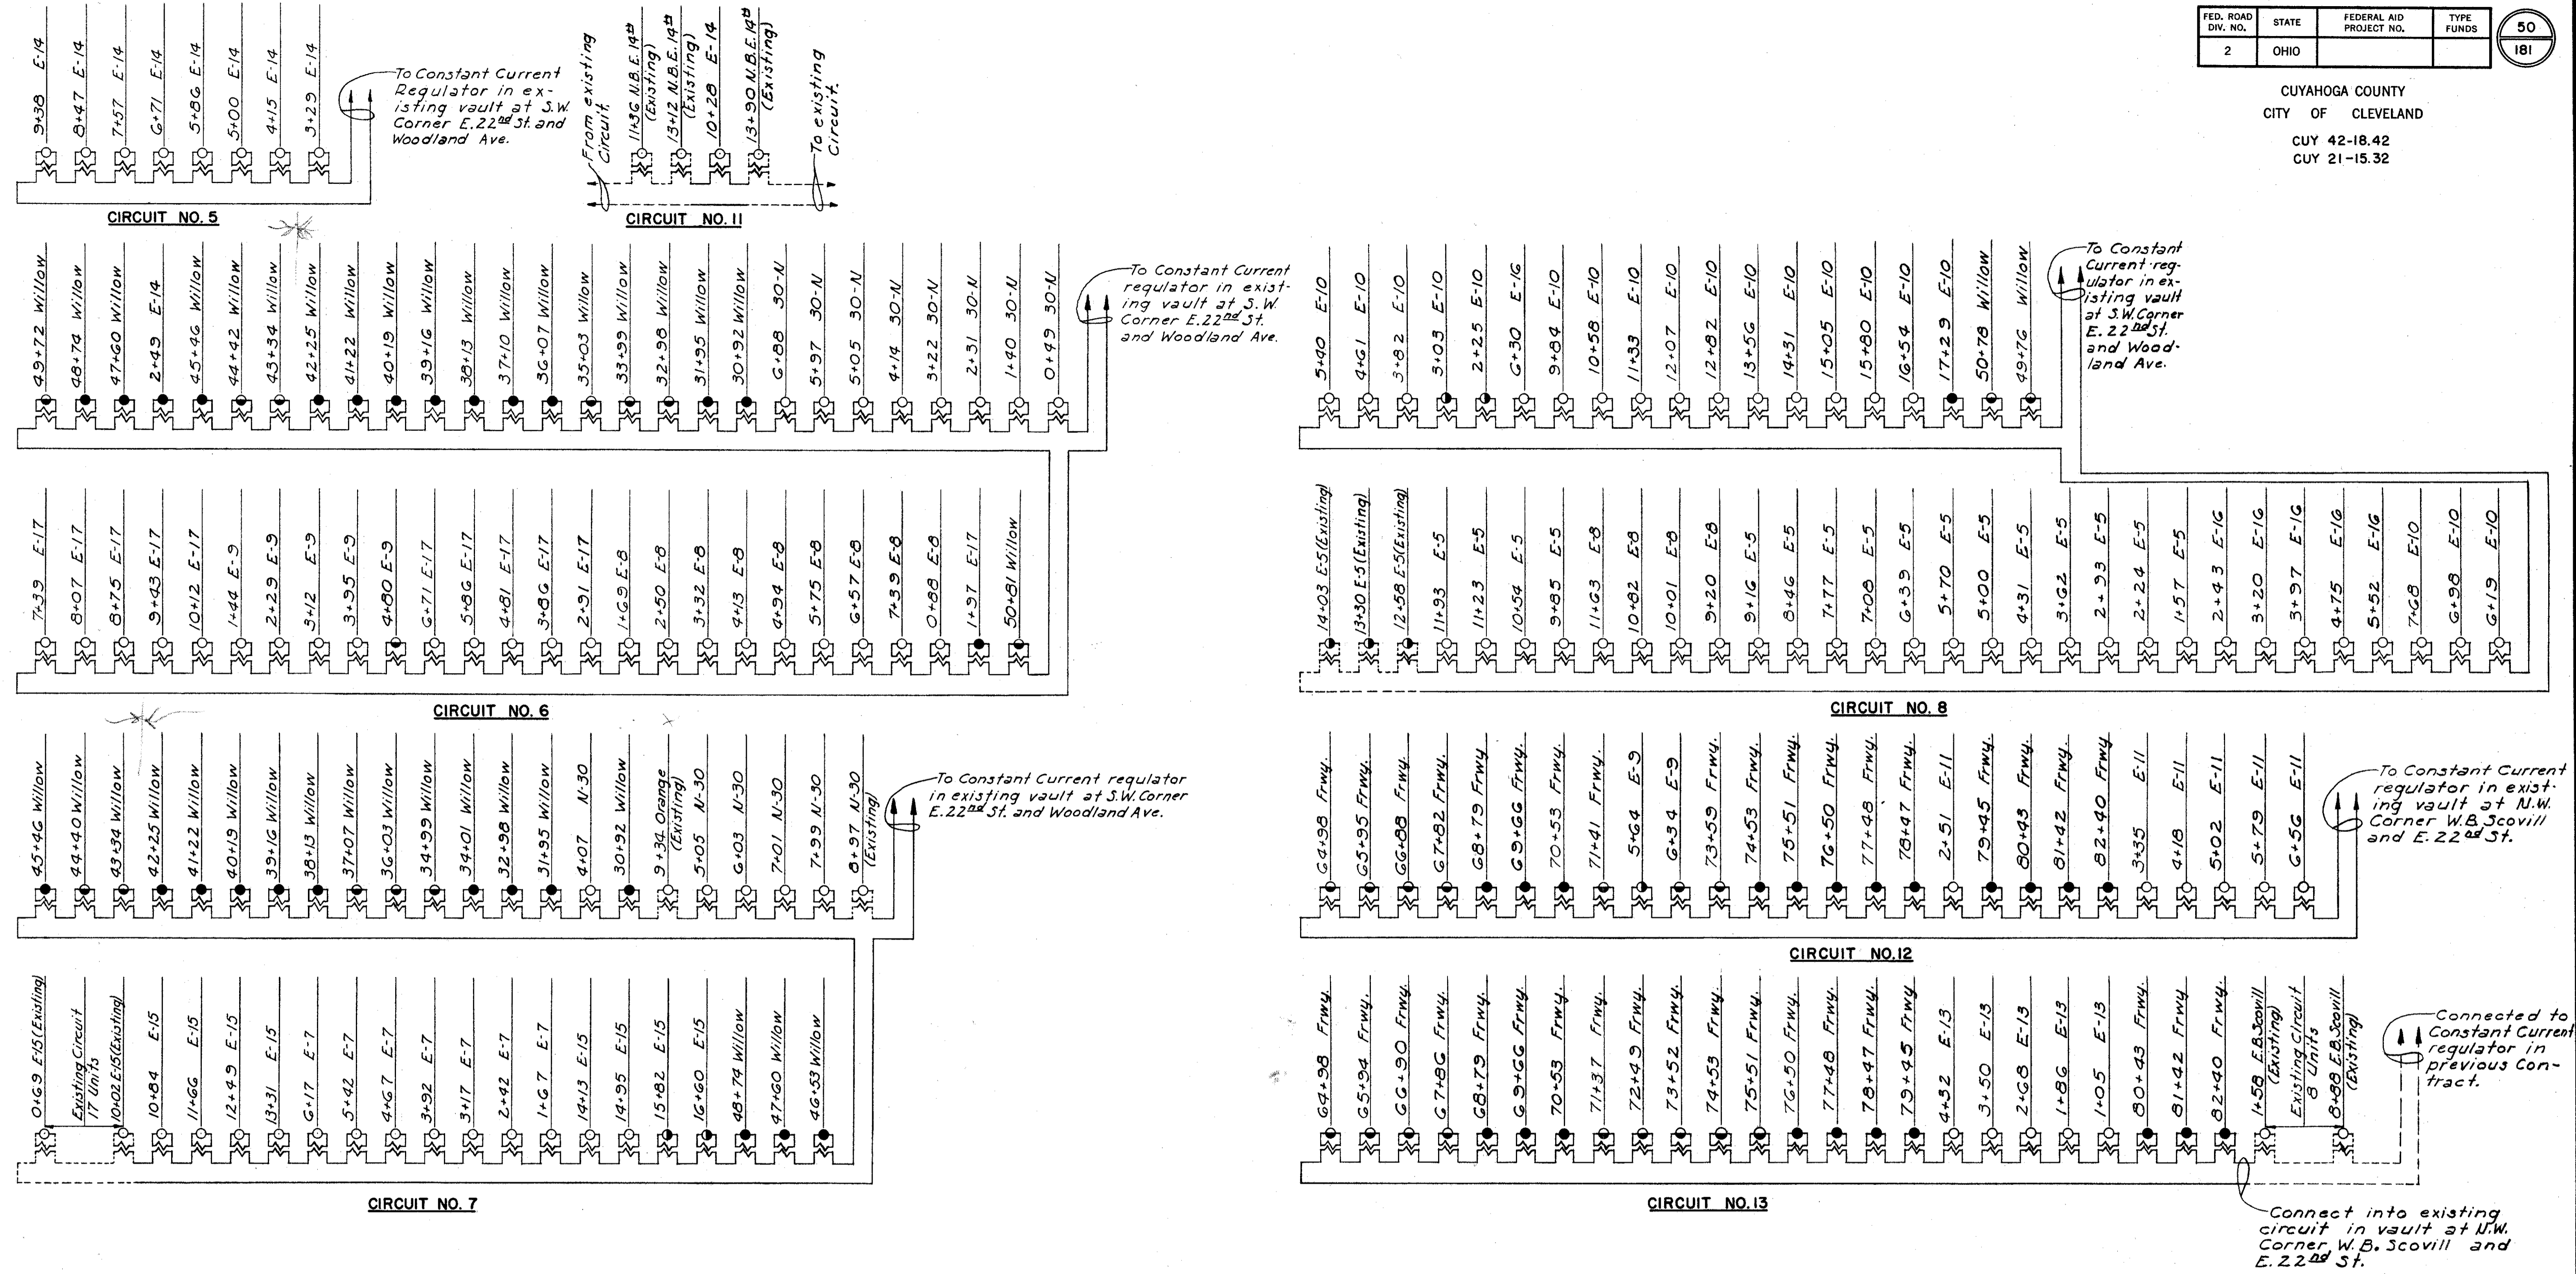


Note: Where Contractor connects with existing ducts, provide coupling and install wiring to next lighting unit.

FED. ROAD DIV. NO.	STATE	FEDERAL AID PROJECT NO.	TYPE FUNDS	51 181
2	OHIO			


CUYAHOGA COUNTY
CITY OF CLEVELAND
CUY-42-18.42
CUY-21-15.32
UNDERDECK LIGHTING

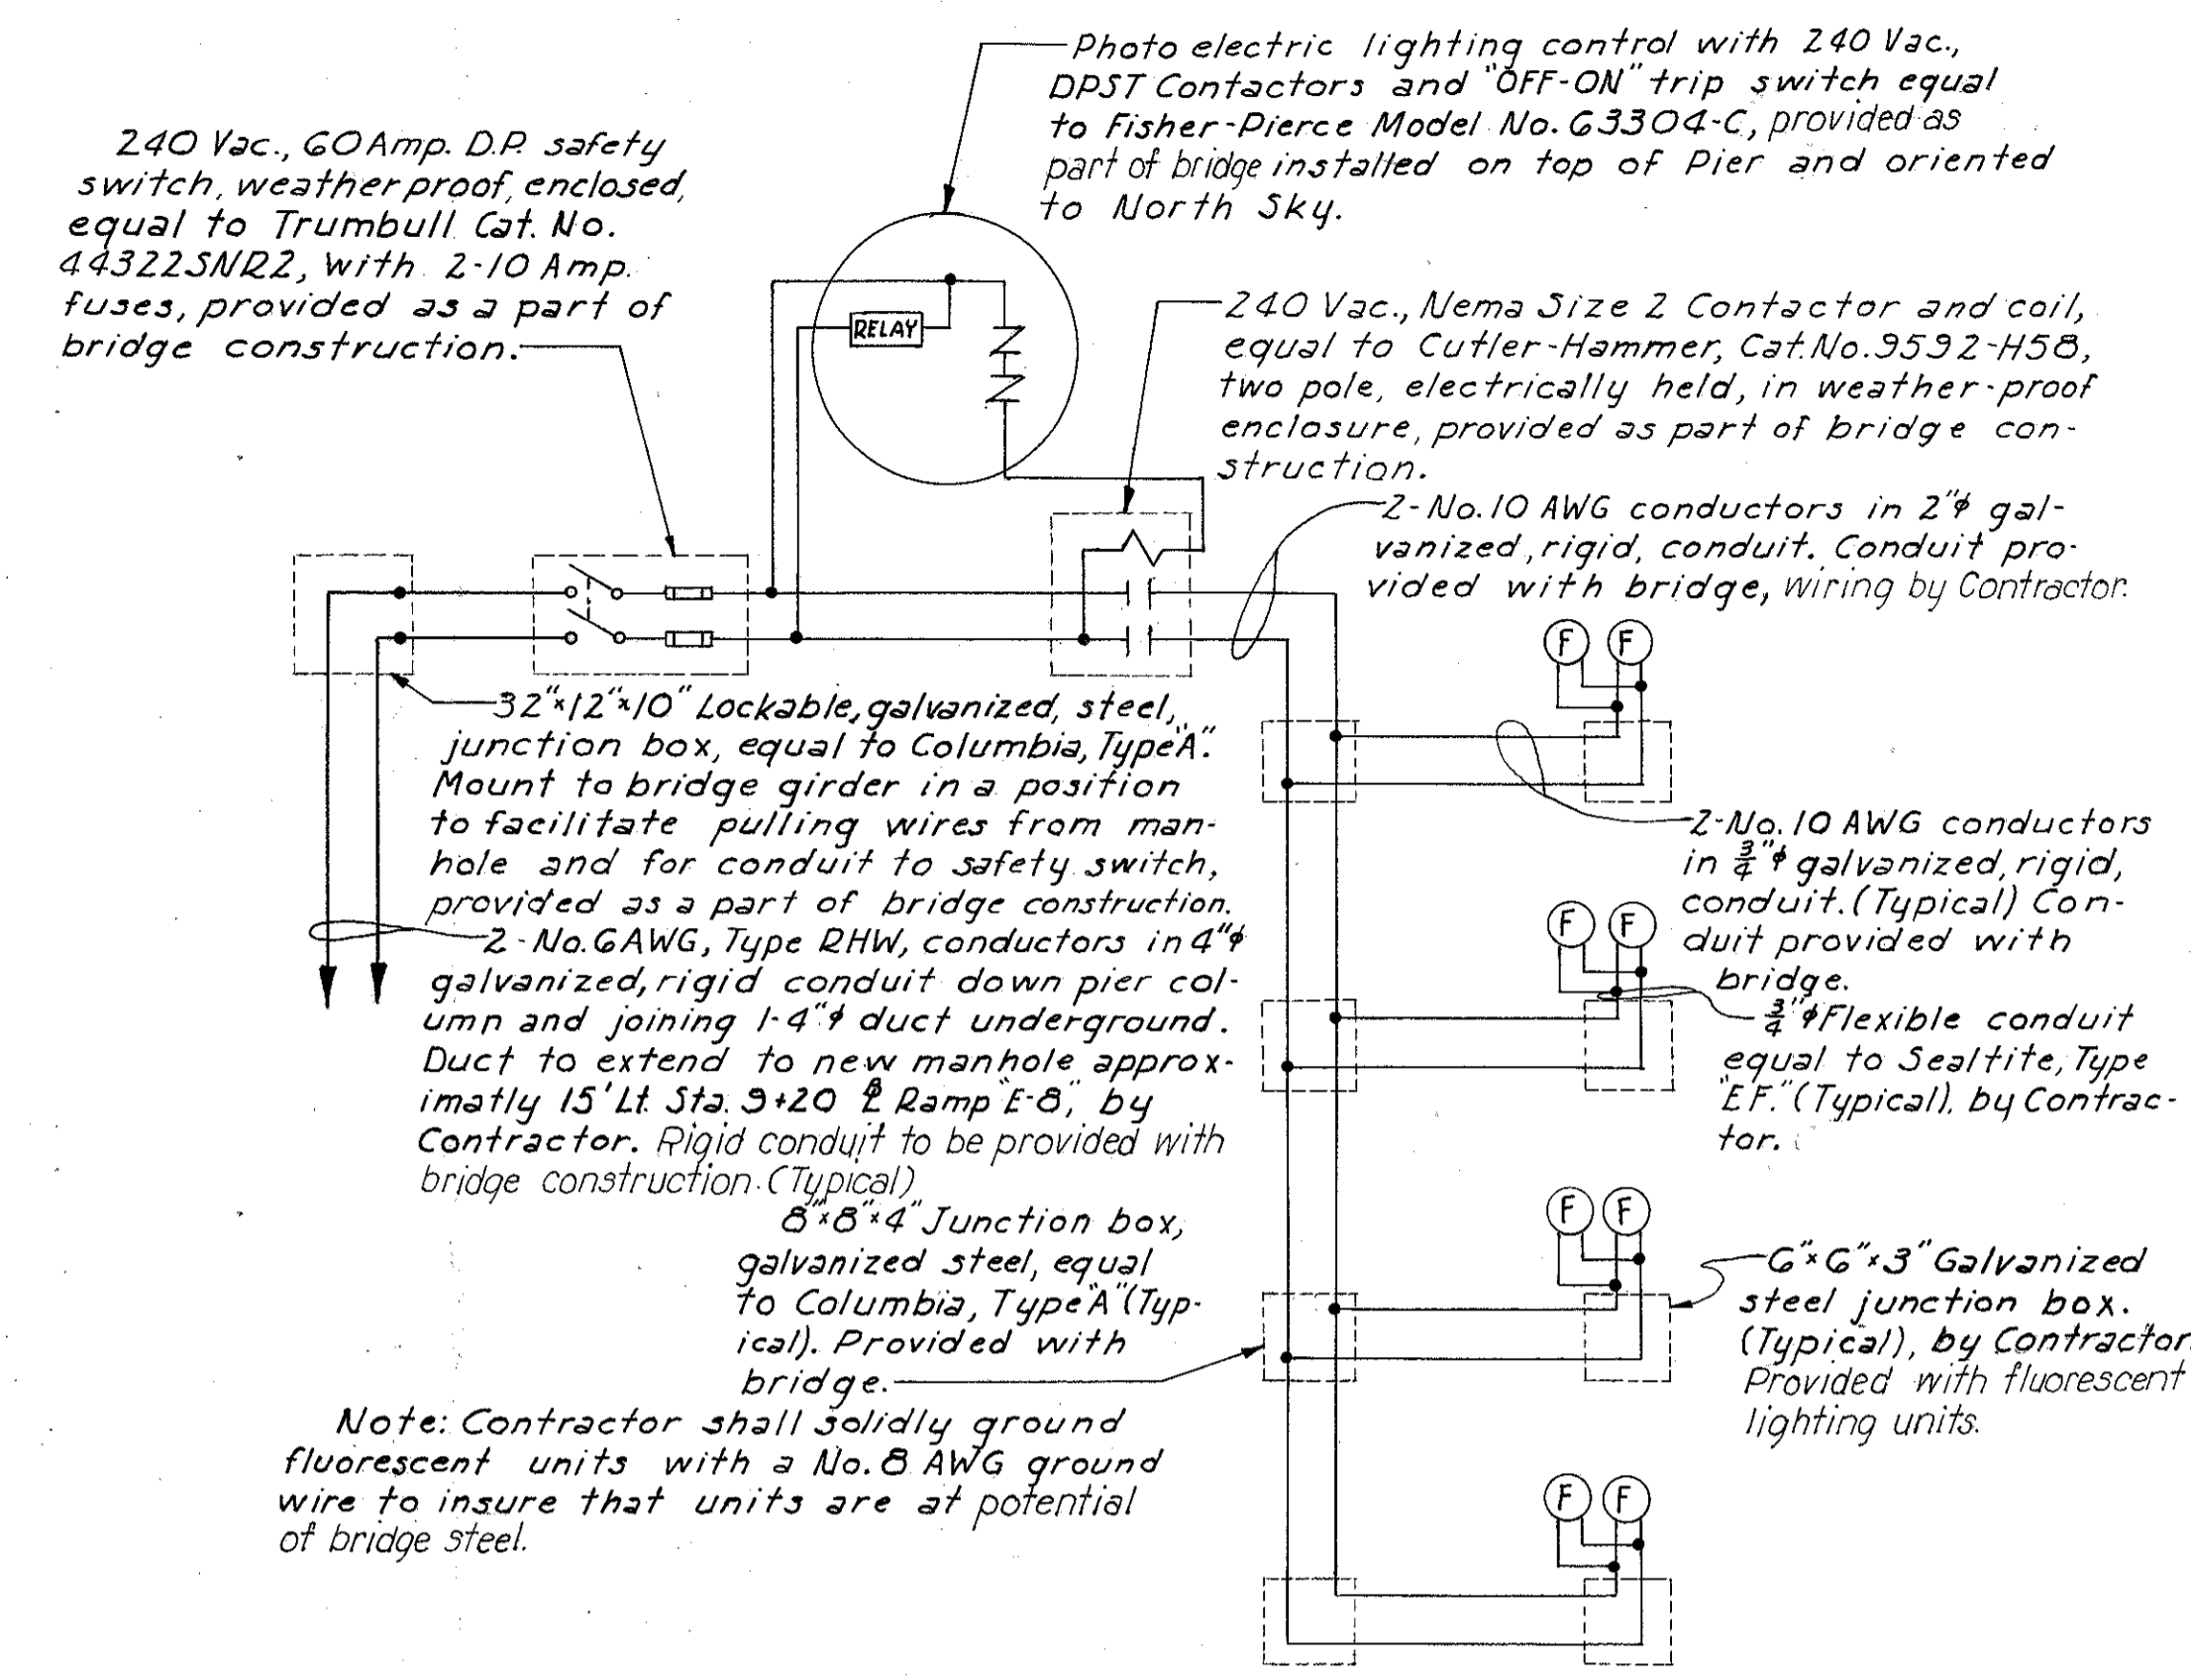


BRIDGE NO. 3 UNDERDECK LIGHTING
WIRING DIAGRAM
No Scale

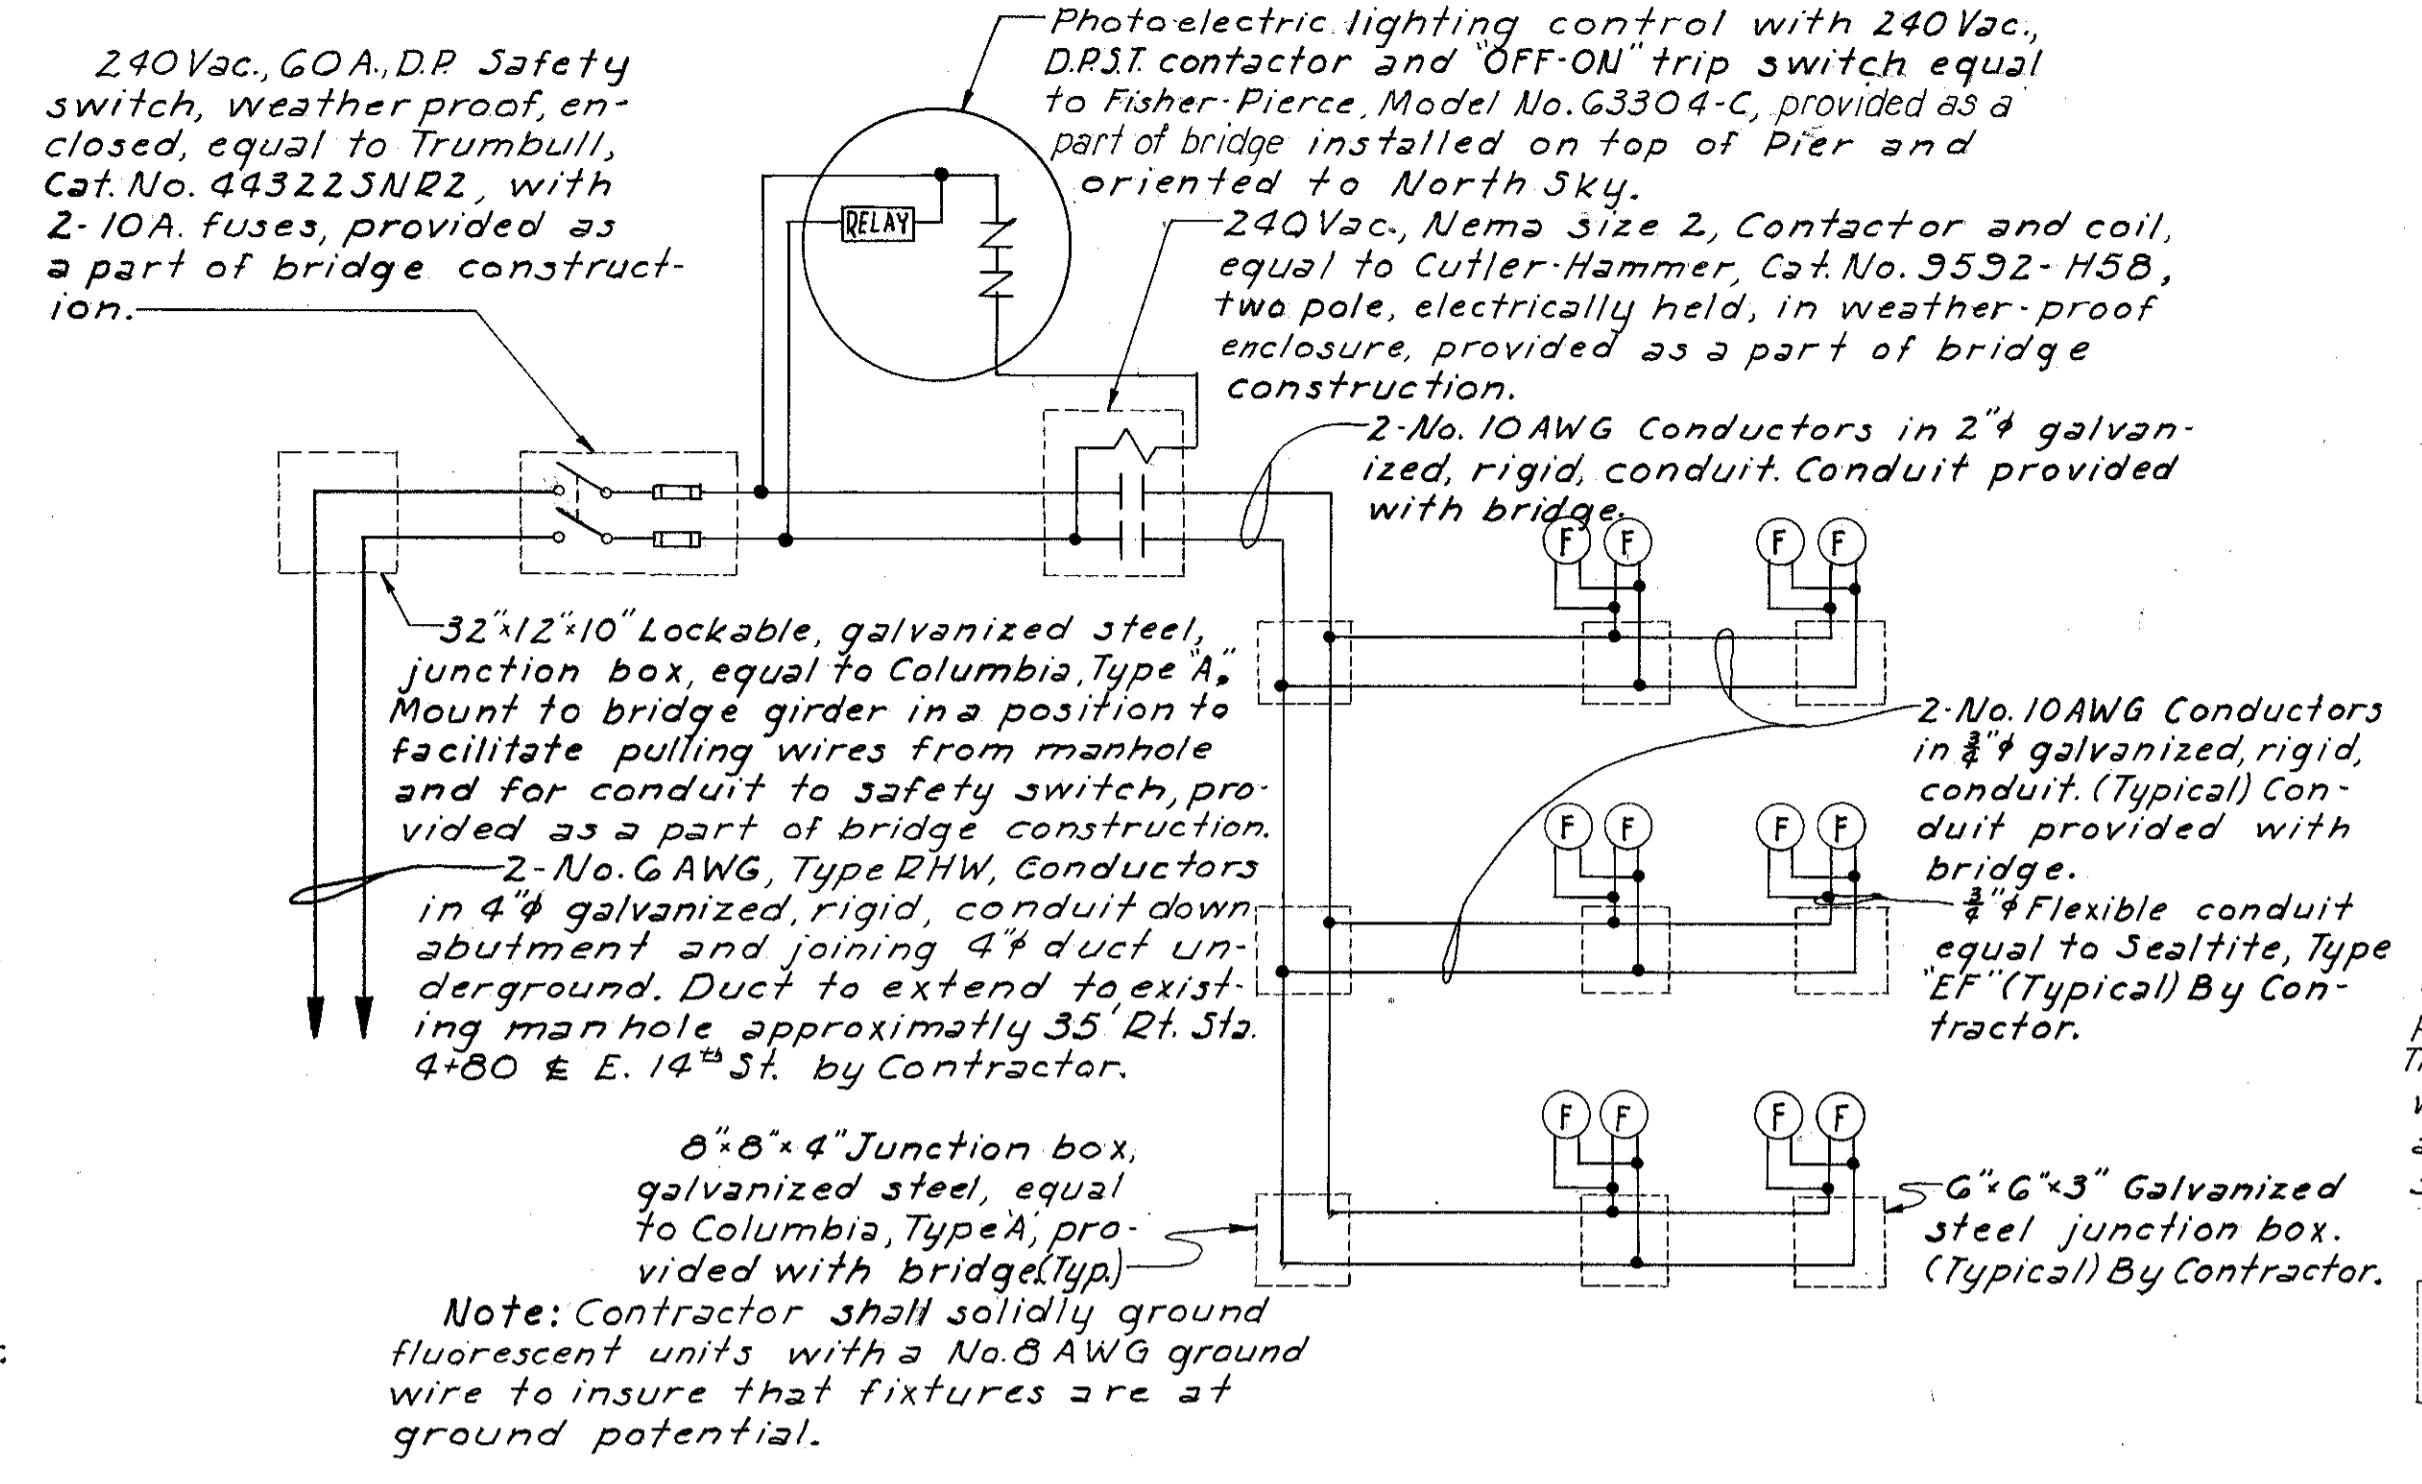


BRIDGE NO. 8&9 UNDERDECK LIGHTING
WIRING DIAGRAM
No Scale

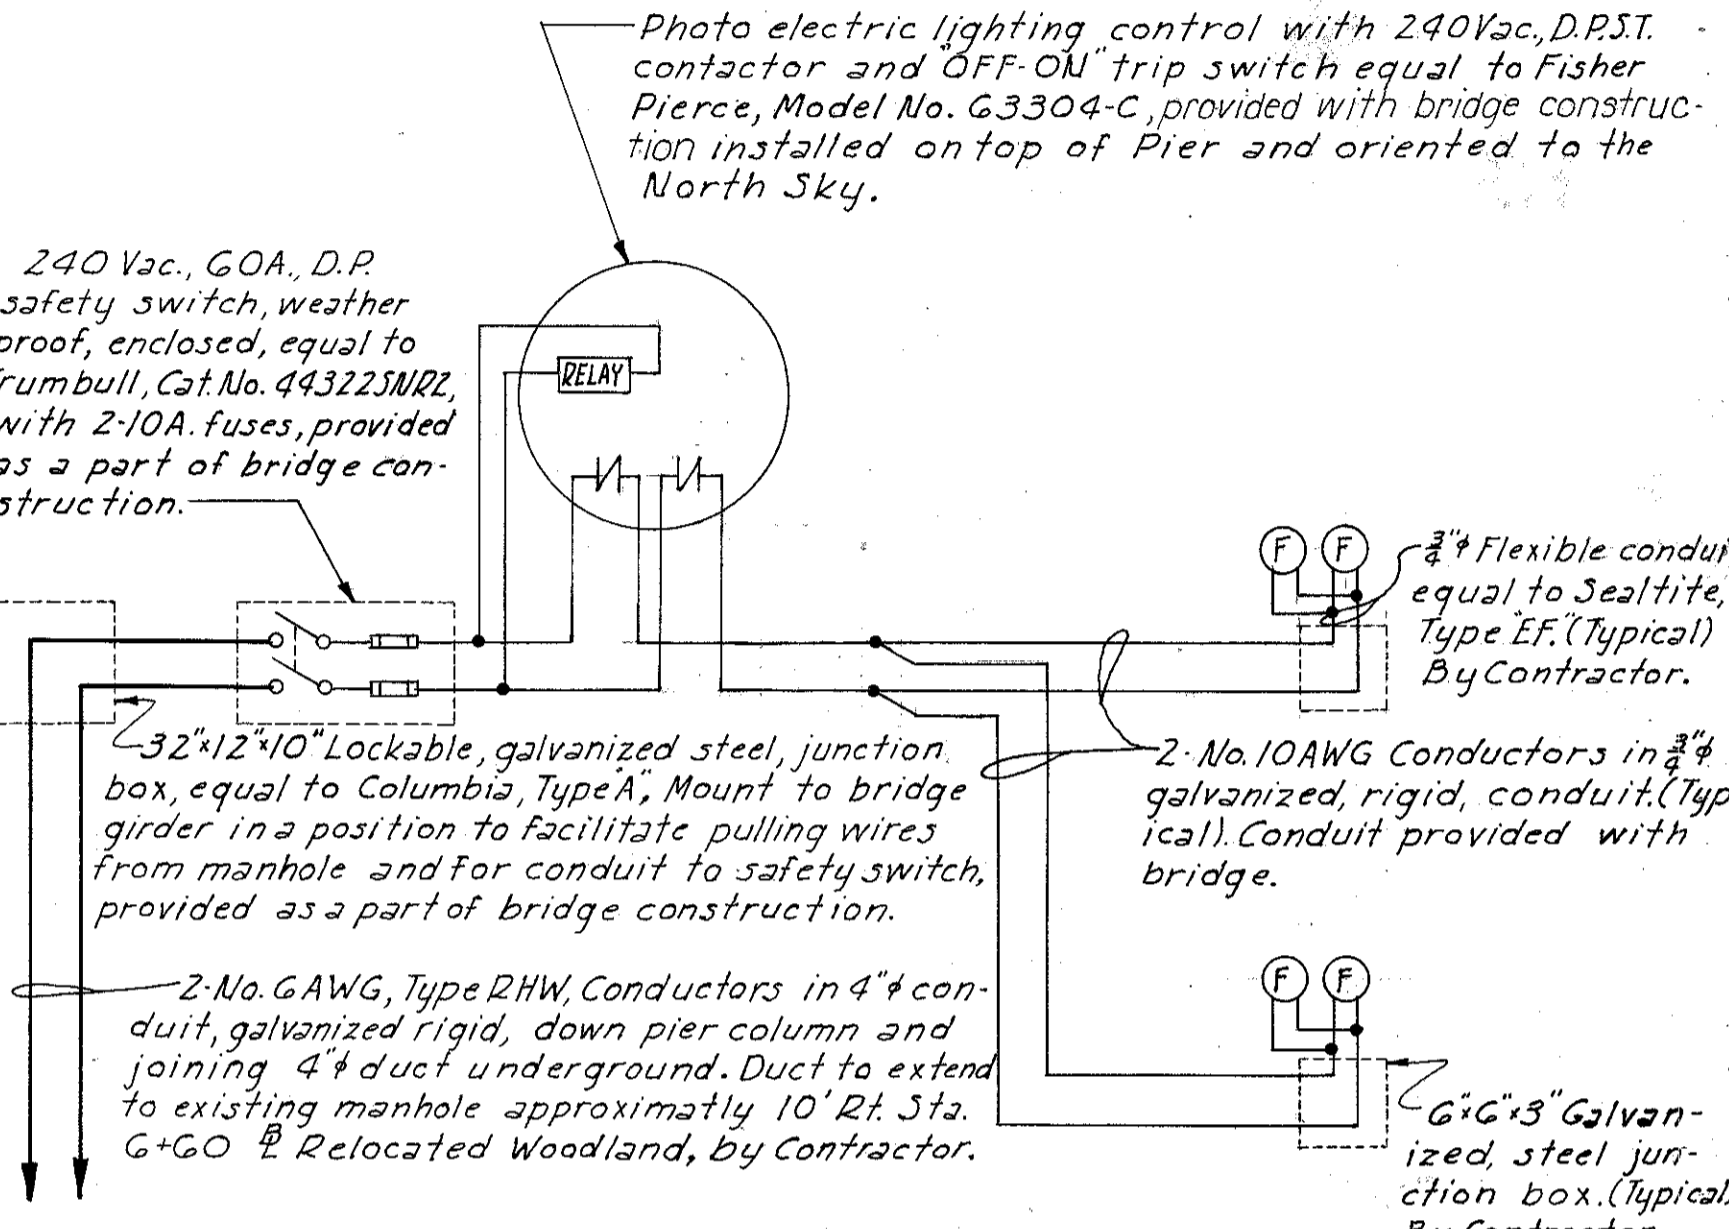

BRIDGE NO. 11 UNDERDECK LIGHTING
WIRING DIAGRAM
No Scale

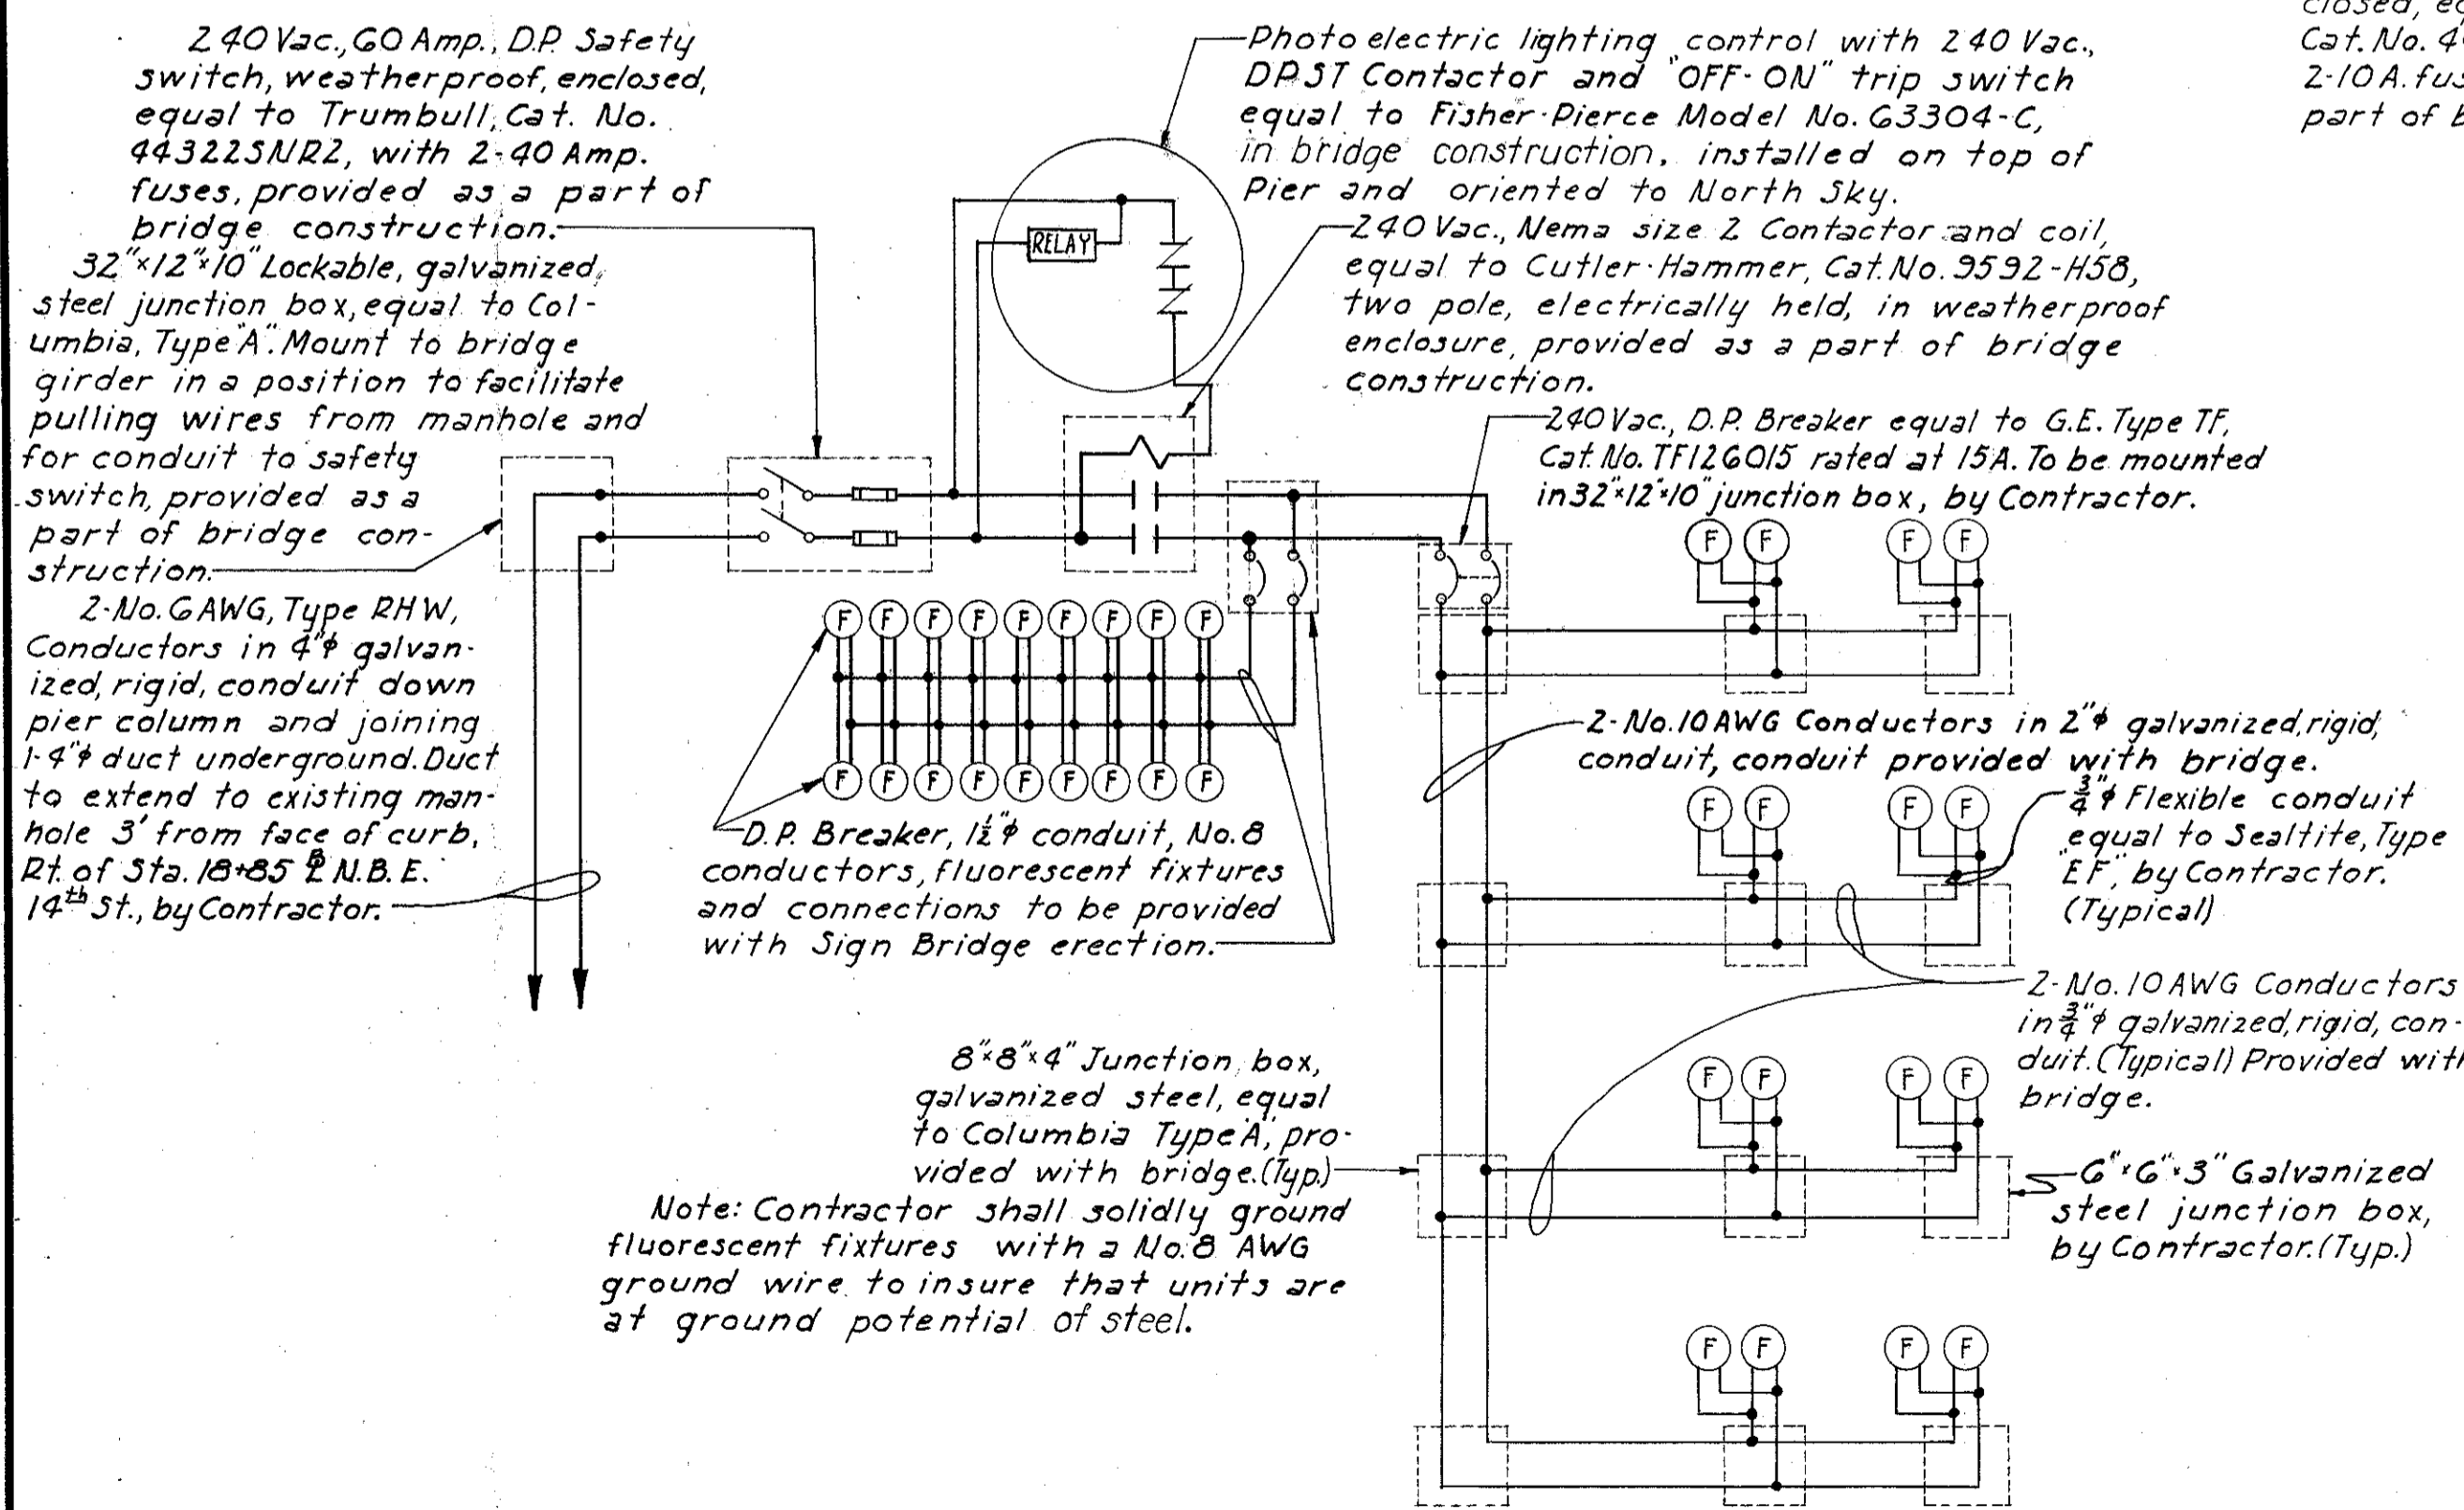


BRIDGE NO. 4 UNDERDECK LIGHTING
WIRING DIAGRAM
No Scale

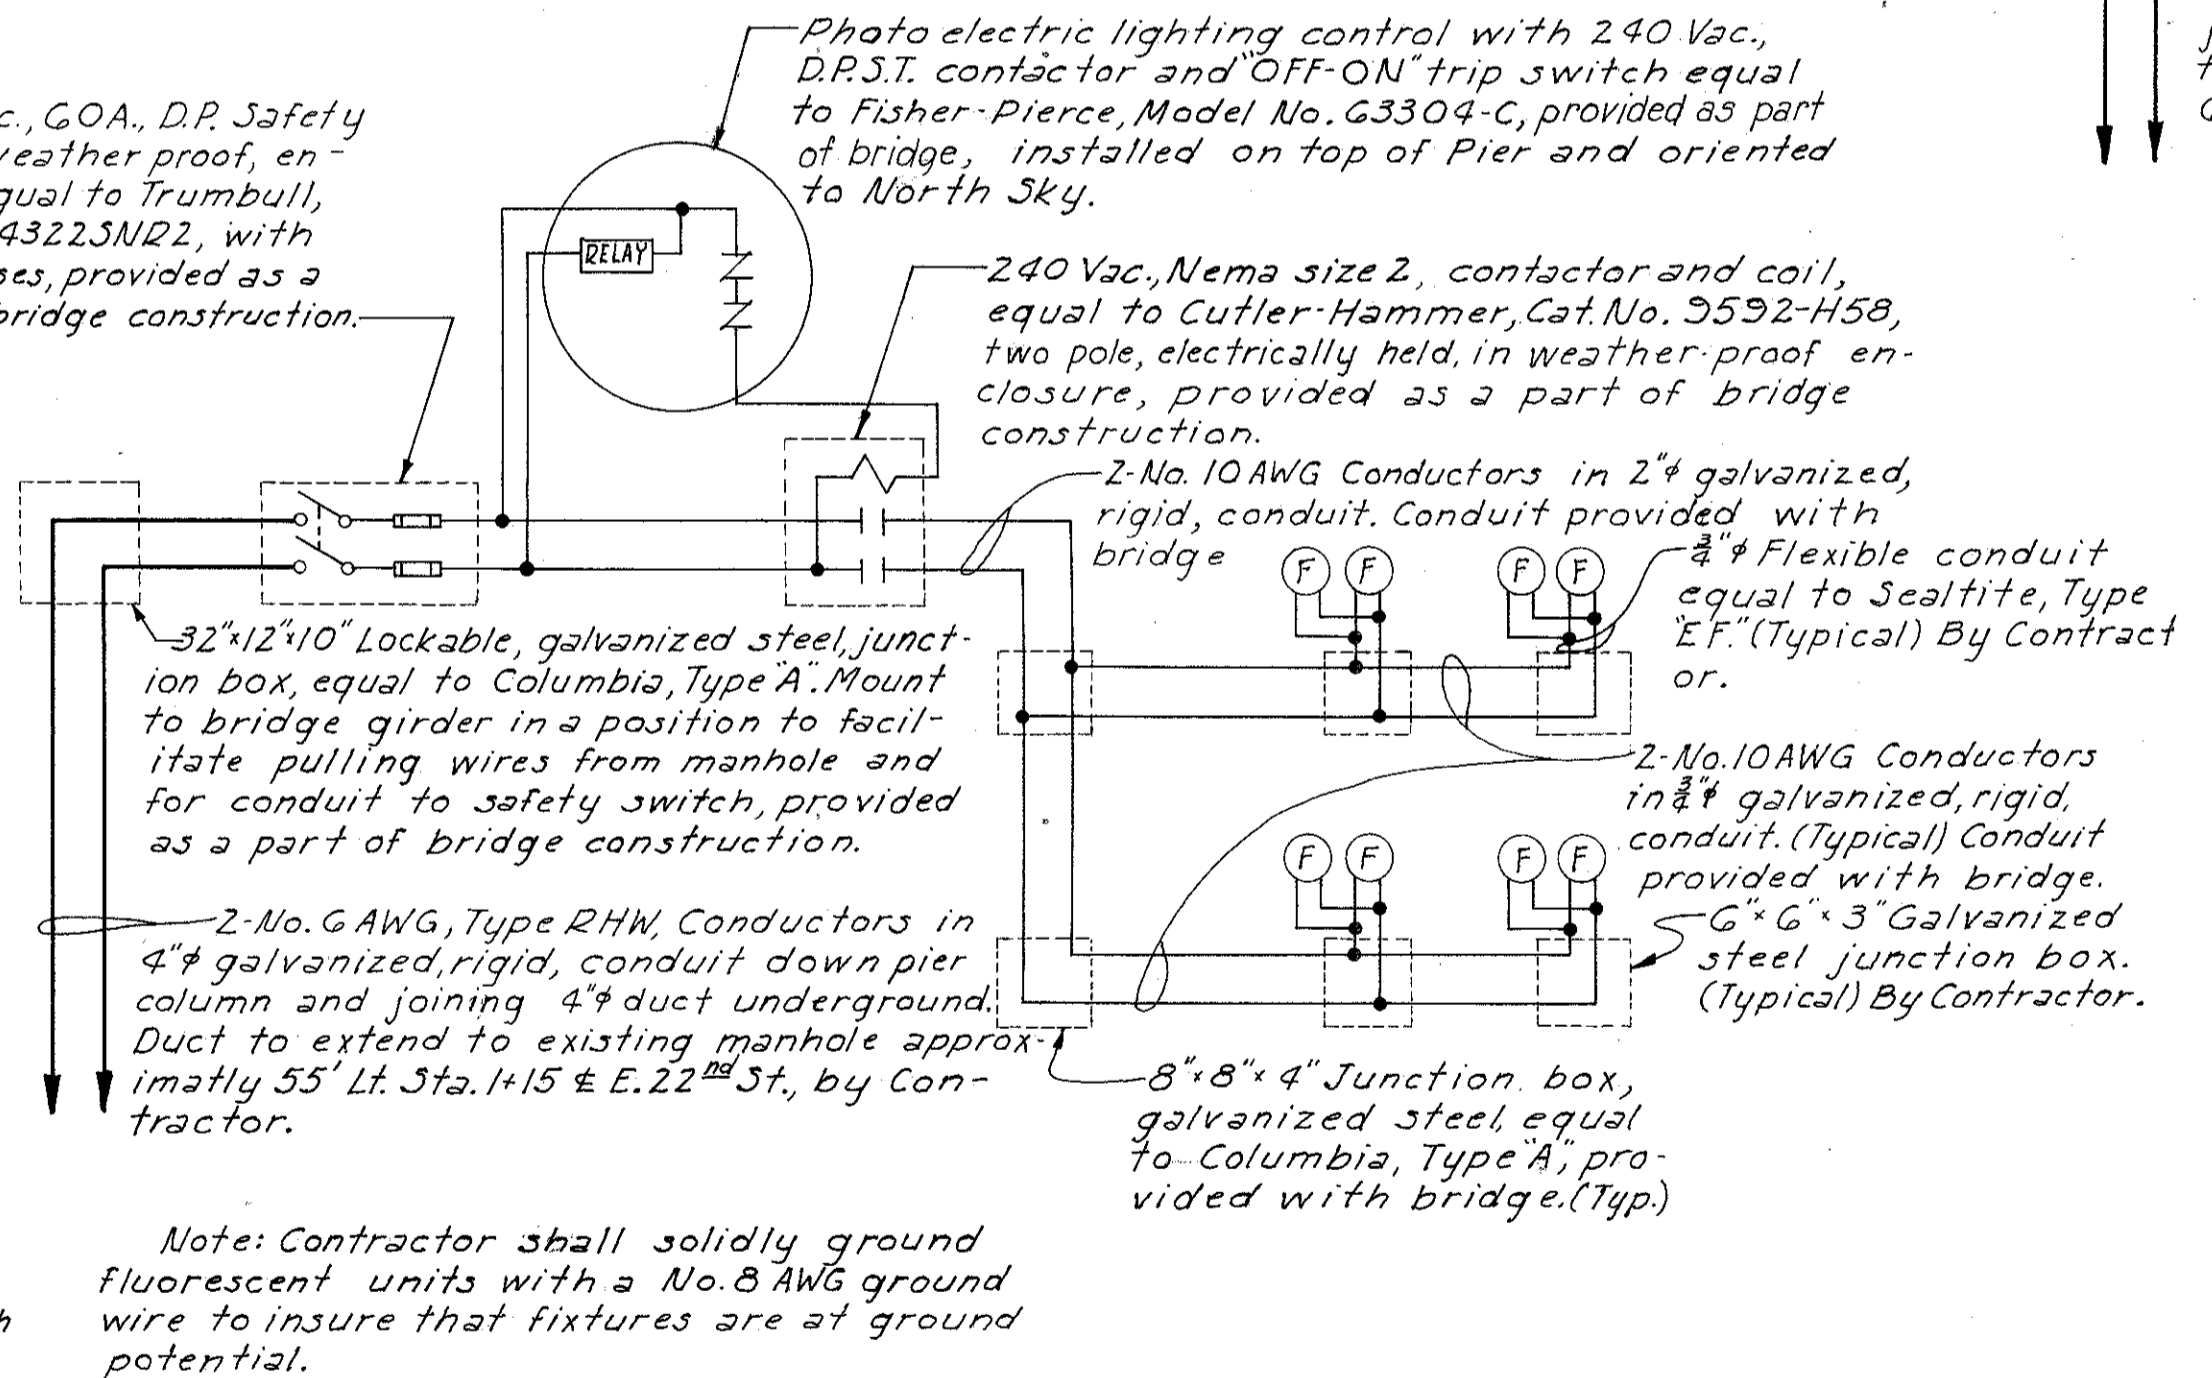

BRIDGE NO. 10 UNDERDECK LIGHTING
WIRING DIAGRAM
No Scale




CUYAHOGA COUNTY
CITY OF CLEVELAND
CUY - 42 - 18.42
CUY - 21 - 15.32

Appropriate handles to be installed in each half cover for lifting. After use handle should slip into holes and be flush with surface of cover.


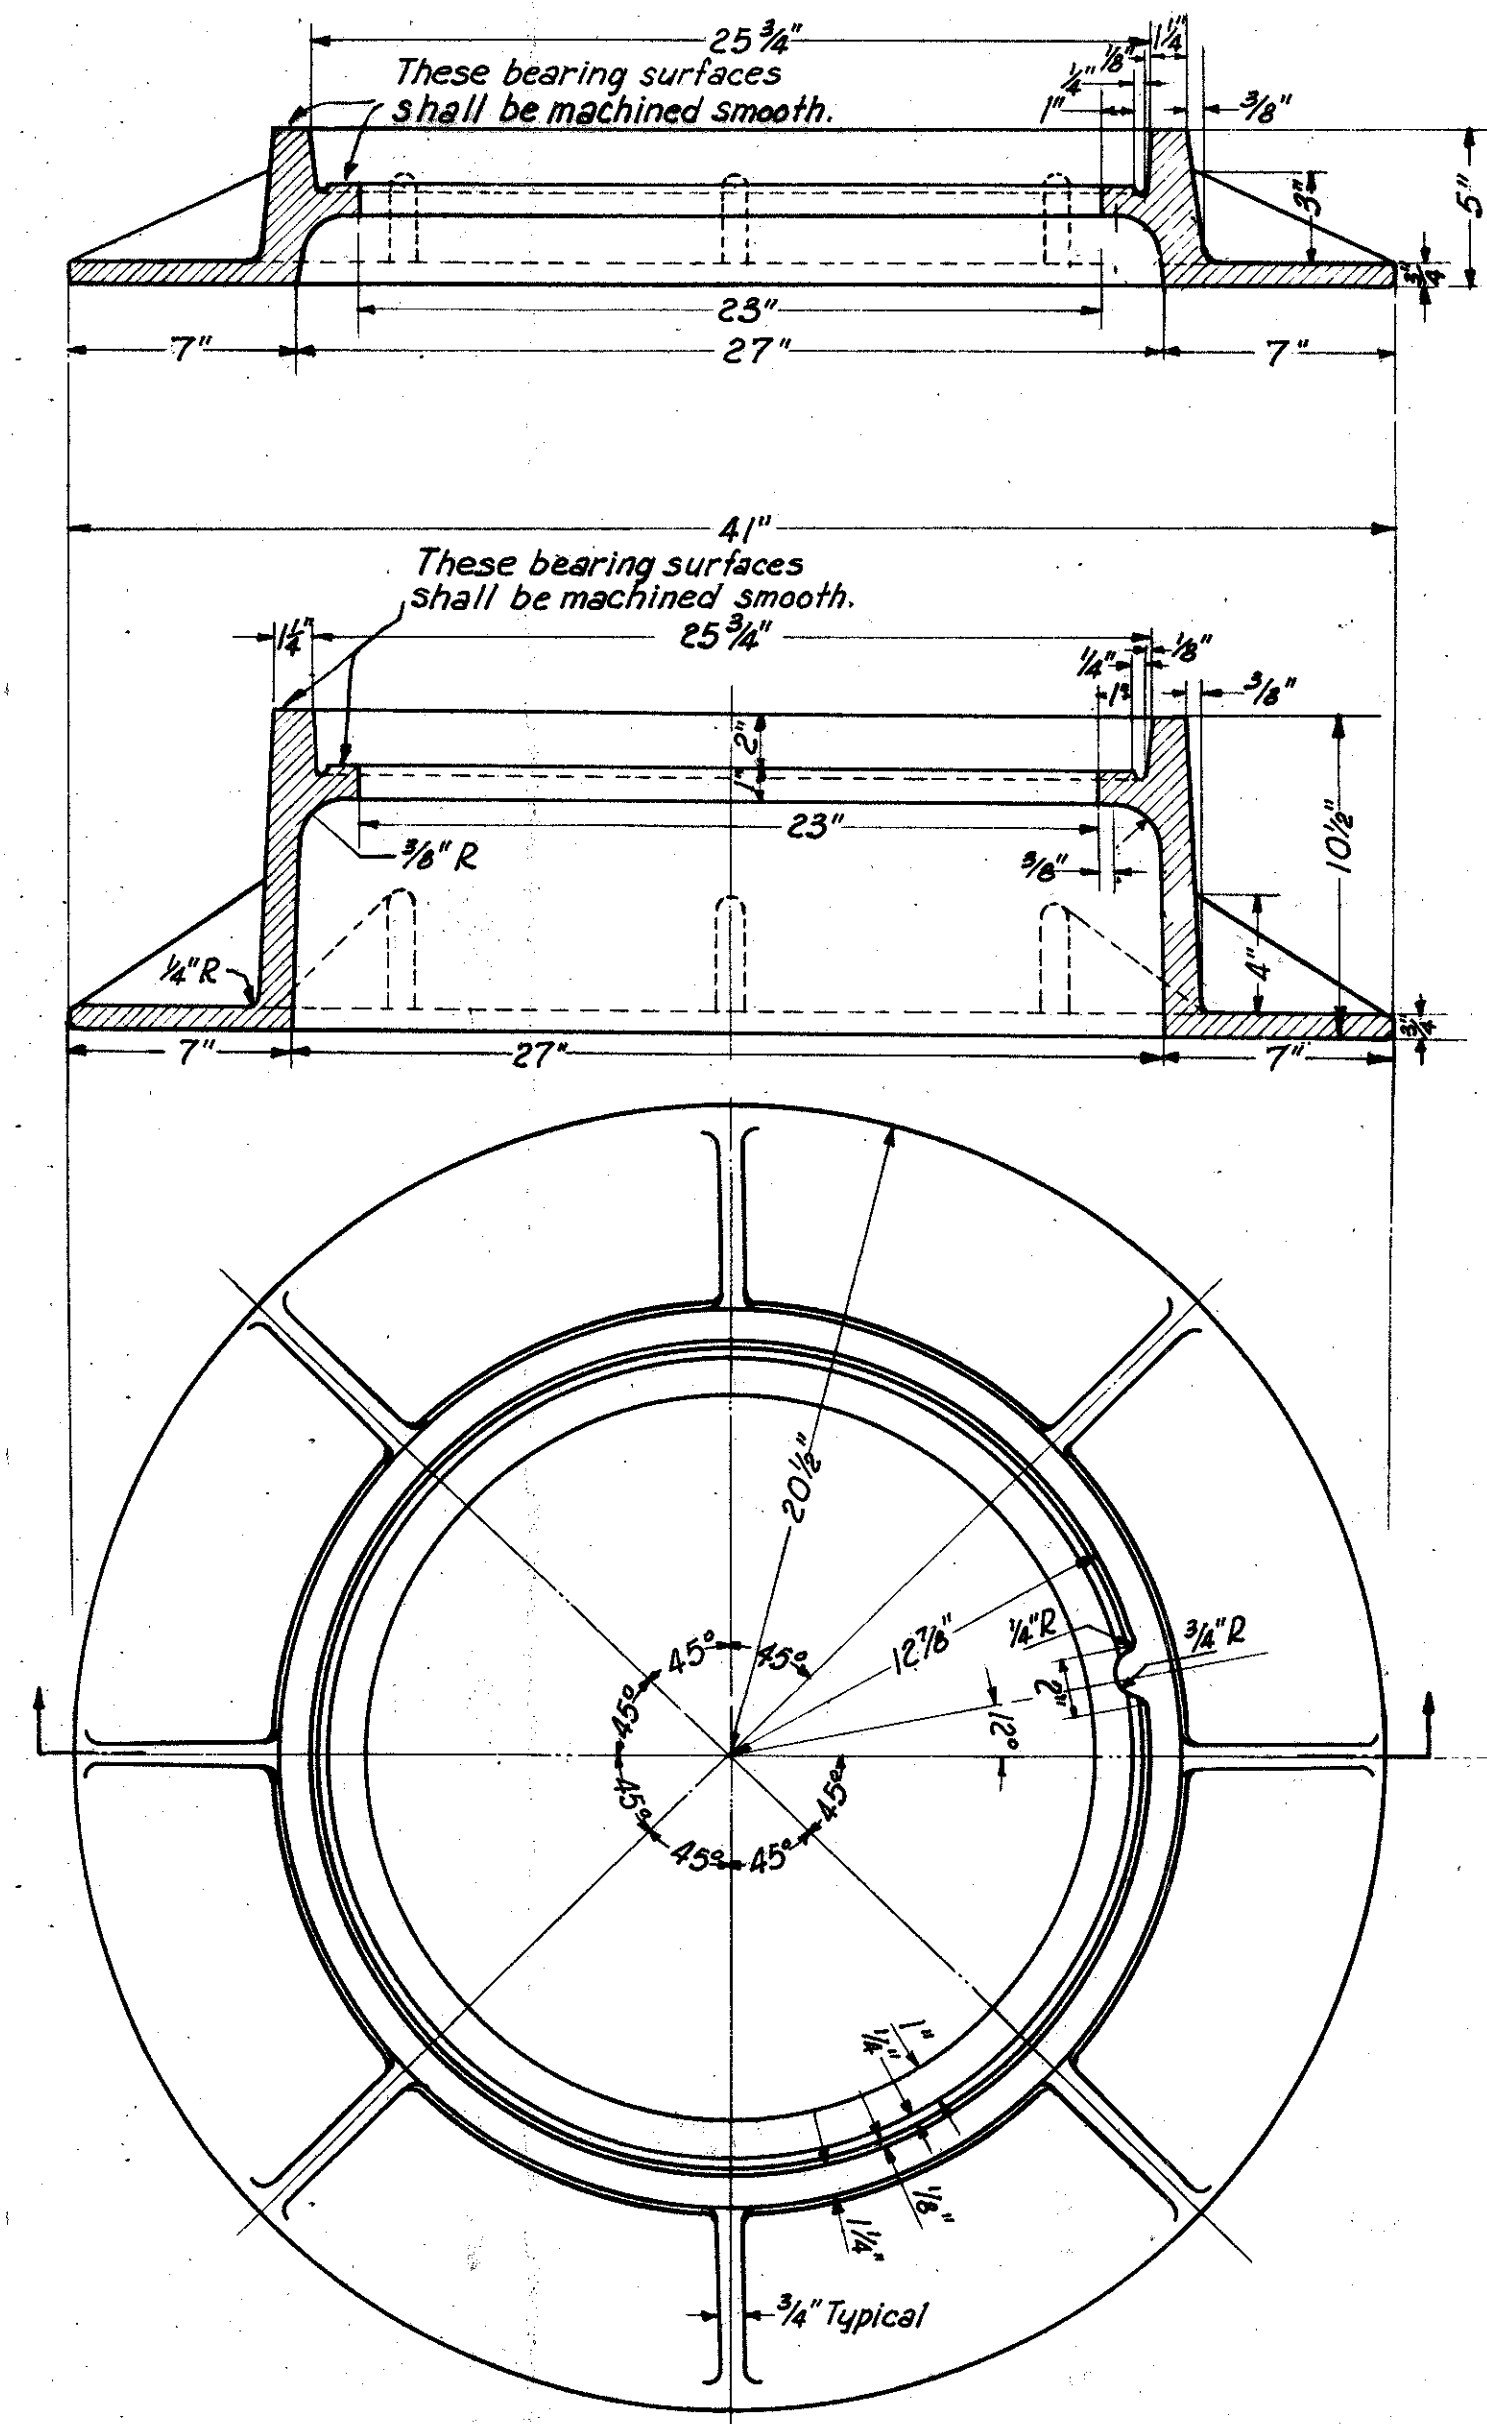


Scale: 2"=1'-0"

Weight of Frame 400 lbs min.

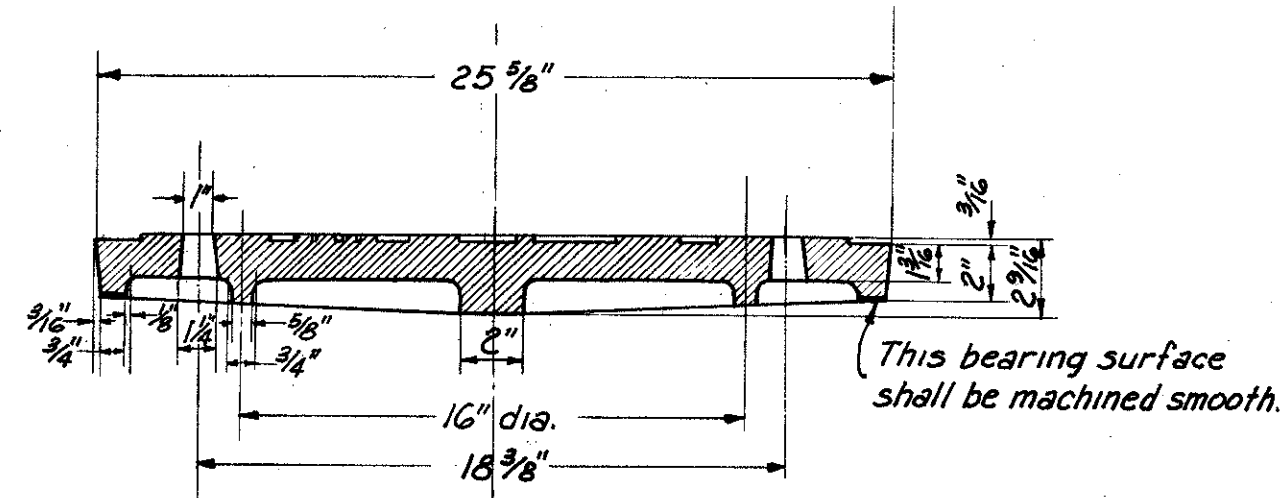
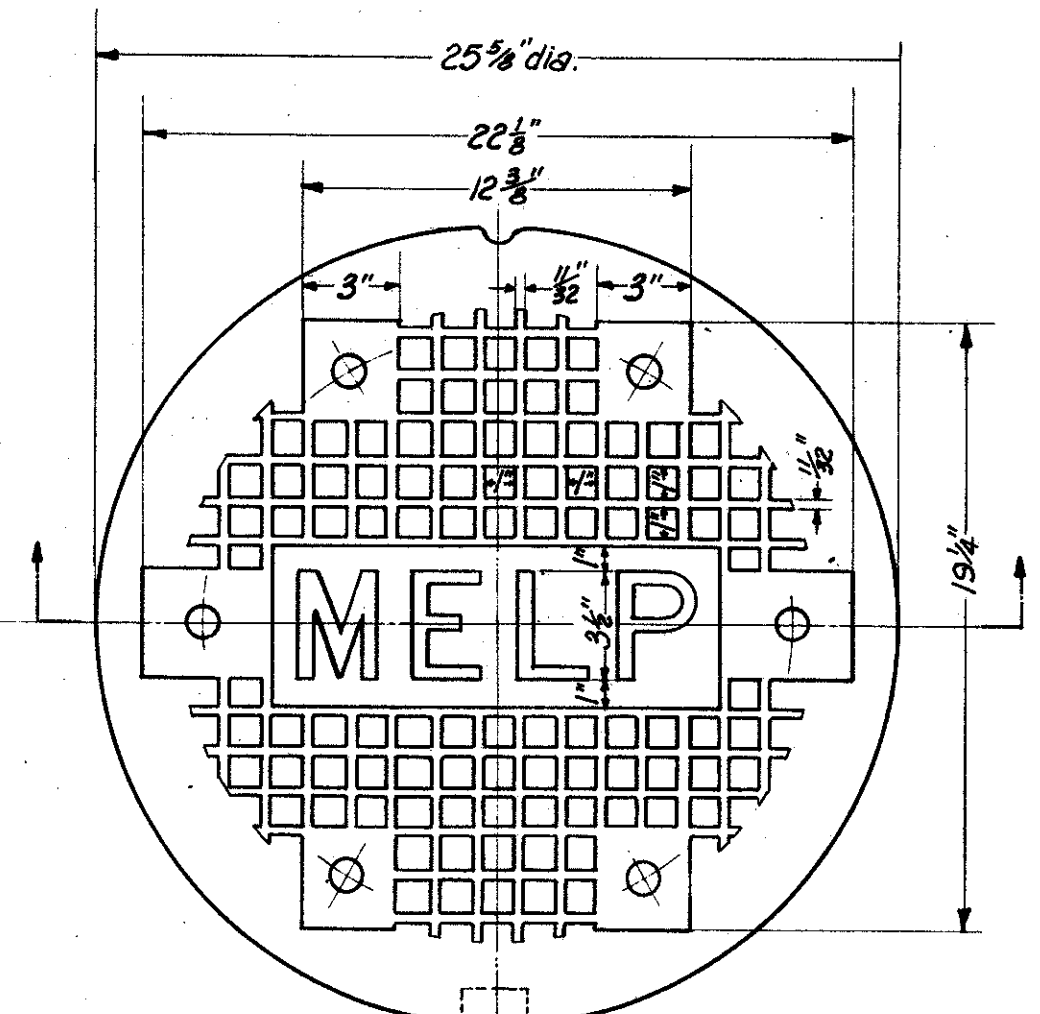
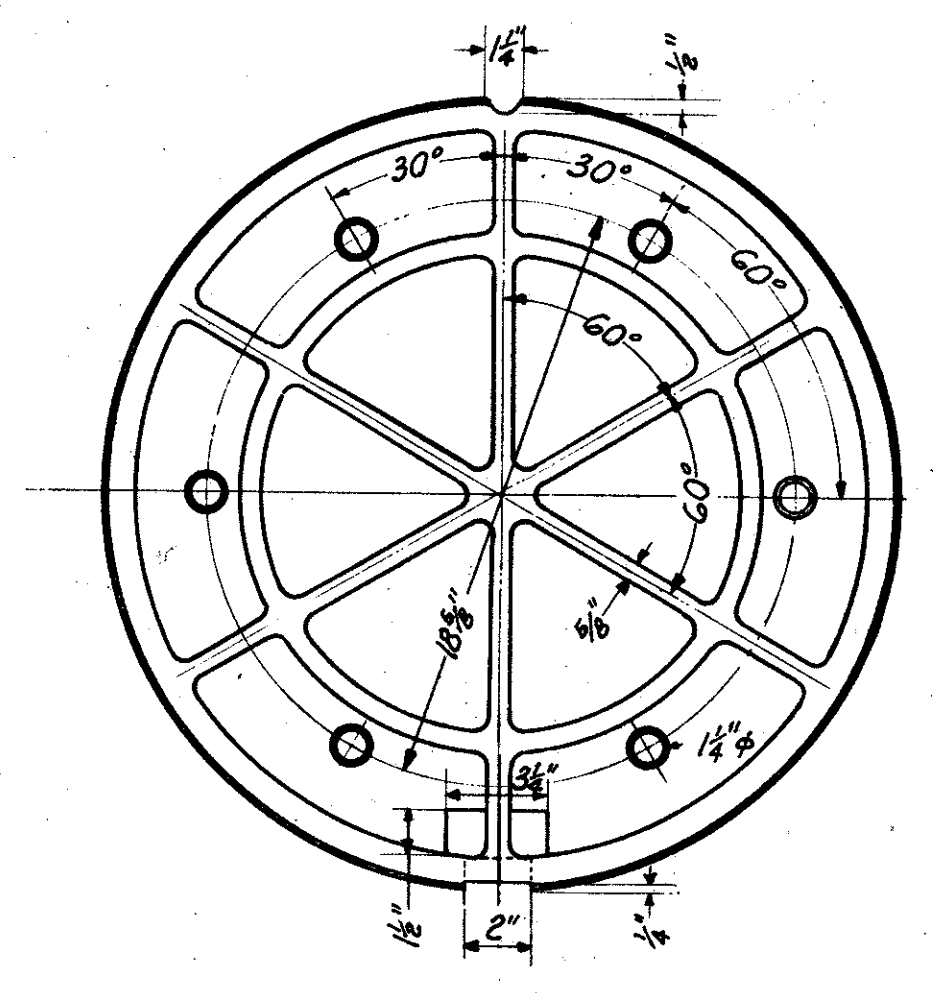


Scale: 2"=1'-0"

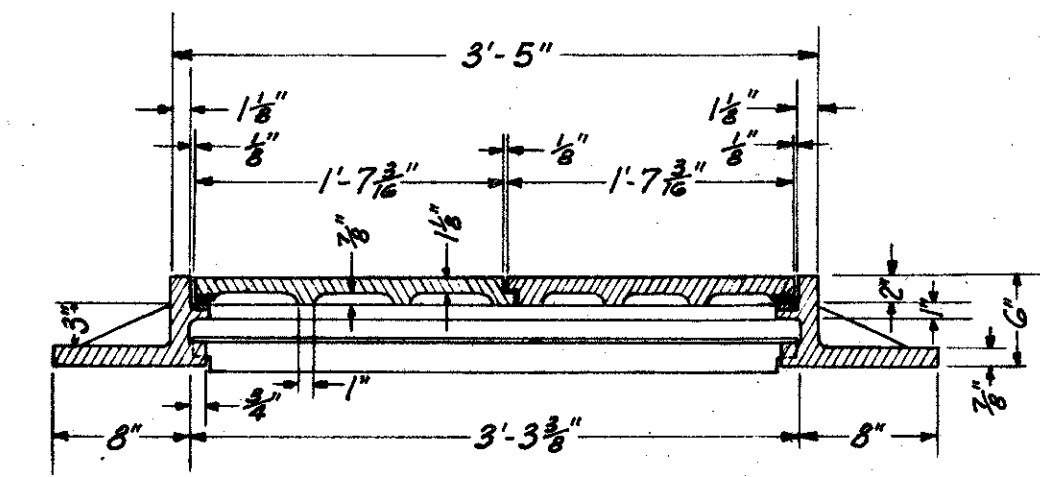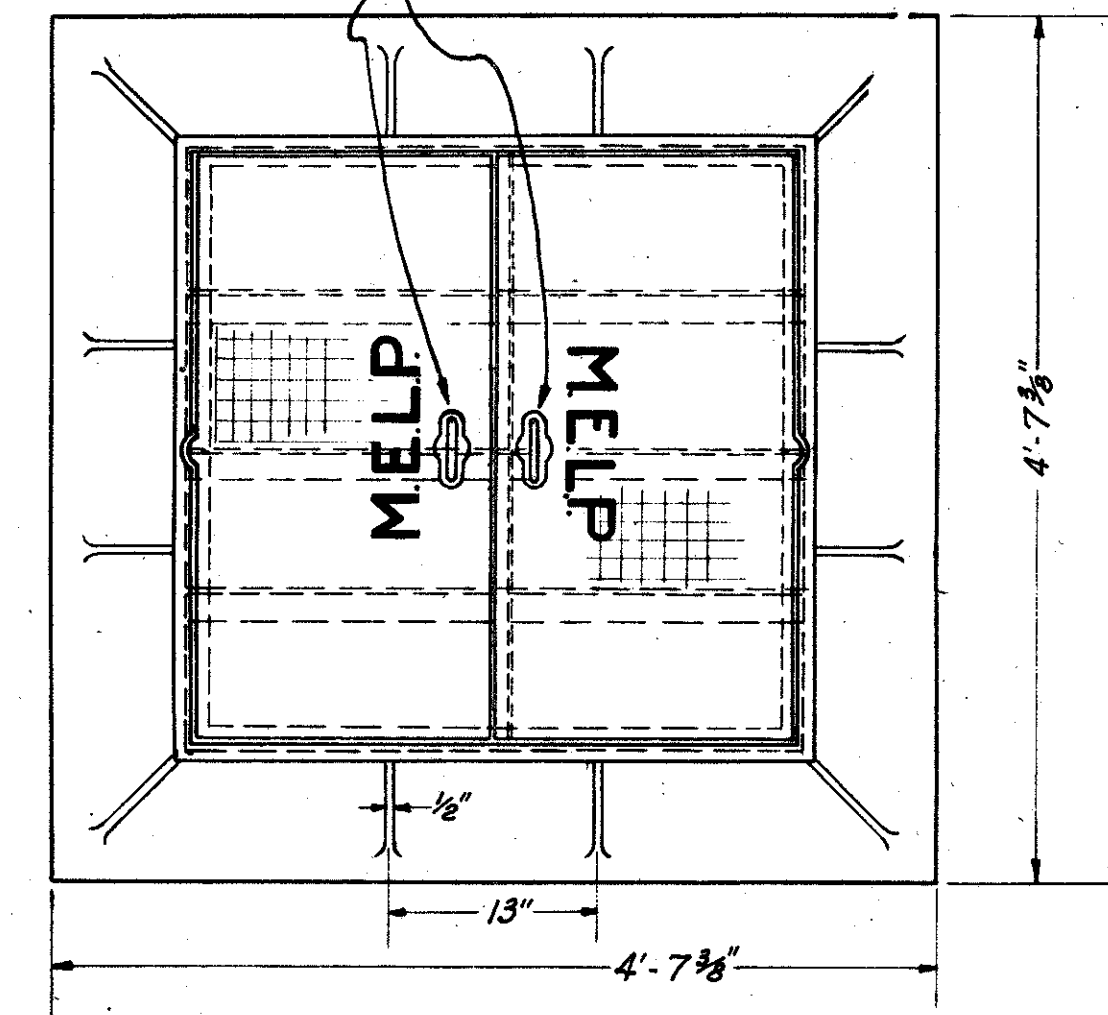


Weight
Street Type Square Manhole Casting Without Cover 700 lbs.
Sidewalk Type Square Manhole Casting Without Cover 450 lbs.
Square Manhole Cover 250 lbs.

Scale: 1"=1'-0"

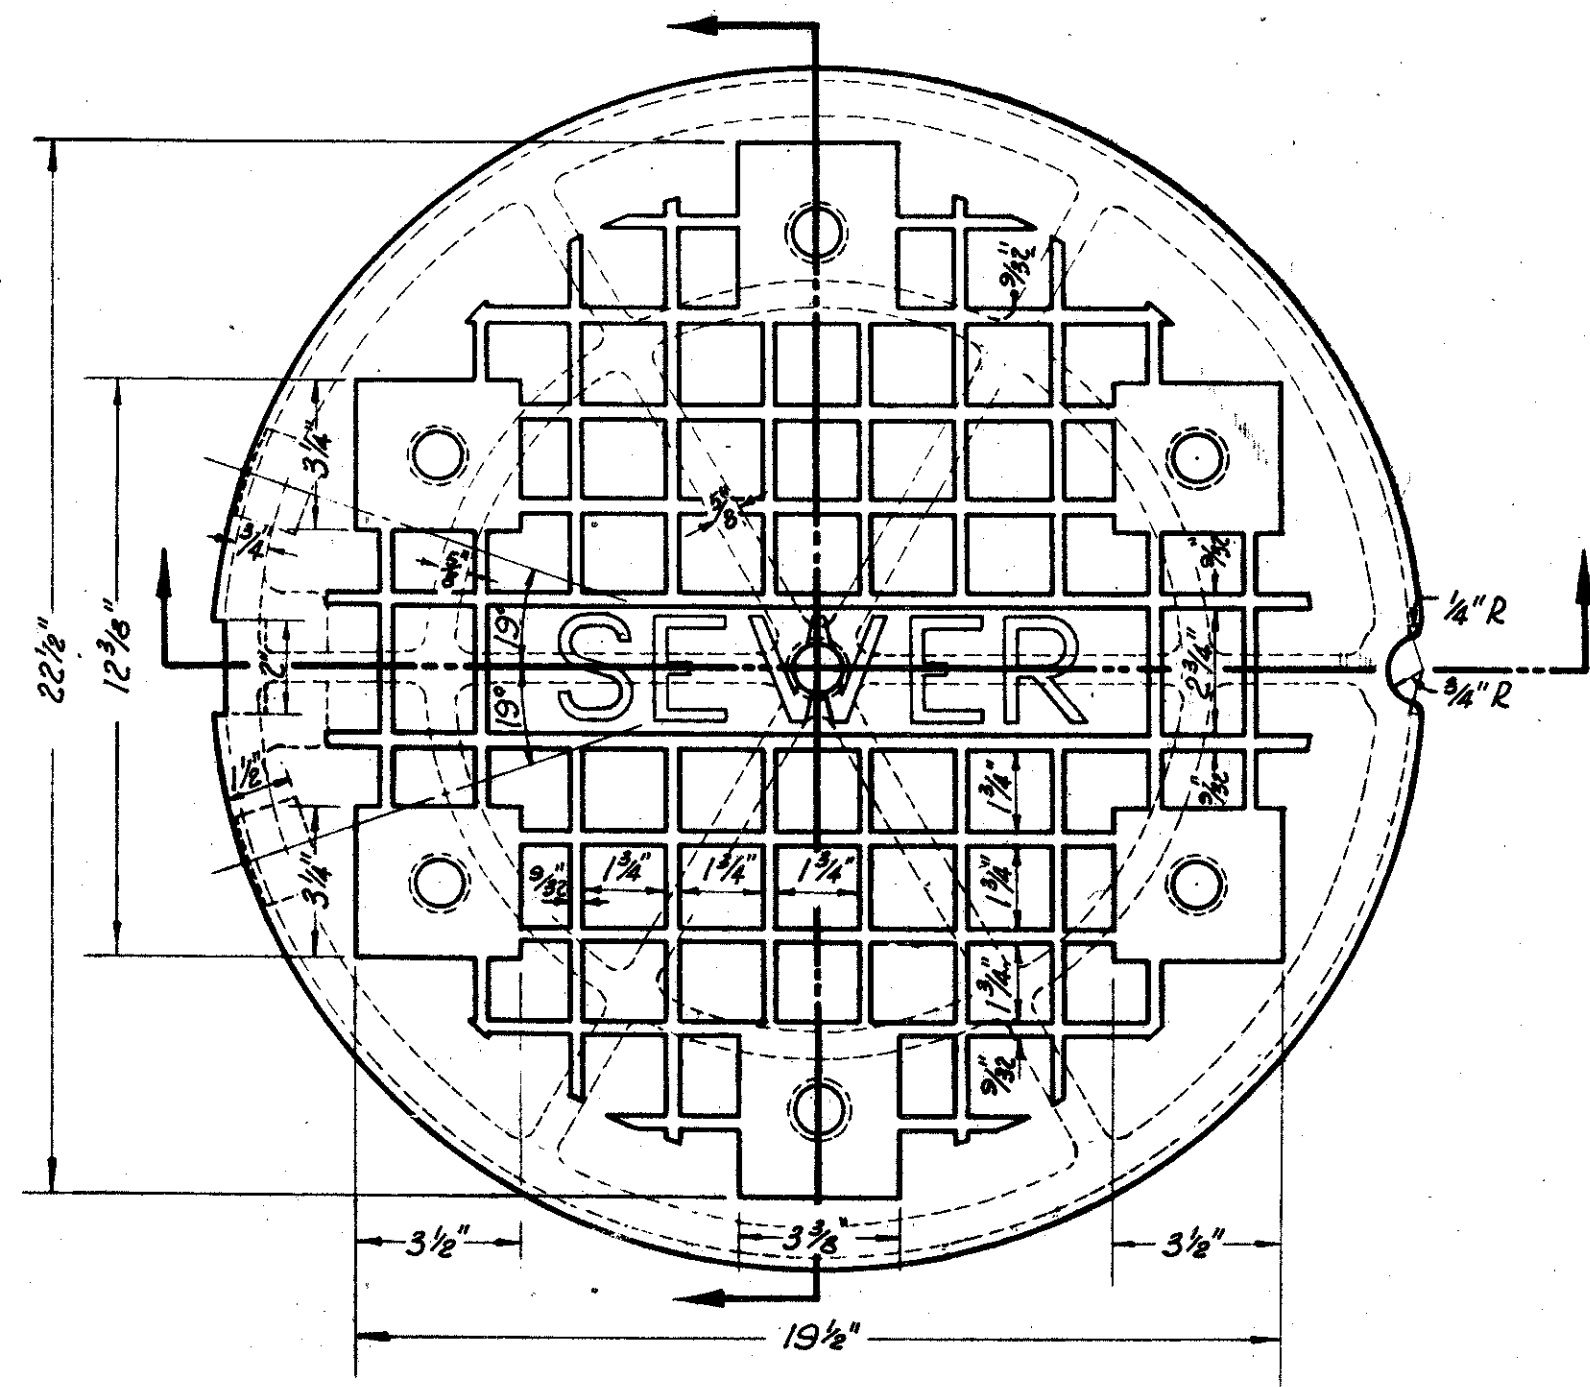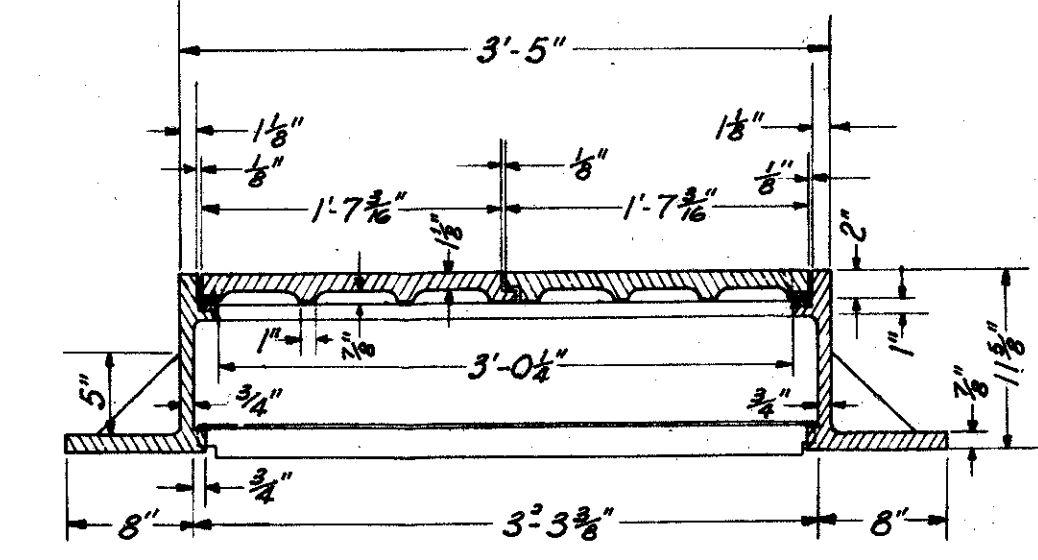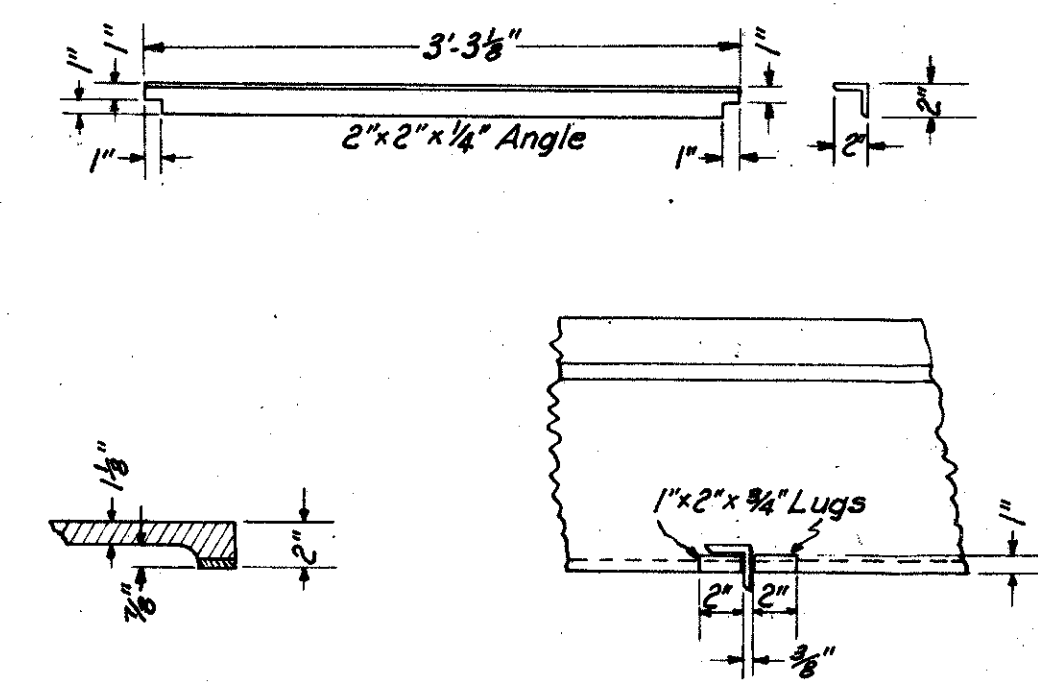

Weight of Cover 195 lbs. min.

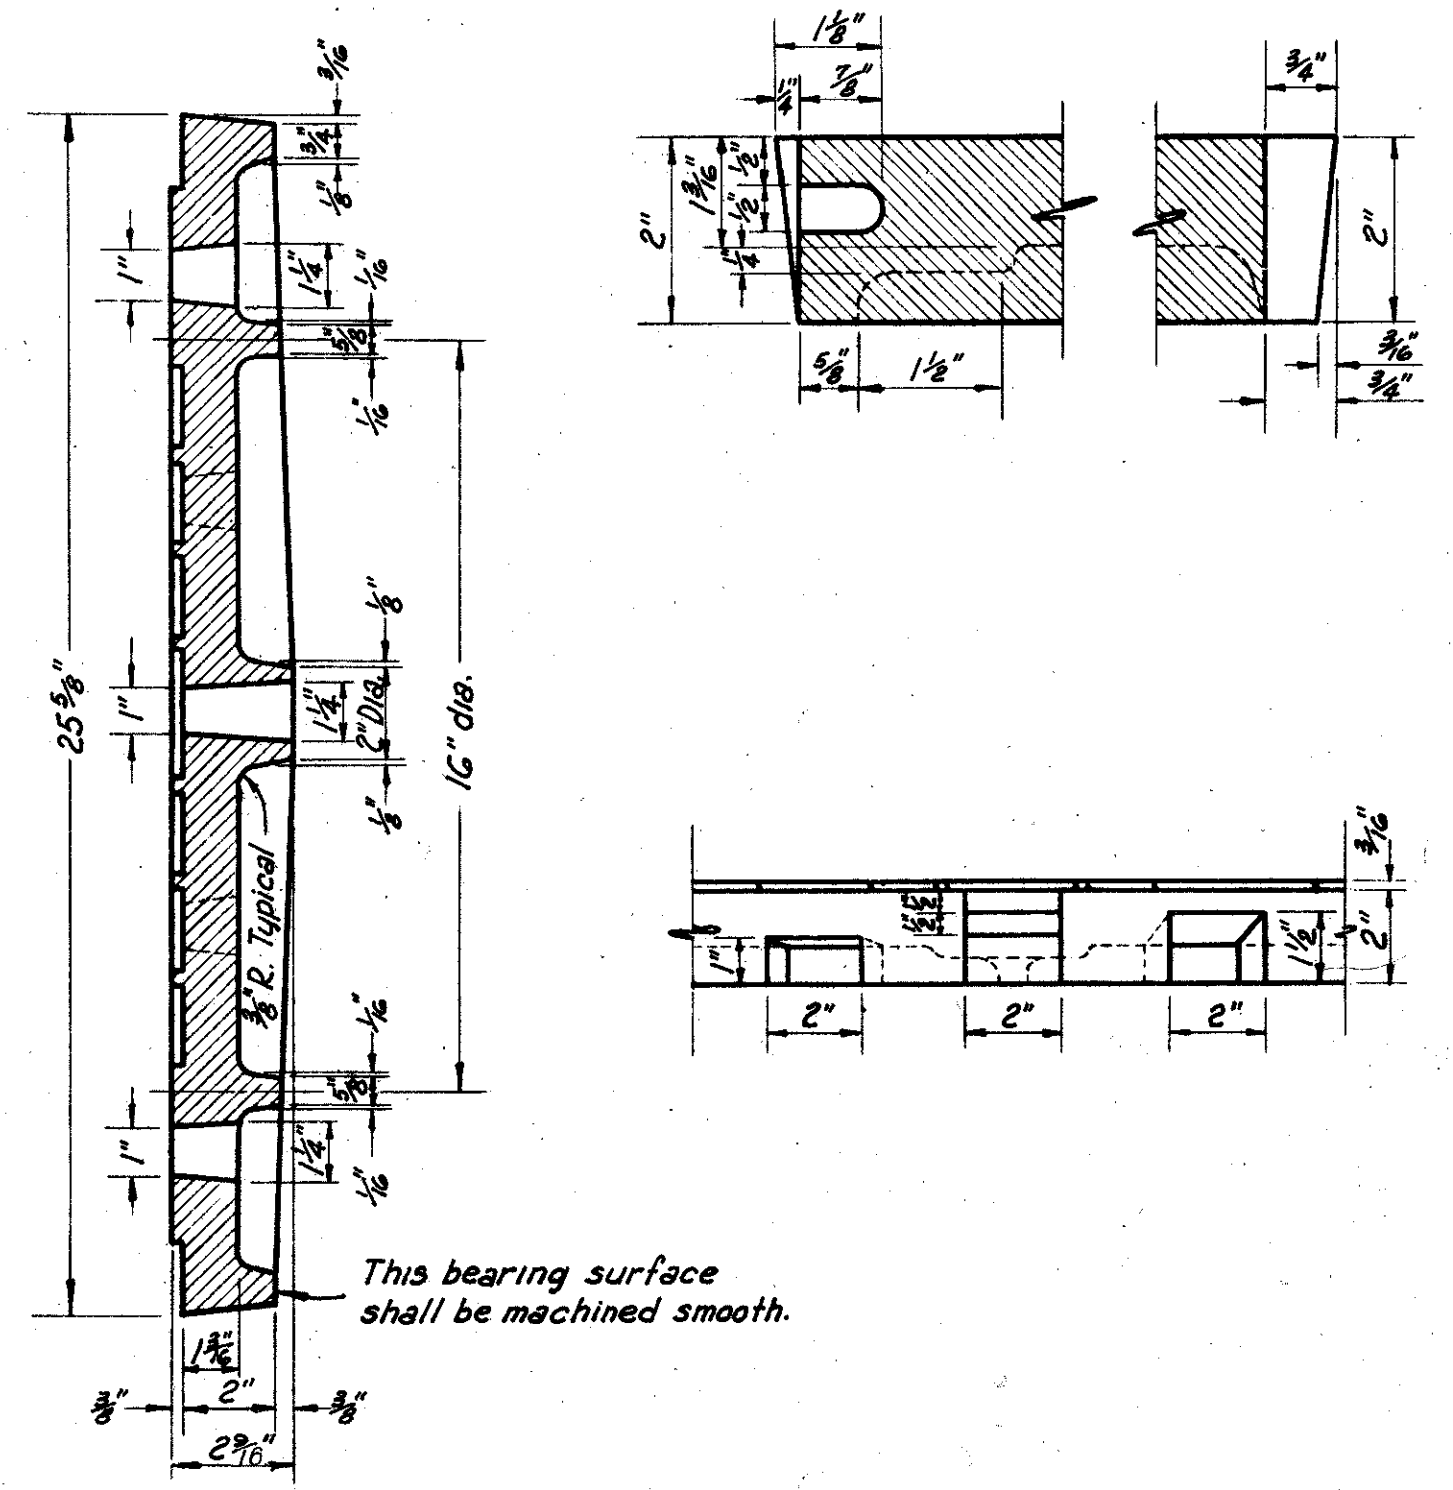


Scale: 3"=1'-0"

Taken from Std. Drawings 2346 & 2731 of City of Cleveland.

FED. ROAD DIV. NO.	STATE	FED. AID PROJ. NO.	TYPE FUNDS
2	OHIO		


53
181

CUYAHOGA COUNTY
CITY OF CLEVELAND
CUY-42-18.42
CUY-21-15.32

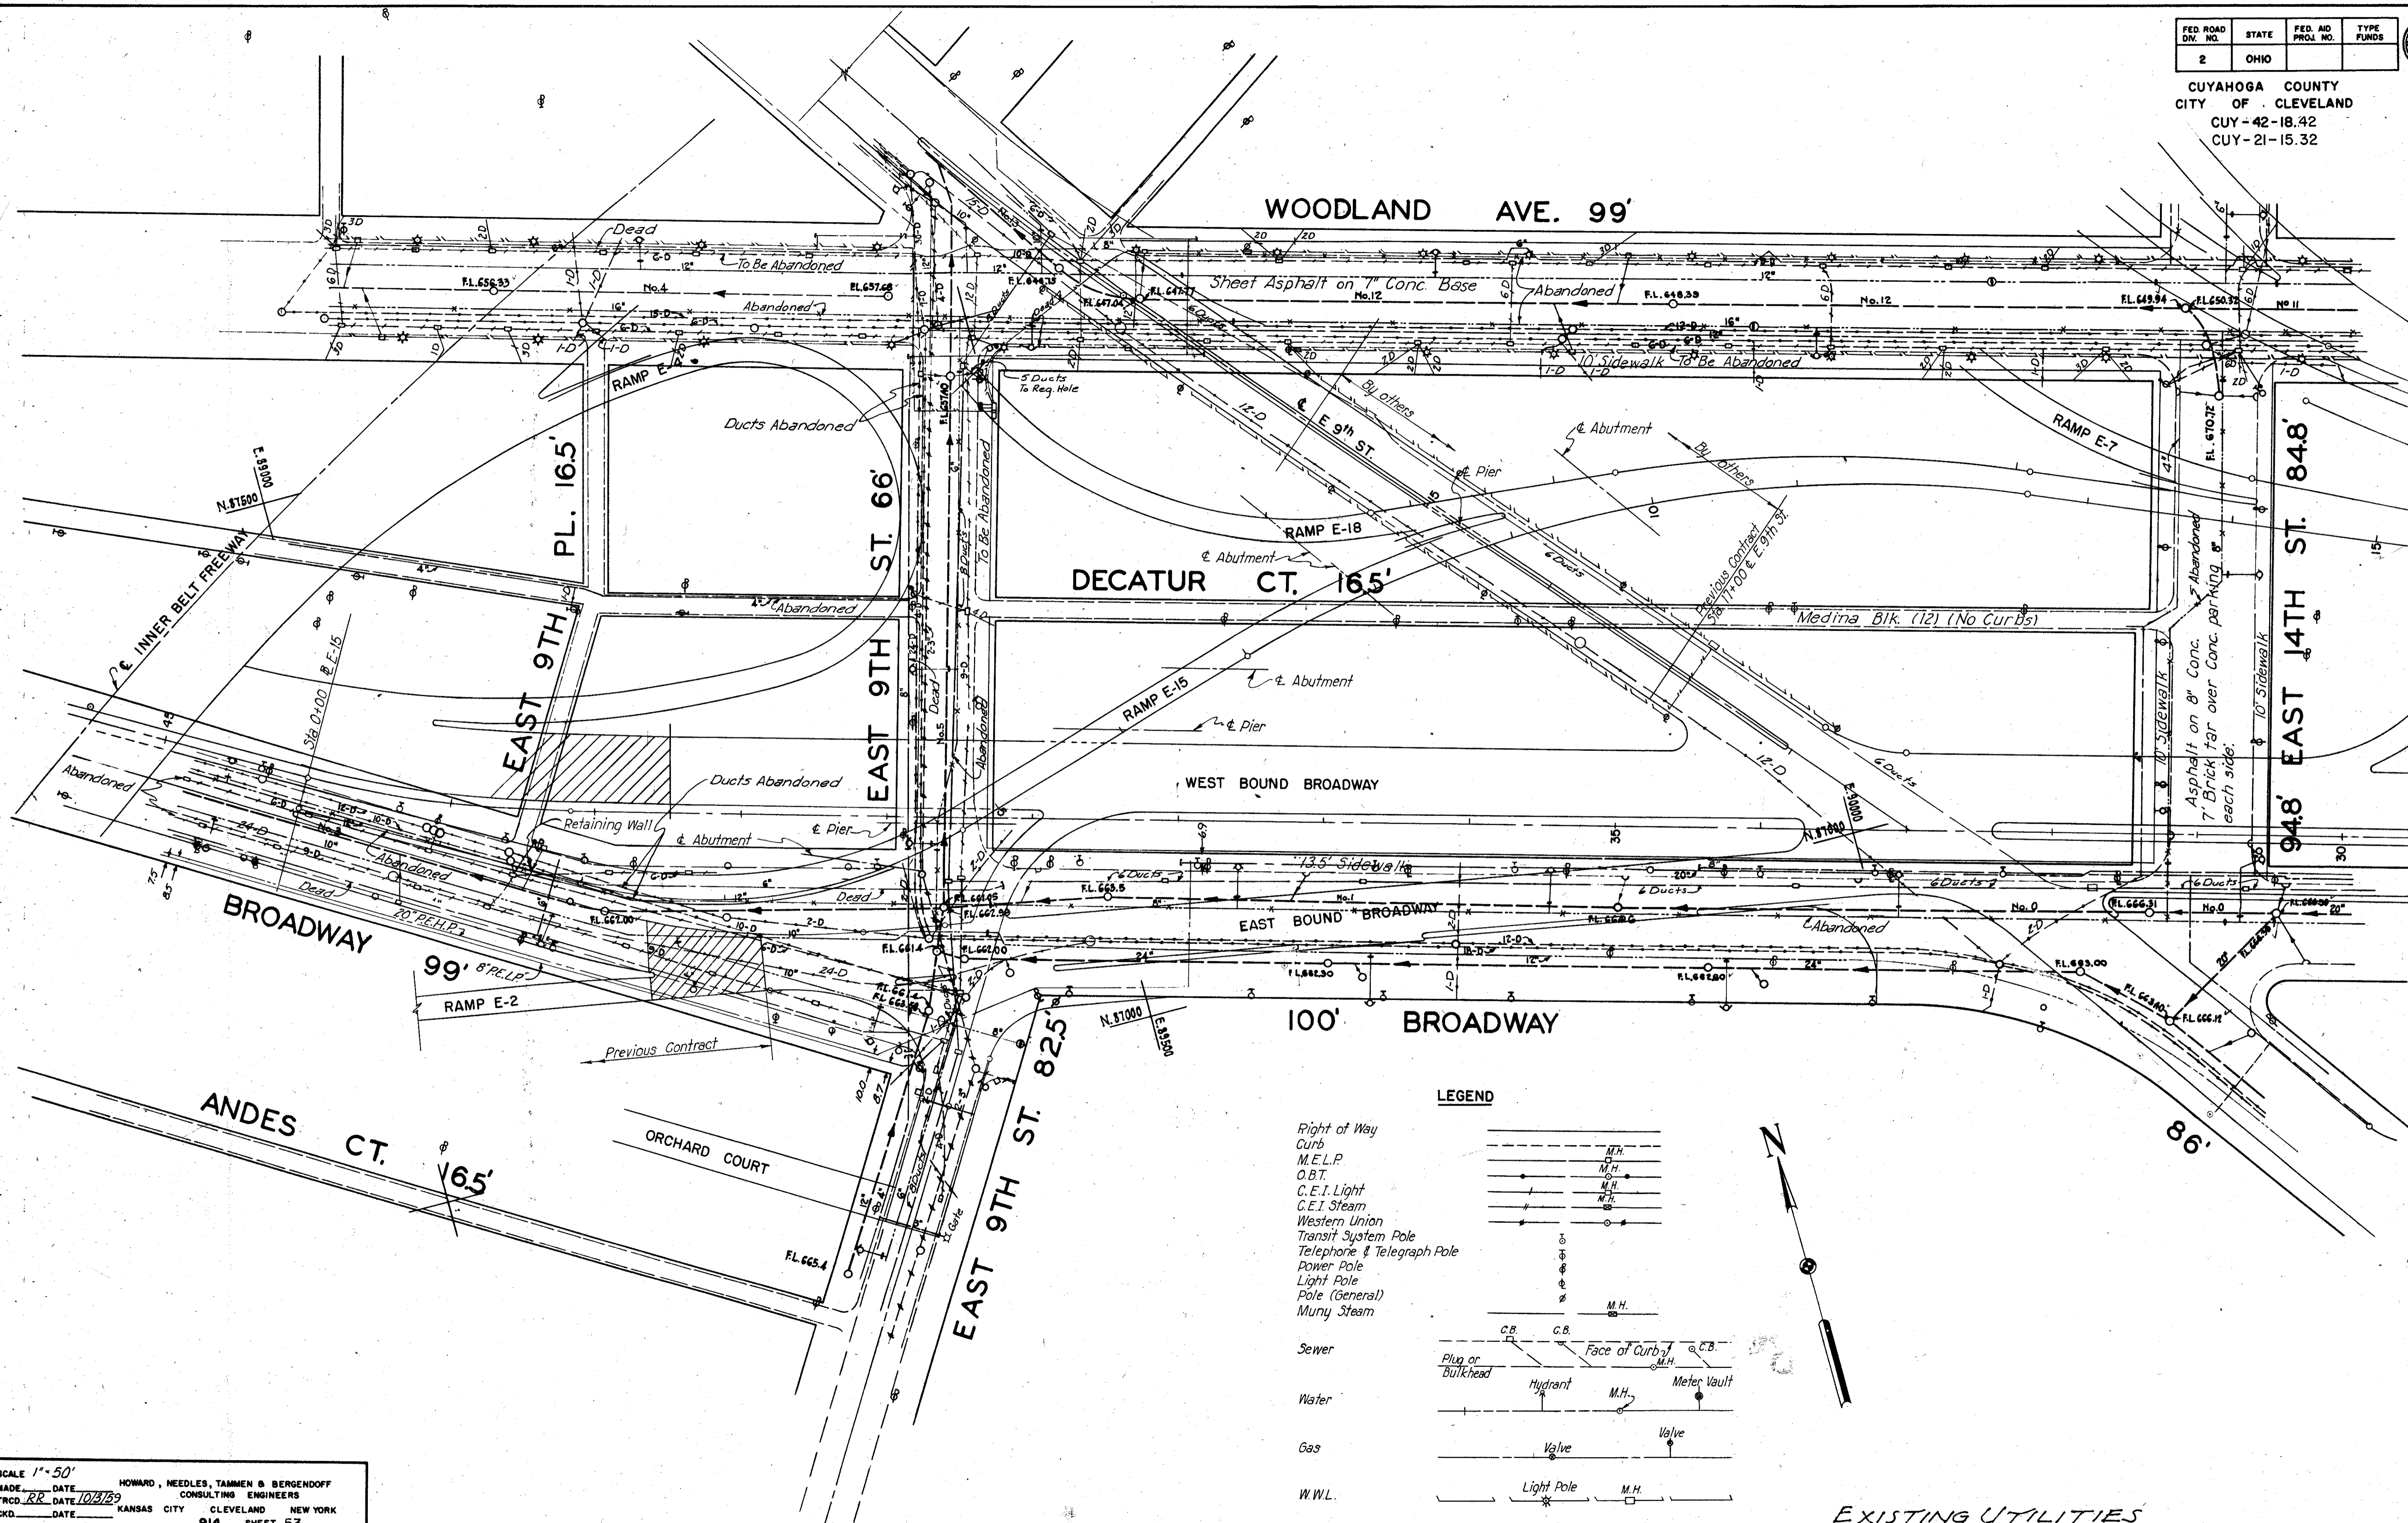

LEGEND

- Right of Way
 - Curb
 - M.E.L.P.
 - O.B.T.
 - C.E.I. Light
 - C.E.I. Steam
 - Western Union
 - Transit System Pole
 - Telephone & Telegraph Pole
 - Power Pole
 - Light Pole
 - Pole (General)
 - Muny Steam
-
- Sewer
 - Water
 - Gas
 - W.W.L.

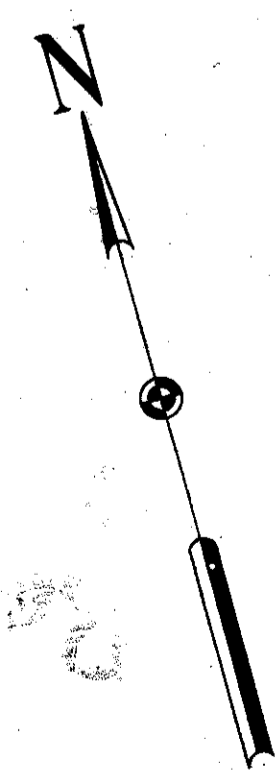


EXISTING UTILITIES

SCALE 1" = 50'
 MADE DATE 10/3/59 HOWARD, NEEDLES, TAMMEN & BERGENOFF
 TRCD. RR DATE 10/3/59 CONSULTING ENGINEERS
 CKD DATE KANSAS CITY CLEVELAND NEW YORK
 914 SHEET 53

FED. ROAD DIV. NO.	STATE	FEDERAL AID PROJECT NO.	TYPE FUNDS
2	OHIO		

54
181

CUYAHOGA COUNTY
CITY OF CLEVELAND
CUY-42-18.42
CUY-21-45.32

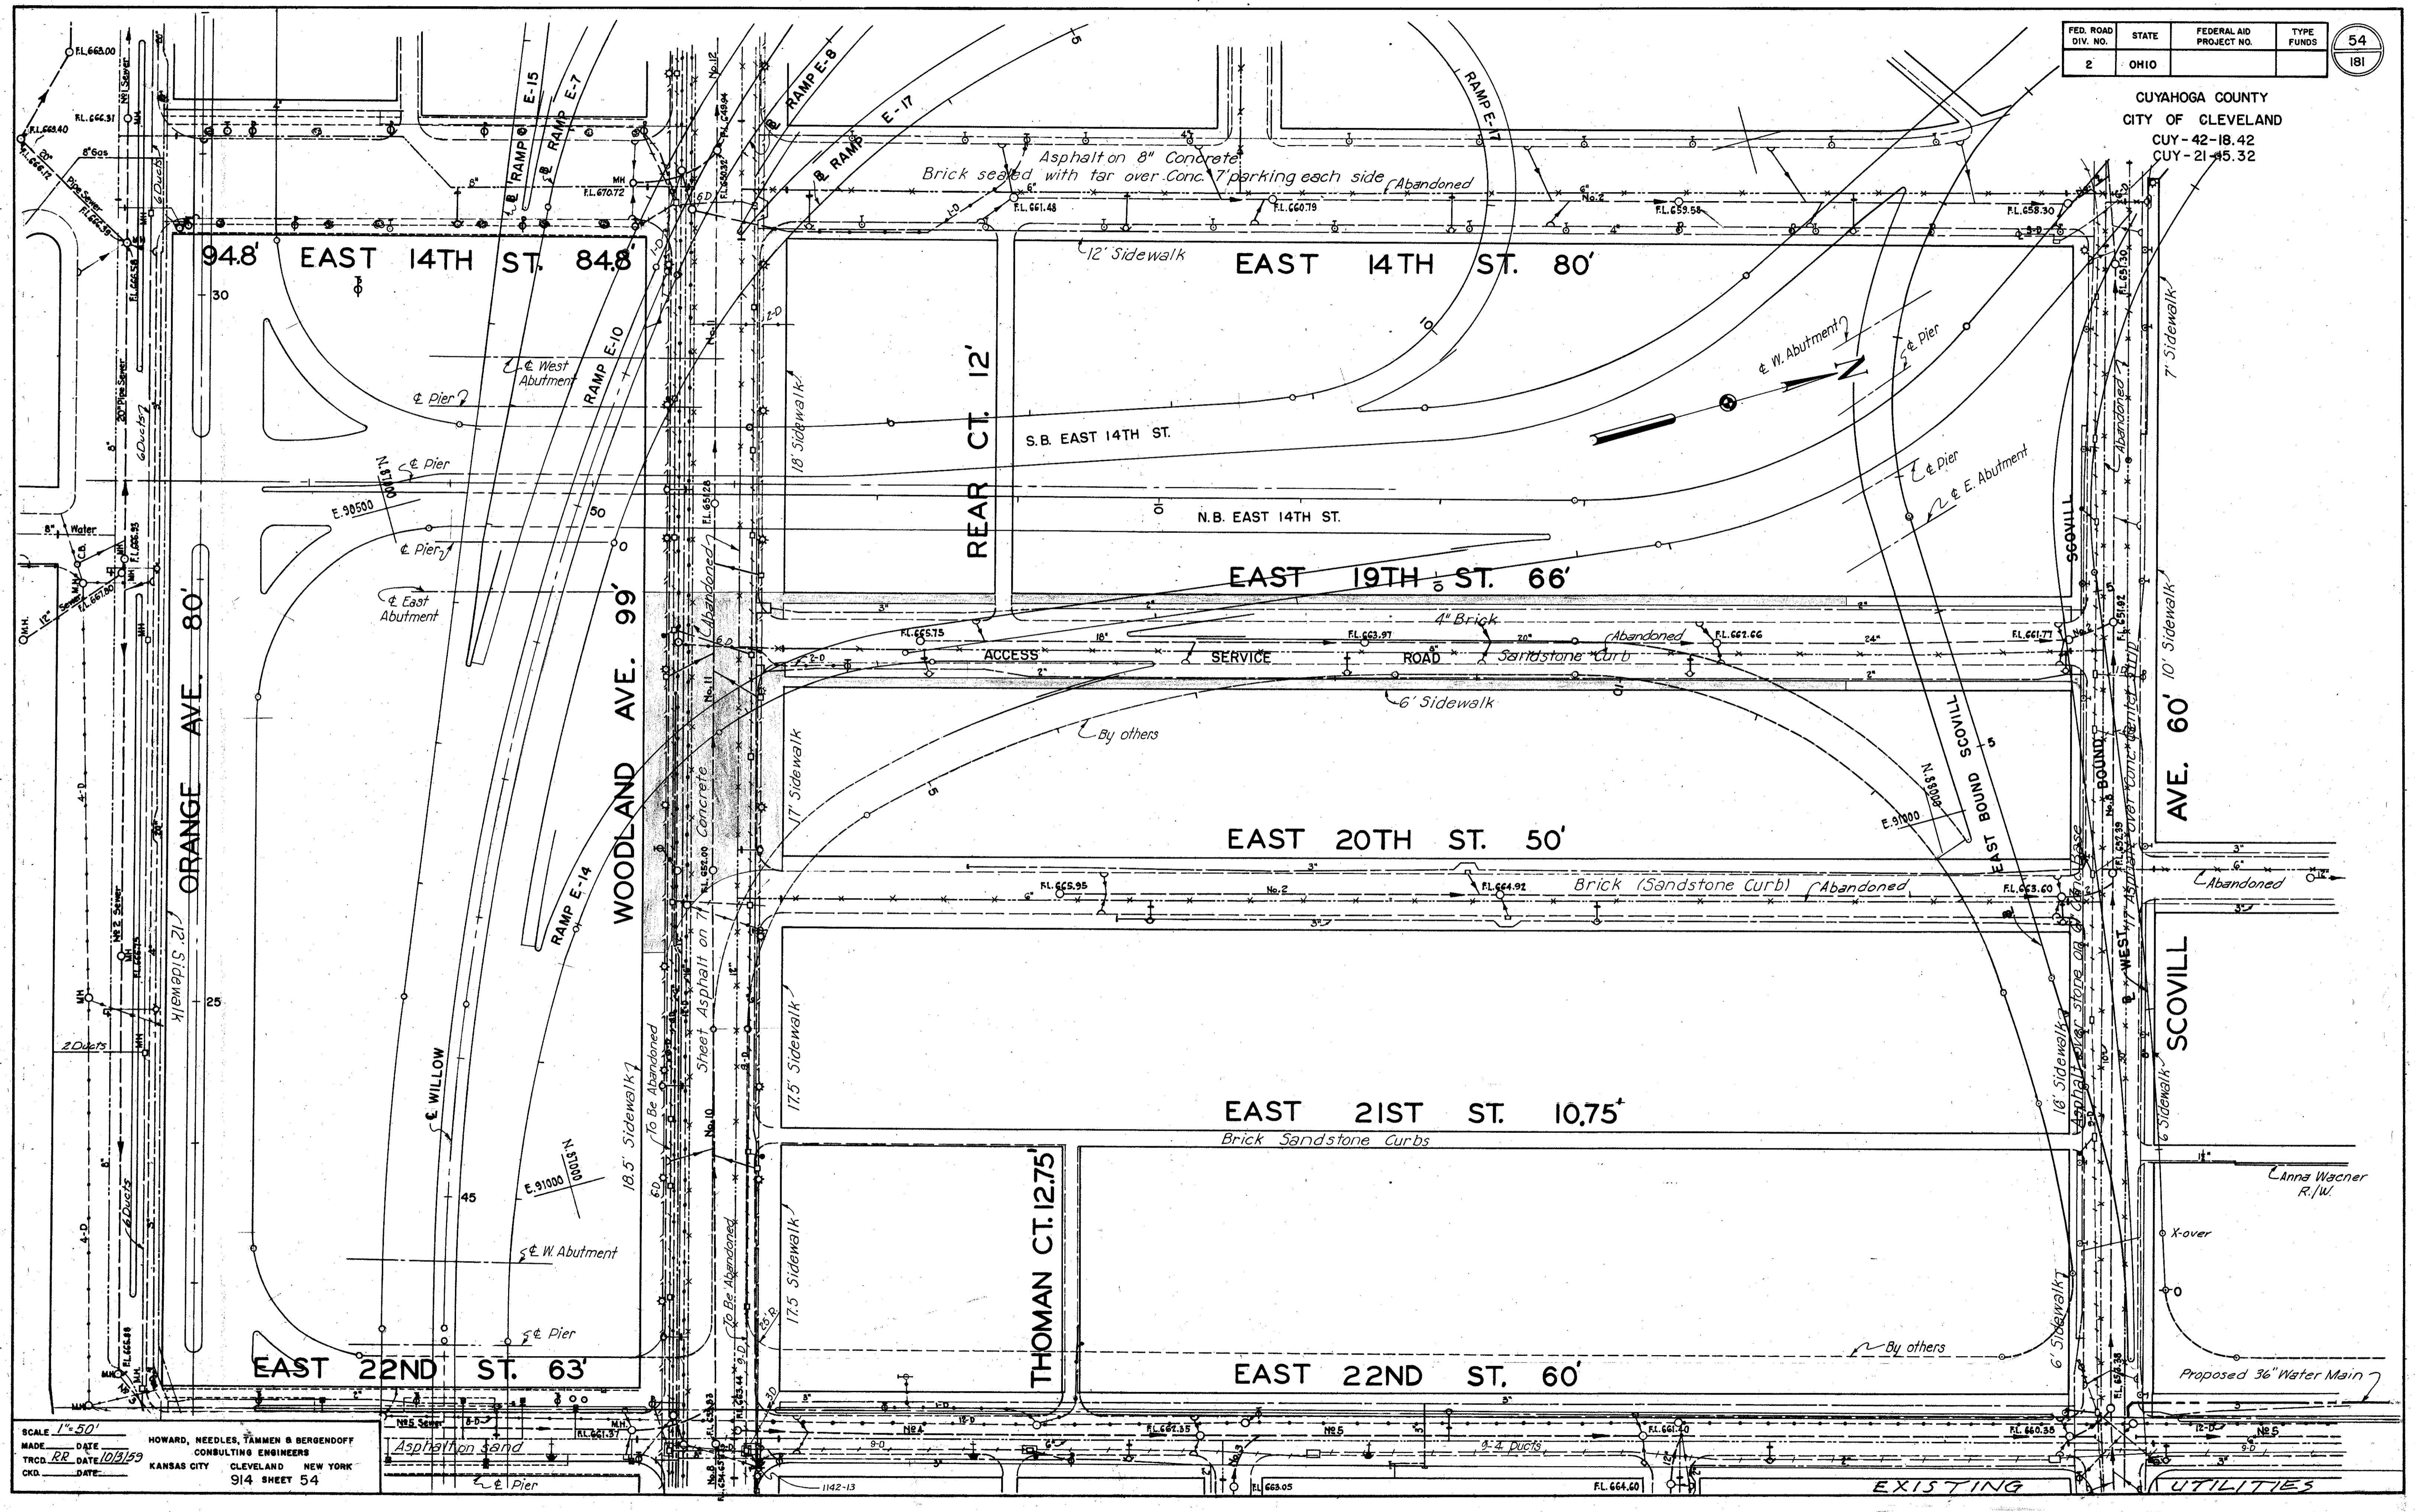



SCALE 1"=50'
 MADE DATE 10/3/59
 TRCD. RR DATE 10/3/59
 CKD DATE
 HOWARD, NEEDLES, TAMMEN & BERGENDOFF
 CONSULTING ENGINEERS
 KANSAS CITY CLEVELAND NEW YORK
 914 SHEET 54

EXISTING UTILITIES

FED. ROAD DIV. NO.	STATE	FEDERAL AID PROJECT NO.	TYPE FUNDS
2	OHIO		

55
181

CUYAHOGA COUNTY
CITY OF CLEVELAND
CUY - 42-18.42
CUY - 21-15.32

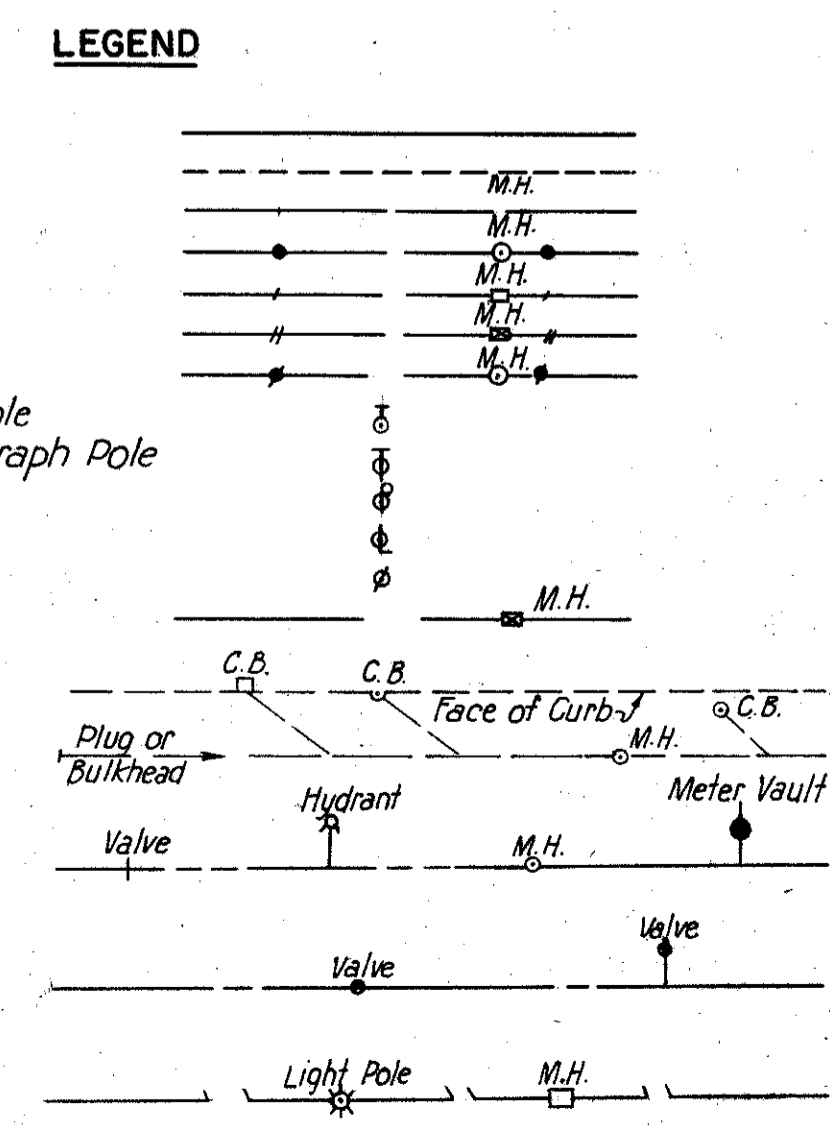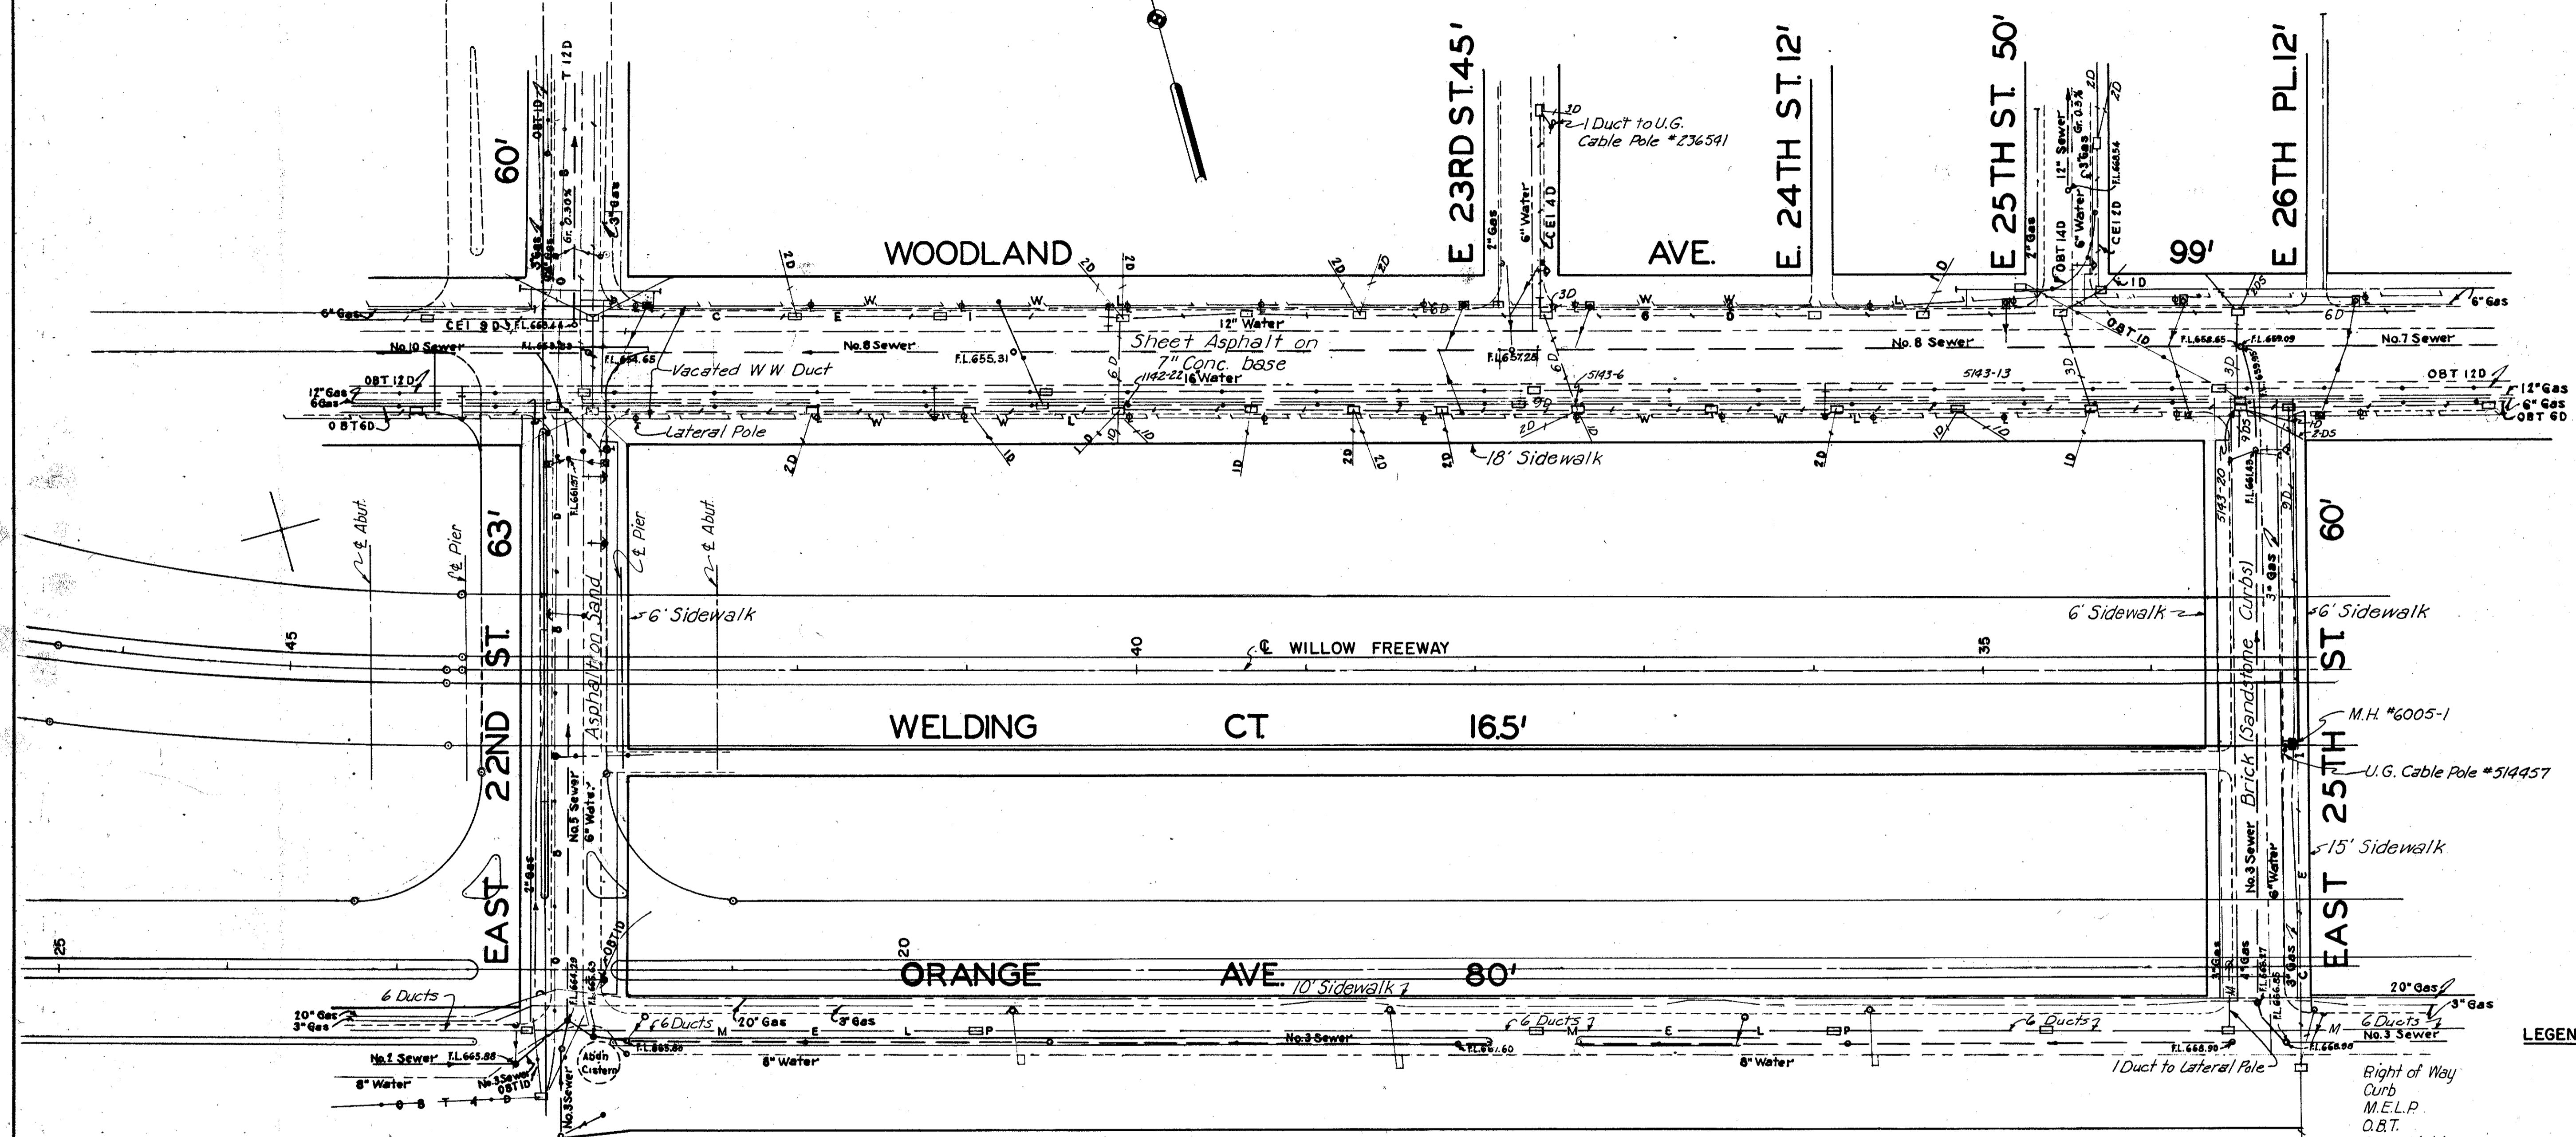




SCALE: 1" = 50'
 MADE DATE HOWARD, NEEDLES, TAMMEN & BERGENDOFF
 TRCD. R.R. DATE 10/3/59 CONSULTING ENGINEERS
 CKD. DATE KANSAS CITY CLEVELAND NEW YORK
 914 SHEET 55

EXISTING UTILITIES

FED. ROAD DIV. NO.	STATE	FEDERAL AID PROJECT NO.	TYPE FUNDS
2	OHIO		

56
181

CUYAHOGA COUNTY
CITY OF CLEVELAND
CUY-42-18.42
CUY-21-15.32

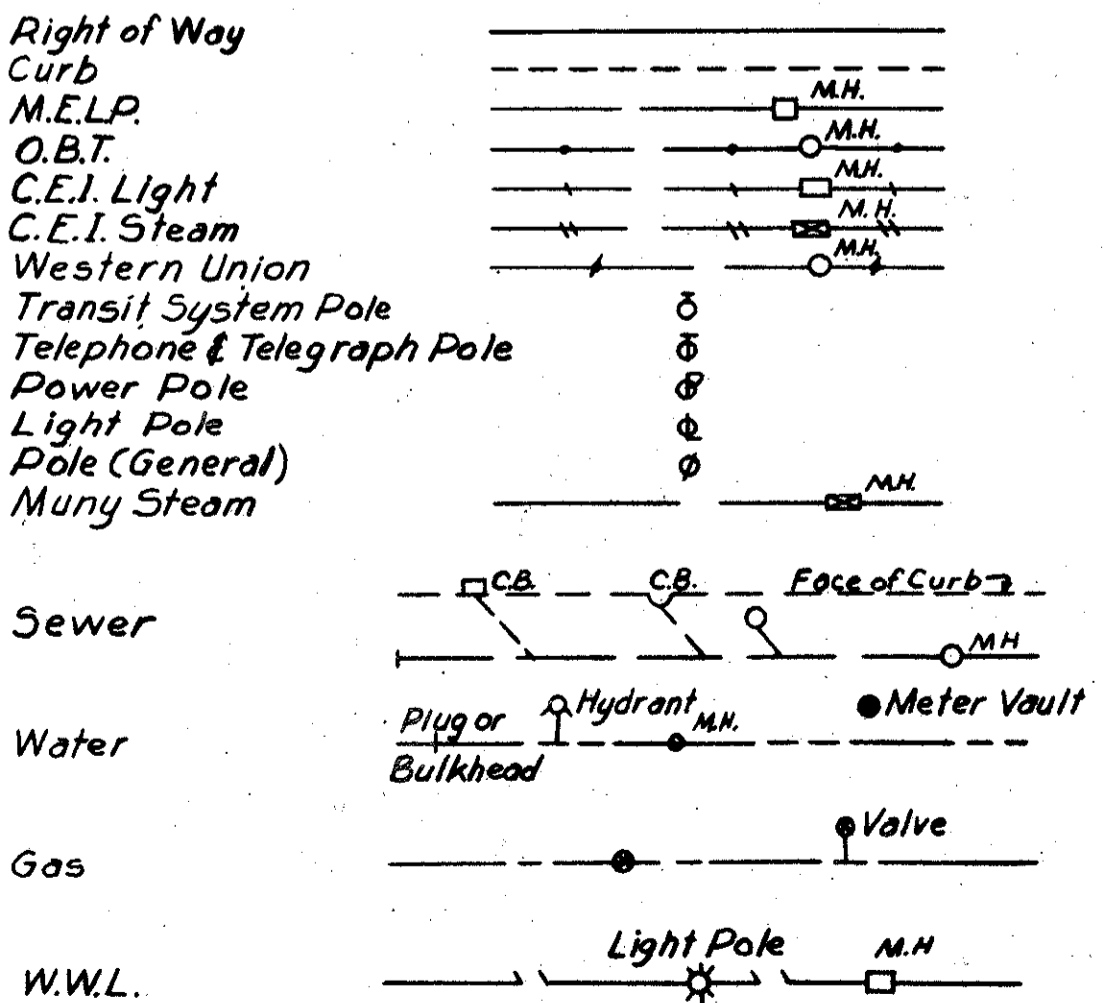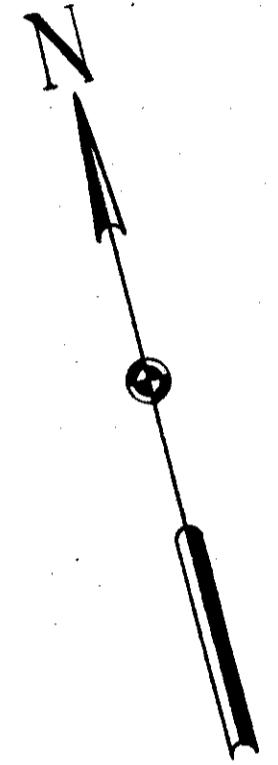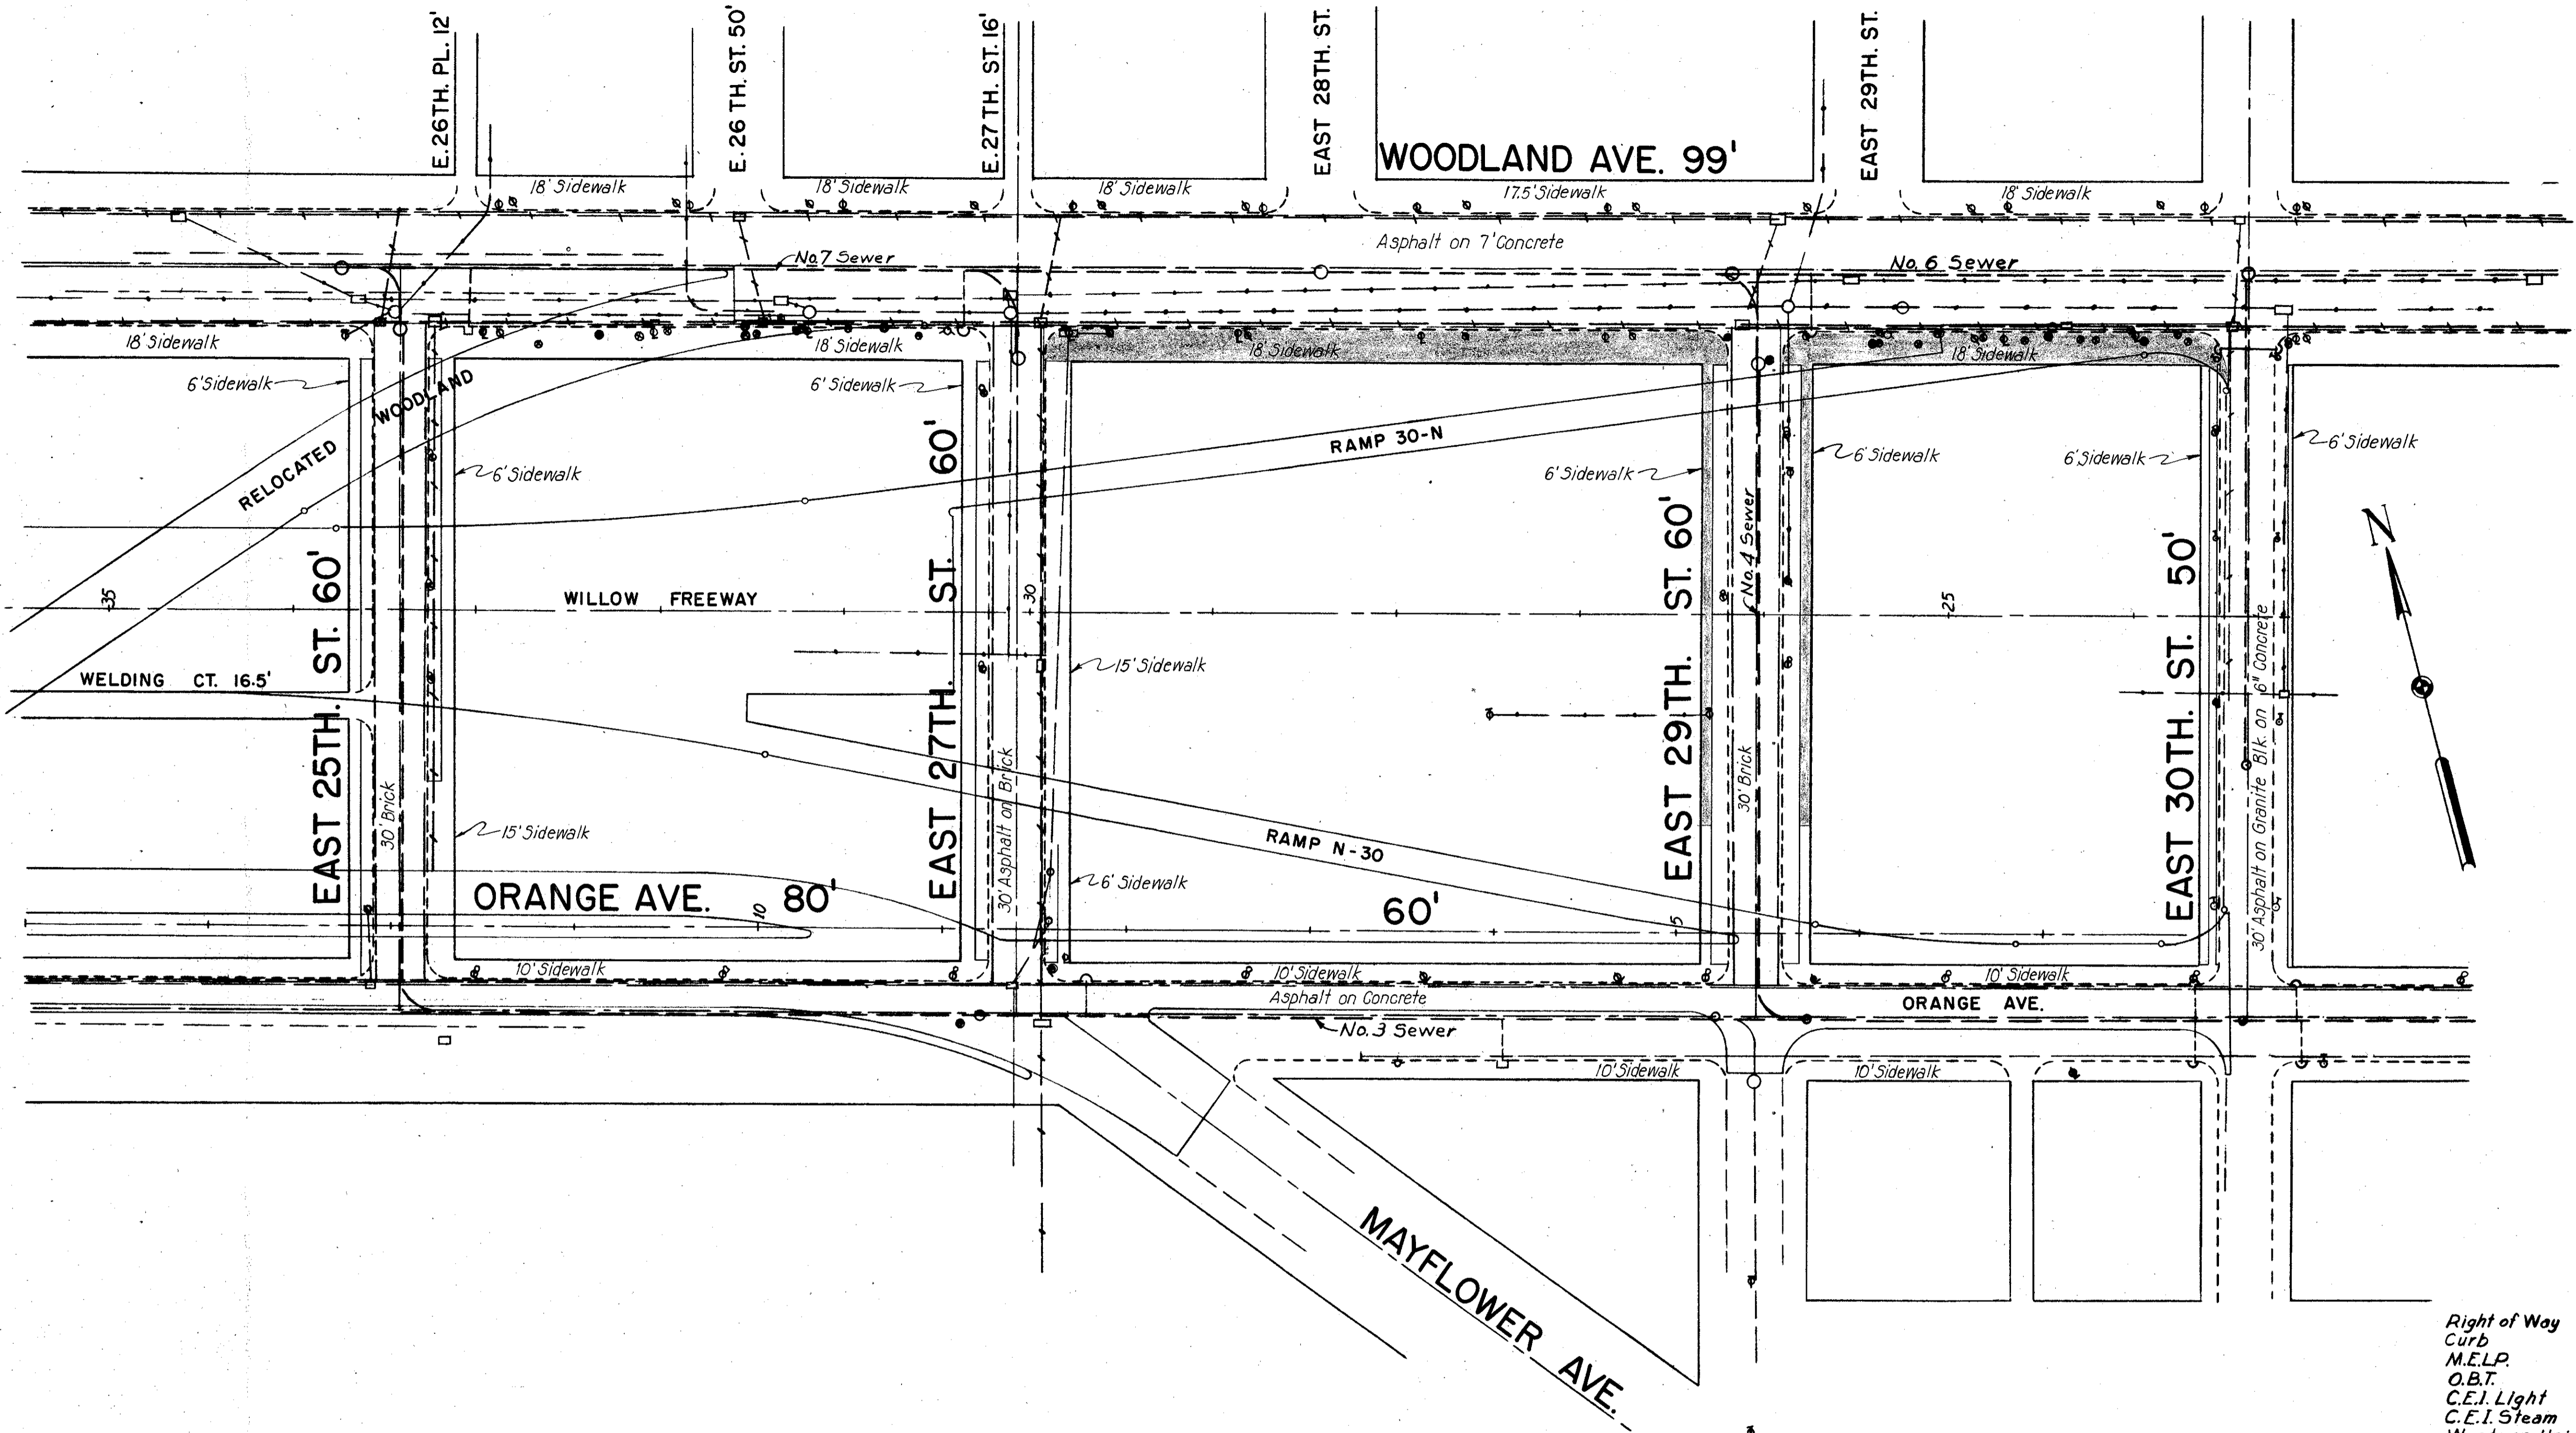

EXISTING UTILITIES


SCALE 1"=30'
MADE B.P.S. DATE 12/1/58
TRCD. R.R. DATE 10/13/59
CKD. DATE

HOWARD, NEEDLES, TAMMEN & BERGENDOFF
CONSULTING ENGINEERS
KANSAS CITY CLEVELAND NEW YORK
914 SHEET 56

FED. ROAD DIV. NO.	STATE	FEDERAL AID PROJECT NO.	TYPE FUNDS
2	OHIO		

58
181

CUYAHOGA COUNTY
CITY OF CLEVELAND
CUY-42-18.42
CUY-21-15.32

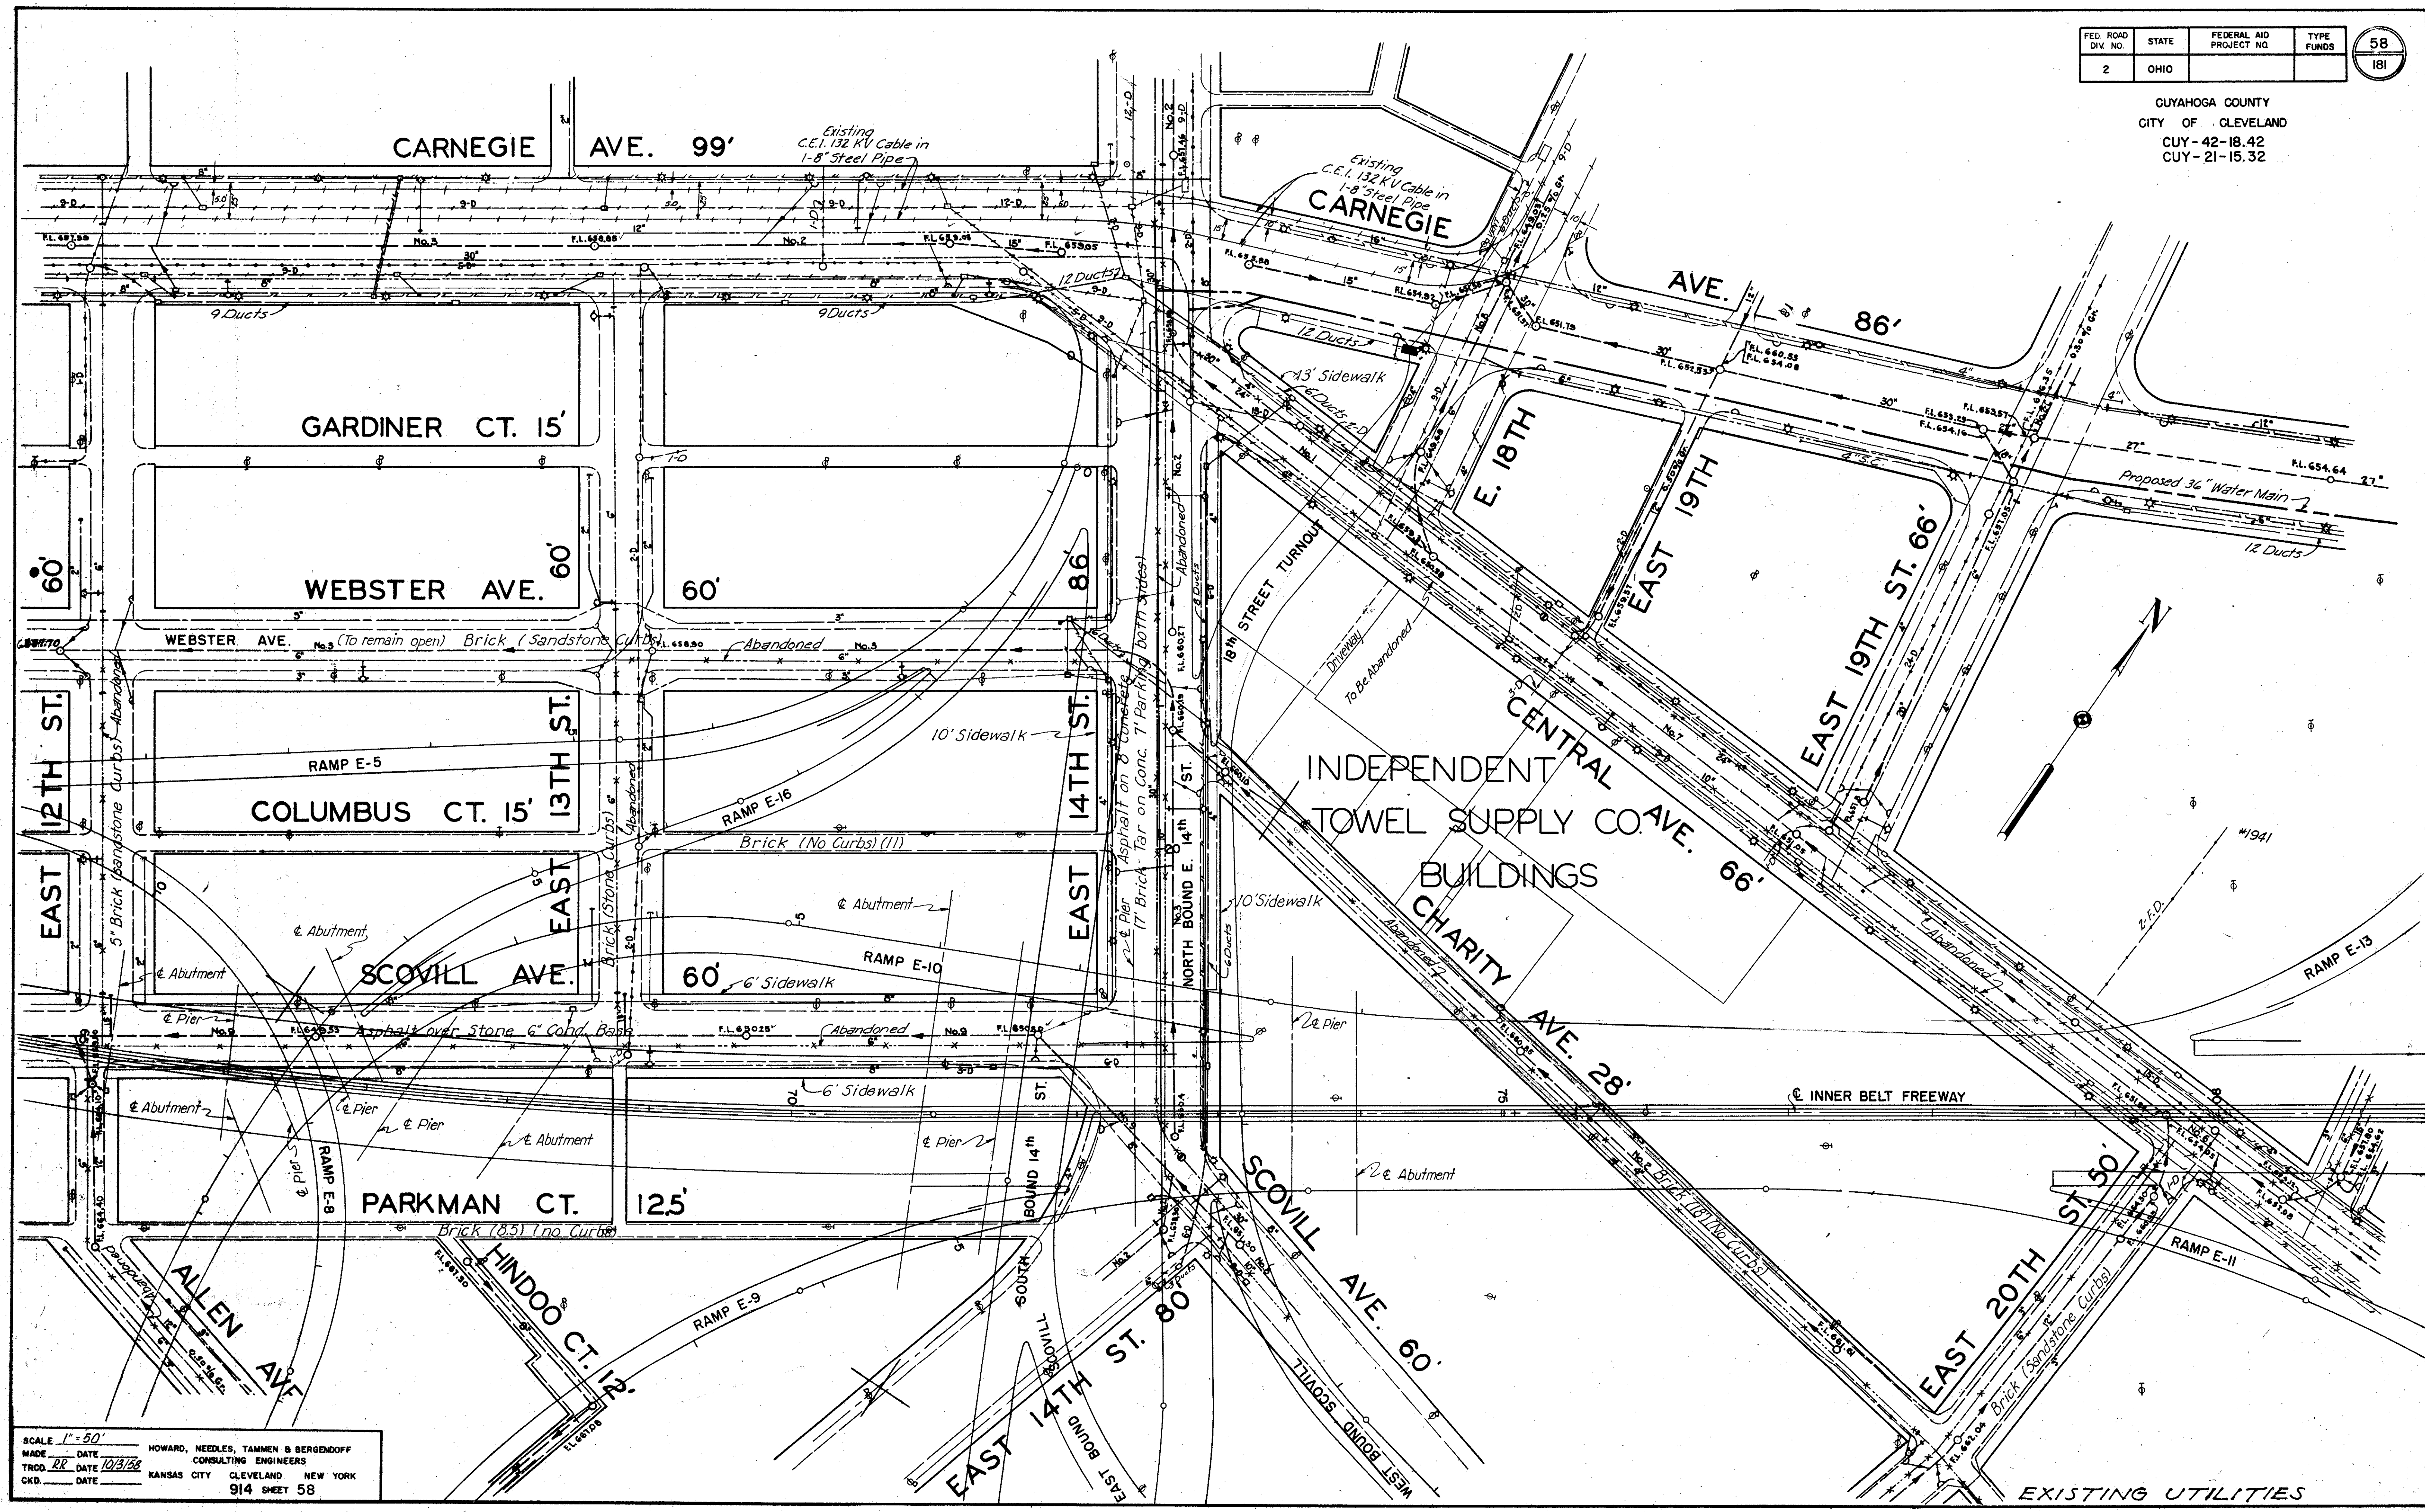


SCALE 1" = 50'
 MADE DATE HOWARD, NEEDLES, TAMMEN & BERGENDOFF
 TRCD RR DATE 10/23/56 CONSULTING ENGINEERS
 CKD DATE KANSAS CITY CLEVELAND NEW YORK
 914 SHEET 58

EXISTING UTILITIES

FED. ROAD DIV. NO.	STATE	FEDERAL AID PROJECT NO.	TYPE FUNDS
2	OHIO		

57
181

CUYAHOGA COUNTY
CITY OF CLEVELAND
CUY-42-18.42
CUY-21-15.32

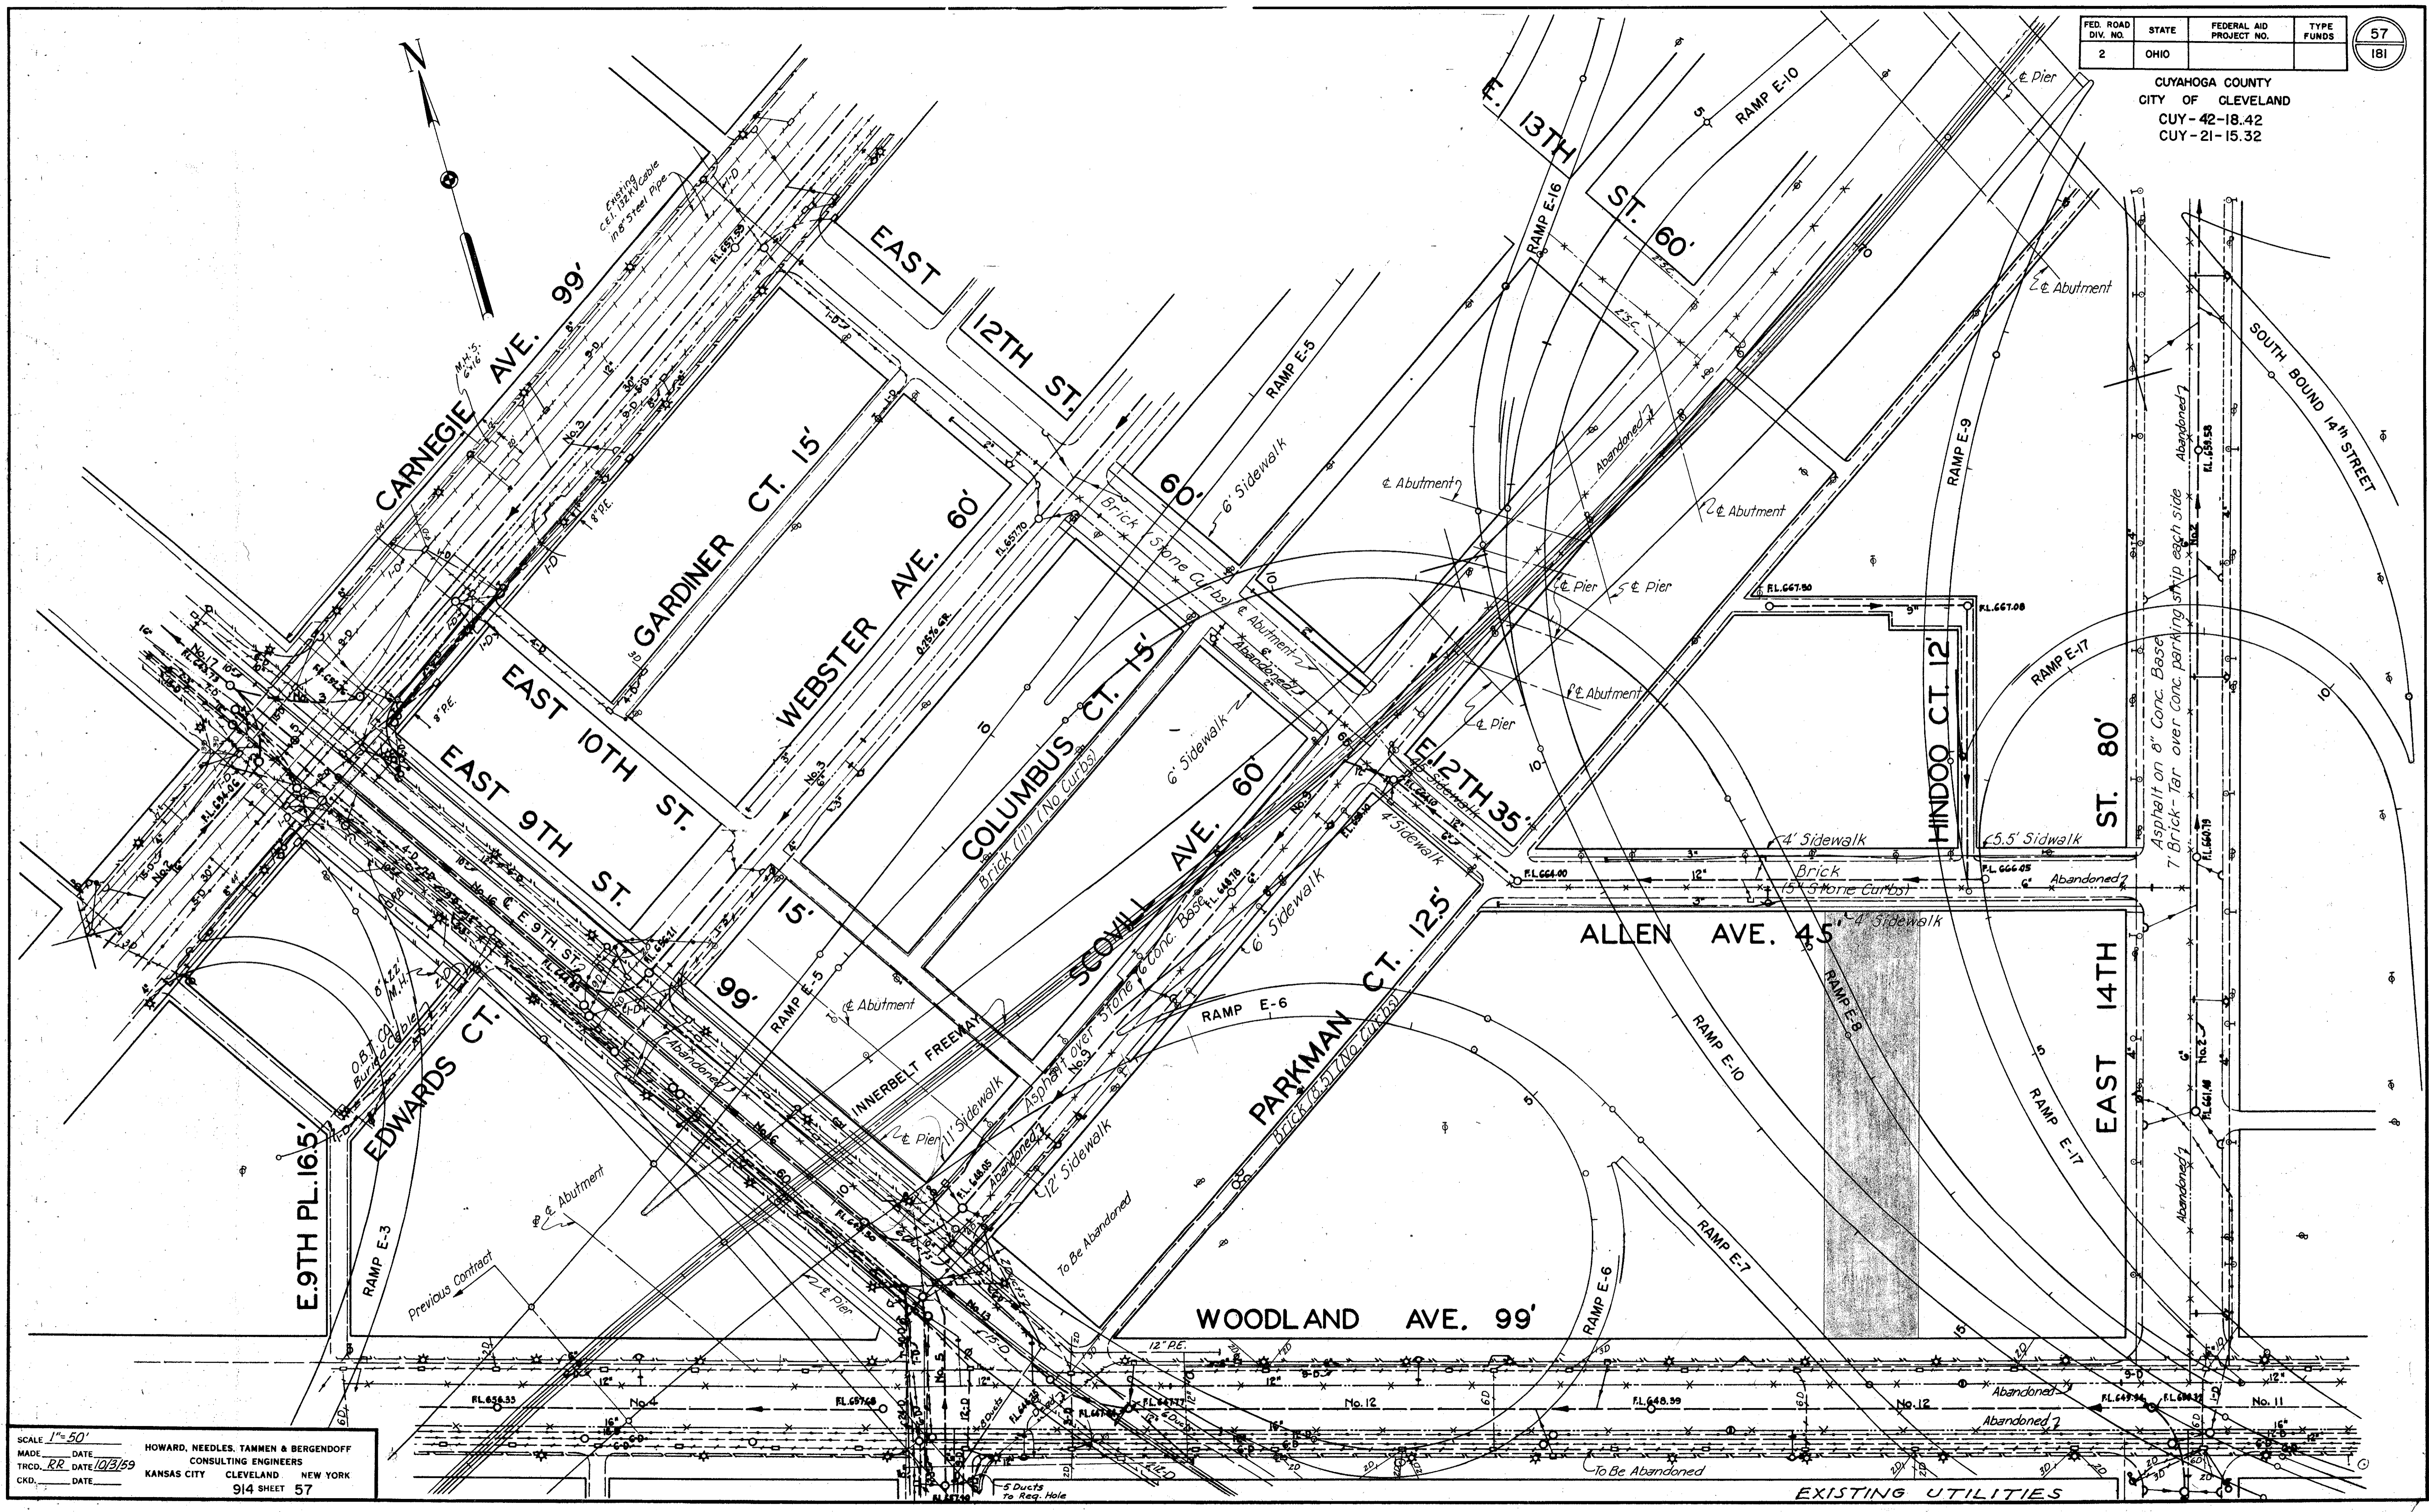


SCALE 1" = 50'
 MADE _____ DATE _____ HOWARD, NEEDLES, TAMMEN & BERGENDOFF
 TRCD. RR. DATE 10/3/59 CONSULTING ENGINEERS
 CKD. _____ DATE _____ KANSAS CITY CLEVELAND NEW YORK
 914 SHEET 57

EXISTING UTILITIES

FED. ROAD DIV. NO.	STATE	FEDERAL AID PROJECT NO.	TYPE FUNDS
2	OHIO		

59
181

CUYAHOGA COUNTY
CITY OF CLEVELAND
CUY-42-18.42
CUY-21-15.32

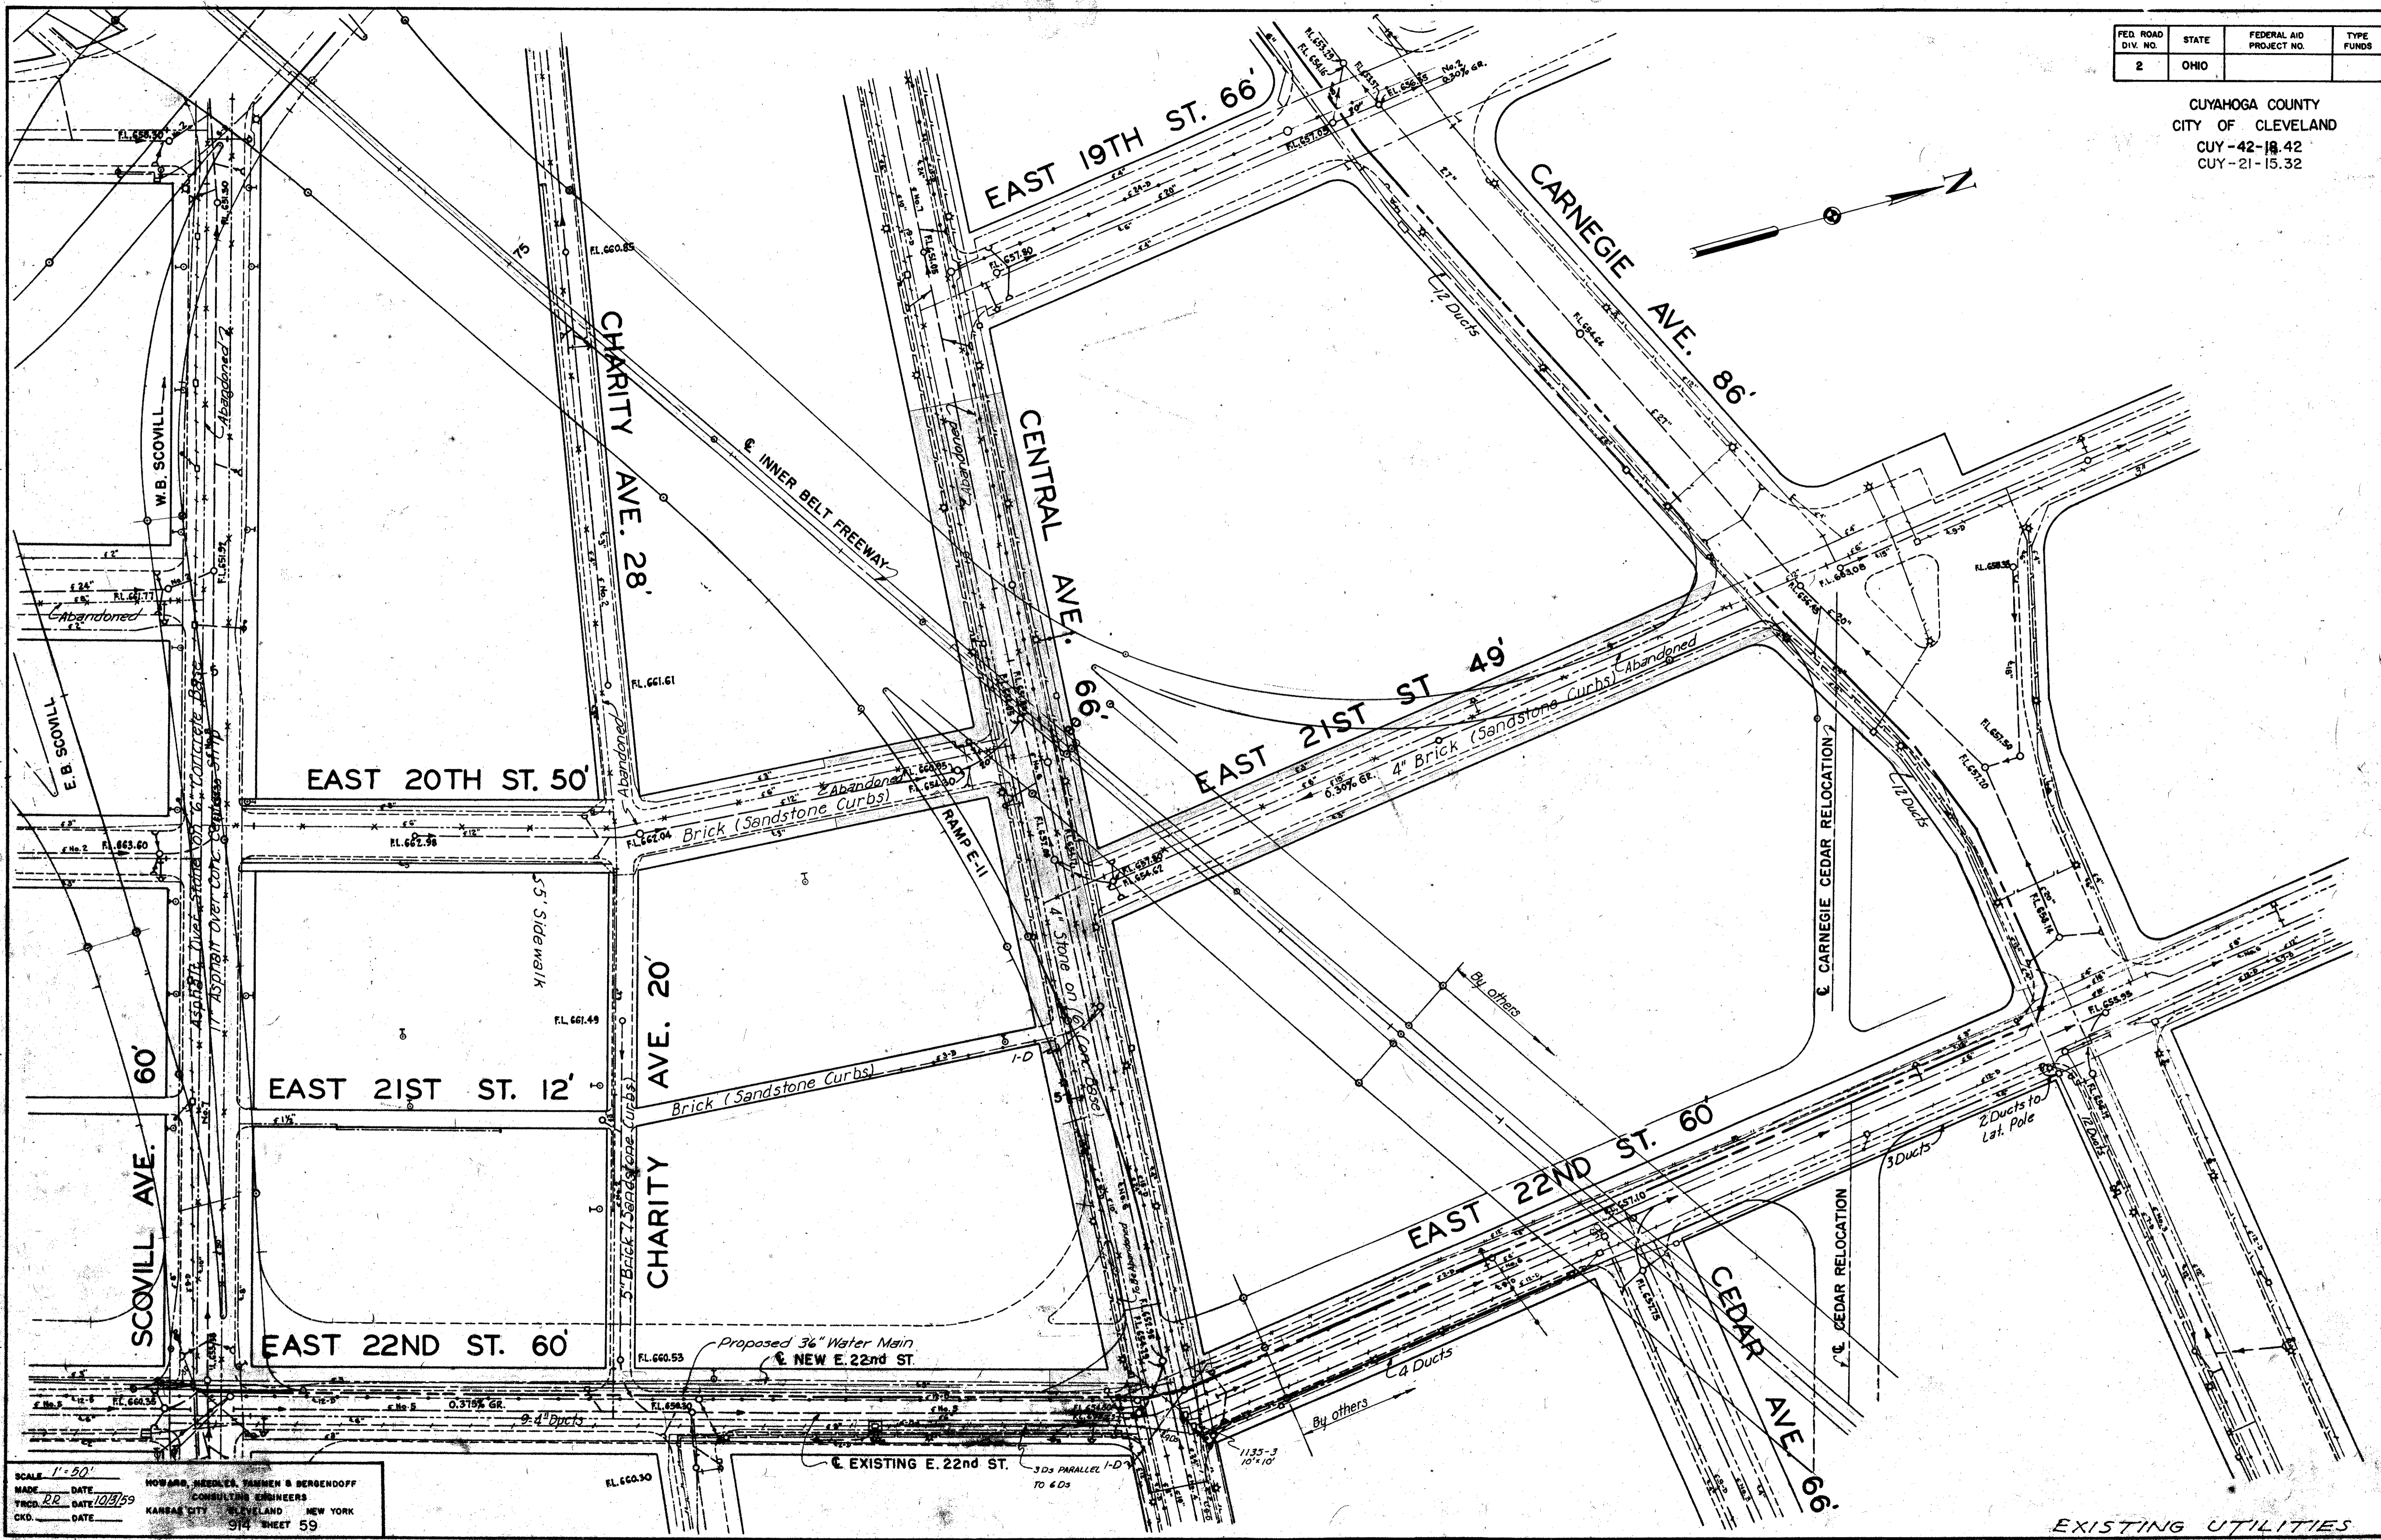

SCALE 1" = 50'
 MADE DATE HOWARD, NEEDLES, TAMMEN & BERGENDOFF
 TRCD. RR DATE 10/21/59 CONSULTING ENGINEERS
 CHKD. DATE KANSAS CITY CLEVELAND NEW YORK
 914 SHEET 59

EXISTING UTILITIES

FED. ROAD DIV. NO.	STATE	FEDERAL AID PROJECT NO.	TYPE FUNDS	60 181
2	OHIO			

CUYAHOGA COUNTY
CITY OF CLEVELAND
CUY-42-18.42
CUY-21-15.32
CROSS SECTION LAYOUT

SERIES	SHEETS	STA. TO STA.	CUY 42-18.42		CUY 21-15.32	
			EXCAVA.	EMBANK.	EXCAVA.	EMBANK.
A	61-65	61+50 71+30	19,260	46,640		
B	65-69	74+07 83+09	23,091	23,299		
C	68-69	0+33 81+00	3,635	0		
D	68-69	5+00 81+50	1,301	0		
E	69-70	2+50 7+25	475	4,375		
F	71-73	0+00 9+31	2,487	45,629		
G	74-76	0+00 7+35	17,113	26,239		
H	77-78	0+00 4+80	3	30,840		
I	79-84	4+35 22+33	5,193	10,427		
J	85-87	23+43 35+05			1,806	51,477
K	87-89	35+42 42+77			0	56,710
L	89-90	44+21 49+24	238	58,066		
M	90	0+00 7+15			1,954	27
TOTALS			72,796	245,515	3,760	108,494
* Deficiency				209,546		121,008




Shrinkage Factor

15%


NOTE:
THE B FOR THE INNER BELT CROSS SECTIONS IS THE FORWARD TANGENT AT STA. 70+99.9 PRODUCED BACK. THIS IS ALSO THE REFERENCE LINE FOR SERIES "I" AND "J".

* Obtain from excavation elsewhere on Parts 6 or 7-B.

- LEGEND
- Previous Contract - Part 5
 - Part 6 - Previous Project
 - Part 7 - Present Project
 - Construction Limits

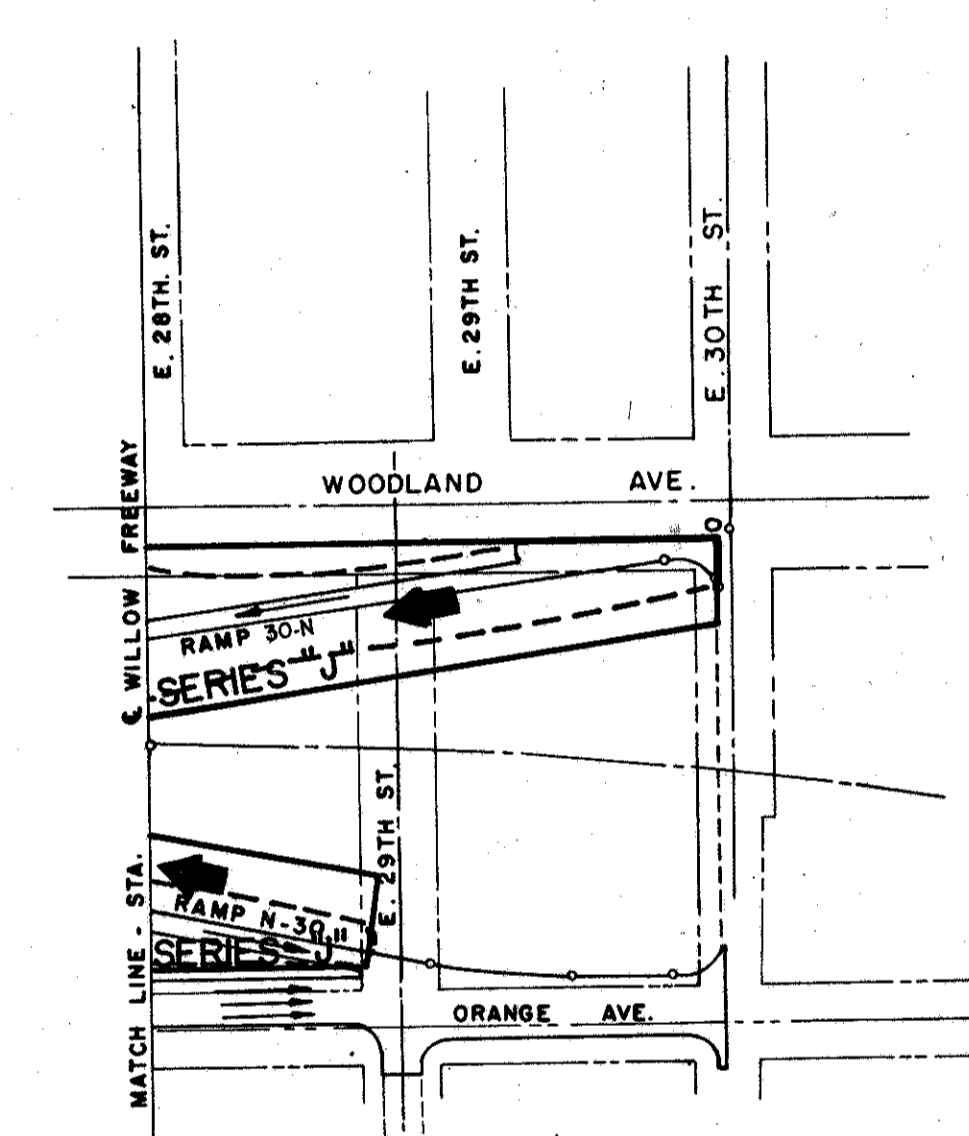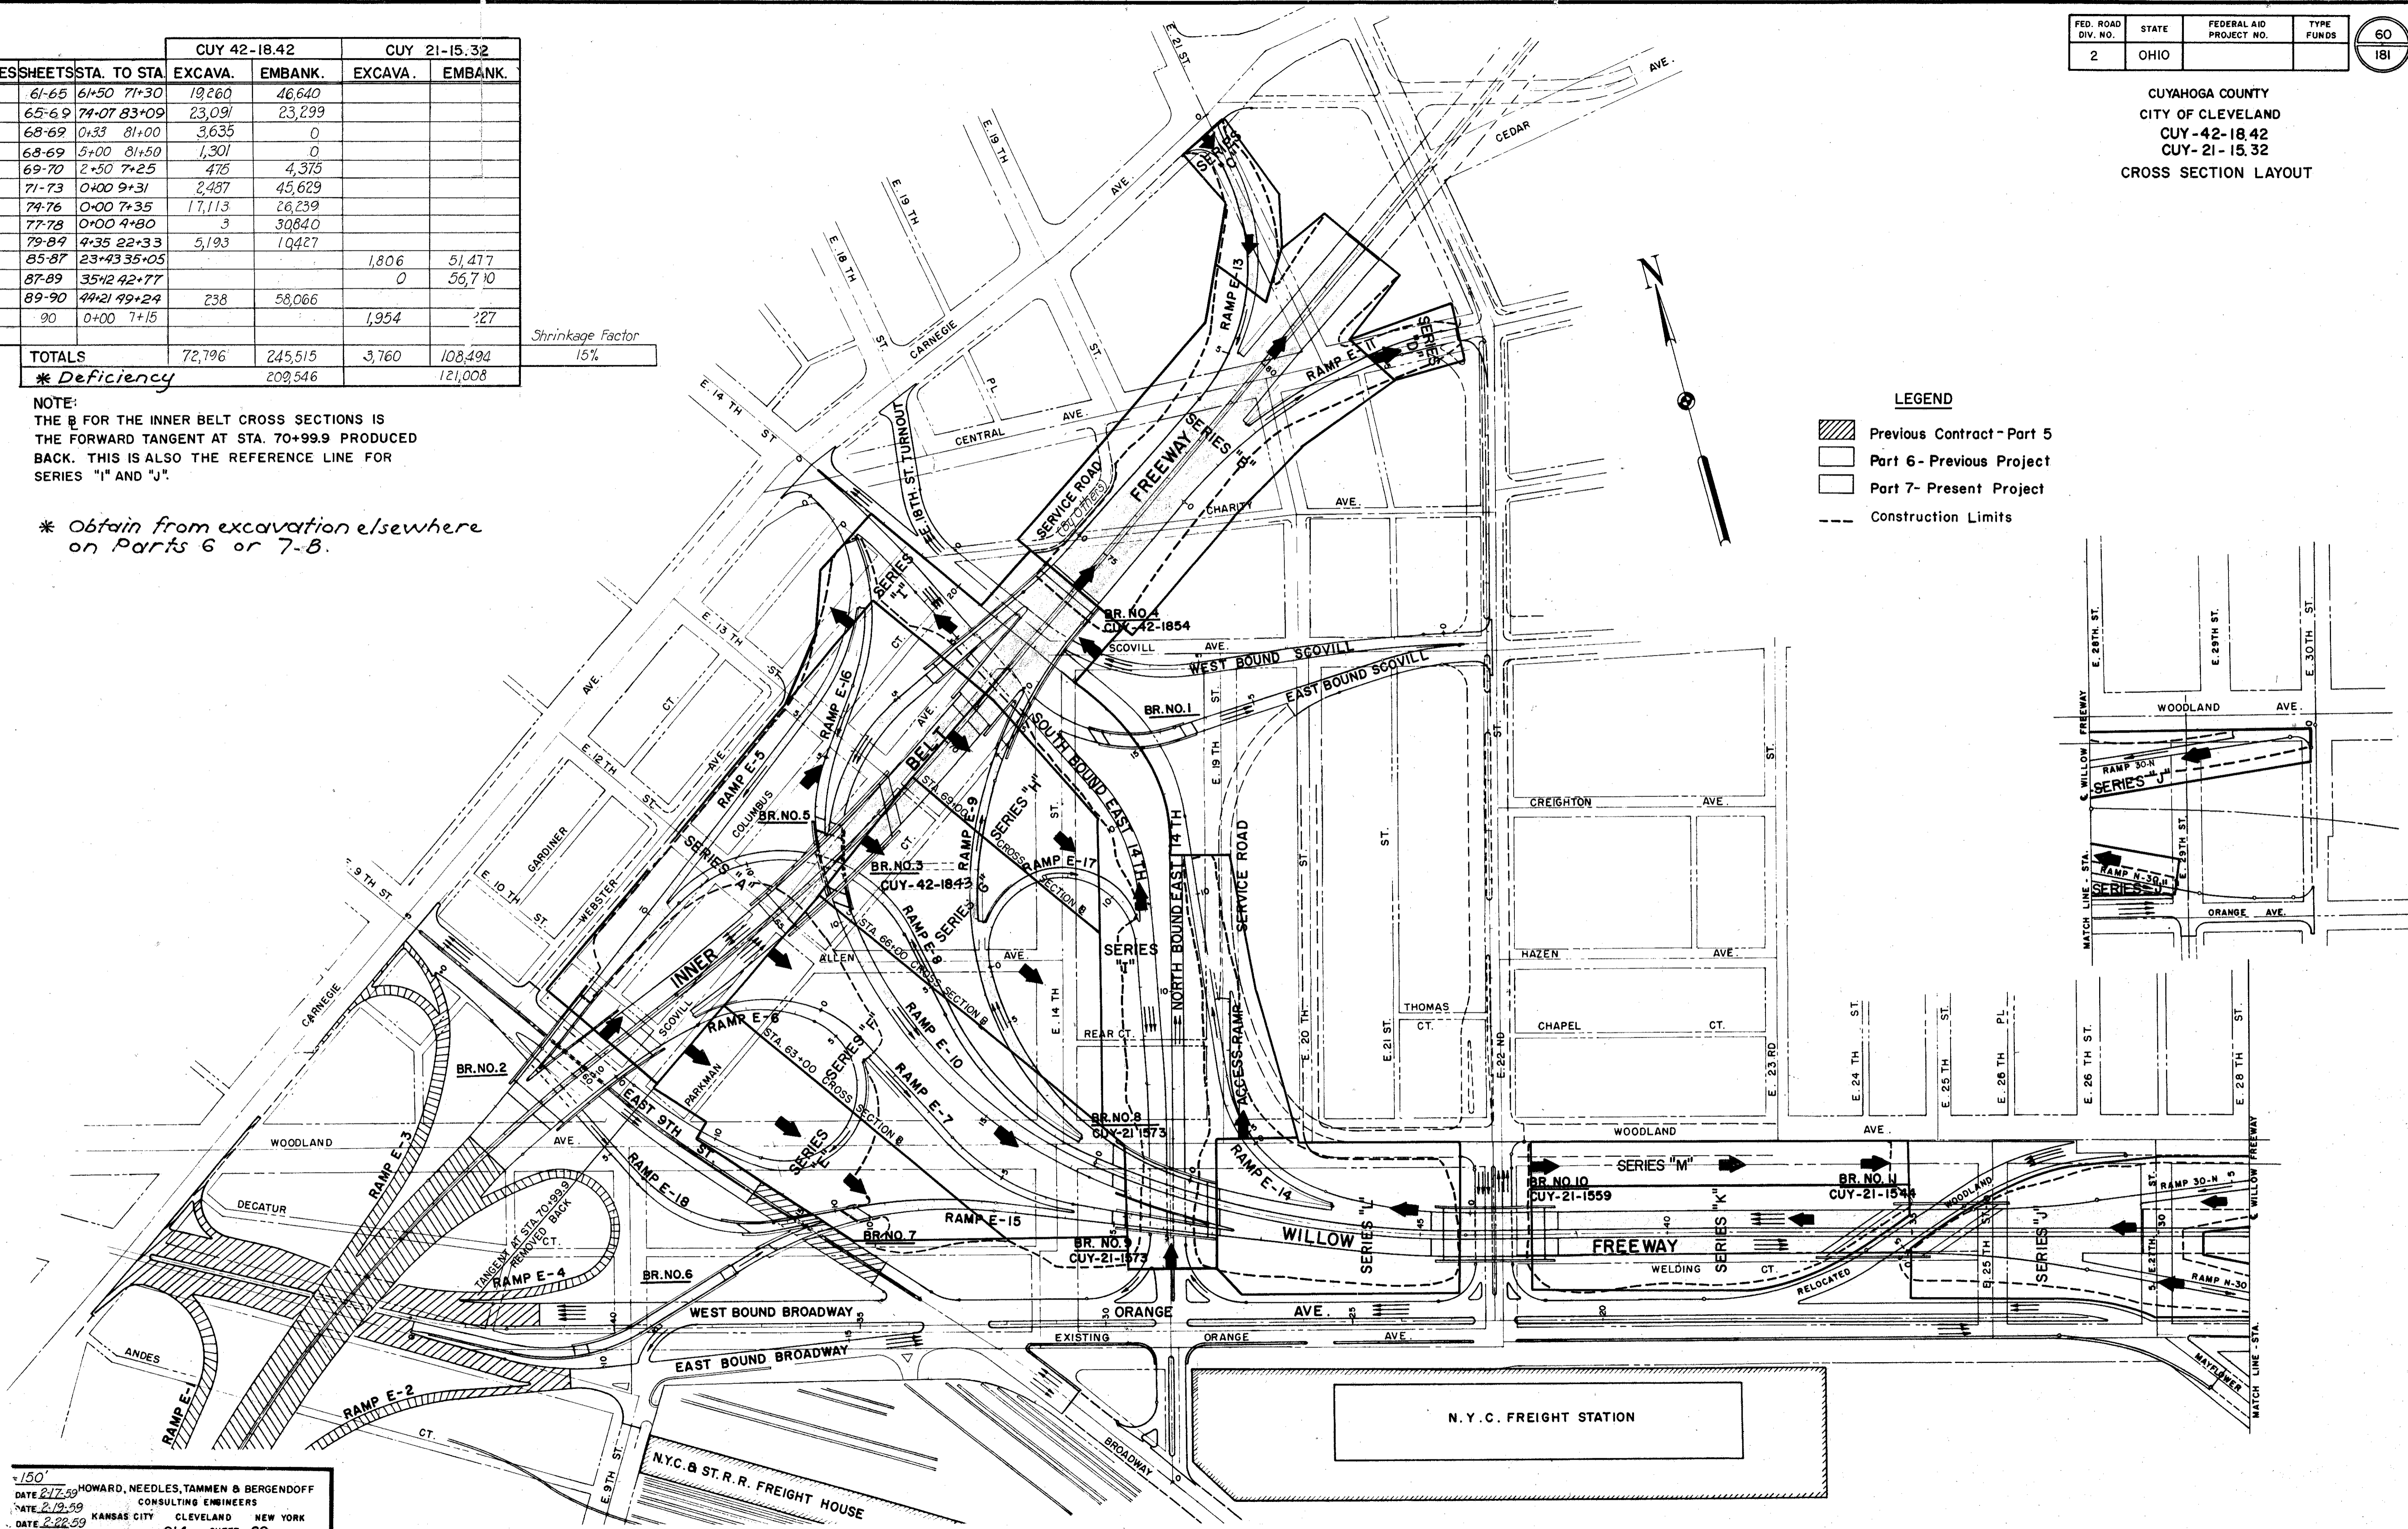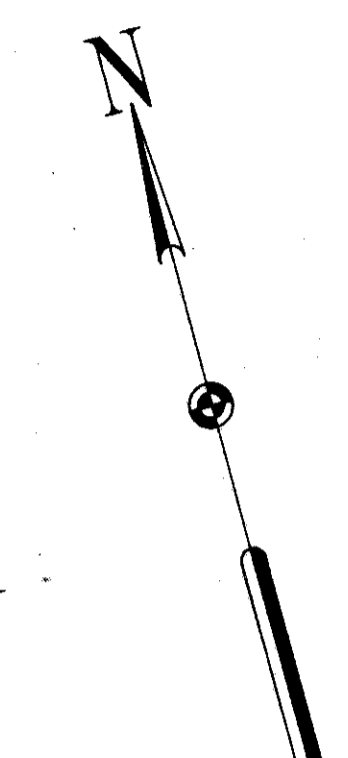

CUYAHOGA COUNTY
CITY OF CLEVELAND
CUY-42-18.42
CUY-21-15.32

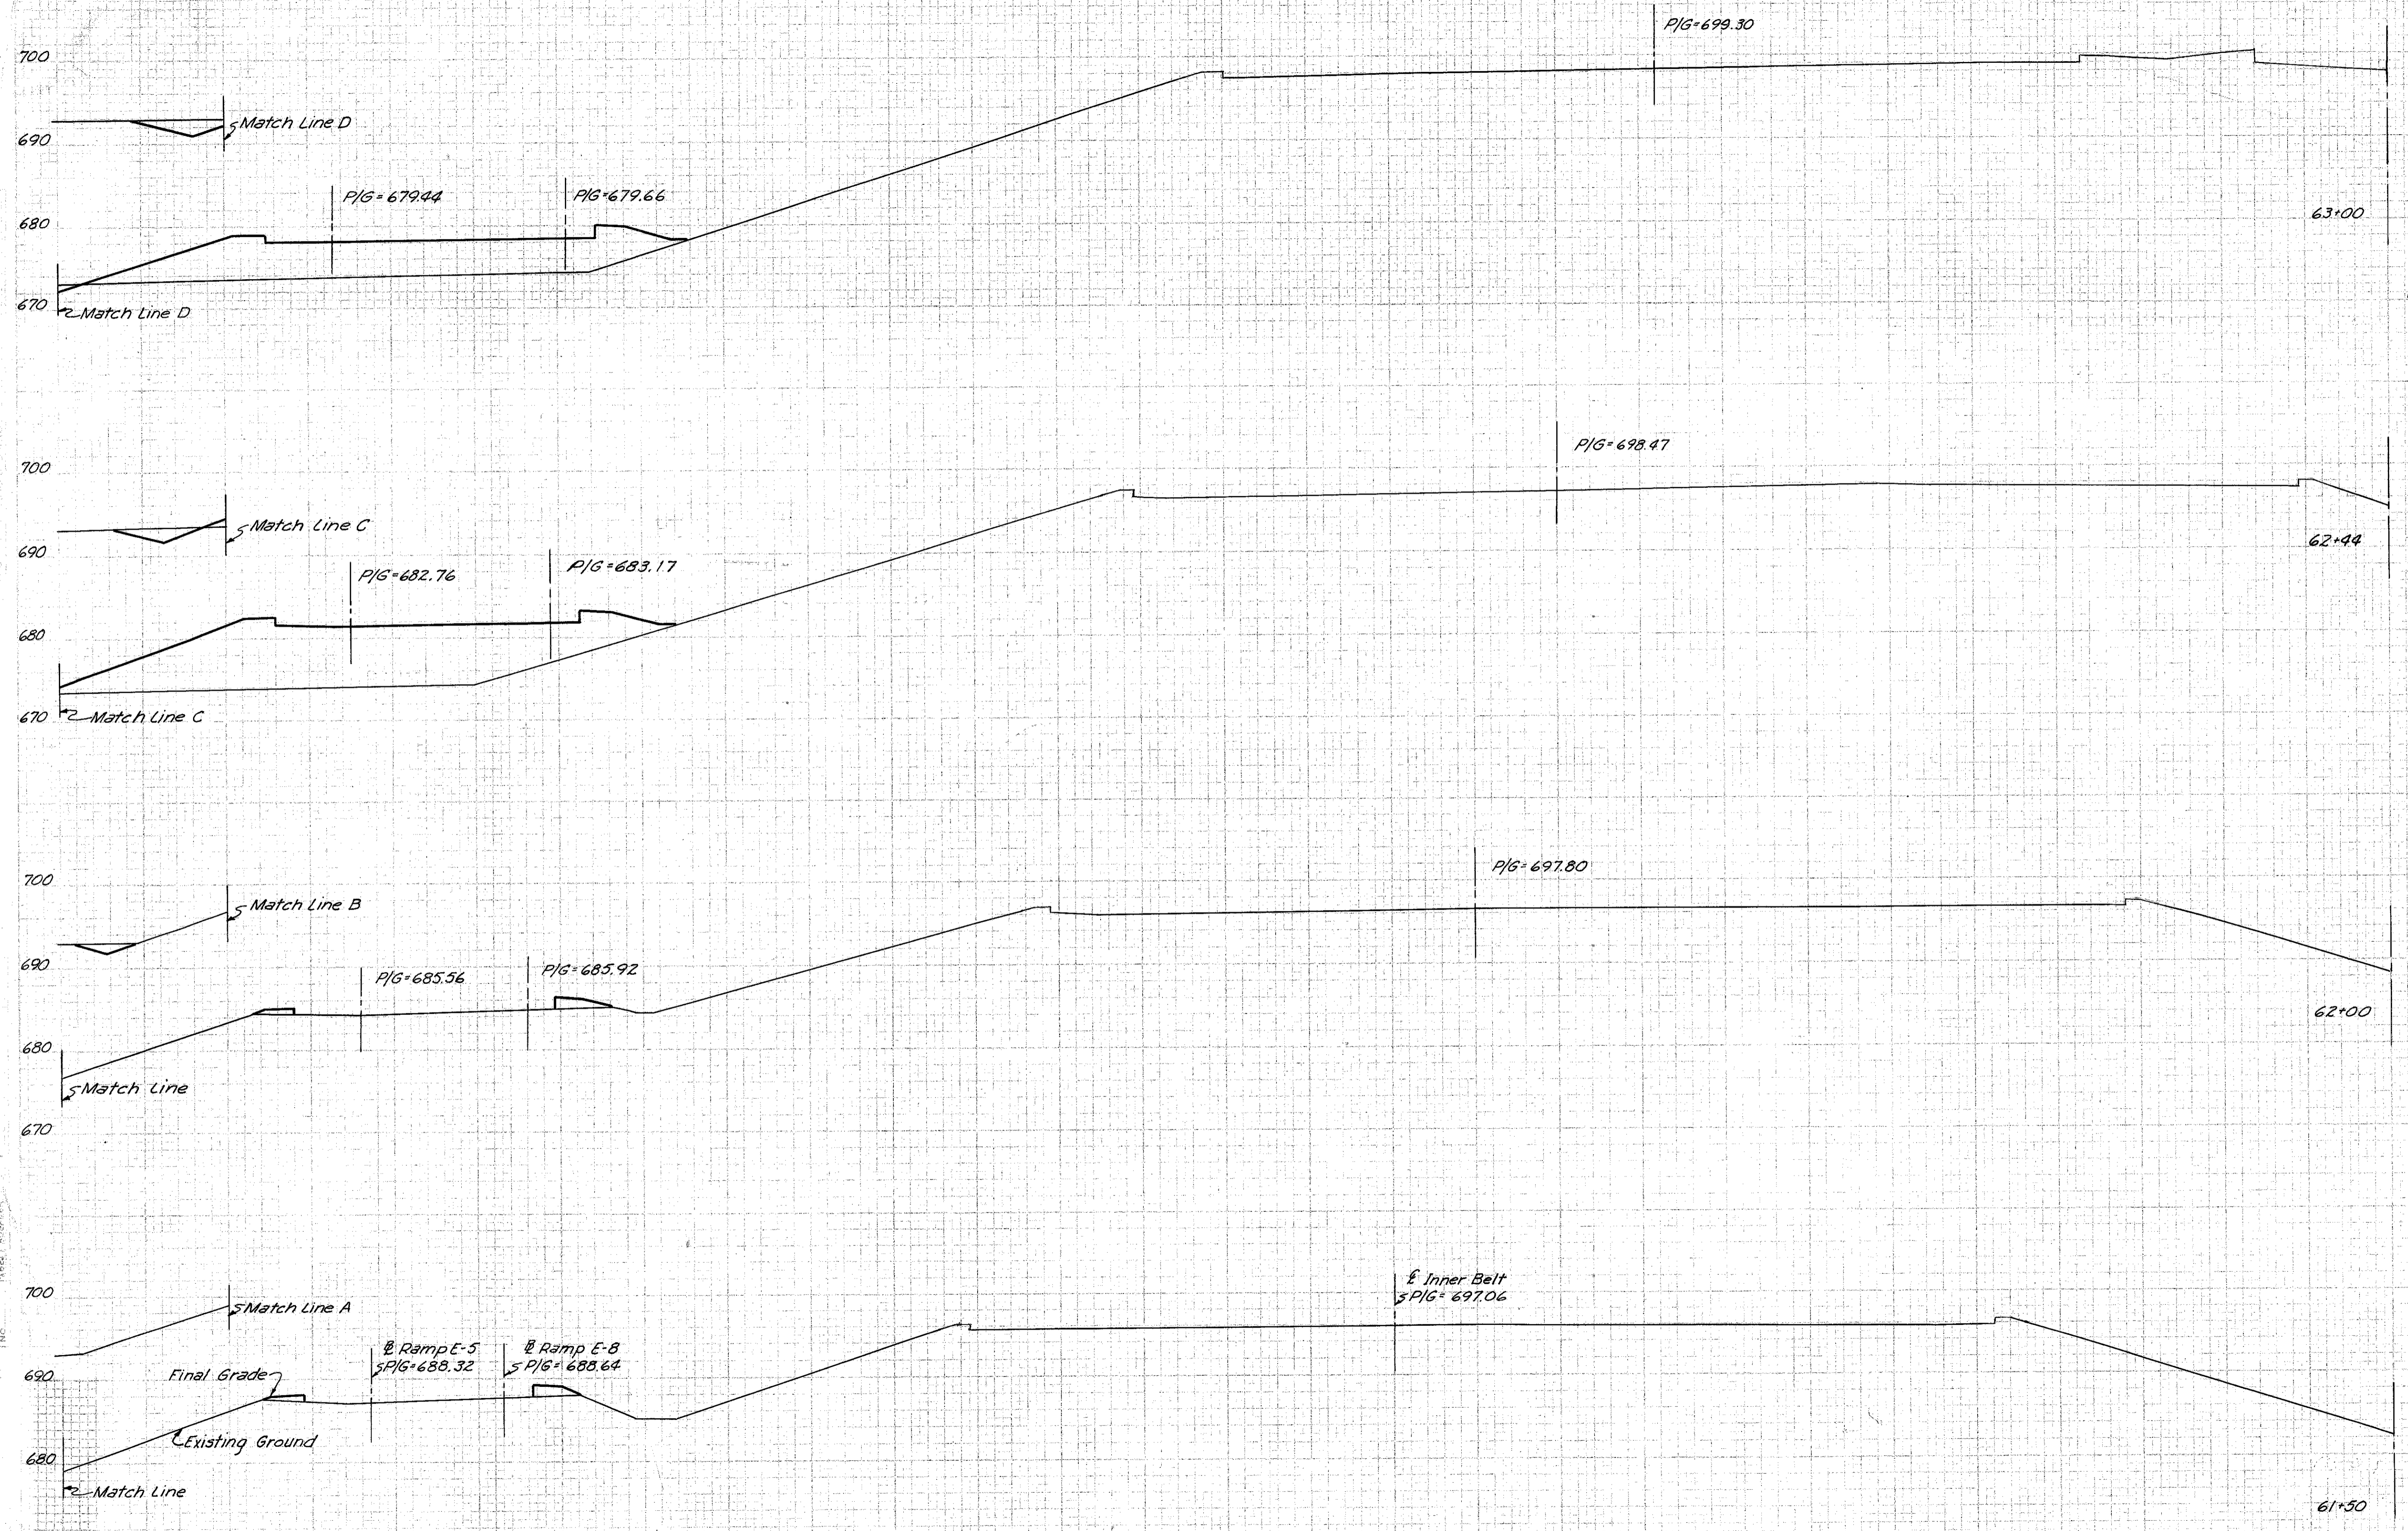

SEEDING		SUBBASE		EARTHWORK			
WIDTH	AREA	AREA	VOL.	END AREA		VOLUME	
L.F.	SQ. YD.	S.F.	C.Y.	EXC.	EMB.	EXC.	EMB.
				14	266		
						24	713
				9	422		
						11	351
				5	9		
						5	16
				0	8		


SERIES A
INNER BELT SECTIONS
STA 61+50 TO STA. 63+00

SCALE: 1"=10'
MADE: 1-5-58 DATE: 8-6-58
TPO: 1-13-58 DATE: 1-3-58
CKD: 1-16-58 DATE: 12-23-58

HOWARD, NEEDLES, TAMMEN & BERGENOFF
CONSULTING ENGINEERS
KANSAS CITY CLEVELAND NEW YORK
914 SHEET 61

FED. ROAD DIV. NO.	STATE	FEDERAL AID PROJECT NO.	TYPE FUNDS	62 181
2	OHIO			

CUYAHOGA COUNTY
CITY OF CLEVELAND
CUY-42-18.42
CUY-21-15.32

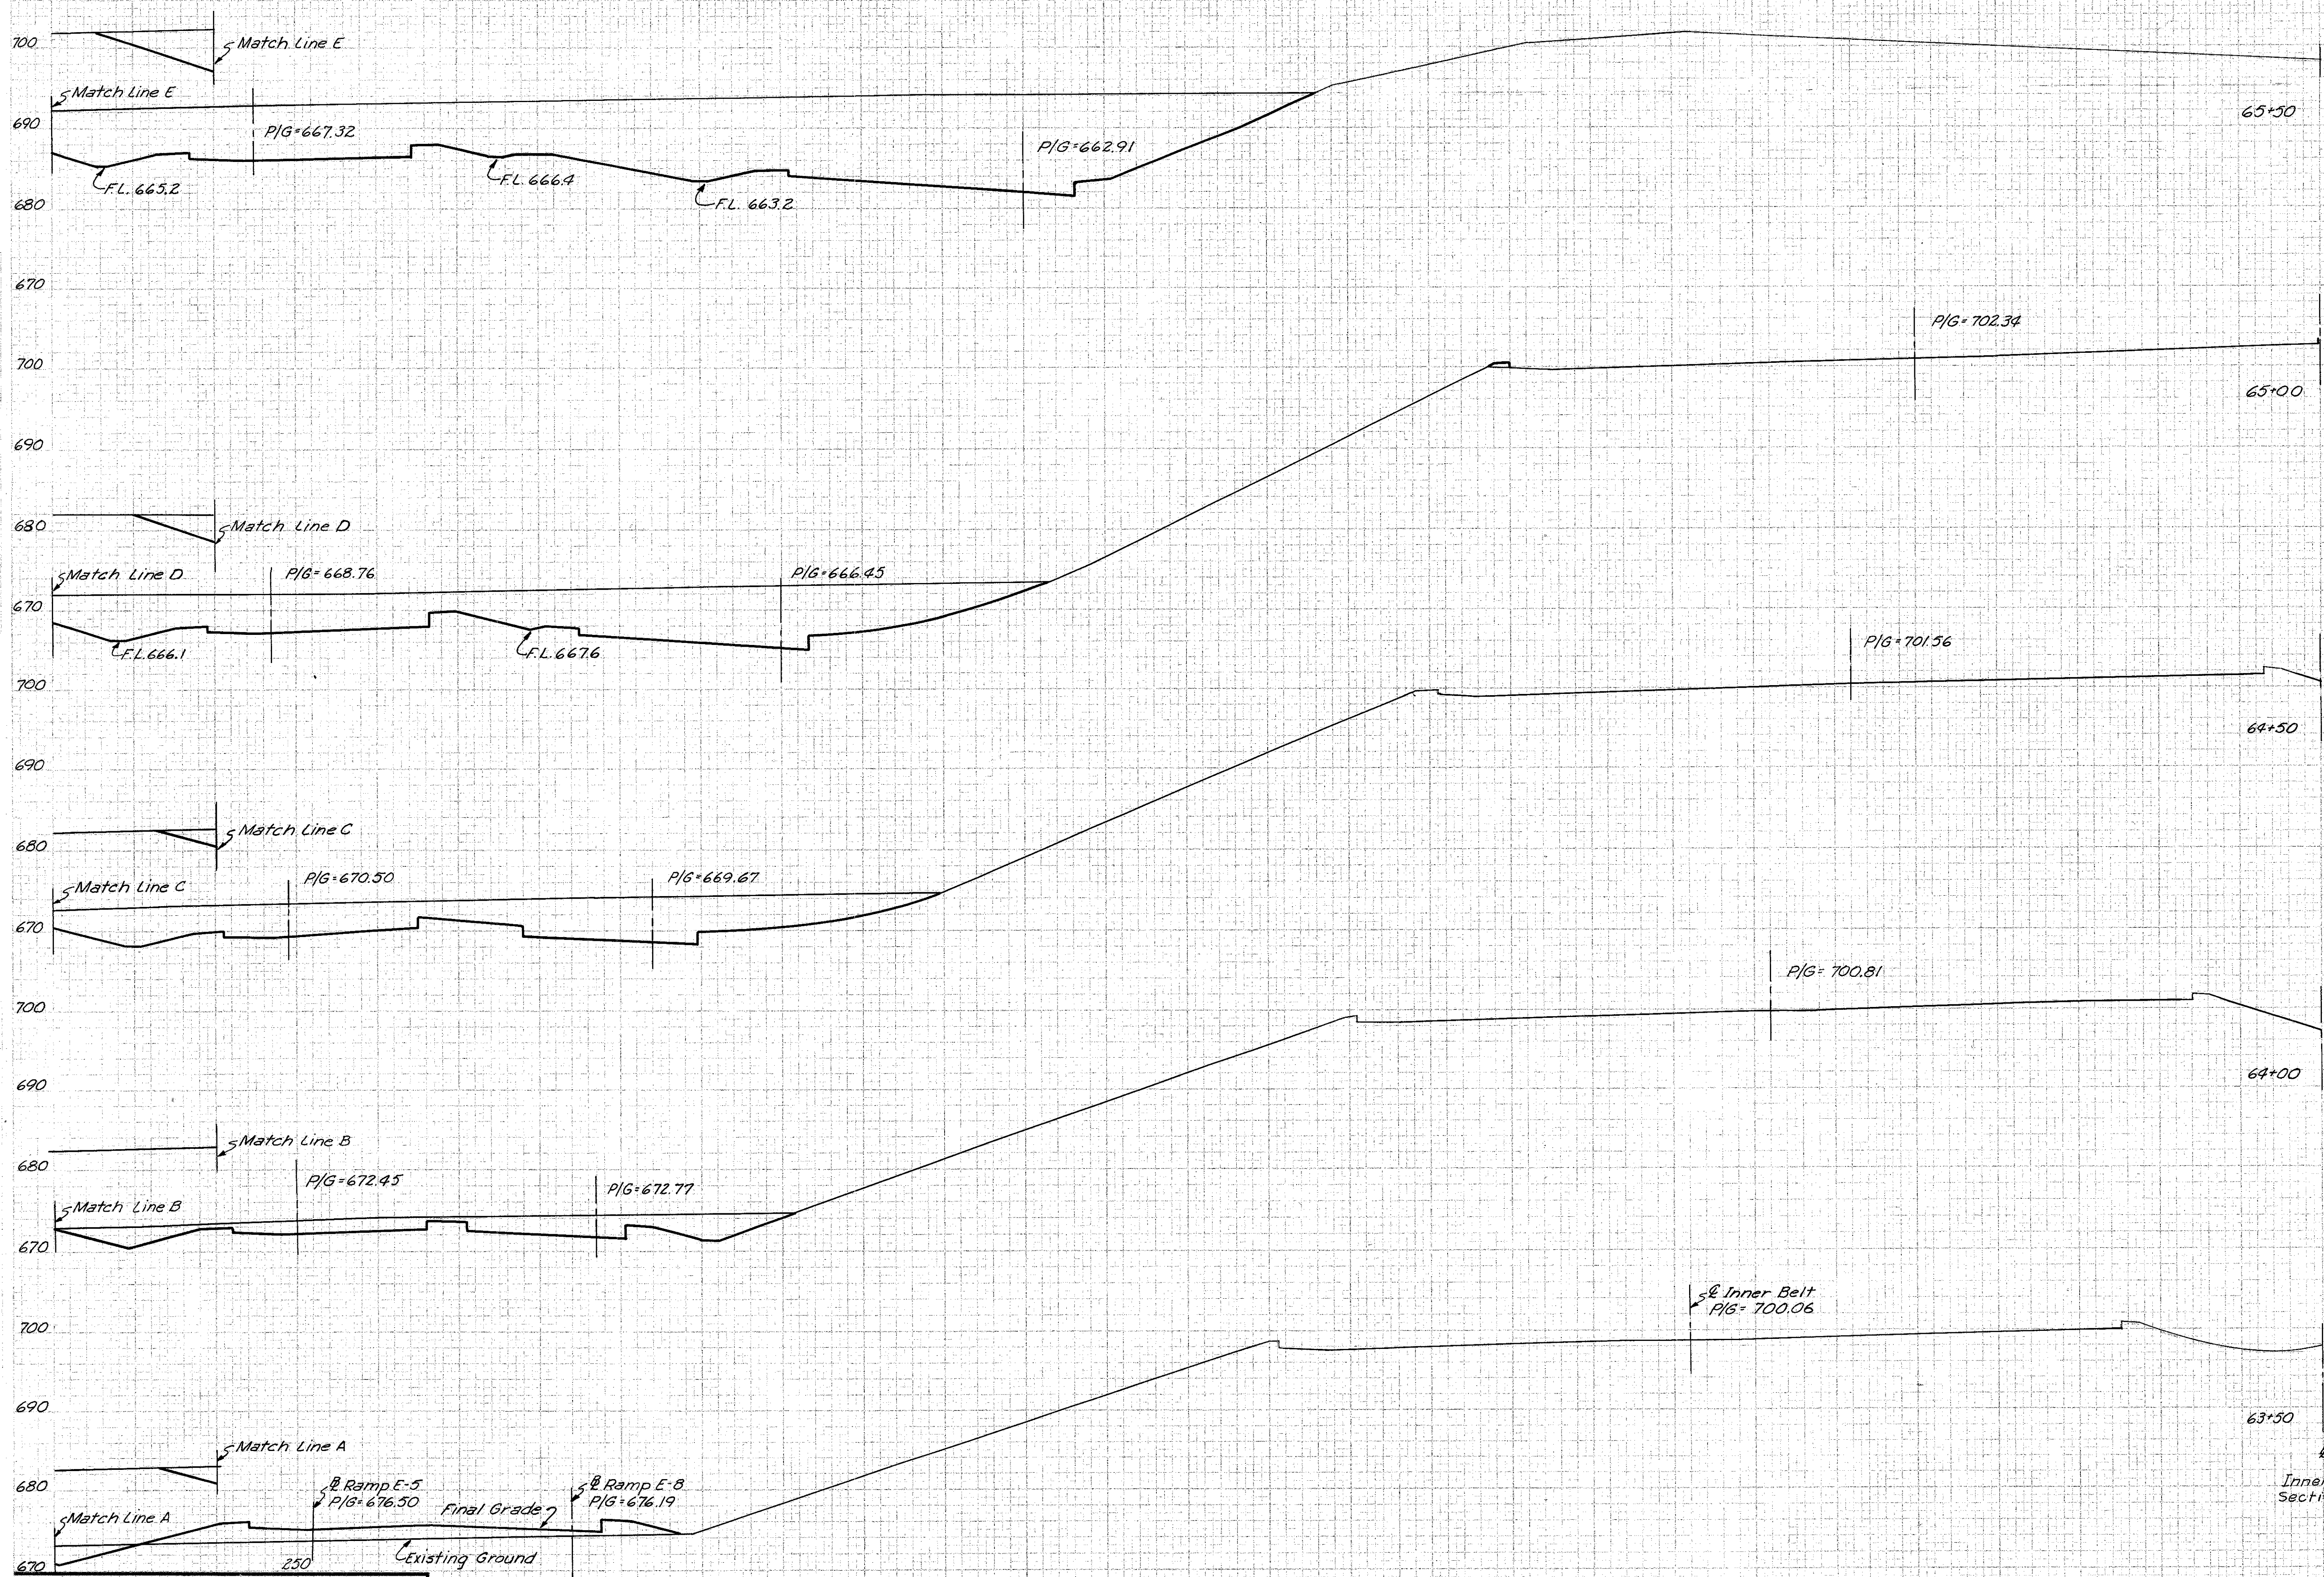

SEEDING		SUBBASE		EARTHWORK			
WIDTH	AREA	AREA	VOL.	END AREA		VOLUME	
L.F.	SQ. YD.	S.F.	C.Y.	EXC.	EMB.	EXC.	EMB.
				1285	0		
65+50						1775	2
65+00				632	2		
65+00						983	2
64+50							
64+50				430	0		
64+50						537	0
64+00				150	0		
64+00						156	96
63+50				18	104		
63+50						26	343
63+00				14	266		
63+00							
Inner Belt Sections							

SERIES A
INNER BELT SECTIONS
STA. 63+50 TO STA. 65+50


SCALE 1"=10'
MADE FL.S. DATE 8-6-58 HOWARD, NEEDLES, TAMMEN & BERGENDOFF
TRCD. M.B. DATE 11-3-58 CONSULTING ENGINEERS
CKD. S.M.G. DATE 12-23-58 KANSAS CITY CLEVELAND NEW YORK
914 SHEET 62

Inner Belt
P/G-704.30

FED. ROAD DIV. NO.	STATE	FEDERAL AID PROJECT NO.	TYPE FUNDS
2	OHIO		

63
181

CUYAHOGA COUNTY
CITY OF CLEVELAND
CUY-42-18.42
CUY-21-15.32

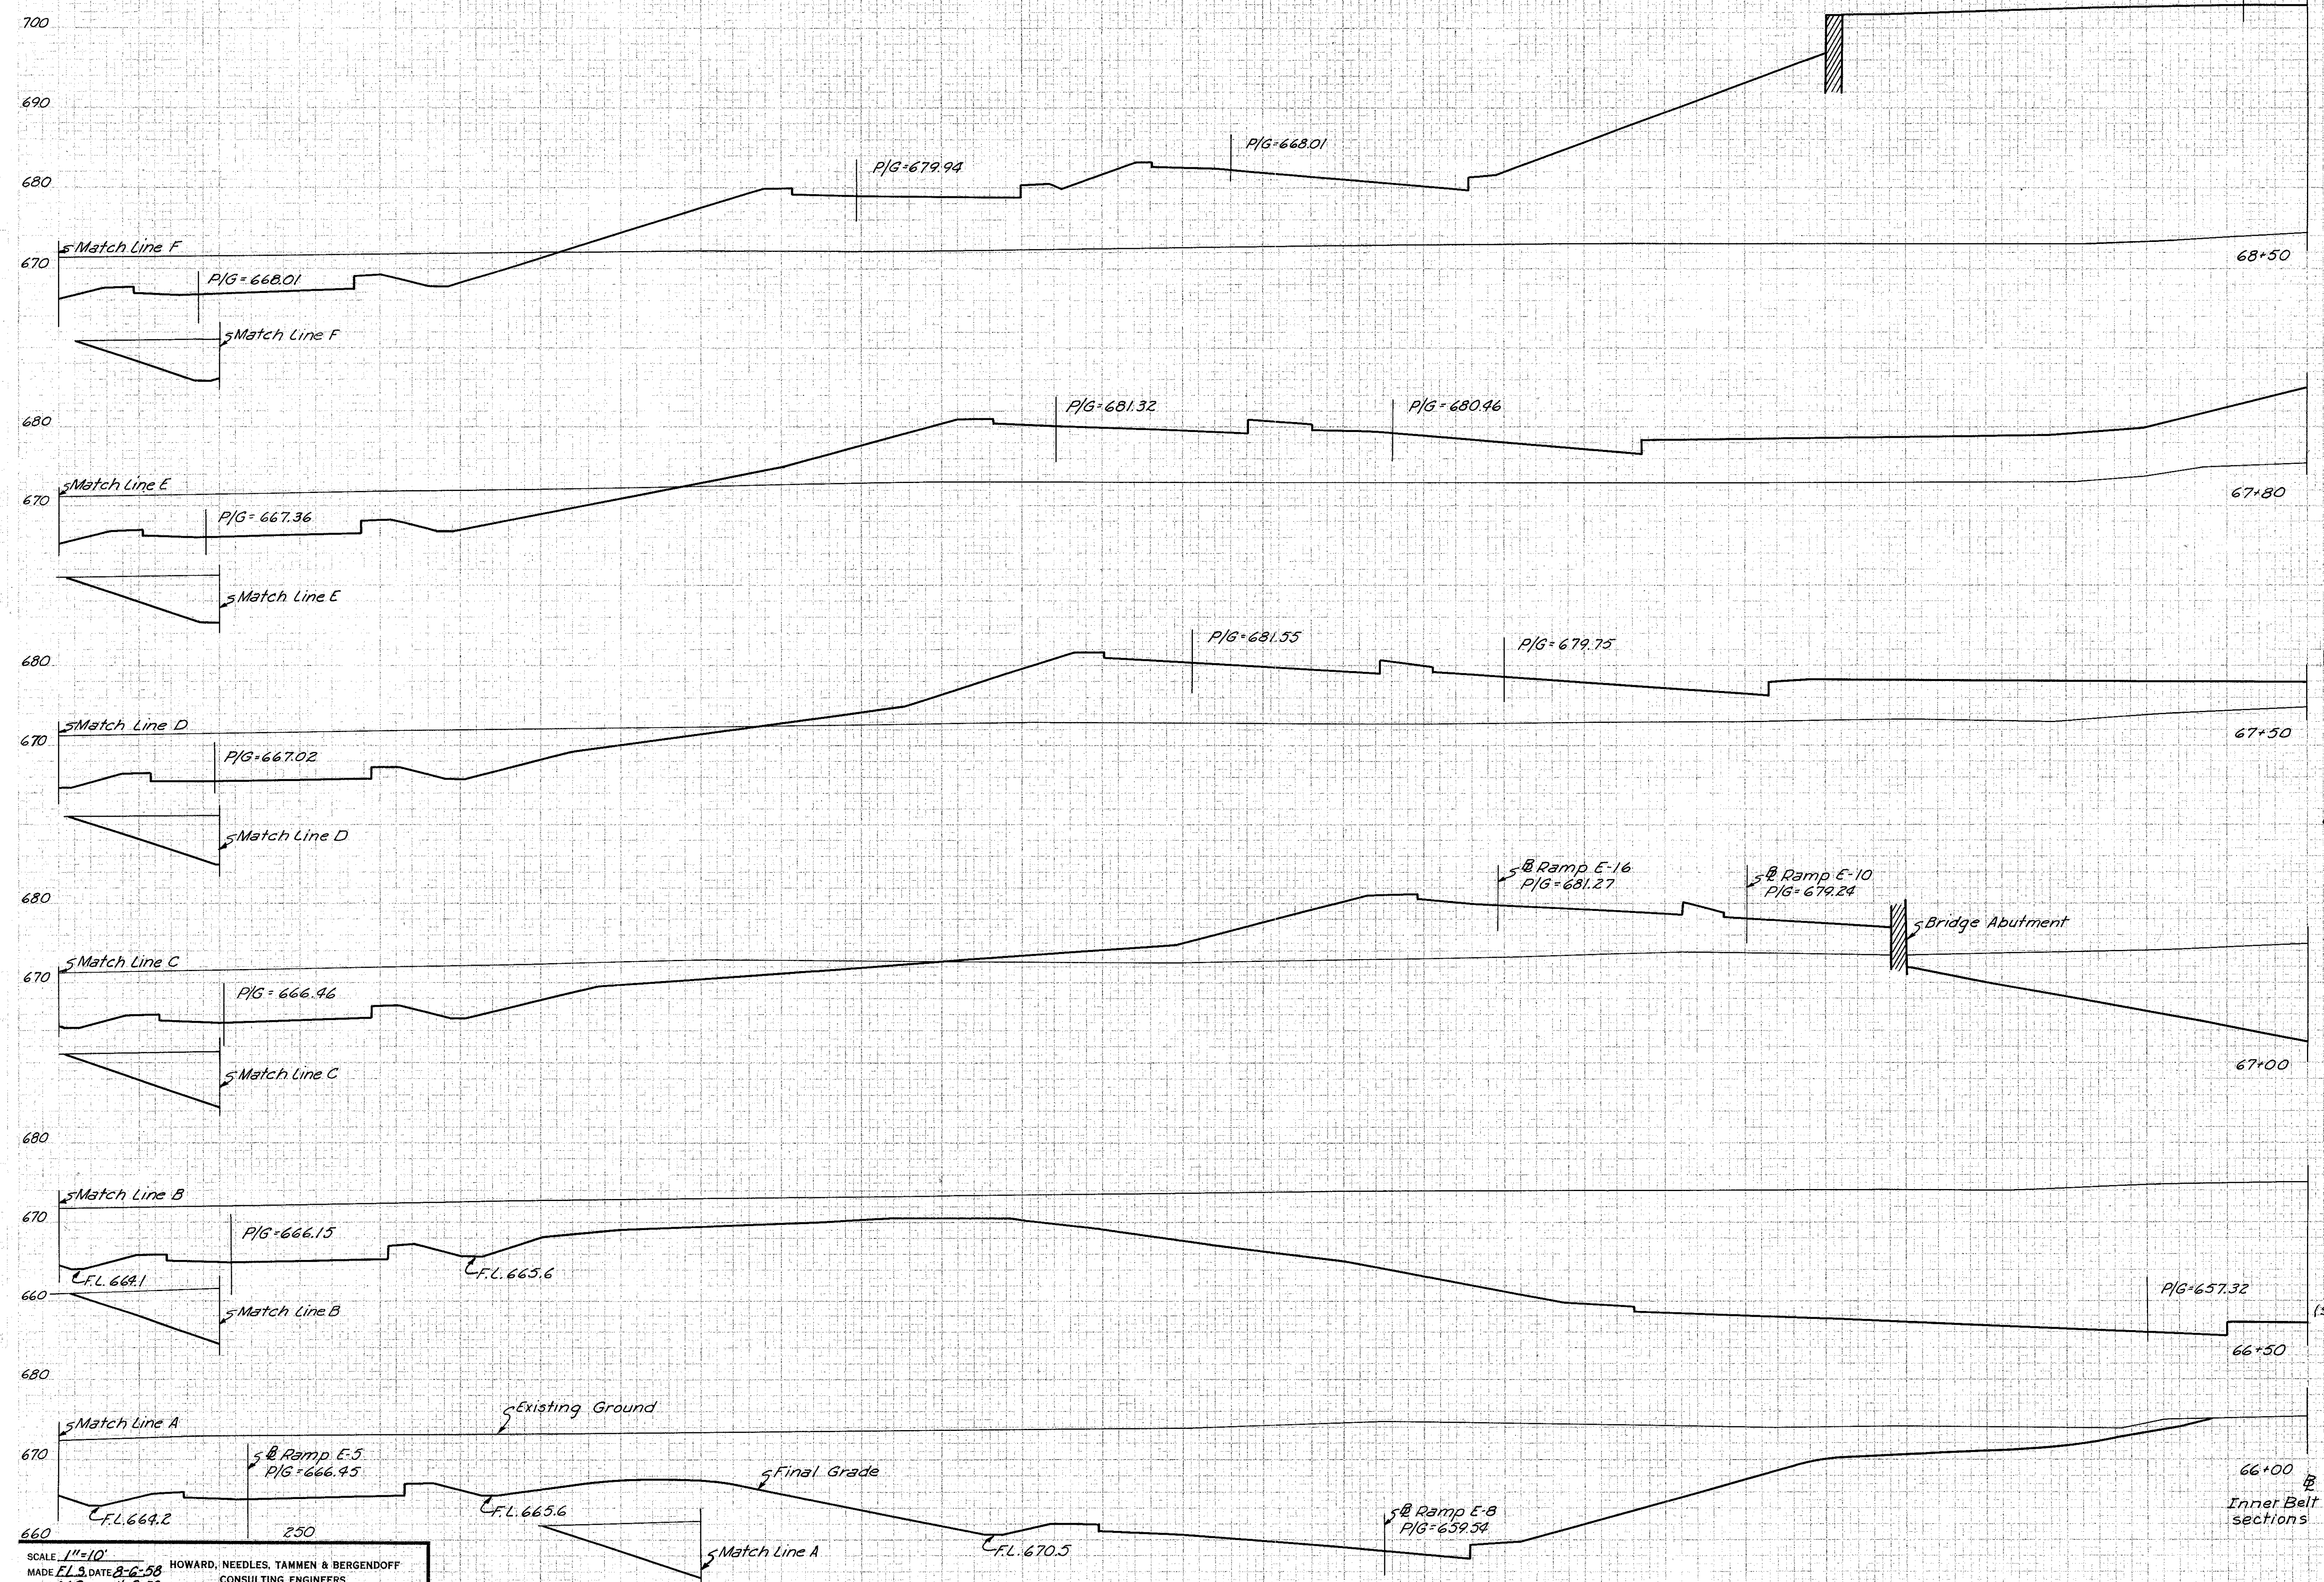

SEEDING		SUBBASE		EARTHWORK			
WIDTH	AREA	AREA	VOL.	END AREA		VOLUME	
L.F.	SQ. YD.	S.F.	C.Y.	EXC.	EMB.	EXC.	EMB.
						290	3250
						861	5734
						374	1173
						454	1196
						444	980
						1224	1404
						878	536
						3427	496
						2823	0
						4849	0
						2414	0
						3425	0
						1285	0

SERIES A
INNER BELT SECTIONS
STA. 66+00 TO STA. 68+50


SCALE 1"=10'
MADE F.L.S. DATE 8-6-58
TRCD. M.B. DATE 11-3-58
CKD. G.M.G. DATE 12-23-58

HOWARD, NEEDLES, TAMMEN & BERGENDOFF
CONSULTING ENGINEERS
KANSAS CITY CLEVELAND NEW YORK

914 SHEET 63

FED. ROAD DIV. NO.	STATE	FEDERAL AID PROJECT NO.	TYPE FUNDS	64 181
2	OHIO			

CUYAHOGA COUNTY
CITY OF CLEVELAND
CUY-42-18.42
CUY-21-15.32

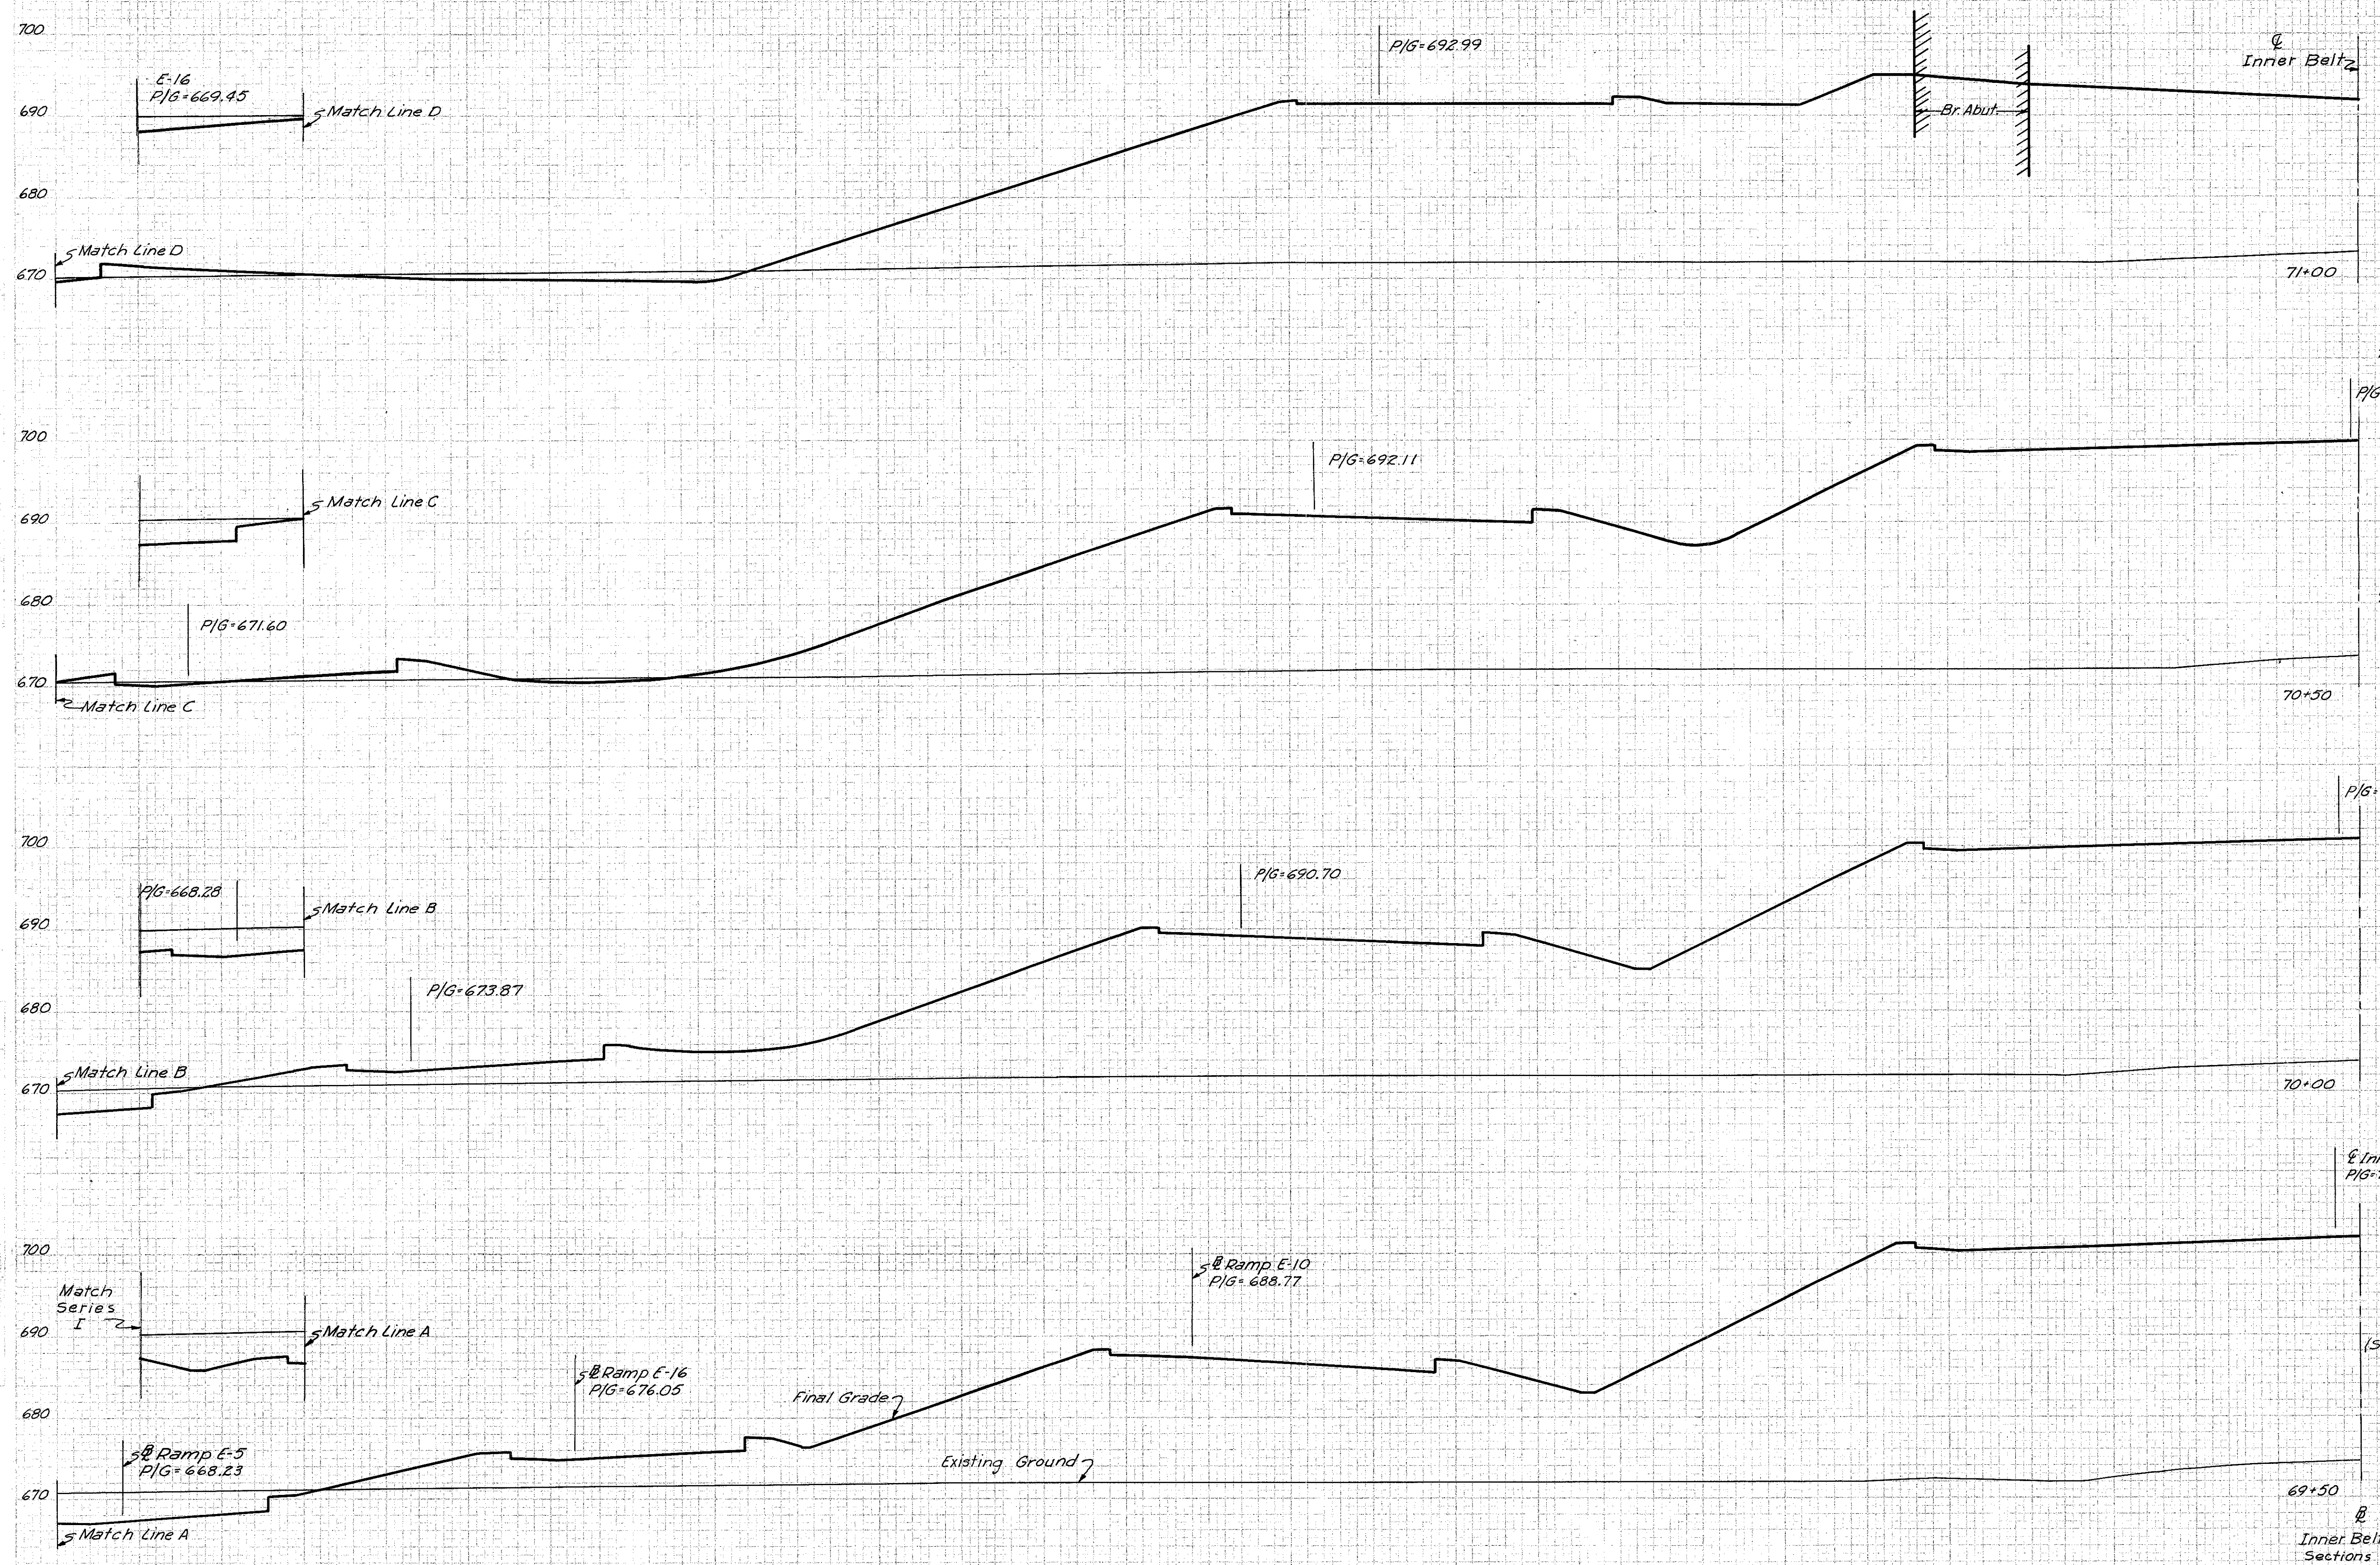

SEEDING		SUBBASE		EARTHWORK			
WIDTH	AREA	AREA	VOL.	END AREA	VOLUME		
L.F.	SQ.YD.	S.F.	C.Y.	EXC.	EMB.	EXC.	EMB.
				72	3352		
				46	3714		
				97	3830		
				192	3765		
				290	3250		
				132	6985		
				109	6543		


SERIES A
INNER BELT SECTIONS
STA. 69+50 TO STA. 71+00

SCALE 1"=10'
MADE E.L.S. DATE 2-6-58
TRCD. M.B. DATE 11-3-58
CKD. Q.M.G. DATE 12-23-58

HOWARD, NEEDLES, TAMMEN & BERGENDOFF
CONSULTING ENGINEERS
KANSAS CITY CLEVELAND NEW YORK
914 SHEET 64

200 150 100 50 0

CUYAHOGA COUNTY
 CITY OF CLEVELAND
 CUY-42-18.42
 CUY-21-15.32

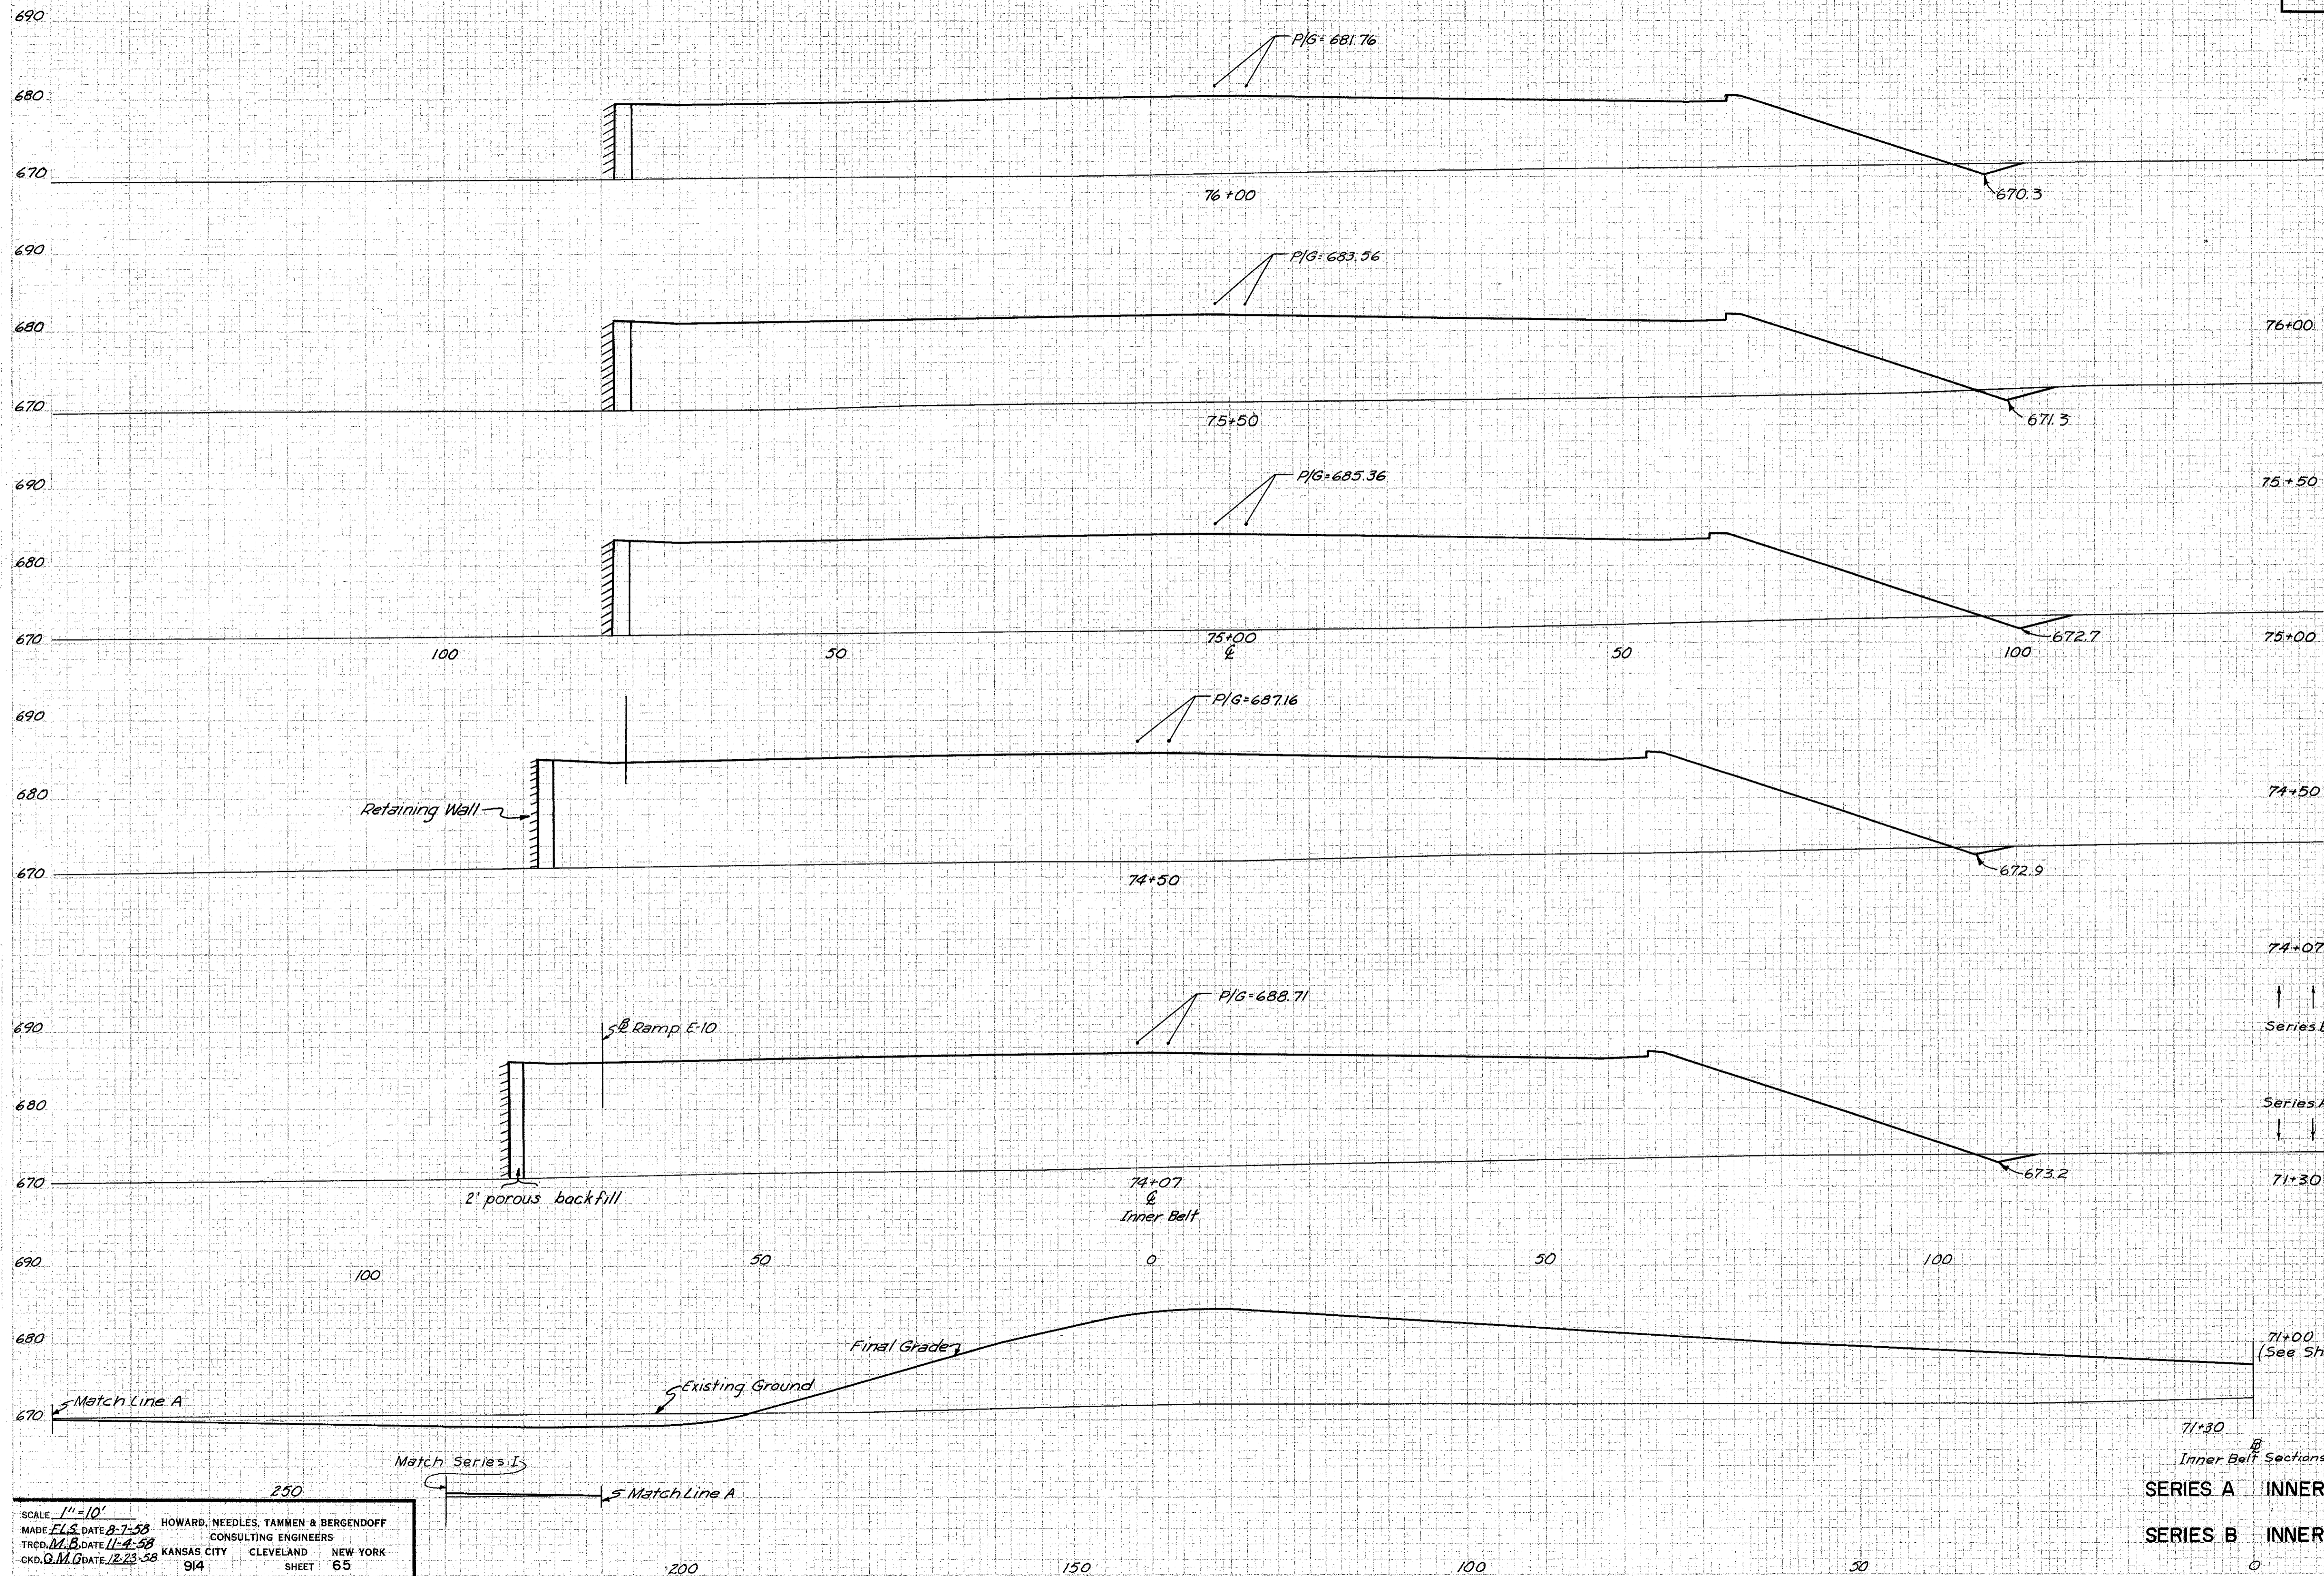


SEEDING		SUBBASE		EARTHWORK			
WIDTH	AREA	AREA	VOL.	END AREA		VOLUME	
L.F.	SQ. YD.	S.F.	C.Y.	EXC.	EMB.	EXC.	EMB.
					8	1501	
						14	2989
				7	1705		
						16	3347
				10	1910		
						13	3755
				4	2201		
						6	3600
				4	2632		
				109	1575		
						101	2736
				72	3352		


SCALE 1"=10'
 MADE E.L.S. DATE 8-7-58 HOWARD, NEEDLES, TAMMEN & BERGENDOFF
 TRD. M.B. DATE 11-4-58 CONSULTING ENGINEERS
 CKD. Q.M.G. DATE 12-23-58 KANSAS CITY CLEVELAND NEW YORK
 914 SHEET 65

SERIES A INNER BELT SECTIONS STA. 71+30
 SERIES B INNER BELT SECTIONS STA. 74+07 TO STA. 76+00

FED. ROAD DIV. NO.	STATE	FEDERAL AID PROJECT NO.	TYPE FUNDS
2	OHIO		

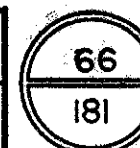

CUYAHOGA COUNTY
CITY OF CLEVELAND
CUY-42-18.42
CUY-21-15.32

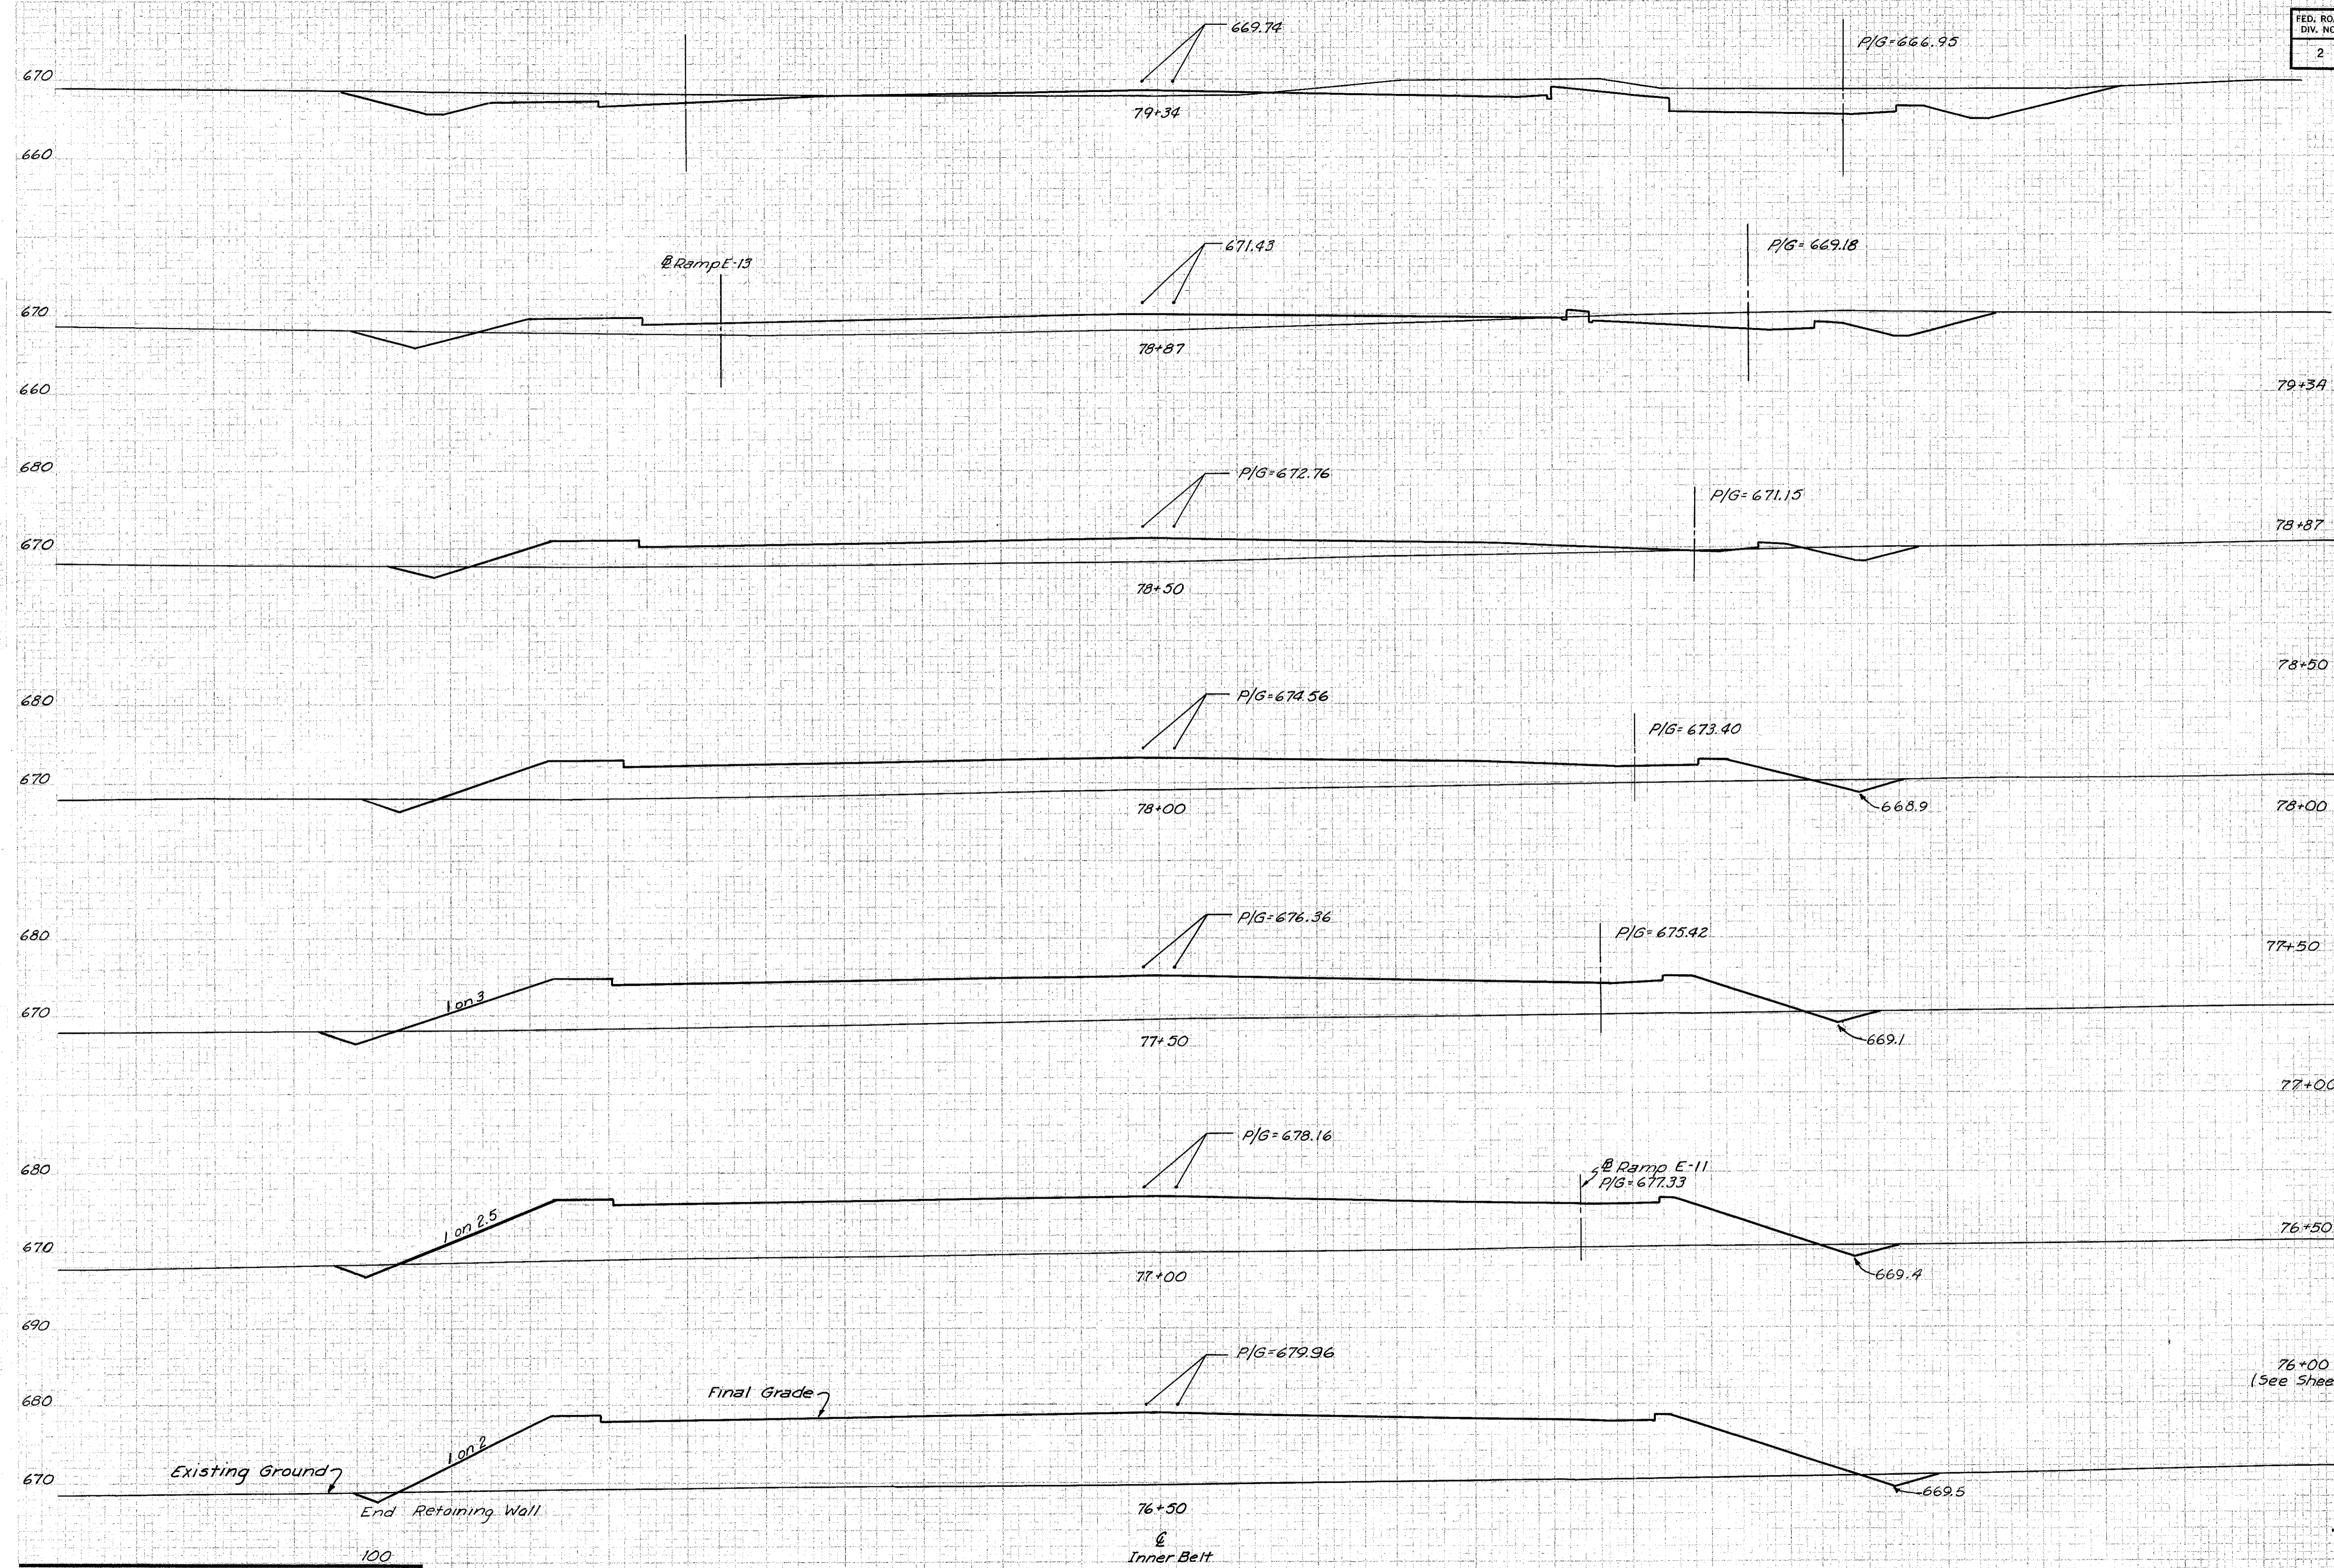

SEEDING		SUBBASE		EARTHWORK			
WIDTH	AREA	AREA	VOL.	END AREA		VOLUME	
L.F.	SQ. YD.	S.F.	C.Y.	EXC.	EMB.	EXC.	EMB.
						324	18
							377 191
				109		202	
							90 378
				23		349	
							31 877
				10		598	
							16 1344
				7		854	
							14 1834
				8		1127	
							15 2320
				8		1379	
							15 2667
				8		1501	

SERIES B
INNER BELT SECTIONS
STA. 76+50 TO STA. 79+34

SCALE 1"=10'
MADE F.L.S. DATE 8-7-58
TRCD. M.B. DATE 11-4-58
CKD. G.M.G. DATE 12-23-58


HOWARD, NEEDLES, TAMMEN & BERGENDOFF
CONSULTING ENGINEERS
KANSAS CITY CLEVELAND NEW YORK

914 SHEET 66

50 0 50 100

FED. ROAD DIV. NO.	STATE	FEDERAL AID PROJECT NO.	TYPE FUNDS	67
2	OHIO			181

CUYAHOGA COUNTY
CITY OF CLEVELAND
CUY-42-18.42
CUY-21-15.32

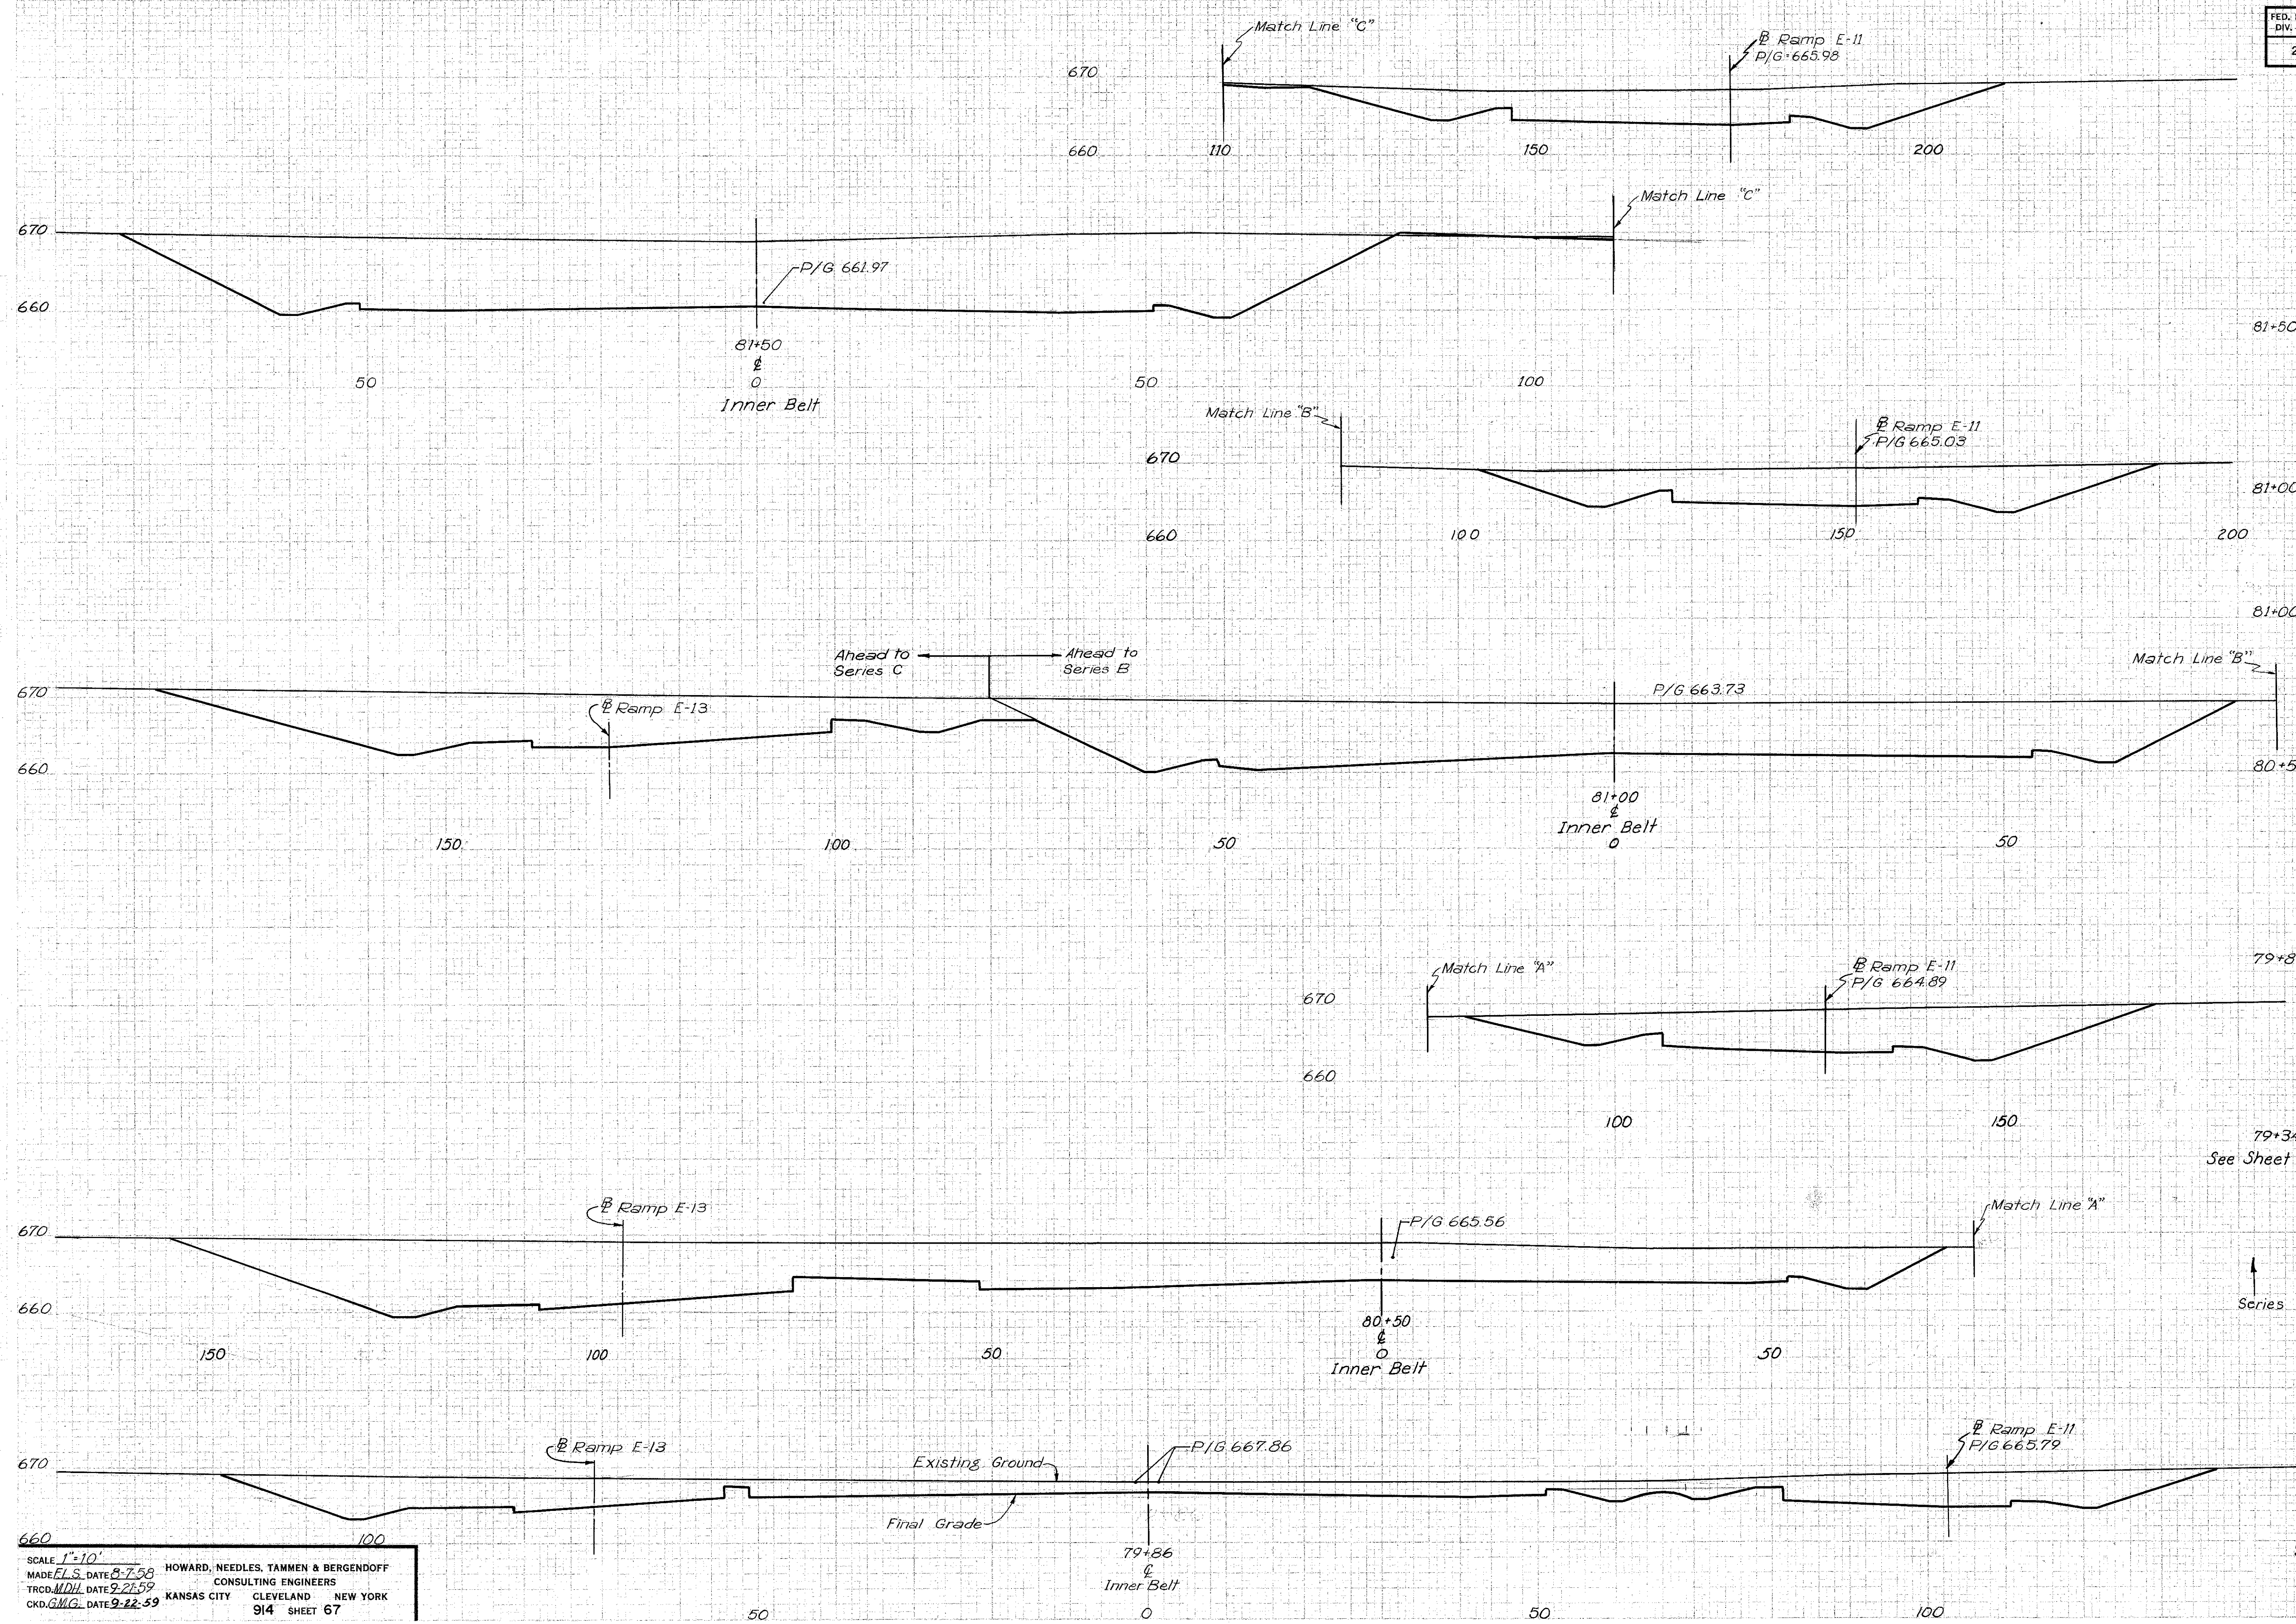

SEEDING		SUBBASE		EARTHWORK			
WIDTH	AREA	AREA	VOL.	END AREA		VOLUME	
L.F.	SQ. YD.	S.F.	C.Y.	EXC.	EMB.	EXC.	EMB.
				1720	0		
						2933	0
				1448	0		
				2010	0		
						3740	0
				1687	0		
						2874	0
						738	0
						1023	17
				324	18		

SERIES B
INNER BELT SECTIONS
STA. 79+86 TO STA. 81+50


SCALE 1"=10'
MADE F.L.S. DATE 8-7-58
TRCD. M.D.H. DATE 9-21-59
CKD. G.M.G. DATE 9-22-59

HOWARD, NEEDLES, TAMMEN & BERGENDOFF
CONSULTING ENGINEERS
KANSAS CITY CLEVELAND NEW YORK
914 SHEET 67

FED. ROAD DIV. NO.	STATE	FEDERAL AID PROJECT NO.	TYPE FUNDS
2	OHIO		

70
181

CUYAHOGA COUNTY
CITY OF CLEVELAND
CUY-42-18.42
CUY-21-15.32

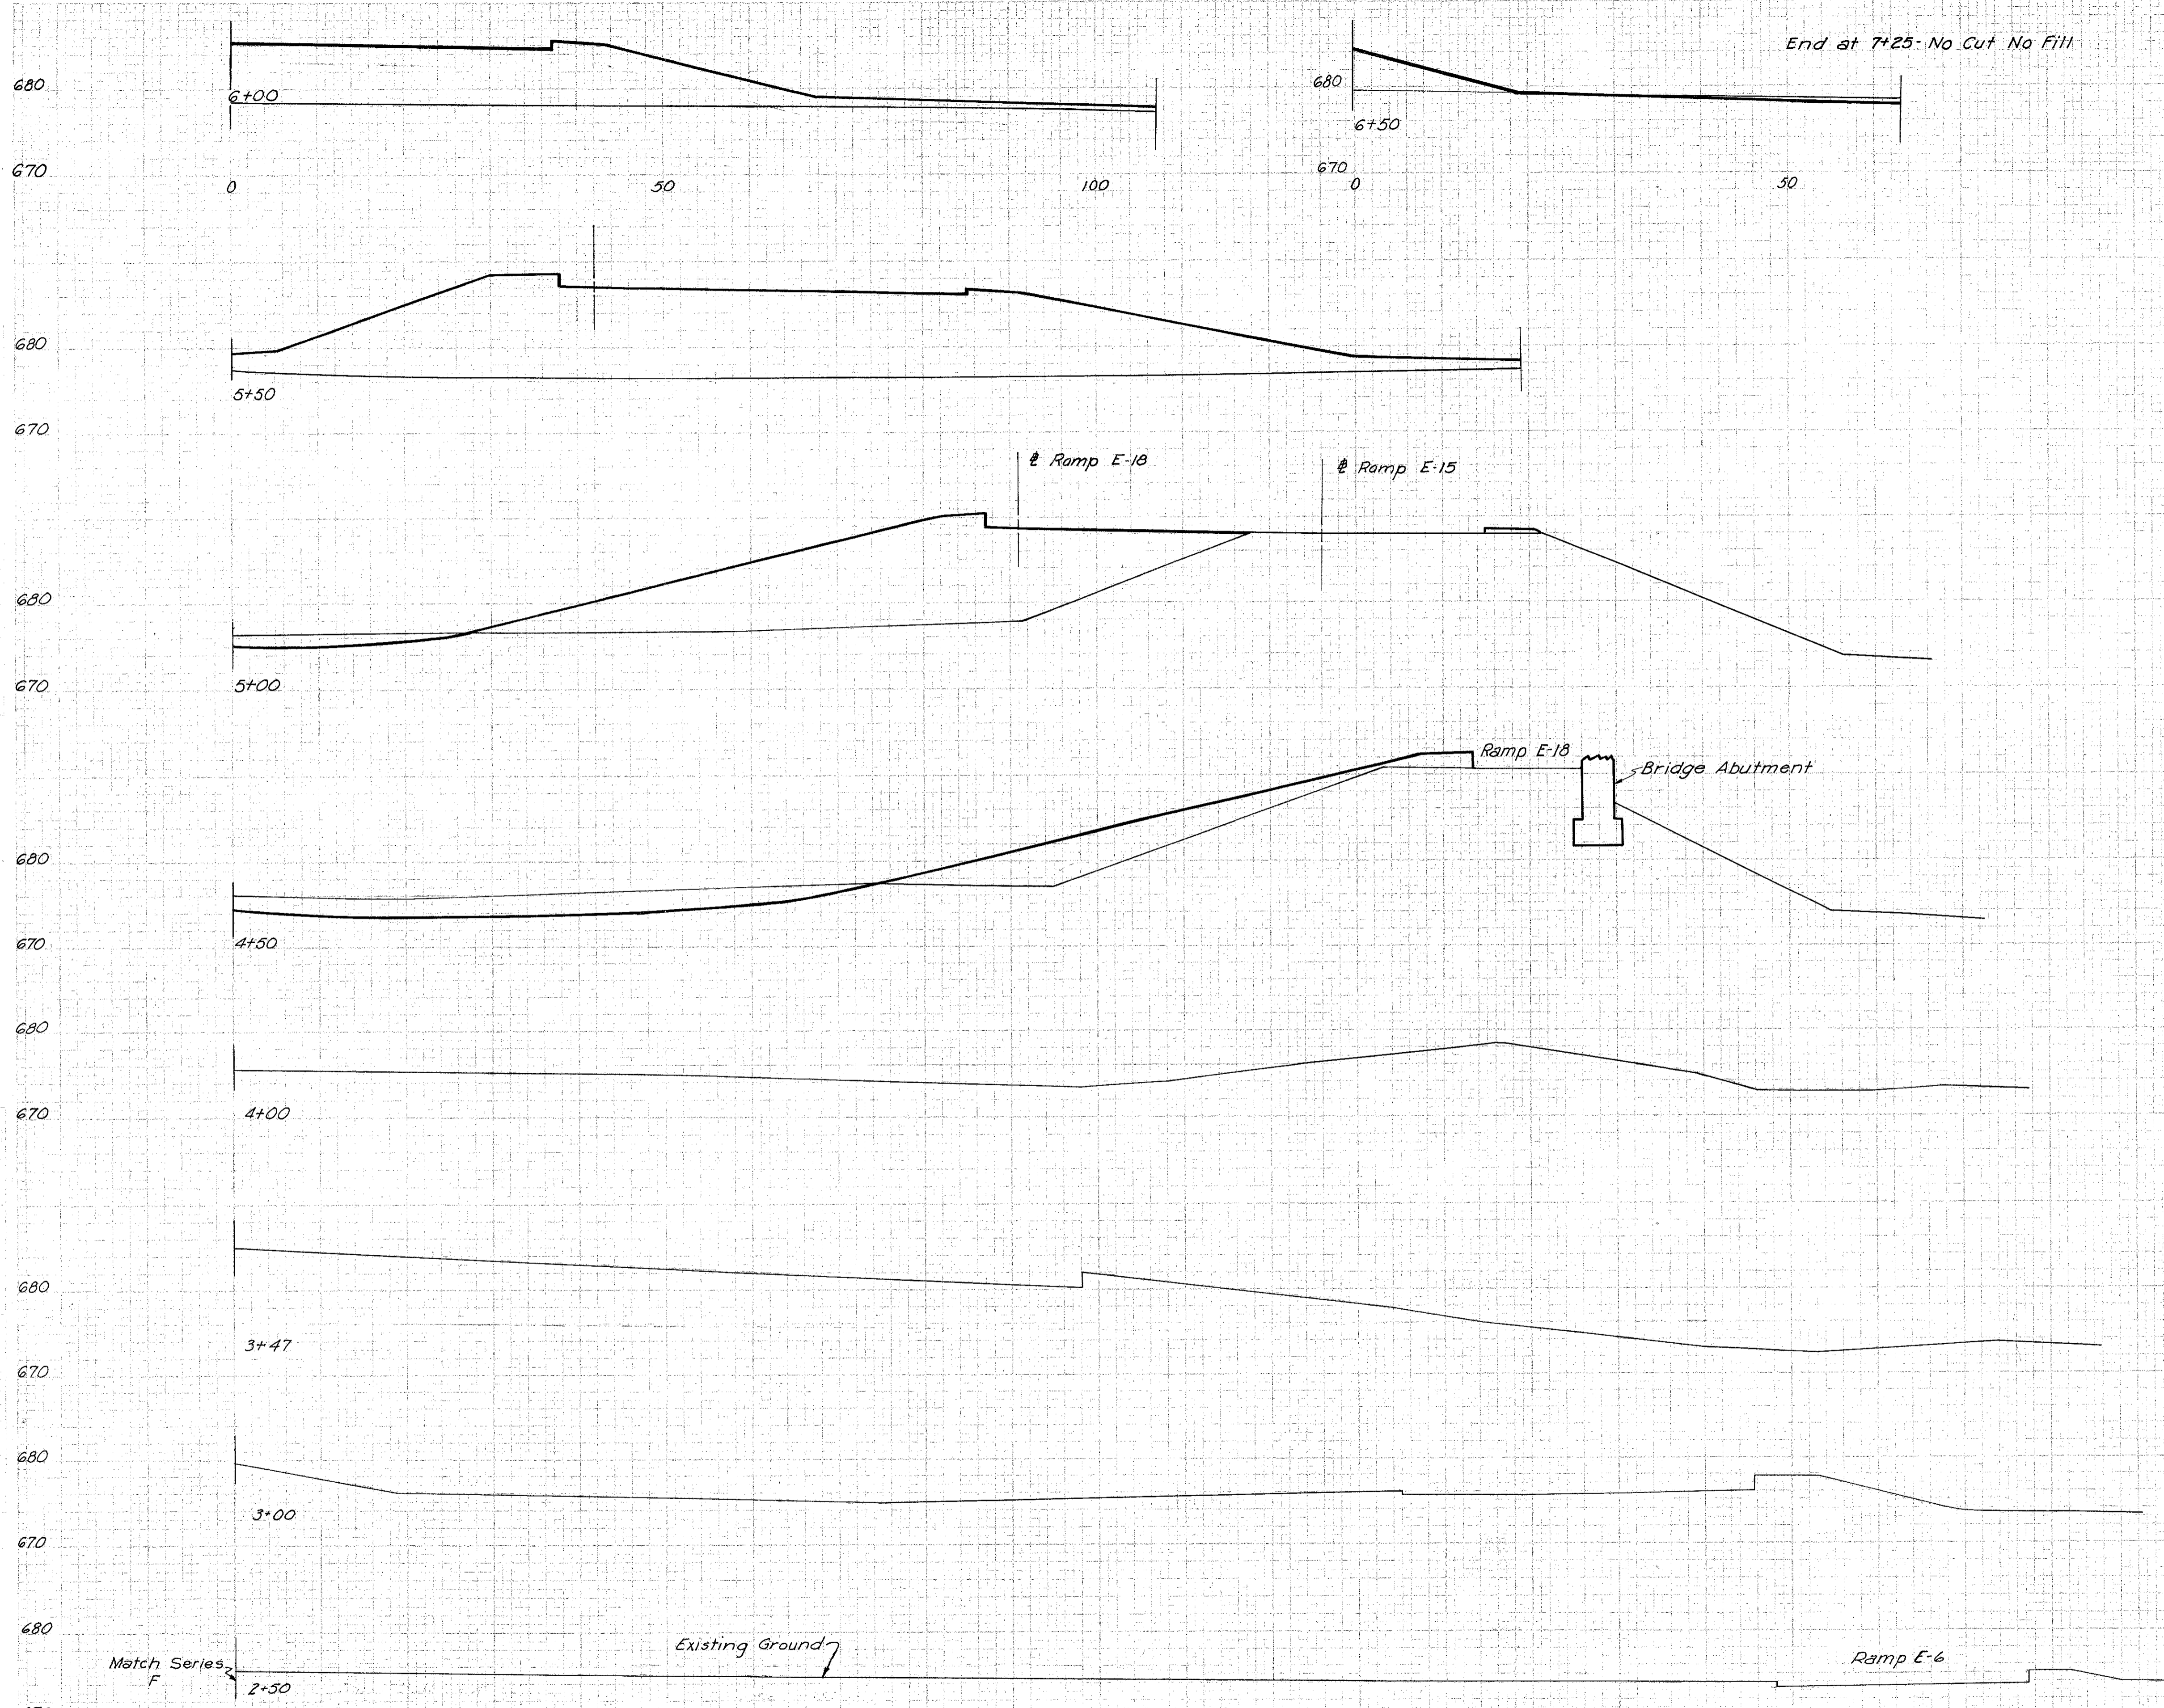

STATION	SEEDING		SUBBASE		EARTHWORK			
	WIDTH L.F.	AREA SQ.YD.	AREA S.F.	VOL. C.Y.	END AREA EXC.	AREA EMB.	VOLUME EXC.	VOLUME EMB.
7+25					0	0		
6+50					13	49	12	68
6+00					0	426		440
5+50					0	1079	0	1394
5+00					32	617	30	1570
4+50					158	179	269	737
4+00					0	0	146	166
3+47					0	0	0	0
3+00					0	0	0	0
2+50					0	0	0	0

SERIES E
SECTIONS RIGHT OF STA. 63+00 B INNER BELT
STA. 2+50 TO STA. 7+25


SCALE: 1" = 10'
MADE C.L.S. DATE 8-6-58
TRCD. M.D. DATE 11-10-58
CKD. R.W.S. DATE 12-10-58

HOWARD, NEEDLES, TAMMEN & BERGENDOFF
CONSULTING ENGINEERS
KANSAS CITY CLEVELAND NEW YORK
914 SHEET 70

0 50 100 150 200

FED. ROAD DIV. NO.	STATE	FEDERAL AID PROJECT NO.	TYPE FUNDS	71 181
2	OHIO			

CUYAHOGA COUNTY
CITY OF CLEVELAND
CUY-42-18.42
CUY-21-15.32

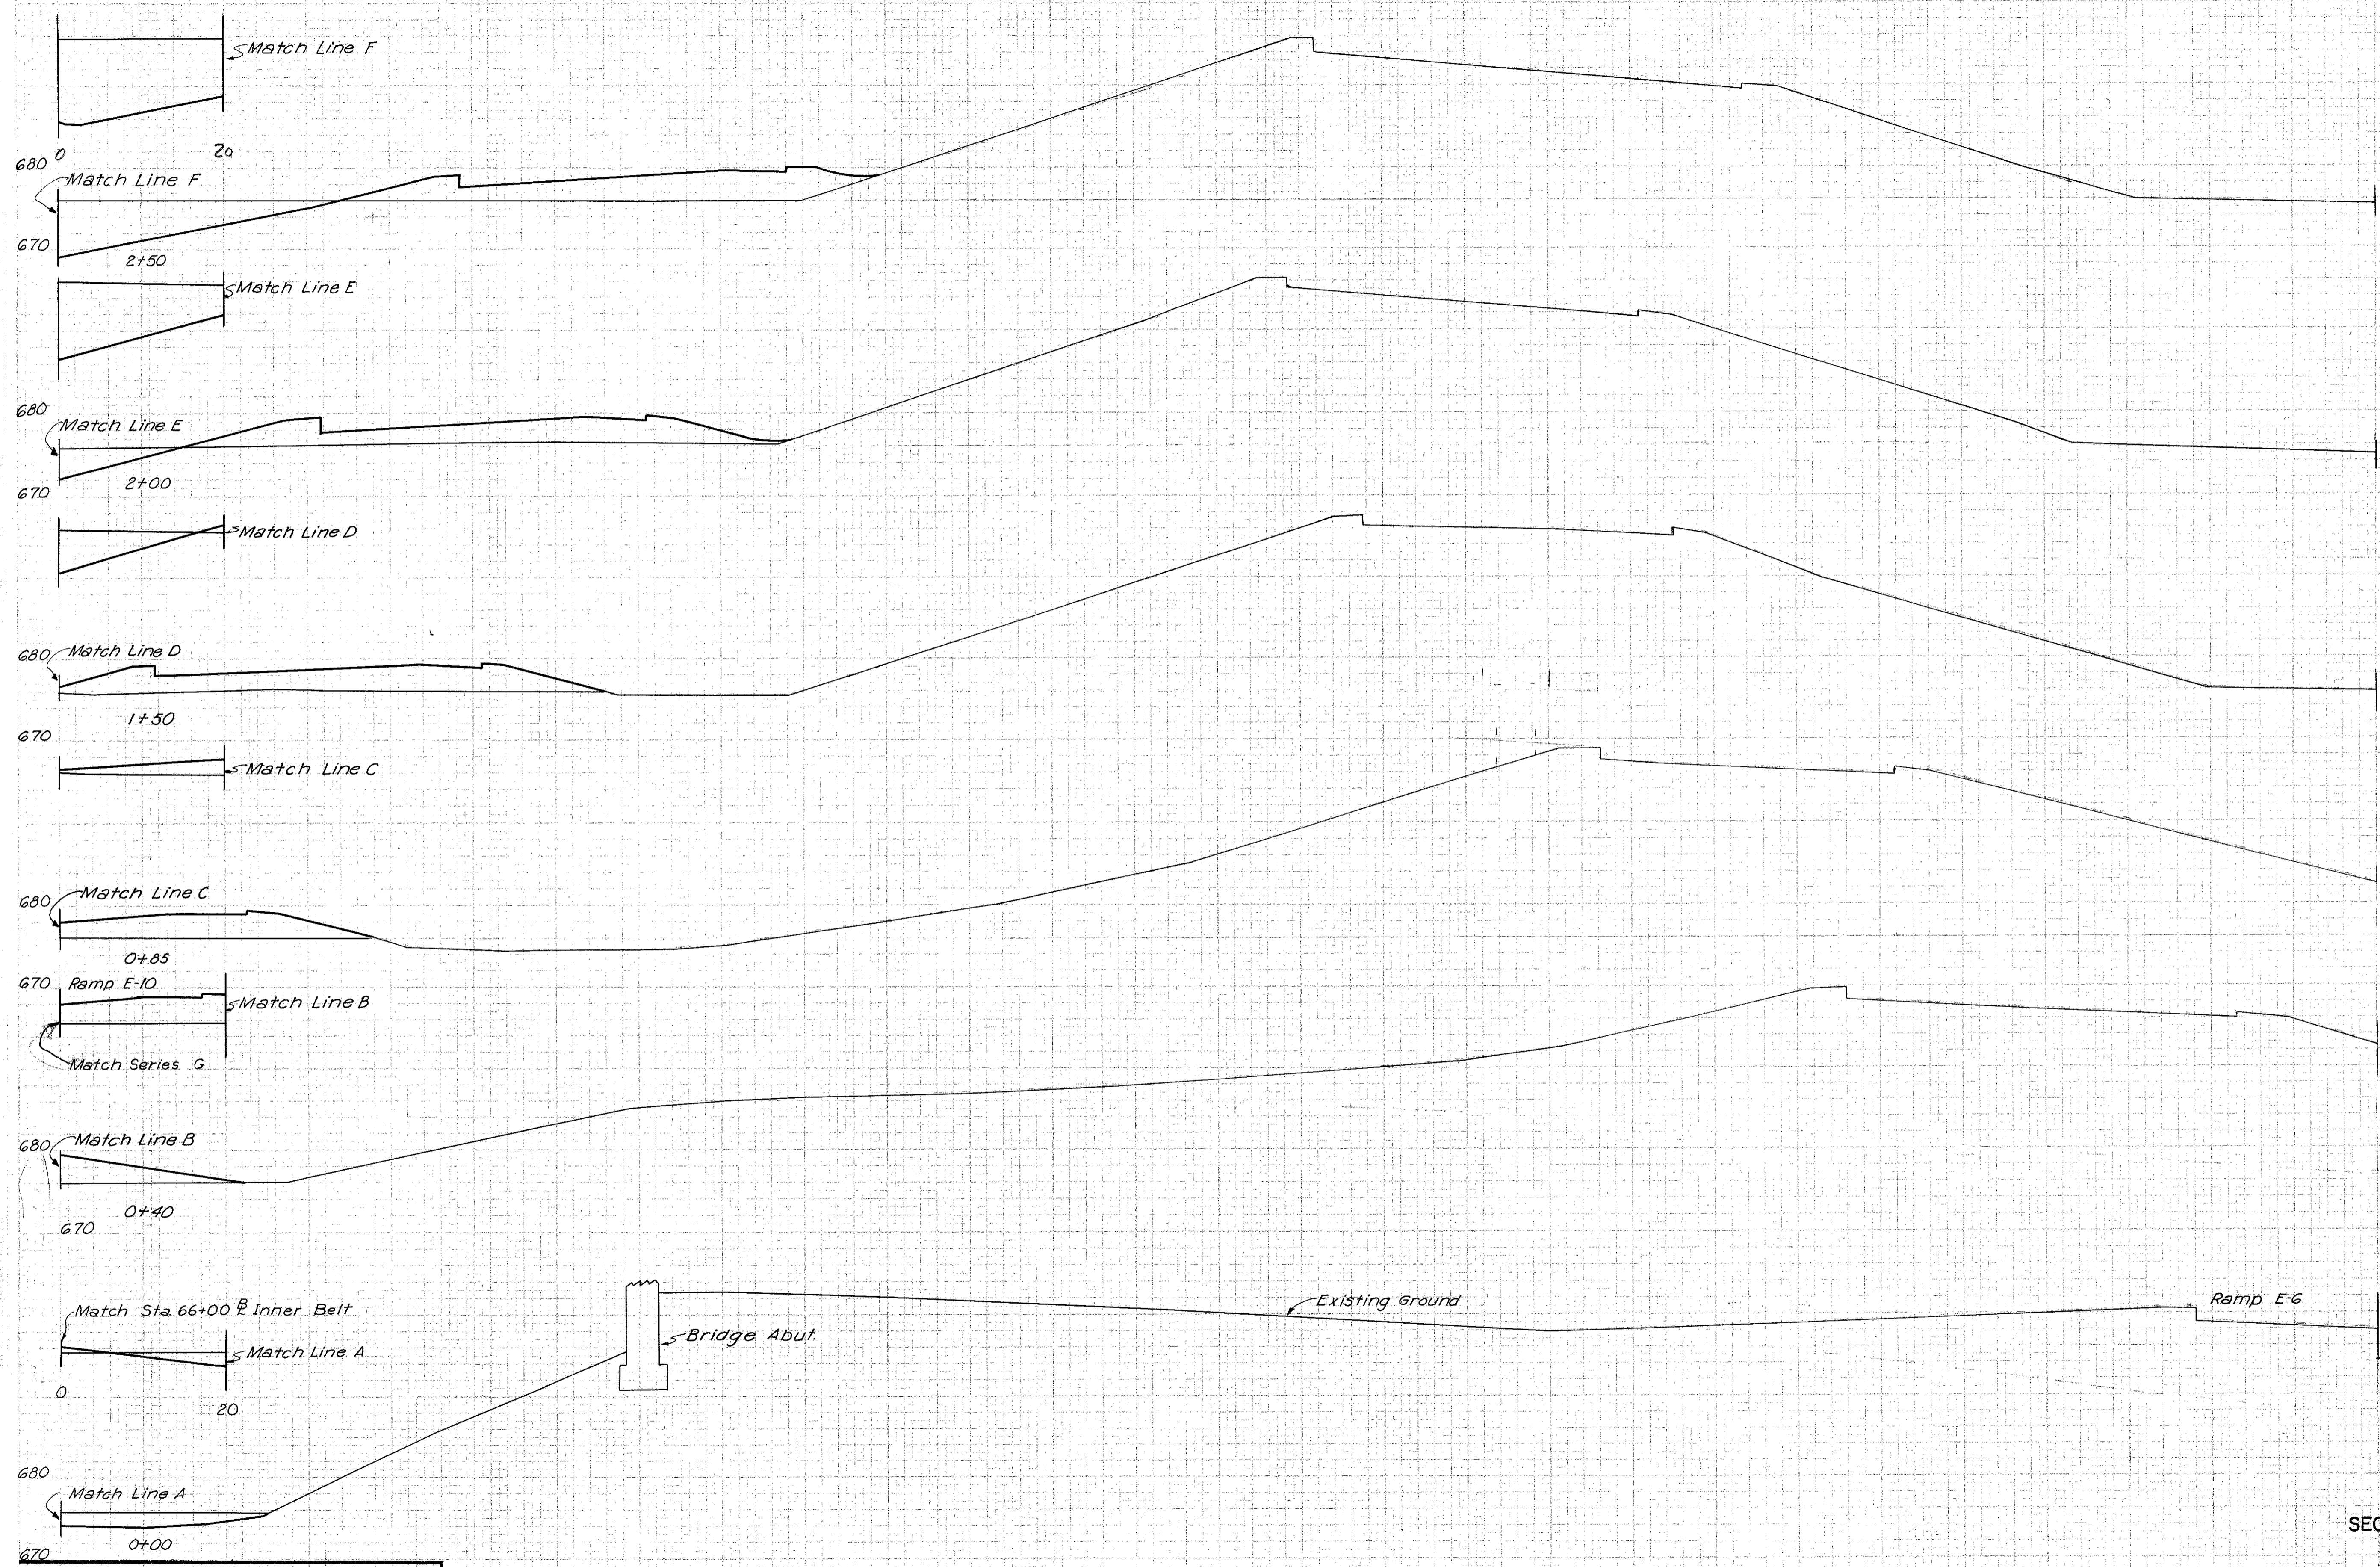

SEEDING		SUBBASE		EARTHWORK			
WIDTH L. F.	AREA SQ. YD.	AREA S. F.	VOL. C. Y.	END AREA EXC.	END AREA EMB.	VOLUME EXC.	VOLUME EMB.
				302	158		
						424	285
				156	150		
						188	295
				47	169		
						57	345
				0	118		
						0	182
				0	100		
						39	76
				52	2		

SERIES F
SECTIONS RIGHT OF STA. 66+00 @ INNER BELT
STA. 0+00 TO STA. 2+50


SCALE 1"=10'
MADE E.L.S. DATE 8-7-58 HOWARD, NEEDLES, TAMMEN & BERGENDOFF
TRCD. S.C. DATE 11-10-58 CONSULTING ENGINEERS
CKD. E.W.S. DATE 12-10-58 KANSAS CITY CLEVELAND NEW YORK
914 SHEET 71

20 50 100 150 200 250 300

FED. ROAD DIV. NO.	STATE	FEDERAL AID PROJECT NO.	TYPE FUNDS
2	OHIO		

72
181

CUYAHOGA COUNTY
CITY OF CLEVELAND
CUY-42-18.42
CUY-21-15.32

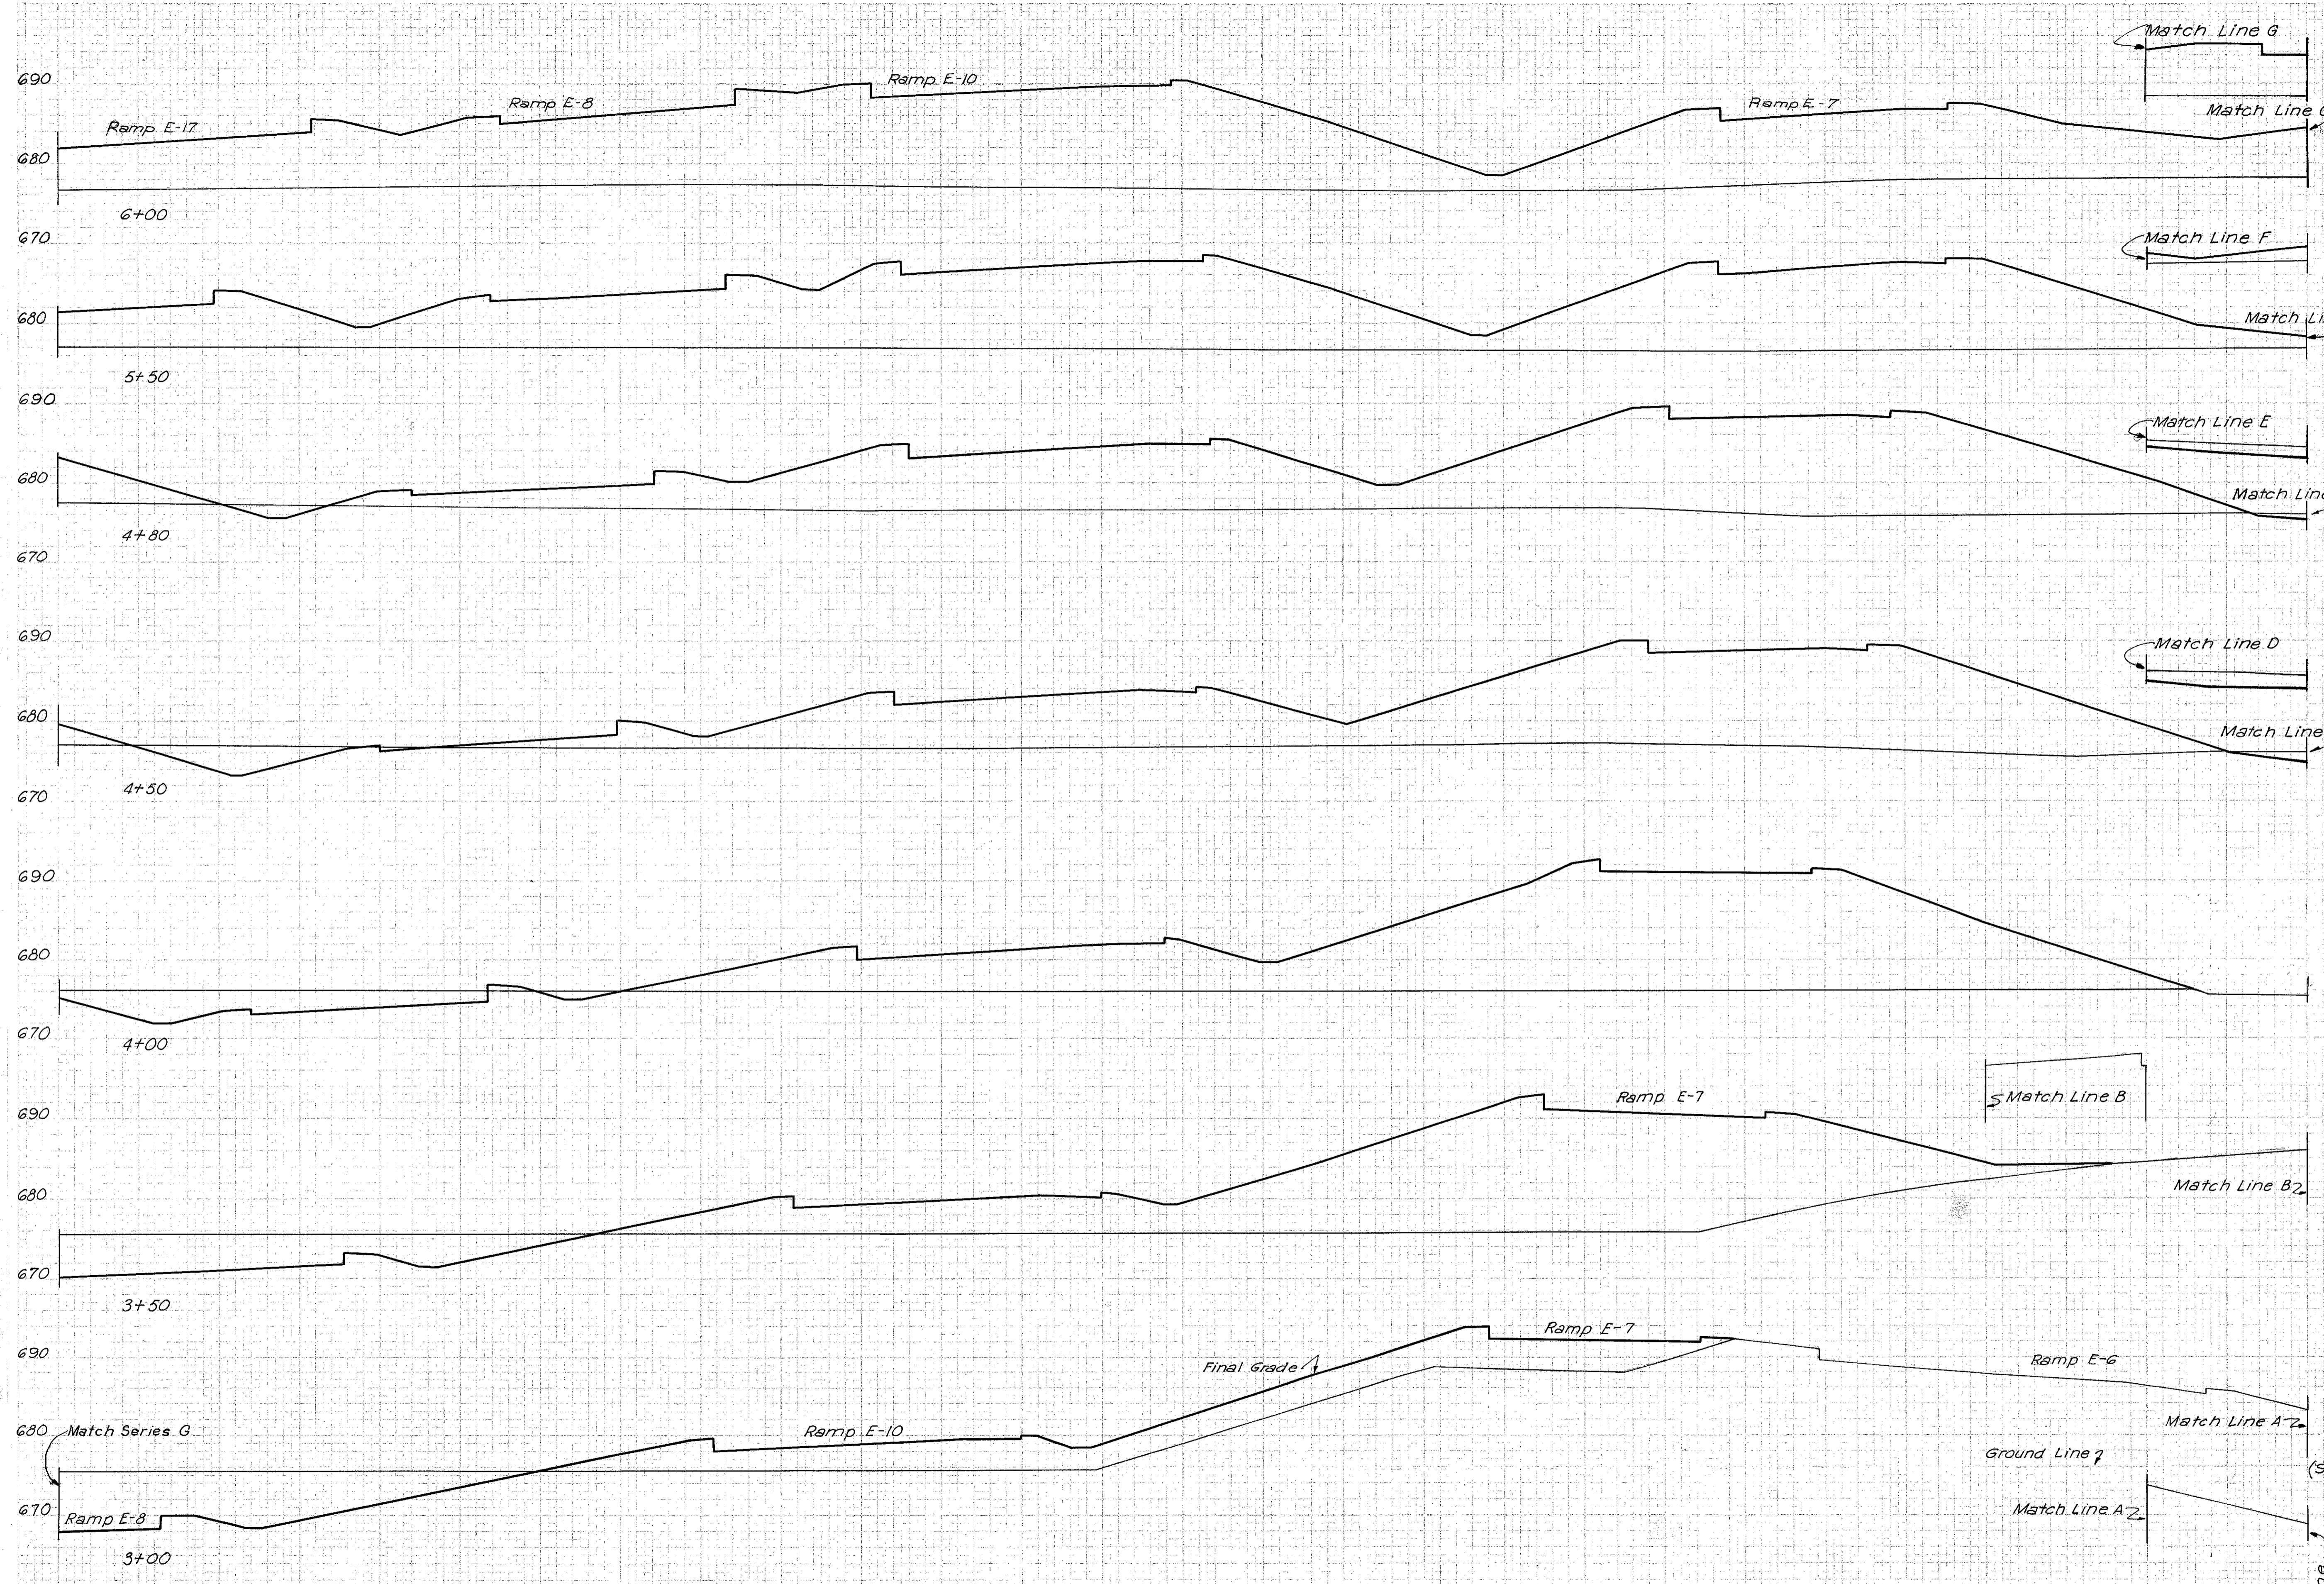

SEEDING		SUBBASE		EARTHWORK			
WIDTH	AREA	AREA	VOL.	END AREA		VOLUME	
L. F.	SQ. YD.	S. F.	C. Y.	EXC.	EMB.	EXC.	EMB.
				0	2402		
						0	4292
				0	2073		
						51	4888
				39	1698		
						75	1762
				96	1473		
						222	2814
				144	1566		
						365	2743
				250	1369		
						509	1737
				300	480		
						557	591
				302	158		

SERIES F
SECTION RIGHT OF STA. 66+00
INNER BELT
STA. 3+00 TO STA. 6+00

SCALE 1" = 10'
MADE E.L.S. DATE 8-8-58
TRCD. S.C. DATE 11-10-58
CKD. B.W.S. DATE 12-10-58


HOWARD, NEEDLES, TAMMEN & BERGENDOFF
CONSULTING ENGINEERS
KANSAS CITY CLEVELAND NEW YORK
914 SHEET 72

0 50 100 150 200 250

FED. ROAD DIV. NO.	STATE	FEDERAL AID PROJECT NO.	TYPE FUNDS
2	OHIO		

73
181

CUYAHOGA COUNTY
CITY OF CLEVELAND
CUY-42-18.42
CUY-21-15.32

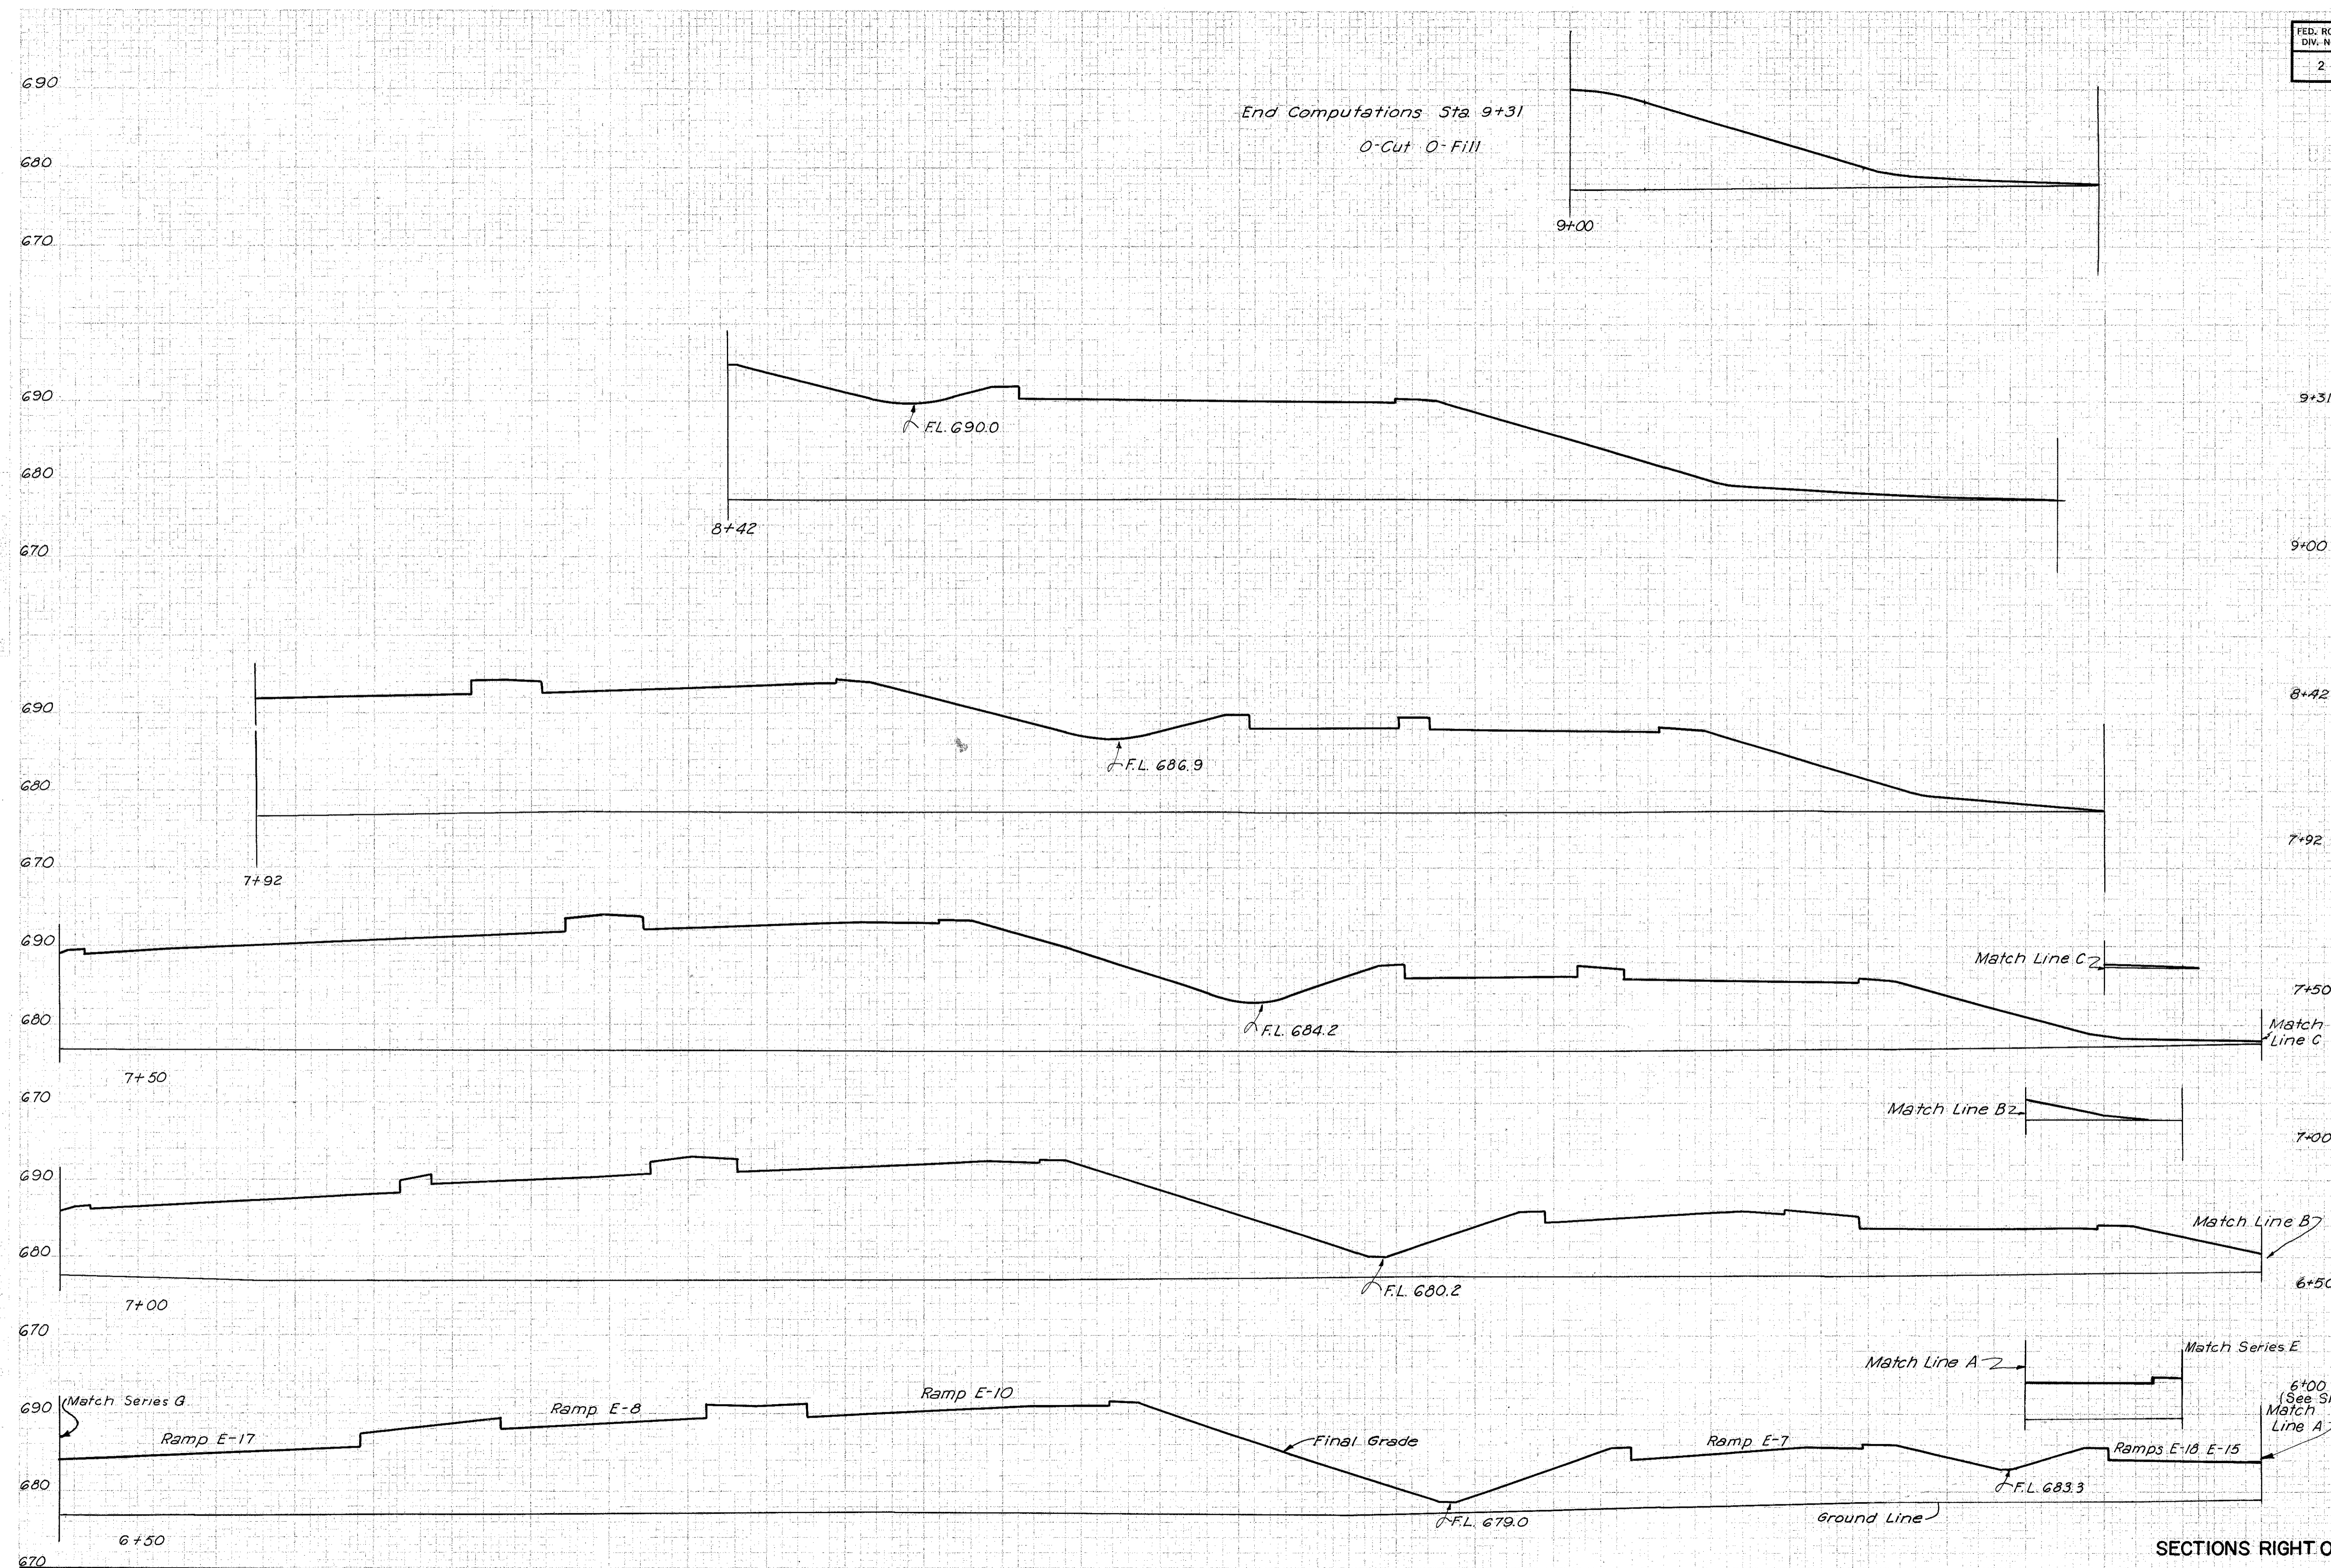

SEEDING		SUBBASE		EARTHWORK			
WIDTH	AREA	AREA	VOL.	END AREA		VOLUME	
L. F.	SQ. YD.	S. F.	C. Y.	EXC.	EMB.	EXC.	EMB.
				0	0		
9+31						0	181
9+00				0	315		
						0	1967
8+42				0	1516		
						0	3886
7+92				0	2681		
						0	4466
7+50				0	3061		
						0	5325
7+00				0	2774		
						0	4956
6+50				0	2300		
						0	4788
				0	2402		


SERIES F
SECTIONS RIGHT OF STA. 66+00 INNER BELT
STA. 6+50 TO STA. 9+31

SCALE 1"=10'
MADE E.L.S. DATE 8-8-58 HOWARD, NEEDLES, TAMMEN & BERGENDOFF
TRCD. S.C. DATE 11-10-58 CONSULTING ENGINEERS
CKD. B.M.S. DATE 12-10-58 KANSAS CITY CLEVELAND NEW YORK
914 SHEET 73

0 50 100 150 200 250

FED. ROAD DIV. NO.	STATE	FEDERAL AID PROJECT NO.	TYPE FUNDS	74 181
2	OHIO			

CUYAHOGA COUNTY
CITY OF CLEVELAND
CUY-42-18.42
CUY-21-15.32

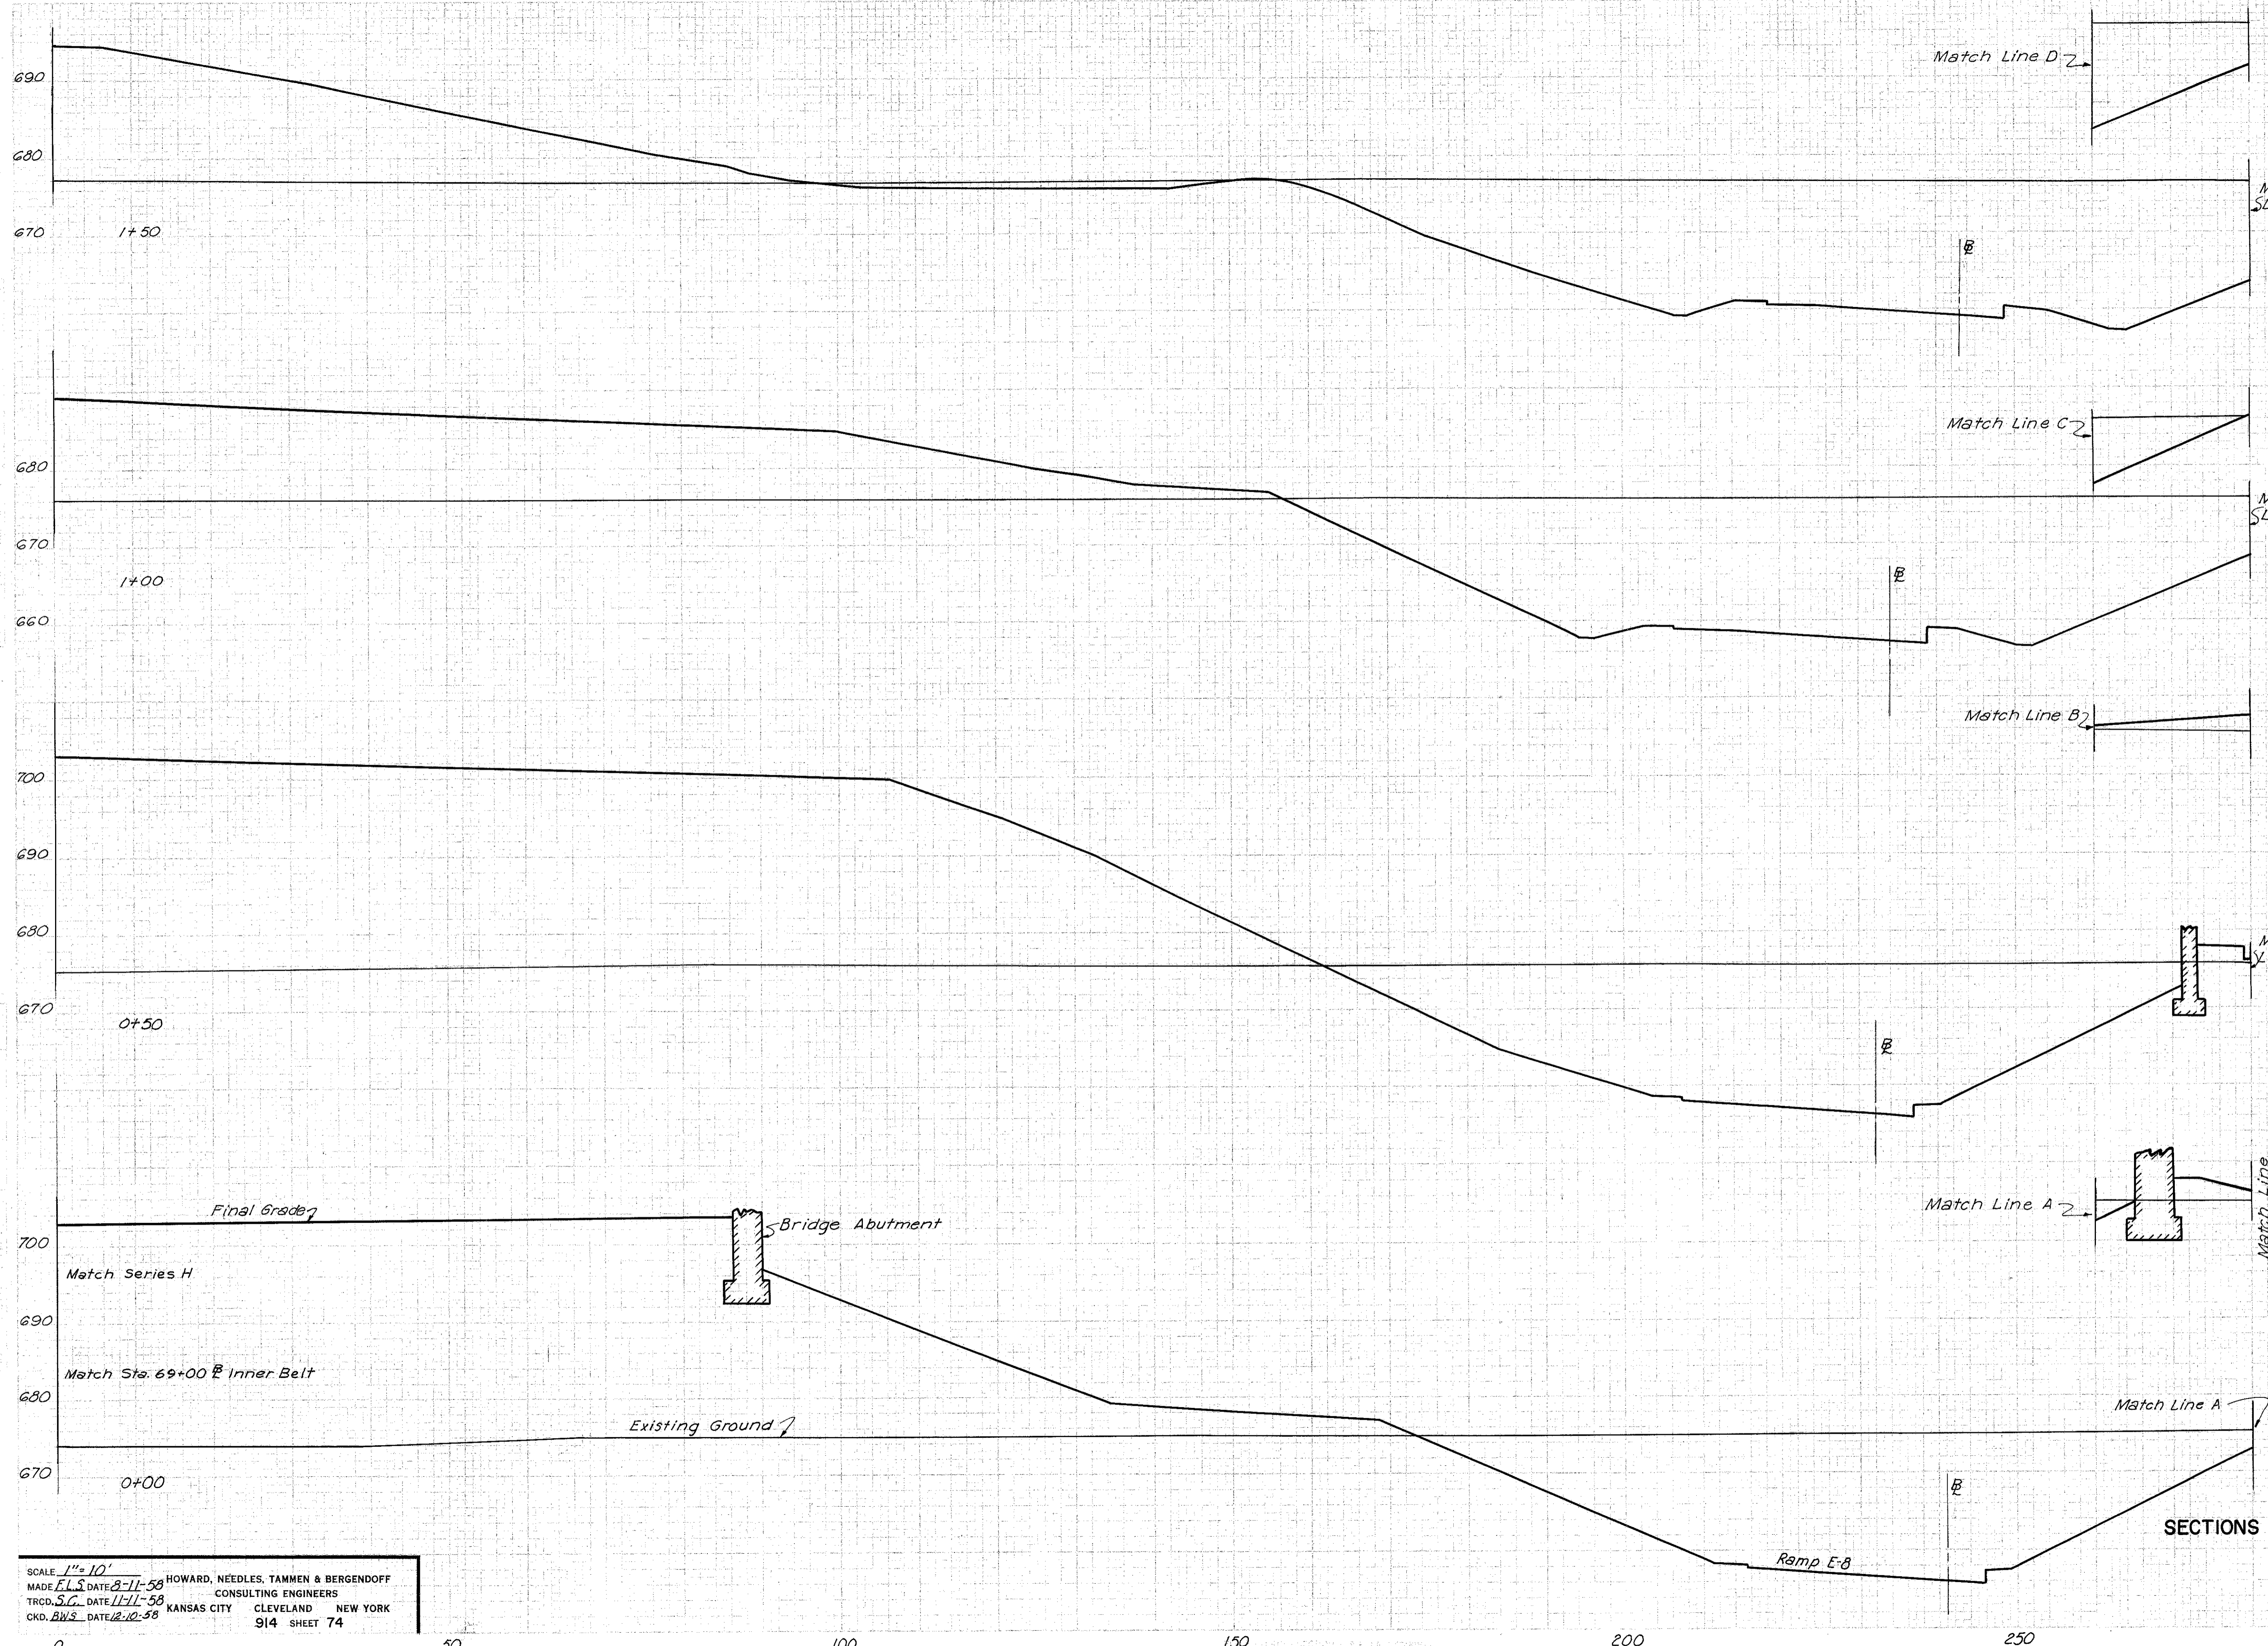

SEEDING		SUBBASE		EARTHWORK			
WIDTH	AREA	AREA	VOL.	END AREA		VOLUME	
L. F.	SQ. YD.	S. F.	C. Y.	EXC.	EMB.	EXC.	EMB.
						1907	889
						3476	2023
						1847	1296
						3044	4398
						1440	3454
						2563	6228
						1330	3272


SERIES G
SECTIONS RIGHT OF STA. 69+00 \bar{E} INNER BELT
STA. 0+00 TO STA. 1+50

SCALE 1" = 10'
MADE E.L.S. DATE 8-11-58 HOWARD, NEEDLES, TAMMEN & BERGENDOFF
TRCD. S.C. DATE 11-11-58 CONSULTING ENGINEERS
CKD. BWS. DATE 12-10-58 KANSAS CITY CLEVELAND NEW YORK
914 SHEET 74

FED. ROAD DIV. NO.	STATE	FEDERAL AID PROJECT NO.	TYPE FUNDS
2	OHIO		

75
181

CUYAHOGA COUNTY
CITY OF CLEVELAND
CUY-42-18.32
CUY-21-15.32

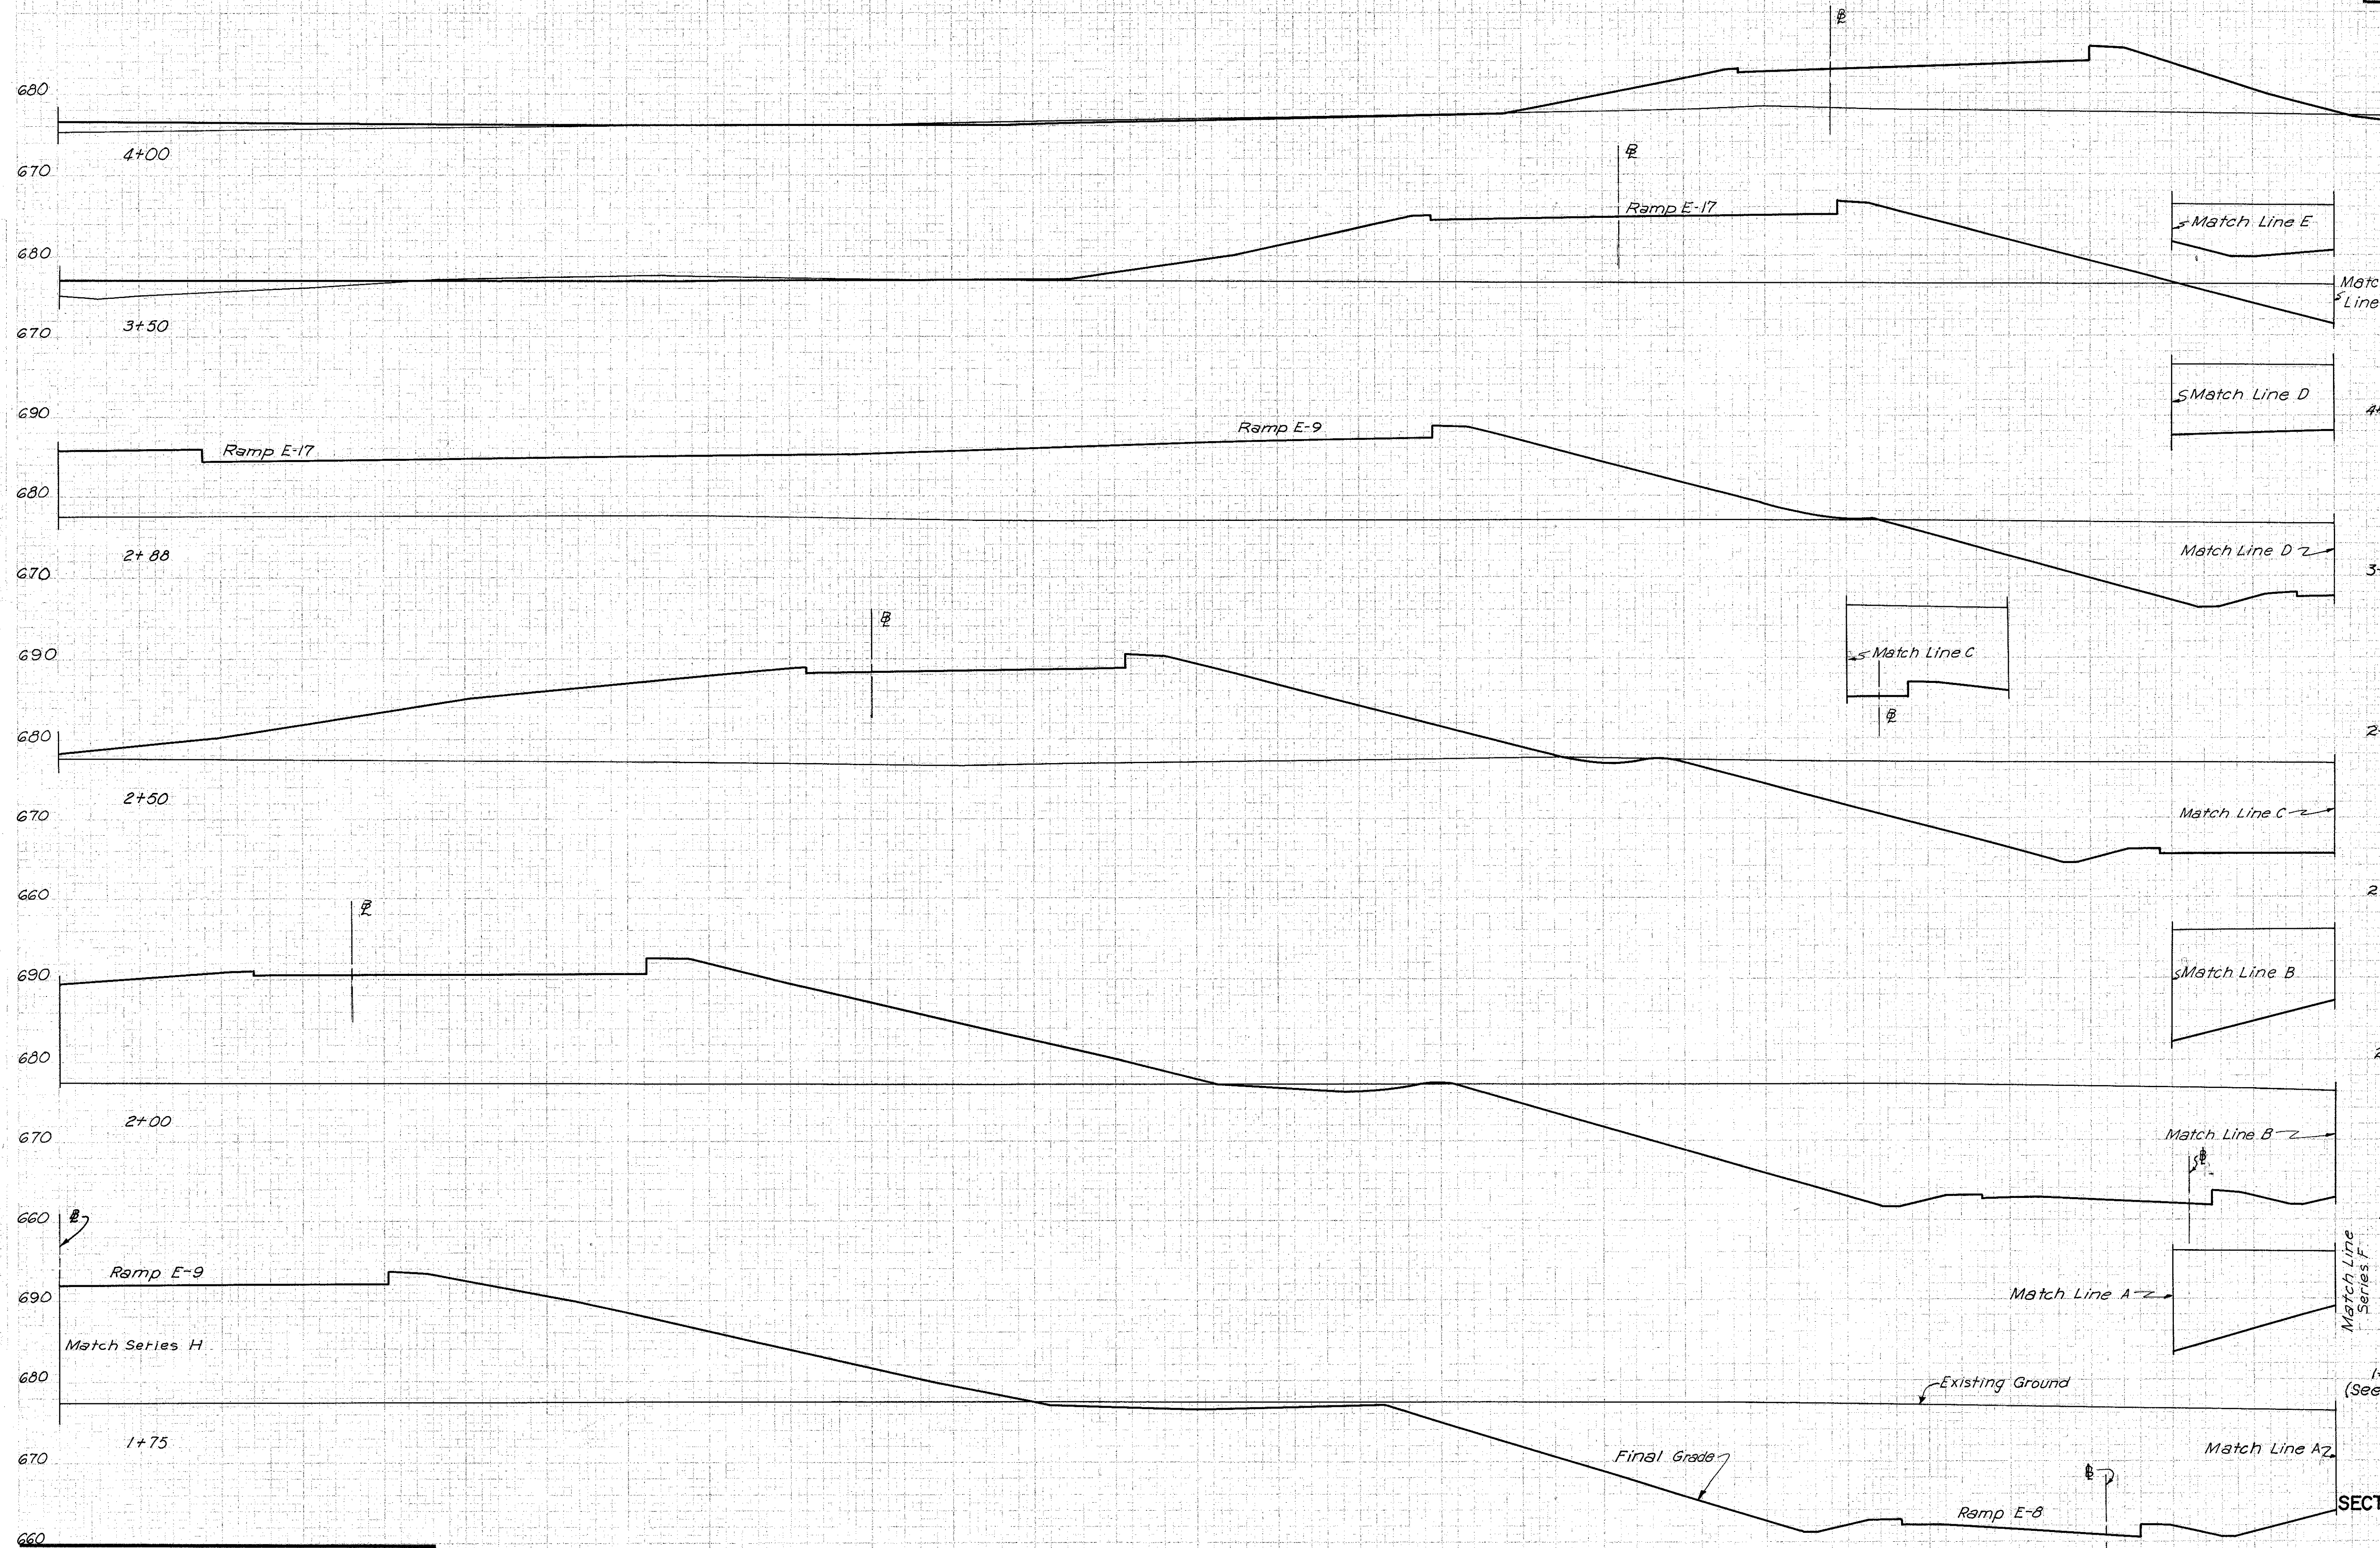

SEEDING		SUBBASE		EARTHWORK			
WIDTH	AREA	AREA	VOL.	END AREA		VOLUME	
L.F.	SQ. YD.	S.F.	C.Y.	EXC.	EMB.	EXC.	EMB.
4+00			33	493			
						199	1273
3+50			182	882			
						820	2989
2+88			532	1721			
						1002	2243
2+50			892	1467			
						2160	2780
2+00			1441	1535			
						1431	1300
1+75			1650	1273			
						1697	1001
1+50			1907	889			

SERIES G
SECTIONS RIGHT OF STA. 69+00 INNER BELT
STA. 1+75 TO STA. 4+00


SCALE 1"=10'
MADE P.L.S. DATE 8-11-58 HOWARD, NEEDLES, TAMMEN & BERGENDOFF
TRCD. S.C. DATE 11-11-58 CONSULTING ENGINEERS
CKD. B.W.S. DATE 12-11-58 KANSAS CITY CLEVELAND NEW YORK
914 SHEET 75

0 50 100 150 200 250

FED. ROAD DIV. NO.	STATE	FEDERAL AID PROJECT NO.	TYPE FUNDS	76 181
2	OHIO			

CUYAHOGA COUNTY
CITY OF CLEVELAND
CUY-42-18.42
CUY-21-15.32

End Computations
Sta. 7+35 0 Cut 0 Fill

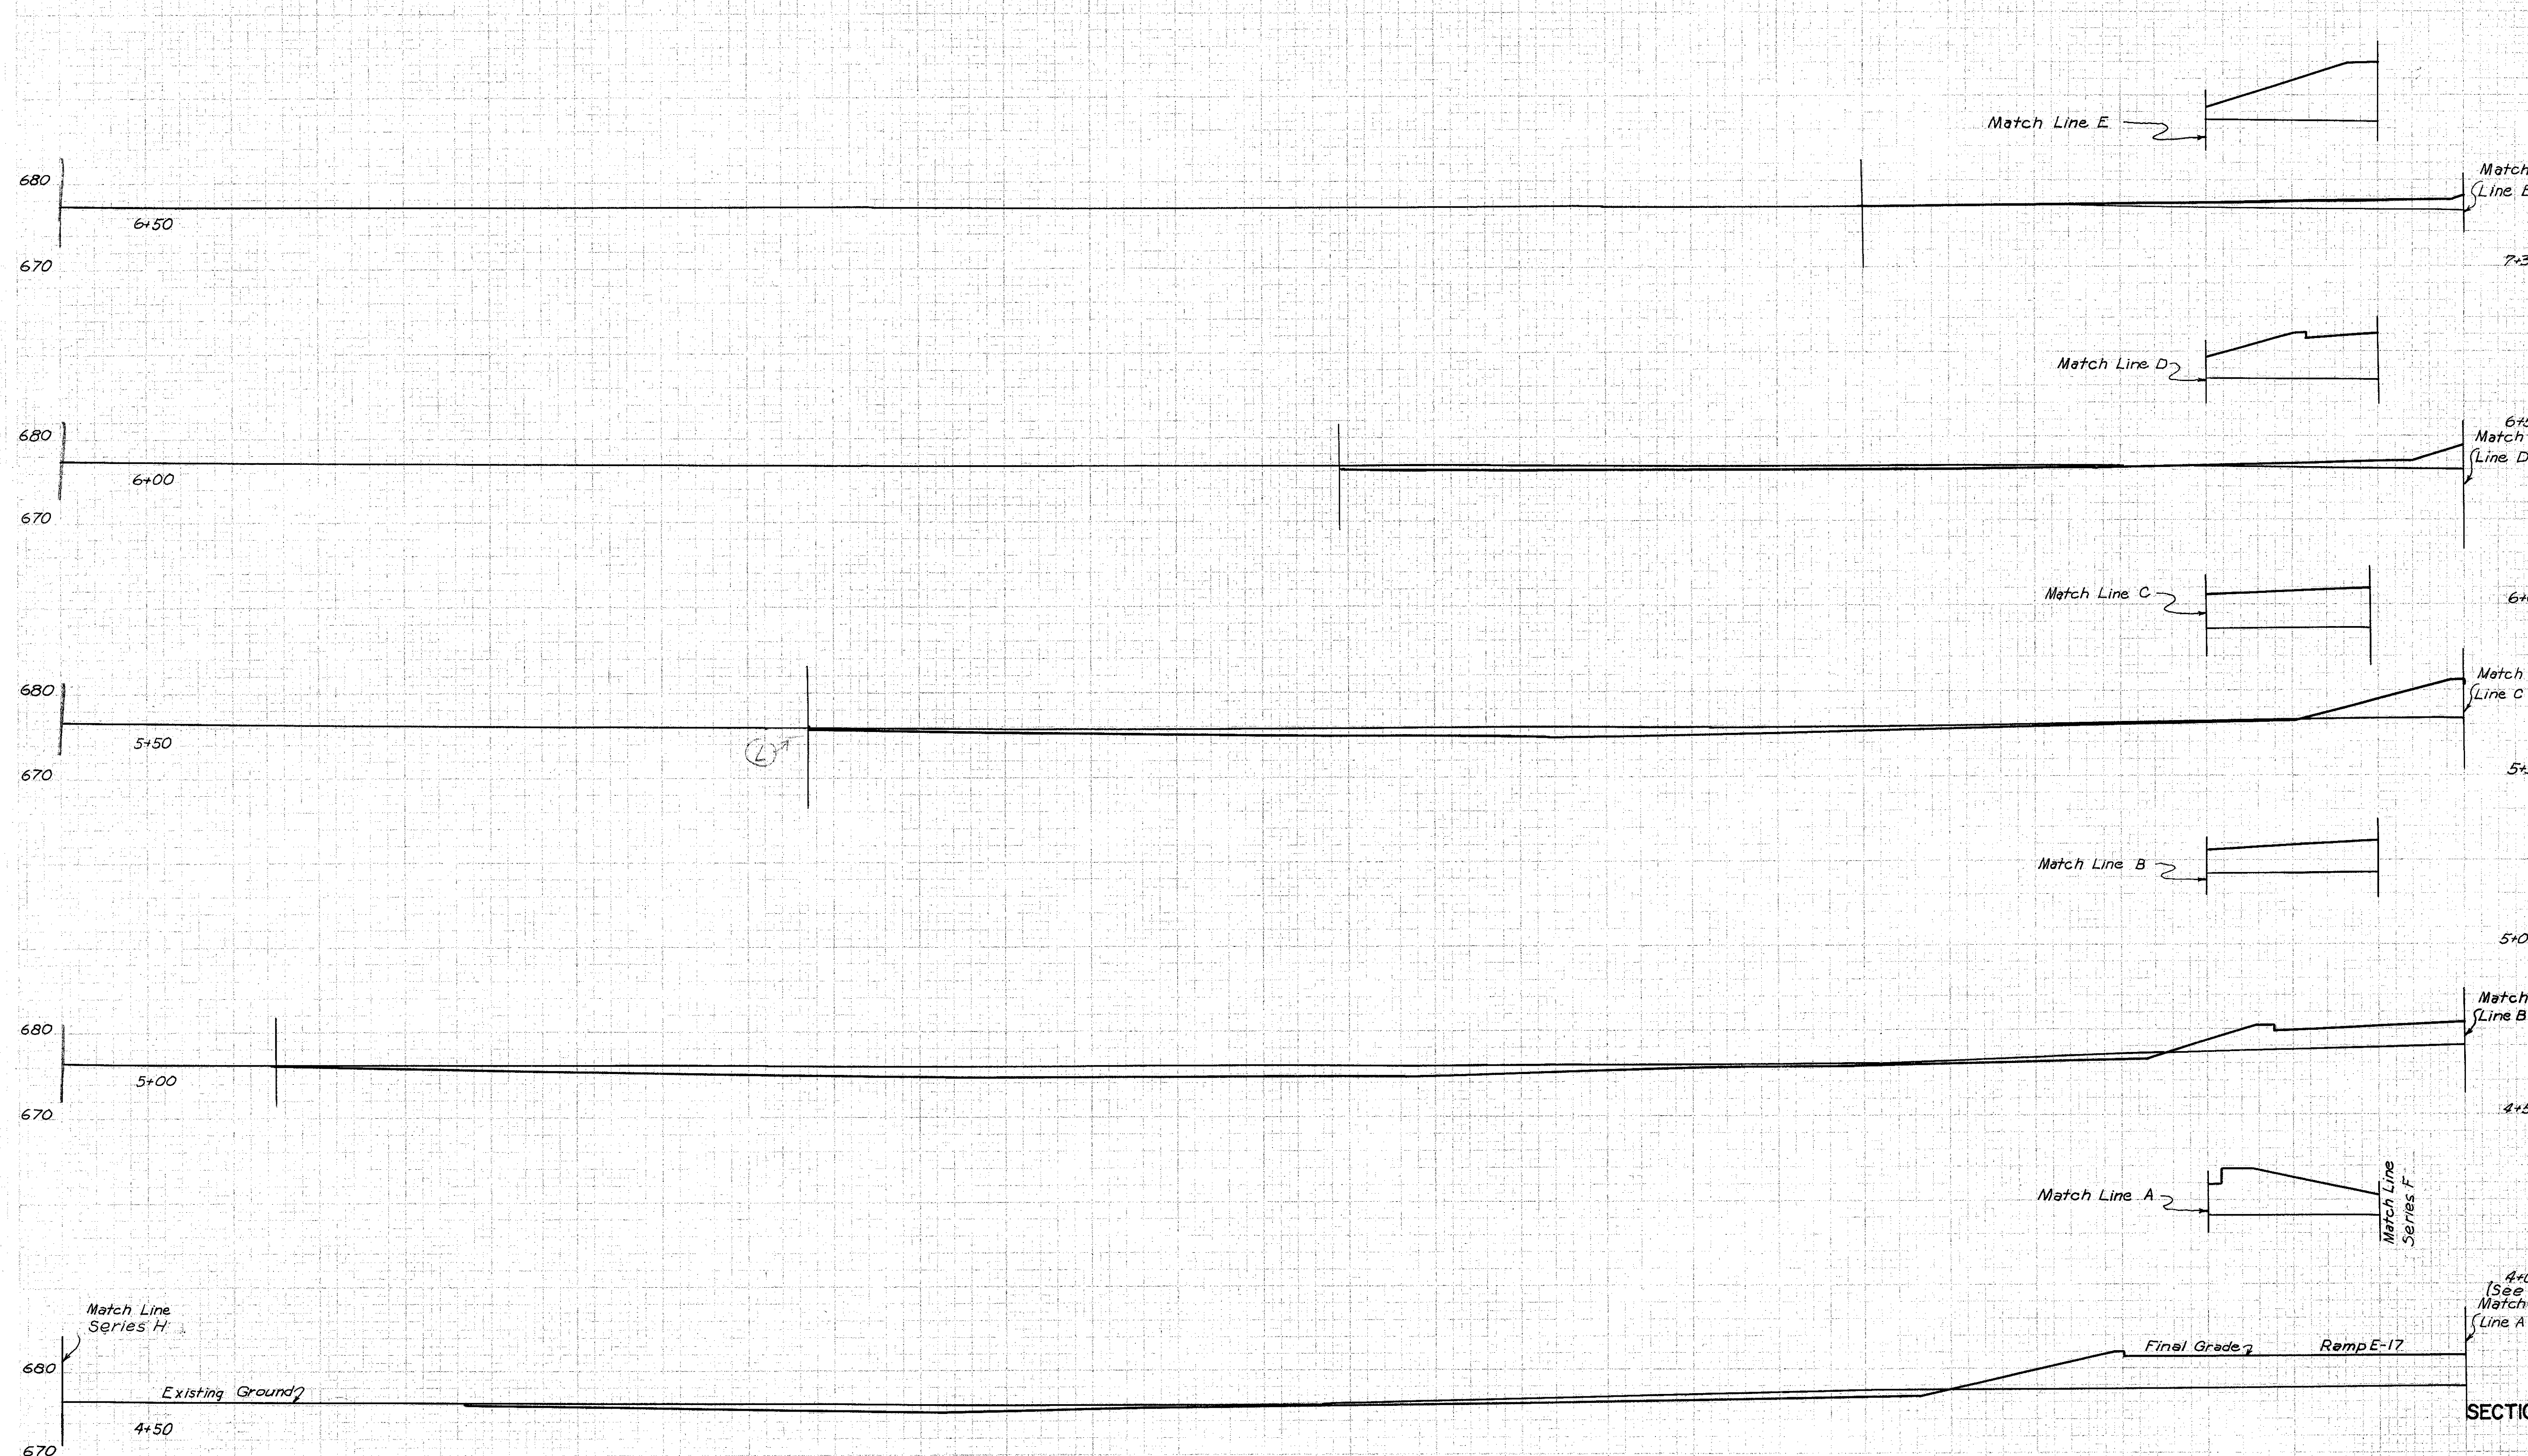

SEEDING		SUBBASE		EARTHWORK			
WIDTH	AREA	AREA	VOL.	END AREA		VOLUME	
L.F.	SQ. YD.	S.F.	C.Y.	EXC.	EMB.	EXC.	EMB.
				0	0		
						0	198
				0	126		
						32	222
				35	119		
							129
				104	131		
							257
				174	148		
							241
				86	273		
							110
				33	493		

SERIES G
SECTIONS RIGHT OF STA. 69+00 & INNER BELT
STA. 4+50 TO STA. 7+35


SCALE: 1" = 10'
MADE FLS. DATE 8-11-58 HOWARD, NEEDLES, TAMMEN & BERGENDOFF
TRCD. M.D.H. DATE 11-12-58 CONSULTING ENGINEERS
CKD. B.W.S. DATE 12-11-58 KANSAS CITY CLEVELAND NEW YORK
914 SHEET 76

0 50 100 150 200 250

FED. ROAD DIV. NO.	STATE	FEDERAL AID PROJECT NO.	TYPE FUNDS
2	OHIO		

77
181

CUYAHOGA COUNTY
CITY OF CLEVELAND
CUY - 42 - 18.42
CUY - 21 - 15.32

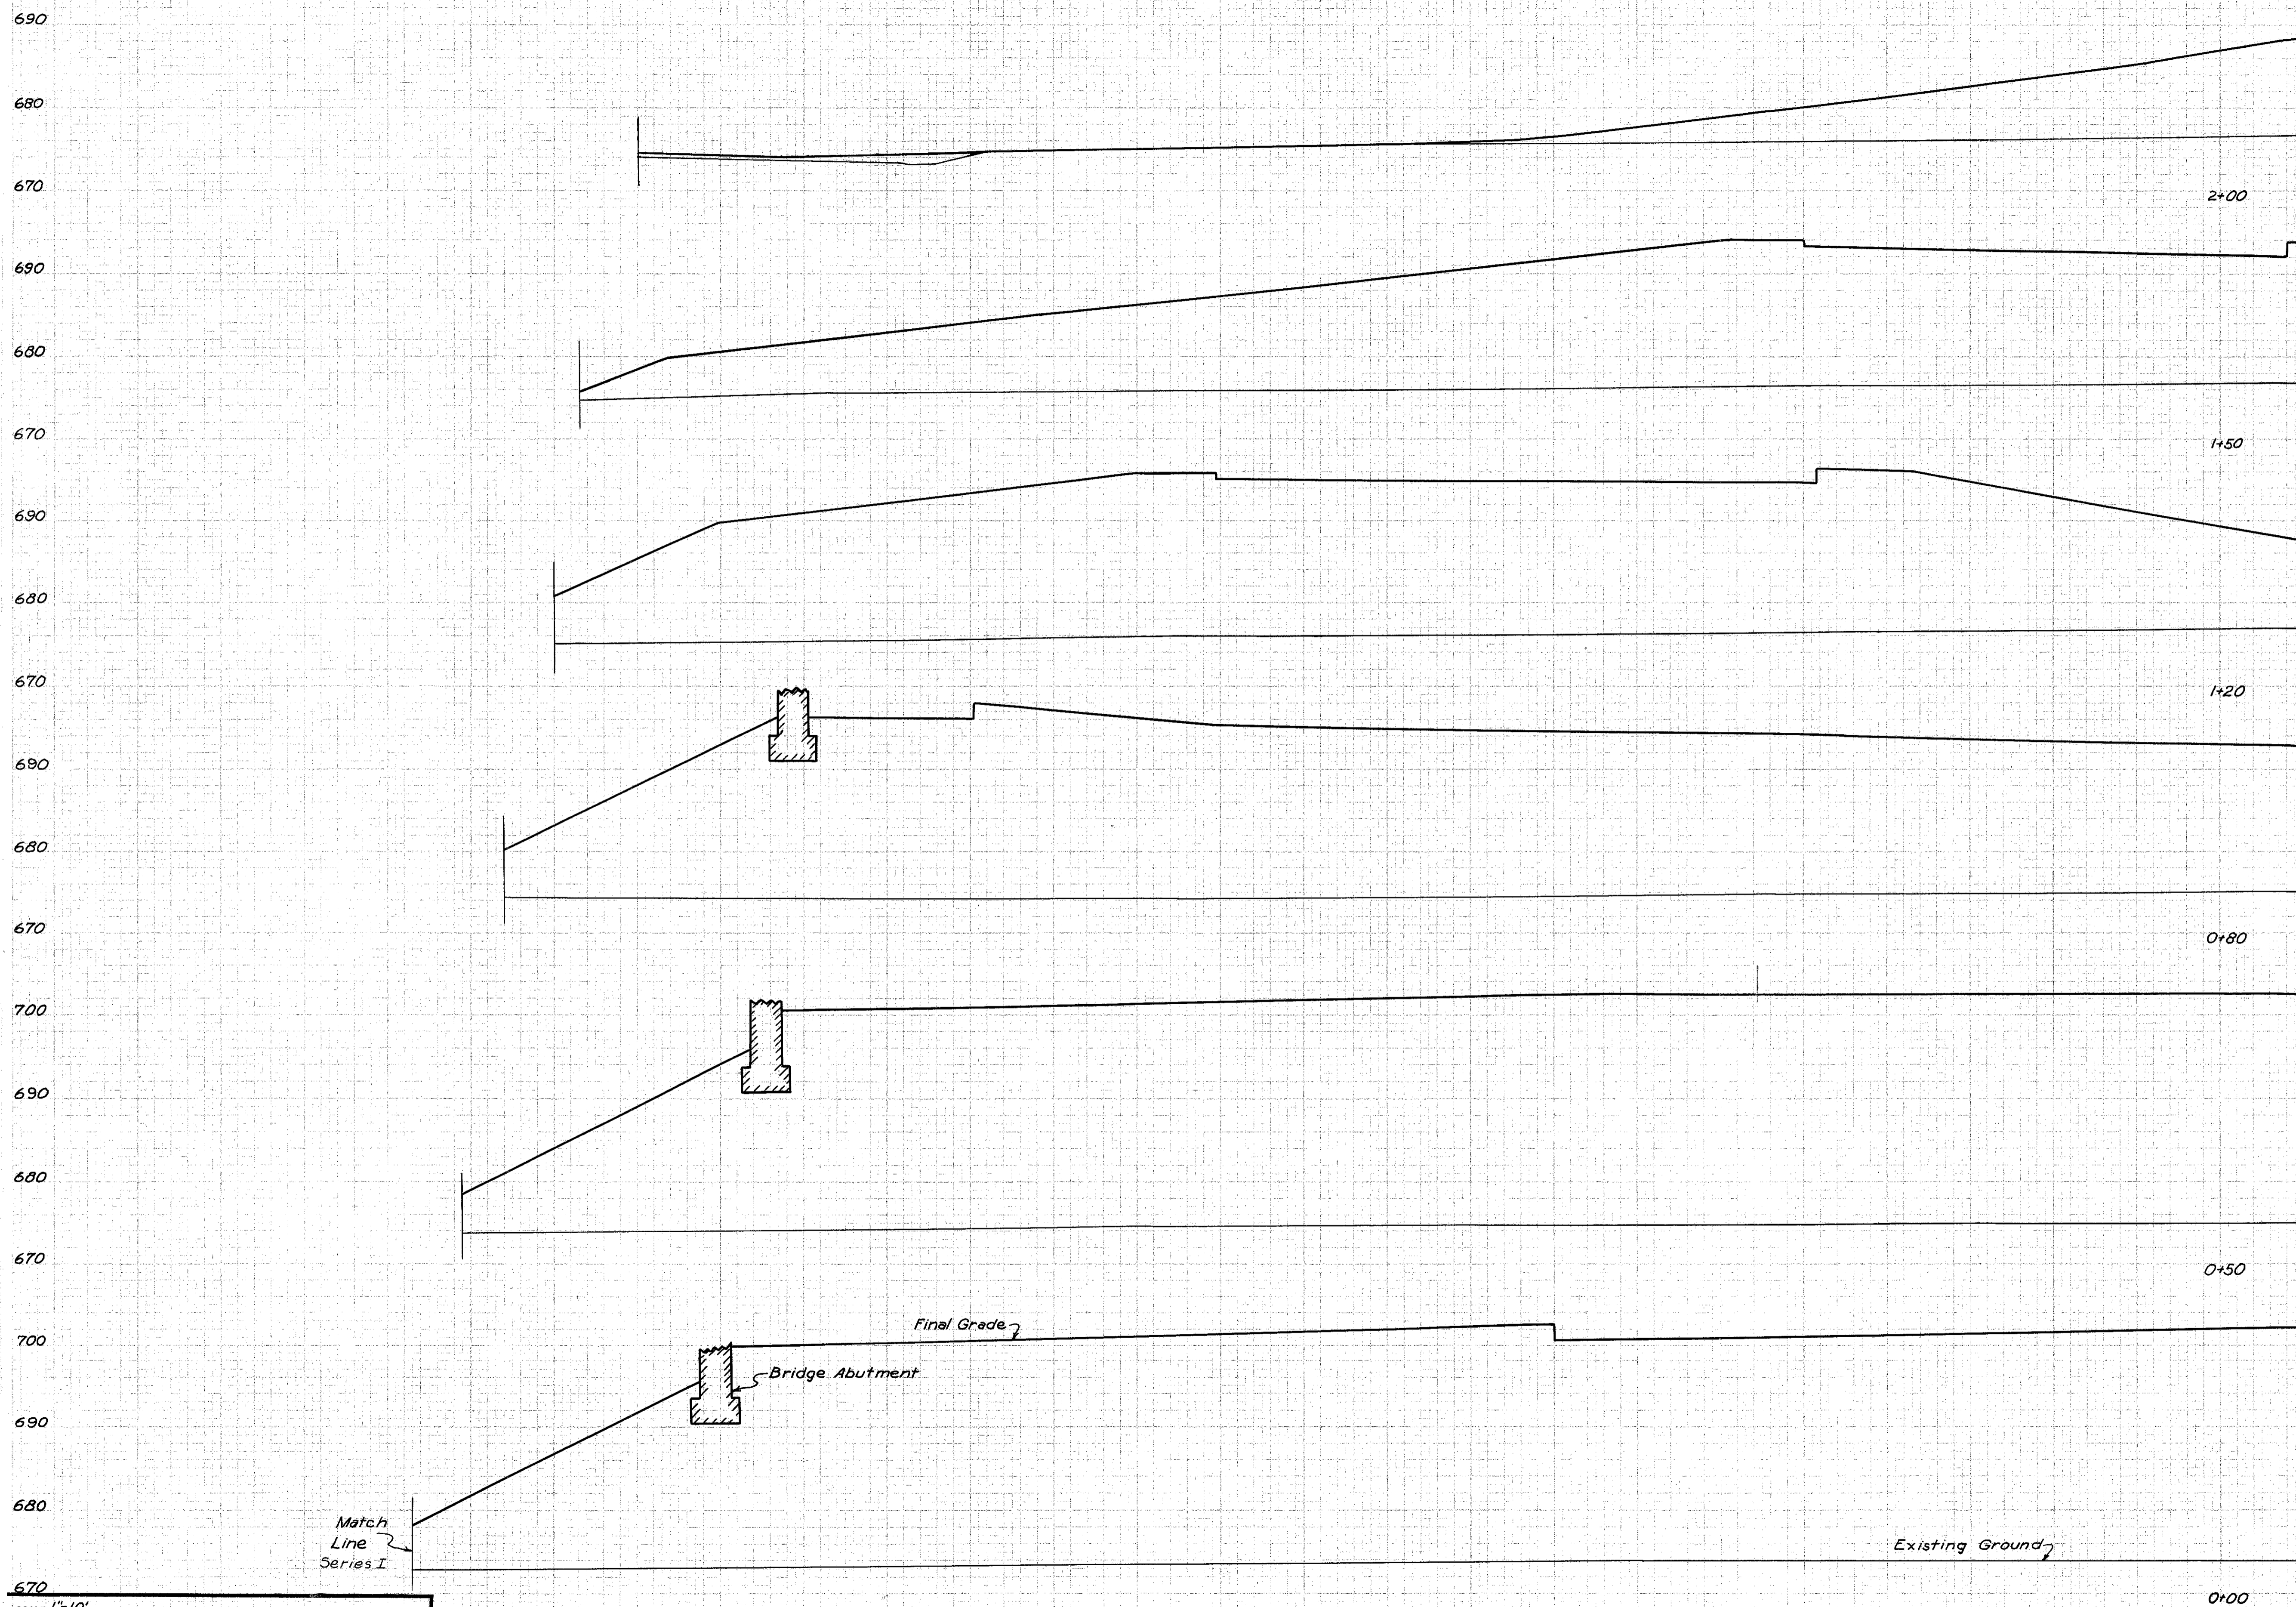

SEEDING	SUBBASE		EARTHWORK			
	WIDTH L.F.	AREA SQ. YD.	AREA S.F.	VOL. C. Y.	END AREA EXC.	VOLUME EMB.
					0	582
					0	2926
					0	2578
					0	3406
					0	3552
					0	5734
					0	4189
					0	5420
					0	5367
					0	10547
					0	5824

SERIES H
SECTIONS LEFT OF STA. 69+00 IN INNER BELT
STA. 0+00 TO STA. 2+00

SCALE 1"=10'
MADE BY DATE 9/2-58 HOWARD, NEEDLES, TAMMEN & BERGENDOFF
TRCD. BY DATE 1/13-58 CONSULTING ENGINEERS
CKD. BY DATE 12/1-58 KANSAS CITY CLEVELAND NEW YORK
914 SHEET 77

250

200

150

100


50

0

FED. ROAD DIV. NO.	STATE	FEDERAL AID PROJECT NO.	TYPE FUNDS	78 181
2	OHIO			

CUYAHOGA COUNTY
CITY OF CLEVELAND
CUY-42-18.42
CUY-21-16.32

End Computations
Sta 4+80 0 Cut 0 Fill

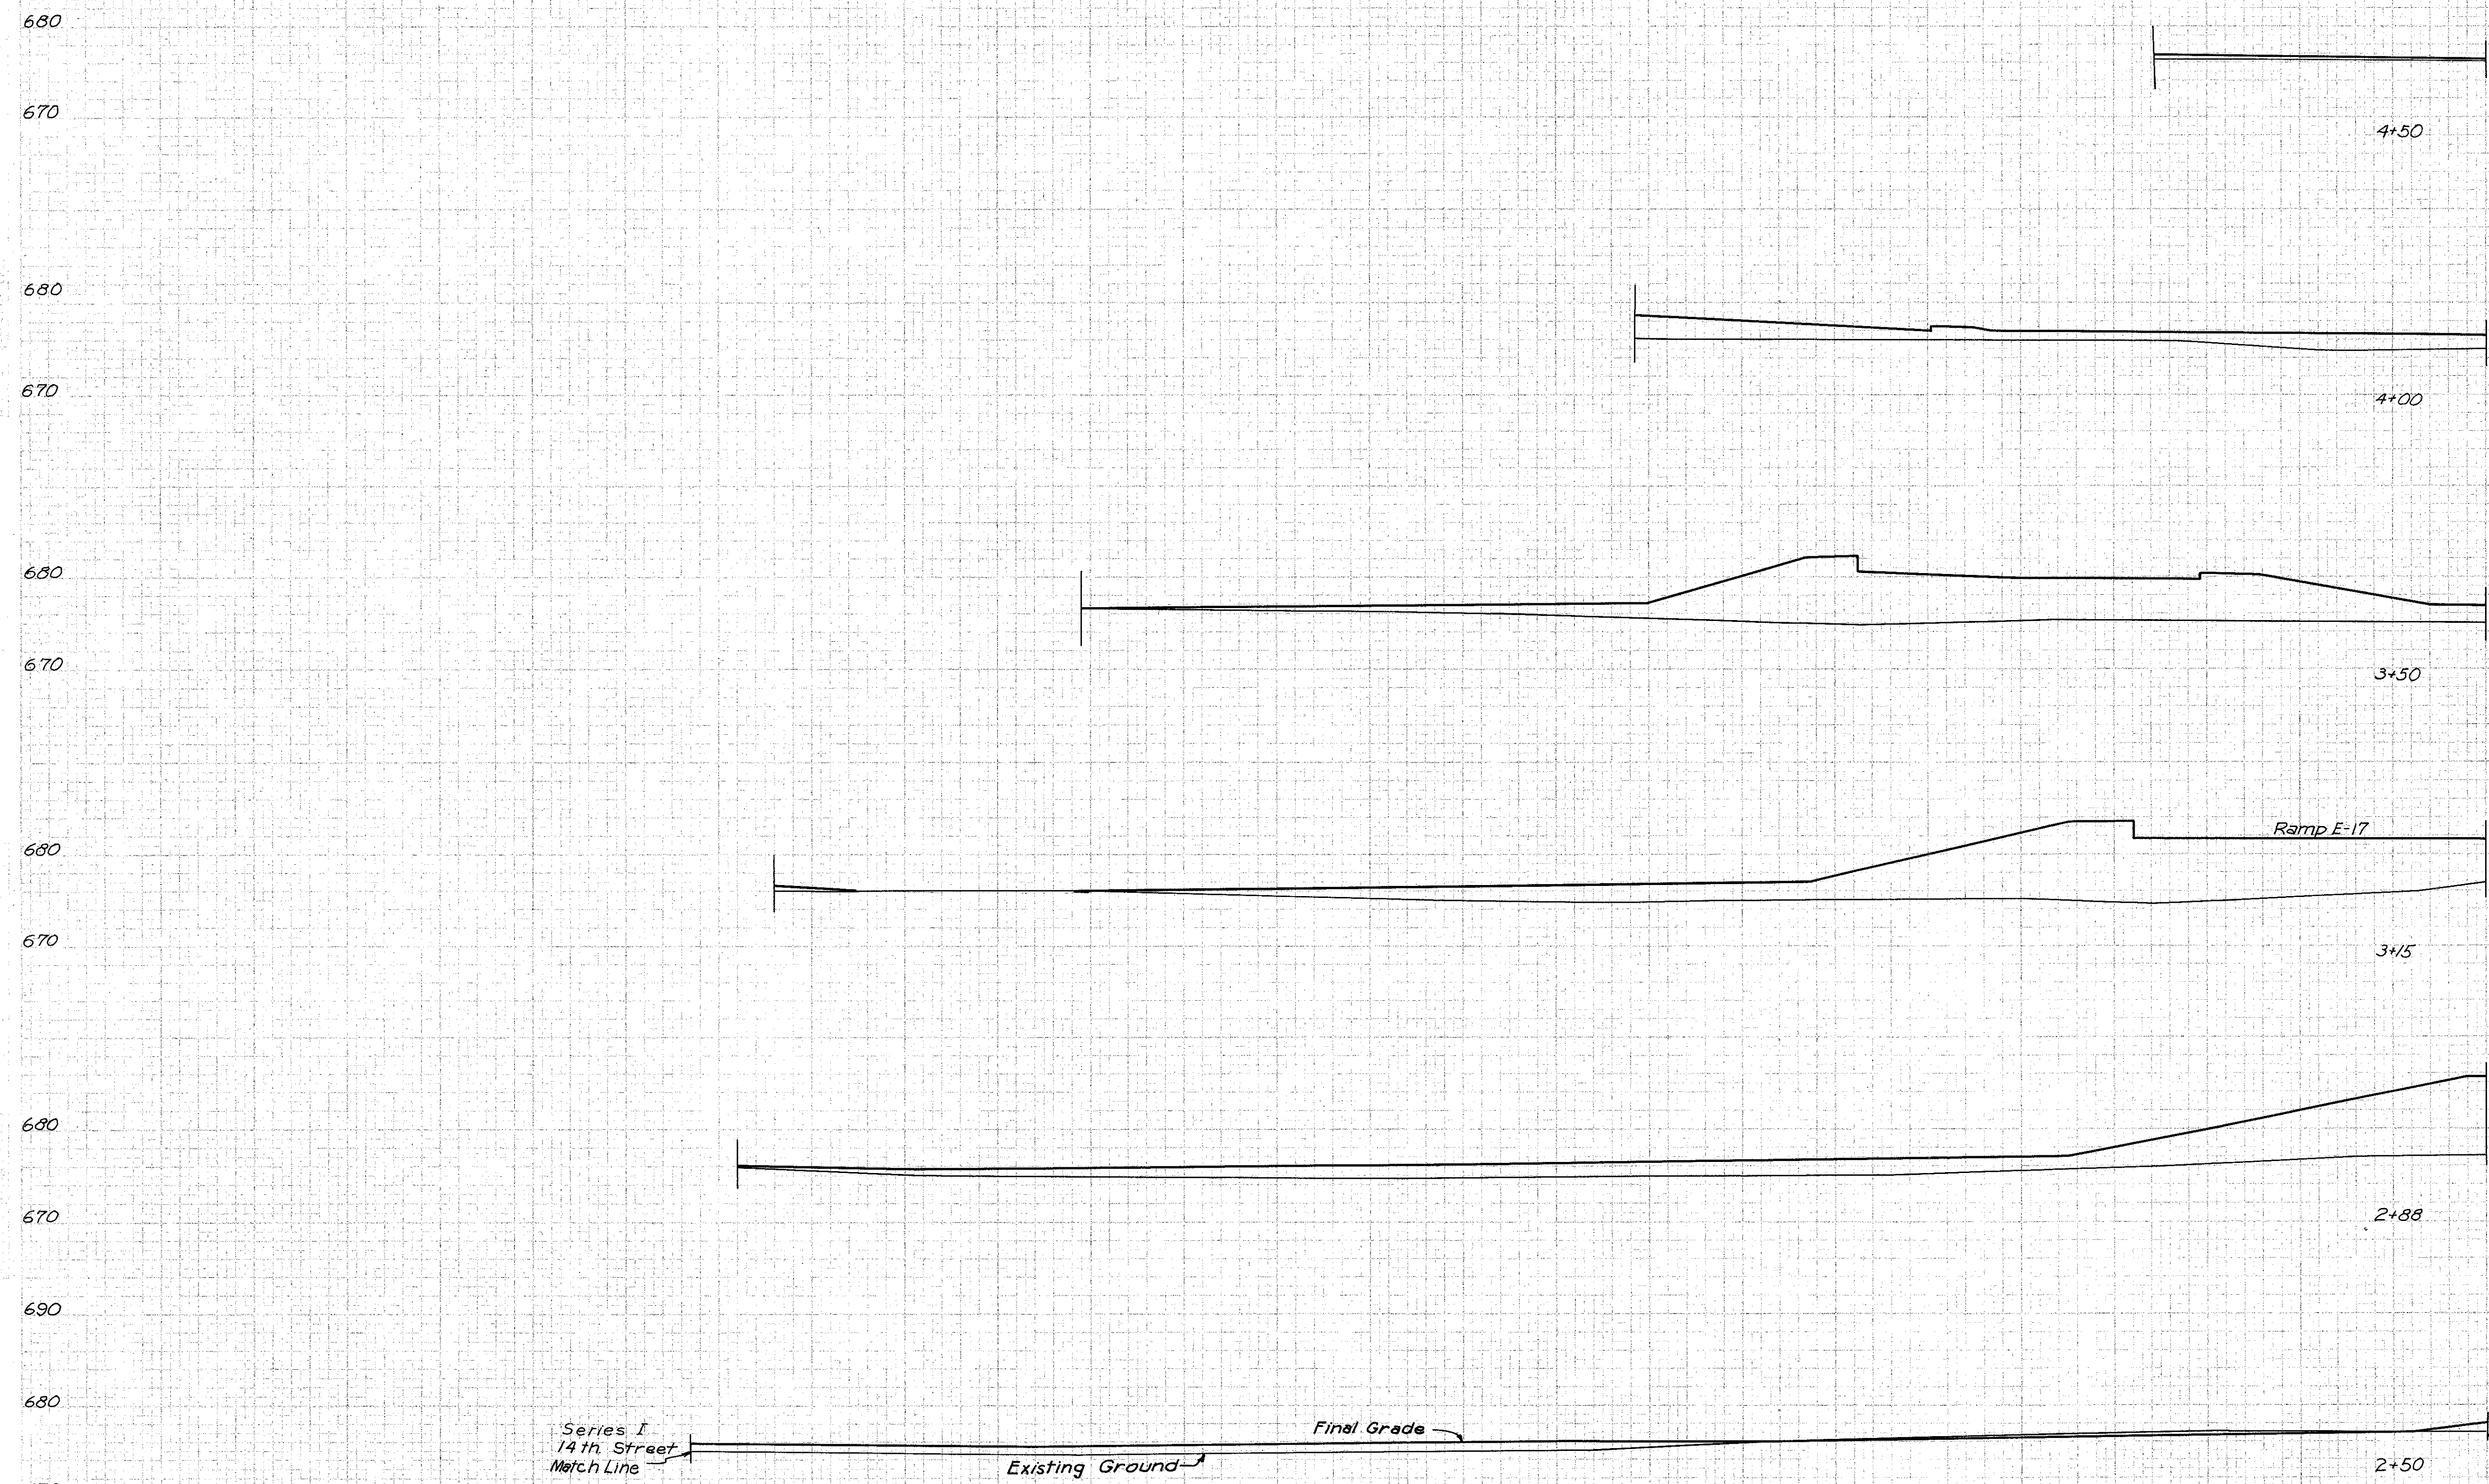


SEEDING	SUBBASE		EARTHWORK					
	WIDTH	AREA	AREA	VOL.	END AREA		VOLUME	
	L.F.	SQ. YD.	S.F.	C.Y.	EXC.	EMB.	EXC.	EMB.
					0	0		
4+80							0	6
4+50					0	11		131
4+00					0	131		533
3+50					0	445		643
3+15					0	547		474
2+88					0	400		367
2+50					2	122		653
2+00 (See Sheet 77)					0	582		

SERIES H
SECTIONS LEFT OF STA. 69 00 **B** INNER BELT
STA. 2+50 TO STA. 4+80

SCALE: 1" = 10'
MADE F.L.S. DATE 8-12-58 HOWARD, NEEDLES, TAMMEN & BERGENDOFF
TRCD. M.B. DATE 11-13-58 CONSULTING ENGINEERS
CKD. B.W.S. DATE 12-11-58 KANSAS CITY CLEVELAND NEW YORK
914 SHEET 78

250 200 150 100 50 0

CUYAHOGA COUNTY
CITY OF CLEVELAND
CUY-42-18.42
CUY-21-15.32

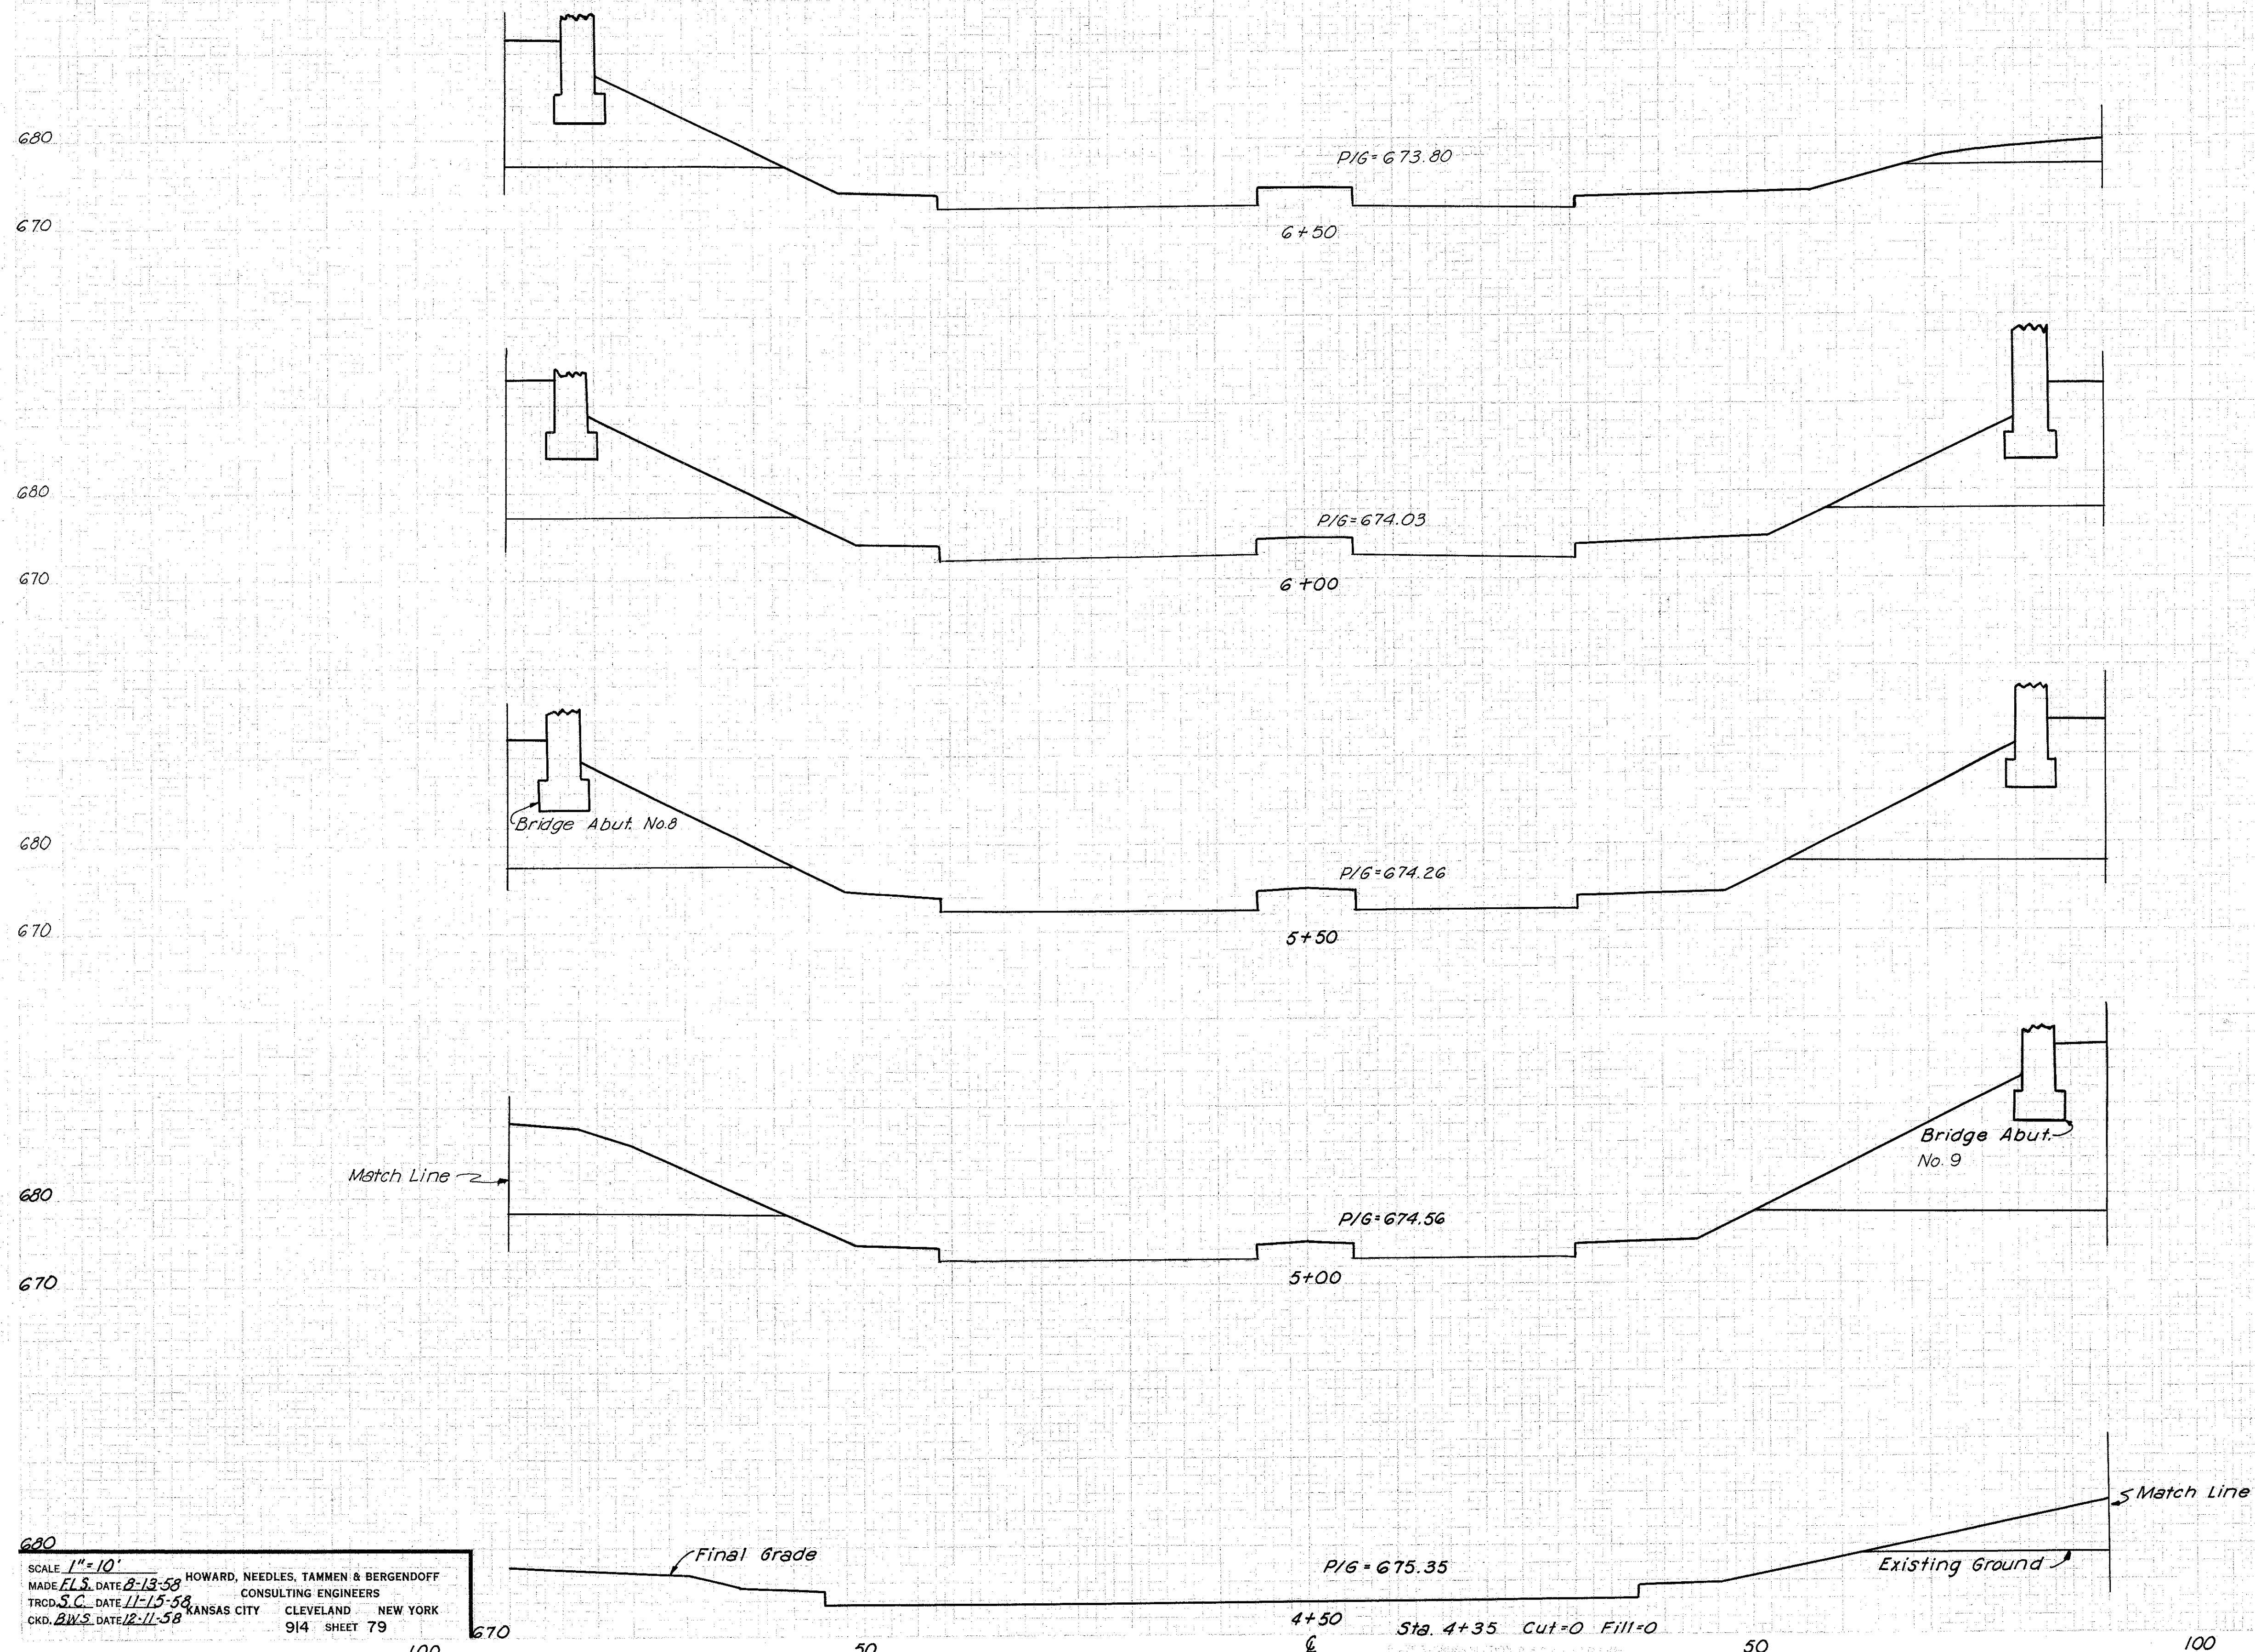


L. F.	SEEDING		SUBBASE		EARTHWORK			
	WIDTH	AREA	AREA	VOL.	END AREA		VOLUME	
	SQ. YD.	S. F.	S. F.	C. Y.	EXC.	EMB.	EXC.	EMB.
6+50					0	262		
							0	665
6+00					0	456		
							0	913
5+50					0	530		
							0	1024
5+00					0	576		
							0	609
4+50					0	82		
							0	23
4+35					0	0		

SERIES I
EAST 14TH ST. SECTIONS
STA. 4+35 TO STA. 6+50

SCALE 1" = 10'
MADE F.L.S. DATE 8-13-58 HOWARD, NEEDLES, TAMMEN & BERGENDOFF
TRCD. S.C. DATE 11-15-58 CONSULTING ENGINEERS
CKD. B.W.S. DATE 12-11-58 KANSAS CITY CLEVELAND NEW YORK
914 SHEET 79

FED. ROAD DIV. NO.	STATE	FEDERAL AID PROJECT NO.	TYPE FUNDS	80 181
2	OHIO			

CUYAHOGA COUNTY
CITY OF CLEVELAND
CUY-42-18.42
CUY-21-15.32

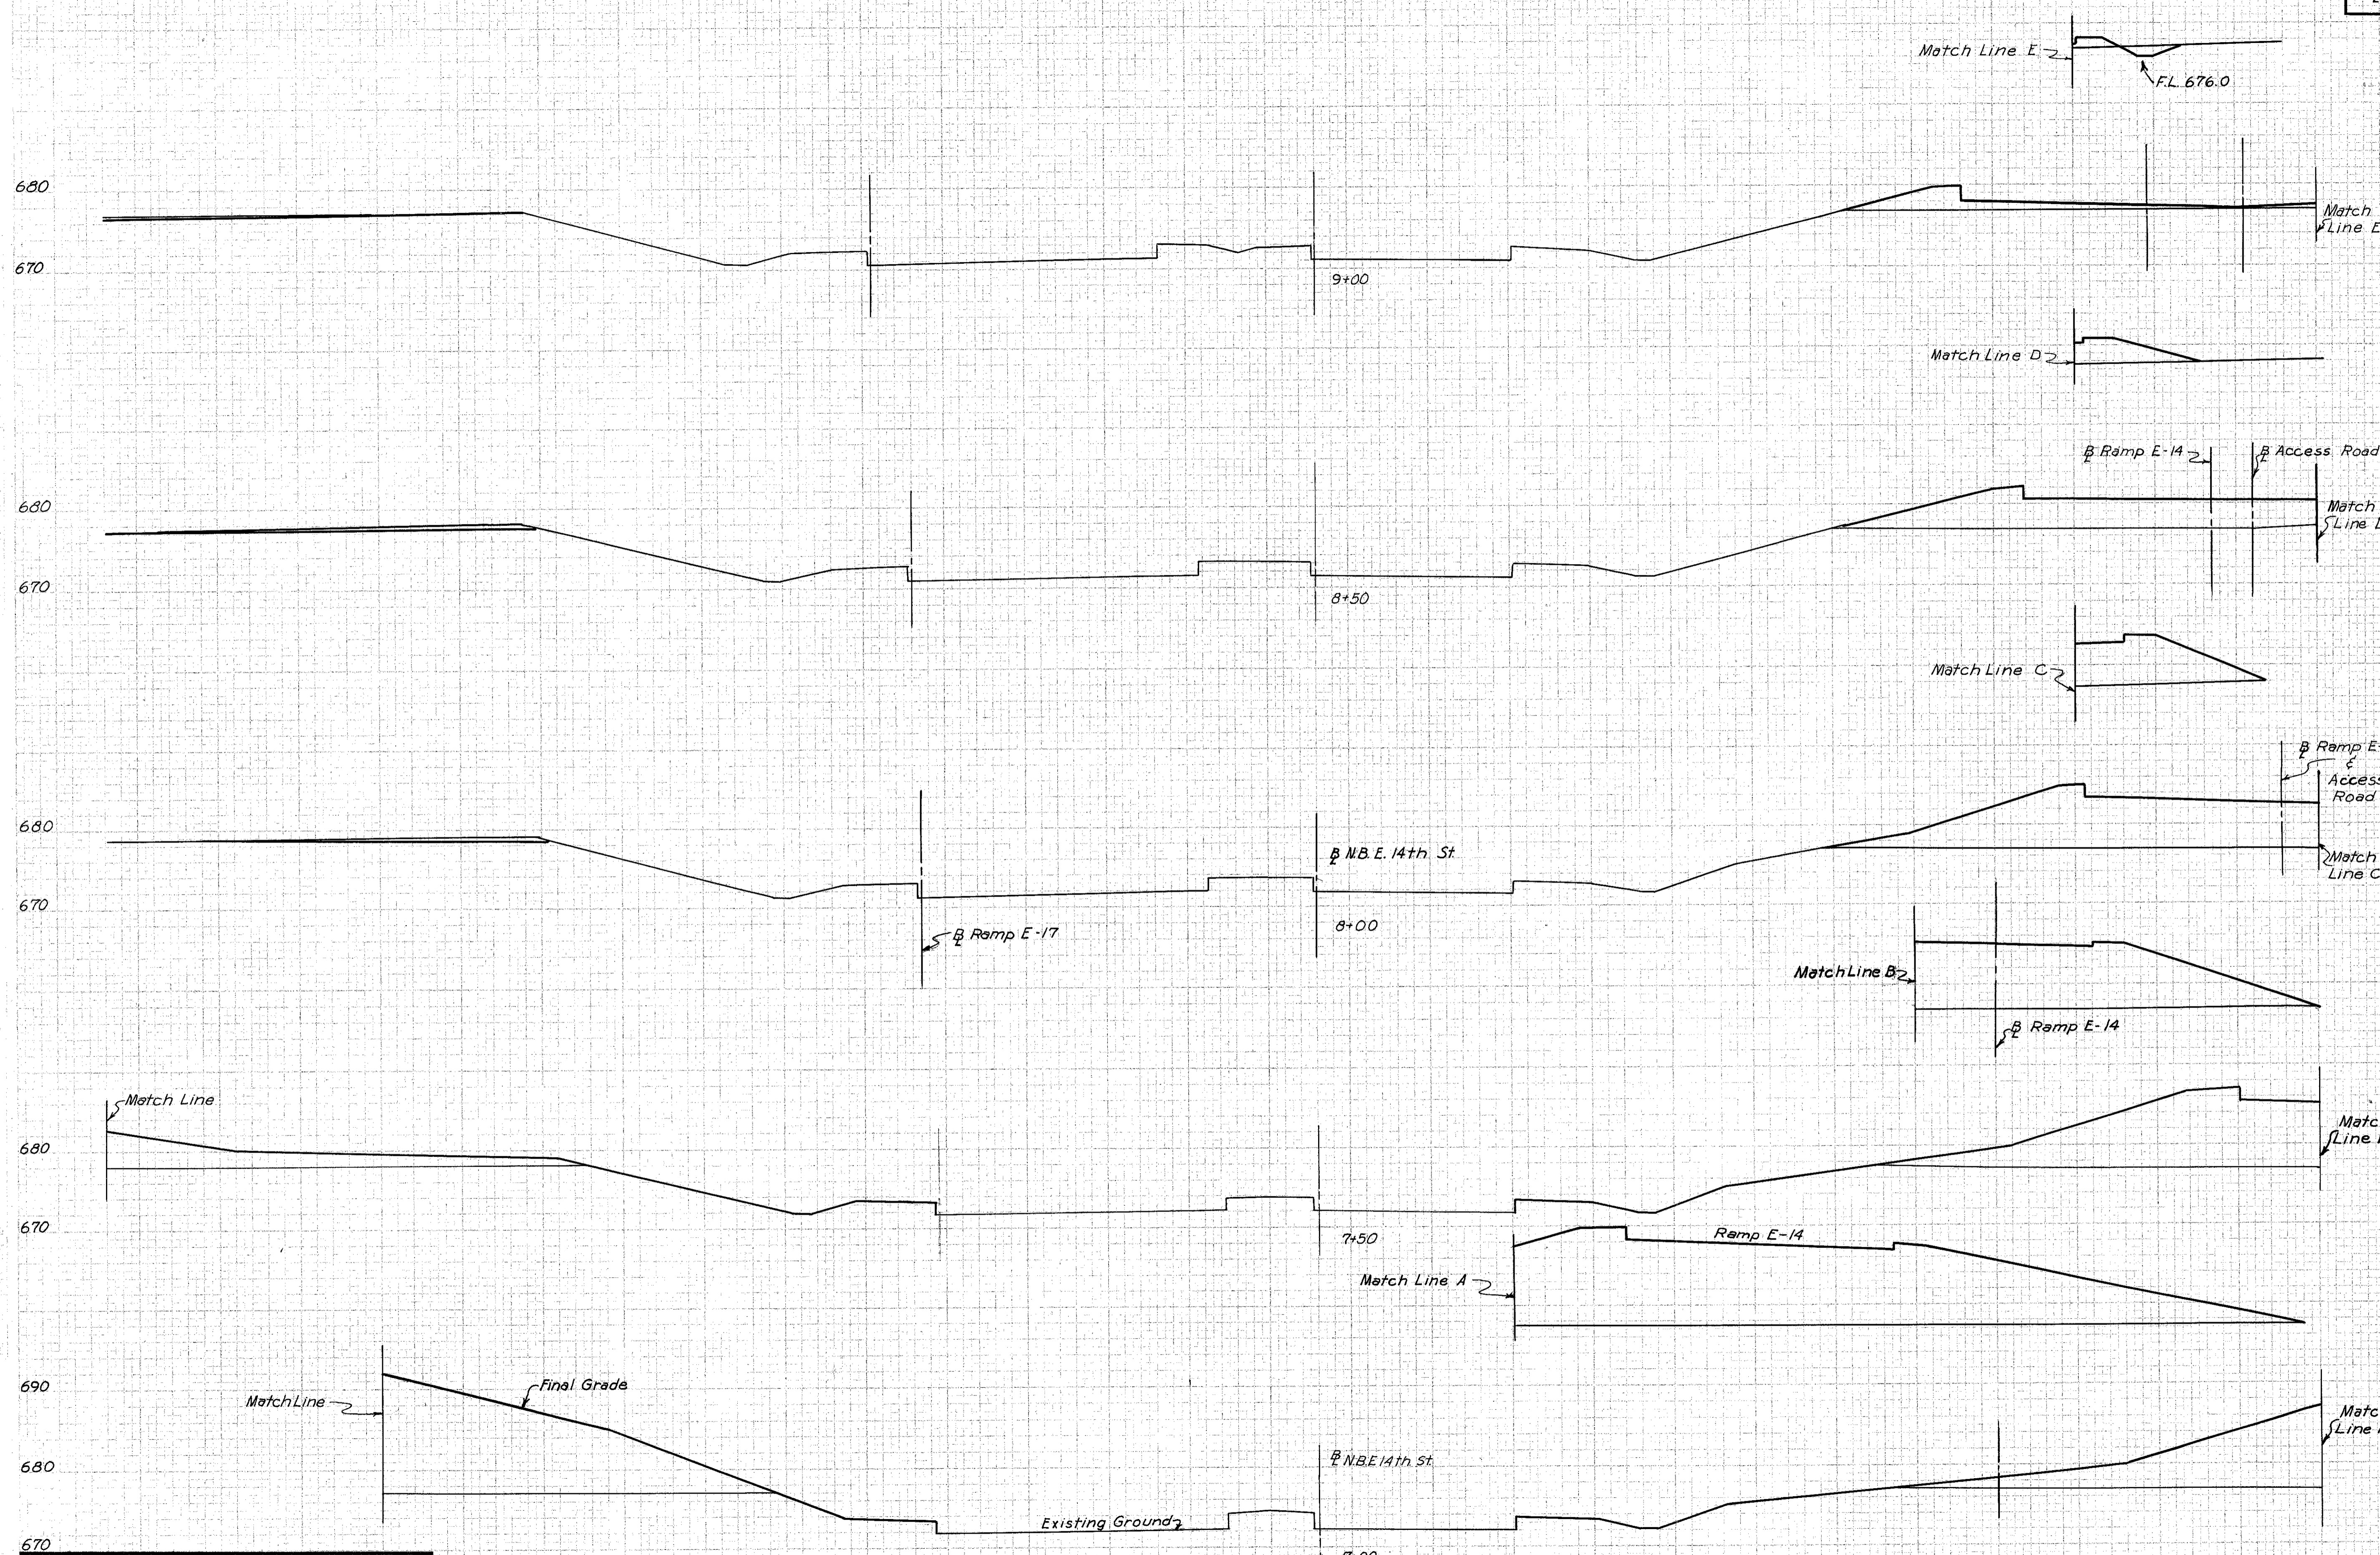

L.F.	SEEDING		SUBBASE		EARTHWORK			
	WIDTH	AREA	AREA	VOL.	END AREA		VOLUME	
	SQ. YD.	S.F.	S.F.	C.Y.	EXC.	EMB.	EXC.	EMB.
9+00					13	70		
8+50					26	224		
8+00					18	401		
7+50					0	766		
7+00 (Ahead)					0	1388		
7+00 (Back)					0	407		
6+50 (See Sheet 79)					0	262		
							36	272
							41	579
							17	1081
							0	1994
							0	619

SERIES I
EAST 14TH ST. SECTIONS
STA. 7+00 TO STA. 9+00


SCALE 1"=10'
MADE F.L.S. DATE 8-13-58
TRCD. M.H. DATE 11-15-58
CKD. B.W.S. DATE 12-11-58

HOWARD, NEEDLES, TAMMEN & BERGENDOFF
CONSULTING ENGINEERS
KANSAS CITY CLEVELAND NEW YORK
914 SHEET 80

150 100 50 0 50 100 150

FED. ROAD DIV. NO.	STATE	FEDERAL AID PROJECT NO.	TYPE FUNDS	81
2	OHIO			181

CUYAHOGA COUNTY
CITY OF CLEVELAND
CUY-42-18.42
CUY-21-15.32

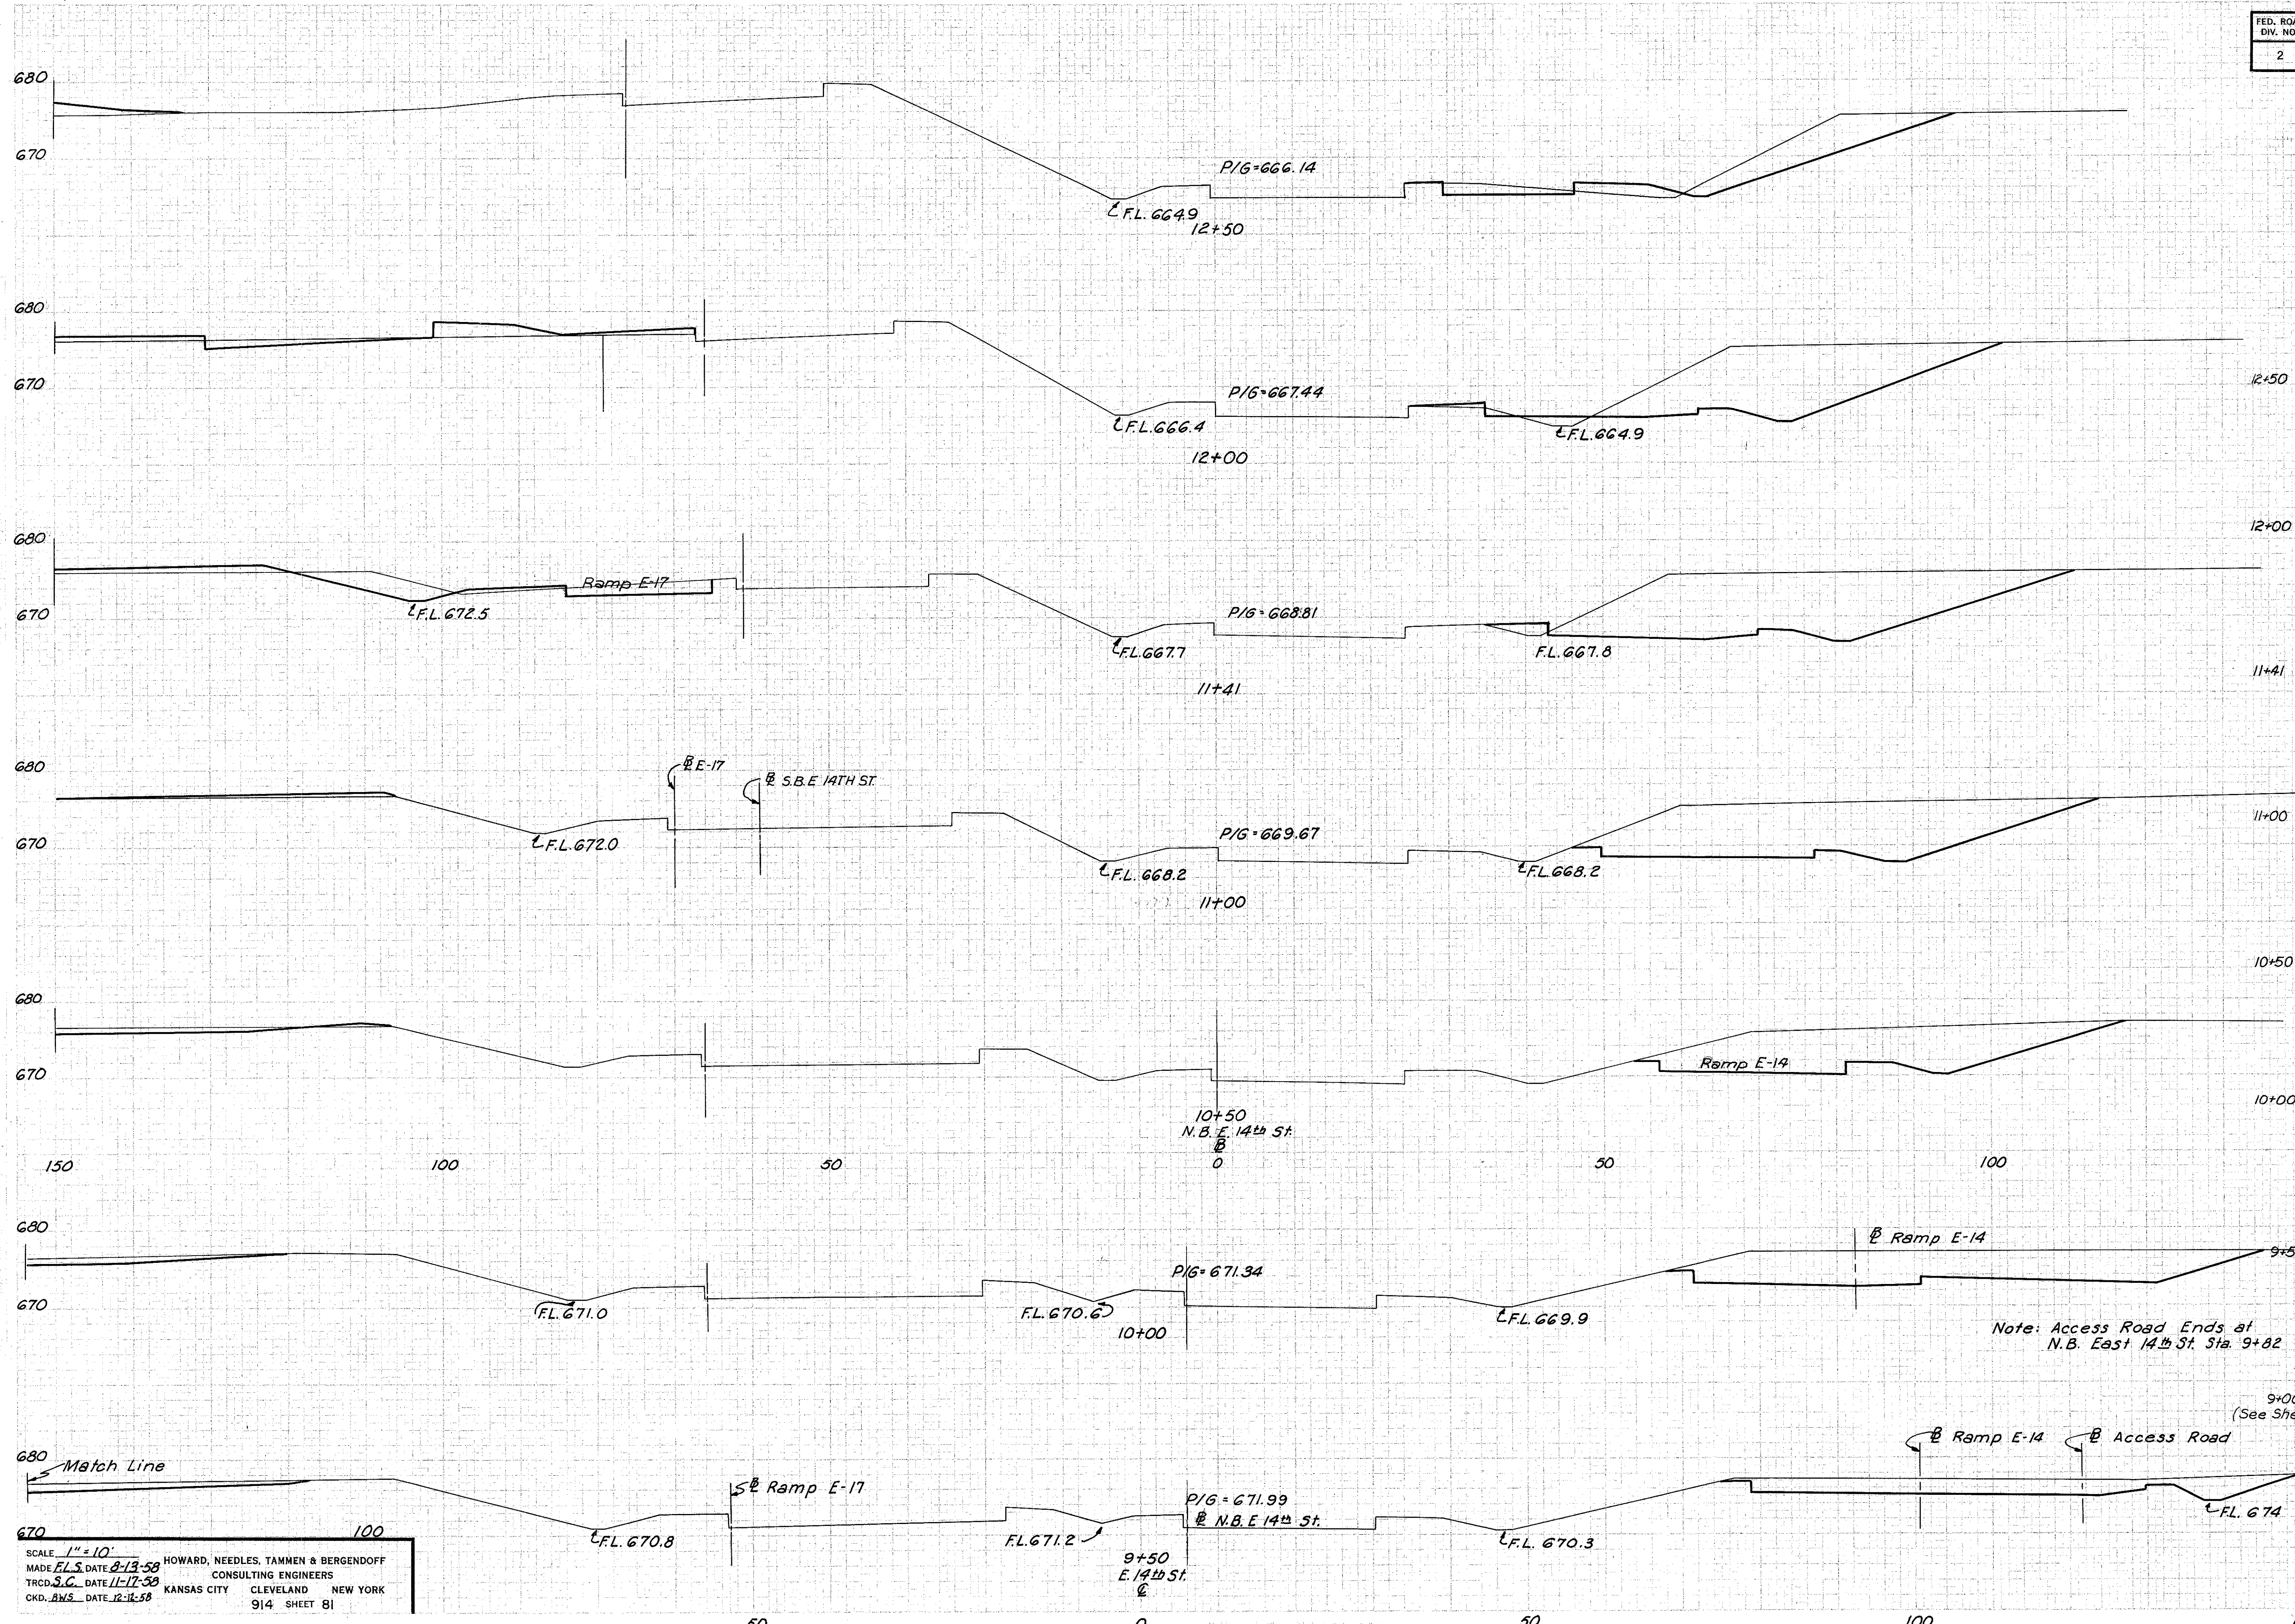

SEEDING		SUBBASE		EARTHWORK			
WIDTH	AREA	AREA	VOL.	END AREA		VOLUME	
L.F.	SQ. YD.	S.F.	C.Y.	EXC.	EMB.	EXC.	EMB.
						114	32
							381 78
				298	52		
						825	96
						457	36
							617 36
				355	12		
						572	12
						263	1
							507 1
				285	0		
						403	0
						150	0
							151 65
				13	70		

SCALE 1" = 10'
MADE F.L.S. DATE 8-13-58
TRCD. S.C. DATE 11-17-58
CKD. B.M.S. DATE 12-18-58


HOWARD, NEEDLES, TAMMEN & BERGENDOFF
CONSULTING ENGINEERS
KANSAS CITY CLEVELAND NEW YORK
914 SHEET 81

SERIES I
EAST 14TH ST SECTIONS
STA 9+50 TO STA 12+50

FED. ROAD DIV. NO.	STATE	FEDERAL AID PROJECT NO.	TYPE FUNDS
2	OHIO		

82
181

CUYAHOGA COUNTY
CITY OF CLEVELAND
CUY-42-18.42
CUY-42-15.32

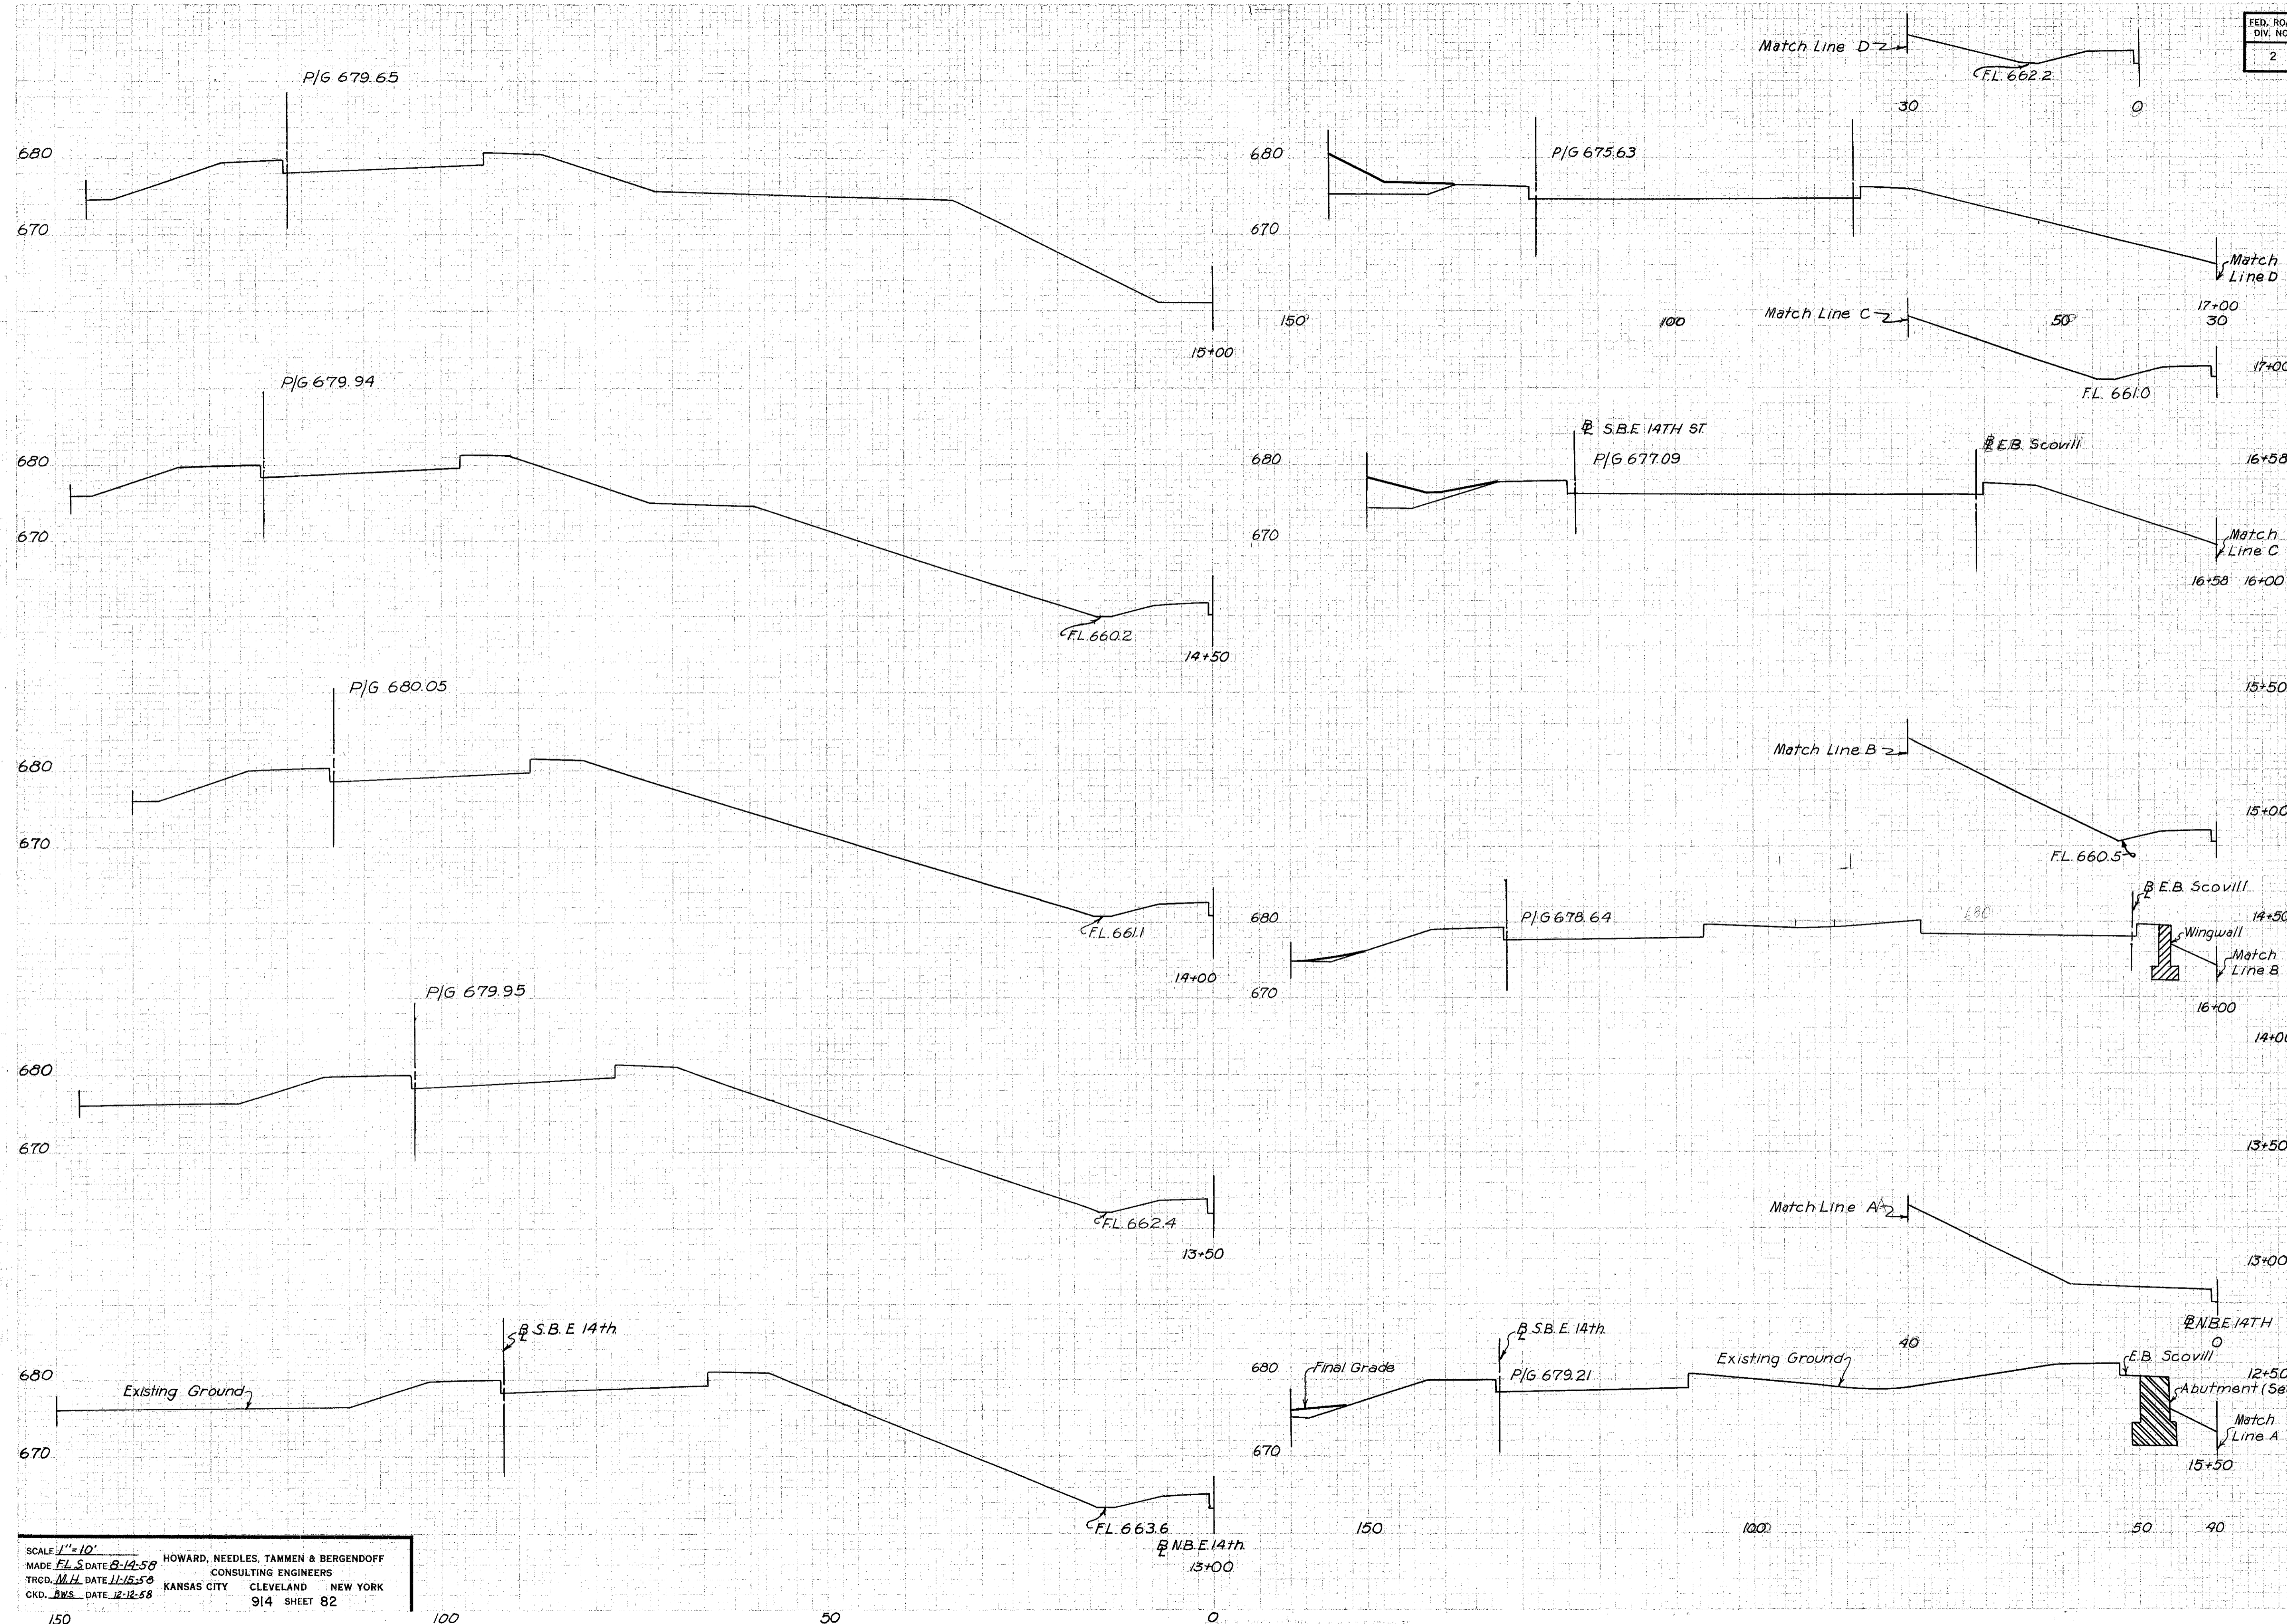

SEEDING		SUBBASE		EARTHWORK			
WIDTH	AREA	AREA	VOL.	END AREA		VOLUME	
L.F.	SQ. YD.	S.F.	C.Y.	EXC.	EMB.	EXC.	EMB.
				0	31		
						0	15
				0	27		
						0	32
				0	3		
						0	8
				0	6		
				0	0		
						0	0
						106	30
				114	32		


SERIES I
EAST 14TH ST SECTIONS
STA. 13+00 TO STA. 17+00

SCALE 1"=10'
MADE F.L.S. DATE 8-14-58
TRCD. M.H. DATE 11-15-58
CKD. BWS. DATE 12-12-58

HOWARD, NEEDLES, TAMMEN & BERGENDOFF
CONSULTING ENGINEERS
KANSAS CITY CLEVELAND NEW YORK
914 SHEET 82

150 100 50 0

CUYAHOGA COUNTY
CITY OF CLEVELAND
CUY-42-18.42
CUY-21-15.32

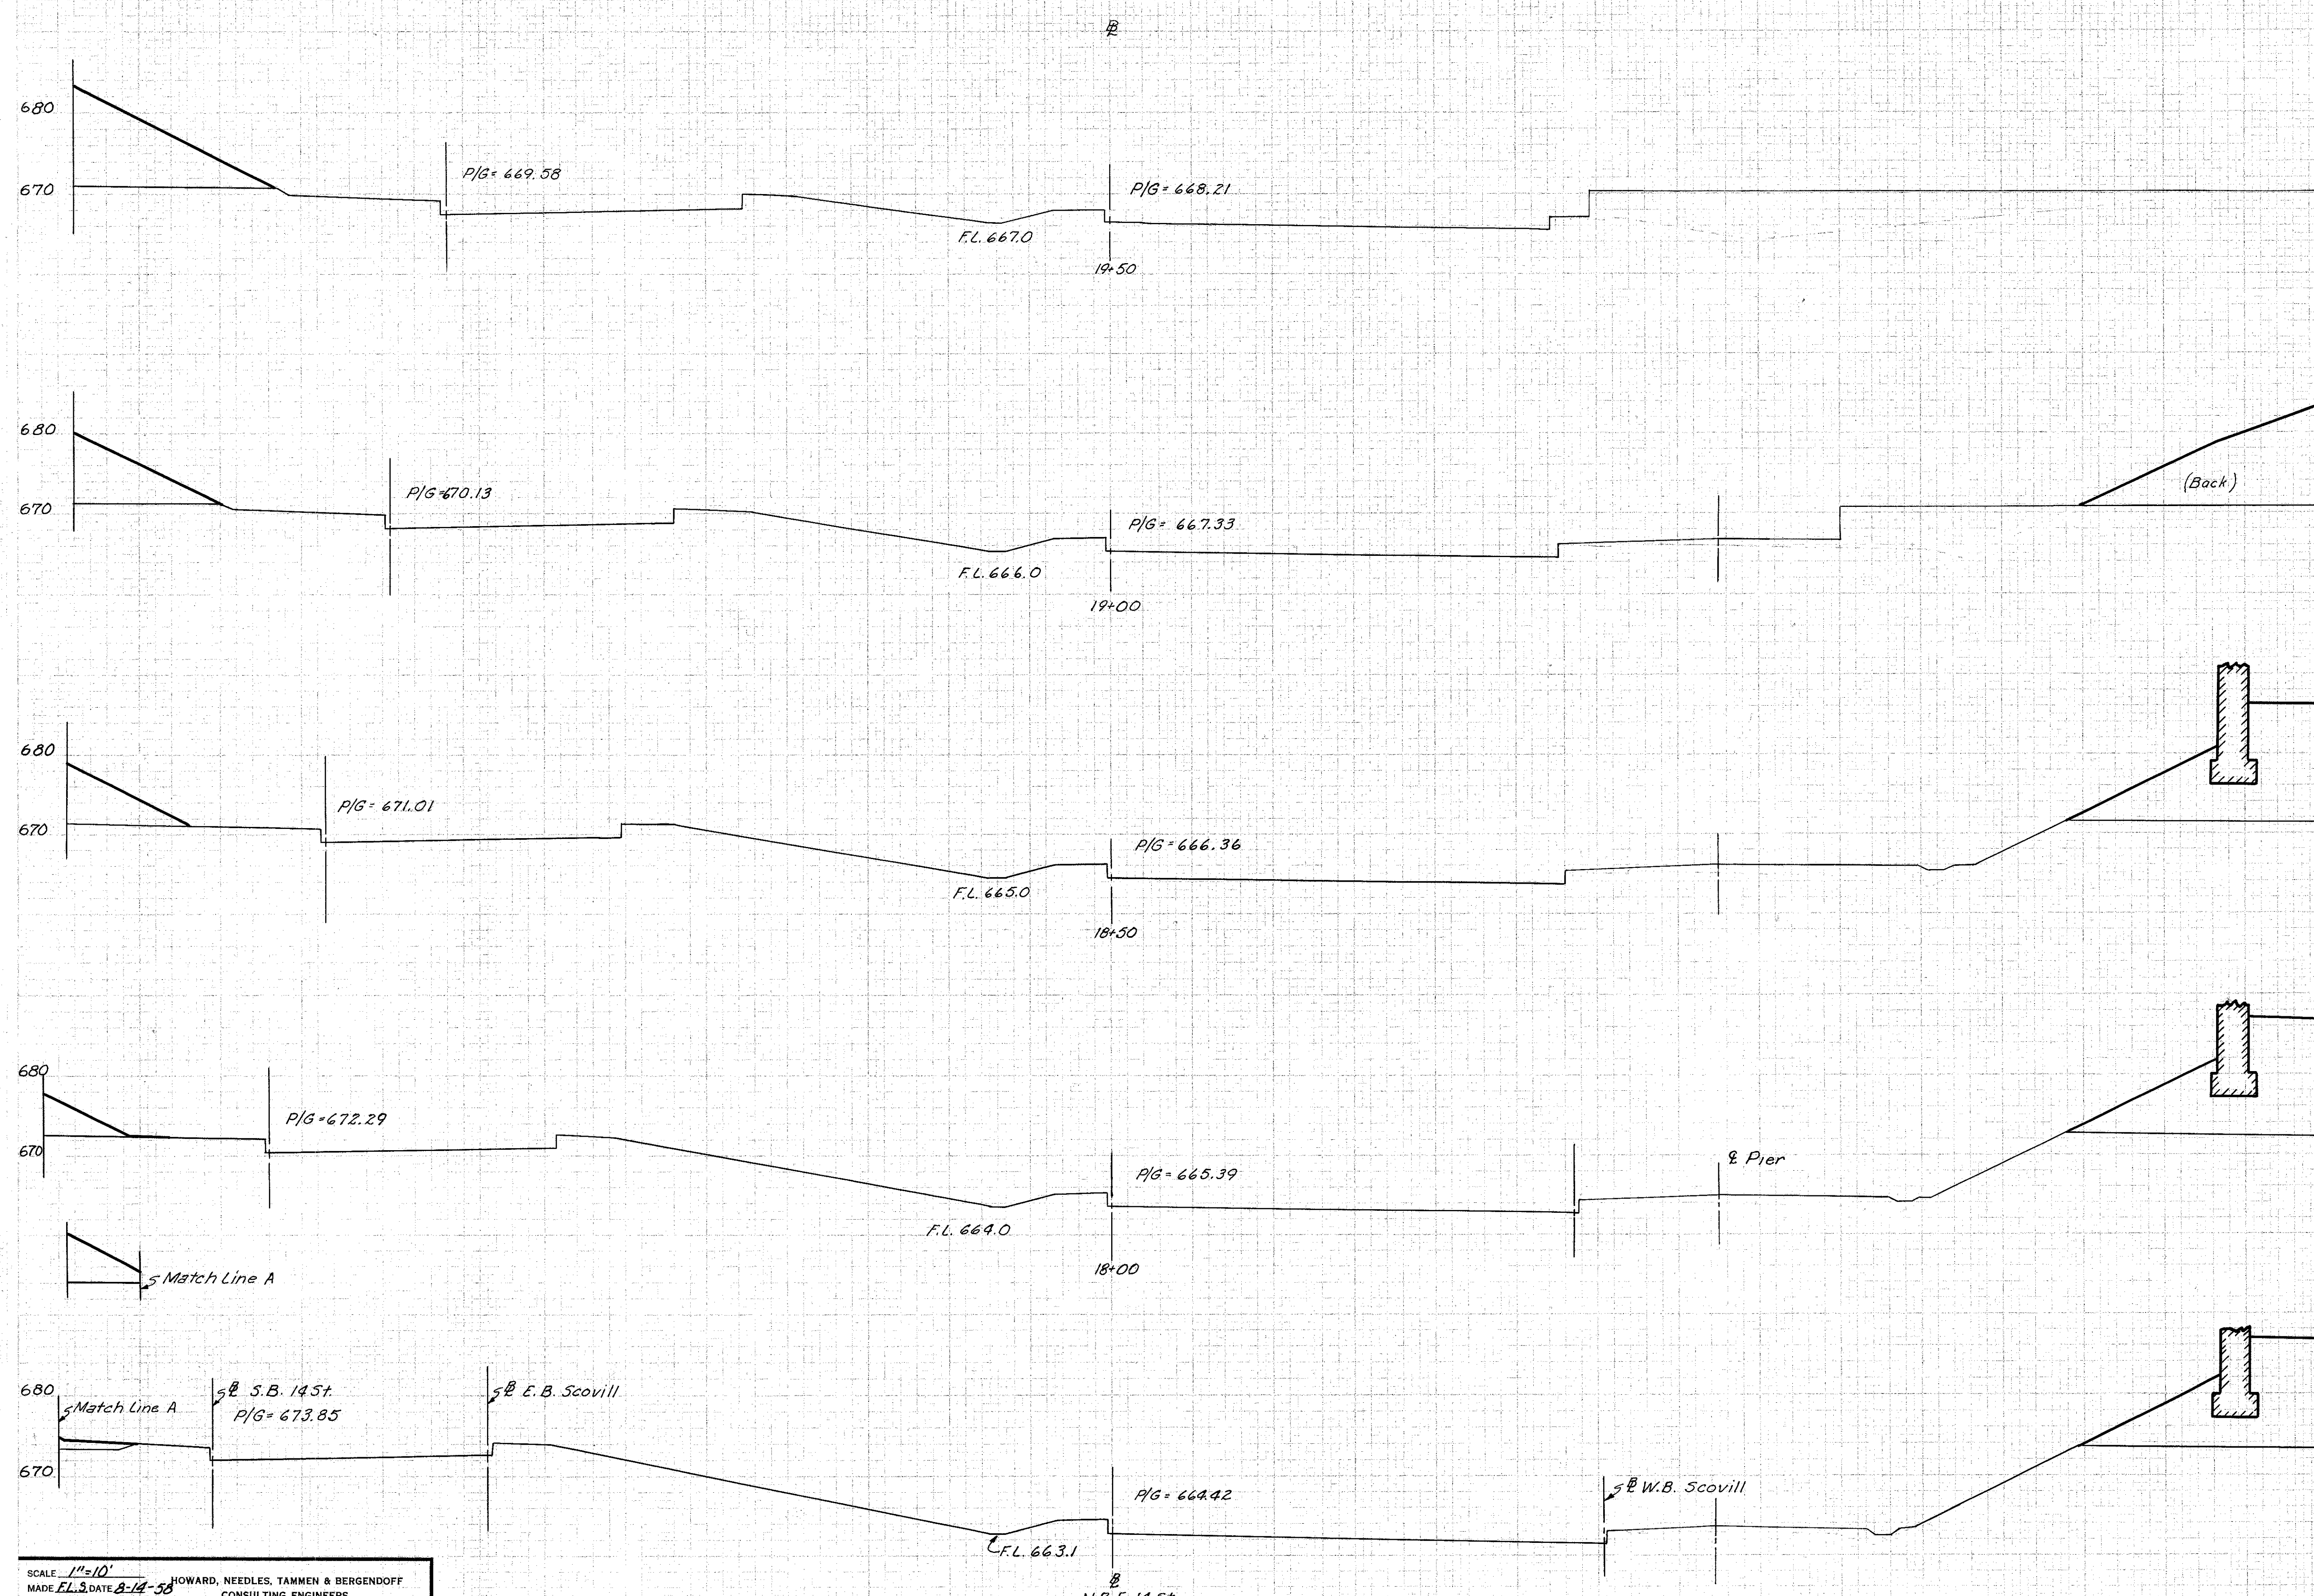

SEEDING		SUBBASE		EARTHWORK			
WIDTH	AREA	AREA	VOL	END AREA		VOLUME	
L.F.	SQ. YD.	S.F.	C.Y.	EXC.	EMB.	EXC.	EMB.
				0	156		
						0	220
				0	81		
				0	276		
						0	542
				0	309		
						0	598
				0	283		
						0	508
				0	266		
						0	275
				0	31		

SERIES I
EAST 14TH ST. SECTIONS
STA. 17+50 TO STA. 19+50

SCALE 1"=10'
MADE F.L.S. DATE 8-14-58
TRCD. M.B. DATE 11-15-58
CKD. B.W.S. DATE 12-12-58
HOWARD, NEEDLES, TAMMEN & BERGENDOFF
CONSULTING ENGINEERS
KANSAS CITY CLEVELAND NEW YORK
914 SHEET 83
100

N.B.E. 14 ST.
17+50
0

50

50

100


150

FED. ROAD DIV. NO.	STATE	FEDERAL AID PROJECT NO.	TYPE FUNDS
2	OHIO		

84
181

CUYAHOGA COUNTY
CITY OF CLEVELAND
CUY-42-18.42
CUY-21-15.32

STATION	SEEDING		SUBBASE		EARTHWORK			
	WIDTH L.F.	AREA SQ.YD.	AREA S.F.	VOL. C.Y.	END AREA EXC.	AREA EMB.	VOLUME EXC.	VOLUME EMB.
22+33					0	0		
22+00					297	0		181 0
21+50					377	0		624 0
21+07					523	2		717 2
21+07					0	0		
20+50					8	0		8 0
20+00					0	0		7 0
19+50					0	156		0 144

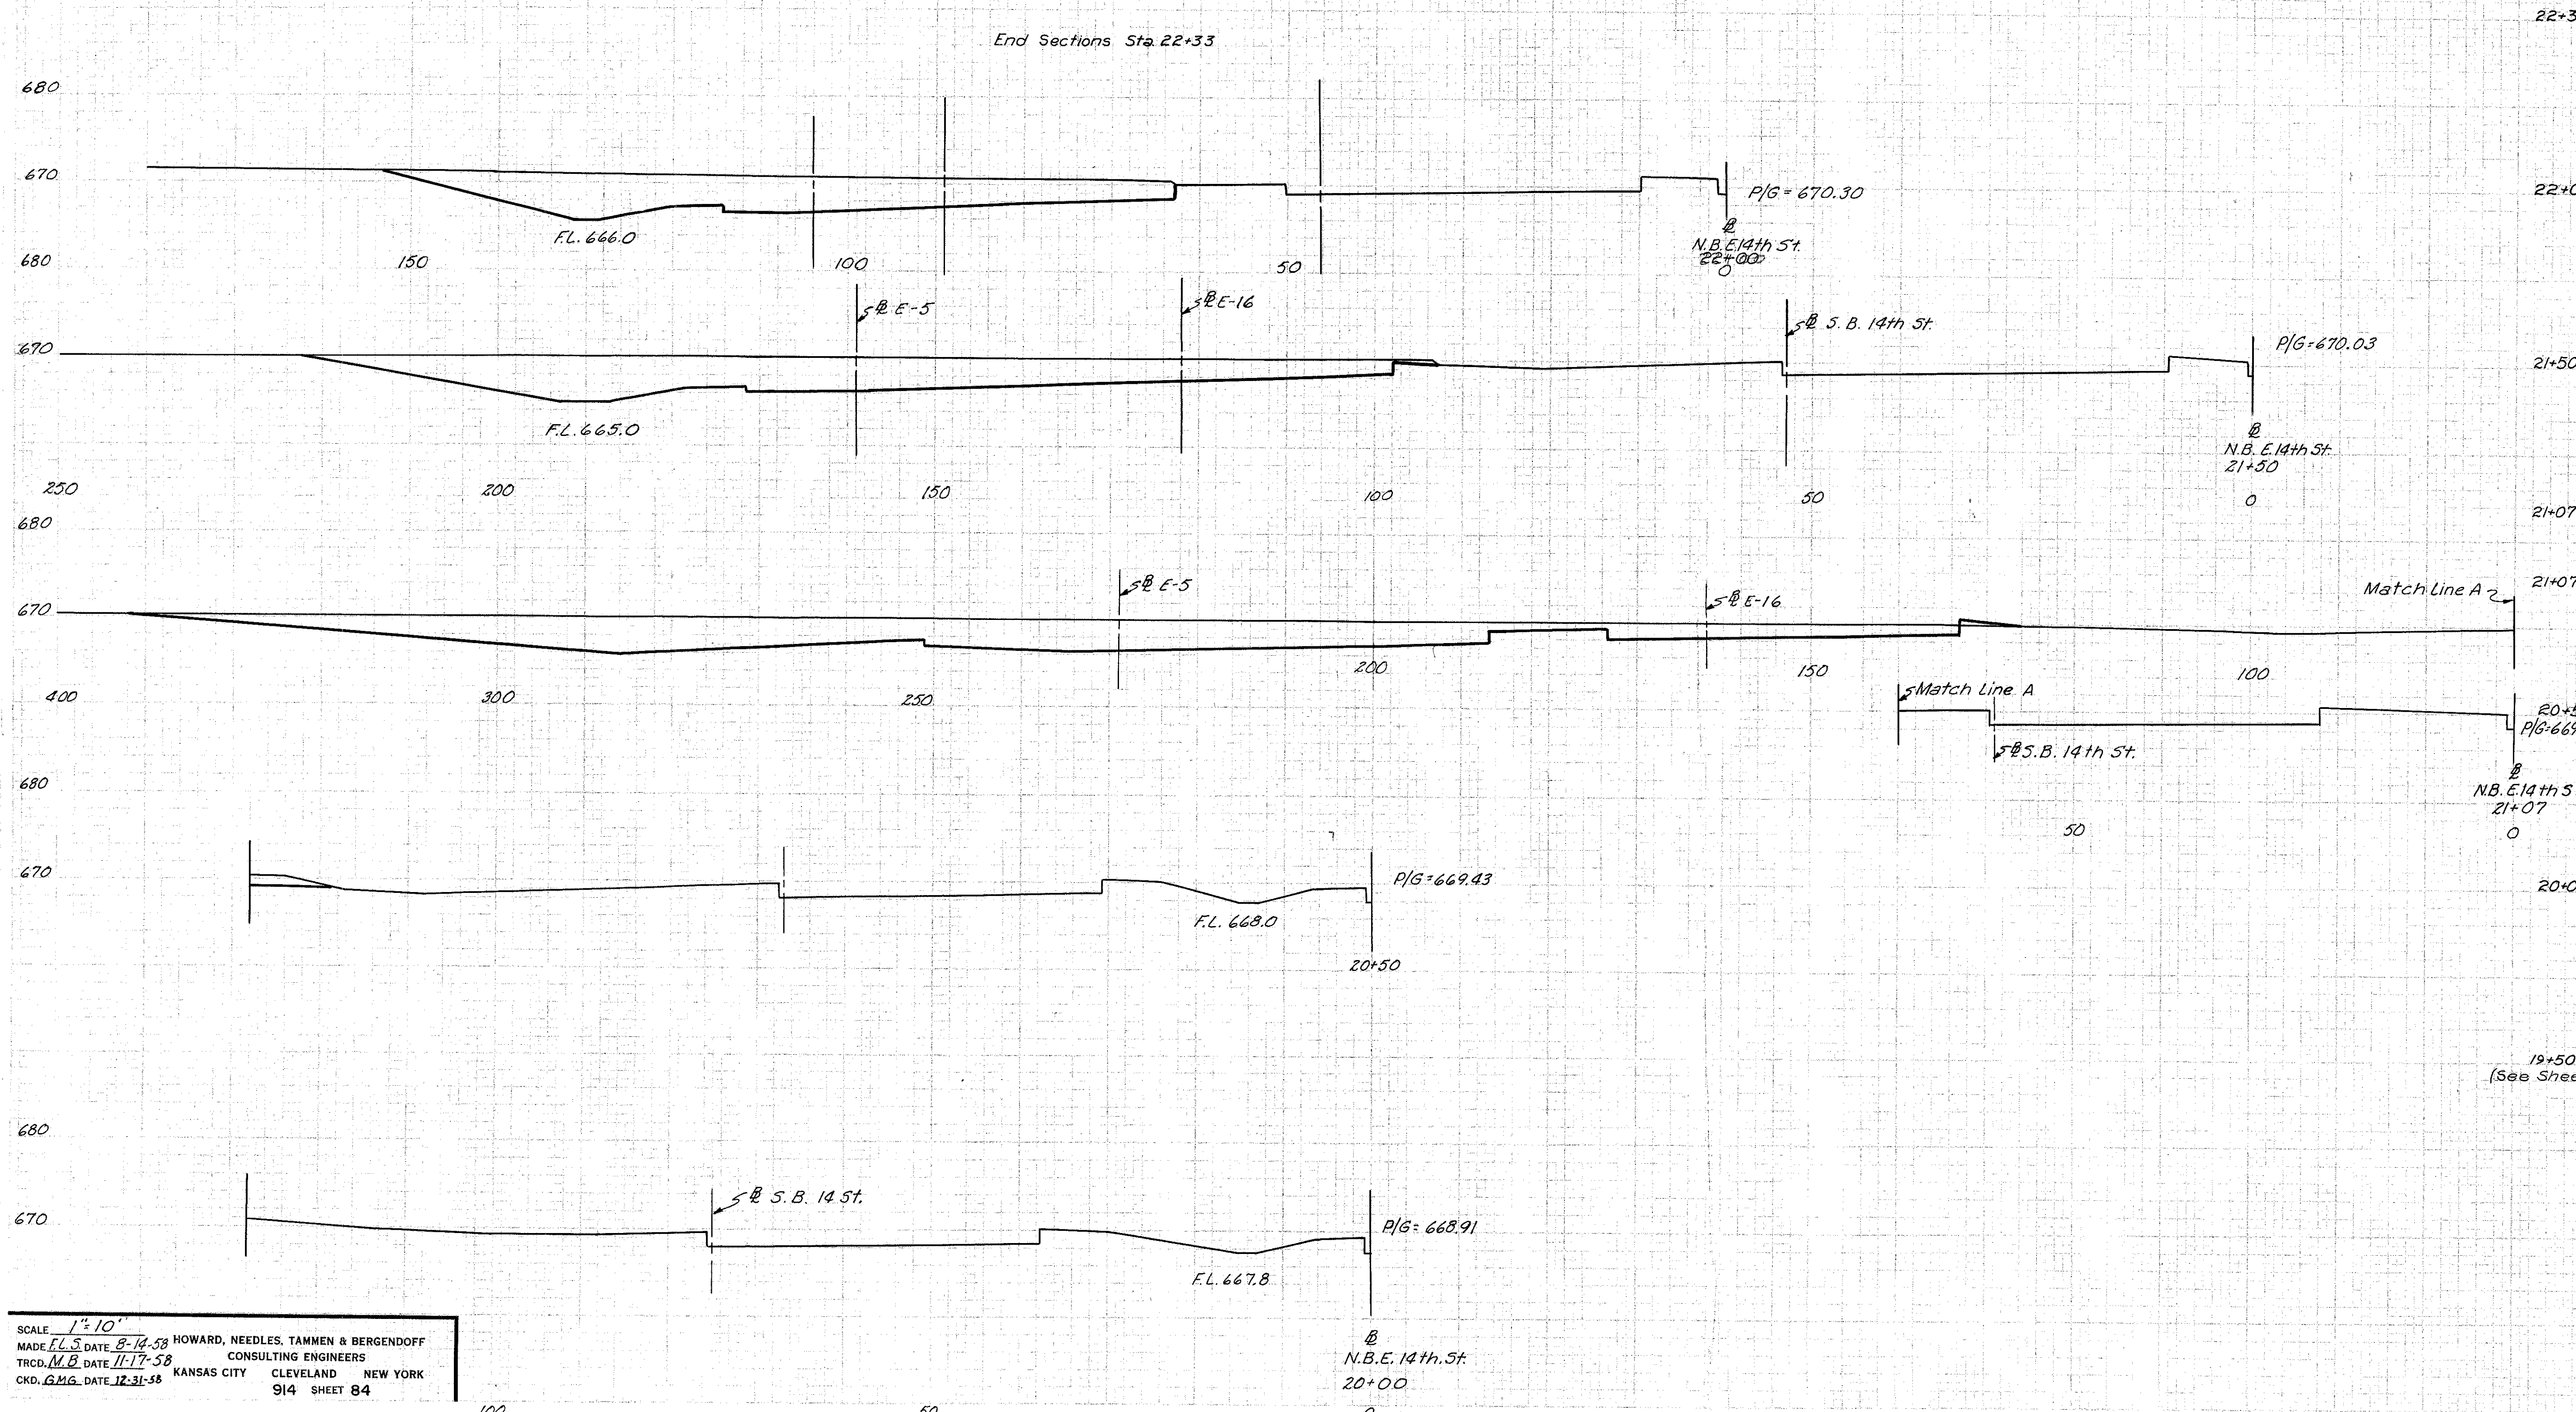


SERIES I
EAST 14TH ST. SECTIONS
STA. 20+00 TO STA. 22+33

SCALE 1" = 10'
MADE F.L.S. DATE 8-14-58 HOWARD, NEEDLES, TAMMEN & BERGENDOFF
TRCD. M.B. DATE 11-17-58 CONSULTING ENGINEERS
CKD. G.M.G. DATE 12-31-58 KANSAS CITY CLEVELAND NEW YORK
914 SHEET 84

FED. ROAD DIV. NO.	STATE	FEDERAL AID PROJECT NO.	TYPE FUNDS
2	OHIO		

85
181

CUYAHOGA COUNTY
CITY OF CLEVELAND
CUY-42-18.42
CUY-21-15.32

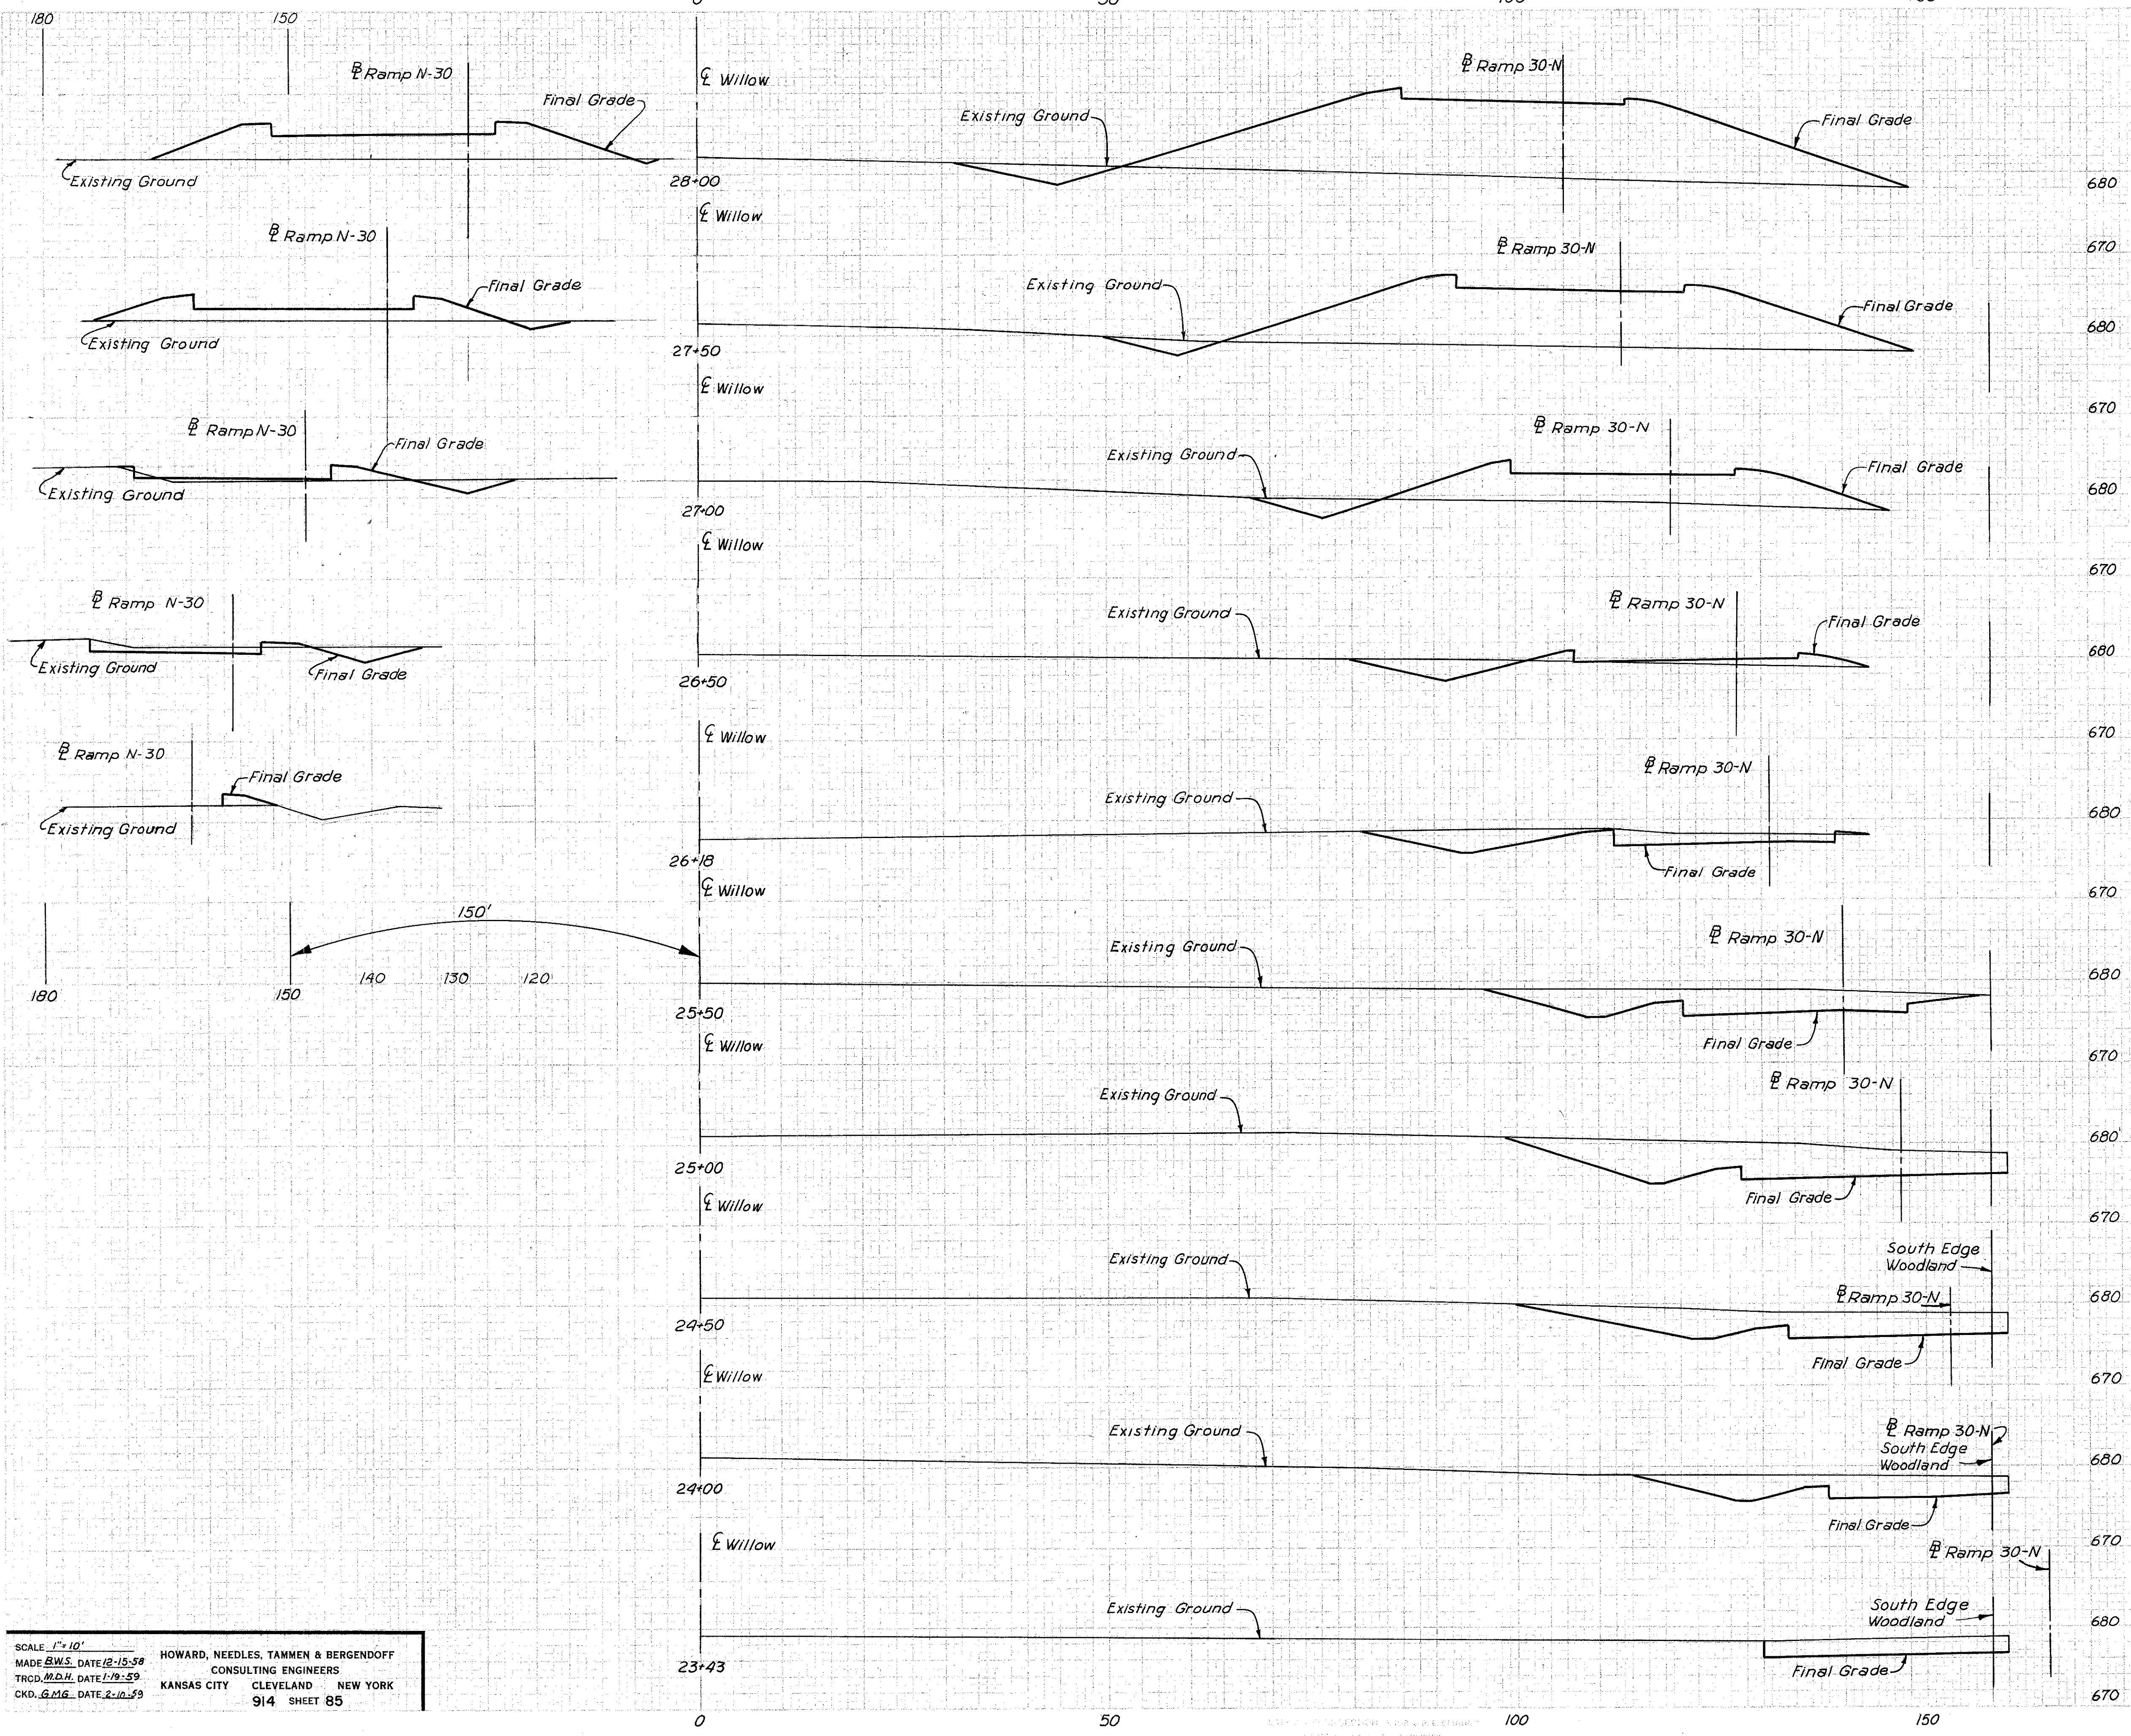

STATION	SEEDING		SUBBASE		EARTHWORK			
	WIDTH L.F.	AREA SQ.YD.	AREA S.F.	VOL. C.Y.	END EXC.	AREA EMB.	VOLUME EXC.	VOLUME EMB.
28+00					26	823		
27+50					20	536	43	1258
27+00							48	683
26+50					22	202		
26+18							88	211
25+50					63	26		
25+00							83	20
24+50					77	7		
24+00							277	9
23+43					143	0		
							326	0
					209	0		
							330	0
					147	0		
							232	0
					104	0		
							175	0
					62	0		

SERIES J
WILLOW FREEWAY SECTIONS
STA. 23+43 TO STA. 28+00


SCALE 1"=10'
MADE B.W.S. DATE 12-15-58
TRCD. M.D.H. DATE 1-19-59
CKD. G.M.G. DATE 2-10-59

HOWARD, NEEDLES, TAMMEN & BERGENDOFF
CONSULTING ENGINEERS
KANSAS CITY CLEVELAND NEW YORK
914 SHEET 85

FED. ROAD DIV. NO.	STATE	FEDERAL AID PROJECT NO.	TYPE FUNDS
2	OHIO		



CUYAHOGA COUNTY
CITY OF CLEVELAND
CUY-42-18.42
CUY-21-15.32

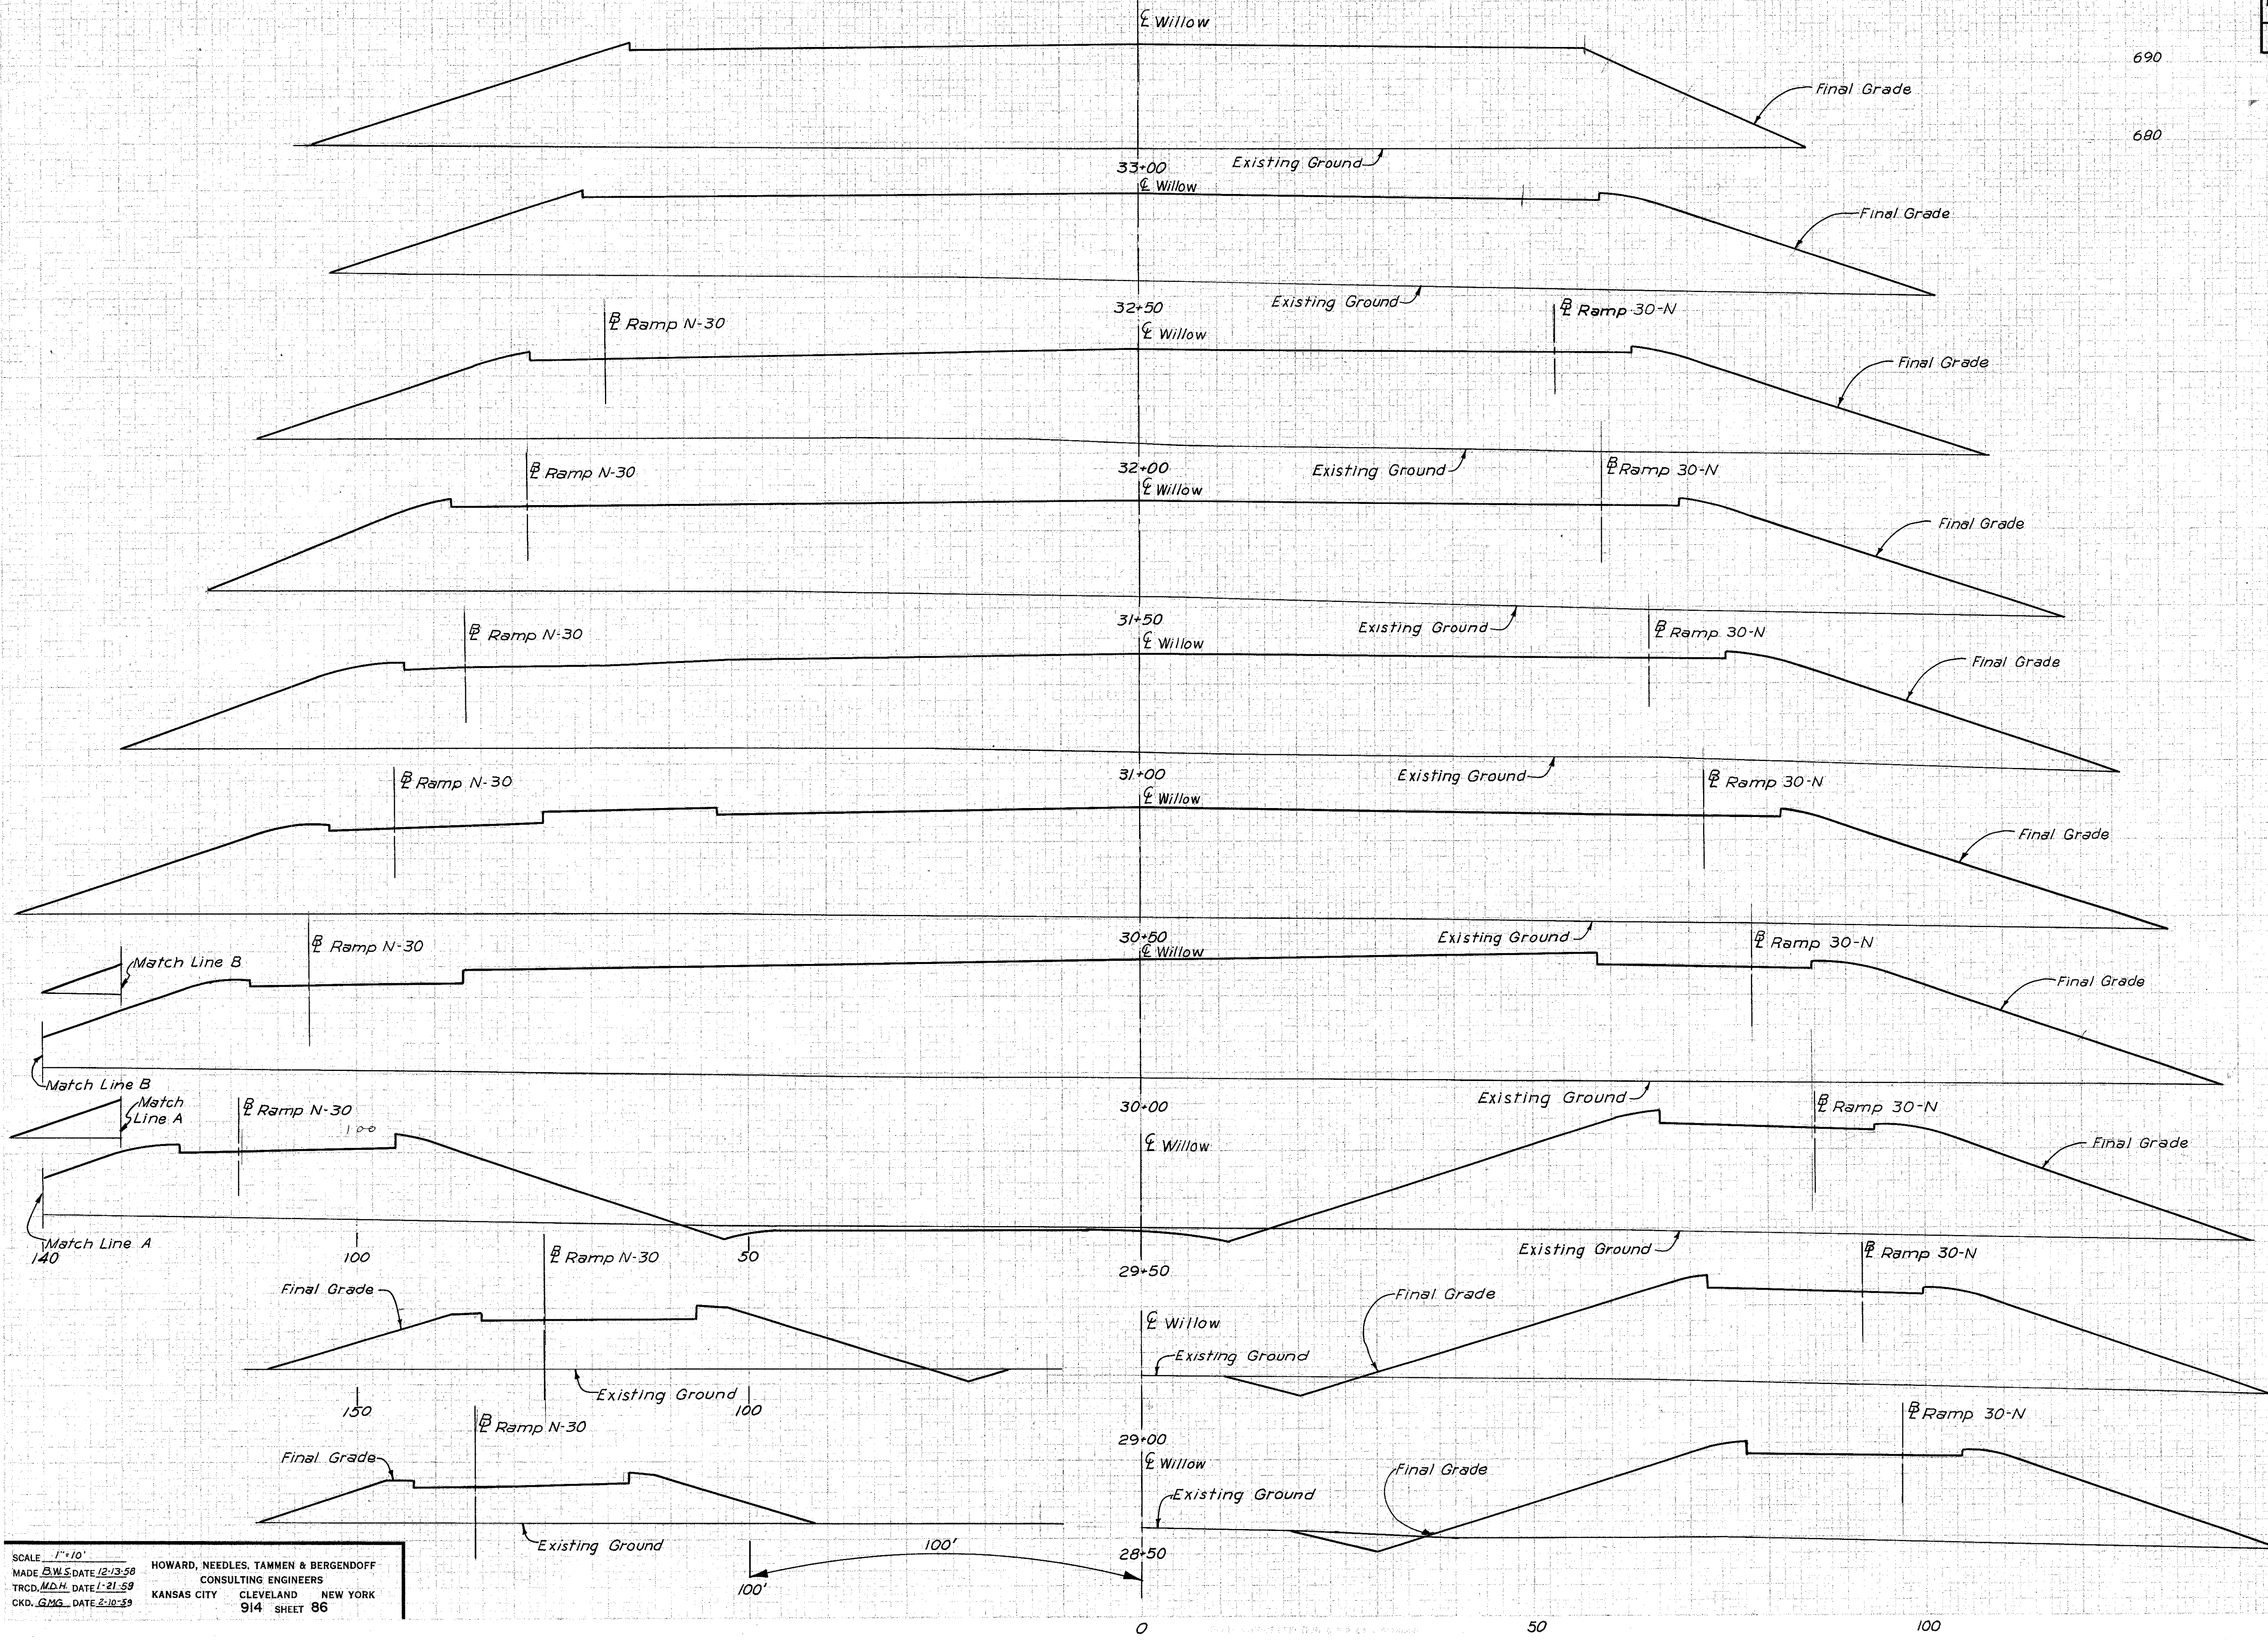

L.F.	SEEDING		SUBBASE		EARTHWORK			
	WIDTH	AREA	AREA	VOL.	END AREA		VOLUME	
	S.F.	SQ. YD.	S.F.	C.Y.	EXC.	EMB.	EXC.	EMB.
670 690	33+00					2032		
680							0	3644
670 690	32+50					1903		
680							0	3761
670 690	32+00					2159		
680							0	4306
670 690	31+50					2491		
680							0	4765
670 690	31+00					2655		
680							0	5368
670 690	30+50					3142		
680							0	6278
670 690	30+00					0	3638	
680							43	5013
670 690	29+50				46	1776		
680							71	2994
670 690	29+00					31	1403	
680							47	2347
670 690	28+50					20	1132	
680							43	1810
670 690	28+00 (See Sheet 85)					26	823	


SERIES J
WILLOW FREEWAY SECTIONS
STA. 28+50 TO STA. 33+00

SCALE 1"=10'
MADE BY S.D. DATE 12-13-58
TRCD. M.D.H. DATE 1-21-59
CKD. G.M.G. DATE 2-10-59

HOWARD, NEEDLES, TAMMEN & BERGENOFF
CONSULTING ENGINEERS
KANSAS CITY CLEVELAND NEW YORK
914 SHEET 86

FED. ROAD DIV. NO.	STATE	FEDERAL AID PROJECT NO.	TYPE FUNDS
2	OHIO		

CUYAHOGA COUNTY
CITY OF CLEVELAND
CUY-42-18.42
CUY-21-15.32

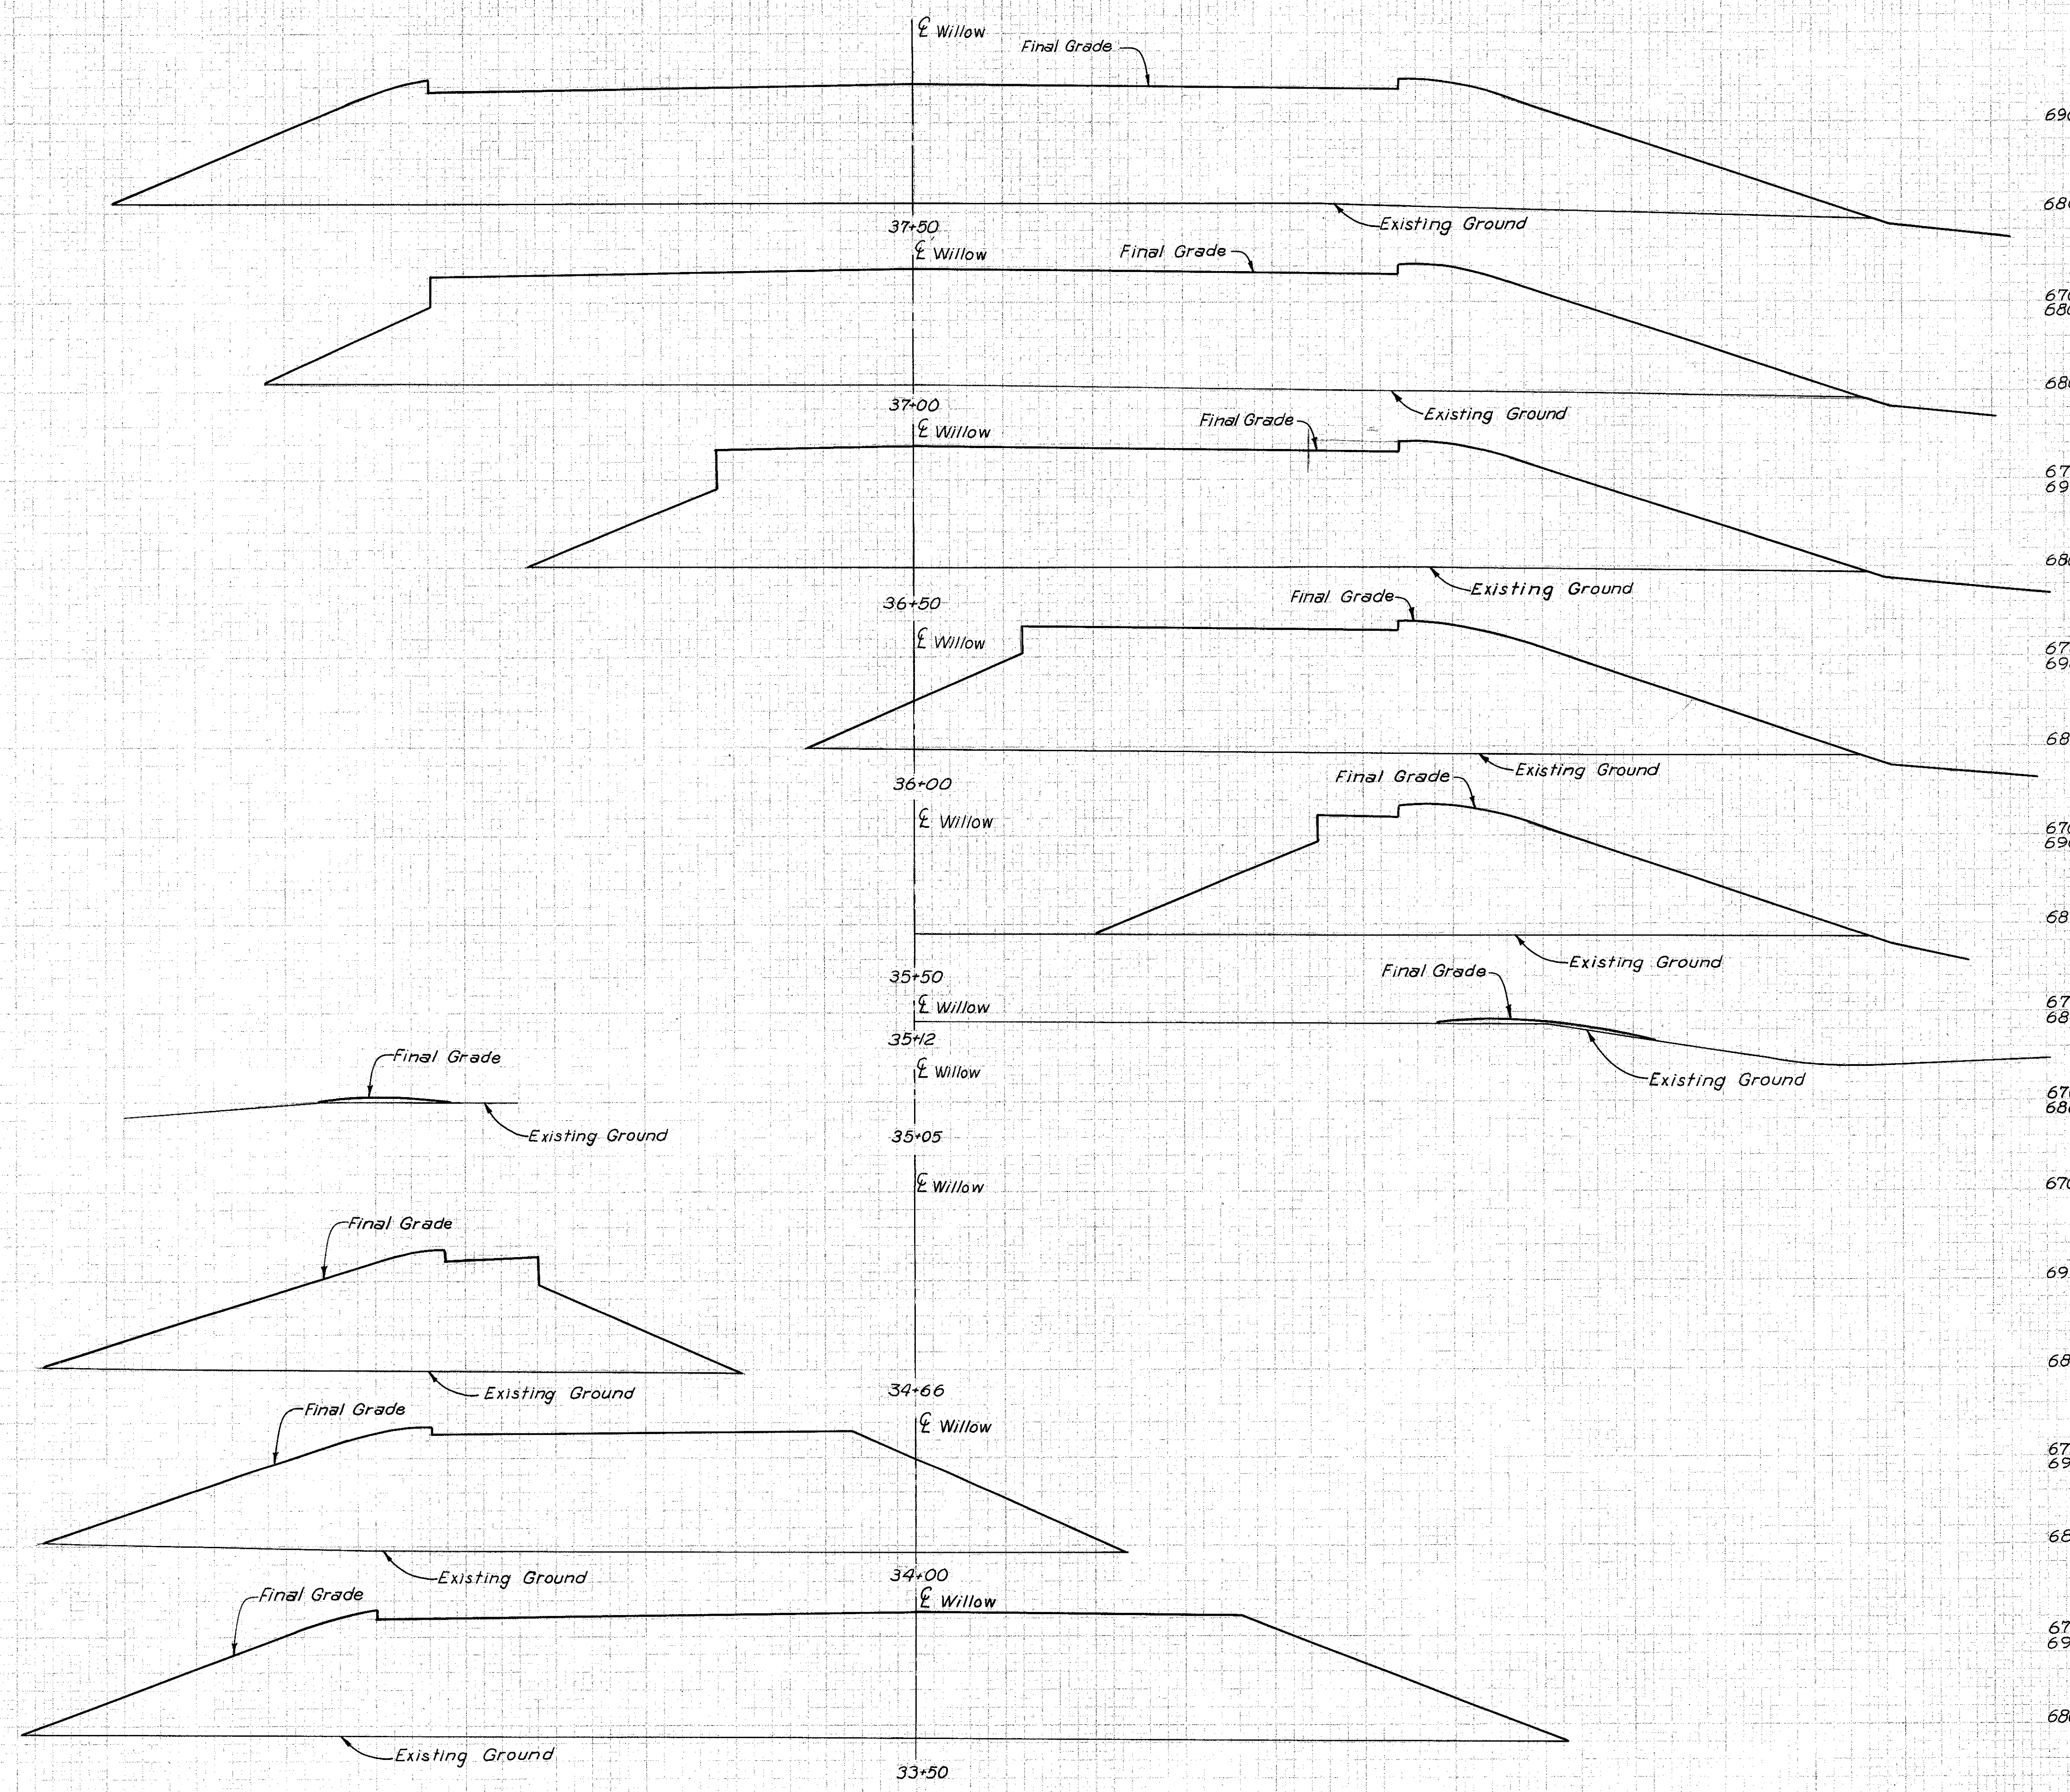

L.F.	SEEDING		SUBBASE		EARTHWORK	
	WIDTH	AREA	AREA	VOL.	END AREA	VOLUME
	L.F.	SQ. YD.	S.F.	C.Y.	EXC.	EMB.
					0	2095
	37+50					0 3673
	37+00				0	1872
						0 3170
	36+50				0	1552
						0 2504
	36+00				0	1152
						0 1730
	35+50				0	716
						0 506
	35+12				0	3
	Series K					
	Series J					
	35+05				0	2
						0 417
	34+66				0	576
						0 2161
	34+00				0	1192
						0 2852
	33+50				0	1888
						0 3630
	33+00 (See Sheet 86)				0	2032

SERIES J WILLOW FREEWAY SECTIONS
STA. 33+50 TO STA. 35+05
SERIES K WILLOW FREEWAY SECTIONS
STA. 35+12 TO STA. 37+50

SCALE 1"=10'
MADE S.W.S. DATE 12-12-58
TRCD. M.O.H. DATE 1-21-59
CKD. G.M.G. DATE 2-10-59
HOWARD, NEEDLES, TAMMEN & BERGENOFF
CONSULTING ENGINEERS
KANSAS CITY CLEVELAND NEW YORK
914 SHEET 87

100

50

0


50

100

150

FED. ROAD DIV. NO.	STATE	FEDERAL AID PROJECT NO.	TYPE FUNDS	88 181
2	OHIO			

CUYAHOGA COUNTY
CITY OF CLEVELAND
CUY-42-18.42
CUY-21-15.32

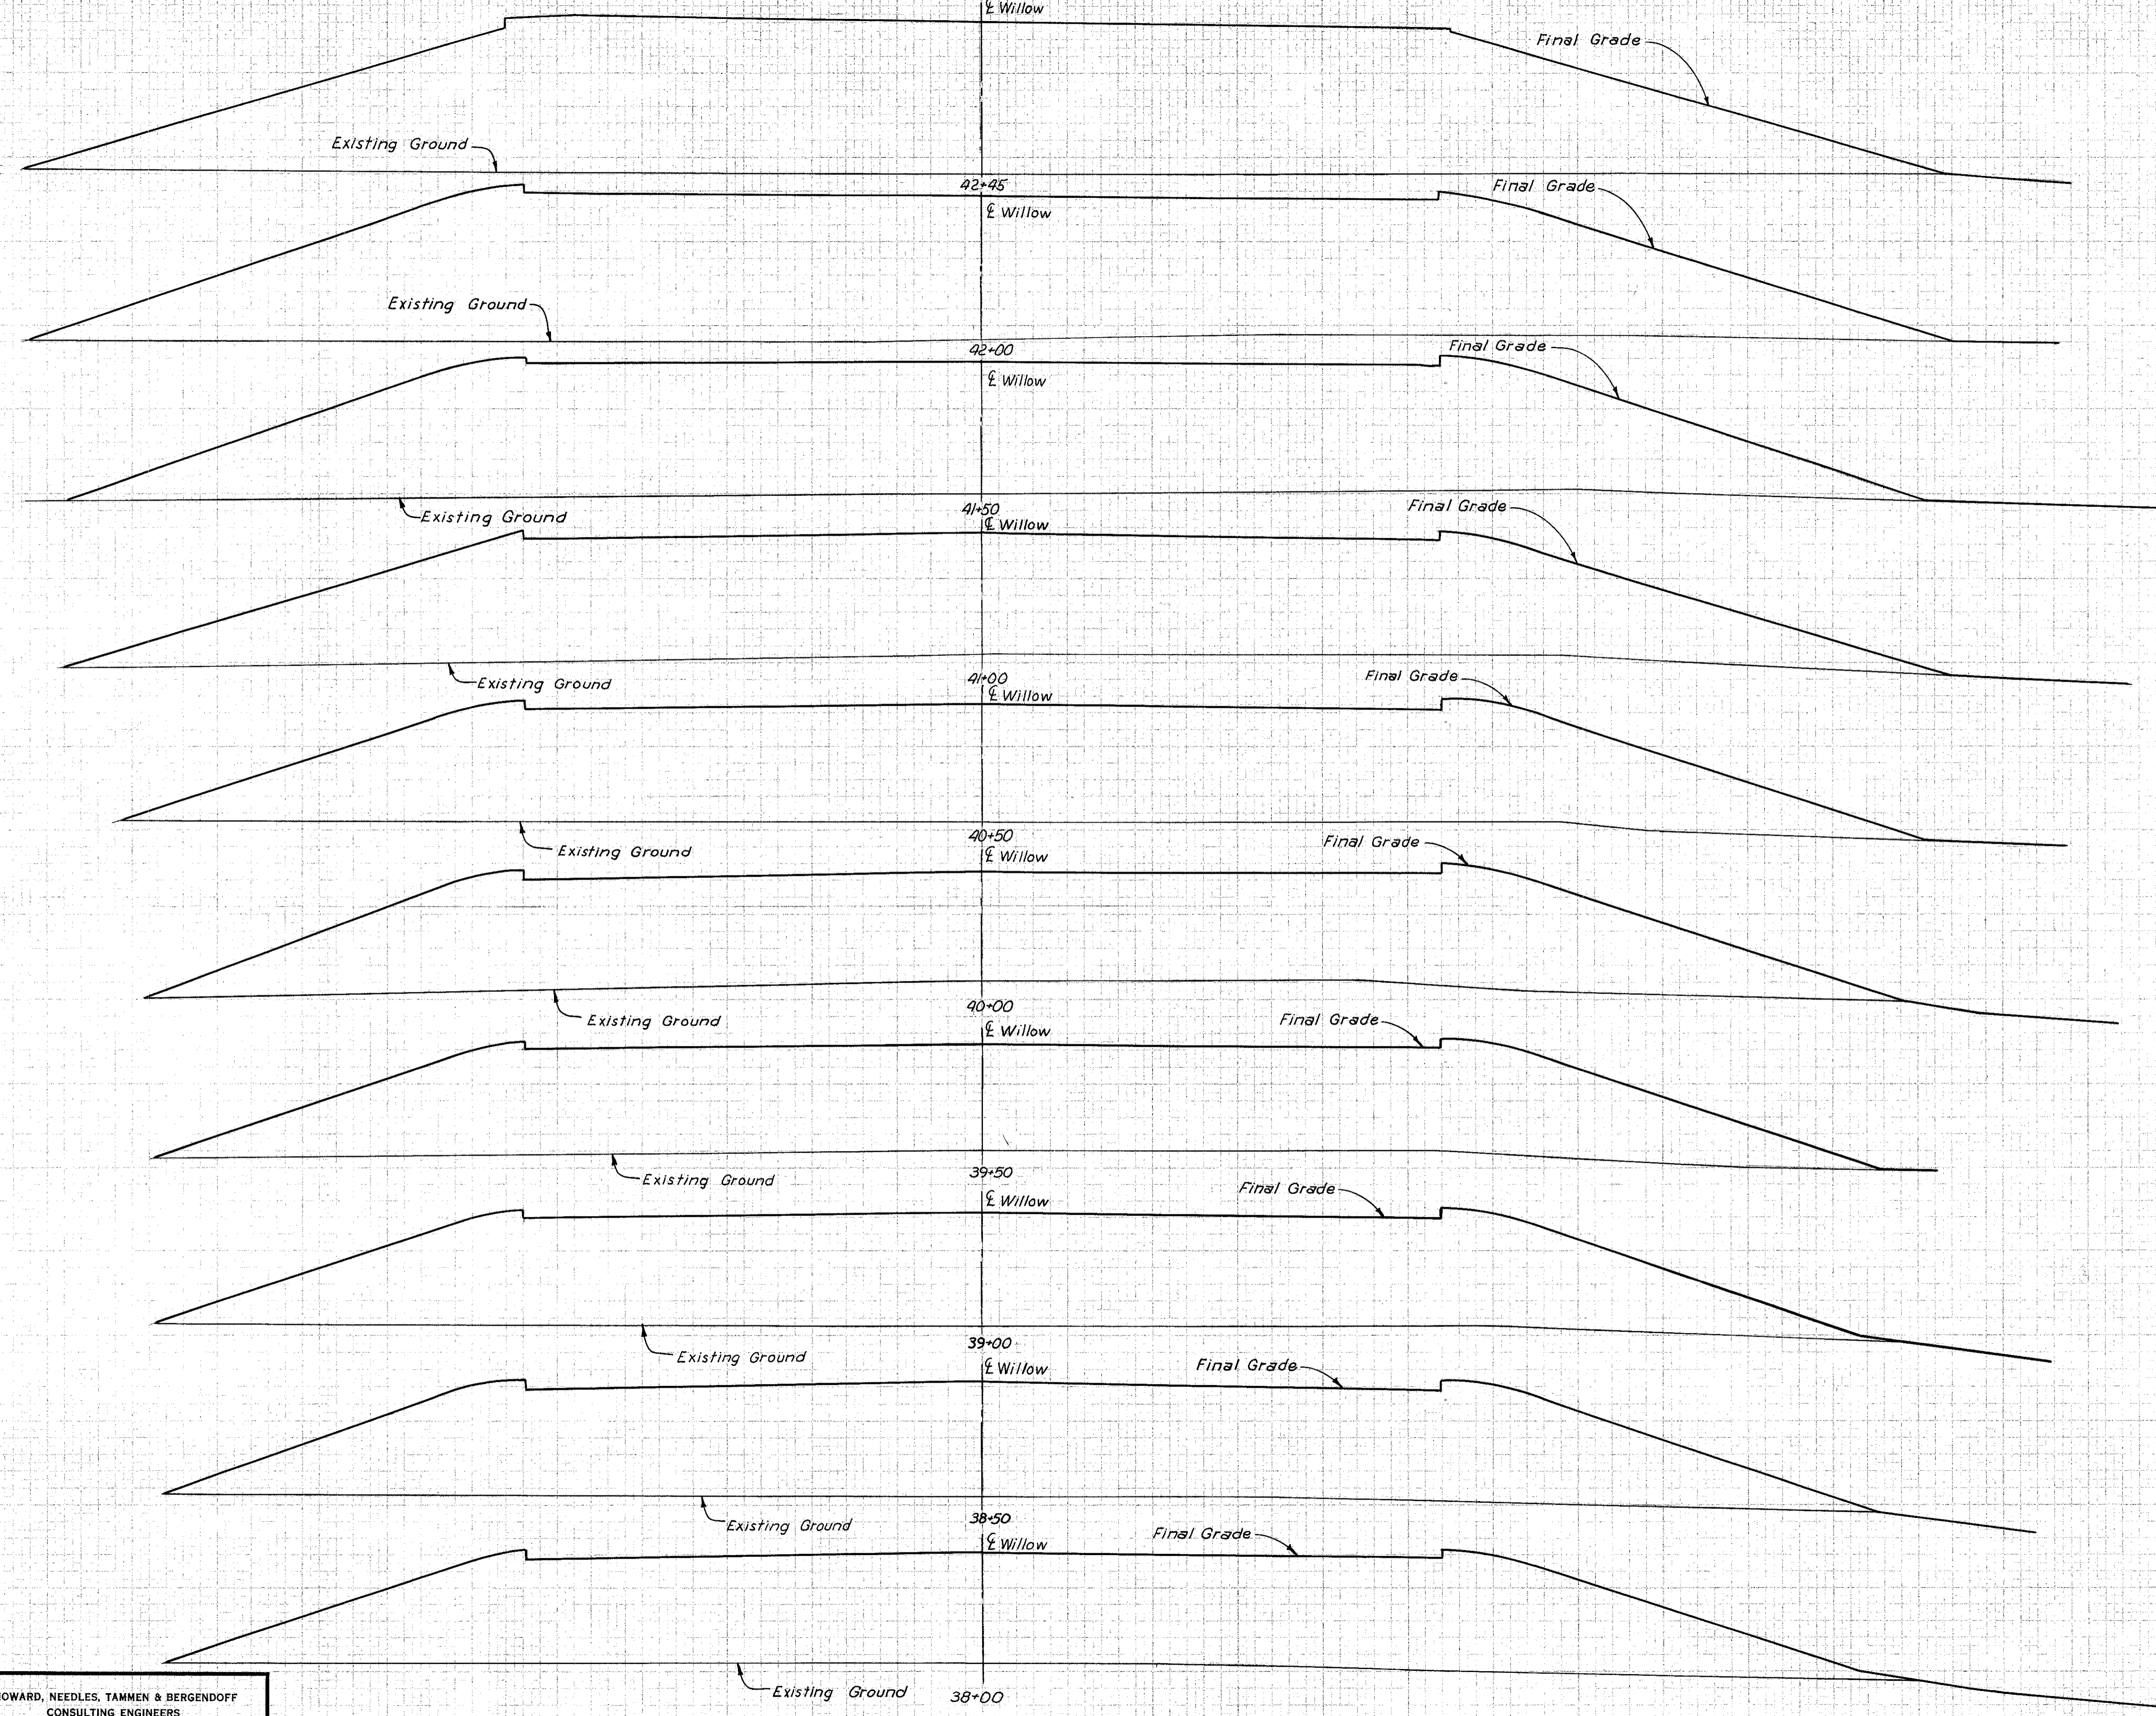

L.F.	SEEDING		SUBBASE		EARTHWORK			
	WIDTH	AREA	AREA	VOL.	END AREA		VOLUME	
	L.F.	SQ. YD.	S.F.	C.Y.	EXC.	EMB.	EXC.	EMB.
42+45					0	3008		
690							0	5007
42+00					0	3000		
680							0	5230
41+50					0	2948		
670							0	4708
690							0	4432
41+00					0	2437		
680							0	4432
690							0	4432
40+50					0	2350		
680							0	4194
690							0	4194
40+00					0	2180		
670							0	3954
690							0	3954
39+50					0	2090		
680							0	3935
690							0	3935
39+00					0	2160		
670							0	4015
690							0	4015
38+50					0	2176		
680							0	4012
690							0	4012
38+00					0	2157		
670							0	3937
690							0	3937
37+50					0	2045		
670							0	3937
690							0	3937

SERIES K
WILLOW FREEWAY SECTIONS
STA. 38+00 TO STA. 42+45

SCALE 1"=10'
MADE B.W.S. DATE 12-12-58
TRCD. M.D.H. DATE 1-27-59
CKD. G.M.G. DATE 2-10-59

HOWARD, NEEDLES, TAMMEN & BERGENDOFF
CONSULTING ENGINEERS
KANSAS CITY CLEVELAND NEW YORK
914 SHEET 88

100

50

0

50


100

150

FED. ROAD DIV. NO.	STATE	FEDERAL AID PROJECT NO.	TYPE FUNDS
2	OHIO		

89
181

CUYAHOGA COUNTY
CITY OF CLEVELAND
CUY-42-18.42
CUY-21-15.32

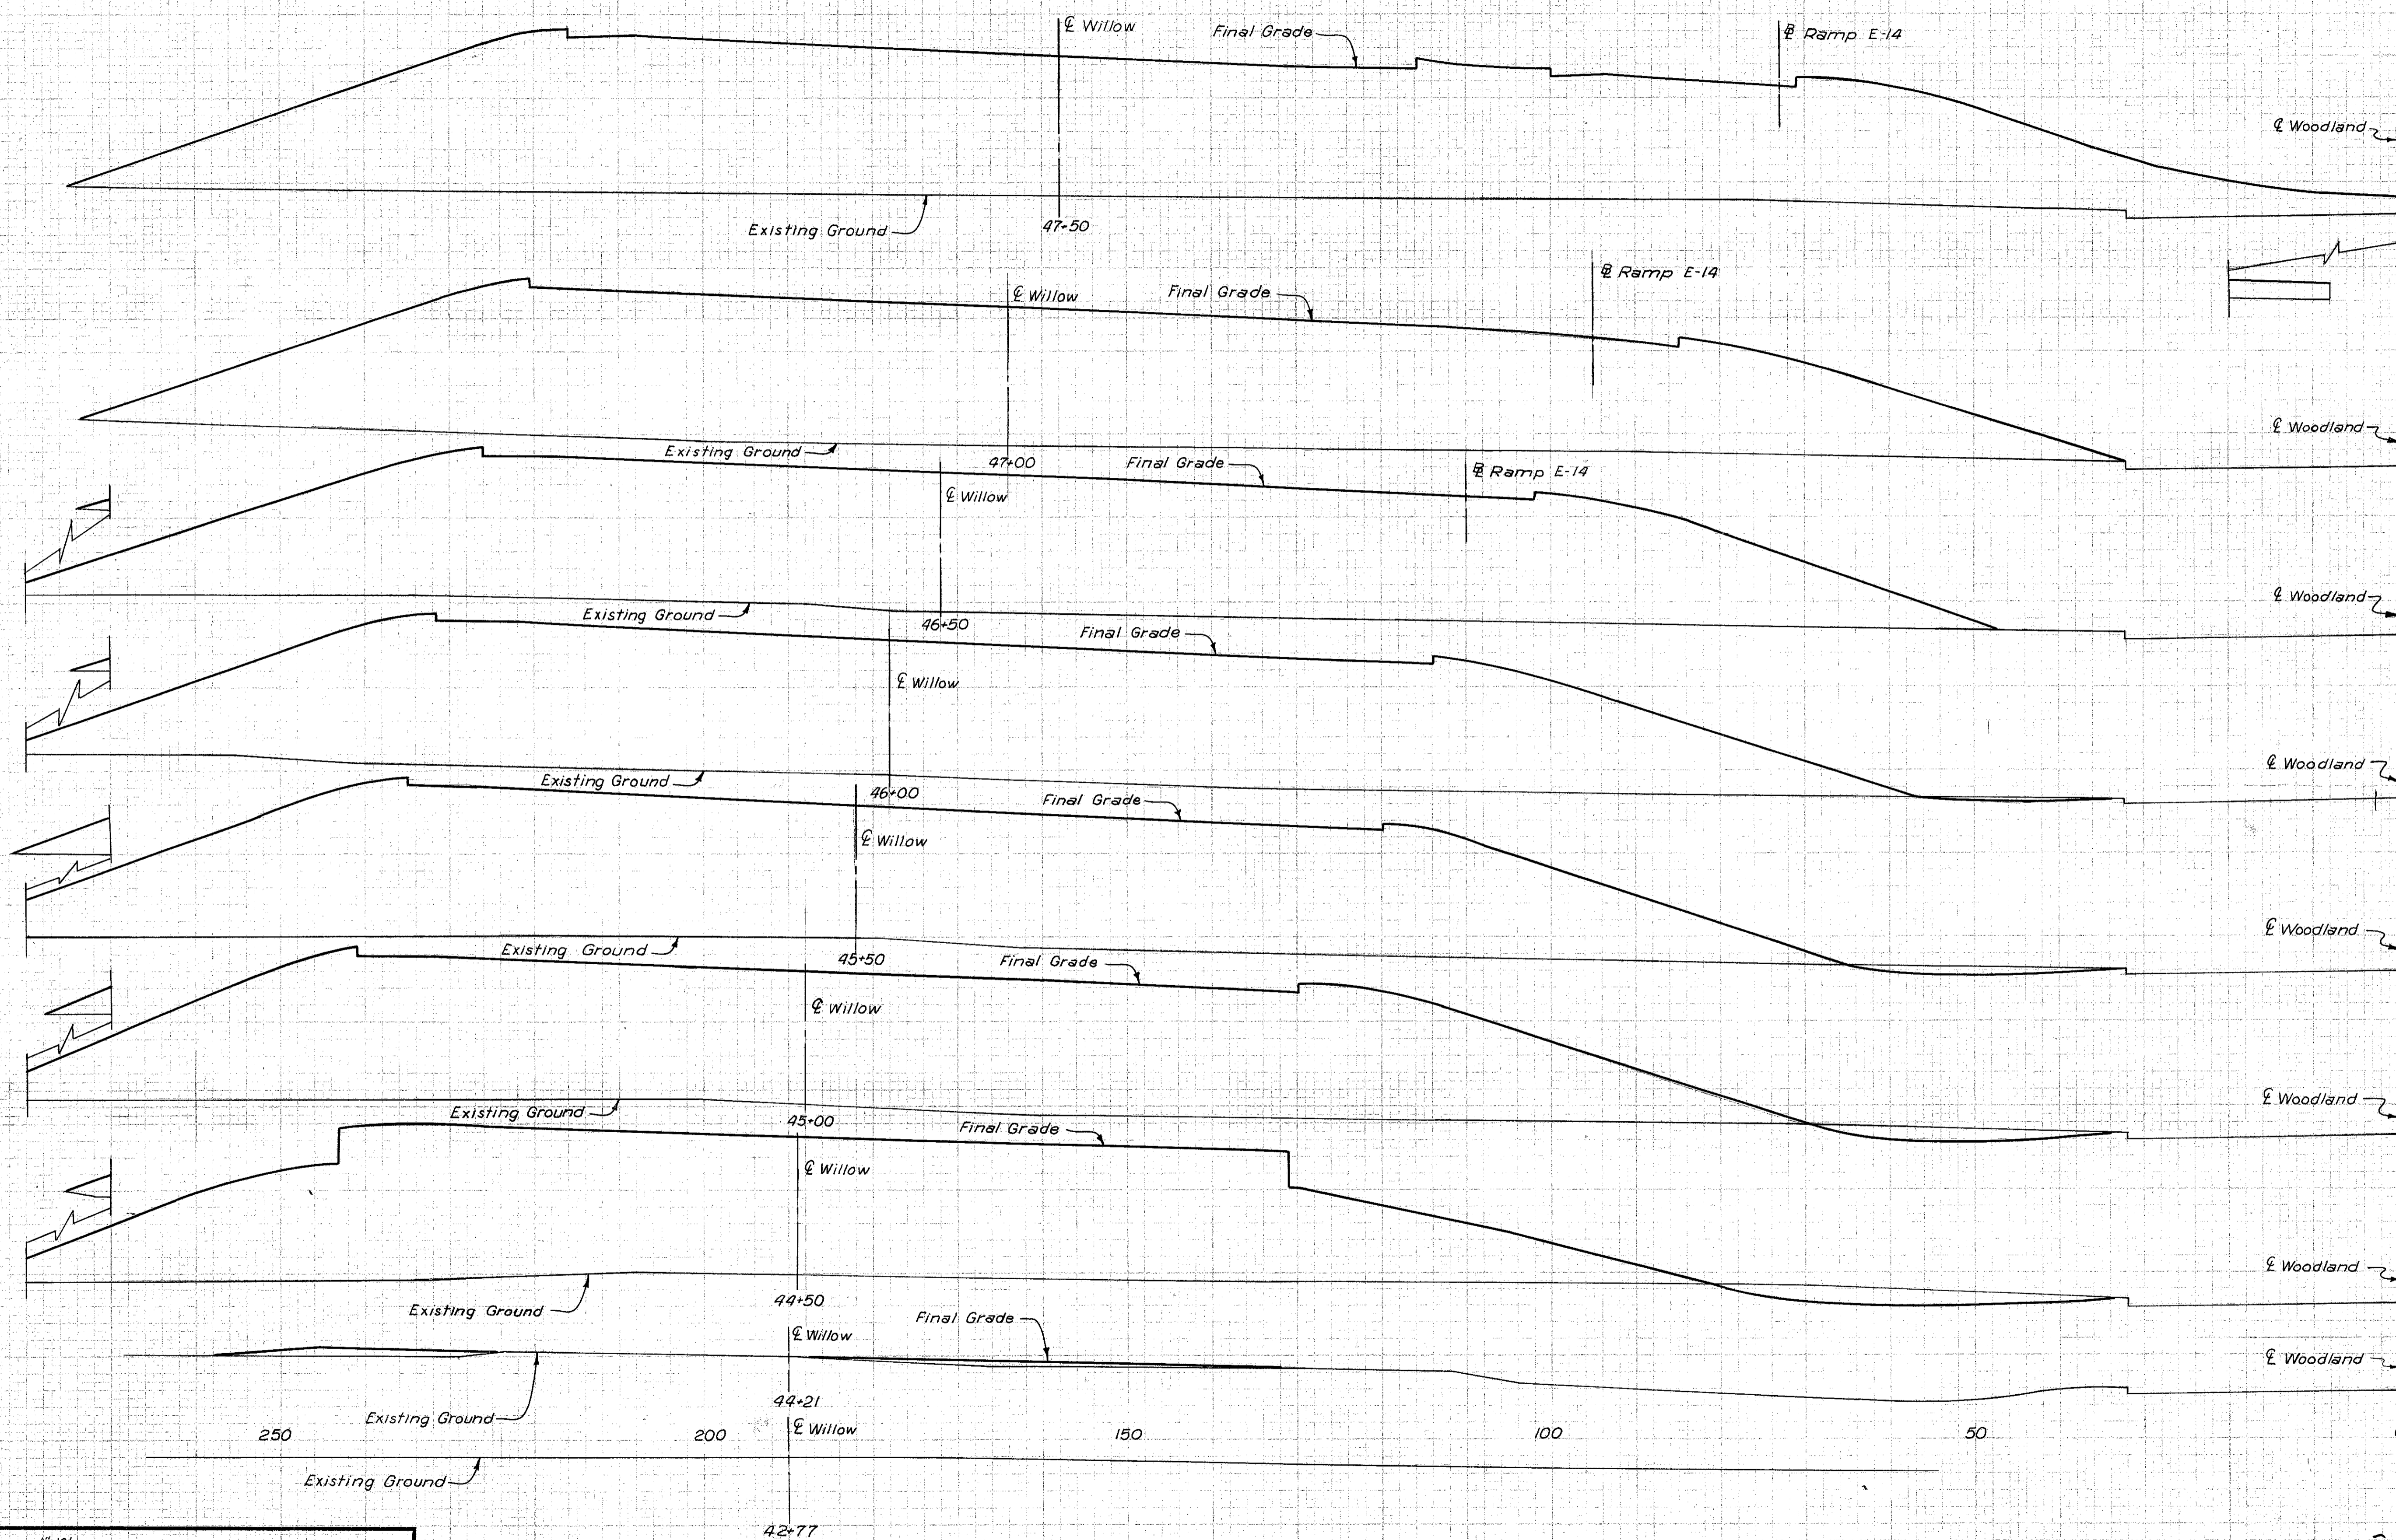

SEEDING		SUBBASE		EARTHWORK			
WIDTH	AREA	AREA	VOL.	END AREA		VOLUME	
L.F.	SQ. YD.	S.F.	C.Y.	EXC.	EMB.	EXC.	EMB.
				0	3540		
47+50						0	6160
47+80				0	3113		0 5673
46+80				0	3014		
46+60			7		2931		6 5505
46+50				23	2947		21 5443
45+60				45	2802		63 5323
44+50				73	2562		109 4967
44+21				0	48		39 1402
42+77				0	0		0 1783
42+45 (See Sheet 88)				0	3008		

SERIES K
WILLOW FREEWAY SECTIONS
STA. 42+77
SERIES L
WILLOW FREEWAY SECTIONS
STA. 44+21 TO STA. 47+50

SCALE 1"=10'
MADE BY S.D. DATE 12-11-58
TRCD. M.D.H. DATE 1-22-59
CKD. G.M.G. DATE 2-10-59

HOWARD, NEEDLES, TAMMEN & BERGENDOFF
CONSULTING ENGINEERS
KANSAS CITY CLEVELAND NEW YORK
914 SHEET 89

250

200

150

100


50

0


FED. ROAD DIV. NO.	STATE	FEDERAL AID PROJECT NO.	TYPE FUNDS.
2	OHIO		

90

CUYAHOGA COUNTY
CITY OF CLEVELAND
CUY-42-18.42
CUY-21-15.32

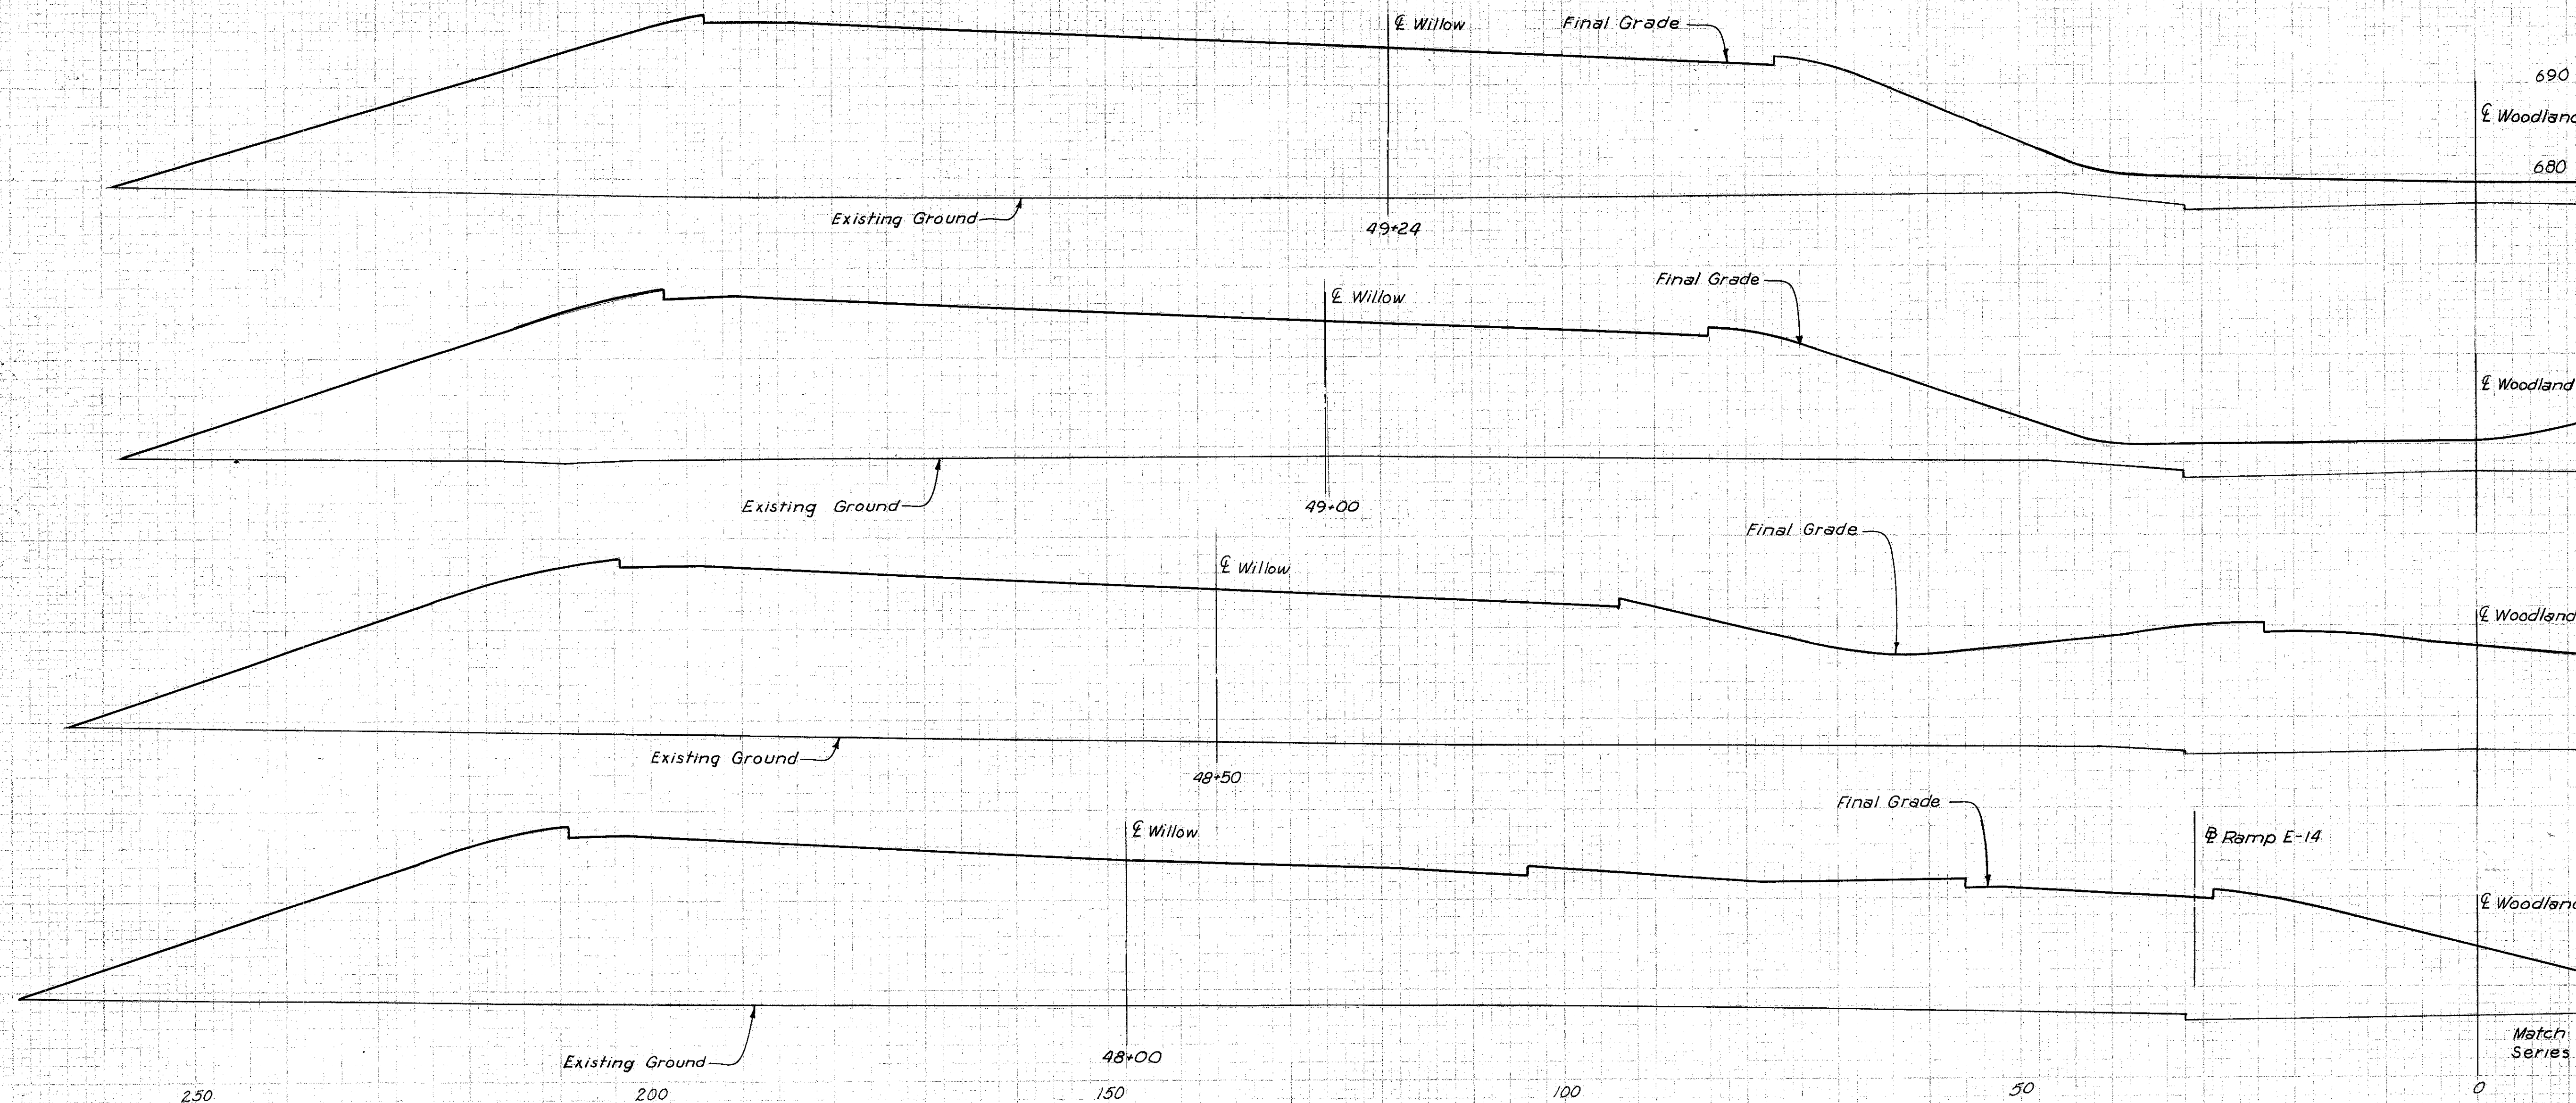

L.F.	SEEDING AREA SQ. YD.	SUBBASE		EARTHWORK	
		AREA S.F.	VOL. C.Y.	END AREA EXC.	VOLUME EMB.
49+24				0	3188
49+00				0	2790
49+00				0	3089
48+50				0	6629
48+50				0	4070
48+00				0	7332
48+00				0	3849
48+00				0	6842
47+50 (See Sheet 89)				0	3540
7+15				99	1
7+02				0	0
6+67				133	2
4+00				102	6
1+35				18	20
0+00				19	3

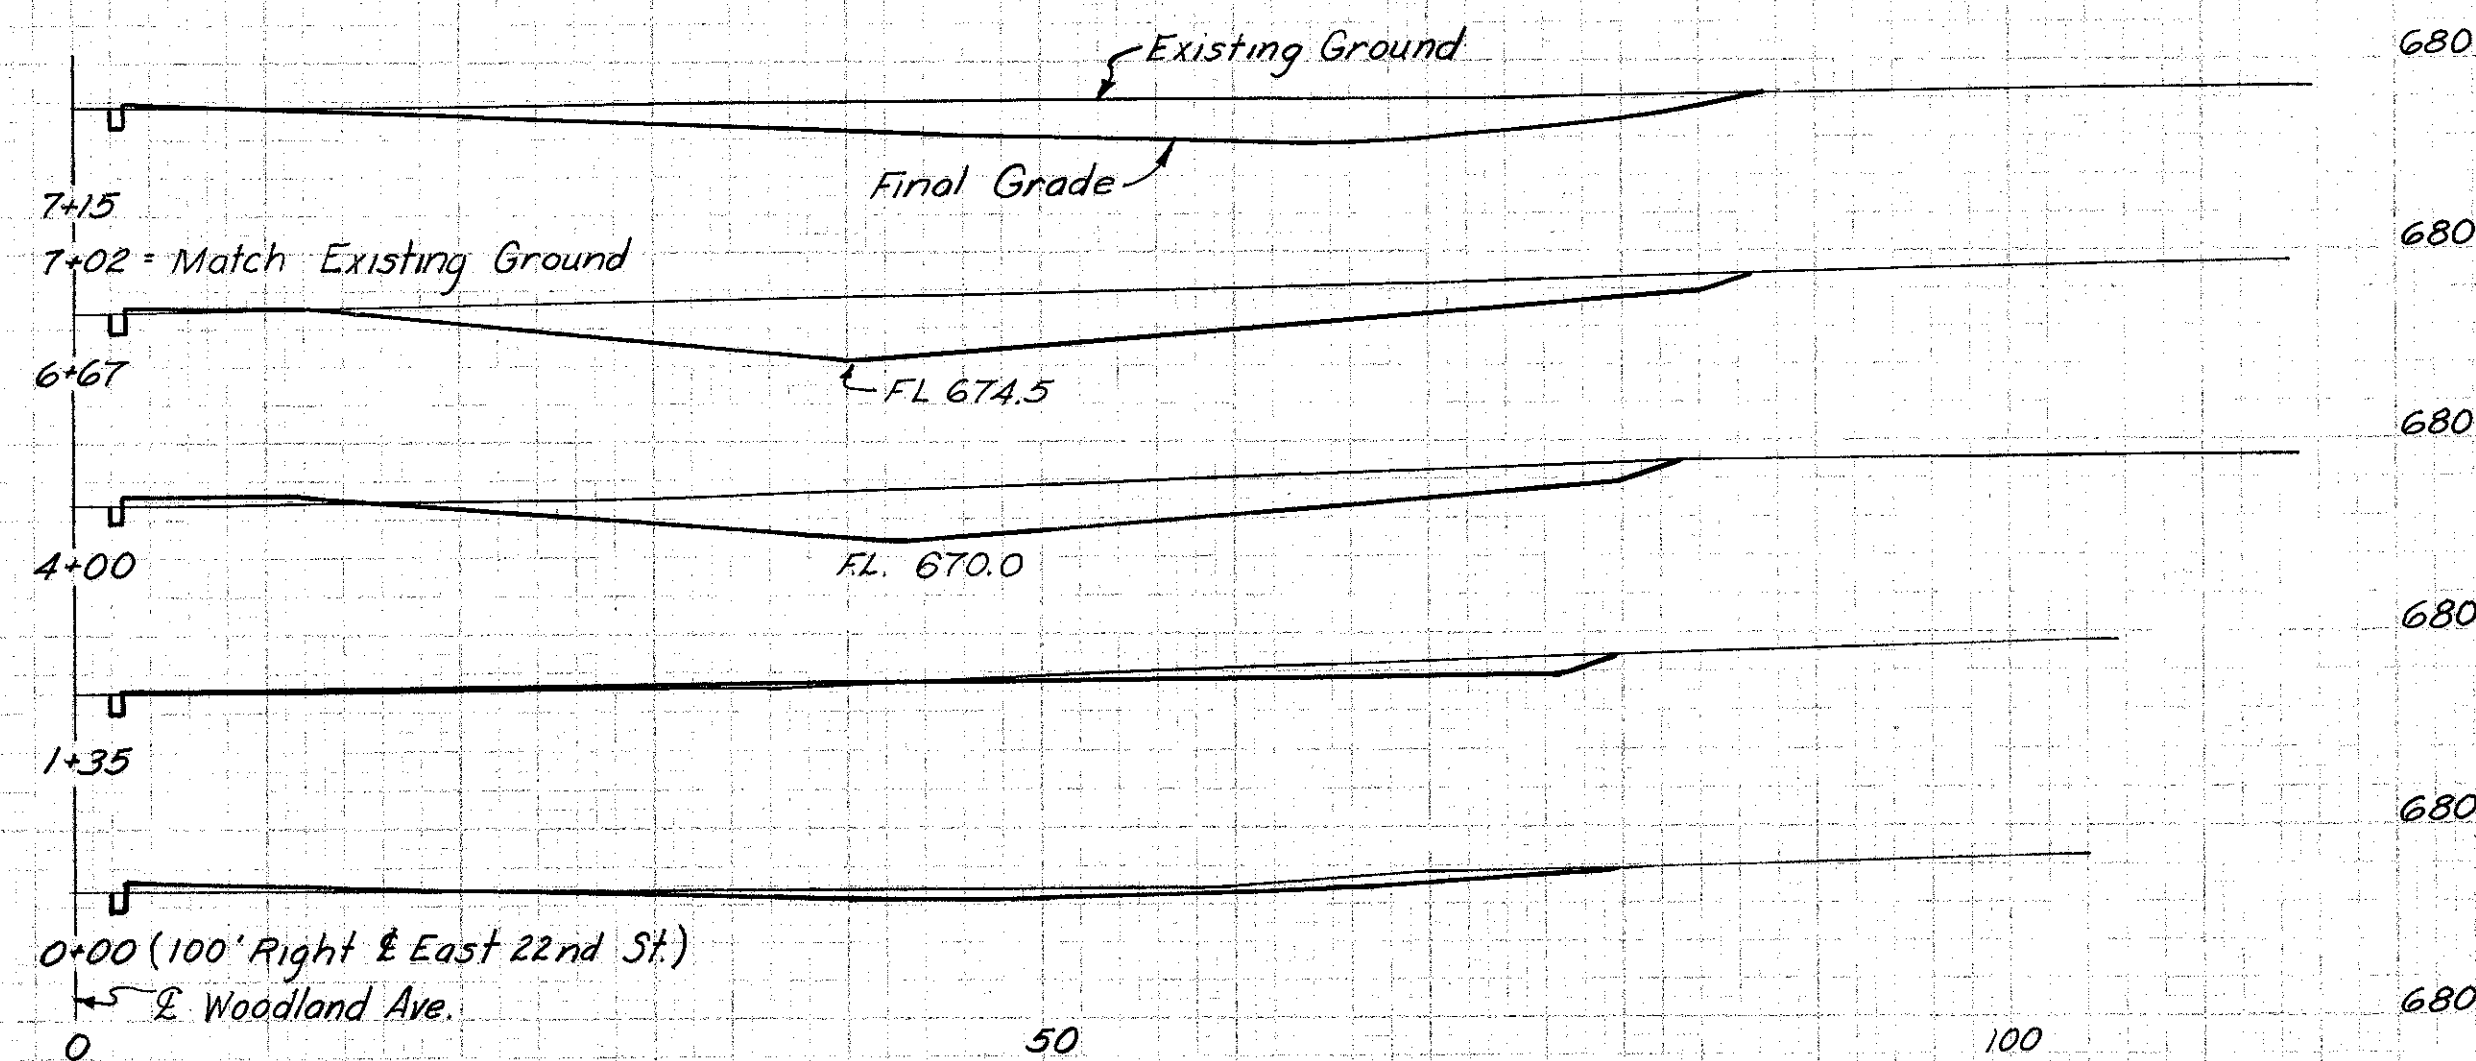

SCALE 1"=10'
MADE S.W.S. DATE 12-11-58
TRGD. DATE 1-22-59
CKD. GMS. DATE 2-10-59

HOWARD, NEEDLES, TAMMEN & BERGENDOFF
CONSULTING ENGINEERS
KANSAS CITY CLEVELAND NEW YORK
914 SHEET 90

SERIES L
WILLOW FREEWAY SECTIONS
STA. 48+00 TO 49+24

SERIES M
WOODLAND AVE. SECTIONS
STA. 0+00 TO STA. 7+15

DESIGN SPECIFICATIONS

DESIGN SPECIFICATIONS FOR HIGHWAY STRUCTURES OF THE STATE OF OHIO, DEPARTMENT OF HIGHWAYS, DATED SEPTEMBER 1, 1957, AND REVISED FEBRUARY 21, 1958.

SUPPLEMENTAL SPECIFICATIONS

REFERENCE SHALL BE MADE TO SUPPLEMENTAL SPECIFICATIONS NO. S-207, HIGH STRENGTH STEEL BOLTS, DATED APRIL 28, 1955, AND NO. M-206, 14 ASBESTOS CEMENT CONDUIT DATED JULY 15, 1949, AND **3-101 DATED 12-2-59**

REFERENCE DRAWINGS

REFERENCE SHALL BE MADE TO STANDARD DRAWING NUMBERS RB-1-55 REVISED 2/2/59, AR-1-57 REVISED 2/2/59, AND TO AS-1-54 REVISED 12/1/54.

DIMENSIONS

DIMENSIONS GIVEN ARE MEASURED HORIZONTALLY AND AT 60°F. UNLESS OTHERWISE NOTED.

UTILITIES

ANY EXISTING UTILITY FACILITIES ENCOUNTERED AT THE SITE OF THE WORK WHICH WILL INTERFERE WITH PORTIONS OF THE FINISHED ROADWAYS OR STRUCTURES WILL BE REMOVED OR RELOCATED BY OTHERS UNLESS OTHERWISE SHOWN. THE CONTRACTOR SHALL COORDINATE HIS OPERATIONS WITH THE WORK OF THE UTILITY OWNERS OR OTHERS WHO MAY BE MAKING THE RELOCATIONS, AND SHALL NOTIFY THE OWNERS OF THE UTILITIES OF HIS SCHEDULE SUFFICIENTLY IN ADVANCE TO PERMIT THEM TO MAKE THE NECESSARY ALTERATIONS.

EXISTING SEWERS WILL BE RELOCATED OR REMOVED BY THE CONTRACTOR AS SHOWN ON THE ROADWAY PLANS.

EXCAVATION

AT THE PIERS THE EXCAVATION QUANTITY FOR PAYMENT WILL BE COMPUTED FROM THE COMPLETED CONSTRUCTION CROSS SECTIONS AND GRADE LINES OF THE LOWER ROADWAY.

FOR THE ABUTMENTS THE EXCAVATION QUANTITY FOR PAYMENT WILL BE COMPUTED FROM THE COMPLETED CROSS SECTION OF THE LOWER ROADWAY AND/OR THE SURFACE OF THE PROPOSED EMBANKMENT.

THE EMBANKMENT SHALL BE PLACED AND COMPACTED UP TO THE FINISHED SPILL-THRU SLOPE AND TO THE LEVEL OF THE SUBGRADE, AFTER WHICH THE EXCAVATION SHALL BE MADE. BACKFILL BEHIND THE ABUTMENTS SHALL BE MADE WITH MATERIAL MEETING THE REQUIREMENTS OF SEC. 1-22 AND SHALL BE COMPACTED IN ACCORDANCE WITH THE REQUIREMENTS FOR EMBANKMENT COMPACTION. THE PAYMENT FOR THIS 1-22 BACKFILL SHALL BE CONSIDERED AS INCLUDED IN THE PAYMENT FOR E-2. UNCLASSIFIED EXCAVATION.

BORINGS

BORING INFORMATION, LOGS AND SAMPLES OF MATERIALS ENCOUNTERED MAY BE EXAMINED AT THE DIVISION OFFICE IN GARFIELD HEIGHTS, OHIO AND AT THE BRIDGE BUREAU OFFICE IN COLUMBUS, OHIO, BUT THE STATE DOES NOT GUARANTEE THESE BORINGS TO PRESENT A COMPLETE PICTURE OF SUBSURFACE CONDITIONS TO BE ENCOUNTERED. FOUNDATION DESIGN AND FOUNDATION QUANTITIES ARE BASED ON A STUDY OF THE BORINGS.

PILING

PILES SHALL BE DRIVEN TO A MINIMUM BEARING CAPACITY OF 35 TONS FOR THE ABUTMENTS AND 45 TONS FOR THE PIERS.

CONCRETE

a. THE CONCRETE ROADWAY SLABS SHALL BE SO CONSTRUCTED THAT, AFTER COMPLETION AND AFTER REMOVAL OF FORMS AND ANY FALSEWORK, AND AFTER THE STEELWORK HAS DEFLECTED UNDER THE WEIGHT OF THE CONCRETE, THE TOP SURFACE OF THE ROADWAY SHALL CONFORM AS NEARLY AS PRACTICABLE TO THE ELEVATIONS AND CONTOUR LINES SHOWN ON THE PLANS.

b. THE TOTAL DEPTH OF THE BRIDGE SLAB AND HAUNCH OVER EACH BEAM (TOP OF CONCRETE TO TOP OF FLANGE) OR GIRDER (TOP OF CONCRETE TO TOP OF WEB) AT THE SUPPORTS IS GIVEN ON THE PLANS. THE STEEL BEAMS AND GIRDERS SHALL BE FABRICATED WITH THE CAMBER, AS SPECIFIED ON THE PLANS, TO COMPENSATE FOR THE DEFLECTIONS DUE TO WEIGHT OF CONCRETE AND STEEL.

THE THEORETICAL DEFLECTIONS ARE TABULATED ON THE PLANS. TO COMPENSATE FOR DEFLECTIONS DUE TO THE DEAD LOAD OF THE CONCRETE THE SCREEDS USED TO STRIKE OFF THE SURFACE OF THE CONCRETE SLAB SHALL BE SET UP WITH CAMBER ABOVE THE FINAL DESIRED GRADE LINE BY AMOUNTS EQUAL TO DEFLECTIONS SHOWN FOR THIS DEAD LOAD. SCREEDS MAY REQUIRE FURTHER ADJUSTMENT DUE TO IRREGULARITIES IN THE FABRICATED STEEL. THE CONCRETE SLAB SHALL BE OF UNIFORM THICKNESS BETWEEN BEAMS WITH CAMBER SETTING OBTAINED BY VARYING THE THICKNESS OF THE HAUNCHES OVER THE BEAMS.

REINFORCING STEEL

BARs SHALL, UNLESS OTHERWISE SHOWN, BE 3 INCHES CLEAR FROM THE FACE OF CONCRETE IN FOOTINGS AND 2 INCHES CLEAR ELSEWHERE, EXCEPT IN SLABS WHERE BARS SHALL BE 1 INCH CLEAR ON THE BOTTOM AND 1 INCH PLUS THE THICKNESS OF THE MONOLITHIC WEARING SURFACE ON THE TOP.

ALL BARS ARE DESIGNATED ON THE PLANS BY BAR NUMBERS. THE BAR SIZE IS INDICATED BY THE FIRST DIGIT OF THREE-DIGIT NUMBERS AND BY THE FIRST TWO DIGITS OF FOUR-DIGIT NUMBERS.

IF REINFORCING BARS ARE FABRICATED FROM STOCK WHICH HAS PREVIOUSLY BEEN TESTED AND APPROVED BY THE OHIO HIGHWAY TESTING LABORATORY, TEST SAMPLES AS PROVIDED IN SEC. S-4.02 NEED NOT BE FURNISHED, AND REPLACEMENT BARS WILL NOT BE REQUIRED.

WATERPROOFING

ALL CONTRACTION AND EXPANSION JOINTS IN BACK FACE OF SUB-STRUCTURE AGAINST WHICH EARTH IS TO BE PLACED SHALL BE WATERPROOFED WITH A PRE-MOLDED SEALING STRIP OR TYPE "B" WATERPROOFING AS SHOWN IN THE PLANS.

WELDING

ALL WELDING SHALL BE CLASS "A" EXCEPT AS NOTED IN THE TAIL OF THE WELDING SYMBOL.

RADIOGRAPHIC EXAMINATION OF WELDS

THIS WORK SHALL CONSIST OF THE PERFORMANCE AND INTERPRETATION OF A RADIOGRAPHIC EXAMINATION OF BUTT WELDS AS REQUIRED BY THESE SPECIFICATIONS. IT SHALL INCLUDE THE PREPARATION AND POSITIONING OF WELDS FOR EXAMINATION, THE RADIOGRAPHING OF WELDS, THE PROCESSING AND EXAMINATION OF RADIOGRAPHS, THE INTERPRETATION OF RADIOGRAPHS FOR COMPLIANCE WITH THESE SPECIFICATIONS, AND THE PERFORMANCE AND INTERPRETATION OF ANY RETAKES OF RADIOGRAPHS REQUIRED FOR WELDS MADE TO REPLACE UNSATISFACTORY WELDS.

a. APPROVAL OF DIRECTOR

THE CONTRACTOR SHALL FURNISH EVIDENCE, ACCEPTABLE TO THE DIRECTOR, OF THE ADEQUACY OF THE EQUIPMENT TO BE USED AND THE COMPETENCE OF THE PERSONNEL.

THE INTERPRETATION OF RADIOGRAPHS AND THE CORRECTION OF DEFECTIVE WELDS SHALL BE SUBJECT TO THE APPROVAL OF THE DIRECTOR.

b. SCOPE OF EXAMINATION

BY MEANS OF RADIOGRAPHIC EXAMINATION, THE CONTRACTOR SHALL FURNISH EVIDENCE OF THE ACCEPTABLE QUALITY OF THE BUTT WELDS OF ALL GIRDERS. THE PARTS OF THESE MEMBERS TO BE RADIOGRAPHED ARE AS FOLLOWS:

(1) THE COMPLETE BUTT WELDS IN THE FLANGES OF EACH GIRDER EXCEPT THE BOTTOM FLANGE OVER THE BEARING DEVICES.

(2) ONE FOOT AT EACH END OF EACH OF THE WEB SPLICE WELDS.

THE SHOP EXAMINATION OF THE BUTT WELDS OF THE FLANGE PLATES AND OF THE WEB PLATES SHALL BE DETERMINED TO BE ACCEPTABLE BEFORE THESE FLANGE AND WEB PLATES ARE ASSEMBLED AND WELDED TO FORM THE GIRDERS. THE EXAMINATION OF FIELD WELDS SHALL BE MADE AS SOON AS PRACTICABLE AFTER WELDING AT EACH FIELD SPLICE IS COMPLETED.

RADIOGRAPHIC INSPECTION OF WELDS OF ROLLED BEAMS WILL NOT BE REQUIRED.

c. WELD CONDITION

ALL WELDED JOINTS WHICH ARE TO BE RADIOGRAPHED SHALL BE FREE OF PAINT, SCALE AND GREASE AND SHALL BE FOUND FREE OF ALL WELD RIPPLES AND SURFACE IRREGULARITIES ON BOTH SIDES. THE DIRECTION OF GRINDING SHALL BE PERPENDICULAR TO THE LENGTH OF THE WELD. THE WELDS SHALL BE GRIND TO SUCH A DEGREE THAT THE RESULTING RADIOGRAPHIC CONTRAST, DUE TO REMAINING IRREGULARITIES, CANNOT MASK OR BE CONFUSED WITH THAT OF ANY OBJECTIONABLE DEFECT AND THAT THE WELD SURFACE WILL MERGE SMOOTHLY INTO THE PLATE SURFACE. UNLESS SPECIFIED TO BE GROUND FLUSH, THE FINISHED SURFACE OF THE REINFORCEMENT MAY HAVE A CROWN EQUAL TO ONE-EIGHTH THE THICKNESS OF THE METAL BUT NOT MORE THAN ONE-EIGHTH INCH.

d. RADIOGRAPHIC TECHNIQUE

THE WELD SHALL BE RADIOGRAPHED WITH A TECHNIQUE WHICH WILL DETERMINE QUANTITATIVELY THE SIZE OF DEFECTS WITH THICKNESSES EQUAL TO OR GREATER THAN 2 PER CENT OF THE THICKNESS OF THE BASE METAL. IN THE CASE OF A WELD JOINING PLATES OF UNEQUAL THICKNESS, BOTH PLATES MUST BE RADIOGRAPHED AT 2 PER CENT SENSITIVITY TOGETHER OR SINGLY, WITH THE WELD JUNCTION EVIDENT IN BOTH VIEWS.

TO DETERMINE WHETHER THE RADIOGRAPHIC TECHNIQUE EMPLOYED IS DETECTING DEFECTS OF A THICKNESS EQUAL TO OR GREATER THAN 2 PER CENT OF THE THICKNESS OF THE BASE MATERIAL, THICKNESS GAGES OR PENETRAMETERS OF THE TYPE HEREINAFTER SPECIFIED SHALL BE PLACED ON THE SIDE OF THE WELDED PLATE NEAREST THE SOURCE OF RADIATION AT AN EXTREME EDGE OF THE RADIOGRAPHIC PLATE OR FILM.

THE MATERIAL OF THE PENETRAMETER SHALL BE SUBSTANTIALLY THE SAME AS THAT OF THE WELDED PLATE.

THE THICKNESS OF THE PENETRAMETER SHALL BE NOT MORE THAN 2 PER CENT OF THE THICKNESS OF THE PLATE EXCLUSIVE OF ANY WELD REINFORCEMENT. PENETRAMETERS DESIGNED FOR INCREMENTS OF 1/8" OF PLATE THICKNESS ARE ACCEPTABLE.

IN EACH PENETRAMETER THERE SHALL BE THREE HOLES WITH DIAMETERS EQUAL RESPECTIVELY TO TWO, THREE, AND FOUR TIMES THE PENETRAMETER THICKNESS, BUT IN NO CASE SHALL LESS THAN 1/16" DIAMETER BE USED.

EACH PENETRAMETER SHALL CARRY AN IDENTIFYING NUMBER REPRESENTING IN TWO SIGNIFICANT FIGURES THE MINIMUM THICKNESS IN INCHES OF THE PLATE FOR WHICH IT MAY BE USED. PENETRAMETERS MAY BE ESTABLISHED FOR DIFFERENCES IN THICKNESS NOT TO EXCEED 1/8" SO THAT A SET OF PENETRAMETERS VARYING FOR INCREMENTS OF PLATE THICKNESS OF 1/8" WILL BE ADEQUATE TO SERVE PLATES HAVING THICKNESSES BETWEEN THESE 1/8" DIMENSIONS.

THE IMAGES OF IDENTIFYING NUMBERS AND THE HOLES OF EACH PENETRAMETER MUST APPEAR CLEARLY ON THE RADIOGRAPH TO ESTABLISH THE 2 PER CENT SENSITIVITY.

FOR PLATES UP TO AND INCLUDING 2-1/2" IN THICKNESS, EACH PENETRAMETER SHALL BE 1-1/2" LONG AND 1/2" WIDE. FOR PLATES THICKER THAN 2-1/2", EACH PENETRAMETER SHALL BE 2-1/4" LONG AND 1" WIDE.

THE FILM DURING EXPOSURE SHALL BE AS CLOSE TO THE WELD AS PRACTICABLE. IF POSSIBLE, THIS DISTANCE SHALL BE NOT GREATER THAN 1 INCH. IN ANY EVENT, THE RATIO

$$\frac{\text{DISTANCE FROM SOURCE OF RADIATION TO WELD SURFACE TO WARD RADIATION}}{\text{DISTANCE FROM WELD SURFACE TOWARD RADIATION TO FILM}}$$

SHALL BE AT LEAST 7 TO 1.

ALL RADIOGRAPHS SHALL BE FREE FROM EXCESSIVE MECHANICAL PROCESSING DEFECTS WHICH WOULD INTERFERE WITH PROPER INTERPRETATION OF THE RADIOGRAPH.

IDENTIFICATION MARKERS, THE IMAGES OF WHICH WILL APPEAR ON THE FILM, SHALL BE PLACED ADJACENT TO THE WELD, AND THEIR LOCATIONS SHALL BE ACCURATELY AND PERMANENTLY MARKED ON THE OUTSIDE SURFACE NEAR THE WELD SO THAT A DEFECT APPEARING ON THE RADIOGRAPH MAY BE ACCURATELY LOCATED.

THE SIZE OF FILM TO BE USED SHALL BE ^{at least} 3" WIDE x 15" LONG UNLESS PERMISSION TO USE A DIFFERENT SIZE IS OBTAINED IN WRITING FROM THE DIRECTOR

e. STANDARDS OF ACCEPTABILITY

THE ACCEPTABILITY OF THE WELDS EXAMINED BY RADIOGRAPHY SHALL BE JUDGED BY THE FOLLOWING STANDARDS.

(1) CRACKS:

DEFINITION - A DISCONTINUITY RESULTING FROM A VERY NARROW SEPARATION OF METAL.

STANDARD - NO WELD CONTAINING CRACKS, REGARDLESS OF LENGTH, SIZE OR LOCATION, SHALL BE CONSIDERED ACCEPTABLE.

(2) GAS POROSITY:

DEFINITION - GAS POCKETS OR VOIDS IN METAL.

STANDARD - THE MAXIMUM DIMENSION OF ANY INDIVIDUAL GAS POCKET SHALL NOT EXCEED 1/8 INCH. THE MAXIMUM ACCUMULATION OF GAS POCKETS SHALL NOT EXCEED THAT SHOWN IN THE "POROSITY STANDARDS" OF THE AMERICAN SOCIETY OF MECHANICAL ENGINEERS.

(3) SLAG INCLUSIONS:

DEFINITION - NONMETALLIC, SOLID MATERIAL ENTRAPPED IN WELD METAL OR BETWEEN WELD METAL AND BASE METAL.

STANDARD-A - ELONGATED SLAG INCLUSIONS: NO ELONGATED SLAG INCLUSION SHALL EXCEED TWO-THIRDS OF THE THICKNESS OF THE THINNER PLATE OF THE JOINT IN LENGTH AND 1/16" IN WIDTH, EXCEPT THAT REGARDLESS OF THE PLATE THICKNESS, NO SUCH INCLUSION SHALL BE LONGER THAN 3/4" AND EXCEPT THAT NO SUCH INCLUSION WHICH IS SHORTER THAN 1/4" SHALL BE CAUSE FOR REJECTION.

B - ISOLATED SLAG INCLUSIONS: IN ANY 12 INCH LENGTH OF WELD, THE MAXIMUM WIDTH OF ANY ISOLATED SLAG INCLUSION SHALL NOT EXCEED 1/8 INCH, THE SUMMATION OF LENGTHS OF ISOLATED SLAG INCLUSIONS SHALL NOT EXCEED 1 INCH, AND THERE SHALL BE NO MORE THAN FOUR ISOLATED SLAG INCLUSIONS OF THE MAXIMUM WIDTH OF 1/8 INCH. ANY TWO SUCH INCLUSIONS SHALL BE SEPARATED BY AT LEAST 2 INCHES OF SOUND WELD METAL.

(4) INCOMPLETE FUSION:

DEFINITION - FAILURE OF THE WELD METAL TO FUSE COMPLETELY WITH THE BASE METAL OR PRECEDING BEADS.

STANDARD - NO INDIVIDUAL LACK OF FUSION SHALL EXCEED 1/2 INCH IN LENGTH. IN ANY 12 INCH LENGTH OF WELD, THE SUMMATION OF LENGTHS OF LACK OF FUSION SHALL NOT EXCEED 3/4 INCH AND INDIVIDUAL DEFECTS SHALL BE SEPARATED BY AT LEAST 6 INCHES OF SOUND METAL.

(5) INCOMPLETE PENETRATION:

DEFINITION - ROOT PENETRATION WHICH IS LESS THAN COMPLETE OR FAILURE OF A ROOT PASS AND A BACKING PASS TO FUSE WITH EACH OTHER.

STANDARD - NO INDIVIDUAL LACK OF PENETRATION SHALL EXCEED 1/2 INCH IN LENGTH. IN ANY 12 INCH LENGTH OF WELD, THE SUMMATION OF LENGTHS OF LACK OF PENETRATION SHALL NOT EXCEED 3/4 INCH AND INDIVIDUAL DEFECTS SHALL BE SEPARATED BY AT LEAST 6 INCHES OF SOUND METAL.

f. REPAIR OF DEFECTIVE WELDS

DEFECTIVE WELDS SHALL BE REPAIRED BY CHIPPING OR MELTING OUT SUCH DEFECTS FROM ONE OR BOTH SIDES OF THE JOINT AS REQUIRED, REMOVING ONLY SUFFICIENT WELD METAL TO CORRECT THE DEFECT. THE JOINT SHALL THEN BE REWELDED AND AGAIN RADIOGRAPHED.

g. ADDITIONAL RADIOGRAPHS

WHEREVER AN UNACCEPTABLE WELD OCCURS, A RADIOGRAPH SHALL BE MADE OF THE ADJOINING 12-INCH LENGTHS OF WELD TO DETERMINE IF THE FLAWS EXTEND BEYOND THE LIMITS OF THE ORIGINAL RADIOGRAPH. IF UNACCEPTABLE FLAWS OCCUR IN THESE ADJOINING LENGTHS OF WELD, THESE DEFECTIVE WELDS SHALL BE REPAIRED, AND THIS ENTIRE PROCEDURE REPEATED FOR THE NEXT ADJOINING 12-INCH LENGTH OF WELD.

h. CUSTODY OF RADIOGRAPHS

AS SOON AS THE RADIOGRAPHING OF THE WELDMENTS ON THE FULL LENGTH OF EACH FLANGE OR WEB PLATE BETWEEN FIELD SPLICES HAS BEEN COMPLETED, THE CONTRACTOR SHALL SEND TO THE STATE THE PROCESSED CONTACT FILM (THAT FILM CLOSEST TO THE SOURCE OF RADIATION) OF ALL ORIGINAL AND RETAKE RADIOGRAPHS. THESE RADIOGRAPHS SHALL BE ACCOMPANIED BY A CERTIFICATION FROM THE CONTRACTOR THAT THE RADIOGRAPHIC EXAMINATION WAS PERFORMED IN CONFORMANCE WITH THESE SPECIFICATIONS. THE RADIOGRAPHS SHALL BECOME THE PROPERTY OF THE STATE. EACH RADIOGRAPH SHALL BE CLEARLY IDENTIFIED TO SHOW THE LOCATION ON THE STRUCTURE AT WHICH IT WAS TAKEN. UNACCEPTABLE DEFECTS SHALL BE IDENTIFIED IN EACH RADIOGRAPH IN WHICH THEY OCCUR, AND THE REPAIR OR REPLACEMENT OF EACH UNACCEPTABLE WELD DEFECT SHALL BE NOTED AND IDENTIFIED.

i. REPORT OF COST

AFTER THE COMPLETION OF THE RADIOGRAPHIC INSPECTION OF WELDS, THE CONTRACTOR SHALL FURNISH THE STATE A COMPLETE REPORT OF THE COST OF PERFORMING THIS WORK, SEPARATED INTO THE ITEMS MENTIONED IN THE FOLLOWING PARAGRAPH.

j. BASIS OF PAYMENT

PAYMENT FOR THIS WORK, INCLUDING ALL LABOR, EQUIPMENT, MATERIALS, AND INCIDENTALS, SHALL BE INCLUDED IN THE UNIT PRICE BID FOR S-7, "STRUCTURAL STEEL."

MICROFILMED

JUL 3 1985

PART 7-A

HOWARD, NEEDLES, TAMMEN & BERGENDOFF
CONSULTING ENGINEERS
KANSAS CITY CLEVELAND NEW YORK

GENERAL NOTES

WILLOW - INNER BELT FREEWAY
CLEVELAND CUYAHOGA COUNTY OHIO

DRAWN H.A.H.	TRACED	CHECKED G.G.	REVIEWED C.F.	REVISED
DATE 10-4-57	DATE	DATE 11-10-59	DATE 11-10-59	SHEET 98

MICROFILMED
JUL 9 1985

CUYAHOGA COUNTY
CITY OF CLEVELAND
CUY-21-15.32
CUY-42-18.42

ESTIMATED QUANTITIES

ITEM	DESCRIPTION	UNIT	BRIDGE NO. 3 I-71-5(8)248					BRIDGE NO. 4 I-71-5(8)248					BRIDGE NO. 5 I-71-5(8)248					BRIDGE NO. 8 I-71-5(8)248								
			ABUT-	PIERS	SUPER-	GENERAL	TOTAL	ABUT-	RETAINING	SUPER-	GENERAL	TOTAL	AS	BUILT	ABUT-	PIERS	SUPER-	GENERAL	TOTAL	AS	BUILT	ABUT-	SUPER-	GENERAL	TOTAL	
			MENTS		STRUCTURE			MENTS	WALL	STRUCTURE						MENTS		STRUCTURE					MENTS	STRUCTURE		
E-2	Cofferdams, Cribbs & Sheeting	Lump Sum																								
E-2	Excavation for Structures (Unclassified)	Cu. Yd.	620	680			1300																			
S-1	Class "C" Concrete, Superstructure	Cu. Yd.			965		965			1605		1605						195						480	480	
S-1	Class "C" Concrete, Pier Columns & Cap	Cu. Yd.		225			225										75	195							480	480
S-1	Class "C" Concrete, Walls	Cu. Yd.							210				210													
S-1	Class "C" Concrete, Abutments & Walls	Cu. Yd.	15				15																			
S-1	Class "E" Concrete, Stub Abutments (above footings)	Cu. Yd.	300				300										110							185	185	
S-1	Class "E" Concrete, Footings	Cu. Yd.	182	223			405										90	80						170	170	
S-3	Waterproofing, Premolded Sealing Strip	Lin. Ft.	80				80																	10	10	
S-4	Reinforcing Steel	Lbs.	33,425	93,475	272,500		399,400																			
S-7	Structural Steel	Lbs.			1,174,000		1,174,000																			
S-8	Field Painting of Structural Steel (3 Coats)	Lbs.			1,174,000		1,174,000																			
S-9	1" Gray Rubber Preformed Expansion Joint Filler	Sq. Ft.	95				95																			
S-14	Aluminum Railing (Including Parapet)	Lin. Ft.	92		612		704																			
S-14	Guard Rail, Steel Beam Barrier Type (Deep)	Lin. Ft.			305		305																			
S-16	First Test Pile (12" or 14" C.I.P.)	Lump Sum																								
S-17	Subsequent Pile Test Load	Lump Sum																								
S-17	Subsequent Pile Test Load	Ea.					1																			
S-18	12" C.I.P. Reinforced Concrete Piles	Lin. Ft.	3890				3890																			
S-18	14" C.I.P. Reinforced Concrete Piles	Lin. Ft.		5400			5400																			
S-25	Electrical Grounds	Ea.					2																			
S-25	Light Standard on Structure, 10-Foot Bracket	Ea.			6		6																			
S-25	Parapet Junction Box (24" x 10" x 10")	Ea.			6		6																			
S-25	2" Conduit	Lin. Ft.	103		612		715																			
S-25	10,000 Lumen Luminaire & Insulating Transformer	Ea.																								
S-25	15,000 Lumen Luminaire & Insulating Transformer	Ea.					8																			
S-25	Fluorescent Underdeck Light	Ea.					4																			
S-25	Service Panel	Ea.			1		1																			
S-25	Junction Box (8" x 4" x 4")	Ea.			2		2																			
S-25	3/4" Rigid Galvanized Conduit	Lin. Ft.			175		175																			
S-25	2" Rigid Galvanized Conduit	Lin. Ft.			65		65																			
S-25	4" Rigid Galvanized Conduit	Lin. Ft.		45			45																			
S-25	1-Way Duct, 4 inch	Lin. Ft.					20																			
S-29	Porous Backfill	Cu. Yd.	140				140																			
S-29	6" W.I. or Galvan. Steel Pipe, incl. Fastenings & Specials	Lin. Ft.		60			60																			
S-29	8" W.I. or Galvan. Steel Pipe, incl. Fastenings & Specials	Lin. Ft.																								
I-10	Crushed Aggregate Slope Protection Sec. I-10.04	Sq. Yd.					3180																			
I-10	Crushed Aggregate Slope Protection (No. 4 or 4 1/2 Stone or Slag)	Sq. Yd.																								
I-10	Concrete Slope Protection Sec. I-10.05	Sq. Yd.																								
I-10	Concrete Slope Protection (4")	Sq. Yd.																								
I-14	Type I - Modified Paved Gutter	Lin. Ft.																								

NOTES:

- Pile Test Loads shall be performed only if required by the Engineer.
- ① North Wingwall, West Abutment.
- ② North Wingwall and adjoining section of abutment as per plan, East Abutment.
- ③ Includes Bridge No. 5
- ④ Includes entire East Abutment common to Bridges No. 8 & 9.
- ⑤ At Pier 2, Bridge No. 4.
- ⑥ At Piers 2 & 3, Bridge No. 4.
- ⑦ Included in the 165' total.

+ 100% City Participation
≠ 100% City Participation. Included with quantities under Roadway Plans.
See sheet 12-7A

- ⑧ FIRST TEST PILE: Payment will be made for only one first test pile. It may be driven for either H.N.T.B. Bridge No. 3 or H.N.T.B. Bridge No. 5.
- ⑨ For additional quantities see sheet 92A-Part 6

H.N.T.B. BR. NO.

- 3
- 4
- 5
- 8

STATE BR. NO.

- CUY-42-1843
- CUY-42-1854
- Ramp E-10 over Ramp E-8
- CUY-21-1573 A

PART 7A

HOWARD, NEEDLES, TAMMEN & BERGENDOFF
CONSULTING ENGINEERS
KANSAS CITY CLEVELAND NEW YORK

ESTIMATED QUANTITIES
BR. NOS. 3, 4, 5 & 8

WILLOW-INNER BELT FREEWAY
CLEVELAND CUYAHOGA COUNTY OHIO

DRAWN DATE 1/14/59	D.R.K. DATE 1/14/59	TRACED DATE 1/14/59	A.E.K. DATE 1/14/59	CHECKED DATE 1/14/59	REVIEWED DATE 1/14/59	REVISED DATE 1/14/59
-----------------------	------------------------	------------------------	------------------------	-------------------------	--------------------------	-------------------------

MICROFILMED
JUL 3 1965

CUYAHOGA COUNTY
CITY OF CLEVELAND
CUY-21-15.32
CUY-42-18.42

ESTIMATED QUANTITIES																			
ITEM	DESCRIPTION	UNIT	BRIDGE NO. 9 I-71-5(2)248					BRIDGE NO. 10 I-71-5(2)248					BRIDGE NO. 11 I-71-5(1)162					SIGN BRIDGE AT STA. 74+25	
			ABUT- MENTS	SUPER- STRUCTURE	GEN- ERALS	TOTAL	AS BUILT	ABUT- MENTS	SUPER- STRUCTURE	GEN- ERALS	TOTAL	AS BUILT	ABUT- MENTS	SUPER- STRUCTURE	GEN- ERALS	TOTAL	AS BUILT	TOTAL	
Special	Sign Bridge, as per Plan	Lump Sum																Lump Sum	
E-2	Excavation for Structures (Unclassified)	Cu. Yd.	110			110			480			480			850			850	
S-1	Class "C" Concrete, Superstructure	Cu. Yd.		190		190	⁰⁰¹⁴ ₋₁₈₇	3		735		735			755	⁰⁰¹⁴ ₋₁₅₄	1		
S-1	Class "C" Concrete, Abutments and Walls	Cu. Yd.												20 ⁰	755	⁰⁰¹⁴ ₋₁₅	15		
S-1	Class "E" Concrete, Stub Abutments (above Footings)	Cu. Yd.	45			45			190		190	⁰⁰¹⁵ ₊₁₁	201	365			365		
S-1	Class "E" Concrete, Footings	Cu. Yd.	35			35			160		160			300			300		
S-3	Waterproofing, Premolded Sealing Strip	Lin. Ft.							50		50	⁰⁰¹⁵ ₊₆	56	90			90		
S-4	Reinforcing Steel	Lbs.	4,981	49,819		54,800			25,000	200,400	225,400			41,070	194,830		235,900		
S-7	Structural Steel	Lbs.		133,500		133,500				839,000	839,000				855,000	⁰⁰⁸ _{+24,621}	879,621		
S-8	Field Painting of Structural Steel (3 Coats)	Lbs.		133,500		133,500				839,000	839,000				855,000	⁰⁰⁸ _{+24,621}	879,621		
S-9	1" Gray Rubber Preformed Expansion Joint Filler	Sq. Ft.							80		80			95			95		
S-14	Aluminum Railing (Including Parapet)	Lin. Ft.	26	334		360			54	413	467			65	419		484		
S-14	Guard Rail, Steel Beam Barrier Type (Deep)	Lin. Ft.								207	207				208		208		
S-16	12" C.I.P. Reinforced Concrete Piles	Lin. Ft.	490			490	⁰⁰¹⁴ ₋₈₁	409	2920		2920			6050		⁰⁰¹¹ ₋₁₈₁	5869		
S-25	Light Standard on Structure, 10-foot Bracket	Ea.		2		2				4	4			1	4		5		
S-25	Parapet Junction Box (24" x 10" x 10")	Ea.		2		2				4	4			1	4		5		
S-25	2" Conduit	Lin. Ft.	15	170		185			60	415	475			70	415		485		
S-25	10,000 Lumen Luminaire & Insulating Transformer	Ea.			2	2													
S-25	15,000 Lumen Luminaire & Insulating Transformer	Ea.								4	4				5		9		
S-25	Fluorescent Underdeck Light	Ea.			2	2				4	4				2		6		
S-25	Service Panel	Ea.		1		1				1	1				1		2		
S-25	3/4" Rigid Galvanized Conduit	Lin. Ft.		125		125				235	235				220	⁰⁰¹⁴ ₋₇	113		
S-25	1-Way Duct, 4 inch	Lin. Ft.			50	50	⁰⁰³⁰ ₊₁₇	69											
S-29	Porous Backfill	Cu. Yd.	12			12			80		80	⁰⁰¹⁴ ₊₁₁	91	180			180		
S-29	6" W.I. or Galvanized Steel Pipe incl. Fastenings & Specials	Lin. Ft.								16 ⁰	16								
I-10	Crushed Aggregate Slope Protection, Sec. I-10.04	Sq. Yd.			345	345	⁰⁰¹⁴ ₋₃₉	306							1375		1375		
I-10	Crushed Aggregate Slope Protection (No. 4 or 4 1/2 Stone or Slag)	Sq. Yd.			145	145	⁰⁰²⁰ ₋₂₇	118							580		580		
I-10	Concrete Slope Protection, Sec. I-10.05	Sq. Yd.								910	910	⁰⁰²⁰ ₊₂₄	994						
I-10	Concrete Slope Protection (4")	Sq. Yd.								855	855								

NOTES:
 Pile Test Loads shall be performed only if required by the Engineer.
 ① Southwest and Northeast Wingwalls.
 ② West Abutment only.
 ③ At Pier 2, Bridge No. 10.
 ④ For additional quantities see sheet 92A-Part 6

+ 100% City Participation
 ≠ 100% City Participation. Included with quantities under Roadway Plans.
 See sheet 12-7A

H.N.T.B. BR. NO. STATE BR. NO.
 9 CUY-21-1573 B
 10 CUY-21-1559
 11 CUY-21-1544

PART 7A

HOWARD, NEEDLES, TAMMEN & BERGENDOFF
 CONSULTING ENGINEERS
 KANSAS CITY CLEVELAND NEW YORK

ESTIMATED QUANTITIES

BR. NOS. 9, 10 & 11
 AND SIGN BRIDGE AT STA. 74+25
WILLOW-INNER BELT FREEWAY
 CLEVELAND CUYAHOGA COUNTY OHIO

DRAWN DRK DATE 1-14-59	TRACED AEK DATE 11-4-59	CHECKED G.R.T. DATE 11-9-59	REVIEWED JCT DATE 11-13-59	REVISED
------------------------------	-------------------------------	-----------------------------------	----------------------------------	---------

SHEET 99A

21-0



Q-16

CUY-90-16.37 CUY-77-15.62

FED. ROADS DIV. NO.	STATE	FED. AID PROJ. NO.	100 181
2	OHIO		


MICROFILMED
JUL 3 1985

CUYAHOGA COUNTY
CITY OF CLEVELAND
CUY-21-15.32
CUY-42-18.42

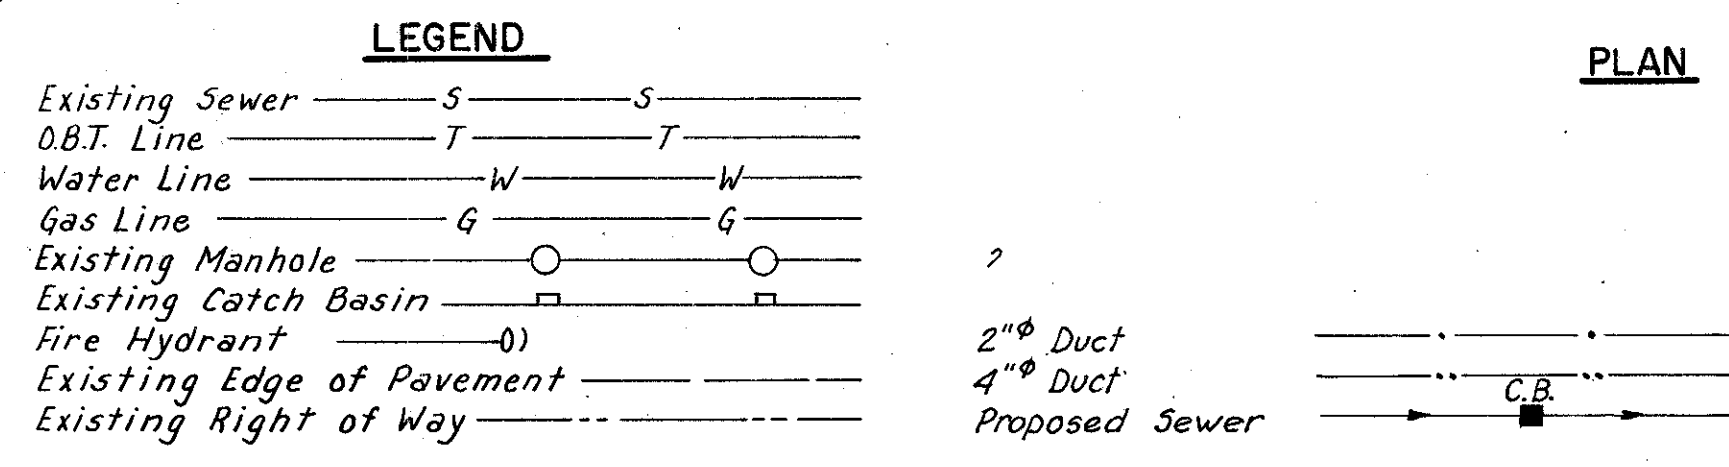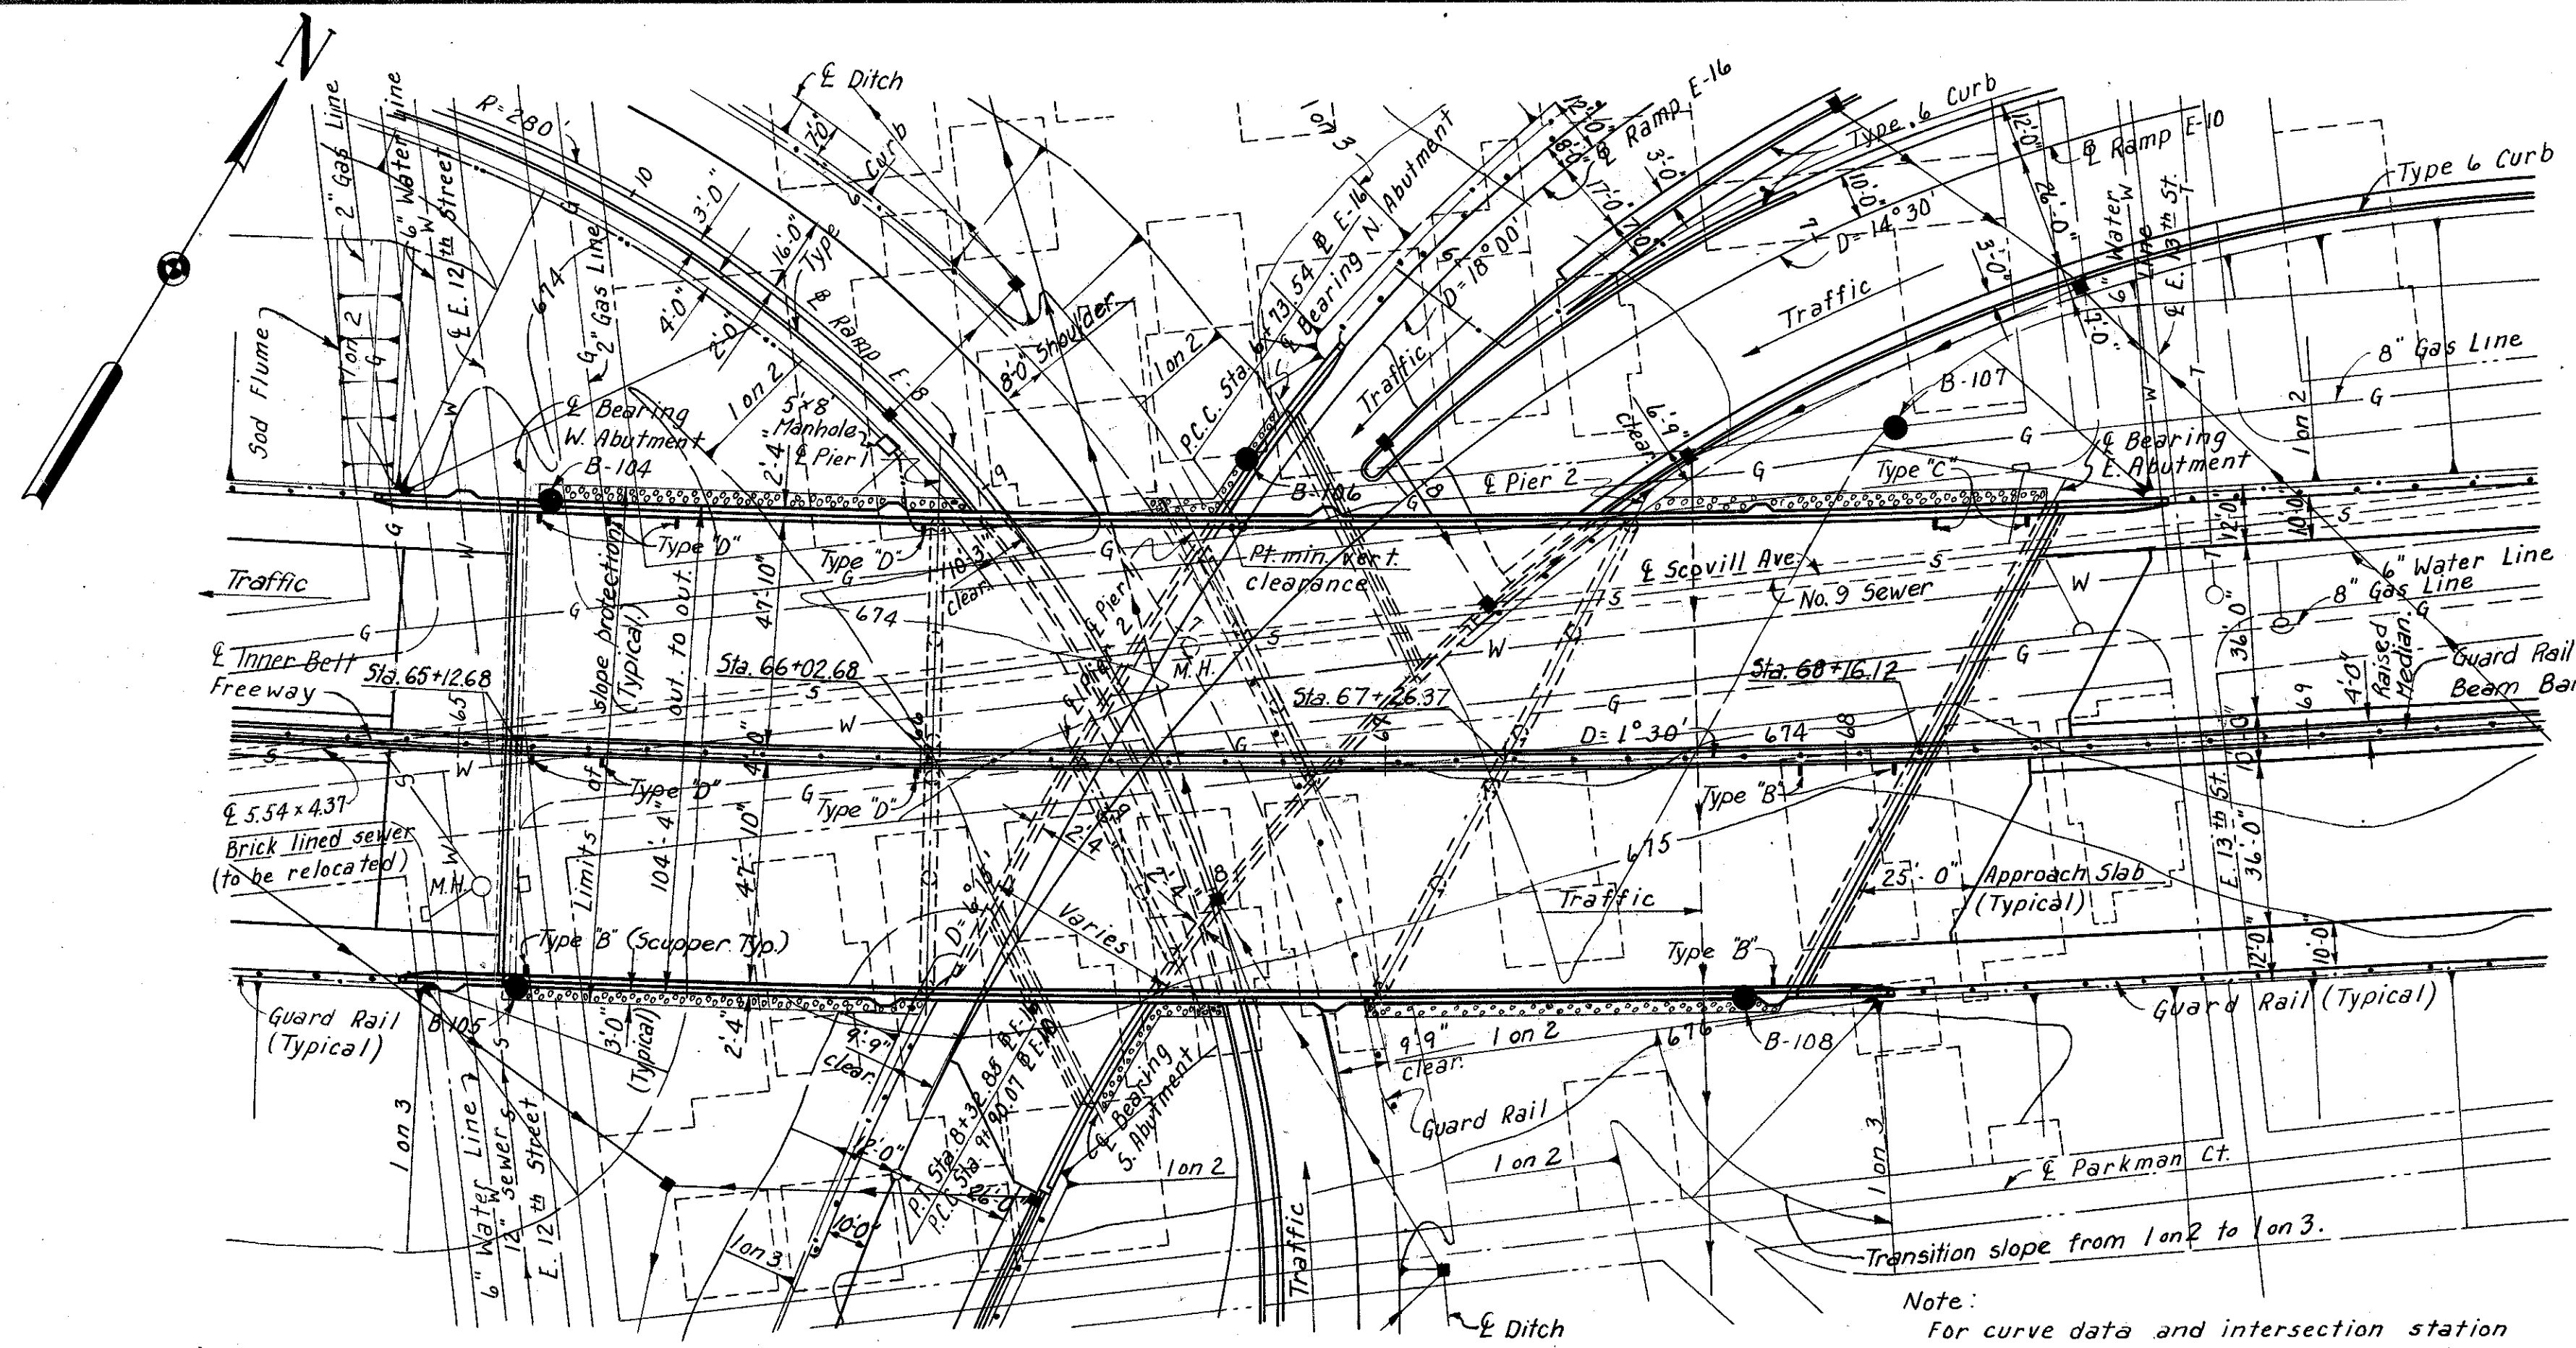

PLAN

Note:
For curve data and intersection station equations of Inner Belt Freeway and Ramps see Site Plan Bridge #5 sheet 137-7A

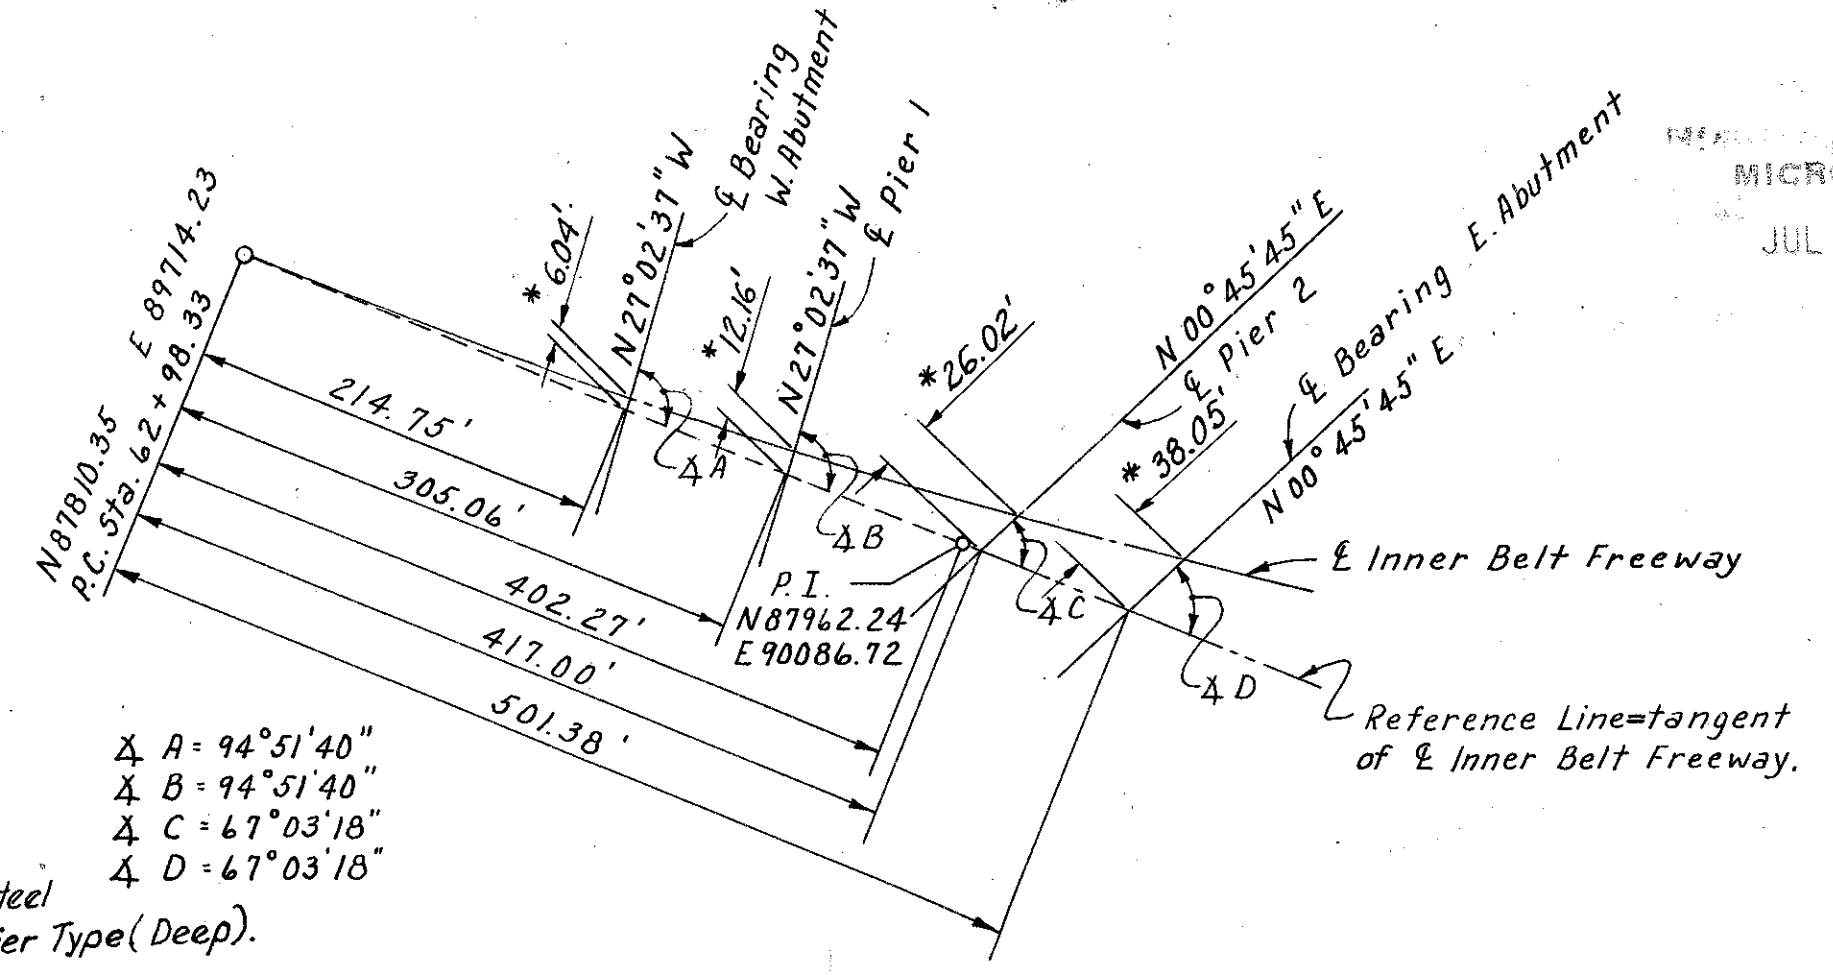

BRIDGE LAYOUT DIAGRAM
No Scale

* Offsets measured from reference line to E Inner Belt Freeway along E bearings.

Elev.	Soil Description
674.8	
13	
11	Brown Silty Gravelly Sand
32	659.8 Brown Silty Sand
36	654.8 Brown Silty Sand
60	649.8 Brown Sand
38	
36	639.8 Brown Silty Sand
45	
58	
68	624.8 Gray Sandy Silt
28	
38	
38	
52	
15	
31	
68	589.8 Gray Silt
584.8	Gray Sand

BORING B-106


Vertical Scale 1" = 20'
Sta. 66+70 65' Lt.

Note:
The figures to the left indicates the number of hammer blows required to drive the sample spoon 1 ft. They are given at 5' intervals starting at Elev. 674.8

NOTES:
Rod soundings only were taken at location B-104, B-105, B-107 and B-108. The core drilling made at B-106 is plotted.
For details of slope protection see sheet 174-7A
The following items are not included in the Bridge Plans. (See Roadway Plans for details.)
Removal of existing pavements, etc.
Relocation or removal of existing utilities.
Approach grading, pavement and slab.
Roadway guard rail.


PILE INFORMATION			
Location	Diameter	Number	Estimated ave. length
W. Abutment	12"	48	39'
E. Abutment	12"	51	40'
Pier 1	14"	56	27'
Pier 2	14"	60	65'

Pile lengths are based on boring data and are approximate only. The Contractor shall assume full responsibility for length of piling selected for driving.

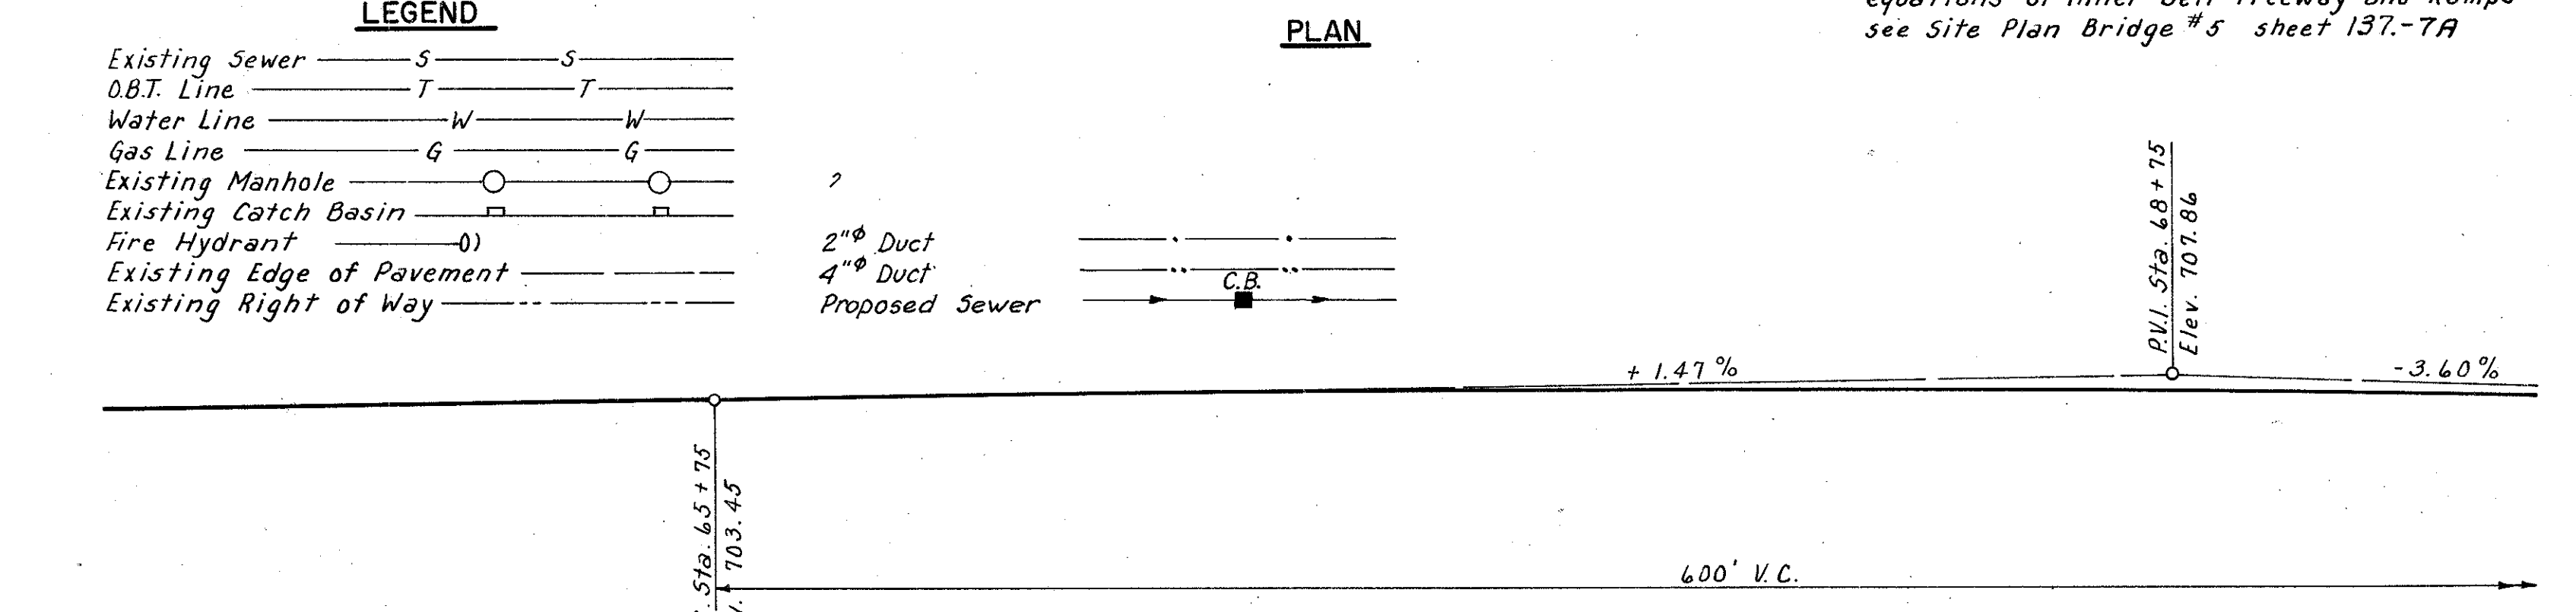

PROFILE

PROPOSED STRUCTURE
Type: Continuous welded steel girder with reinforced concrete deck and substructure
Spans: 90'-0", 123'-8 1/2", 89'-9" (along E Inner Belt Fr'wy.)
Roadway: 102'-0" f/f. parapets
Loading: CF 2000- Adequate for A.A.S.H.O. alternate loading
Skew: Varies
Surface Course: 1" Monolithic Concrete.
Alignment: 1° 30' curve left.
Approach Slabs: AS-1-54 (25' Long)
Superelevation: .03' per ft.

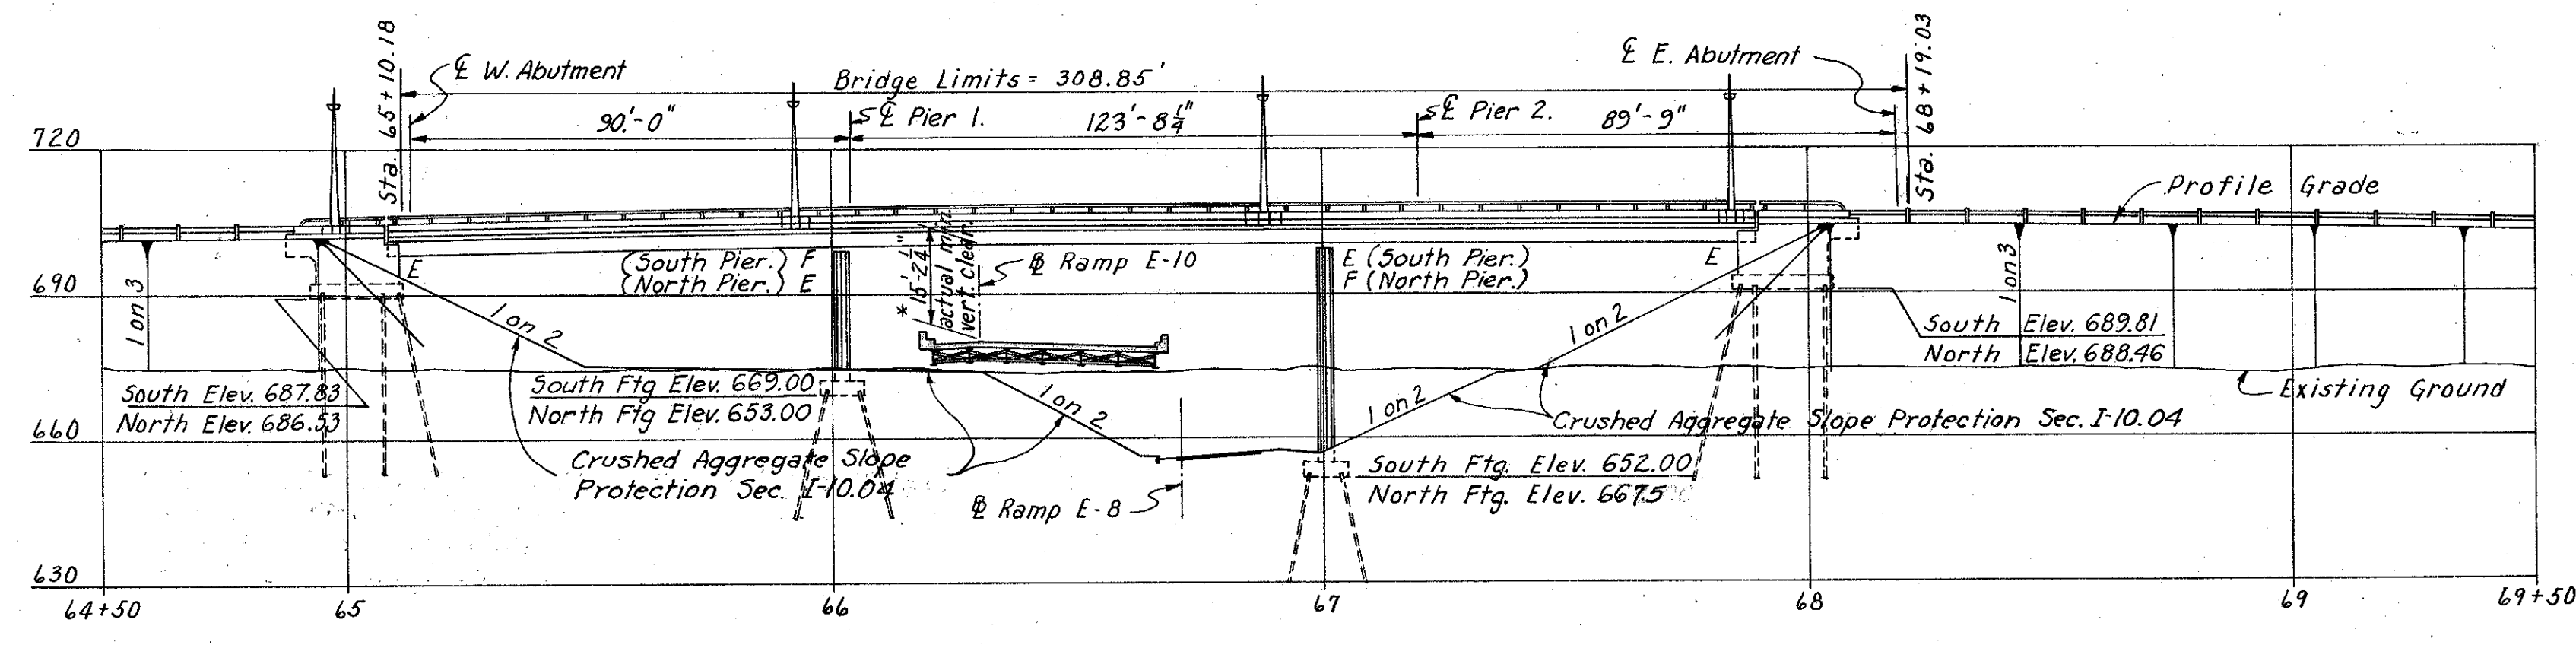

ELEVATION

Note: Elevations for pier footings are shown for exterior footing only. For other elevations see sheets 101-7A & 102-7A

* 15'-0" Required minimum vertical clearance. Point of actual minimum vertical clearance occurs at North exterior girder and 2'-6" Rt. E Ramp E-16.

H.N.T.B. BR. NO. 3 PART 7A

HOWARD, NEEDLES, TAMMEN & BERGENDOFF
CONSULTING ENGINEERS
KANSAS CITY CLEVELAND NEW YORK

SITE PLAN
INNER BELT FREEWAY OVER
RAMPS E-8, E-10 AND E-16
BR. NO. CUY-42-1843 STA. 65+10.18
Scale: 1" = 30' STA. 68+19.03


WILLOW-INNER BELT FREEWAY
CLEVELAND CUYAHOGA COUNTY OHIO

DRAWN A.J.S. TRACED A.E.K. CHECKED D.M. REVIEWED J.C.T. REVISIONS
DATE 7-2-58 DATE 8-20-58 DATE 8-4-58 DATE 11-13-57


SHEET 100

MICROFILMED JUL 3 1985

CUYAHOGA COUNTY CITY OF CLEVELAND CUY-21-15.32 CUY-42-18.42

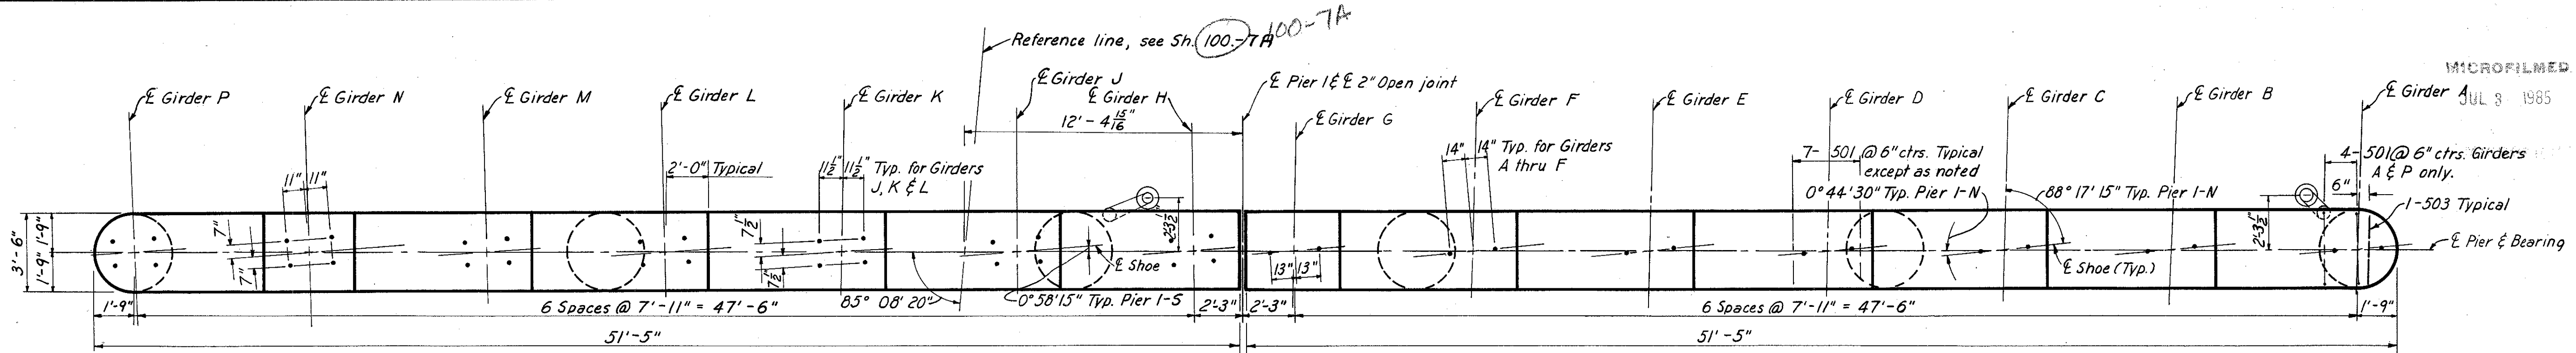


Note: Special care shall be taken when placing reinforcing steel so as not to interfere with anchor bolt or anchor bar setting.

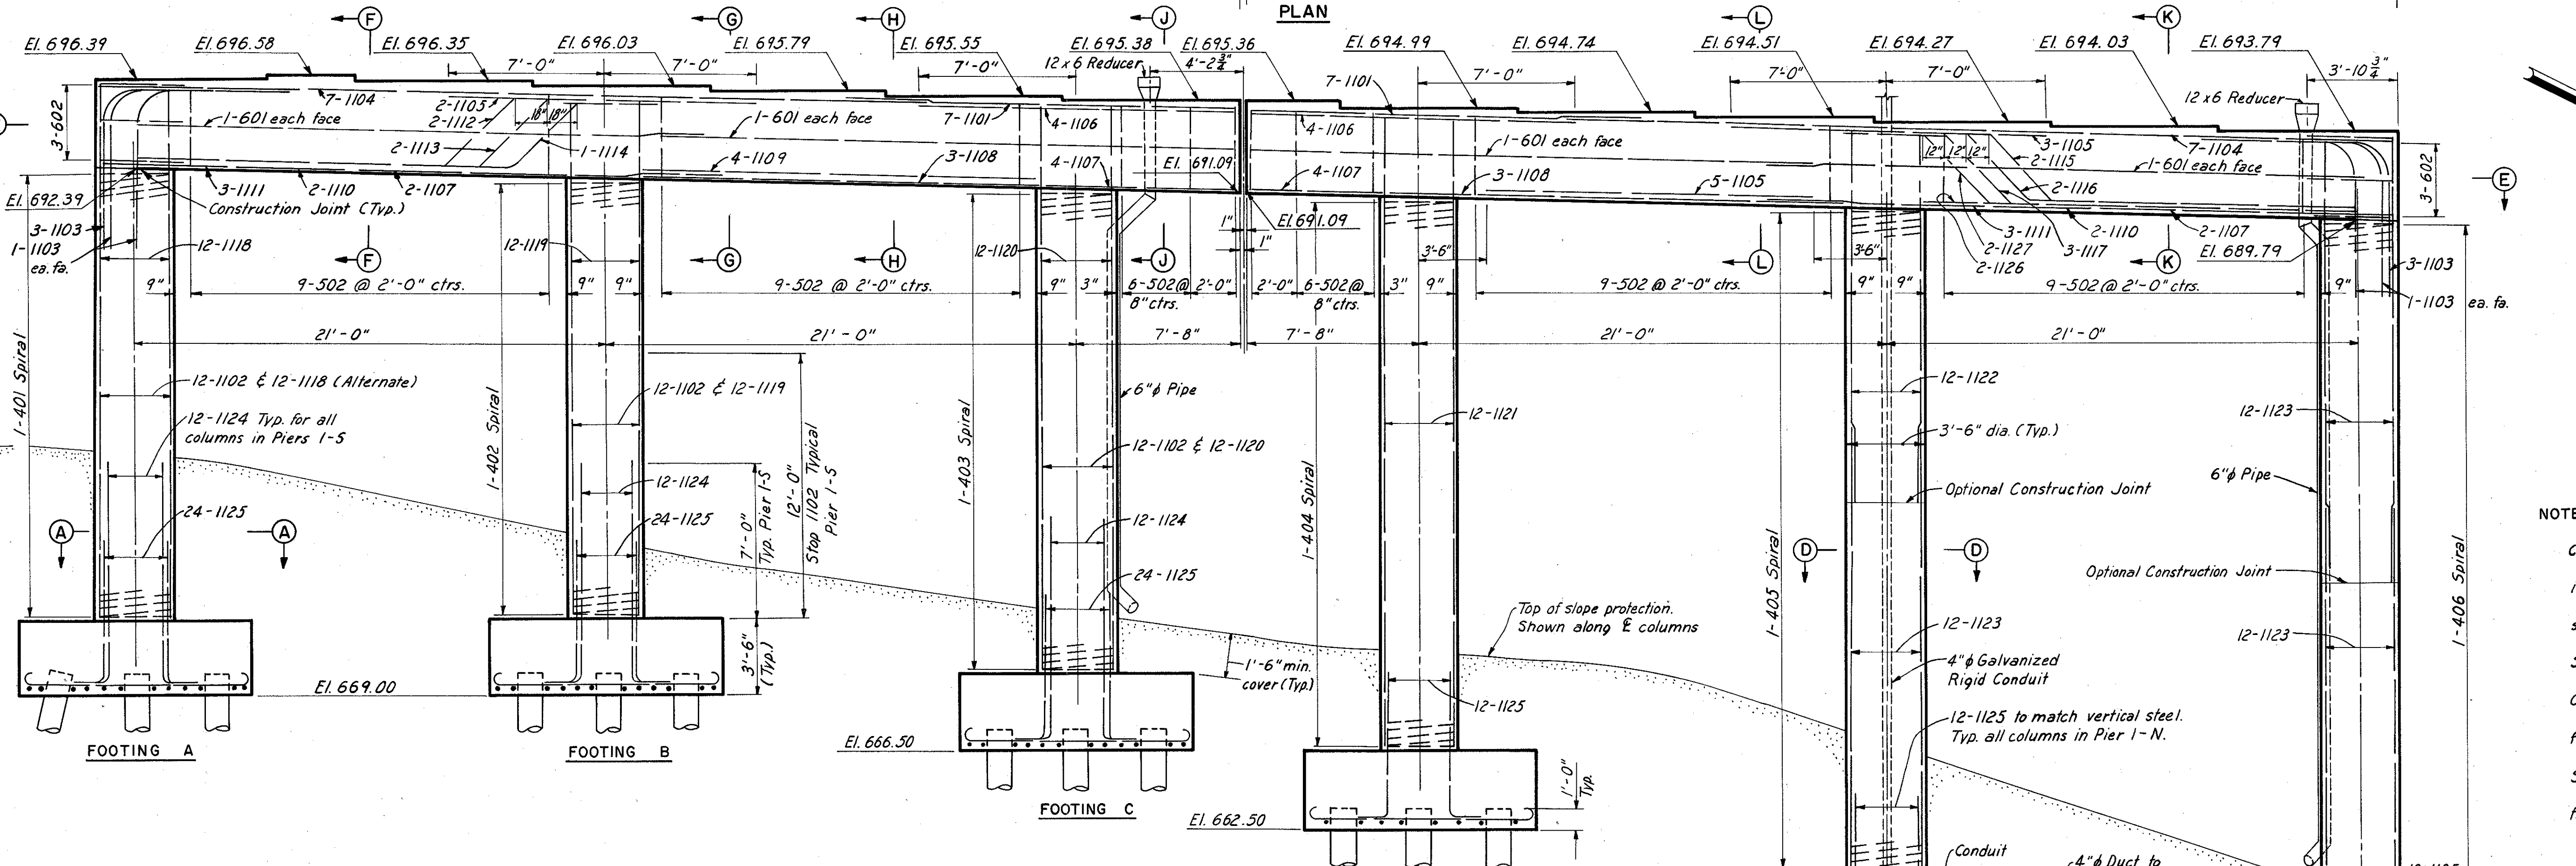

Note: Prefix "PA" shall be assigned to all bar marks.

NOTES: All piles shall be 14" dia. C.I.P. Reinforced Concrete. All battered piles shall be battered 3 in 12 in direction shown. For Sections and Reinforcement Schedule, see Sh. 103-7A. For details of 4" rigid conduit, see Sh. 177-7A. For masonry plate details, see Sh. 173-7A and Ohio Standards, Drawing RB-1-55. Reinforcement bars shall be 3 inches clear from bottom of footing and 2 inches elsewhere. Provide electrical ground wire in Column A. See notes on Sh. 98A-7A. Pile spacings are given along bottom of footings.

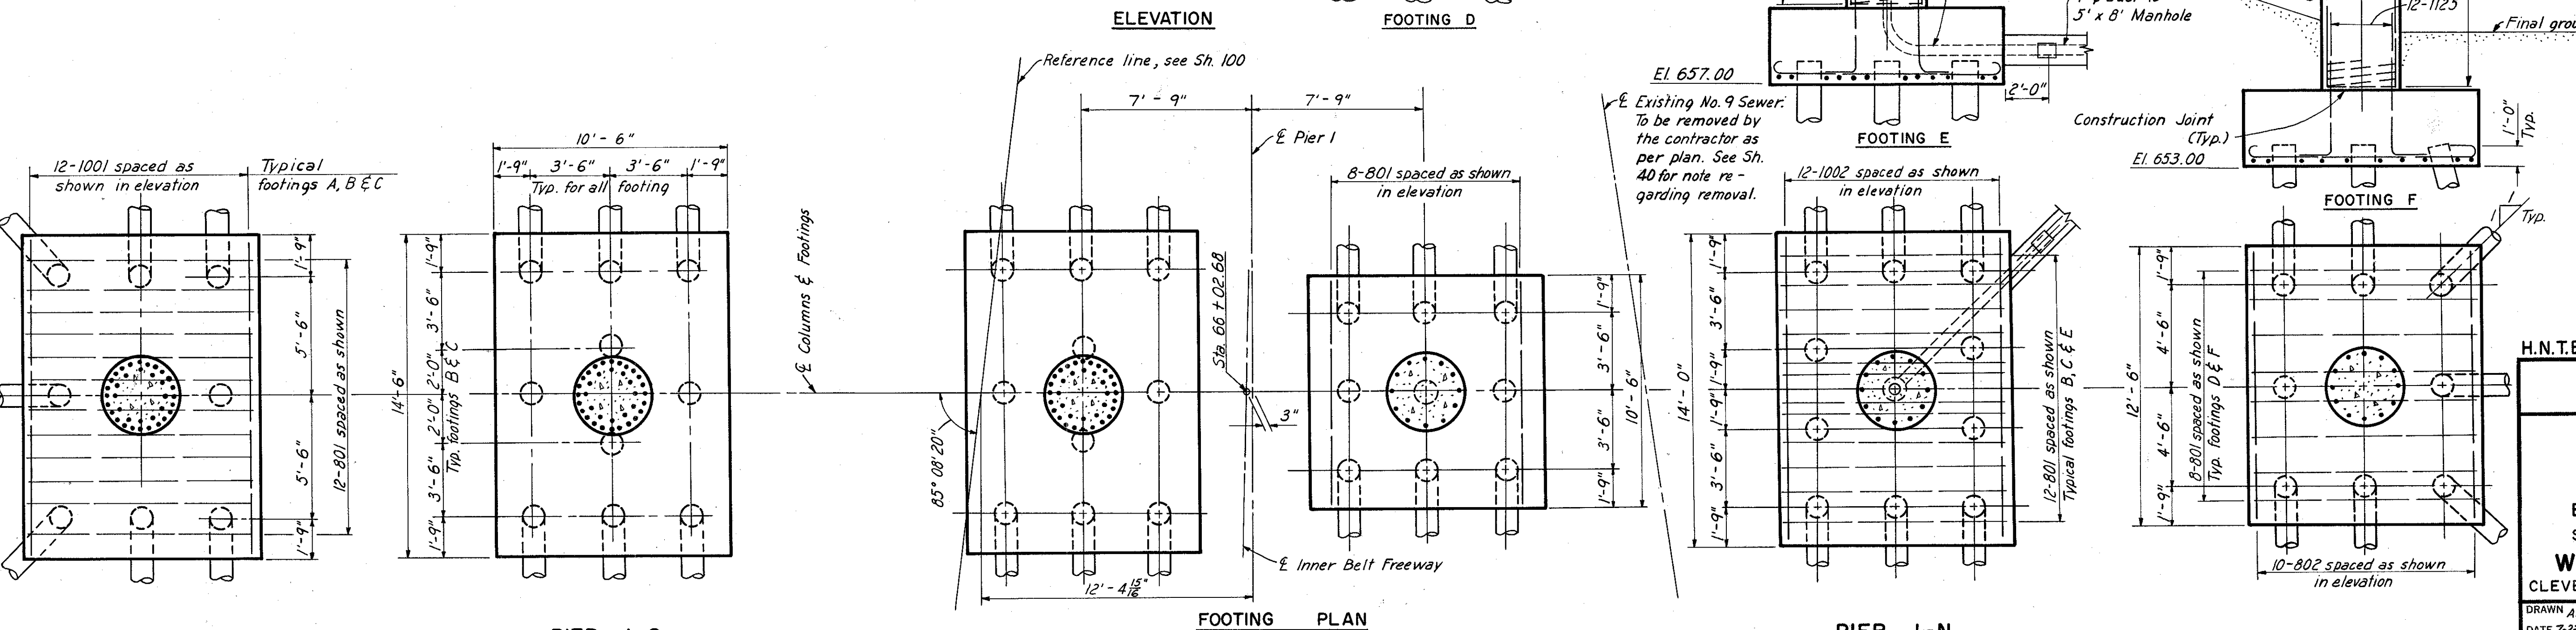

H.N.T.B. BR. NO. 3 PART 7A HOWARD, NEEDLES, TAMMEN & BERGENDOFF CONSULTING ENGINEERS KANSAS CITY CLEVELAND NEW YORK

PIER I INNER BELT FREEWAY OVER RAMPS E-8, E-10 AND E-16 BR. NO. CUY-42-1843 STA. 65+10.18 Scale: 1/4" = 1'-0" STA. 68+19.03 WILLOW-INNER BELT FREEWAY CLEVELAND CUYAHOGA COUNTY OHIO




DRAWN A.L. TRACED J.A.G. CHECKED B.R. REVIEWED J.C.T. REVISIONS DATE 7-23-58 DATE 5-11-59 DATE 8-22-58 DATE 11-13-59 SHEET 101

Note: Special care shall be taken when placing reinforcing steel so as not to interfere with anchor bolt or anchor bar setting.

Holes for anchor bars noted as thus \odot are to be drilled before placing bottom angle of the cross frame.

JUL 3 1965

CUYAHOGA COUNTY
CITY OF CLEVELAND
CUY-21-15.32
CUY-42-18.42

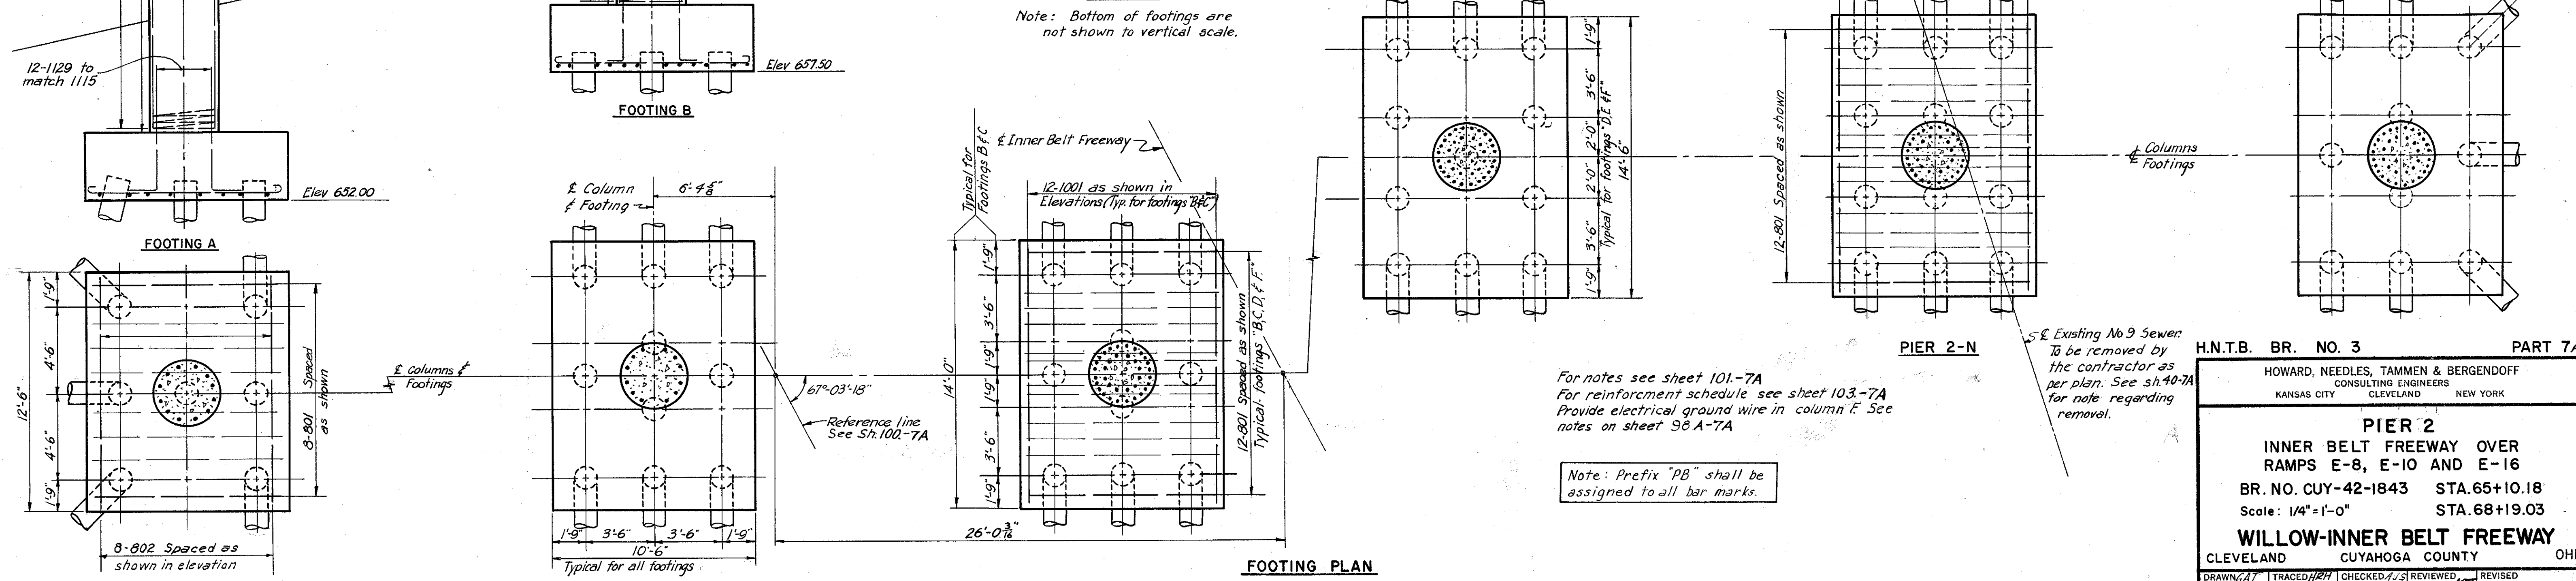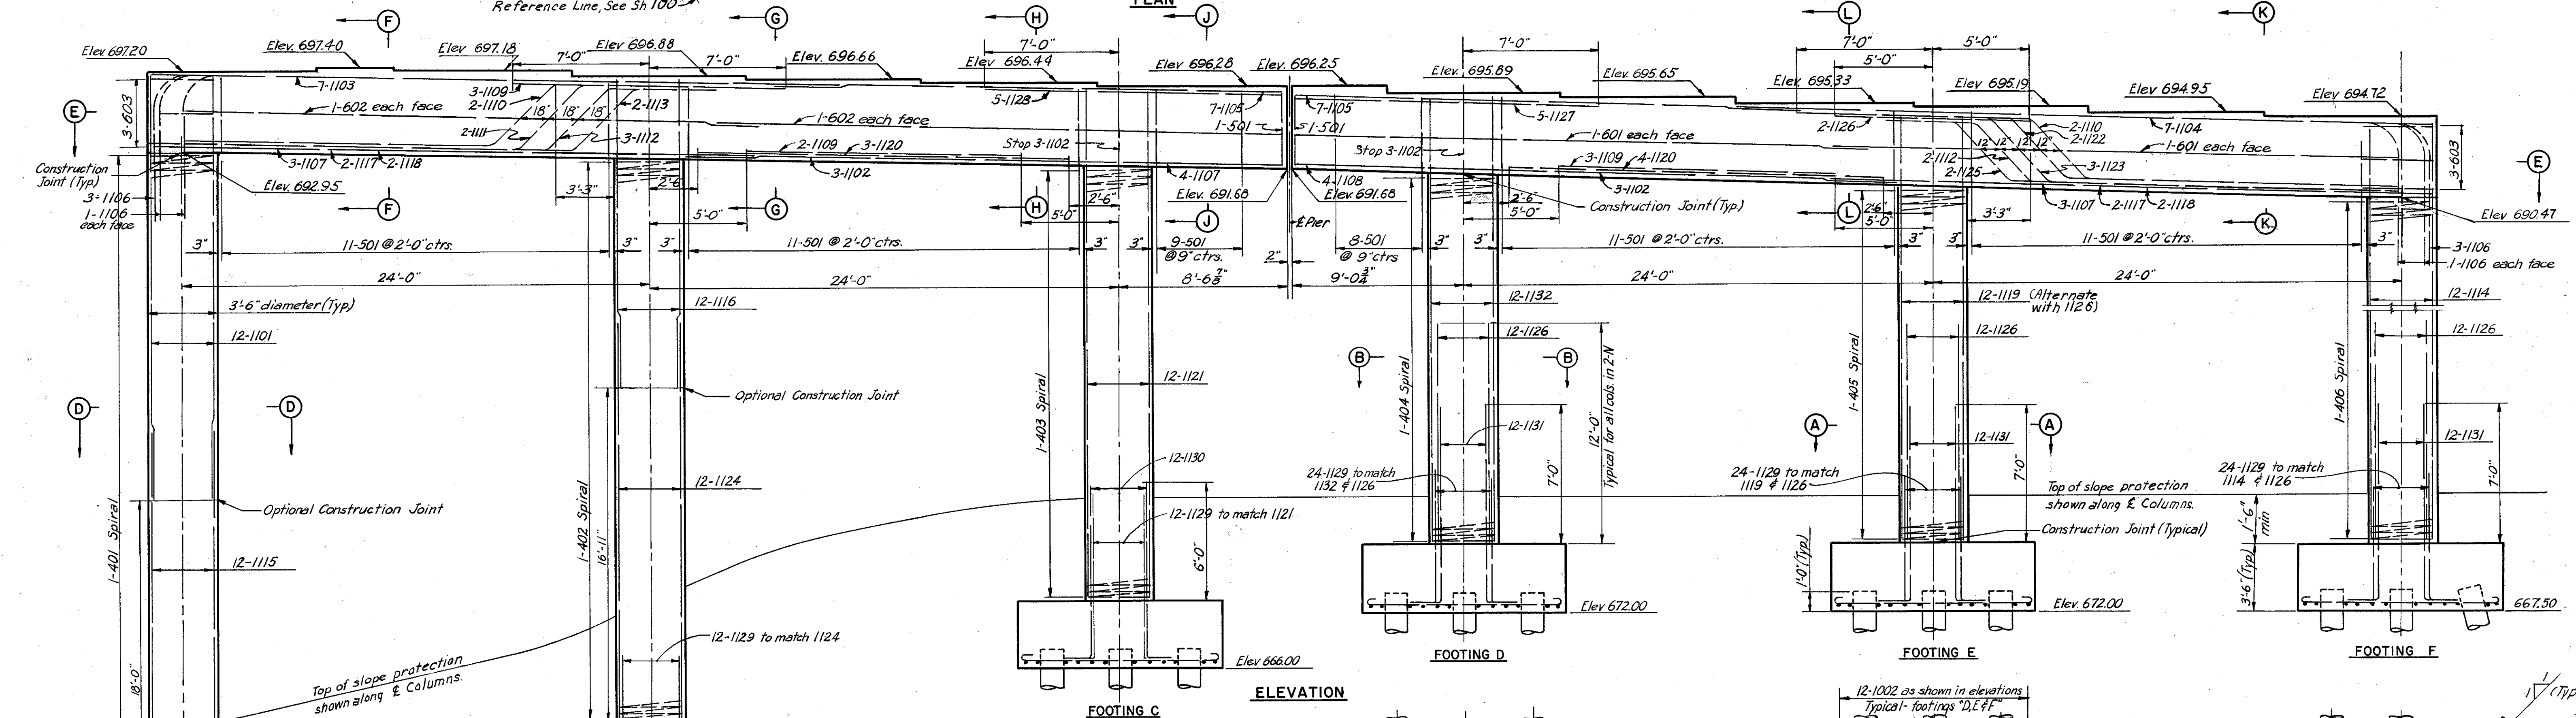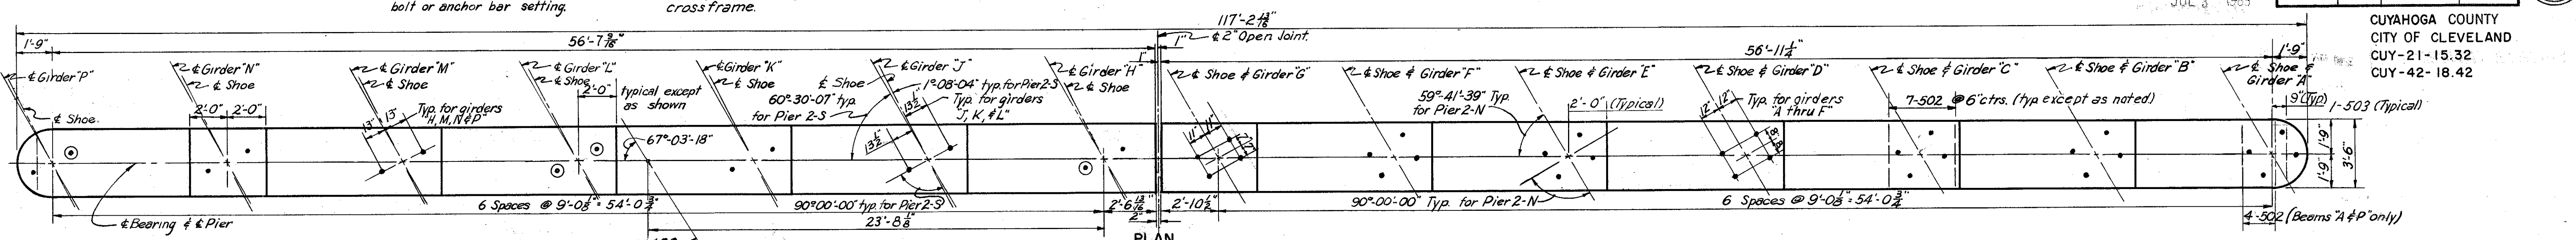

For notes see sheet 101-7A
For reinforcement schedule see sheet 103-7A
Provide electrical ground wire in column F. See notes on sheet 98A-7A.

Note: Prefix "PB" shall be assigned to all bar marks.

Existing No 9 Sewer to be removed by the contractor as per plan. See sheet 40-7A for note regarding removal.

H.N.T.B. BR. NO. 3 PART 7A

HOWARD, NEEDLES, TAMMEN & BERGENDOFF
CONSULTING ENGINEERS
KANSAS CITY CLEVELAND NEW YORK

PIER 2
INNER BELT FREEWAY OVER
RAMPS E-8, E-10 AND E-16
BR. NO. CUY-42-1843 STA. 65+10.18
Scale: 1/4" = 1'-0" STA. 68+19.03

WILLOW-INNER BELT FREEWAY
CLEVELAND CUYAHOGA COUNTY OHIO

DRAWN BY TRACED BY CHECKED BY REVIEWED BY
DATE 7-24-65 DATE 8-26-65 DATE 11-13-65 SHEET 102

CUYAHOGA COUNTY
CITY OF CLEVELAND
CUY-21-15.32
MICROFILMED CUY-42-18.42
JUL 9 1985

REINFORCEMENT SCHEDULES FOR PIER 1									
MARK	NO.	LENGTH	TYPE	DIMENSIONS				SERIES INCRE-MENT	WEIGHT (POUNDS)
				A	B	C	D		
501	92	5'-11"	105	3'-2"	1'-6"				568
502	50	13'-10"	109	3'-2"	3'-6"				721
503	2	5'-9"	105	3'-0"	1'-6"				12
601	8	25'-9"	5tr.						309
602	6	8'-10"	144	1'-11"	5'-0"				80
801	72	12'-10"	100	10'-2"					2467
802	10	14'-10"	100	12'-2"					396
1001	36	17'-10"	100	14'-2"					2763
1002	12	16'-4"	100	13'-8"					843
1101	14	17'-6"	5tr.						1302
1102	36	12'-0"	5tr.						2295
1103	14	14'-6"	123	5'-10"	5'-10"				1079
1104	14	37'-0"	5tr.						2752
1105	10	14'-0"	5tr.						744
1106	8	14'-6"	5tr.						616
1107	12	26'-6"	5tr.						1690
1108	6	19'-0"	5tr.						606
1109	4	17'-6"	5tr.						372
1110	4	27'-9"	5tr.						590
1111	6	28'-0"	5tr.						893
1112	2	29'-2"	118	11'-0"	14'-0"	3'-1"	3'-1"		310
1113	2	23'-2"	118	3'-6"	15'-6"	3'-1"	3'-1"		244
1114	3	24'-8"	118	3'-6"	17'-0"	3'-1"	3'-1"		393
1115	2	29'-2"	118	11'-6"	13'-8"	2'-10"	2'-10"		310
1116	2	29'-2"	118	10'-6"	14'-8"	2'-10"	2'-10"		310
1117	3	23'-2"	118	3'-6"	15'-8"	2'-10"	2'-10"		369
1118	12	23'-3"	5tr.						1729
1119	12	23'-0"	5tr.						1466
1120	12	25'-6"	5tr.						1626
1121	12	28'-6"	5tr.						1817
1122	12	16'-6"	5tr.						1052
1123	36	20'-3"	5tr.						3873
1124	36	11'-5"	104	10'-3"	1'-6"				2184
1125	108	7'-11"	104	6'-9"	1'-6"				4543
1126	2	19'-3"	5tr.						205
1127	2	24'-2"	118	3'-6"	16'-8"	2'-10"	2'-10"		257
								Total	41,788



SPIRAL REINFORCEMENT SCHEDULE						
MARK	NO.	CORE DIA. % SPIRAL	LENGTH	PITCH	NO. OF TURNS	WEIGHT (POUNDS)
401	1	3'-2"	19'-10"	4"	62	461
402	1	3'-2"	19'-4"	4"	61	454
403	1	3'-2"	21'-3"	4"	67	498
404	1	3'-2"	24'-10"	4"	78	580
405	1	3'-2"	29'-10"	4"	92	685
406	1	3'-2"	33'-3"	4"	103	767
					Total	3,445

NOTE:
All bar dimensions are given out to out.


REINFORCEMENT SCHEDULES FOR PIER 2									
MARK	NO.	LENGTH	TYPE	DIMENSIONS				SERIES INCRE-MENT	WEIGHT (POUNDS)
				A	B	C	D		
501	63	14'-7"	109	3'-2"	3'-11"				958
502	92	5'-11"	105	3'-2"	1'-6"				568
503	2	5'-9"	105	3'-0"	1'-6"				12
601	4	29'-6"	5tr.						177
602	4	29'-3"	5tr.						176
603	6	8'-10"	144	1'-11"	5'-0"				80
801	68	12'-2"	100	10'-0"					2209
802	8	14'-2"	100	12'-0"					303
1001	24	16'-4"	100	13'-6"					1487
1002	36	16'-10"	100	14'-0"					2608
1101	12	23'-6"	5tr.						1498
1102	6	22'-3"	5tr.						709
1103	7	35'-6"	5tr.						1320
1104	7	36'-0"	5tr.						1339
1105	14	26'-0"	5tr.						1934
1106	14	14'-6"	123	5'-10"	5'-10"				1079
1107	10	30'-9"	5tr.						1634
1108	4	31'-3"	5tr.						664
1109	8	14'-0"	5tr.						595
1110	4	32'-0"	118	12'-0"	15'-11"	3'-1"	3'-1"		680
1111	2	32'-5"	118	10'-6"	17'-7"	3'-4"	3'-4"		344
1112	5	26'-6"	118	3'-6"	18'-11"	3'-1"	3'-1"		704
1113	2	28'-0"	118	3'-6"	20'-5"	3'-1"	3'-1"		298
1114	12	23'-3"	5tr.						1482
1115	12	21'-3"	5tr.						1355
1116	12	18'-9"	5tr.						1195
1117	4	30'-3"	5tr.						643
1118	4	29'-0"	5tr.						616
1119	12	19'-3"	5tr.						1227
1120	7	19'-0"	5tr.						707
1121	12	26'-6"	5tr.						1690
1122	2	32'-0"	118	11'-0"	16'-11"	3'-1"	3'-1"		340
1123	3	32'-5"	118	10'-0"	17'-11"	3'-4"	3'-4"		517
1124	12	20'-3"	5tr.						1291
1125	2	27'-6"	118	3'-6"	19'-11"	3'-1"	3'-1"		292
1126	38	12'-0"	5tr.						2423
1127	5	16'-0"	5tr.						425
1128	5	15'-6"	5tr.						412
1129	108	8'-0"	104	6'-9"	1'-6"				4590
1130	12	10'-6"	104	9'-3"	1'-6"				669
1131	36	11'-6"	104	10'-3"	1'-6"				2200
1132	12	20'-0"	5tr.						1275
								Total	44,925

SPIRAL REINFORCEMENT SCHEDULE						
MARK	NO.	CORE DIA. % SPIRAL	LENGTH	PITCH	NO. OF TURNS	WEIGHT (POUNDS)
401	1	3'-2"	37'-5"	4"	115	859
402	1	3'-2"	31'-5"	4"	97	724
403	1	3'-2"	22'-5"	4"	70	522
404	1	3'-2"	16'-0"	4"	61	380
405	1	3'-2"	15'-6"	4"	49	365
406	1	3'-2"	19'-5"	4"	61	455
					Total	3,305

Note: Prefixes shall be assigned to bar marks as follows:
Pier 1 "PA"
Pier 2 "PB"

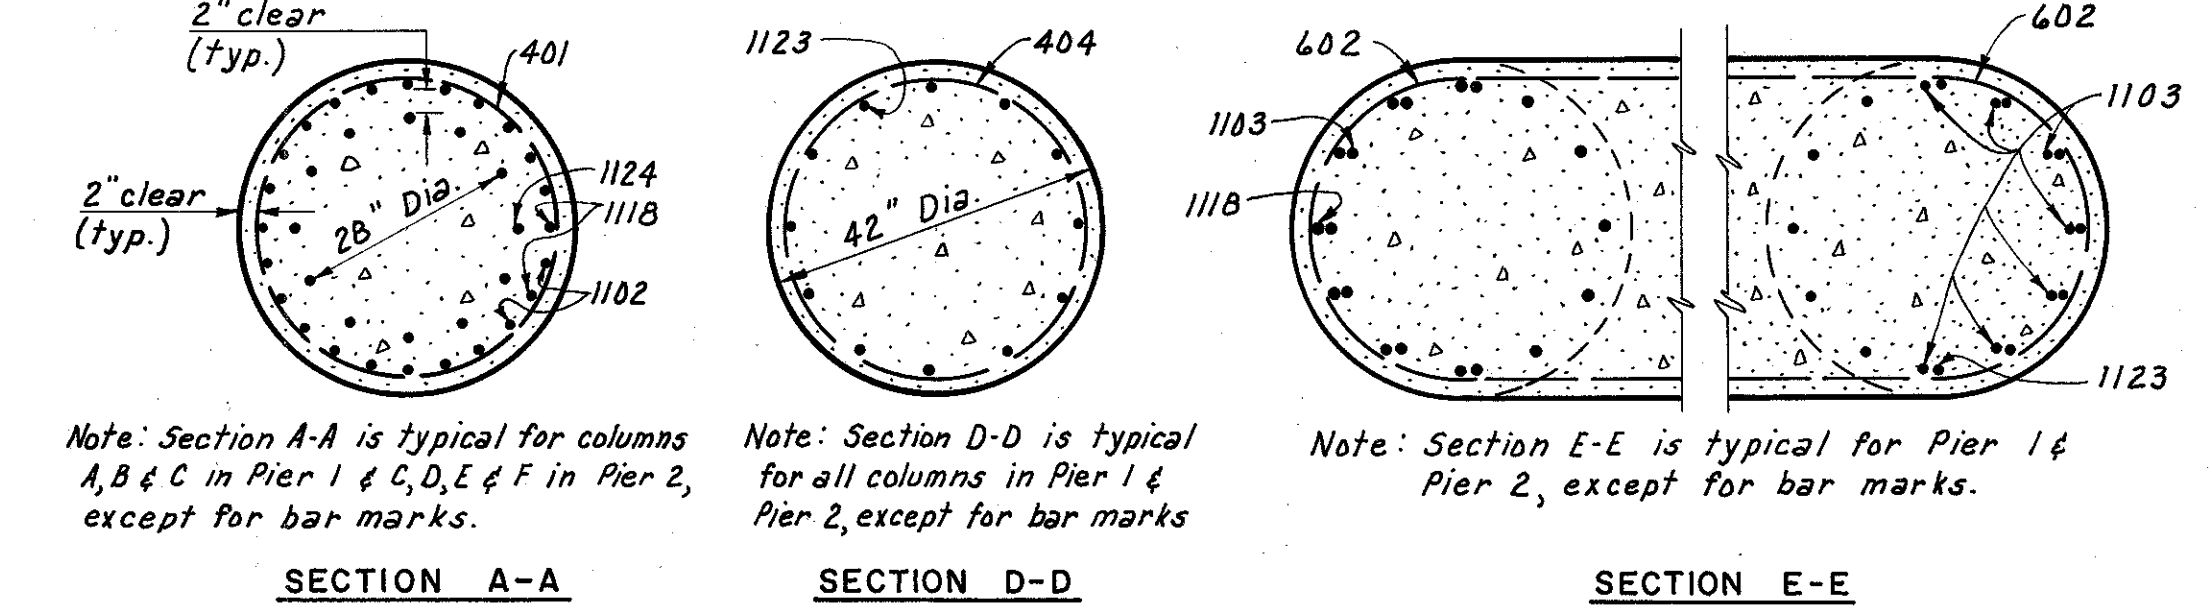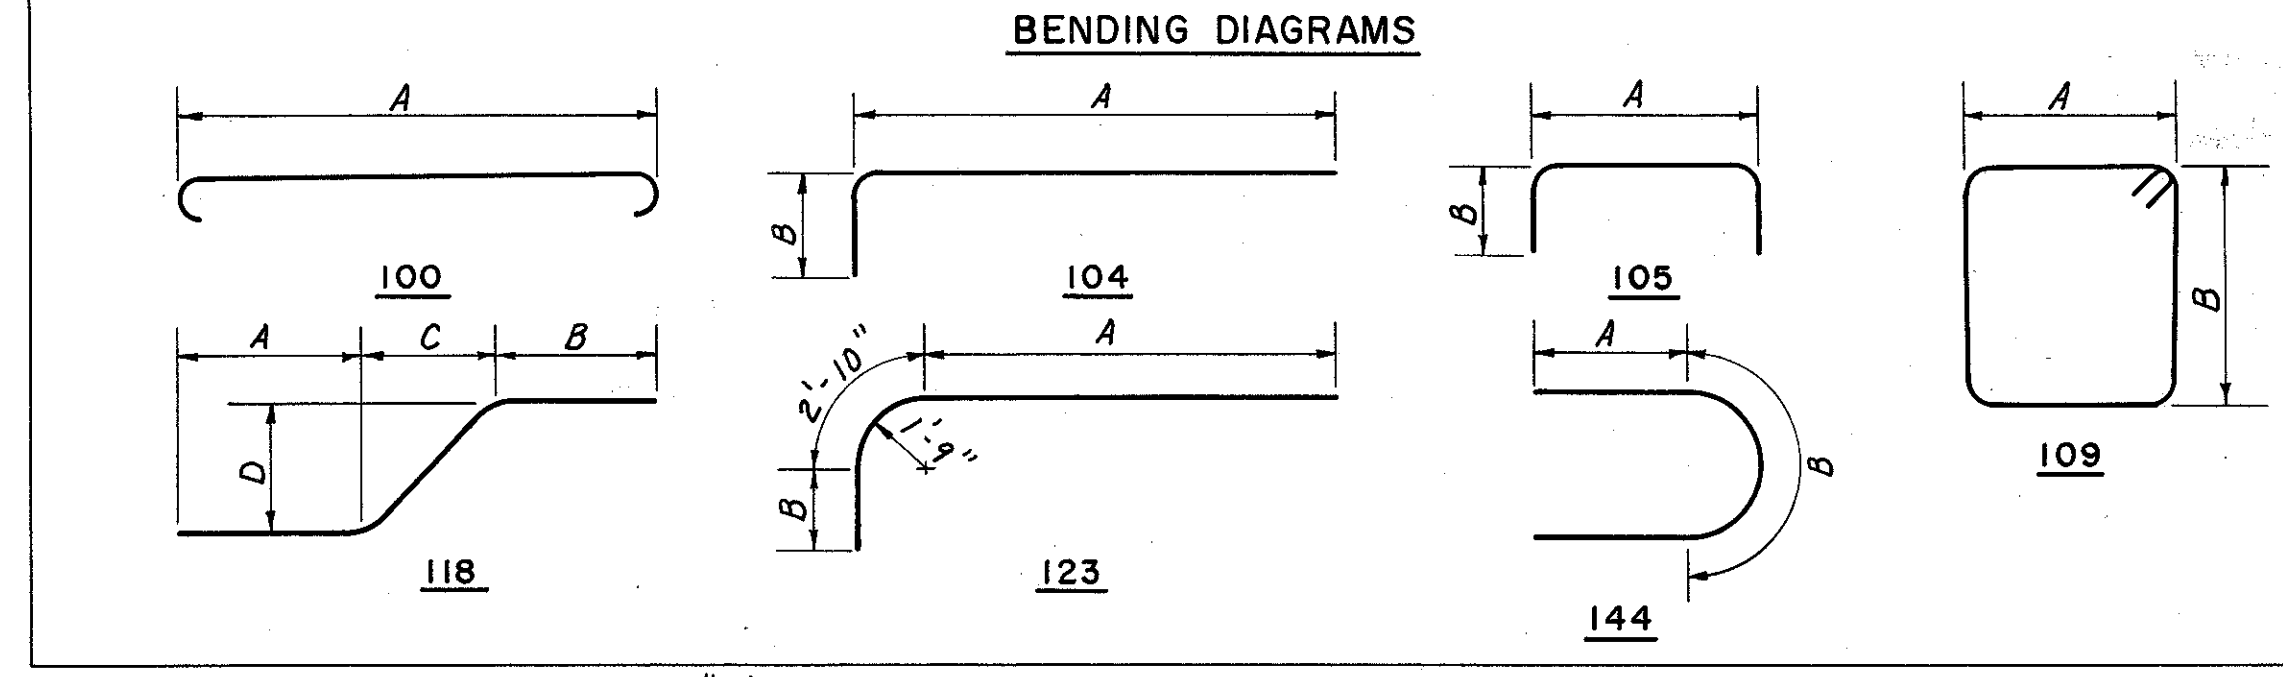

Note: Section A-A is typical for columns A, B & C in Pier 1 & C, D, E & F in Pier 2, except for bar marks.
Note: Section D-D is typical for all columns in Pier 1 & Pier 2, except for bar marks.
Note: Section E-E is typical for Pier 1 & Pier 2, except for bar marks.

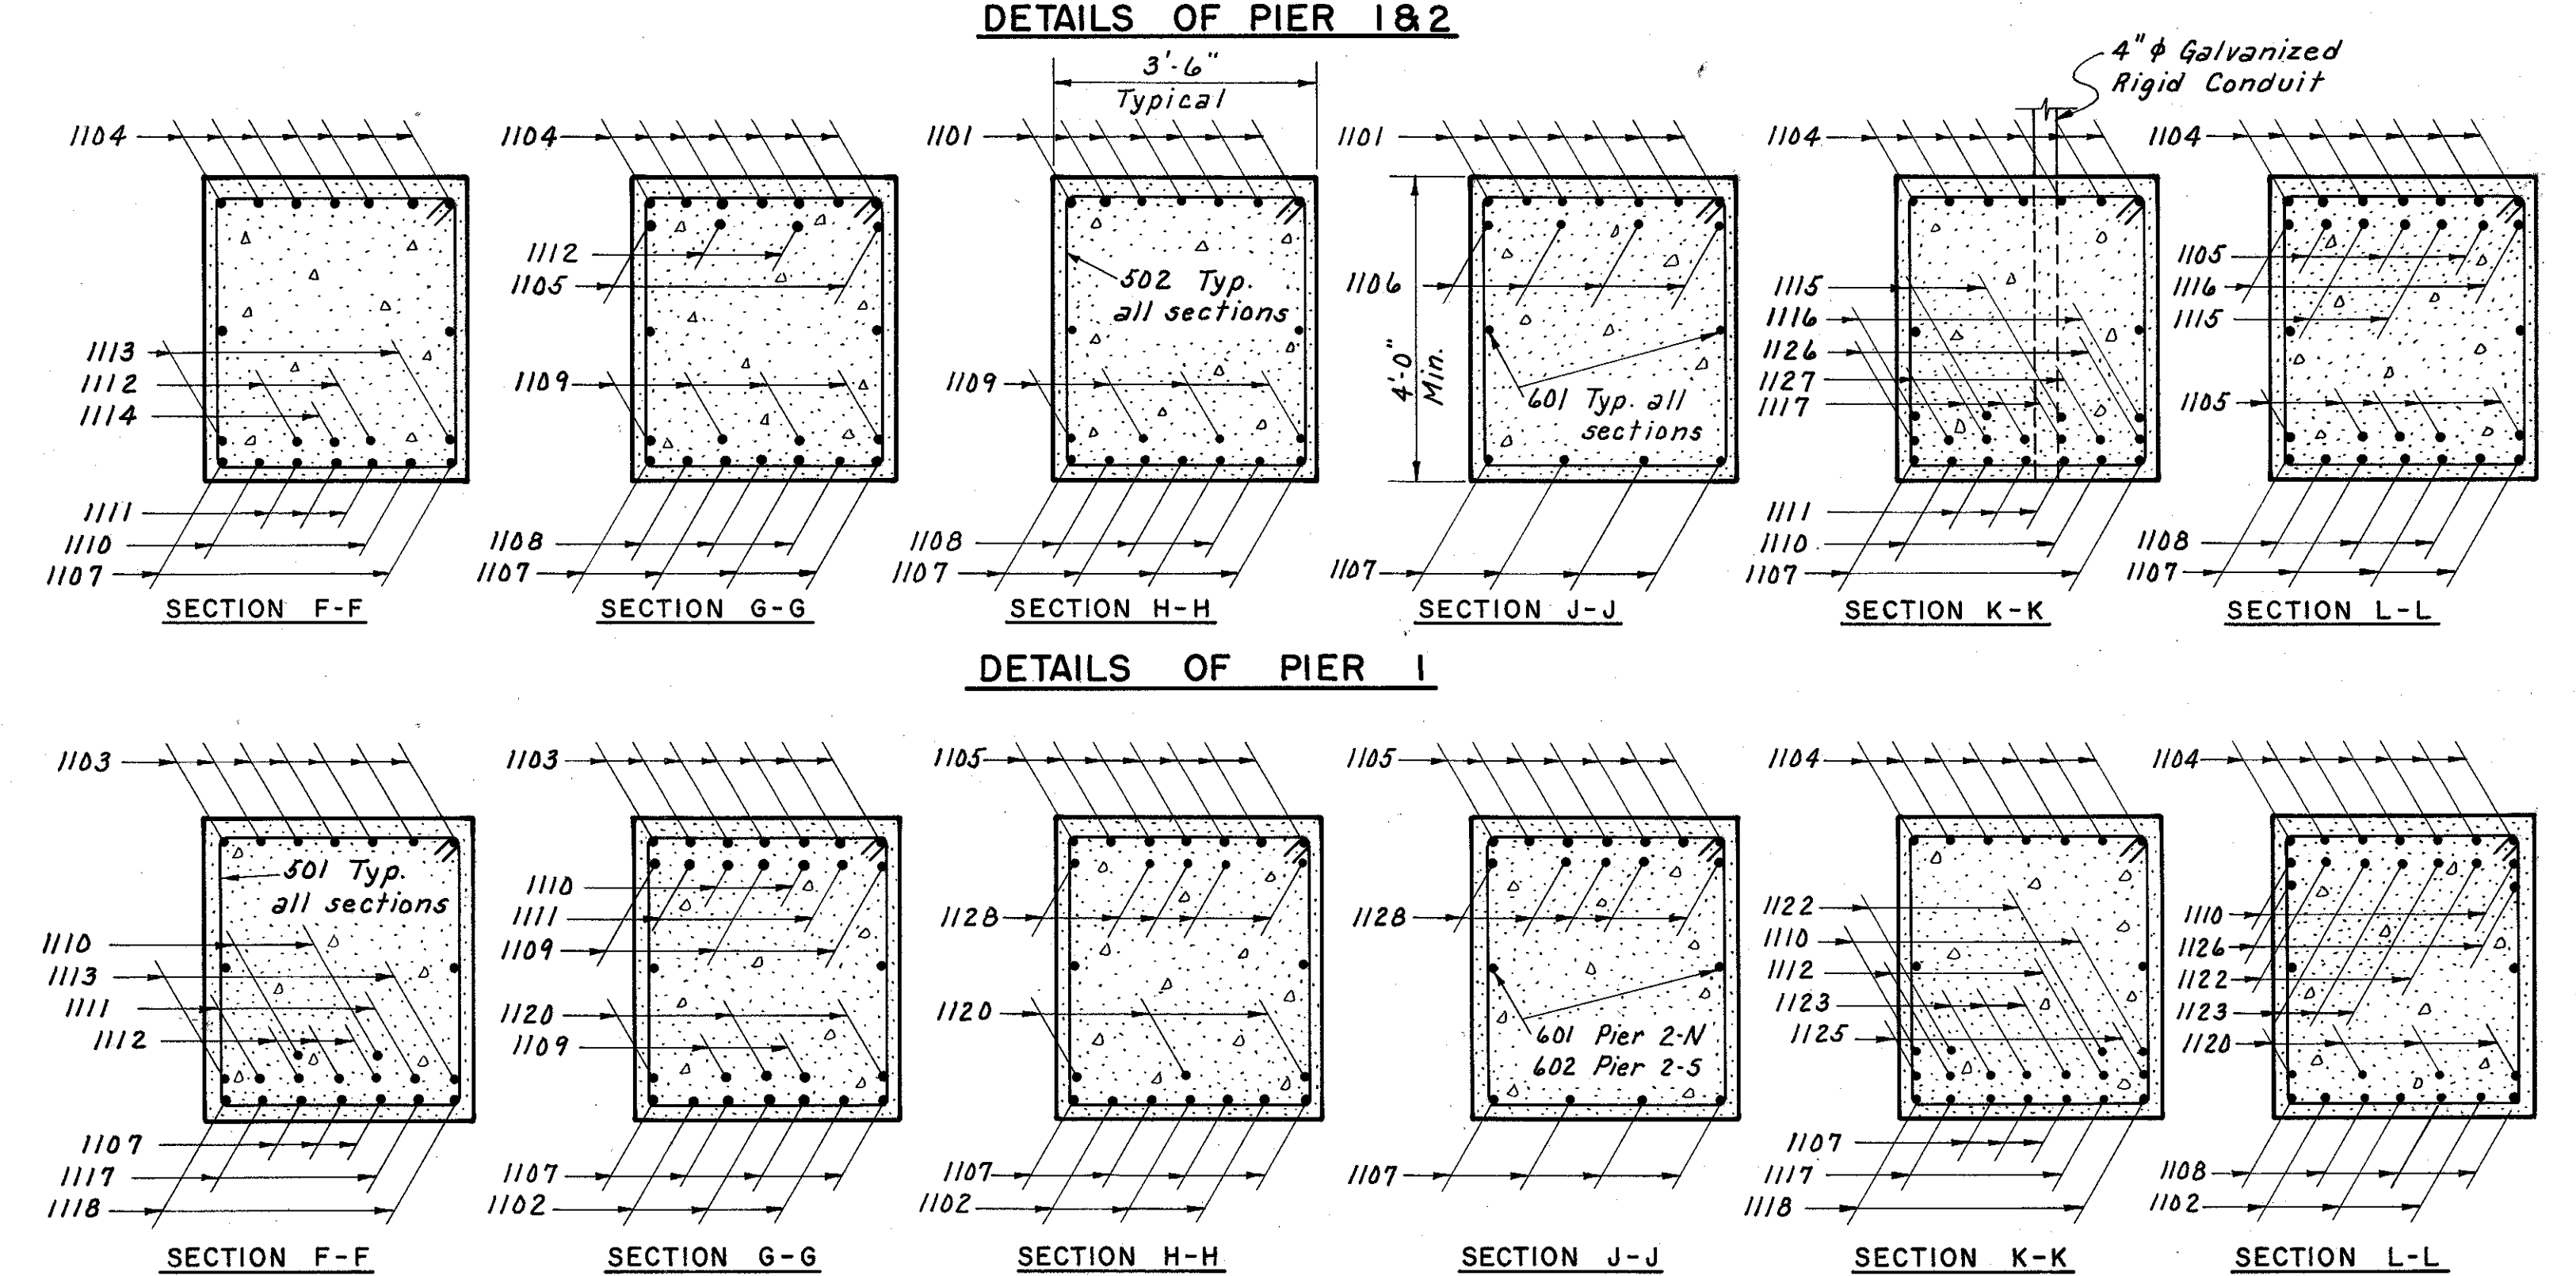

DETAILS OF PIER 2

SPIRAL REINFORCING BARS:
The "length" shown in the reinforcement schedule for the spiral bars is the distance from the top of the footing to the bottom of the pier cap.
The "No. of Turns" shown is the "length" divided by the pitch, plus 3 turns (total number of closed coils), expressed as the nearest whole number.
Spiral reinforcing bars shall not have deformations, but shall in other respects conform to Item S-4.
1/2 closed coils shall be provided at the ends of each spiral unit.
Four steel channel, tee or angle spacers, weighing approximately 0.68 lb. per lin. ft. of spacer, shall be provided for each spiral unit. They shall be equally spaced along the periphery of the coil. The number of pounds of these spacers, based on 0.68 lb. per lin. ft., will be paid for as reinforcing steel and is included in the tabulated quantity of spiral bars.

REPLACEMENT REINFORCEMENT SCHEDULE			
SIZE	NO.	LENGTH	TYPE
4	2	5'-3"	5tr.
5	24	5'-9"	5tr.
6	51	6'-0"	5tr.
7	4	6'-3"	5tr.
8	1	6'-6"	5tr.
9	1	7'-0"	5tr.
10	1	7'-3"	5tr.
11	4	7'-6"	5tr.




Replacement bars are listed for the entire contract.

H.N.T.B. BR. NO. 3 PART 7A
HOWARD, NEEDLES, TAMMEN & BERGENOFF
CONSULTING ENGINEERS
CLEVELAND NEW YORK
PIER DETAILS
INNER BELT FREEWAY OVER
RAMPS E-8, E-10 AND E-16
BR. NO. CUY-42-1843 STA. 65+10.18
Scale: 1/2"=1'-0" STA. 68+19.03
WILLOW-INNER BELT FREEWAY
CLEVELAND CUYAHOGA COUNTY OHIO
DRAWN A.L. TRACED A.E.K. CHECKED D.R.M. REVIEWED J.C.T.
DATE 7-23-58 DATE 5-6-59 DATE 9-9-58 DATE 11-13-59 SHEET 103

MICROFILMED
JUL 8 1985

CUYAHOGA COUNTY
CITY OF CLEVELAND
CUY-21-15.32
CUY-42-18.42

Note: Prefix "AA" shall be assigned to all bar marks.

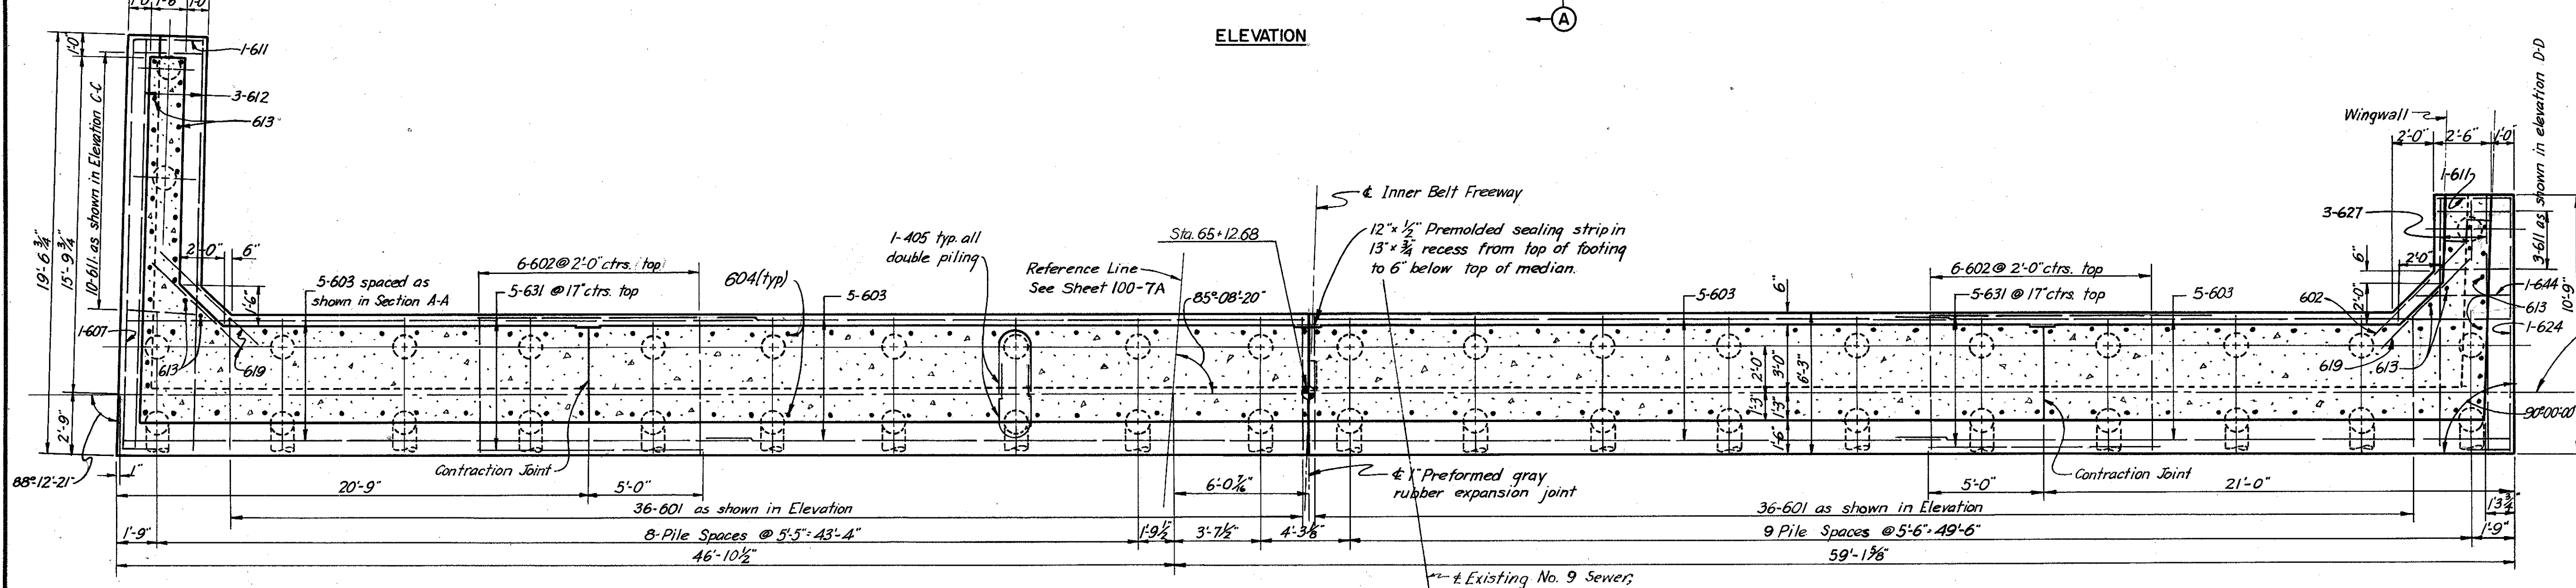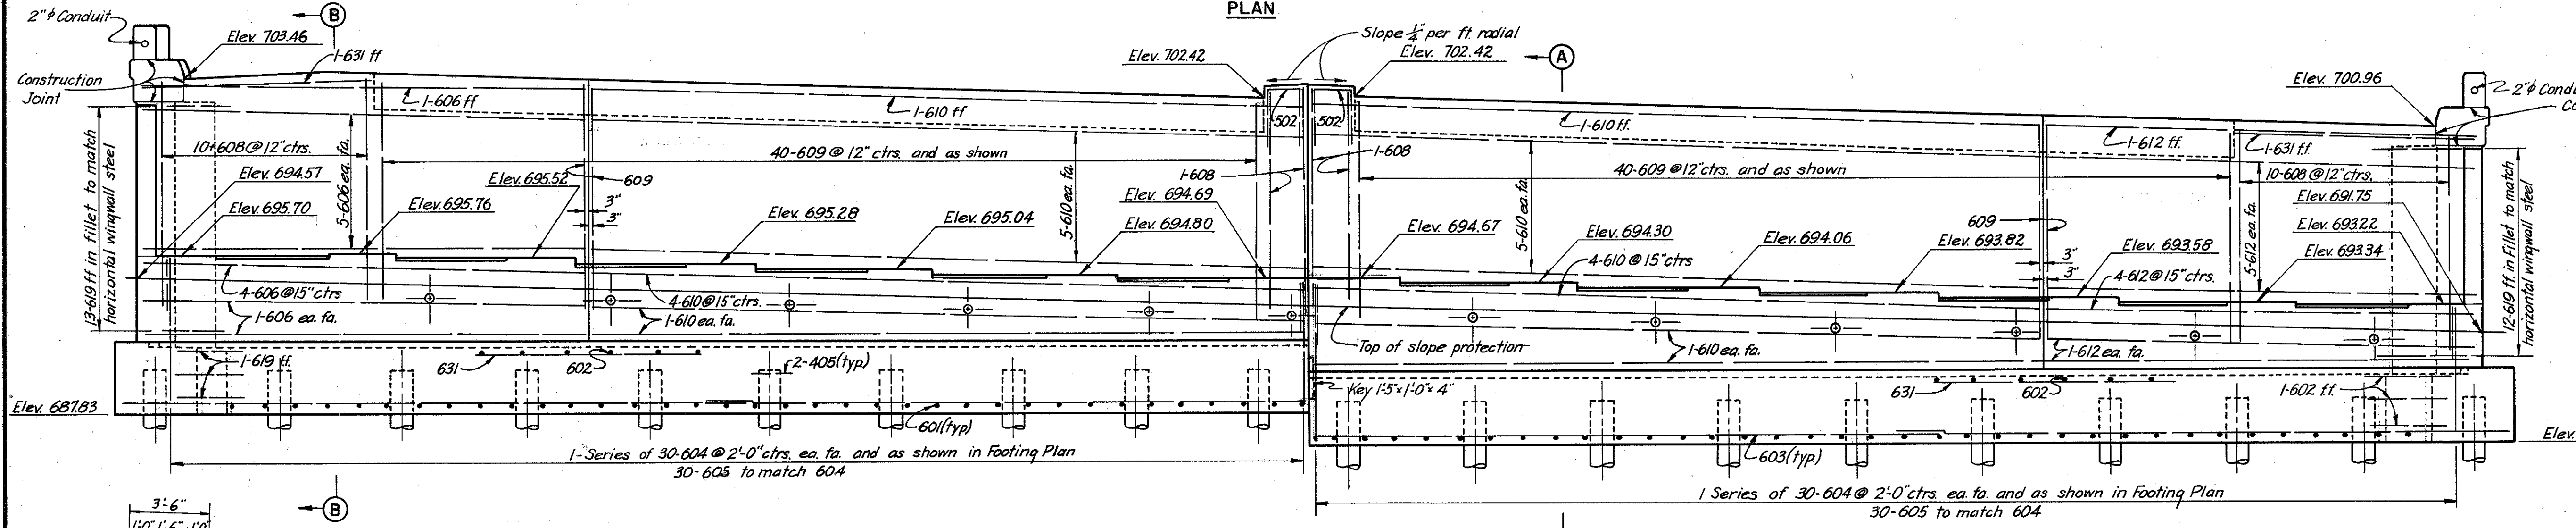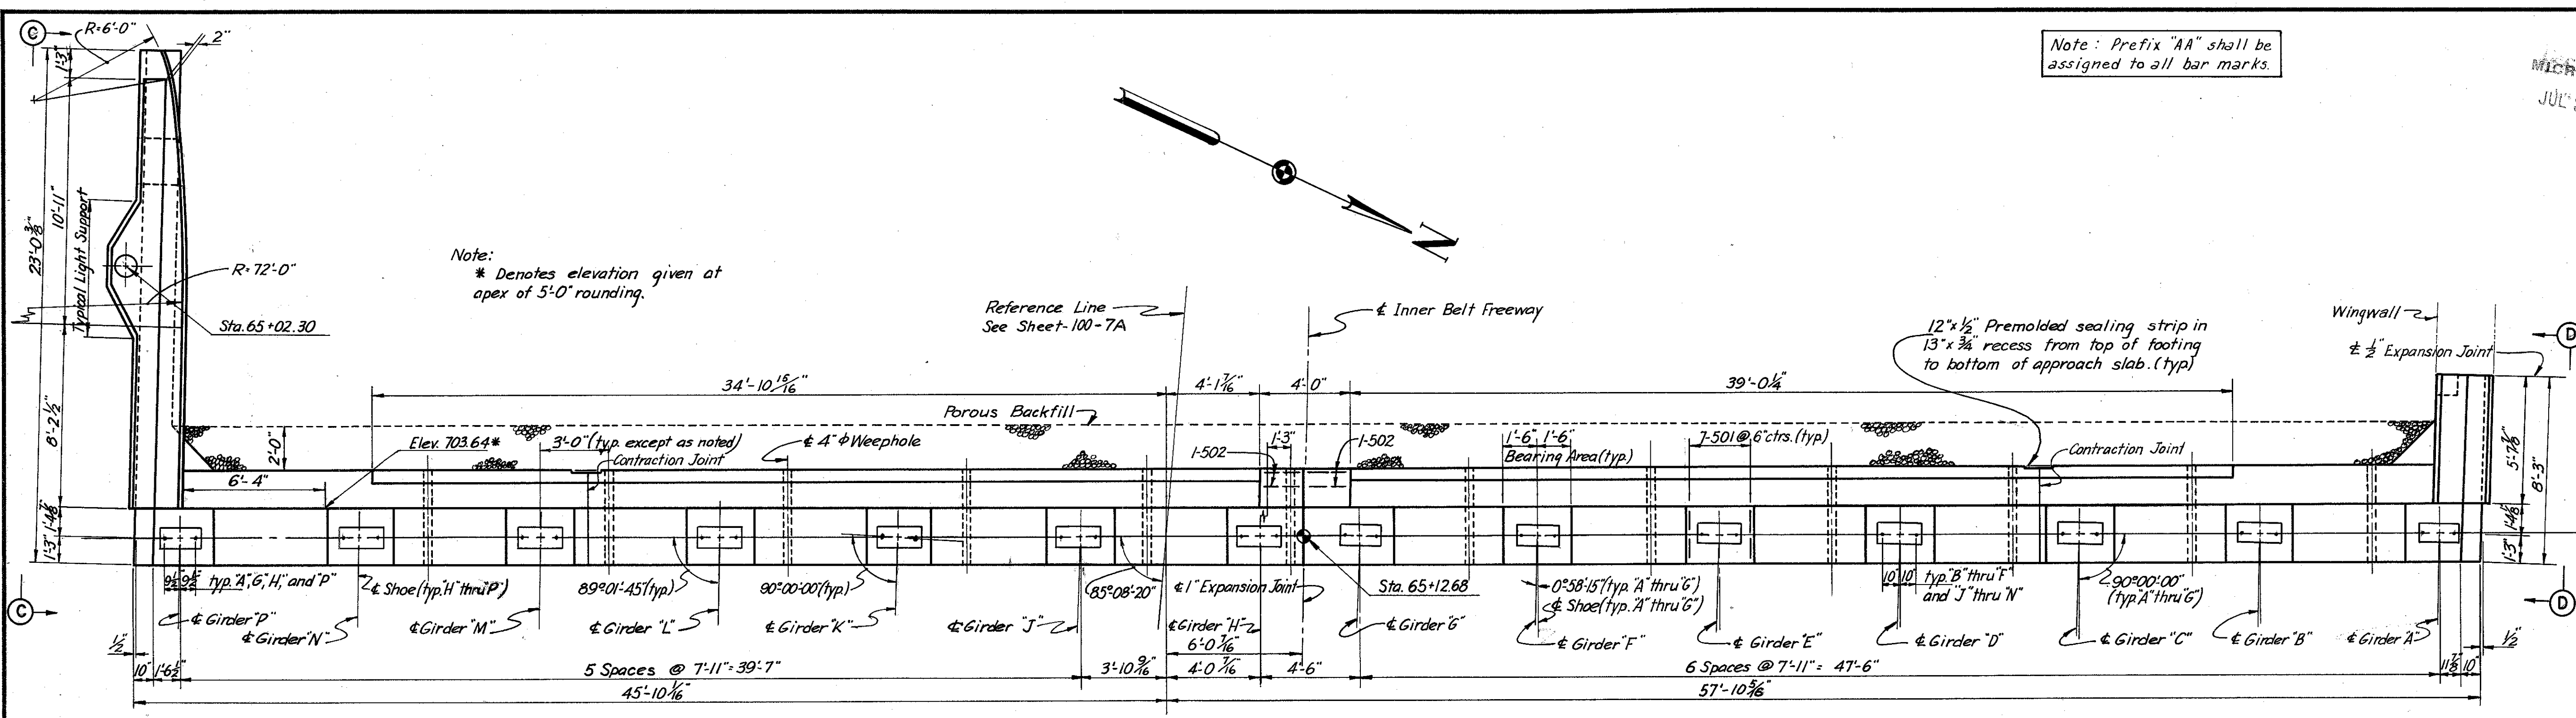

Note: For sections and additional notes, See Sheet 105-7A

H.N.T.B. BR. NO. 3 PART 7A

HOWARD, NEEDLES, TAMMEN & BERGENDOFF
CONSULTING ENGINEERS
KANSAS CITY CLEVELAND NEW YORK

WEST ABUTMENT
INNERBELT FREEWAY OVER
RAMPS E-8, E-10 AND E-16








BR. NO. CUY-42-1843 STA. 65+10.18
Scale: 1/4"=1'-0" STA. 68+19.03

WILLOW-INNER BELT FREEWAY
CLEVELAND CUYAHOGA COUNTY OHIO

DRAWN BY: TRACED BY: CHECKED BY: REVIEWED BY: REVISIONS

DATE 7-26-58 DATE 3-16-59 DATE 2-20-59 DATE 11-13-59 SHEET 104

REINFORCEMENT SCHEDULE									
MARK	NO.	LENGTH	TYPE	DIMENSIONS				SERIES INCREMENT	WEIGHT (LBS.)
				A	B	C	D		
401	32	6'-7"	154	1'-4"	1'-10"	1'-4"	1'-8"		141
402	2Series 6	6'-4" to 6'-7"	154	1'-4"	1'-10"	1'-4"	1'-8"	1'-8"	51
403	2Series 6	4'-7" to 5'-11"	154	1'-4"	1'-10"	1'-4"	1'-8"	3'-2"	42
404	41	5'-7"	105	8"	2'-7"				153
405	42	6'-4"	144	2'-3"	1'-10"				178
*451	4	8'-11"	131	2'-6"	1'-2"				24
*452	4	9'-11"	131	3'-0"	1'-8"				26
*453	6	9'-5"	131	3'-2"	1'-0"				38
*454	4	5'-7"	155	2'-2"					14
*455	4	6'-1"	155	2'-8"					16
*456	6	6'-3"	155	2'-10"					26
501	98	5'-1"	105	2'-2"	1'-7"				520
502	4	5'-5"	105	1'-8"	2'-0"				23
601	72	7'-3"	100	5'-11"					784
602	15	5'-9"	Str.						130
603	20	2'-6"	Str.						826
604	4Series 30	6'-3" to 7'-8"	104	5'-7" to 7'-0"	10"			8"	1254
605	60	7'-5"	105	3'-11"	1'-11"			8"	668
606	19	19'-3"	Str.						549
607	1	20'-9"	104	19'-0"	1'-11"				31
608	24	22'-6"	154	9'-6"	1'-5"	9'-6"	1'-4"		811
609	80	23'-8"	112	10"	1'-5"	8'-2"	9'-6"		2844
610	38	3'-9"	Str.						1812
611	15	4'-6"	100	3'-2"					101
612	25	19'-0"	Str.						713
613	37	5'-6"	104	4'-10"	10"				306
614	5	18'-5"	104	16'-8"	1'-11"				138
615	3	22'-6"	Str.						101
616	5	16'-6"	Str.						124
617	3	20'-0"	Str.						90
618	31	12'-9"	Str.						594
619	30	6'-9"	Str.						304
620	6	11'-3"	Str.						101
621	14	3'-9"	Str.						79
622	20	4'-3"	Str.						128
623	3	20'-0"	133	12'-0"	8'-0"				90
624	1	12'-0"	104	10'-3"	1'-11"				18
*625	6	25'-6"	Str.						—
626	4	7'-0"	100	5'-8"					42
627	3	10'-3"	Str.						46
628	4	12'-11"	127	7'-11"	8"	1'-11"	2'-11"		78
629	8	11'-2"	126	7'-11"	8"	2'-11"			134
630	6	5'-3"	Str.						47
631	20	10'-0"	Str.						300
632	13	11'-9"	Str.						229
633	3	26'-10"	133	12'-0"	14'-10"				121
634	4	3'-8"	105	8"	1'-8"				22
635	21	4'-3"	104	2'-9"	1'-8"				134
636	9	7'-7"	149	2'-9"	7"	1'-8"	3'-0"		103
637	4	4'-0"	100	2'-8"					24
638	9	26'-9"	Str.						362
639	2Series 5	6'-0" to 18'-9"	Str.					3'-2"	186
640	2Series 10	5'-6" to 10'-0"	Str.					6"	233
*641	6	18'-9"	Str.						—
642	6	8'-11"	104	8'-3"	10"				80
*643	6	5'-3"	Str.						—
644	1	5'-6"	100	4'-2"					8
*651	4	9'-5"	141	2'-11"	1'-10"				56
*652	6	14'-6"	141	5'-3"	3'-0"				130
*653	2	5'-0"	Str.						16
801	2	25'-0"	Str.						134
Total									16,933

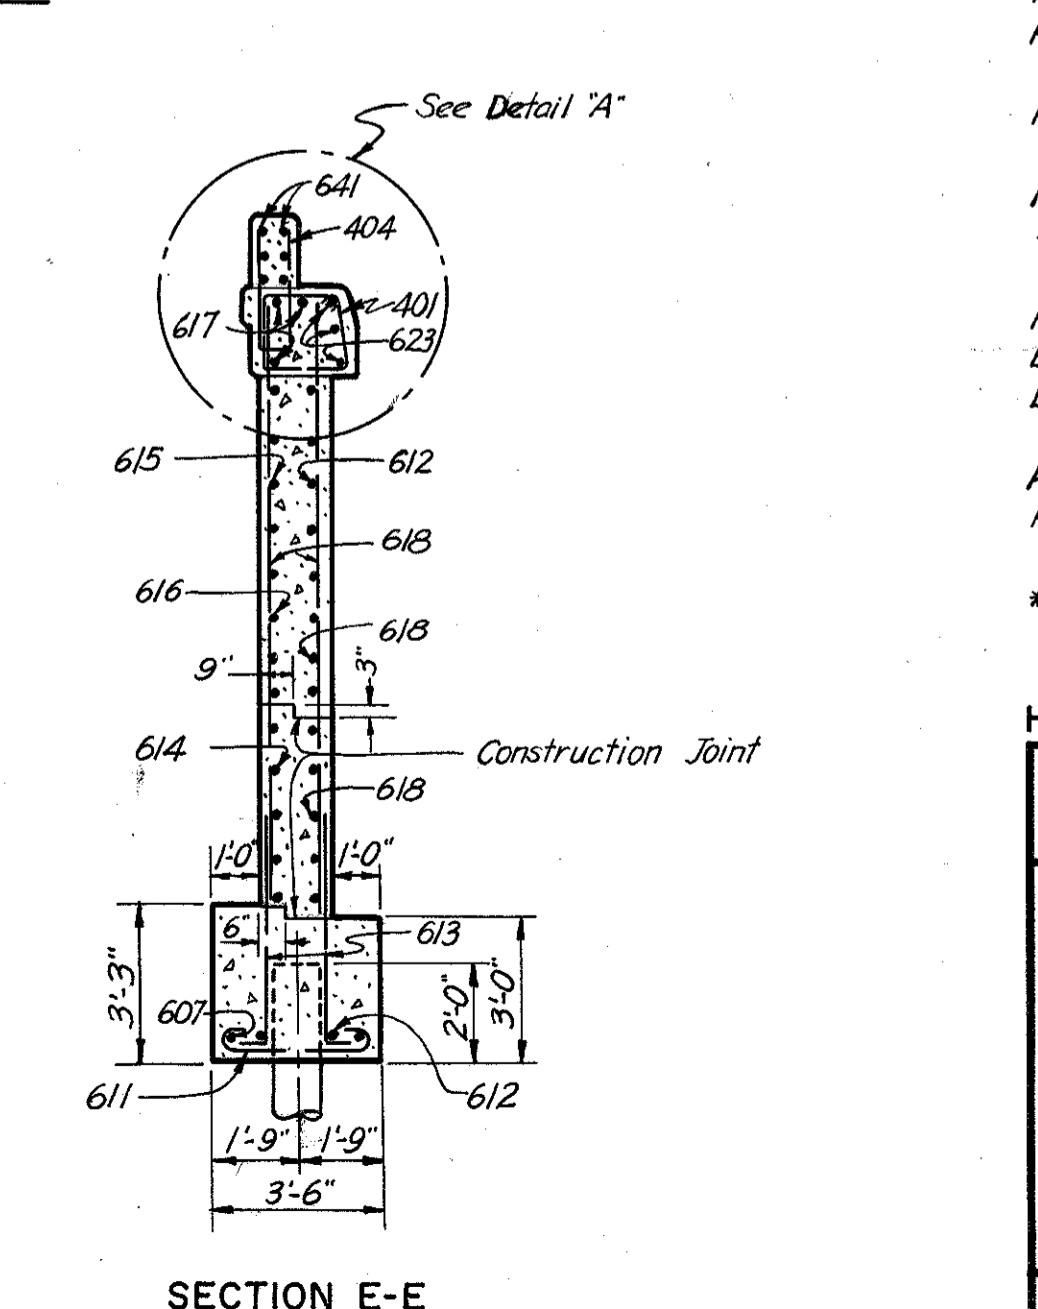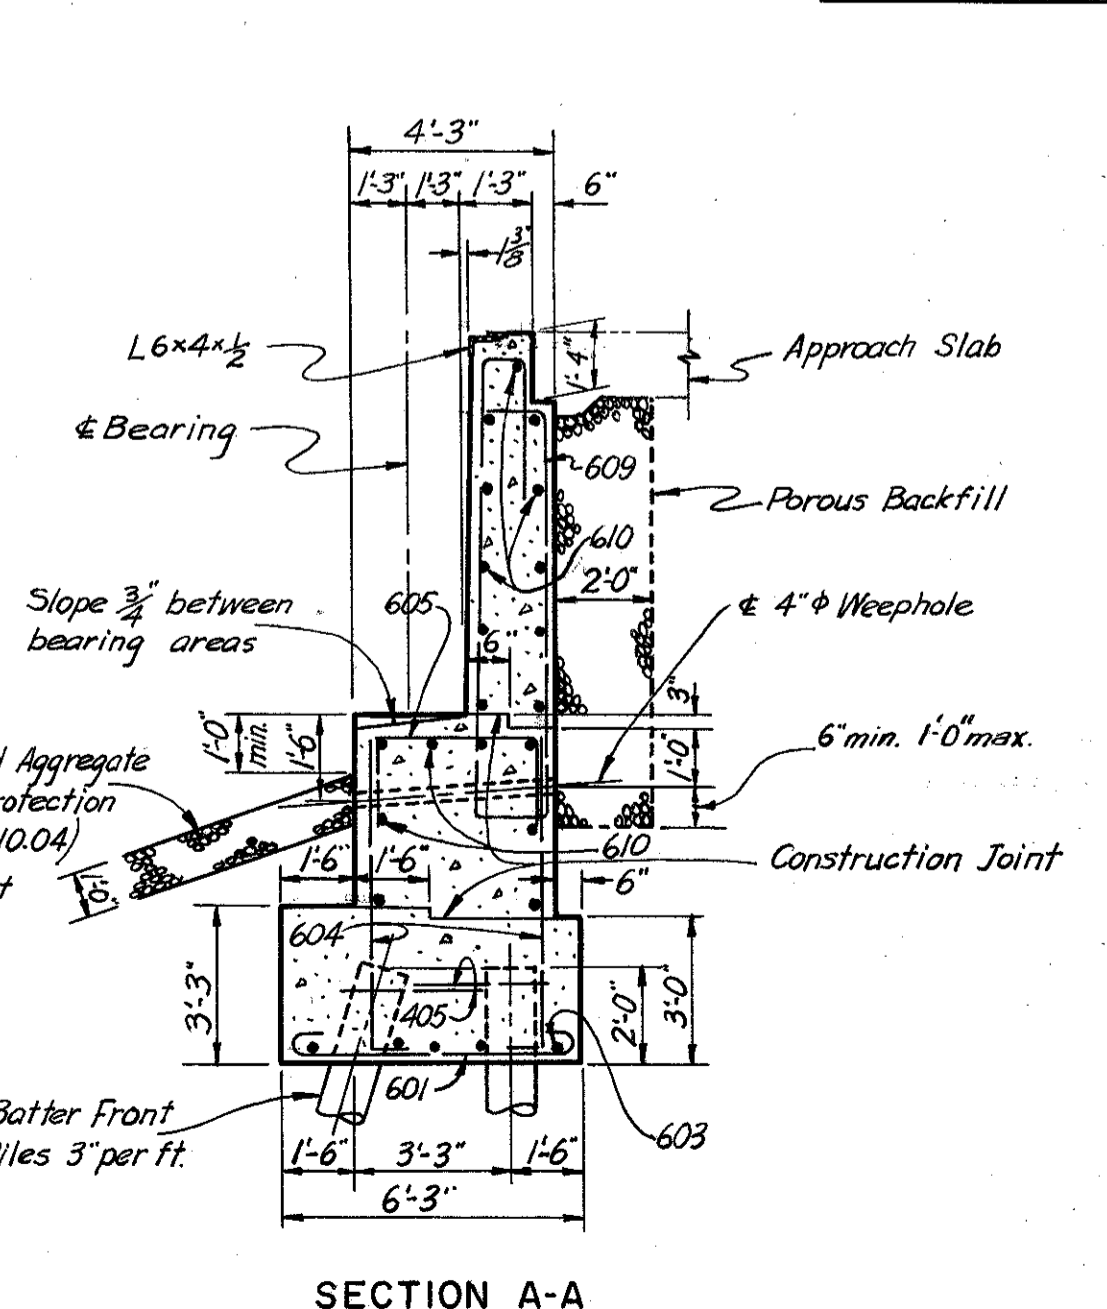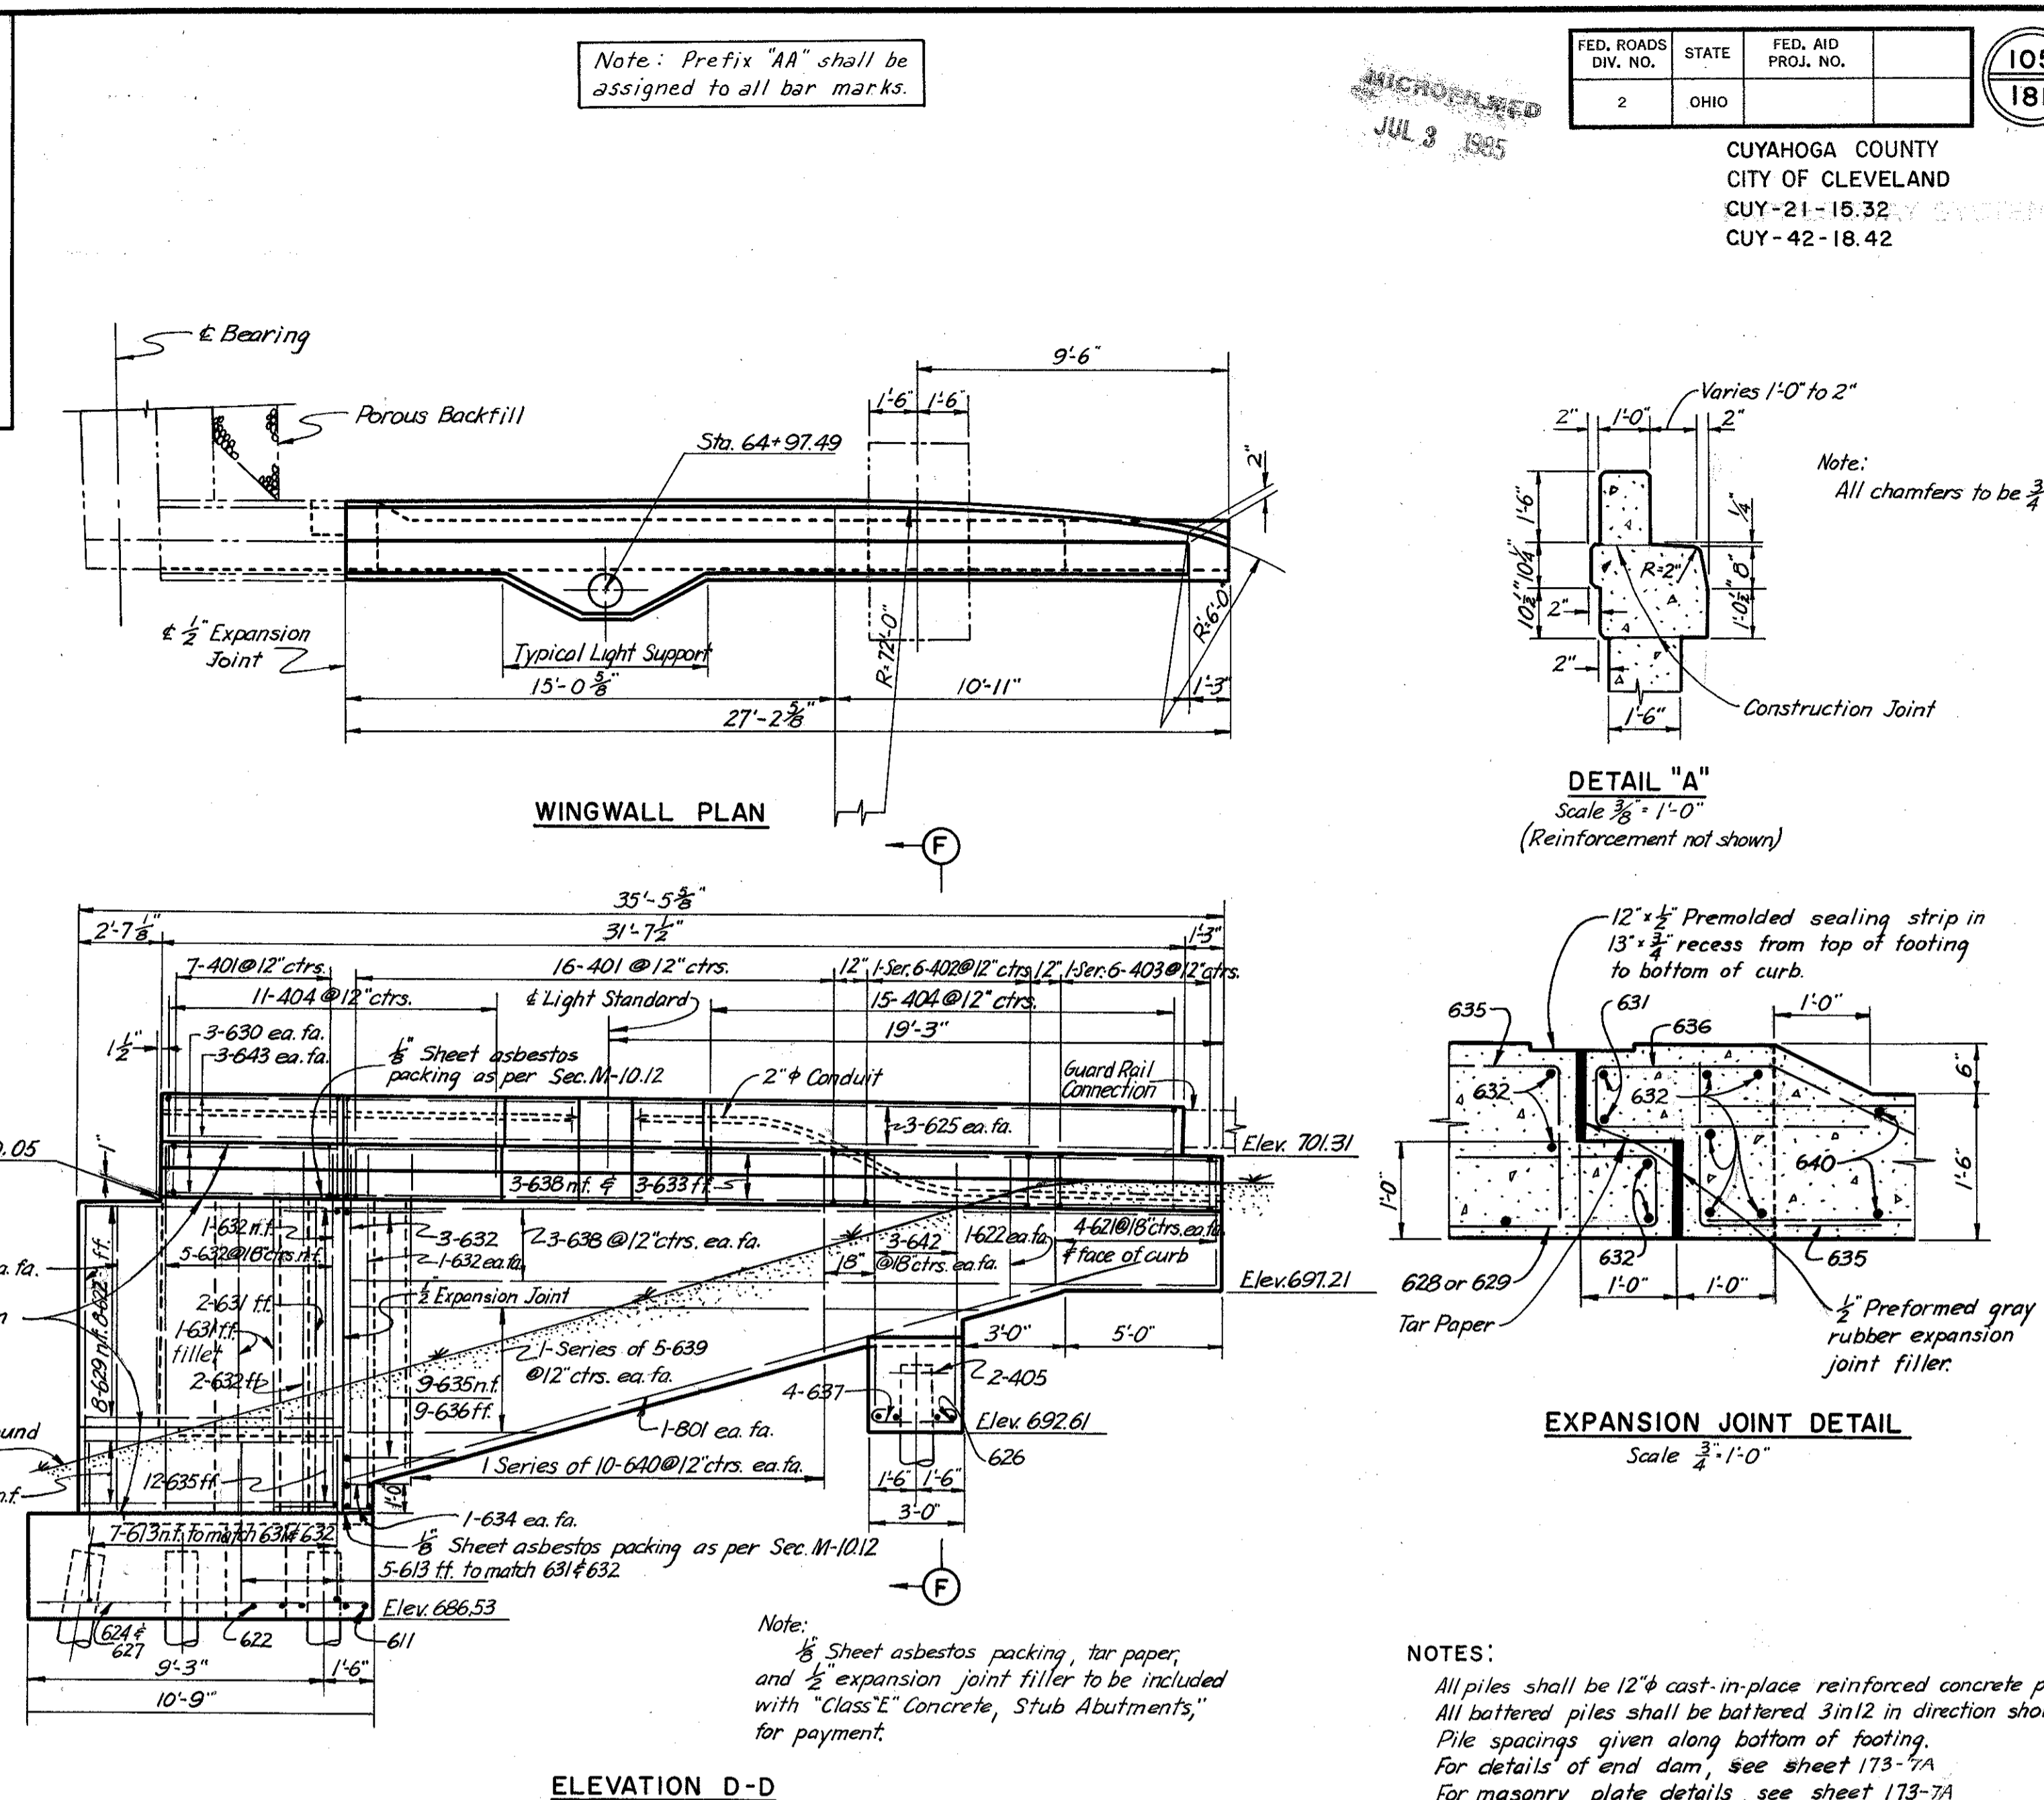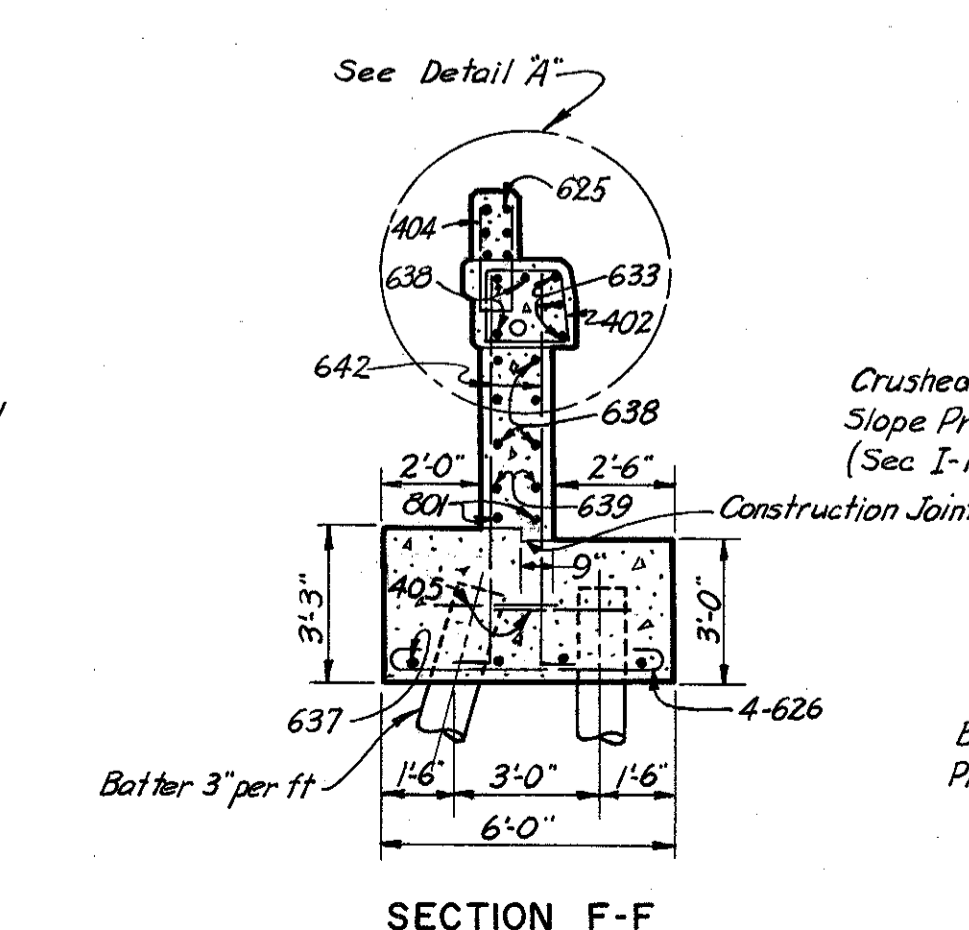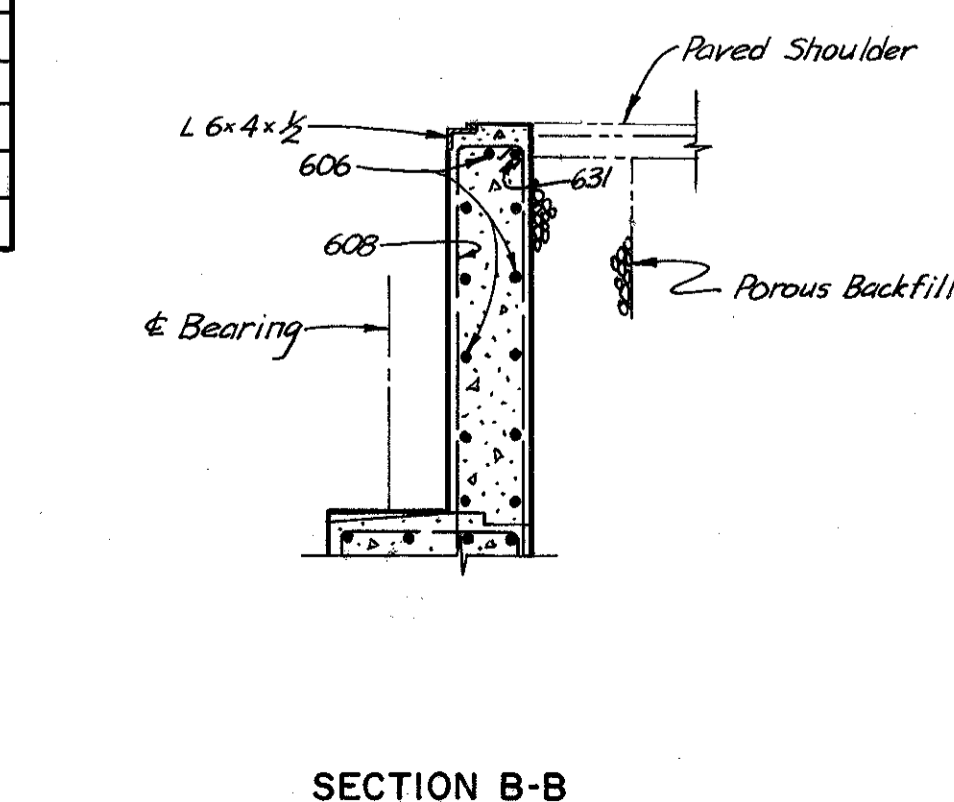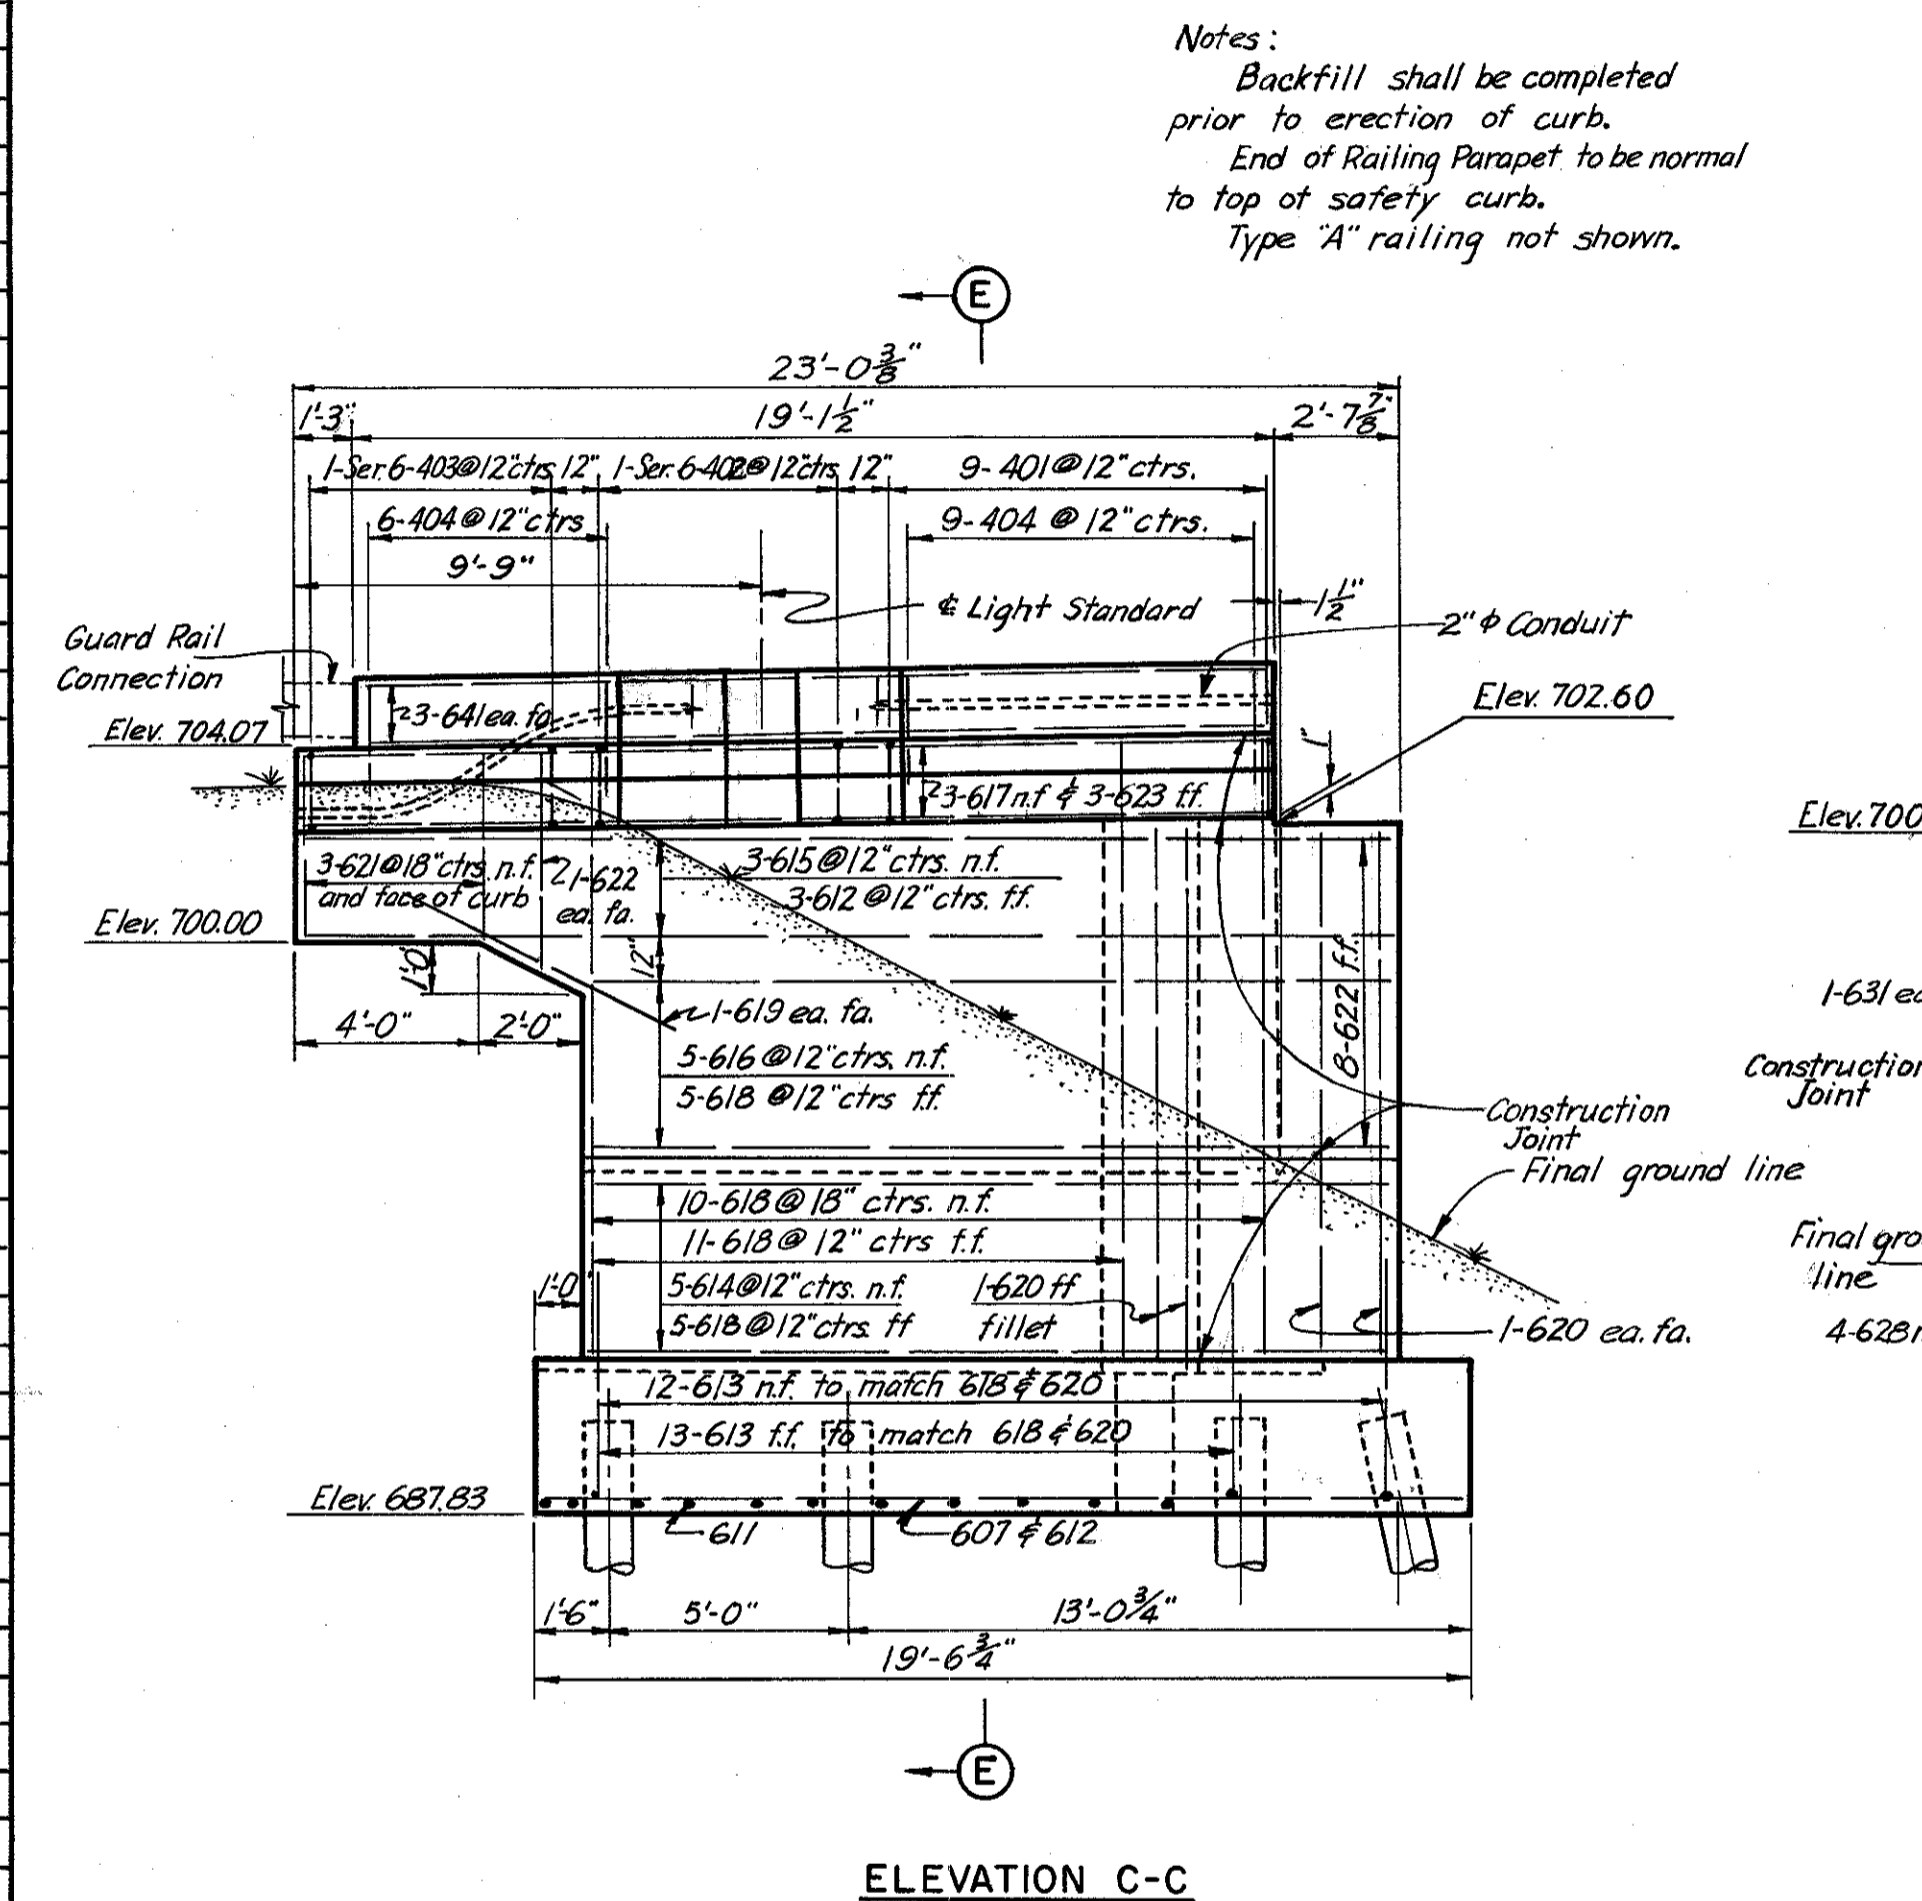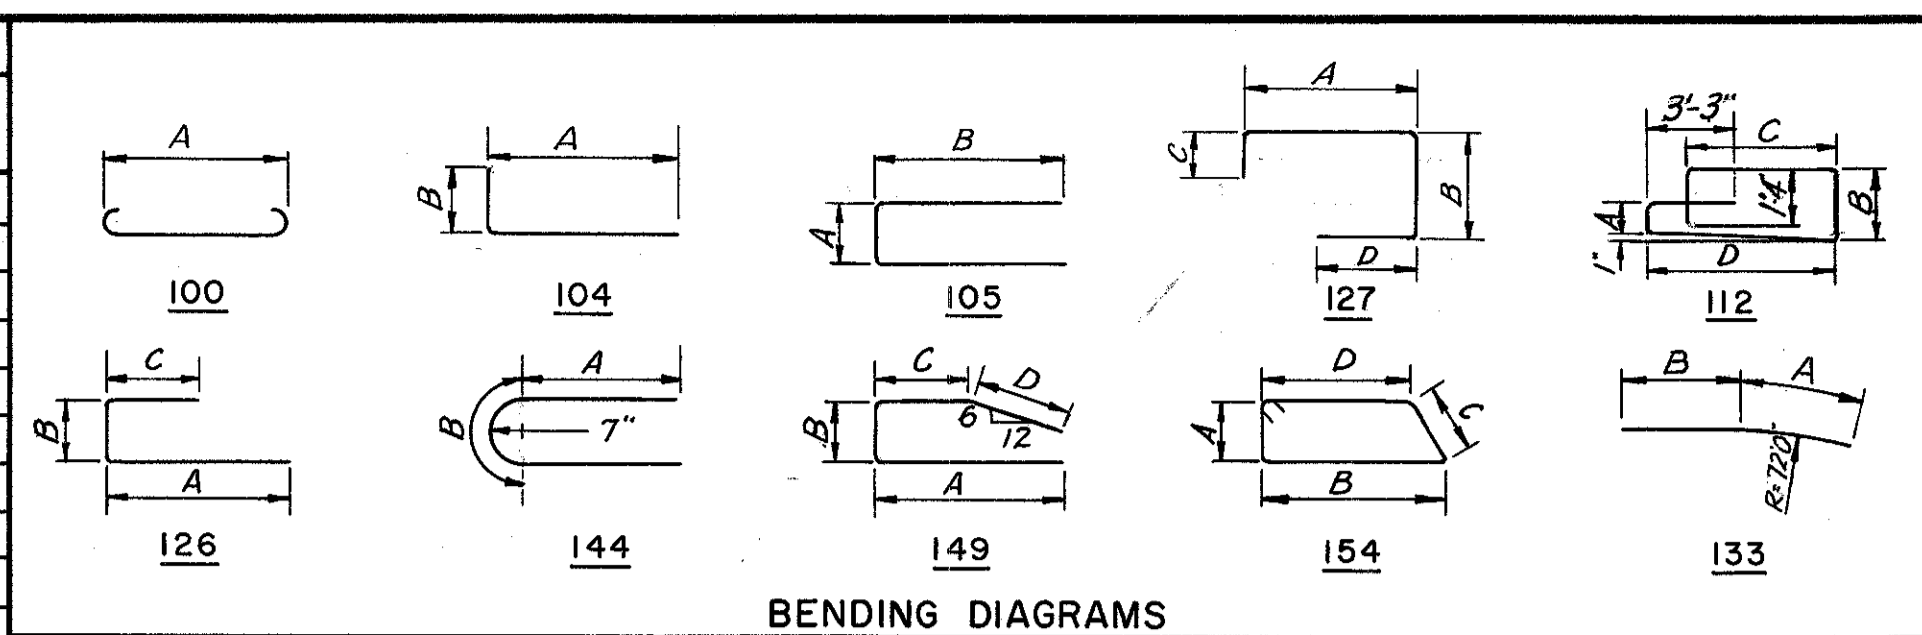

FED. ROADS DIV. NO. 2

STATE OHIO

FED. AID PROJ. NO.

105

181

CUYAHOGA COUNTY

CITY OF CLEVELAND

CUY-21-15.32

CUY-42-18.42

JUL 3 1965

DETAIL "A"
Scale $\frac{3}{8}$ " = 1'-0"

EXPANSION JOINT DETAIL
Scale $\frac{3}{4}$ " = 1'-0"

NOTES:

All piles shall be 12" cast-in-place reinforced concrete piles. All battered piles shall be battered 3in/2 in direction shown. Pile spacings given along bottom of footing. For details of end dam, see sheet 173-7A. For masonry plate details, see sheet 173-7A. For Railing Post spacing, details of Railing and Guard Rail Connection, see sheet 175-7A. Reinforcement bars shall be 3 inches clear from bottom of footings and 2 inches elsewhere. n.f. = near face; f.f. = far face; ea.fa. = each face. # Bars 625, 641, and 643 are included for payment with "Item S-14, Railing". For Slope Protection details, see sheet 174-7A. Bar dimensions are given out to out. Bars of a series shall vary in length by a constant increment. For Replacement Schedule, see sheet 103-7A. For reinforcement details of Light Standard Support, see sheet 176-7A. * Designates Light Standard Support Reinforcement steel. For details of Light Standard Support, see sheet 176-7A.

H.N.T.B. BR. NO. 3 PART 7A

HOWARD, NEEDLES, TAMMEN & BERGENOFF
CONSULTING ENGINEERS
KANSAS CITY CLEVELAND NEW YORK

WEST ABUTMENT DETAILS
INNER BELT FREEWAY OVER
RAMPS E-8, E-10 AND E-16

BR. NO. CUY-42-1843 STA. 65+10.18
Scale: 1/4" = 1'-0" Except STA. 68+19.03
as noted

WILLOW-INNER BELT FREEWAY
CLEVELAND CUYAHOGA COUNTY OHIO

DATE 7-24-58 TRACED 11/11/59 CHECKED 11/11/59 REVIEWED 11/11/59
DATE 2-23-59 DATE 11-13-59



SHEET 105

CUYAHOGA COUNTY
CITY OF CLEVELAND
CUY-21-15.32
CUY-42-18.42





JUL 3 1985

Note: Prefix 'AB' shall be assigned to all barmarks.

Note: Special care shall be taken when placing reinforcing steel so as not to interfere with anchor bar setting.

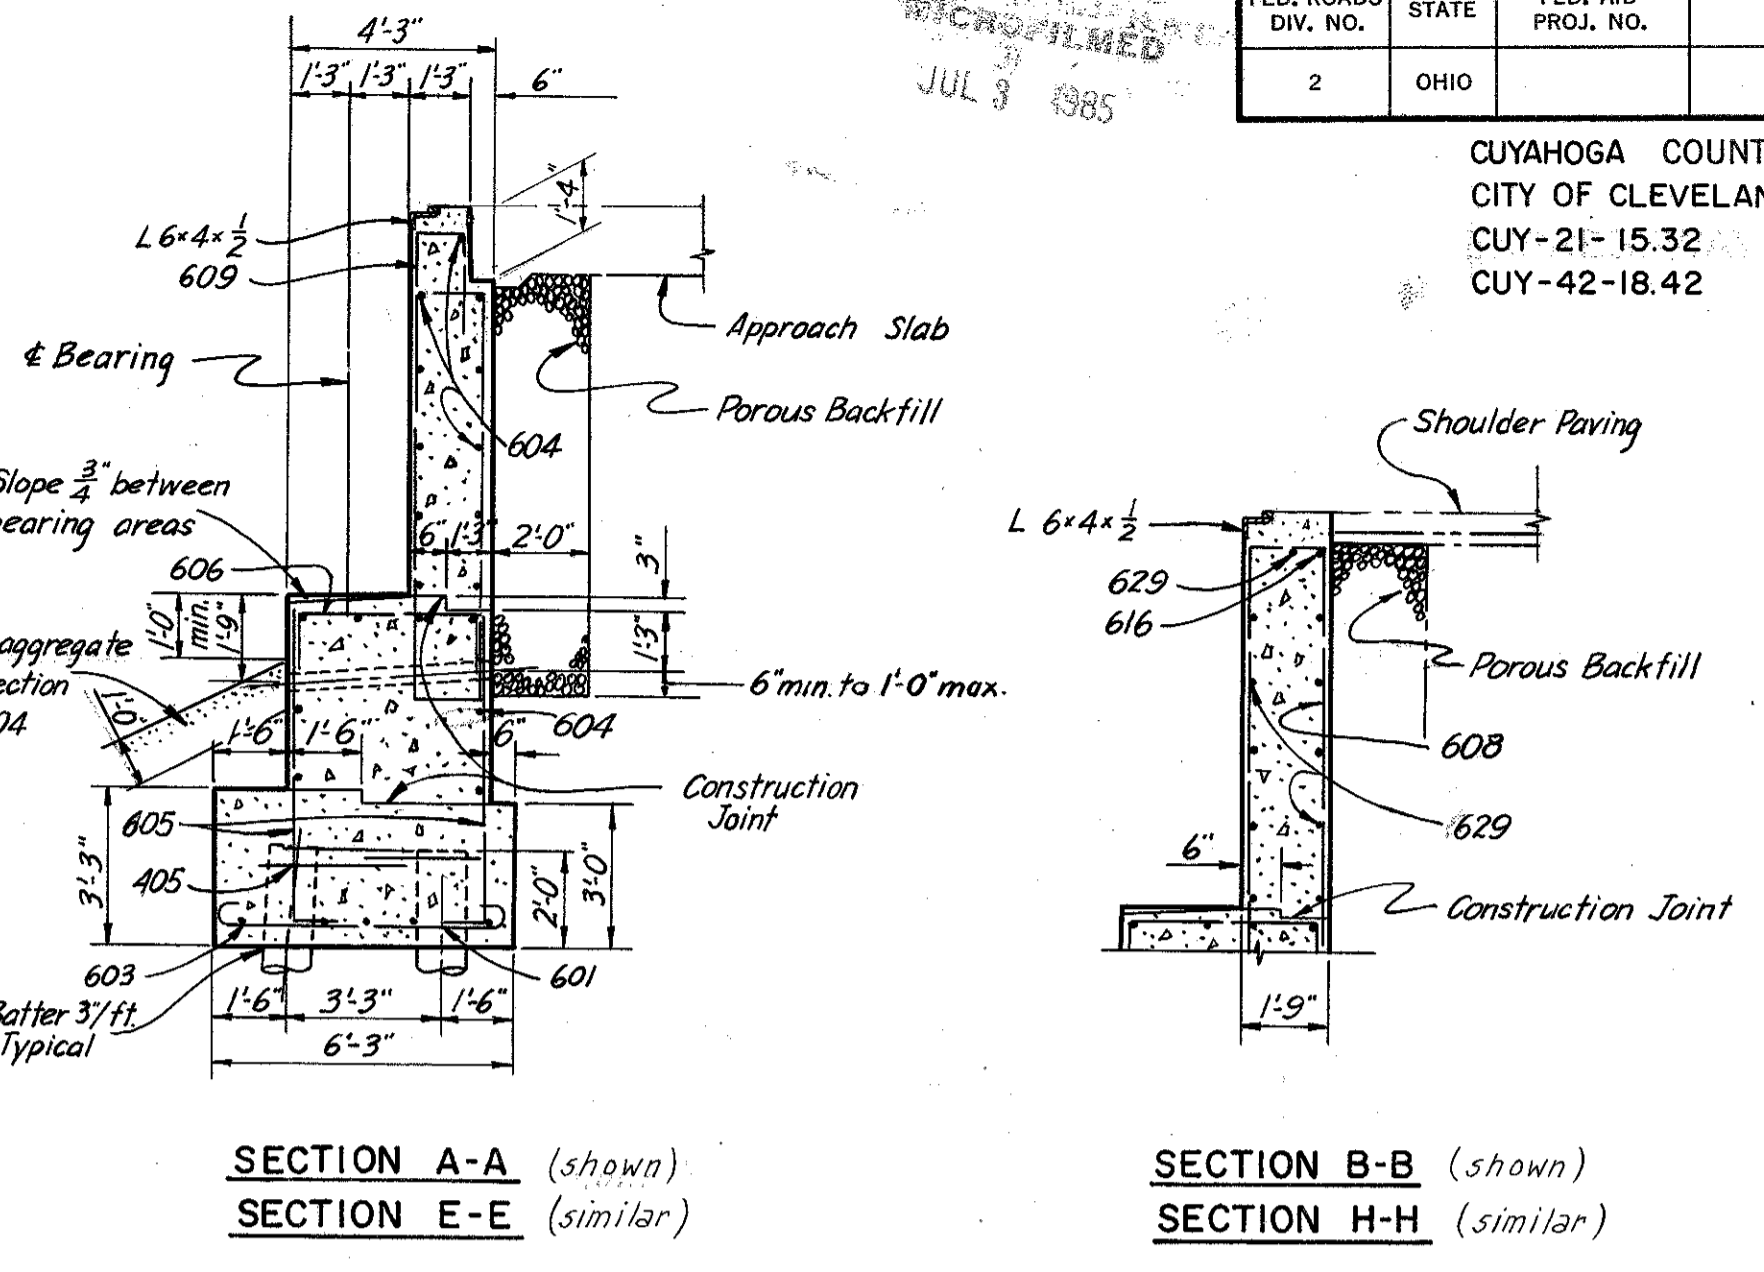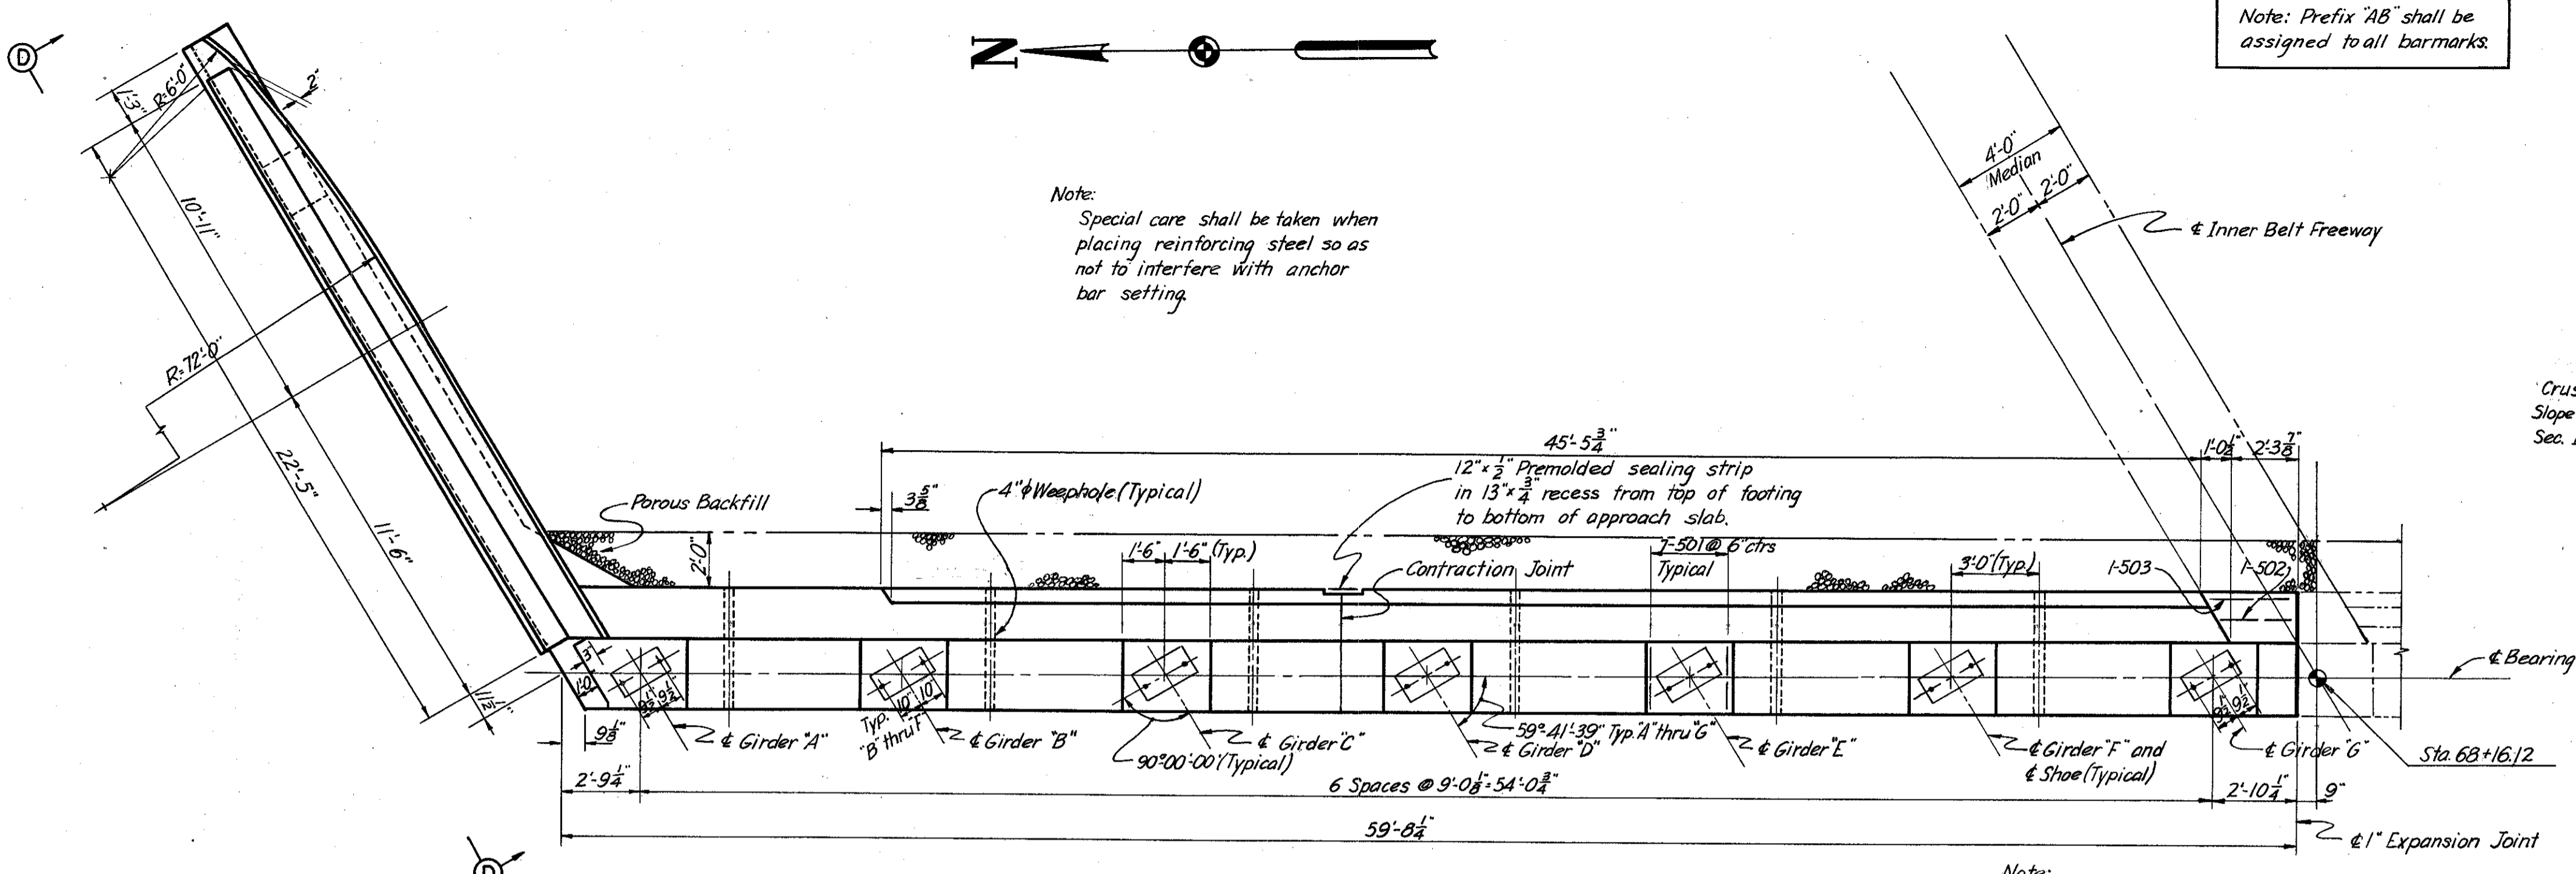

Note: Elevations along backwall are given to back of 6" x 4 1/2" angle.

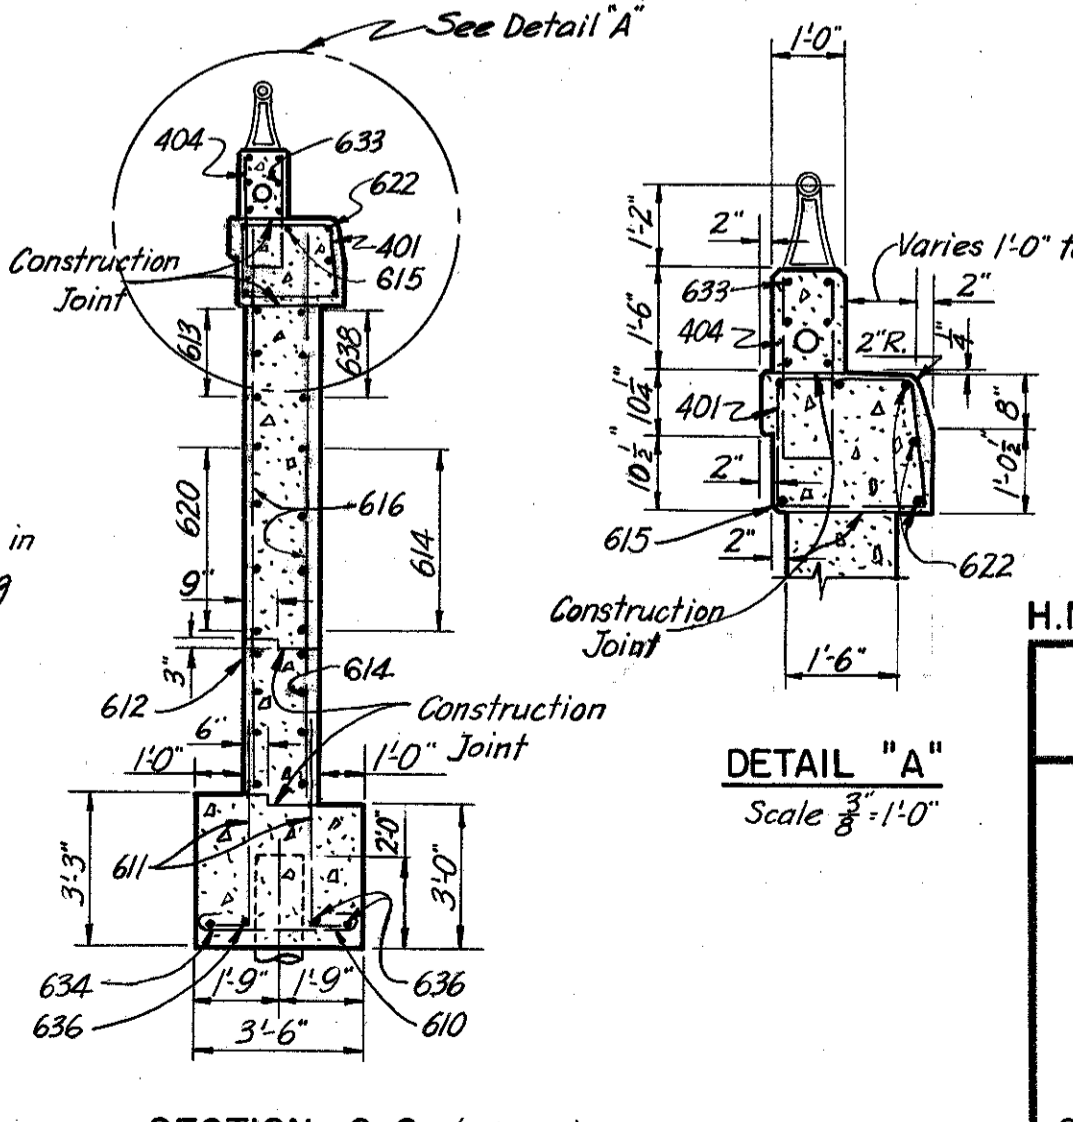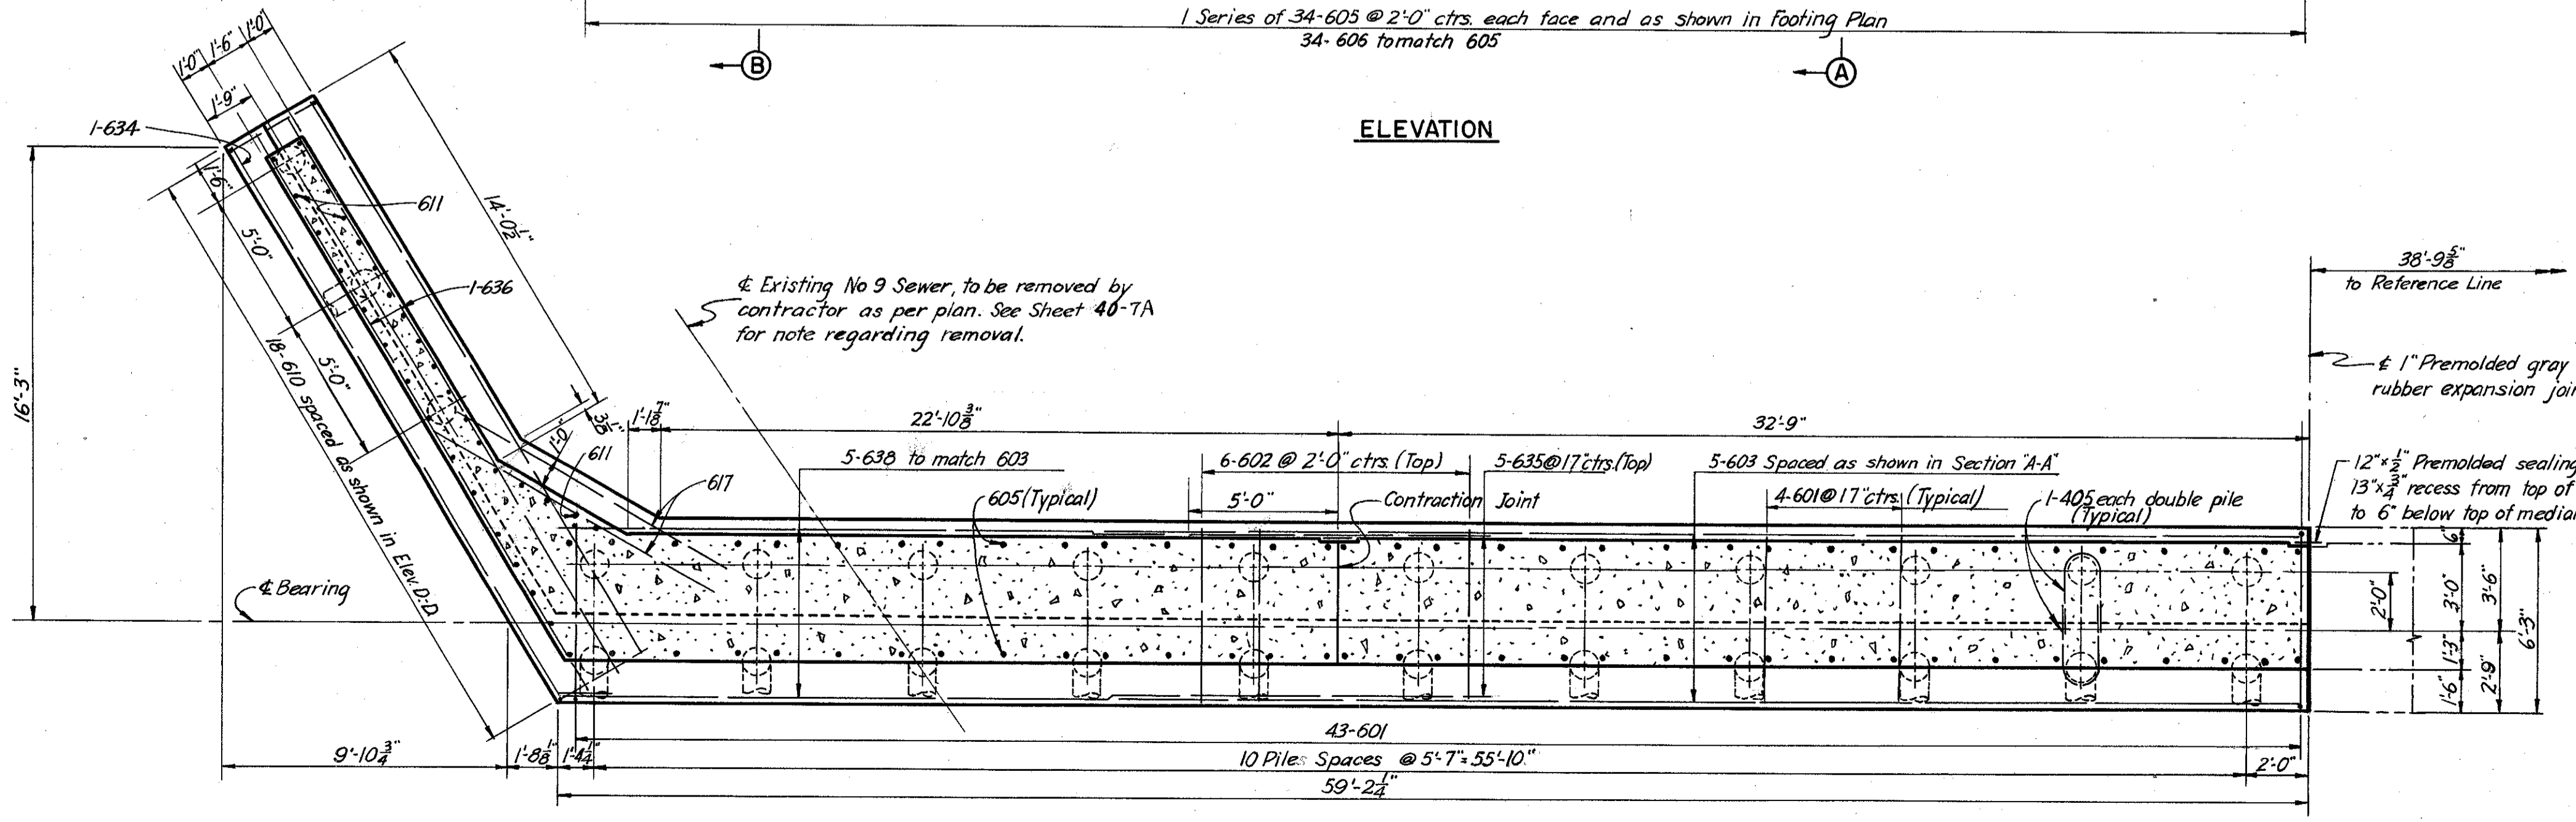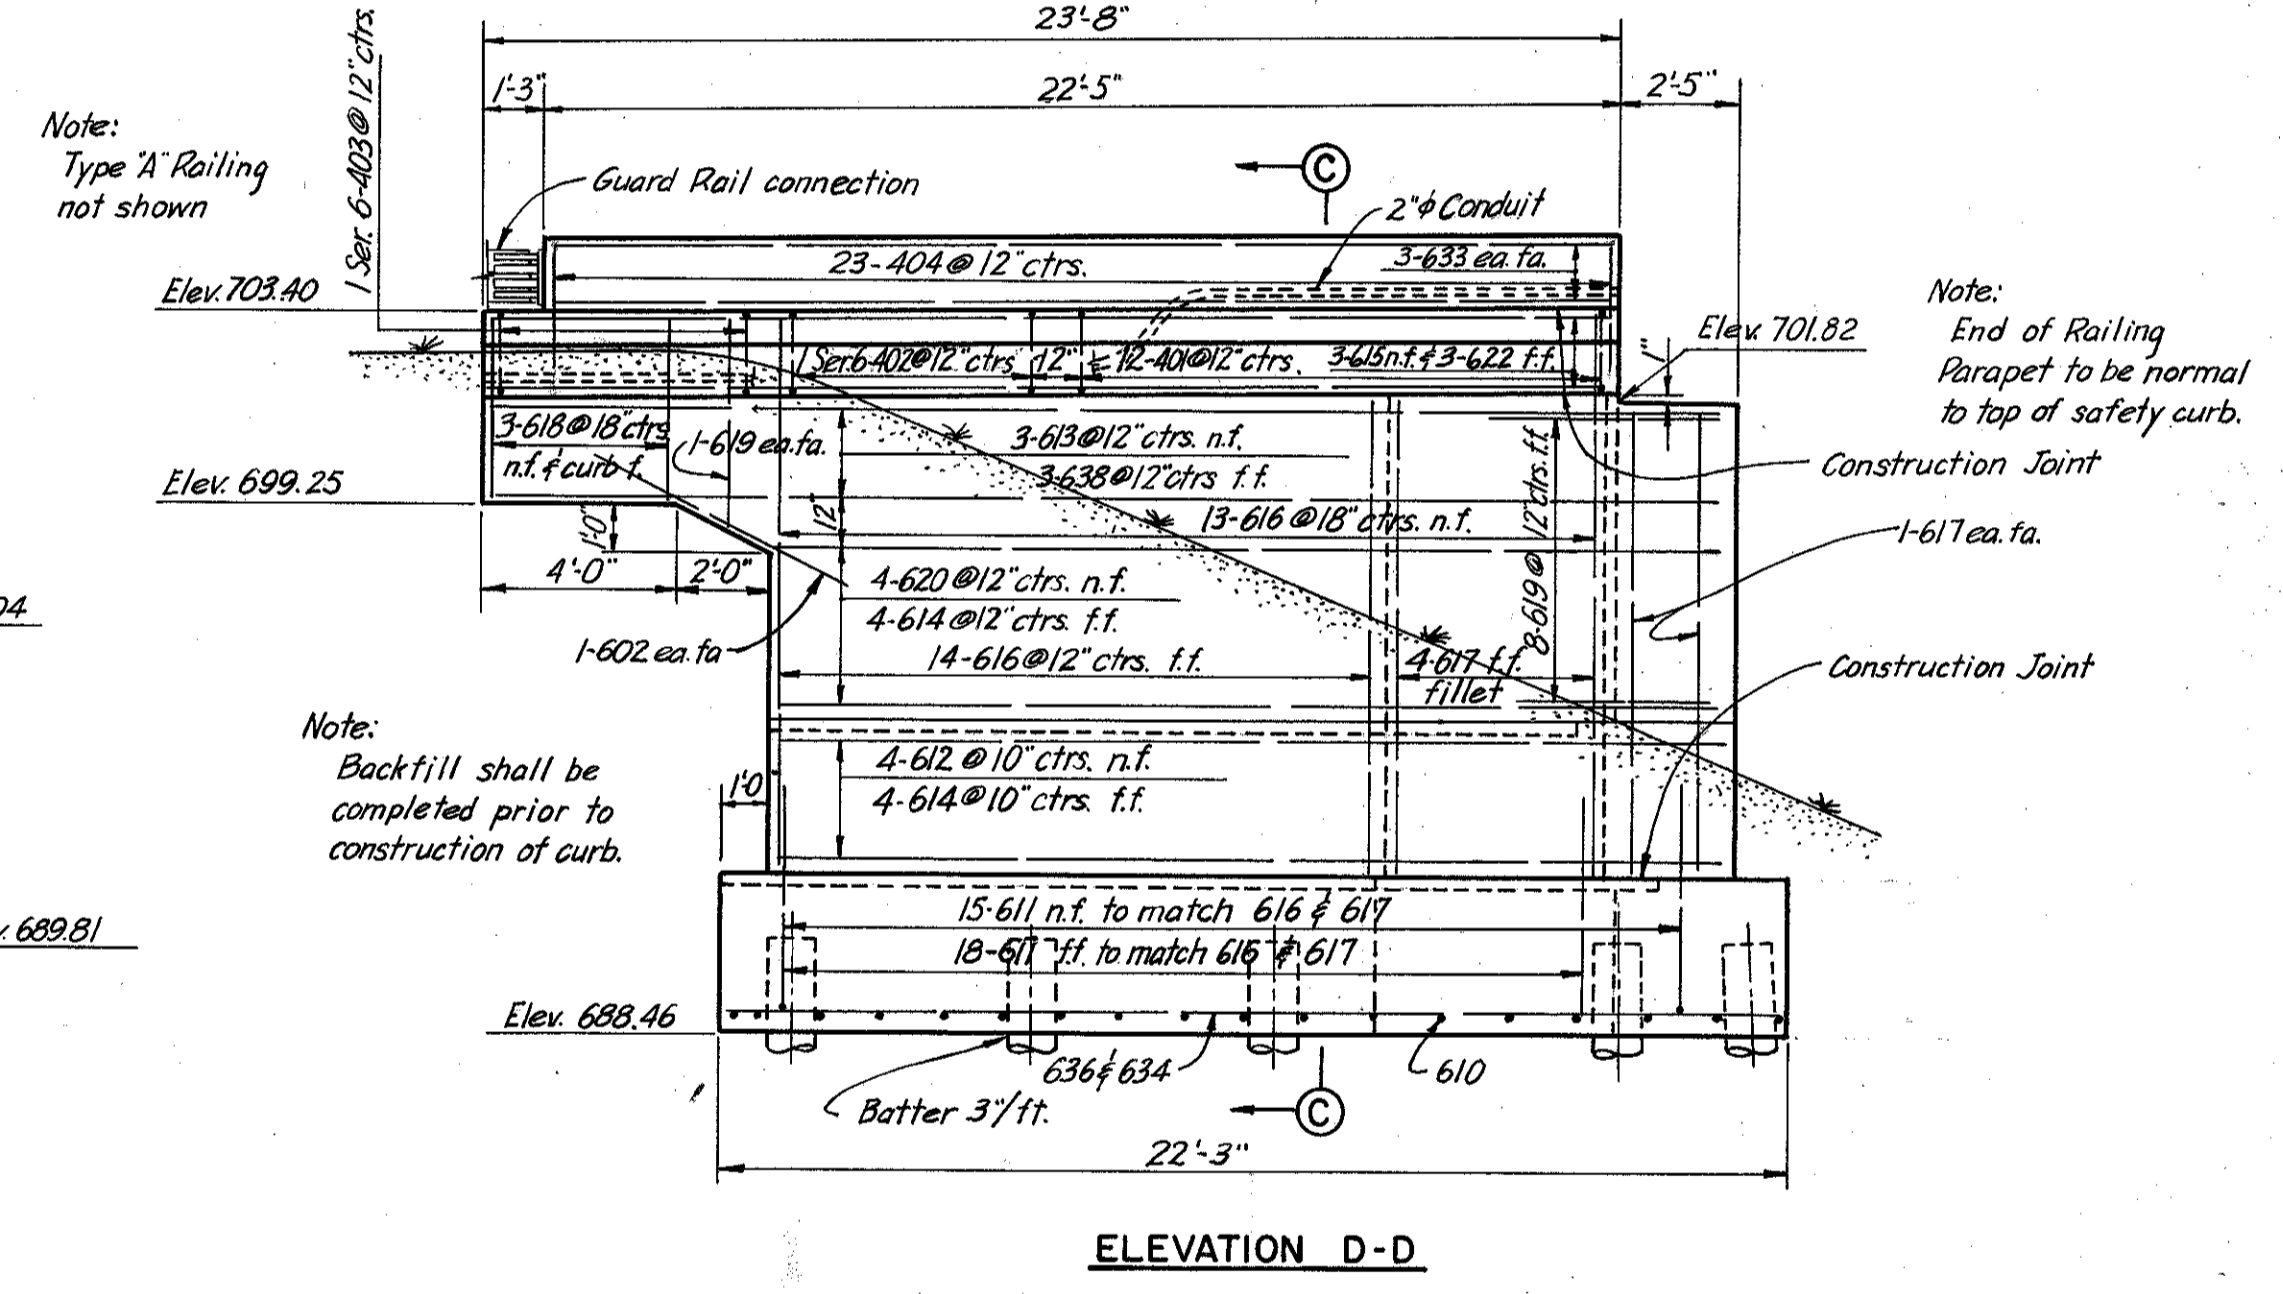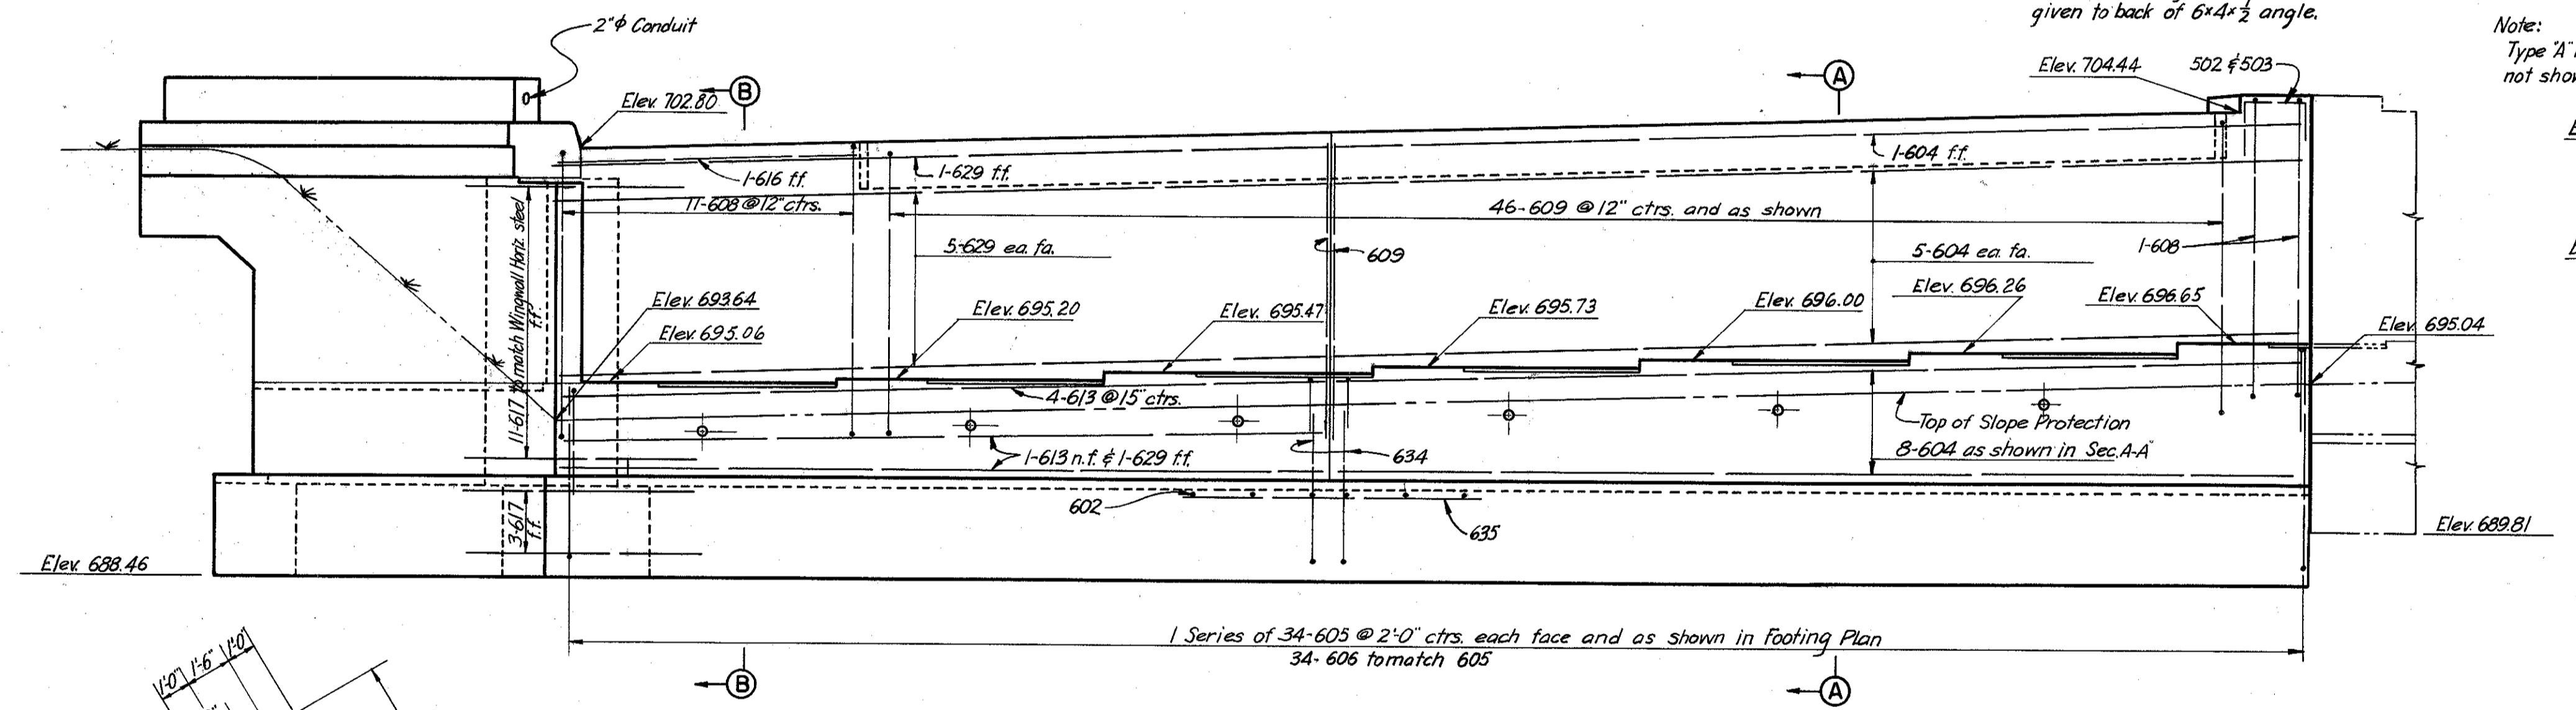

NOTES:
For Reinforcement schedule see sheet 101-7A
For additional notes see sheet 101-7A

H.N.T.B. BR. NO. 3 PART 7A

HOWARD, NEEDLES, TAMMEN & BERGENDOFF
CONSULTING ENGINEERS
KANSAS CITY CLEVELAND NEW YORK

**EAST ABUTMENT-NORTH HALF
INNER BELT FREEWAY OVER
RAMPS E-8, E-10 AND E-16**

BR. NO. CUY-42-1843 STA. 65+10.18
Scale: 1/4" = 1'-0" Except STA. 68+19.03
as noted


WILLOW-INNER BELT FREEWAY
CLEVELAND CUYAHOGA COUNTY OHIO

DRAWN N.V.	TRACED/RP	CHECKED T.J.P.	REVIEWED J.C.T.
DATE 6-20-58	DATE 3-12-59	DATE 2-18-59	DATE 11-13-59

SHEET 106

MARK	NO.	LENGTH	TYPE	DIMENSIONS				SERIES INCREMENT	WEIGHT
				A	B	C	D		
401	21	6'-9"	154	1'-5"	1'-10"	1'-5"	1'-8"	95	
402	2 Ser. of 6	6'-3 7/8 to 6'-9"	154	1'-5"	1'-7 to 1'-10"	1'-5"	1'-5 to 1'-8"	52	
403	2 Ser. of 6	4'-9" to 6'-1"	154	1'-5"	1'-7 to 1'-10"	1'-5"	1'-5 to 1'-8"	43	
404	43	5'-5"	105	8"	2'-6"			156	
405	44	6'-3"	144	2'-3"	1'-9"			184	
501	98	5'-1"	105	2'-2"	1'-7"			520	
502	1	5'-5"	105	2'-6"	1'-7"			6	
503	1	5'-9"	105	2'-10"	1'-7"			6	
504	1	3'-10"	105	11"	1'-7"			4	
505	1	4'-5"	105	1'-6"	1'-7"			5	
601	86	7'-3"	100	5'-11"				936	
602	40	5'-9"	Str.					345	
603	10	40'-0"	Str.					601	
604	38	32'-3"	Str.					1841	
605	4 Ser. of 34	6'-2" to 7'-8"	104	5'-6 to 7'-0"	10"			1413	
606	68	7'-5"	105	3'-11"	1'-11"			758	
607	2	27'-9"	Str.					83	
608	26	22'-7"	109	1'-5"	9'-6"			882	
609	92	22'-6"	112	11"	1'-5"	8'-2"	9'-6"	3109	
610	32	4'-6"	100	3'-2"				216	
611	59	5'-6"	104	4'-10"	10"			481	
612	4	21'-7"	108	19'-9"	1'-11"	20"		130	
613	9	25'-9"	Str.					348	
614	8	15'-0"	Str.					180	
615	8	23'-3"	Str.					279	
616	35	11'-3"	Str.					591	
617	22	9'-9"	Str.					322	
618	12	3'-9"	Str.					68	
619	12	4'-3"	Str.					77	
620	4	19'-9"	Str.					119	
621	1	6'-6"	124	2'-9"	2'-0"	2'-0"	8	10	
622	3	23'-9"	133	12'-0"	11'-9"			107	
623	5	19'-2"	124	17'-0"	6"	1'-11"	8	144	
624	5	17'-0"	Str.					128	
625	3	23'-0"	Str.					104	
626	10	12'-0"	Str.					180	
627	3	20'-0"	Str.					90	
628	22	13'-0"	Str.					430	
629	13	27'-3"	Str.					532	
630	3	19'-6"	133	12'-0"	7'-6"			88	
*631	6	8'-9"	Str.						
632	1	7'-8"	104	7'-0"	10"			12	
*633	6	22'-0"	Str.						
634	1	23'-9"	108	21'-11"	1'-11"	20"		36	
635	10	10'-0"	Str.					150	
636	3	22'-3"	Str.					100	
637	7	18'-9"	Str.					197	
638	8	21'-0"	Str.					252	
639	13	26'-0"	Str.					308	
640	1 Ser. of 4	26'-0" to 27'-9"	Str.					161	
								Total 17,085	

BENDING DIAGRAMS

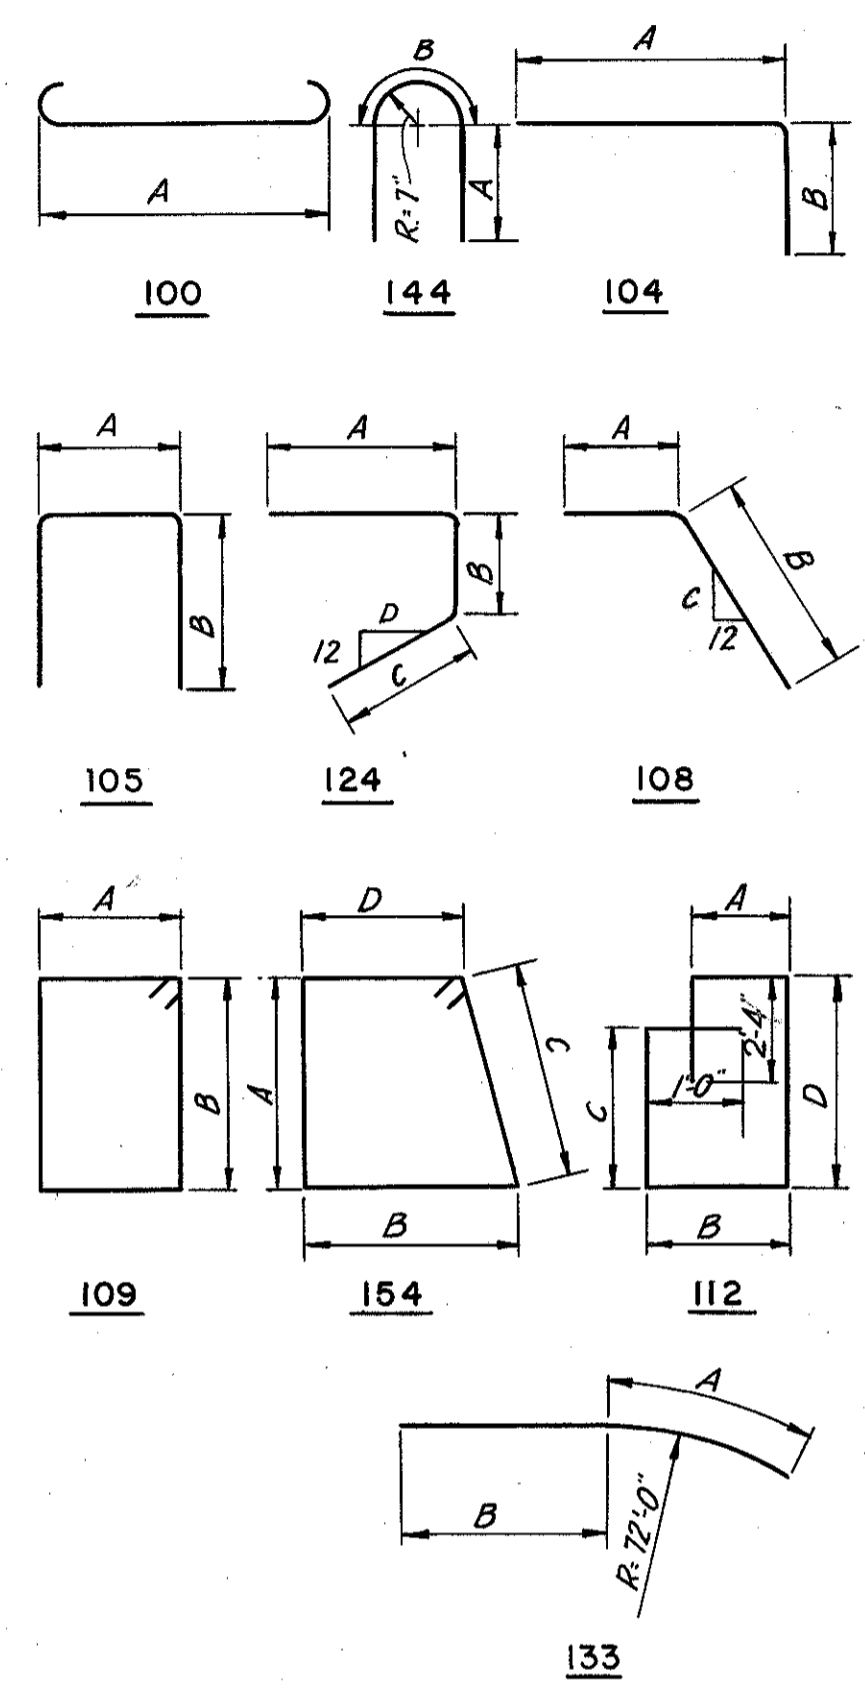

NOTES:
 All piles shall be 12" Cast-in-place reinforced concrete piles.
 All battered piles shall be battered 3 in 12 in direction shown.
 Pile spacings are given along bottom of footing. Reinforcement bars shall be 3 inches clear from bottom of footing and 2 inches elsewhere.
 For Replacement Schedule see sheet 103-7A. Bars of a series shall vary in length by a constant increment.
 * Bars 631 & 633 are included for payment with Item 5-14, Railing.
 Bar dimensions are given out to out. n.f. - near face; f.f. - far face; ea. fa. - each face. For masonry plate details see sheet 173-7A for details of end dam see sheet 173-7A for Slope Protection details see sheet 174-7A for location of lighting conduit see sheet 176-7A for Railing Post spacing, details of Railing, and Guard Rail connection see sheet 175-7A for additional sections see sheet 106-7A

Note: Prefix AB shall be assigned to all bar marks


Note: Special care shall be taken when placing reinforcing steel so as not to interfere with anchor bar setting.

Note: # Denotes Elevation given at P.V.I. of 5'-0" rounding


Note: Elevation along backwall are given to back of 6"x4"x 1/2" angle.

Note: Type "A" Railing not shown.


Note: End of Railing Parapet to be normal to top of safety curb. Backfill shall be completed prior to construction of safety curb.

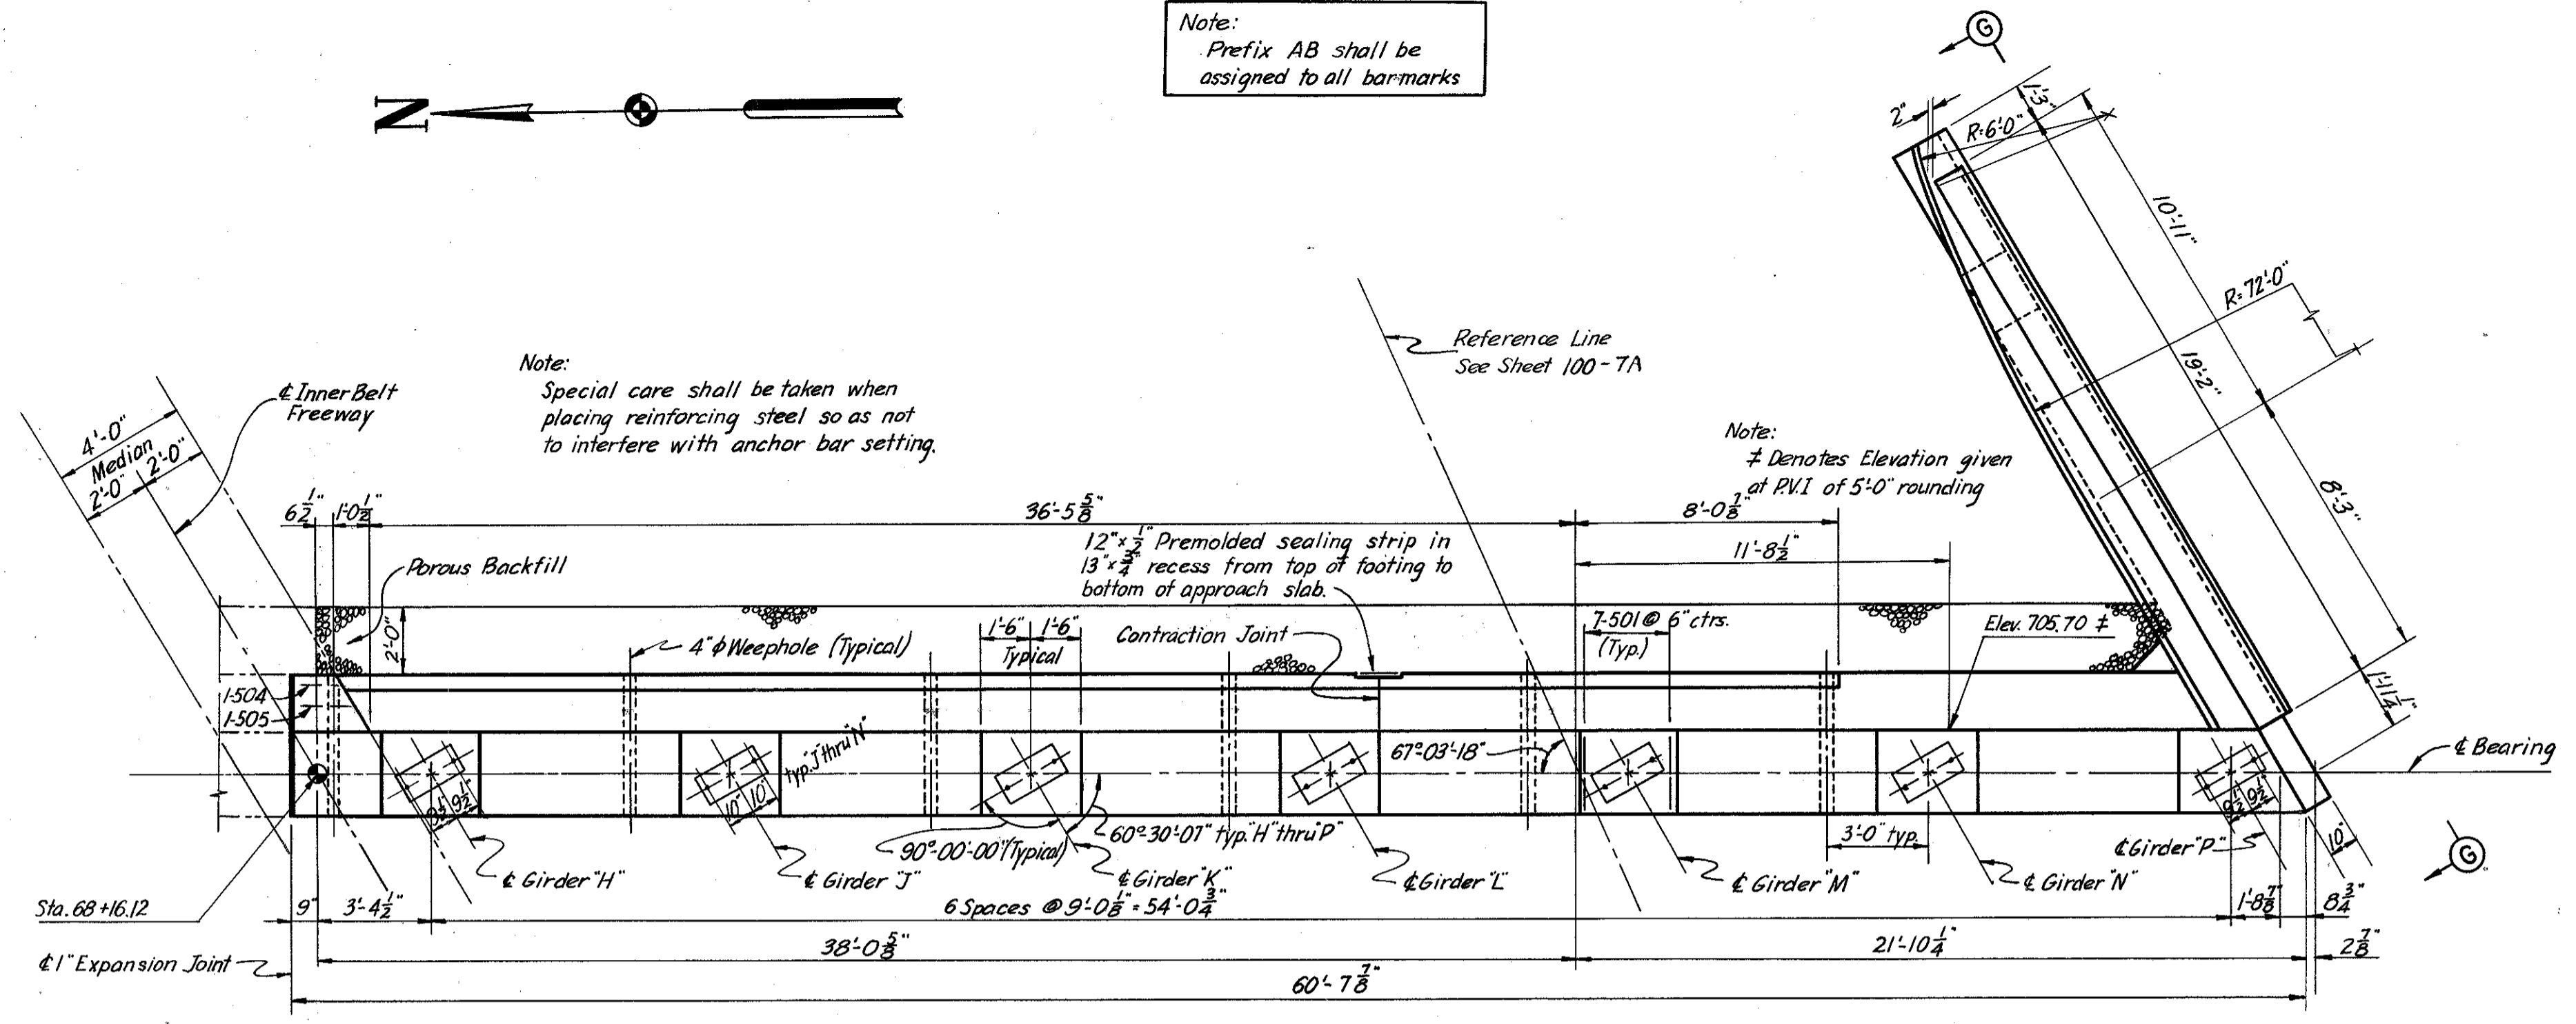


PLAN

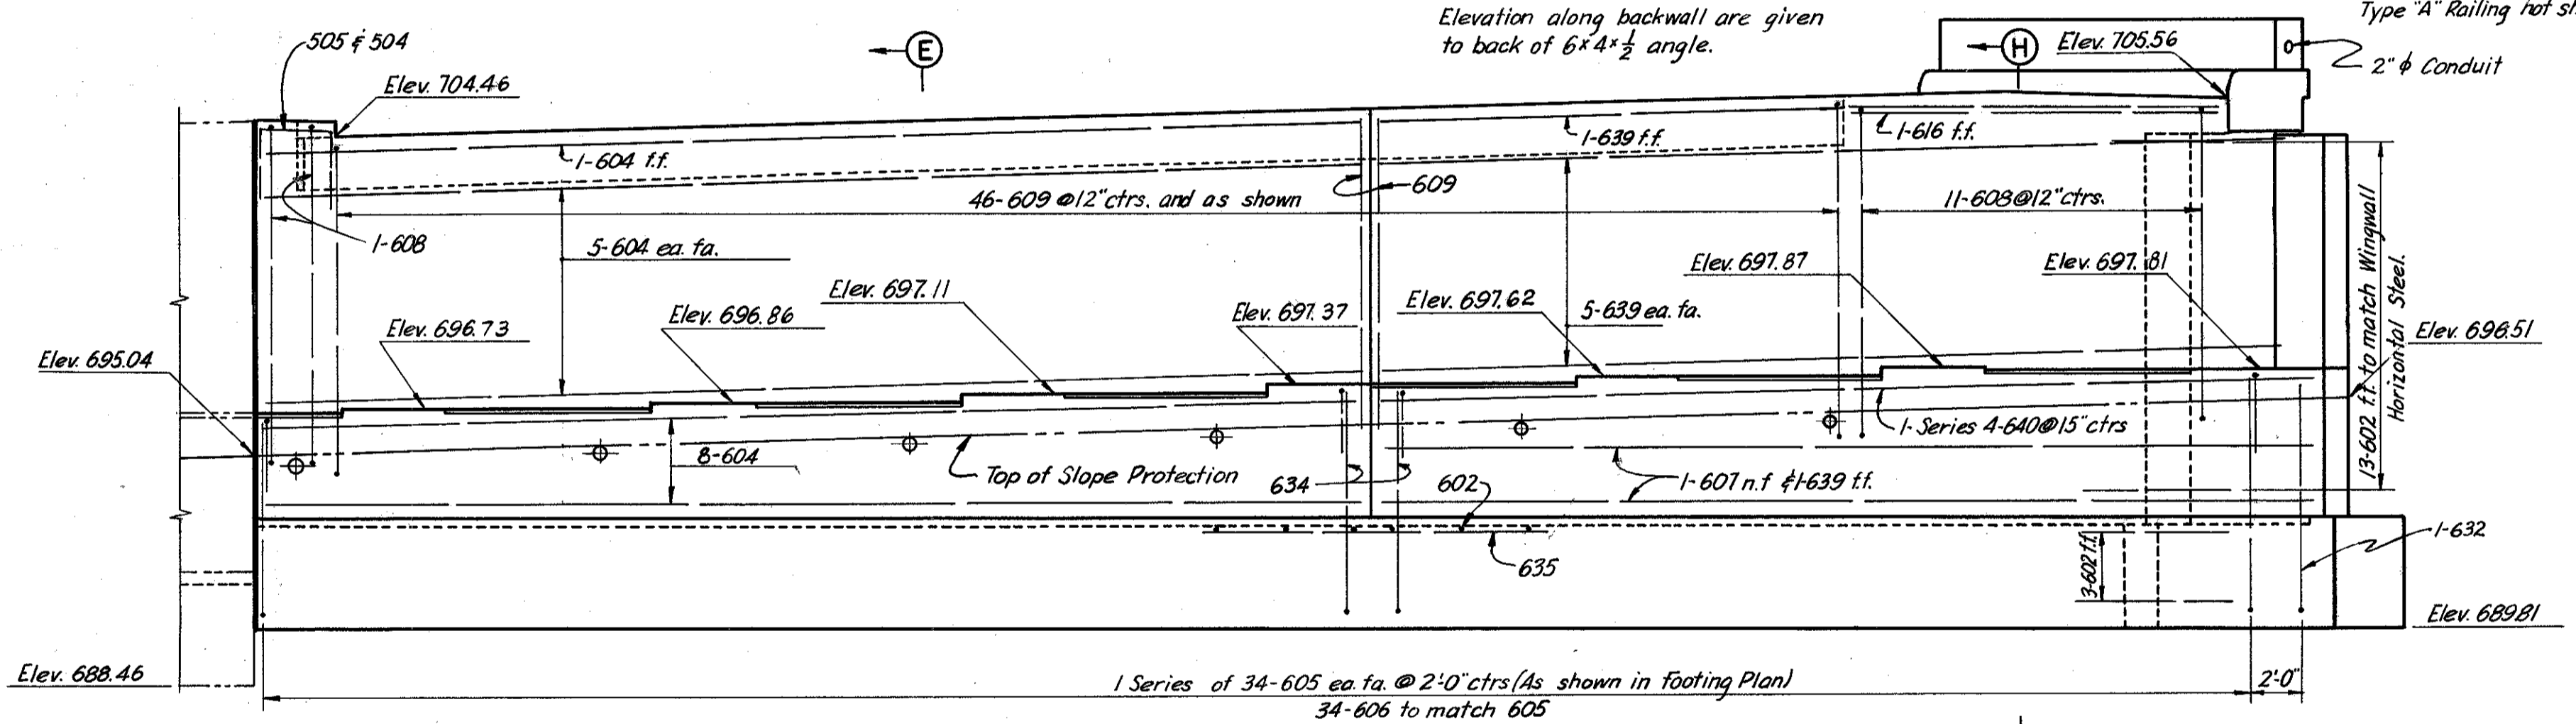

ELEVATION

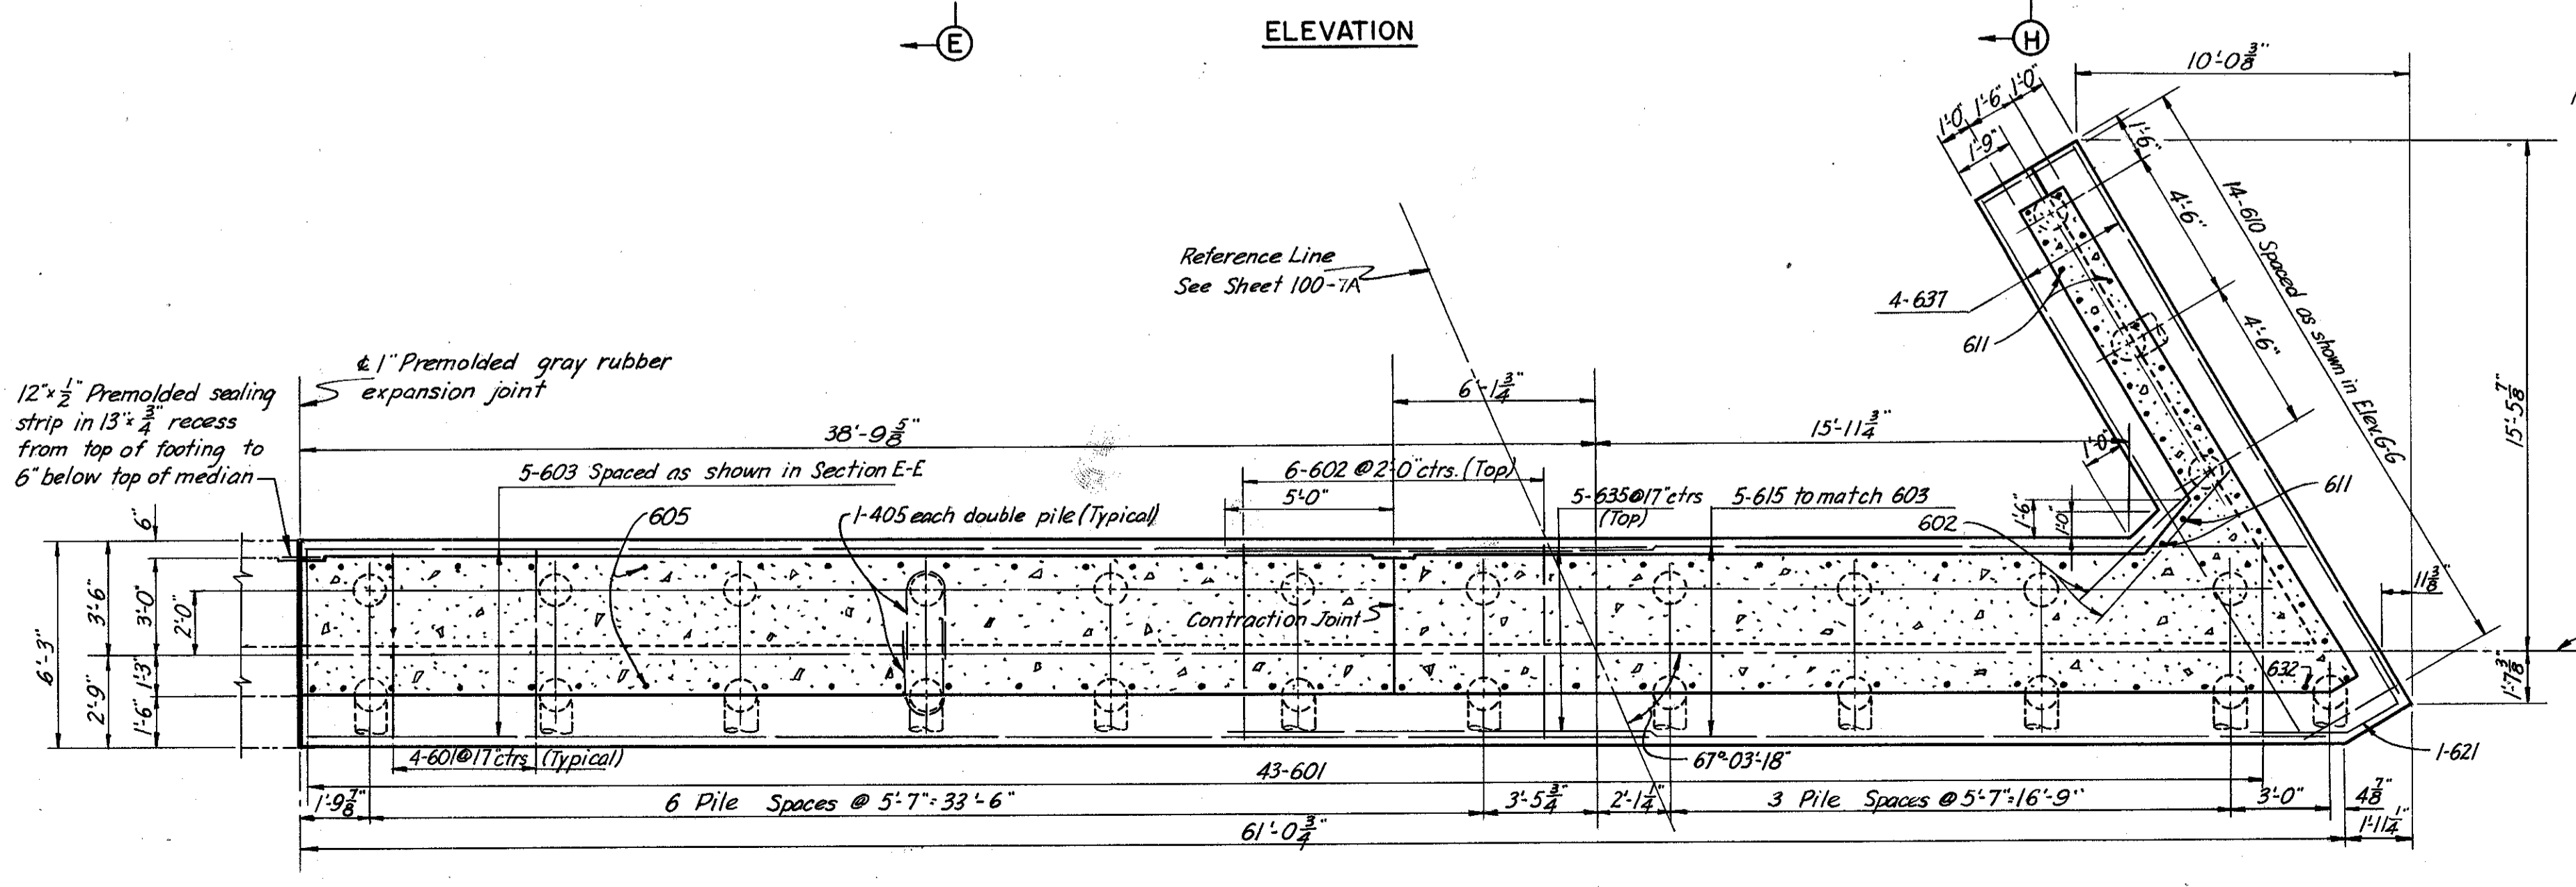


FOOTING PLAN

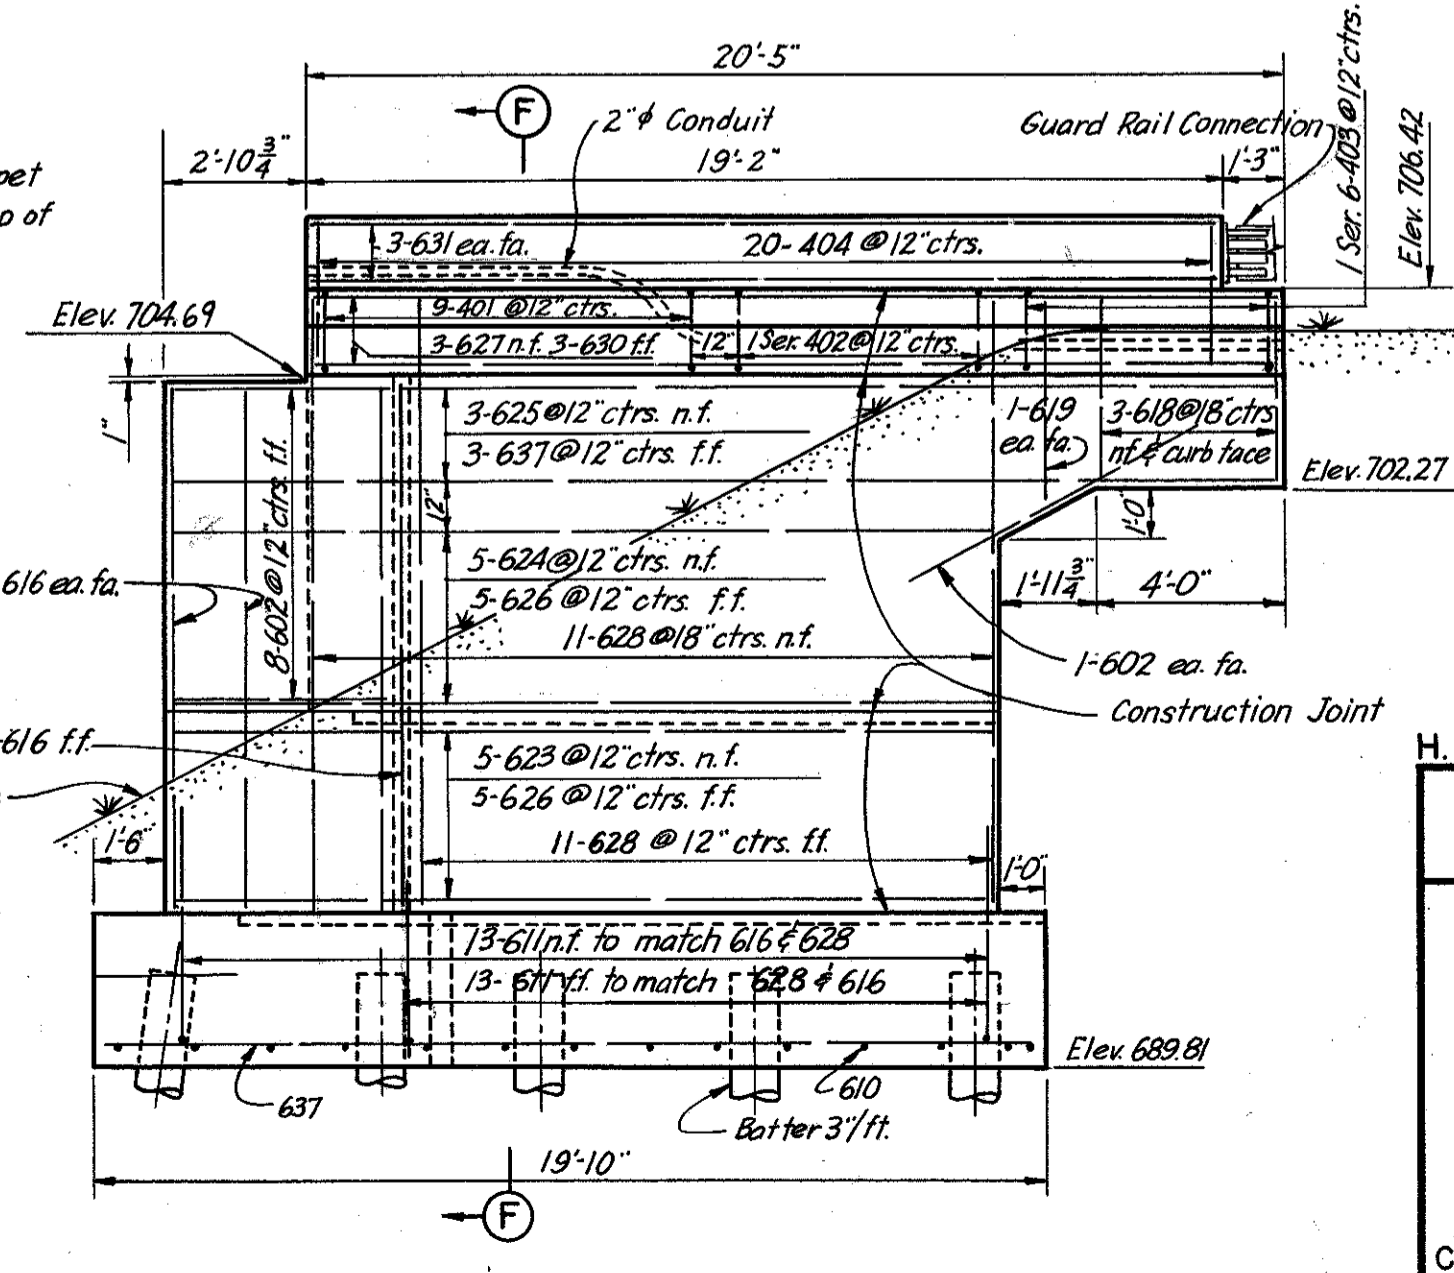

ELEVATION G-G

H.N.T.B. BR. NO. 3 PART 7A
 HOWARD, NEEDLES, TAMMEN & BERGENDOFF
 CONSULTING ENGINEERS
 KANSAS CITY CLEVELAND NEW YORK
EAST ABUTMENT-SOUTH HALF
 INNER BELT FREEWAY OVER
 RAMPS E-8, E-10 AND E-16
 BR. NO. CUY-42-1843 STA. 65+10.18
 Scale: 1/4" = 1'-0" STA. 68+19.03
WILLOW-INNER BELT FREEWAY
 CLEVELAND CUYAHOGA COUNTY OHIO
 DRAWN N/V TRACED H/W CHECKED J.P.P. REVIEWED J.C.T. REVISIONS
 DATE 7/2/58 DATE 3/16/59 DATE 2-21-59 DATE 1-13-59 SHEET 107

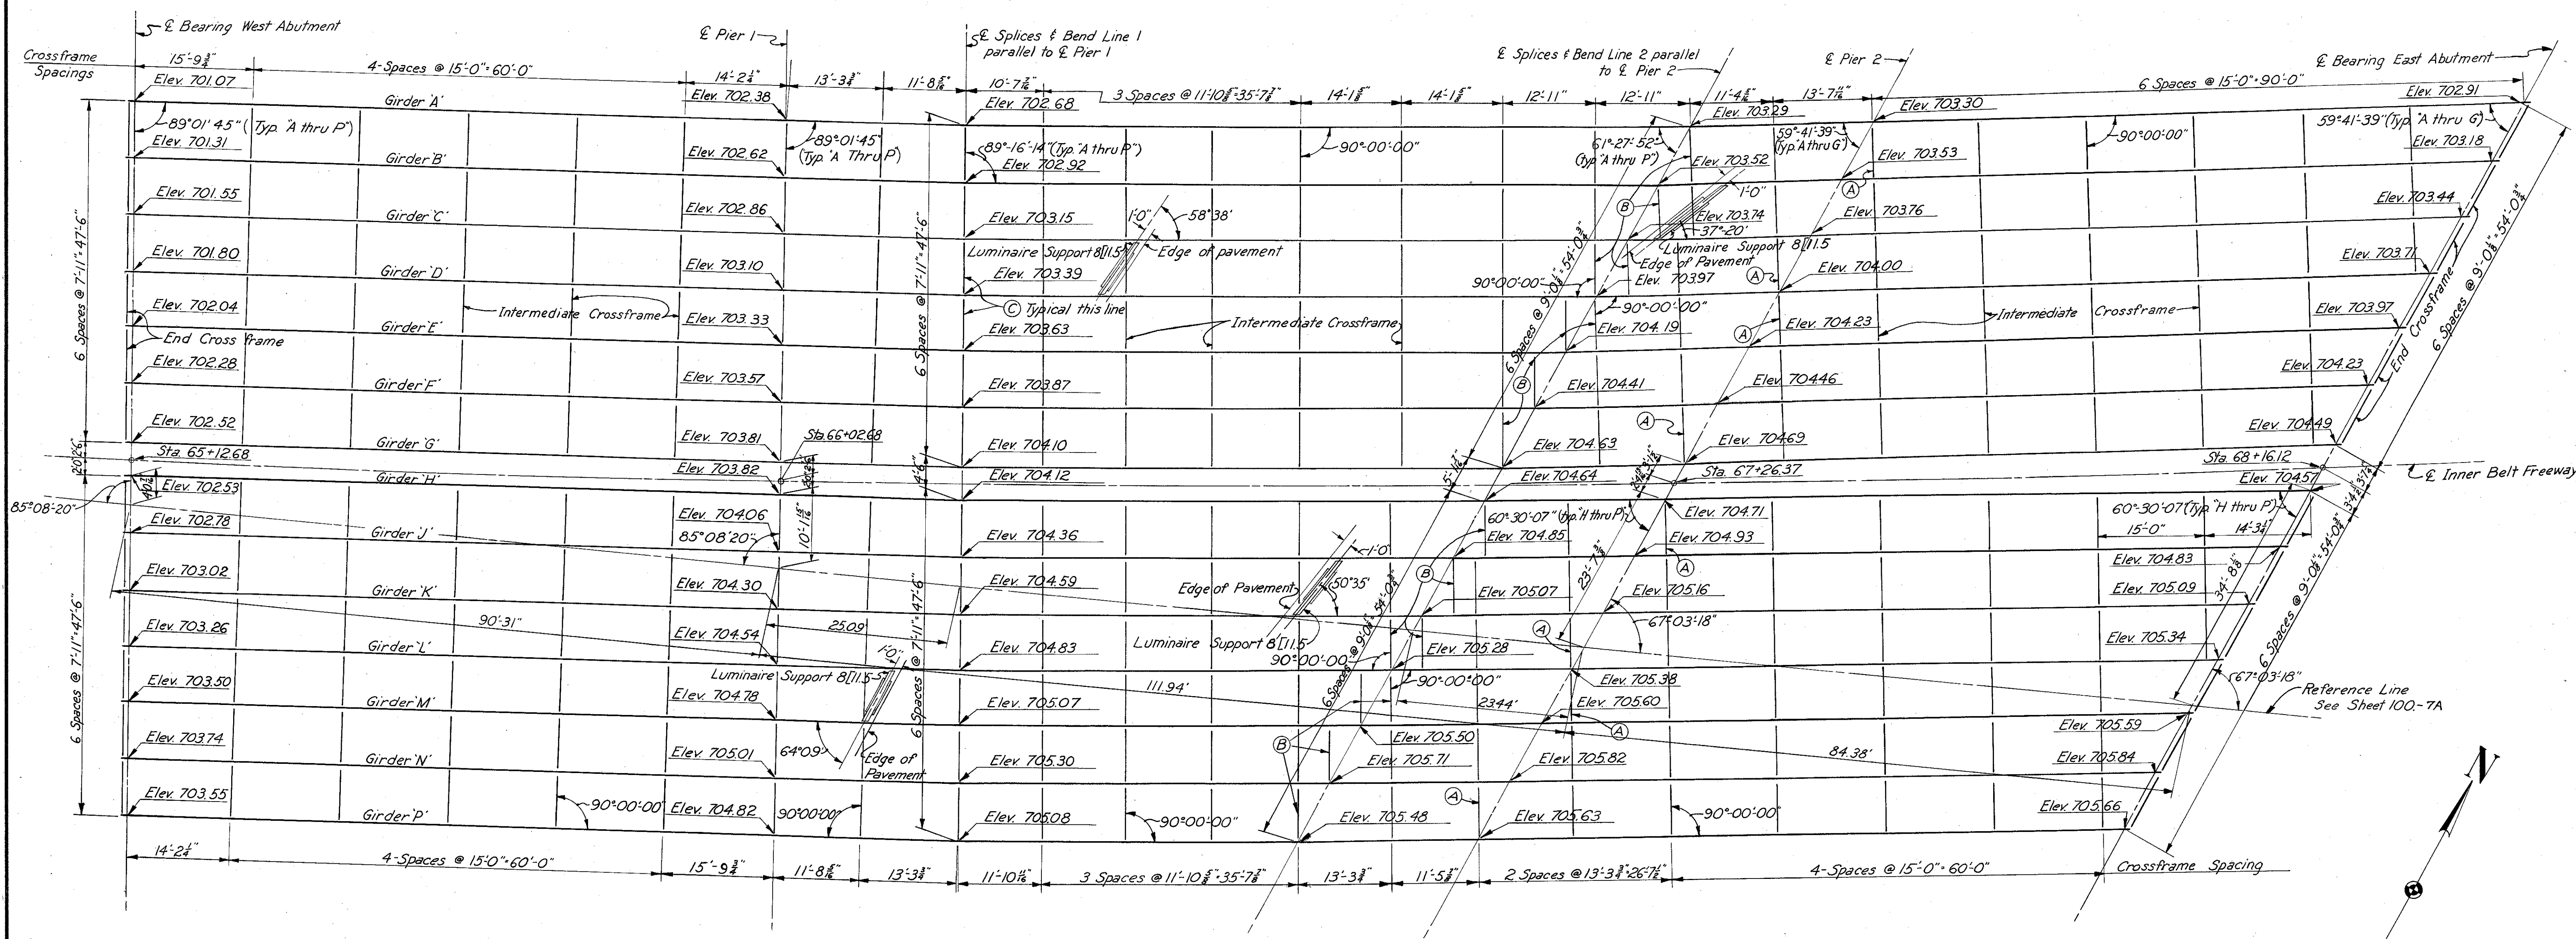

FRAMING PLAN

NOTES:
Elevations shown are to the top of pavement
For superstructure details, other than girder
elevations, see sheet 112-7A
For girder notes see sheet 109-7A
Ⓐ Ⓑ Ⓒ indicate special crossframes, see
sheet 112-7A for their details.

H.N.T.B. BR. NO. 3 PART 7A

HOWARD, NEEDLES, TAMMEN & BERGENDOFF CONSULTING ENGINEERS KANSAS CITY CLEVELAND NEW YORK			
FRAMING PLAN			
INNER BELT FREEWAY OVER RAMPS E-8, E-10 AND E-16			
BR. NO. CUY-42-1843		STA. 65+10.18	
Scale: 3/32" = 1'-0"		STA. 68+19.03	
WILLOW-INNER BELT FREEWAY			
CLEVELAND		CUYAHOGA COUNTY OHIO	
DRAWN A.B.	TRACED R.C.	CHECKED C.A.	REVIEWED J.C.T.
DATE 4-18-58	DATE 5-7-59	DATE 8-25-58	DATE 11-13-57

JUL 3 1955

CUYAHOGA COUNTY
CITY OF CLEVELAND
CUY-21-15.32
CUY-42-18.42

NOTES:

Top of finished pavement elevations along girders are given at tenth points between bearings and are shown on sheet 111-7A. The girders shall be fabricated to lines parallel to profiles formed by these elevations, plus the camber required to compensate for dead load deflections.

Top and bottom flange plates are to be the same and shall be spliced at the points shown in the girder elevations, and as otherwise required. The web plate may be spliced as required by available plate lengths.

Intermediate stiffeners shall be as shown in Table 'A' below and shall be placed in pairs on all interior girders. These stiffeners shall not be welded to the flanges, but fitted to close enough contact that the shop coat, when applied, shall fill and close the openings.

Intermediate stiffeners shall be used on the inside only of exterior girders and shall be welded to top or bottom flanges within the limits shown on the girder elevations with a 5/16" fillet weld on both sides of the joint for a distance of 2" from the outside edge of the stiffener. The other end shall have a tight fit with the flange.

Bearing stiffeners shall be 5 x 1/8" R.s. at the abutments and 8 x 1" R.s. at the piers and shall be placed in pairs on all girders. They shall be grooved and fully butt welded to the lower flange and fitted to close contact, without welding, at the upper flange.

Angles shall be used as shown in Table 'A' at all field splices. All girder field splices shall be made with 7/8" high strength bolts conforming to Supplemental Spec. S-207. The bolts shall be placed with the heads on the outside face of exterior girders and on bottom of girder flanges.

At bend points, the girders change direction at the center line of the field splice. Specially cut splice plates will be required at these locations.

Welding shown for girder "A" is typical for all girders.

Welding shall be done in accordance with Sec. S-7.22 of the Specifications.

Longitudinal dimensions of the girders are measured horizontally along E of web plate.

For top of pavement elevations and deflections see sheet 111-7A.

For splice details and other superstructure details see sheet 112-7A.

For details of rocker masonry plates see sheet 123-7A.


For other rocker details and details of bolsters see Ohio Standards, Dwg. RB-1-35.

For details of end dams see sheet 123-7A.

Intermediate stiffeners shall be spaced equally as shown between crossframes.

For Shop Drawing and Assembly Notes see sheet 128-7A.

GIRDER FLANGE WIDTH	INTERMEDIATE STIFFENER	SPLICE ANGLE
12"	R 5X 3/8"	5X 3 1/2 X 3/8"
14" - 16"	R 6X 3/8"	6X 3 1/2 X 3/8"
18" U/D	R 8X 3/8"	8X 4 X 3/8"

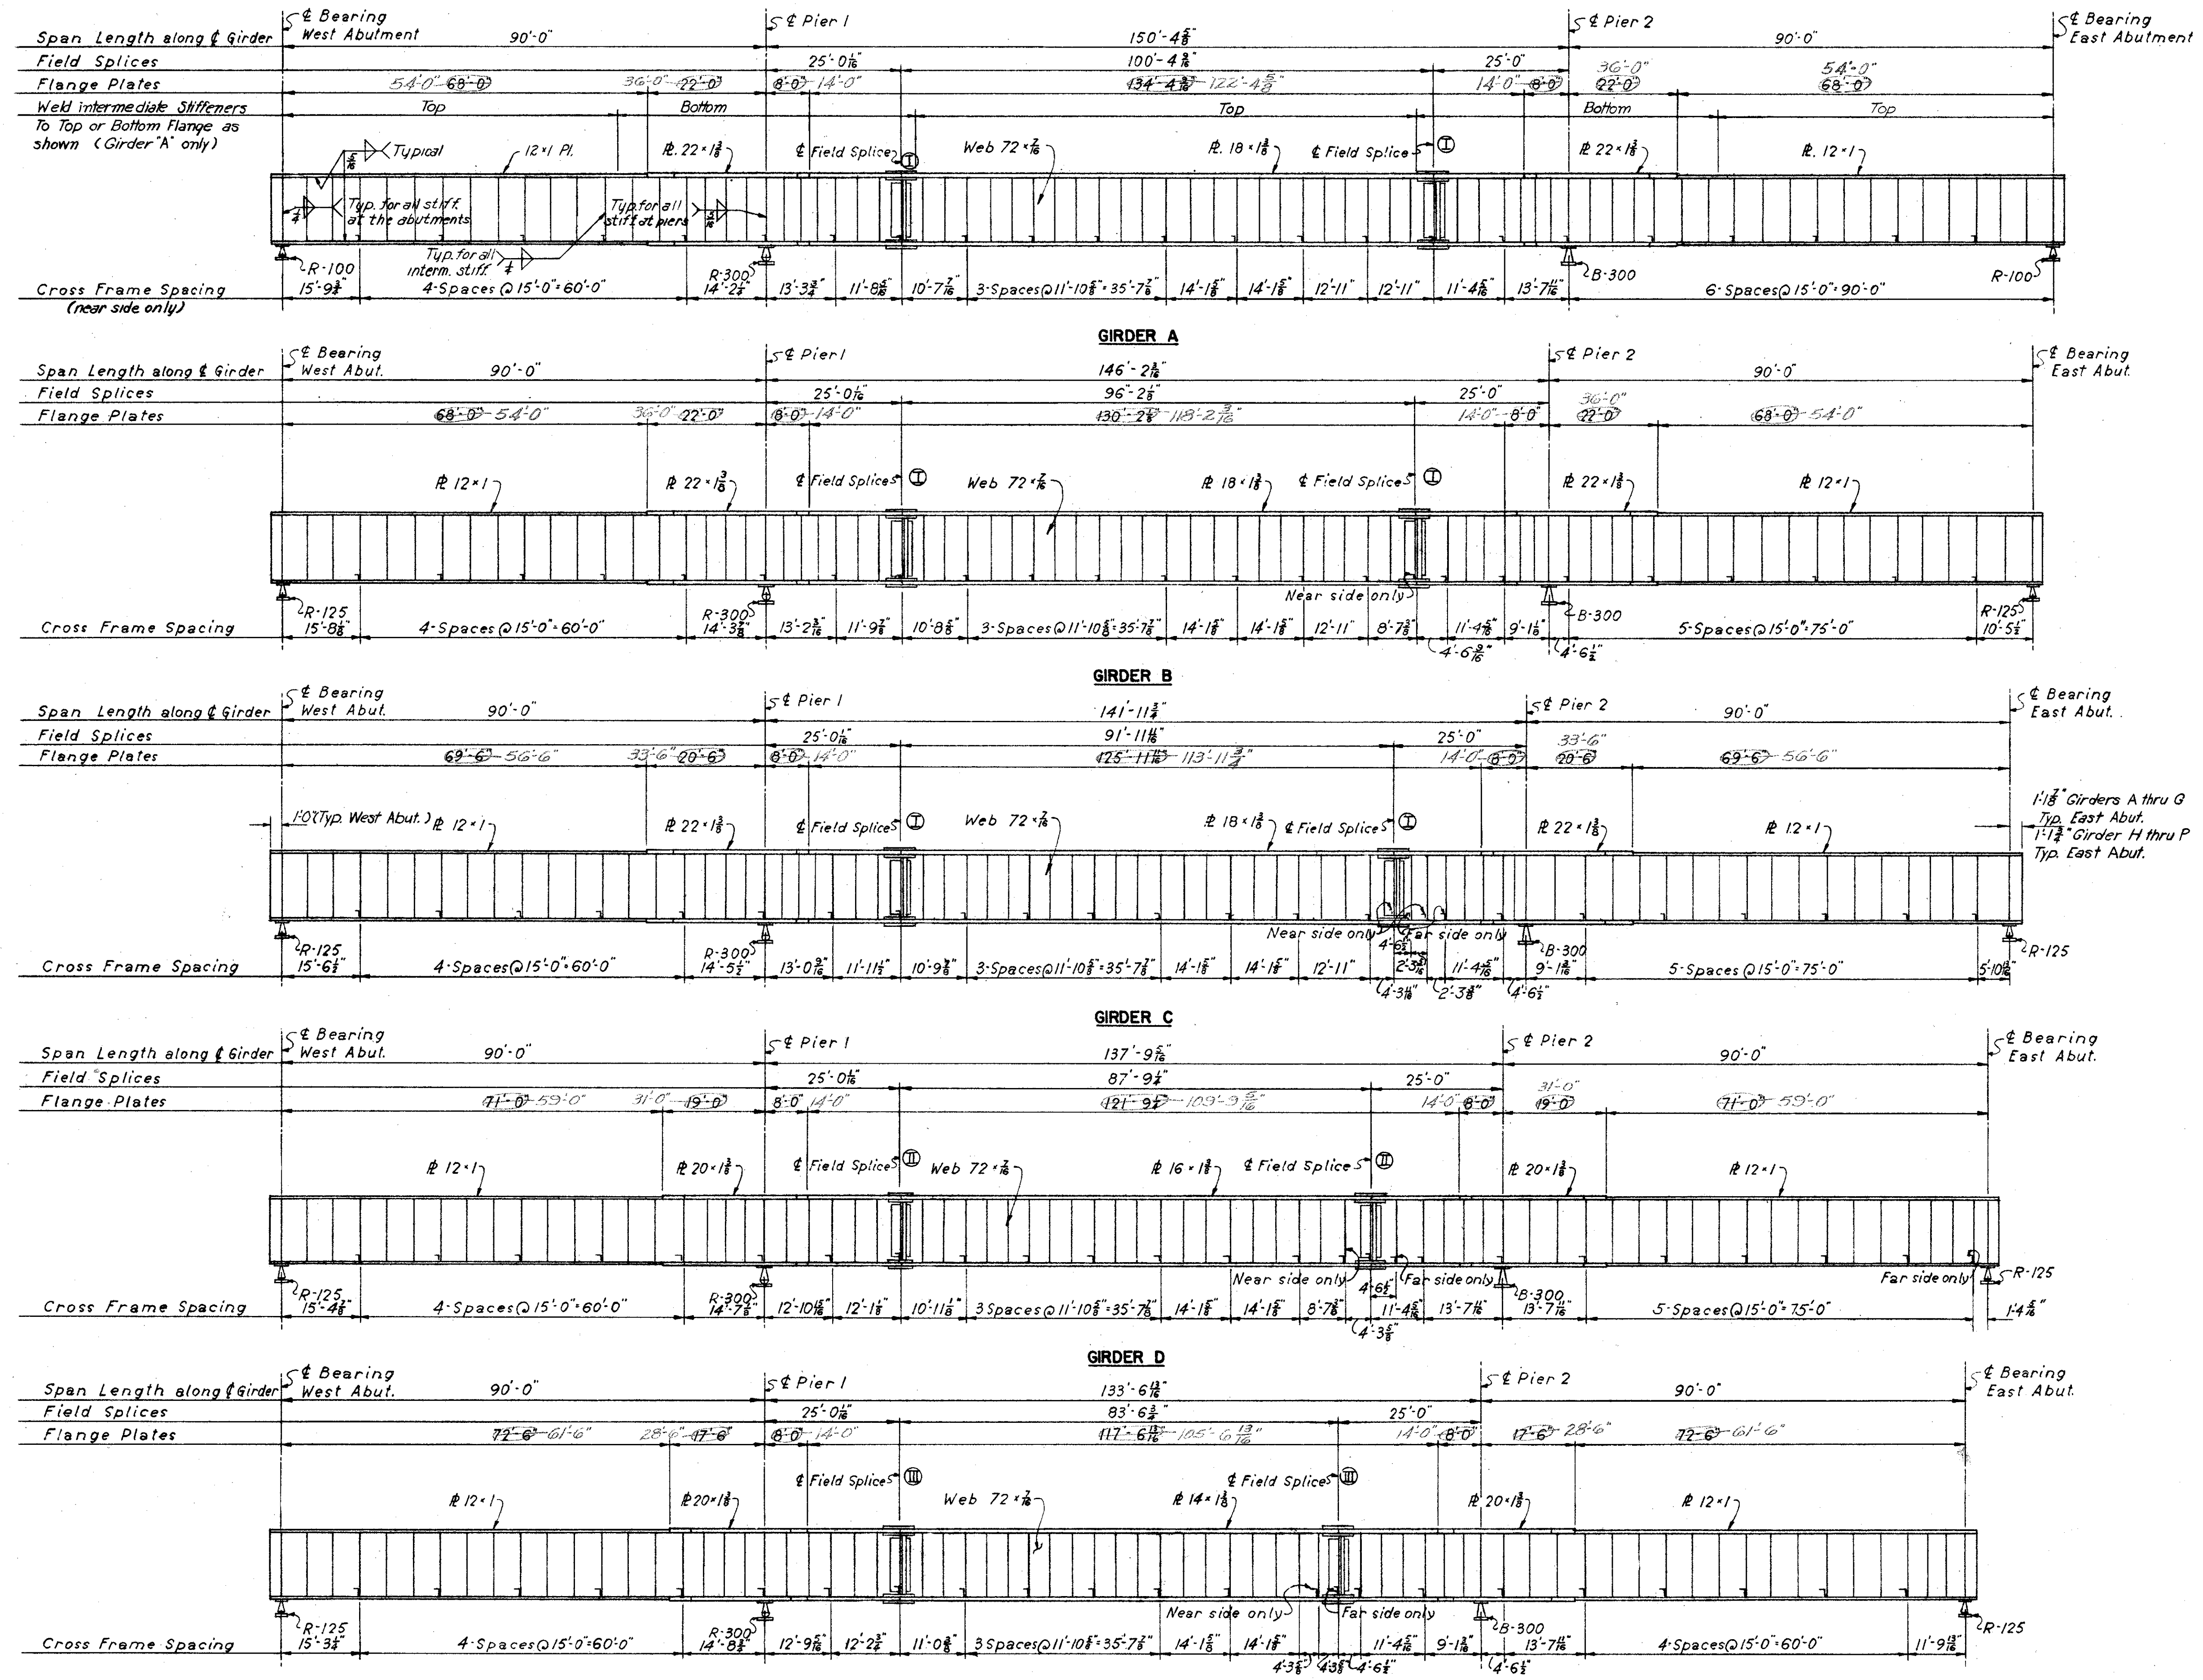

GIRDER E
Horizontal Scale 1/8" = 1'-0"
No Vertical Scale

H.N.T.B. BR. NO. 3 PART 7A

HOWARD, NEEDLES, TAMMEN & BERGENDOFF
CONSULTING ENGINEERS
KANSAS CITY CLEVELAND NEW YORK







GIRDER ELEVATIONS
INNER BELT FREEWAY OVER
RAMPS E-8, E-10 AND E-16
BR. NO. CUY-42-1843 STA. 65+10.18
Scale: As noted STA. 68+19.03

WILLOW-INNER BELT FREEWAY
CLEVELAND CUYAHOGA COUNTY OHIO

DRAWN A.B.	TRACED	CHECKED L.C.	REVIEWED JCT	REVISED 5-20-60
DATE 5-19-55	DATE	DATE 7-2-55	DATE 11-13-57	SHEET 109

JUL 3 1965

CUYAHOGA COUNTY
CITY OF CLEVELAND
CUY-21-15.32
CUY-42-18.42

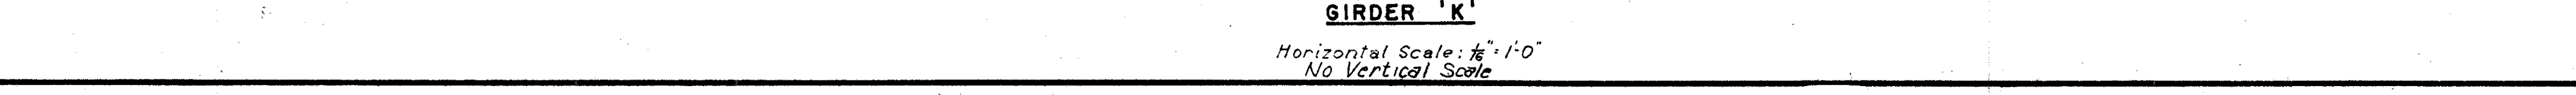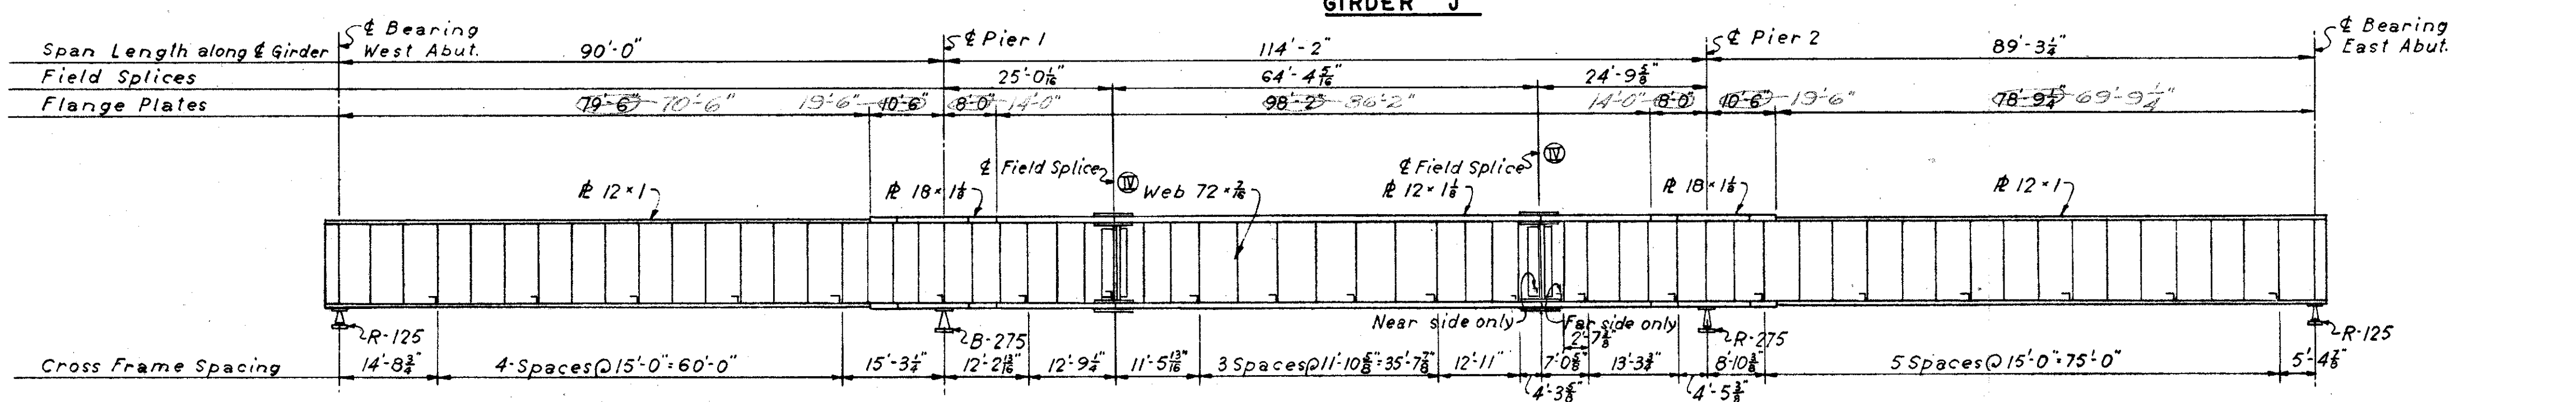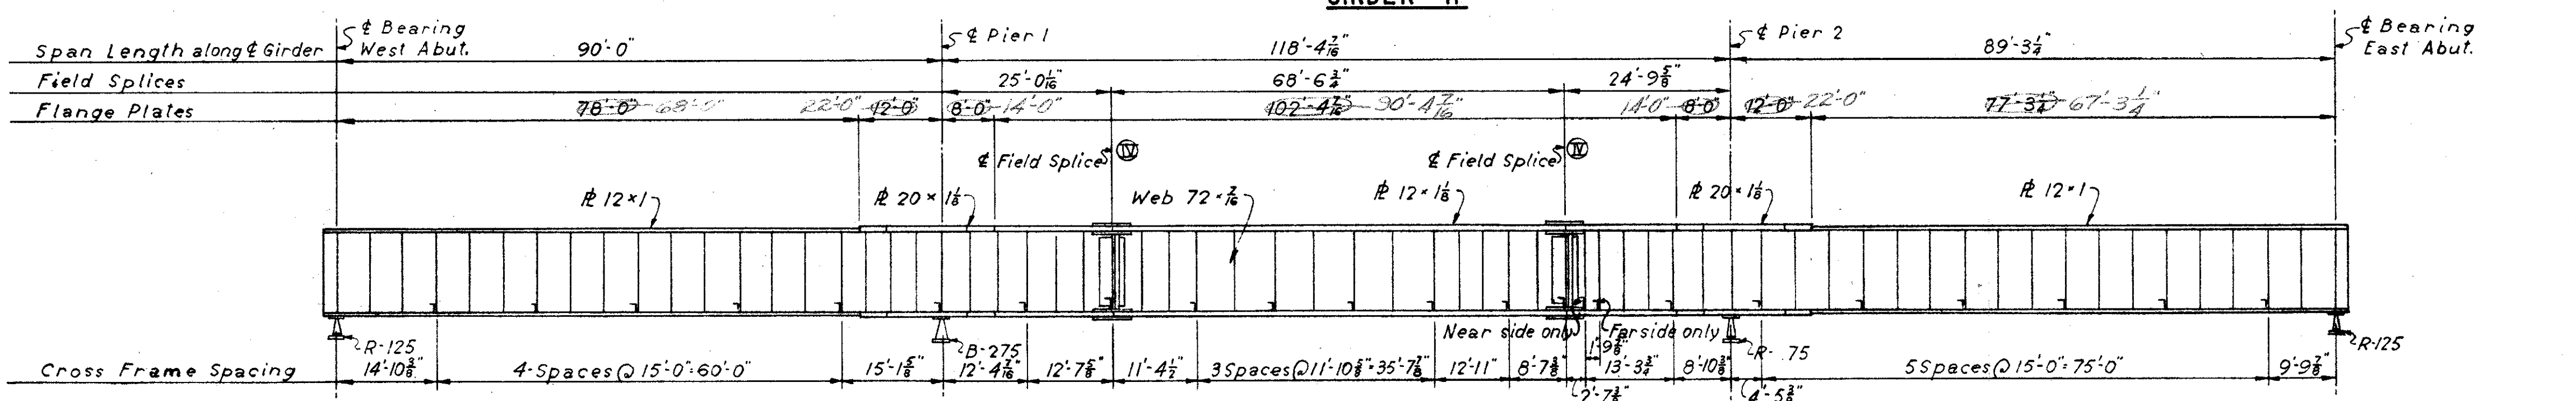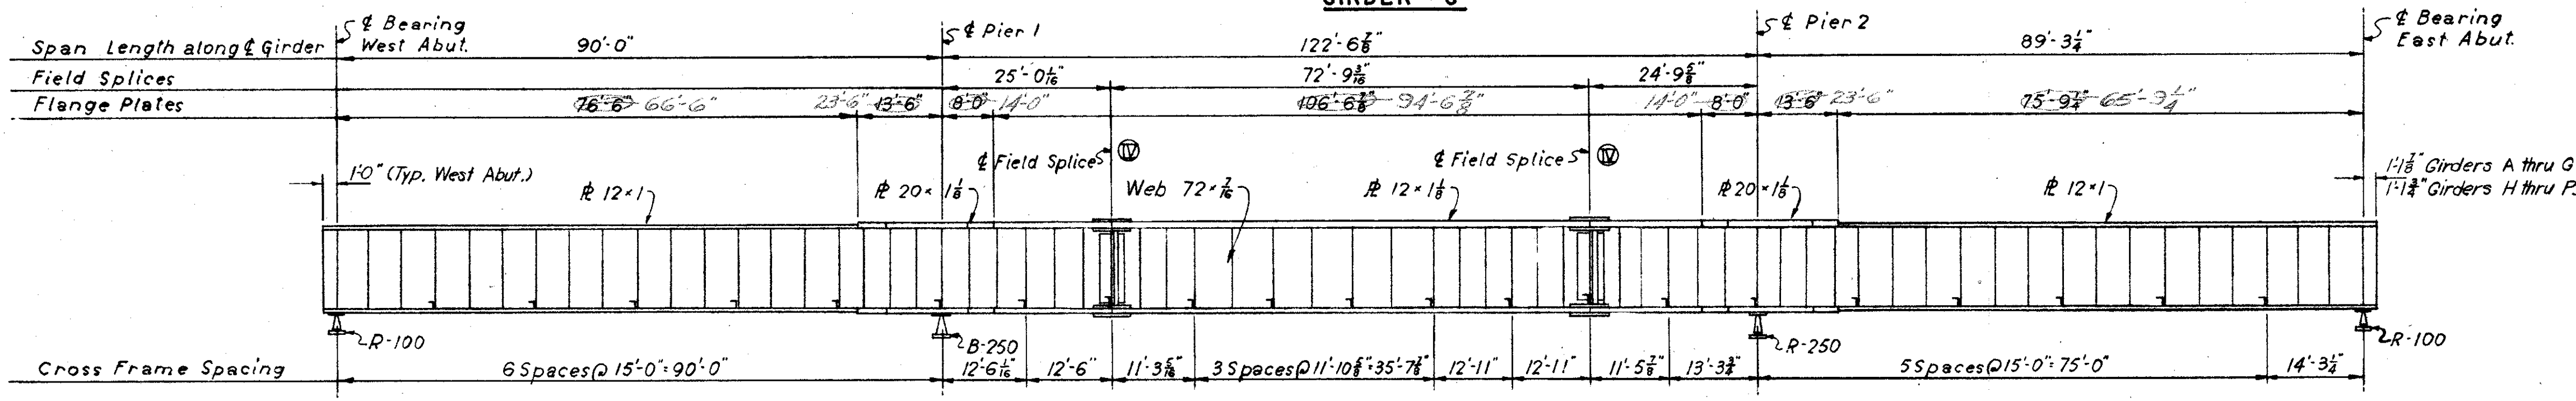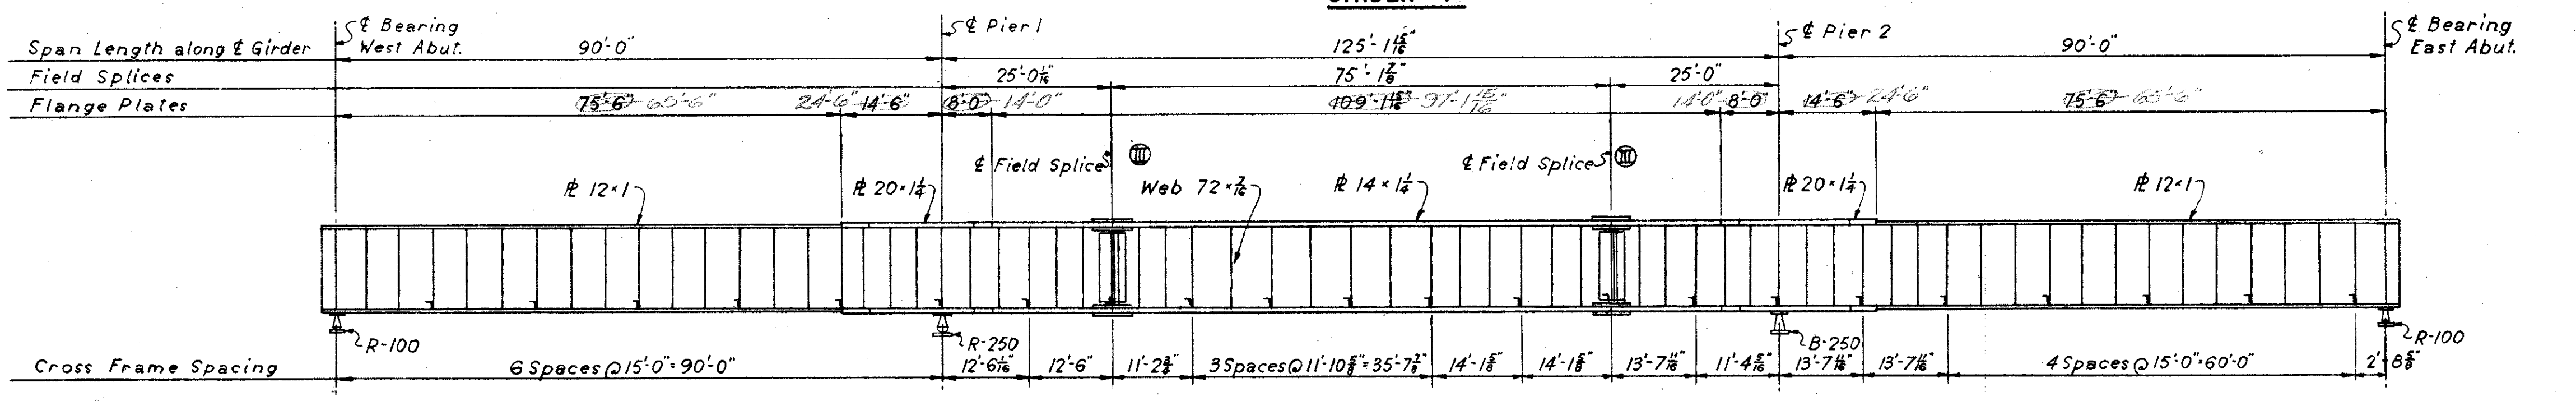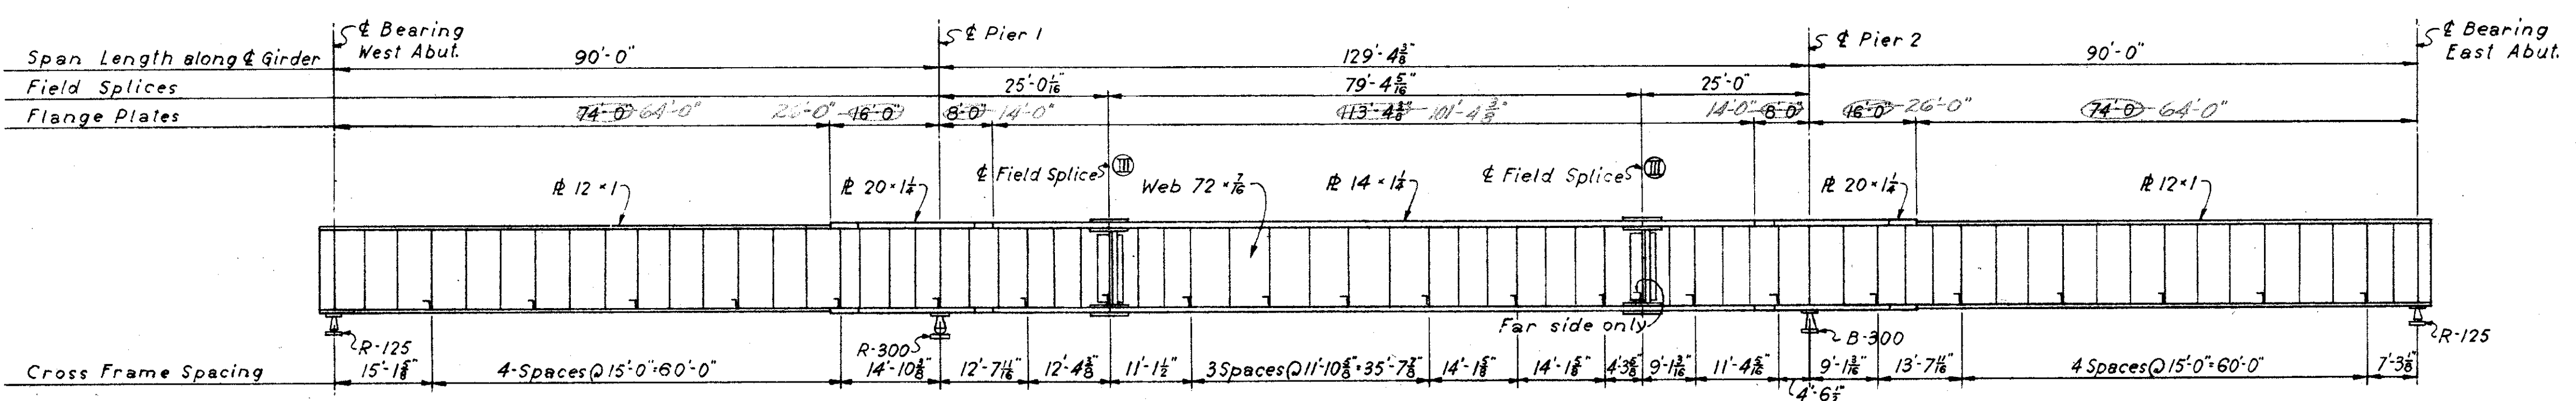

NOTE: For girder notes see sheet 109-7A.

H.N.T.B. BR. NO. 3 PART 7A


HOWARD, NEEDLES, TAMMEN & BERGENDOFF
CONSULTING ENGINEERS
KANSAS CITY CLEVELAND NEW YORK

GIRDER ELEVATIONS
INNER BELT FREEWAY OVER
RAMPS E-8, E-10 AND E-16
BR. NO. CUY-42-1843 STA. 65+10.18
Scale: As noted STA. 68+19.03

WILLOW-INNER BELT FREEWAY
CLEVELAND CUYAHOGA COUNTY OHIO

DRAWN A.B.	TRACED	CHECKED J.L.C.	REVIEWED J.C.T.	REVISED 6-20-60
DATE 5-23-59	DATE	DATE 7-3-59	DATE 11-13-59	SHEET 110


Horizontal Scale: 1/4" = 1'-0"
No Vertical Scale

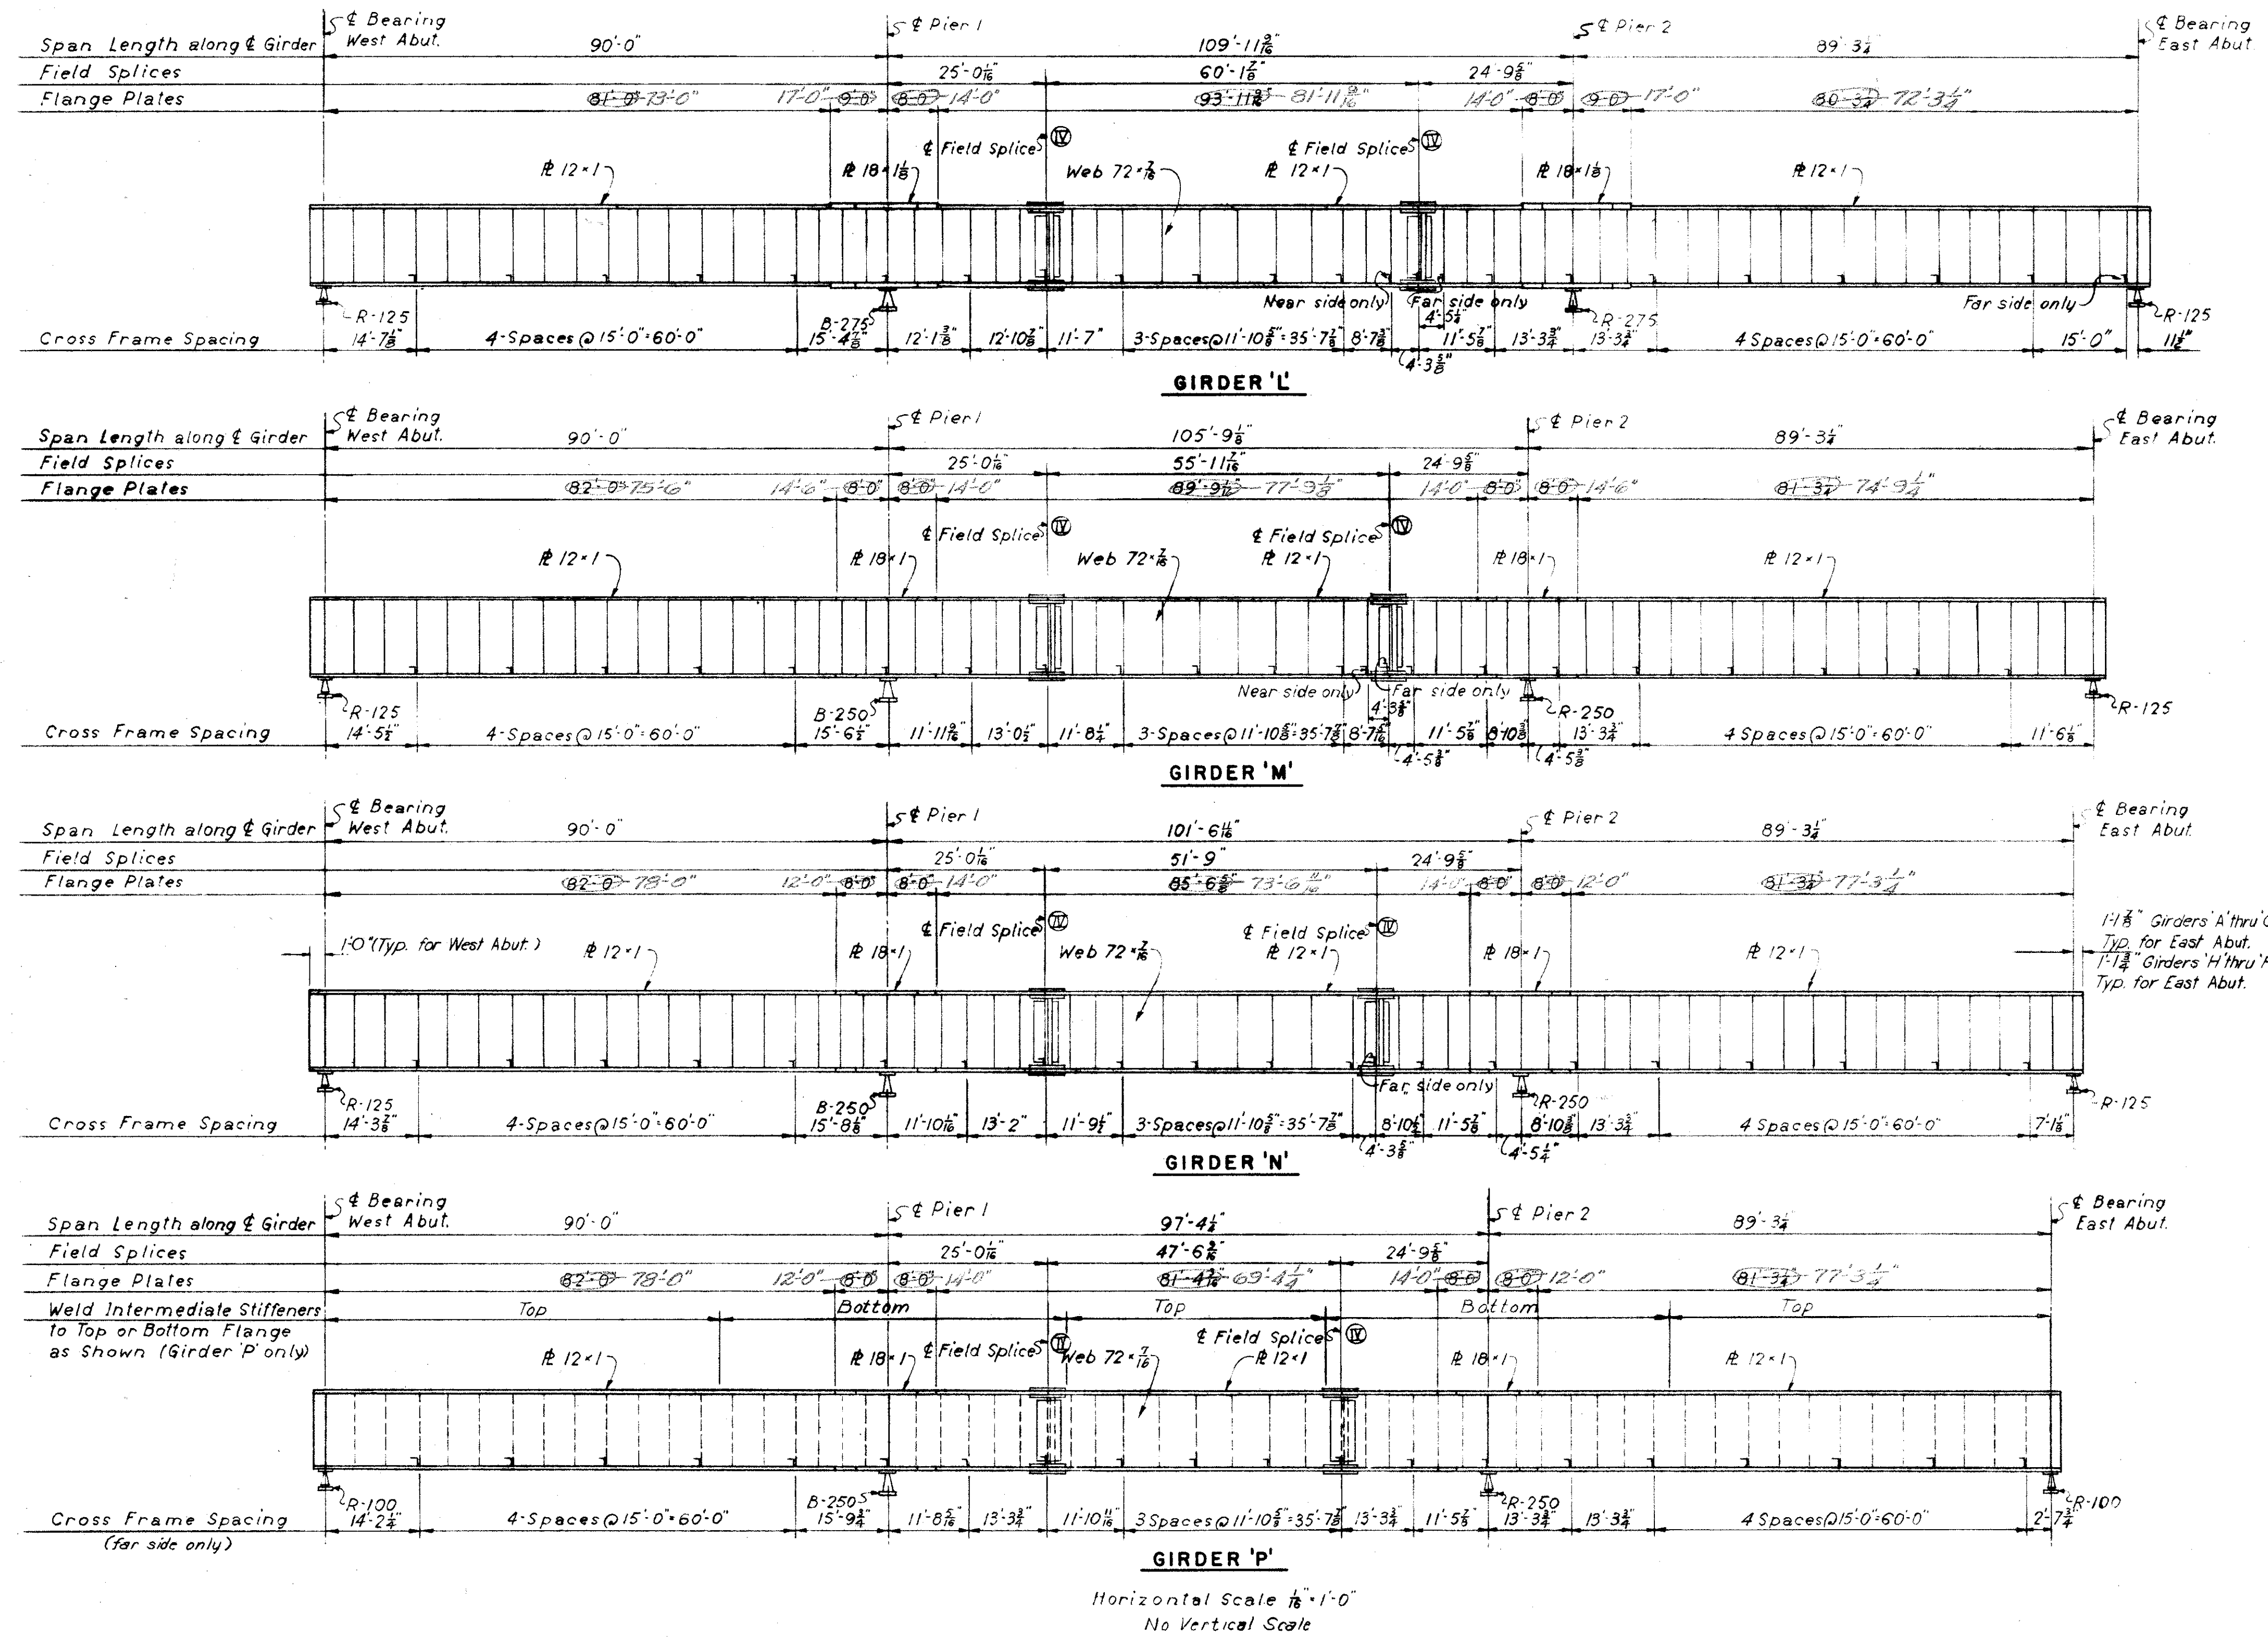

TOP OF PAVEMENT ELEVATIONS AND DEAD LOAD DEFLECTIONS

GIRDERS

	A	B	C	D	E	F	G	H	J	K	L	M	N	P
1	701.20	701.44	701.68	701.92	702.17	702.41	702.65	702.89	703.13	703.37	703.61	703.85	704.09	704.33
2	701.34	701.58	701.82	702.06	702.30	702.54	702.78	703.02	703.26	703.50	703.74	703.98	704.22	704.46
3	701.47	701.71	701.95	702.19	702.43	702.67	702.91	703.15	703.39	703.63	703.87	704.11	704.35	704.59
4	701.60	701.84	702.08	702.32	702.56	702.80	703.04	703.28	703.52	703.76	704.00	704.24	704.48	704.72
5	701.74	701.97	702.21	702.45	702.69	702.93	703.17	703.41	703.65	703.89	704.13	704.37	704.61	704.85
6	701.87	702.11	702.35	702.59	702.83	703.07	703.31	703.55	703.79	704.03	704.27	704.51	704.75	704.99
7	702.00	702.24	702.48	702.72	702.96	703.20	703.44	703.68	703.92	704.16	704.40	704.64	704.88	705.12
8	702.14	702.37	702.61	702.85	703.09	703.33	703.57	703.81	704.05	704.29	704.53	704.77	705.01	705.25
9	702.26	702.50	702.74	702.98	703.22	703.46	703.70	703.94	704.18	704.42	704.66	704.90	705.14	705.38
10	702.39	702.63	702.87	703.11	703.35	703.59	703.83	704.07	704.31	704.55	704.79	705.03	705.27	705.51
11	702.52	702.76	703.00	703.24	703.48	703.72	703.96	704.20	704.44	704.68	704.92	705.16	705.40	705.64
12	702.65	702.89	703.13	703.37	703.61	703.85	704.09	704.33	704.57	704.81	705.05	705.29	705.53	705.77
13	702.78	703.02	703.26	703.50	703.74	703.98	704.22	704.46	704.70	704.94	705.18	705.42	705.66	705.90
14	702.91	703.15	703.39	703.63	703.87	704.11	704.35	704.59	704.83	705.07	705.31	705.55	705.79	706.03
15	703.04	703.28	703.52	703.76	704.00	704.24	704.48	704.72	704.96	705.20	705.44	705.68	705.92	706.16
16	703.17	703.41	703.65	703.89	704.13	704.37	704.61	704.85	705.09	705.33	705.57	705.81	706.05	706.29
17	703.30	703.54	703.78	704.02	704.26	704.50	704.74	704.98	705.22	705.46	705.70	705.94	706.18	706.42
18	703.43	703.67	703.91	704.15	704.39	704.63	704.87	705.11	705.35	705.59	705.83	706.07	706.31	706.55
19	703.56	703.80	704.04	704.28	704.52	704.76	705.00	705.24	705.48	705.72	705.96	706.20	706.44	706.68
20	703.69	703.93	704.17	704.41	704.65	704.89	705.13	705.37	705.61	705.85	706.09	706.33	706.57	706.81
21	703.82	704.06	704.30	704.54	704.78	705.02	705.26	705.50	705.74	705.98	706.22	706.46	706.70	706.94
22	703.95	704.19	704.43	704.67	704.91	705.15	705.39	705.63	705.87	706.11	706.35	706.59	706.83	707.07
23	704.08	704.32	704.56	704.80	705.04	705.28	705.52	705.76	706.00	706.24	706.48	706.72	706.96	707.20
24	704.21	704.45	704.69	704.93	705.17	705.41	705.65	705.89	706.13	706.37	706.61	706.85	707.09	707.33
25	704.34	704.58	704.82	705.06	705.30	705.54	705.78	706.02	706.26	706.50	706.74	706.98	707.22	707.46
26	704.47	704.71	704.95	705.19	705.43	705.67	705.91	706.15	706.39	706.63	706.87	707.11	707.35	707.59
27	704.60	704.84	705.08	705.32	705.56	705.80	706.04	706.28	706.52	706.76	707.00	707.24	707.48	707.72

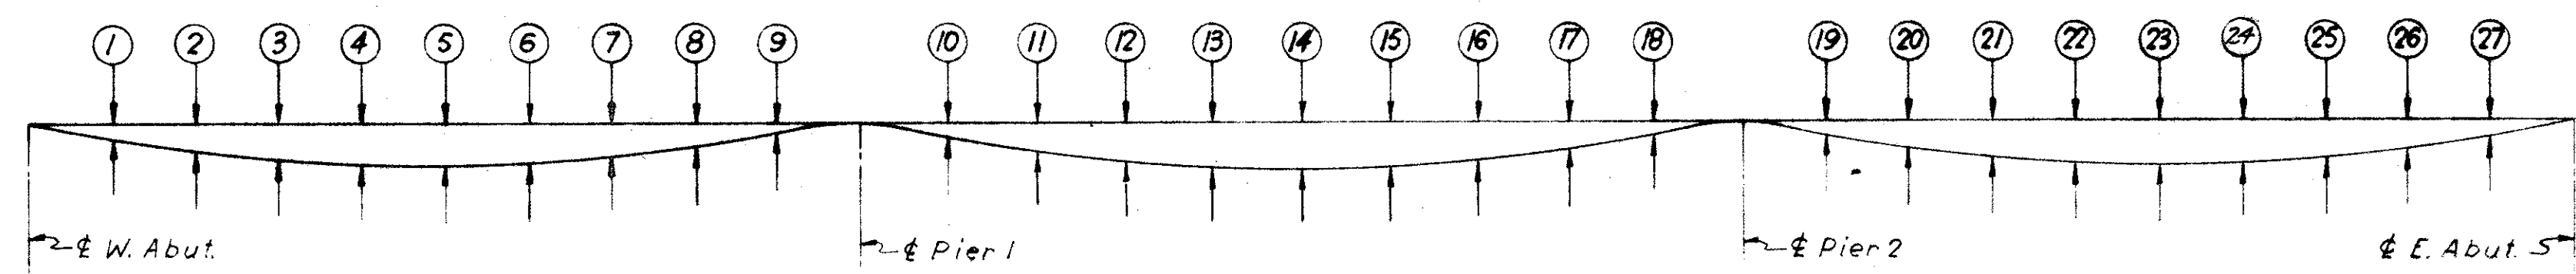

DEAD LOAD DEFLECTION DIAGRAM
This diagram locates points only and does not necessarily show the correct direction of deflections

NOTES:
Figures in the left columns are the total deflections due to the dead load of concrete and steel. Figures in the right columns are dead load deflections due to concrete only.

Negative sign indicates upward deflection. Deflections are given to the nearest 1/16" inch.

Note: For girder notes see sheet 109-7A

H.N.T.B. BR. NO. 3 PART 7A

HOWARD, NEEDLES, TAMMEN & BERGENOFF
CONSULTING ENGINEERS
KANSAS CITY CLEVELAND NEW YORK



GIRDER ELEVATIONS
INNER BELT FREEWAY OVER
RAMPS E-8, E-10 AND E-16
BR. NO. CUY-42-1843 STA. 65+10.18
Scale: As noted STA. 68+19.03

WILLOW-INNER BELT FREEWAY
CLEVELAND CUYAHOGA COUNTY OHIO


DRAWN A.B. TRACED DATE 5-29-58 CHECKED F.C. DATE 7-7-58 REVIEWED J.C. DATE 11-13-59 REVISIONS 6-20-60 SHEET 111

Note: Prefix "S" shall be assigned to all bar marks


CUYAHOGA COUNTY
CITY OF CLEVELAND
CUY-21-15.32
CUY-42-18.42

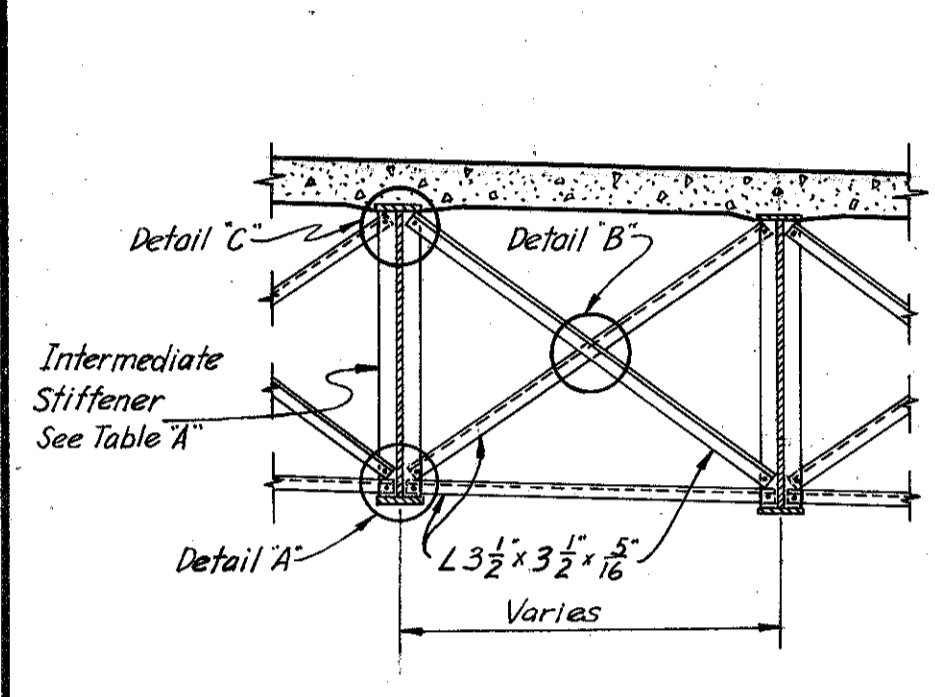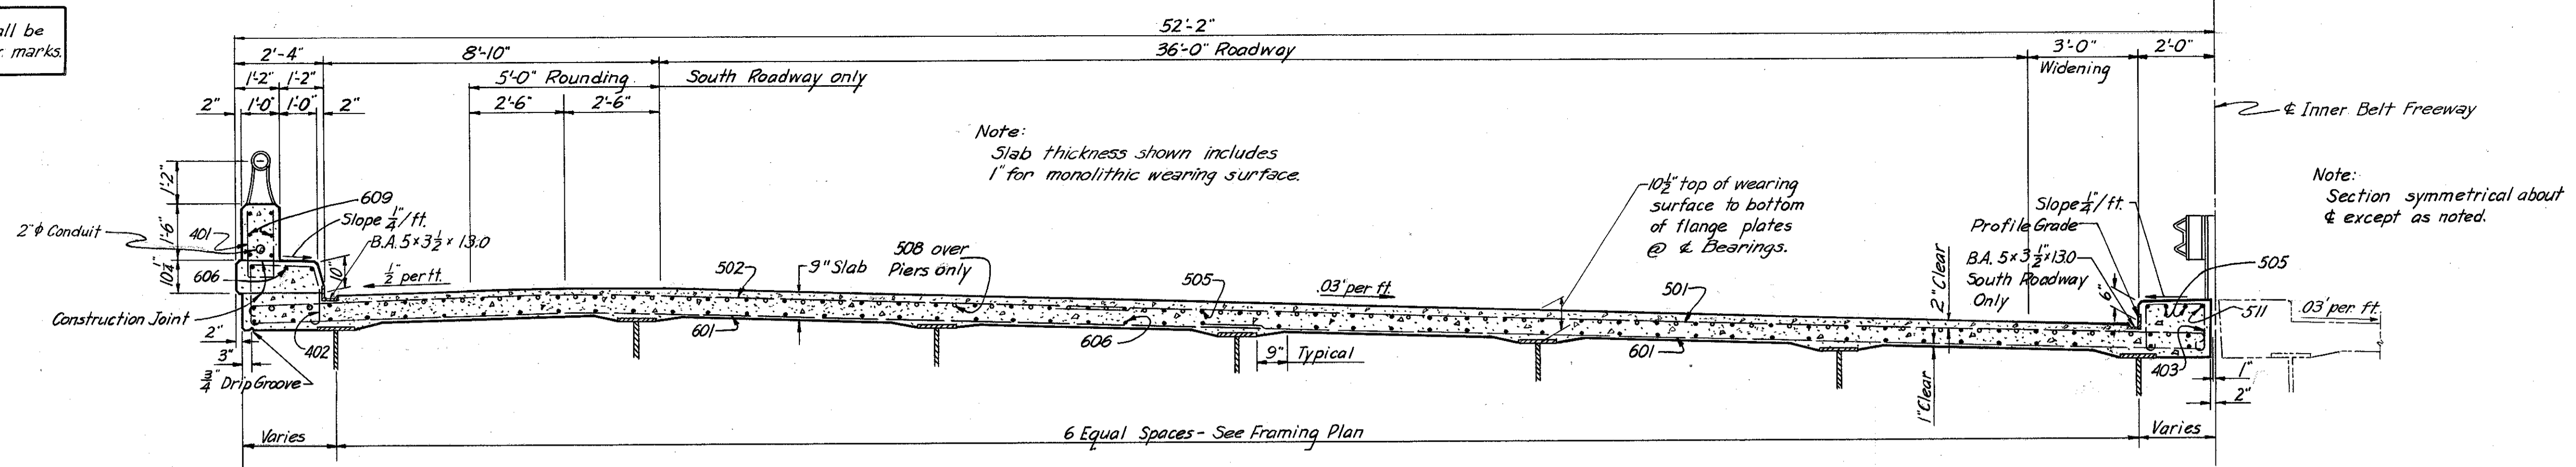


INTERMEDIATE CROSSFRAME
Scale: 1/4" = 1'-0"

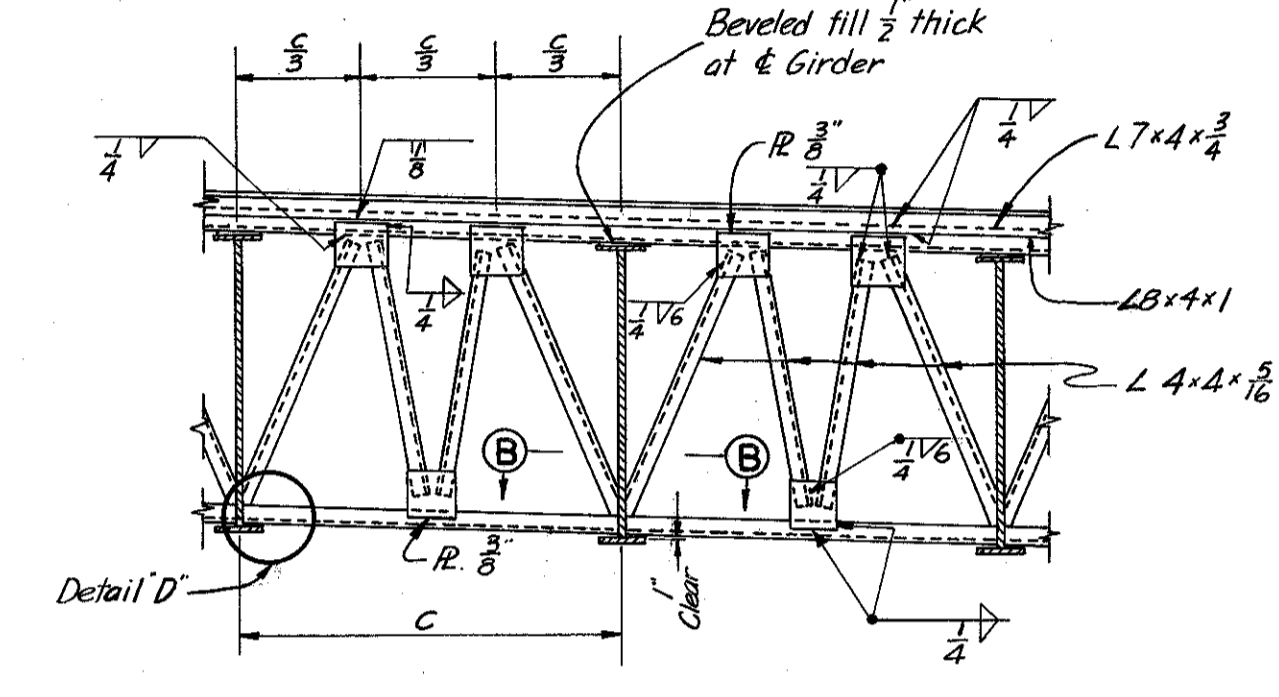


END CROSSFRAME
Scale: 1/4" = 1'-0"

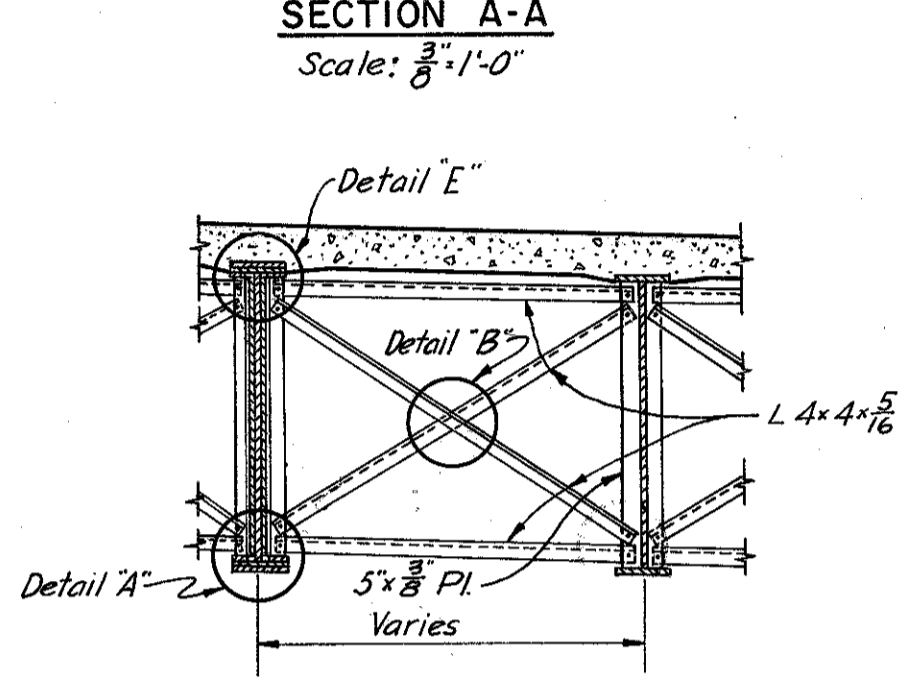


CROSSFRAME "B"
Scale: 1/4" = 1'-0"

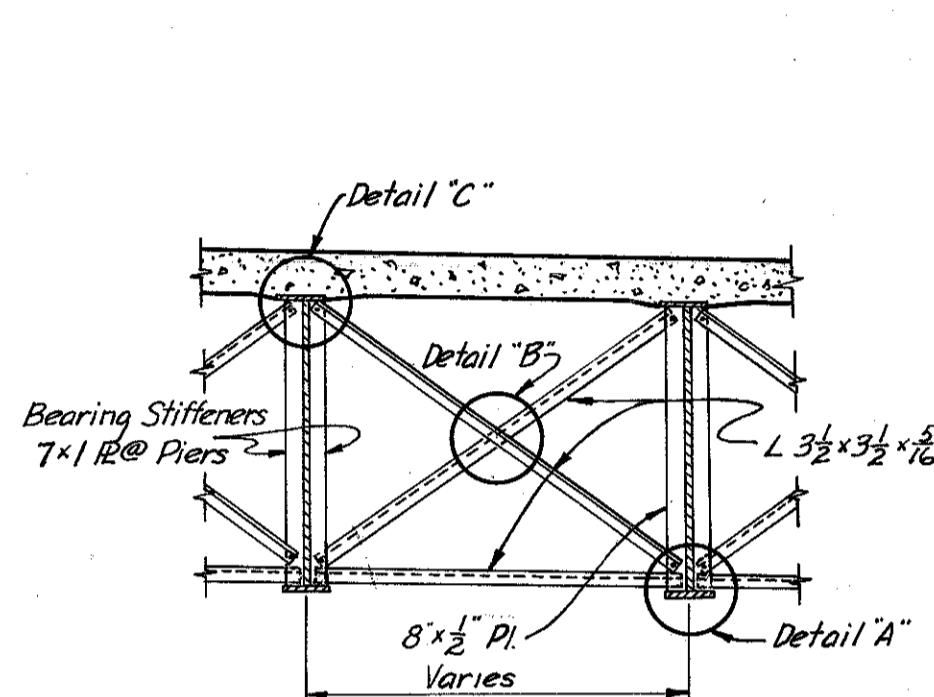


CROSSFRAME "A"
Scale: 1/4" = 1'-0"

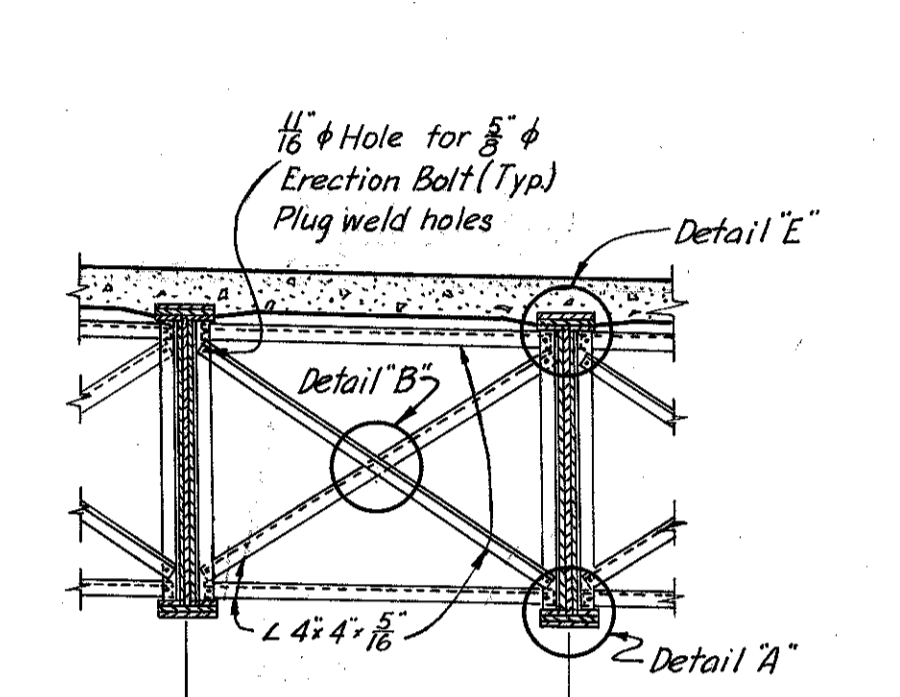


CROSSFRAME "C"
Scale: 1/4" = 1'-0"

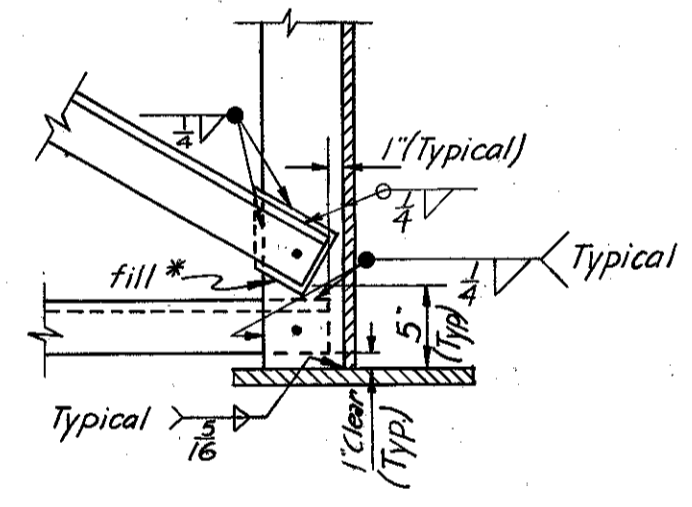


DETAIL "A"
Scale: 1/4" = 1'-0"

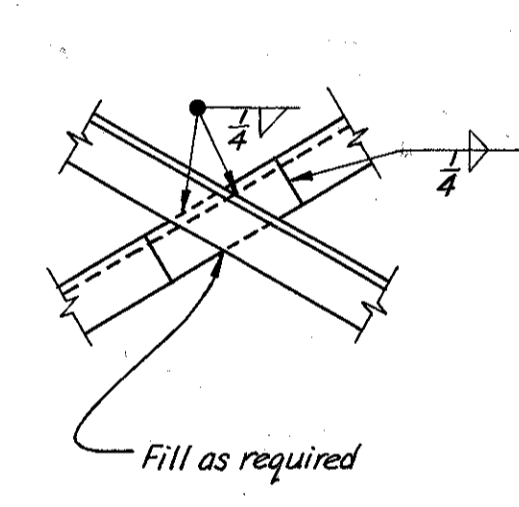


DETAIL "B"
Scale: 1" = 1'-0"

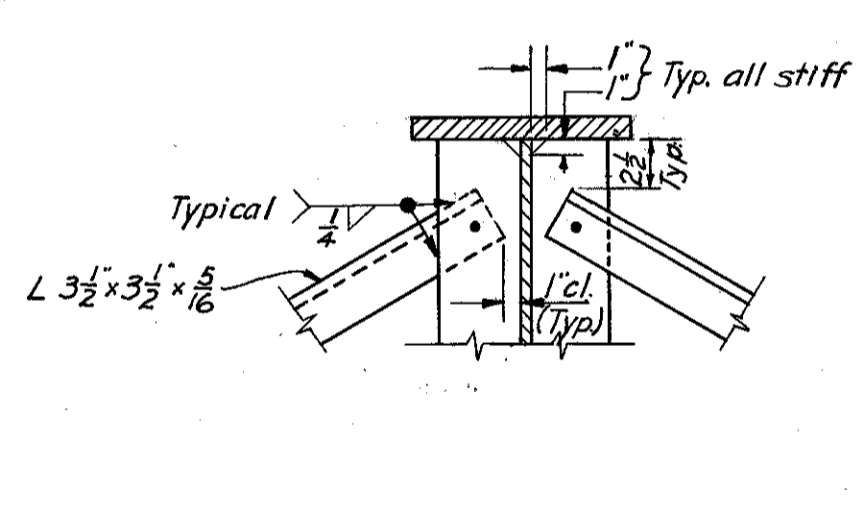


DETAIL "C"
Scale: 1" = 1'-0"

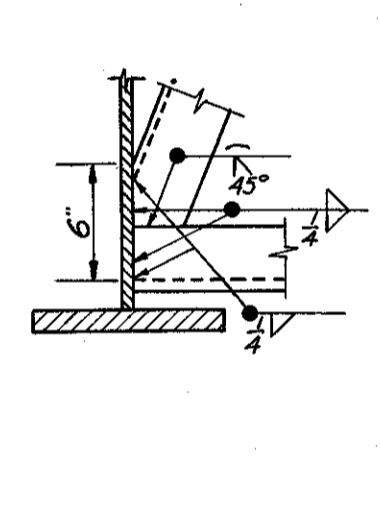

DETAIL "D"
Scale: 1" = 1'-0"

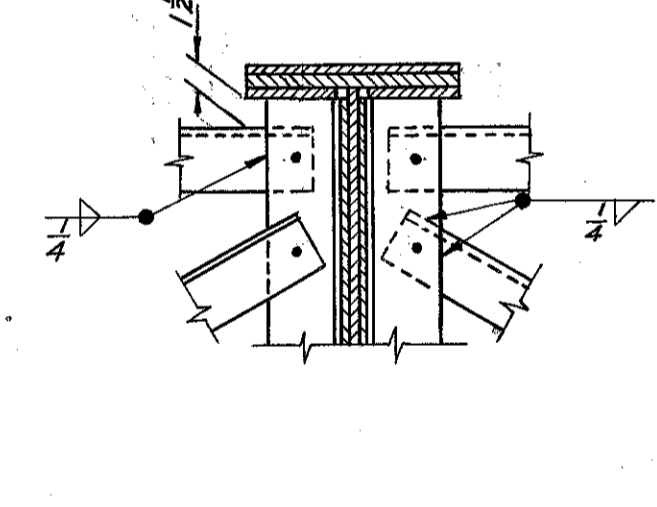


DETAIL "E"
Scale: 1" = 1'-0"

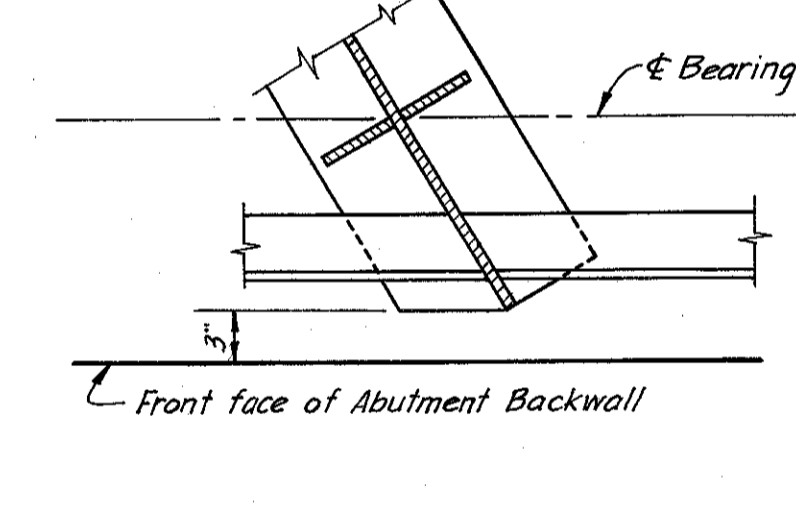


SECTION B-B
Scale: 1" = 1'-0"

FLANGE WIDTH	INTERMEDIATE STIFFENER
12"	R 5" x 3/8"
14" to 16"	R 6" x 3/8"
18" and Up	R 8" x 1/2"


NOTES:
For Deck Plan and location of Section A-A see sheet 113-7A
For additional notes see sheet 109-7A

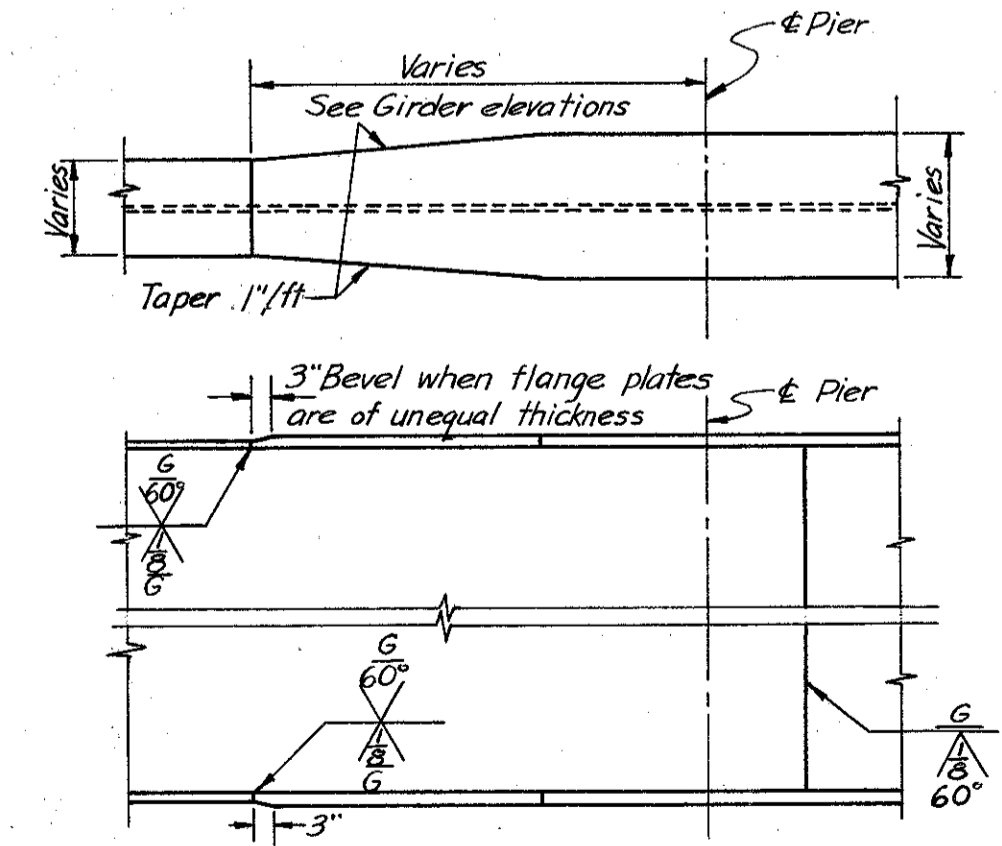


GIRDER SHOP SPLICE DETAILS
No Scale

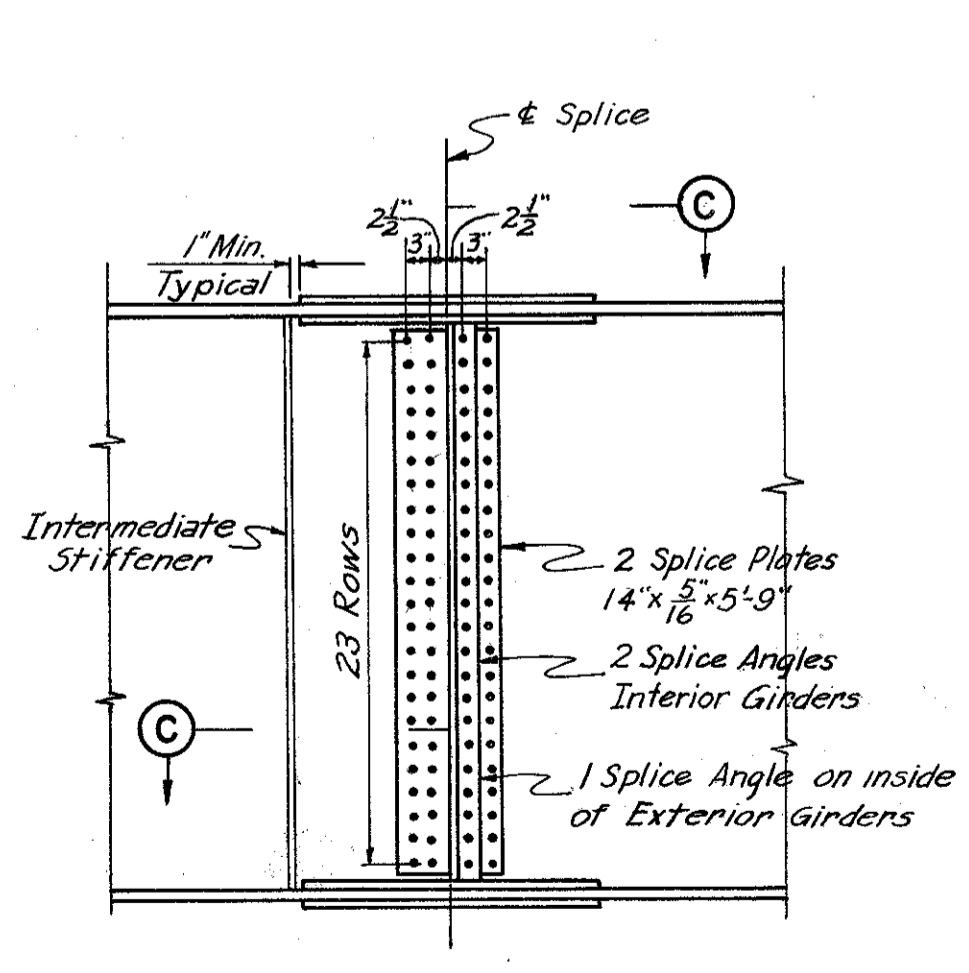

ELEVATION
Scale: 1/2" = 1'-0"

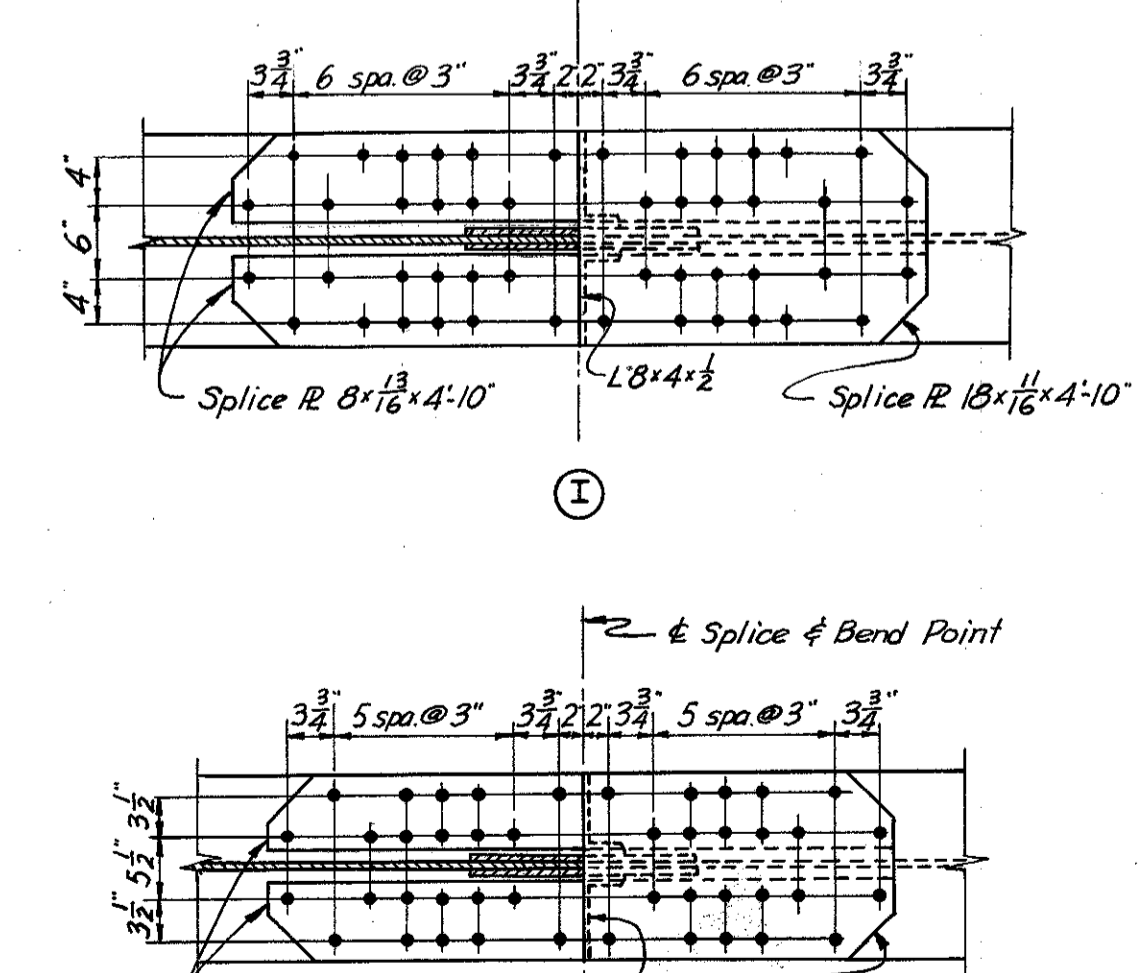

GIRDER FIELD SPLICE DETAILS

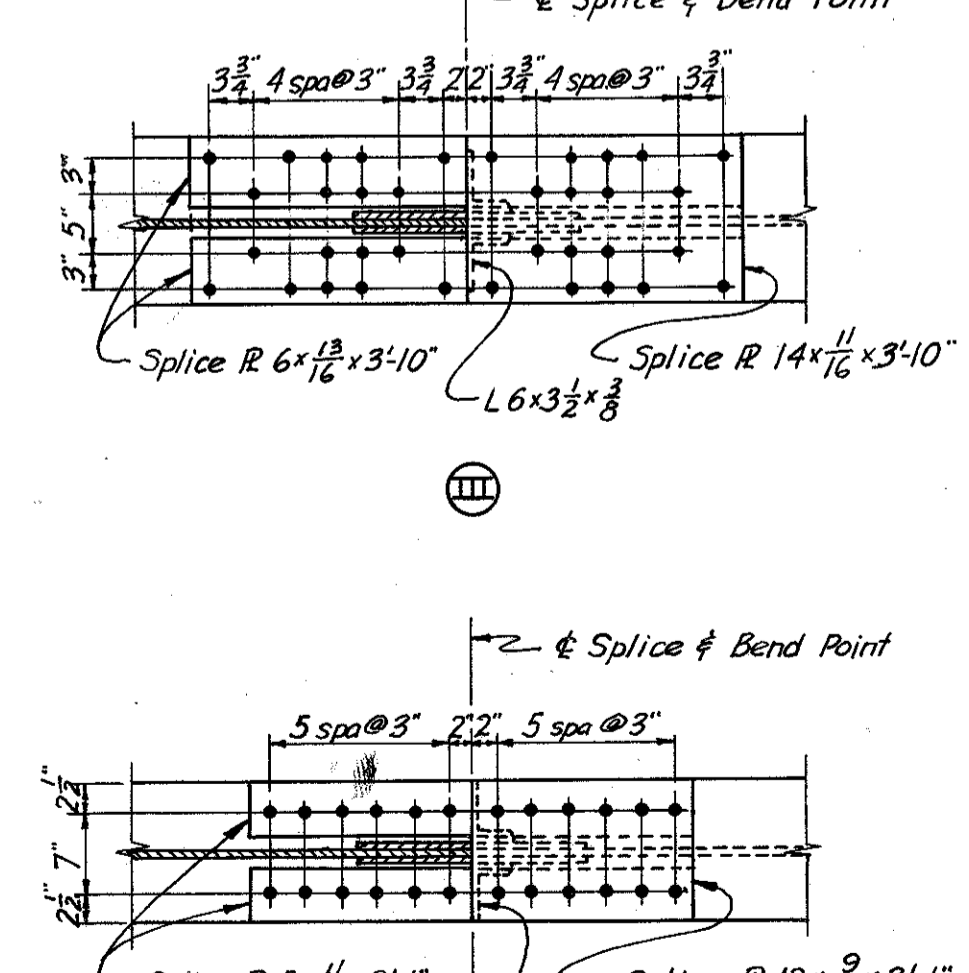

SECTION C-C
Scale: 1/2" = 1'-0"

H.N.T.B. BR. NO. 3 PART 7A

HOWARD, NEEDLES, TAMMEN & BERGENOFF
CONSULTING ENGINEERS
KANSAS CITY CLEVELAND NEW YORK

SUPERSTRUCTURE DETAILS
INNER BELT FREEWAY OVER
RAMPS E-8, E-10 AND E-18
BR. NO. CUY-42-1843 STA. 65+10.18
Scale: As noted STA. 68+19.03

WILLOW-INNER BELT FREEWAY
CLEVELAND CUYAHOGA COUNTY OHIO

DRAWN: R.L.	TRACED: J.H.	CHECKED: J.K.	REVIEWED: J.C.T.
DATE: 6-20-38	DATE: 9-Mar-39	DATE: 7-21-38	DATE: 1-13-39

SHEET 112

RECORDED
JUL 3 1955

FED. ROADS DIV. NO.	STATE	FED. AID PROJ. NO.
2	OHIO	

113
181

CUYAHOGA COUNTY
CITY OF CLEVELAND
CUY-21-15.32
CUY-42-18.42


NOTE:

In order to facilitate water curing of the concrete of the deck slab, the placing of concrete shall progress upgrade. The slab may be placed in sections, between transverse construction joints which are parallel to the transverse bars in the slab and are located near the center of any span.

NOTES:

For details of railing parapet joints and guard rail see sheet 175-7A
 (1) For details of Light Standard Support and other lighting details see sheet 176-7A
 For cross section thru deck and other superstructure details see sheet 112-7A
 For Drainage details see sheet 174-7A
 For End Dam details see sheet 173-7A
 For Section A-A see sheet 112-7A


Note: Prefix "S" shall be assigned to all bar marks.

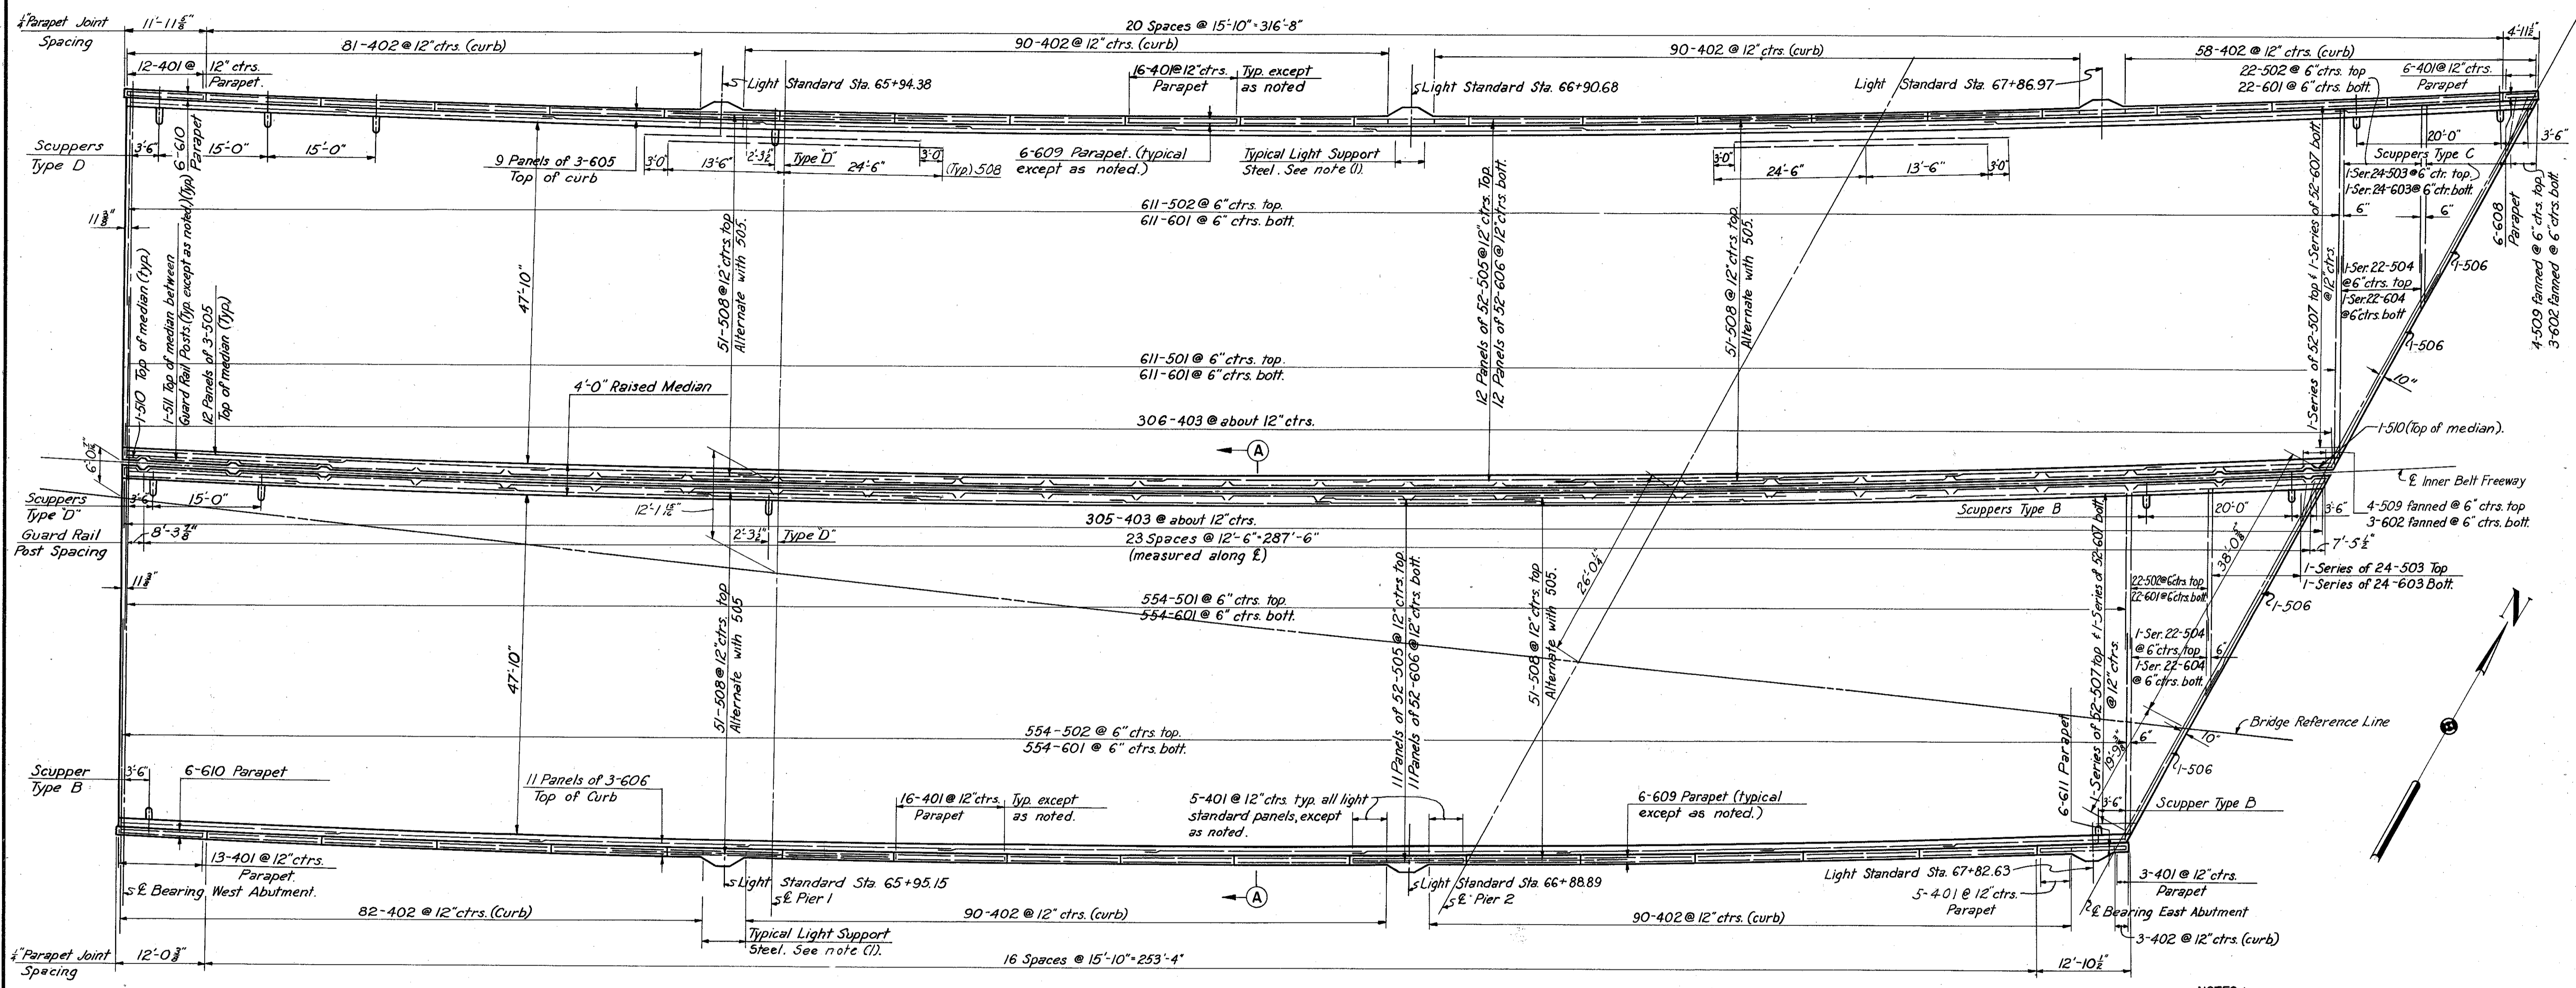

PLAN

REINFORCEMENT SCHEDULE																																
MARK	NO.	LENGTH	TYPE	DIMENSIONS				SERIES INC.	WEIGHT (LBS)	MARK	NO.	LENGTH	TYPE	DIMENSIONS				SERIES INC.	WEIGHT (LBS)													
				A	B	C	D							A	B	C	D															
401	585	4'-5"	105	8"	2'-0"				1726	511	48	13'-0"	159	11'-2"	0'-6"	0'-10"			651	12	8'-11"	131	2'-6"	1'-2"						72		
402	584	5'-1"	122	1'-8"	1'-4"				1983											452	12	9'-11"	131	3'-0"	1'-8"					78		
403	611	4'-3"	122	1'-6"	1'-0"				1735											453	18	9'-5"	131	3'-2"	1'-0"					114		
501	1165	30'-7"	101	30'-0"					37162	601	2374	26'-9"	Str.							95384	454	12	5'-7"	155	2'-2"					42		
502	1209	23'-7"	101	23'-0"					29738	602	6	7'-6"	Str.							68	455	12	6'-1"	155	2'-8"					48		
503	2 Series of 24	7'-7" to 29'-7"	101	7'-0" to 29'-0"				11 1/2"	930	603	2 Series of 24	7'-0" to 29'-0"	Str.							11 1/2"	1298	456	18	6'-3"	155	2'-10"				78		
504	2 Series of 24	8'-6" to 28'-0"	Str.					11 1/2"	838	604	2 Series of 24	5'-6" to 24'-6"	Str.							10 3/8"	991											
505	1268	26'-9"	Str.						35378	605	27	38'-9"	Str.							1571	651	12	9'-5"	141	2'-11"	1'-10"					168	
506	4	30'-3"	Str.						126	606	1229	27'-0"	Str.							49841	652	18	14'-6"	141	5'-3"	3'-0"					390	
507	2 Series of 24	3'-0" to 29'-0"	Str.					6 3/8"	1376	607	2 Series of 24	3'-0" to 29'-0"	Str.							2499	653	6	5'-0"	Str.						48		
508	204	38'-0"	Str.						8085	*609	216	15'-6"	Str.																		Total	272,493
509	8	7'-6"	Str.						63	*610	12	11'-6"	Str.																			
510	4	2'-11"	108	2'-0"	0'-6"	0'-10"			12	*611	6	12'-6"	Str.																			

BAR BENDING DIAGRAMS

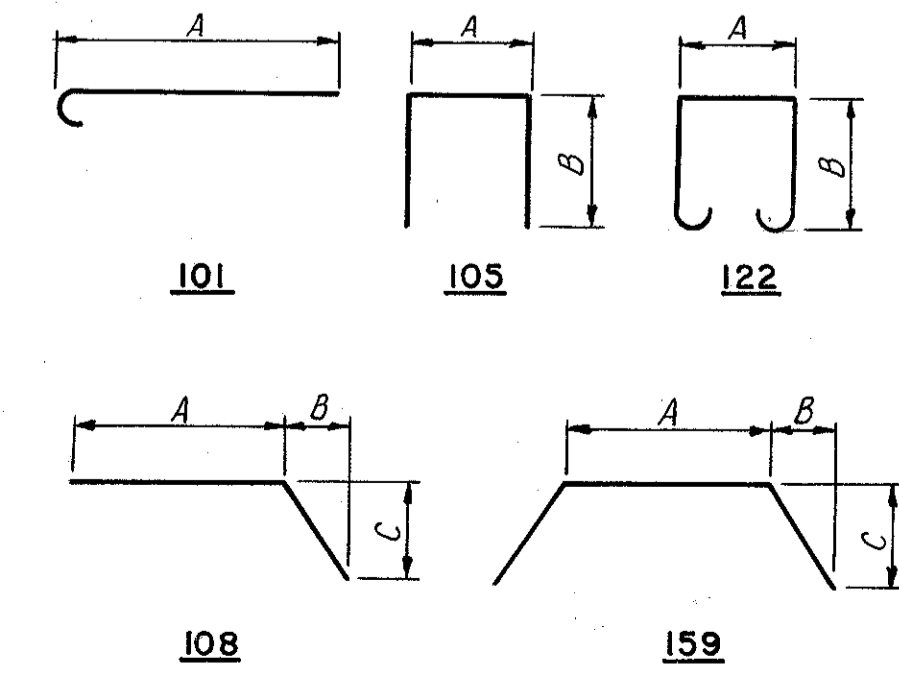

NOTES:
 * Bars are for the Light Standard Supports. For their bending diagrams and placement see sheet 176-7A
 * Bars are included with Item 3-14, Railing for payment.
 For Replacement Schedule See Sheet 103-7A
 All bar dimensions are given out to out. Bars of a series shall vary in length by a constant increment.



H.N.T.B. BR. NO. 3 PART 7A

HOWARD, NEEDLES, TAMMEN & BERGENDOFF
 CONSULTING ENGINEERS
 KANSAS CITY CLEVELAND NEW YORK

DECK PLAN
 INNER BELT FREEWAY OVER
 RAMPS E-8, E-10 AND E-16
 BR. NO. CUY-42-1843 STA. 65+10.18
 Scale: 3/32" = 1'-0" STA. 68+19.03
WILLOW-INNER BELT FREEWAY
 CLEVELAND CUYAHOGA COUNTY OHIO



DRAWN A.B.	TRACED R.K.	CHECKED A.L.	REVIEWED J.C.T.	REVISED
DATE 4-25-58	DATE 3-4-59	DATE 6-30-59	DATE 11-13-59	

SHEET 113

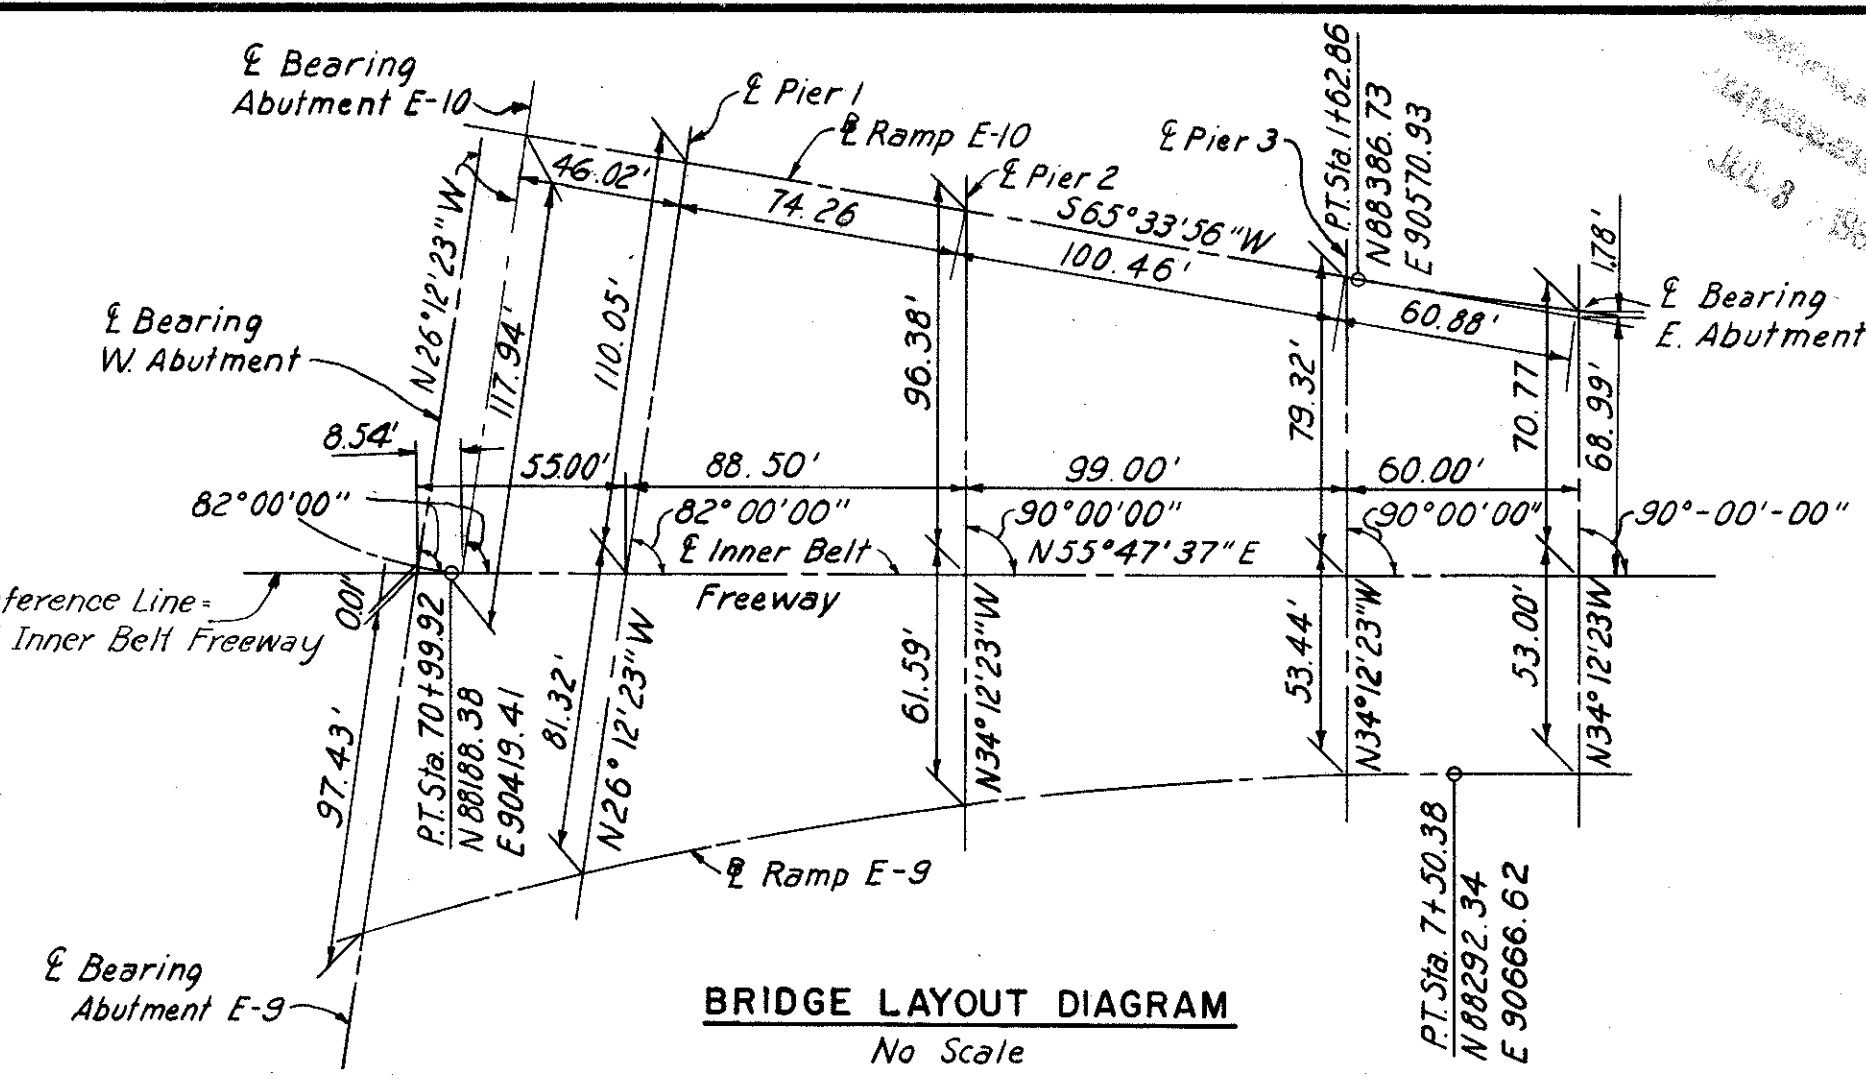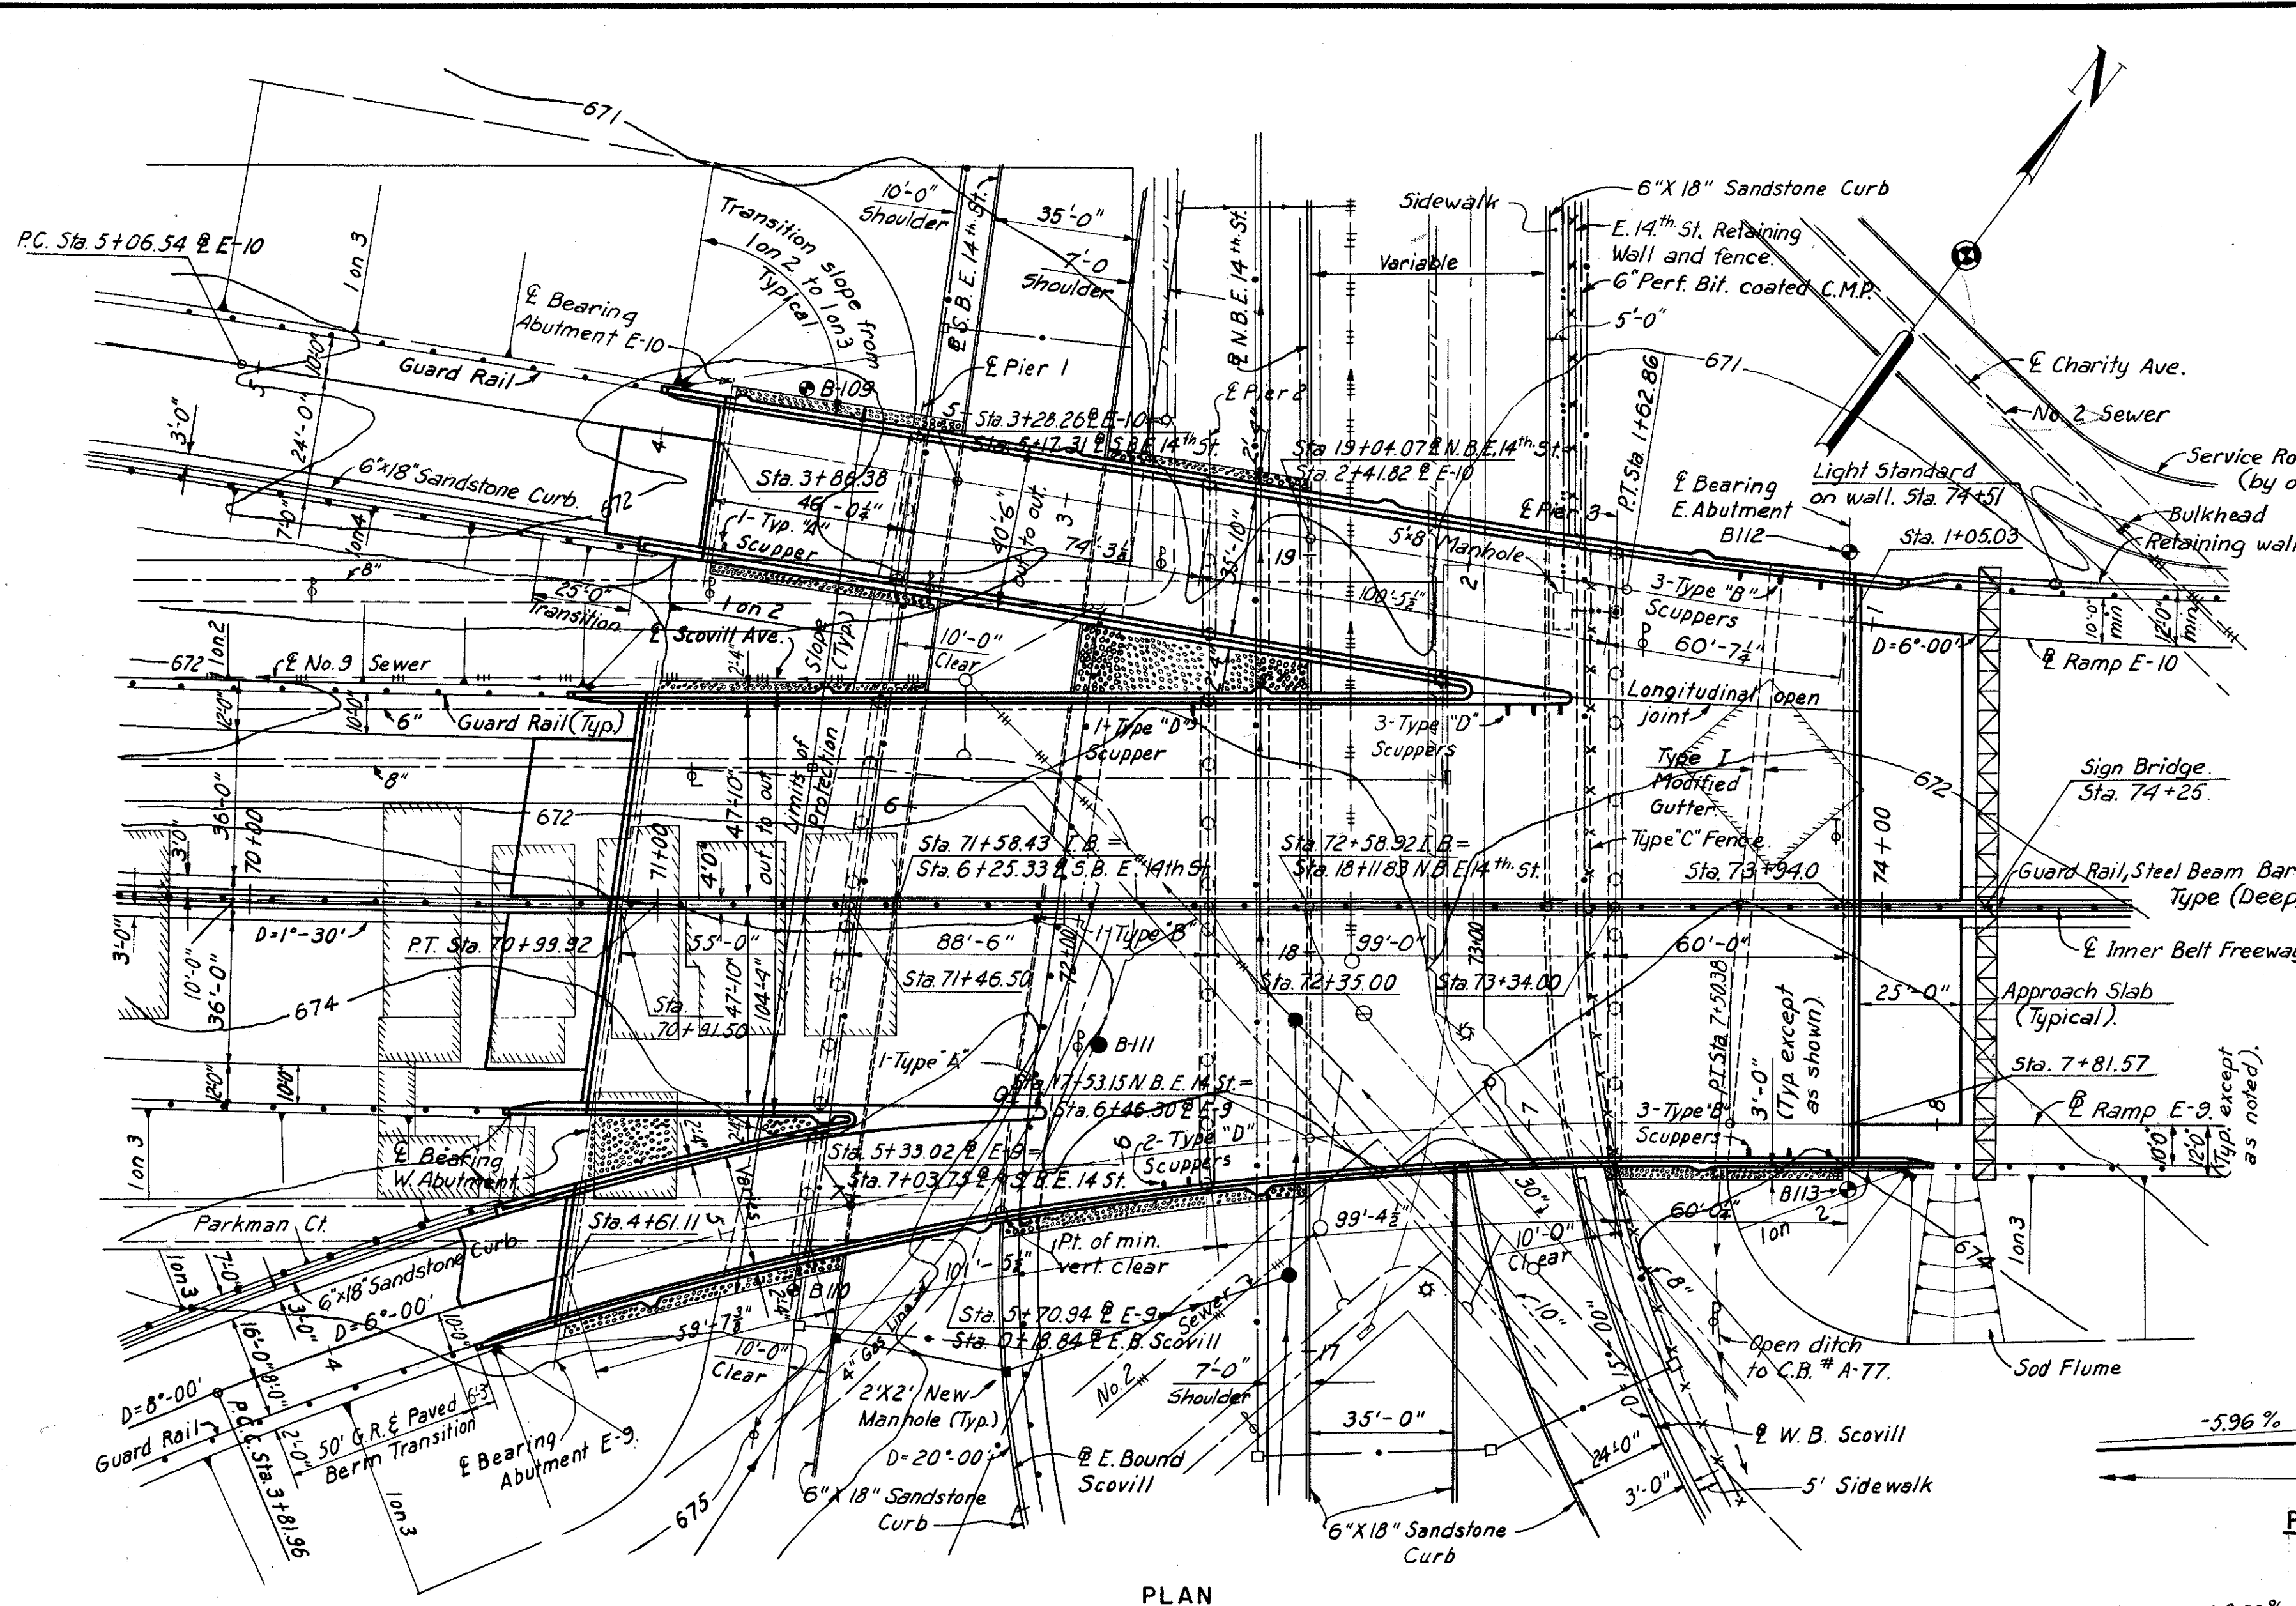

Elev. 673.0	Brick & Cinder
19 668.0	Brown Silty Sand
24 663.0	Brown Silty Gravelly Sand
41	
18	
21	
40	
93 638.0	Brown Silty Sand
36 633.0	Gray Sandy Silt
34	
21	
39	
20	
26	
34	
27	
45 592.0	Gray Silt

CURVE DATA I. B. FREEWAY		CURVE DATA RAMP E-9		CURVE DATA RAMP E-10	
$\Delta = 12^\circ 01' 26''$	$\Delta = 22^\circ 06' 19''$	$\Delta = 9^\circ 46' 18''$	$\Delta = 9^\circ 46' 18''$	$\Delta = 9^\circ 46' 18''$	$\Delta = 9^\circ 46' 18''$
$D = 1^\circ 30'$	$D = 6^\circ 00'$	$D = 6^\circ 00'$	$D = 6^\circ 00'$	$D = 6^\circ 00'$	$D = 6^\circ 00'$
$R = 3819.72'$	$R = 954.93'$	$R = 954.93'$	$R = 954.93'$	$R = 954.93'$	$R = 954.93'$
$T = 402.27'$	$T = 186.53'$	$T = 186.53'$	$T = 186.53'$	$T = 186.53'$	$T = 186.53'$
$L = 801.59'$	$L = 368.42'$	$L = 368.42'$	$L = 368.42'$	$L = 368.42'$	$L = 368.42'$

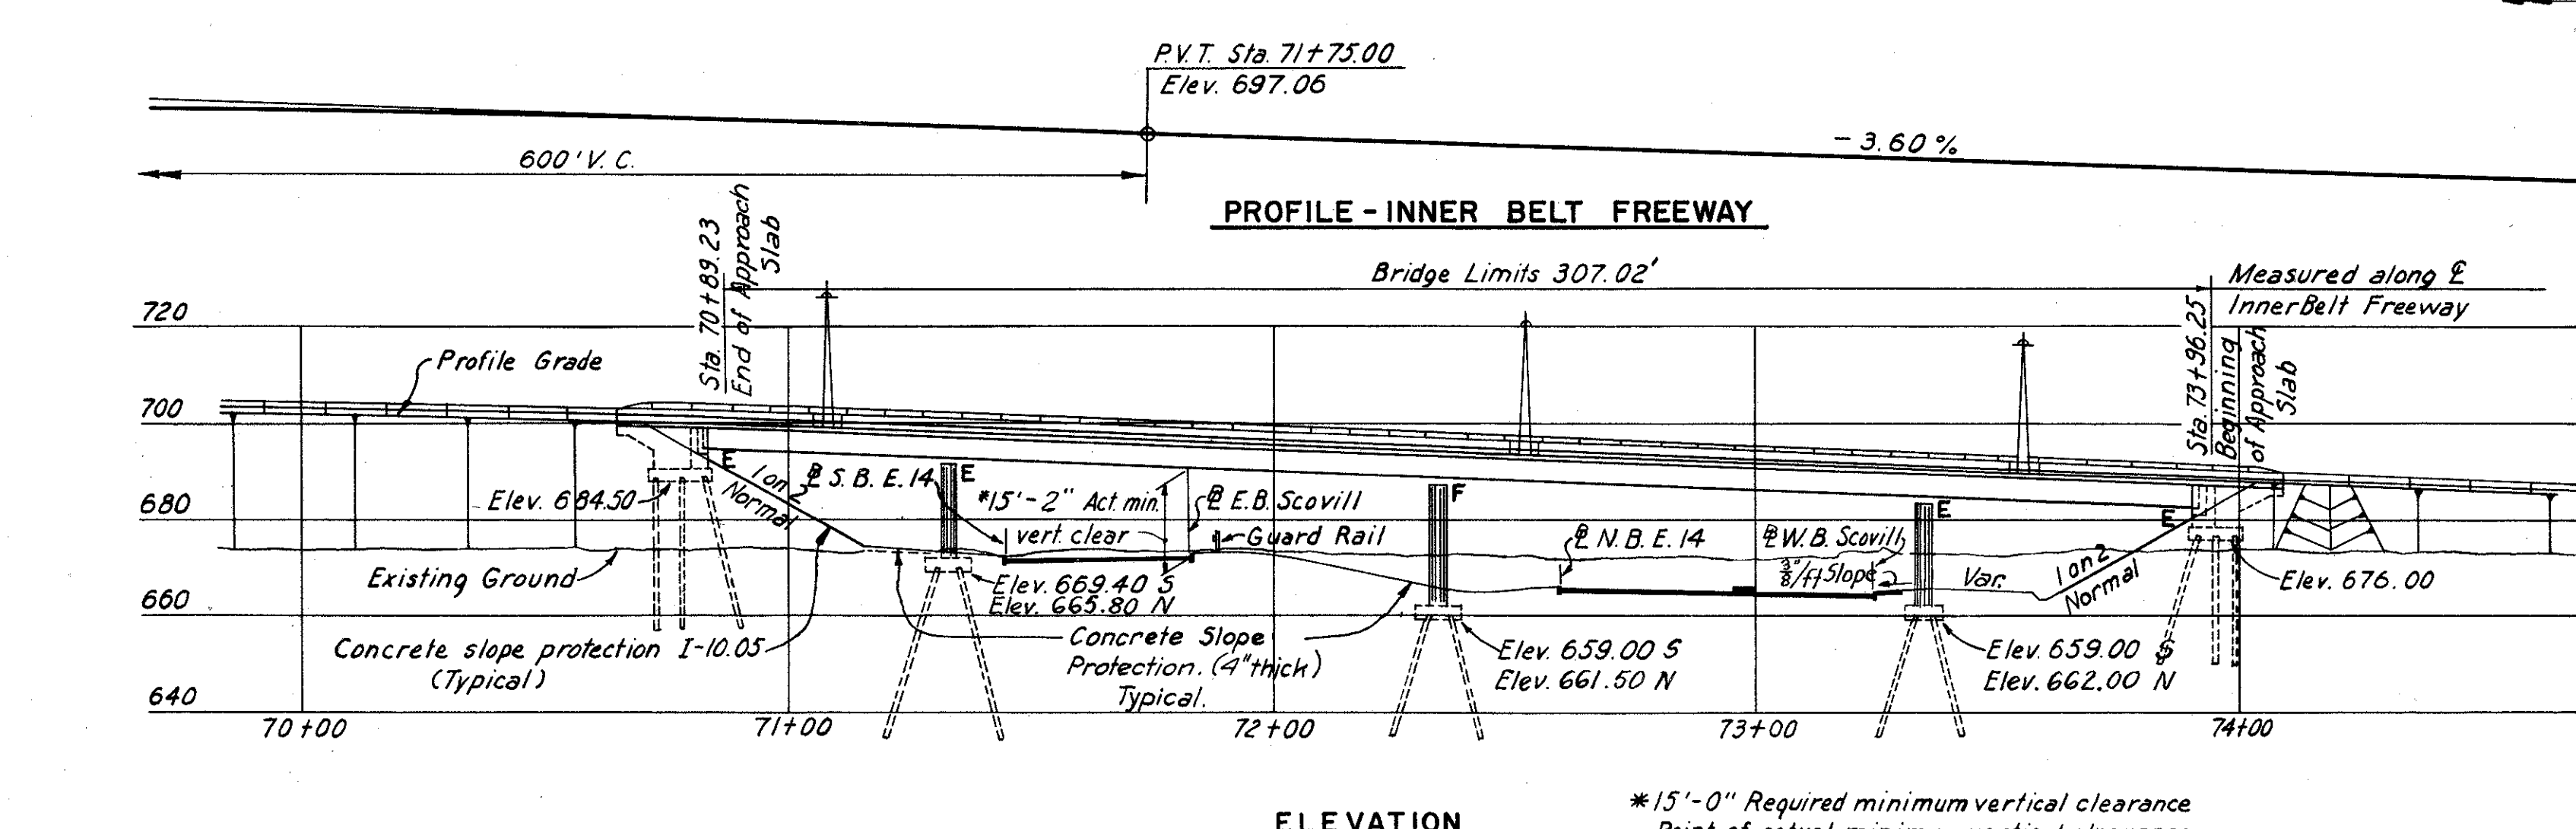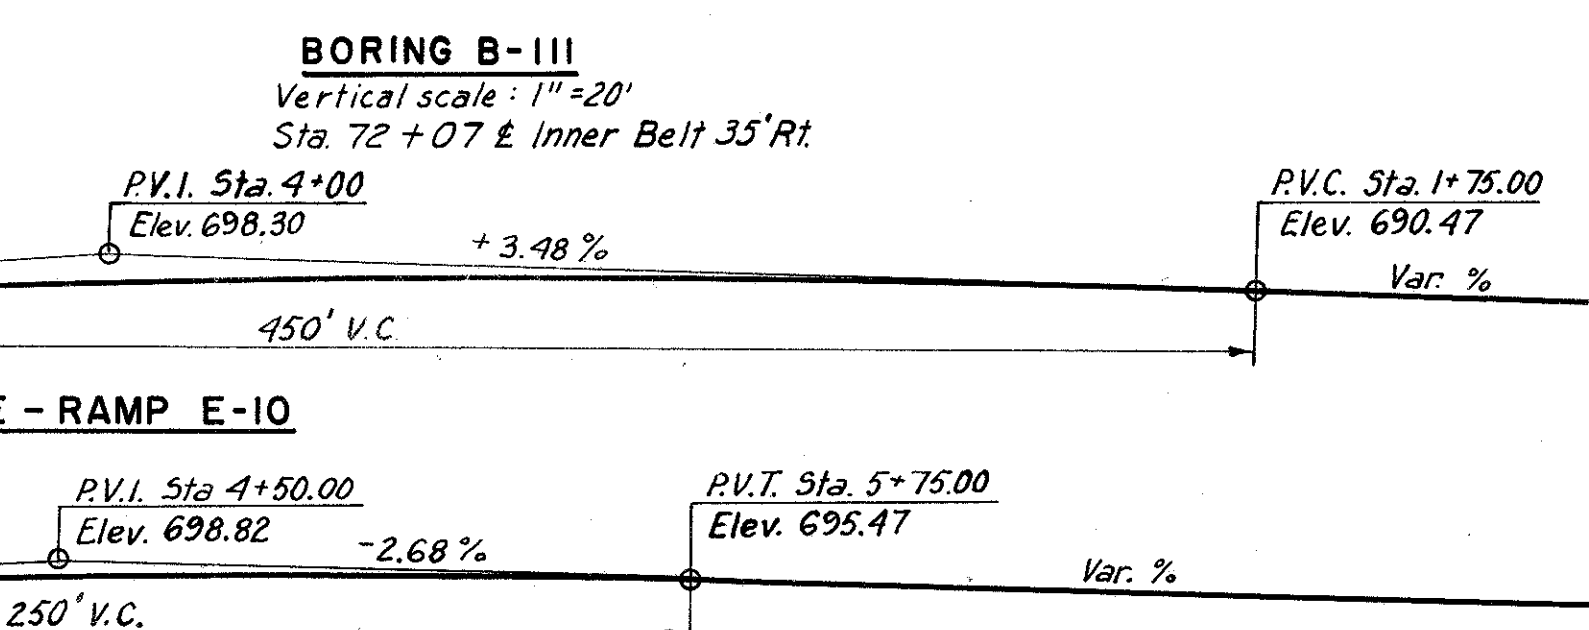

PILE INFORMATION			
Location	Diameter	Number	Estimated ave. length
Abutment E-9	12"	17	23'
Abutment E-10	12"	20	23'
W. Abutment	12"	42	28'
E. Abutment	12"	74	28'
Retaining wall	12"	92	27'
Pier 1	14"	48	28'
Pier 2	14"	80	26'
Pier 3	14"	56	27'
E. 14th St. Retain. wall	12"	39	29'

All piles to be C.I.P. Reinforced Concrete.
Note: Piers for Br. No. 4 and E. 14th St. Retaining Walls, are included in Part 6.

PROPOSED STRUCTURE
TYPE: Continuous welded steel girder with reinforced concrete deck and substructure.
SPANS: 55'-0", 88'-6", 99'-0", & 60'-0" along E. I. B. ROADWAY: Varies
LOADING: C.F. - 2000 - Adequate for A.A.S.H.O. alternate loading.
SKEW: Varies
SURFACE COURSE: 1" Monolithic Concrete
ALIGNMENT: 1° 30' Lt. Tangent
APPROACH SLABS: AS-1-54 (25' long)
SUPERELEVATION: Varies

NOTES:
The following items are not included in the Bridge Plans: (See Roadway Plans for Details) Approach grading, pavement and slabs, Roadway Guard Rail, Sod Flumes.
For details of pier plans & drain pipe locations at piers see sheets 135-7A, 172-7A & 174-7A
For details of slope protection, see Sh. 174-7A
Rod sounding only were taken at location B-109, B-110, B-112, & B-113. The core drilling made at B-111 is plotted.

Pile lengths are based on boring data and are approximate only. The Contractor shall assume full responsibility for length of piling selected for driving.
For details of slope protection behind Pier 3, see sheet 120-7A
For details of Sign Bridge, see sheets 177A-7A, 178-7A

H.N.T.B. BR. NO. 4 PART 7A
HOWARD, NEEDLES, TAMMEN & BERGENDOFF CONSULTING ENGINEERS
KANSAS CITY CLEVELAND NEW YORK

SITE PLAN
INNER BELT FREEWAY OVER EAST 14th ST.
BR. NO. CUY-42-1854 STA. 70+89.23
- Scale: 1" = 30' STA. 73+96.25
WILLOW-INNER BELT FREEWAY
CLEVELAND CUYAHOGA COUNTY OHIO







REVISIONS
JUL 3 1955

CUYAHOGA COUNTY
CITY OF CLEVELAND
CUY-21-15.32
CUY-42-1842

Note:
End of railing parapet to be normal to top of safety curb.

Note: Prefix "AA" shall be assigned to all bar marks.

REINFORCEMENT SCHEDULE									
MARK	NO.	LENGTH	TYPE	DIMENSIONS			SERIES INCREMENT	WEIGHT	
				A	B	C	D		
401	1-Ser. of 6	4'-6" to 6'-0"	109	8" to 1'-5"	1'-5"			3 3/8"	21
402	1-Ser. of 6	6'-2" to 6'-6"	109	1'-6" to 1'-8"	1'-5"			3 3/8"	25
403	25	6'-6"	109	1'-8"	1'-5"				109
404	34	5'-7"	105	8"	2'-7"				127
406	14	6'-10"	144	2'-6"	1'-10"	7"			64
501	35	4'-5"	105	1'-8"	1'-6"				162
601*	12	16'-3"	Str.						
602	16	17'-6"	Str.						421
603	4	19'-6"	Str.						117
604	9	7'-6"	Str.						101
605	2	13'-6"	Str.						41
606	2	11'-0"	Str.						33
607	2	11'-9"	Str.						35
608	2	9'-9"	Str.						29
609	6	8'-3"	Str.						74
610	6	5'-9"	126	1'-8"	1'-2"	3'-3"			52
611	2	8'-4"	105	1'-2"	3'-9"				25
612	2	10'-10"	105	1'-2"	5'-0"				33
613	24	9'-3"	Str.						333
614	30	6'-4"	104	5'-8"	10"				285
615	4	8'-8"	108	6'-9"	1'-6"	1'-3"			52
616	26	6'-9"	100	5'-5"					264
617	6	13'-4"	104	11'-6"	2'-0"				120
618	1	10'-6"	Str.						16
619	8	4'-0"	Str.						48
620	17	39'-6"	Str.						1009
621	12	6'-0"	Str.						108
622	27	19'-11"	112	10"	7'-8"	6'-4"	0"		808
623	10	18'-7"	109	7'-8"	1'-4"				279
624	2-Ser. of 20	6'-2" to 6'-8"	104	5'-6" to 6'-0"	10"			3/8"	386
625	20	7'-1"	105	3'-5"	2'-0"				212
626	8	21'-9"	Str.						261
627	1	7'-3"	Str.						11
628	2-Ser. of 6	4'-7" to 5'-4"	100	3'-3" to 4'-0"				1 3/8"	45
629	10	15'-1"	100	13'-9"					226
									Total 5932

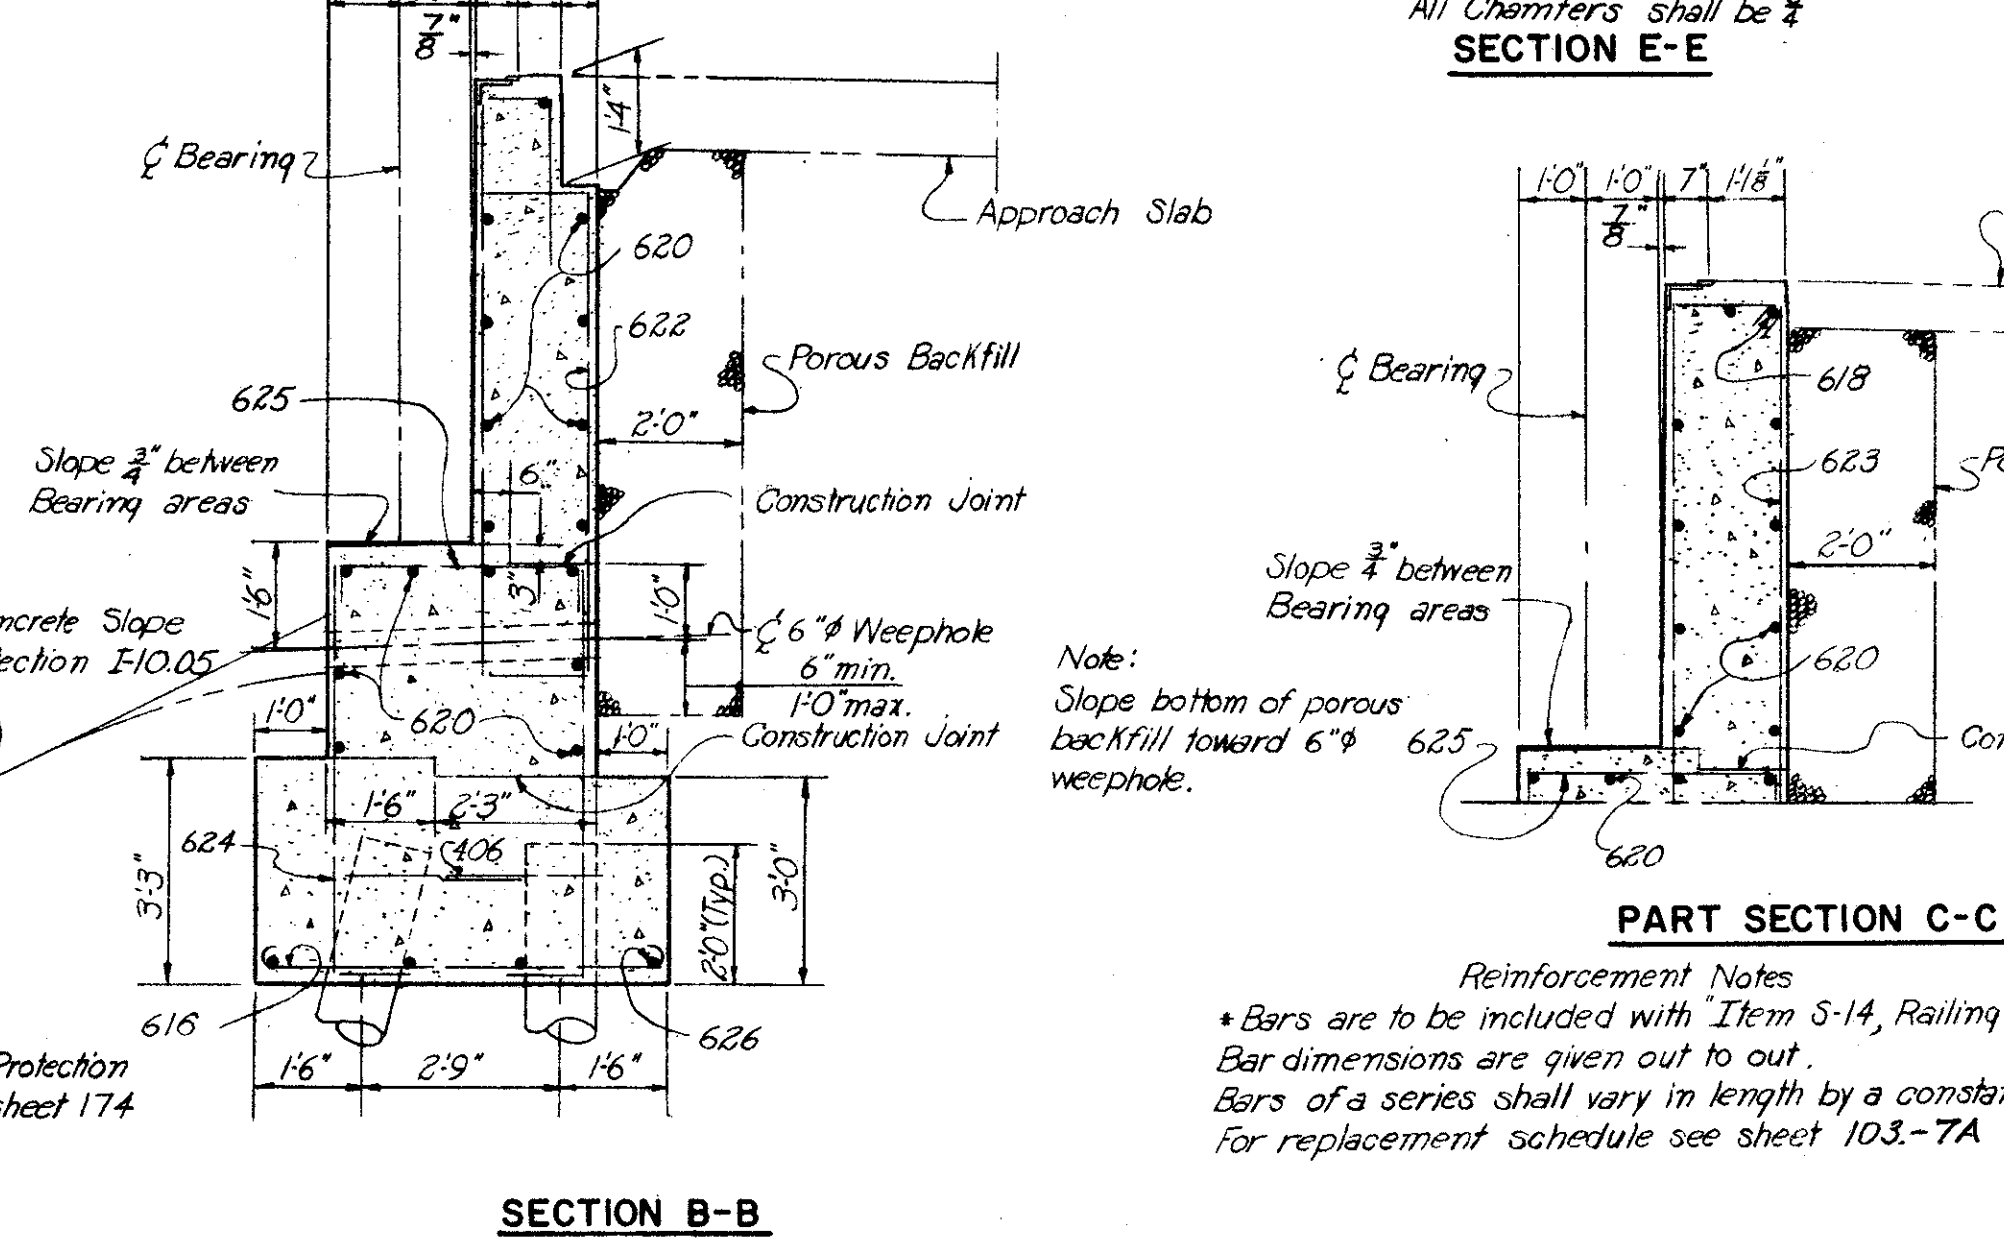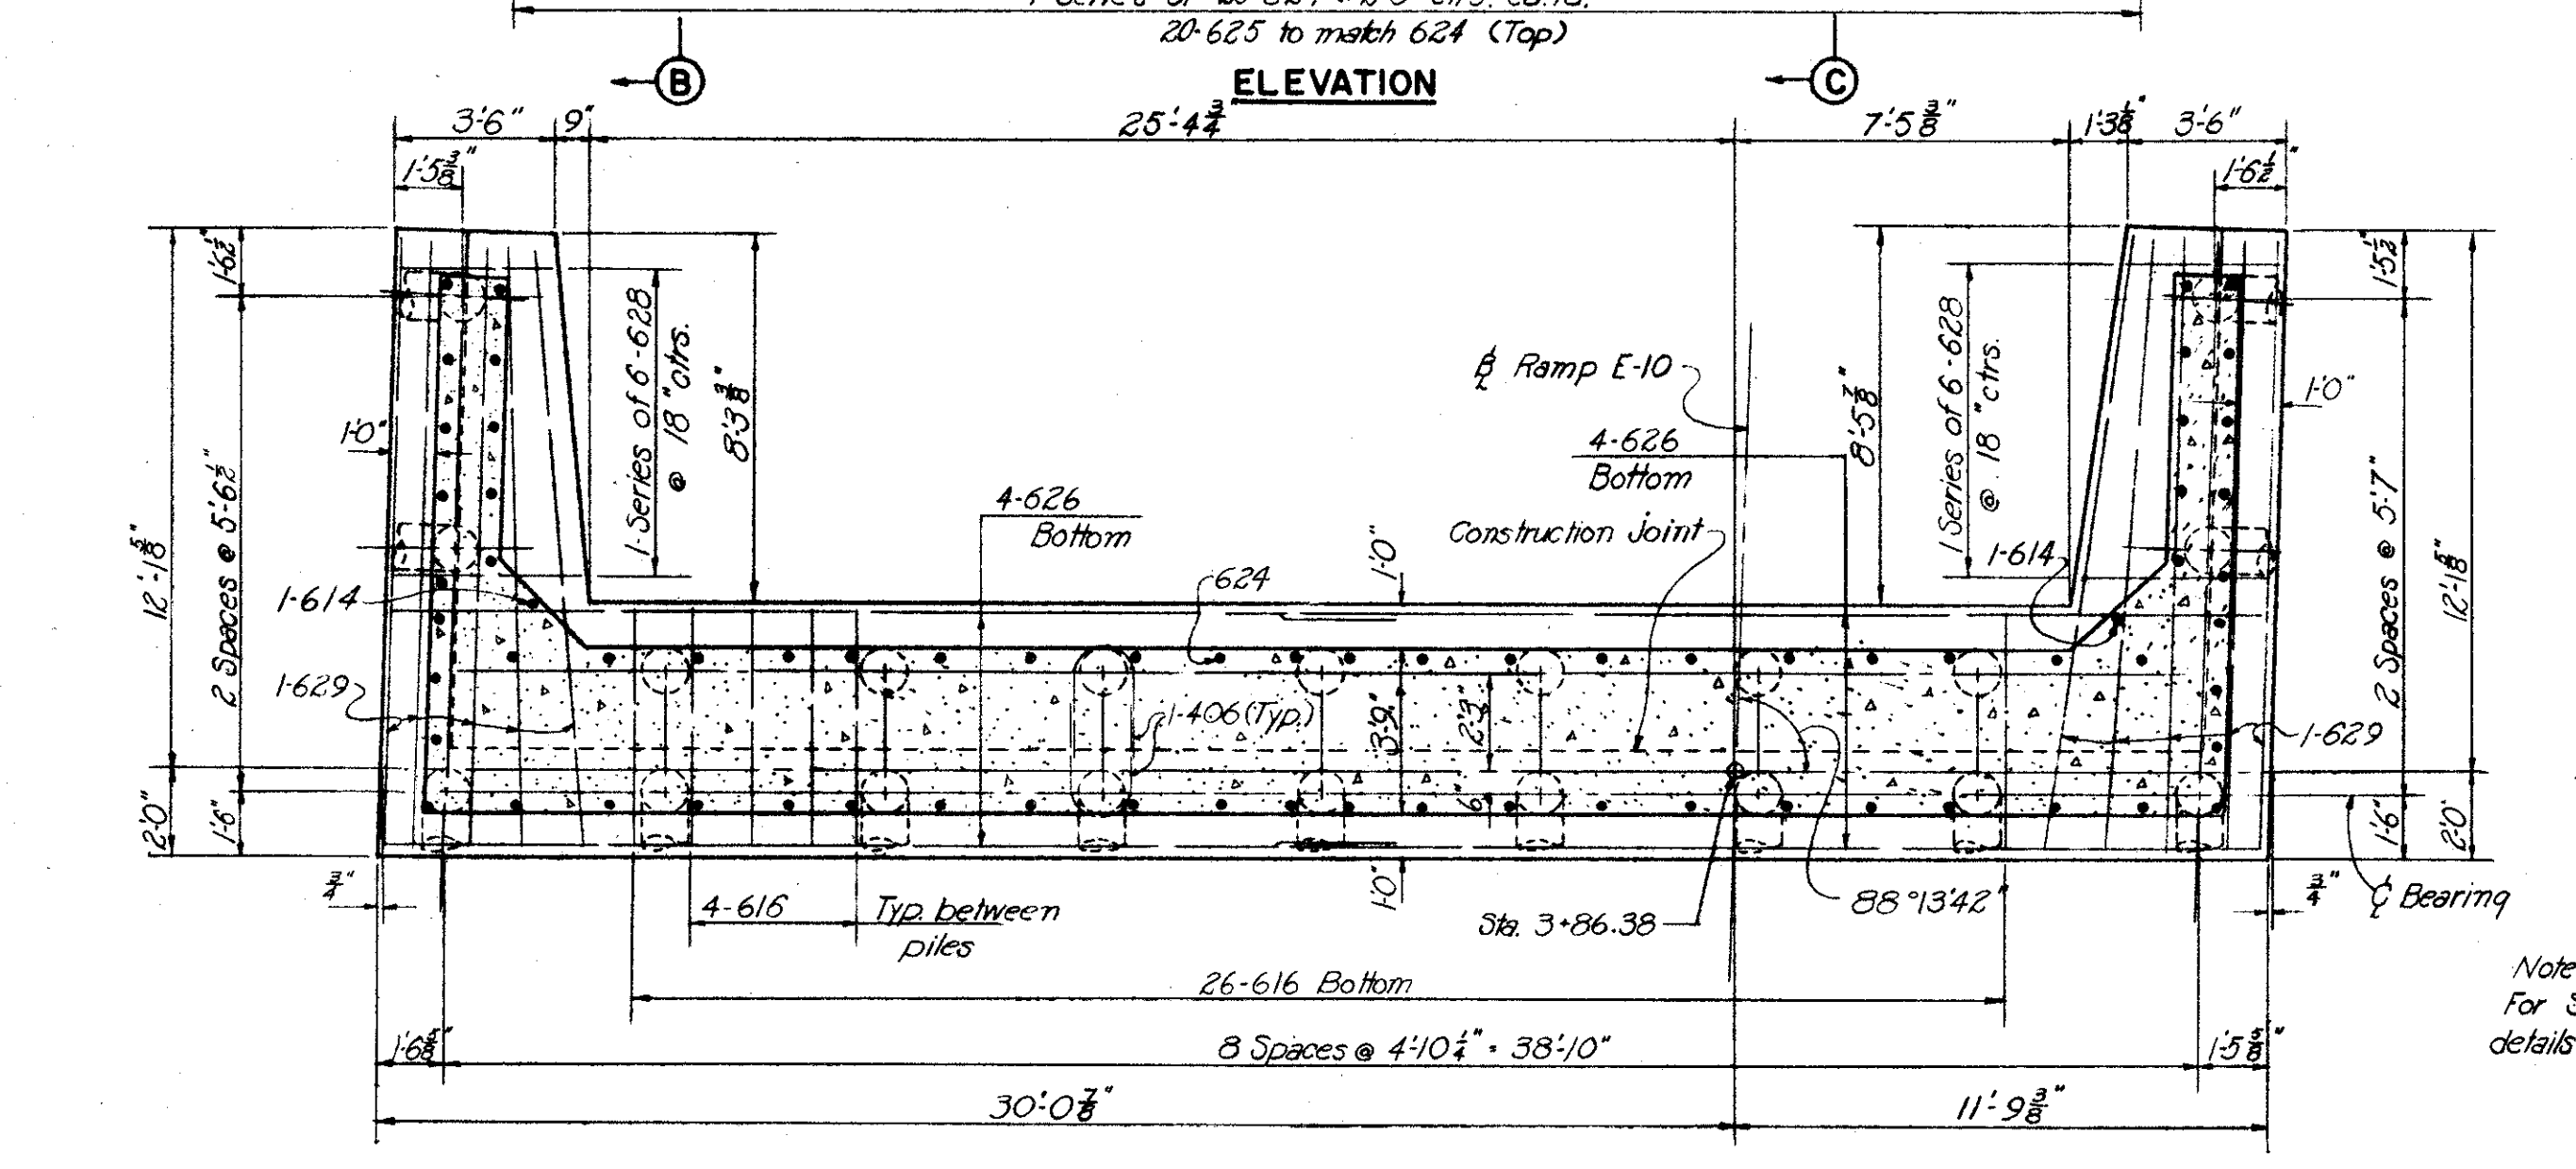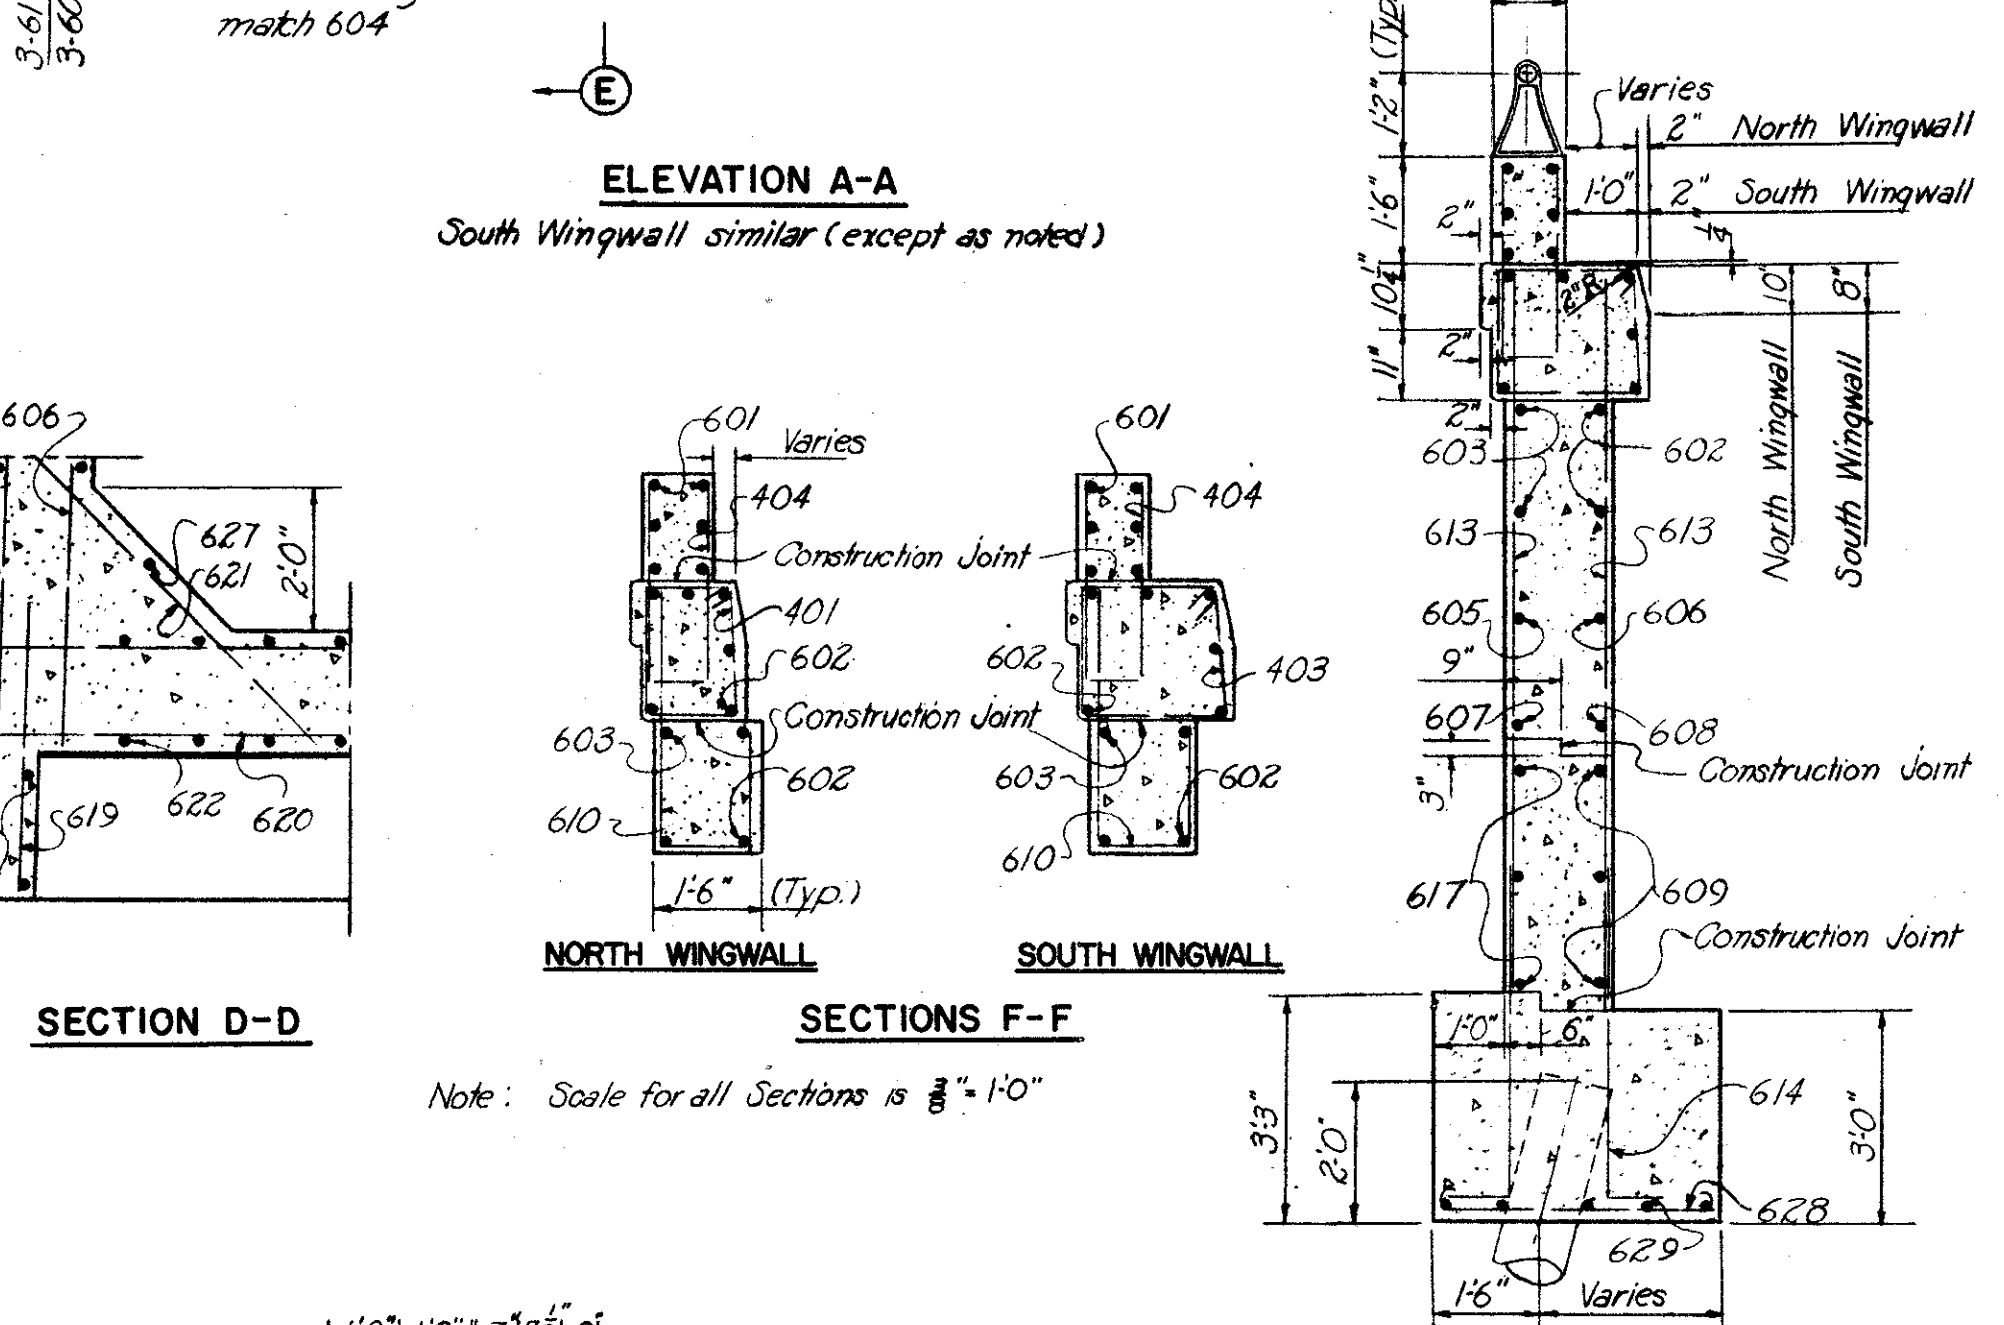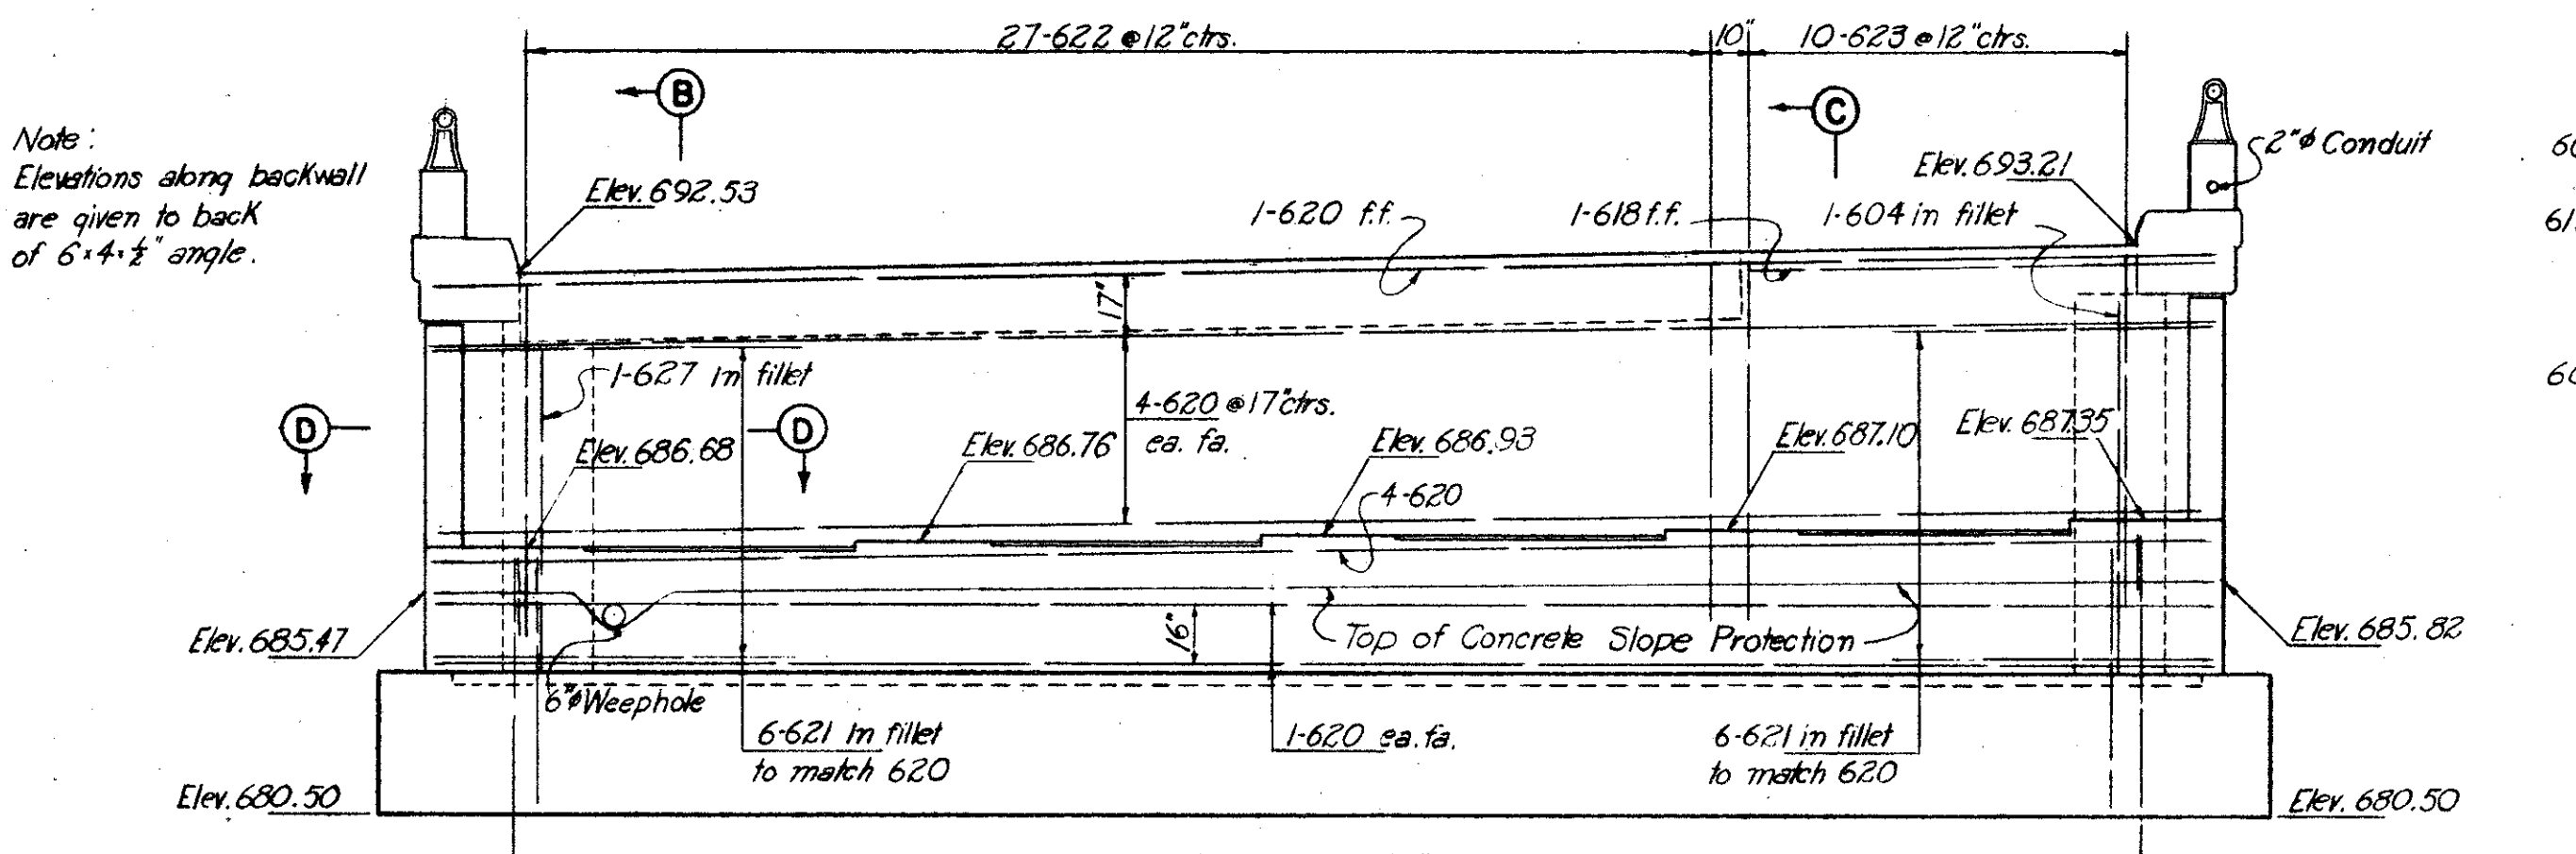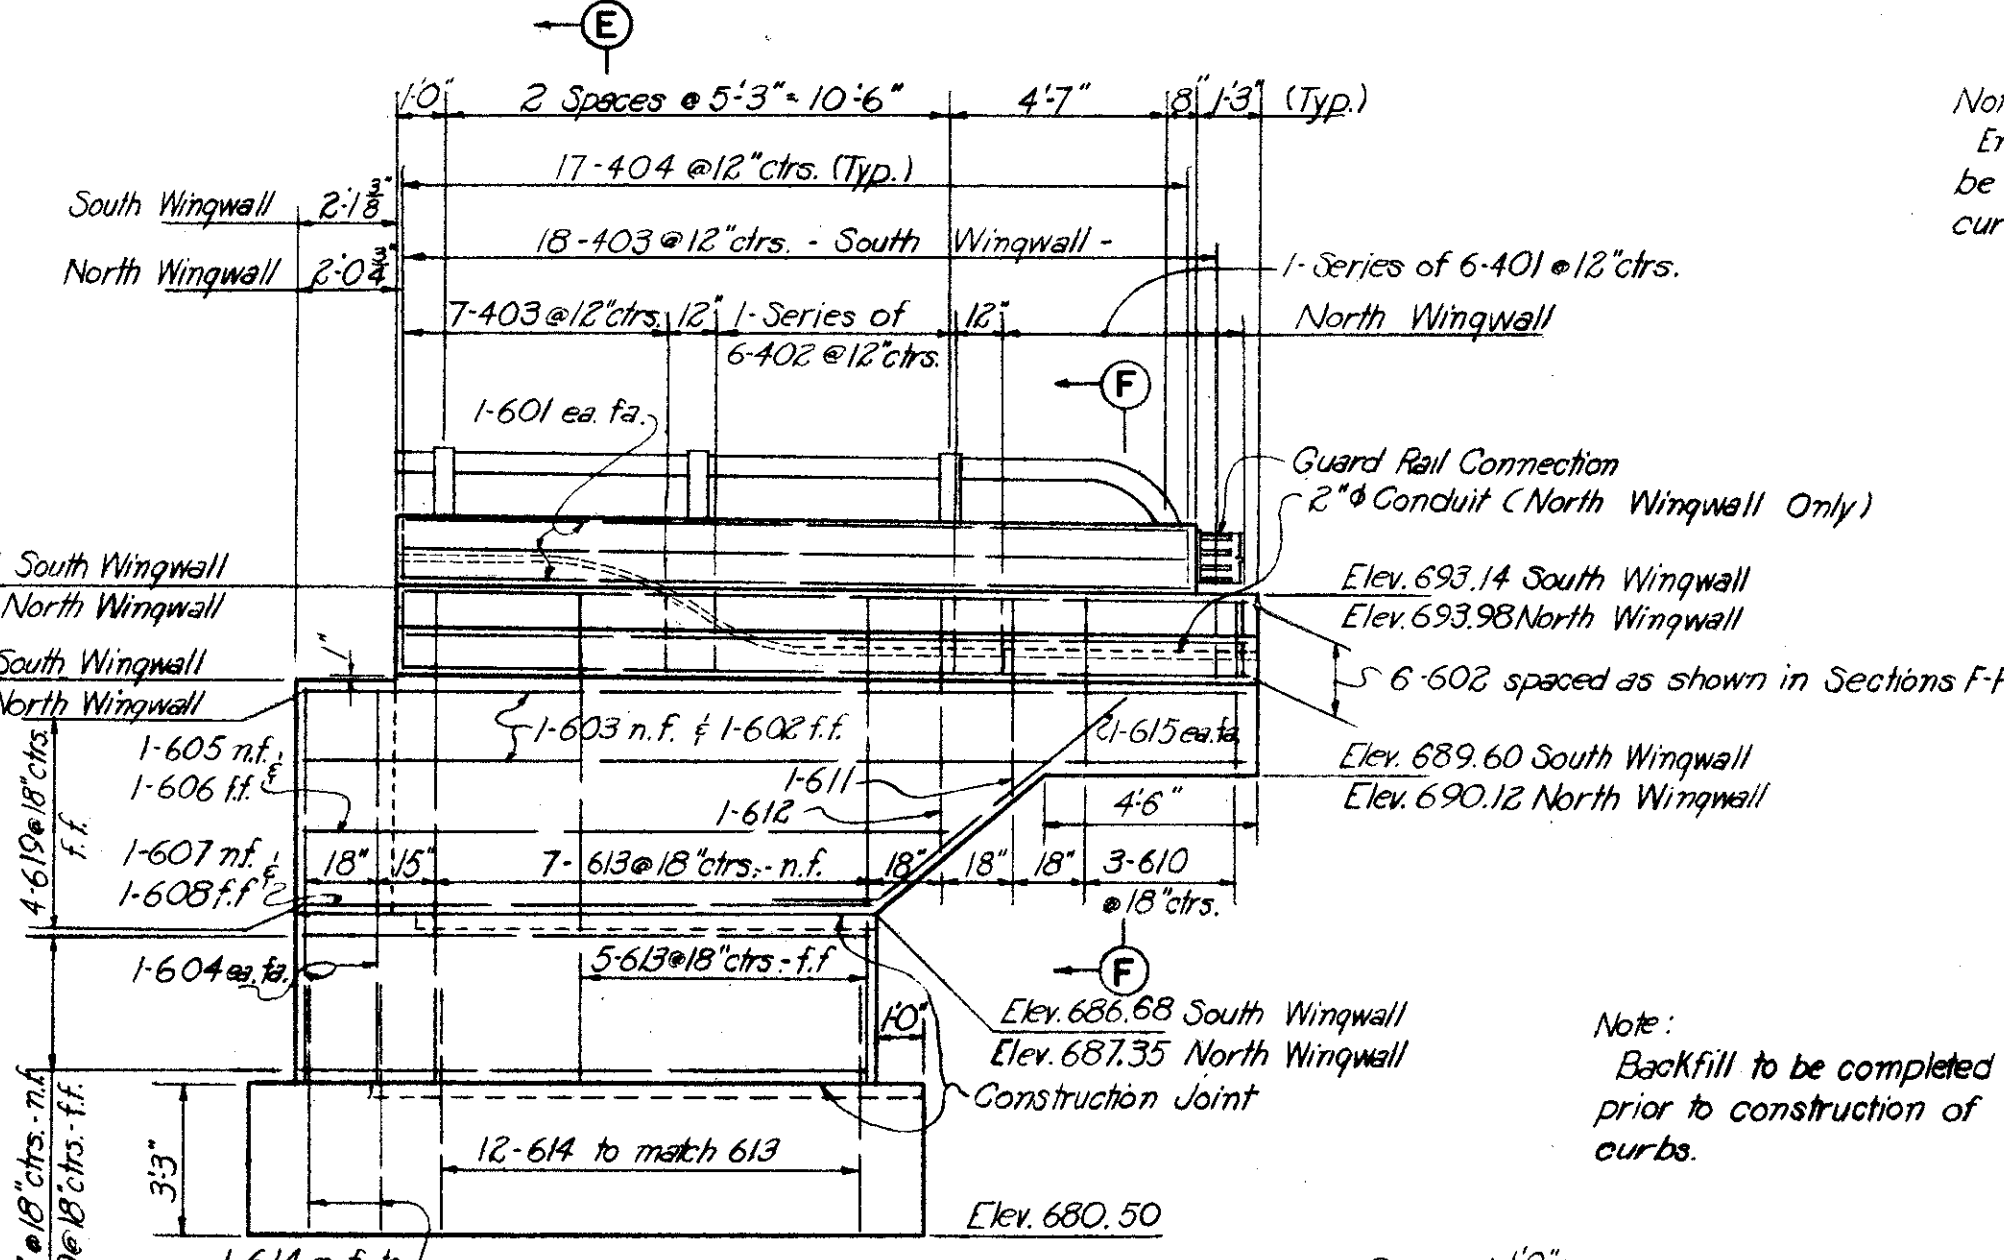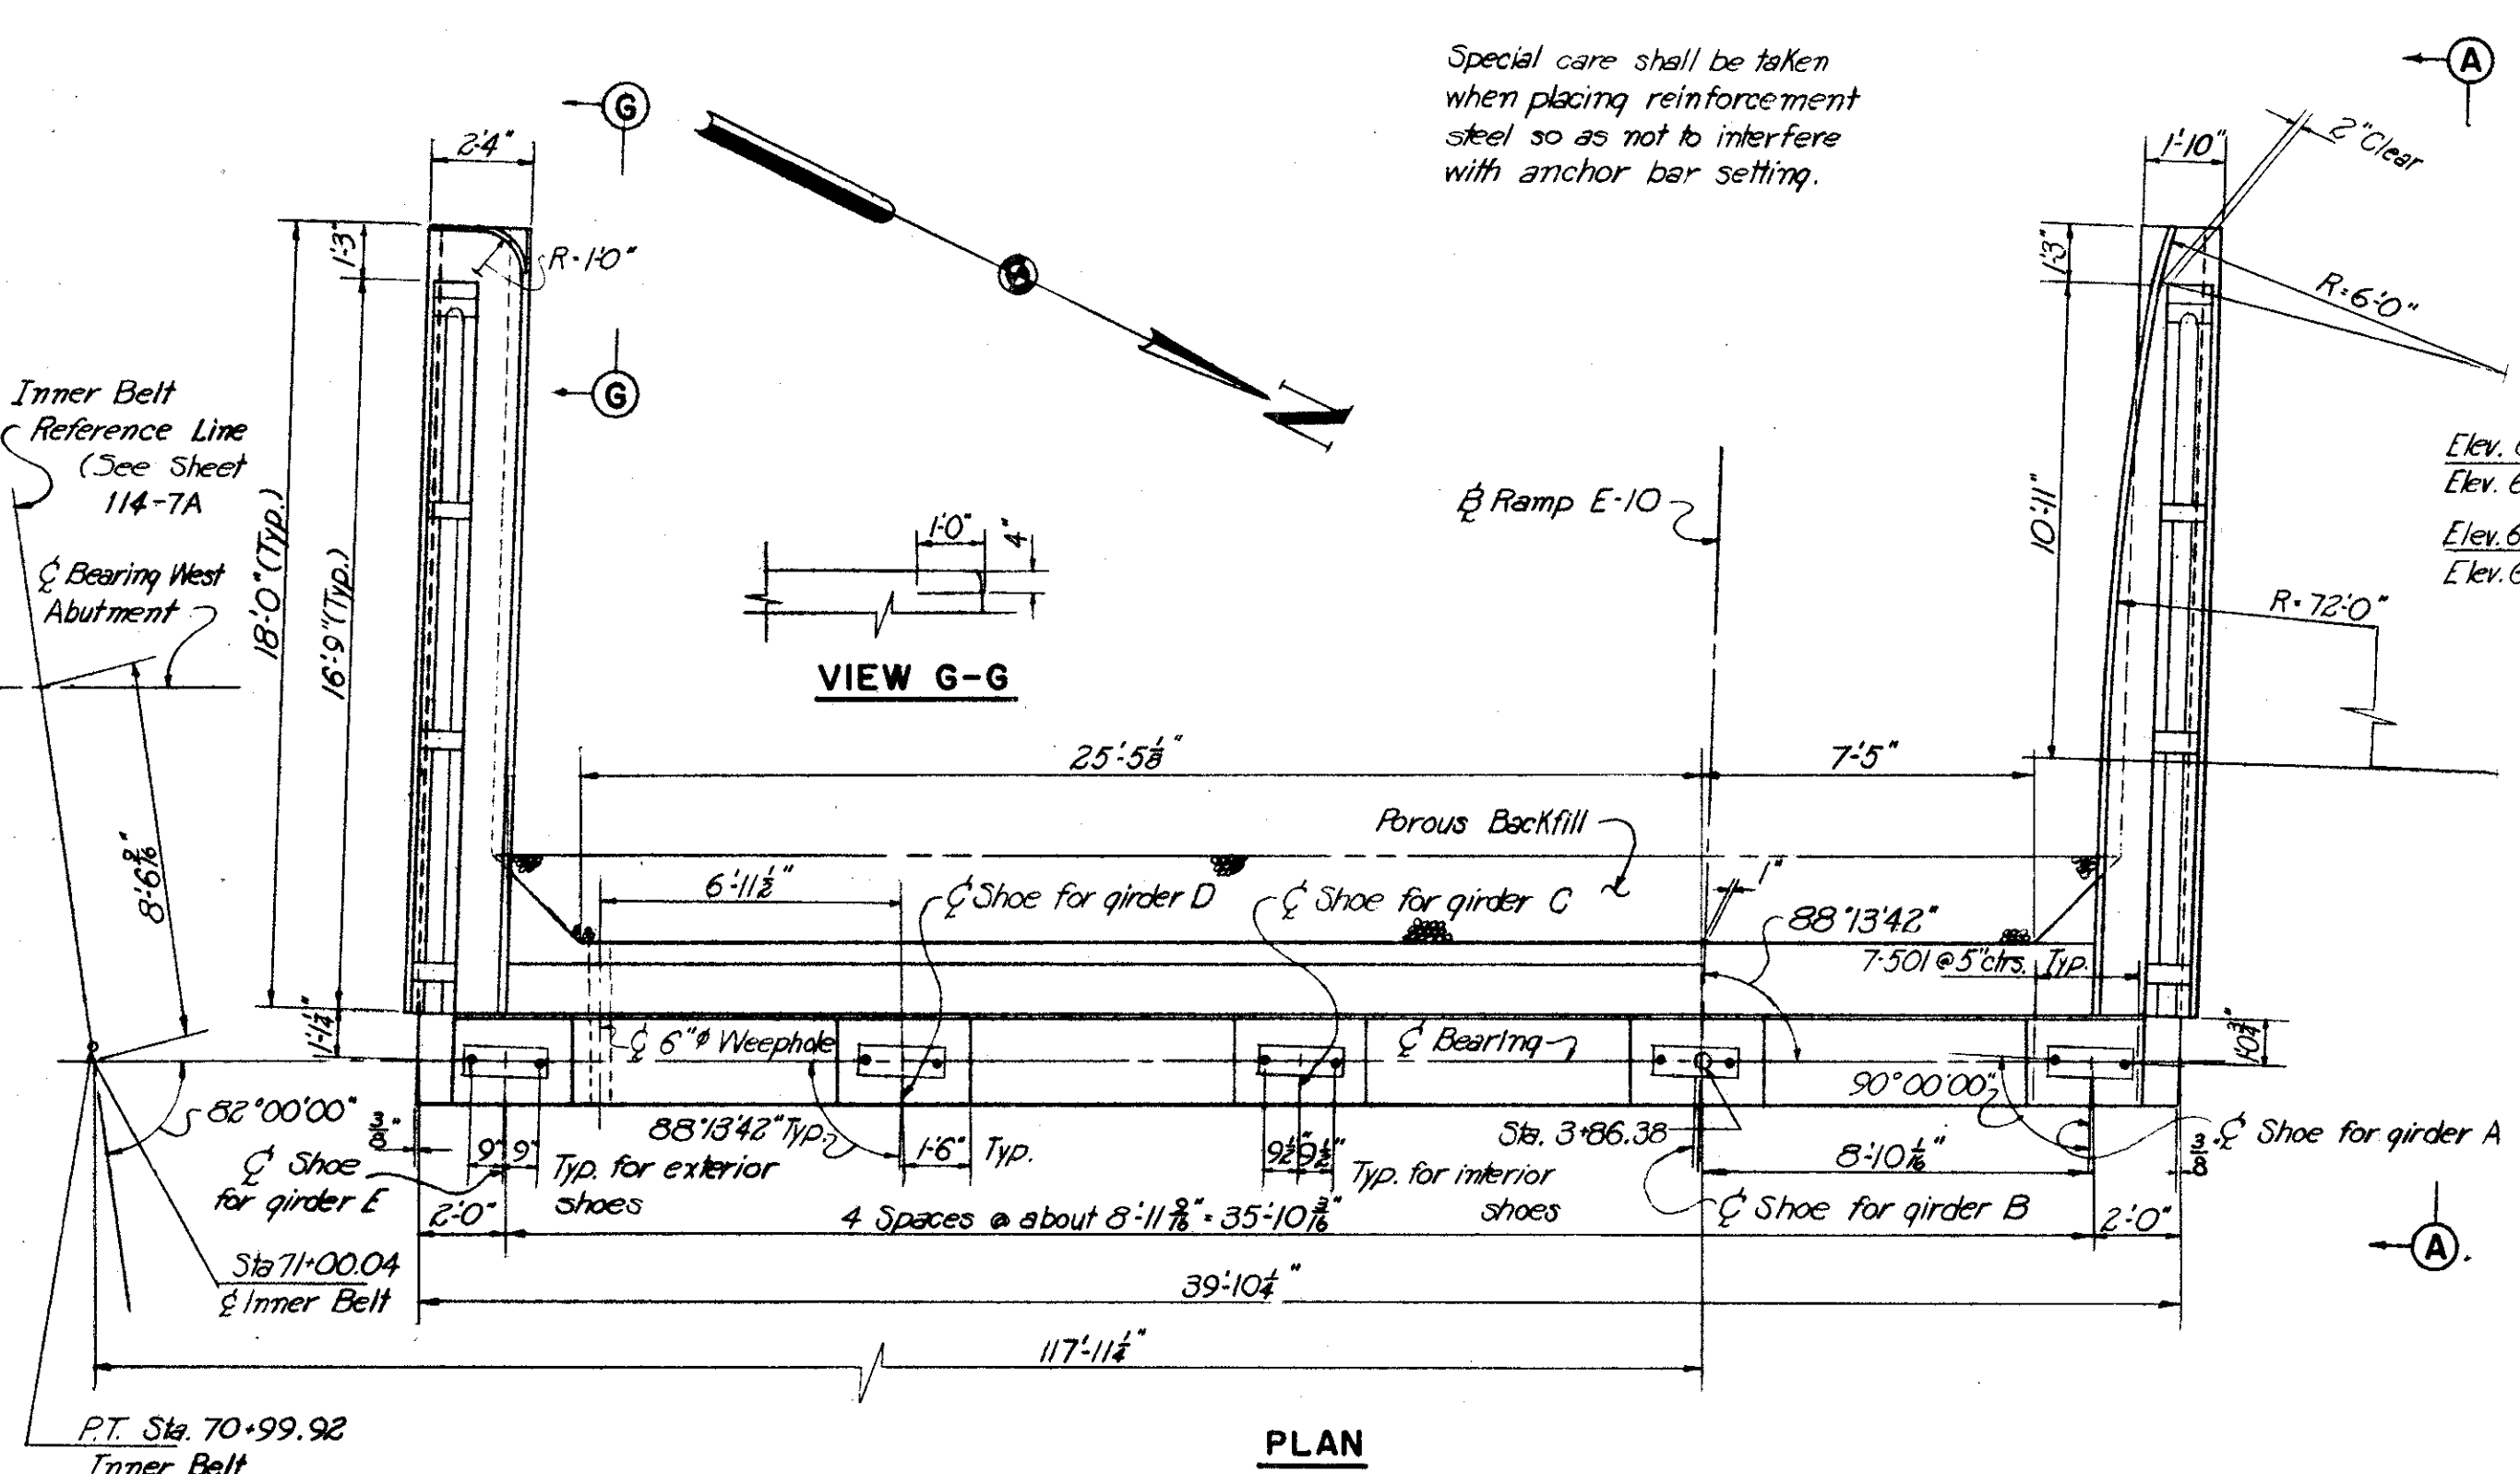

NOTES:
All piles shall be 12" C.I.P. reinforced concrete.
All battered piles shall be battered 3 in 12 in the direction shown.
Pile spacings are given along bottom of footing for details of end dam see sheet 173-7A
For masonry plate detail see sheet 173-7A
Reinforcement bars shall be 3" clear from bottom of footing, 2" elsewhere.
For Reinforcement Bending Diagram see sheet 117-7A
For location of lighting conduit see sheet 176-7A
For guard rail connection and railing details see sheet 175-7A
n.f. = near face; ff. = far face; ea. fa. = each face;

H.N.T.B. BR. NO. 4 PART 7A

HOWARD, NEEDLES, TAMMEN & BERGENDOFF
CONSULTING ENGINEERS
KANSAS CITY CLEVELAND NEW YORK




ABUTMENT E-10
INNER BELT FREEWAY OVER EAST 14th ST.
BR. NO. CUY-42-1854 STA. 70+89.23
Scale: 1/4" = 1'-0" STA. 73+96.25
Except as noted
WILLOW-INNER BELT FREEWAY
CLEVELAND CUYAHOGA COUNTY OHIO

DRAWN CAB	TRACED	CHECKED C.A.M.	REVIEWED J.C.T.	REVISOR
DATE 1-3-59	DATE	DATE 2-26-55	DATE 11-13-59	DATE

SHEET 115


CUYAHOGA COUNTY
CITY OF CLEVELAND
CUY-21-15.32
CUY-42-18.42

Note: Prefix "AB" shall be assigned to all bar marks.

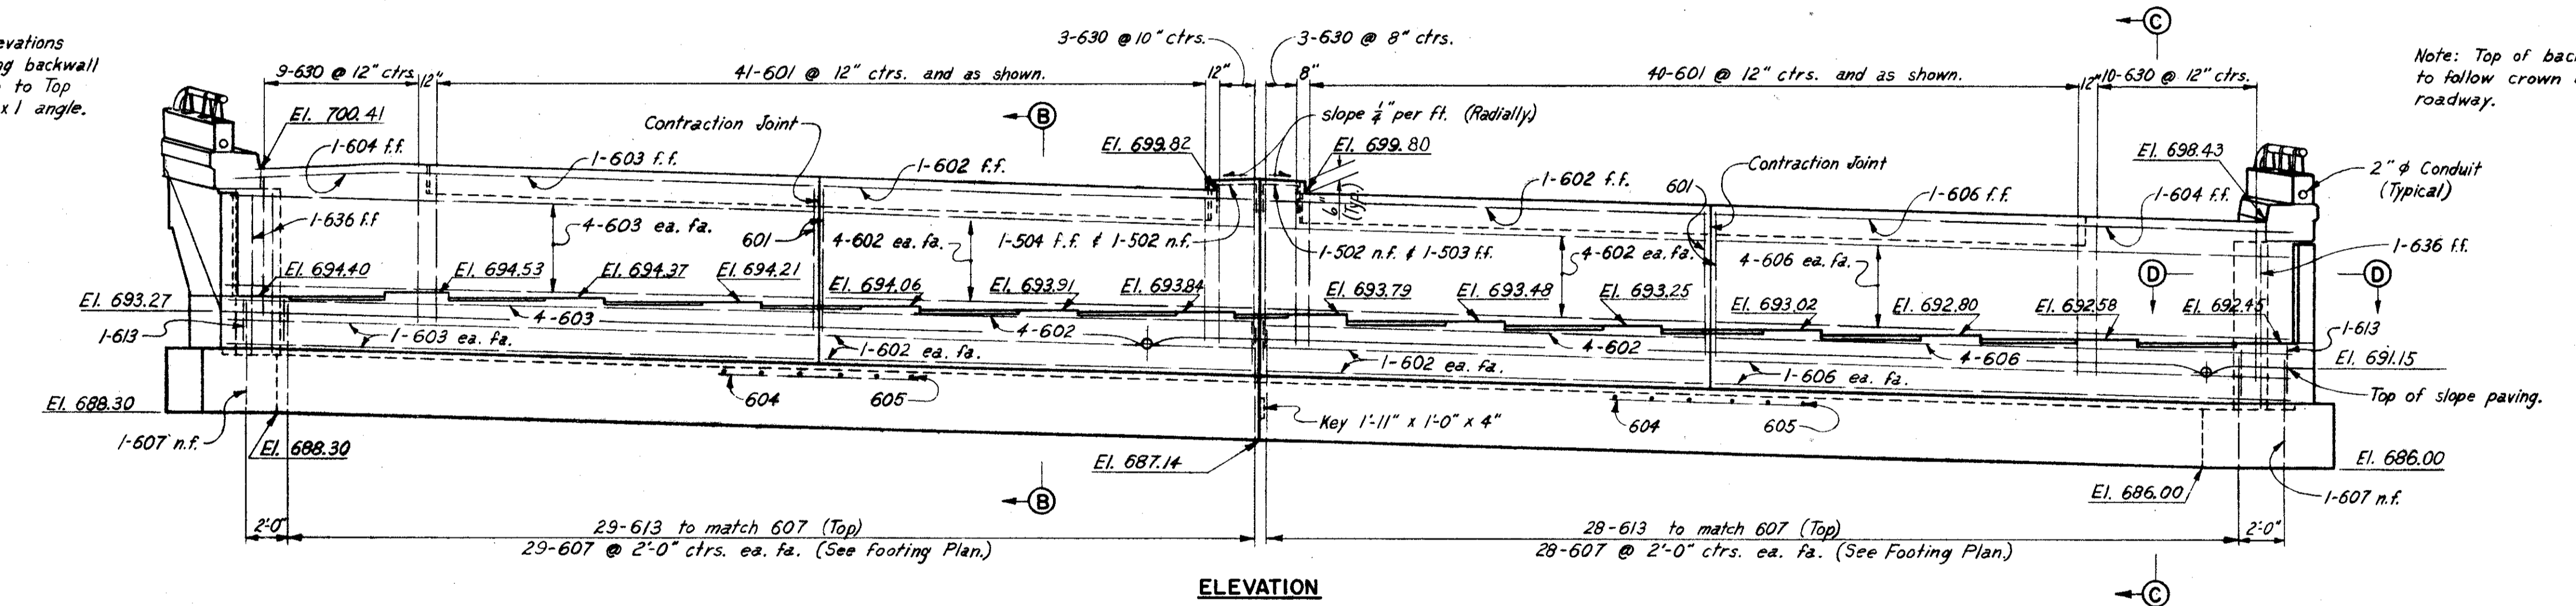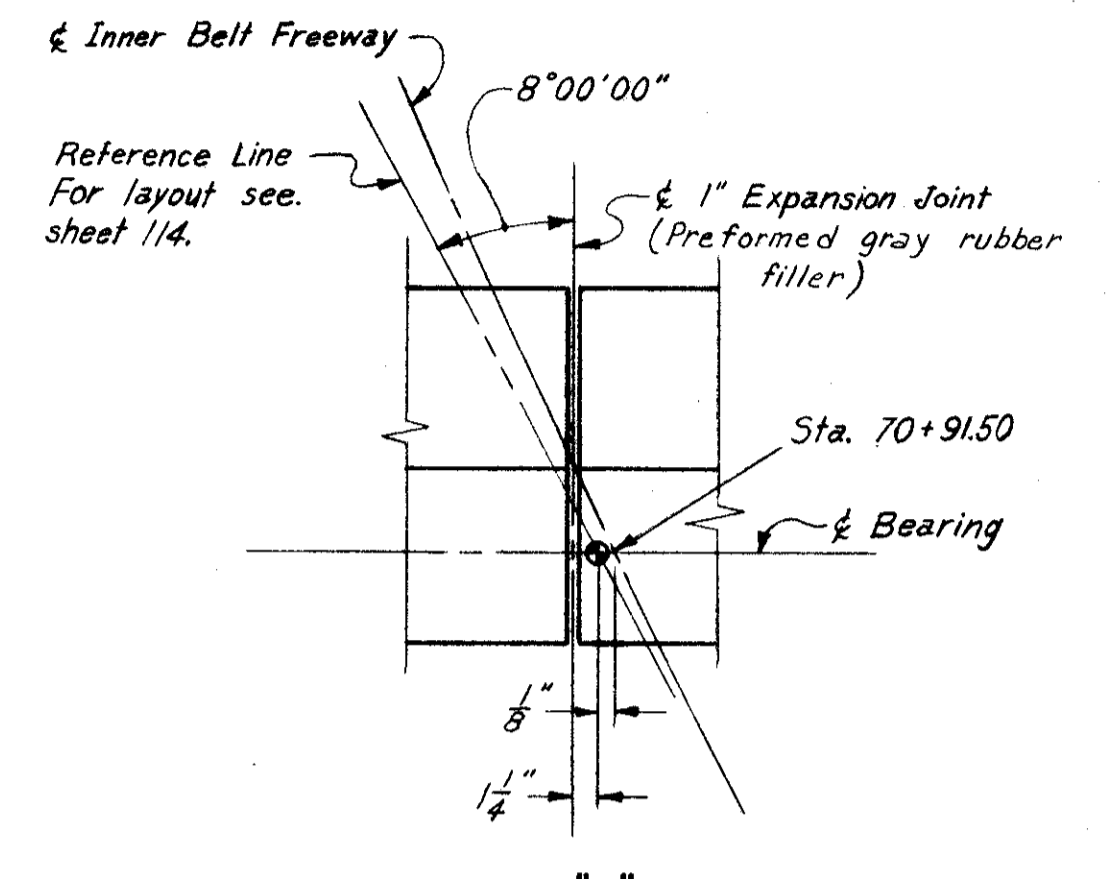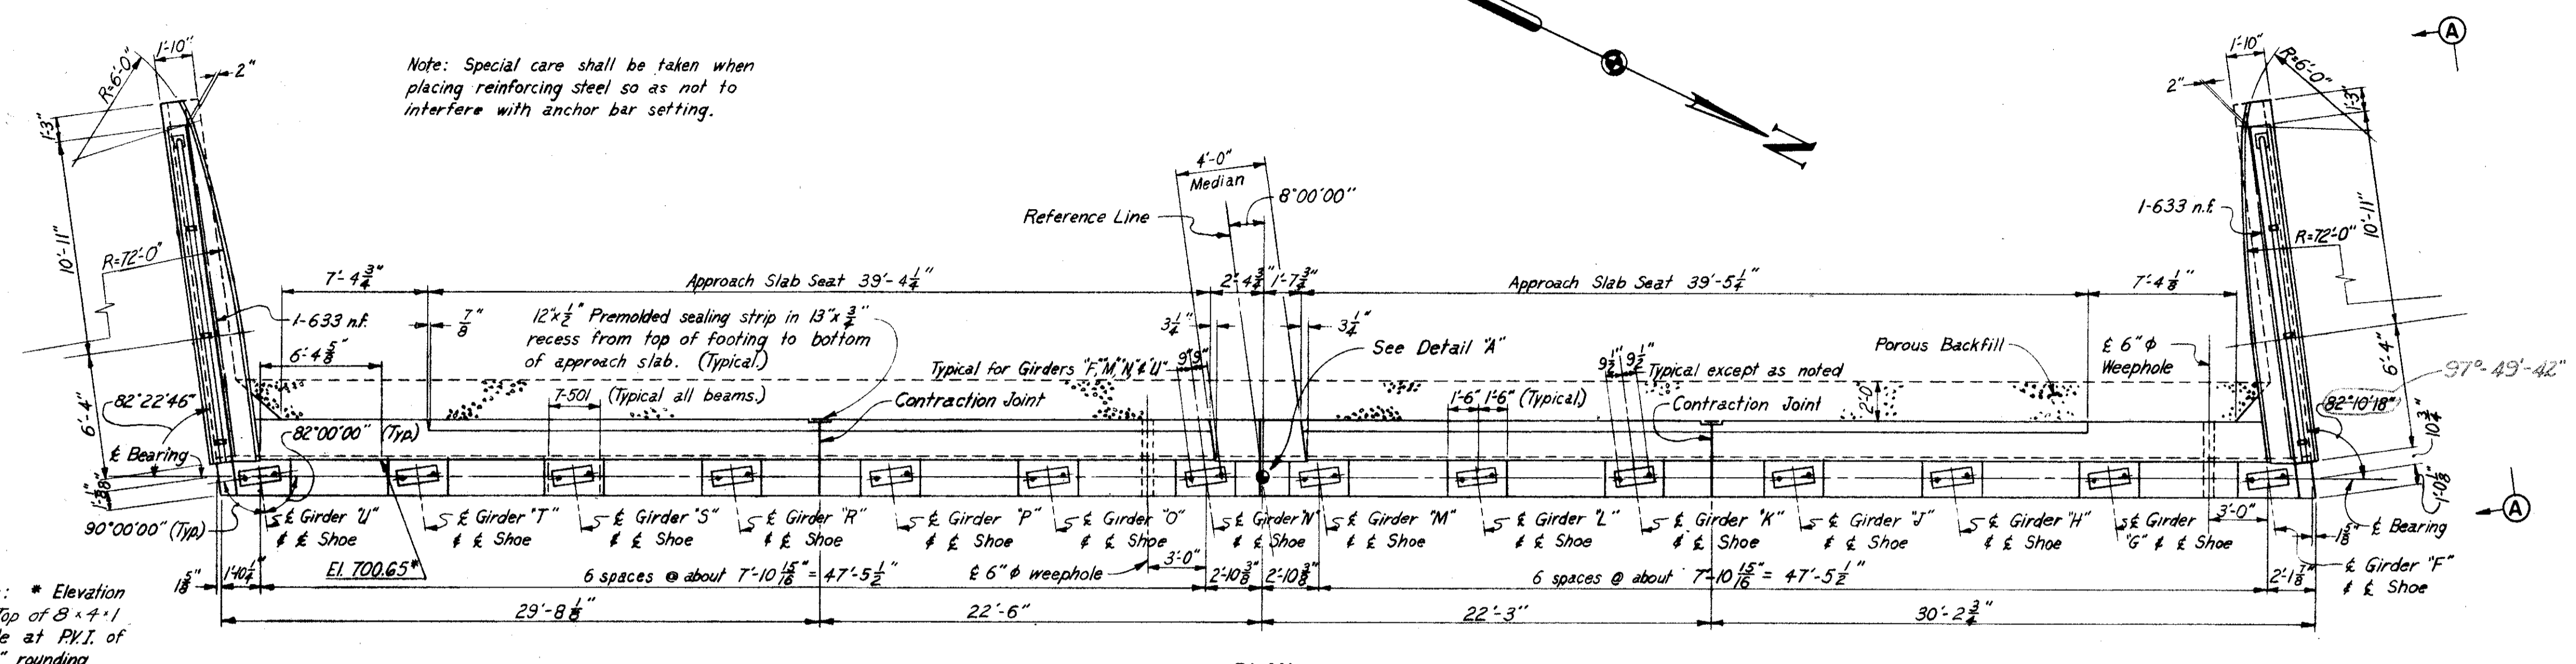

NOTES:

- All piles shall be 12" ϕ Cast-in-Place reinforced Concrete.
- All battered piles shall be battered 3 in 12 in direction shown.
- Pile spacings are given along bottom of footing.
- For details of end dam, see Sheet 173-7A
- For masonry plate details, see Sheet 174-7A
- Reinforcement bars shall be 3 inches clear from bottom of footing and 2 inches elsewhere.
- For Reinforcement Schedule, see Sheet 117-7A
- For Slope Protection details, see Sheet 174-7A
- For location of lighting conduit, see Sheet 176-7A
- For Railing details and Guard Rail connection details, see Sheet 175-7A
- For sections, see Sheet 117-7A
- n.f. = near face; f.f. = far face; ea. fa. = each face.

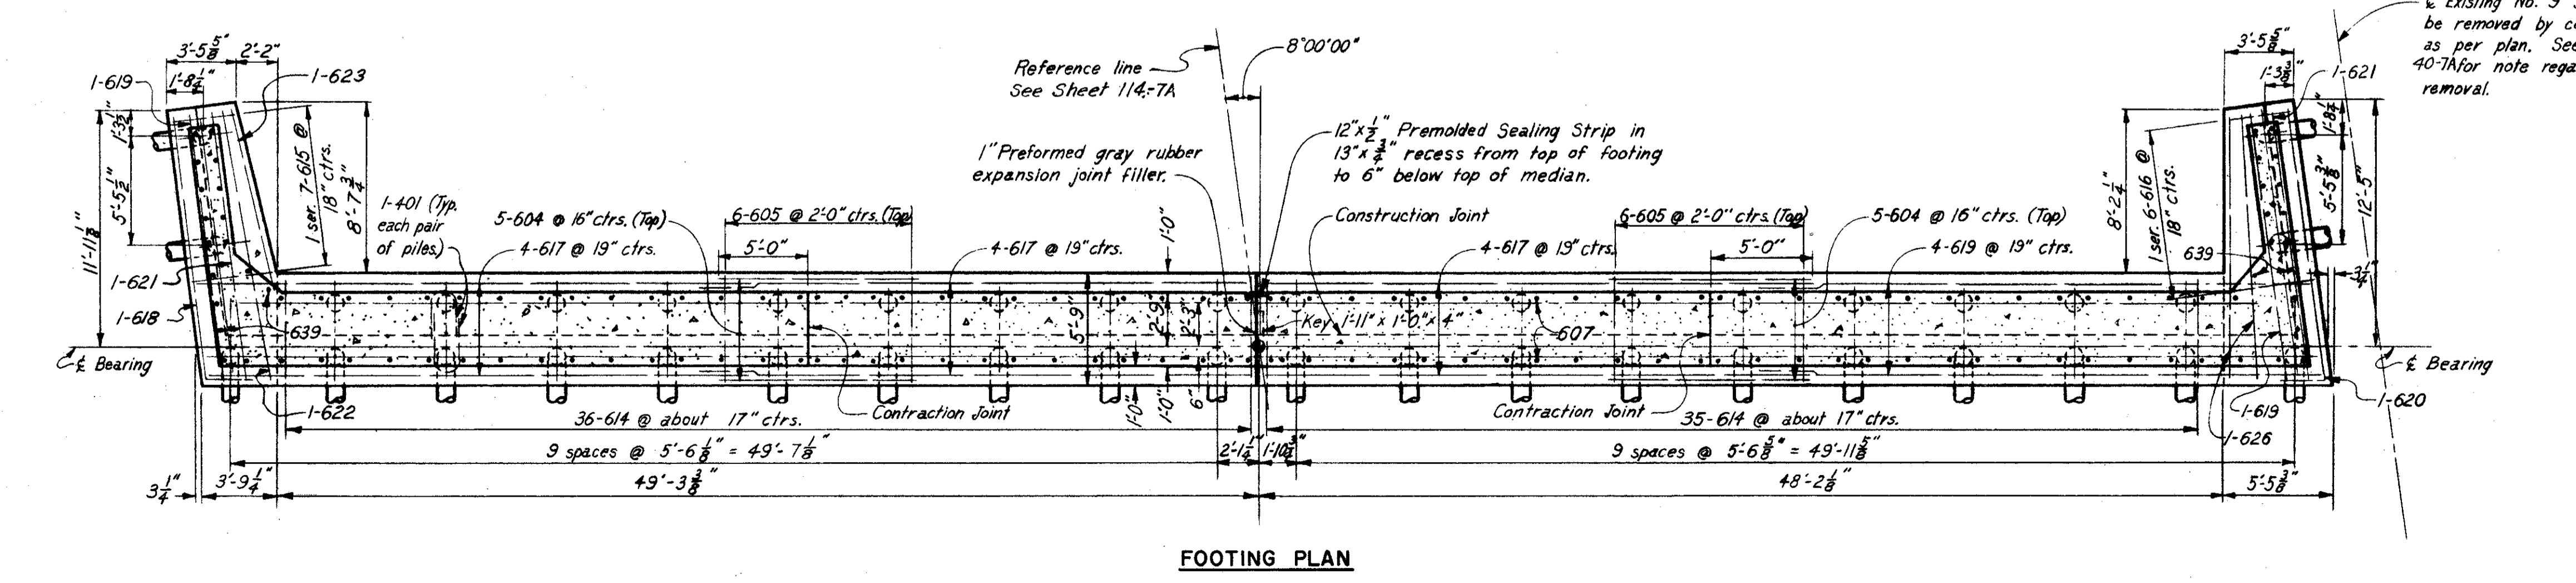

H.N.T.B. BR. NO. 4 PART 7A

HOWARD, NEEDLES, TAMMEN & BERGENDOFF
CONSULTING ENGINEERS
KANSAS CITY CLEVELAND NEW YORK

WEST ABUTMENT

INNER BELT FREEWAY OVER EAST 14th ST.
BR. NO. CUY - 42-1854 STA. 70 + 89.23
Scale: 3/16" = 1'-0" STA. 73 + 96.25
Except as noted


WILLOW-INNER BELT FREEWAY
CLEVELAND CUYAHOGA COUNTY OHIO

DRAWN C.M.	TRACED	CHECKED H.R.L.	REVIEWED J.C.T.	REVISED 6-17-60
DATE 1-14-59	DATE	DATE 1-22-59	DATE 1-13-59	SHEET 116

CUYAHOGA COUNTY
CITY OF CLEVELAND
CUY-21-15.32
CUY-42-1842


Note: Prefix "AB" shall be assigned to all bar marks.

Note: End of railing parapet to be normal to top of safety curb.

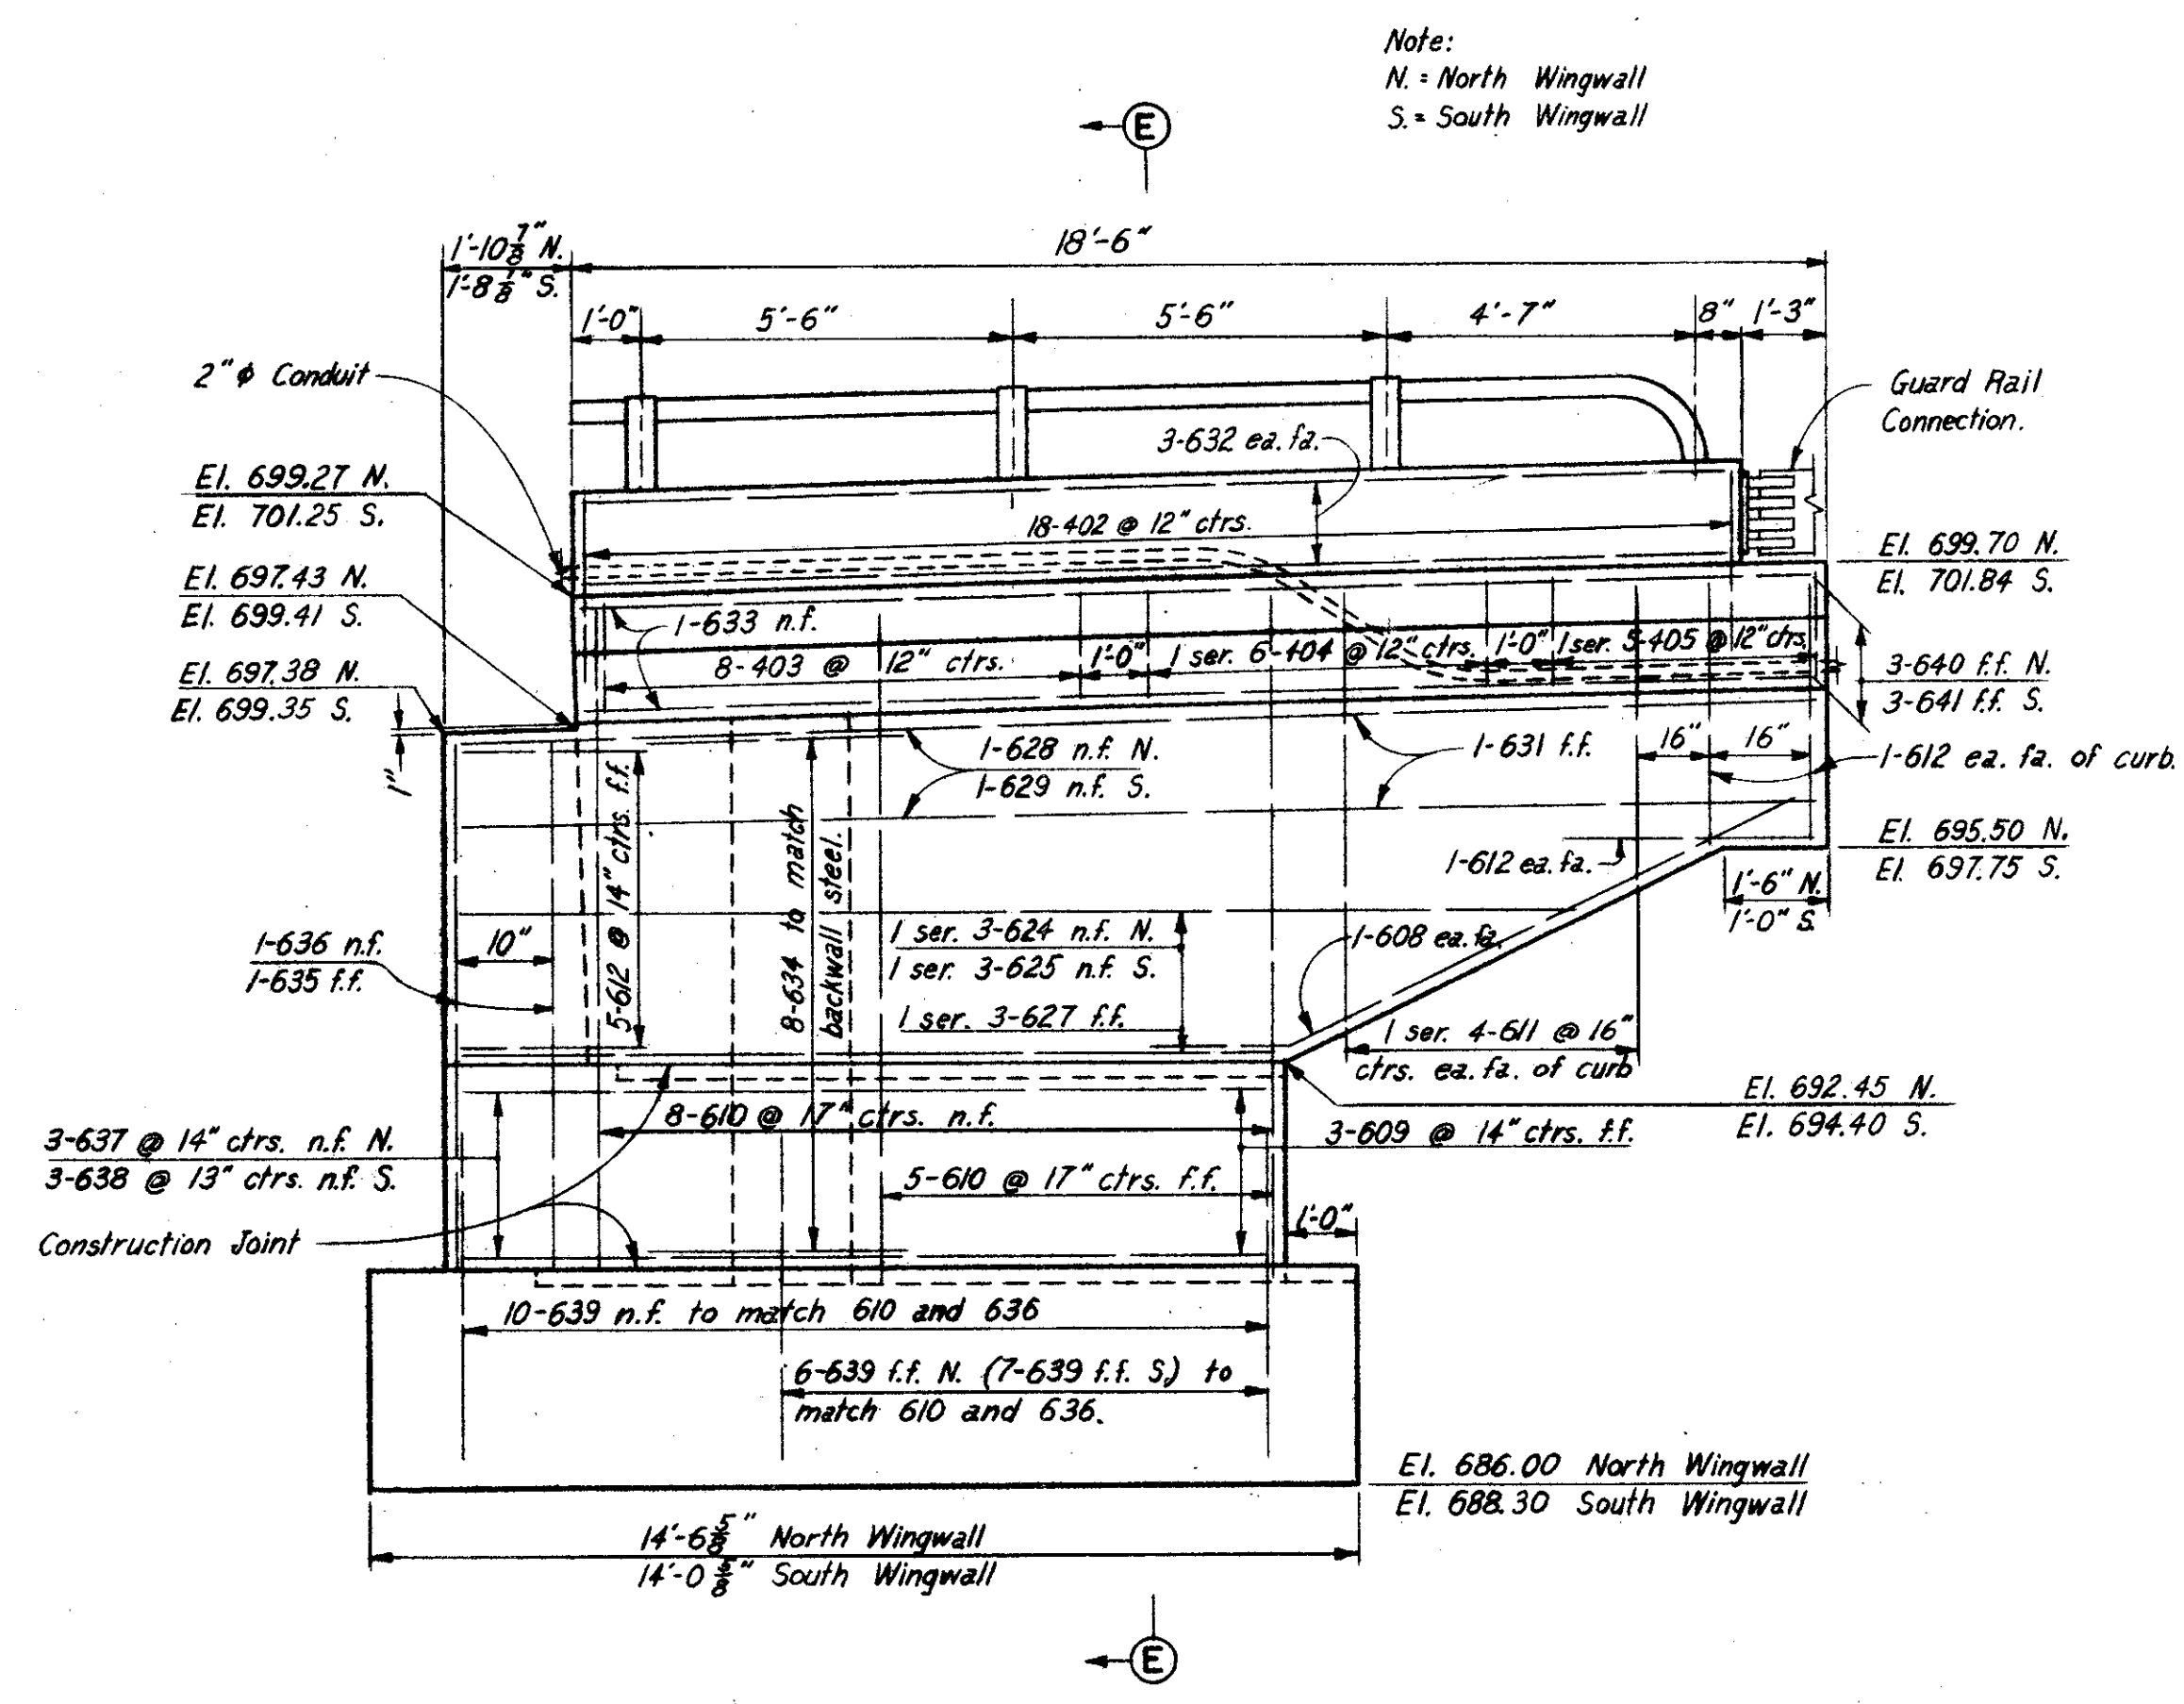


ELEVATION A-A


Elevation South Wingwall similar except as noted.

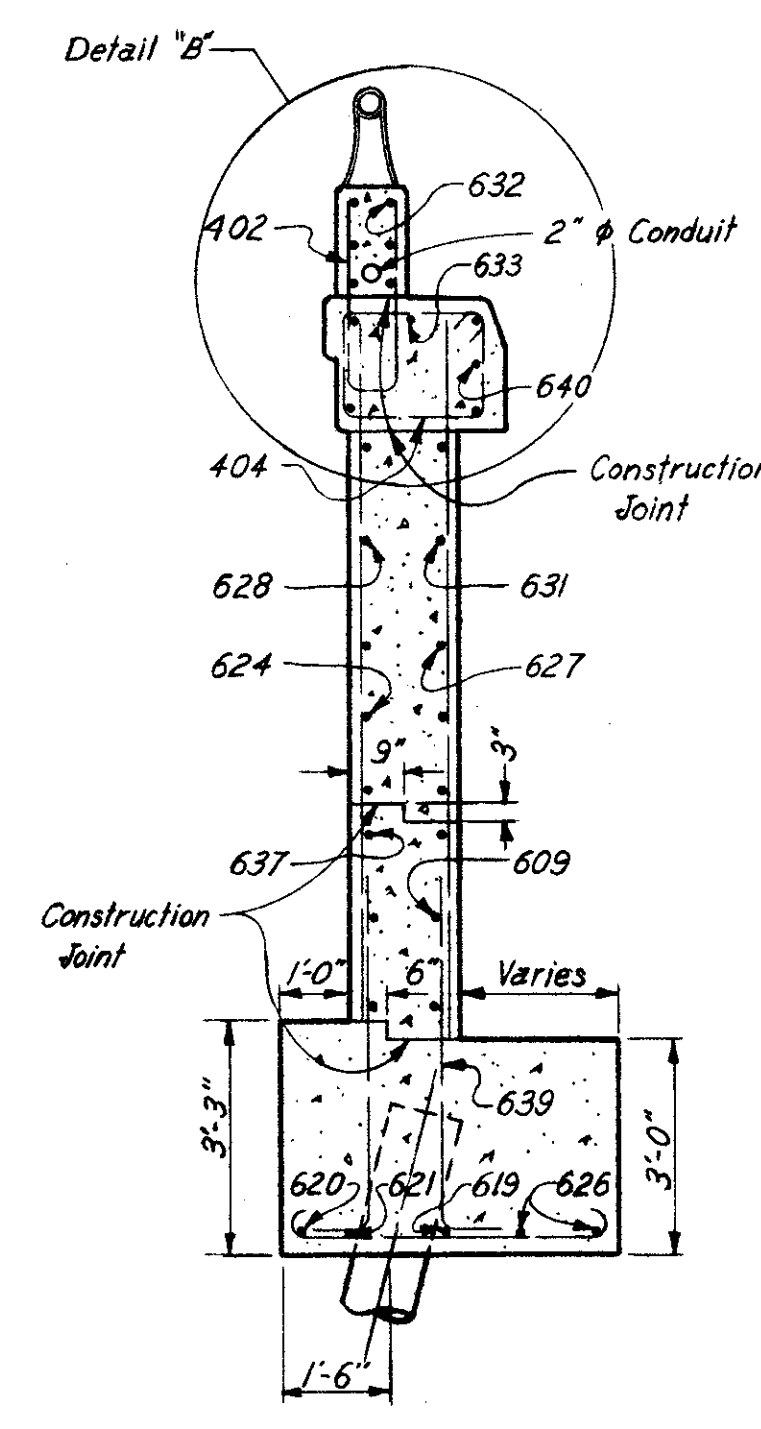


SECTION E-E

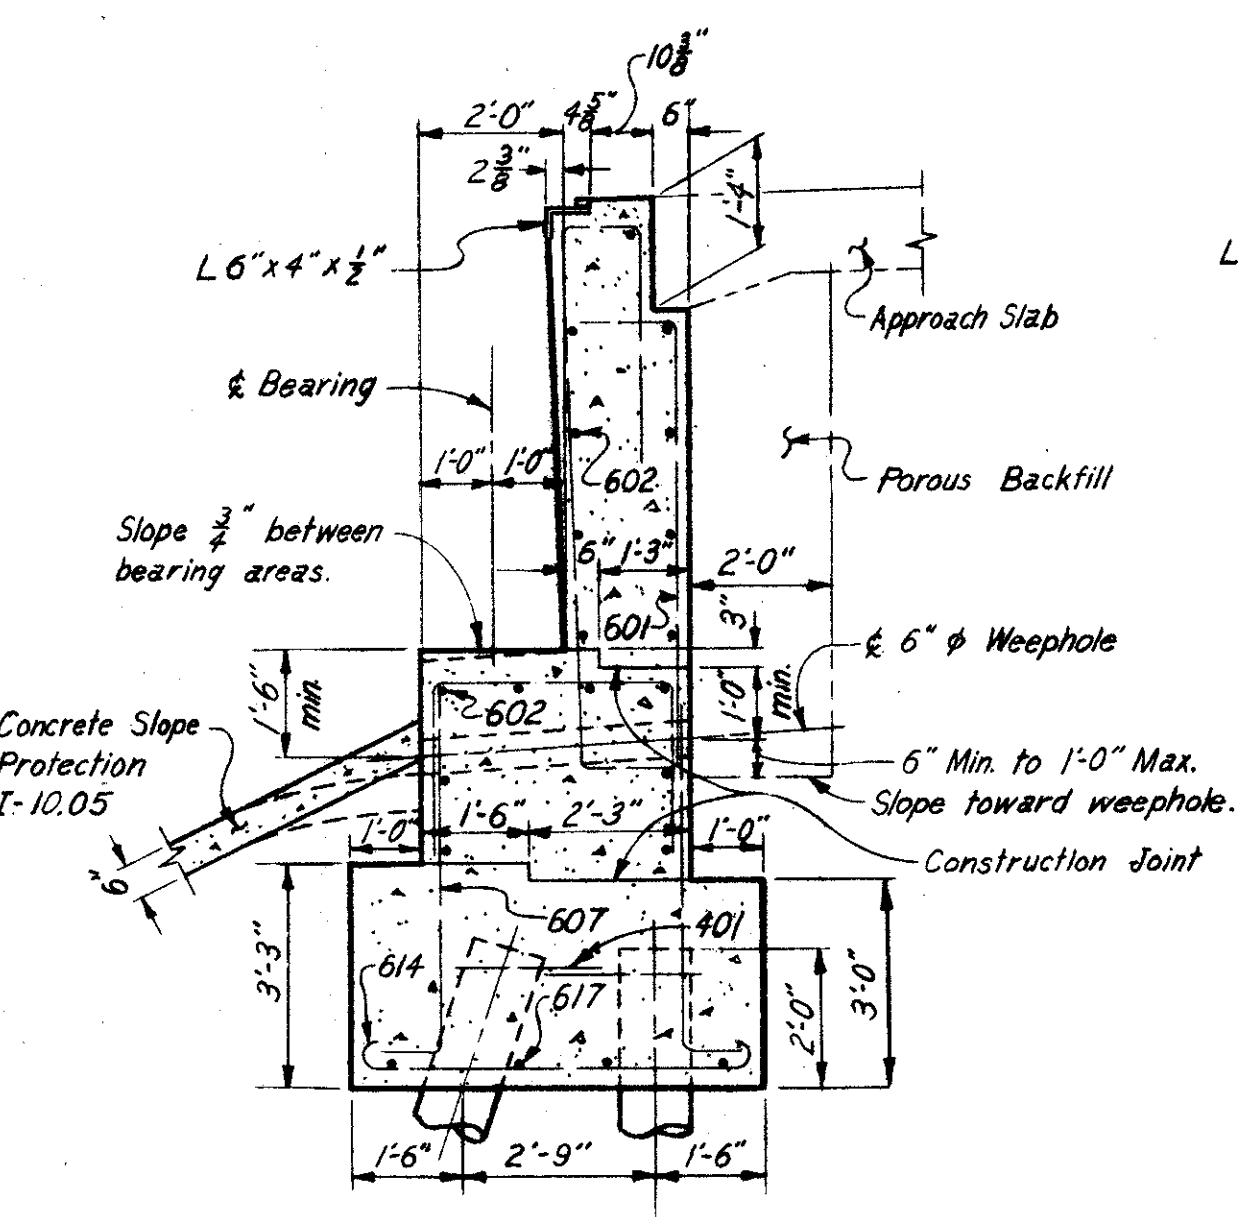


SECTION B-B

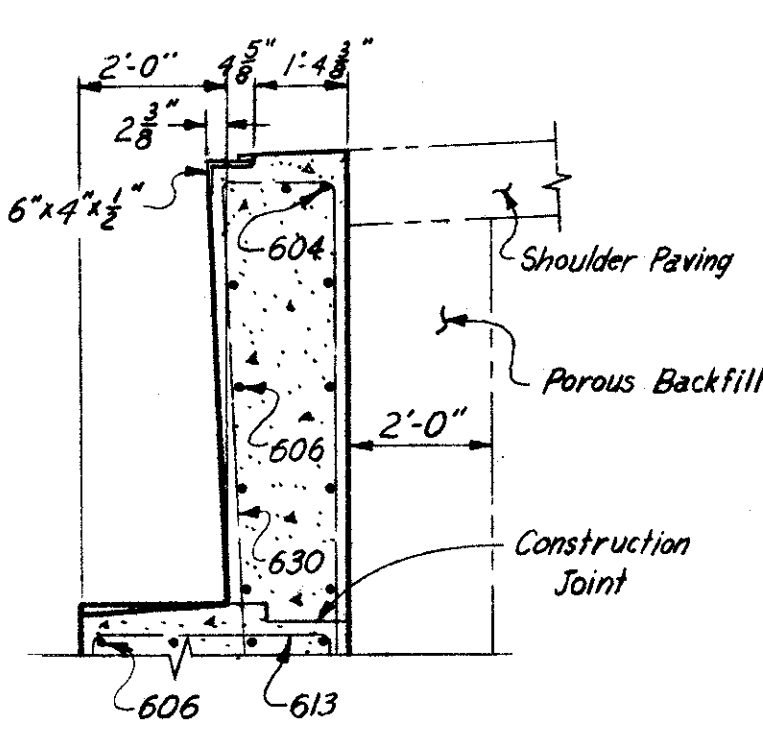

PART SECTION C-C

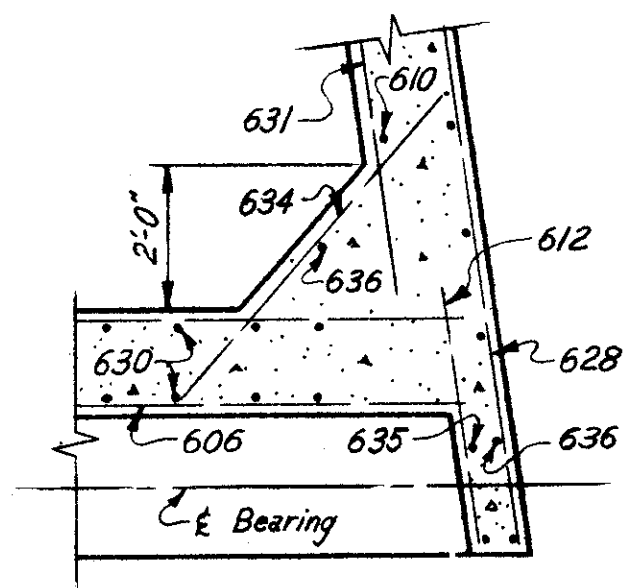

SECTION D-D

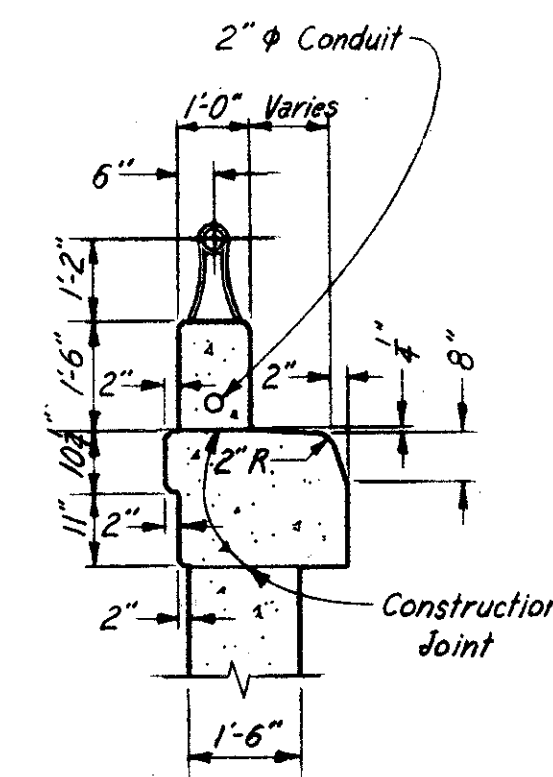


DETAIL "B"

All chamfers to be 3/4"

MARK	NO.	LENGTH	TYPE	DIMENSIONS				SERIES INCREMENT	WEIGHT (LBS)
				A	B	C	D		
401	36	5'-10"	144	2'-0"	1'-10"	7"		140	
402	36	5'-9"	105	8"	2'-8"			138	
403	16	6'-7"	109	1'-8"	1'-5"			70	
404	2-series-6	6'-1" to 6'-7"	109	1'-5" to 1'-8"	1'-5"		1/8"	51	
405	2-series-5	4'-3" to 5'-11"	109	0'-6" to 1'-4"	1'-5"		5"	34	
501	98	4'-5"	105	1'-8"	1'-6"			452	
502	2	4'-7"	105	1'-8"	1'-7"			10	
503	1	4'-4"	105	1'-5"	1'-7"			5	
504	1	4'-10"	105	1'-11"	1'-7"			5	
601	81	19'-10"	112	1'-1"	7'-6"	6'-2"	2"	2413	
602	34	22'-0"	str.					1123	
603	17	29'-6"	str.					753	
604	12	10'-0"	str.					180	
605	12	5'-3"	str.					95	
606	17	29'-3"	str.					747	
607	116	6'-2"	104	5'-6"	10"			1074	
608	4	10'-8"	108	8'-9"	1'-9 1/2"	10 3/4"		64	
609	6	8'-3"	str.					74	
610	26	9'-6"	str.					371	
611	4-series-4	4'-3" to 6'-3"	str.				8"	126	
612	22	3'-9"	str.					124	
613	59	7'-1"	105	3'-5"	2'-0"			627	
614	71	6'-9"	100	5'-5"				720	
615	1-series-7	4'-6" to 5'-6"	100	3'-2" to 4'-2"			2"	53	
616	1-series-6	4'-6" to 5'-6"	100	3'-2" to 4'-2"			2 3/8"	45	
617	16	27'-9"	str.					667	
618	1	15'-8"	108	13'-9"	3 1/2"	1'-11"		23	
619	2	13'-9"	str.					41	
620	1	15'-9"	148	14'-2"	1'-11"	3 1/2"		24	
621	2	14'-0"	str.					42	
622	1	14'-3"	str.					21	
623	1	10'-6"	str.					16	
624	1-series-3	12'-0" to 16'-9"	str.				2'-4 1/2"	65	
625	1-series-3	11'-9" to 16'-6"	str.				2'-4 1/2"	64	
626	2	13'-6"	str.					41	
627	2-series-3	8'-3" to 13'-0"	str.				2'-4 1/2"	96	
628	2	20'-0"	str.					60	
629	2	19'-9"	str.					59	
630	25	18'-6"	154	1'-4"	1'-7"	7'-6"	7'-6"	695	
631	4	16'-0"	str.					96	
*632	12	16'-9"	str.						
633	6	18'-0"	str.					162	
634	16	5'-9"	str.					138	
635	4	6'-9"	str.					41	
636	7	7'-6"	str.					79	
637	3	13'-10"	148	12'-0"	2'-0"	3"		62	
638	3	13'-6"	108	11'-8"	3"	2'-0"		61	
639	33	5'-8"	104	5'-0"	10"			281	
640	3	18'-0"	133	6'-0"	12'-0"	71'-10"		81	
641	3	18'-4"	133	6'-4"	12'-0"	71'-10"		83	
Total								12,492	

NOTES:

*Bars included for payment with "Item 5-14, Railing."
Bar dimensions are given out to out.
Bars of a series shall vary in length by a constant increment.
For replacement schedule, see Sheet 103-7A.
For additional notes, see Sheet 116-7A.

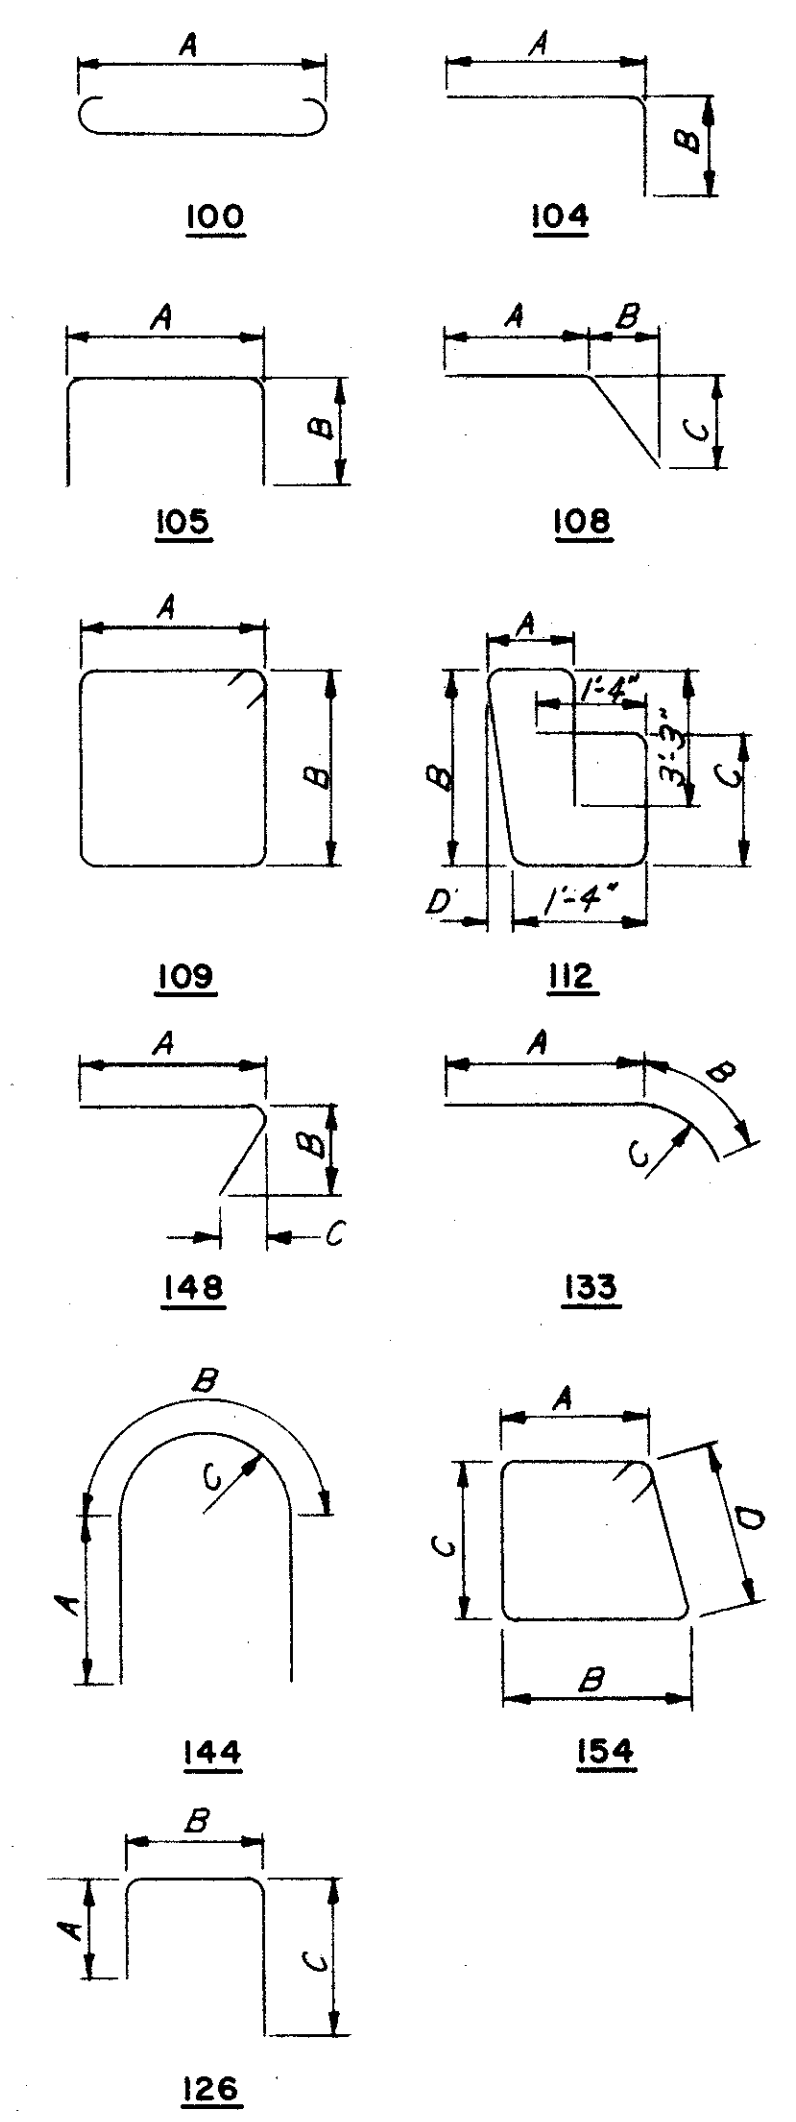

BENDING DIAGRAMS

H.N.T.B. BR. NO. 4 PART 7A

HOWARD, NEEDLES, TAMMEN & BERGENDOFF
CONSULTING ENGINEERS
KANSAS CITY CLEVELAND NEW YORK

WEST ABUTMENT-SECTIONS

INNER BELT FREEWAY OVER EAST 14th ST.
BR. NO. CUY - 42-1854 STA. 70+89.23
Scale: 3/8" = 1'-0" STA. 73+96.25








WILLOW-INNER BELT FREEWAY
CLEVELAND CUYAHOGA COUNTY OHIO

DRAWN C.M.	TRACED	CHECKED H.P.L.	REVIEWED J.C.T.	REVISED
DATE 1-14-59	DATE	DATE 1-22-59	DATE 1-13-59	SHEET 117


JUL 3 1985

CUYAHOGA COUNTY
 CITY OF CLEVELAND
 CUY-21-1532
 CUY-42-1842

Note: Prefix "AC" shall be assigned to all bar marks.

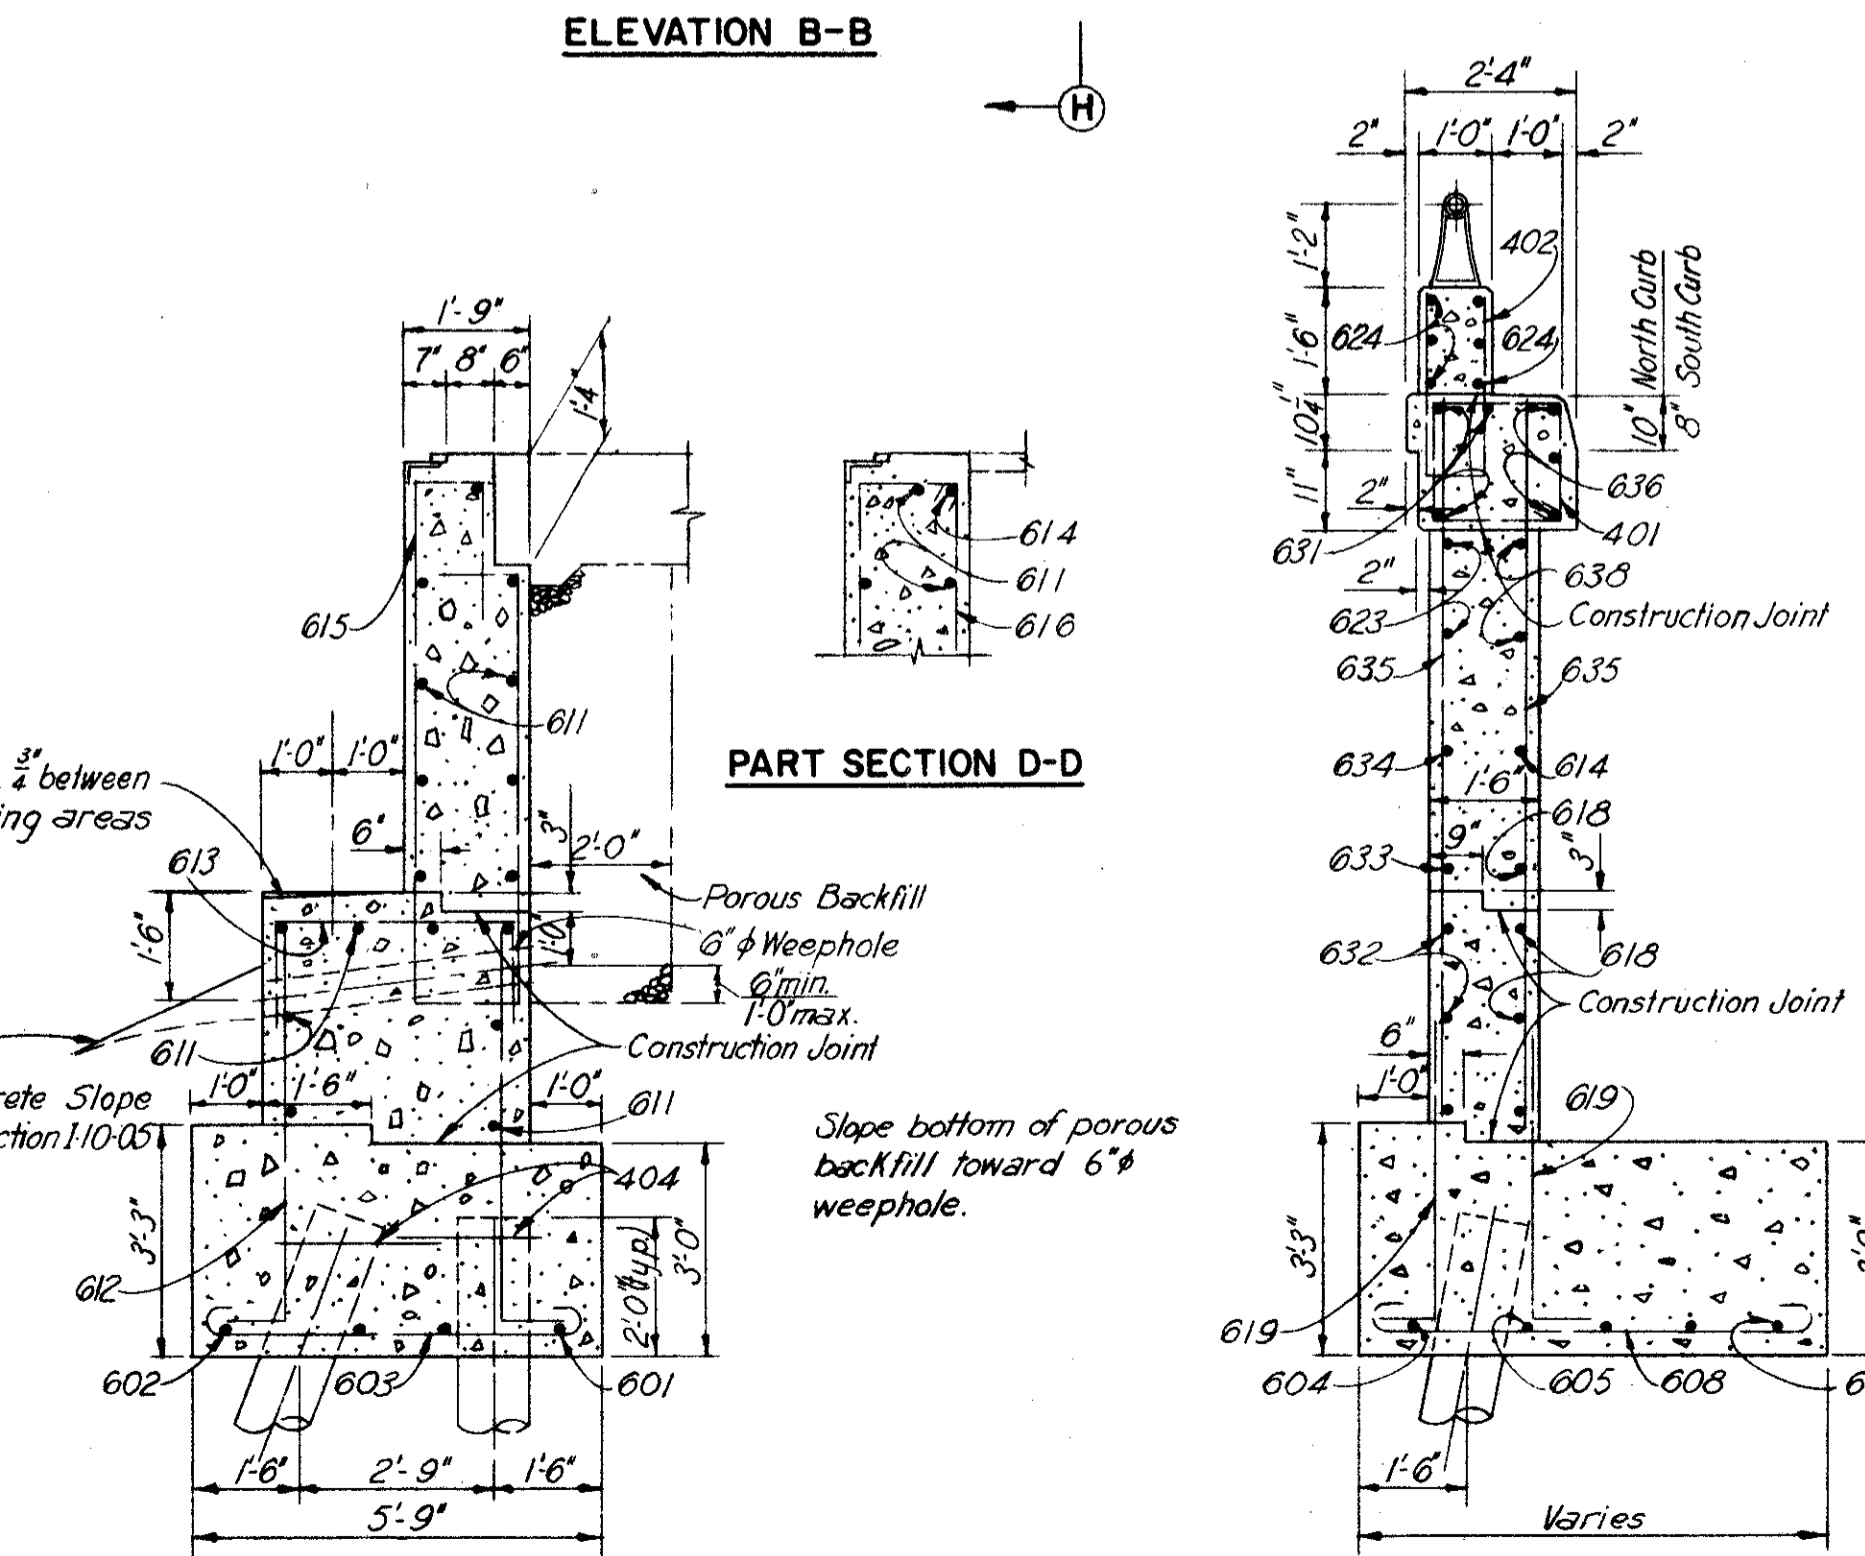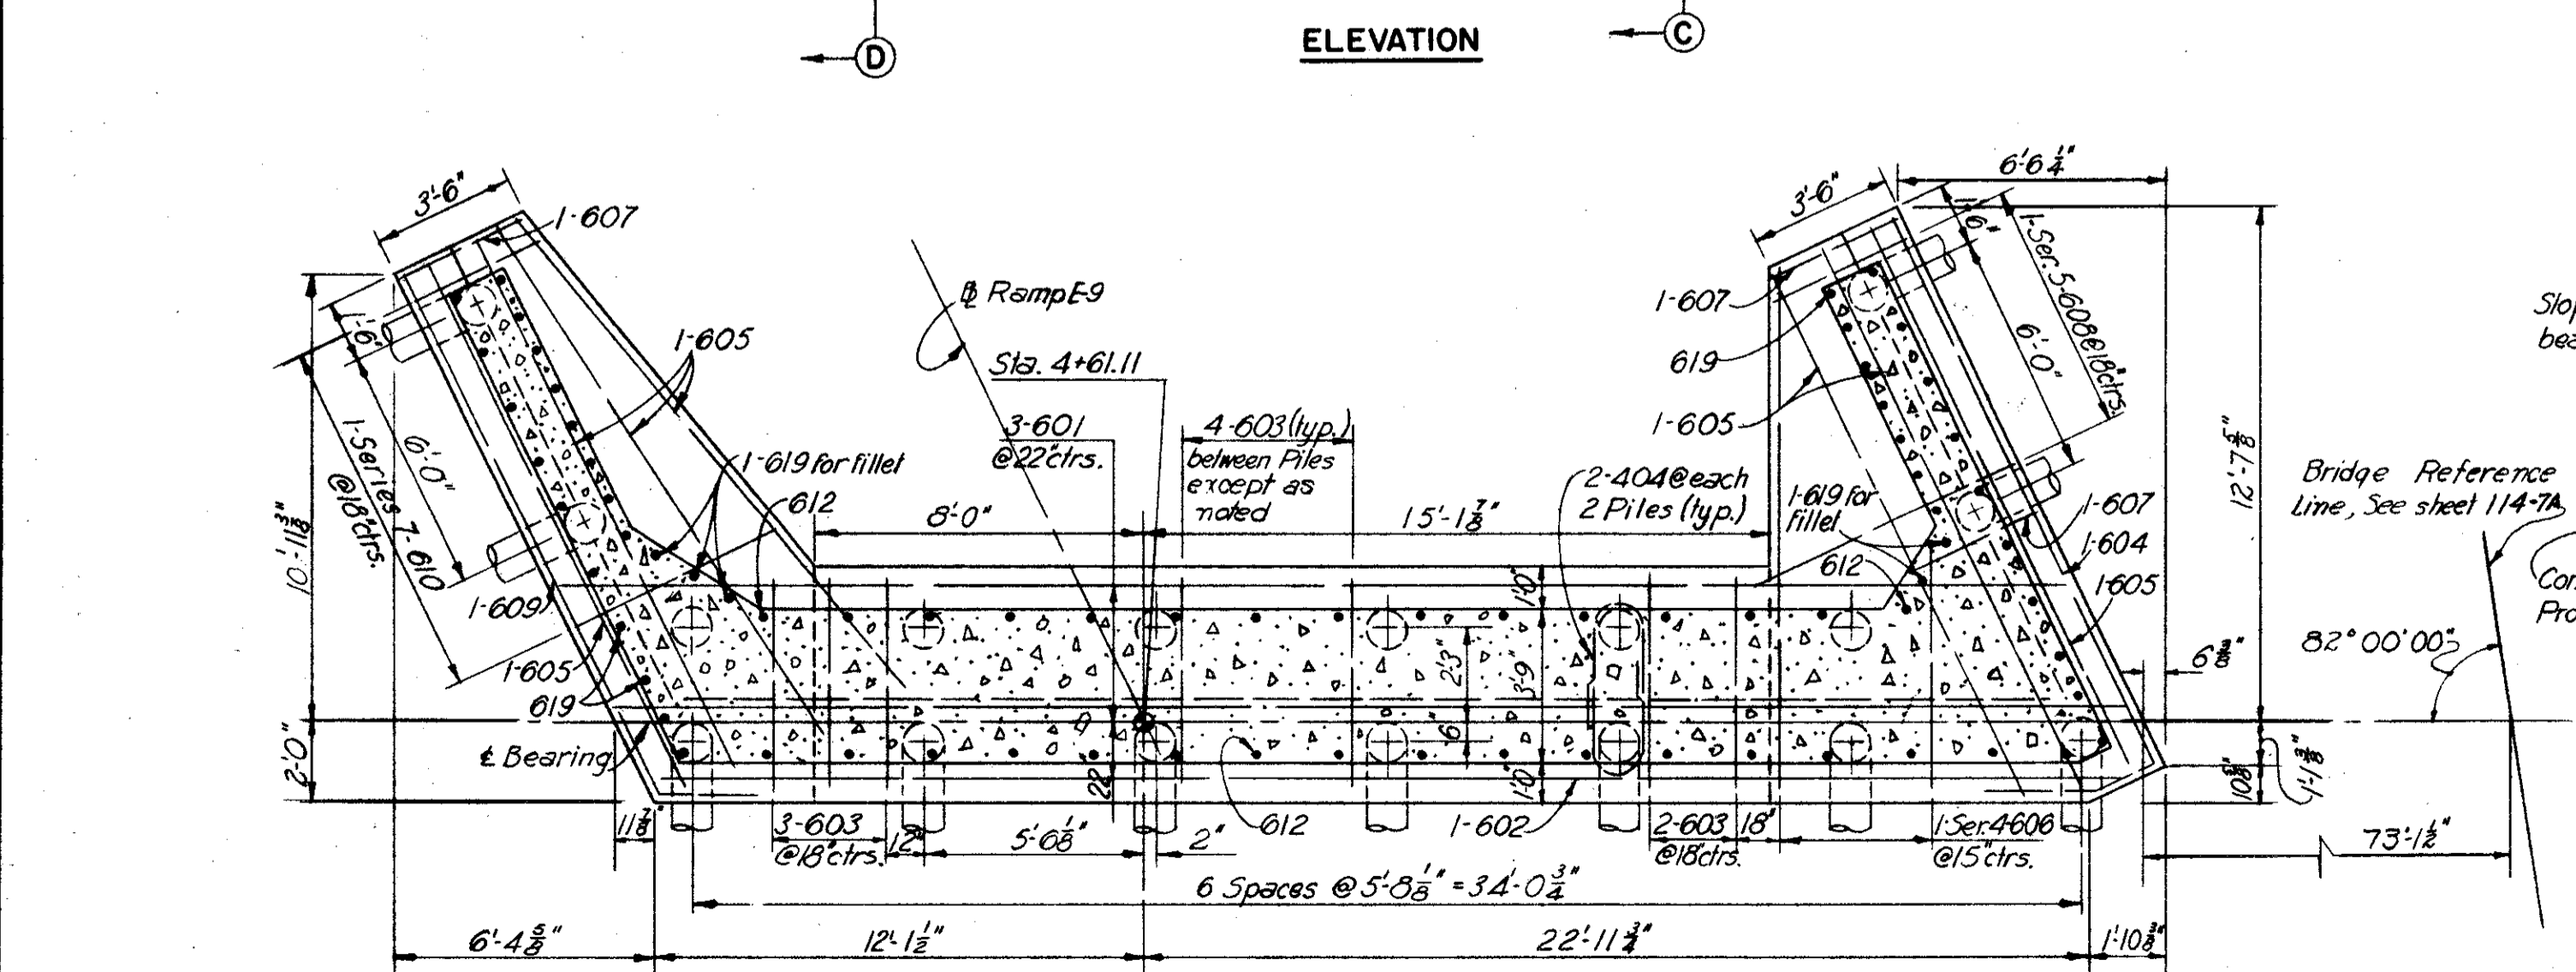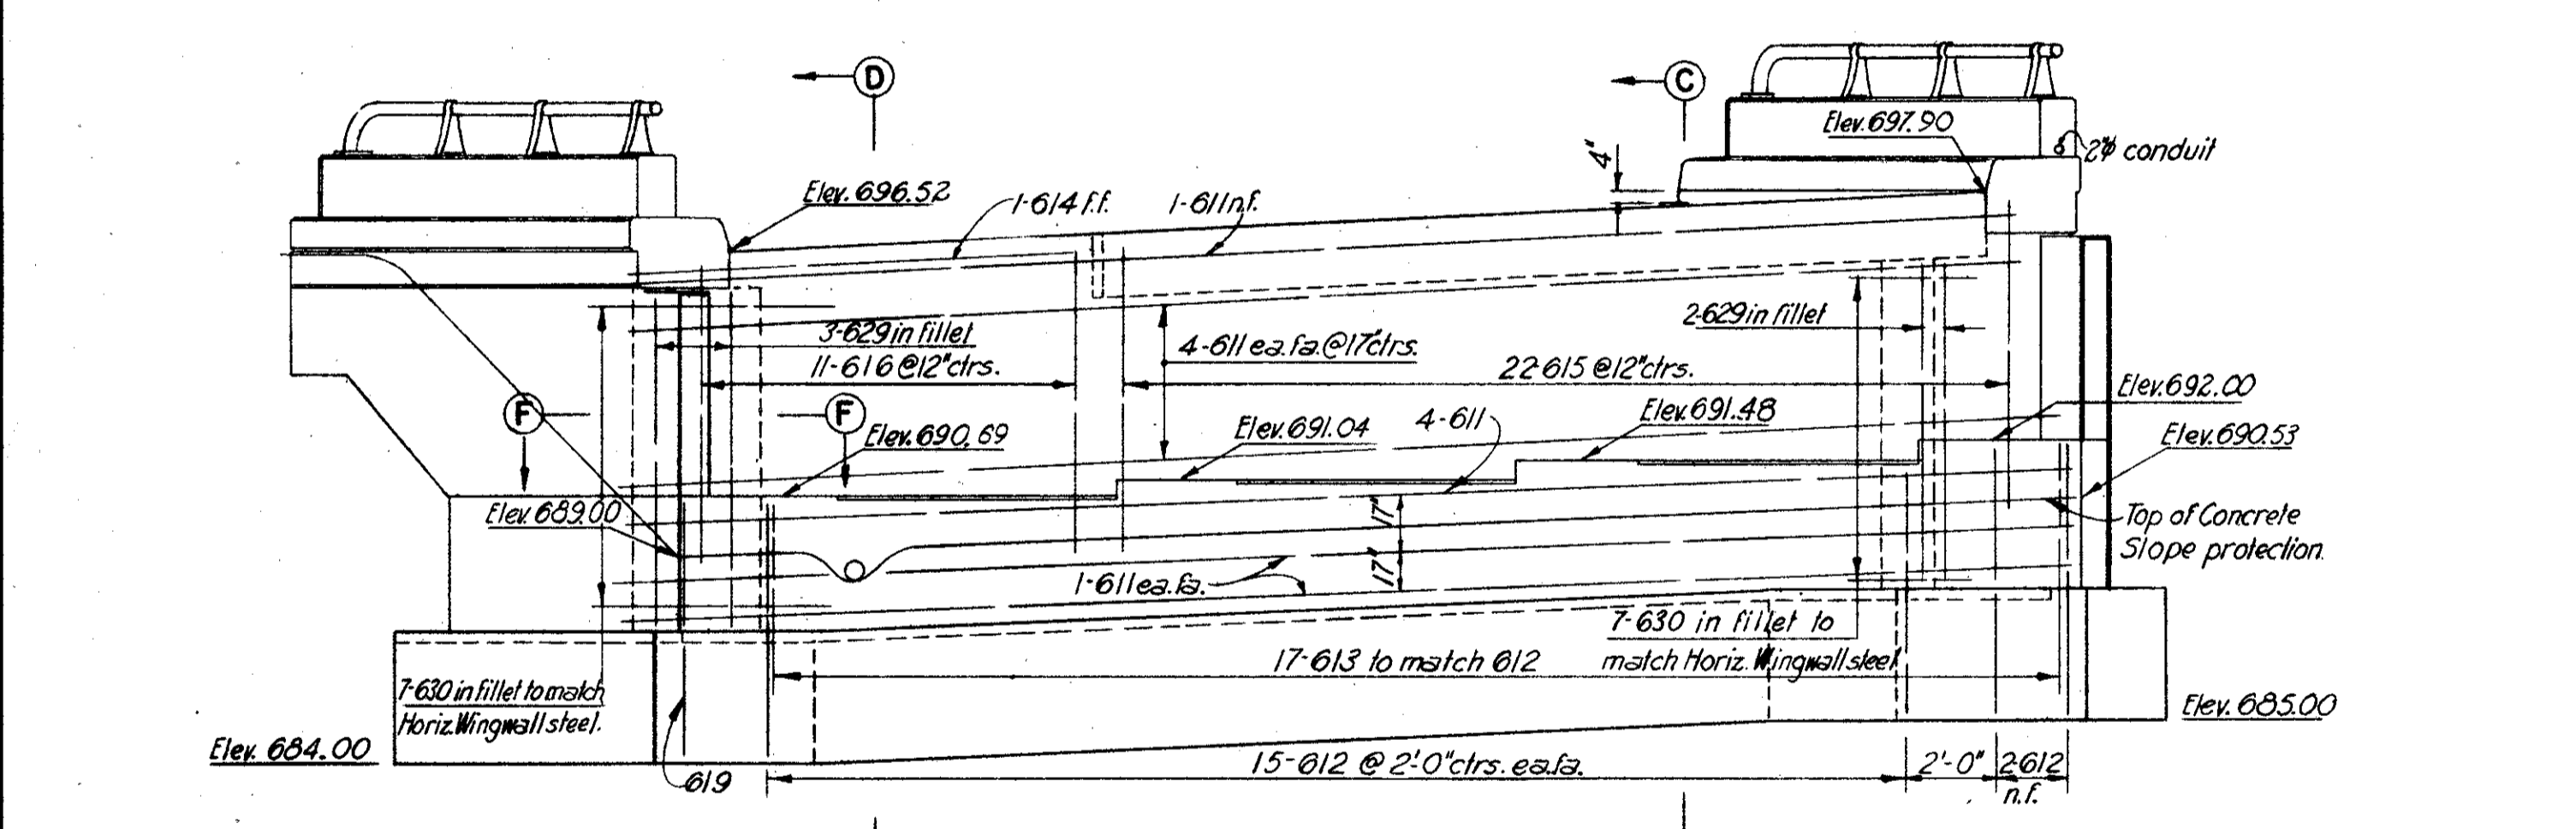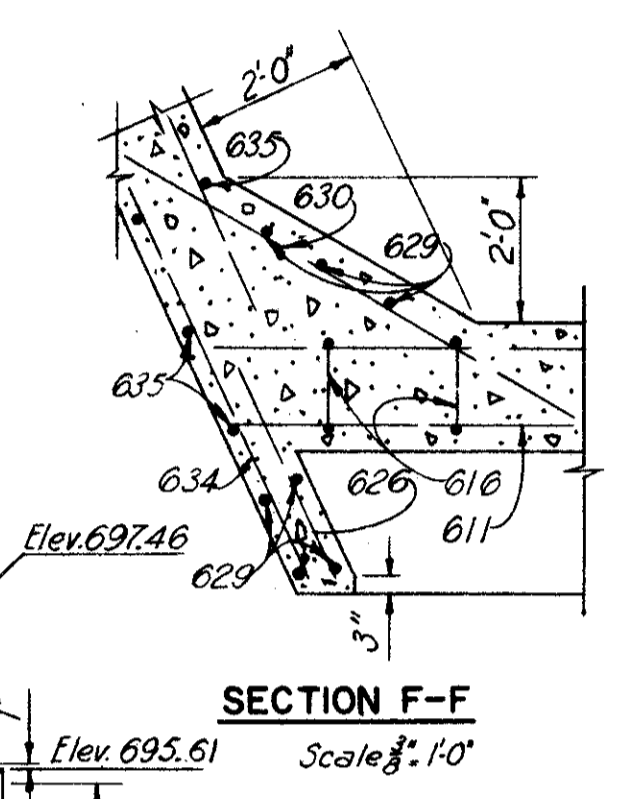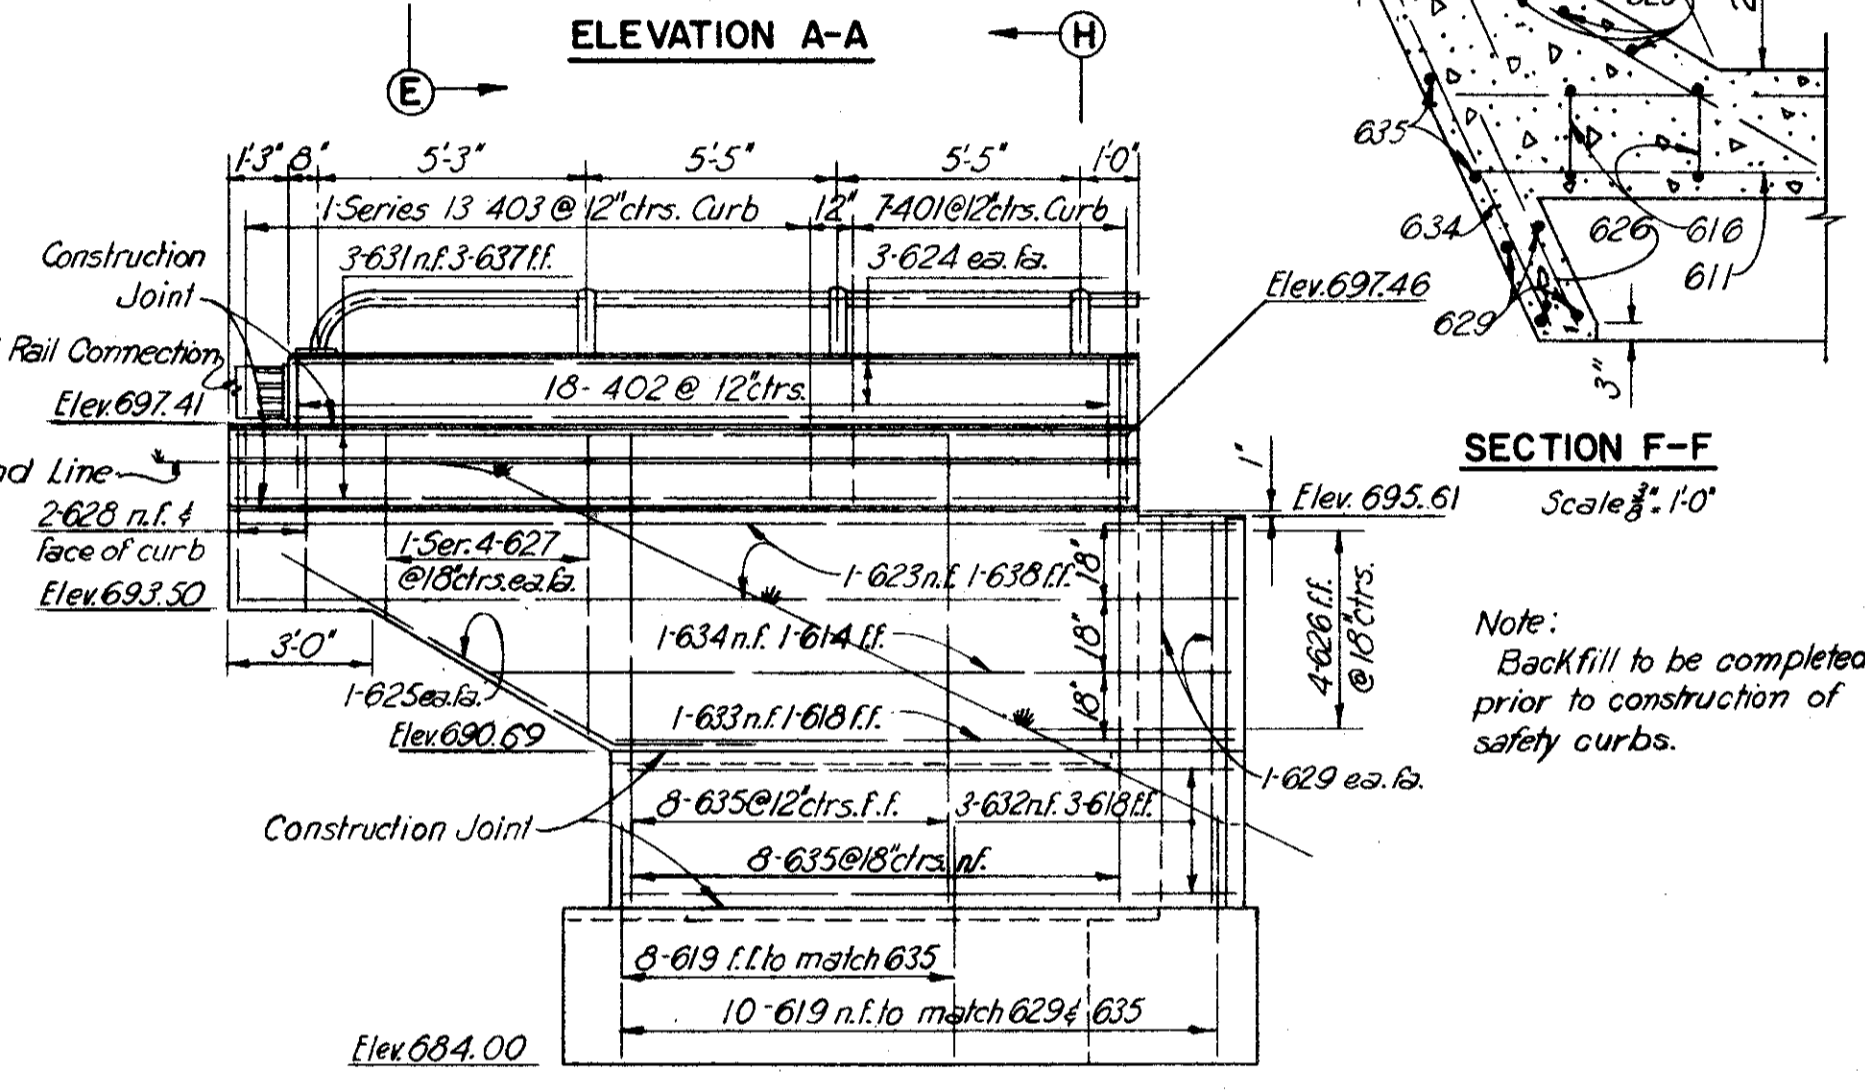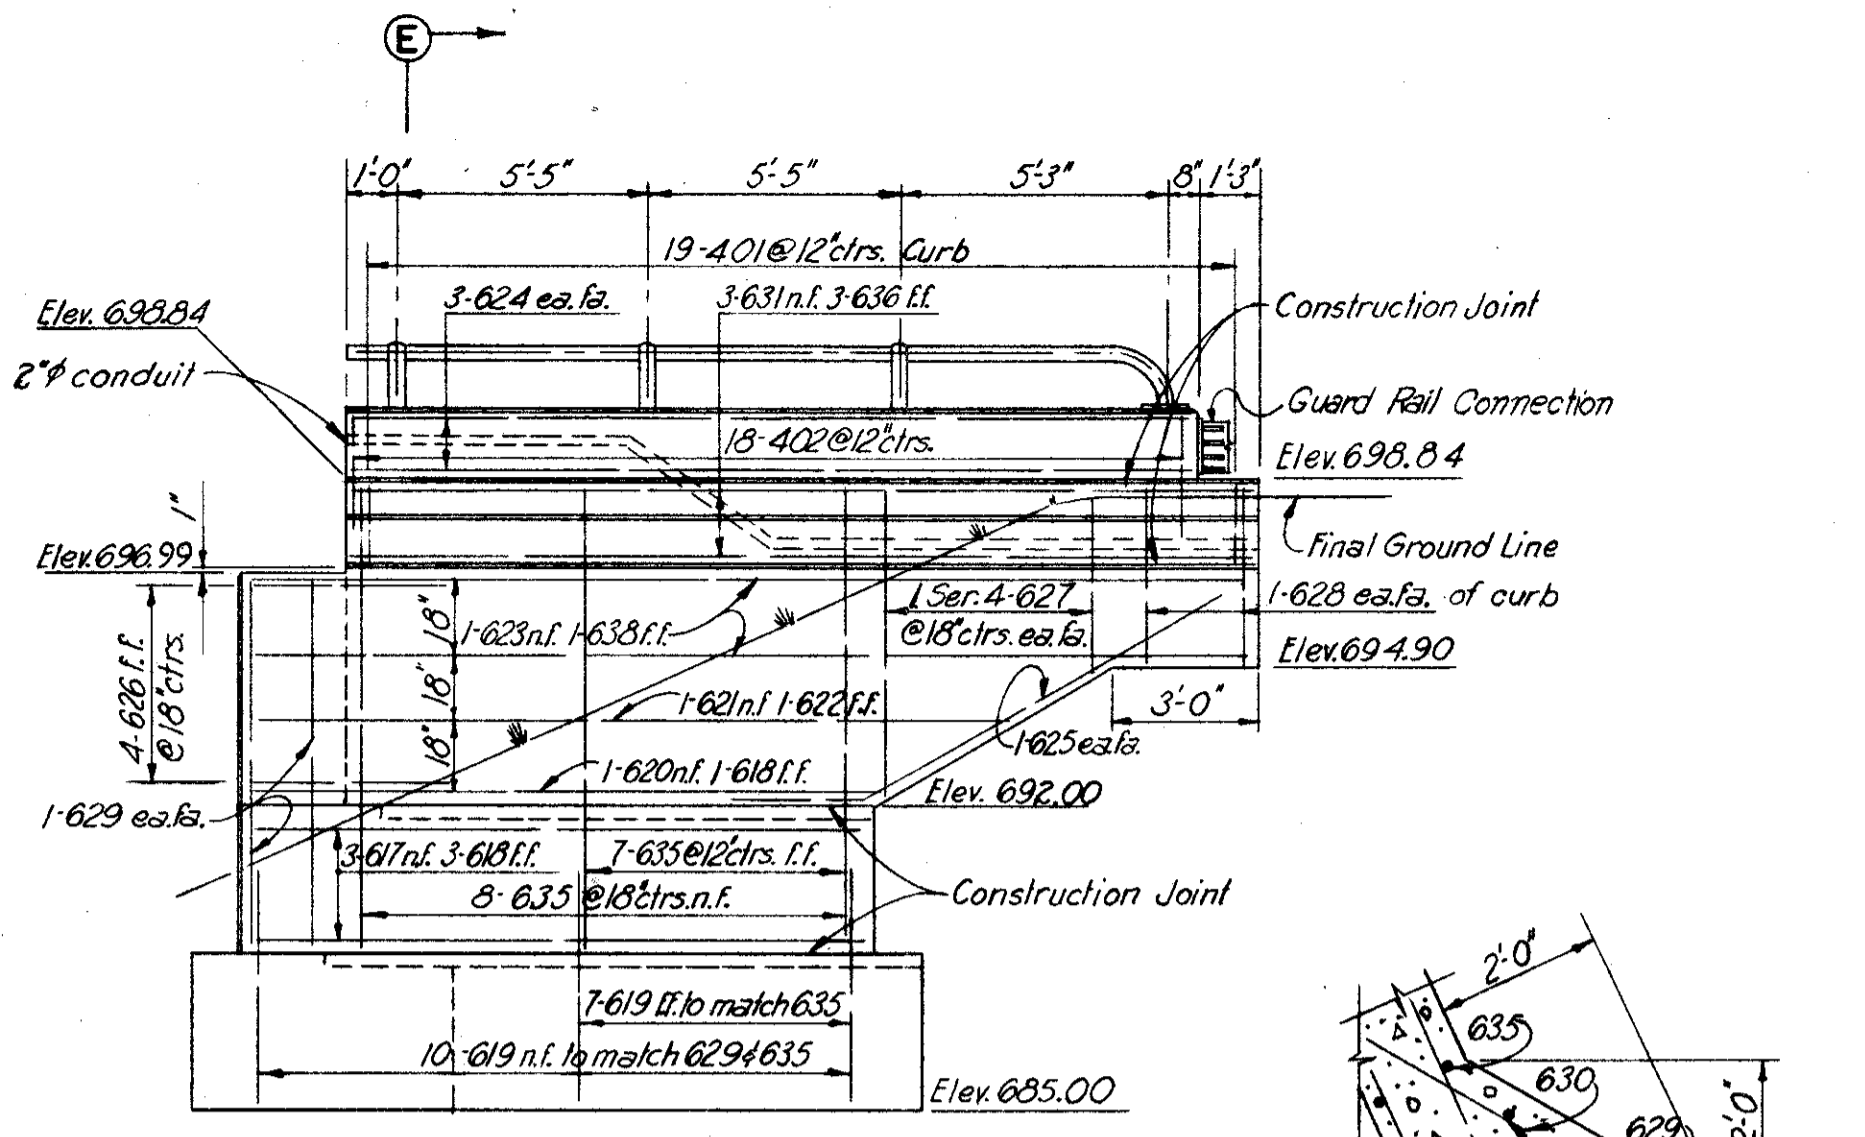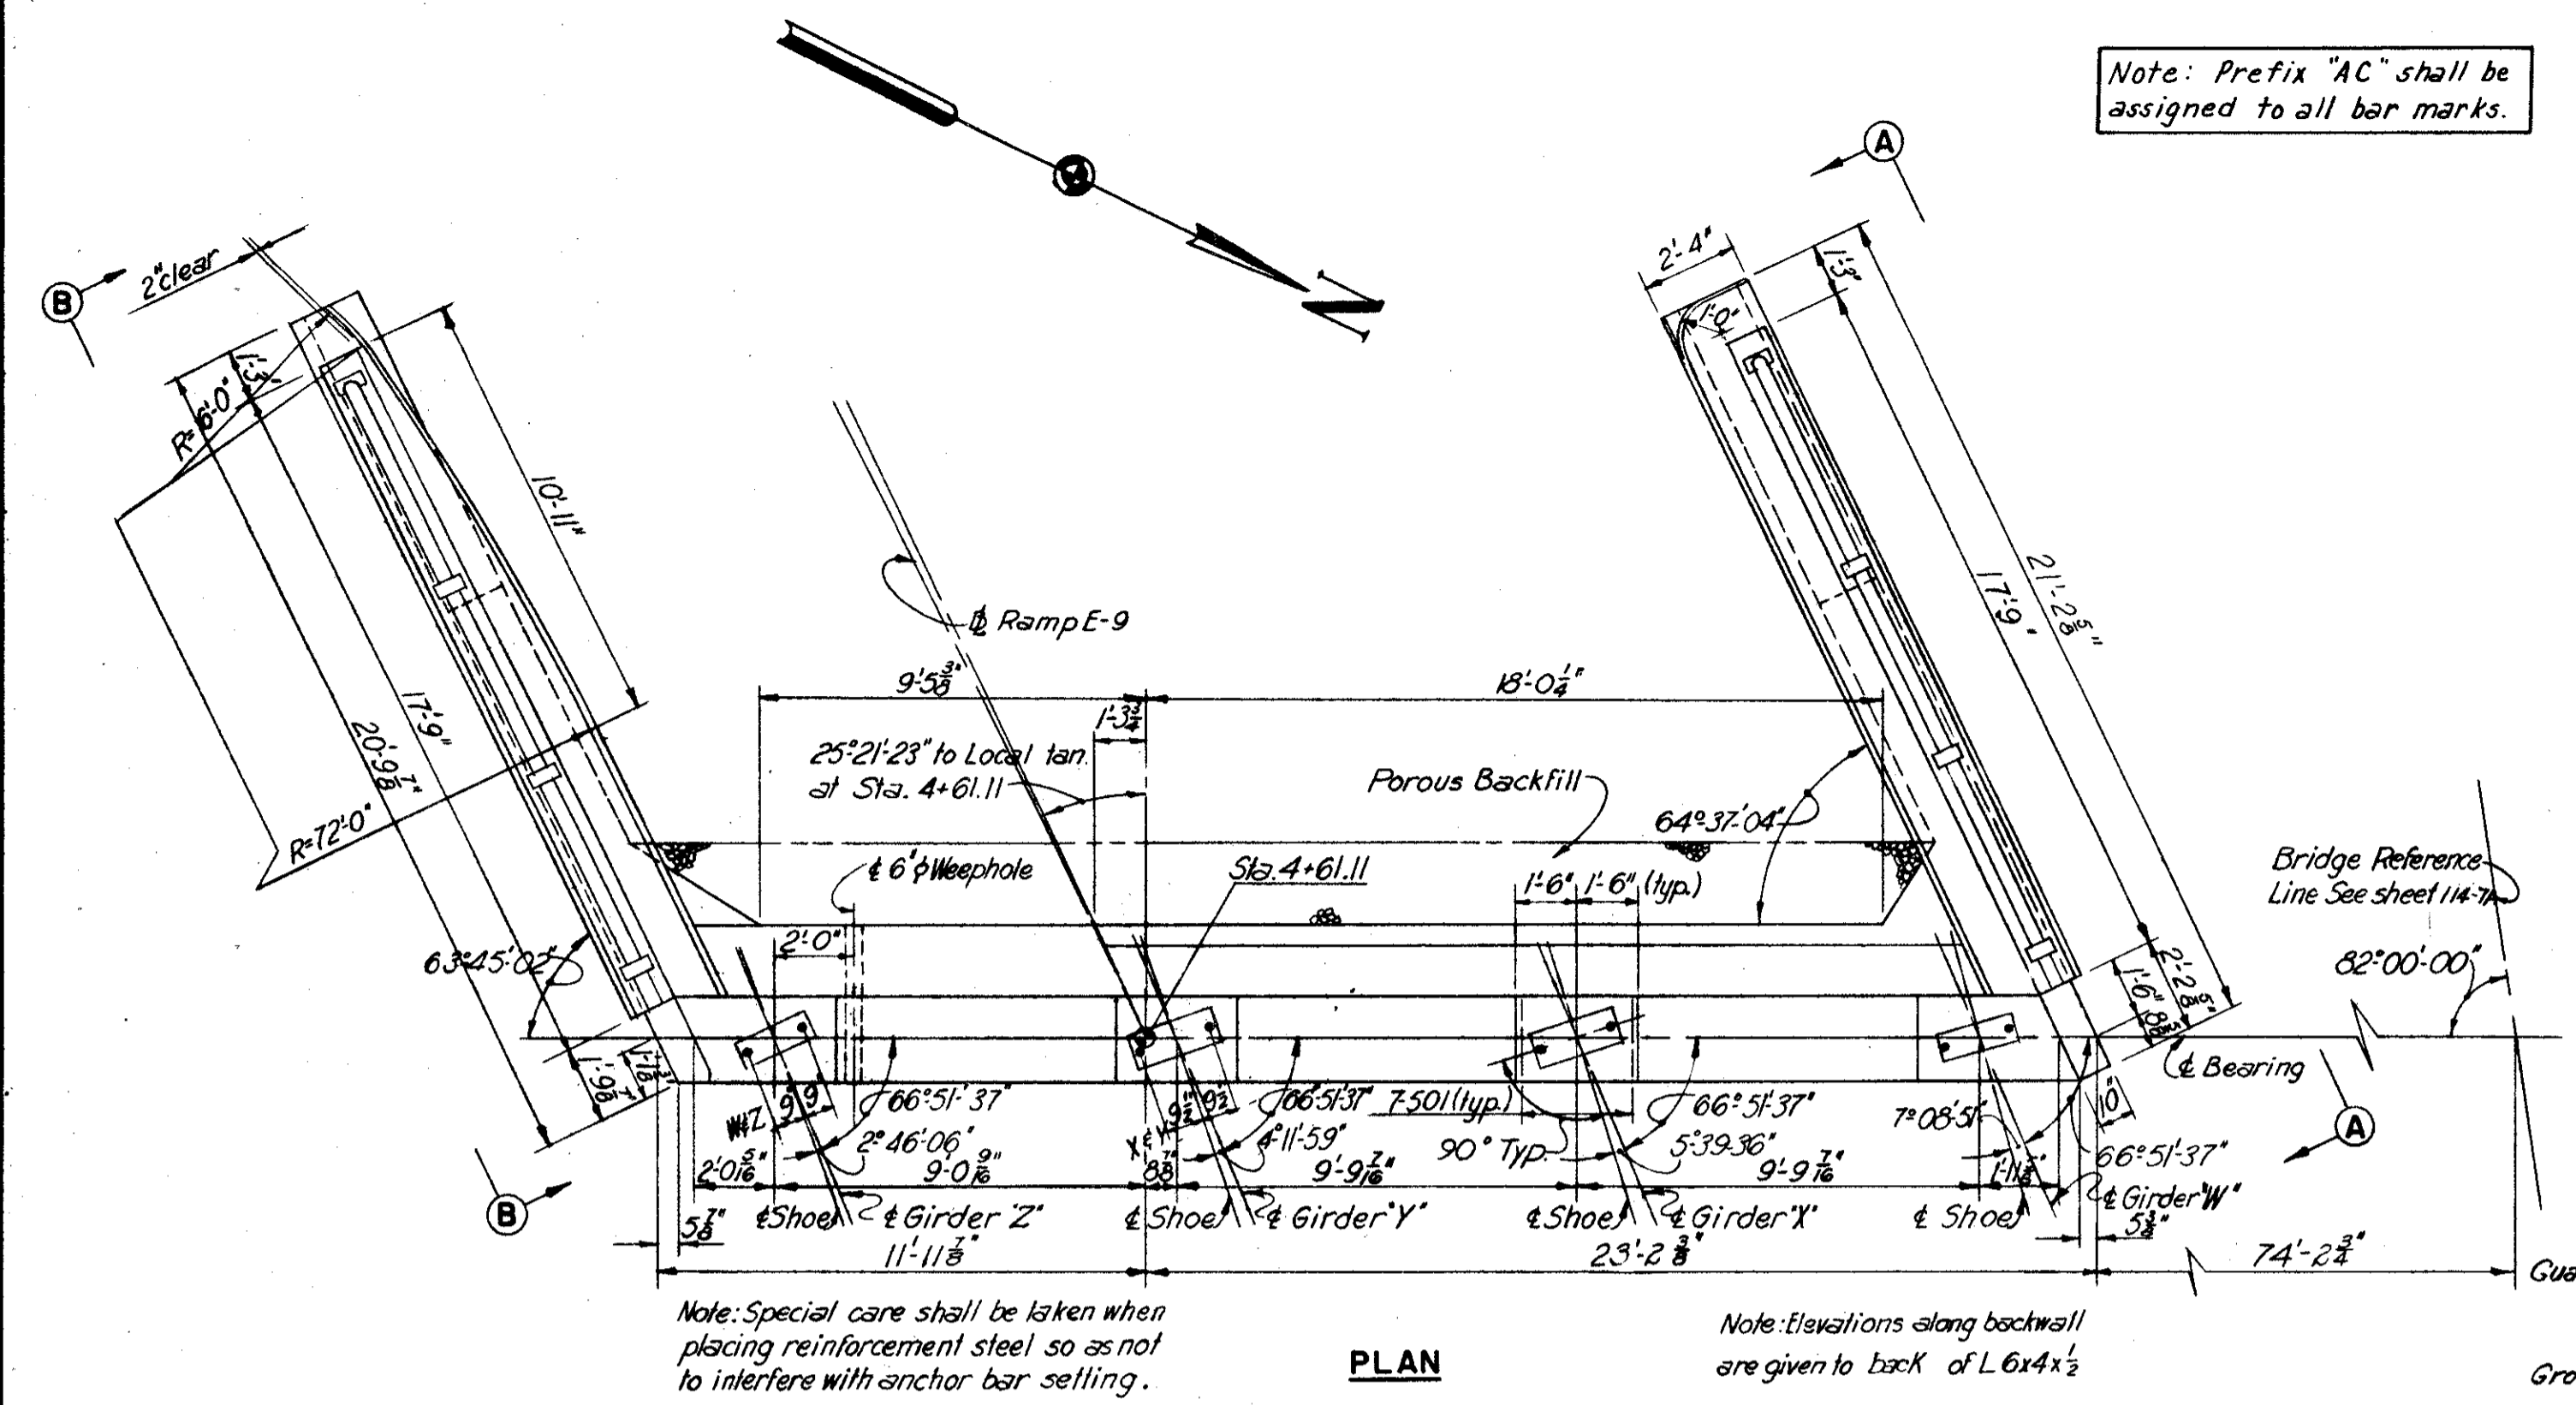

REINFORCEMENT SCHEDULE										
MARK	NO.	LENGTH	TYPE	DIMENSIONS				SERIES INCR.	WEIGHT	
				A	B	C	D			
401	26	6'-5"	109	1'-8"	1'-5"				113	
402	36	5'-5"	105	8"	2'-6"				130	
403	13	4'-8" to 6'-6"	109	8 1/2"	1'-5"			2'	48	
404	12	6'-10"	144	6"	1'-10"				55	
501	28	4'-7"	105	1'-8"	1'-7"				134	
601	3	3'-0"	Str.						167	
602	1	3'-0"	Str.						54	
603	17	6'-8"	100	5'-4"					170	
604	1	18'-1"	124	14'-9"	1'-7"	2'-0"			27	
605	7	14'-9"	Str.						155	
606	1 Ser. 4	7'-5" to 13'-5"	101	6 3/4"			2'-0"		63	
607	3	4'-6"	100	3'-2"					20	
608	1 Ser. 5	4'-10" to 8'-4"	100	3 1/2"			10 1/2"		49	
609	1	16'-0"	108	14'-0"	2'-0"				24	
610	1 Ser. 7	4'-7" to 6'-7"	100	8 3/4"			4'		59	
611	17	34'-5"	Str.						875	
612	32	8'-5"	104	10'	5'-9"				308	
613	17	7'-5"	105	3'-5"	2'-2"				189	
614	2	11'-0"	Str.						33	
615	22	20'-6"	112	11'	8'-6"	1'-5"	7'-2"		677	
616	11	20'-4"	109	1'-5"	8'-6"				336	
617	3	15'-0"	124	12'-9"	8"	2'-0"			68	
618	8	9'-0"	Str.						108	
619	40	5'-8"	104	10'	5'-0"				340	
620	1	13'-3"	Str.						20	
621	1	16'-0"	Str.						24	
622	1	12'-3"	Str.						18	
623	4	20'-9"	Str.						125	
624	12	17'-3"	Str.							
625	4	10'-6"	108	8'-6"	2'-0"				63	
626	8	4'-0"	Str.						48	
627	4 Ser. 8	3'-6" to 6'-3"	Str.				11'		117	
628	8	3'-6"	Str.						42	
629	13	8'-3"	Str.						161	
630	14	6'-0"	Str.						126	
631	6	18'-6"	Str.						167	
632	3	14'-6"	108	12'-8"	2'-0"				63	
633	1	12'-6"	Str.						19	
634	1	15'-0"	Str.						22	
635	31	10'-0"	Str.						466	
636	3	18'-0"	Str.						81	
637	3	19'-0"	Str.						86	
638	4	17'-3"	Str.						104	
									Total	5,956

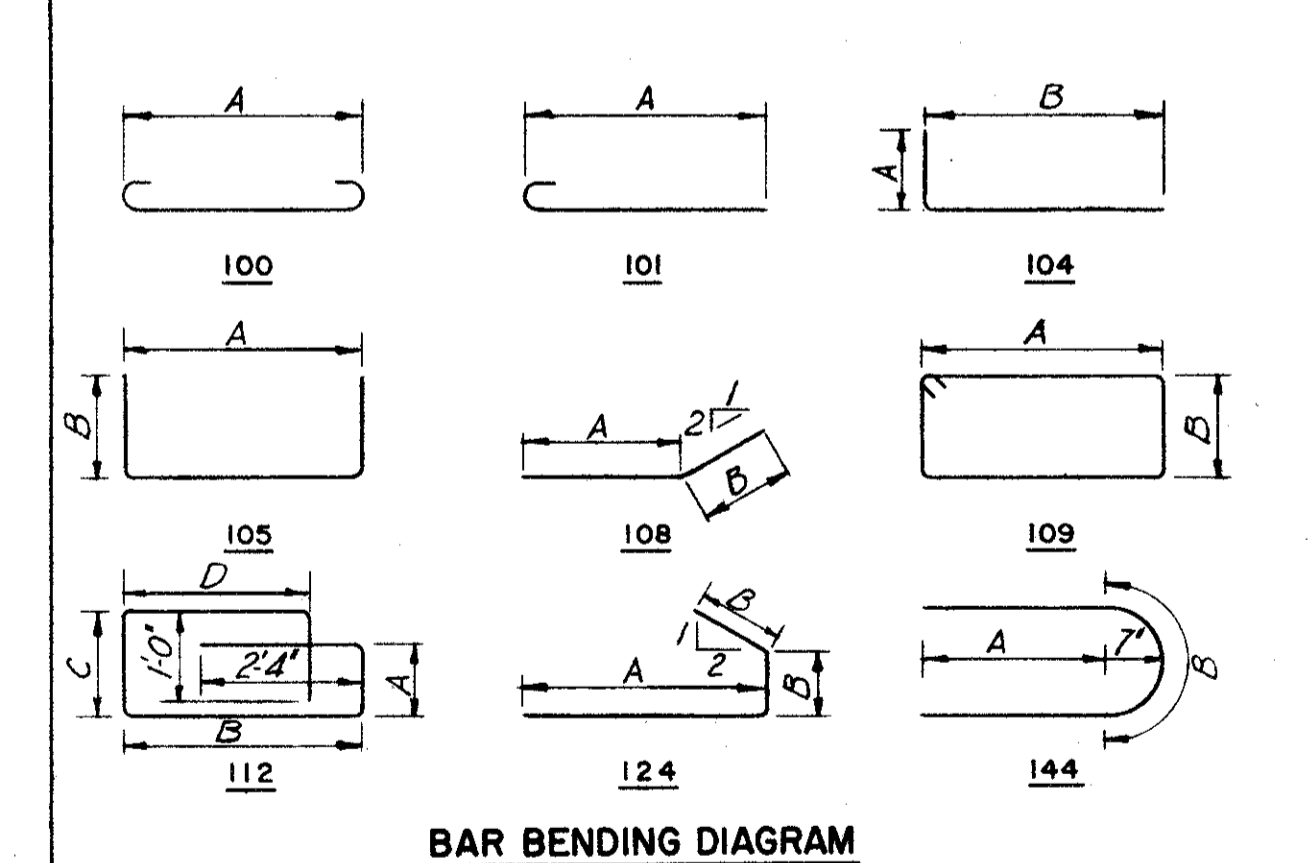

NOTES:
 * bars are included for payment with Item 'S14' Railing
 For additional notes see sheet 115-7A

H.N.T.B. BR. NO. 4 PART 7A

HOWARD, NEEDLES, TAMMEN & BERGENDOFF
 CONSULTING ENGINEERS
 KANSAS CITY CLEVELAND NEW YORK

ABUTMENT E-9

INNER BELT FREEWAY OVER EAST 14th ST.
 BR. NO. CUY-42-1854 STA. 70+89.23
 Scale: 1/4" = 1'-0" STA. 73+96.25
 Except as noted

WILLOW-INNER BELT FREEWAY
 CLEVELAND CUYAHOGA COUNTY OHIO

DRAWN BY: TRACED CHECKED: REVIEWED: REVISIONS:
 DATE: 1-20-59 DATE: 1-22-59 DATE: 11-13-59




SHEET 118

CUYAHOGA COUNTY
CITY OF CLEVELAND
CUY-21-15.32
CUY-42-18.42

Note: Prefix "AD" shall be assigned to all bar marks.

Note: Special care shall be taken when placing reinforcing steel so as not to interfere with anchor bar setting.

Note: Elevations given along backwall are given to top of 8"x1" angle.

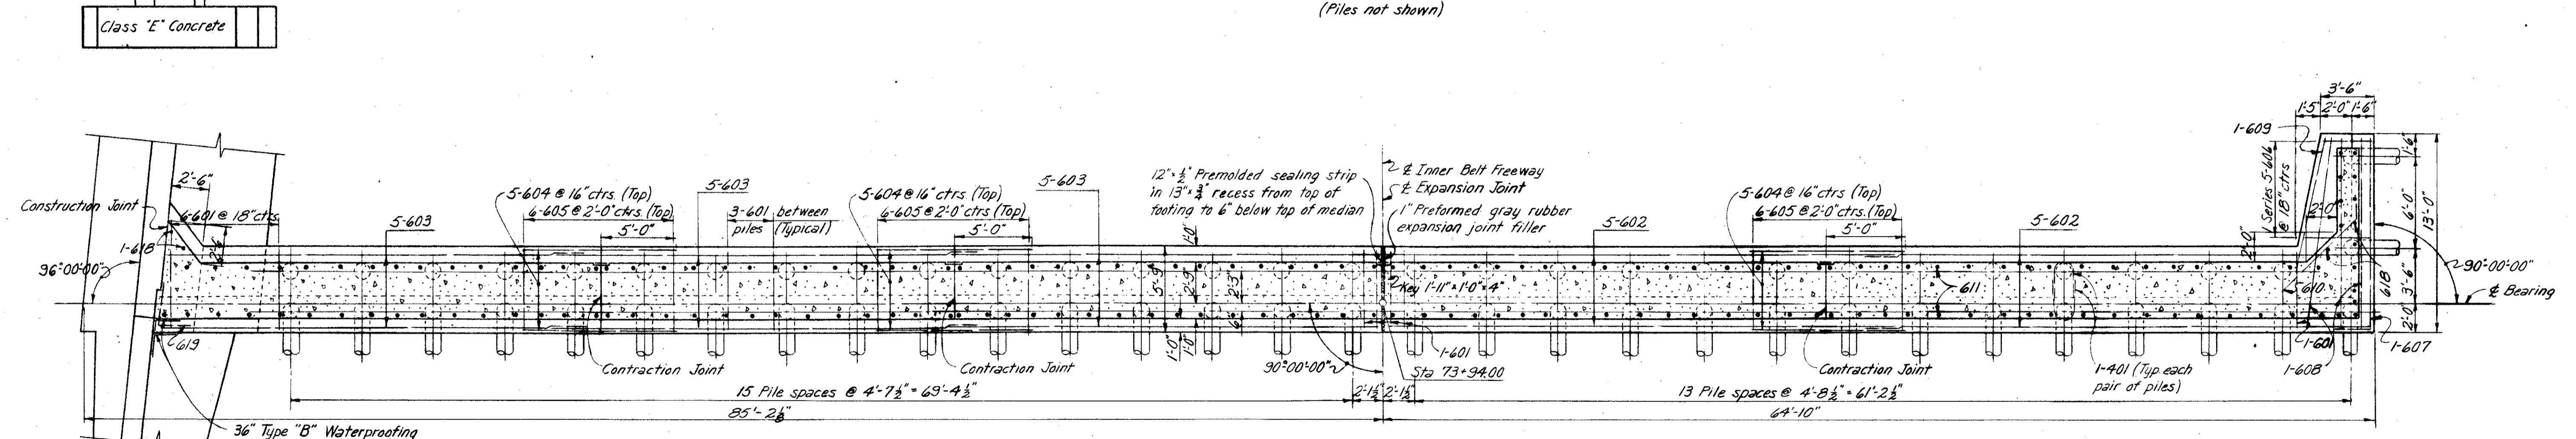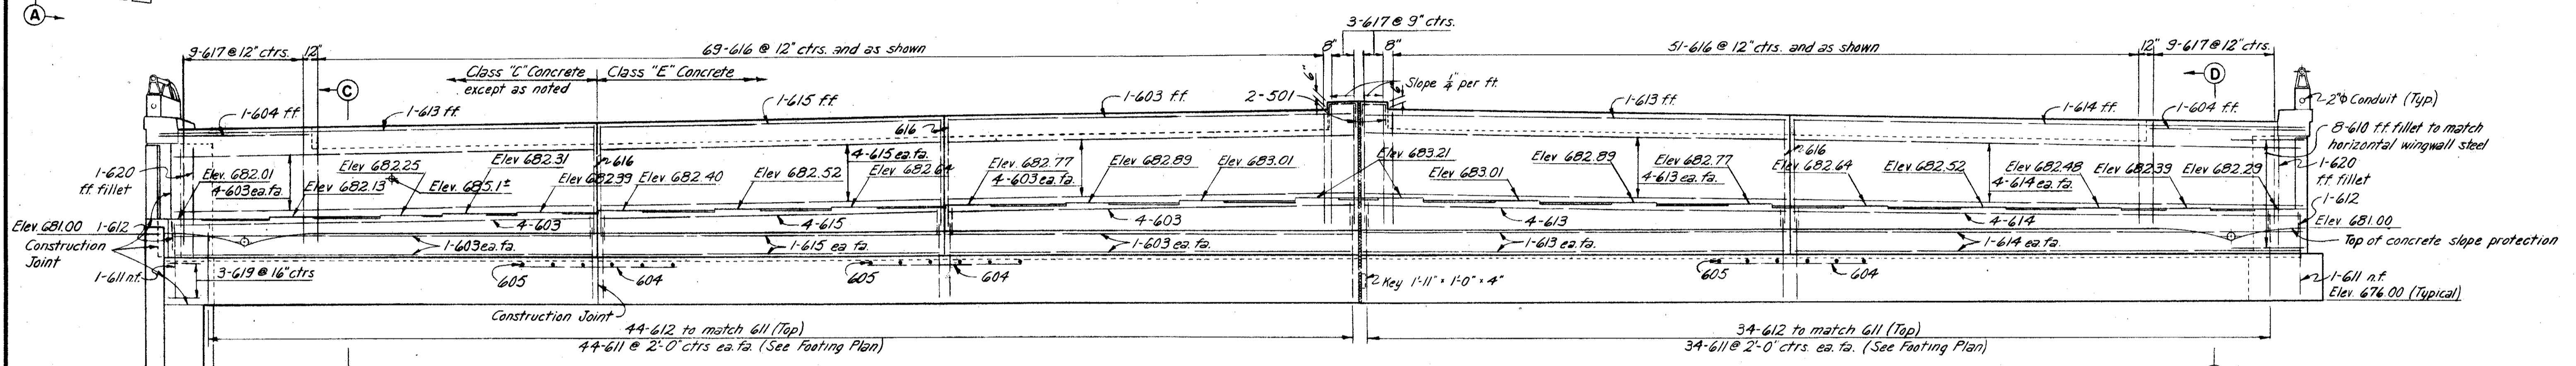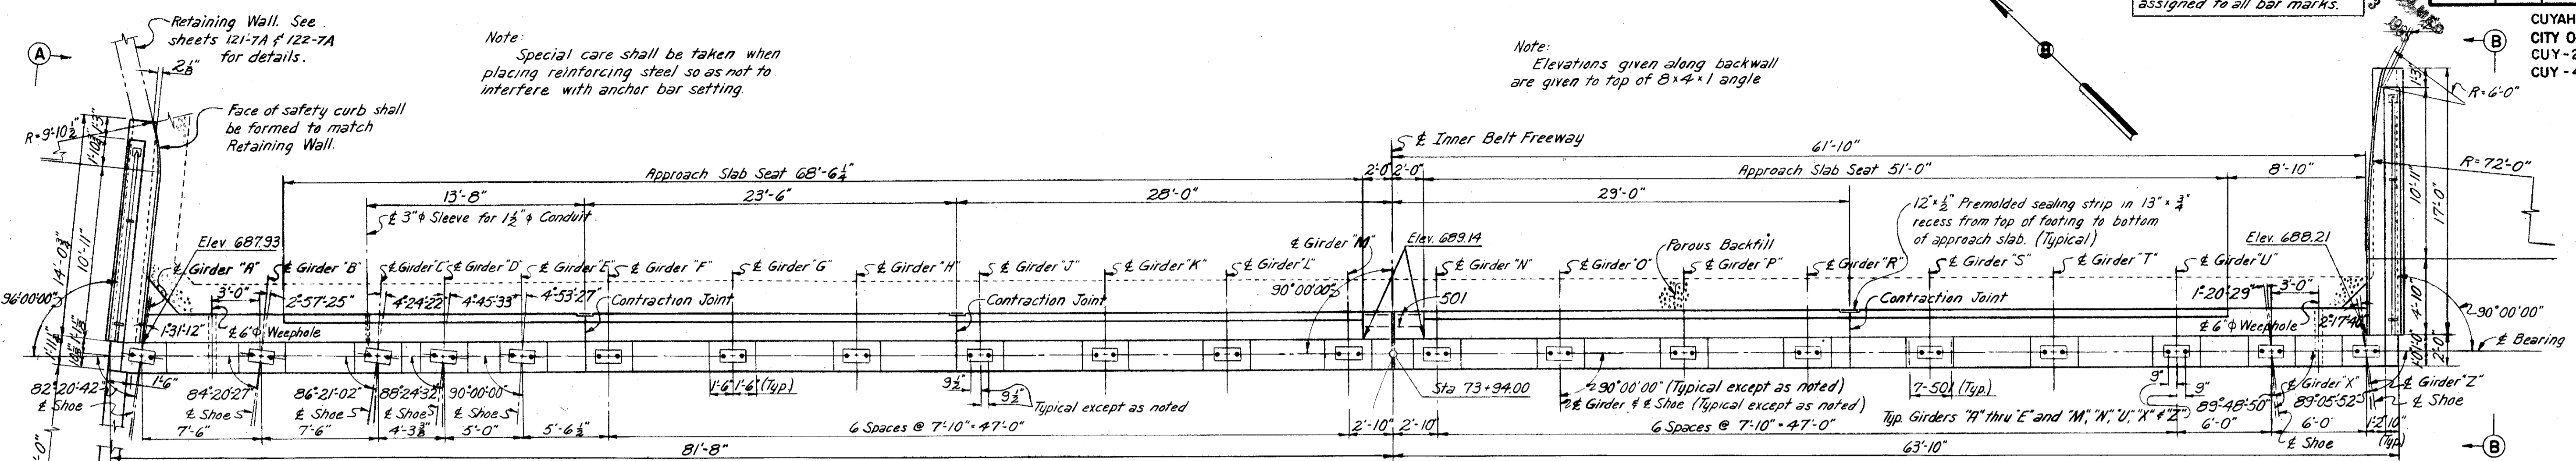

NOTES:

All piles shall be 12" Cast-in-place reinforced concrete.

All battered piles shall be battered 3 in 12 in direction shown.

Pile spacings are given along bottom of footing.

For details of end dam, see sheet 173-7A.

For details of masonry plates, see sheet 173-7A.

Reinforcement bars shall be 3 inches clear from bottom of footing and 2 inches elsewhere.

For Reinforcement Schedule, see sheet 120-7A.

For location of lighting conduit, see sheet 176-7A.

For Railing details, Railing Post spacing and Guard Rail connection details, see sheet 175-7A.

For Slope Protection details, abutment details, and additional notes, see sheet 120-7A n.f. - near face, ff - far face, ea fa. - each face

H.N.T.B. BR. NO. 4 PART 7A

HOWARD, NEEDLES, TAMMEN & BERGENDOFF
CONSULTING ENGINEERS
KANSAS CITY CLEVELAND NEW YORK

EAST ABUTMENT

INNER BELT FREEWAY OVER EAST 14th ST.

BR. NO. CUY-42-1854 STA. 70+89.23

Scale: 3/16" = 1'-0" STA. 73+96.25






WILLOW-INNER BELT FREEWAY

CLEVELAND CUYAHOGA COUNTY OHIO

DRAWN	TRACED	CHECKED	REVIEWED
CKB		ESJ	JCT
DATE 12-28-59	DATE	DATE 11-4-59	DATE 11-13-59



SHEET 119

CUYAHOGA COUNTY
 CITY OF CLEVELAND
 CUY-21-15.32
 CUY-42-18.42

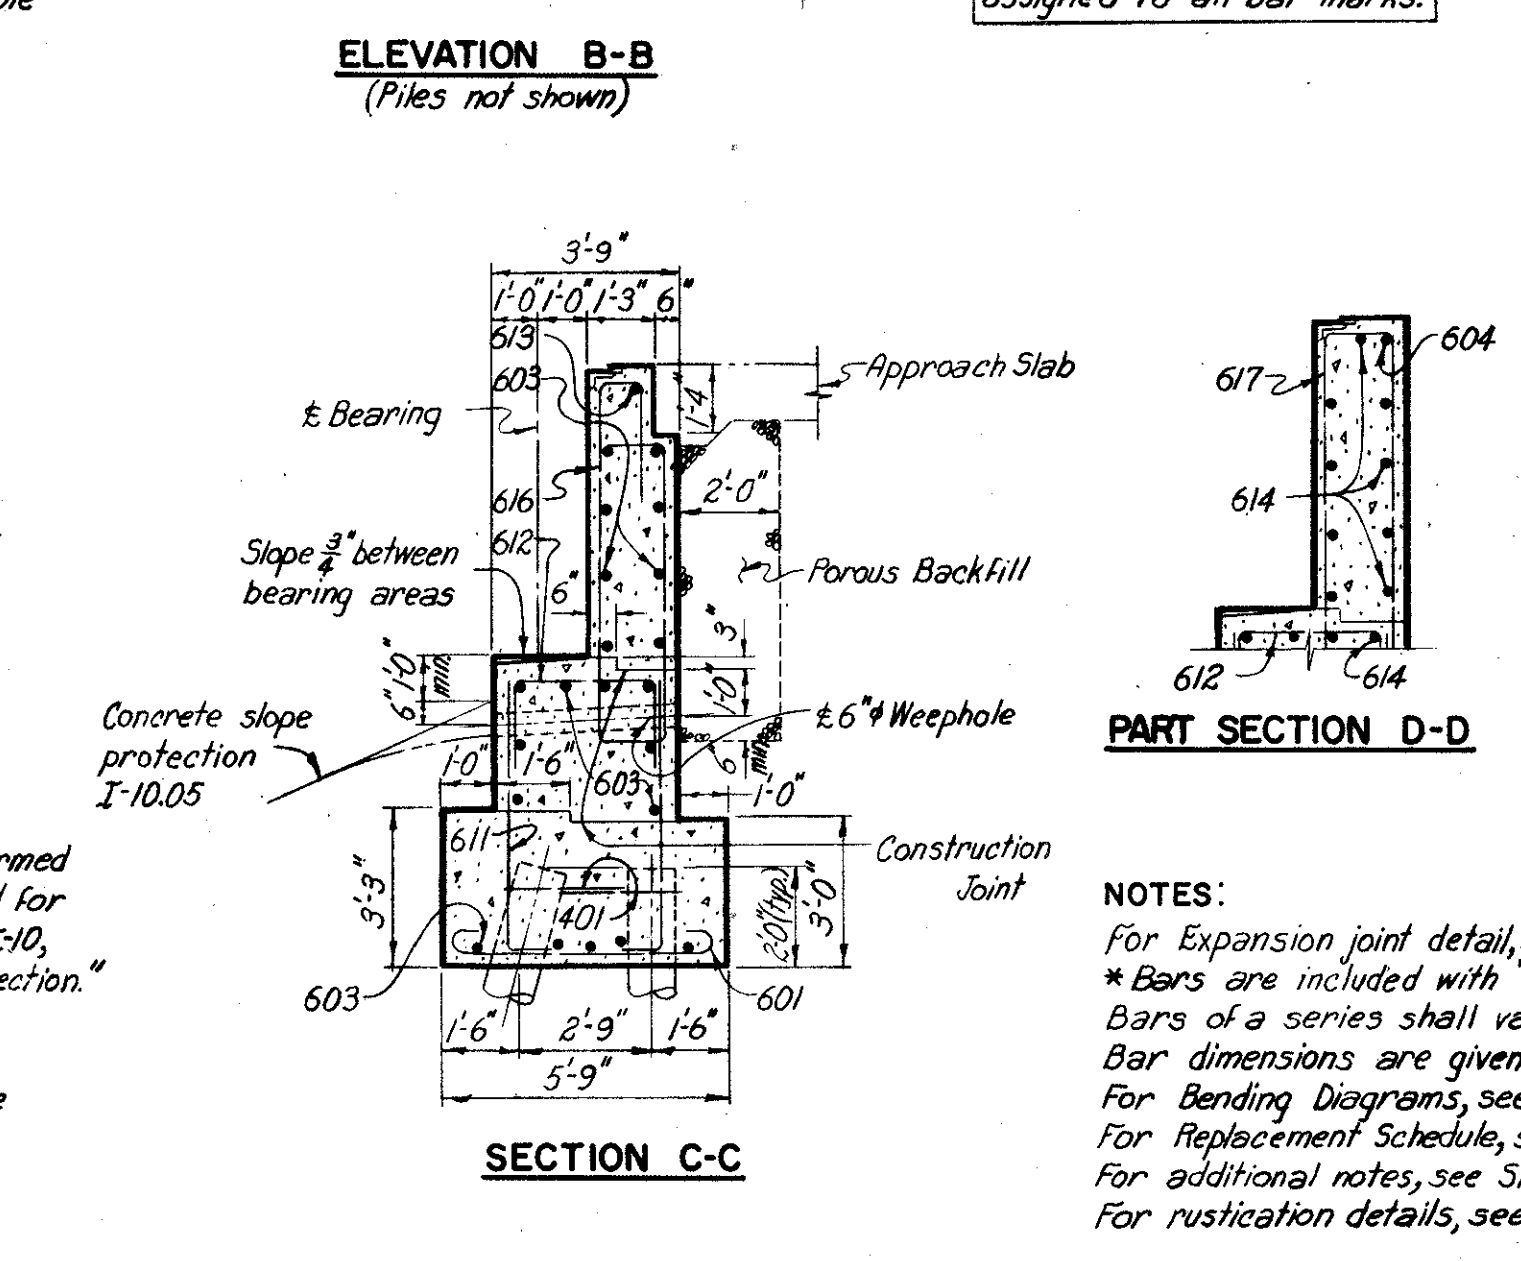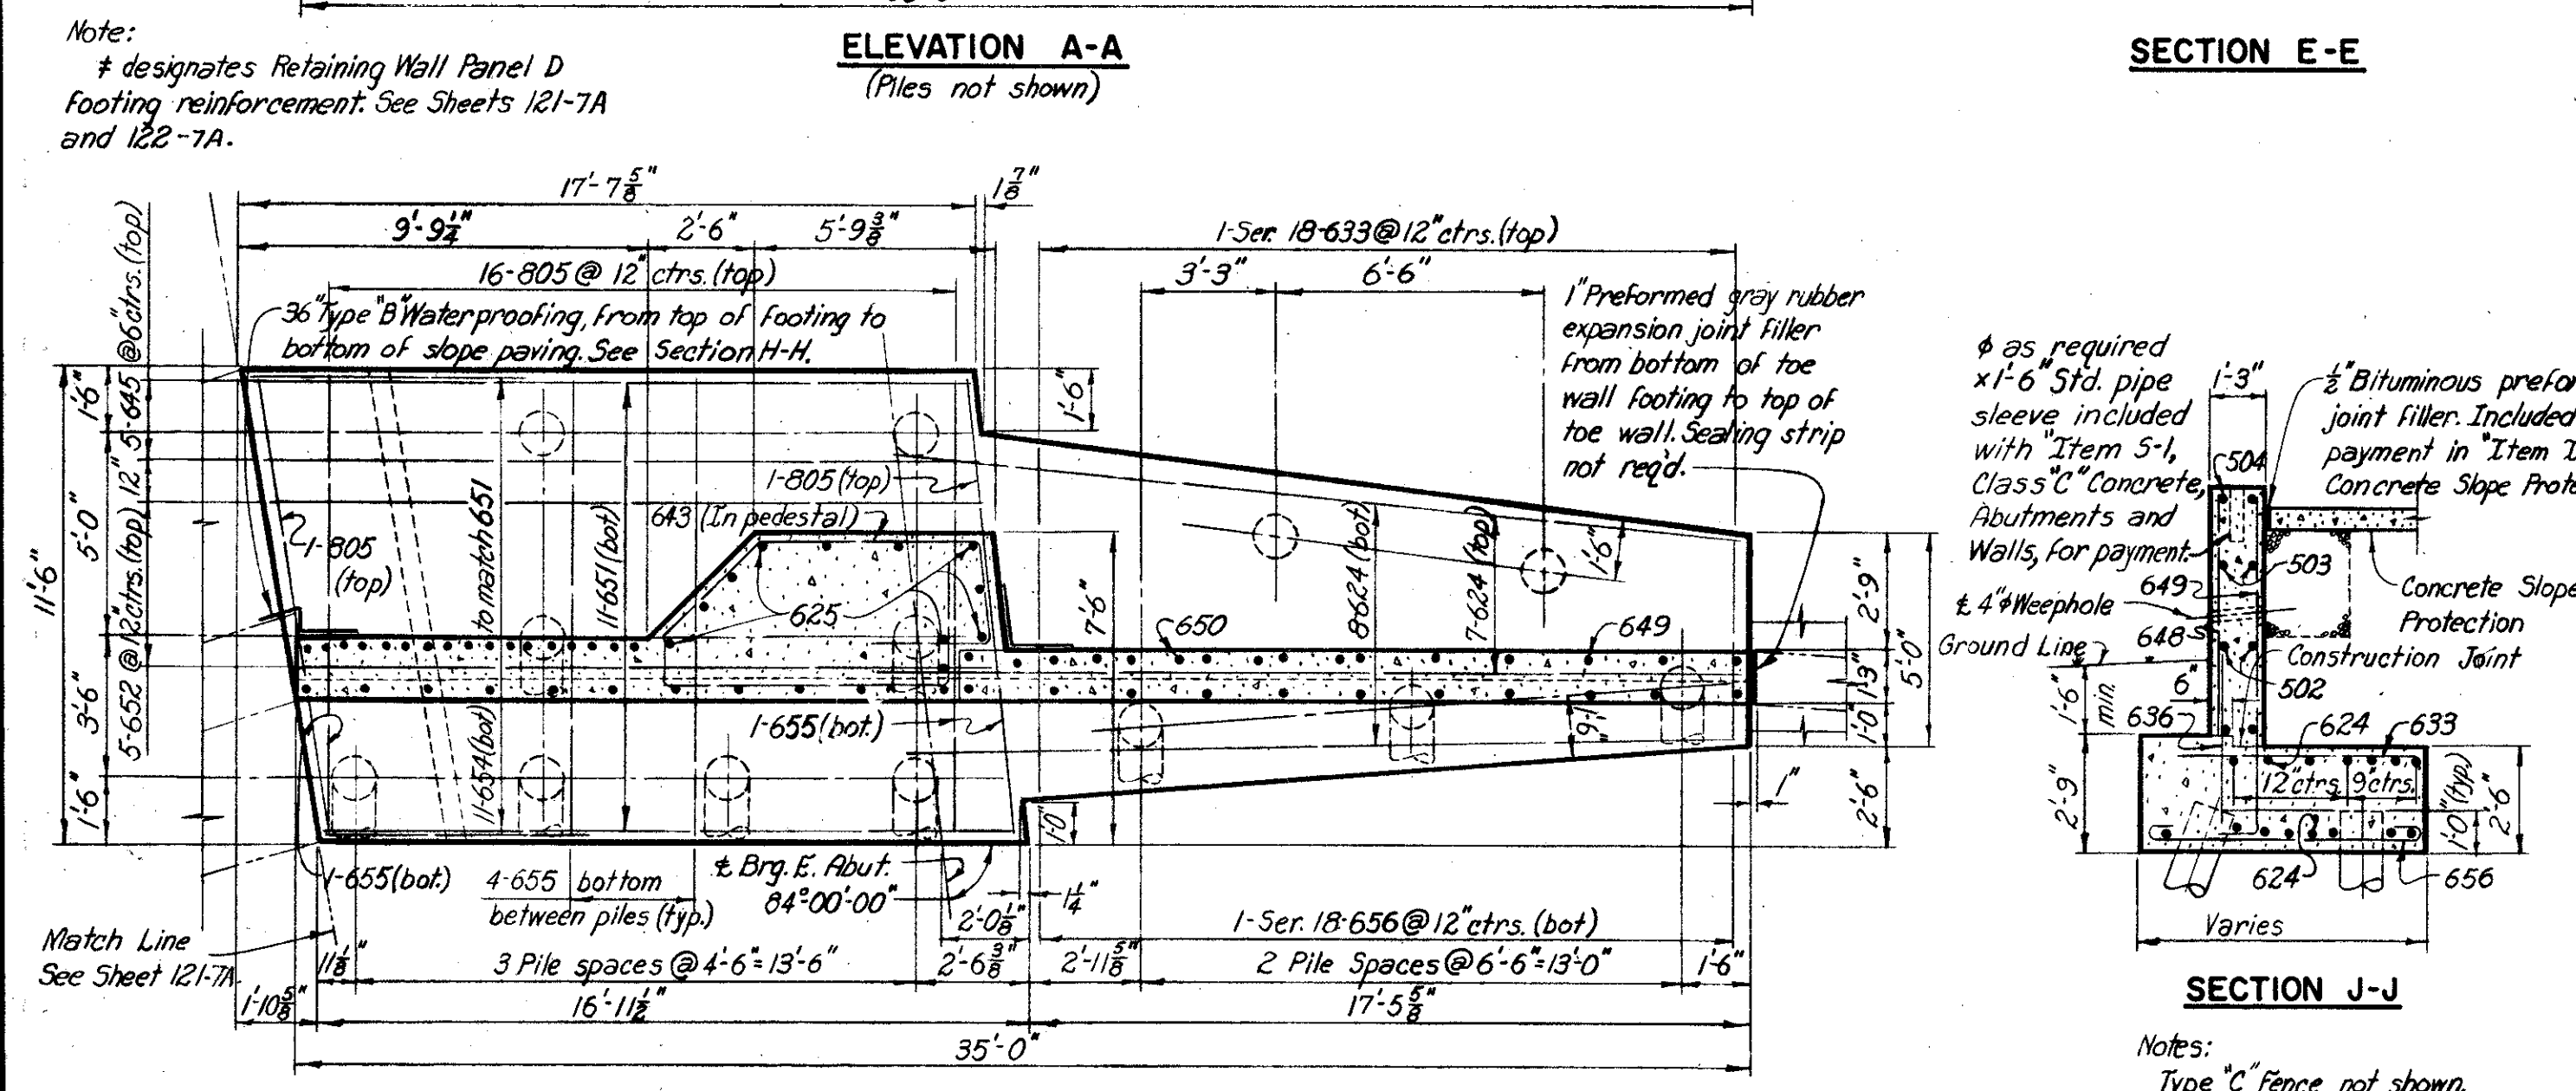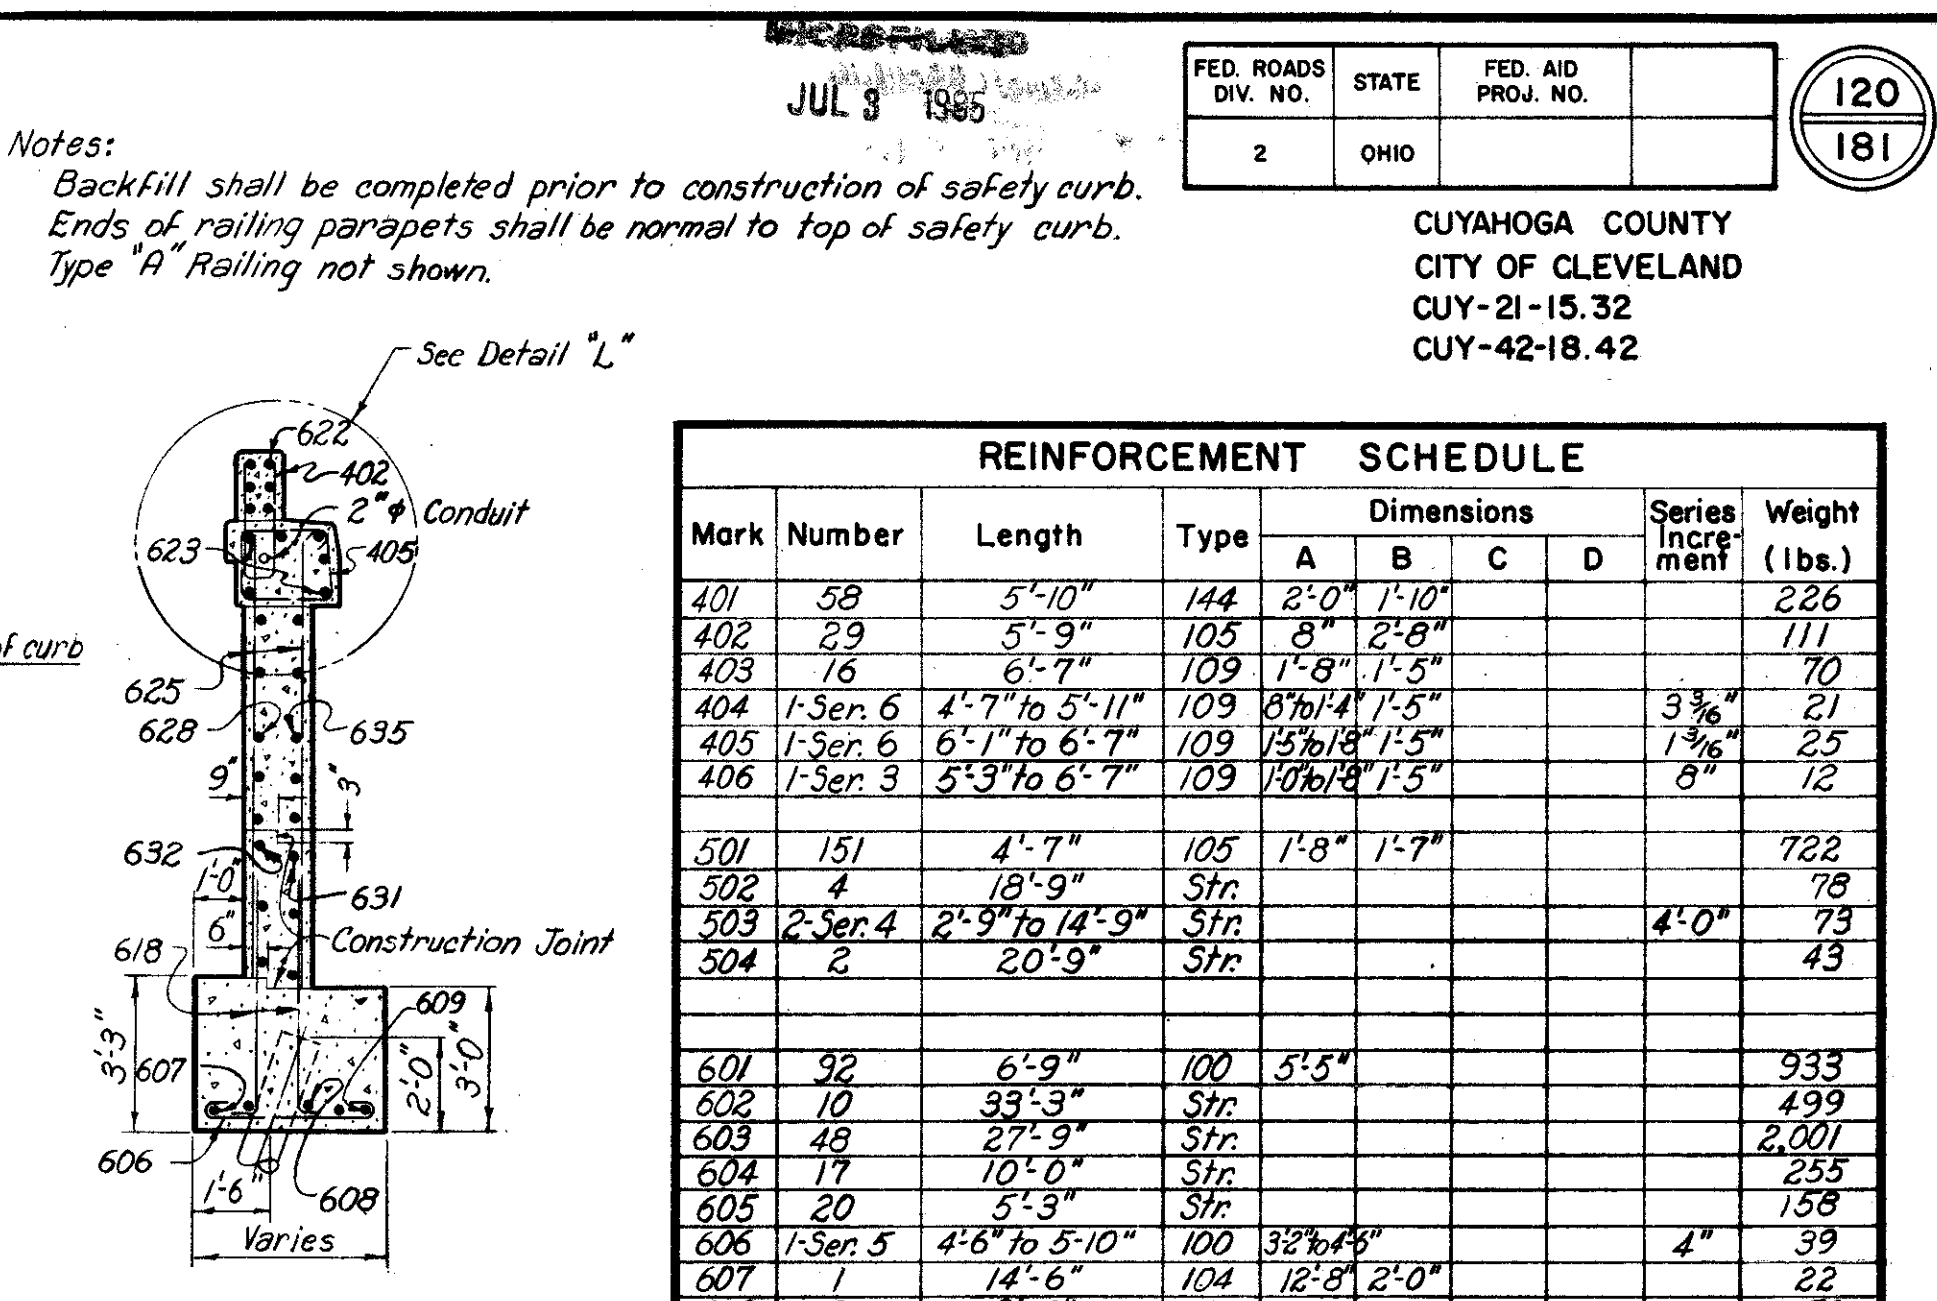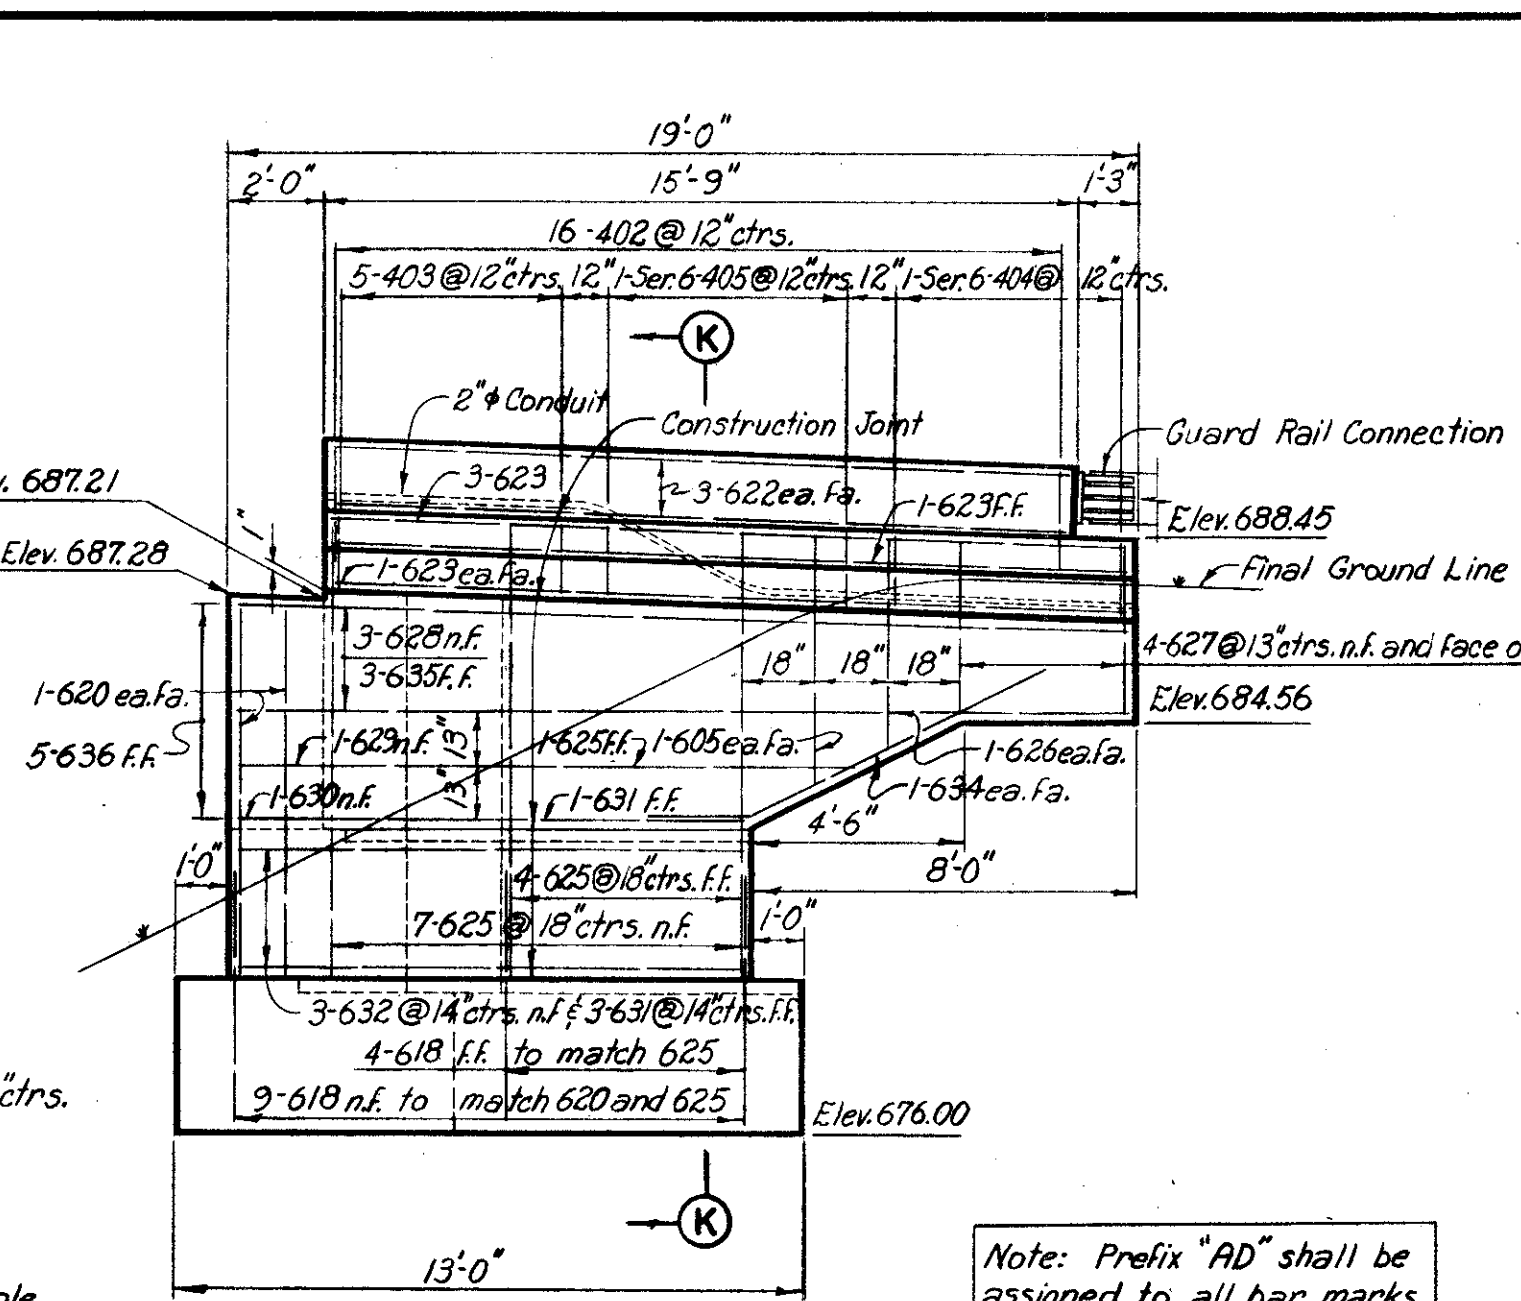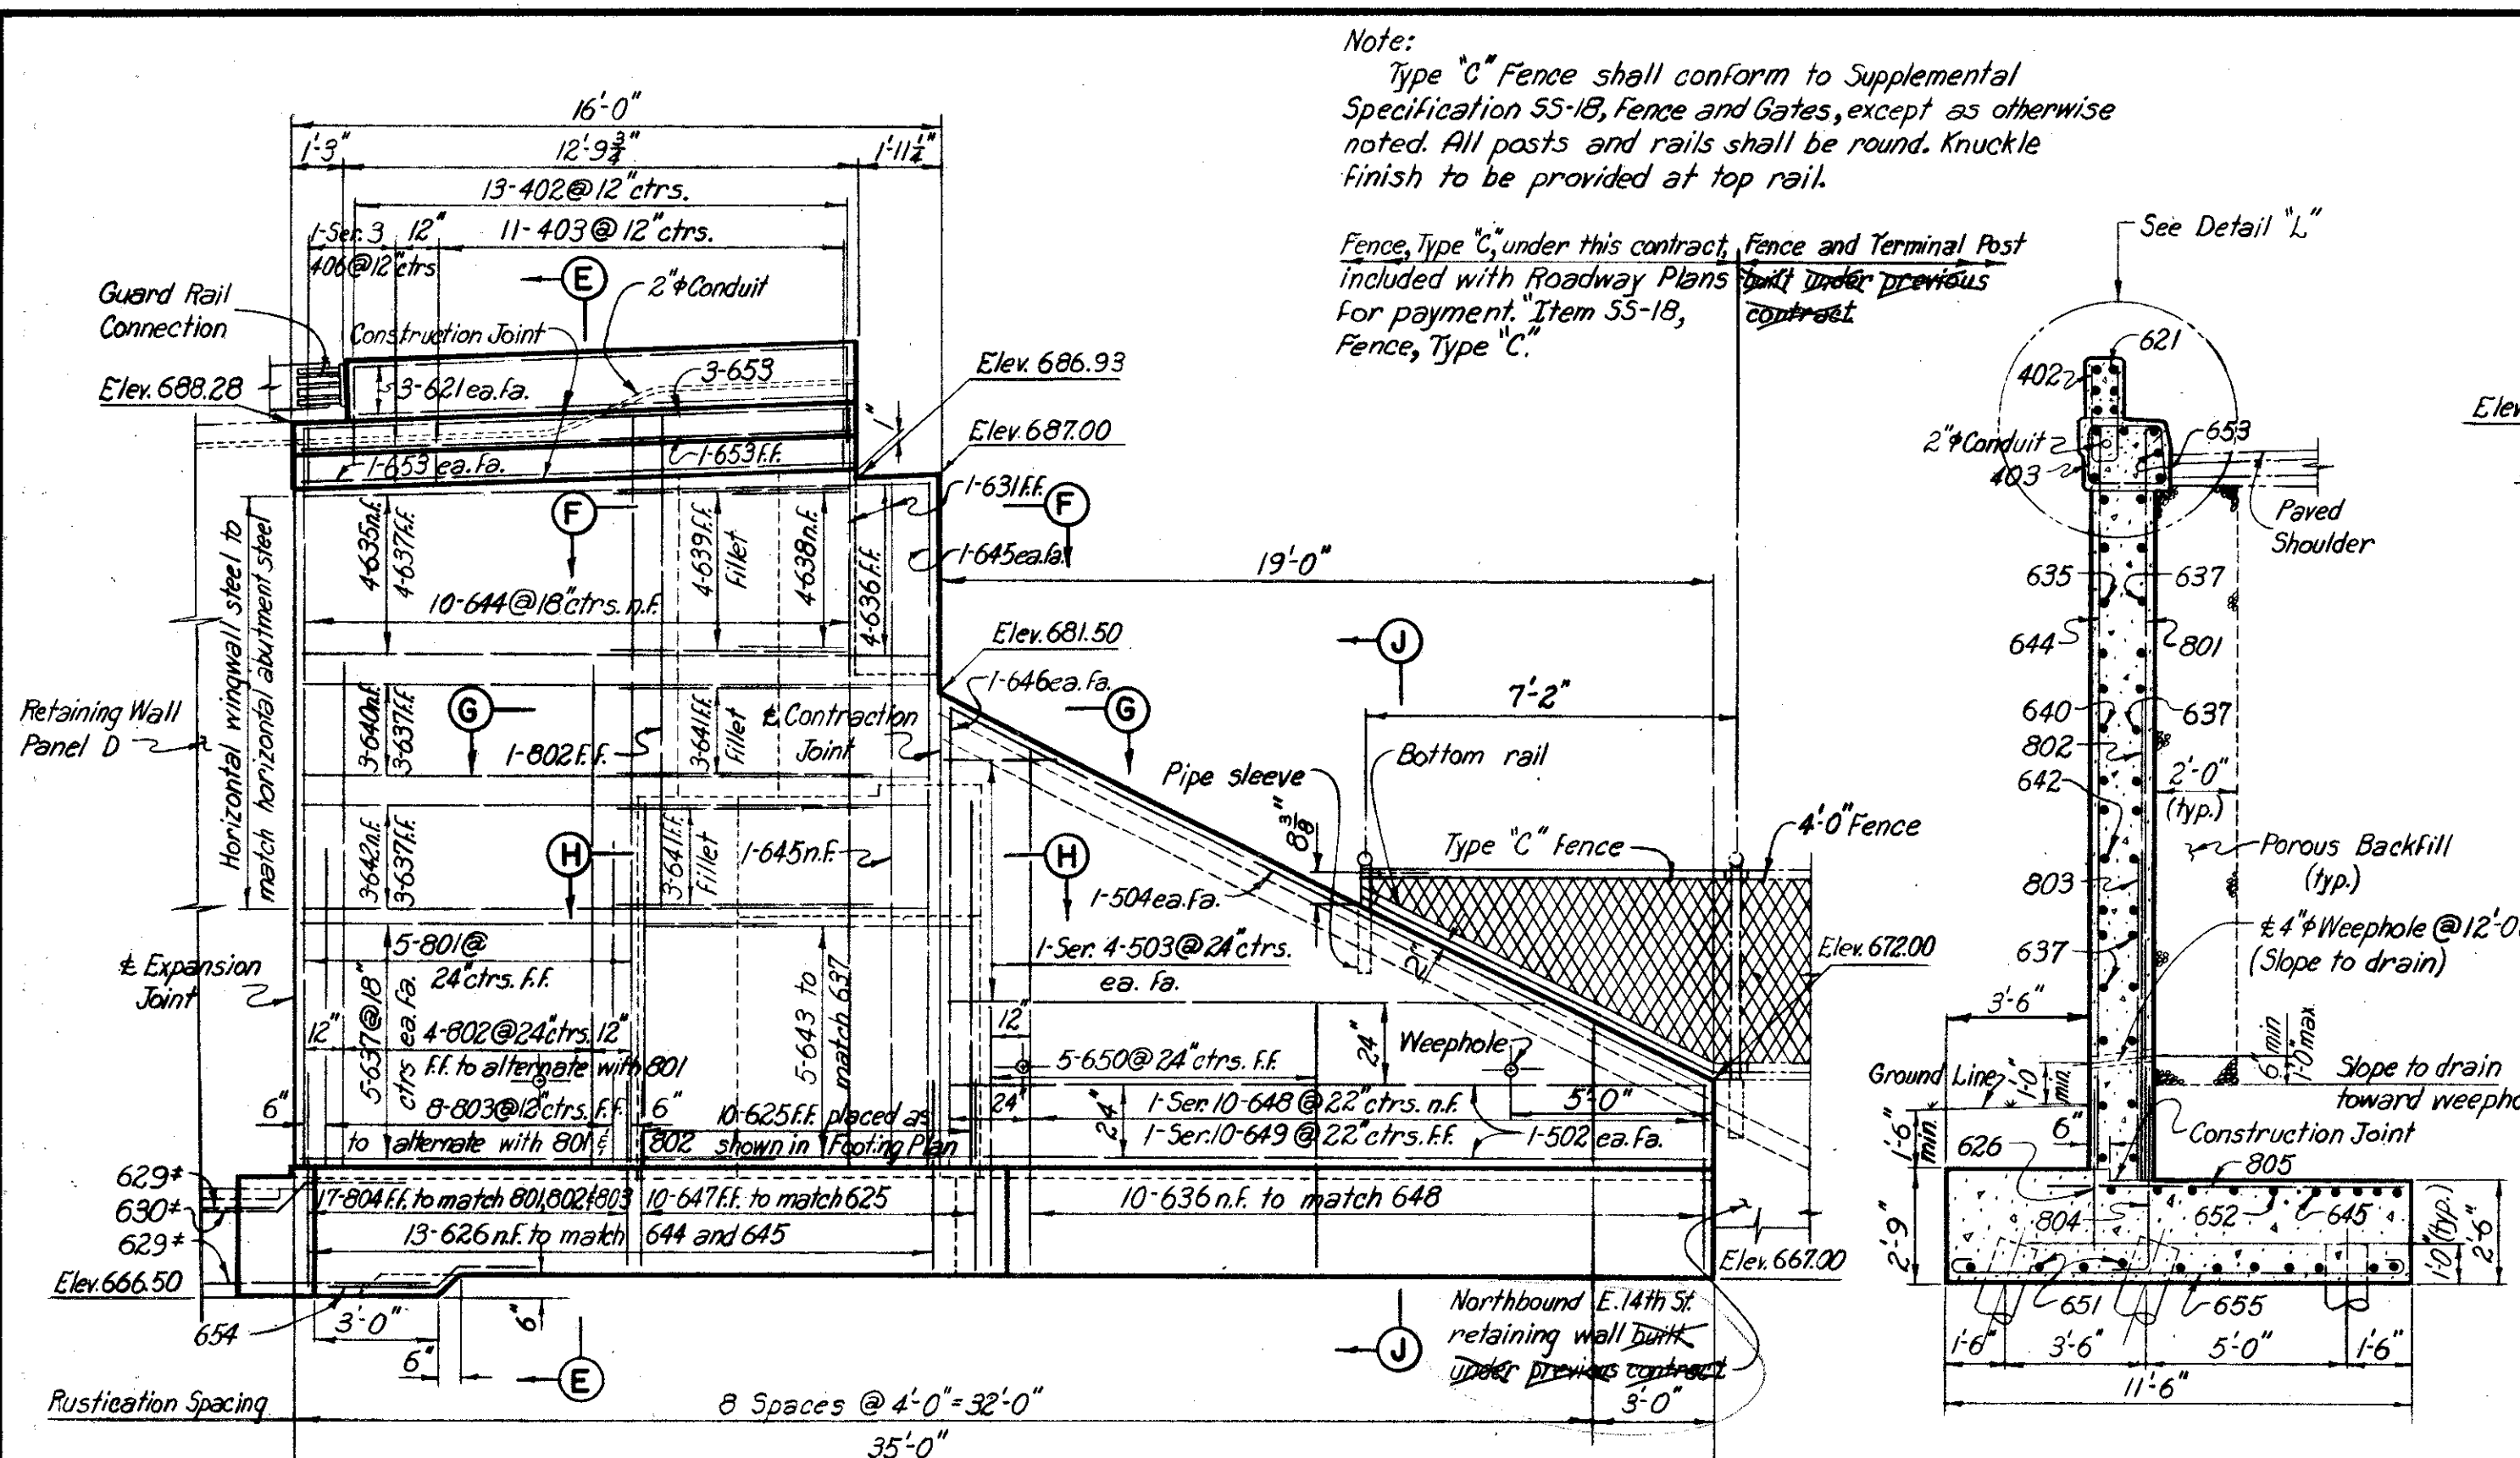

REINFORCEMENT SCHEDULE

Mark	Number	Length	Type	Dimensions	Series	Weight (lbs.)
				A B C D		
401	58	5'-10"	144	2'-0" 1'-10"		226
402	29	5'-9"	105	8" 2'-8"		111
403	16	6'-7"	109	1'-8" 1'-5"		70
404	1-Ser. 6	4'-7" to 5'-11"	109	8 1/2" 4" 1'-5"	3 3/4"	21
405	1-Ser. 6	6'-1" to 6'-7"	109	15 1/2" 1'-5"	1 7/8"	25
406	1-Ser. 3	5'-3" to 6'-7"	109	10 1/2" 1'-5"	8"	12
501	151	4'-7"	105	1'-8" 1'-7"		722
502	4	18'-9"	Str.			78
503	2-Ser. 4	2'-9" to 14'-9"	Str.		4'-0"	73
504	2	20'-9"	Str.			43
601	92	6'-9"	100	5'-5"		933
602	10	33'-3"	Str.			499
603	48	27'-9"	Str.			2,001
604	17	10'-0"	Str.			255
605	20	5'-3"	Str.			158
606	1-Ser. 5	4'-6" to 5'-10"	100	3 3/4" 4 1/2"	4"	39
607	1	14'-6"	104	12'-8" 2'-0"		22
608	3	12'-6"	Str.			56
609	1	9'-6"	Str.			14
610	8	7'-5"	108	6'-8" 10" 12		89
611	158	6'-2"	104	5'-8" 10"		1,463
612	80	8'-1"	105	3'-5" 2'-6"		971
613	18	28'-9"	Str.			777
614	17	34'-6"	Str.			881
615	17	23'-3"	Str.			594
616	120	19'-9"	112	11" 7'-6" 6'-2" 1'-5"		3,560
617	24	18'-7"	109	7'-6" 1'-5"		670
618	16	5'-8"	104	5'-0" 10"		136
619	3	5'-4"	103	3'-0" 2'-6"	1	24
620	7	7'-5"	Str.			81
621	6	12'-6"	Str.			—
622	6	15'-6"	Str.			151
623	0	16'-9"	Str.			467
624	15	20'-9"	Str.			306
625	22	3'-3"	Str.			101
626	15	4'-6"	Str.			42
627	8	3'-6"	Str.			84
628	3	18'-9"	Str.			19
629	7	12'-9"	Str.			76
630	1	10'-9"	Str.			63
631	5	7'-0"	104	1'-11" 10'-9"		56
632	3	12'-6"	104	1'-11" 10'-9"		135
633	1-Ser. 18	4'-9" to 6'-9"	Str.		1 7/8"	27
634	2	8'-10"	108	1'-11" 7'-0" 6		166
635	7	15'-9"	Str.			114
636	19	4'-0"	Str.			353
637	20	11'-9"	Str.			35
638	4	5'-9"	148	4'-0" 1'-11" 1		48
639	4	8'-0"	141	6'-6" 10"		88
640	3	13'-6"	148	15'-8" 4'-0" 1		74
641	6	8'-2"	108	7'-8" 10" 12		84
642	3	18'-7"	104	15'-8" 3'-11" 1'-4"		185
643	5	24'-7"	135	7'-0" 3'-0" 2'-9" 1'-4"		274
644	10	18'-3"	Str.			204
645	8	17'-0"	Str.			35
646	2	11'-6"	Str.			78
647	10	5'-2"	104	4'-6" 10"		94
648	1-Ser. 10	2'-0" to 10'-6"	Str.		1 1/2"	141
649	1-Ser. 10	5'-2" to 13'-8"	104	4 1/2" 13" 10"	1 1/2"	54
650	5	7'-2"	104	6'-6" 10"		231
651	11	14'-0"	Str.			126
652	5	18'-9"	Str.			89
653	6	13'-9"	Str.			171
654	11	5'-8"	118	2'-10" 6" 6"		300
655	16	12'-8"	100	11'-2"		435
656	1-Ser. 18	6'-0" to 9'-8"	100	4 1/2" 4"	2 3/4"	212
801	5	18'-6"	Str.			160
802	3	12'-0"	Str.			171
803	8	8'-0"	Str.			257
804	17	5'-8"	104	4'-9" 1'-1"		435
805	18	9'-0"	Str.			20,468

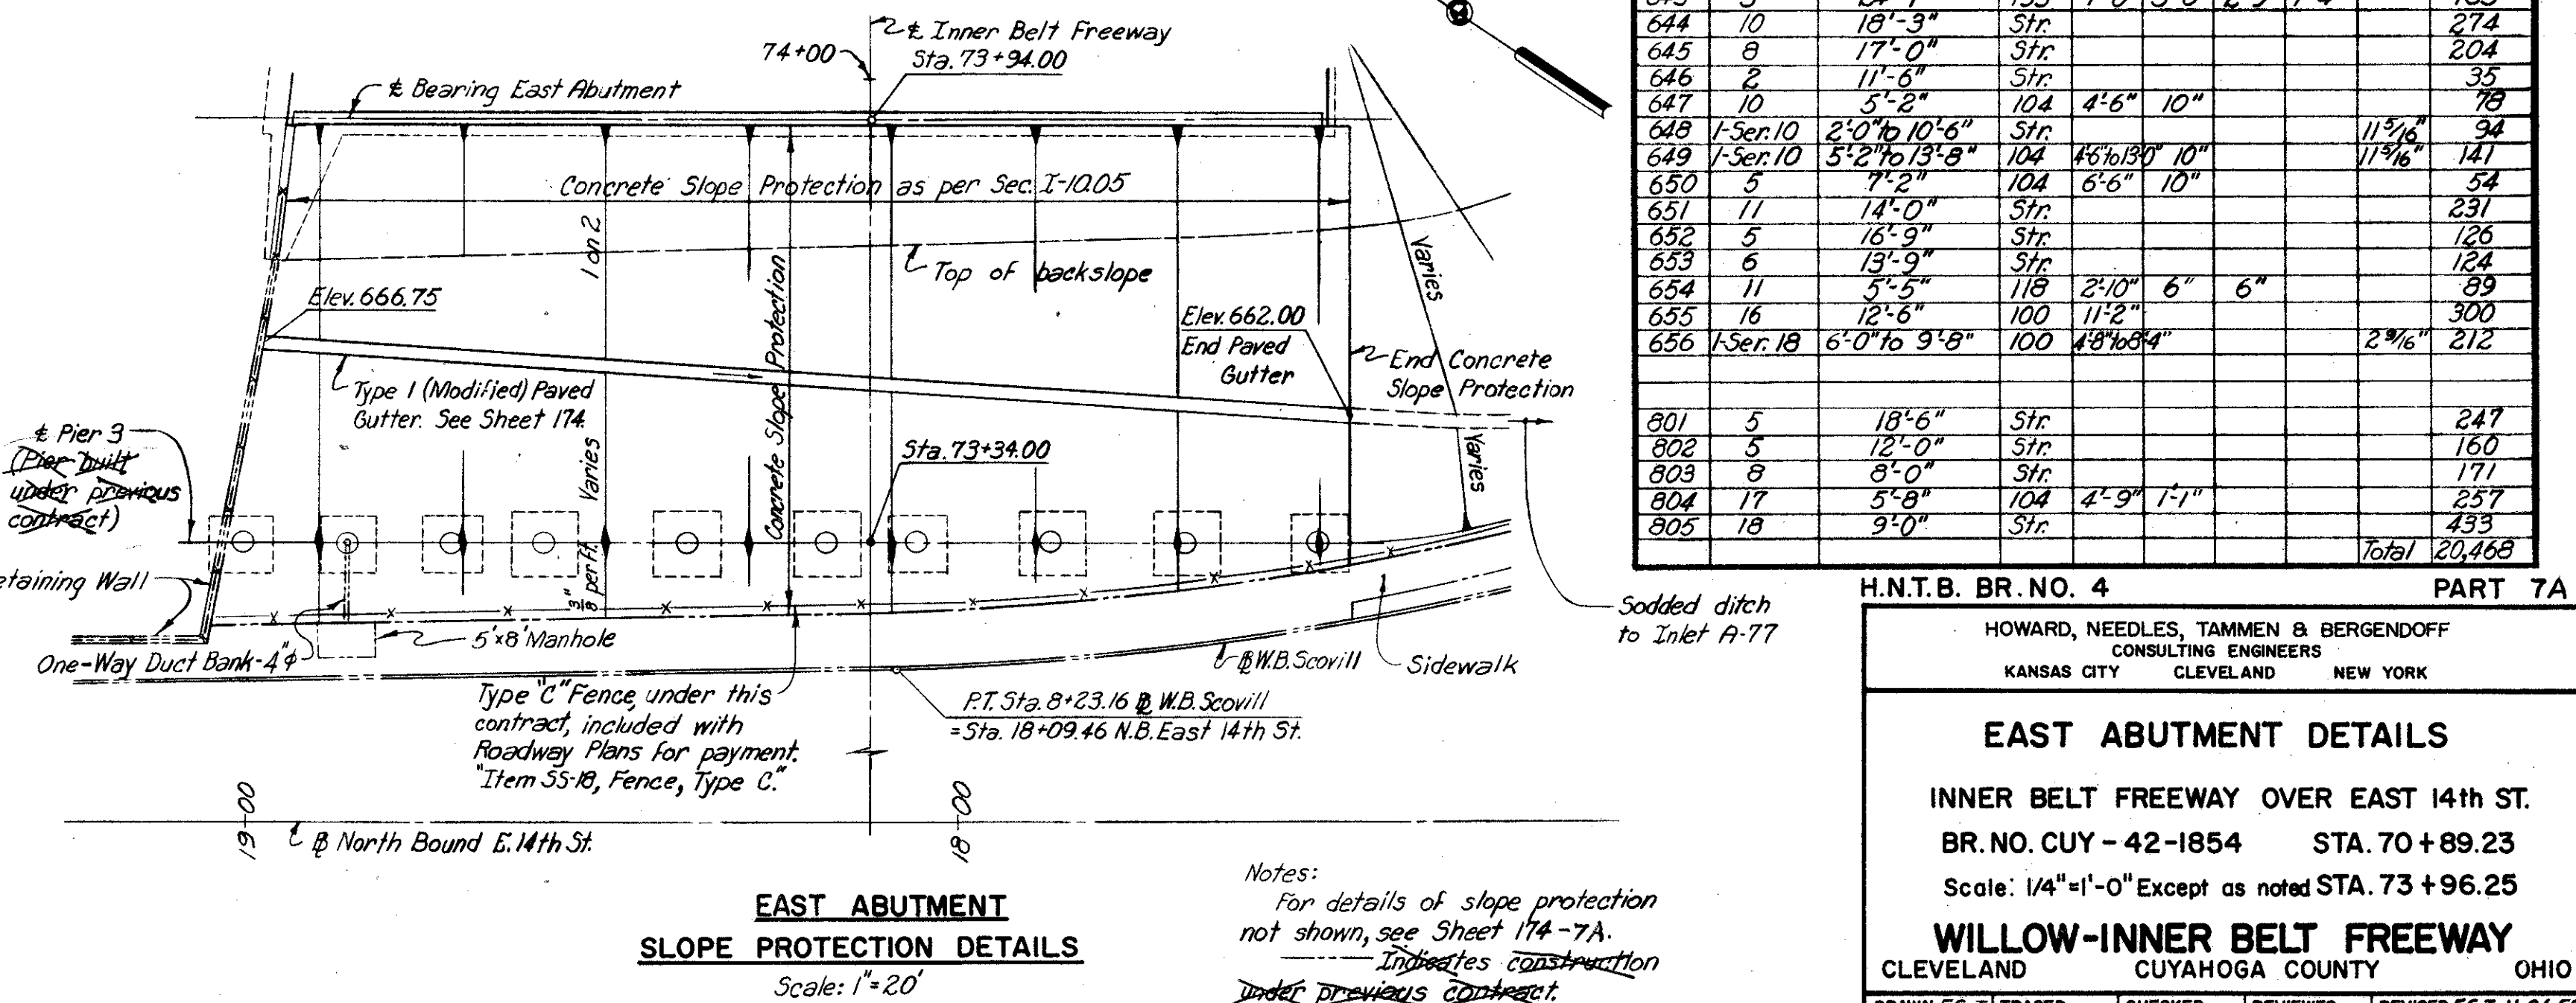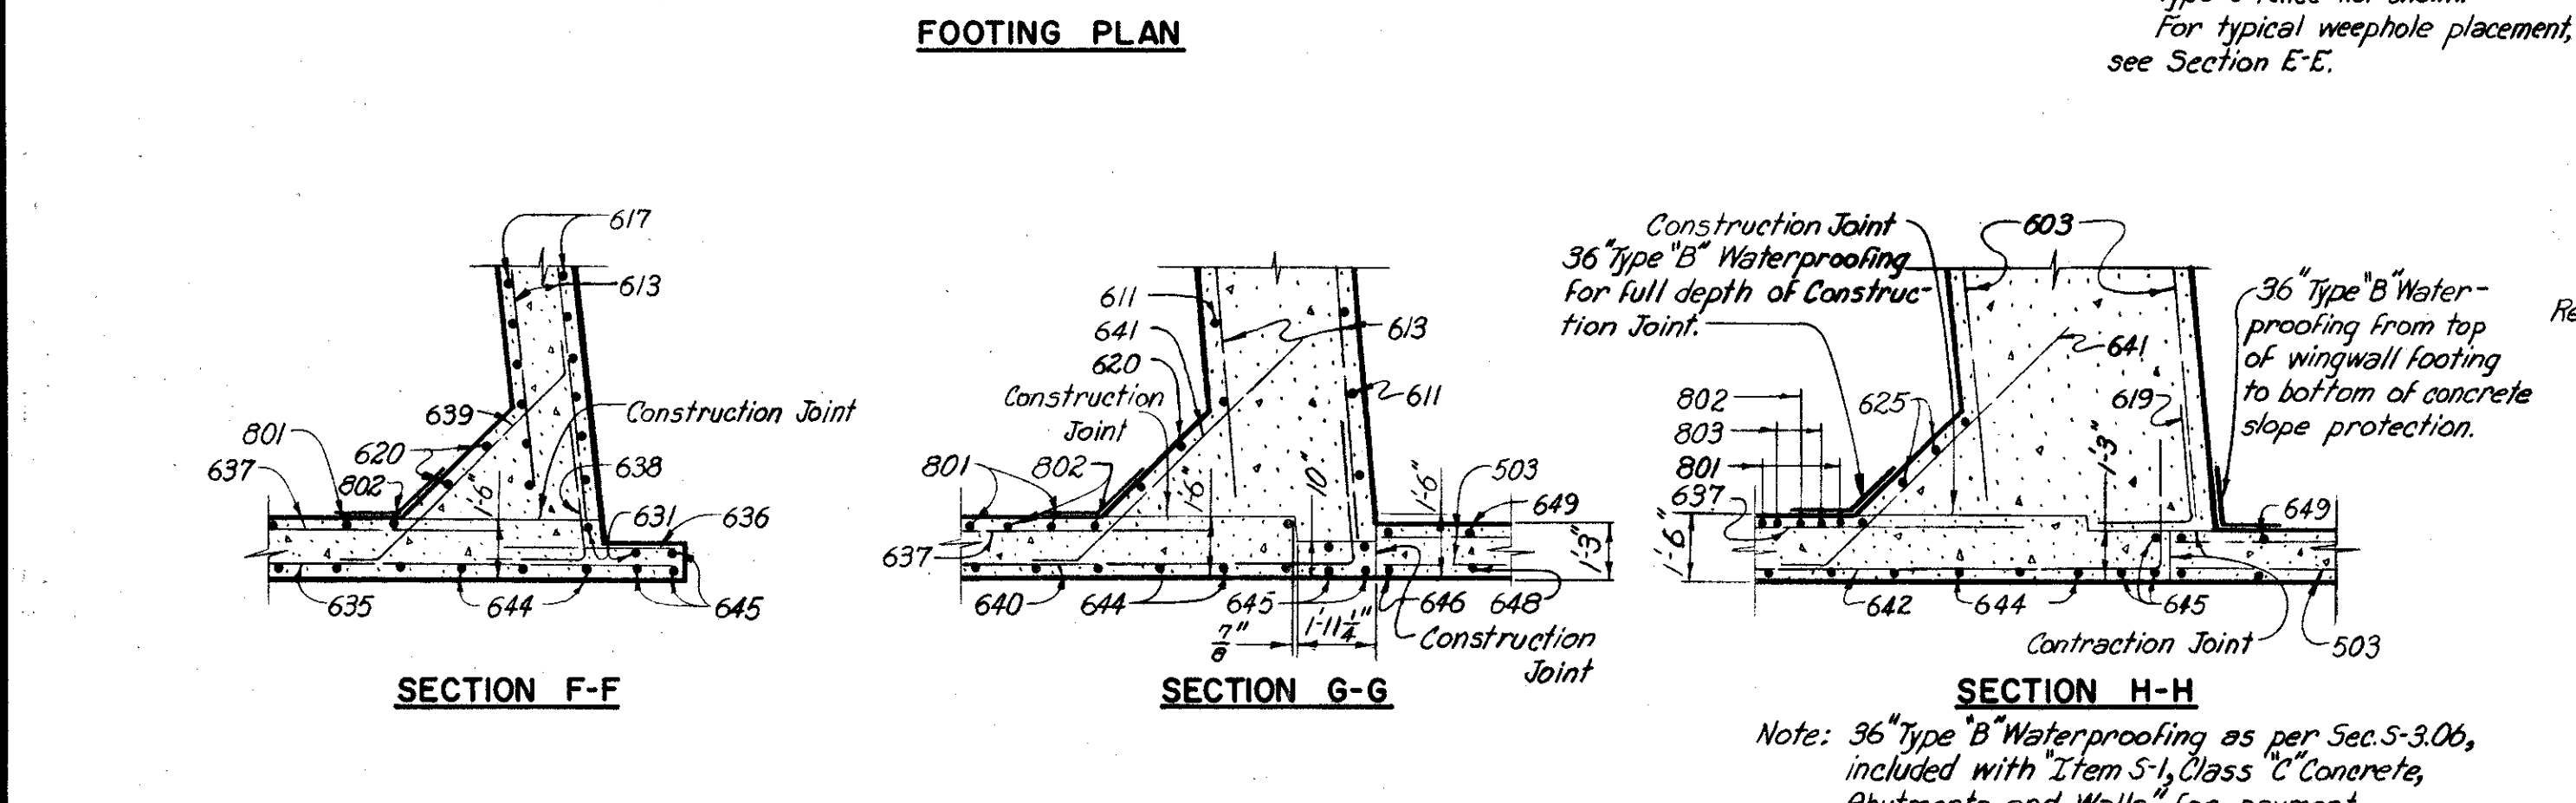

H.N.T.B. BR. NO. 4 PART 7A

HOWARD, NEEDLES, TAMMEN & BERGENDOFF
 CONSULTING ENGINEERS
 KANSAS CITY CLEVELAND NEW YORK

EAST ABUTMENT DETAILS




INNER BELT FREEWAY OVER EAST 14th ST.
 BR. NO. CUY - 42-1854 STA. 70+89.23
 Scale: 1/4" = 1'-0" Except as noted STA. 73+96.25

WILLOW-INNER BELT FREEWAY
 CLEVELAND CUYAHOGA COUNTY OHIO

DRAWN: F.S.J. TRACED CHECKED: K.B. DATE: 10-29-59 REVISIONS: J.T. DATE: 11-13-59 REVISED: F.S.J. 11-24-59 SHEET 120

CUYAHOGA COUNTY
CITY OF CLEVELAND
CUY-21-15.32
CUY-42-18.42

Location	Offset (X)	Station (Y)
1	80.08'	74+09.07
2	81.82'	74+16.88
3	80.04'	74+40.81
4	78.61'	74+72.78
5	78.25'	75+04.78
6	78.25'	75+36.78
7	78.25'	75+68.78
8	78.25'	75+96.78
9	78.25'	76+24.78
10	93.29'	76+49.39

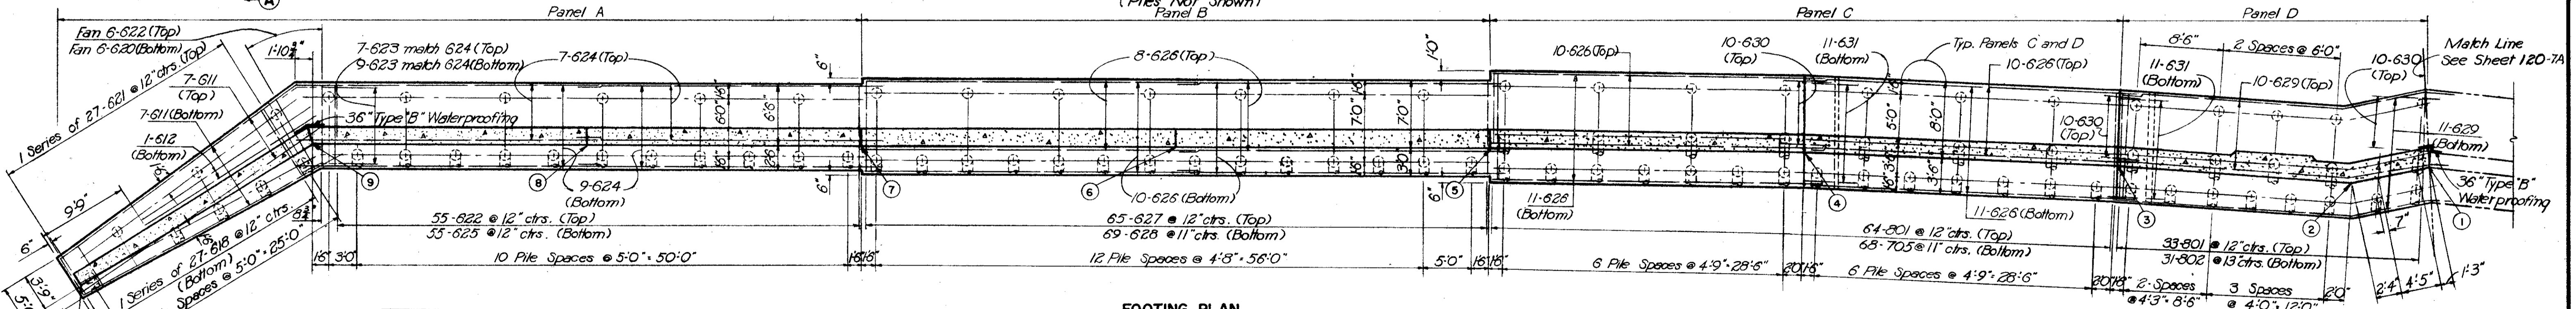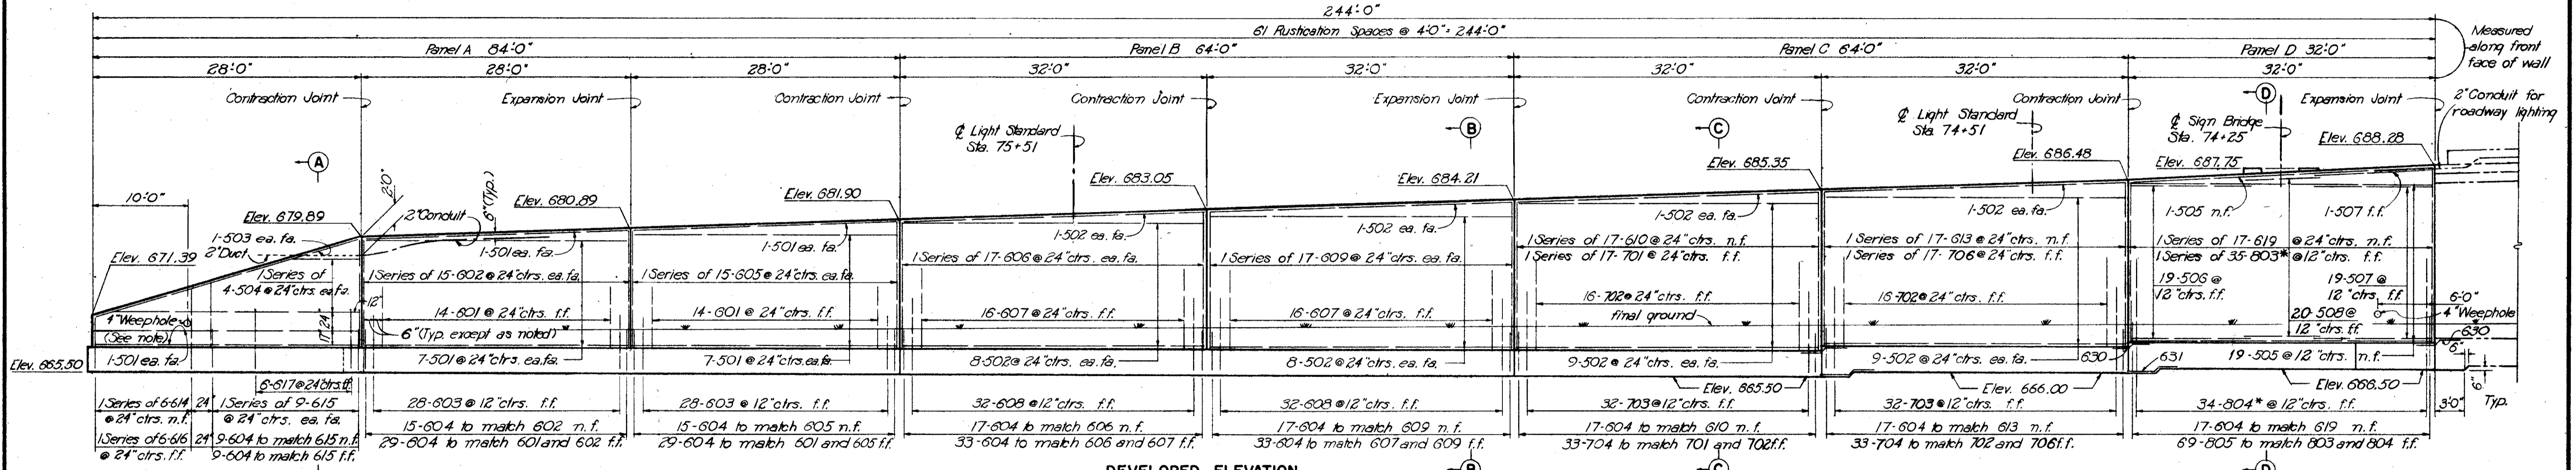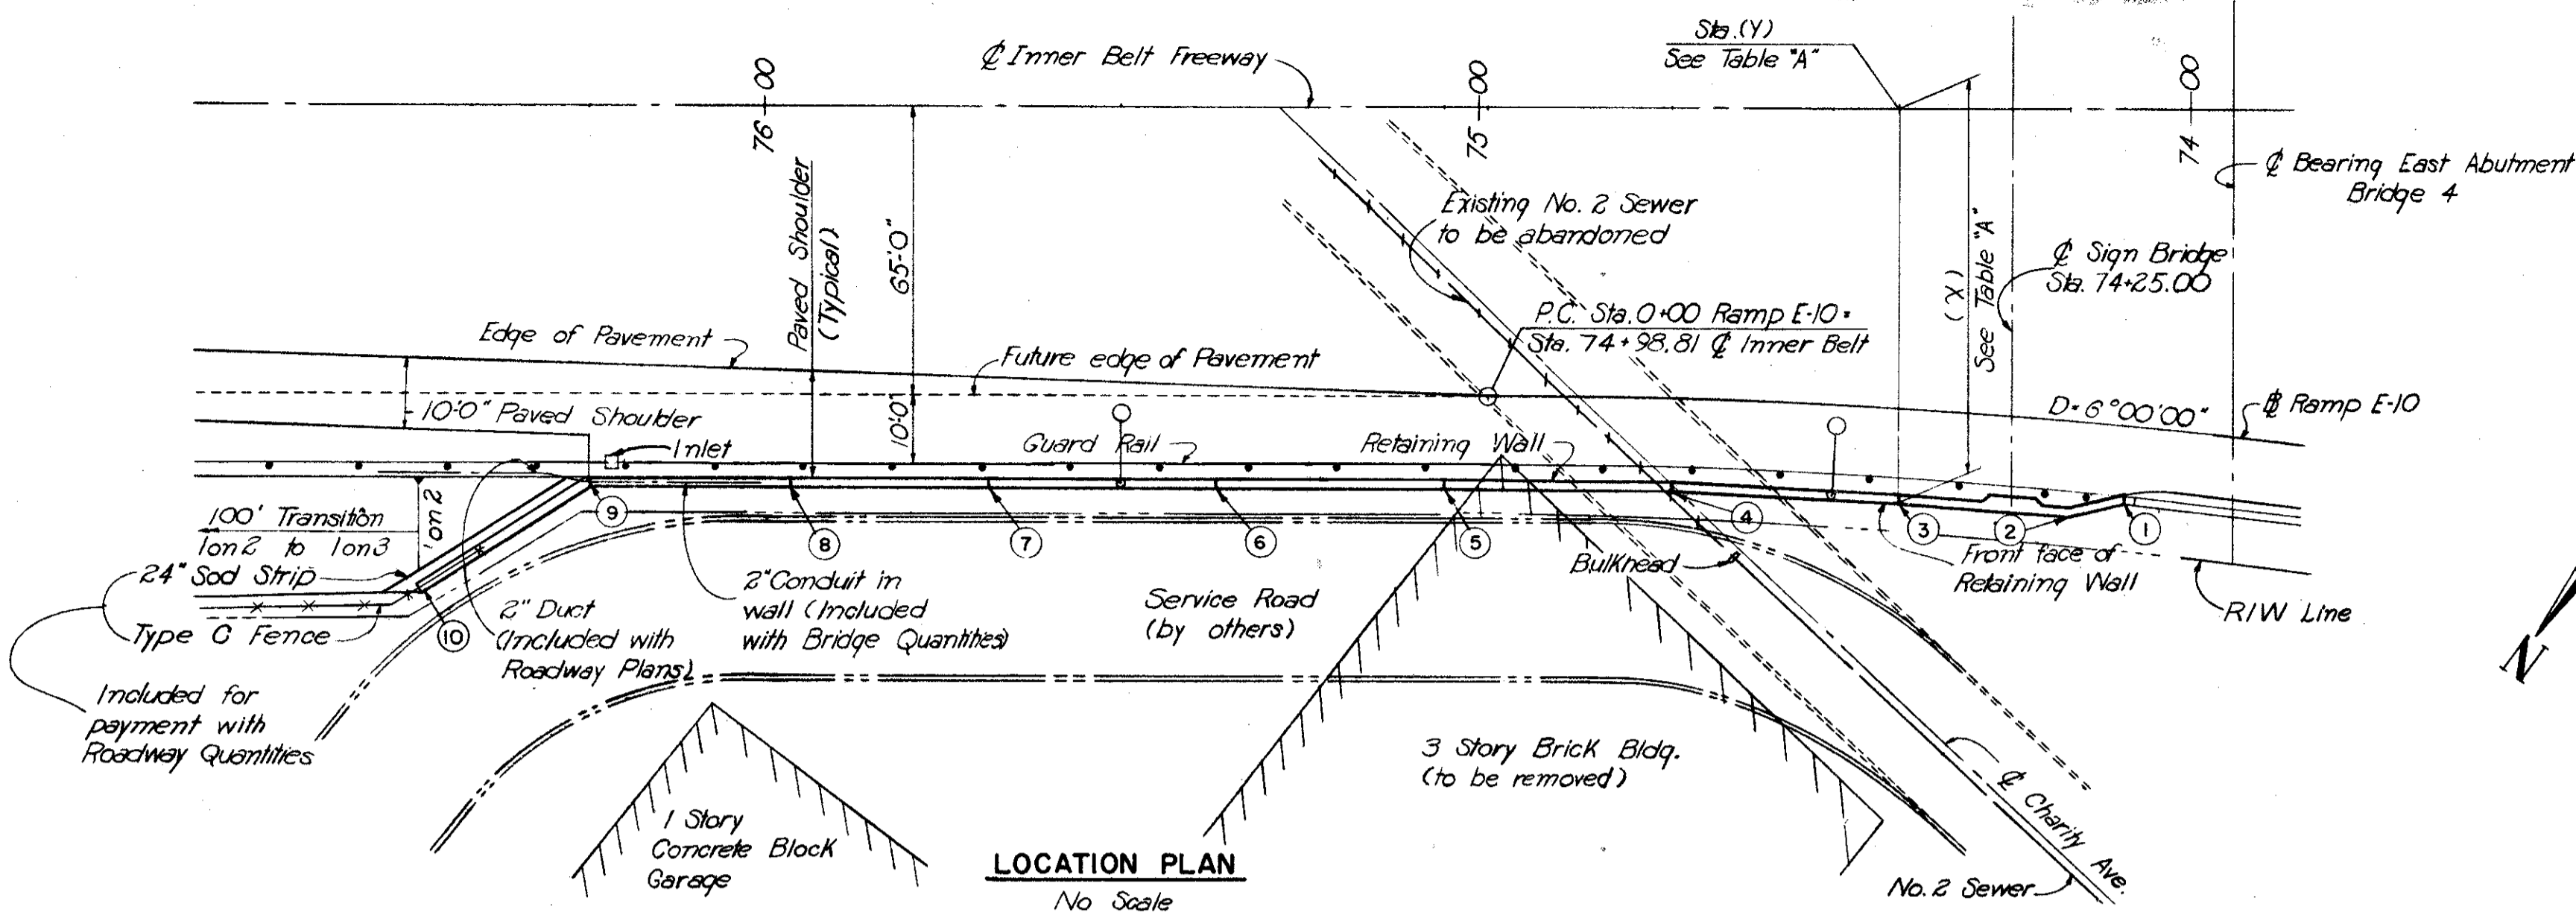

Note: Prefix "W" shall be assigned to all bar marks.

NOTES:
For details of light standard support see sheet 122-7A.
For lighting details see sheet 176-7A.
All piles shall be 12" cast-in-place reinforced concrete.
Front and center row piles shall be battered 3 in 12 in the direction shown.
Pile spacings are given along front face of retaining wall.
Reinforcing bars shall be 3-inches clear from bottom of footing and 2-inches elsewhere.
Spacing of longitudinal footing reinforcement in a panel is similar to that shown in the section for that panel.

For reinforcement schedule and bar bending diagrams; expansion and contraction joint details; sections; rustication details; sign bridge support details see sheet 122-7A.
The two extreme weepholes shown in the "Developed Elevation" shall be set 1'0" above final ground. Intermediate weepholes, not shown, shall be placed at 12'-0" ctrs. measured along the front face of the wall, and set on a straight line grade between the two extreme weepholes.
* For placement of these bars see sign bridge details, sheet 122-7A.
n.f. - near face; f.f. - far face; ea. fa. - each face.

Optional transverse construction joints in footing may be located beneath any wall joint.

HOWARD, NEEDLES, TAMMEN & BERGENOFF
CONSULTING ENGINEERS
KANSAS CITY CLEVELAND NEW YORK

RETAINING WALL

INNER BELT FREEWAY OVER EAST 14th ST.
BR. NO. CUY - 42-1854 STA. 70+89.23
Scale: 1/8" = 1'-0" STA. 73+96.25
Except as noted

WILLOW-INNER BELT FREEWAY
CLEVELAND CUYAHOGA COUNTY OHIO


H.N.T.B. BR. NO. 4
PART 7A

DRAWN	TRACED	CHECKED	REVIEWED	REVISED
DATE 11-3-82	DATE	DATE 11-13-82	DATE 11-18-82	


SHEET 121

CUYAHOGA COUNTY
CITY OF CLEVELAND
CUY-21-15.32
CUY-42-18.42


Note: Prefix "W" shall be assigned to all bar marks.

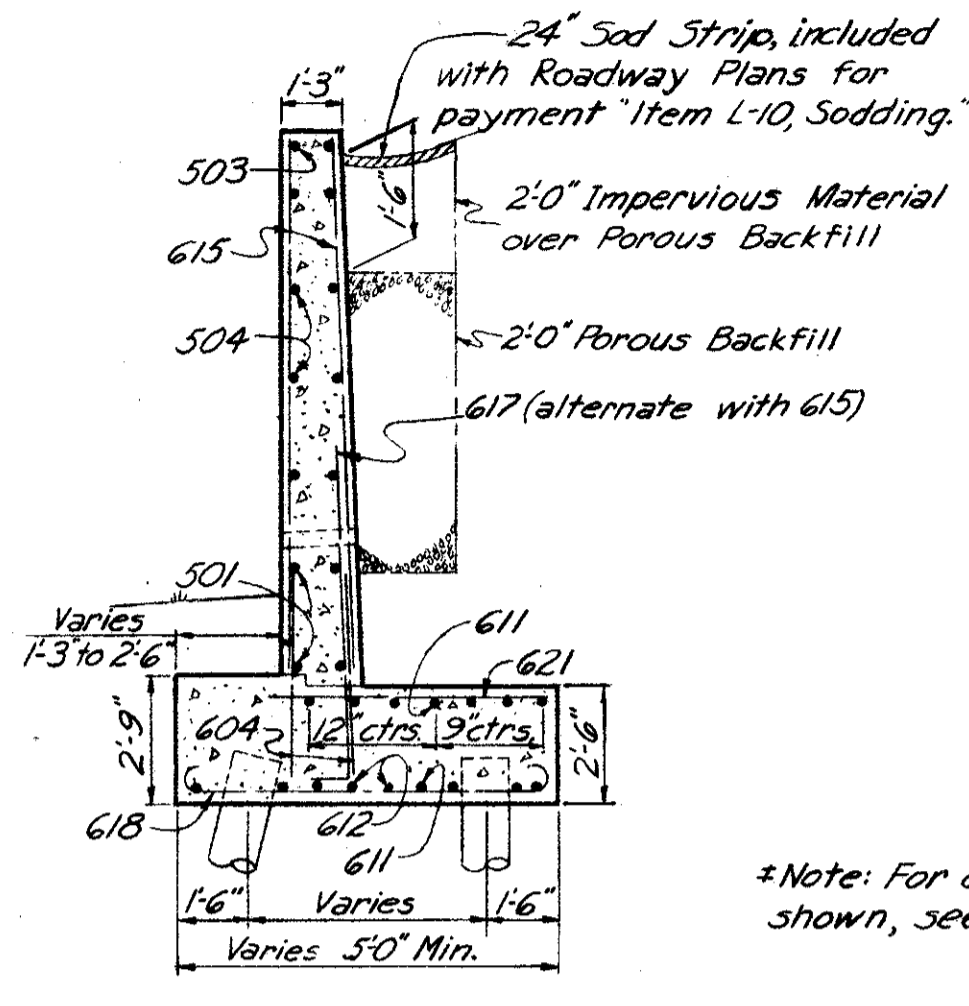


SECTION A-A #
Typical Panel A
except for Sod Strip

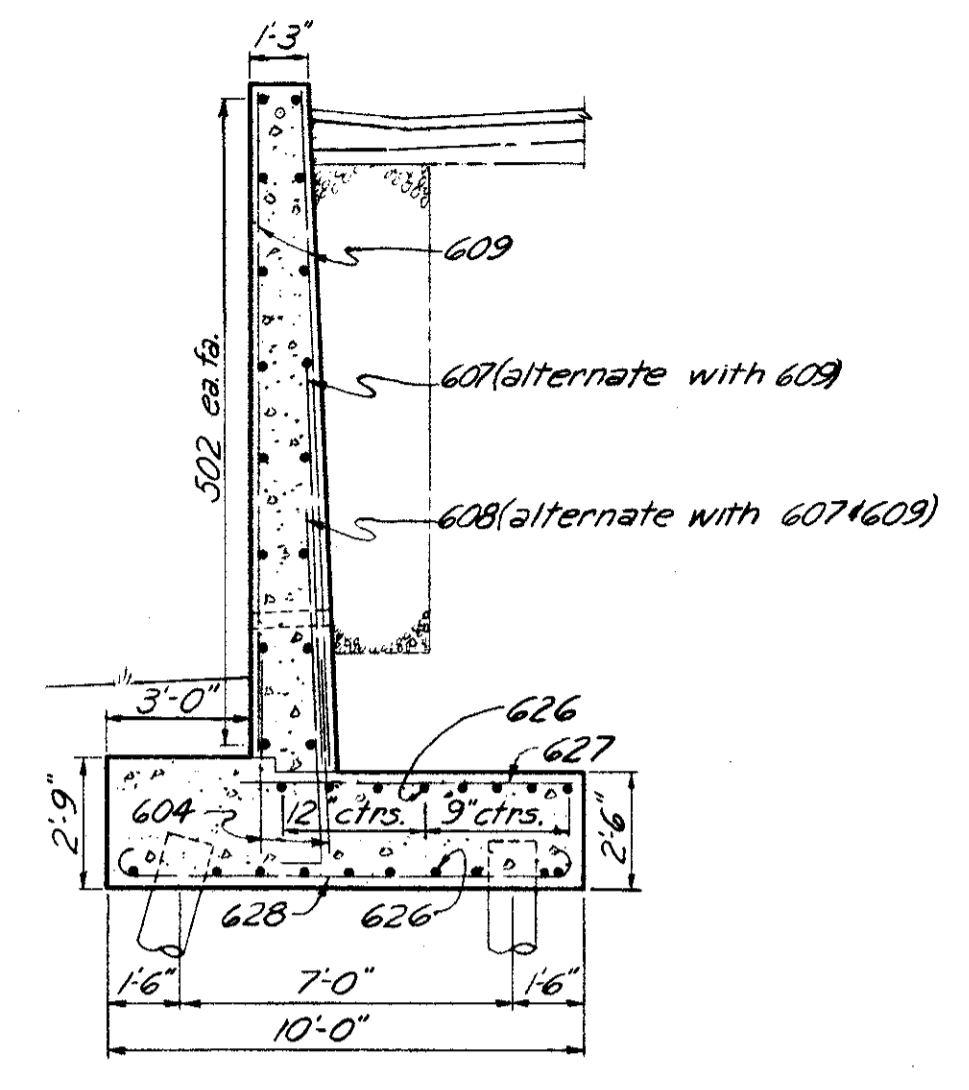


SECTION B-B #
Typical Panel B

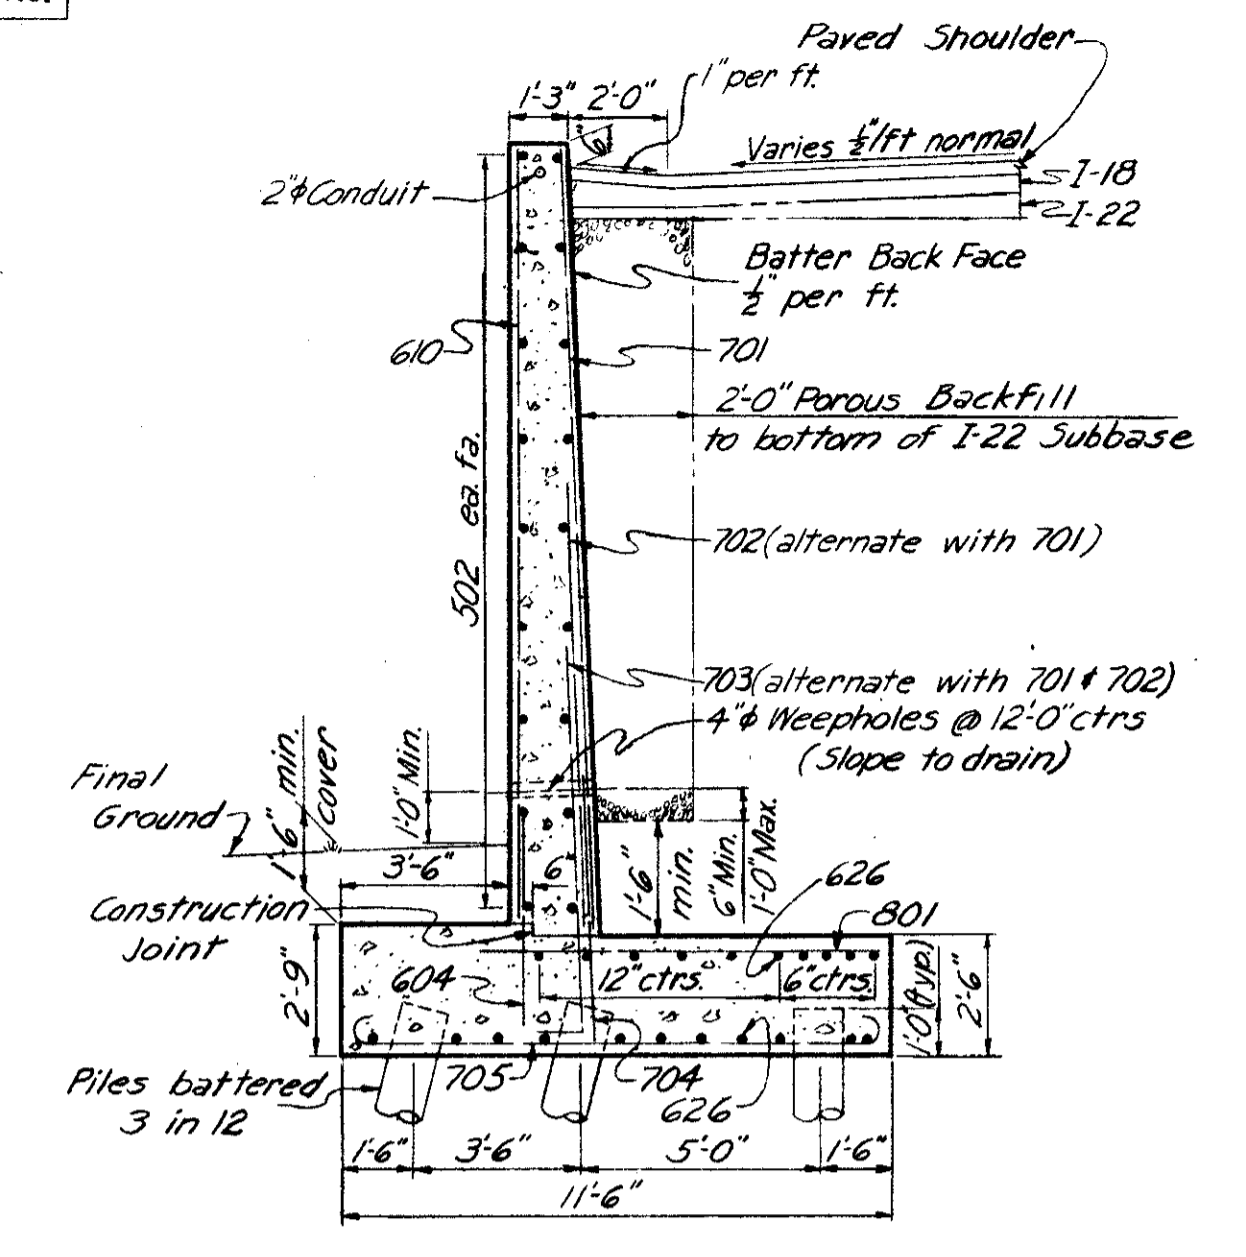

SECTION C-C #
Typical Panel C

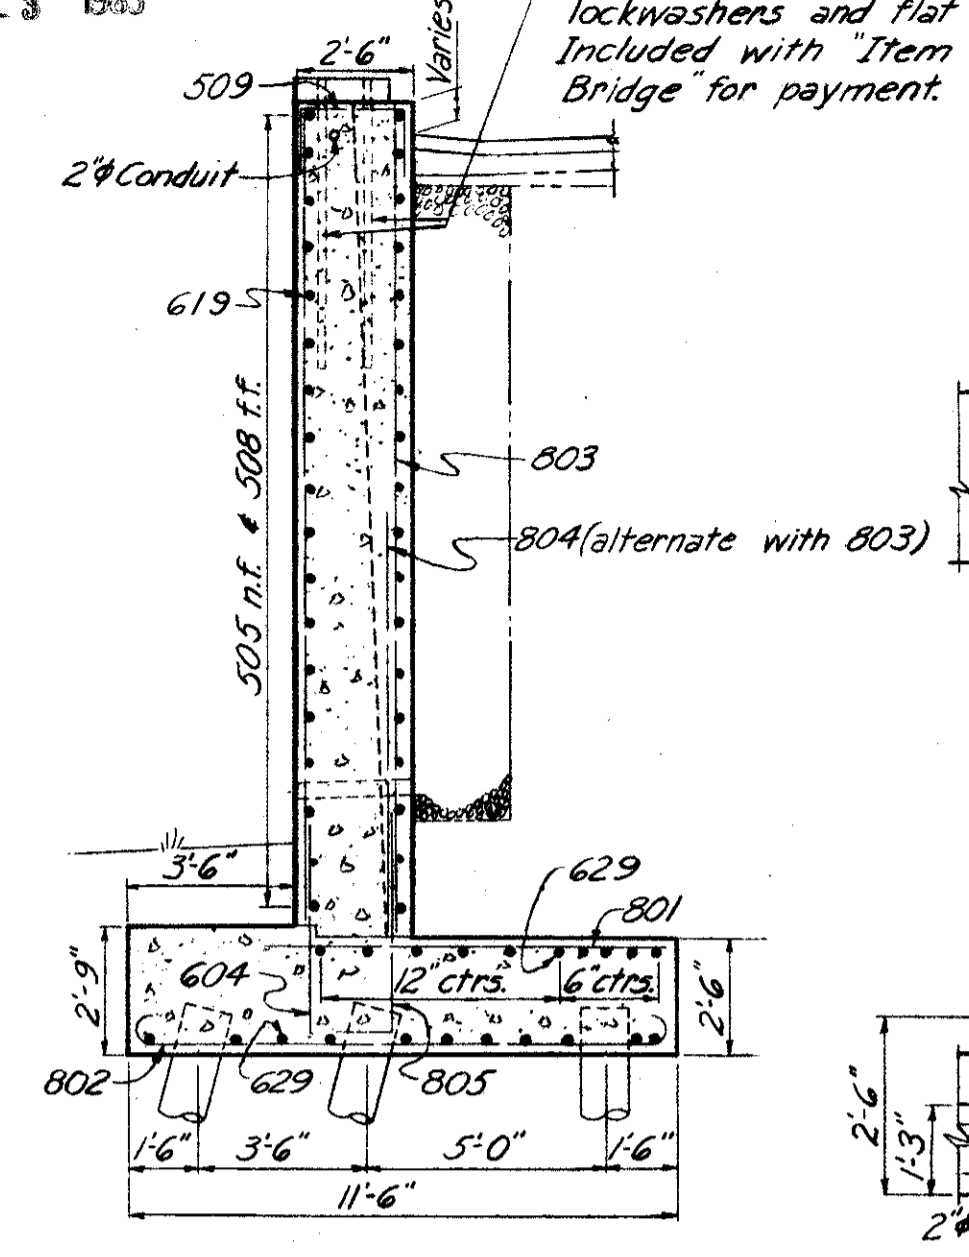


SECTION D-D #
Typical Panel D
except for wall width

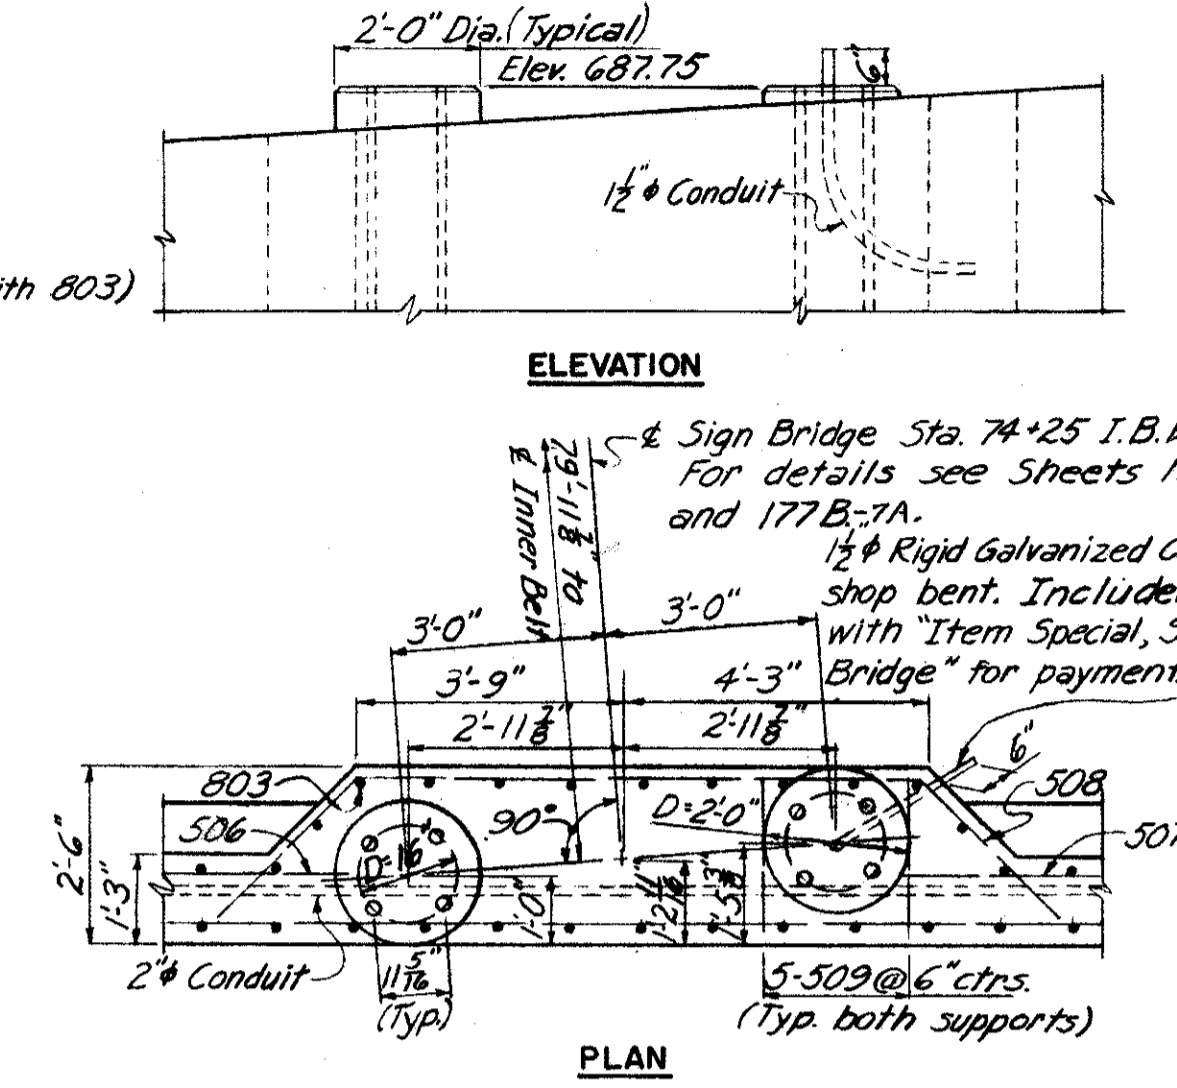


SIGN BRIDGE SUPPORT DETAILS
Scale: 3/8" = 1'-0"


Note: Sign Bridge support pads to be poured monolithic with retaining wall. For general notes and details not shown, see Sheet 177B-7A.

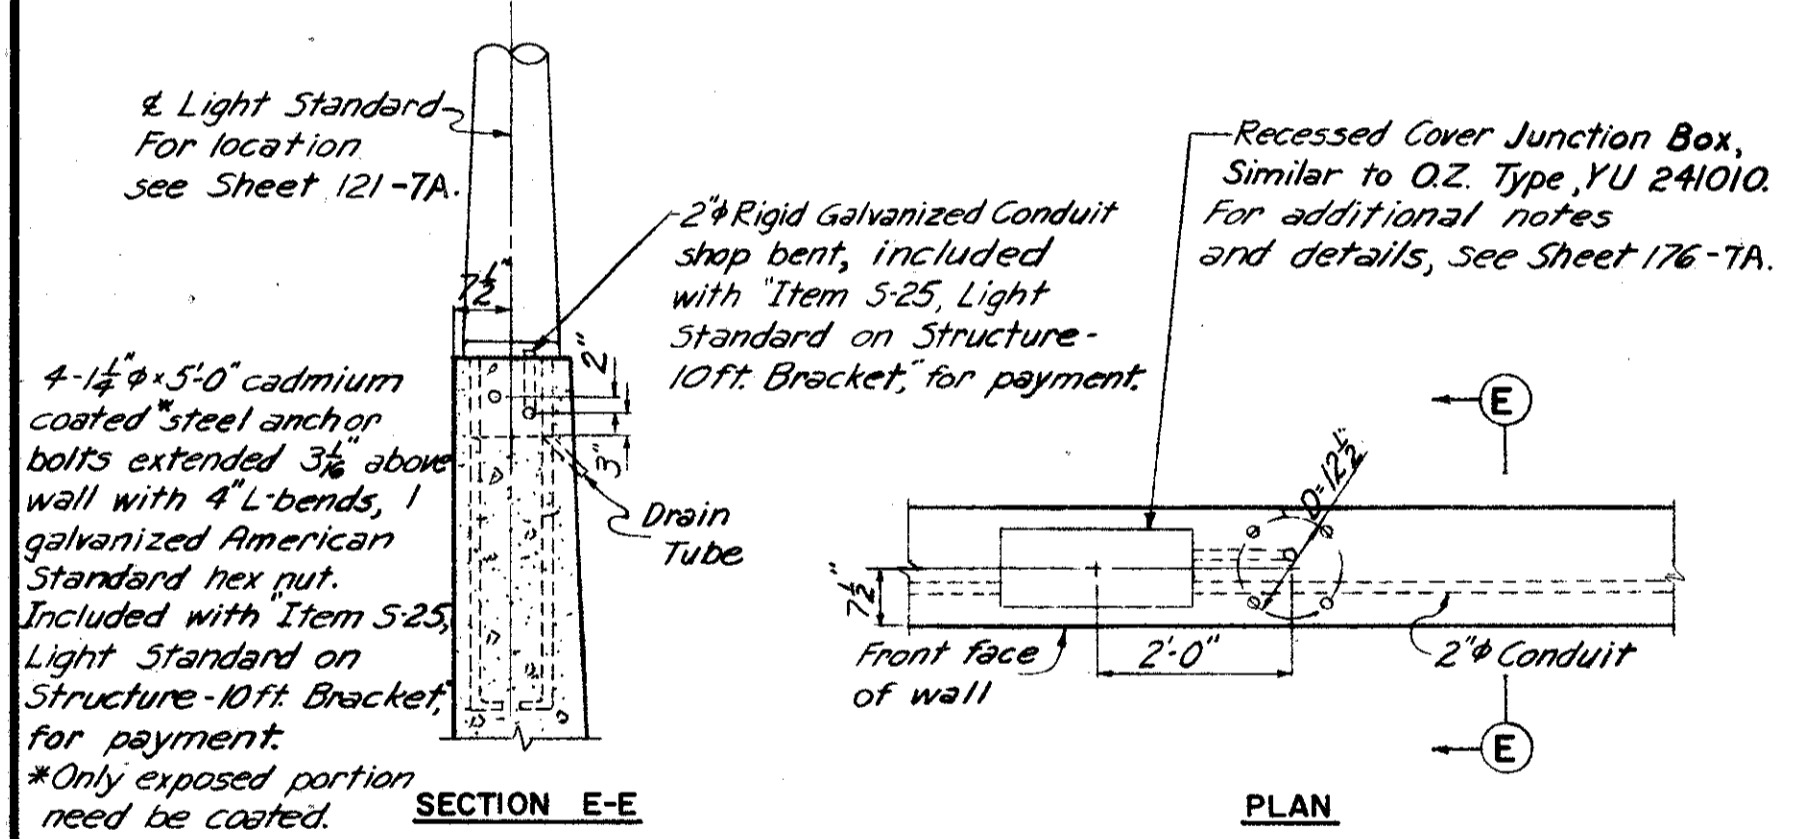


DETAILS AT LIGHT STANDARDS
Scale: 1/2" = 1'-0"

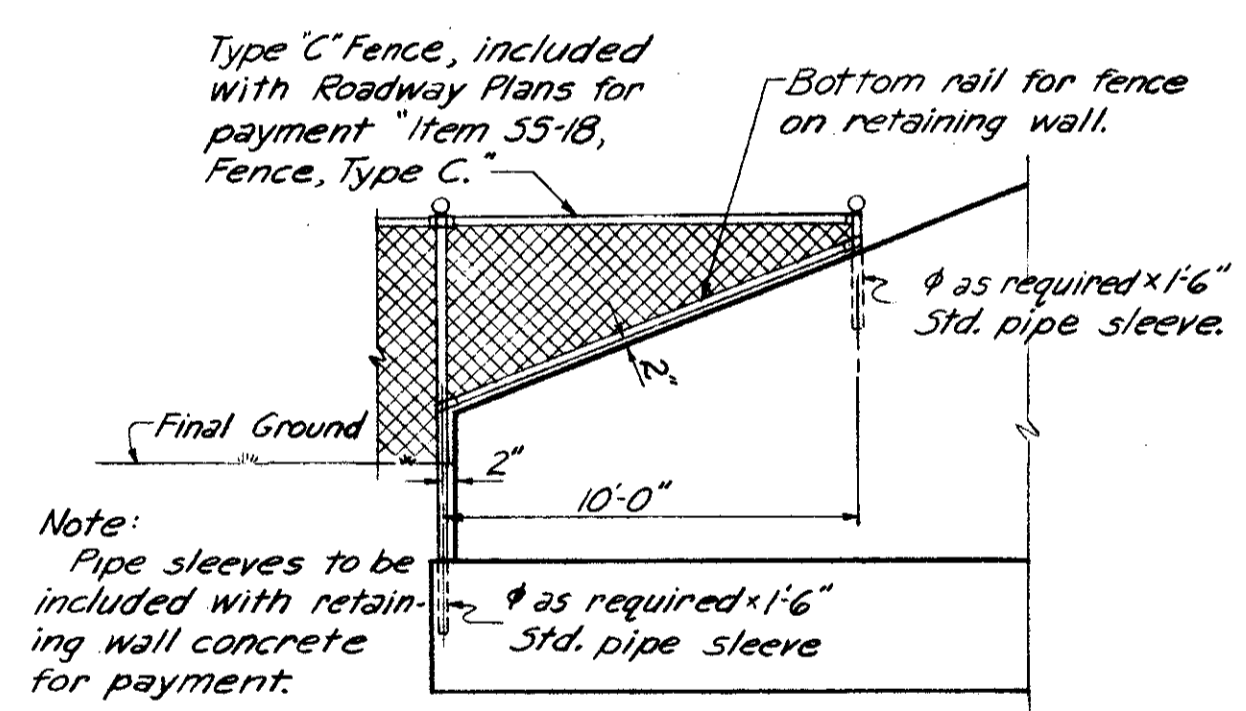

FENCE DETAIL

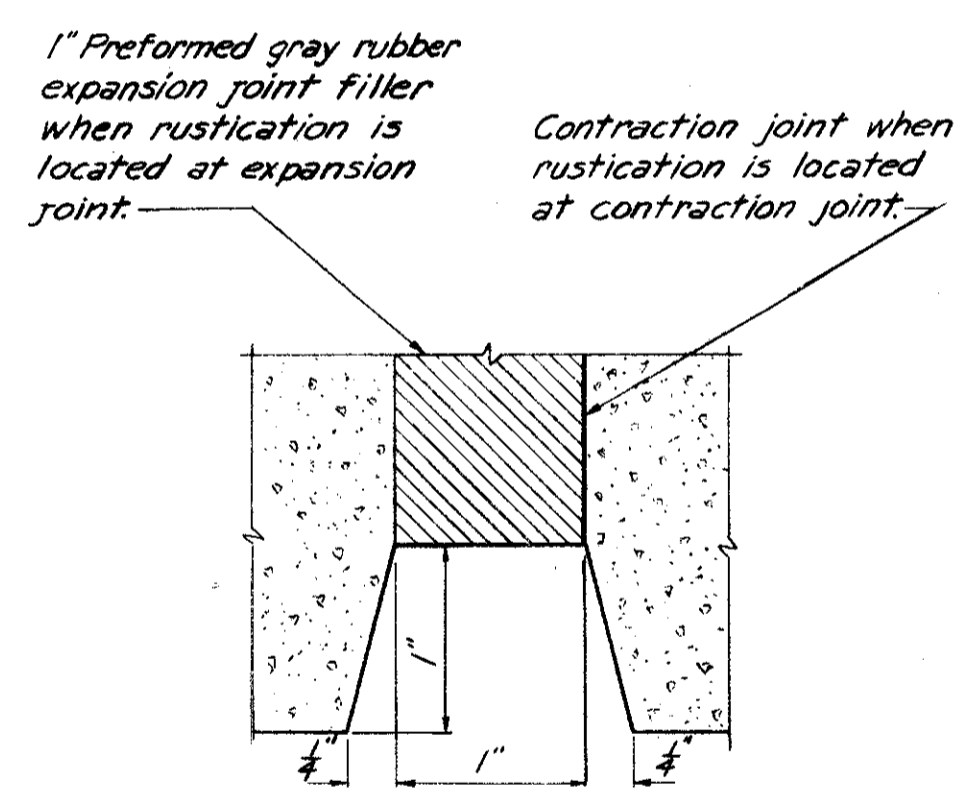


RUSTICATION DETAIL
Scale: Full Size

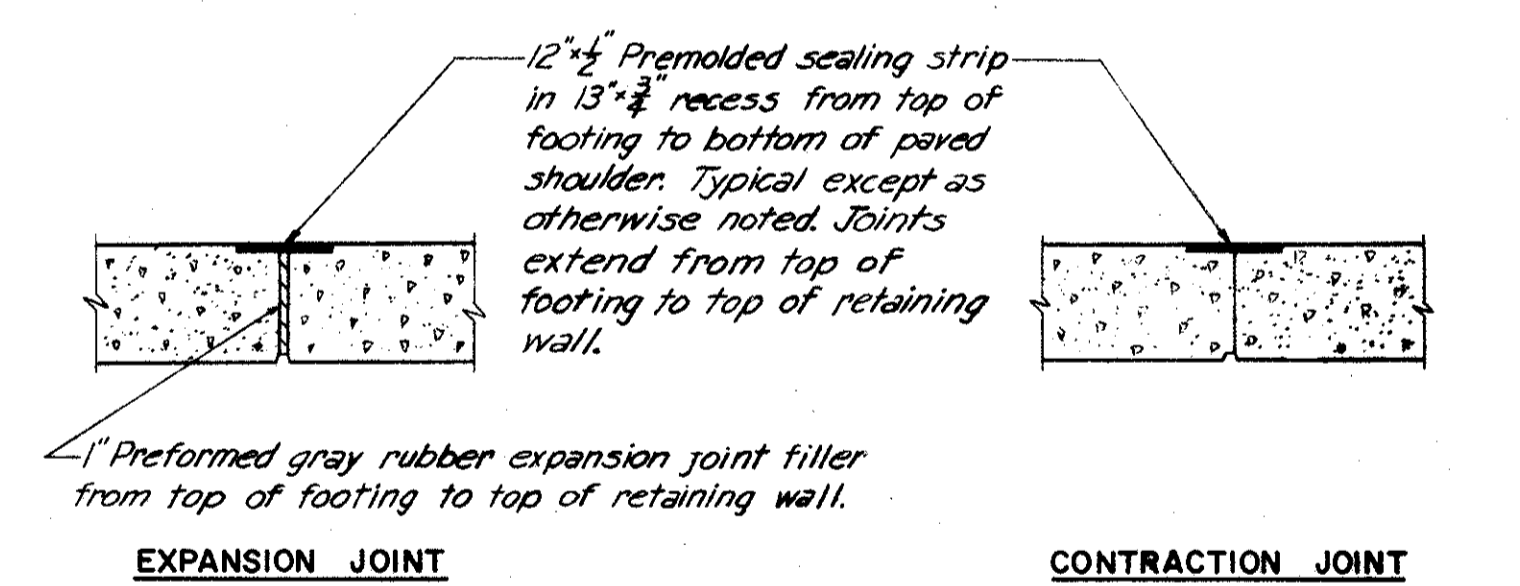

JOINT DETAILS
Scale: 1/2" = 1'-0"

REINFORCEMENT SCHEDULE																										
MARK	NO.	LENGTH	TYPE	DIMENSIONS			SERIES INCREMENT	WEIGHT (LBS)	MARK	NO.	LENGTH	TYPE	DIMENSIONS			SERIES INCREMENT	WEIGHT (LBS)	MARK	NO.	LENGTH	TYPE	DIMENSIONS			SERIES INCREMENT	WEIGHT (LBS)
				A	B	C							A	B	C							A	B	C		
501	36	27'-6"	Str.				1033	609	2 Series of 17	14'-6" to 15'-9"	Str.	1/2"	772	627	65	7'-0"	Str.									683
502	76	31'-6"	Str.				2497	610	1 Series of 17	15'-9" to 16'-9"	Str.	3/4"	415	628	69	11'-0"	100	9'-8"							1140	
503	2	28'-9"	Str.				60	611	14	30'-0"	Str.		631	629	21	34'-0"	118	24'-0"	2'-4"	7'-8"					1072	
504	2 Series of 17	6'-6" to 26'-6"	Str.				138	612	2	20'-3"	Str.		61	630	30	4'-7"	118	2'-0"	6"	6"					207	
505	20	31'-8"	108	23'-10"	7'-10"	3 1/2	661	613	1 Series of 17	16'-3" to 17'-6"	Str.	1/2"	431	631	22	5'-7"	118	3'-0"	6"	6"					184	
506	19	12'-6"	Str.				248	614	1 Series of 17	5'-6" to 8'-6"	Str.	7/8"	63													
507	20	12'-3"	108	4'-5"	7'-10"	3 1/2	256	615	2 Series of 17	6'-6" to 11'-3"	Str.	7/8"	240	701	1 Series of 17	15'-9" to 16'-9"	Str.								565	
508	20	13'-2"	141	7'-8"	2'-10"		275	616	1 Series of 17	6'-2" to 9'-2"	148	5/8" to 10"	7/8"	69	702	32	9'-6"	Str.							621	
509	10	3'-3"	105	2'-2"	8"		34	617	6	6'-11"	148	6'-3" to 10"	1/2"	62	703	64	9'-1"	148	8'-3"	1'-0"	1/2				1188	
								618	1 Series of 17	6'-0" to 9'-6"	100	4'-8" to 8'-2"	1/2"	314	704	66	4'-9"	Str.								641
								619	1 Series of 17	17'-0" to 18'-9"	Str.	1/2"	456	705	68	12'-10"	100	11'-2"							1784	
601	28	6'-6"	Str.				273	620	6	9'-4"	101	8'-8"		84	706	1 Series of 17	16'-3" to 17'-6"	Str.							586	
602	2 Series of 17	11'-6" to 12'-6"	Str.				541	621	6	9'-4"	101	8'-8"		84												
603	56	6'-5"	148	5'-9"	10"	1/2	540	621	1 Series of 17	4'-6" to 6'-3"	Str.		218													
604	257	4'-6"	Str.				1737	622	61	6'-9"	Str.		619	801	97	8'-6"	Str.								2201	
605	2 Series of 17	12'-6" to 13'-6"	Str.				586	623	16	3'-11"	108	2'-0" to 2'-0"	7	94	802	31	13'-4"	100	11'-2"						1104	
606	2 Series of 17	13'-6" to 14'-6"	Str.				715	624	32	31'-0"	Str.		1490	803	1 Series of 17	17'-0" to 18'-9"	Str.								1670	
607	32	8'-6"	Str.				409	625	55	10'-0"	100	8'-8"		826	804	34	12'-0"	Str.							1089	
608	64	8'-5"	148	7'-9"	10"	1/2	809	626	78	34'-0"	Str.		3983	805	69	5'-11"	148	5'-0"	1'-1"	1/2					1090	

Total Weight = 37,465

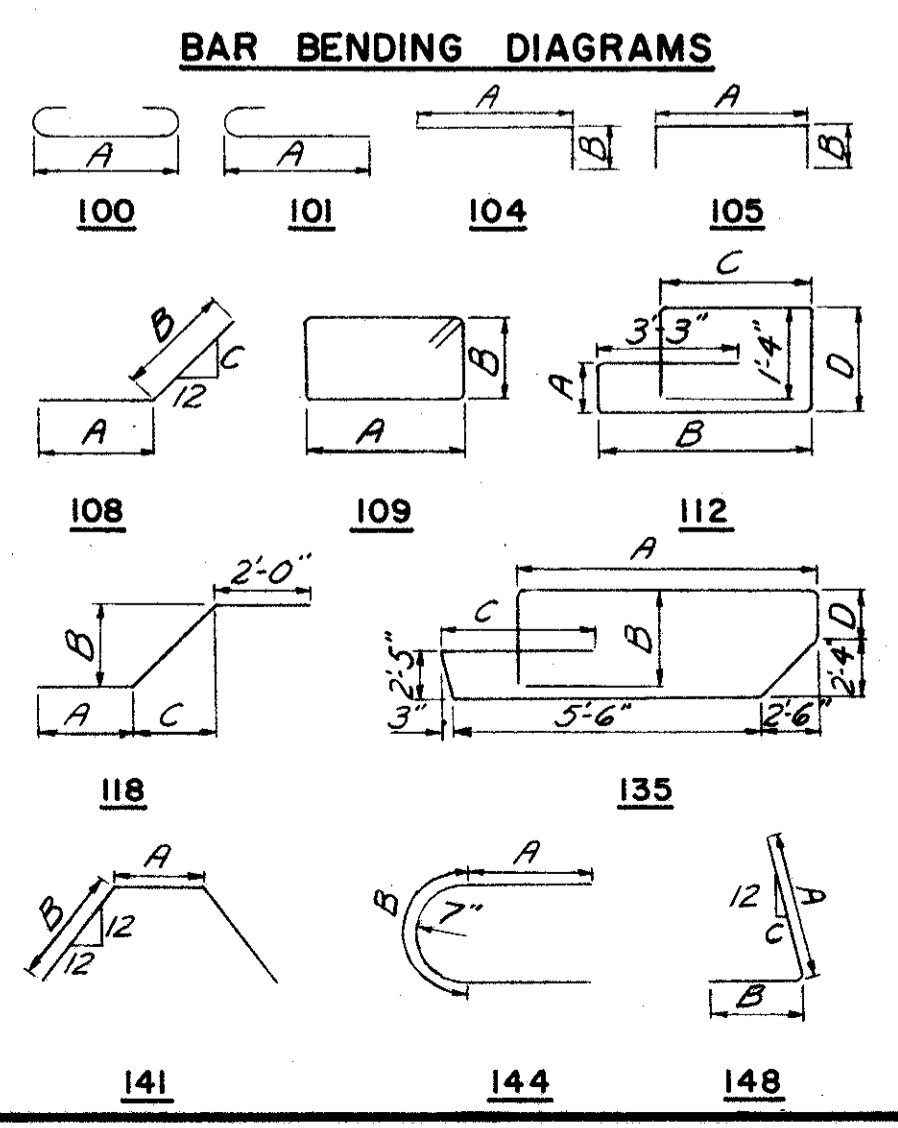


NOTES:
For Location Plan, Developed Elevation and Footing Plan see Sheet 121-7A.
For Replacement Schedule see Sheet 103-7A.
All bar dimensions are given out to out. Bars of a series shall vary in length by a constant increment.

H.N.T.B. BR. NO. 4 PART 7A
HOWARD, NEEDLES, TAMMEN & BERGENDOFF
CONSULTING ENGINEERS
CLEVELAND NEW YORK
KANSAS CITY CLEVELAND NEW YORK

RETAINING WALL DETAILS
INNER BELT FREEWAY OVER EAST 14th ST.
BR. NO. CUY-42-1854 STA. 70+89.23
Scale: 1/4" = 1'-0" STA. 73+96.25
Except as noted
WILLOW-INNER BELT FREEWAY
CLEVELAND CUYAHOGA COUNTY OHIO

DRAWN: ARZ TRACED: G.A.B. CHECKED: J.C.T. REVIEWED: J.C.T. REVISION: J.C.T.
DATE: 11/6/55 DATE: 11/13/59 DATE: 11/13/59 SHEET 122

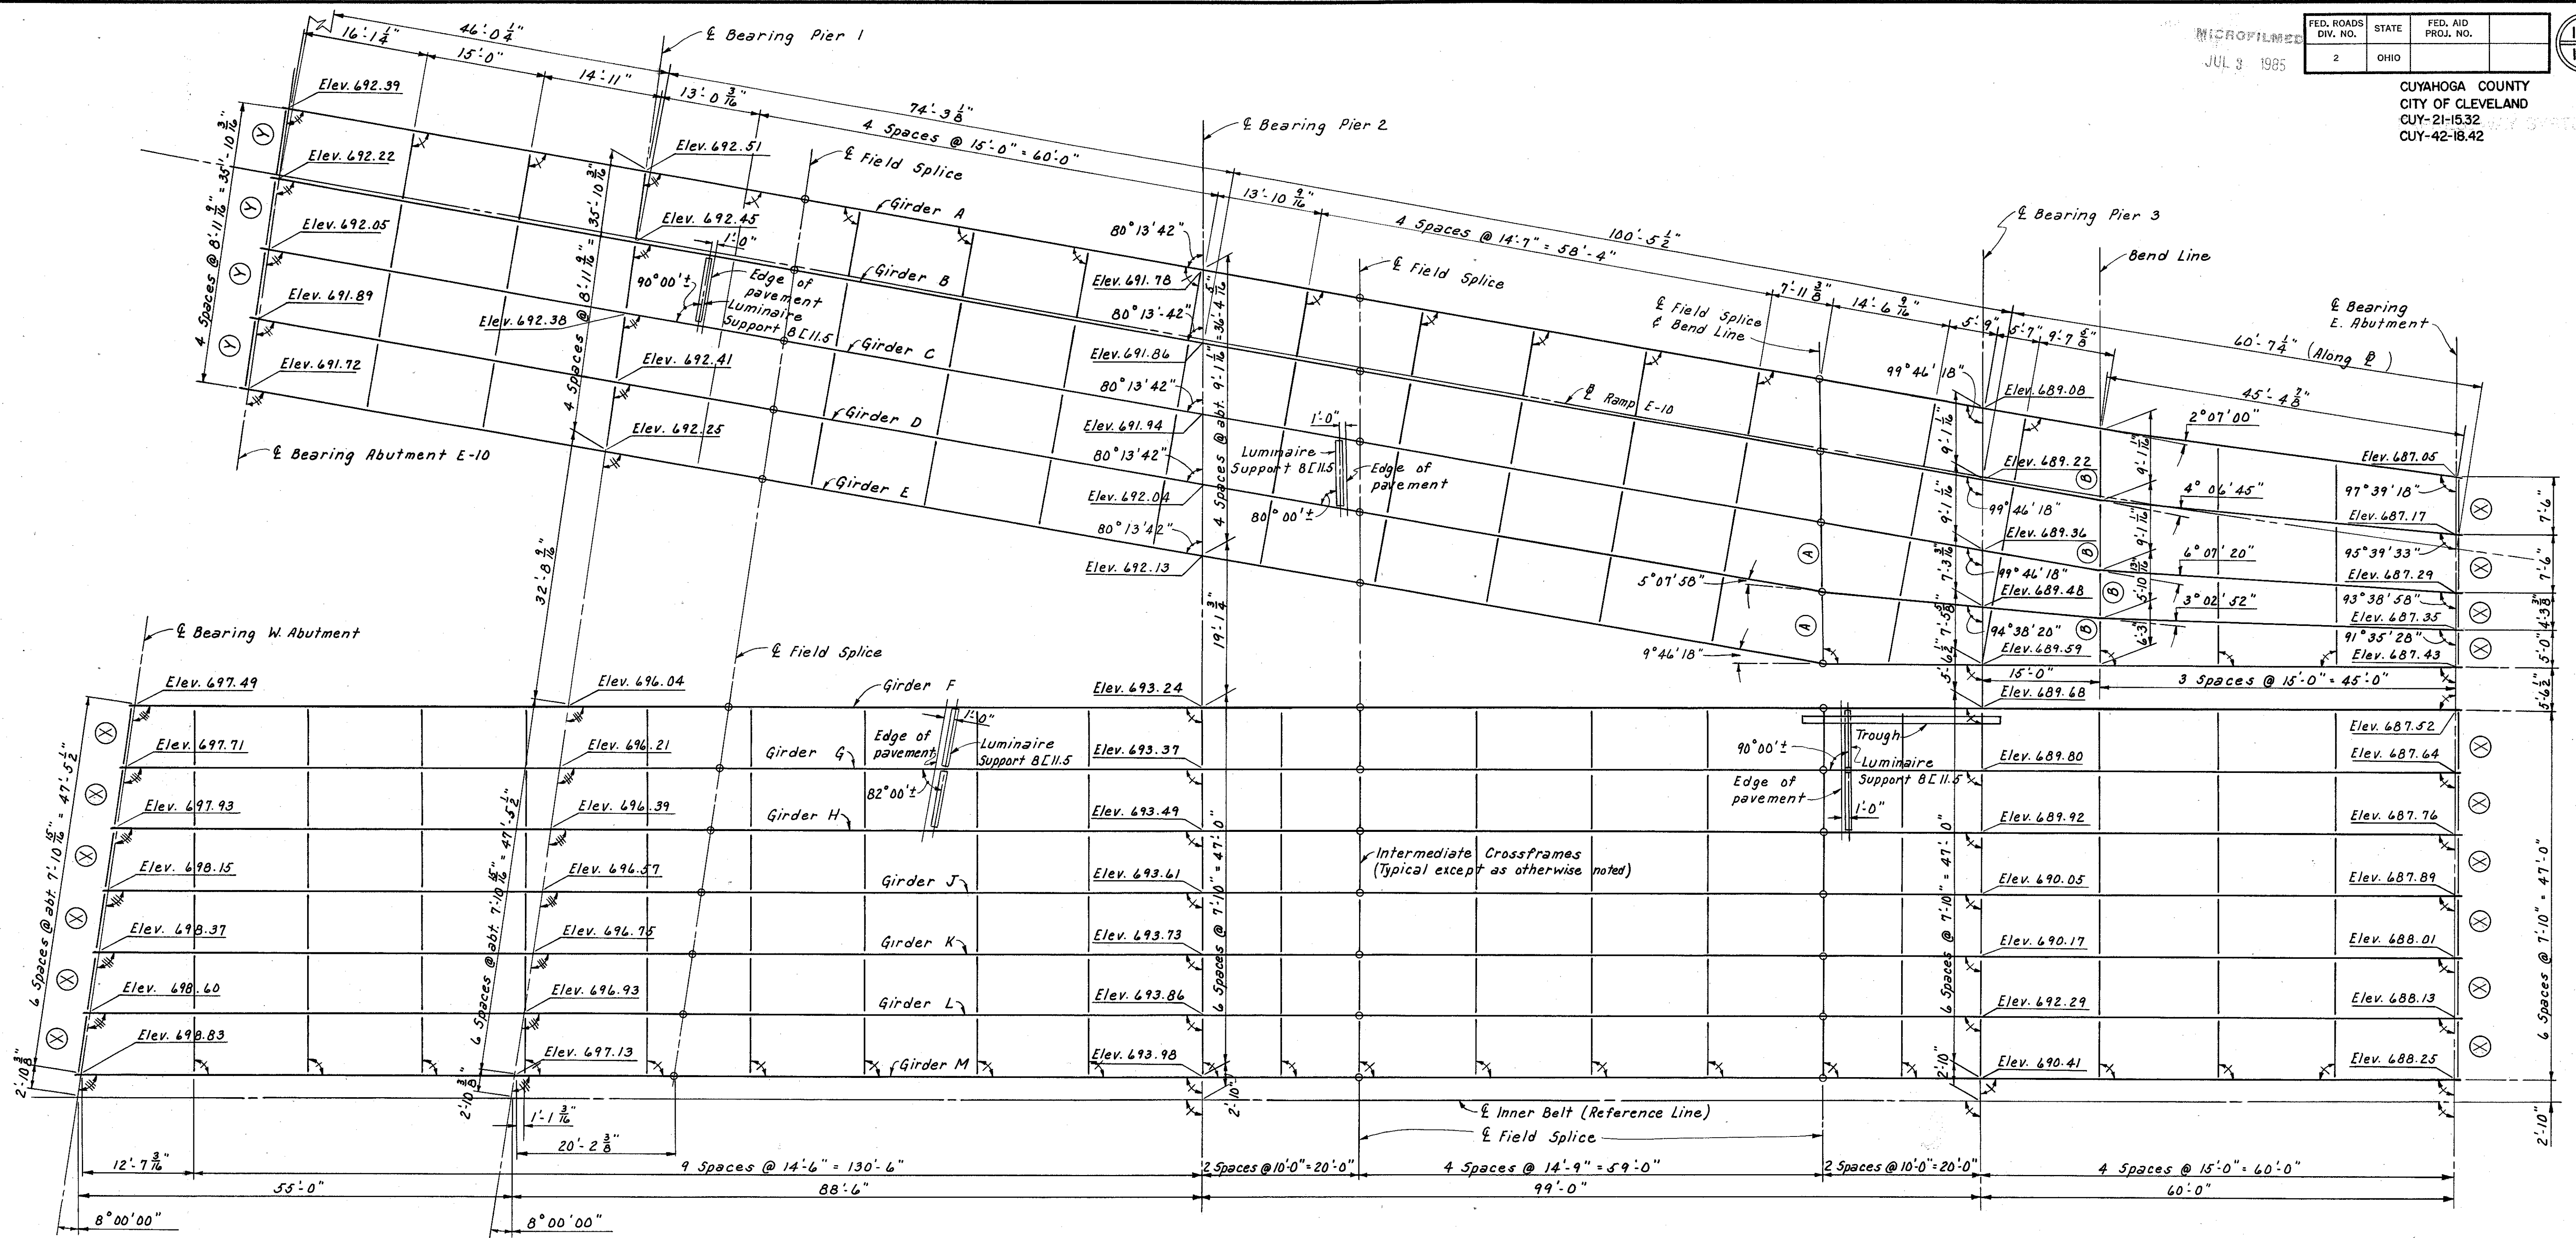

FRAMING PLAN


LEGEND

- Indicates 90° angles
- Indicates 88° 13' 42" angle
- Indicates 98° 00' 00" angle

(A), (B), (X) or (Y) indicates type of crossframe, see sheet 130 for details.

NOTES:

For end dam details see sheet 173-7A
For trough details see sheet 174-7A
For details of underdeck lighting see sheets 176-7A and 177-7A
For details of shoes see Ohio State Standard, Drawing RB-1-55.
Elevations shown are to the top of web over the supports.

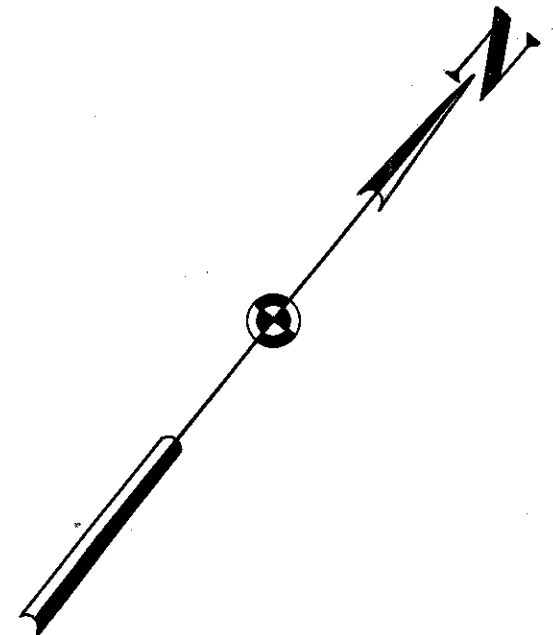

H.N.T.B. BR. NO. 4 PART 7A


HOWARD, NEEDLES, TAMMEN & BERGENDOFF
CONSULTING ENGINEERS
KANSAS CITY CLEVELAND NEW YORK

FRAMING PLAN-NORTH HALF
INNER BELT FREEWAY OVER EAST 14th ST.
BR. NO. CUY-42-1854 STA. 70+89.23
Scale: 1" = 10'-0" STA. 73+96.25
WILLOW-INNER BELT FREEWAY
CLEVELAND CUYAHOGA COUNTY OHIO


DRAWN BY L.B.	TRACED BY A.E.K.	CHECKED BY R.L.R.	REVIEWED BY J.C.T.	REVISED
DATE 5-10-58	DATE 4-20-59	DATE 7-10-59	DATE 11-13-59	SHEET 123

JUL 2 1985


CUYAHOGA COUNTY
CITY OF CLEVELAND
CUY-21-15.32
CUY-42-18.42

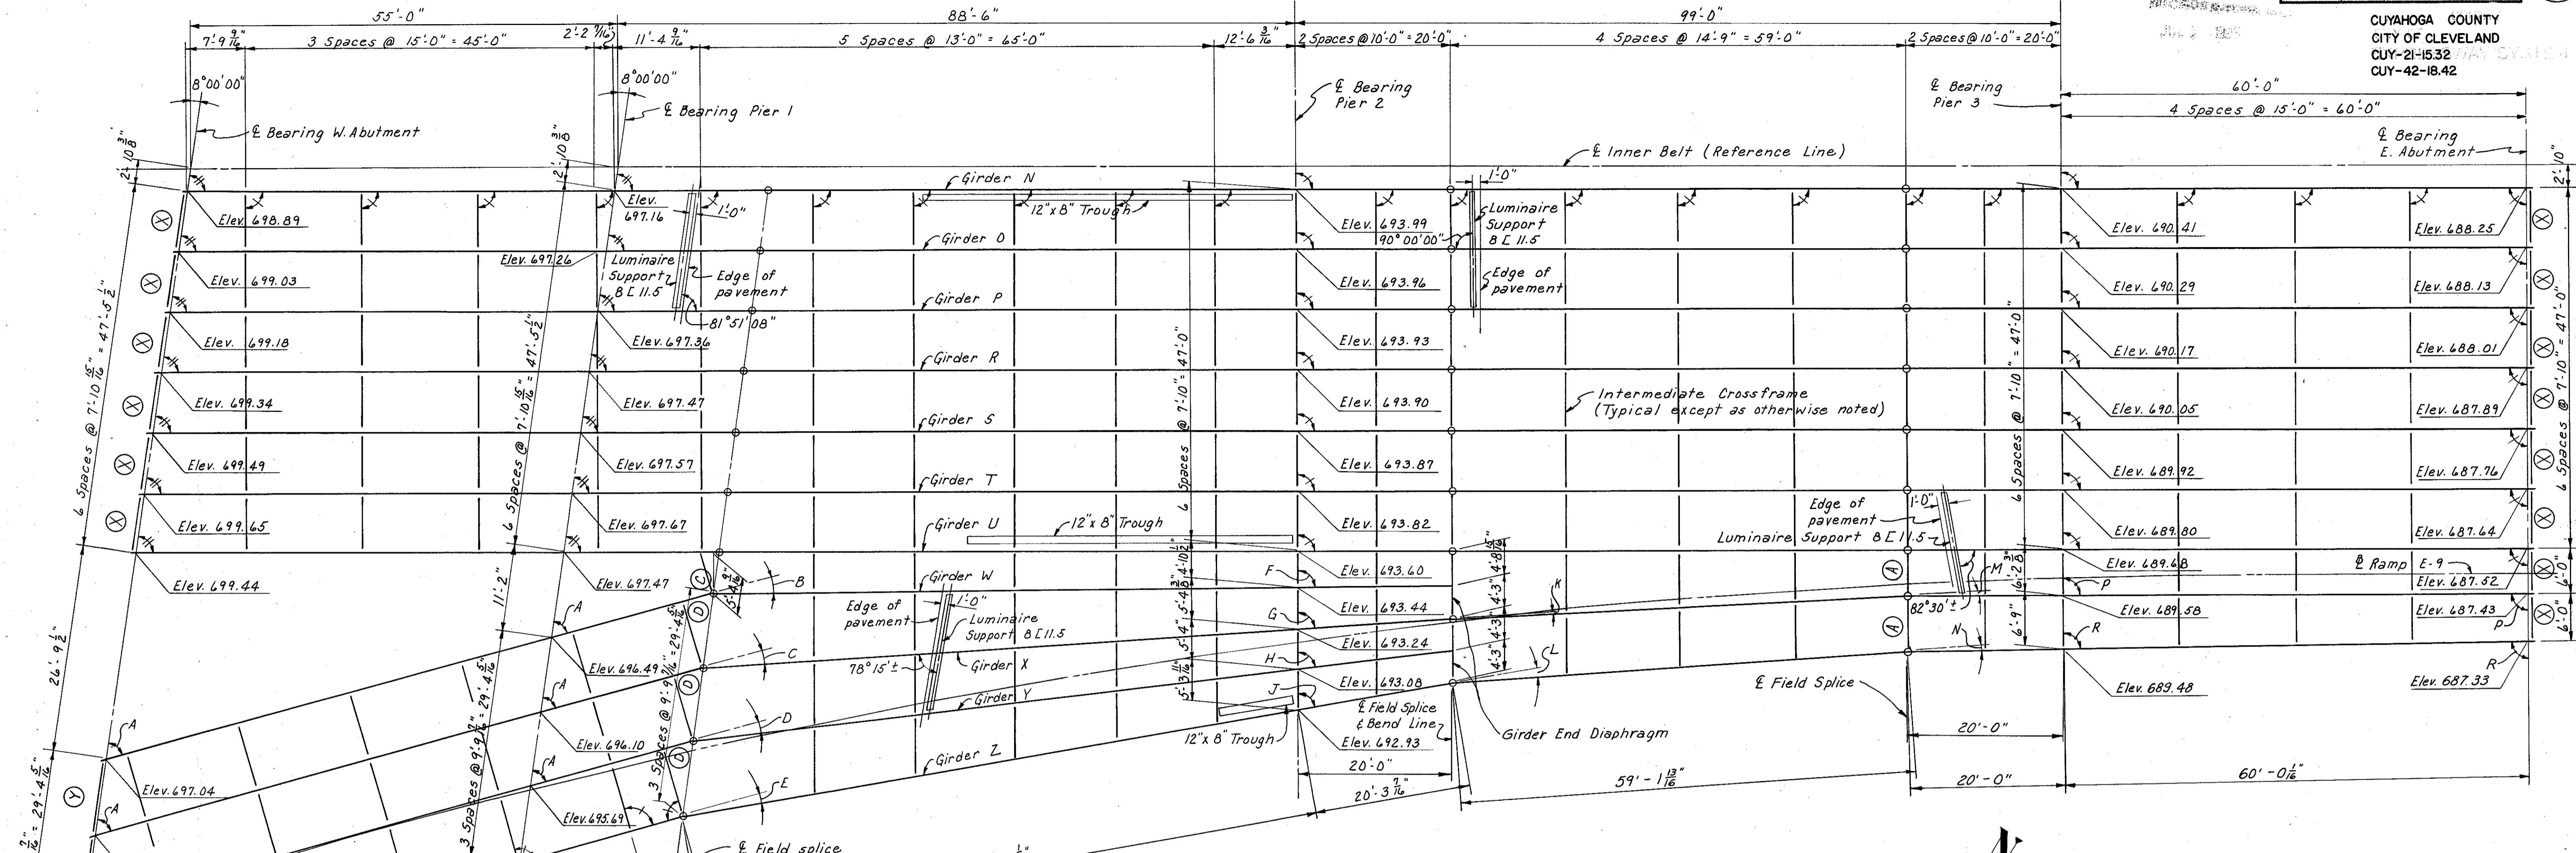

FRAMING PLAN

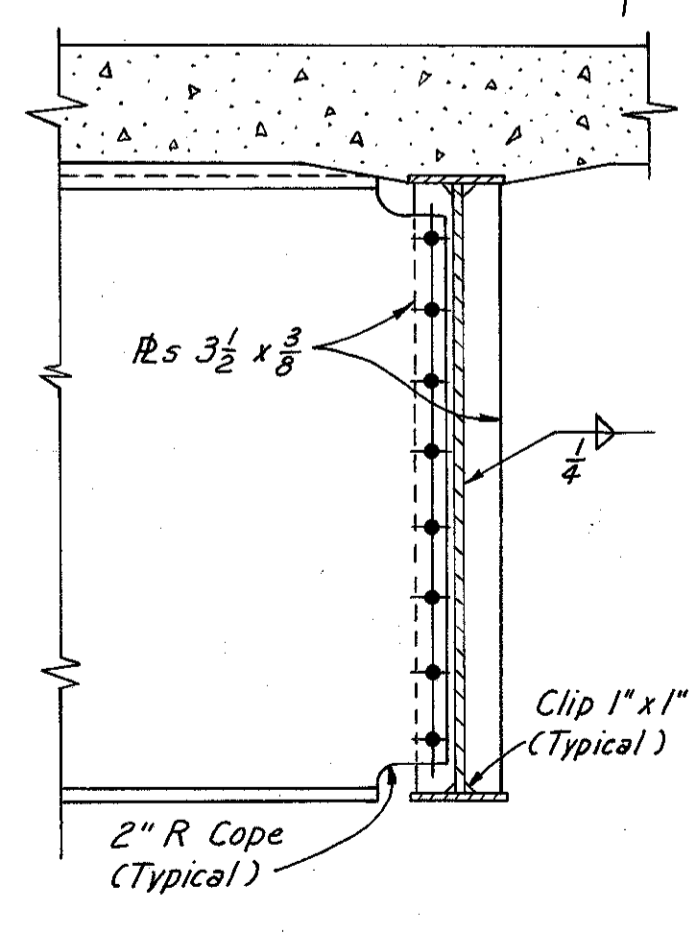


SECTION A-A Scale: 3/4" = 1'-0"

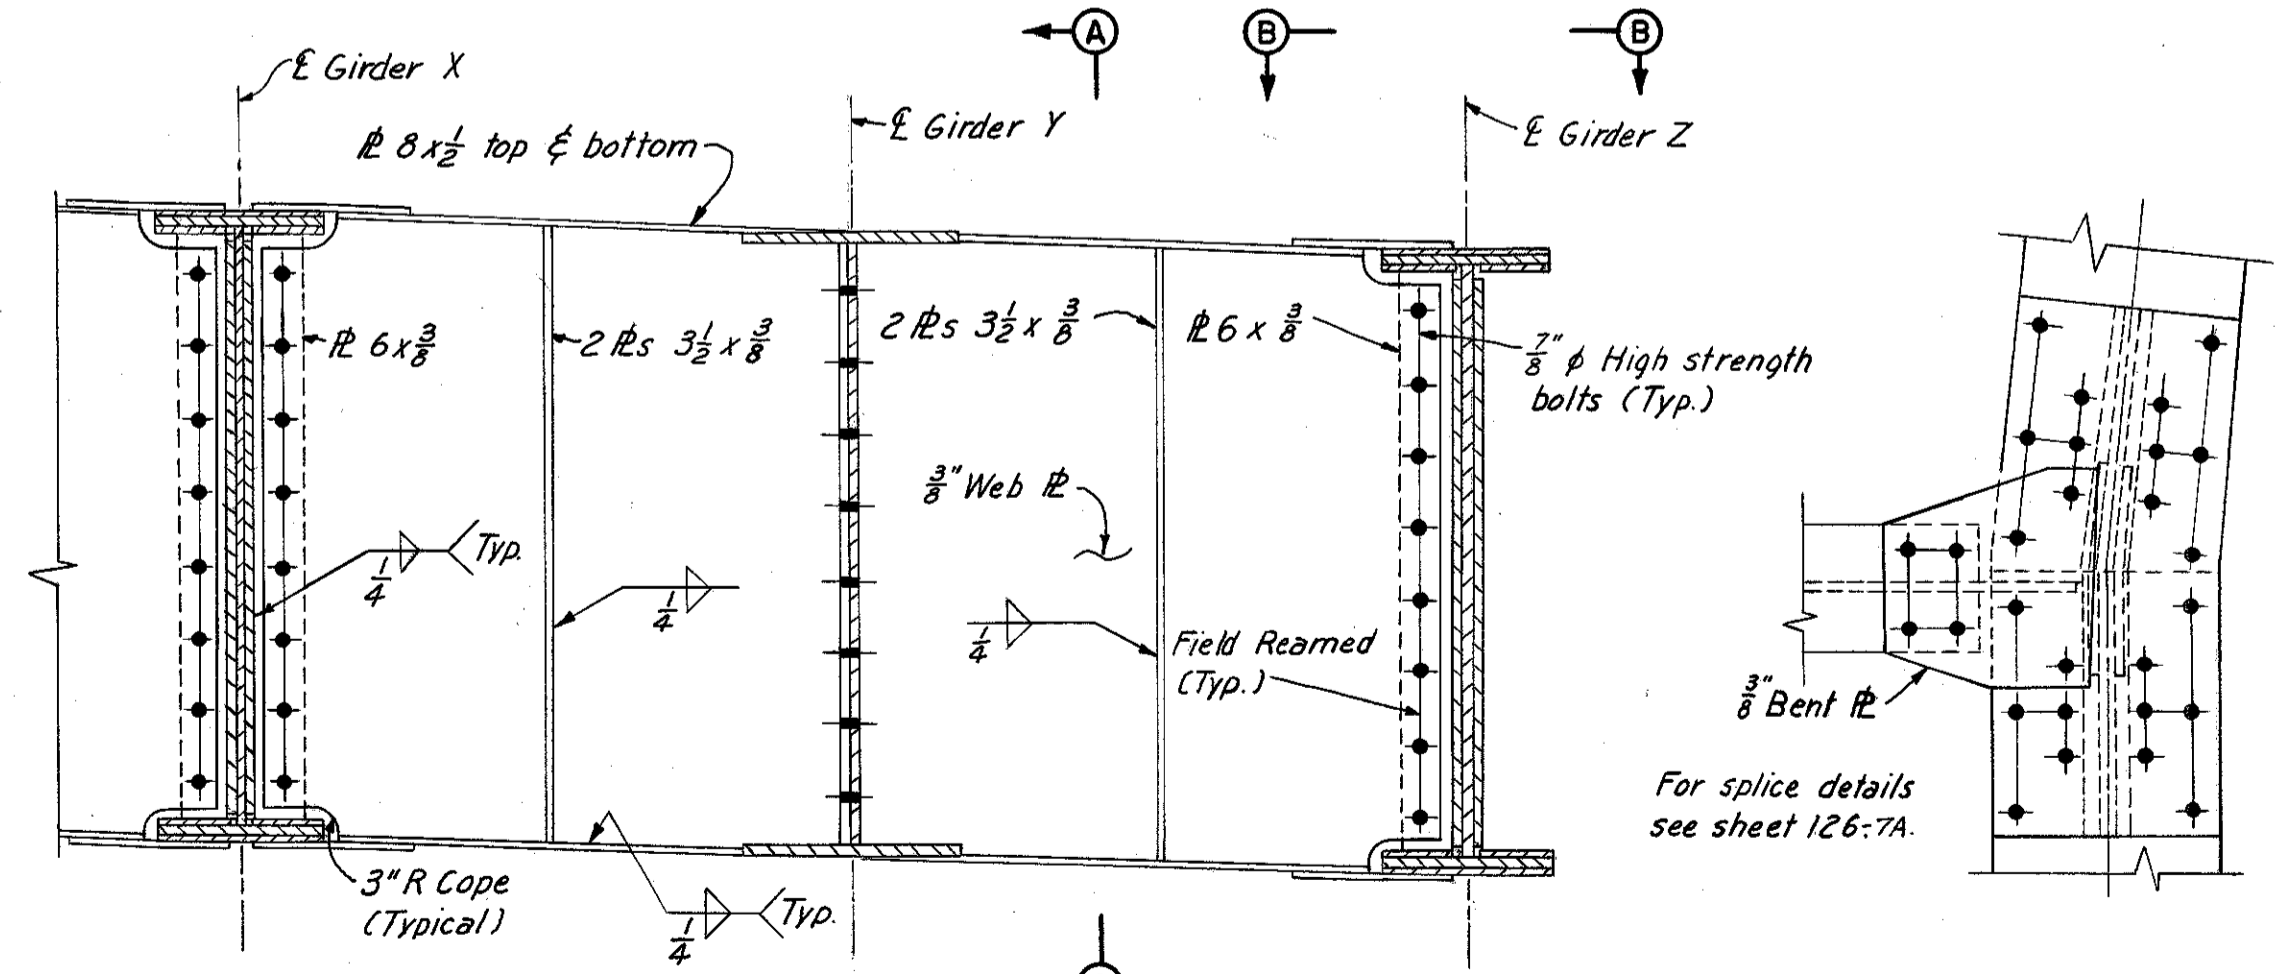

ELEVATION

GIRDER END DIAPHRAGM Scale: 3/4" = 1'-0"

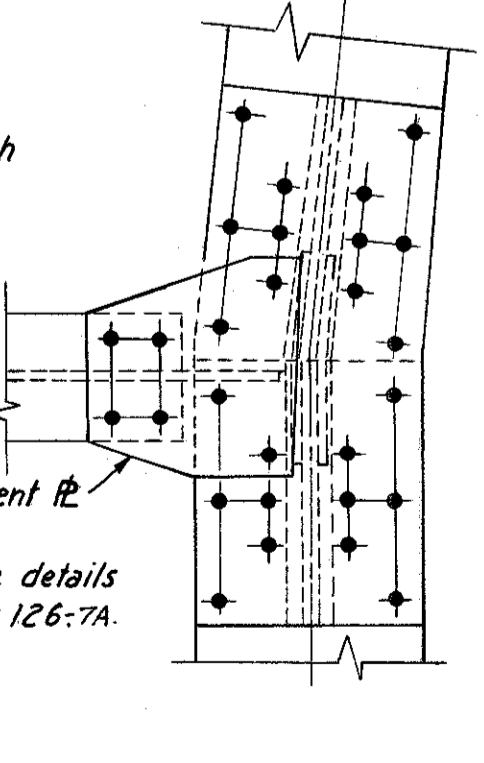

VIEW B-B Scale: 1" = 1'-0"

TABLE OF ANGLES			
A	66° 51' 37"	H	83° 20' 51"
B	14° 45' 33"	J	80° 23' 11"
C	11° 34' 08"	K	00° 55' 10"
D	8° 29' 14"	L	5° 30' 38"
E	5° 31' 34"	M	2° 27' 56"
F	89° 37' 10"	N	3° 12' 03"
G	86° 25' 45"	P	89° 48' 50"
		R	89° 05' 52"

LEGEND




- ☒ Indicates 90° angle
- ☒ Indicates 82° angle
- (A) (C) (D) (X) or (Y) indicates type of cross frame, see sheet 130 for details

NOTES:
 For end dam details see sheet 173-7A
 For trough details see sheet 174-7A
 For details of underdeck lighting see sheets 176-7A & 177-7A
 For details of shoes see Ohio State Standard, Drawing RB-1-55.
 Elevations shown are to the top of web over the supports.

H.N.T.B. BR. NO. 4 PART 7A

HOWARD, NEEDLES, TAMMEN & BERGENDOFF
CONSULTING ENGINEERS
KANSAS CITY CLEVELAND NEW YORK

FRAMING PLAN-SOUTH HALF
 INNER BELT FREEWAY OVER EAST 14th ST.
 BR. NO. CUY-42-1854 STA. 70+89.23
 Scale: As shown STA. 73+96.25
WILLOW-INNER BELT FREEWAY
 CLEVELAND CUYAHOGA COUNTY OHIO

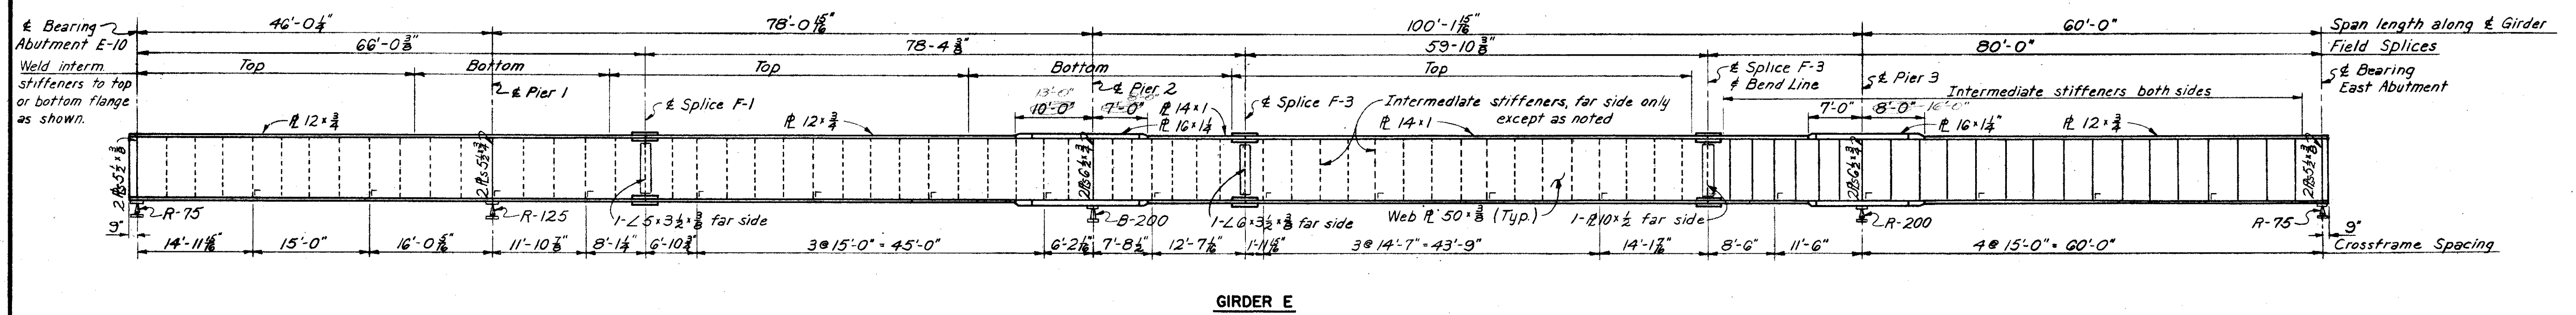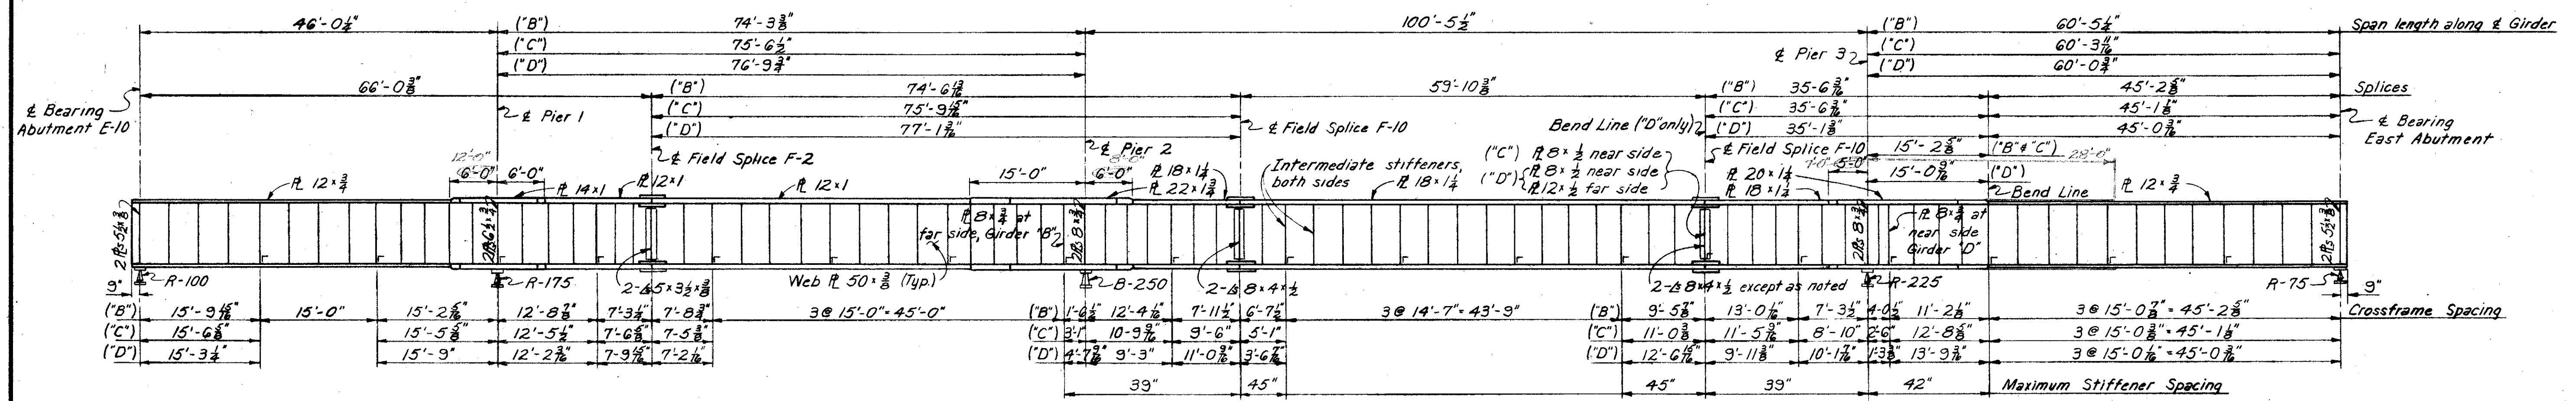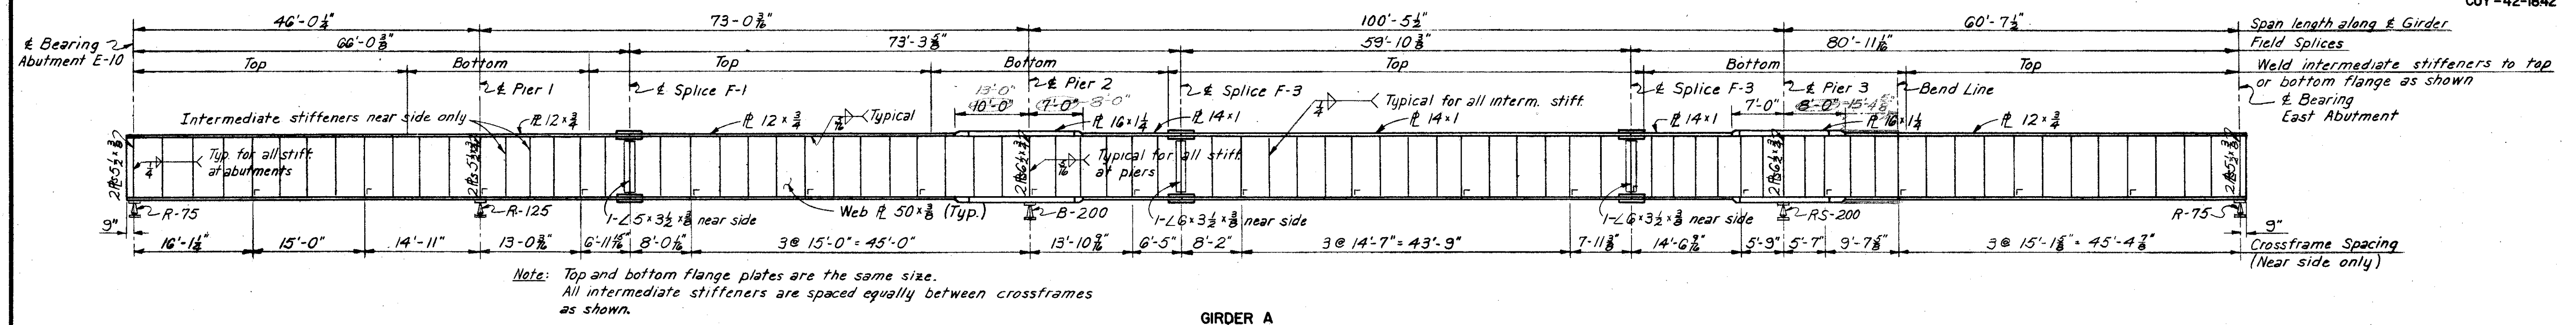

For notes see sheet 127-7A

H.N.T.B. BR. NO. 4 PART 7A

HOWARD, NEEDLES, TAMMEN & BERGENDOFF
CONSULTING ENGINEERS
KANSAS CITY CLEVELAND NEW YORK

GIRDER ELEVATIONS.


INNER BELT FREEWAY OVER EAST 14th ST.
BR. NO. CUY-42-1854 STA. 70+89.23
Scale: None STA. 73+96.25

WILLOW-INNER BELT FREEWAY
CLEVELAND CUYAHOGA COUNTY OHIO

DRAWN	TRACED	CHECKED	REVIEWED	REVISED
CKB		PH	CT	6-20-60
DATE 1-3-59	DATE	DATE 1-15-59	DATE 11-13-59	SHEET 125


CUYAHOGA COUNTY
CITY OF CLEVELAND
CUY-21-15.32
CUY-42-18.42

JUL 3 1965

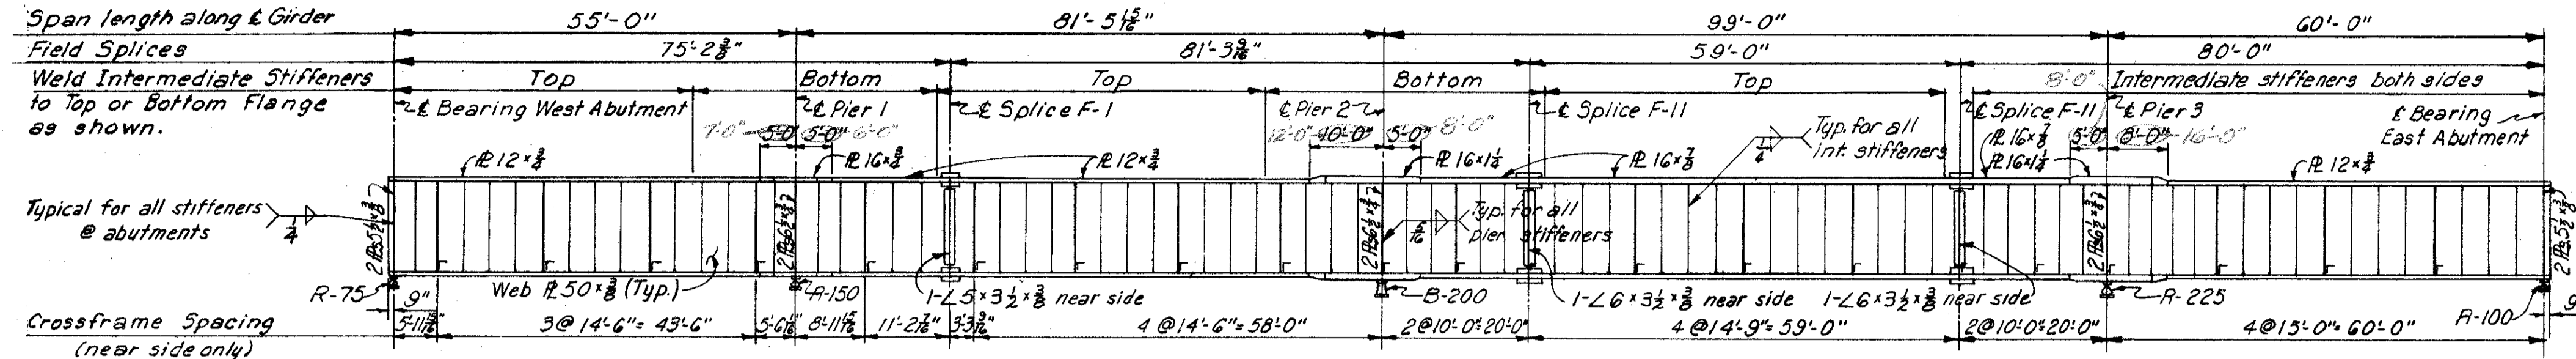


GIRDER F

Note: Intermediate stiffeners near side only except as noted.

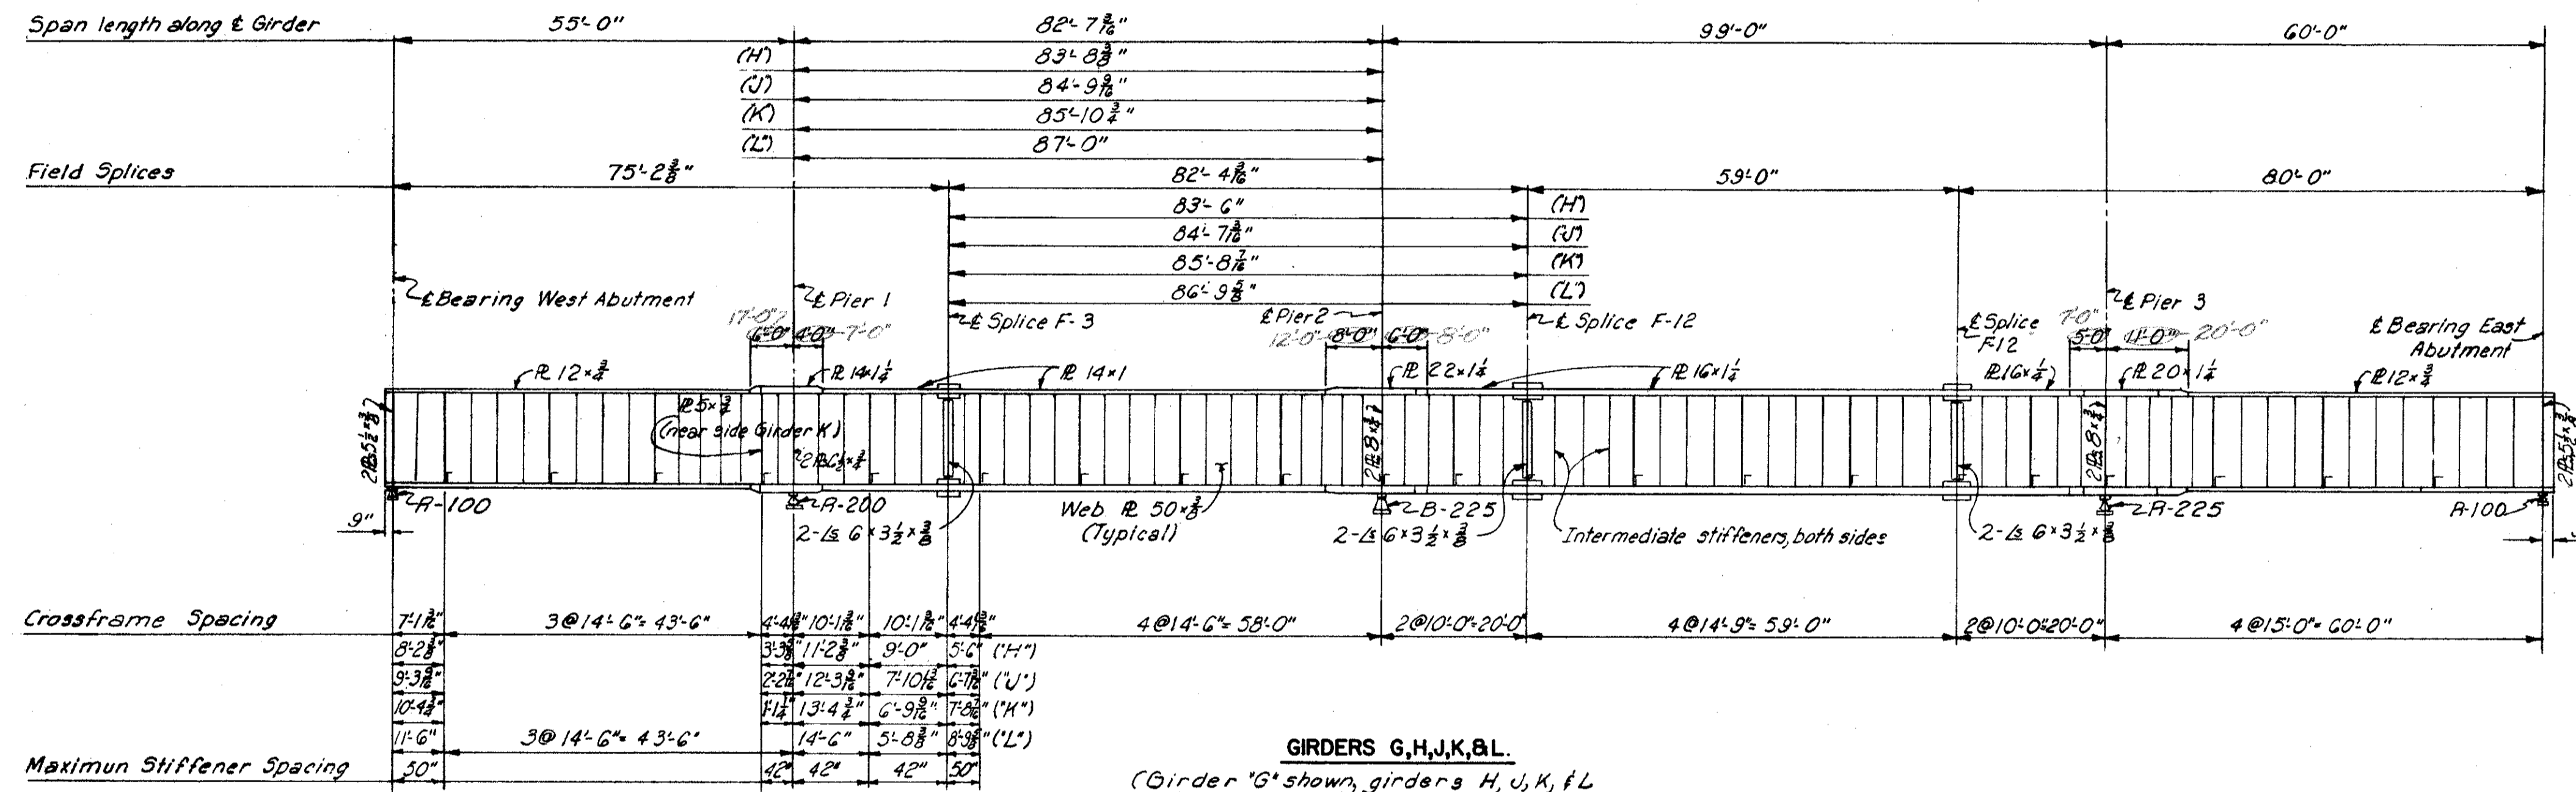



GIRDERS G, H, J, K, & L

(Girder 'G' shown, girders H, J, K, & L similar except as noted)

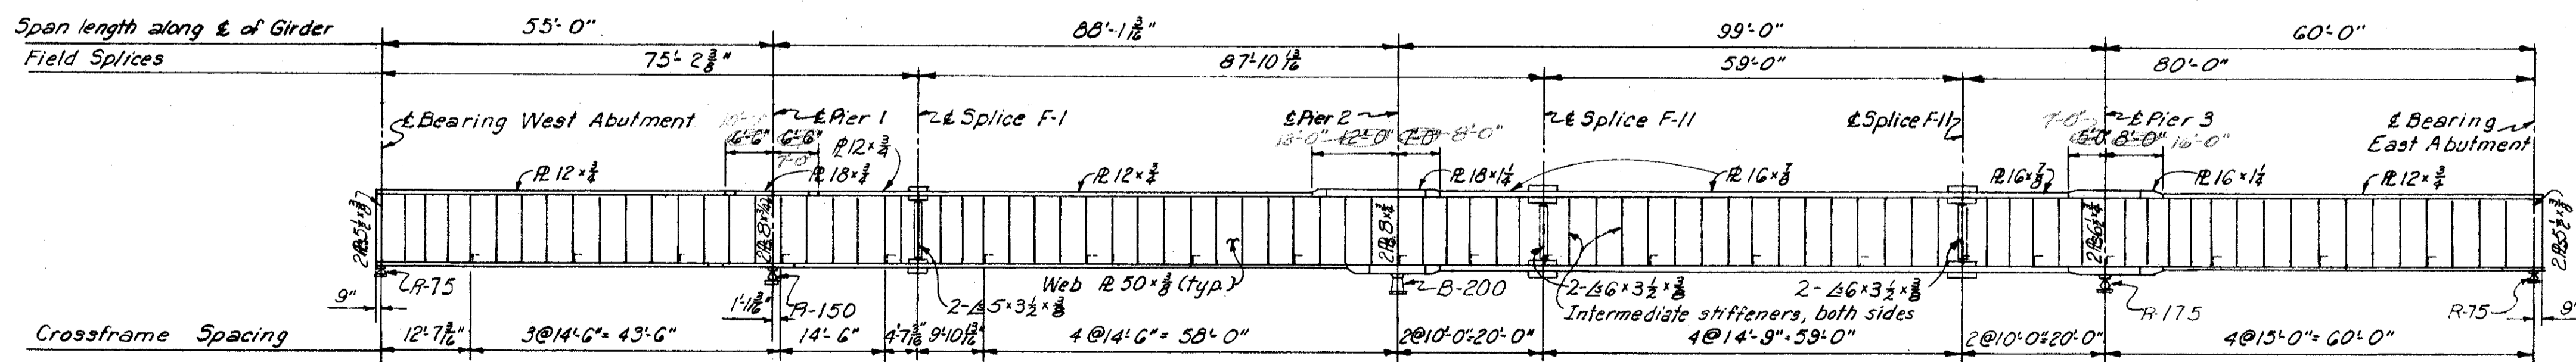

GIRDER M

NOTES:
For modification of splices at crossframes Types A, C & D see Detail "A" sheet 130-7A
For girder notes see sheet 127-7A

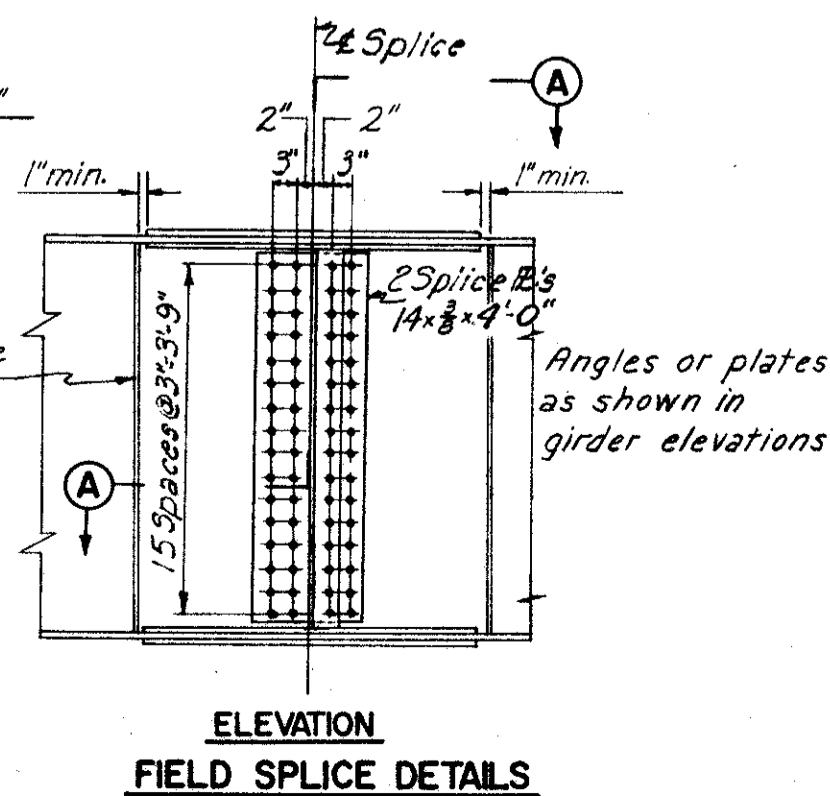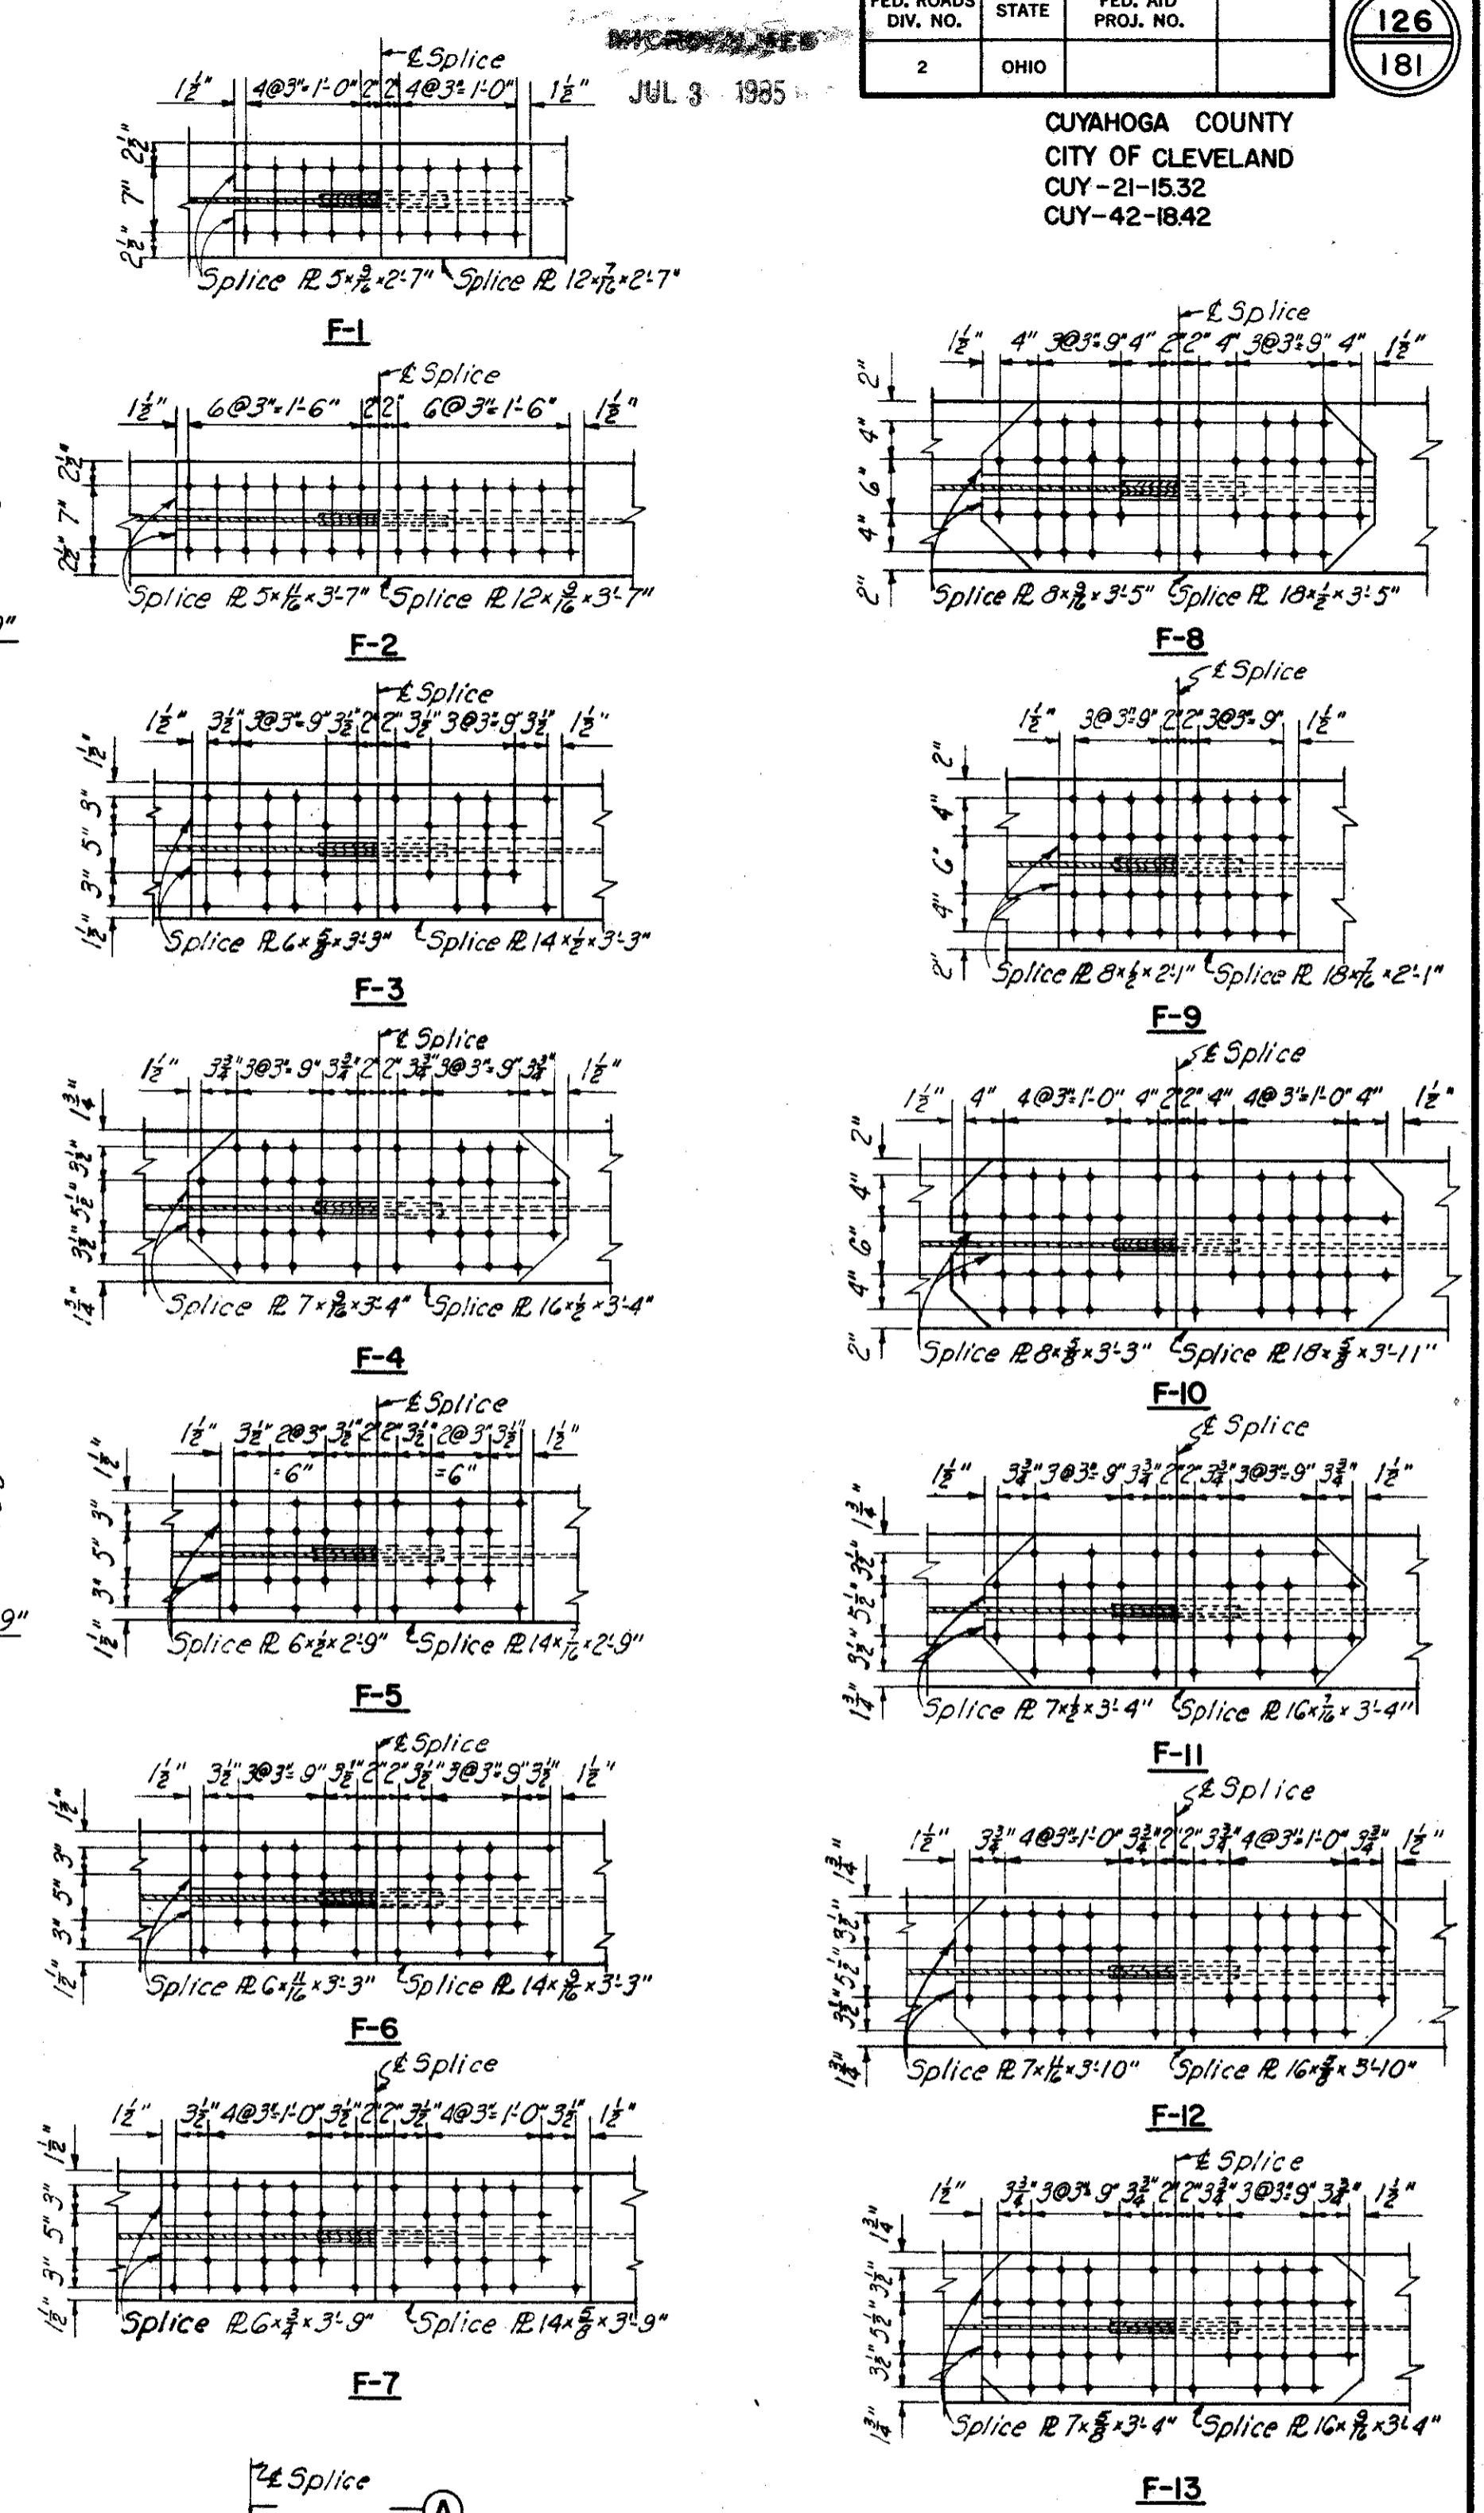

H.N.T.B. BR. NO. 4 PART 7A

HOWARD, NEEDLES, TAMMEN & BERGENOFF
CONSULTING ENGINEERS
KANSAS CITY CLEVELAND NEW YORK

GIRDER ELEVATIONS

INNER BELT FREEWAY OVER EAST 14th ST.
BR. NO. CUY-42-1854 STA. 70+89.23
Scale: None STA. 73+96.25

WILLOW-INNER BELT FREEWAY

CLEVELAND CUYAHOGA COUNTY OHIO


DRAWN RA	TRACED	CHECKED CAN	REVIEWED JCT	REVISED 6-20-60
DATE 1-7-57	DATE	DATE 1-23-59	DATE 11-13-59	SHEET 126

JUL 3 1955


FED. ROADS DIV. NO.	STATE	FED. AID PROJ. NO.
2-55	OHIO	

127
181

CUYAHOGA COUNTY
CITY OF CLEVELAND
CUY-21-1532
CUY-42-1842

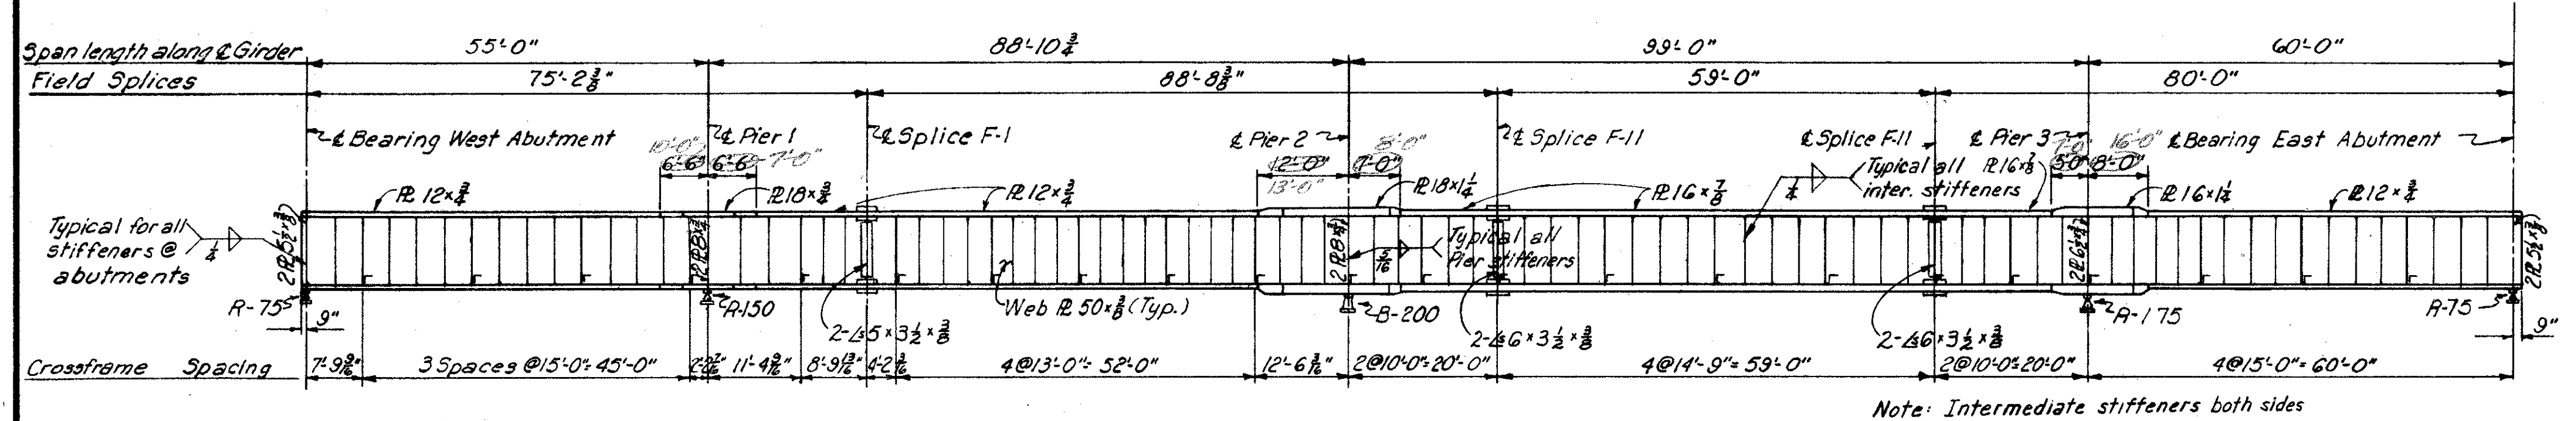


GIRDER N

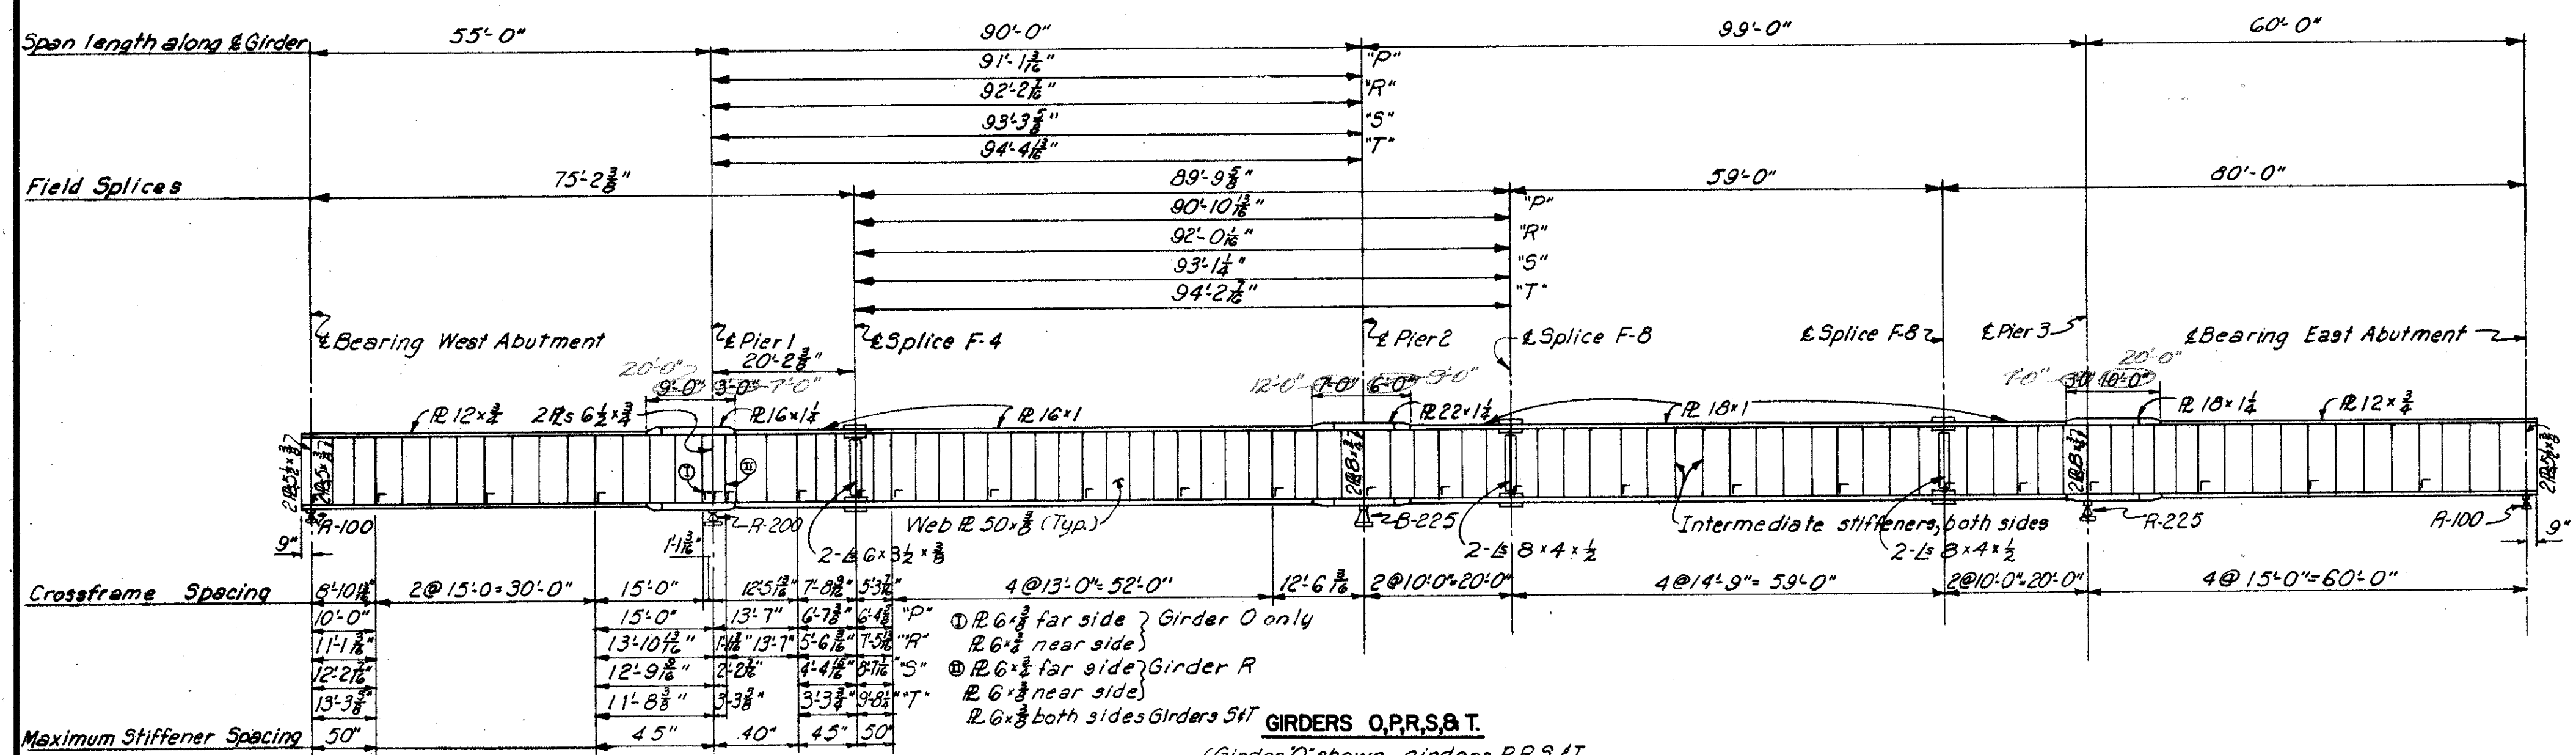


GIRDERS O,P,R,S & T


(Girder O shown, girders P,R,S,T similar except as noted)

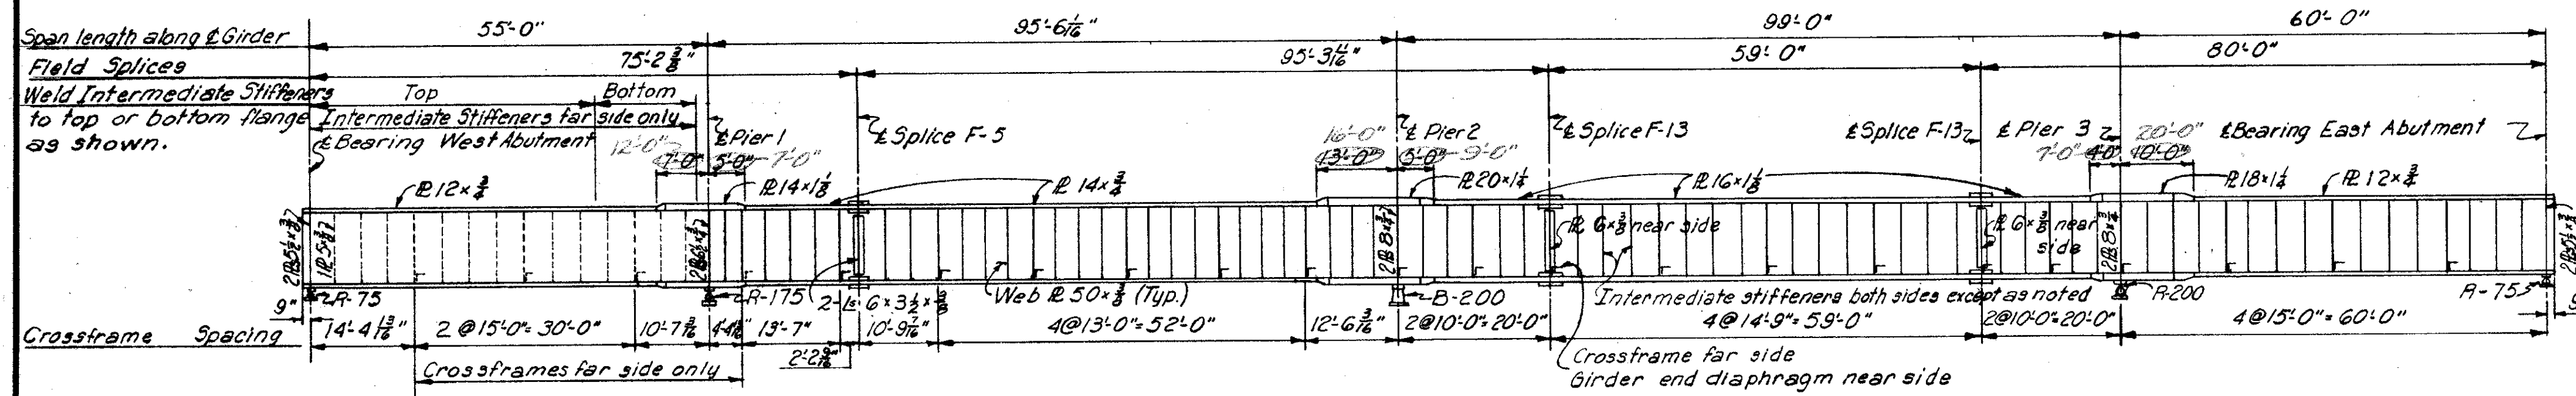

GIRDER U

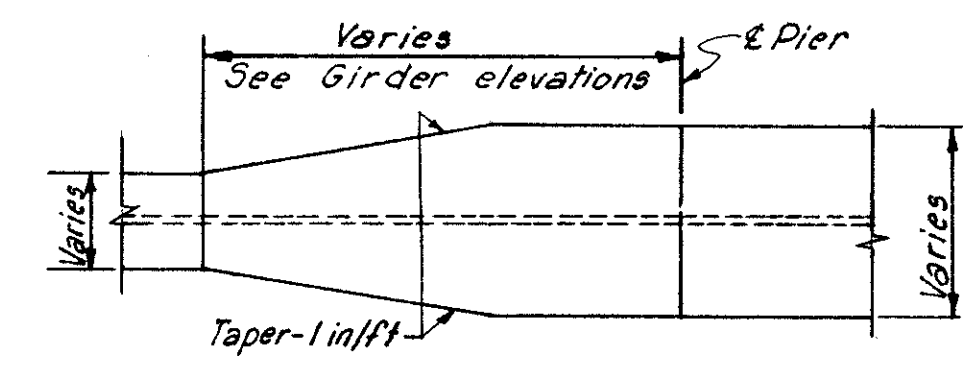

PLAN

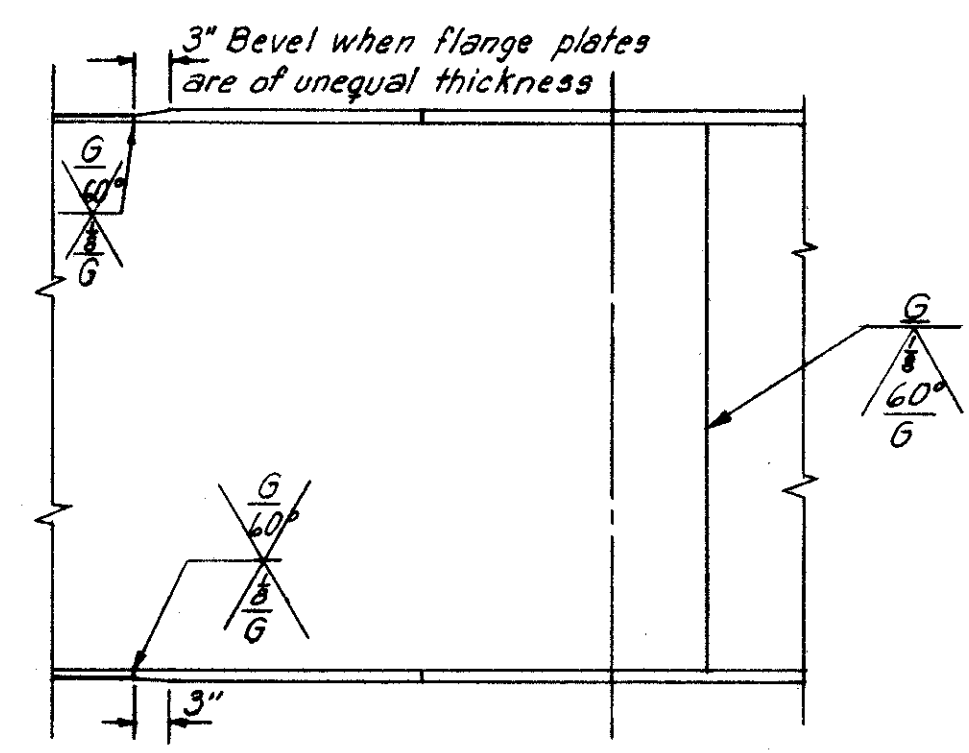

ELEVATION
TYPICAL SHOP SPLICE DETAIL

Note: Shop splices may be located as required by available plate lengths. Web and flange splices should not coincide.

GIRDER NOTES

The girders shall be fabricated to lines parallel to profiles formed by top of pavement elevations directly over the girders, plus the camber required to compensate for dead load deflections.
Top and bottom flange plates are to be the same and shall be spliced at the points shown in girder elevations, and as otherwise required.
The web plate may be spliced as required by available plate lengths.
Intermediate stiffeners shall be as shown in Table "A", except as otherwise noted at special crossframes. These stiffeners shall be placed singly or in pairs as shown on the girder elevations. Stiffeners placed in pairs shall not be welded to the flanges, but shall be fitted to close enough contact that the shop coat, when applied, will fill and close the openings. Stiffeners placed singly shall be welded to top or bottom flanges within the limits shown on the girder elevations with a 3/16" fillet weld on both sides of the joint for a distance of 2" from the outside edge of the stiffener. The other end shall have a tight fit with the flange.
Angles or plates as noted on the girder elevations shall be used at all field splices.

All field connections and girder field splices shall be made with 5/8" high strength bolts conforming to Supplemental Spec. 5-207. The bolts shall be placed with their heads on the outside face of exterior girders and on the bottom of girder flanges.
At bend points, the girders change direction at the center line of the field splice. Specialty cut splice plates will be required at these locations.
Welding shall be done in accordance with Sec. 5-7.22 of the Specifications.
Longitudinal dimensions of the girders are measured horizontally along center line of web plate.
For top of pavement elevations see sheets 134-7A & 135-7A.
For deflections see sheet 129-7A.
For cross section through deck and other superstructure details see sheet 130-7A.
For details of rocker masonry plates see sheet 173-7A.
For other rocker details and details of bolsters see Ohio Standards, DWG. RB-1-55.
For details of end dams see sheet 173-7A.
For Shop Drawing and Assembly Notes see sheet 128-7A.

TABLE "A"	
GIRDER FLANGE WIDTH	INTERMEDIATE STIFFENER
12"	R 5 x 3/8
14" to 16"	R 6 x 3/8
18" and up	R 8 x 1/2

H.N.T.B. BR. NO. 4 PART 7A

HOWARD, NEEDLES, TAMMEN & BERGENDOFF
CONSULTING ENGINEERS
KANSAS CITY CLEVELAND NEW YORK

GIRDER ELEVATIONS
INNER BELT FREEWAY OVER EAST 14th ST.
BR. NO. CUY-42-1854 STA. 70+89.23
Scale: None STA. 73+96.25
WILLOW-INNER BELT FREEWAY
CLEVELAND CUYAHOGA COUNTY OHIO

DRAWN R.A.	TRACED R.A.	CHECKED R.A.	REVIEWED R.A.	REVISED 6-20-60
DATE 1-7-55	DATE	DATE 1-11-55	DATE 11-13-55	SHEET 127






CUYAHOGA COUNTY
 CITY OF CLEVELAND
 CUY-21-1532
 CUY-42-1842

SHOP DRAWING AND ASSEMBLY NOTES

SHOP DRAWINGS for the girders shall include an overall layout with dimensions showing the relative unloaded vertical position of each girder or girder segment with respect to the others in the same girder line and with respect to a full length base or work line taking into account camber and the profile of the highway.

SHOP ASSEMBLY. At least three adjacent girder segments shall be assembled in the shop in their correct unloaded positions as shown on the shop drawing layout required in the adjacent note, so that the faced joints for welding the segments together may be checked for proper fit-up.

The same procedure of assembly shall also be used for reaming of holes for high strength bolts in field splices.

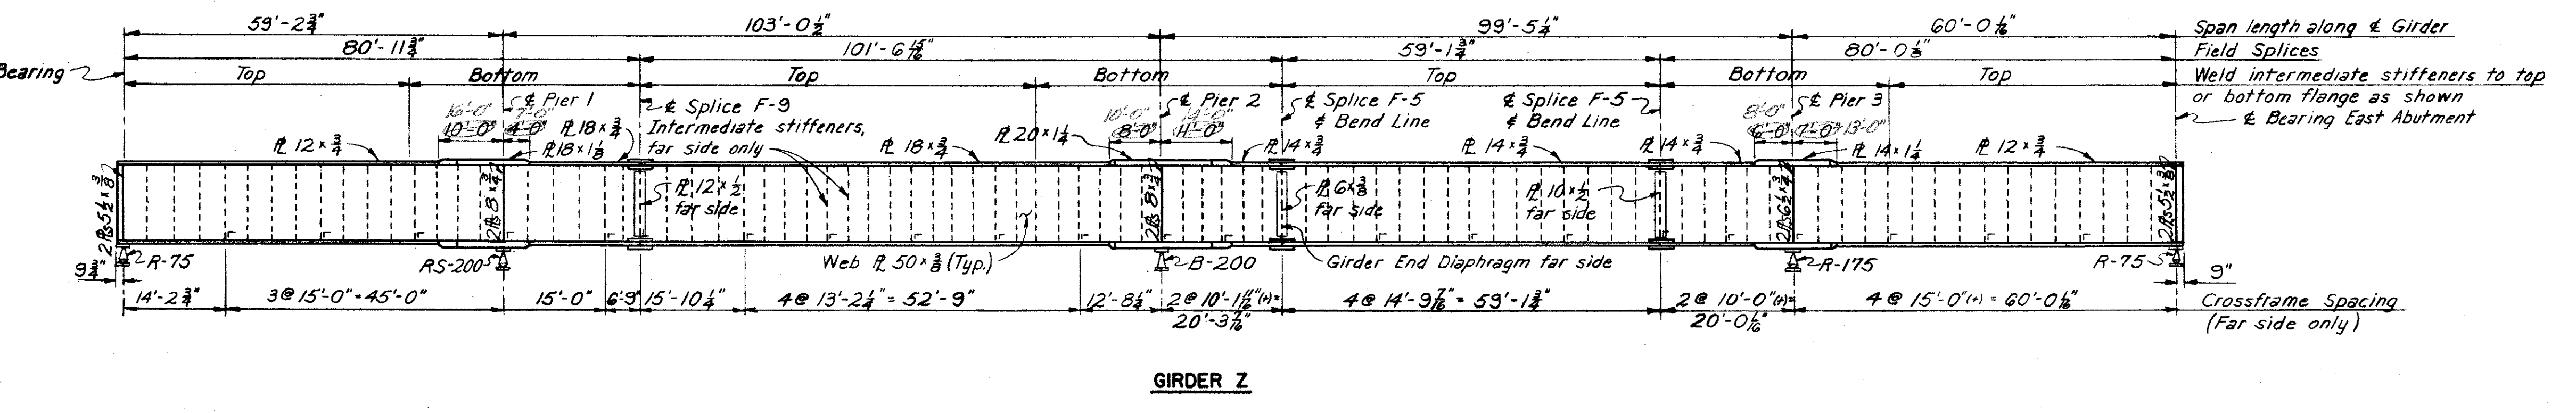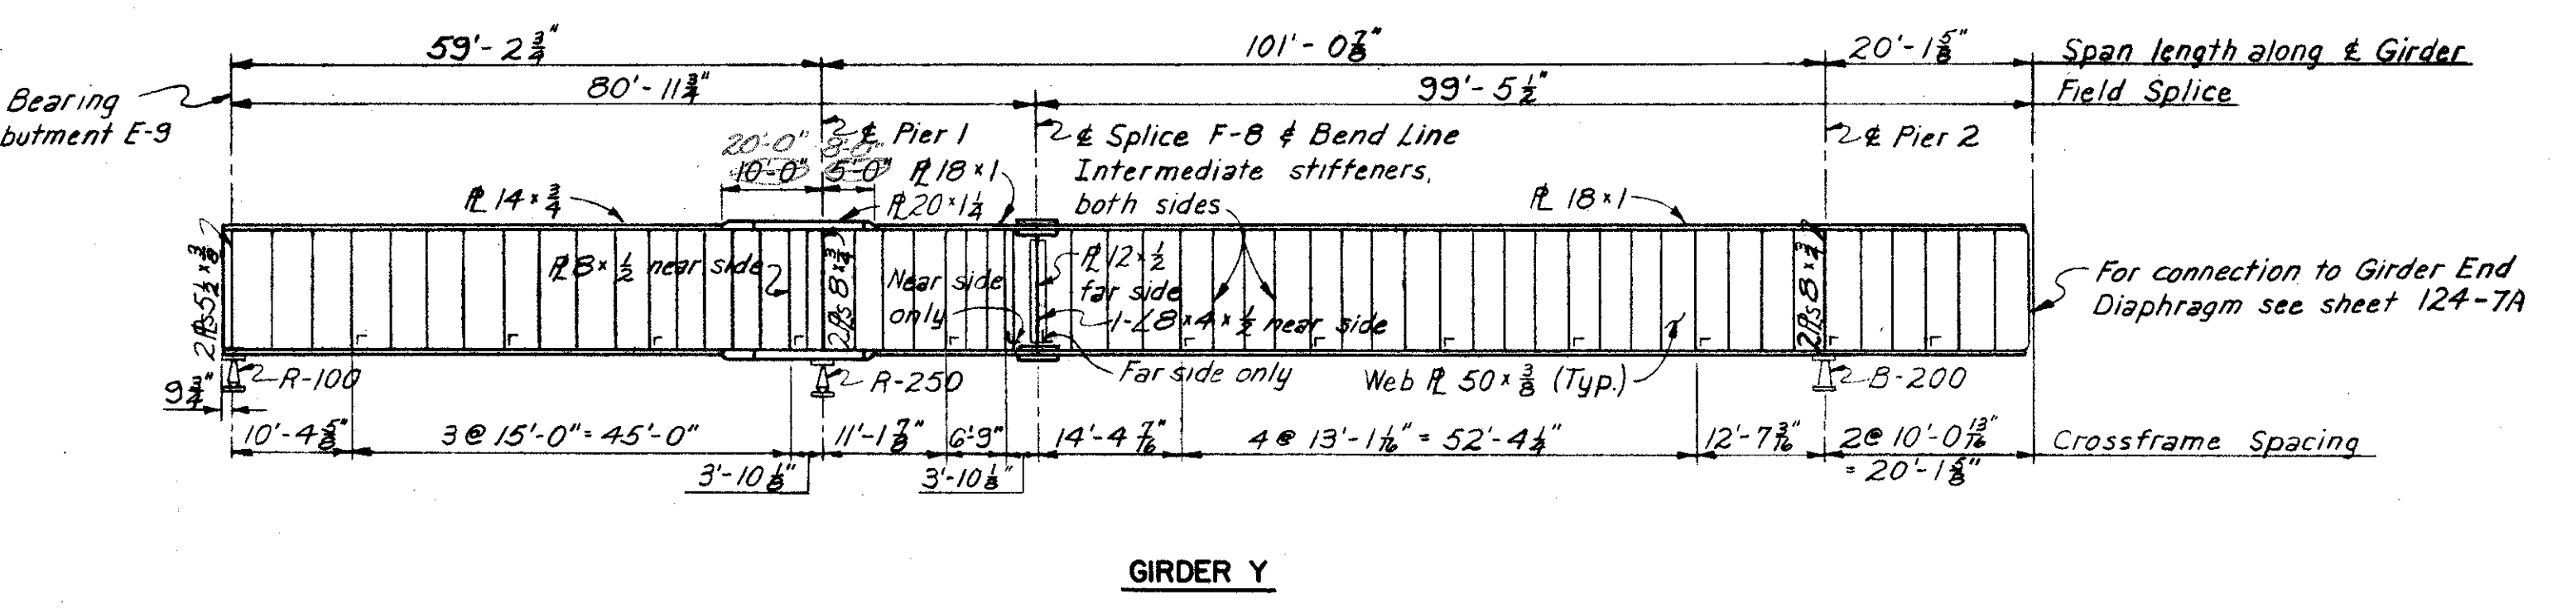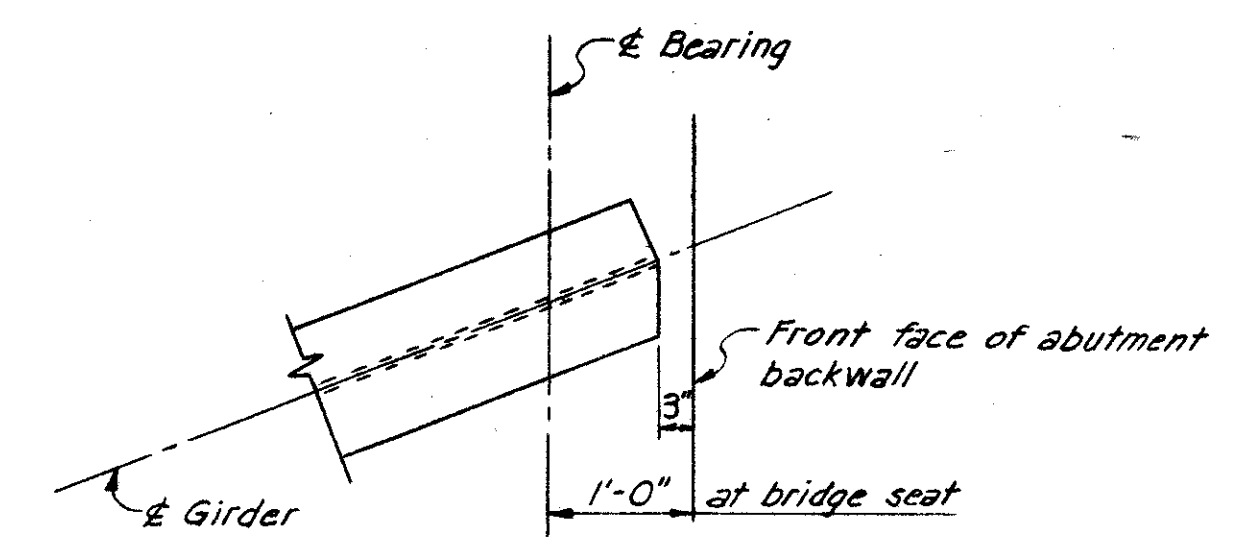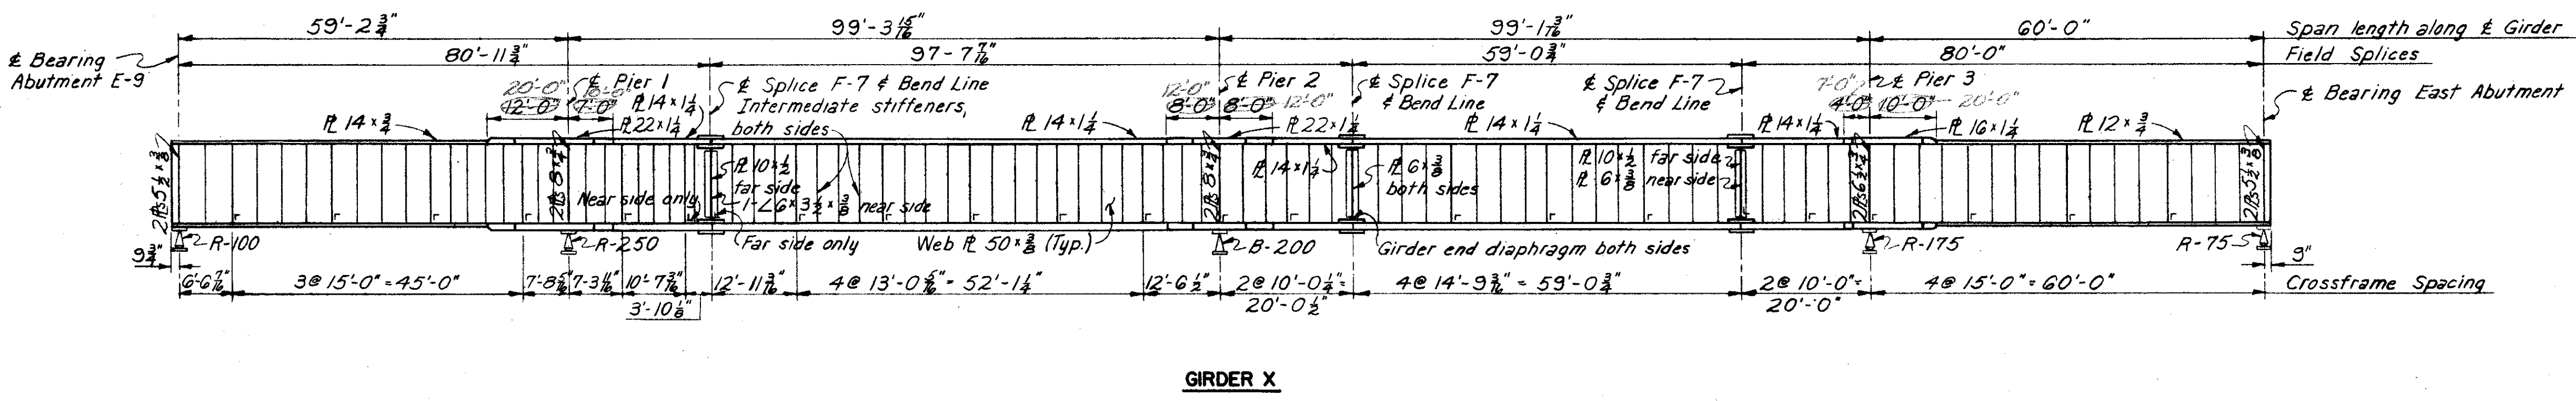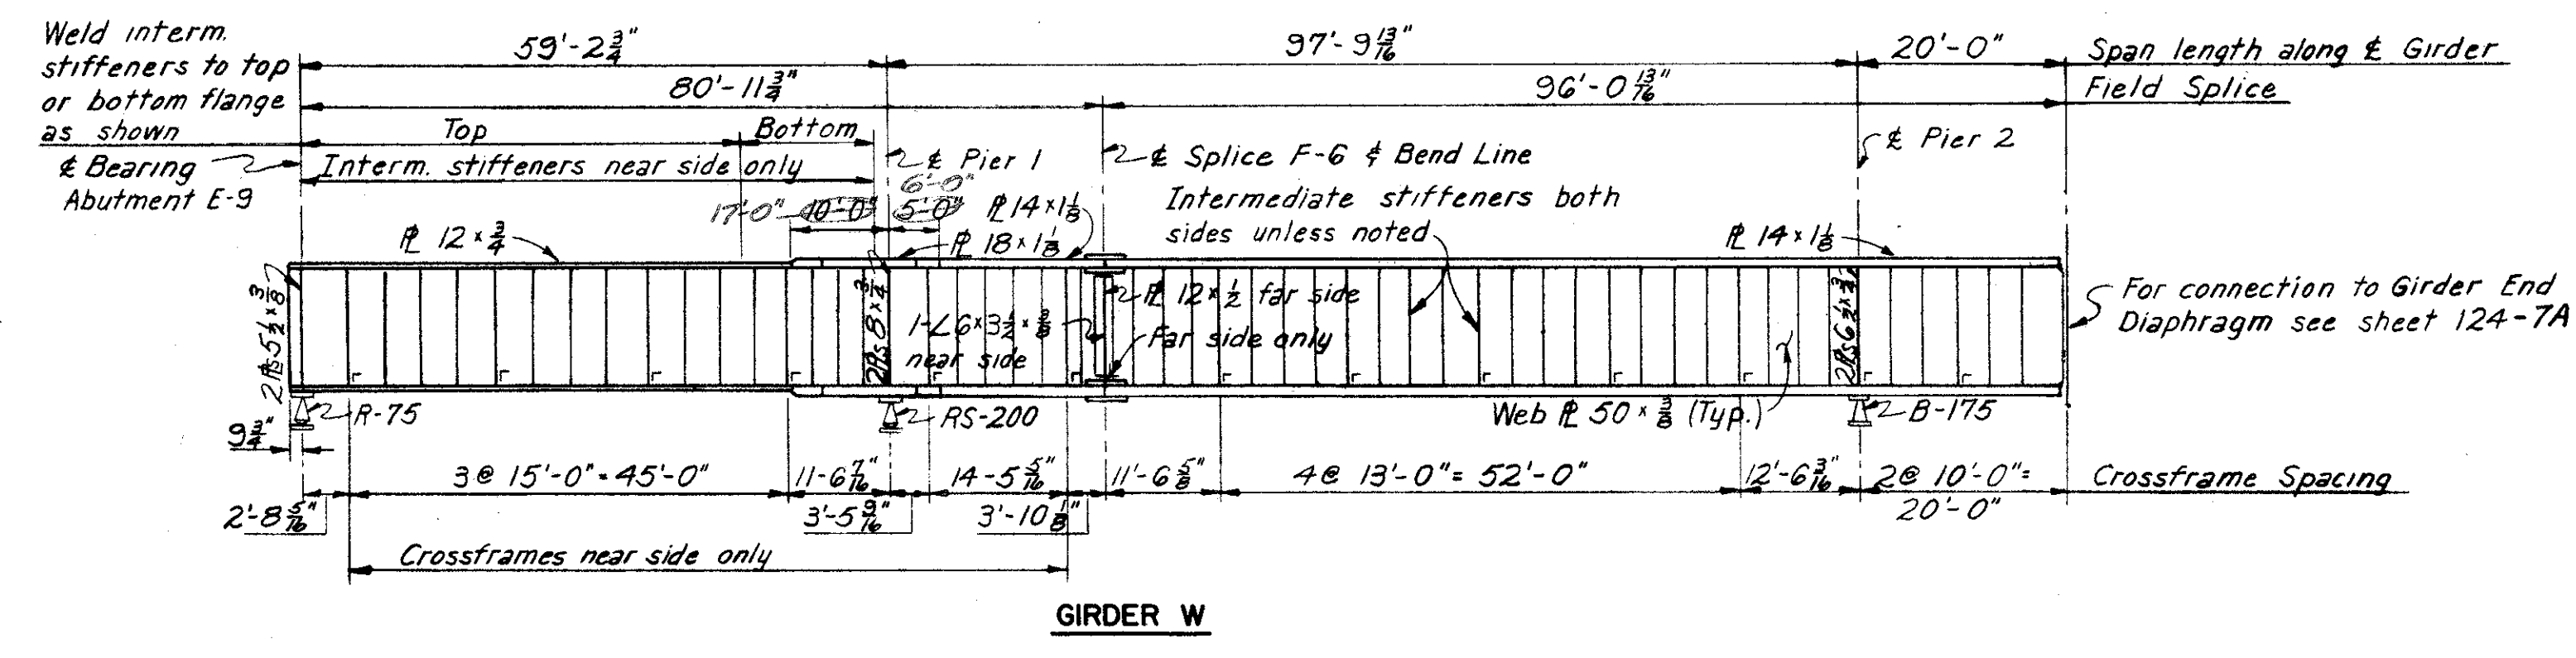

For notes see sheet 127-7A.

H.N.T.B. BR. NO. 4 PART 7A

HOWARD, NEEDLES, TAMMEN & BERGENDOFF
 CONSULTING ENGINEERS
 KANSAS CITY CLEVELAND NEW YORK

GIRDER ELEVATIONS

INNER BELT FREEWAY OVER EAST 14th ST.
 BR. NO. CUY-42-1854 STA. 70+89.23
 Scale: None STA. 73+96.25

WILLOW-INNER BELT FREEWAY
 CLEVELAND CUYAHOGA COUNTY OHIO

DRAWN C.K.B.	TRACED DATE	CHECKED P.H.	REVIEWED J.C.T.	REVISED 6-20-60
DATE 7-3-59	DATE	DATE 2-5-59	DATE 11-13-59	SHEET 128

Legend: (Conc.) in deflection table refers to deflections due to dead load of concrete.

Note: Deflections are measured to the nearest 1/16". Negative sign indicates upward deflection.

DEFLECTION TABLE - SPAN 1

Table with columns for Beam (A-Z) and Deflection (Dead Load Conc., Total) for Spans 1-5 (A-J).

DEFLECTION TABLE - SPAN 3



Table with columns for Beam (A-Z) and Deflection (Dead Load Conc., Total) for Spans 1-5 (A-J).

DEFLECTION TABLE - SPAN 2

Table with columns for Beam (A-Z) and Deflection (Dead Load Conc., Total) for Spans 1-5 (A-J).

DEFLECTION TABLE - SPAN 4

Table with columns for Beam (A-Z) and Deflection (Dead Load Conc., Total) for Spans 1-5 (A-J).

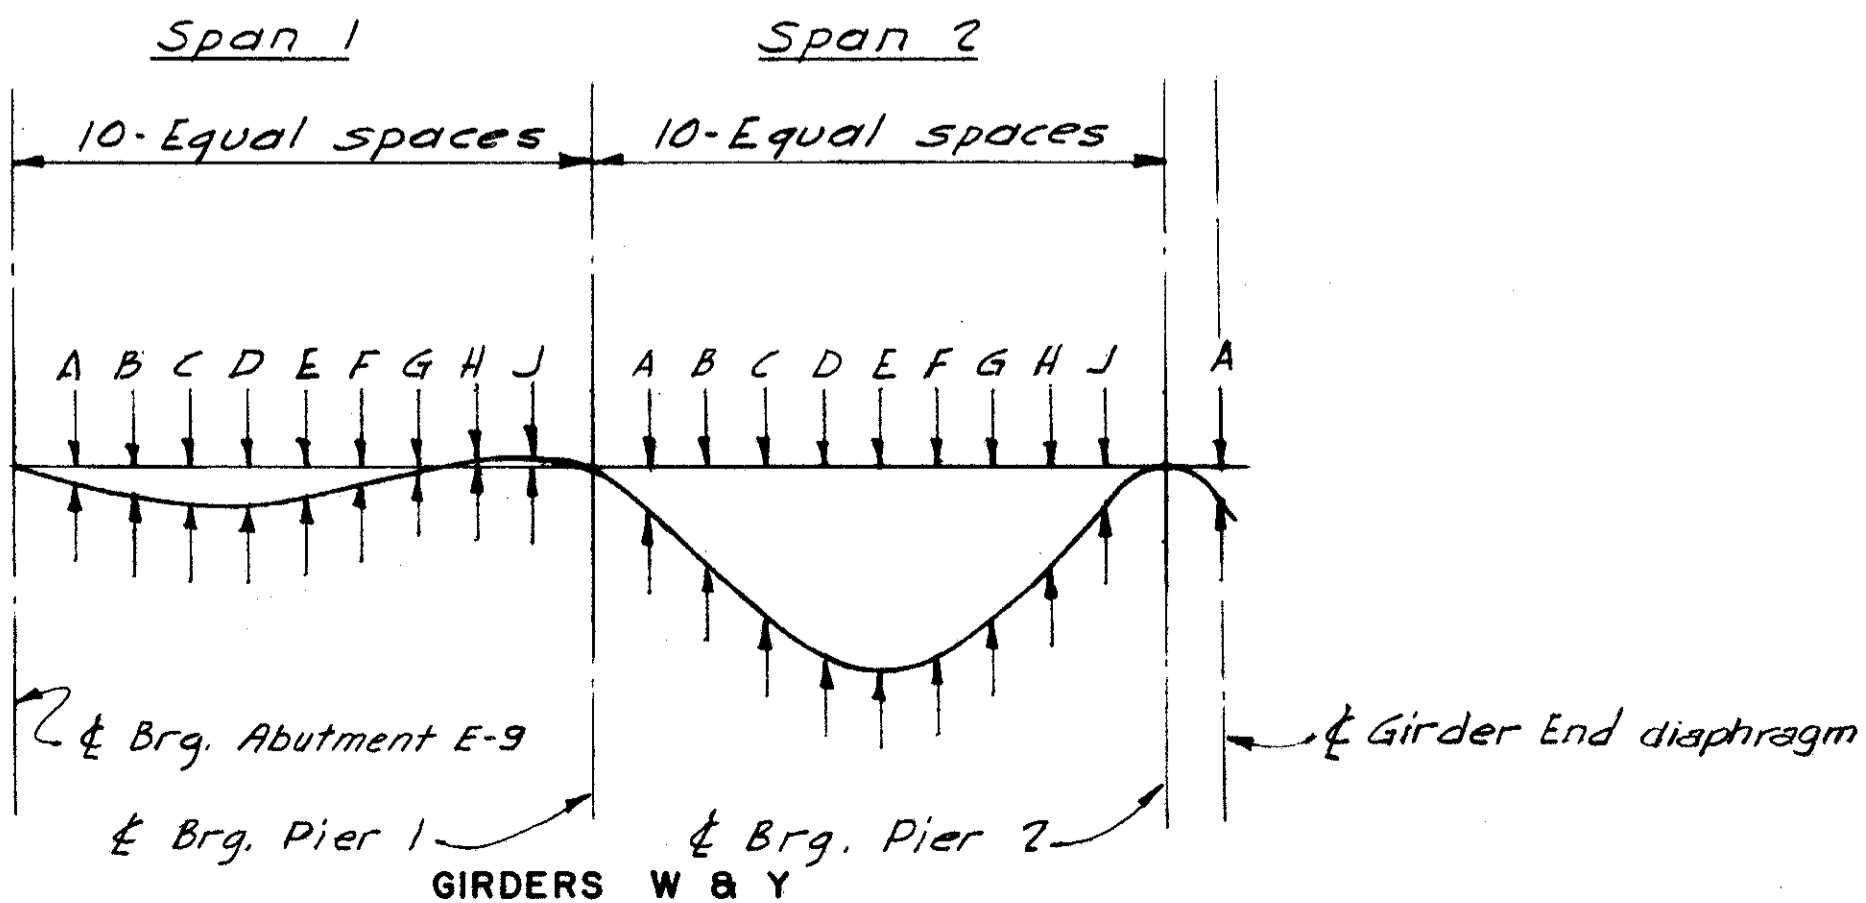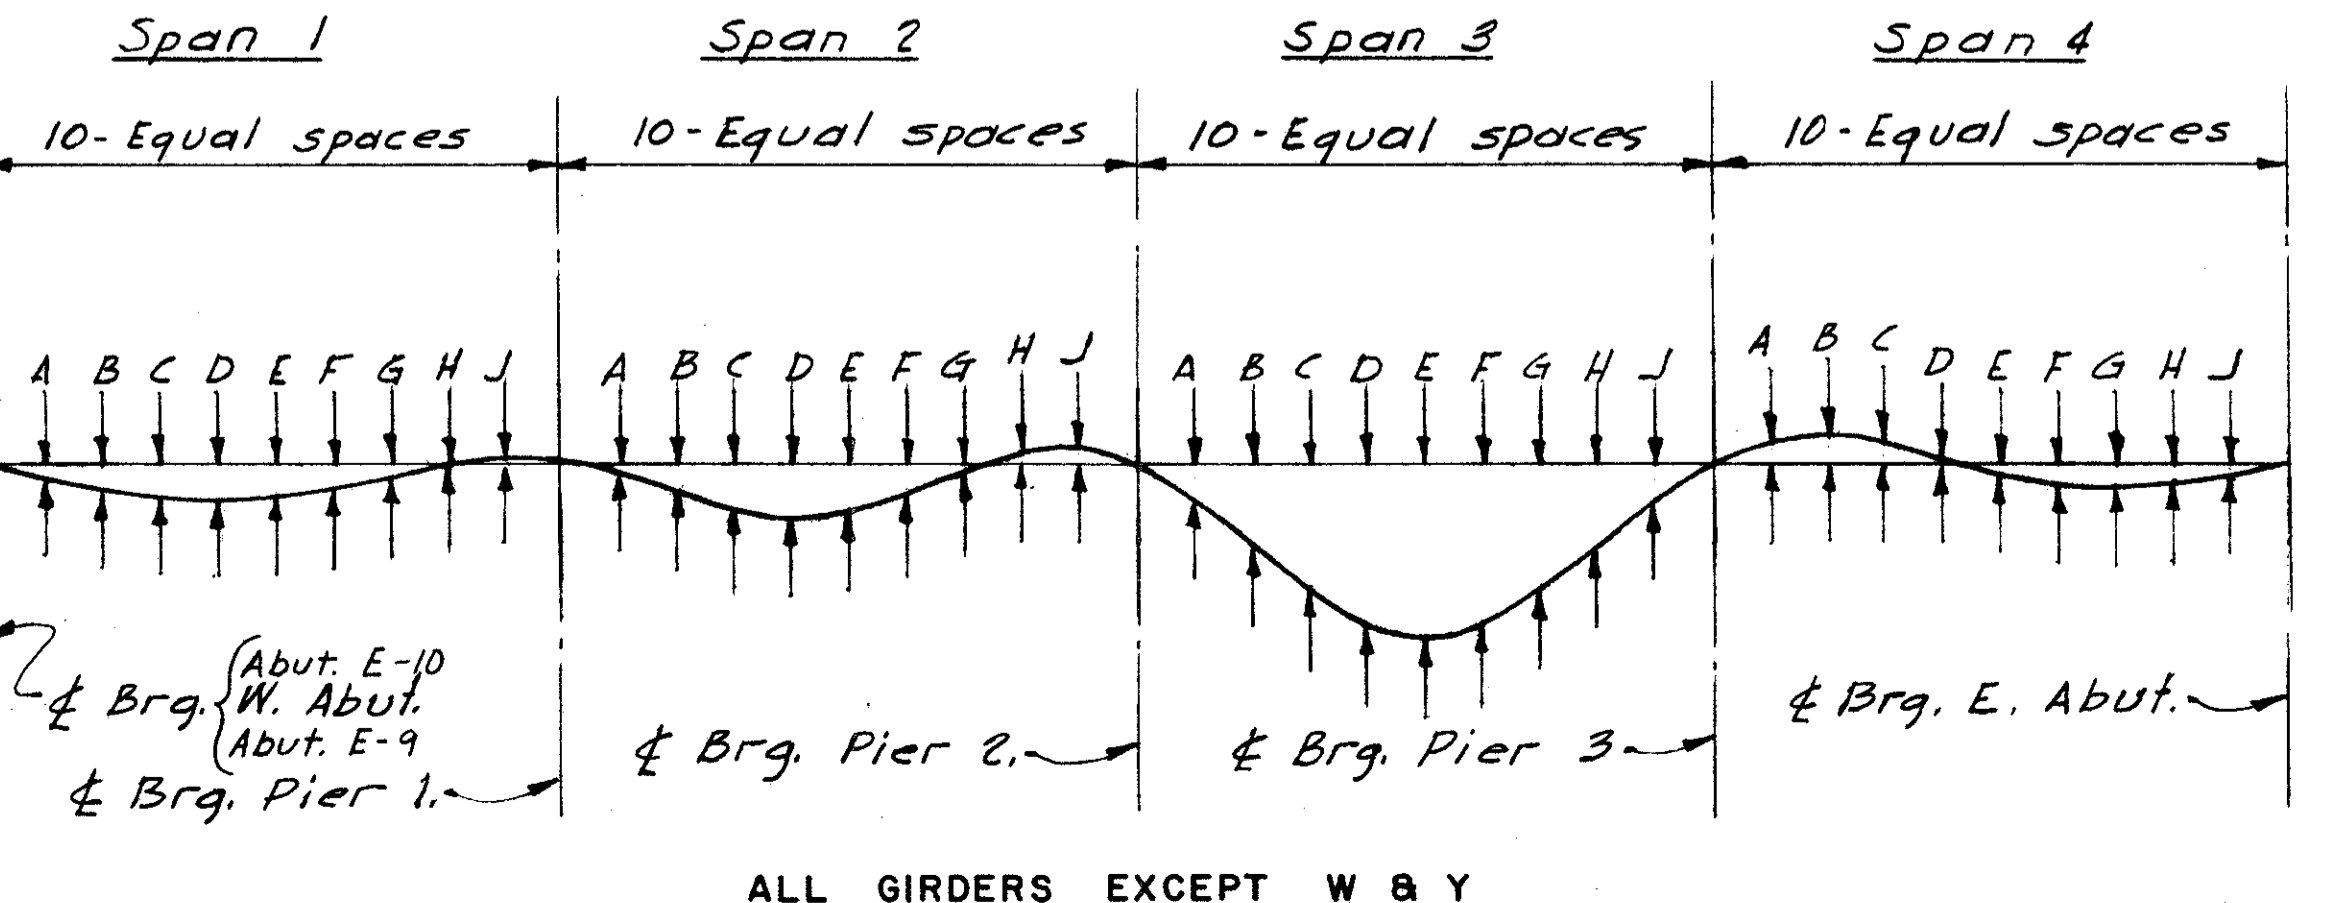

Engineering title block: H.N.T.B. BR. NO. 4 PART 7A. HOWARD, NEEDLES, TAMMEN & BERGENDOFF CONSULTING ENGINEERS CLEVELAND NEW YORK. GIRDER DEFLECTIONS. INNER BELT FREEWAY OVER EAST 14th ST. BR. NO. CUY-42-1854 STA. 70 + 89.23. Scale: None STA. 73 + 96.25. WILLOW-INNER BELT FREEWAY. CLEVELAND CUYAHOGA COUNTY OHIO.

Note: Prefix "SB" shall be assigned to all bar marks.


MICROFILMED
JUL 8 1985

FED. ROADS DIV. NO.	STATE	FED. AID PROJ. NO.
2	OHIO	

130
181


CUYAHOGA COUNTY
CITY OF CLEVELAND
CUY-21-1532
CUY-42-1842

Note:
Details shown in section A-A are typical throughout superstructure except for bar marks, direction of roadway slope, and roadway width.
For location of Section A-A see sh. 132-7A.
For location of 2" Conduit see sh. 134-7A & 135-7A.

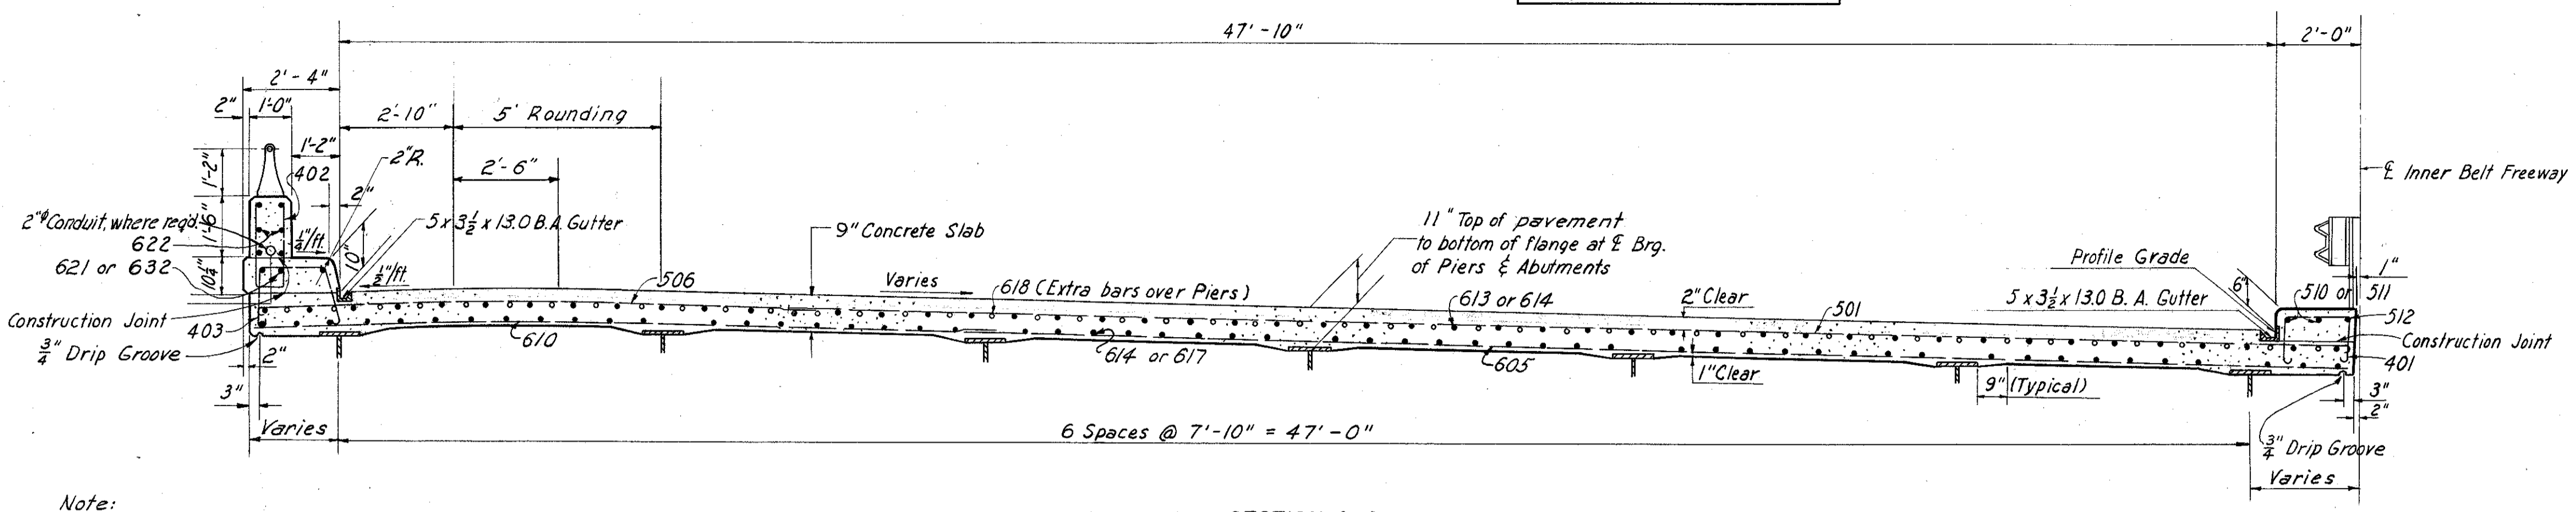


SECTION A-A
Scale: 3/8" = 1'-0"


Note:
Slab thickness shown includes 1" for monolithic wearing surface.

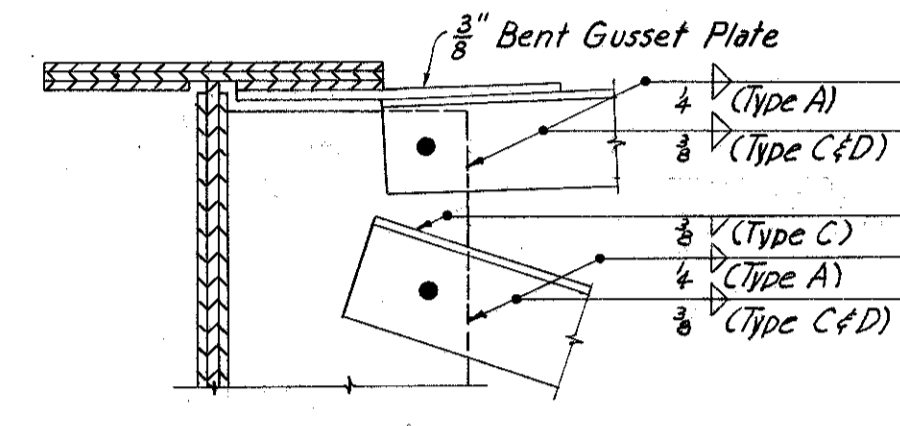


DETAIL "A"
Scale: 1/2" = 1'-0"

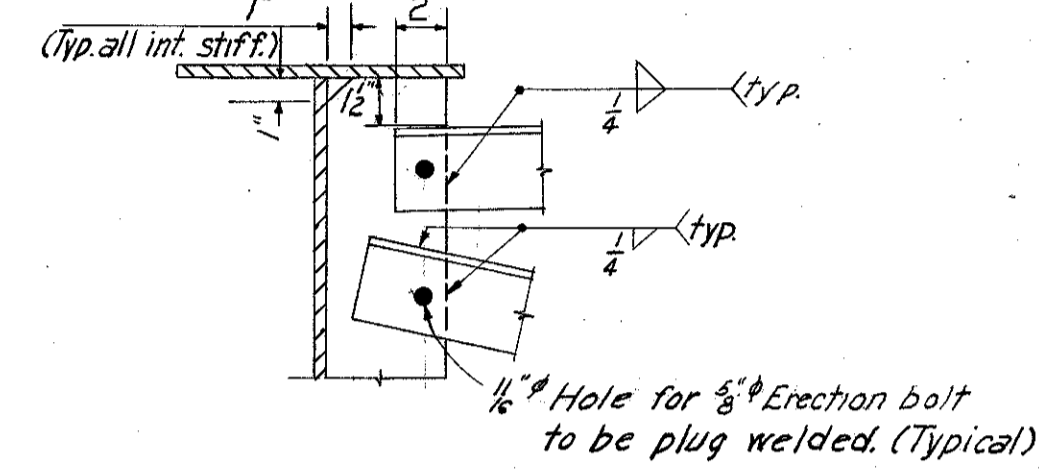


DETAIL "B"
Scale: 1/2" = 1'-0"

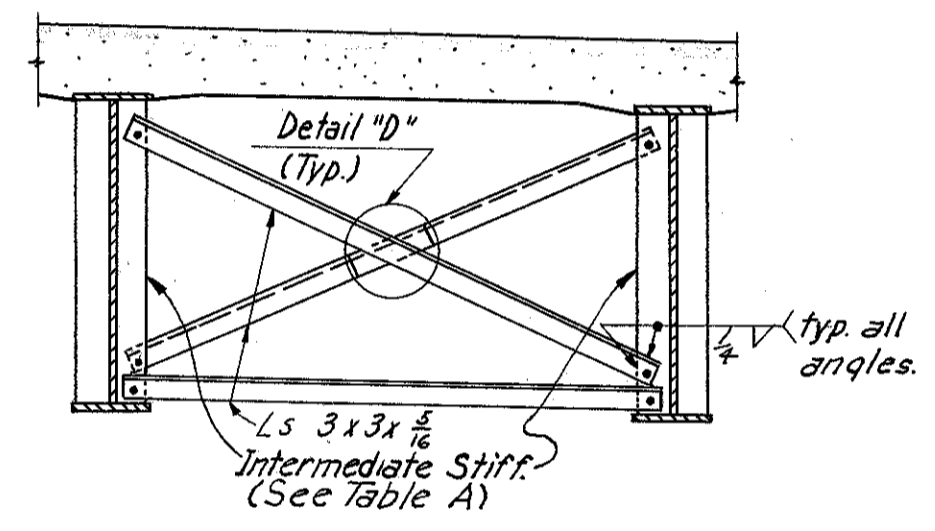


TYPICAL INTERMEDIATE CROSSFRAME

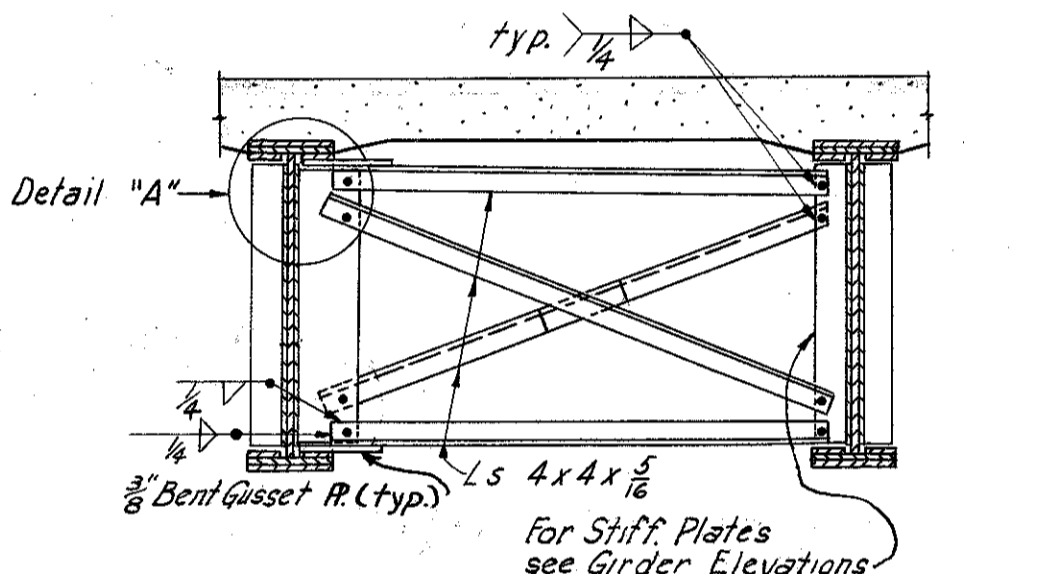


BEND LINE CROSSFRAME AT FIELD SPLICE TYPE (A)

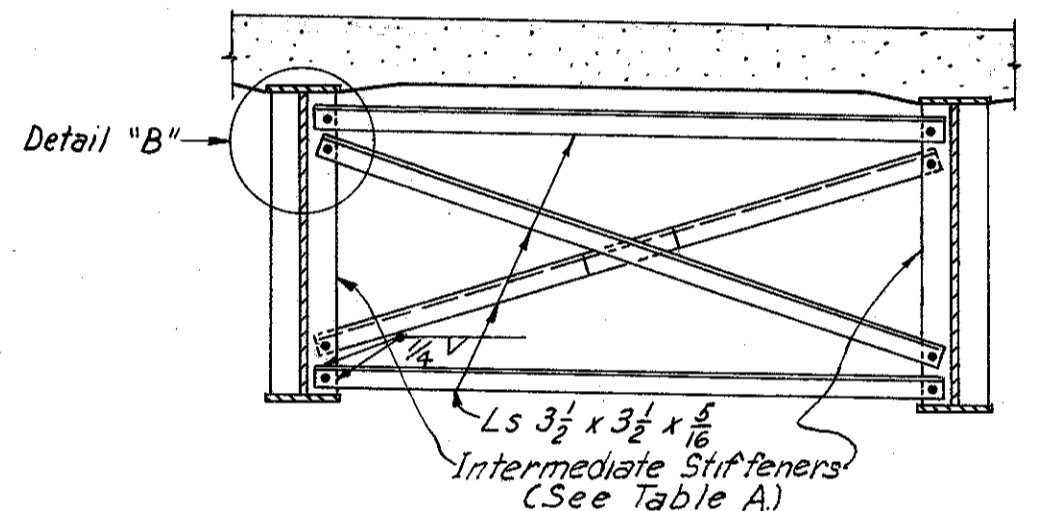


BEND LINE CROSSFRAME TYPE (B)

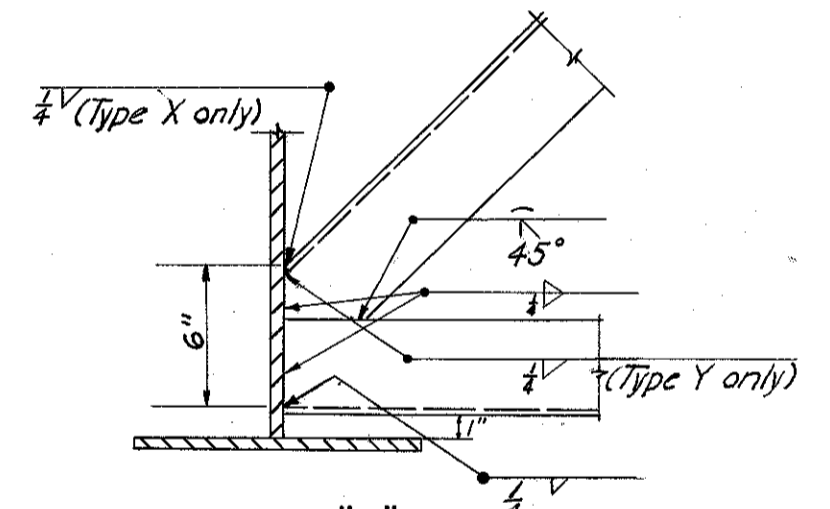


DETAIL "C"
Scale: 1/2" = 1'-0"

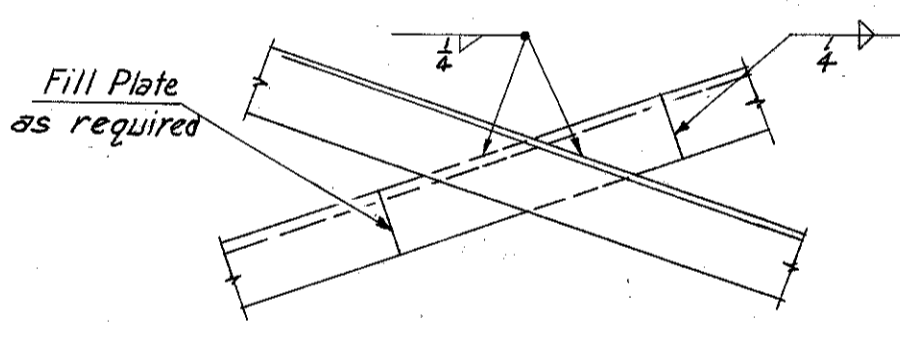


DETAIL "D"
Scale: 1/2" = 1'-0"

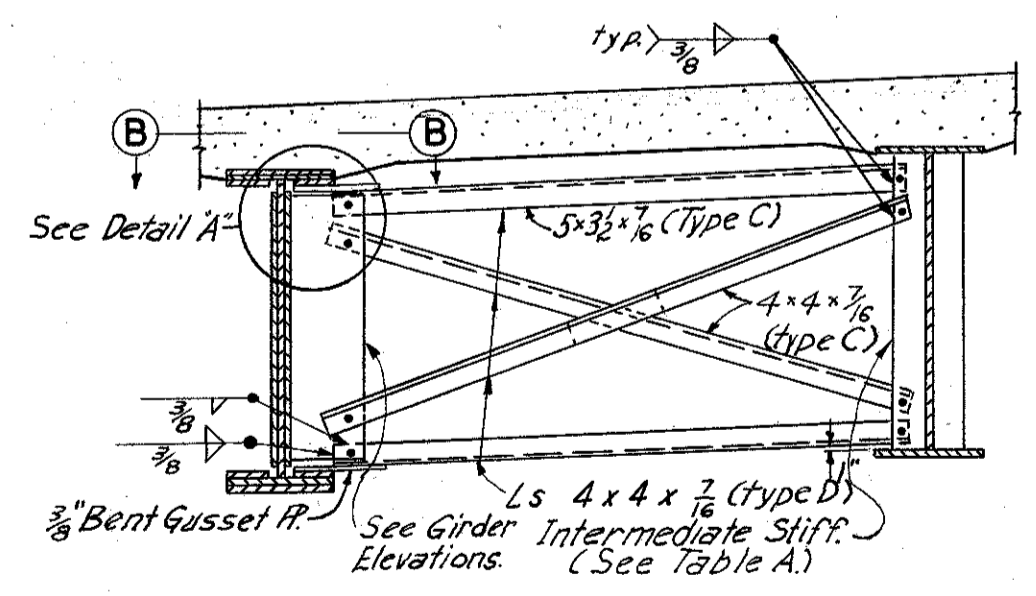

BEND LINE CROSSFRAME AT FIELD SPLICE TYPE (C&D)

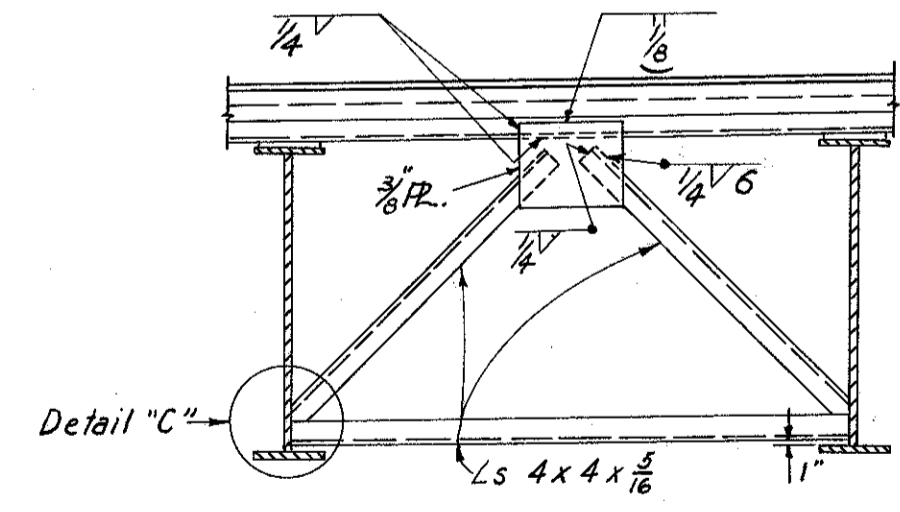


END CROSSFRAME TYPE (X)

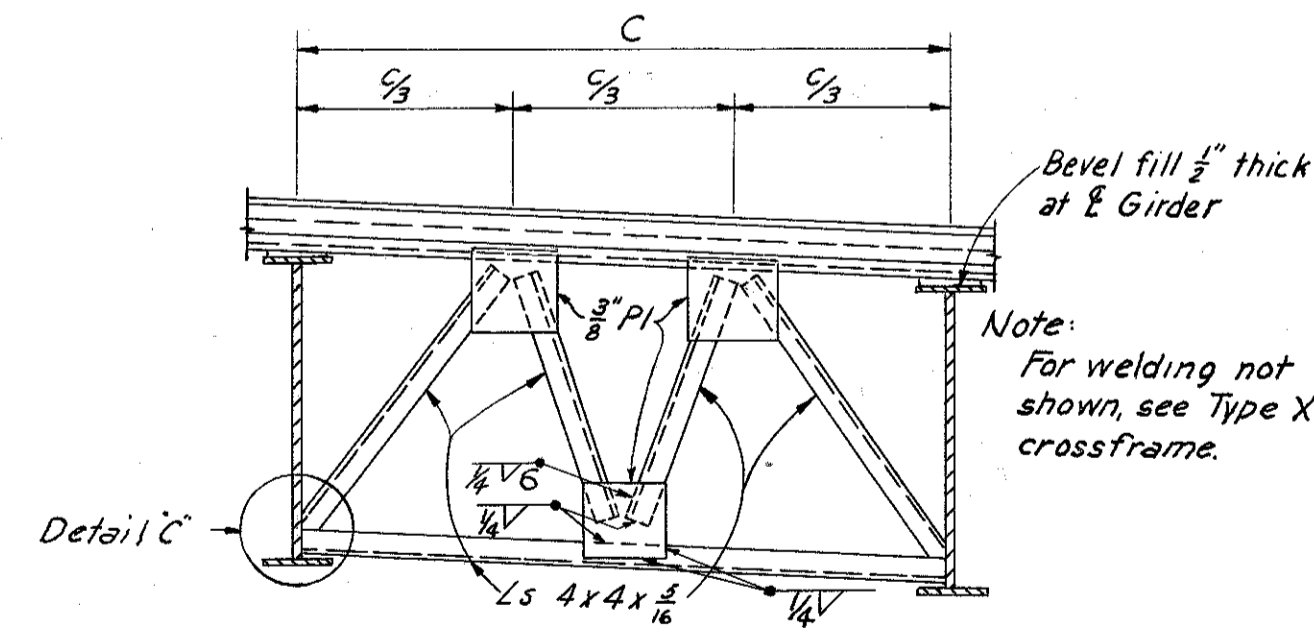

END CROSSFRAME TYPE (Y)

Note:
For End Dam Details see sh. 173-7A
For Drainage Details see sh. 174-7A

FLANGE WIDTH	INTERMEDIATE STIFFENER
12"	5" x 3/8"
14"-16"	6" x 3/8"
18"-22"	8" x 1/2"

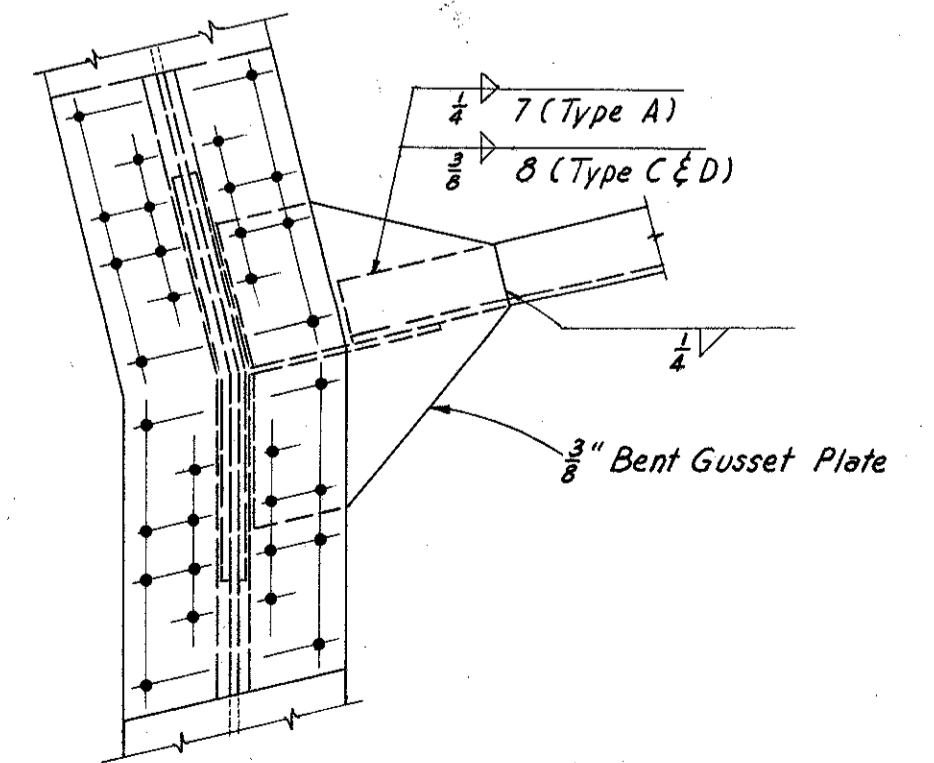

SECTION B-B
Scale: 1" = 1'-0"
(Connection typical for top and bottom flanges, crossframes types A, C & D.)

H.N.T.B. BR. NO. 4 PART 7A

HOWARD, NEEDLES, TAMMEN & BERGENDOFF
CONSULTING ENGINEERS
KANSAS CITY CLEVELAND NEW YORK

TYPICAL SECTIONS

INNER BELT FREEWAY OVER EAST 14th ST.
BR. NO. CUY.-42-1854 STA. 70+89.23
Scale: 3/8" = 1'-0" Except as noted STA. 73+96.25

WILLOW-INNER BELT FREEWAY
CLEVELAND CUYAHOGA COUNTY OHIO



DRAWN GAT	TRACED G.A.T.	CHECKED A.F.	REVIEWED J.C.T.
DATE 2-27-59	DATE 2-27-59	DATE 11-4-59	DATE 11-13-59

SHEET 130

JUL 8 1965

CUYAHOGA COUNTY
CITY OF CLEVELAND
CUY-21-1532
CUY-42-1842

Note: Prefix "SA" shall be assigned to all bar marks.

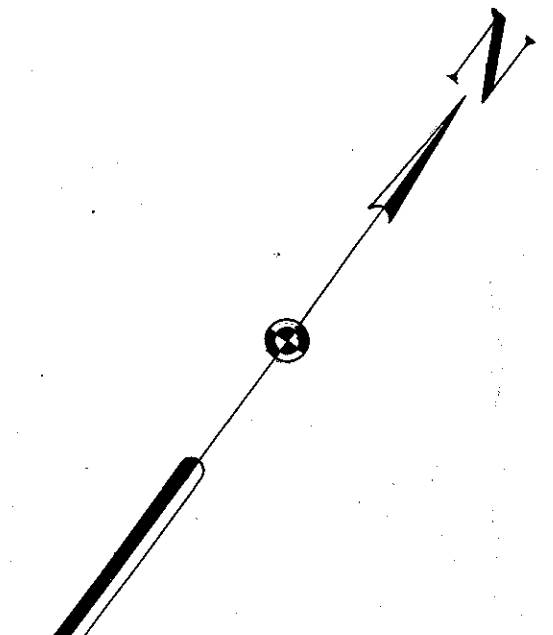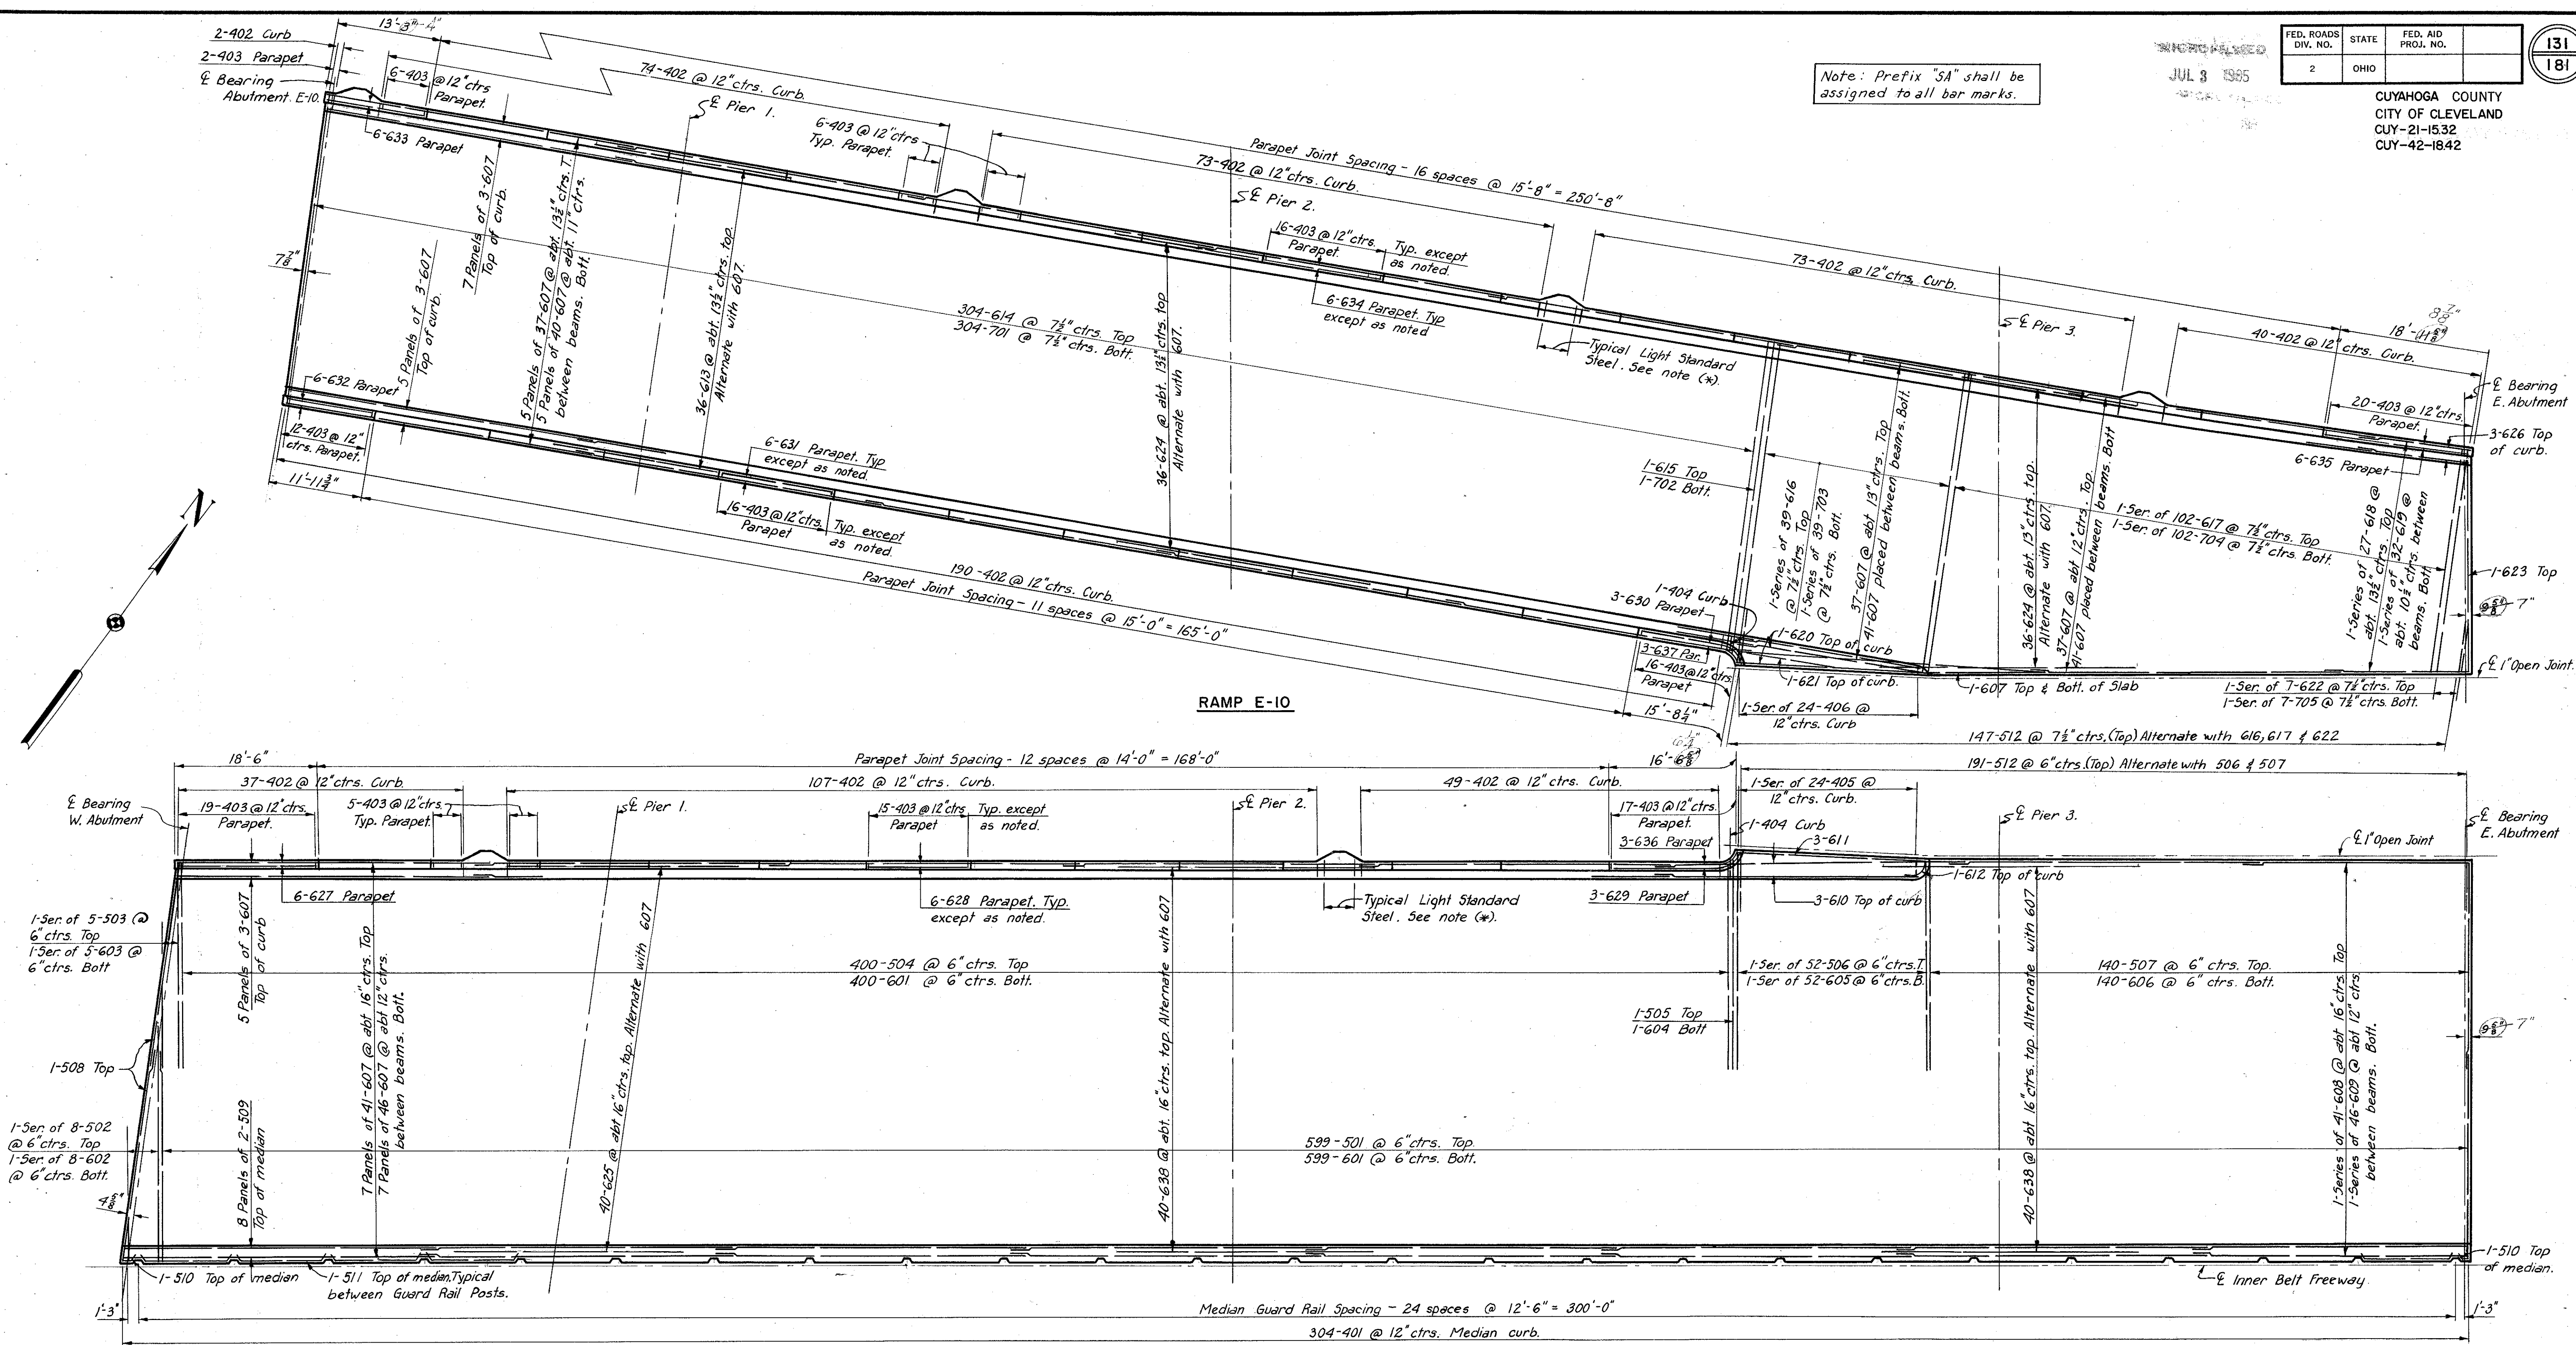

NOTES:
For Typical Roadway Section, see Sheet 130-7A
For Reinforcement Schedule, see Sheet 133-7A
For Light Standard locations, see Sheet 134-7A
(* For Light Standard Support details, see Sheet 176-7A
For additional notes, see Sheet 132-7A
For nose details, see Sheet 136-7A

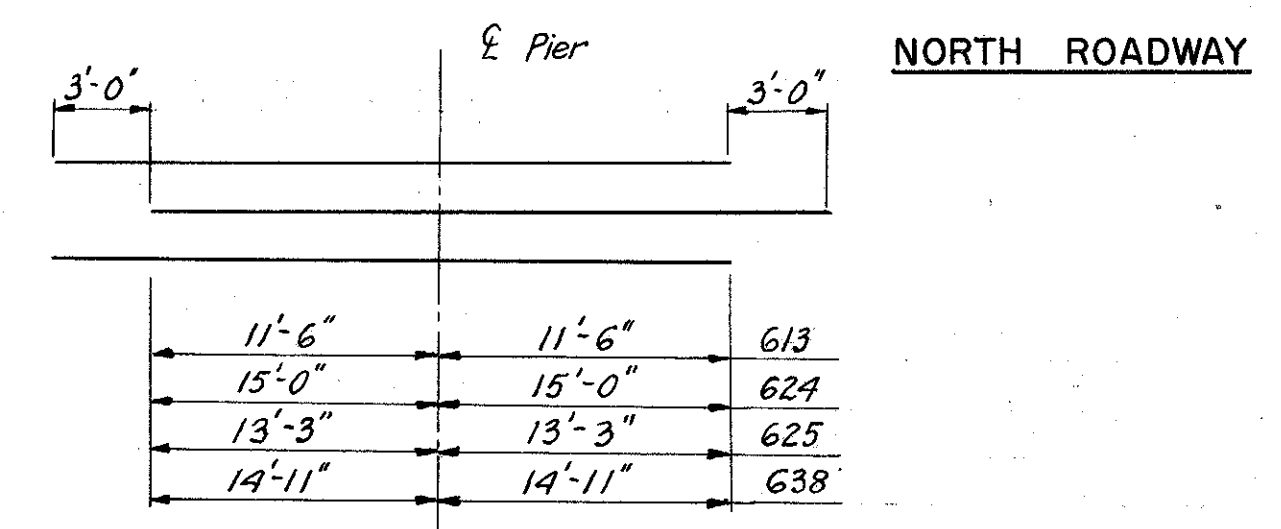


DIAGRAM SHOWING STAGGER OF BARS
613, 624, 625 & 638 OVER PIERS

H.N.T.B. BR. NO. 4 PART 7A

HOWARD, NEEDLES, TAMMEN & BERGENDOFF
CONSULTING ENGINEERS
KANSAS CITY CLEVELAND NEW YORK

DECK PLAN-NORTH HALF

INNER BELT FREEWAY OVER EAST 14th ST.
BR. NO. CUY-42-1854 STA. 70+89.23
Scale: 1" = 10'-0" STA. 73+96.25


WILLOW-INNER BELT FREEWAY
CLEVELAND CUYAHOGA COUNTY OHIO

DRAWN A.L.	TRACED A.L.	CHECKED 6/7	REVIEWED JCT	REVISED 4-17-60
DATE 2-6-59	DATE 2-6-59	DATE 2-9-59	DATE 11-13-57	SHEET 131

CUYAHOGA COUNTY
CITY OF CLEVELAND
CUY-21-1532
CUY-42-1842

Note: Prefix "SB" shall be assigned to all bar marks.

MICROFILMED
NOV 8 1985




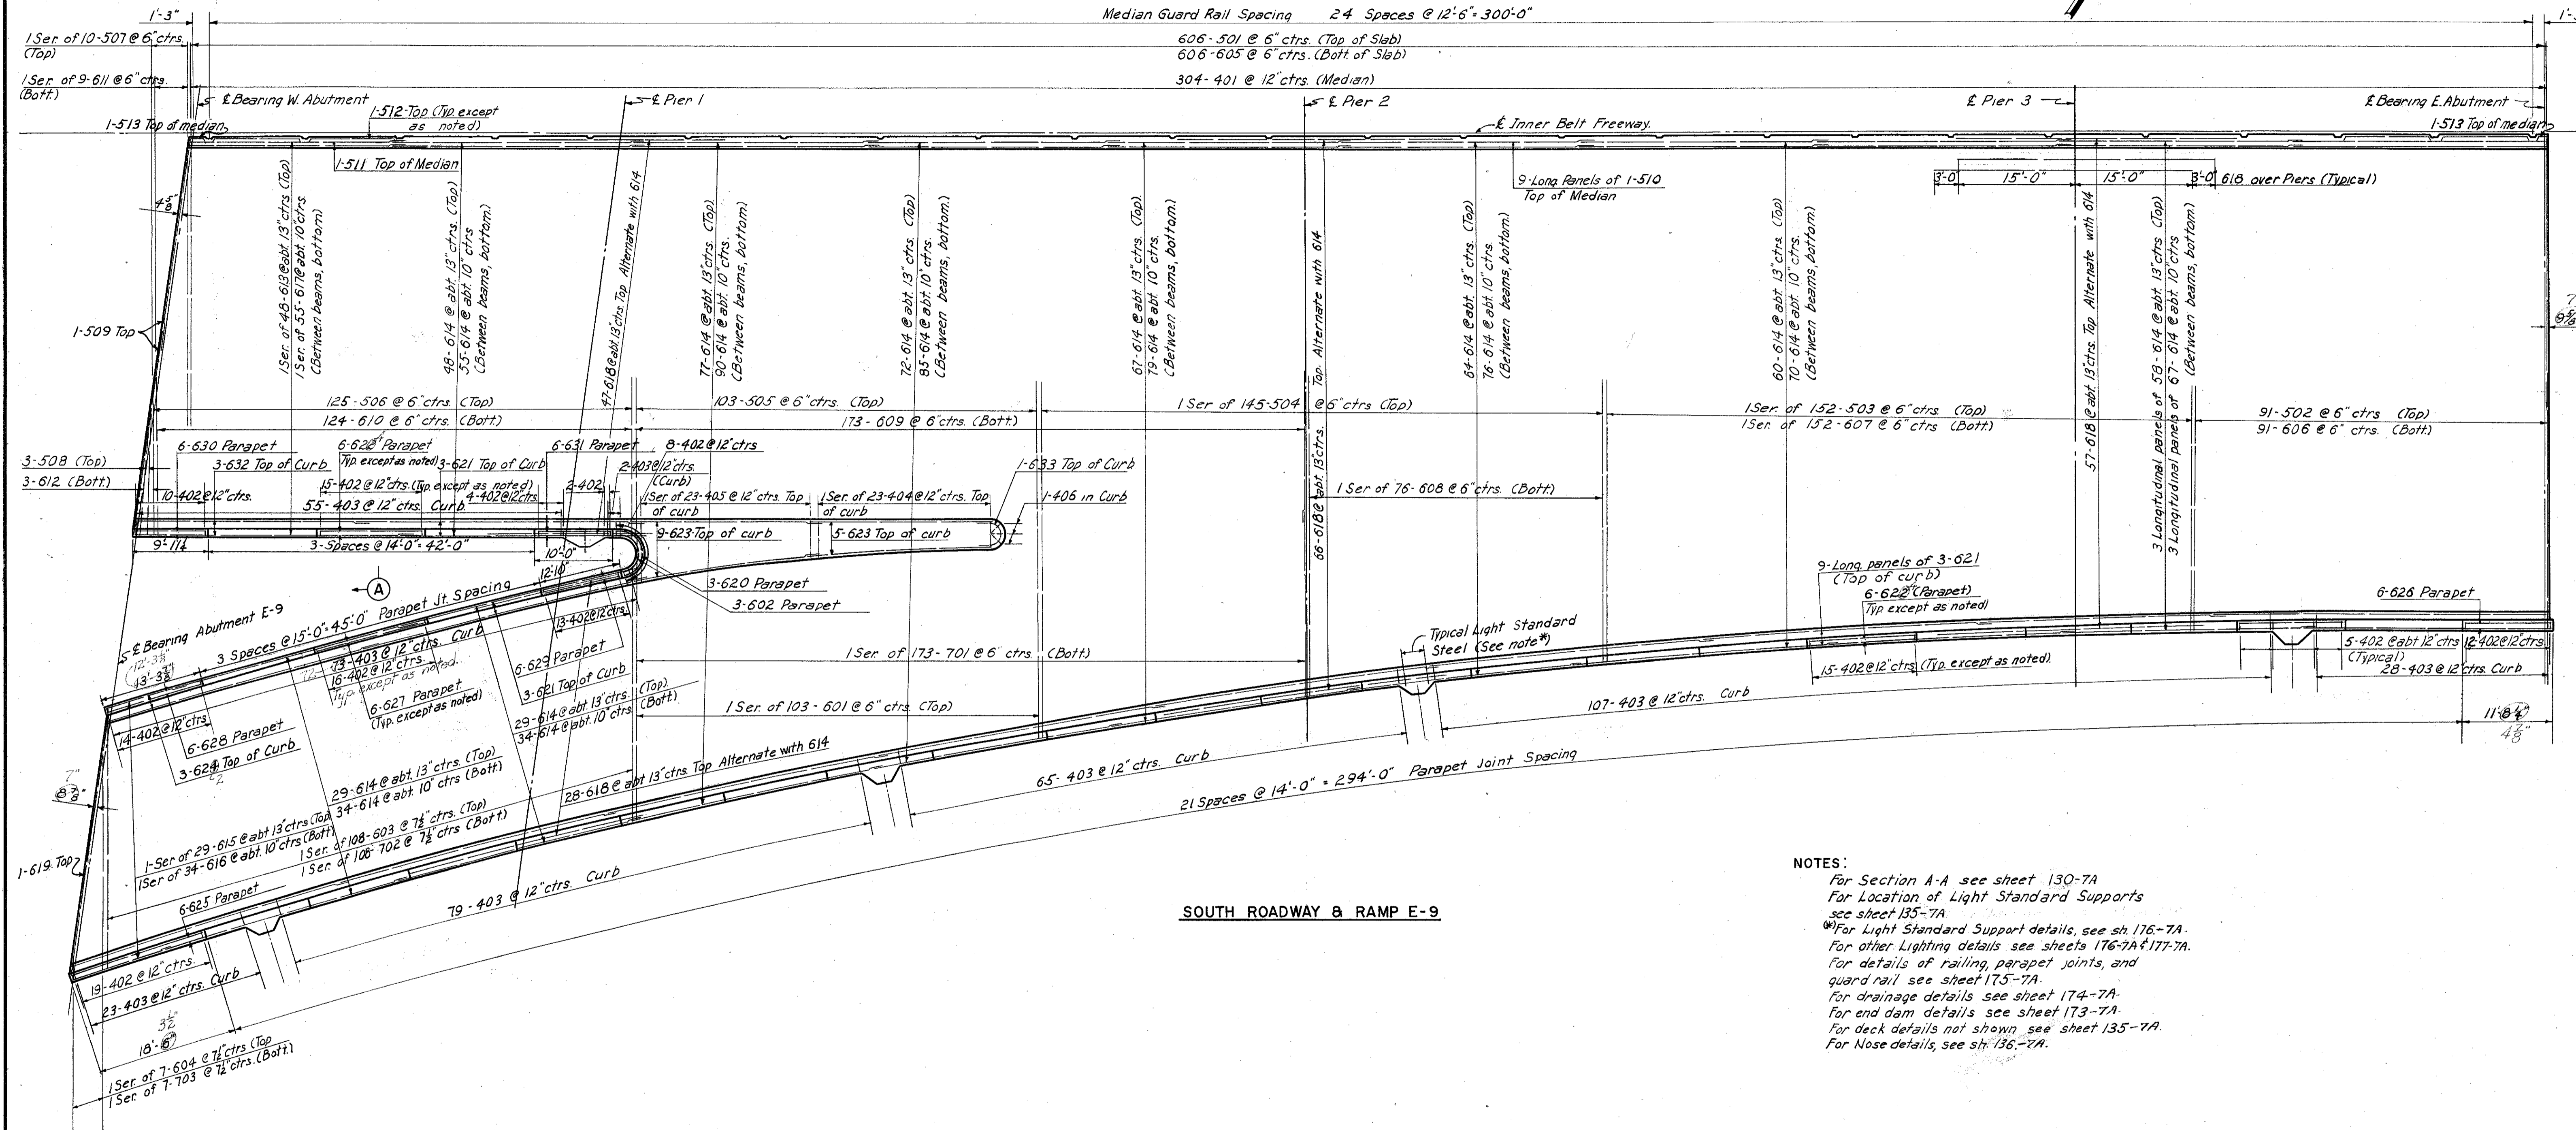


SOUTH ROADWAY & RAMP E-9


- NOTES:**
- For Section A-A see sheet 130-7A
 - For Location of Light Standard Supports see sheet 135-7A
 - For Light Standard Support details, see sh. 176-7A
 - For other Lighting details see sheets 176-7A & 177-7A
 - For details of railing, parapet joints, and guard rail see sheet 175-7A
 - For drainage details see sheet 174-7A
 - For end dam details see sheet 173-7A
 - For deck details not shown see sheet 135-7A
 - For Nose details, see sh. 136-7A

H.N.T.B. BR. NO. 4 PART 7A

HOWARD, NEEDLES, TAMMEN & BERGENDOFF CONSULTING ENGINEERS KANSAS CITY CLEVELAND NEW YORK	
DECK PLAN- SOUTH HALF	
INNER BELT FREEWAY OVER EAST 14th ST.	
BR. NO. CUY- 42-1854	STA. 70+8923
Scale: 1" = 10'-0"	STA. 73+96.25
WILLOW-INNER BELT FREEWAY	
CLEVELAND	CUYAHOGA COUNTY OHIO
DRAWN BY: [Signature]	TRACED BY: [Signature]
CHECKED BY: [Signature]	REVIEWED BY: [Signature]
DATE: 2-12-59	DATE: 2-24-59
DATE: 2-13-59	DATE: 11-13-59
SHEET 132	

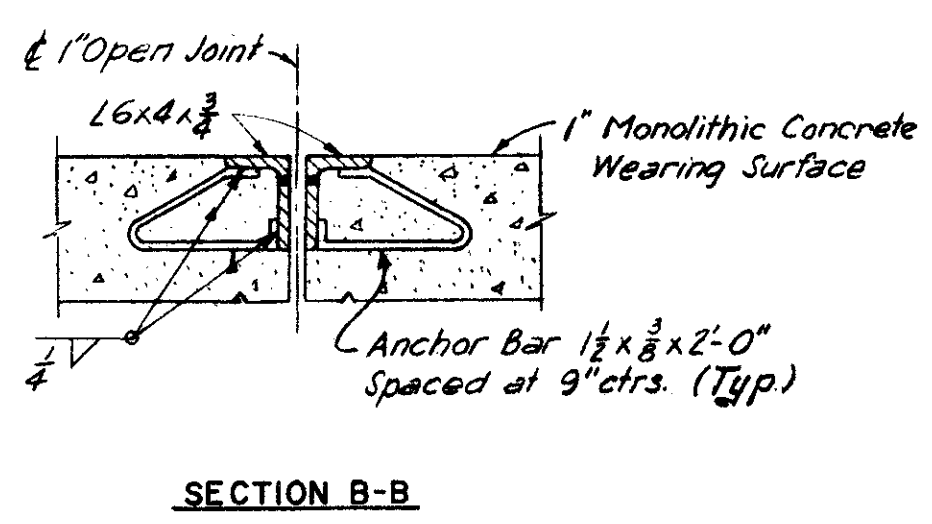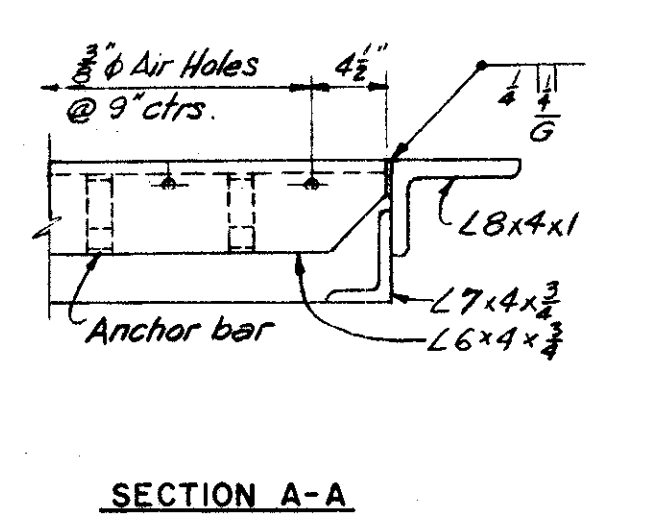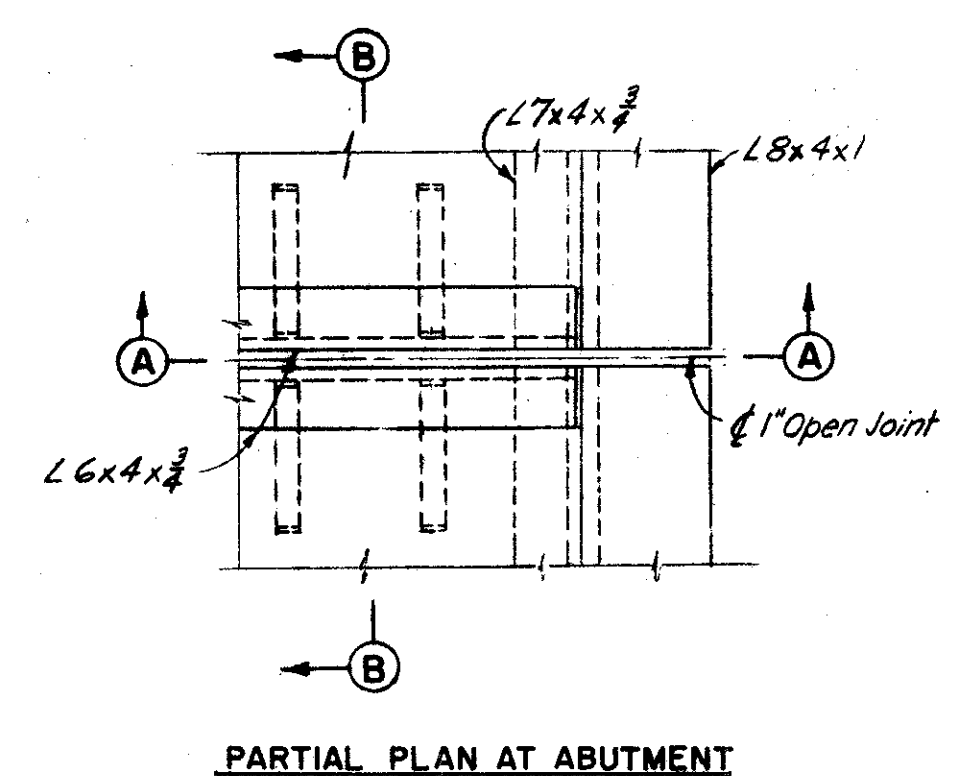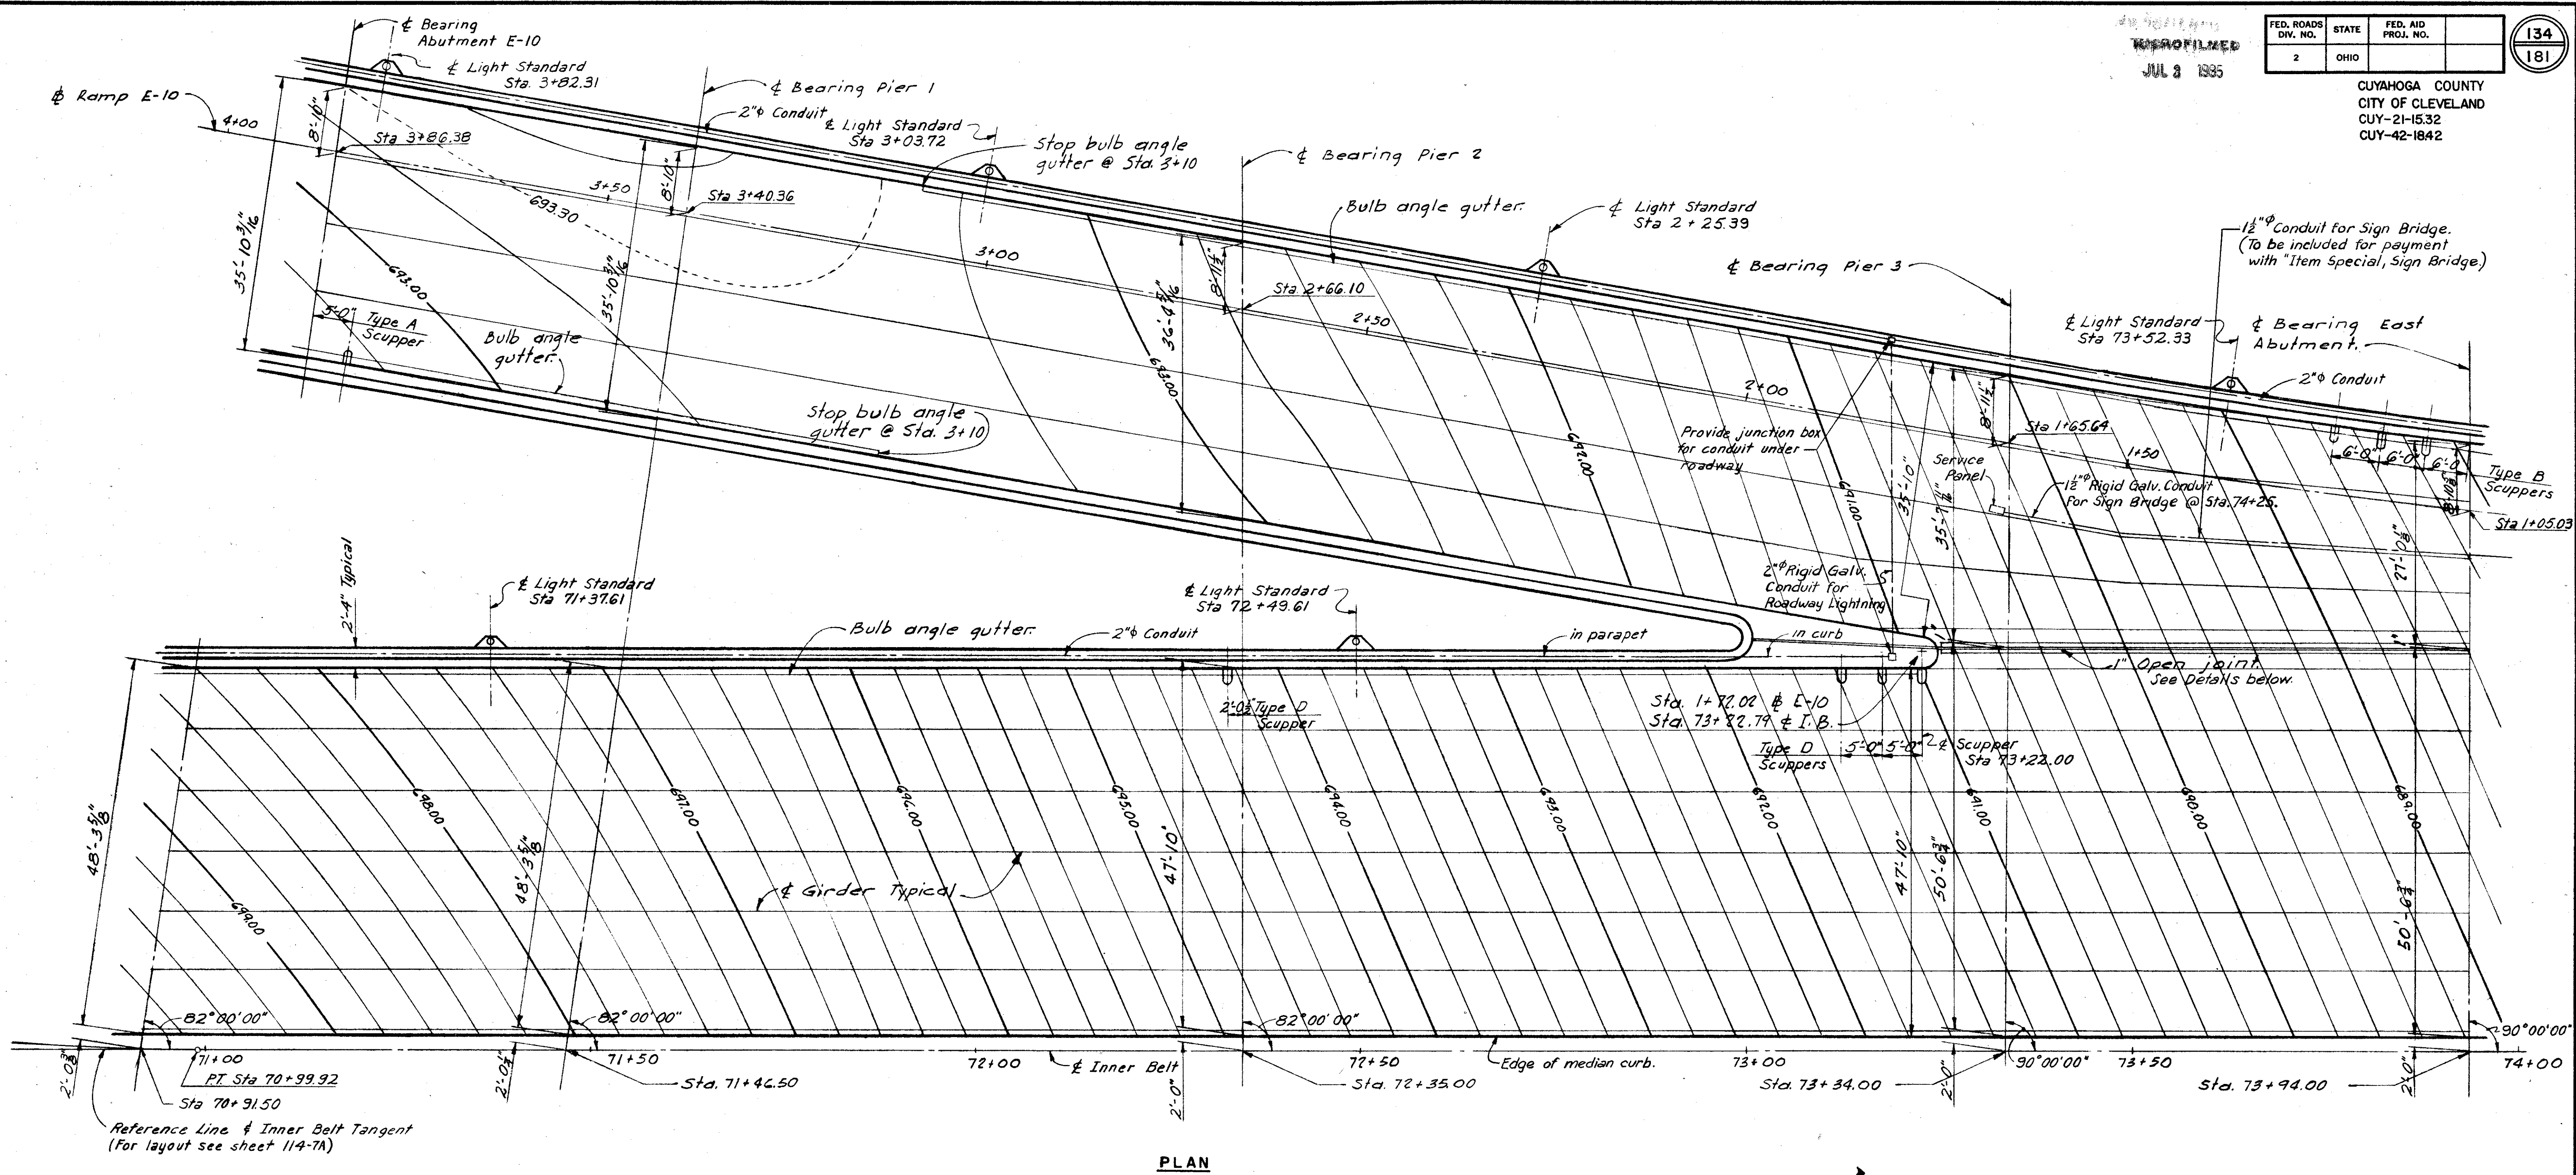

DETAILS OF 1" OPEN JOINT
Scale 1"=1'-0"

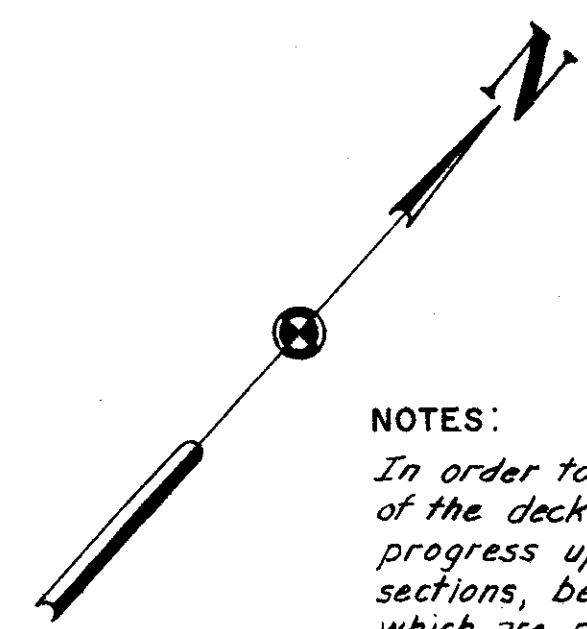

NOTES:
In order to facilitate water curing of the concrete of the deck slab, the placing of concrete shall progress upgrade. The slab may be placed in sections, between transverse construction joints which are parallel to transverse reinforcing steel and are located near the center of any span. For Light Standard support and other lighting details see sheets 176-7A & 177-7A. For Railing details see sheet 175-7A. For Guard Rail details see sheet 175-7A. For Drainage details see sheet 135-7A & 174-7A. Conduit shown crossing ramps shall be placed below girders. For details see sheets 176-7A & 177-7A. For Nosa details see sheet 136-7A.

H.N.T.B. BR. NO. 4 **PART 7A**

HOWARD, NEEDLES, TAMMEN & BERGENDOFF
CONSULTING ENGINEERS
KANSAS CITY CLEVELAND NEW YORK

DECK DETAILS-NORTH HALF

INNER BELT FREEWAY OVER EAST 14th ST
BR. NO. CUY-42-1854 STA. 70+89.23
Scale: 1"=10'-0" Except STA. 73+96.25 as noted

WILLOW-INNER BELT FREEWAY
CLEVELAND CUYAHOGA COUNTY OHIO



DRAWN L.D.F.	TRACED	CHECKED T.M.	REVIEWED J.C.T.	REVISED
DATE 5-13-56	DATE	DATE 6-6-58	DATE 11-13-57	SHEET 134

JUL 8 1965


FED. ROADS DIV. NO.	STATE	FED. AID PROJ. NO.
2	OHIO	

135
181

CUYAHOGA COUNTY
CITY OF CLEVELAND
CUY-21-15.32
CUY-42-18.42

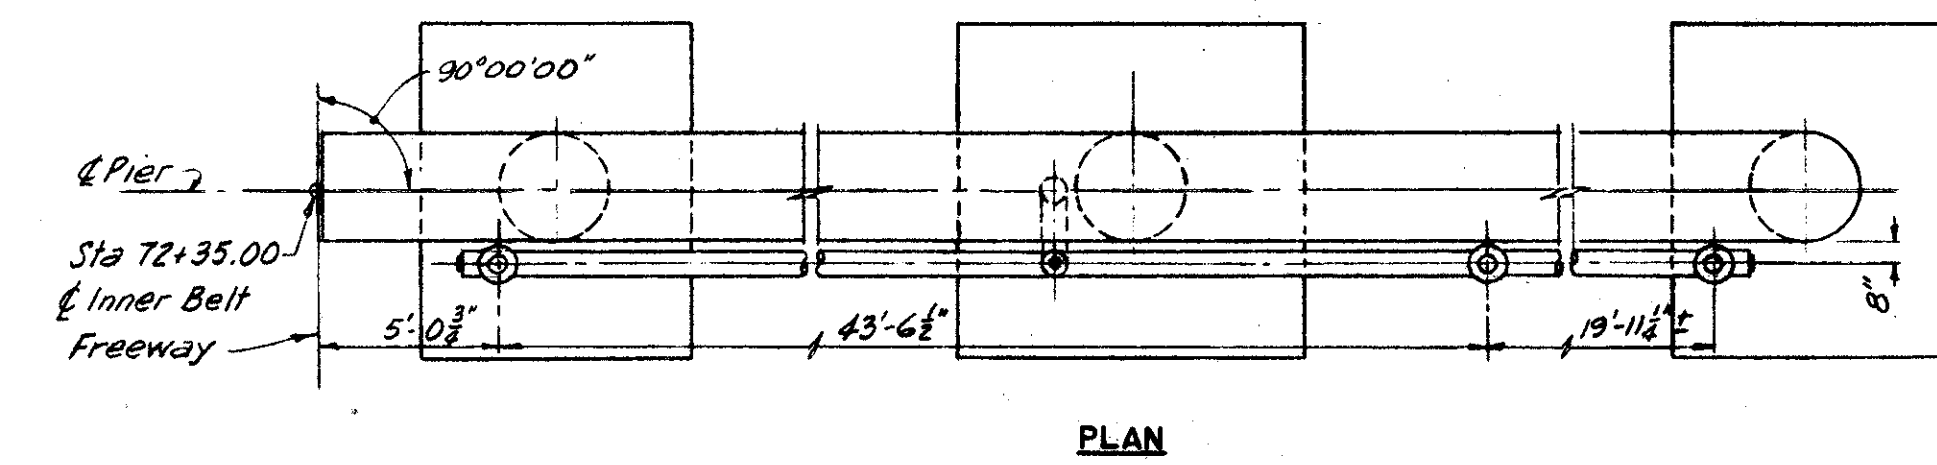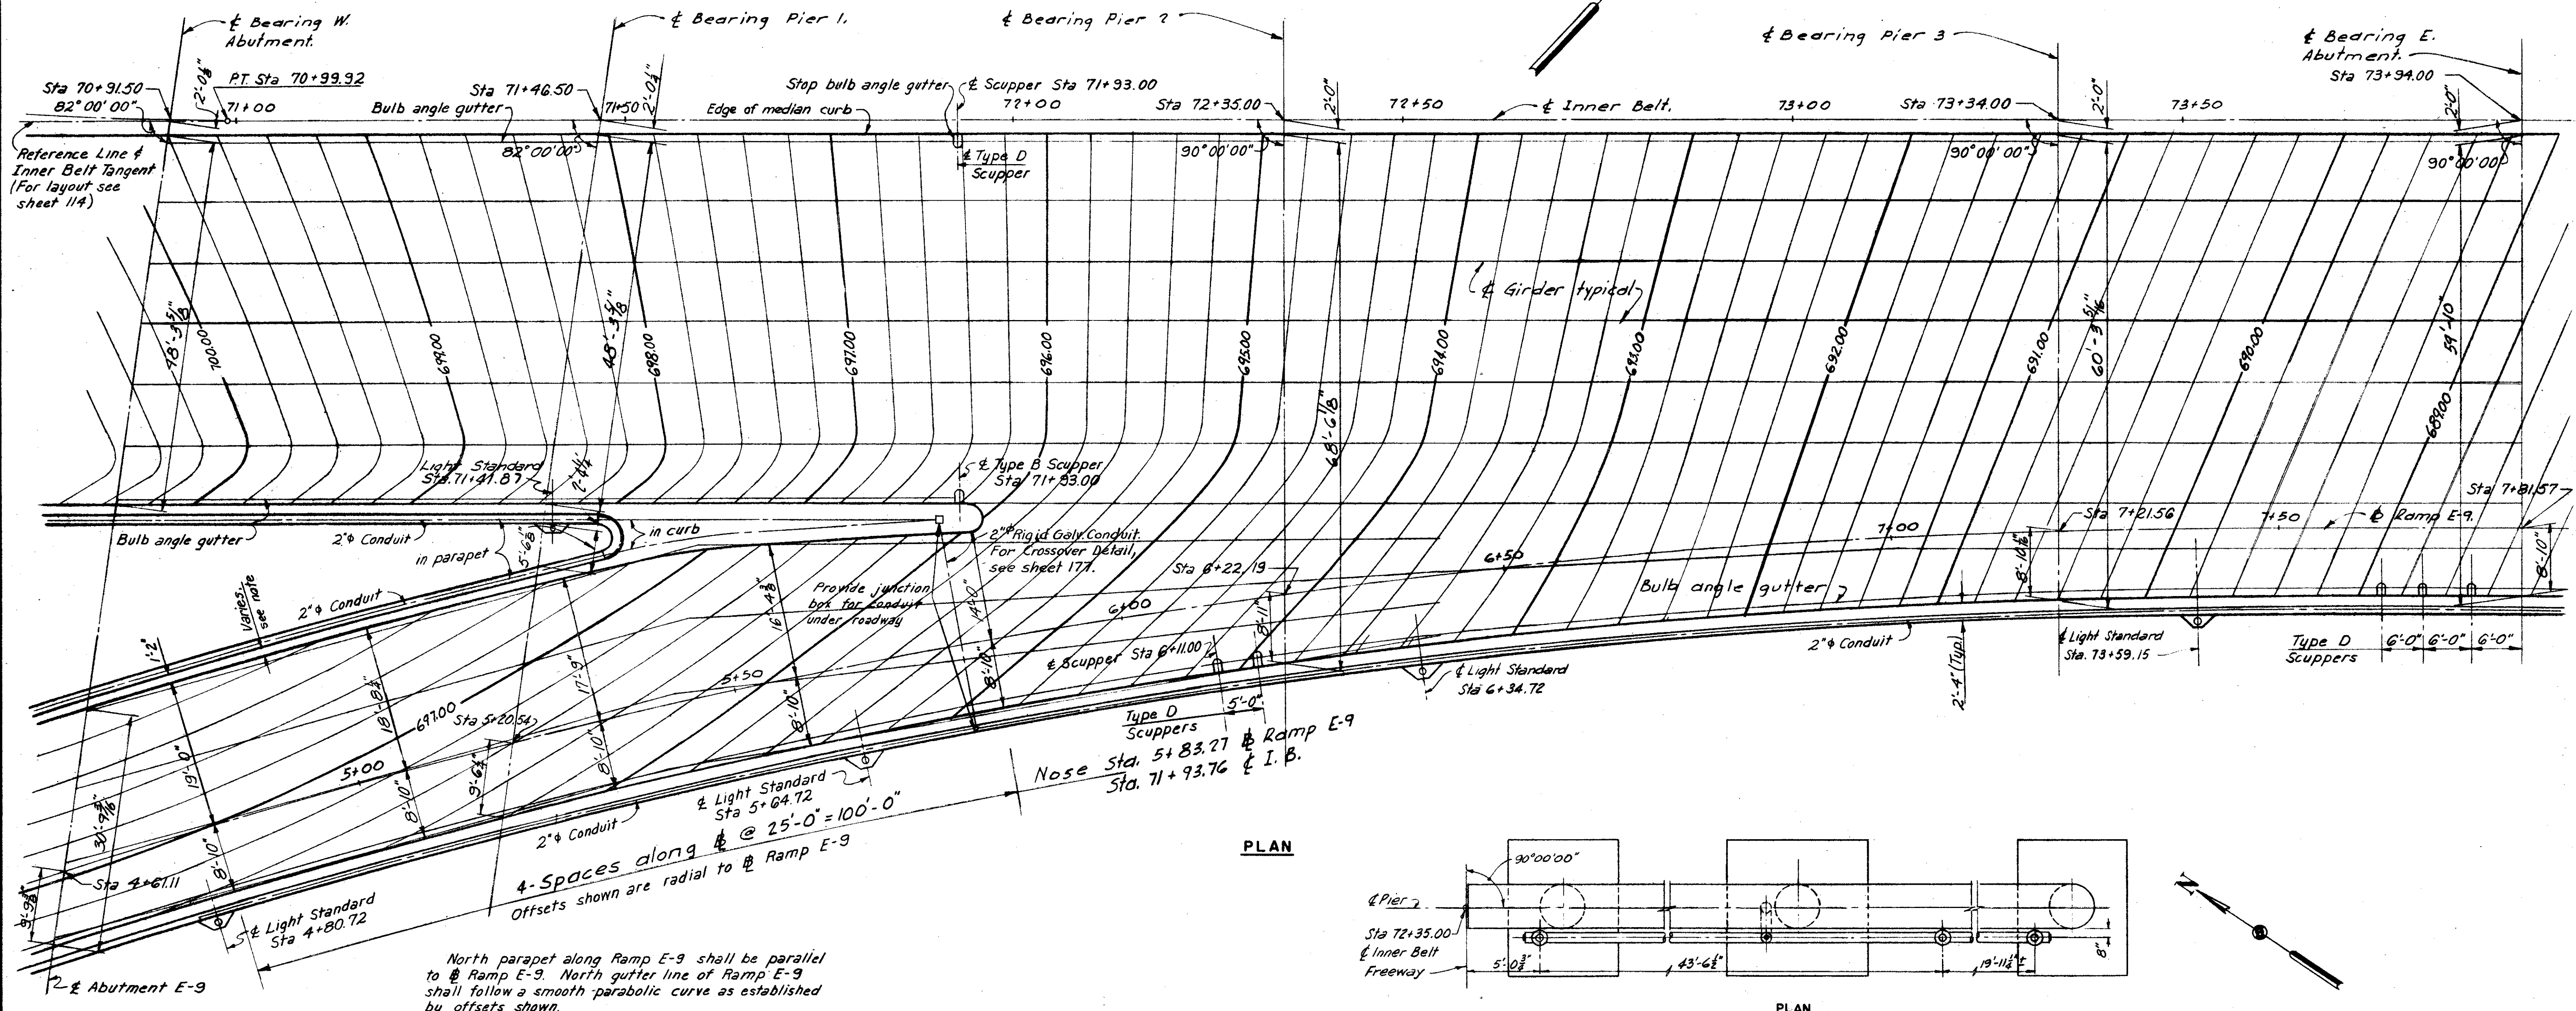

PLAN

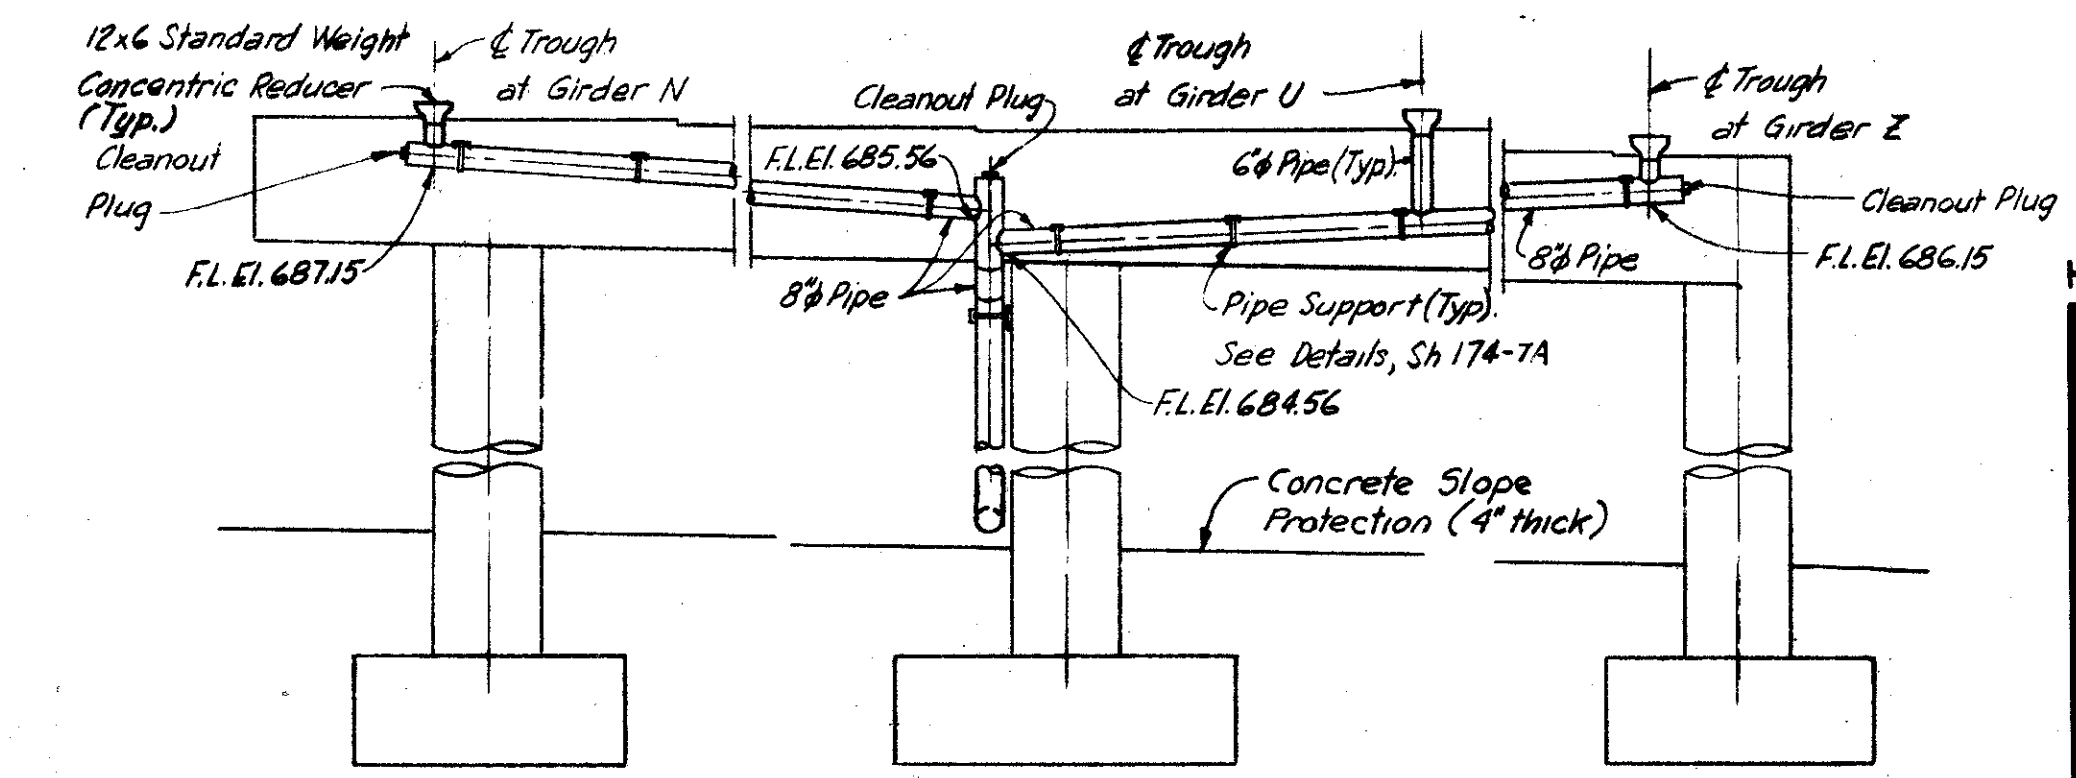

DRAINAGE PROVISION AT PIER 2-S
Scale 1/2" = 1'-0"

For notes see sheet 134-7A

H.N.T.B. BR. NO. 4 PART 7A

HOWARD, NEEDLES, TAMMEN & BERGENDOFF
CONSULTING ENGINEERS
KANSAS CITY CLEVELAND NEW YORK

DECK DETAILS - SOUTH HALF
INNER BELT FREEWAY OVER EAST 14th ST.
BR. NO. CUY-42-1854 STA. 70+89.23
Scale: 1" = 10'-0" Except STA. 73+96.25
as noted
WILLOW-INNER BELT FREEWAY
CLEVELAND CUYAHOGA COUNTY OHIO


DRAWN	TRACED	CHECKED	REVIEWED
L. D. F.	CAN	JCT	JCT
DATE 5-20-58	DATE 6-5-58	DATE 11-13-57	

MICROFILMED
JUL 3 1985


FED. ROADS DIV. NO.	STATE	FED. AID PROJ. NO.	
2	OHIO		

136
181

CUYAHOGA COUNTY
CITY OF CLEVELAND
CUY-21-15.32
CUY-42-18.42

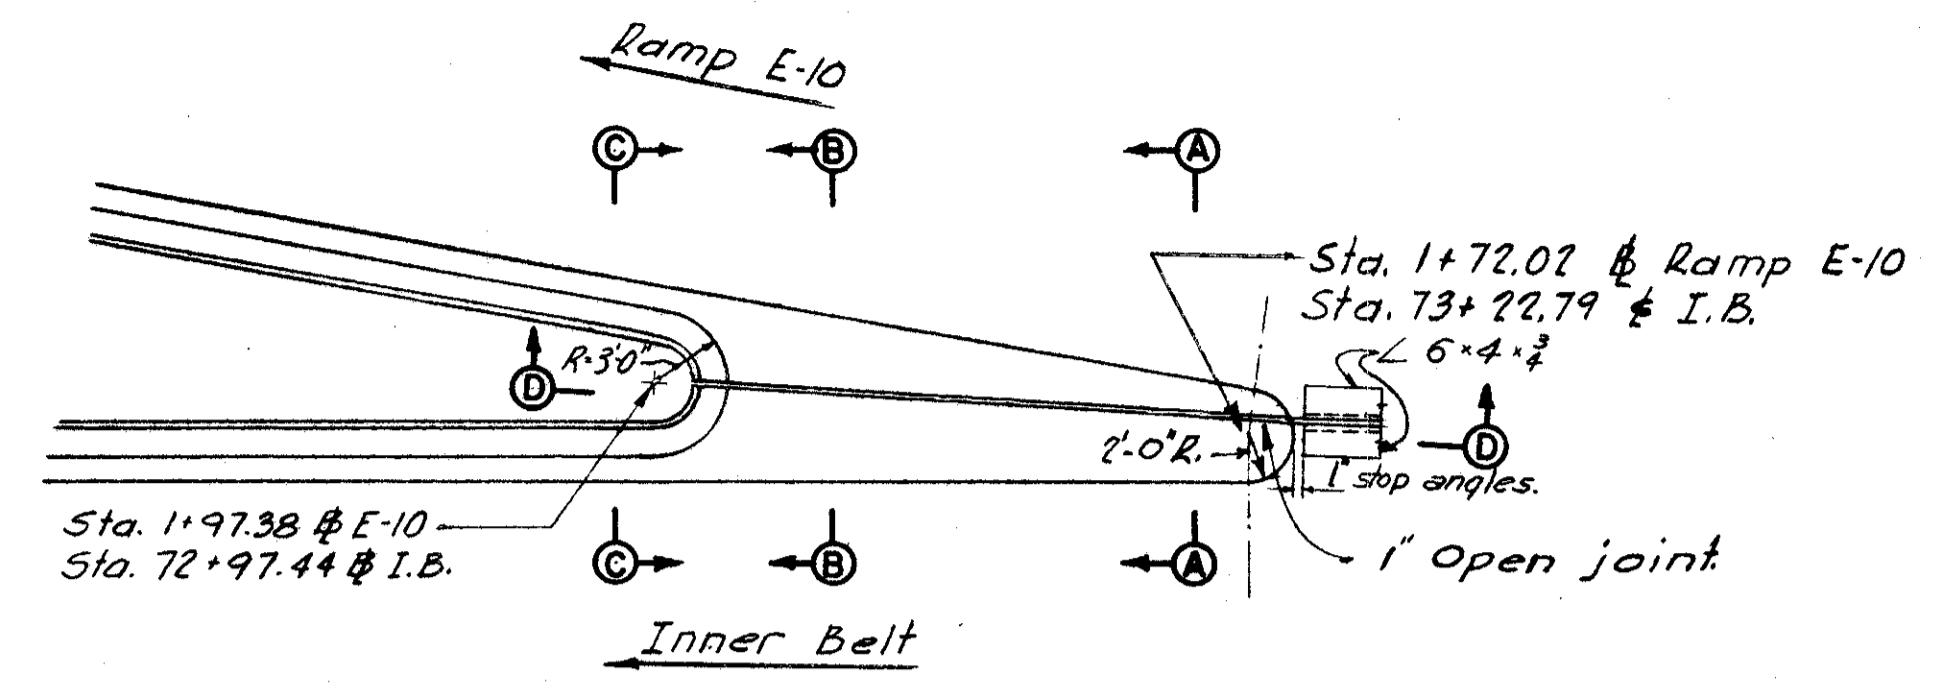


NOSE PLAN - WEST BOUND

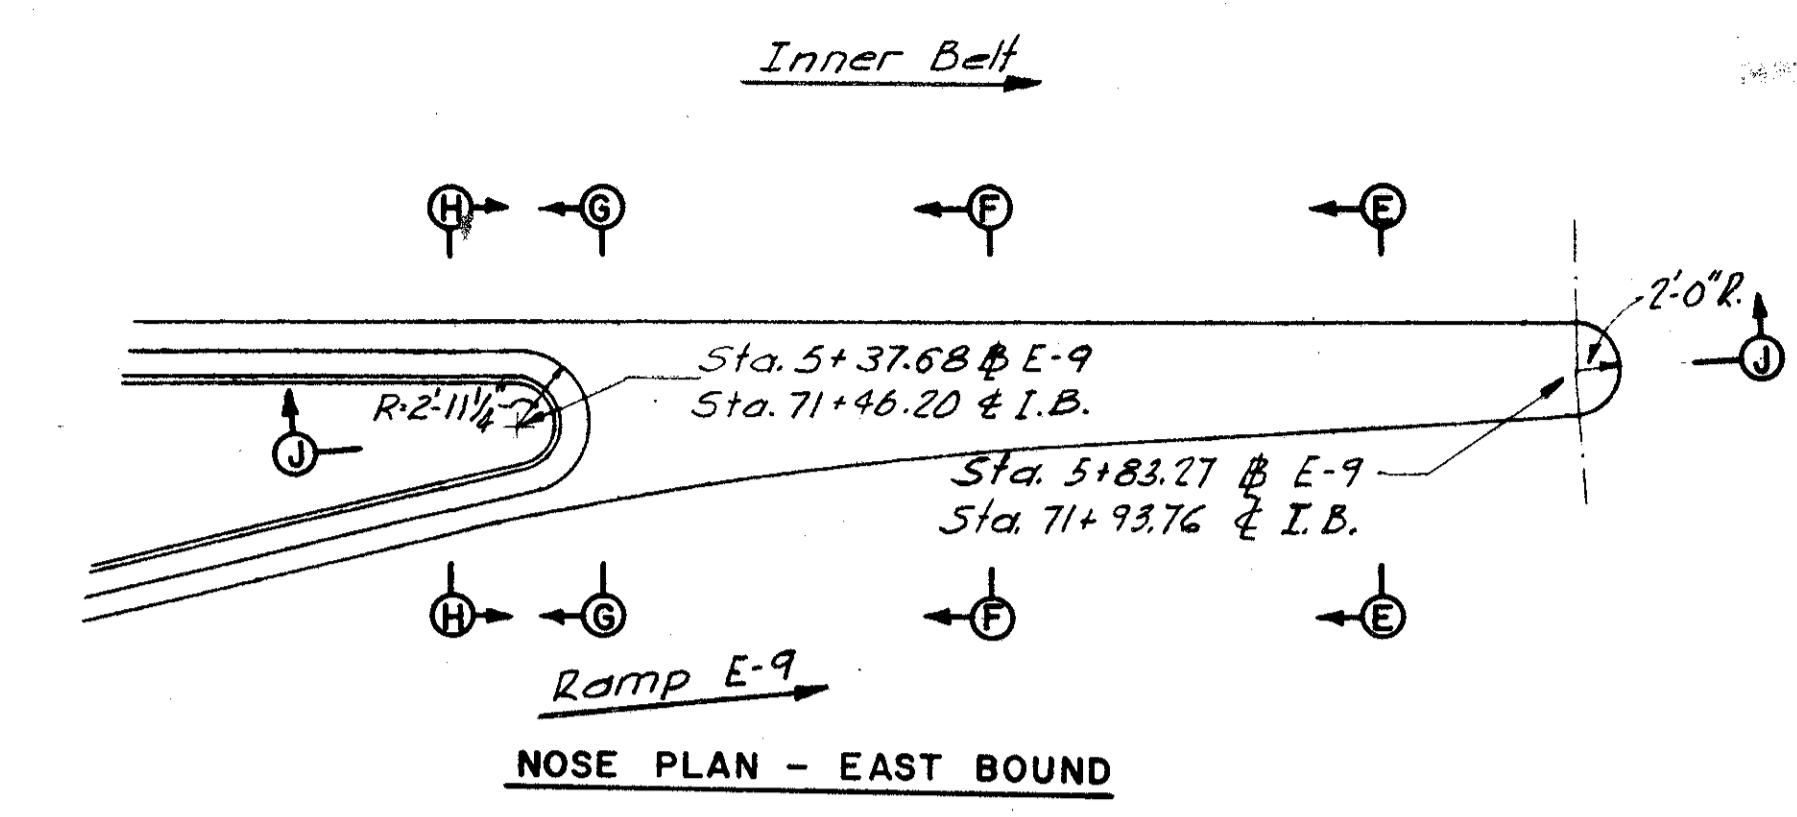


NOSE PLAN - EAST BOUND


Note: Prefix "SA" shall be assigned to all bar marks.

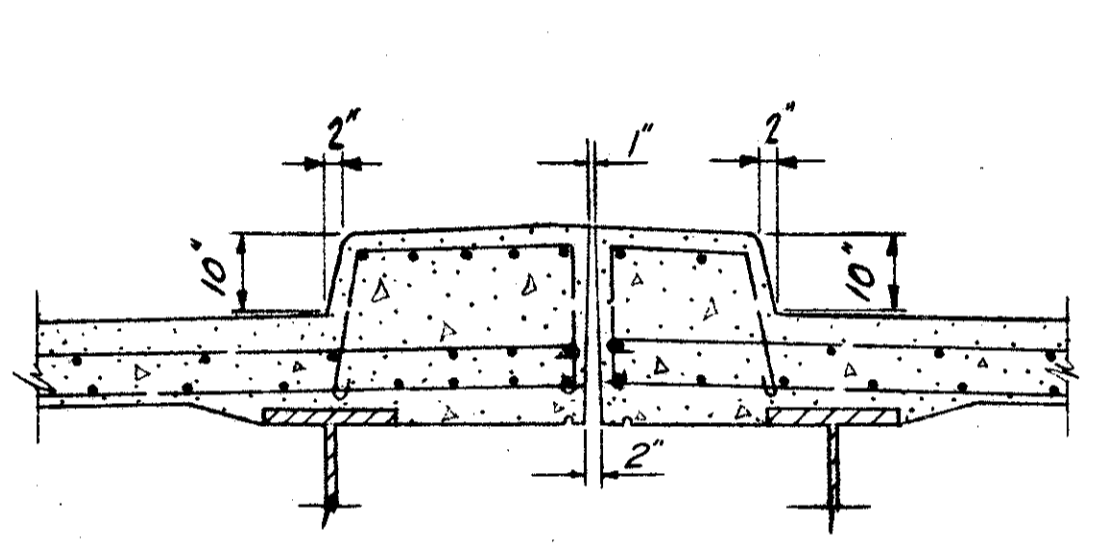


SECTION A-A

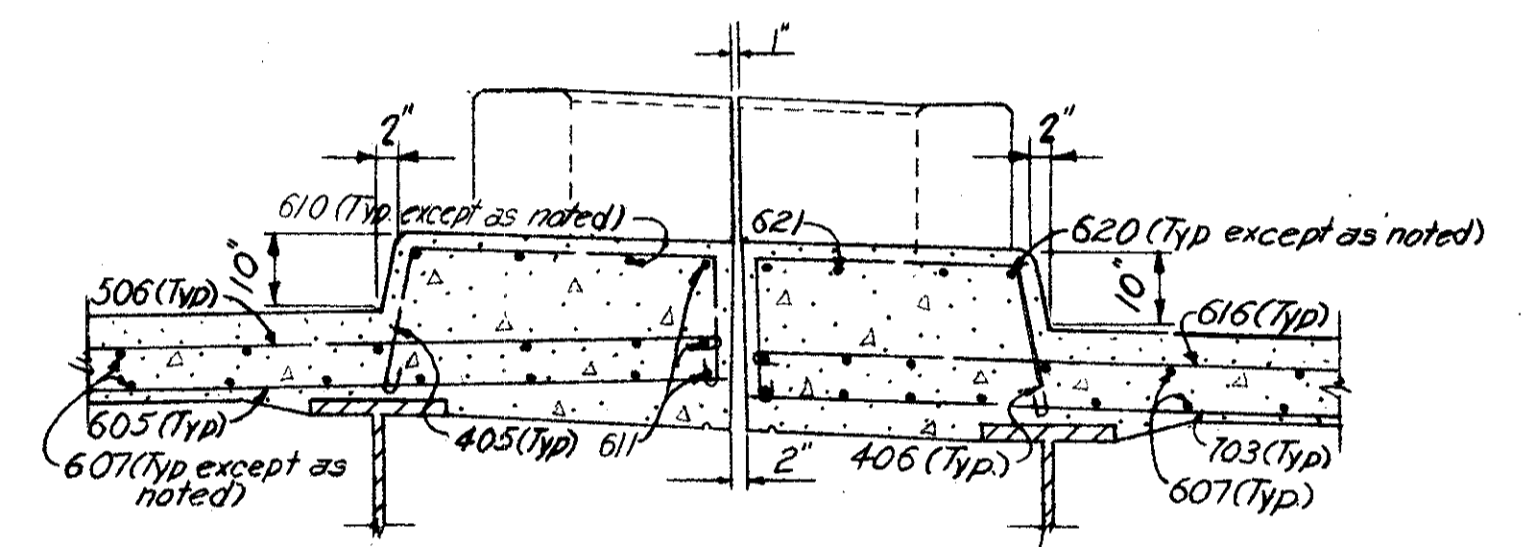

SECTION B-B

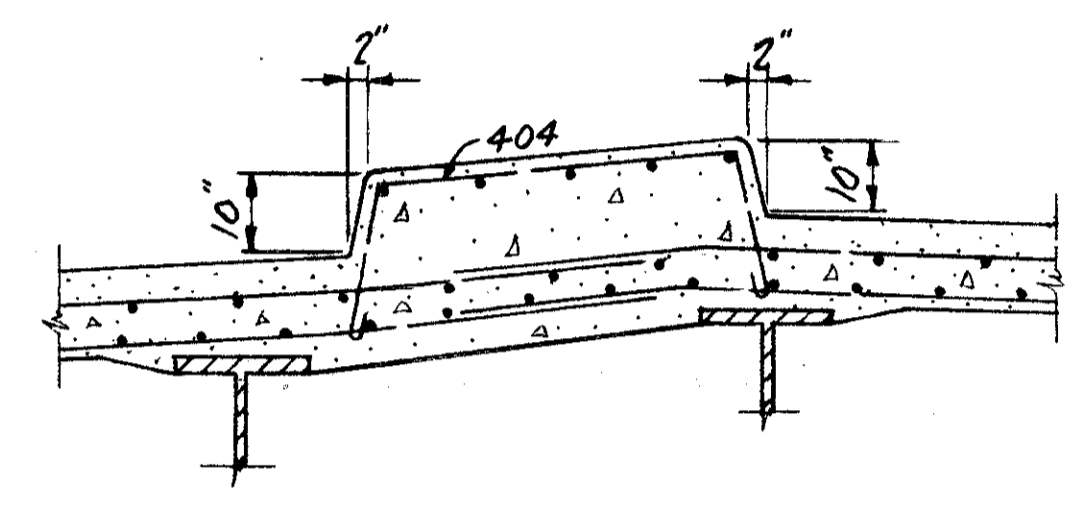


SECTION E-E

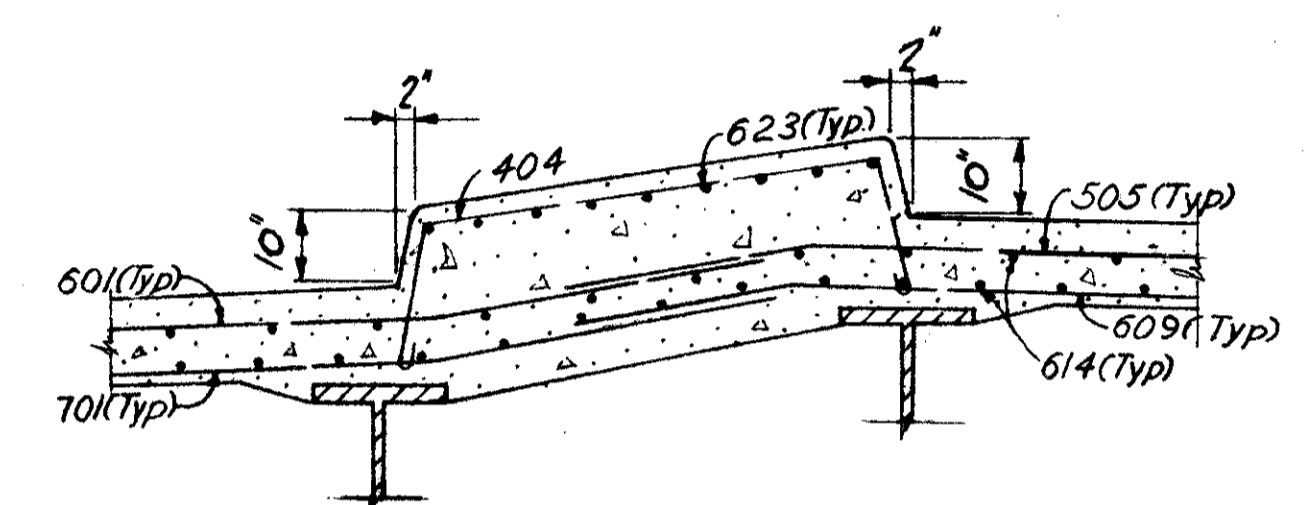


SECTION F-F


Note: Prefix "SB" shall be assigned to all bar marks.

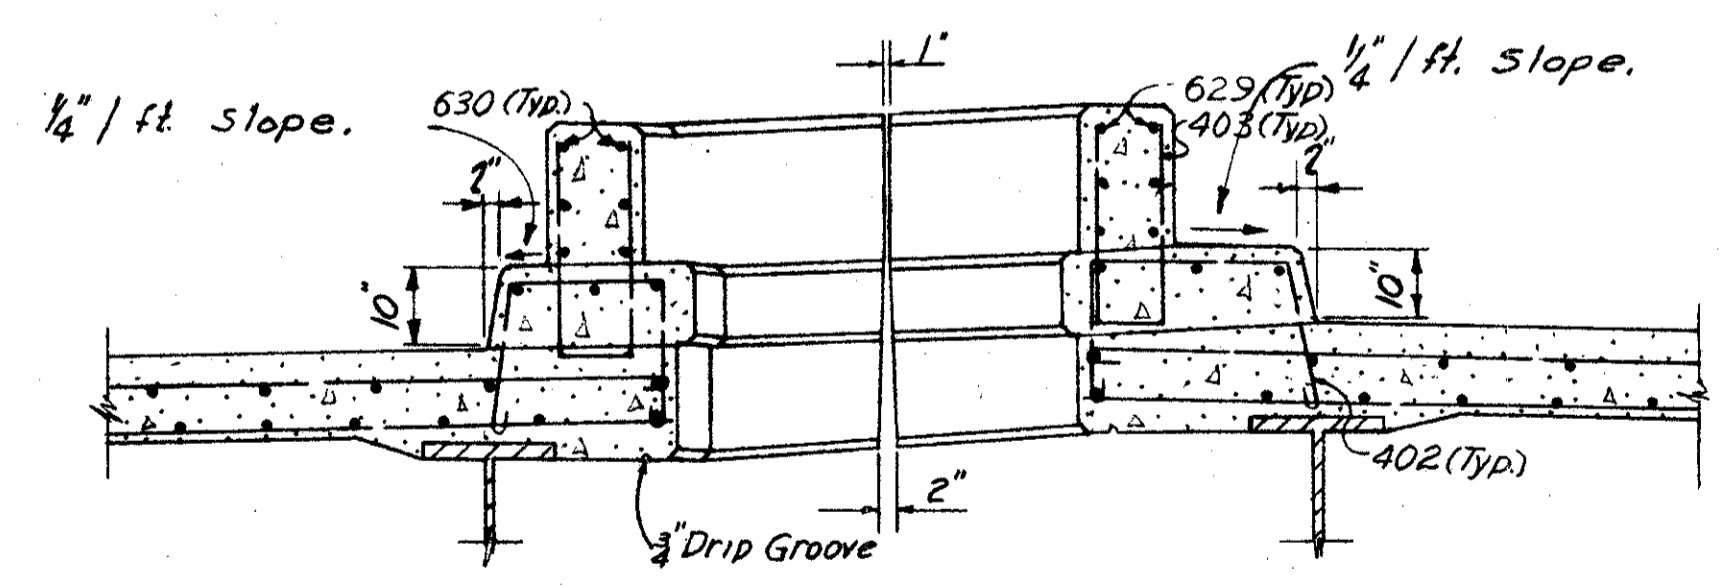


SECTION C-C

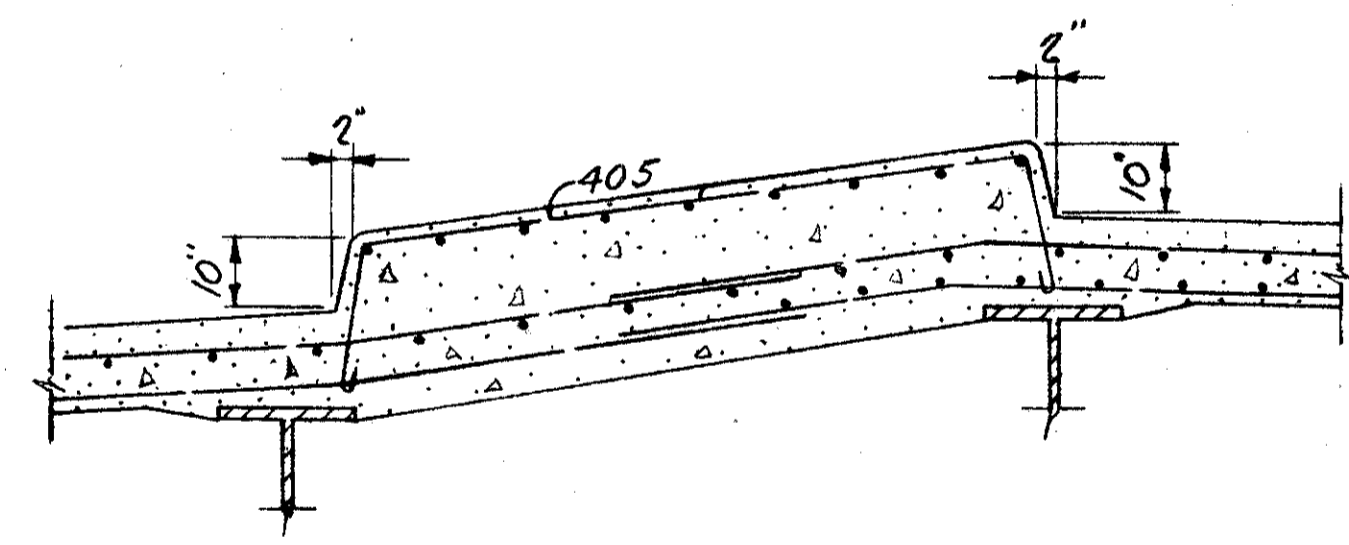


SECTION G-G

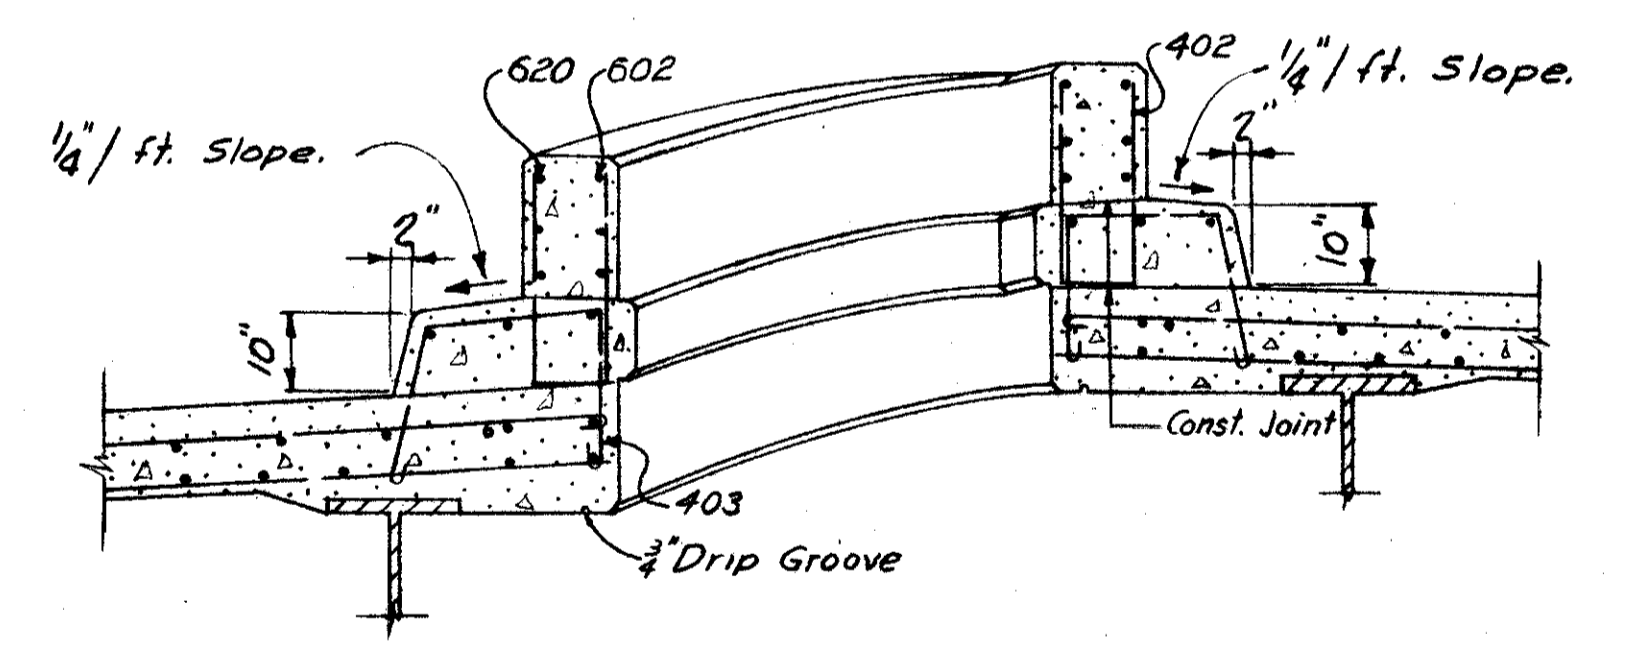

SECTION H-H

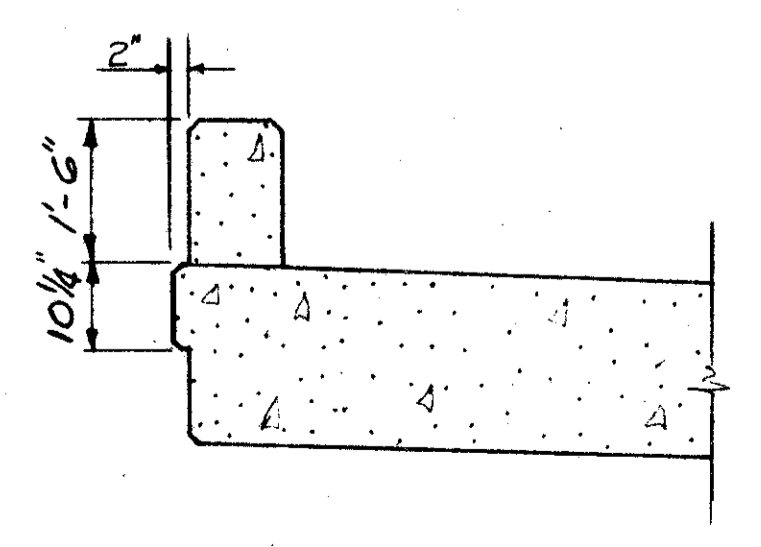

SECTION D-D

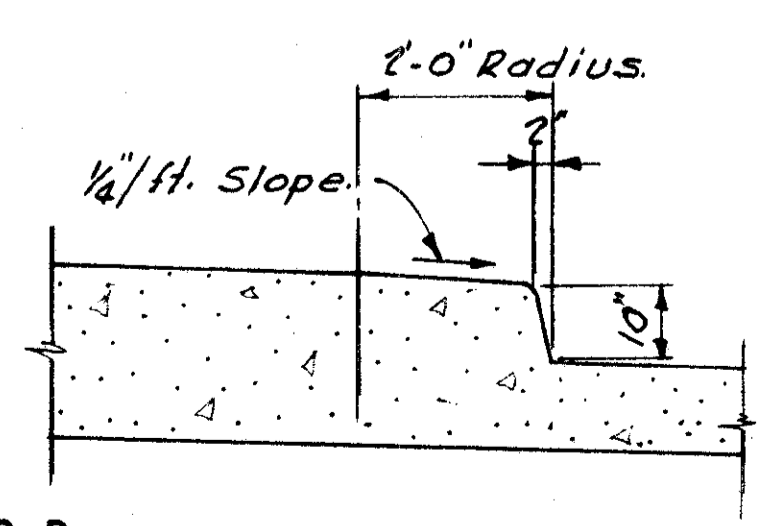

SECTION J-J

H.N.T.B. BR. NO. 4 PART 7A

HOWARD, NEEDLES, TAMMEN & BERGENDOFF
CONSULTING ENGINEERS
KANSAS CITY CLEVELAND NEW YORK

NOSE DETAILS

INNER BELT FREEWAY OVER EAST 14th ST.
BR. NO. CUY-42-1854 STA. 70+89.23
Scale: 1/2" = 1'-0" STA. 73+96.25


WILLOW-INNER BELT FREEWAY
CLEVELAND CUYAHOGA COUNTY OHIO

DRAWN L.D.F.	TRACED	CHECKED T.C.H.	REVIEWED J.C.T.	REVISED
DATE 6-3-86	DATE	DATE 7/3/86	DATE 11-13-87	SHEET 136


MICROFILMED
JUL 3 1985

FED. ROADS DIV. NO.	STATE	FED. AID PROJ. NO.	137 181
2	OHIO		


CUYAHOGA COUNTY
CITY OF CLEVELAND
CUY-21-15.32
CUY-42-18.42

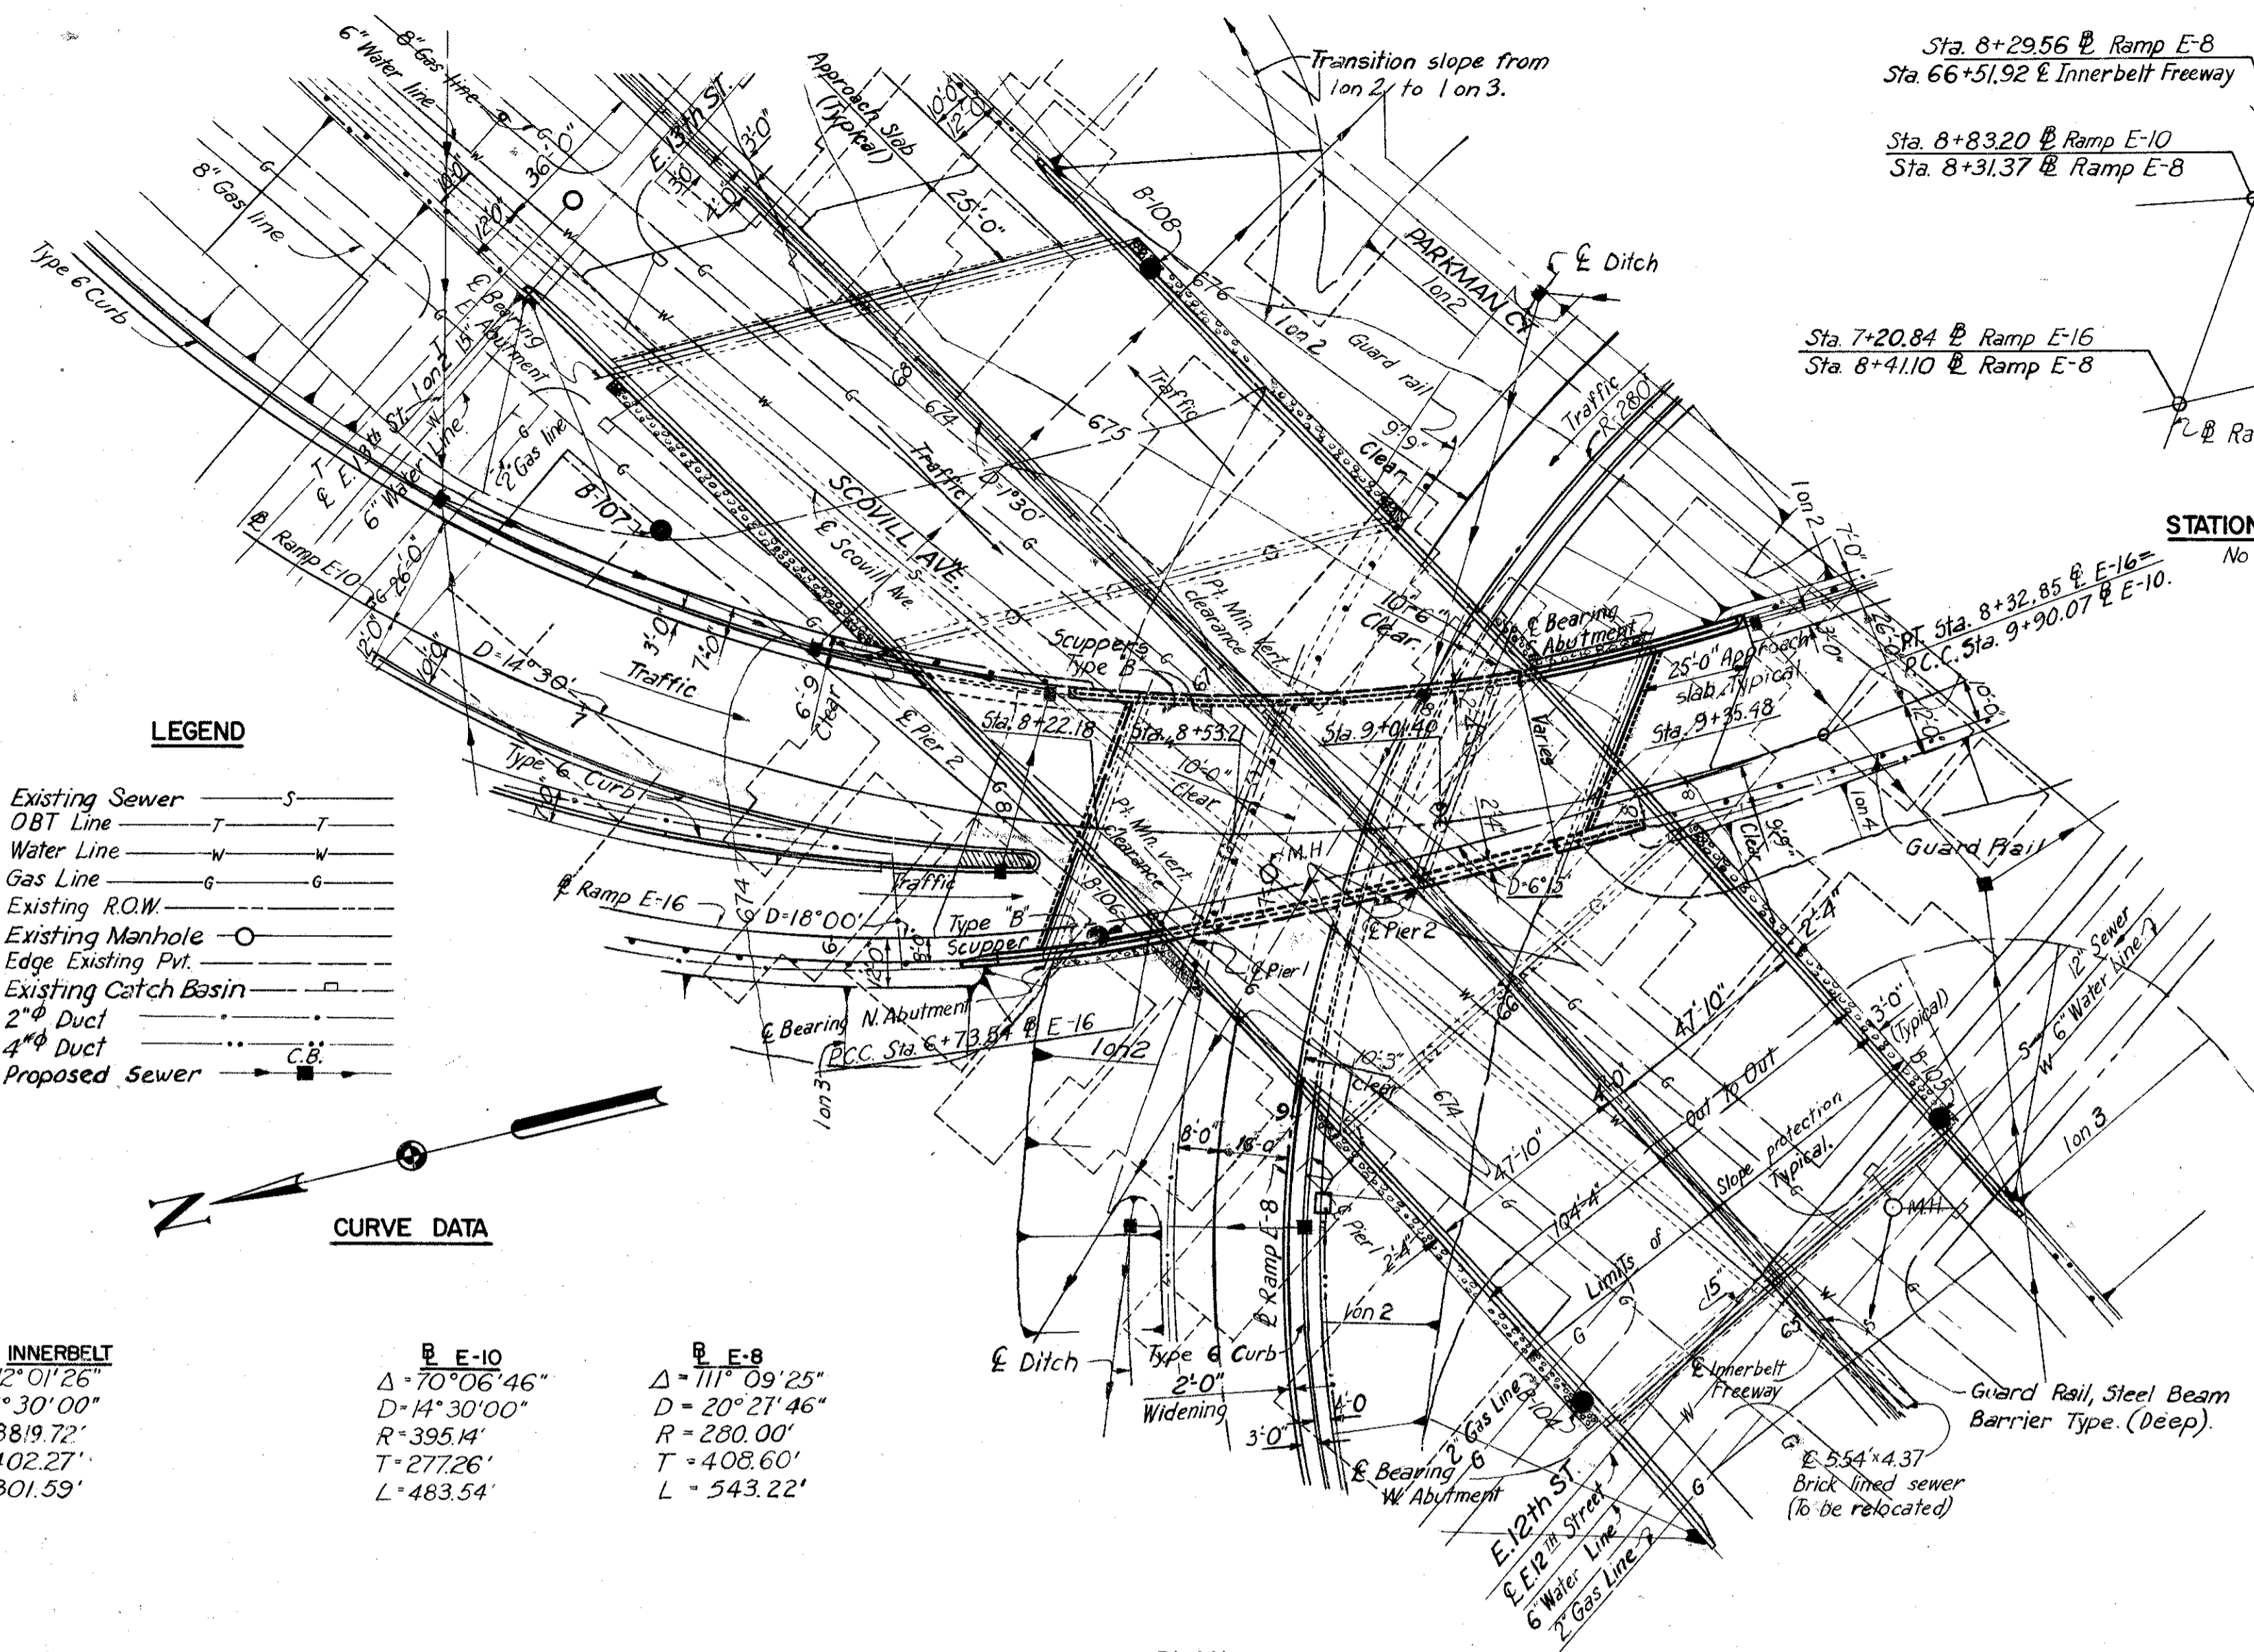

- LEGEND**
- Existing Sewer — S —
 - OBT Line — T —
 - Water Line — W —
 - Gas Line — G —
 - Existing R.O.W. — G —
 - Existing Manhole — O —
 - Edge Existing Pvt. — —
 - Existing Catch Basin — □ —
 - 2" Duct — —
 - 4" Duct — —
 - Proposed Sewer — —

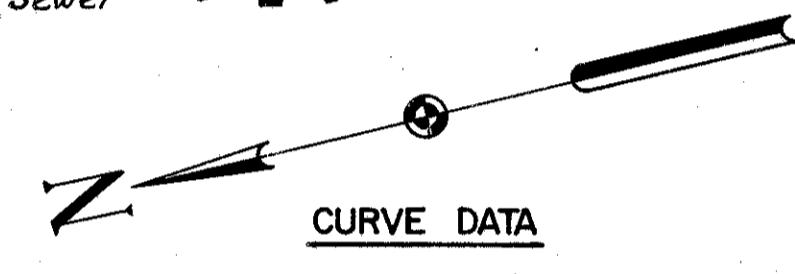

- INNERBELT**
 $\Delta = 12^\circ 01' 26''$
 $D = 18^\circ 30' 00''$
 $R = 389.72'$
 $T = 402.27'$
 $L = 801.59'$
- E-10**
 $\Delta = 70^\circ 06' 46''$
 $D = 14^\circ 30' 00''$
 $R = 395.14'$
 $T = 277.26'$
 $L = 483.54'$
- E-8**
 $\Delta = 111^\circ 09' 25''$
 $D = 20^\circ 27' 46''$
 $R = 280.00'$
 $T = 408.60'$
 $L = 543.22'$
- E-16**
 $\Delta = 31^\circ 31' 44''$
 $D = 18^\circ 00' 00''$
 $R = 318.31'$
 $T = 89.86'$
 $L = 175.16'$
- E-16**
 $\Delta = 9^\circ 57' 26''$
 $D = 6^\circ 15' 00''$
 $R = 916.73'$
 $T = 79.86'$
 $L = 159.32'$

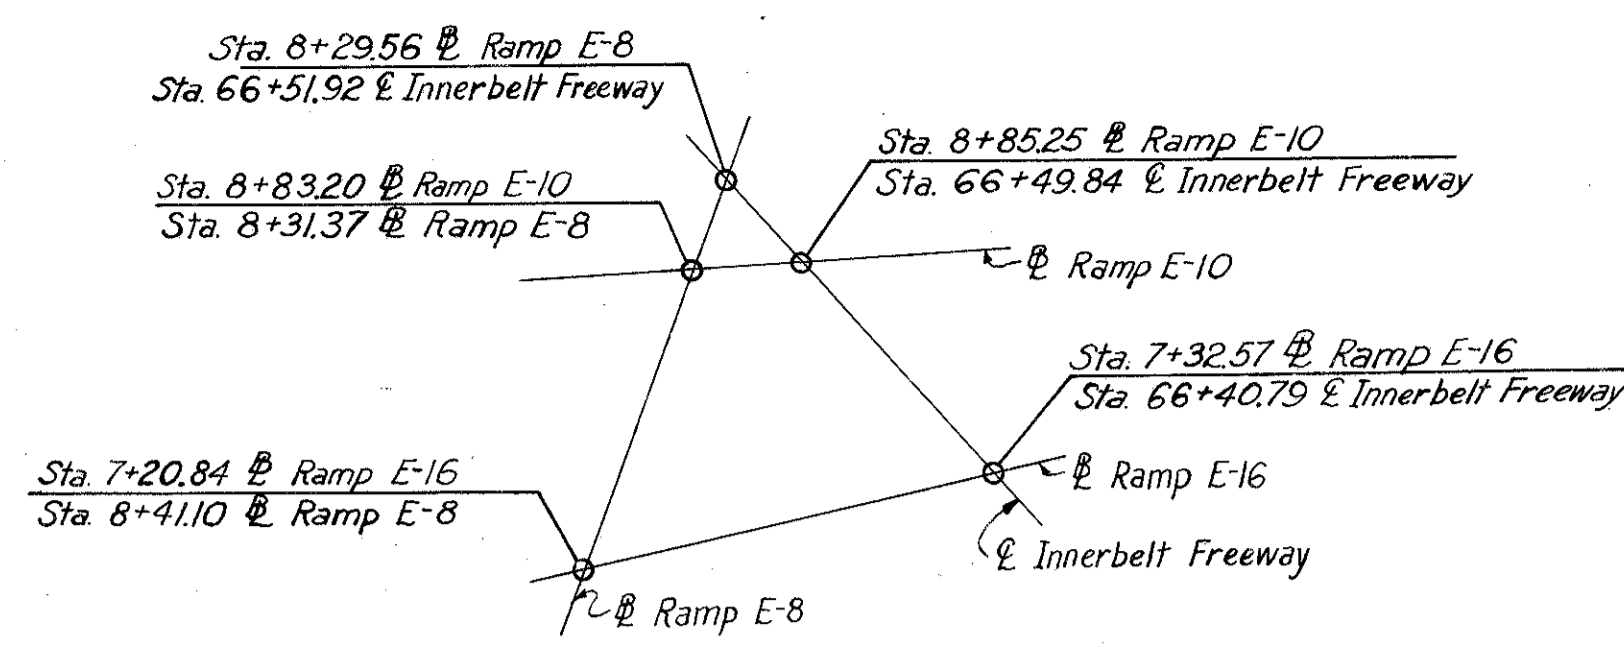

PROPOSED STRUCTURE BR. NO. 5

Type: Continuous steel beam with reinforced concrete deck and substructure
 Spans: 31'-0" 48'-2" 34'-1" along E-10
 Roadway: Varies
 Loading: CF-2000 Adequate for A.A.S.H.O. alternate loading.
 Skew: Varies
 Surface Course: 1" Monolithic Concrete.
 Alignment: 14'30" curve left.
 Approach Slabs: AS-1-54 (25' long).
 Superelevation: .08 ft. per ft.

NOTES:

The following items are not included in the Bridge Plans: (See Roadway Plans for Details).
 Removal of existing pavements, etc.
 Relocation or removal of existing utilities.
 Approach grading, pavement and slabs.
 Roadway Guard Rail.




Rod soundings were taken at location B-104, B-105, B-107 and B-108. The core drilling made at B-106 is plotted on site plan for Bridge No. 3. For details of slope protection see sheet 17A.

PILE INFORMATION

Location	Diameter	Number	Estimated ave. length
N. Abutment	12"	22	29'
S. Abutment	12"	19	29'
Pier 1	14"	18	65'
Pier 2	14"	16	65'

All piling to be C.I.P. Reinforced Concrete.

Pile lengths are based on boring data and are approximate only. The Contractor shall assume full responsibility for length of piling selected for driving.

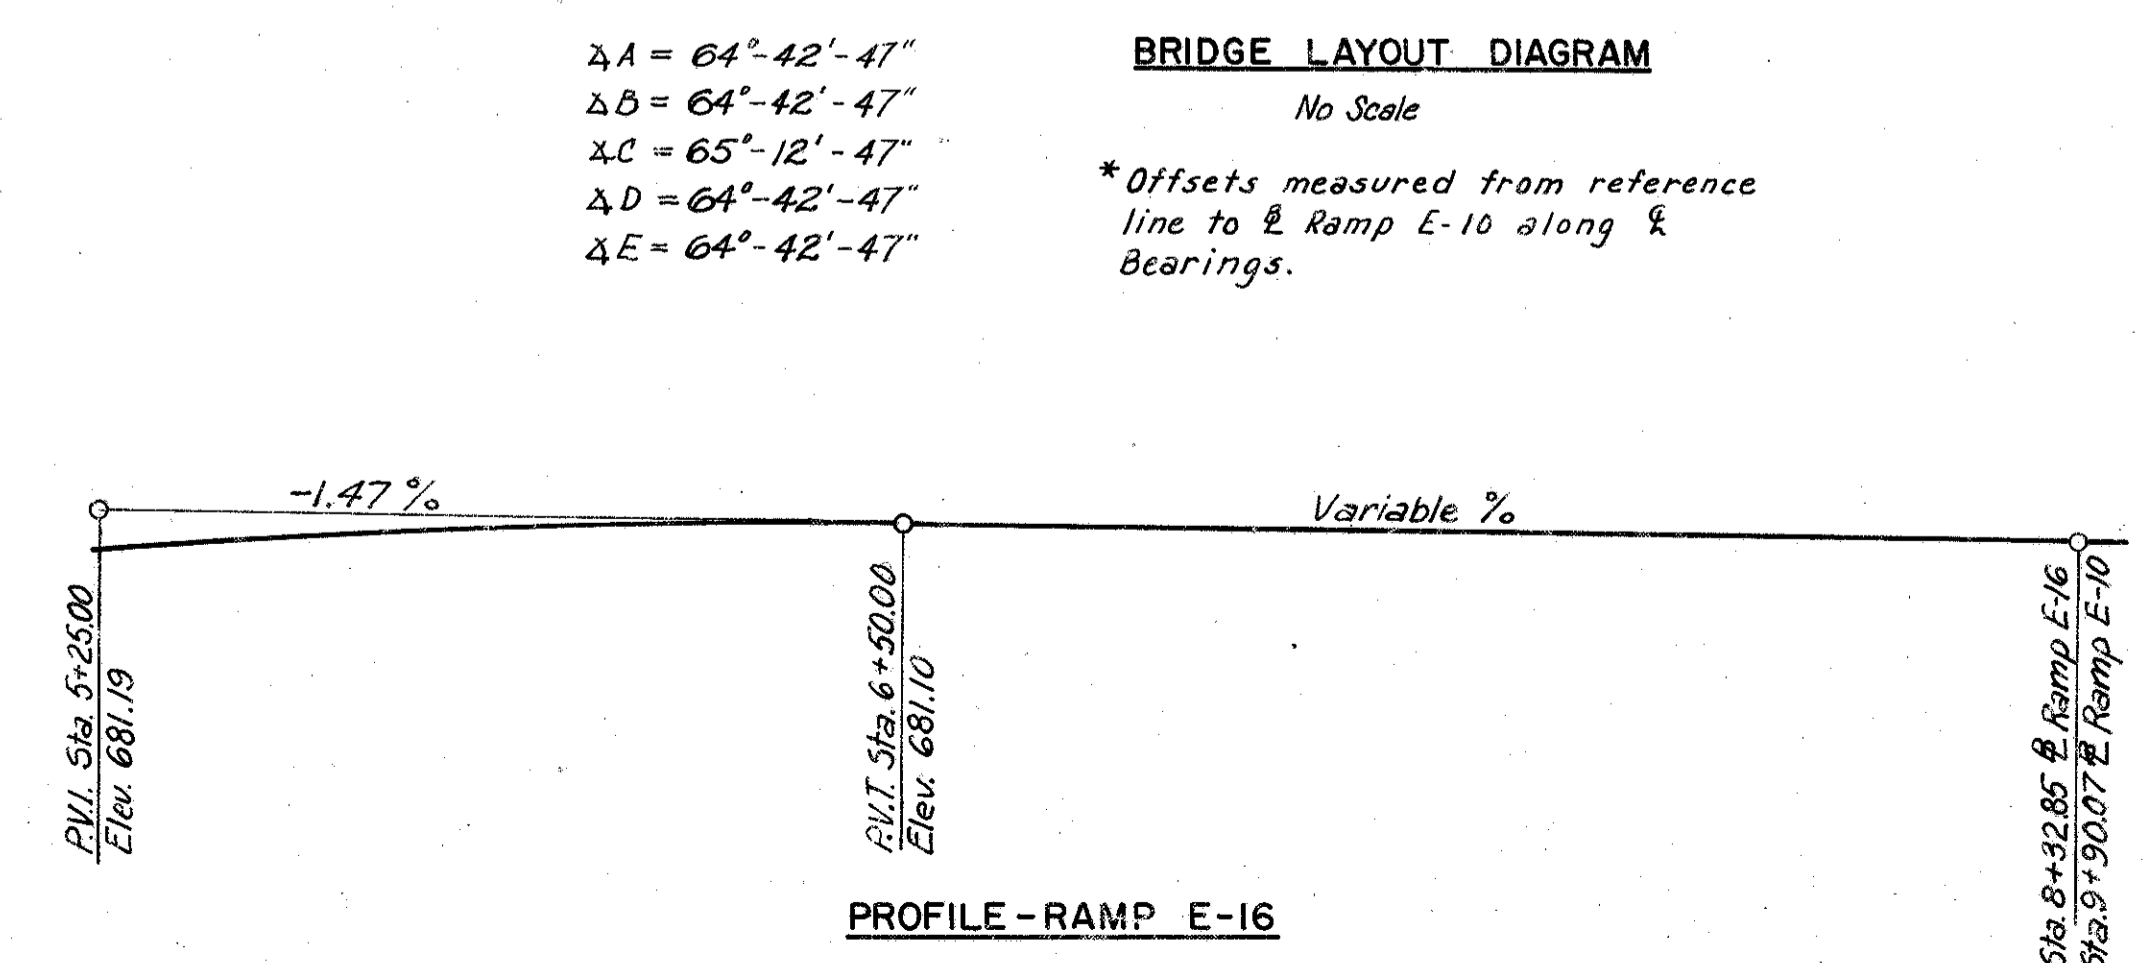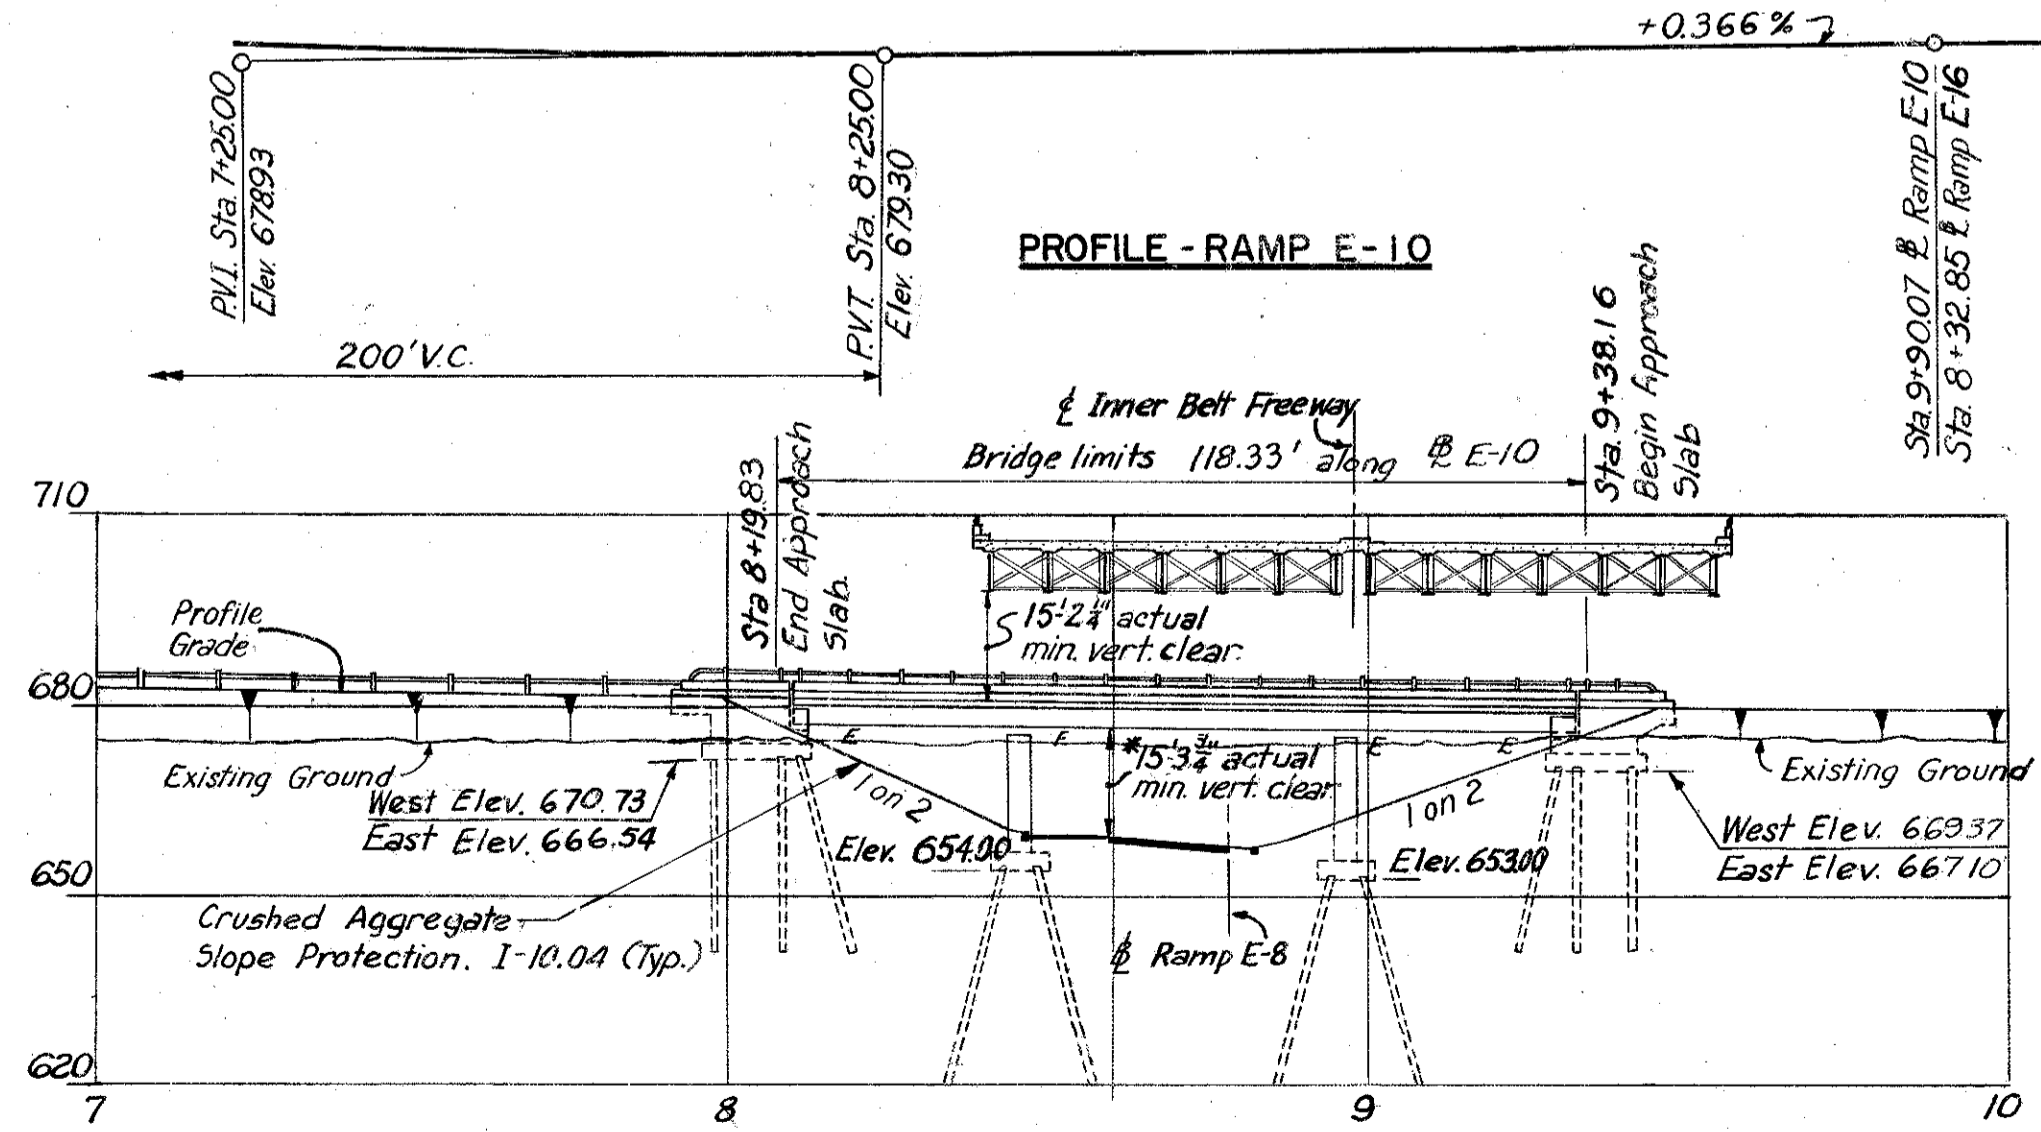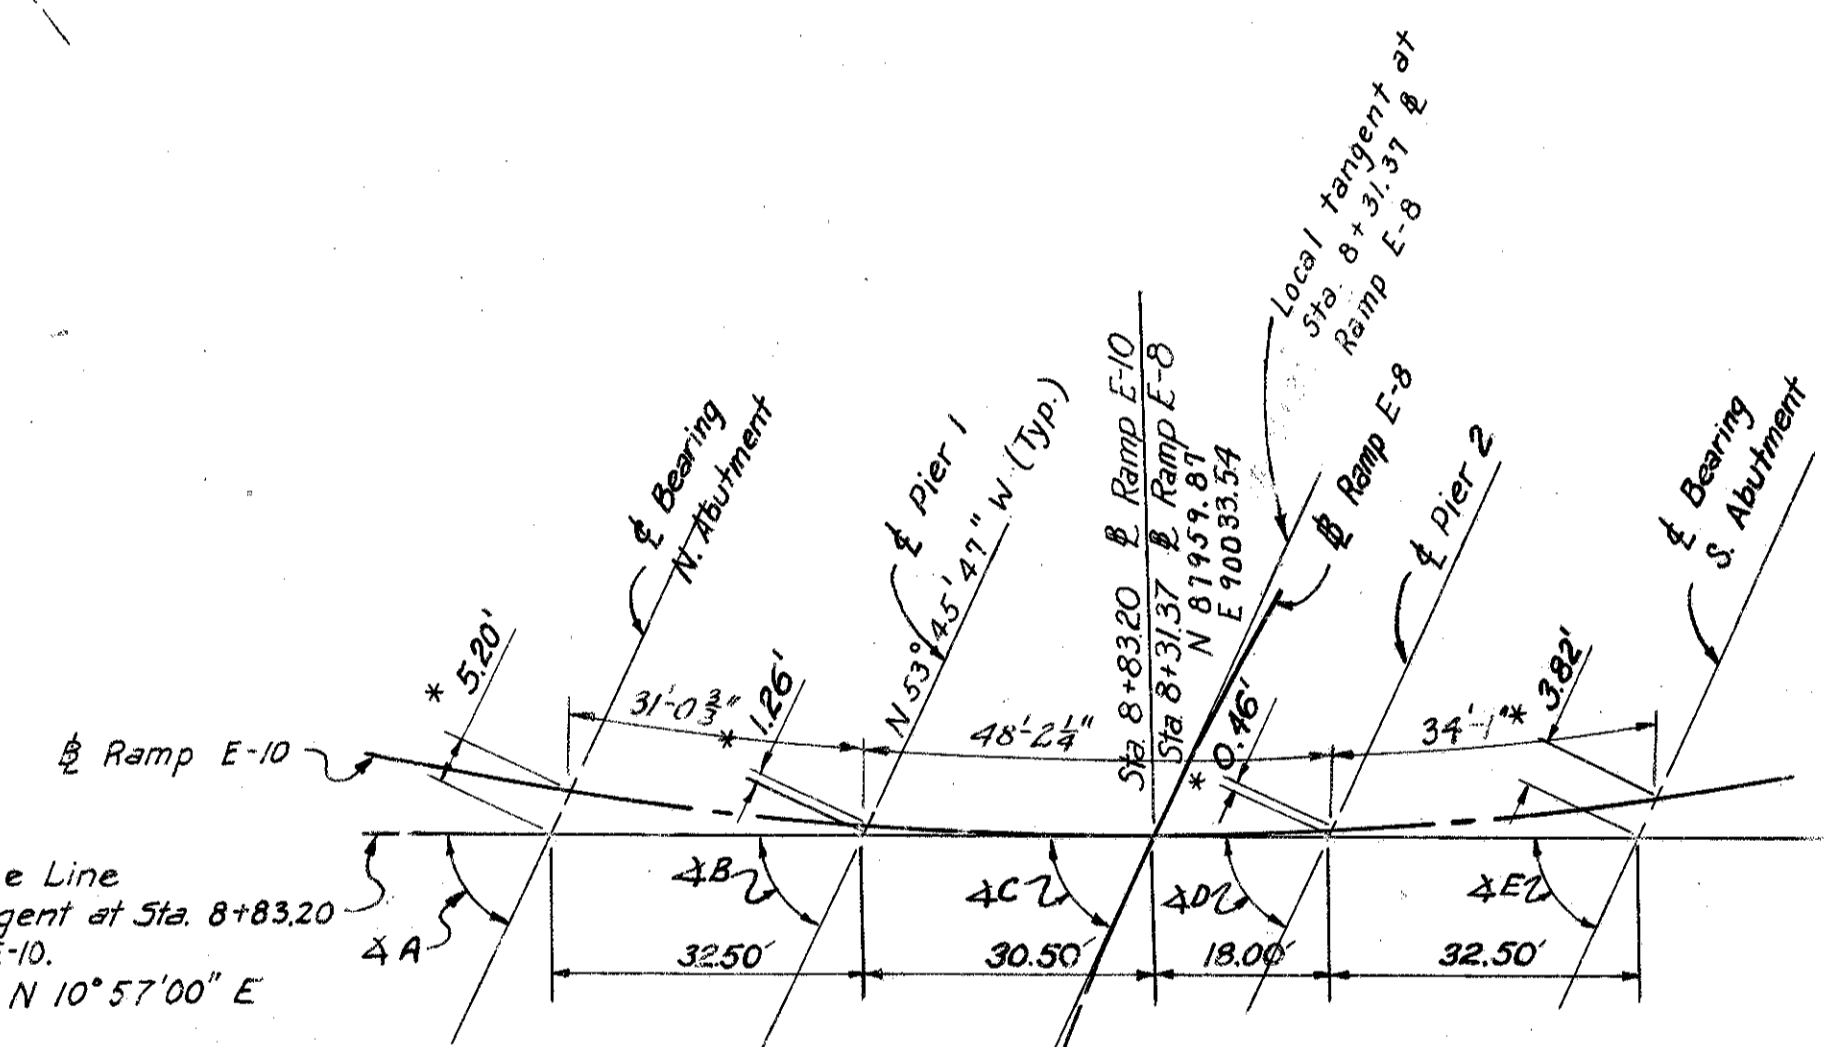

*15'-0" Required minimum vertical clearance. Point of actual minimum vertical clearance occurs at East exterior beam and North edge of Ramp E-8.

Note: Slopes shown in Elevation are normal to Ramp E-8.

H.N.T.B. BR. NO. 5 PART 7A

HOWARD, NEEDLES, TAMMEN & BERGENDOFF
CONSULTING ENGINEERS
KANSAS CITY CLEVELAND NEW YORK

SITE PLAN

RAMP E-10 OVER RAMP E-8

Scale: 1" = 30'

STA 8+19.83
STA 9+38.16

WILLOW-INNER BELT FREEWAY

CLEVELAND CUYAHOGA COUNTY OHIO


DRAWN J.J.S.	TRACED	CHECKED D.M.	REVIEWED J.C.T.	REVISED
DATE 6-19-53	DATE	DATE 7-28-53	DATE 11-13-53	

SHEET 137


JUL 3 1985

CUYAHOGA COUNTY
CITY OF CLEVELAND
CUY-21-15.32
CUY-42-18.42

Note: Prefix "PA" shall be assigned to all bar marks.

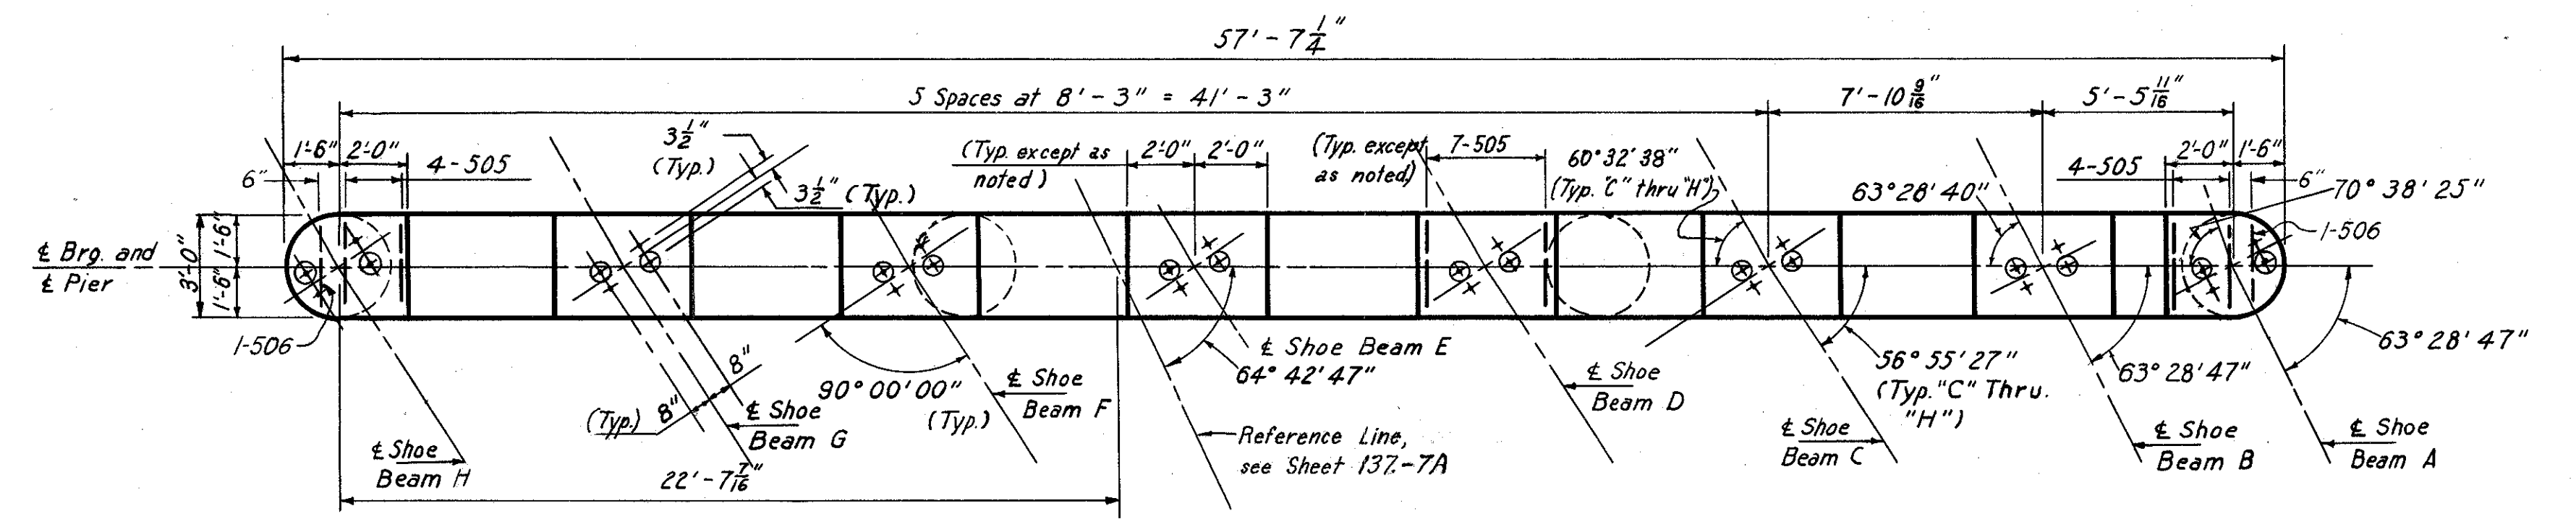


NOTE:
Special care to be taken when placing reinforcing steel so as not to interfere with anchor bolt setting.
Holes for anchor bolts, noted as such, are to be drilled before placing of diaphragm.

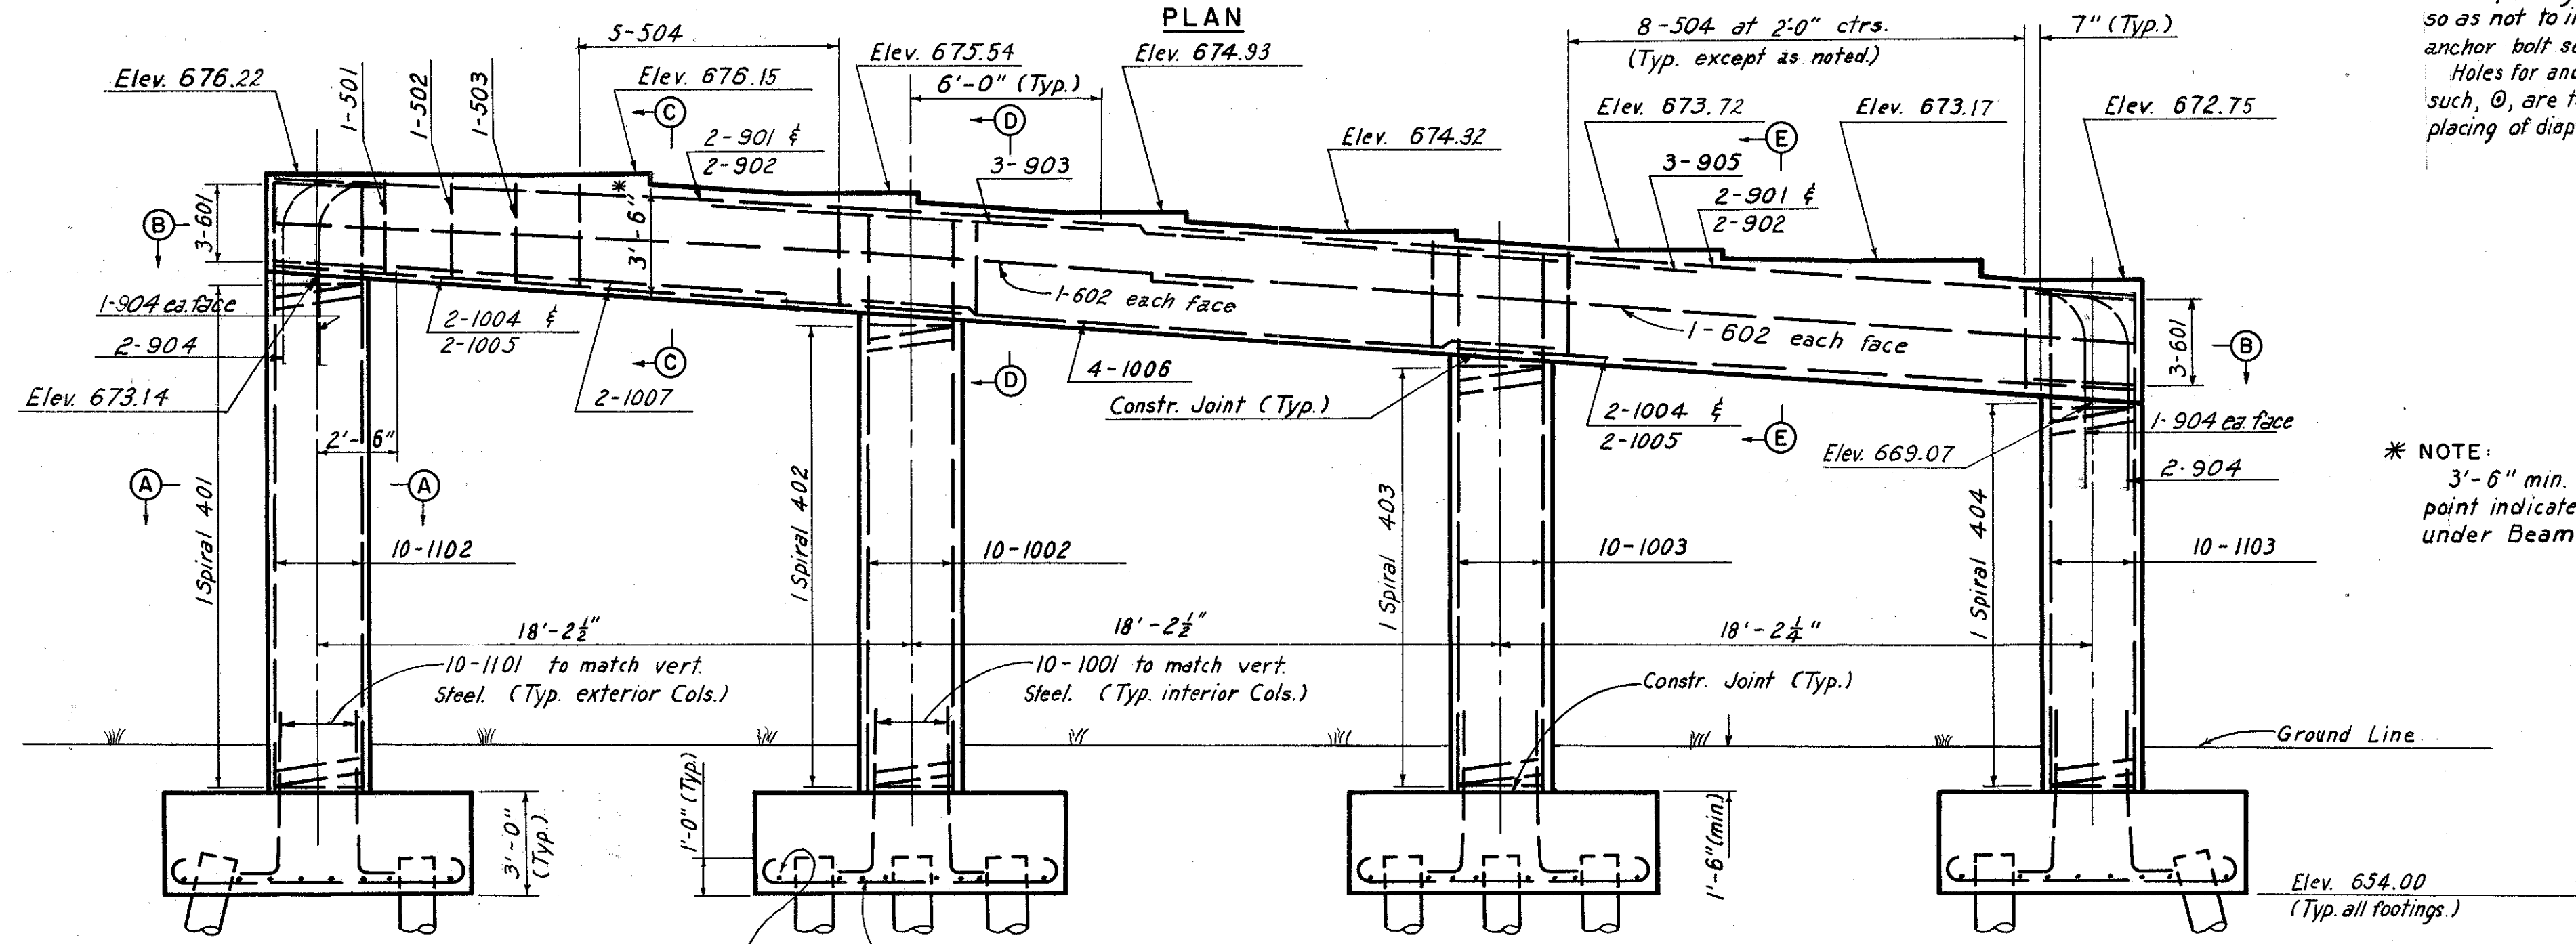

* NOTE:
3'-6" min. to be held from point indicated through section under Beam "A".

MARK	NO.	LENGTH	TYPE	DIMENSIONS				SERIES INCR. MENT	WEIGHT (POUNDS)
				A	B	C	D		
501	1	11'-6"	109	2'-8"	2'-10"				12
502	1	11'-10"	109	2'-8"	3'-0"				12
503	1	12'-0"	109	2'-8"	3'-1"				12
504	21	12'-2"	109	2'-8"	3'-2"				266
505	50	5'-5"	105	2'-8"	1'-6"				283
506	2	5'-3"	105	2'-6"	1'-6"				11
601	6	7'-11"	144	1'-11"	4'-1"				71
602	4	28'-3"	str.						170
701	64	10'-10"	100	9'-2"					1417
901	4	28'-9"	Str.						391
902	4	30'-0"	Str.						408
903	6	12'-0"	str.						245
904	8	11'-6"	123	4'-4"	4'-4"				313
1001	20	6'-11"	104	5'-10"	1'-4"				595
1002	10	17'-9"	str.						764
1003	10	16'-6"	str.						710
1004	4	19'-9"	str.						340
1005	4	21'-0"	str.						361
1006	4	21'-6"	str.						370
1007	2	12'-0"	str.						103
1101	20	7'-0"	104						744
1102	10	18'-9"	str.						996
1103	10	15'-3"	str.						810
Total =									9,404

SPIRAL REINFORCEMENT SCHEDULE						
MARK	NO.	CORE DIA. % SPIRAL	LENGTH	PITCH	NO. OF TURNS	WEIGHT (POUNDS)
401	1	2'-8"	16'-0"	4 1/2"	46	416
402	1	2'-8"	14'-8"	4 1/2"	42	379
403	1	2'-8"	13'-4"	4 1/2"	38	342
404	1	2'-8"	11'-11"	4 1/2"	35	305
Total =						1442

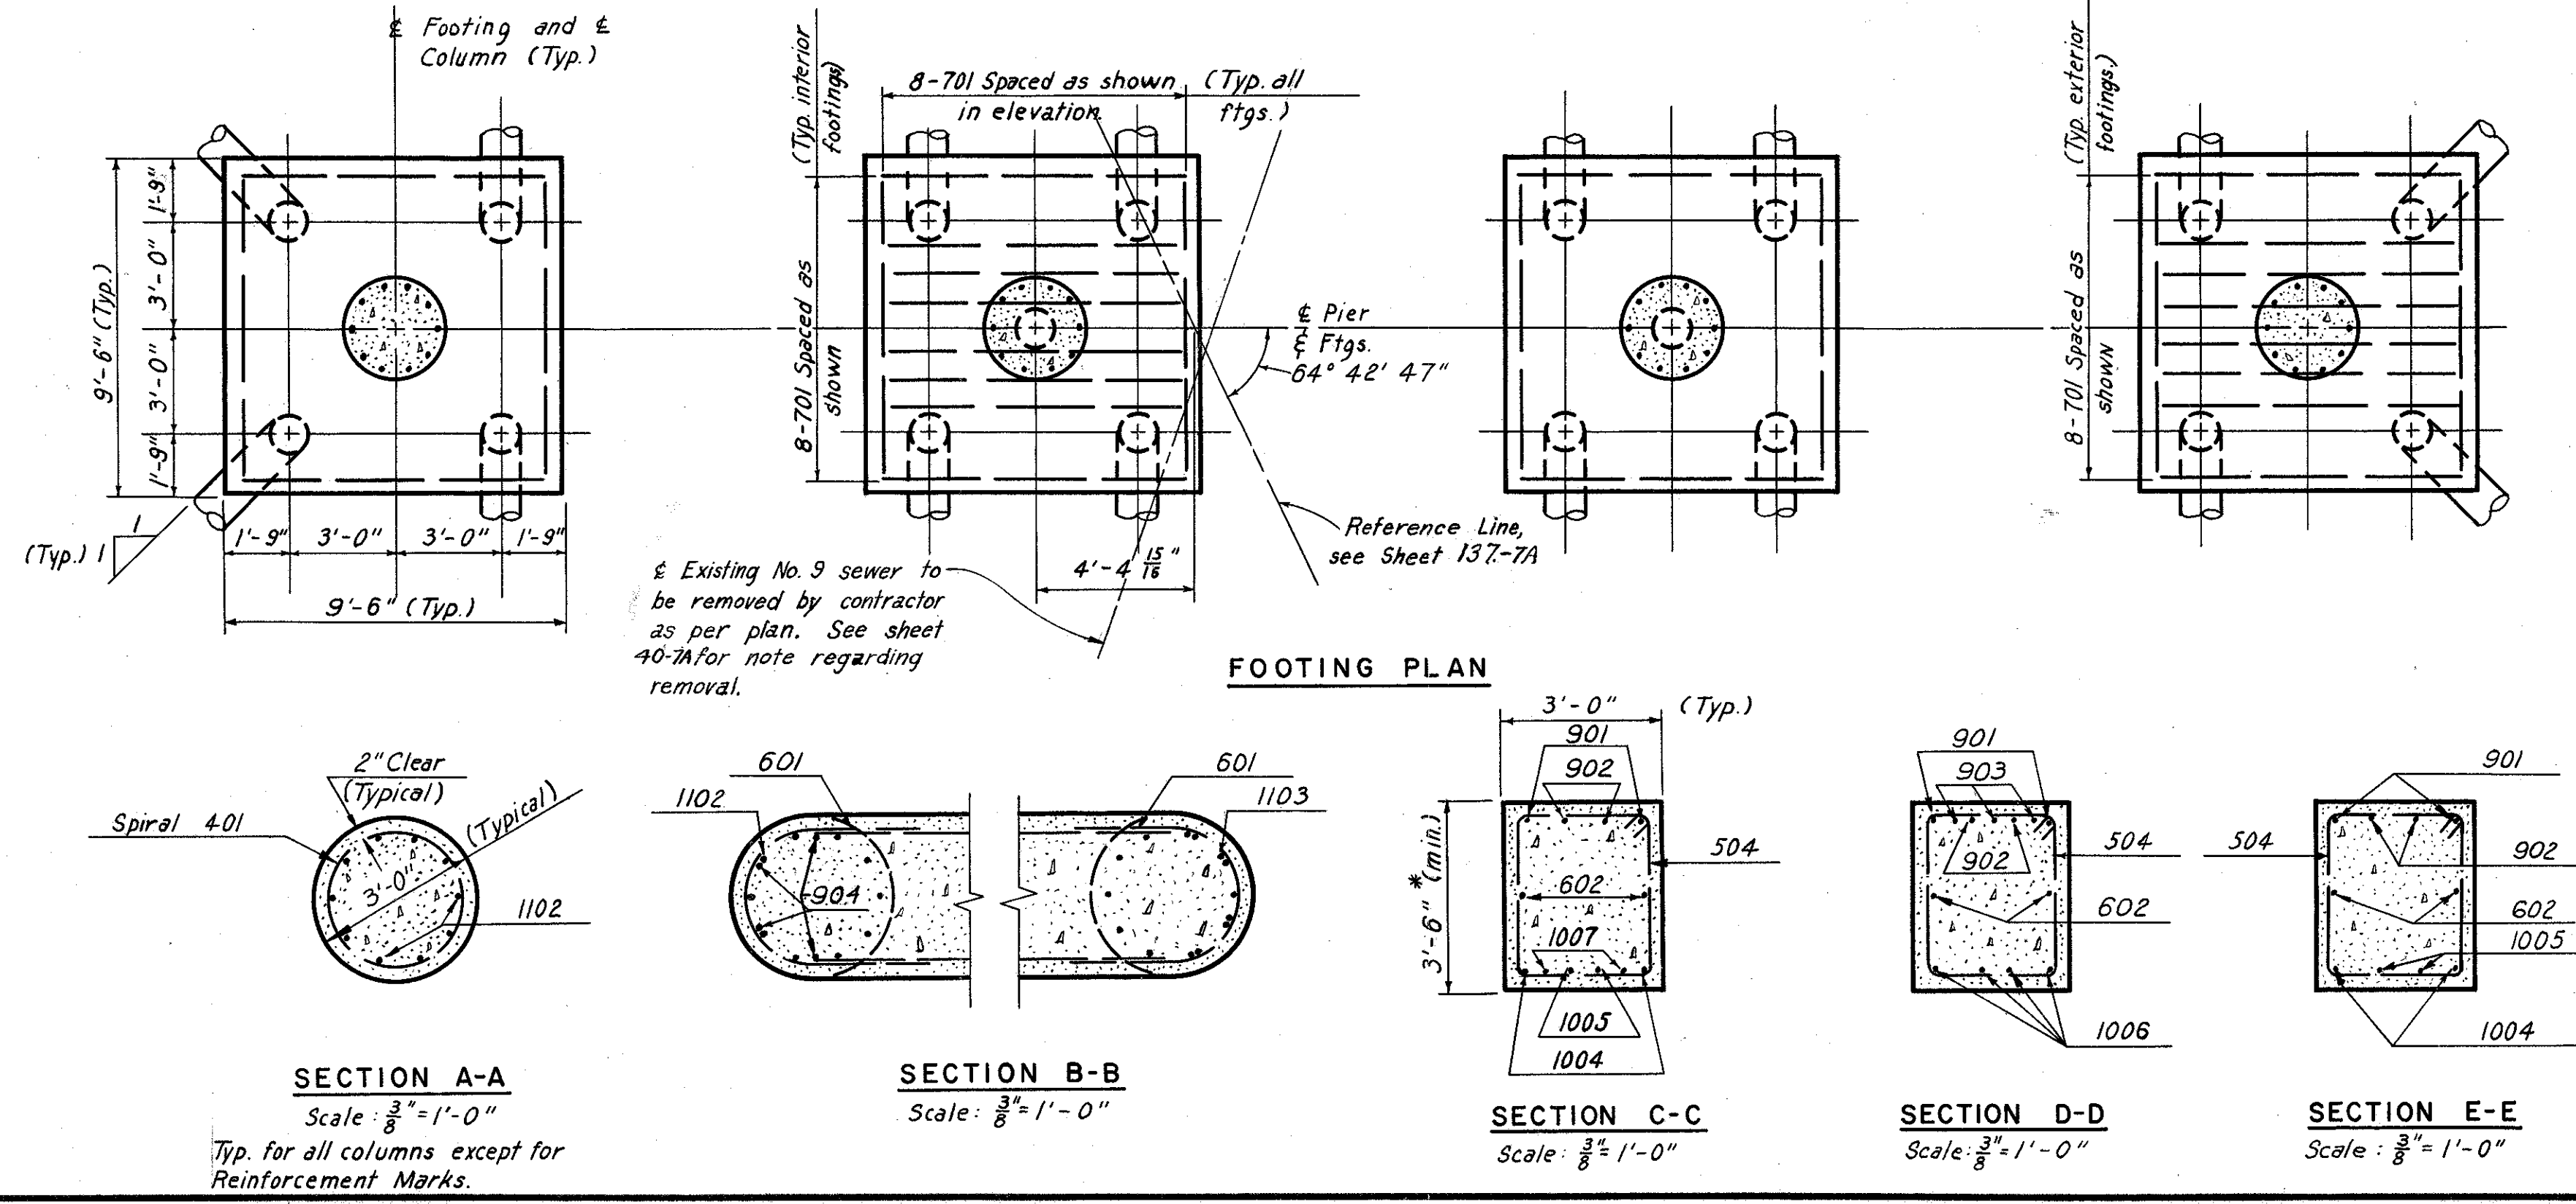

NOTES:
All Battered Piles shall be battered 3 in 12 in direction shown.
All Piles shall be 14" # C.I.P. Reinforced Concrete.
For bar bending diagram, see sheet 103-7A.
For masonry plate details, see Ohio Standards, Drawing RB-1-55.
For replacement steel schedule, see sheet 103-7A.
For spiral reinforcement notes, see sheet 103-7A.
Pile spacings are given along bottom of footing.
Reinforcement bars shall be 3 inches clear from face of concrete in footings and 2 inches elsewhere.
All bar dimensions are given out to out.

H.N.T.B. BR. NO. 5 PART 7A


HOWARD, NEEDLES, TAMMEN & BERGENOFF
CONSULTING ENGINEERS
KANSAS CITY CLEVELAND NEW YORK

PIER I
RAMP E-10 OVER RAMP E-8
Scale: 1/4" = 1'-0"
STA. 8+19.83
Except as noted STA. 9+38.16

WILLOW-INNER BELT FREEWAY
CLEVELAND CUYAHOGA COUNTY OHIO


DRAWN: M. TRACED: J.A.G. CHECKED: J. REVIEWED: J.C.T. REVISION: J.C.T.
DATE: 7-11-58 DATE: 8-22-58 DATE: 7-25-58 DATE: 11-13-59

SHEET 138

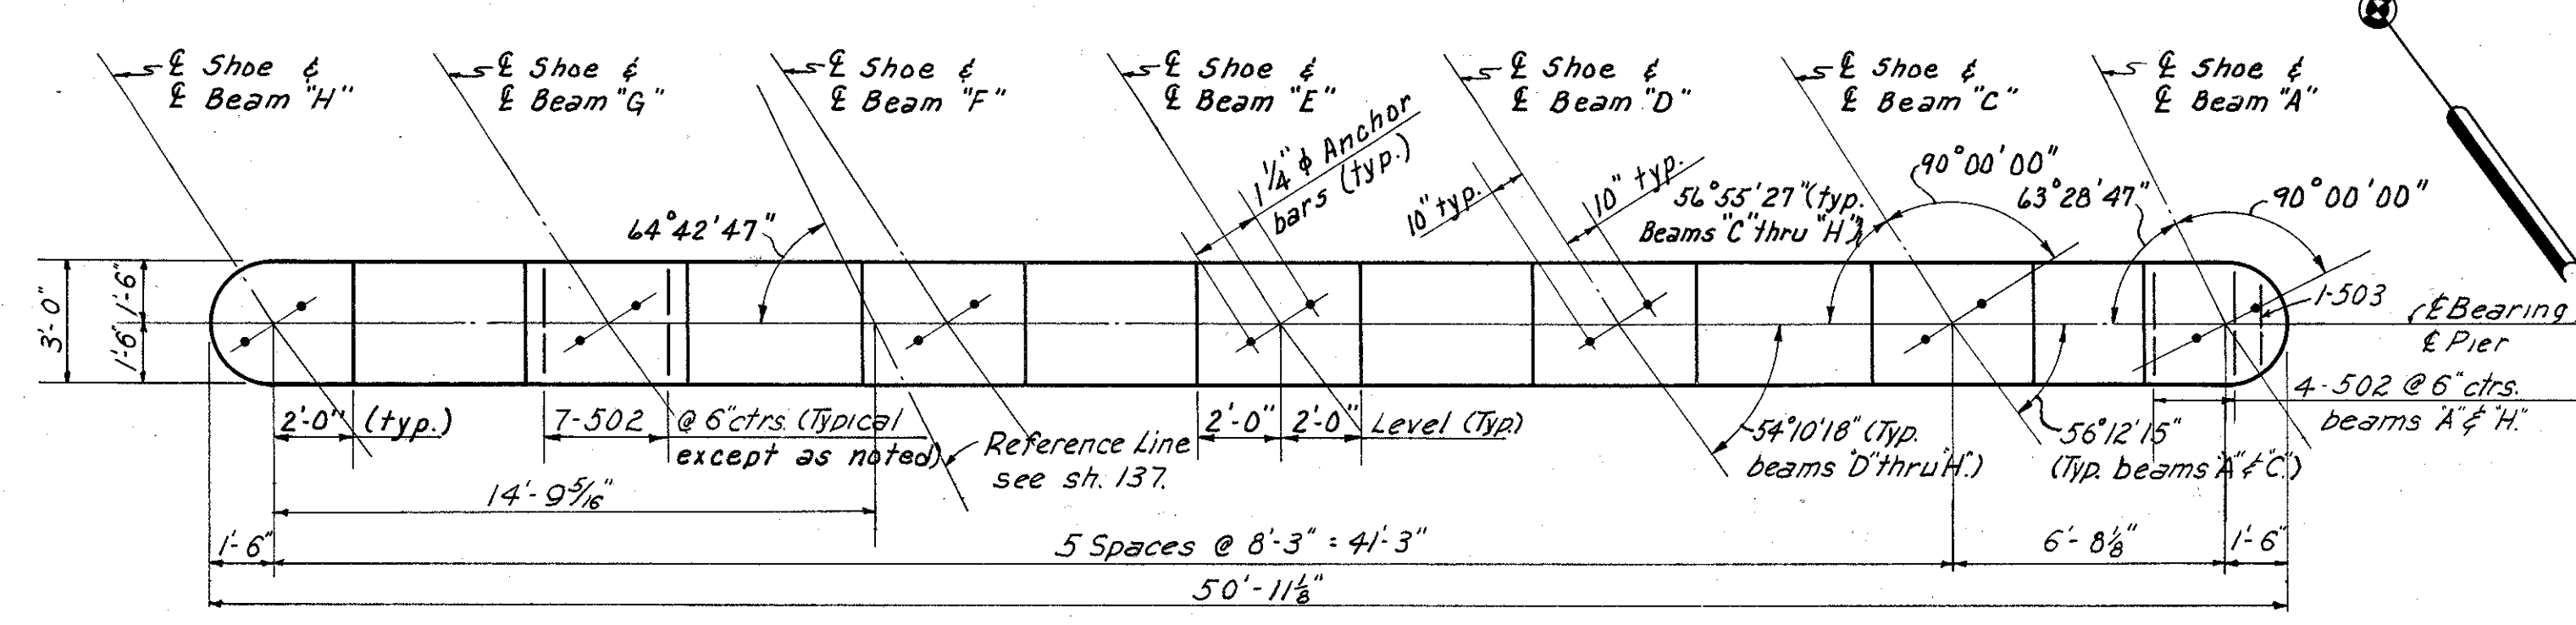


PLAN

Note: Special care shall be taken when placing reinforcing steel so as not to interfere with anchor bar setting.

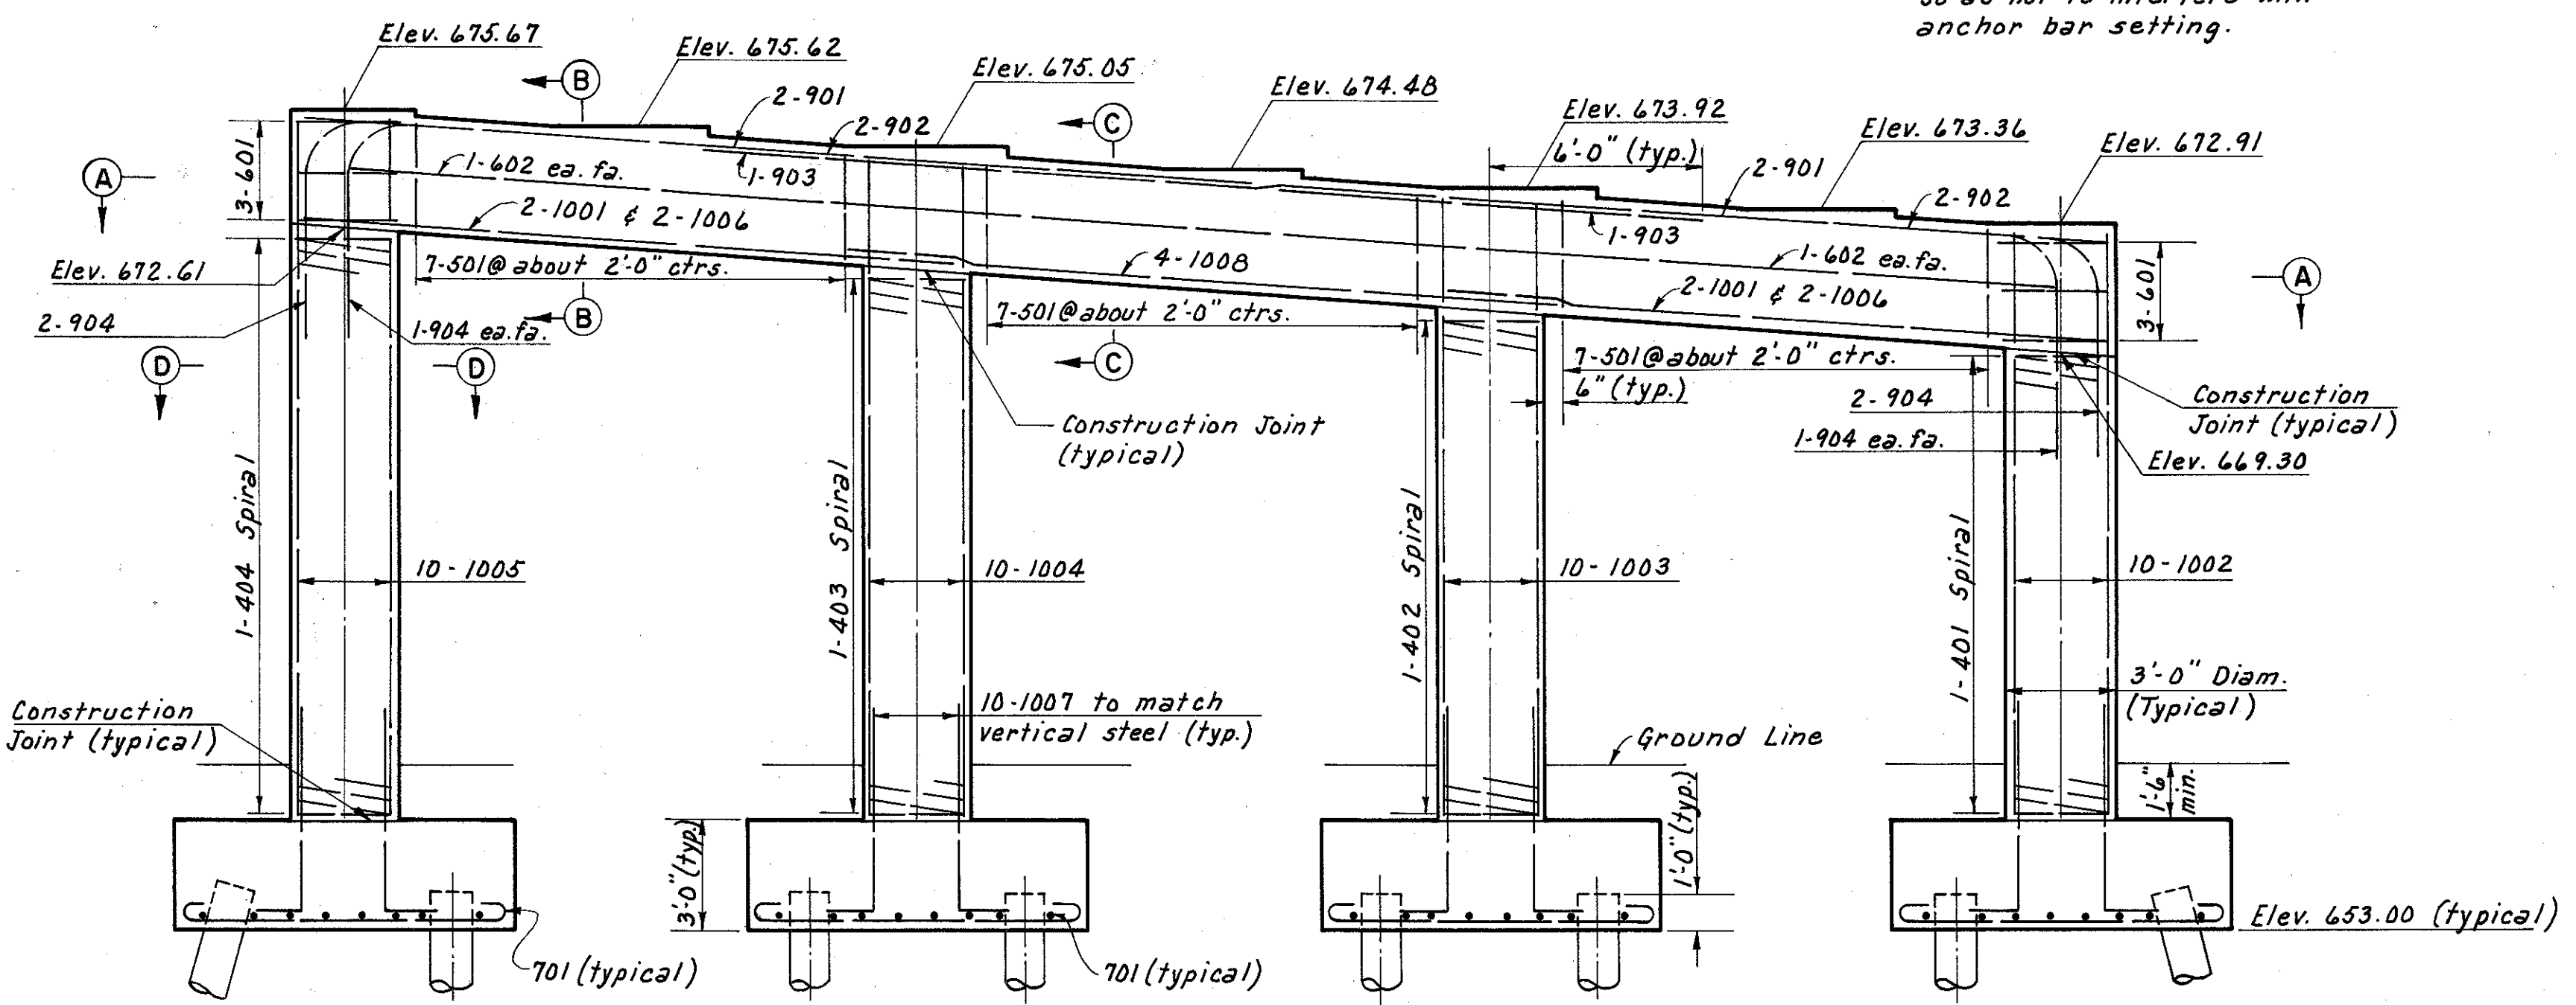


ELEVATION

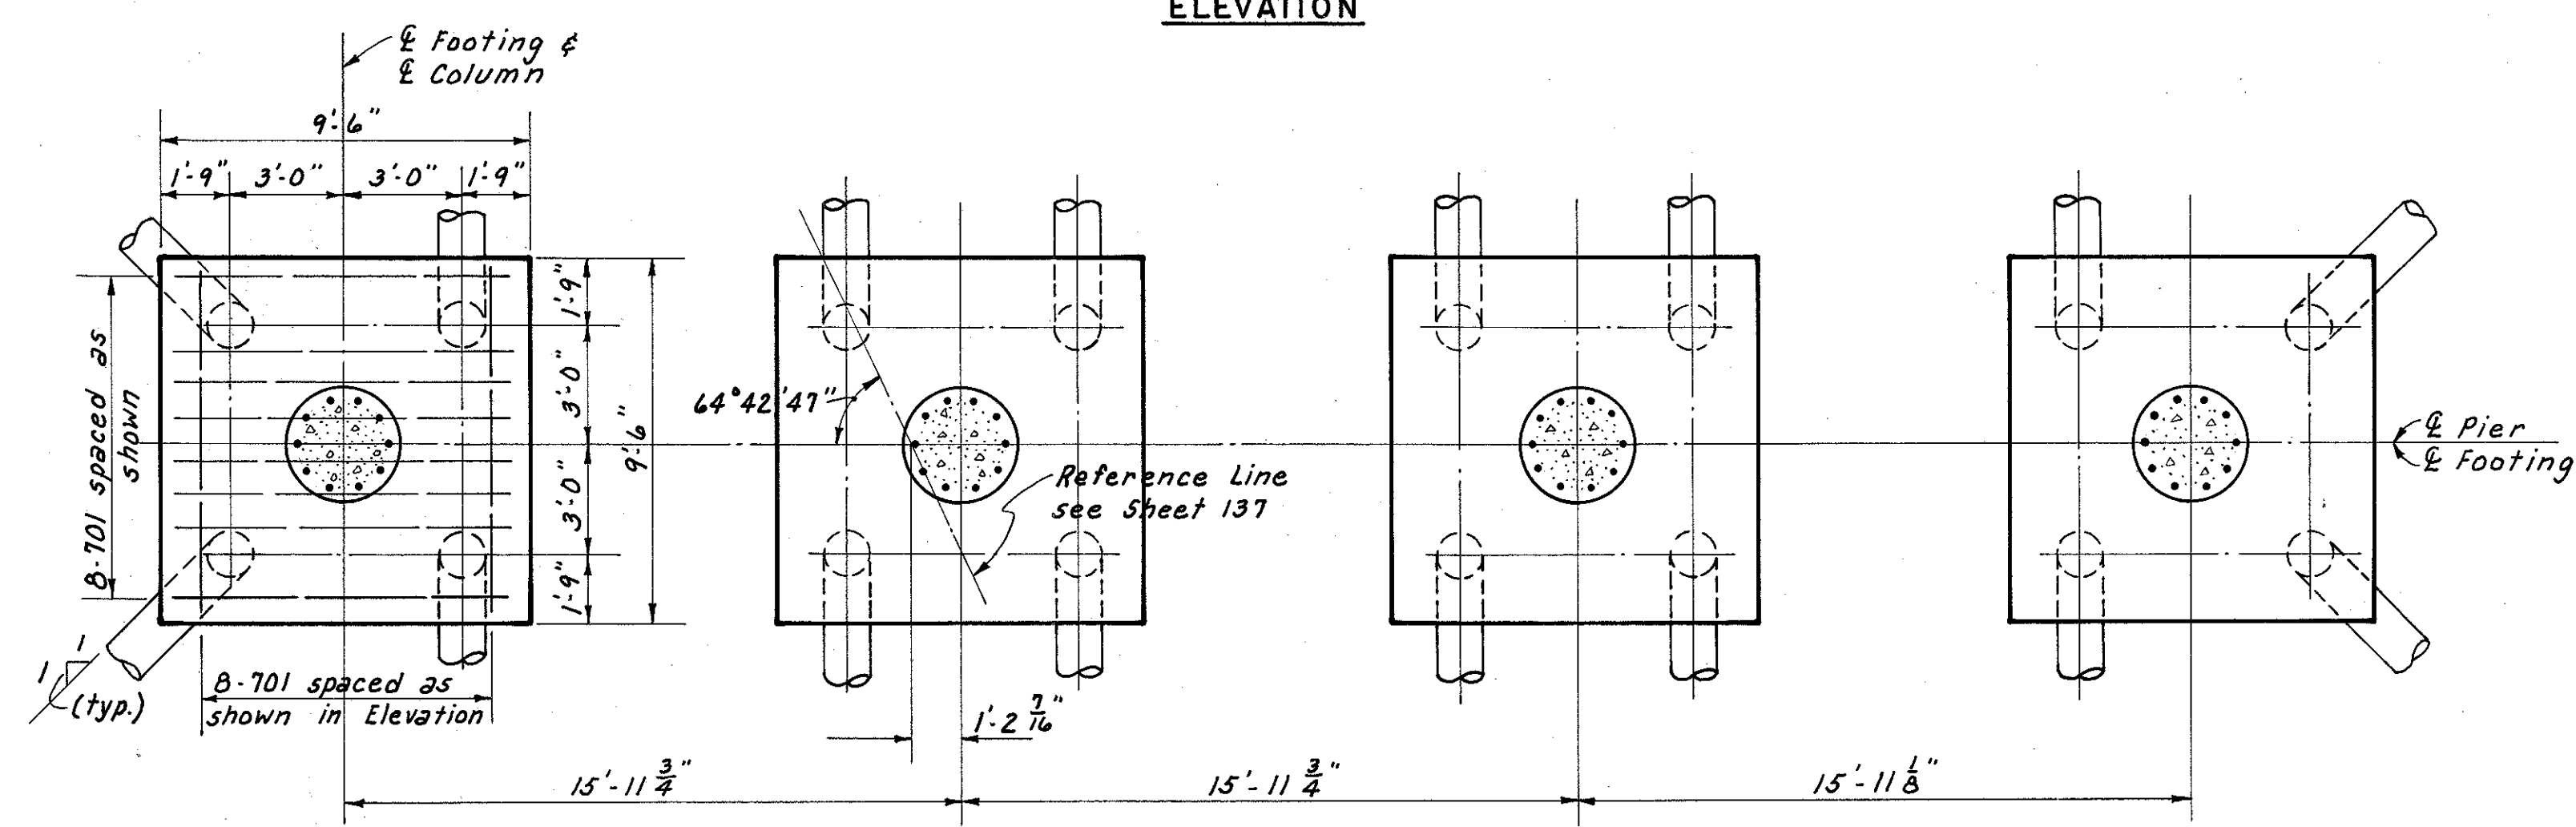


FOOTING PLAN


Note: Footing reinforcement and dimensions are typical for all footings.

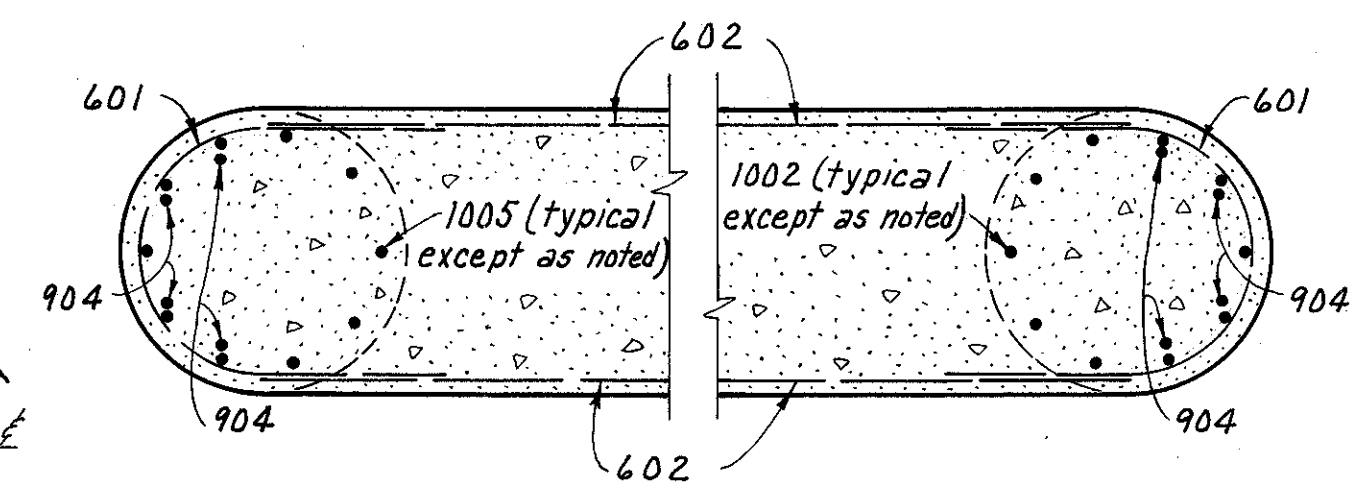


SECTION A-A

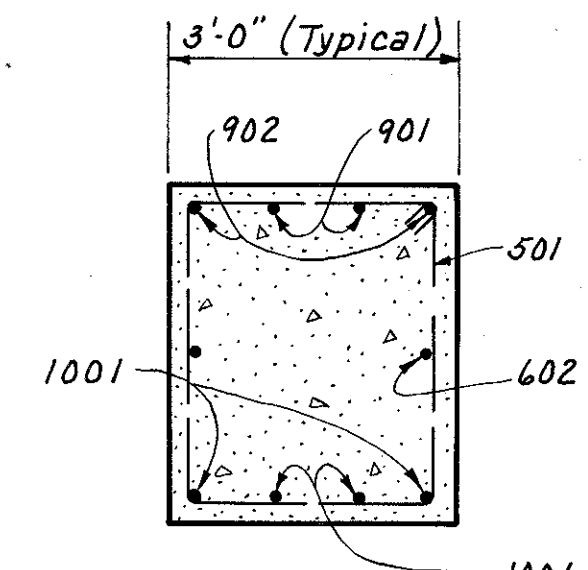

SECTION B-B

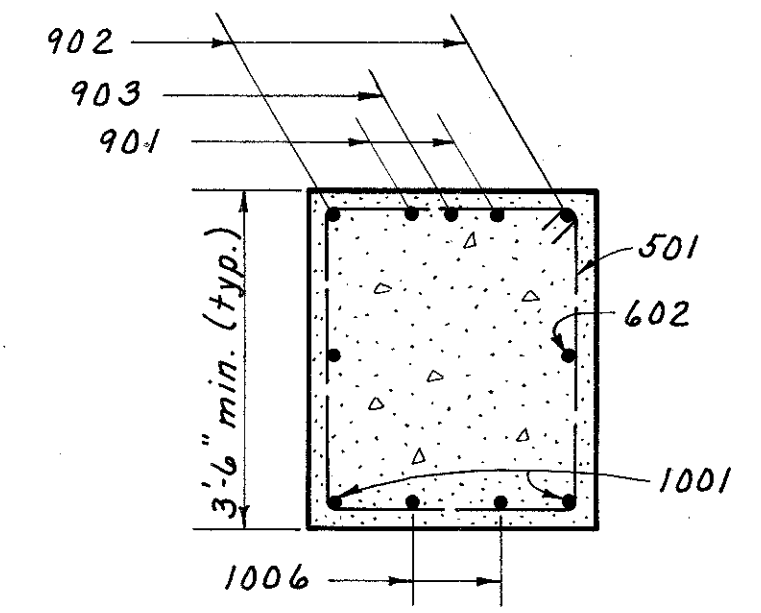

SECTION C-C

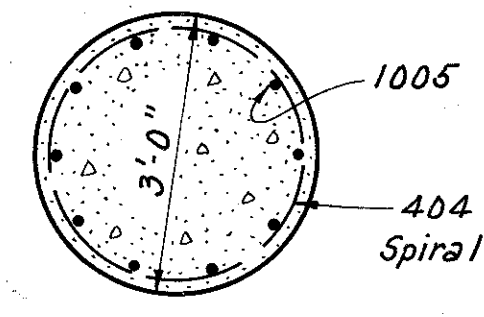

SECTION D-D

Scale: 1/2" = 1'-0"
 Typical for all columns except for bar marks

Note: Prefix "PB" shall be assigned to all bar marks.

REINFORCEMENT SCHEDULE									
MARK	NO.	LENGTH	TYPE	DIMENSIONS				SERIES INCREMENT	WEIGHT (POUNDS)
				A	B	C	D		
1001	4	17'-9"	Str.						306
1002	10	16'-6"	Str.						710
1003	10	17'-6"	Str.						753
1004	10	18'-9"	Str.						807
1005	10	19'-3"	Str.						828
1006	4	18'-9"	Str.						323
1007	40	6'-10"	104	5'-9"	16 1/2"				1176
1008	4	19'-3"	Str.						331
901	4	26'-6"	Str.						361
902	4	25'-3"	Str.						343
903	2	12'-0"	Str.						82
904	8	11'-6"	123	4'-4"	4'-4"				313
701	64	10'-10"	100						1417
601	6	7'-11"	144	1'-11"	4'-0"				71
602	4	24'-6"	Str.						147
501	21	12'-1"	109	2'-8"	3'-2"				265
502	43	3'-8"	105	2'-8"	1'-6"				247
503	2	3'-6"	105	2'-6"	1'-6"				11
Total									8,491

SPIRAL REINFORCEMENT SCHEDULE						
MARK	NO.	CORE DIA. % SPIRAL	LENGTH	PITCH	NO. OF TURNS	WEIGHT (POUNDS)
401	1	2'-8"	13'-2"	4 1/2"	39	254
402	1	2'-8"	14'-4"	4 1/2"	41	267
403	1	2'-8"	15'-5"	4 1/2"	44	287
404	1	2'-8"	16'-6"	4 1/2"	47	307
Total						1115

NOTES:
 All battered piles shall be battered 3 in 12 in direction shown.
 For details of masonry plate, see sheet 173-7A.
 Reinforcement bars shall be 3 inches clear from face of concrete in footings and 2 inches elsewhere.
 Bar dimensions are given out to out.
 For bar bending diagram, see sheet 103-7A.
 For Spiral Reinforcement Note, see sheet 103-7A.
 For Replacement Schedule, see sheet 103-7A.

H.N.T.B. BR. NO. 5 PART 7A
 HOWARD, NEEDLES, TAMMEN & BERGENDOFF
 CONSULTING ENGINEERS
 KANSAS CITY CLEVELAND NEW YORK
PIER 2
 RAMP E-10 OVER RAMP E-8
 Scale: 1/4" = 1'-0" STA. 8+19.83
 Except as noted STA. 9+38.16
WILLOW-INNER BELT FREEWAY
 CLEVELAND CUYAHOGA COUNTY OHIO
 DRAWN R.A. TRACED R.E.M. CHECKED J.C.T. REVISIONS
 DATE 9-3-80 DATE 5-13-81 DATE 9-16-83 DATE 11-13-89 SHEET 139


MICROFILMED
JUL 9 1985

CUYAHOGA COUNTY
CITY OF CLEVELAND
CUY-21-15.32
CUY-42-18.42

REINFORCEMENT SCHEDULE FOR NORTH ABUTMENT									
MARK	NO.	LENGTH	TYPE	DIMENSIONS				SERIES INCREMENT	WEIGHT (LBS)
				A	B	C	D		
401	28	5'-7"	105	8"	2'-7"				105
402	17	6'-7"	154	1'-10"	1'-4"				75
403	1 Ser. of 6	6'-1" to 6'-7"	154	1'-7" to 1'-10"	1'-4"			1 1/8"	25
404	1 Ser. of 6	4'-7" to 5'-11"	154	10" to 1'-6"	1'-4"			3 3/8"	21
405	1	6'-3"	109	1'-10"	1'-1"				4
406	20	6'-4"	144	2'-3"	1'-10"				85
501	54	4'-7"	105	1'-8"	1'-7"				258
601	10	34'-9"	Str.						522
602	6	12'-3"	Str.						110
603	1	5'-9"	124	2'-4"	1'-8"	1'-11"	4		9
604	8	10'-0"	Str.						120
605	47	6'-9"	100	5'-5"					477
606	14	4'-6"	100	3'-2"					95
607	1	13'-4"	108	11'-6"	1'-11"	24			20
608	6	5'-3"	Str.						47
609	4	31'-9"	Str.						191
610	2	33'-0"	Str.						99
611	1 Ser. of 4	31'-9" to 33'-0"	Str.					5"	195
612	7	32'-6"	Str.						342
613	1	9'-0"	Str.						14
614	9	31'-0"	Str.						419
615	1 Ser. of 4	31'-0" to 31'-9"	Str.					3"	189
616	72	6'-1"	104	5'-5"	10				658
617	35	7'-7"	105	3'-5"	2'-3"				399
618	55	15'-11"	112	1'-5"	5'-9"				1,315
619	8	15'-1"	109	1'-5"	5'-9"				181
620	6	12'-9"	Str.						-
621	7	14'-0"	Str.						147
622	6	14'-6"	Str.						131
623	2	15'-9"	Str.						47
624	4	6'-10"	108	1'-11"	5'-0"	6			41
625	1	9'-9"	Str.						15
626	3	11'-9"	108	9'-11"	1'-11"	24			53
627	4	8'-6"	Str.						51
628	8	4'-0"	Str.						48
629	6	3'-6"	Str.						32
630	2	4'-9"	Str.						14
631	27	7'-9"	Str.						314
632	20	6'-0"	Str.						180
633	6	13'-3"	Str.						-
634	1	15'-3"	123	13'-2"	1'-3"	10"			23
635	2	16'-6"	Str.						50
636	3	12'-10"	124	10'-8"	6"	1'-11"	4		58
637	4	6'-3"	Str.						38
638	6	3'-0"	Str.						27
639	1	10'-6"	Str.						16
640	34	5'-6"	104	4'-10"	10"				281
									Total 7,541


REINFORCEMENT SCHEDULE FOR SOUTH ABUTMENT									
MARK	NO.	LENGTH	TYPE	DIMENSIONS				SERIES INCREMENT	WEIGHT (LBS)
				A	B	C	D		
401	34	5'-7"	105	8"	2'-7"				127
402	22	6'-7"	154	1'-10"	1'-4"				97
403	1 Ser. of 6	4'-3" to 5'-9"	154	8" to 1'-5"	1'-4"			3 3/8"	20
404	1	6'-3"	109	1'-10"	1'-1"				4
405	14	6'-4"	144	2'-3"	1'-10"				59
406	1 Ser. of 6	5'-11" to 6'-7"	154	1'-6" to 1'-10"	1'-4"			1 1/8"	25
501	40	4'-5"	105	1'-8"	1'-6"				184
601	10	28'-0"	Str.						421
602	2	6'-6"	104	5'-10"	10"				20
603	6	3'-0"	Str.						27
604	3	29'-9"	Str.						134
605	33	6'-9"	100	5'-5"					335
606	19	4'-6"	100	3'-2"					128
607	1	21'-0"	108	19'-1"	2'-0"	16			32
608	2	19'-6"	Str.						59
609	1	17'-6"	108	15'-0"	2'-7"	12			26
610	8	10'-0"	Str.						120
611	1	4'-0"	Str.						6
612	6	5'-3"	Str.						47
613	2	22'-3"	Str.						69
614	54	6'-1"	104	5'-5"	10"				493
615	39	5'-8"	104	5'-0"	10"				332
616	34	7'-9"	Str.						396
617	5	6'-3"	Str.						47
618	11	3'-6"	Str.						58
619	2	23'-6"	Str.						71
620	5	21'-9"	Str.						163
621	4	19'-7"	108	17'-8"	2'-0"	16			118
622	5	15'-9"	Str.						118
623	3	14'-0"	Str.						63
624	3	9'-3"	Str.						42
625	4	10'-4"	124	8'-2"	6"	1'-11"	9		62
626	1	8'-0"	Str.						12
627	6	20'-6"	Str.						-
628	1	4'-1"	123	2'-0"	1'-3"	10"			6
629	3	20'-3"	Str.						91
630	4	6'-10"	108	1'-11"	5'-0"	6			41
631	6	10'-3"	Str.						-
632	3	11'-9"	Str.						53
633	27	7'-1"	105	3'-5"	2'-0"				287
634	38	15'-11"	112	1'-5"	5'-9"				908
635	10	15'-1"	109	1'-5"	5'-9"				227
636	6	28'-6"	Str.						257
637	7	21'-3"	Str.						223
638	2	19'-0"	Str.						57
639	2	30'-6"	Str.						92
640	3	11'-0"	Str.						50
641	1 Ser. of 4	28'-6" to 30'-6"	Str.					8"	177
642	1 Ser. of 4	19'-0" to 21'-3"	Str.					9"	121
643	1	17'-6"	Str.						26
644	8	5'-6"	Str.						66
645	8	4'-3"	Str.						51
646	3	3'-9"	Str.						17
647	4	6'-0"	Str.						36
648	3	5'-0"	Str.						23
649	1	13'-7"	124	10'-0"	1'-10"	2'-0"	9		20
									Total 6,744

Note:
All chamfers to be 3/4"

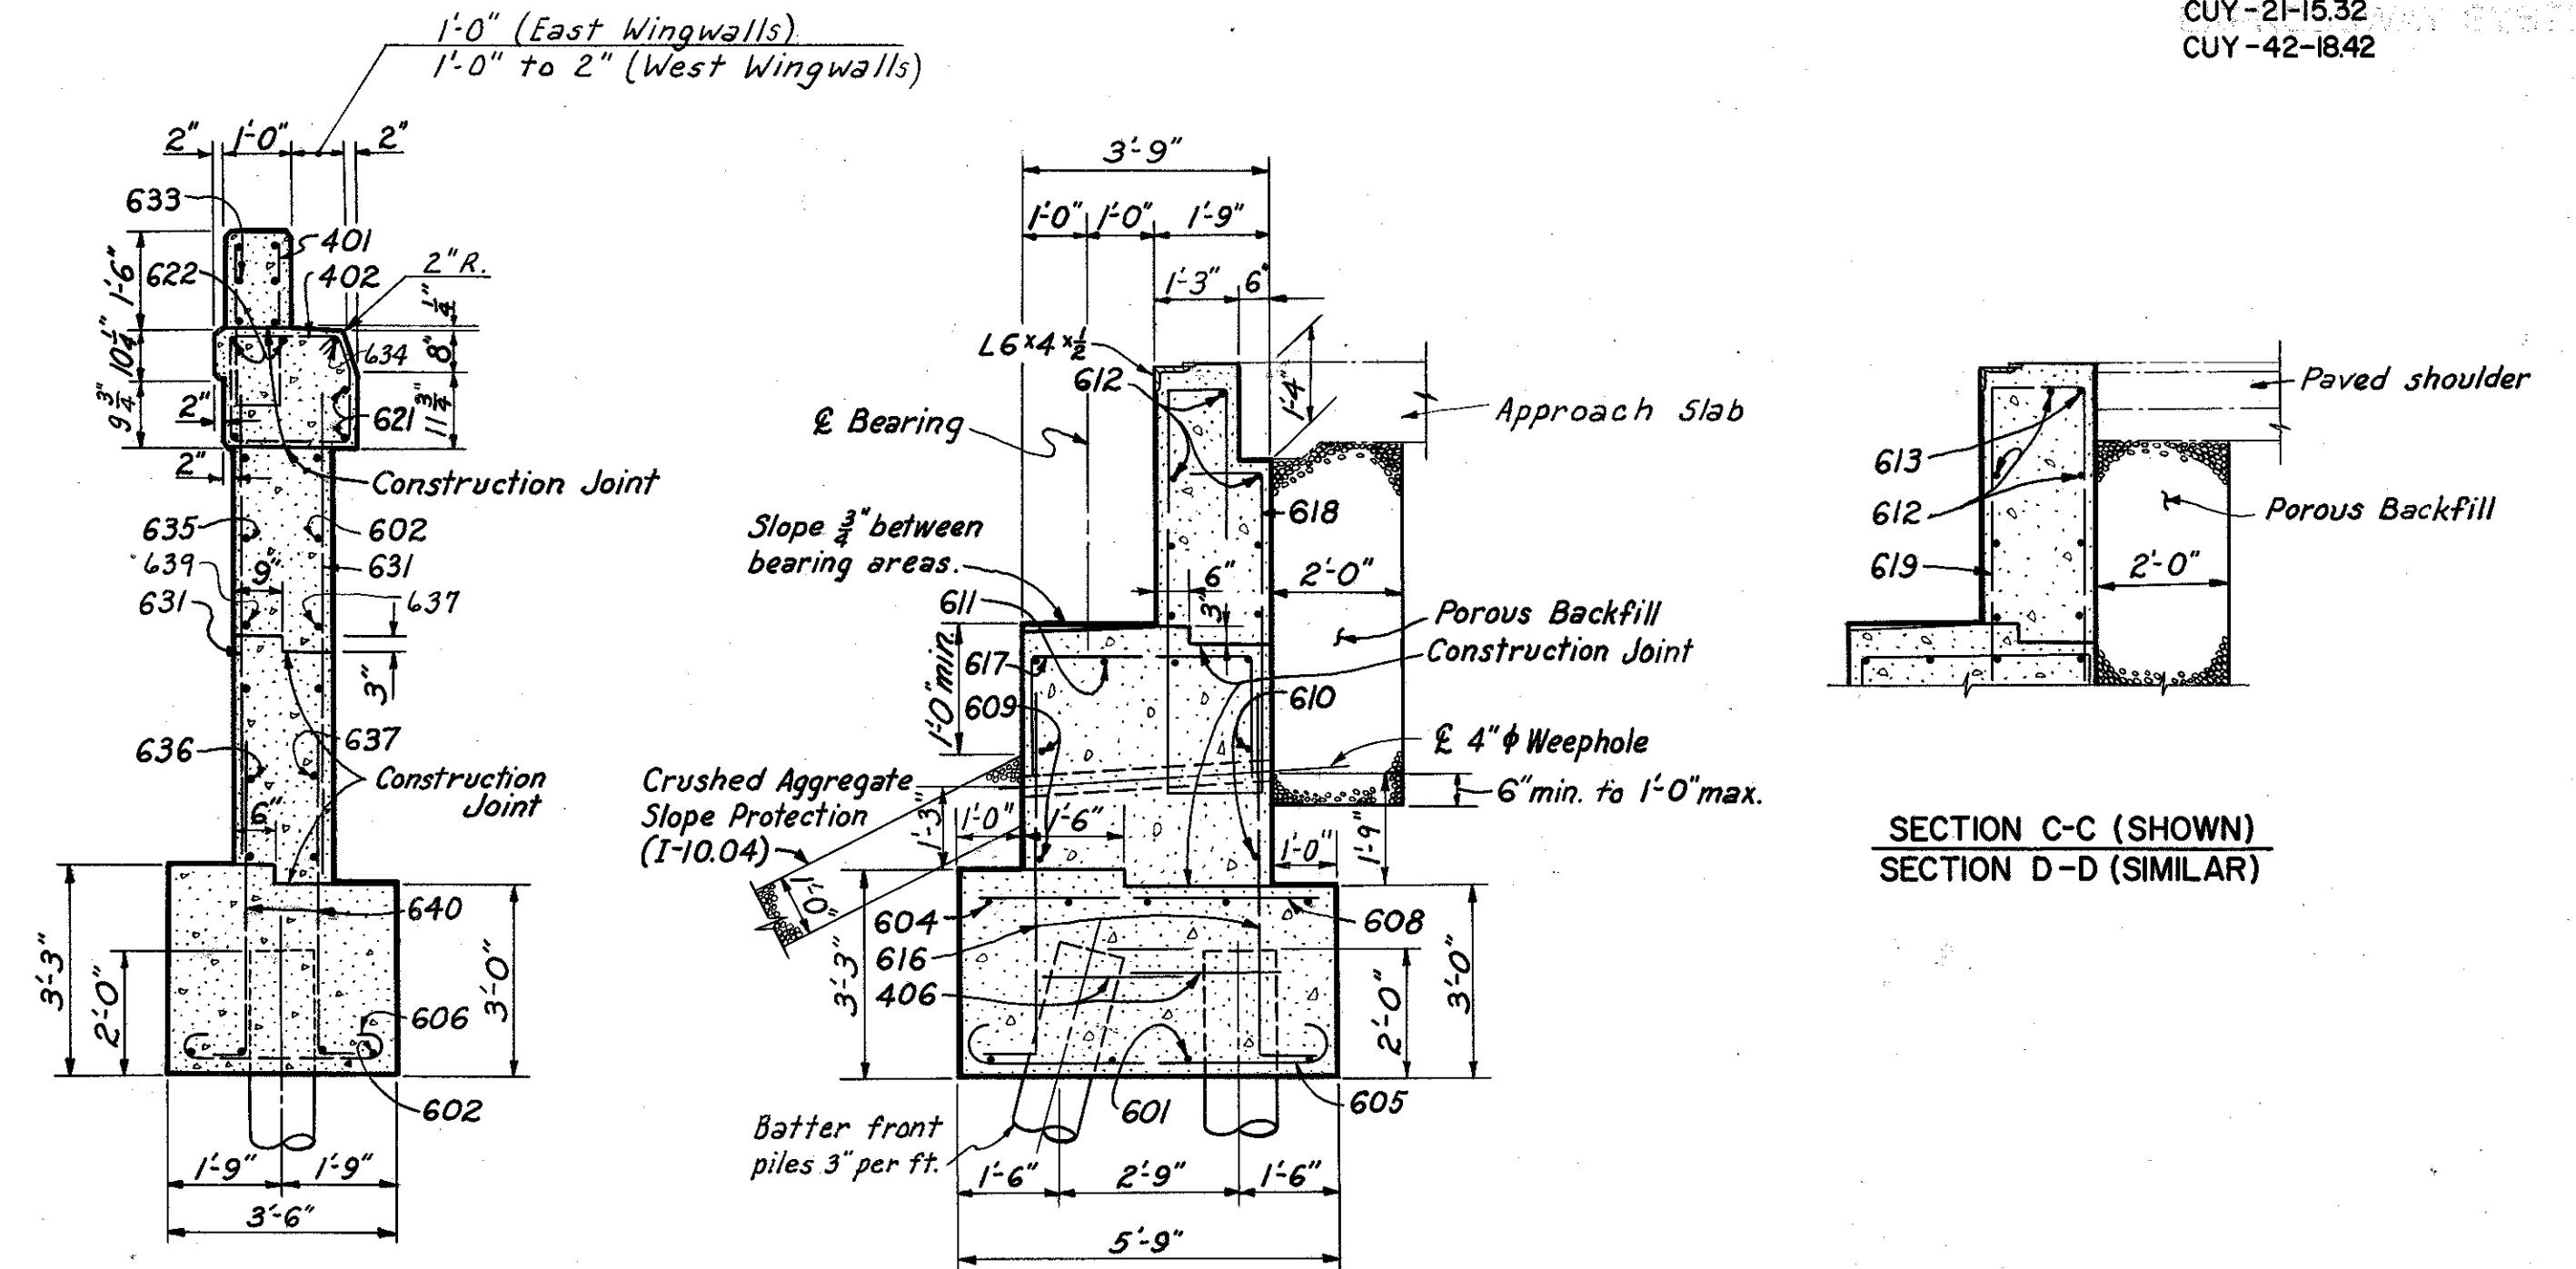


SECTION G-G (SHOWN)
SECTION F-F (SIMILAR)

SECTION H-H (SHOWN)
SECTION E-E (SIMILAR)

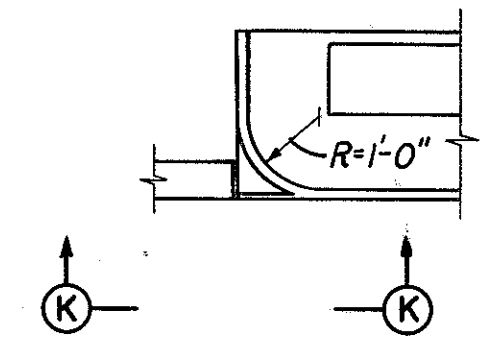

DETAIL J-J

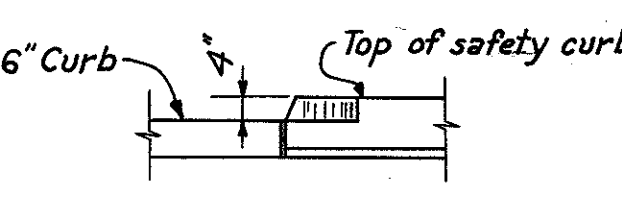


ELEVATION K-K

NOTES:
* Bars are included with "Item S-14, Railing" for payment.
Bar dimensions are given out to out.
Bars of a series shall vary in length by a constant increment.
For replacement schedule see sheet 103-7A
For additional notes, see sheet 141-7A

Note: Prefixes shall be assigned to bar marks as follows:
North Abutment: "AA"
South Abutment: "AB"

BENDING DIAGRAMS

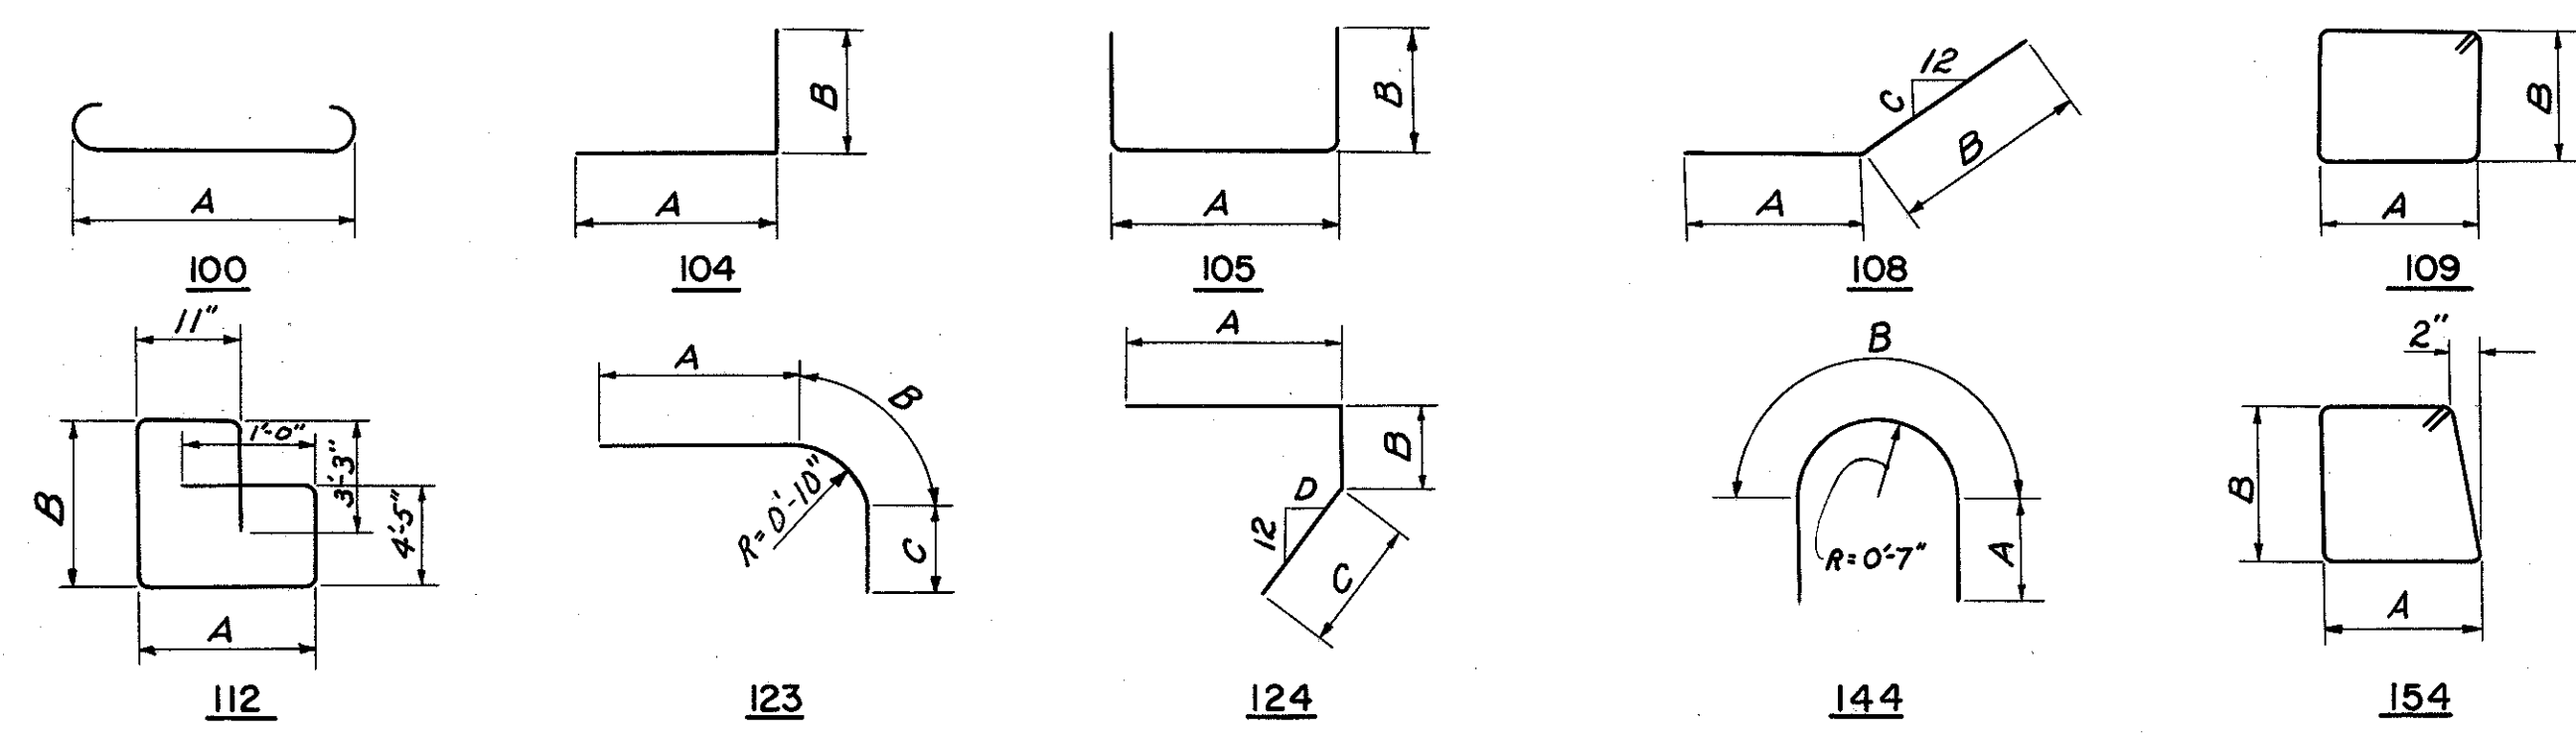

H.N.T.B. BR. NO. 5 PART 7/A

HOWARD, NEEDLES, TAMMEN & BERGENDOFF
CONSULTING ENGINEERS
KANSAS CITY CLEVELAND NEW YORK

ABUTMENT DETAILS
RAMP E-10 OVER RAMP E-8

Scale: 3/8" = 1'-0" STA. 8+19.83
STA. 9+38.16


WILLOW-INNER BELT FREEWAY
CLEVELAND CUYAHOGA COUNTY OHIO

DRAWN A.B. TRACED A.M. CHECKED R.C. REVIEWED J.C.T. REVISIONS
DATE 6-28-58 DATE 3-7-59 DATE 7-31-58 DATE 11-13-59

SHEET 142


JUL 8 1955

CUYAHOGA COUNTY
CITY OF CLEVELAND
CUY-21-15.32
CUY-42-18.42

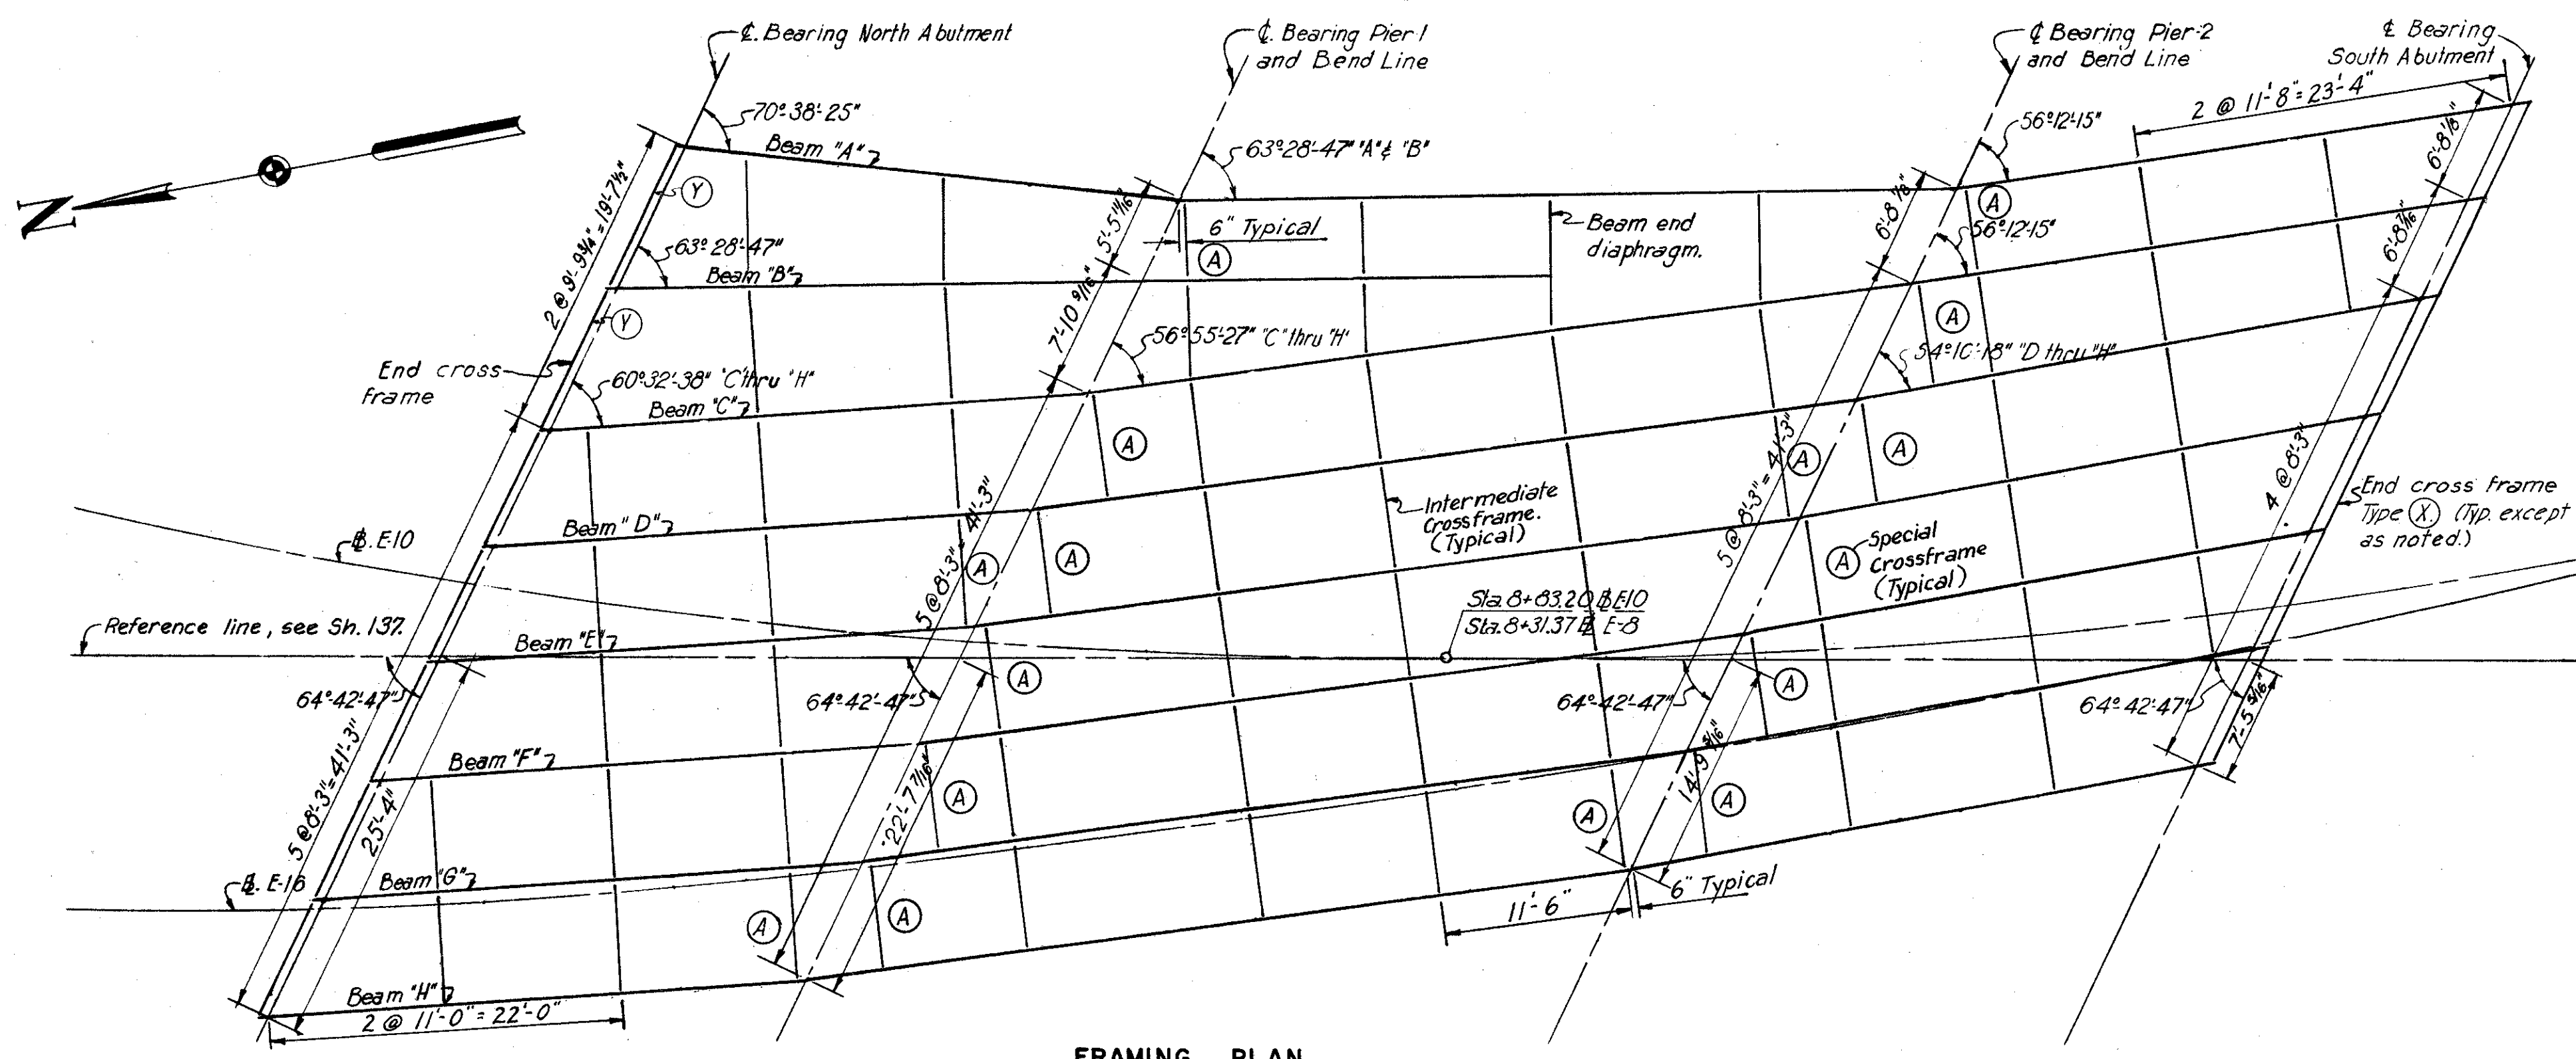




BEAM SPLICE WELDING PROCEDURE

- 1- With the beams in their final position, butt-weld the beam flanges and web at the piers, using the following sequence; make two passes on each flange, then two on the web; repeat, using one pass at each location, until welds are completed.
- 2- Weld bottom and top cover plates.
- 3- Weld Type 'A' cross frames into position.

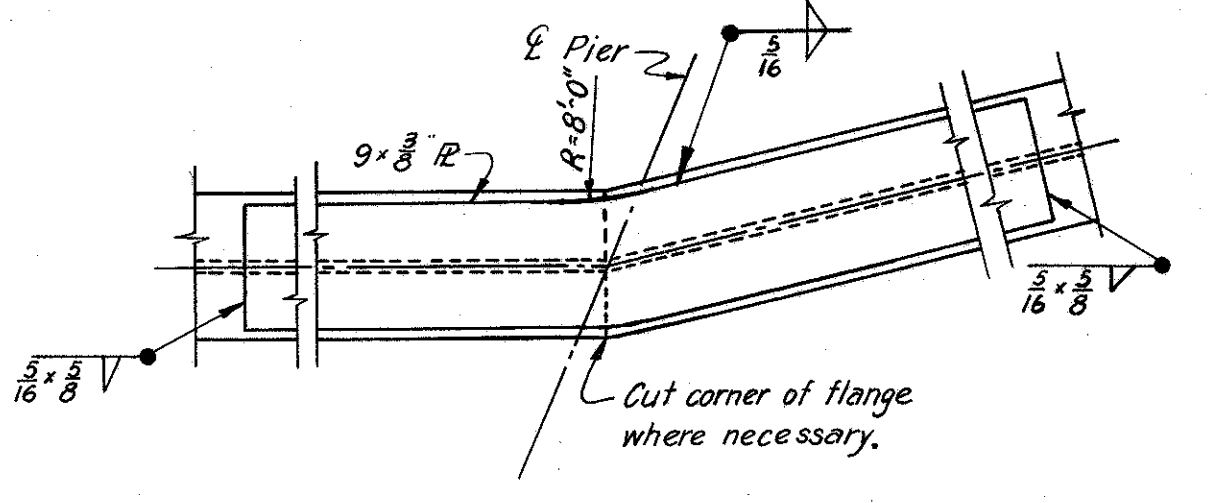

NOTES:

Cover Plates may be fabricated from a single wide plate or from two plates butt welded for full strength and ground smooth in the shop. The splice shall be a minimum of 2'-0" from the bend point.
"G" indicates a smooth grind in the direction of the stress.

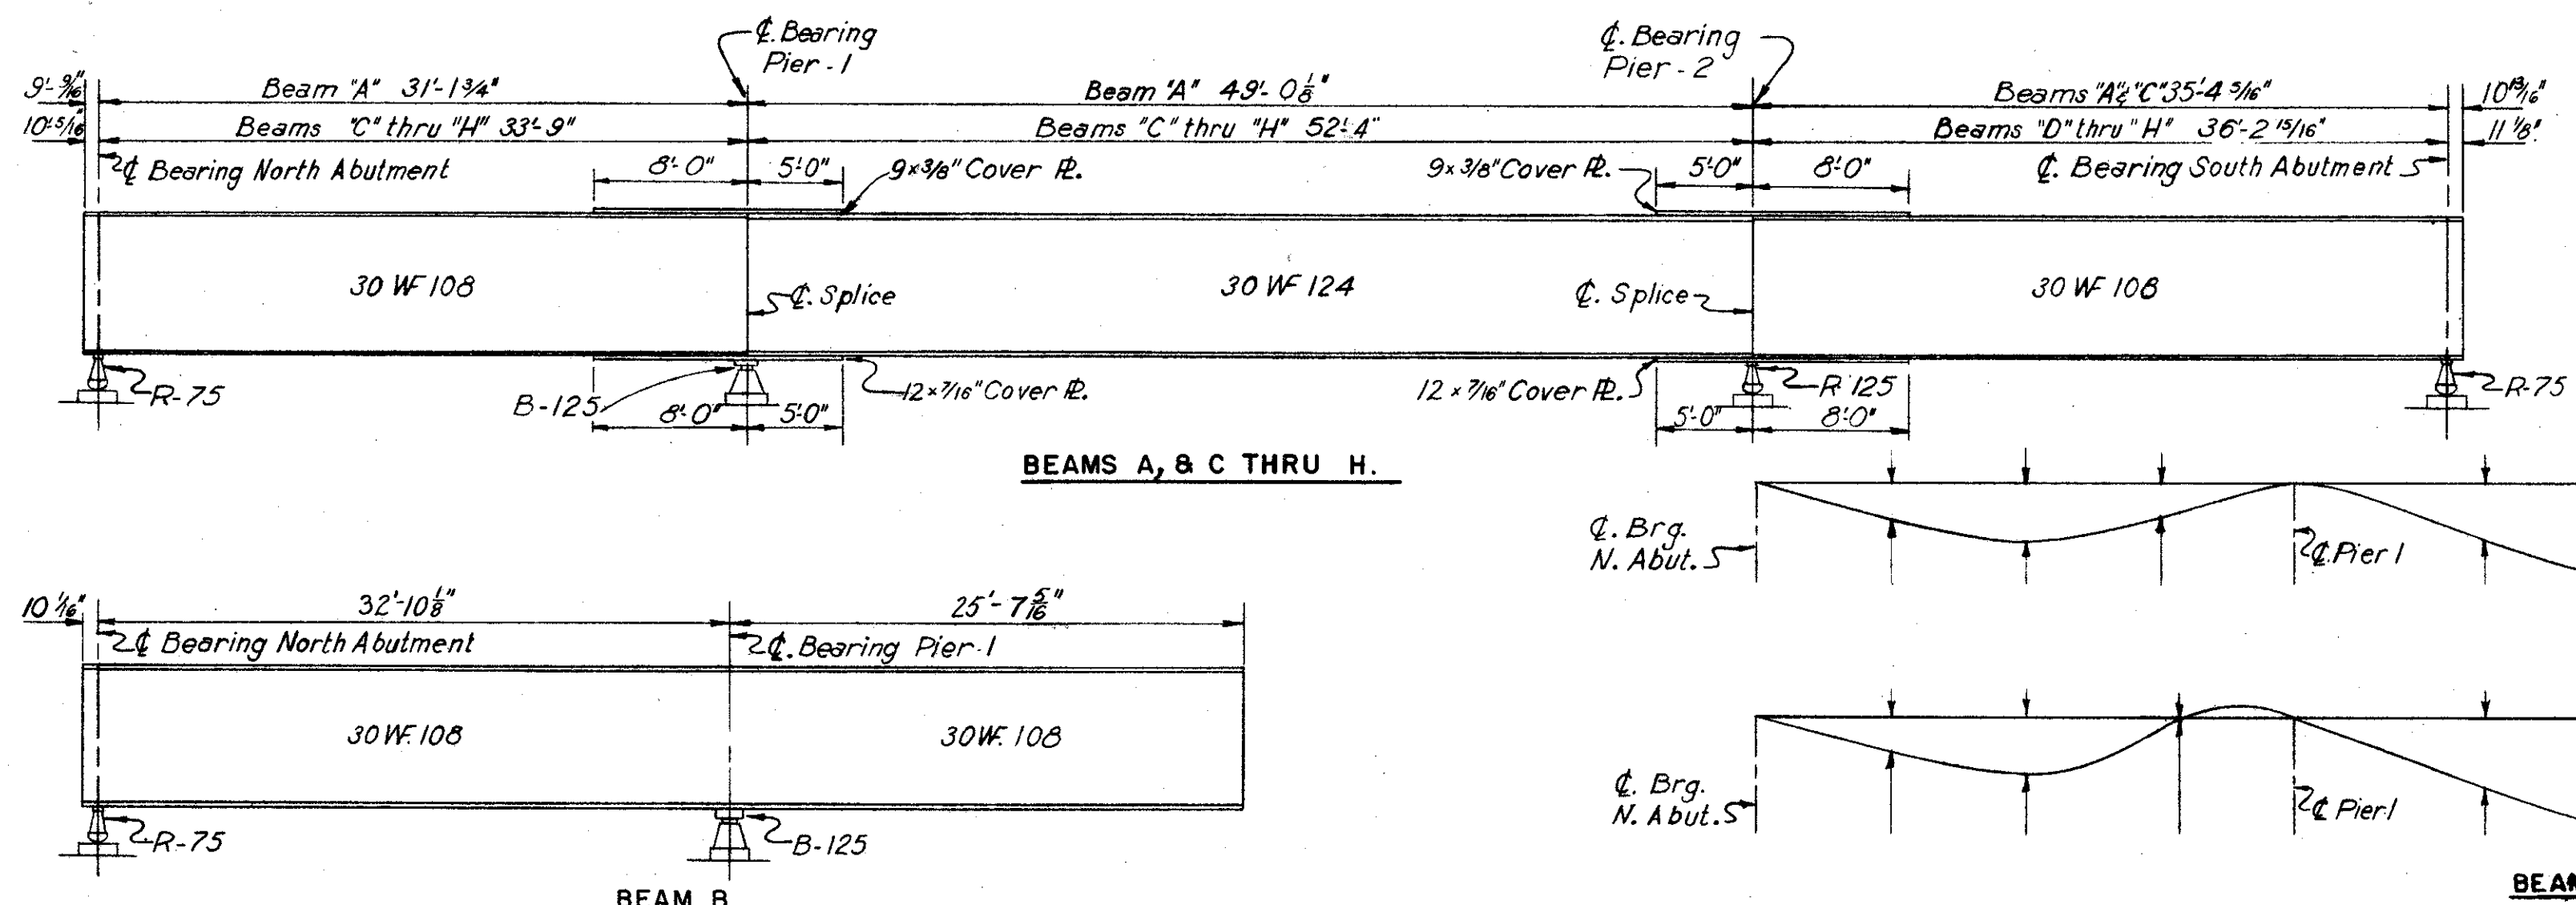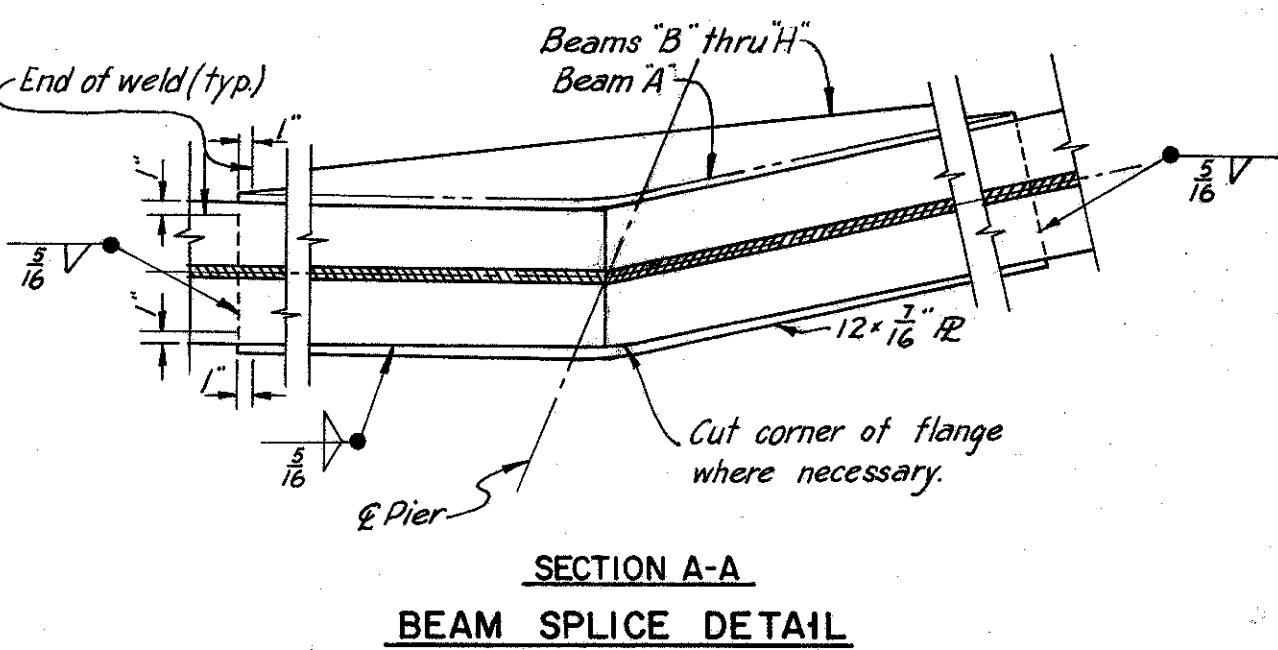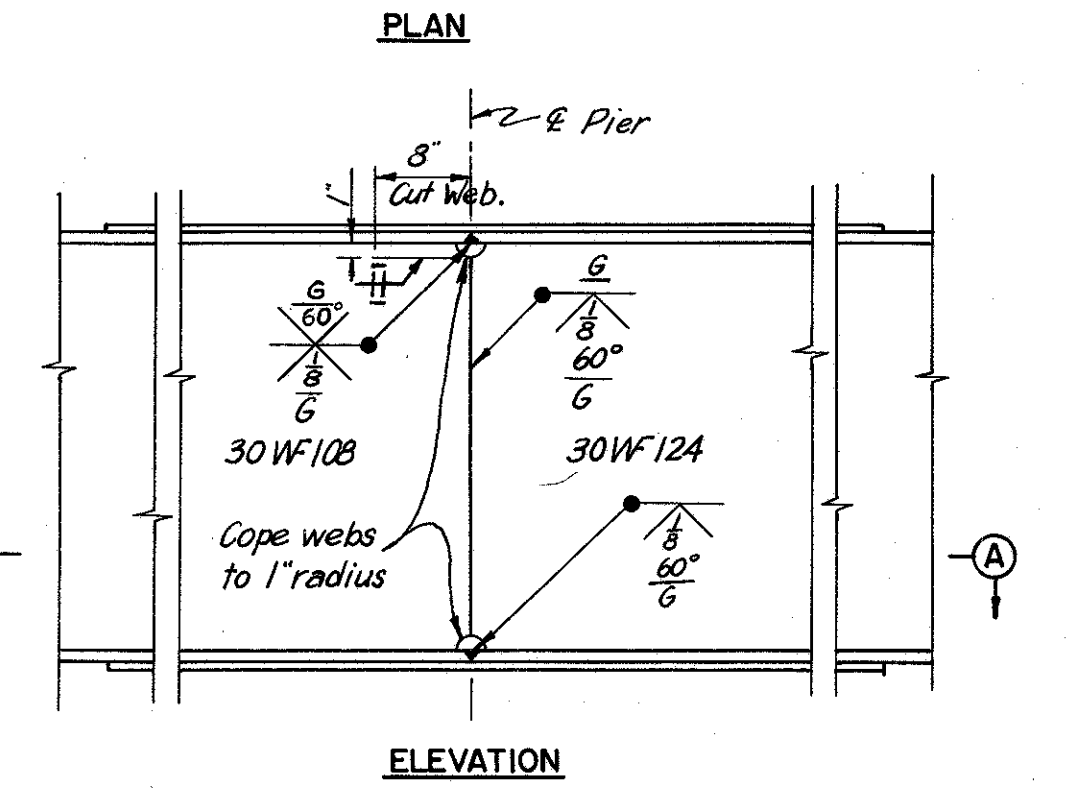

No cambering of the beams is required, but they shall be so fabricated and erected that any curved beam shall be placed with the convex flange up.

Elevations shown in table are located at intersection of E bearings & E beams

ELEVATIONS

Deflections are given at the quarter points and are measured to the nearest 1/16 inch.

BEAM DEFLECTION DIAGRAMS.

No Scale

(D.L. Defl.) - denotes dead load deflections.
(Tot.) - refers to the total deflection from dead load of steel and concrete.
(Con.) - denotes deflections for concrete.
(PVMT) - denotes pavement.

BEAM	DEFLECTION & ELEVATION TABLE																																							
	NORTH ABUTMENT				SPAN 1								PIER 1				SPAN 2								PIER 2				SPAN 3								SOUTH ABUTMENT			
	TOP OF BEAM ELEV.	TOP OF PVMT. ELEV.	TOP OF PVMT. ELEV.	CON/TOT	DL DEF.	TOP OF PVMT. ELEV.	CON/TOT	DL DEF.	TOP OF PVMT. ELEV.	CON/TOT	DL DEF.	TOP OF PVMT. ELEV.	CON/TOT	DL DEF.	TOP OF PVMT. ELEV.	CON/TOT	DL DEF.	TOP OF PVMT. ELEV.	CON/TOT	DL DEF.	TOP OF PVMT. ELEV.	CON/TOT	DL DEF.	TOP OF PVMT. ELEV.	CON/TOT	DL DEF.	TOP OF PVMT. ELEV.	CON/TOT	DL DEF.	TOP OF PVMT. ELEV.	CON/TOT									
A	676.25	677.00	677.02	0	1/16	677.05	0	1/16	677.10	0	0	676.29	677.16	0	1/16	677.19	0	1/16	677.25	0	1/16	676.48	677.35	677.35	0	0	677.37	0	1/16	677.40	0	1/16	676.71	677.46						
B	676.99	677.74	677.67	0	1/16	677.62	0	1/16	677.58	0	0	676.69	677.56	0	1/16	677.53	0	1/16	677.89	0	1/16	676.93	677.80	677.79	0	0	677.80	0	1/16	677.83	0	1/16	677.13	677.83						
C	677.73	678.48	678.37	0	1/16	678.27	0	1/16	678.19	0	0	677.26	678.13	677.99	1/16	677.89	1/16	677.83	1/16	677.83	1/16	676.93	677.80	677.79	0	0	677.80	0	1/16	677.83	1/16	677.13	677.83							
D	678.35	679.10	678.99	0	1/16	678.89	0	1/16	678.80	0	0	677.86	678.73	678.58	1/16	678.47	1/16	678.40	1/16	678.40	1/16	678.36	678.36	678.32	0	0	678.29	0	1/16	678.29	0	1/16	677.55	678.30						
E	678.98	679.73	679.60	0	1/16	679.50	0	1/16	679.41	0	0	678.47	679.34	679.18	1/16	679.06	1/16	678.97	1/16	678.97	1/16	678.05	678.92	678.87	0	0	678.84	0	1/16	678.83	1/16	678.08	678.83							
F	679.61	680.36	680.23	0	1/16	680.12	0	1/16	680.02	0	0	679.07	679.94	679.78	1/16	679.65	1/16	679.55	1/16	679.55	1/16	678.62	679.49	679.43	0	0	679.39	0	1/16	679.37	1/16	678.61	679.36							
G	680.24	680.99	680.85	0	1/16	680.74	0	1/16	680.64	0	0	679.68	680.55	680.38	1/16	680.24	1/16	680.13	1/16	680.13	1/16	679.19	680.06	679.99	0	0	679.95	0	1/16	679.91	1/16	679.15	679.90							
H	680.34	681.09	680.99	0	1/16	680.88	0	1/16	680.76	0	0	679.77	680.64	680.49	1/16	680.35	1/16	680.22	1/16	680.22	1/16	679.24	680.11	680.11	0	0	680.00	0	1/16	679.95	1/16	679.16	679.91							

H.N.T.B. BR. NO. 5 PART 7A

HOWARD, NEEDLES, TAMMEN & BERGENDOFF
CONSULTING ENGINEERS
CLEVELAND NEW YORK

FRAMING PLAN

RAMP E-10 OVER RAMP E-8



Scale: 1/8" = 1'-0"
Except as noted

STA. 8 + 19.83
STA. 9 + 38.16









WILLOW-INNER BELT FREEWAY

CLEVELAND CUYAHOGA COUNTY OHIO

DRAWN N.N. TRACED H.L. CHECKED J.C.T. REVISIONS J.C.T. SHEET 143

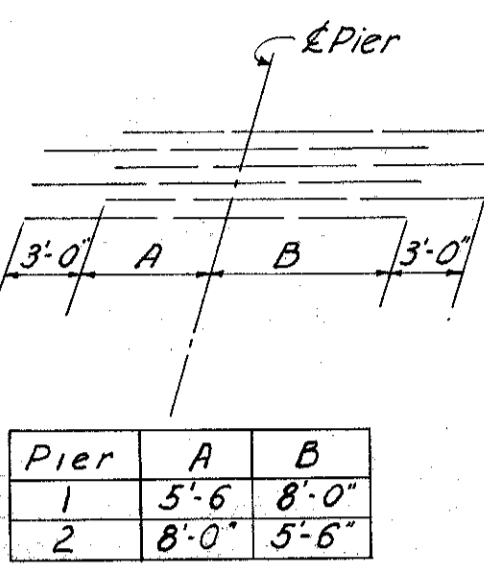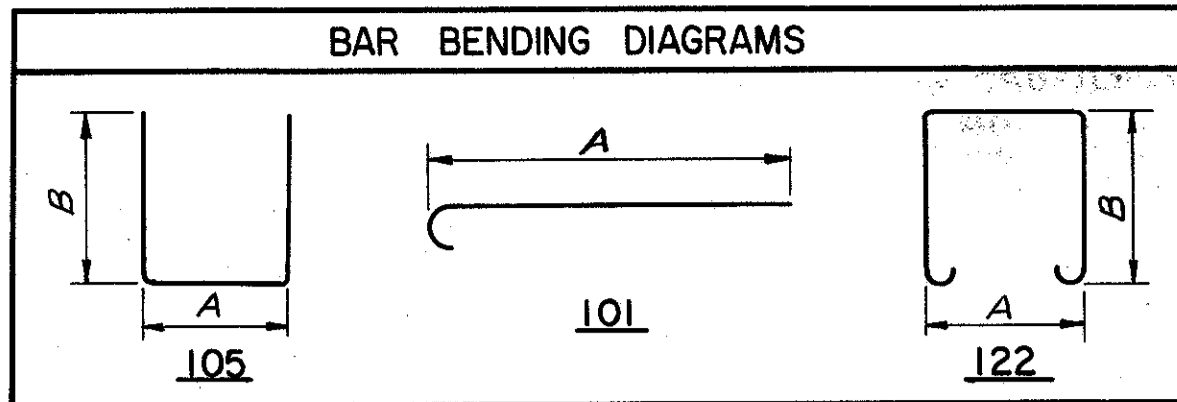

REINFORCEMENT SCHEDULE						
MARK	NO.	LENGTH	TYPE	DIMENSIONS		WEIGHT
				A	B	
401	250	4'-5"	105	8"	2'-0"	738
402	243	5'-1"	122	1'-8"	1'-4"	825
501	94	16'-6"	Str.			1617
502	2	32'-9"	Str.			68
503	202	28'-1"	101	27'-6"		5917
504	1	12'-0"	Str.			12
505	6	30'-6"	Str.			191
506	184	32'-3"	Str.			6189
507	1 Ser. of 5	5'-9" to 26'-9"	Str.		5'-3"	85
508	1 Ser. of 4	6'-9" to 26'-9"	Str.		6'-8"	70
509	1 Ser. of 3	8'-9" to 26'-9"	Str.		9'-0"	56
510	10	6'-7"	101	6'-0"		69
511	1 Ser. of 40	7'-7" to 40'-7"	101	7'-0" to 40'-0"	10 3/8"	1005
512	3	26'-0"	Str.			81
513	1 Ser. of 21	15'-1" to 30'-7"	101	14'-6" to 30'-0"	9 3/8"	500
514	1 Ser. of 91	22'-4" to 31'-7"	101	22'-3" to 31'-0"	1 1/8"	2583
515	1 Ser. of 91	17'-4" to 22'-10"	101	16'-9" to 22'-3"	3/4"	1906
516	1 Ser. of 51	7'-4" to 40'-7"	101	6'-9" to 40'-0"	8"	1214
601	72	16'-0"	Str.			
602	6	4'-9"	Str.			
603	6	13'-0"	Str.			
604	12	12'-3"	Str.			
605	220	30'-9"	Str.			10161
606	196	32'-6"	Str.			9568
607	1 Ser. of 5	5'-9" to 26'-9"	Str.		5'-3"	122
608	1 Ser. of 4	7'-0" to 27'-0"	Str.		6'-8"	102
609	1 Ser. of 3	9'-0" to 27'-0"	Str.		9'-0"	81
610	10	6'-0"	Str.			90
611	1 Ser. of 40	7'-0" to 40'-0"	Str.		10 3/8"	1412
612	1	29'-6"	Str.			44
613	1 Ser. of 21	11'-9" to 26'-9"	Str.		9"	607
614	1 Ser. of 91	19'-3" to 27'-9"	Str.		1 1/8"	3212
615	1 Ser. of 91	13'-9" to 19'-3"	Str.		3/4"	2256
616	1 Ser. of 51	6'-9" to 40'-0"	Str.		8"	1791
Total						52632

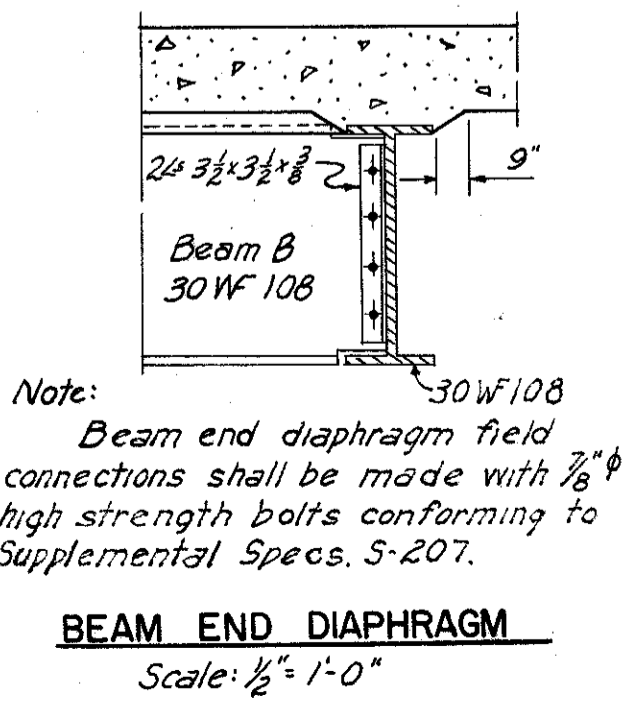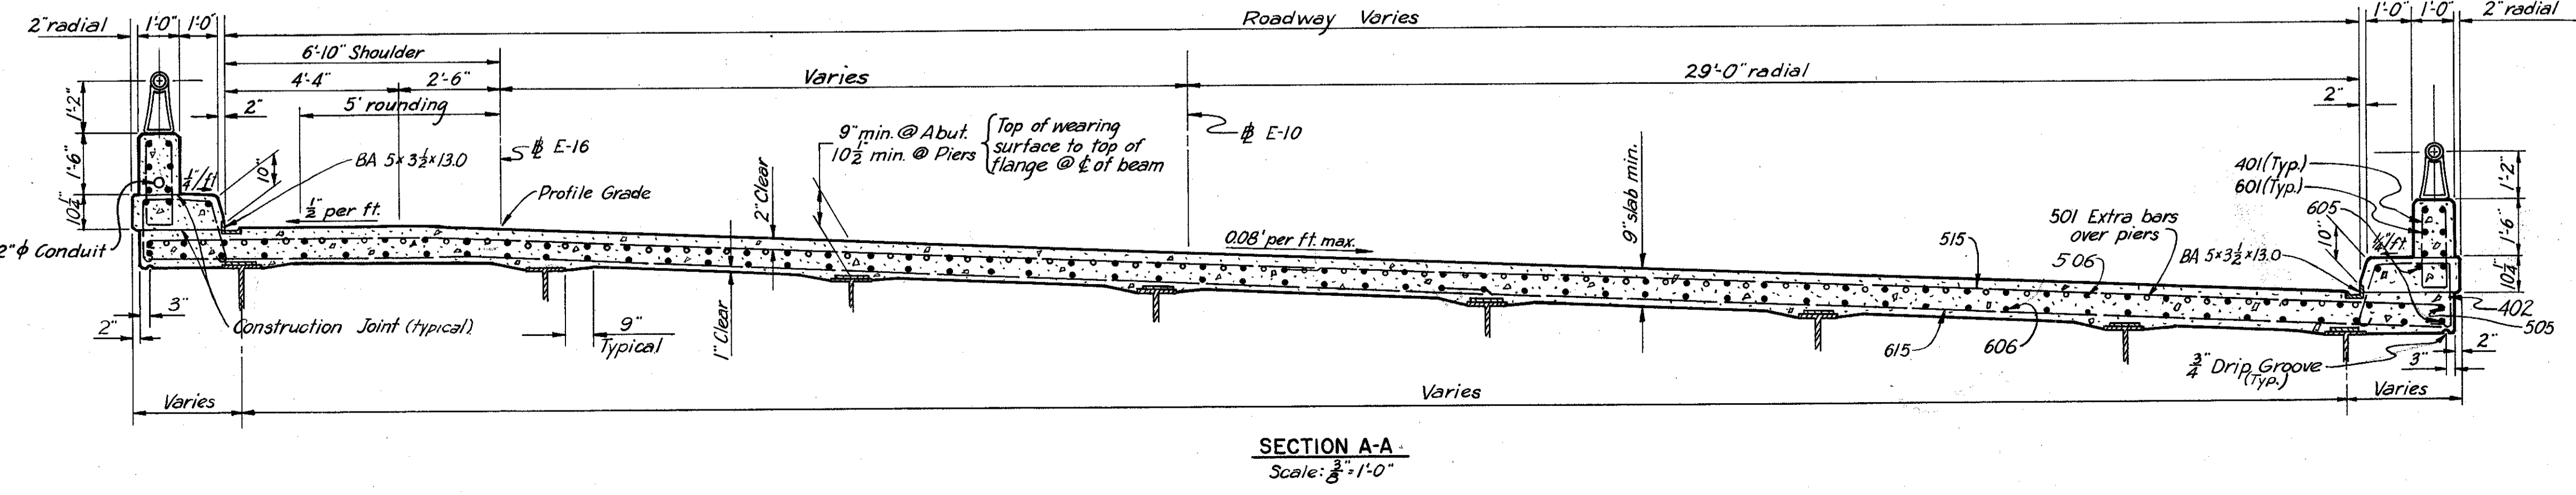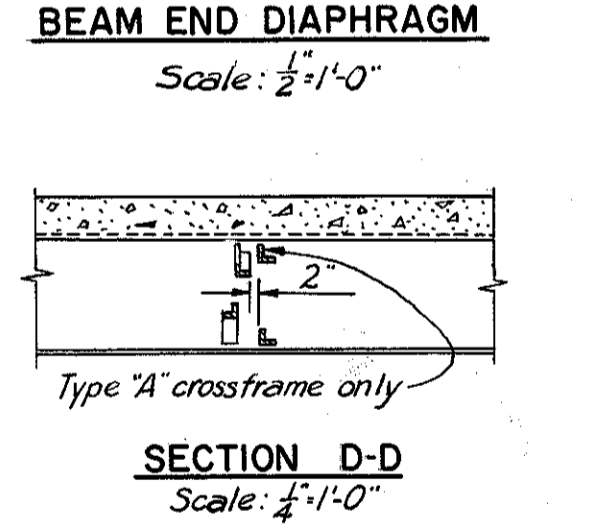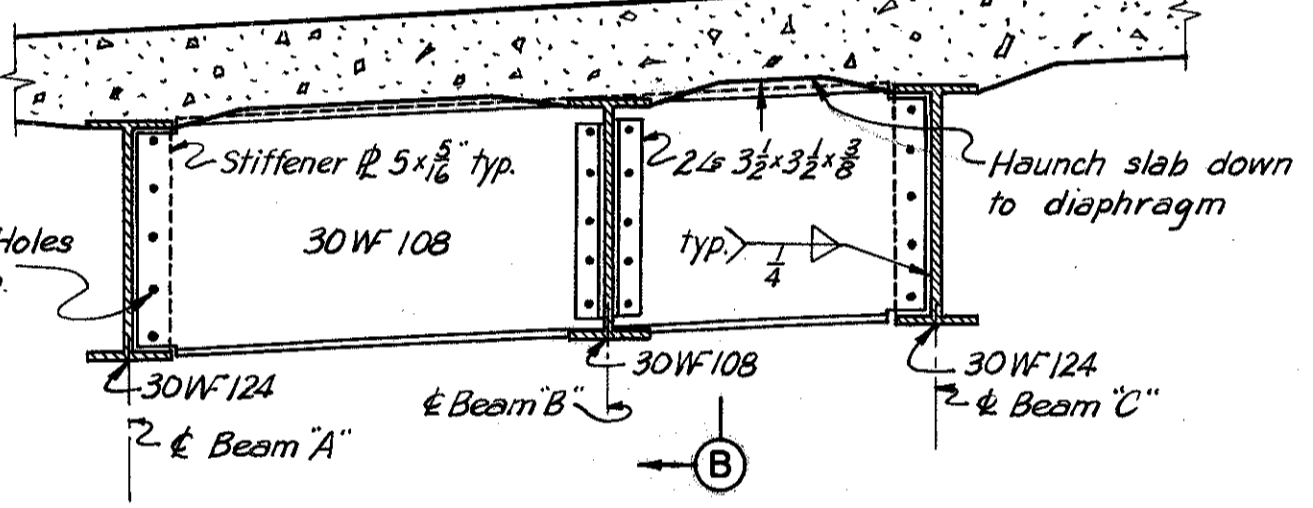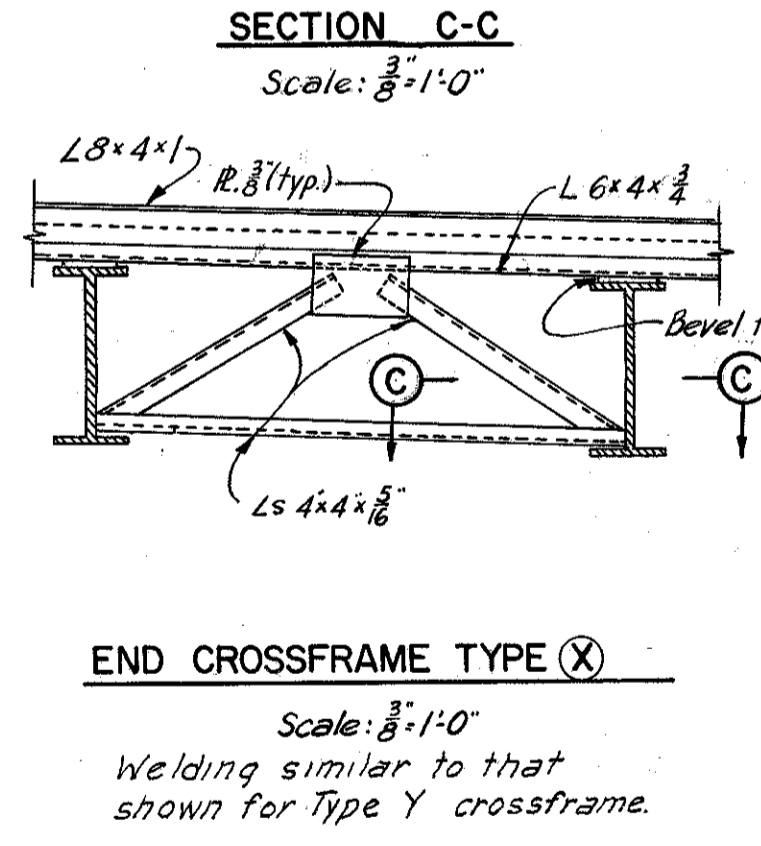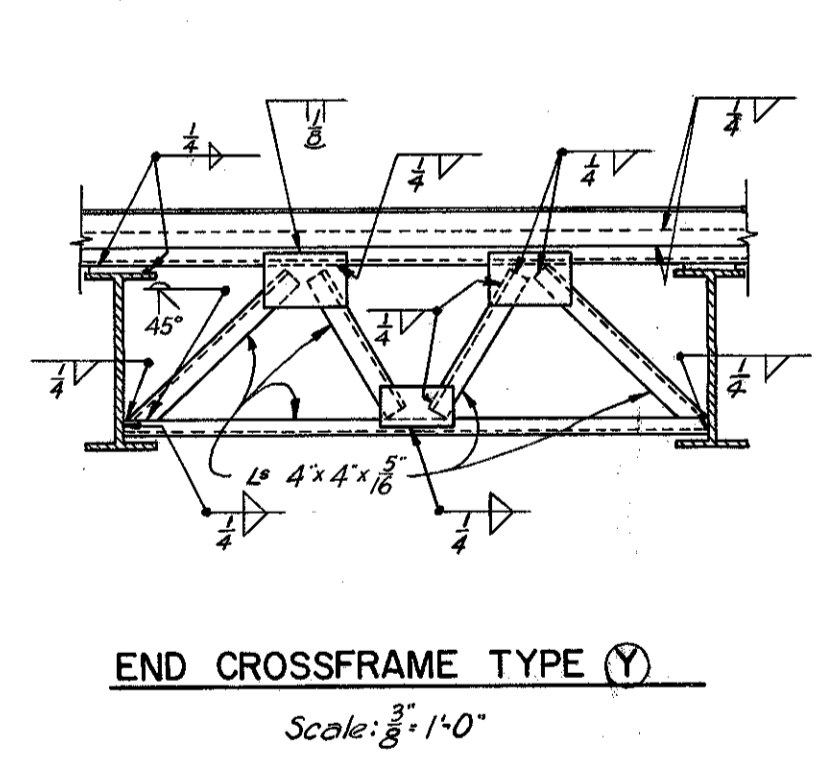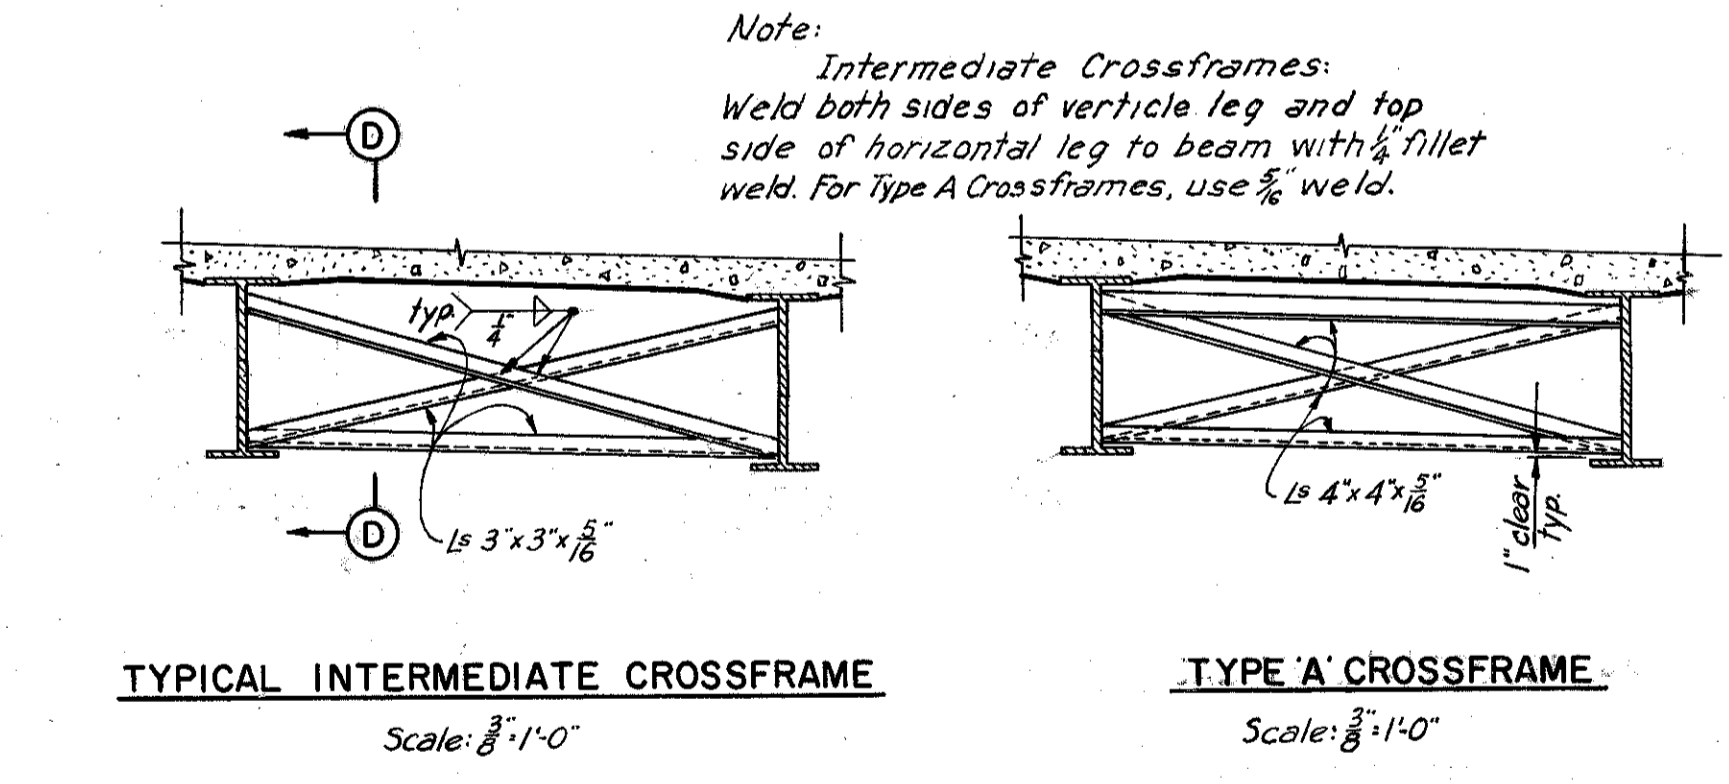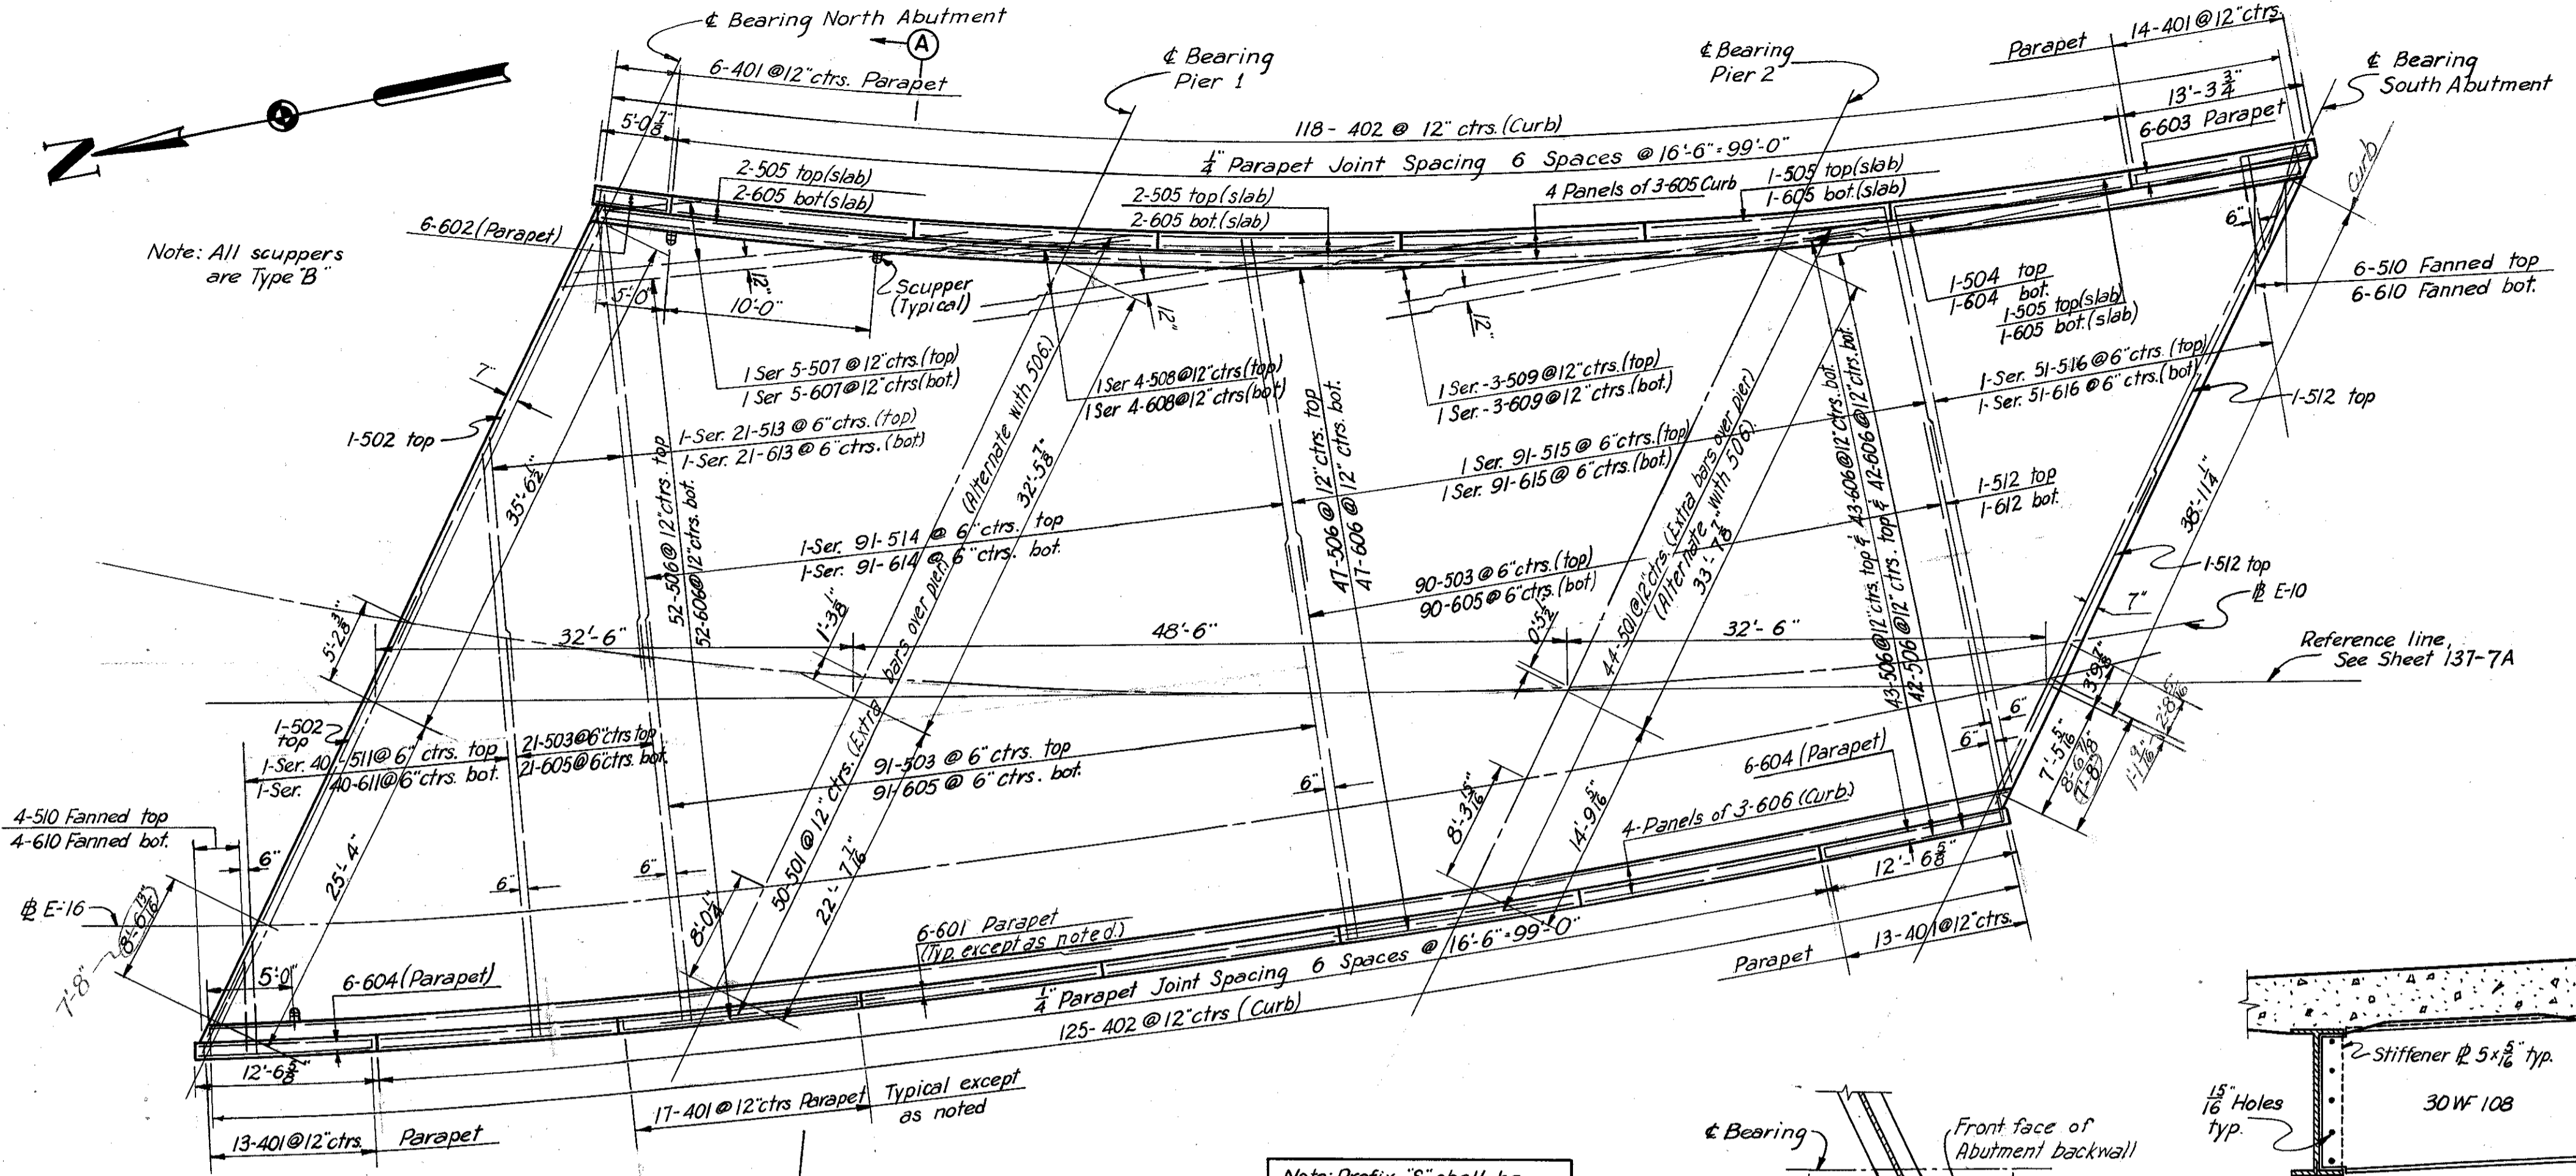

NOTES:
 Bars of a series shall vary in length by a constant increment. For replacement schedule, see Sheet 103-7A.
 All bar dimensions are given out to out.
 † Bars are included with "Item S-14, Railing" for payment.
 For drainage details, see Sheet 174-7A.
 For Railing and Parapet Joint details, see Sheet 175-7A.
 In order to facilitate water curing of the concrete of the deck slab, the placing of concrete shall progress upgrade. The slab may be placed in sections, between transverse construction joints which are parallel to transverse bars in the slab, and are located near the center of any span.
 For Lighting details, see Sheet 176-7A.
 For End Finish details not shown see Sheet 156-7A.

H.N.T.B. BR. NO. 5 PART 7A
 HOWARD, NEEDLES, TAMMEN & BERGENOFF
 CONSULTING ENGINEERS
 KANSAS CITY CLEVELAND NEW YORK
DECK PLAN
RAMP E-10 OVER RAMP E-8
 Scale: 1/8"=1'-0" STA. 8+19.83
 Except as noted STA. 9+38.16
WILLOW-INNER BELT FREEWAY
 CLEVELAND CUYAHOGA COUNTY OHIO
 DRAWN N.N. TRACED H.R.H. CHECKED G.T. REVIEWED J.C.T. REVISION 1-12-61
 DATE 9-25-58 DATE 5-7-59 DATE 3-11-59 DATE 11-13-59 SHEET 144

210


MICROFILMED
JUL 2 1985

FED. ROADS DIV. NO.	STATE	FED. AID PROJ. NO.
2	OHIO	

145
181


CUYAHOGA COUNTY
CITY OF CLEVELAND
CUY-21-15.32
CUY-42-18.42

LEGEND

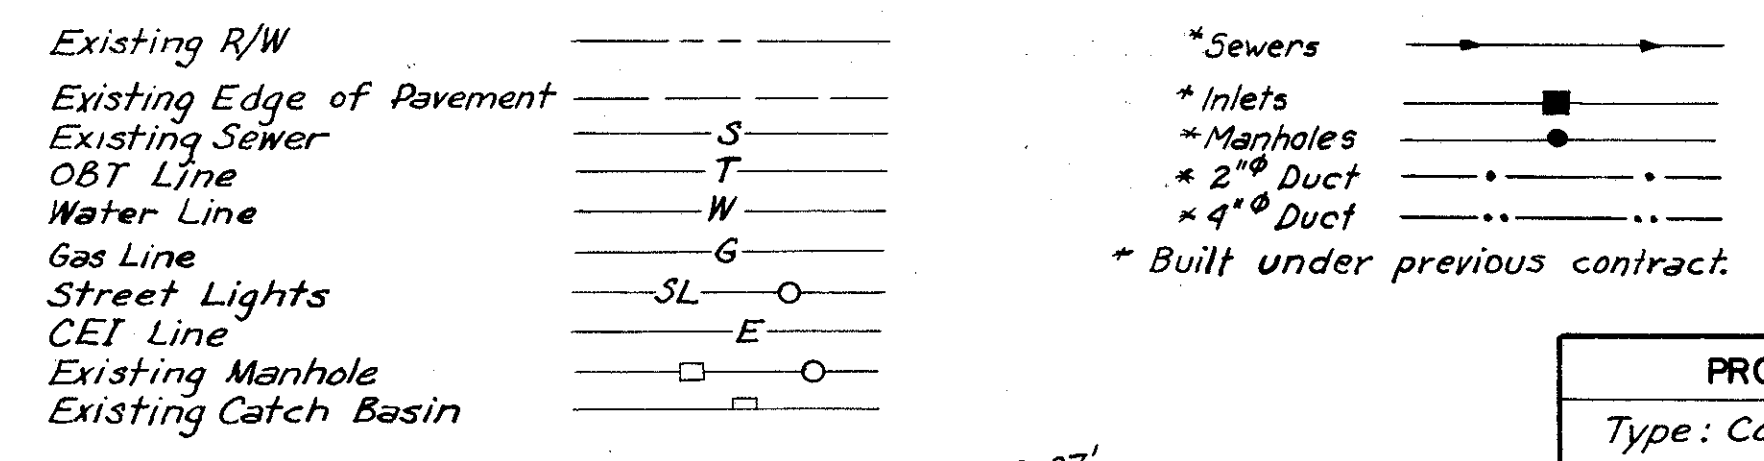


CURVE DATA

Willow Freeway Δ = 23°06'48" D = 3°00'00" R = 1909.86' T = 390.54' L = 770.50'	Ramp E-17 Δ = 60°33'40" D = 9°45'00" R = 587.65' T = 343.13' L = 621.14'
---	---

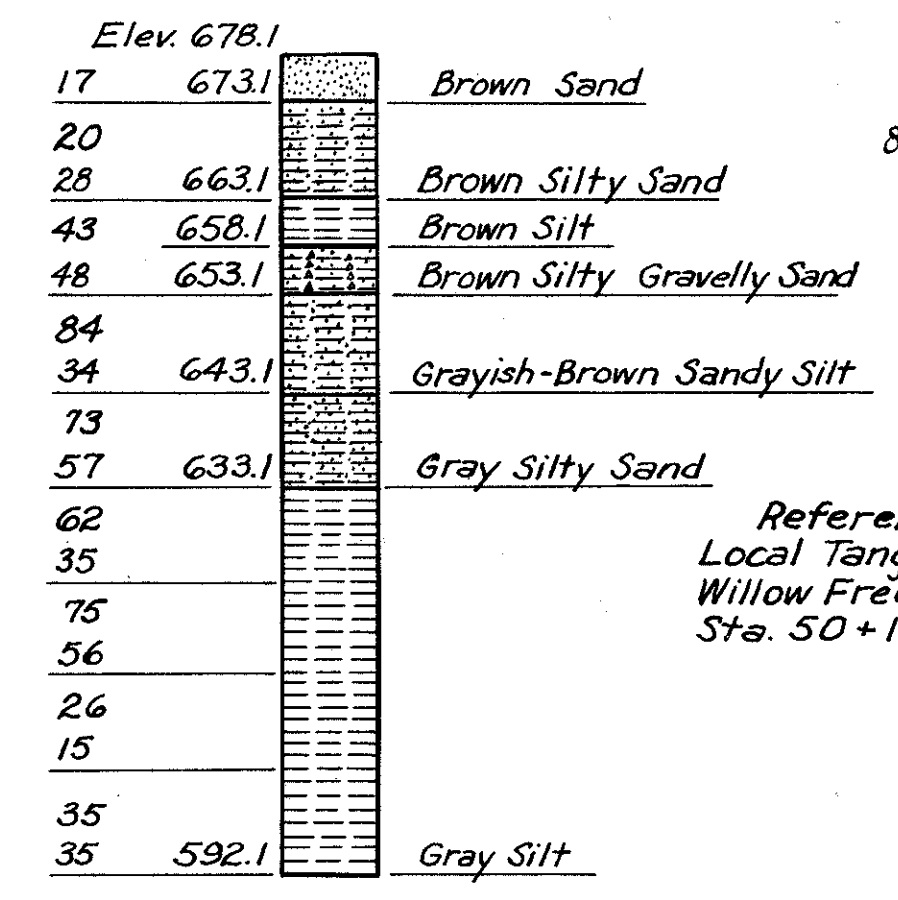

BORING 121


Vertical Scale: 1"=20'
Sta. 14+63 Ramp E-15 33' Rt.
Note: The figures to the left indicate the number of hammer blows required to drive the sampling spoon 1 ft. They are given at 5' intervals starting at elev. 678.1.

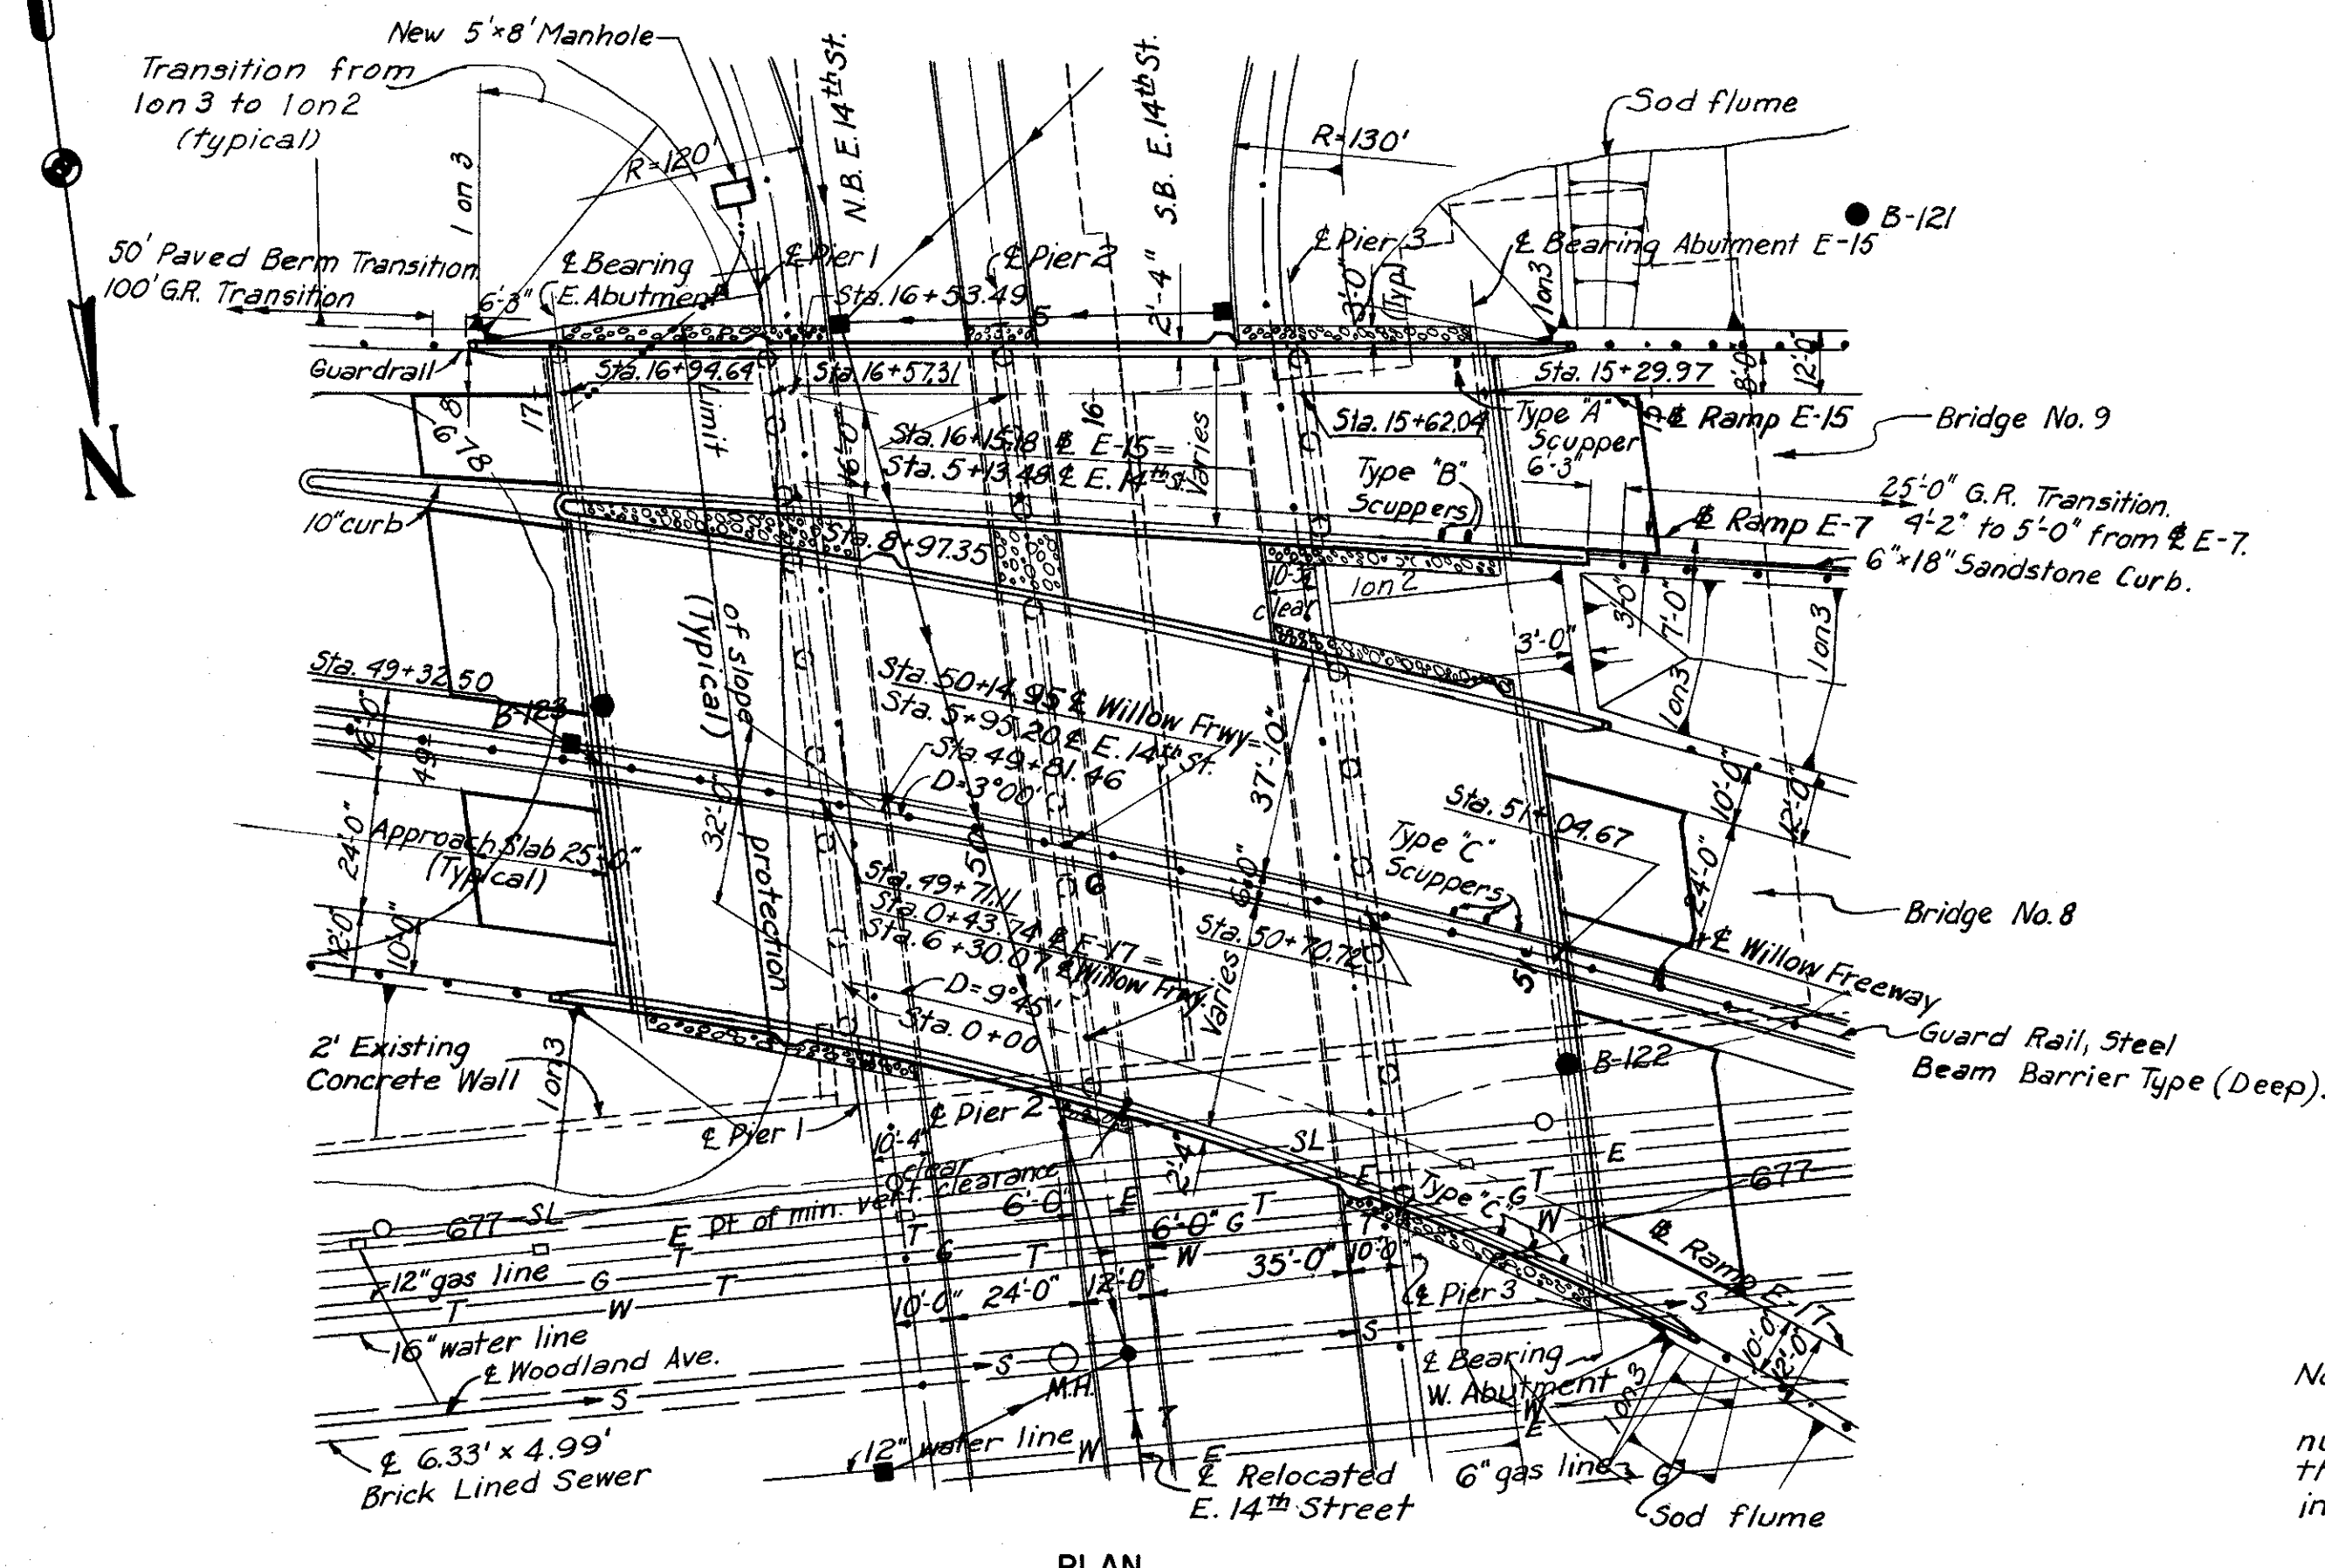


PLAN



PROFILE BRIDGE NO. 8

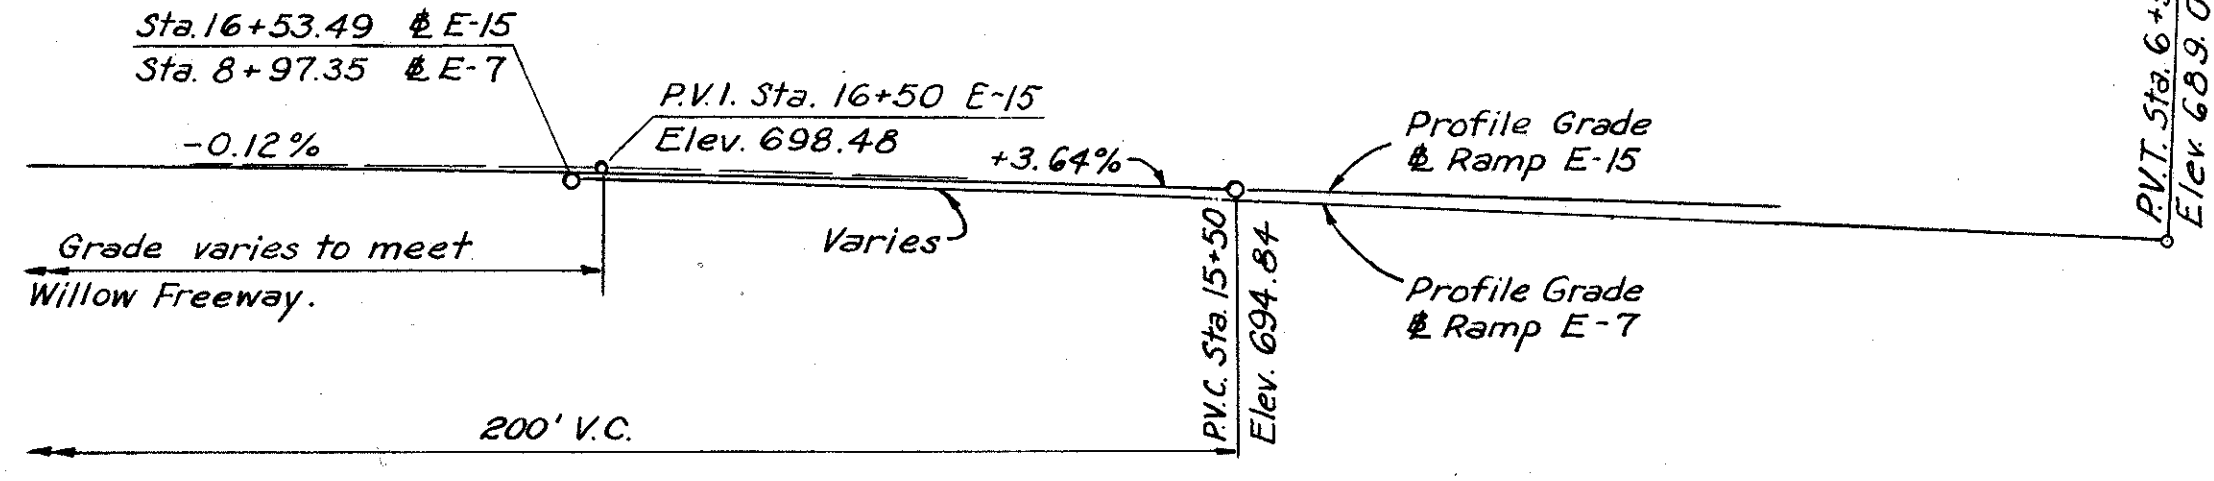


PROFILE BRIDGE NO. 9

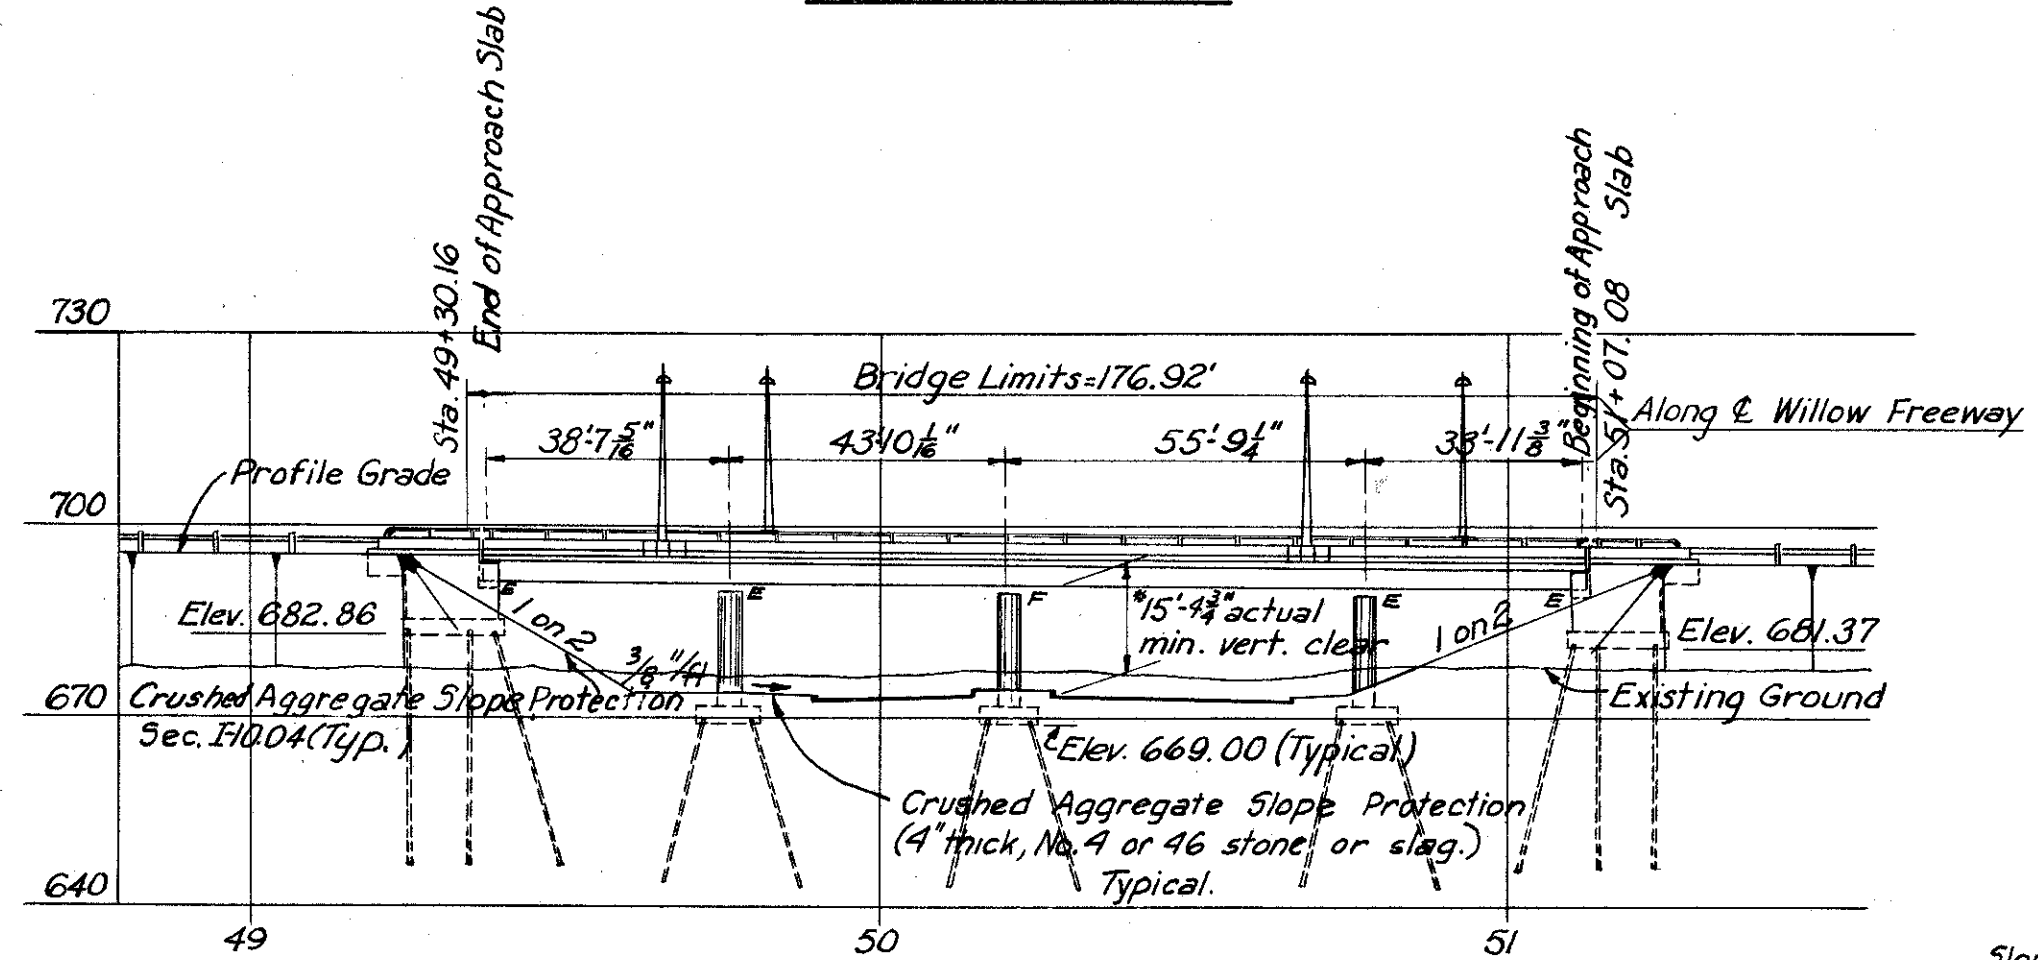

ELEVATION BRIDGE NO. 8

*15'-0" required minimum vertical clearance. Point of actual minimum vertical clearance occurs at the median curb of Southbound E. 14th St. and the north exterior beam.

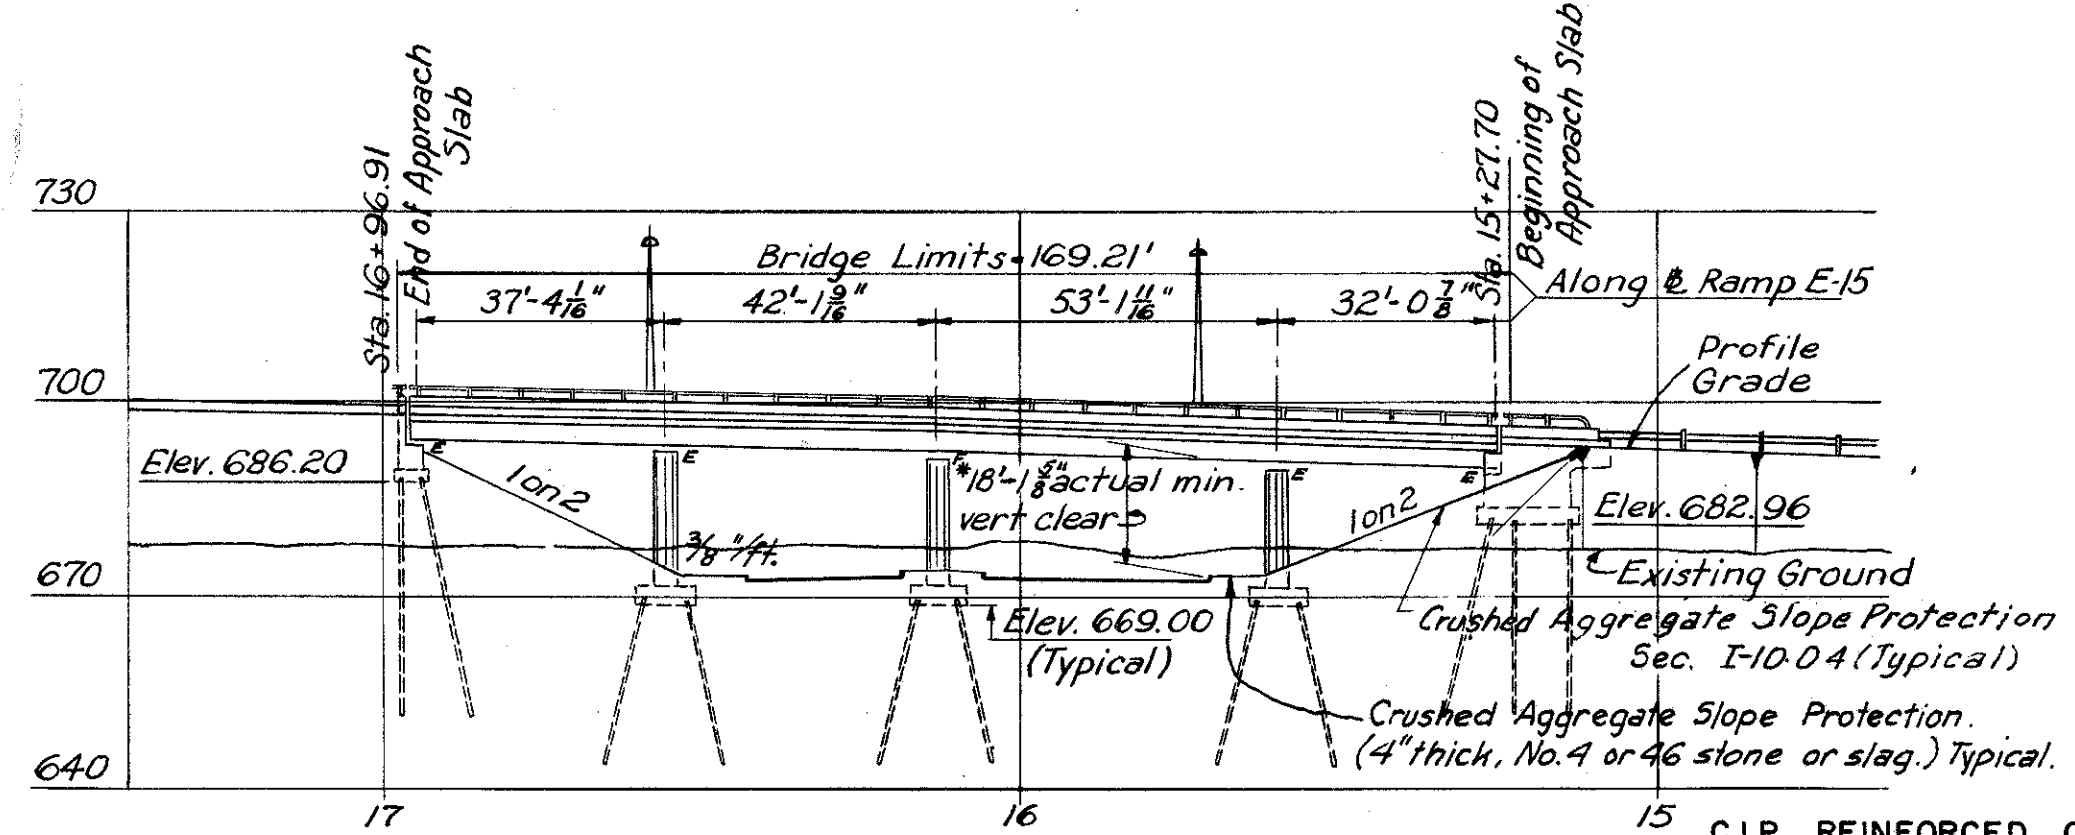

ELEVATION BRIDGE NO. 9

*15'-0" required minimum vertical clearance. Point of actual minimum vertical clearance occurs at the west curb of Southbound E. 14th St. and the north exterior beam.

RAMP E-15 OVER EAST 14th ST.

C.I.P. REINFORCED CONCRETE PILES.			
PILE INFORMATION			
Location	Diameter	Number	Estimated ave. length
Bridge 8			
West Abutment	12"	36	35 ft
Piers 1, 2, & 3	14"	75	27 ft
Bridge No. 9			
Abutment E-15	12"	14	35 ft
Piers 1, 2, & 3	14"	36	27 ft
Bridge No. 8 & No. 9			
East Abutment	12"	40	37 ft

PROPOSED STRUCTURE BR. NO. 8

Type: Continuous steel beam with reinforced concrete deck and substructure.
Spans: 38'-7 1/2", 43'-10", 55'-9 1/2", 33'-11 1/2" along Willow Freeway.
Roadway: 84'-0" (nominal) face to face parapets.
Loading: CF-2000-Adequate for A.A.H.S.O. alternate loading.
Skew: Varies
Surface Course: 1" Monolithic Concrete.
Alignment: 3°00'00" Rt.
Approach Slabs: AS-1-54 (25' Long)
Superelevation: .05 ft/ft.

PROPOSED STRUCTURE BR. NO. 9

Type: Continuous steel beam with reinforced concrete deck and substructure.
Spans: 37'-4 1/2", 42'-1 1/2", 53'-1 1/2", 32'-0 3/8" along E-15.
Roadway: Varies
Loading: CF-2000-Adequate for A.A.H.S.O. alternate loading.
Skew: 6°43'20"
Surface Course: 1" Monolithic Concrete.
Alignment: Tangent.
Approach Slabs: AS-1-54 (25' Long)
Superelevation: Varies.

NOTES:
Rod soundings only were taken at location B-122 and B-123. The core drilling made at B-121 is plotted.
Pile lengths are based on boring data and are approximate only. The Contractor shall assume full responsibility for length of piling selected for driving.
The following items are not included in the bridge plans: (See Roadway Plans for details).
Approach grading, pavements, and slabs.
Roadway Guard Rail, Sod Flumes.
For details of slope protection see Sh. 174-7A.
For details of pier plans & drain pipe locations at piers see Sh. 171-7A & 174-7A.


Note:
Piers for Bridges 8 & 9 are included in Part 6.

H.N.T.B. BRS. NO. 8 AND 9 PART 7A



HOWARD, NEEDLES, TAMMEN & BERGENDOFF
CONSULTING ENGINEERS
KANSAS CITY CLEVELAND NEW YORK

SITE PLAN
WILLOW FREEWAY & RAMP E-15 OVER E. 14TH STREET
STA. 49+30.16 STA. 51+07.08 (WILLOW FREEWAY)
STA. 15+27.70 STA. 16+96.91 (RAMP E-15)
BR. NO. CUY-21-1573 A & B Scale: 1" = 30'
WILLOW-INNER BELT FREEWAY
CLEVELAND CUYAHOGA COUNTY OHIO

DATE: 6-26-58 TRACED: DLV CHECKED: DRX REVIEWED: JCT REVISION:
DATE: 7-29-58 DATE: 7-14-58 DATE: 11-13-57

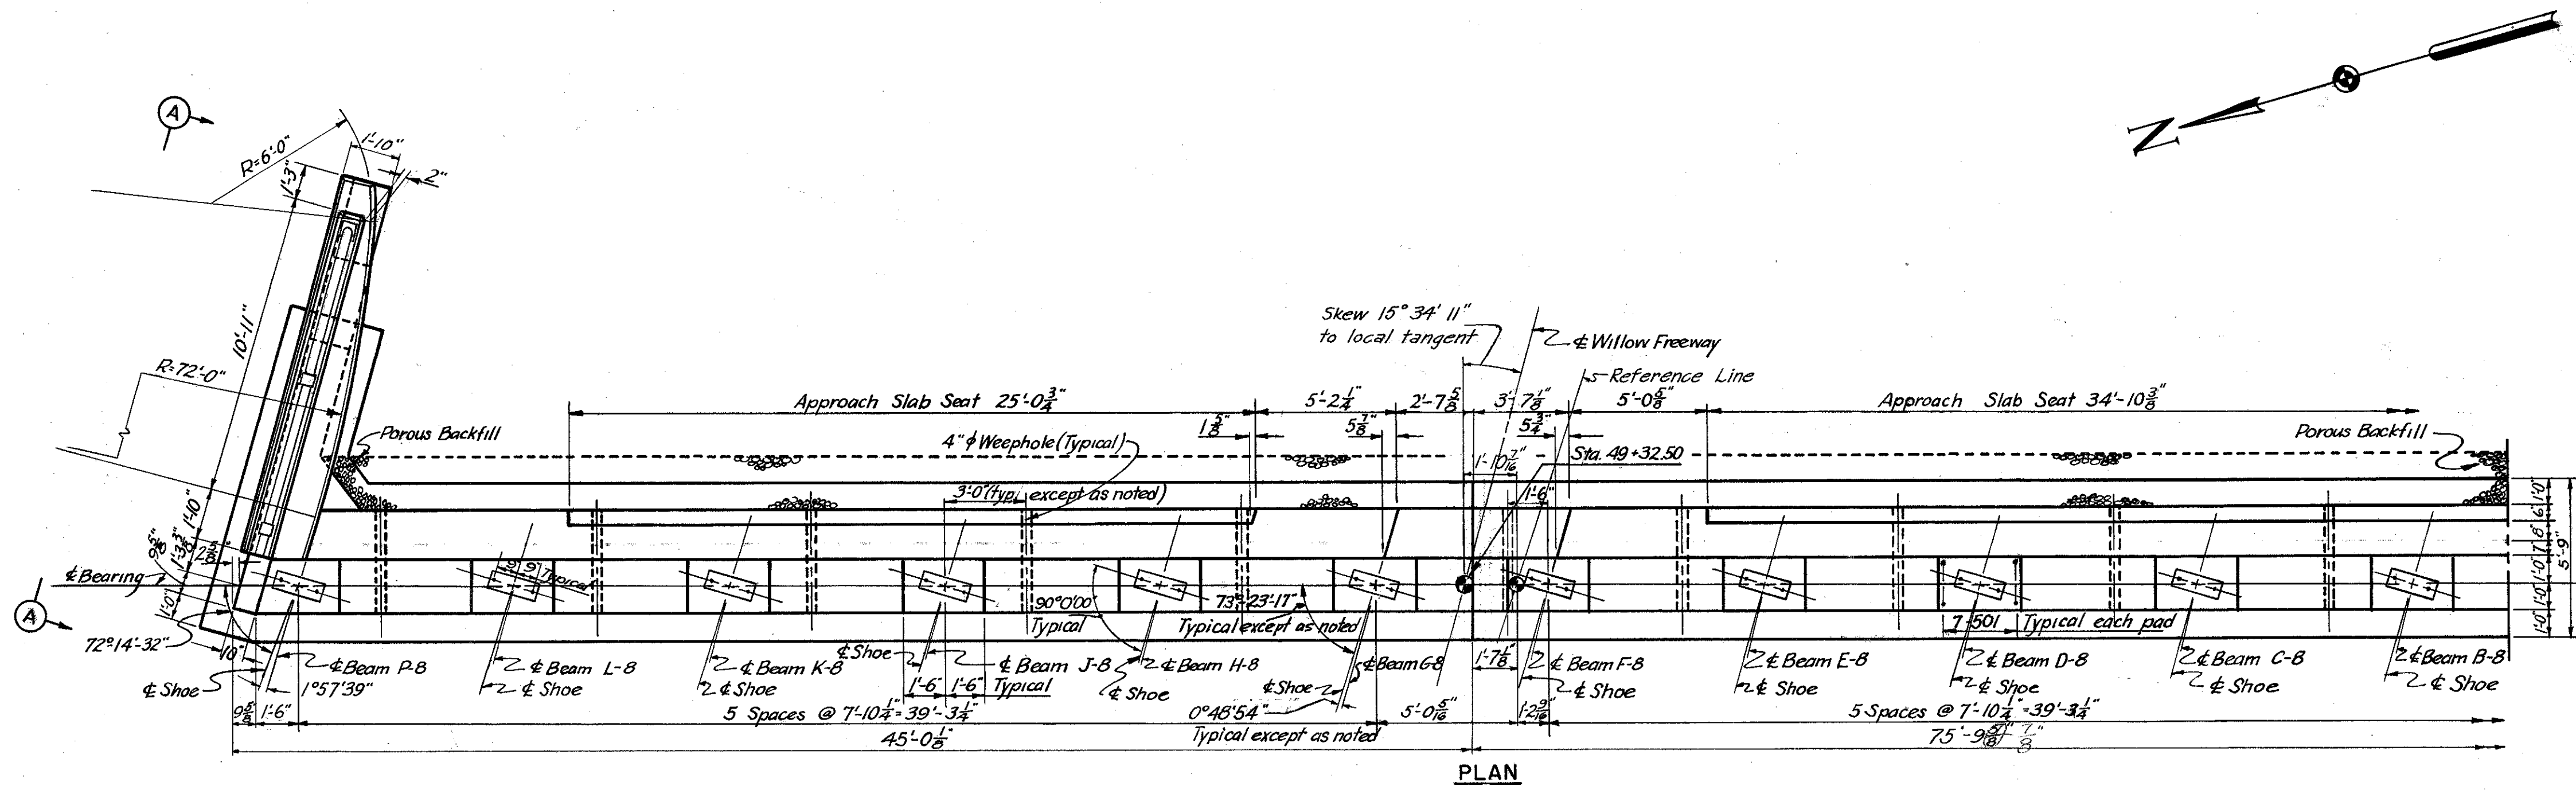


Note:
Special care shall be taken when placing reinforcing steel so as not to interfere with anchor bar setting.

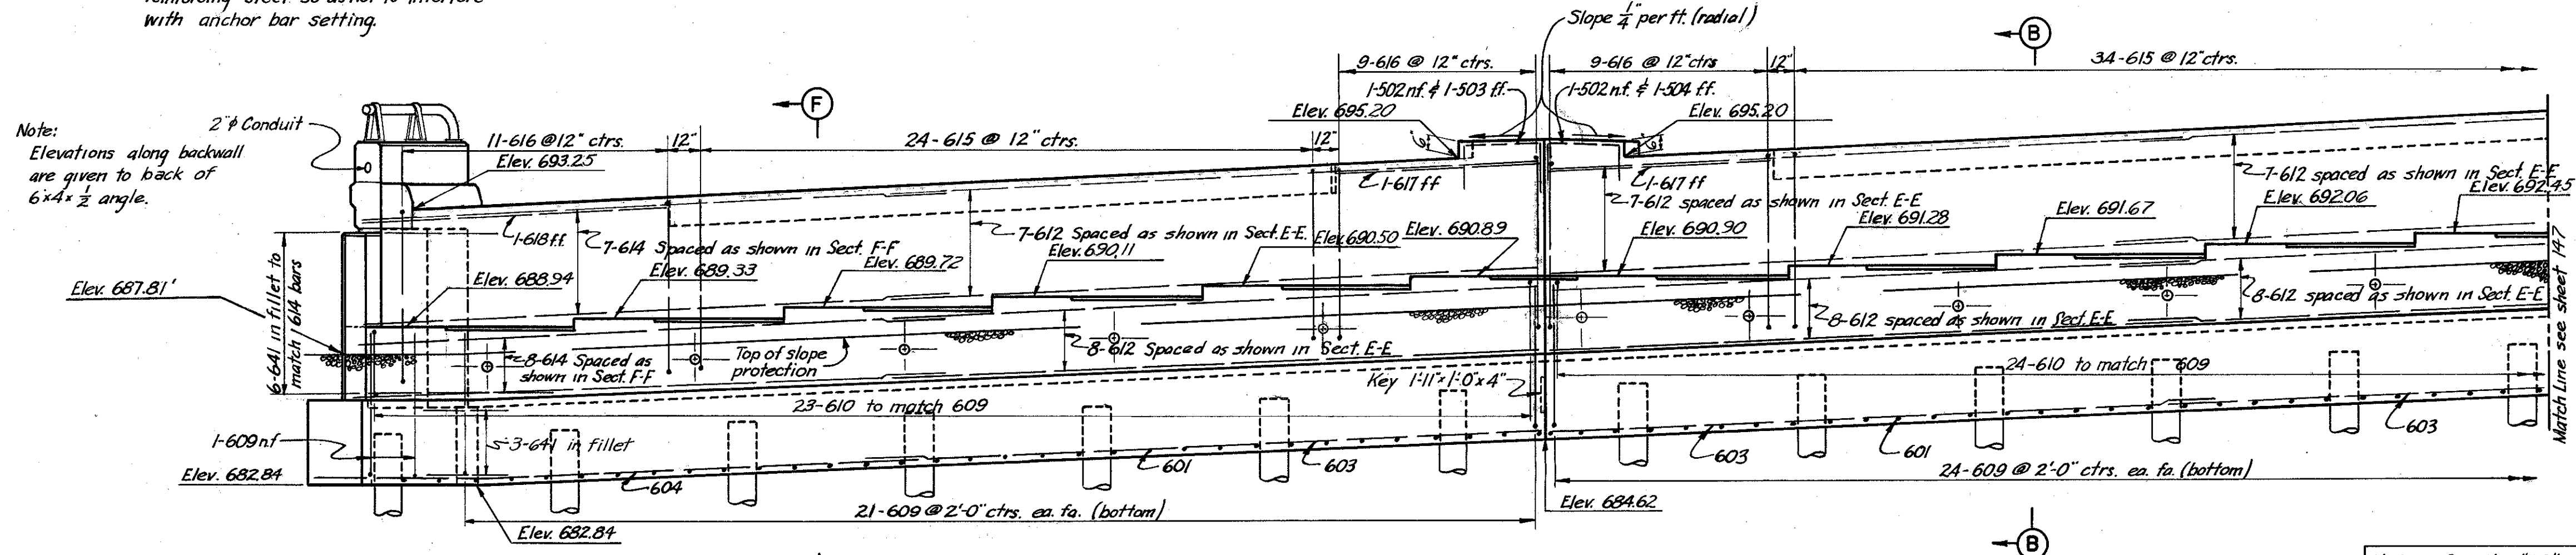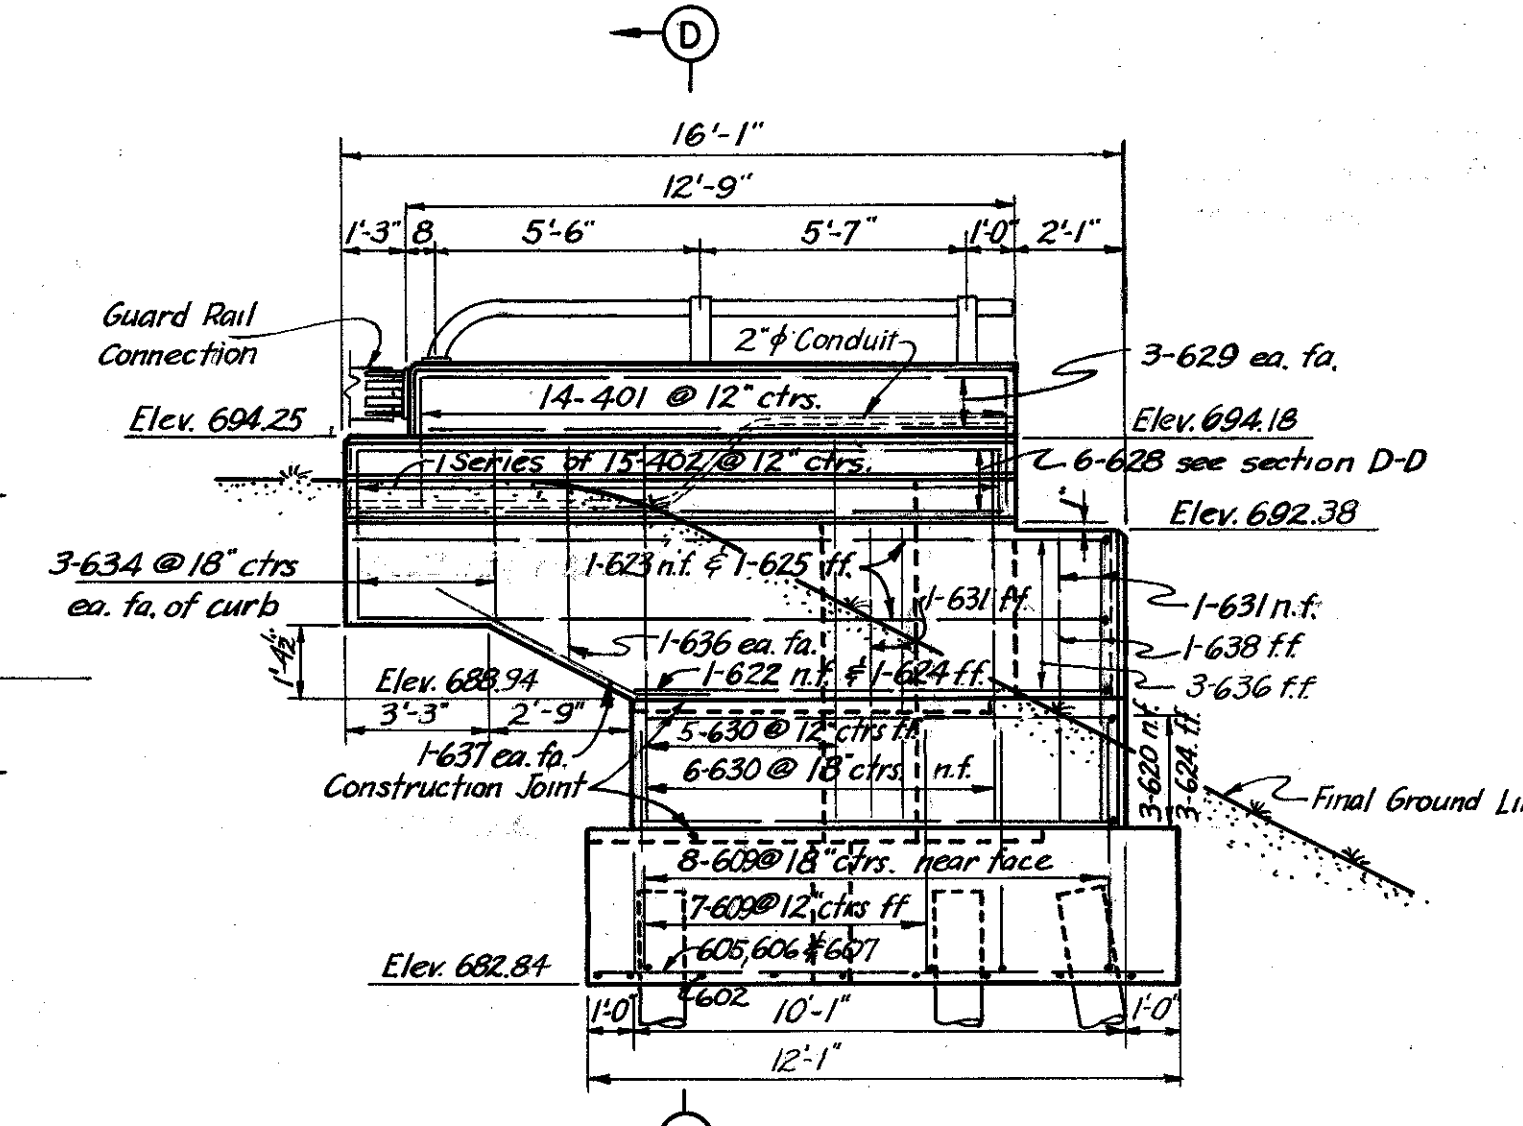


Note:
Elevations along backwall are given to back of 6x4 1/2 angle.

Note: Prefix "AA" shall be assigned to all bar marks.

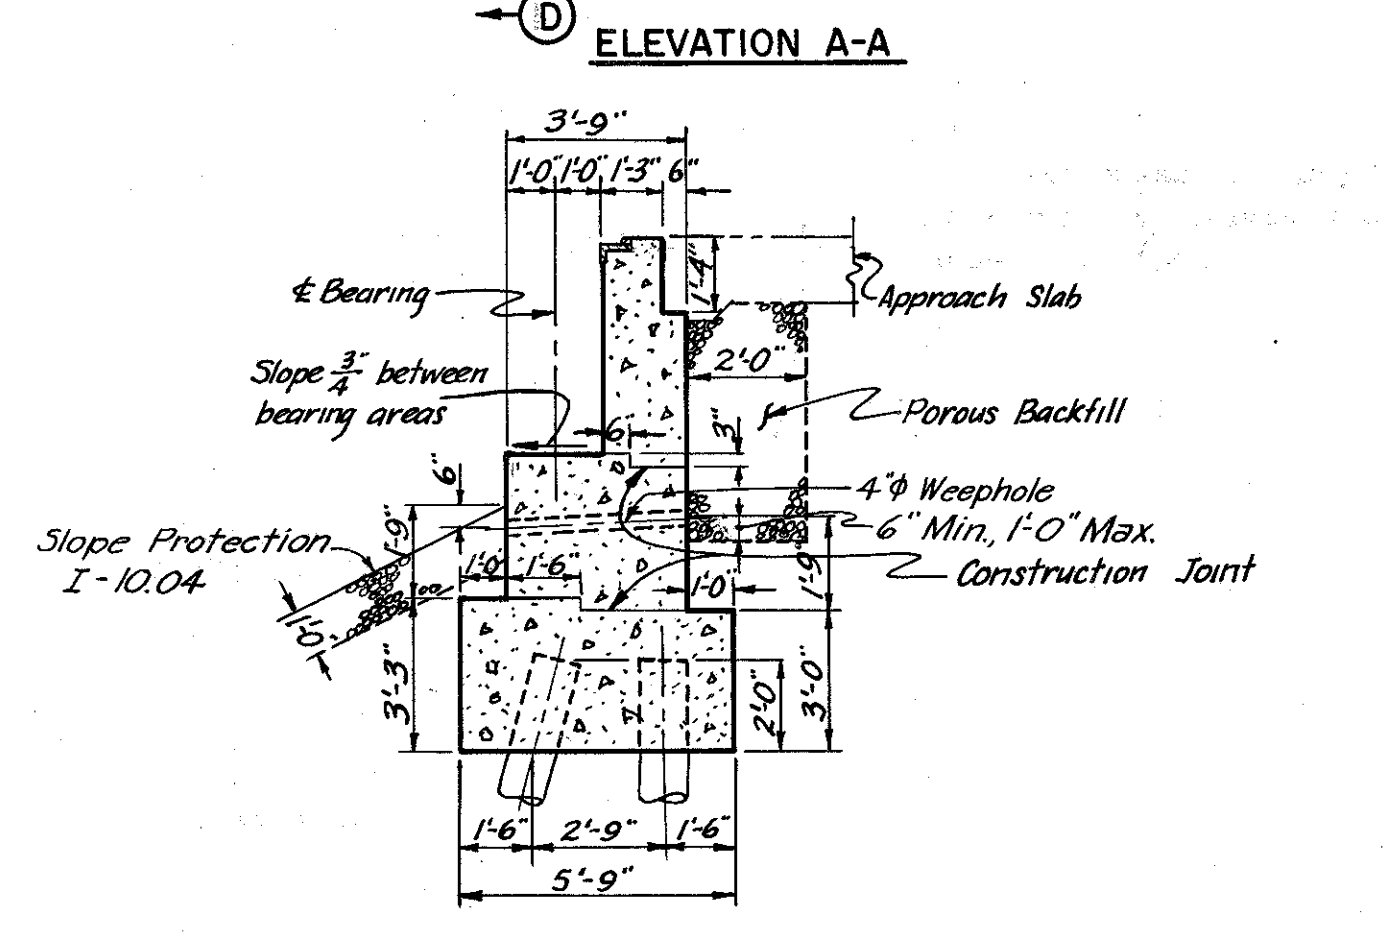

Reinforcing not shown.

NOTES:
 All piles shall be 12" Cast-in-place reinforced concrete
 All battered piles shall be battered 3in12 in direction shown
 Pile spacings given along bottom of footing
 For details of roadway expansion dam see sh. 173-7A
 For Masonry Plate details see sheet 173-7A
 For Railing details and Guard Rail connection details see sheet 175-7A
 For location of lighting conduits see sheet 176-7A
 For Reinforcement schedule see sheet 151-7A
 For Replacement schedule see sheet 103-7A
 Reinforcement bars shall be 3 inches clear from bottom of footing and 2 inches elsewhere.
 For slope Protection details see sheet 174-7A
 Top of parapet and safety curb construction joints are to be parallel to roadway grade.
 n.f. = near face; ff. = far face; ea. fa. = each face
 For additional sections see sheet 147-7A

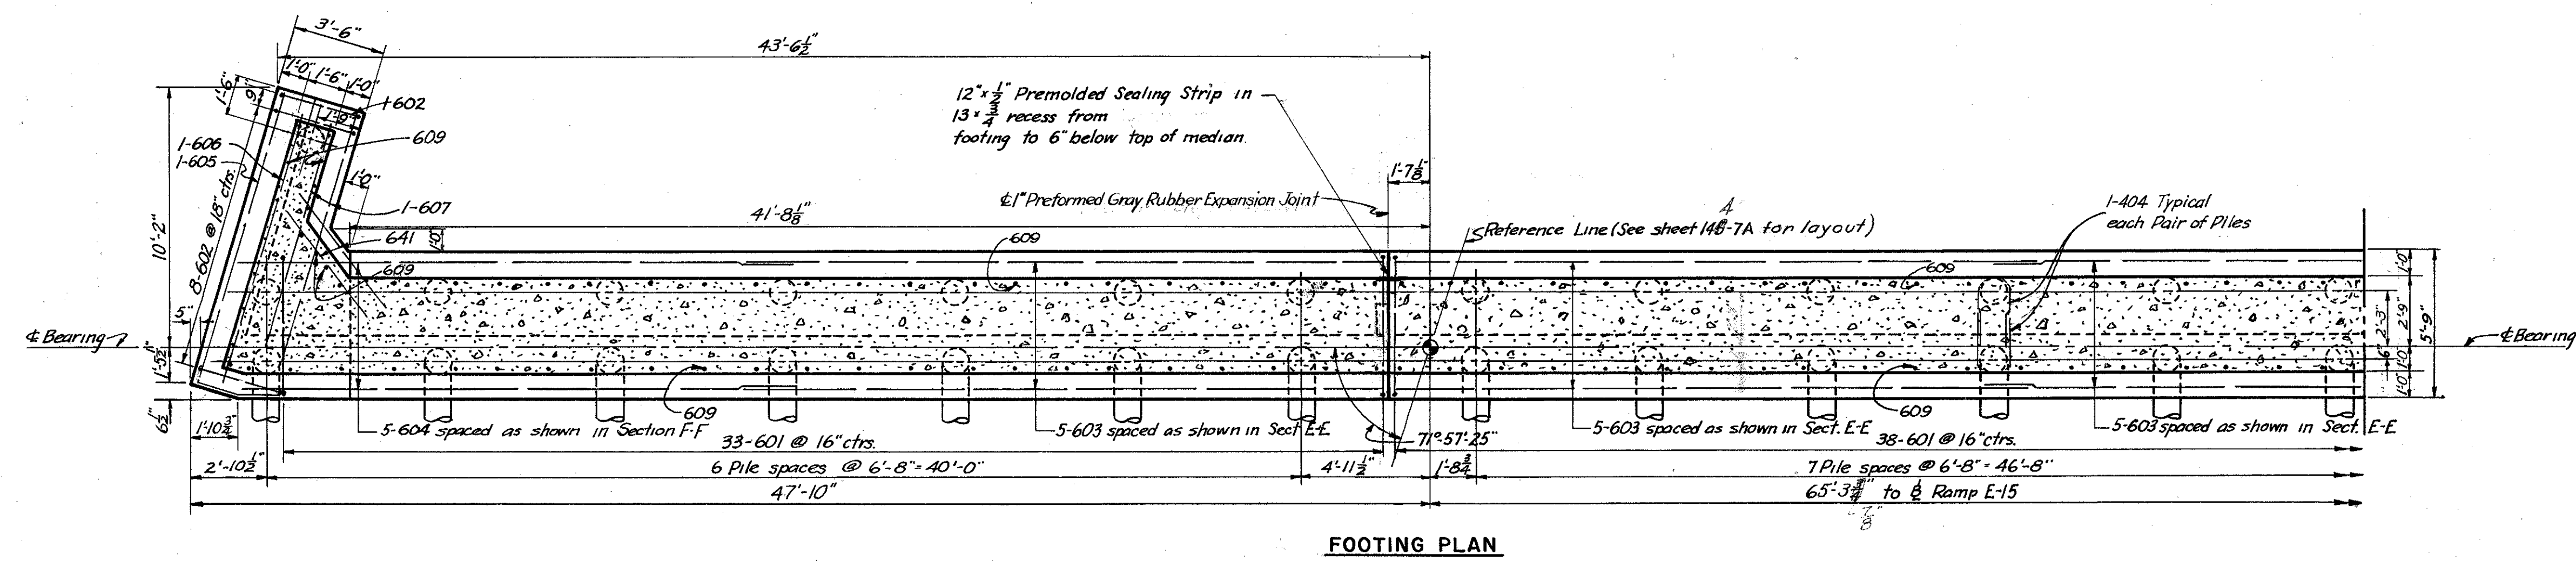

H.N.T.B. BRS. NO. 8 AND 9 PART 7A

HOWARD, NEEDLES, TAMMEN & BERGENDOFF
 CONSULTING ENGINEERS
 KANSAS CITY CLEVELAND NEW YORK

EAST ABUTMENT-NORTH HALF

WILLOW FREEWAY OVER EAST 14th ST.
 STA. 49+30.16 STA. 51+07.08(WILLOW FREEWAY)
 STA. 15+27.70 STA. 16+96.91(RAMP E-15)
 BR. NO. CUY-21-1573 A&B Scale: 1/4" = 1'-0"
WILLOW-INNER BELT FREEWAY
 CLEVELAND CUYAHOGA COUNTY OHIO

DRAWING	TRACED	CHECKED	REVIEWED	REVISED
DATE 7-18-65	DATE 8-23-65	DATE 7-25-65	DATE 11-13-59	DATE 9-21-60



SHEET 146

MICROFILMED
JUL 3 1965


FED. ROADS DIV. NO.	STATE	FED. AID PROJ. NO.	147
2	OHIO		181

CUYAHOGA COUNTY
CITY OF CLEVELAND
CUY-21-15.32
CUY-42-18.42


Note:
Special care shall be taken when placing reinforcing steel so as not to interfere with anchor bar setting.

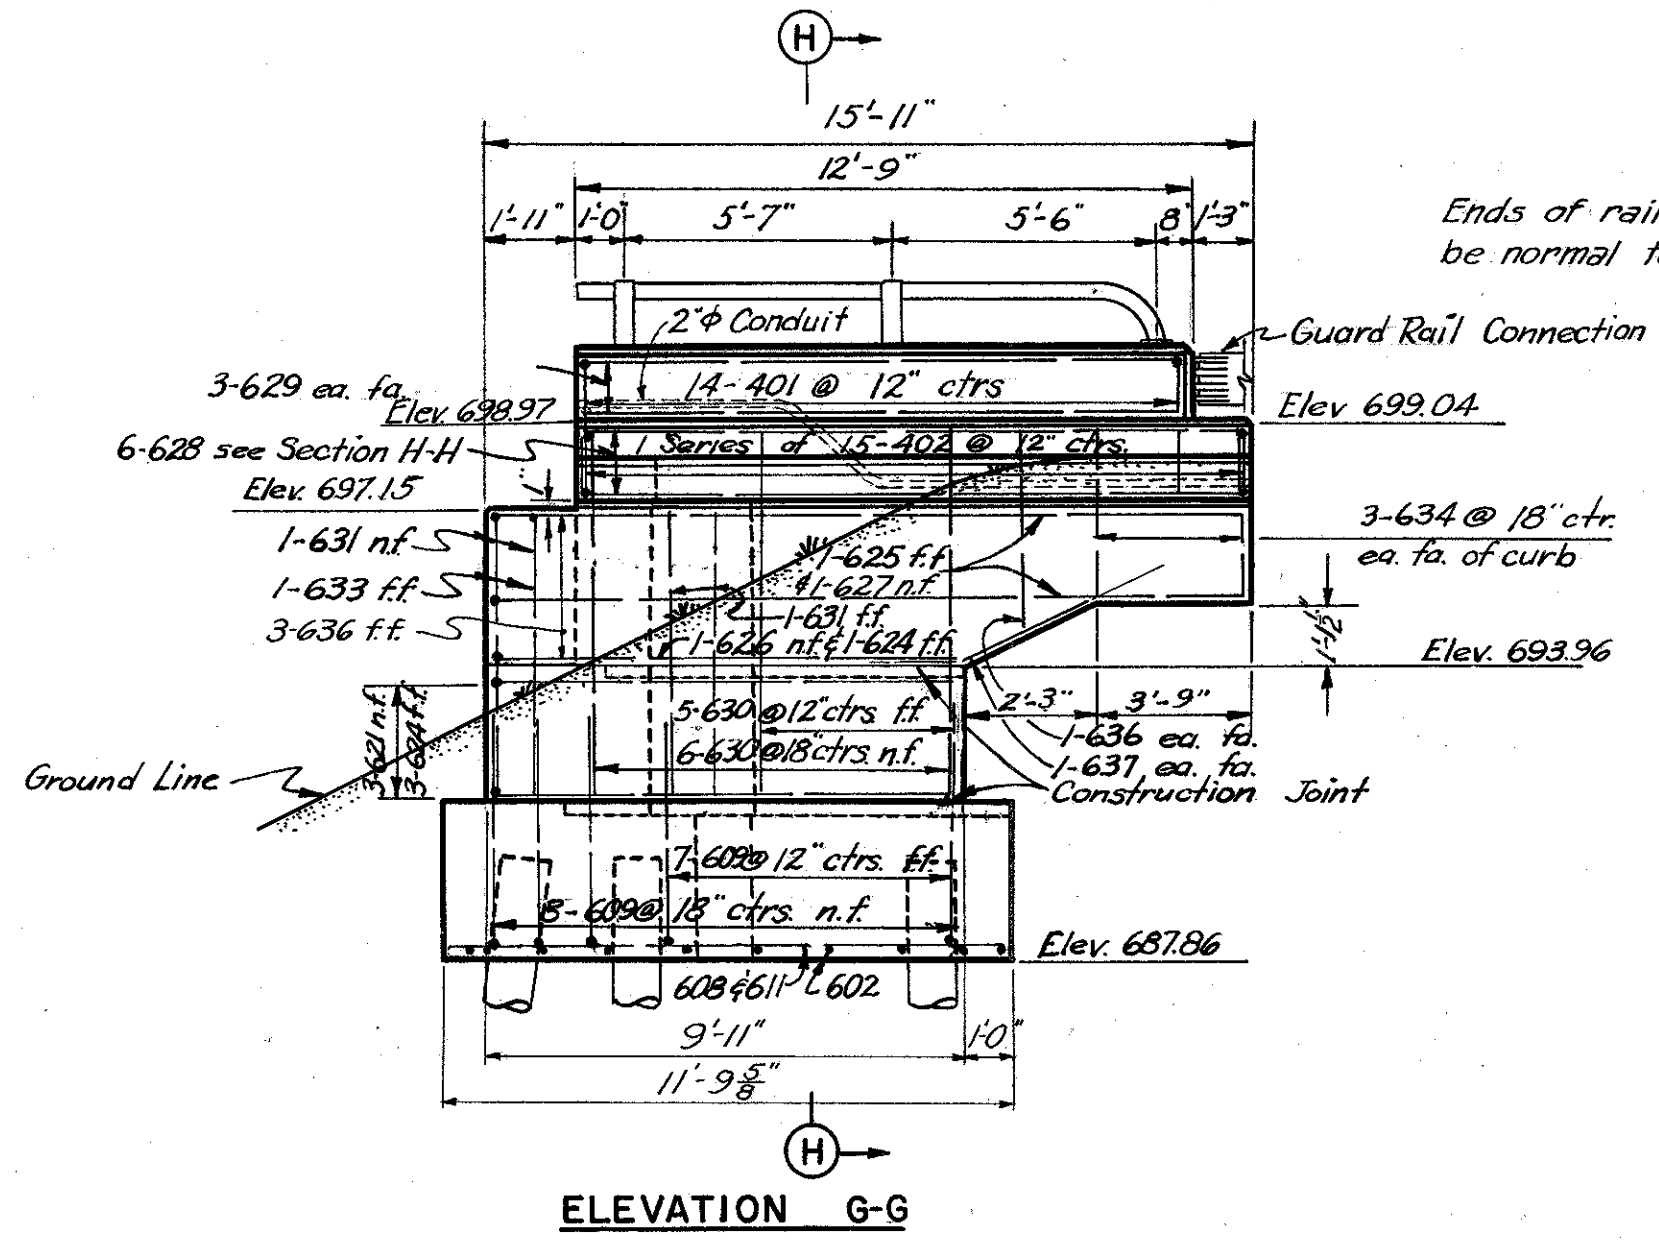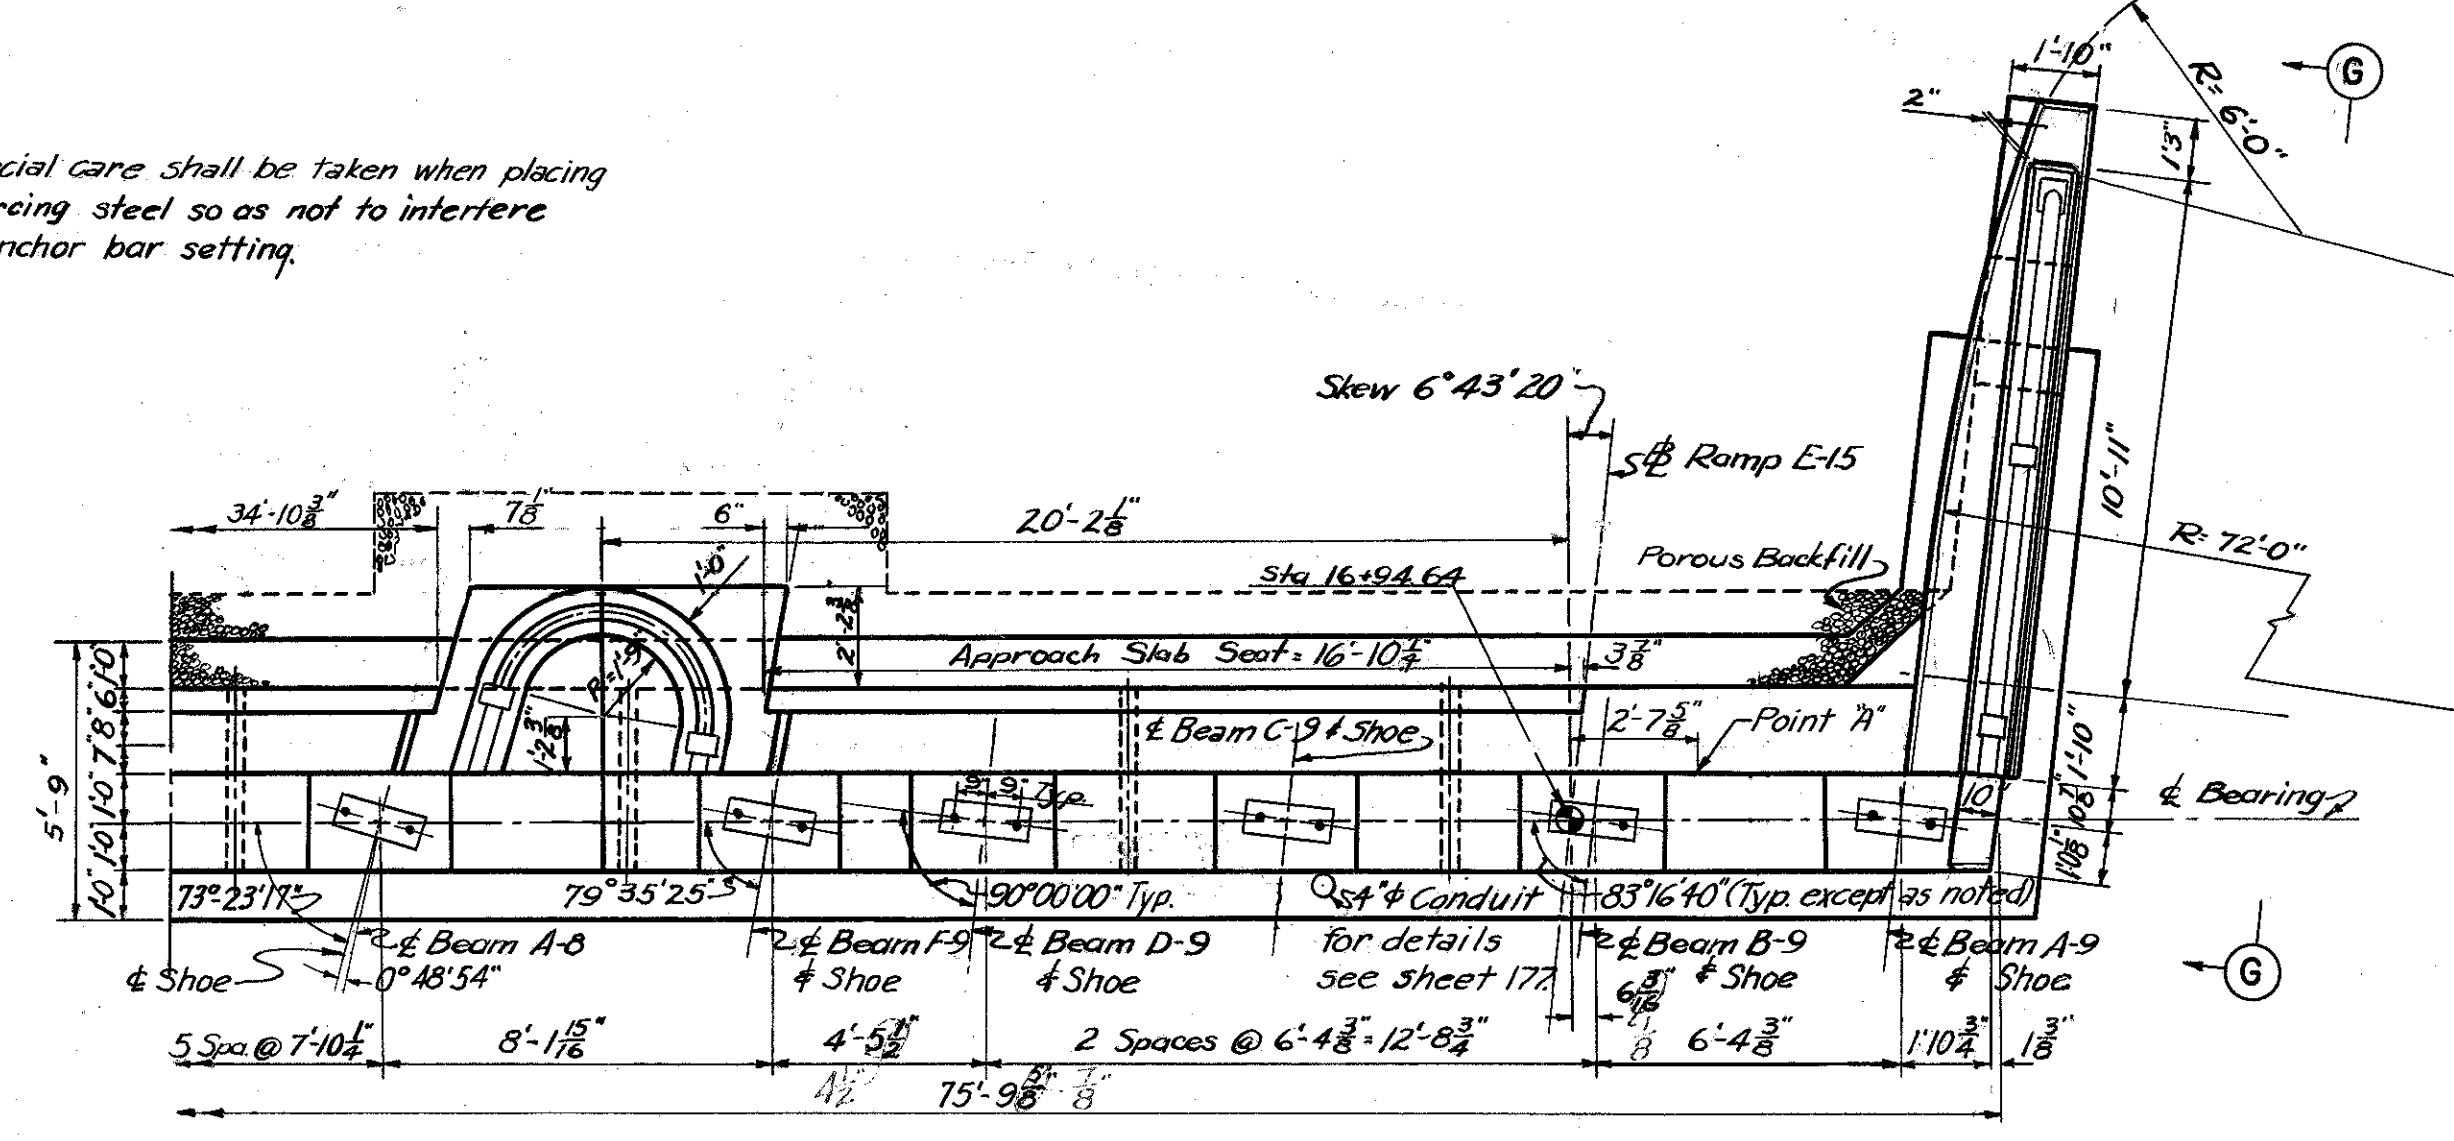




Ends of railing parapet shall be normal to top of safety curb.

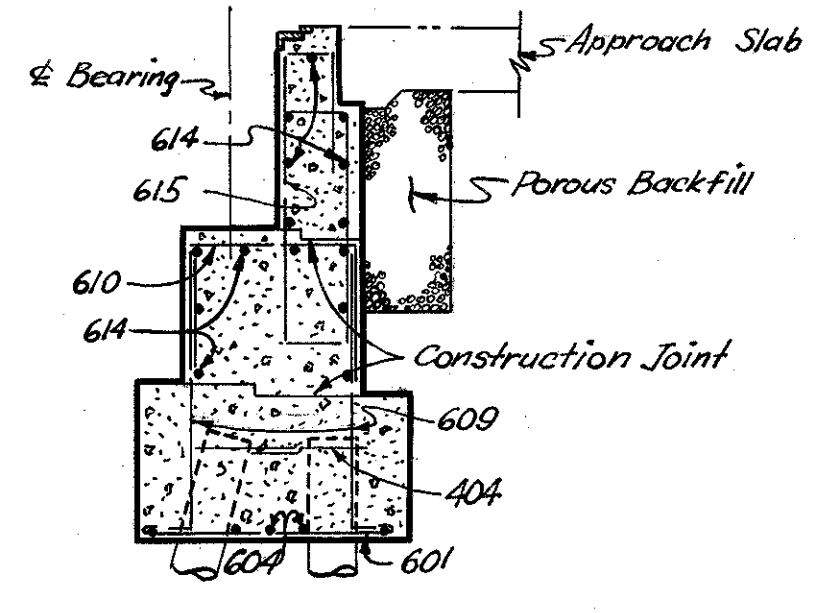



Note:
Elevations along backwall are given to back of 6x4x1/2 angle.

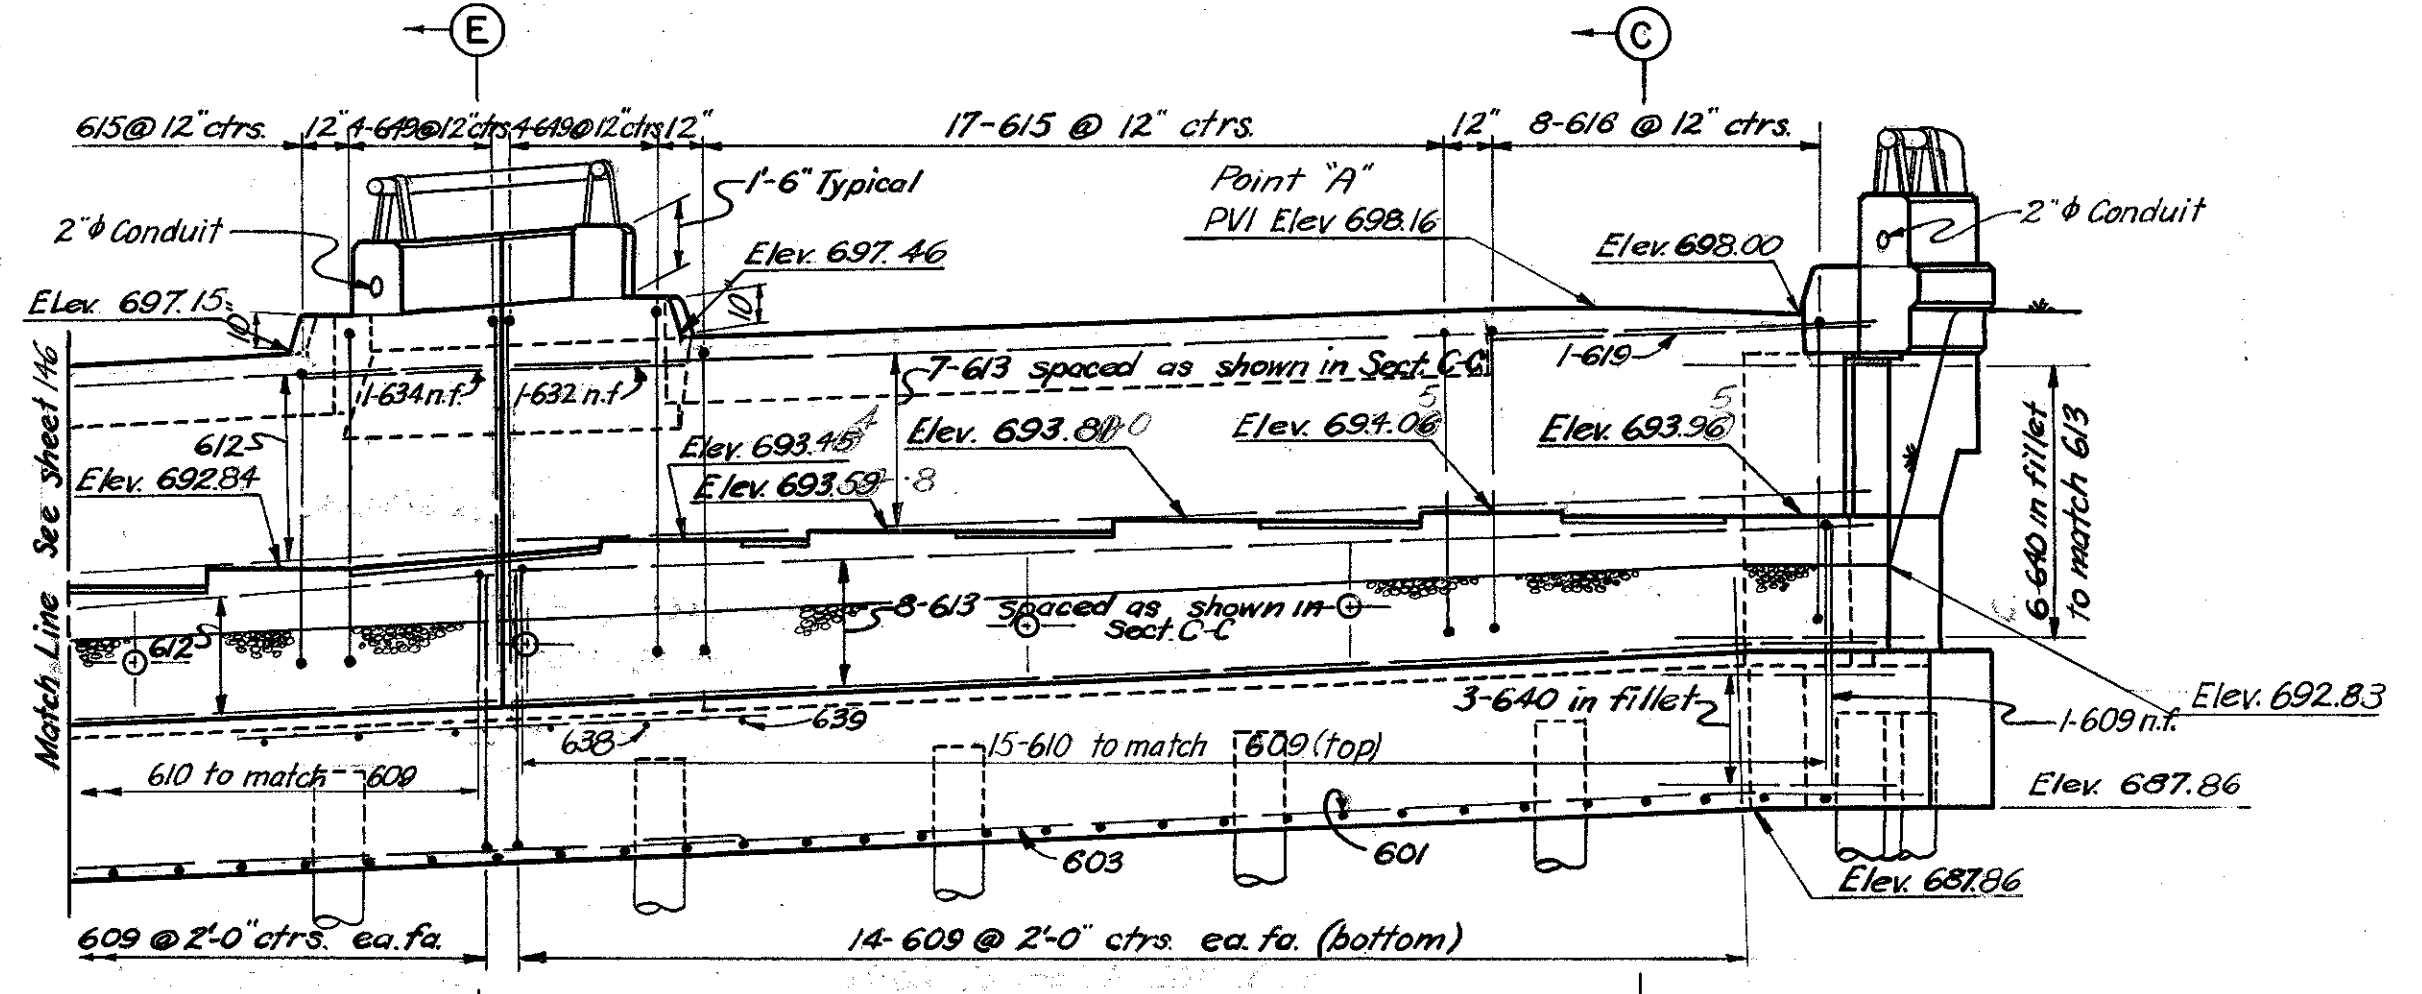



Note: Top of backwall to follow crown of roadway

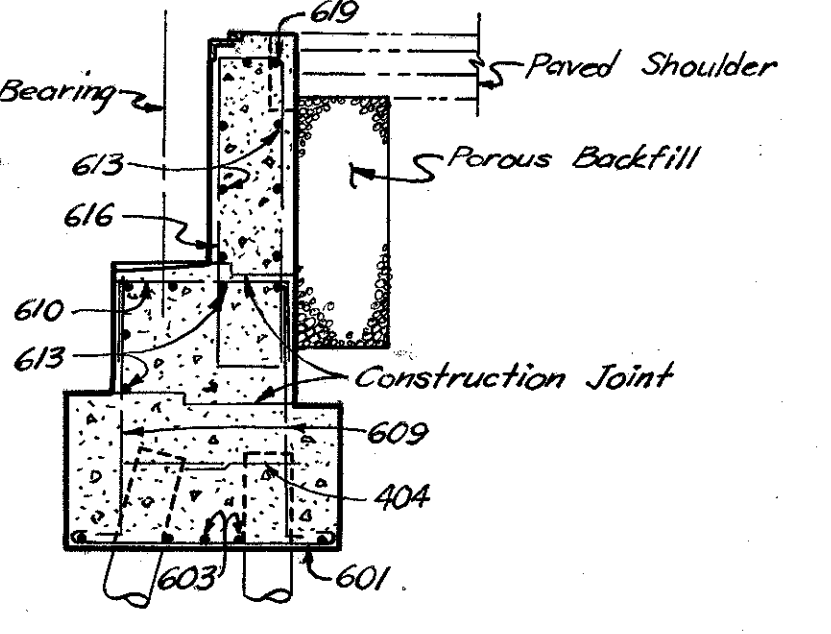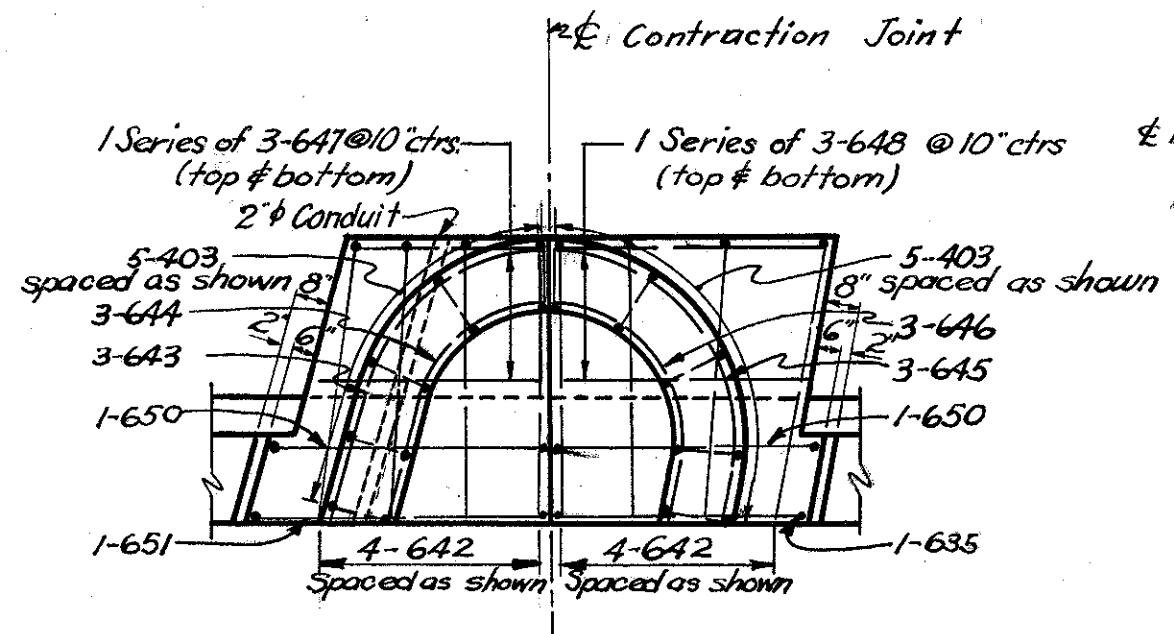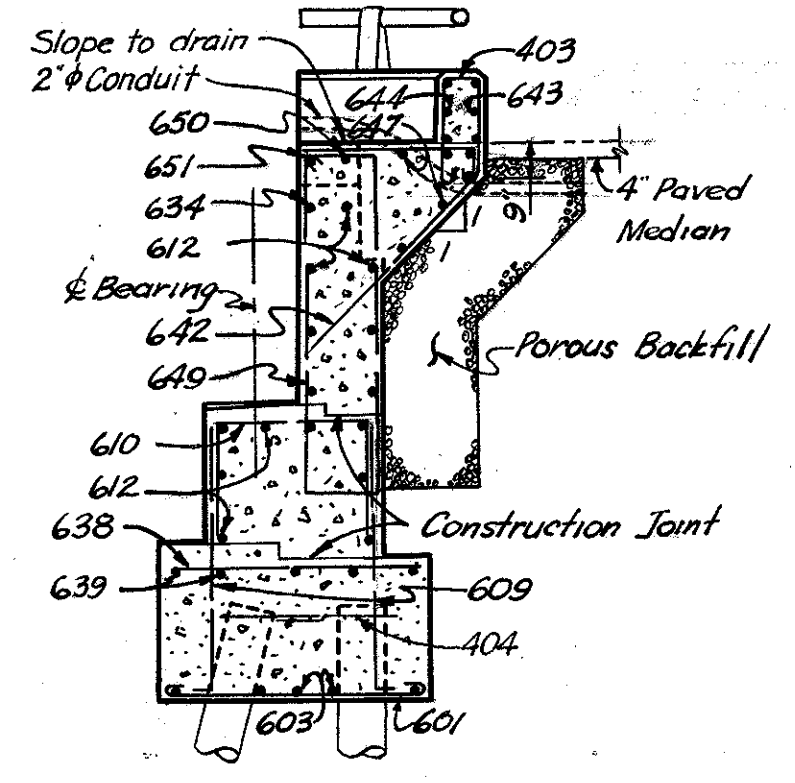

Note: Prefix "AA" shall be assigned to all bar marks.

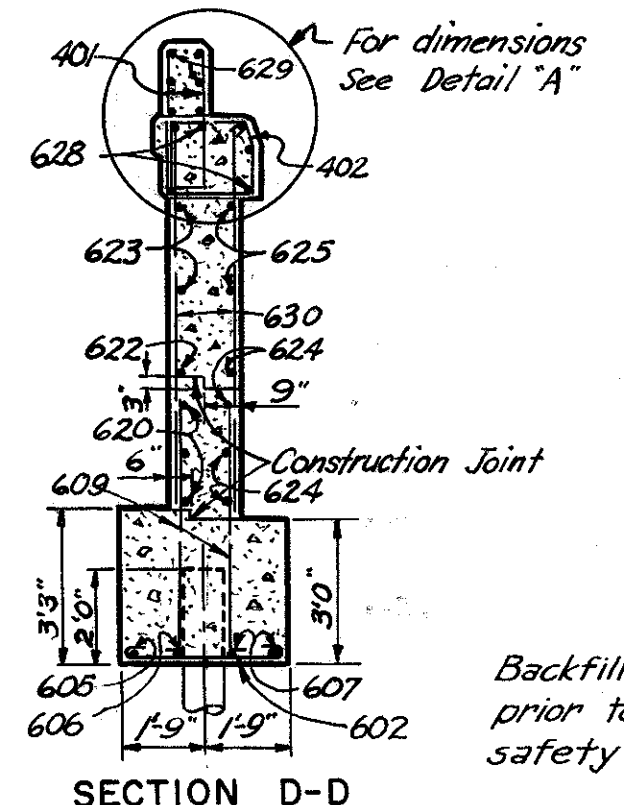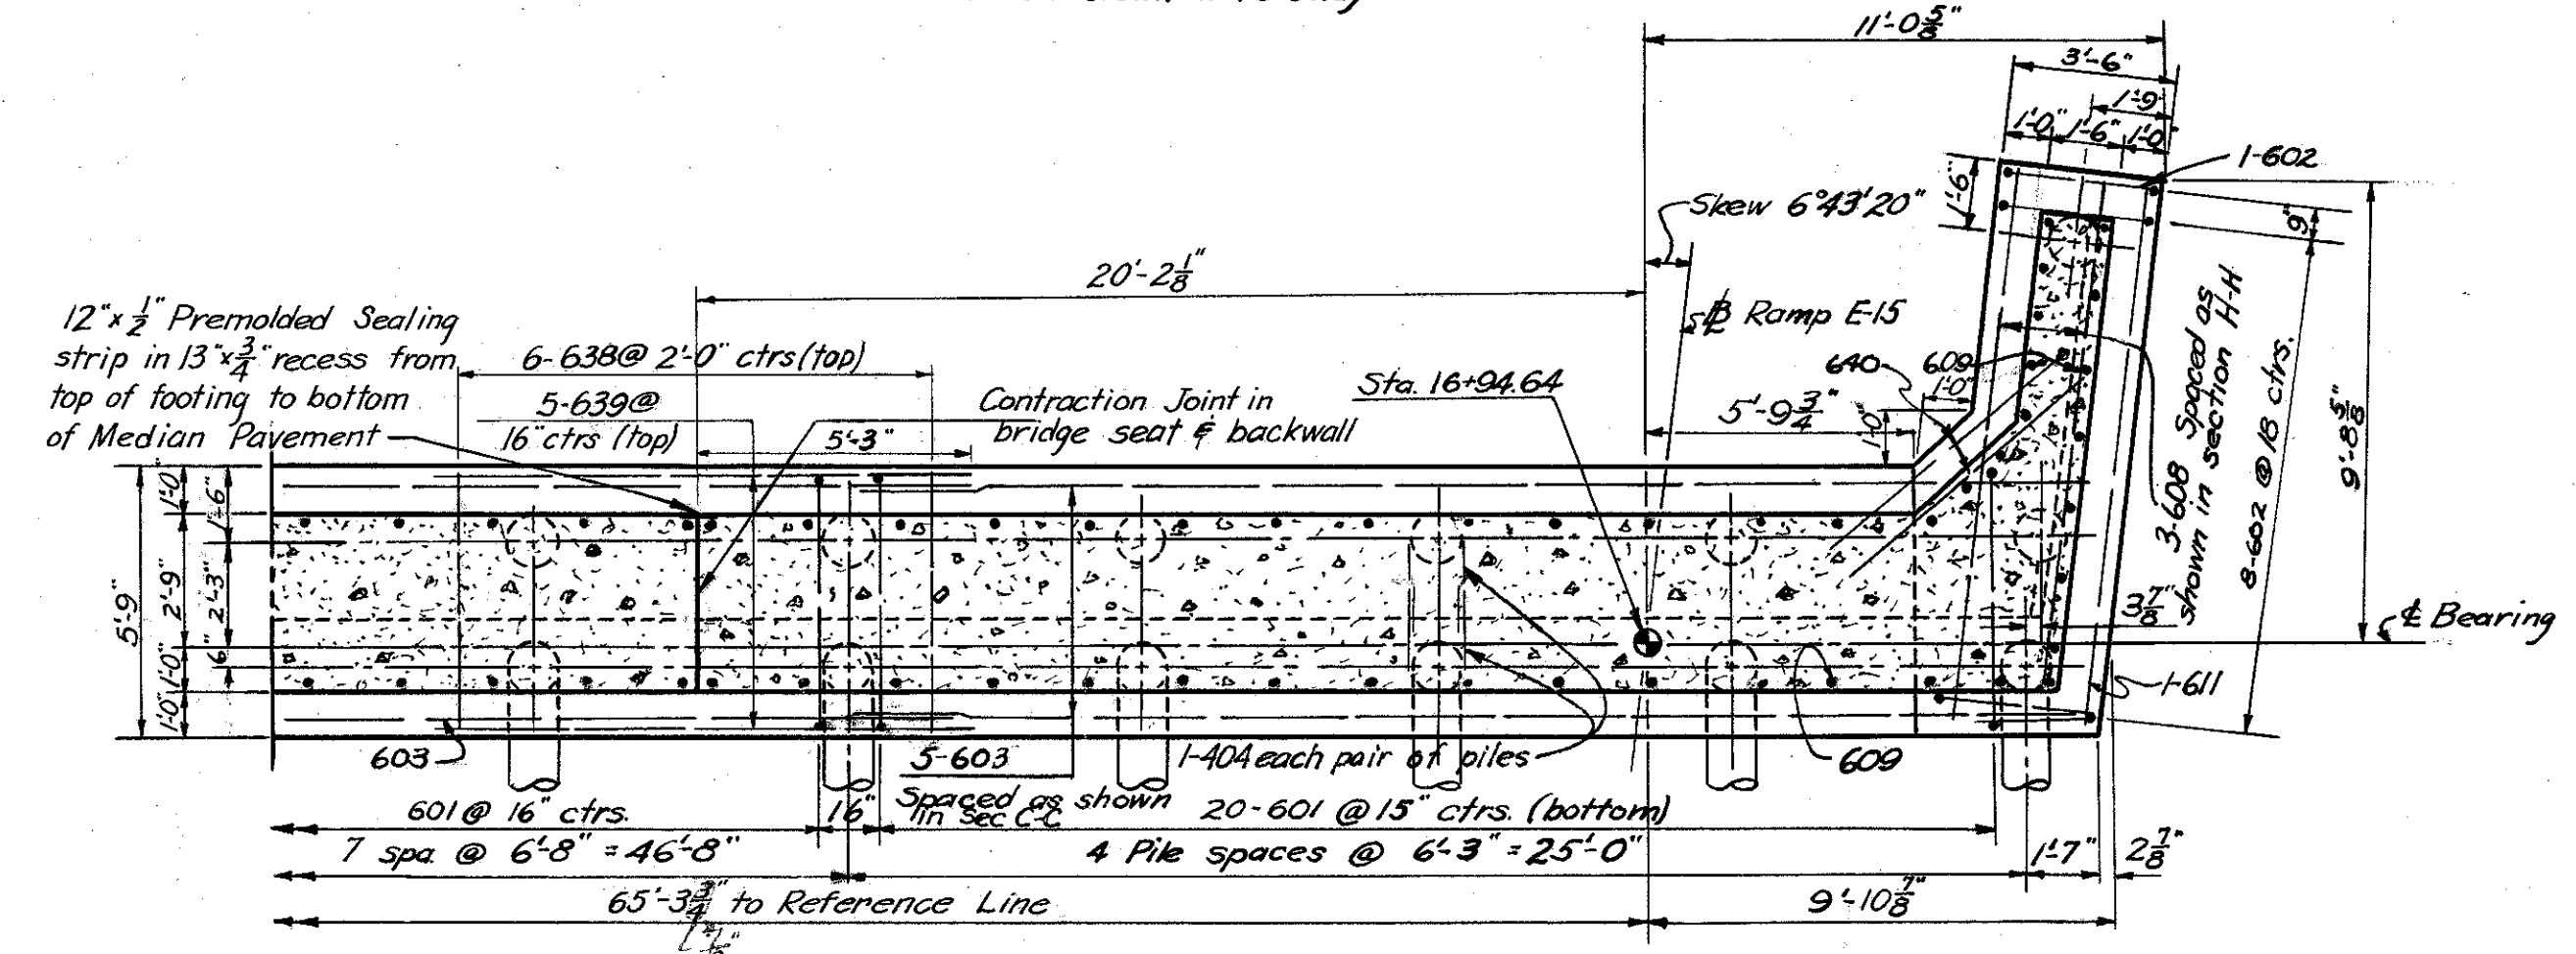

Backfill shall be placed prior to placing of safety curb.

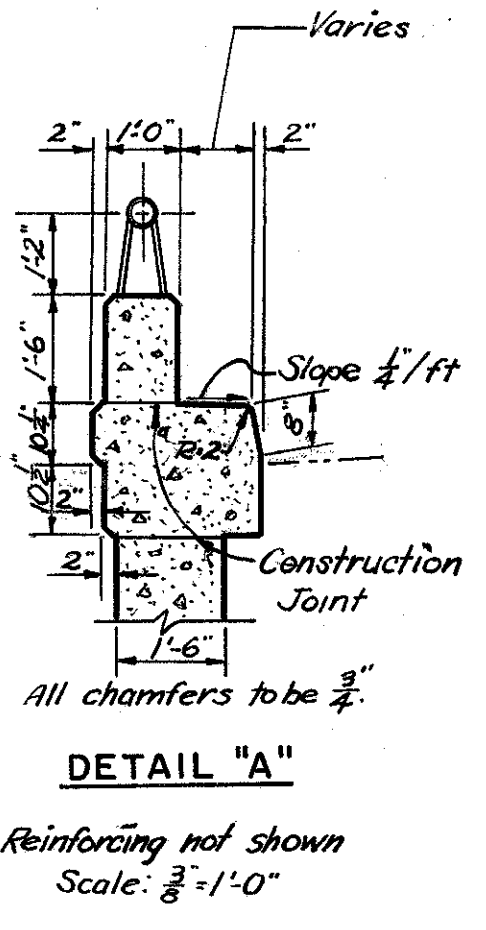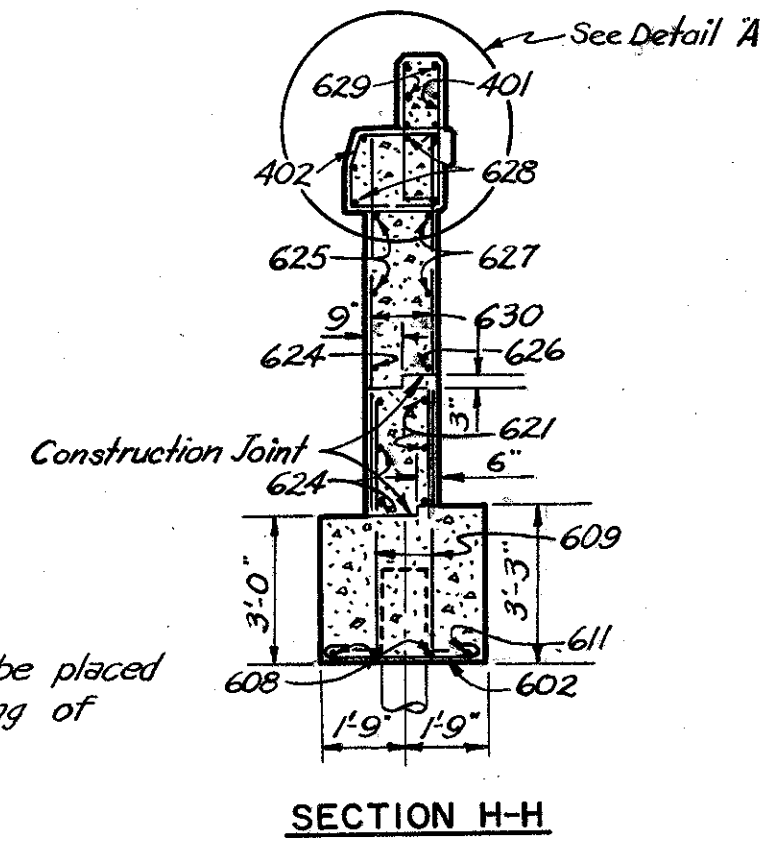

NOTES:
For dimensions and details not shown in section views see Section B-B sheet 146-7A.
Top of parapet and safety curb construction joints are to be parallel with roadway grade.
n.f. = near face; f.f. = far face; ea. fa. = each face
For reinforcement schedule see sheet 151-7A
For additional notes see sheet 146-7A

H.N.T.B. BRS. NO. 8 AND 9 PART 7A

HOWARD, NEEDLES, TAMMEN & BERGENDOFF
CONSULTING ENGINEERS
KANSAS CITY CLEVELAND NEW YORK


EAST ABUTMENT-SOUTH HALF
WILLOW FREEWAY OVER EAST 14th ST.
STA. 49+30.16 STA. 51+07.08 (WILLOW FREEWAY)
STA. 15+27.70 STA. 16+96.91 (RAMP E-15)
BR. NO. CUY-21-1573A¹⁸ Scale: 1/4" = 1'-0" Except as noted
WILLOW-INNER BELT FREEWAY
CLEVELAND CUYAHOGA COUNTY OHIO

DRAWN	TRACED	CHECKED	REVIEWED	REVISED
DATE 7/25/60	DATE 8/18/60	DATE 7/31/60	DATE 11-13-59	


Revised 9-21-60

JUL 3 1958


CUYAHOGA COUNTY
CITY OF CLEVELAND
CUY-21-15.32
CUY-42-18.42

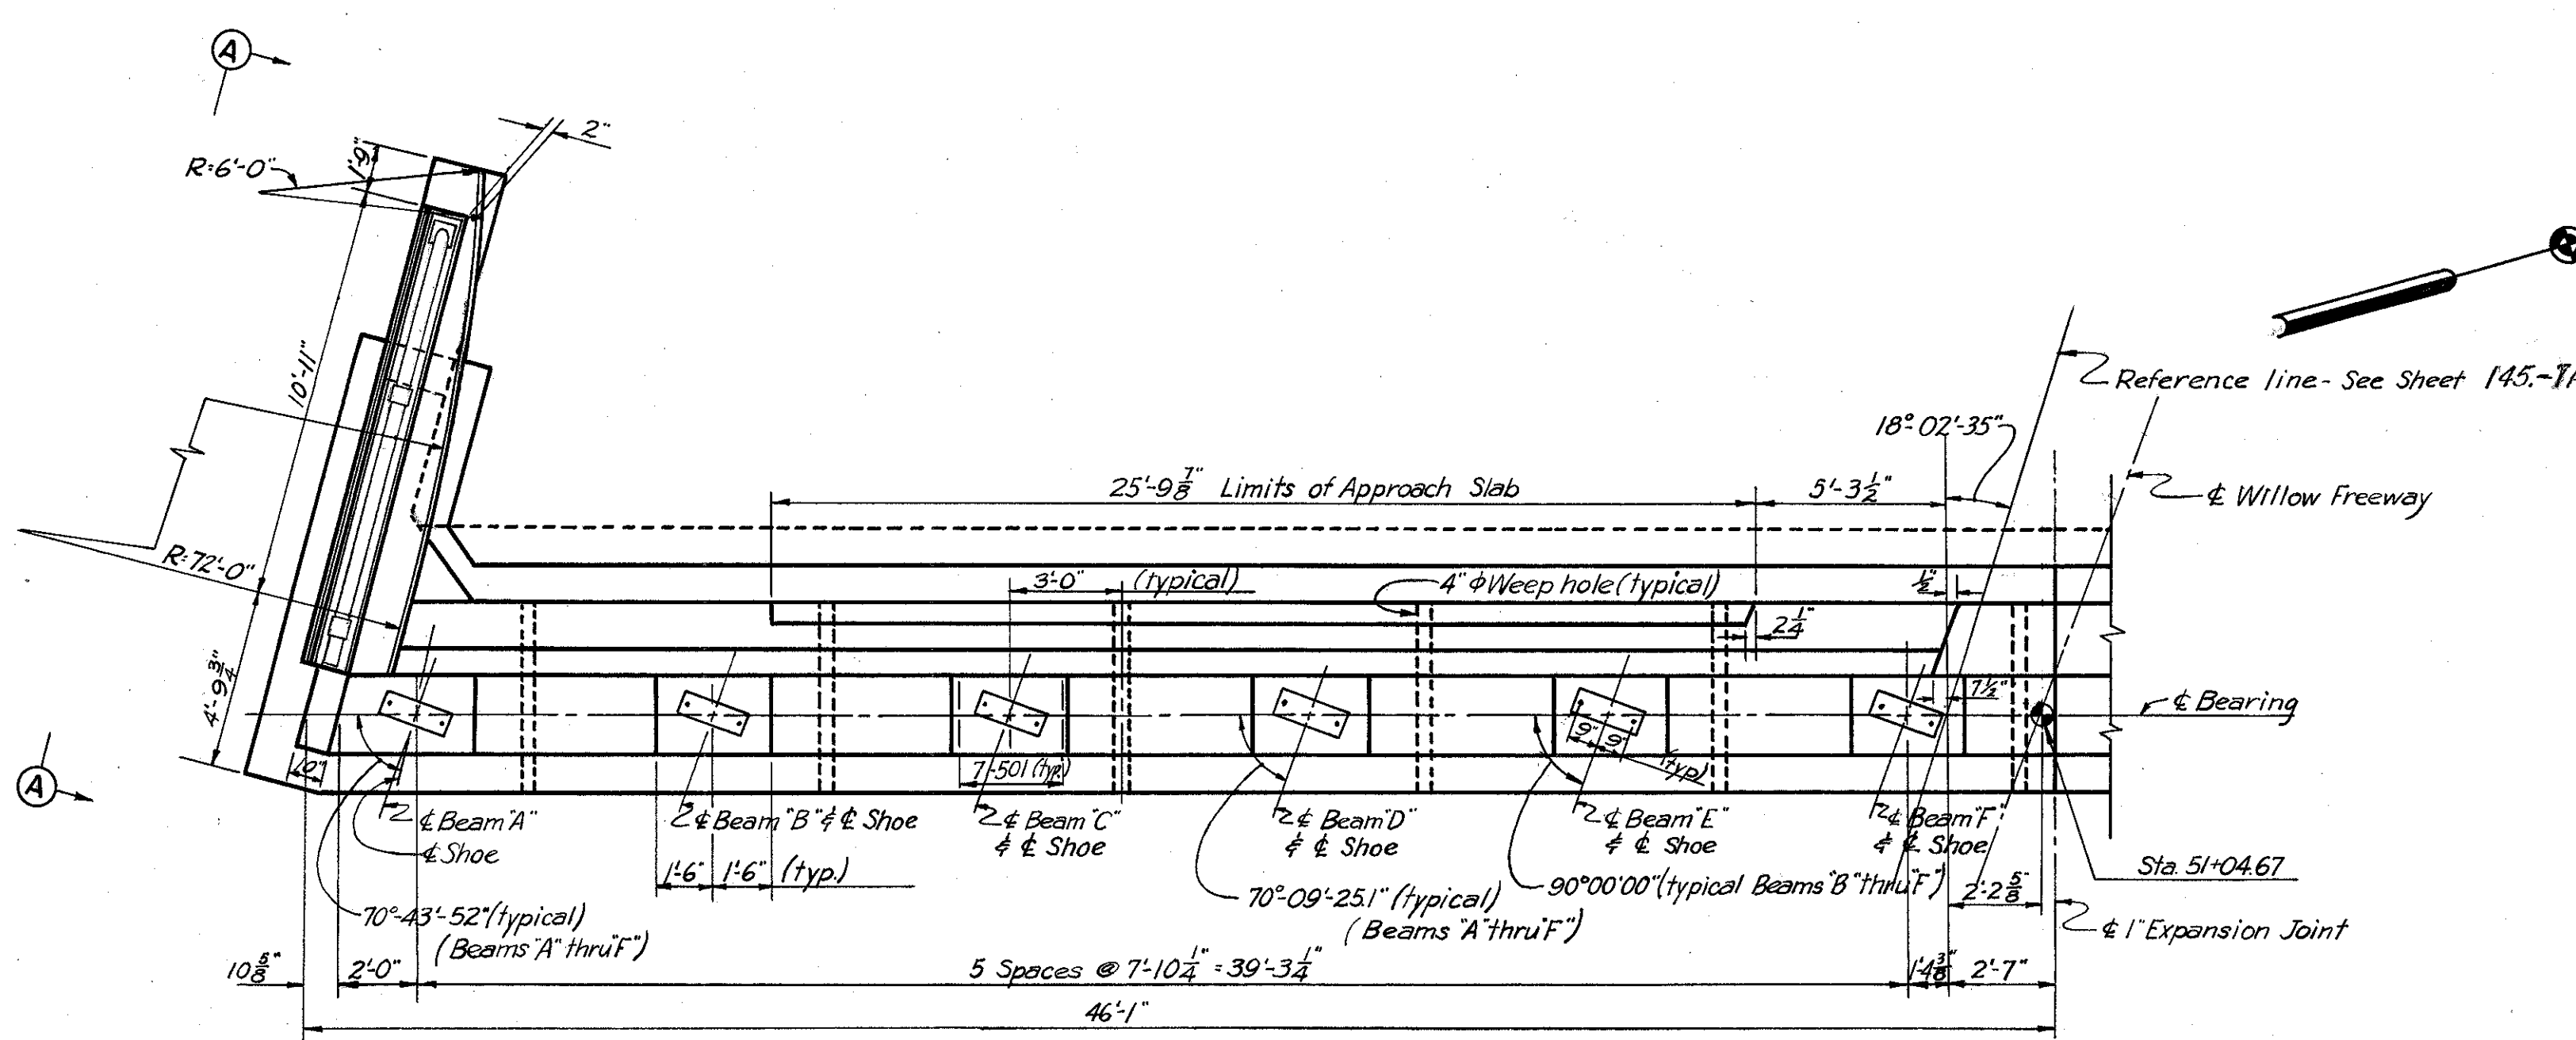

PLAN

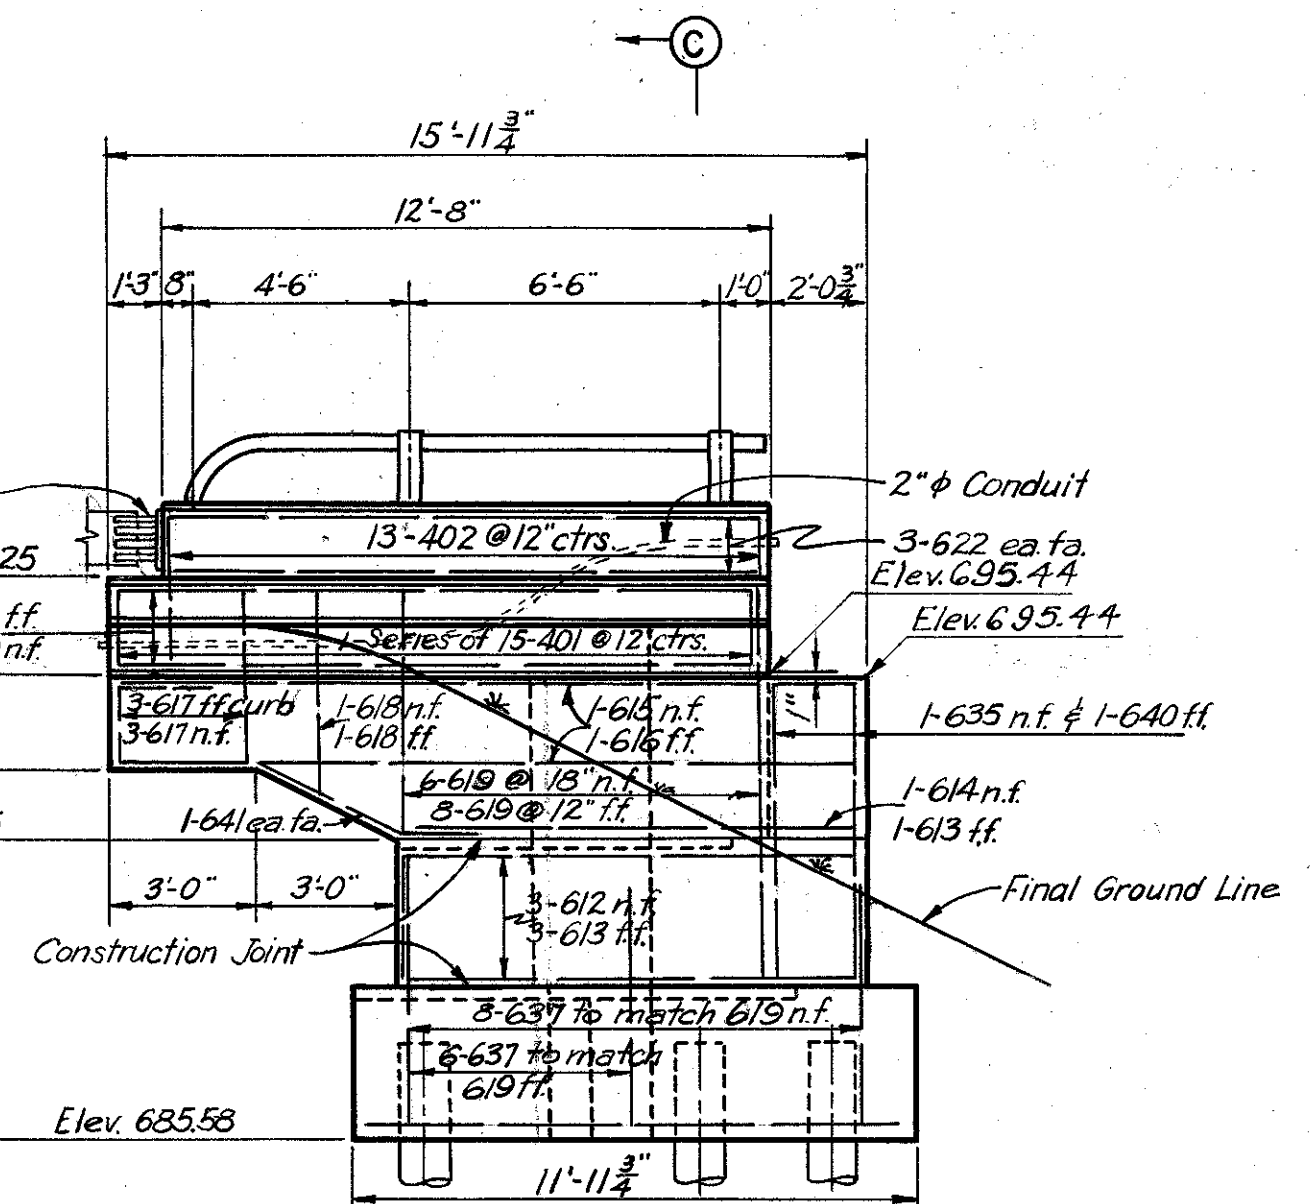


ELEVATION A-A

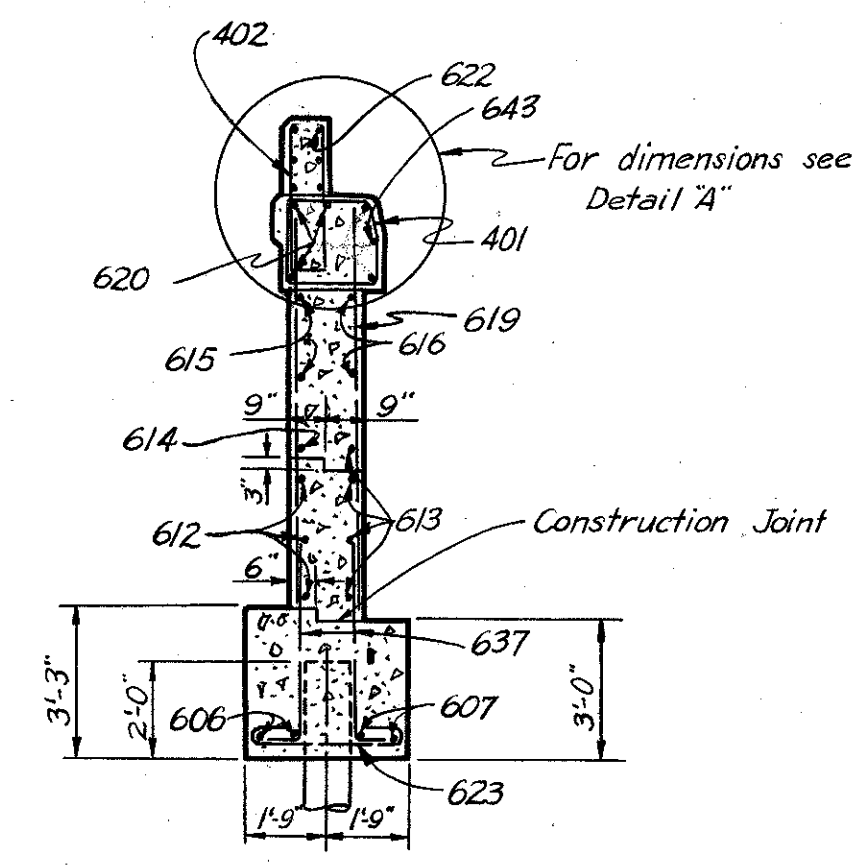


SECTION C-C

Note:
Elevations along backwall
are given to back of
6x4x1/2 angle.

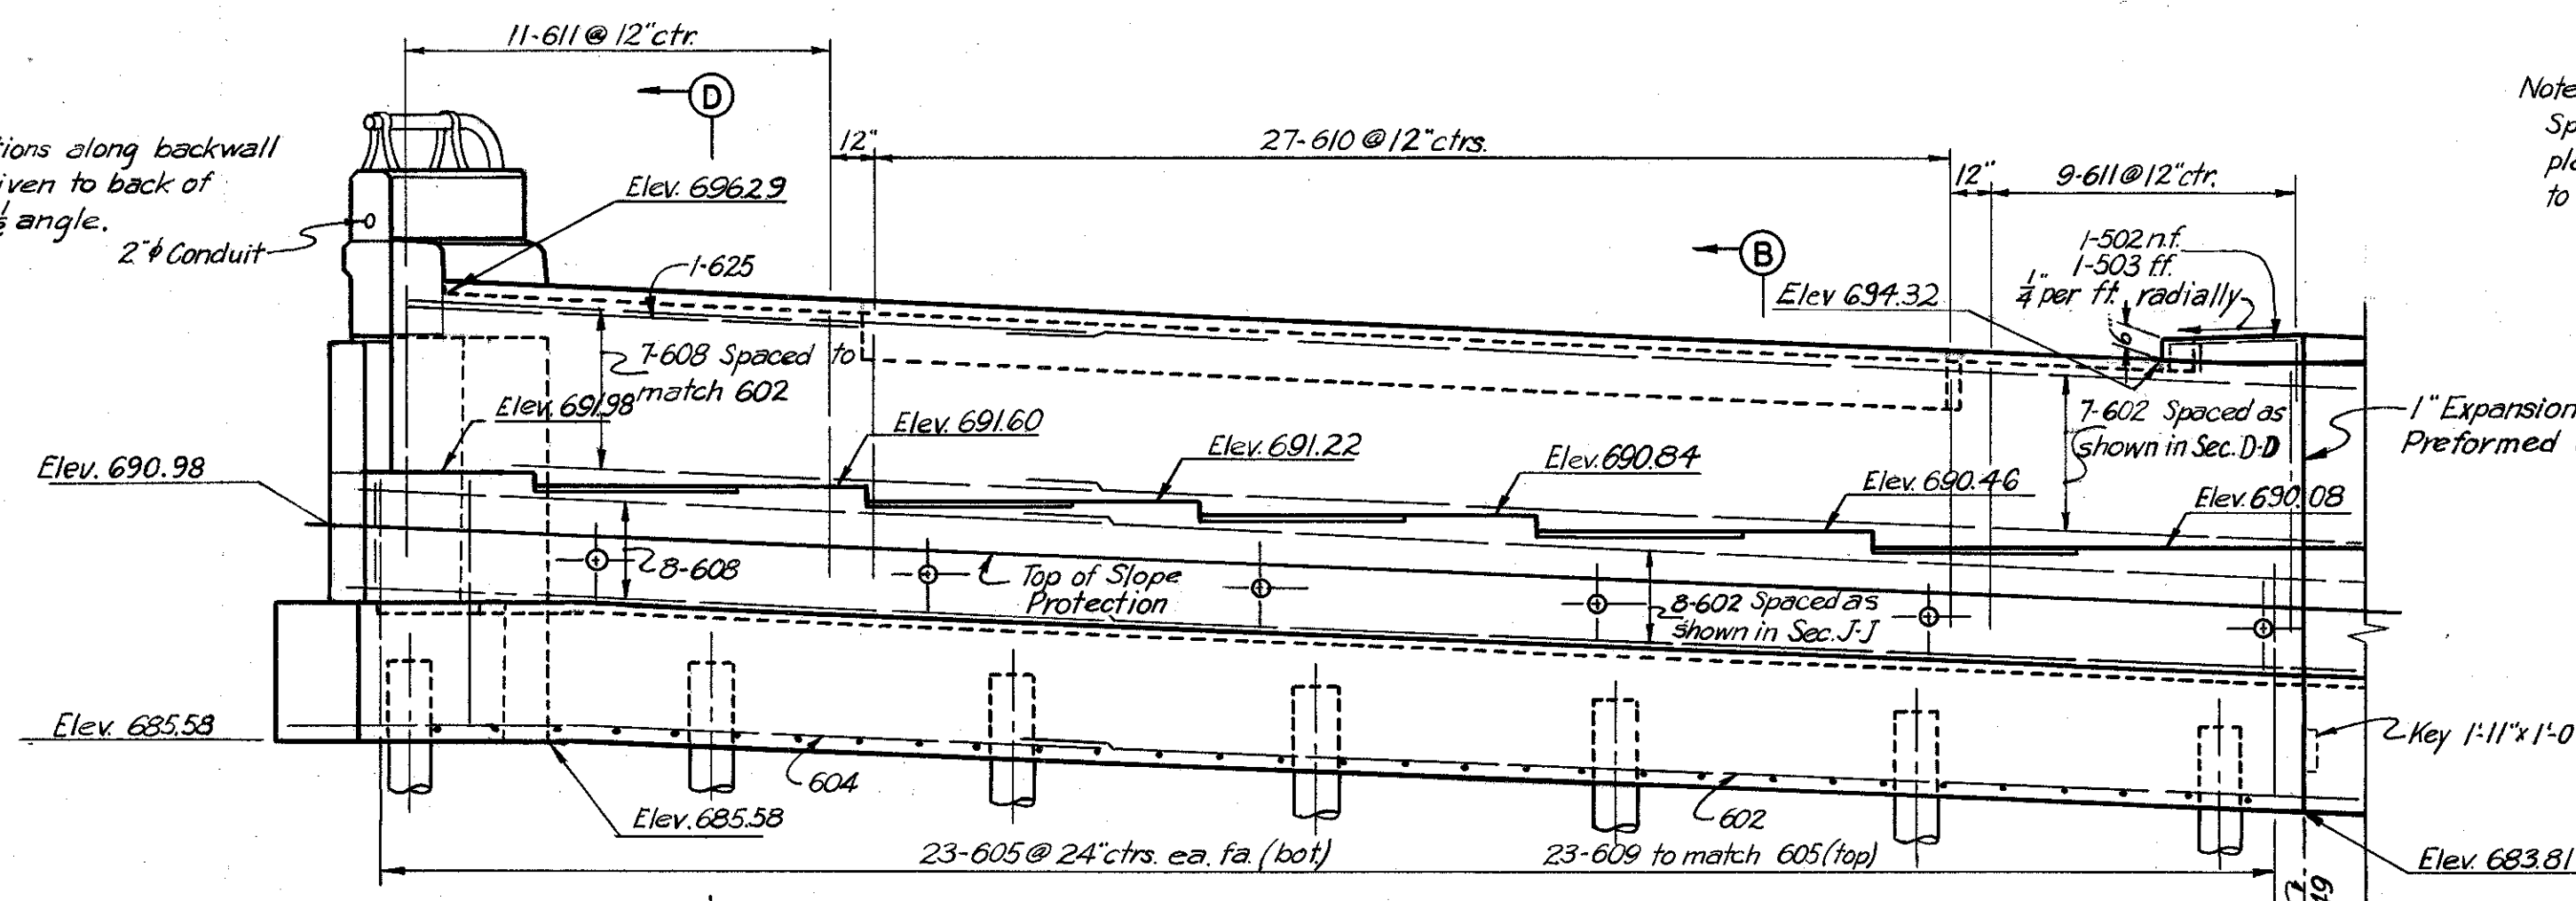


ELEVATION


Note:
Special care shall be taken when
placing reinforcing steel so as not
to interfere with anchor bar setting.

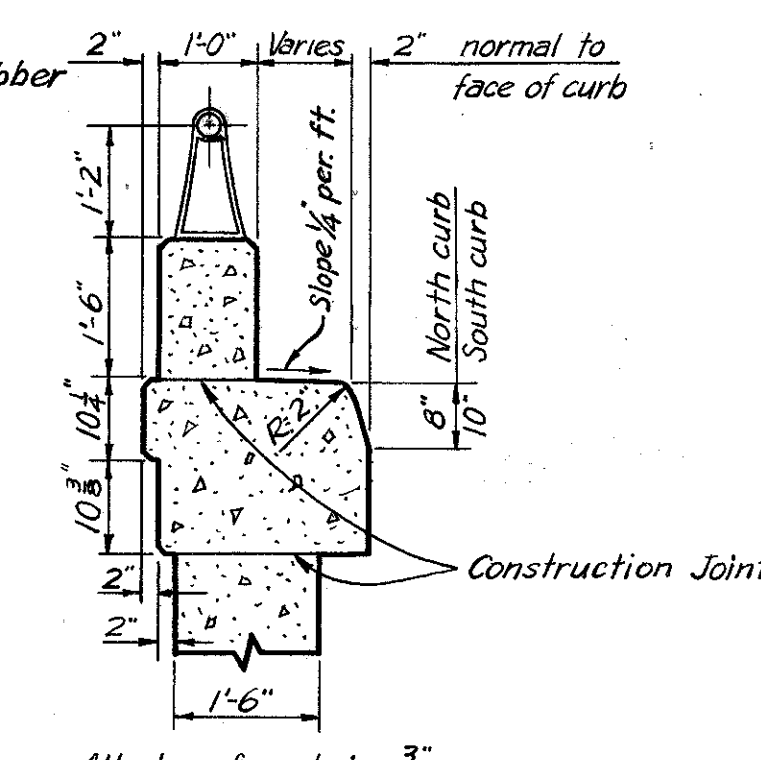

DETAIL "A"

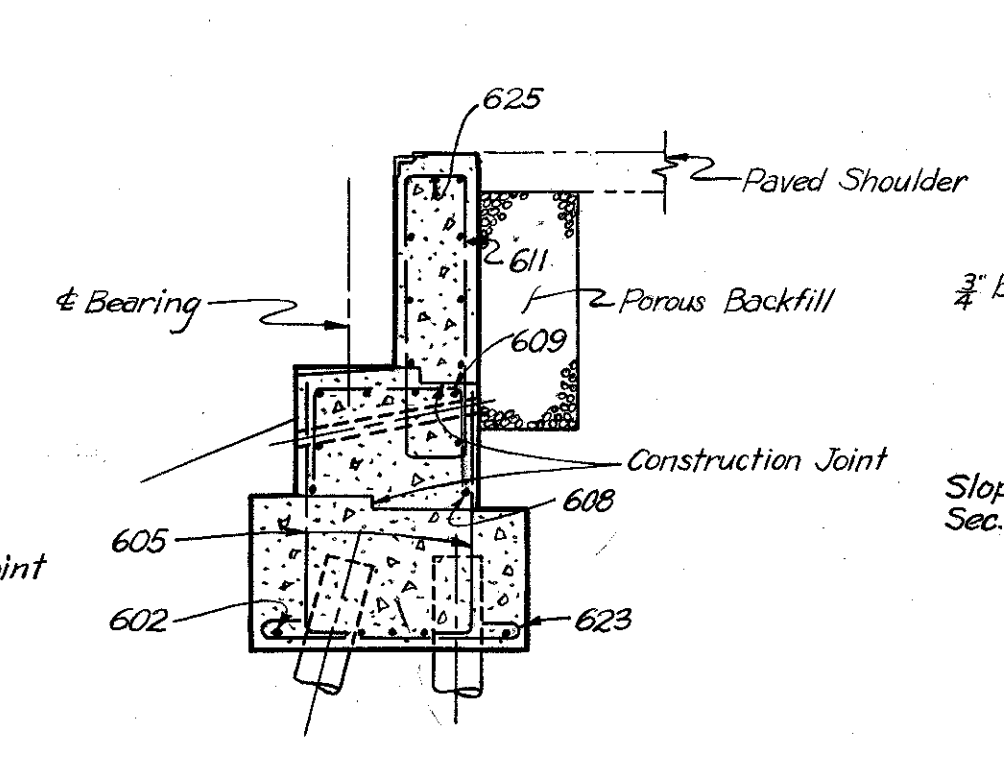


SECTION D-D

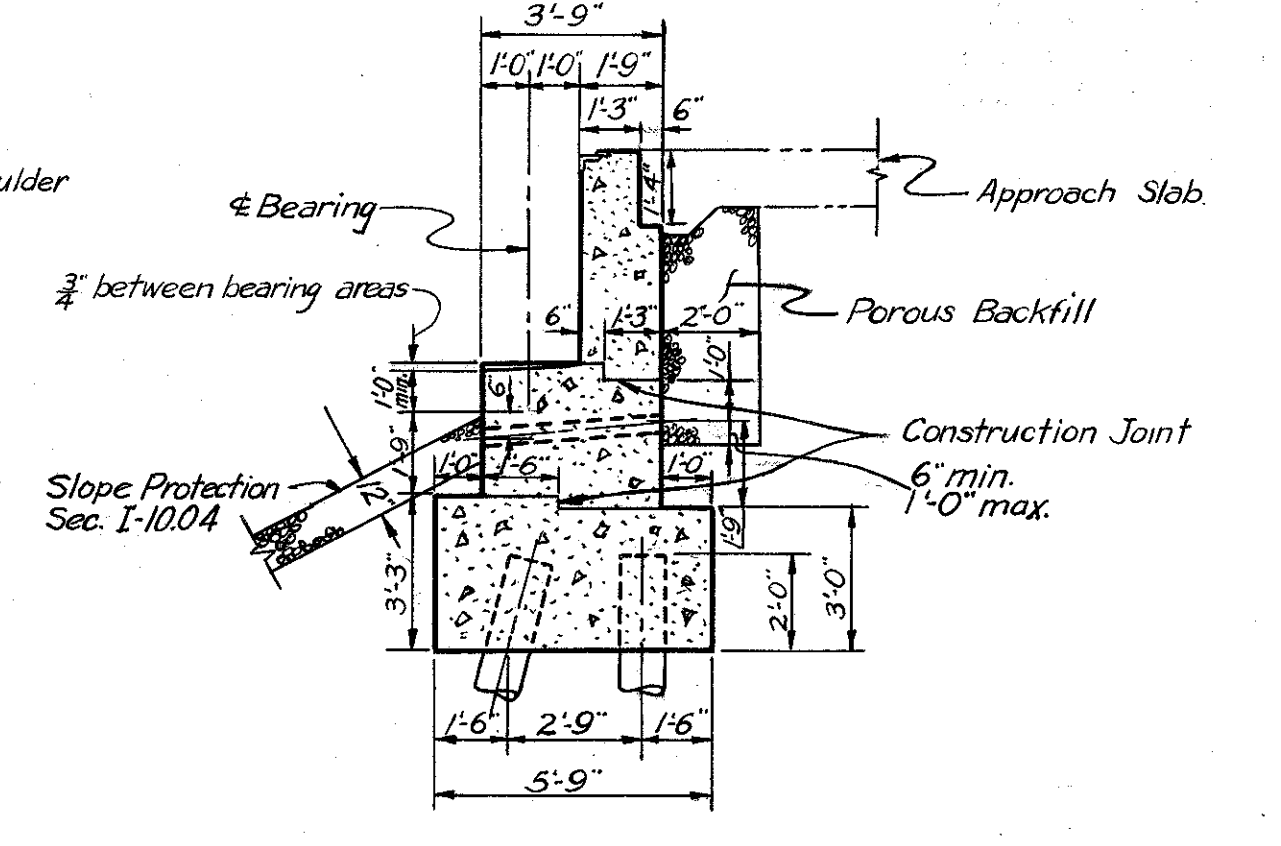

SECTION B-B

NOTES:
All piles shall be 12" C.I.P. reinforced concrete
All battered piles shall be battered 3 in 12 in direction shown
Pile spacings are given along bottom of footing
For additional notes see sh. 146-7A

Note: Prefix "AB" shall be
assigned to all bar marks.

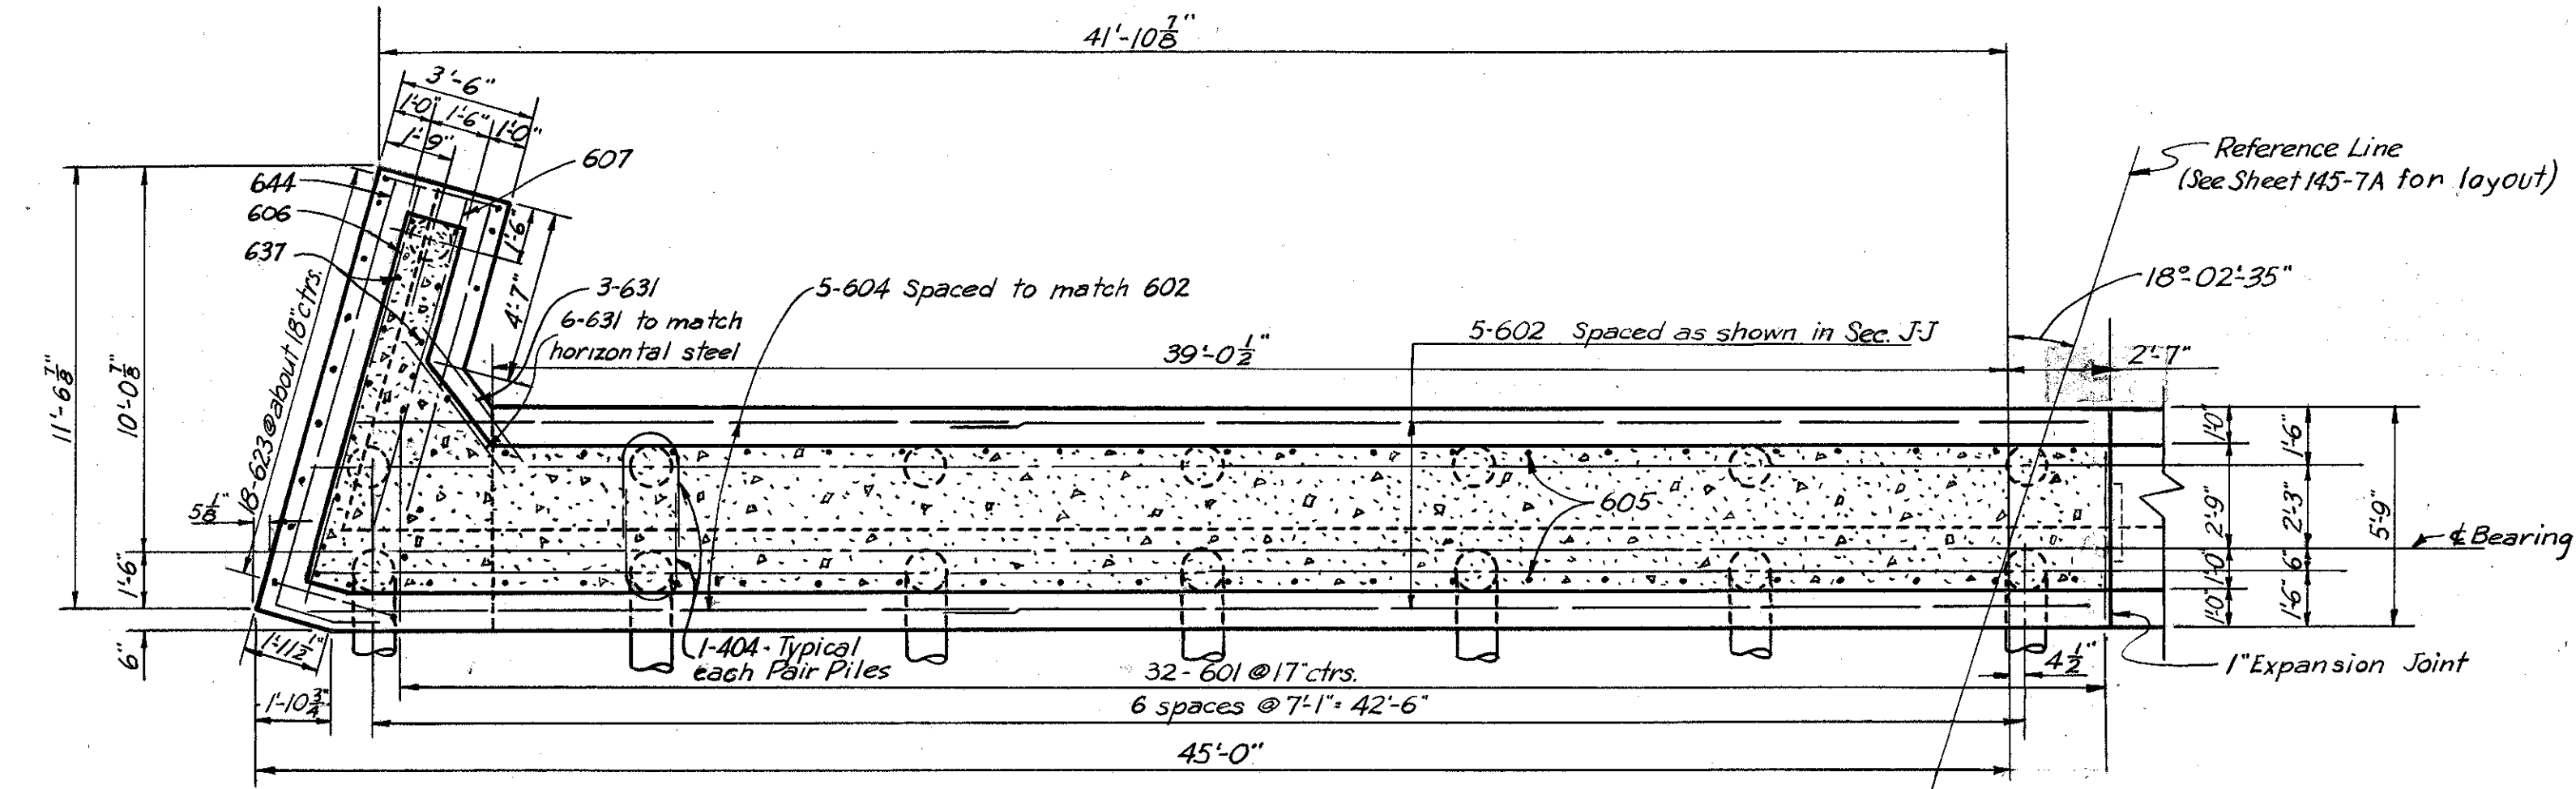

FOOTING PLAN

H.N.T.B. BR. NO. 8 PART 7A



HOWARD, NEEDLES, TAMMEN & BERGENDOFF
CONSULTING ENGINEERS
KANSAS CITY CLEVELAND NEW YORK

WEST ABUTMENT-SOUTH HALF
WILLOW FREEWAY OVER EAST 14th ST.
BR. NO. CUY-21-1573 A STA. 49+30.16
Scale: 1/4"=1'-0" Except as noted STA. 51+07.08
WILLOW-INNER BELT FREEWAY
CLEVELAND CUYAHOGA COUNTY OHIO


DRAWN	TRACED/REV	CHECKED	REVIEWED
DATE 7/18/58	DATE 9-8-58	DATE 8-4-58	DATE 11-13-57

CUYAHOGA COUNTY
CITY OF CLEVELAND
CUY-21-15.32
CUY-42-18.42


Note:
Ends of railing parapet shall be normal to top of safety curb.

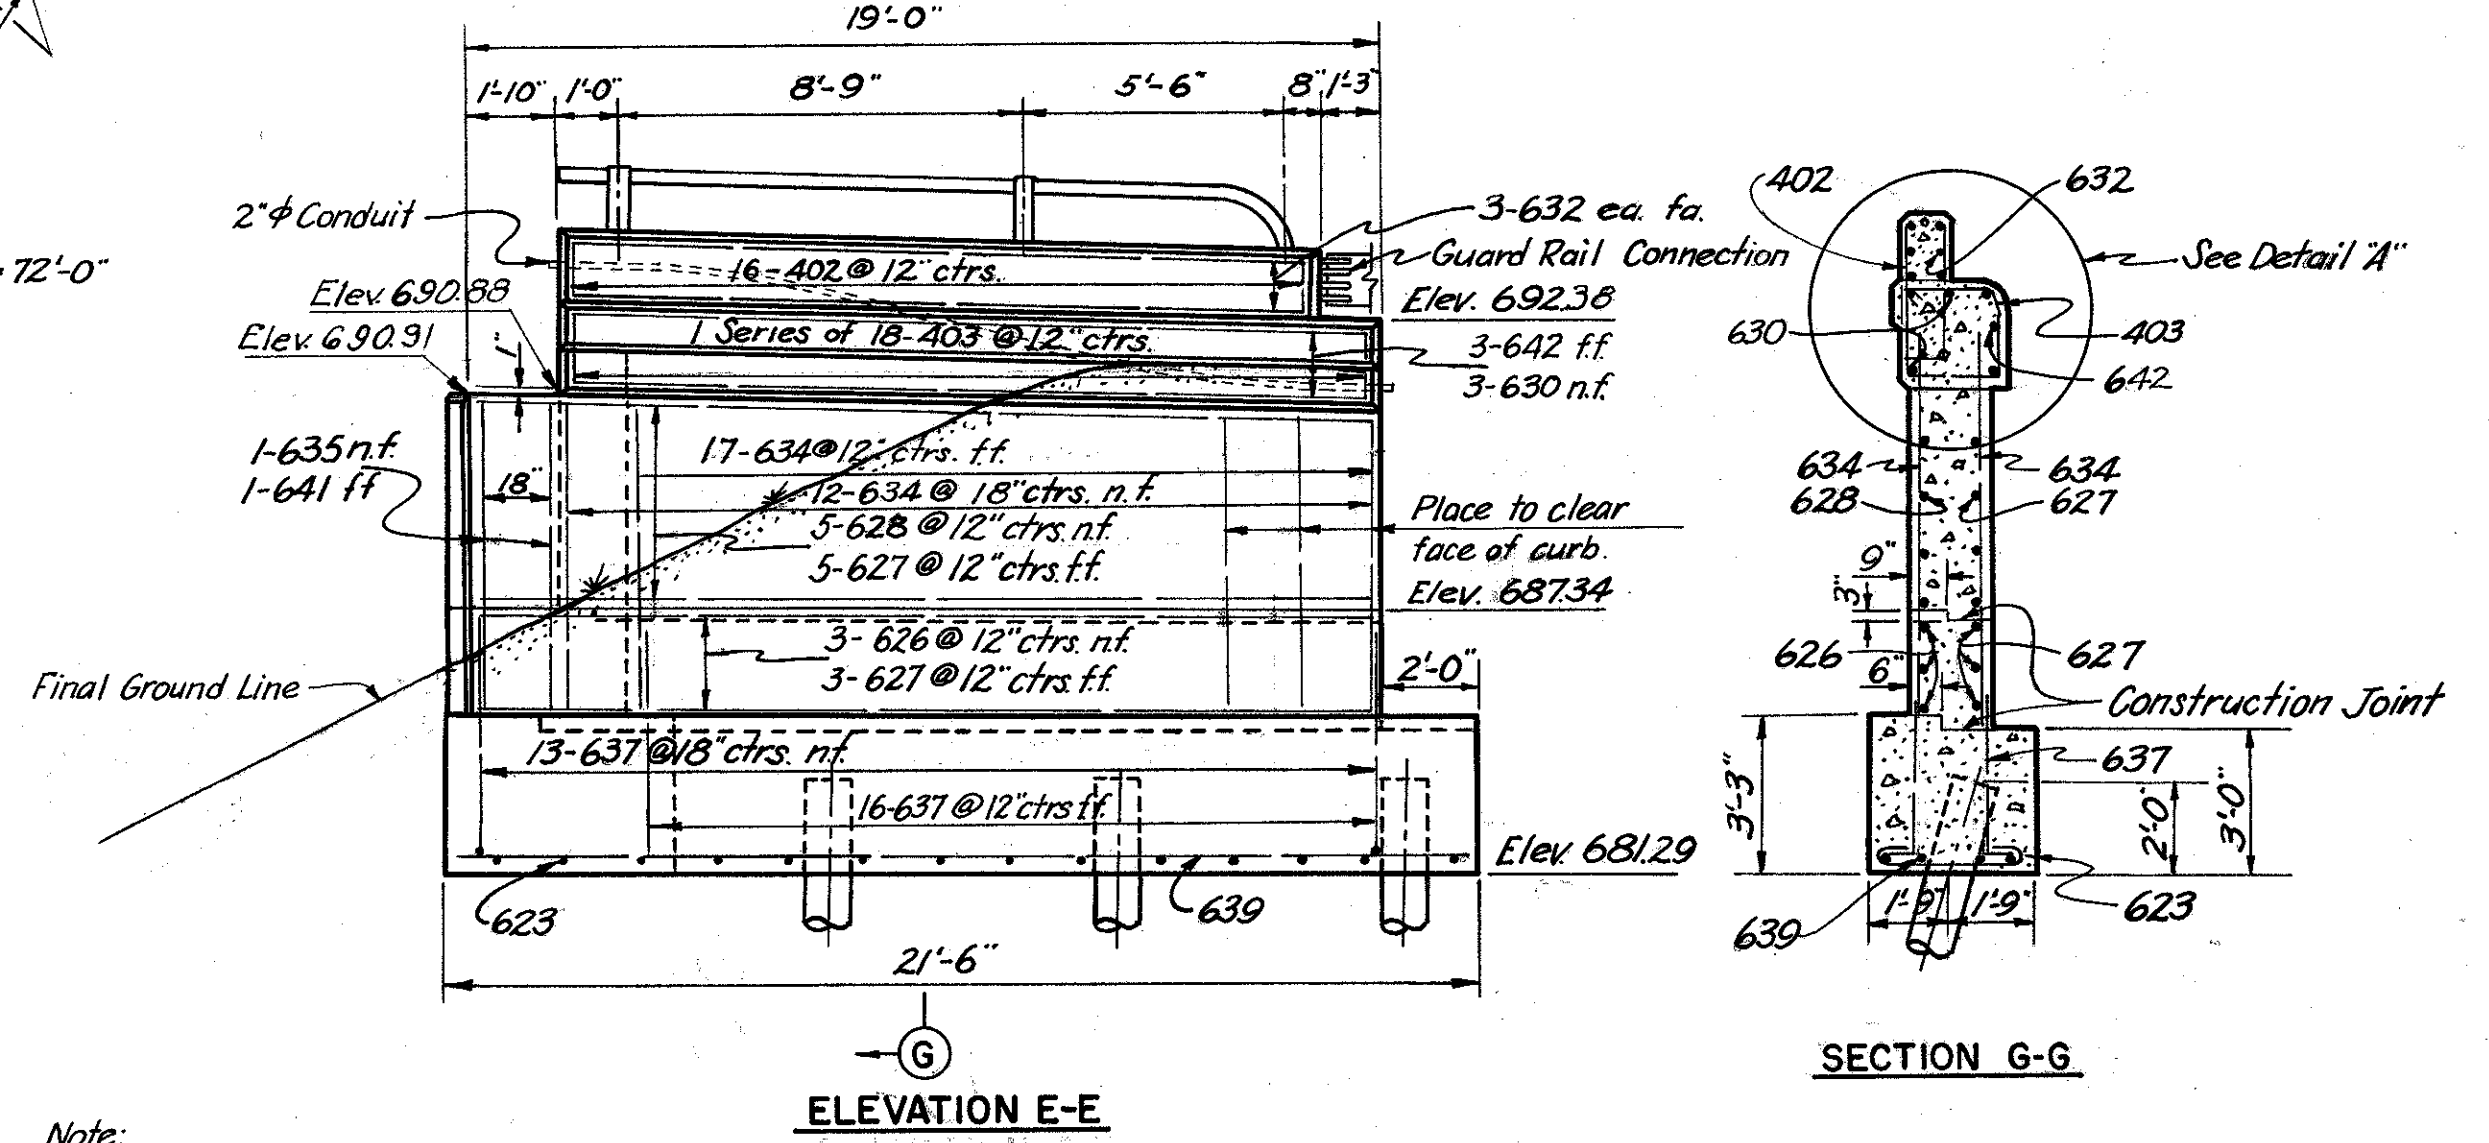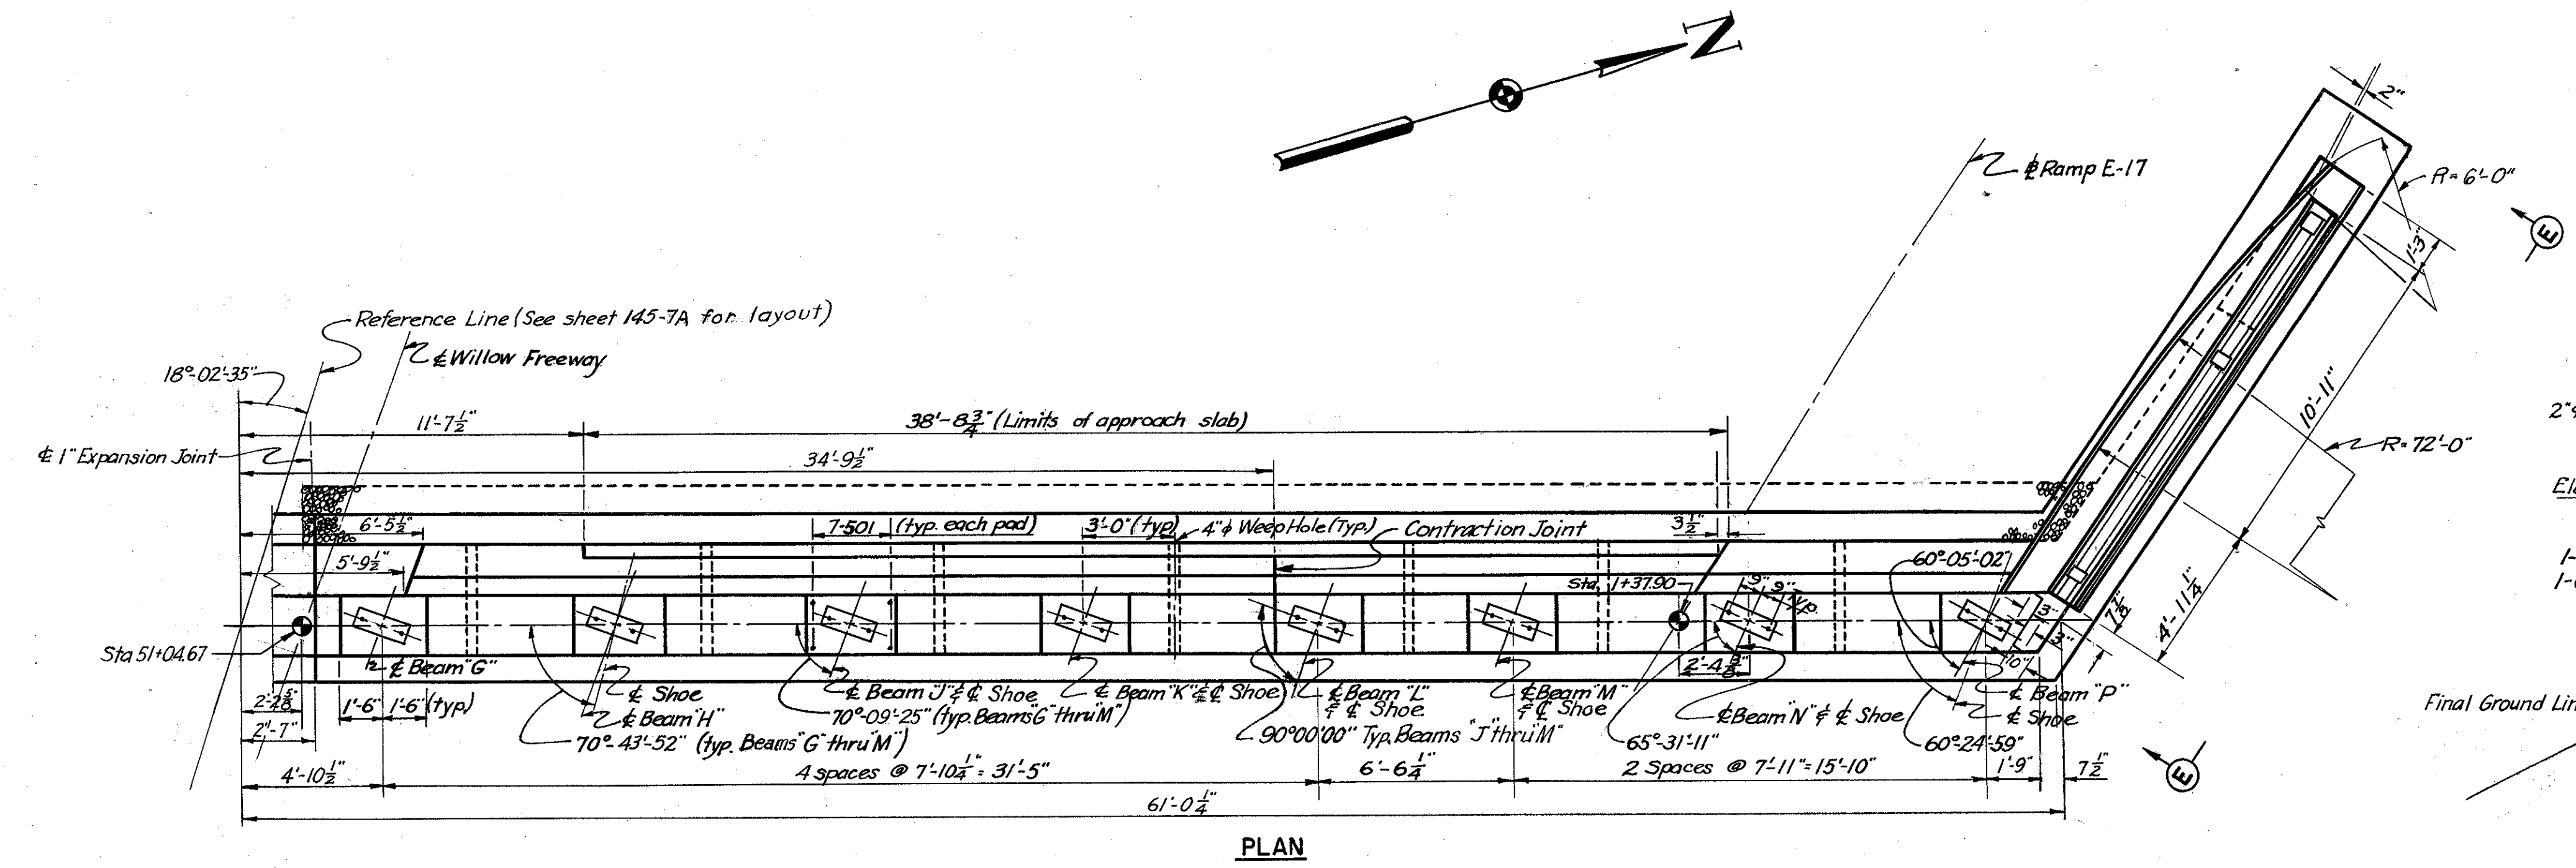


Note:
Special care shall be taken when placing reinforcing steel so as not to interfere with anchor bar setting.

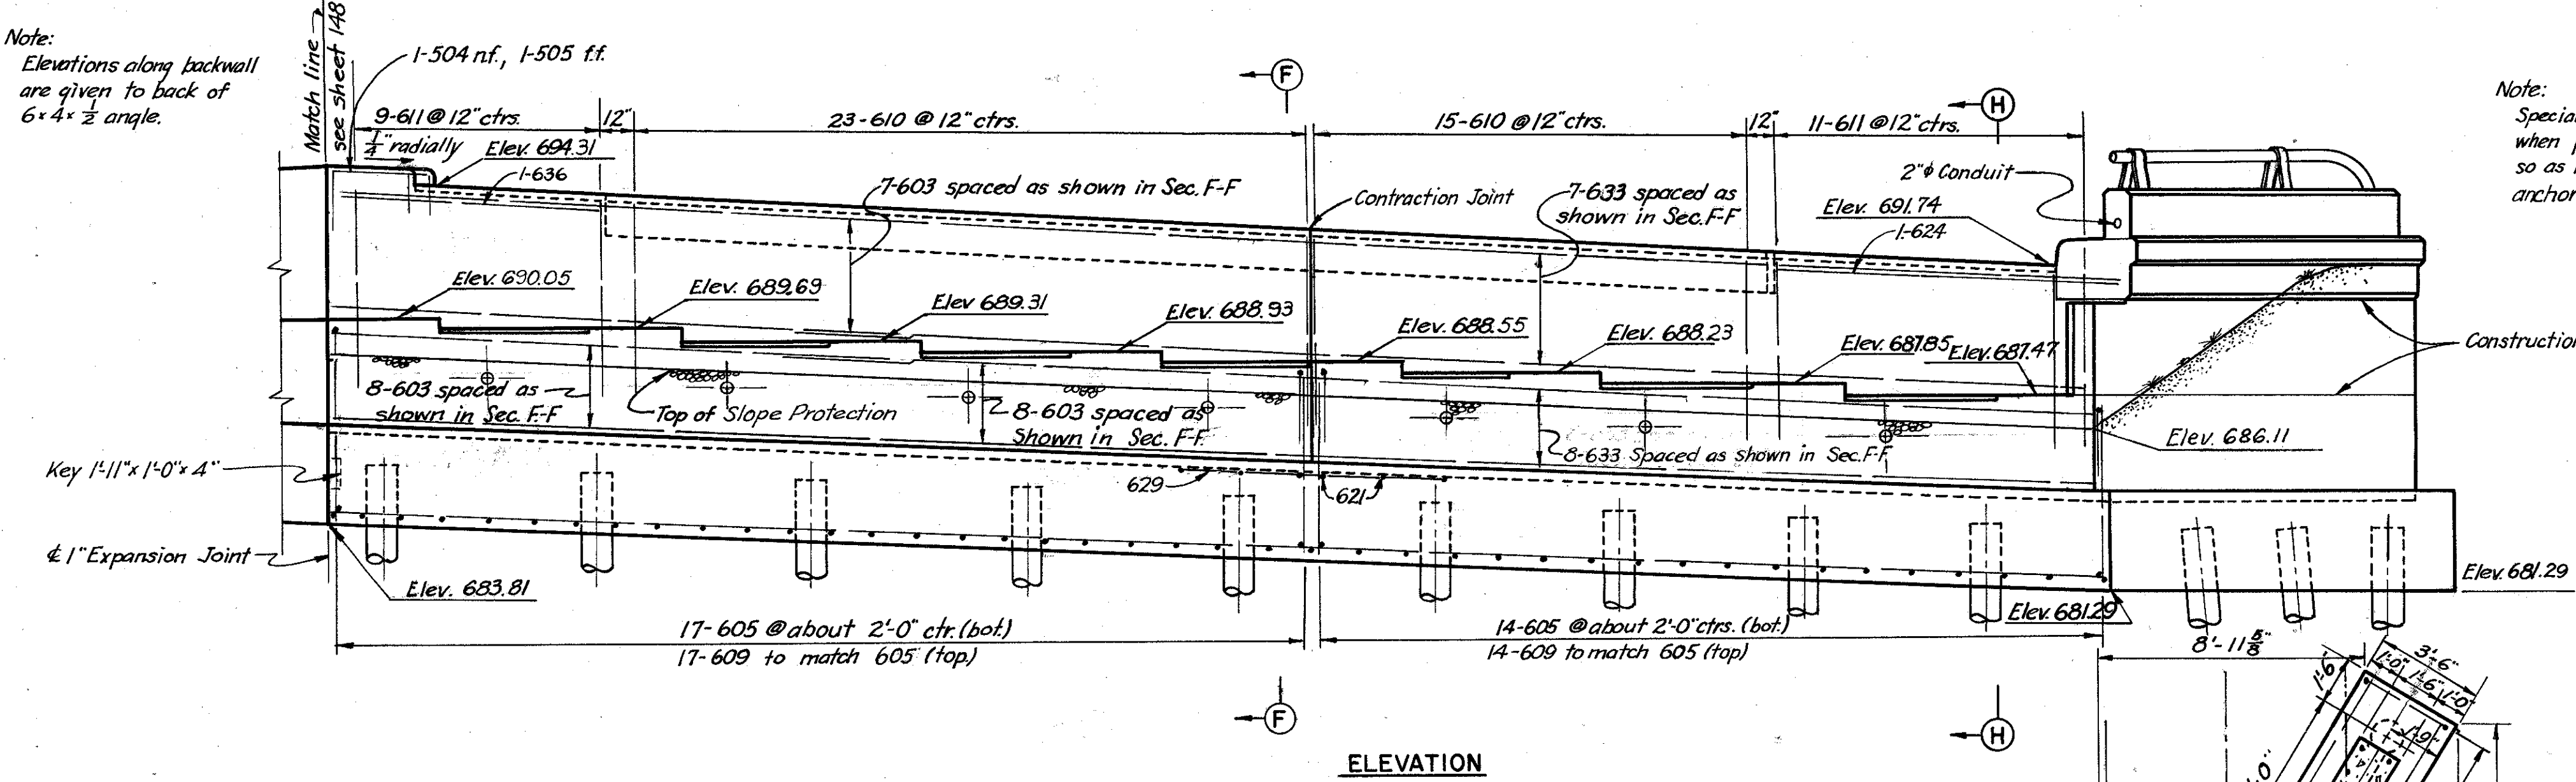

Note:
Elevations along backwall are given to back of 6\"/>

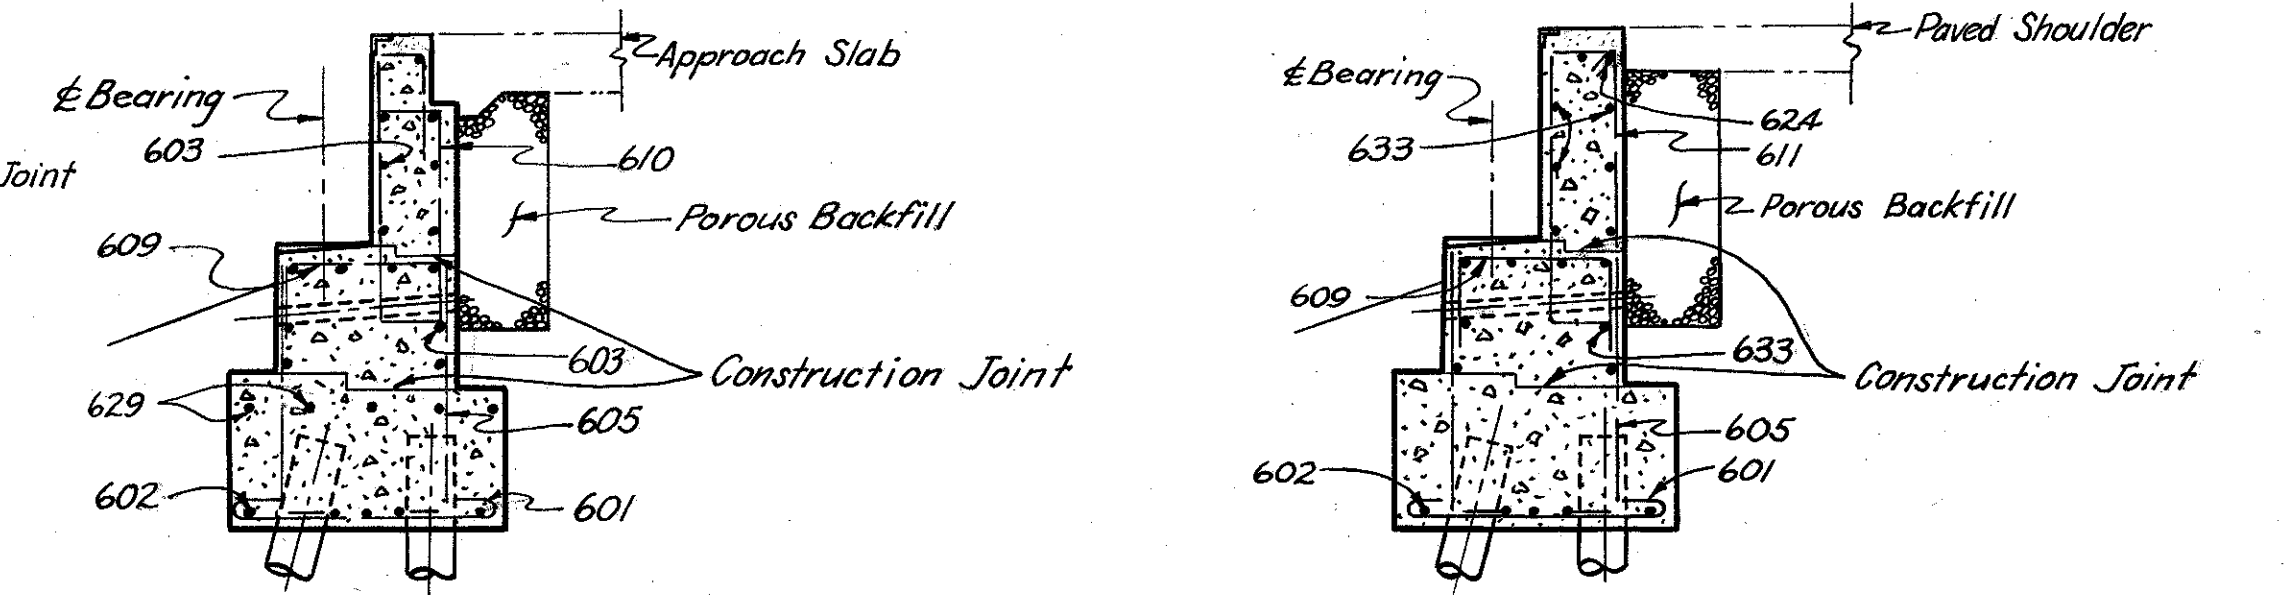

For dimensions and details not shown in view, see section B-B sheet

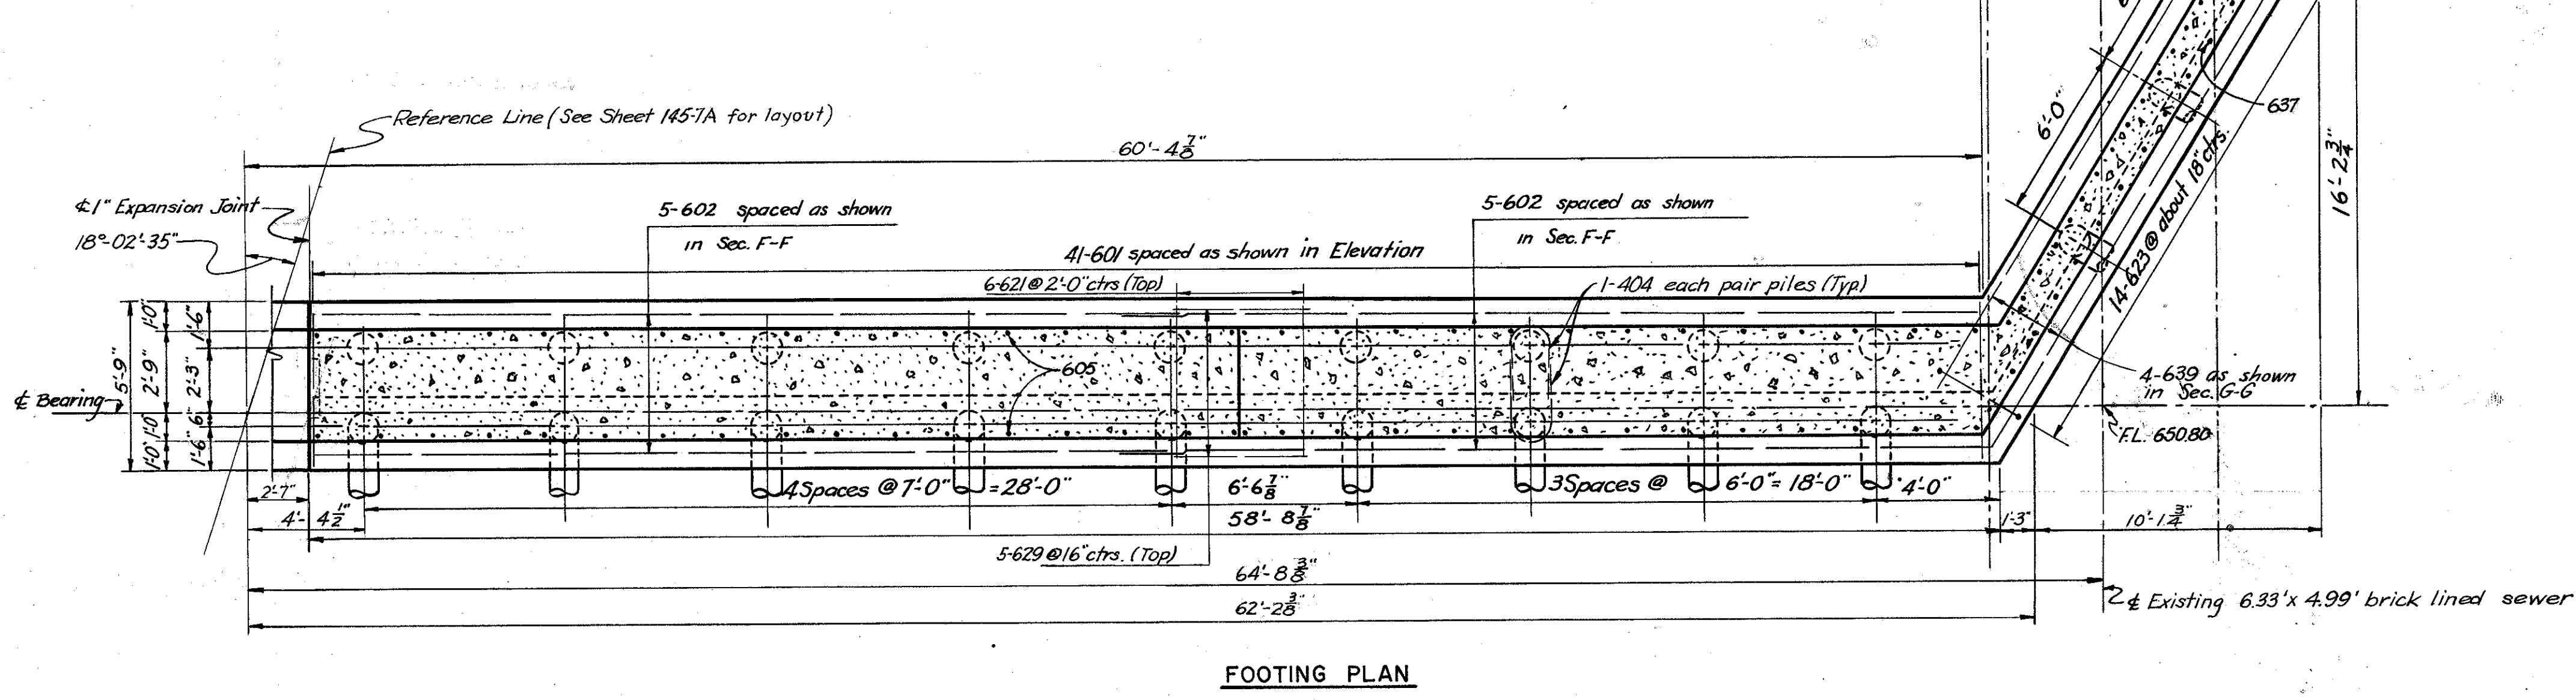

Note: Prefix 'AB' shall be assigned to all bar marks.

For additional notes see sheet 146-7A

H.N.T.B. BR. NO. 8 PART 7A

HOWARD, NEEDLES, TAMMEN & BERGENDOFF
CONSULTING ENGINEERS
KANSAS CITY CLEVELAND NEW YORK

WEST ABUTMENT-NORTH HALF

WILLOW FREEWAY OVER EAST 14th ST.
BR. NO. CUY-21-1573A STA. 49+30.16
Scale: 1/4" = 1'-0" STA. 51+07.08

WILLOW-INNER BELT FREEWAY
CLEVELAND CUYAHOGA COUNTY OHIO

DRAWN BY	TRACED BY	CHECKED BY	REVIEWED BY	REVISED
DATE 7-31-59	DATE 8-20-58	DATE 8-7-59	DATE 11-13-59	





SHEET 149

MICROFILMED
JUL 8 1985

FED. ROADS DIV. NO.	STATE	FED. AID PROJ. NO.
2	OHIO	

150
181



CUYAHOGA COUNTY
CITY OF CLEVELAND
CUY - 21-15.32
CUY - 42-18.42

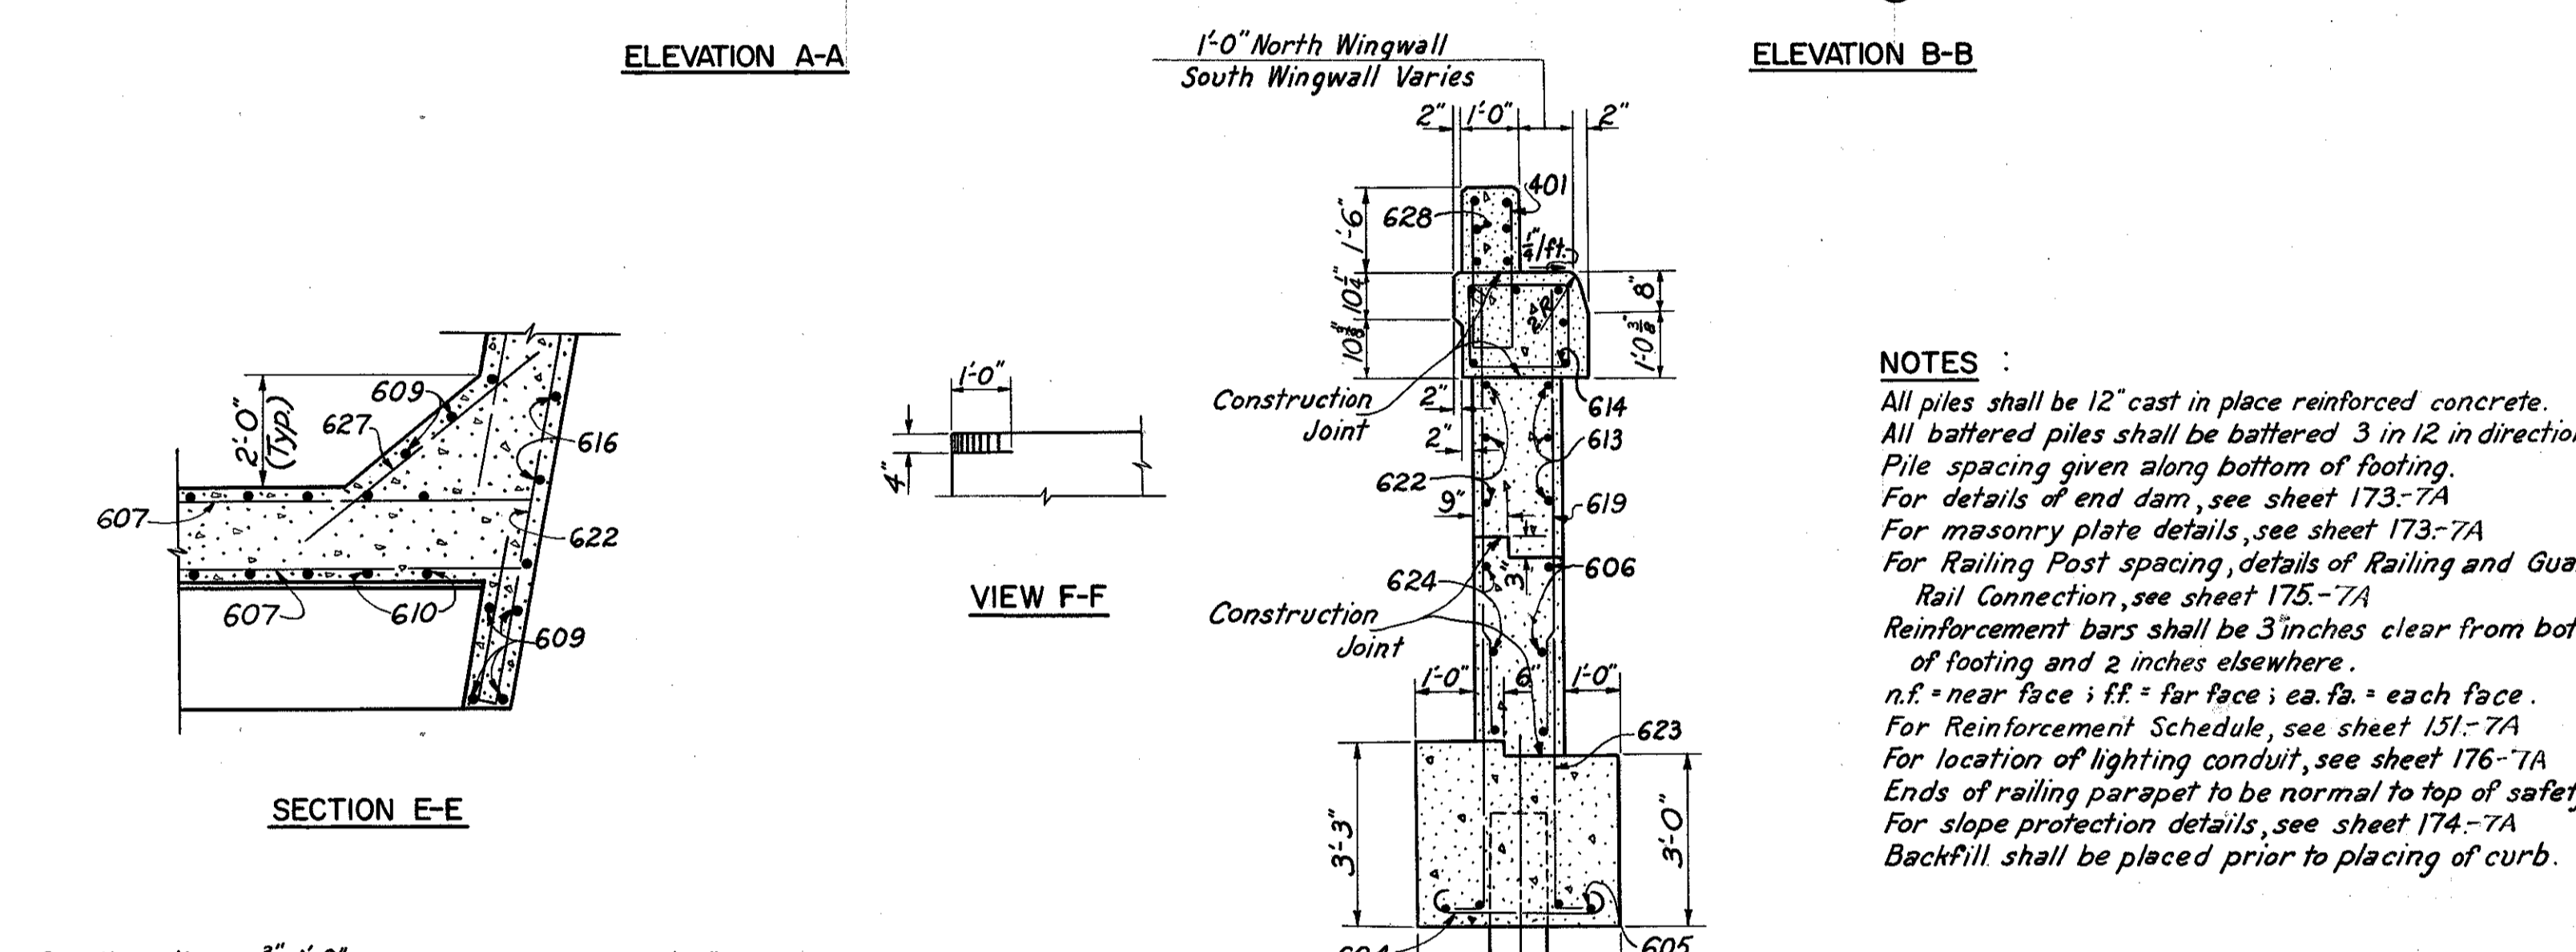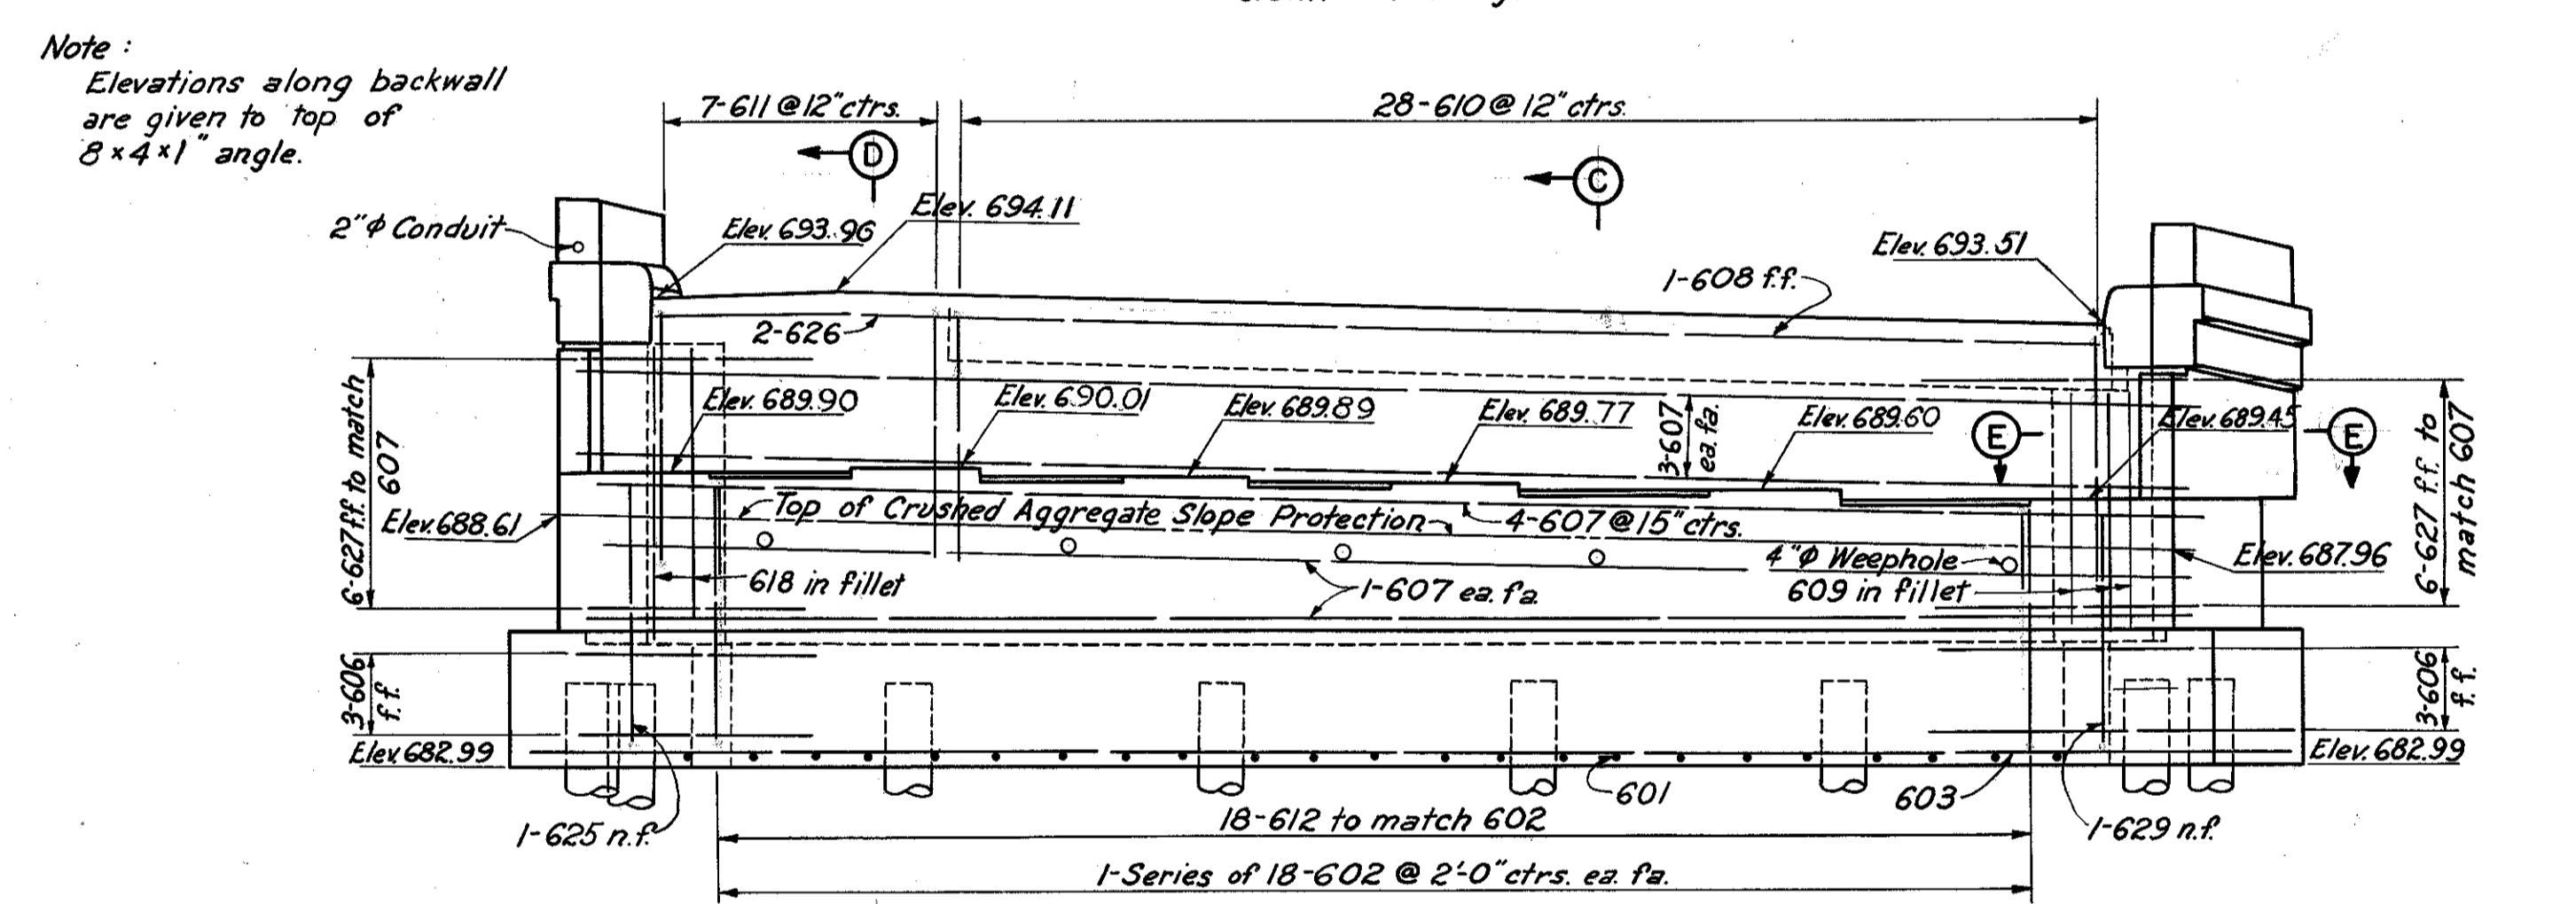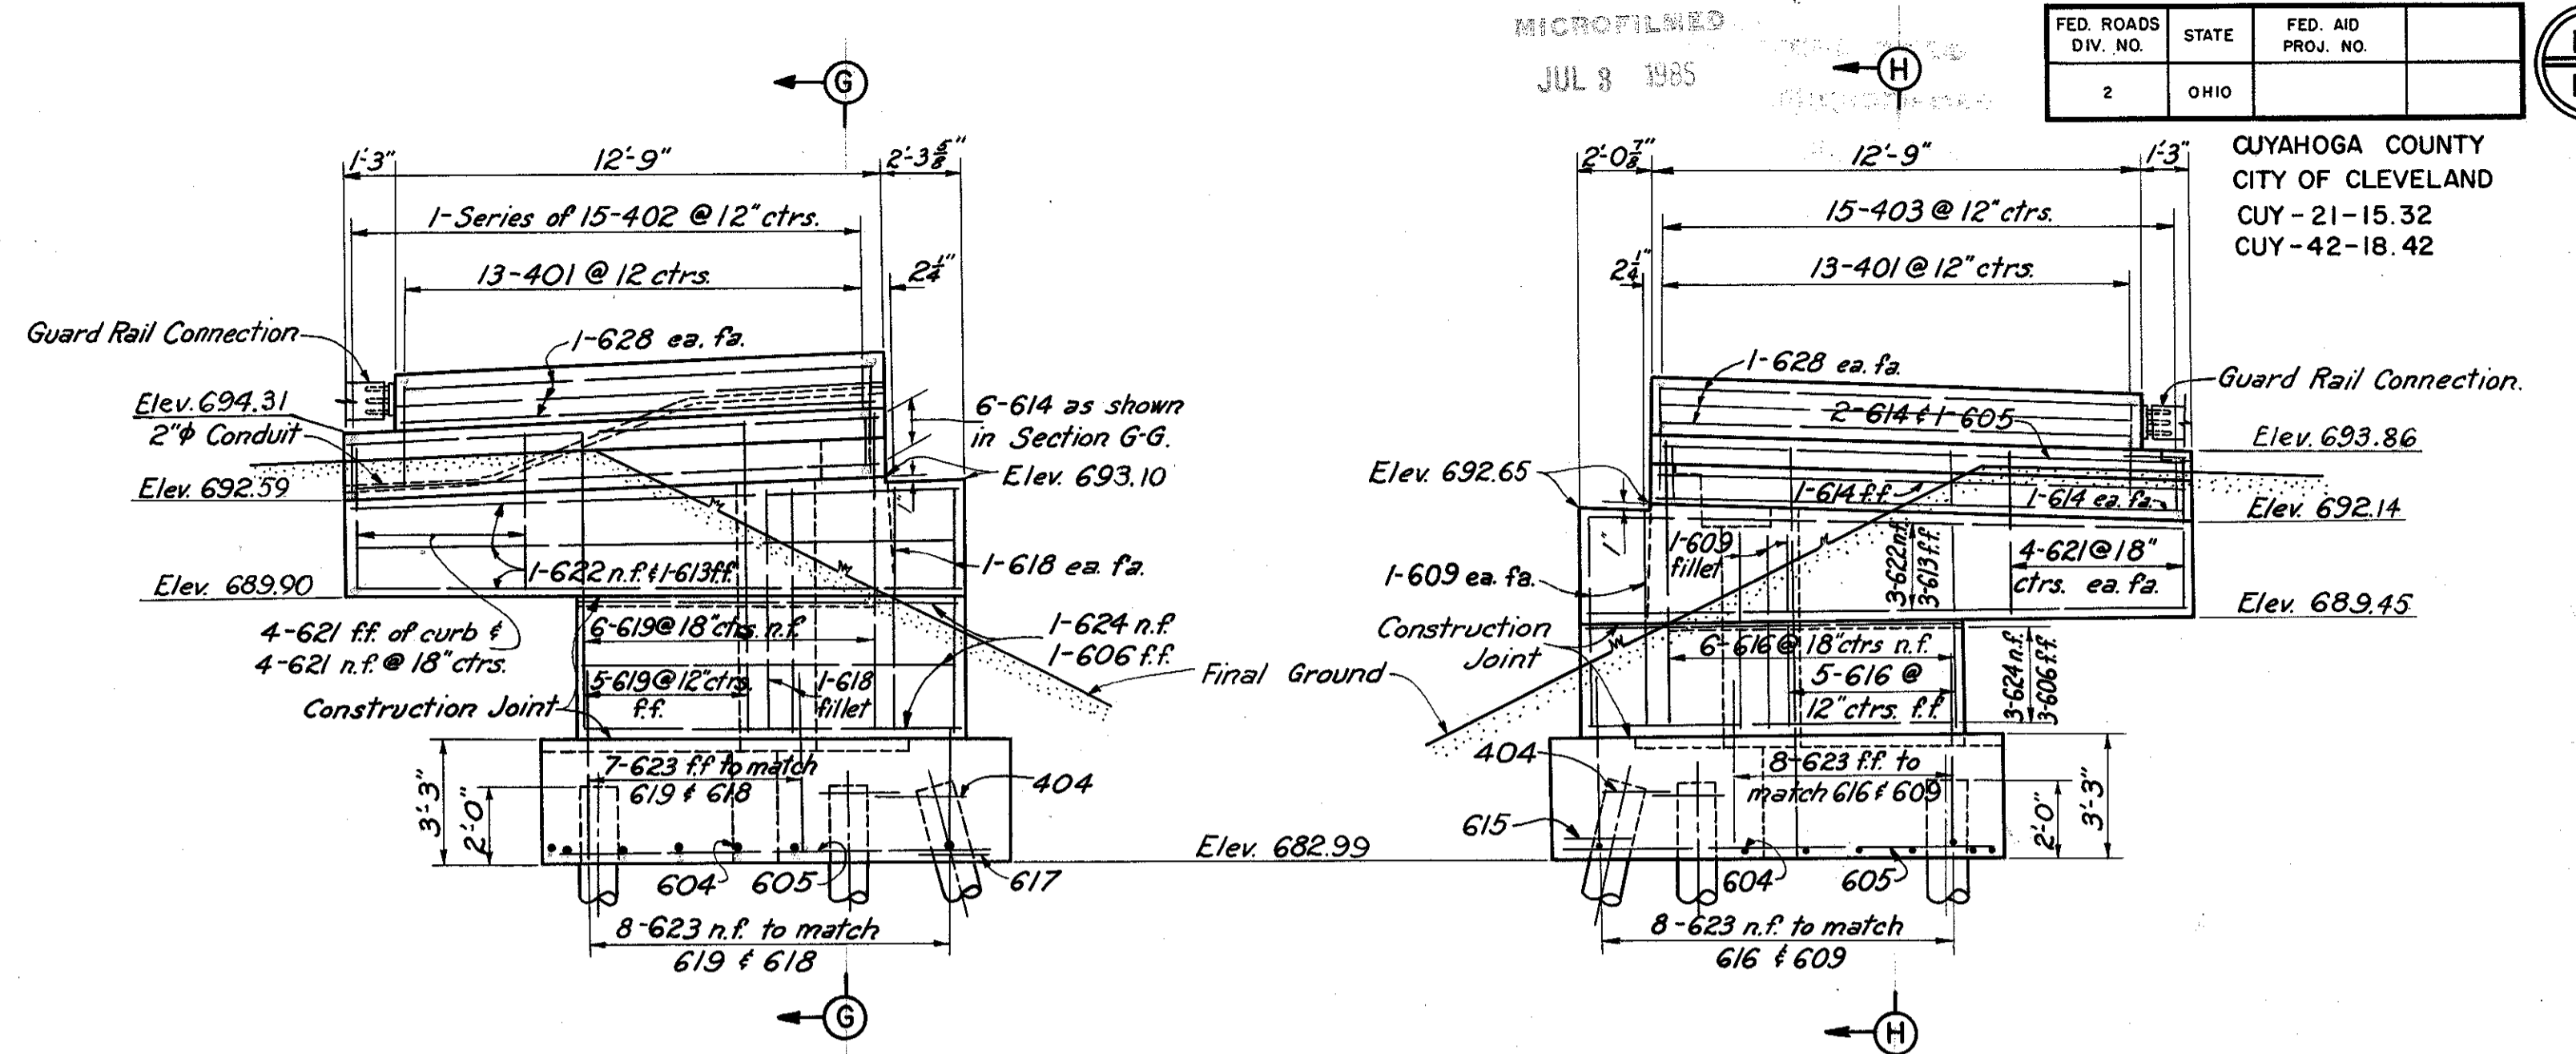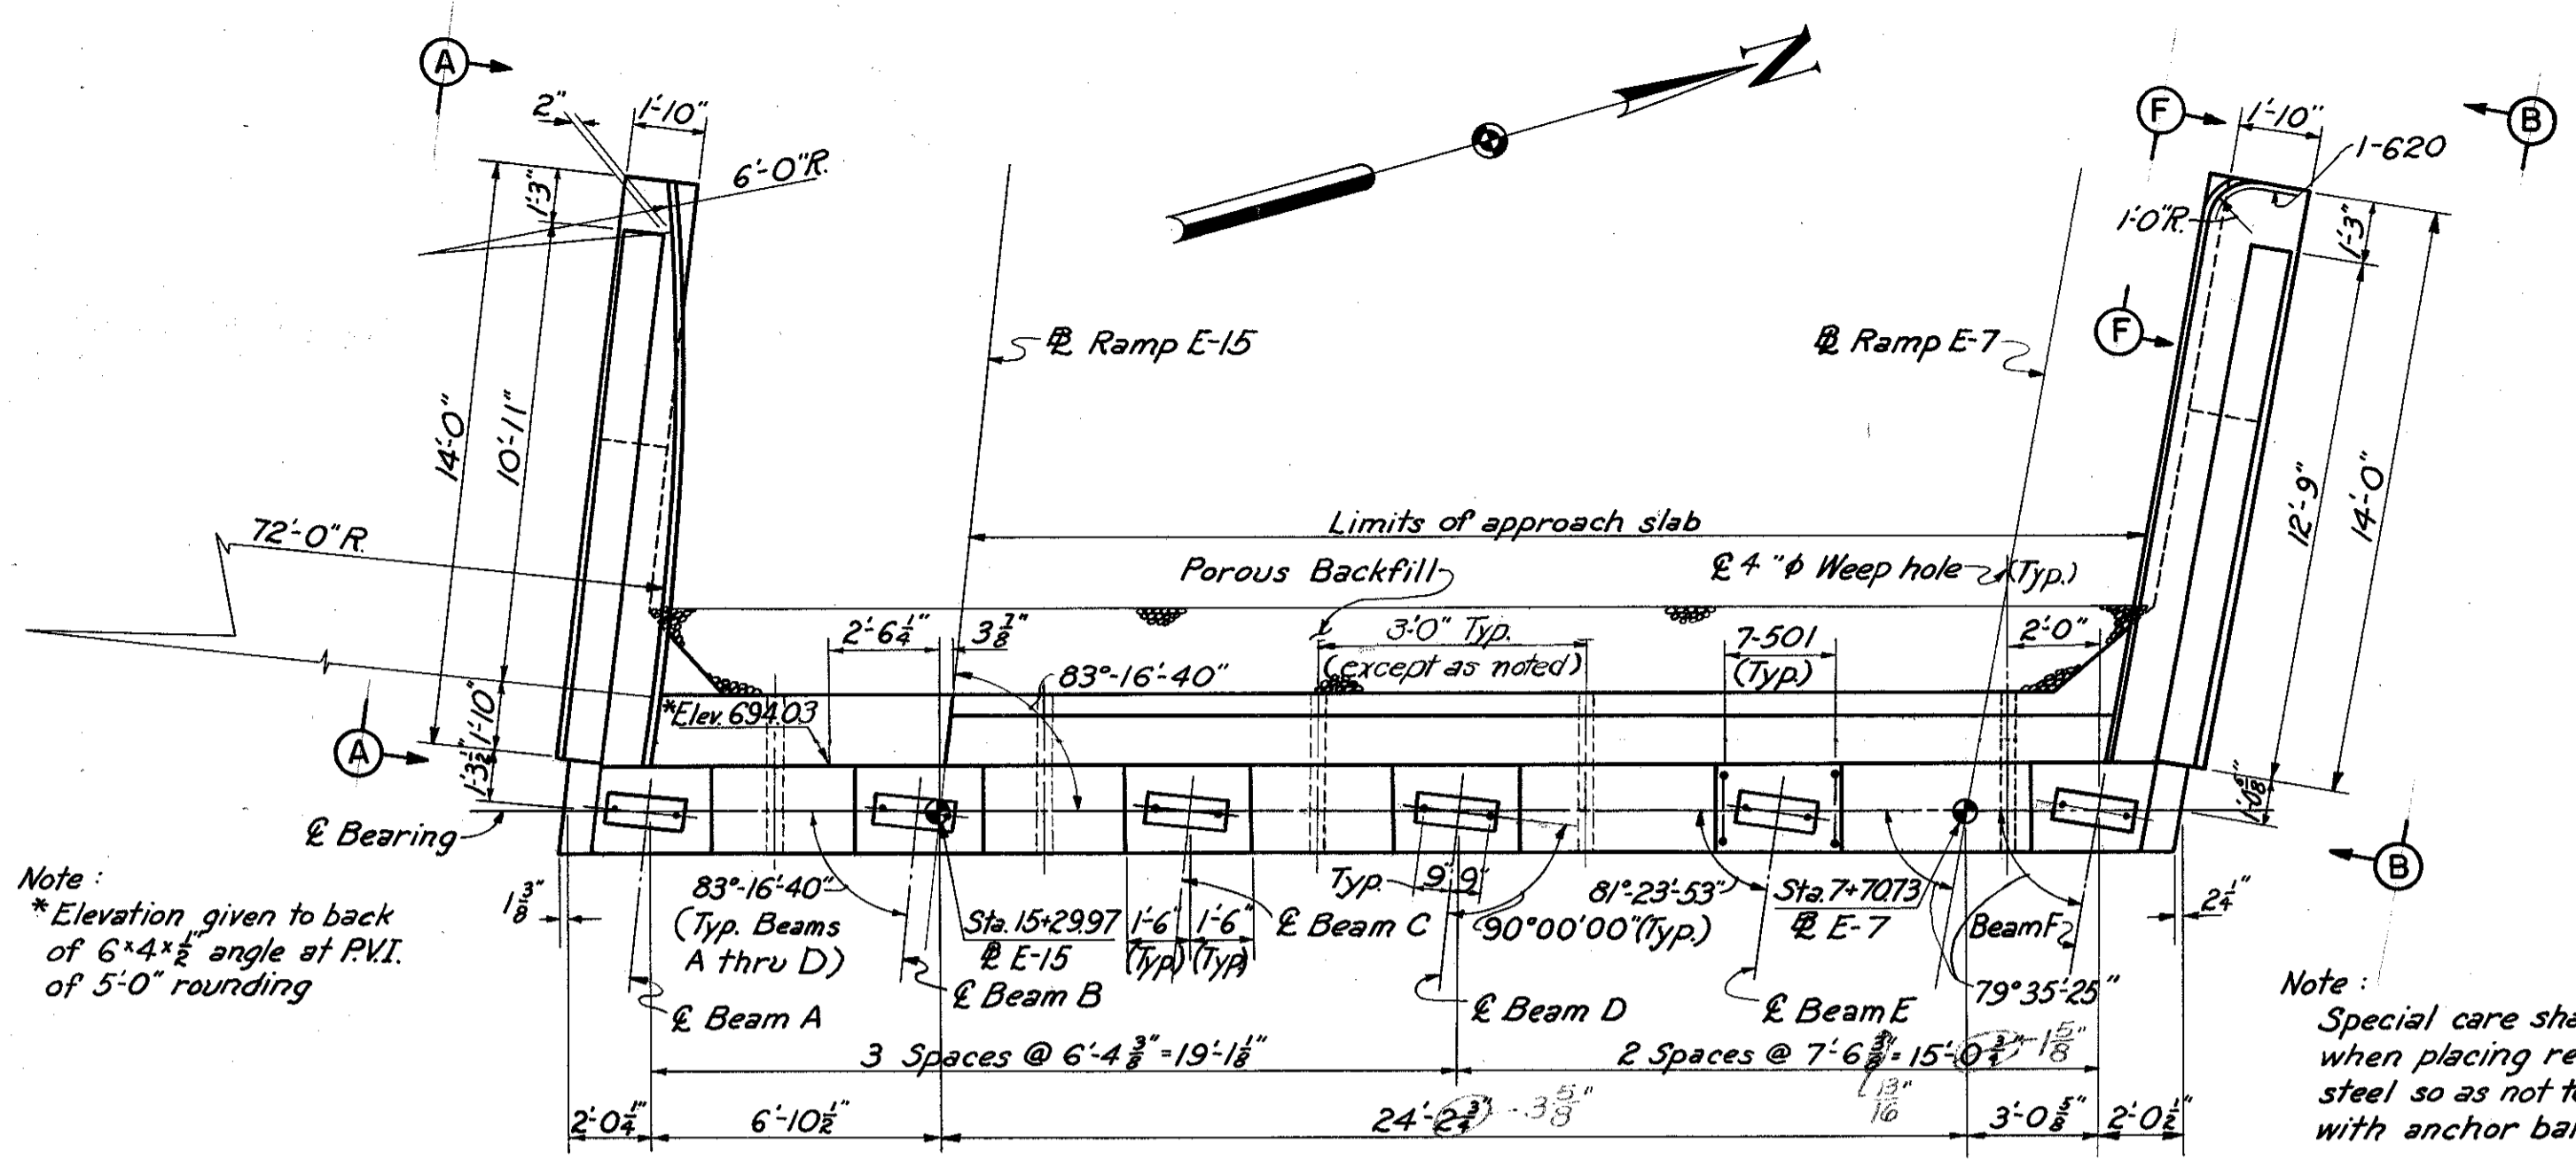

NOTES:

- All piles shall be 12" cast in place reinforced concrete.
- All battered piles shall be battered 3 in 12 in direction shown.
- Pile spacing given along bottom of footing.
- For details of end dam, see sheet 173-7A
- For masonry plate details, see sheet 173-7A
- For Railing Post spacing, details of Railing and Guard Rail Connection, see sheet 175-7A
- Reinforcement bars shall be 3 inches clear from bottom of footing and 2 inches elsewhere.
- n.f. = near face; ff. = far face; ea. fa. = each face.
- For Reinforcement Schedule, see sheet 151-7A
- For location of lighting conduit, see sheet 176-7A
- Ends of railing parapet to be normal to top of safety curb.
- For slope protection details, see sheet 174-7A
- Backfill shall be placed prior to placing of curb.

Note: Prefix "AC" shall be assigned to all bar marks.

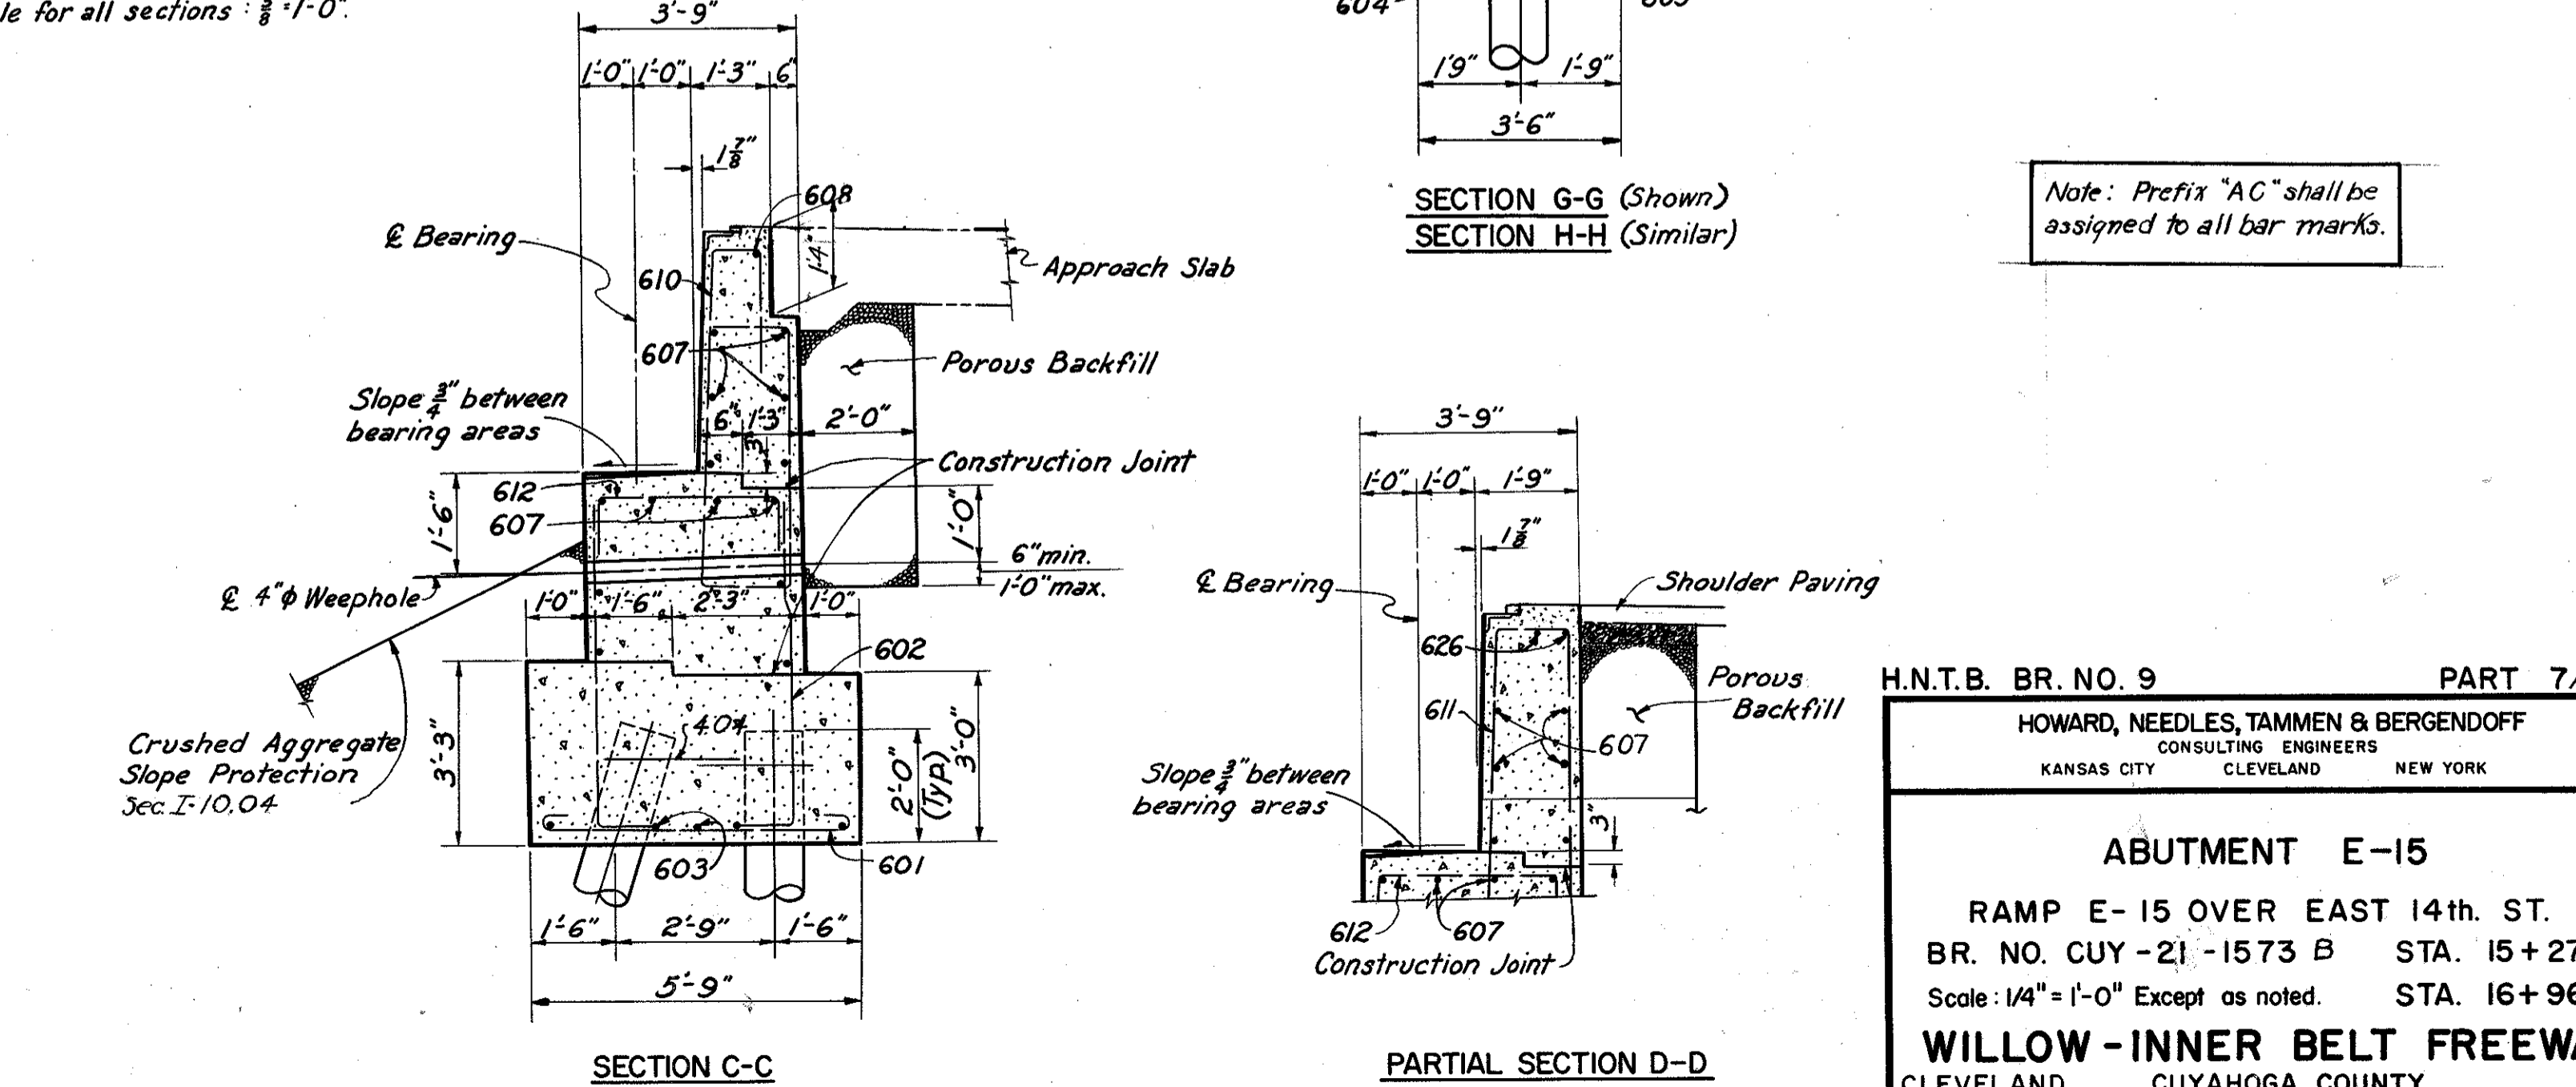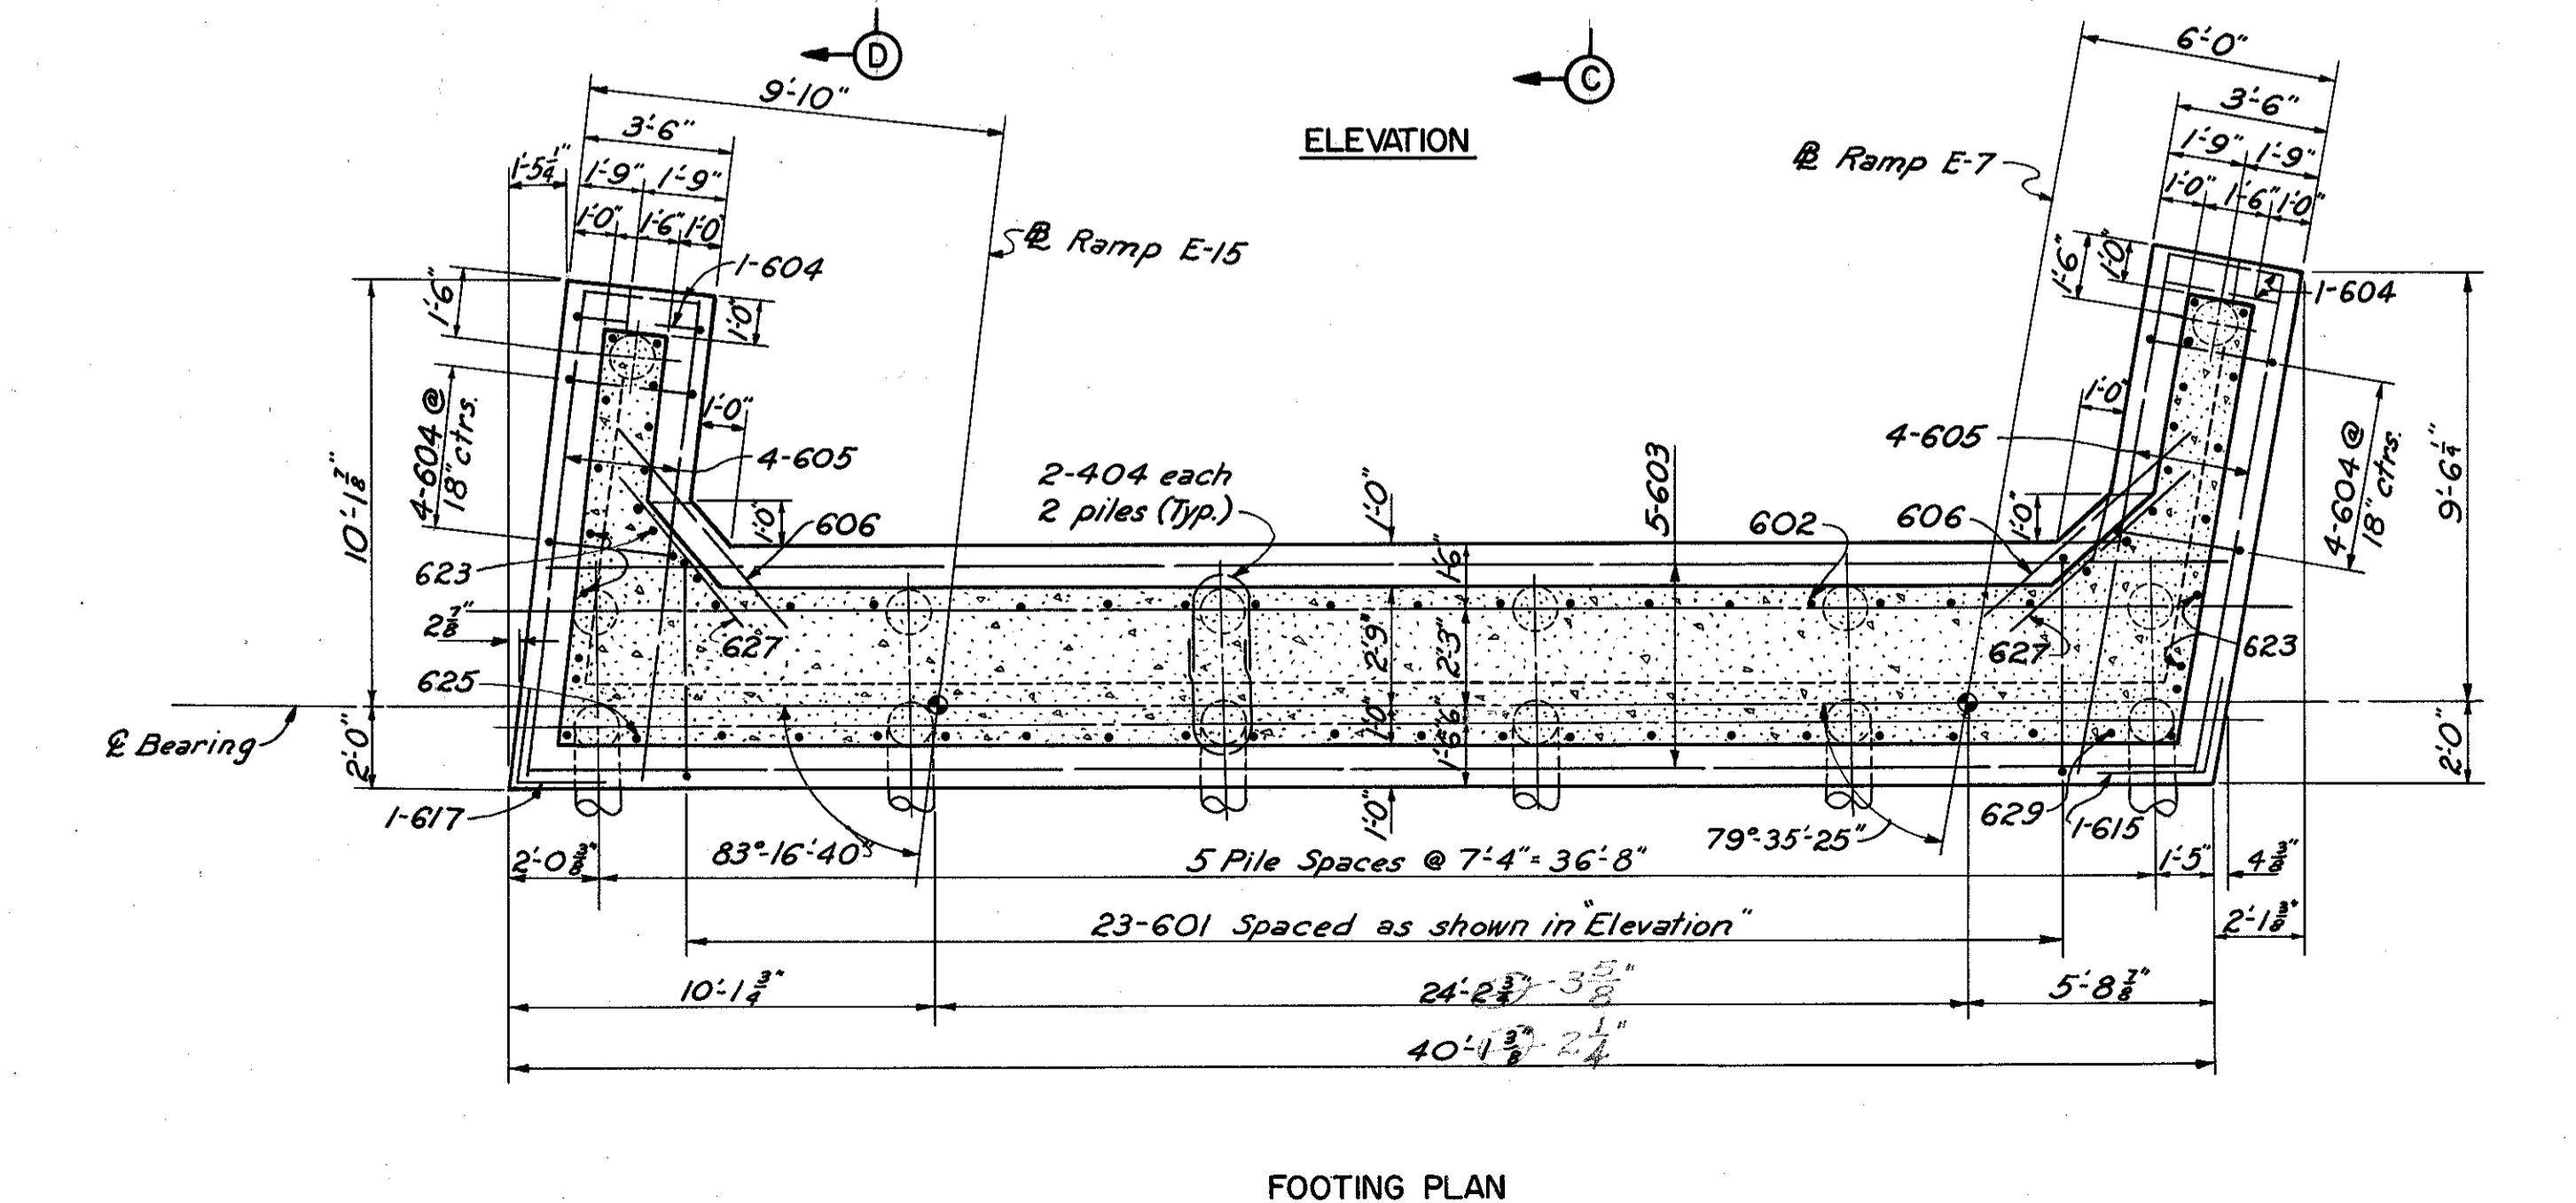

H.N.T.B. BR. NO. 9 PART 7A

HOWARD, NEEDLES, TAMMEN & BERGENDOFF
CONSULTING ENGINEERS
KANSAS CITY CLEVELAND NEW YORK

ABUTMENT E-15
RAMP E-15 OVER EAST 14th. ST.
BR. NO. CUY - 21 - 1573 B STA. 15+27.70
Scale: 1/4" = 1'-0" Except as noted. STA. 16+96.91


WILLOW - INNER BELT FREEWAY
CLEVELAND CUYAHOGA COUNTY OHIO

DRAWN C.C.D.	TRACED R.M.K.	CHECKED C.A.B.	REVIEWED J.C.T.
DATE 3-20-59	DATE 3-25-59	DATE 3-25-59	DATE 4-13-59


REVISED 9-21-60
SHEET 150

JUL 3 1935

CUYAHOGA COUNTY
CITY OF CLEVELAND
CUY-21-15.32
CUY-42-18.42

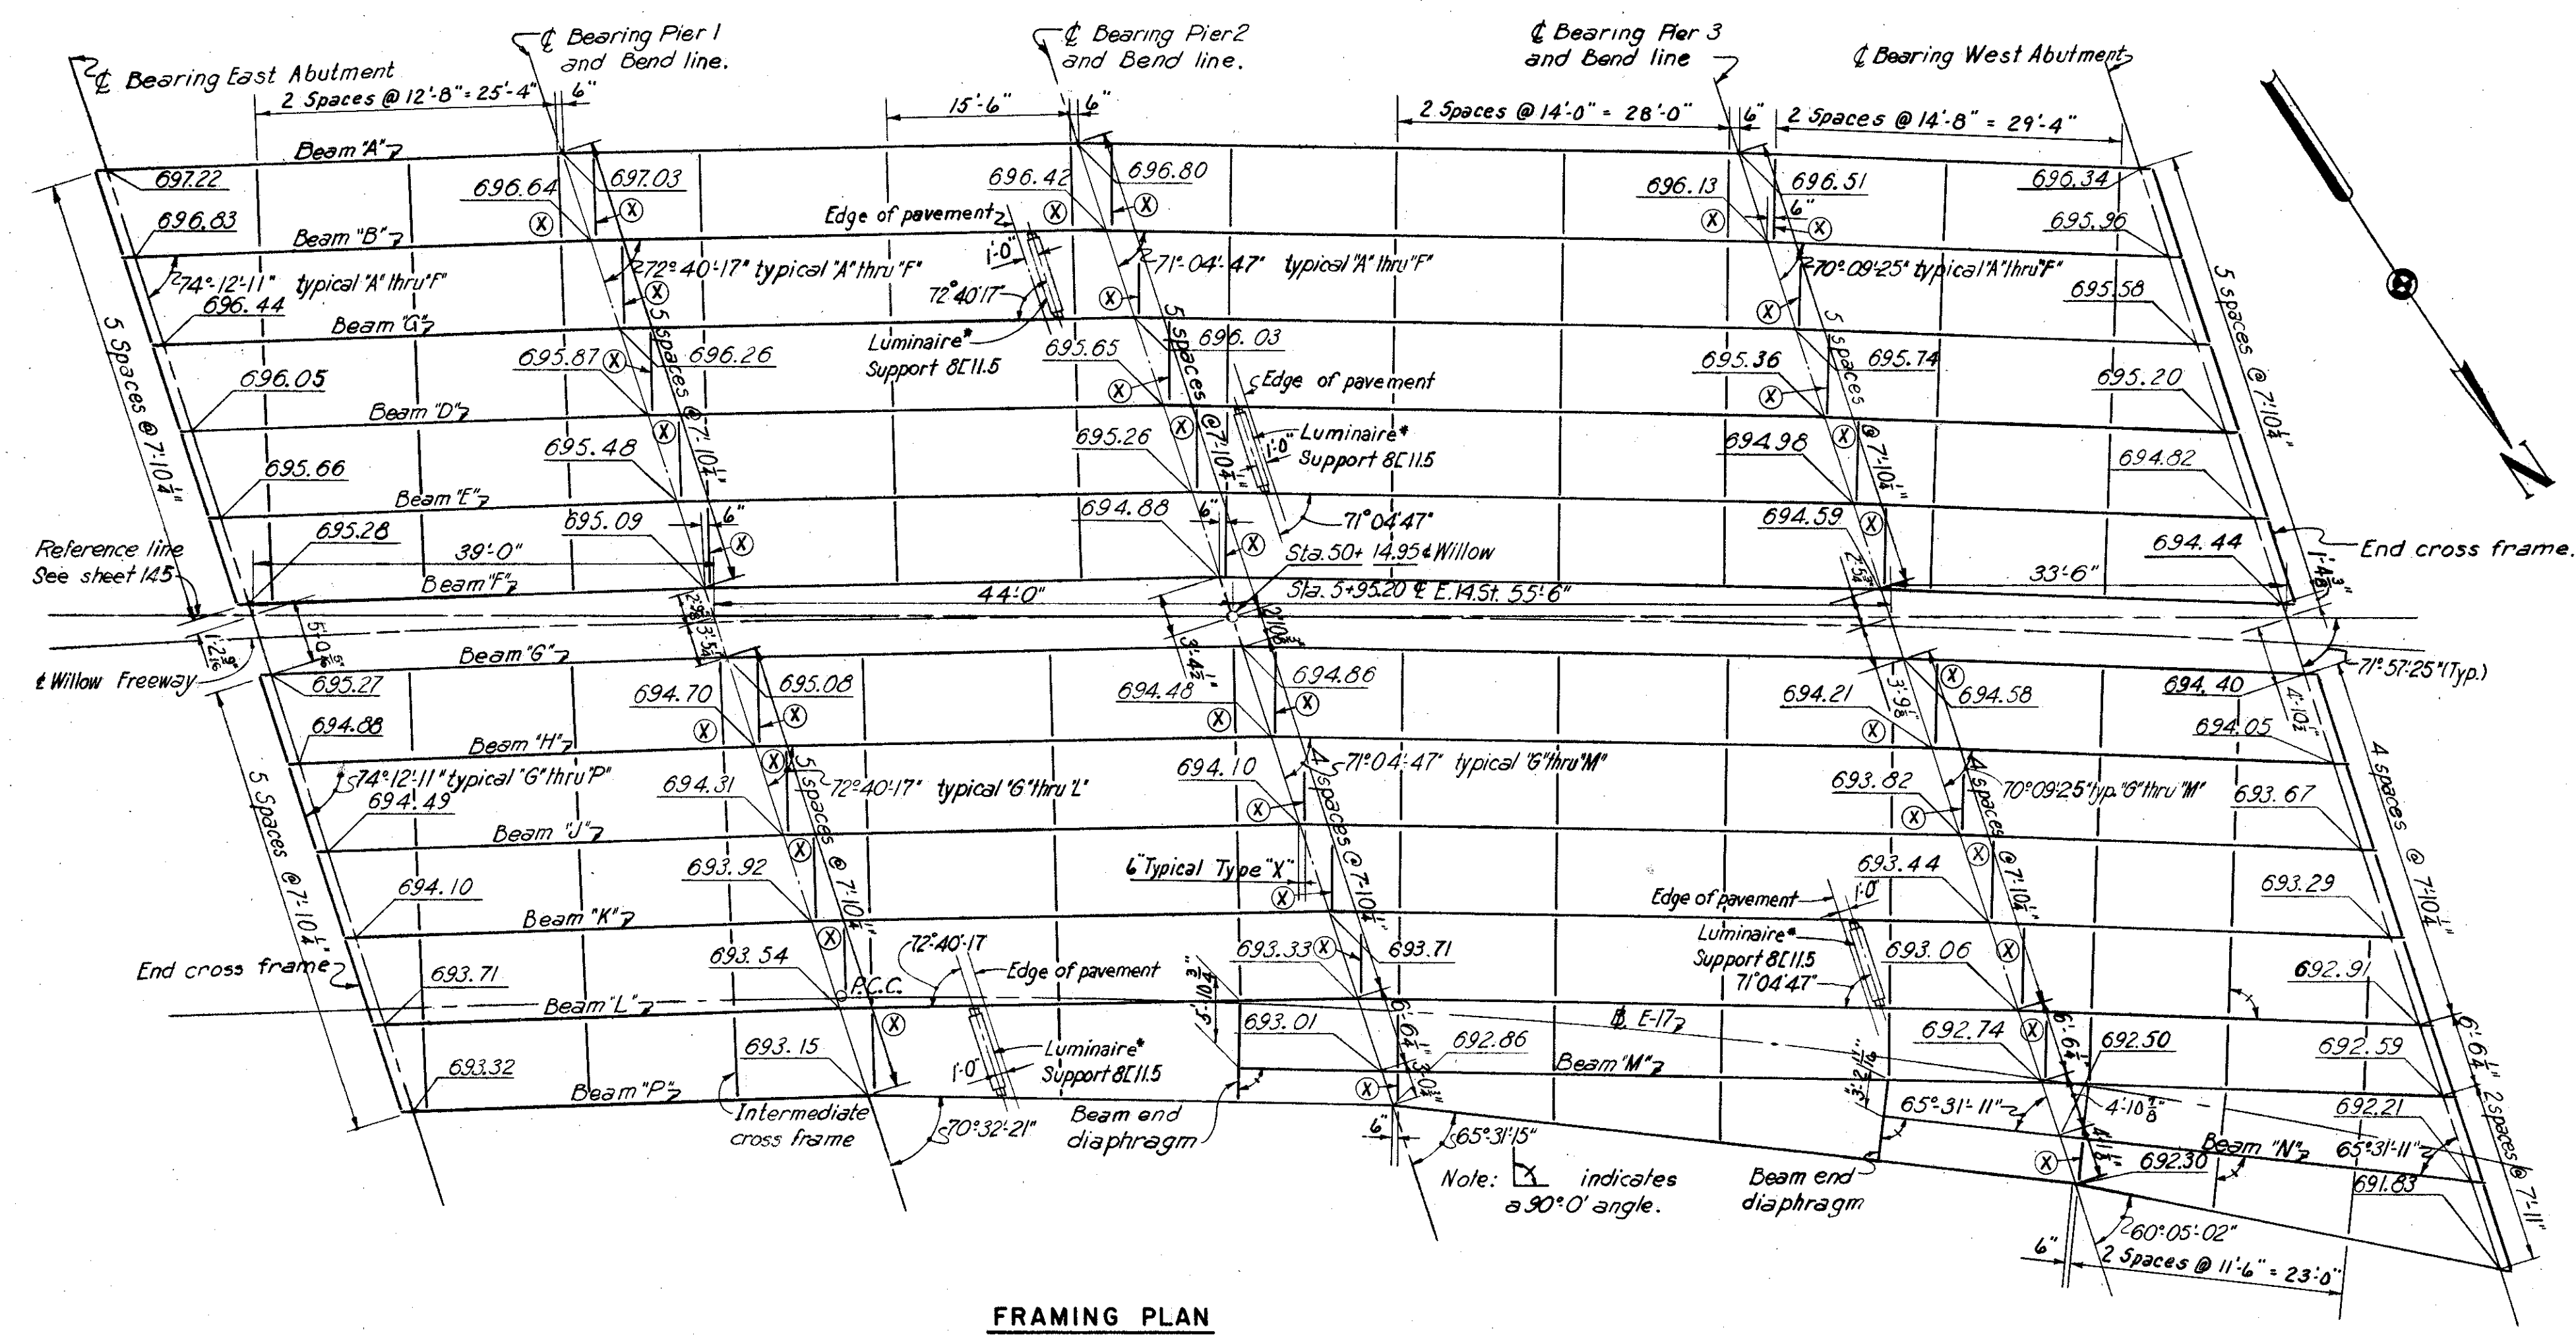

FRAMING PLAN
Scale: 3/8" = 1'-0"

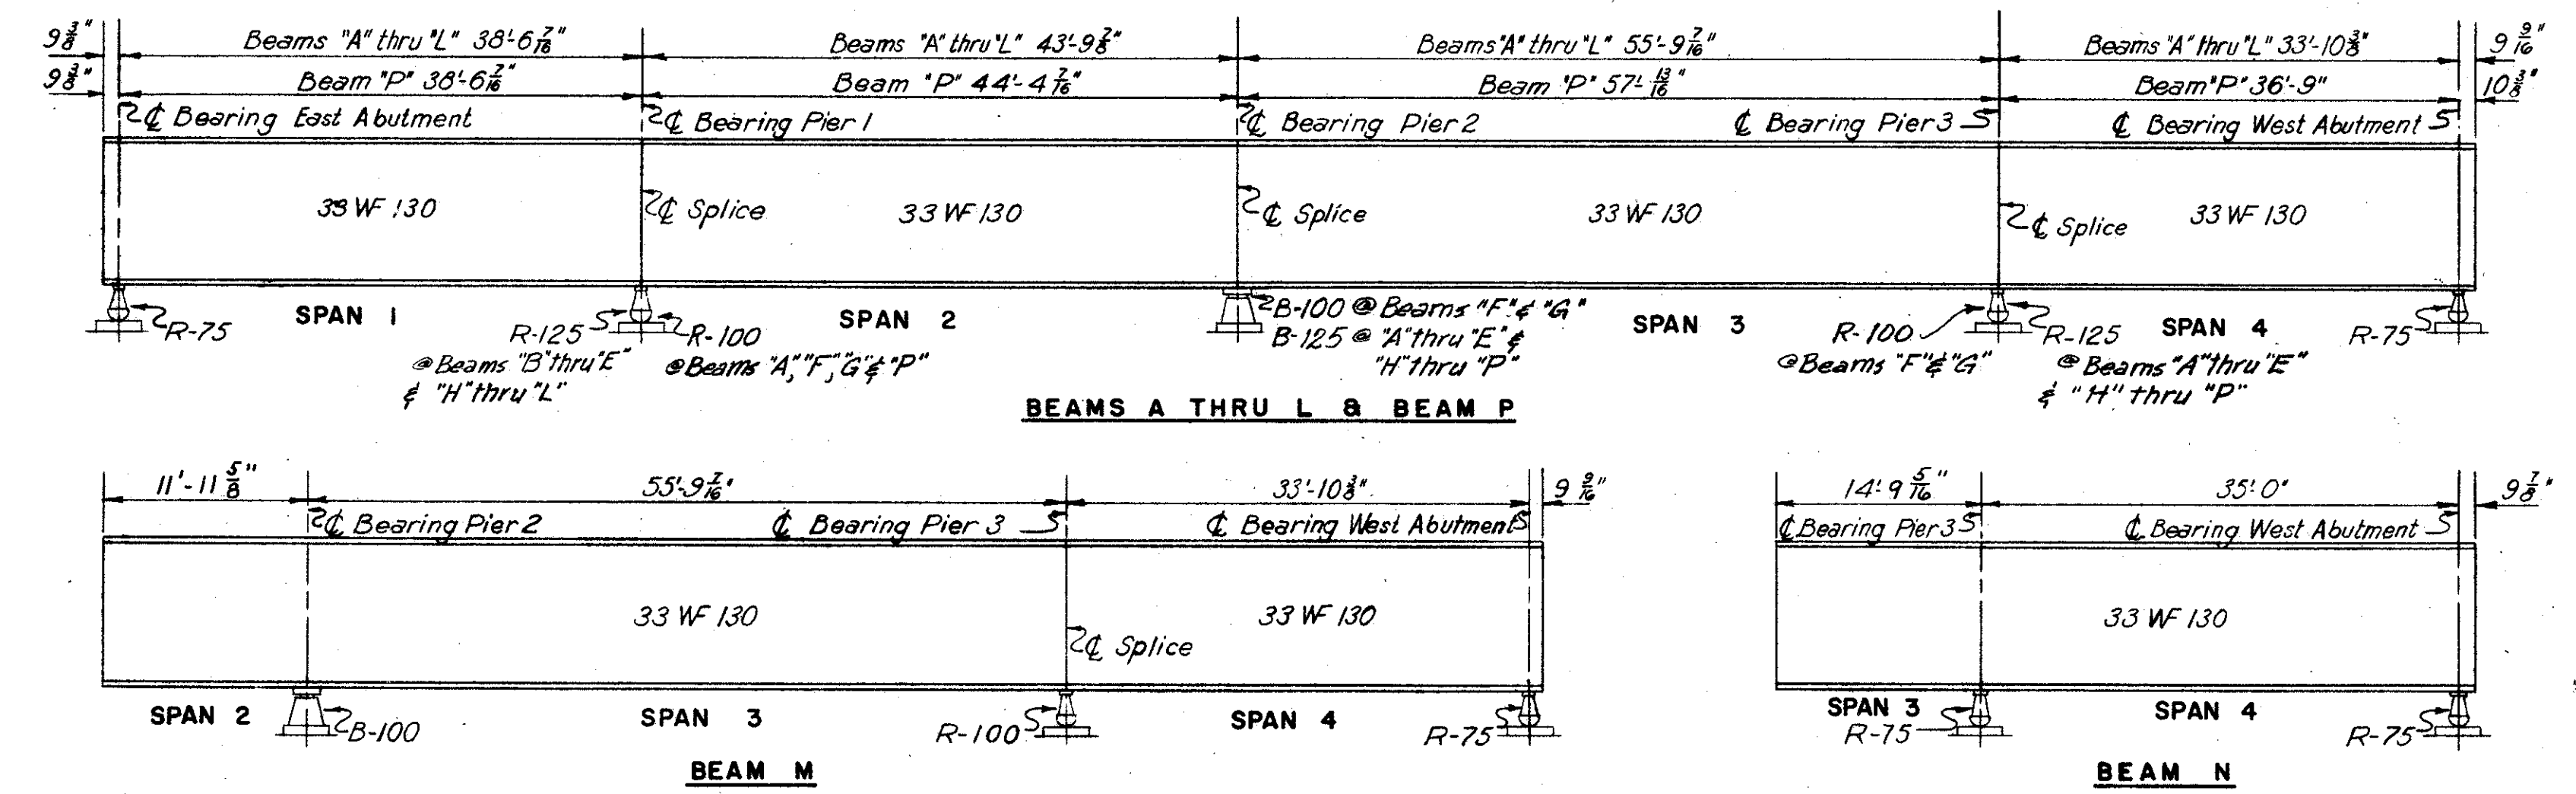


BEAM ELEVATIONS
Scale: 3/8" = 1'-0"

BEAM DEFLECTION DIAGRAMS
No Scale

These diagrams locate points only and do not necessarily show the correct direction of deflections.

BEAM SPLICE WELDING PROCEDURE

1. Raise beams "A" thru "L" 1/2" & beam "P" 3/8" at Pier 1
2. Butt-weld the beam flanges and web at Pier 2, using the following sequence: make two passes on each flange, then two on the web; repeat, using one pass at each location, until welds are completed.
3. Weld Type "X" crossframes into position.
4. Lower the beam ends to final position.
5. Repeat step 2 at Piers 1 and 3 for all beams. No raising of beams at abutments required.

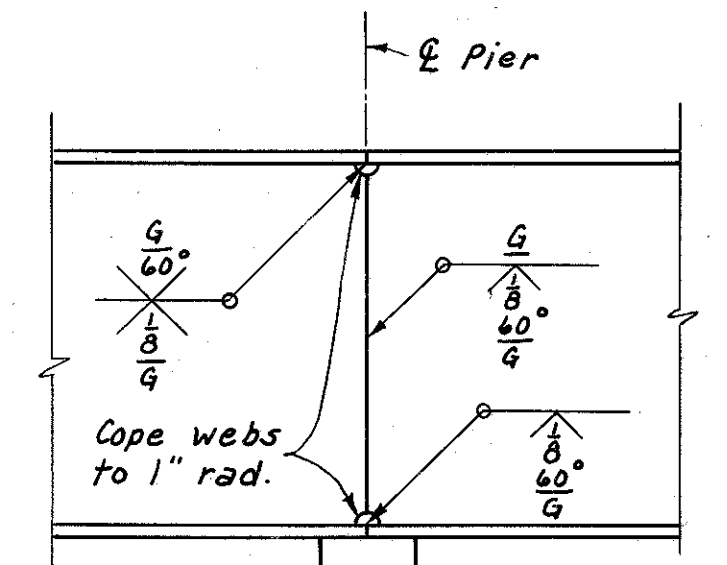

BEAM SPLICE DETAIL
Scale: 3/4" = 1'-0"

BEAM	TOP OF PAVEMENT ELEVATIONS											
	SPAN 1			SPAN 2			SPAN 3			SPAN 4		
	1/4	C	3/4	1/4	C	3/4	1/4	C	3/4	1/4	C	3/4
A	697.17	697.12	697.07	696.97	696.91	696.86	696.72	696.65	696.58	696.46	696.42	696.38
B	696.78	696.73	696.69	696.58	696.52	696.47	696.34	696.26	696.19	696.08	696.04	696.00
C	696.39	696.34	696.30	696.20	696.14	696.08	695.95	695.88	695.81	695.70	695.66	695.62
D	696.00	695.96	695.91	695.81	695.75	695.70	695.57	695.49	695.42	695.32	695.28	695.24
E	695.61	695.57	695.52	695.42	695.36	695.31	695.18	695.11	695.04	694.93	694.89	694.85
F	695.23	695.18	695.14	695.03	694.98	694.92	694.80	694.73	694.66	694.55	694.51	694.47
G	695.22	695.17	695.12	695.02	694.96	694.91	694.79	694.72	694.65	694.53	694.49	694.4
H	694.83	694.78	694.74	694.61	694.56	694.54	694.41	694.34	694.27	694.16	694.12	694.09
J	694.44	694.40	694.35	694.25	694.20	694.15	694.02	693.95	693.88	693.78	693.74	693.70
K	694.05	694.00	693.96	693.87	693.81	693.76	693.64	693.57	693.50	693.40	693.36	693.32
L	693.66	693.62	693.58	693.48	693.42	693.38	693.25	693.18	693.12	693.02	692.98	692.94
M							*693.09	692.93	692.86	692.80	692.70	692.66
N									*692.64	692.43	692.35	692.28
P	693.28	693.23	693.19	693.07	693.00	692.92	692.71	692.57	692.43	692.18	692.06	691.94

* Denotes end of beam




BEAM	DEAD LOAD DEFLECTION TABLE											
	SPAN 1			SPAN 2			SPAN 3			SPAN 4		
	1/4	C	3/4	1/4	C	3/4	1/4	C	3/4	1/4	C	3/4
A	1/16	3/16	5/16	1/16	3/16	5/16	0	0	0	0	0	0
B	1/16	3/16	5/16	1/16	3/16	5/16	0	0	0	0	0	0
C	1/16	3/16	5/16	1/16	3/16	5/16	0	0	0	0	0	0
D	1/16	3/16	5/16	1/16	3/16	5/16	0	0	0	0	0	0
E	1/16	3/16	5/16	1/16	3/16	5/16	0	0	0	0	0	0
F	1/16	3/16	5/16	1/16	3/16	5/16	0	0	0	0	0	0
G	1/16	3/16	5/16	1/16	3/16	5/16	0	0	0	0	0	0
H	1/16	3/16	5/16	1/16	3/16	5/16	0	0	0	0	0	0
J	1/16	3/16	5/16	1/16	3/16	5/16	0	0	0	0	0	0
K	1/16	3/16	5/16	1/16	3/16	5/16	0	0	0	0	0	0
L	1/16	3/16	5/16	1/16	3/16	5/16	0	0	0	0	0	0
M							*0	0	1/16	3/16	5/16	0
N									1/16	3/16	5/16	0
P	1/16	3/16	5/16	1/16	3/16	5/16	0	0	0	0	0	0

NOTES:
In Dead Load Deflection Table, CON = Dead load deflection due to concrete.
TOT = Total dead load deflection
On Framing Plan, Elevations shown are to top of pavement, 0.81' above top of beams.
Deflections are given at the quarter points and are measured to the nearest tenth for details of rocker masonry plates see sheet 173-7A.
For other rocker details and details of bolsters see Ohio Standards, Sheet RB-1-55.
For details of end dams see sheet 173-7A
* For under deck lighting details see sheet 176-7A & 177-7A
The W beams shall not be cambered but shall be fabricated so that any curved beam will be placed with the convex flange up.
For cross frame details see sheet 154-7A

H.N.T.B. BR. NO. 8 PART 7A
HOWARD, NEEDLES, TAMMEN & BERGENOFF
CONSULTING ENGINEERS
KANSAS CITY CLEVELAND NEW YORK
FRAMING PLAN
WILLOW FREEWAY OVER EAST 14th ST.
BR. NO. CUY-21-1573 A STA. 49+30.16
Scale: As noted STA. 51+07.08
WILLOW-INNER BELT FREEWAY
CLEVELAND CUYAHOGA COUNTY OHIO
DRAWN N/N TRACED CHECKED J.A. REWISD J.C.T.
DATE 7-1-38 DATE 7-28-38 DATE 11-13-39 SHEET 152



JUL 3 1935

CUYAHOGA COUNTY
CITY OF CLEVELAND
CUY-21-15.32
CUY-42-18.42

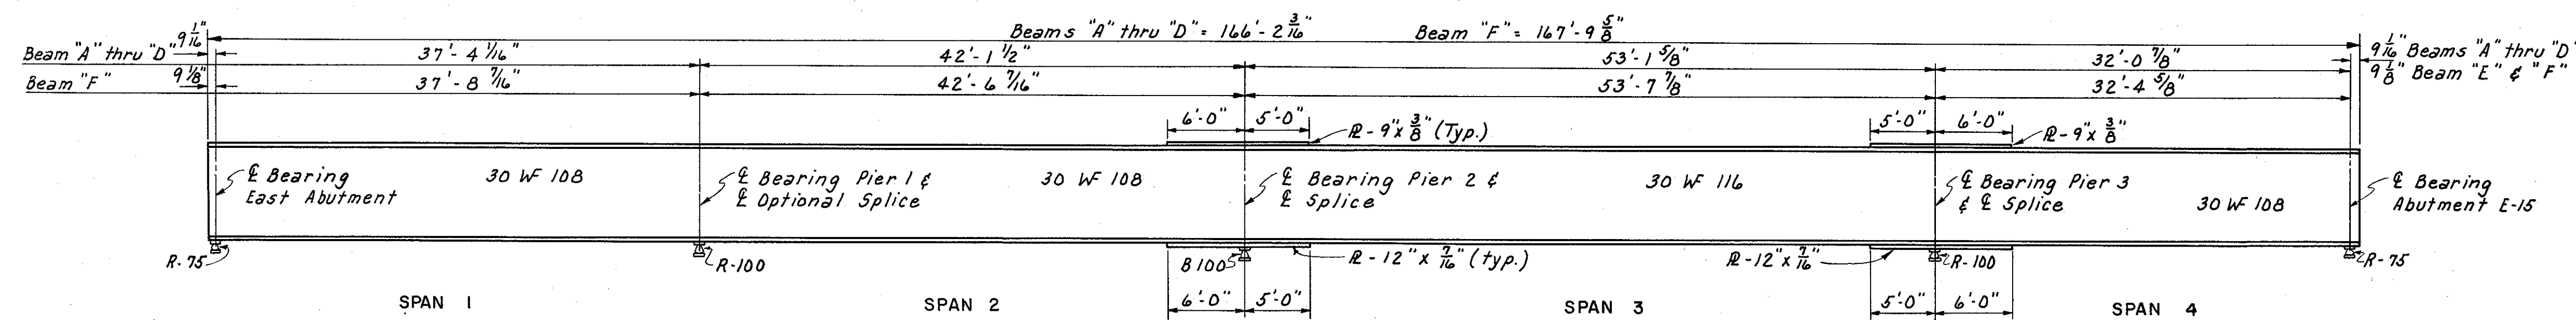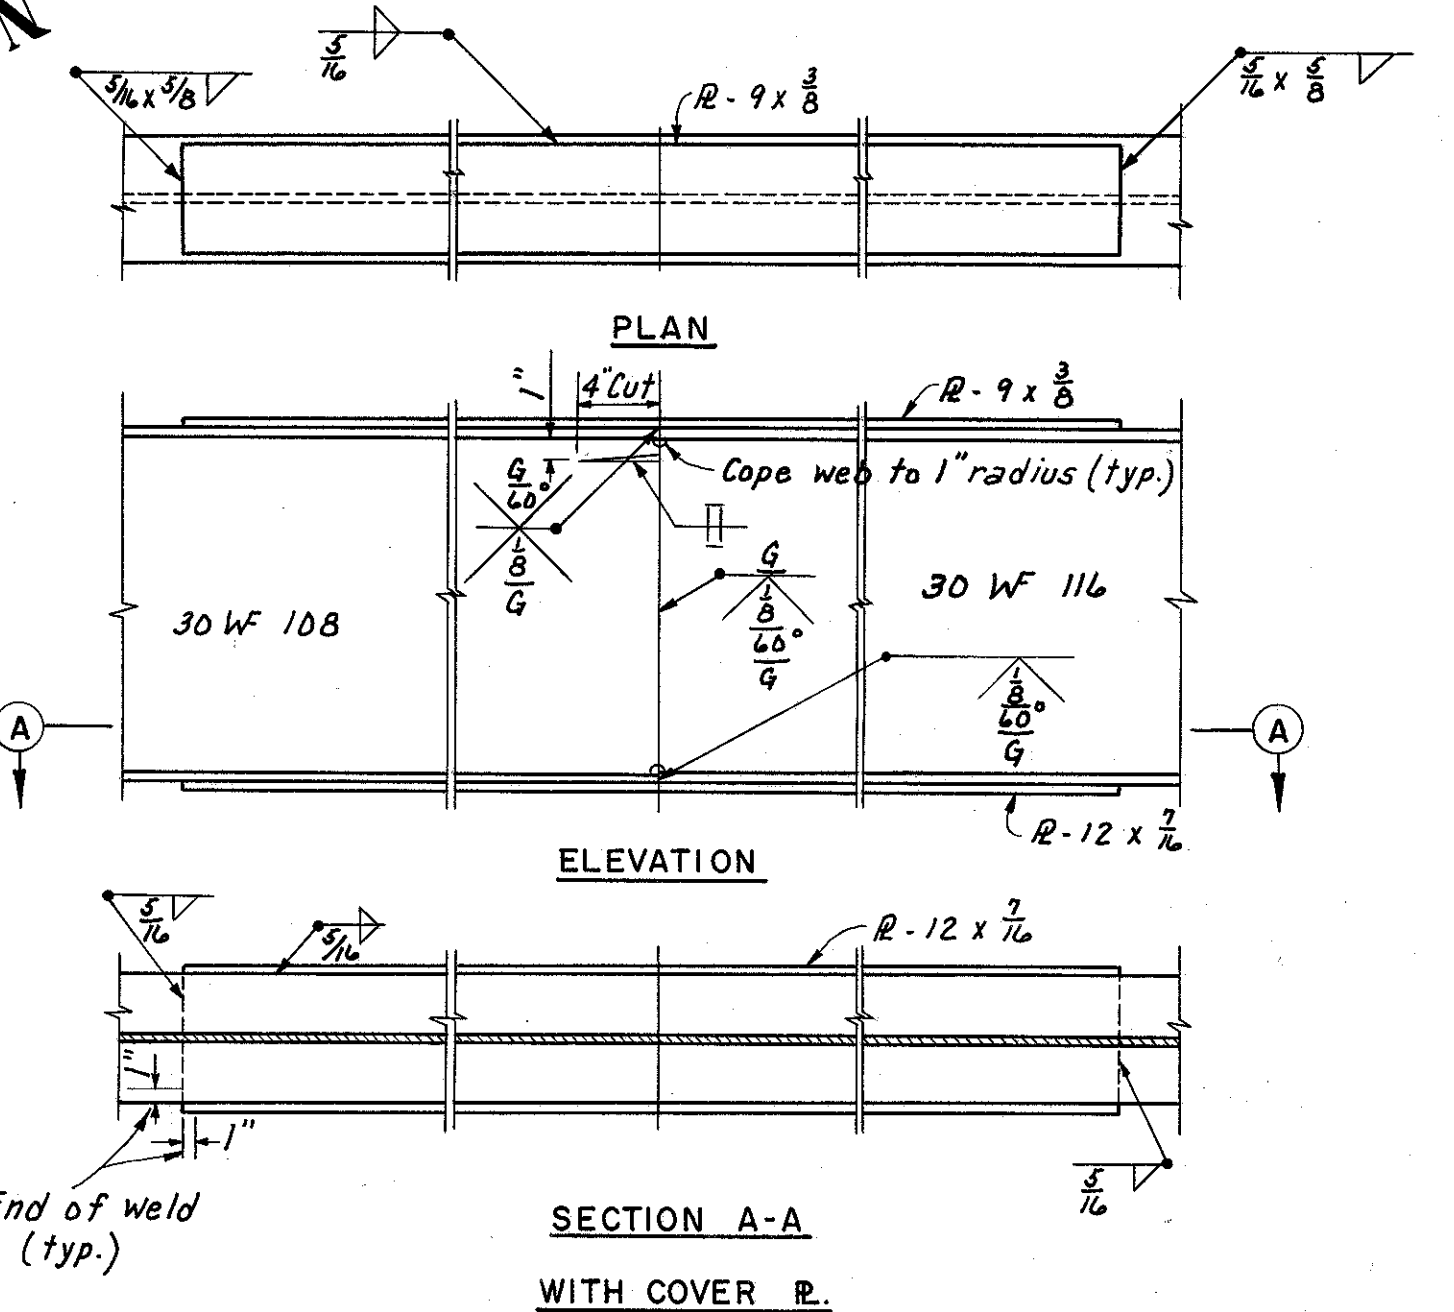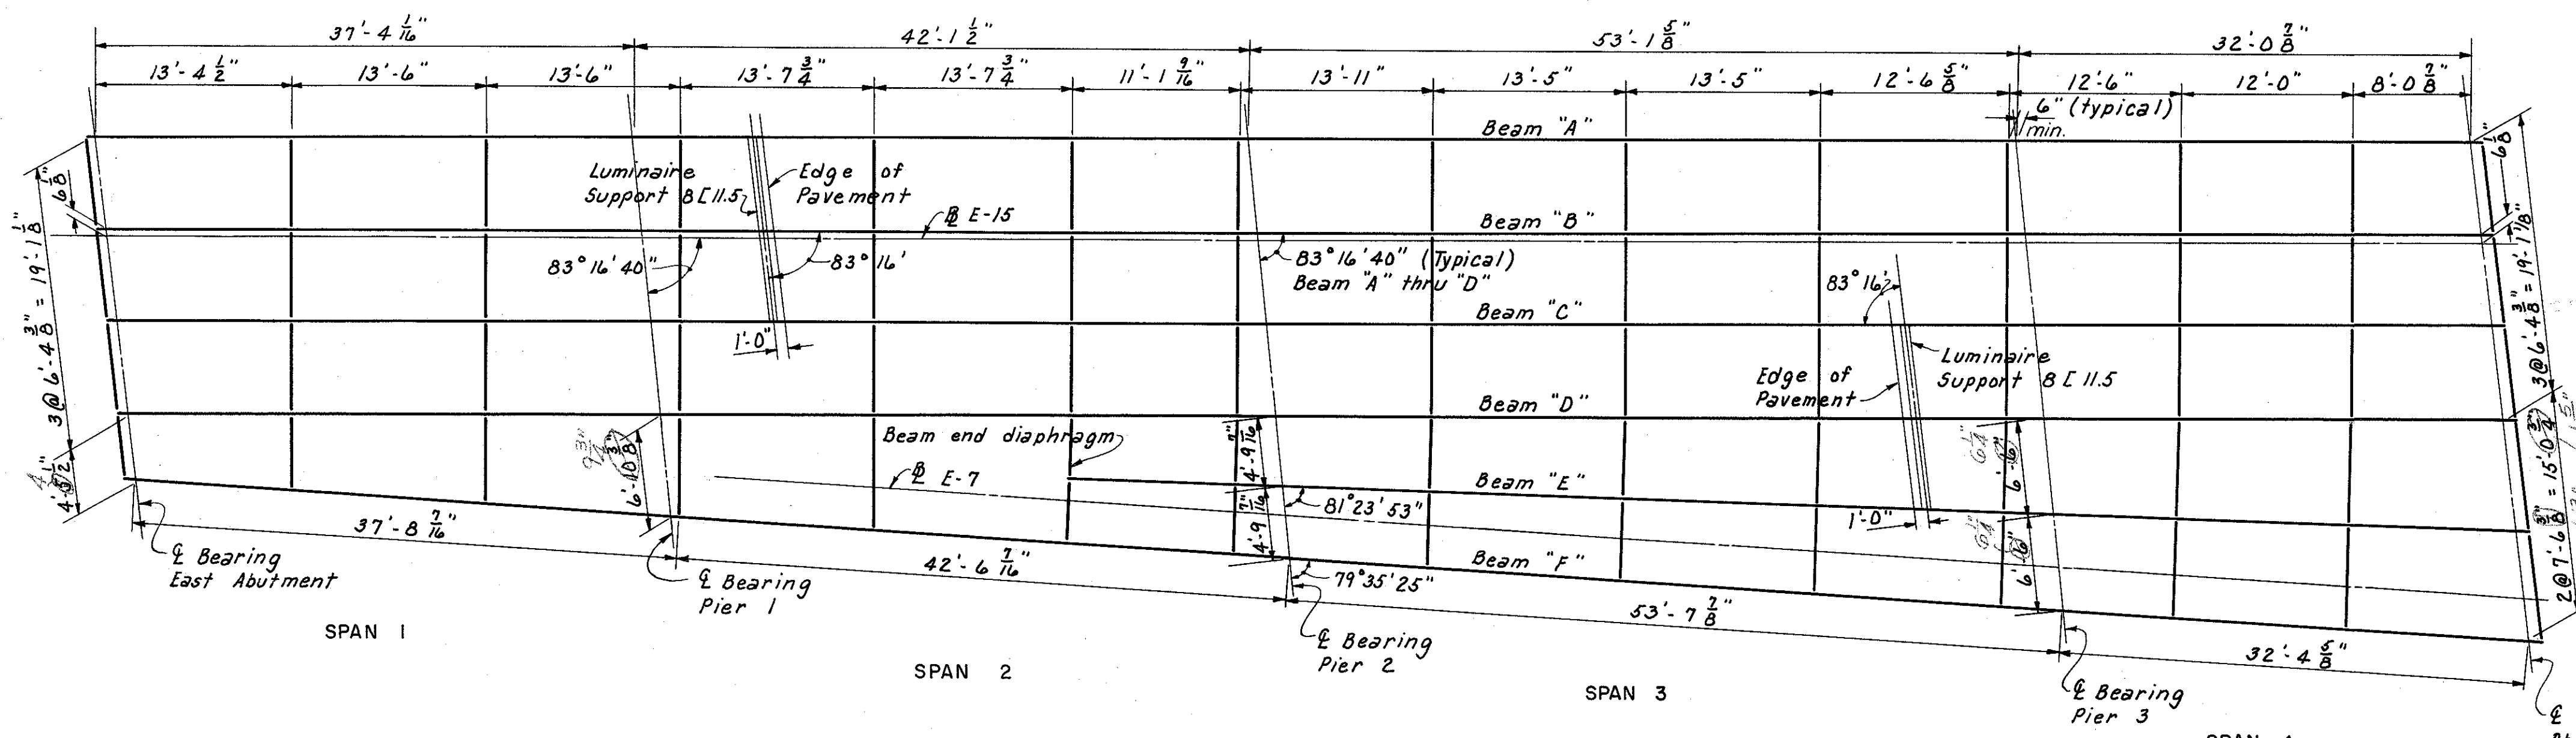

BEAM E

Beam "A"	697.94	697.83	697.70	697.36	697.15	696.93	696.36	695.98	695.60	694.88	694.59	694.29
Beam "B"	698.05	697.93	697.80	697.48	697.27	697.06	696.47	696.08	695.70	694.97	694.68	694.40
Beam "C"	697.84	697.77	697.67	697.37	697.16	696.94	696.34	695.97	695.58	694.85	694.56	694.28
Beam "D"	697.64	697.59	697.50	697.26	697.05	696.83	696.22	695.85	695.47	694.72	694.44	694.16
Beam "F"	697.50	697.43	697.37	697.13	696.91	696.67	696.03	695.66	695.25	694.48	694.18	693.87

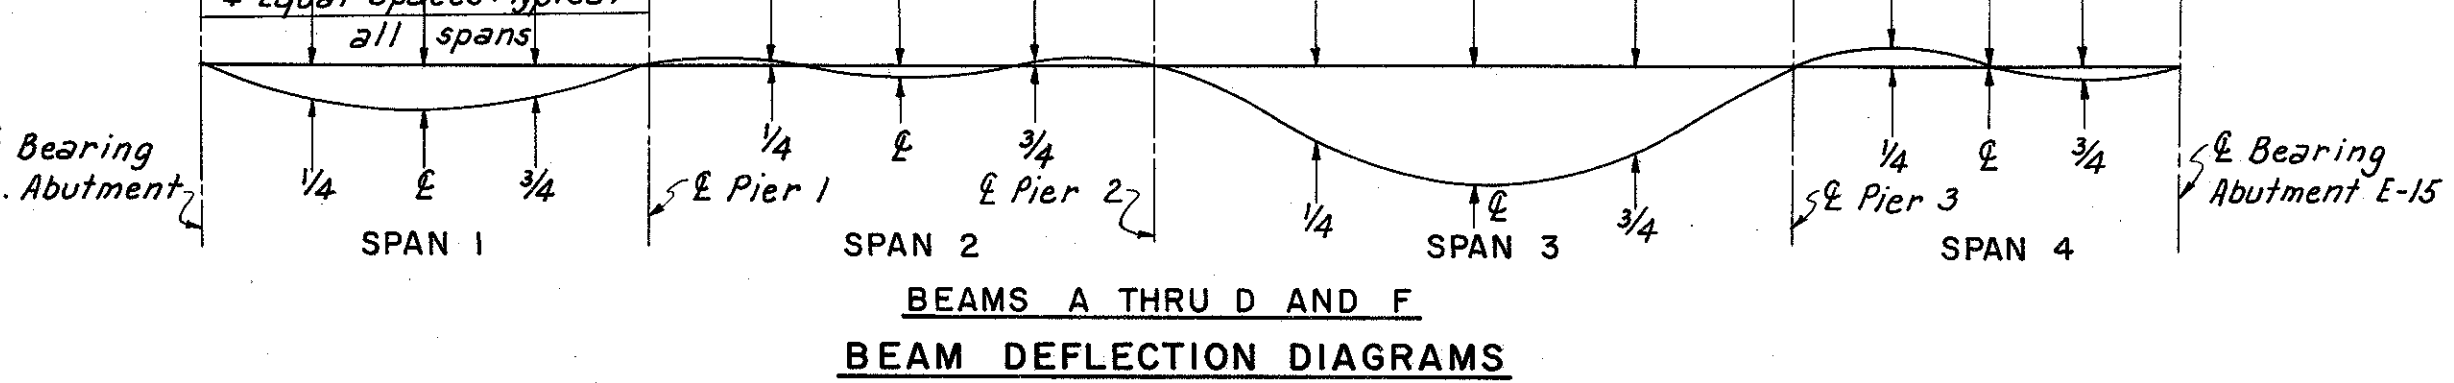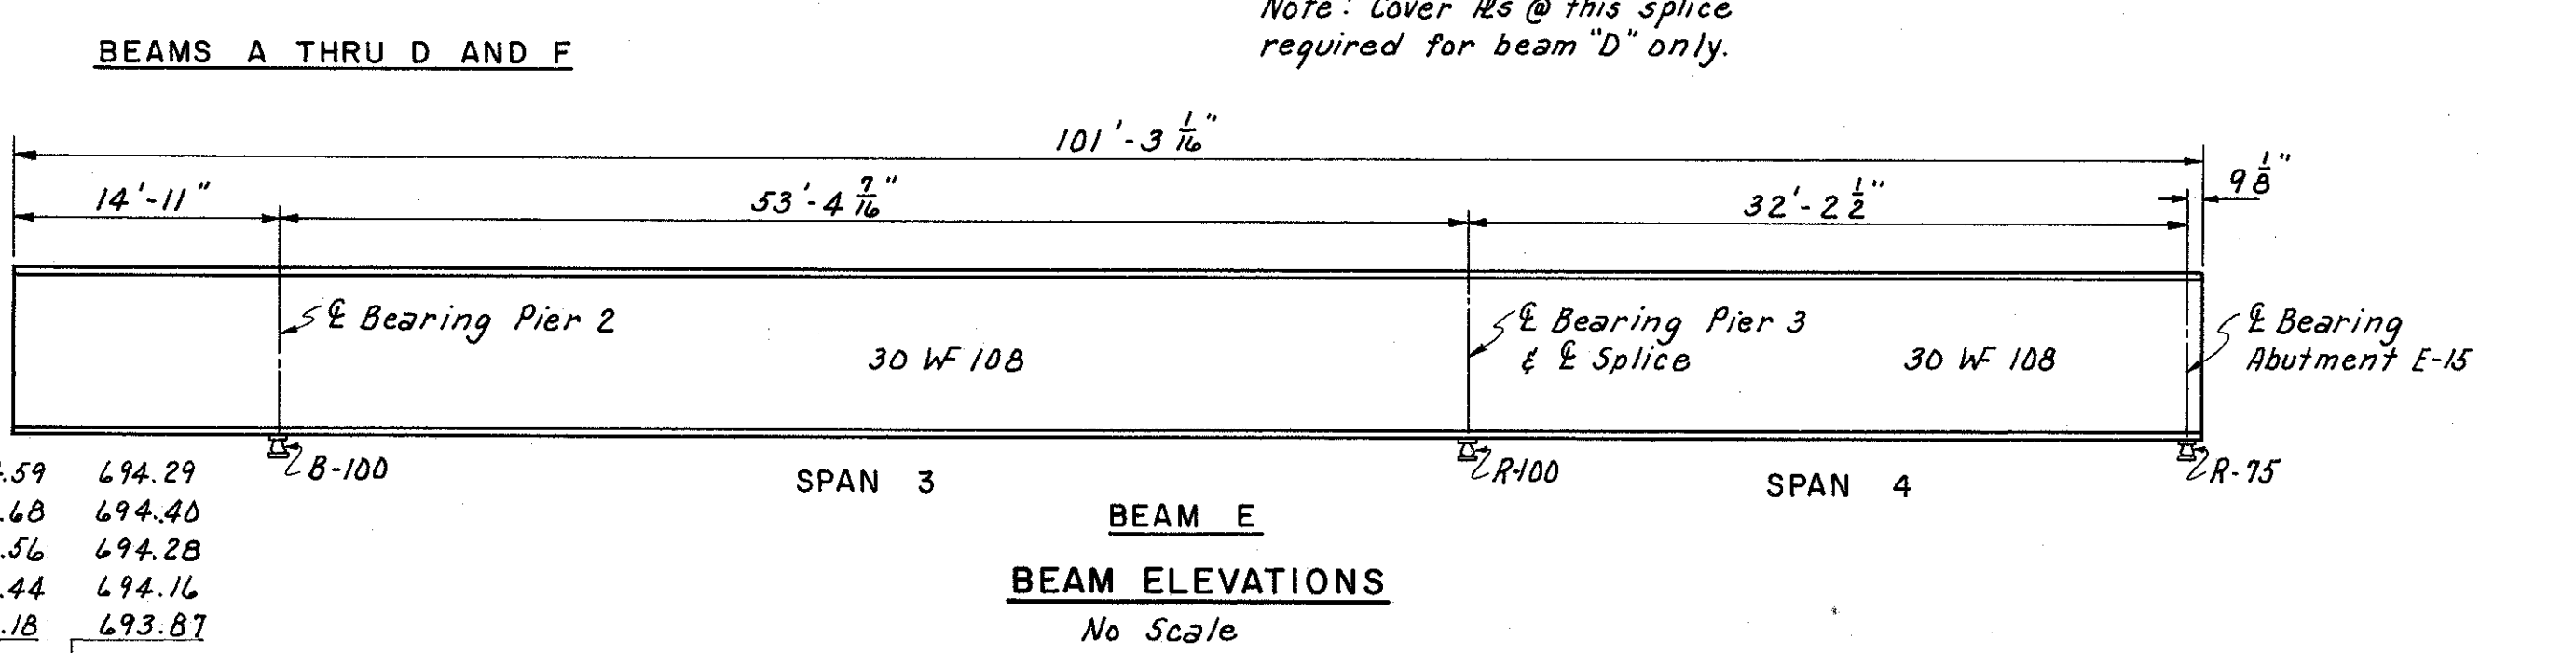

NOTES:
Top of beam elevations are exclusive of cover plates.
For details of end dams, see sheet 173-7A
For crossframe details, see sheet 155-7A
For Drainage Details, see sheet 174-7A
For details of rocker masonry plates, see sheet 173-7A
For other rocker and bolster details, see Ohio Standard Drawing RB-1-55.
Elevations shown in table are located at intersections of bearing and beams.

BEAM SPLICE WELDING PROCEDURE

1. Raise ends of beams "A" thru "D" and "F" 3/8" at Pier 3.
2. Butt-weld the beam flanges and web at Pier 2 using the following sequence: make two passes on each flange then two on the web; repeat, using one pass at each location, until welds are completed.
3. Weld the top and bottom cover plates.
4. Lower the beam ends at Pier 3 to final position.
5. Repeat step 2 and, in the case of beam "D", also step 3 at Pier 3. No raising of beam ends @ Abutment E-15 required. (The above procedure assumes that no splice is made at Pier 1. If the beams are spliced at Pier 1, only step 2 is required.)

ELEVATIONS AND DEFLECTIONS

BEAM	EAST ABUTMENT		SPAN 1			PIER NO. 1			SPAN 2			PIER NO. 2			SPAN 3			PIER NO. 3			SPAN 4			ABUTMENT E-15													
	TOP OF BEAM	TOP OF PVMT.	D.L. DEF.	D.L. DEF.	D.L. DEF.	TOP OF BEAM	TOP OF PVMT.	D.L. DEF.	D.L. DEF.	D.L. DEF.	TOP OF BEAM	TOP OF PVMT.	D.L. DEF.	D.L. DEF.	D.L. DEF.	TOP OF BEAM	TOP OF PVMT.	D.L. DEF.	D.L. DEF.	D.L. DEF.	TOP OF BEAM	TOP OF PVMT.	D.L. DEF.	D.L. DEF.													
	ELEVATION	ELEVATION	CON	TOT	CON	TOT	ELEVATION	ELEVATION	CON	TOT	CON	TOT	ELEVATION	ELEVATION	CON	TOT	ELEVATION	ELEVATION	CON	TOT	CON	TOT	ELEVATION	ELEVATION													
A	697.25	698.05	3/8	3/8	1/4	1/4	1/8	1/8	0	0	1/16	1/16	0	0	0	0	695.90	696.70	3/8	3/8	1/2	9/16	5/8	1/4	3/8	3/8	694.30	695.16	-1/16	-1/16	0	0	0	0	693.20	694.00	
B	697.34	698.15	1/8	1/8	3/16	3/16	1/16	1/16	0	0	0	0	0	0	0	0	696.02	696.82	1/4	1/4	1/2	5/16	3/8	5/8	1/4	1/4	3/4	694.43	695.25	0	0	0	0	0	0	693.32	694.11
C	697.10	697.90	1/8	1/8	3/16	3/16	1/16	1/16	0	0	0	0	0	0	0	0	695.90	696.70	1/4	1/4	3/8	5/16	3/8	5/8	1/4	1/4	3/8	694.34	695.14	0	0	0	0	0	0	693.20	693.99
D	696.88	697.68	1/8	1/8	1/8	1/8	1/16	1/16	0	0	0	0	0	0	0	0	695.77	696.57	1/4	1/4	1/2	5/16	3/8	3/4	3/16	3/16	3/4	694.22	695.02	0	0	0	0	0	0	693.00	693.87
E	697.50	697.54	1/4	1/4	5/16	5/16	3/16	3/16	End of beam	-1/16	-1/16	0	0	0	0	0	695.68	696.48	1/4	1/4	1/2	5/16	3/8	1/2	1/4	1/4	3/4	694.08	694.88	0	0	0	0	1/16	1/16	692.90	693.70
F	696.74	697.54	1/4	1/4	5/16	5/16	3/16	3/16	0	0	0	0	-1/16	-1/16	0	0	695.61	696.41	3/8	3/8	3/8	9/16	5/8	1	3/8	3/8	1	693.93	694.76	-1/16	-1/16	0	0	0	0	692.75	693.55

NOTES:
The beams in Span 3 shall be cambered as follows:
Where the sum of the deflections and convexity is 3/4" to 1" the required camber will be 1", and if greater than 1", the required camber will be the same as the sum.
Beams in Span 1, 2 & 4 do not require camber, but shall be fabricated so that any curved beam will be placed with the convex flange up.
Deflections are given at the quarter points and are measured to the nearest 1/16 inch.
In Elevation and Deflection Table, the following abbreviations are used:
(D.L. Defl.) denotes dead load deflections. (Tot.) refers to total deflections from dead load of steel, and concrete.
(Con.) denotes deflections for concrete.
Convexity denotes corrections required for vertical curvature of the roadway gradient.
(P.V.M.T.) - denotes pavement.

H.N.T.B. BR. NO. 9 PART 7A

HOWARD, NEEDLES, TAMMEN & BERGENOFF
CONSULTING ENGINEERS
KANSAS CITY CLEVELAND NEW YORK

FRAMING PLAN

RAMP E-15 OVER EAST 14th ST.
BR. NO. CUY - 21-1573 B STA. 15+27.70
Scale: As noted STA. 16+96.91


WILLOW - INNER BELT FREEWAY
CLEVELAND CUYAHOGA COUNTY OHIO

DRAWN R.B. TRACED R.J.K. CHECKED A.L. REVIEWED C.T. REVISION 7-22-60
DATE 8-8-58 DATE 3-18-59 DATE 8-15-58 DATE 11-13-59 SHEET 153

NOTES:
 Bars of a series shall vary in length by a constant increment.
 For replacement schedule, see Sh. 103-7A
 All bar dimensions are given out to out.
 (*) Bars 451 thru 456 and 651 thru 653 are for light standard support. For their placement and bending diagram, see Sh. 176-7A
 † Bars 601 thru 605 are to be included with "Item 5-14, Railing", for payment.


Note: Transverse bars to extend to vertical leg of end dam angle.

MICROFILMED
JUL 3 1985

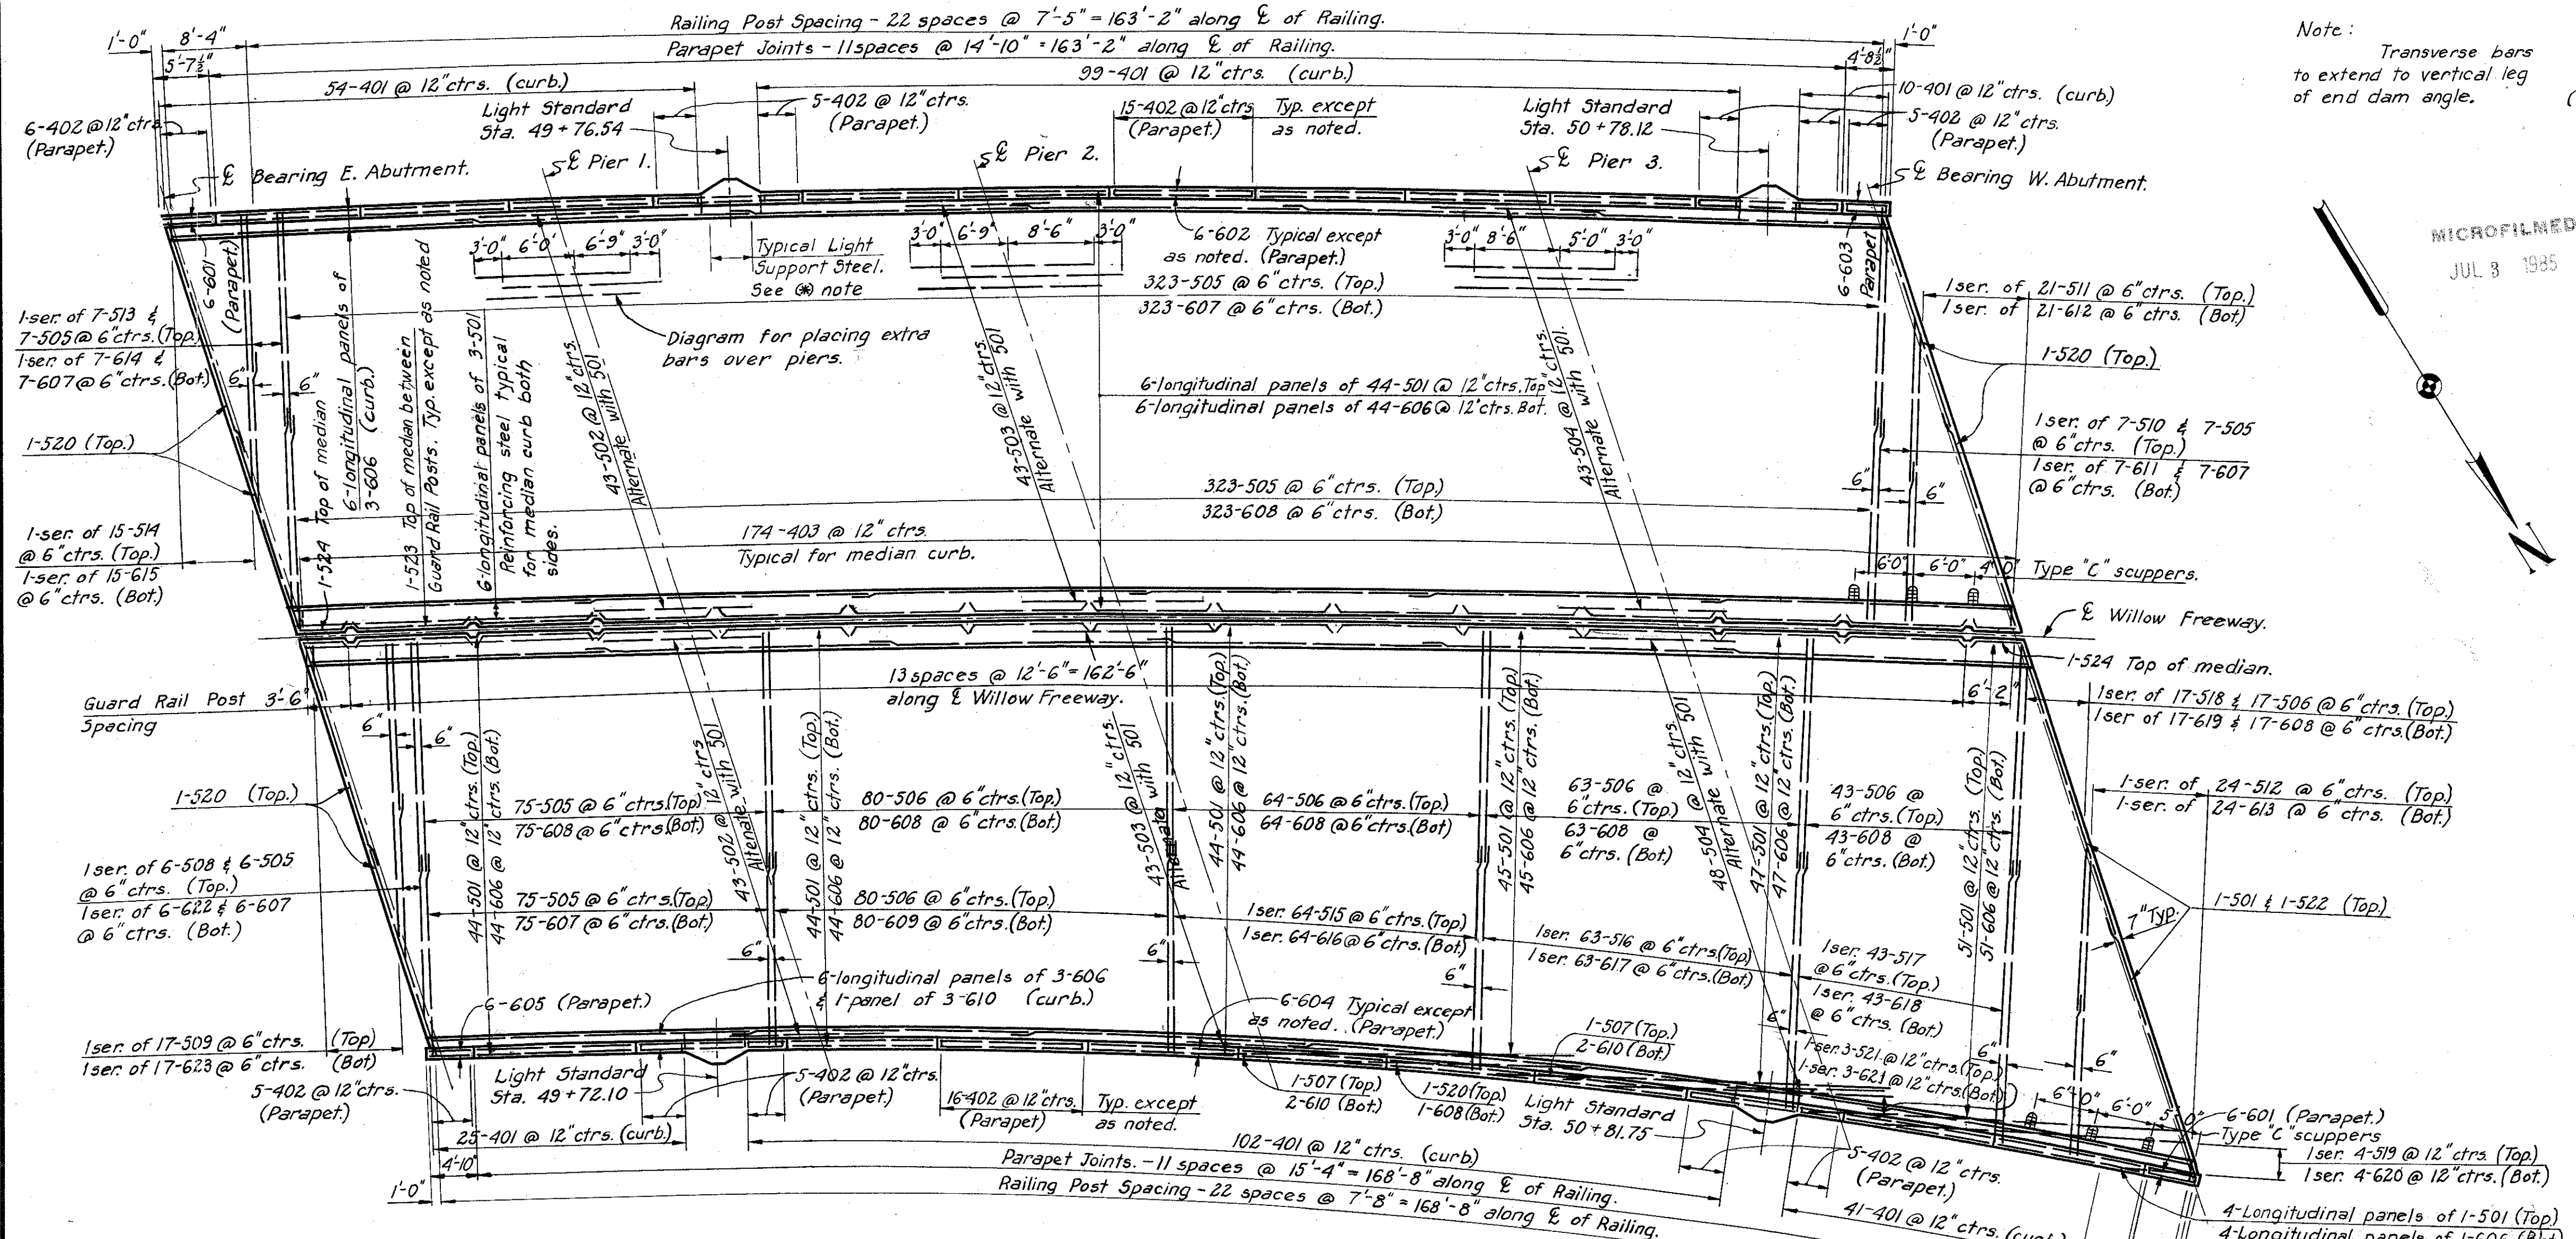


MARK	NO.	LENGTH	TYPE	DIMENSIONS				SERIES INCREMENT	WEIGHT (POUNDS)
				A	B	C	D		
401	321	5'-1"	122	1'-8"	1'-4"			1090	
402	341	4'-3"	105	0'-8"	2'-0"			1310	
403	348	5'-2"	122	2'-5"	1'-0"			1201	
451 *	8	9'-3"	131	2'-6"	3'-0"	1'-2"		49	
452 *	8	10'-3"	131	3'-0"	3'-0"	1'-8"		55	
453 *	12	9'-9"	131	3'-2"	3'-0"	1'-0"		78	
454 *	8	5'-9"	155	2'-2"	1'-6"			31	
455 *	8	6'-5"	155	2'-8"	1'-6"			34	
456 *	12	6'-7"	155	2'-10"	1'-6"			53	
501	580	30'-9"	5tr					18602	
502	86	15'-9"	5tr					1413	
503	86	18'-3"	5tr					1637	
504	91	16'-6"	5tr					1566	
505	816	22'-8"	101	22'-1"				19291	
506	347	23'-1"	101	22'-6"				8354	
507	2	12'-0"	5tr					25	
508	1ser of 6	11'-6" to 19'-6"	5tr				1'-7 1/2"	97	
509	1ser of 17	2'-10" to 30'-7"	101	2'-3" to 30'-0"			1'-8 1/2"	296	
510	1ser of 7	11'-6" to 19'-6"	5tr				1'-4"	113	
511	1ser of 21	2'-10" to 30'-7"	101	2'-3" to 30'-0"			1'-4 1/2"	366	
512	1ser of 24	2'-10" to 30'-7"	101	2'-3" to 30'-0"			1'-2 1/2"	418	
513	1ser of 7	11'-6" to 21'-6"	5tr				1'-8"	120	
514	1ser of 15	2'-10" to 30'-7"	101	2'-3" to 30'-0"			1'-11 1/2"	261	
515	1ser of 64	23'-2" to 25'-2"	101	22'-5" to 24'-7"			3"	1613	
516	1ser of 63	25'-2" to 28'-2"	101	24'-7" to 27'-7"			3"	1752	
517	1ser of 43	28'-2" to 31'-2"	101	27'-7" to 30'-7"			3"	1331	
518	1ser of 17	10'-3" to 29'-9"	5tr				1'-2 3/4"	355	
519	1ser of 4	7'-0" to 25'-0"	5tr				6'-0"	67	
520	7	24'-0"	5tr					175	
521	1ser of 3	10'-0" to 26'-0"	5tr				8'-0"	56	
522	1	27'-9"	5tr					29	
523	26	13'-0"	141	1'-0"	11'-2"			353	
524	4	4'-1"	108	3'-2"	1'-0"			17	
601 †	12	5'-3"	5tr						
602 †	66	14'-6"	5tr						
603 †	6	4'-3"	5tr						
604 †	66	15'-0"	5tr						
605 †	6	4'-6"	5tr						
606	579	30'-9"	5tr					26742	
607	418	18'-0"	5tr					11301	
608	666	26'-6"	5tr					24509	
609	80	19'-0"	5tr					2283	
610	5	7'-0"	5tr					53	
611	1ser of 7	16'-0" to 24'-0"	5tr				1'-4"	210	
612	1ser of 21	2'-6" to 30'-0"	5tr				1'-4 1/2"	513	
613	1ser of 24	2'-6" to 30'-0"	5tr				1'-2 3/4"	586	
614	1ser of 7	16'-0" to 26'-0"	5tr				1'-8"	221	
615	1ser of 15	2'-6" to 30'-0"	5tr				1'-11 1/2"	366	
616	1ser of 64	19'-0" to 21'-0"	5tr				3"	1923	
617	1ser of 63	21'-0" to 24'-0"	5tr				3"	2129	
618	1ser of 43	24'-0" to 27'-0"	5tr				3"	1647	
619	1ser of 17	6'-6" to 26'-3"	5tr				1'-2 3/4"	418	
620	1ser of 4	7'-0" to 25'-0"	5tr				6'-0"	96	
621	1ser of 3	10'-0" to 26'-0"	5tr				8'-0"	81	
622	1ser of 6	16'-0" to 25'-0"	5tr				1'-9 3/8"	185	
623	1ser of 17	2'-6" to 30'-0"	5tr				1'-8 3/8"	415	
651 *	8	9'-5"	141	2'-11"	1'-10"			113	
652 *	12	14'-6"	141	5'-3"	3'-0"			261	
653 *	4	5'-0"	5tr					30	
Total									138,290


DECK PLAN
Scale: 3/8" = 1'-0"

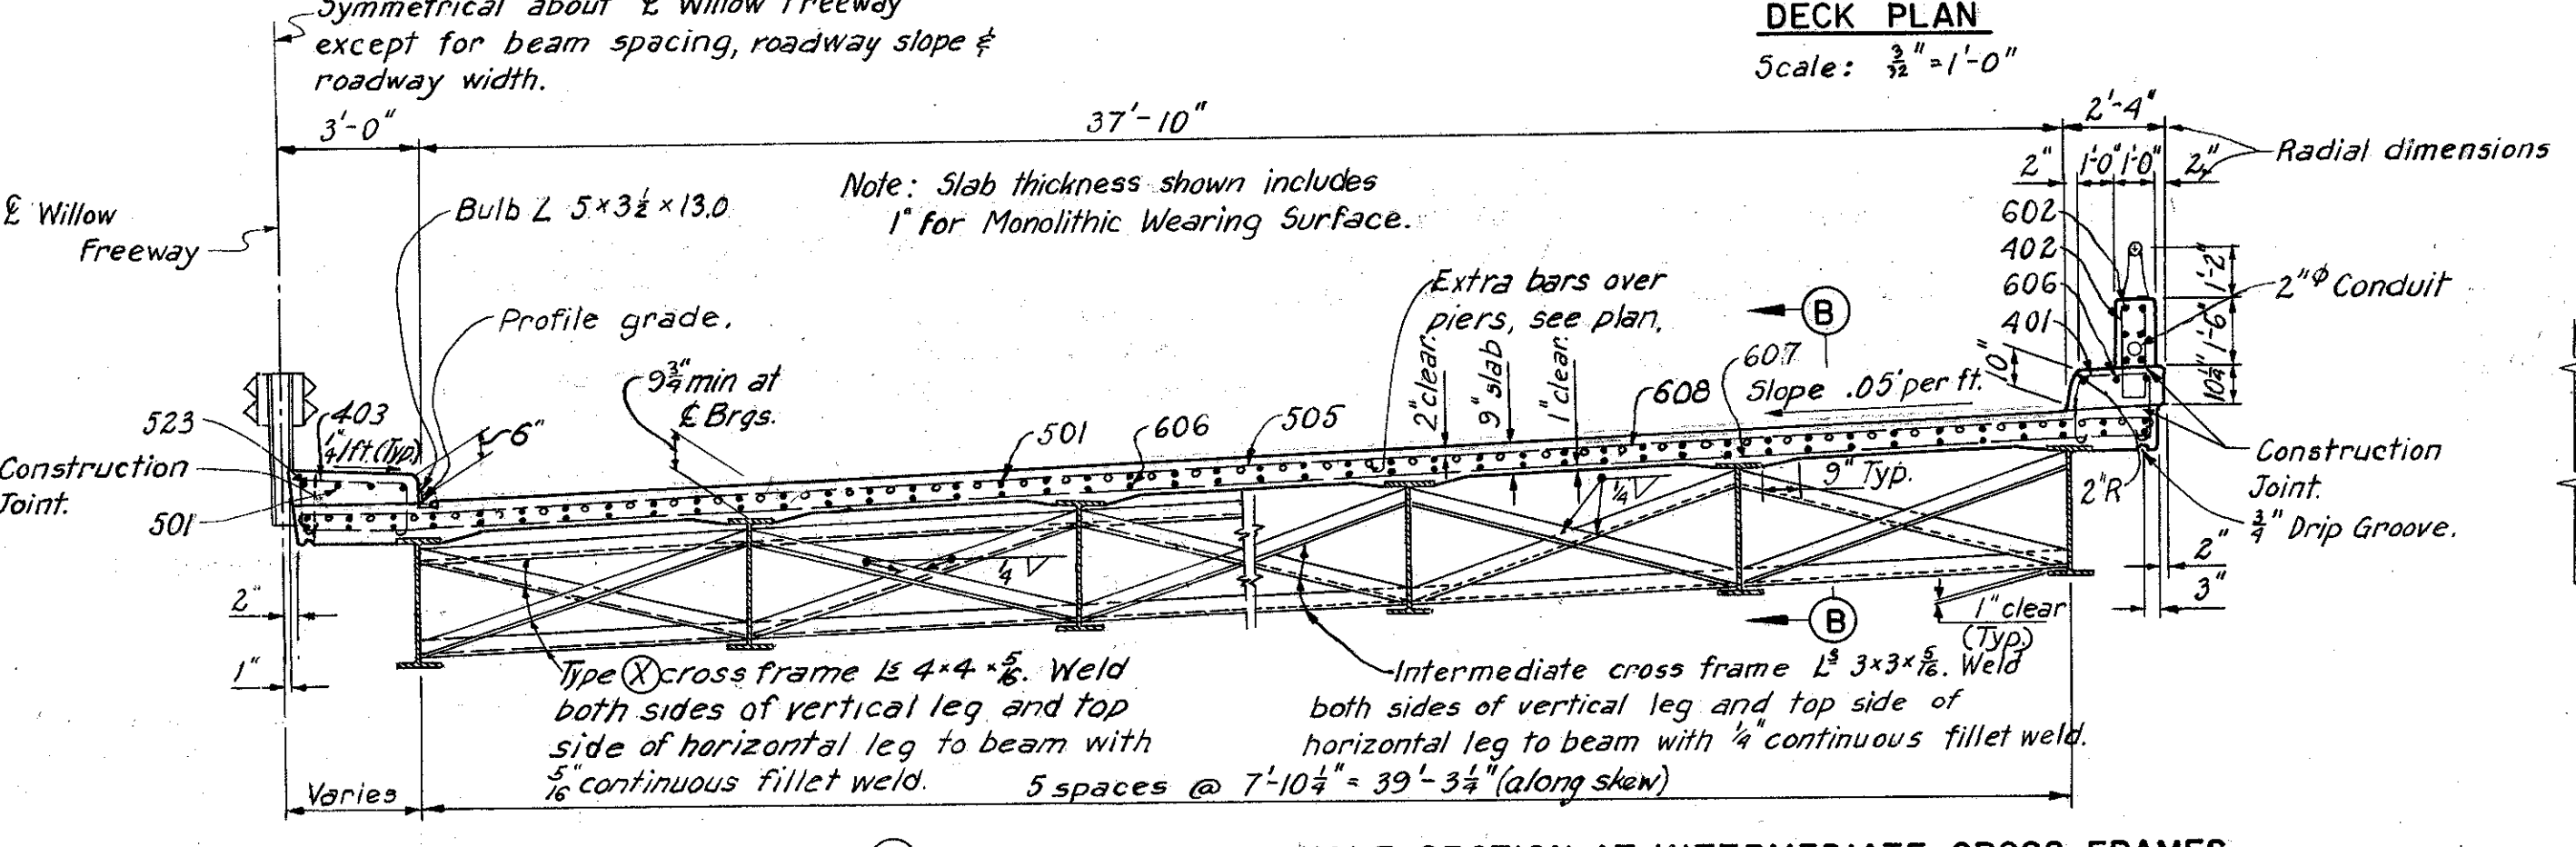


HALF SECTION AT TYPE (X) CROSSFRAMES
Scale: 3/8" = 1'-0"

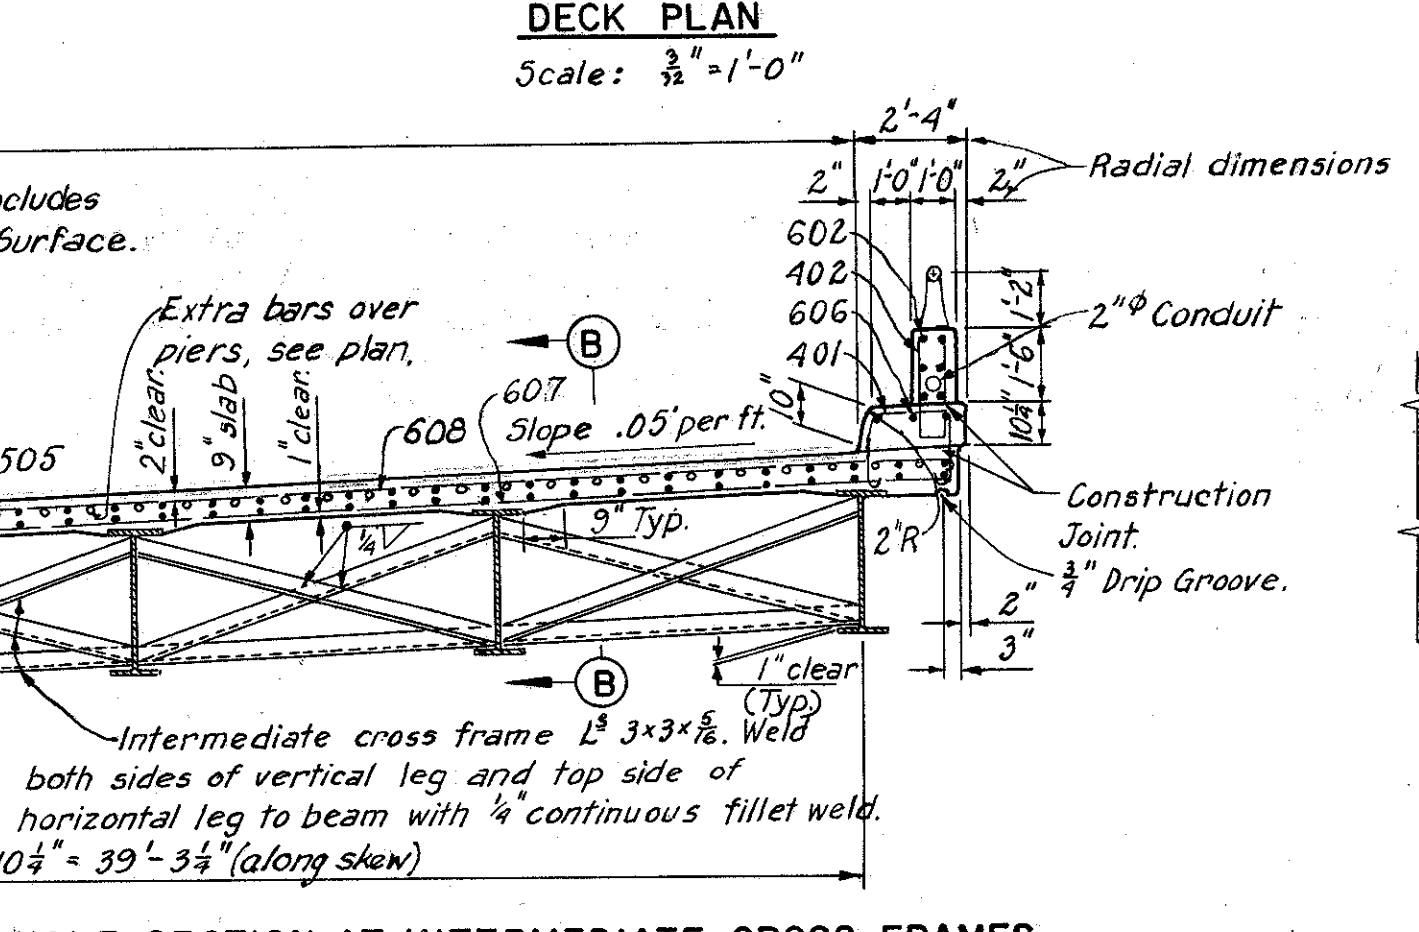


HALF SECTION AT INTERMEDIATE CROSS FRAMES
Scale: 3/8" = 1'-0"

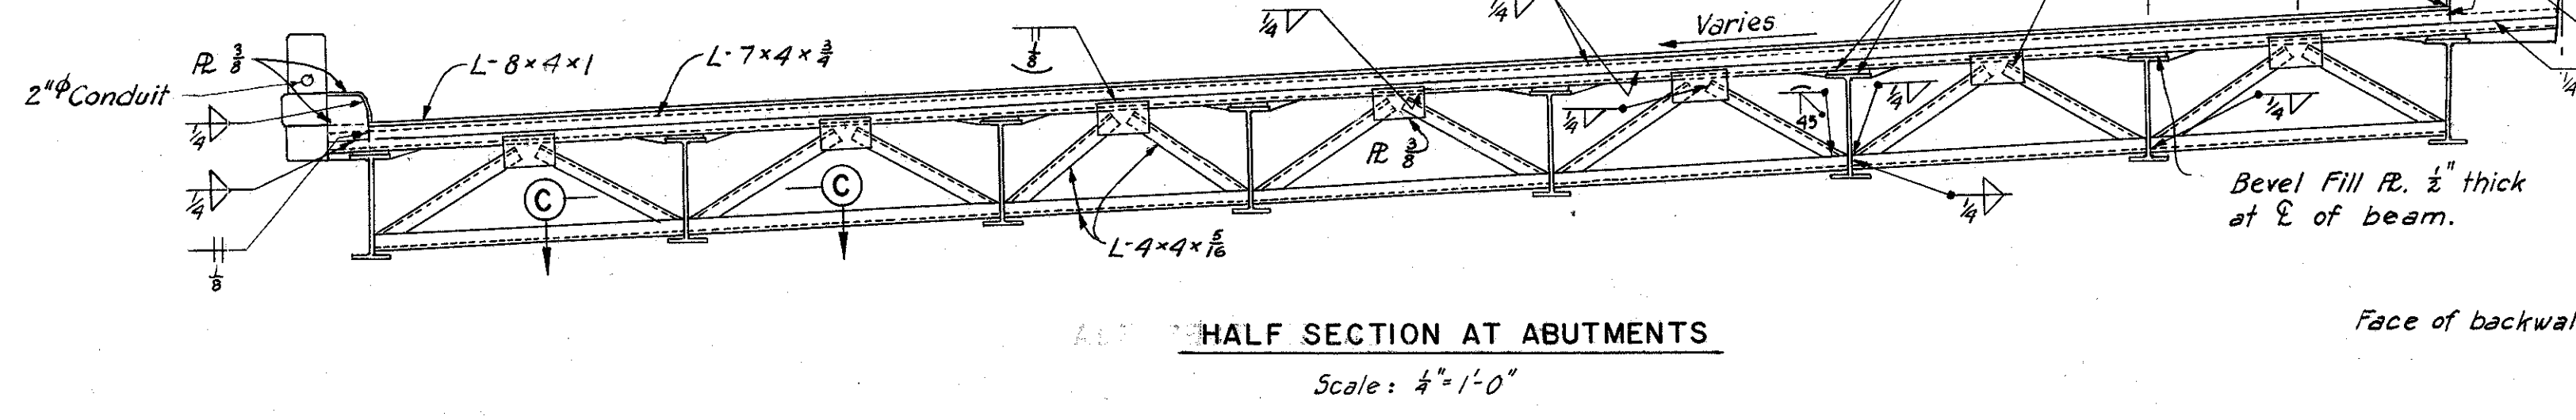

HALF SECTION AT ABUTMENTS
Scale: 3/8" = 1'-0"

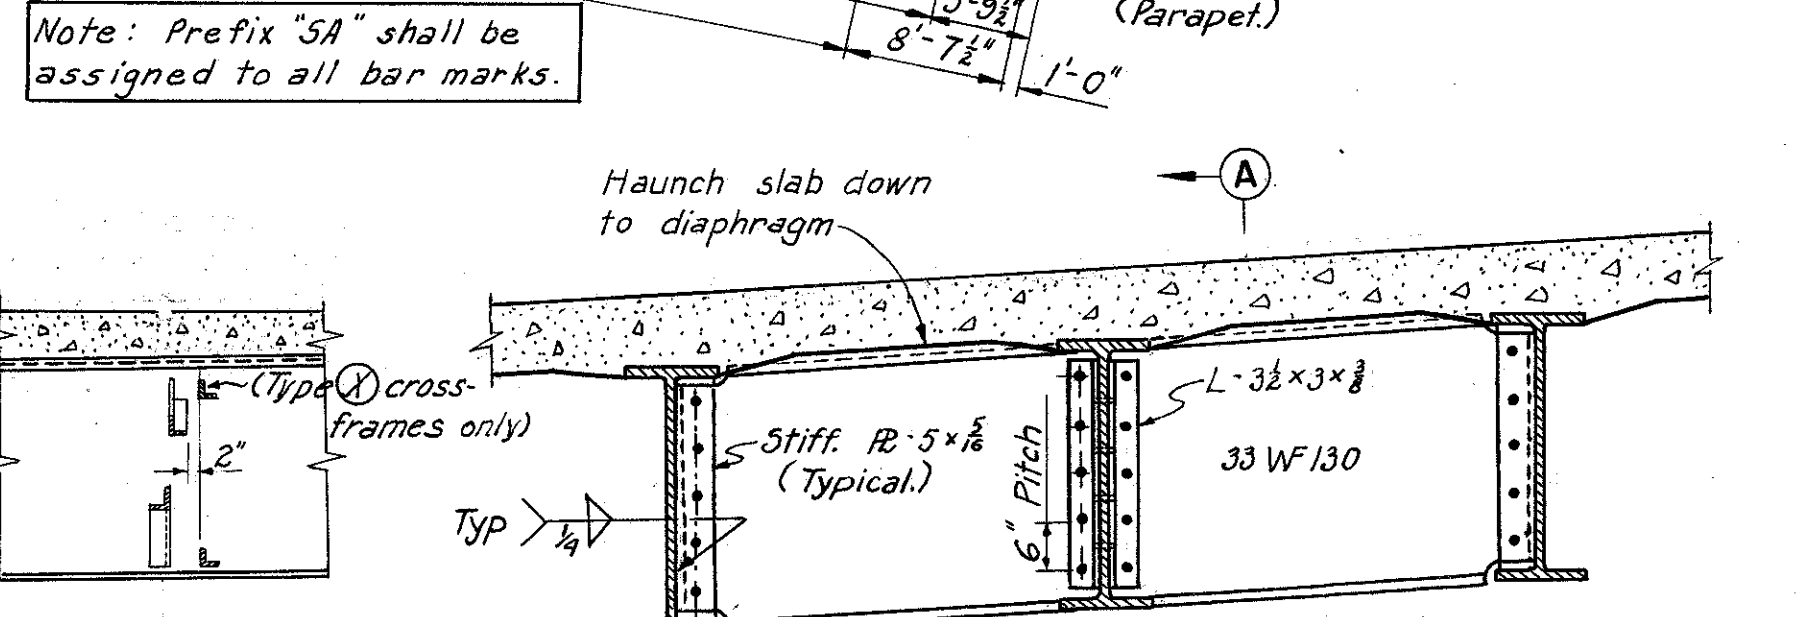

BEAM END DIAPHRAGM
Scale: 1/2" = 1'-0"

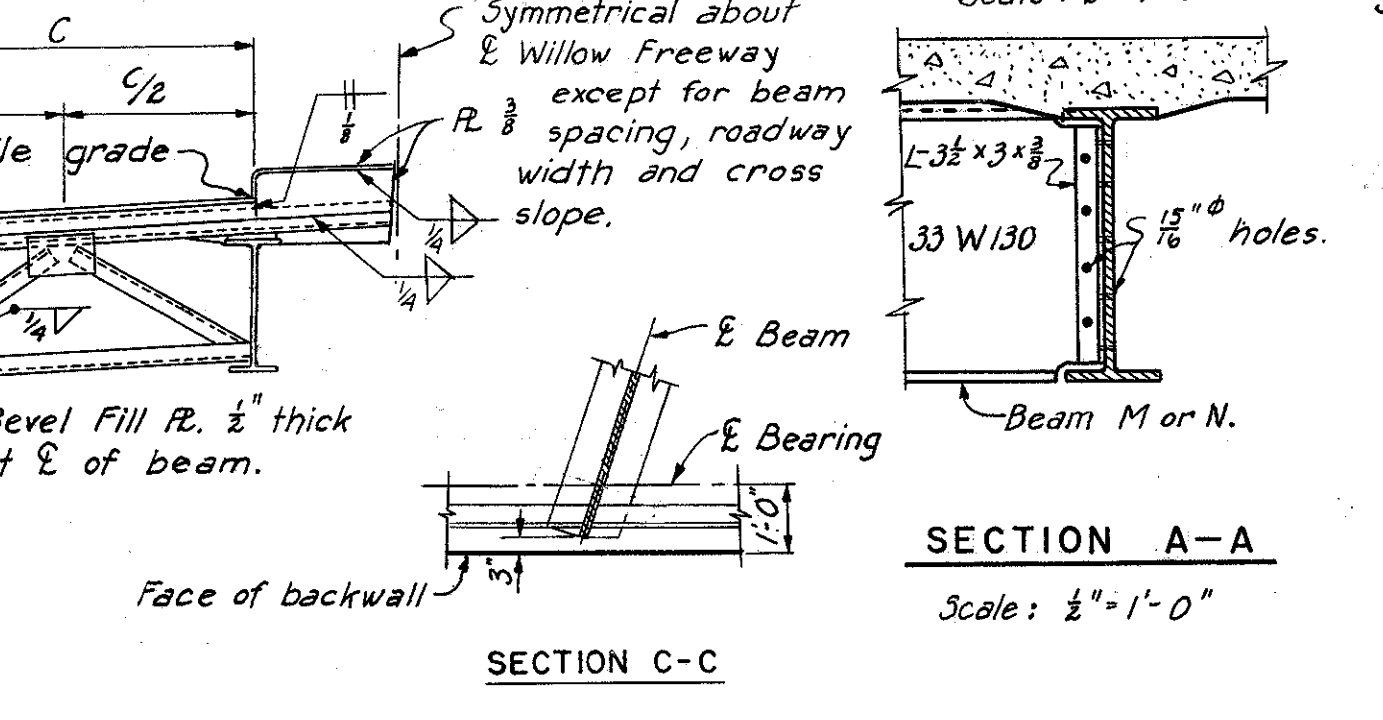

SECTION A-A
Scale: 1/2" = 1'-0"

NOTES:
 For drainage details, see Sh. 174-7A
 For light standard support and other lighting details, see Sh. 176-7A & 177-7A
 For Railing, Guard Rail, and Parapet Joint details, see Sh. 175-7A
 In order to facilitate water curing of the concrete of the deck slab, the placing of concrete shall progress upwards. The slab may be placed in sections, between transverse construction joints, which are parallel to the transverse bars in the slab, and are located near the center of any span. For bar bending diagrams, see Sh. 170-7A

H.N.T.B. BR. NO. 8 PART 7A

HOWARD, NEEDLES, TAMMEN & BERGENDOFF
CONSULTING ENGINEERS
KANSAS CITY CLEVELAND NEW YORK


DECK PLAN
 WILLOW FREEWAY OVER EAST 14th ST.
 BR. NO. CUY-21-1573 A STA. 49+30.16
 Scale: As noted STA. 51+07.08
WILLOW-INNER BELT FREEWAY
 CLEVELAND CUYAHOGA COUNTY OHIO

DATE 9-10-58 DATE 9-10-58 DATE 9-17-58 DATE 11-13-59


SHEET 154

CUYAHOGA COUNTY
CITY OF CLEVELAND
CUY-21-15.32
CUY-42-18.42


Note: Prefix "SB" shall be assigned to all bar marks.

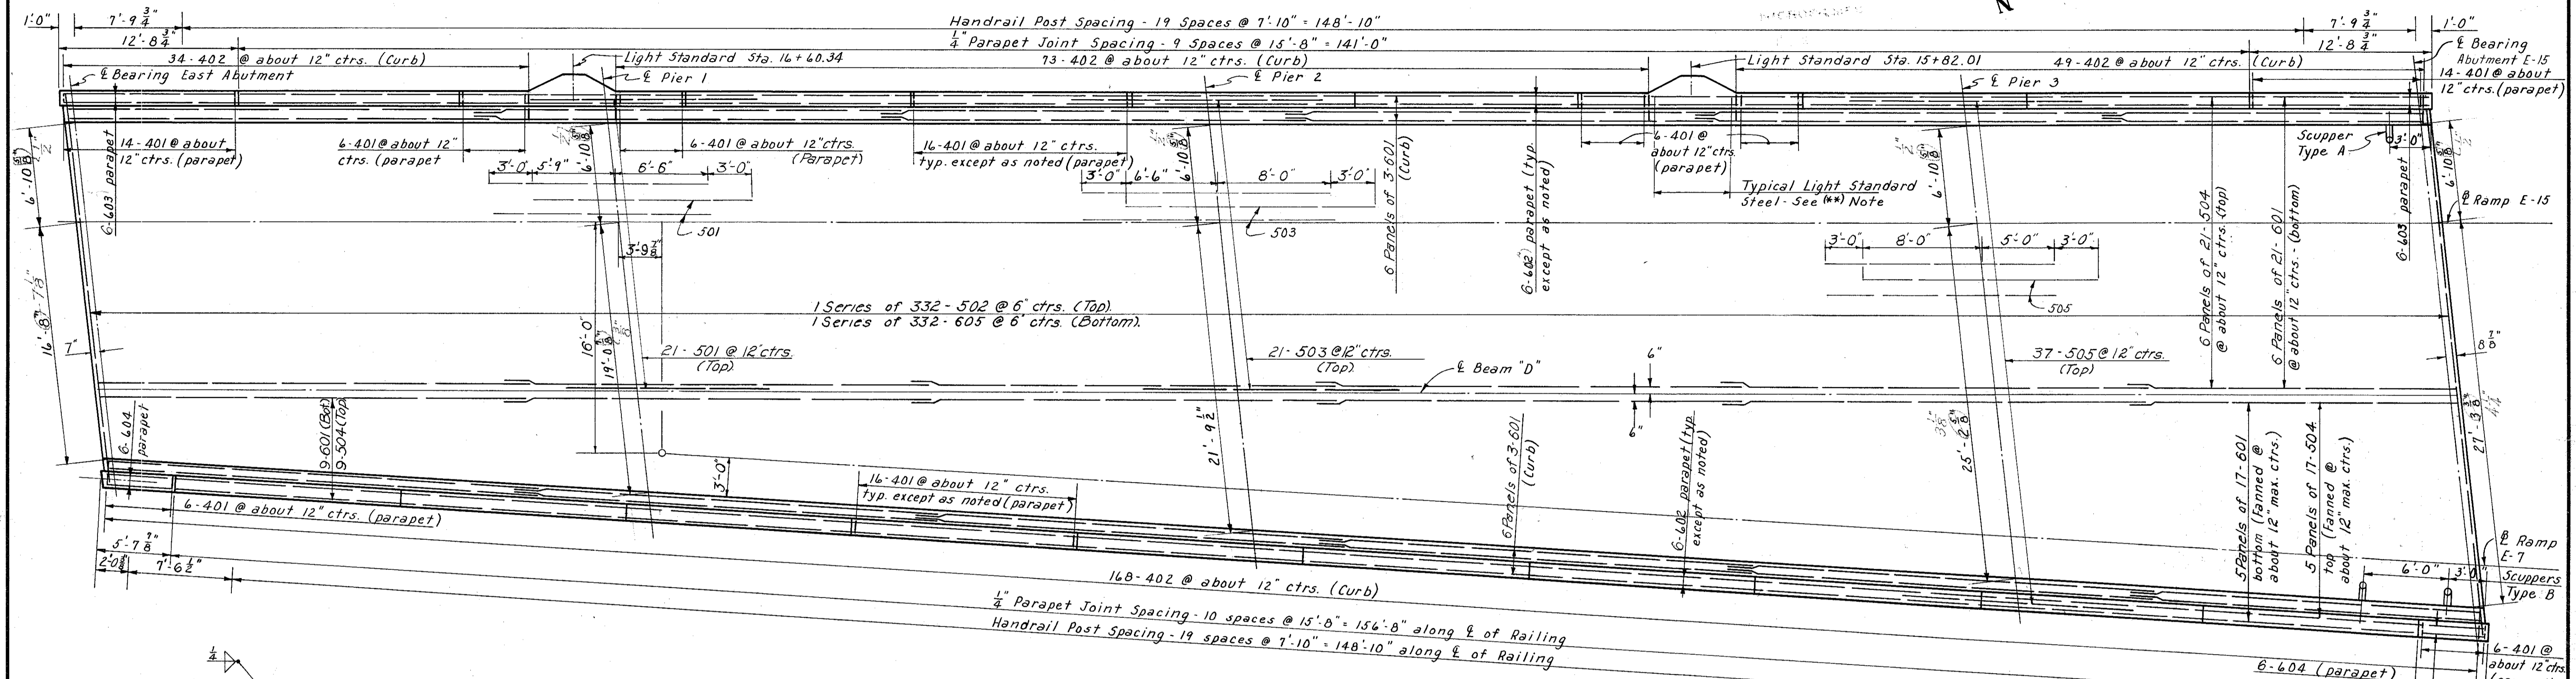


DECK PLAN
Scale: 1/8" = 1'-0"

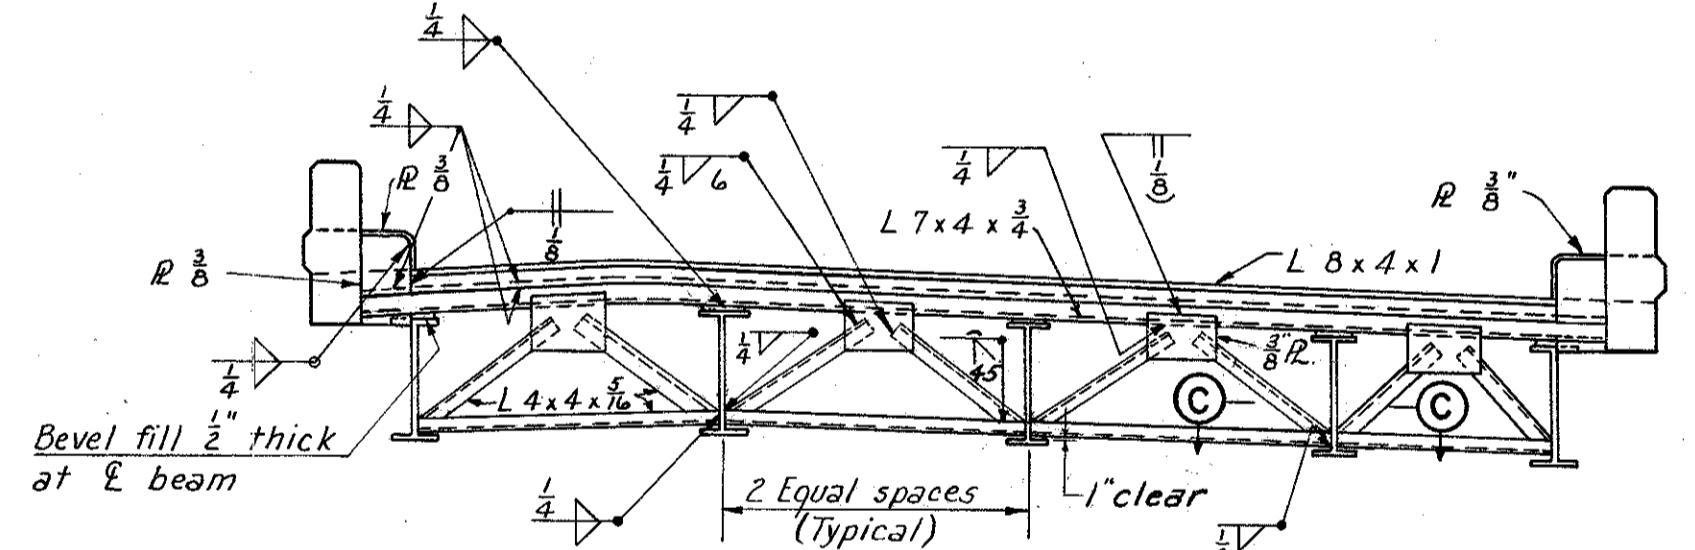


SECTION AT END FINISH
East End Shows, West End similar except for the number of panels.
Scale: 1/4" = 1'-0"

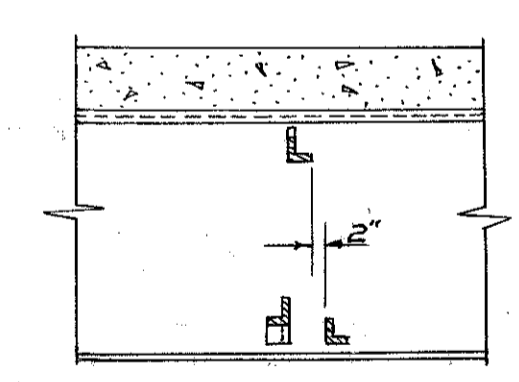

SECTION B-B
Scale: 1/2" = 1'-0"

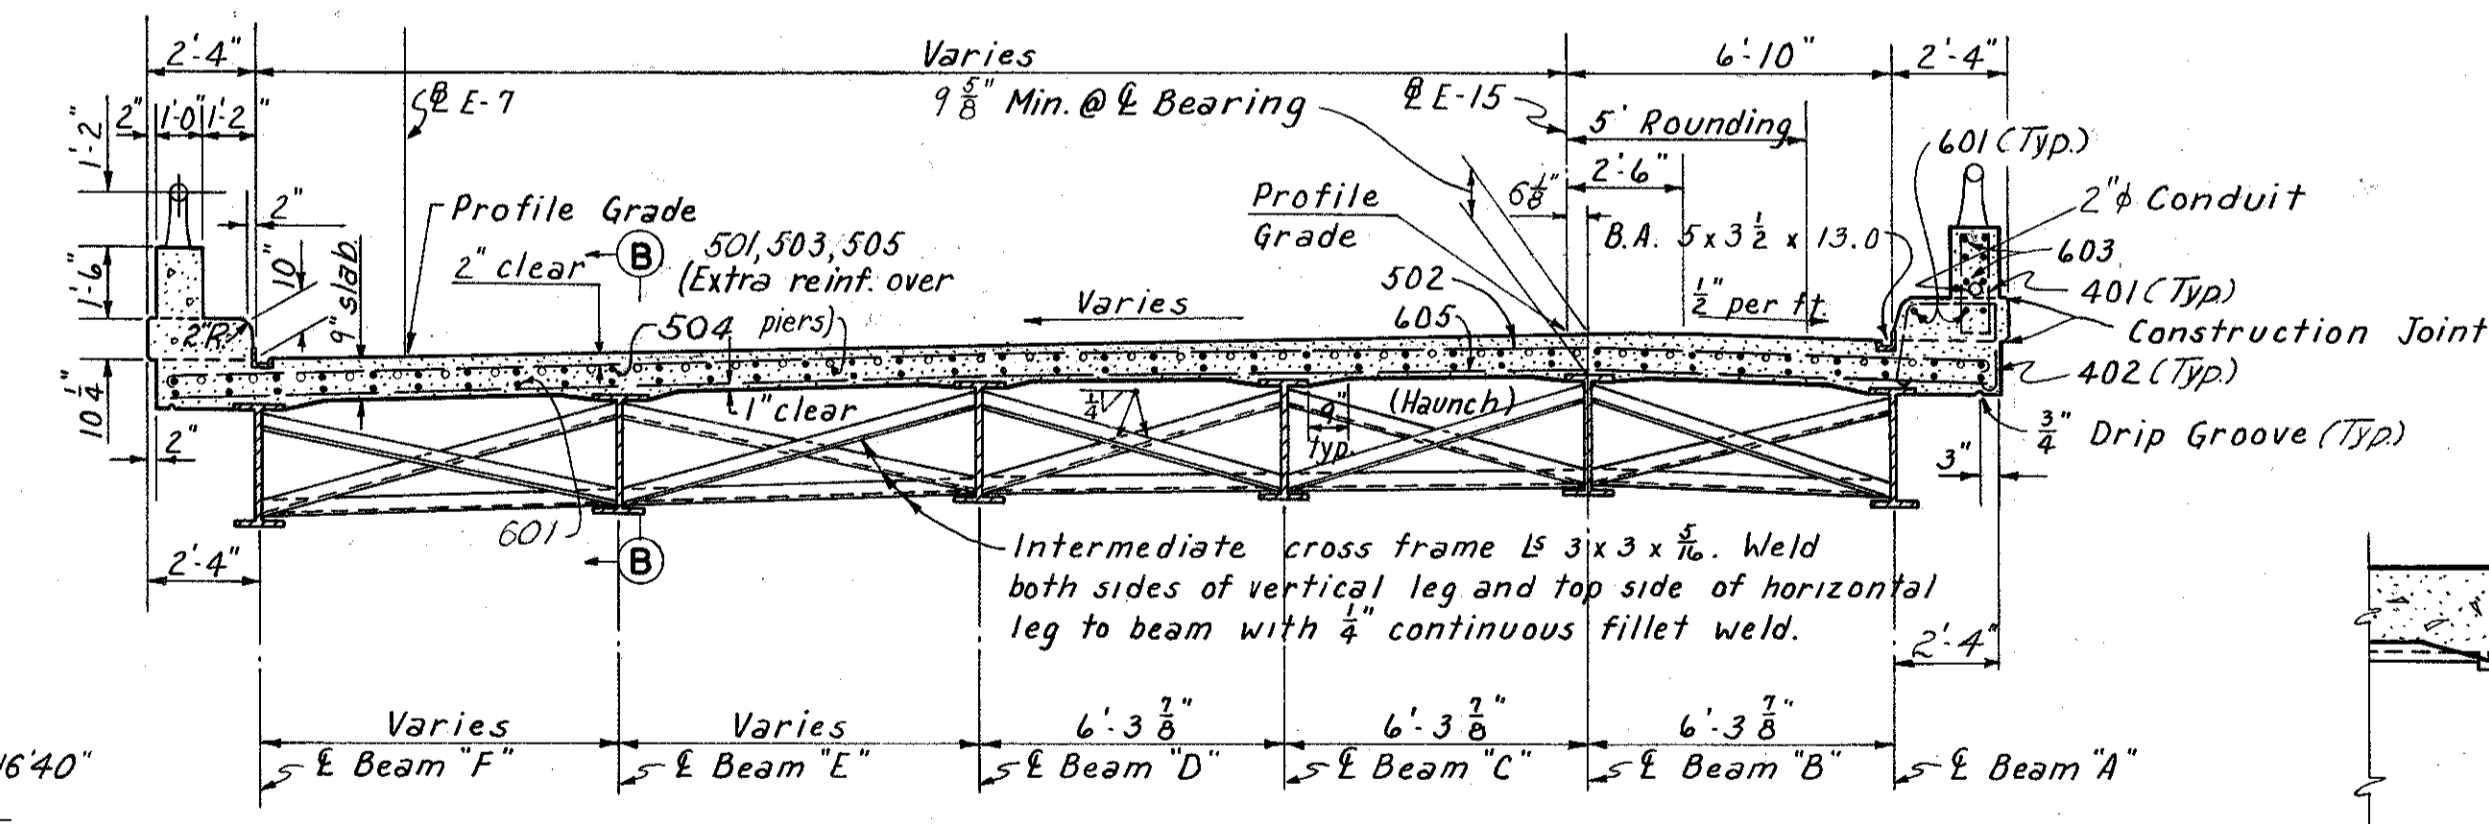

TYPICAL SECTION AT INTERMEDIATE CROSS FRAMES
Scale: 1/4" = 1'-0"

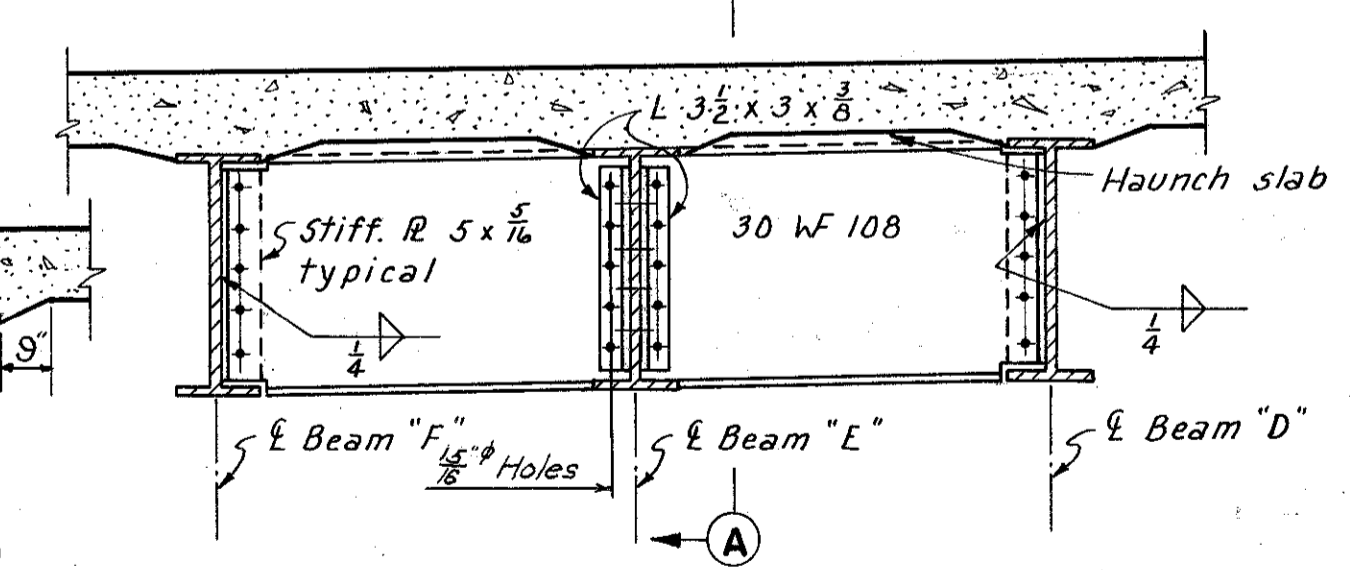

SECTION A-A
Scale: 1/2" = 1'-0"

BEAM END DIAPHRAGM
Scale: 1/2" = 1'-0"


Note: Beam end diaphragm connections shall be made with 7/8" high strength bolts conforming to Supplemental Specs. S-201.

Note: Slab thickness shown includes 1" for monolithic wearing surface.

NOTES:

In order to facilitate water curing of the concrete of the deck slab, the placing of the concrete shall progress up grade. The slab may be placed in sections between transverse construction joints which are parallel to the transverse reinforcing steel and are located near the center of any span.
For Railing details see sheet 175-7A
** for Light Standard Support and other lighting details see sheet 176-7A & 177-7A
For drainage details see sheet 174-7A
For end dam details see sheet 173-7A
* Bars are for the Light Standard Support. For their placement and bending diagram see sheet 176-7A
† Bars included for payment with "Item 5-14, Railing"
For replacement bars see sheet 103-7A

REINFORCEMENT SCHEDULE		DIMENSIONS		SERIES INCRE-MENT	WEIGHT (POUNDS)	
MARK	NO.	LENGTH	TYPE			A
401	336	4'-5"	105	0'-8"	2'-0"	991
402	324	5'-11"	122	1'-8"	1'-4"	1100
* 451	4	9'-3"	131	2'-6"	1'-2"	24
* 452	4	10'-3"	131	3'-0"	1'-8"	28
* 453	6	9'-9"	131	3'-2"	1'-0"	40
* 454	4	5'-11"	155	2'-2"		16
* 455	4	6'-5"	155	2'-8"		18
* 456	6	6'-7"	155	2'-10"		26
501	21	15'-3"	Str.			334
502	1 Ser. of 332	28'-5" to 39'-2"	100	27'-3" to 38'-0"		1101
503	21	17'-6"	Str.			383
504	220	29'-3"	Str.			6712
505	37	16'-0"	Str.			617
601	256	29'-6"	Str.			11343

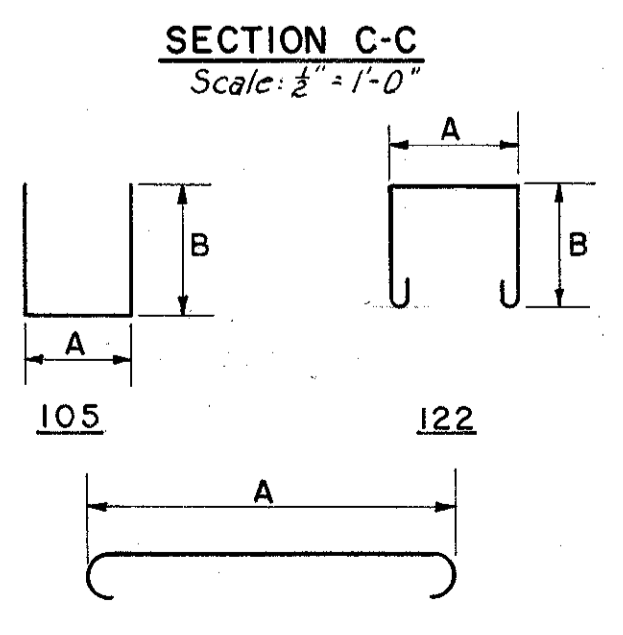

BAR BENDING DIAGRAMS

REINFORCEMENT SCHEDULE		DIMENSIONS		SERIES INCRE-MENT	WEIGHT (POUNDS)	
MARK	NO.	LENGTH	TYPE			A
† 602	114	15'-3"	Str.			
† 603	12	12'-3"	Str.			
† 604	12	5'-0"	Str.			
605	1 Ser. of 332	27'-3" to 38'-0"	Str.			16269
* 651	4	9'-5"	141	2'-11"	1'-10"	57
* 652	6	14'-6"	141	5'-3"	3'-0"	131
* 653	2	5'-0"	Str.			15
Total						49,805

H.N.T.B. BR. NO. 9 PART 7A

HOWARD, NEEDLES, TAMMEN & BERGENDOFF
CONSULTING ENGINEERS
KANSAS CITY CLEVELAND NEW YORK

DECK PLAN

RAMP E-15 OVER EAST 14th ST.
BR. NO. CUY-21-1573 B STA. 15+27.70

Scale: As noted STA. 16+96.91


WILLOW-INNER BELT FREEWAY
CLEVELAND CUYAHOGA COUNTY OHIO

DRAWN CKB TRACED AEX CHECKED TJP REVIEWED CT REVISIONS 9-21-60
DATE 5-13-58 DATE 9-3-58 DATE 6-12-58 DATE 11-13-59 SHEET 155

JUL 3 1955
 CUYAHOGA COUNTY
 CITY OF CLEVELAND
 CUY-21-15.32
 CUY-42-18.42

- LEGEND**
- Existing Right of Way
 - Existing Edge of Pavement
 - Existing Sewer Line
 - O.B.T. Line
 - Water Line
 - Gas Line
 - Existing Manhole
 - Existing Catch Basin
 - * Inlet
 - * Manhole
 - * Sewer
 - * 2" Duct
 - * 4" Duct


* Built under previous contract.

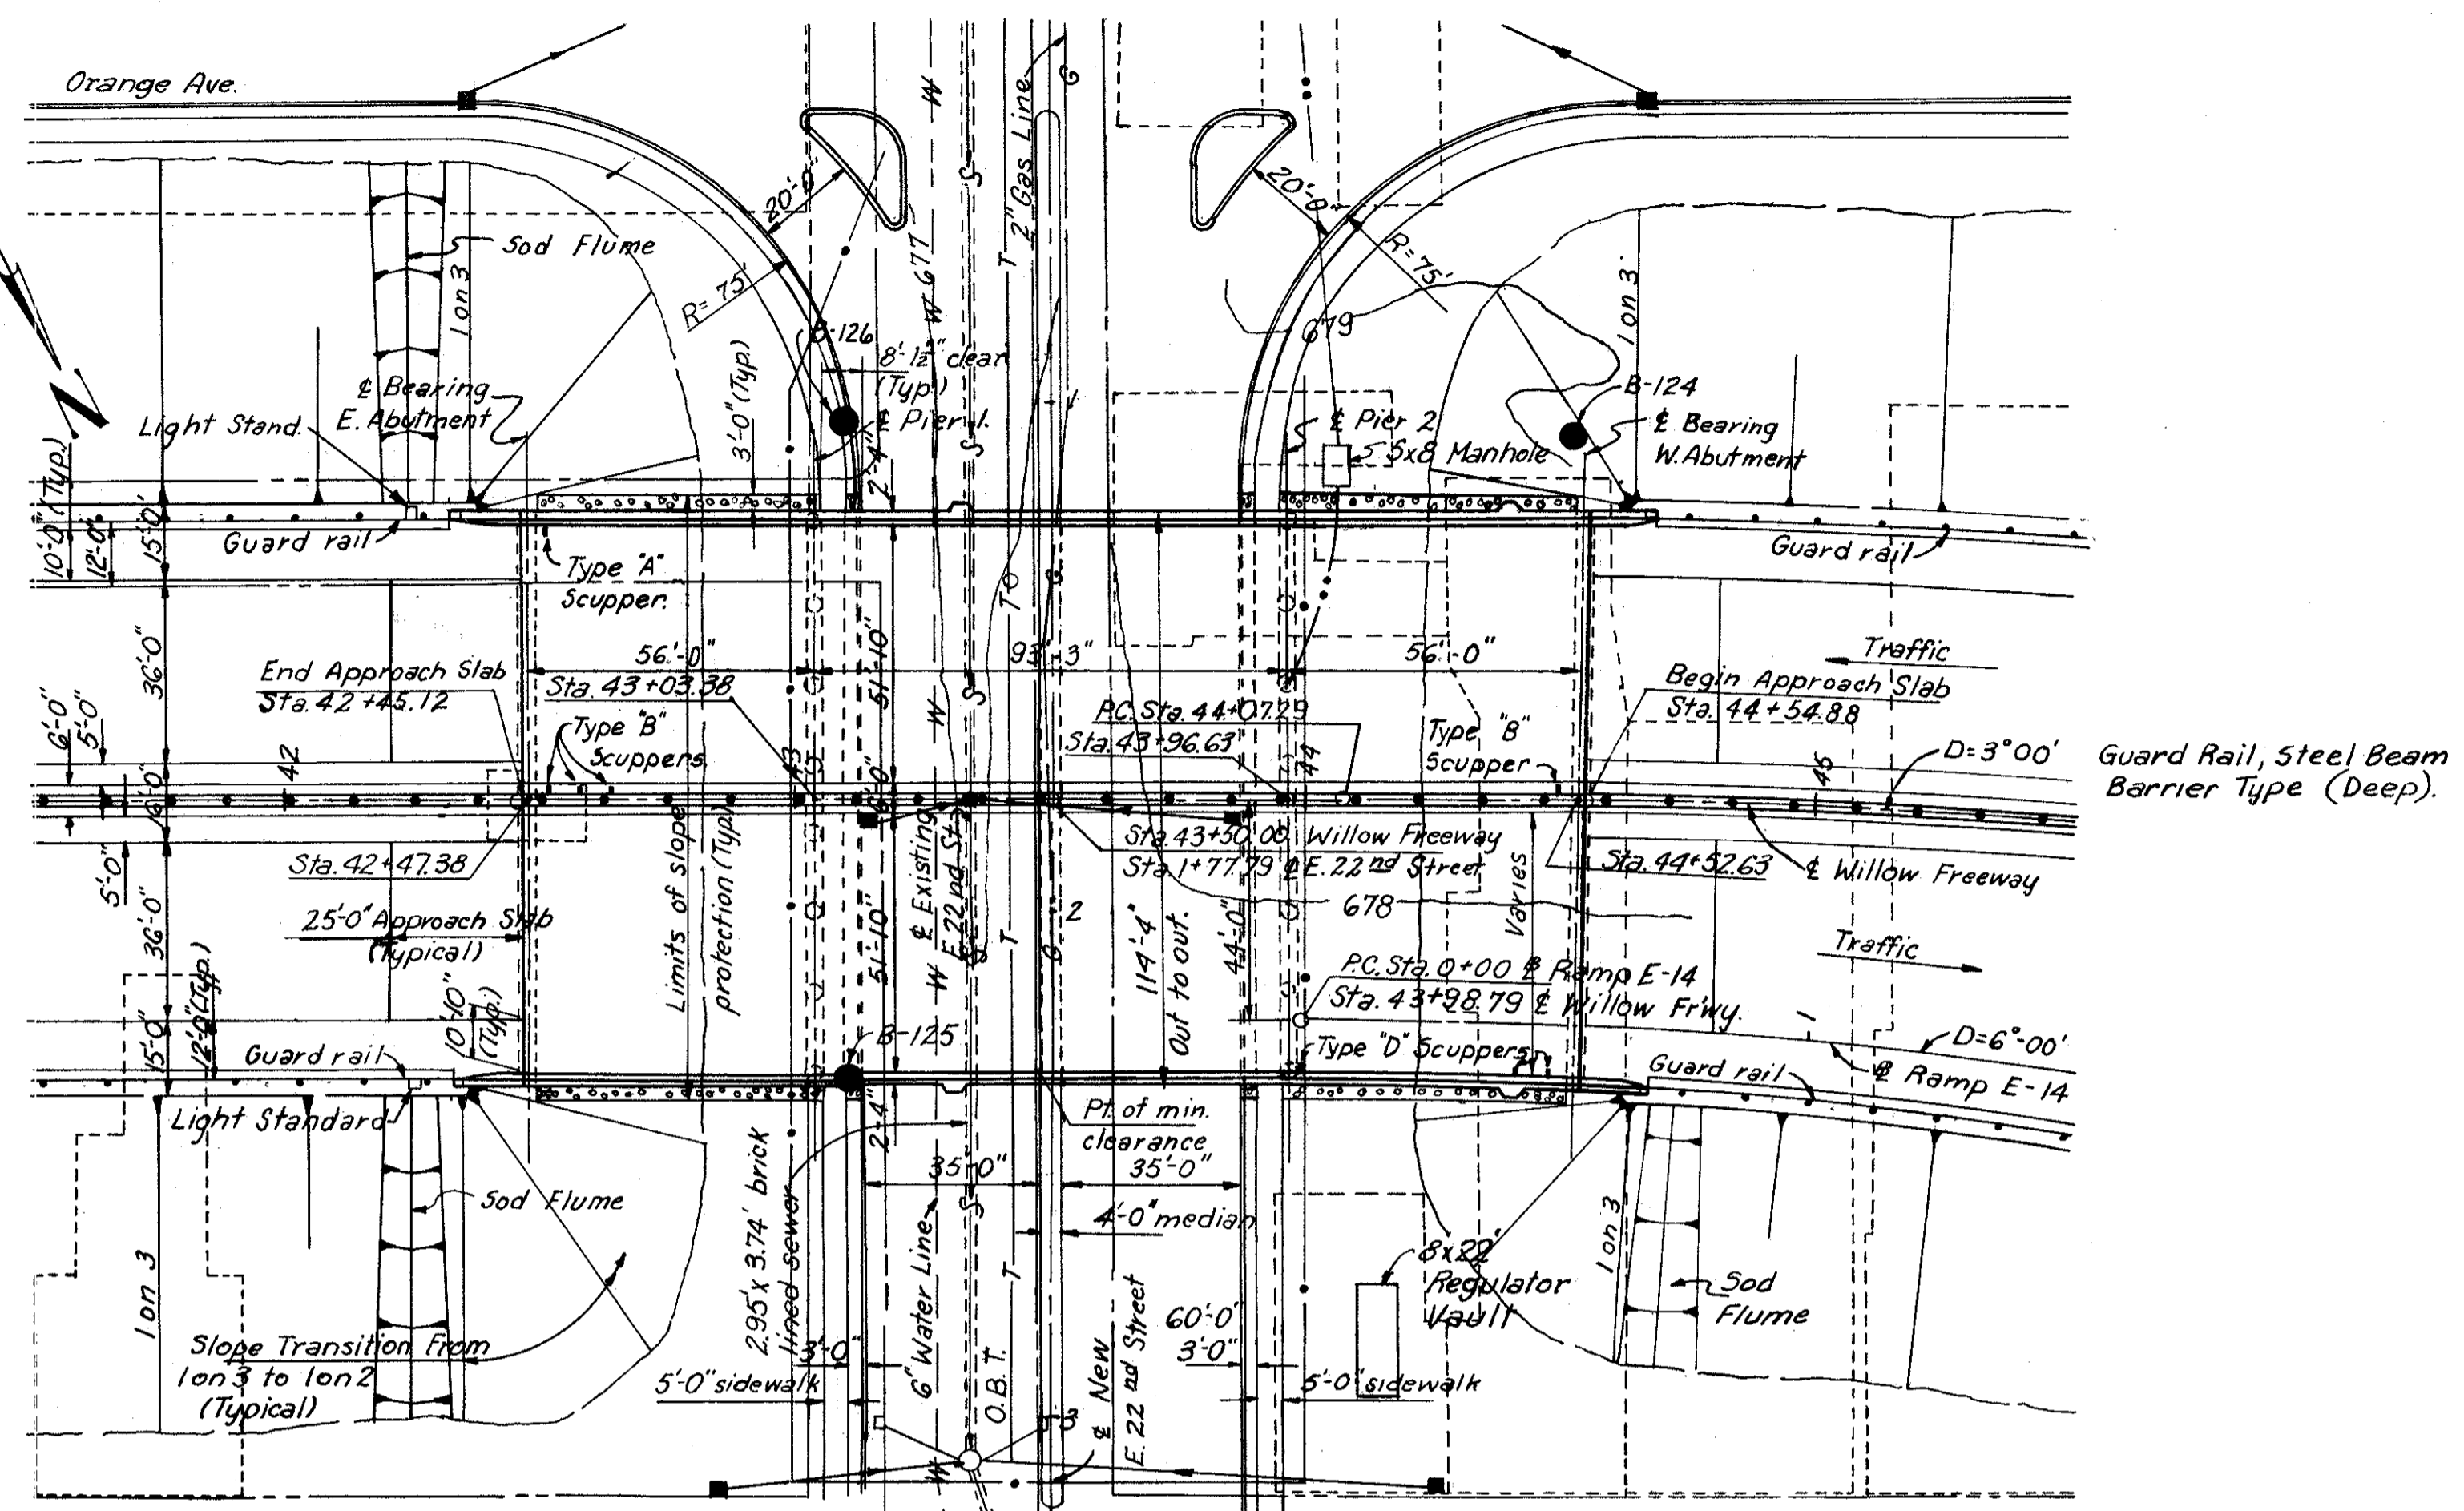

Guard Rail, Steel Beam Barrier Type (Deep).

CURVE DATA

WILLOW	RAMP E-14
$\Delta = 23^{\circ} 06' 48''$	$\Delta = 17^{\circ} 52' 41''$
$D = 3^{\circ} 00' 00''$	$D = 6^{\circ} 00' 00''$
$R = 1909.86'$	$R = 954.93'$
$L = 770.50'$	$L = 297.97'$
$T = 390.54'$	$T = 150.20'$

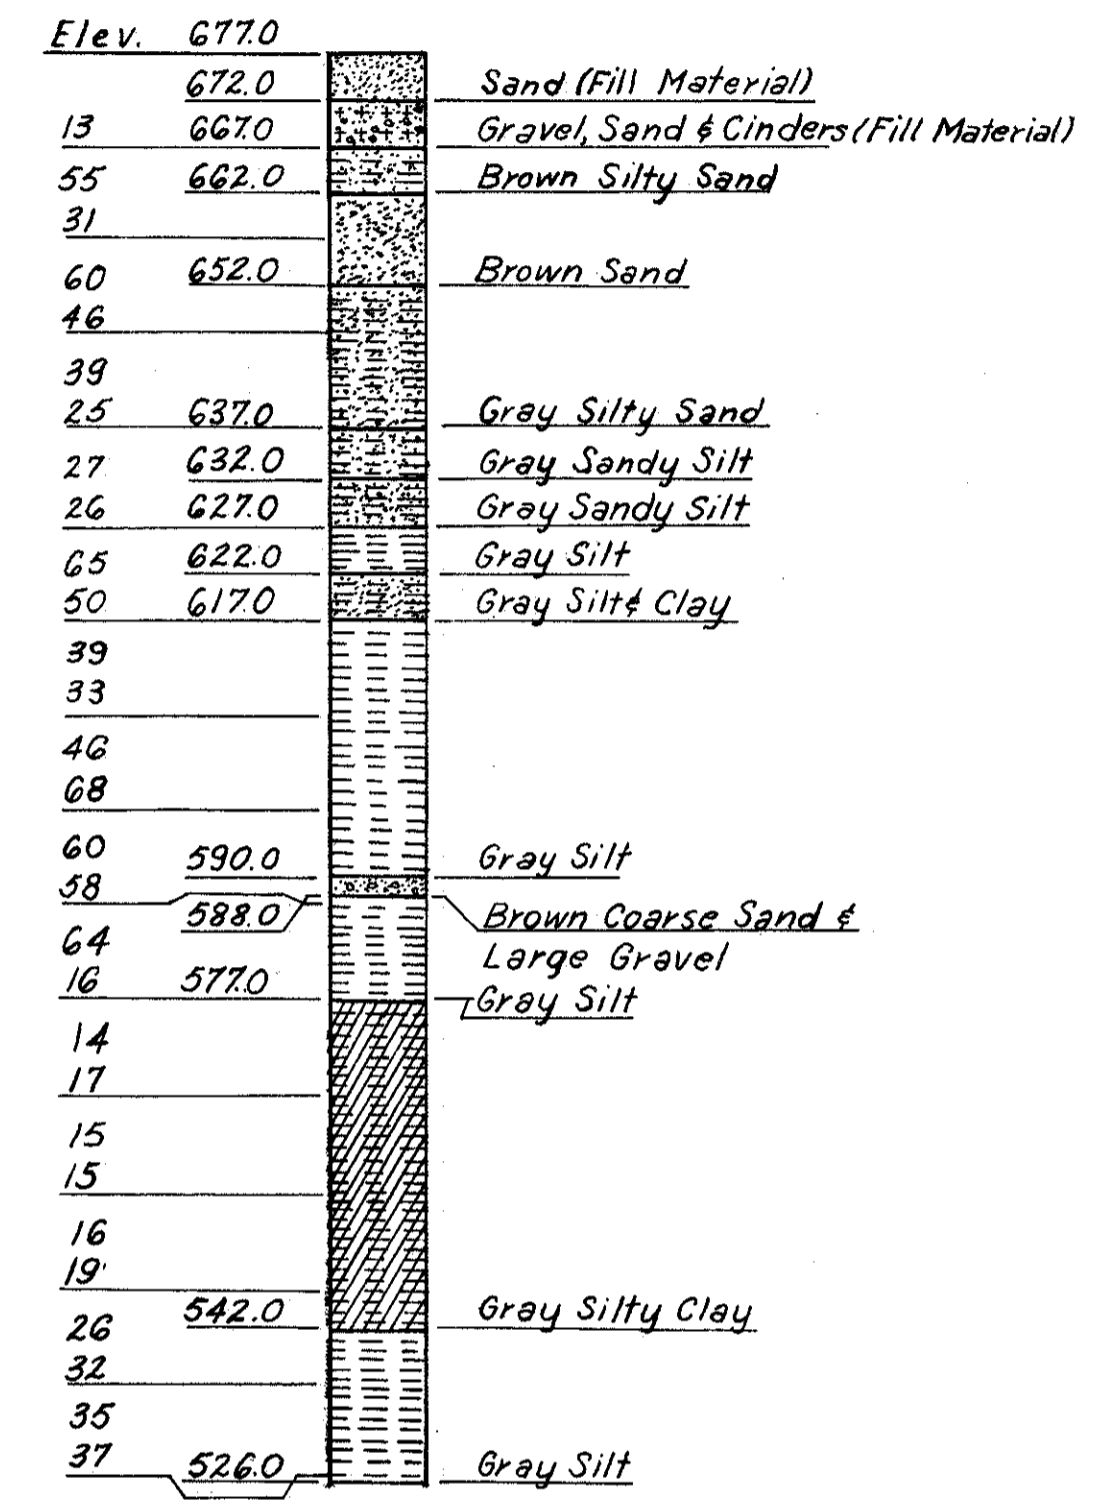


BORING B-125
 Sta. 43+10 60' Rt
 Vertical Scale: 1" = 20'

Note:
 The figures to the left indicates the number of hammer blows required to drive the sample spoon 1 ft. They are given at 5' intervals starting at elevation 667.0.

PROPOSED STRUCTURE

Type: Continuous steel beam with reinforced concrete deck and substructure.
 Spans: 56'-0", 93'-3", 56'-0" along Willow Frwy.
 Roadway: 112'-0" (nominal) flt parapets.
 Loading: CF 2000-Adequate for A.A.S.H.O. alternate loading.
 Surface Course: 1" Monolithic Concrete.
 Alignment: Tangent to 3°00' Rt.
 Approach Slabs: AS-1-54 (25' Long).
 Superelevation: Varies.
 Skew: 0°00'.

Note:
 Piers for Bridge No. 10 are included in Part 6.

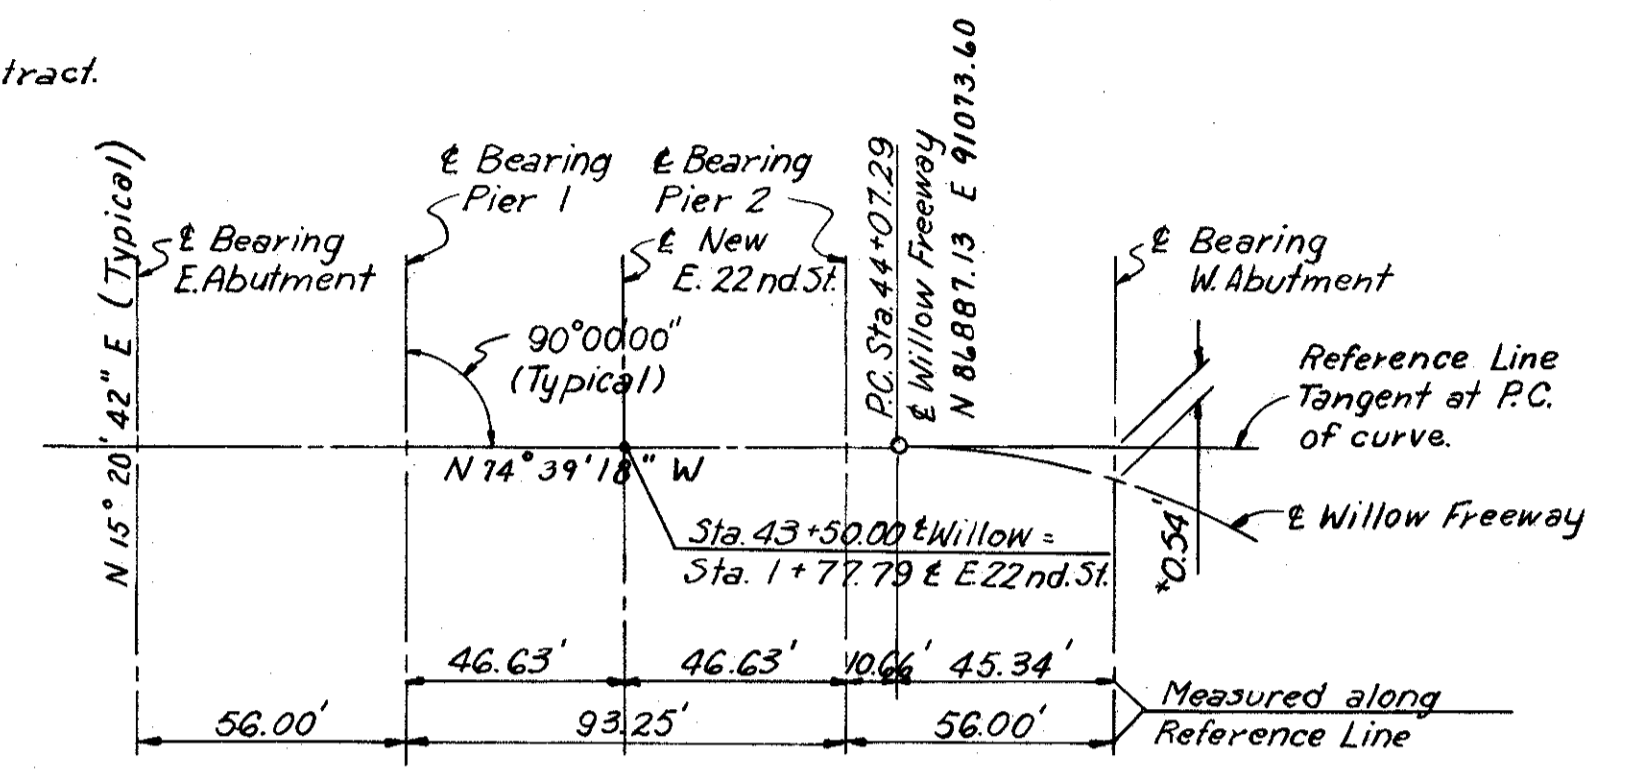

BRIDGE LAYOUT DIAGRAM
 No Scale

* Offset measured from reference line to Willow Freeway along Bearings


PILE INFORMATION

Location	Diameter	Number	Estimated ave. length
E. Abutment	12"	42	34'
W. Abutment	12"	42	35'
Pier 1	14"	50	26'
Pier 2	14"	50	26'

All piling to be C.I.P. Reinforced Concrete.

NOTES:

Rod soundings only were taken at location B-124 & B-126. The core drilling made at B-125 is plotted. Detail for slope protection see sheet 174-7A. Pile lengths are based on boring data and are approximate only. The Contractor shall assume full responsibility for length of piling selected for driving. The following items are not included in the bridge plans. See Roadway Plans for details. Approach grading, pavements and slabs. Roadway Guard Rail. Sod Flumes. For details of pier plans & drain pipe locations at piers see sheets 172-7A & 174-7A.

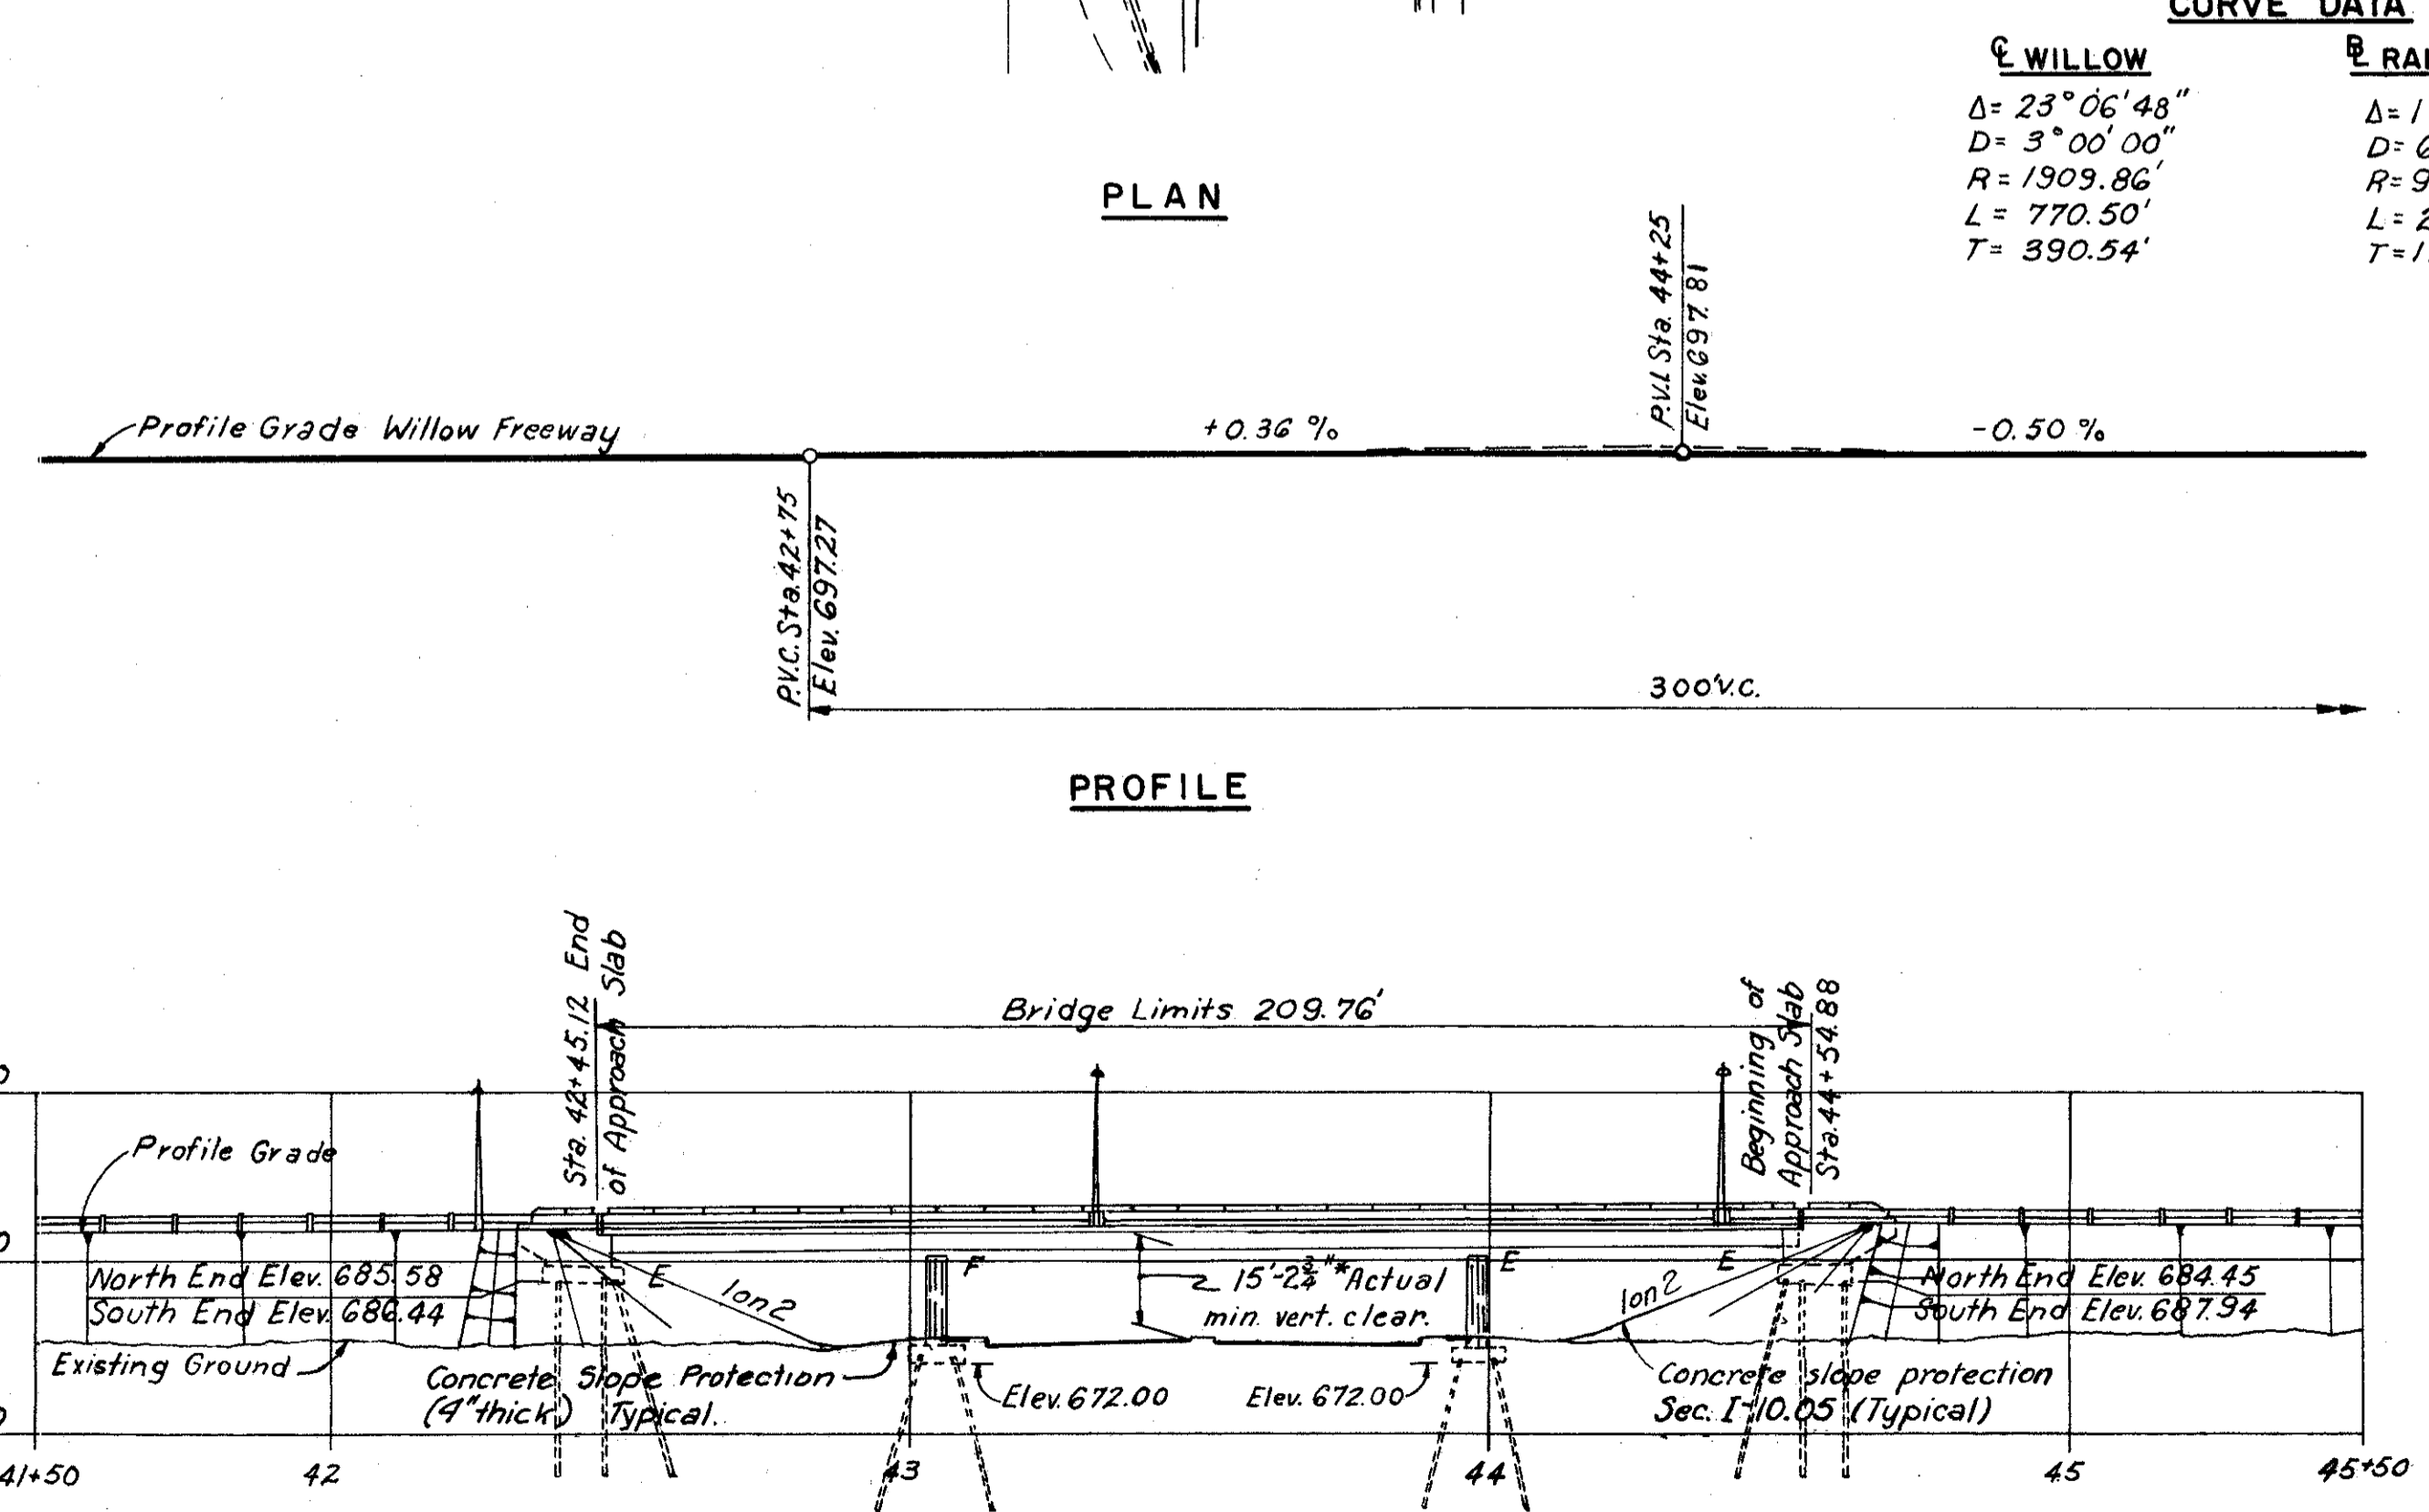

ELEVATION

* 15'-0" Required minimum vertical clearance. Point of actual minimum vertical clearance occurs at East edge of median and the North exterior beam.

H.N.T.B. BR. NO. 10 PART 7A

HOWARD, NEEDLES, TAMMEN & BERGENDOFF
 CONSULTING ENGINEERS
 KANSAS CITY CLEVELAND NEW YORK

SITE PLAN

WILLOW FREEWAY OVER EAST 22nd. ST.
 BR. NO. CUY-21-1559 STA. 42+45.12
 Scale: 1" = 30' STA. 44+54.88


WILLOW-INNER BELT FREEWAY
 CLEVELAND CUYAHOGA COUNTY OHIO

DATE 4/14/50 TRACED N.E.S. CHECKED D.M. REVIEWED J.C.T. REVISION SHEET 156

JUL 3 1965


CUYAHOGA COUNTY
CITY OF CLEVELAND
CUY-21-15.32
CUY-42-18.42

Note: Prefix "AA" shall be assigned to all bar marks.

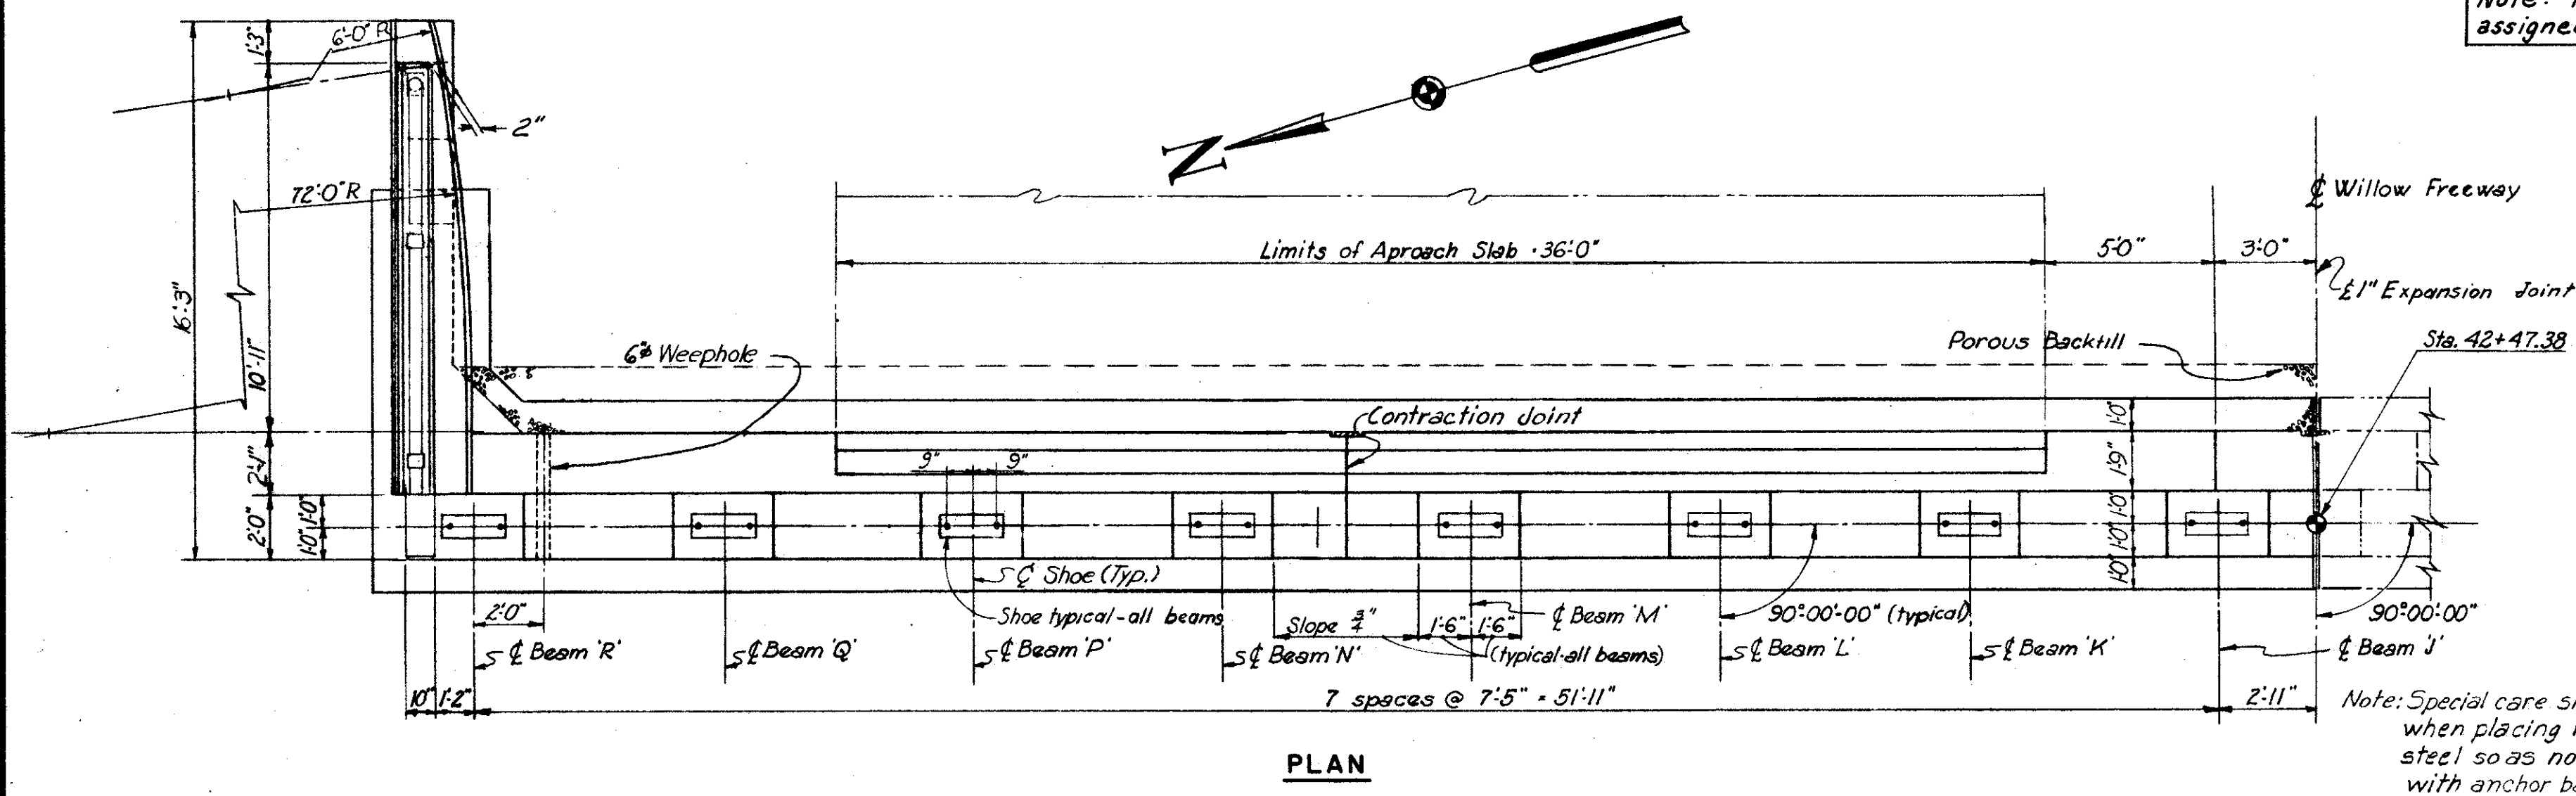


PLAN


Note: Special care shall be taken when placing reinforcing steel so as not to interfere with anchor bar setting.

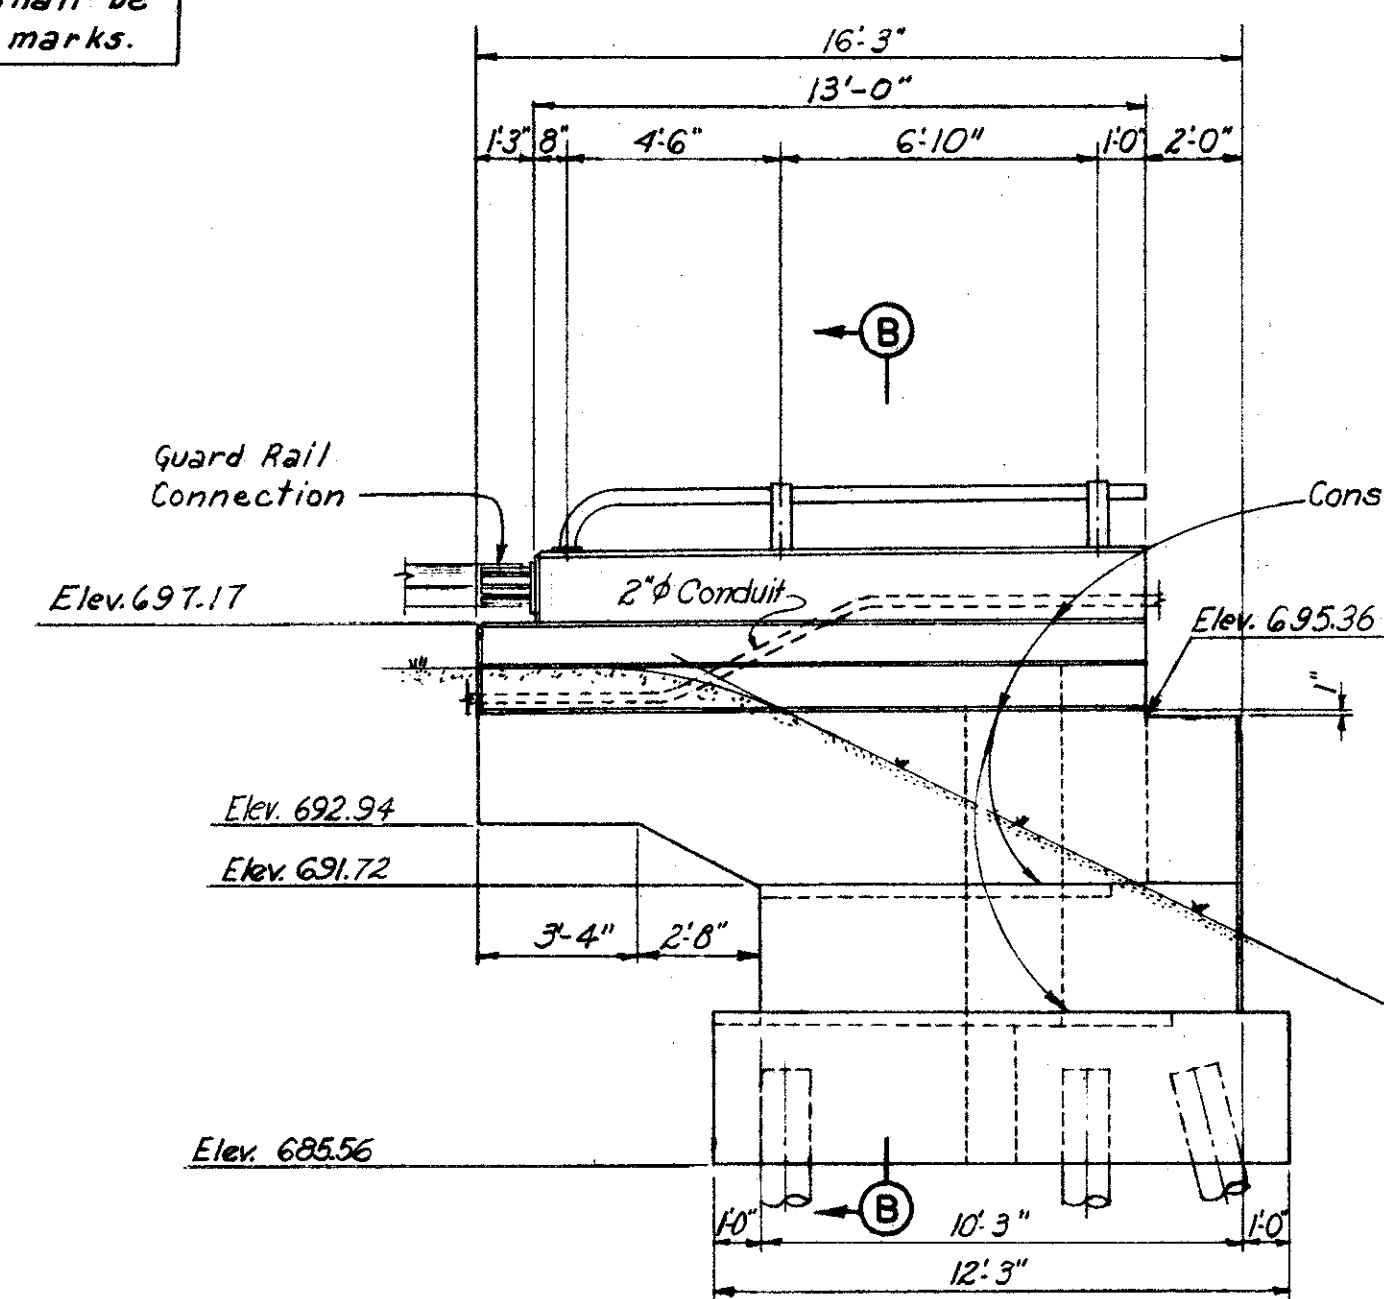

ELEVATION A-A (For reinforcement see sheet 158-7A)

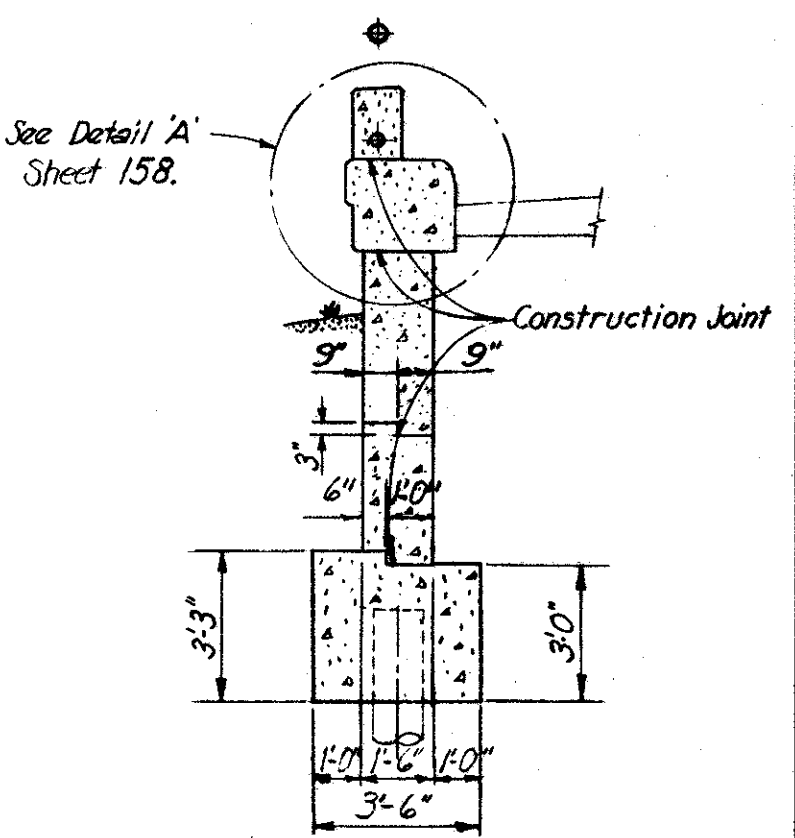


SECTION B-B (Reinforcement not shown)

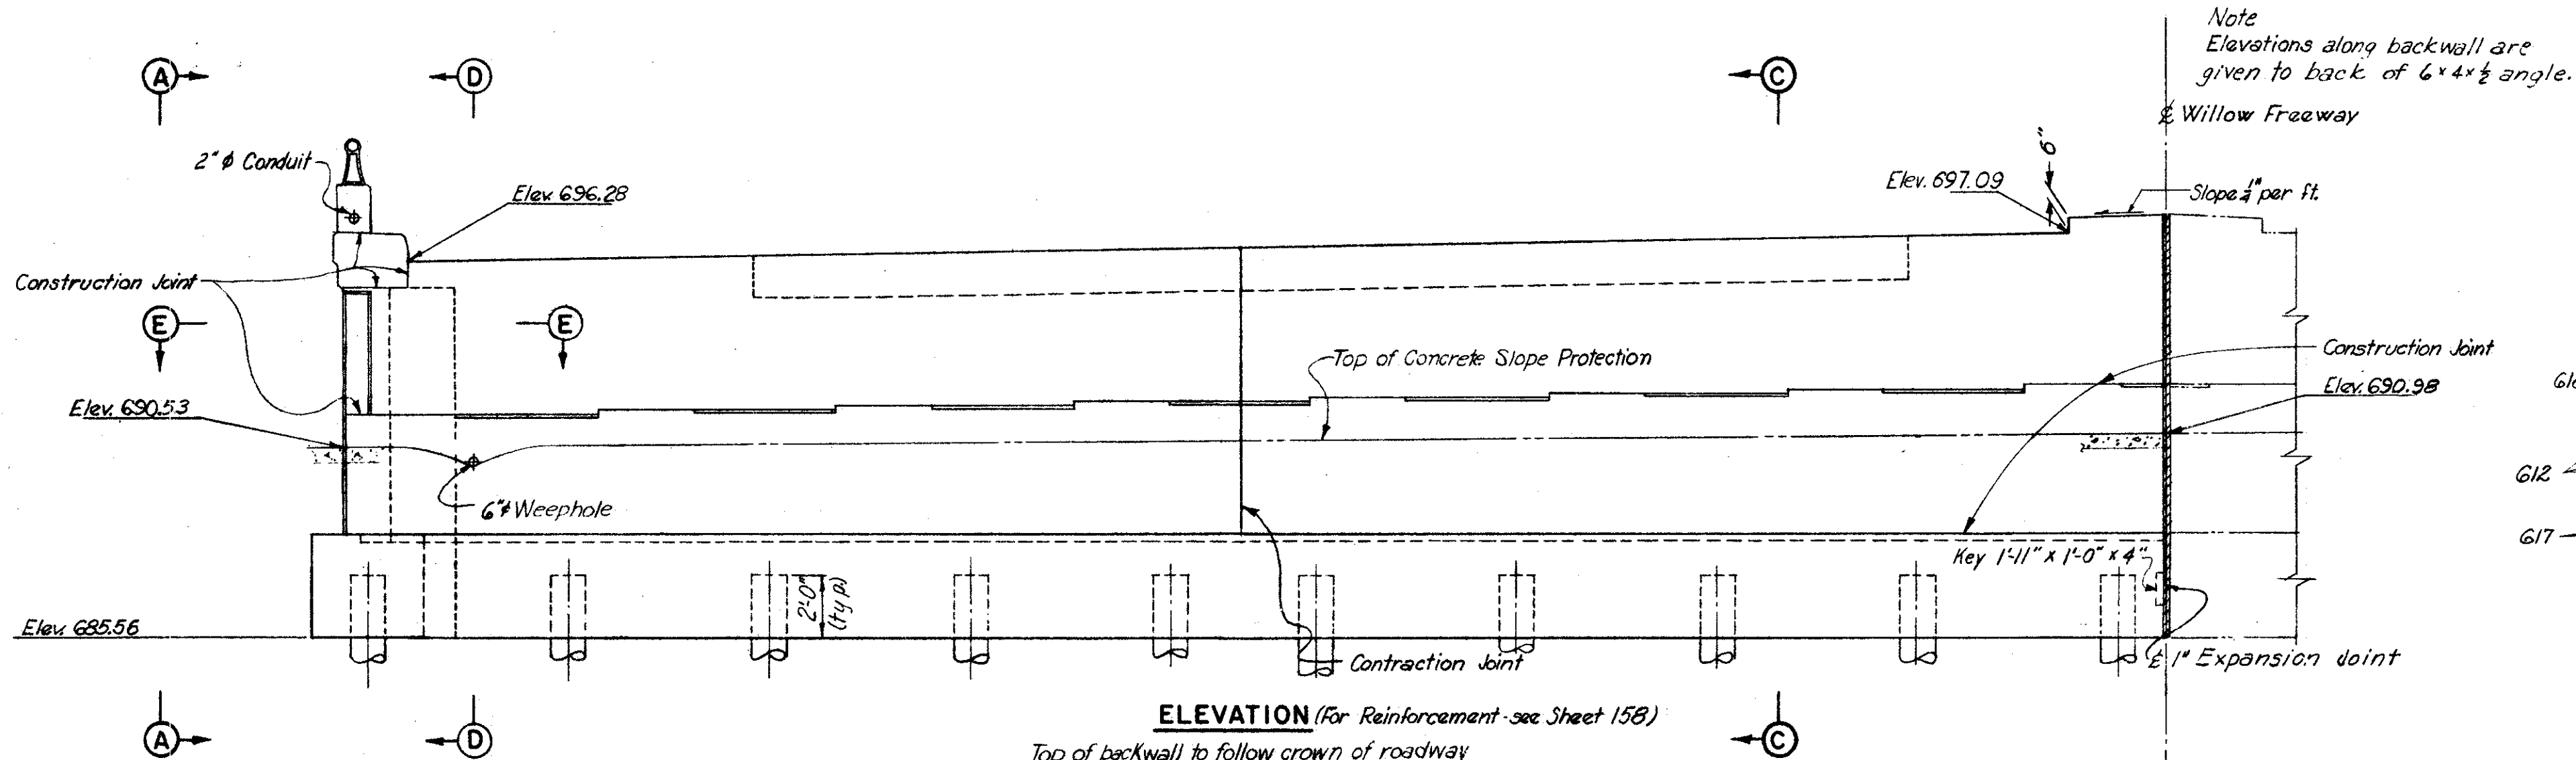


ELEVATION (For Reinforcement see Sheet 158)

Top of backwall to follow crown of roadway


Note: Elevations along backwall are given to back of 6x4x1/2 angle.

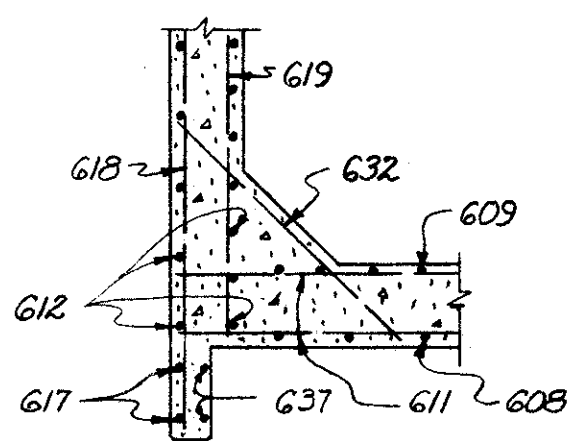


SECTION E-E

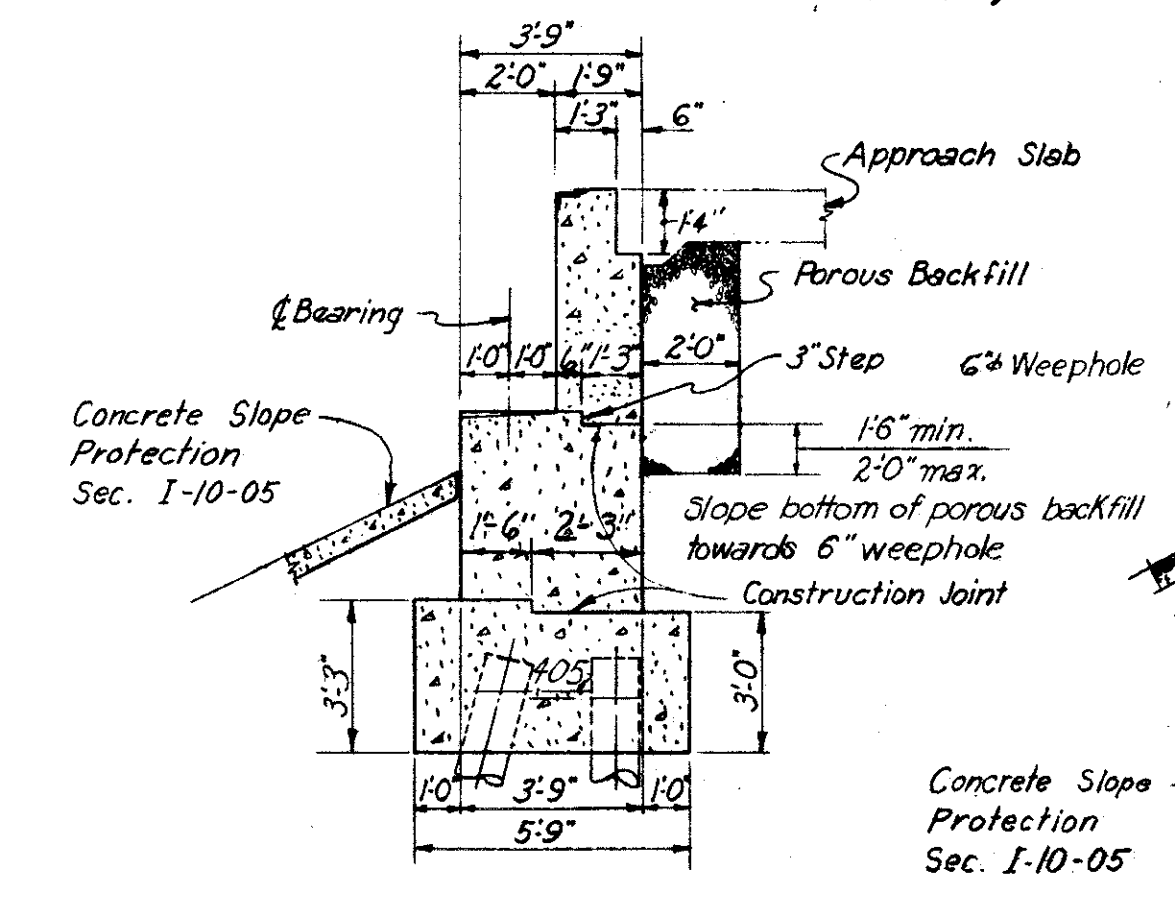

SECTION C-C (Reinforcement not shown, See Sheet 158-7A)

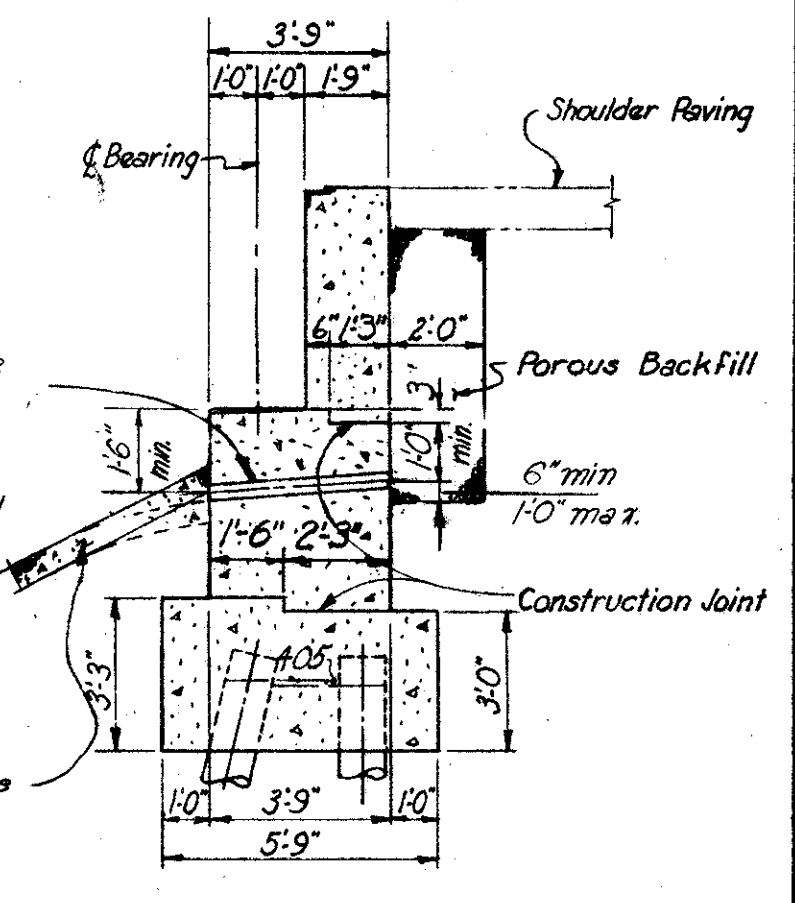

SECTION D-D (Reinforcement not shown, See Sheet 158-7A)

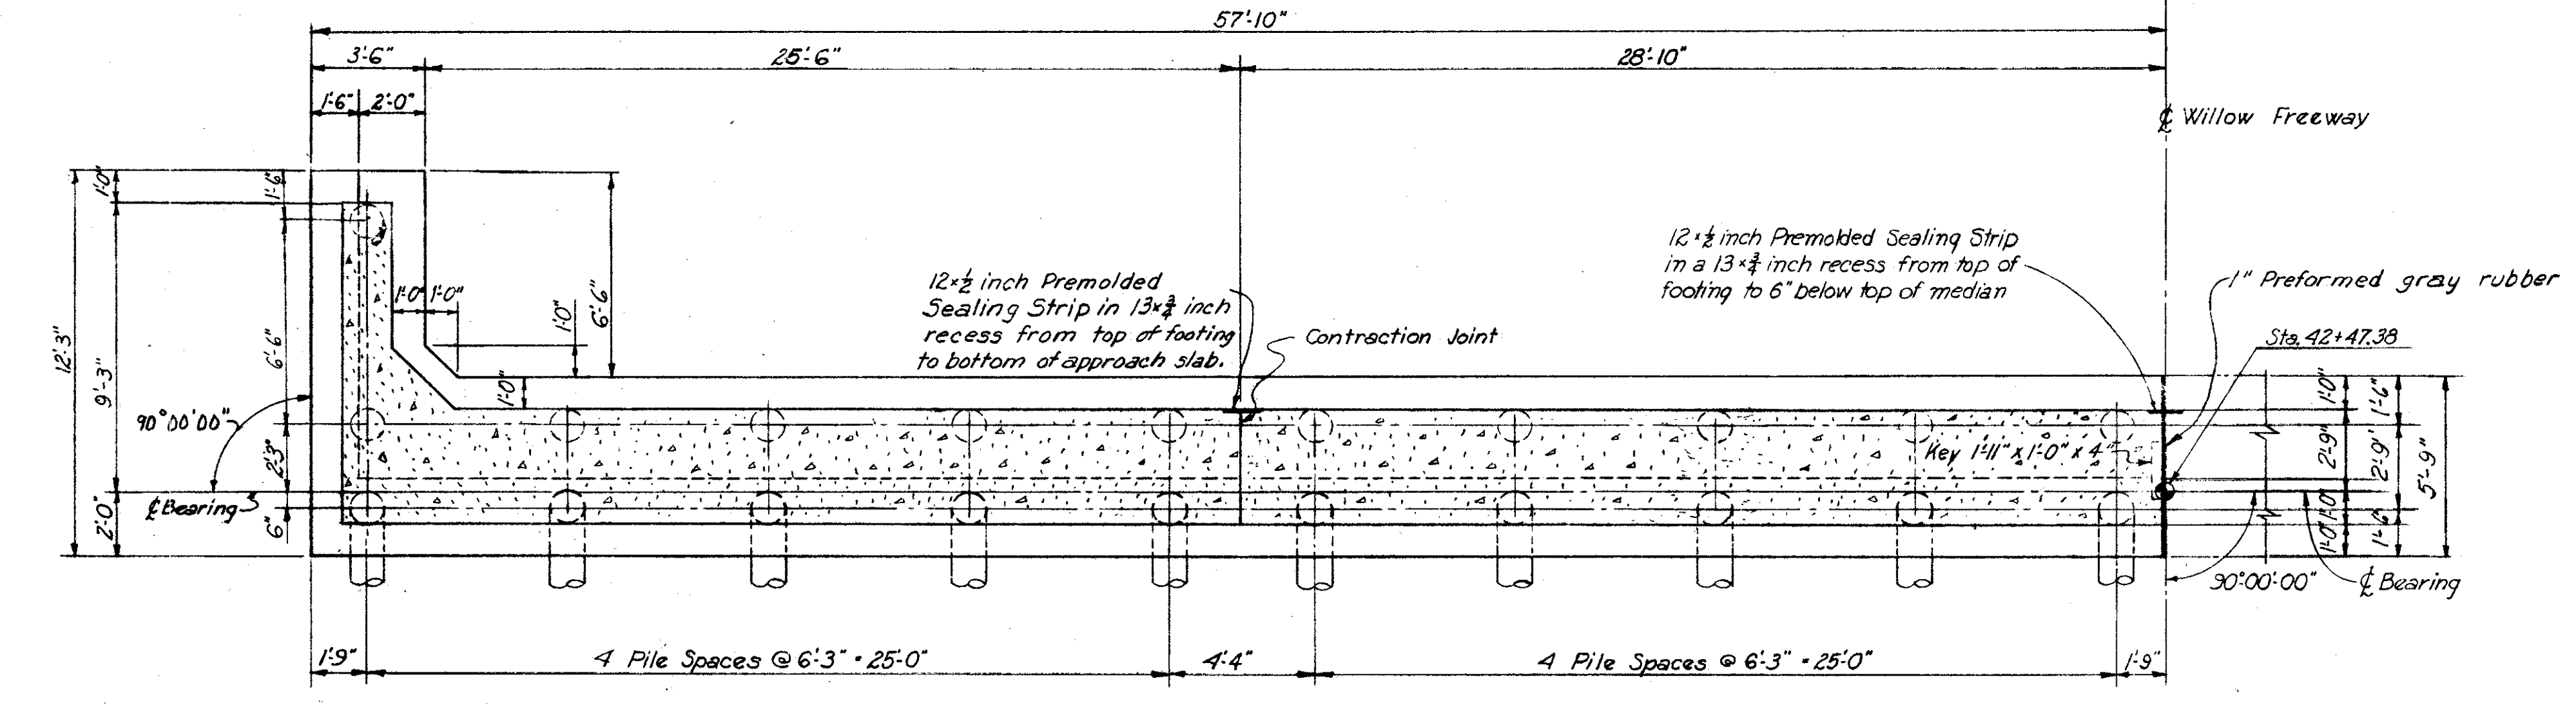

FOOTING PLAN (For Reinforcement see Sheet 158)

NOTES:
All piles shall be 12" dia. C.I.P. reinforced concrete.
Pile spacing given along bottom of footing.
All battered piles shall be battered 3 in 12 in direction shown.
For Masonry Plate details, see sheet 173-7A.
For Railing details and Guard Rail connection details, see Sheet 175-7A.
For location of lighting conduits, see Sheet 176-7A.
For Reinforcement schedule, see Sheet 161-7A.
For Replacement schedule, see Sheet 103-7A.
Reinforcement bars shall be 3 inches clear from bottom of footing and 2 inches elsewhere.
For details of end dam, see Sheet 173-7A.
For slope Protection details, see Sheet 174-7A.
n.f. = near face; f.f. = far face; ea. fa. = each face.
Backfill shall be placed prior to placing of curb.
Ends of railing parapet shall be normal to top of safety curb.







Beam	Elevation
J	692.53
K	692.42
L	692.30
M	692.19
N	692.07
P	691.95
Q	691.84
R	691.72

H.N.T.B. BR. NO. 10 PART 7A
HOWARD, NEEDLES, TAMMEN & BERGENDOFF
CONSULTING ENGINEERS
KANSAS CITY CLEVELAND NEW YORK

EAST ABUTMENT-NORTH HALF
WILLOW FREEWAY OVER EAST 22nd ST.
BR. NO. CUY-21-1559 STA. 42+45.12
Scale: 1/4" = 1'-0" STA. 44+54.88
WILLOW-INNER BELT FREEWAY
CLEVELAND CUYAHOGA COUNTY OHIO

DRAWN C.D.D. TRACED DATE 5-9-58
CHECKED C.M. REVIEWED J.C.T. DATE 2-27-59
REVISIONS
DATE 11-13-59 SHEET 157

CUYAHOGA COUNTY
CITY OF CLEVELAND
CUY-21-1532
CUY-42-18.42

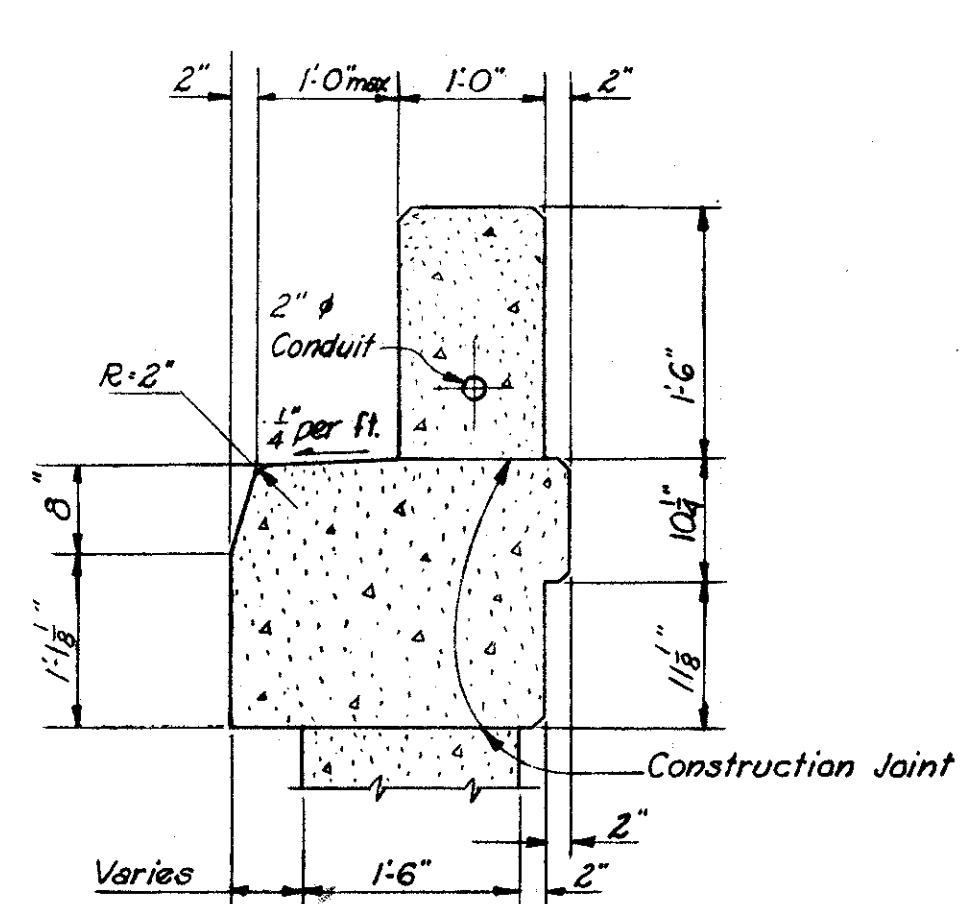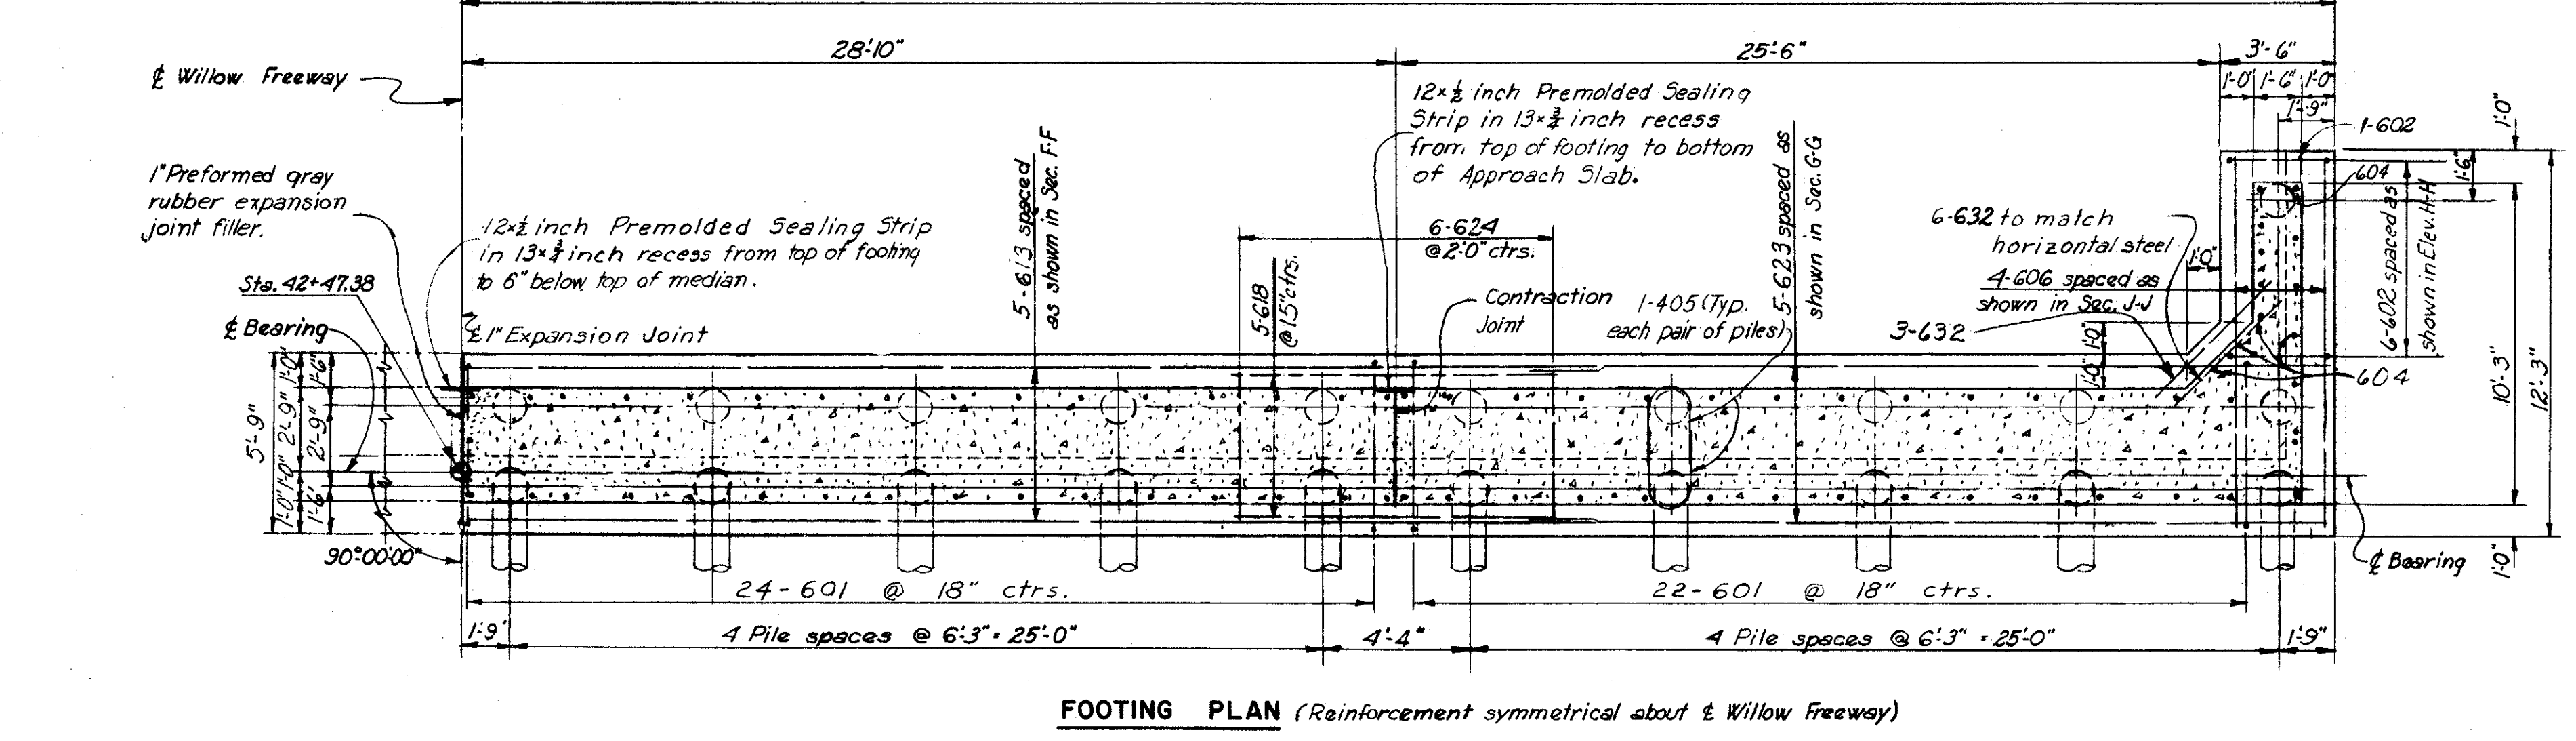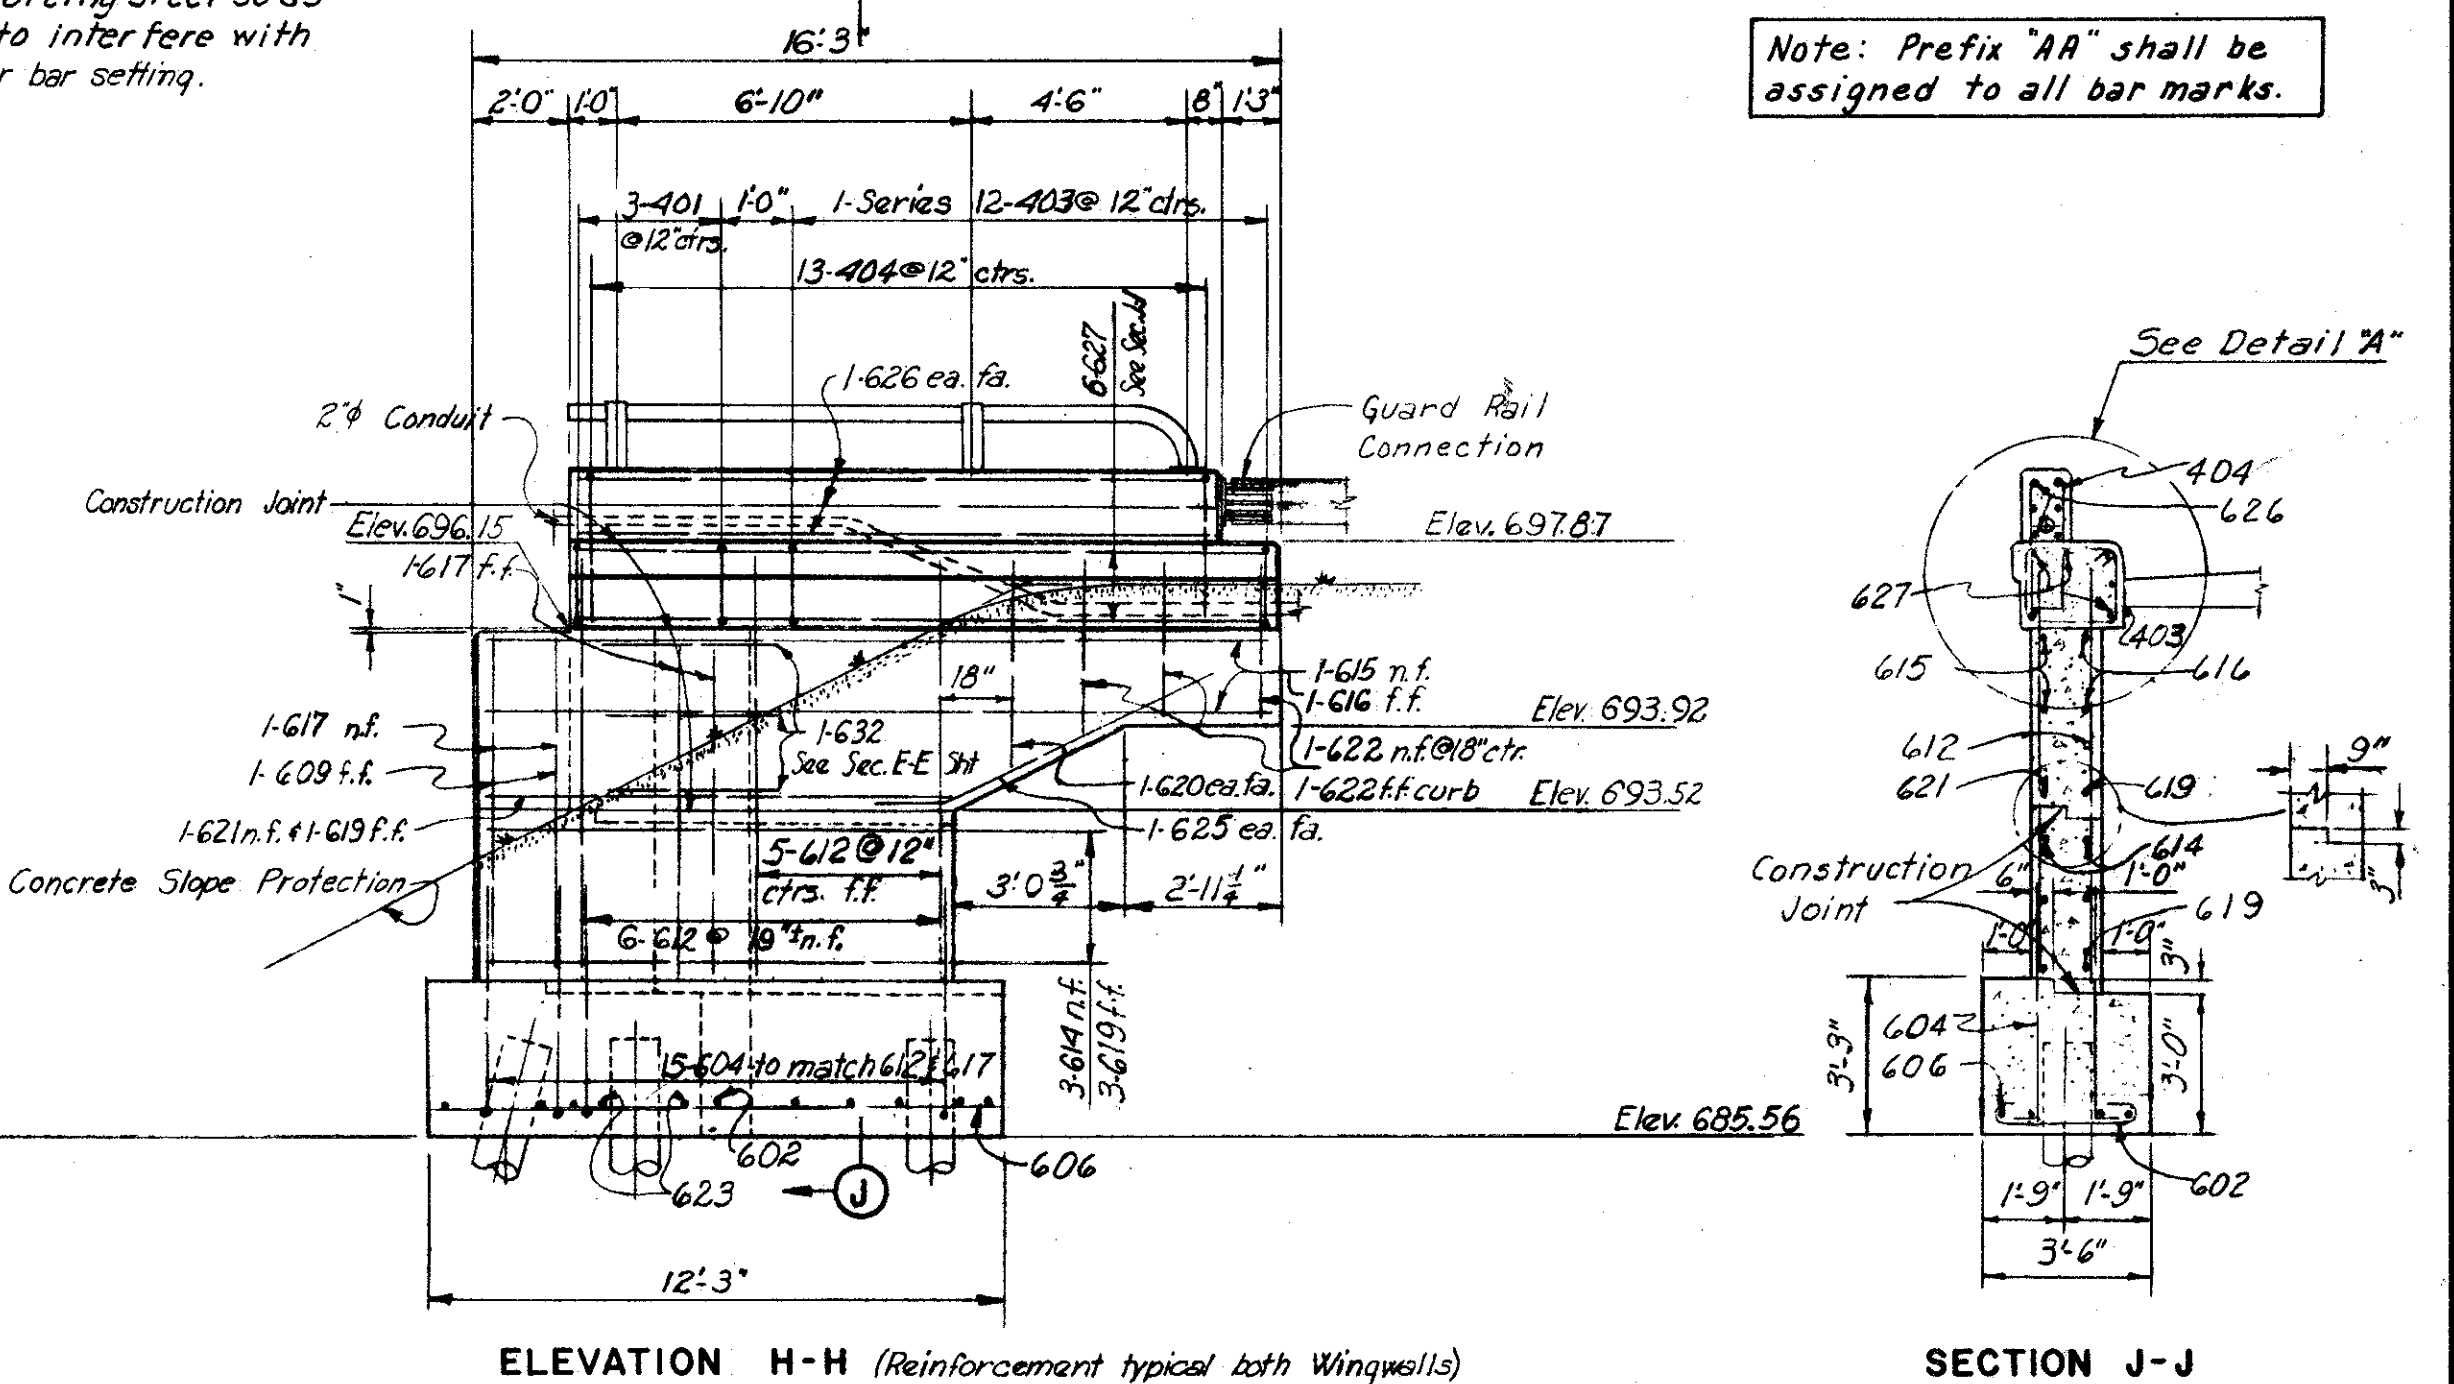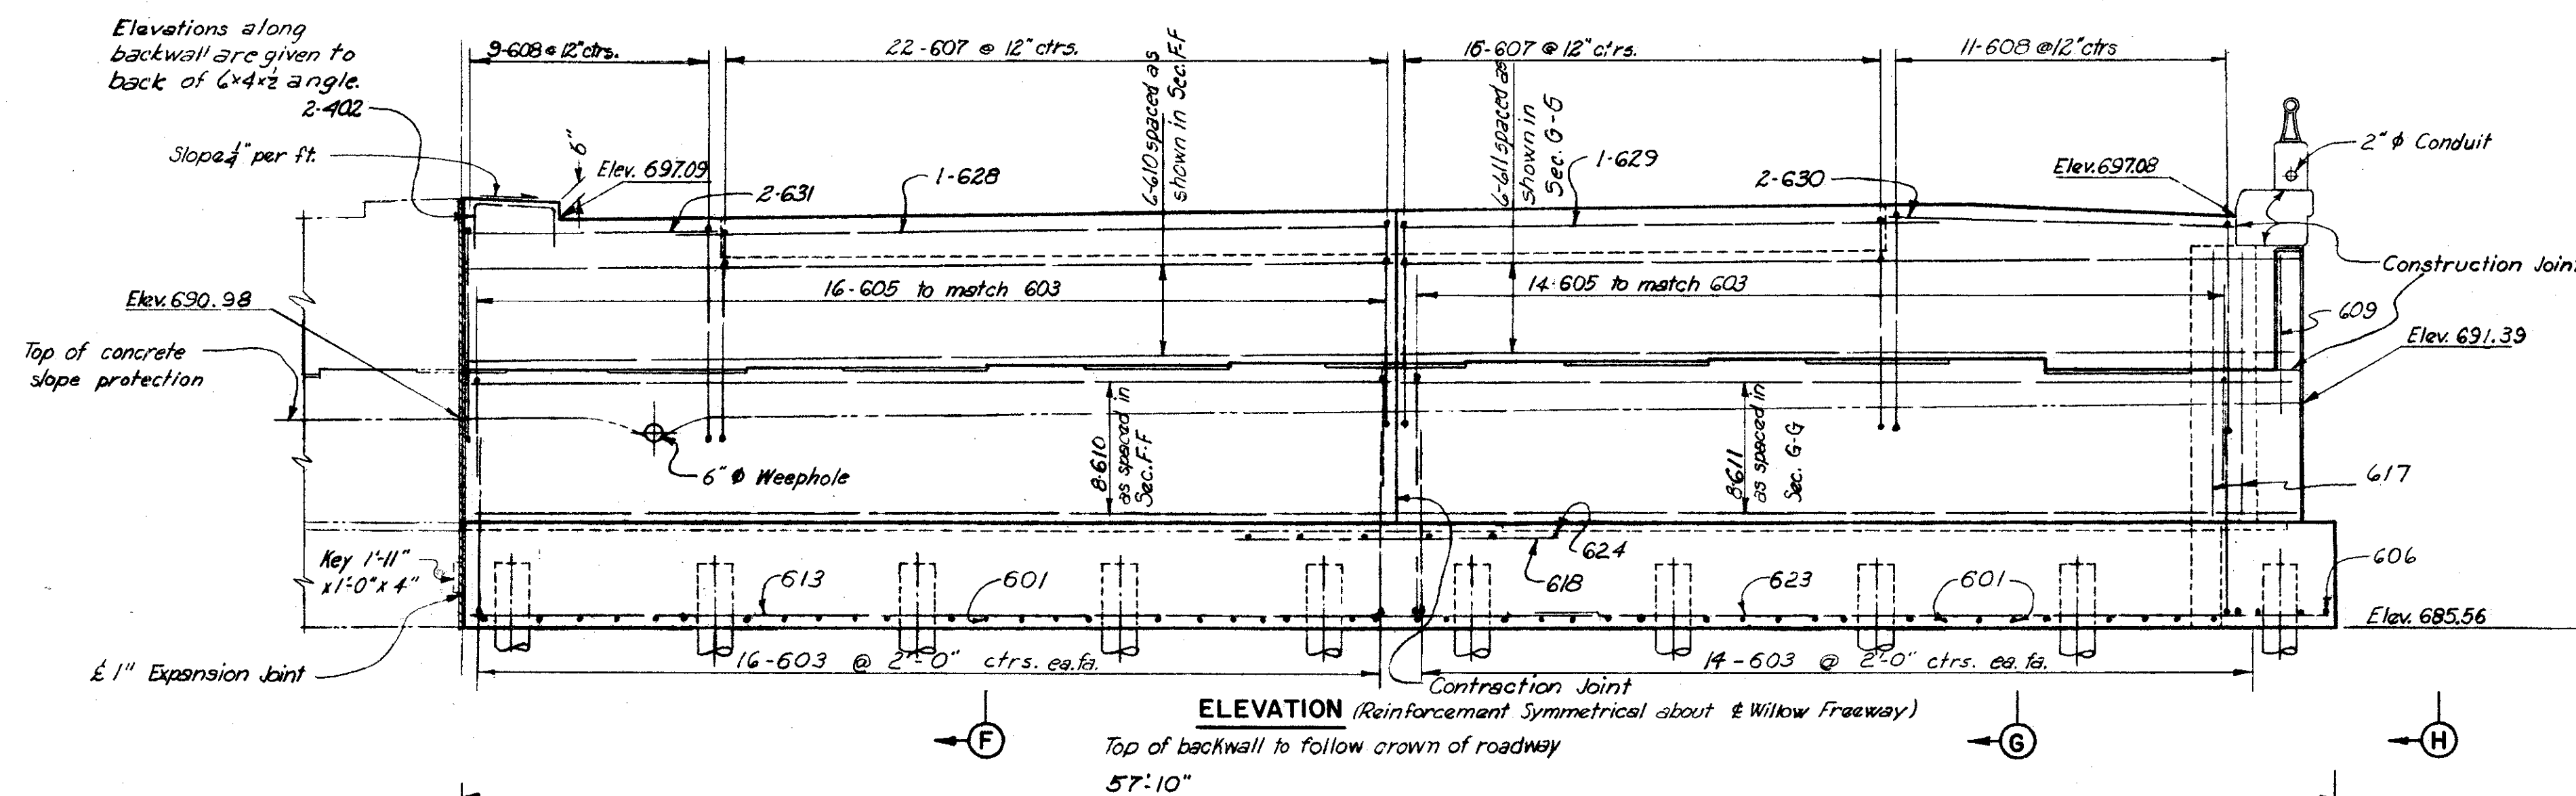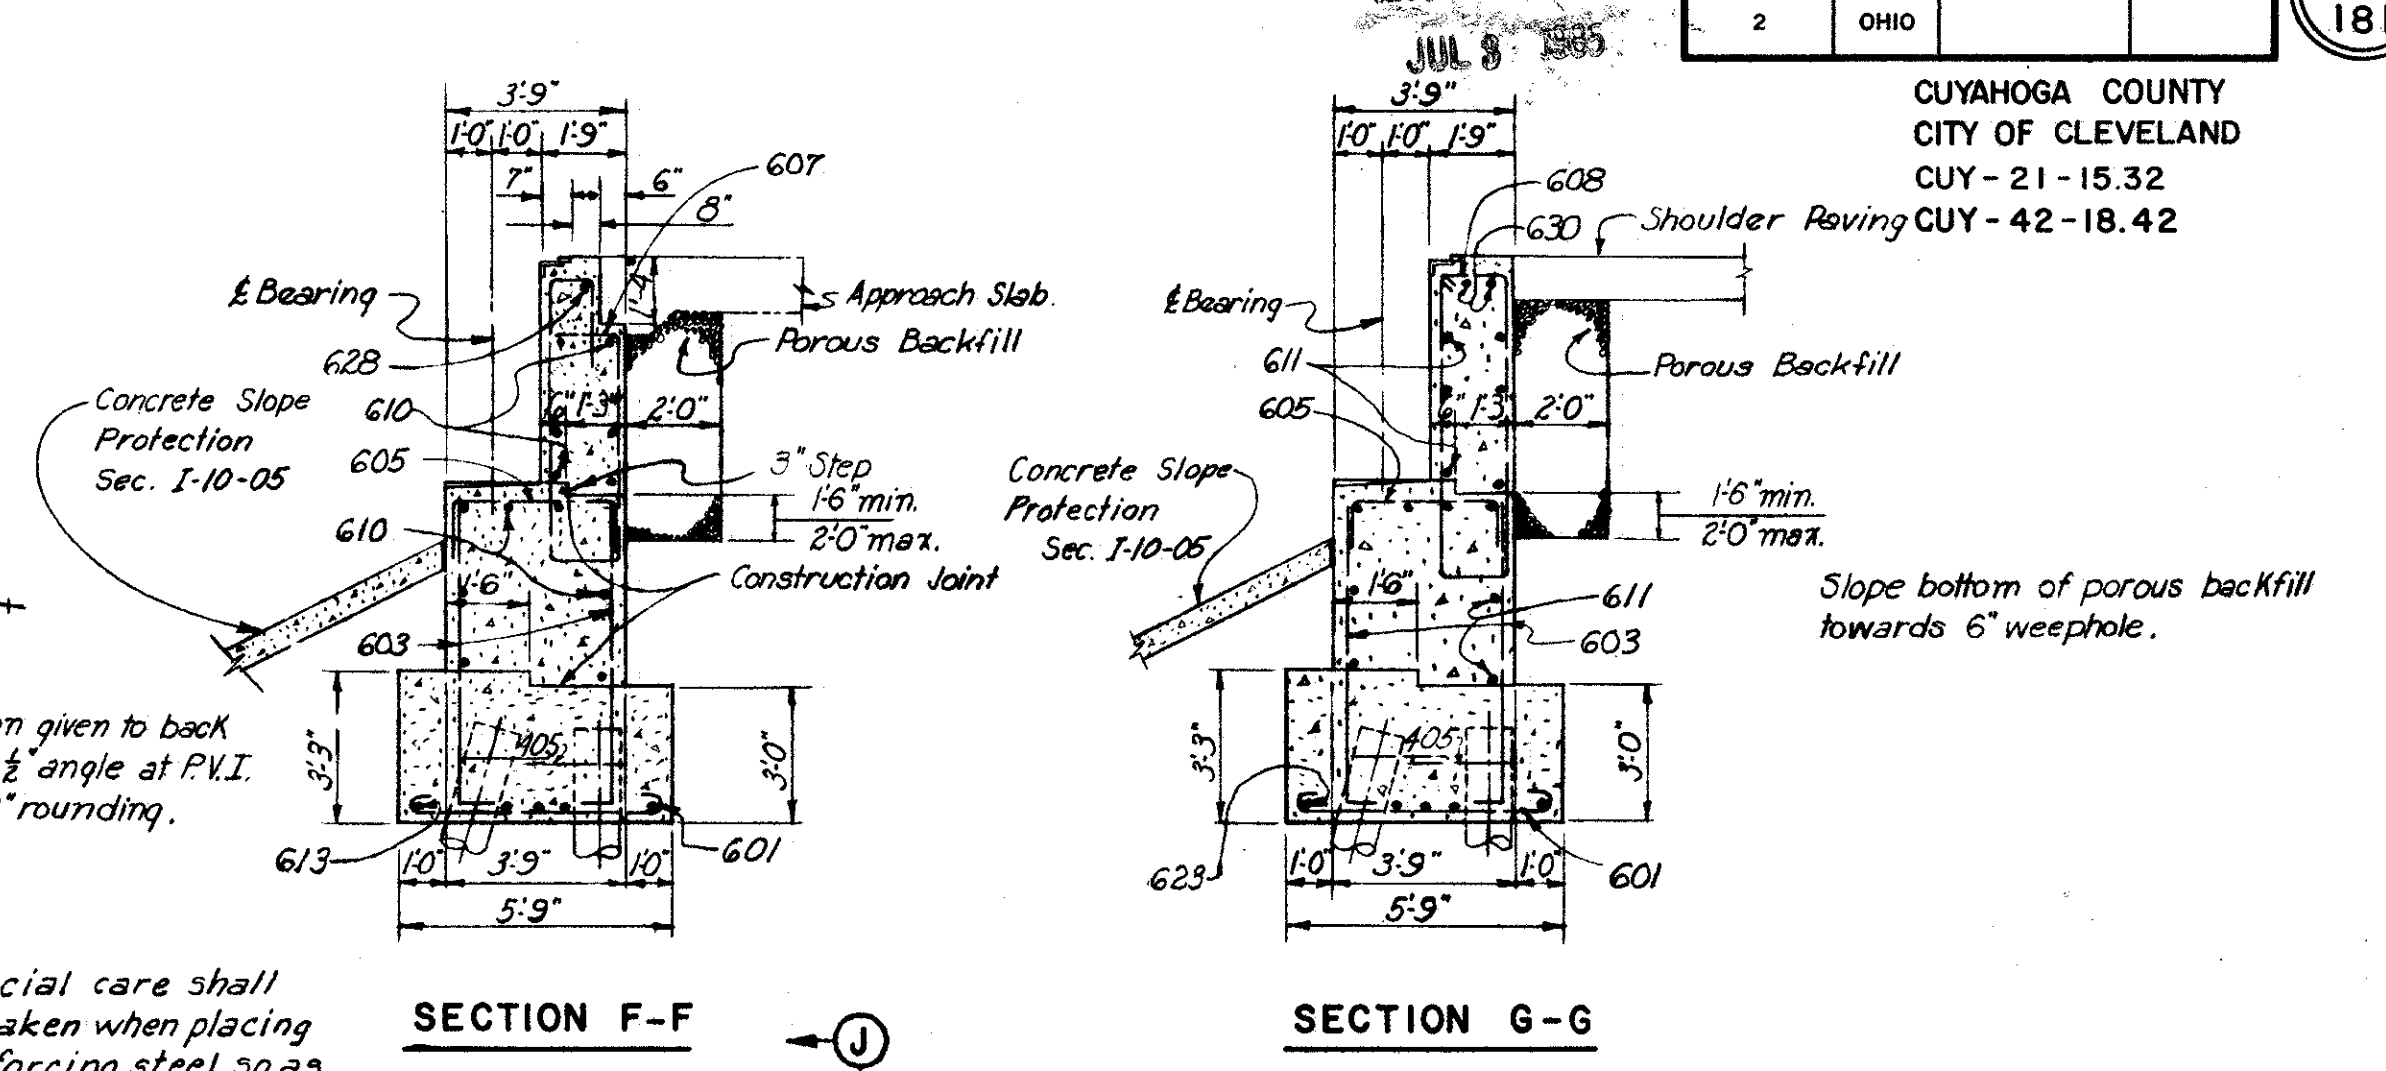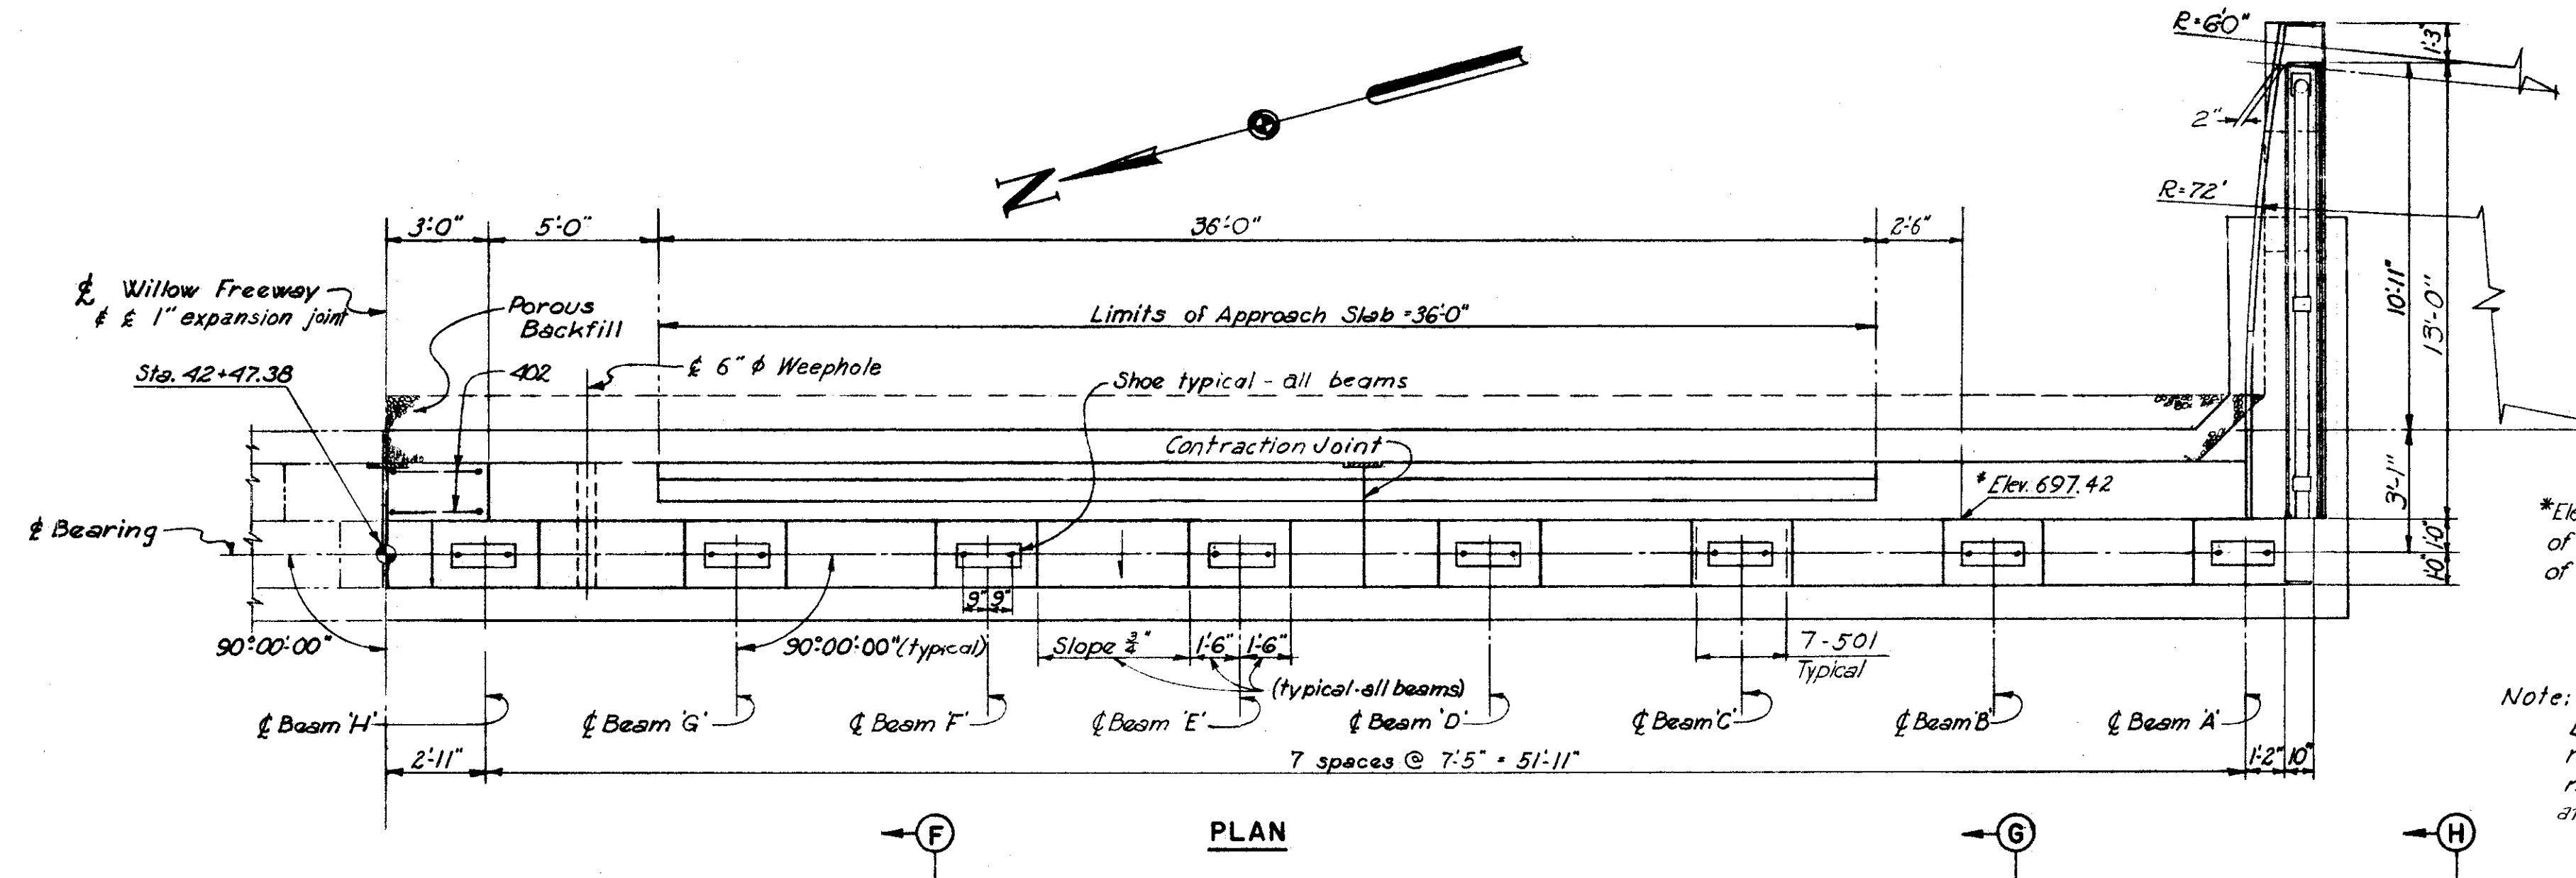

Beam	Elevation
A	692.52
B	692.82
C	692.82
D	692.76
E	692.71
F	692.65
G	692.59
H	692.53

For Notes see Sheet 157-7A.

H.N.T.B. BR. NO. 10 PART 7A




HOWARD, NEEDLES, TAMMEN & BERGENDOFF
CONSULTING ENGINEERS
KANSAS CITY CLEVELAND NEW YORK

EAST ABUTMENT-SOUTH HALF
WILLOW FREEWAY OVER EAST 22nd ST.
BR. NO. CUY-21-1559 STA. 42+45.12
Scale: 1/4" = 1'-0" Except as noted STA. 44+54.88
WILLOW-INNER BELT FREEWAY
CLEVELAND CUYAHOGA COUNTY OHIO




DRAWN C.D.D.	TRACED	CHECKED C.M.	REVIEWED W.C.T.	REVISED
DATE 5-14-59	DATE	DATE 2-27-59	DATE 11-13-59	

JUL 3 1955

CUYAHOGA COUNTY CITY OF CLEVELAND CUY-21-15.32 CUY-42-18.42

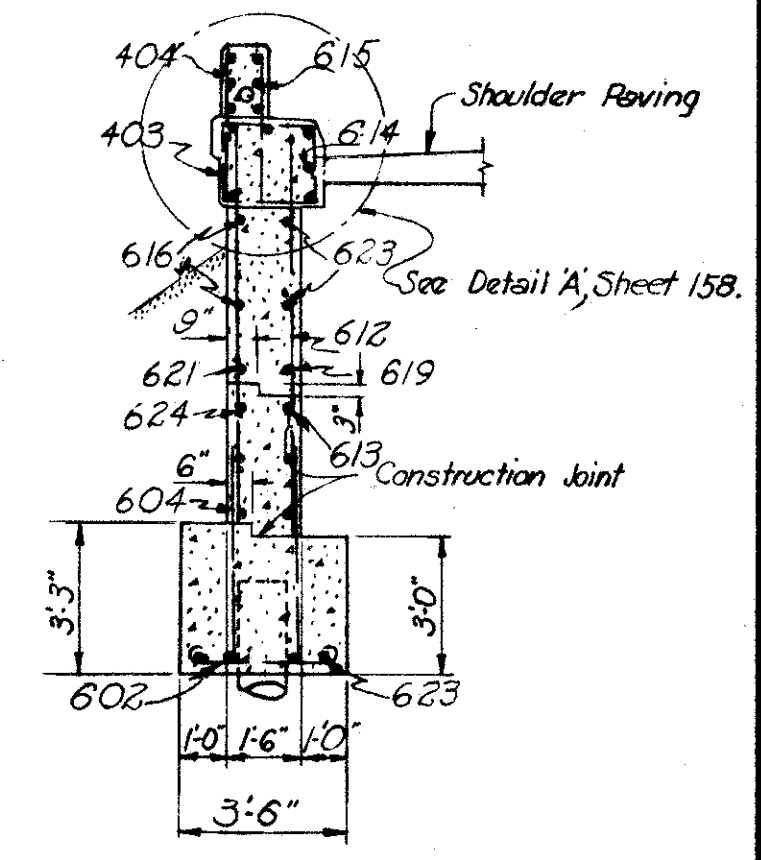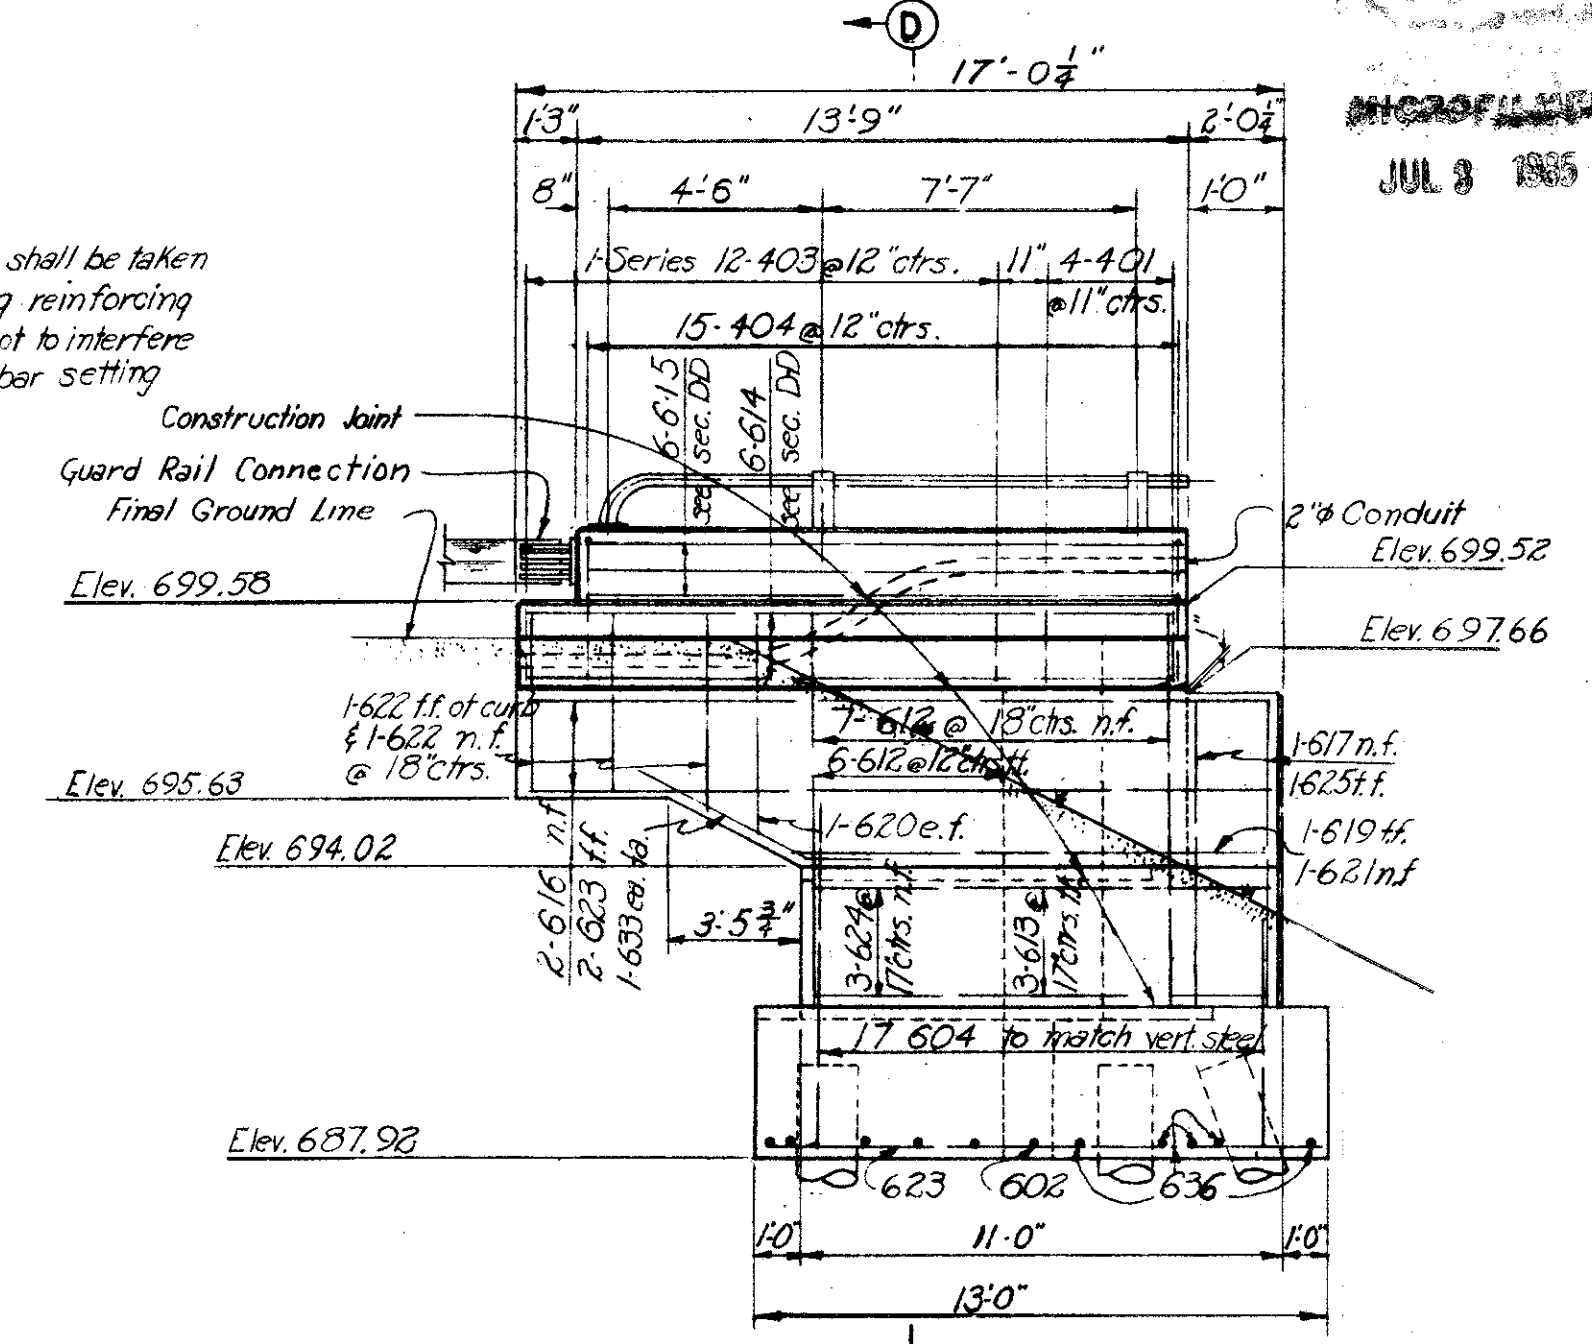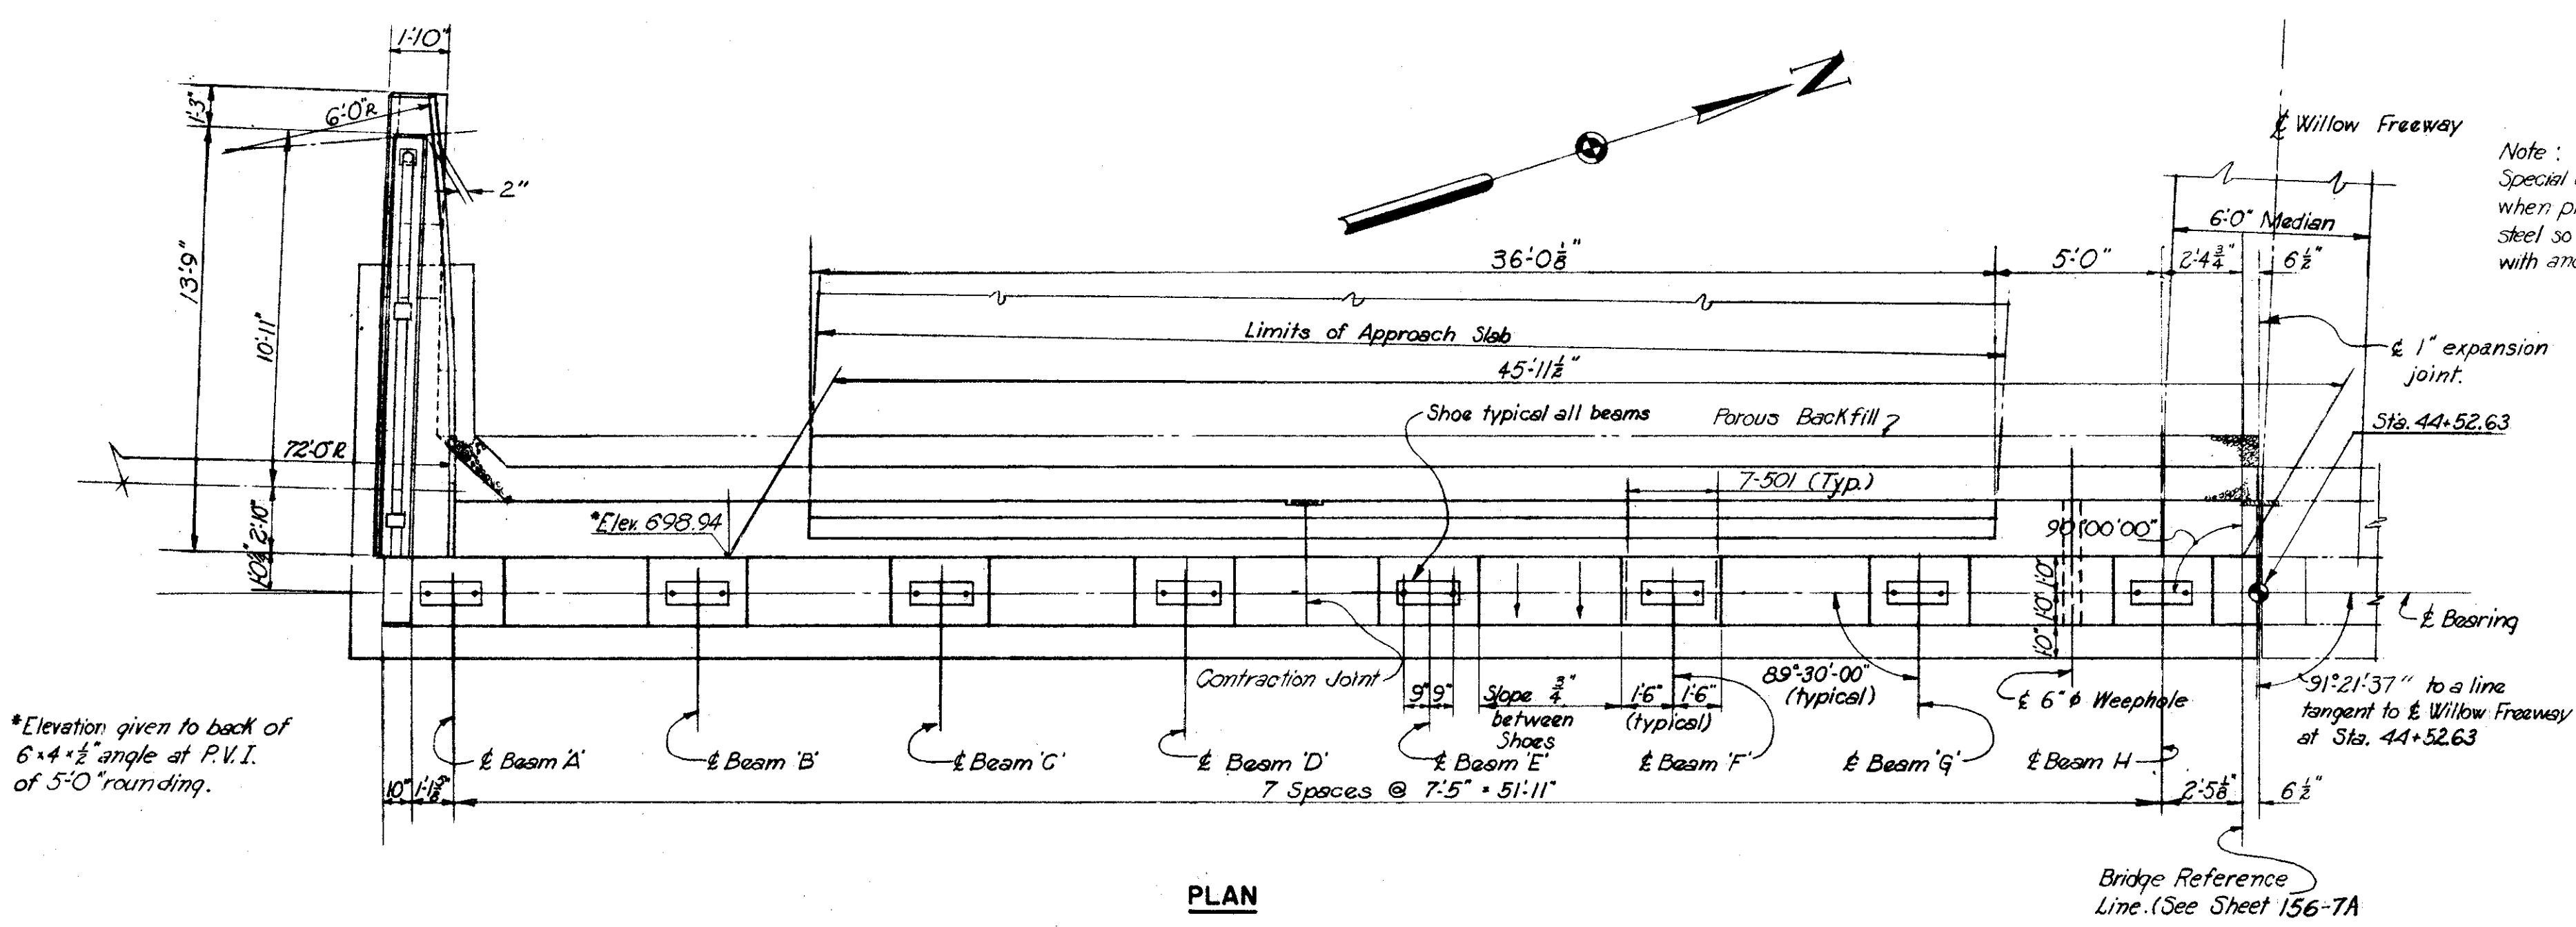


Note: Prefix "AB" shall be assigned to all bar marks.

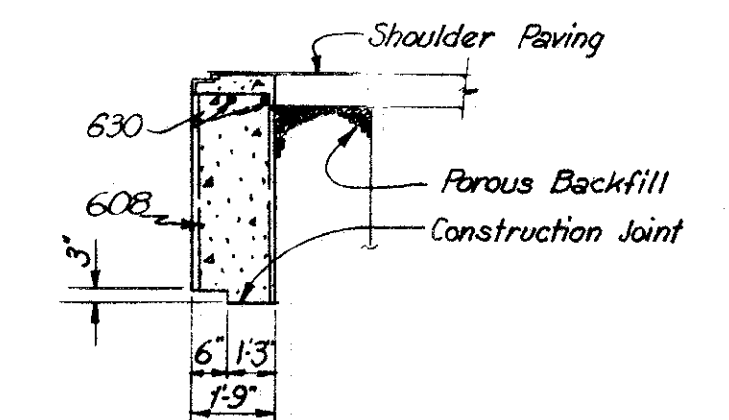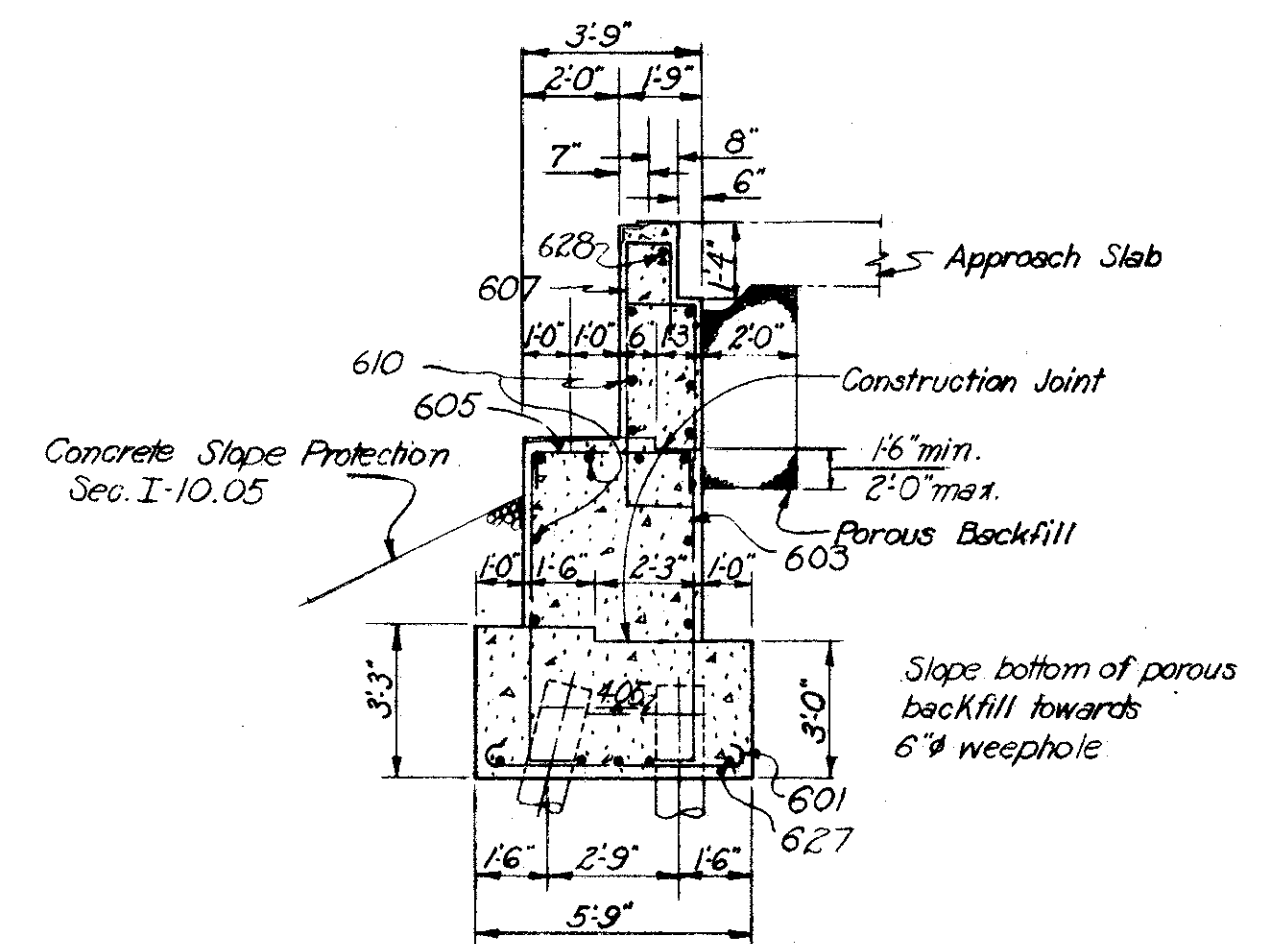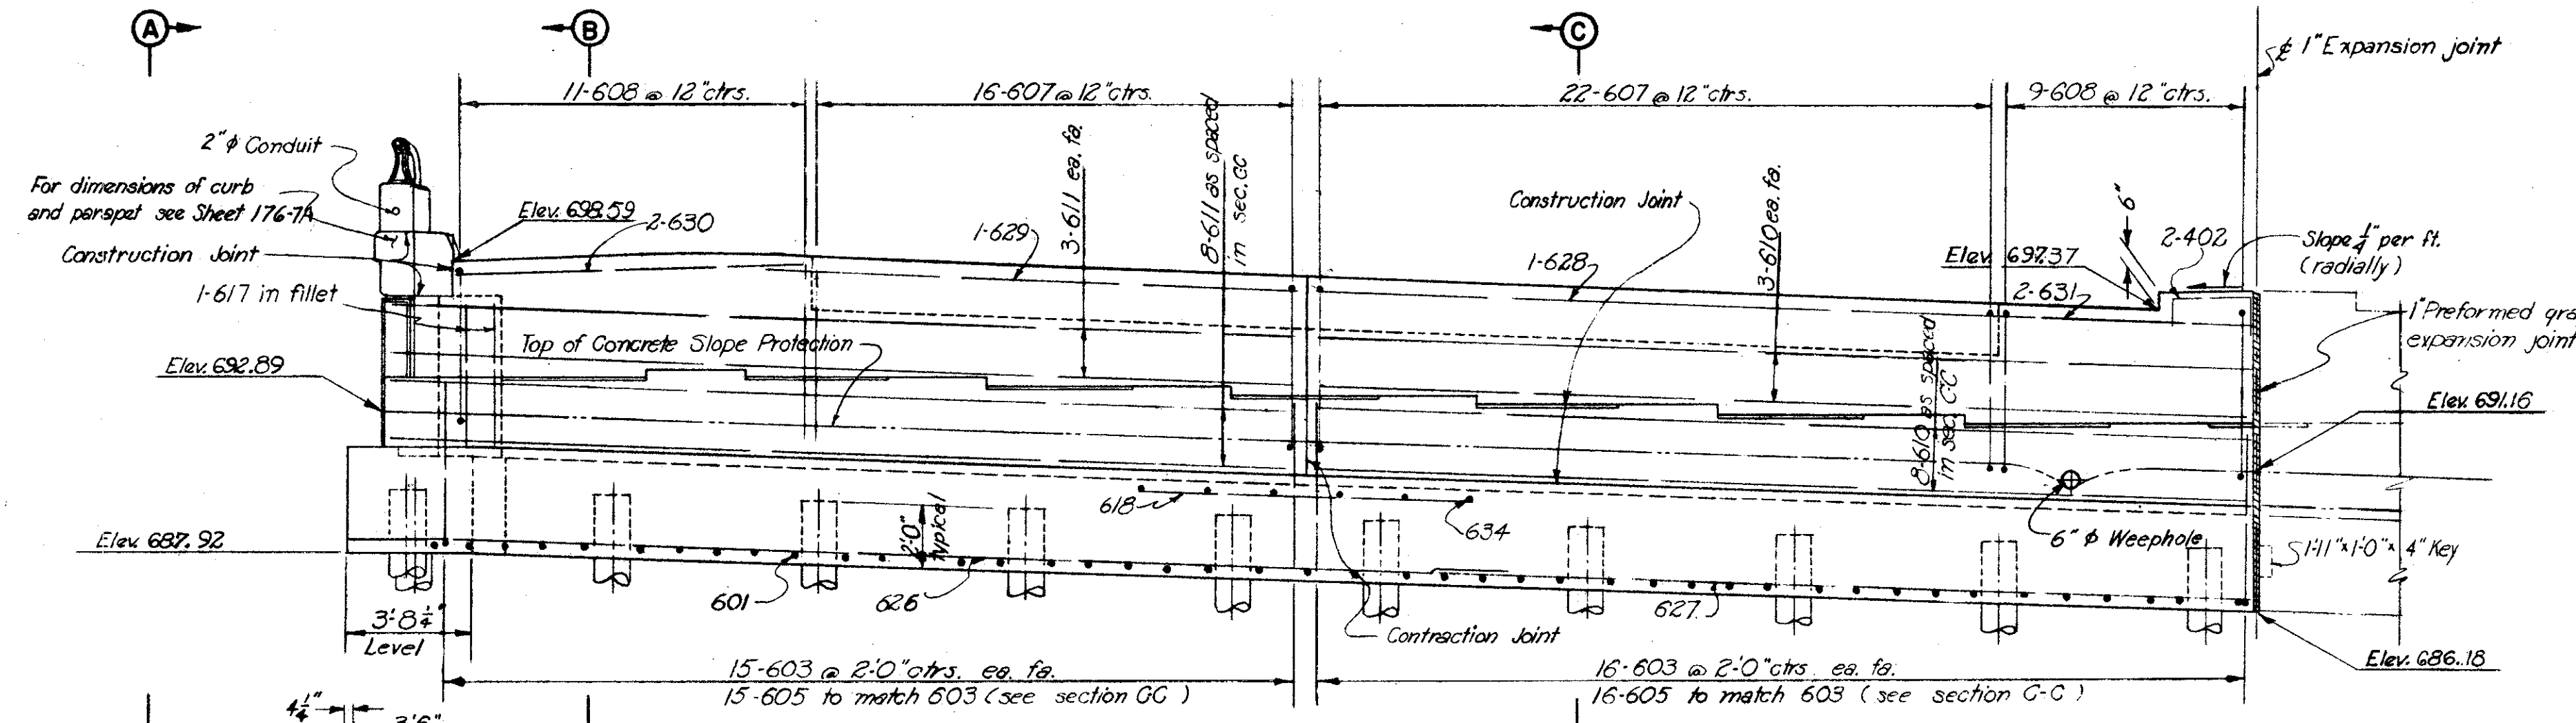

NOTES:
For Masonry Plate details, see sheet 173-7A.
For Railing details and Guard Rail connection details, see sheet 175-7A.
For location of lighting conduits, see sheet 176-7A.
For Reinforcement schedule, see sheet 103-7A.
Reinforcement bars shall be 3 inches clear from bottom of footing and 2 inches elsewhere.
All piles shall be 12" Cast-in-Place reinforced concrete.
All battered piles shall be 3 in 12 in direction shown.
Pile spacing given along bottom of footing.
For details of end dams, see 173-7A.
For Slope Protection details, see sheet 174-7A.
n.f. - near face; f.f. - far face; ea. fa. - each face.
Backfill shall be placed prior to placing of curb.
Ends of railing parapet shall be normal to top of safety curb.

Beam	Elevation
A	694.02
B	694.31
C	694.14
D	693.88
E	693.61
F	693.35
G	693.08
H	692.82

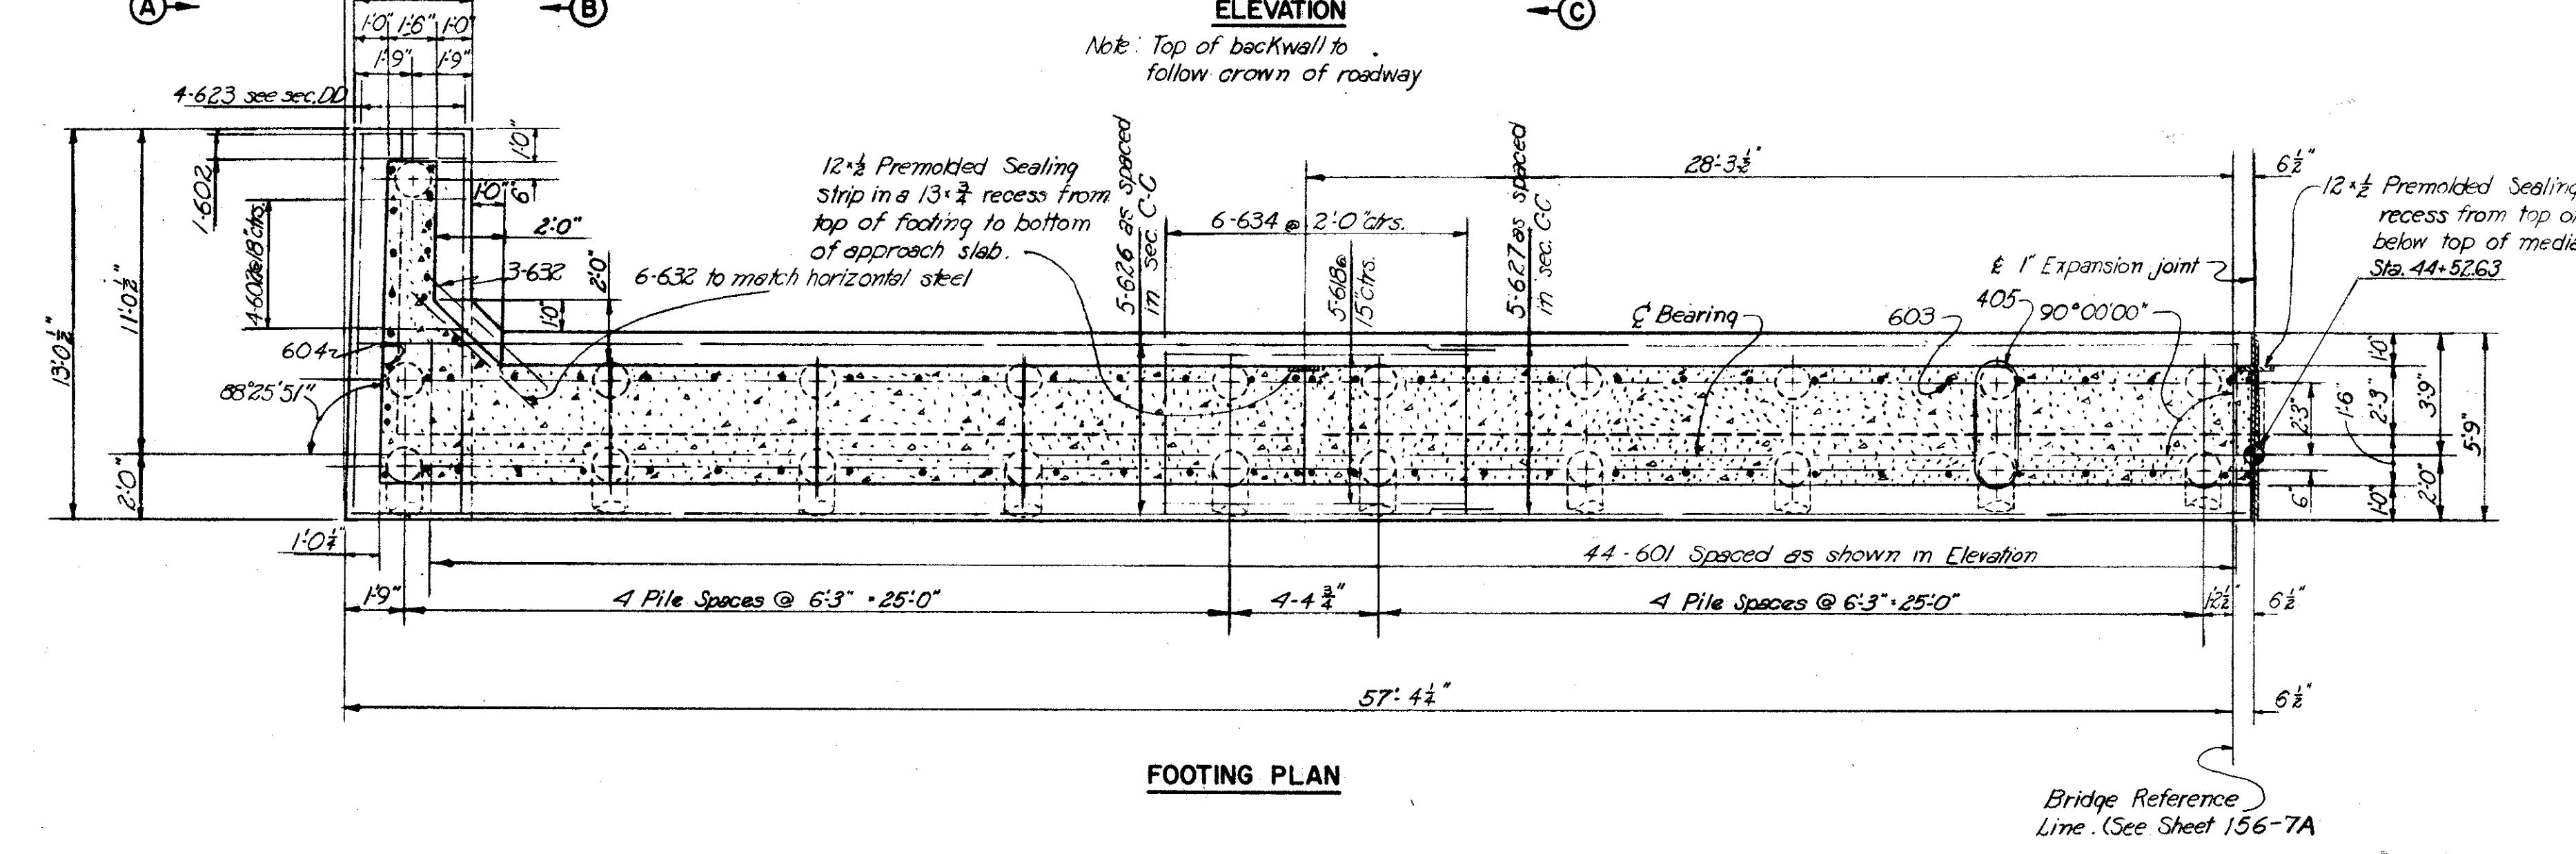






H.N.T.B. BR. NO. 10 PART 7A

HOWARD, NEEDLES, TAMMEN & BERGENOFF
CONSULTING ENGINEERS
KANSAS CITY CLEVELAND NEW YORK

WEST ABUTMENT-SOUTH HALF
WILLOW FREEWAY OVER EAST 22nd ST.
BR. NO. CUY-21-1559 STA. 42+45.12
Scale: 1/4" = 1'-0" STA. 44+54.88
WILLOW-INNER BELT FREEWAY
CLEVELAND CUYAHOGA COUNTY OHIO

DRAWN C.D.D. TRACED CHECKED C.M. REVIEWED J.C.T. REVISIONS
DATE 5-16-55 DATE 2-27-55 DATE 11-13-59 SHEET 159

CUYAHOGA COUNTY
CITY OF CLEVELAND
CUY - 21-15.32
CUY - 42-18.42

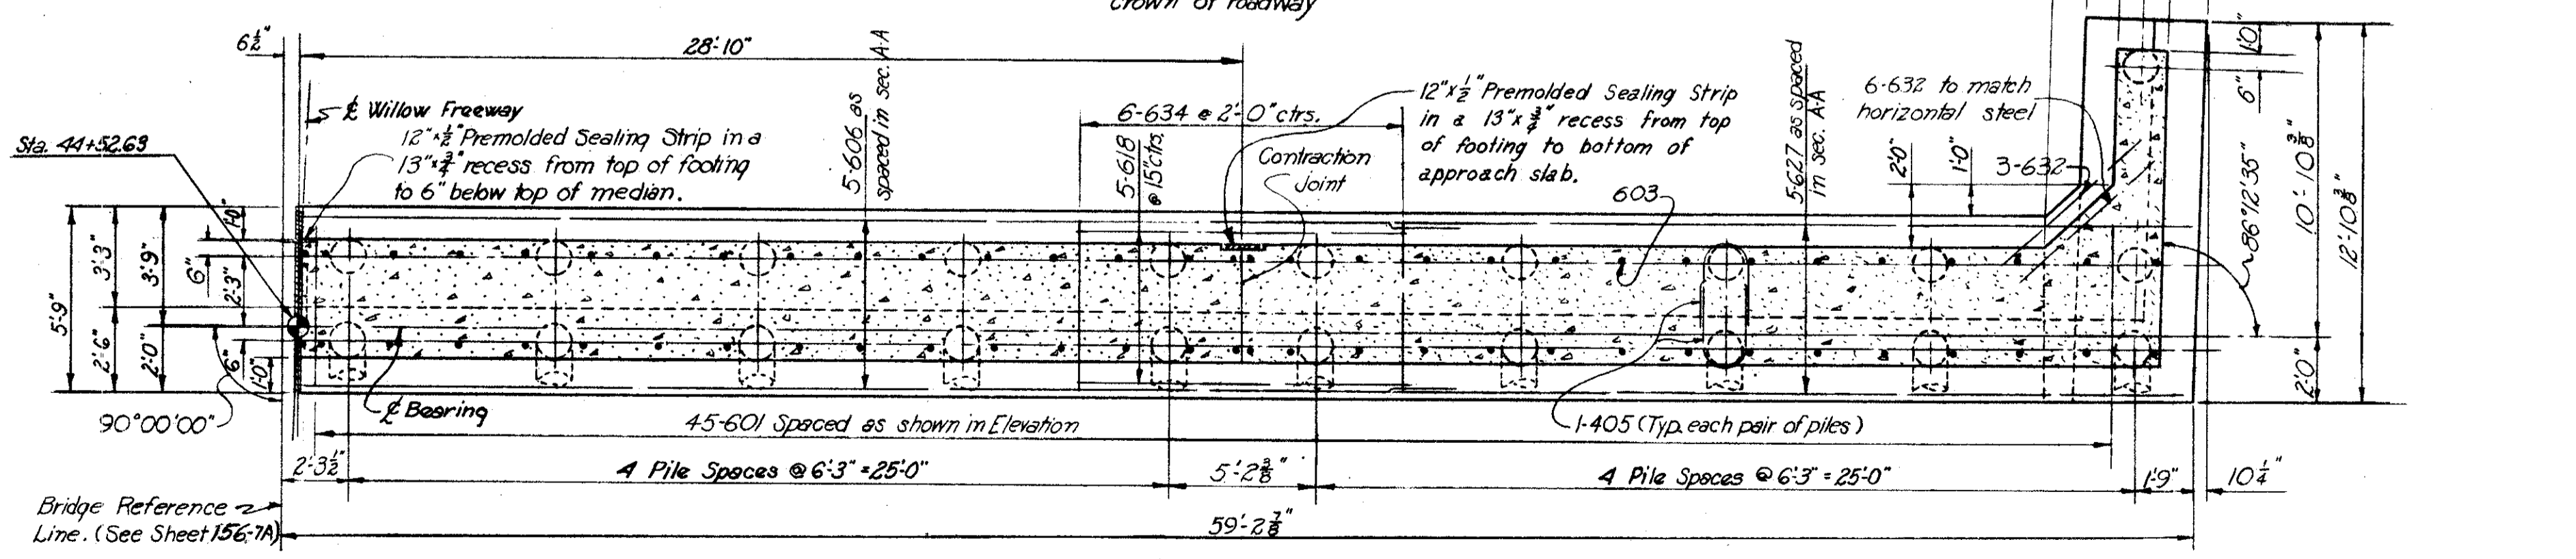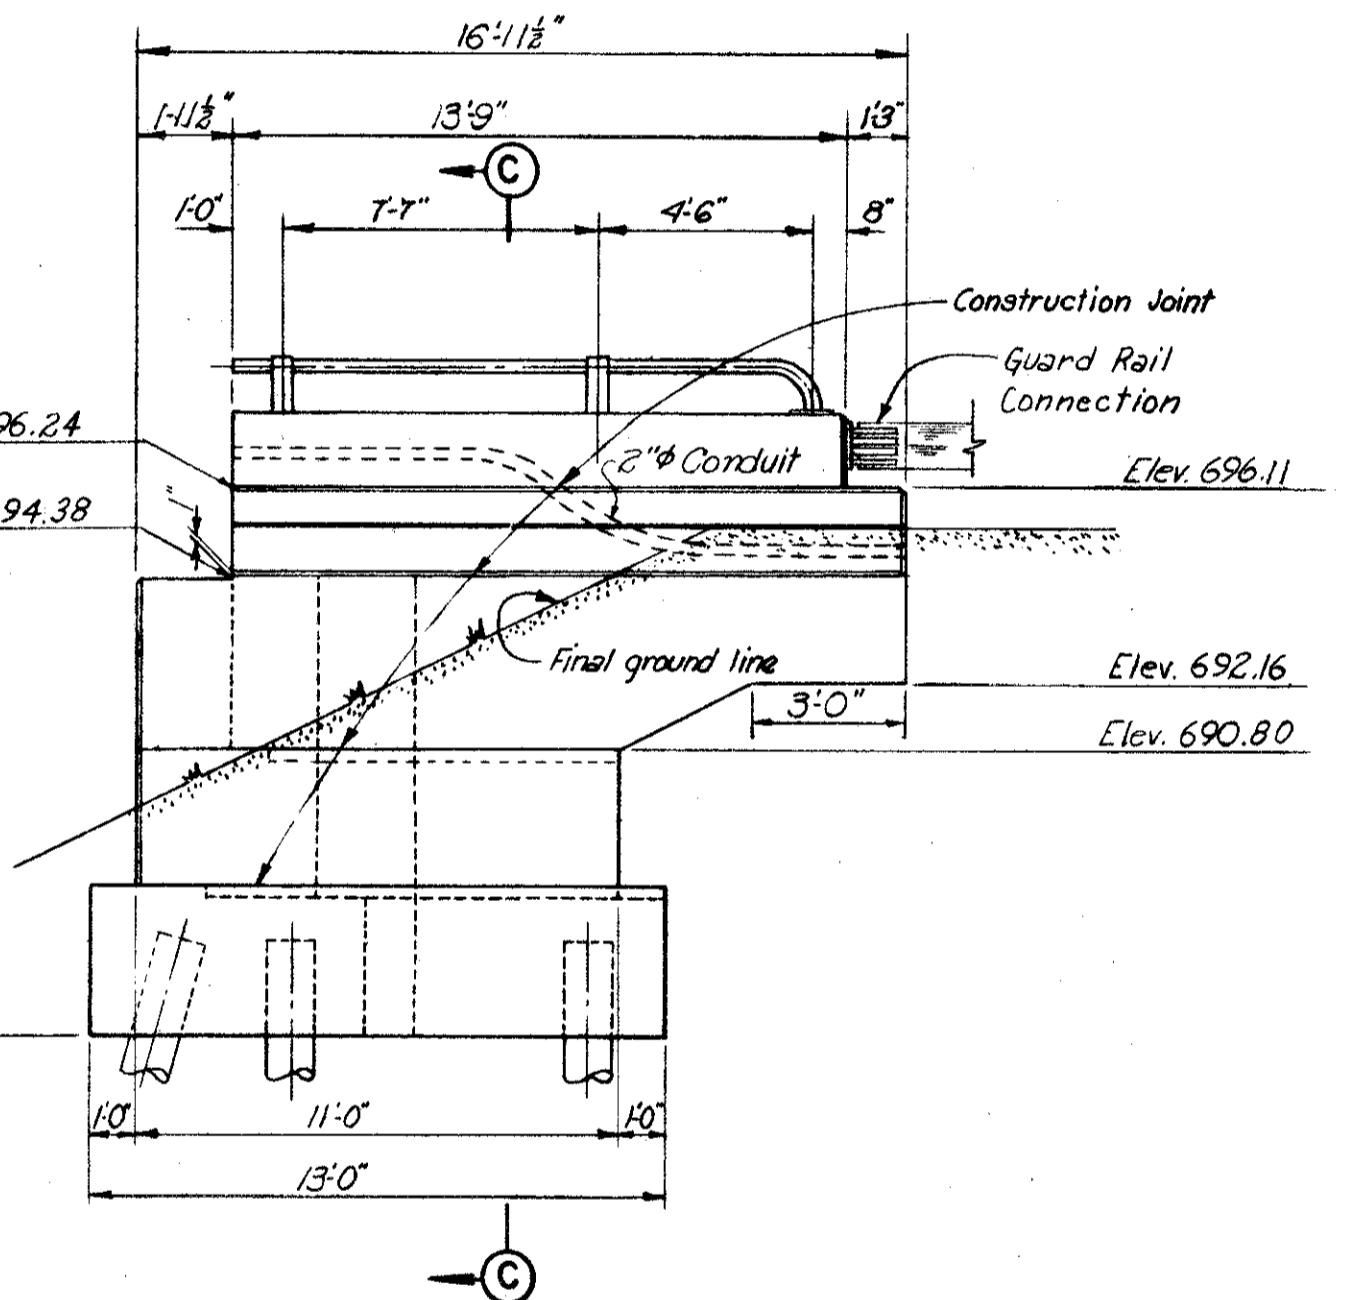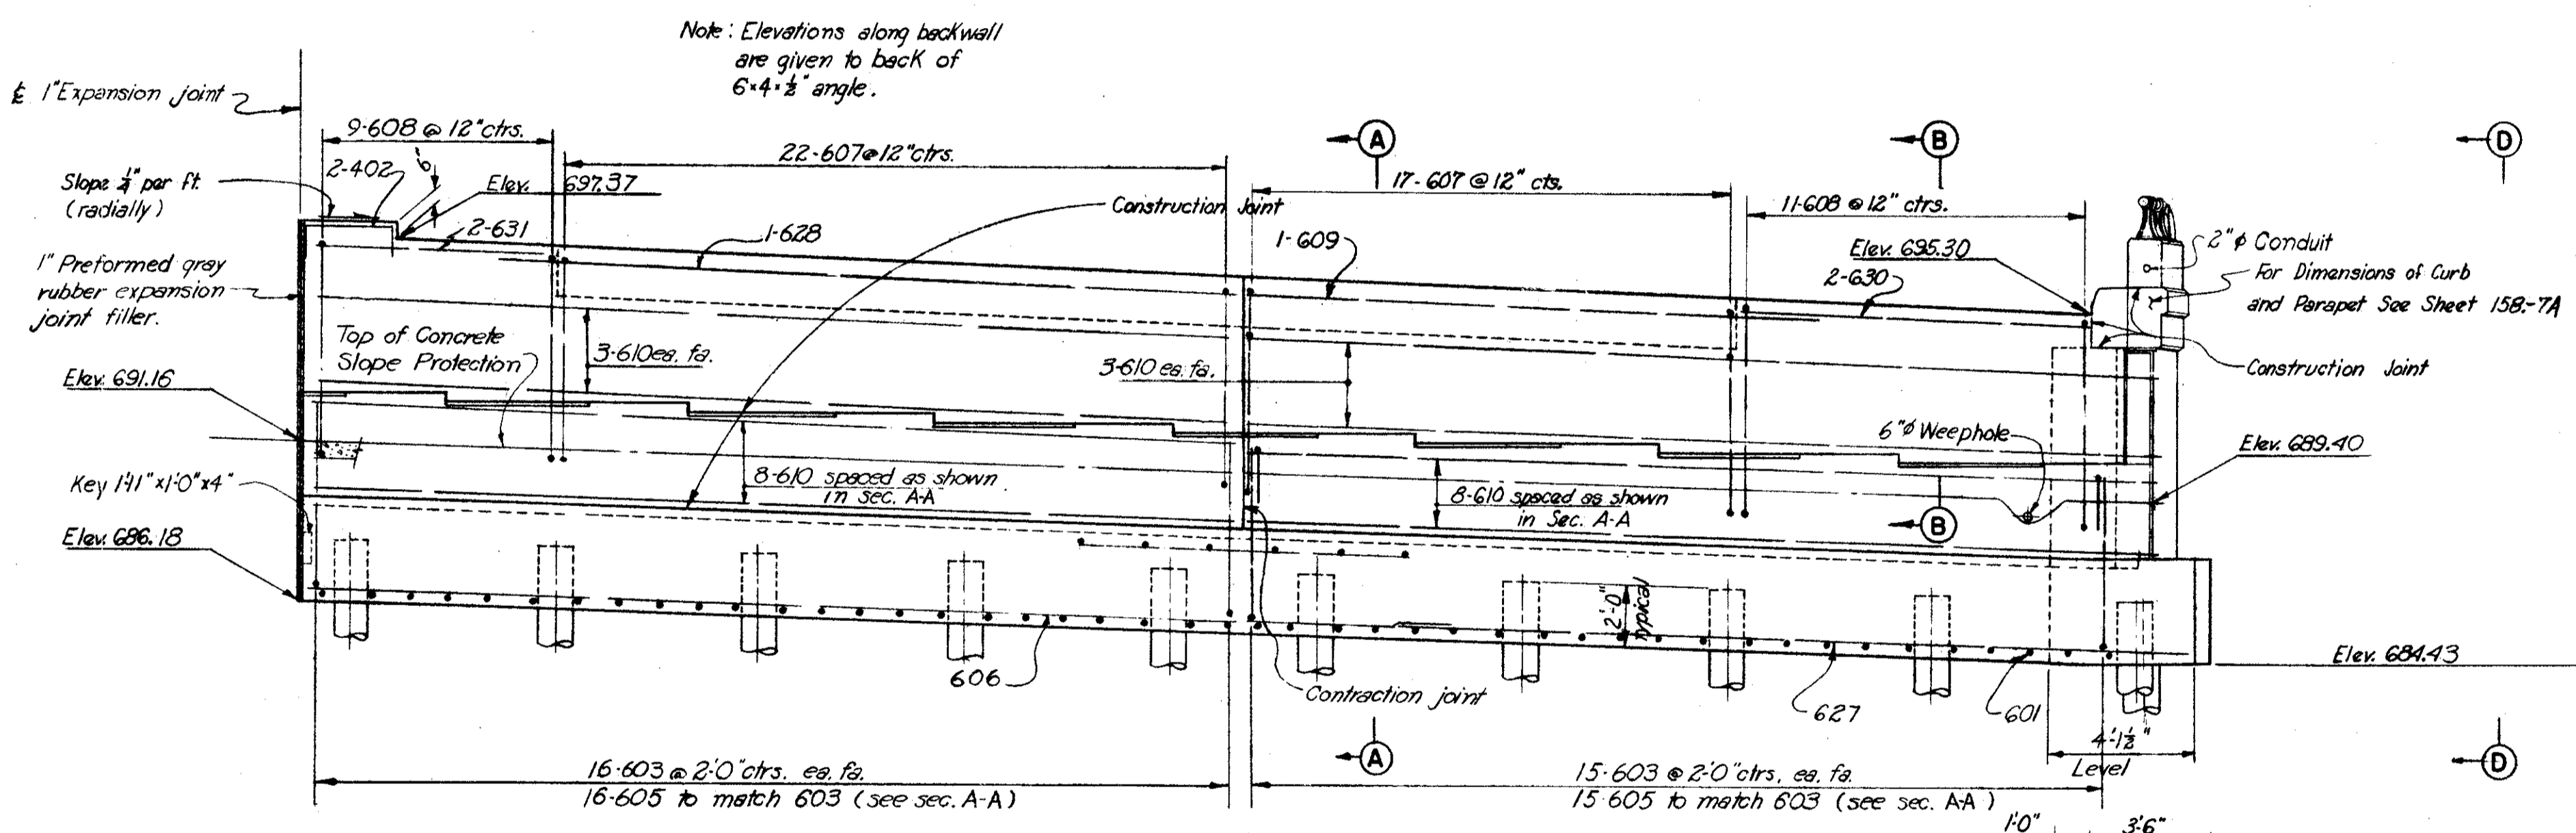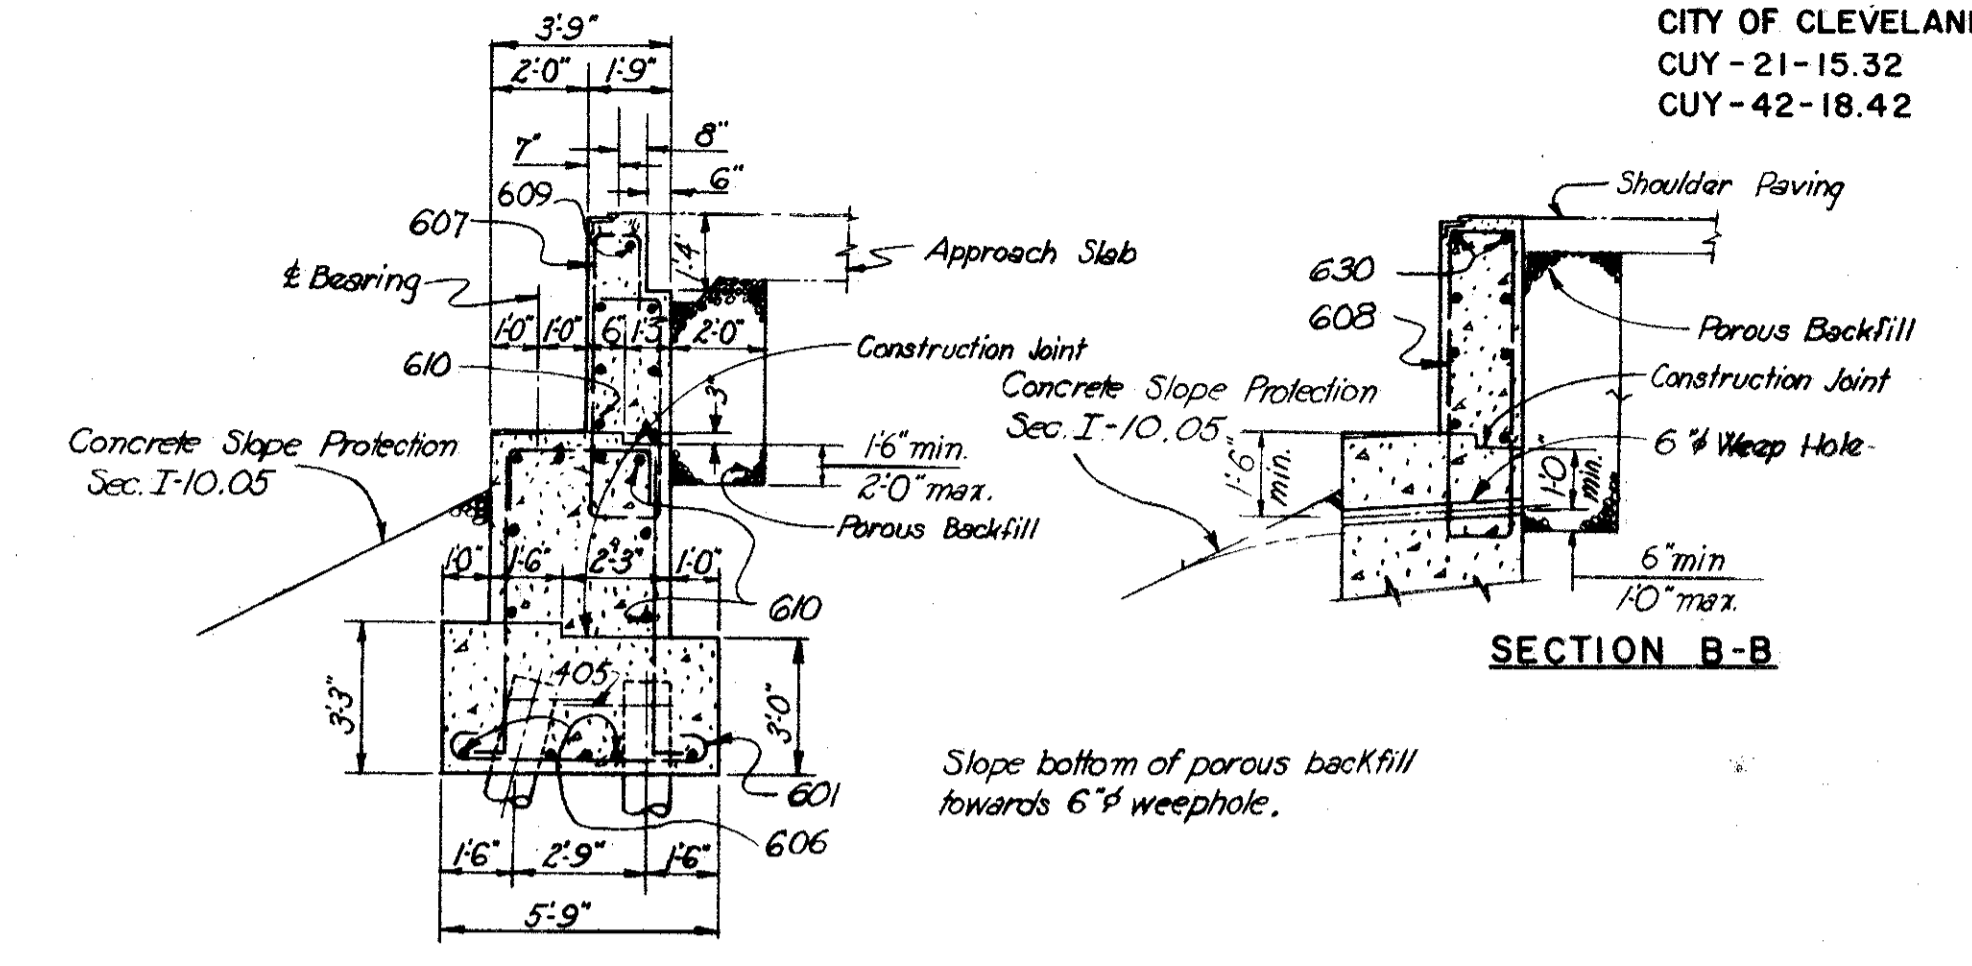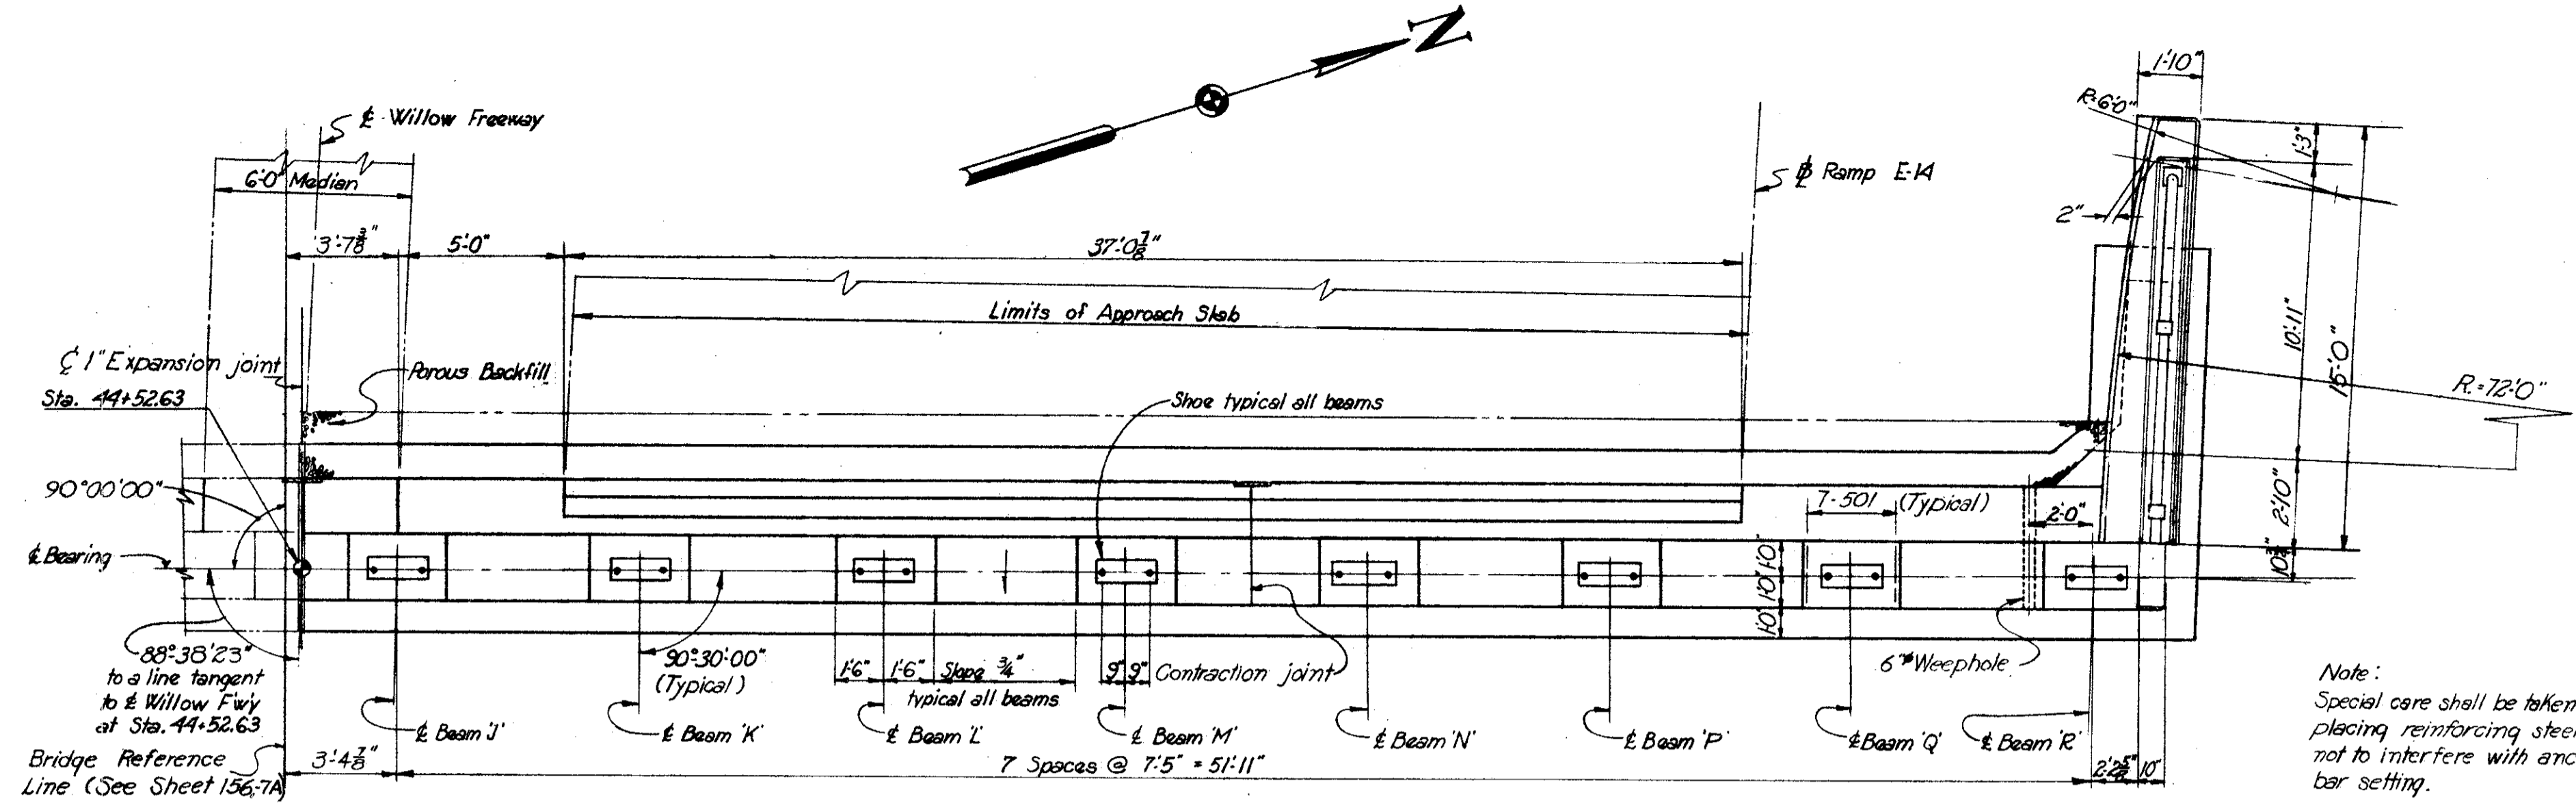

Beam	Elevation
J	692.82
K	692.53
L	692.25
M	691.96
N	691.67
P	691.38
Q	691.09
R	690.80

For notes see sheet 159-7A.

H.N.T.B. BR. NO. 10 PART 7A

HOWARD, NEEDLES, TAMMEN & BERGENDOFF
CONSULTING ENGINEERS
KANSAS CITY CLEVELAND NEW YORK

WEST ABUTMENT-NORTH HALF

WILLOW FREEWAY OVER EAST 22nd ST
BR. NO. CUY - 21-1559 STA. 42+45.12
Scale: 1/4" = 1'-0" STA. 44+54.88

WILLOW-INNER BELT FREEWAY
CLEVELAND CUYAHOGA COUNTY OHIO

DRAWN C.D.D.	TRACED	CHECKED C.M.	REVIEWED J.C.T.	REVISED
DATE 5-20-58	DATE	DATE 2-27-59	DATE 11-13-59	

SHEET 160

EAST ABUTMENT


MARK	NO.	LENGTH	TYPE	DIMENSIONS				SERIES INCREMENT	WEIGHT (LBS)
				A	B	C	D		
401	6	4'-7"	109	1'-8"	1'-5"			26	
402	4	4'-9"	105	2'-6"	1'-3"			13	
403	23	4'-7" to 6'-7"	109	0'-8" to 1'-8"	1'-5"			90	
404	26	6'-5"	105	8"	3'-0"			111	
405	40	5'-10"	144	2'-0"	1'-10"	7"		156	
501	112	4'-5"	105	1'-8"	1'-6"			526	
601	92	6'-9"	100	5'-5"				933	
602	12	4'-6"	100	3'-2"				81	
603	180	6'-2"	104	5'-6"	10"			1112	
604	30	5'-8"	104	5'-0"	10"			255	
605	60	9'-5"	105	3'-5"	3'-2"			849	
606	8	12'-0"	Str.					144	
607	76	17'-10"	112	6'-6"	1'-5"	0'-11"	5'-2"	2035	
608	40	16'-4"	109	6'-6"	1'-5"			981	
609	4	3'-3"	Str.					20	
610	28	28'-6"	Str.					1199	
611	28	27'-6"	Str.					1157	
612	22	8'-3"	Str.					273	
613	10	35'-0"	Str.					526	
614	6	11'-7"	104	9'-10"	1'-11"			104	
615	4	19'-6"	126	15'-11"	0'-6"	3'-9"		117	
616	4	12'-9"	Str.					77	
617	8	6'-3"	Str.					75	
618	10	10'-3"	Str.					154	
619	8	6'-9"	Str.					81	
620	4	4'-3"	Str.					26	
621	2	13'-6"	126	9'-11"	0'-6"	3'-9"		41	
622	12	3'-6"	Str.					63	
623	10	25'-0"	Str.					376	
624	12	5'-3"	Str.					95	
625	4	7'-2"	108	2'-0"	5'-3"	6	12	43	
626	12	12'-6"	Str.					20	
627	12	13'-9"	Str.					248	
628	2	22'-9"	Str.					68	
629	2	17'-3"	Str.					52	
630	4	10'-6"	Str.					63	
631	4	7'-6"	Str.					45	
632	18	6'-0"	Str.					162	
Total								12,377	

WEST ABUTMENT

MARK	NO.	LENGTH	TYPE	DIMENSIONS				SERIES INCREMENT	WEIGHT (LBS)
				A	B	C	D		
401	8	6'-7"	109	1'-8"	1'-5"			35	
402	4	4'-9"	105	2'-6"	1'-3"			13	
403	23	4'-7" to 6'-7"	109	0'-8" to 1'-8"	1'-5"			90	
404	30	6'-5"	105	8"	3'-0"			129	
405	40	5'-10"	144	2'-0"	1'-10"			156	
501	112	4'-5"	105	1'-8"	1'-6"			526	
601	89	6'-9"	100	5'-5"				902	
602	12	4'-6"	100	3'-2"				81	
603	184	6'-2"	104	5'-6"	10"			1149	
604	34	5'-8"	104	5'-0"	10"			290	
605	62	9'-5"	105	3'-5"	3'-2"			877	
606	5	34'-0"	Str.					270	
607	77	17'-10"	112	1'-5"	6'-6"	0'-11"	5'-2"	2063	
608	40	16'-4"	109	6'-6"	1'-5"			981	
609	1	18'-0"	Str.					27	
610	42	28'-6"	Str.					1798	
611	14	27'-6"	Str.					578	
612	26	8'-3"	Str.					322	
613	6	7'-3"	Str.					65	
614	12	14'-6"	Str.					261	
615	12	13'-3"	Str.					124	
616	4	20'-7"	126	16'-8"	0'-6"	3'-9"		75	
617	8	6'-3"	Str.					154	
618	10	10'-3"	Str.					23	
619	2	7'-6"	Str.					26	
620	4	4'-3"	Str.					44	
621	2	14'-8"	126	10'-9"	0'-6"	3'-9"		63	
622	12	3'-6"	Str.					276	
623	12	12'-6"	Str.					110	
624	6	12'-9"	104	10'-11"	1'-11"			20	
625	4	3'-3"	Str.					263	
626	5	35'-0"	Str.					375	
627	10	25'-0"	Str.					68	
628	2	22'-9"	Str.					26	
629	1	17'-3"	Str.					63	
630	4	10'-6"	Str.					45	
631	4	7'-6"	Str.					162	
632	18	6'-0"	Str.					43	
633	4	7'-2"	108	2'-0"	5'-3"	6	12	95	
634	12	5'-3"	Str.						
Total								12,618	

MARK	NO.	LENGTH	TYPE	DIMENSIONS				SERIES INCREMENT	WEIGHT (LBS)
				A	B	C	D		

BENDING DIAGRAMS

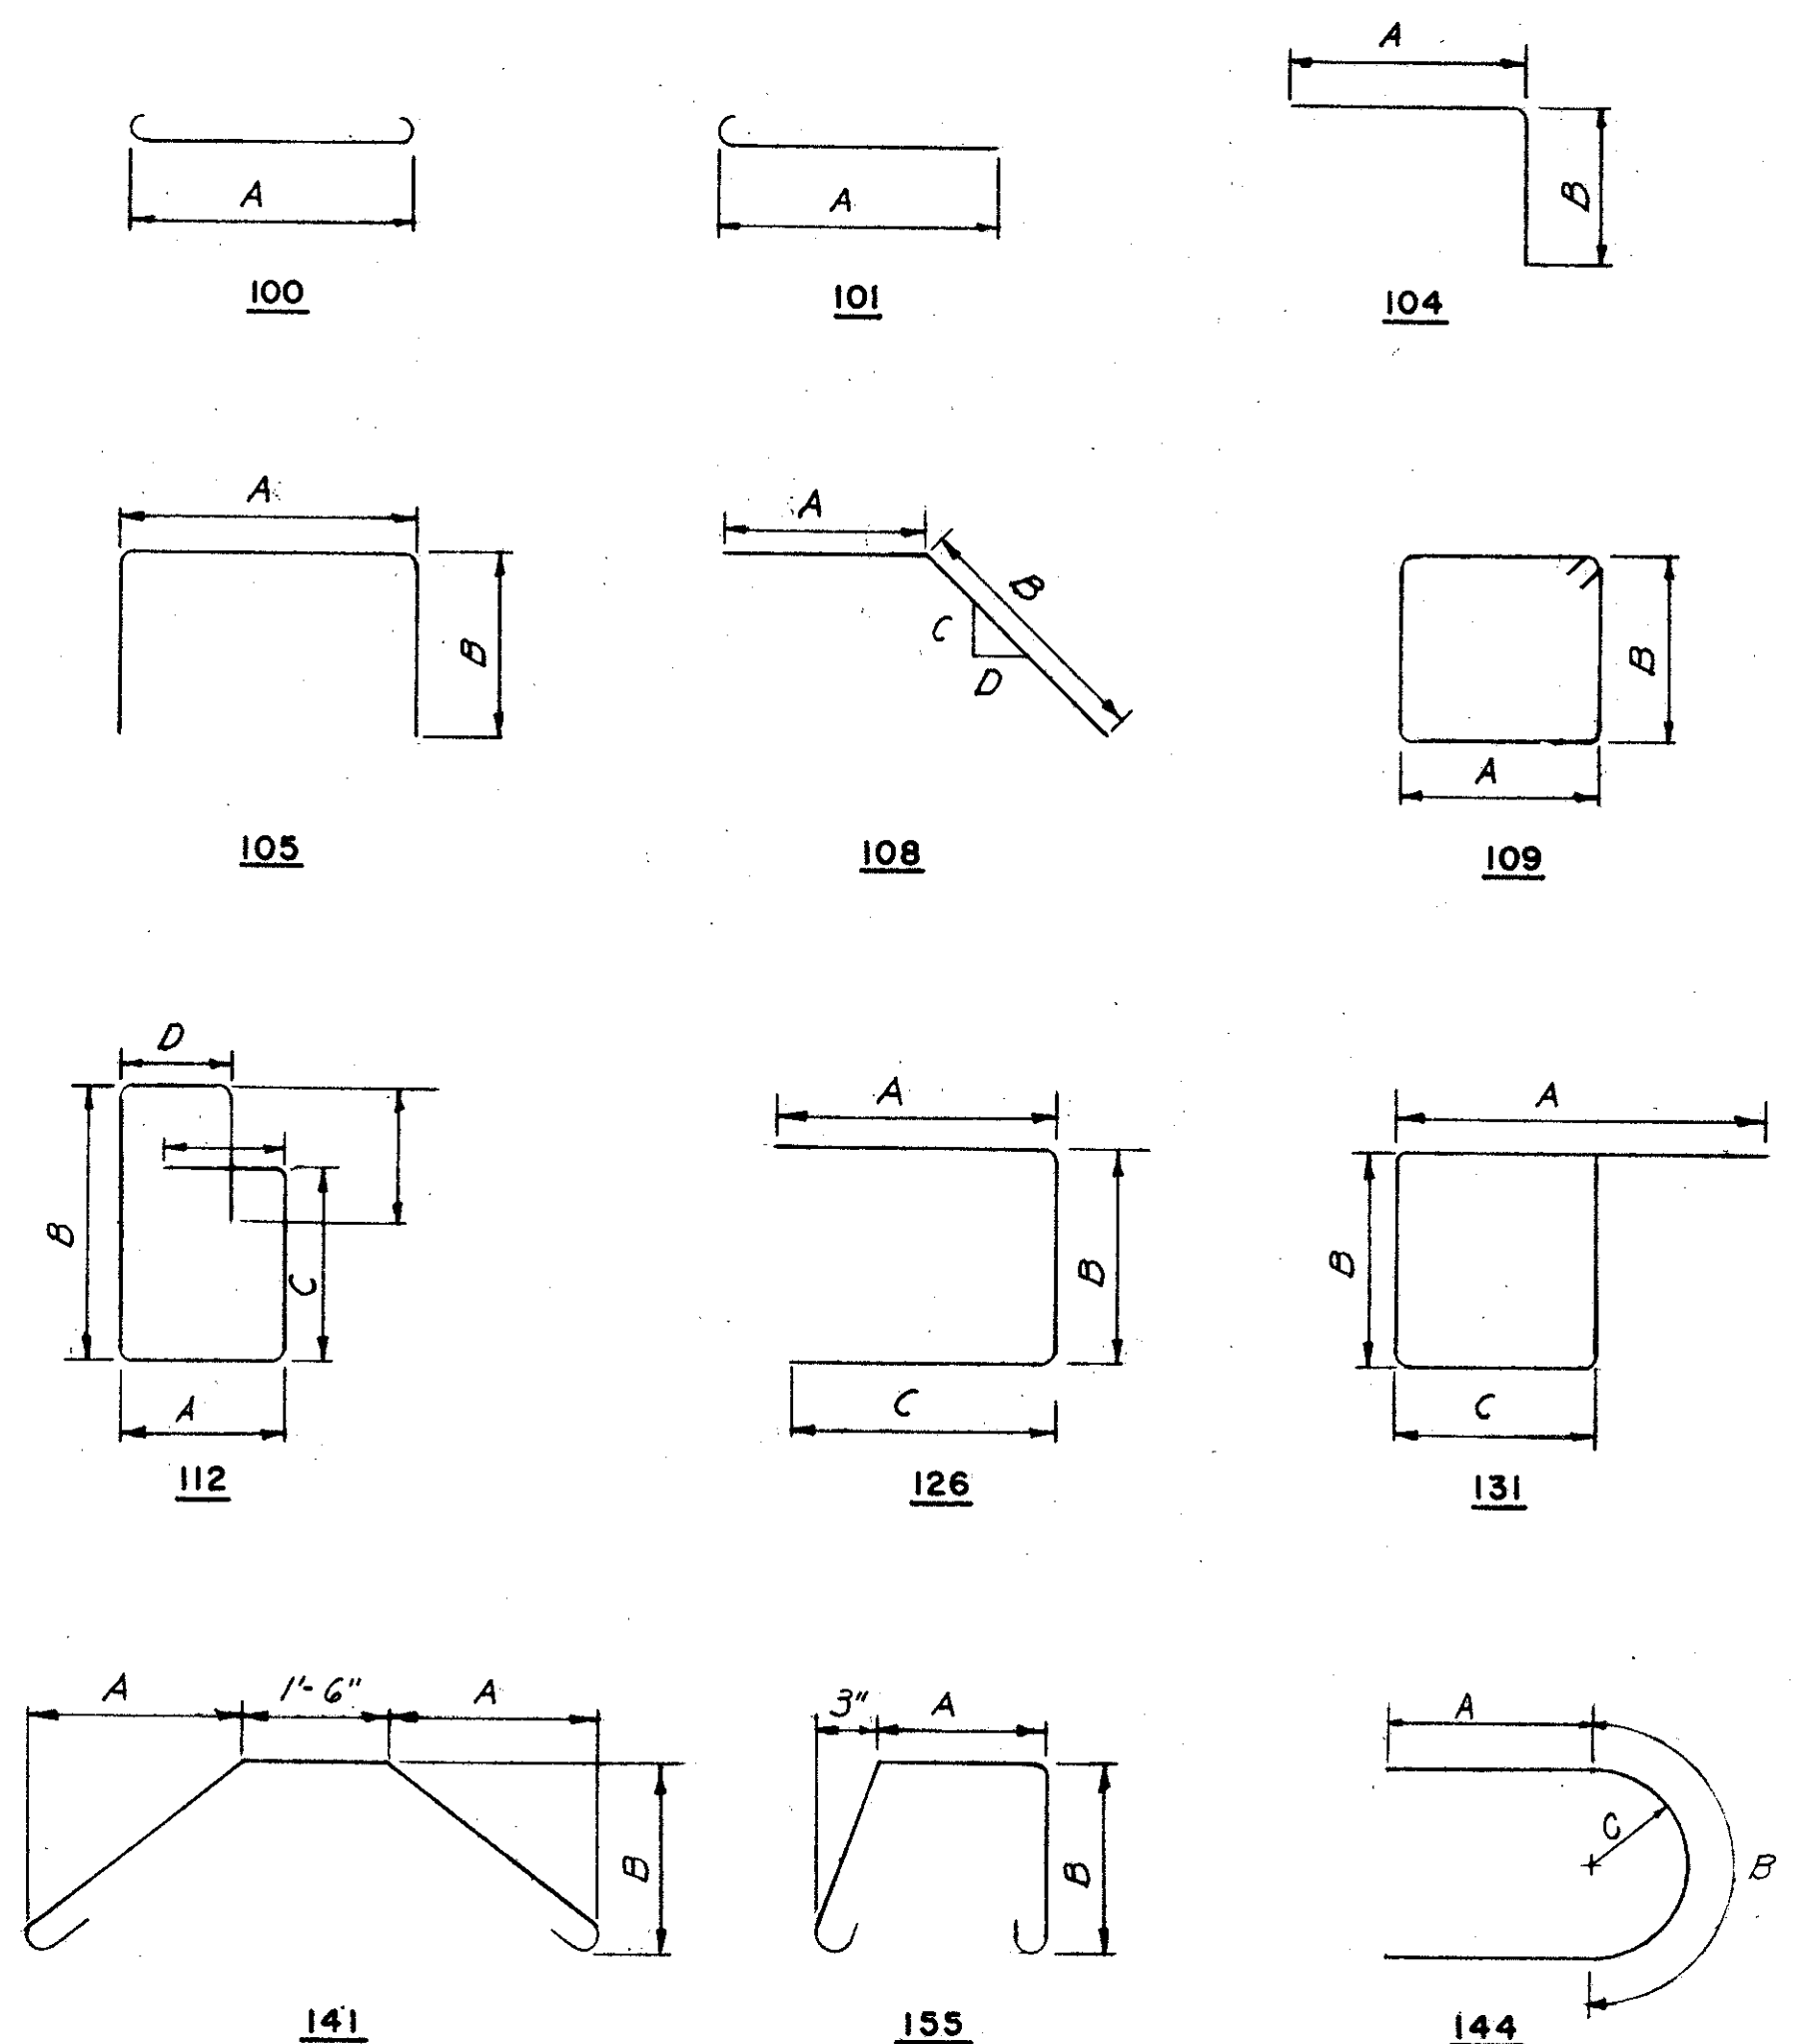

Note: Prefixes shall be assigned to bar marks as follows:
East Abutment "AA"
West Abutment "AB"

NOTE:
* Bars included for payment with "Item S-14 Rebaring".
Bar dimensions are given out to out.
Bars in a series shall vary in length by a constant increment.
For replacement schedule see Sh. 103.-7A

H.N.T.B. BR. NO. 10 PART 7A

HOWARD, NEEDLES, TAMMEN & BERGENDOFF
CONSULTING ENGINEERS
KANSAS CITY CLEVELAND NEW YORK


REINFORCEMENT SCHEDULE-ABUTMENTS

WILLOW FREEWAY OVER EAST 22nd ST.
BR. NO. CUY-21-1559 STA. 42+45.12
Scale: None STA. 44+54.88

WILLOW-INNER BELT FREEWAY
CLEVELAND CUYAHOGA COUNTY OHIO


DRAWN BY DATE CHECKED BY DATE REVISIONS DATE

SHEET 161

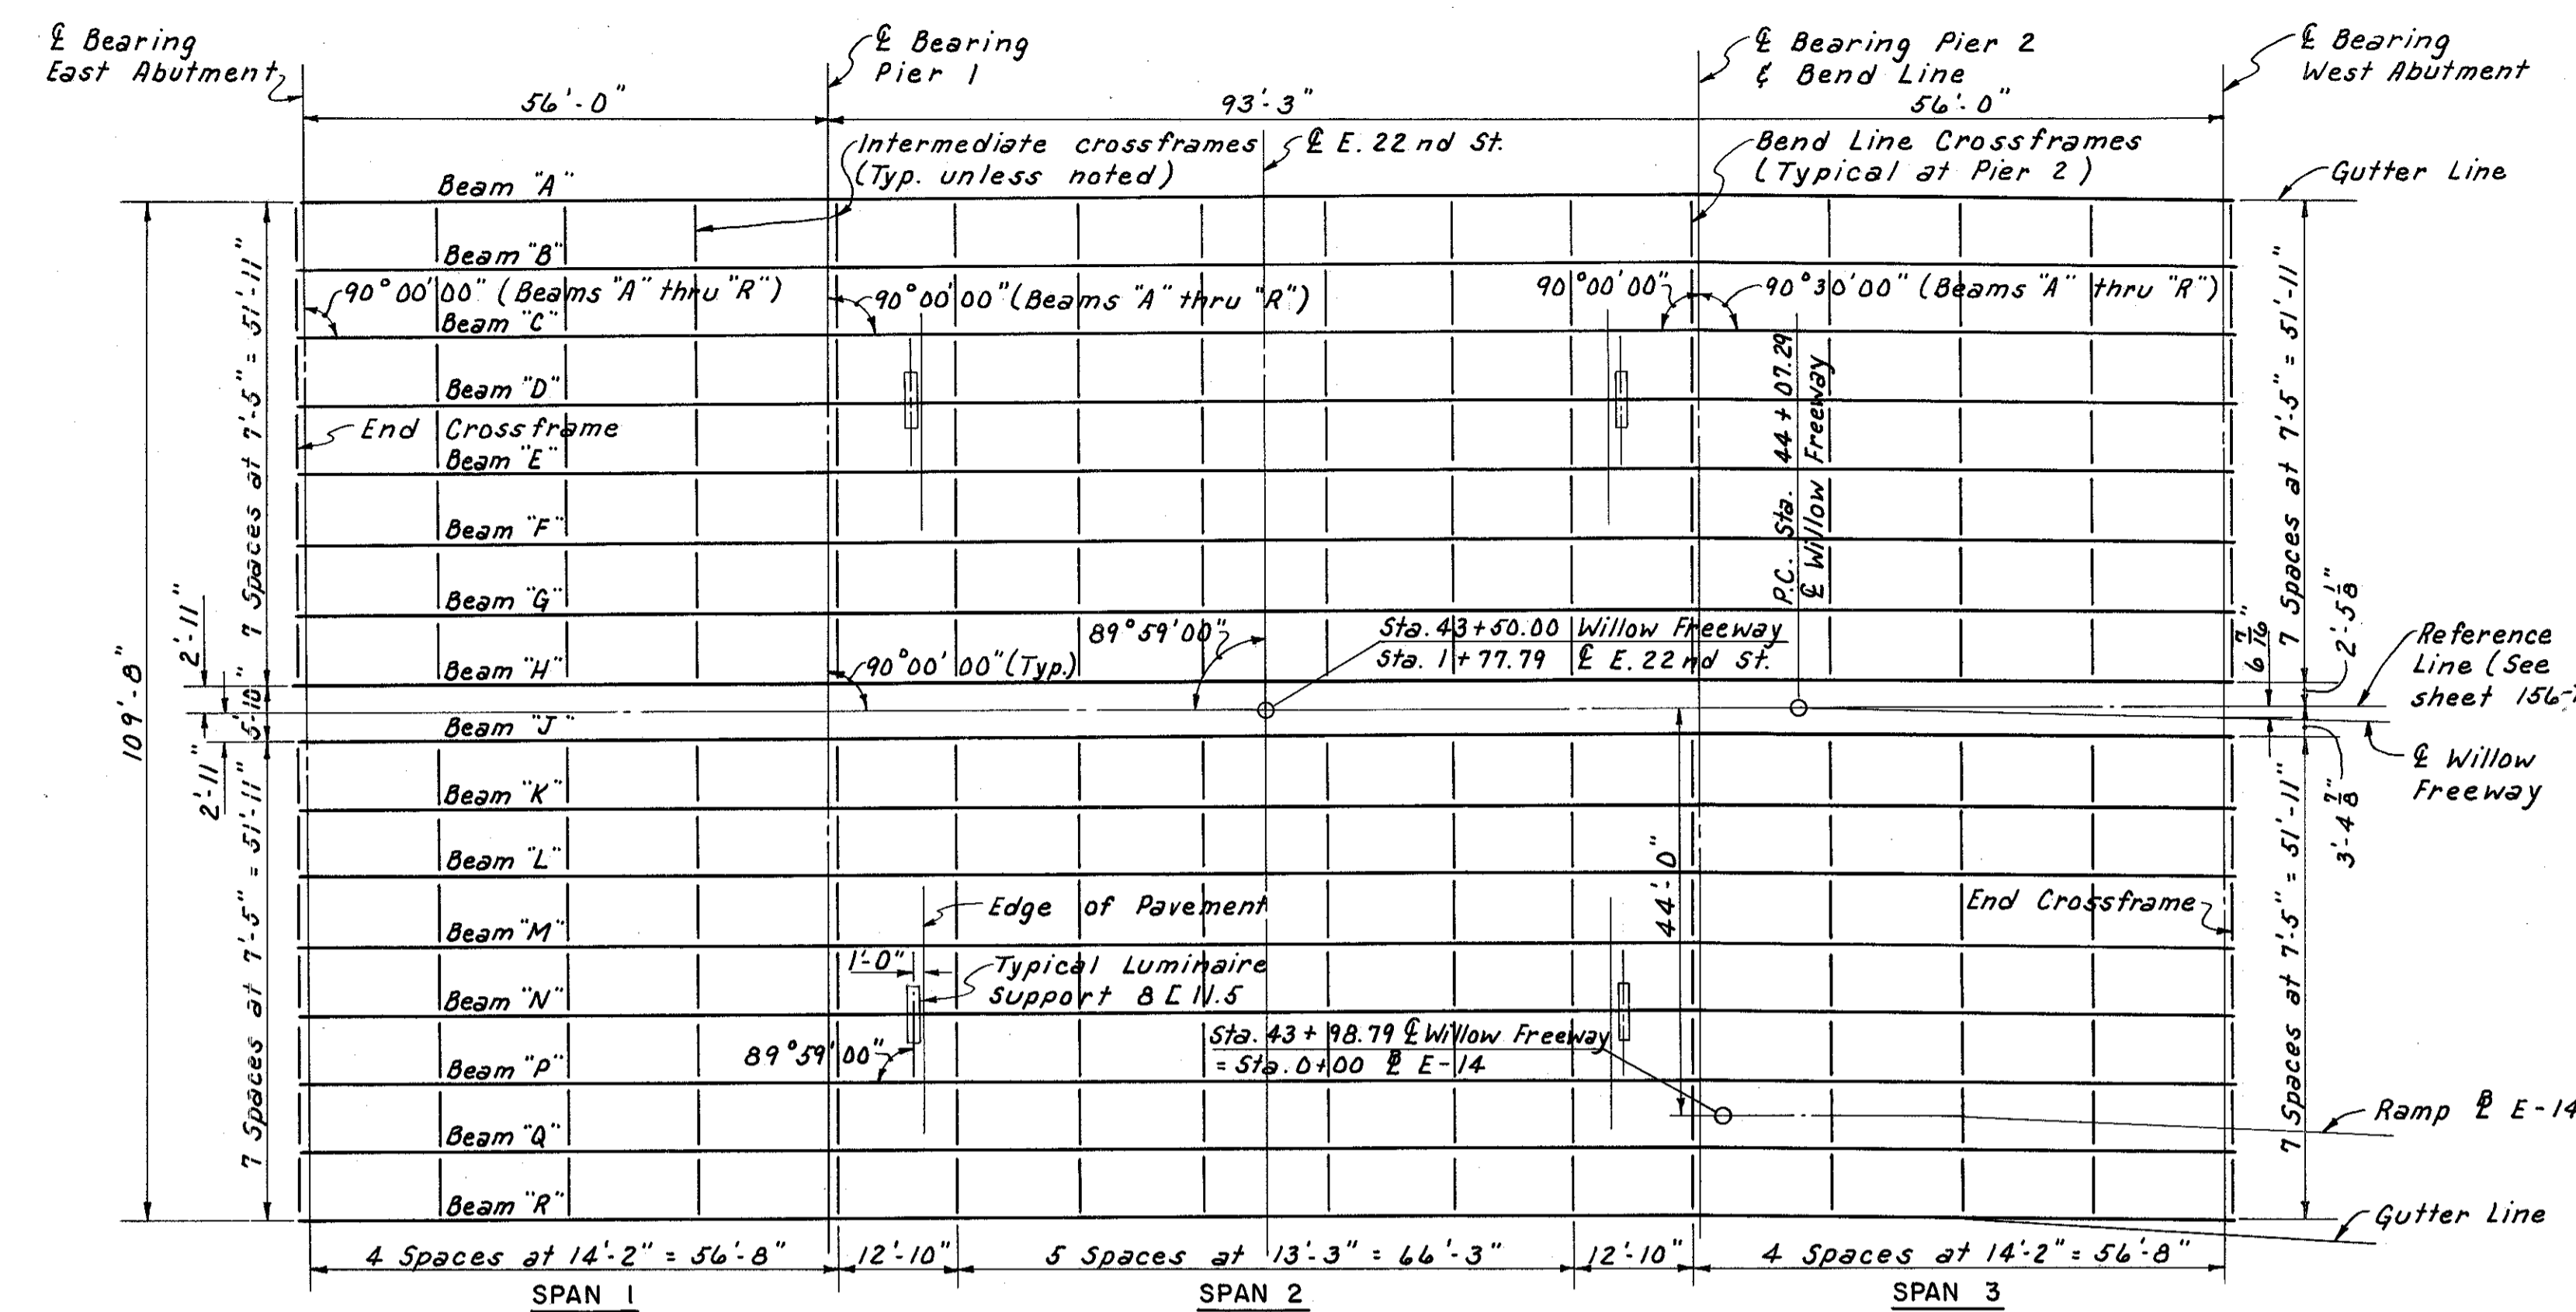


ELEVATION AND DEFLECTION TABLE

BEAM	EAST ABUTMENT		SPAN 1			PIER 1		SPAN 2					PIER 2		SPAN 3			WEST ABUTMENT										
	TOP OF BEAM ELEV.	TOP OF PAVEMENT ELEV.	D.L. DEFL.		D.L. DEFL.	TOP OF BEAM ELEV.	TOP OF PAVEMENT ELEV.	D.L. DEFL.		D.L. DEFL.		D.L. DEFL.		TOP OF BEAM ELEV.	TOP OF PAVEMENT ELEV.	D.L. DEFL.		TOP OF BEAM ELEV.	TOP OF PAVEMENT ELEV.									
			CON	TOT				CON	TOT	CON	TOT	CON	TOT			CON	TOT			CON	TOT							
"A"	696.32	697.16	1/16	1/8	0	0	-1/4	-1/4	696.85	697.69	1/16	1/8	1/16	1/8	1/16	1/8	1/16	1/8	697.53	698.37	-1/4	-1/4	0	0	1/16	1/8	697.82	698.66
"B"	696.62	697.46	1/16	1/8	0	0	-3/16	-3/16	697.14	697.98	1/16	1/8	1/16	1/8	1/16	1/8	1/16	1/8	697.82	698.66	-3/16	-3/16	0	0	1/16	1/8	698.11	698.95
"C"	696.62	697.46	1/16	1/8	0	0	-3/16	-3/16	697.09	697.93	1/16	1/8	1/16	1/8	1/16	1/8	1/16	1/8	697.75	698.59	-3/16	-3/16	0	0	1/16	1/8	697.94	698.78
"D"	696.56	697.40	1/16	1/8	0	0	-3/16	-3/16	696.98	697.82	1/16	1/8	1/16	1/8	1/16	1/8	1/16	1/8	697.49	698.33	-3/16	-3/16	0	0	1/16	1/8	697.68	698.52
"E"	696.51	697.34	1/16	1/8	0	0	-3/16	-3/16	696.87	697.70	1/16	1/8	1/16	1/8	1/16	1/8	1/16	1/8	697.28	698.12	-3/16	-3/16	0	0	1/16	1/8	697.41	698.25
"F"	696.45	697.29	1/16	1/8	0	0	-3/16	-3/16	696.75	697.59	1/16	1/8	1/16	1/8	1/16	1/8	1/16	1/8	697.07	697.91	-3/16	-3/16	0	0	1/16	1/8	697.15	697.99
"G"	696.39	697.23	1/16	1/8	0	0	-3/16	-3/16	696.64	697.47	1/16	1/8	1/16	1/8	1/16	1/8	1/16	1/8	696.86	697.70	-3/16	-3/16	0	0	1/16	1/8	696.88	697.72
"H"	696.33	697.17	1/16	1/8	0	0	-3/16	-3/16	696.52	697.36	1/16	1/8	1/16	1/8	1/16	1/8	1/16	1/8	696.66	697.50	-3/16	-3/16	0	0	1/16	1/8	696.62	697.46
"J"	696.33	697.17	1/16	1/8	0	0	-3/16	-3/16	696.52	697.36	1/16	1/8	1/16	1/8	1/16	1/8	1/16	1/8	696.66	697.50	-3/16	-3/16	0	0	1/16	1/8	696.62	697.46
"K"	696.22	697.06	1/16	1/8	0	0	-3/16	-3/16	696.36	697.20	1/16	1/8	1/16	1/8	1/16	1/8	1/16	1/8	696.42	697.26	-3/16	-3/16	0	0	1/16	1/8	696.34	697.17
"L"	696.10	696.94	1/16	1/8	0	0	-3/16	-3/16	696.20	697.04	1/16	1/8	1/16	1/8	1/16	1/8	1/16	1/8	696.18	697.02	-3/16	-3/16	0	0	1/16	1/8	696.05	696.89
"M"	695.99	696.82	1/16	1/8	0	0	-3/16	-3/16	696.04	696.88	1/16	1/8	1/16	1/8	1/16	1/8	1/16	1/8	695.94	696.78	-3/16	-3/16	0	0	1/16	1/8	695.76	696.60
"N"	695.87	696.71	1/16	1/8	0	0	-3/16	-3/16	695.88	696.72	1/16	1/8	1/16	1/8	1/16	1/8	1/16	1/8	695.70	696.54	-3/16	-3/16	0	0	1/16	1/8	695.47	696.31
"P"	695.75	696.59	1/16	1/8	0	0	-3/16	-3/16	695.72	696.56	1/16	1/8	1/16	1/8	1/16	1/8	1/16	1/8	695.46	696.30	-3/16	-3/16	0	0	1/16	1/8	695.18	696.02
"Q"	695.64	696.48	1/16	1/8	0	0	-3/16	-3/16	695.56	696.40	1/16	1/8	1/16	1/8	1/16	1/8	1/16	1/8	695.22	696.06	-3/16	-3/16	0	0	1/16	1/8	694.89	695.73
"R"	695.52	696.36	1/16	1/8	0	0	-3/16	-3/16	695.40	696.24	1/16	1/8	1/16	1/8	1/16	1/8	1/16	1/8	694.98	695.82	-3/16	-3/16	0	0	1/16	1/8	694.60	695.44

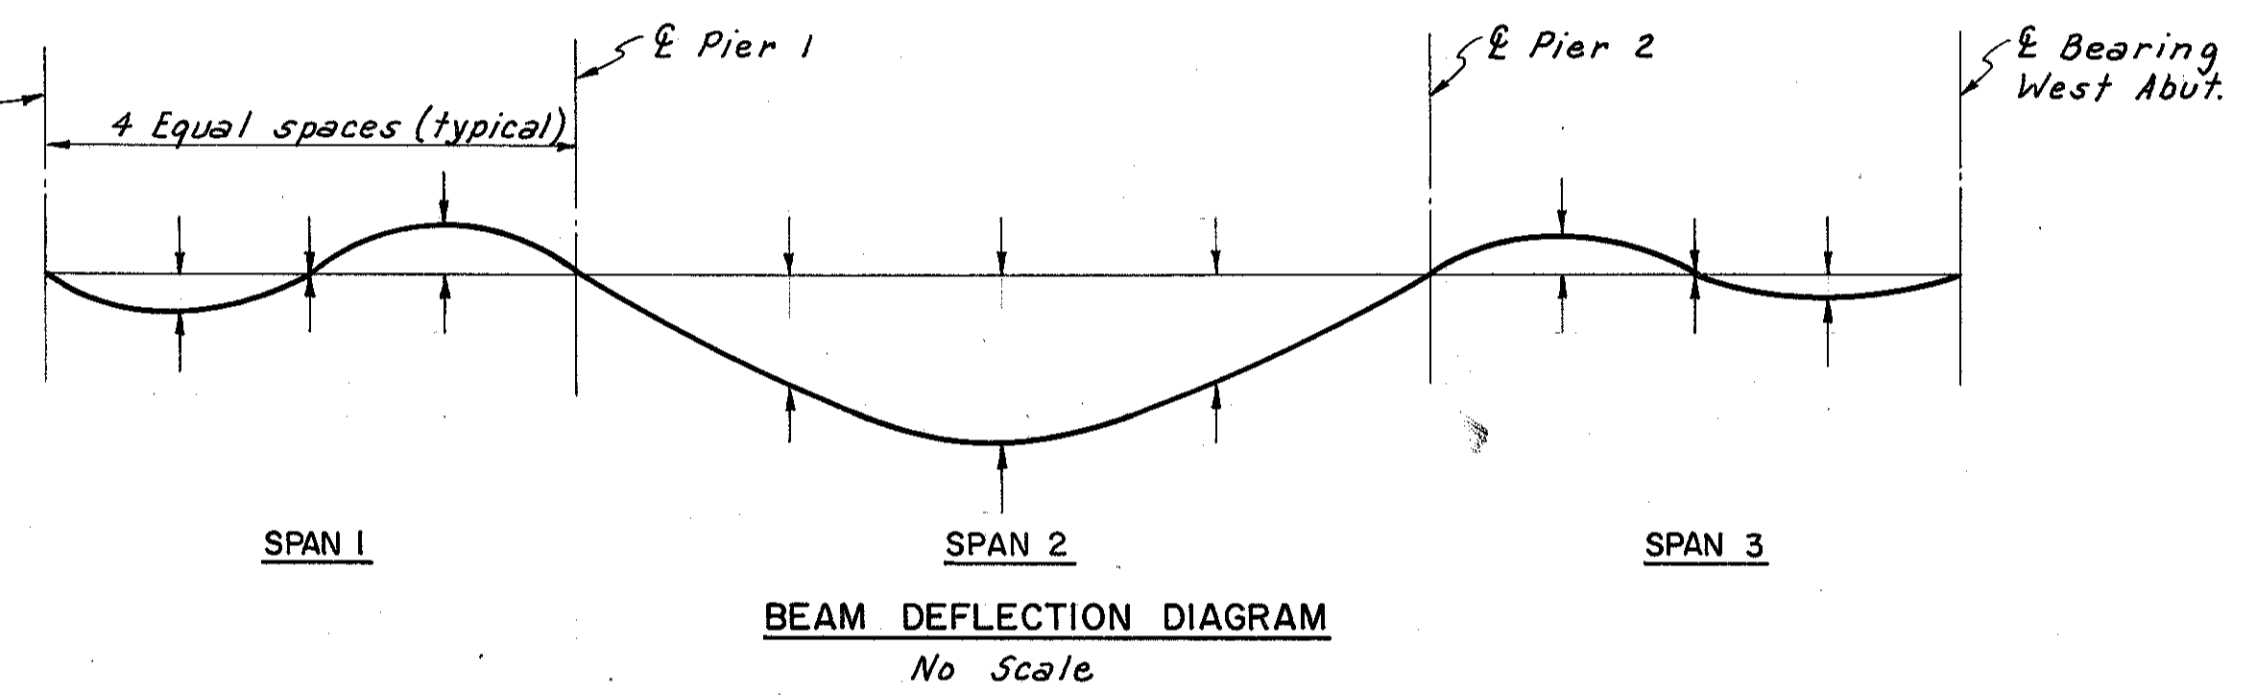


TOP OF PAVEMENT ELEVATIONS

BEAMS	SPAN 1		SPAN 2		SPAN 3				
	1/4	3/4	1/4	3/4	1/4	3/4			
"A"	697.29	697.42	697.55	697.88	698.07	698.23	698.45	698.52	698.59
"B"	697.58	697.71	697.84	698.17	698.36	698.52	698.75	698.82	698.89
"C"	697.58	697.70	697.81	698.11	698.27	698.41	698.59	698.65	698.71
"D"	697.51	697.61	697.71	697.97	698.11	698.23	698.42	698.46	698.46
"E"	697.44	697.53	697.61	697.83	697.95	698.04	698.15	698.18	698.22
"F"	697.36	697.44	697.52	697.69	697.78	697.86	697.93	697.95	697.97
"G"	697.29	697.36	697.42	697.55	697.62	697.67	697.71	697.71	697.72
"H"	697.22	697.27	697.32	697.42	697.46	697.49	697.49	697.49	697.48
"J"	697.22	697.27	697.32	697.42	697.46	697.49	697.49	697.49	697.48
"K"	697.10	697.14	697.17	697.24	697.26	697.27	697.24	697.22	697.20
"L"	696.97	697.00	697.02	697.06	697.06	696.05	696.99	696.96	696.92
"M"	696.85	696.86	696.87	696.88	696.86	696.83	696.74	696.69	696.64
"N"	696.72	696.72	696.72	696.70	696.66	696.61	696.48	696.43	696.37
"P"	696.55	696.59	696.58	696.52	696.46	696.39	696.23	696.16	696.09
"Q"	696.47	696.45	696.43	696.33	696.26	696.17	695.98	695.90	695.81
"R"	696.35	696.31	696.28	696.15	696.06	695.95	695.73	695.63	695.54

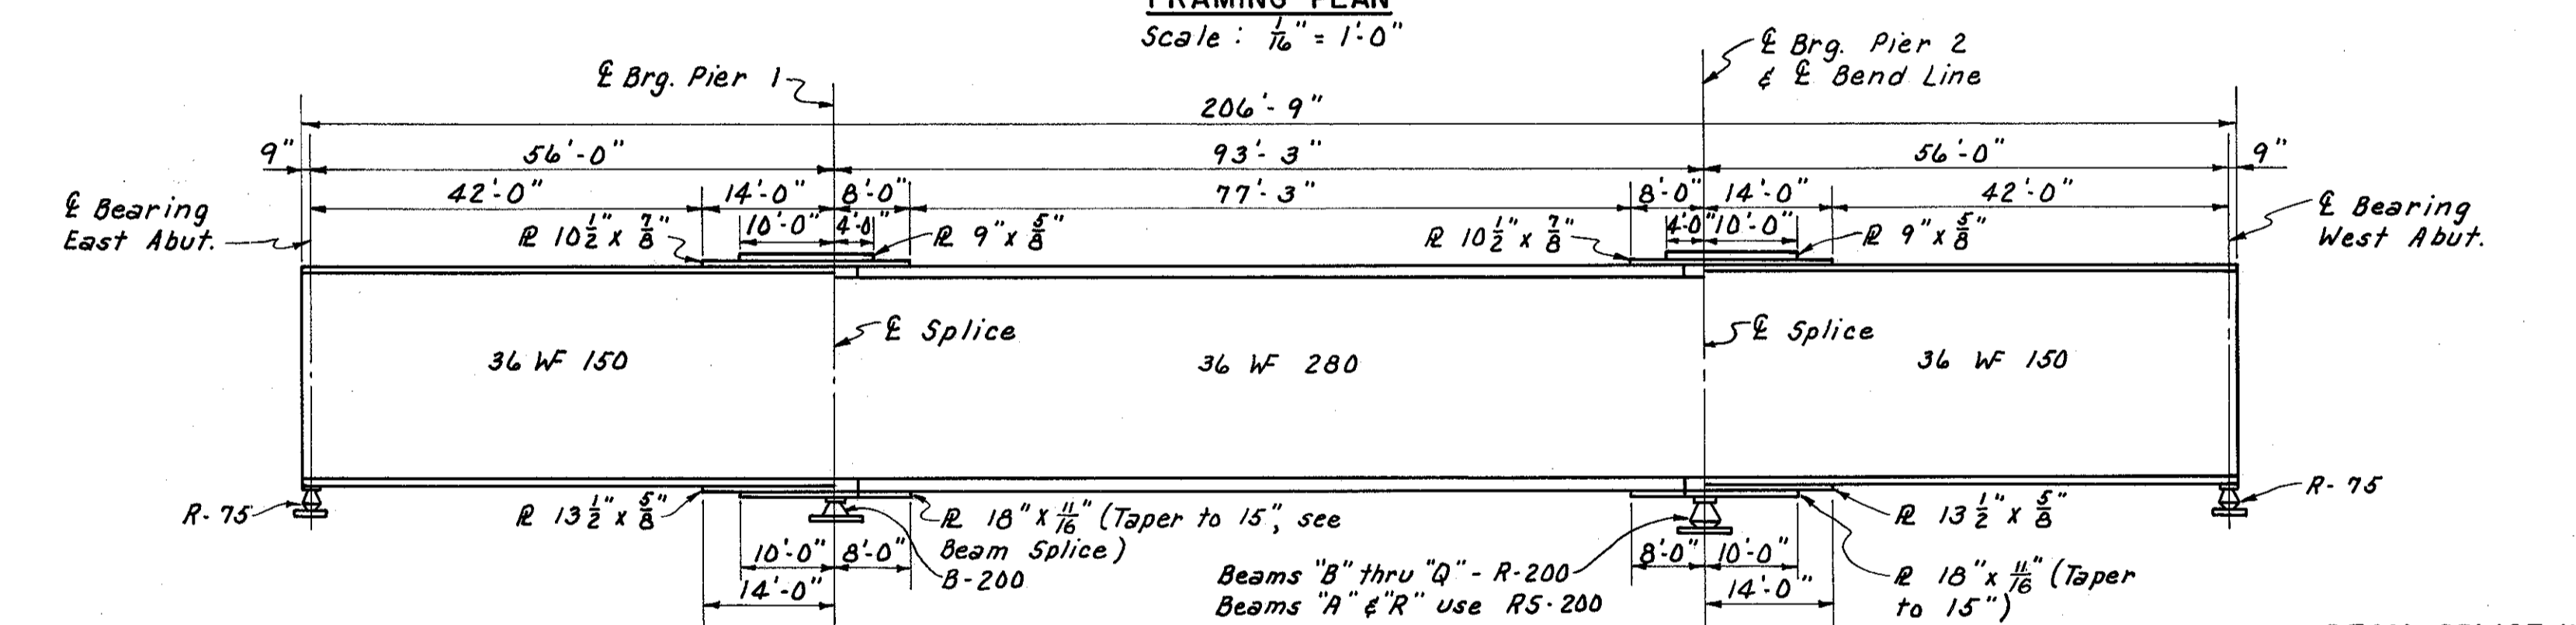

- BEAM SPLICE WELDING PROCEDURE**
1. Raise the abutment ends of the beams 1/2".
 2. Butt-weld the beam flanges and web, using the following sequences: make two passes on each flange, then two on the web; repeat using one pass at each location, until welds are completed.
 3. Weld the top and bottom cover plates.
 4. Lower the beam ends to final position.

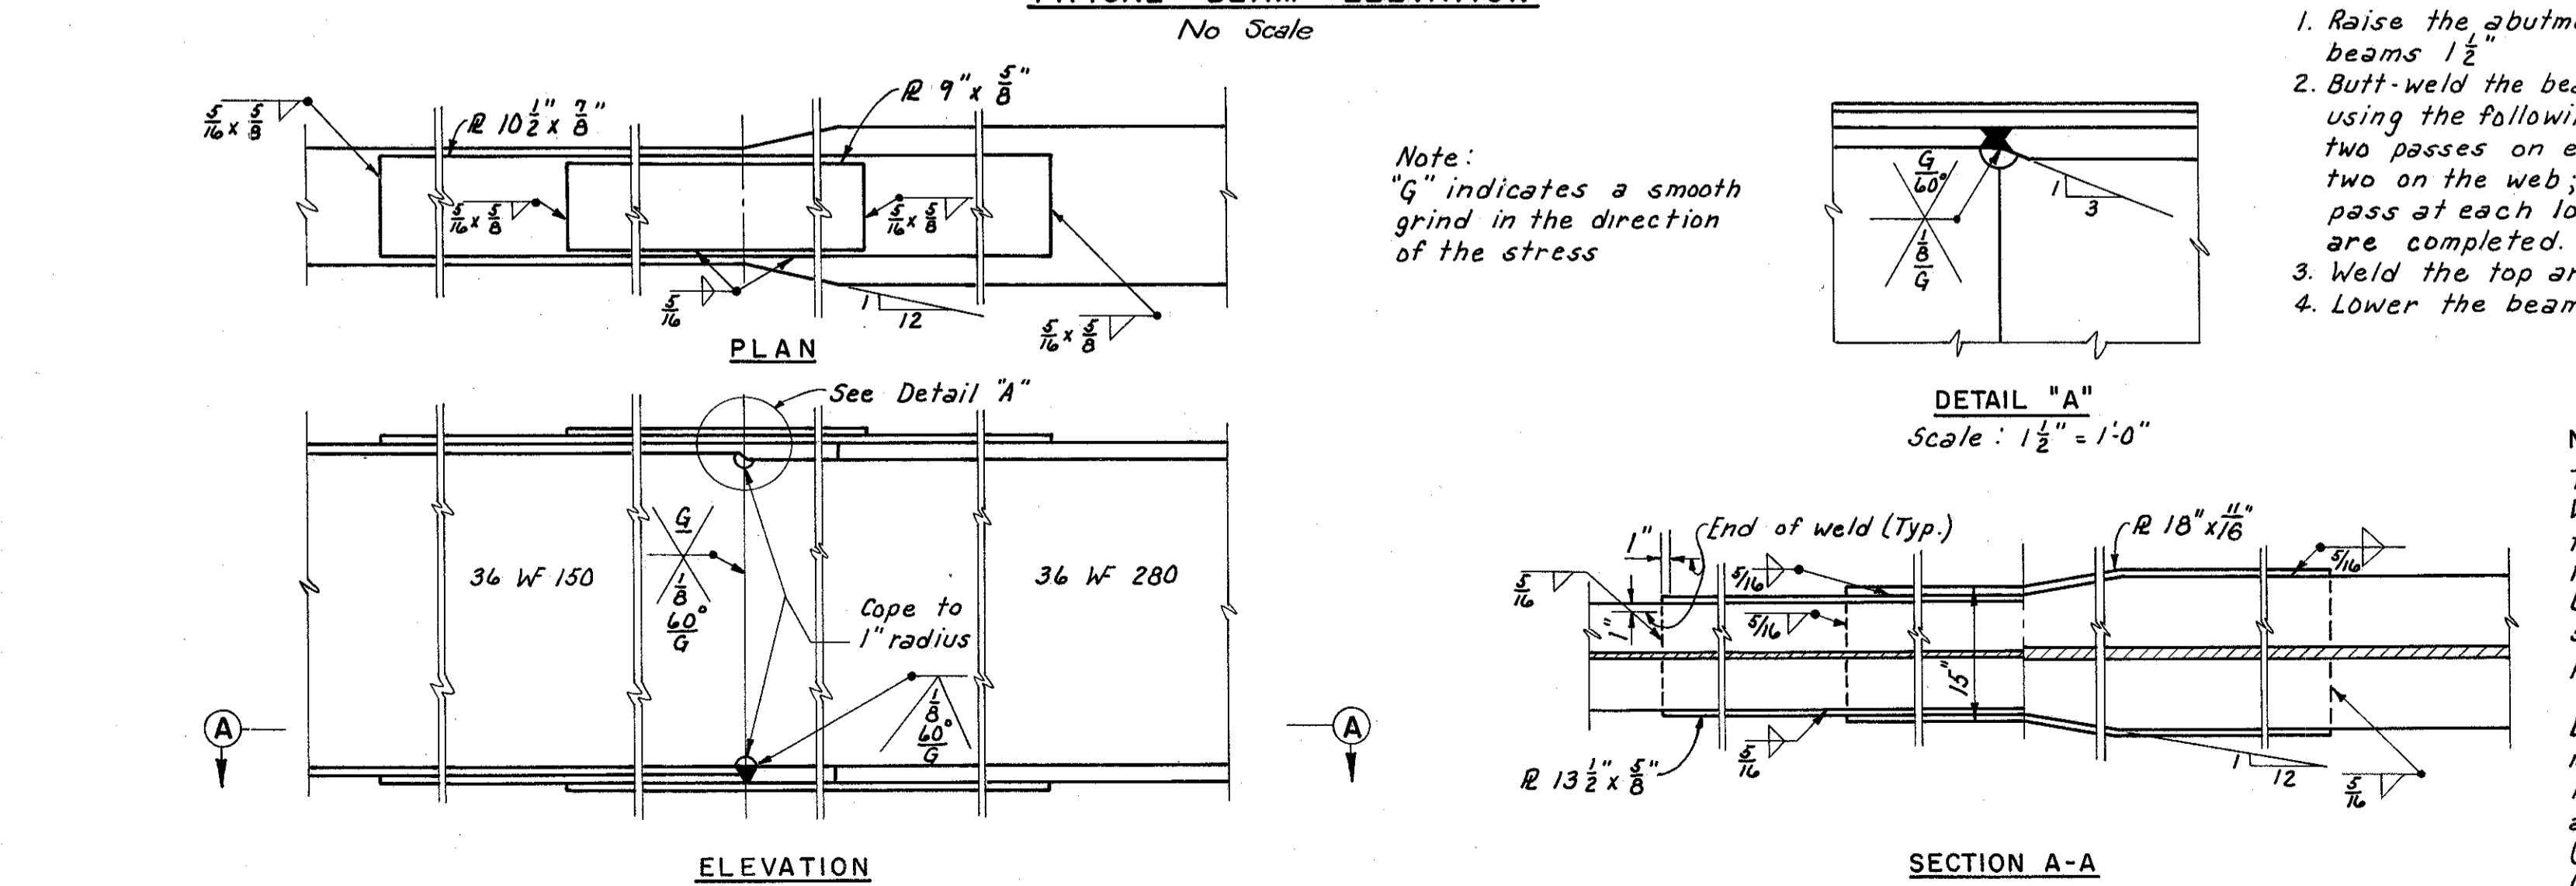


NOTES:
 The beams in Span 2 shall be cambered as follows: Where the sum of the deflections and convexity is 3/8" to 1" the required camber will be 1", and if greater than 1" the required camber will be the same as the sum. Beams in Spans 1 and 3 do not require camber, but shall be fabricated so that any curved beam will be placed with the convex flange up.
 Deflections are given at the quarter points and are measured to the nearest 1/16 inch.
 In Elevation and Deflection Table, the following abbreviations are used:
 (D.L. Defl.) denotes dead load deflections.
 (Tot.) refers to total deflections from dead load of steel and concrete.
 (Con.) denotes deflections due to concrete.

Elevations shown in the "Elevation and Deflection Table" are given at intersection of bearings and beams. Top of beam elevations are exclusive of cover plates.
 Notes:
 For details of end dams see sheet 173-7A
 For cross-frame details see sheet 163-7A
 For drainage details see sheet 174-7A
 For details of rocker masonry plates see sheet 173-7A
 For other rocker and bolster details see Ohio Standard Drawing RB 1-55.
 For details of Underdeck Lighting see sheet 177-7A




H.N.T.B. BR. NO. 10 PART 7A
 HOWARD, NEEDLES, TAMMEN & BERGENOFF
 CONSULTING ENGINEERS
 KANSAS CITY CLEVELAND NEW YORK
FRAMING PLAN
 WILLOW FREEWAY OVER EAST 22nd ST.
 BR. NO. CUY - 21-1559 STA. 42+45.12
 Scale: As noted STA. 44+54.88
WILLOW-INNER BELT FREEWAY
 CLEVELAND CUYAHOGA COUNTY OHIO
 DRAWN P.A. TRACED J.E.K. CHECKED D.R.K. REVIEWED J.C.T. REVISION 12-6-60
 DATE 4-15-59 DATE 10-2-59 DATE 6-25-59 SHEET 162

MICROFILMED
JUL 3 1965

Note: Prefix 'S' shall be assigned to all bar marks.

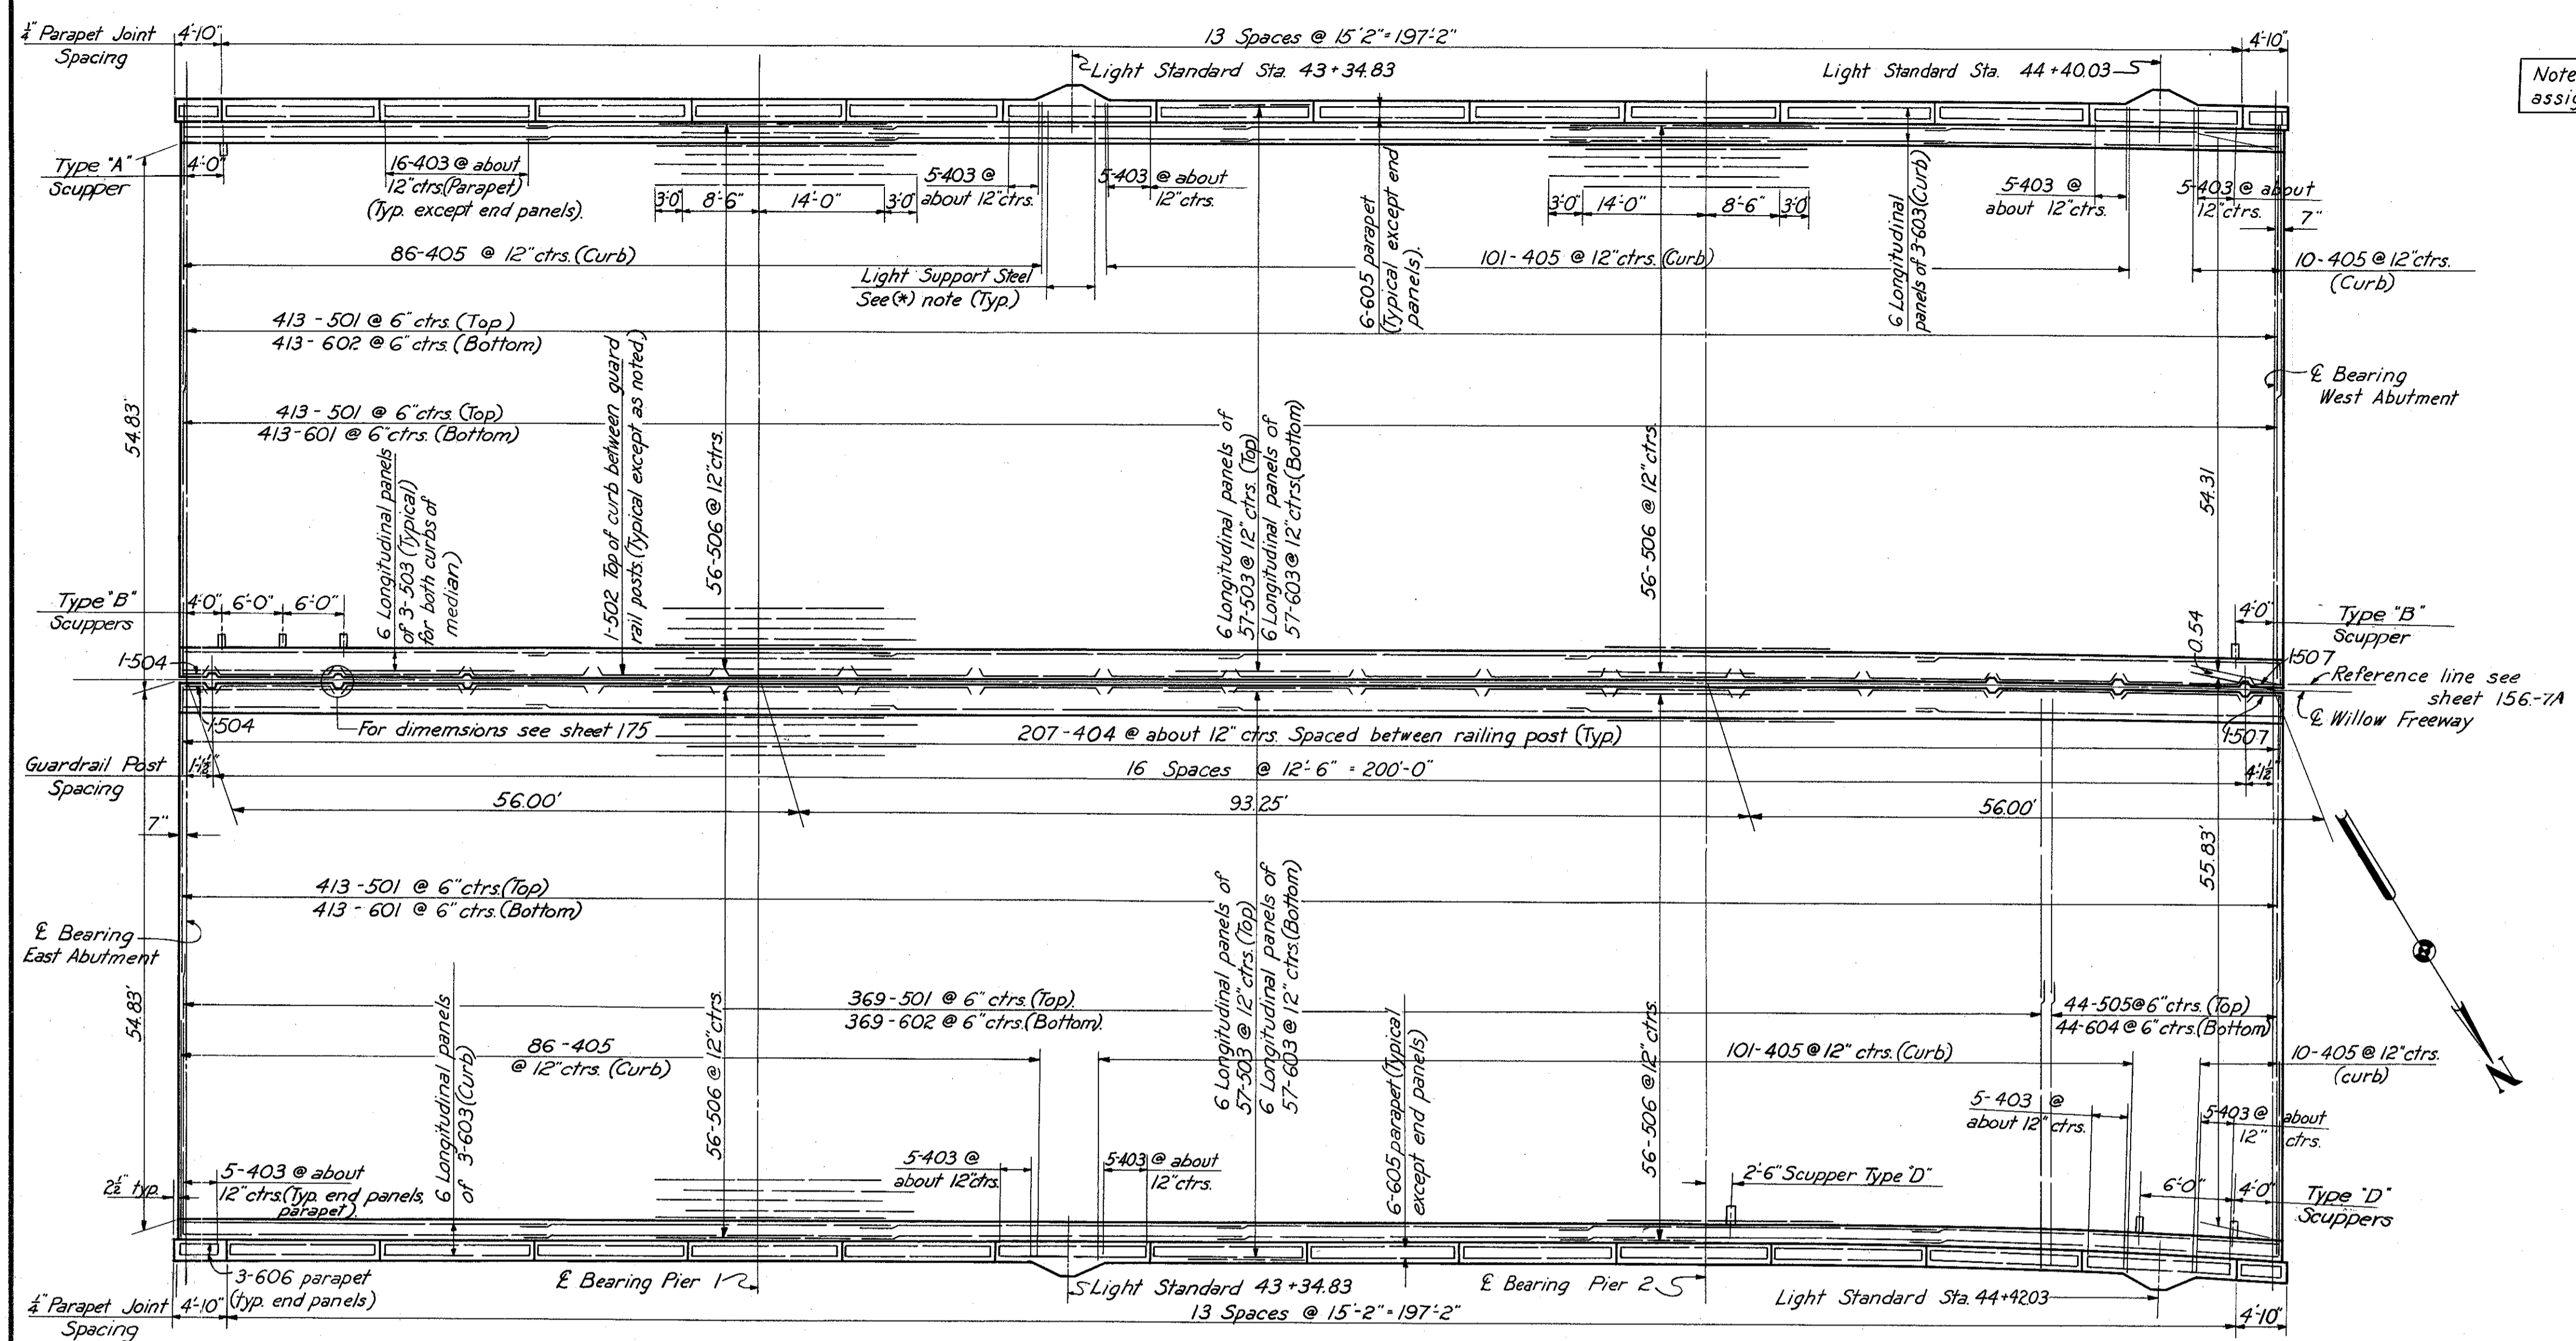


MARK	NUMBER	LENGTH	TYPE	DIMENSIONS				SERIES INCREMENT	WEIGHT (LBS.)	
				A	B	C	D			
403	412	4'-5"	105	0'-8"	2'-0"				1,217	
404	414	5'-3"	122	2'-6"	1'-0"				1,454	
405	394	5'-1"	122	1'-8"	1'-4"				1,340	
451*	8	9'-3"	131	2'-6"	3'-0"	1'-2"			48	
452*	8	10'-3"	131	3'-0"	3'-0"	1'-8"			56	
453*	12	9'-9"	131	3'-2"	3'-0"	1'-0"			80	
454*	8	5'-9"	155	2'-2"	1'-6"				32	
455*	8	6'-5"	155	2'-8"	1'-6"				36	
456*	12	6'-7"	155	2'-10"	1'-6"				52	
501	1608	29'-7"	101	29'-0"					49,615	
502	32	13'-0"	159	11'-2"	0'-6"	0'-10"			434	
503	720	35'-9"	Str.						26,847	
504	2	1'-9"	108	0'-10"	0'-6"	0'-10"			4	
505	44	30'-10"	101	30'-3"					1,415	
506	224	25'-6"	Str.						5,958	
507	2	4'-8"	108	3'-8"	0'-6"	0'-10"			10	
601	826	27'-9"	Str.						34,428	
602	782	30'-9"	Str.						36,118	
603	720	36'-0"	Str.						38,932	
604	44	32'-0"	Str.						2,115	
605*	156	14'-9"	Str.							
606*	24	4'-6"	Str.							
651*	8	9'-5"	141	2'-11"	1'-10"				112	
652*	12	14'-6"	141	5'-3"	3'-0"				260	
653*	4	5'-0"	Str.						32	
									Total	200,595

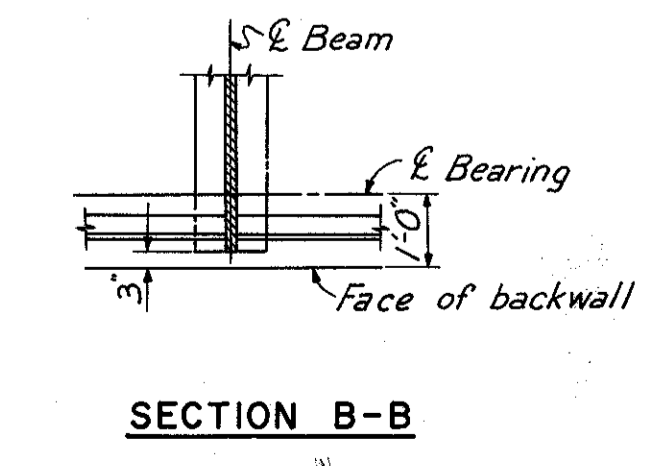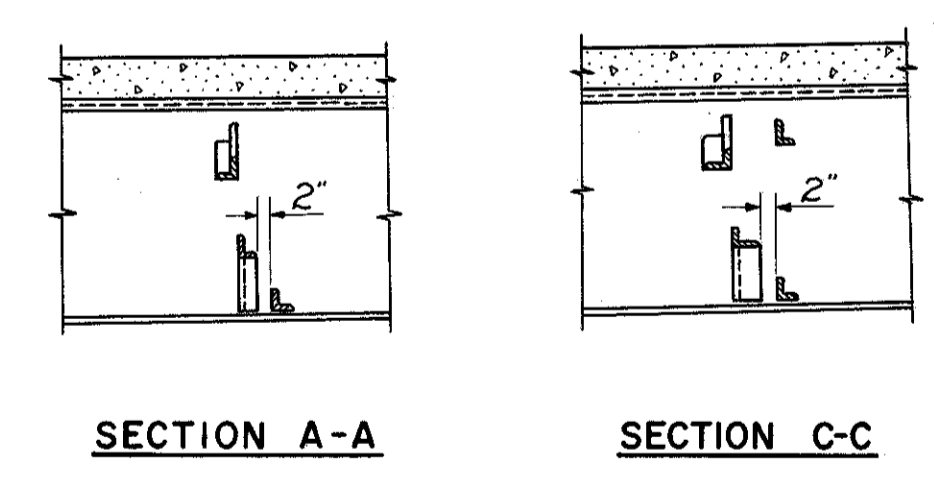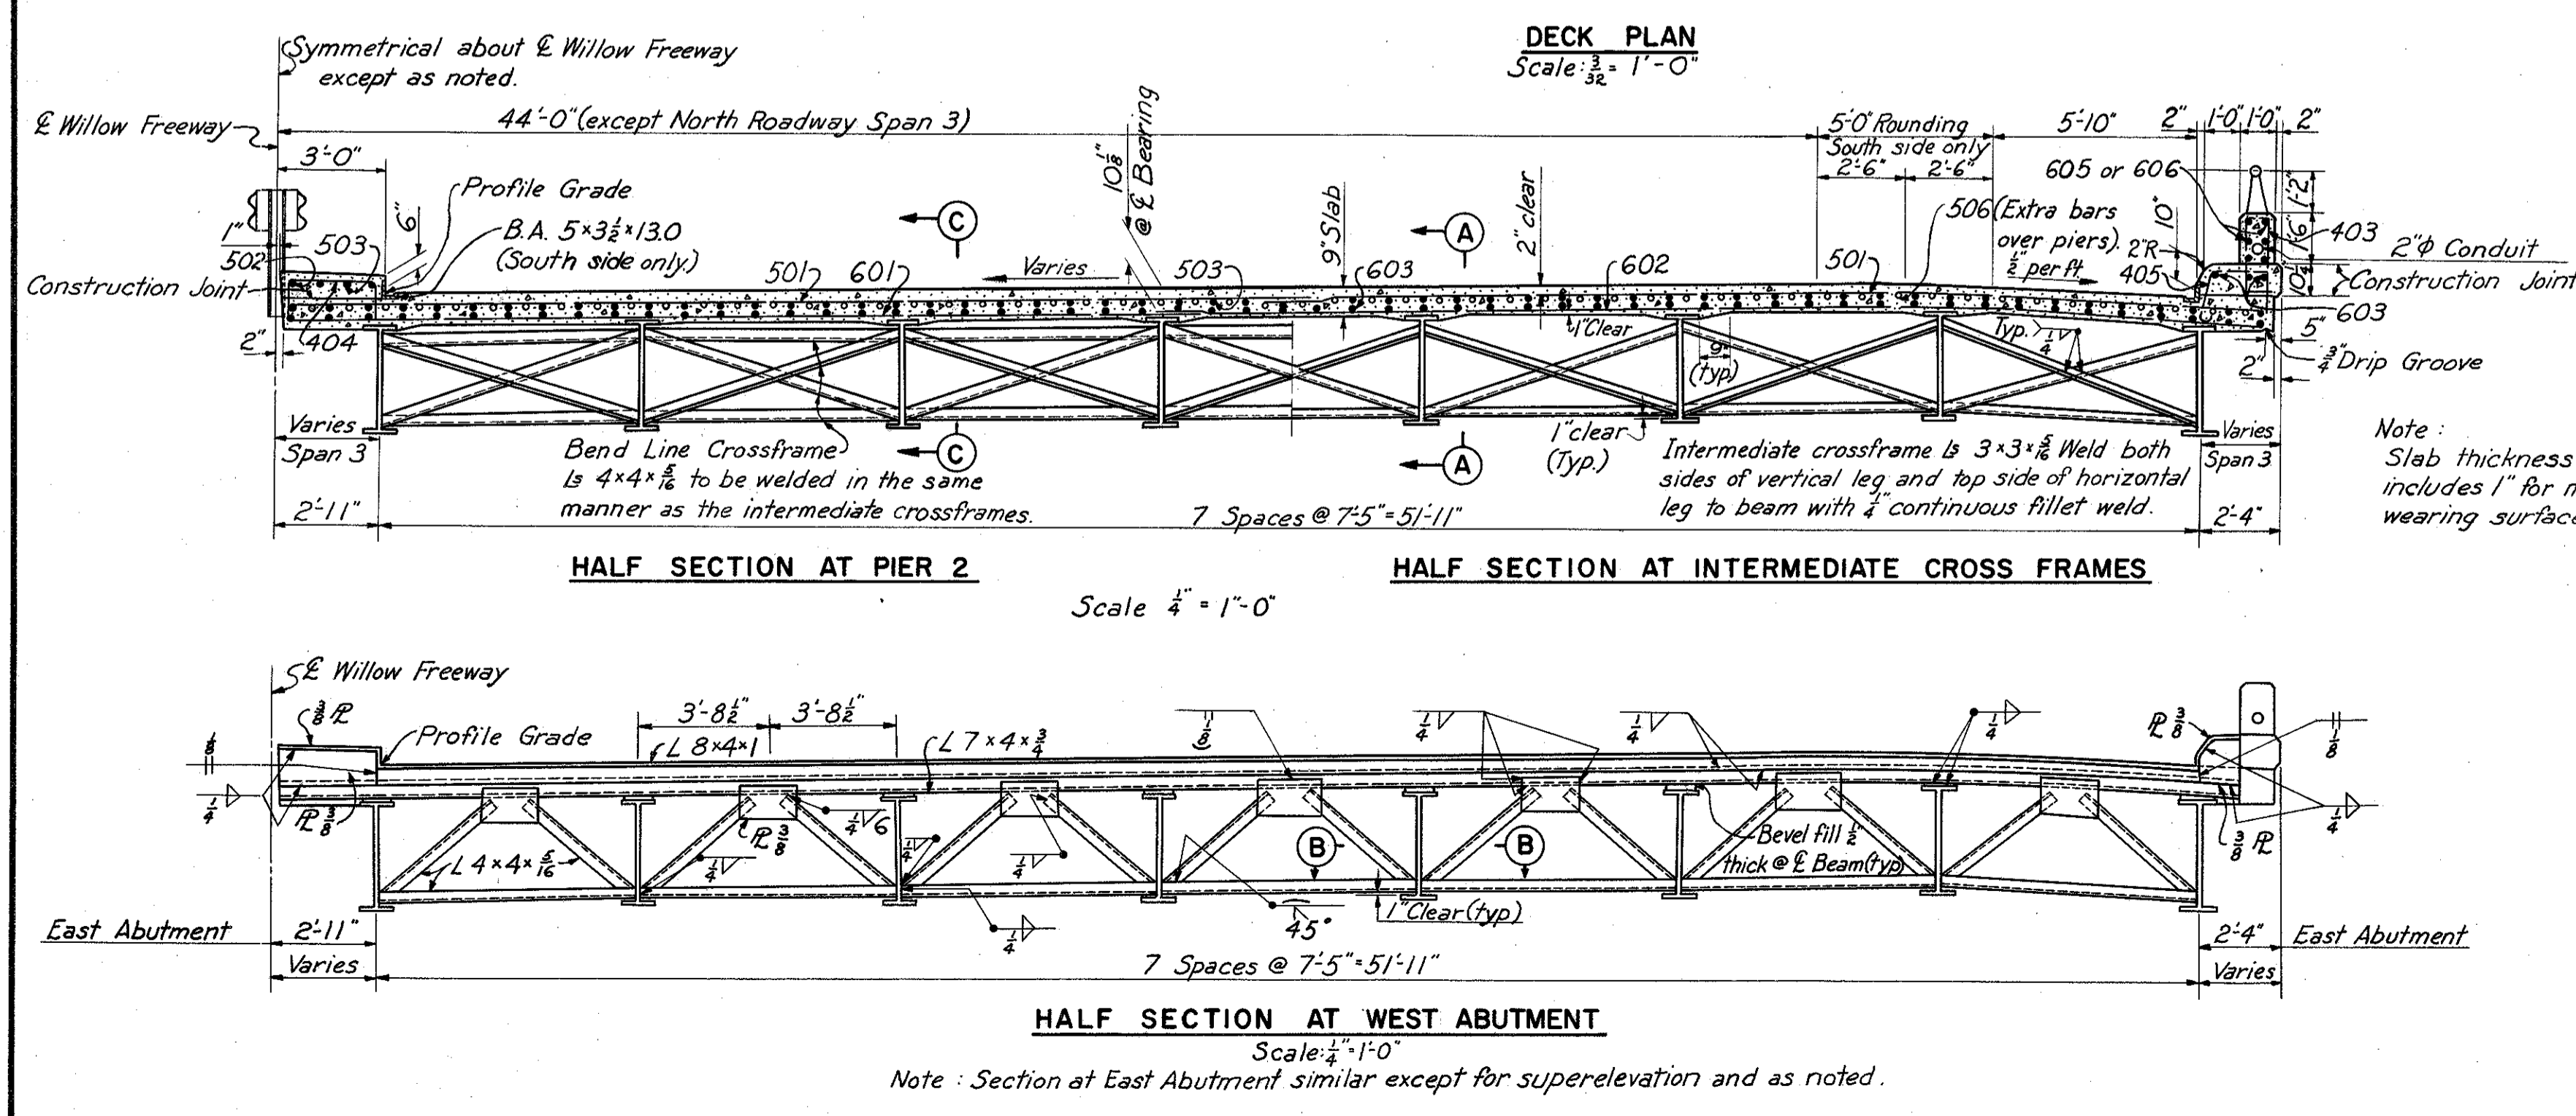

NOTES:
 *Bars 451 thru 456 and 651 thru 653 are for the light standard supports. For their bar bending diagrams and placement see sheet 176-7A
 *Bars 605 and 606 are included for payment with "Item S-14, Railing".
 All bar dimensions are given out to out. For replacement schedule see sheet 103-7A
 For light standard and other lighting details see sheets 176-7A & 177-7A
 For railing details see sheet 175-7A
 For expansion dam details see sheet 173-7A
 For parapet joint details see sheet 175-7A
 For drainage details see sheet 174-7A
 In order to facilitate water curing of the concrete of the deck slab, the placing of concrete shall progress up-grade. The slab may be placed in sections, between transverse construction joints which are parallel to the transverse bars in the slab and are located near the center of any span.
 For bar bending diagram, see sheet 170-7A

H.N.T.B. BR. NO. 10 PART 7A
 HOWARD, NEEDLES, TAMMEN & BERGENDOFF
 CONSULTING ENGINEERS
 KANSAS CITY CLEVELAND NEW YORK
DECK PLAN
 WILLOW FREEWAY OVER EAST 22nd ST.
 BR. NO. CUY-21-1559 STA. 42+45.12
 Scale: As noted STA. 44+54.88
WILLOW-INNER BELT FREEWAY
 CLEVELAND CUYAHOGA COUNTY OHIO
 DRAWN R.A. TRACED R/R CHECKED C.A.B. REVIEWED J.C.T. REVISION
 DATE 6/17/59 DATE 5/6/59 DATE 6-28-59 DATE 11-13-59
 SHEET 163

CUYAHOGA COUNTY
CITY OF CLEVELAND
CUY-21-15.32
CUY-42-18.42

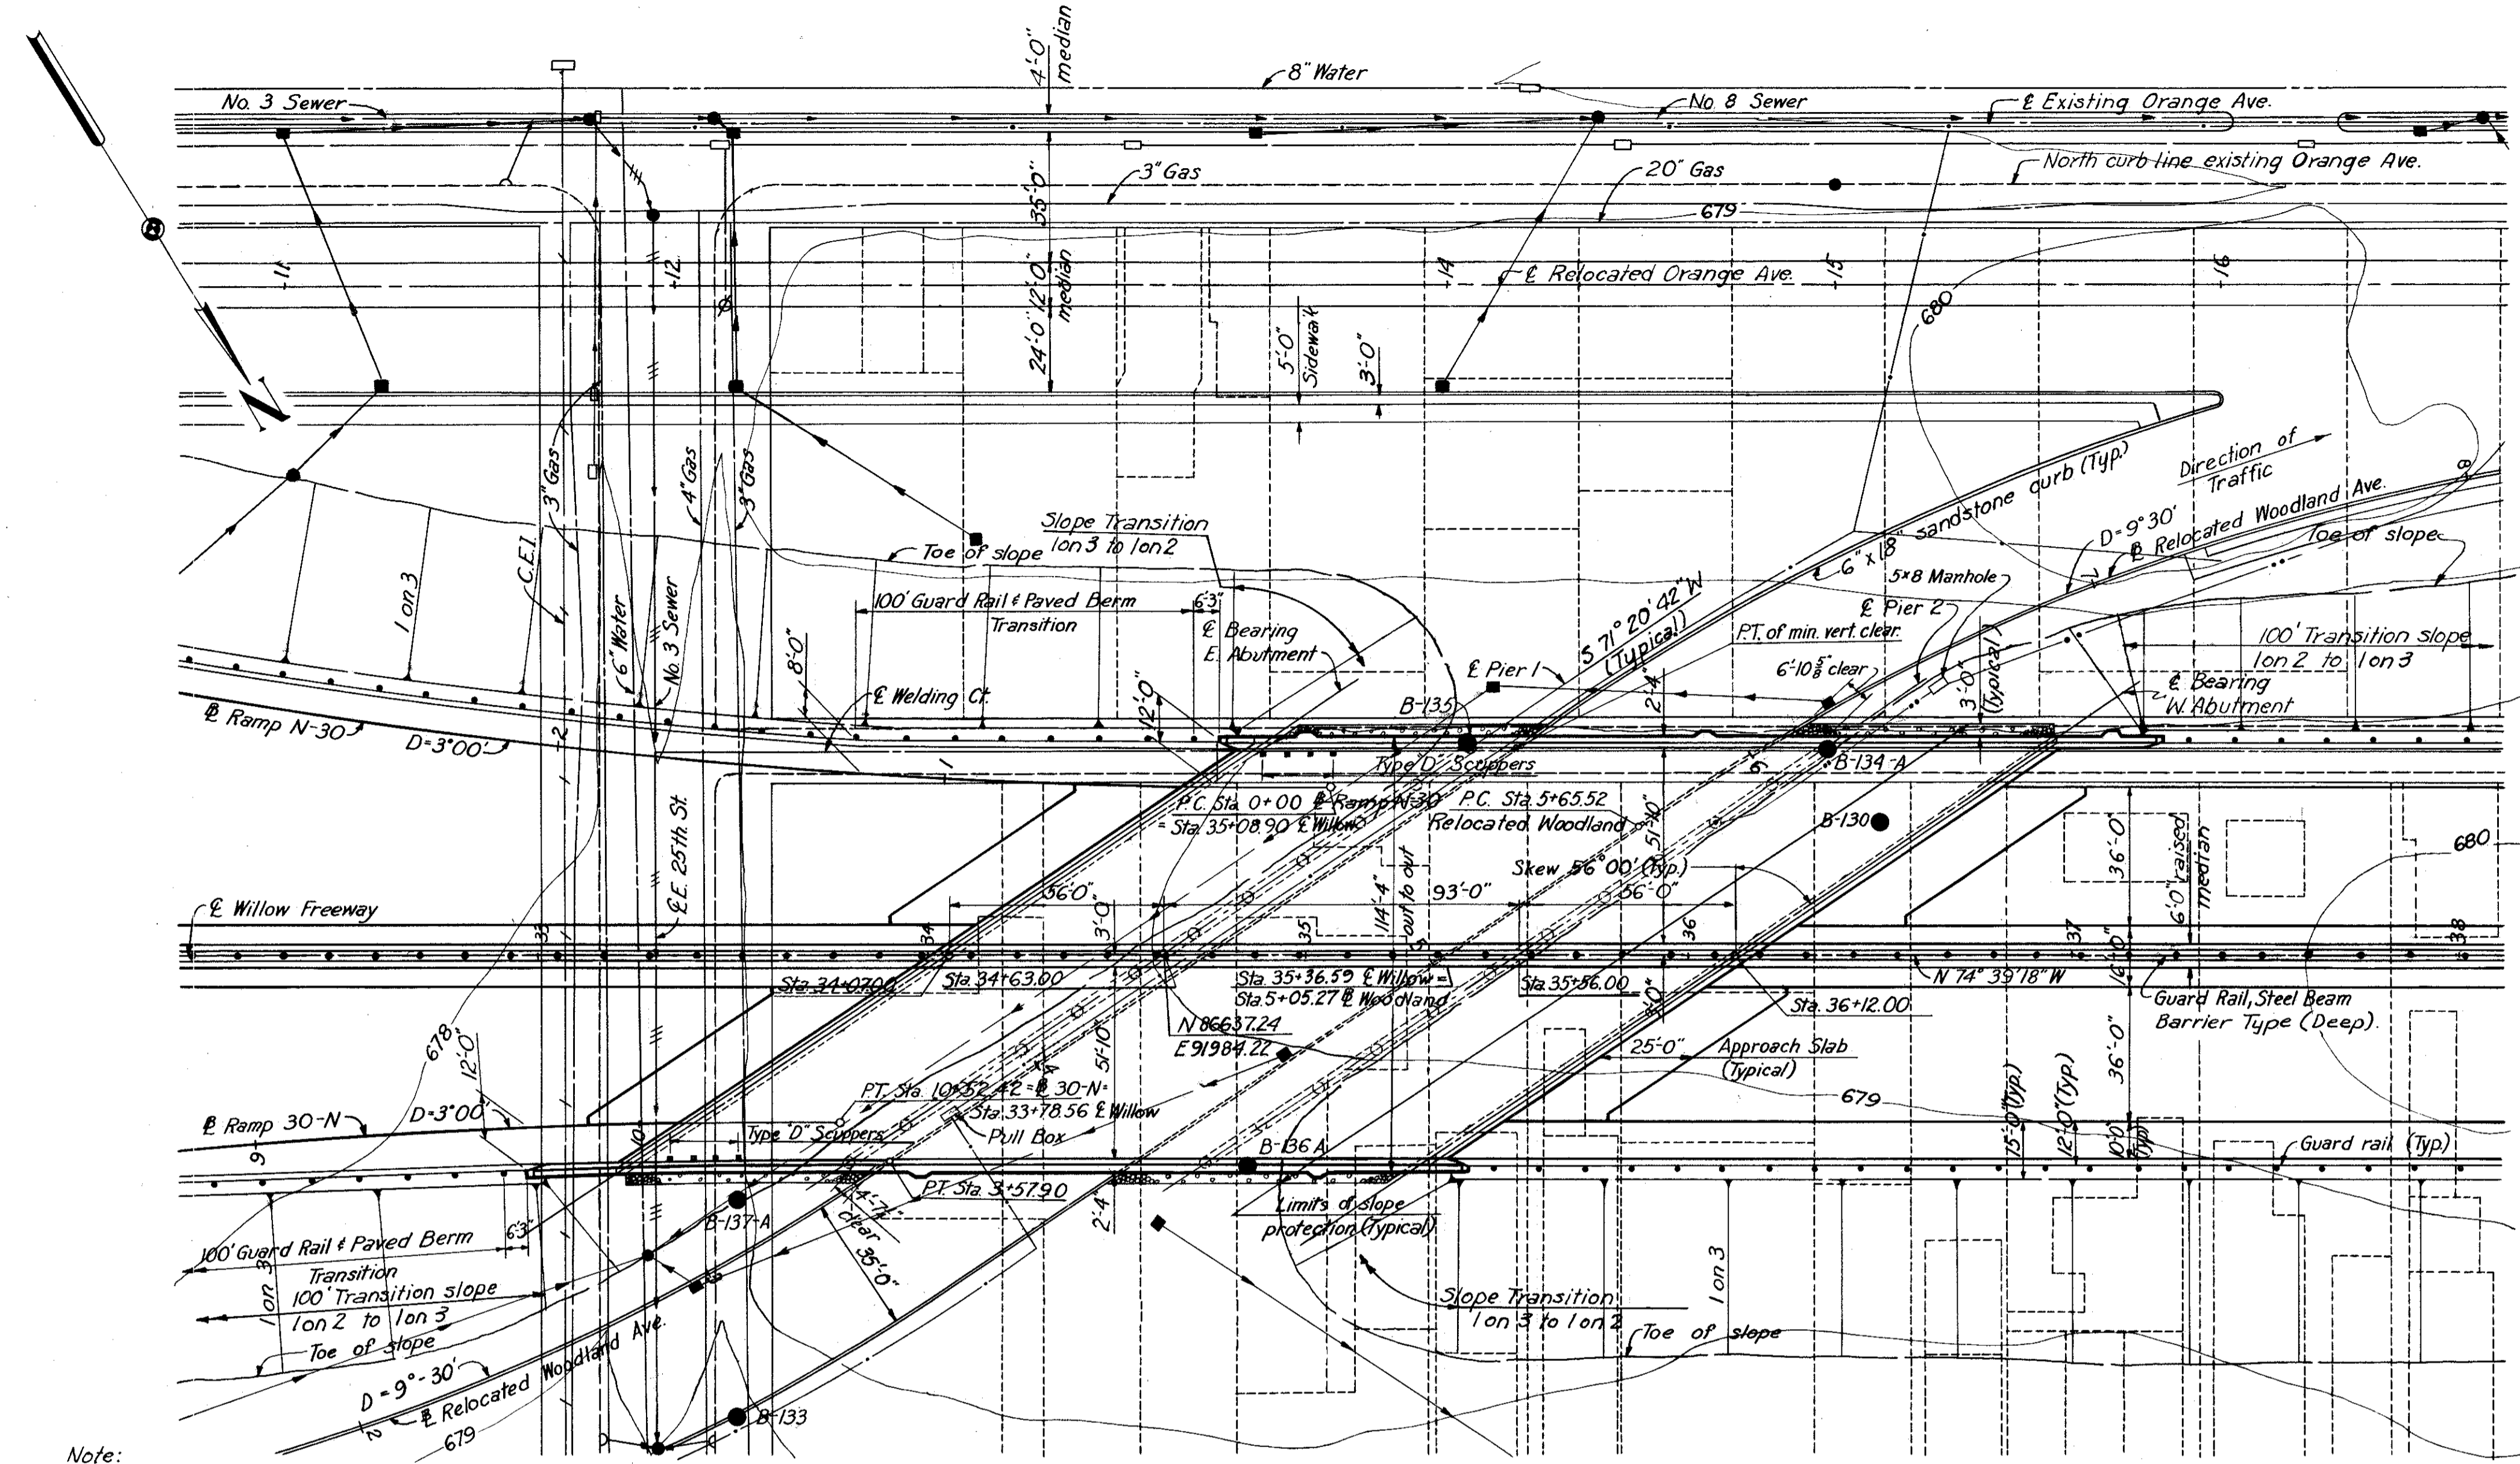

Elev 678.3

19	673.3	Brown Silty Gravelly Sand
10		
11	663.3	Brown Gravelly Sand
12	658.3	Brown Sand
15	653.3	Brown Silty Sand
36	648.3	Gray Silty Sand
11		
15	638.3	Gray Silt
32	633.3	Gray Gravelly Sand
51	628.3	Gray Sandy Silt
48		
47		
9		
20		
60		
26	598.3	Gray Silt

Elev 676.5

5	671.5	Brown Sand
8	666.5	Brown Silty Gravelly Sand
11		
17	656.5	Brown Silty Sand
16		
14		
18	641.5	Gray Silt
36	636.5	Brown Gravelly Sandy Silt
57	631.5	Gray Sandy Gravelly Silt
67		
19		
40		
14		
70	601.5	Gray Silt

BORING B-134 A
Vertical Scale: 1"=20'
Sta. 36+36 55Lt.

BORING B-137 A
Vertical Scale: 1"=20'
Sta. 33+52 65Rt.

Note:
The figures to the left indicates the number of hammer blows required to drive the sample spoon 1ft. They are given at 5' intervals starting at Elev. 678.3 and Elev. 676.5.

CURVE DATA

RAMP N-30
Δ=11°00'00"
D=3°00'
R=1909.86'
T=183.90'
L=366.67'


RAMP 30-N
Δ=7°42'07"
D=3°00'
R=1909.86'
T=183.90'
L=256.73'

REL. WOODLAND AVE.
Δ=34°00'00"
D=9°30'
R=603.11'
T=184.39'
L=357.90'


REL. WOODLAND AVE.
Δ=33°59'37"
D=9°30'
R=603.11'
T=184.35'
L=357.83'

Note:
Relocated Woodland Ave. shifts from left to right at Sta. 3+75.

PLAN

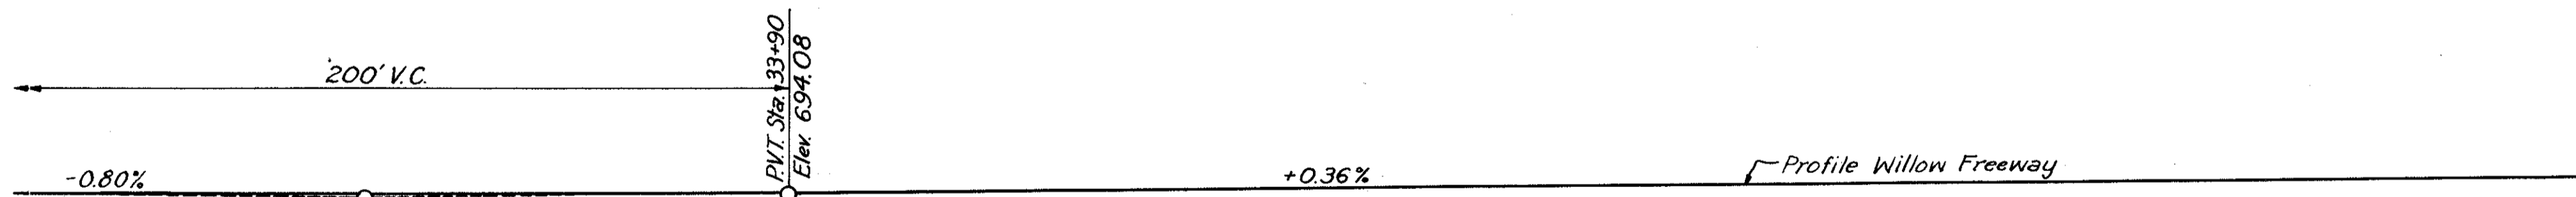

PROFILE

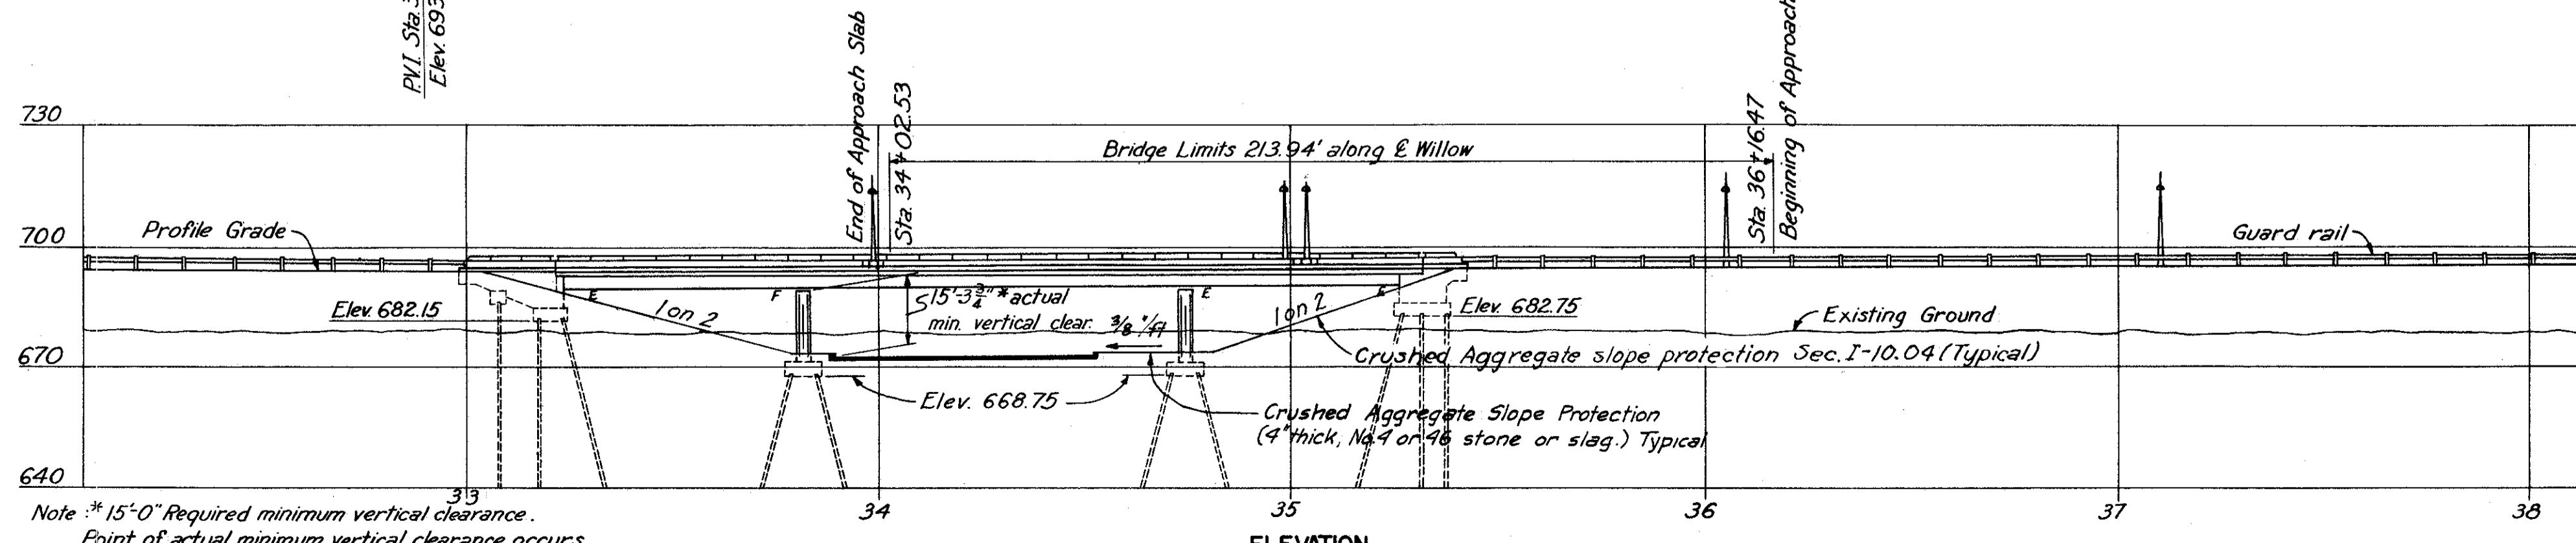

Note: *15'-0" Required minimum vertical clearance. Point of actual minimum vertical clearance occurs at the South exterior beam and the East curb line of Relocated Woodland Ave.

ELEVATION

PROPOSED STRUCTURE
Type: Continuous steel beam with reinforced concrete deck and substructure.
Spans: 56'-0", 93'-0" & 56'-0"
Roadway: 112'-0" (normal) 1/1' parapets.
Loading: CF 2000 - Adequate for A.A.S.H.O. alternate loading.
Surface Course: 1" Monolithic Concrete.
Alignment: Tangent.
Approach Slabs: AS-1-54. (25' long).
Superelevation: None.
Skew: 56° 00'.

NOTES:

Rod soundings only were taken at location B-130, B-133, B-135 A & B-136 A. The core drillings made at B-134 A & B-137 A are plotted.
For details of slope protection see sheet 174-7A. Foundation design and foundation quantities are based on a study of these borings.
The following items are not included in the Bridge Plans. See Roadway Plans for details.
Approach grading, pavement and slabs.
Roadway guard rail.
For details of pier plans & drain pipe locations at piers see sheets 172-7A & 174-7A.

LEGEND

—	Right of Way
—	Curb
—	M.E.L.P.
—	Sewer
—	C.E.I.
—	Water
—	Gas
—	*Sewer
—	*2" Duct
—	*4" Duct
—	Sewer to be abandoned

PILE INFORMATION

Location	Diameter	Number	Estimated ave. length
East Abutment	12"	61	49'
West Abutment	12"	61	50'
Pier 1	14"	56	35'
Pier 2	14"	56	35'

* Drill under previous contract.

Note:
Piers for Bridge No. 11 are included in Part 6.

H.N.T.B. BR. NO. 11 PART 7A

HOWARD, NEEDLES, TAMMEN & BERGENDOFF
CONSULTING ENGINEERS
KANSAS CITY CLEVELAND NEW YORK

SITE PLAN
WILLOW FREEWAY OVER REL. WOODLAND AVE.
BR. NO. CUY-21-1544 STA. 34+02.53
Scale: 1"=30' STA. 36+16.47

WILLOW-INNER BELT FREEWAY
CLEVELAND CUYAHOGA COUNTY OHIO



DRAWN A.J.S. TRACED R.W.K. CHECKED J.C.T. REVISIONS
DATE 11-24-58 DATE 12-30-58 DATE 12-11-58 DATE 11-13-59

SHEET 164


JUL 3 1955

CUYAHOGA COUNTY
CITY OF CLEVELAND
CUY-21-15.32
CUY-42-18.42


Note: Prefix "A" shall be assigned to all bar marks.

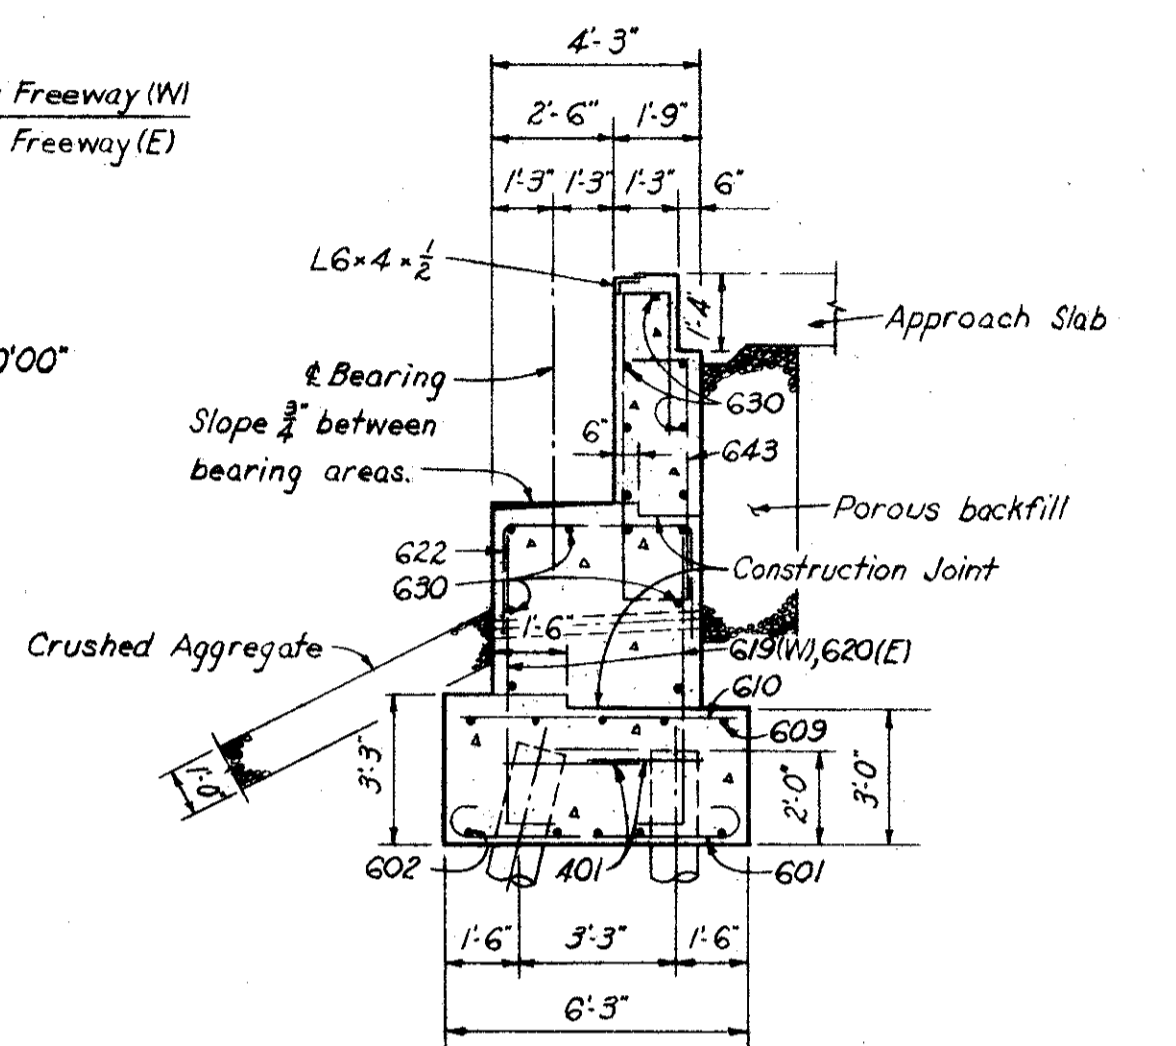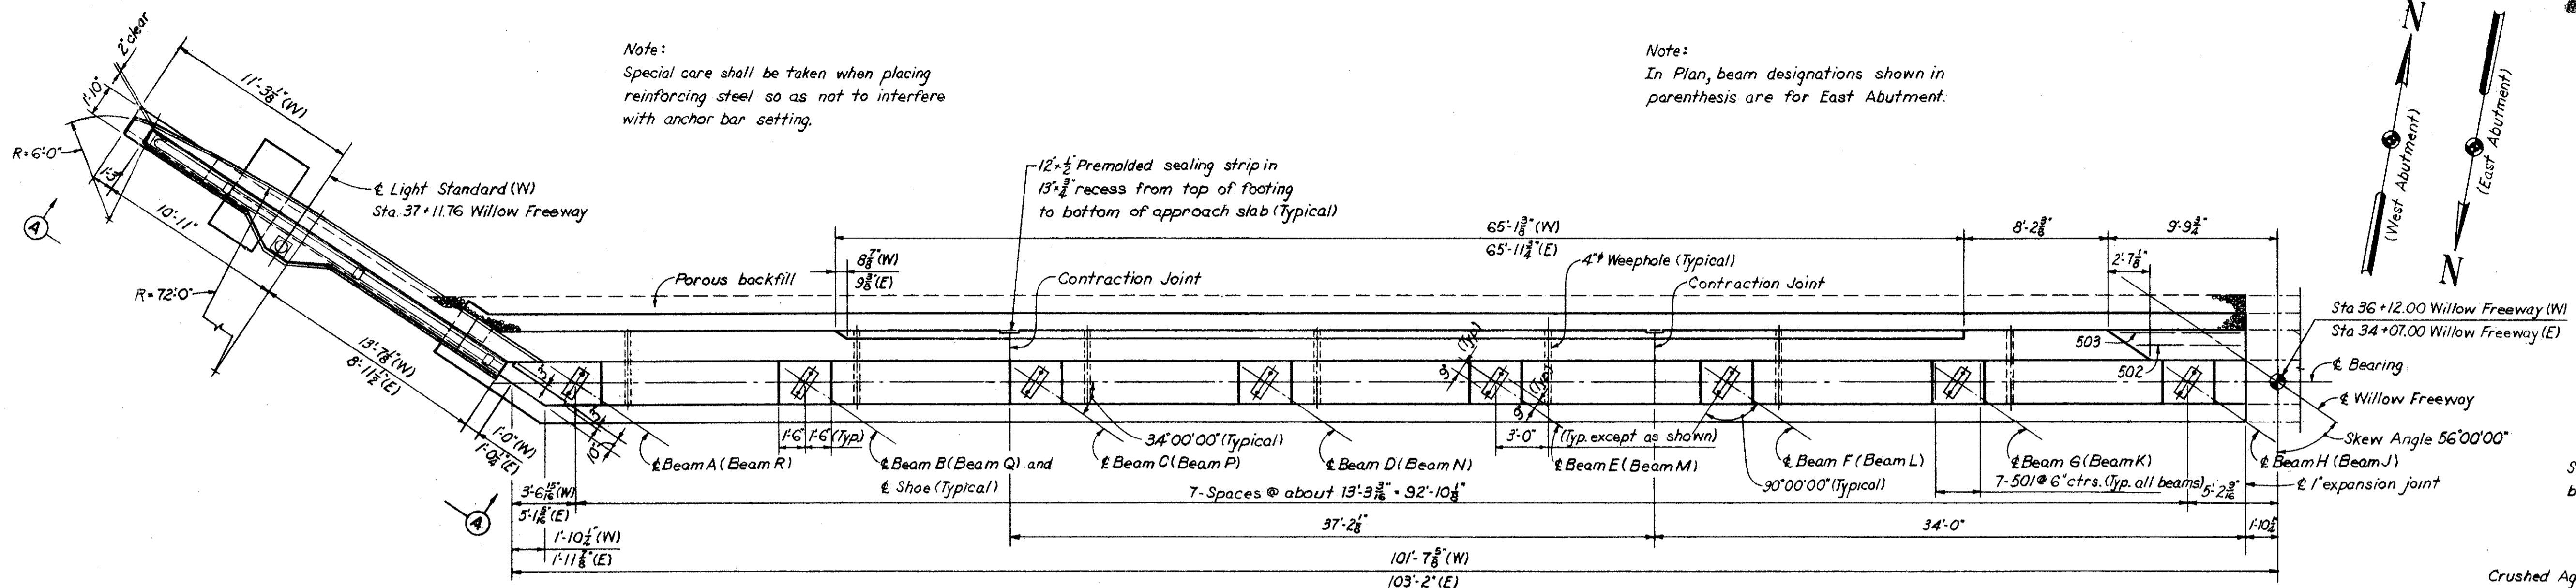

Note: Elevations along backwall are given to back of 6x4 1/2 angle.

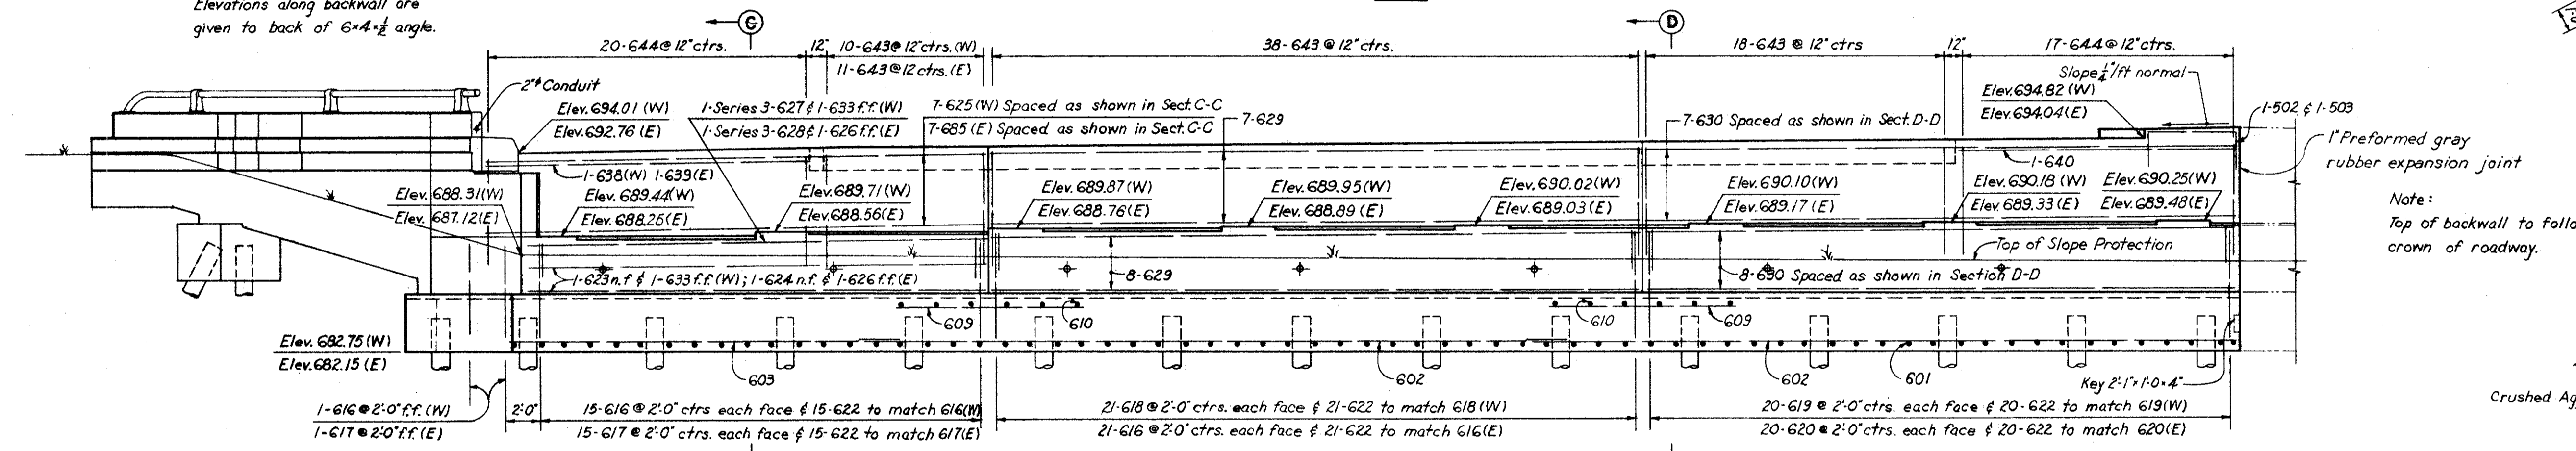

Note: Top of backwall to follow crown of roadway.

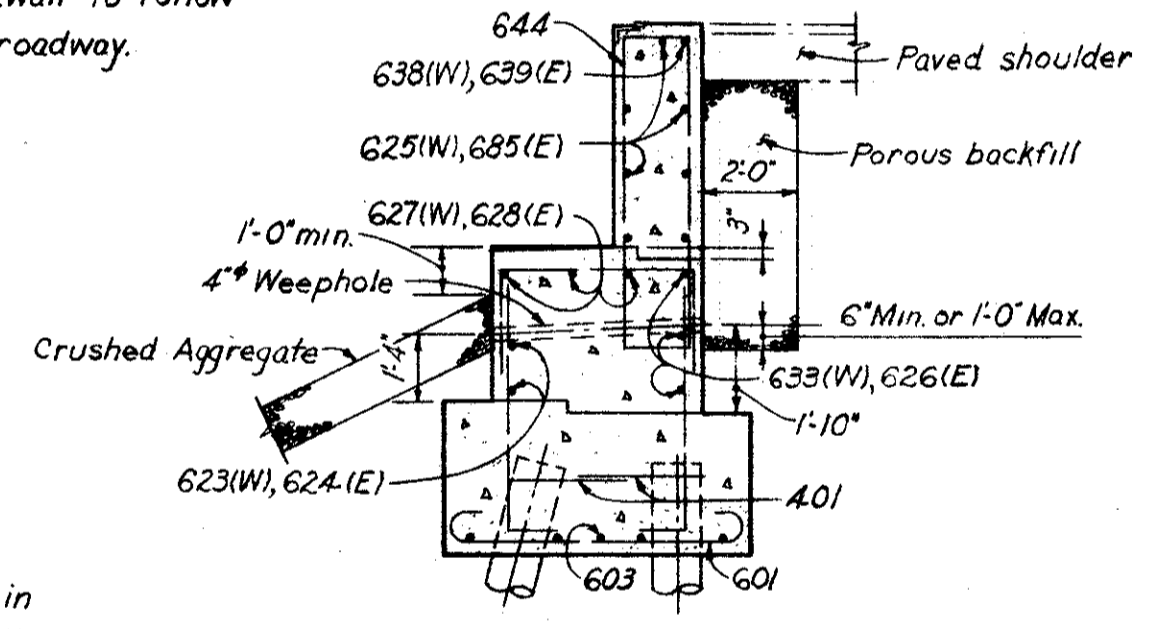

NOTES:

- All piles shall be 12" C.I.P. Reinforced Concrete.
- All battered piles shall be battered 3 in 12 in direction shown.
- For details of end dam see sheet 173-7A
- For details of masonry plates see sh. 173-7A
- For Reinforcement schedule see sheet 168-7A
- For Railing details and Guard Rail connection details see sheet 175-7A
- Reinforcement bars shall be 3 inches clear from bottom of footing and 2 inches elsewhere.
- Top of parapet and safety curb construction joints are to be parallel to roadway grade.
- Pile spacings given along bottom of footing.
- For additional notes and sections see sheet 167-7A

H.N.T.B. BR. NO. 11 PART 7A


HOWARD, NEEDLES, TAMMEN & BERGENDOFF
CONSULTING ENGINEERS
KANSAS CITY CLEVELAND NEW YORK

ABUTMENTS
WILLOW FREEWAY OVER REL. WOODLAND AVE.
BR. NO. CUY-21-1544 STA. 34+02.53
Scale: 3/16" = 1'-0" Except as noted
STA. 36+16.47
WILLOW-INNER BELT FREEWAY
CLEVELAND CUYAHOGA COUNTY OHIO

DRAWN T/P TRACED CHECKED S/J REVIEWED C/T
DATE 12/29/54 DATE 1-10-55 DATE 1-13-55 SHEET 165

Note: Dimensions and reinforcement are the same for both abutments except where noted as follows:
(W) denotes West Abutment
(E) denotes East Abutment

FOOTING PLAN

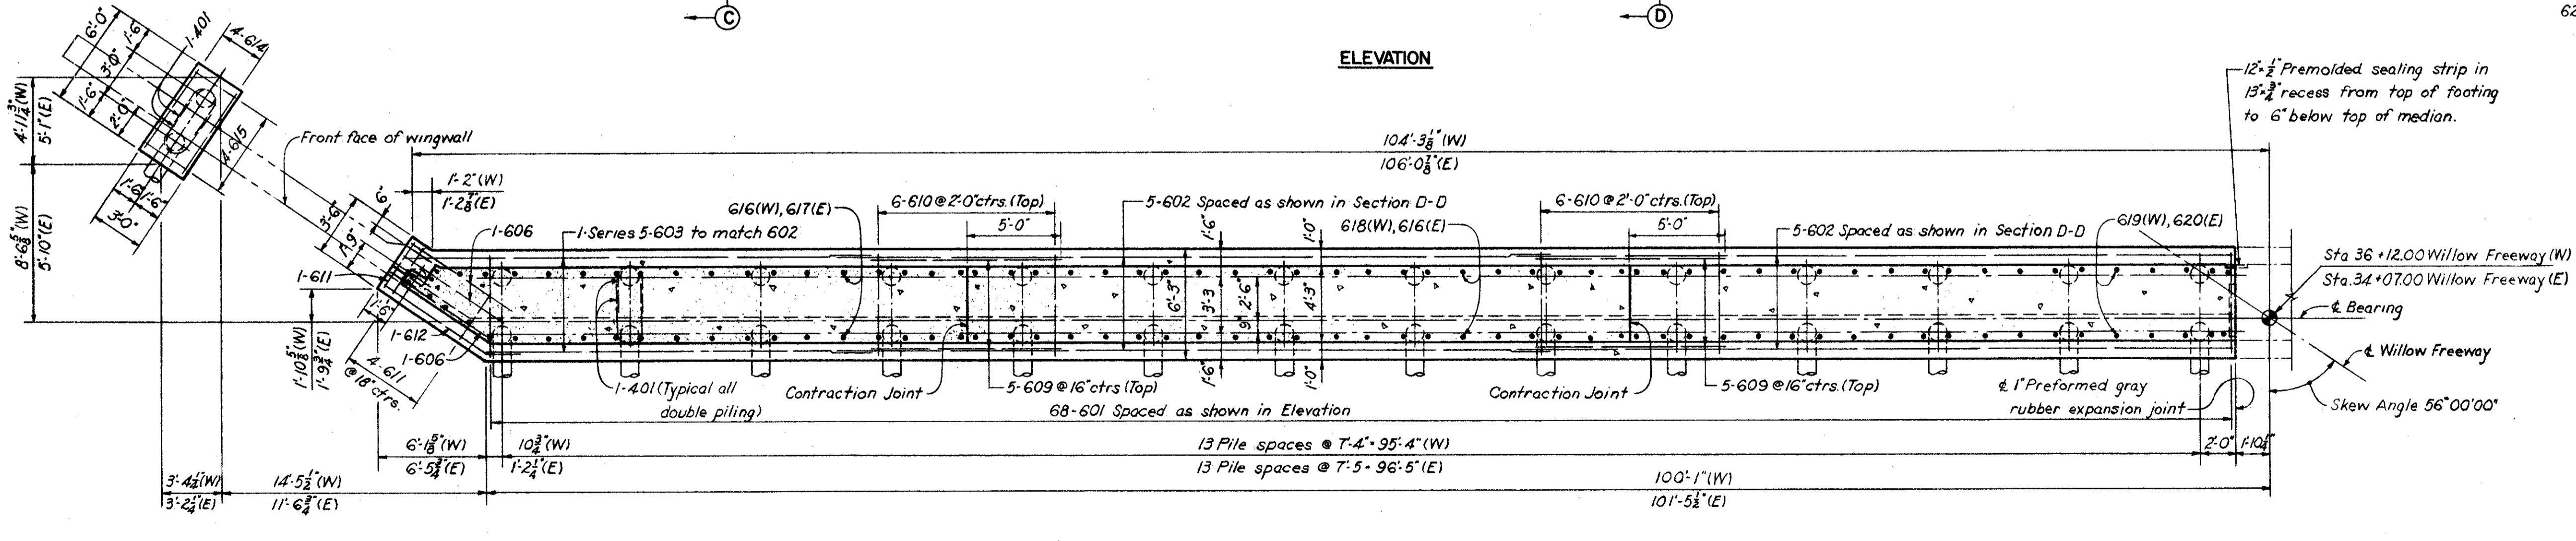

NOT RECORDED
JUL 3 1965

FED. ROADS DIV. NO.	STATE	FED. AID PROJ. NO.
2	OHIO	


166
181

CUYAHOGA COUNTY
CITY OF CLEVELAND
CUY-21-15.32
CUY-42-18.42

Note:
Special care shall be taken when placing reinforcing steel so as not to interfere with anchor bar setting.


12" x 1/2" Premolded sealing strip in 13" x 3/4" recess from top of footing to bottom of approach slab. (Typical)

Note:
In Plan, beam designations shown in parenthesis are for East Abutment.

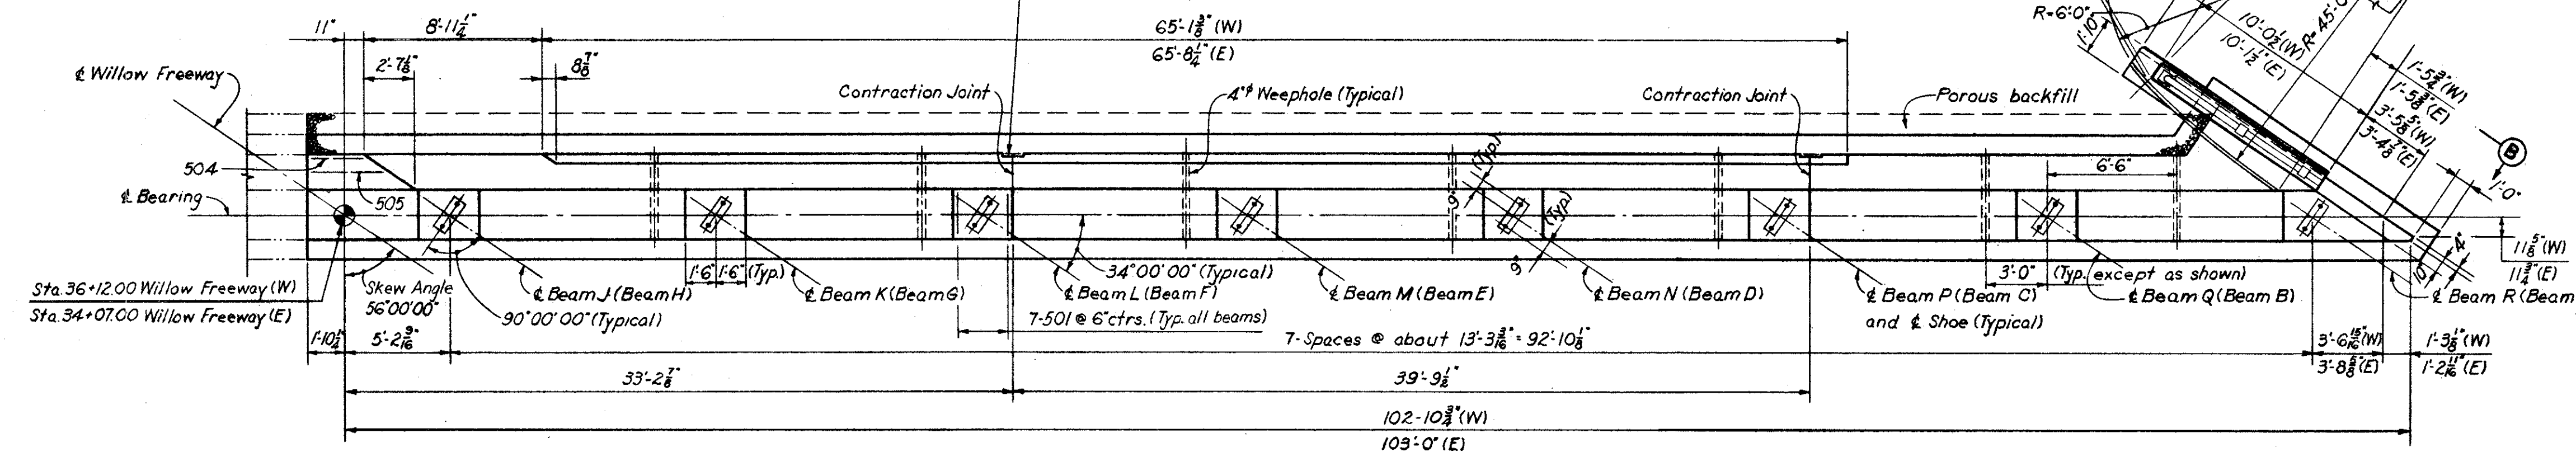

PLAN


Note:
Elevations along backwall are given to back of 6'-4-1/2" angle.

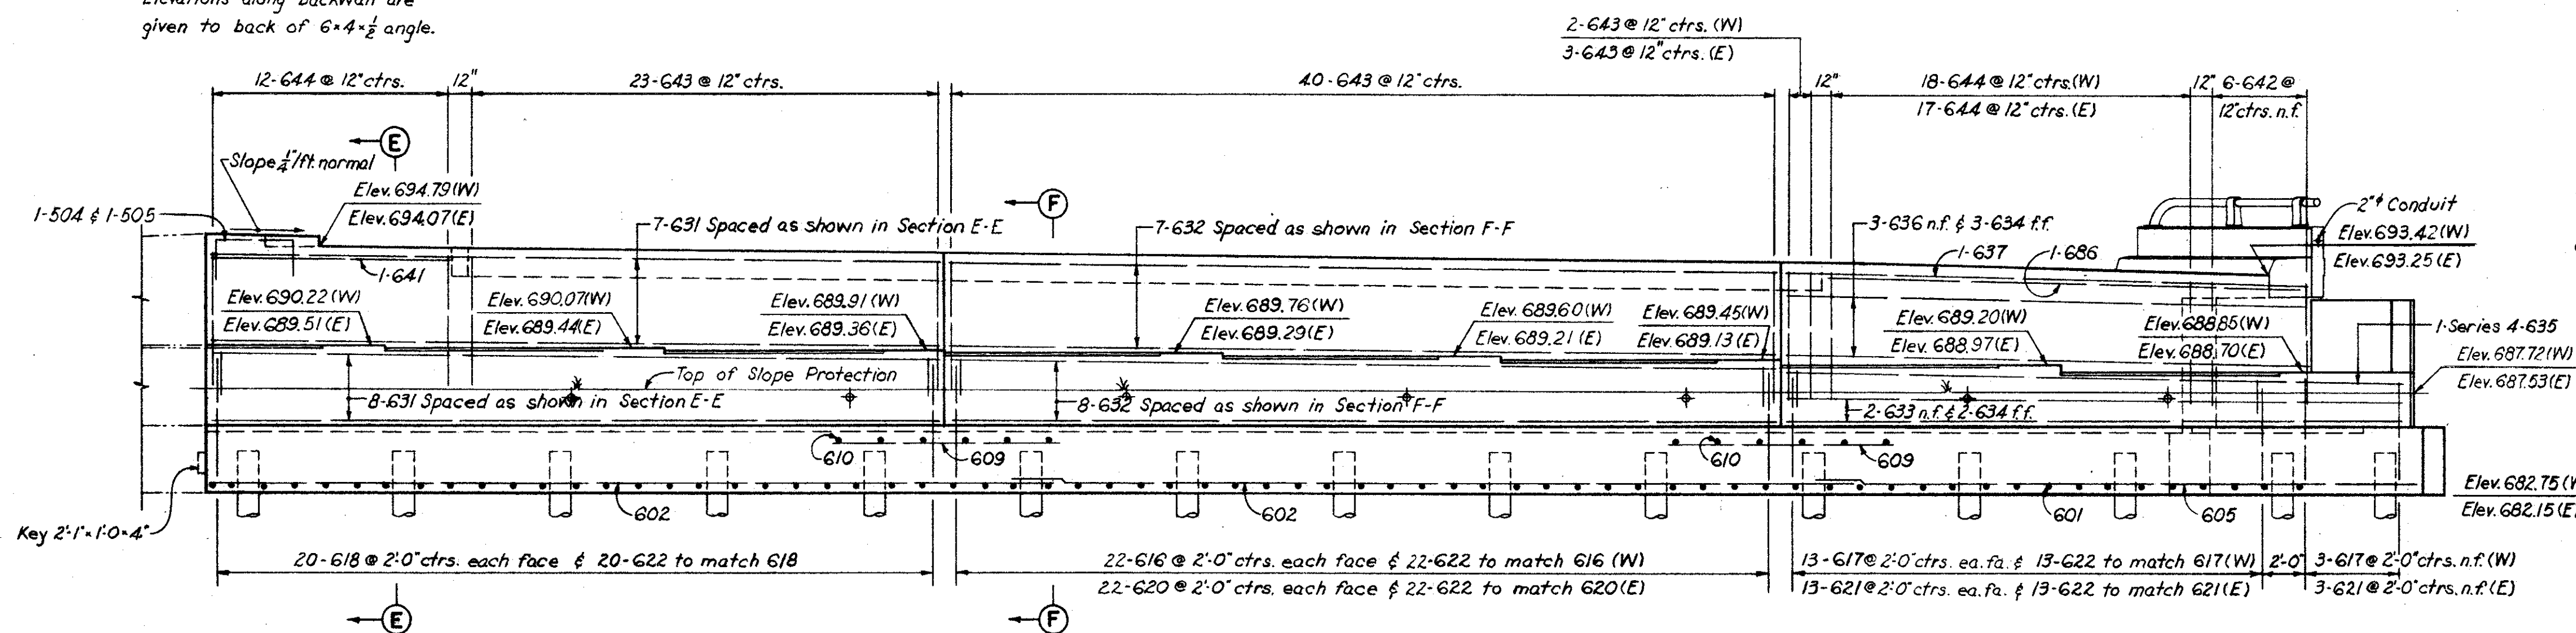

ELEVATION

Note:
Top of backwall to follow crown of roadway.

Note: Prefix "A" shall be assigned to all bar marks.

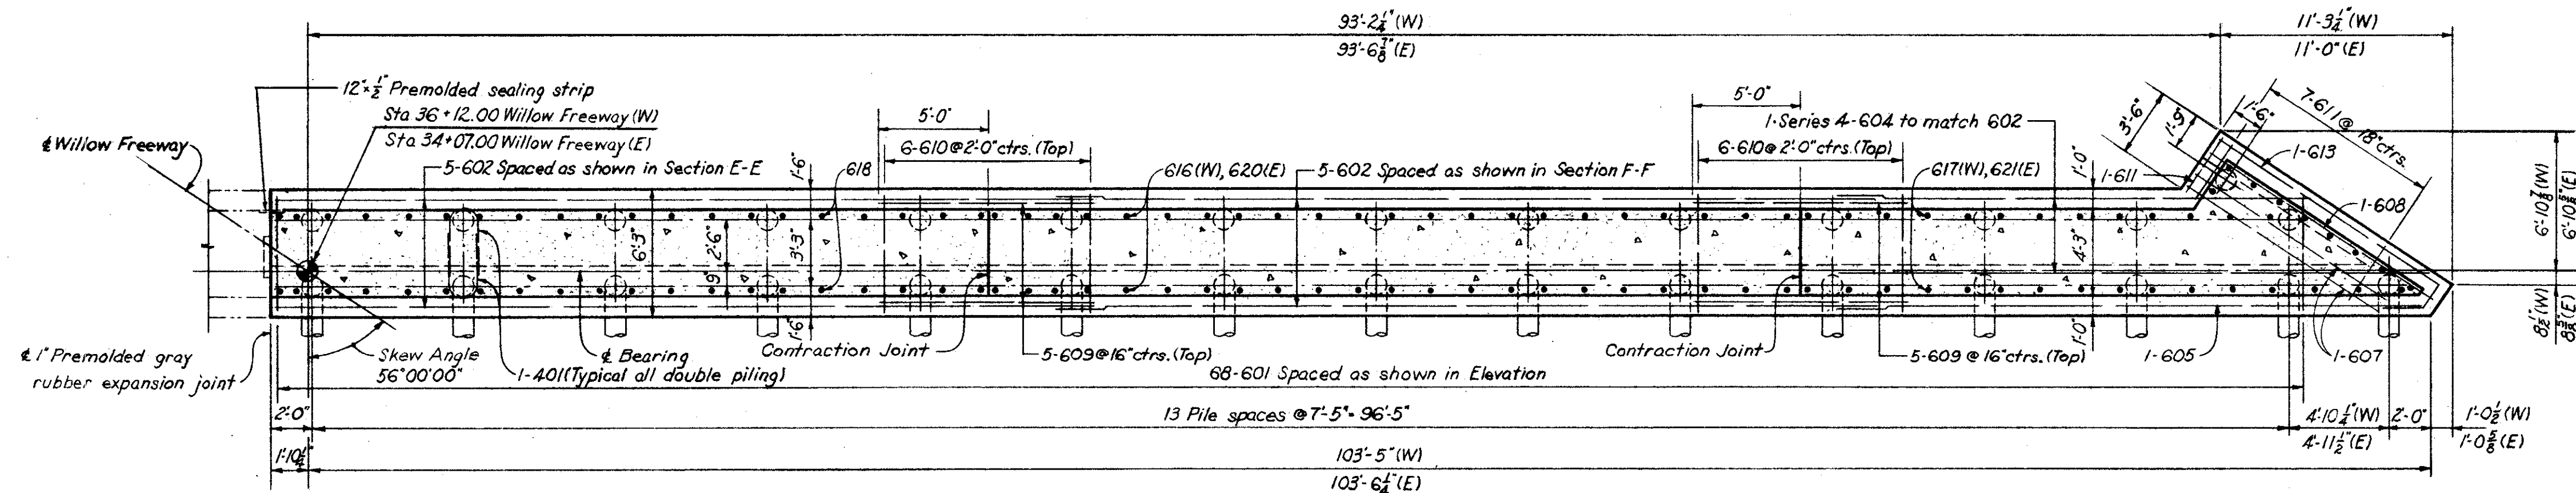

FOOTING PLAN

Note:
Dimensions and reinforcement are the same for both abutments except where noted as follows:
(W) denotes West Abutment
(E) denotes East Abutment


NOTES:
n.f. - near face; f.f. - far face; ea. fa. - each face
For additional notes and sections see sheets 165-7A & 147-7A

H.N.T.B. BR. NO. 11 PART 7A

HOWARD, NEEDLES, TAMMEN & BERGENDOFF
CONSULTING ENGINEERS
KANSAS CITY CLEVELAND NEW YORK

ABUTMENTS
WILLOW FREEWAY OVER REL. WOODLAND AVE.
BR. NO. CUY-21-1544 STA. 34+02.53
Scale: 3/16" = 1'-0" STA. 36+16.47
WILLOW-INNER BELT FREEWAY
CLEVELAND CUYAHOGA COUNTY OHIO


DRAWN T/J/P	TRACED	CHECKED F.S.J.	REVIEWED C.T.	REVISED
DATE 12/30/58	DATE	DATE 1/15/59	DATE 11/13/59	SHEET 166

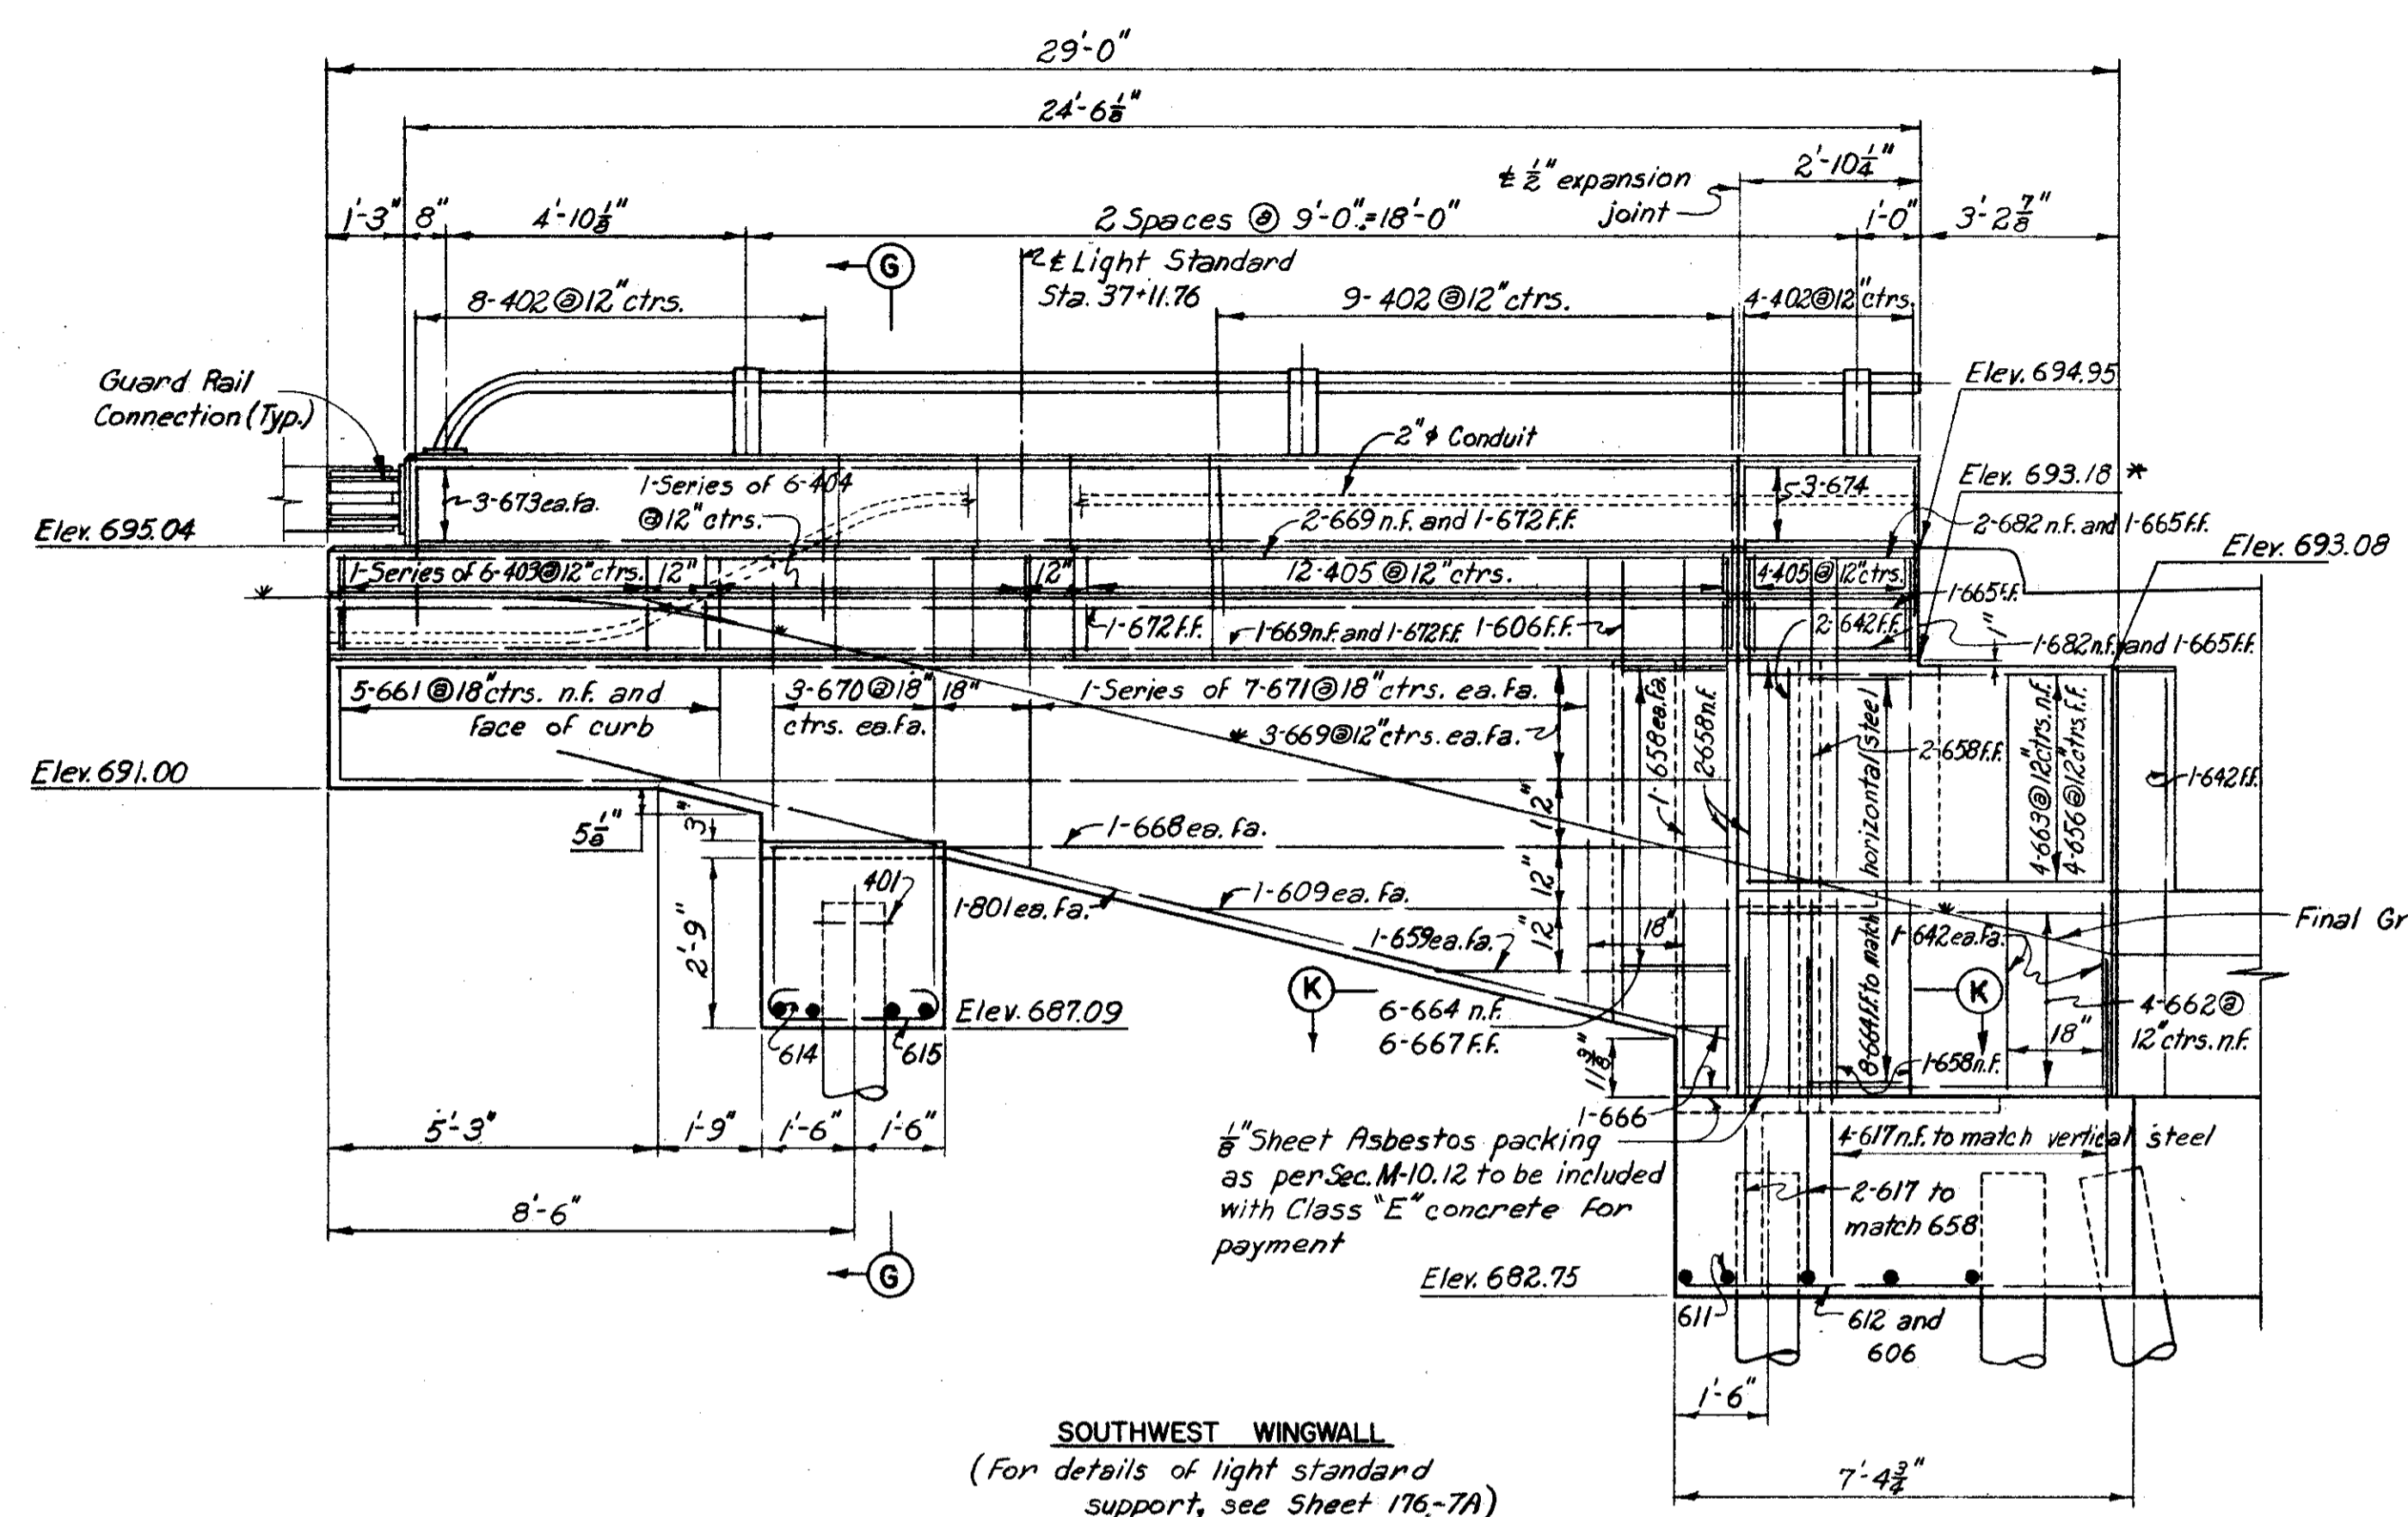


SOUTHWEST WINGWALL
(For details of light standard support, see Sheet 176-7A)

Notes.
Backfill shall be completed prior to construction of curb.
Ends of railing parapet shall be normal to top of safety curb.
*denotes elevation given at construction joint.


Note: Prefix "A" shall be assigned to all bar marks.

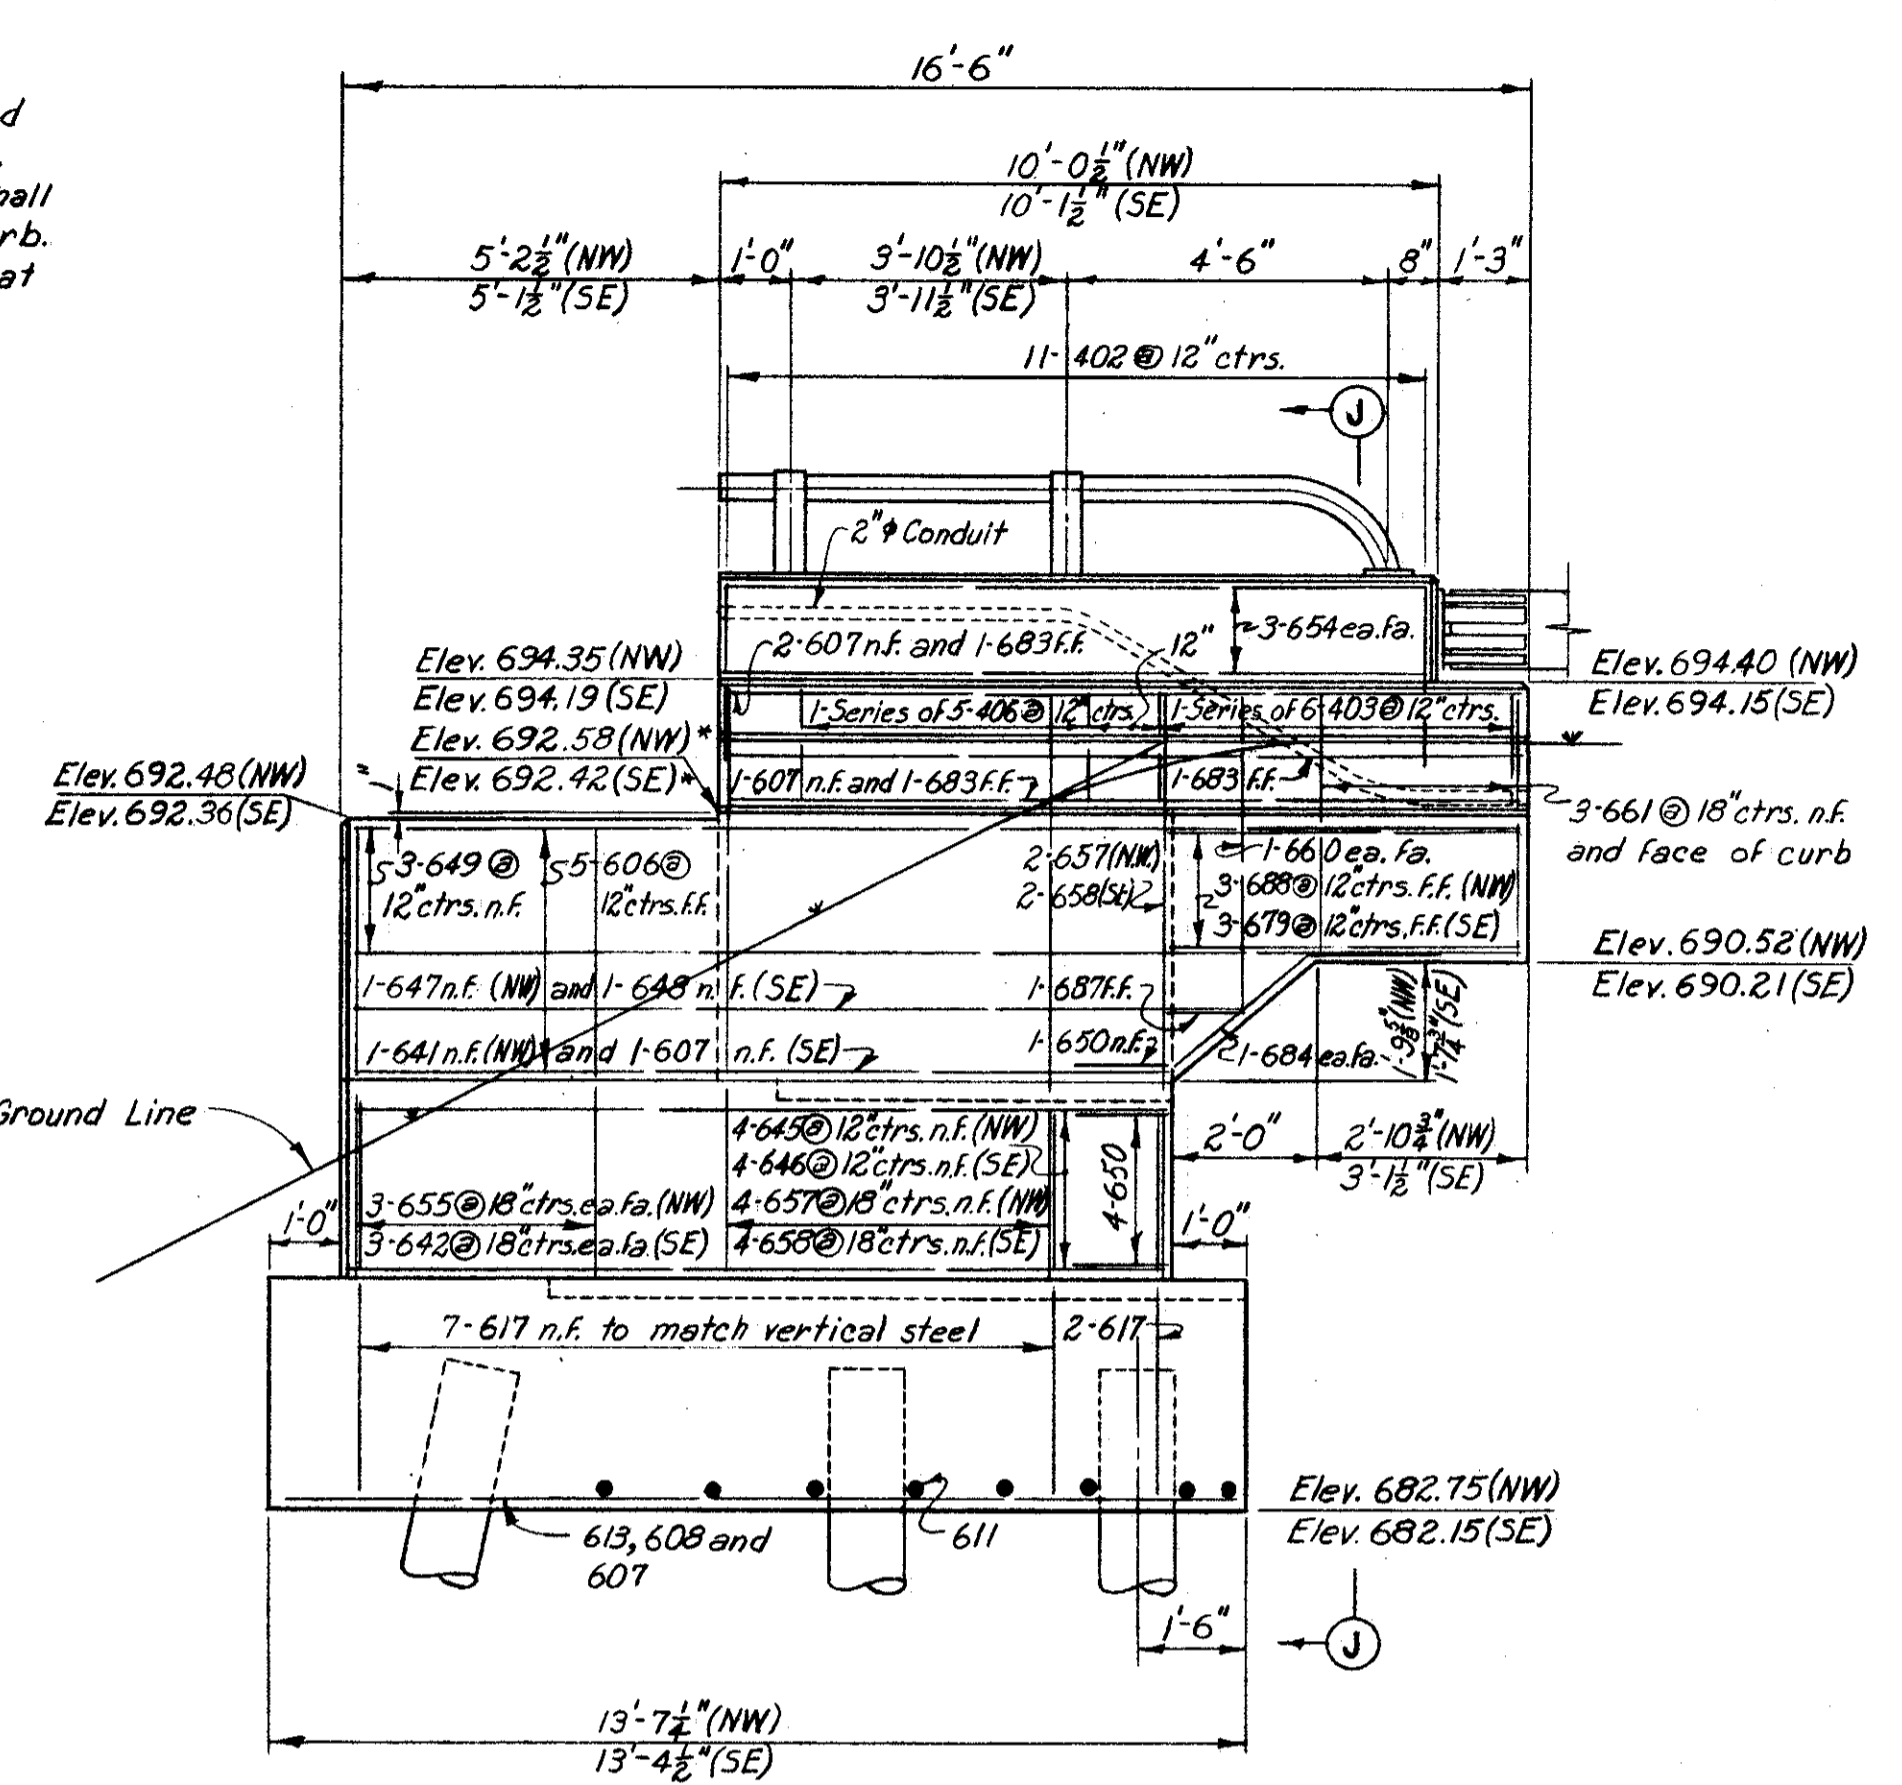

ELEVATION B-B
(Northwest wingwall shown)
(Southeast wingwall similar except as noted)

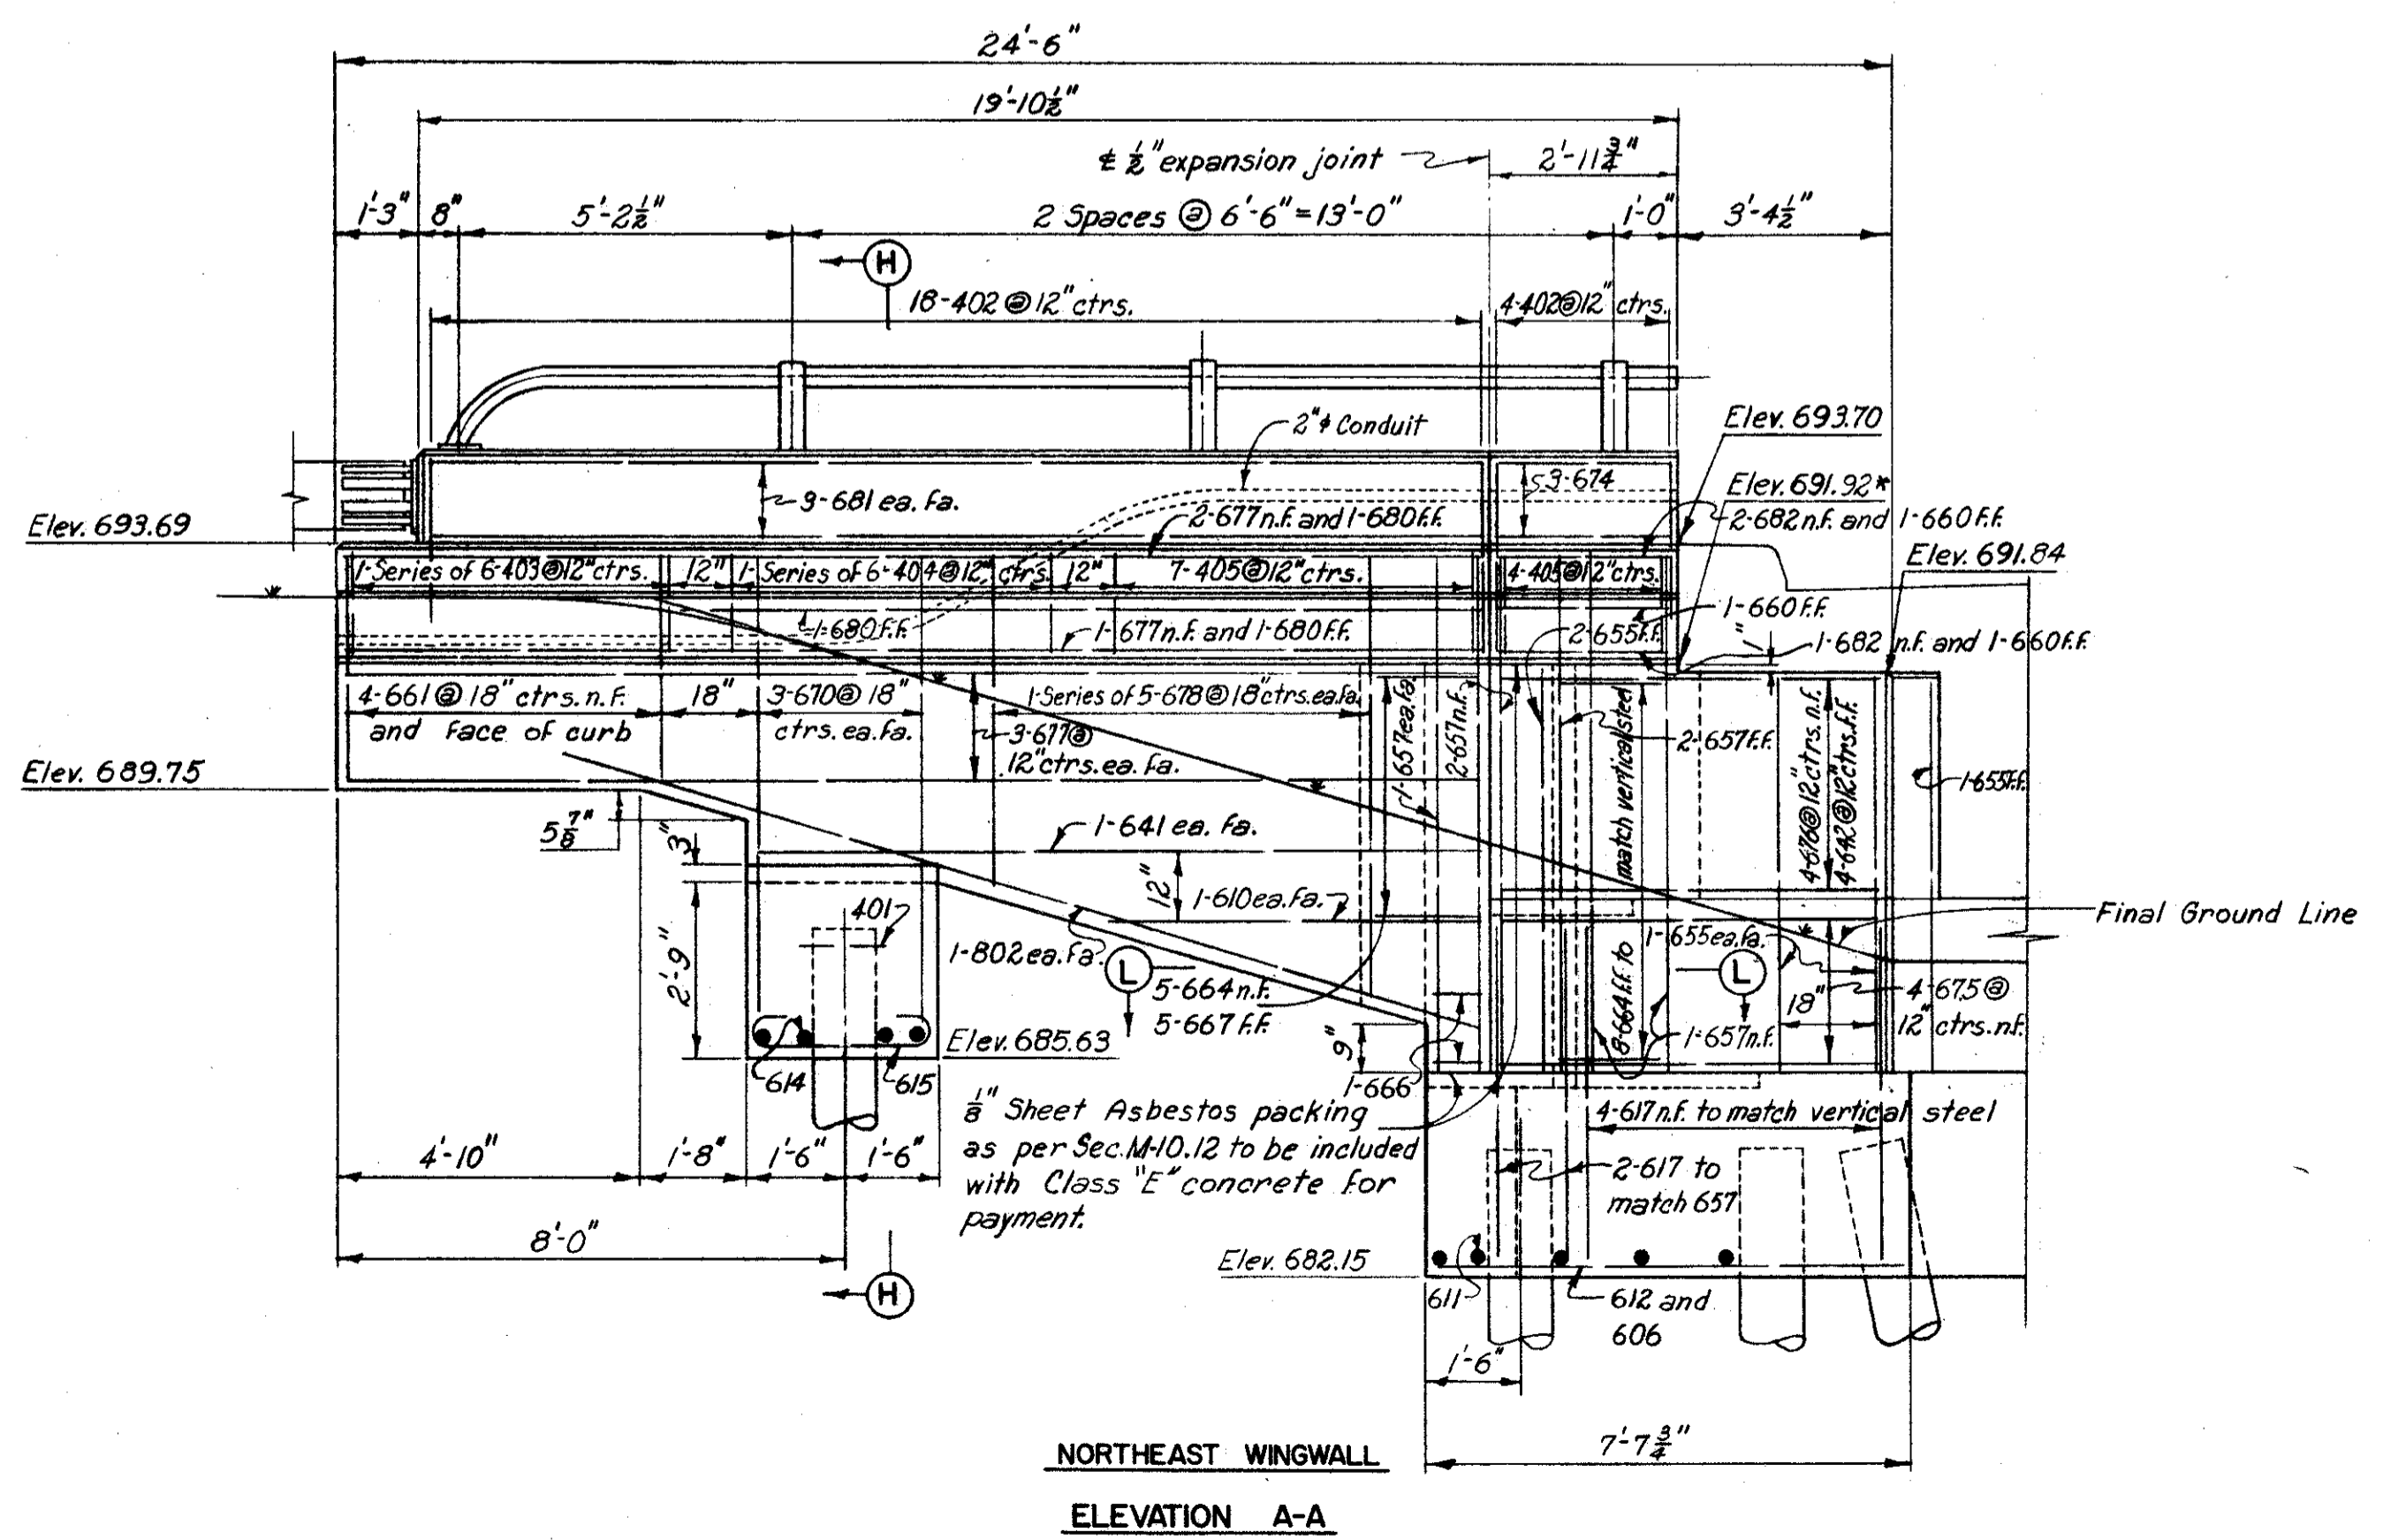


NORTHEAST WINGWALL
ELEVATION A-A

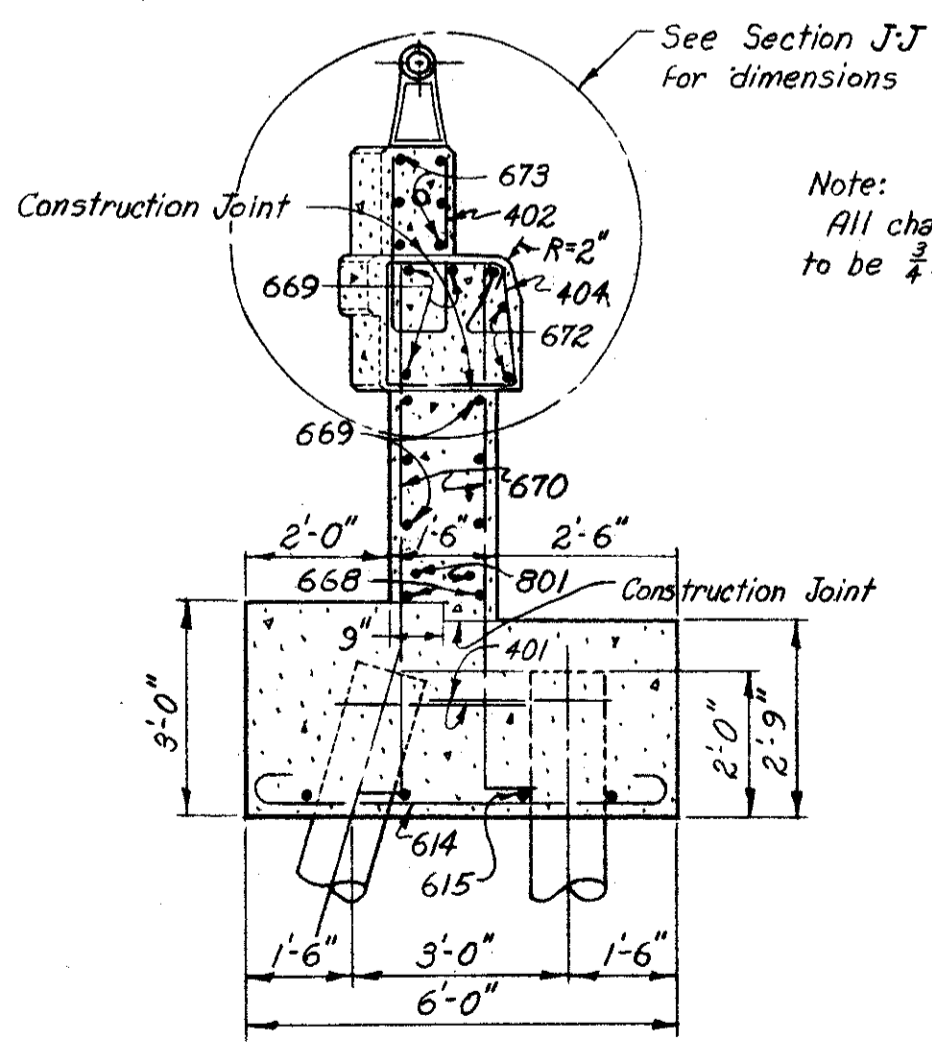


SECTION G-G (Shown)

SECTION H-H (Similar except for bar marks and lighting standard)

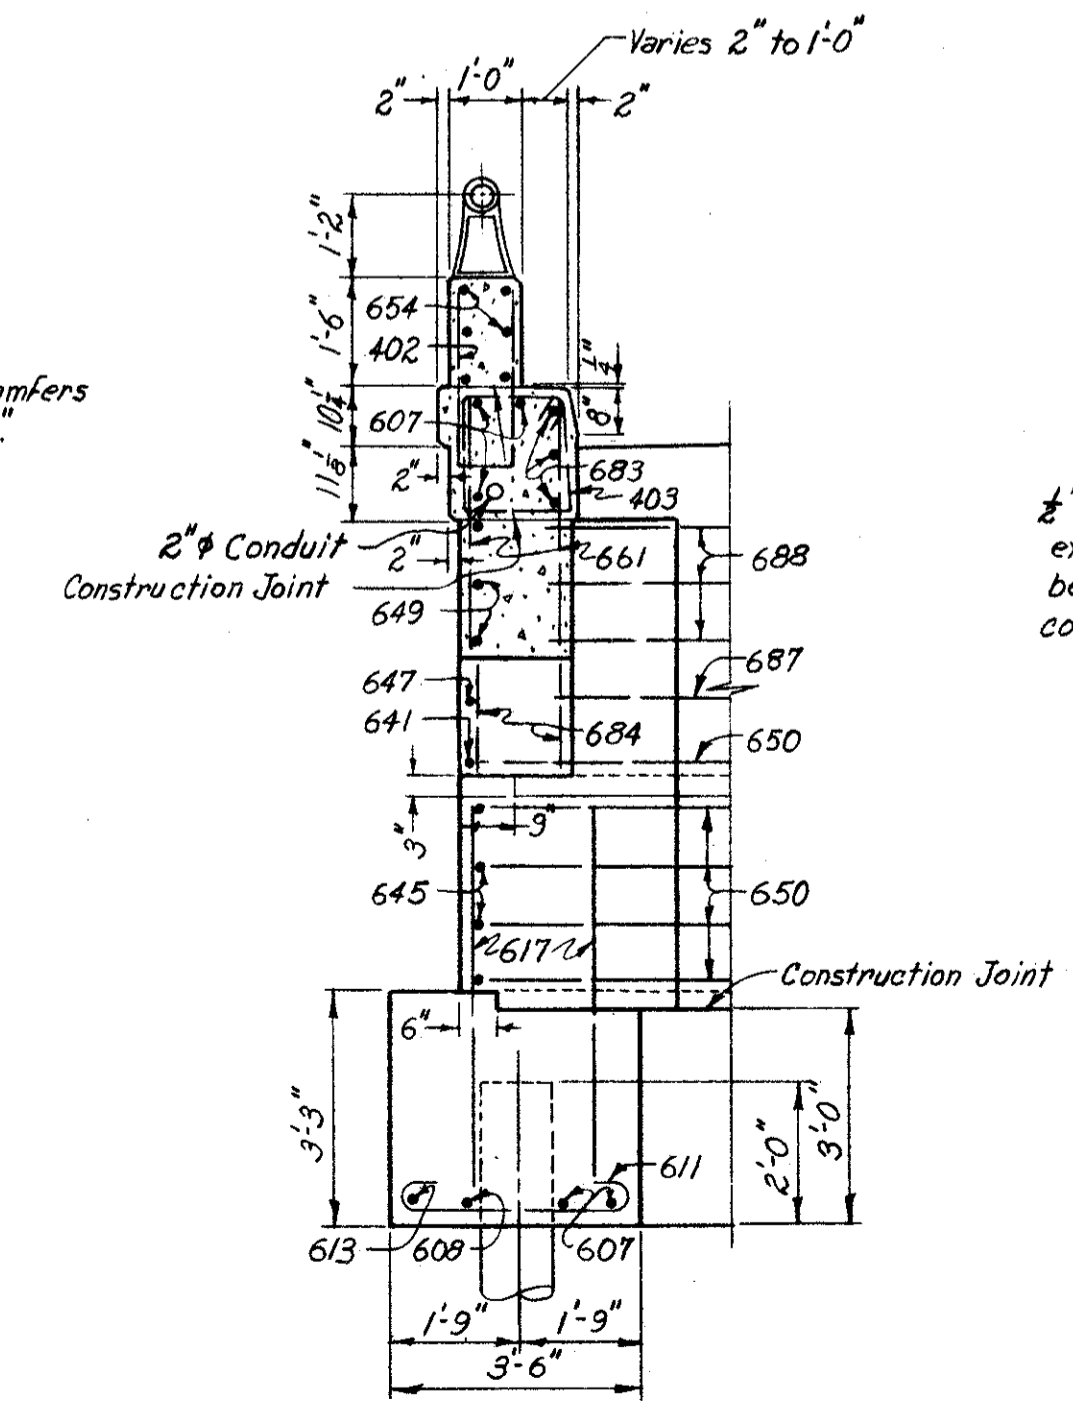

SECTION J-J
(Northwest wingwall shown)
(Southeast wingwall similar)

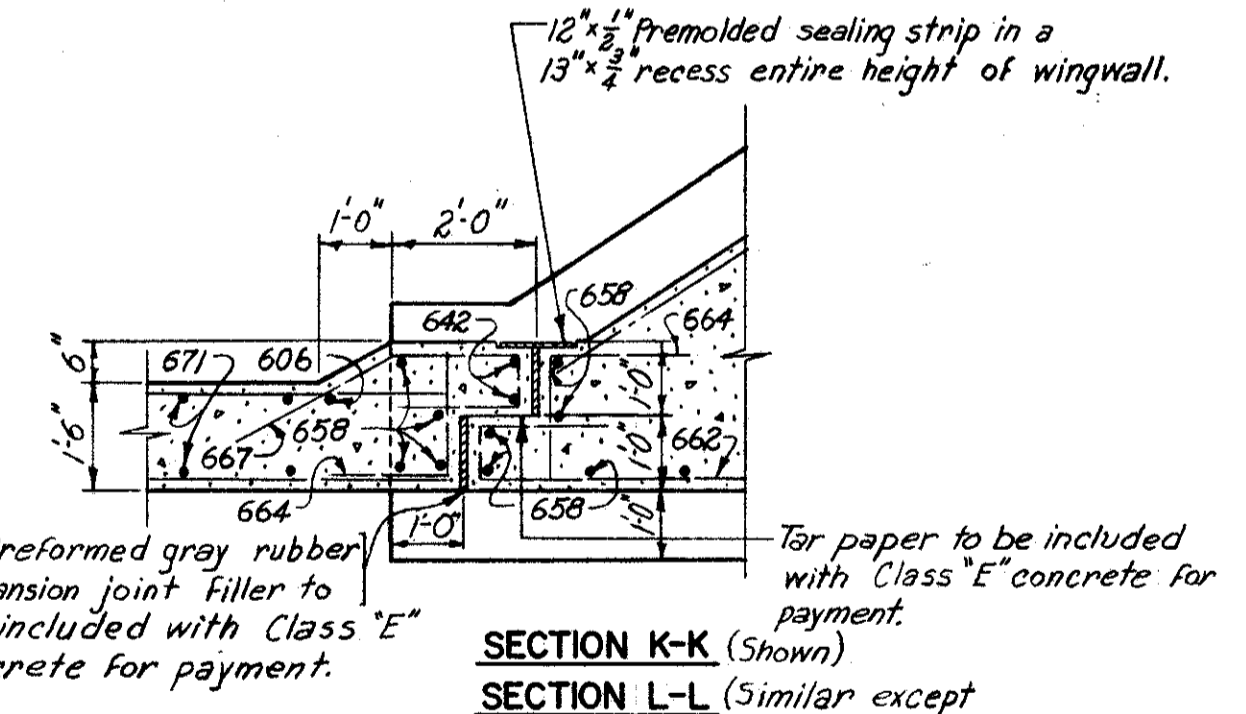

NOTES:
For location of lighting conduit, see Sheet 176-7A
For railing details and Guard Rail connection details, see Sheet 175-7A
Following abbreviations are used: (NW) = Northwest; (SE) = Southeast; n.f. = near face; f.f. = far face and ea. fa. = ea. face.
For additional notes, see Sheet 165-7A

H.N.T.B. BR. NO. 11 PART 7A

HOWARD, NEEDLES, TAMMEN & BERGENDOFF
CONSULTING ENGINEERS
KANSAS CITY CLEVELAND NEW YORK

ABUTMENT DETAILS

WILLOW FREYWAY OVER REL. WOODLAND AVE.
BR. NO. CUY-21-1544 STA. 34+02.53
Scale: 3/8" = 1'-0" STA. 36+16.47

WILLOW-INNER BELT FREEWAY
CLEVELAND CUYAHOGA COUNTY OHIO

DRAWN: F.S.J. TRACED CHECKED: J.W.R. REVIEWED: J.C.T.
DATE: 1-3-59 DATE: 1-15-59 DATE: 1-13-59


SHEET 167

MICROFILMED

JUL 3 1985

CUYAHOGA COUNTY
CITY OF CLEVELAND
CUY-21-15.32
CUY-42-18.42

BENDING DIAGRAMS

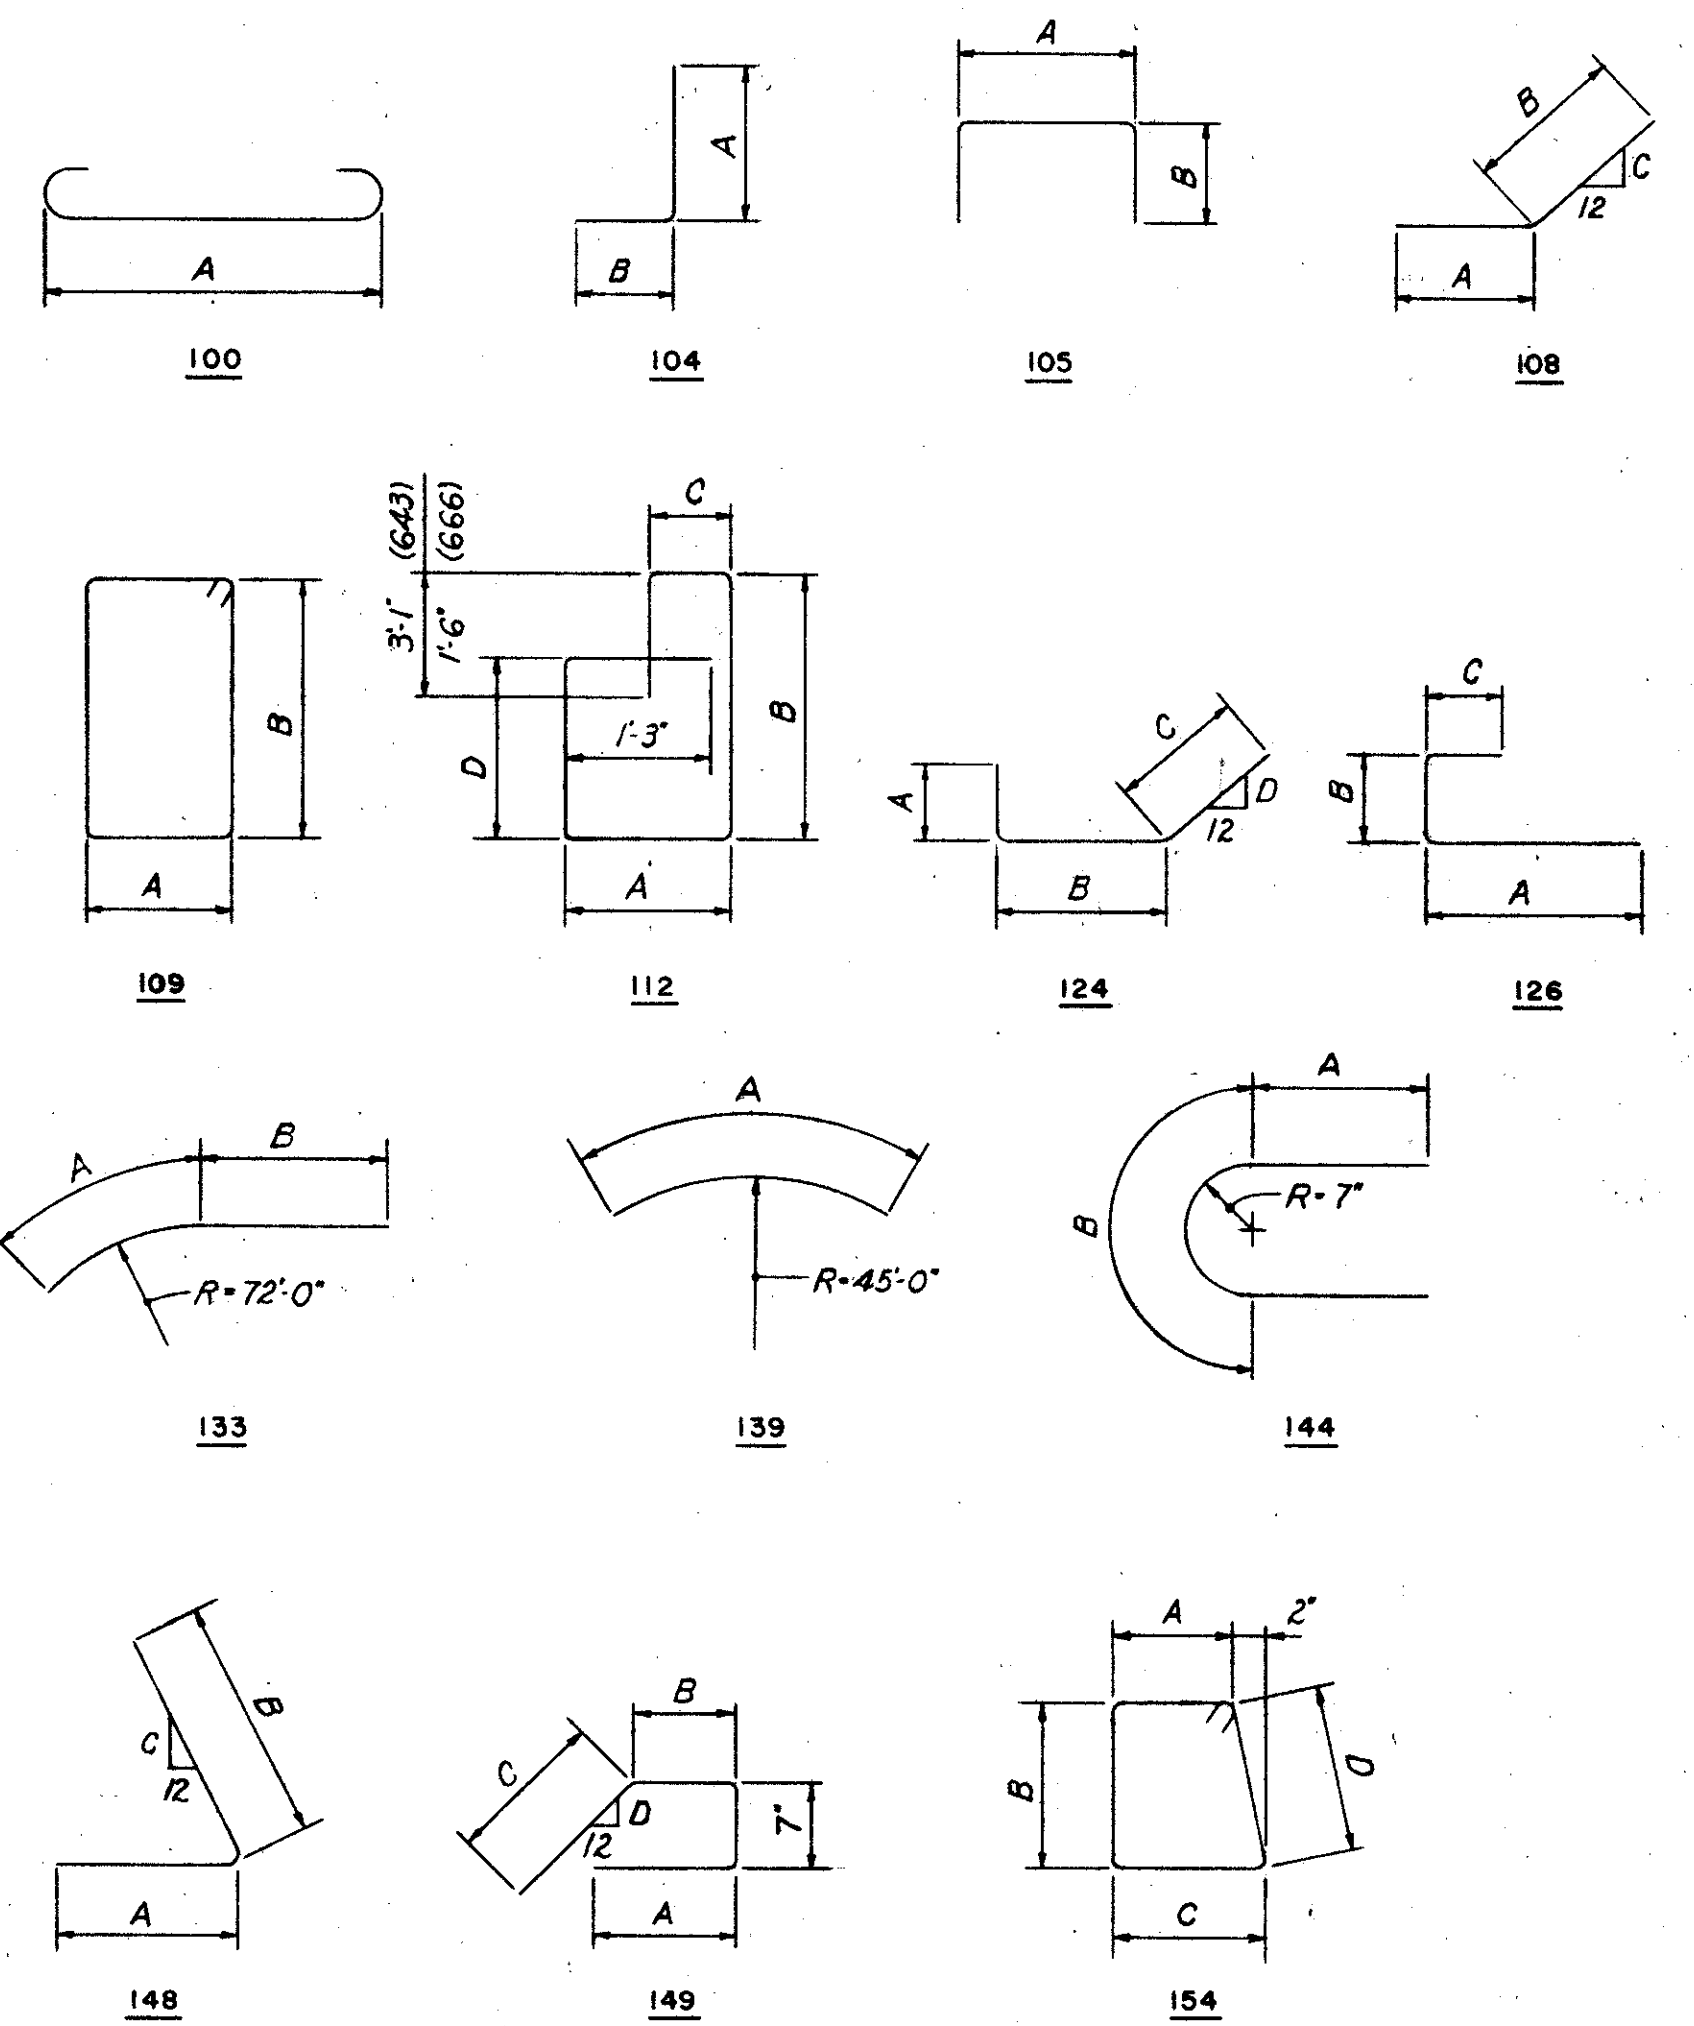

NOTES:
*Bars 451 thru 456 and 651 thru 653 are for the Light Standard Support. For their bar bending diagrams and placement see sheet 176-7A
*Bars 654, 673, 674 and 681 are included for payment with Item S-14, Railing.
All bar dimensions are given out to out.
Bars of a series shall vary in length by a constant increment.
For Replacement Schedule see sheet 103-7A

Note: Prefix "A" shall be assigned to all bar marks.

Table with columns: MARK, NO., LENGTH, TYPE, DIMENSIONS (A, B, C, D), SERIES INCREMENT, WEIGHT (LBS). Contains 450 rows of reinforcement bar data.


Table with columns: MARK, NO., LENGTH, TYPE, DIMENSIONS (A, B, C, D), SERIES INCREMENT, WEIGHT (LBS). Contains 200 rows of reinforcement bar data.

Table with columns: MARK, NO., LENGTH, TYPE, DIMENSIONS (A, B, C, D), SERIES INCREMENT, WEIGHT (LBS). Contains 100 rows of reinforcement bar data.


H.N.T.B. BR. NO. 11 PART 7A
HOWARD, NEEDLES, TAMMEN & BERGENDOFF CONSULTING ENGINEERS KANSAS CITY CLEVELAND NEW YORK
REINFORCEMENT SCHEDULE-ABUTMENTS
WILLOW FREEWAY OVER REL. WOODLAND AVE.
BR. NO. CUY-21-1544 STA. 34+02.53
Scale: None STA. 36+16.47
WILLOW-INNER BELT FREEWAY
CLEVELAND CUYAHOGA COUNTY OHIO
DRAWN TJP TRACED CHECKED P.S.J. REVIEWED J.C.T. REVISOR
DATE 1-16-85 DATE 1-19-85 DATE 1-13-85 SHEET 168

CUYAHOGA COUNTY
CITY OF CLEVELAND
CUY-21-15.32
CUY-42-18.42


Note: Elevations shown are to the top of WF beams. (Exclusive of cover plates)
Top elevations are for the south half.
Bottom elevations are for the north half.
To obtain top of pavement elevations at supports add 0.84' to top of WF beam elevations shown.

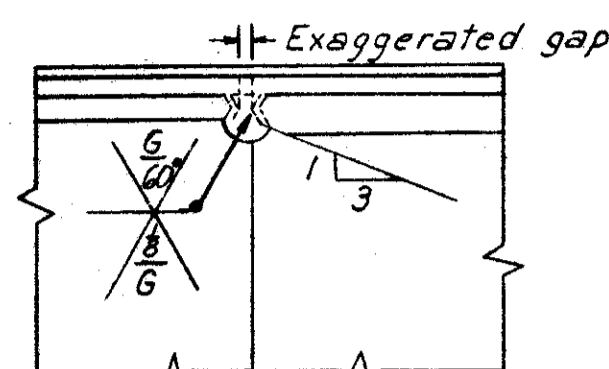


DETAIL "A"
No Scale

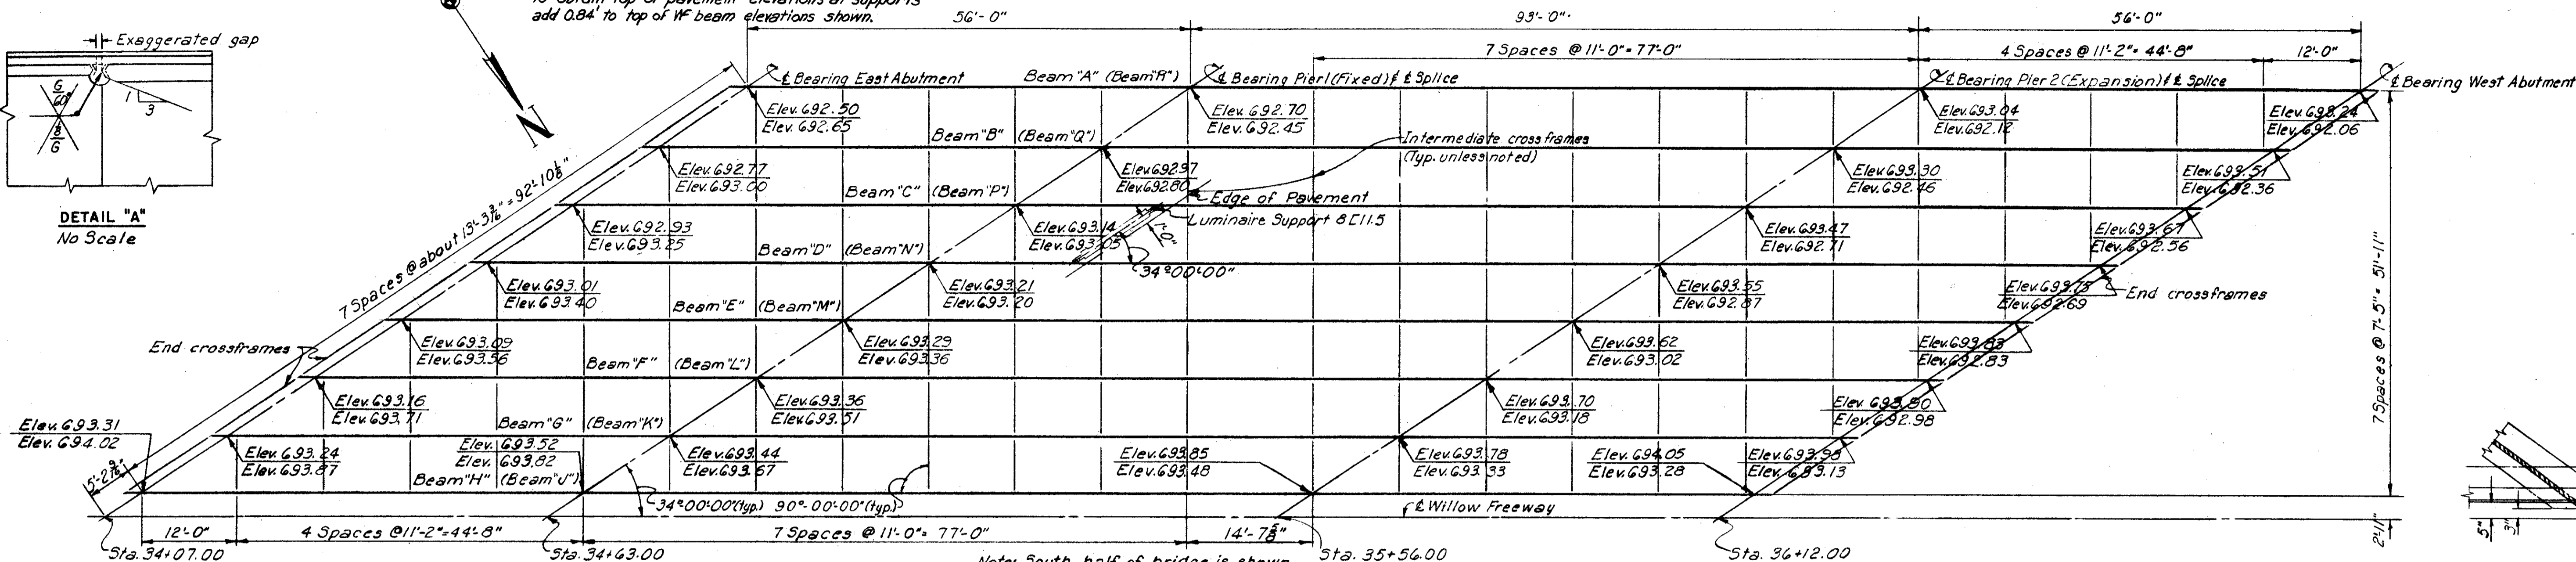


FRAMING PLAN
Scale 1/8" = 1'-0"

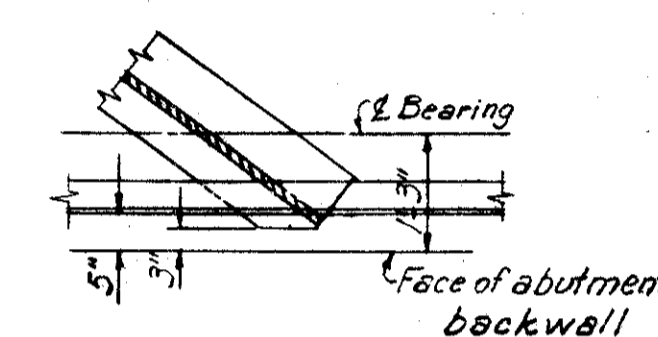


SECTION B-B
No Scale

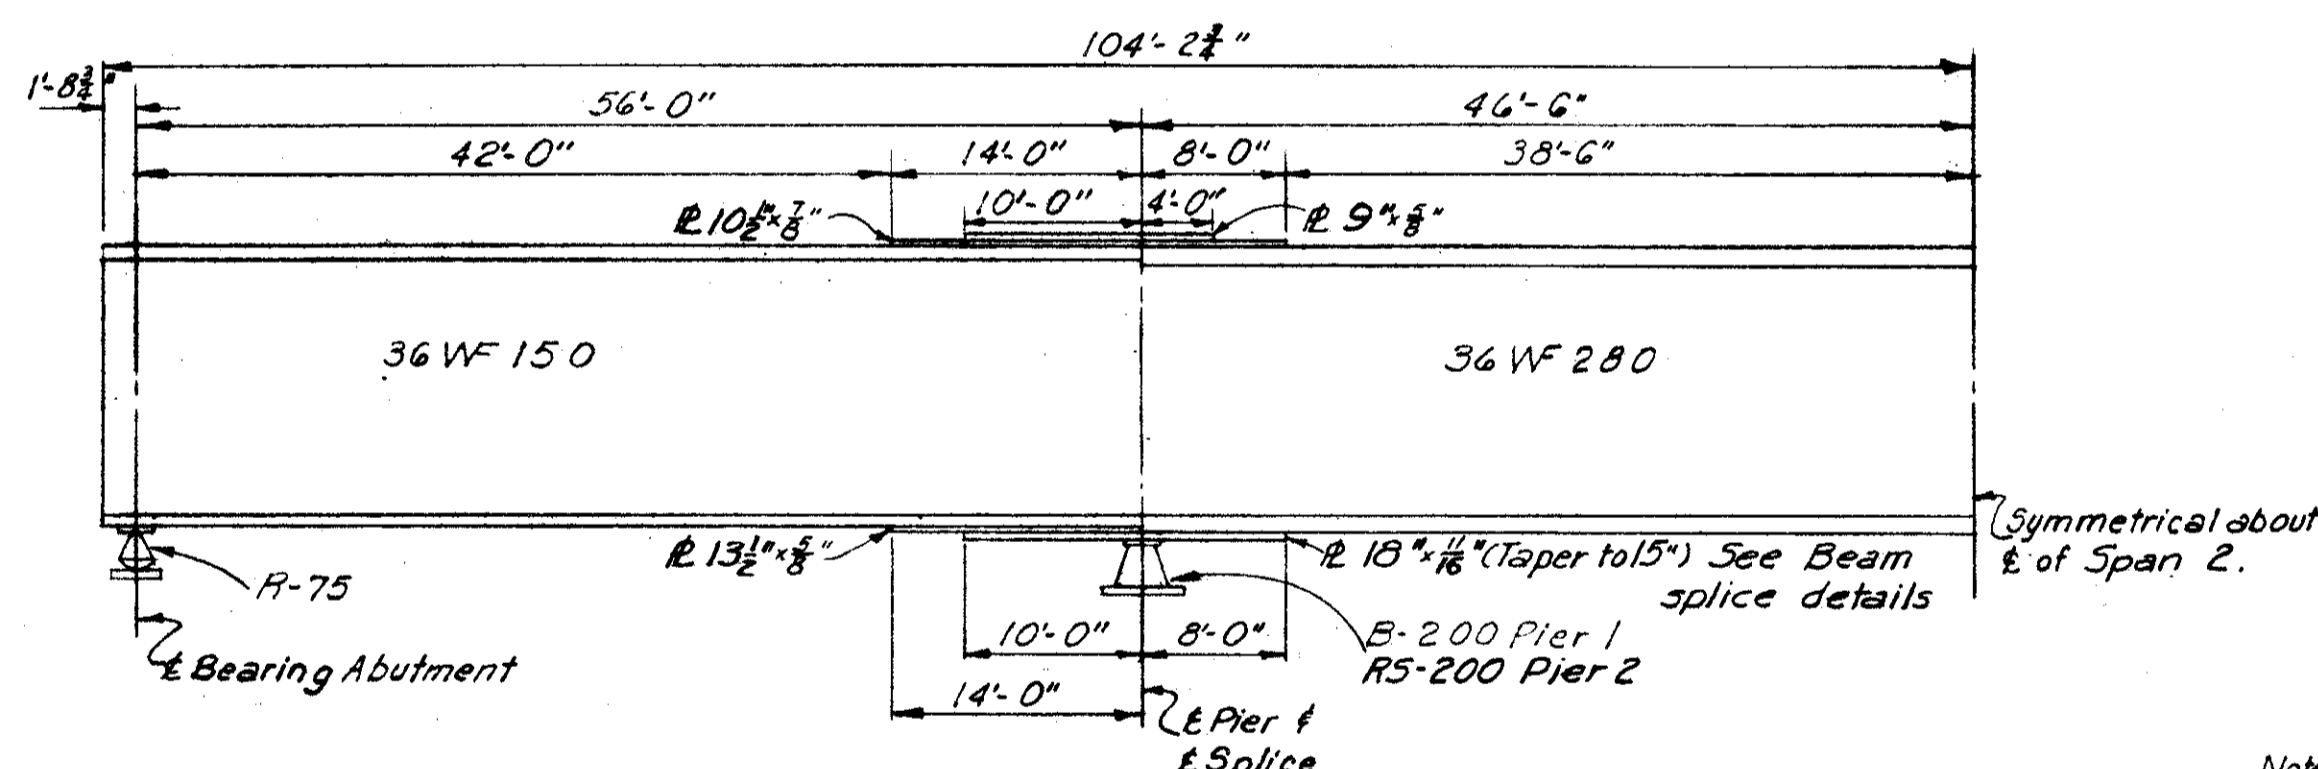


TYPICAL BEAM ELEVATION
No Scale

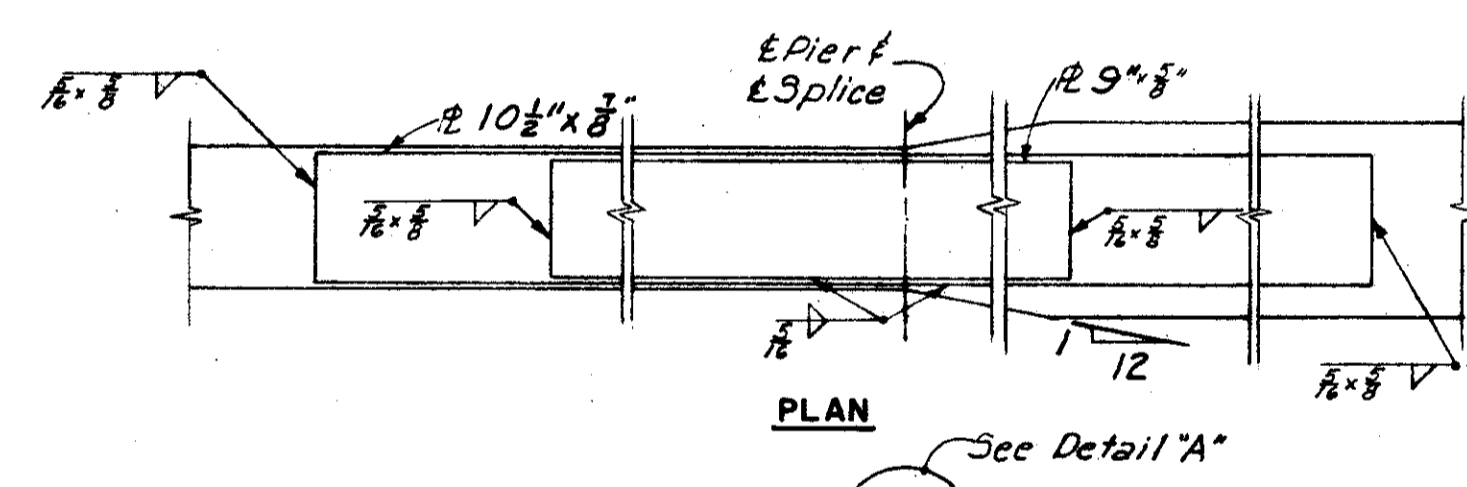

PLAN

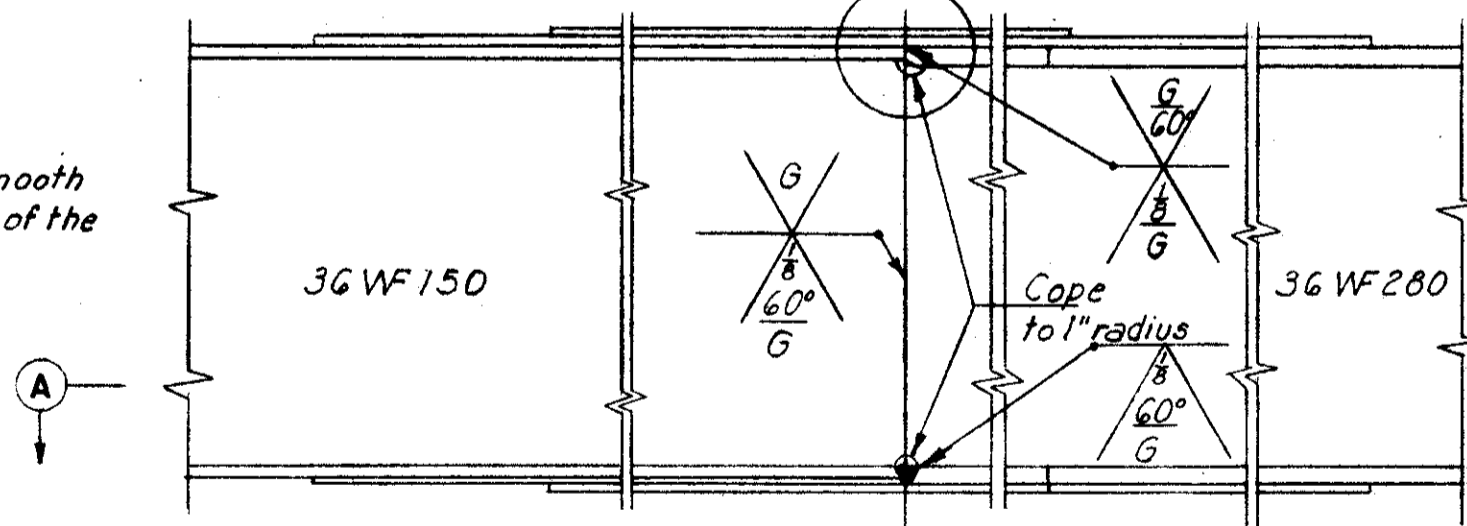

ELEVATION

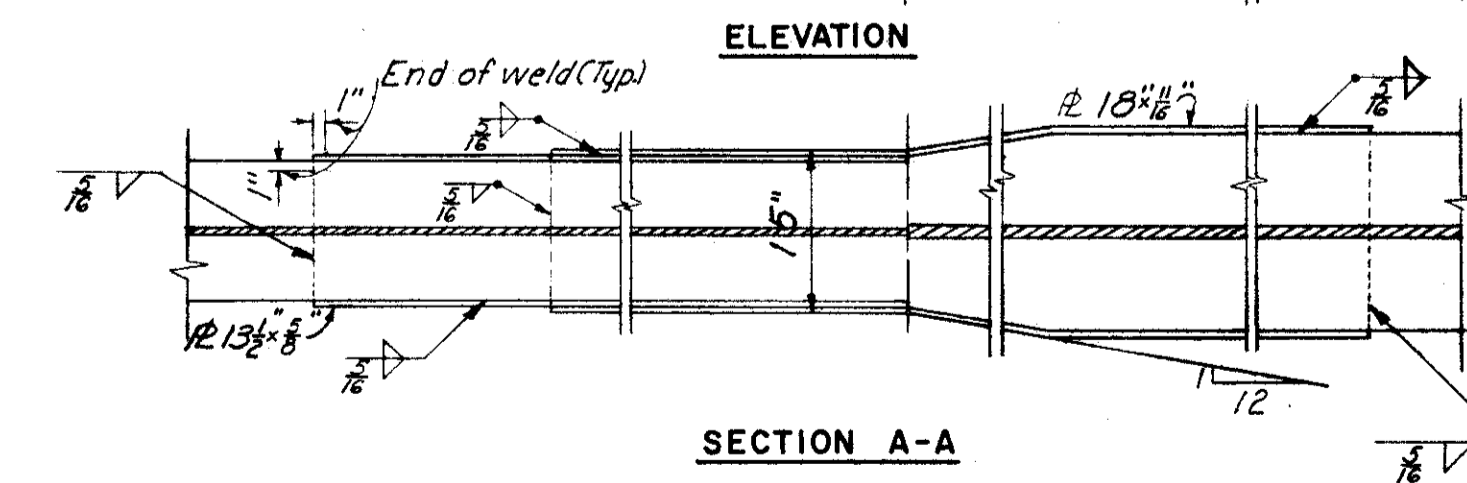


SECTION A-A

BEAM SPLICE

No Scale

BEAM SPLICE WELDING PROCEDURE

- 1-Raise the abutment ends of the beams 1 1/2".
- 2-Butt-Weld the beam flanges and web using the following sequence: make two passes on each flange, then two on the web; repeat, using one pass at each location, until welds are completed.
- 3-Weld the bottom and top cover plates.
- 4-Lower the beam ends to final position.

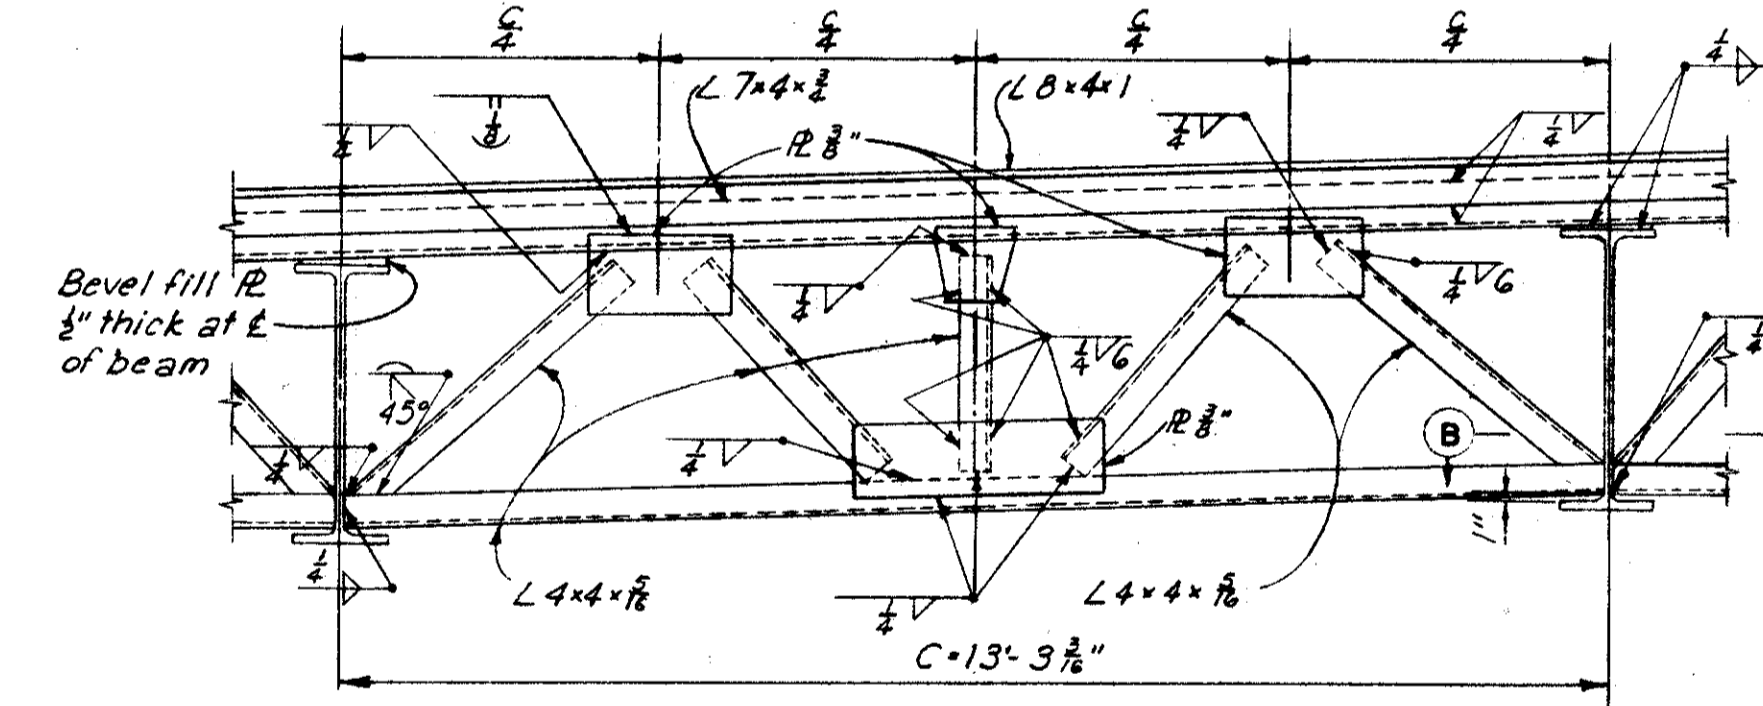


END CROSSFRAME

Scale 1/8" = 1'-0"

NOTES:

- The beams in Span 2 shall be cambered as follows. Where the total deflection is 3/4" to 1", the required camber will be 1", and if greater than 1", the required camber will be the same as this amount.
- Beams in Spans 1 & 3 do not require camber, but shall be fabricated so that any curved beam will be placed with the convex flange down.
- For drainage details, see Sh. 174-7A
- For intermediate cross-frame details, see Sh. 163-7A
- For typical cross-section through deck, see Sh. 170-7A
- For details of end dams, see Sh. 173-7A
- For details of underdeck lighting see Sh. 176-7A & 177-7A
- For details of rocker base plates, see Sh. 173-7A
- For other rocker details, and details of bolsters, see Ohio Standard Drawing RB-1-55.

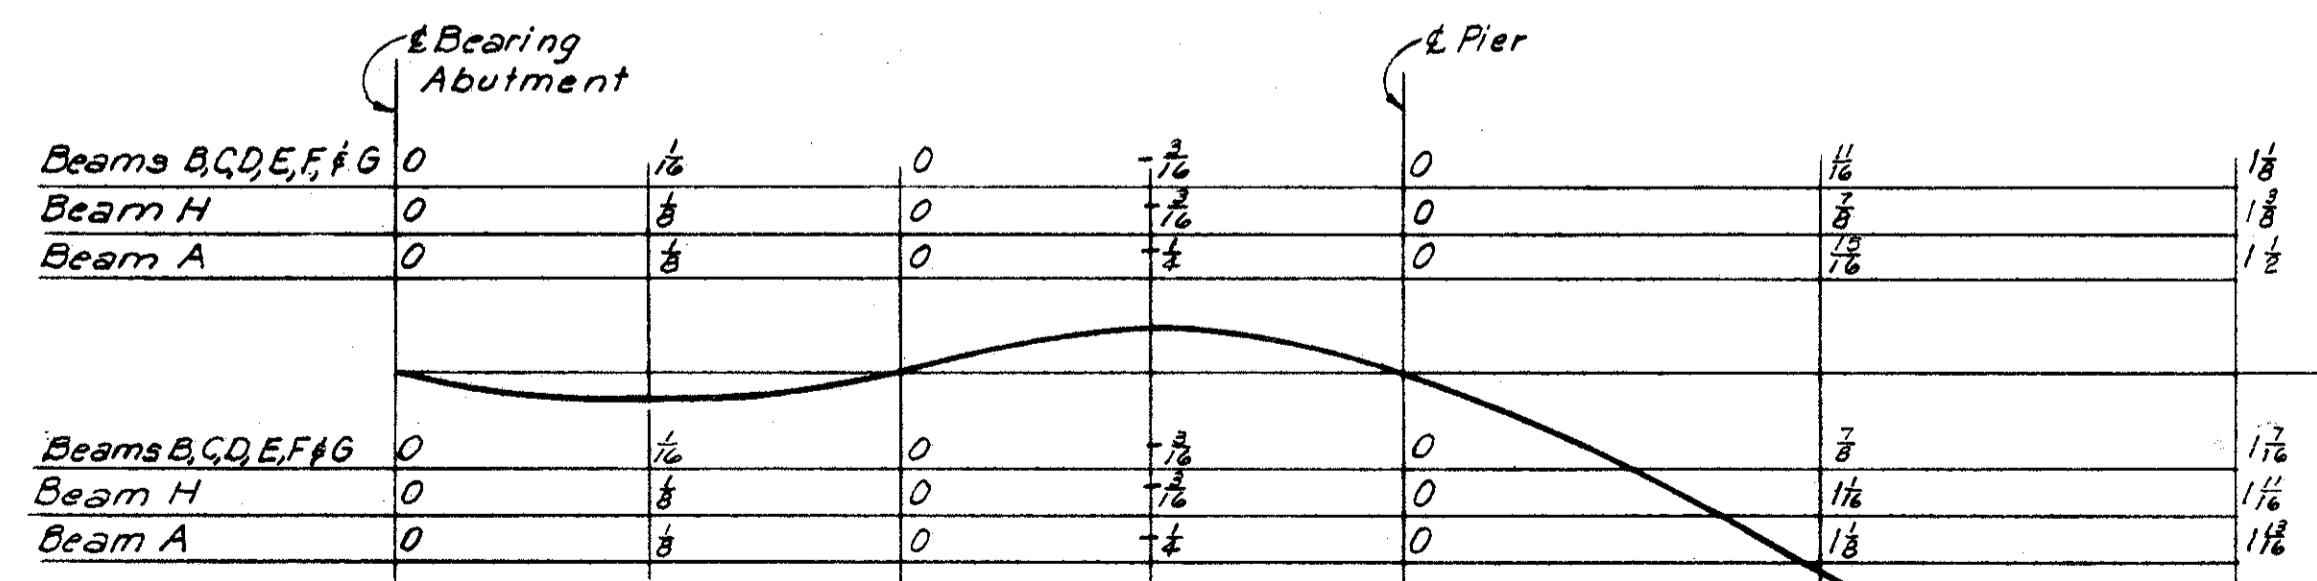

BEAM DEFLECTION DIAGRAM

No Scale

Deflections are given at the quarter points.
Deflections shown above base line are deflections due to concrete.
Deflections shown below base line are total dead load deflections.
Deflections are measured to the nearest 1/8 inch.
Negative deflections are upward.

H.N.T.B. BR. NO. 11 PART 7A

HOWARD, NEEDLES, TAMMEN & BERGENDOFF
CONSULTING ENGINEERS
KANSAS CITY CLEVELAND NEW YORK

FRAMING PLAN
WILLOW FREEWAY OVER REL. WOODLAND AVE.
BR. NO. CUY-21-1544 STA. 34+02.53
Scale: As noted STA. 36+16.47
WILLOW INNER BELT FREEWAY
CLEVELAND CUYAHOGA COUNTY OHIO

DRAWN	TRACED	CHECKED	REVIEWED	REVISED
DATE	DATE	DATE	DATE	DATE
11-15-57		12-2-58	11-13-59	


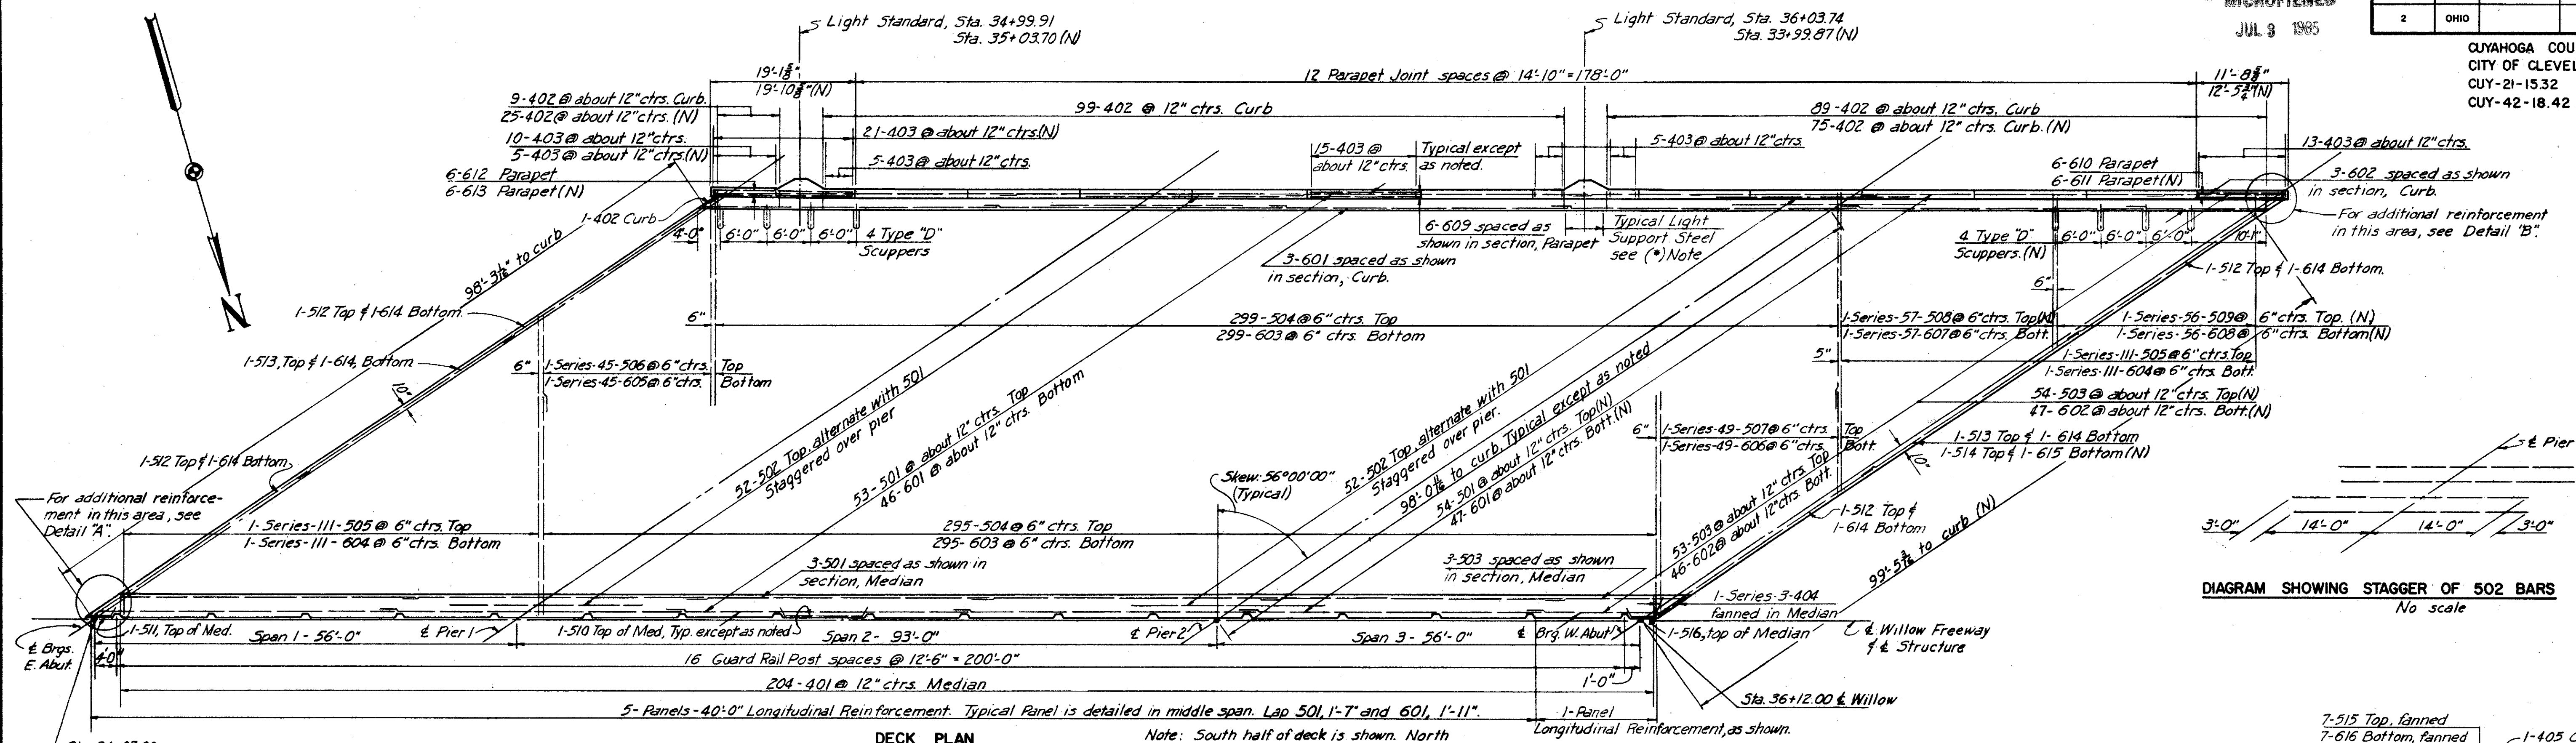


DIAGRAM SHOWING STAGGER OF 502 BARS
No scale

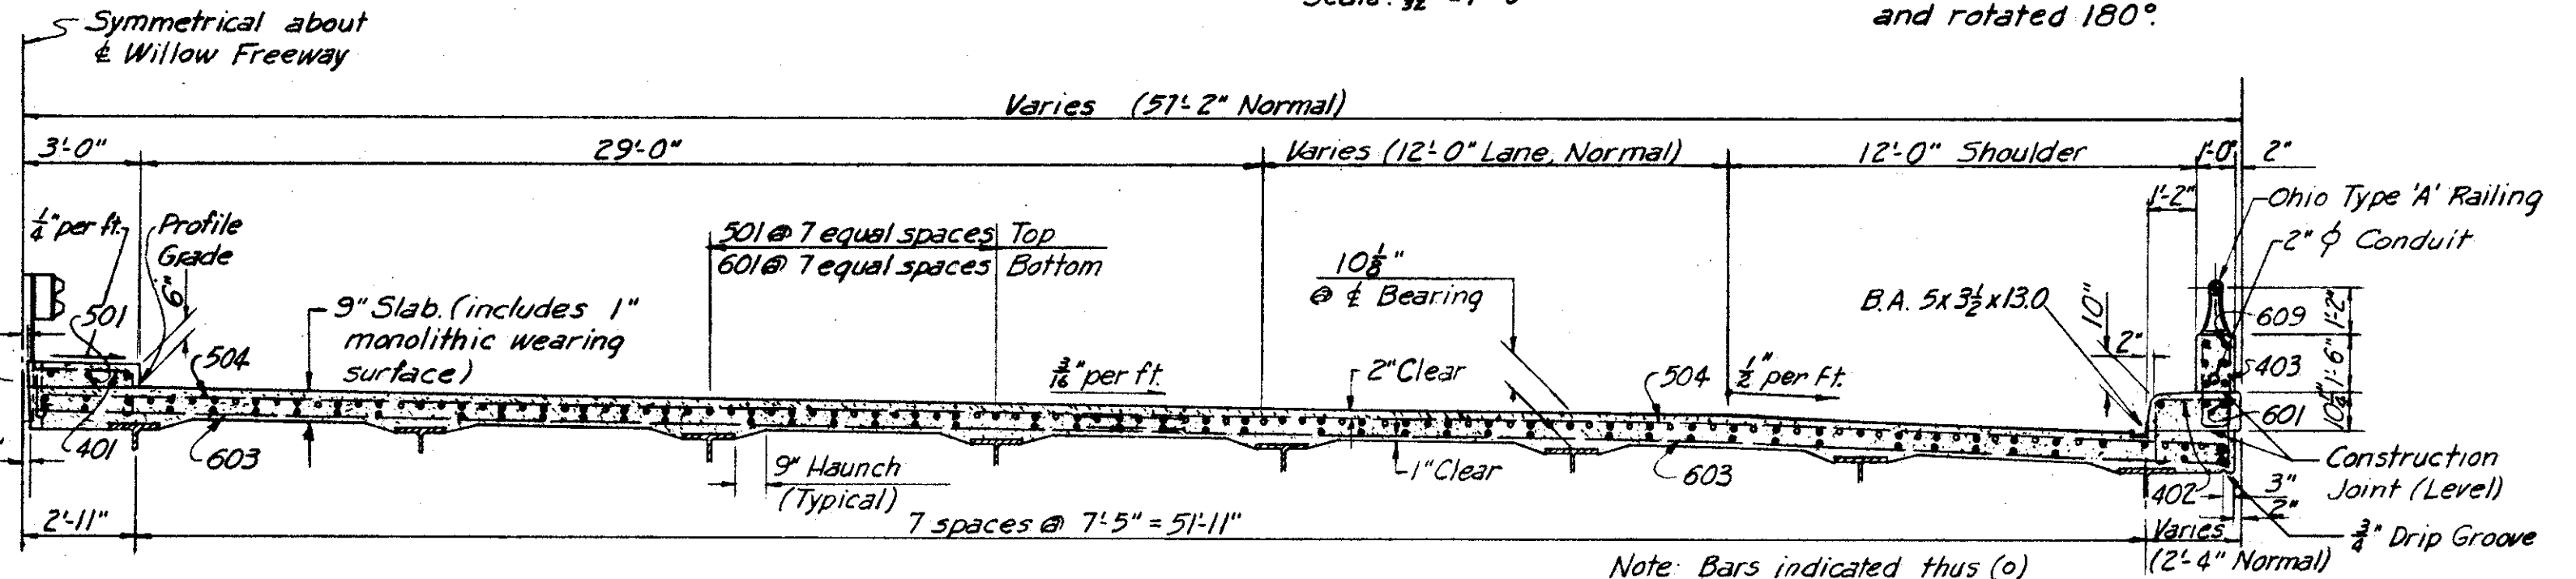


TYPICAL SECTION
Scale: 1/4" = 1'-0"

Note: Prefix '5' shall be assigned to all bar marks.

NOTES:
In order to facilitate water curing of the concrete of the deck slab, the placing of concrete shall progress upgrade. The slab may be placed in sections, between transverse construction joints which are parallel to the transverse bars in the slab and are located near the center of any span.
For intermediate cross frame details see sheet 163-7A
For end cross frame details, see sheet 169-7A
For light standard support and other lighting details, see sheet 176-7A
For Railing, Guard Rail and Parapet Joint details, see sheet 175-7A
For Drainage details, see sheet 174-7A
For End Dam details, see sheet 173-7A
Bars of a series shall vary in length by a constant increment.

REINFORCEMENT SCHEDULE																											
MARK	NUMBER	LENGTH	TYPE	DIMENSIONS			SERIES INCREMENT	WEIGHT POUNDS	MARK	NUMBER	LENGTH	TYPE	DIMENSIONS			SERIES INCREMENT	WEIGHT POUNDS	MARK	NUMBER	LENGTH	TYPE	DIMENSIONS			SERIES INCREMENT	WEIGHT POUNDS	
				A	B	C							A	B	C							A	B	C			
401	408	5'-3"	122	2'-6"	1'-0"		1431	505	3 Series of 11	3'-6" to 40'-7"	101	2'-11" to 40'-0"	4 1/2"	76.55	606	2 Series of 49	13'-4" to 29'-6"	Str.	4 1/2"	3152							
402	398	5'-1"	122	1'-8"	1'-4"		1351	506	2 Series of 49	12'-10" to 27'-8"	Str.		4 1/2"	1901	607	1 Series of 31	21'-3" to 40'-0"	Str.	4"	2622							
403	422	4'-5"	105	8'-0"	2'-0"		1201	507	2 Series of 49	13'-1" to 29'-3"	Str.		4 1/2"	2164	608	1 Series of 31	3'-0" to 21'-0"	Str.	3 1/2"	1009							
404	4 Series of 3	5'-3" to 6'-11"	122	2'-6" to 4'-2"	1'-0"	10"	49	508	1 Series of 57	21'-10" to 40'-7"	101	2'-3" to 40'-0"	4"	1855	609	1 Series of 56	14'-6"	Str.									
405	2	5'-3"	122	1'-10"	1'-4"		7	509	1 Series of 36	3'-7" to 21'-7"	101	3'-0" to 2'-0"	3 1/2"	735	610	6	11'-3"	Str.									
406	2	6'-1"	122	2'-8"	1'-4"		8	510	32	13'-0"	159	11'-2"	0'-6"	0'-10"	434	611	6	12'-0"	Str.								
451	8	8'-11"	131	2'-6"	1'-2"	2'-10"	48	511	2	6'-0"	108	5'-1"	0'-6"	0'-10"	13	612	6	18'-9"	Str.								
452	8	9'-11"	131	3'-0"	1'-8"	2'-10"	52	512	8	35'-1"	101	34'-6"		293	613	6	19'-6"	Str.									
453	12	9'-5"	131	3'-2"	1'-0"	2'-10"	76	513	3	34'-6"	Str.			108	614	11	34'-9"	Str.		574							
454	8	5'-7"	155	2'-2"	1'-4"		28	514	1	36'-0"	Str.			38	615	1	36'-0"	Str.		54							
455	8	6'-4"	155	2'-8"	1'-4"		32	515	28	3'-7"	101	3'-0"		105	616	28	3'-0"	Str.		126							
456	12	6'-3"	155	2'-10"	1'-4"		52	516	2	3'-2"	108	2'-3"	0'-6"	0'-10"	7	651	8	9'-5"	141	113							
501	561	40'-0"	Str.				23405	602	491	40'-0"	Str.			29499	652	12	14'-6"	141	261								
502	208	31'-0"	Str.				6725	603	99	17'-9"	Str.			2639	653	4	5'-0"	Str.		30							
503	113	16'-0"	Str.				1886	604	1188	29'-6"	Str.			52639													
504	1188	29'-10"	101	29'-3"			36966	605	3 Series of 111	2'-11" to 40'-0"	Str.			10733													
									2 Series of 45	12'-11" to 27'-9"	Str.			4 1/2"													
Total Weight																								194,825			

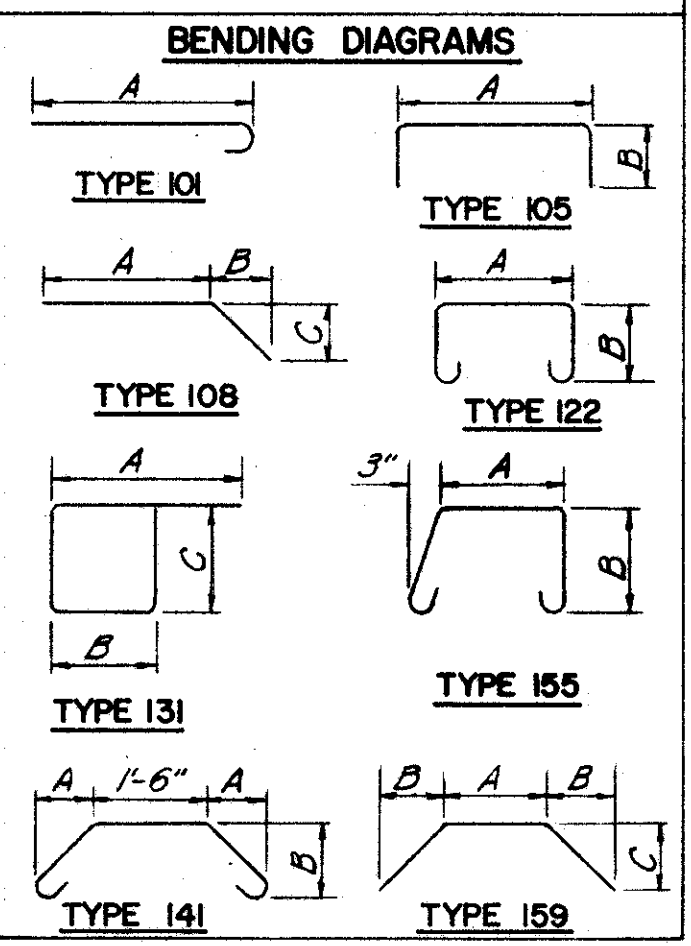

* Bars 451 through 456 and 651 through 653 are for the light supports. For their placement, see sheet 176
† Bars 609, 610, 611, 612 & 613 are included for payment with "Item 5-14, Railing."

Note: All bar dimensions are given out to out.
For Replacement Schedule, see sheet 103-7A



H.N.T.B. BR. NO. 11 PART 7A

HOWARD, NEEDLES, TAMMEN & BERGENDOFF
CONSULTING ENGINEERS
KANSAS CITY CLEVELAND NEW YORK


DECK PLAN
WILLOW FREEWAY OVER REL. WOODLAND AVE.
BR. NO. CUY-21-1544 STA. 34+02.53
Scale: As noted STA. 36+16.47
WILLOW-INNER BELT FREEWAY
CLEVELAND CUYAHOGA COUNTY OHIO

DRAWN: DRA DATE: 11-20-58
TRACED: DATE: 12-3-58
CHECKED: G.A.T. DATE: 11-13-59
REVIEWED: J.C.T. DATE: 11-13-59
SHEET 170


CUYAHOGA COUNTY
CITY OF CLEVELAND
CUY-21-15.32
CUY-42-18.42

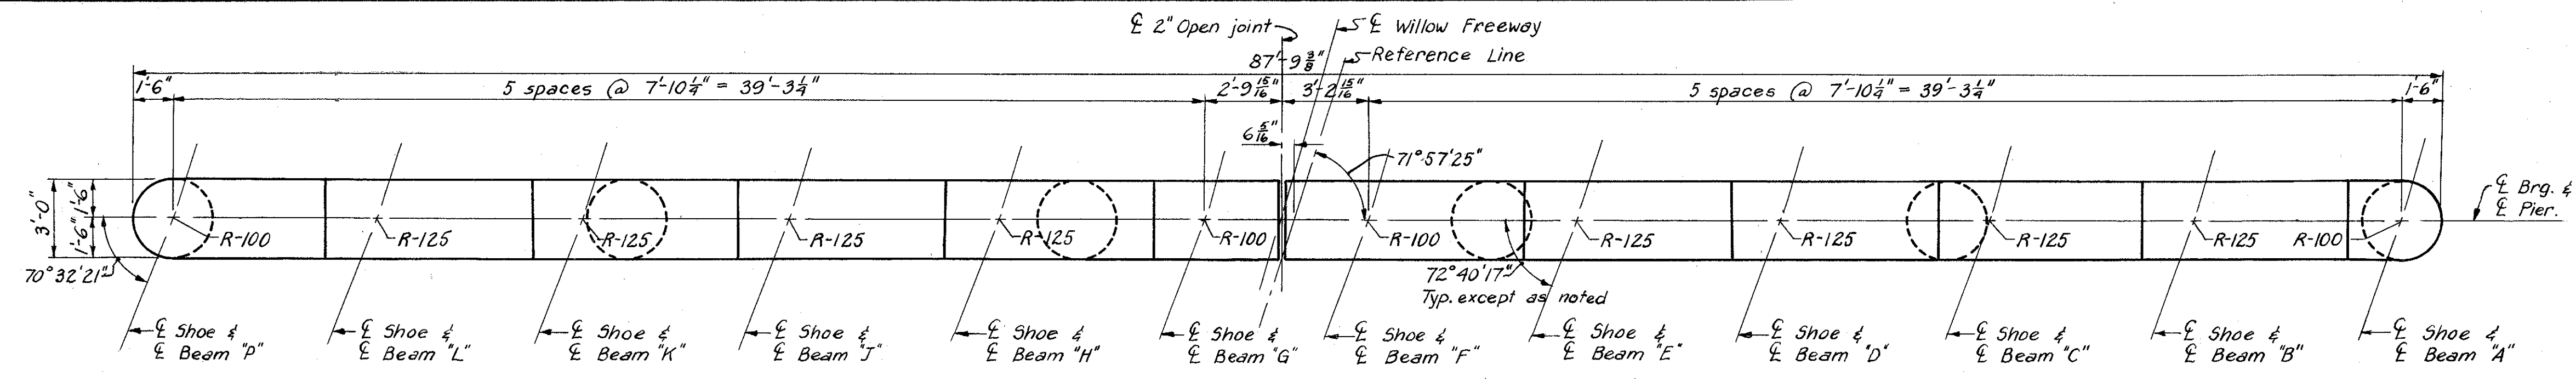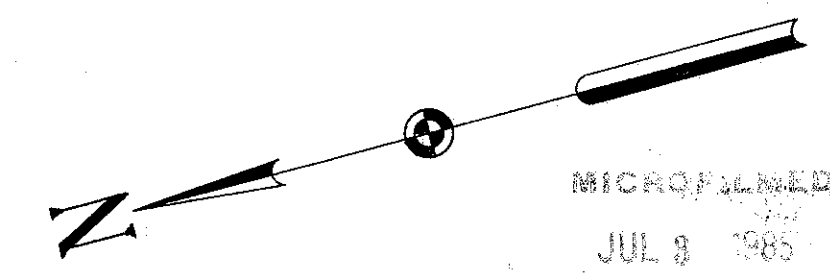


BRIDGE NO. 8 - PIER 1

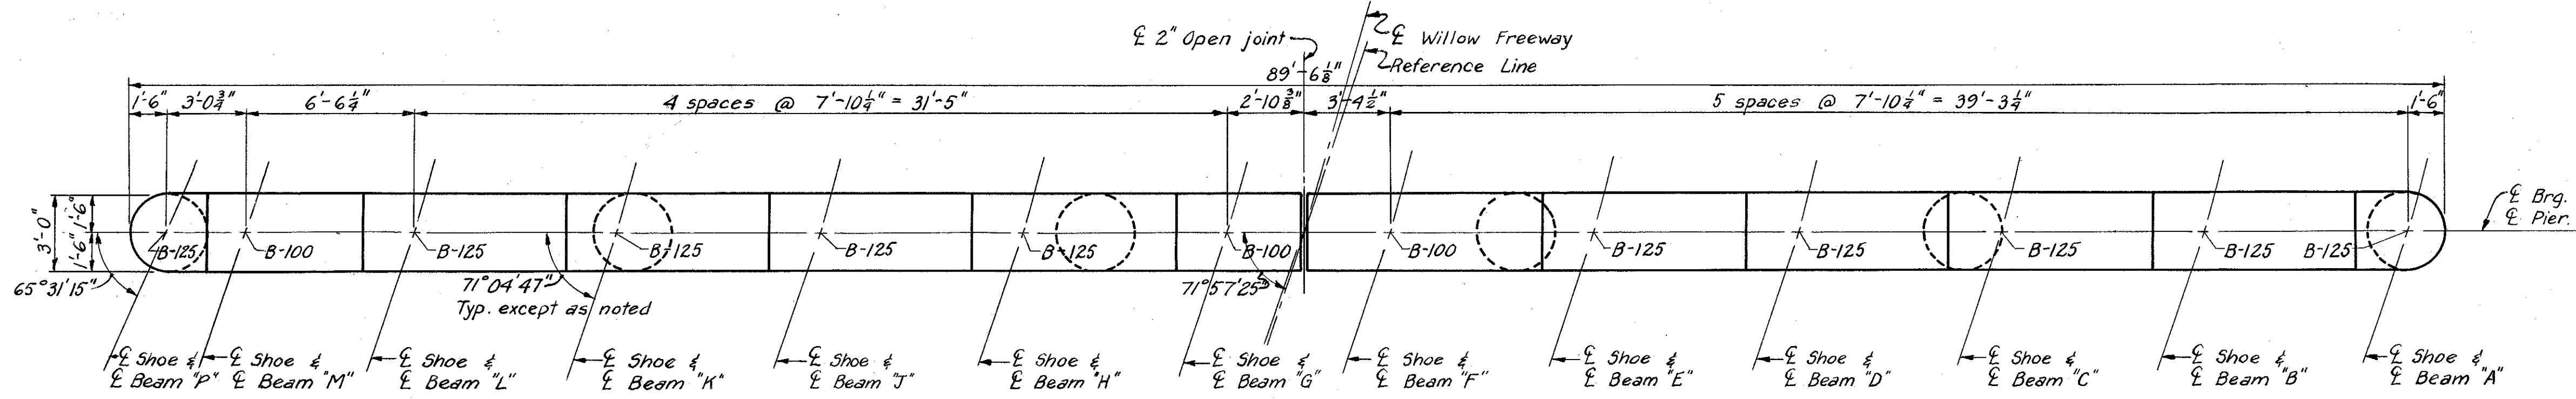


BRIDGE NO. 8 - PIER 2

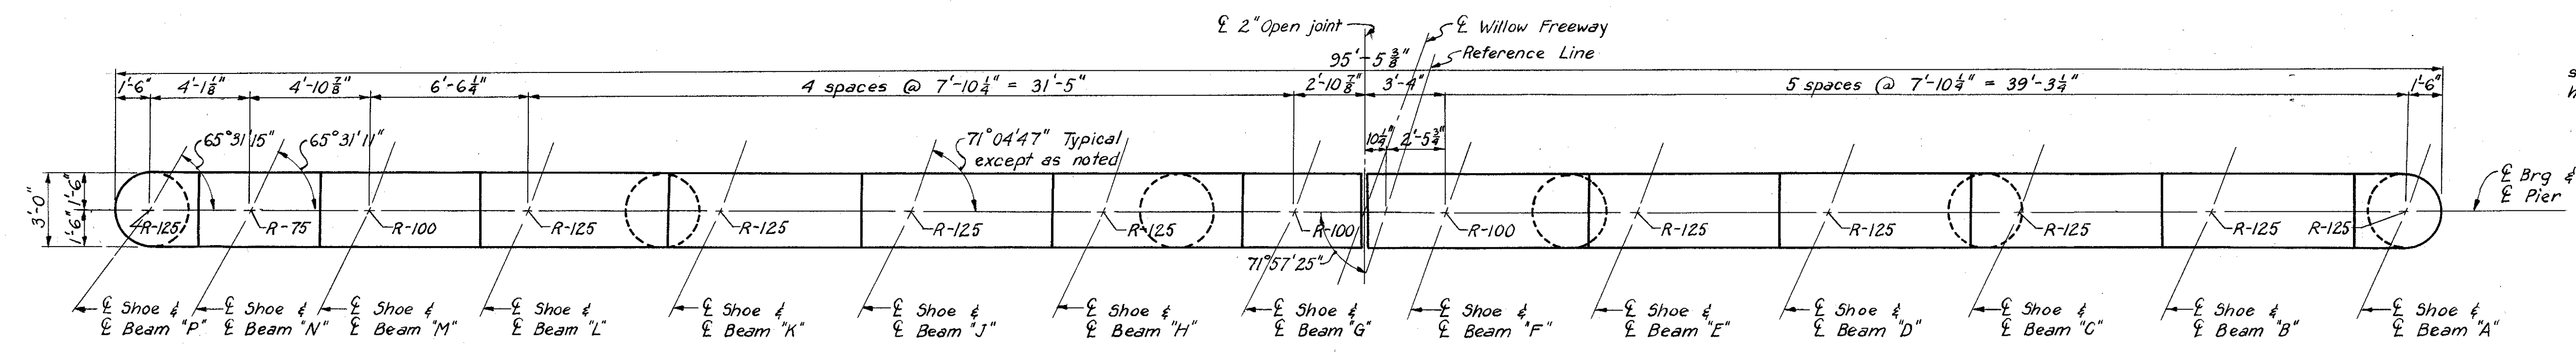


BRIDGE NO. 8 - PIER 3

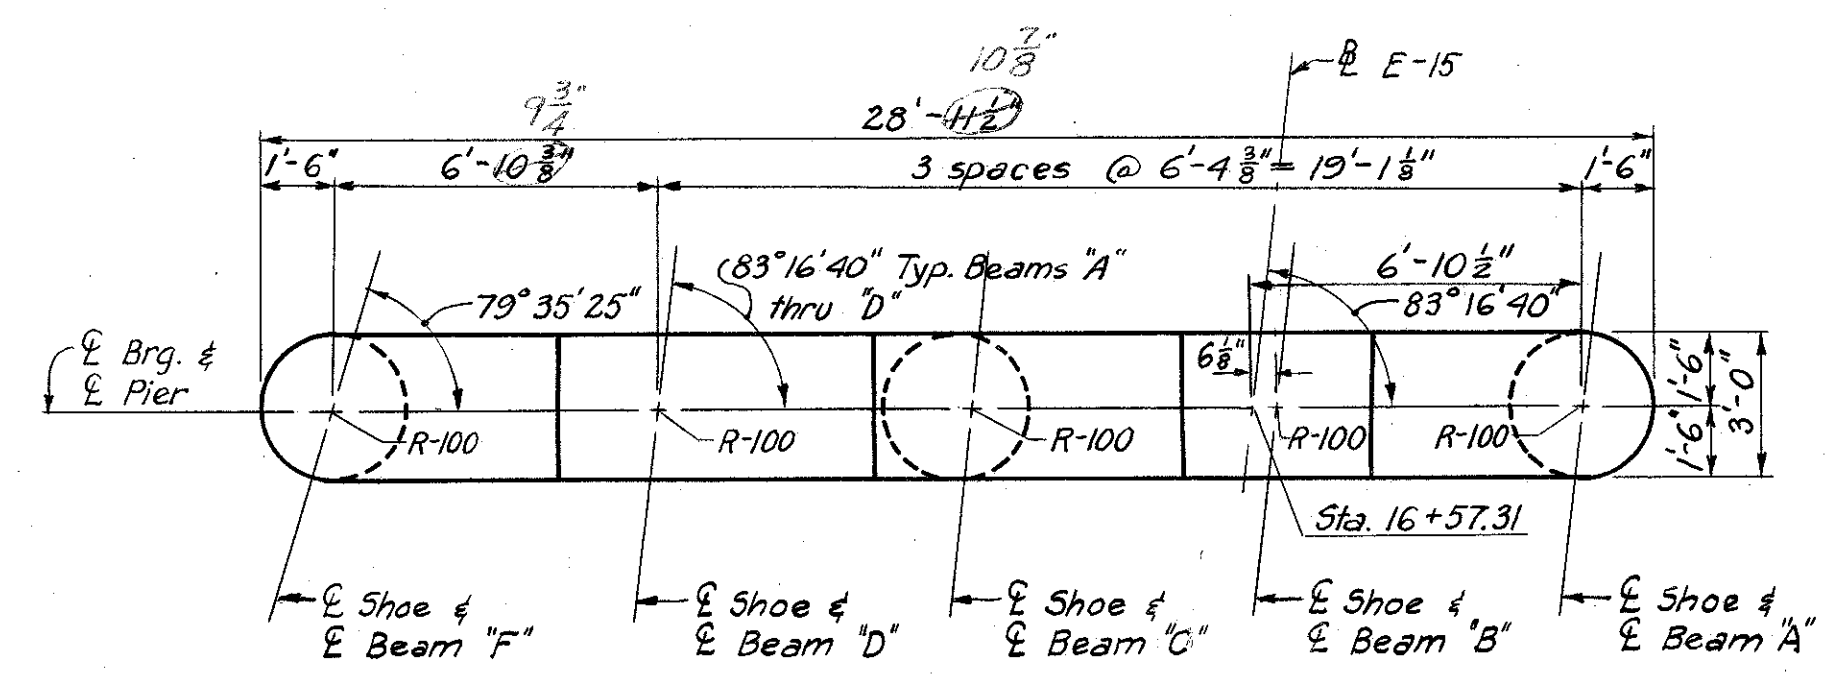


BRIDGE NO. 9 - PIER 1

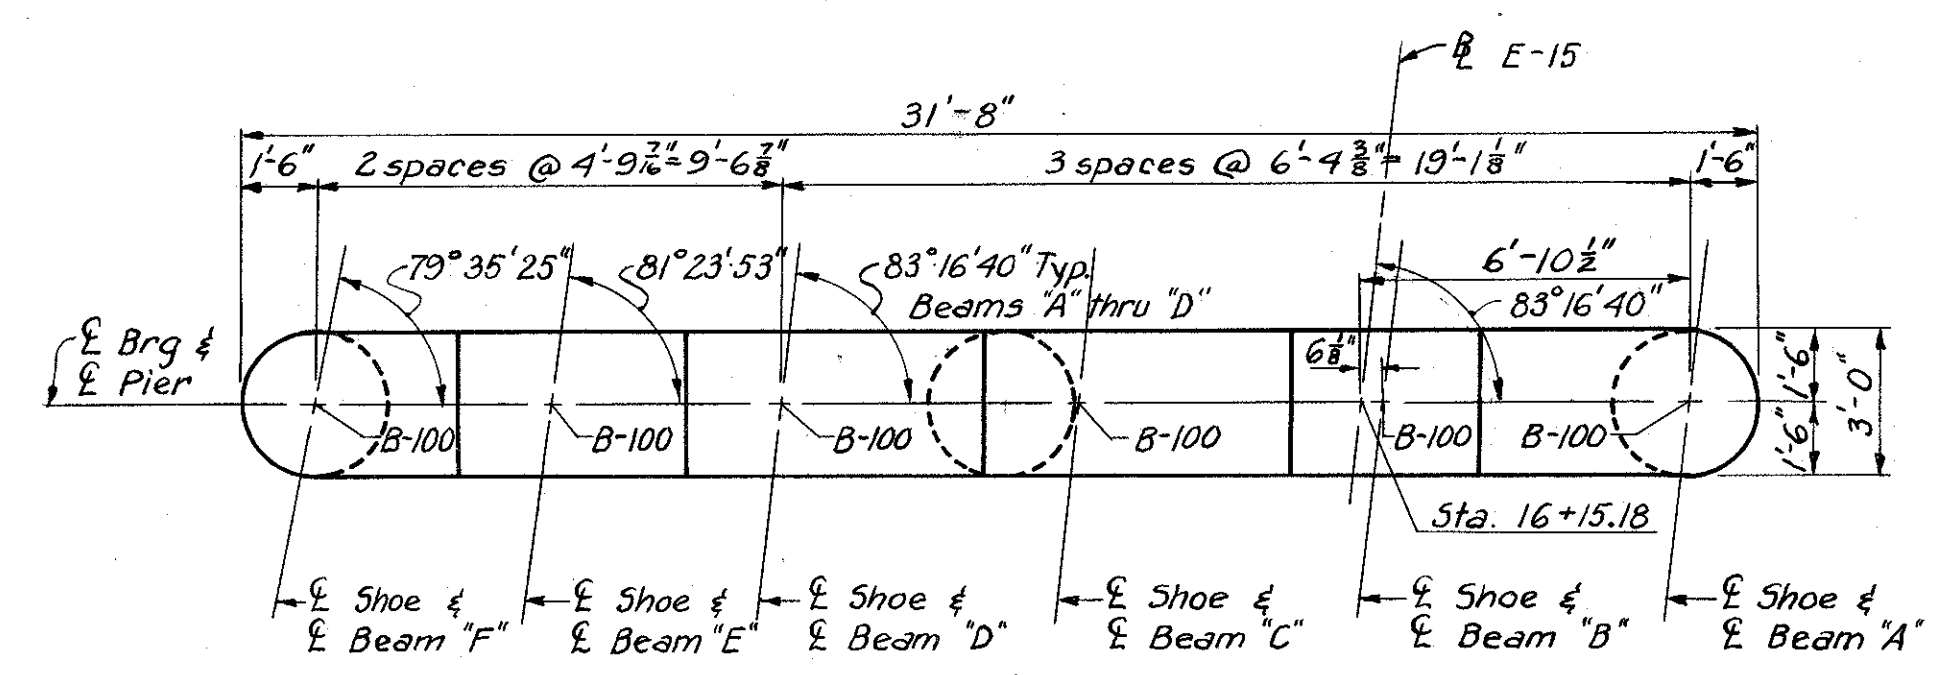

BRIDGE NO. 9 - PIER 2

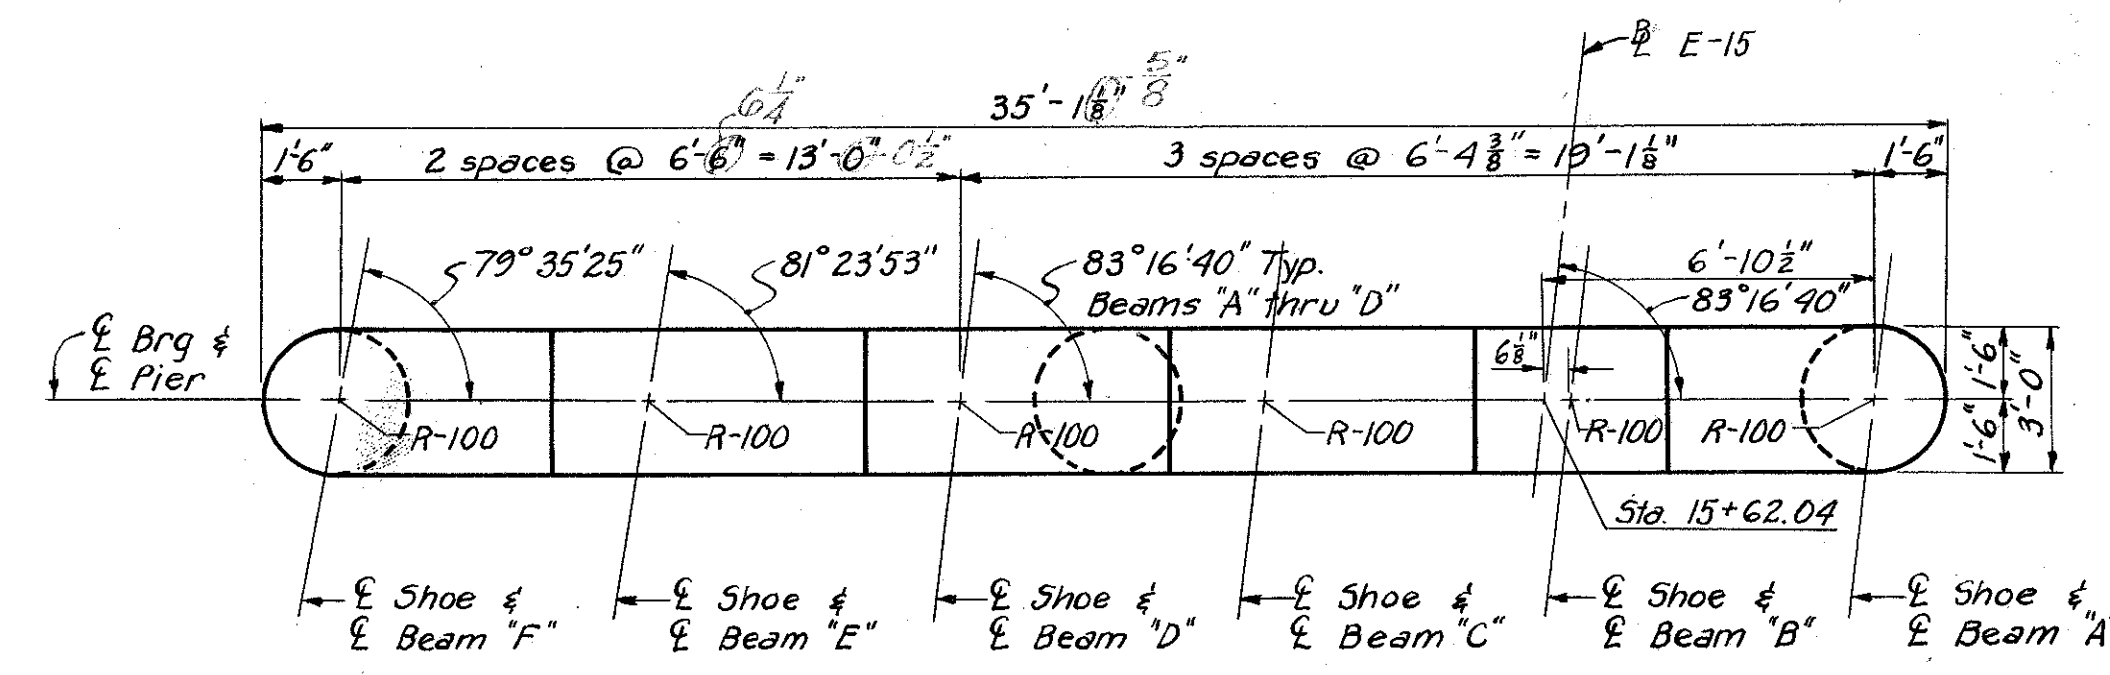

BRIDGE NO. 9 - PIER 3

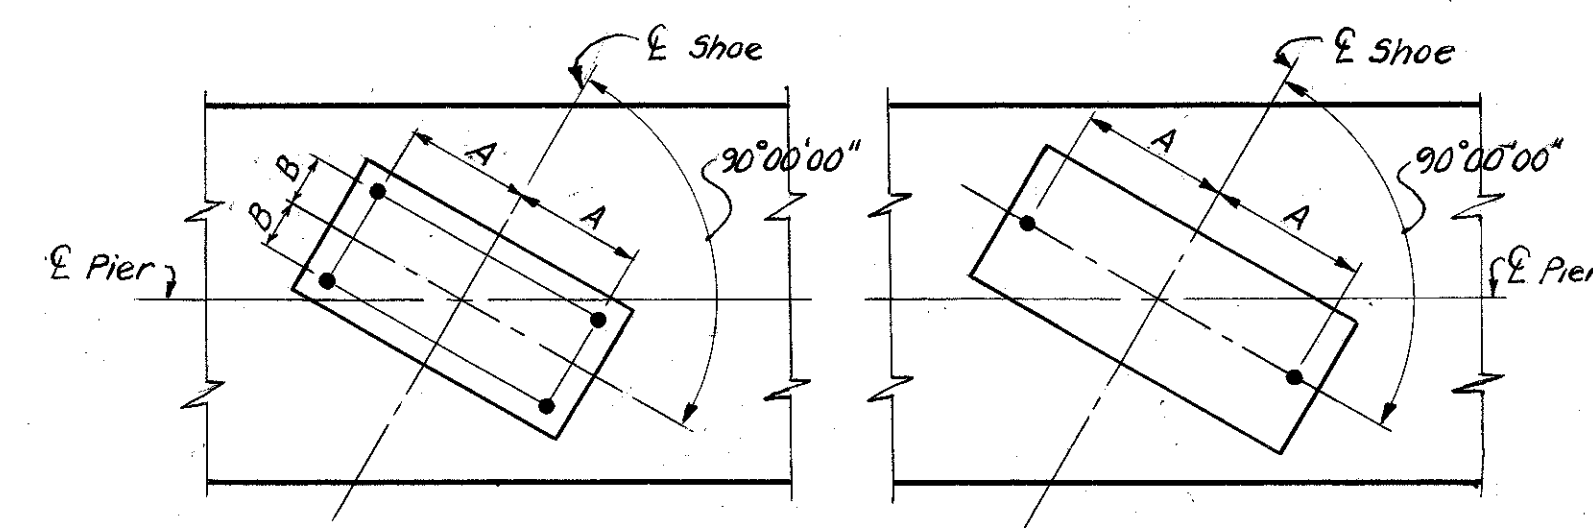

ANCHOR BOLTS ANCHOR BARS

LAYOUT DIAGRAMS

No scale

NOTES:
The anchor bolts and anchor bars and all drainage provisions shall be furnished and set under this contract.
The 4" rigid galvanized conduits were placed and capped 1'-0" above tops of masonry under a previous contract. Connections to service panels shall be included in this contract.
Electrical grounds which extend above top of masonry were placed under a previous contract. These grounds shall be spliced and connected to the superstructure with a No. 6 copper wire bolted to the bottom flange and to the bottom portion of the shoe. Grounds are located in the outside columns as follows:
Bridge No. 4 Pier 2-N45.
Bridge No. 8 Pier 2. Bridge No. 10 Pier 1.
Bridge No. 9 Pier 2. Bridge No. 11 Pier 1.
For drainage details, see Sh. 174-7A
For additional drainage details at Pier 2, Bridge 4, see Sh. 135-7A
For details of 4" rigid galvanized conduit, see Sh. 177-7A
Crossframes or beam/girder flanges will interfere with the setting of anchor bars or anchor bolts at all piers, therefore the holes shall be drilled prior to erection of the interfering member.

TYPE OF SHOE	DIMENSIONS	
	A	B
R-75	9"	
R-100	9 1/2"	
R-125	10"	
B-100	7 1/2"	3"
B-125	8"	3 1/2"

TOP OF MASONRY ELEVATIONS											
BRIDGE NO. 8							BRIDGE NO. 9				
BEAM	PIER 1	PIER 2	PIER 3	BEAM	PIER 1	PIER 2	PIER 3	BEAM	PIER 1	PIER 2	PIER 3
A	692.57	692.21	691.92	H	690.11	689.89	689.62	A	693.35	692.447	690.906
B	692.06	691.83	691.54	J	689.72	689.57	689.24	B	693.49	692.569	690.909
C	691.67	691.44	691.15	K	689.34	689.12	688.85	C	693.37	692.447	690.889
D	691.28	691.06	690.77	L	688.95	688.74	688.47	D	693.24	692.304	690.769
E	690.89	690.67	690.39	M		688.54	688.28	E		692.30	690.70
F	690.63	690.29	690.13	N			688.12	F	693.11	692.1573	690.5016
G	690.61	690.27	689.11	P	688.69	688.27	687.71				

HOWARD, NEEDLES, TAMMEN & BERGENDOFF
CONSULTING ENGINEERS
KANSAS CITY CLEVELAND NEW YORK

PIER CAP PLANS
BRIDGE NOS. 8 & 9

Scale: 1/4"=1'-0"


WILLOW-INNER BELT FREEWAY
CLEVELAND CUYAHOGA COUNTY OHIO

DRAWN A.L. TRACED A.L. CHECKED C.A.B. REVIEWED J.C.T. REVISION 1-23-60
DATE 1-26-59 DATE 1-26-59 DATE 1-29-59 DATE 1-13-59 SHEET 171

Revised 9-21-60

JUL 9 1965

CUYAHOGA COUNTY
CITY OF CLEVELAND
CUY-21-15.32
CUY-42-18.42

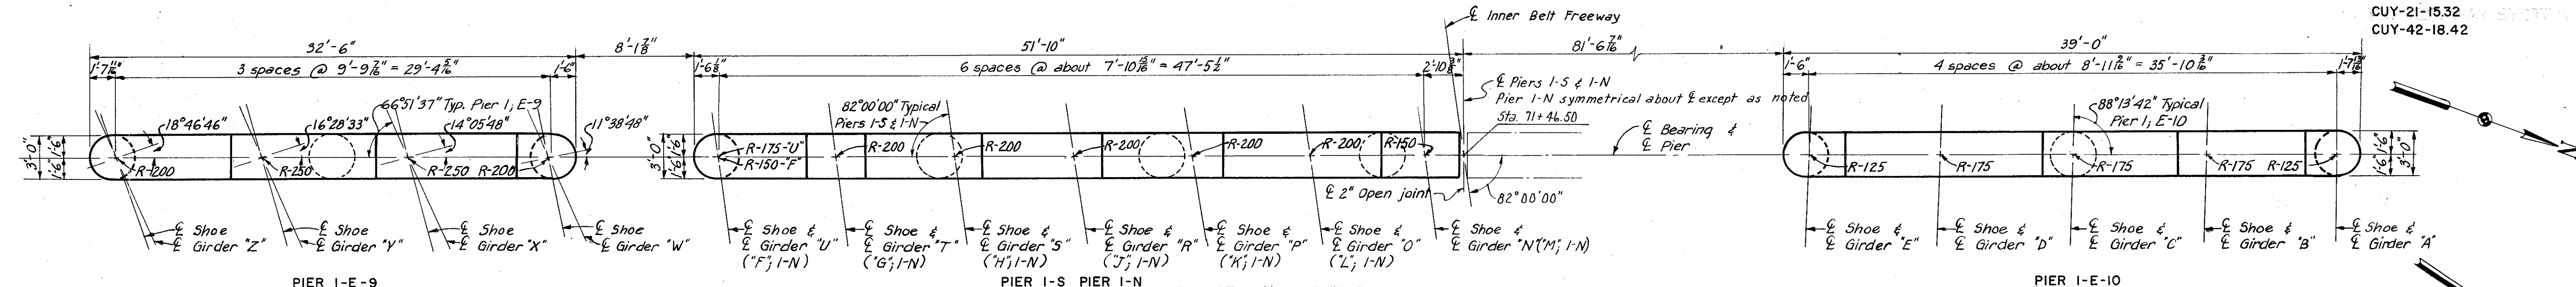


PIER 1-E-9

PIER 1-S PIER 1-N

BRIDGE NO. 4 - PIER 1

PIER 1-E-10

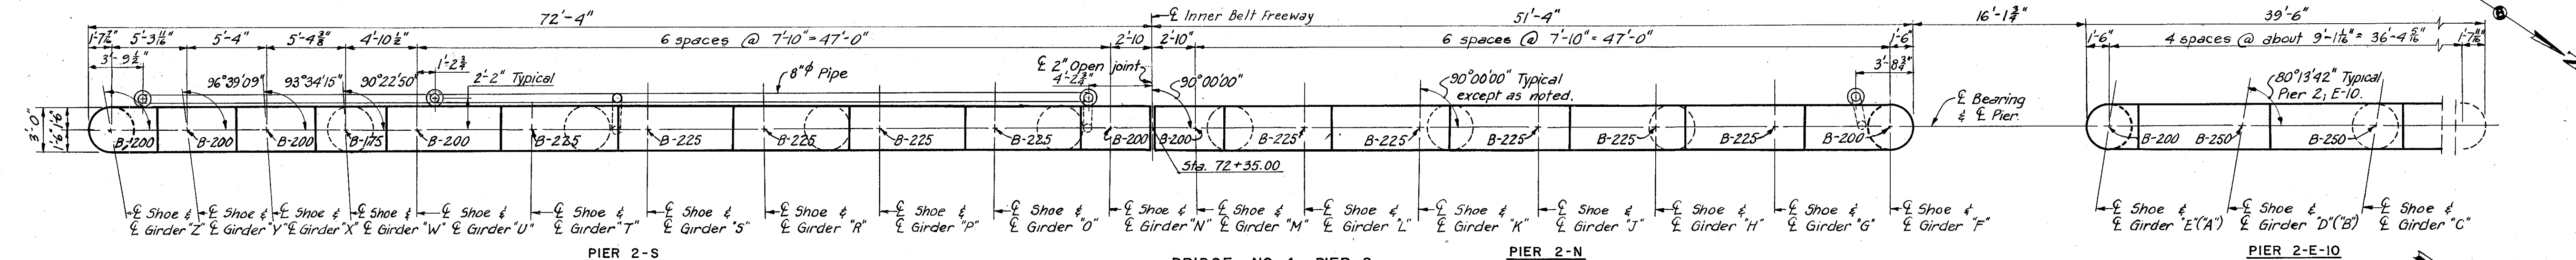


PIER 2-S

BRIDGE NO. 4 - PIER 2

PIER 2-N

PIER 2-E-10

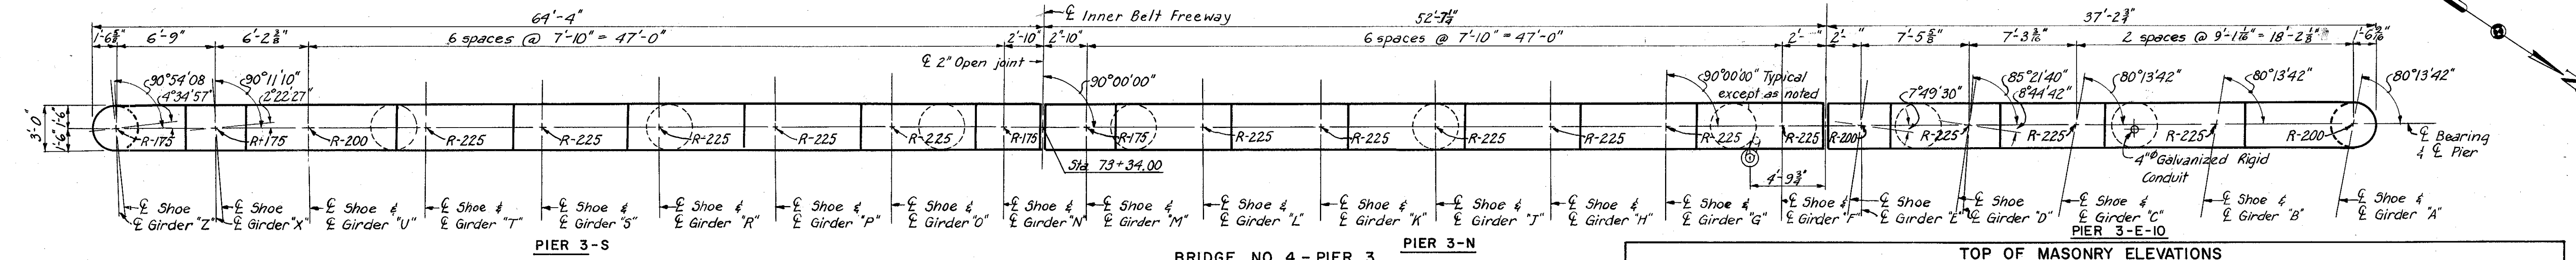


PIER 3-S

BRIDGE NO. 4 - PIER 3


PIER 3-N

PIER 3-E-10

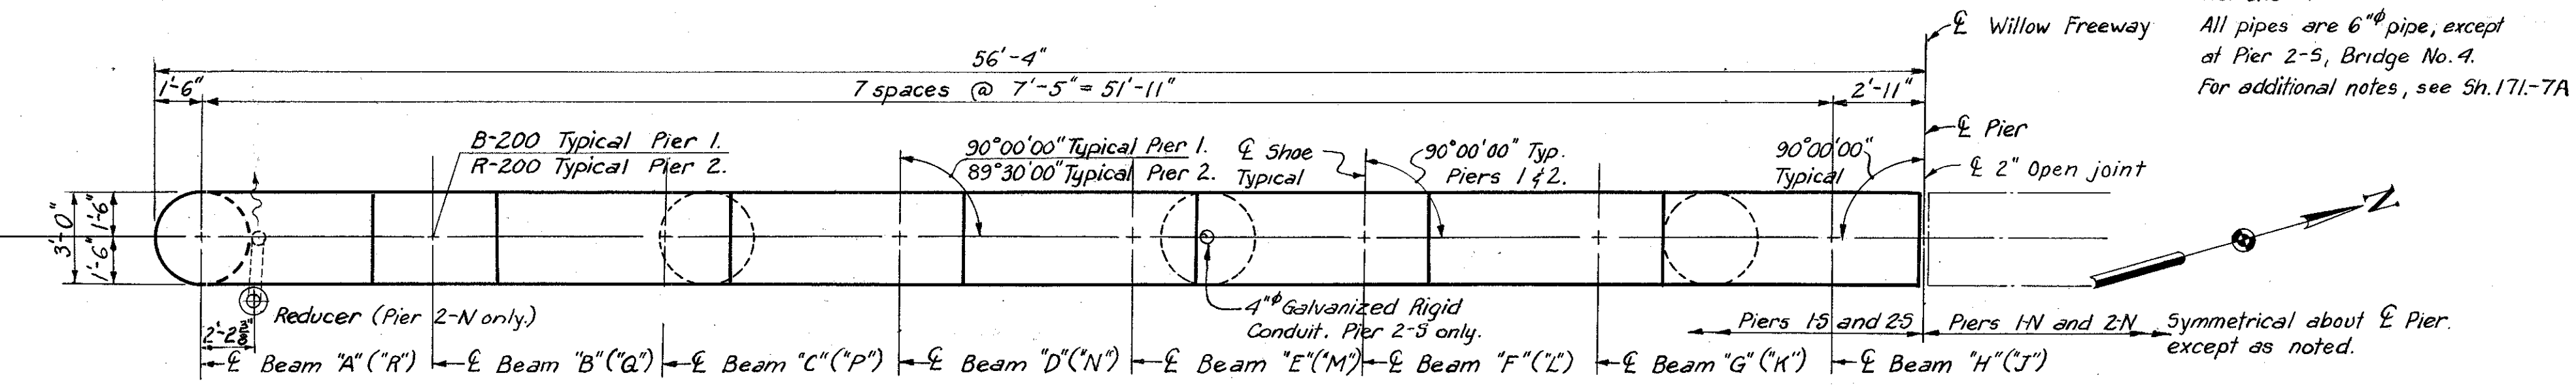

BRIDGE NO. 10 - PIERS 1 & 2

Scale: 1/4" = 1'-0"

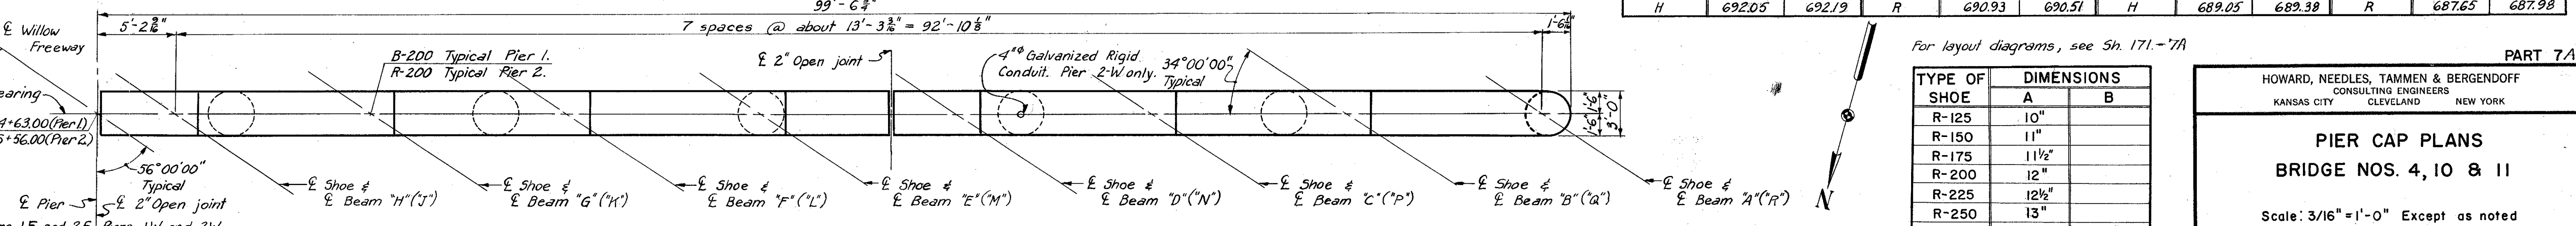

BRIDGE NO. 11 - PIERS 1 & 2

TOP OF MASONRY ELEVATIONS											
BRIDGE NO. 4											
GIRDER	PIER 1	PIER 2	PIER 3	GIRDER	PIER 1	PIER 2	PIER 3	GIRDER	PIER 1	PIER 2	PIER 3
A	687.26	686.13	683.43	J	690.92	687.92	684.36	S	691.92	688.18	684.23
B	686.93	686.07	683.53	K	691.10	688.04	684.48	T	692.02	688.13	684.11
C	686.86	686.15	683.67	L	691.28	688.17	684.60	U	691.94	687.95	684.03
D	686.79	686.25	683.79	M	691.78	688.33	684.87	W	690.86	687.91	
E	687.00	686.47	683.94	N	691.81	688.34	684.87	X	690.35	687.59	684.04
F	690.69	687.59	683.99	O	691.61	688.27	684.60	Y	689.94	687.46	
G	690.56	687.68	684.11	P	691.71	688.24	684.48	Z	689.66	687.28	683.94
H	690.74	687.80	684.23	R	691.82	688.21	684.36				

BRIDGE NO. 10						BRIDGE NO. 11					
BEAM	PIER 1	PIER 2	BEAM	PIER 1	PIER 2	BEAM	PIER 1	PIER 2	BEAM	PIER 1	PIER 2
A	692.38	693.06	J	692.05	692.19	A	688.23	688.57	J	689.02	689.35
B	692.67	693.35	K	691.89	691.95	B	688.50	688.84	K	688.86	689.20
C	692.63	693.28	L	691.73	691.71	C	688.67	689.00	L	688.71	689.04
D	692.51	693.02	M	691.57	691.47	D	688.74	689.08	M	688.55	688.89
E	692.40	692.81	N	691.41	691.23	E	688.82	689.15	N	688.40	688.73
F	692.28	692.60	P	691.25	690.99	F	688.90	689.23	P	688.24	688.58
G	692.17	692.39	Q	691.09	690.75	G	688.97	689.31	Q	688.00	688.33
H	692.05	692.19	R	690.93	690.51	H	689.05	689.38	R	687.65	687.98

⊙ - Indicates 6x12' reducer
 (---) - Indicates similar girder not shown.
 All pipes are 6" pipe, except at Pier 2-S, Bridge No. 4.
 For additional notes, see Sh. 171-7A

For layout diagrams, see Sh. 171-7A

TYPE OF SHOE	DIMENSIONS	
	A	B
R-125	10"	
R-150	11"	
R-175	11 1/2"	
R-200	12"	
R-225	12 1/2"	
R-250	13"	
B-175	9 1/2"	5"
B-200	10"	6"
B-225	10 1/2"	6 1/2"
B-250	11"	7"

HOWARD, NEEDLES, TAMMEN & BERGENOFF
 CONSULTING ENGINEERS
 KANSAS CITY CLEVELAND NEW YORK

PIER CAP PLANS
BRIDGE NOS. 4, 10 & 11

Scale: 3/16" = 1'-0" Except as noted

WILLOW - INNER BELT FREEWAY
 CLEVELAND CUYAHOGA COUNTY OHIO



DRAWN A.L. TRACED A.L. CHECKED C.H.B. REVIEWED J.C.T. REVISIONS
 DATE 1-29-57 DATE 1-29-59 DATE 1-30-59 DATE 1-13-59

PART 7A
 SHEET 172


Note: Roadway and curb joints shall be shop assembled, corrected to provide uniform close contact between the two mating parts of each joint, match-marked and erected to required lines and grades. Omit shop coat on all portions of end dams. Portions in contact with steel or concrete shall not be painted. All other portions shall be cleaned and given the shop coat in the field as well as the two field coats.
All sliding contact surfaces of the expansion joint materials shall not be painted and shall be lubricated with flake graphite prior to placing of backwall concrete.

JUL 8 1960

CUYAHOGA COUNTY
CITY OF CLEVELAND
CUY-2-15.32
CUY-42-18.42



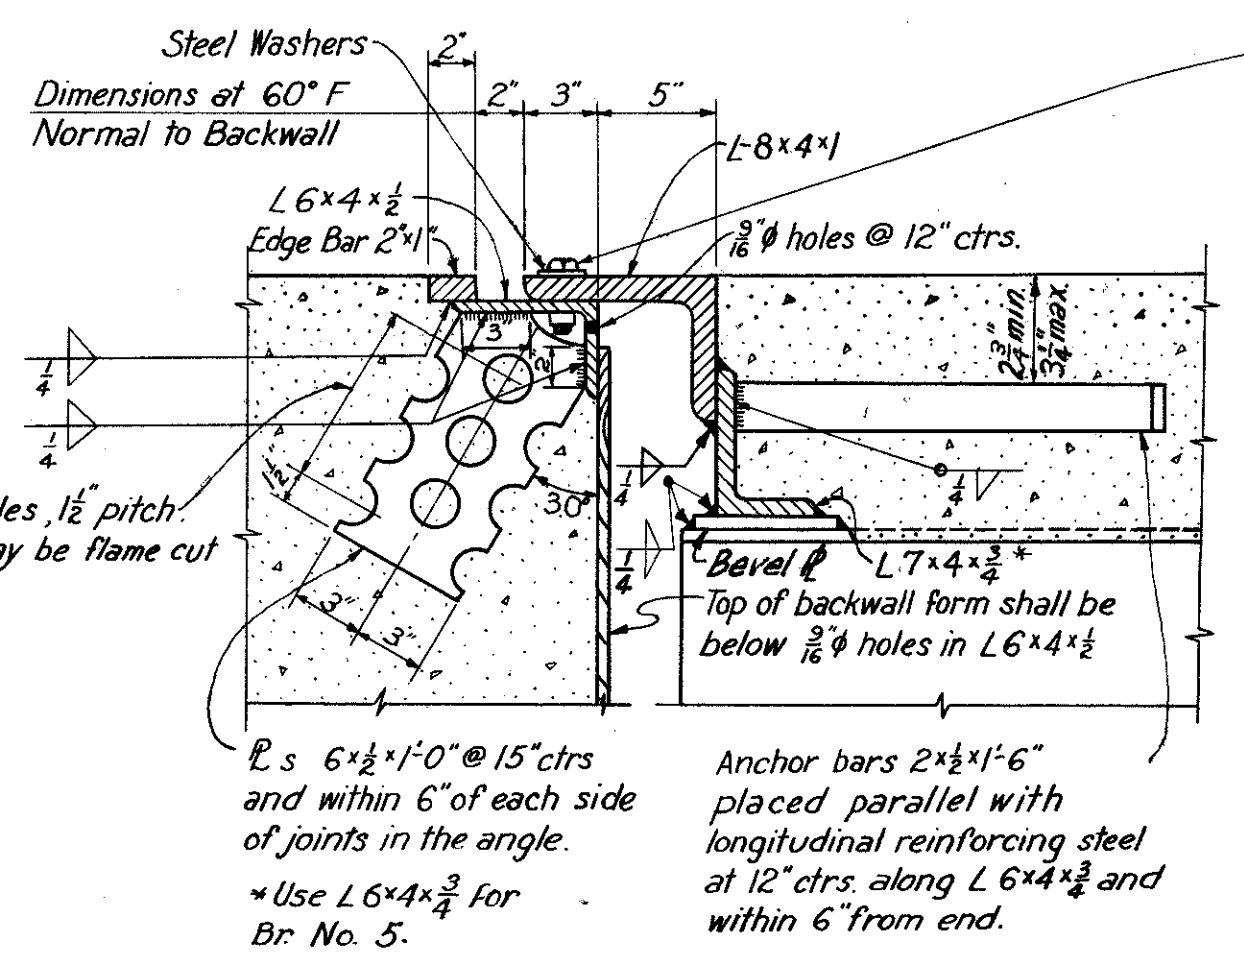
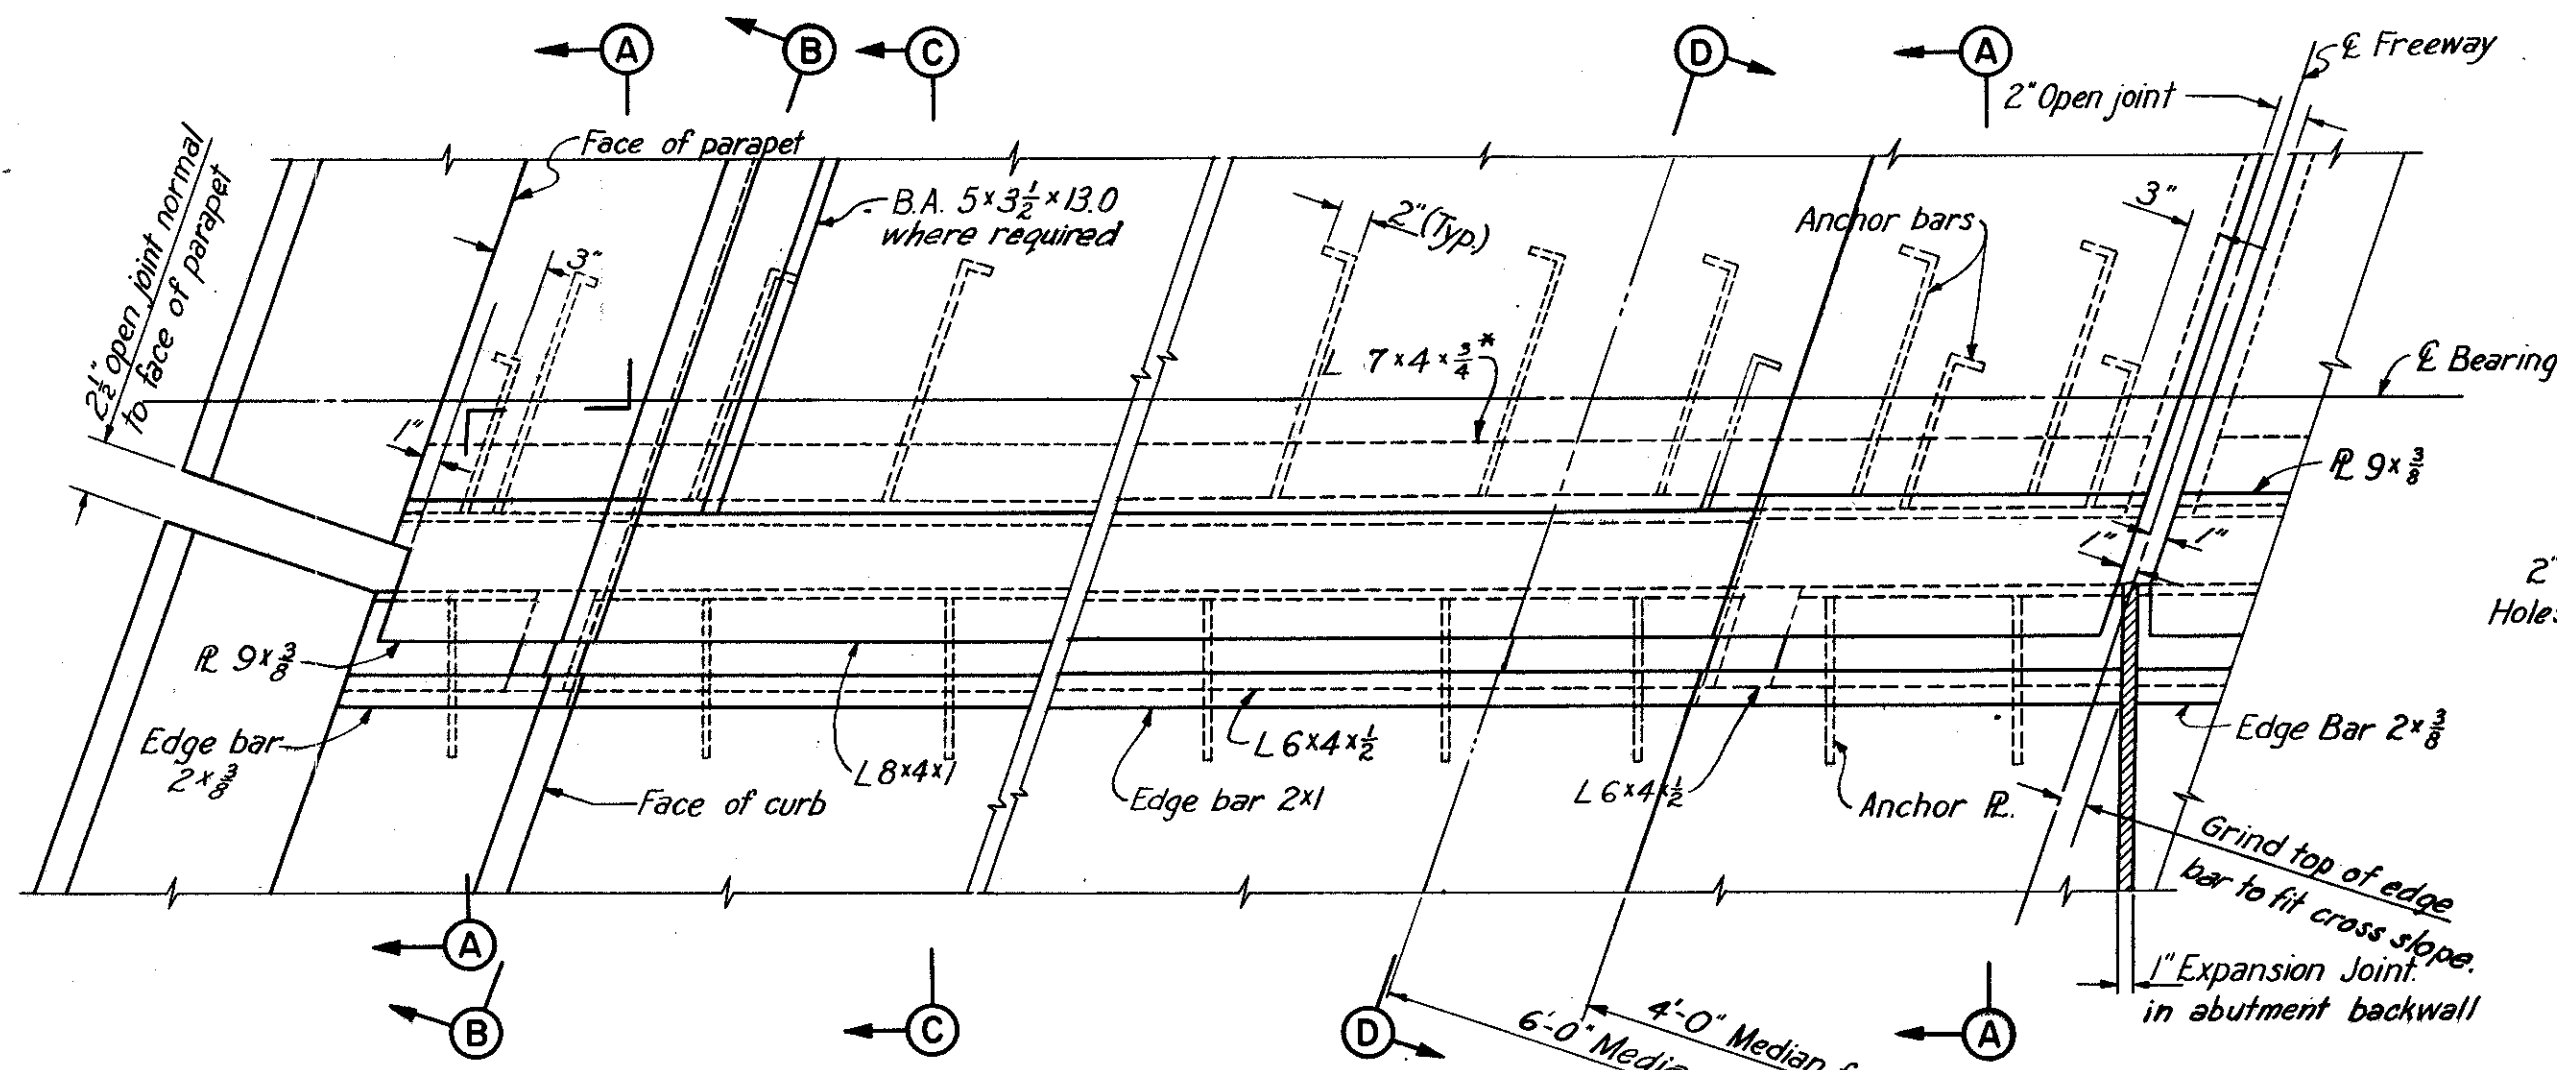


3/8" x 2" bolts at not more than 2'-0" ctrs. with nuts tack-welded to under side of lower angle. Holes to be 1/8" in upper angle. Center 3/8" bolts in 1/8" holes. Apply flake graphite between washers and angles. Turn bolts tight and release one-half turn. Remove bolts as soon as concrete has reasonably set preferably within 2 hours after placing. Fill holes with bituminous material.

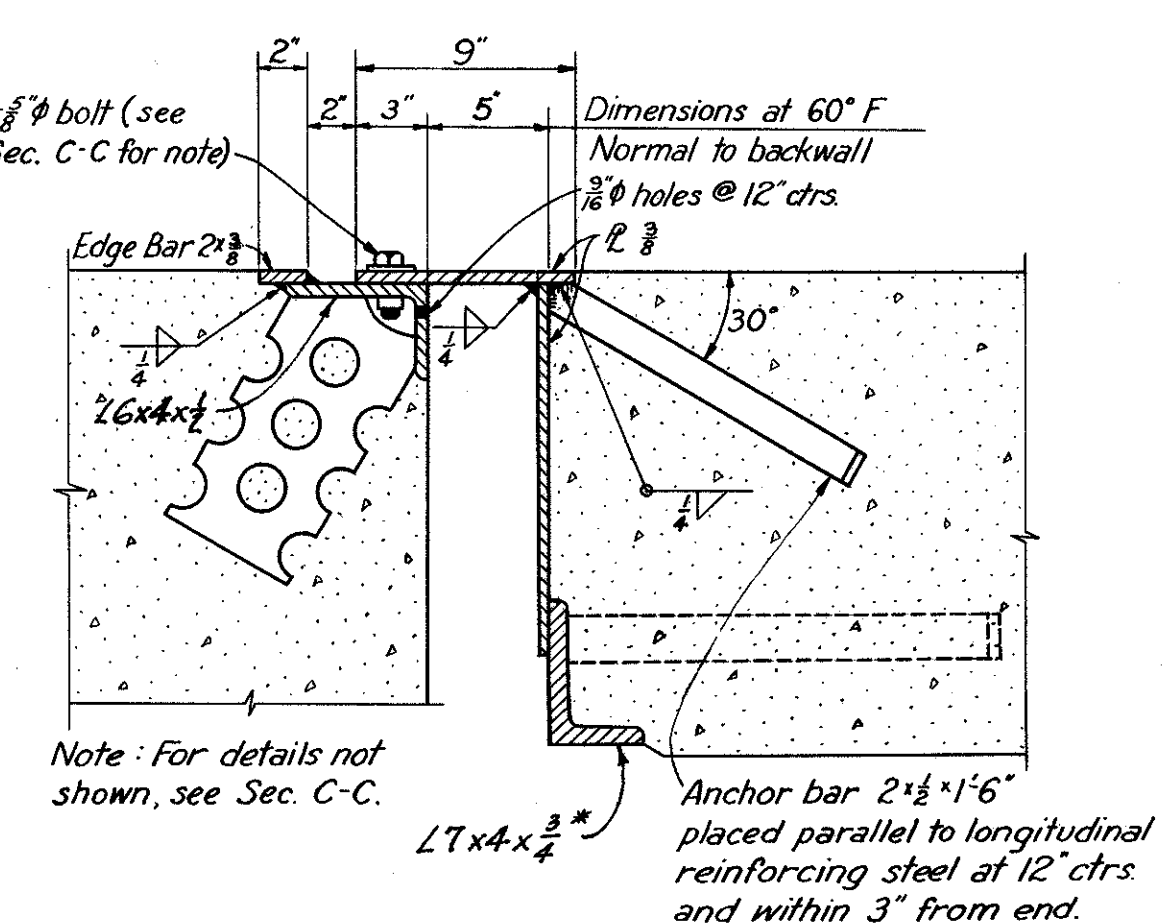

Note: A welded butt joint shall be provided at the apex of the 5'-0" rounding for that portion of the end dam attached to the superstructure of Bridges No. 3, 4, 5, 9, 10 & 11. (See detail of Welded Butt Joint). The portion attached to the backwall shall be placed in segments not less than 6'-0" in length with a joint at the apex of the 5'-0" rounding and at all abutment contraction joints. These shall be closely butted but shall not be welded. Beveled bearing bars shall be used for end dams at the following locations only:
1. Bridge No. 4, East and West Abutments
2. Bridge No. 9, Abutment E-15
See detail of Beveled Bearing Bar.

PARTIAL PLAN OF END DAM Scale 1"=1'-0"

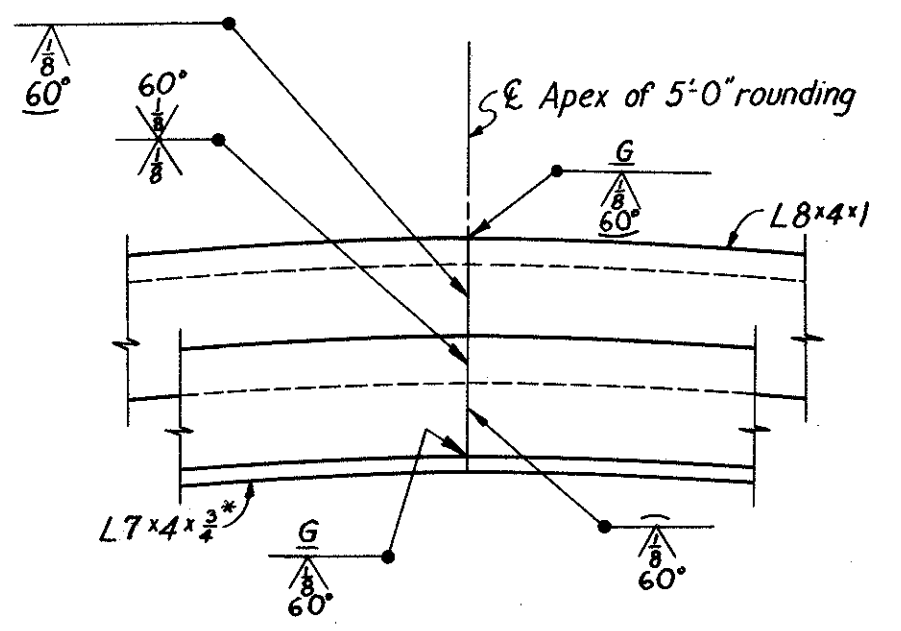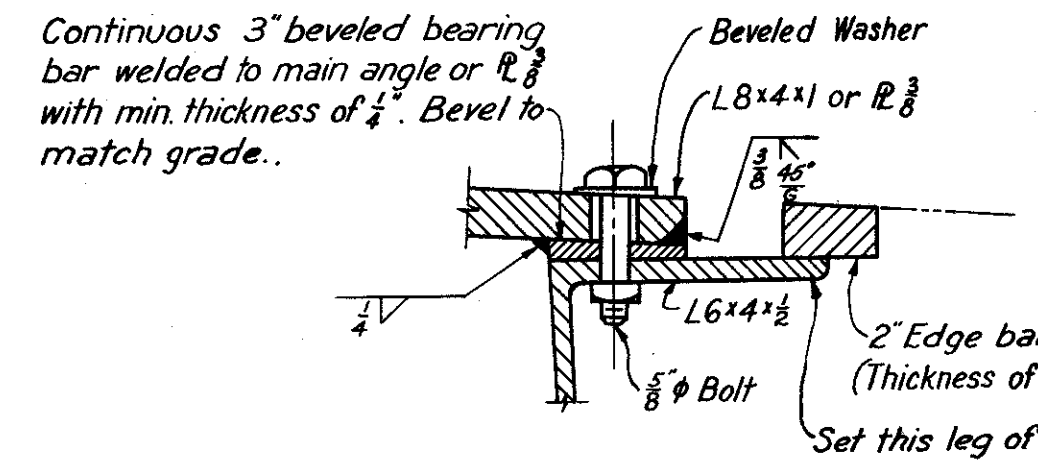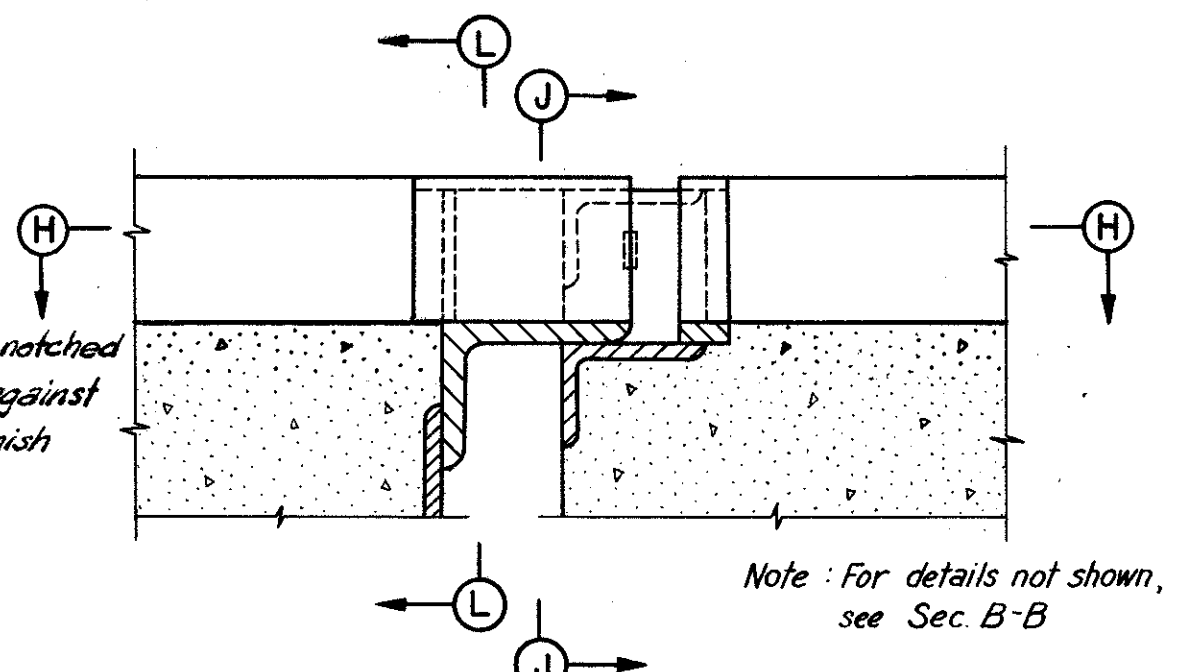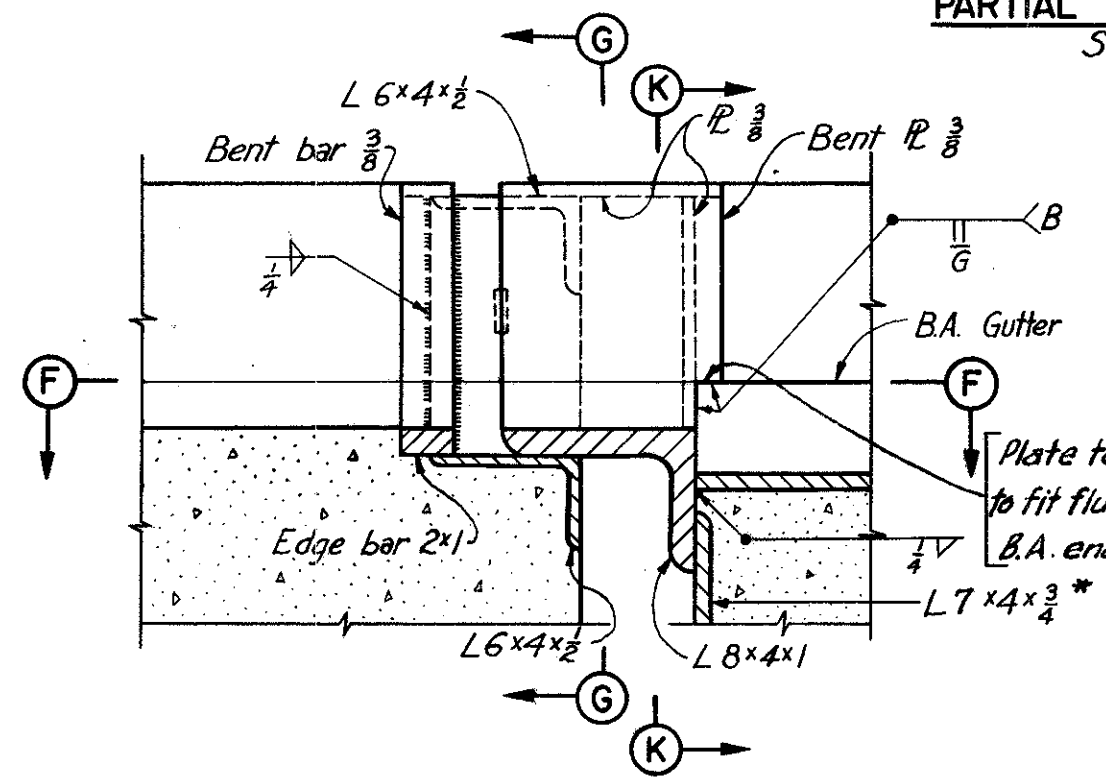

Note: All end dam steel shall be included with Item 5-7, Structural Steel for payment.

SECTION B-B



SECTION D-D

DETAIL OF BEVELED BEARING BAR (This section taken parallel to line of expansion) Scale 3"=1'-0"

WELDED BUTT JOINT IN SUPERSTRUCTURE END DAM ANGLES AT APEX OF 5'-0" ROUNDING

ROCKER NO.	DIMENSIONS	
	A (in.)	B (in.)
R-75	22	8
R-100	23	10
R-125	24	11
R-150	26	12
R-175	27	14
R-200	28	16
R-225	29	17
R-250	30	18
R-275	31	19
R-300	32	20

Note: Details for Rockers marked "RS" are the same as for Rockers marked "R".

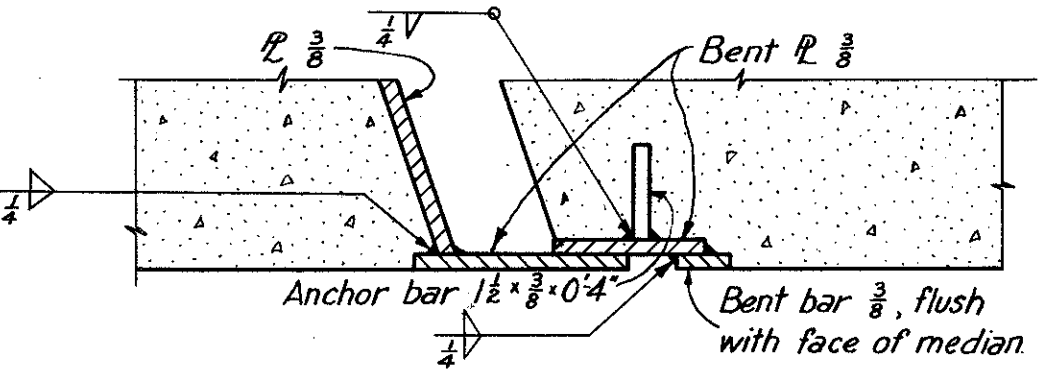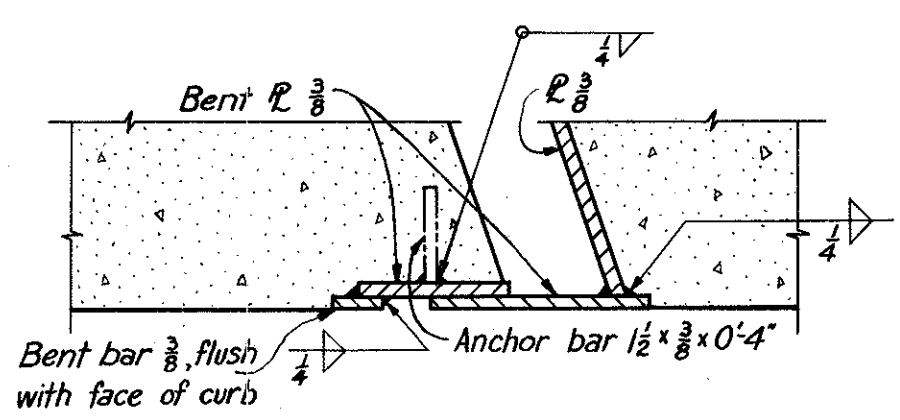



1 1/8" holes for 1 1/2" x 3/8" x 6" anchor bars. Anchor bars to be embedded to such depth that the top of bar is 1/4" below the top of masonry. Typical for all masonry plates.

PLAN OF TYPICAL ROCKER MASONRY PLATE No Scale

PLAN OF SPECIAL ROCKER MASONRY PLATE FOR ROCKERS MARKED "R S" No Scale

SECTION F-F



SECTION H-H

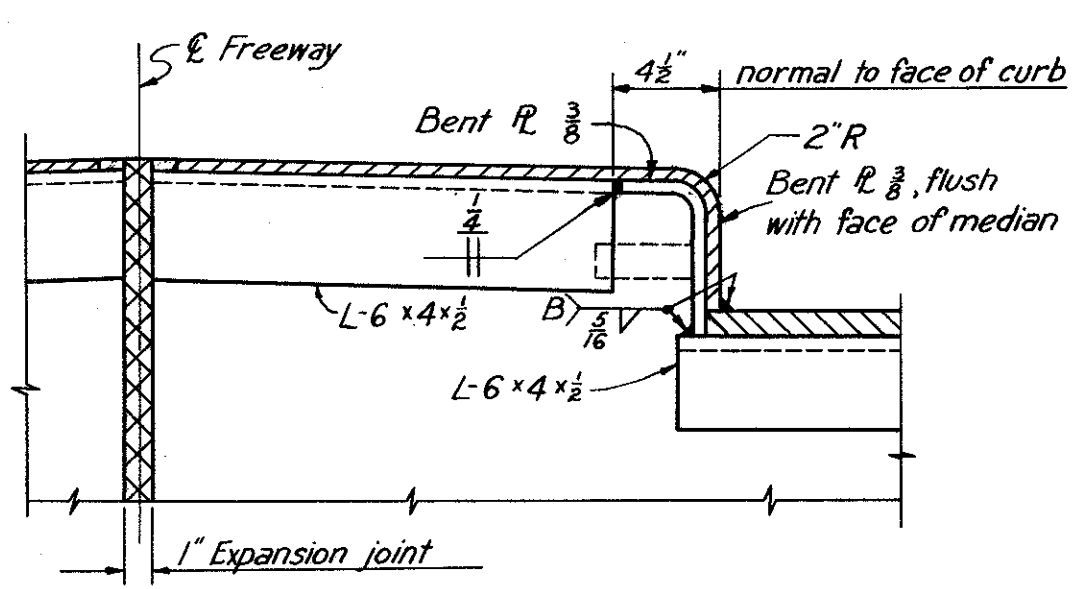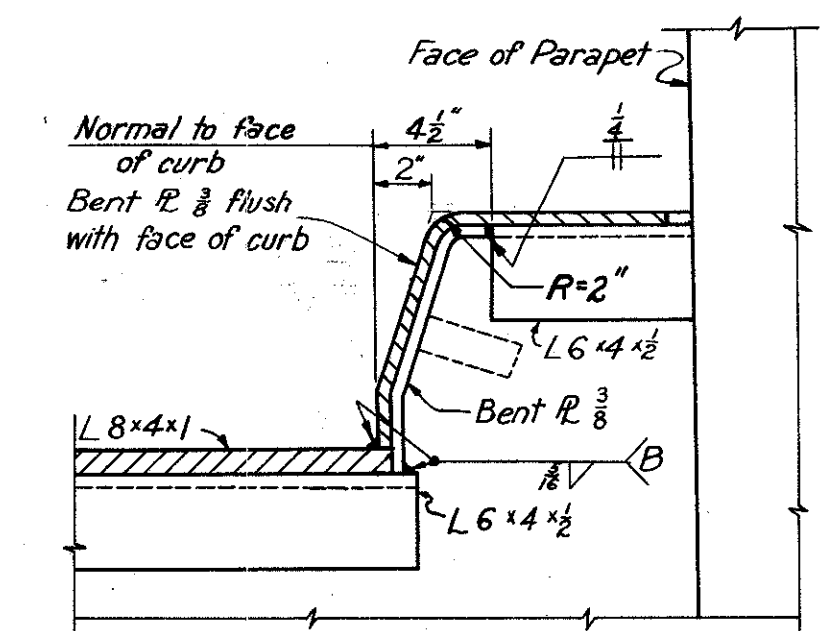

Note: Bend Curb @ Safety Curb with B.A. Gutter only.

SECTION G-G

SECTION J-J

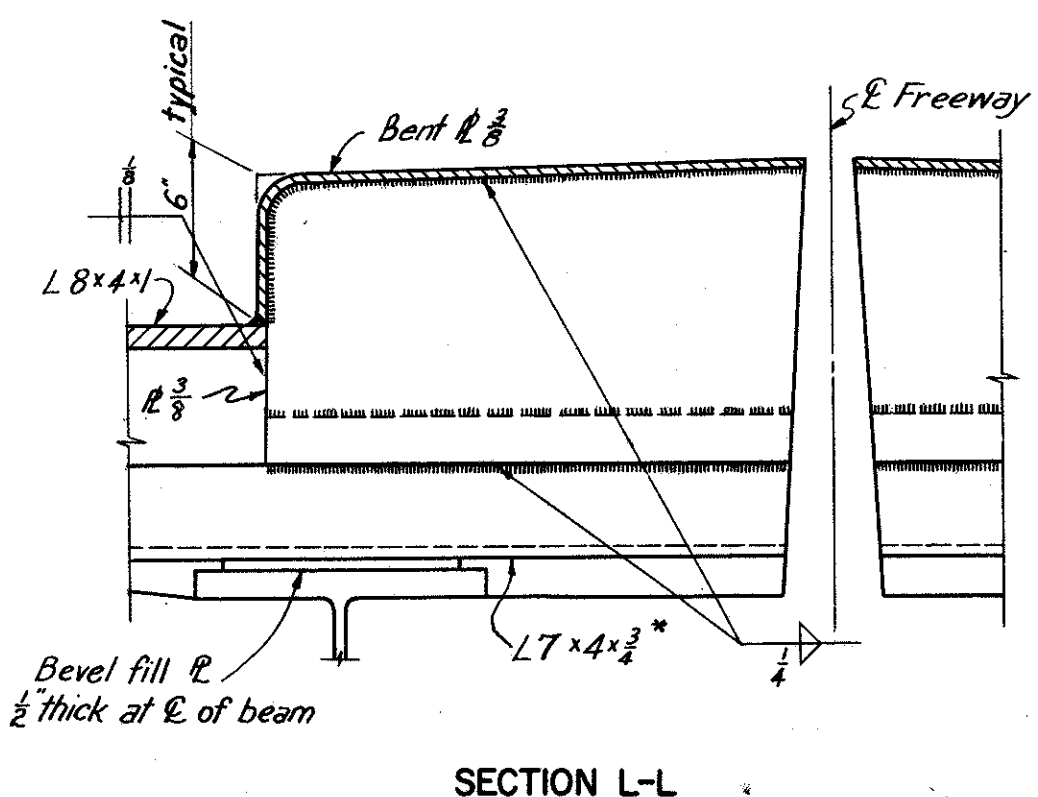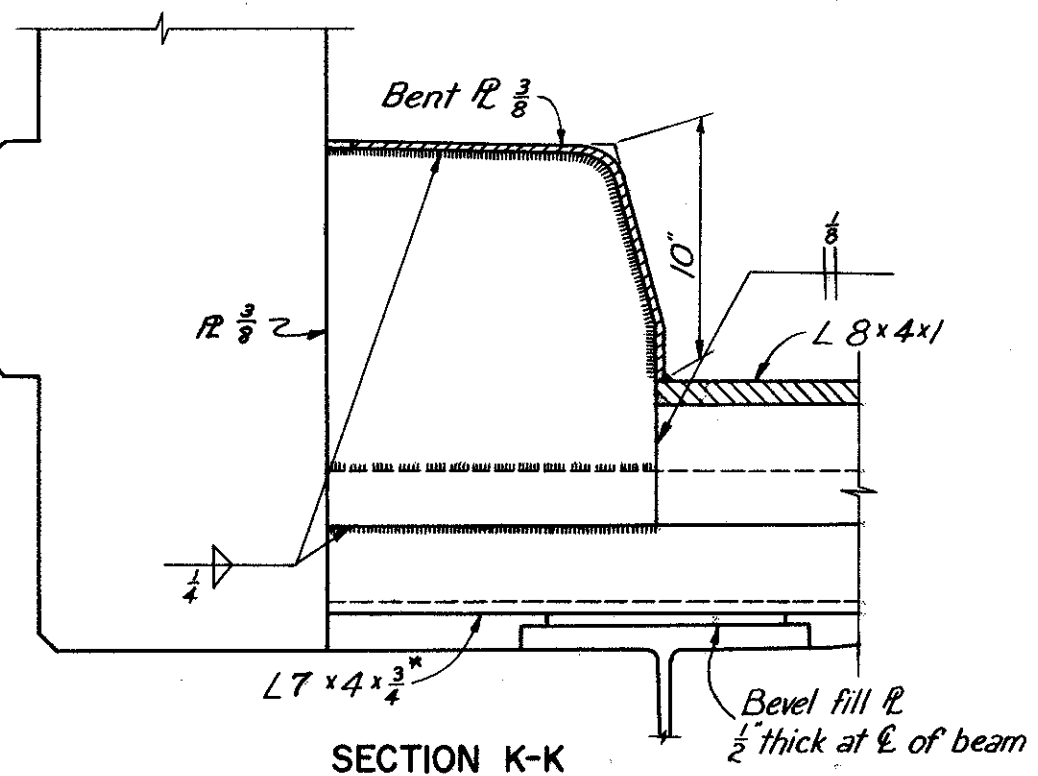

SECTION K-K

SECTION L-L

PART 7A

HOWARD, NEEDLES, TAMMEN & BERGENOFF
CONSULTING ENGINEERS
KANSAS CITY CLEVELAND NEW YORK

END DAM DETAILS

Scale: 1 1/2" = 1'-0" Except as noted








WILLOW-INNER BELT FREEWAY

CLEVELAND CUYAHOGA COUNTY OHIO

DRAWN FLC	TRACED RJK	CHECKED J.J.	REVIEWED JCT	REVISED
DATE 11-24-58	DATE 11-26-58	DATE 12-5-58	DATE 11-13-59	


SHEET 173

JUL 8 1985

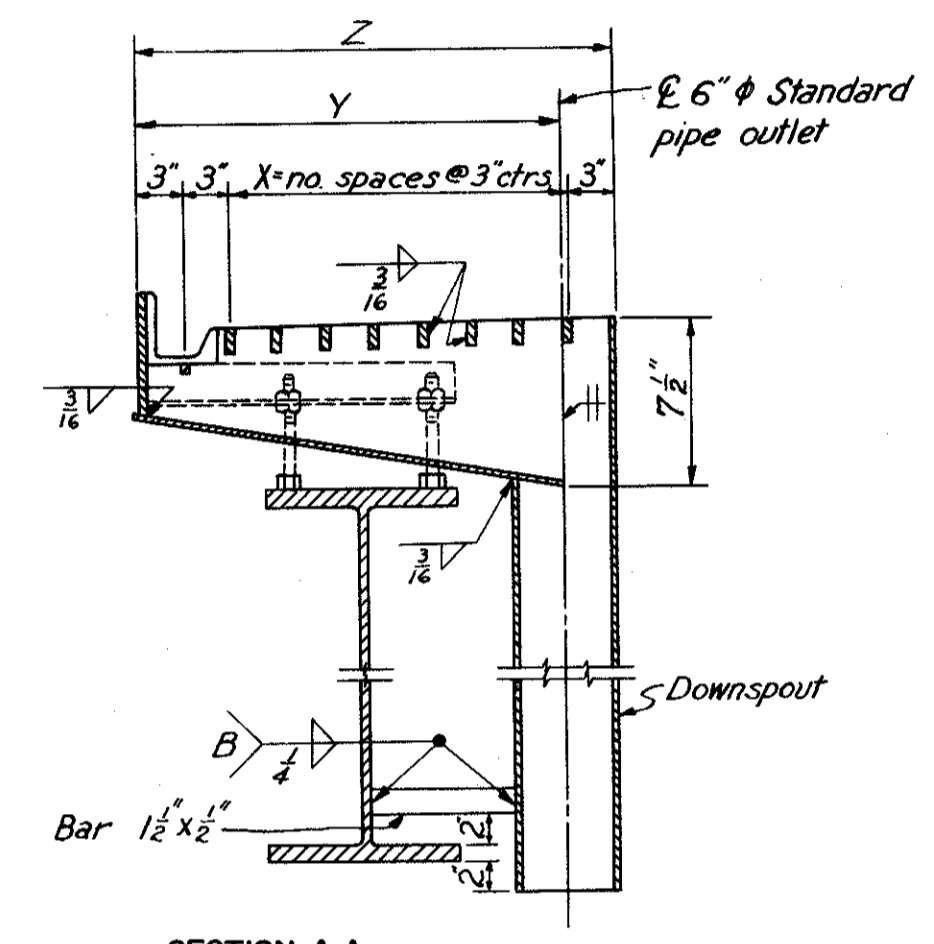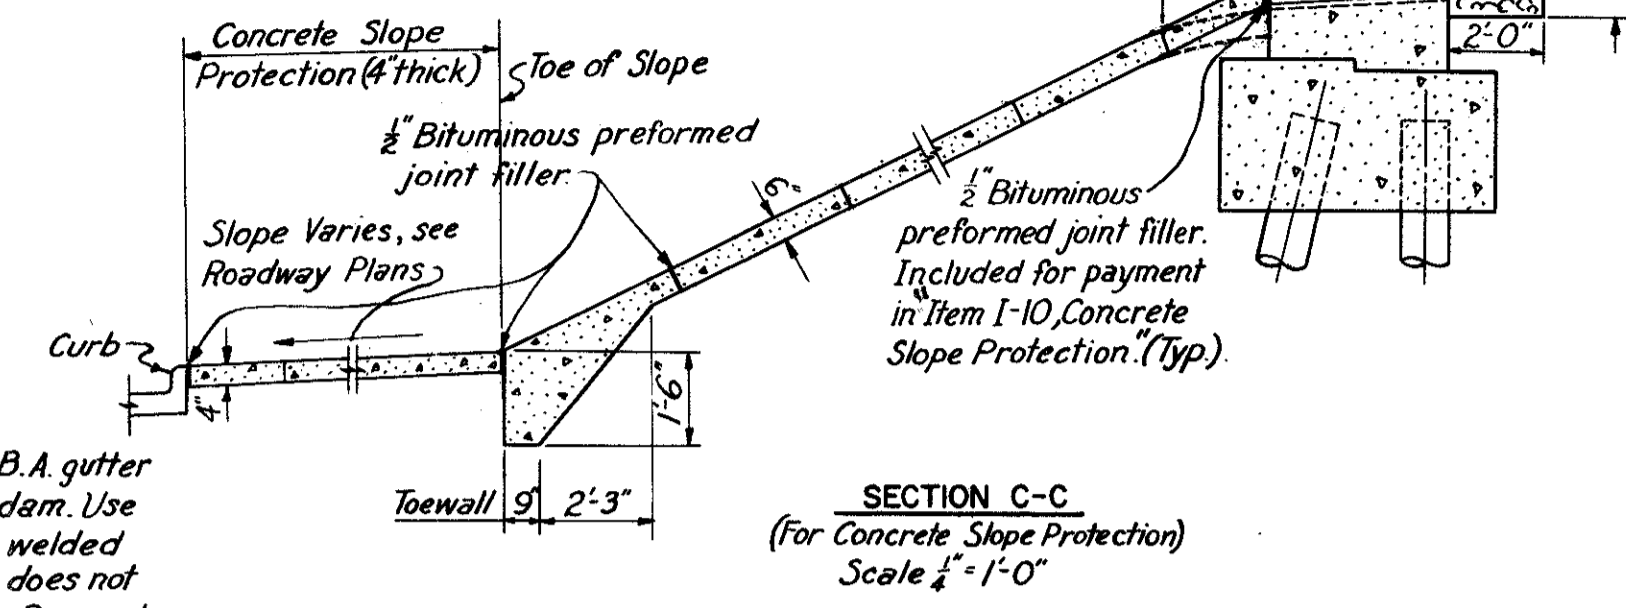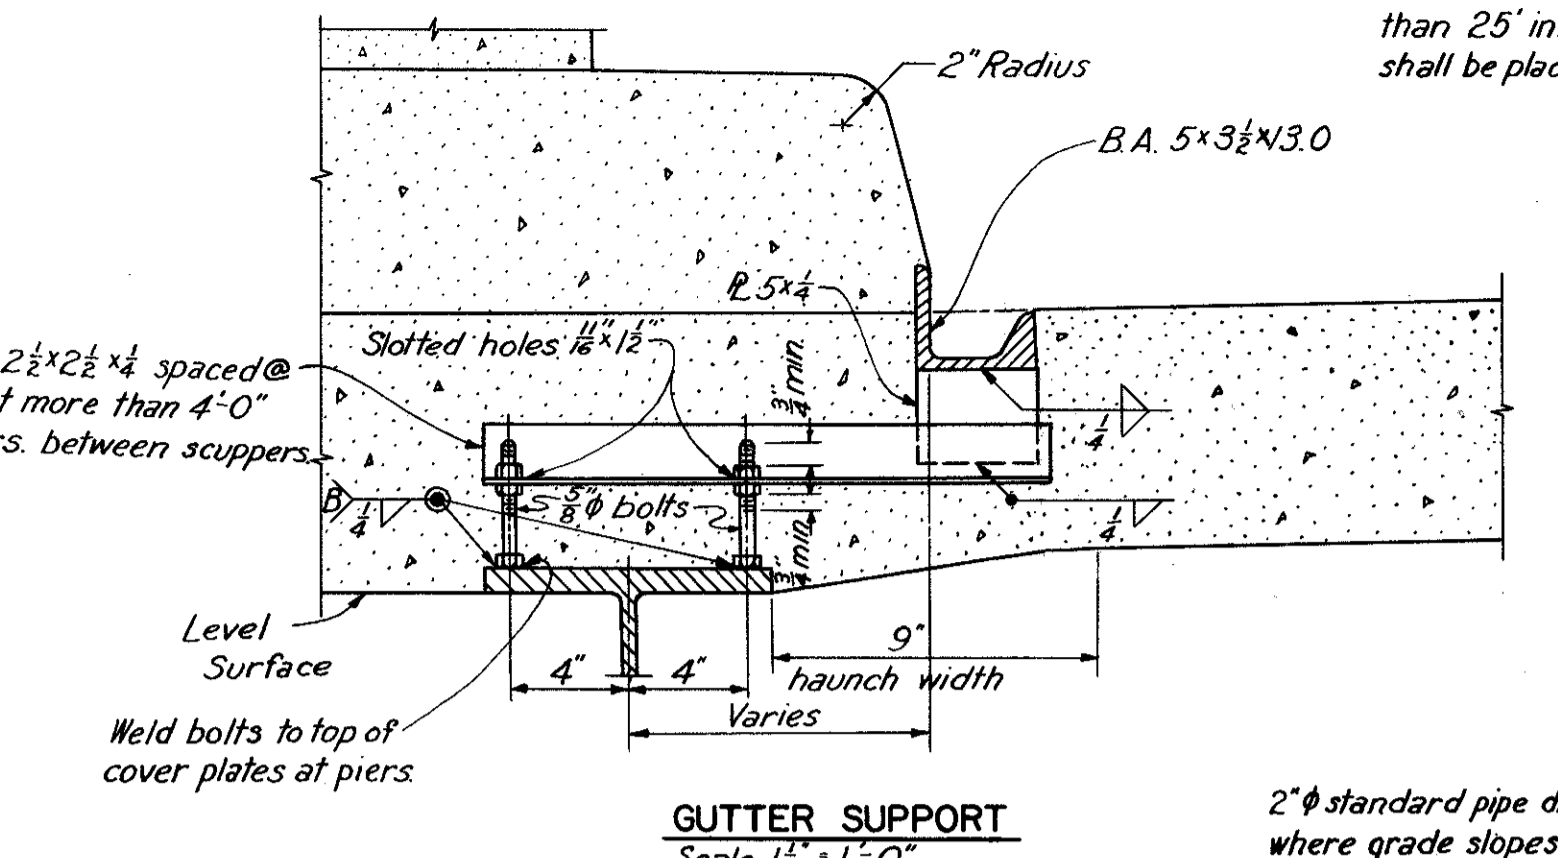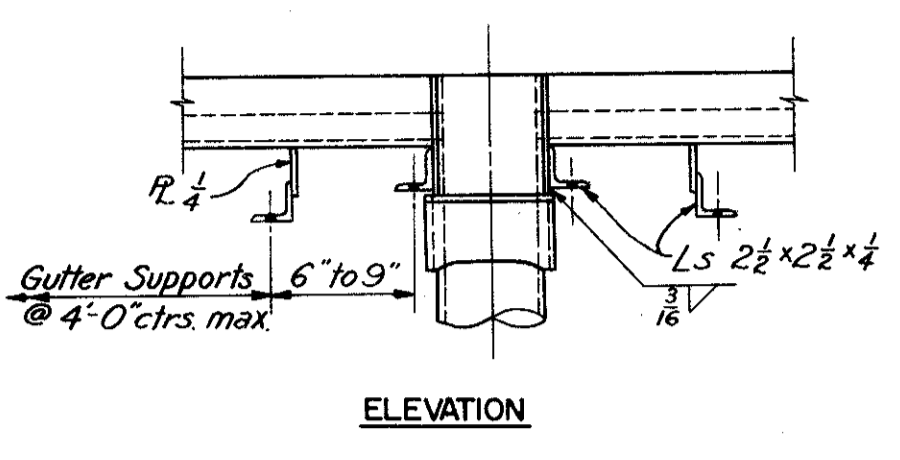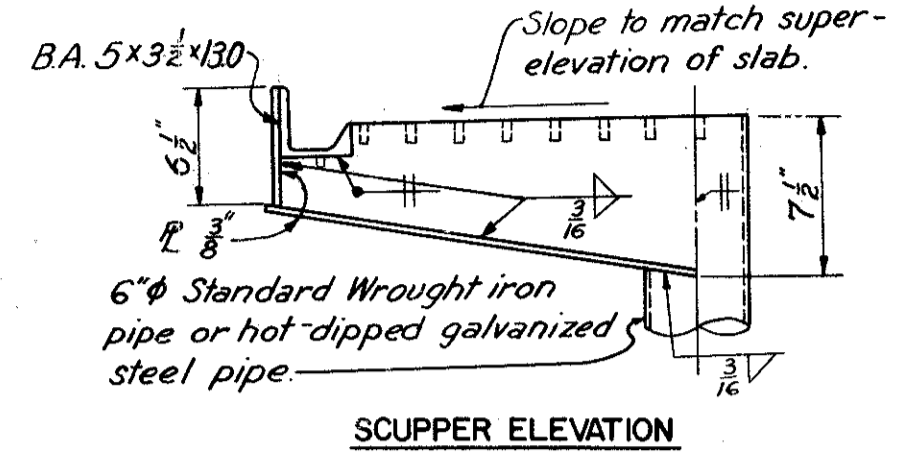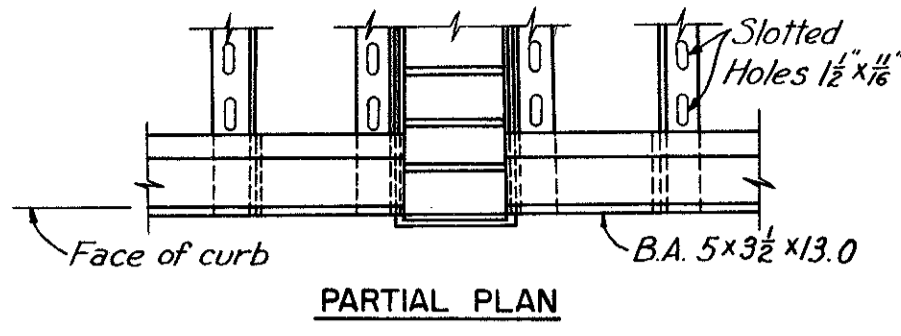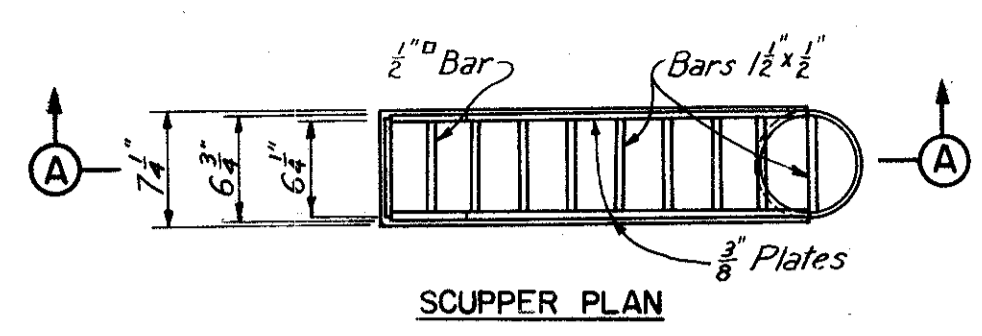


SCUPPER TYPE	X	Y	Z
A	2	11 3/4	1'-3"
B	3	1'-2 3/4	1'-6"
C	5	1'-8 3/4	2'-0"
D	7	2'-2 3/4	2'-6"

SCUPPER DETAILS Scale 1"=1'-0"

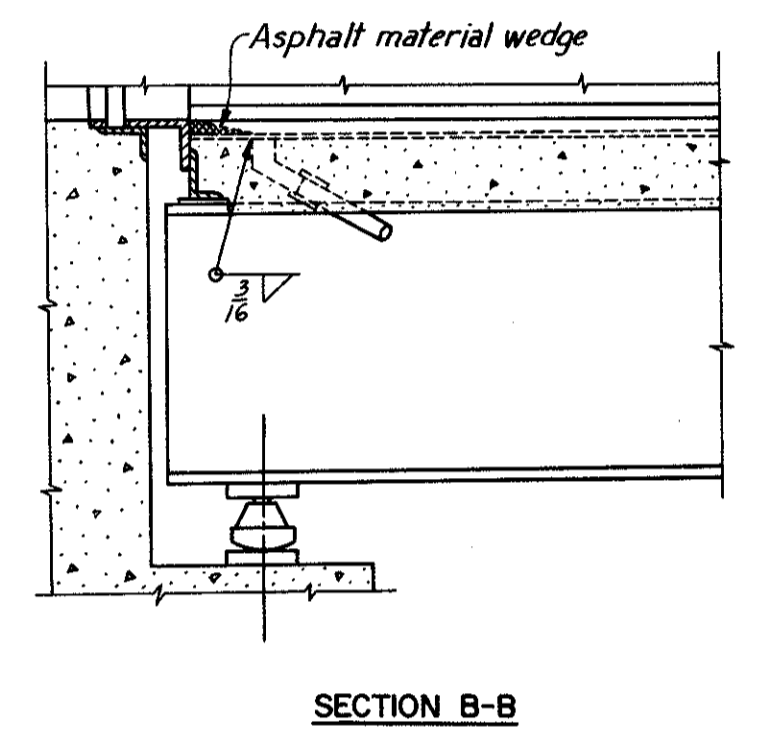


SECTION B-B

DETAIL OF DRAIN AT LOW END OF GUTTER Scale 1/2"=1'-0"

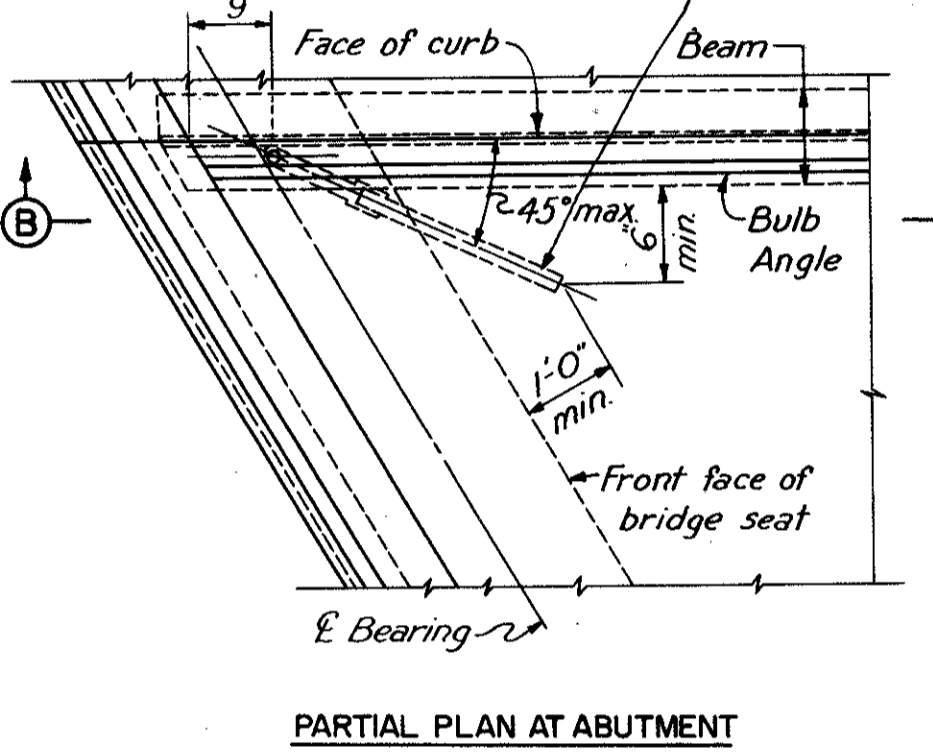

PARTIAL PLAN AT ABUTMENT

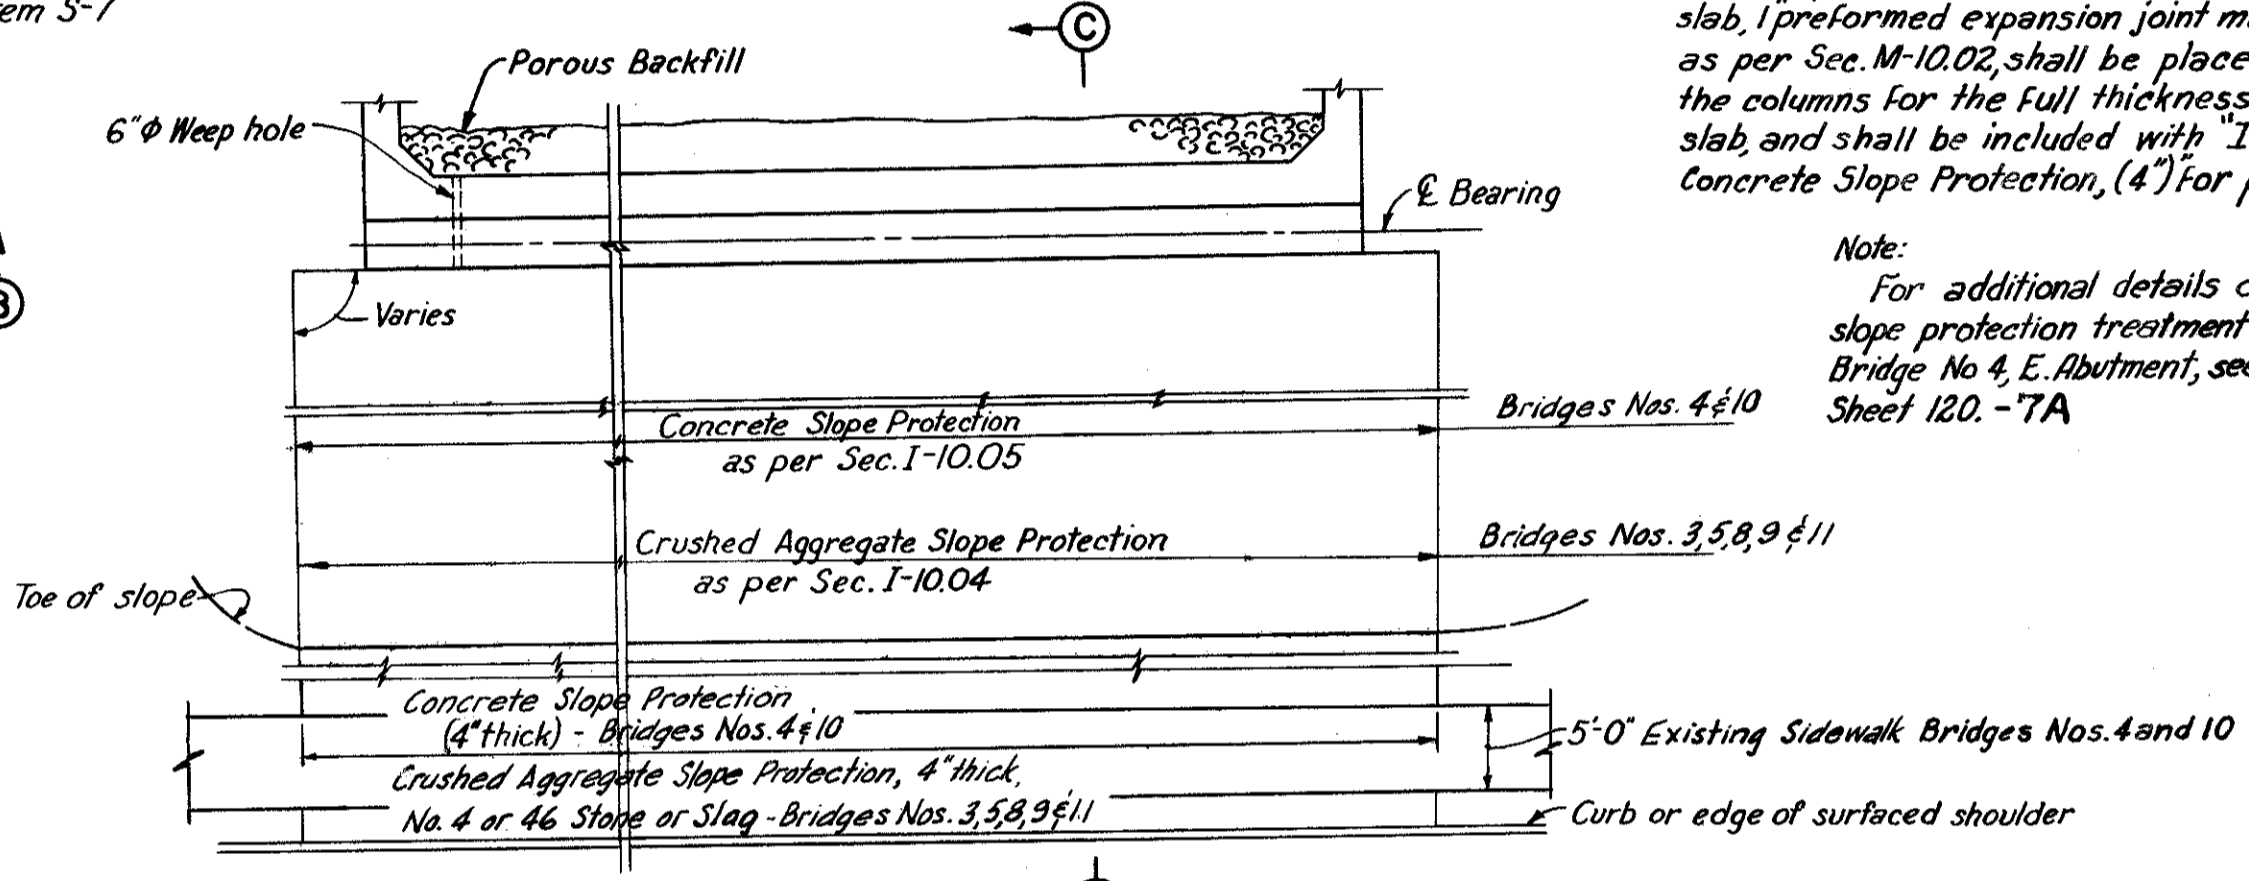


PLAN Not to scale


Note: Concrete or Crushed Aggregate Slope Protection material, as required, shall be placed within the limits shown on the Site Plans. Slope Protection material required on all roadway areas beyond the toe of slopes shall be as follows: Concrete shall conform to Sec. I-10.05 except that it shall be 4" thick.

Crushed aggregate shall be 4" thick and shall consist of No. 4 or 46 stone or slag placed flush with the adjacent finished ground. Where pier columns extend through the slab, 1 preformed expansion joint material, as per Sec. M-10.02, shall be placed around the columns for the full thickness of the slab and shall be included with Item I-10, Concrete Slope Protection, (4") for payment.


Note: For additional details of slope protection treatment at Bridge No. 4, E. Abutment, see Sheet 120.-7A

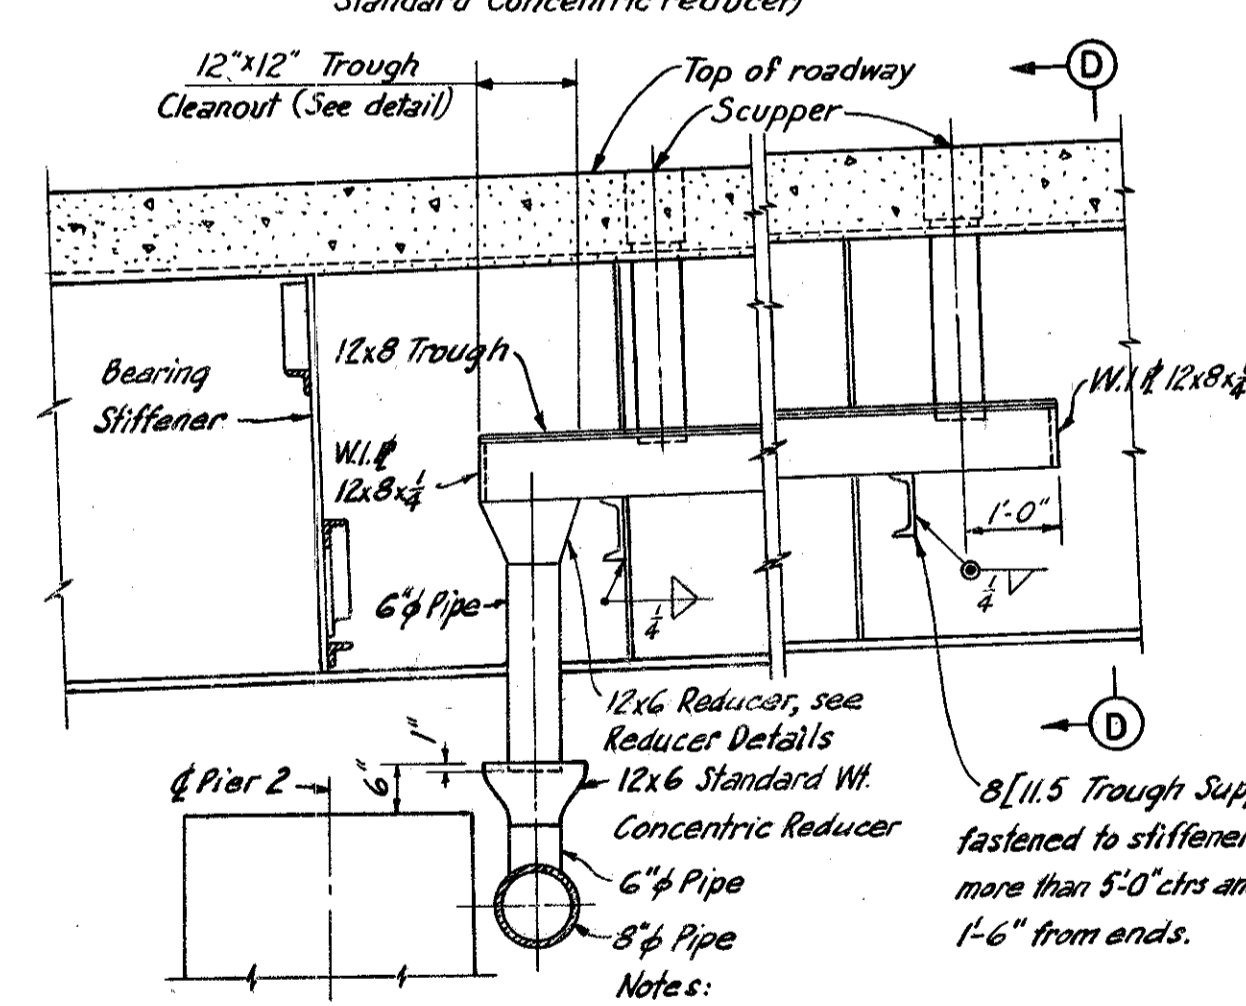


TROUGH ELEVATION (Elevation of trough attached to Girder Z, Bridge No. 4, shown. Other troughs similar.) Scale 1/2"=1'-0"

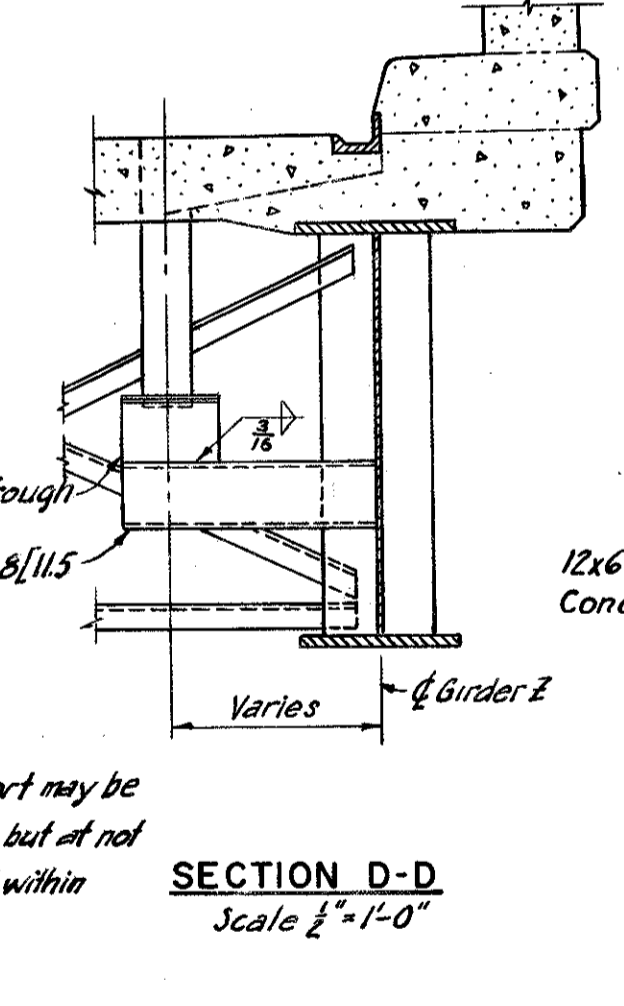

SECTION D-D Scale 1/2"=1'-0"

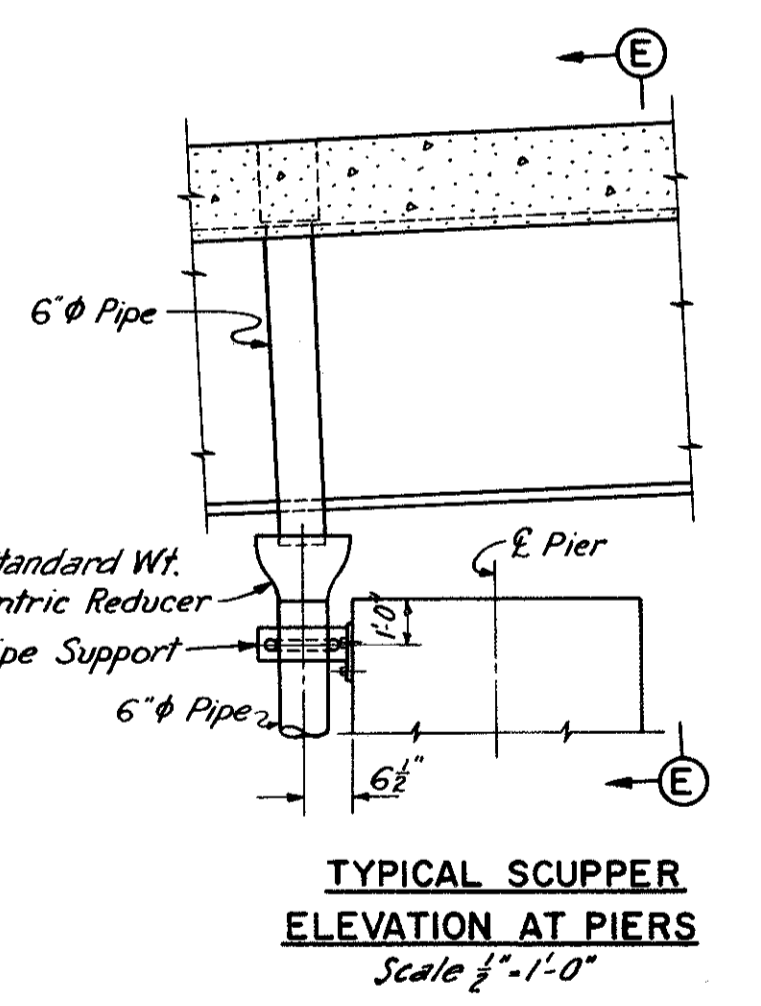


TYPICAL SCUPPER ELEVATION AT PIERS Scale 1/2"=1'-0"

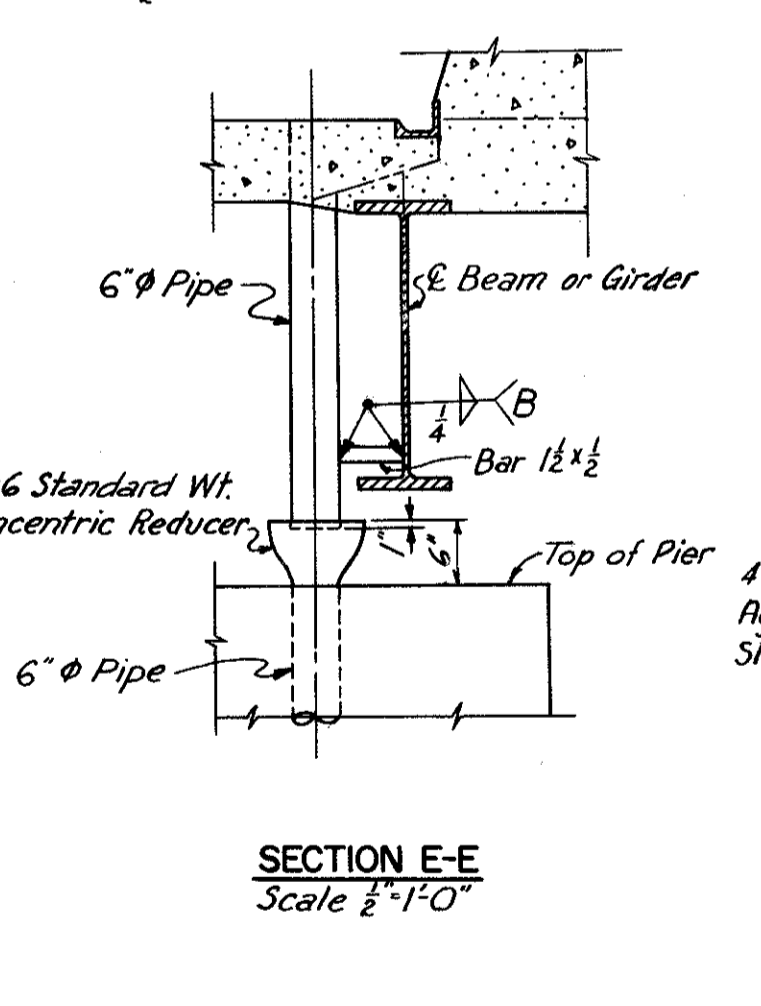

SECTION E-E Scale 1/2"=1'-0"


DRAINAGE PROVISIONS AT PIERS Scale 1/4"=1'-0"

SLOPE PROTECTION DETAILS Scale 1/2"=1'-0"

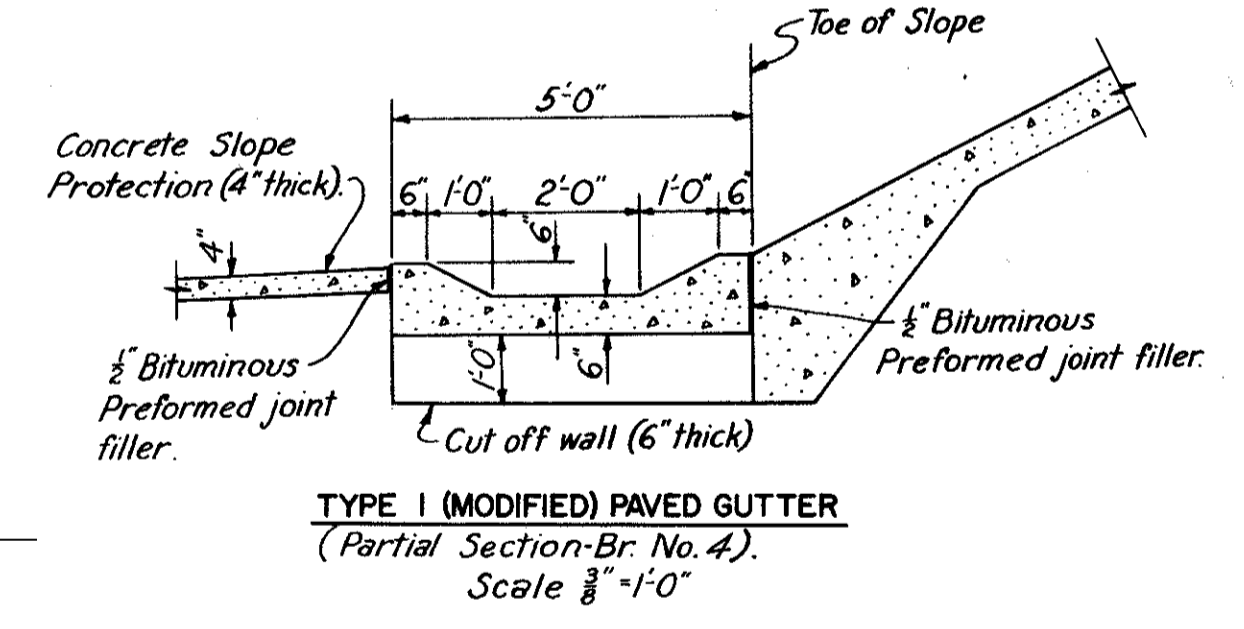


TYPE I (MODIFIED) PAVED GUTTER (Partial Section-Br No. 4.) Scale 3/8"=1'-0"


NOTES: All 6" x 8" pipe shall be standard weight wrought iron or hot dipped galvanized steel pipe with extra strong weld type seamless steel fittings or galvanized Victaulic couplings or approved equal. Welded joints of all pipes and fittings to be single bevel butt welds - full penetration with 1/8" root opening and 45° included angle. Where W.I. plates are called for, Mayari R or Cor-Ten steel may be used. All welds on drainage fittings shall be 1/8" fillet welds except as shown. Steel pipe, all steel fittings, all pipe supports, trough supports, nuts, bolts and washers shall be hot dipped galvanized after fabrication. Field welds shall be field galvanized by an approved method. Cut 7" holes in 10 Ga. E of trough for 6" pipes. For scupper locations, see Deck Plans. For trough locations, see Framing Plans Bridge No. 4. All pipes attached to the substructure including fittings, supports and accessories shall be included in Item S-29, 6" W.I. or Galvanized Steel Pipe including Fastenings & Specials for payment. All other metalwork of the drainage system shall be included in Item S-7.

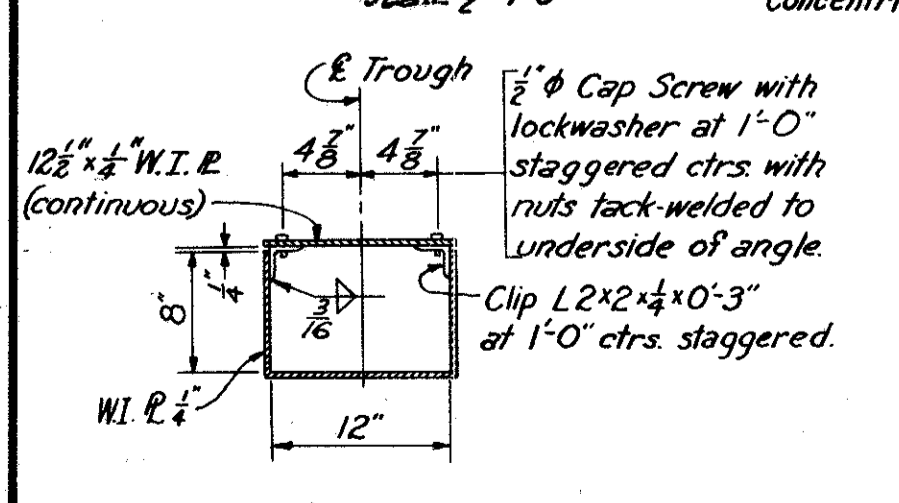


TYPICAL TROUGH SECTION Scale 1"=1'-0"

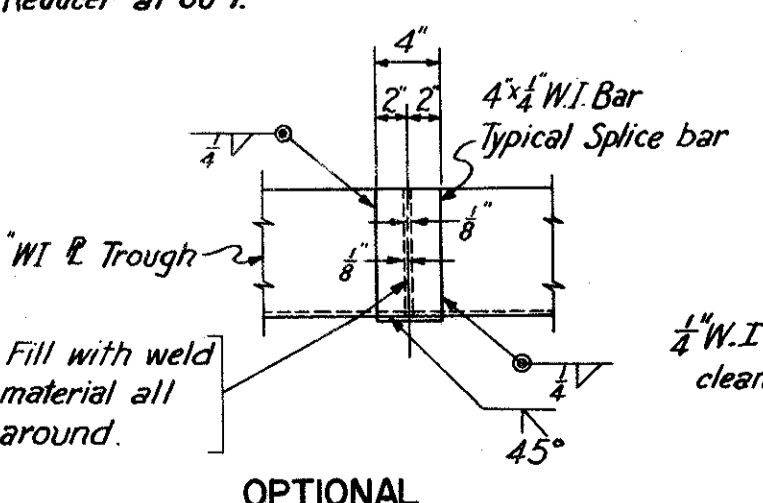


OPTIONAL TROUGH FIELD SPICE Scale 1"=1'-0"

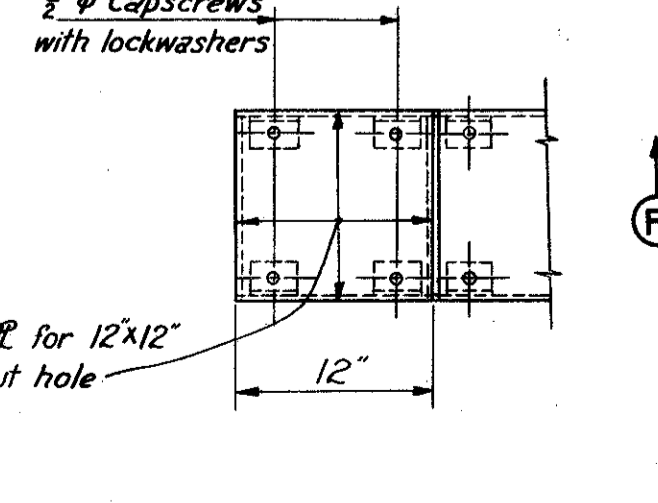


PLAN OF TROUGH CLEANOUT Scale 1"=1'-0"

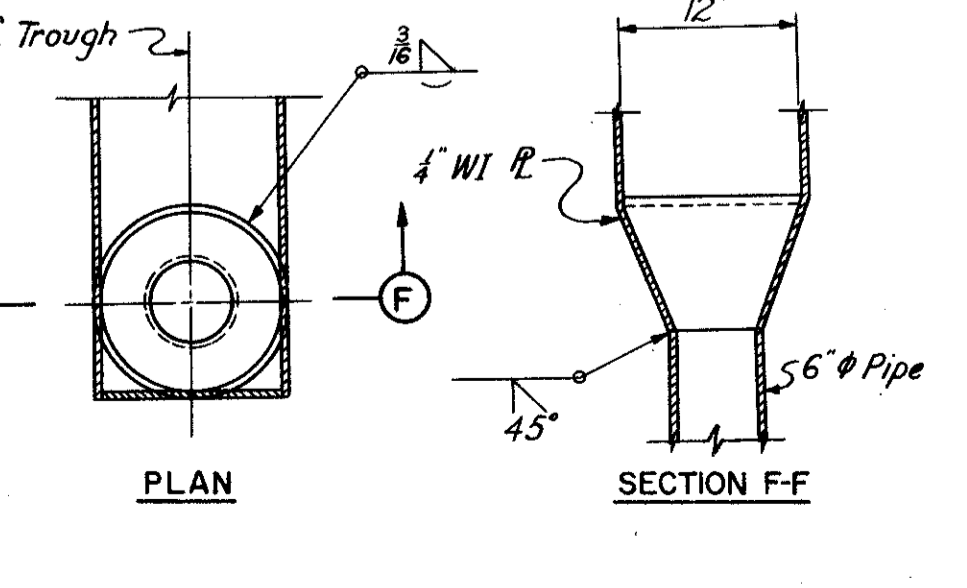

REDUCER DETAILS Scale 1"=1'-0"

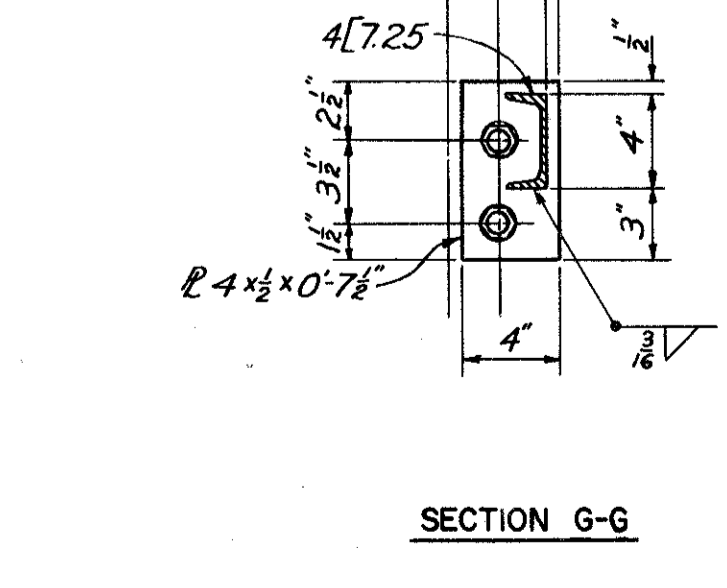

PIPE SUPPORT DETAILS Scale 1/2"=1'-0"

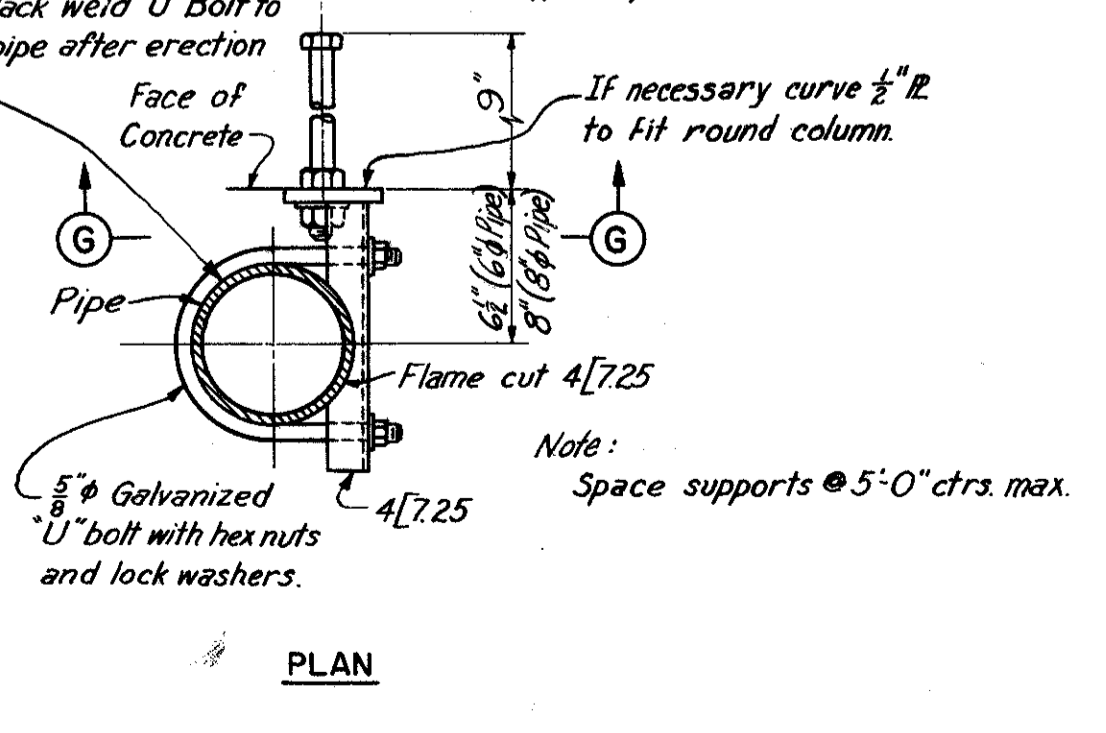

PLAN

HOWARD, NEEDLES, TAMMEN & BERGENDOFF CONSULTING ENGINEERS KANSAS CITY CLEVELAND NEW YORK

DRAINAGE DETAILS

Scale: As shown

WILLOW-INNER BELT FREEWAY

CLEVELAND CUYAHOGA COUNTY OHIO

DATE 11-4-88 TRACED RJK CHECKED J.S.J. REVIEWED JCT


DATE 12-22-88 DATE 12-22-88 DATE 11-13-89

SHEET 174


Bridge No.	Railing.	West Abutment North Abutment		East Abutment South Abutment	
3	North	4'-8 1/2" 3 spa. @ 8'-5"	7'-1 1/8"	41 spa. @ 7'-11" = 324'-7"	2 spa. @ 8'-0" 4'-9"
	South	4'-7 1/2" 2 spa. @ 6'-5"	7'-2 3/8"	34 spa. @ 7'-11" = 269'-2"	2 spa. @ 6'-6" 4'-6"
4	North (Ramp E-10)	4'-7" 2 spa. @ 5'-3"	8'-4 3/8"	34 spa. @ 7'-10" = 266'-4"	1 spa. @ 5'-7 1/2" 5'-6"
	South (Ramp E-10)	4'-7" 2 spa. @ 5'-3"	7'-2 3/4"	23 spa. @ 7'-6" = 172'-6"	(See Nose details)
	North (I.B.F.)	4'-7" 2 spa. @ 5'-6"	(do)	27 spa. @ 7'-0" = 189'-0"	(do)
	South (I.B.F.)	4'-7" 2 spa. @ 5'-6"	(do)	8 spa. @ 7'-0" = 56'-0"	(do)
	North (Ramp E-9)	5'-3" 2 spa. @ 5'-5"	6'-9 3/8"	7 spa. @ 7'-6" = 52'-6"	(do)
	South (Ramp E-9)	5'-3" 2 spa. @ 5'-5"	6'-9 3/8"	45 spa. @ 7'-0" = 315'-0"	1 spa. @ 8'-7" 5'-6"
5	East	4'-6" 1 spa. @ 7'-4 1/8"	8'-2 3/8"	12 spa. @ 8'-3" = 99'-0"	2 spa. @ 7'-4 1/8" 4'-6"
8	West	4'-6" 1 spa. @ 7'-0 1/8"	7'-5 1/8"	13 spa. @ 8'-3" = 107'-3"	1 spa. @ 4'-7 1/8" 4'-6"
	North	5'-6" 1 spa. @ 8'-9"	8'-7 1/2"	22 spa. @ 7'-8" = 168'-8"	1 spa. @ 5'-7" 5'-6"
	South	4'-6" 1 spa. @ 6'-6"	8'-4"	22 spa. @ 7'-5" = 163'-2"	(See Nose detail)
9	North	4'-6" 1 spa. @ 6'-7"	8'-7"	19 spa. @ 7'-10" = 148'-10"	(do)
	South	4'-6" 1 spa. @ 6'-7"	7'-9 3/8"	19 spa. @ 7'-10" = 148'-10"	1 spa. @ 5'-7" 5'-6"
10	North	4'-6" 1 spa. @ 7'-7"	7'-7 1/2"	25 spa. @ 7'-7" = 189'-7"	1 spa. @ 6'-10" 4'-6"
	South	4'-6" 1 spa. @ 7'-7"	7'-7 1/2"	25 spa. @ 7'-7" = 189'-7"	1 spa. @ 6'-10" 4'-6"
11	North	4'-6" 1 spa. @ 3'-10 1/2"	7'-9 1/4"	26 spa. @ 7'-5" = 192'-10"	2 spa. @ 6'-6" 5'-6"
	South	4'-10 1/8" 2 spa. @ 9'-0"	7'-0 1/8"	26 spa. @ 7'-5" = 192'-10"	1 spa. @ 3'-11 1/2" 4'-6"

* See Nose detail for distance from E. Post to end of parapet.


RAILING POST SPACING
No Scale

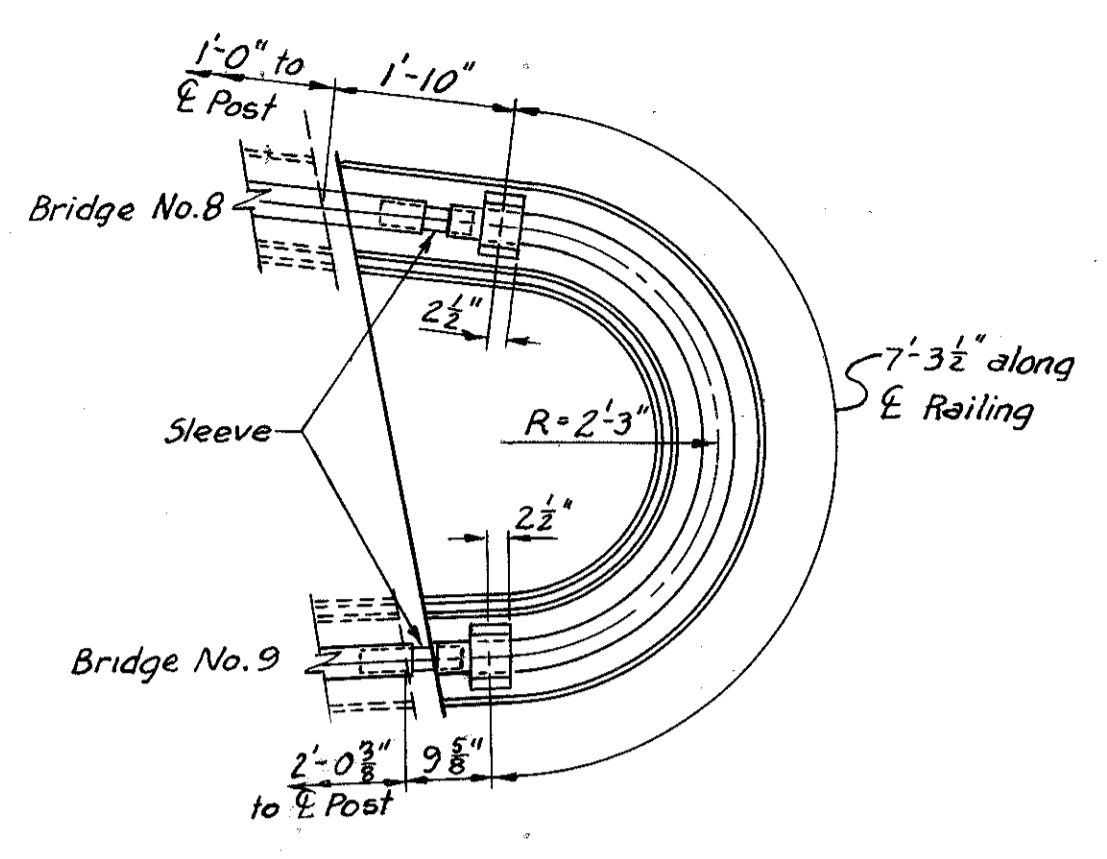


NOSE DETAIL FOR
BRIDGE NO. 8 & 9
Scale: 1/2" = 1'-0"

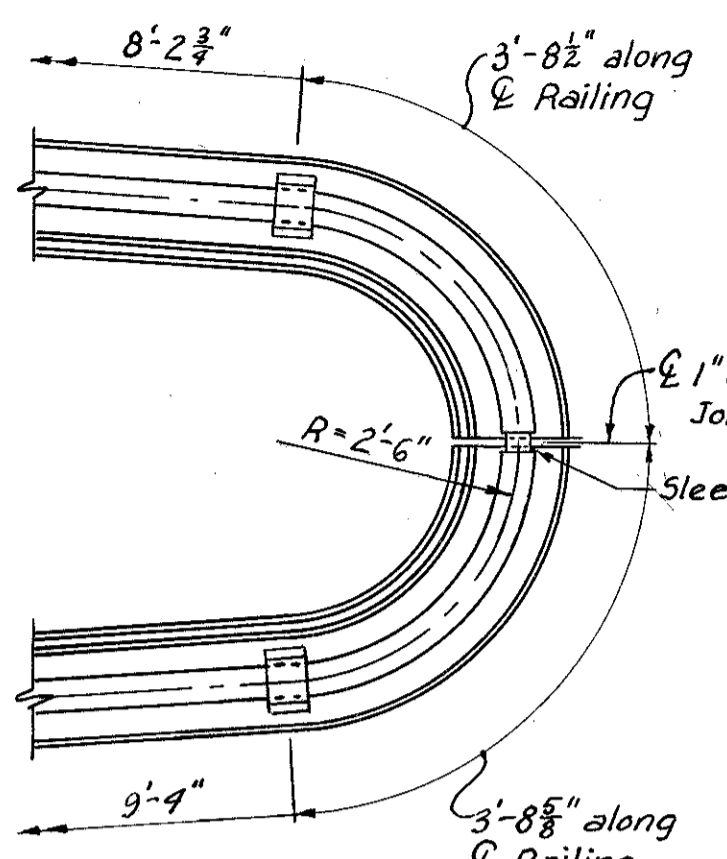


NOSE DETAIL FOR
INNER BELT & RAMP E-10
Scale: 1/2" = 1'-0"

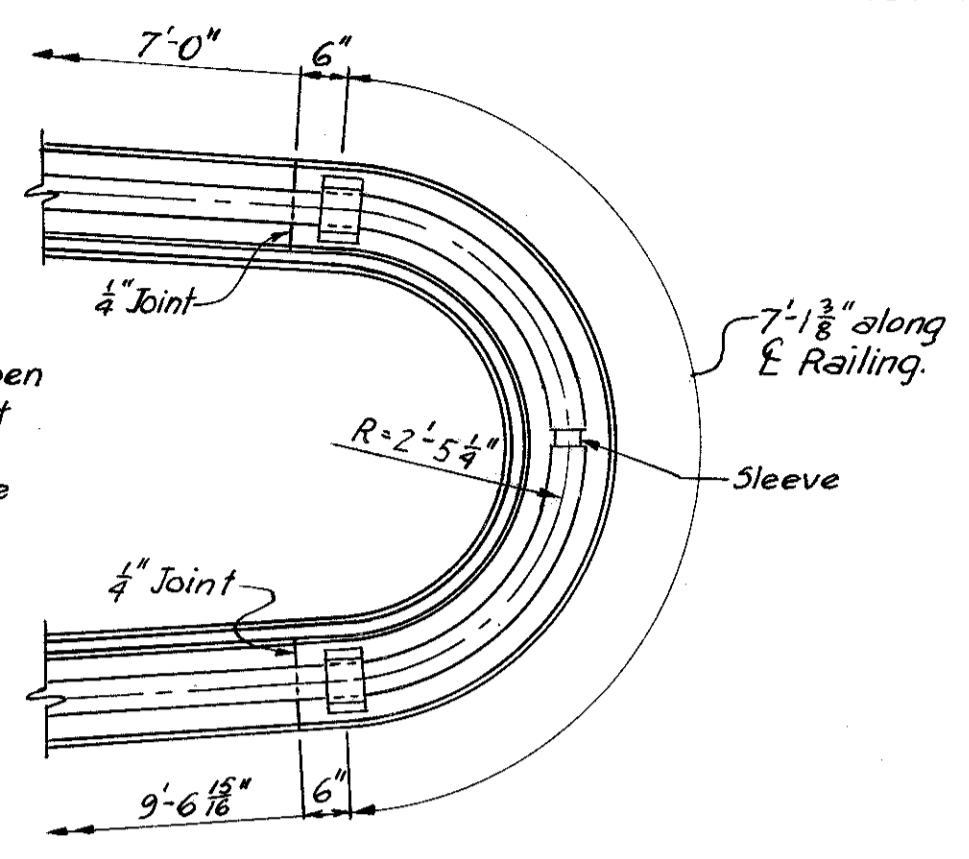


NOSE DETAIL FOR
INNER BELT & RAMP E-9
Scale: 1/2" = 1'-0"

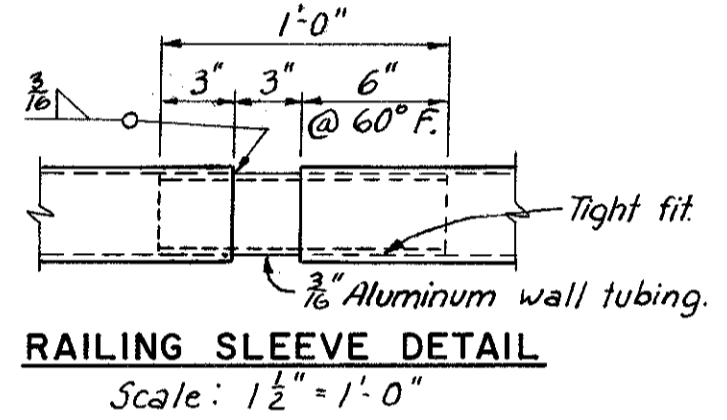


RAILING SLEEVE DETAIL
Scale: 1 1/2" = 1'-0"

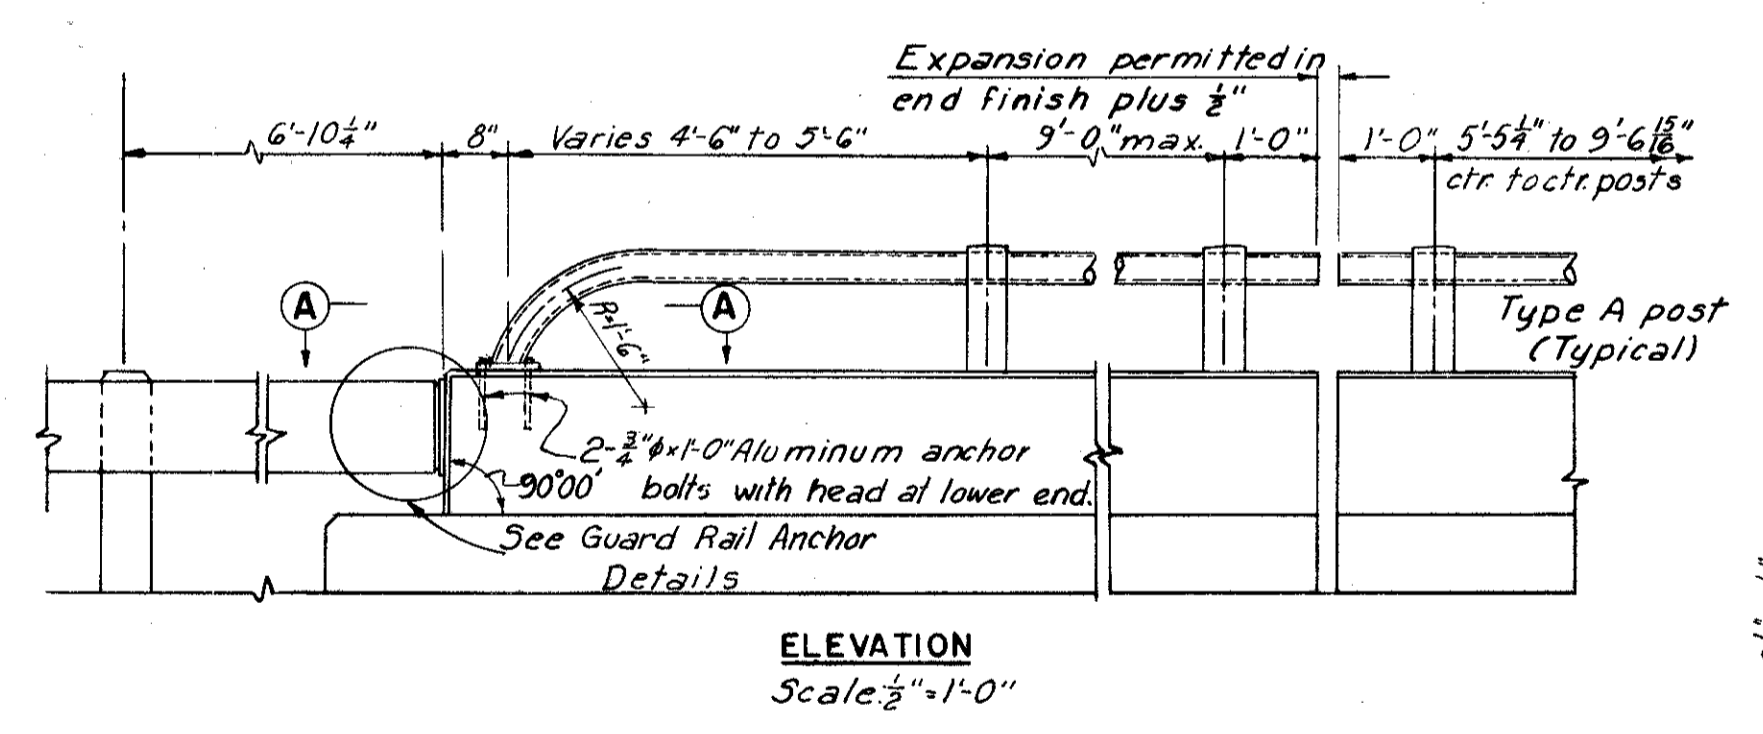


DETAILS AT END OF RAILING

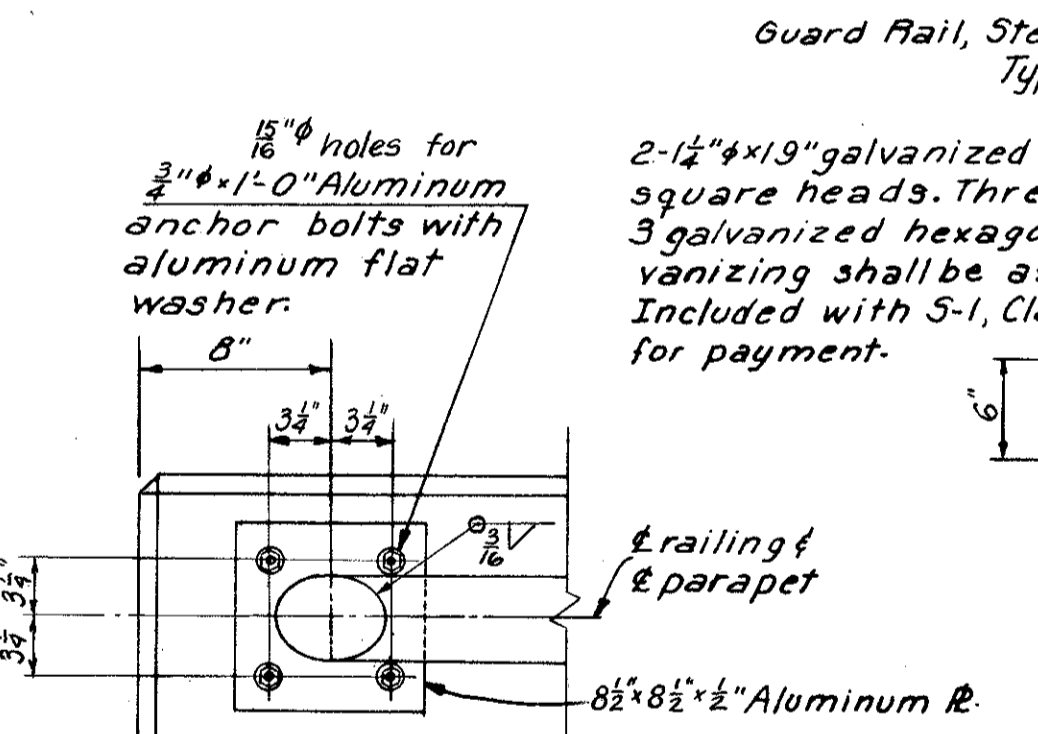


SECTION A-A
Scale: 1 1/2" = 1'-0"

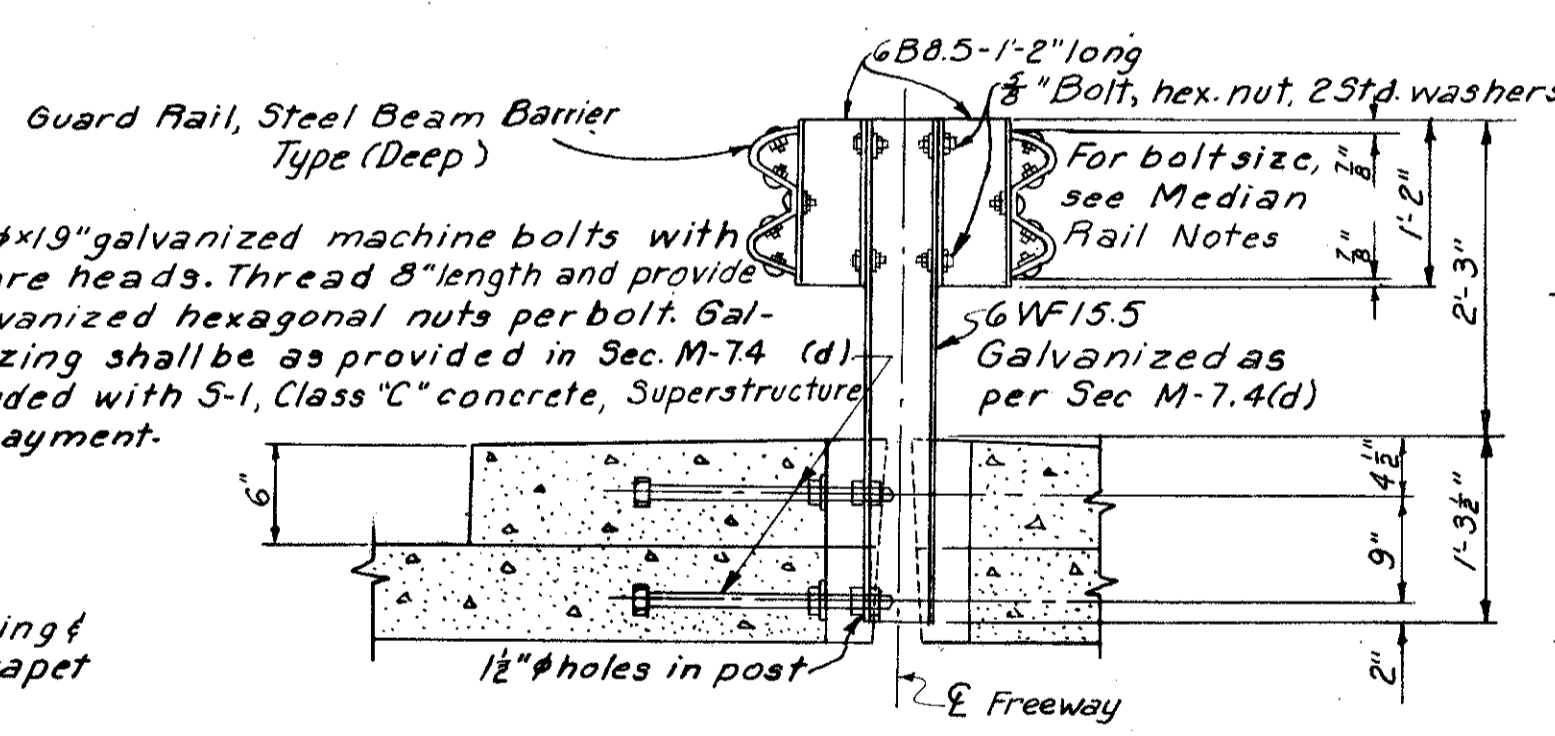


MEDIAN GUARD RAIL
Scale: 3/4" = 1'-0"

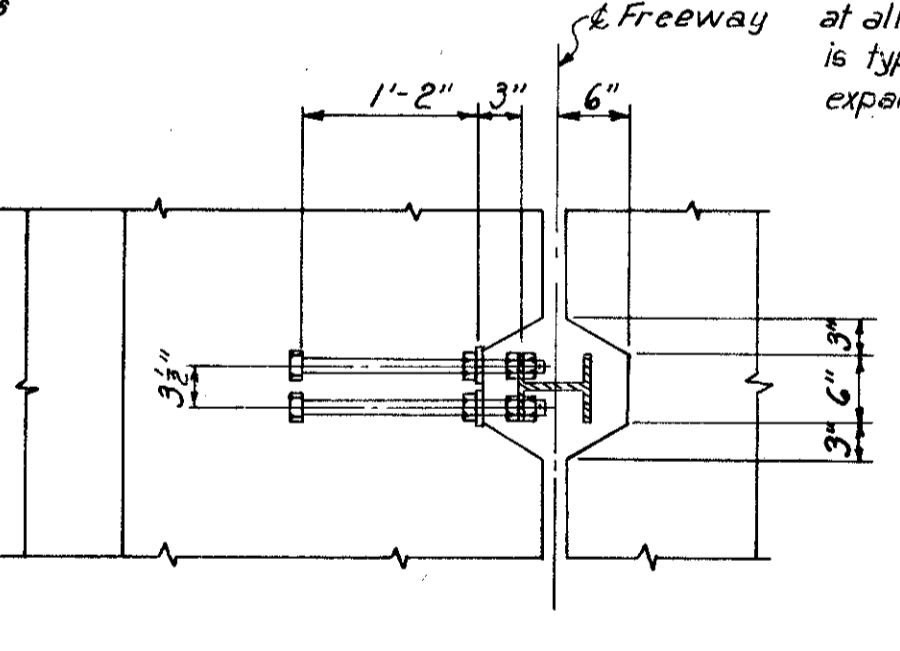

POST ANCHOR DETAIL
Scale: 3/4" = 1'-0"

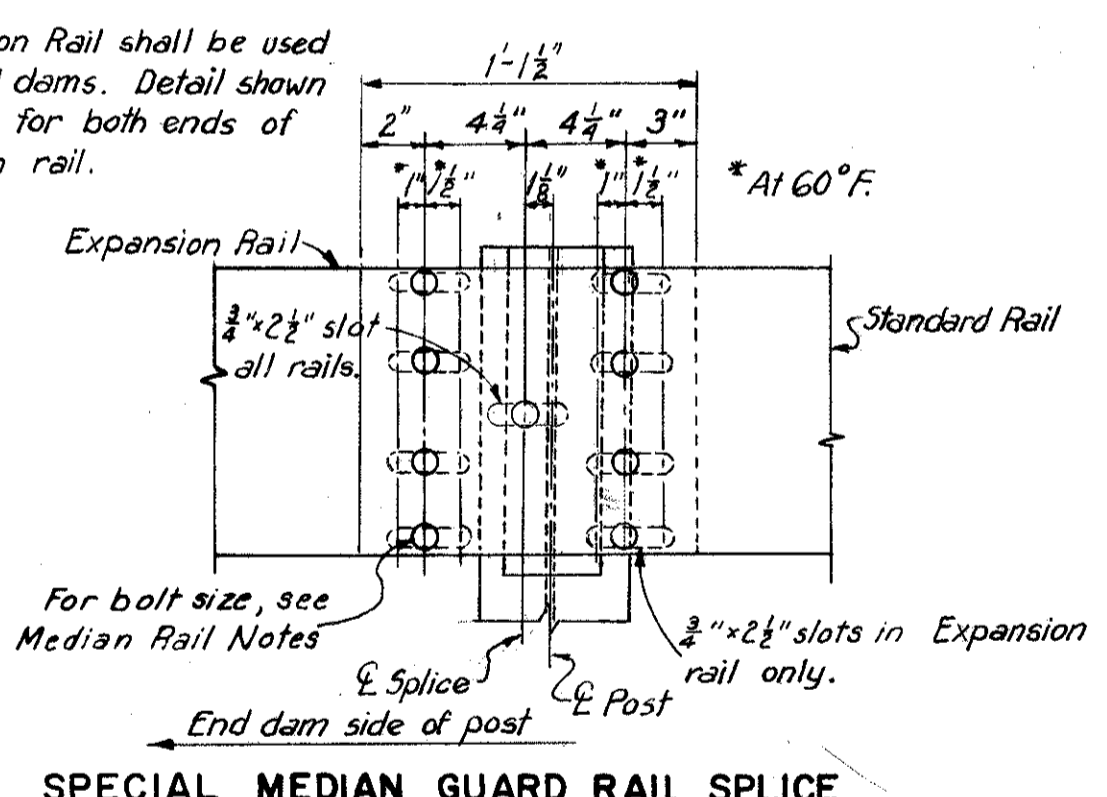

SPECIAL MEDIAN GUARD RAIL SPLICE
Scale: 1 1/2" = 1'-0"

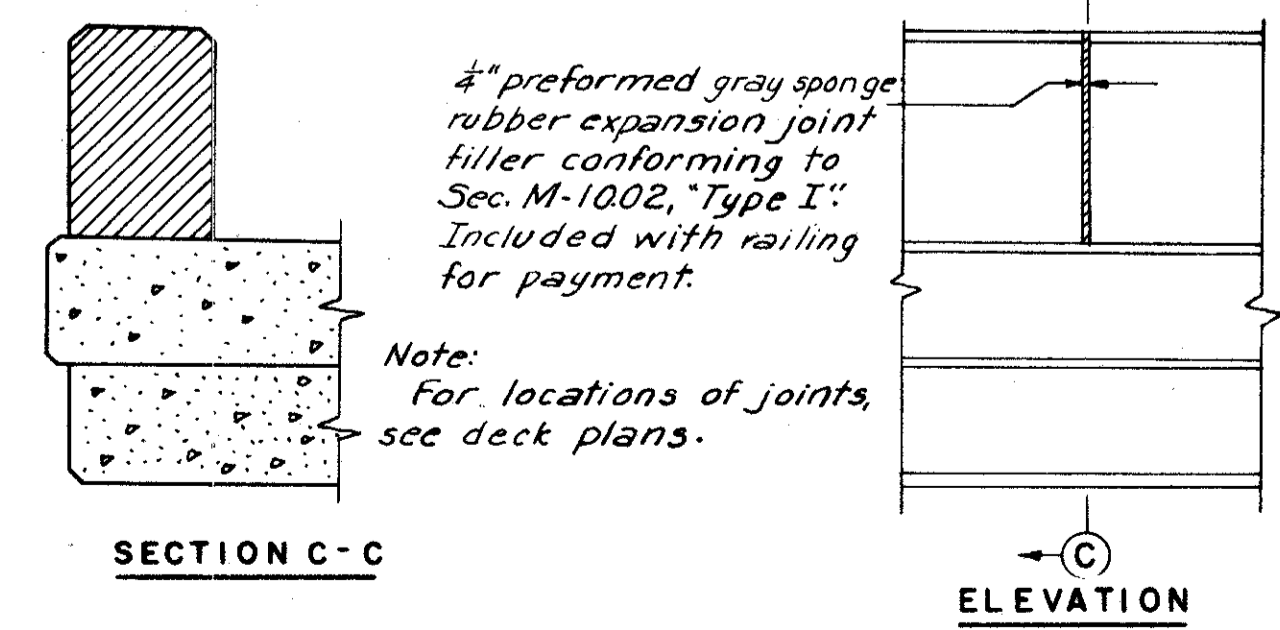


PARAPET JOINT
Scale: 3/4" = 1'-0"

Railing shall be fabricated in lengths not less than three panels each and furnished railing shall be free of burrs, sharp corners and rough surfaces. Shims if required for adjustment to line or grade, shall be of aluminum alloy, 2 3/8" x 1/2" x 8", and shall be slotted to permit insertion after posts are in place. Anchor bolts shall be aluminum with a head or nut at lower end. They shall be 1'-0" long and shall have a minimum diameter of 0.62" at the root of the thread. Bolts and nuts shall be anodized. Railing posts shall be normal to grade and the final adjustment of the railing shall be such that the top rail shall not depart more than 3/8" from correct line or grade.


For additional details and notes regarding railing see Ohio Standard Drawing AR-1-57.

Payment for Railing shall be made at the contract unit price bid for Item 5-14, Aluminum Railing (including parapet). Pay length shall be the overall length of the parapets and shall include cost of anchor bolts, set screws, nuts, shims and etc. necessary to complete the installation of railing.

Concrete and longitudinal reinforcing steel in the parapet shall be included in Item 5-14, Railing, (including parapet) for payment. All other reinforcing steel in parapet shall be included in Item 5-4 for payment.

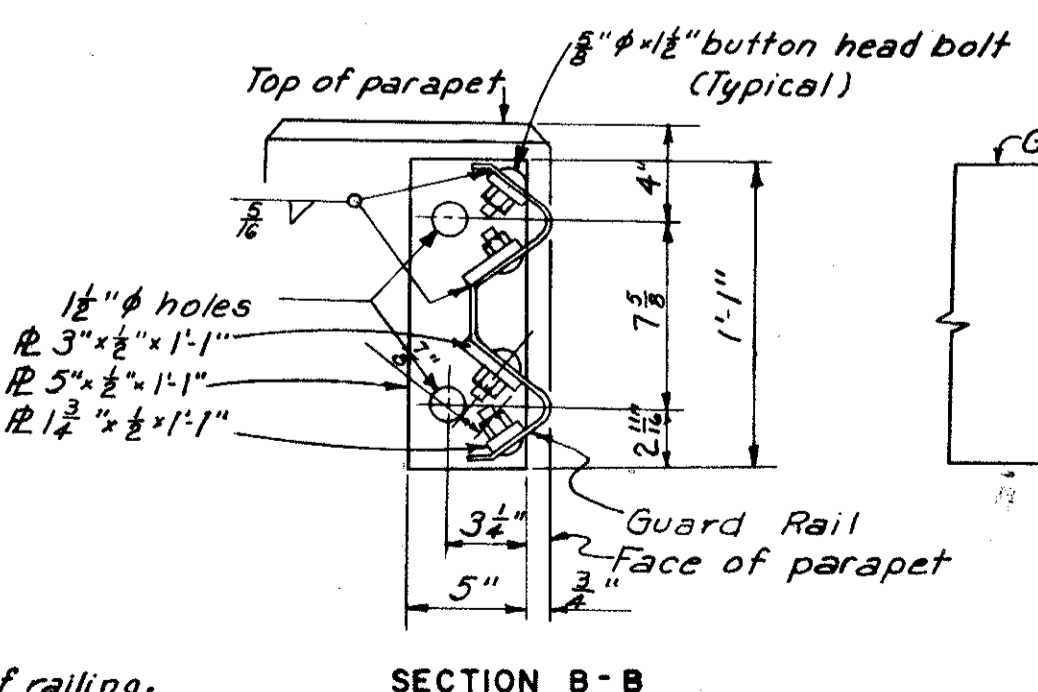

SECTION B-B

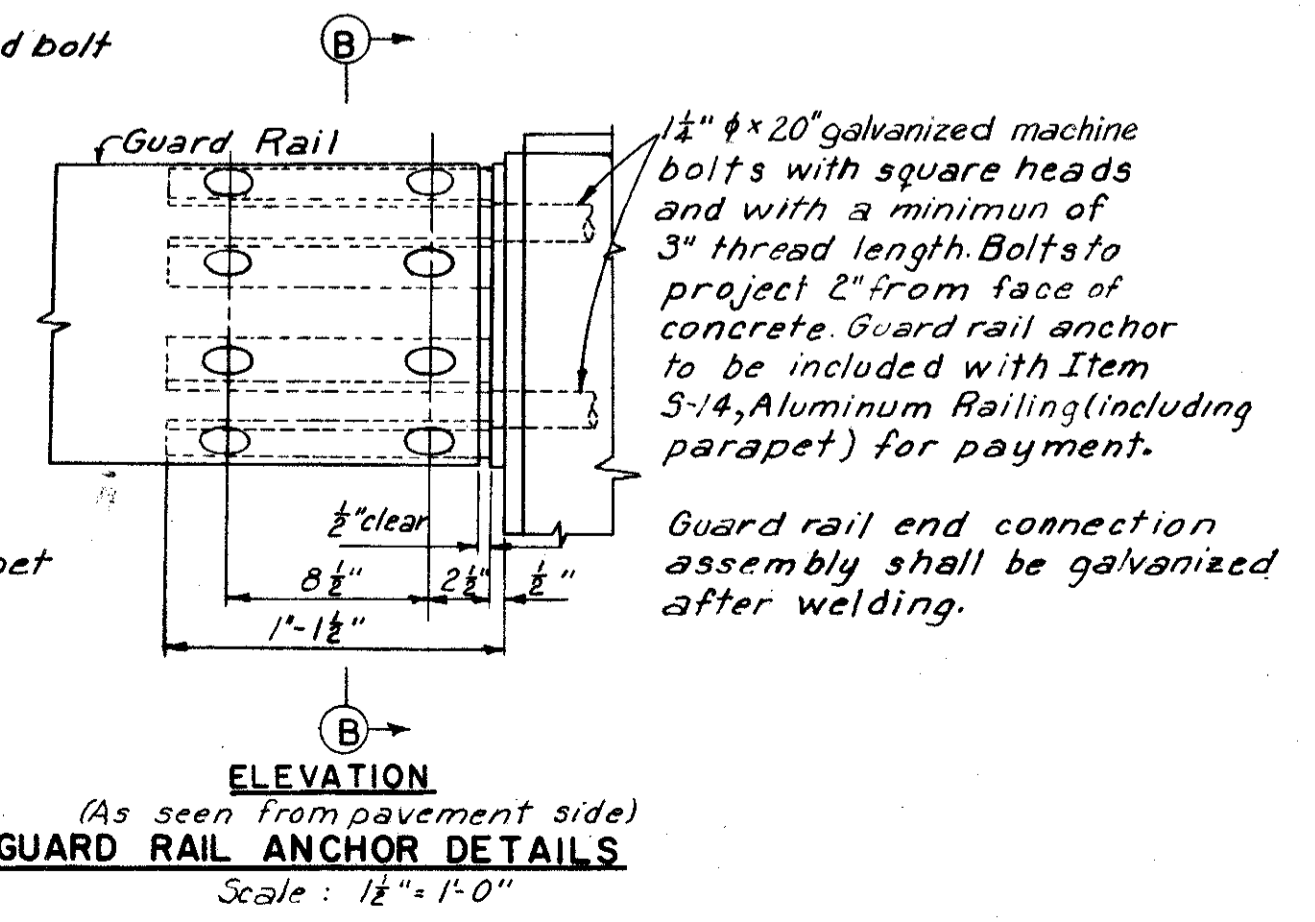

RAILING ANCHOR DETAILS
Scale: 1 1/2" = 1'-0"

Median Rail Notes.
Bolts for rail splice and for fastening rail to posts shall be 3/8" diameter with button head, washer and hexagon nuts.
For median guard rail spacing See Deck plans.

PART 7A

**RAILING AND
GUARD RAIL DETAILS**

Scale: As noted


WILLOW-INNER BELT FREEWAY

CLEVELAND CUYAHOGA COUNTY OHIO

DRAWN A.L.	TRACED A.L.	CHECKED DRK	DATE 3-20-59	REVIEWED JCT	DATE 11-13-59	REVISED 6-17-60
2-26-59	2-26-59	3-20-59				


SHEET 175

CUYAHOGA COUNTY
CITY OF CLEVELAND
CUY-21-15.32
CUY-42-18.42







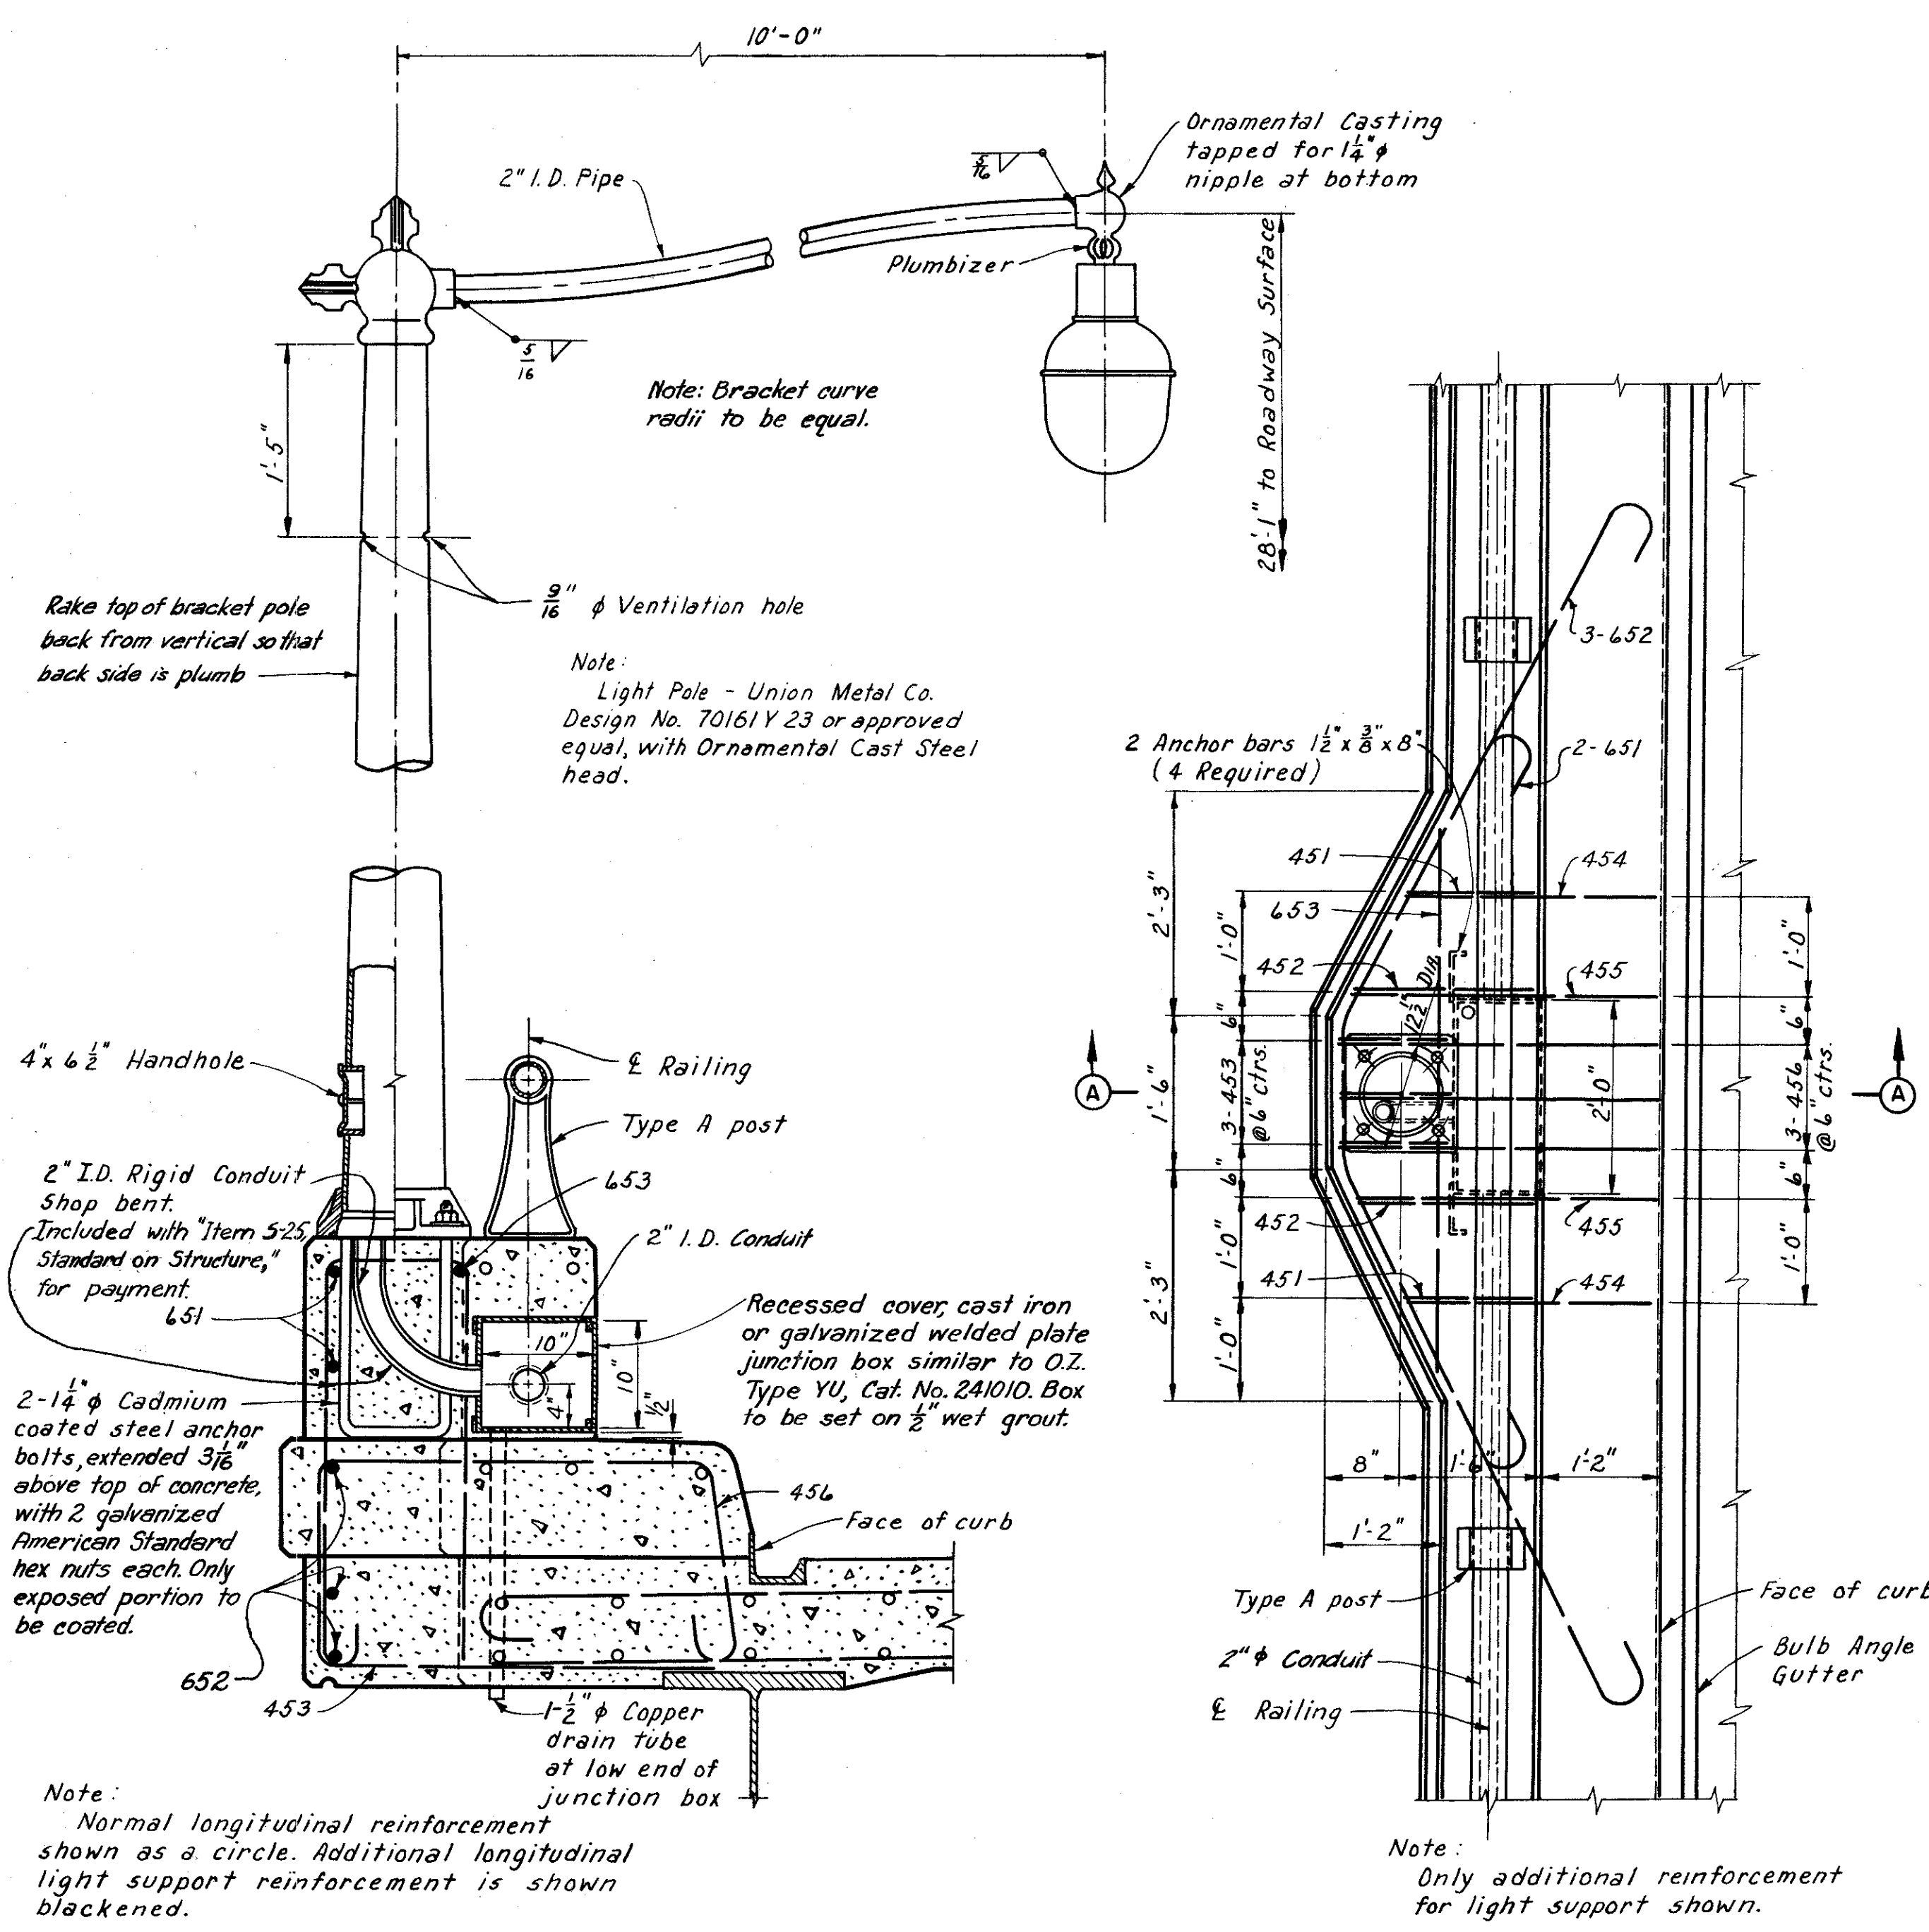


REINFORCEMENT SCHEDULE FOR LIGHT STANDARD SUPPORT						
MARK	NO.	LENGTH	TYPE	DIMENSIONS		WEIGHT
				A	B	
4.51	2	8'-11"	131	2'-6"	1'-2"	12
4.52	2	9'-11"	131	3'-0"	1'-8"	13
4.53	3	9'-5"	131	3'-2"	1'-0"	19
4.54	2	5'-7"	155	2'-2"		7
4.55	2	6'-1"	155	2'-8"		8
4.56	3	6'-3"	155	2'-10"		13
6.51	2	9'-5"	141	2'-11"	1'-10"	28
6.52	3	14'-6"	141	5'-3"	3'-0"	65
6.53	1	5'-0"	Str.			8
				Total		173

Notes: Bar list is for one light standard support. Total No. Required: 34. Bar dimensions are given out to out.

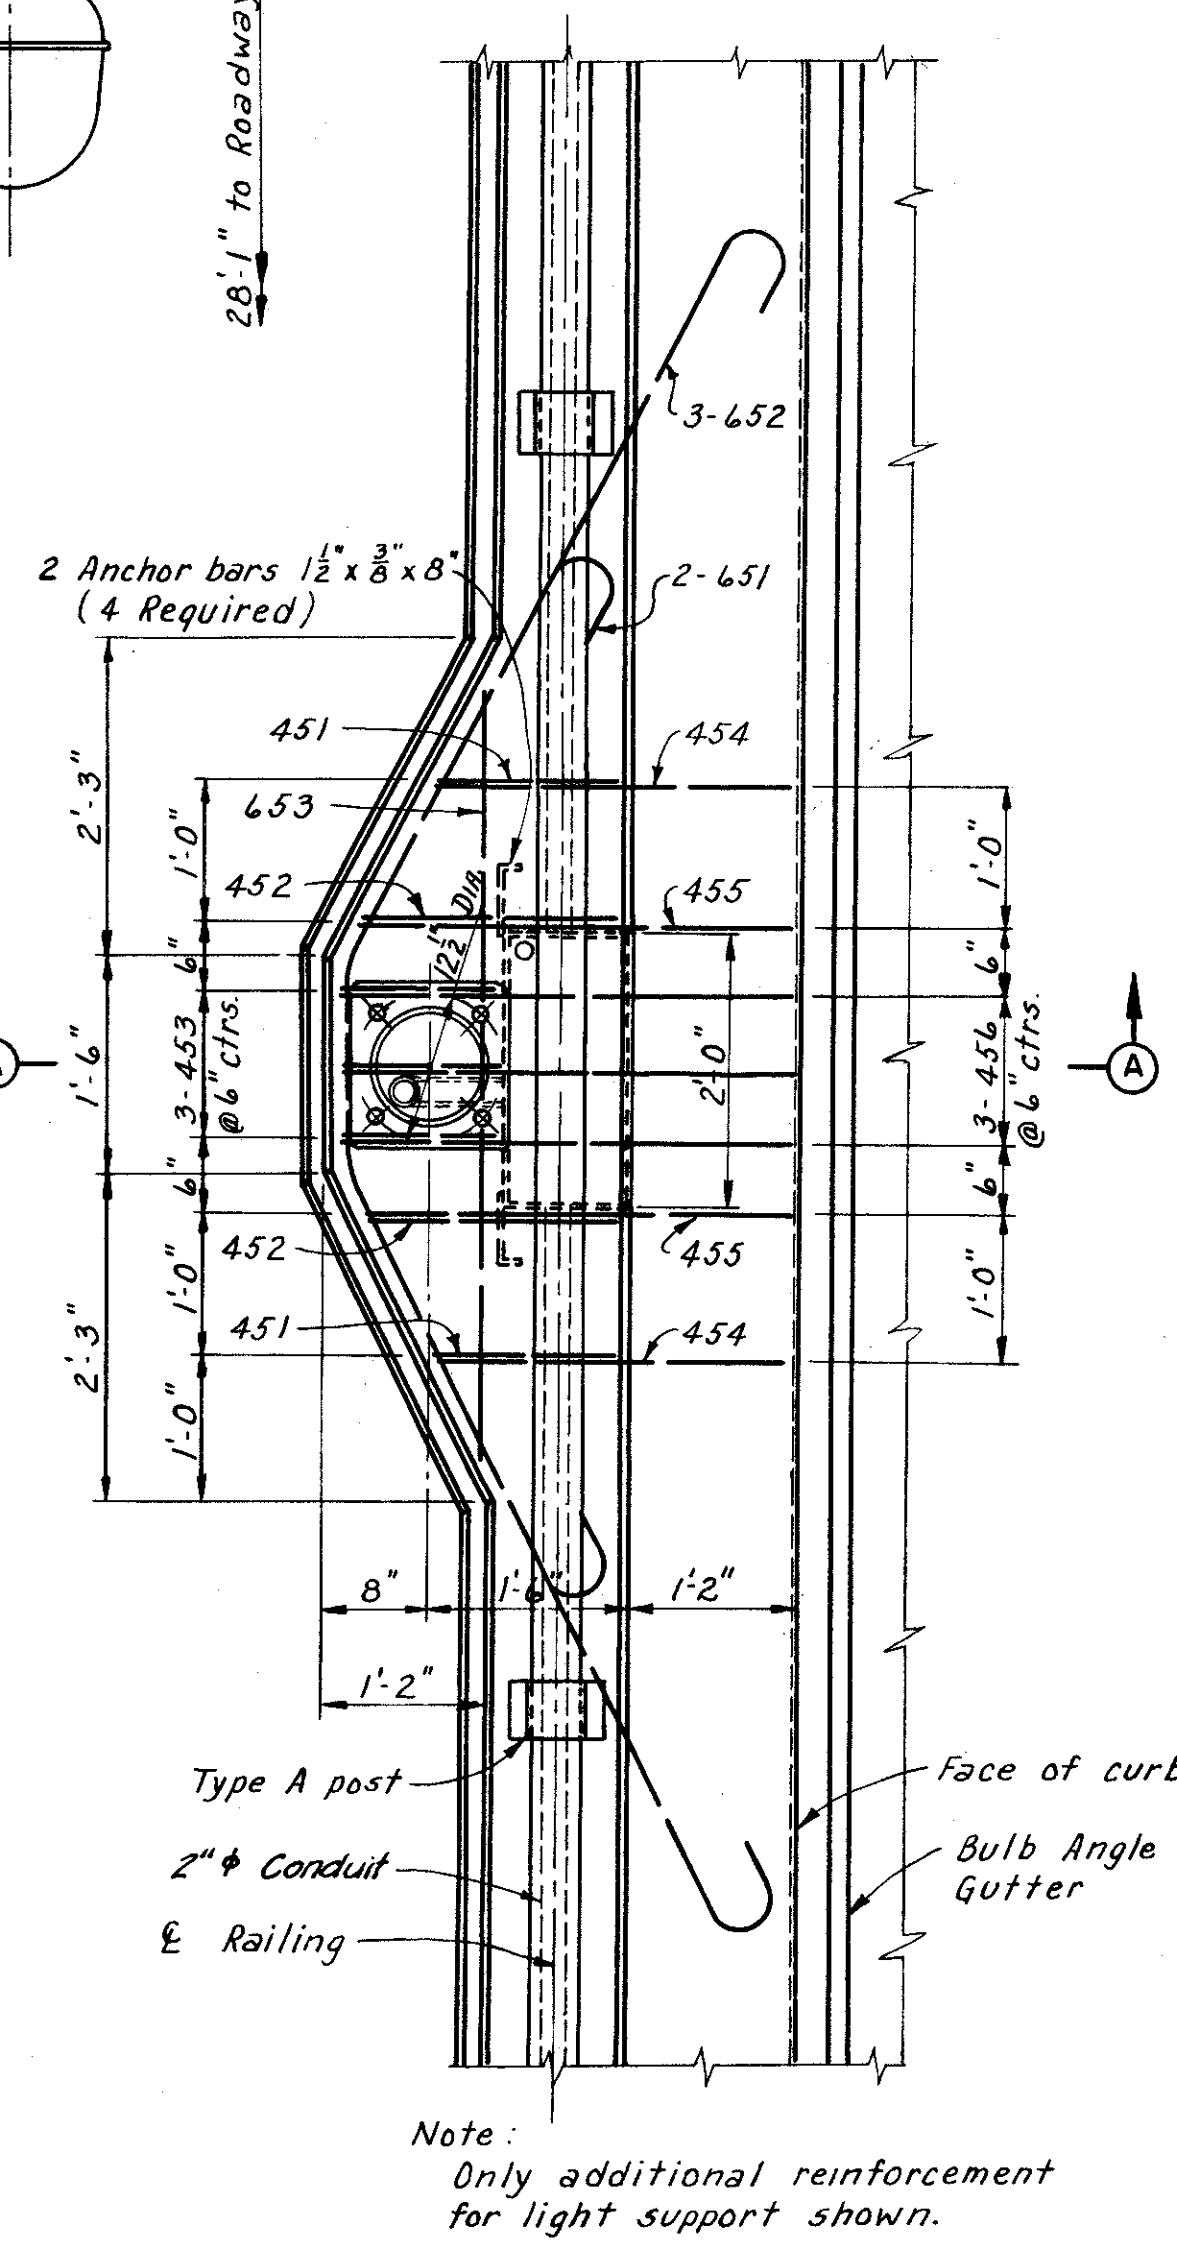

Note: For details of light standard support on the retaining wall adjoining Bridge No. 4, East Abutment, see sheet 12.2-7A.

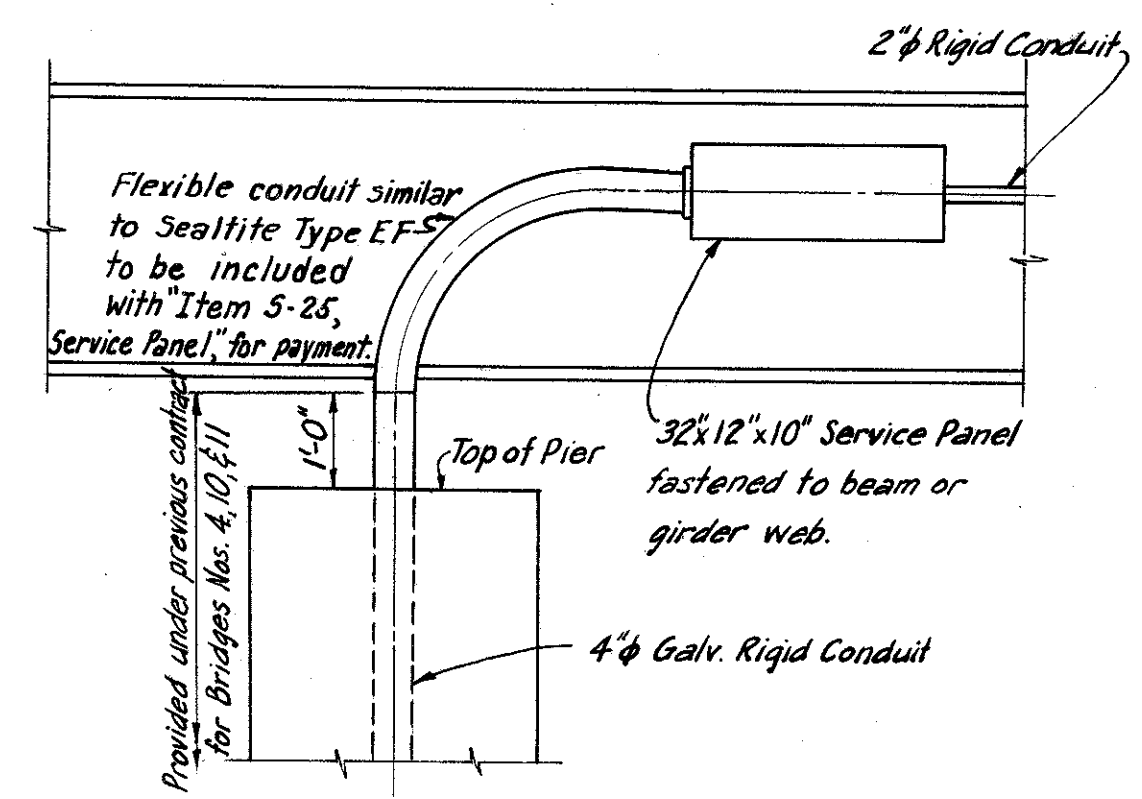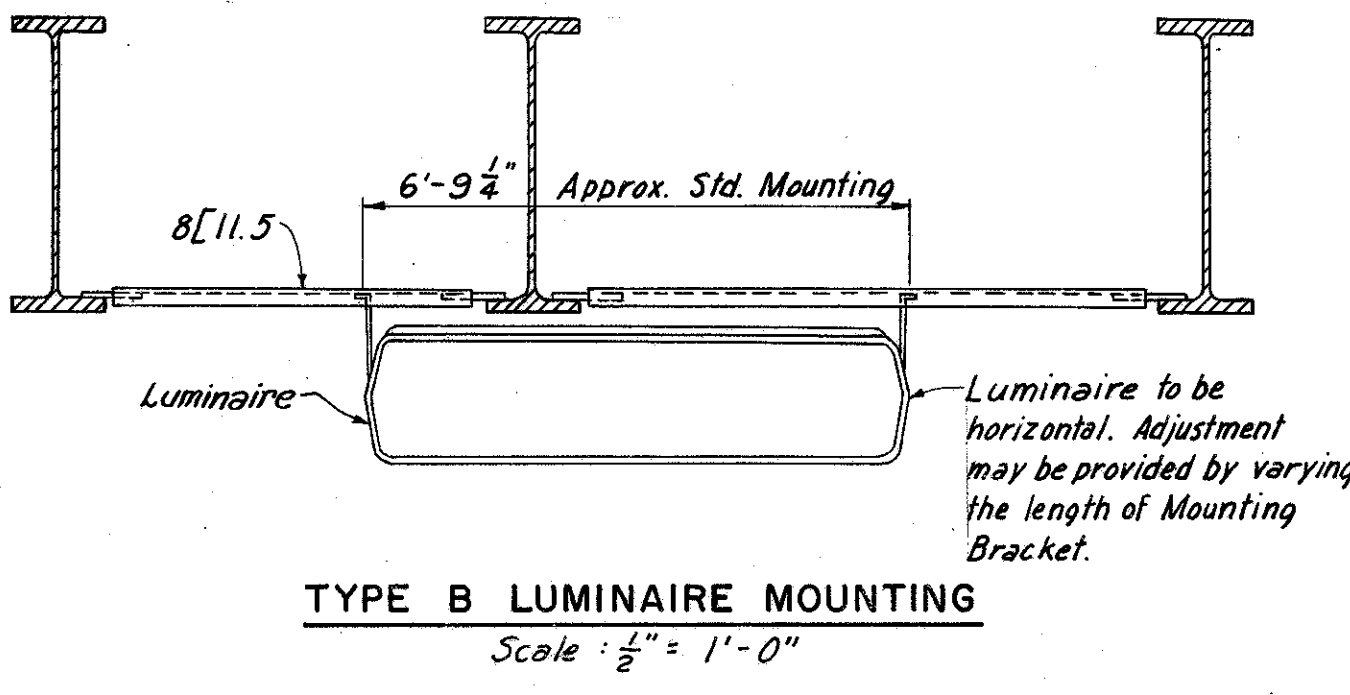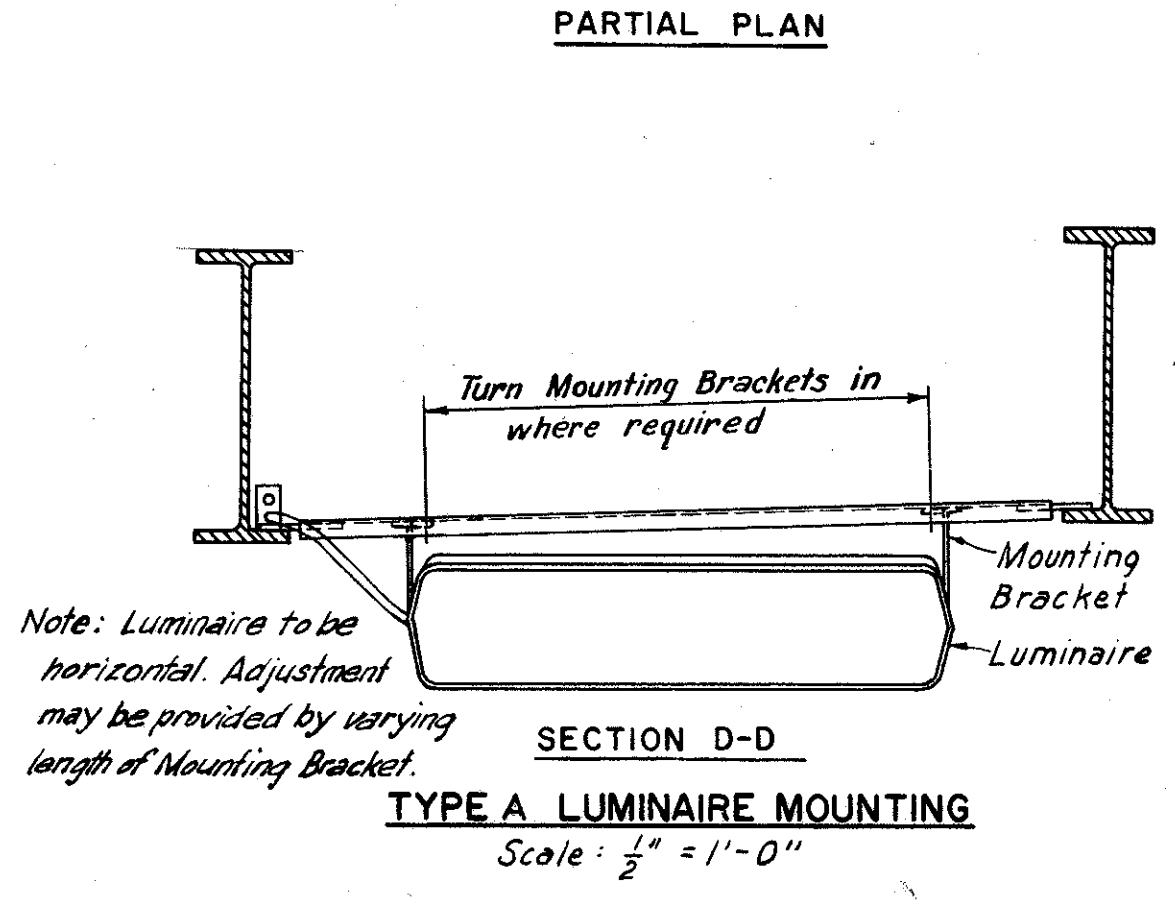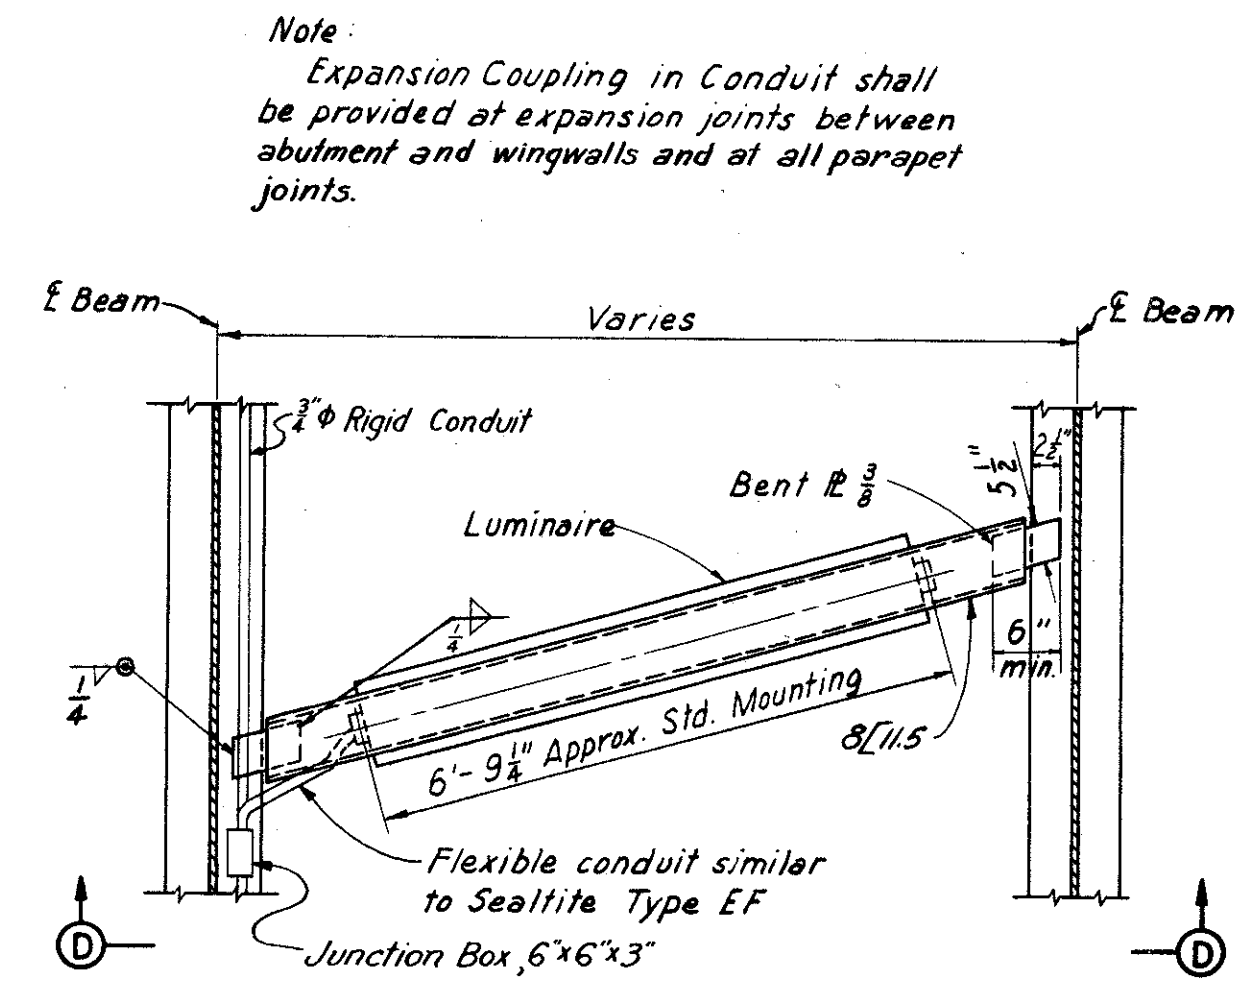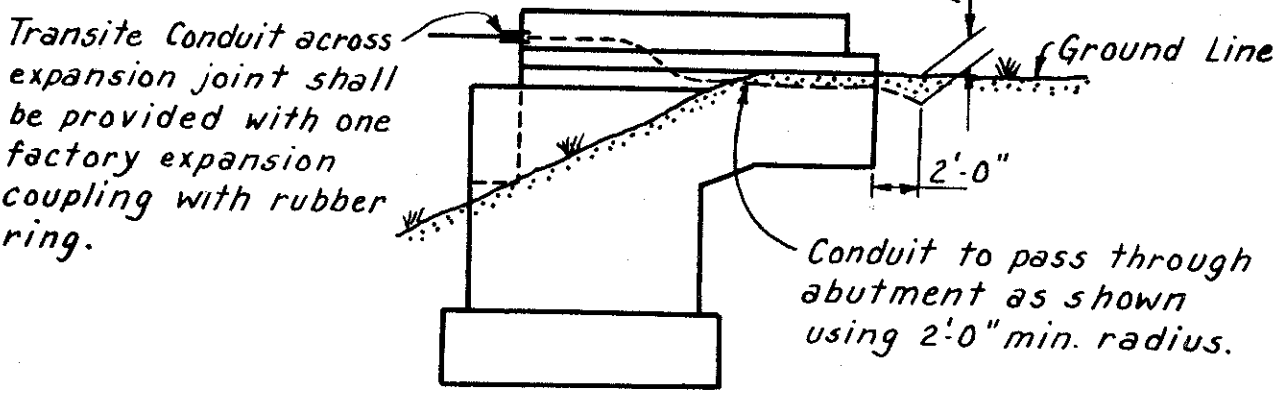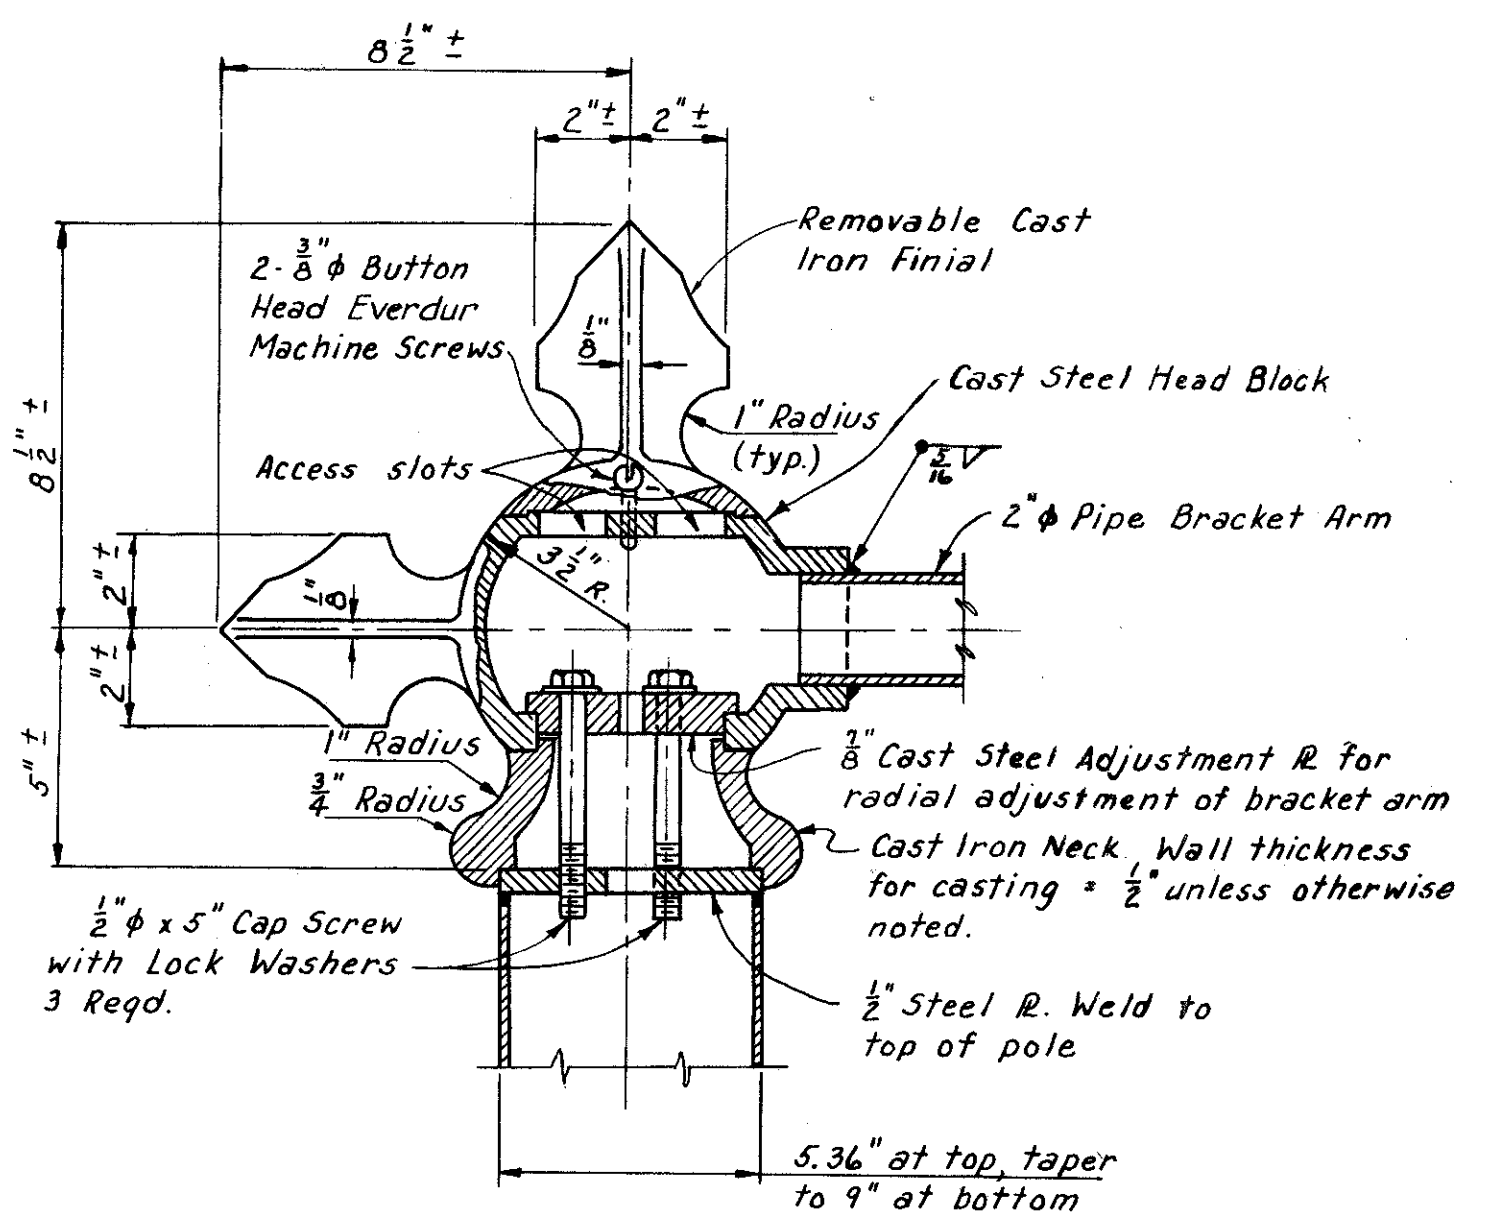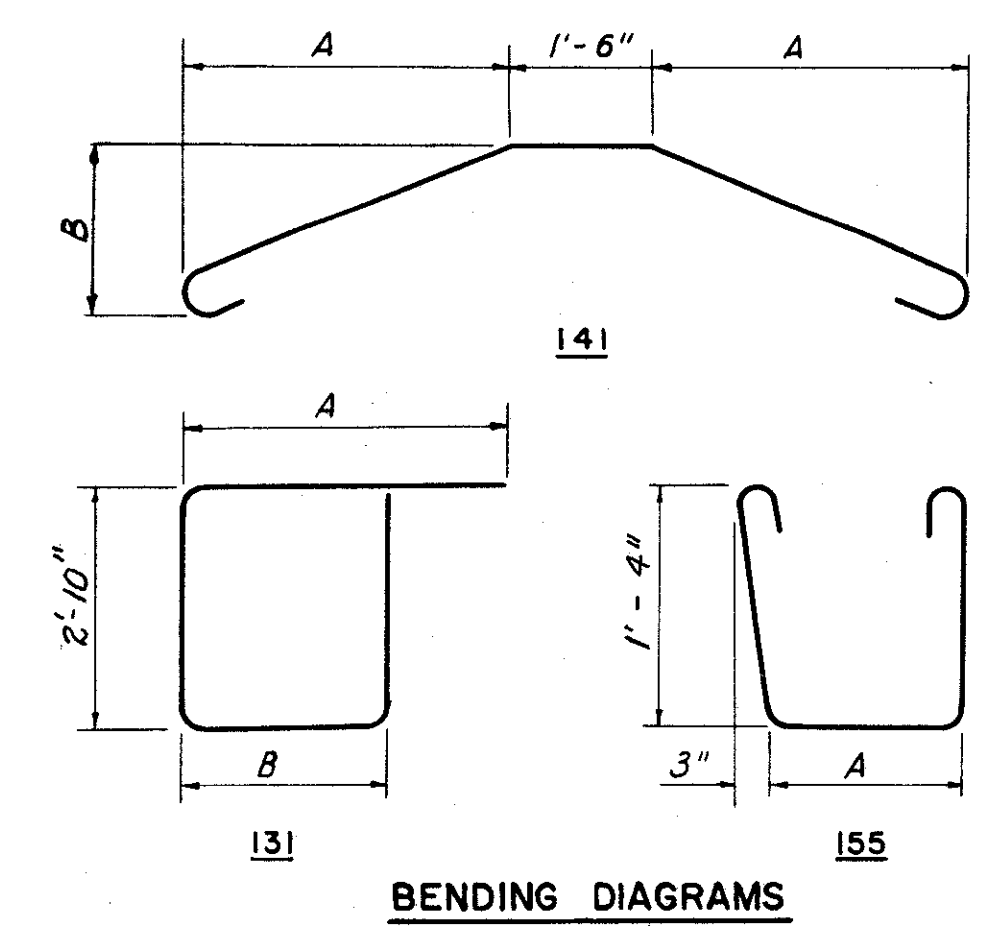

Note: Junction box 6"x6"x3" to be included with Item 5-25, Fluorescent Underdeck Light for payment. The 8C11.5 supports and connections to beams are to be included with Item 5-7, Structural Steel for payment. Underdeck luminaires shall be equal to Line Material No. LF1F1. For size of safety switch, contactor and photo cell control unit in Service Panel, see Sheet 42-7 of Roadway Plans.

NOTES:
For location of light standards and conduit, see Deck Plans.
For location of Underdeck Luminaires see sheet 171-7A.
For additional lighting notes, see Sheet 171-7A.

PART 7A

HOWARD, NEEDLES, TAMMEN & BERGENDOFF
CONSULTING ENGINEERS
KANSAS CITY CLEVELAND NEW YORK

LIGHTING DETAILS

Scale as noted


WILLOW-INNER BELT FREEWAY

CLEVELAND CUYAHOGA COUNTY OHIO


DRAWN P.L.G. TRACED J.A.G. CHECKED S.J. REVIEWED J.C.T. REVISIONS
DATE 9-24-58 DATE 11-26-58 DATE 12-18-58 DATE 11-13-59

SHEET 176


CUYAHOGA COUNTY
CITY OF CLEVELAND
CUY - 21-15.32
CUY - 42-18.42

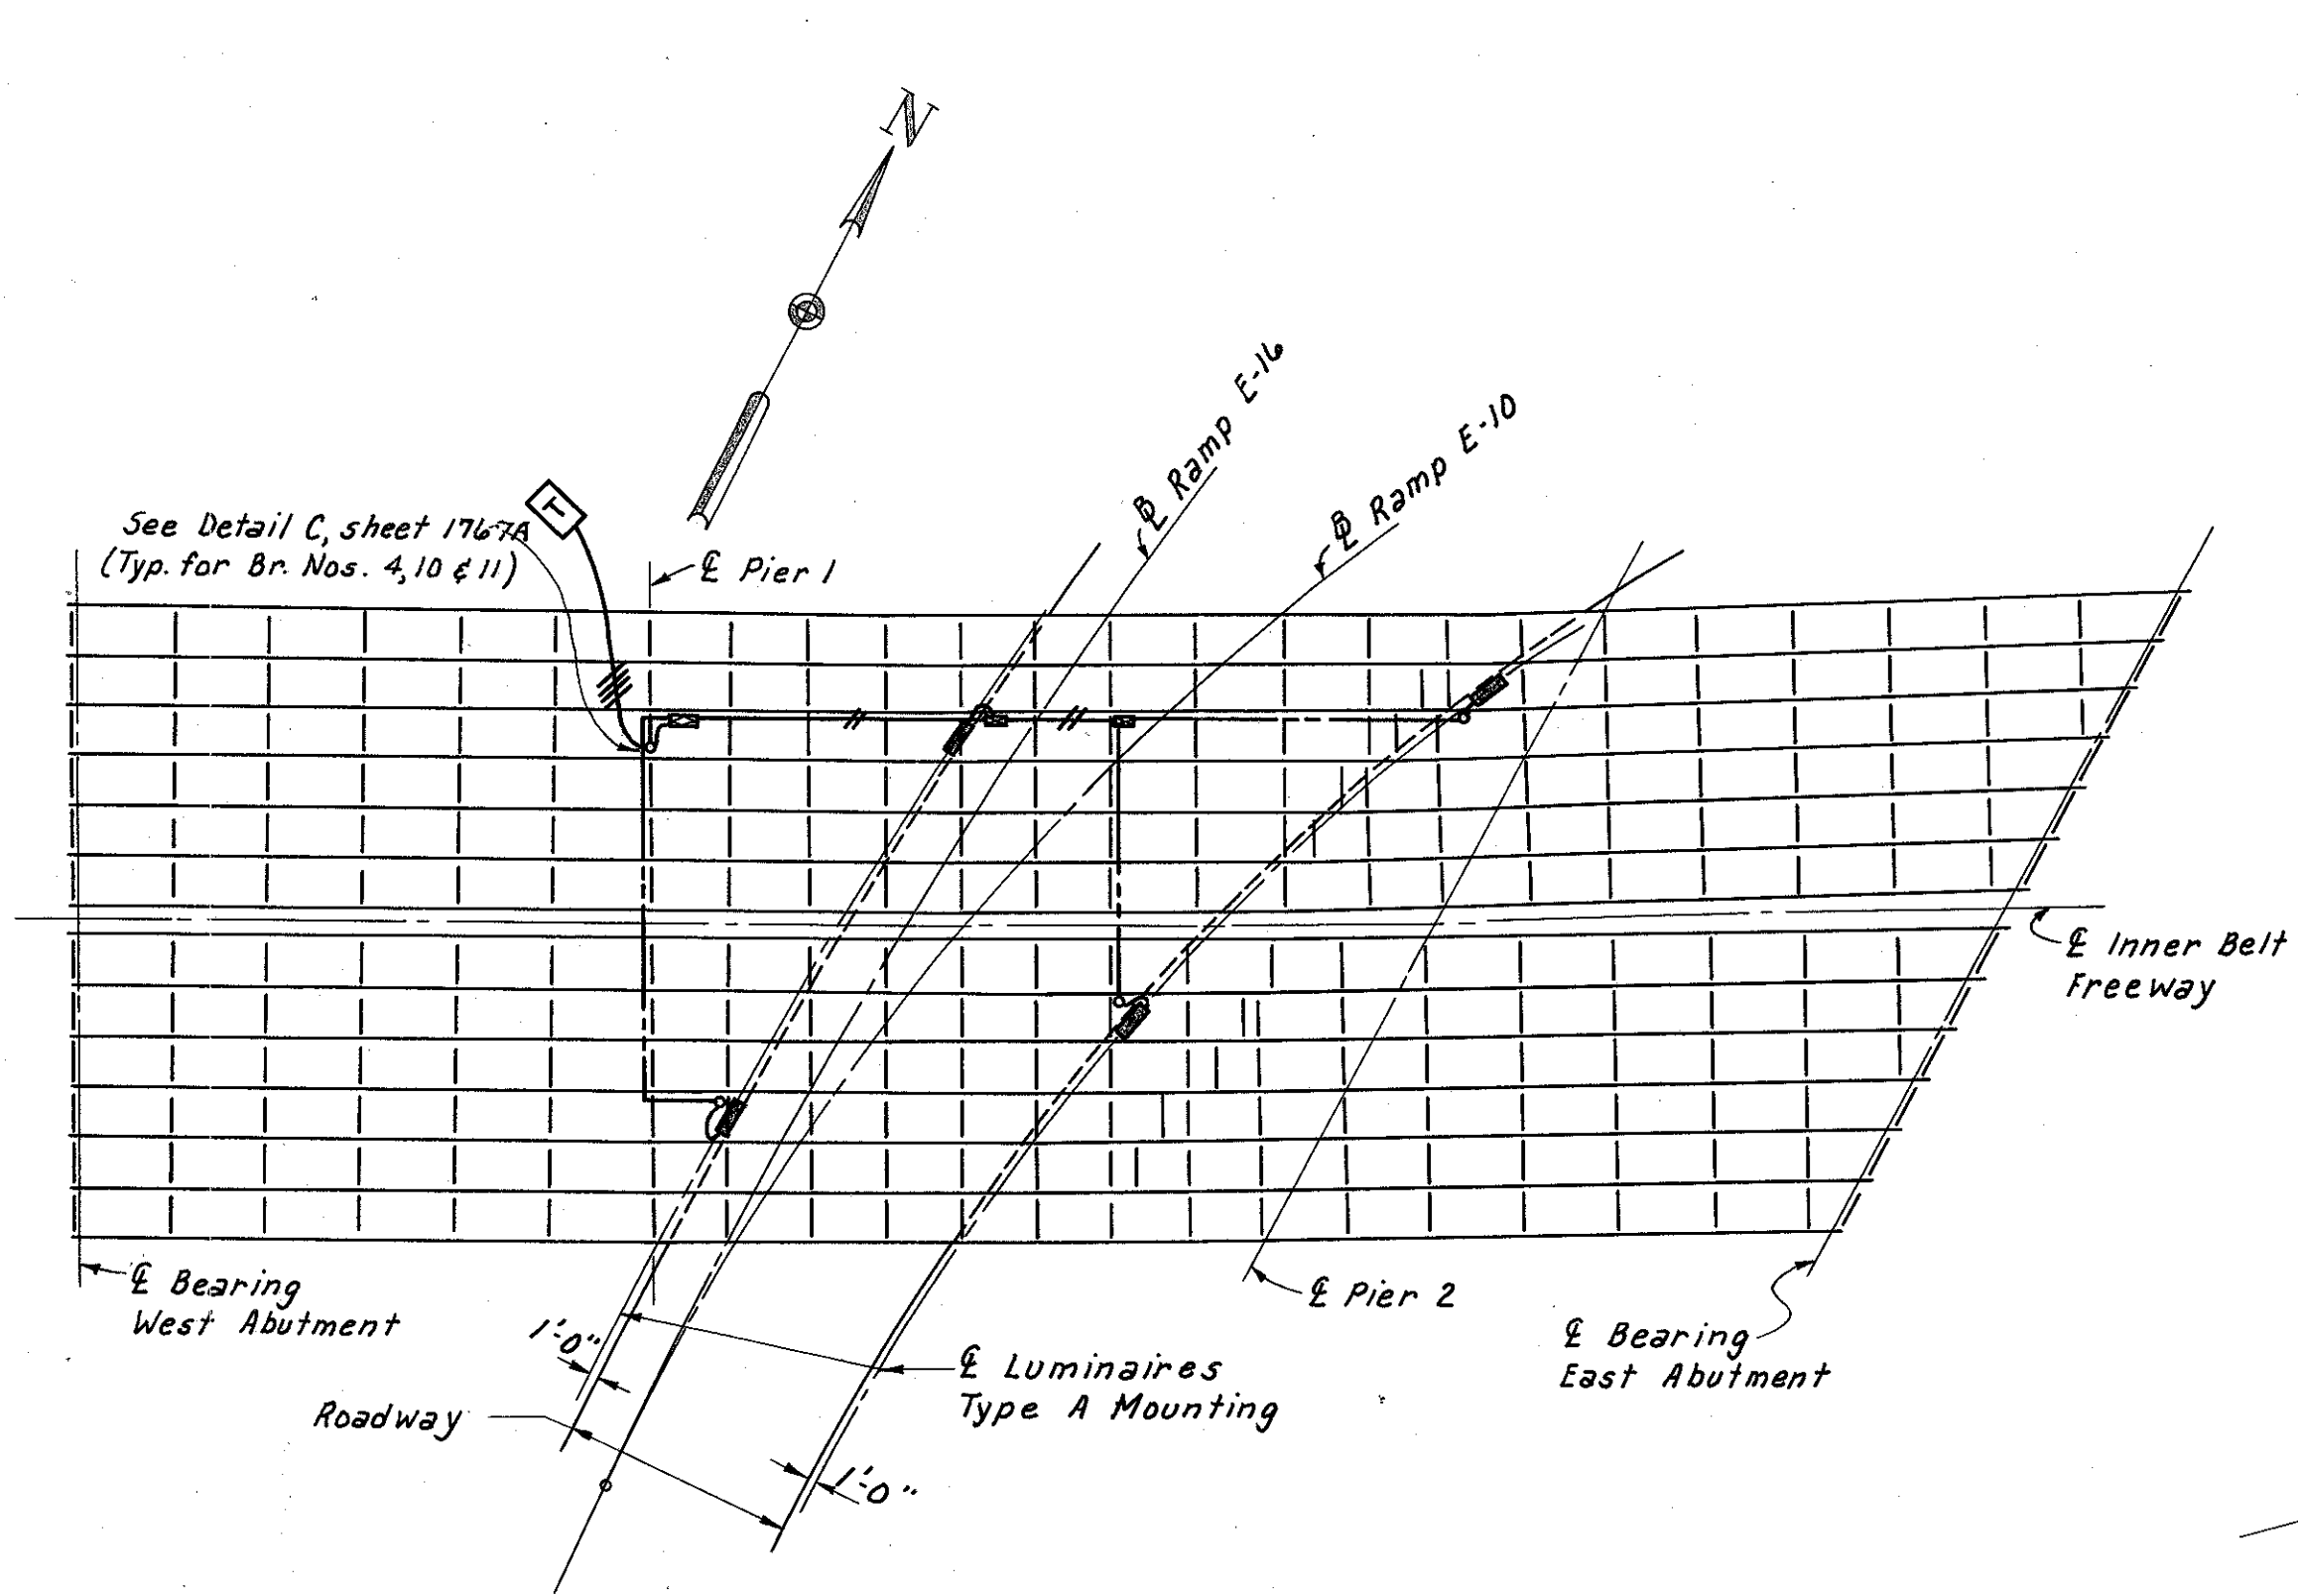


BRIDGE NO. 3
(for additional information see sheet 108-7A)

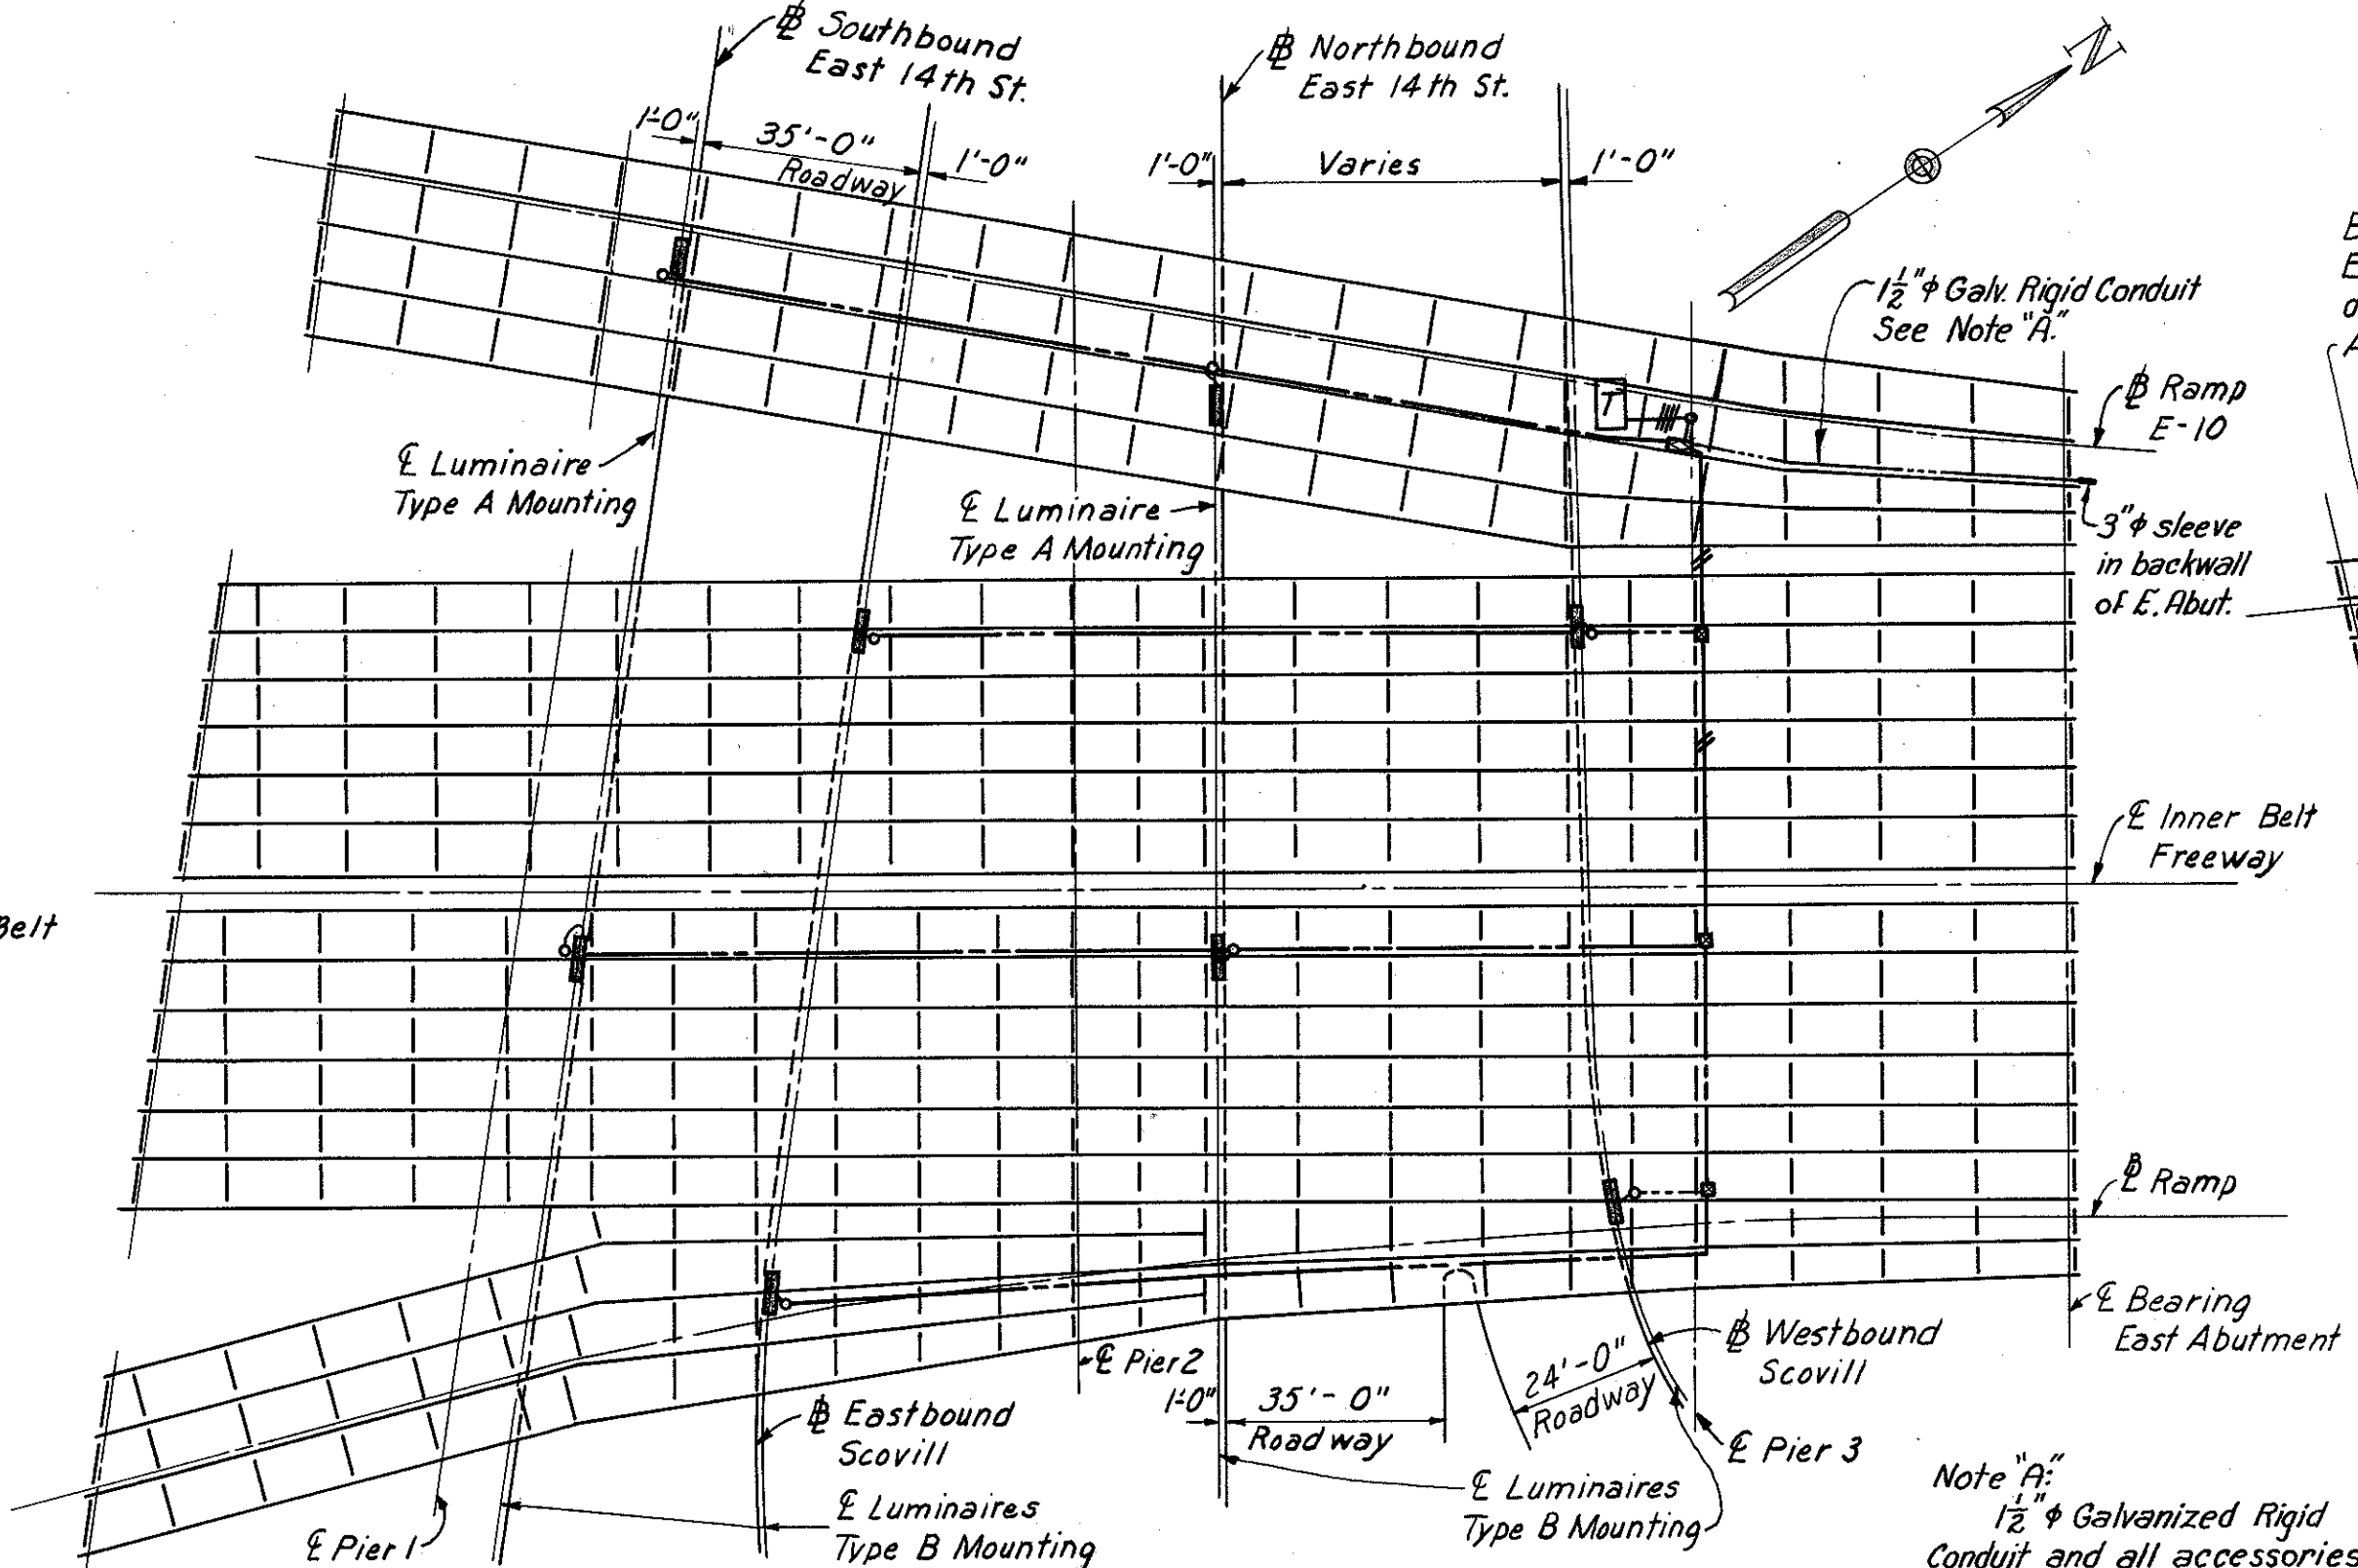


BRIDGE NO. 4
(for additional information see sheets 123-7A & 124-7A)

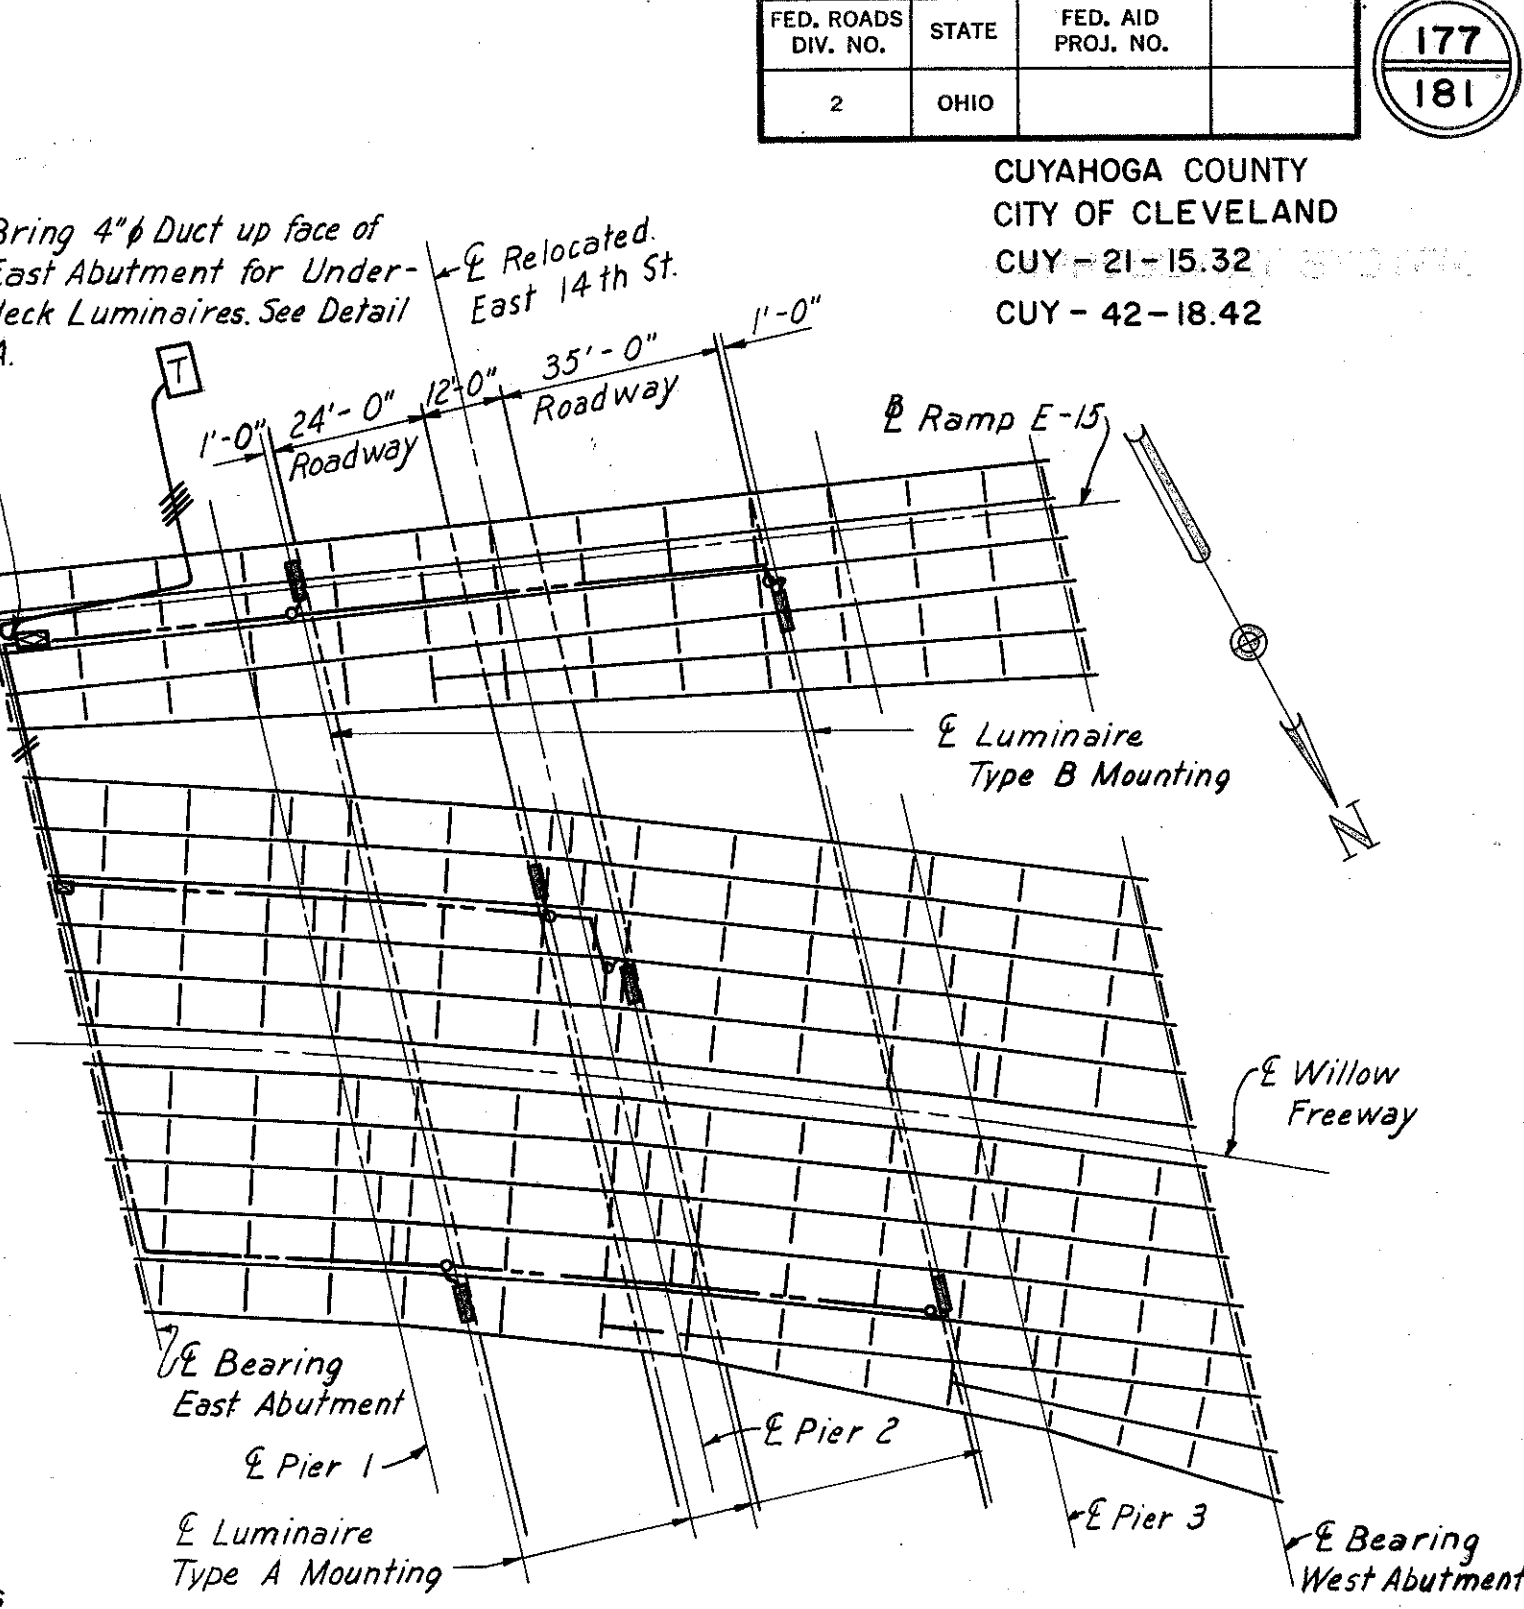

BRIDGES NO. 8 & 9
(for additional information see sheets 152-7A & 153-7A)

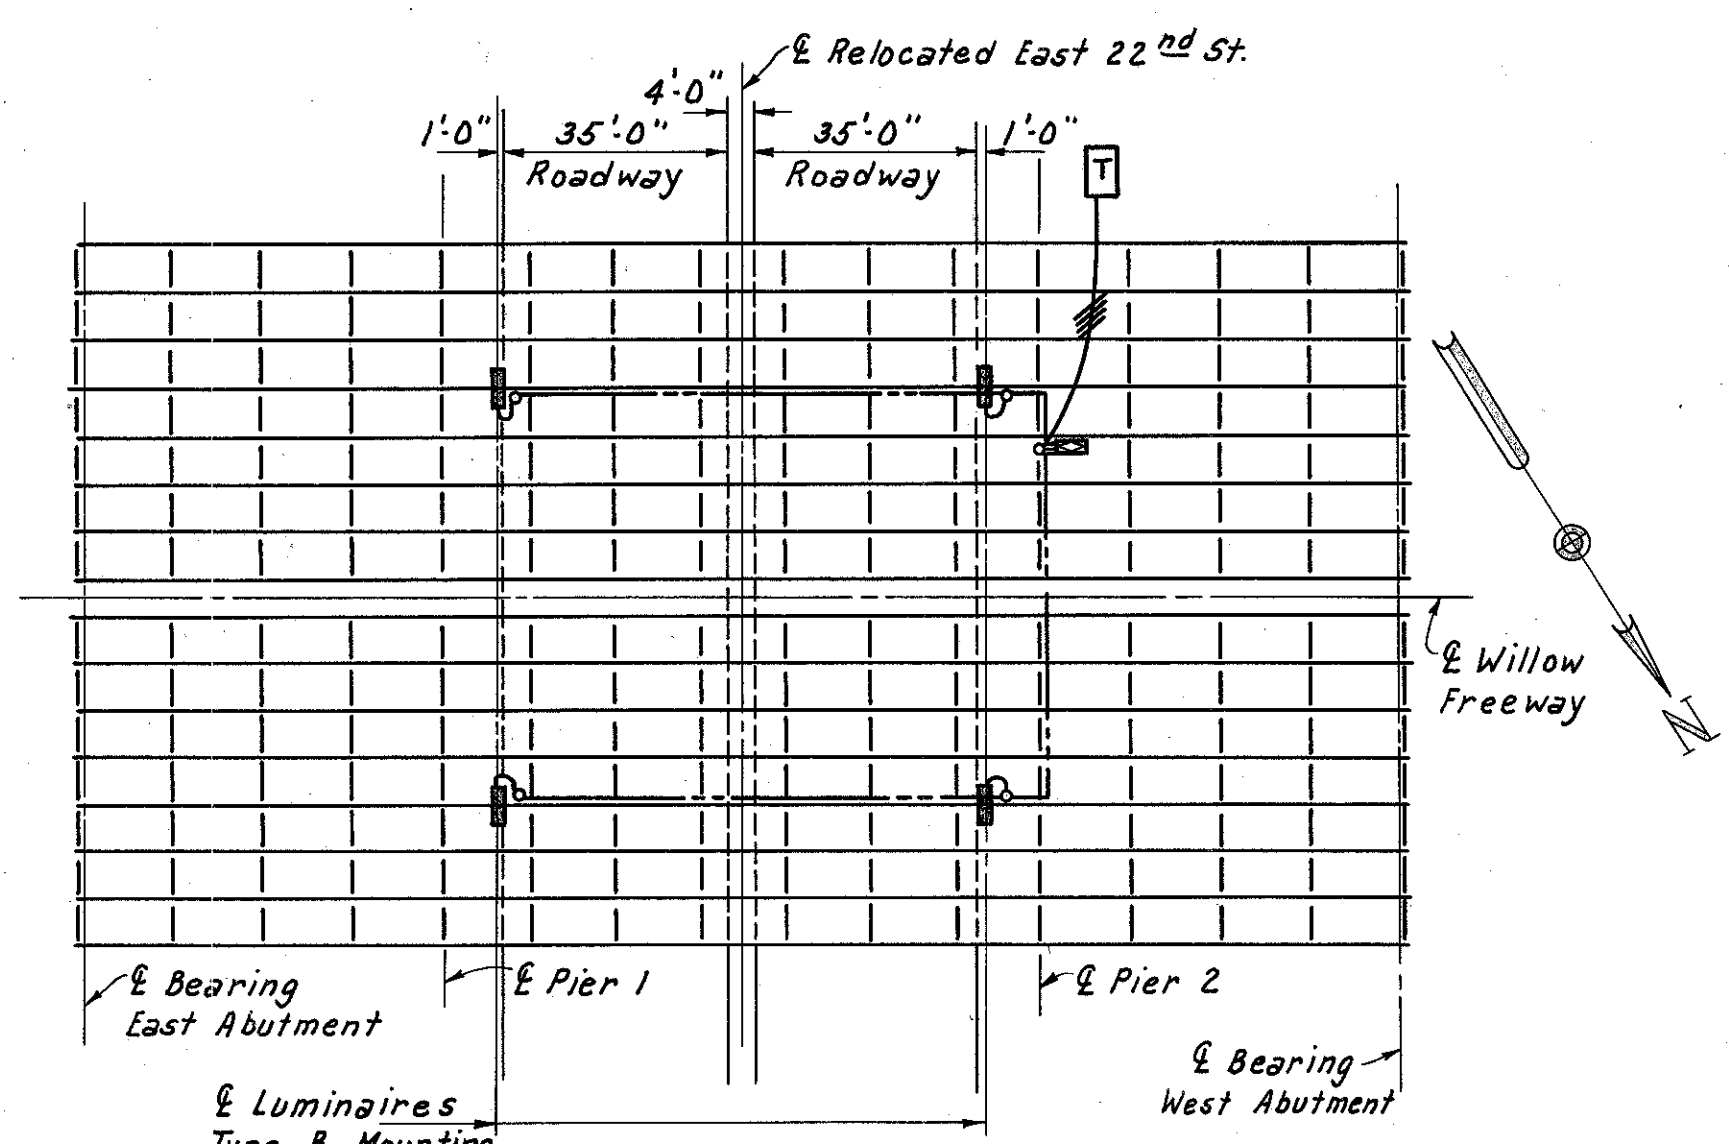


BRIDGE NO. 10
(for additional information see sheet 162-7A)

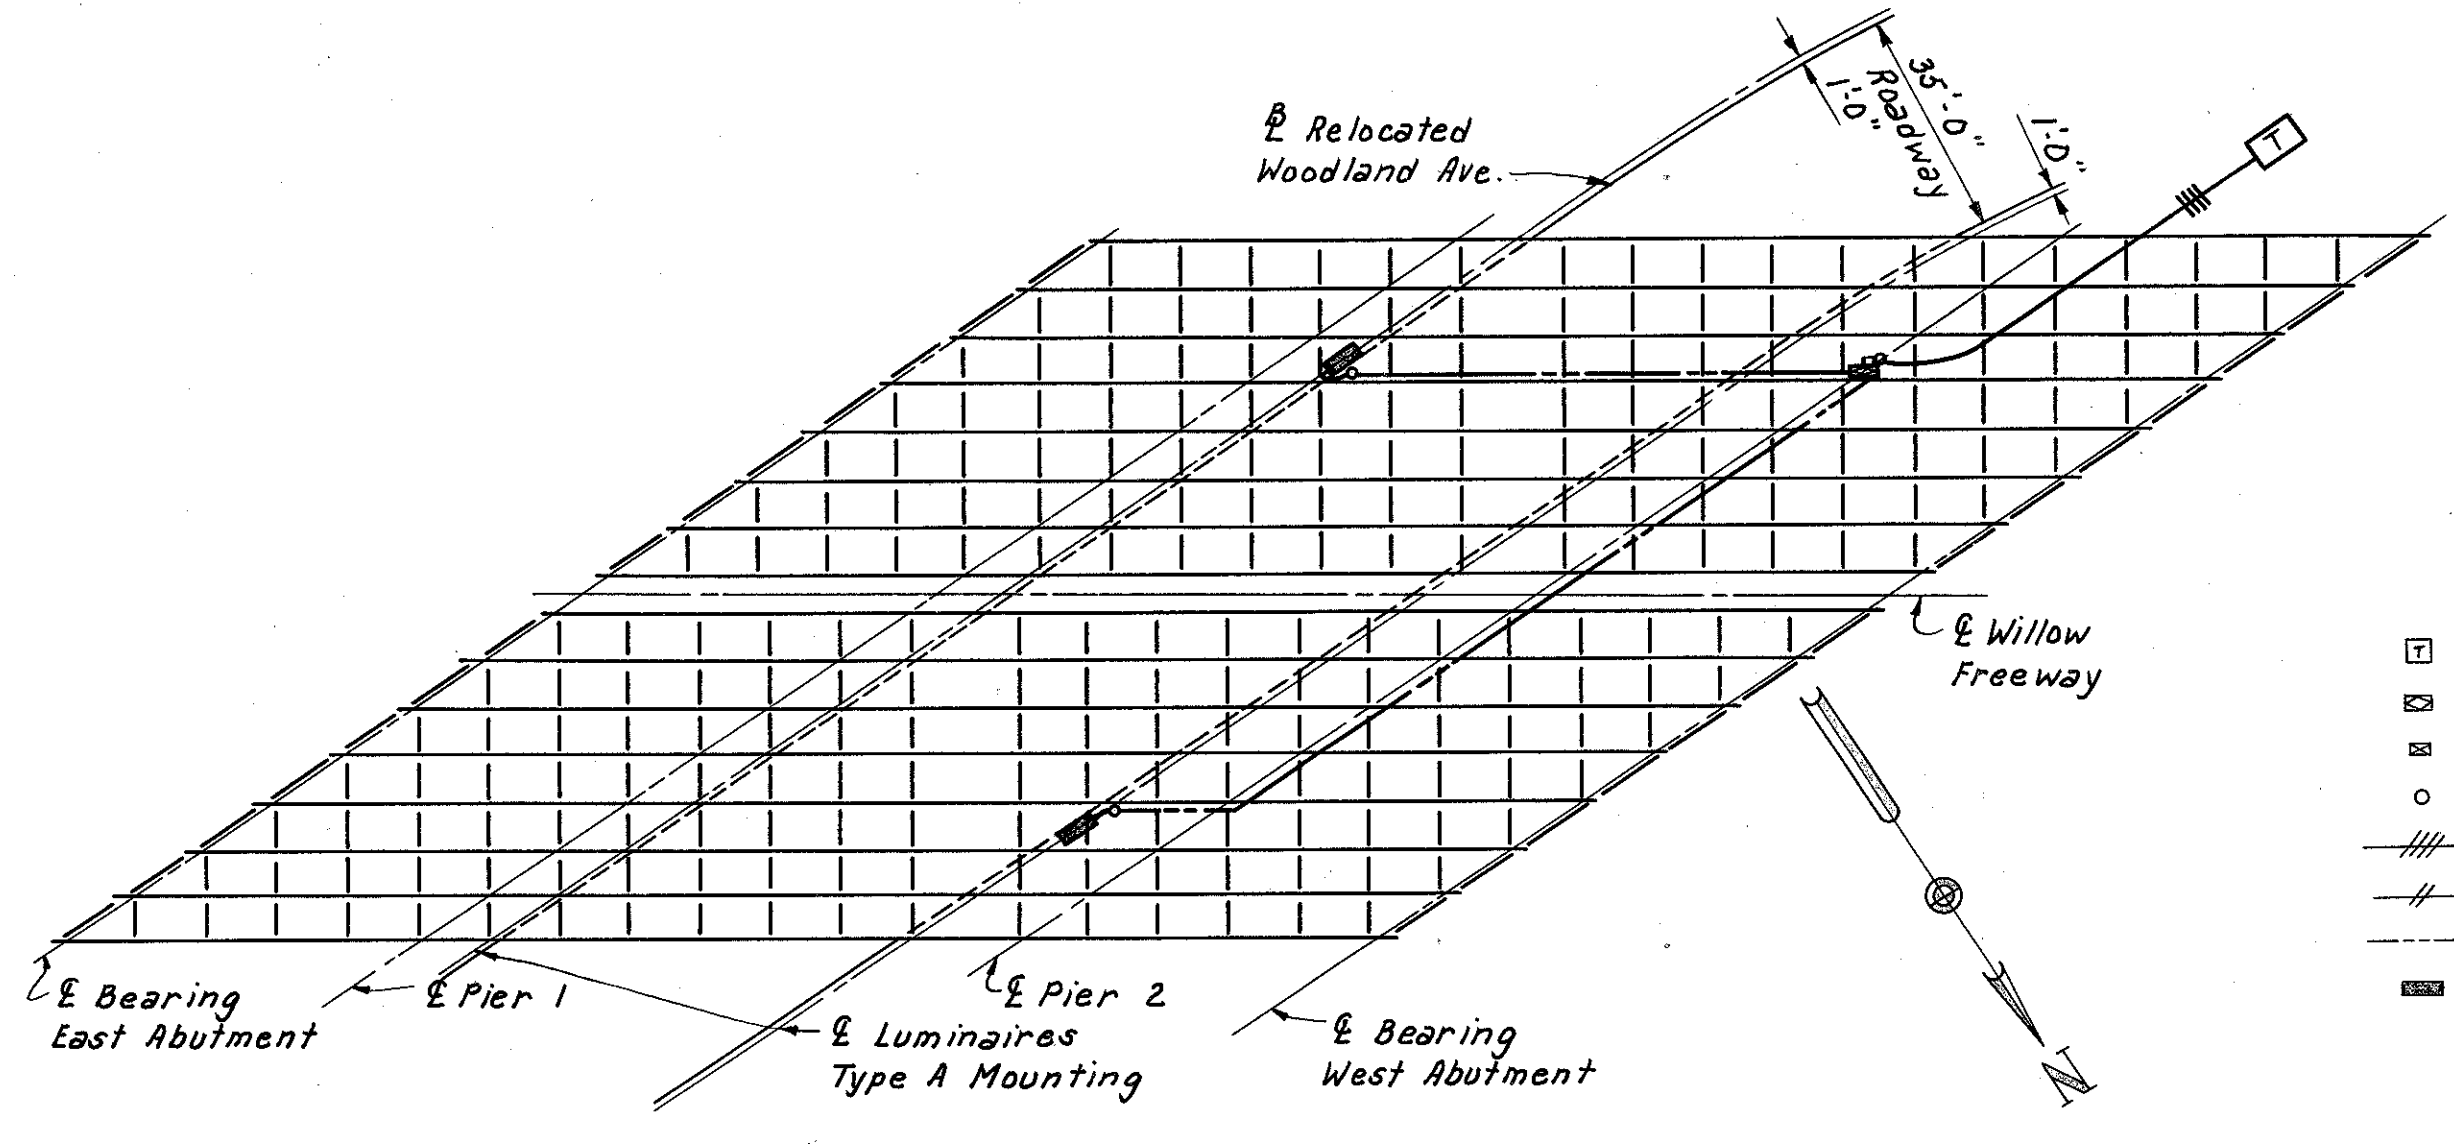


BRIDGE NO. 11
(for additional information see sheet 169-7A)

- LEGEND**
- Manhole for transformer
 - ▣ Service Panel, 32"x12"x10"
 - Junction Box, 8"x8"x4"
 - Junction Box, 6"x6"x3"
 - 4" Duct
 - 2" Galvanized Rigid Conduit
 - 3/4" Galvanized Rigid Conduit
 - Underdeck Luminaire

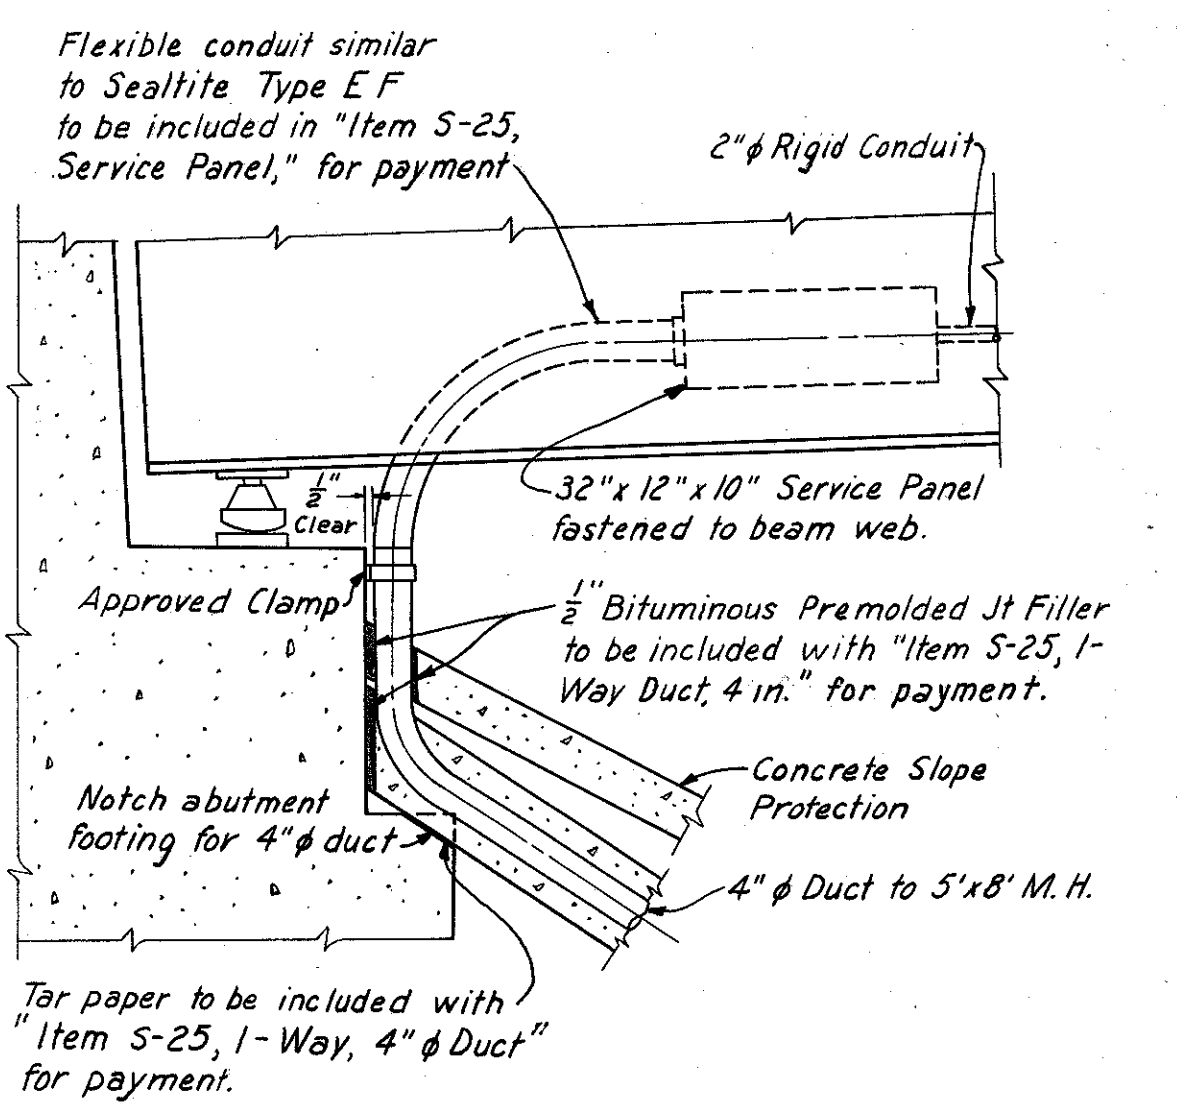


DETAIL A
Scale: 1/2" = 1'-0"

Note:
Conduit running parallel to the beams shall be fastened to the beam web just above the intersection of the diagonal and bottom chord cross-frame angles with approved clamps at not more than 4'-0" ctrs.*
Conduit running transversely to beams and girders shall be fastened to the beam or girder flanges and shall be located in-line with the crossframe angles, except as shown in the plans.

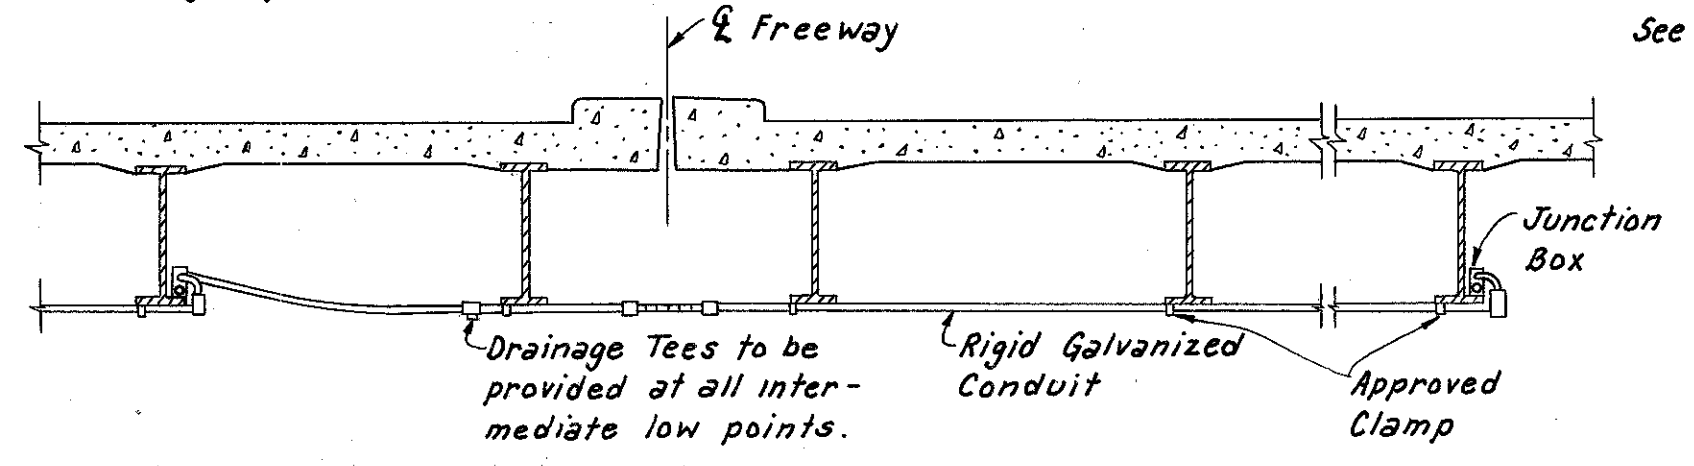


UNDERDECK LIGHTING - CONDUIT DETAILS
Scale: 1/4" = 1'-0"


LOCATION OF UNDERDECK LUMINAIRES
Scale: 1" = 30'-0"

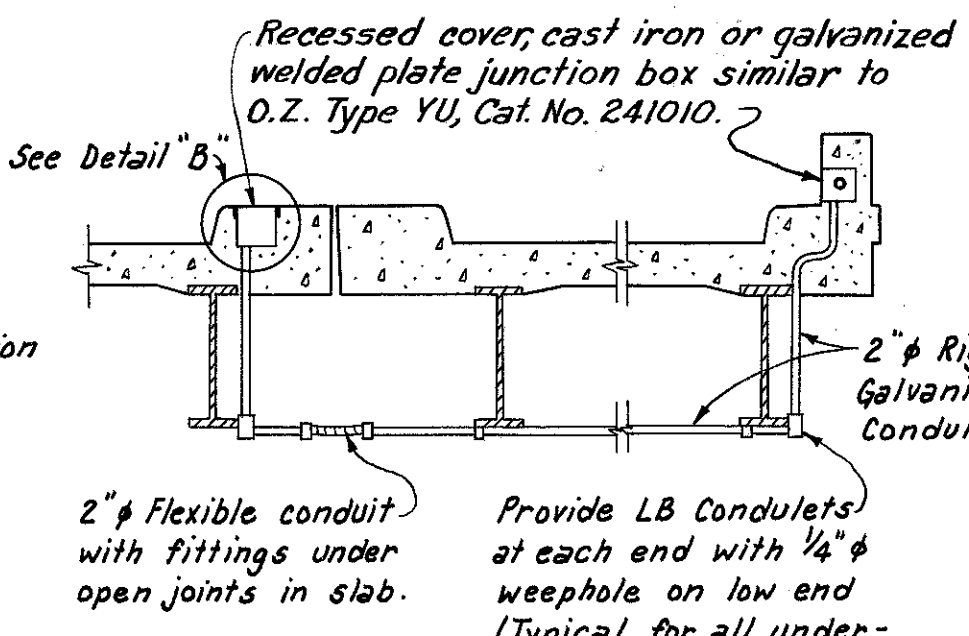

CONDUIT CROSSOVER DETAIL
Scale: 1/4" = 1'-0"

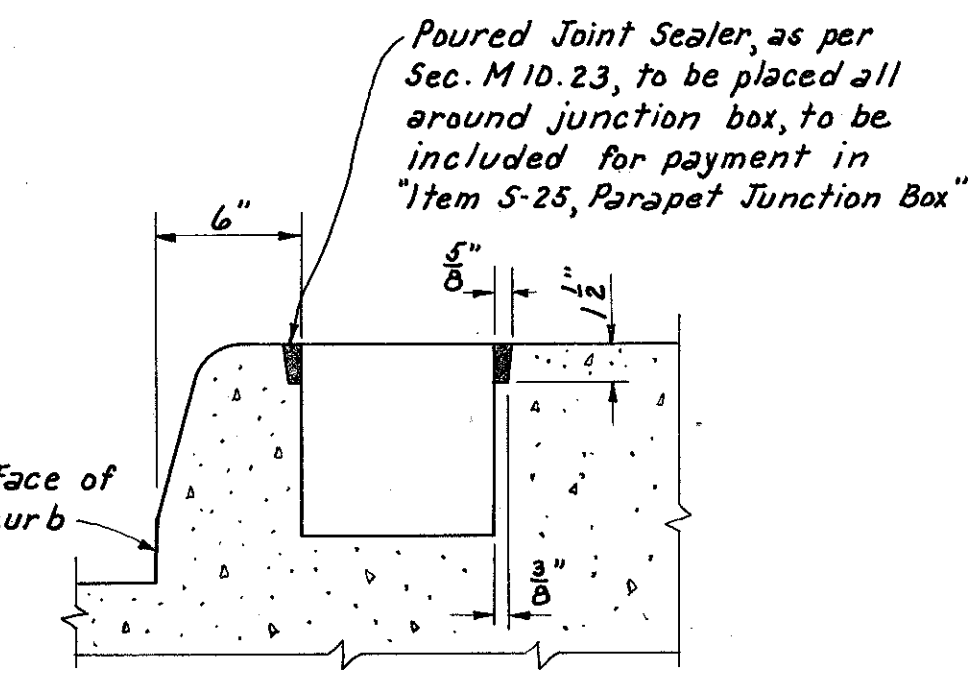

DETAIL B
Scale: 1 1/2" = 1'-0"

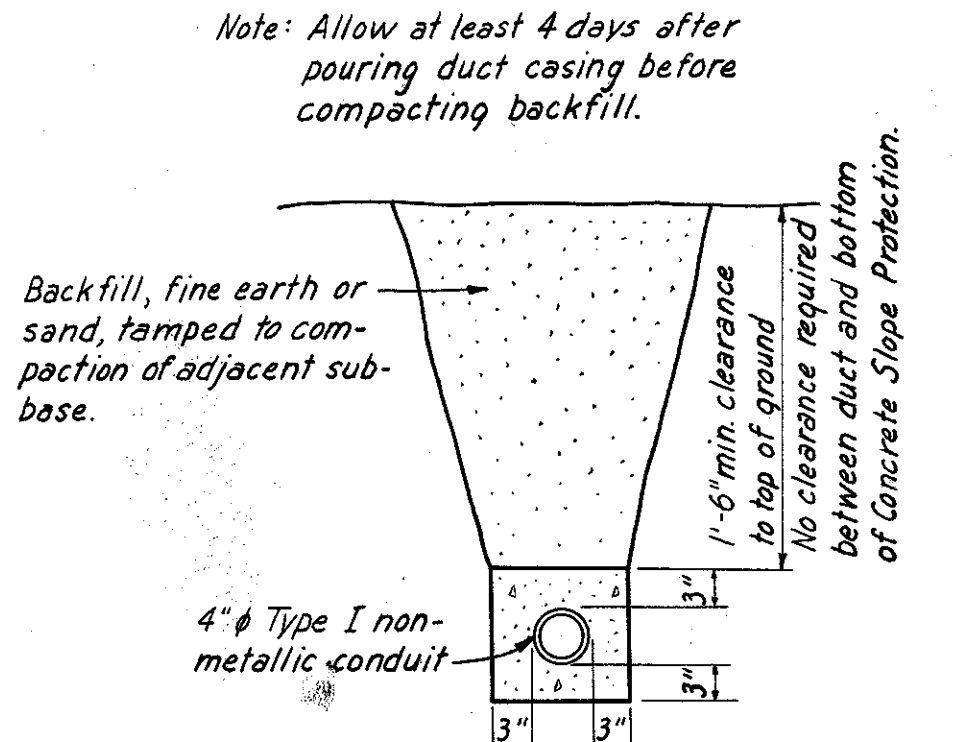

ONE-WAY DUCT BANK
Scale: 3/4" = 1'-0"

* Note: For girder bridges, conduit shall be fastened to alternate stiffeners just above the intersection of the diagonal and bottom chord crossframe angles.

PART 7A


HOWARD, NEEDLES, TAMMEN & BERGENDOFF
CONSULTING ENGINEERS
KANSAS CITY CLEVELAND NEW YORK

LIGHTING DETAILS


Scale as noted
WILLOW-INNER BELT FREEWAY
CLEVELAND CUYAHOGA COUNTY OHIO

DRAWN P.L.C.	TRACED J.H.G.	CHECKED E.S.J.	REVIEWED J.C.T.	REVISED
DATE 12-12-58	DATE 8-22-59	DATE 1-20-59	DATE 11-13-57	

SHEET 177

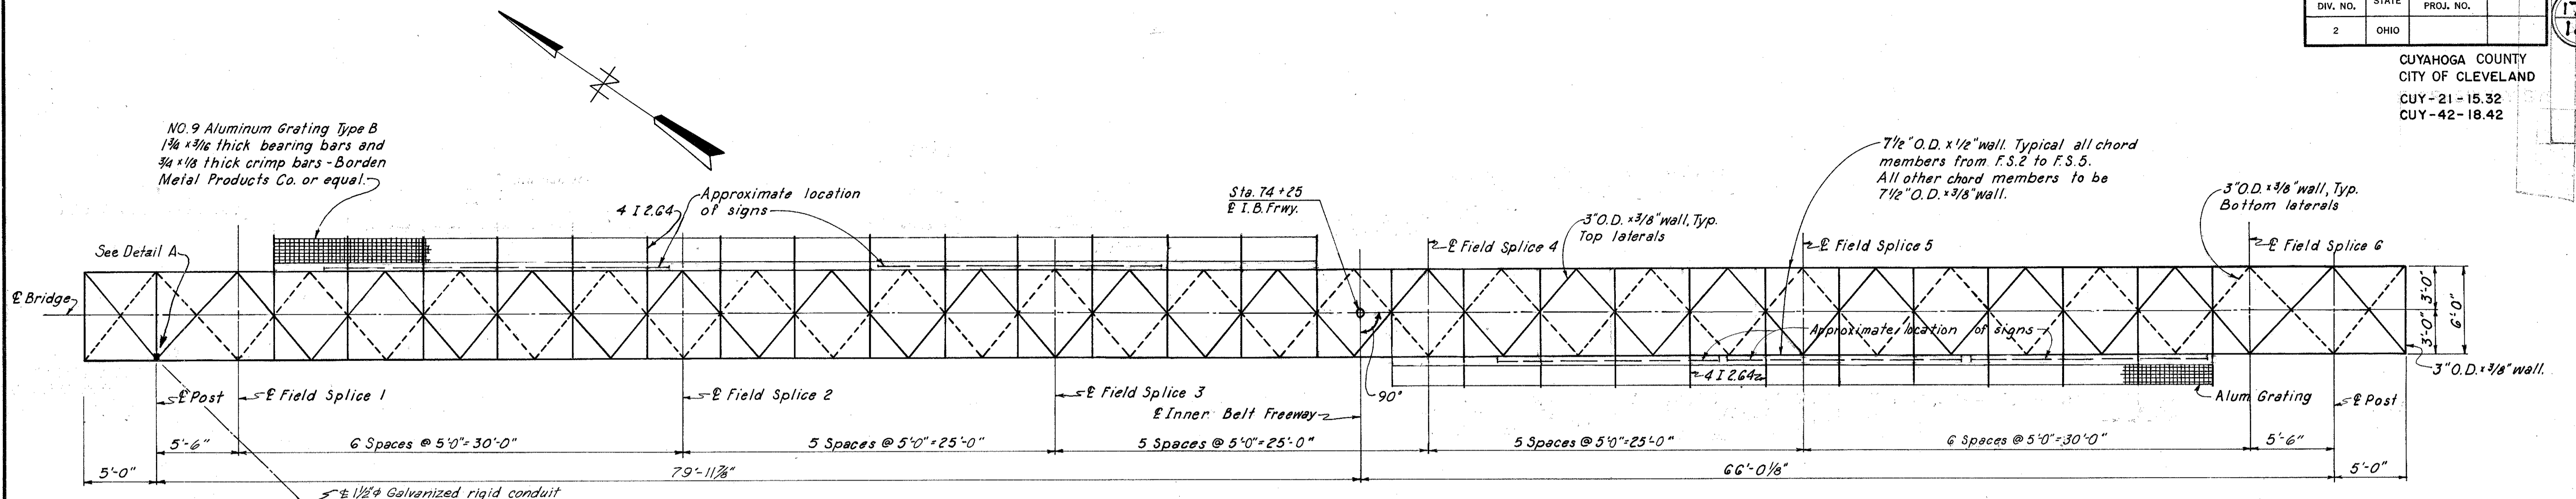


PLAN

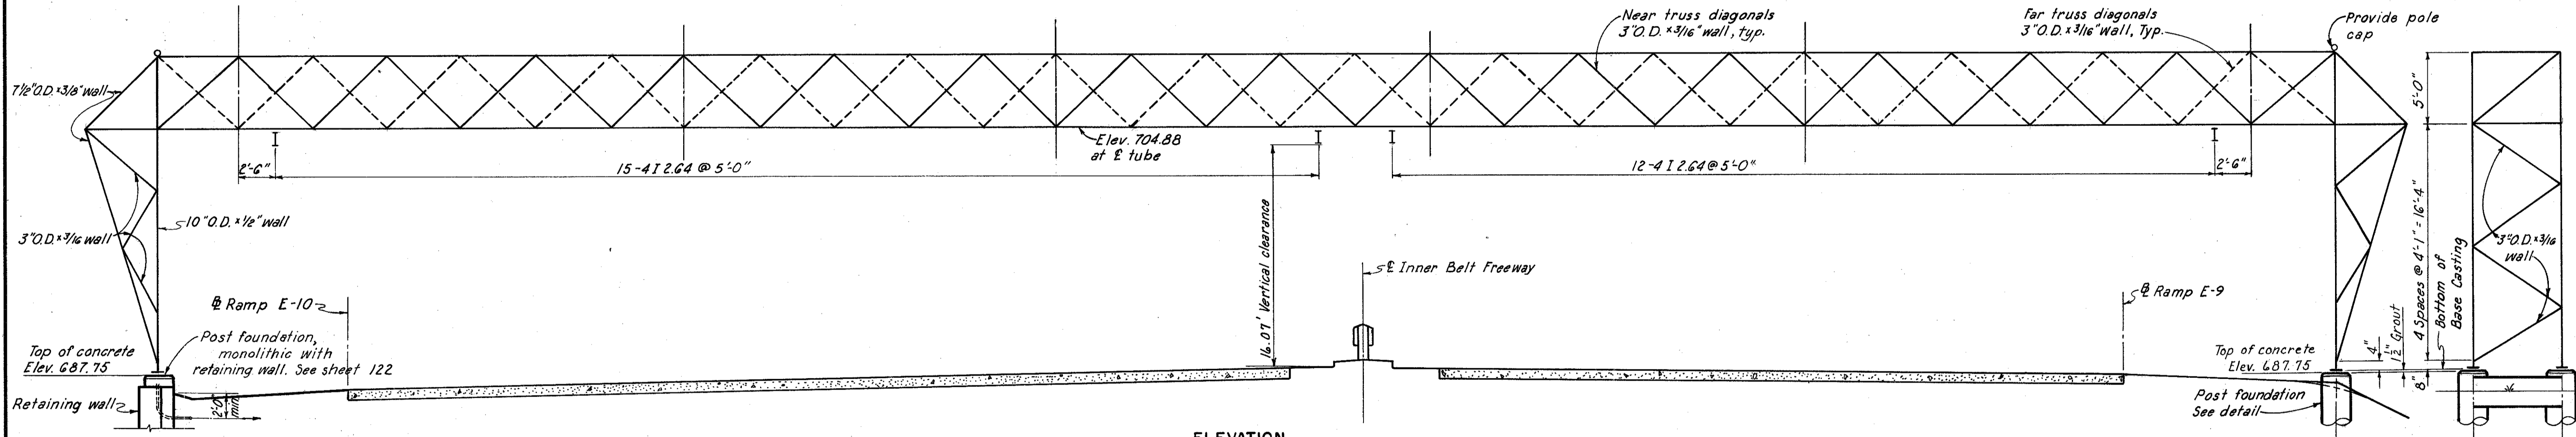


ELEVATION

VERTICAL POST
END ELEVATION

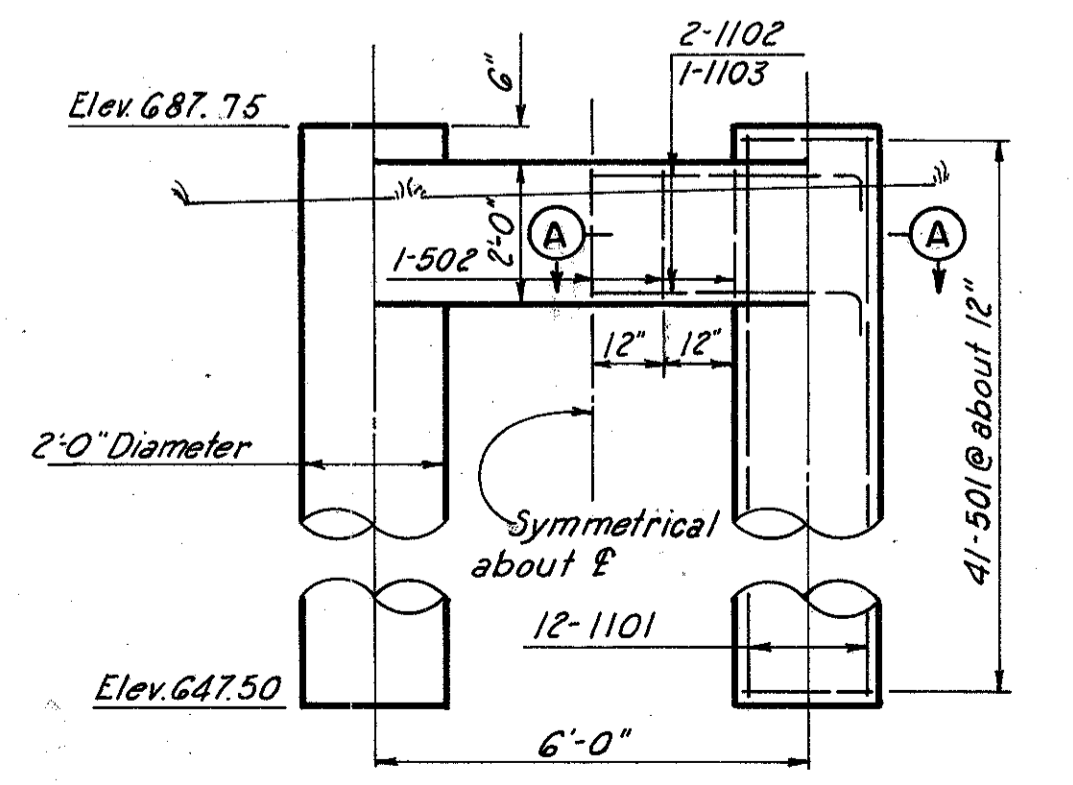


CONCRETE FOUNDATION FOR SOUTH POST
Scale: 3/8" = 1'-0"

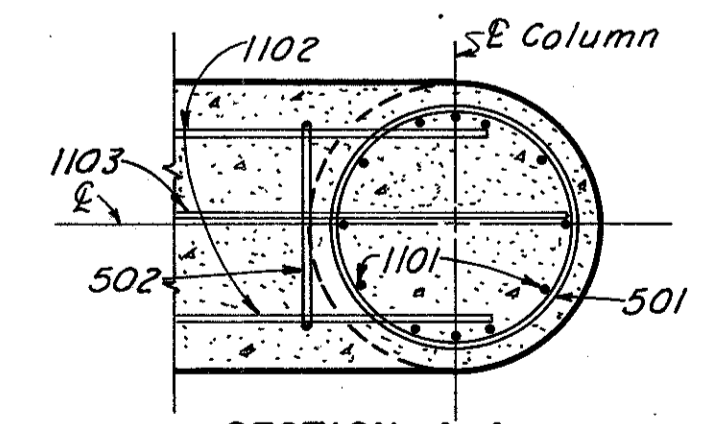


SECTION A-A
Scale: 3/4" = 1'-0"

REINFORCEMENT SCHEDULE				
MARK	NO.	LENGTH	TYPE	DIM. "A"
501	82	6'-4"	119	
502	5	7'-2"	109	
1101	24	39'-9"	Str.	
1102	4	7'-9"	105	6'-4"
1103	2	8'-9"	105	7'-4"

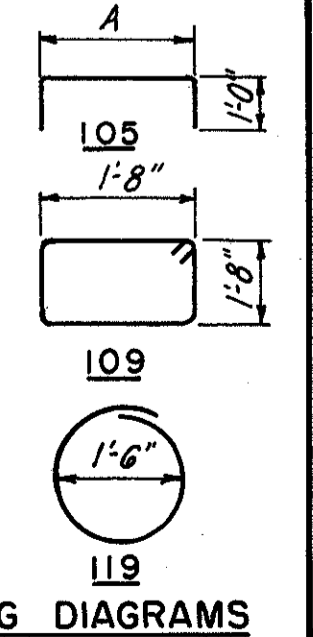

BENDING DIAGRAMS

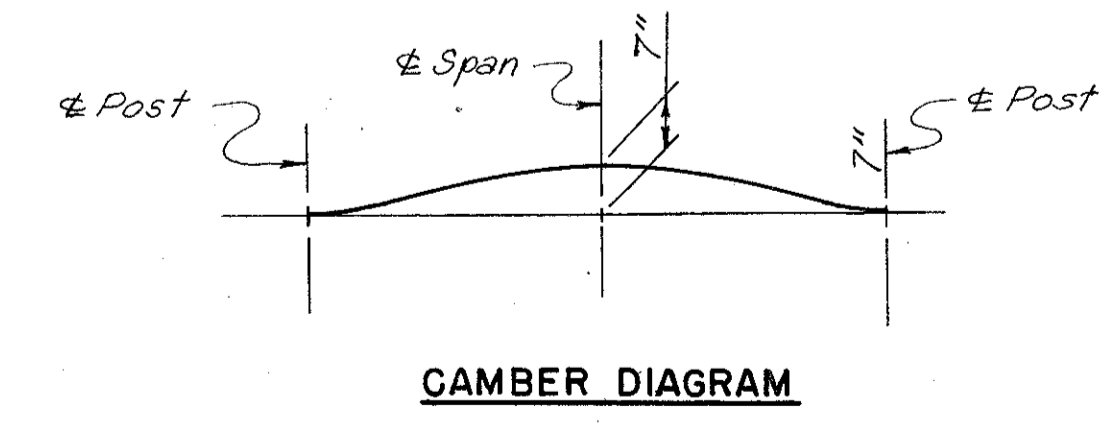

CAMBER DIAGRAM

Notes:

Sway braces not shown in plan and elevation views.
Bracing shown in post End Elevation is in the vertical plane only.

Note: Prefix "SB" shall be assigned all bar marks.
Note: Reinforcing included for payment under "Item Special, Sign Bridge, as per plan."

PART 7

HOWARD, NEEDLES, TAMMEN & BERGENDOFF
CONSULTING ENGINEERS
KANSAS CITY CLEVELAND NEW YORK

SIGN BRIDGE AT STA. 74 + 25
GENERAL PLAN AND ELEVATION

Scale: 3/16"=1'-0" Except as noted

WILLOW-INNER BELT FREEWAY
CLEVELAND CUYAHOGA COUNTY OHIO

DRAWN W.Z.D. TRACED C.R.J. CHECKED B.L.C. REVIEWED J.C.T. REVISION
DATE 8-6-59 DATE 10-14-59 DATE 8-13-59 DATE 11-13-59

Rev. 3-16-60 R.E.C. SHEET 177A

A. FOUNDATIONS
One foundation shall be monolithic with the retaining wall as shown on the plans. The other foundation shall be constructed as specified in Section S-25.11 of the Specifications except that concrete shall be Class E. Posts shall be adjusted by leveling nuts as shown on the plans. Anchor rods shall be accurately held in place until the concrete has set. Grout shall consist of one (1) part Portland Cement, one (1) part Embecco or equal, one (1) part sand. The 24" diameter shafts for the post foundations shall not be placed until all pile driving in the area is completed.

B. STRUCTURAL MATERIALS
All metalwork shall conform to the following applicable A.S.T.M. Designations -B-209-58T, B-210-58T, B-211-58T, B-221-58T, B-235-58T and B-241-58T for GS11A-T6 aluminum alloy unless otherwise specified herein or shown on the plans. Stainless steel U-bolts and bolts for field splices shall conform to A.S.T.M. Designation A 320-58T Grade B8 annealed. Nuts shall conform to A.S.T.M. Designation A 194-58T, and washers shall be of the same material as the bolts. Castings shall conform to the requirements of A.S.T.M. Designation B-26-58T for SG70A-T6 aluminum alloy. Ornamental pole cap shall be aluminum alloy of a standard design.
Grating shall be constructed of GS11A-T6 aluminum alloy except crimp bars may be of GS10A-T5 aluminum alloy.

C. FABRICATION AND ERECTION
The sign bridge structure shall be shop fabricated in sections suitable for shipment. All shop connections shall be welded. The sections shall be assembled in the field with bolts.
Fabrication and erection shall conform to the requirements of Item S-7 except as hereinafter modified. Aluminum tubing shall be sawed or cut with a router. Other material may be sheared, sawed or cut with a router. Cut edges shall be true and smooth and free from excessive burrs or ragged breaks.
Center punching and scribing shall be done where such marks will remain on completed members. Hole centers may be punch marked by punching or scribing. All fabrication marks and irregularities shall be removed.
Parts shall be welded with an arc or resistance welding process. No welding process that requires the use of a welding flux shall be used. The filler metal shall be aluminum alloy 4043 (ASTM Designation SSB), 5154 (ASTM Designation GR40A) or approved equal. Preheating for welding is permissible provided the temperature does not exceed 400° F. for a total time of 30 minutes.
In preparation for welding, dirt, grease, forming or machining lubricants or any organic materials shall be removed from the areas to be welded by cleaning with a suitable solvent or by vapor degreasing.
Additional operations to remove the oxide coating just prior to welding are required when the inert gas tungsten arc welding method is used. This may be done by etching or by scratch brushing. The oxide coating may not need to be removed if the welding is done with the automatic or semiautomatic inert gas shielded metal arc. Suitable edge preparation to ensure 100 per cent penetration in butt welds shall be used. Flame cutting shall not be used. Sawing, chipping or machining may be used.
Holes in castings shall be cored or drilled.
Drain holes shall be provided for hollow members.
Conduit inlet holes and handholes shall be provided in the structural columns to provide access for installation of electrical cables.
The bottom surface of the post base castings shall be coated with one (1) heavy coat of alkali-resistant bituminous paint equal to Bitumastic Super-Service Black as manufactured by Koppers Company, Inc.

D. ELECTRICAL WORK
a. General
The sign bridge item shall include furnishing and installing electrical components as noted below and structure grounding in accordance with Item S-25. This work shall include:
Underground conduit from "Service Panel" under deck of Bridge No. 4, including conduit on bridge and through approaches.
Grounding of the sign bridge.
Conduit through sign bridge foundation, and all mounting holes and fittings.
The photo cell control unit for feeder on Bridge No. 4 is not included in the sign bridge item.
Where materials, equipment, or other products are specified by manufacturer, brand name type, or catalog number, such designation is to establish standards of desired quality and style and shall be the basis of the bid; however, materials and equipment approved equal by the Director will be allowed.
Where such substitutions alter design or space requirements, the Contractor shall include all items of cost for the revised design and construction including cost of all trades involved.
All electrical materials, construction and installations shall meet the requirements of the Cleveland Division of Light and Power and the Cleveland Electric Illuminating Company in addition to the requirements of the Standard Specifications.


The electrical work shall be laid out and installed in conjunction with the construction of the Bridge 4 abutment and slab and shall include furnishing and installing all necessary hangers to support the conduit on Bridge 4.
b. Service
Power for the sign fixtures will be available from the load side of photo-cell-controlled contactors in the service panel below the deck of Bridge No. 4 over 14th Street. This service will be 230 volts.
This item shall include furnishing and installing a weatherproof, double-pole, 250-volt safety switch and all wiring connections to the load side of the contactors. Terminals, conduit, fittings, lugs, etc., as necessary to make a complete connection shall be provided. The safety switch shall be mounted on or immediately adjacent to the service panel.
c. Grounding
The sign bridge structure shall be grounded by an equipment ground for not over 25 ohms resistance to ground. Grounding shall be accomplished by means of at least one copper-clad ground rod, 1-inch diameter, and ten feet long with an approved type grounding clamp at the top and a No. 6 AWG bare stranded copper conductor to the sign bridge grounding lug.
The top of the ground rod shall be at least one foot below finished grade. The grounding conductor shall be so installed through the sign bridge base so as to permit the shortest and most direct path from support to ground rod. The ground conductor shall be installed in a 1" concealed galvanized rigid metal conduit sleeve with conductor and conduit bonded at each end.
The resistance between ground and absolute earth shall be measured by the Contractor in the presence of the Engineer.

d. Conduits
Conduit on Bridge No. 4 and in the underground portion shall be 1-1/2" galvanized steel.
Insulated bushings shall be used at terminations of the 1-1/2" conduits. Insulated bushings shall be equal to O. Z. Type A.
Exposed conduits under Bridge No. 4 shall be securely fastened in place at not more than 5-foot centers, and hangers, supports or fastenings shall be provided at each elbow. Conduit runs on Bridge No. 4 may be supported by hangers, two-hole malleable straps or beam clamps. Hangers shall be made of durable materials suitable for the application and shall be galvanized. The use of perforated iron for supporting conduits will not be permitted.
An expansion coupling similar to O.Z. Type AX shall be provided at the abutment, complete with bonding jumper, and a malleable "T" 1-1/2" x 1-1/2" x 1-1/2" drain at the low point in the run, complete with one-half cubic yard gravel pocket.


e. Cables
All conductors shall be insulated for 600 volts. The conductors for the branch circuit between the service panel on Bridge No. 4 and the handhole at the sign bridge shall be stranded, Type RHW. The pole and bracket cable for circuits on the sign bridge above the handhole to the ballast primaries shall be type for 600-volt rating, stranded, polyvinylchloride insulation.
Conductors shall be thoroughly tinned, soft drawn copper. Wire size, insulation type and manufacturer's name shall be permanently marked on the conductor jackets at regular intervals. Wires shall be color coded and the coding used consistently throughout the installation.
Wire and cable shall be as manufactured by Okonite, Phelps-Dodge, Ansco, General Electric, General Cable, Kaiser, or approved equal.
f. Wireway
A wireway shall be provided along each walkway, complete with necessary fittings, to house ballasts, the transverse branch circuit, and the transverse wiring between ballast secondaries and lamps. The cross-sectional dimensions of the wireways shall be 6 inch by 6 inch.
Wireways shall be of high strength, corrosion-resistant aluminum alloy extrusions, and shall conform with the Joint Industry Conference Standards. Metal shall be aluminum alloy 6061-T6, not less than .071" thick in body and .125" thick flanges.
Wireways shall be sectionalized generally in not less than ten-foot sections. The top cover shall have a sponge-rubber neoprene gasket. Closure plates and telescoping fittings shall have solid neoprene gaskets. Double 1/8 inch drain holes shall be placed in bottom at not over 12 inch centers. Attach wire way by not less than 3/8 inch stainless steel bolts at each support, complete with stainless steel nuts and lock washers. Covers shall be lift-off hinges with two chains per cover. External clamps shall be at not over 4 foot centers. Use telescoping fittings to move flanges off supports. Nuts and bolts for joining sections of wireway shall be aluminum or stainless steel. Attach ballasts to wireway with some type bolts and nuts. Knockouts shall be provided at the proper locations for attaching conduits by "Screw-It" connectors with neoprene gaskets. The wireway with complete complement of fittings shall be a tight sectionalized type as manufactured by the Hoffman Engineering Corporation of Anoka, Minnesota or approved equal.

g. Fixtures
The sign lighting fixtures shall consist of aluminum housings with baked enamel reflecting surfaces, cast aluminum and fittings suitable for standard 3/4 inch conduit connections, spring loaded telescopic lamp holders, and clear door covers of impact-resistant plastic material. The units shall be for 4 foot power groove lamps, and shall have all external surfaces protected by weather and corrosion-resistant enamel, with stainless steel hardware.
Fixtures shall be adjusted for optimum sign illumination and uniformity, and shall be adjustable so as to permit positive locking in any desired position.
Fixtures shall be wired with not smaller than No. 14 Type AF asbestos covered wire. No splice or tap shall be located within an arm. Wire shall be continuous from lamp sockets to ballast terminals.
The units shall be listed by Underwriters' Laboratories. Units shall be General Electric Type L 104 Fluorofloods or as approved by the Director.
h. Ballasts
Ballasts shall be of the high power factor type and their construction shall conform to the Certified Ballast Manufacturers' Standards.
Ballasts shall provide completely reliable starting to 20° F., shall be for 230-volt operation, shall fit in the 6x6 wireways, and shall be designed for power groove or super-high output lamps.
The ballasts for each set of 2 lamps shall be No. 6G2519 outdoor type with one No. 2T51Y6432 (240-120) 500 Va transformer as manufactured by the General Electric Company, or approved equal.
i. Lamps
Fixtures shall be provided with cool white double dimpled power groove or super-high output lamps equal to General Electric F48PG17/CW.


E. METHOD OF MEASUREMENT AND BASIS OF PAYMENT
Except as noted below, no measurement will be made of the component parts comprising the Sign Bridge Installation and payment will be made of the contract lump sum price for "Item Special, Sign Bridge as per plan" in place completed and accepted, which price and payment shall constitute full compensation for all excavation, backfill, concrete, reinforcing steel, anchor bolts, aluminum alloy, stainless steel, welding, preparing and erecting all materials including electrical work consisting of grounds, conduits, end connections, and all other items specified herein and that may be required to construct the Sign Bridge, complete, and for all labor, materials, equipment, tools, and incidentals necessary to complete this item. Payment for the foundation that is monolithic with the retaining wall will be measured for payment as concrete and reinforcing steel in the retaining wall. The signs will be furnished and mounted on the bridge by others.

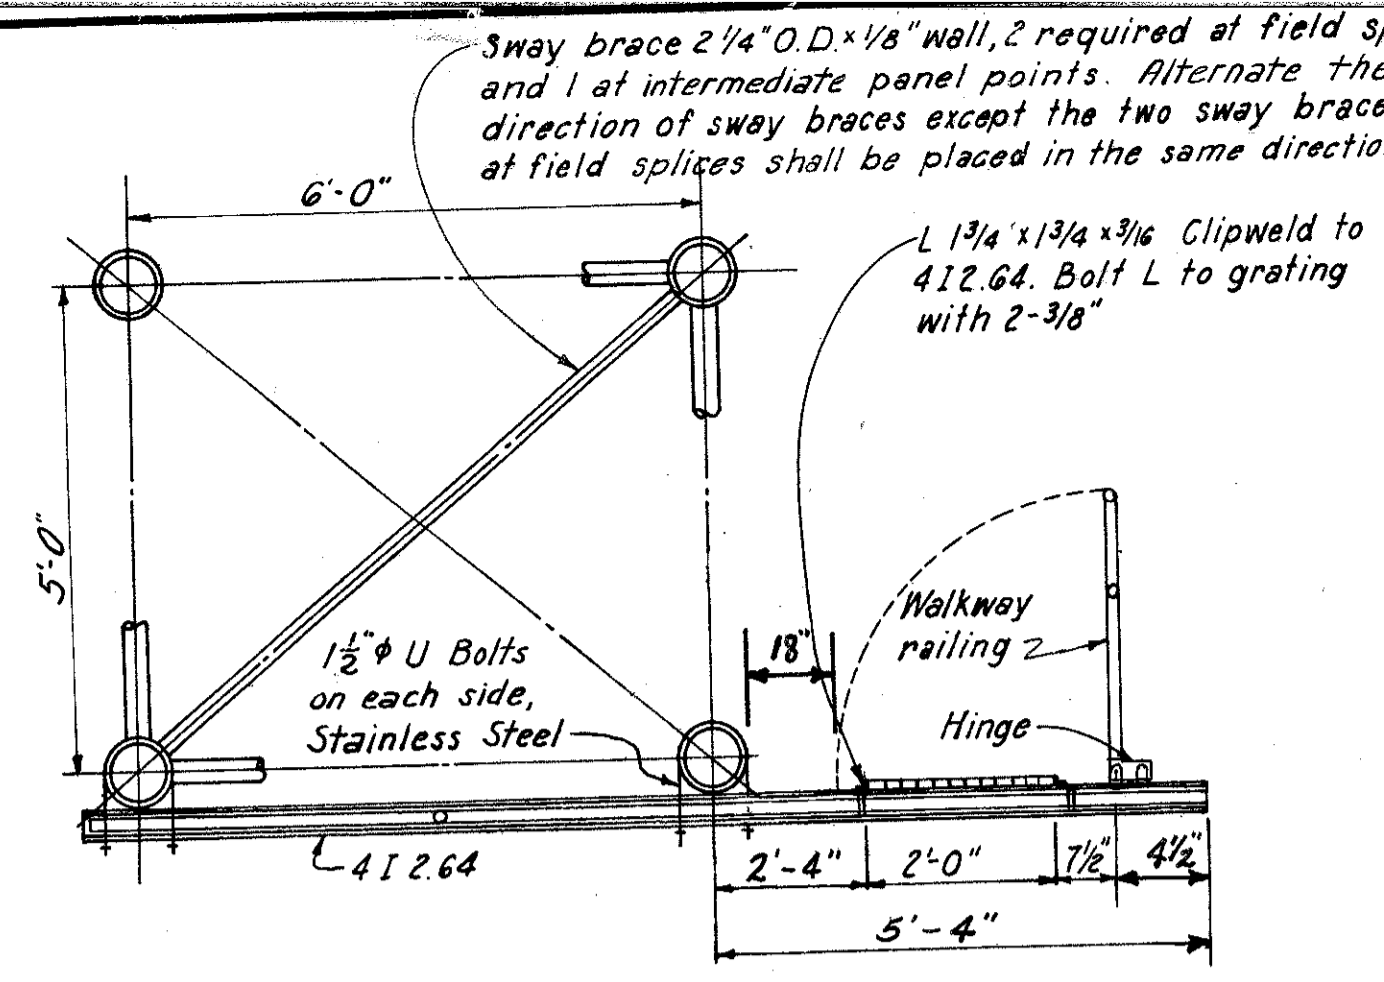

TYPICAL SECTION
Scale: 1/2" = 1'-0"

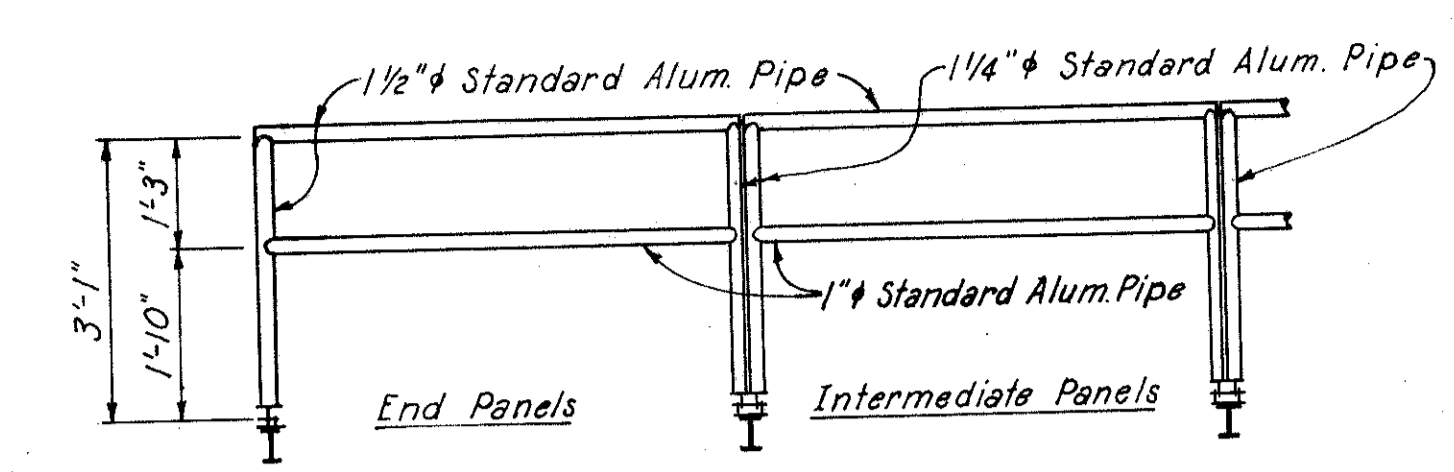


WALKWAY RAILING DETAIL
Scale: 1/2" = 1'-0"

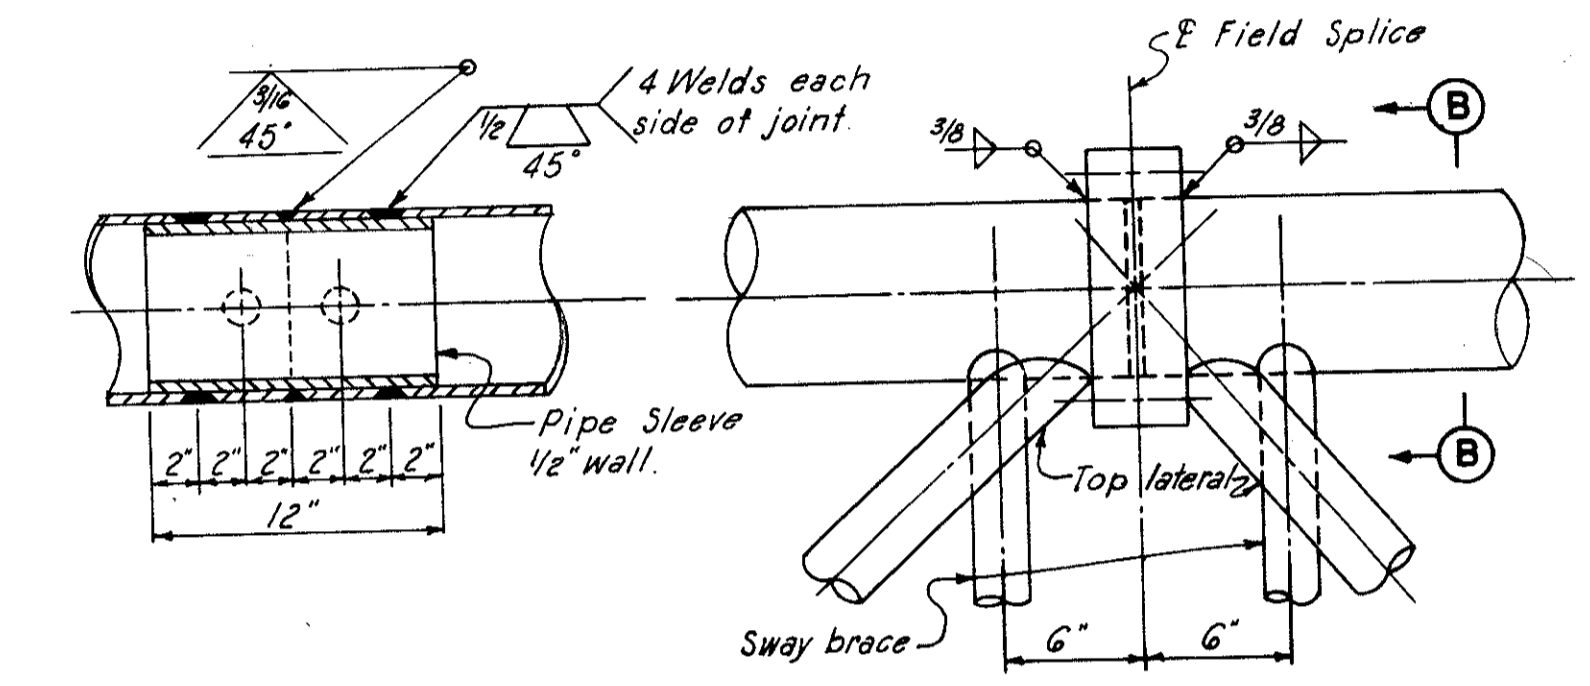


SHOP CHORD SPLICE
Scale: 1/2" = 1'-0"


FIELD CHORD SPLICE
Scale: 1 1/2" = 1'-0"

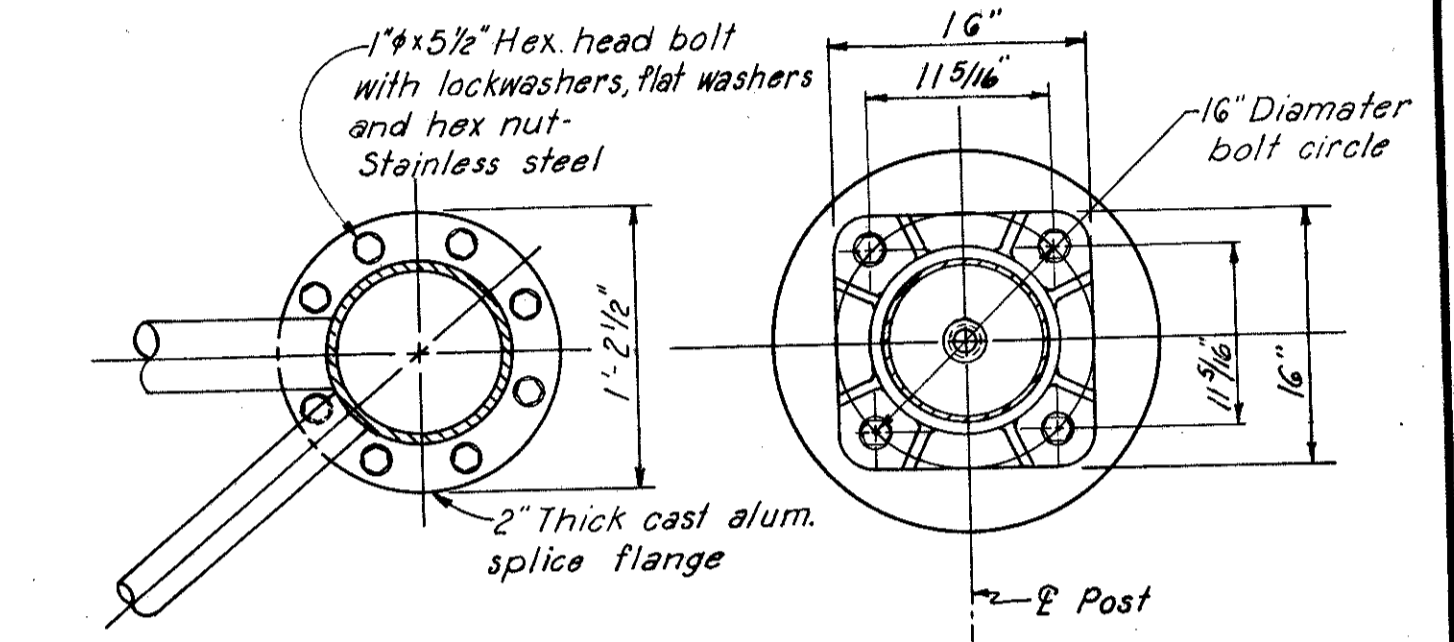


SECTION B-B
Scale: 1 1/2" = 1'-0"

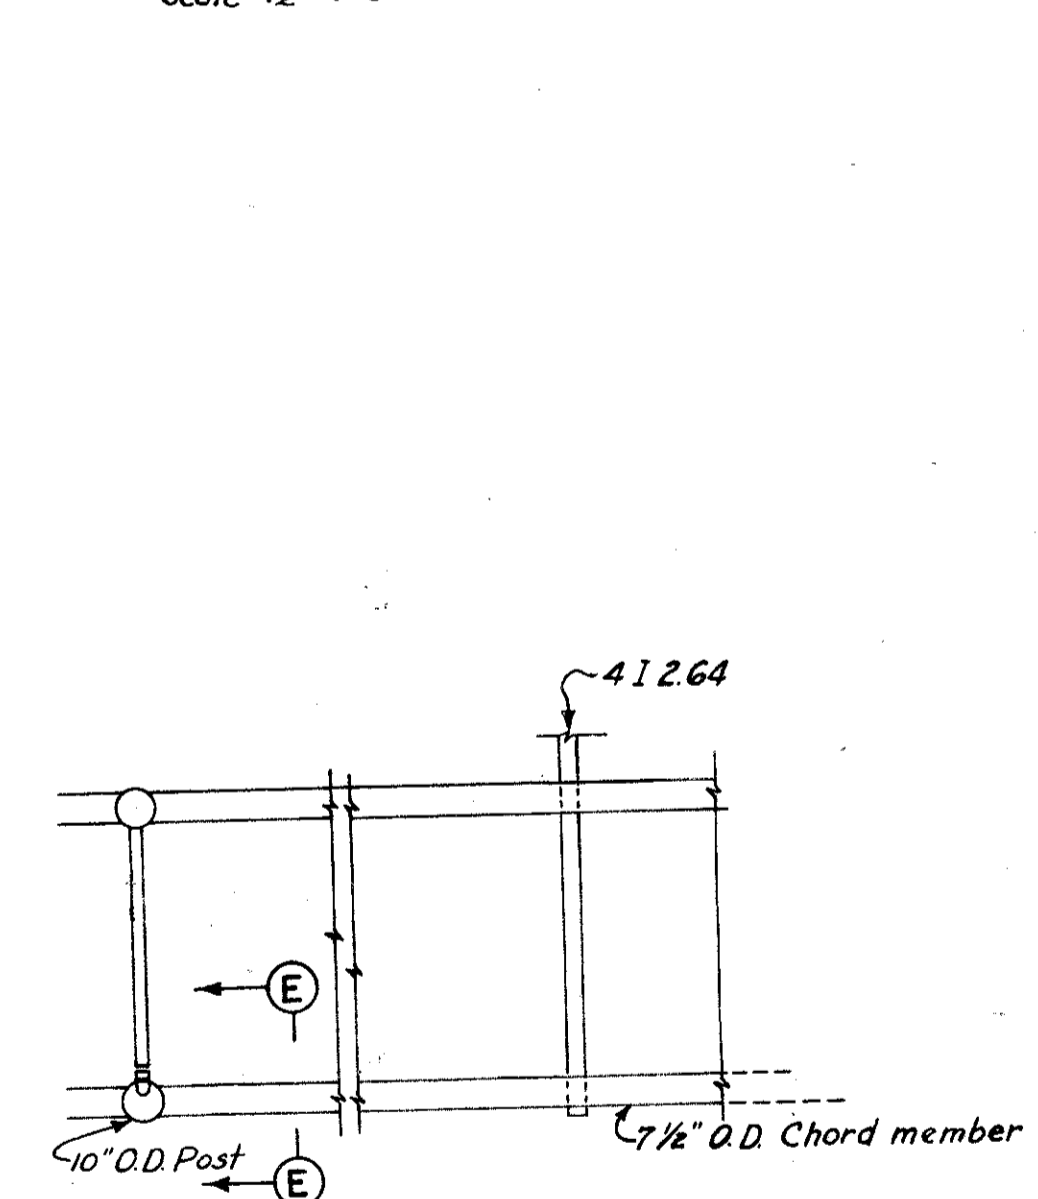


DETAIL "A"
Scale: 1/4" = 1'-0"

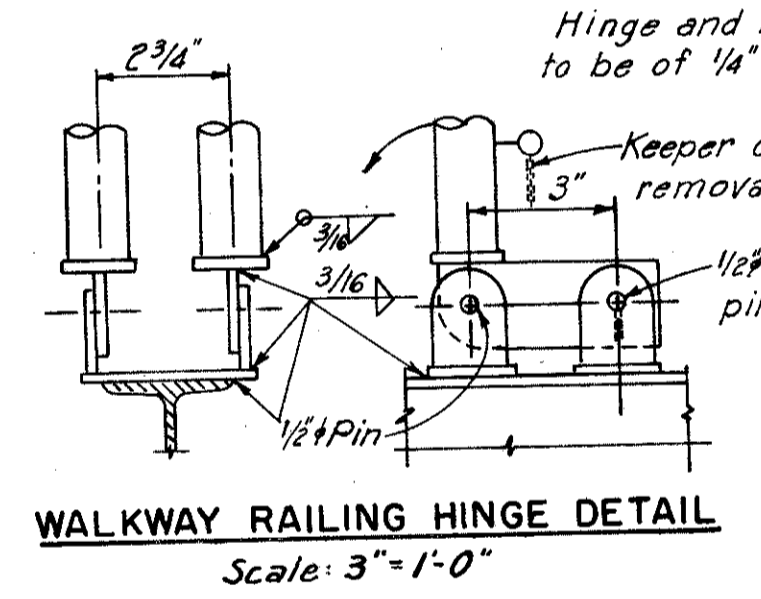

WALKWAY RAILING HINGE DETAIL
Scale: 3" = 1'-0"

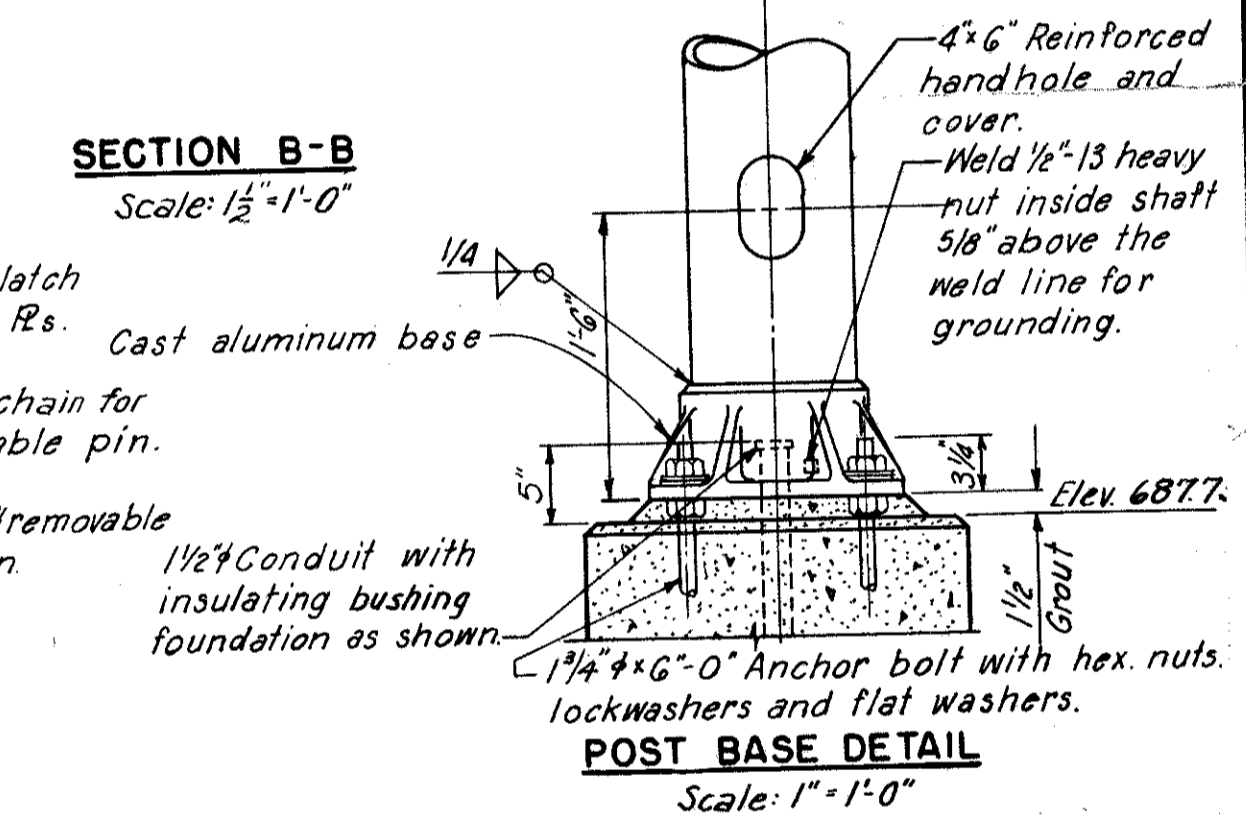

POST BASE DETAIL
Scale: 1" = 1'-0"

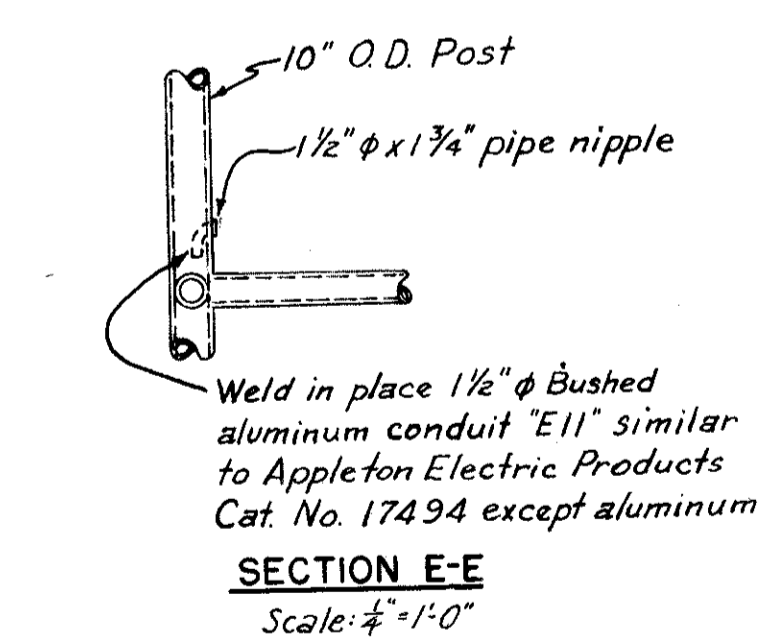

SECTION E-E
Scale: 1/2" = 1'-0"

PART 7

HOWARD, NEEDLES, TAMMEN & BERGENDOFF
CONSULTING ENGINEERS
KANSAS CITY CLEVELAND NEW YORK

SIGN BRIDGE AT STA. 74 + 25
GENERAL NOTES AND DETAILS

Scale: As noted

WILLOW-INNER BELT FREEWAY
CLEVELAND CUYAHOGA COUNTY OHIO

DRAWN: J.D.	TRACED: R.J.	CHECKED: A.L.G.	REVIEWED: J.C.T.
DATE: 8-6-59	DATE: 10-16-59	DATE: 8-13-59	DATE: 11-13-59

SHEET 177B

R.W. 3-16-60 R.E.C.